



CUY-90-14.90

PID 77332/85531

APPENDIX ST-07

CCG1 Bridge Location Plan (Basic Configuration)


State of Ohio
Department of Transportation
Jolene M. Molitoris, Director

**Innerbelt Bridge
Construction Contract Group 1 (CCG1)**

BRIDGE LOCATION PLAN
CLEVELAND INNERBELT CCG1
PID 77332



D	EDITORIAL UPDATE	RLF	2/25/11
C	EDITORIAL UPDATE	RLF	2/18/11
B	EDITORIAL UPDATE	RLF	2/4/11
A	UPDATED BRIDGE INFO & ADDED WALLS	RLF	1/14/11
NO.	REVISIONS	BY	DATE

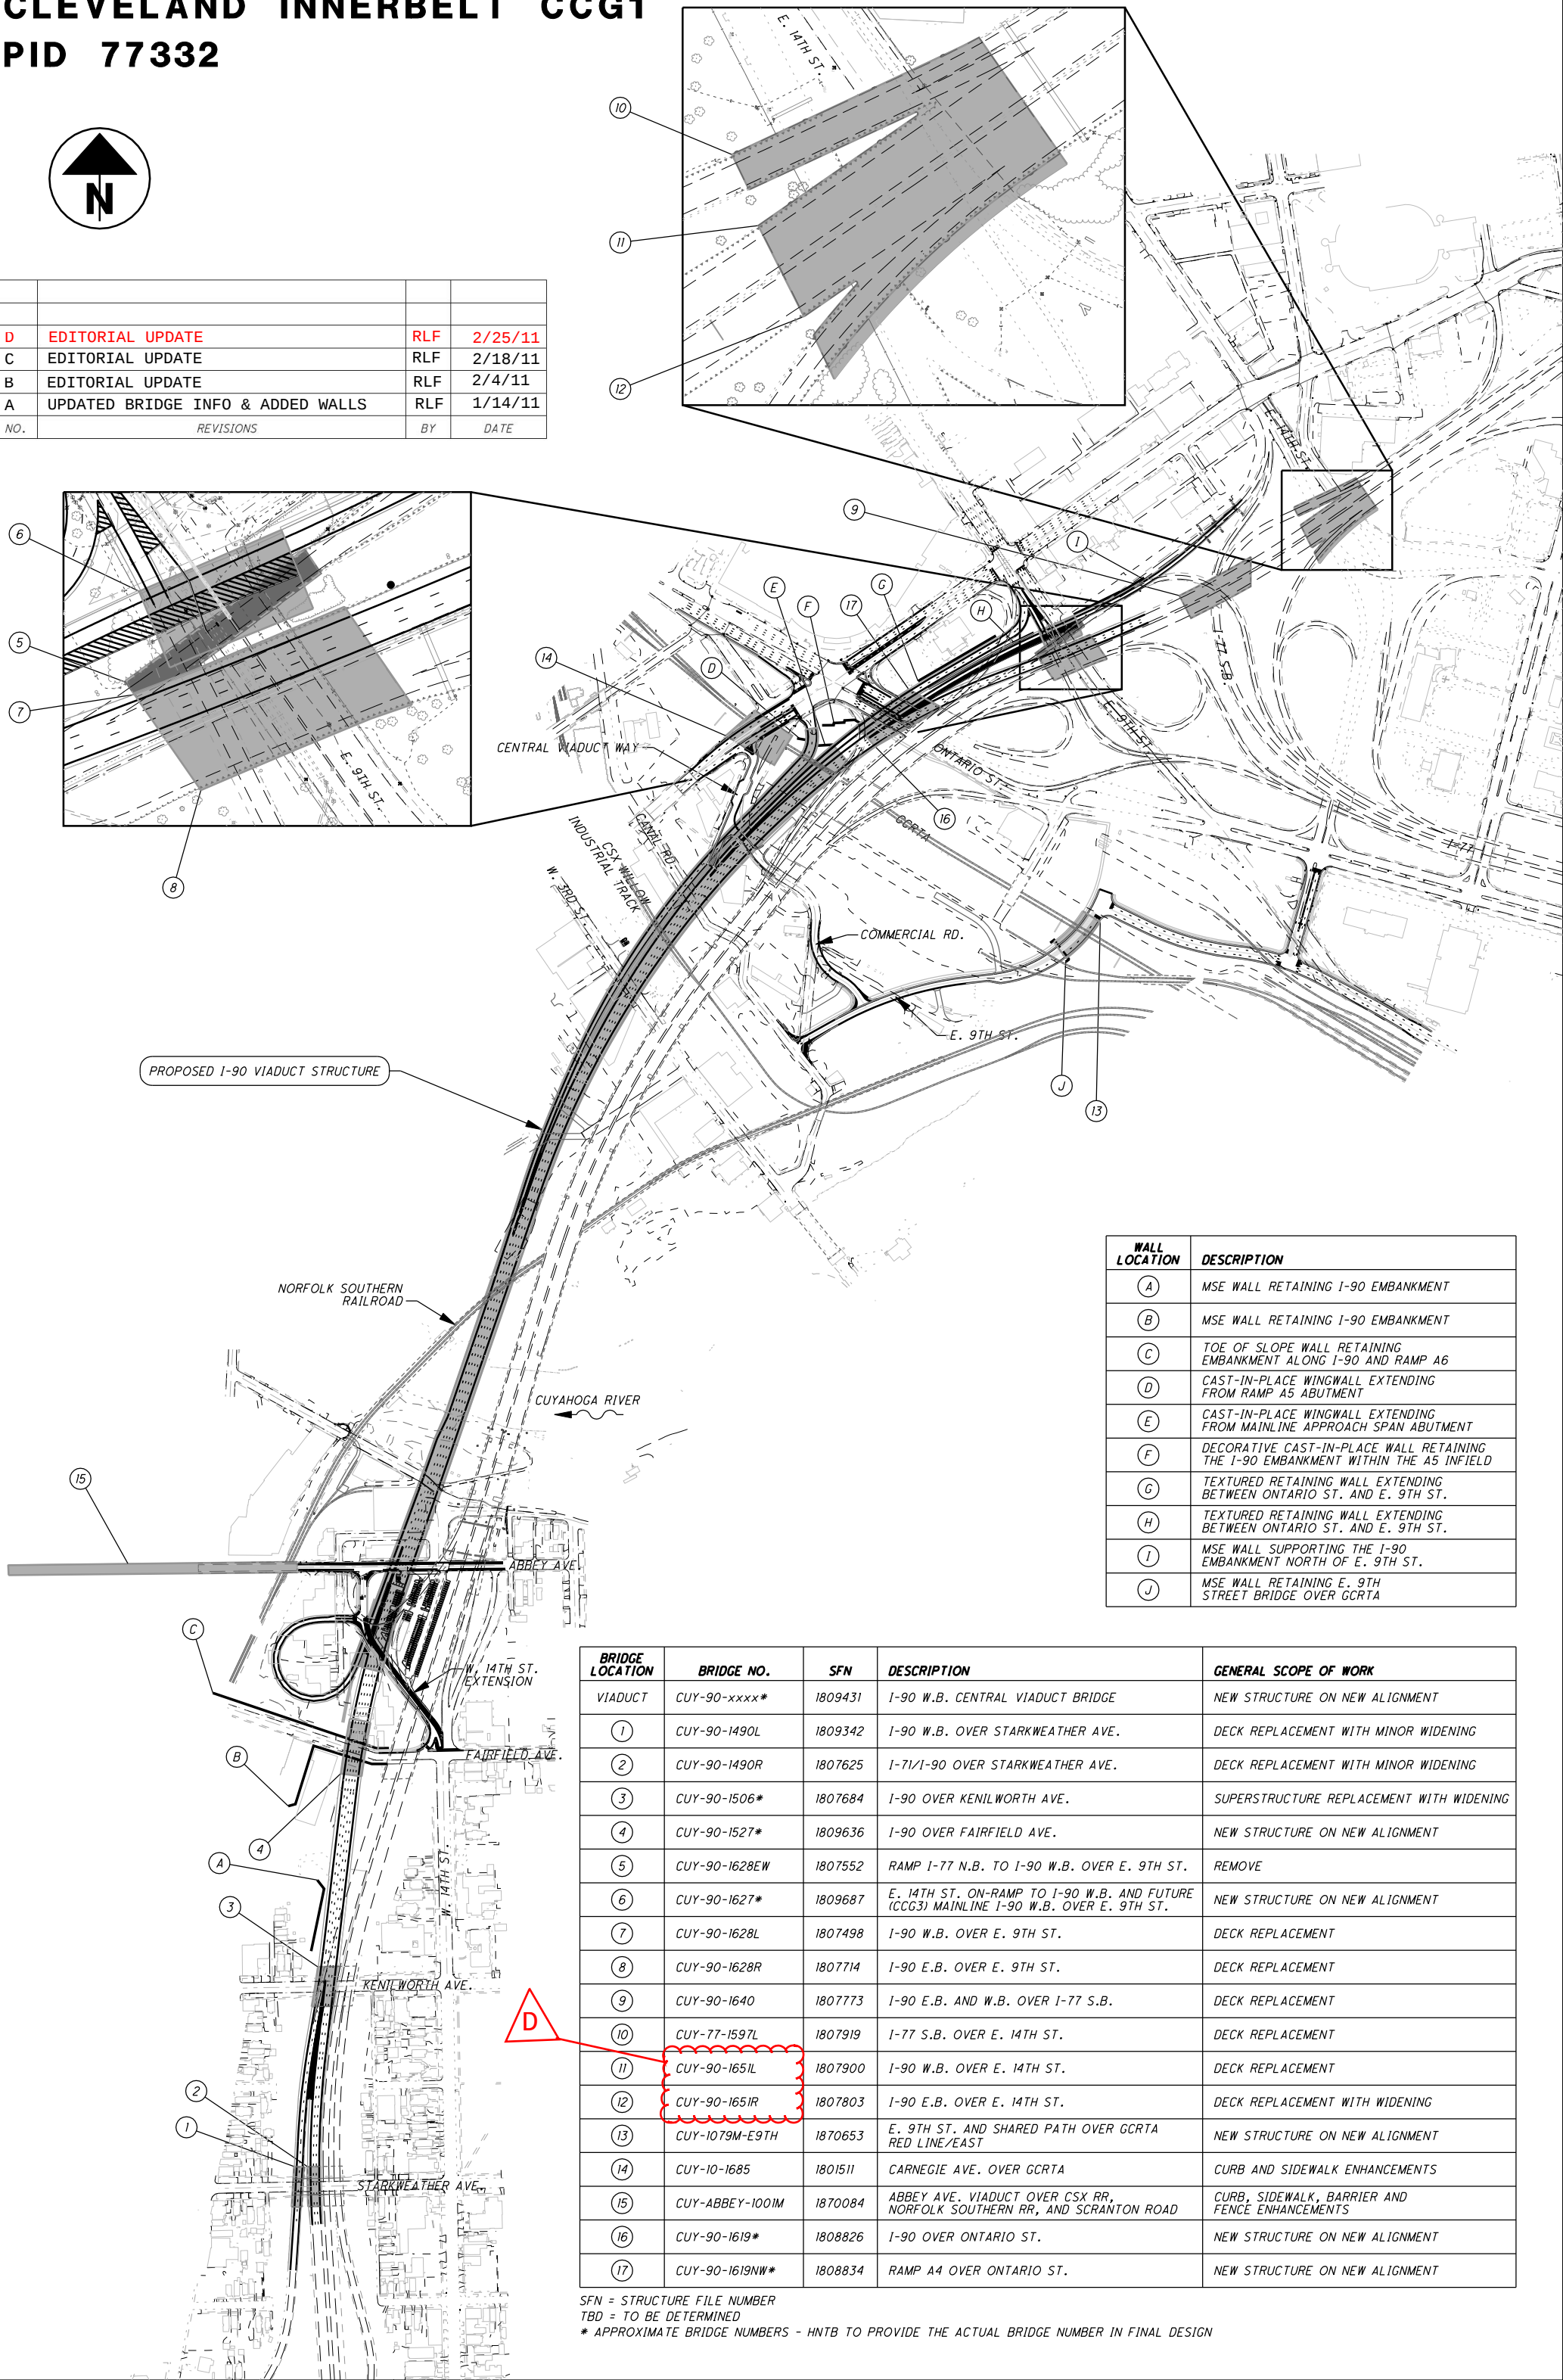

WALL LOCATION	DESCRIPTION
A	MSE WALL RETAINING I-90 EMBANKMENT
B	MSE WALL RETAINING I-90 EMBANKMENT
C	TOE OF SLOPE WALL RETAINING EMBANKMENT ALONG I-90 AND RAMP A6
D	CAST-IN-PLACE WINGWALL EXTENDING FROM RAMP A5 ABUTMENT
E	CAST-IN-PLACE WINGWALL EXTENDING FROM MAINLINE APPROACH SPAN ABUTMENT
F	DECORATIVE CAST-IN-PLACE WALL RETAINING THE I-90 EMBANKMENT WITHIN THE A5 INFIELD
G	TEXTURED RETAINING WALL EXTENDING BETWEEN ONTARIO ST. AND E. 9TH ST.
H	TEXTURED RETAINING WALL EXTENDING BETWEEN ONTARIO ST. AND E. 9TH ST.
I	MSE WALL SUPPORTING THE I-90 EMBANKMENT NORTH OF E. 9TH ST.
J	MSE WALL RETAINING E. 9TH STREET BRIDGE OVER GCRTA

BRIDGE LOCATION	BRIDGE NO.	SFN	DESCRIPTION	GENERAL SCOPE OF WORK
VIADUCT	CUY-90-xxxx*	1809431	I-90 W.B. CENTRAL VIADUCT BRIDGE	NEW STRUCTURE ON NEW ALIGNMENT
1	CUY-90-1490L	1809342	I-90 W.B. OVER STARKWEATHER AVE.	DECK REPLACEMENT WITH MINOR WIDENING
2	CUY-90-1490R	1807625	I-71/I-90 OVER STARKWEATHER AVE.	DECK REPLACEMENT WITH MINOR WIDENING
3	CUY-90-1506*	1807684	I-90 OVER KENILWORTH AVE.	SUPERSTRUCTURE REPLACEMENT WITH WIDENING
4	CUY-90-1527*	1809636	I-90 OVER FAIRFIELD AVE.	NEW STRUCTURE ON NEW ALIGNMENT
5	CUY-90-1628EW	1807552	RAMP I-77 N.B. TO I-90 W.B. OVER E. 9TH ST.	REMOVE
6	CUY-90-1627*	1809687	E. 14TH ST. ON-RAMP TO I-90 W.B. AND FUTURE (CCG3) MAINLINE I-90 W.B. OVER E. 9TH ST.	NEW STRUCTURE ON NEW ALIGNMENT
7	CUY-90-1628L	1807498	I-90 W.B. OVER E. 9TH ST.	DECK REPLACEMENT
8	CUY-90-1628R	1807714	I-90 E.B. OVER E. 9TH ST.	DECK REPLACEMENT
9	CUY-90-1640	1807773	I-90 E.B. AND W.B. OVER I-77 S.B.	DECK REPLACEMENT
10	CUY-77-1597L	1807919	I-77 S.B. OVER E. 14TH ST.	DECK REPLACEMENT
11	CUY-90-1651L	1807900	I-90 W.B. OVER E. 14TH ST.	DECK REPLACEMENT
12	CUY-90-1651R	1807803	I-90 E.B. OVER E. 14TH ST.	DECK REPLACEMENT WITH WIDENING
13	CUY-1079M-E9TH	1870653	E. 9TH ST. AND SHARED PATH OVER GCRTA RED LINE/EAST	NEW STRUCTURE ON NEW ALIGNMENT
14	CUY-10-1685	1801511	CARNEGIE AVE. OVER GCRTA	CURB AND SIDEWALK ENHANCEMENTS
15	CUY-ABBEY-1001M	1870084	ABBEY AVE. VIADUCT OVER CSX RR, NORFOLK SOUTHERN RR, AND SCRANTON ROAD	CURB, SIDEWALK, BARRIER AND FENCE ENHANCEMENTS
16	CUY-90-1619*	1808826	I-90 OVER ONTARIO ST.	NEW STRUCTURE ON NEW ALIGNMENT
17	CUY-90-1619NW*	1808834	RAMP A4 OVER ONTARIO ST.	NEW STRUCTURE ON NEW ALIGNMENT

SFN = STRUCTURE FILE NUMBER
TBD = TO BE DETERMINED
* APPROXIMATE BRIDGE NUMBERS - HNTB TO PROVIDE THE ACTUAL BRIDGE NUMBER IN FINAL DESIGN