


STATE OF OHIO  
DEPARTMENT OF TRANSPORTATION  
**CUY-480-11.60**  
CITY OF BROOKLYN  
CUYAHOGA COUNTY



LOCATION MAP

LATITUDE: N40°20'10" LONGITUDE: W82°52'55"

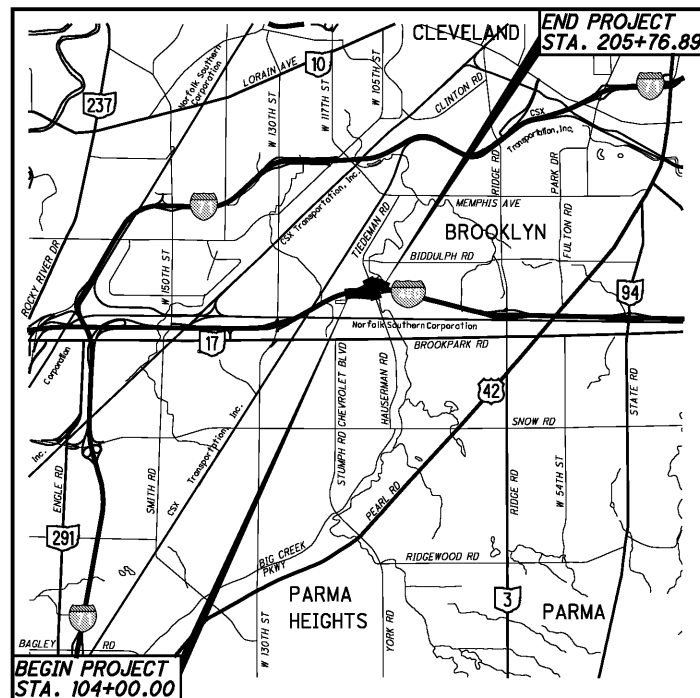

- PORTION TO BE IMPROVED -----
- INTERSTATE HIGHWAY -----
- STATE & FEDERAL ROUTES -----
- COUNTY & TOWNSHIP ROADS -----
- OTHER ROADS -----

DESIGN DESIGNATION	TIEDEMAN ROAD	I-480	TIEDEMAN ROAD TO I-480 WB (RAMP T-1)	I-480 EB TO TIEDEMAN ROAD (RAMP T-2)	I-480 WB TO TIEDEMAN ROAD (RAMP T-3)	TIEDEMAN ROAD TO I-480 EB (RAMP T-4)
CURRENT ADT (2013)	24,000	120,500	6,610	6,420	7,600	8,730
DESIGN YEAR ADT (2033)	24,000	120,500	6,610	6,420	7,600	8,730
DESIGN HOURLY VOLUME (2033)	2,300	11,900	710	990	940	900
DIRECTIONAL DISTRIBUTION	53%	51%				
TRUCKS (24 HOUR B&C)	4%	8%	3%	2%	6%	4%
DESIGN SPEED	40 MPH	65 MPH	35 MPH	45 MPH/35 MPH	35 MPH	35 MPH
LEGAL SPEED	35 MPH	60 MPH				
DESIGN FUNCTIONAL CLASSIFICATION:	URBAN MINOR ARTERIAL	URBAN INTERSTATE	URBAN INTERSTATE RAMP	URBAN INTERSTATE RAMP	URBAN INTERSTATE RAMP	URBAN INTERSTATE RAMP
NHS PROJECT	NO	YES	YES	YES	YES	YES

DESIGN EXCEPTIONS - NONE

**UNDERGROUND UTILITIES**  
CONTACT BOTH SERVICES  
CALL TWO WORKING DAYS  
**BEFORE YOU DIG**

CALL  
**1-800-362-2764**  
(TOLL FREE)

OHIO UTILITIES PROTECTION SERVICE  
NON-MEMBERS  
MUST BE CALLED DIRECTLY

OIL & GAS PRODUCERS PROTECTIVE  
SERVICE CALL: 1-800-925-0988

PLAN PREPARED BY:



564 WHITE POND DRIVE  
AKRON, OHIO 44320-1100  
(330) 836-9111

ENGINEERS SEAL:



SIGNED: \_\_\_\_\_  
DATE: March 17, 2014

INDEX OF SHEETS:

TITLE SHEET	1	PLAN AND PROFILE - RAMP T-3	45-46
SCHEMATIC PLAN	2	CROSS SECTIONS - RAMP T-3	47-50
PRIMARY PROJECT CONTROL	3	PLAN AND PROFILE - RAMP T-4	51
TYPICAL SECTIONS	4-10	CROSS SECTIONS - RAMP T-4	52
GENERAL NOTES	11-12	PLAN AND PROFILE - TIEDEMAN ROAD	53-54
MAINTENANCE OF TRAFFIC	13-30	CROSS SECTIONS - TIEDEMAN ROAD	55-60
SWPPP	31	SUPERELEVATION TABLES	61-63
PLAN AND PROFILE - RAMP T-1	32	PAVEMENT DETAILS	64-66
CROSS SECTIONS - RAMP T-1	33	INTERSECTION DETAILS	67-70
PLAN AND PROFILE - RAMP T-2	34-36	TRAFFIC CONTROL	71-84
CROSS SECTIONS - RAMP T-2	37-44		

**APPROVED FOR  
CONSTRUCTION PLANS  
MARCH 17, 2014**

**AS-BUILT DRAWINGS**

STANDARD CONSTRUCTION DRAWINGS										SUPPLEMENTAL SPECIFICATIONS
BP-2.1	7/19/13	DM-1.1	1/18/13	HL-20.11	1/17/14	MT-110.10	7/19/13	TC-51.12	1/17/14	800-2013 10/18/13
BP-2.2	7/18/08	DM-1.2	1/18/13	HL-30.11	1/17/14			TC-52.10	10/18/13	805 7/16/10
BP-2.3	7/19/13	DM-1.4	1/18/13	HL-30.21	1/17/14	TC-9.10	1/17/14	TC-52.20	1/17/14	821 4/20/12
BP-2.5	7/19/13	DM-4.2	7/20/12	HL-30.22	1/17/14	TC-16.21	10/18/13	TC-61.30	1/17/14	832 10/18/13
BP-3.1	4/20/12	DM-4.3	7/19/13			TC-21.10	10/18/13	TC-65.10	1/17/14	902 12/31/12
BP-5.1	7/19/13	DM-4.4	7/20/12	MT-95.31	7/19/13	TC-21.20	10/18/13	TC-65.11	1/17/14	903 7/20/12
BP-6.1	7/19/13			MT-95.32	7/19/13	TC-22.10	10/18/13	TC-71.10	1/17/14	921 4/20/12
BP-7.1	10/15/10	MGS-1.1	7/19/13	MT-95.41	7/19/13	TC-22.20	1/17/14	TC-81.10	10/18/13	
		MGS-2.1	7/19/13	MT-97.11	7/19/13	TC-41.10	7/19/13	TC-81.21	1/17/14	
CB-2.2	1/17/14	MGS-4.2	7/19/13	MT-98.20	7/19/13	TC-41.20	10/18/13	TC-82.10	10/18/13	
		MGS-4.3	1/18/13	MT-98.21	7/19/13	TC-41.30	10/18/13	TC-83.20	10/18/13	
MH-1.1	1/18/13	MGS-5.2	7/19/13	MT-98.28	7/19/13	TC-41.40	10/18/13	TC-85.20	10/18/13	
MH-1.2	1/18/13	MGS-5.3	7/19/13	MT-99.20	7/19/13	TC-41.41	10/18/13			
MH-3.1	1/18/13			MT-101.70	1/17/14	TC-41.50	10/18/13			
		RM-1.1	1/18/13	MT-101.90	7/19/13	TC-42.20	10/18/13			
		RM-3.1	7/19/13	MT-105.10	7/19/13	TC-51.11	1/17/14			

SPECIAL PROVISIONS

PROJECT DESCRIPTION

IMPROVEMENTS WILL INCLUDE THE RECONSTRUCTION OF 0.21 MILES OF THE I-480 EASTBOUND EXIT RAMP TO TIEDEMAN ROAD; THE RECONSTRUCTION OF 0.10 MILES OF THE I-480 WESTBOUND EXIT RAMP TO TIEDEMAN ROAD; MINOR WIDENING OF THE ENTRANCE RAMP; THE UPGRADED SIGNALIZATION OF THE EXIT/ENTRANCE RAMP INTERSECTIONS WITH TIEDEMAN ROAD; SIGNAL RETIMING AND COORDINATION ALONG TIEDEMAN ROAD BETWEEN BROOKPARK ROAD AND BIDDULPH ROAD INCLUDING NEW CURBS, RAISED CONCRETE MEDIANS, CURB RAMPS, DRAINAGE, NEW SIGNING AND PAVEMENT MARKINGS.

PROJECT EARTH DISTURBED AREA: 3.78 ACRES  
ESTIMATED CONTRACTOR EARTH DISTURBED AREA: 0.30 ACRES  
NOTICE OF INTENT EARTH DISTURBED AREA: 4.90 ACRES

LIMITED ACCESS

THIS IMPROVEMENT IS ESPECIALLY DESIGNED FOR THROUGH TRAFFIC AND HAS BEEN DECLARED A LIMITED ACCESS HIGHWAY OR FREEWAY BY ACTION OF THE DIRECTOR IN ACCORDANCE WITH THE PROVISIONS OF SECTION 5511.02 OF THE OHIO REVISED CODE.

2013 SPECIFICATIONS

THE STANDARD SPECIFICATIONS OF THE STATE OF OHIO, DEPARTMENT OF TRANSPORTATION, INCLUDING CHANGES AND SUPPLEMENTAL SPECIFICATIONS LISTED IN THE PROPOSAL SHALL GOVERN THIS IMPROVEMENT.

I HEREBY APPROVE THESE PLANS AND DECLARE THAT THE MAKING OF THIS IMPROVEMENT WILL NOT REQUIRE THE CLOSING TO TRAFFIC OF THE HIGHWAY AND THAT PROVISIONS FOR THE MAINTENANCE AND SAFETY OF TRAFFIC WILL BE AS SET FORTH ON THE PLANS.

FEDERAL PROJECT NO.  
**E130 (241)**

PID NO.  
**94723**

CONSTRUCTION PROJECT NO.

RAILROAD INVOLVEMENT  
**NONE**

**CUY-480-11.60**

1  
84



**SCHEMATIC PLAN**

**CUY - 480 - 11.60**

**T-1A** EX. RAMP T-1  
CURVE DATA  
P.I.Sta. 1632+58.80  
 $\Delta = 12^\circ 39' 07''$  (LT)  
 $Dc = 4^\circ 00' 00''$   
 $R = 1,432.40'$   
 $T = 158.80'$   
 $L = 316.30'$   
 $E = 8.78'$   
 $eMAX = 0.0419$

**I-480** EX. I-480  
CURVE DATA  
P.I.Sta. 634+64.69  
 $\Delta = 44^\circ 06' 29''$  (RT)  
 $Dc = 1^\circ 00' 00''$   
 $R = 5,729.58'$   
 $T = 2,321.19'$   
 $L = 4,410.81'$   
 $E = 452.33'$   
 $eMAX = 0.024$   
P.C.Sta. 611+43.51  
P.T.Sta. 655+54.32


**T-3A** CONSTR. RAMP T-3  
CURVE DATA  
P.I.Sta. 203+42.04  
 $\Delta = 21^\circ 30' 23''$  (RT)  
 $Dc = 4^\circ 45' 00''$   
 $R = 1,206.23'$   
 $T = 229.08'$   
 $L = 452.77'$   
 $E = 21.56'$   
 $eMAX = 0.038$   
DESIGN SPEED = 35 MPH

**T-2A** CONSTR. RAMP T-2  
CURVE DATA  
P.I.Sta. 102+51.44  
 $\Delta = 15^\circ 00' 00''$  (RT)  
 $Dc = 3^\circ 00' 00''$   
 $R = 1,909.86'$   
 $T = 251.44'$   
 $L = 500.00'$   
 $E = 16.48'$   
 $eMAX = 0.039$   
DESIGN SPEED = 45 MPH

**T-2B** CONSTR. RAMP T-2  
CURVE DATA  
P.I.Sta. 107+36.82  
 $\Delta = 10^\circ 03' 46''$  (RT)  
 $Dc = 5^\circ 00' 00''$   
 $R = 1,145.92'$   
 $T = 100.89'$   
 $L = 201.26'$   
 $E = 4.43'$   
 $eMAX = 0.051$   
DESIGN SPEED = 35 MPH

**T-2C** CONSTR. RAMP T-2  
CURVE DATA  
P.I.Sta. 112+71.45  
 $\Delta = 6^\circ 54' 37''$  (LT)  
 $Dc = 2^\circ 00' 00''$   
 $R = 2,864.79'$   
 $T = 172.97'$   
 $L = 345.52'$   
 $E = 5.22'$   
 $eMAX = 0.021$   
DESIGN SPEED = 35 MPH

**T-4A** EX. RAMP T-4  
CURVE DATA  
P.I.Sta. 4648+72.73  
 $\Delta = 20^\circ 40' 54''$  (RT)  
 $Dc = 4^\circ 30' 00''$   
 $R = 1,273.24'$   
 $T = 232.32'$   
 $L = 459.59'$   
 $E = 21.02'$   
 $eMAX = 0.0469$

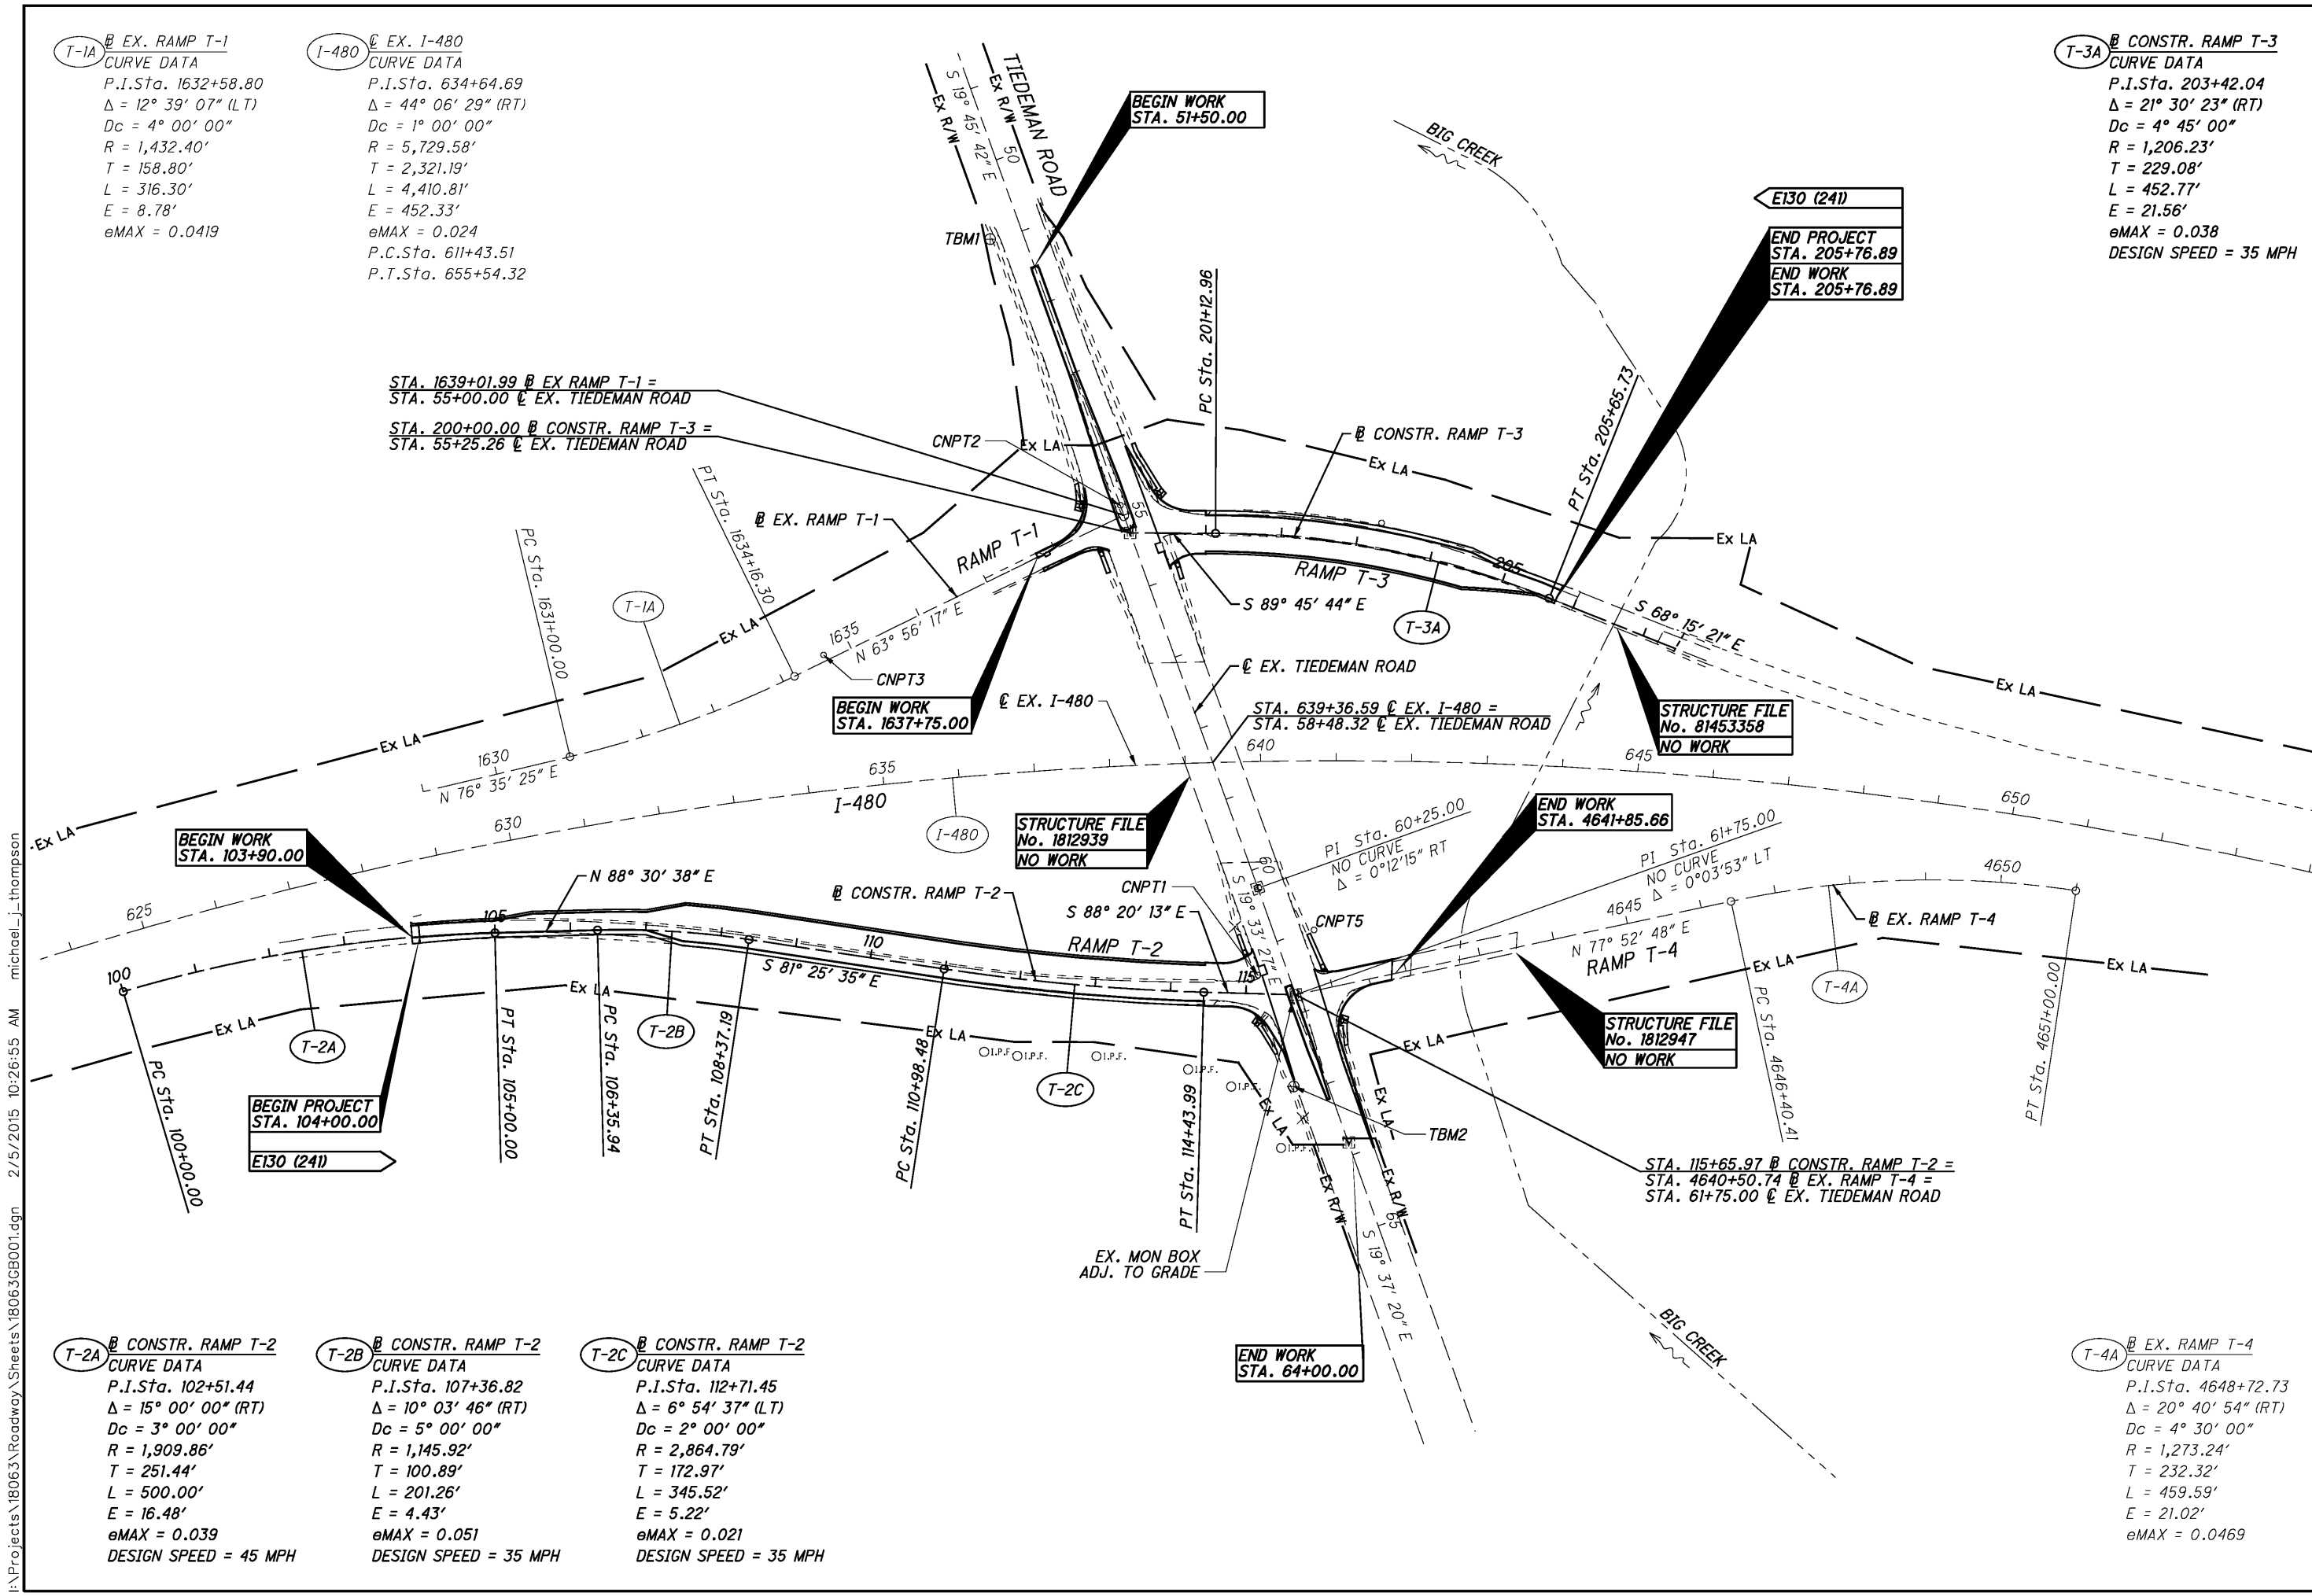


I:\Projects\18063\Roadway\Sheets\18063GB001.dgn 2/5/2015 10:26:55 AM michael\_j.thompson


POINT	POINT NUMBER	NORTHING	EASTING	ELEVATION	DESCRIPTION	STATION	OFFSET	REFERENCE ALIGNMENT
CNPT1	1	641605.950	2171304.133	779.38	CAPPED "URS CORP CONTROL POINT" REBAR SET ON NW CORNER OF I-480 EB OFF RAMP AND TIEDEMAN. 3.5' N OF N EDGE OF PAVEMENT FOR OFF RAMP & 3.2' W OF W EDGE OF PAVEMENT OF TIEDEMAN.	115+15.48	24.21' LT.	☉ CONSTR. RAMP T-2
CNPT2	2	642228.349	2171121.768	778.14	MAGS IN CONC. ISLAND IN ☉ OF TIEDEMAN & ON N SIDE OF INTERSECTION OF I-480 WB ON AND OFF RAMPS & TIEDEMAN. MAG SET IN CENTER OF ABOVE MENTIONED CONC. ISLAND AND 20.5' N OF S END OF CONC. ISLAND.	54+86.61	0.13' LT.	☉ EX. TIEDEMAN
CNPT3	3	642030.209	2170728.679	768.41	CAPPED "URS CORP CONTROL POINT" REBAR SET 3.0' N OF N EDGE OF BERM OF ON RAMP FROM TIEDEMAN TO I-480 WB AT APPROX. LONGITUDINAL CENTER OF RAMP.	1634+63.42	8.00' LT.	☉ EX. RAMP T-1
CNPT5	5	641665.826	2171378.284	780.01	CAPPED "URS CORP CONTROL POINT" REBAR ON E SIDE OF TIEDEMAN 60' FROM N CURB LINE OF I-480 EB ON RAMP AND 6.5' FROM BACK OF WALK.	61+02.55	51.62' LT.	☉ EX. TIEDEMAN
TBM1	260	642581.1	2170949.3	770.35	CHS "+ " SE ANCHOR BOLT ON LIGHT POLE 42.1' W ☉ TIEDEMAN AND 221.3' S OF ☉ DRIVE TO PLAIN DEALER.	50+96.37	42.94' RT.	☉ EX. TIEDEMAN
TBM2	843	641458.6	2171351.5	777.25	CHS "+ " NE ANCHOR BOLT ON OVERHEAD SIGN FOUNDATION, 43.5' W ☉ TIEDEMAN AND 133.7' S ☉ I-480 EB OFF RAMP.	62+88.80	43.15' RT.	☉ EX. TIEDEMAN

**EXISTING LEGEND**


- (A) 9"± REINFORCED CONCRETE PAVEMENT
- (B) 6"± SUBBASE
- (C) 6"± BITUMINOUS AGGREGATE BASE
- (D) 6" UNDERDRAIN
- (E) 6"x7" INTEGRAL CONCRETE CURB
- (F) 3"± ASPHALT CONCRETE
- (G) 10"± SUBBASE
- (H) 9"± CONCRETE MEDIAN

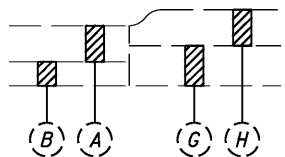

TIEDEMAN ROAD CONCRETE MEDIAN DETAIL

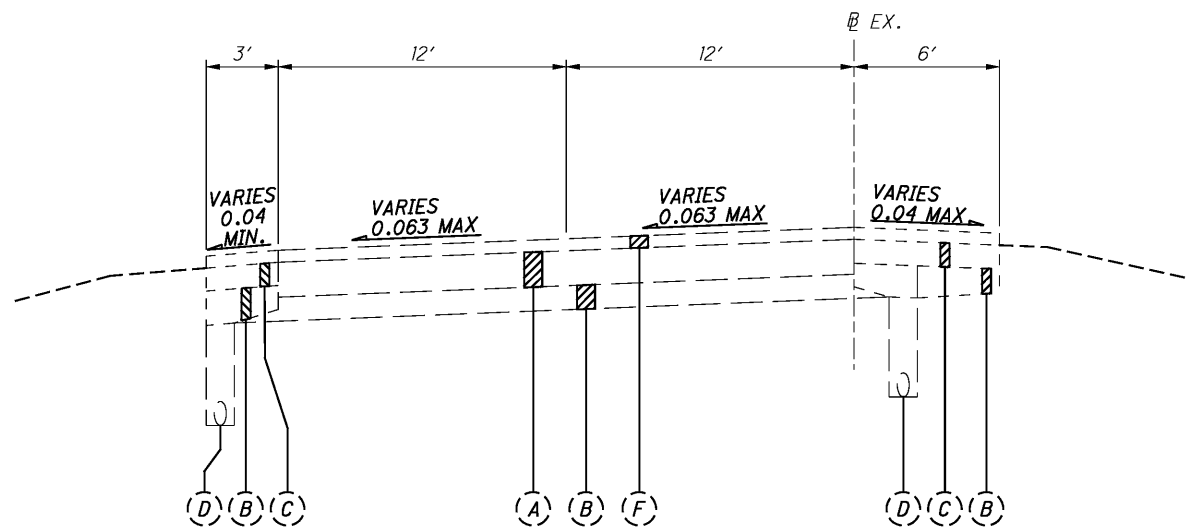


TWO LANE SUPERELEVATED SECTION (LT)  
RAMP T-2 - STA. 2636+66 TO STA. 2638+39

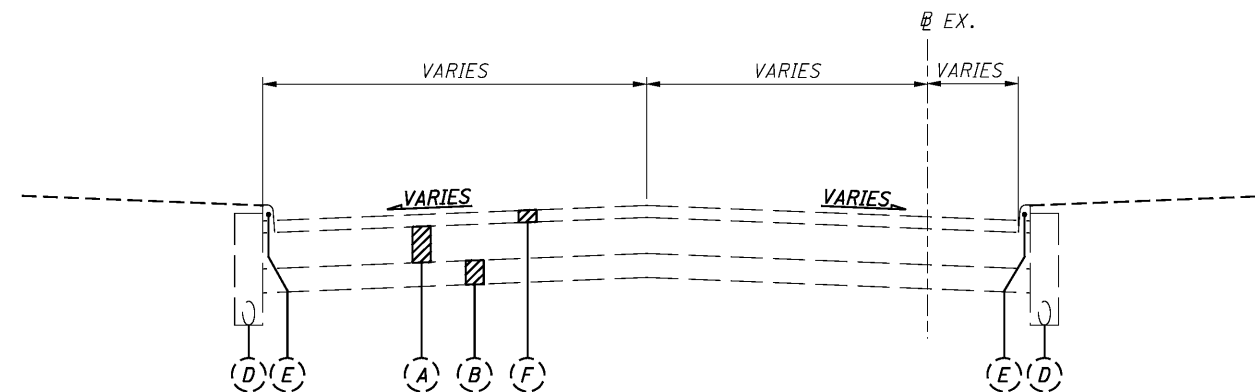


RAMP INTERSECTION SECTION  
RAMP T-1 - STA. 1637+77 TO STA. 1638+66  
RAMP T-2 - STA. 2639+06 TO STA. 2639+79  
RAMP T-3 - STA. 3637+93 TO STA. 3638+70  
RAMP T-4 - STA. 4640+85 TO STA. 4641+81

NOTE: RAMP T-4 DOES NOT HAVE A 3" ASPHALT CONCRETE OVERLAY (LAYER (F))

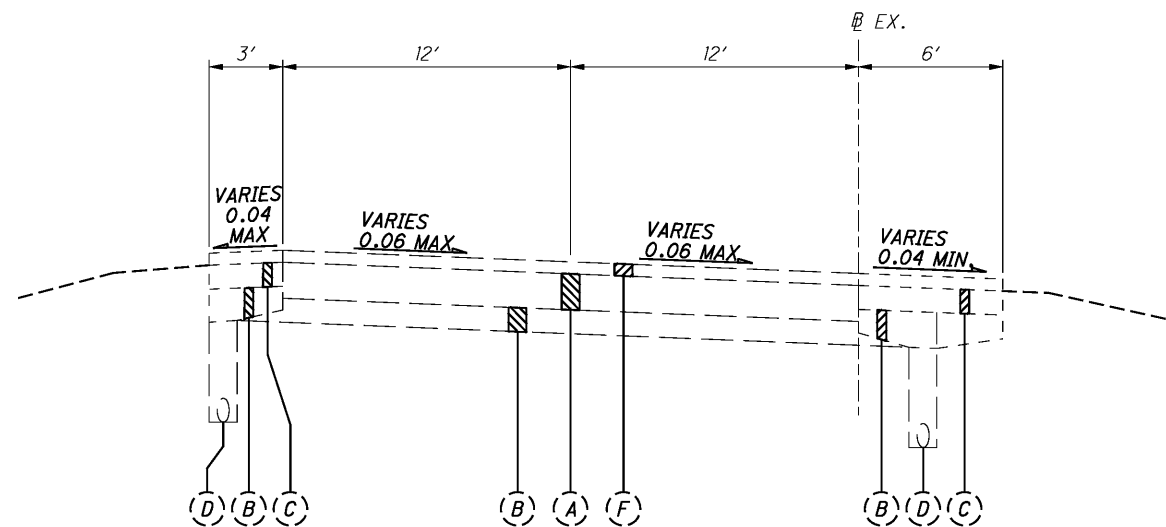


TWO LANE SUPERELEVATED SECTION (RT)  
RAMP T-2 - STA. 2638+39 TO STA. 2639+06  
RAMP T-3 - STA. 3638+70 TO STA. 3642+63

NOTE:  
FOR RAMP T-3 REVERSE  
LOCATION OF 6' AND  
3' SHOULDERS

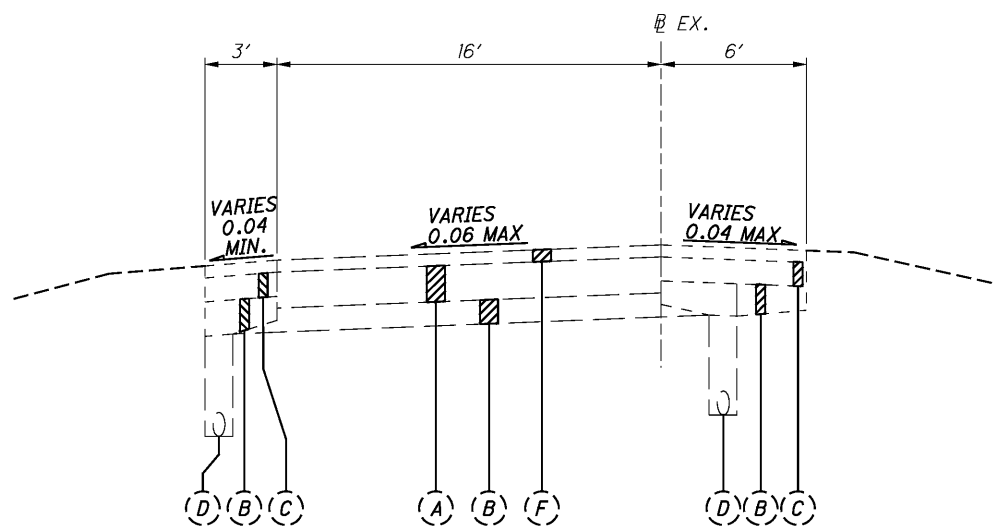

ONE LANE SUPERELEVATED SECTION (LT)  
RAMP T-1 - STA. 1637+75 TO STA. 1637+77  
RAMP T-2 - STA. 2635+00 TO STA. 2636+66  
RAMP T-3 - STA. 3642+95 TO STA. 3645+20

NOTE:  
FOR RAMPS T-1 AND T-3  
REVERSE LOCATION OF  
6' AND 3' SHOULDERS

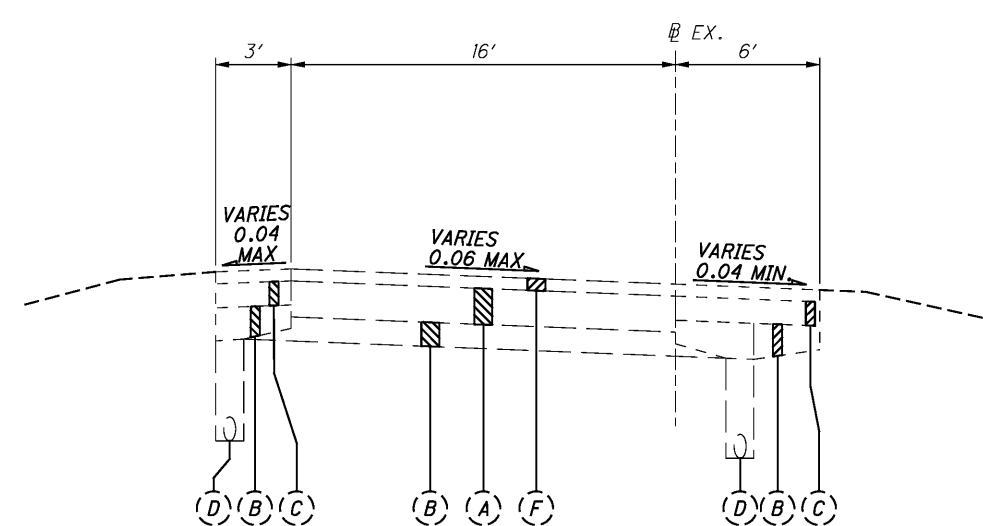

ONE LANE SUPERELEVATED SECTION (RT)  
RAMP T-2 - STA. 2628+43 TO STA. 2635+00  
RAMP T-3 - STA. 3642+63 TO STA. 3642+95

NOTE:  
FOR RAMP T-3 REVERSE  
LOCATION OF 6' AND  
3' SHOULDERS

I:\Projects\18063\Roadway\Sheets\18063C\Y001.dgn 2/5/2015 10:26:55 AM michael\_j.thompson




**PROPOSED LEGEND**

- ① ITEM 204 - SUBGRADE COMPACTION
- ② ITEM 254 - 3" PAVEMENT PLANING, ASPHALT CONCRETE
- ③ ITEM 304 - 5" AGGREGATE BASE
- ④ ITEM 304 - 6" AGGREGATE BASE
- ⑤ NOT USED
- ⑥ ITEM 304 - AGGREGATE BASE (THICKNESS VARIES 10" TO 12")
- ⑦ ITEM 407 - TACK COAT (APPLIED AT 0.075 GALLON/SQ YD)
- ⑧ ITEM 407 - TACK COAT FOR INTERMEDIATE COURSE (APPLIED AT 0.04 GALLON/SQ YD)
- ⑨ ITEM 448 - 1.75" ASPHALT CONCRETE INTERMEDIATE COURSE, TYPE 2, PG64-22
- ⑩ ITEM 448 - 1.25" ASPHALT CONCRETE SURFACE COURSE, TYPE 1, PG64-22, AS PER PLAN
- ⑪ ITEM 452 - 9" NON-REINFORCED CONCRETE PAVEMENT
- ⑫ ITEM 452 - 10" NON-REINFORCED CONCRETE PAVEMENT
- ⑬ ITEM 605 - 6" BASE PIPE UNDERDRAINS WITH FABRIC WRAP
- ⑭ ITEM 606 - GUARDRAIL, TYPE MGS
- ⑮ ITEM 608 - 4" CONCRETE WALK
- ⑯ ITEM 609 - CURB, TYPE 2-A
- ⑰ ITEM 609 - CURB, TYPE 6
- ⑱ ITEM 609 - 6" CONCRETE TRAFFIC ISLAND PER SCD RM-3.1
- ⑲ ITEM 659 - SEEDING AND MULCHING, CLASS 1
- L LONGITUDINAL JOINT

**NOTE:**


FOR EXISTING LEGEND SEE SHEET 4

FOR SHOULDER CROSS SLOPE DETAILS SEE SHEET 8

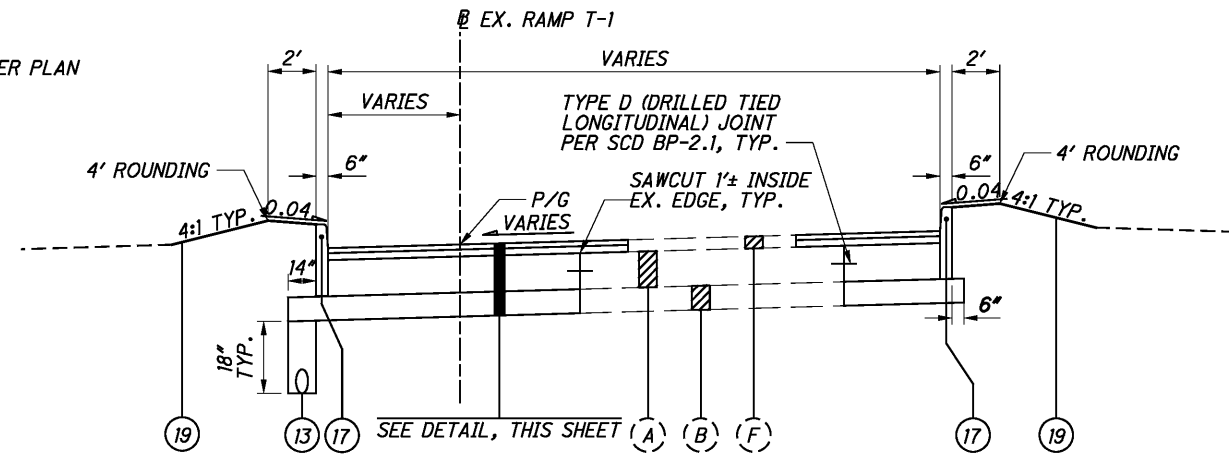


SUPERELEVATED SECTION - RAMP T-1 (LT)  
STA. 1637+75.00 TO STA. 1638+70.00

SEE INTERSECTION DETAIL FOR MORE INFORMATION

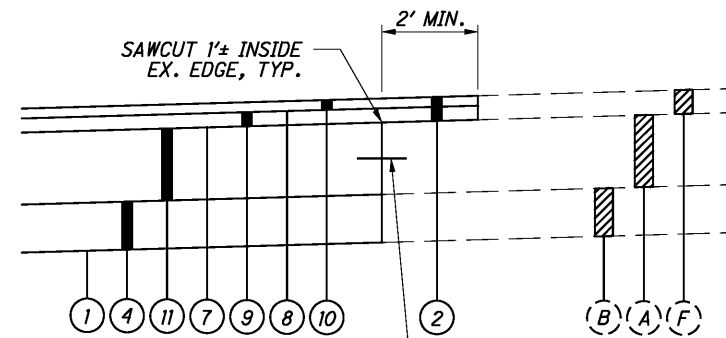


RAMP T-1 - PAVEMENT BUILD-UP DETAIL

**NOTE:**  
 FOR EXISTING LEGEND SEE SHEET 4  
 FOR PROPOSED LEGEND SEE SHEET 5  
 FOR SHOULDER CROSS SLOPE DETAILS SEE SHEET 8

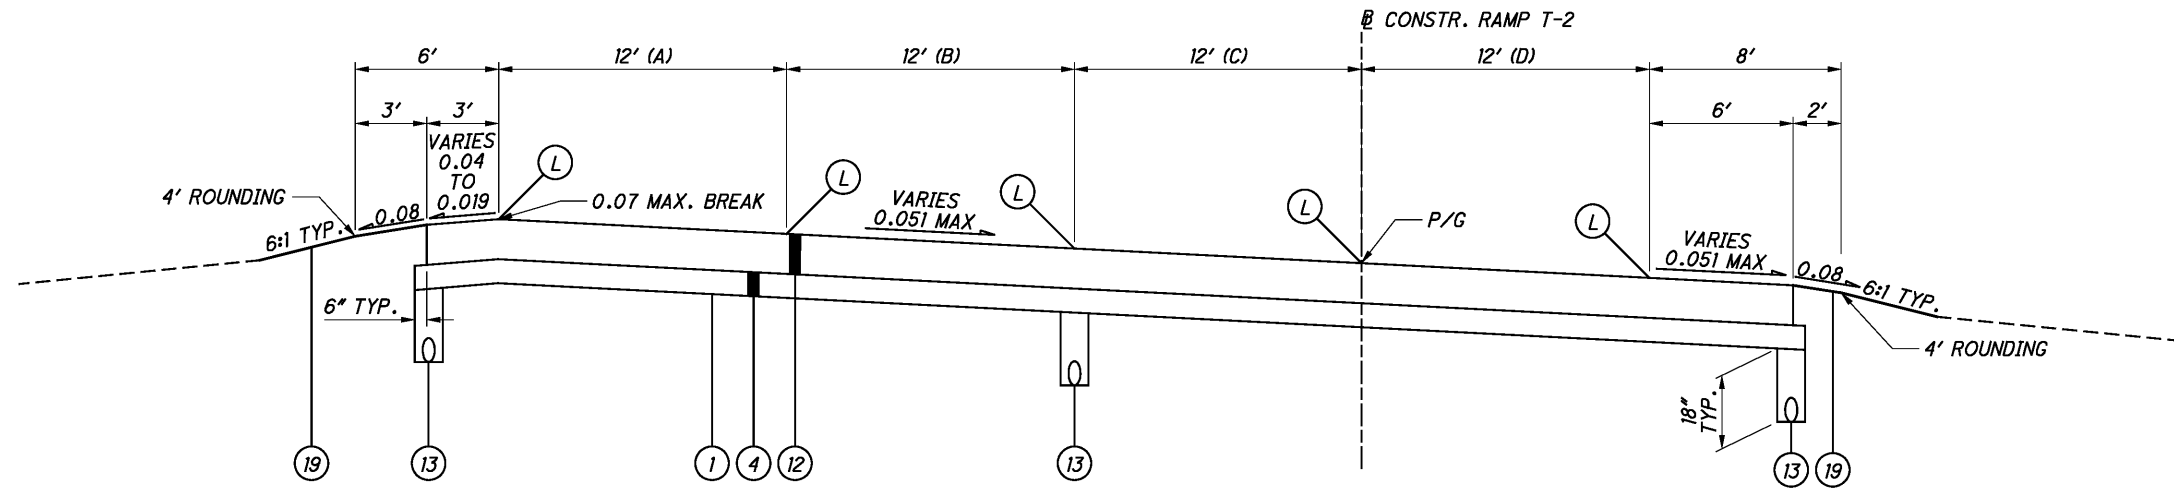

**SUPERELEVATED SECTION - RAMP T-2 (RT)**  
 STA. 104+00.00 TO STA. 110+21.00

- (A)  
 0' STA. 104+00 TO STA. 107+00  
 VARIES 0' TO 12' STA. 107+00 TO STA. 107+50  
 12' STA. 107+50 TO STA. 110+21
- (B)  
 0' STA. 104+00 TO STA. 105+50  
 12' STA. 105+50 TO STA. 110+21
- (C)  
 16' STA. 104+00 TO STA. 105+00  
 VARIES 16' TO 24' STA. 105+00 TO STA. 105+50  
 12' STA. 105+50 TO STA. 110+21
- (D)  
 0' STA. 104+00 TO STA. 107+00  
 VARIES 0' TO 12' STA. 107+00 TO STA. 107+50  
 12' STA. 107+50 TO STA. 110+21

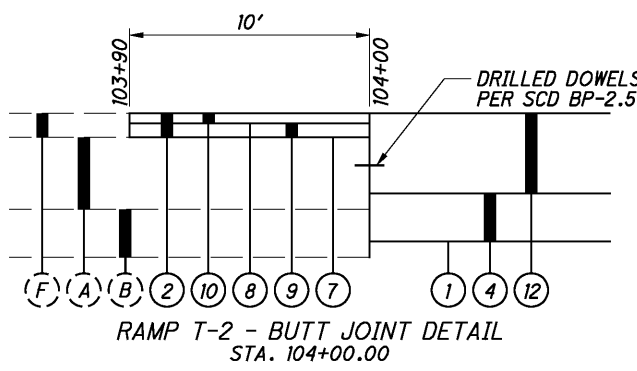


**RAMP T-2 - BUTT JOINT DETAIL**  
 STA. 104+00.00


BUTT JOINT BETWEEN EXISTING PAVEMENT AND PROPOSED PAVEMENT, A DOWELED TYPE Y JOINT AS PER BP-2.5 SHALL BE PROVIDED. GROUTING AND DRILLING REQUIREMENTS SHALL BE PER SPECIFICATION 255 AND BP-2.5 EXCEPT THE REQUIREMENT THAT THE DRILLING DEVICE SHALL BE CAPABLE OF DRILLING THREE HOLES AT ONE TIME SHALL BE WAIVED.

I:\Projects\18063\Roadway\Sheets\18063C\Y003.dgn 2/5/2015 10:26:56 AM michael.j.thompson

**NOTE:**  
 FOR PROPOSED LEGEND SEE SHEET 5  
 FOR SHOULDER CROSS SLOPE DETAILS SEE SHEET 8

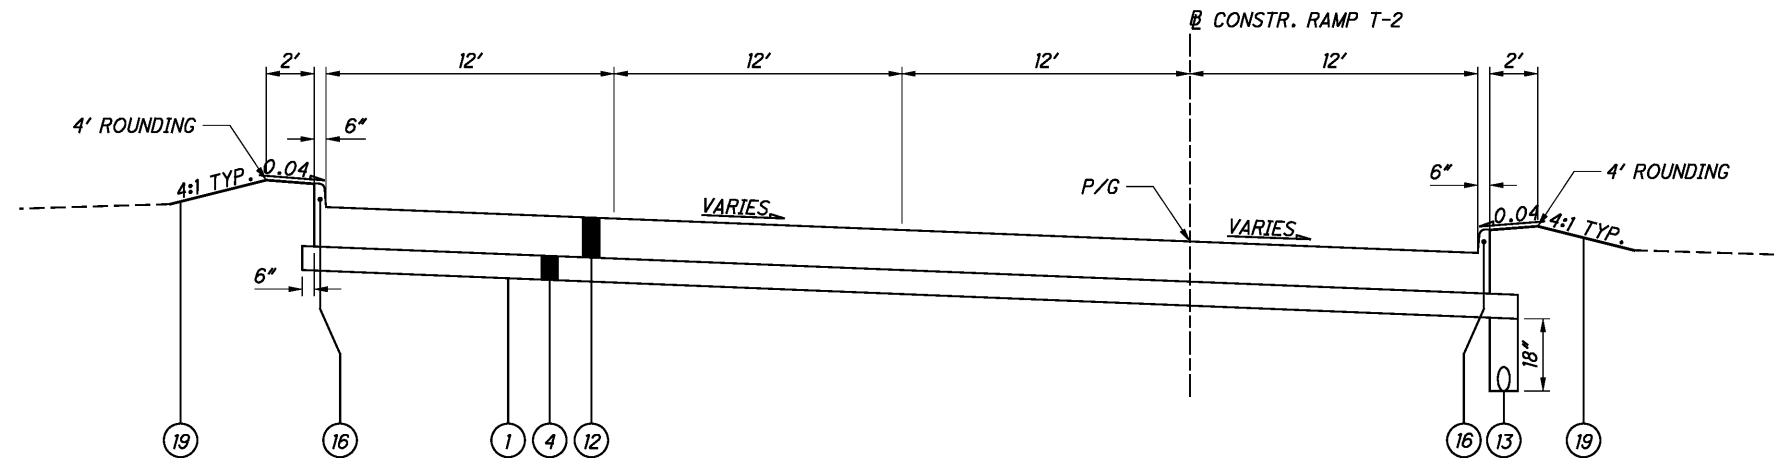


**CURBED SECTION - RAMP T-2**  
 STA. 114+43.99 TO STA. 115+65.97  
 STA. 114+45, LT. & RT. - END SHOULDER, BEGIN CURB  
 SEE PAVEMENT DETAILS FOR JOINT LAYOUT  
 SEE INTERSECTION DETAIL FOR MORE INFORMATION

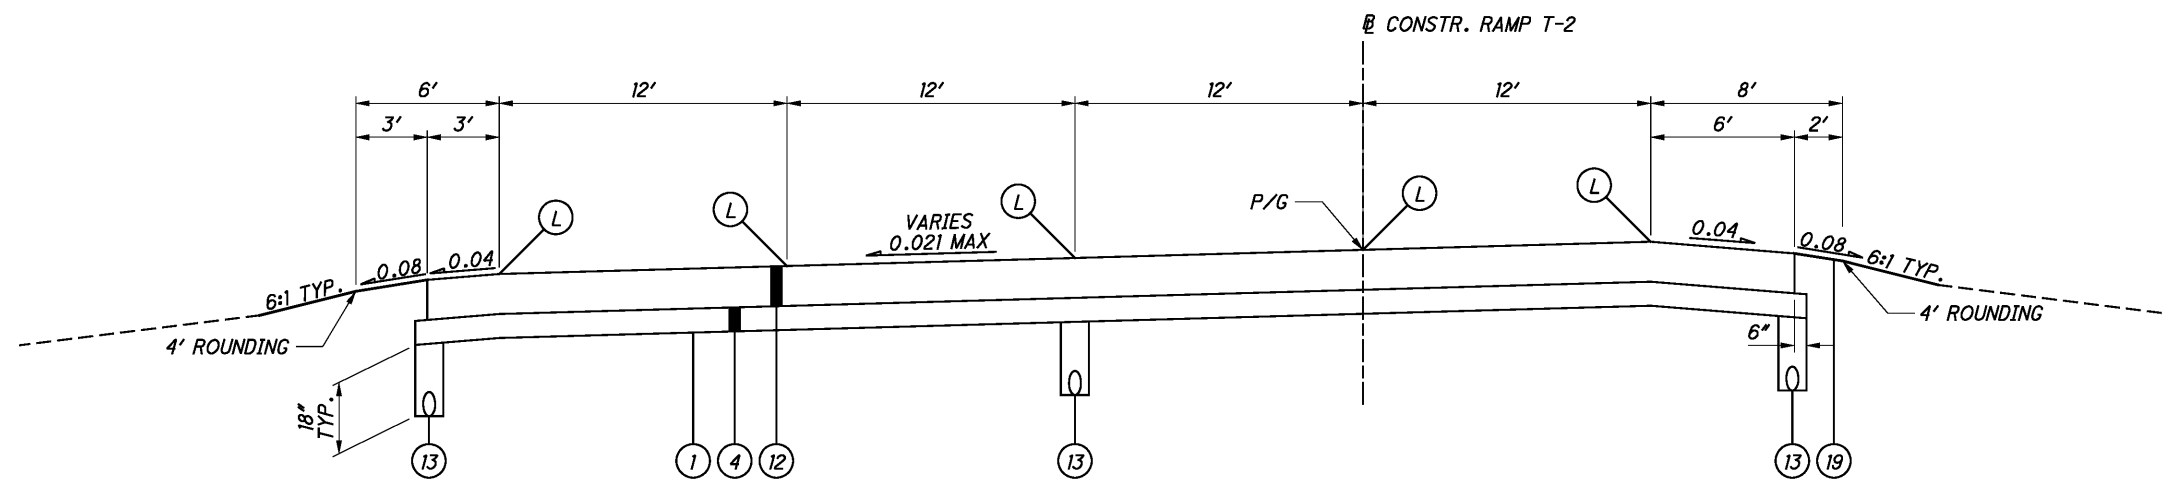


**SUPERELEVATED SECTION - RAMP T-2 (LT)**  
 STA. 110+21 TO STA. 114+43.99

NOTE:  
FOR PROPOSED LEGEND SEE SHEET 5

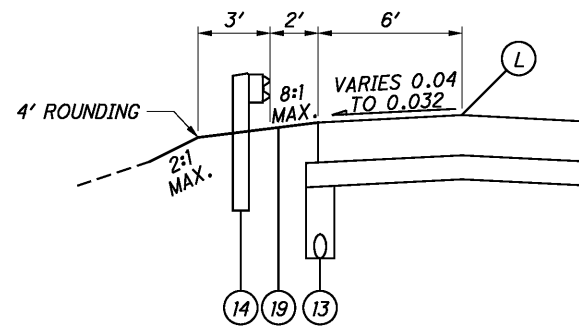


GUARDRAIL SECTION - RAMP T-3  
STA. 203+00.00 TO STA. 205+00.00

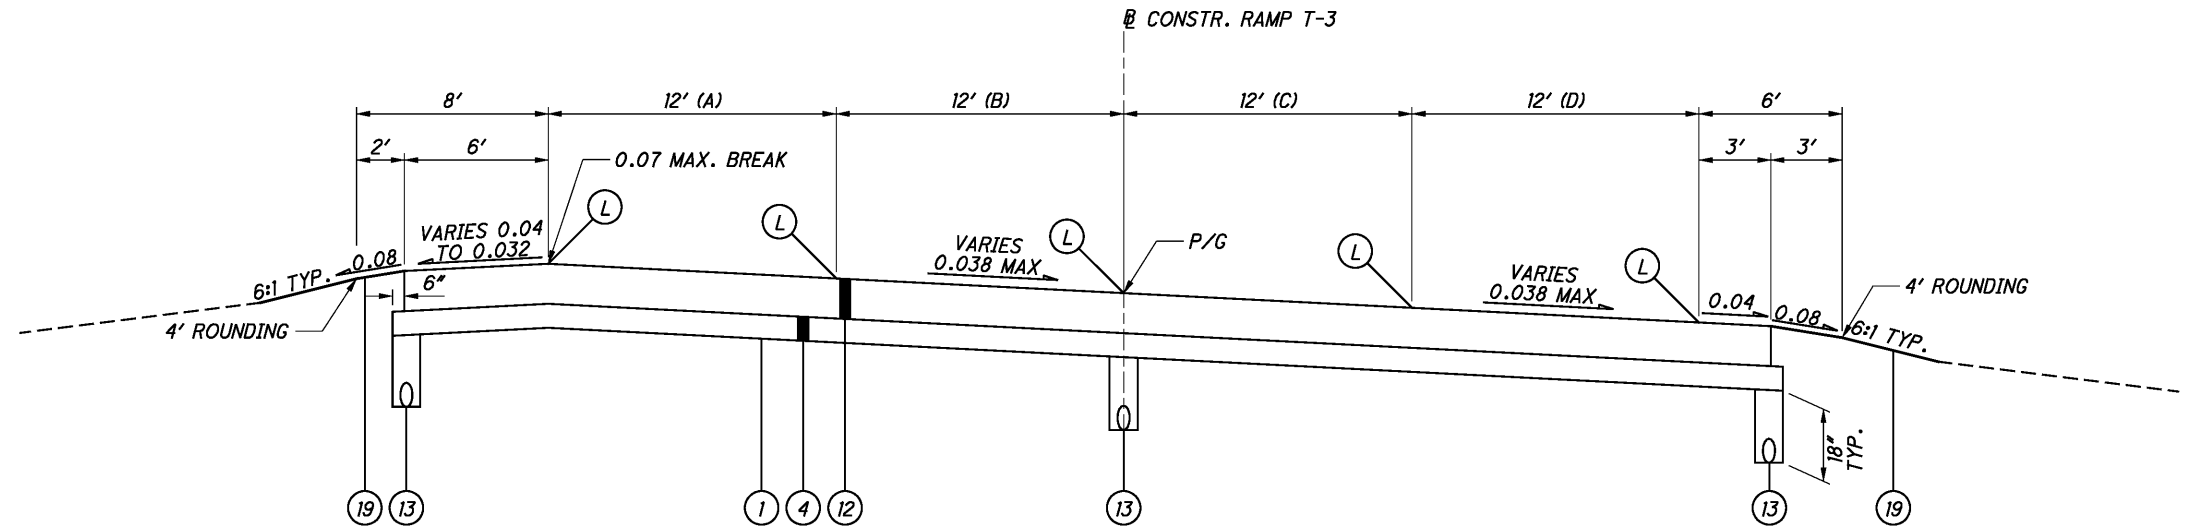


SUPERELEVATED SECTION - RAMP T-3 (RT)  
STA. 201+00.00 TO STA. 205+74.45

- (A)  
12' STA. 201+00 TO STA. 204+50  
0' STA. 204+50 TO STA. 205+74.45
- (B)  
12' STA. 201+00 TO STA. 204+50  
VARIES 24' TO 16' STA. 204+50 TO STA. 205+00  
16' STA. 205+00 TO STA. 205+74.45
- (C)  
12' STA. 201+00 TO STA. 205+00  
VARIES 12' TO 0' STA. 205+00 TO STA. 205+50  
0' STA. 205+50 TO STA. 205+74.45
- (D)  
12' STA. 201+00 TO STA. 204+50  
VARIES 12' TO 0' STA. 204+50 TO STA. 205+00  
0' STA. 205+00 TO STA. 205+74.45

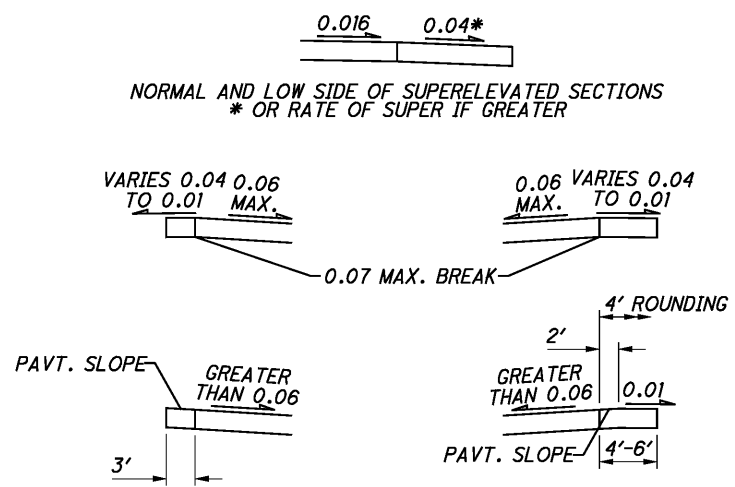

HIGH SIDE OF SUPERELEVATED SECTIONS

SHOULDER CROSS SLOPE DETAIL

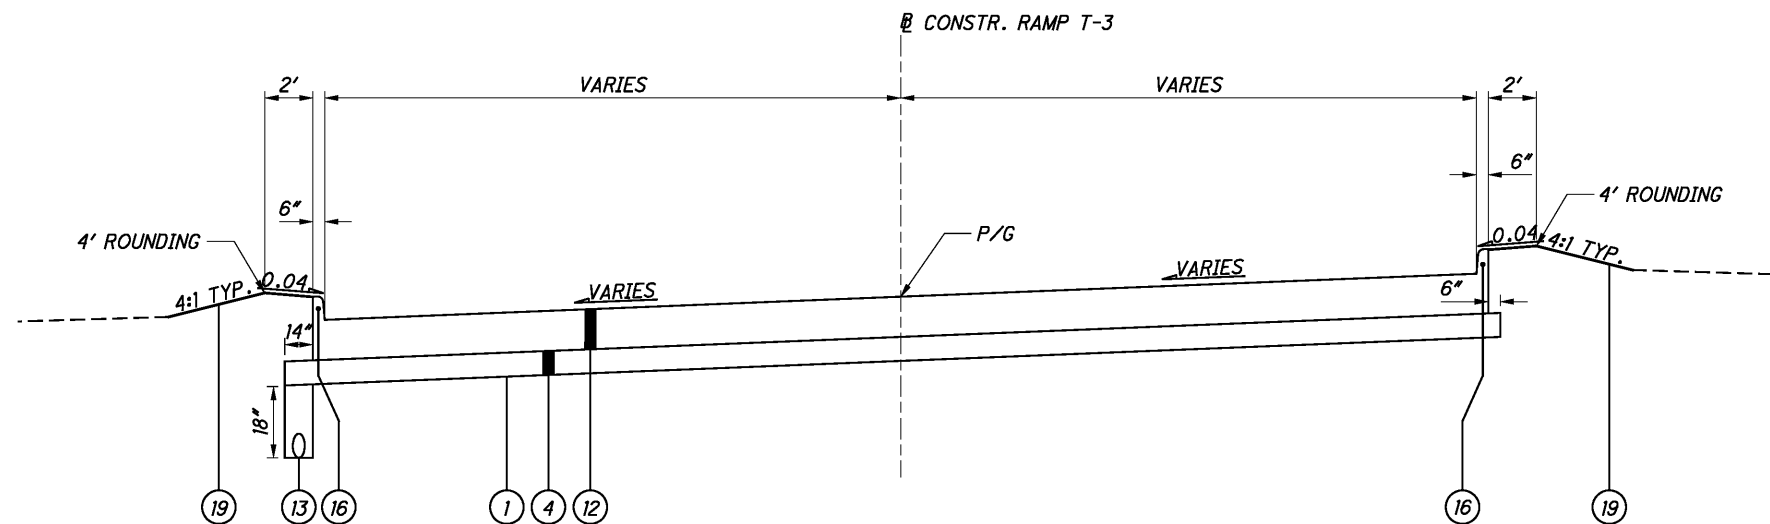

SUPERELEVATED CURBED SECTION - RAMP T-3 (LT)  
STA. 200+00.00 TO STA. 201+00.00


SEE PAVEMENT DETAILS FOR JOINT LAYOUT  
SEE INTERSECTION DETAIL FOR MORE INFORMATION

**NOTE:**

FOR EXISTING LEGEND SEE SHEET 4

FOR PROPOSED LEGEND SEE SHEET 5

FOR SHOULDER CROSS SLOPE DETAILS SEE SHEET 8

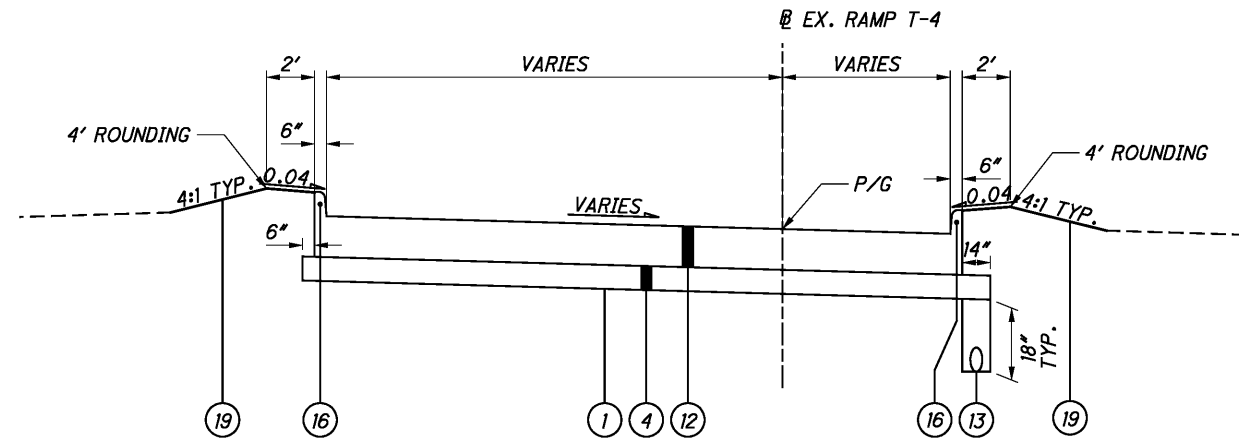


**SUPERELEVATED SECTION - RAMP T-4 (RT)**  
STA. 4640+83.90 TO STA. 4641+80.87

SEE PAVEMENT DETAILS FOR JOINT LAYOUT  
SEE INTERSECTION DETAIL FOR MORE INFORMATION


I:\Projects\18063\Roadway\Sheets\18063C\Y006.dgn 2/5/2015 10:26:57 AM michael.j.\_thompson

**NOTE:**  
 FOR EXISTING LEGEND SEE SHEET 4  
 FOR PROPOSED LEGEND SEE SHEET 5

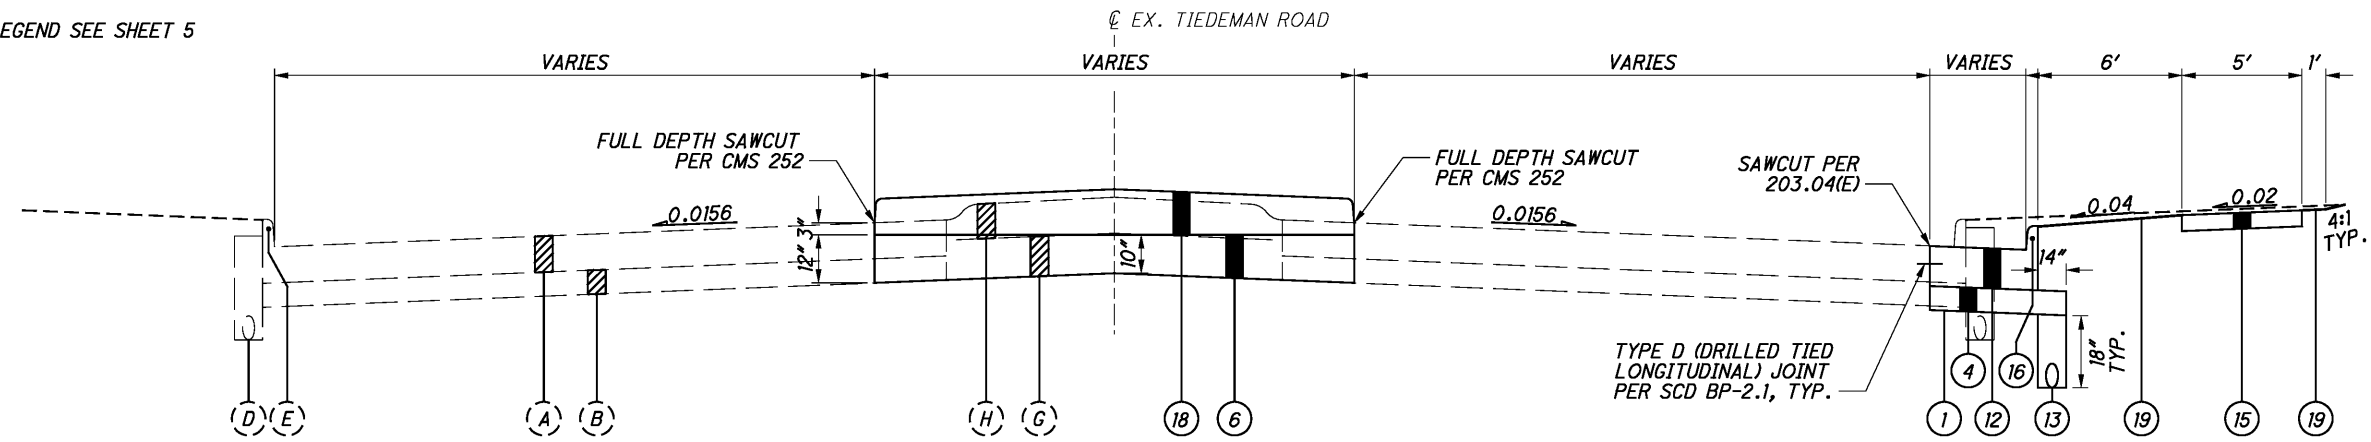


**TIEDEMAN ROAD - CONCRETE MEDIAN AND WIDENING SECTION**  
 SEE PLANS AND INTERSECTION DETAILS FOR LIMITS AND DIMENSIONS  
 REVERSE AS NECESSARY

**NOTES:**  
 TRANSITION MEDIAN NOSE HEIGHT FROM 2" TO 6" OVER 10'  
 FOR PAVEMENT REPLACEMENT OUTSIDE OF PROPOSED MEDIAN LIMITS, SEE BELOW DETAIL  
 ANY DAMAGE TO EX. ASPHALT DURING SAWCUT OPERATION SHALL BE REPAIRED TO THE APPROVAL OF THE ENGINEER

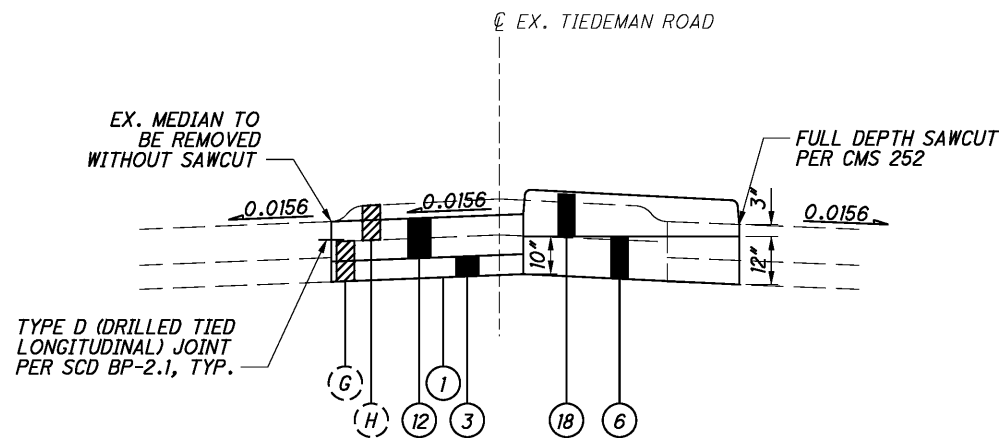

**TIEDEMAN ROAD - OFFSET CONCRETE MEDIAN DETAIL**  
 SEE PLANS AND INTERSECTION DETAILS FOR LIMITS AND DIMENSIONS

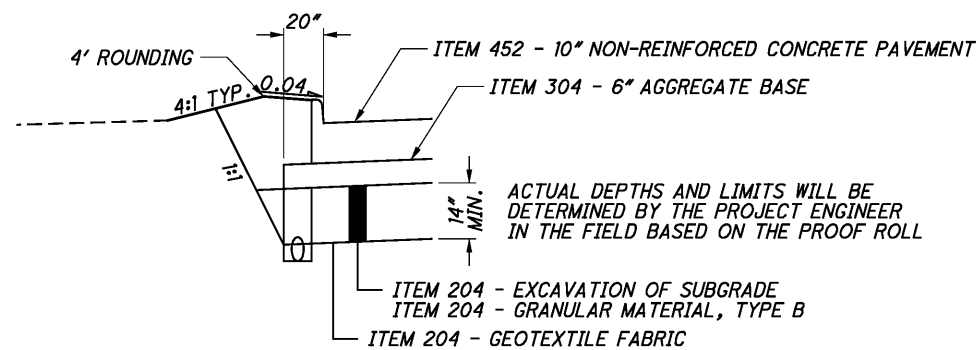

**EXCAVATE AND REPLACE DETAIL**  
 AS DIRECTED BY THE PROJECT ENGINEER FOLLOWING PROOF ROLL  
 SEE GENERAL NOTES FOR MORE INFORMATION

I:\Projects\18063\Roadway\Sheets\18063CY007.dgn 2/5/2015 10:26:57 AM michael.j.\_thompson

**GENERAL**

**ROUNDING**

THE ROUNDING AT SLOPE BREAKPOINTS SHOWN ON THE TYPICAL SECTIONS APPLIES TO ALL CROSS-SECTIONS EVEN THOUGH OTHERWISE SHOWN.

**UTILITIES**

LISTED BELOW ARE ALL UTILITIES LOCATED WITHIN THE PROJECT CONSTRUCTION LIMITS TOGETHER WITH THEIR RESPECTIVE OWNERS:

**AT&T**

ATTN.: HAROLD MAYNARD  
13630 LORAIN ROAD  
CLEVELAND, OH 44111  
PHONE: (216) 476-6138  
FAX: (216) 476-6013  
EMAIL: HM2147@ATT.COM

**AT&T CORP.**

ATTN.: TONY LYLE  
5980-G WILCOX PLACE  
DUBLIN, OH 43016  
PHONE: (614) 760-8320  
FAX: (614) 760-8323  
EMAIL: TLYLE@HLGENGINEERING.COM

**CEI ILLUMINATING CO.**

ATTN.: MARK ROBINSON  
6896 MILLER ROAD  
BRECKSVILLE, OH 44141  
PHONE: (440) 717-6845

**CITY OF BROOKLYN**

ATTN.: DOUGLAS COURTNEY  
7619 MEMPHIS AVENUE  
BROOKLYN, OH 44144  
PHONE: (440) 683-5745  
EMAIL: DCOURTNEY@CWCOURTNEY.COM

**CUYAHOGA COUNTY PUBLIC WORKS DEPT.  
SANITARY ENGINEERING DIVISION**

ATTN.: MARK ELSSESSER  
2100 SUPERIOR VIADUCT  
CLEVELAND, OH 44113  
PHONE: (216) 348-380  
EMAIL: MELSESSER@CUYAHOGACOUNTY.US

**CLEVELAND WATER ENGINEERING**

ATTN.: TINA GOSHA  
1201 LAKESIDE AVENUE, 2ND FLOOR  
CLEVELAND, OH 44114  
PHONE: (216) 664-2444 X5526  
EMAIL: TINA.GOSHA@CLEVELANDWATER.COM

**DOMINION EAST OHIO**

ATTN.: MARY J. LONG  
320 SPRINGSIDE DRIVE, SUITE 320  
AKRON, OH 44333  
PHONE: (330) 664-2409  
FAX: (888) 504-0126  
EMAIL: RELOCATION@DOM.COM

**NEORS**

ATTN.: ERIC PARHAM  
4747 EAST 49TH STREET  
CUYAHOGA HEIGHTS, OH 44125  
PHONE: (216) 641-9010 X2441

**TIME WARNER CABLE**

ATTN.: PAUL SILVESTRO  
8150 EAST DOW CIRCLE  
STRONGSVILLE, OH 44136  
PHONE: (216) 575-8016 X5034  
EMAIL: PAUL.SILVESTRO@TWCABLE.COM

**ODOT DISTRICT 12**

ATTN.: JEFF HEBEBRAND  
5500 TRANSPORTATION BOULEVARD  
GARFIELD HEIGHTS, OH 44125  
PHONE: (216) 584-2155  
EMAIL: JEFFERY.HEBEBRAND@DOT.STATE.OH.US

THE LOCATION OF THE UNDERGROUND UTILITIES SHOWN ON THE PLANS ARE AS OBTAINED FROM THE OWNERS AS REQUIRED BY SECTION 153.64 O.R.C.

**EXISTING PLANS**

EXISTING PLANS ENTITLED CUY-480-10.39 (1983) MAY BE INSPECTED IN THE ODOT DISTRICT 12 OFFICE IN GARFIELD HEIGHTS, OH.

**SURVEYING PARAMETERS**

USE THE FOLLOWING VERTICAL POSITIONING AND HORIZONTAL POSITIONING PARAMETERS FOR ALL SURVEYING:

**VERTICAL POSITIONING**

ORTHOMETRIC HEIGHT DATUM: NAVD 88  
GEOID: 12A

**HORIZONTAL POSITIONING**

REFERENCE FRAME: NAD 83 (CORS2011)  
ELLIPSOID: GRS80  
MAP PROJECTION: LAMBERT CONFORMAL CONIC  
COORDINATE SYSTEM: OHIO NORTH ZONE (3401)  
COMBINED SCALE FACTOR: 0.99992693

ORIGIN OF SCALE (X,Y) - EASTING (X): 0 NORTHING (Y): 0

FURNISH UNITS IN U.S. SURVEY FEET. USE THE FOLLOWING CONVERSION FACTOR:  
1 METER = 3.28083333333 U.S. SURVEY FEET.

**WORK LIMITS**

THE WORK LIMITS SHOWN ON THESE PLANS ARE FOR PHYSICAL CONSTRUCTION ONLY. PROVIDE THE INSTALLATION AND OPERATION OF ALL WORK ZONE TRAFFIC CONTROL AND WORK ZONE TRAFFIC CONTROL DEVICES REQUIRED BY THESE PLANS WHETHER INSIDE OR OUTSIDE THESE WORK LIMITS.

**PROTECTION OF RIGHT-OF-WAY LANDSCAPING**

PRIOR TO BEGINNING WORK, THE CONTRACTOR, THE PROJECT ENGINEER, AND A REPRESENTATIVE OF THE MAINTAINING AGENCY WILL REVIEW AND RECORD ALL LANDSCAPING ITEMS WITHIN THE RIGHT-OF-WAY (BOTH WITHIN AND OUTSIDE THE CONSTRUCTION LIMITS) A RECORD OF THIS REVIEW WILL BE KEPT IN THE PROJECT ENGINEER'S FILES. PRIOR TO FINAL ACCEPTANCE, A FINAL REVIEW OF LANDSCAPING ITEMS WILL BE MADE.

CONSTRUCT ALL ACTIVITIES, EQUIPMENT STORAGE, AND STAGING TO WITHIN THE CONSTRUCTION LIMITS. UNLESS OTHERWISE IDENTIFIED IN THE PLANS OR PROPOSAL, THE CONSTRUCTION LIMITS ARE IDENTIFIED AS 30 FEET FROM THE EDGE OF PAVEMENT.

SUBMIT A WRITTEN REQUEST TO THE PROJECT ENGINEER TO USE ANY AREA OUTSIDE THESE LIMITS. THE DOCUMENT SUBMITTED MUST CLEARLY IDENTIFY THE AREA AND EXPLAIN THE PROPOSED USE AND RESTORATION OF THE AREA. THE REQUEST MUST BE APPROVED, IN WRITING, BEFORE THE CONTRACTOR HAS PERMISSION TO USE THE AREA.

ANY ITEMS DAMAGED BEYOND THE CONSTRUCTION LIMITS, AS DEFINED ABOVE, WILL BE REPLACED IN KIND OR AS APPROVED BY THE PROJECT ENGINEER.

**MONUMENT ASSEMBLIES**

CONSTRUCT MONUMENT ASSEMBLIES IN ACCORDANCE WITH THE DETAILS SHOWN ON THE STANDARD CONSTRUCTION DRAWINGS AND AT THE LOCATIONS SHOWN ON SHEET NO. 2.

**AIRWAY/HIGHWAY CLEARANCE FOR AIRPORTS AND HELIPORTS**

THIS PROJECT HAS BEEN IDENTIFIED AS BEING WITHIN THE INFLUENCE AREA OF A PUBLIC USE AIRPORT OR HELIPORT. NO TEMPORARY STRUCTURES OR CONSTRUCTION EQUIPMENT AT MAXIMUM OPERATING HEIGHT SHALL EXCEED A HEIGHT OF 150 FT. IF ANY TEMPORARY STRUCTURES OR CONSTRUCTION EQUIPMENT WILL EXCEED THIS HEIGHT, FURTHER COORDINATION WITH THE FEDERAL AVIATION ADMINISTRATION (FAA), AND ODOT OFFICE OF AVIATION, WILL BE NECESSARY PRIOR TO ERECTING SUCH TEMPORARY STRUCTURES OR OPERATING SUCH EQUIPMENT ON THE PROJECT. THE CONTRACTOR WILL BE REQUIRED TO SUBMIT FORM 7460-1 TO THE FAA. NOTIFY THE ODOT OFFICE OF AVIATION WHEN SUBMITTING FAA FORM 7460-1.

NO TEMPORARY STRUCTURES OR CONSTRUCTION EQUIPMENT SHALL EXCEED THE PERMISSIBLE HEIGHT, UNTIL A COPY OF THE FAA APPROVAL AND THE ODOT OFFICE OF AVIATION PERMIT HAS BEEN FURNISHED TO THE PROJECT ENGINEER.

EXPRESS PROCESSING CENTER  
THE FEDERAL AVIATION ADMINISTRATION  
SOUTHWEST REGIONAL OFFICE  
AIR TRAFFIC AIRSPACE BRANCH ASW-520  
2601 MEACHAN BLVD.  
FORT WORTH, TX 76137-4298

OHIO DEPARTMENT OF TRANSPORTATION  
OFFICE OF AVIATION  
2829 WEST DUBLIN-GRANVILLE ROAD  
COLUMBUS, OHIO 43235  
614-387-2346

**WORK ADJACENT TO DOMINION EAST OHIO GAS LINES**

IT IS THE CONTRACTOR'S RESPONSIBILITY TO MAINTAIN THE LATERAL AND SUBJACENT SUPPORT OF DOMINION'S PIPELINE(S), IN COMPLIANCE TO 29 CFR, PART 1926, SUBPART P, (SAFE EXCAVATION & SHORING). ONE-FOOT MINIMUM VERTICAL AND HORIZONTAL CLEARANCE MUST BE MAINTAINED BETWEEN DOMINION EAST OHIO'S (DEO) EXISTING PIPELINE(S) AND ALL OTHER IMPROVEMENTS. EXTREME CARE SHOULD BE TAKEN NOT TO HARM ANY DEO FACILITY (PIPELINES, ETC.) OR APPURTENANCE (PIPE COATING, TRACER WIRE, CATHODIC PROTECTION TEST STATION WIRES & DEVICES, VALVE BOXES, ETC.). DEO FACILITIES MUST BE PROTECTED WITH A TARP DURING BRIDGE CONSTRUCTION. THE CONTRACTOR WILL BE RESPONSIBLE AND LIABLE FOR ENSURING THAT ALL DEO EXISTING FACILITIES, ABOVE AND BELOW GROUND, REMAIN UNDAMAGED, ACCESSIBLE AND IN WORKING ORDER. THE CROSSING OF DEO'S PIPELINE WITH ANOTHER STEEL FACILITY MAY CREATE A POTENTIAL CORROSION ISSUE FOR THE PROPOSED FACILITY AND THE EXISTING DEO FACILITY. PLEASE CONTACT DOMINION'S CORROSION DEPARTMENT: DAVE CUTLIP (330-266-2121), RICK MCDONALD (330-266-2122), OR AL HUMRICHOUER (330-478-3757).

**ROADWAY**

**CONNECTION BETWEEN EXISTING AND PROPOSED GUARDRAIL**

WHEN IT IS NECESSARY TO SPLICE PROPOSED GUARDRAIL TO EXISTING GUARDRAIL, ONLY THE EXISTING GUARDRAIL SHALL BE CUT, DRILLED, OR PUNCHED. THE CONNECTION SHALL BE MADE USING A "W-BEAM RAIL SPLICE" AS SHOWN IN AASHTO M 180.

**ITEM 606 - ANCHOR ASSEMBLY, TYPE B**

THIS ITEM SHALL CONSIST OF FURNISHING AND INSTALLING ANY OF THE GUARDRAIL END TERMINALS FOR TYPE MGS GUARDRAIL AS LISTED ON ROADWAY ENGINEERING'S WEB PAGE UNDER ROADSIDE SAFETY DEVICES FOR APPROVED GUARDRAIL END TREATMENTS. INSTALLATION SHALL BE AT THE LOCATIONS SPECIFIED IN THE PLANS, IN ACCORDANCE WITH THE MANUFACTURER'S SPECIFICATIONS.

REFER TO THE MANUFACTURER'S INSTRUCTIONS REGARDING THE INSTALLATION OF, AND THE GRADING AROUND, THE FOUNDATION TUBES AND GROUND STRUT. THE TOP OF ANY FOUNDATION TUBE SHOULD BE LESS THAN 4 INCHES ABOVE THE GROUND. THE PLACEMENT OF THE FOUNDATION TUBES SHOULD BE AN APPROPRIATE DEPTH BELOW THE LEVEL LINE IN ORDER TO MAINTAIN THE FINISHED GUARDRAIL HEIGHT OF 31 INCHES FROM THE EDGE OF THE SHOULDER.

ON-SITE GRADING IS REQUIRED IF THE TOP OF THE FOUNDATION TUBES OR TOP OF THE GROUND STRUT DOES PROJECT MORE THAN 4 INCHES ABOVE THE GROUND LINE.

THE FACE OF THE TYPE B IMPACT HEAD SHALL BE COVERED WITH TYPE G REFLECTIVE SHEETING, PER CMS 730.19.

**PAVEMENT**

**CONTRACTION AND/OR EXPANSION JOINTS**

ALTHOUGH SPECIFIC LOCATIONS OF CERTAIN CONTRACTION AND EXPANSION JOINTS HAVE BEEN DETAILED ON THIS PLAN, NO WAIVER OF THE SPECIFICATIONS IS INTENDED. IN ALL CASES, THE PROVISION OF EXPANSION JOINTS AT ALL MAJOR STRUCTURES INCLUDING THE MAXIMUM SPACING BETWEEN CONTRACTION JOINTS IS IN ACCORDANCE WITH STANDARD CONSTRUCTION DRAWING BP-2.2 AND THE SPECIFICATIONS.

**CONTRACTION JOINTS IN CONCRETE PAVEMENT WIDENING**

WHERE NEW CONCRETE IS PLACED ADJACENT TO AND TIED TO EXISTING CONCRETE, THE CONTRACTION JOINT SPACING REQUIRED IN STANDARD CONSTRUCTION DRAWING BP-2.2 WILL BE WAIVED. CONSTRUCT CONTRACTION JOINTS IN THE NEW CONCRETE PAVEMENT TO FORM A CONTINUOUS LINE WITH ALL CONTRACTION JOINTS IN THE EXISTING CONCRETE PAVEMENT. INSTALL EXPANSION JOINTS IN THE NEW CONCRETE PAVEMENT TO FORM A CONTINUOUS LINE WITH ALL EXPANSION JOINTS IN THE EXISTING CONCRETE PAVEMENT.

**ITEM 448 - 1.25" ASPHALT CONCRETE SURFACE COURSE, TYPE 1, PG64-22, AS PER PLAN**

ONLY LIMESTONE OR GRANULATED SLAG (GS) SHALL BE PERMITTED FOR THIS ITEM. GRAVEL SHALL NOT BE PERMITTED. ALL OTHER REQUIREMENTS OF SECTIONS 448 AND 703.05 OF THE CONSTRUCTION AND MATERIAL SPECIFICATIONS SHALL STILL BE APPLICABLE.

CALCULATED  
MEP  
CHECKED  
FR

GENERAL NOTES

CUY - 480 - 11.60

11  
84

I:\Projects\18063\Roadway\Sheets\18063GN001.dgn 2/5/2015 10:26:58 AM michael\_j.thompson

**DRAINAGE**

**CROSSINGS AND CONNECTIONS TO EXISTING PIPES AND UTILITIES**

WHERE PLANS PROVIDE FOR A PROPOSED CONDUIT TO BE CONNECTED TO, OR CROSS OVER OR UNDER AN EXISTING SEWER OR UNDERGROUND UTILITY, THE CONTRACTOR SHALL LOCATE THE EXISTING PIPES OR UTILITIES BOTH AS TO LINE AND GRADE BEFORE STARTING TO LAY THE PROPOSED CONDUIT.

IF IT IS DETERMINED THAT THE ELEVATION OF THE EXISTING CONDUIT, OR EXISTING APPURTENANCE TO BE CONNECTED, DIFFERS FROM THE PLAN ELEVATION OR RESULTS IN A CHANGE IN THE PLAN CONDUIT SLOPE, THE ENGINEER SHALL BE NOTIFIED BEFORE STARTING CONSTRUCTION OF ANY PORTION OF THE PROPOSED CONDUIT WHICH WILL BE AFFECTED BY THE VARIANCE IN THE EXISTING ELEVATIONS.

IF IT IS DETERMINED THAT THE PROPOSED CONDUIT WILL INTERSECT AN EXISTING SEWER OR UNDERGROUND UTILITY IF CONSTRUCTED AS SHOWN ON THE PLAN, THE ENGINEER SHALL BE NOTIFIED BEFORE STARTING CONSTRUCTION OF ANY PORTION OF THE PROPOSED CONDUIT WHICH WOULD BE AFFECTED BY THE INTERFERENCE WITH AN EXISTING FACILITY.

**REVIEW OF DRAINAGE FACILITIES**

BEFORE ANY WORK IS STARTED ON THE PROJECT AND AGAIN BEFORE FINAL ACCEPTANCE BY THE STATE, REPRESENTATIVES OF THE STATE AND THE CONTRACTOR, ALONG WITH LOCAL REPRESENTATIVES, SHALL MAKE AN INSPECTION OF ALL EXISTING SEWERS WHICH ARE TO REMAIN IN SERVICE AND WHICH MAY BE AFFECTED BY THE WORK. THE CONDITION OF THE EXISTING CONDUITS AND THEIR APPURTENANCE SHALL BE DETERMINED FROM FIELD OBSERVATIONS. RECORDS OF THE INSPECTION SHALL BE KEPT IN WRITING BY THE STATE.

ALL NEW CONDUITS, INLETS, CATCH BASINS, AND MANHOLES CONSTRUCTED AS A PART OF THE PROJECT SHALL BE FREE OF ALL FOREIGN MATTER AND IN A CLEAN CONDITION BEFORE THE PROJECT WILL BE ACCEPTED BY THE STATE.

ALL EXISTING SEWERS INSPECTED INITIALLY BY THE ABOVE MENTIONED PARTIES SHALL BE MAINTAINED AND LEFT IN A CONDITION REASONABLY COMPARABLE TO THAT DETERMINED BY THE ORIGINAL INSPECTION. ANY CHANGE IN THE CONDITION RESULTING FROM THE CONTRACTOR'S OPERATIONS SHALL BE CORRECTED BY THE CONTRACTOR TO THE SATISFACTION OF THE ENGINEER.

**EXISTING UNDERDRAINS**

PROVIDE UNOBSTRUCTED OUTLETS FOR ALL EXISTING UNDERDRAINS ENCOUNTERED DURING CONSTRUCTION.

PROVIDE AN OUTLET PER STANDARD CONSTRUCTION DRAWING DM-1.1 FOR ALL UNDERDRAINS THAT OUTLET TO A SLOPE.

UNDERDRAINS THAT CAN BE CONNECTED TO THE NEW OR EXISTING UNDERDRAINS AT THE END OF THE PROJECT LIMITS AS WELL AS ALL NECESSARY BENDS OR BRANCHES REQUIRED FOR CONNECTION ARE INCLUDED IN THE BASIS OF PAYMENT FOR UNCLASSIFIED PIPE UNDERDRAINS.

**EROSION CONTROL**

**SEEDING AND MULCHING**

THE FOLLOWING ITEMS SHALL BE PROVIDED TO PROMOTE GROWTH AND CARE OF PERMANENT SEEDED AREAS:

- ITEM 659 - SOIL ANALYSIS TEST
- ITEM 659 - TOPSOIL
- ITEM 659 - SEEDING AND MULCHING
- ITEM 659 - REPAIR SEEDING AND MULCHING
- ITEM 659 - INTER-SEEDING
- ITEM 659 - COMMERCIAL FERTILIZER
- ITEM 659 - LIME
- ITEM 659 - WATER

SEEDING AND MULCHING SHALL BE APPLIED TO ALL AREAS OF EXPOSED SOIL BETWEEN THE RIGHT-OF-WAY LINES, AND WITHIN THE CONSTRUCTION LIMITS FOR AREAS OUTSIDE THE RIGHT-OF-WAY LINES COVERED BY WORK AGREEMENT OR SLOPE EASEMENT.

**POST CONSTRUCTION STORM WATER TREATMENT**

THIS PLAN UTILIZES VEGETATED FILTER STRIP BEST MANAGEMENT PRACTICES (BMP'S) FOR POST CONSTRUCTION STORM WATER TREATMENT.

**TRAFFIC CONTROL**

**ITEM 632 - SIGNAL SUPPORT, MECHANICAL DAMPER FOR TC-81.21 MAST ARM (GREATER THAN 59' IN LENGTH), AS PER PLAN**

THIS ITEM SHALL CONSIST OF THE CONTRACTOR INSTALLING A TUNED MECHANICAL STOCKBRIDGE OR MASS-SPRING TYPE DAMPER ON A TC-81.21 MAST ARM SIGNAL SUPPORT TO REDUCE THE POSSIBILITY OF HARMONIC VIBRATIONS CAUSED BY WIND LOADS. A MECHANICAL DAMPER SHALL BE APPLIED TO ALL MAST ARMS OVER 59 FEET IN LENGTH. THE INSTALLED DAMPER SHALL BE CAPABLE OF REDUCING THE LOADED MAXIMUM VERTICAL MOVEMENT AT THE TIP OF THE ARM TO 8 INCHES MEASURED FROM THE HIGHEST TO THE LOWEST POINT OF DEFLECTION AT WIND SPEEDS OF 5-20 MPH.

ALL ATTACHMENT HARDWARE CONNECTIONS SHALL BE STAINLESS STEEL. STOCKBRIDGE-TYPE DAMPERS SHALL HAVE A STAINLESS STEEL SAFETY CHAIN ANCHORED TO THE MAST ARM TO PREVENT WEIGHTS FROM FALLING SHOULD THEY BECOME SEPARATED FROM THE REST OF THE ASSEMBLY. THE DAMPER SHALL BE ATTACHED TO THE ARM WITHIN 8 FEET OF MAST ARM TIP. INSTALLATION SHALL BE PER THE MANUFACTURER'S GUIDELINES. STATIC DAMPERS SUCH AS HORIZONTAL FLAT SIGN MOUNTINGS SHALL NOT BE USED. ACCEPTABLE DEVICES INCLUDE THE FOLLOWING OR APPROVED EQUAL:

1. UNION METAL ALCOA DAMPER DEVICE - DWG. NO. 2G-1817-C1
2. VALMONT STRUCTURES ALCOA DEVICE - DWG. NO. OH104242P1
3. FLORIDA DOT SPRING-MASS DAMPER - DRAWING INDEX NO. 17749

**GEOTECHNICAL**

**SUBGRADE PREPARATIONS**

ALL EXPOSED SUBGRADES SHALL BE PROOF ROLLED IN ACCORDANCE WITH ODOT ITEM 204. AREAS THAT FAIL A PROOF ROLL SHALL BE IMPROVED BY UNDERCUT AND REPLACEMENT STABILIZATION METHODS. MINIMUM UNDERCUT DEPTH SHALL BE 14-INCHES. AN 8 OZ. NON-WOVEN GEOTEXTILE SHALL BE PLACED IN THE BOTTOM OF THE EXCAVATION PRIOR TO PLACEMENT OF REPLACEMENT MATERIALS. ALL REPLACEMENT MATERIALS SHALL MEET ODOT 703.16 SUBSECTION C, TYPE B GRANULAR MATERIALS. PLACEMENT OF GRANULAR MATERIALS SHALL BE IN ACCORDANCE WITH ODOT ITEM 203. UPON COMPLETION OF BACKFILLING, THE STABILIZED SUBGRADE SHALL BE PROOF ROLLED AGAIN, TO VERIFY THAT THE REPAIR WAS SUCCESSFUL.

I:\Projects\18063\Roadway\Sheets\18063GN002.dgn 2/5/2015 10:26:58 AM michael.j.\_thompson

CALCULATED  
MEP  
CHECKED  
FR

GENERAL NOTES

CUY - 480 - 11.60

12  
84



**ITEM 614 MAINTENANCE OF TRAFFIC**

**SEQUENCE OF OPERATIONS**

**PHASE 1: SHIFT TRAFFIC TO THE OUTSIDE SHOULDERS AND LANES ON ALL RAMPS.**

1. CONSTRUCT TEMPORARY PAVEMENT TO BE USED DURING PHASE 1.
2. CONSTRUCT THE LEFT LANES AND LEFT SHOULDERS OF RAMPS T-2 AND T-3.
3. CONSTRUCT THE LEFT LANE, SHOULDER AND RADIUS RETURN OF RAMP T-1.
4. REMOVE EX. CURB AND GUARDRAIL AND CONSTRUCT TEMPORARY PAVEMENT ALONG NORTH SIDE OF RAMP T-4.
5. MAINTAIN SIGNAL DETECTION BY THE USE OF TEMPORARY RADAR DETECTORS.
6. INSTALL THE GROUND MOUNTED "RAMP NARROWS" SIGNS WITH "11'0" PLAQUES AND PCMS BOARDS IN ADVANCE OF RAMP T-3 PRIOR TO NARROWING THE ROADWAY WIDTH BETWEEN BARRIERS AT STA. 204+50 AND 206+00.
7. CONSTRUCT PROPOSED SIGNALS TO BE USED THROUGHOUT CONSTRUCTION.

**PHASE 2: SHIFT TRAFFIC ONTO THE NEW PAVEMENT ON RAMPS T-1, T-2 AND T-3. SHIFT TRAFFIC TO NORTH SIDE OF RAMP T-4.**

1. CONSTRUCT THE RIGHT LANES AND RIGHT SHOULDERS OF RAMPS T-2 AND T-3.
2. CONSTRUCT THE RIGHT LANE, SHOULDER AND RADIUS RETURN OF RAMP T-1.
3. CONSTRUCT THE SOUTH SIDE OF RAMP T-4.
4. MAINTAIN SIGNAL DETECTION BY THE USE OF TEMPORARY RADAR DETECTORS.
5. MAINTAIN THE GROUND MOUNTED "RAMP NARROWS" SIGNS WITH "11'0" PLAQUES AND PCMS BOARDS IN ADVANCE OF RAMP T-3 PRIOR TO NARROWING THE ROADWAY WIDTH BETWEEN BARRIERS AT STA. 204+50 AND 206+00.

**PHASE 3: SHIFT TRAFFIC TO THE INSIDE LANES OF TIEDEMAN ROAD. SHIFT TRAFFIC ONTO THE NEW PAVEMENT ON RAMP T-4.**

1. CONSTRUCT THE FINAL TIE-IN PAVEMENT NEAR RAMPS T-2 AND T-3.
2. CONSTRUCT THE NORTH SIDE OF RAMP T-4.

**TIEDEMAN MEDIAN**

1. REMOVE AND REPLACE THE MEDIAN ON TIEDEMAN RD, AS PER PLAN. ALL EXCAVATED AREAS SHALL BE BACKFILLED OR PROTECTED AS PER MT-101.90.

**SEEDING, STRIPING, TRAFFIC SIGNAL DETECTION, FINAL CLEAN UP**

1. ANY WORK REQUIRING LANE CLOSURES SHALL TAKE PLACE DURING OFF PEAK PERIODS.

**PERMITTED LANE CLOSURES**

LANE CLOSURES ARE PERMITTED ONLY DURING THE TIME PERIODS SHOWN BELOW:

**I-480 EASTBOUND**

WEEKDAYS		WEEKENDS	
1 LANE CLOSED	2 LANES CLOSED	1 LANE CLOSED	2 LANES CLOSED
9AM-2PM	7:30PM-6AM	8PM FRI - 6AM MON	9PM FRI - 11AM SAT
7PM-6AM			8PM SAT - 12PM SUN
			8PM SUN - 6AM MON

**I-480 WESTBOUND**

WEEKDAYS		WEEKENDS	
1 LANE CLOSED	2 LANES CLOSED	1 LANE CLOSED	2 LANES CLOSED
9AM-3PM	7:30PM-6AM	8PM FRI - 6AM MON	9PM FRI - 11:30AM SAT
8PM-6AM			8PM SAT - 1PM SUN
			7PM SUN - 6AM MON

**RAMP T-2:**

ONE LANE OF TRAFFIC SHALL BE MAINTAINED AT ALL TIMES

ONE LANE MAY BE CLOSED BETWEEN STA 112+50 AND STA. 115+00 NEAR TIEDEMAN RD BETWEEN:  
8 PM TO 5 AM WEEK NIGHTS  
8 PM FRIDAY TO 5 AM MONDAY

**RAMP T-3:**

ONE LANE OF TRAFFIC SHALL BE MAINTAINED AT ALL TIMES

ONE RAMP LANE MAY BE CLOSED AT TIEDEMAN RD STA. 200+50 TO STA 203+50 BETWEEN:  
8 PM TO 5 AM WEEK NIGHTS  
8 PM FRIDAY TO 5 AM MONDAY

**RAMP T-1 AND RAMP T-4:**

ONE LANE OF TRAFFIC SHALL BE MAINTAINED AT ALL TIMES

**TIEDEMAN RD:**

BOTH THRU LANES SHALL BE OPEN TO TRAFFIC BETWEEN THE HOURS OF 5 AM AND 9 AM AND BETWEEN THE HOURS OF 3 PM AND 7 PM WEEKDAYS. ONE THRU LANE MAY BE CLOSED TO TRAFFIC AT OTHER TIMES.

ALL TURN LANES ON TIEDEMAN RD SHALL BE MAINTAINED.

**PAVEMENT MARKINGS AND DELINEATION**

EXISTING PAVEMENT MARKINGS IN CONFLICT WITH THE IMPLEMENTATION OF THE MOTP SHALL BE REMOVED IN ACCORDANCE WITH CMS 614.11G. TEMPORARY WORK ZONE STRIPING SHALL BE CLASS I PAINT EXCEPT ON NEW PERMANENT SURFACES. REMOVABLE TAPE SHALL BE USED ON NEW PERMANENT SURFACES.

**MAINTAINING TRAFFIC**

ALL TRAFFIC CONTROL DEVICES SHALL BE FURNISHED, ERECTED, MAINTAINED AND REMOVED BY THE CONTRACTOR IN ACCORDANCE WITH THE OHIO MANUAL OF UNIFORM TRAFFIC CONTROL DEVICES FOR STREETS AND HIGHWAYS (CURRENT EDITION). COPIES ARE AVAILABLE FROM THE OHIO DEPARTMENT OF TRANSPORTATION, OFFICE OF CONTRACTS, 1980 WEST BROAD STREET, COLUMBUS, OHIO 43216. NOTE: ALL DEVICES SHALL COMPLY, FOR CONDITION AND LOCATION, WITH THE CURRENT EDITION OF THE NCHRP 350 CRASH TESTING GUIDELINES AND WITH THE CRITERIA PUBLISHED IN QUALITY STANDARDS FOR TEMPORARY TRAFFIC CONTROL DEVICES AND ACCEPTABLE DELINEATION METHODS FOR VEHICLES, AVAILABLE ONLINE AT [http://www.dot.state.oh.us/Divisions/Engineering/Roadway/DesignStandards/Traffic/qualityguidelines/Documents/QualityStandards\\_October2010\\_101410.PDF](http://www.dot.state.oh.us/Divisions/Engineering/Roadway/DesignStandards/Traffic/qualityguidelines/Documents/QualityStandards_October2010_101410.PDF).

CONSTRUCTION OPERATIONS SHALL NOT BEGIN UNTIL ALL TRAFFIC CONTROL IS IN PLACE AND APPROVED BY ODOT OR MODIFIED AS DIRECTED BY THE TEMPORARY TRAFFIC CONTROL COORDINATOR OR THE PROJECT ENGINEER.

**ITEM 614, MAINTAINING TRAFFIC (AT ALL TIMES)**

THE MINIMUM NUMBER OF LANES OF TRAFFIC IN EACH DIRECTION, AS DESCRIBED ABOVE, SHALL BE MAINTAINED AT ALL TIMES BY USE OF THE EXISTING PAVEMENT, THE COMPLETED PAVEMENT, ITEM 502 STRUCTURE FOR MAINTAINING TRAFFIC, ITEM 615 PAVEMENT FOR MAINTAINING TRAFFIC, ITEM 615 ROADS FOR MAINTAINING TRAFFIC, AND TEMPORARY SURFACES USING ITEMS 410 AND 614.

**TRENCH FOR WIDENING**

TRENCH EXCAVATION FOR BASE WIDENING SHALL BE ONLY ON ONE SIDE OF THE PAVEMENT AT A TIME. THE OPEN TRENCH SHALL BE ADEQUATELY MAINTAINED AND PROTECTED WITH DRUMS OR BARRICADES AT ALL TIMES. PLACEMENT OF PROPOSED SUBBASE AND BASE MATERIAL SHALL FOLLOW AS CLOSELY AS POSSIBLE BEHIND EXCAVATION OPERATIONS. THE LENGTH OF WIDENING TRENCH WHICH IS OPEN AT ANY ONE TIME SHALL BE HELD TO A MINIMUM AND SHALL AT ALL TIMES BE SUBJECT TO APPROVAL OF THE ENGINEER.

**OVERNIGHT TRENCH CLOSING**

THE BASE WIDENING SHALL BE COMPLETED TO A DEPTH OF NO MORE THAN 3 INCHES BELOW THE EXISTING PAVEMENT BY THE END OF EACH WORK DAY. NO TRENCH SHALL BE LEFT OPEN OVERNIGHT EXCEPT FOR A SHORT LENGTH (25 FEET OR LESS) OF A WORK SECTION AT THE END OF THE TRENCH. IN CASE WORK MUST BE SUSPENDED BECAUSE OF INCLEMENT WEATHER OR OTHER REASONS, THE TRENCH FOR THE UNCOMPLETED BASE WIDENING SHALL BE BACKFILLED AT THE DIRECTION OF THE ENGINEER.

**DUST CONTROL**

THE CONTRACTOR SHALL FURNISH AND APPLY WATER FOR DUST CONTROL AS DIRECTED BY THE ENGINEER.

**EARTHWORK FOR MAINTAINING TRAFFIC**

WHEN UNDERCUTS ARE NECESSARY FOR MAINLINE PAVEMENT OR EMBANKMENT CONSTRUCTION, EVALUATE THE NEED FOR TEMPORARY ROAD UNDERCUTS IF WITHIN A CLOSE PROXIMITY TO THE MAINLINE UNDERCUTS. A GEOTECHNICAL EVALUATION SHOULD BE CONSIDERED TO DETERMINE IF THE EXISTING SOIL CONDITIONS ARE ADEQUATE TO SUPPORT THE TEMPORARY ROAD. ADDITIONAL SOIL BORINGS ALONG THE TEMPORARY ROAD ARE NOT NORMALLY REQUIRED.

**FLOODLIGHTING**

FLOODLIGHTING OF THE WORK SITE FOR OPERATIONS CONDUCTED DURING NIGHTTIME PERIODS SHALL BE ACCOMPLISHED SO THAT THE LIGHTS DO NOT CAUSE GLARE TO THE DRIVERS ON THE ROADWAY. TO ENSURE THE ADEQUACY OF THE FLOODLIGHT PLACEMENT, THE CONTRACTOR AND THE ENGINEER SHALL DRIVE THROUGH THE WORK SITE EACH NIGHT WHEN THE LIGHTING IS IN PLACE AND OPERATIVE PRIOR TO COMMENCING ANY WORK. IF GLARE IS DETECTED, THE LIGHT PLACEMENT AND SHIELDING SHALL BE ADJUSTED TO THE SATISFACTION OF THE ENGINEER BEFORE WORK PROCEEDS.

**ITEM 614, WORK ZONE IMPACT ATTENUATOR FOR 24" WIDE HAZARDS (UNIDIRECTIONAL)**

THIS ITEM SHALL CONSIST OF FURNISHING AND INSTALLING A NON-GATING IMPACT ATTENUATOR. FURNISH AN IMPACT ATTENUATOR FROM THE OFFICE OF ROADWAY ENGINEERING'S APPROVED LIST FOR WORK ZONE IMPACT ATTENUATORS, FROM THE ROADWAY STANDARD'S WEB PAGE FOR ROADWAY STANDARDS APPROVED PRODUCTS.

INSTALLATION SHALL BE AT THE LOCATIONS SPECIFIED IN THE PLANS IN ACCORDANCE WITH THE MANUFACTURER'S SPECIFICATIONS. THE CONTRACTOR SHALL REPAIR OR REPLACE A DAMAGED UNIT WITHIN 24 HOURS OF A DAMAGING IMPACT. WHEN BIDIRECTIONAL DESIGNS ARE SPECIFIED, THE CONTRACTOR SHALL SUPPLY APPROPRIATE TRANSITIONS. WHEN GATING IMPACT ATTENUATORS ARE DESIRED, THE CONTRACTOR SHALL SUBMIT DOCUMENTATION TO THE ENGINEER FOR ACCEPTANCE.

THE ADDITIONAL BARRIER REQUIRED FOR A GATING IMPACT ATTENUATOR SHALL BE INCLUDED IN WITH THE GATING IMPACT ATTENUATOR.

THE ABOVE WORK AND SHALL INCLUDE ALL LABOR, TOOLS, EQUIPMENT AND MATERIALS NECESSARY TO CONSTRUCT AND MAINTAIN A COMPLETE AND FUNCTIONAL IMPACT ATTENUATOR SYSTEM, INCLUDING ALL RELATED BACKUPS, TRANSITIONS, LEVELING PADS, HARDWARE AND GRADING, NOT SEPARATELY SPECIFIED, AS REQUIRED BY THE MANUFACTURER.

I:\Projects\18063\MOT\Sheets\94273MN001.dgn 2/5/2015 10:27:04 AM michael\_j.thompson

CALCULATED  
BLW  
CHECKED  
RAM

MAINTENANCE OF TRAFFIC GENERAL NOTES

CUY - 480 - 11.60

ITEM 614, WORK ZONE IMPACT ATTENUATOR FOR HAZARDS OVER 24" AND LESS THAN 36" WIDE (UNIDIRECTIONAL)

THIS ITEM SHALL CONSIST OF FURNISHING AND INSTALLING A NON-GATING IMPACT ATTENUATOR. FURNISH AN IMPACT ATTENUATOR FROM THE OFFICE OF ROADWAY ENGINEERING'S APPROVED LIST FOR WORK ZONE IMPACT ATTENUATORS, FROM THE ROADWAY STANDARD'S WEB PAGE FOR ROADWAY STANDARDS APPROVED PRODUCTS.

INSTALLATION SHALL BE AT THE LOCATIONS SPECIFIED IN THE PLANS, IN ACCORDANCE WITH THE MANUFACTURER'S SPECIFICATIONS. THE CONTRACTOR SHALL REPAIR OR REPLACE A DAMAGED UNIT WITHIN 24 HOURS OF A DAMAGING IMPACT.

WHEN BIDIRECTIONAL DESIGNS ARE SPECIFIED, THE CONTRACTOR SHALL SUPPLY APPROPRIATE TRANSITIONS.

THE WORK SHALL INCLUDE ALL LABOR, TOOLS, EQUIPMENT AND MATERIALS NECESSARY TO CONSTRUCT AND MAINTAIN A COMPLETE AND FUNCTIONAL IMPACT ATTENUATOR SYSTEM, INCLUDING ALL RELATED BACKUPS, TRANSITIONS, LEVELING PADS, HARDWARE AND GRADING, NOT SEPARATELY SPECIFIED, AS REQUIRED BY THE MANUFACTURER.

ITEM 614 - WORK ZONE RAISED PAVEMENT MARKER, AS PER PLAN

WORK ZONE RAISED PAVEMENT MARKERS, AS PER PLAN, AND THEIR INSTALLATION SHALL CONFORM TO C&MS 614 OR C&MS 621 AS SPECIFIED HEREIN.

RAISED PAVEMENT MARKERS IN USE DURING THE SNOW-PLOWING SEASON SHALL CONFORM TO 621.

RAISED PAVEMENT MARKERS IN USE DURING THE NON-SNOW-PLOW SEASON SHALL CONFORM TO EITHER 614 OR TO 621.

THE SNOW-PLOWING SEASON SHALL RUN FROM OCTOBER 15 THROUGH APRIL 1.

IF PROJECT DELAYS, NOT THE FAULT OF ODOT, CAUSE THE WORK TO EXTEND INTO THE SNOW-PLOWING SEASON, THE CONTRACTOR SHALL BE RESPONSIBLE FOR REPLACING WORK ZONE RAISED PAVEMENT MARKERS (WZRPMS) CONFORMING TO C&MS 614, WITH RAISED PAVEMENT MARKERS CONFORMING TO 621, AS DETERMINED BY THE ENGINEER, AT THE CONTRACTOR'S EXPENSE.

THIS ITEM SHALL INCLUDE PURCHASE, INSTALLATION AND REMOVAL OF ITEM 614 WORK ZONE RAISED PAVEMENT MARKER, AS PER PLAN, INCLUDING FILLING OF ANY DEPRESSIONS CREATED IN THE PAVEMENT AS PER C&MS 621.08.

RESURFACING OF THE TRANSITION AREAS SHALL BE PERFORMED AT THE TIME THAT THE SURFACE COURSE IS BEING APPLIED TO THE ENTIRE PROJECT. PRIOR TO APPLICATION OF THE SURFACE COURSE ON THE PROJECT, THE EXISTING PAVEMENT WITHIN THE TRANSITION AREA SHALL BE REMOVED TO A DEPTH NECESSARY TO REACH THE LEVEL OF THE INTERMEDIATE COURSE OF THE PAVEMENT, AS DETERMINED BY THE ENGINEER.

ITEM 614 - WORK ZONE RAISED PAVEMENT MARKERS ON CONCRETE SURFACES

RAISED PAVEMENT MARKERS IN WORK ZONES, INSTALLED ON TO CONCRETE SURFACES, SHALL BE ITEM 614 WORK ZONE RAISED PAVEMENT MARKERS. WZRPMS ARE INTENDED FOR USE ONLY DURING THE NONSNOW-PLOWING SEASON. WZRPMS SHALL NOT BE PROVIDED DURING THE SNOW-PLOWING SEASON.

THE SNOW-PLOWING SEASON SHALL RUN FROM OCTOBER 15 THROUGH APRIL 1.

WHERE A TEMPORARY ALIGNMENT WILL REMAIN IN USE THROUGH THE WINTER, THE WZRPMS SHALL BE REMOVED PRIOR TO THE BEGINNING OF THE SNOW-PLOWING SEASON AND REPLACED APPROXIMATELY APRIL 1, OR AS OTHERWISE DETERMINED BY THE ENGINEER.

THIS ITEM SHALL INCLUDE PURCHASE, INSTALLATION AND REMOVAL OF ITEM 614 WORK ZONE RAISED PAVEMENT MARKERS

DELINEATION OF PORTABLE AND PERMANENT BARRIER

BARRIER REFLECTORS AND OBJECT MARKERS SHALL BE INSTALLED ON ALL PORTABLE BARRIER (PB) USED FOR TRAFFIC CONTROL AND ON PERMANENT CONCRETE BARRIER (INCLUDING BRIDGE PARAPETS) LOCATED WITHIN 5 FEET OF THE EDGE OF THE ADJACENT TRAVEL LANE.

BARRIER REFLECTORS SHALL CONFORM TO C&MS 626, EXCEPT THAT THE SPACING SHALL BE AS PER TRAFFIC SCD MT-101.70. OBJECT MARKERS AND THEIR INSTALLATION SHALL CONFORM TO C&MS 614.03 AND SCD MT-101.70. WHEN THE PB CONTAINS GLARE SCREEN, ONE SET OF THREE VERTICAL STRIPES OF SHEETING SHALL BE CONSIDERED EQUIVALENT TO AN OBJECT MARKER, ONE-WAY.

DELINEATION OF TEMPORARY AND PERMANENT GUARDRAIL

BARRIER REFLECTORS SHALL BE INSTALLED ON ALL TEMPORARY GUARDRAIL USED FOR TRAFFIC CONTROL AND ON ALL PERMANENT GUARDRAIL LOCATED WITHIN 5 FEET OF THE EDGE OF THE ADJACENT TRAVEL LANE. BARRIER REFLECTORS SHALL CONFORM TO C&MS 626.

OBJECT MARKERS SHALL BE INSTALLED ON ALL TEMPORARY AND PERMANENT GUARDRAIL LOCATED WITHIN 5 FEET OF THE EDGE OF THE ADJACENT TRAVEL LANE. GUARDRAIL-MOUNTING OF OBJECT MARKERS SHALL BE MADE BY INSTALLING THE OBJECT MARKERS ON THE EXTENSION BLOCKS RATHER THAN DIRECTLY ONTO THE GUARDRAIL ITSELF. OBJECT MARKERS SHALL CONFORM TO C&MS 614.03 AND THE SPACING SHALL BE APPROXIMATELY 50 FEET.

ITEM 614 PORTABLE CHANGEABLE MESSAGE SIGNS, AS PER PLAN

THE CONTRACTOR SHALL FURNISH, INSTALL, MAINTAIN AND REMOVE, WHEN NO LONGER NEEDED, A CHANGEABLE MESSAGE SIGN. THE SIGN SHALL BE OF A TYPE SHOWN ON A LIST OF APPROVED PCMS UNITS AVAILABLE ON THE OFFICE OF MATERIALS MANAGEMENT WEB PAGE. THE LIST CONTAINS CLASS A AND B UNITS WITH MINIMUM LEGIBILITY DISTANCES OF 650 FEET AND 475 FEET, RESPECTIVELY.

EACH SIGN SHALL BE TRAILER-MOUNTED AND EQUIPPED WITH A FUNCTIONAL DIMMING MECHANISM, TO DIM THE SIGN DURING DARKNESS, AND A TAMPER AND VANDAL PROOF ENCLOSURE. EACH SIGN SHALL BE PROVIDED WITH APPROPRIATE TRAINING AND OPERATION INSTRUCTIONS TO ENABLE ON-SITE PERSONNEL TO OPERATE AND TROUBLESHOOT THE UNIT. THE SIGN SHALL ALSO BE CAPABLE OF BEING POWERED BY AN ELECTRICAL SERVICE DROP FROM A LOCAL UTILITY COMPANY. PCMS TRAILERS SHALL BE DELINEATED ON A PERMANENT BASIS BY AFFIXING CONSPICUITY TAPE CONFORMING TO CMS 614.03, IN A CONTINUOUS LINE ON THE FACE OF THE TRAILER AS SEEN BY ONCOMING ROAD USERS.

PLACEMENT, OPERATION, MAINTENANCE AND ALL ACTIVATION OF THE SIGNS BY THE CONTRACTOR SHALL BE AS DIRECTED BY THE ENGINEER. THE PCMS SHALL BE LOCATED IN A HIGHLY VISIBLE POSITION YET PROTECTED FROM TRAFFIC. THE CONTRACTOR SHALL, AT THE DIRECTION OF THE ENGINEER, RELOCATE THE PCMS TO IMPROVE VISIBILITY OR ACCOMMODATE CHANGED CONDITIONS. WHEN NOT IN USE, THE PCMS SHALL BE TURNED OFF. ADDITIONALLY, WHEN NOT IN USE FOR EXTENDED PERIODS OF TIME, THE PCMS SHALL BE TURNED, FACING AWAY FROM ALL TRAFFIC, AND SHALL DISPLAY ONE OR MORE TYPE G YELLOW RETROREFLECTIVE SHEETING SURFACES OF 9-INCH BY 15-INCH MINIMUM SIZE FACING TRAFFIC.

THE ENGINEER SHALL BE PROVIDED ACCESS TO EACH SIGN UNIT AND SHALL BE PROVIDED WITH APPROPRIATE TRAINING AND OPERATION INSTRUCTIONS TO ENABLE ODOT PERSONNEL TO OPERATE AND TROUBLESHOOT THE UNIT, AND TO REVISE SIGN MESSAGES, IF NECESSARY. THE CONTRACTOR SHALL IMPLEMENT A SYSTEM WHEREBY CHANGEABLE MESSAGES WILL BE IMPLEMENTED WITHIN ONE HOUR FOLLOWING TELEPHONE NOTIFICATION FROM THE PROJECT ENGINEER TO A DESIGNATED PHONE.

ALL MESSAGES TO BE DISPLAYED ON THE SIGN WILL BE PROVIDED BY THE ENGINEER. A LIST OF ALL REQUIRED PRE-PROGRAMMED MESSAGES WILL BE GIVEN TO THE CONTRACTOR AT THE PROJECT PRECONSTRUCTION CONFERENCE. THE SIGN SHALL HAVE THE CAPABILITY TO STORE UP TO 99 MESSAGES. MESSAGE MEMORY OR PRE-PROGRAMMED DISPLAYS SHALL NOT BE LOST AS A RESULT OF POWER FAILURES TO THE ON-BOARD COMPUTER. THE SIGN LEGEND SHALL BE CAPABLE OF BEING CHANGED IN THE FIELD. THREE-LINE PRESENTATION FORMATS WITH UP TO SIX MESSAGE PHASES SHALL BE SUPPORTED. PCMS FORMAT SHALL PERMIT THE COMPLETE MESSAGE FOR EACH PHASE TO BE READ AT LEAST TWICE.

ITEM 614 PORTABLE CHANGEABLE MESSAGE SIGNS, AS PER PLAN CONT'D

THE PCMS SHALL CONTAIN AN ACCURATE CLOCK AND PROGRAMMING LOGIC WHICH WILL ALLOW THE SIGN TO BE ACTIVATED, DEACTIVATED OR MESSAGES CHANGED AUTOMATICALLY AT DIFFERENT TIMES OF THE DAY FOR DIFFERENT DAYS OF THE WEEK.

ALL PCMS UNITS SHALL BE EQUIPPED WITH A RADAR EMULATOR OR A RADAR DEVICE. A RADAR EMULATOR SENDS OUT A SIGNAL THAT ACTIVATES RADAR DETECTORS. THE DEVICE MUST BE APPROVED BY THE F.C.C. THE RADAR EMULATOR SHALL USE THE SAME POWER SUPPLY AS THE PCMS. THE RADAR SHALL BE ABLE TO BE ACTIVATED REGARDLESS OF WHETHER THE PCMS IS RUNNING OR NOT. THE DEVICE SHALL HAVE AN EFFECTIVE RANGE NOT TO EXCEED ONE HALF MILE.

THE RADAR EMULATOR MAY BE PURCHASED FROM ONE OF THE FOLLOWING COMPANIES:

Triplex Group  
<http://www.triplexgroup.com/safety%20beam.htm>

Speed Measurement Laboratories, Inc.  
[http://www.speedlabs.com/radar\\_drones.html](http://www.speedlabs.com/radar_drones.html)

Traffic Safety Technologies  
<http://www.traffic-safety-technologies.com/drones.htm>

THE PCMS UNIT SHALL BE MAINTAINED IN GOOD WORKING ORDER BY THE CONTRACTOR IN ACCORDANCE WITH THE PROVISIONS OF CMS 614.07. THE CONTRACTOR SHALL, PRIOR TO ACTIVATING THE UNIT, MAKE ARRANGEMENTS, WITH AN AUTHORIZED SERVICE AGENT FOR THE PCMS, TO ASSURE PROMPT SERVICE IN THE EVENT OF FAILURE. ANY FAILURE SHALL NOT RESULT IN THE SIGN BEING OUT OF SERVICE FOR MORE THAN 12 HOURS, INCLUDING WEEKENDS. FAILURE TO COMPLY MAY RESULT IN AN ORDER TO STOP WORK AND OPEN ALL TRAFFIC LANES AND/OR IN THE DEPARTMENT TAKING APPROPRIATE ACTION TO SAFELY CONTROL TRAFFIC. THE ENTIRE COST TO CONTROL TRAFFIC, ACCRUED BY THE DEPARTMENT DUE TO THE CONTRACTOR'S NONCOMPLIANCE, WILL BE DEDUCTED FROM MONEYS DUE, OR TO BECOME DUE THE CONTRACTOR ON HIS OR HER CONTRACT.

THE CONTRACTOR SHALL BE RESPONSIBLE FOR 24-HOUR-PER-DAY OPERATION AND MAINTENANCE OF THESE SIGNS ON THE PROJECT FOR THE DURATION OF THE PHASES WHEN THE PLAN REQUIRES THEIR USE. PAYMENT FOR THE ABOVE DESCRIBED ITEM SHALL BE AT THE CONTRACT UNIT PRICE. PAYMENT SHALL INCLUDE ALL LABOR, MATERIALS, EQUIPMENT, FUELS, LUBRICATING OILS, SOFTWARE, HARDWARE AND INCIDENTALS TO PERFORM THE ABOVE DESCRIBED WORK. THERE SHALL BE A TOTAL OF 4 PCMS TO BE USED TO INFORM MOTORISTS OF WORK ON RAMP.

ITEM 614, MAINTAINING TRAFFIC

ALL WORK AND TRAFFIC CONTROL DEVICES SHALL BE IN ACCORDANCE WITH CMS 614 AND OTHER APPLICABLE PORTIONS OF THE SPECIFICATIONS, AS WELL AS THE OHIO MANUAL OF UNIFORM TRAFFIC CONTROL DEVICES.

CALCULATED  
BLW  
CHECKED  
RAM

MAINTENANCE OF TRAFFIC GENERAL NOTES

CUY - 480 - 11.60

I:\Projects\18063\WOT\Sheets\94273\MN002.dgn 2/5/2015 10:27:04 AM michael.j.thompson

ITEM 614 - MAINTAINING TRAFFIC (LANES OPEN DURING HOLIDAYS OR SPECIAL EVENTS)

NO WORK SHALL BE PERFORMED AND ALL EXISTING LANES SHALL BE OPEN TO TRAFFIC DURING THE FOLLOWING DESIGNATED HOLIDAYS OR EVENTS:

NEW YEARS                      EASTER  
 MEMORIAL DAY                FOURTH OF JULY  
 LABOR DAY                      THANKSGIVING  
 CHRISTMAS

THE PERIOD OF TIME THAT THE LANES ARE TO BE OPEN DEPENDS ON THE DAY OF THE WEEK ON WHICH THE HOLIDAY OR EVENT FALLS. THE FOLLOWING SCHEDULE SHALL BE USED TO DETERMINE THIS PERIOD:

DAY OF HOLIDAY/EVENT TIME ALL LANES MUST BE OPEN TO TRAFFIC

SUNDAY                            6:00 AM FRI - 7:00 PM MON  
 MONDAY                           6:00 AM FRI - 7:00 PM TUE  
 TUESDAY                         6:00 AM MON - 7:00 PM WED  
 WEDNESDAY                    6:00 AM TUE - 7:00 PM THU  
 THURSDAY                       6:00 AM WED - 7:00 PM FRI  
 THURSDAY (THANKSGIVING) 6:00 AM TUE - 7:00 PM MON  
 FRIDAY                            6:00 AM THU - 7:00 PM MON  
 SATURDAY                        6:00 AM FRI - 7:00 PM MON

ITEM 614 - LAW ENFORCEMENT OFFICER (WITH PATROL CAR) FOR ENFORCEMENT IN WORK ZONES

WHEN LAW ENFORCEMENT OFFICERS (LEOS) ARE USED AS A SPEED CONTROL MEASURE IN STATIONARY WORK ZONES, THEY SHALL BE USED AS SHOWN IN THESE PLANS. LEOS CAN BE USED IN THE FORM OF:

STATIONARY PATROL CAR, CIRCULATING PATROL CAR, AND/OR AIR ENFORCEMENT IN COMBINATION WITH GROUND PATROL CAR.

THE LEO WORKS AT THE DIRECTION OF THE CONTRACTOR. THE CONTRACTOR IS RESPONSIBLE FOR ARRANGING THE SERVICES OF THE LEO WITH AN OFFICIAL PATROL CAR (CAR WITH TOP-MOUNTED EMERGENCY FLASHING LIGHTS AND COMPLETE MARKINGS OF THE APPROPRIATE LAW ENFORCEMENT AGENCY). THE CONTRACTOR SHOULD SCHEDULE THE LEO A MINIMUM OF ONE WEEK IN ADVANCE AND SHALL INCLUDE ANY MINIMUM SHOW-UP TIME REQUIRED BY THE LAW ENFORCEMENT AGENCY INVOLVED. THE ENGINEER SHALL RESOLVE ANY ISSUES THAT MAY ARISE BETWEEN THE TWO PARTIES.

ITEM 614 - LAW ENFORCEMENT OFFICER (WITH PATROL CAR) FOR ENFORCEMENT IN WORK ZONES CONT'D

THE LEO SHALL REPORT TO THE CONTRACTOR PRIOR TO THE START OF THE SHIFT, IN ORDER TO RECEIVE INSTRUCTIONS REGARDING SPECIFIC WORK ASSIGNMENTS AS SHOWN IN THE PLANS. THE LEO IS EXPECTED TO STAY AT THE PROJECT SITE FOR THE ENTIRE DURATION OF HIS/HER SHIFT. THE LEO SHALL REPORT TO THE CONTRACTOR AT THE END OF HIS/HER SHIFT. SHOULD IT BE NECESSARY TO LEAVE THE PROJECT SITE, THE LEO SHALL NOTIFY THE ENGINEER. THE CONTRACTOR SHALL PROVIDE THE LEO WITH A TWO-WAY COMMUNICATIONS DEVICE WHICH SHALL BE RETURNED TO THE CONTRACTOR AT THE END OF HIS/HER SHIFT. A MEETING WITH DISTRICT PERSONNEL, CENTRAL OFFICE PERSONNEL, WORK ZONE TRAFFIC SUPERVISOR (IF APPLICABLE) AND APPROPRIATE LAW ENFORCEMENT AGENCIES SHALL TAKE PLACE PRIOR TO THE BEGINNING OF THE PROJECT. WORK ZONE SAFETY AND MOBILITY TRAINING SPECIFIC TO THE PROJECT WILL TAKE PLACE AT THIS TIME ALONG WITH DISTRIBUTION OF PRE-WORK ZONE CRASH ANALYSES. DURING THIS MEETING, DUTIES AND RESPONSIBILITIES OF THE LEO WILL BE DISCUSSED.

LAW ENFORCEMENT OFFICERS (LEOS) FOR ASSISTANCE

LEOS WITHOUT PATROL CARS SHALL BE REQUIRED FOR THE FOLLOWING SITUATIONS:

LEOS SHALL BE PROVIDED AT A TRAFFIC SIGNAL WHEN IMPACTING THE NORMAL FUNCTION OF THE SIGNAL OR THE FLOW OF TRAFFIC, OR WHEN TRAFFIC NEEDS TO BE DIRECTED THROUGH AN ENERGIZED TRAFFIC SIGNAL CONTRARY TO THE SIGNAL DISPLAY (E.G. DIRECTING MOTORISTS THROUGH A RED LIGHT). LEOS SHALL NOT BE USED WHERE THE OMTCD INTENDS THAT FLAGGERS BE USED.

LEOS SHALL BE USED DURING CONSTRUCTION OPERATIONS AT AND WITHIN 150 FEET OF SIGNALIZED INTERSECTIONS.

TRAFFIC CONTROL DEVICES QUALITY

THE DBT SHALL PROVIDE, ERECT, AND MAINTAIN DRUMS, SIGNS, BARRIERS, AND OTHER TRAFFIC CONTROL DEVICES USED FOR MAINTENANCE OF TRAFFIC IN ACCEPTABLE CONDITION, IN ACCORDANCE WITH ODOT'S QUALITY GUIDELINES FOR TEMPORARY TRAFFIC CONTROL DEVICES.

CONSTRUCTION EQUIPMENT & MATERIALS

CONSTRUCTION VEHICLES USED BY THE DBT AND TRUCK TRAFFIC REQUIRED BY THE DBT SHALL COMPLY WITH ANY AND ALL LOAD RESTRICTIONS AND VEHICLE DELINEATION REQUIREMENTS. AS PER CMS 614.03, CONTRACTOR EQUIPMENT AND MATERIALS SHALL ALWAYS BE STORED IN LOCATIONS THAT DO NOT POSE A SAFETY RISK TO THE TRAVELING PUBLIC.

NOTIFICATION AND COORDINATION

MOT PHASE CHANGES: NOTIFICATION & COORDINATION REQUIREMENTS AT LEAST FOURTEEN (14) DAYS PRIOR TO ANY CONSTRUCTION ACTIVITIES, THE CONTRACTOR SHALL ADVISE THE DISTRICT OFFICE OF COMMUNICATIONS VIA EMAIL AT AMANDA.LEE@DOT.STATE.OH.US AND THE DISTRICT WORK ZONE TRAFFIC MANAGER VIA EMAIL AT DENNIS.ONEIL@DOT.STATE.OH.US AND THE CITY OF BROOKLYN'S EMERGENCY SERVICES, SCHOOL DISTRICT AND ADJACENT RESIDENTS AND BUSINESSES ON TIEDEMAN RD. OF THE ANTICIPATED START DATE OF ANY CONSTRUCTION ACTIVITIES, INCLUDING BUT NOT LIMITED TO THE PLACING OF WORK ZONE SIGNS. THE NOTIFICATION SHALL ALSO INCLUDE THE PROJECT NUMBER, PID, NAME AND PHONE NUMBER OF THE CONTRACTOR, A POINT OF CONTACT AND THE ANTICIPATED IMPACT ON TRAFFIC. THE CONTRACTOR SHALL IMMEDIATELY INFORM THE DISTRICT OFFICE OF COMMUNICATIONS AND THE DISTRICT WORK ZONE TRAFFIC MANAGER OF ANY AND ALL DELAYS AND/OR CHANGES REGARDING THE CONSTRUCTION INITIATION DATE.

THROUGHOUT THE DURATION OF THE PROJECT, THE CONTRACTOR SHALL NOTIFY THE PROJECT ENGINEER AND THE OTHERS LISTED IN THIS SECTION IN WRITING OF ALL TRAFFIC RESTRICTIONS AND UPCOMING MAINTENANCE OF TRAFFIC CHANGES. THE CONTRACTOR SHALL ENSURE THE WRITTEN NOTIFICATION IS SUBMITTED IN A TIMELY MANNER TO ALLOW THE PROJECT ENGINEER TO MEET THE REQUIRED TIME FRAMES SET FORTH IN THE TABLE BELOW. THIS NOTIFICATION SHALL BE RECEIVED BY THE PROJECT ENGINEER PRIOR TO THE PHYSICAL SETUP OF ANY APPLICABLE SIGNS OR MESSAGE BOARDS.

INFORMATION SHALL INCLUDE BUT IS NOT LIMITED TO ALL CONSTRUCTION ACTIVITIES THAT IMPACT OR INTERFERE WITH TRAFFIC AND SHALL LIST THE SPECIFIC LOCATION, TYPE OF WORK, ROAD STATUS, DATE AND TIME OF RESTRICTION, DURATION OF RESTRICTION, NUMBER OF LANES MAINTAINED, DETOUR ROUTES IF APPLICABLE, AND ANY OTHER INFORMATION REQUESTED BY THE PROJECT ENGINEER AND THE DISTRICT 12 COMMUNICATIONS OFFICE. A SUMMARY OF THE NOTIFICATION TIME FRAME REQUIREMENTS FOR CLOSURES AND RESTRICTIONS IS PROVIDED IN THE NOTIFICATION TIME FRAME TABLE BELOW.

NOTIFICATION TIME FRAME TABLE

ITEM	DURATION OF CLOSURE	NOTIFICATION TIME FRAME
LANE CLOSURES/RESTRICTIONS	GREATER THAN 2 WEEKS	7 BUSINESS DAYS PRIOR TO CLOSURE
	2 WEEKS OR LESS	2 BUSINESS DAYS PRIOR TO CLOSURE

NOTIFICATION AND COORDINATION CONT'D

ANY UNFORESEEN CONDITIONS NOT SPECIFIED IN THE PLANS REQUIRING TRAFFIC RESTRICTIONS SHALL ALSO BE REPORTED TO THE PROJECT ENGINEER, THE DISTRICT 12 COMMUNICATIONS OFFICE, AND THE DISTRICT WORK ZONE TRAFFIC MANAGER USING THE NOTIFICATION TIME FRAME TABLE.

POINTS OF CONTACT:

ODOT DISTRICT 12 COMMUNICATIONS OFFICE  
 AMANDA MCFARLAND  
 (216) 584-2005  
 Amanda.McFarland@dot.state.oh.us

ODOT DISTRICT 12, DISTRICT 12 WORK ZONE TRAFFIC MANAGER  
 DENNIS O'NEIL  
 (216) 584-2204  
 Dennis.ONeil@dot.state.oh.us

CITY OF BROOKLYN  
 DIRECTOR OF PUBLIC SERVICE  
 JOHN VERBA, JR.  
 (216) 635-4219

CITY OF BROOKLYN  
 CITY ENGINEER  
 DOUGLAS COURTNEY, P.E.  
 (440) 449-4005 EXT. 5745

CITY OF BROOKLYN  
 CHIEF OF POLICE  
 SCOTT MIELKE  
 (216) 749-1234

CITY OF BROOKLYN  
 FIRE CHIEF  
 JOE ZEMEK  
 (216) 635-4226




I:\Projects\18063\MOT\Sheets\94273\MN003.dgn 2/5/2015 10:27:06 AM michael\_j.\_thompson



CALCULATED  
 BLW  
 CHECKED  
 RAM

MAINTENANCE OF TRAFFIC GENERAL NOTES

CUY - 480 - 11.60




**PAVEMENT LEGEND**





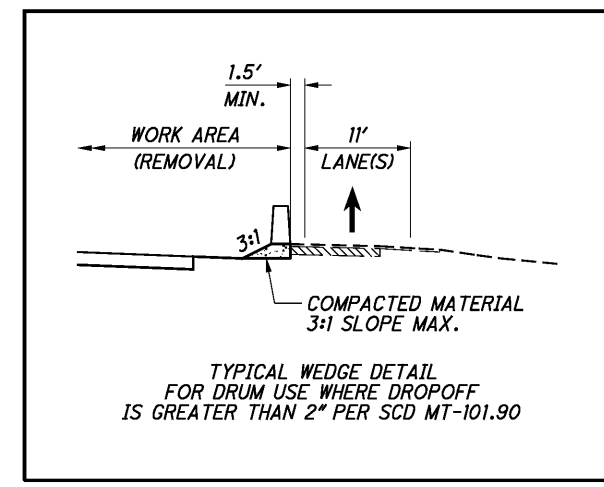
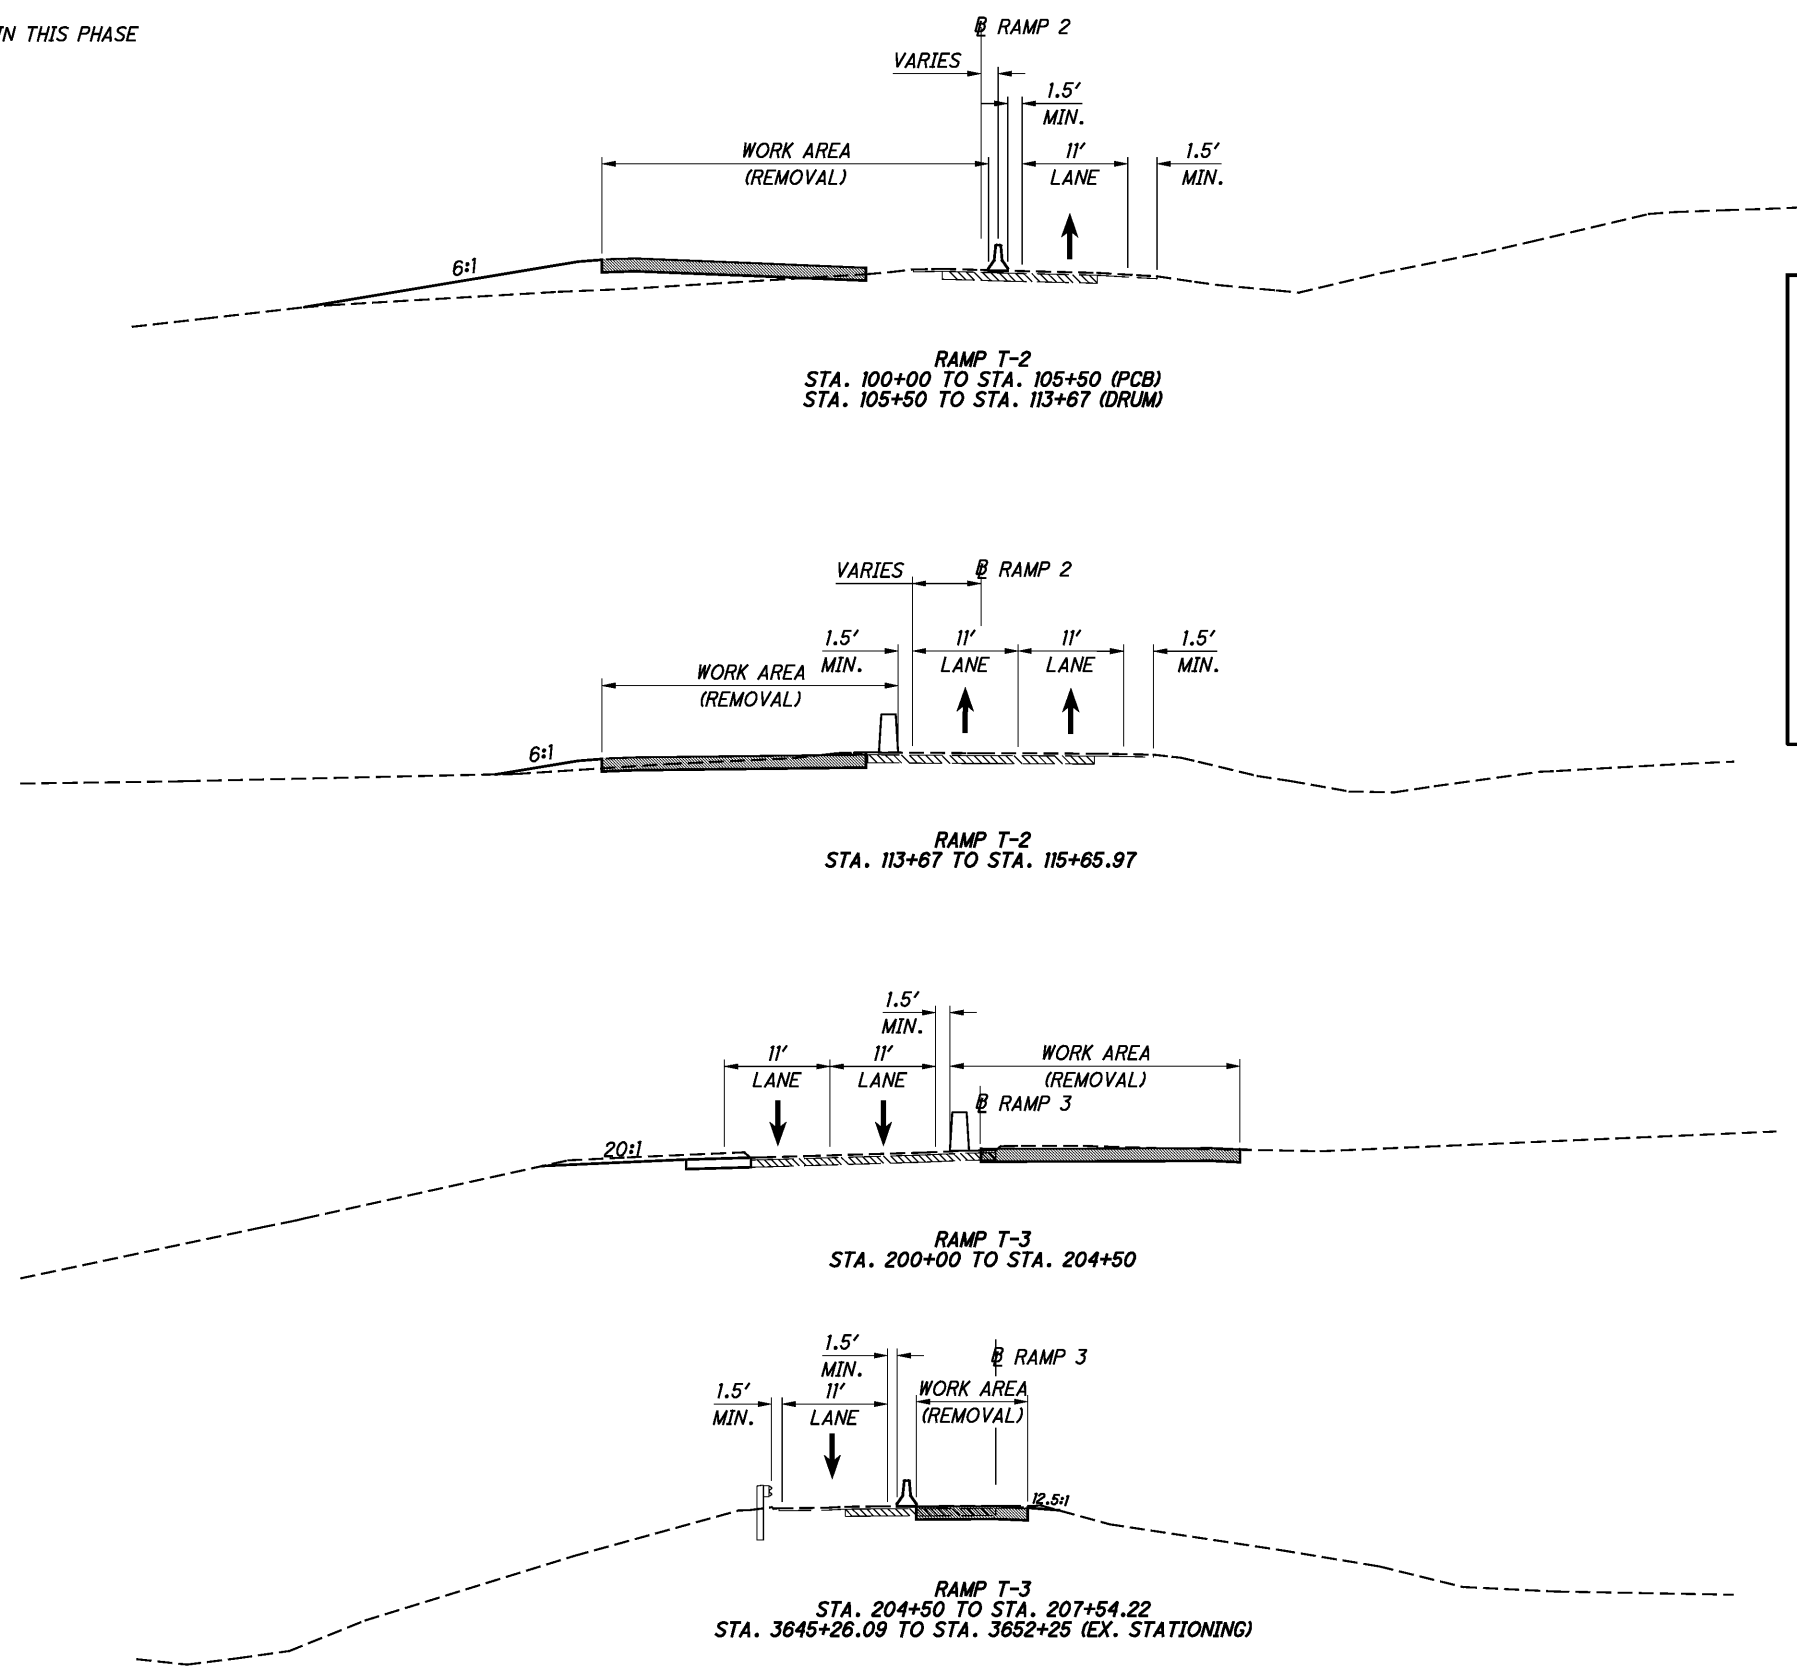
-  EXISTING PAVEMENT
-  PAVEMENT CONSTRUCTED IN THIS PHASE
-  COMPLETED PAVEMENT





I:\Projects\18063\MOT\Sheets\94273MY101.dgn 2/5/2015 10:27:13 AM michael.j.thompson

**PAVEMENT LEGEND**

-  EXISTING PAVEMENT
-  PAVEMENT CONSTRUCTED IN THIS PHASE
-  COMPLETED PAVEMENT

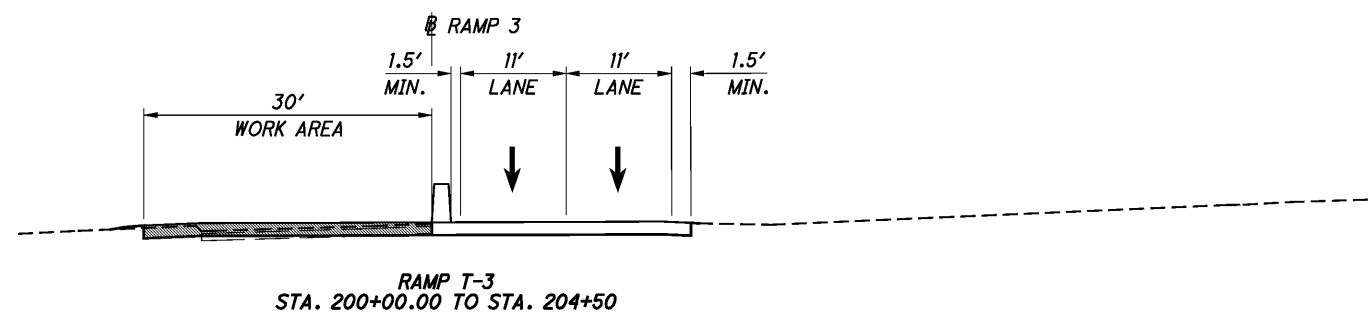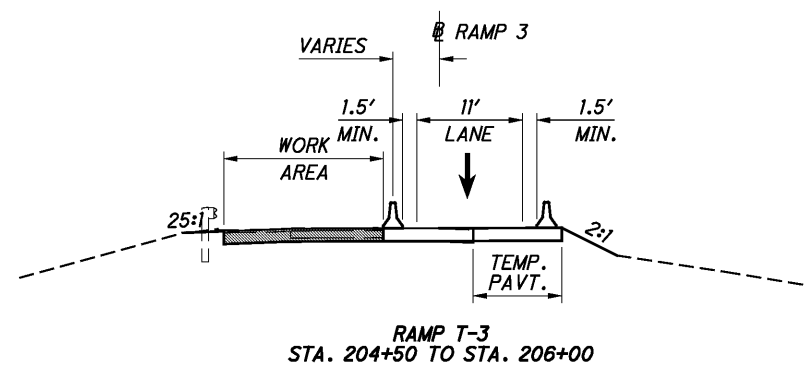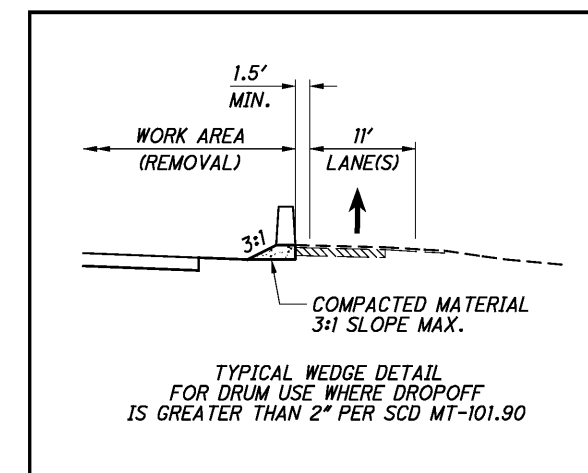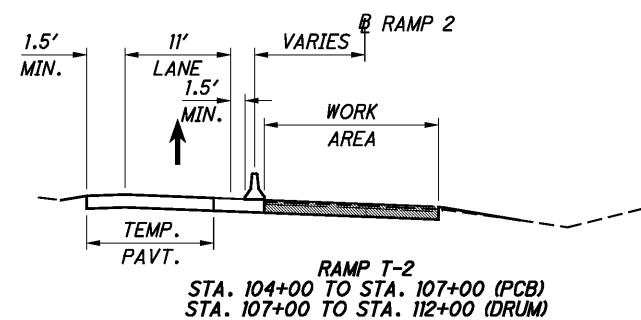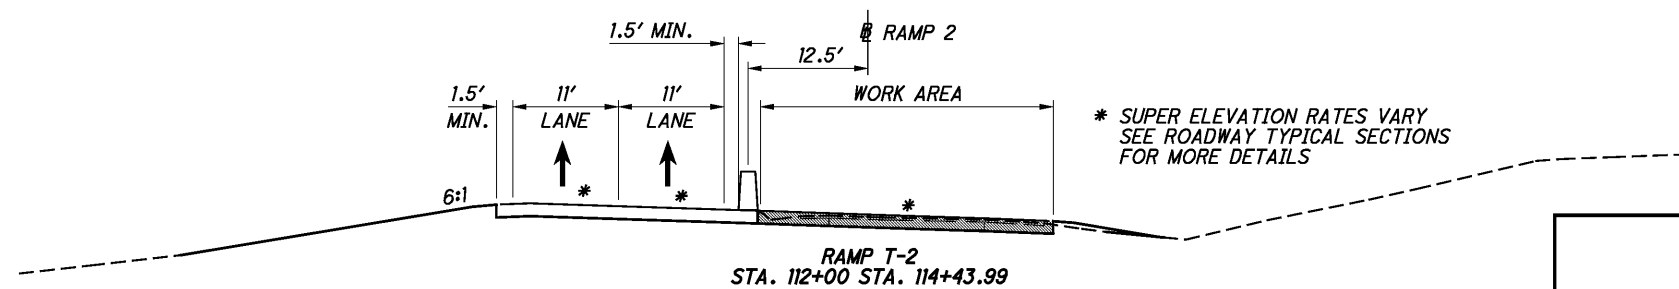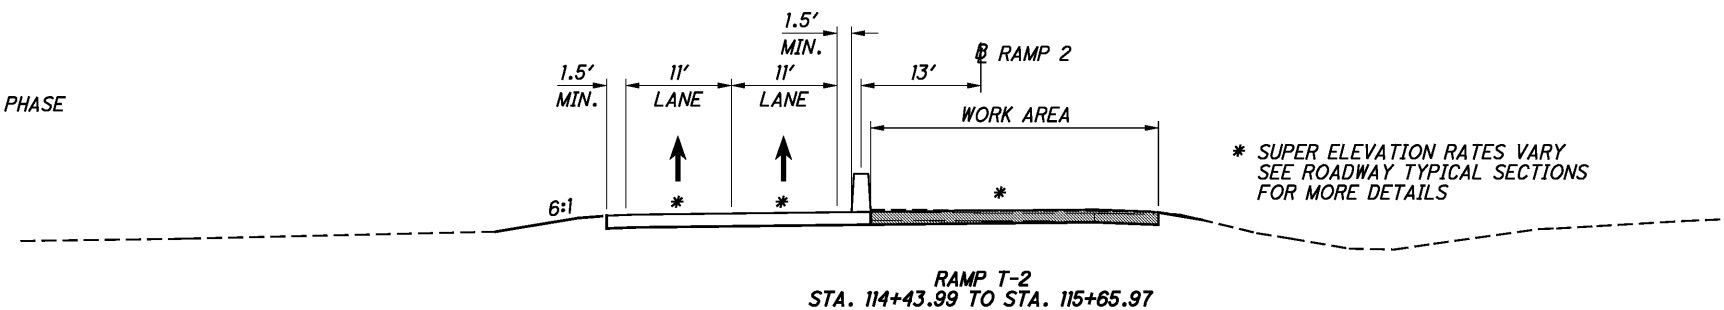


I:\Projects\18063\MOT\Sheets\94273MP001.dgn 2/5/2015 10:28:26 AM michael\_j\_thompson

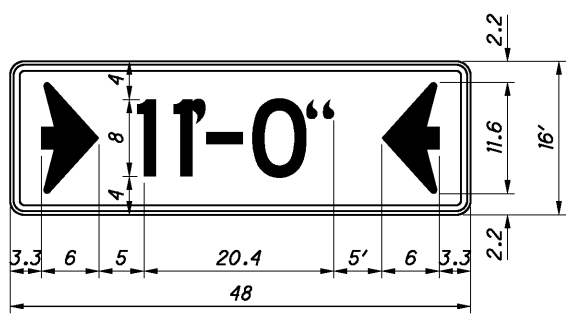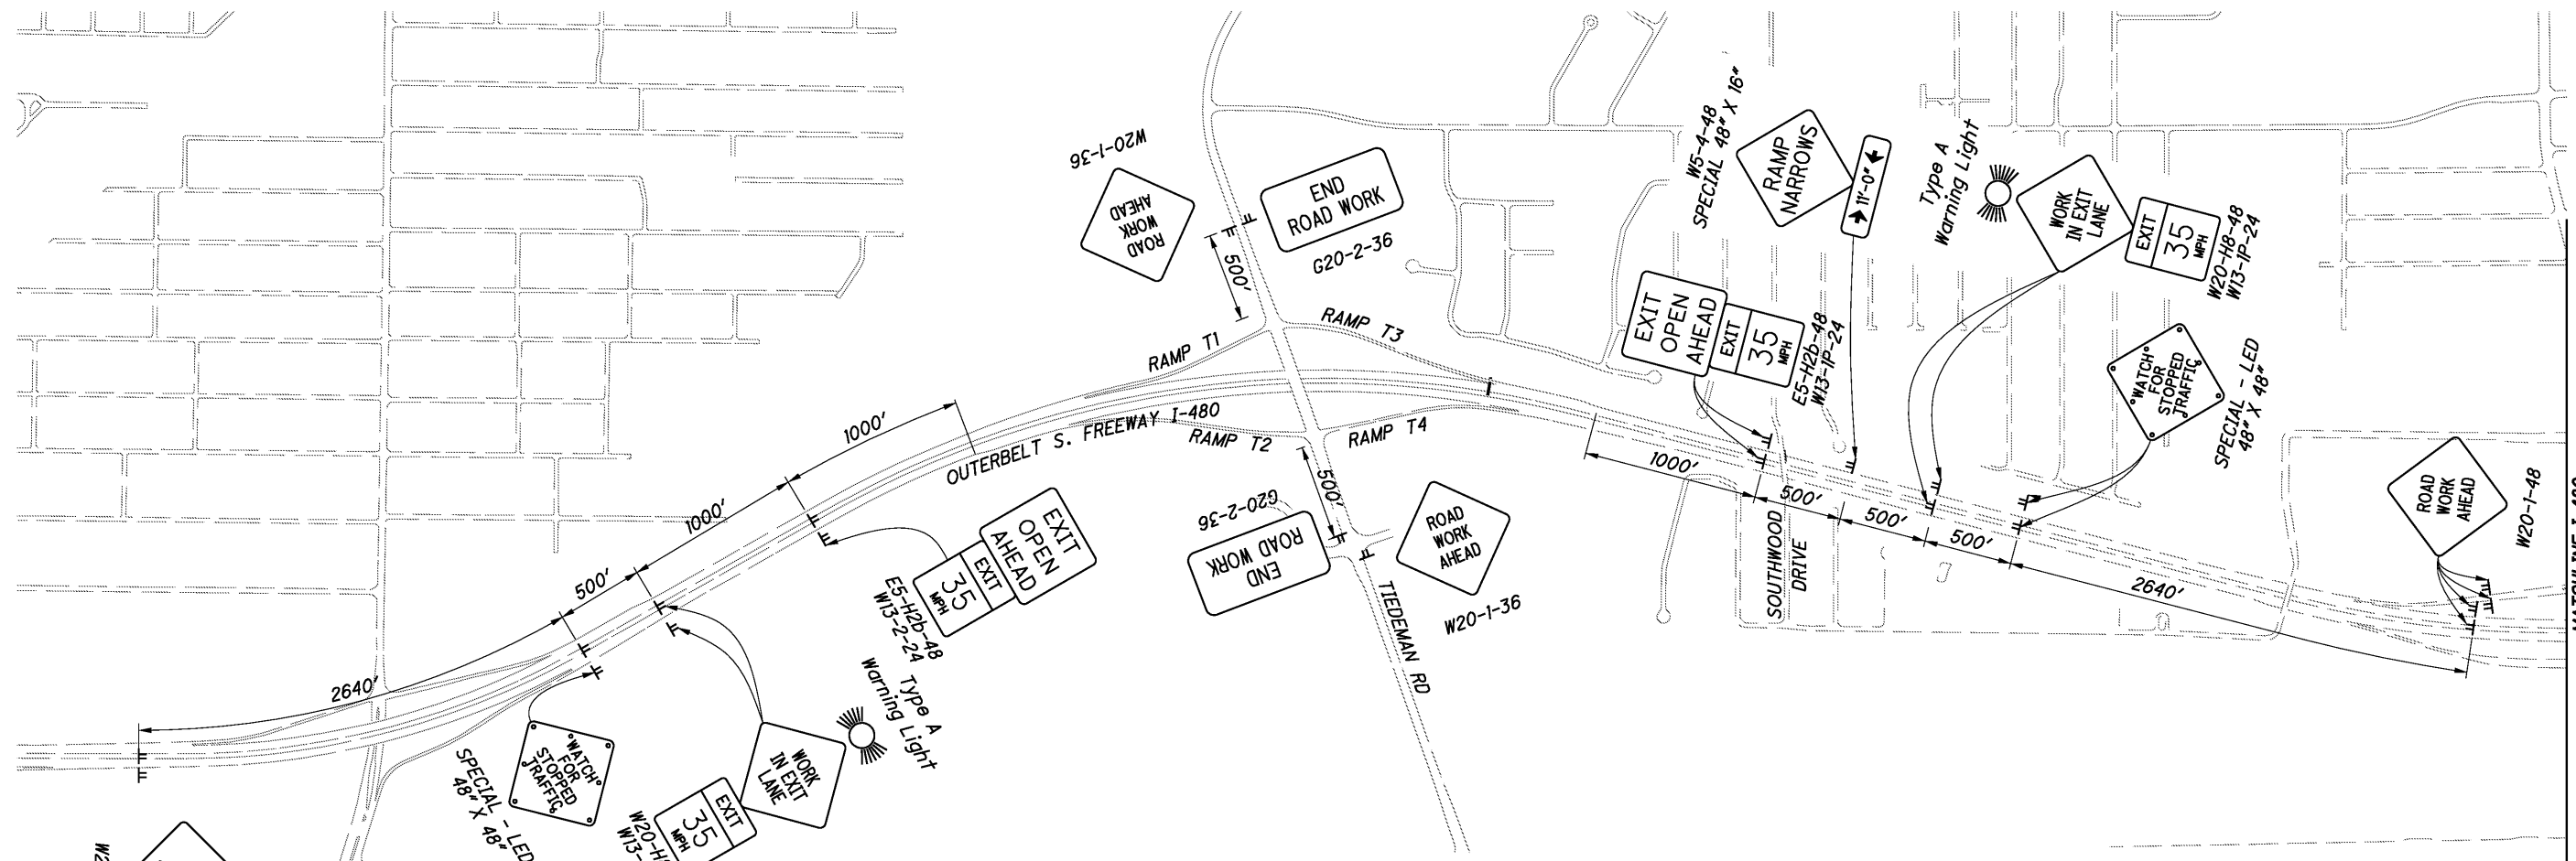

SIGN DETAIL  
SPECIAL - 48" X 16"

NARROW WIDTH PLAQUE: 1.5" RADIUS, 0.6" BORDER, 0.4" INDENT, BLACK ON ORANGE  
STANDARD ARROW CUSTOM 6.0" X 1.0" 0°, "11'-0" D, STANDARD ARROW CUSTOM 6.0" X 1.0" 0°,

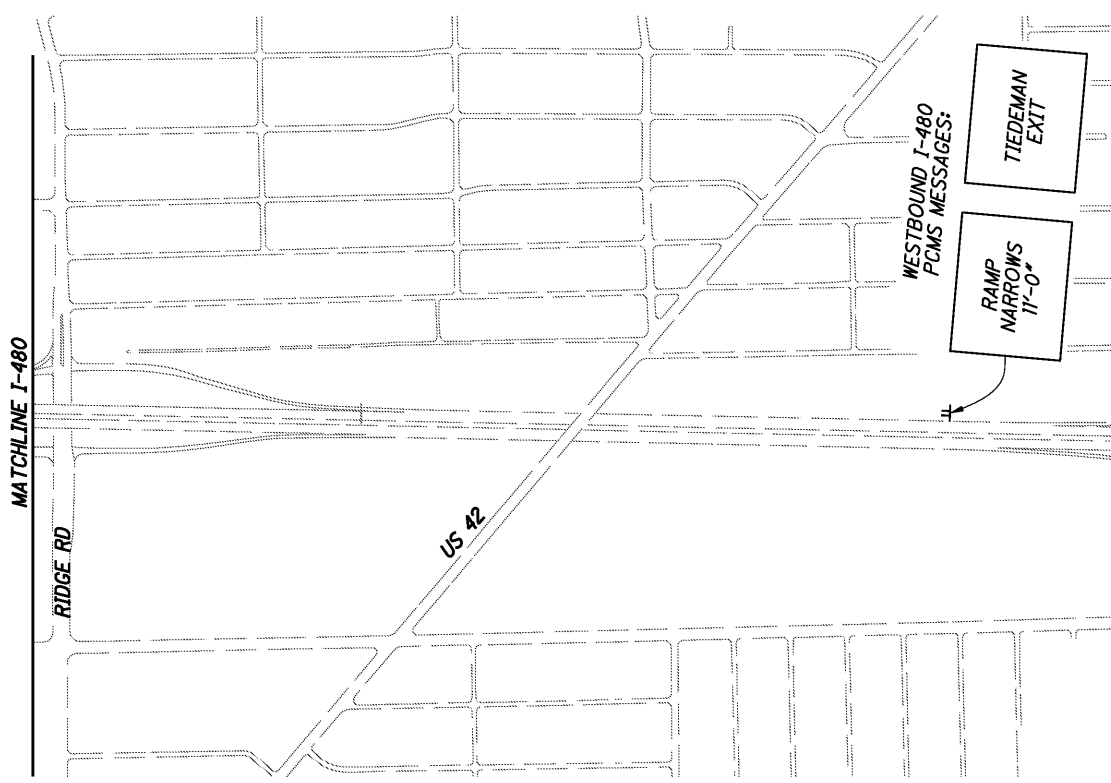

**SPECIAL - "WATCH FOR STOPPED TRAFFIC" WITH LED SIGNS**


BEFORE WORK STARTS ON THE RAMPS OR ANY TIME WORK IS PERFORMED ON THE PROJECT AND IS CAUSING RAMP TRAFFIC TO SLOW OR STOP TRAFFIC ON THE FREEWAY, THE "WATCH FOR STOPPED TRAFFIC" SIGNS WITH LED LIGHTS SHALL BE UP AND THE LIGHTS SHALL BE FLASHING.

THE "WATCH FOR STOPPED TRAFFIC" SIGNS SHALL HAVE 8 LED AMBER FLASHING LIGHTS THAT BLINK ON AND OFF DURING THE TIME THE SIGN IS UP. THESE ARE TO BE DUAL MOUNTED ON I-480, APPROXIMATELY 2000 FEET FROM THE RAMPS OR AS DIRECTED BY THE ENGINEER.

THE LED AMBER FLASHING LIGHT SIGNS CAN BE PURCHASED AT TAPCO, TRAFFIC AND PARKING CONTROL CO. THE SIGN IS CALLED "BlinkerSigns".

THE WEBSITE IS: <http://www.tapconet.com/store/category/2e75b275-a044-4b1f-9f4b-b86a9c6b192/BlinkerSigns.aspx>

AN APPROVED EQUAL SIGN CAN BE SUBSTITUTED.

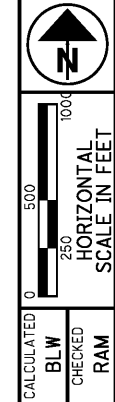


**MAINTENANCE OF TRAFFIC - PHASES 1 & 2  
LEAD-IN SIGNAGE**

**CUY - 480 - 11.69**


FOR PCB \*Y\* CONNECTOR SEGMENT  
DETAIL, SEE SHEET 30

CALCULATED  
BLW  
CHECKED  
RAM

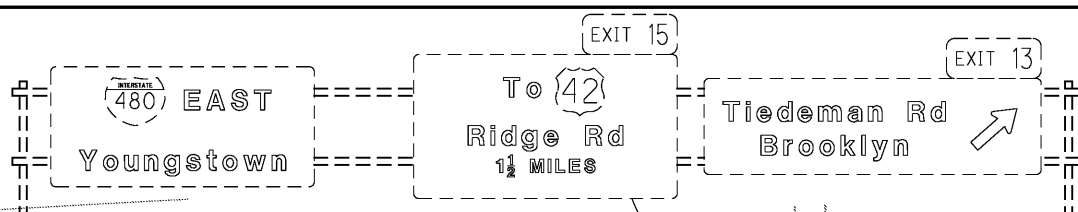

**LEGEND**

- EDGE LINE - YELLOW
- EDGE LINE - WHITE
- CHANNELIZING LINE
- STOP LINE
- ATTENUATOR
- PORTABLE CONCRETE BARRIER
- TEMPORARY PAVEMENT AREA
- CONSTRUCTION AREA
- TRAVEL DIRECTION

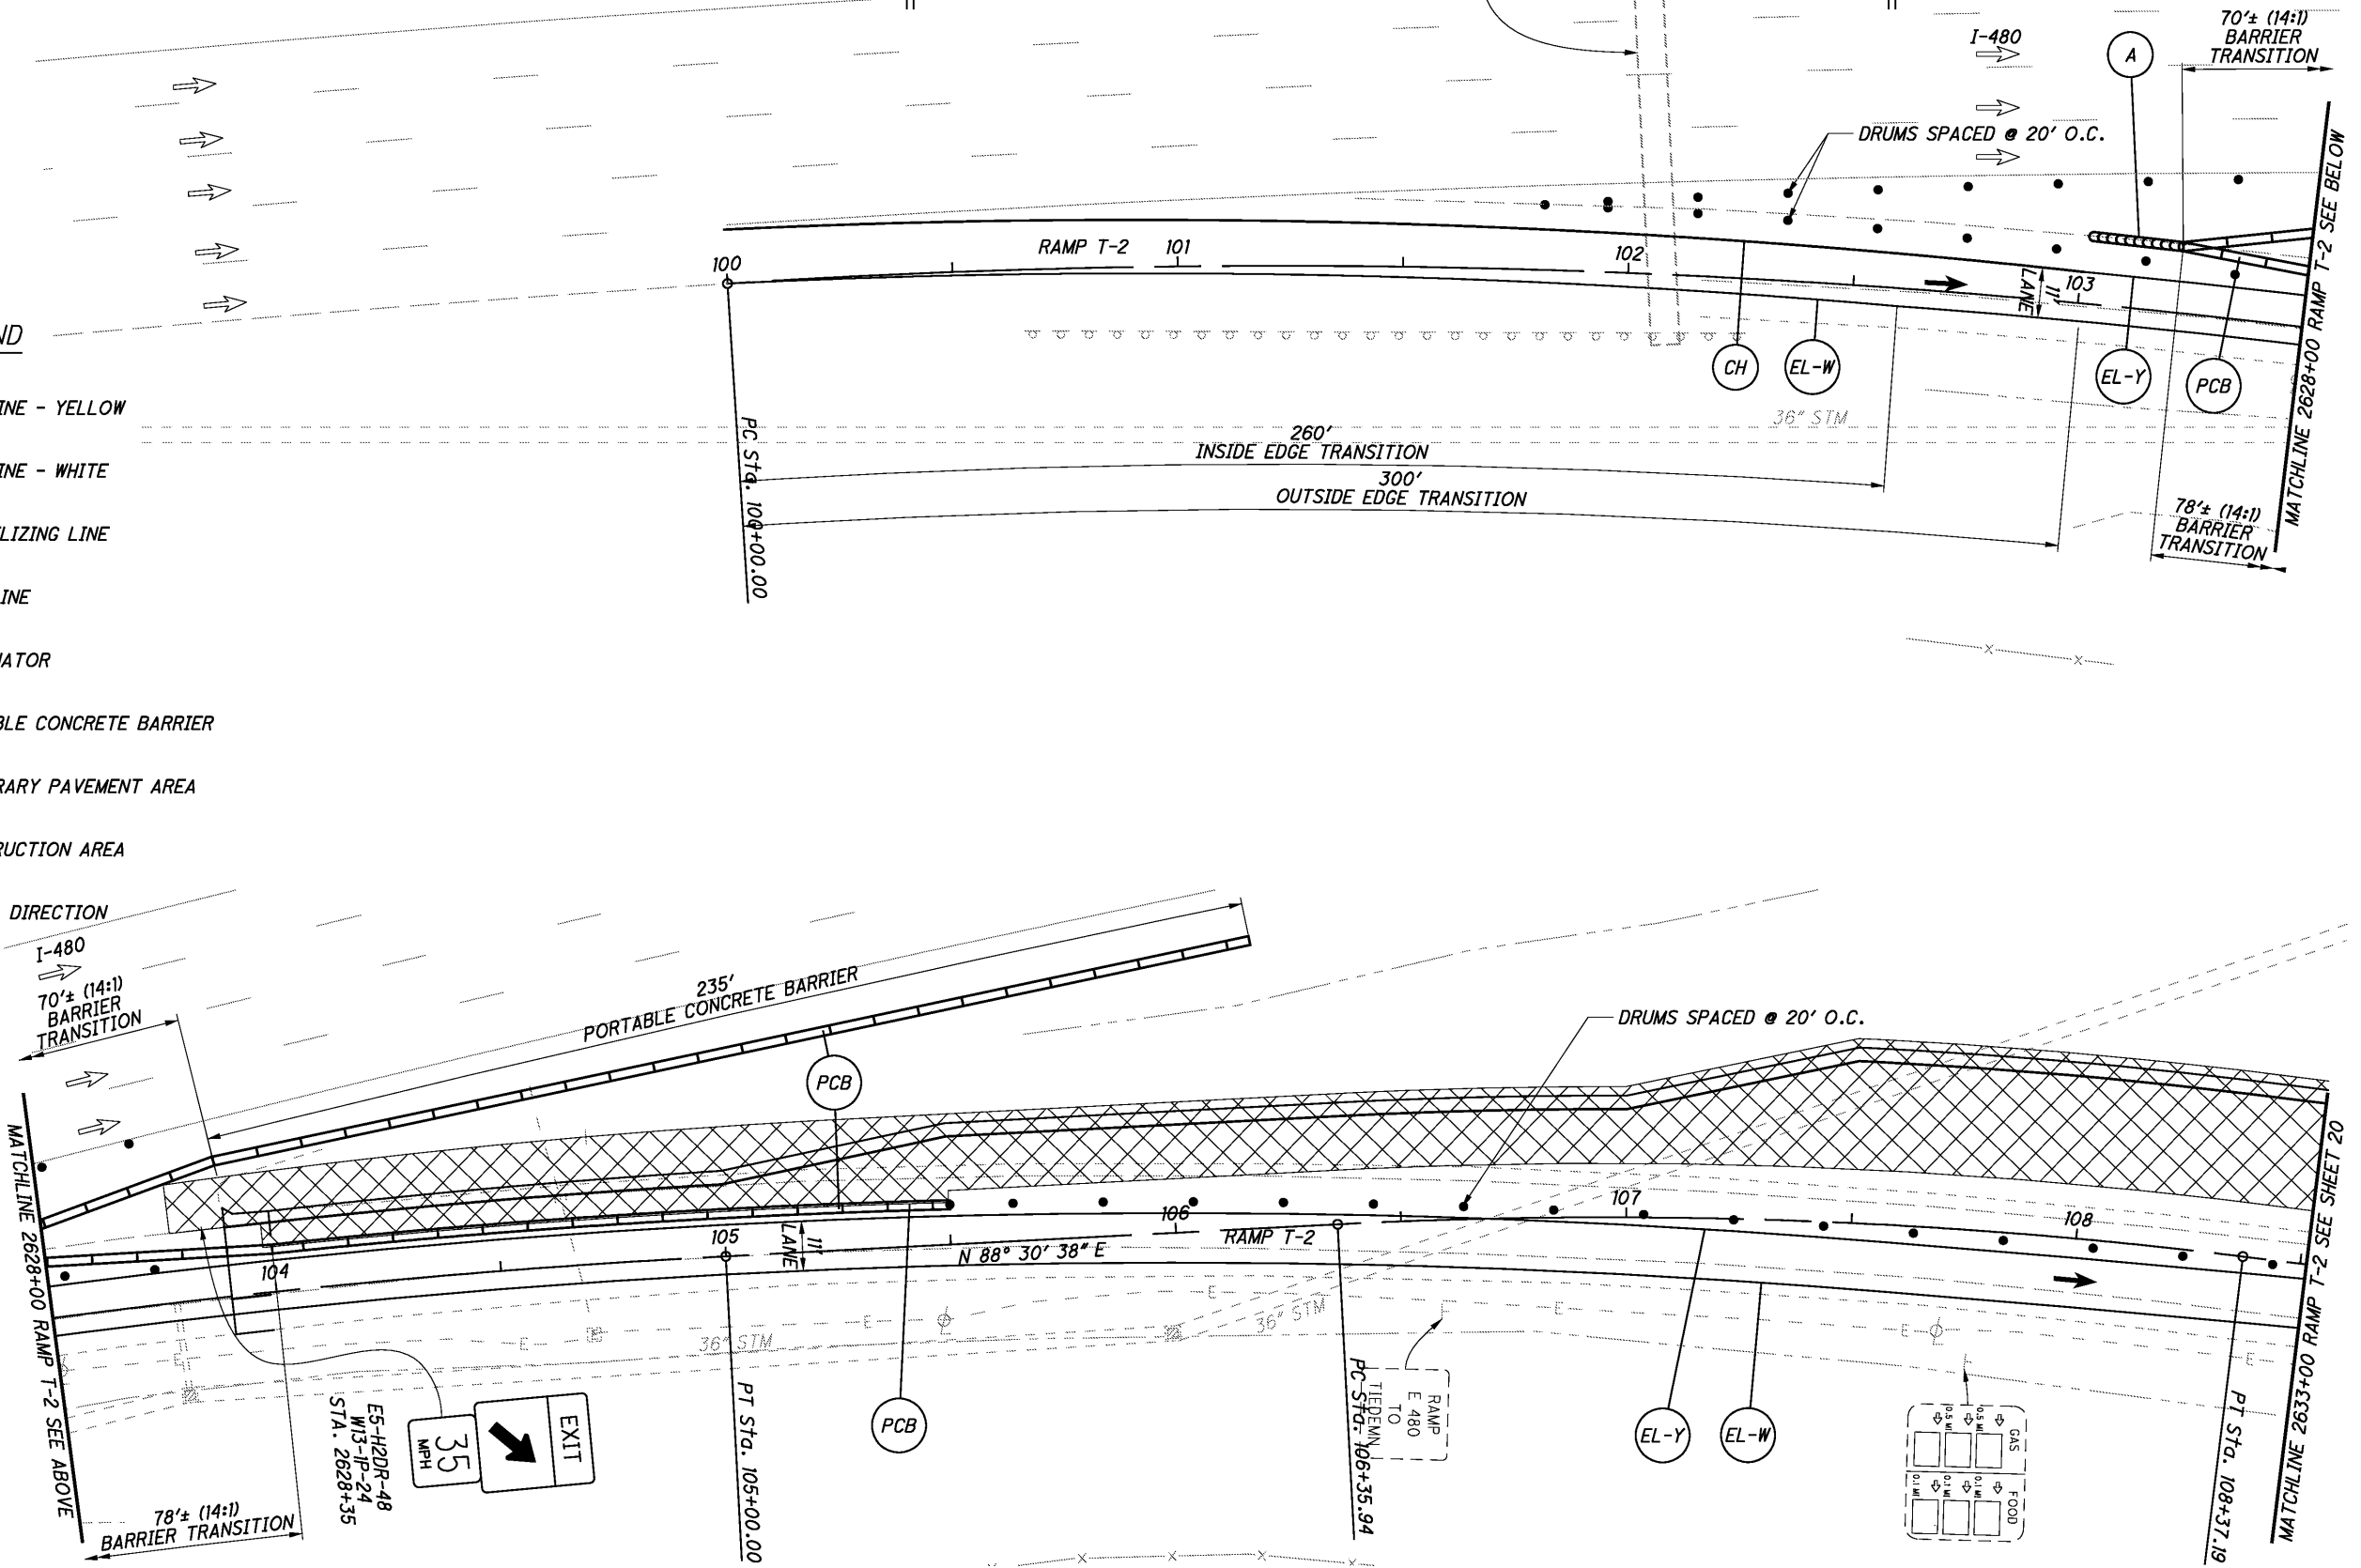


**MAINTENANCE OF TRAFFIC PLAN - PHASE 1**  
**STA. 2624+50 TO STA. 2633+00 RAMP T-2**

**CUY-480-11.60**

I:\Projects\18063\MOT\Sheets\94273MP101.dgn 2/5/2015 10:28:32 AM michael\_j\_thompson

I:\Projects\18063\MOT\Sheets\94273MP102.dgn 2/5/2015 10:28:34 AM michael\_j.thompson

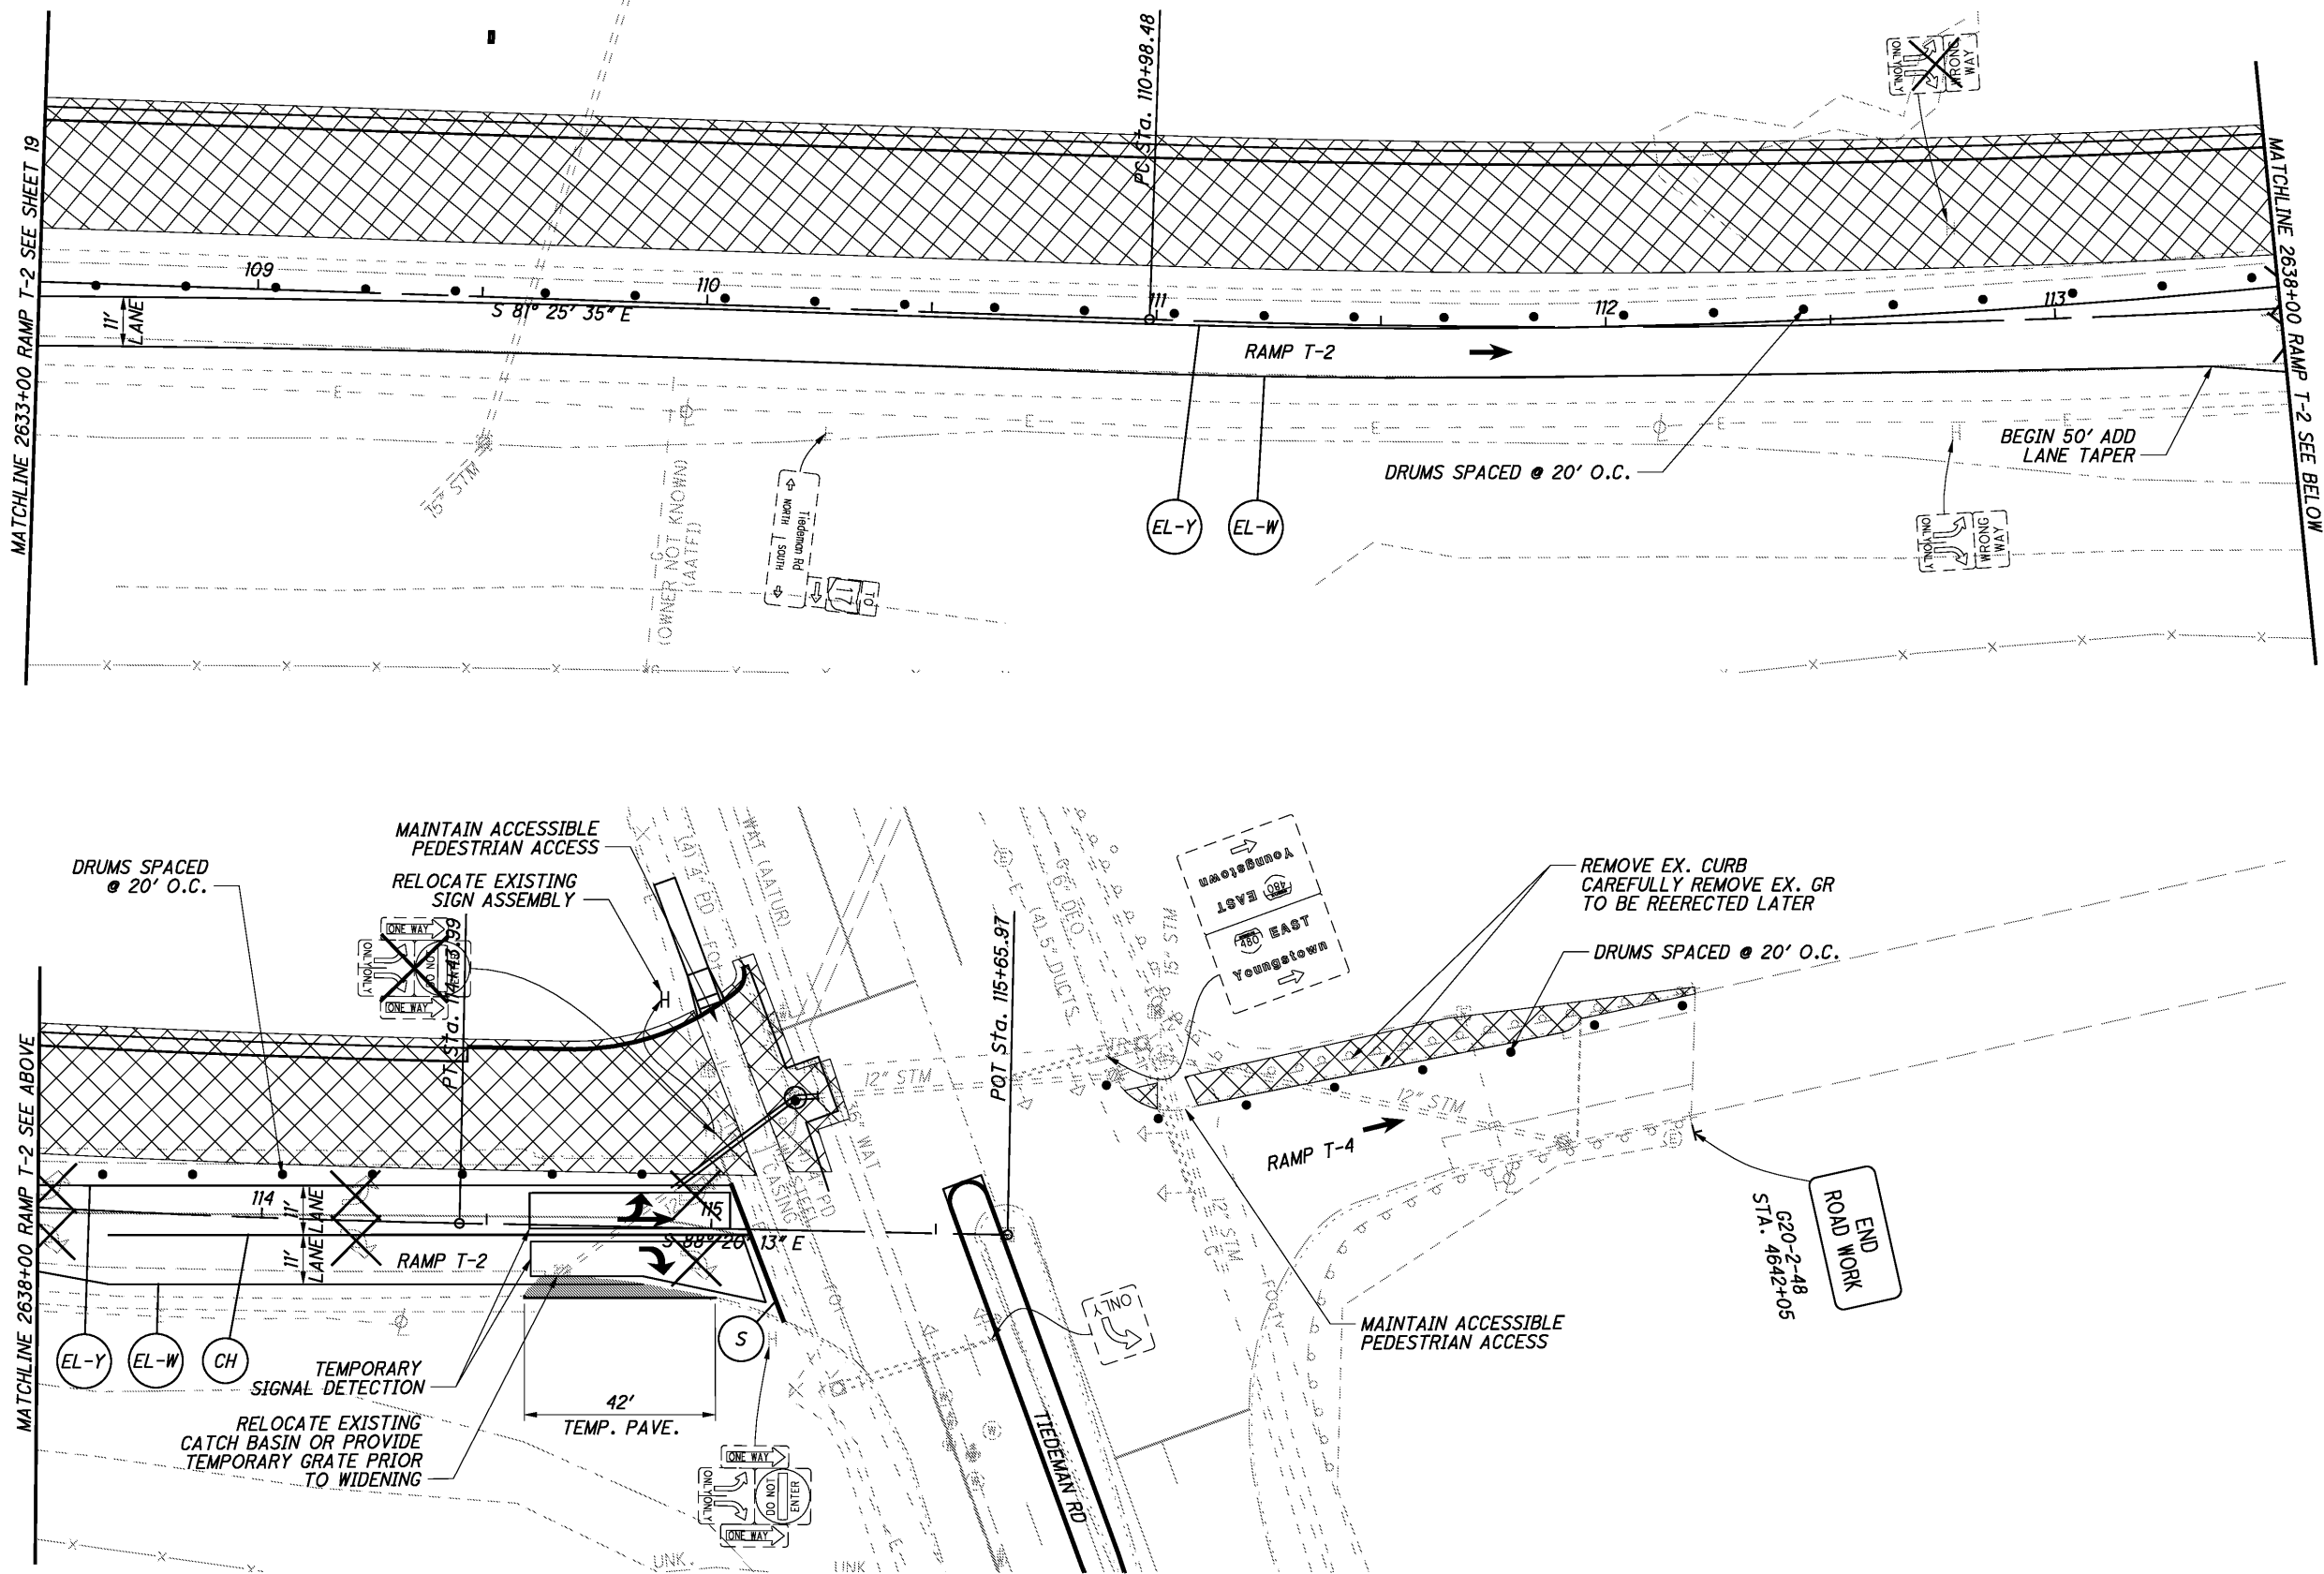

FOR LEGEND, SEE SHEET 19

NOTE:  
FOR MAINTENANCE OF TRAFFIC LEAD IN SIGNAGE ON  
TIEDEMAN ROAD SEE SHEET 18

CALCULATED  
BLW  
CHECKED  
RAM

0 10 20 40  
HORIZONTAL  
SCALE IN FEET



20  
84

**MAINTENANCE OF TRAFFIC PLAN - PHASE 1**  
**STA. 2633+00 TO STA. 2640+15.76 RAMP T-2**

**CUY-480-11.60**



NOTE:  
FOR MAINTENANCE OF TRAFFIC LEAD IN SIGNAGE ON  
TIEDEMAN ROAD SEE SHEET 18

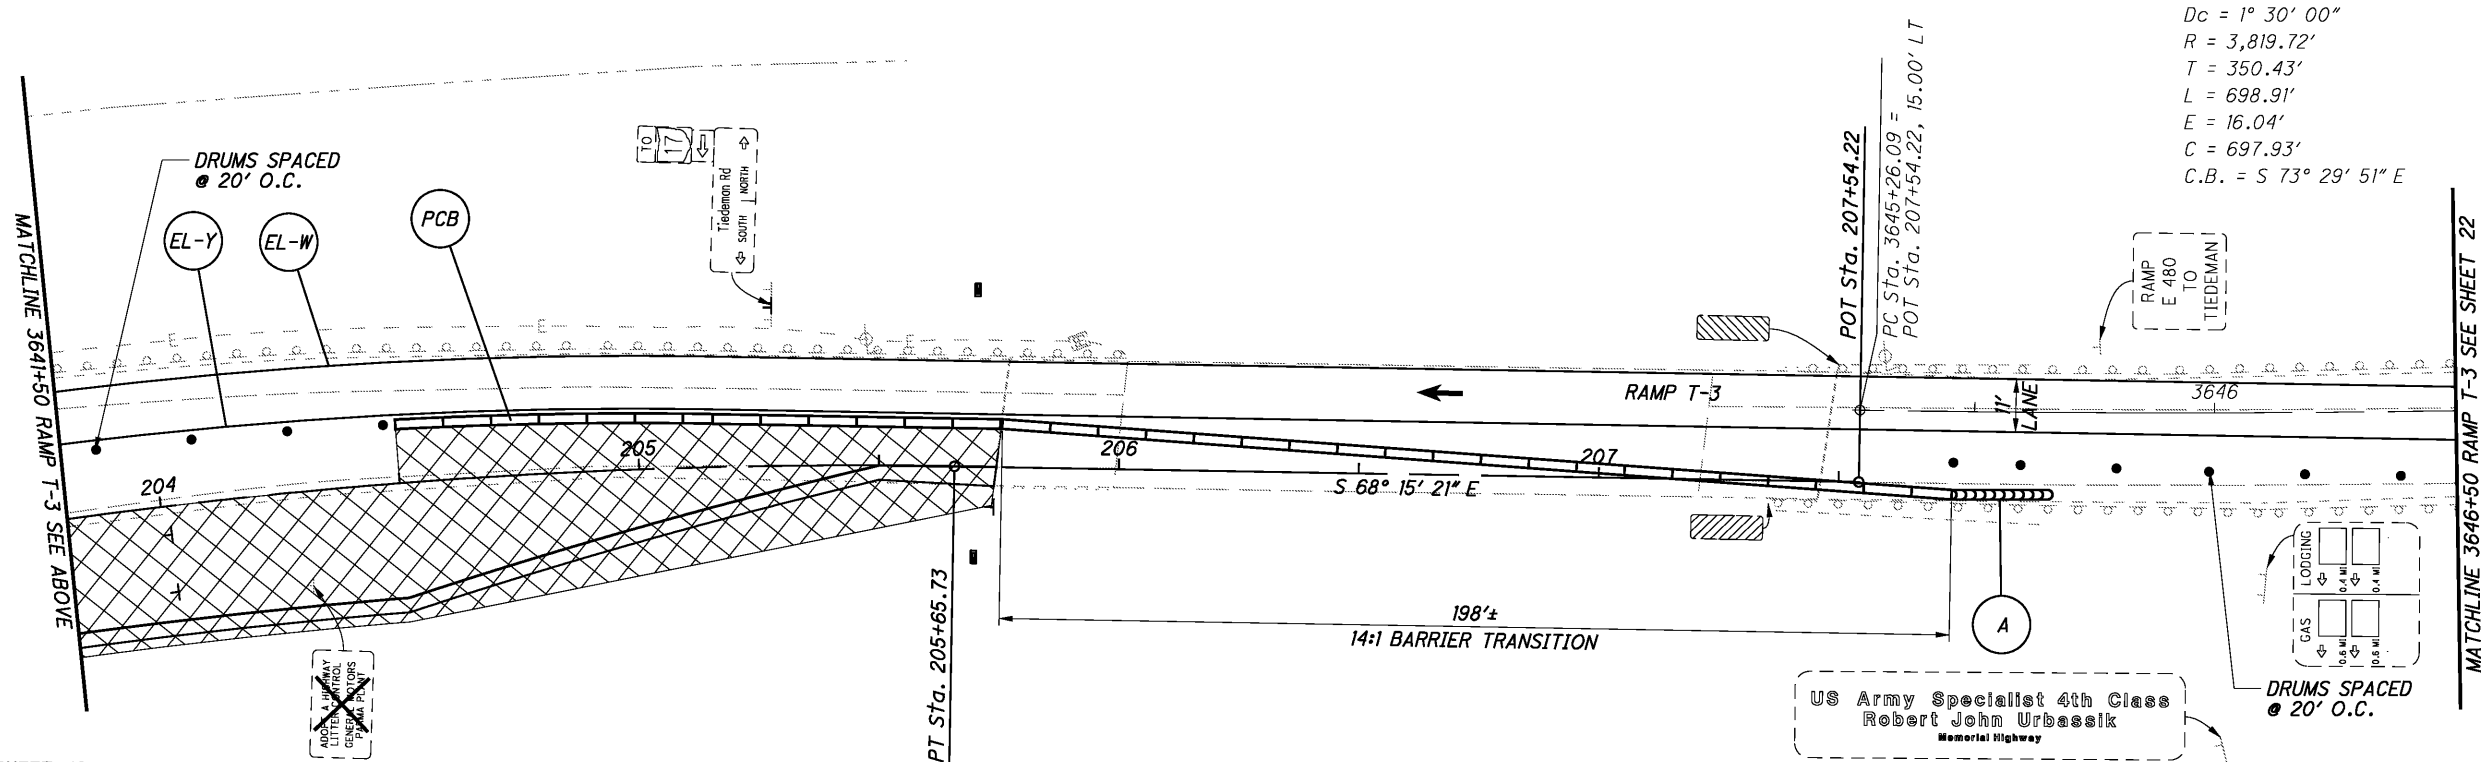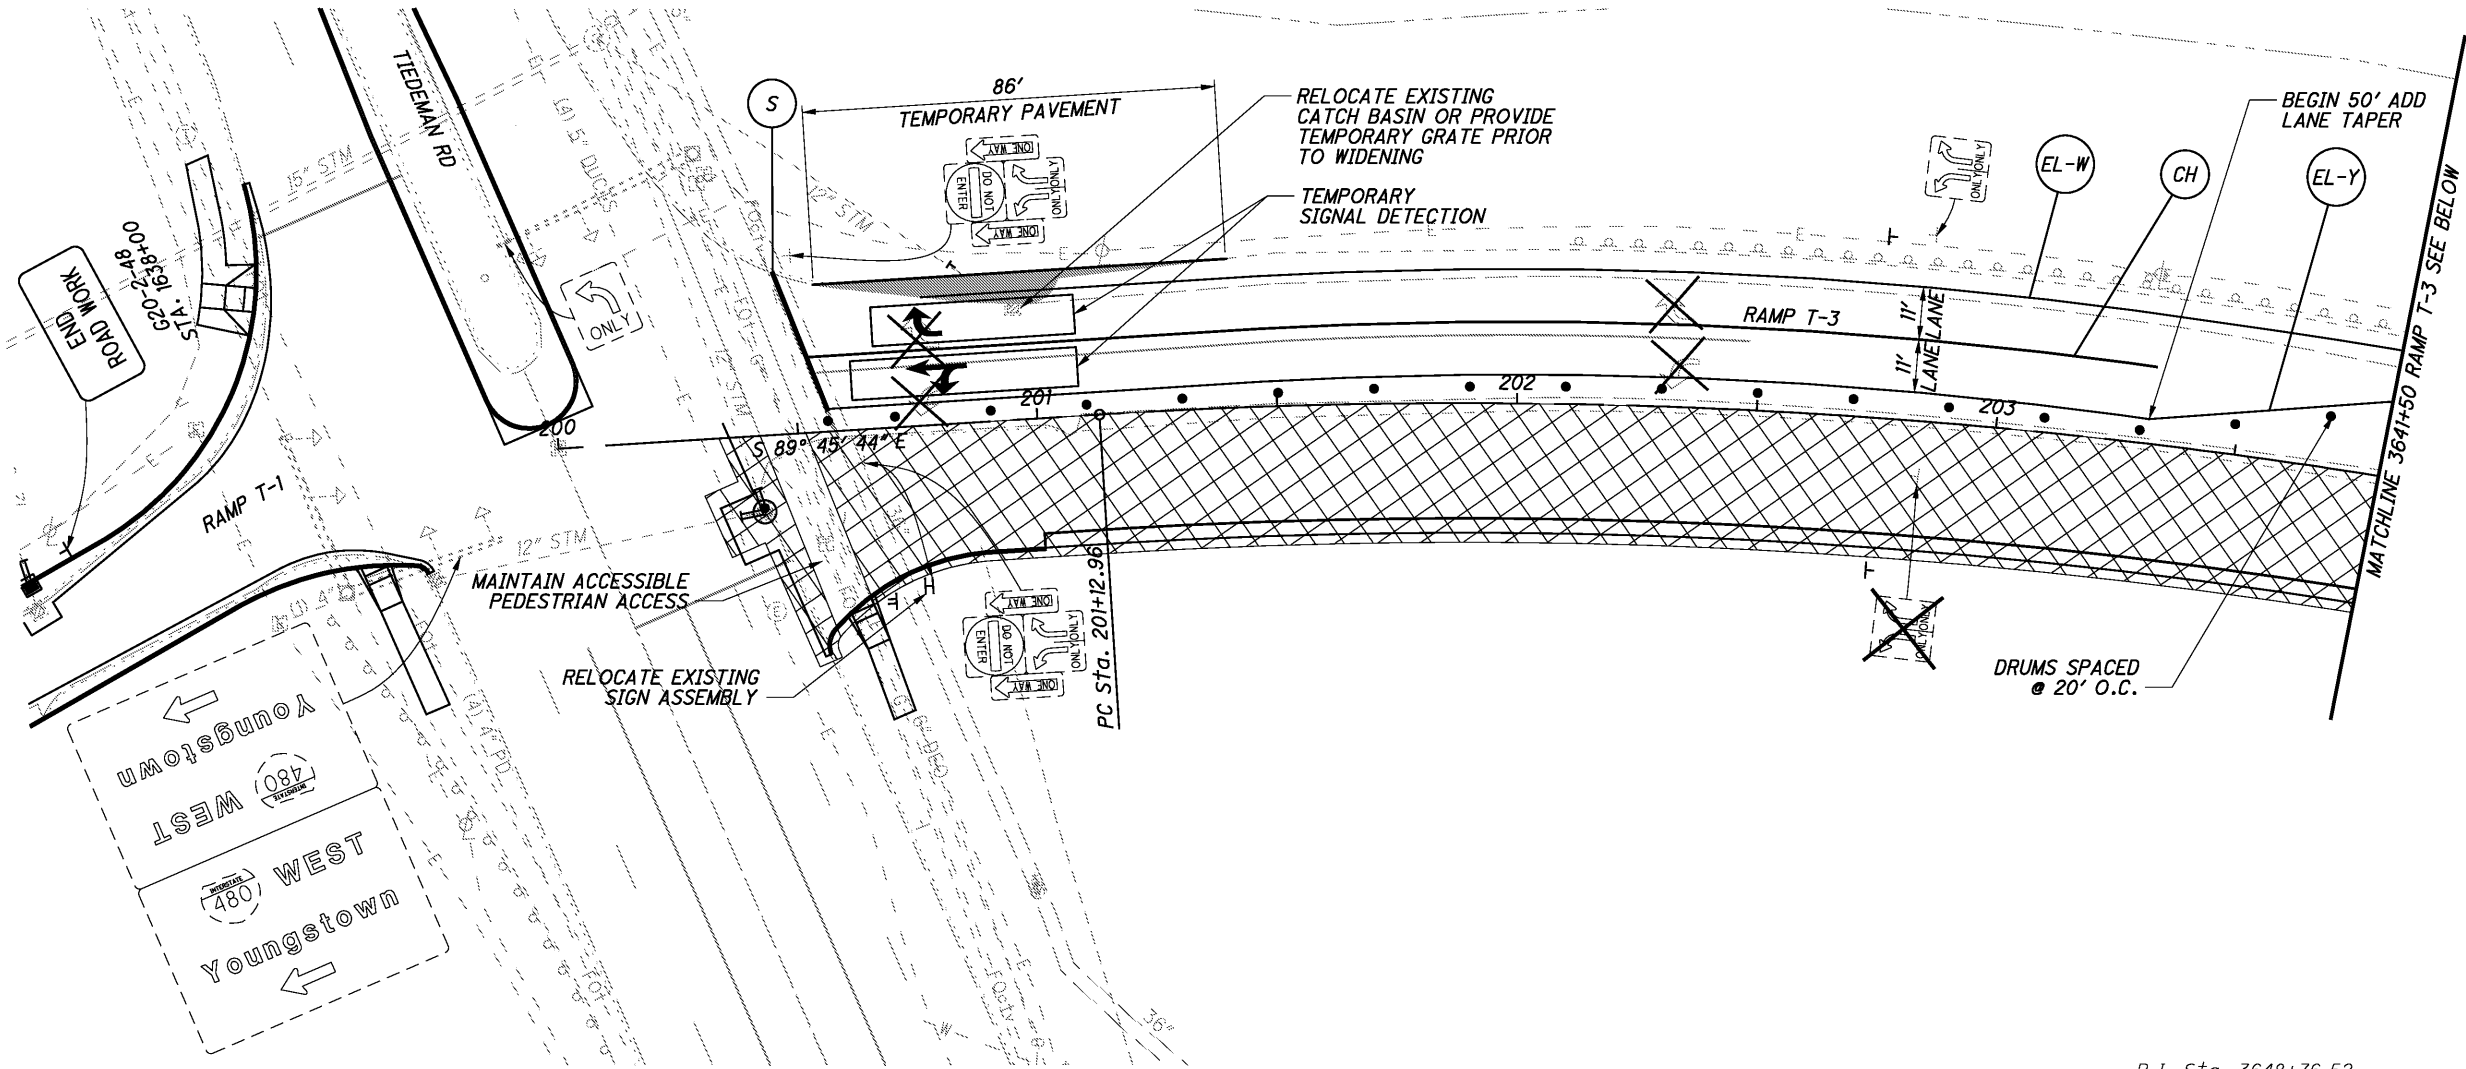




FOR LEGEND, SEE SHEET 19



MAINTENANCE OF TRAFFIC PLAN - PHASE 1  
STA. 3637 +54.75 TO STA. 3646 +50 RAMP T-3

CUY - 480 - 11.60

P.I. Sta. 3648+76.52  
 $\Delta = 10^\circ 29' 01''$  (LT)  
 $D_c = 1^\circ 30' 00''$   
 $R = 3,819.72'$   
 $T = 350.43'$   
 $L = 698.91'$   
 $E = 16.04'$   
 $C = 697.93'$   
 $C.B. = S 73^\circ 29' 51'' E$

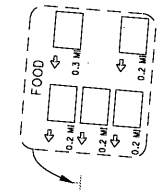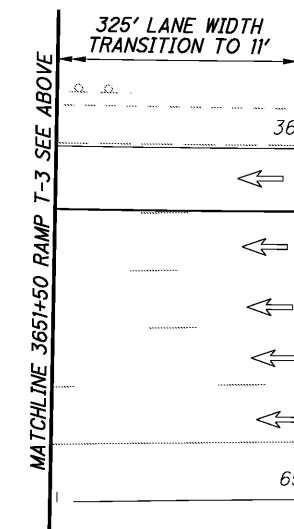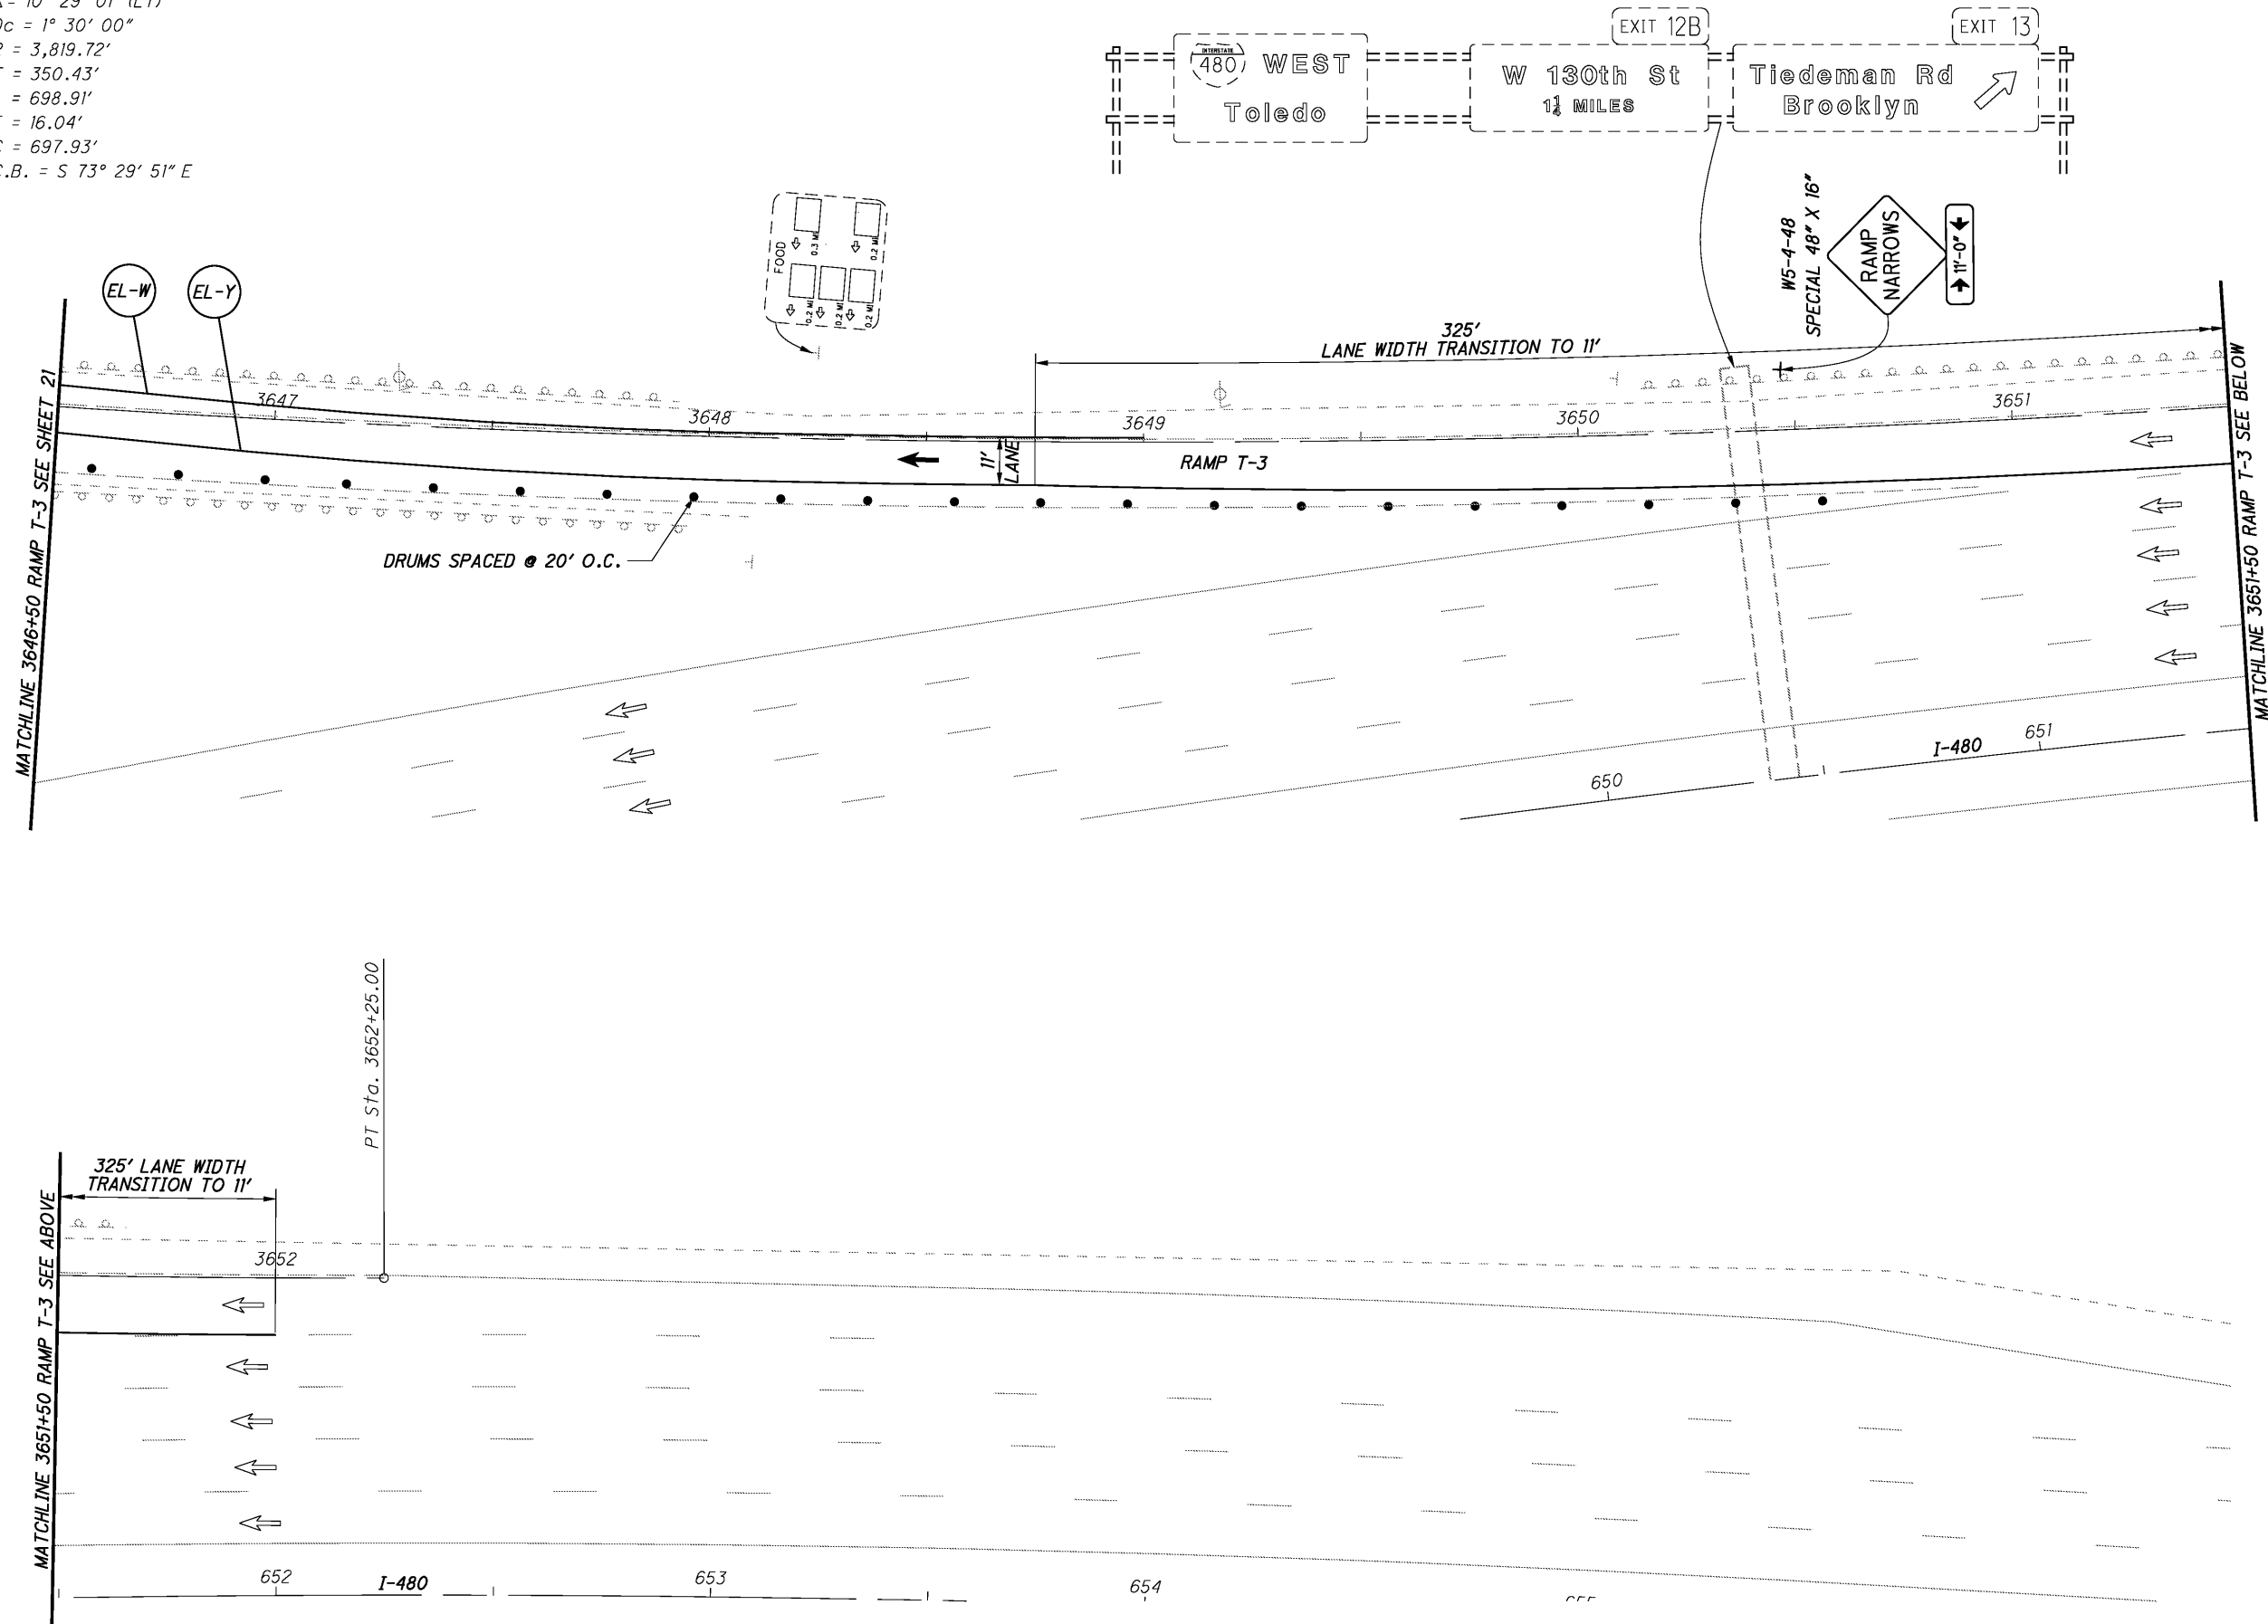

**MAINTENANCE OF TRAFFIC PLAN - PHASE 1**  
**STA. 3646+50 TO STA. 3652+25 RAMP T-3**









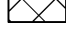
**CUY-480-11.60**


I:\Projects\18063\MOT\Sheets\94273MP104.dgn 2/5/2015 10:28:37 AM michael\_j\_thompson

FOR LEGEND, SEE SHEET 19

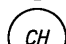I:\Projects\18063\MOT\Sheets\94273MP201.dgn 2/5/2015 10:28:41 AM michael\_j\_thompson

**LEGEND**

-  EDGE LINE - YELLOW
-  EDGE LINE - WHITE
-  CHANNELIZING LINE
-  STOP LINE
-  ATTENUATOR
-  PORTABLE CONCRETE BARRIER
-  TEMPORARY PAVEMENT AREA
-  CONSTRUCTION AREA
-  TRAVEL DIRECTION

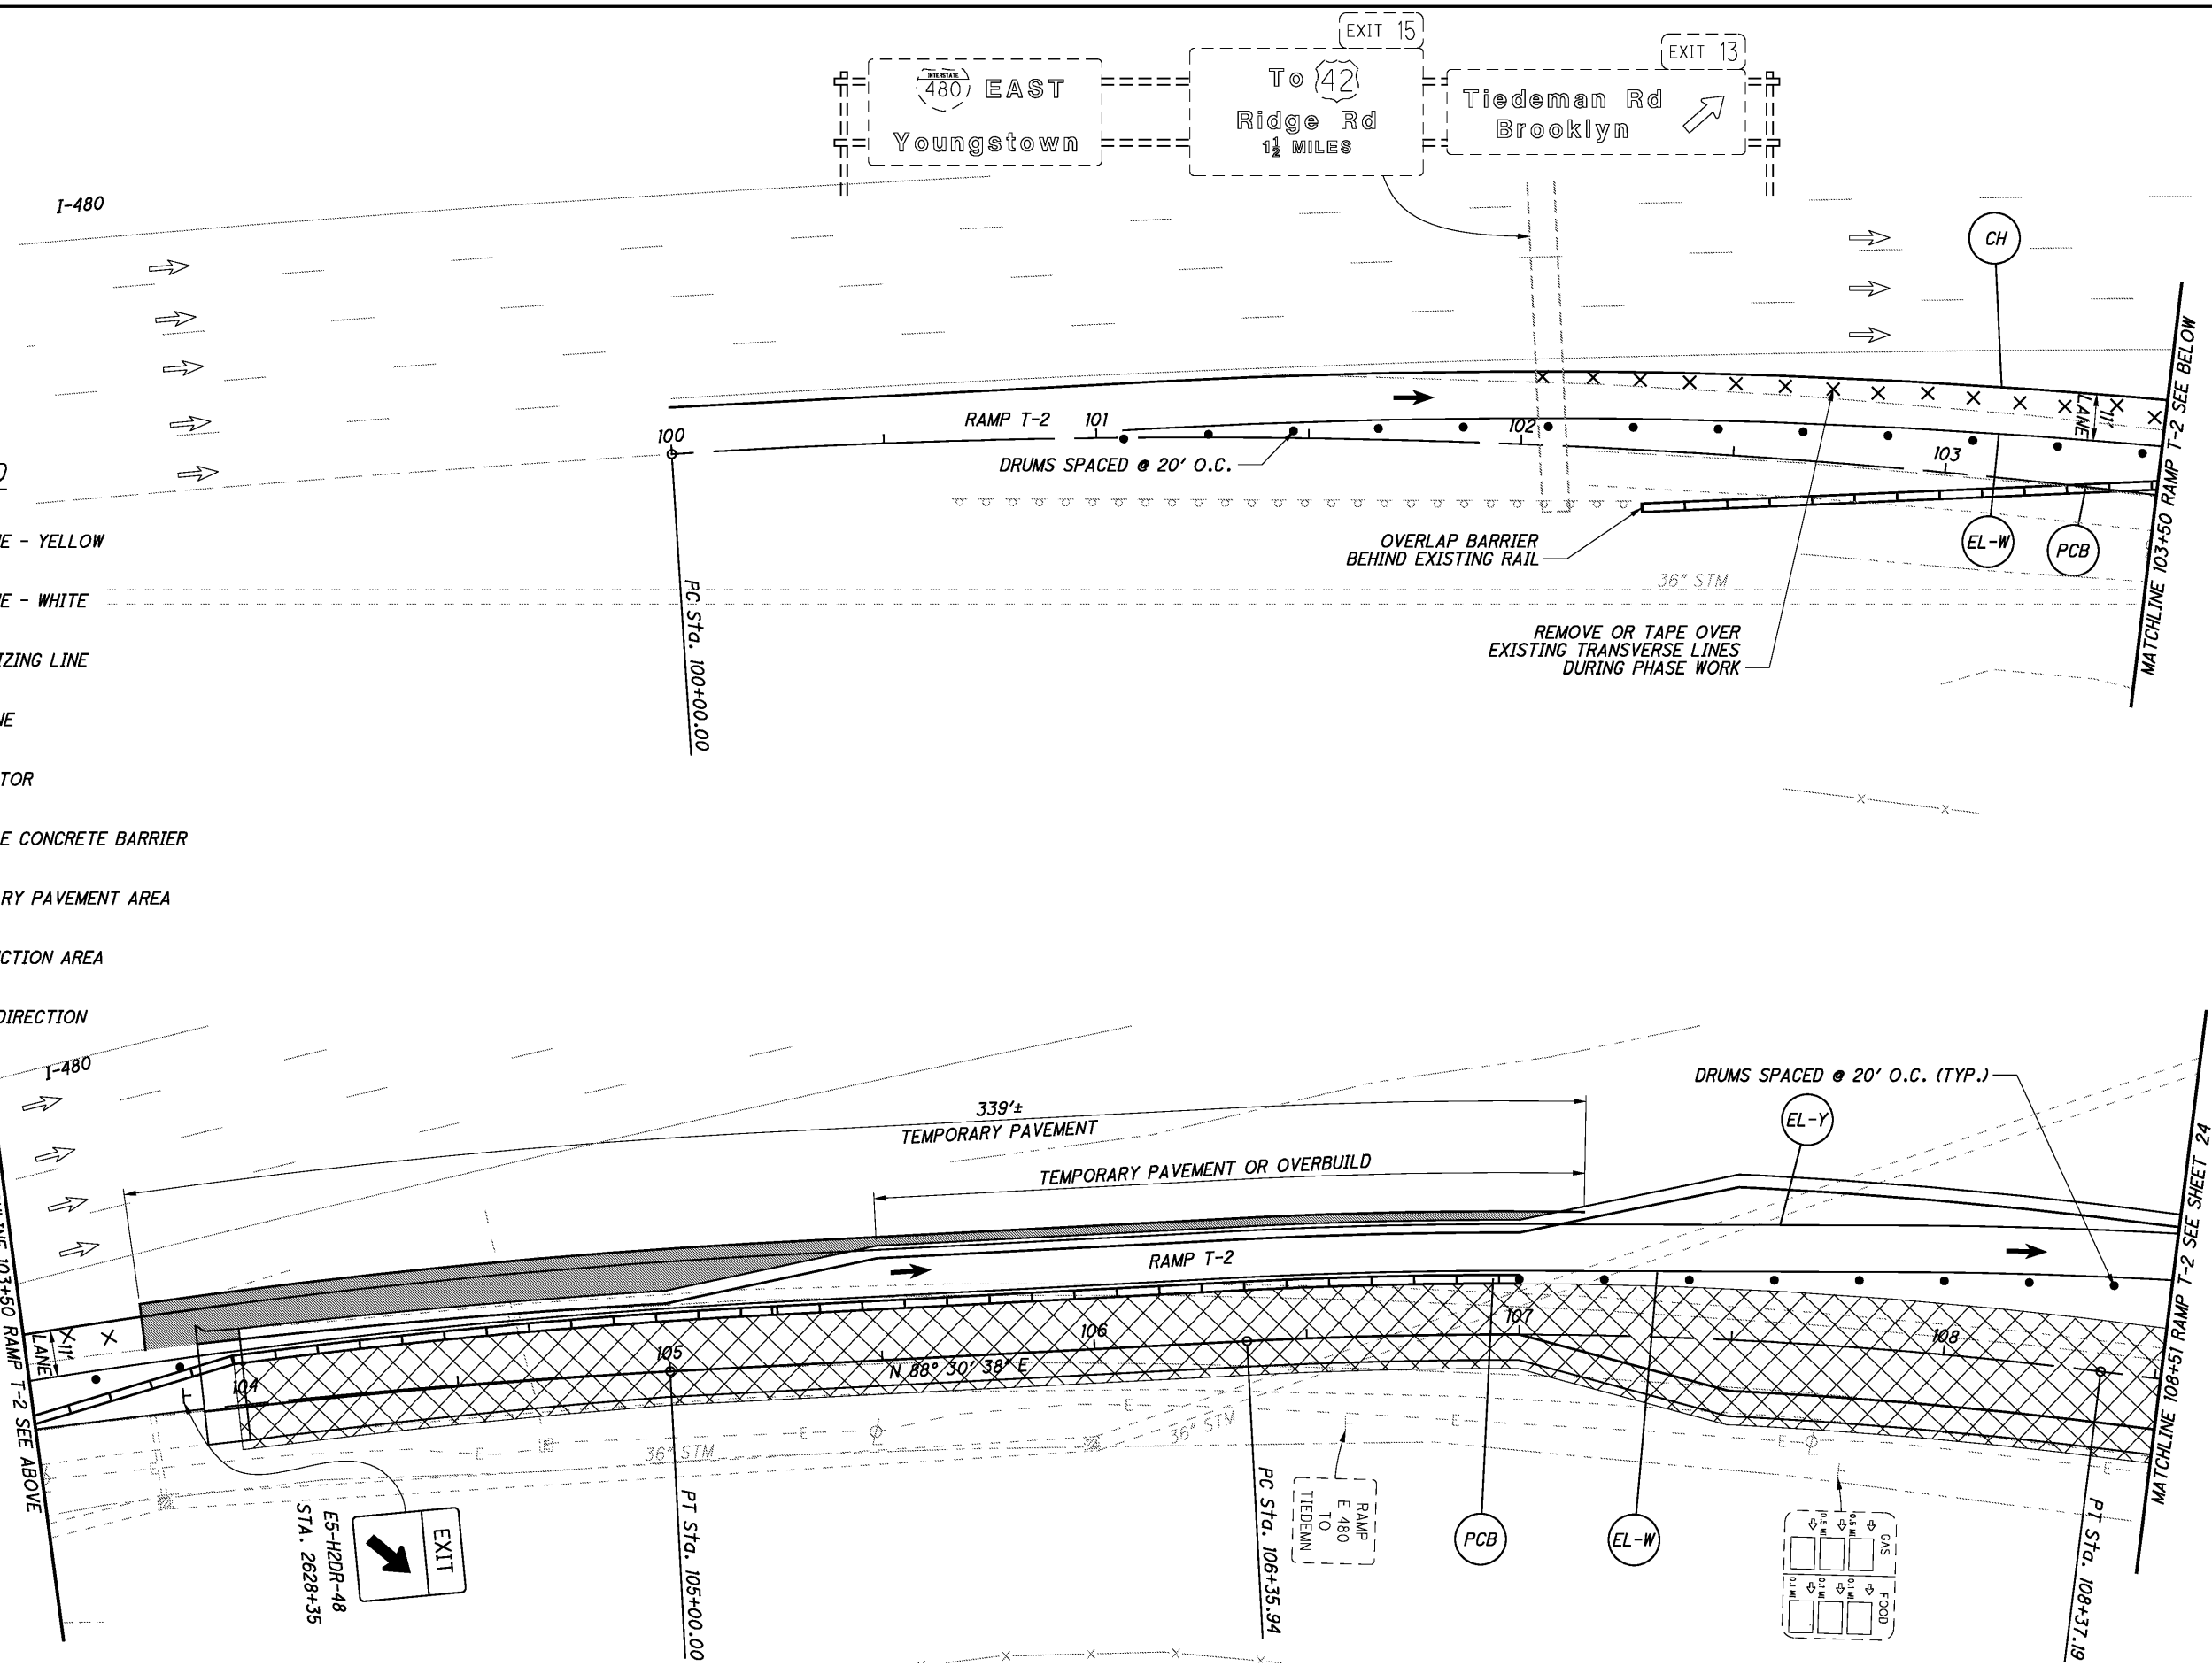


CALCULATED  
BLW  
CHECKED  
RAM

0 10 20 40  
HORIZONTAL  
SCALE IN FEET

**MAINTENANCE OF TRAFFIC PLAN - PHASE 2**  
**STA. 100+00 TO STA. 108+51 RAMP T-2**

**CUY-480-11.60**

I:\Projects\18063\MOT\Sheets\94273MP202.dgn 2/5/2015 10:28:42 AM michael.j.thompson

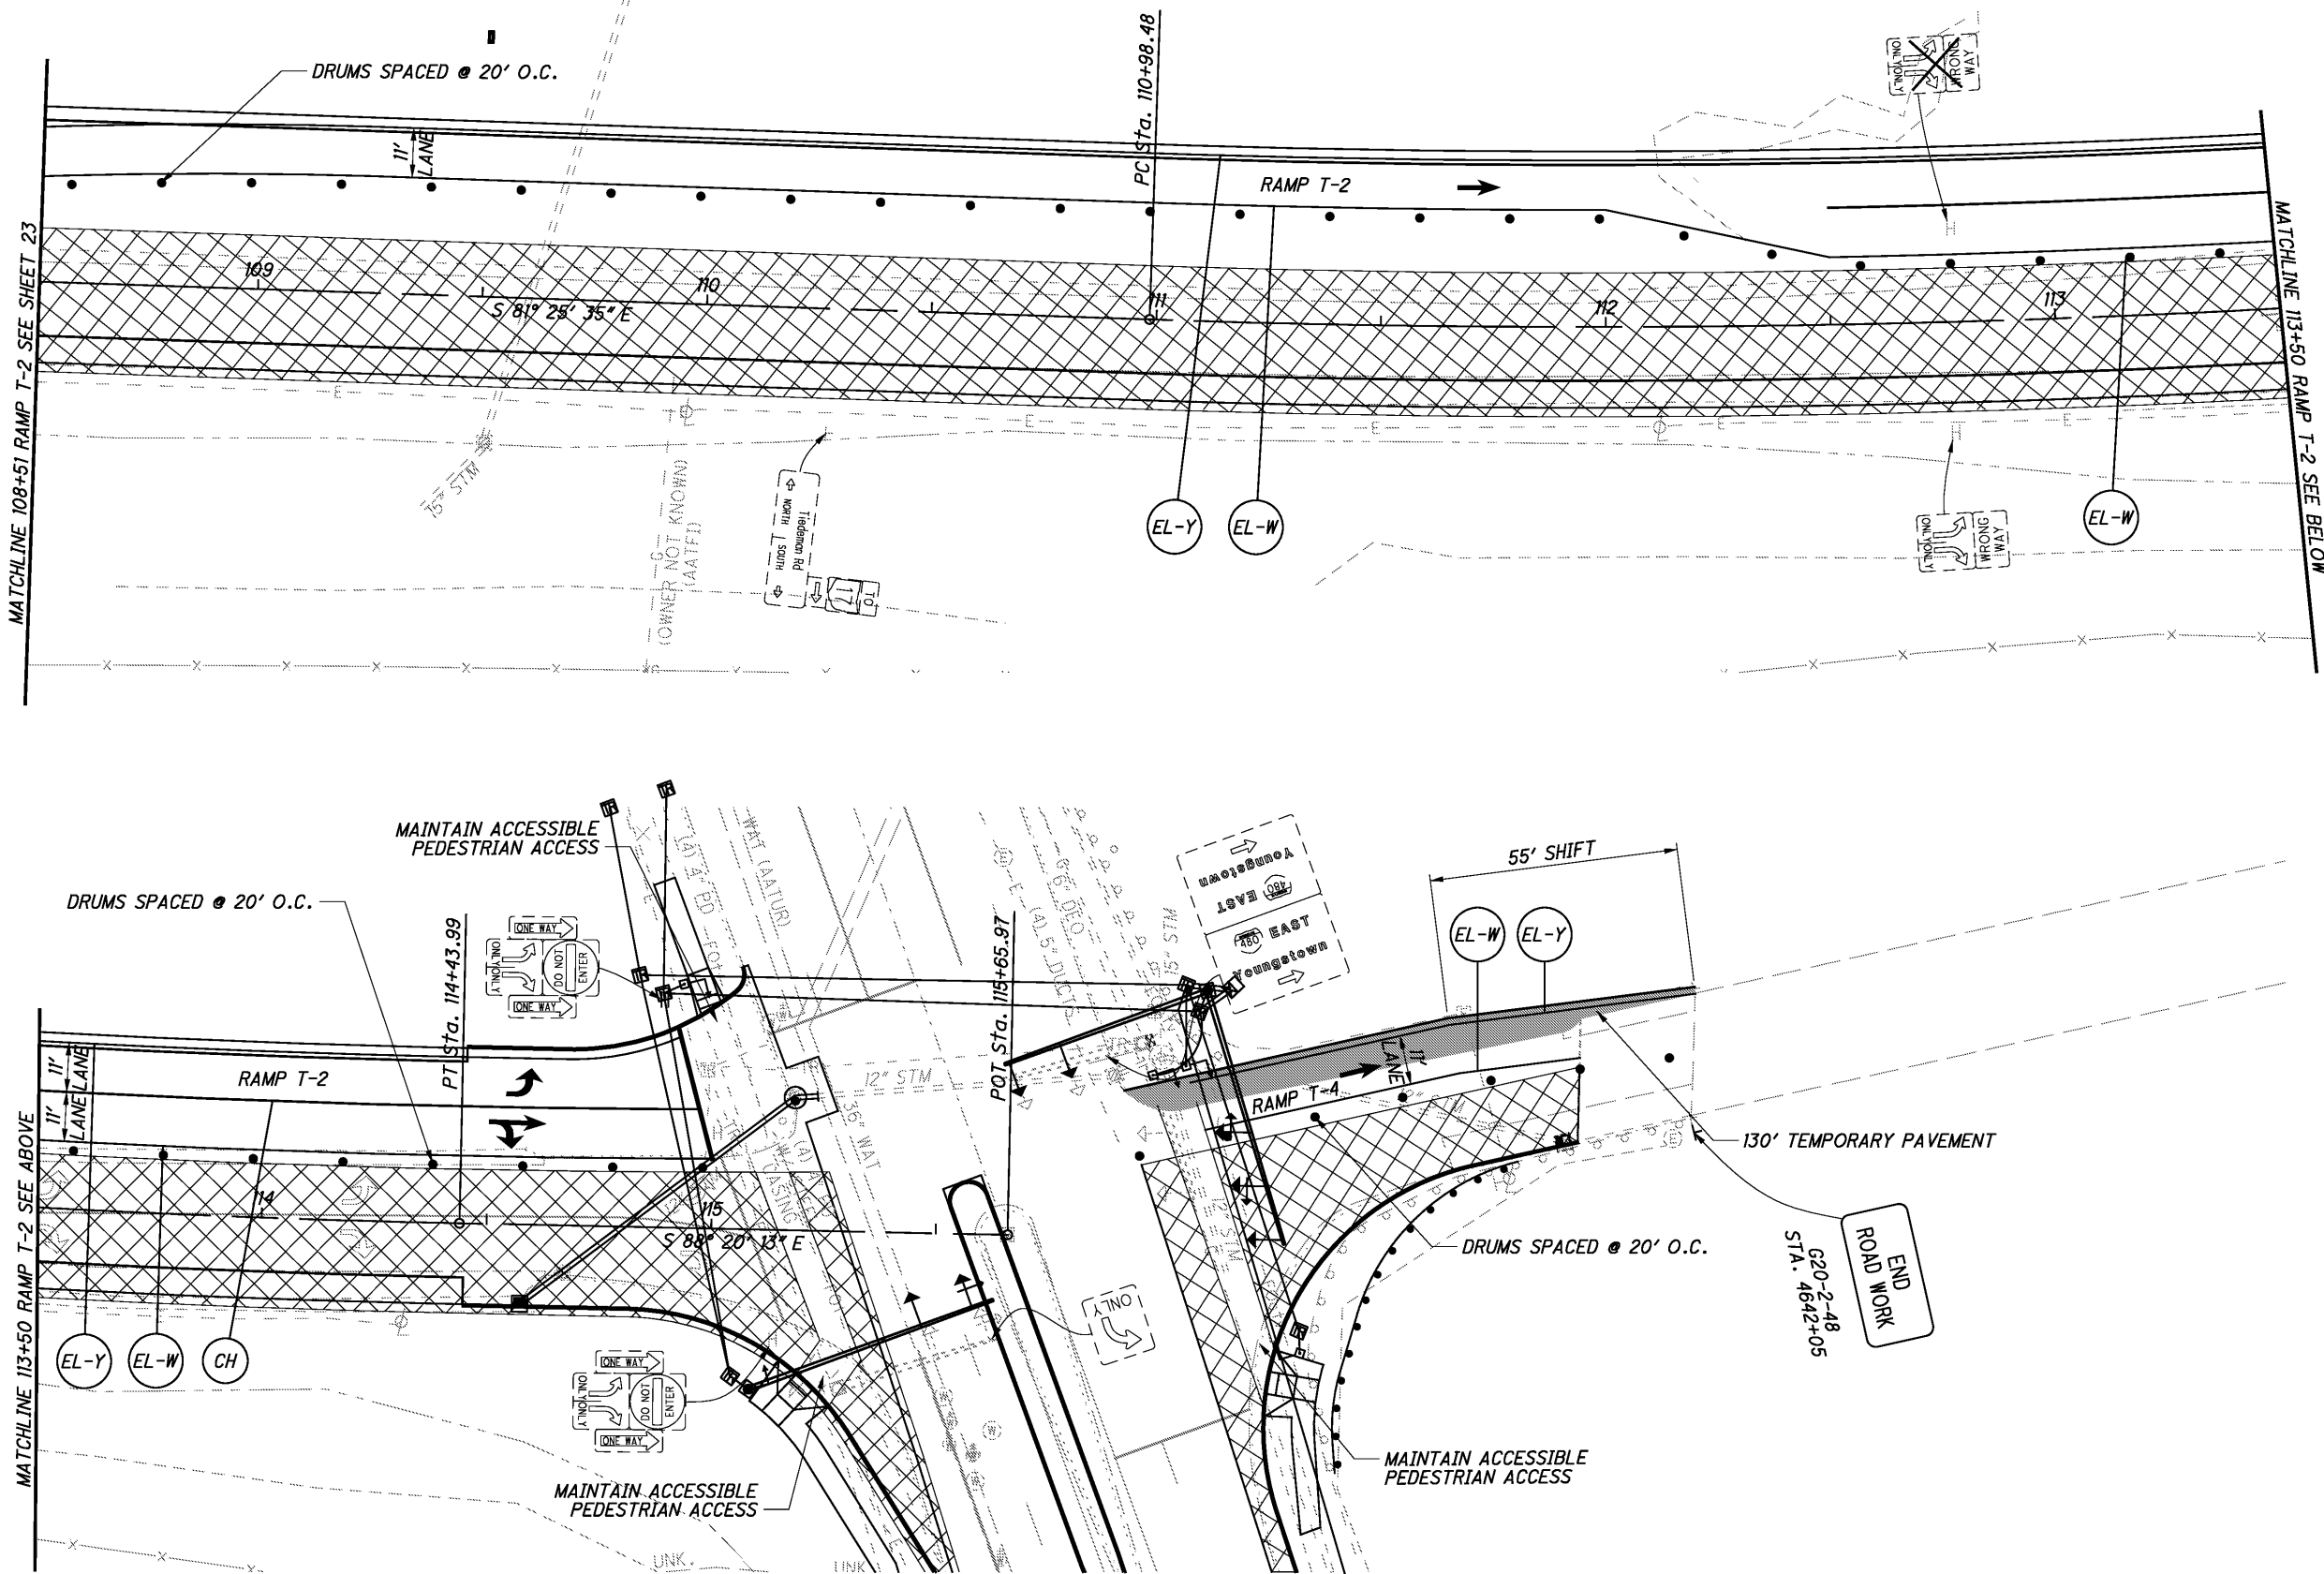

FOR LEGEND, SEE SHEET 23

NOTE:  
FOR MAINTENANCE OF TRAFFIC LEAD IN SIGNAGE ON  
TIEDEMAN ROAD SEE SHEET 18



CALCULATED  
BLW  
CHECKED  
RAM

0 20 40  
HORIZONTAL  
SCALE IN FEET

**MAINTENANCE OF TRAFFIC PLAN - PHASE 2**  
**STA. 108+51 TO STA. 115+65.97 RAMP T-2**

**CUY-480-11.60**

NOTE:  
FOR MAINTENANCE OF TRAFFIC LEAD IN SIGNAGE ON  
TIEDEMAN ROAD SEE SHEET 18

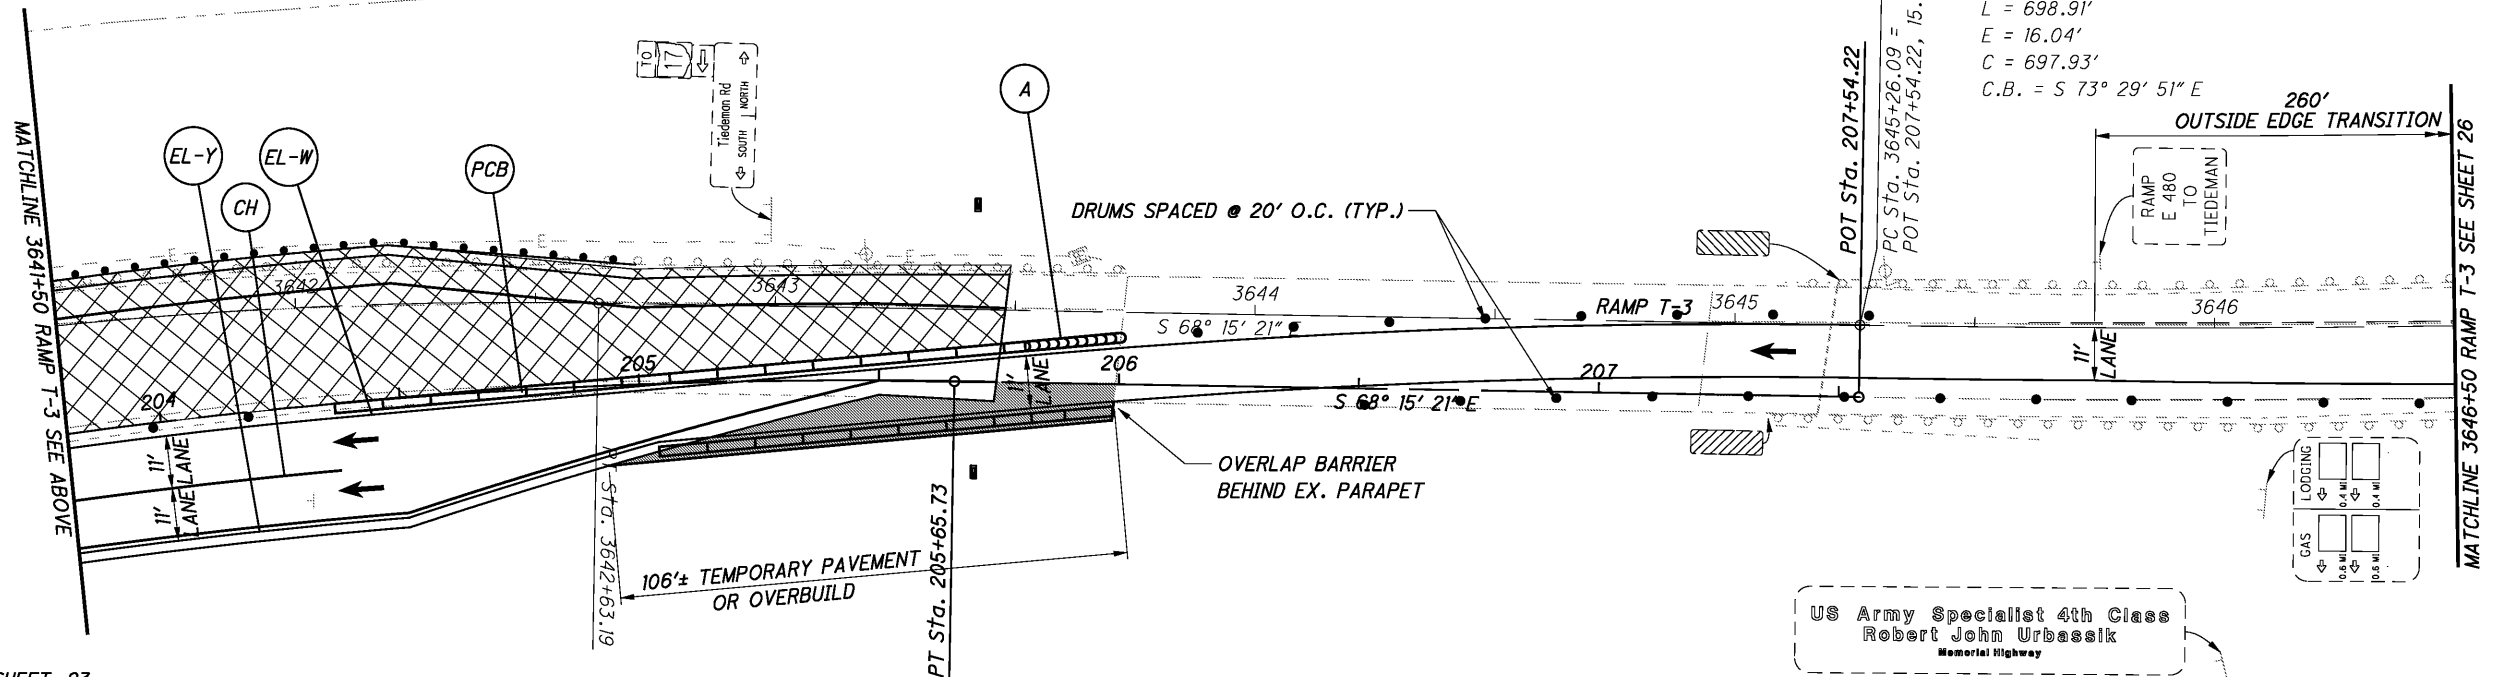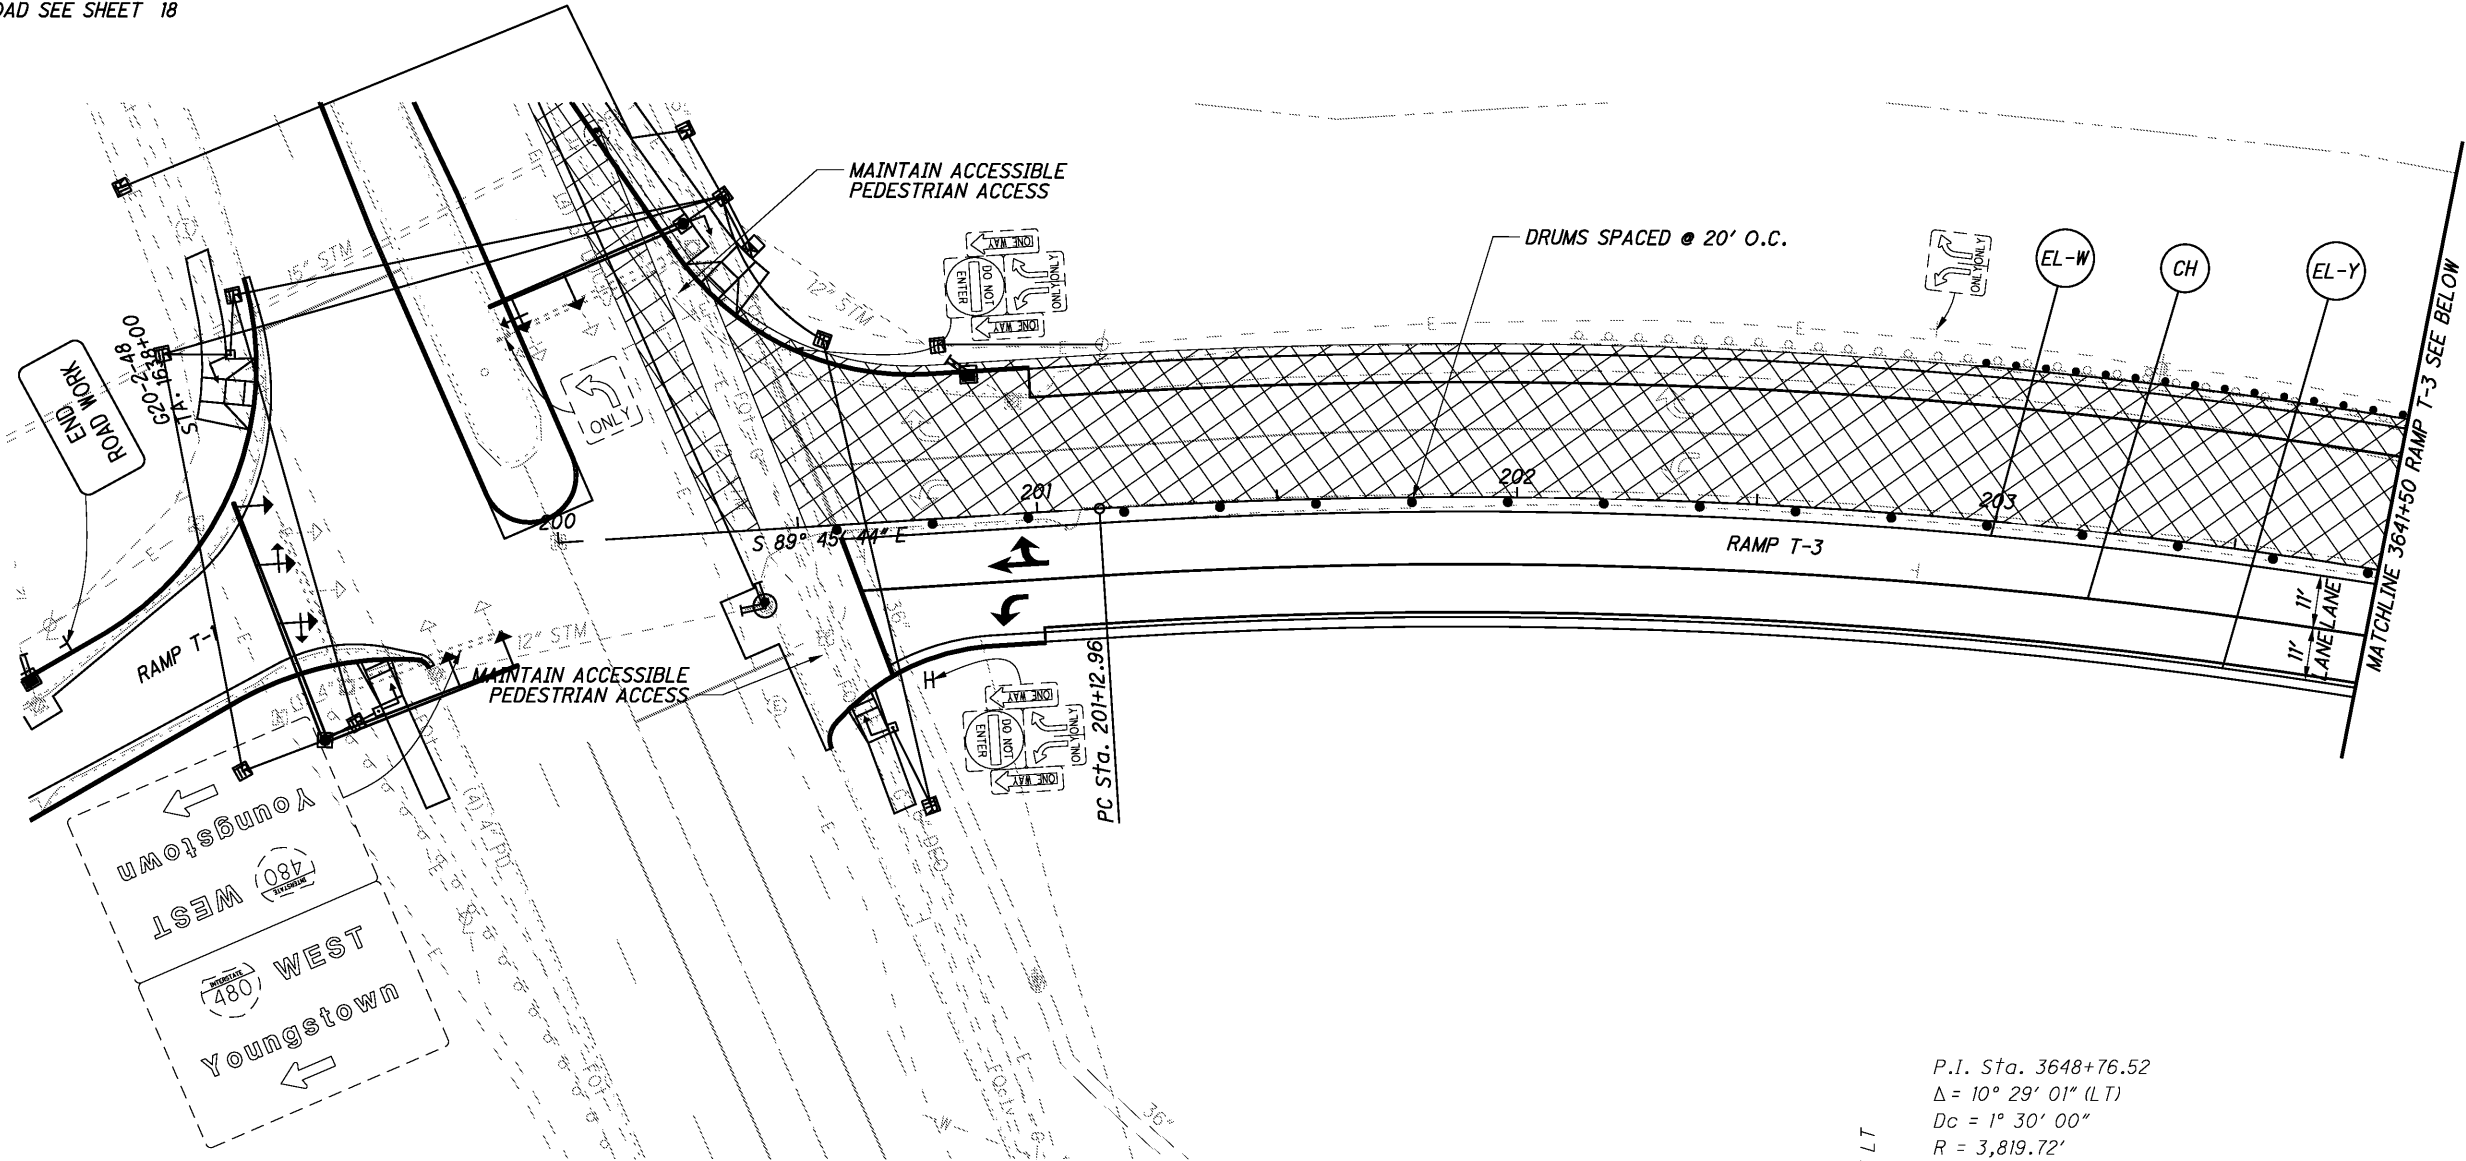

P.I. Sta. 3648+76.52  
 $\Delta = 10^\circ 29' 01''$  (LT)  
 $Dc = 1^\circ 30' 00''$   
 $R = 3,819.72'$   
 $T = 350.43'$   
 $L = 698.91'$   
 $E = 16.04'$   
 $C = 697.93'$   
 $C.B. = S 73^\circ 29' 51'' E$

US Army Specialist 4th Class  
 Robert John Urbassik  
 Memorial Highway



CALCULATED  
 BLW  
 CHECKED  
 RAM



**MAINTENANCE OF TRAFFIC PLAN - PHASE 2**  
**STA. 200+00 TO STA. 3646+50 RAMP T-3**

**CUY-480-11.60**

I:\Projects\18063\MOT\Sheets\94273MP203.dgn 2/5/2015 10:28:42 AM michael.j.thompson

FOR LEGEND, SEE SHEET 23

P.I. Sta. 3648+76.52  
 $\Delta = 10^\circ 29' 01''$  (LT)  
 $Dc = 1^\circ 30' 00''$   
 $R = 3,819.72'$   
 $T = 350.43'$   
 $L = 698.91'$   
 $E = 16.04'$   
 $C = 697.93'$   
 $C.B. = S 73^\circ 29' 51'' E$

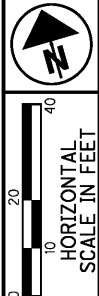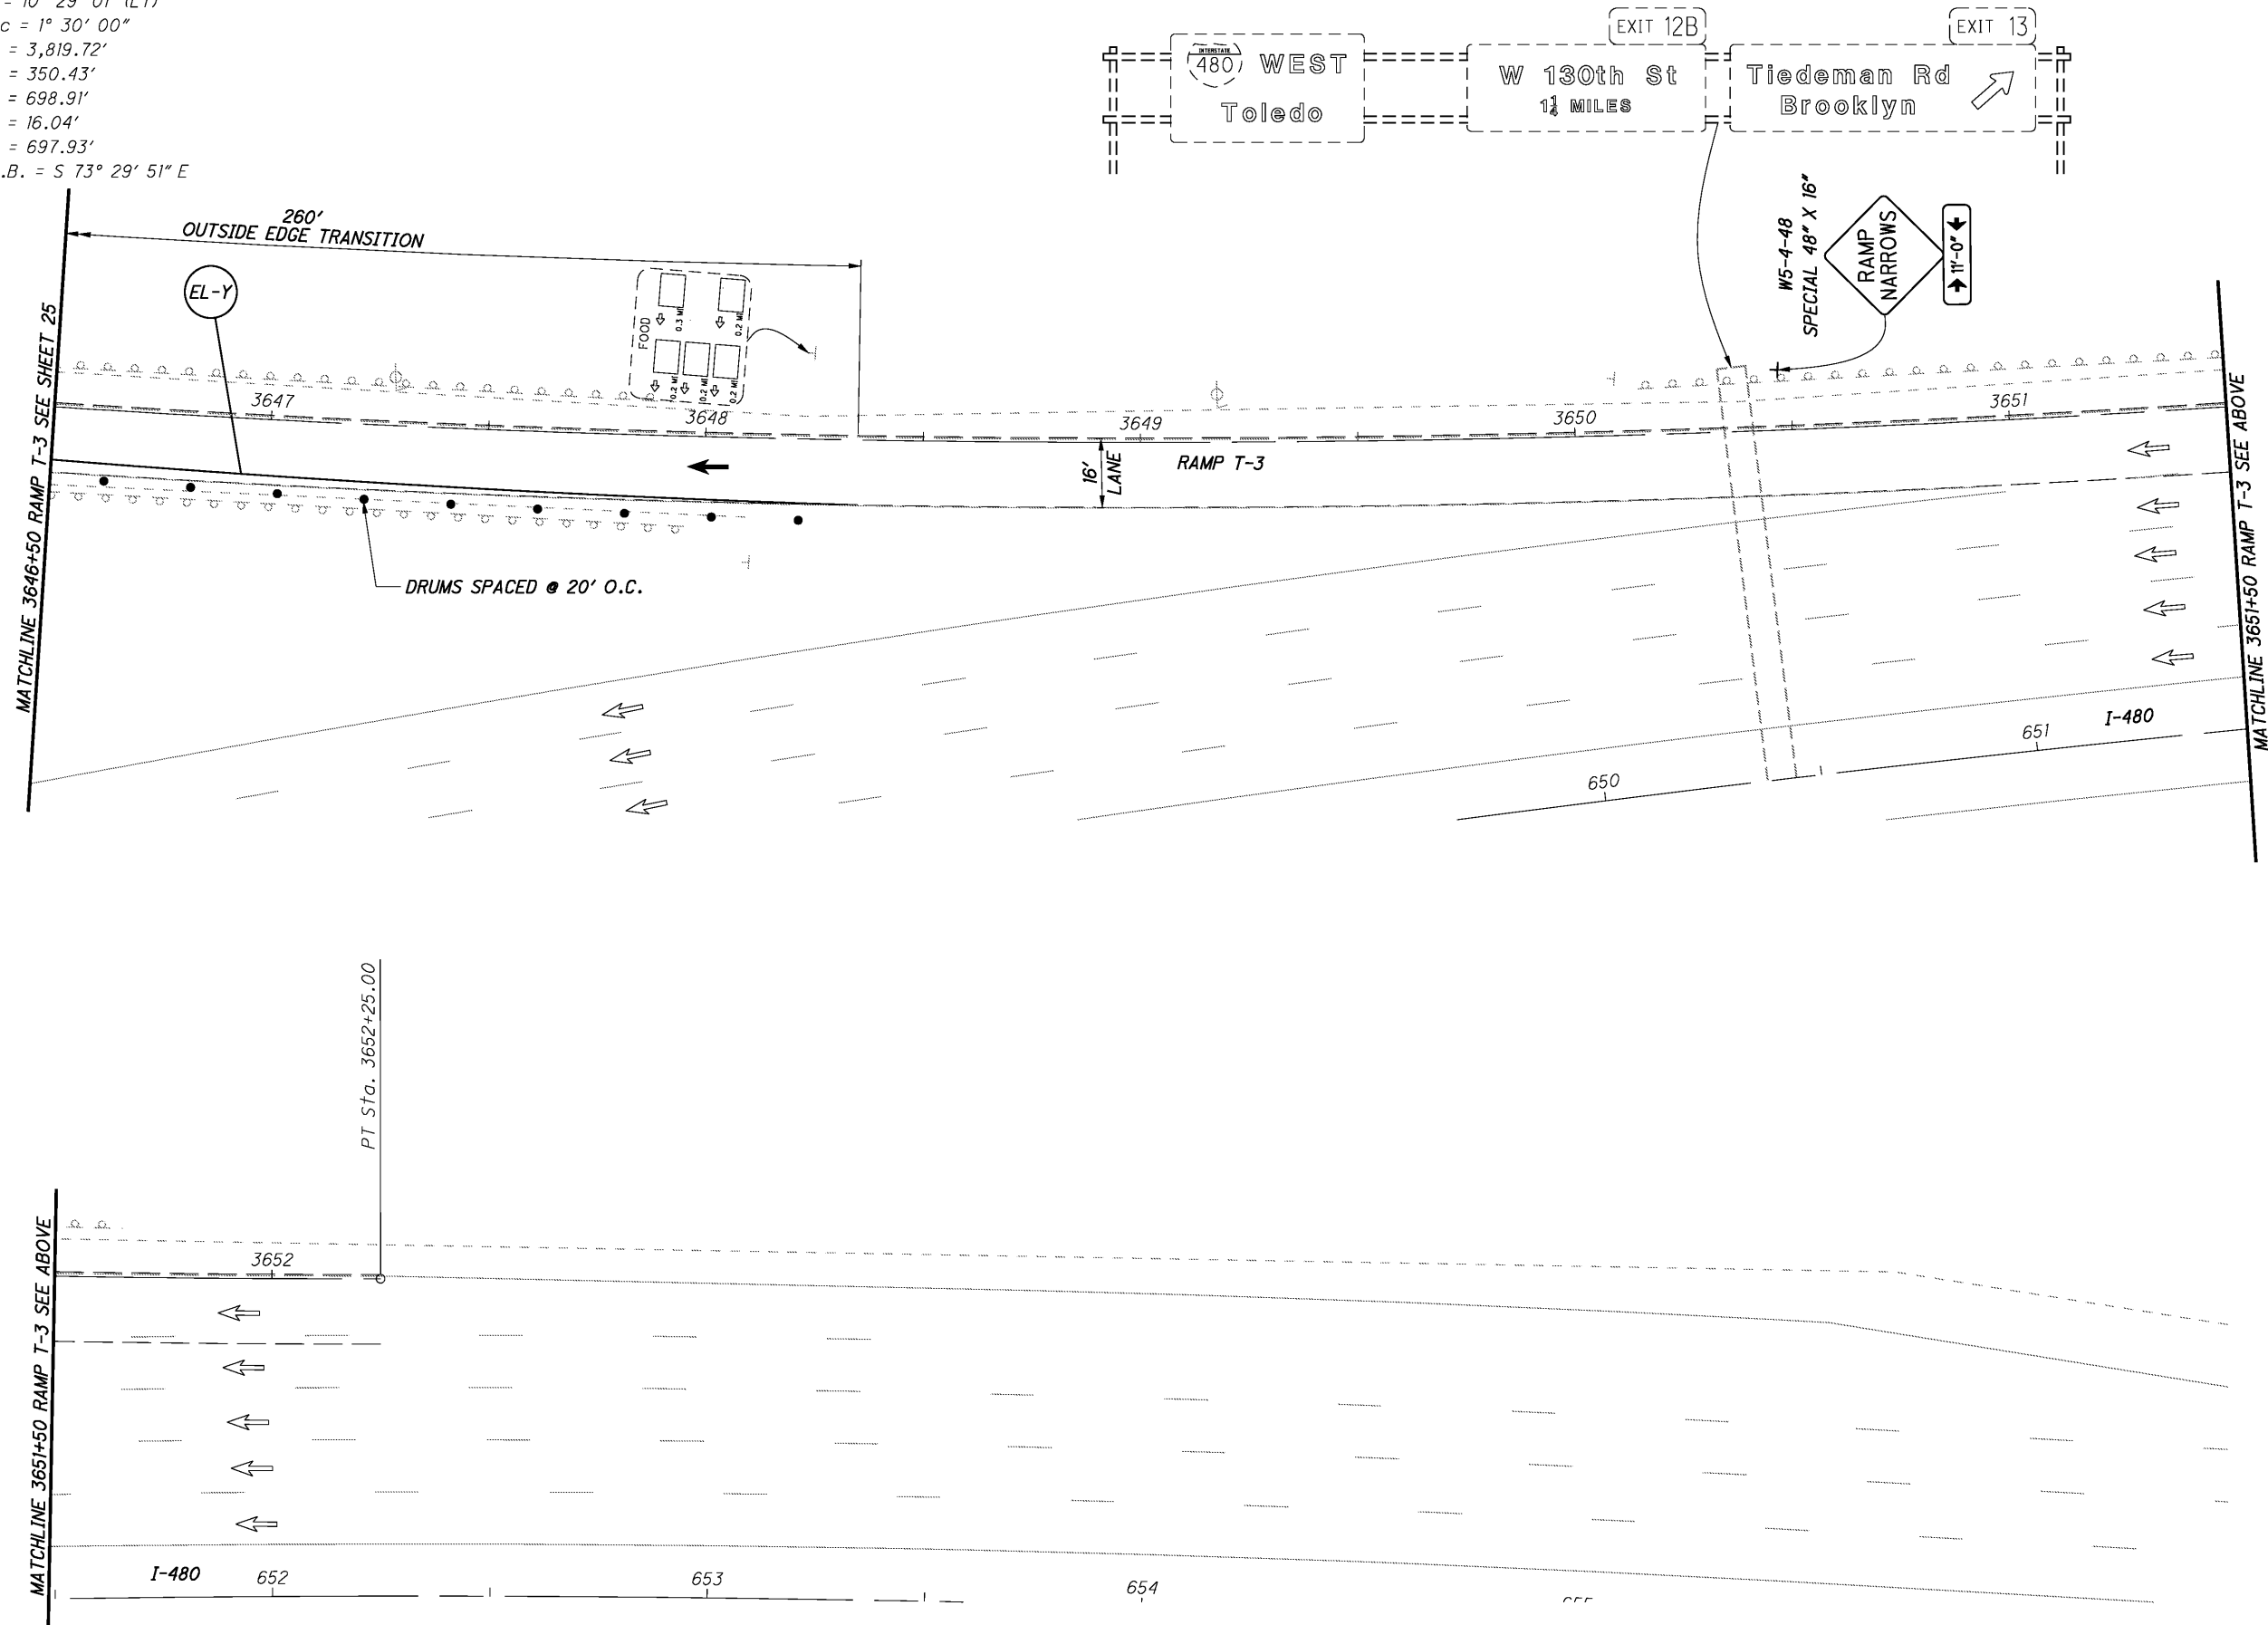

CALCULATED  
 BLW  
 CHECKED  
 RAM


**MAINTENANCE OF TRAFFIC PLAN - PHASE 2**  
**STA. 3646+50 TO STA. 3652+25 RAMP T-3**

**CUY-480-11.60**

I:\Projects\18063\MOT\Sheets\94273MP204.dgn 2/5/2015 10:28:43 AM michael.j.\_thompson


FOR LEGEND, SEE SHEET 23

MATCHLINE STA. 51+00 TEIDEMAN ROAD SEE BELOW

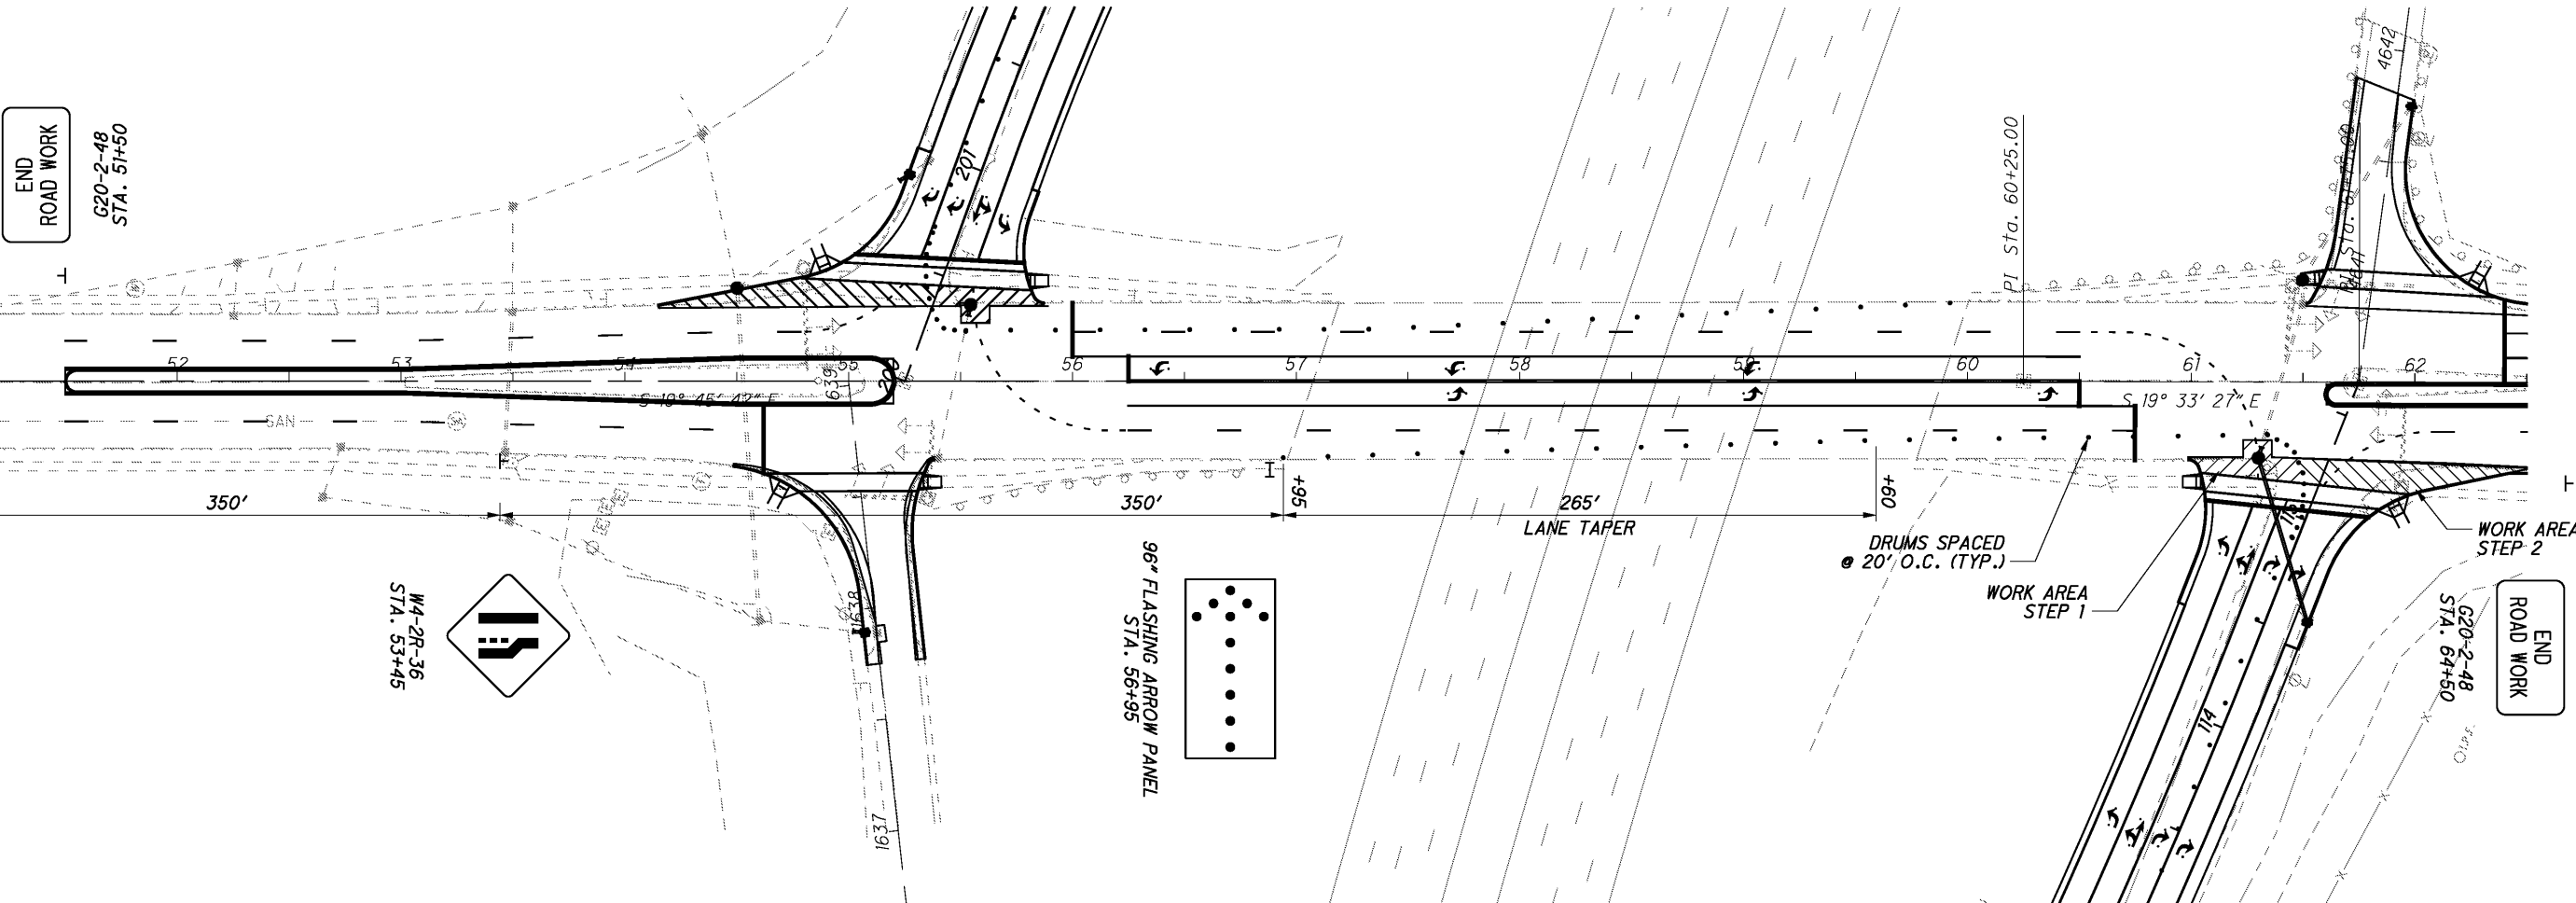

NOTE:

LEO REQUIRED IN INTERSECTION DURING CLOSURE.

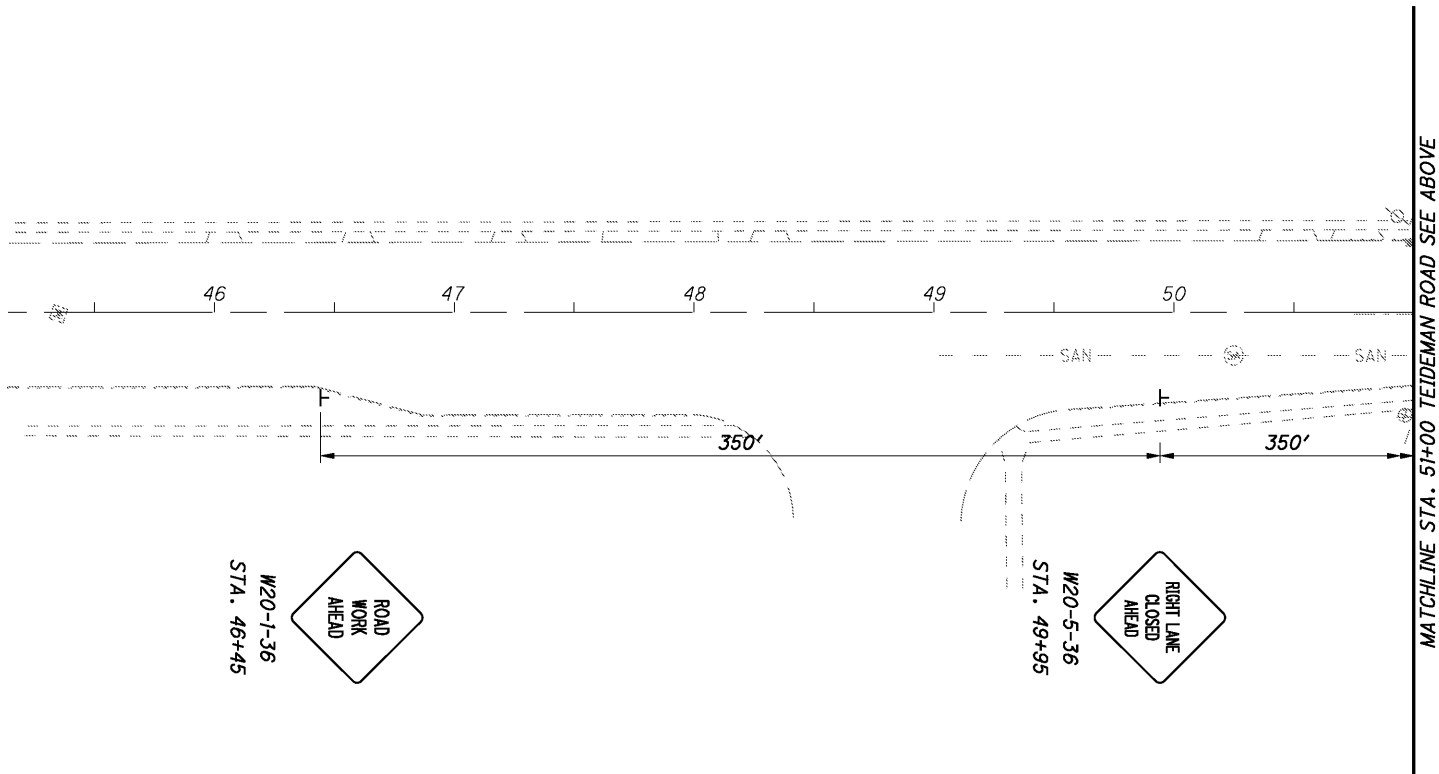


CALCULATED  
BLW  
CHECKED  
RAM


0 20 40 80  
HORIZONTAL  
SCALE IN FEET

**MAINTENANCE OF TRAFFIC - PHASE 3**  
**SOUTHBOUND TIEDEMAN RD AT RAMP T-2**

**CUY - 480 - 11.69**

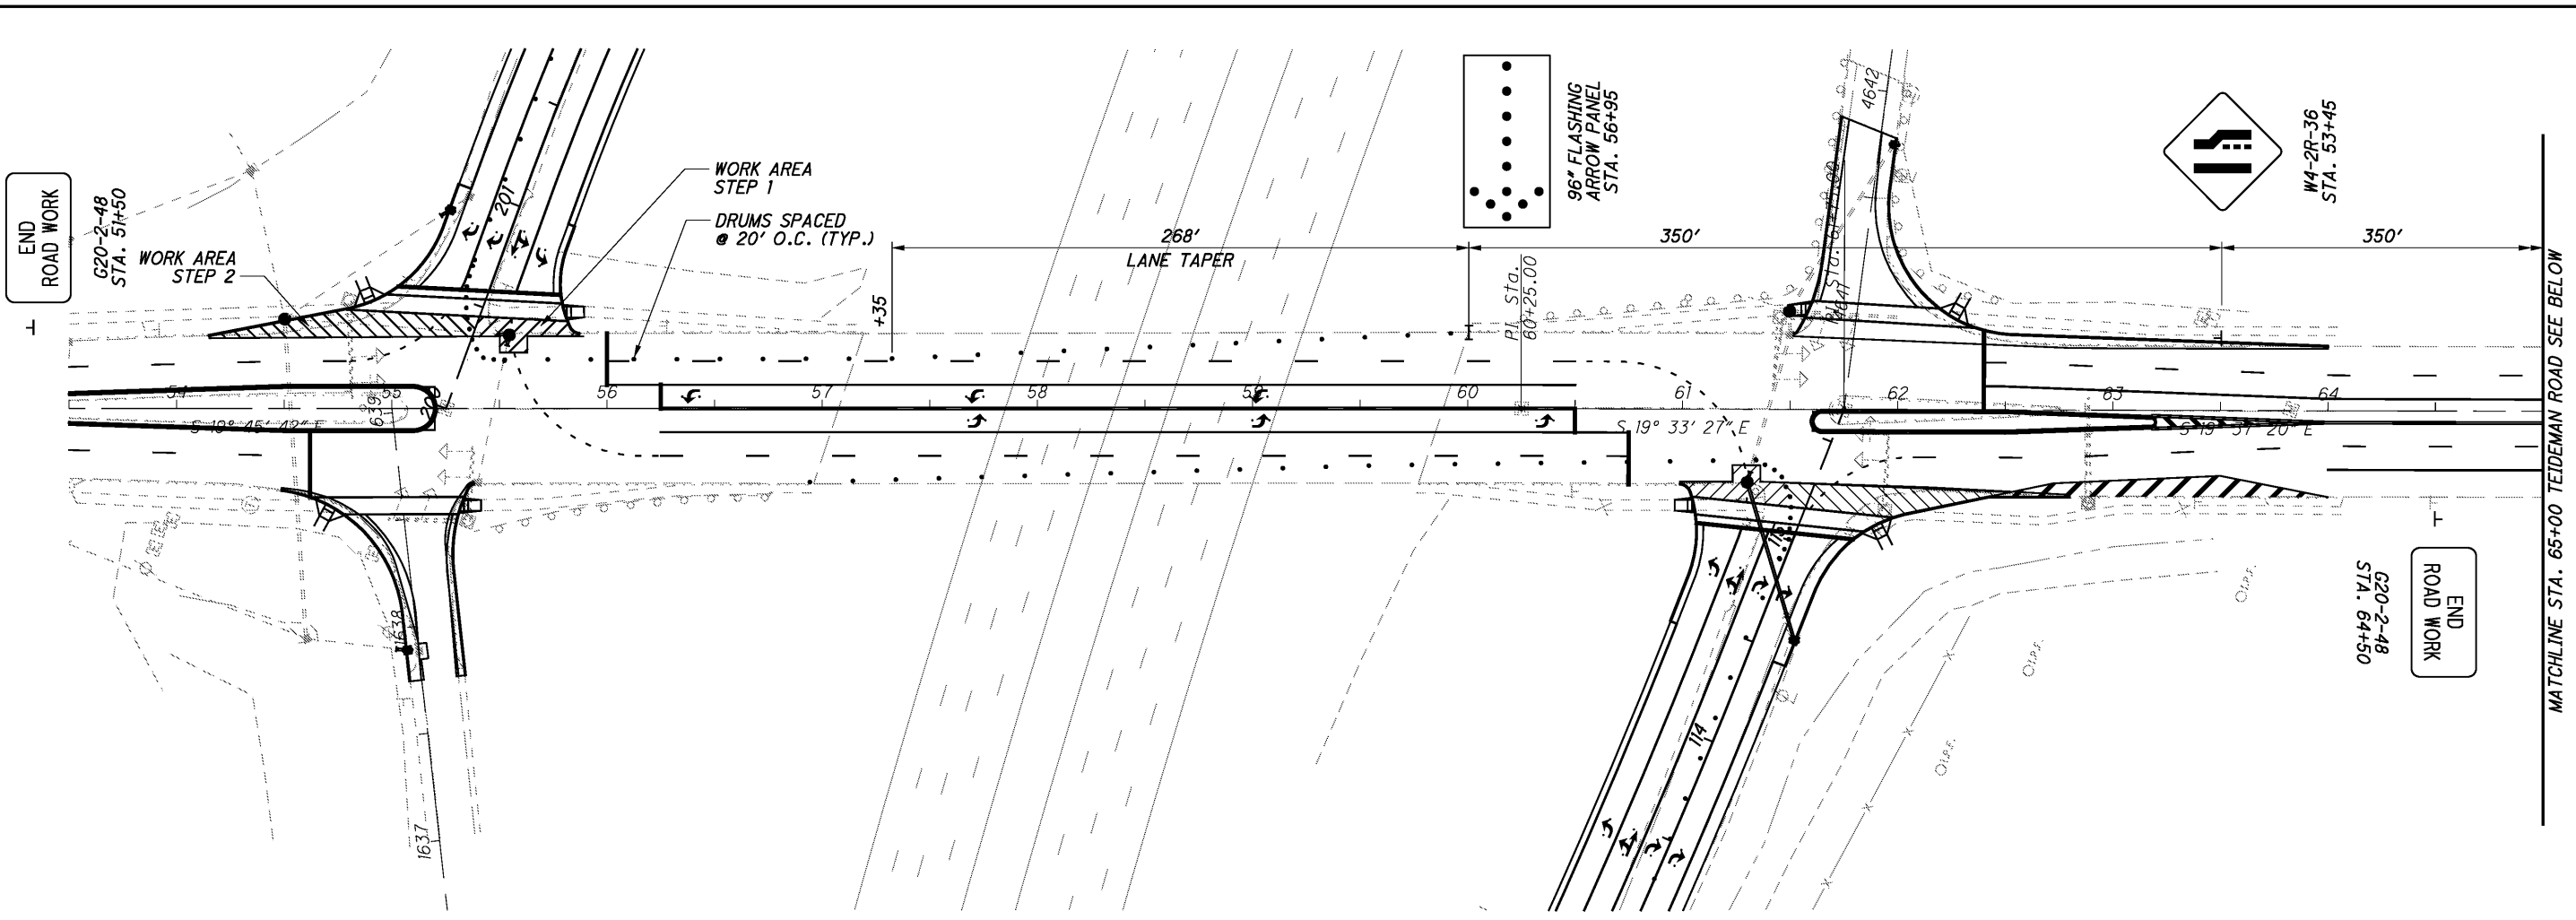

**NOTE:**  
LEO REQUIRED IN INTERSECTION DURING CLOSURE.

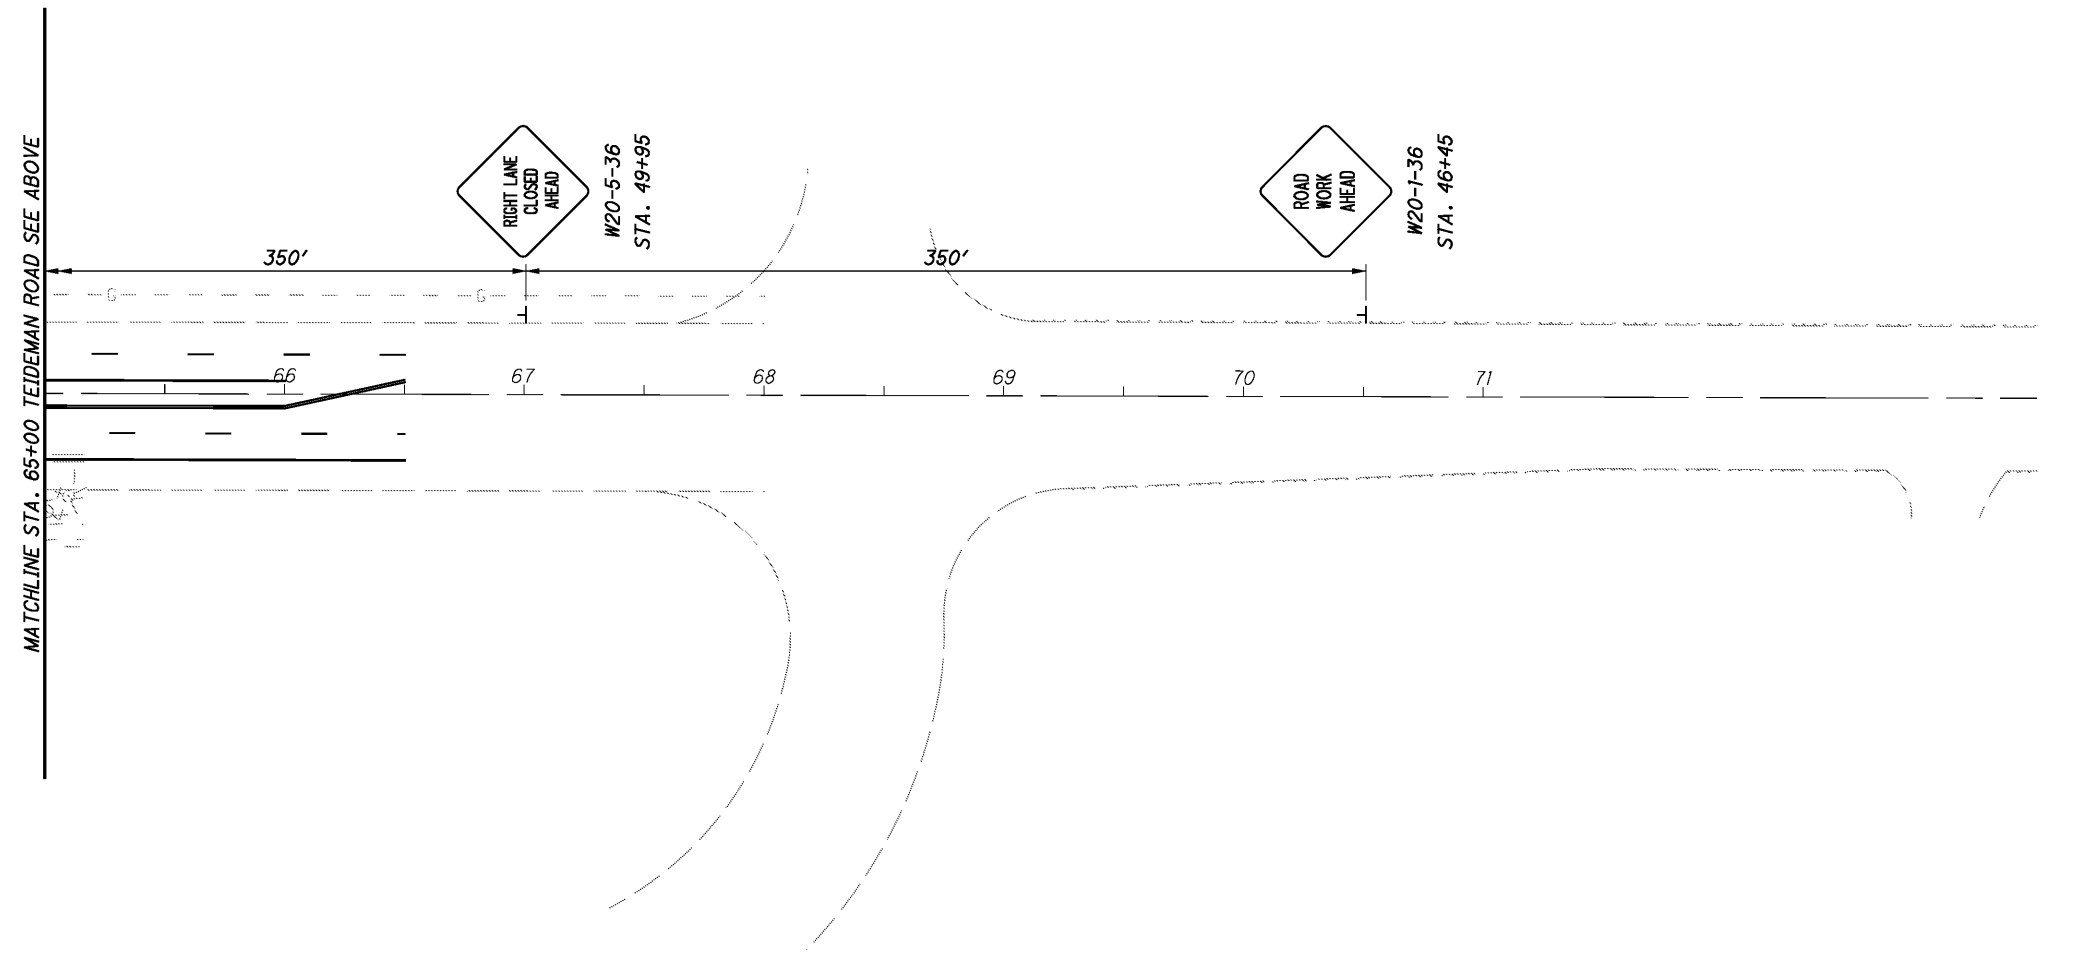

CALCULATED  
BLW  
CHECKED  
RAM

80  
20  
40  
HORIZONTAL  
SCALE IN FEET

**MAINTENANCE OF TRAFFIC - PHASE 3**  
**NORTHBOUND TIEDEMAN RD AT RAMP T-3**

**CUY - 480 - 11.69**




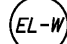
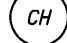

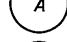

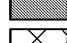
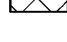



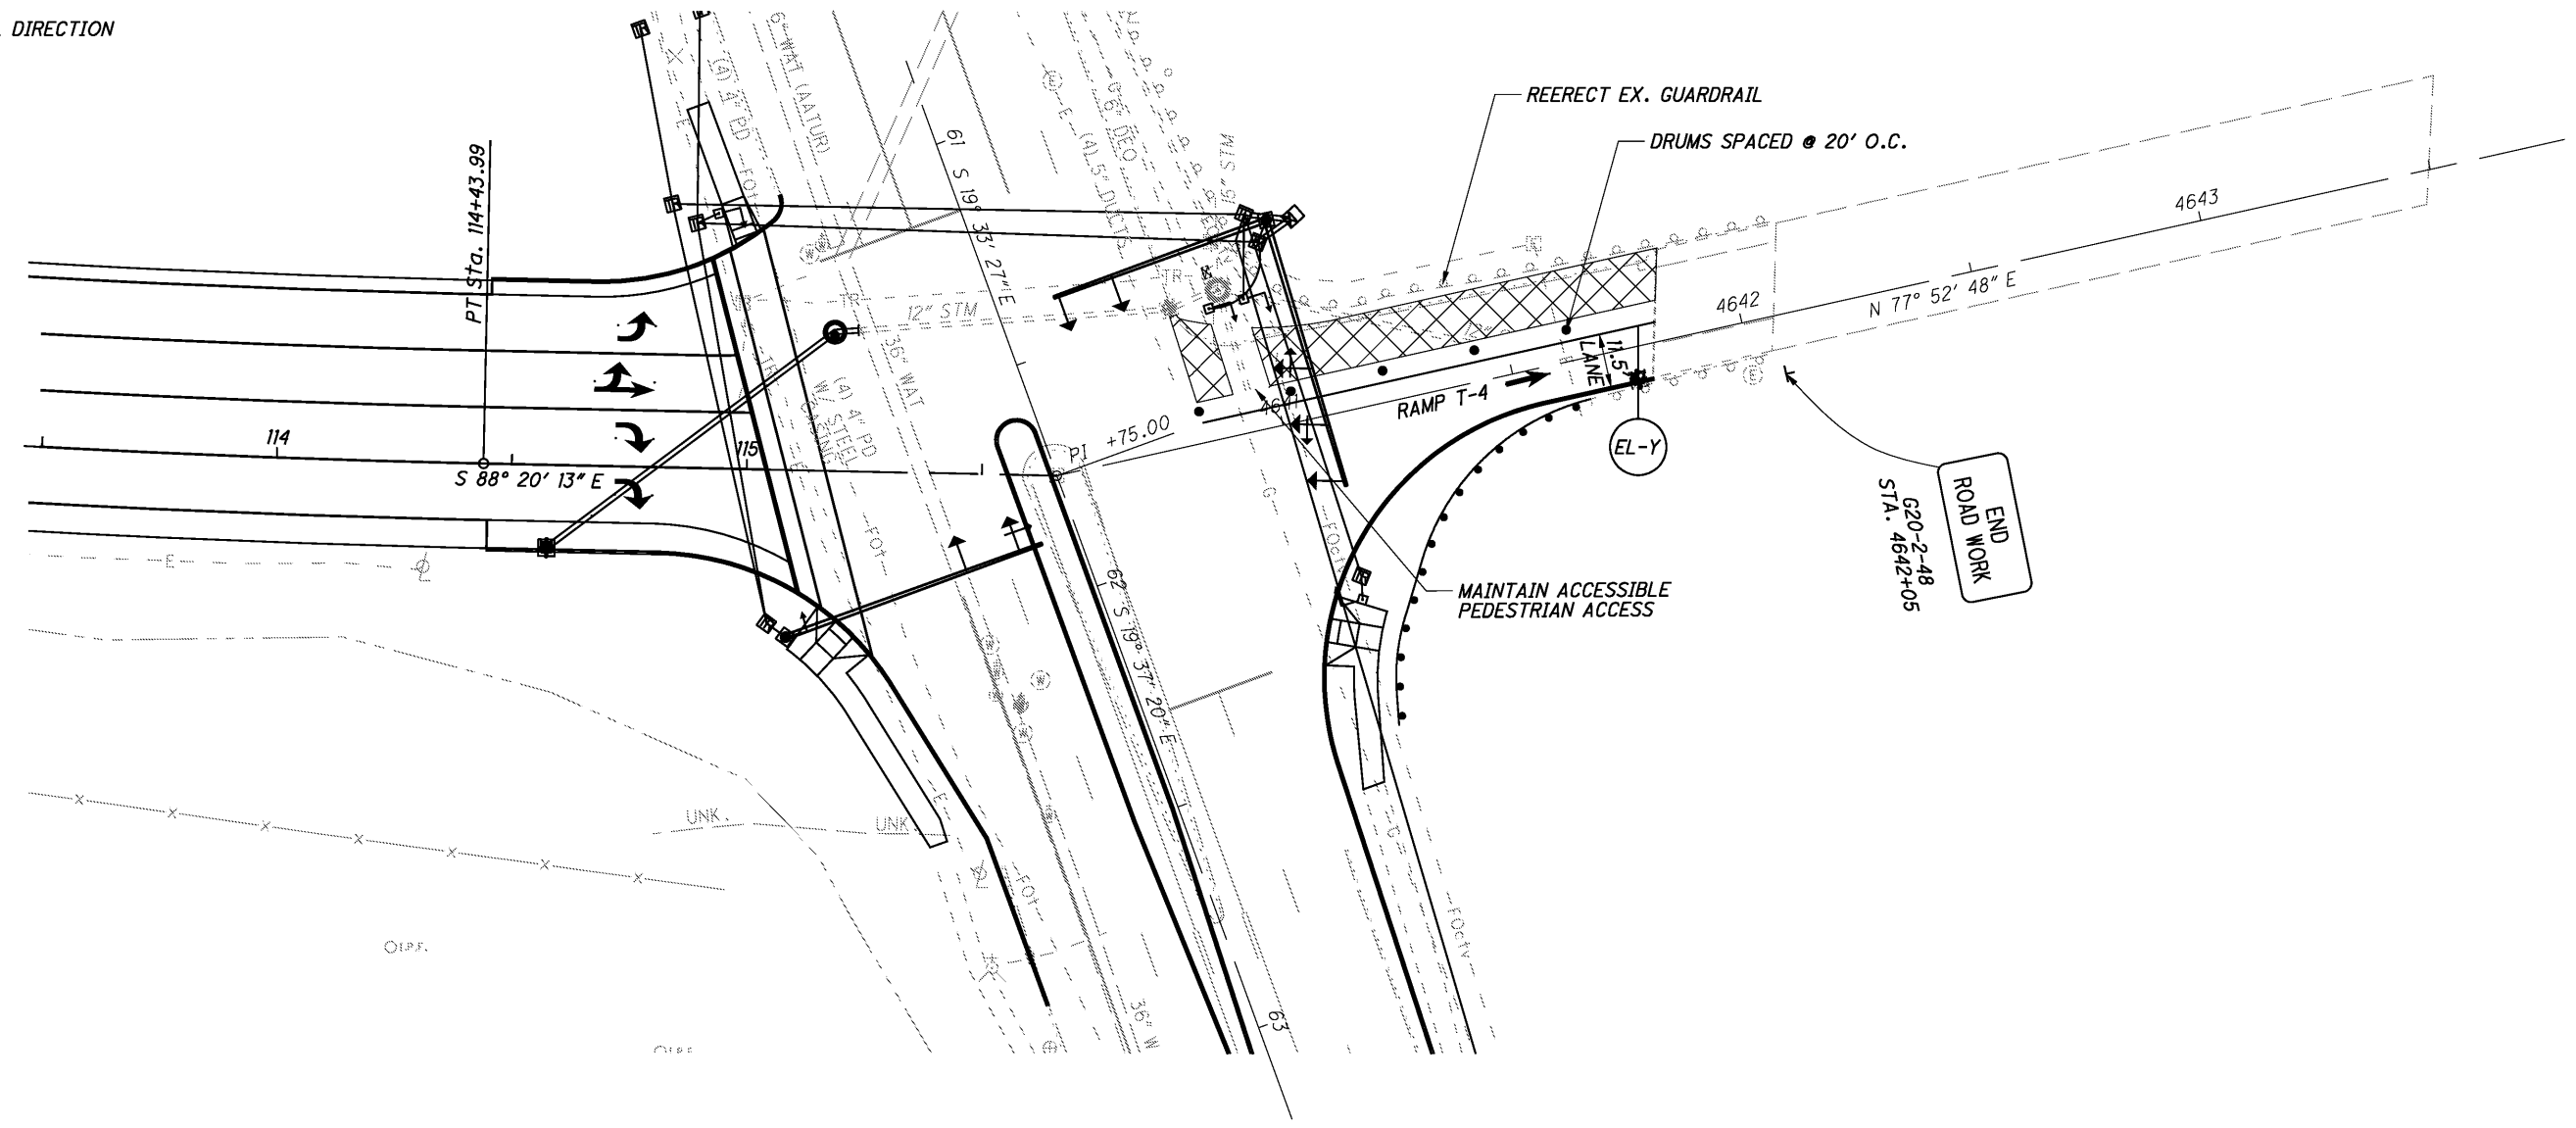
CALCULATED	BLW	CHECKED	RAM
------------	-----	---------	-----

**MAINTENANCE OF TRAFFIC PLAN - PHASE 3  
RAMP T-4**

**CUY - 480 - 11.60**

**LEGEND**

-  EDGE LINE - YELLOW
-  EDGE LINE - WHITE
-  CHANNELIZING LINE
-  STOP LINE
-  ATTENUATOR
-  PORTABLE CONCRETE BARRIER
-  TEMPORARY PAVEMENT AREA
-  CONSTRUCTION AREA
-  TRAVEL DIRECTION




**NOTE:**  
FOR MAINTENANCE OF TRAFFIC LEAD IN SIGNAGE ON  
TIEDEMAN ROAD SEE SHEET 18

FOR LEGEND, SEE SHEET 23


I:\Projects\18063\MOT\Sheets\94273MP303.dgn 2/5/2015 10:28:47 AM michael.j.thompson

5" x 5" by 3" deep  
Lifting Hook cutouts  
(Typical of 3)


Fabricate 5 anchor holes on each  
side using the method shown on  
Structural Engineering's SCD PCB-91

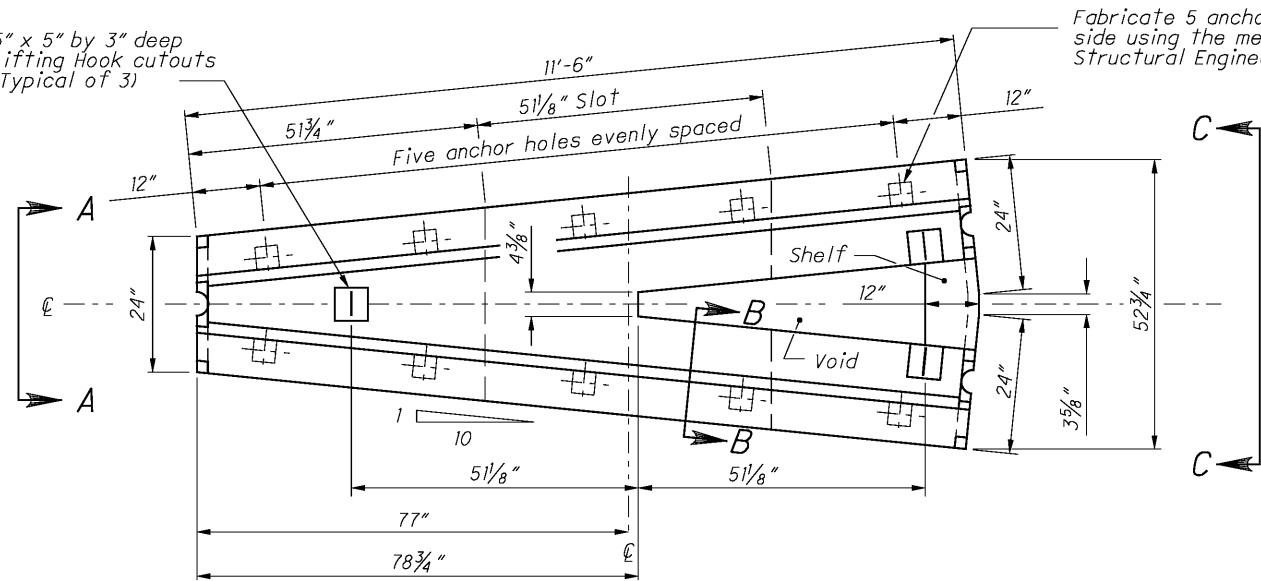


PLAN

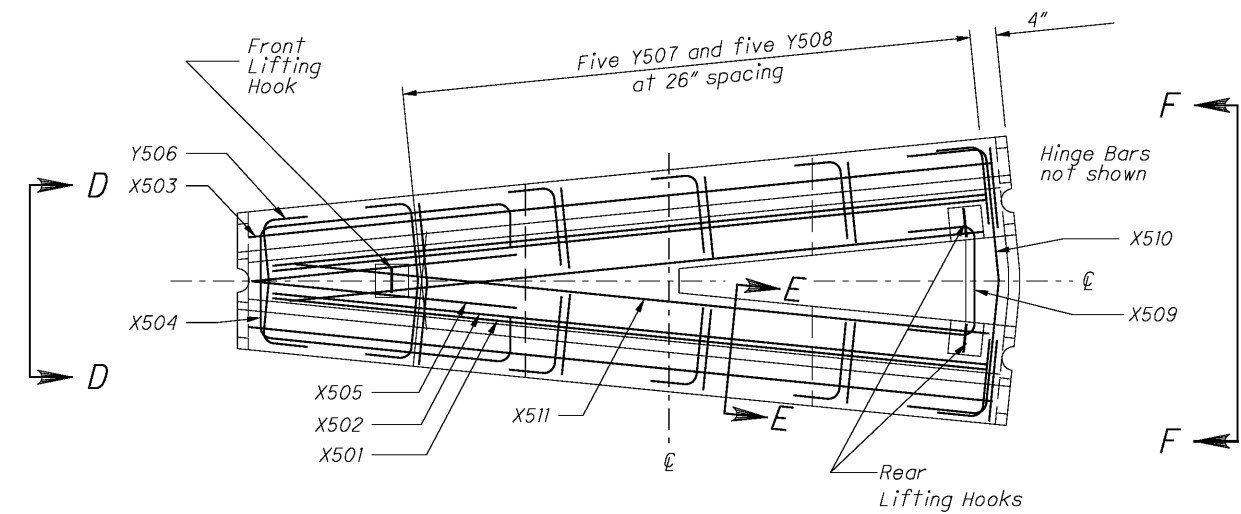


REINFORCING PLAN VIEW

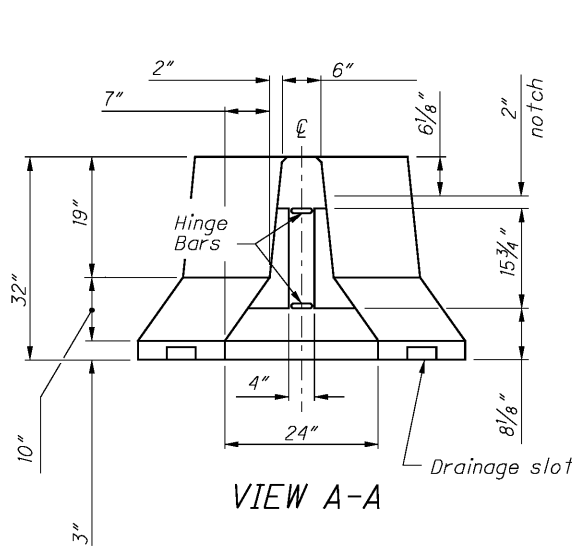

VIEW A-A

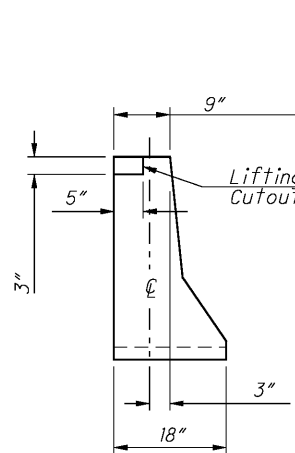

SECTION B-B

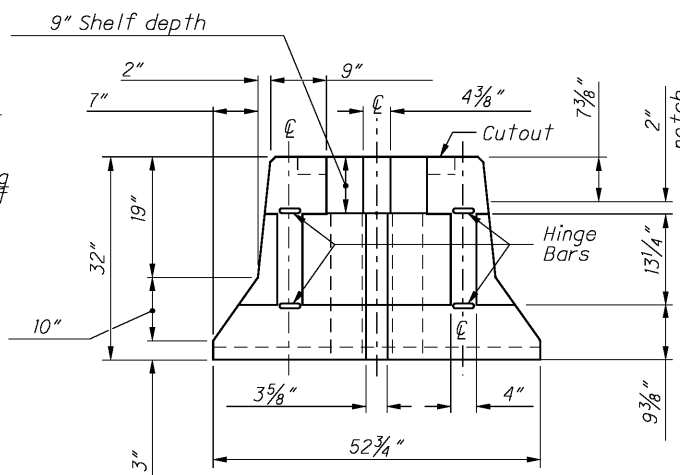

VIEW C-C

NOTES

**GENERAL:** This barrier segment is used to split one run of portable concrete barrier into dual runs. Attach directly to ODOT's 32" PCB; however, other approved barrier shapes may be connected to this segment by the use of an appropriate transition unit. Attach at least one standard PCB segment in between this "Y" and an Impact Attenuator. Its field application is shown in MOT plans and on MT standard drawings. Do not use this barrier in an unanchored configuration next to bridge deck edges or similar dropoffs, anchor according to method shown on PCBDD or other approved method.


**BARRIER DETAILS:** Use SCD RM-4.2 for details not shown here, including the geometry of this pin and loop segment matches in every way the design of the end connections shown on the HINGED CONNECTION and JOINT CONNECTION Details (the alternate J-J Hooks connection design is permitted). Additionally, barrier edges may be radiused or chamfered as per the LEGEND Note, barrier is to be permanently marked as mentioned in the MARKINGS Note, and delineate as per the REFLECTORIZATON Note.

**MATERIAL SPECIFICATIONS:** The minimum design strength of the concrete is 4,000 psi and meets the requirements of CMS 499. For reinforcing steel, use ASTM A615 Grade 60 black steel and provide 2" min. rebar cover. Material specifications for the Hinge and Reinforcing Bars, as well as the Connecting Hardware may be found on SCD RM-4.2. For additional material specifications not shown here, see SCD RM-4.2 and CMS 622.


**HANDLING:** The fabricator is responsible for the design of a lifting system for handling segments. As a minimum, use three lifting points at the locations suggested in the Plan views, and design with a lifting factor of safety of 4. Any protrusions from the lifting hook design is not to affect the crash worthiness of the barrier. The calculations shall be signed, sealed and dated by a Registered Engineer and include these calculations with the Manufacturing Drawings required by Supplement 1073.12. Refer to Part 5 of the PCI Handbook. Approximate segment weight is 8,500 lbs [3850 kg].

**PAYMENT:** Payment will be made under Item 622 - Portable Barrier, "Y" Connector, Each, and will include all forms, materials and labor to cast this segment.


**ALTERNATE METHOD:** Contractors may choose to use a wide Impact Attenuator in lieu of the concrete "Y" alternate. The chosen unit will be a Type 2 or 3 Impact Attenuator matching the product previously called for on the project plans at the expected installation location.

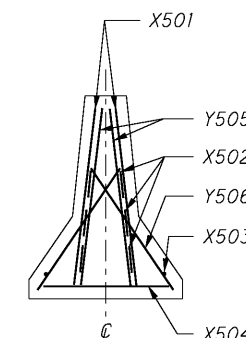

VIEW D-D

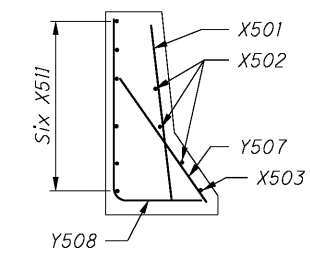


SECTION E-E

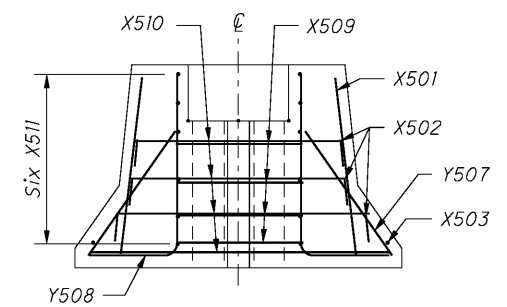

VIEW F-F

REINFORCING DETAILS

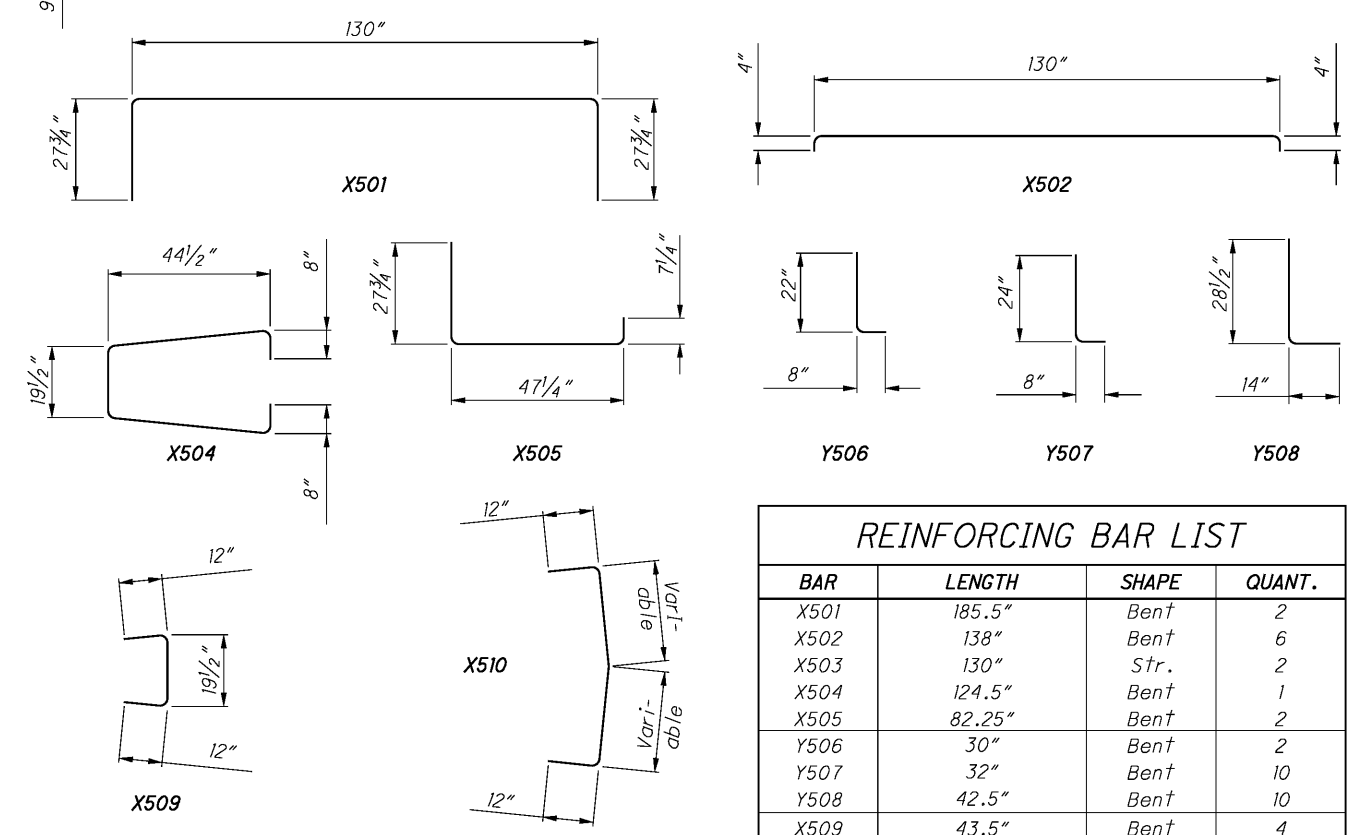

BENDING DIAGRAMS

REINFORCING BAR LIST			
BAR	LENGTH	SHAPE	QUANT.
X501	185.5"	Bent	2
X502	138"	Bent	6
X503	130"	Str.	2
X504	124.5"	Bent	1
X505	82.25"	Bent	2
Y506	30"	Bent	2
Y507	32"	Bent	10
Y508	42.5"	Bent	10
X509	43.5"	Bent	4
X510	Varies	Bent	4
X511	124"	Str.	12

I:\Projects\18063\MOT\Sheets\94273MM001.dgn 2/5/2015 10:28:47 AM michael.j.thompson


START STATION (RAMP T-2)	END STATION (RAMP T-2)	SIDE	FILTER STRIP WIDTH (FT)	PAVEMENT WIDTH TREATED (FT)	AREA CREDITED FOR TREATMENT (ACRES)
104+00.00	110+21.00	LEFT	15	3	0.26
104+00.00	105+00.00	RIGHT	15	22	0.09
105+00.00	107+08.00	RIGHT	25	29 (AVERAGE)	0.26
110+21.00	114+44.00	RIGHT	15	6	0.22
TOTAL TREATMENT AREA:					0.83

THE TOTAL TREATMENT AREA EXCEEDS THE REQUIRED 0.76-ACRES.

ESTIMATED QUANTITIES CARRIED TO GENERAL SUMMARY			
ITEM	DESCRIPTION	ESTIMATED QUANTITY	UNIT
670	SLOPE EROSION PROTECTION MAT, TYPE A	2602	SY
832	PERIMETER FILTER FABRIC FENCE	1415	FT
832	FILTER FABRIC DITCH CHECK	125	FT
832	INLET PROTECTION	208	FT

**PROJECT DESCRIPTION**

IMPROVEMENTS WILL INCLUDE THE RECONSTRUCTION OF 0.21 MILES OF THE I-480 EASTBOUND EXIT RAMP TO TIEDEMAN ROAD; THE RECONSTRUCTION OF 0.10 MILES OF THE I-480 WESTBOUND EXIT RAMP TO TIEDEMAN ROAD; MINOR WIDENING OF THE ENTRANCE RAMP; THE UPGRADED SIGNALIZATION OF THE EXIT/ENTRANCE RAMP INTERSECTIONS WITH TIEDEMAN ROAD; SIGNAL RETIMING AND COORDINATION ALONG TIEDEMAN ROAD BETWEEN BROOKPARK ROAD AND BIDDULPH ROAD INCLUDING NEW CURBS, RAISED CONCRETE MEDIANS, CURB RAMPS, DRAINAGE, NEW SIGNING AND PAVEMENT MARKINGS.

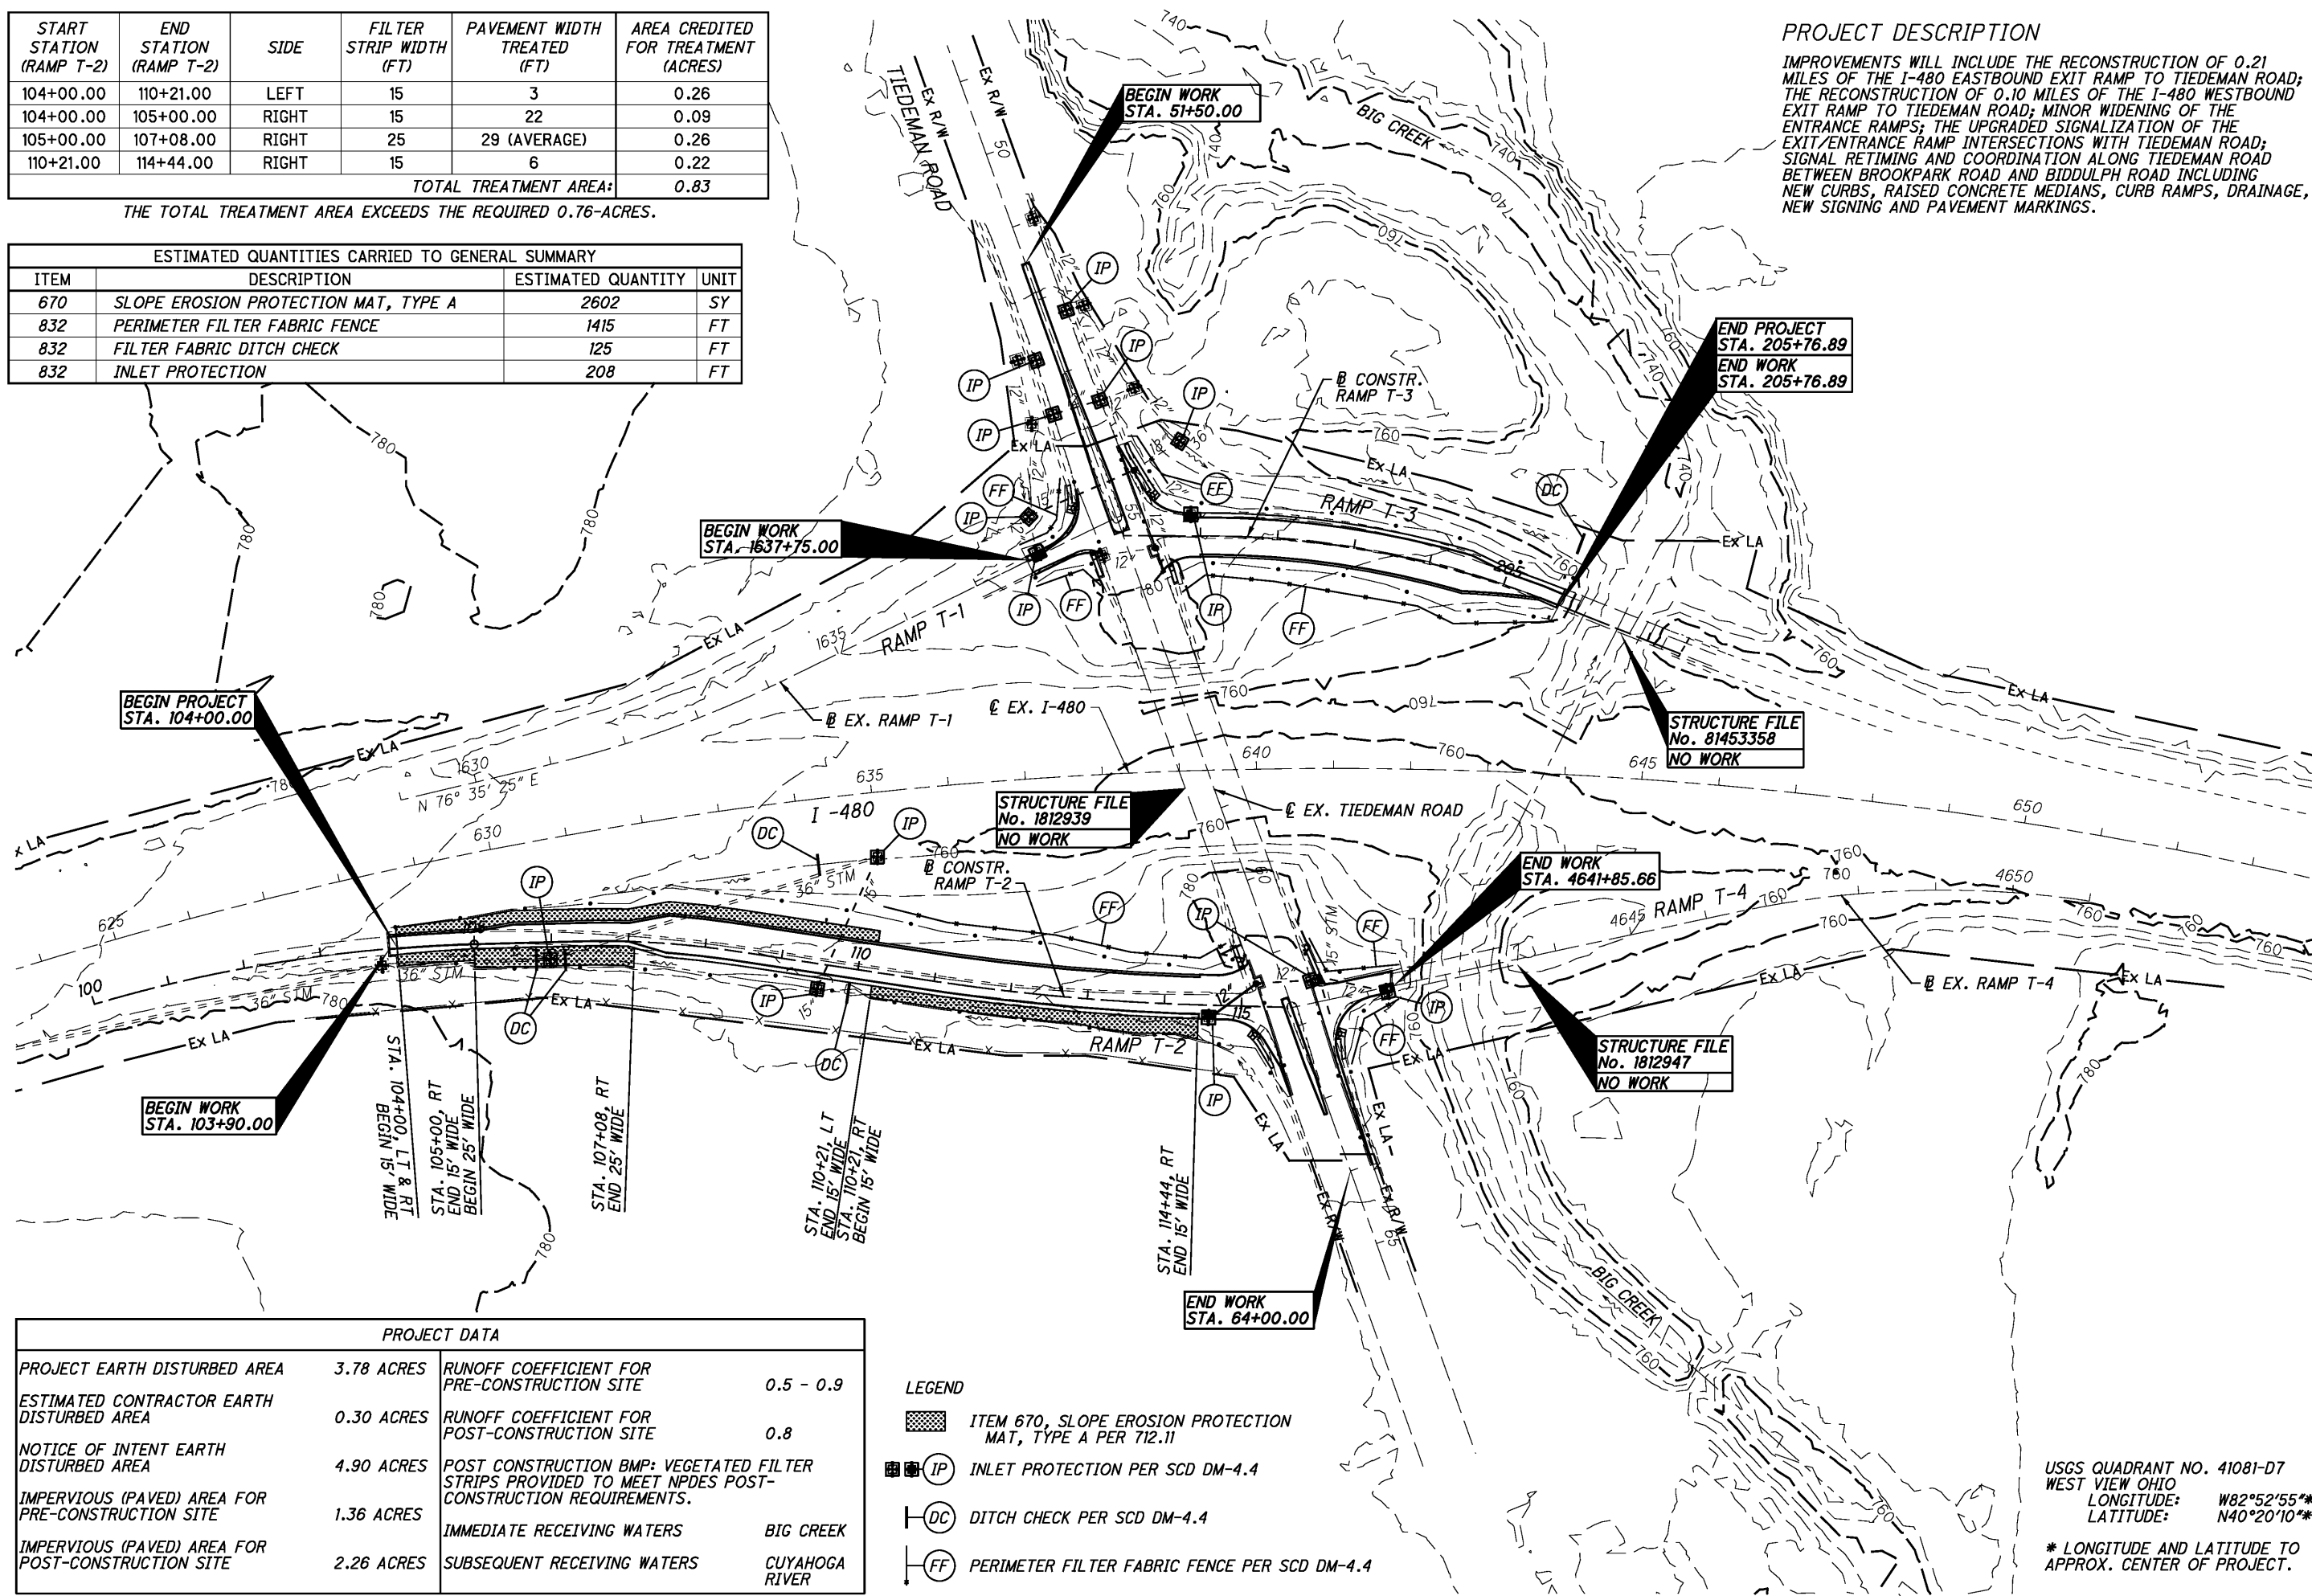

PROJECT DATA			
PROJECT EARTH DISTURBED AREA	3.78 ACRES	RUNOFF COEFFICIENT FOR PRE-CONSTRUCTION SITE	0.5 - 0.9
ESTIMATED CONTRACTOR EARTH DISTURBED AREA	0.30 ACRES	RUNOFF COEFFICIENT FOR POST-CONSTRUCTION SITE	0.8
NOTICE OF INTENT EARTH DISTURBED AREA	4.90 ACRES	POST CONSTRUCTION BMP: VEGETATED FILTER STRIPS PROVIDED TO MEET NPDES POST-CONSTRUCTION REQUIREMENTS.	
IMPERVIOUS (PAVED) AREA FOR PRE-CONSTRUCTION SITE	1.36 ACRES	IMMEDIATE RECEIVING WATERS	BIG CREEK
IMPERVIOUS (PAVED) AREA FOR POST-CONSTRUCTION SITE	2.26 ACRES	SUBSEQUENT RECEIVING WATERS	CUYAHOGA RIVER

- LEGEND**
- ITEM 670, SLOPE EROSION PROTECTION MAT, TYPE A PER 712.11
  - INLET PROTECTION PER SCD DM-4.4
  - DITCH CHECK PER SCD DM-4.4
  - PERIMETER FILTER FABRIC FENCE PER SCD DM-4.4

USGS QUADRANT NO. 41081-D7  
 WEST VIEW OHIO  
 LONGITUDE: W82°52'55"\*  
 LATITUDE: N40°20'10"\*  
 \* LONGITUDE AND LATITUDE TO APPROX. CENTER OF PROJECT.

STORM WATER POLLUTION PREVENTION PLAN

CUY-480-11.60



31  
84

I:\Projects\18063\Roadway\Sheets\18063DE001.dgn 2/5/2015 10:28:48 AM michael\_j.thompson

FOR CROSS SECTIONS, SEE SHEET 33

FOR INTERSECTION DETAIL, SEE SHEET 67

DEO = THE EAST OHIO GAS COMPANY,  
DBA DOMINION EAST OHIO, 1-800-362-7557

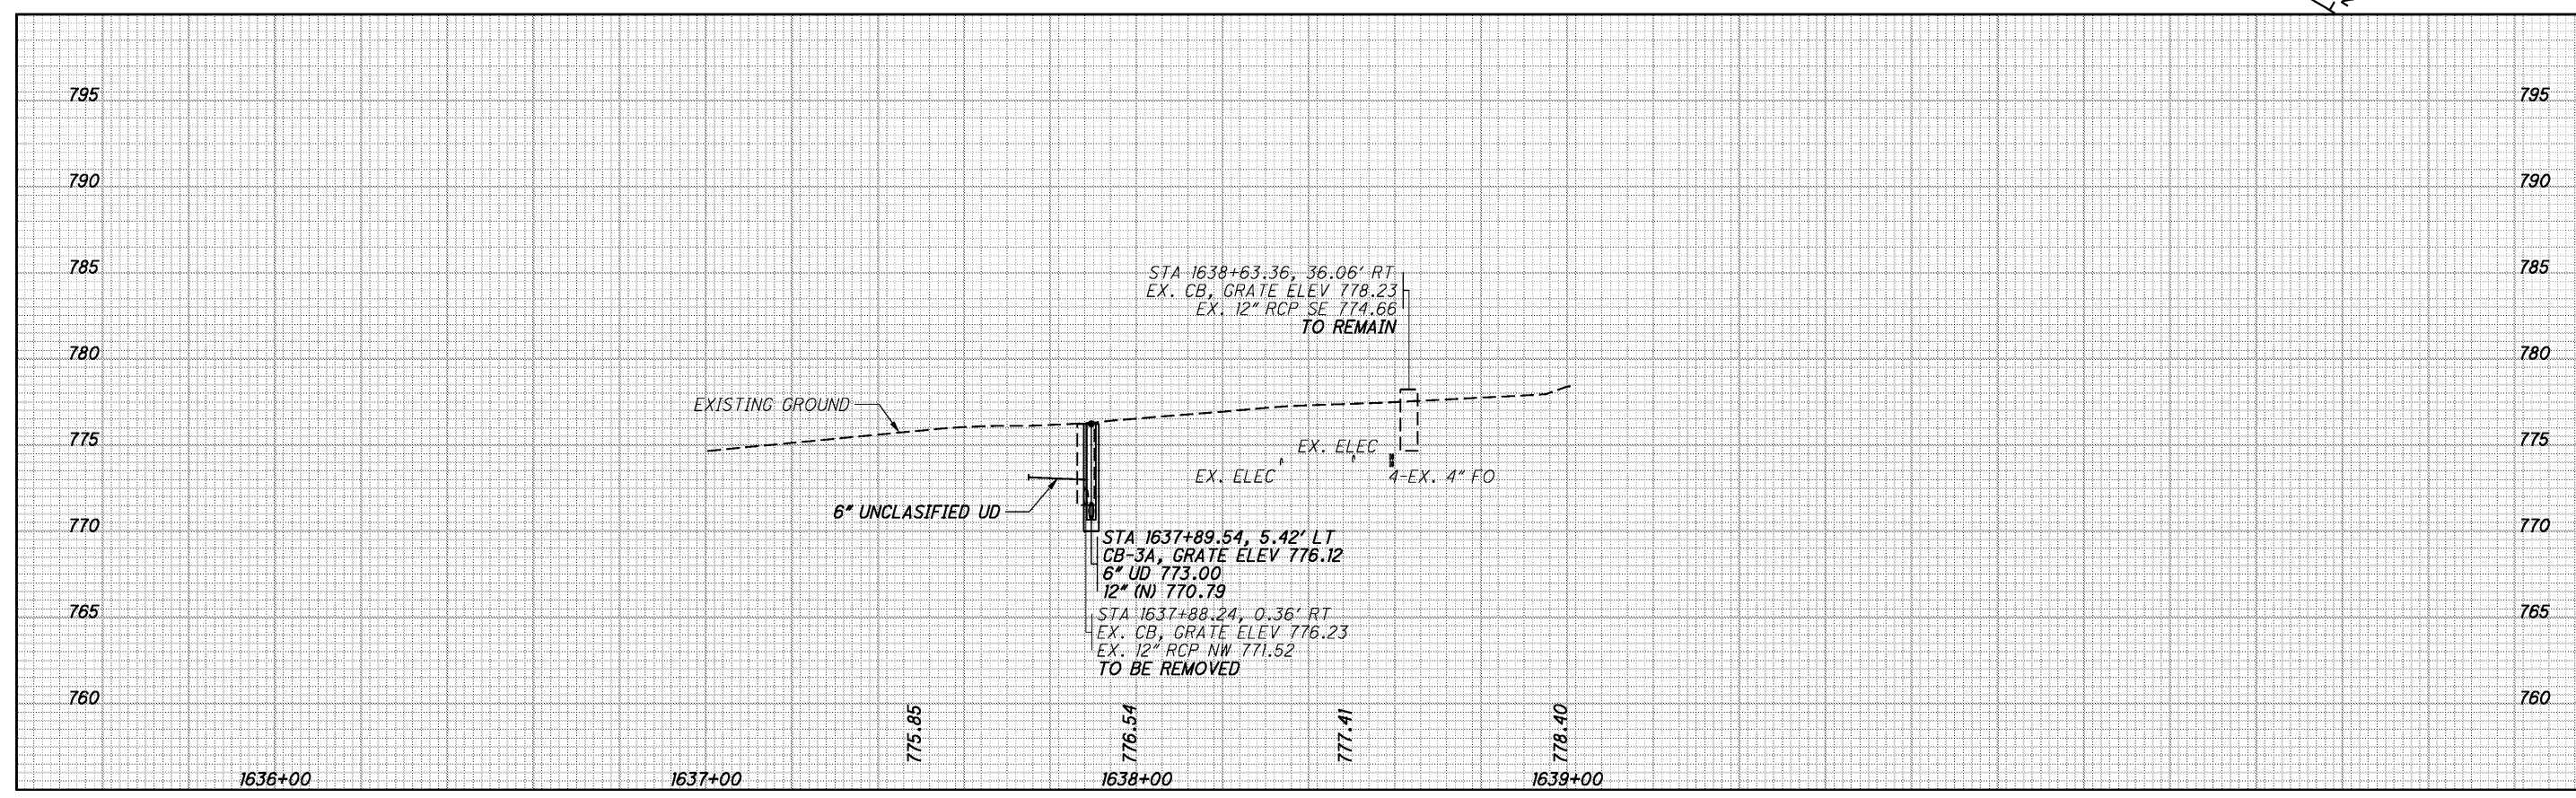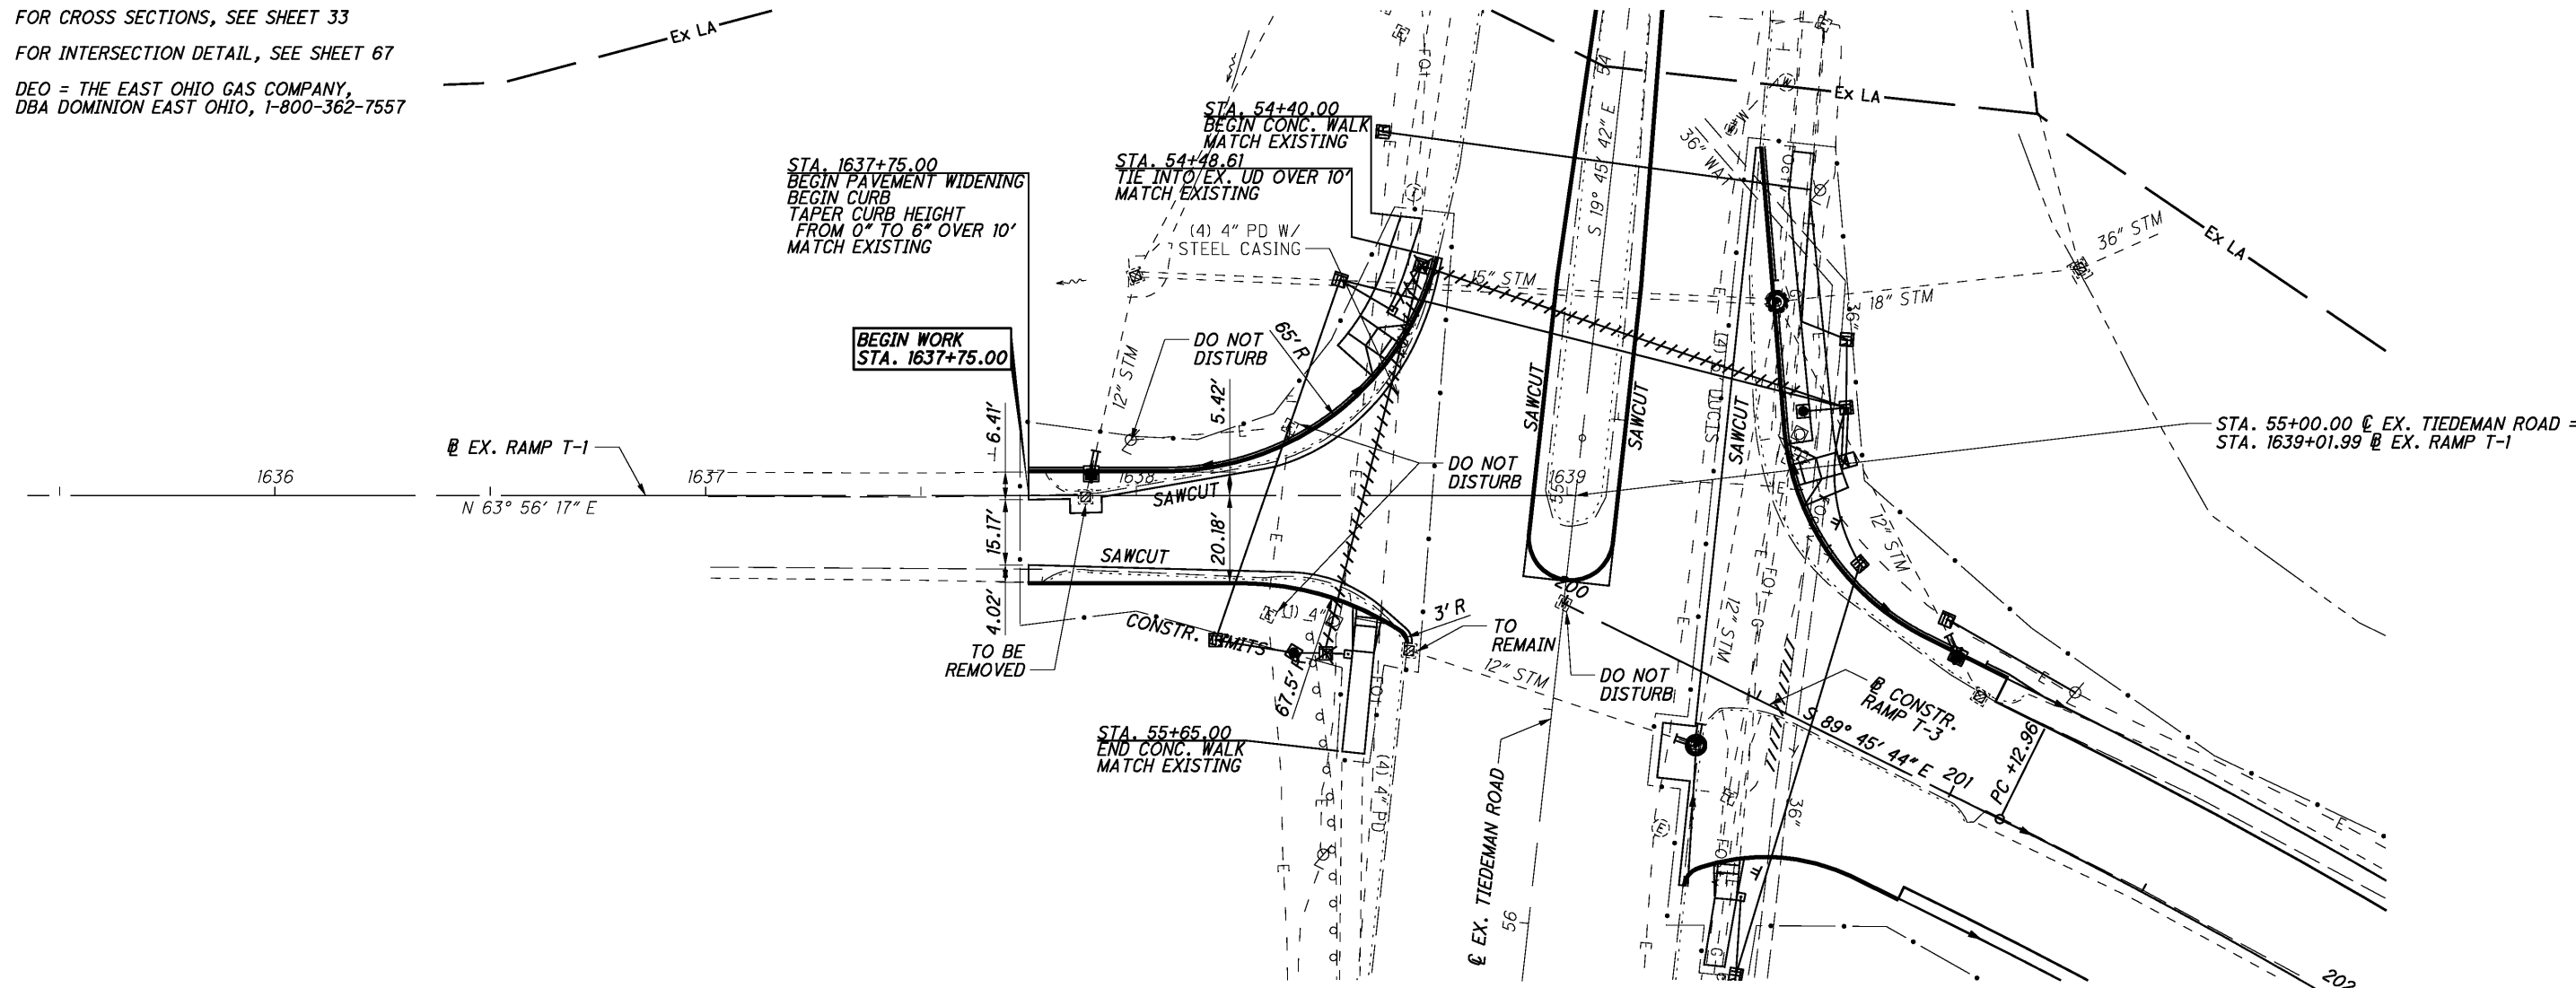

PLAN AND PROFILE  
RAMP T-1

CUY-480-11.60

I:\Projects\18063\Roadway\Sheets\18063GP006.dgn 2/5/2015 10:28:49 AM michael.j.thompson


I:\Projects\18063\Roadway\Sheets\18063X5001.dgn 2/5/2015 10:28:51 AM michael\_j\_thompson

SEEDING

END WIDTH	SO. YDS.

END AREA VOLUME

CUT	FILL	CUT	FILL	CALCULATED JEM	CHECKED MEP

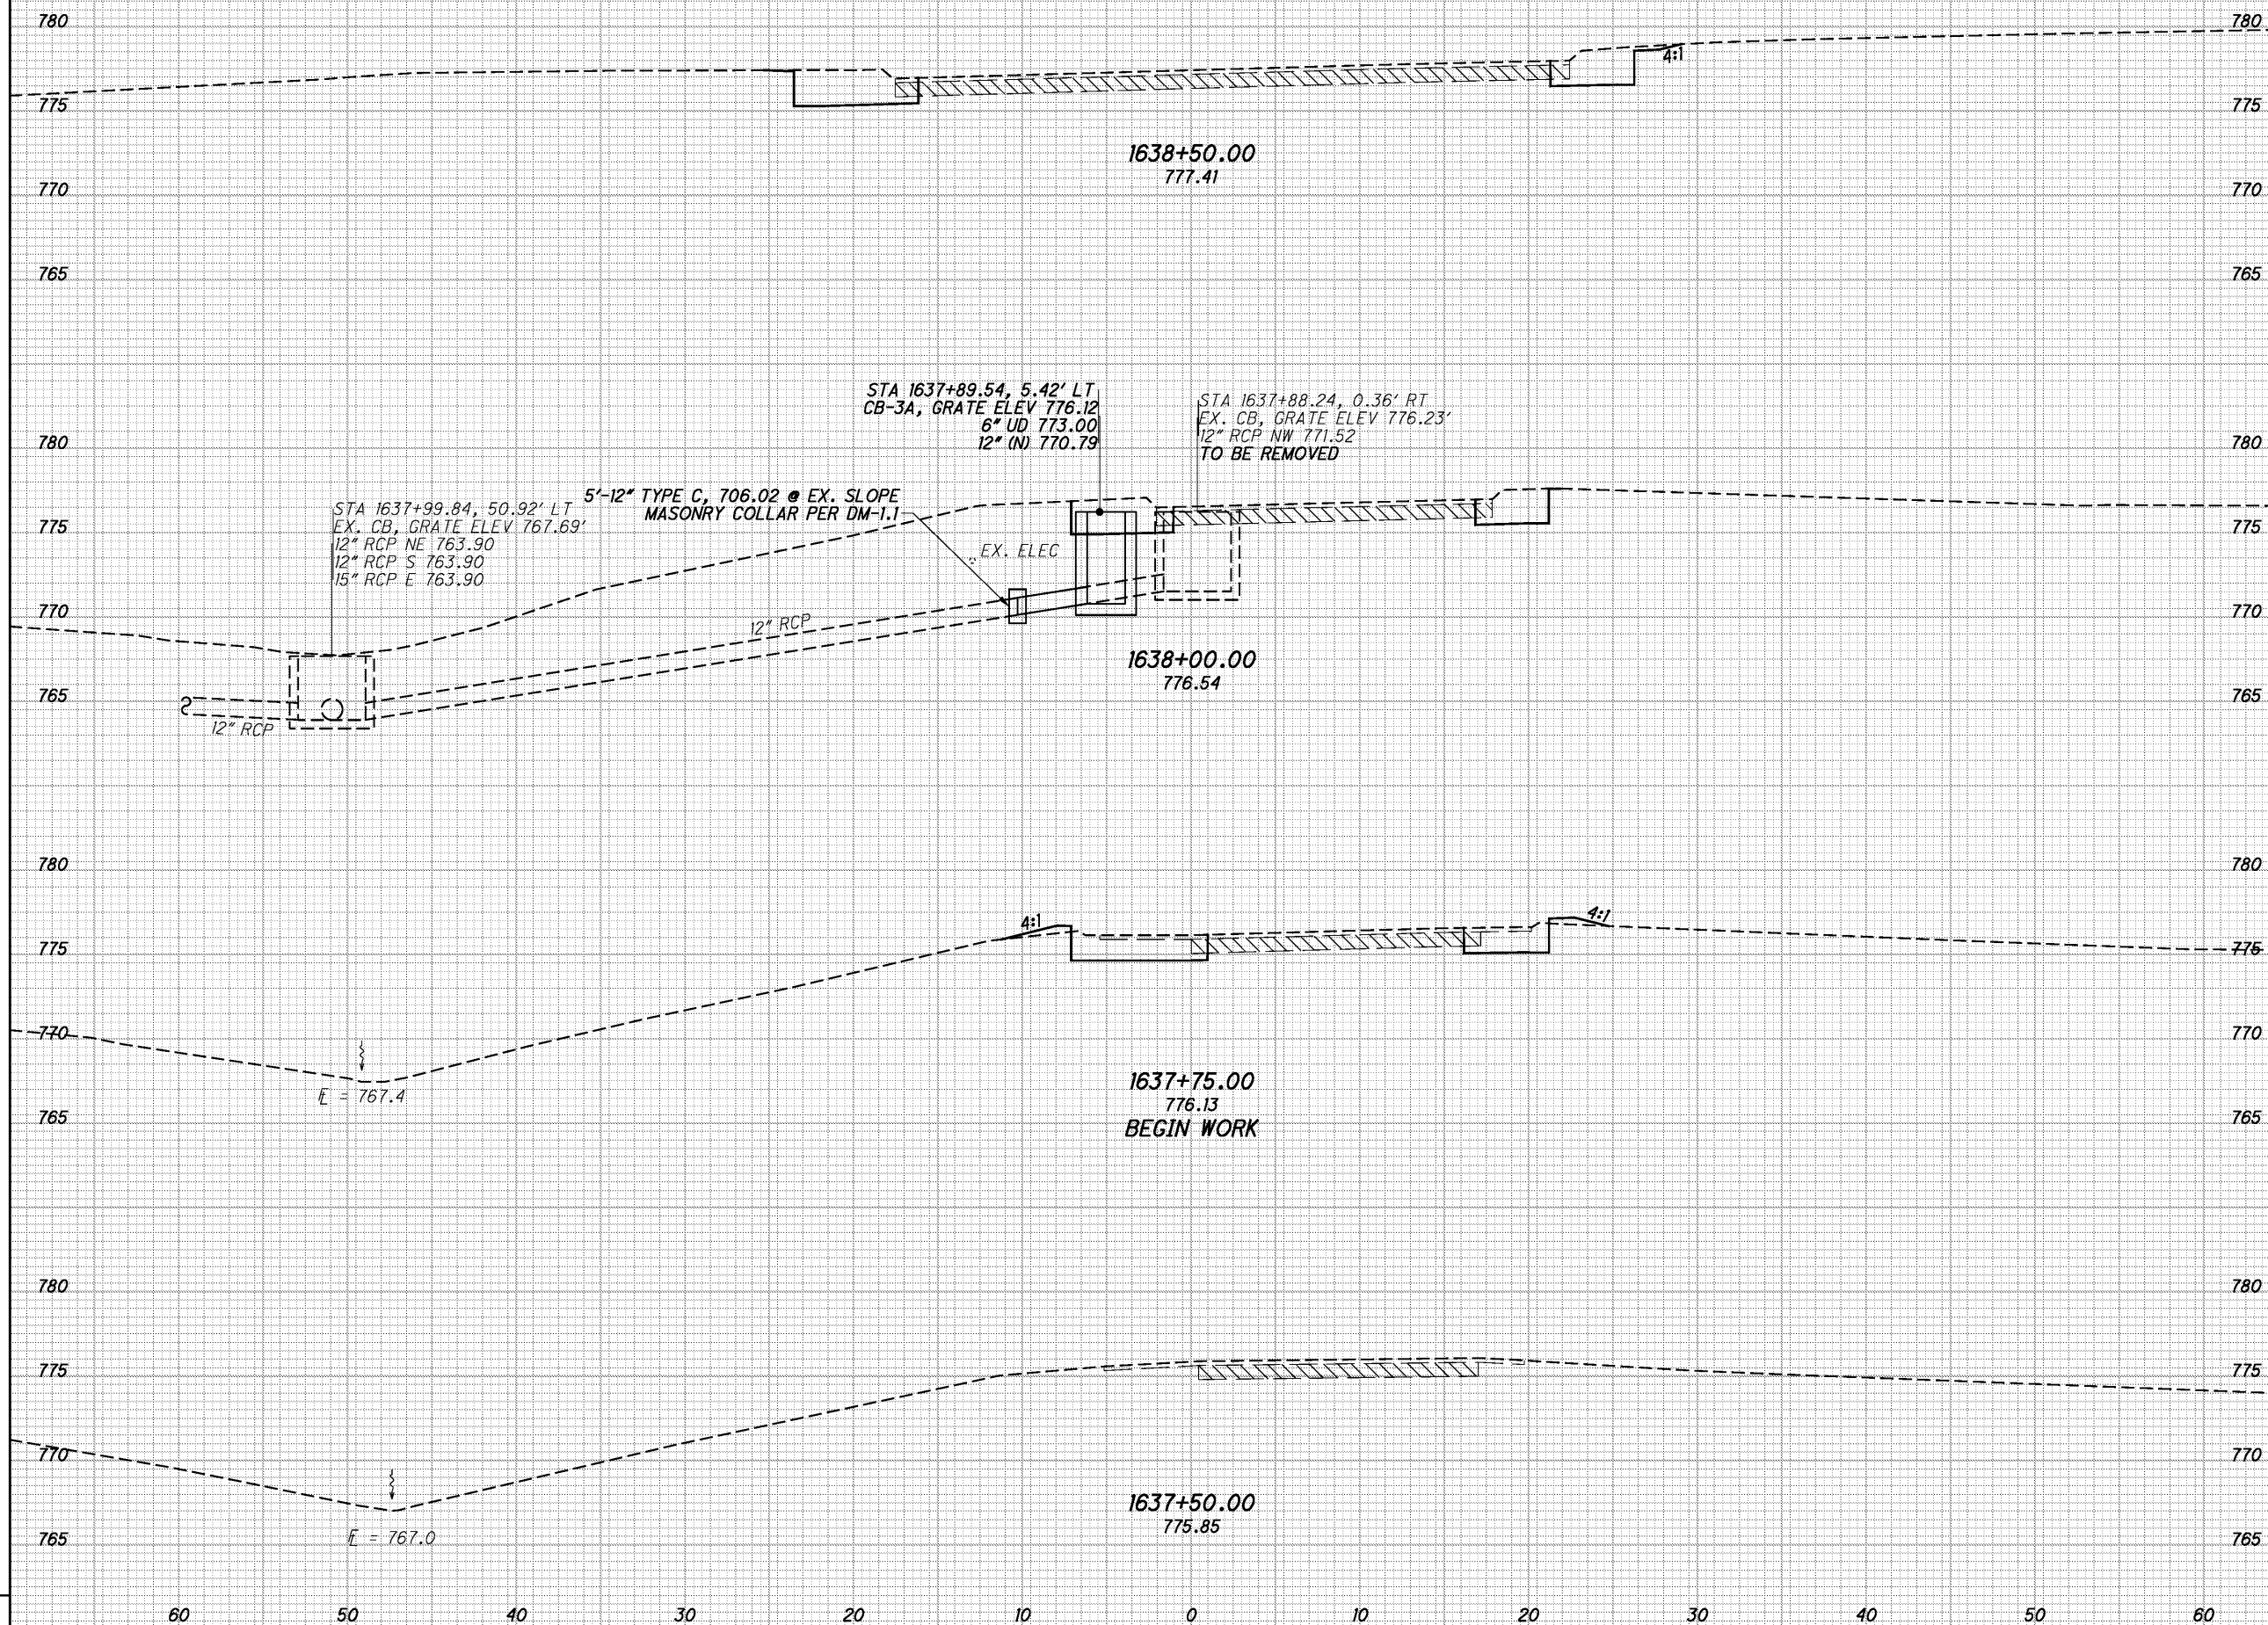


CROSS SECTIONS RAMP T-1  
STA. 1637+50.00 TO STA. 1638+50

CUY-480-11.60


33  
84

FOR CROSS SECTIONS, SEE SHEETS 37 - 44  
 FOR SUPERELEVATION TABLE, SEE SHEET 61 - 62

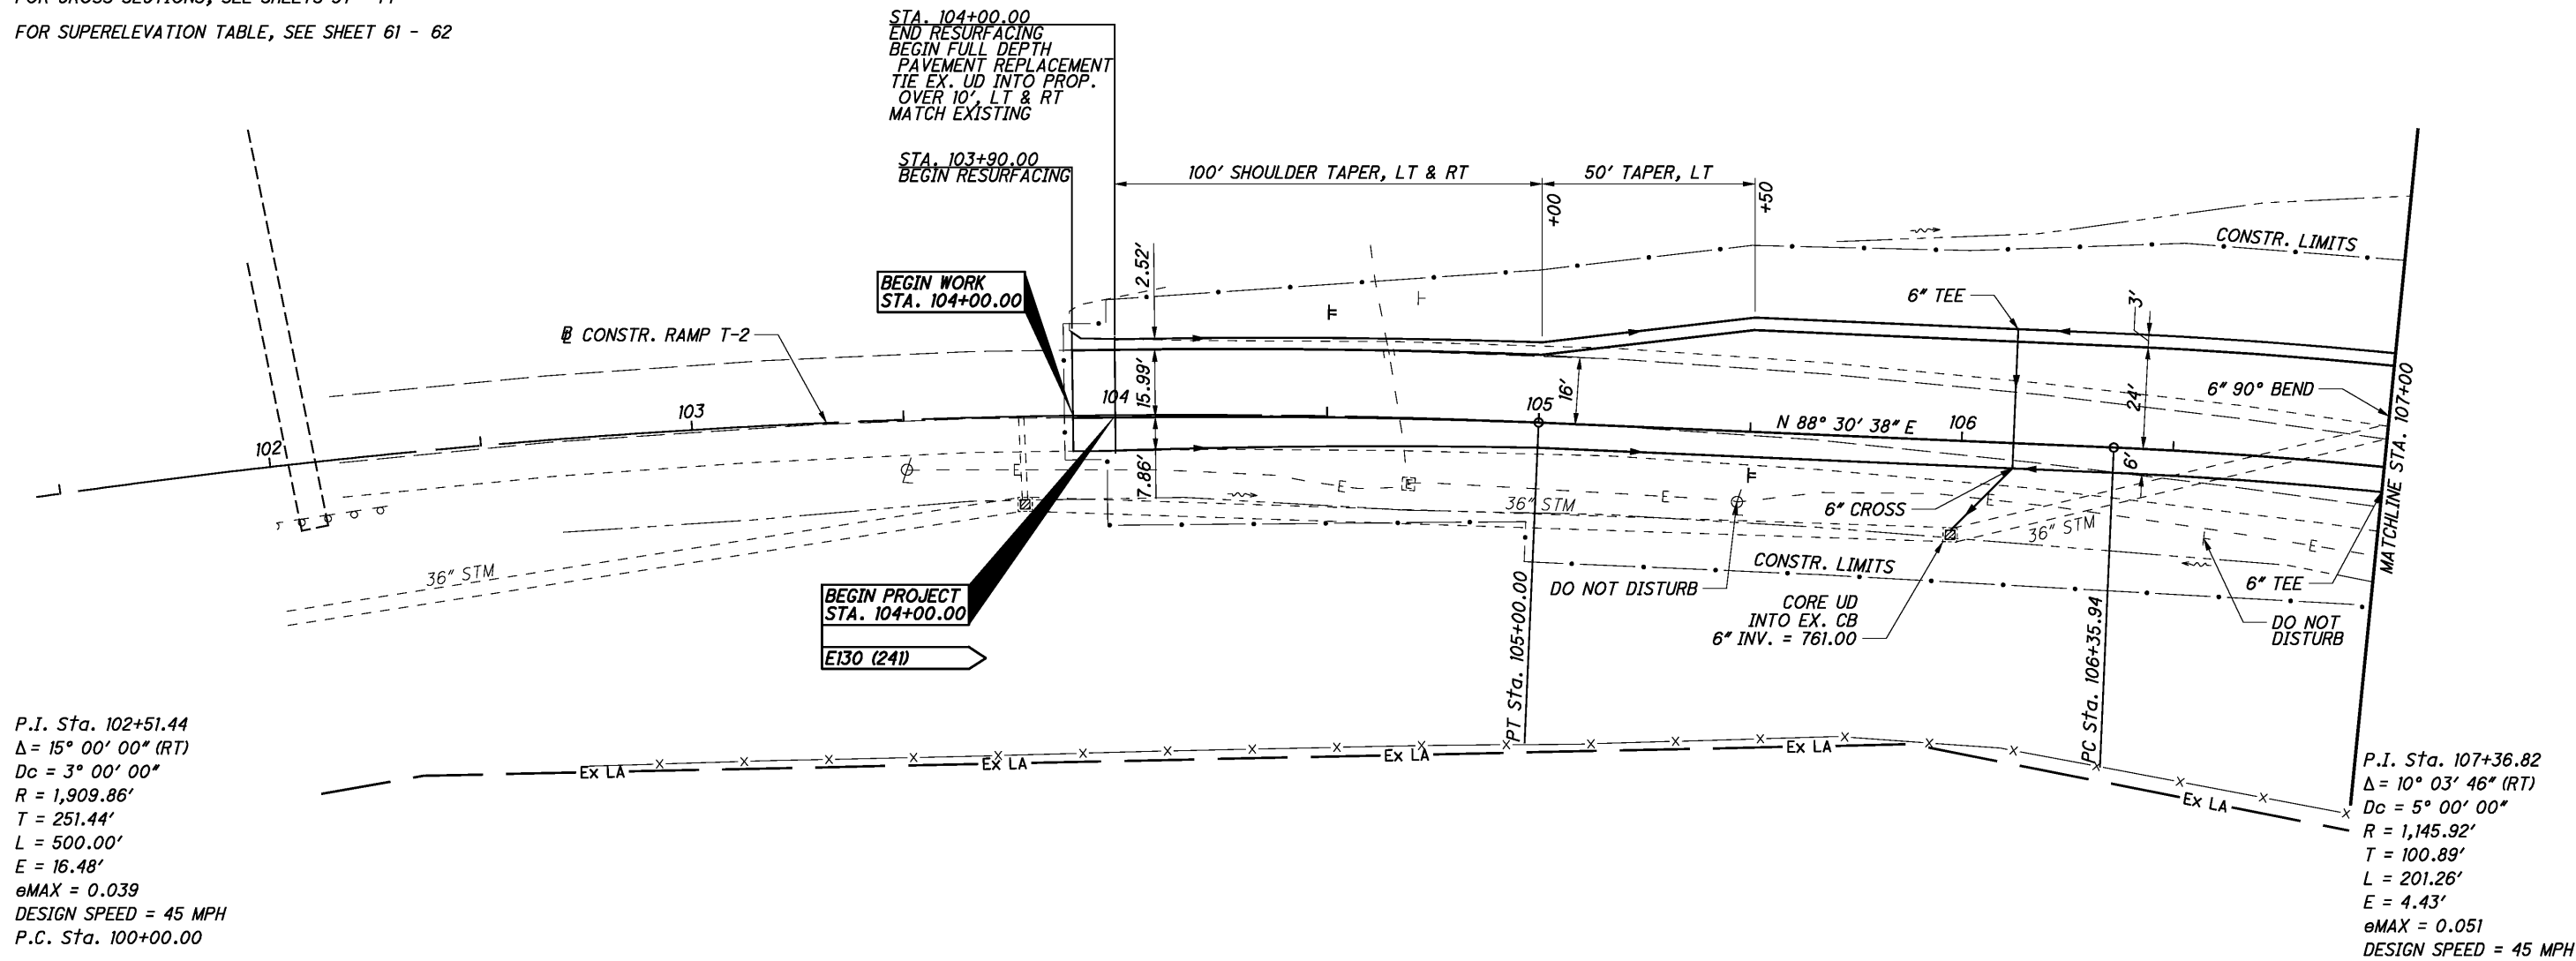

P.I. Sta. 102+51.44  
 $\Delta = 15^\circ 00' 00''$  (RT)  
 $D_c = 3^\circ 00' 00''$   
 $R = 1,909.86'$   
 $T = 251.44'$   
 $L = 500.00'$   
 $E = 16.48'$   
 $e_{MAX} = 0.039$   
 DESIGN SPEED = 45 MPH  
 P.C. Sta. 100+00.00

P.I. Sta. 107+36.82  
 $\Delta = 10^\circ 03' 46''$  (RT)  
 $D_c = 5^\circ 00' 00''$   
 $R = 1,145.92'$   
 $T = 100.89'$   
 $L = 201.26'$   
 $E = 4.43'$   
 $e_{MAX} = 0.051$   
 DESIGN SPEED = 45 MPH

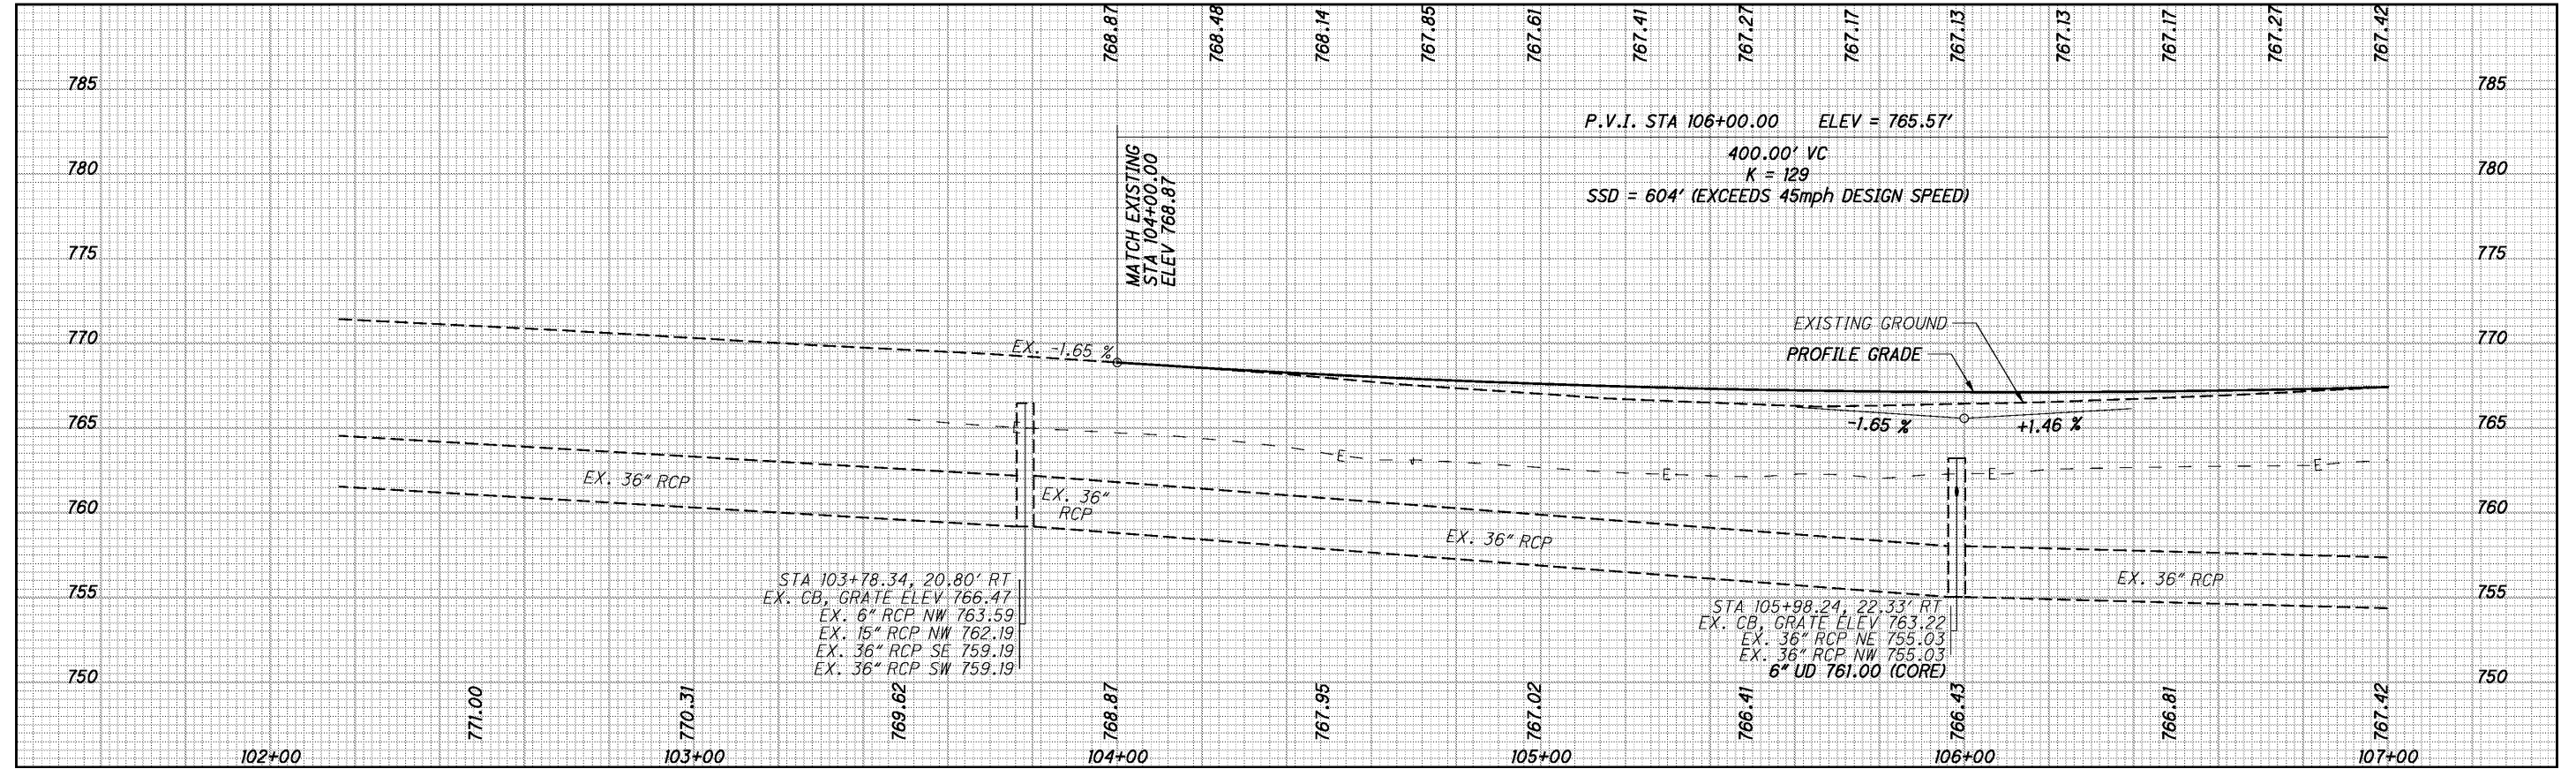

PLAN AND PROFILE - RAMP T-2  
 BEGINNING TO STA. 107+00

CUY-480-11.60


I:\Projects\18063\Roadway\Sheets\18063GP001.dgn 2/5/2015 10:28:51 AM michael\_j\_thompson

FOR CROSS SECTIONS, SEE SHEETS 37 - 44  
 FOR SUPERELEVATION TABLE, SEE SHEET 61 - 62  
 FOR INTERSECTION DETAIL, SEE SHEET 68


MJT	2/5/15	AS-BUILTS
REV. BY	DATE	DESCRIPTION
DATE COMPLETED		



P.I. Sta. 107+36.82  
 $\Delta = 10^\circ 03' 46''$  (RT)  
 $Dc = 5^\circ 00' 00''$   
 $R = 1,145.92'$   
 $T = 100.89'$   
 $L = 201.26'$   
 $E = 4.43'$   
 $e_{MAX} = 0.051$   
 DESIGN SPEED = 45 MPH

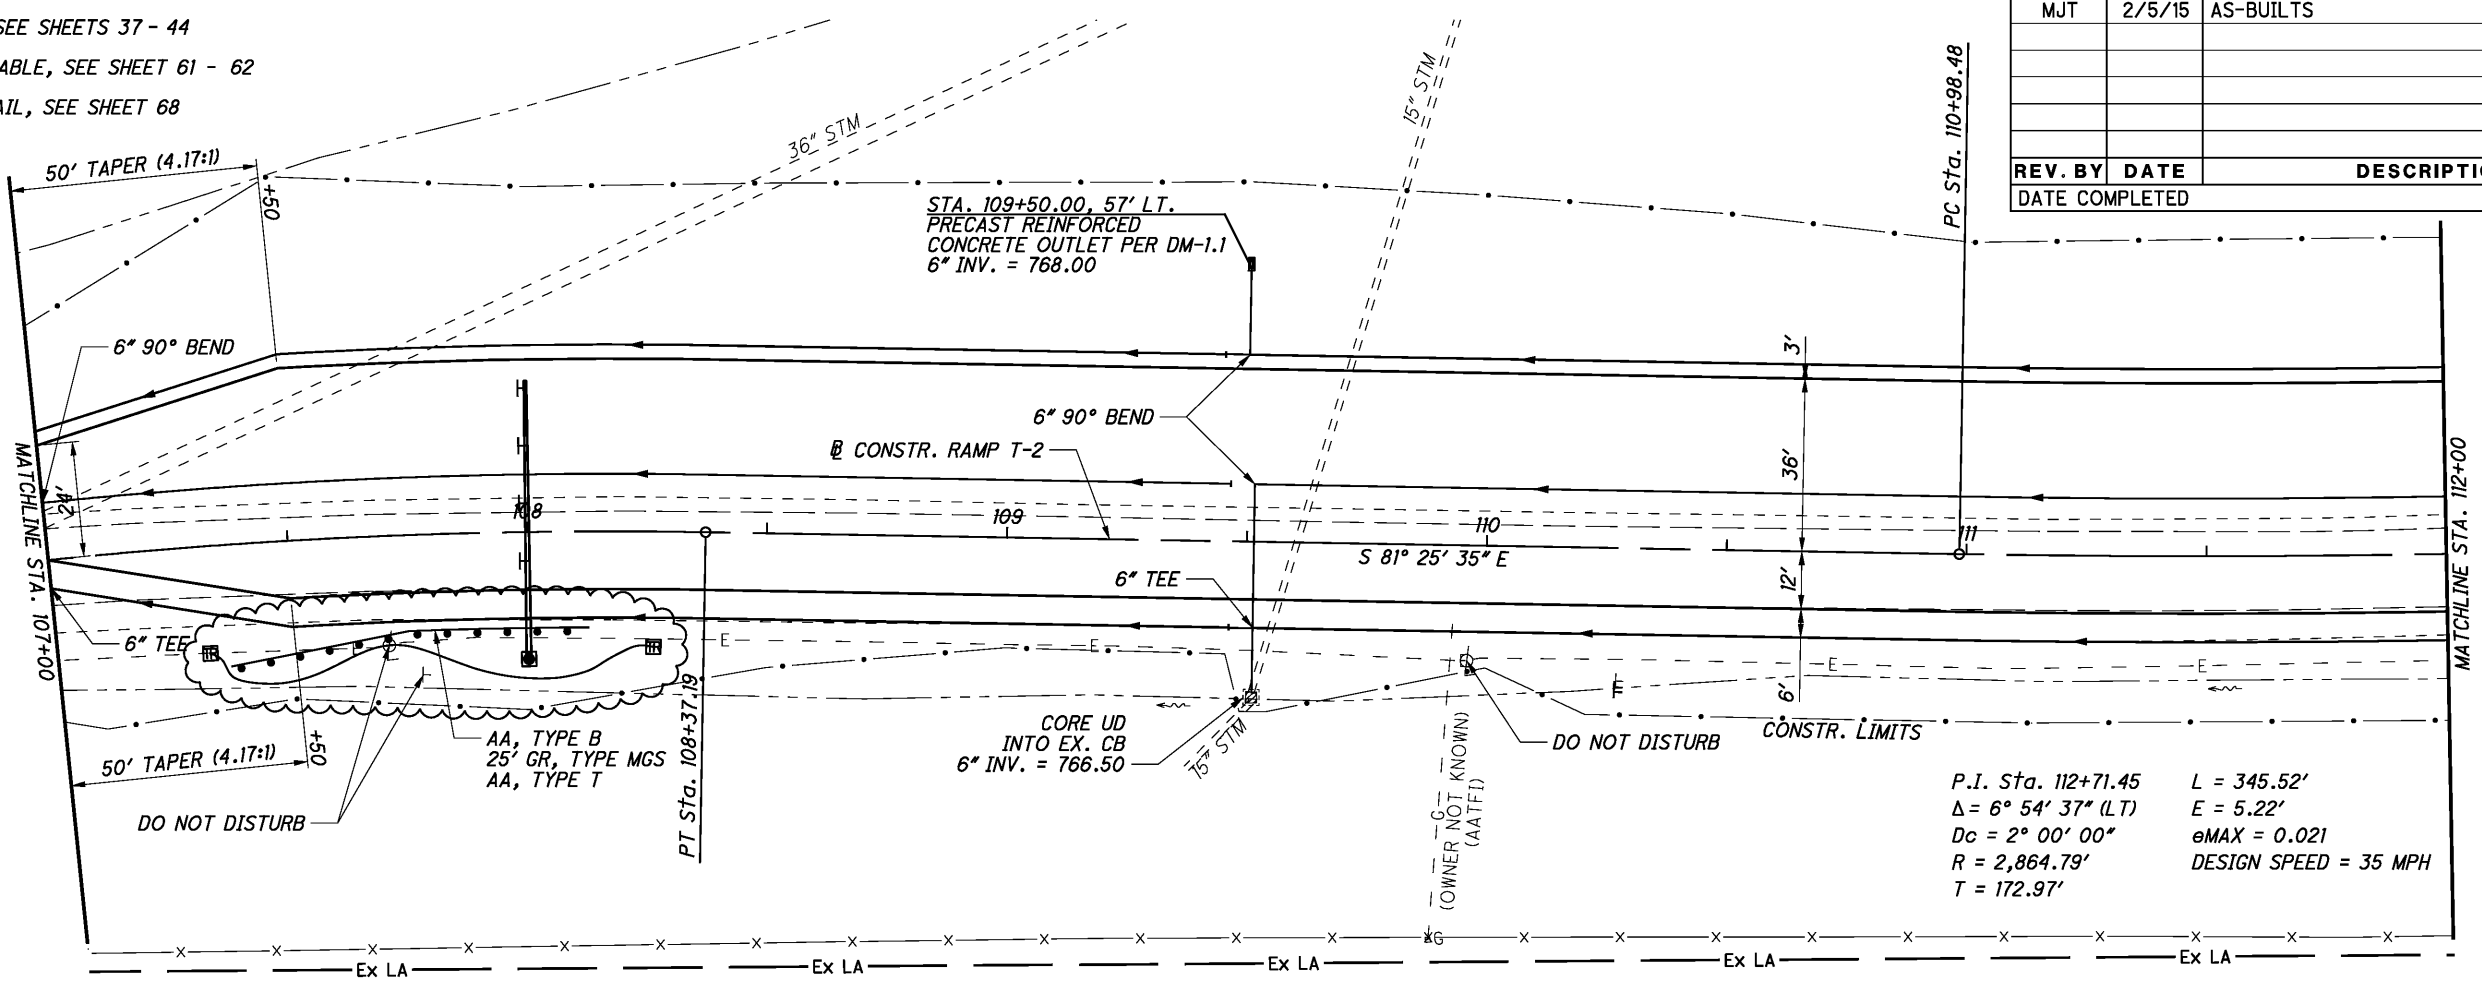

P.I. Sta. 112+71.45     $L = 345.52'$   
 $\Delta = 6^\circ 54' 37''$  (LT)     $E = 5.22'$   
 $Dc = 2^\circ 00' 00''$      $e_{MAX} = 0.021$   
 $R = 2,864.79'$     DESIGN SPEED = 35 MPH  
 $T = 172.97'$

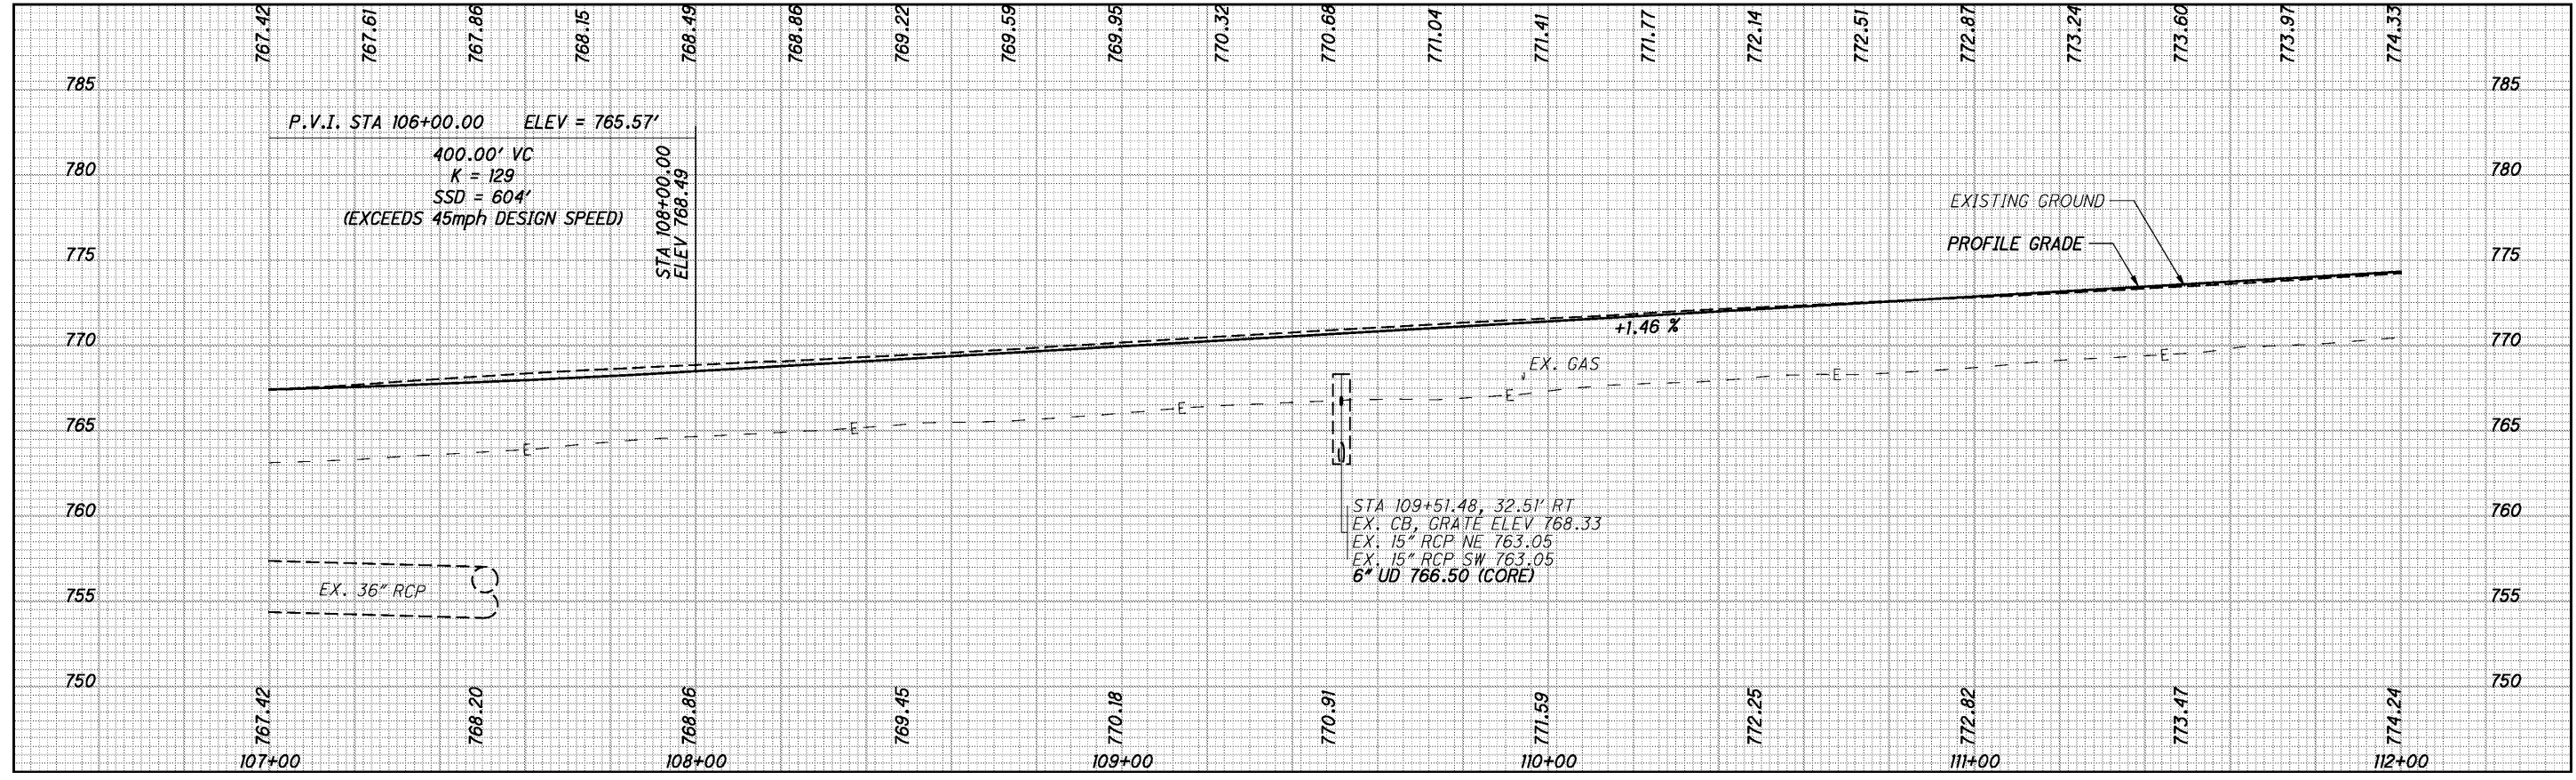

PLAN AND PROFILE - RAMP T-2  
 STA. 107+00 TO STA. 112+00



CUY-480-11.60

I:\Projects\18063\Roadway\Sheets\18063GP002.dgn 2/5/2015 10:28:52 AM michael.j.thompson



FOR CROSS SECTIONS, SEE SHEETS 37 - 44  
 FOR SUPERELEVATION TABLE, SEE SHEET 61 - 62  
 FOR INTERSECTION DETAIL, SEE SHEET 68  
 DEO = THE EAST OHIO GAS COMPANY,  
 DBA DOMINION EAST OHIO, 1-800-362-7557

P.I. Sta. 112+71.45  
 $\Delta = 6^\circ 54' 37''$  (LT)  
 $D_c = 2^\circ 00' 00''$   
 $R = 2,864.79'$   
 $T = 172.97'$   
 $L = 345.52'$   
 $E = 5.22'$   
 $e_{MAX} = 0.021$   
 DESIGN SPEED = 35 MPH

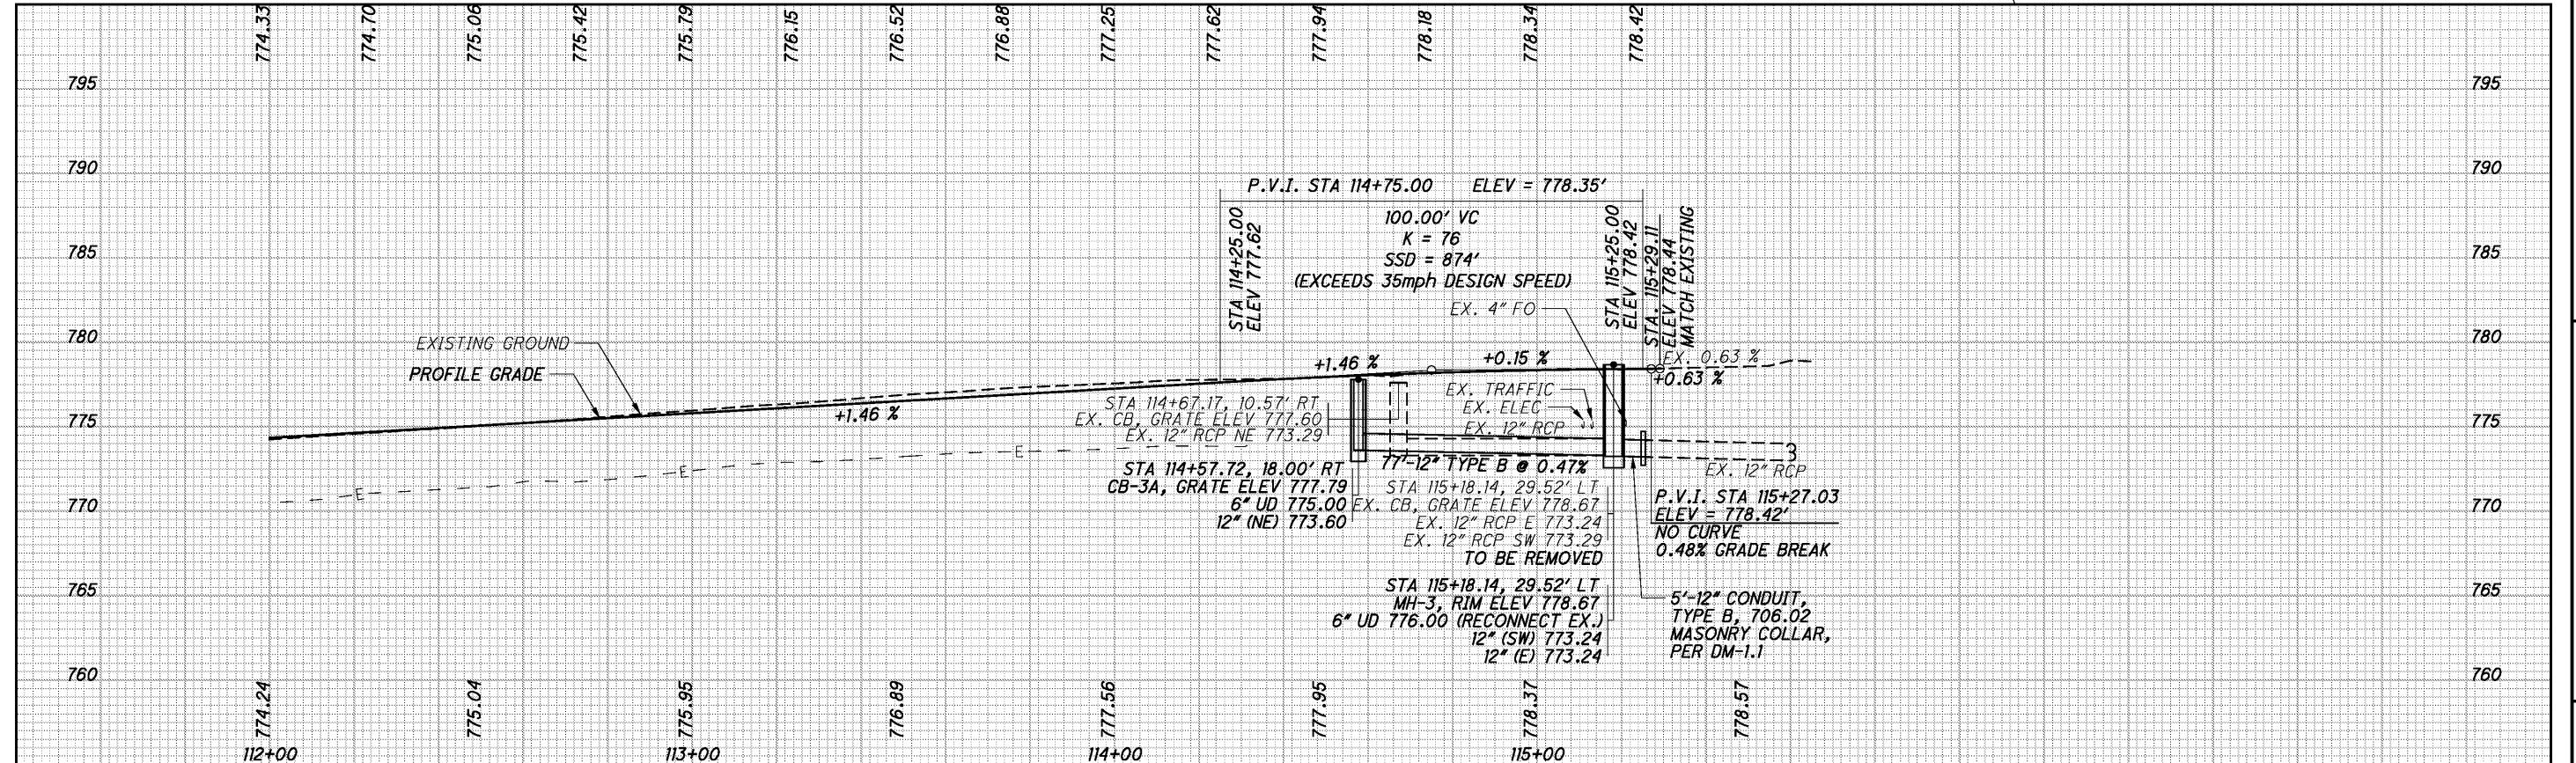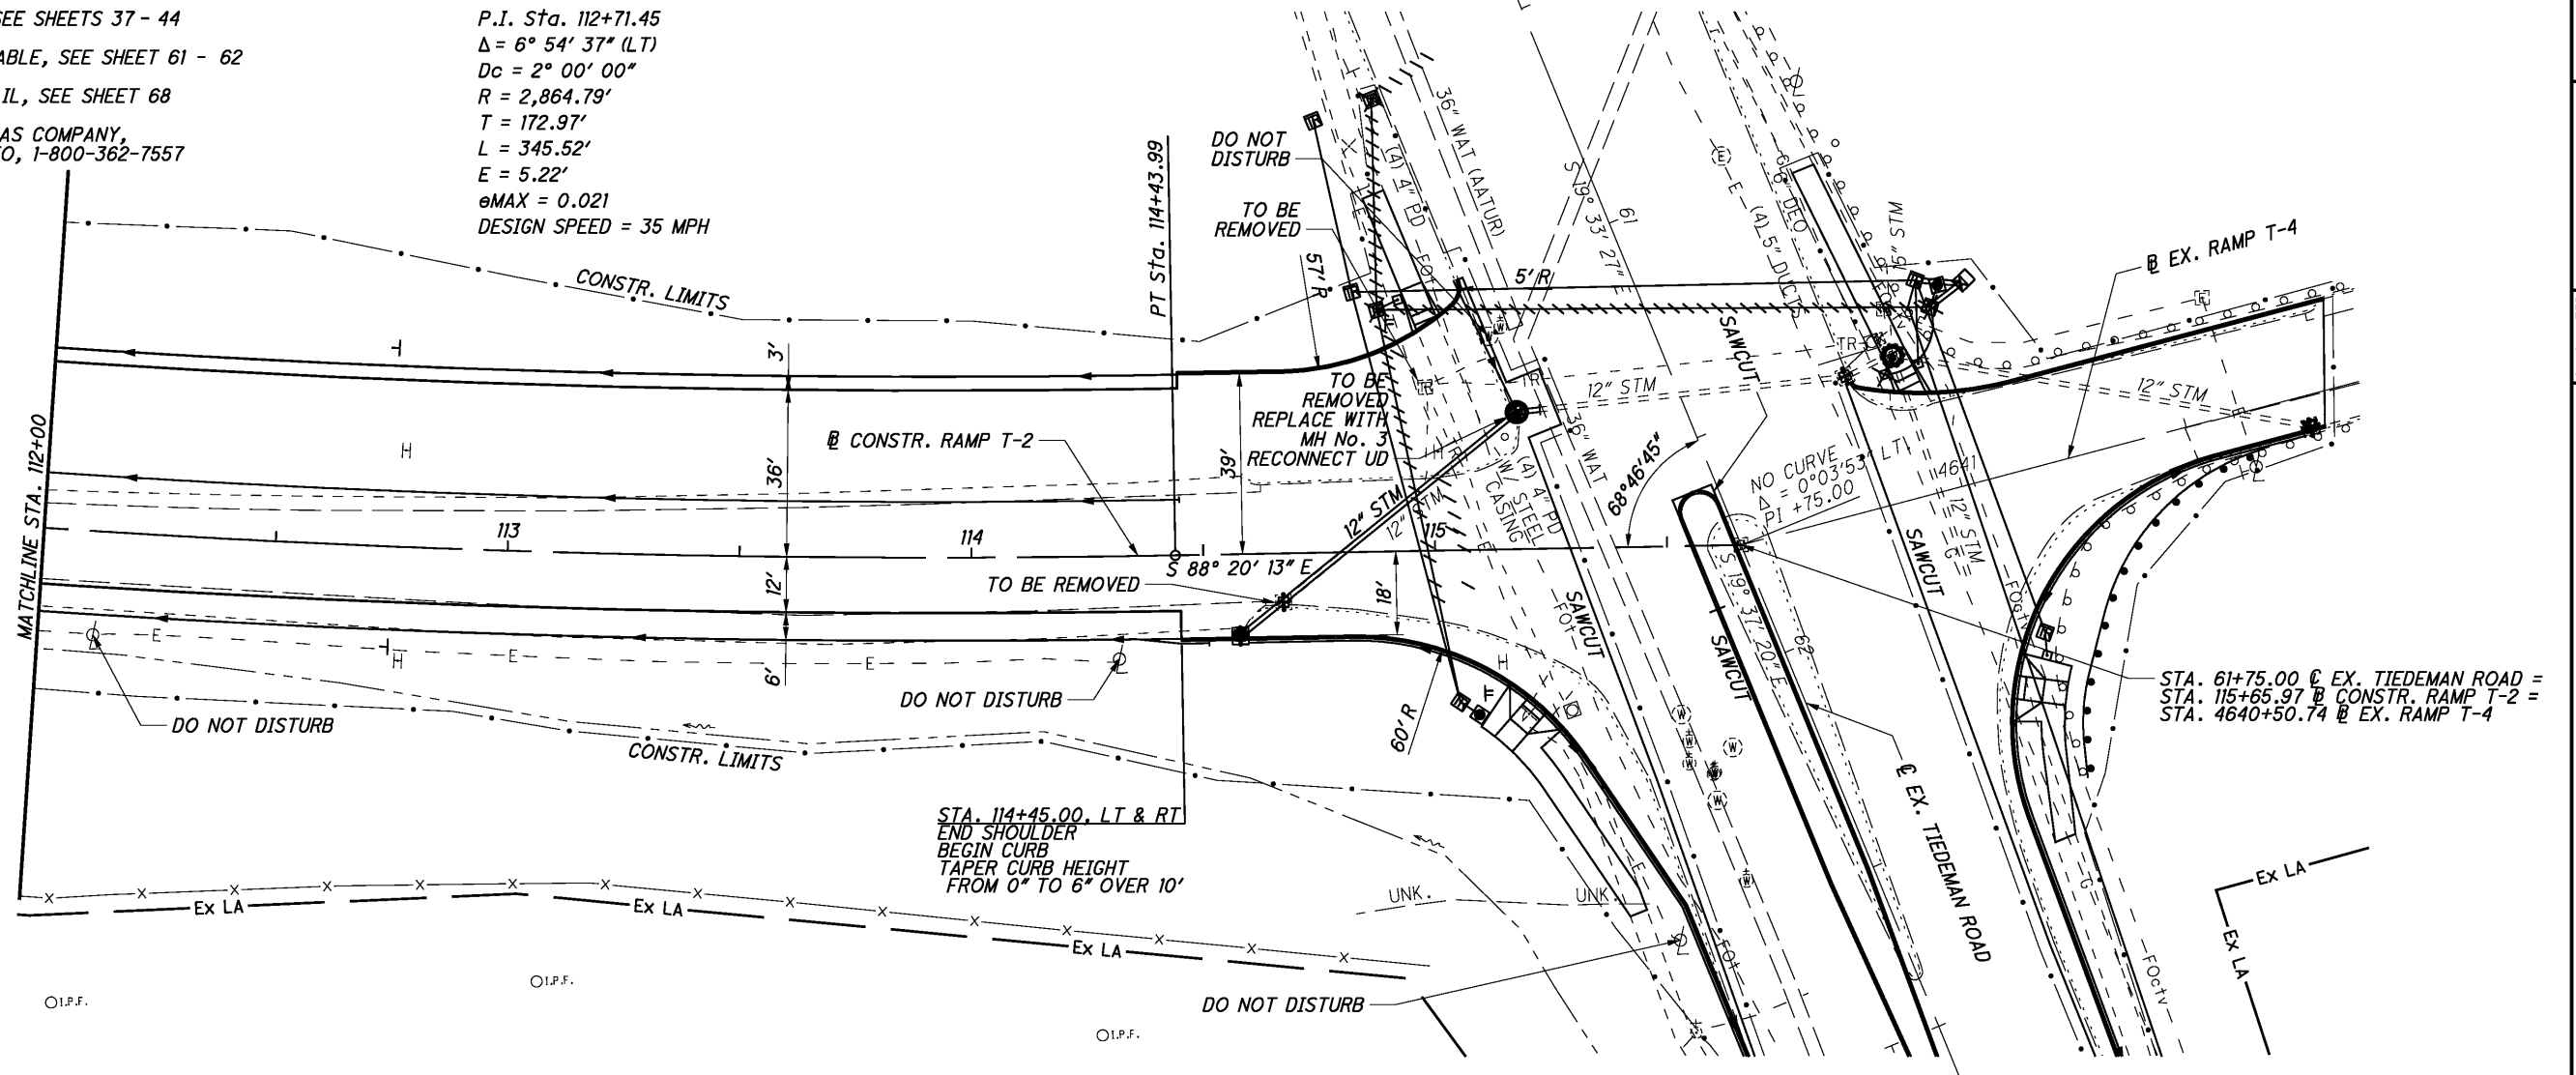

PLAN AND PROFILE - RAMP T-2  
 STA. 112+00 TO ENDING

CUY - 480 - 11.60

I:\Projects\18063\Roadway\Sheets\18063GP003.dgn 2/5/2015 10:28:52 AM michael.j.thompson




I:\Projects\18063\Roadway\Sheets\18063XS002.dgn 2/5/2015 10:28:54 AM michael.j.\_thompson

SEEDING

END WIDTH	SO. YDS.

END AREA		VOLUME		CALCULATED JEM	CHECKED MEP
CUT	FILL	CUT	FILL		

TEMPORARY PAVEMENT AND GRADING

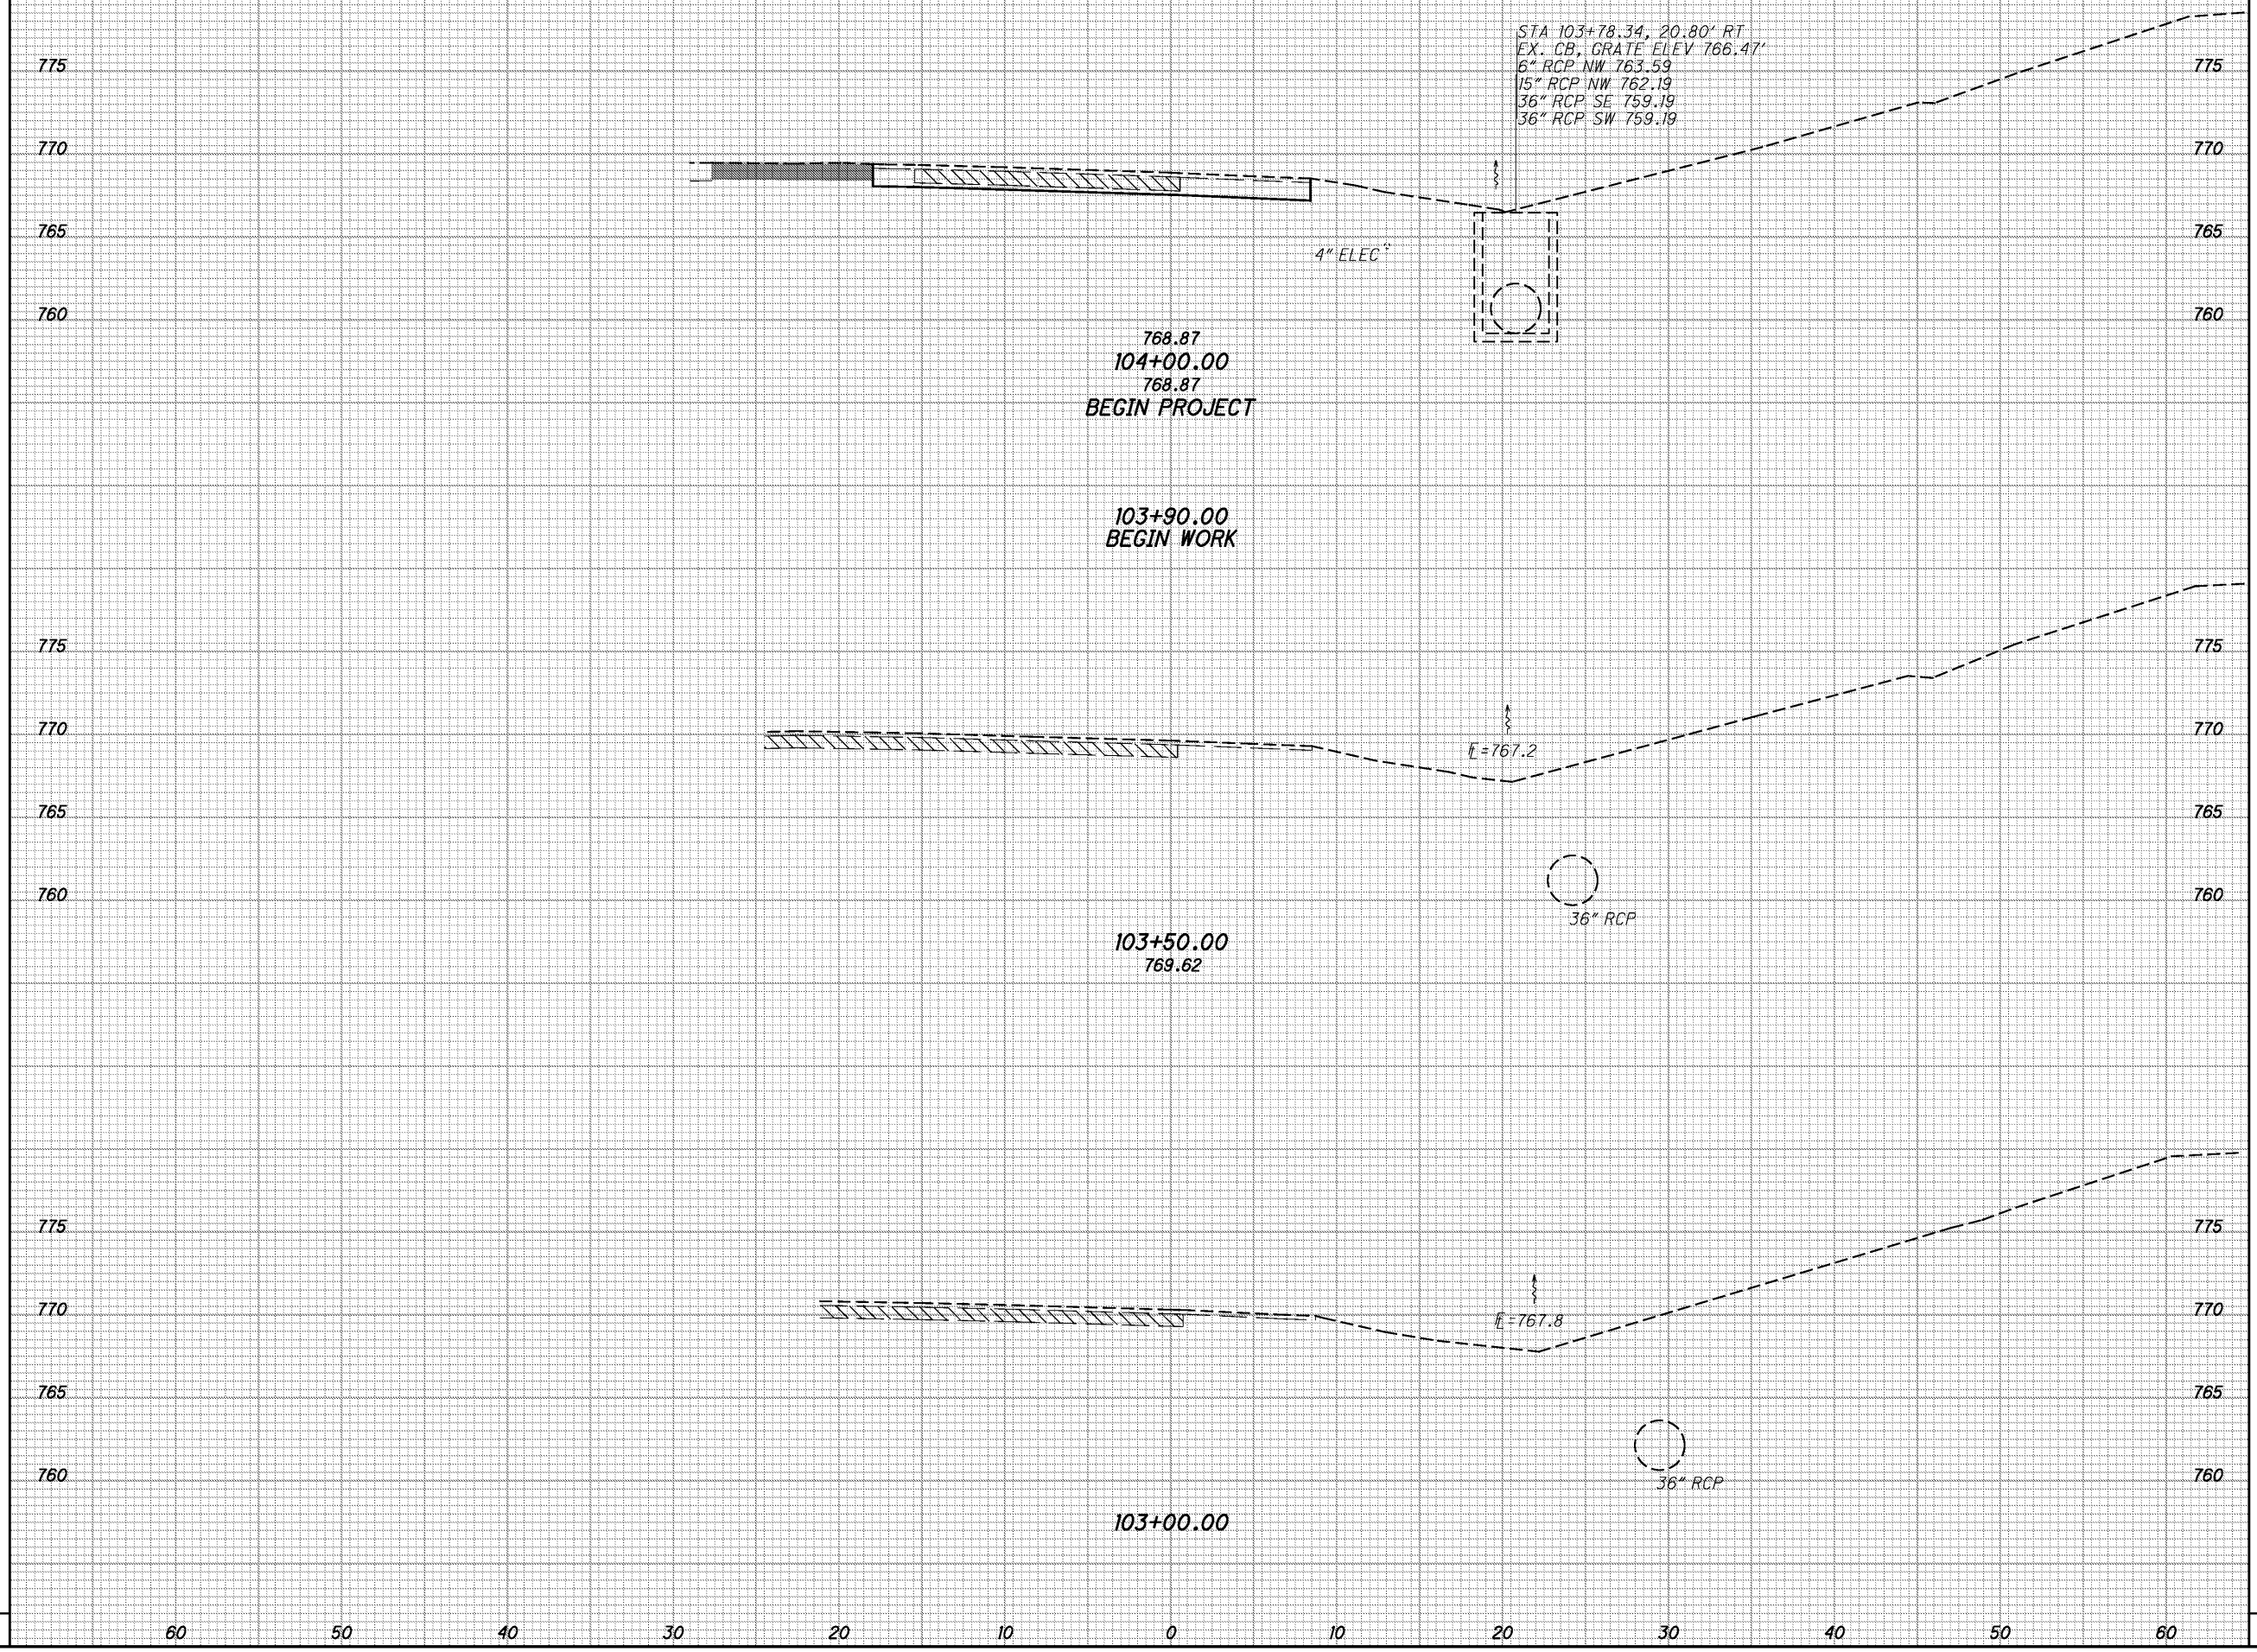

CROSS SECTIONS RAMP T-2  
 STA. 103+00.00 TO STA. 104+00.00

CUY - 480 - 11.60


I:\Projects\18063\Roadway\Sheets\18063XS002.dgn 2/5/2015 10:28:54 AM michael\_j\_thompson

**SEEDING**

END WIDTH	SO. YDS.

TEMPORARY PAVEMENT AND GRADING

END AREA		VOLUME		CALCULATED JEM	CHECKED MEP
CUT	FILL	CUT	FILL		

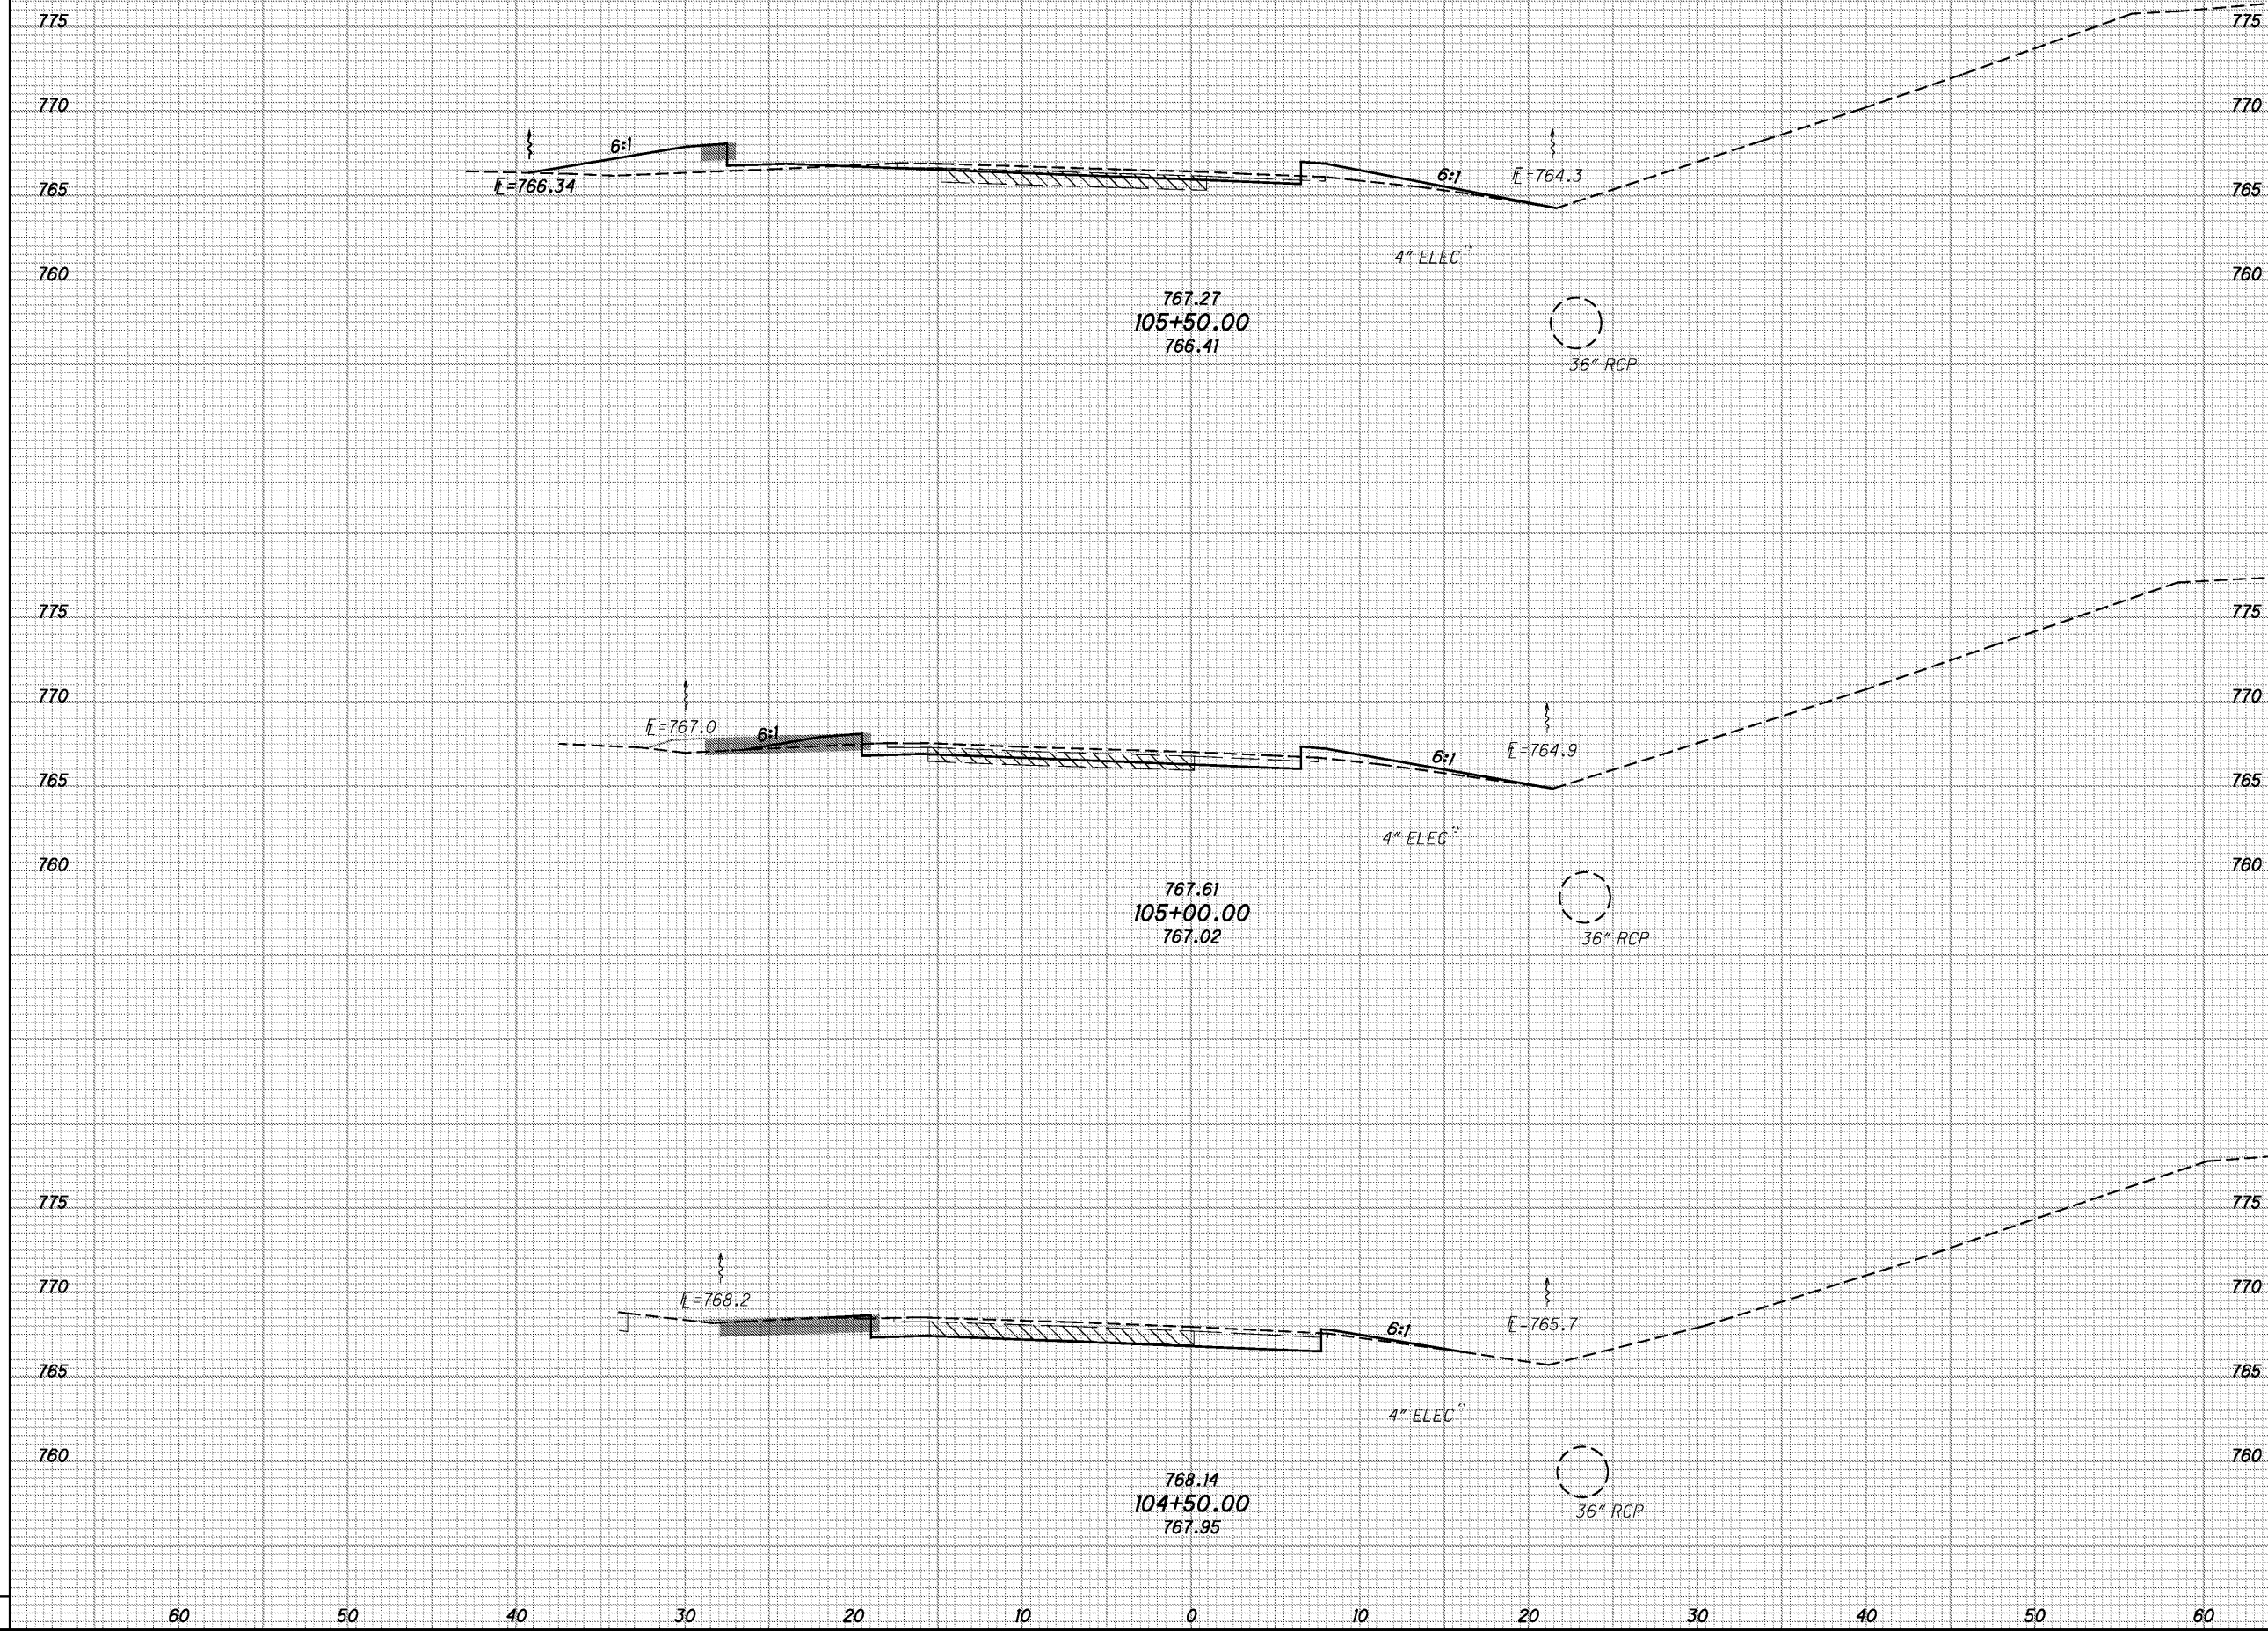

**CROSS SECTIONS RAMP T-2  
STA. 104+50.00 TO STA. 105+50.00**


**CUY - 480 - 11.60**

**SEEDING**

END WIDTH	SO. YDS.

TEMPORARY PAVEMENT AND GRADING

END AREA		VOLUME		CALCULATED JEM	CHECKED MEP
CUT	FILL	CUT	FILL		

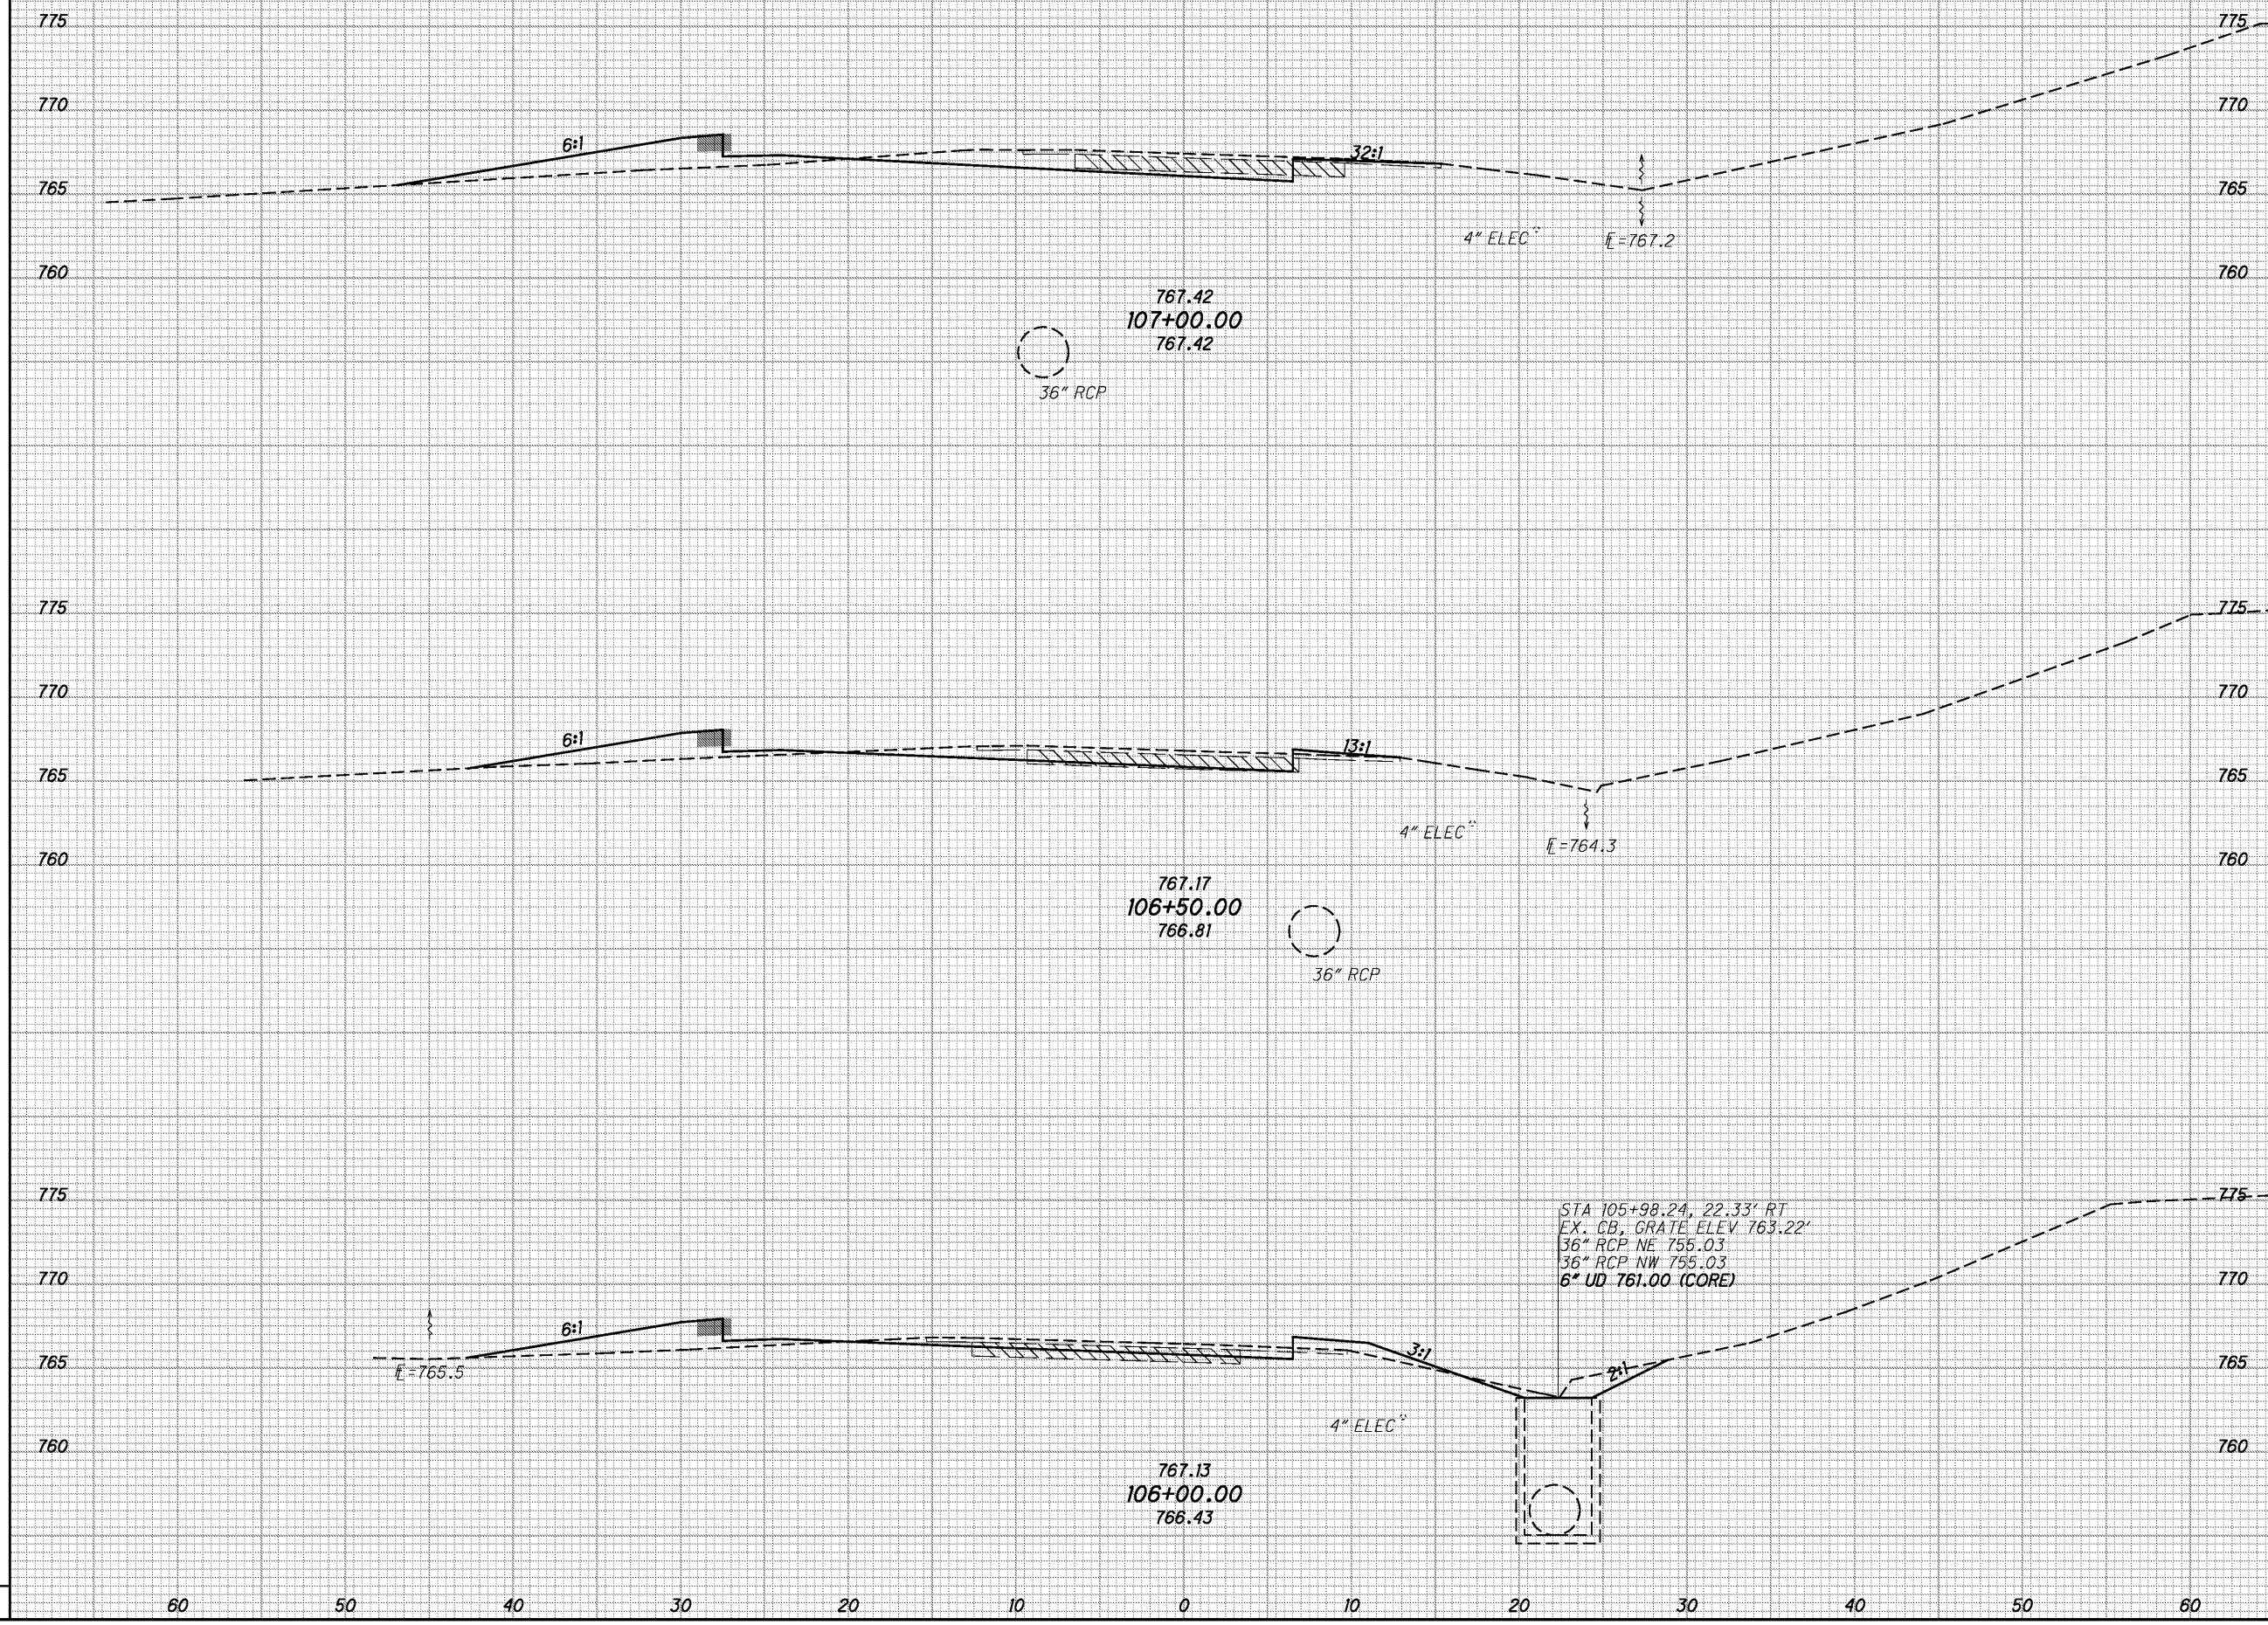

767.42  
107+00.00  
767.42

36" RCP

4" ELEC"

E=767.2

767.17  
106+50.00  
766.81

36" RCP

4" ELEC"

E=764.3

STA 105+98.24, 22.33' RT  
EX. CB, GRATE ELEV. 763.22'  
36" RCP NE 755.03  
36" RCP NW 755.03  
6" UD 761.00 (CORE)

767.13  
106+00.00  
766.43

36" RCP


4" ELEC"

**CROSS SECTIONS RAMP T-2**  
**STA. 106+00.00 TO STA. 107+00.00**

**CUY - 480 - 11.60**

39  
84

I:\Projects\18063\Roadway\Sheets\18063XS002.dgn 2/5/2015 10:28:55 AM michael.j.\_thompson

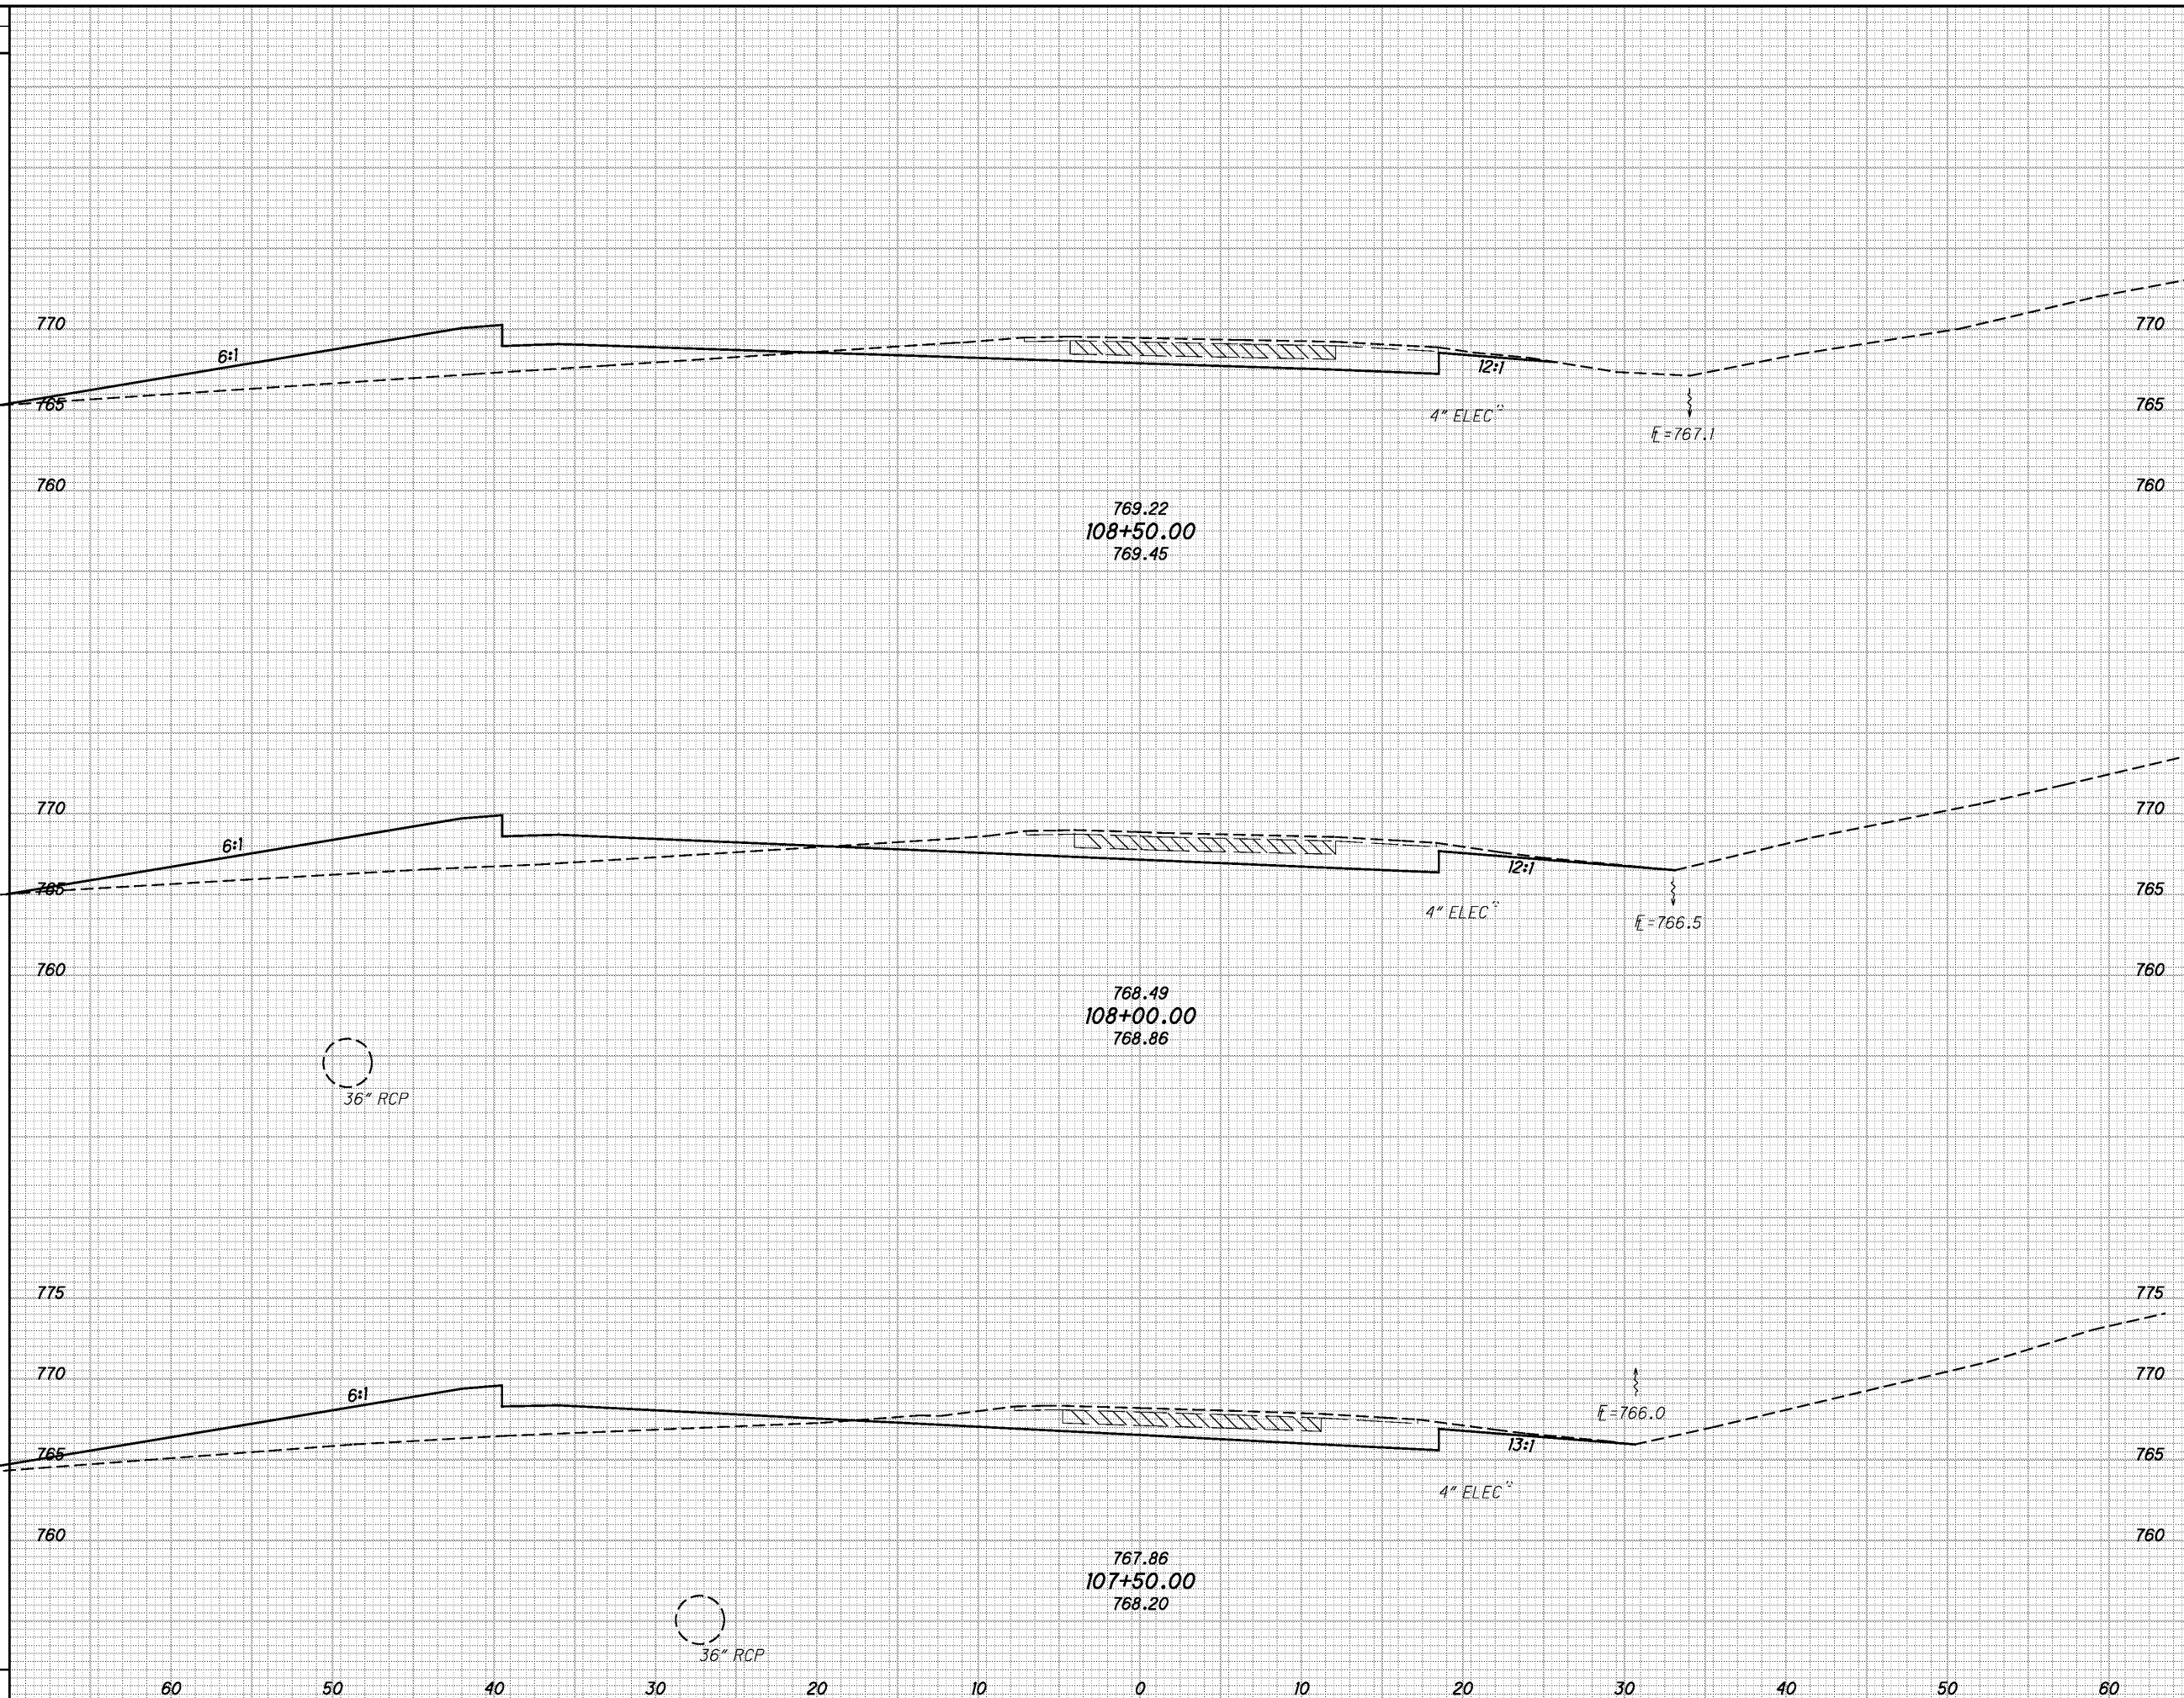


SEEDING		END AREA		VOLUME		CALCULATED	
END WIDTH	SO. YDS.	CUT	FILL	CUT	FILL	JEM	MEP

**CROSS SECTIONS RAMP T-2**  
**STA. 107+50.00 TO STA. 108+50.00**

**CUY-480-11.60**

40
84

SEEDING  
END WIDTH SO. YDS.  
I:\Projects\18063\Roadway\Sheets\18063XS002.dgn 2/5/2015 10:28:55 AM michael\_j\_thompson

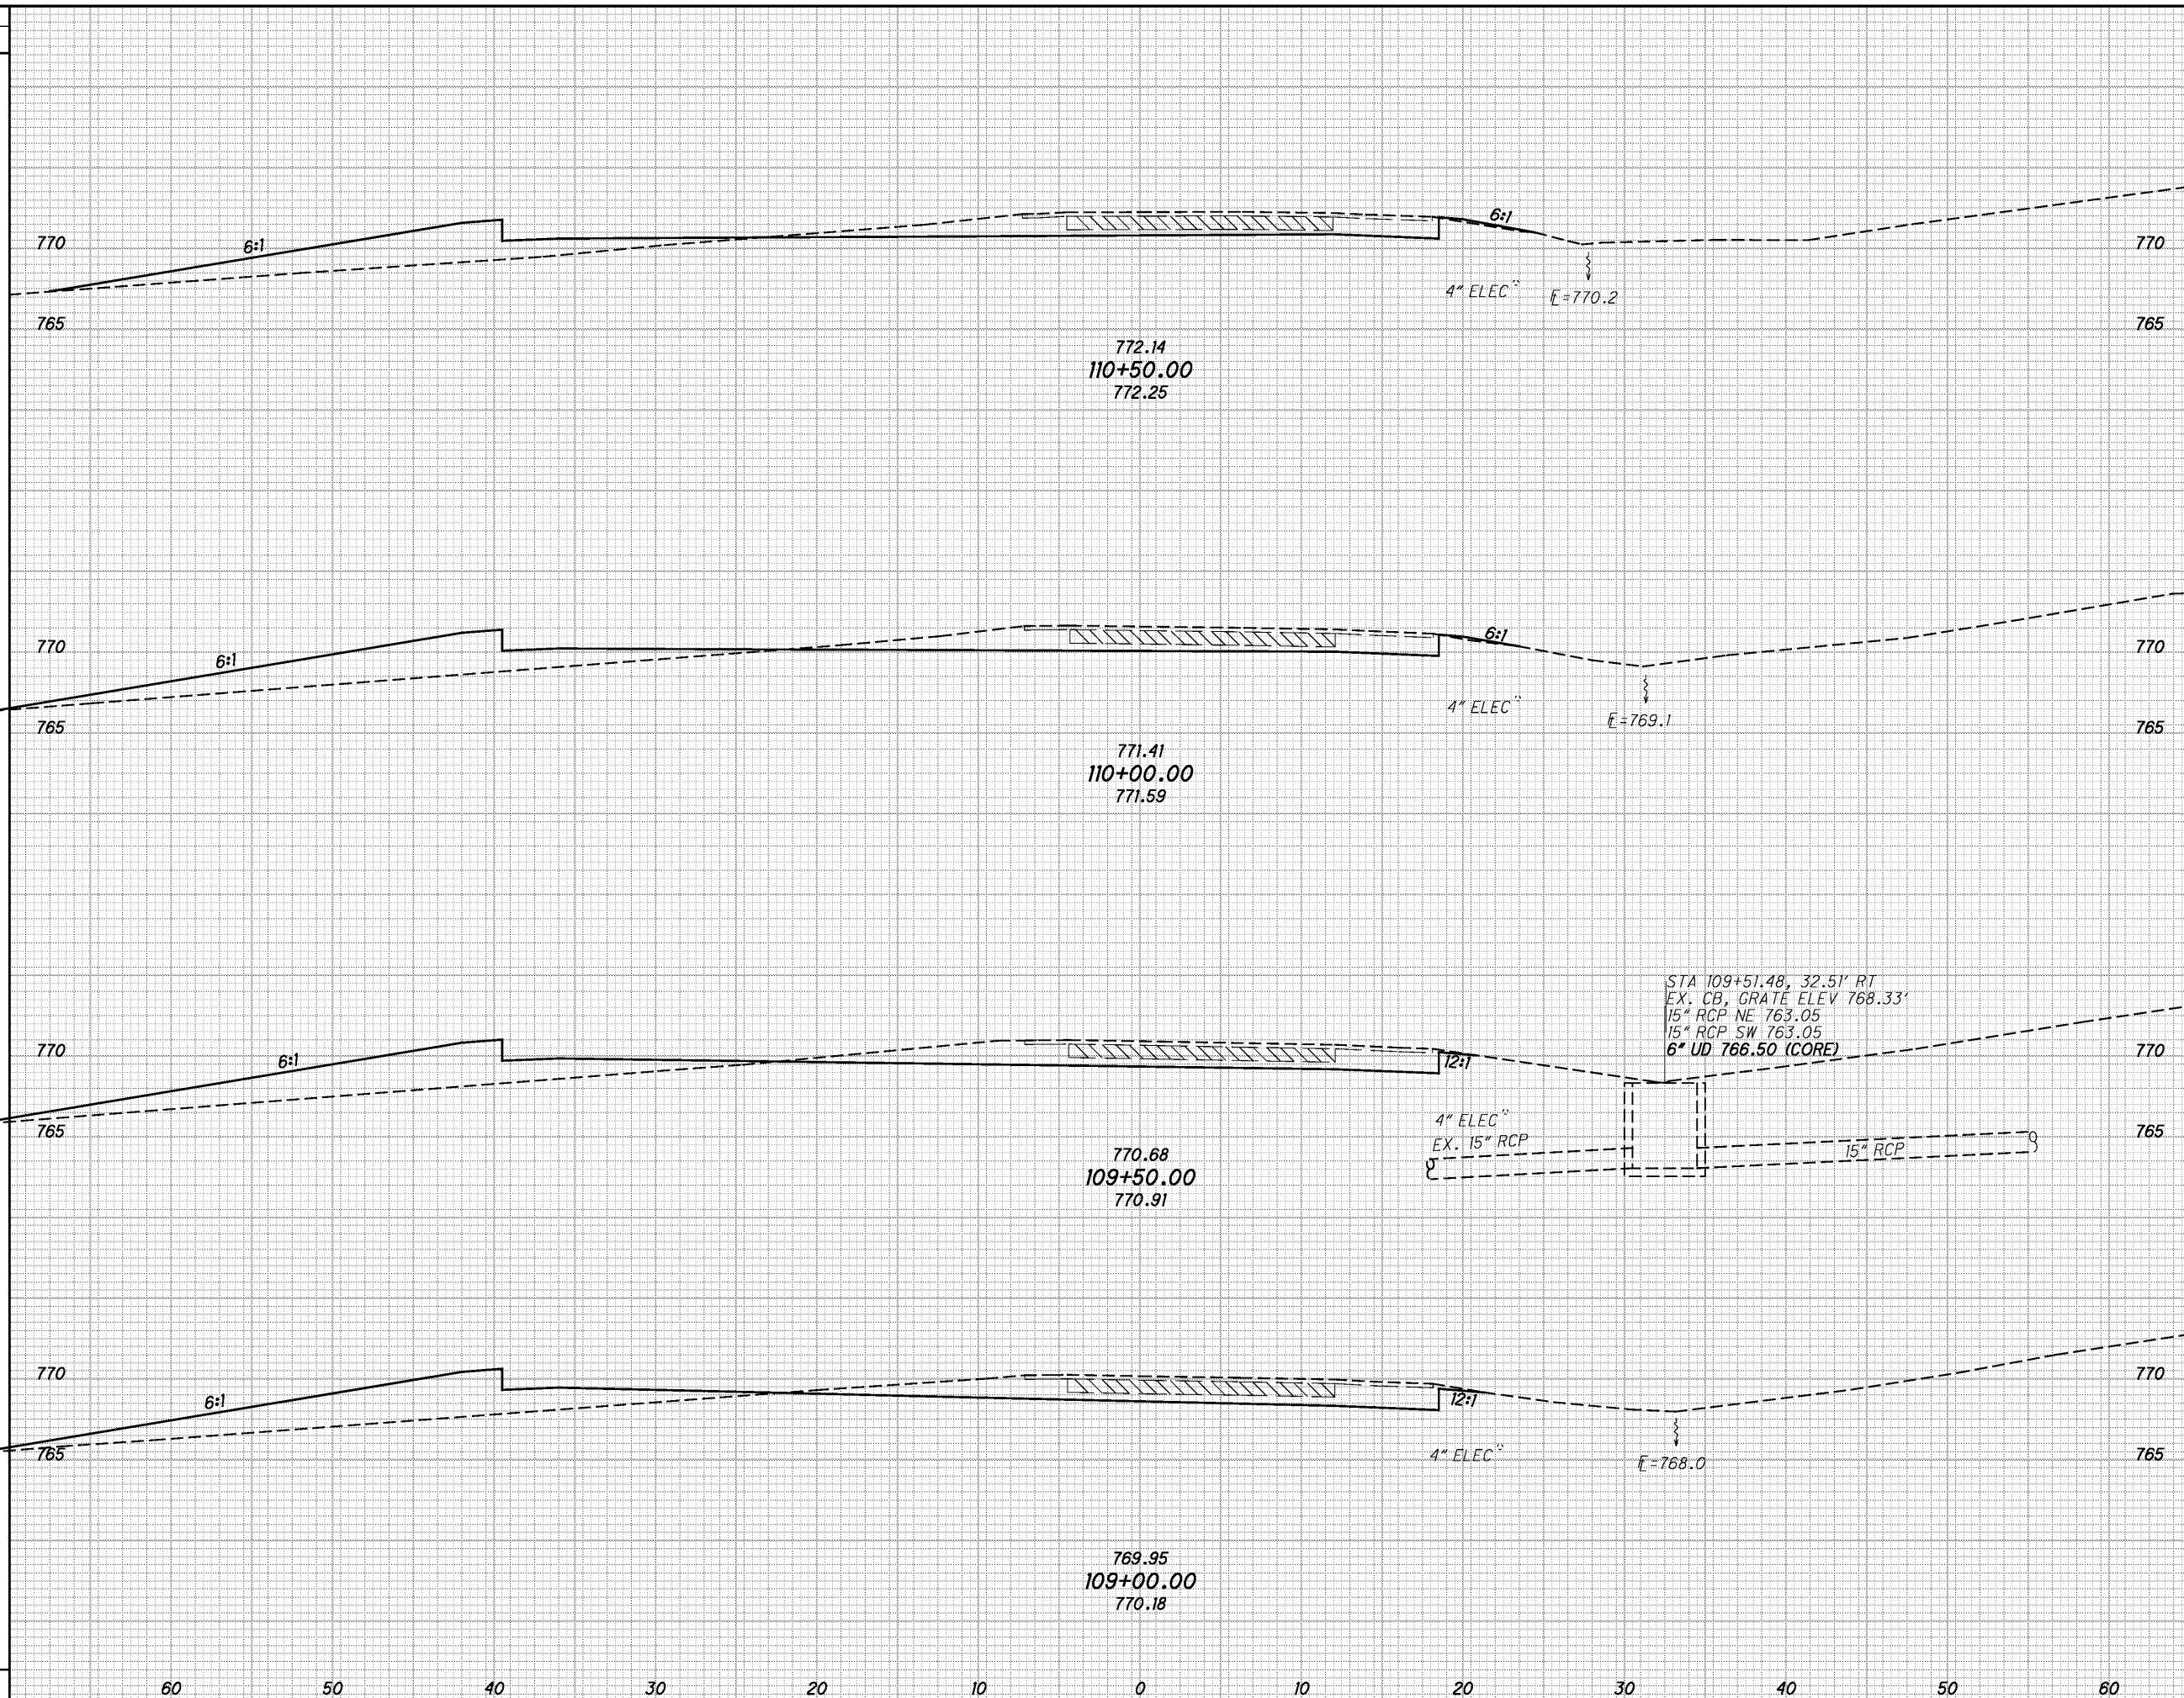

END AREA		VOLUME		CALCULATED JEM	CHECKED MEP
CUT	FILL	CUT	FILL		

**CROSS SECTIONS RAMP T-2**  
**STA. 109+00.00 TO STA. 110+50.00**

**CUY-480-11.60**


41  
84

I:\Projects\18063\Roadway\Sheets\18063XS002.dgn 2/5/2015 10:28:55 AM michael\_j.\_thompson

**SEEDING**

END WIDTH	SO. YDS.

END AREA		VOLUME		CALCULATED JEM	CHECKED MEP
CUT	FILL	CUT	FILL		

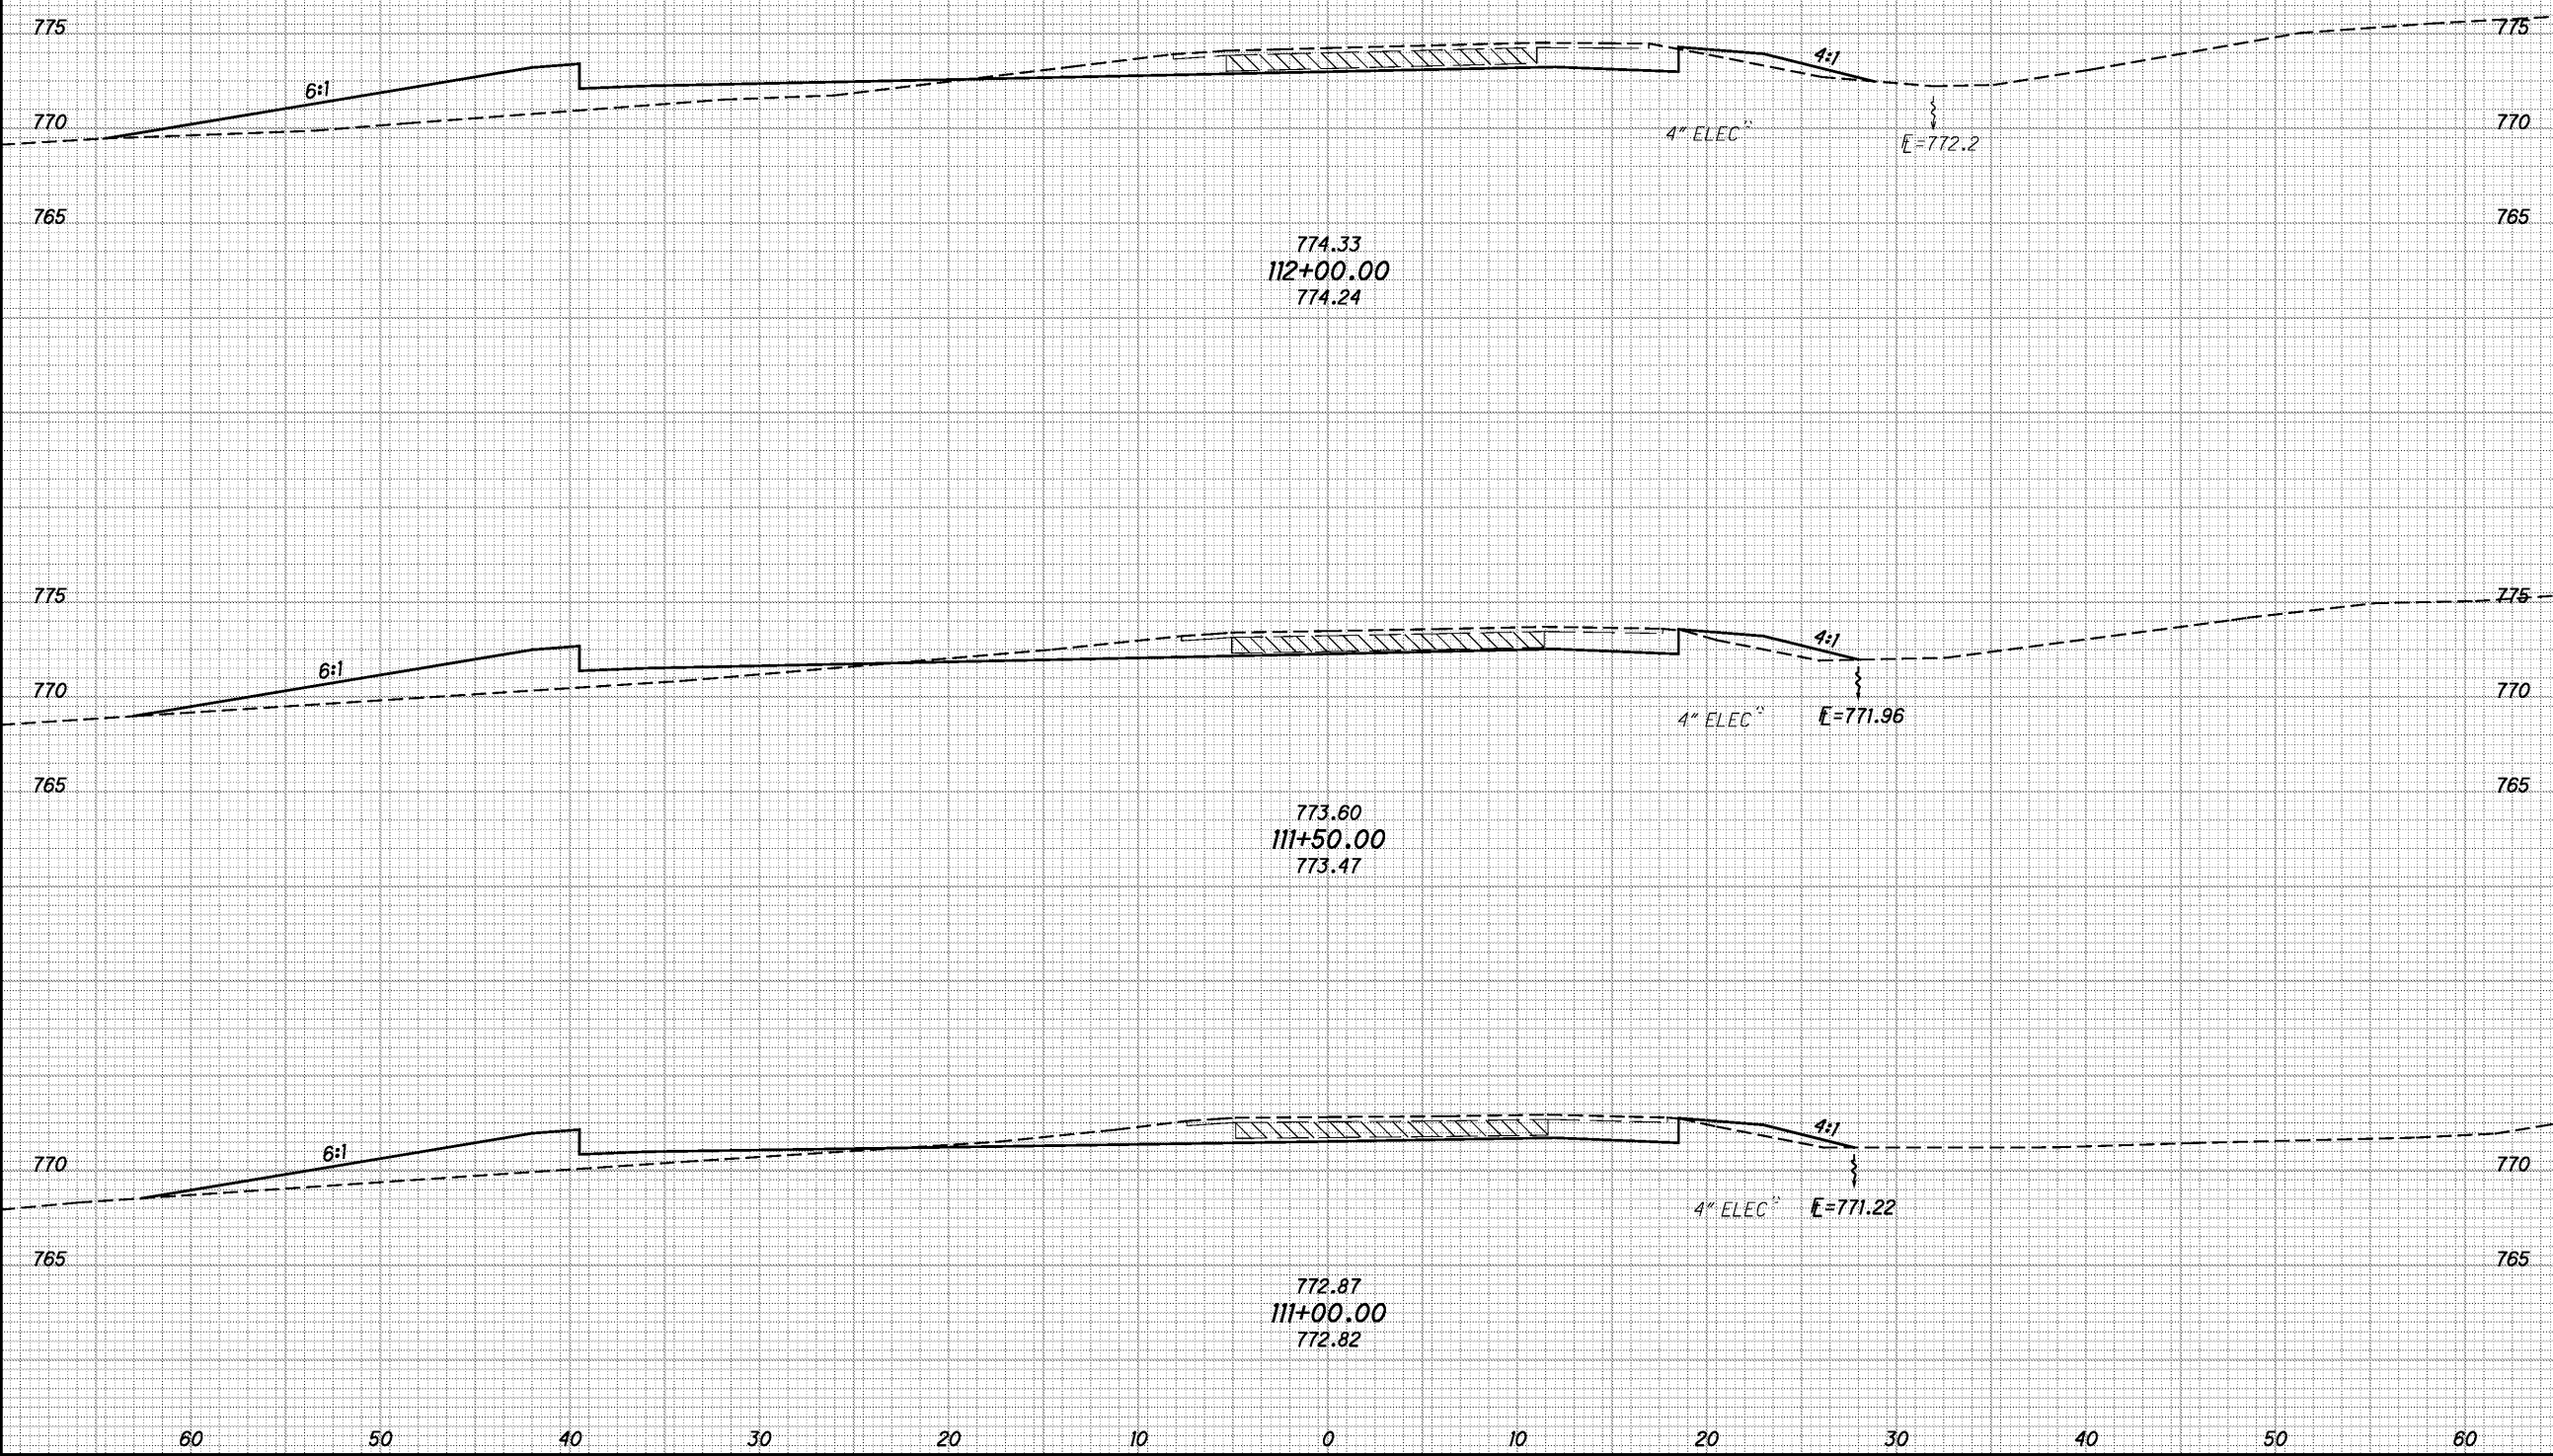

**CROSS SECTIONS RAMP T-2**  
**STA. 111+00.00 TO STA. 112+00.00**


**CUY - 480 - 11.60**

SEEDING

END SO. SEEDING  
WIDTH YDS.

END AREA VOLUME  
CUT FILL CUT FILL

END AREA		VOLUME		CALCULATED	CHECKED
CUT	FILL	CUT	FILL	JEM	MEP

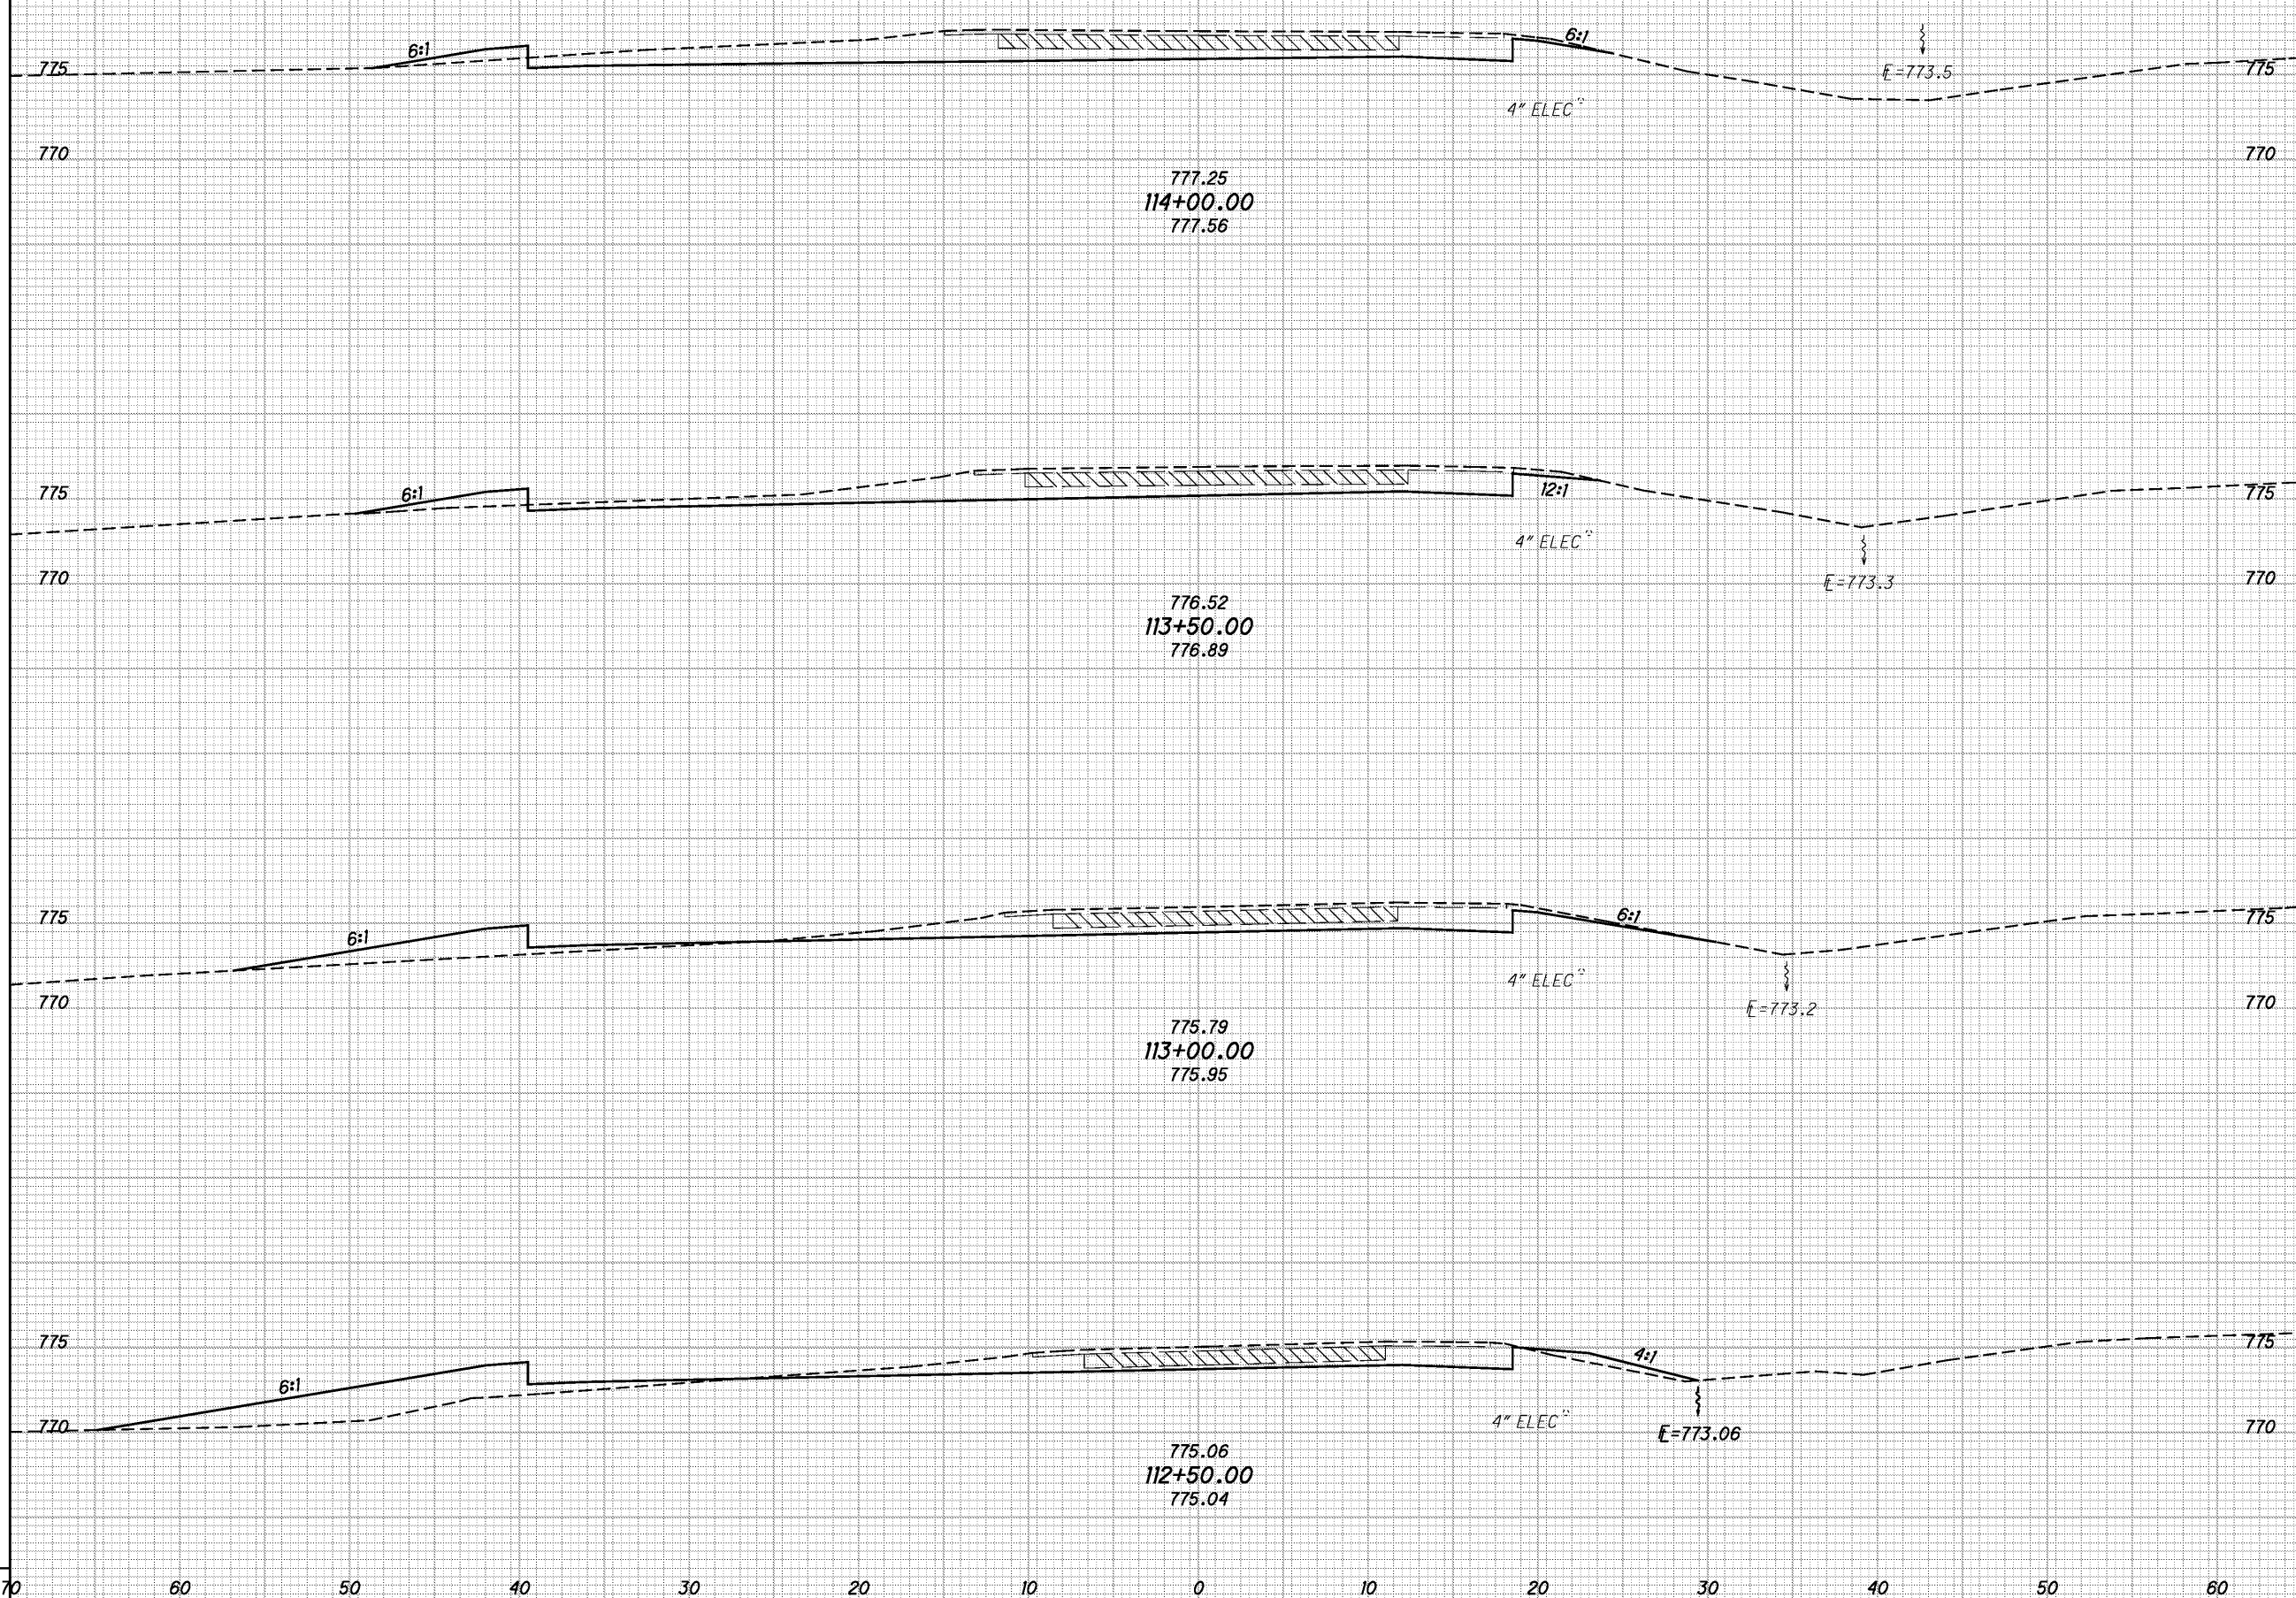

CROSS SECTIONS RAMP T-2  
STA. 112+50.00 TO STA. 114+00.00


CUY-480-11.60

43  
84

I:\Projects\18063\Roadway\Sheets\18063XS002.dgn 2/5/2015 10:28:56 AM michael\_j\_thompson

SEEDING	
END WIDTH	SO. YDS.

END AREA		VOLUME		CALCULATED	
CUT	FILL	CUT	FILL	JEM	MEP

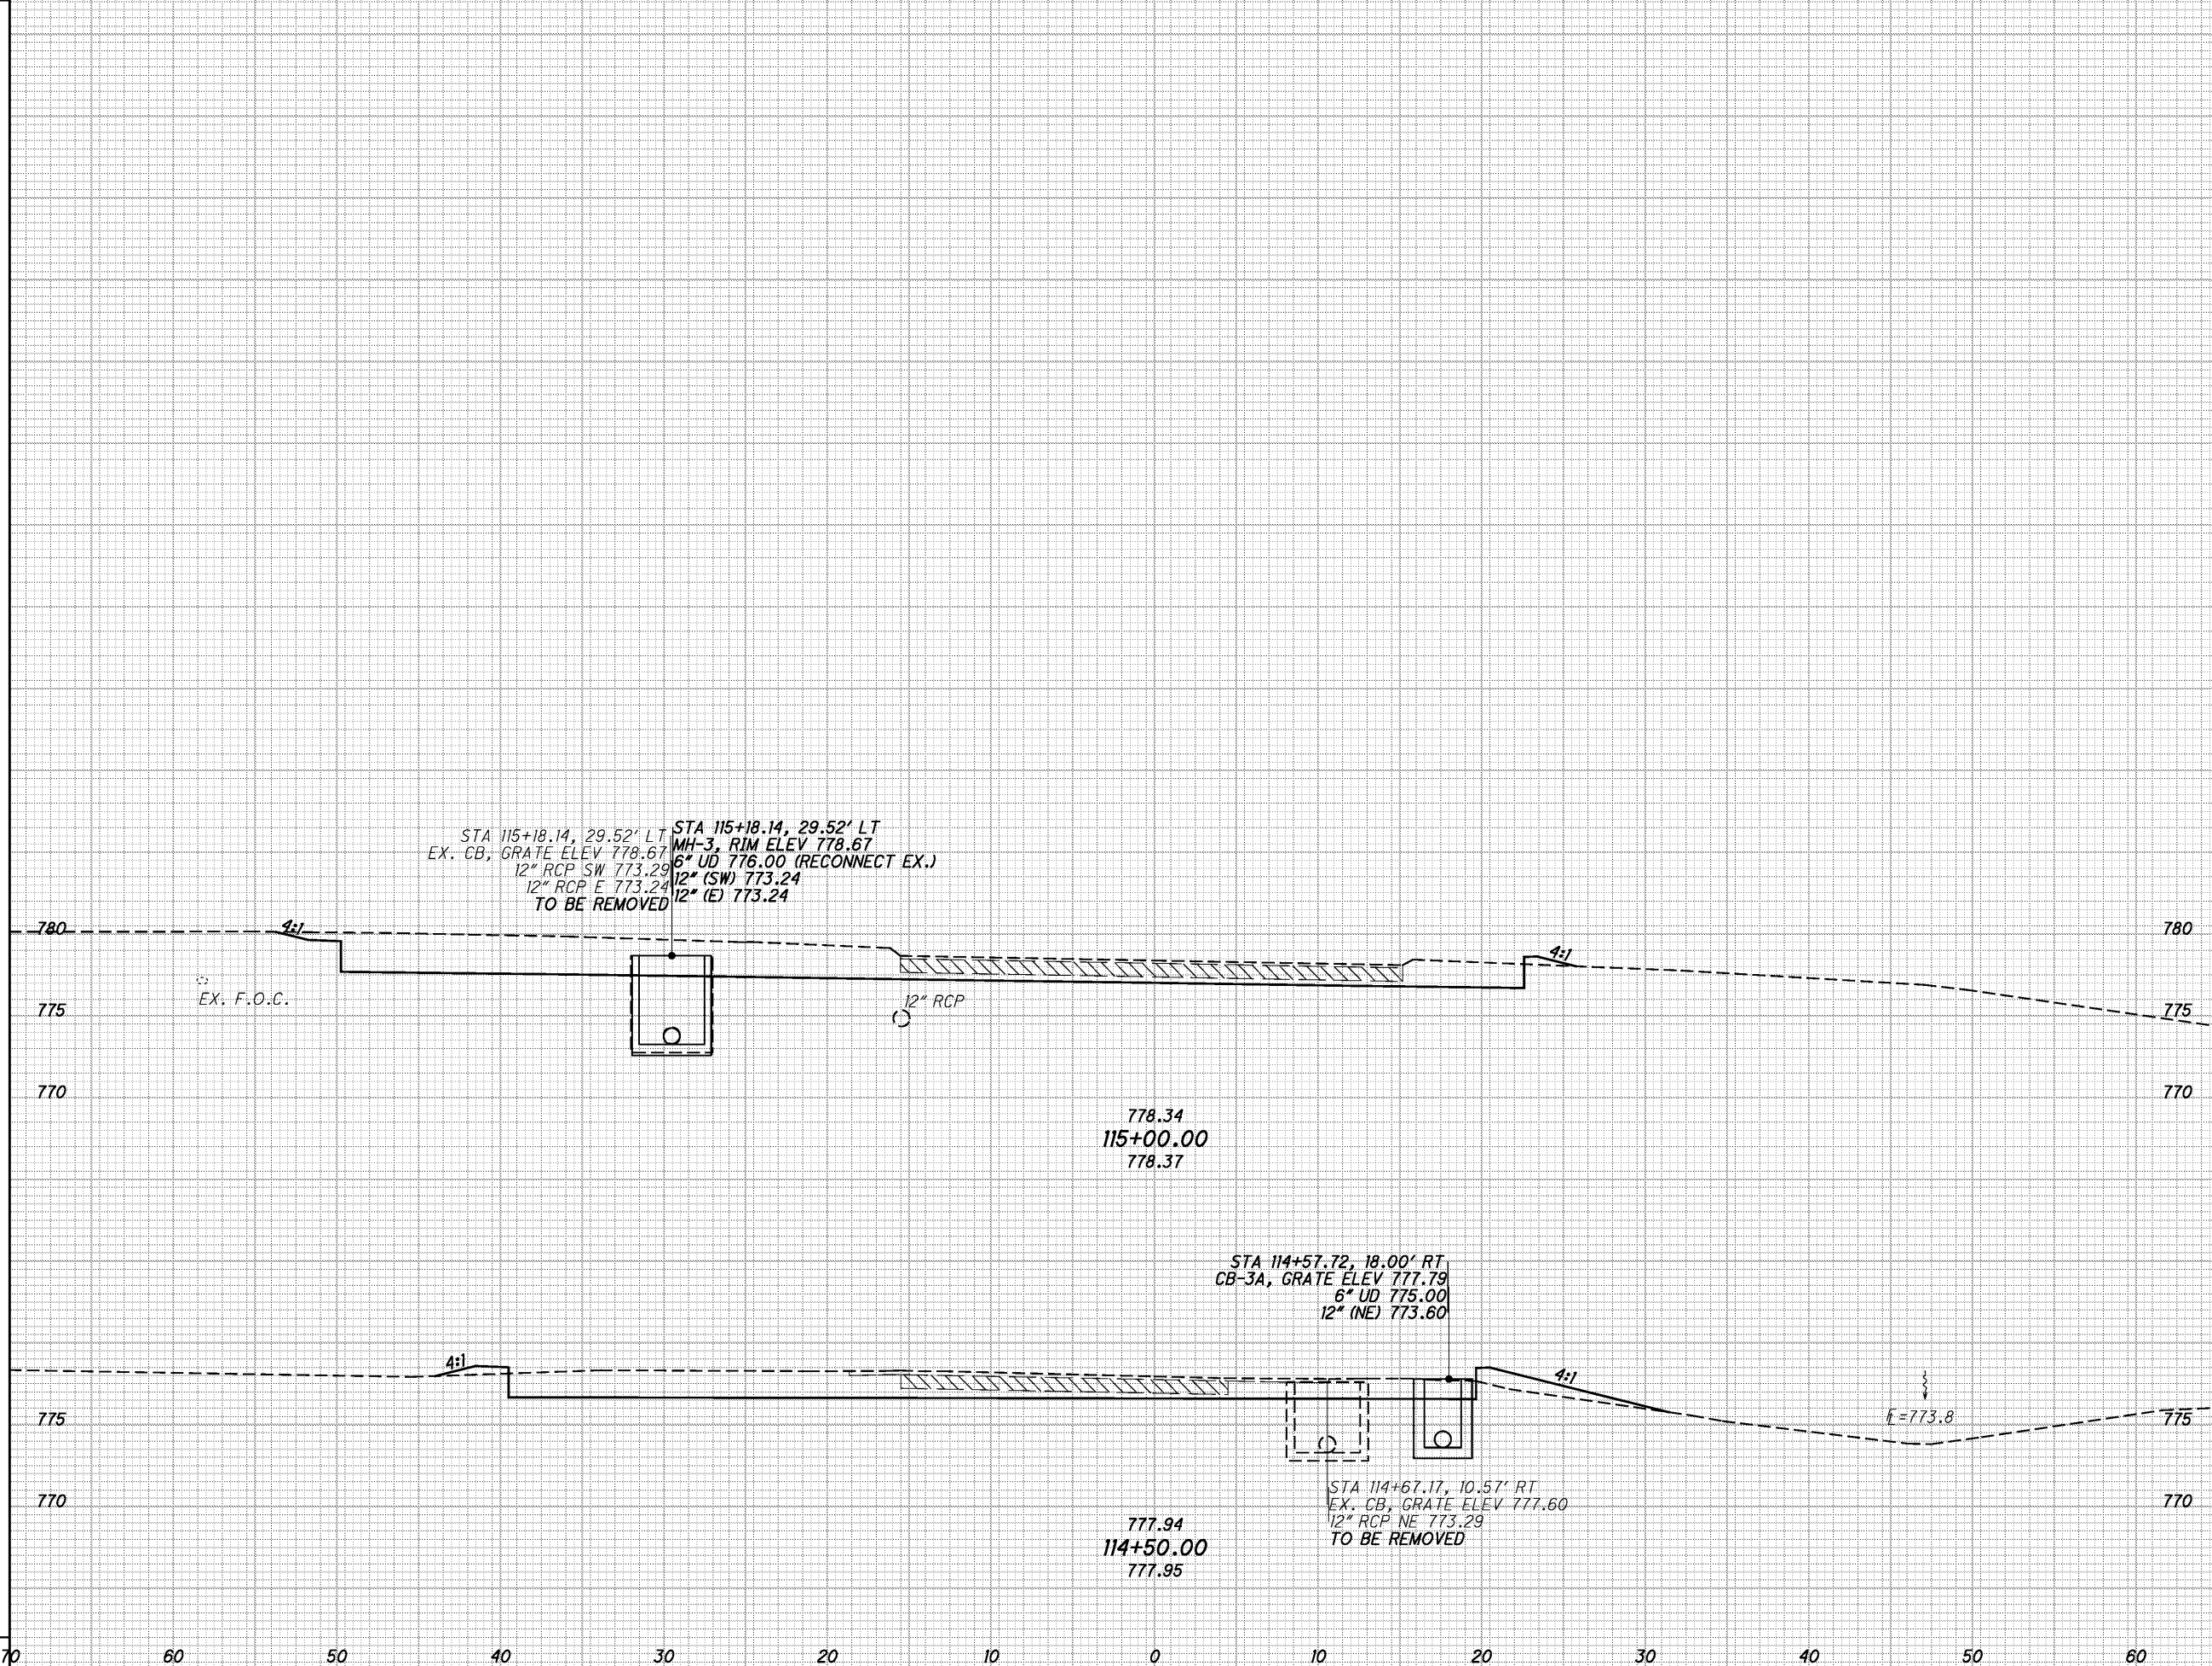


CROSS SECTIONS RAMP T-2  
STA. 114+50.00 TO STA. 115+00.00


CUY - 480 - 11.60



FOR CROSS SECTIONS, SEE SHEETS 47 - 50  
 FOR SUPERELEVATION TABLE, SEE SHEET 63  
 FOR INTERSECTION DETAIL, SEE SHEET 69  
 DEO = THE EAST OHIO GAS COMPANY,  
 DBA DOMINION EAST OHIO, 1-800-362-7557

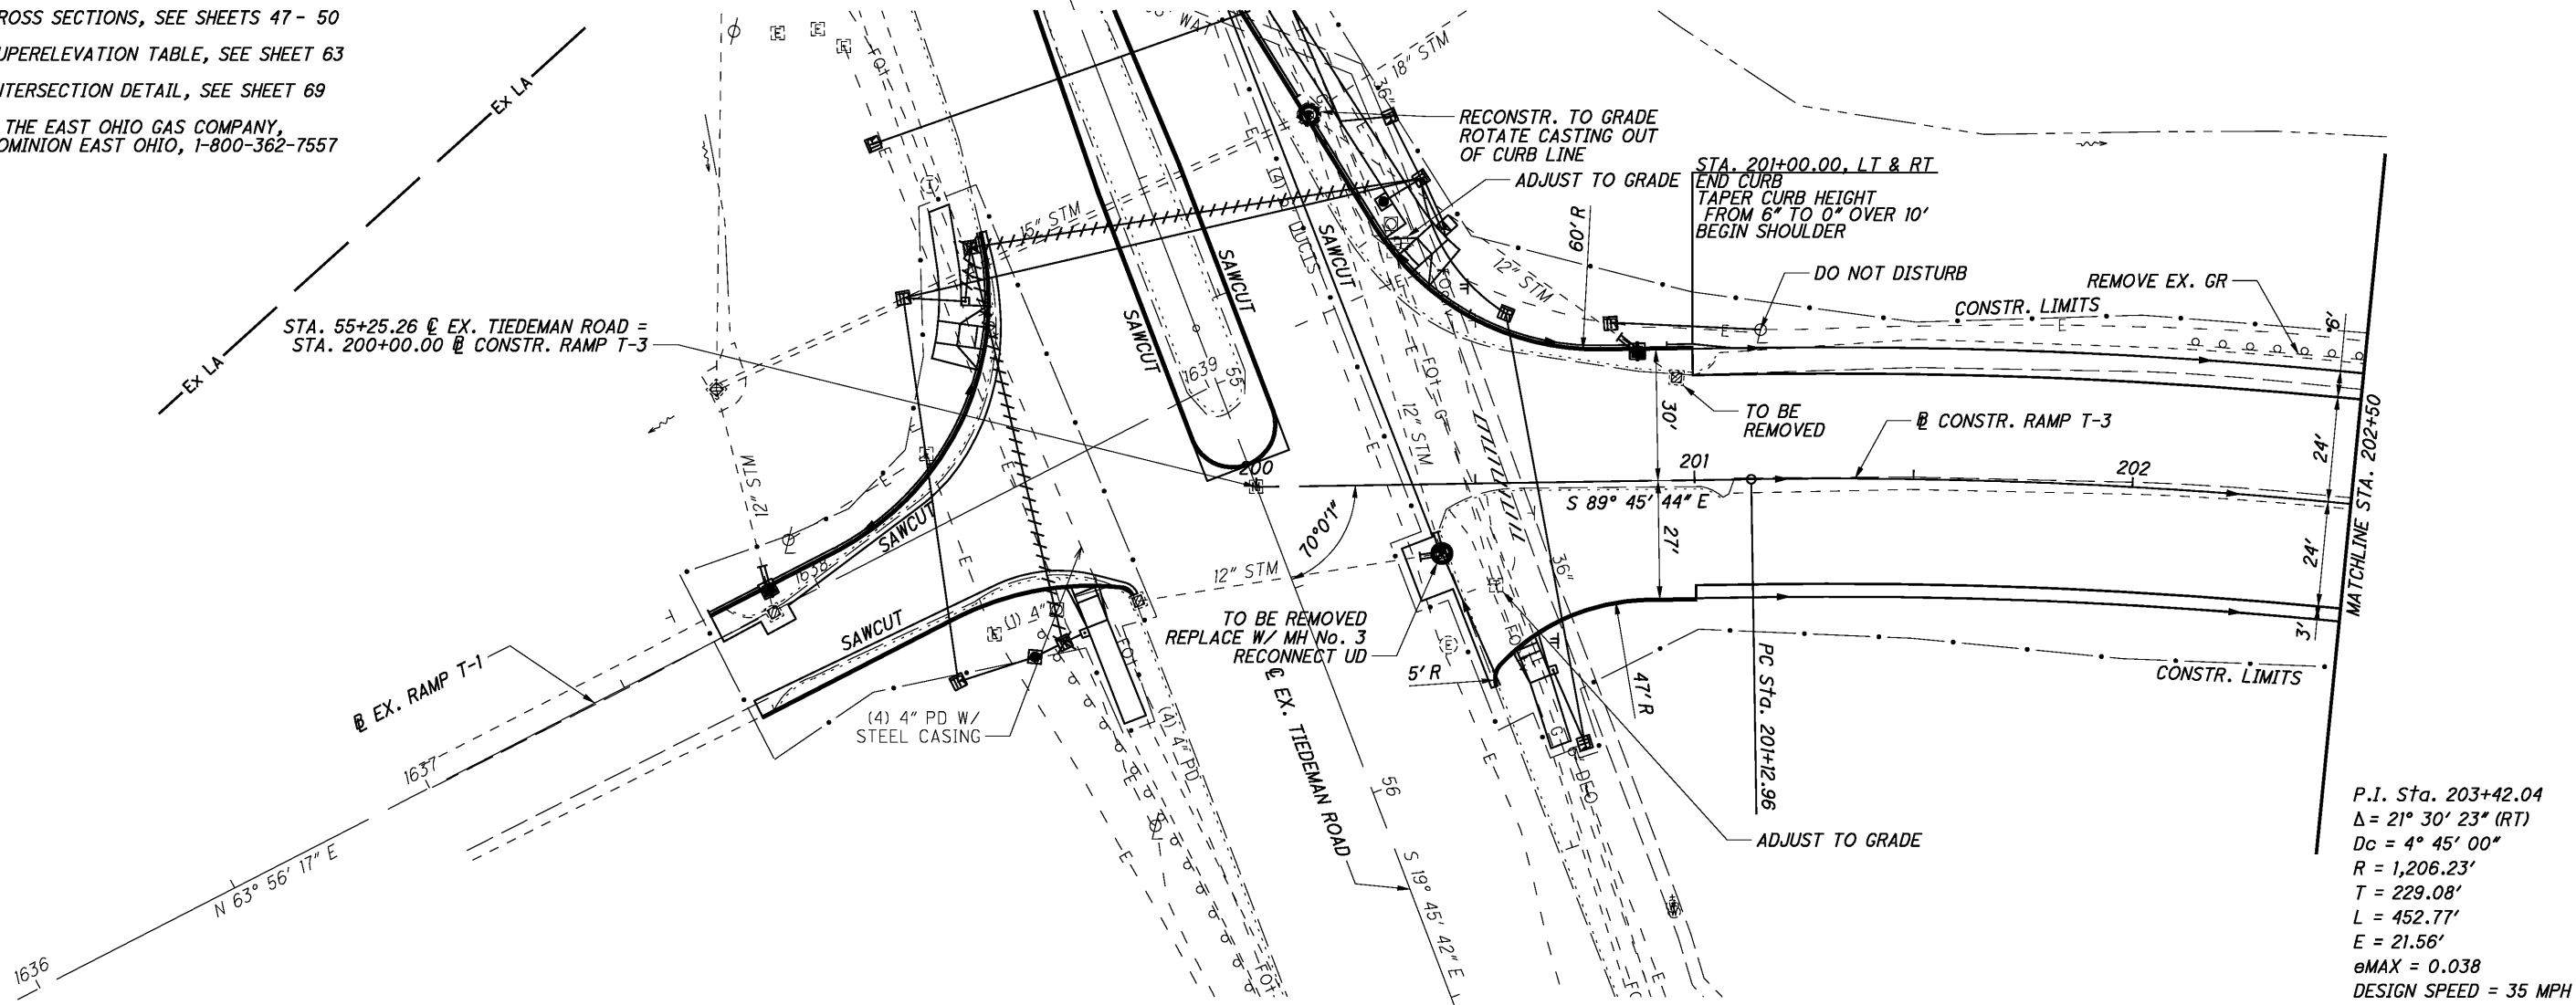

P.I. Sta. 203+42.04  
 $\Delta = 21^\circ 30' 23''$  (RT)  
 $D_c = 4^\circ 45' 00''$   
 $R = 1,206.23'$   
 $T = 229.08'$   
 $L = 452.77'$   
 $E = 21.56'$   
 $e_{MAX} = 0.038$   
 DESIGN SPEED = 35 MPH

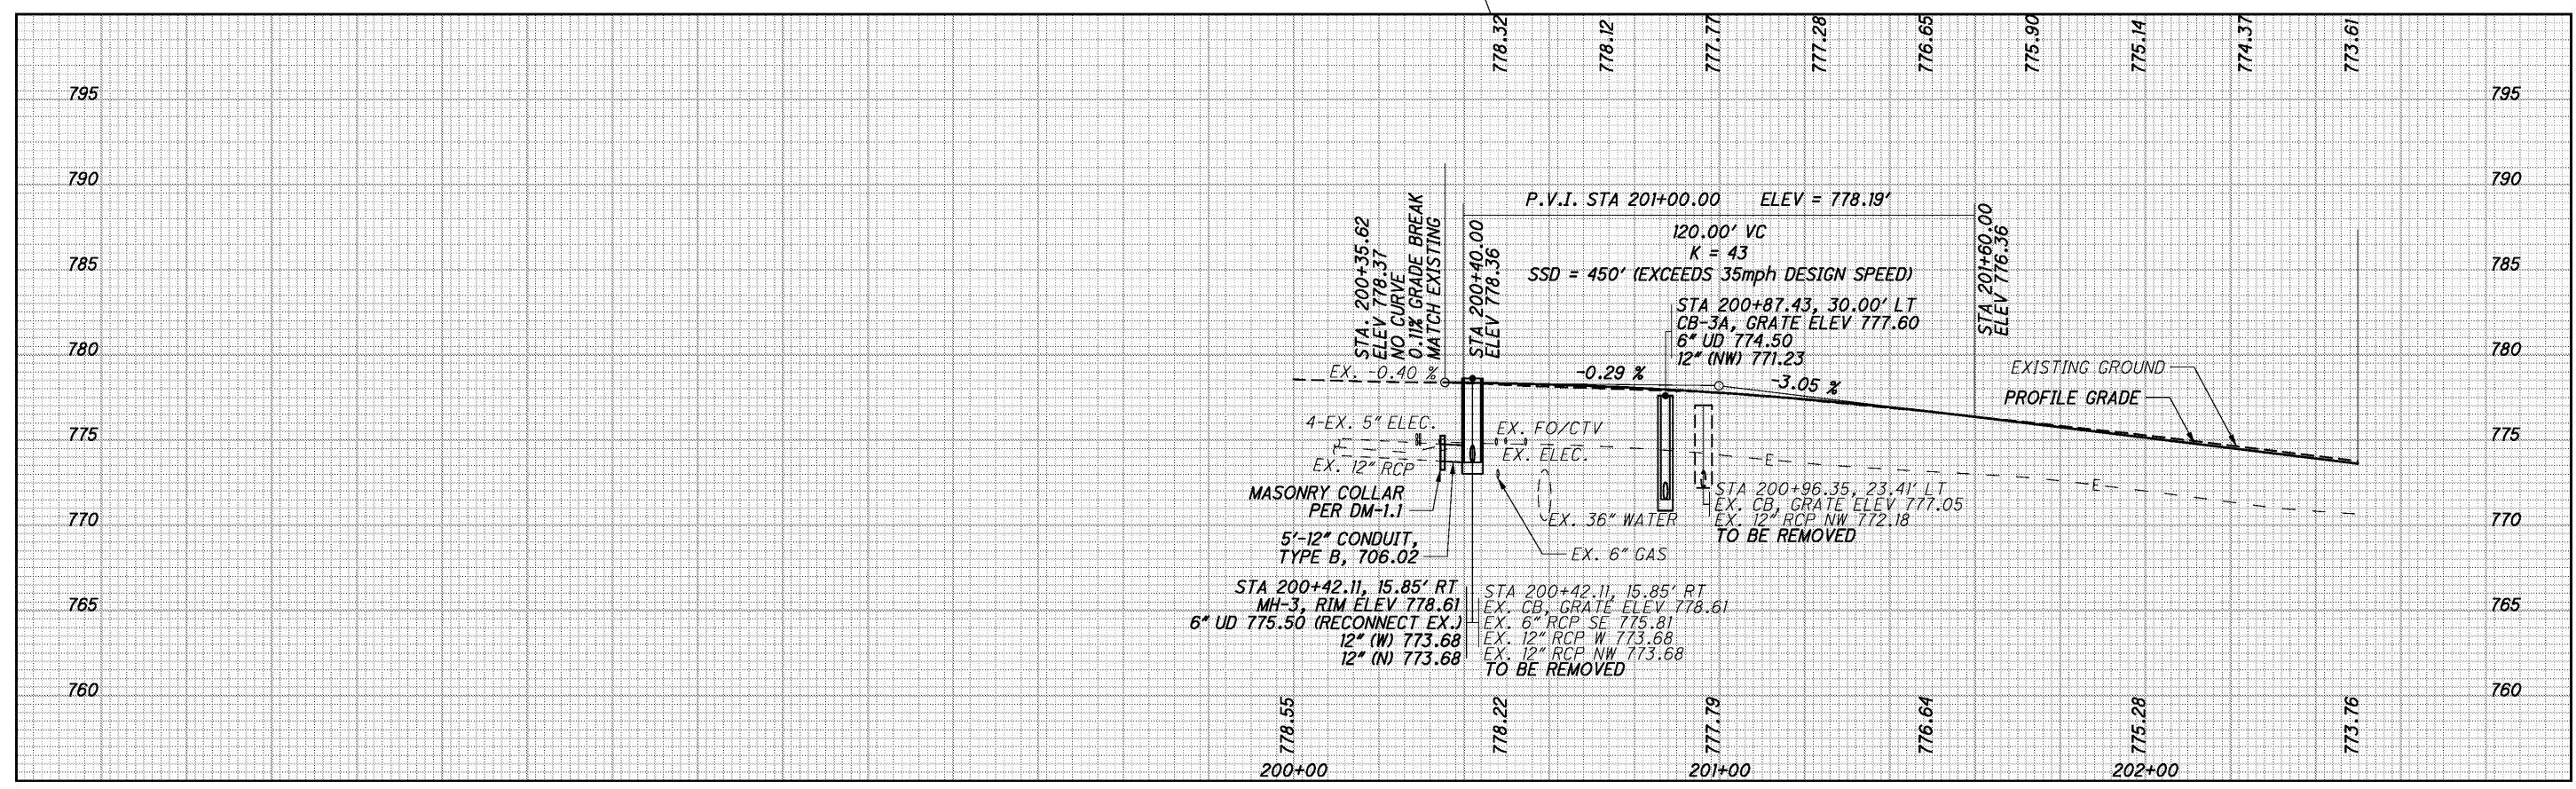

I:\Projects\18063\Roadway\Sheets\18063GP004.dgn 2/5/2015 10:28:58 AM michael.j.\_thompson




CALCULATED  
 MEP  
 CHECKED  
 FR

**PLAN AND PROFILE - RAMP T-3  
 BEGINNING TO STA. 202+50**


**CUY-480-11.60**

45  
 84

FOR CROSS SECTIONS, SEE SHEETS 47 - 50  
 FOR SUPERELEVATION TABLE, SEE SHEET 63  
 FOR INTERSECTION DETAIL, SEE SHEET 69

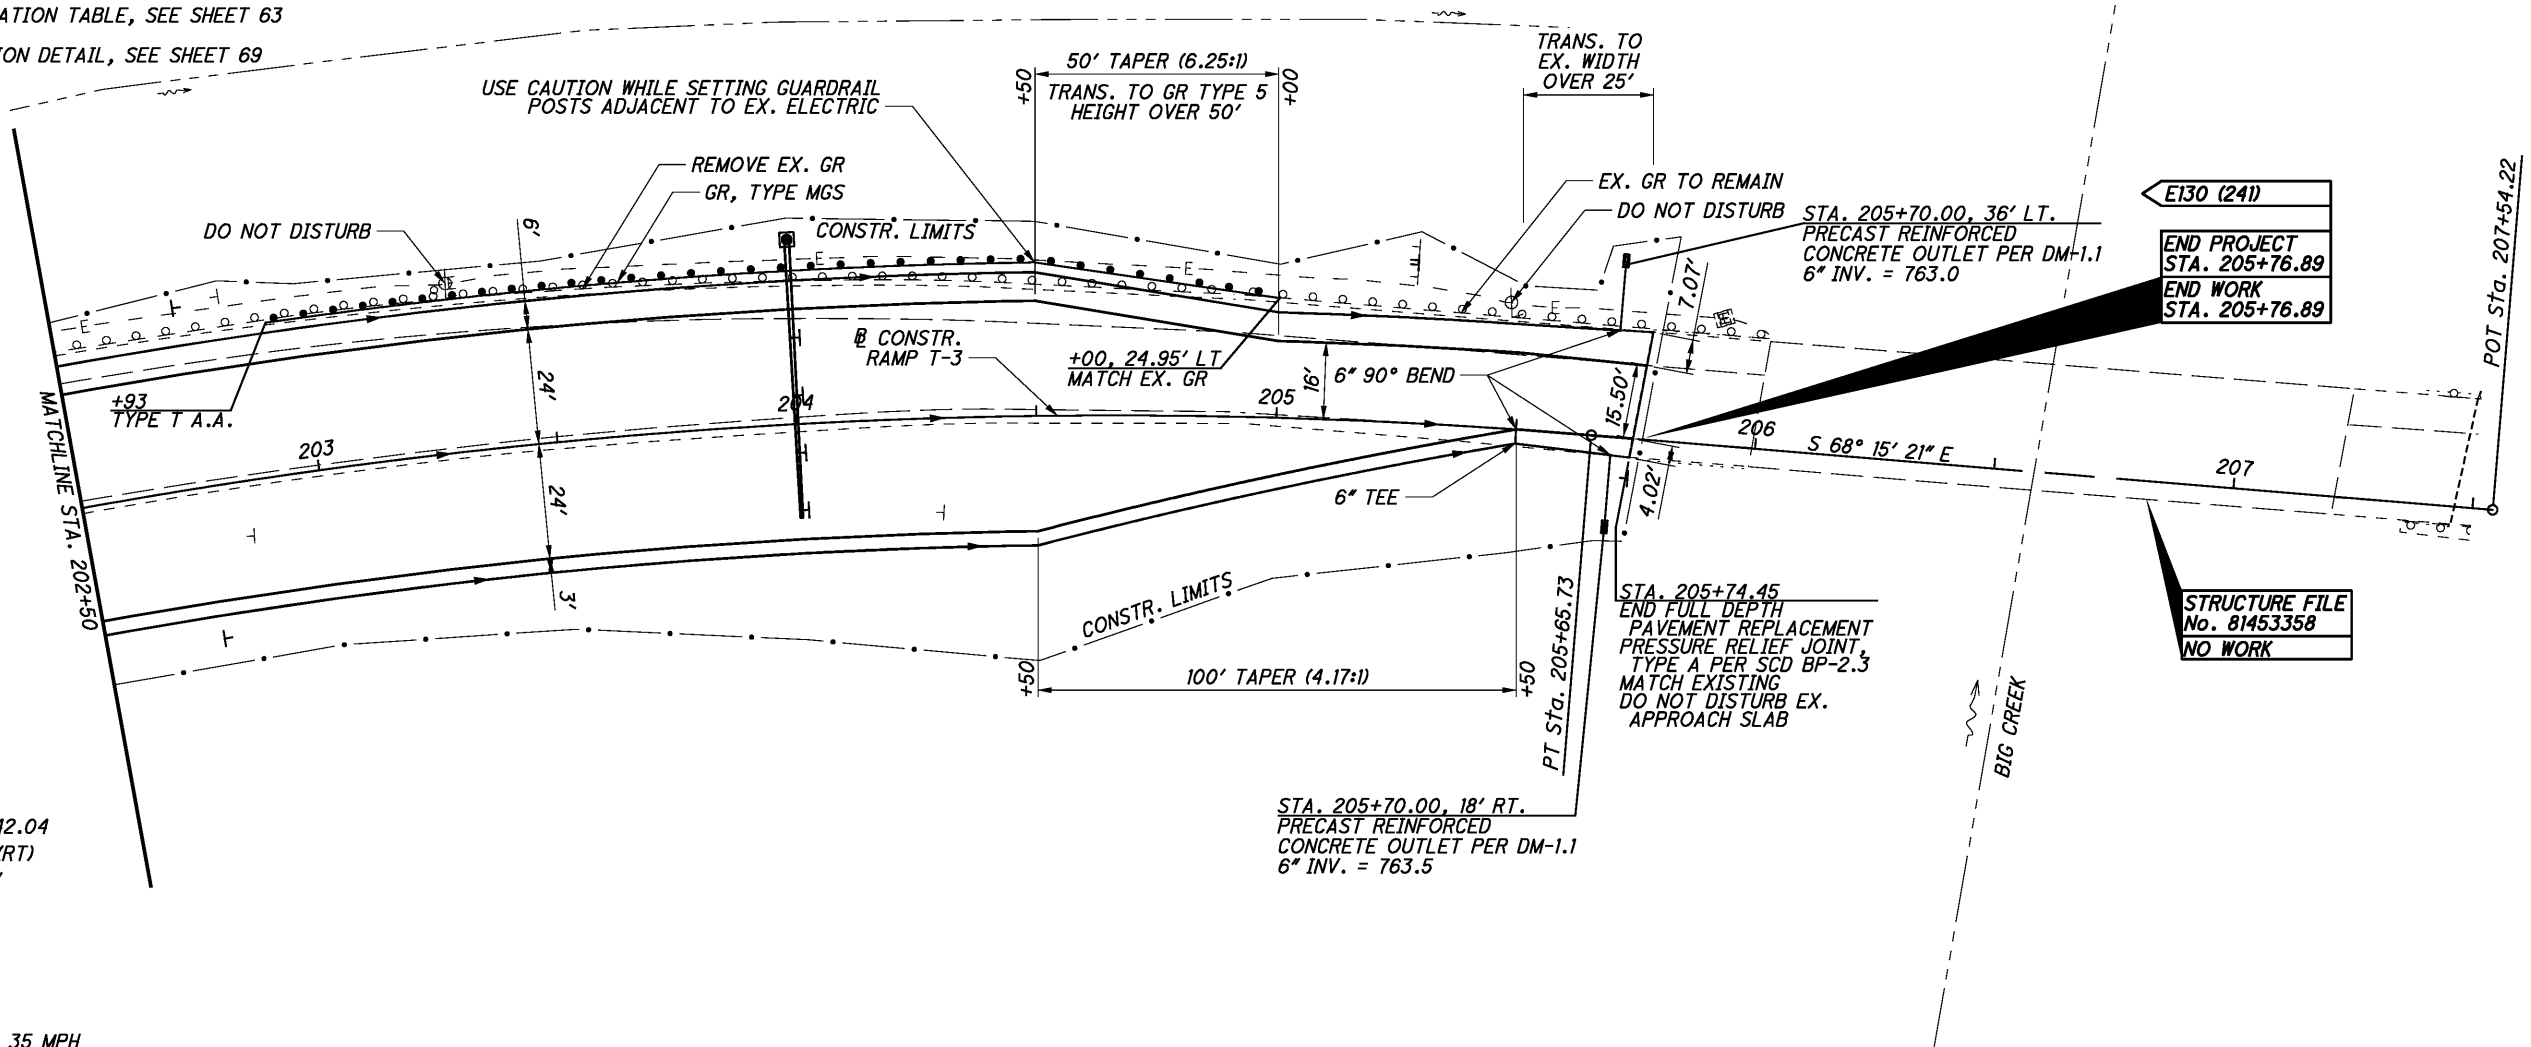

P.I. Sta. 203+42.04  
 $\Delta = 21^\circ 30' 23''$  (RT)  
 $D_c = 4^\circ 45' 00''$   
 $R = 1,206.23'$   
 $T = 229.08'$   
 $L = 452.77'$   
 $E = 21.56'$   
 $e_{MAX} = 0.038$   
 DESIGN SPEED = 35 MPH

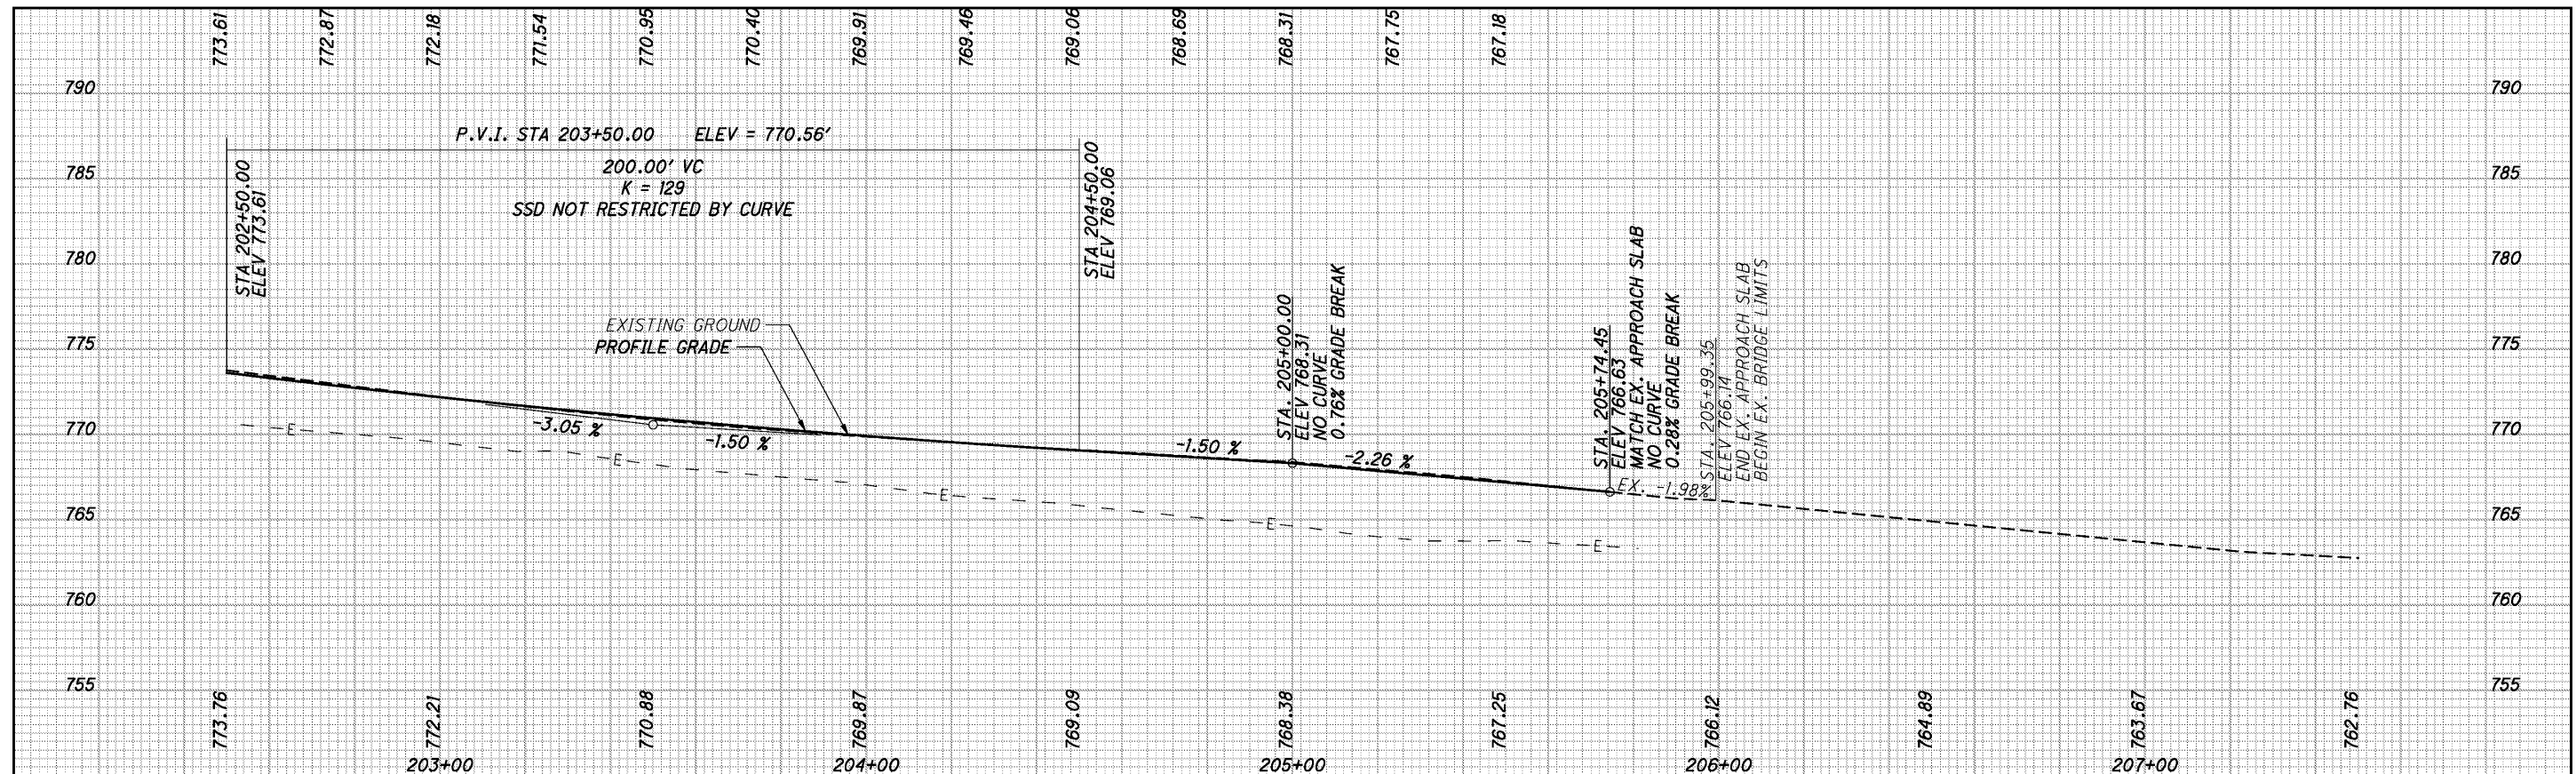

PLAN AND PROFILE - RAMP T-3  
 STA. 202+50 TO ENDING


CUY - 480 - 11.60

I:\Projects\18063\Roadway\Sheets\18063GP005.dgn 2/5/2015 10:28:59 AM michael.j.\_thompson

SEEDING  
END SO.  
WIDTH YDS.

TEMPORARY  
PAVEMENT  
AND GRADING

END AREA		VOLUME		CALCULATED JEM	CHECKED MEP
CUT	FILL	CUT	FILL		

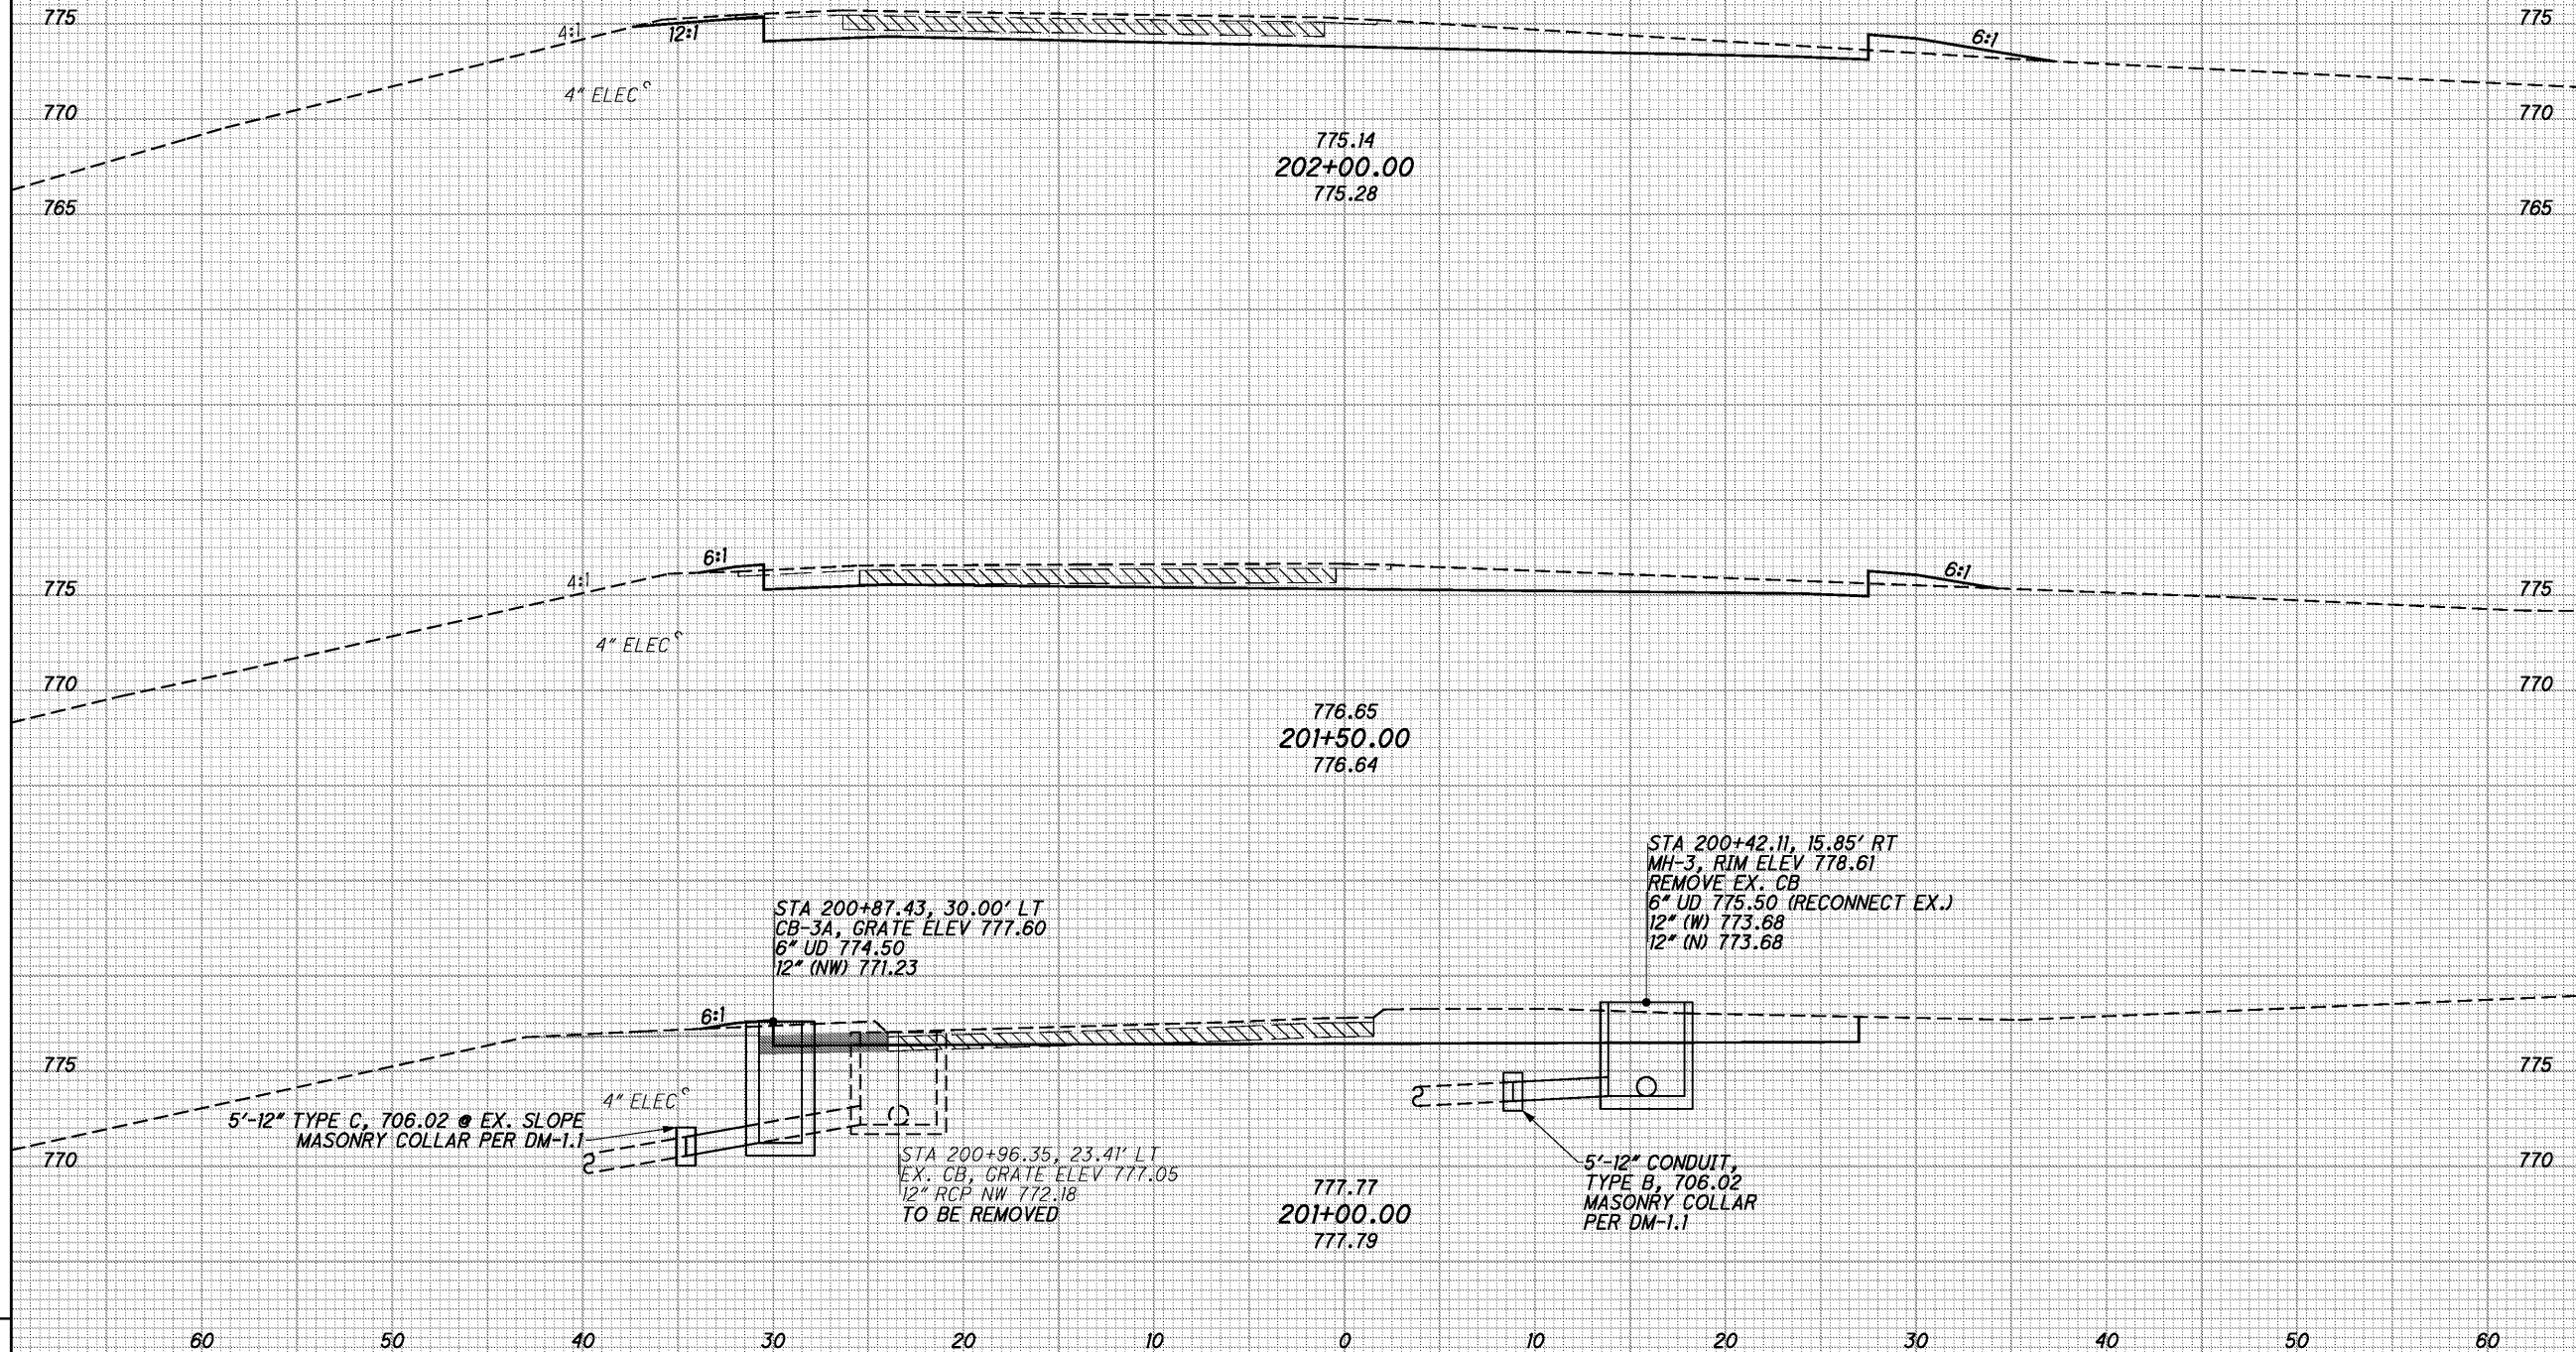

CROSS SECTIONS RAMP T-3  
STA. 201+00.00 TO STA. 202+00.00

CUY-480-11.60


47  
84

I:\Projects\18063\Roadway\Sheets\18063XS003.dgn 2/5/2015 10:29:01 AM michael\_j\_thompson

I:\Projects\18063\Roadway\Sheets\18063XS003.dgn 2/5/2015 10:29:01 AM michael\_j\_thompson

SEEDING	
END WIDTH	SO. YDS.


END AREA		VOLUME		CALCULATED JEM	CHECKED MEP
CUT	FILL	CUT	FILL		

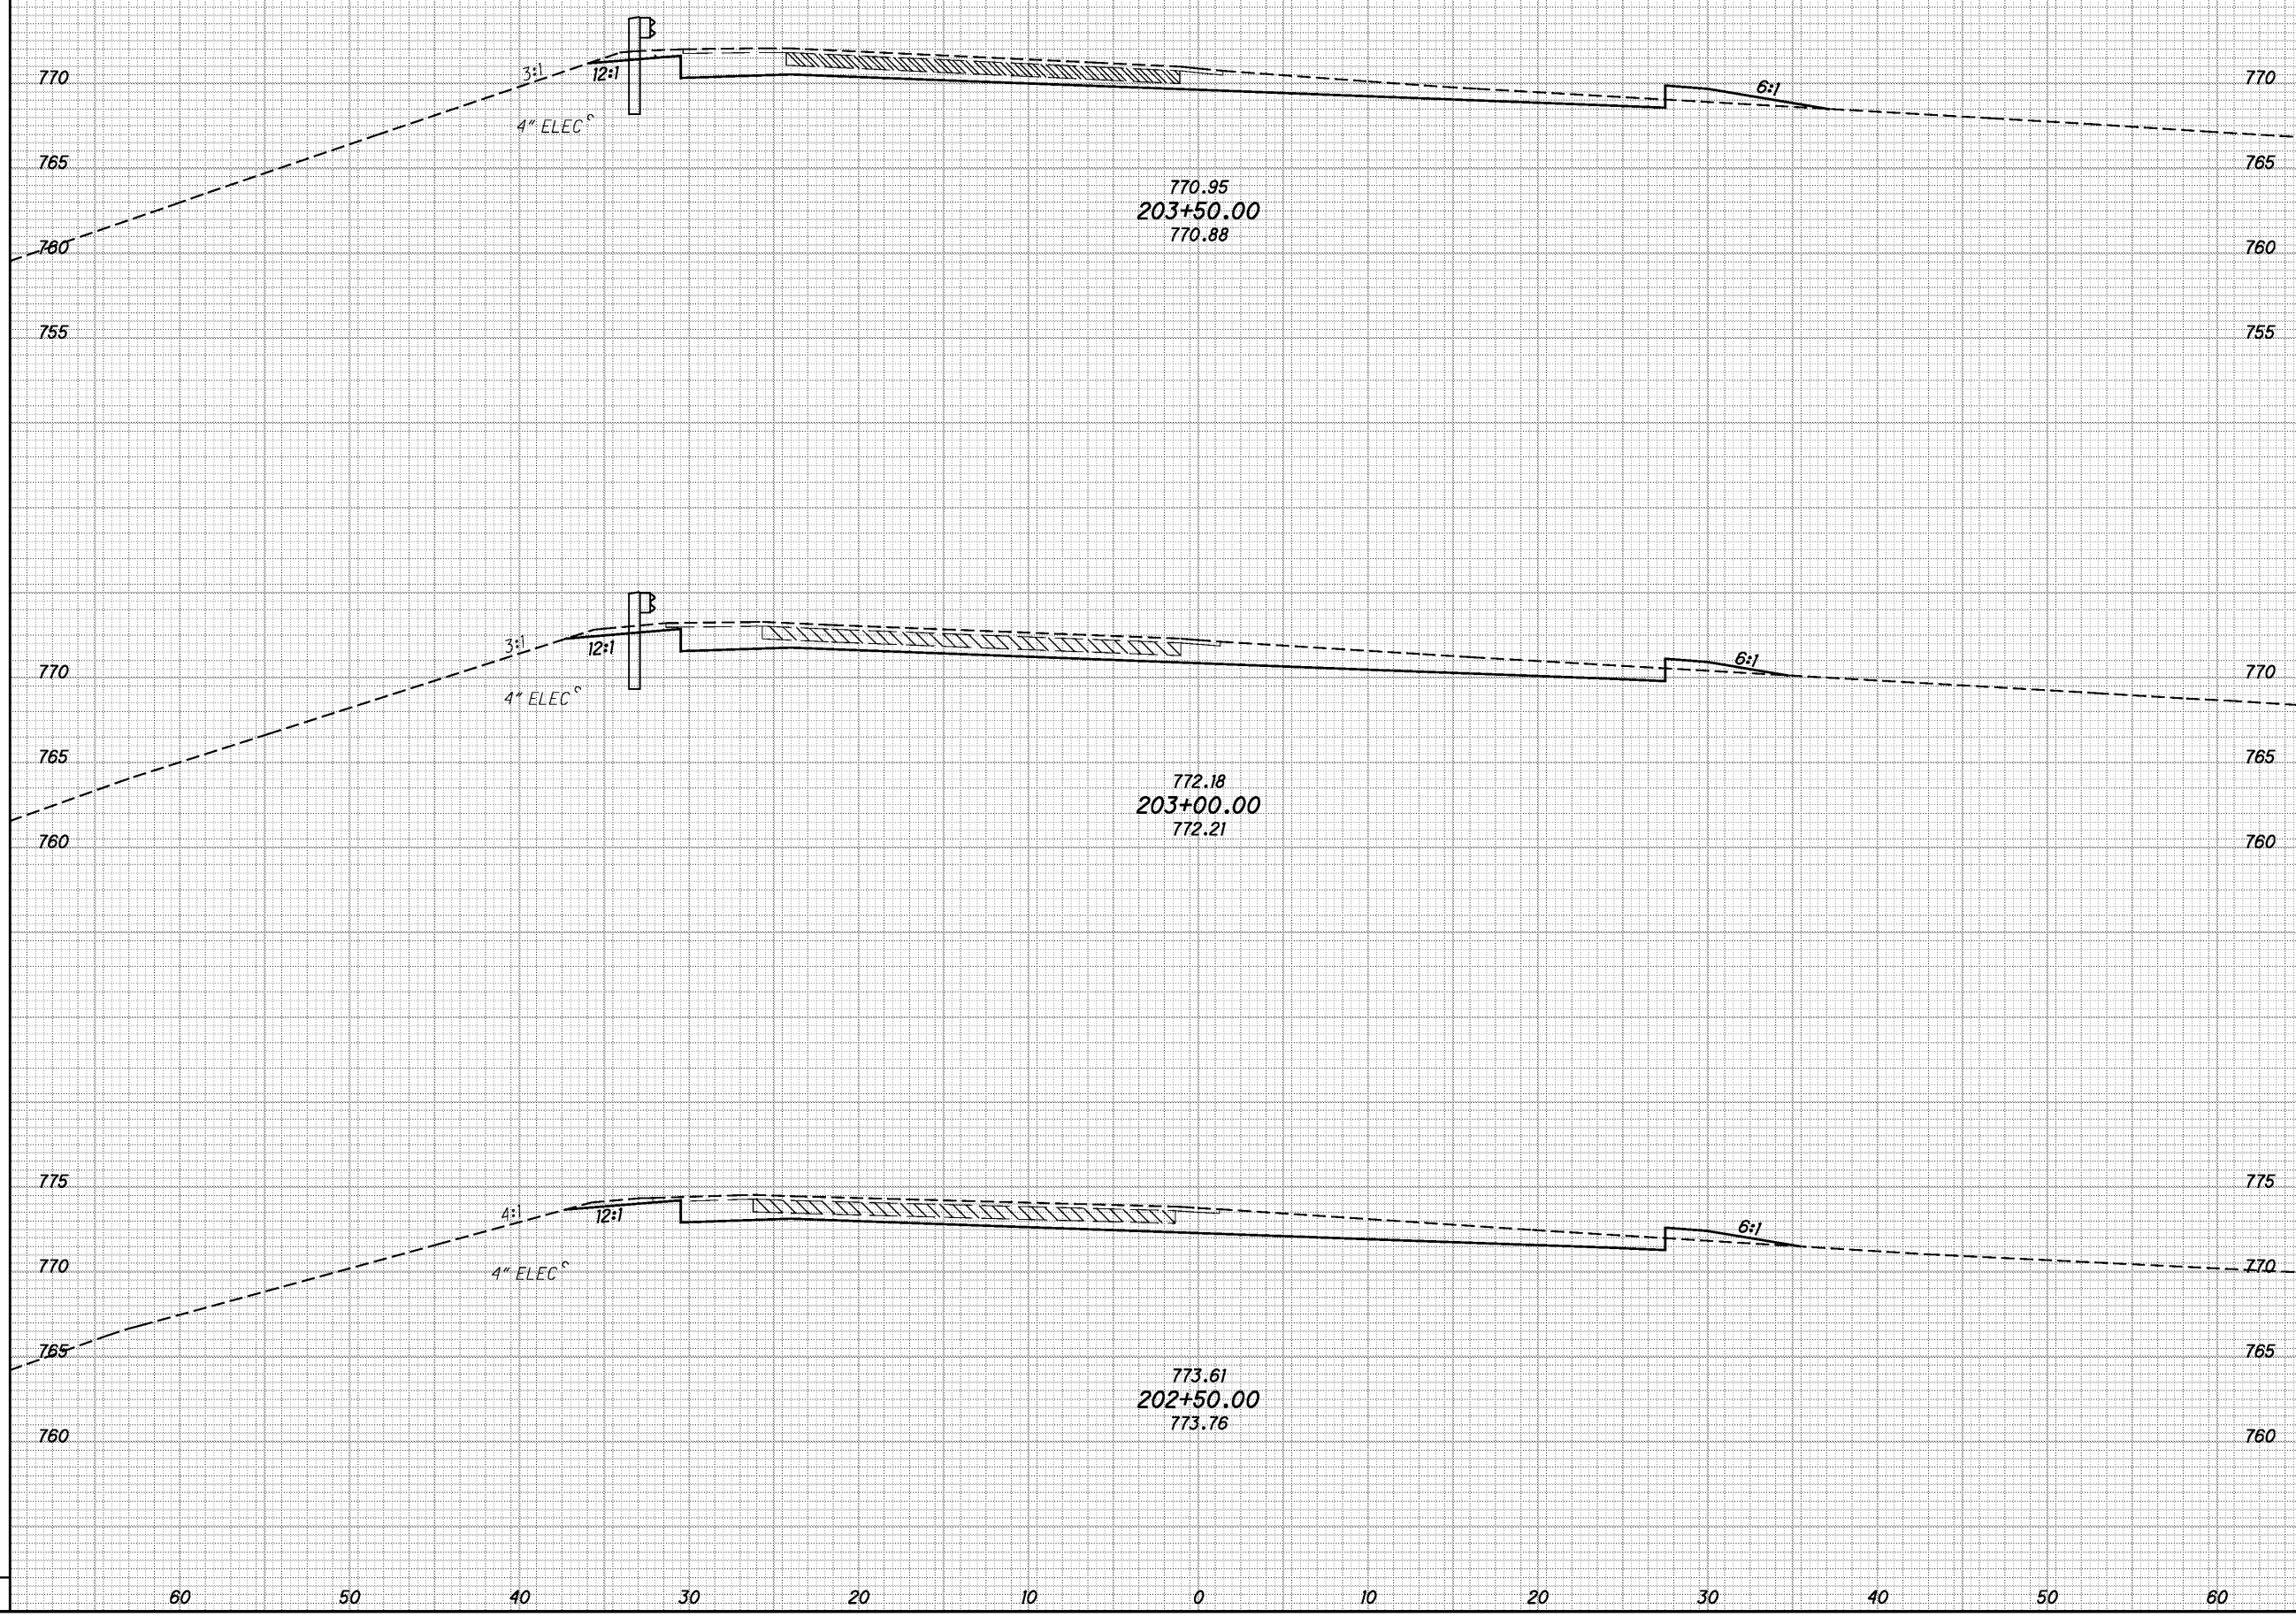

CROSS SECTIONS RAMP T-3  
STA. 202+50.00 TO STA. 203+50.00

CUY-480-11.60

SEEDING  
 END SO.  
 WIDTH YDS.  
 I:\Projects\18063\Roadway\Sheets\18063XS003.dgn 2/5/2015 10:29:01 AM michael\_j\_thompson

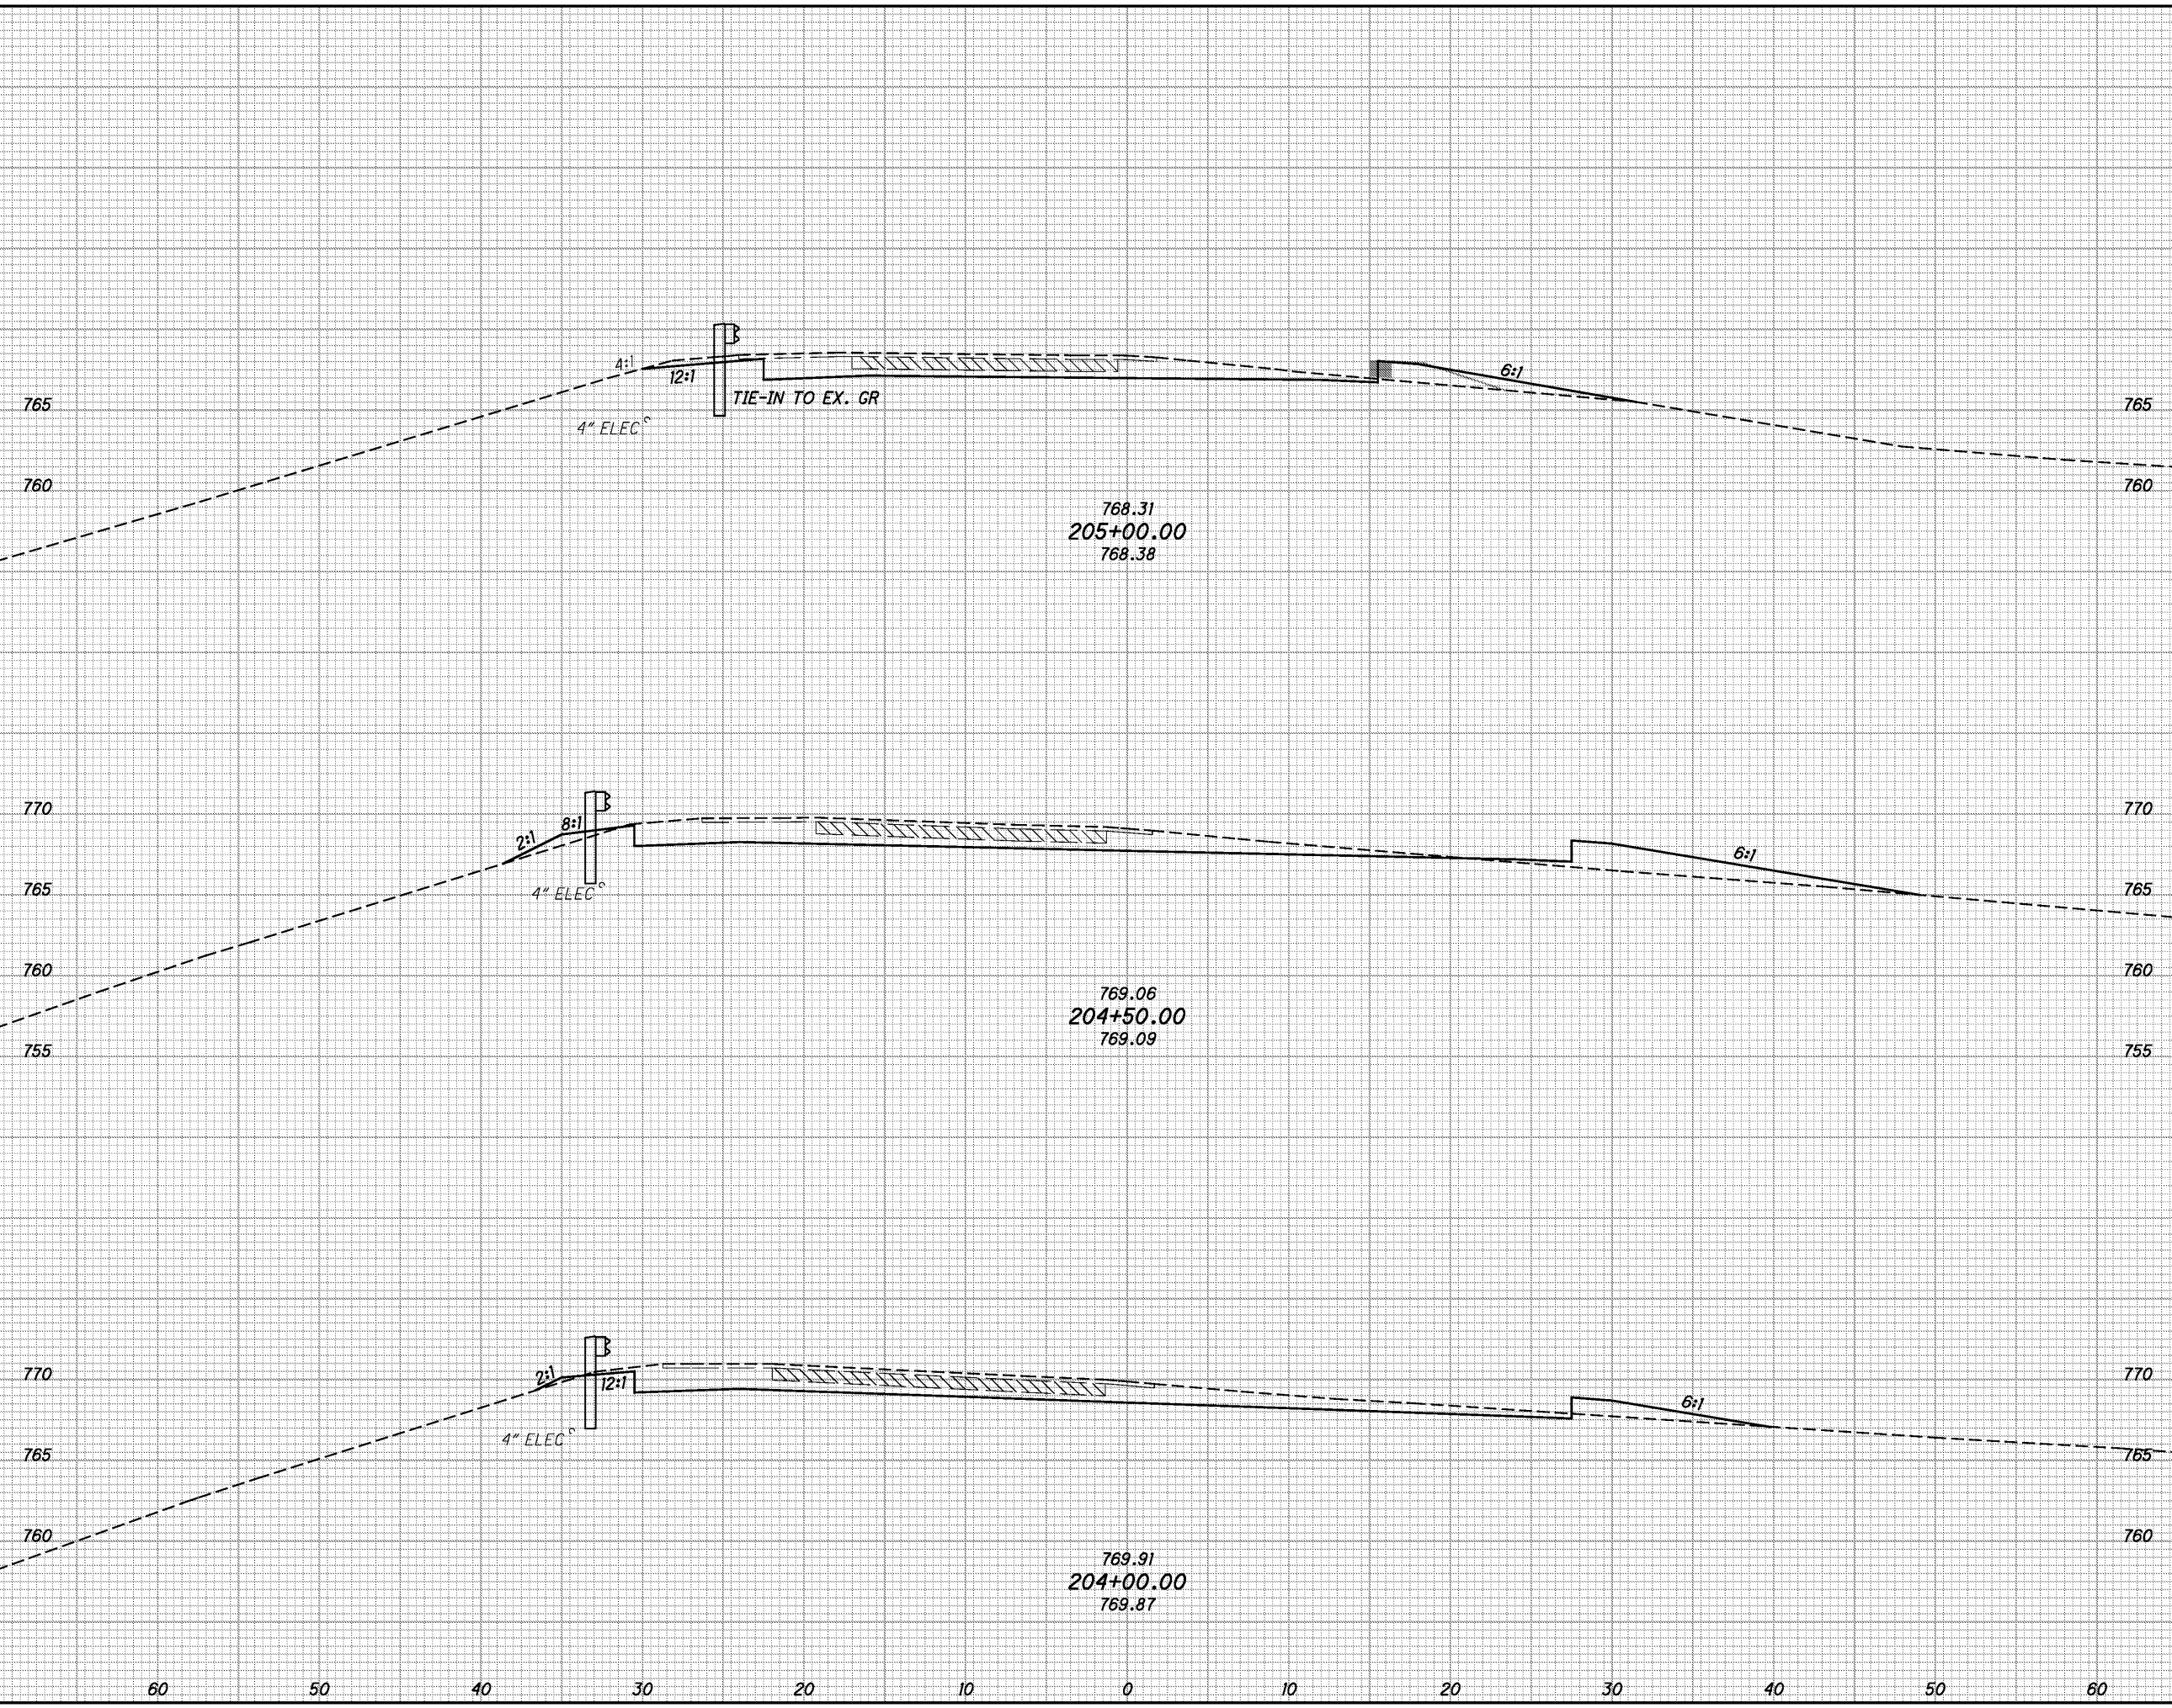

END AREA		VOLUME		CALCULATED JEM	CHECKED MEP
CUT	FILL	CUT	FILL		

**CROSS SECTIONS RAMP T-3**  
**STA. 204+00.00 TO STA. 205+00.00**


**CUY-480-11.60**

49  
84

SEEDING	
END WIDTH	SO. YDS.

TEMPORARY PAVEMENT AND GRADING

END AREA	VOLUME	CALCULATED JEM	CHECKED MEP

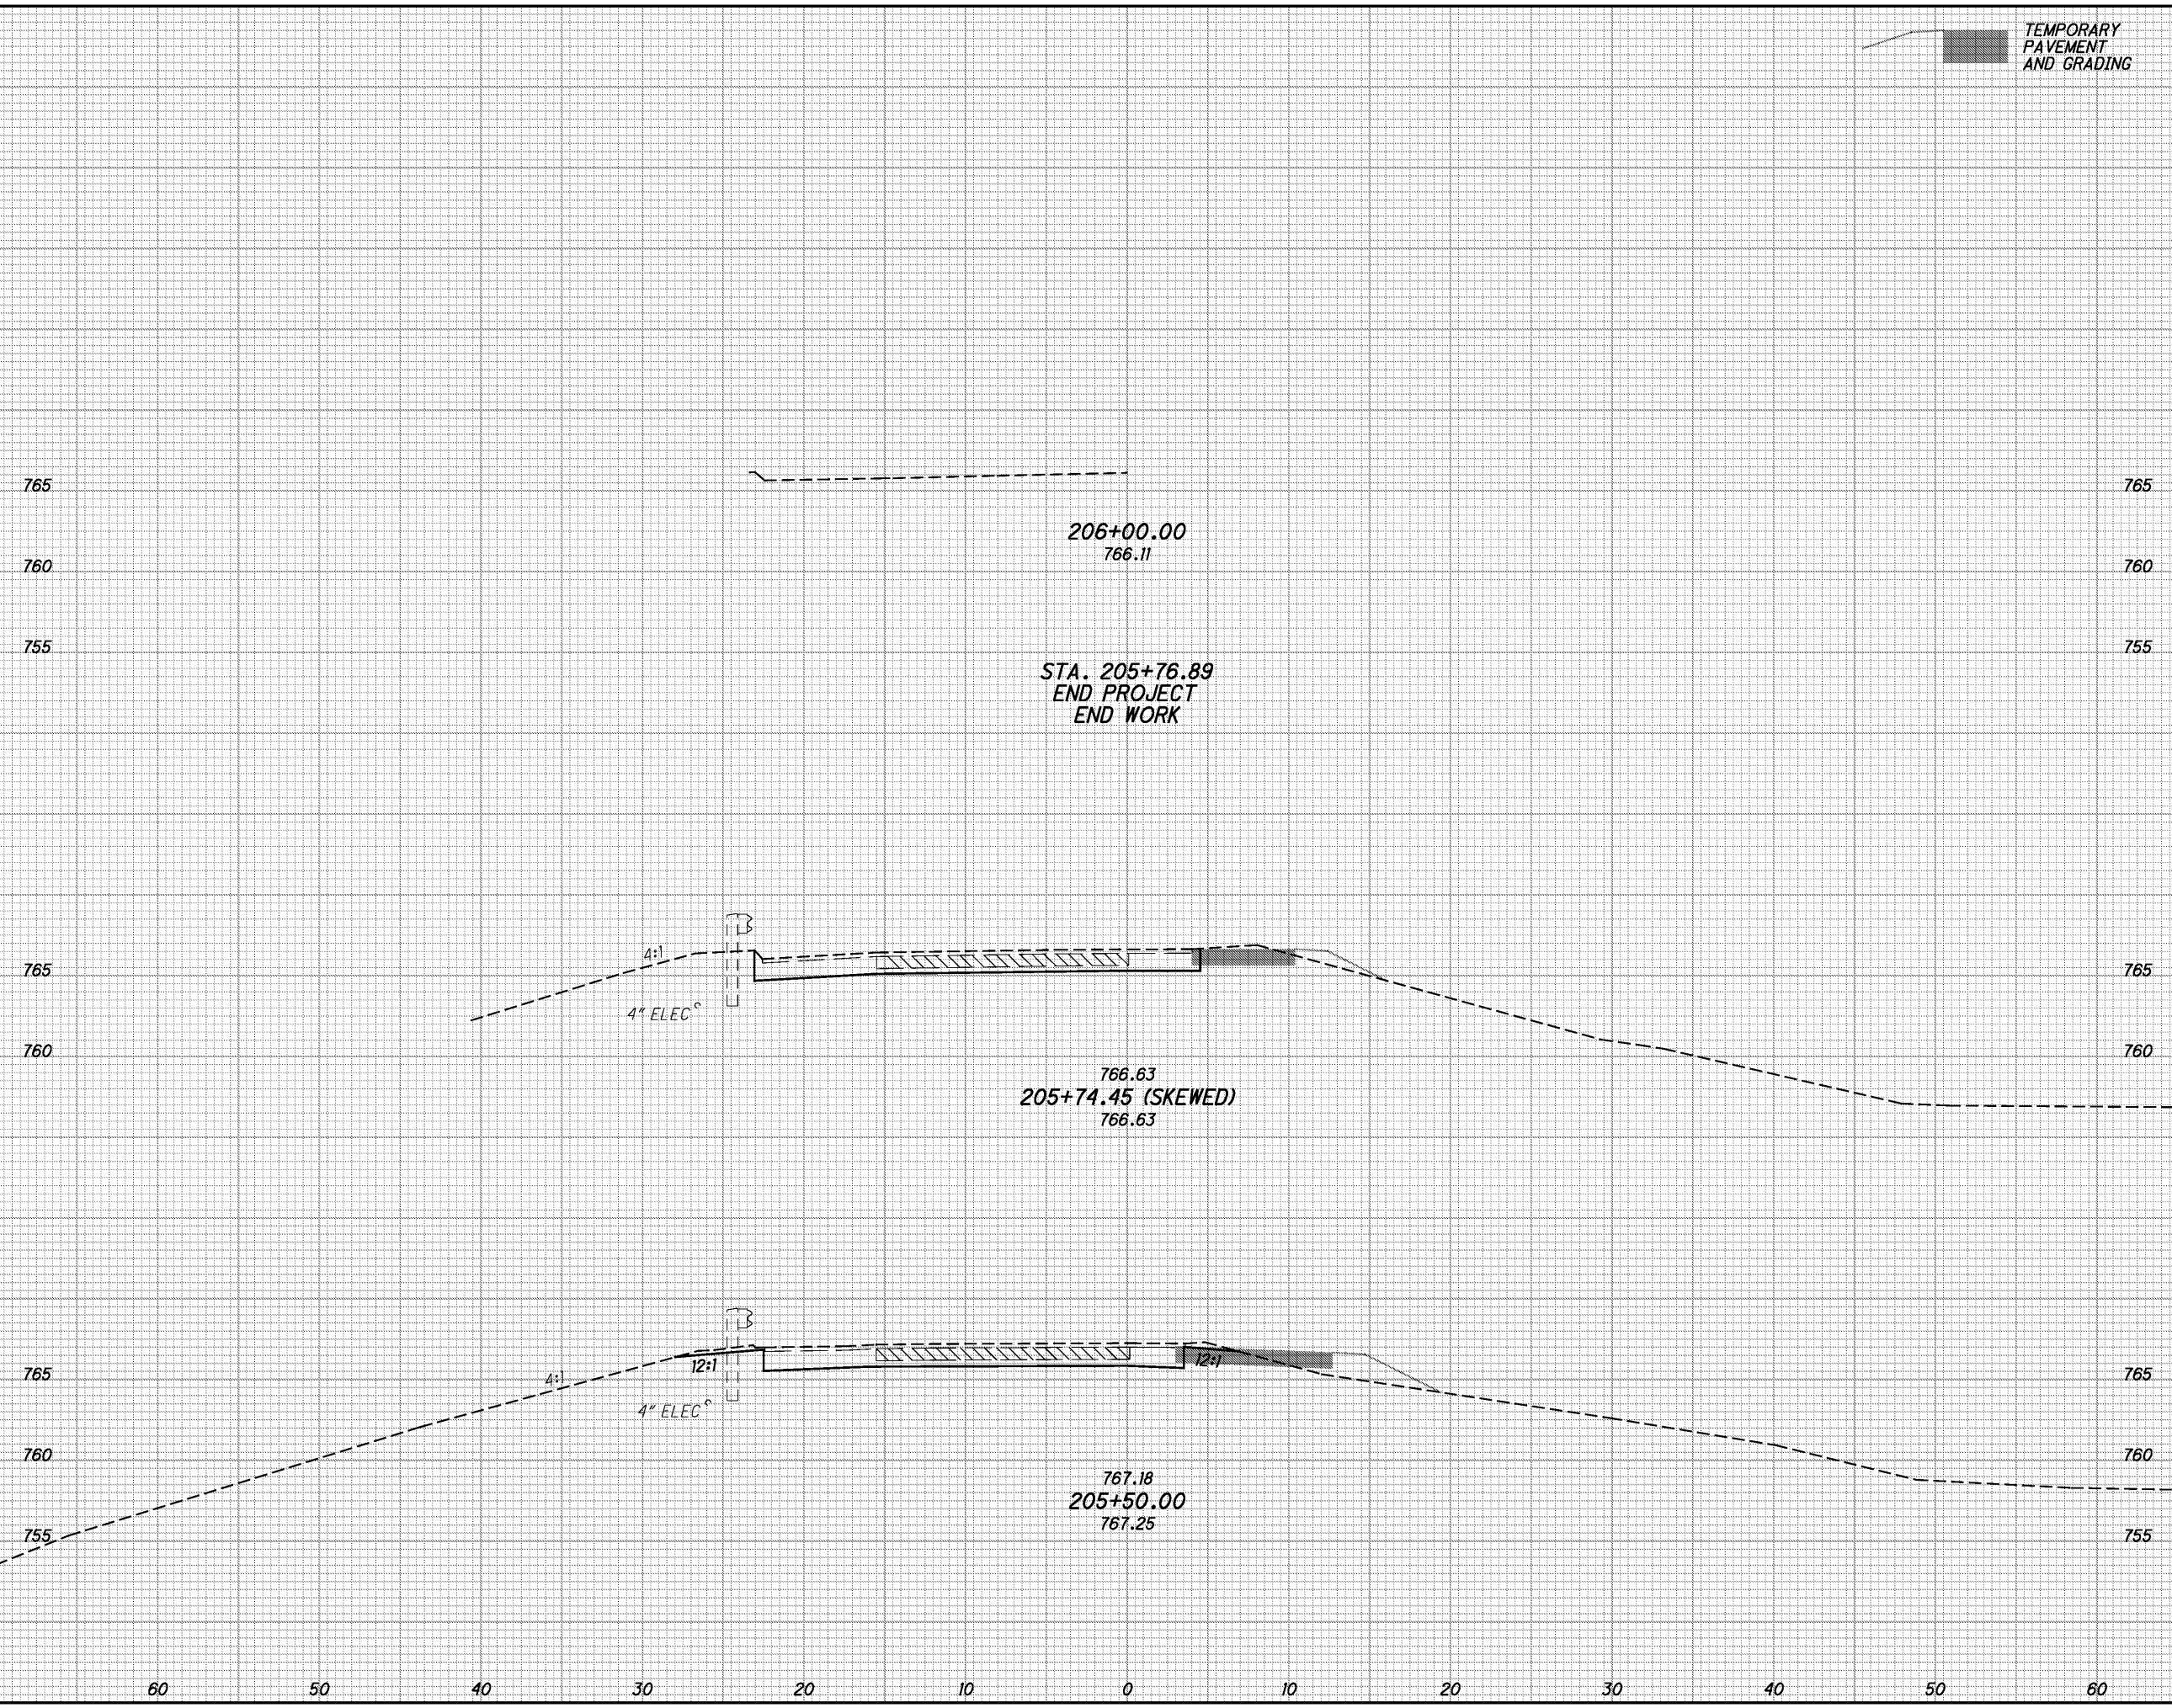

CROSS SECTIONS RAMP T-3  
STA. 205+50.00 TO STA. 206+00.00



CUY-480-11.60

FOR CROSS SECTIONS, SEE SHEET 52

FOR INTERSECTION DETAIL, SEE SHEET 70

DEO = THE EAST OHIO GAS COMPANY,  
DBA DOMINION EAST OHIO, 1-800-362-7557

NOTE:  
DO NOT DISTURB EX. LIGHT POLE  
AT STA. 4641+62±, 12'± RT

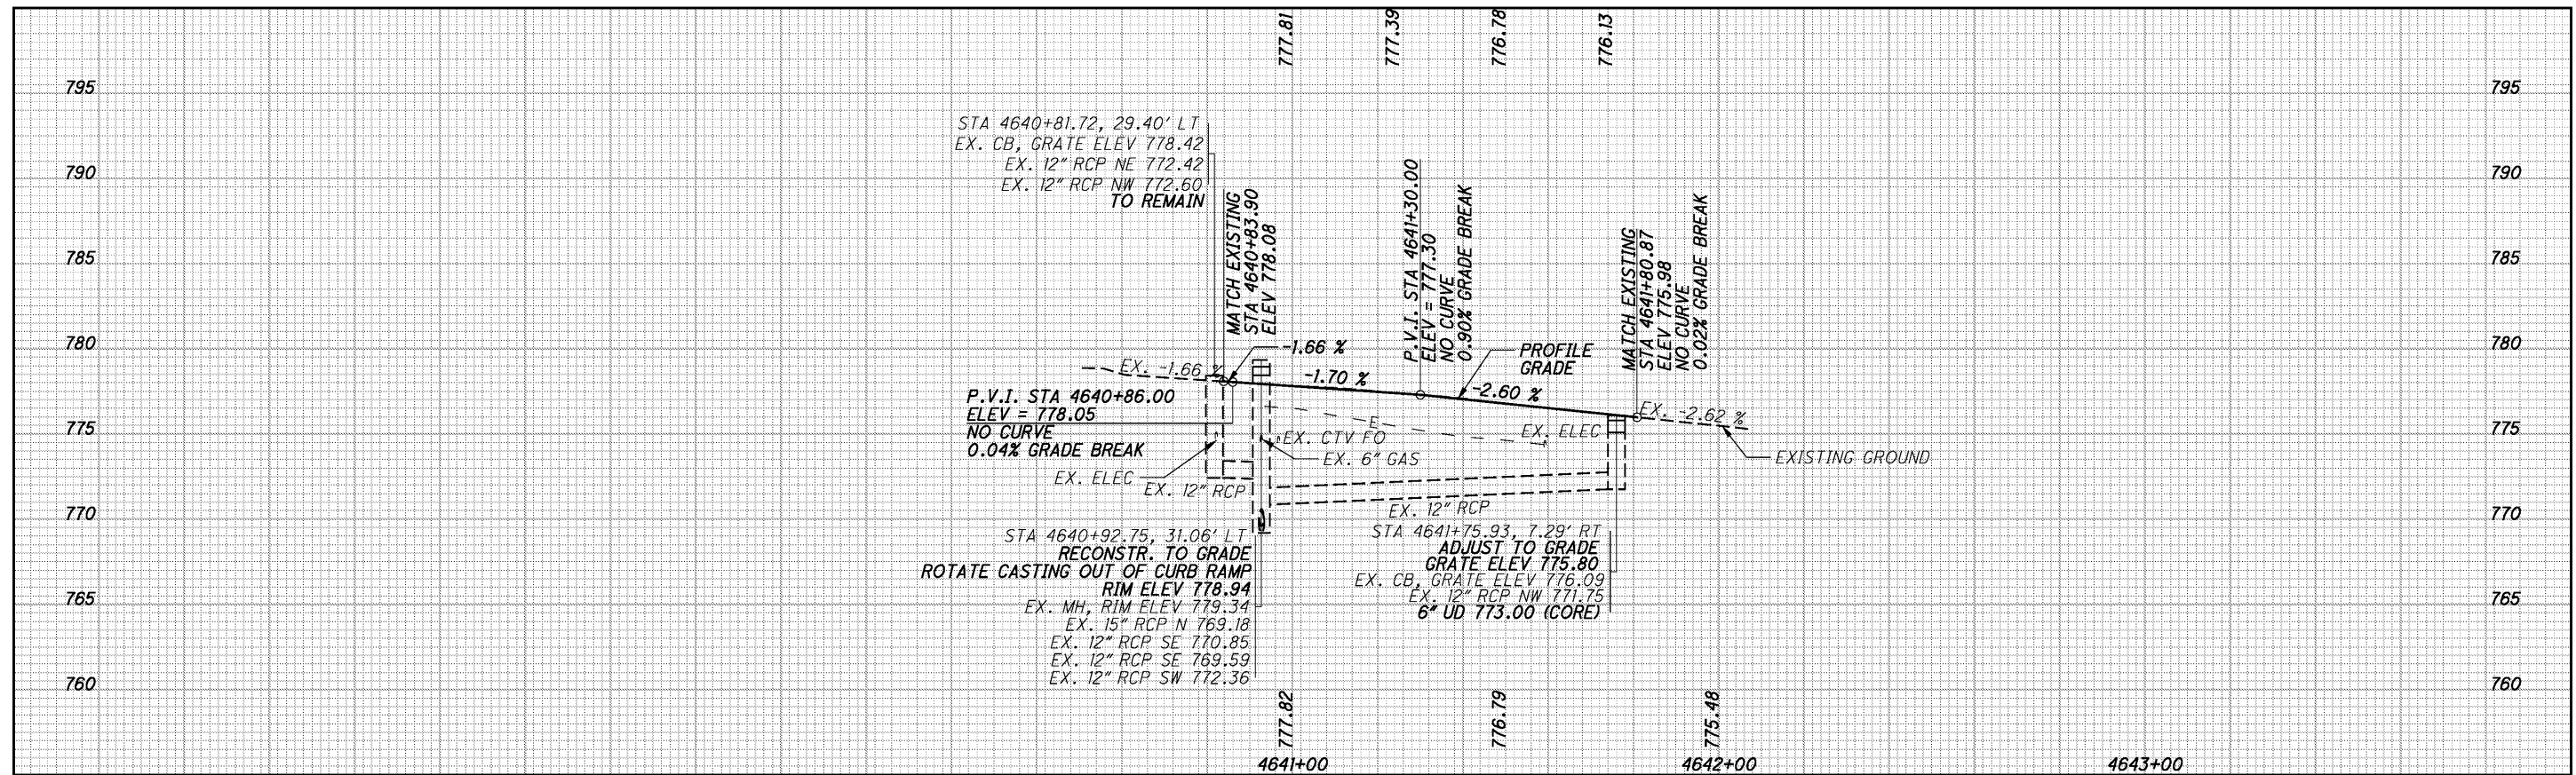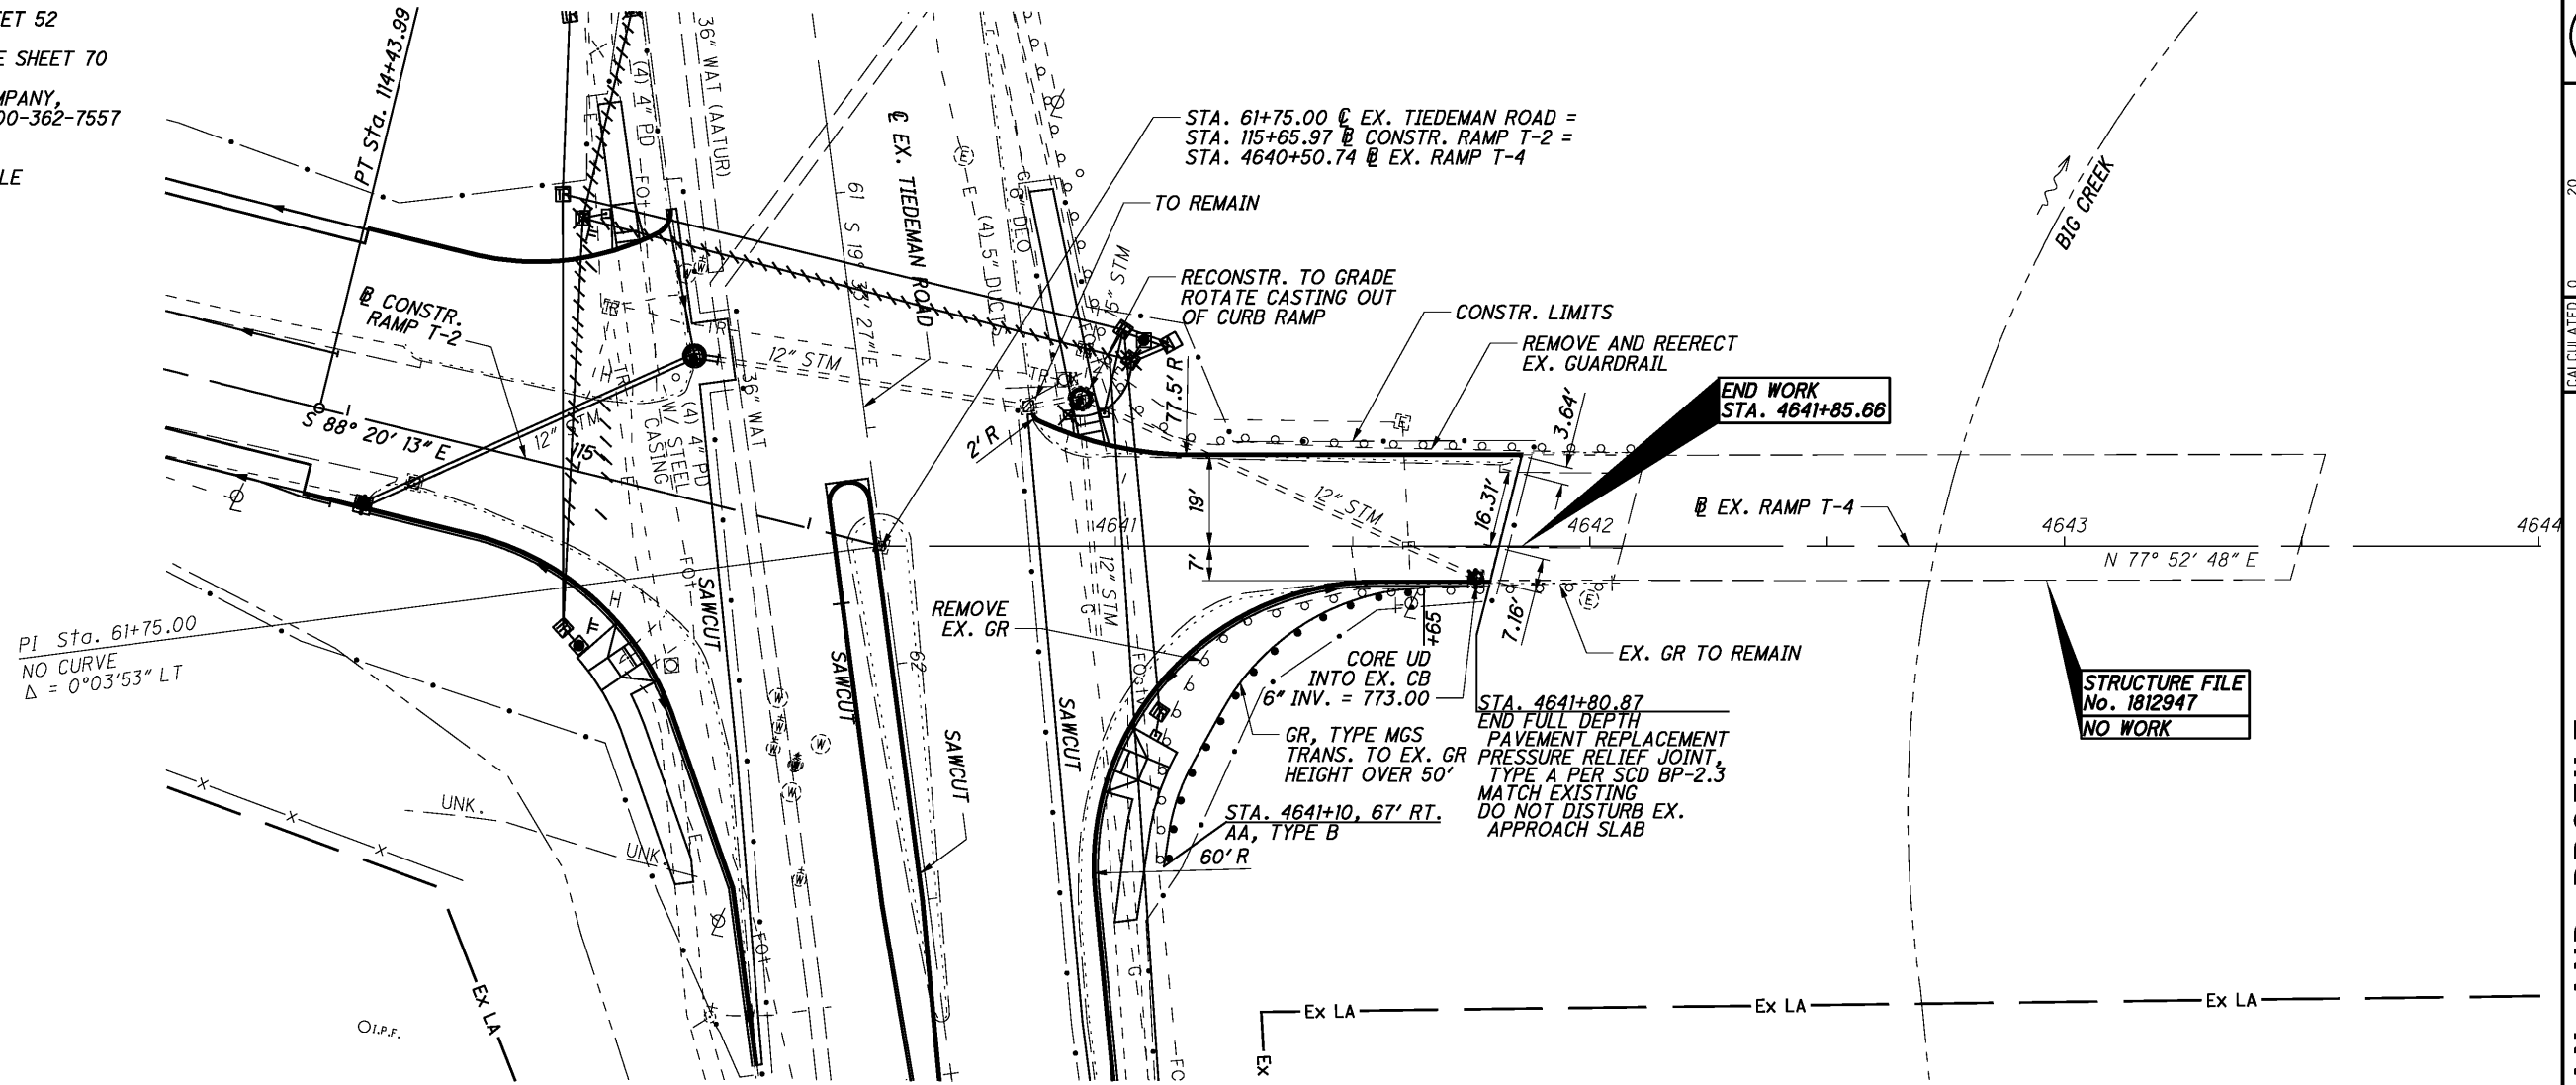

CALCULATED  
MEP  
CHECKED  
FR

PLAN AND PROFILE  
RAMP T-4

CUY-480-11.60


I:\Projects\18063\Roadway\Sheets\18063GP007.dgn 2/5/2015 10:29:03 AM michael\_j\_thompson



I:\Projects\18063\Roadway\Sheets\18063X5004.dgn 2/5/2015 10:29:04 AM michael.j.\_thompson

SEEDING  
END SO.  
WIDTH YDS.

END AREA		VOLUME		CALCULATED JEM	CHECKED MEP
CUT	FILL	CUT	FILL		

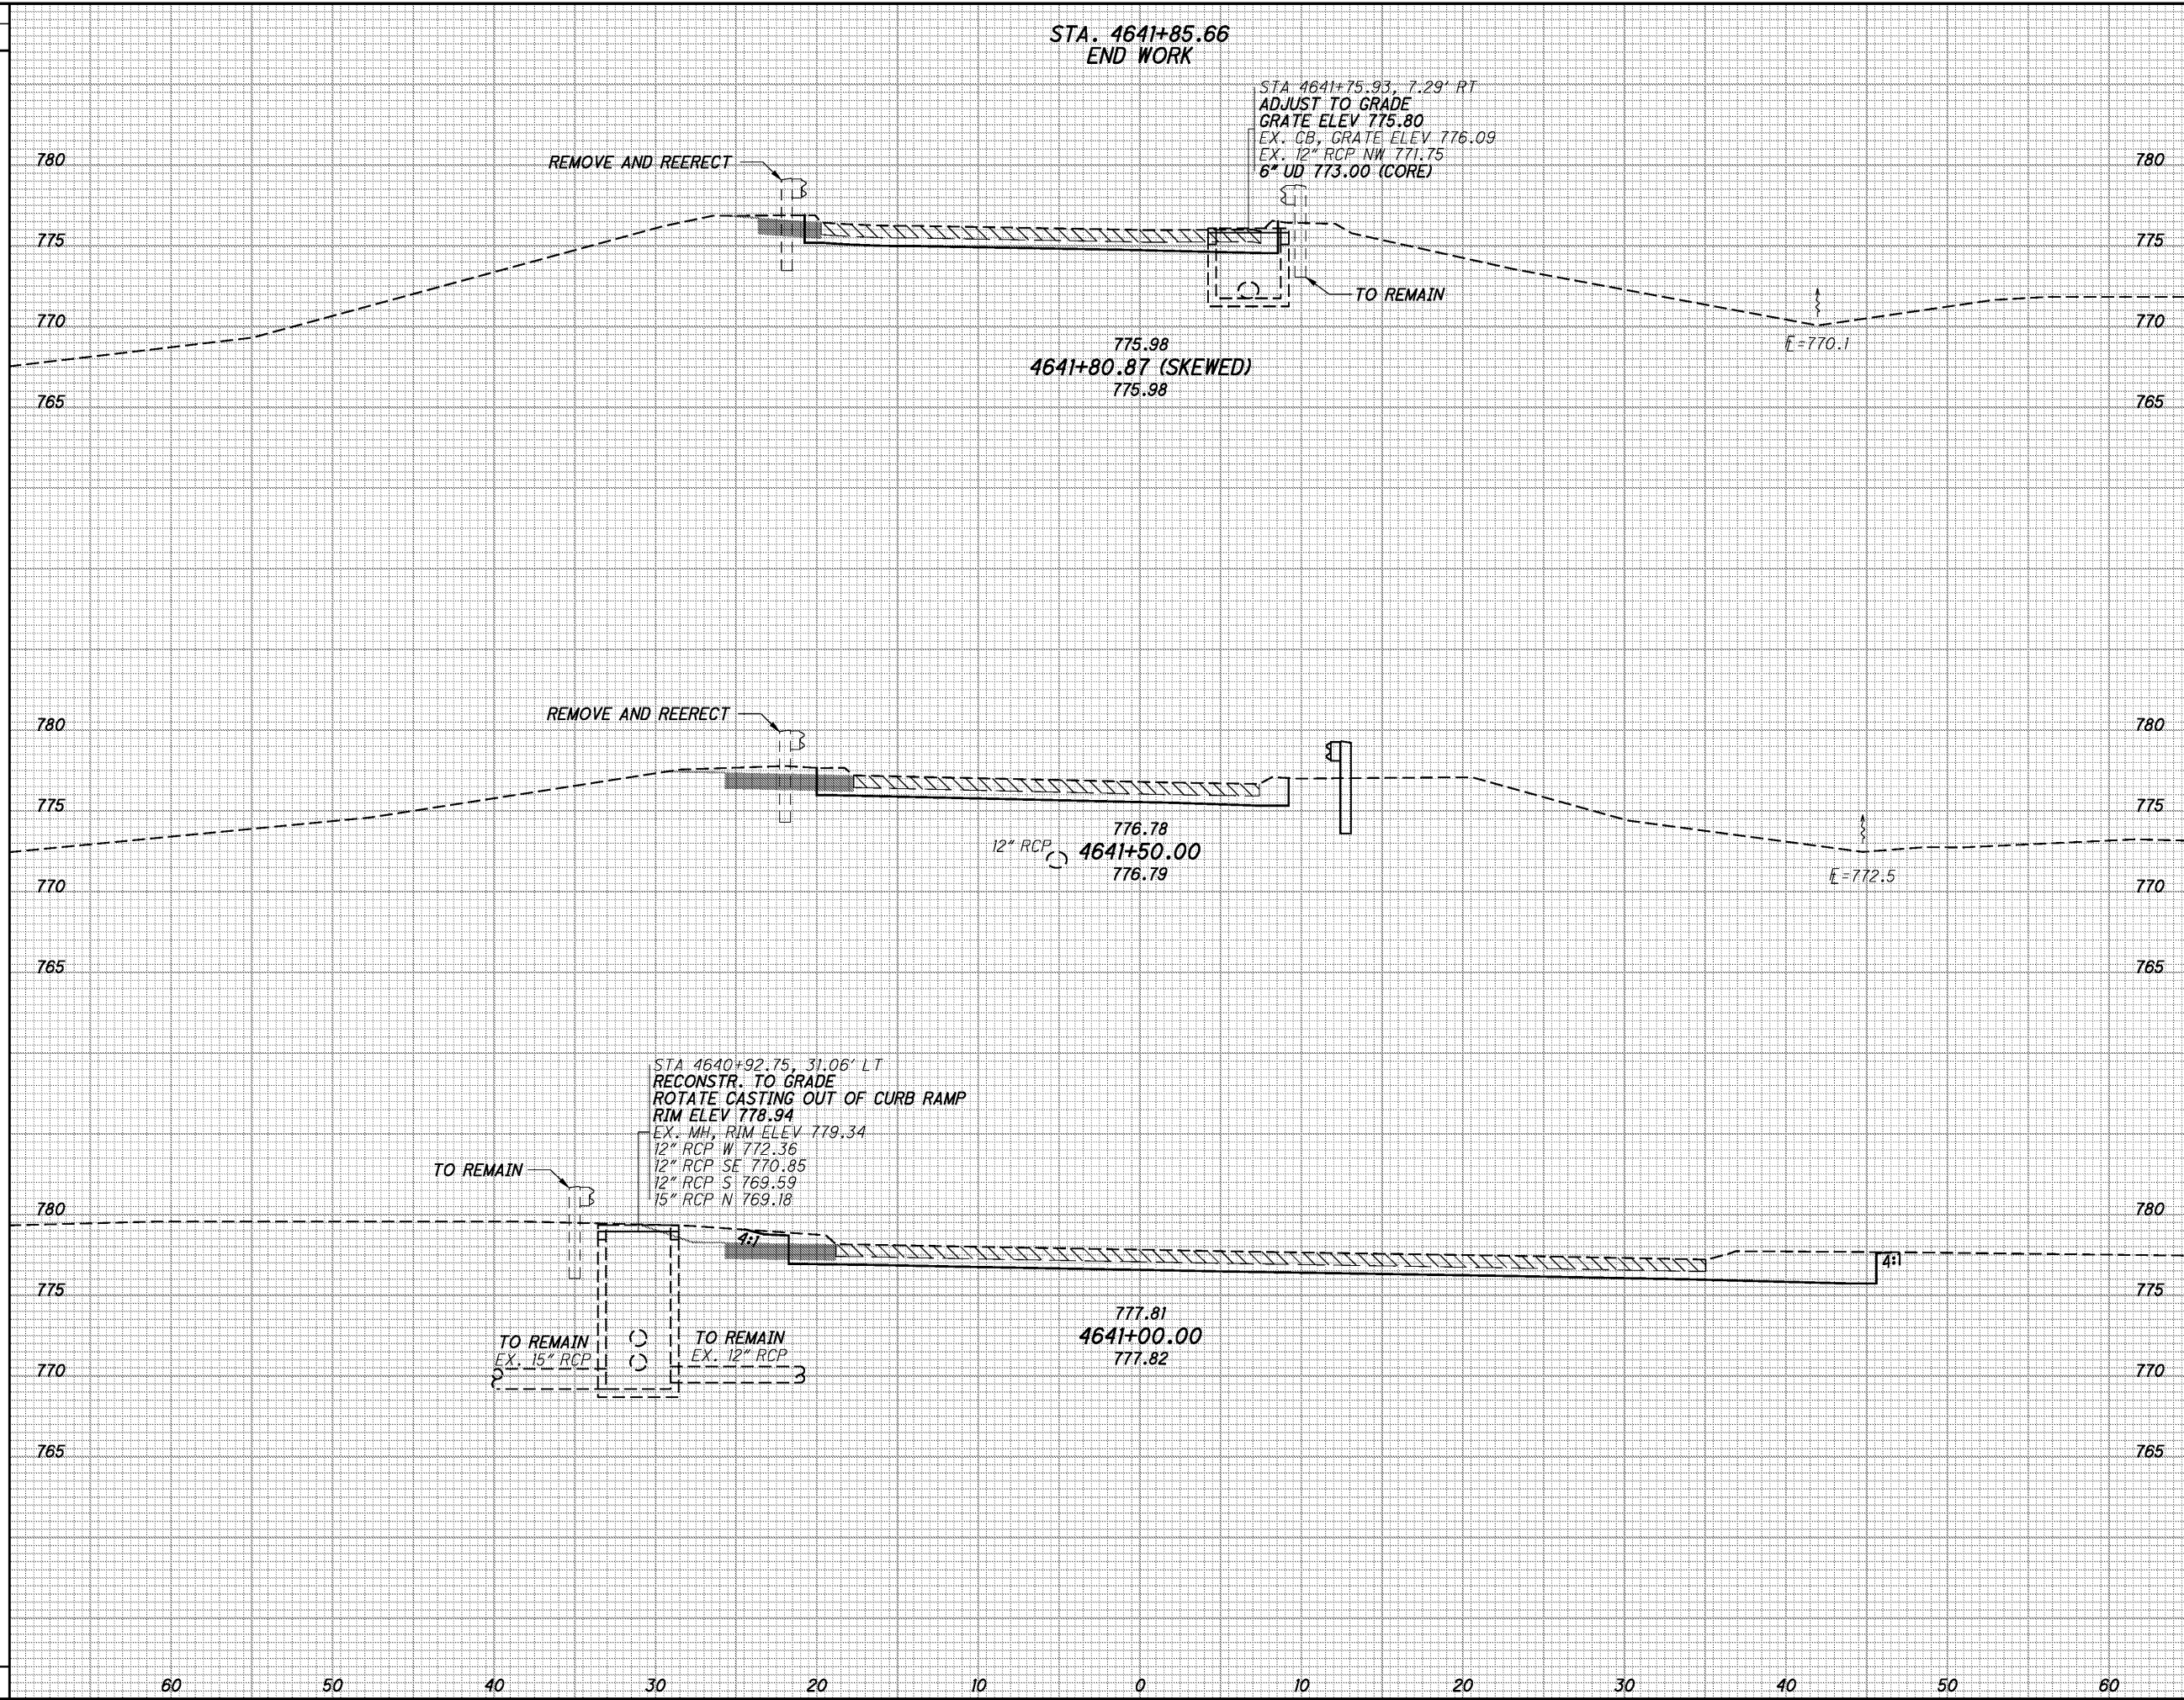

CROSS SECTIONS RAMP T-4  
STA. 1637+50.00 TO STA. 1638+50

CUY-480-11.60

52  
84

60 50 40 30 20 10 0 10 20 30 40 50 60





FOR CROSS SECTIONS, SEE SHEETS 55 - 60

FOR INTERSECTION DETAILS, SEE SHEETS 67 & 69

DEO = THE EAST OHIO GAS COMPANY,  
DBA DOMINION EAST OHIO, 1-800-362-7557

NOTE (A)  
RECONSTRUCT TO GRADE  
ROTATE CASTING OUT OF CURB LINE  
CORE UD INTO EX. MH  
6" INV. = 773.00

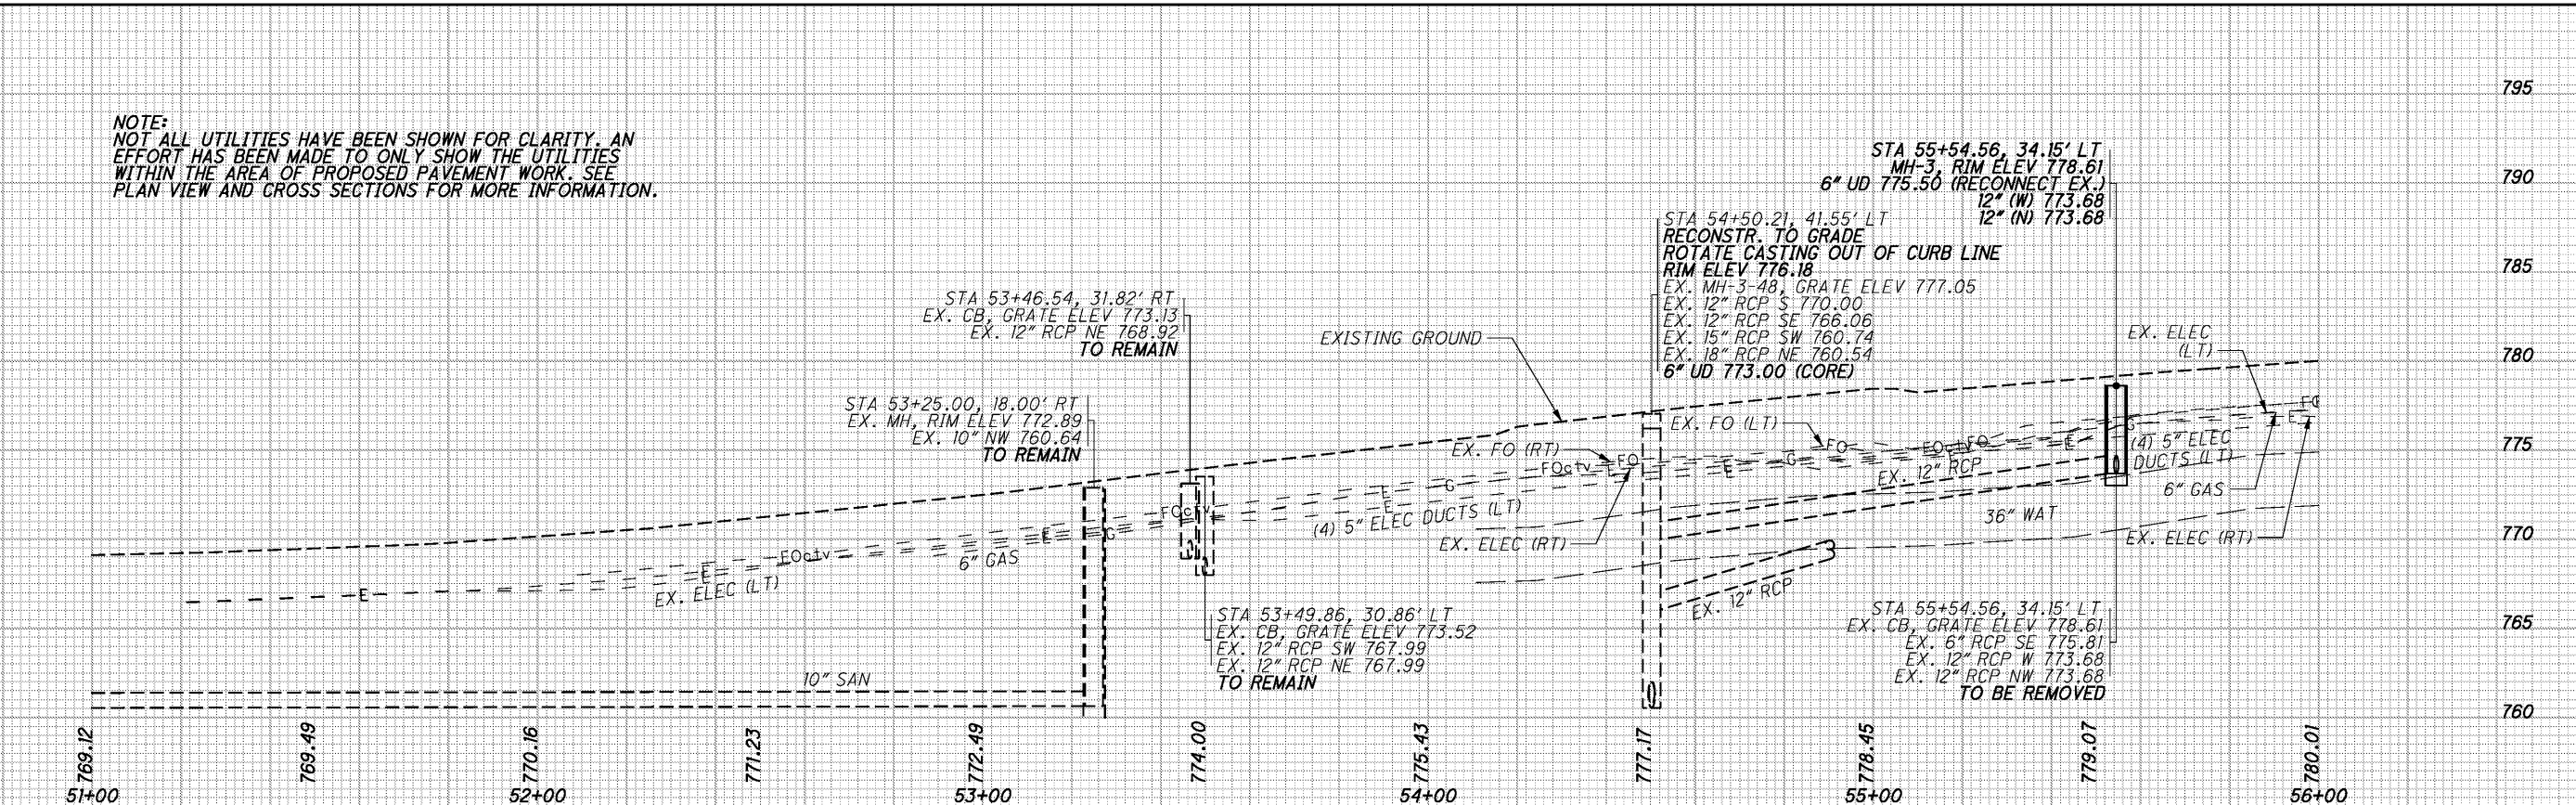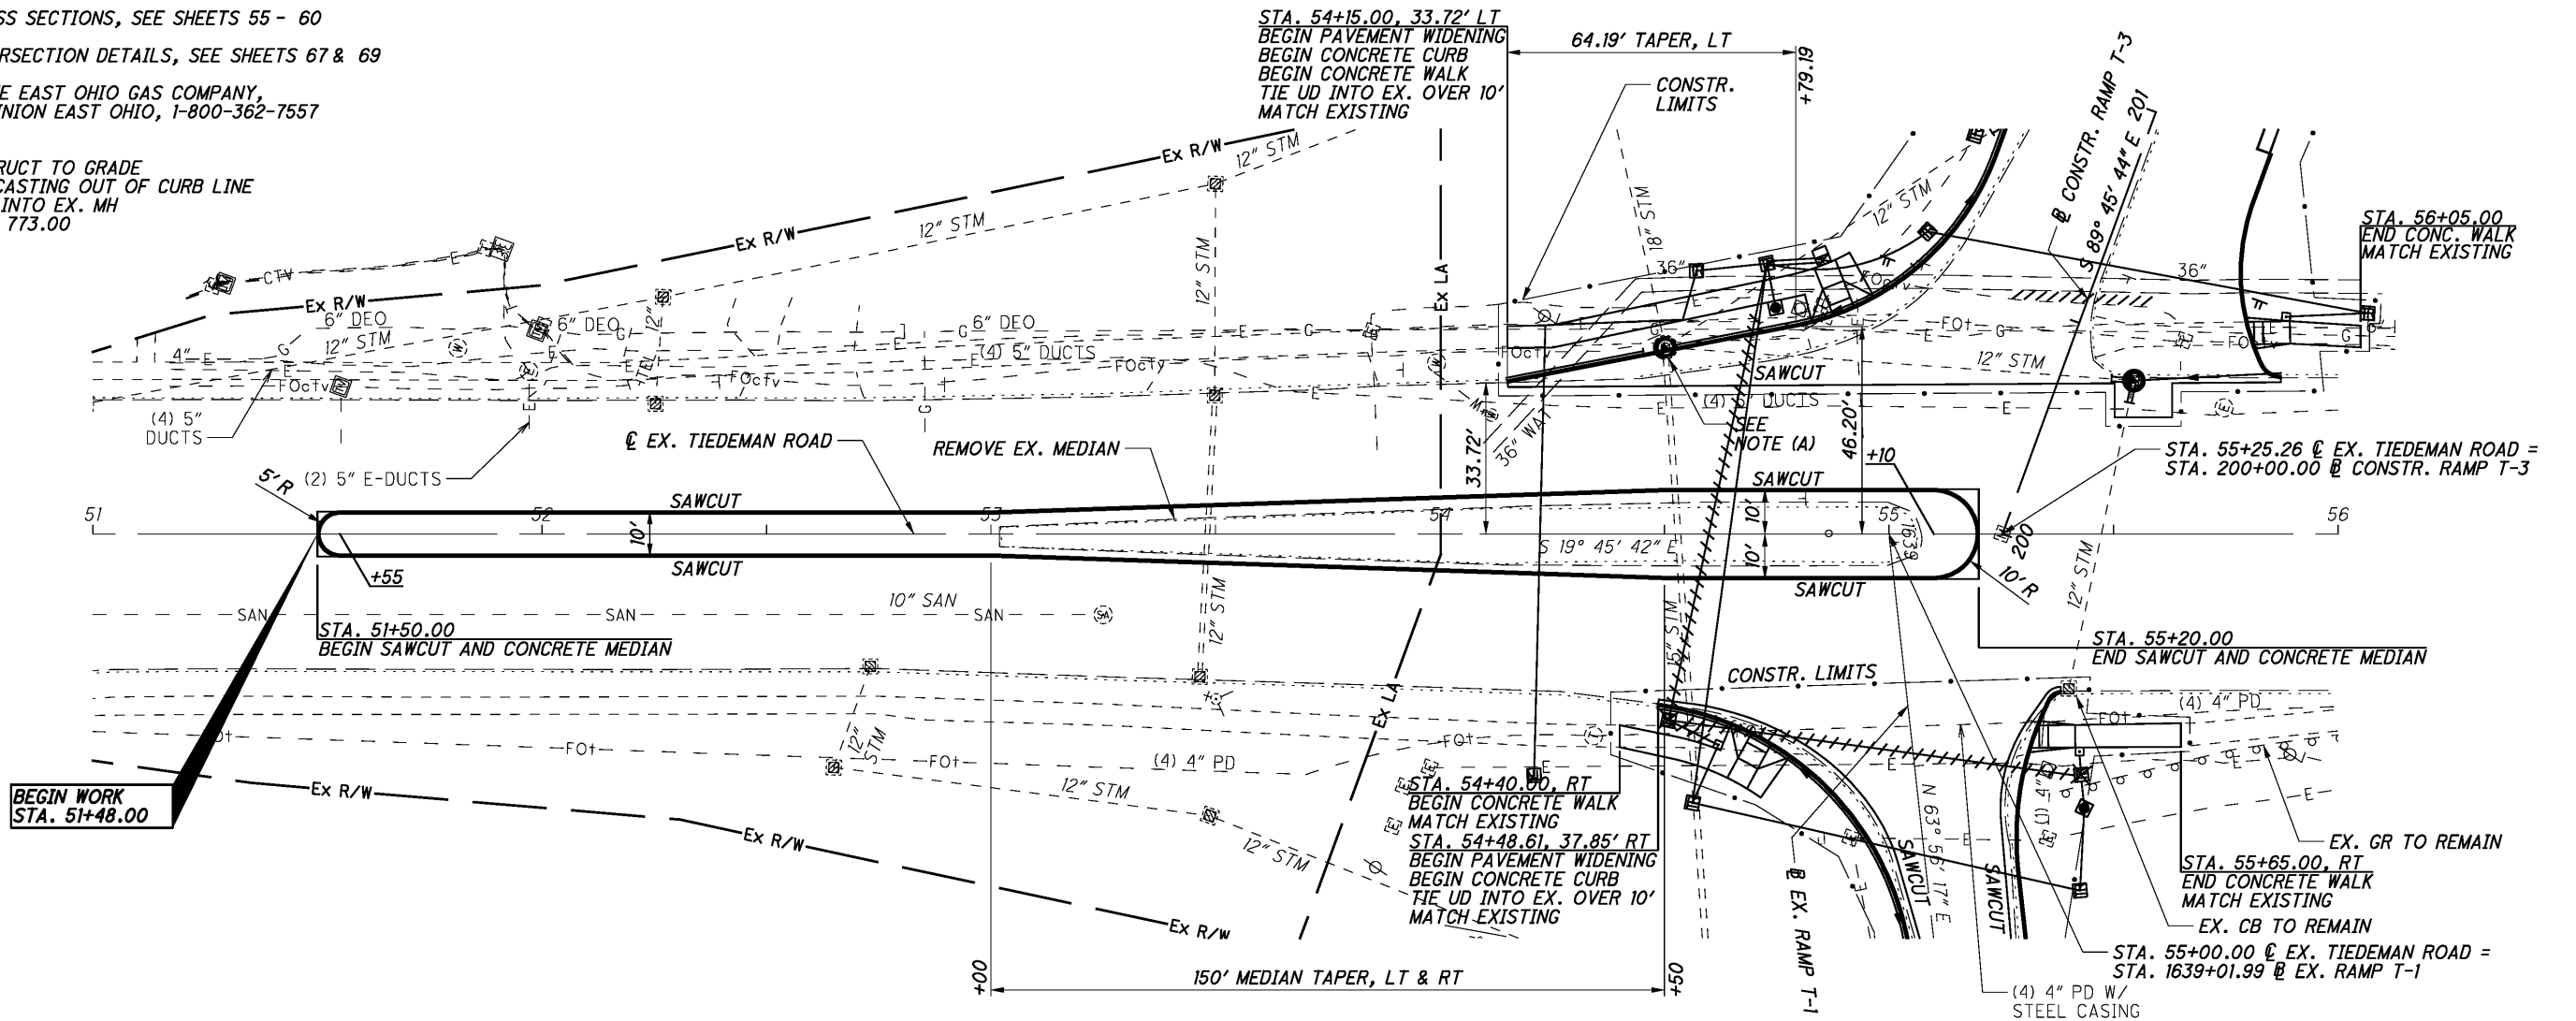

NOTE:  
NOT ALL UTILITIES HAVE BEEN SHOWN FOR CLARITY. AN  
EFFORT HAS BEEN MADE TO ONLY SHOW THE UTILITIES  
WITHIN THE AREA OF PROPOSED PAVEMENT WORK. SEE  
PLAN VIEW AND CROSS SECTIONS FOR MORE INFORMATION.



CALCULATED  
MEP  
CHECKED  
FR

PLAN AND PROFILE  
TIEDEMAN ROAD - STA. 51+00 TO STA. 56+00

CUY - 480 - 11.60



I:\Projects\18063\Roadway\Sheets\18063GP008.dgn 2/5/2015 10:29:05 AM michael\_j.\_thompson

FOR CROSS SECTIONS, SEE SHEETS 55 - 60

FOR INTERSECTION DETAILS, SEE SHEETS 68 & 70

DEO = THE EAST OHIO GAS COMPANY,  
DBA DOMINION EAST OHIO, 1-800-362-7557

(A)  
STA. 61+60.50  
BEGIN SAWCUT AND CONCRETE MEDIAN

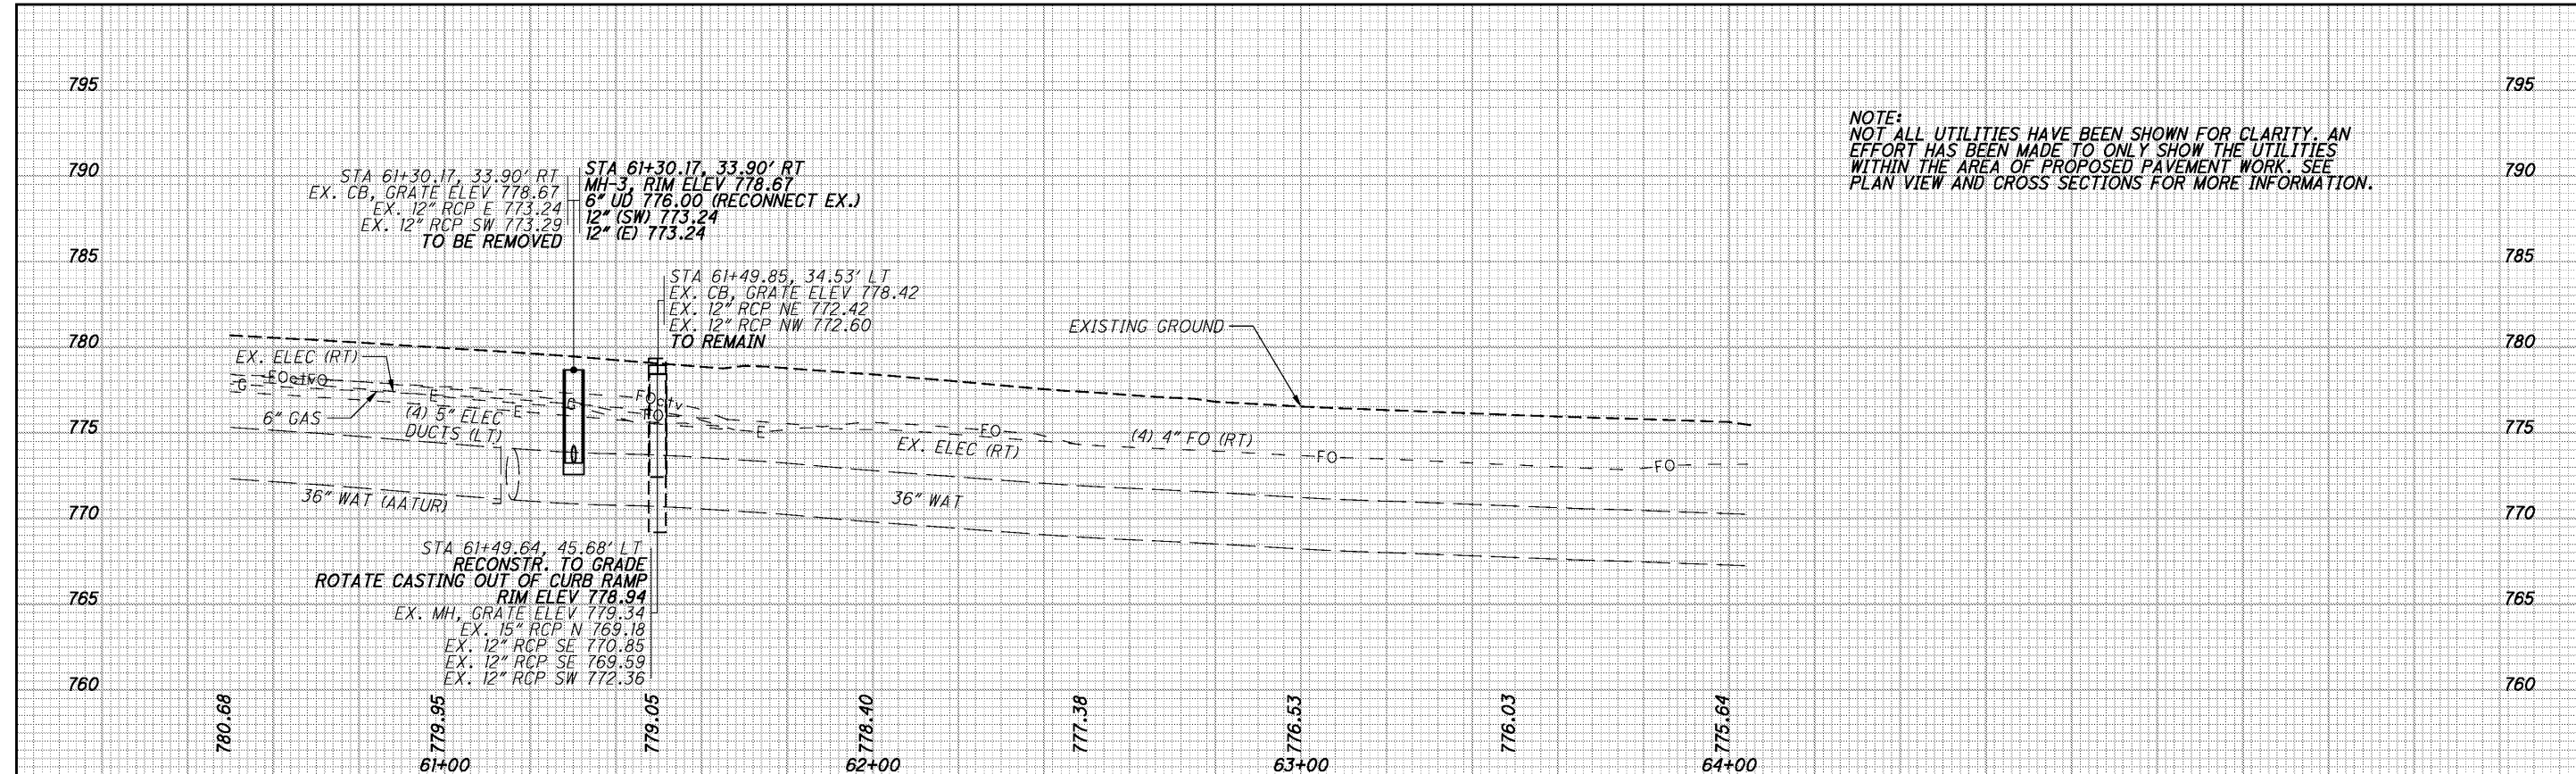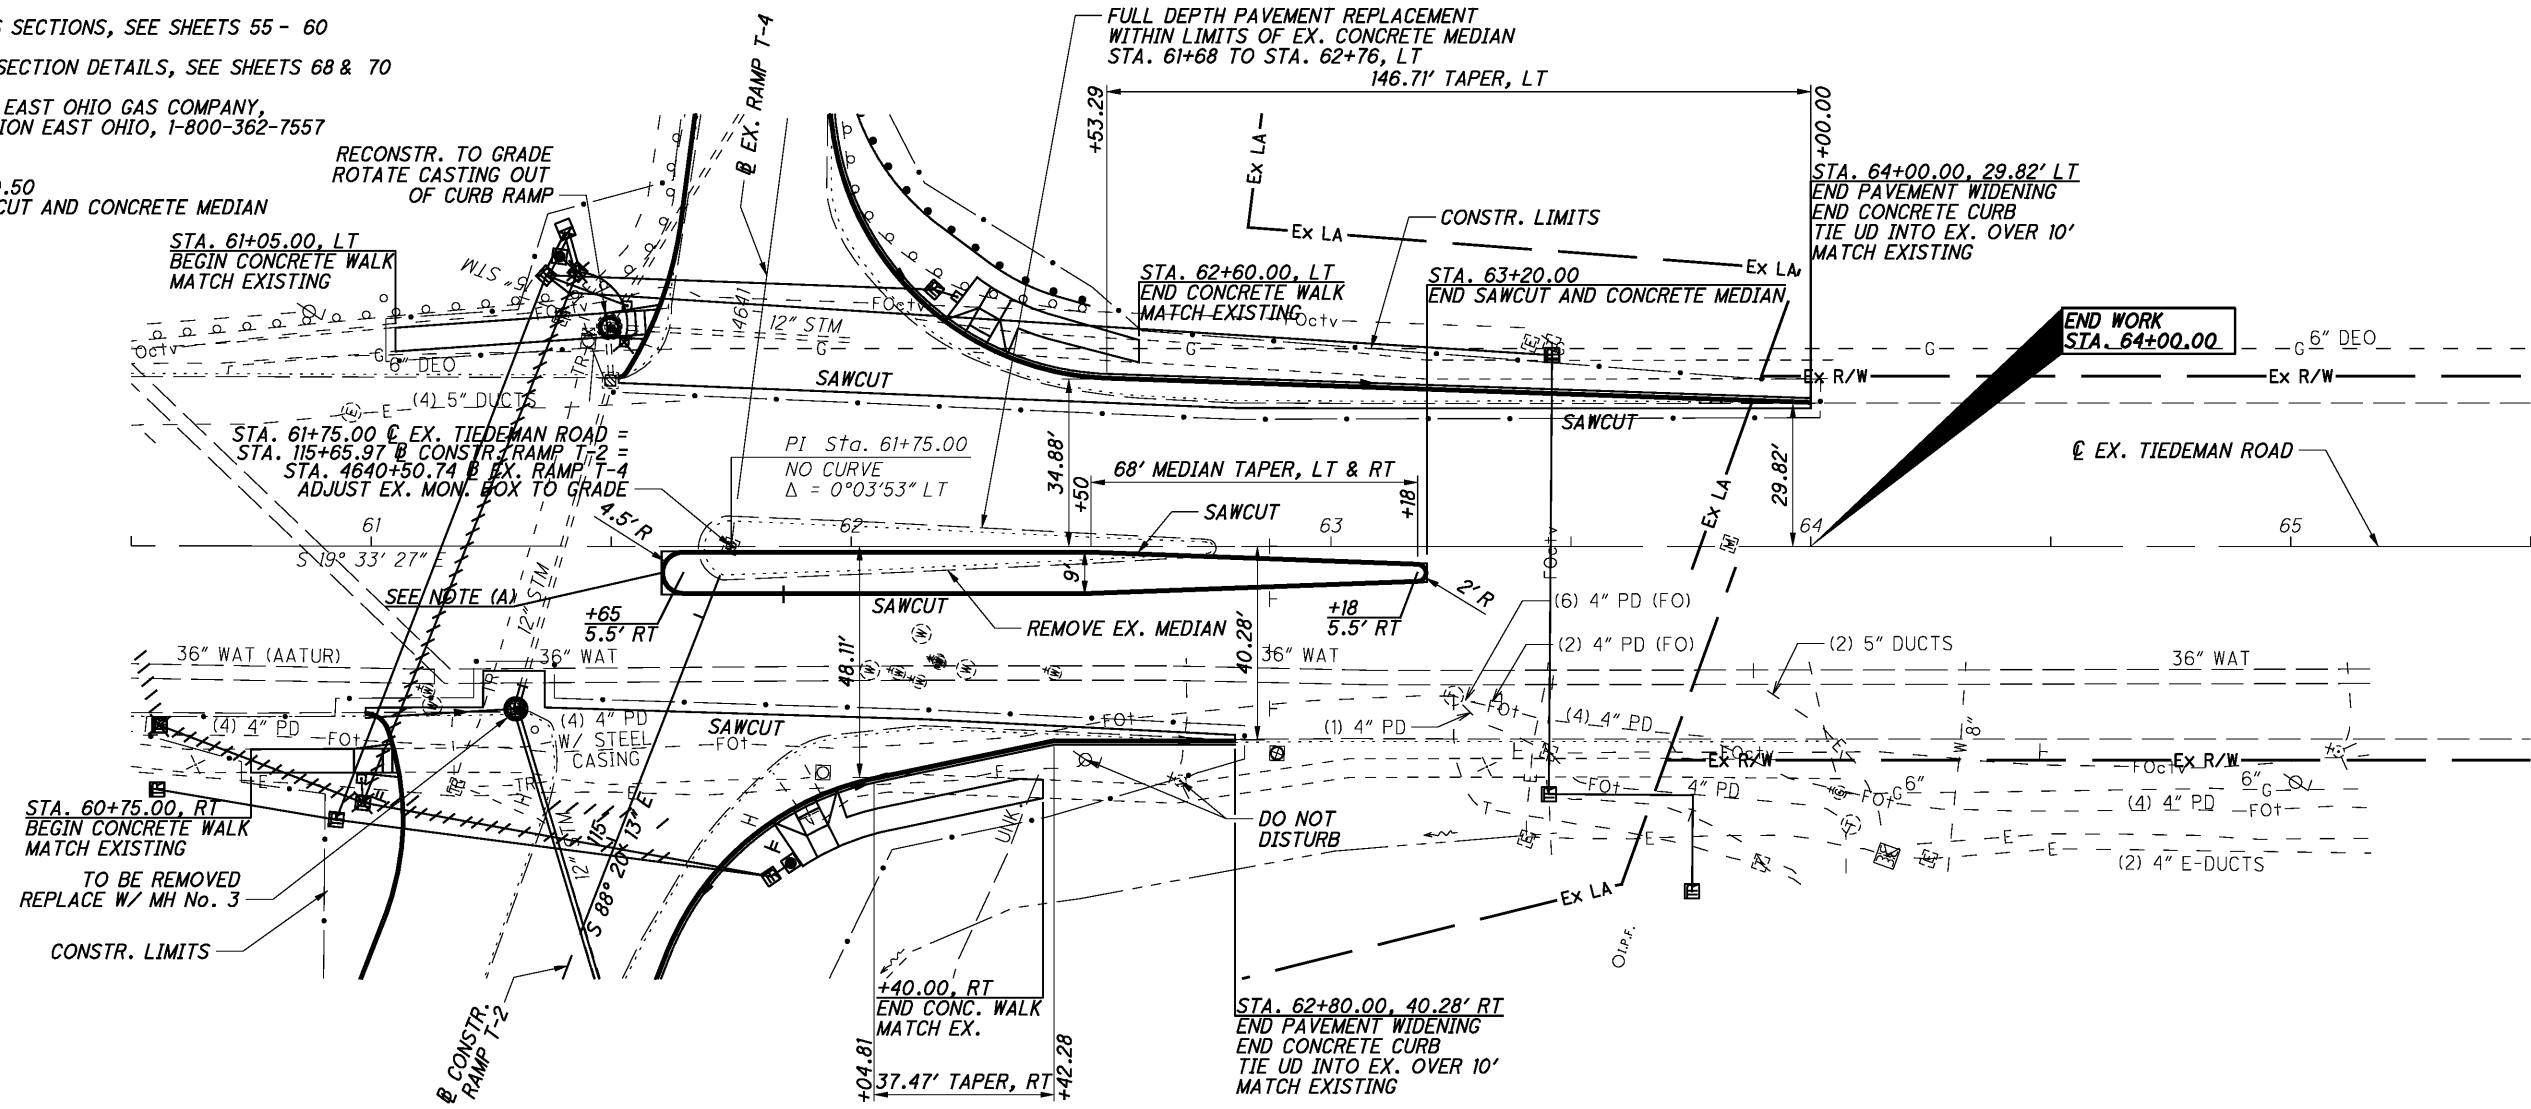

NOTE:  
NOT ALL UTILITIES HAVE BEEN SHOWN FOR CLARITY. AN EFFORT HAS BEEN MADE TO ONLY SHOW THE UTILITIES WITHIN THE AREA OF PROPOSED PAVEMENT WORK. SEE PLAN VIEW AND CROSS SECTIONS FOR MORE INFORMATION.



PLAN AND PROFILE  
TIEDEMAN ROAD - STA. 60+50 TO STA. 65+50


CUY - 480 - 11.60

54  
84

I:\Projects\18063\Roadway\Sheets\18063GP009.dgn 2/5/2015 10:29:05 AM michael\_j.\_thompson

I:\Projects\18063\Roadway\Sheets\18063XS005.dgn 2/5/2015 10:29:07 AM michael\_j\_thompson

SEEDING	
END WIDTH	SO. YDS.
60	770
50	765
40	760
30	775
20	770
10	765
0	760
10	775
20	770
30	765
40	760
50	775
60	770

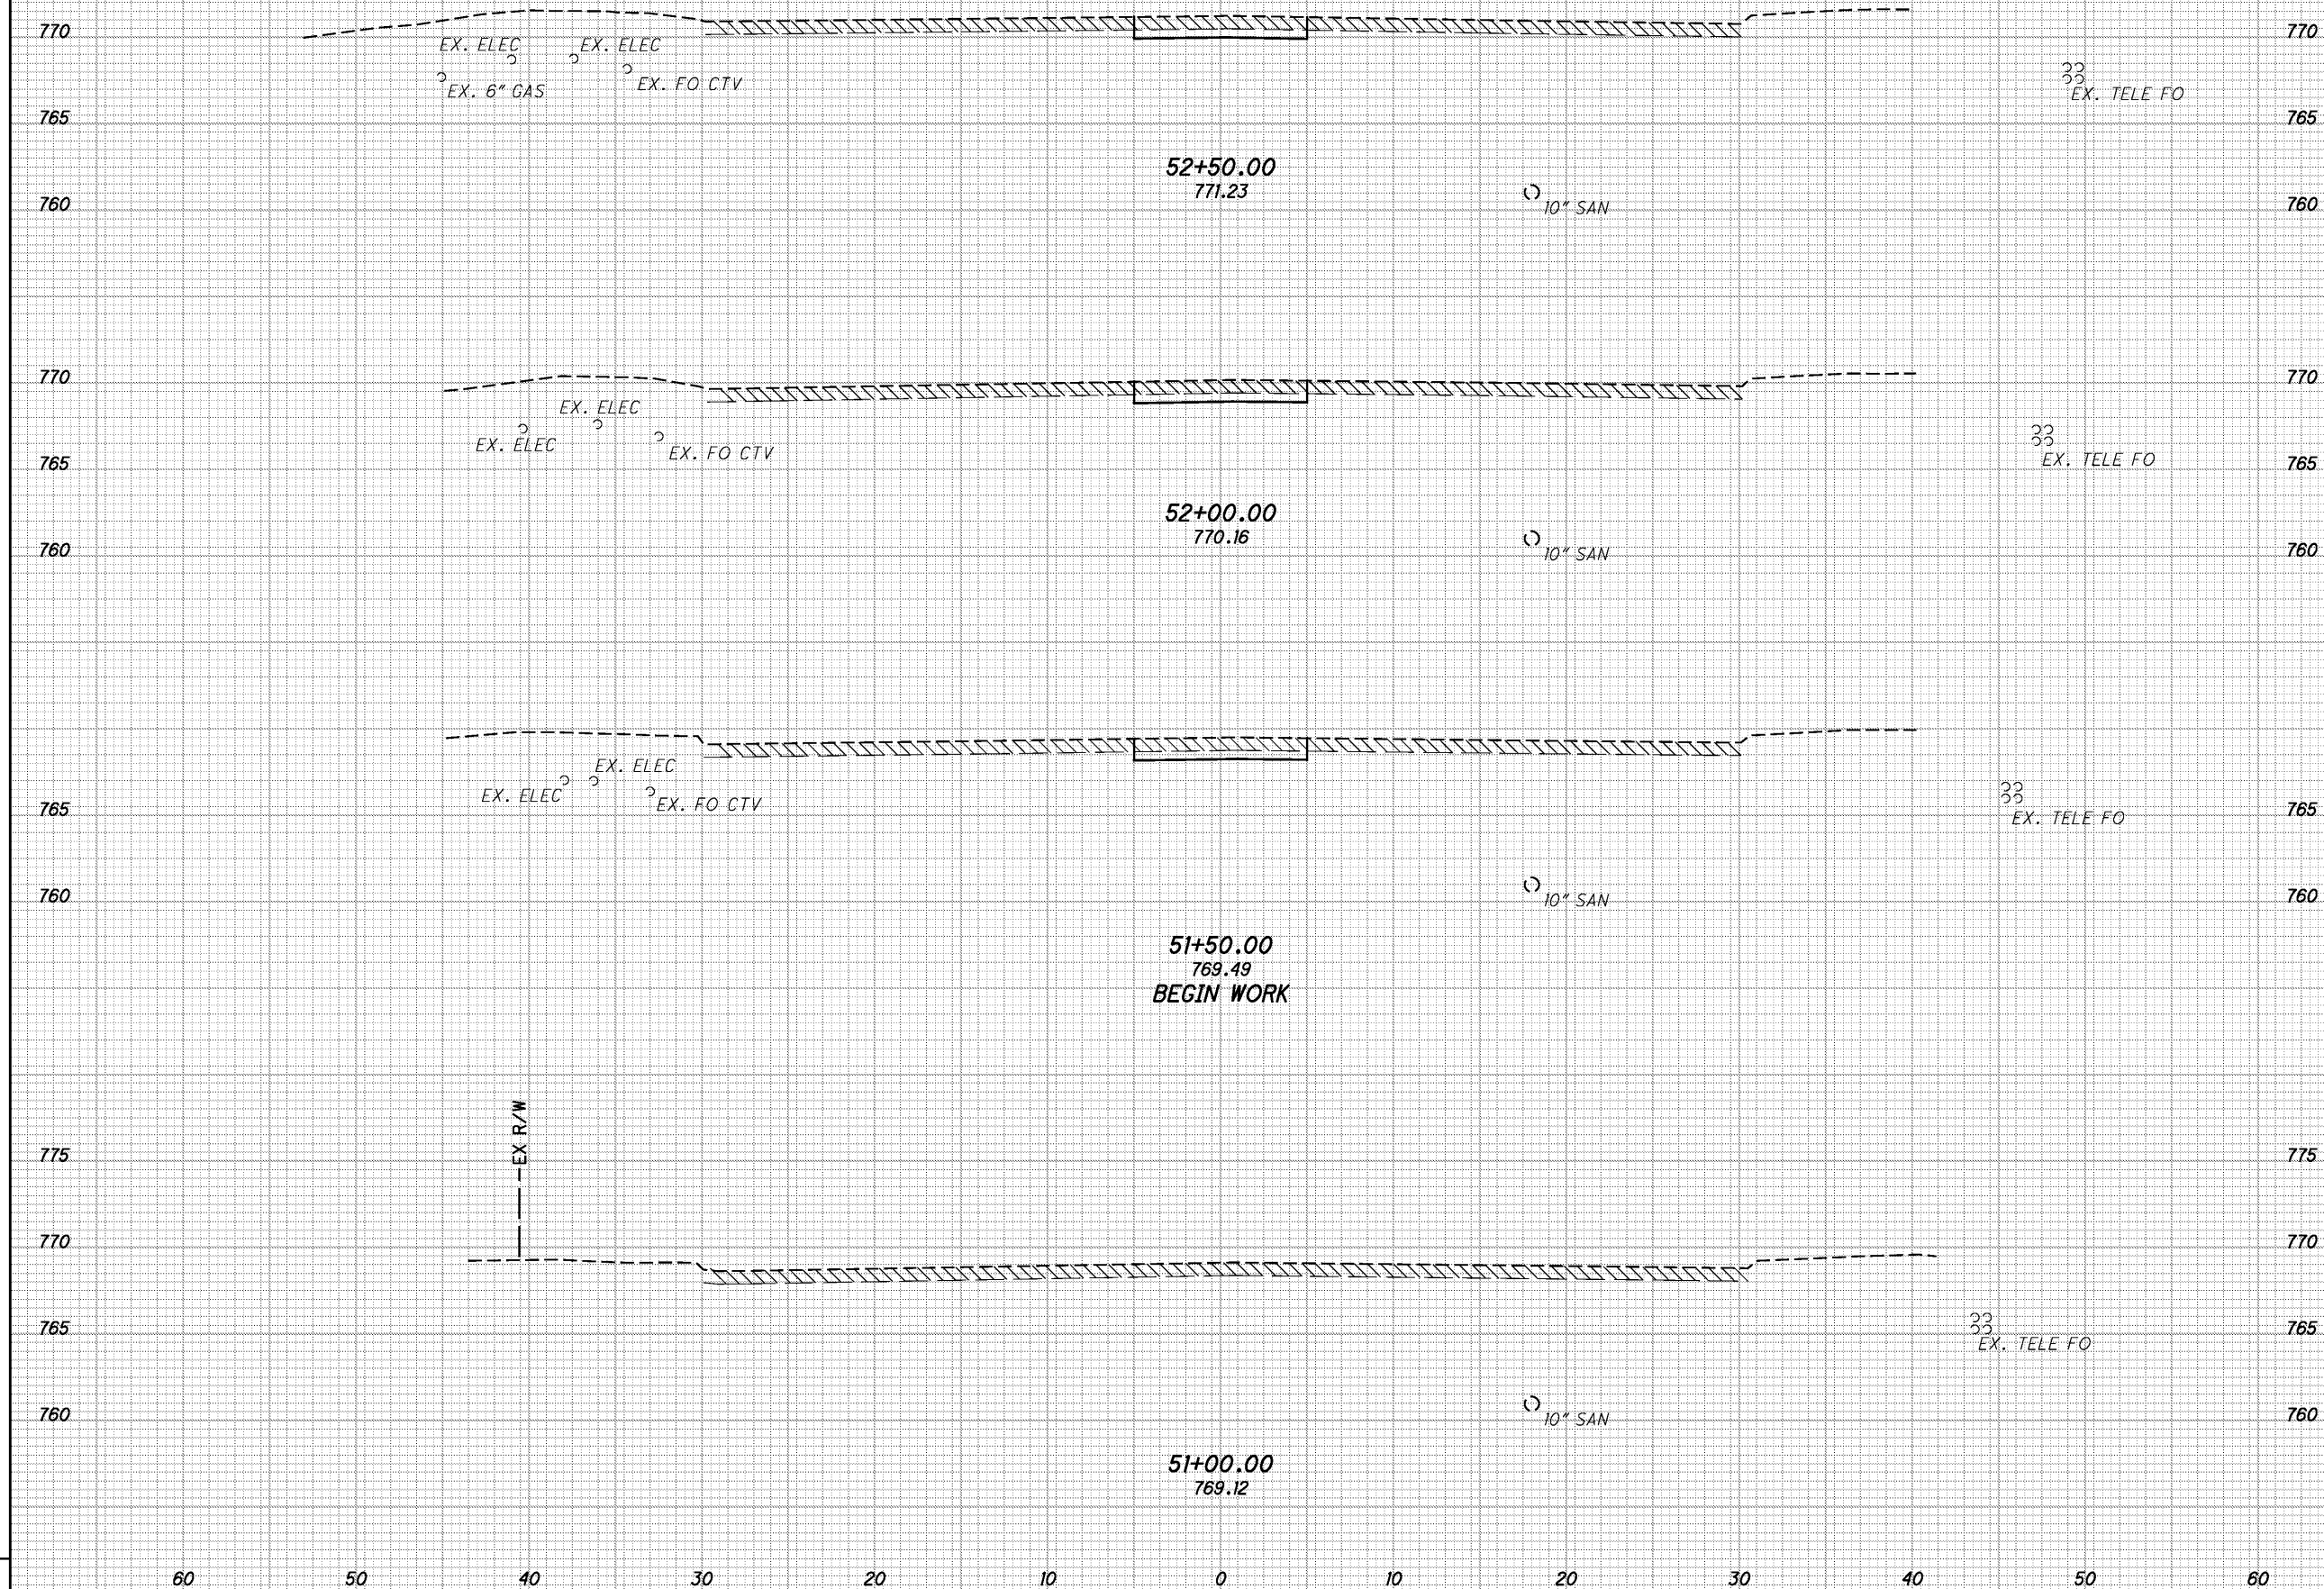

END AREA	VOLUME	CALCULATED	CHECKED	MAW
·	·	·	·	·

**CROSS SECTIONS TIEDEMAN ROAD**  
**STA. 51+00.00 TO STA. 52+50.00**


**CUY - 480 - 11.60**

I:\Projects\18063\Roadway\Sheets\18063XS005.dgn 2/5/2015 10:29:08 AM michael\_j\_thompson

SEEDING

END WIDTH	SO. YDS.
60	
50	
40	
30	
20	
10	
0	
10	
20	
30	
40	
50	
60	

END AREA		VOLUME		CALCULATED MEP	CHECKED MAW
CUT	FILL	CUT	FILL		

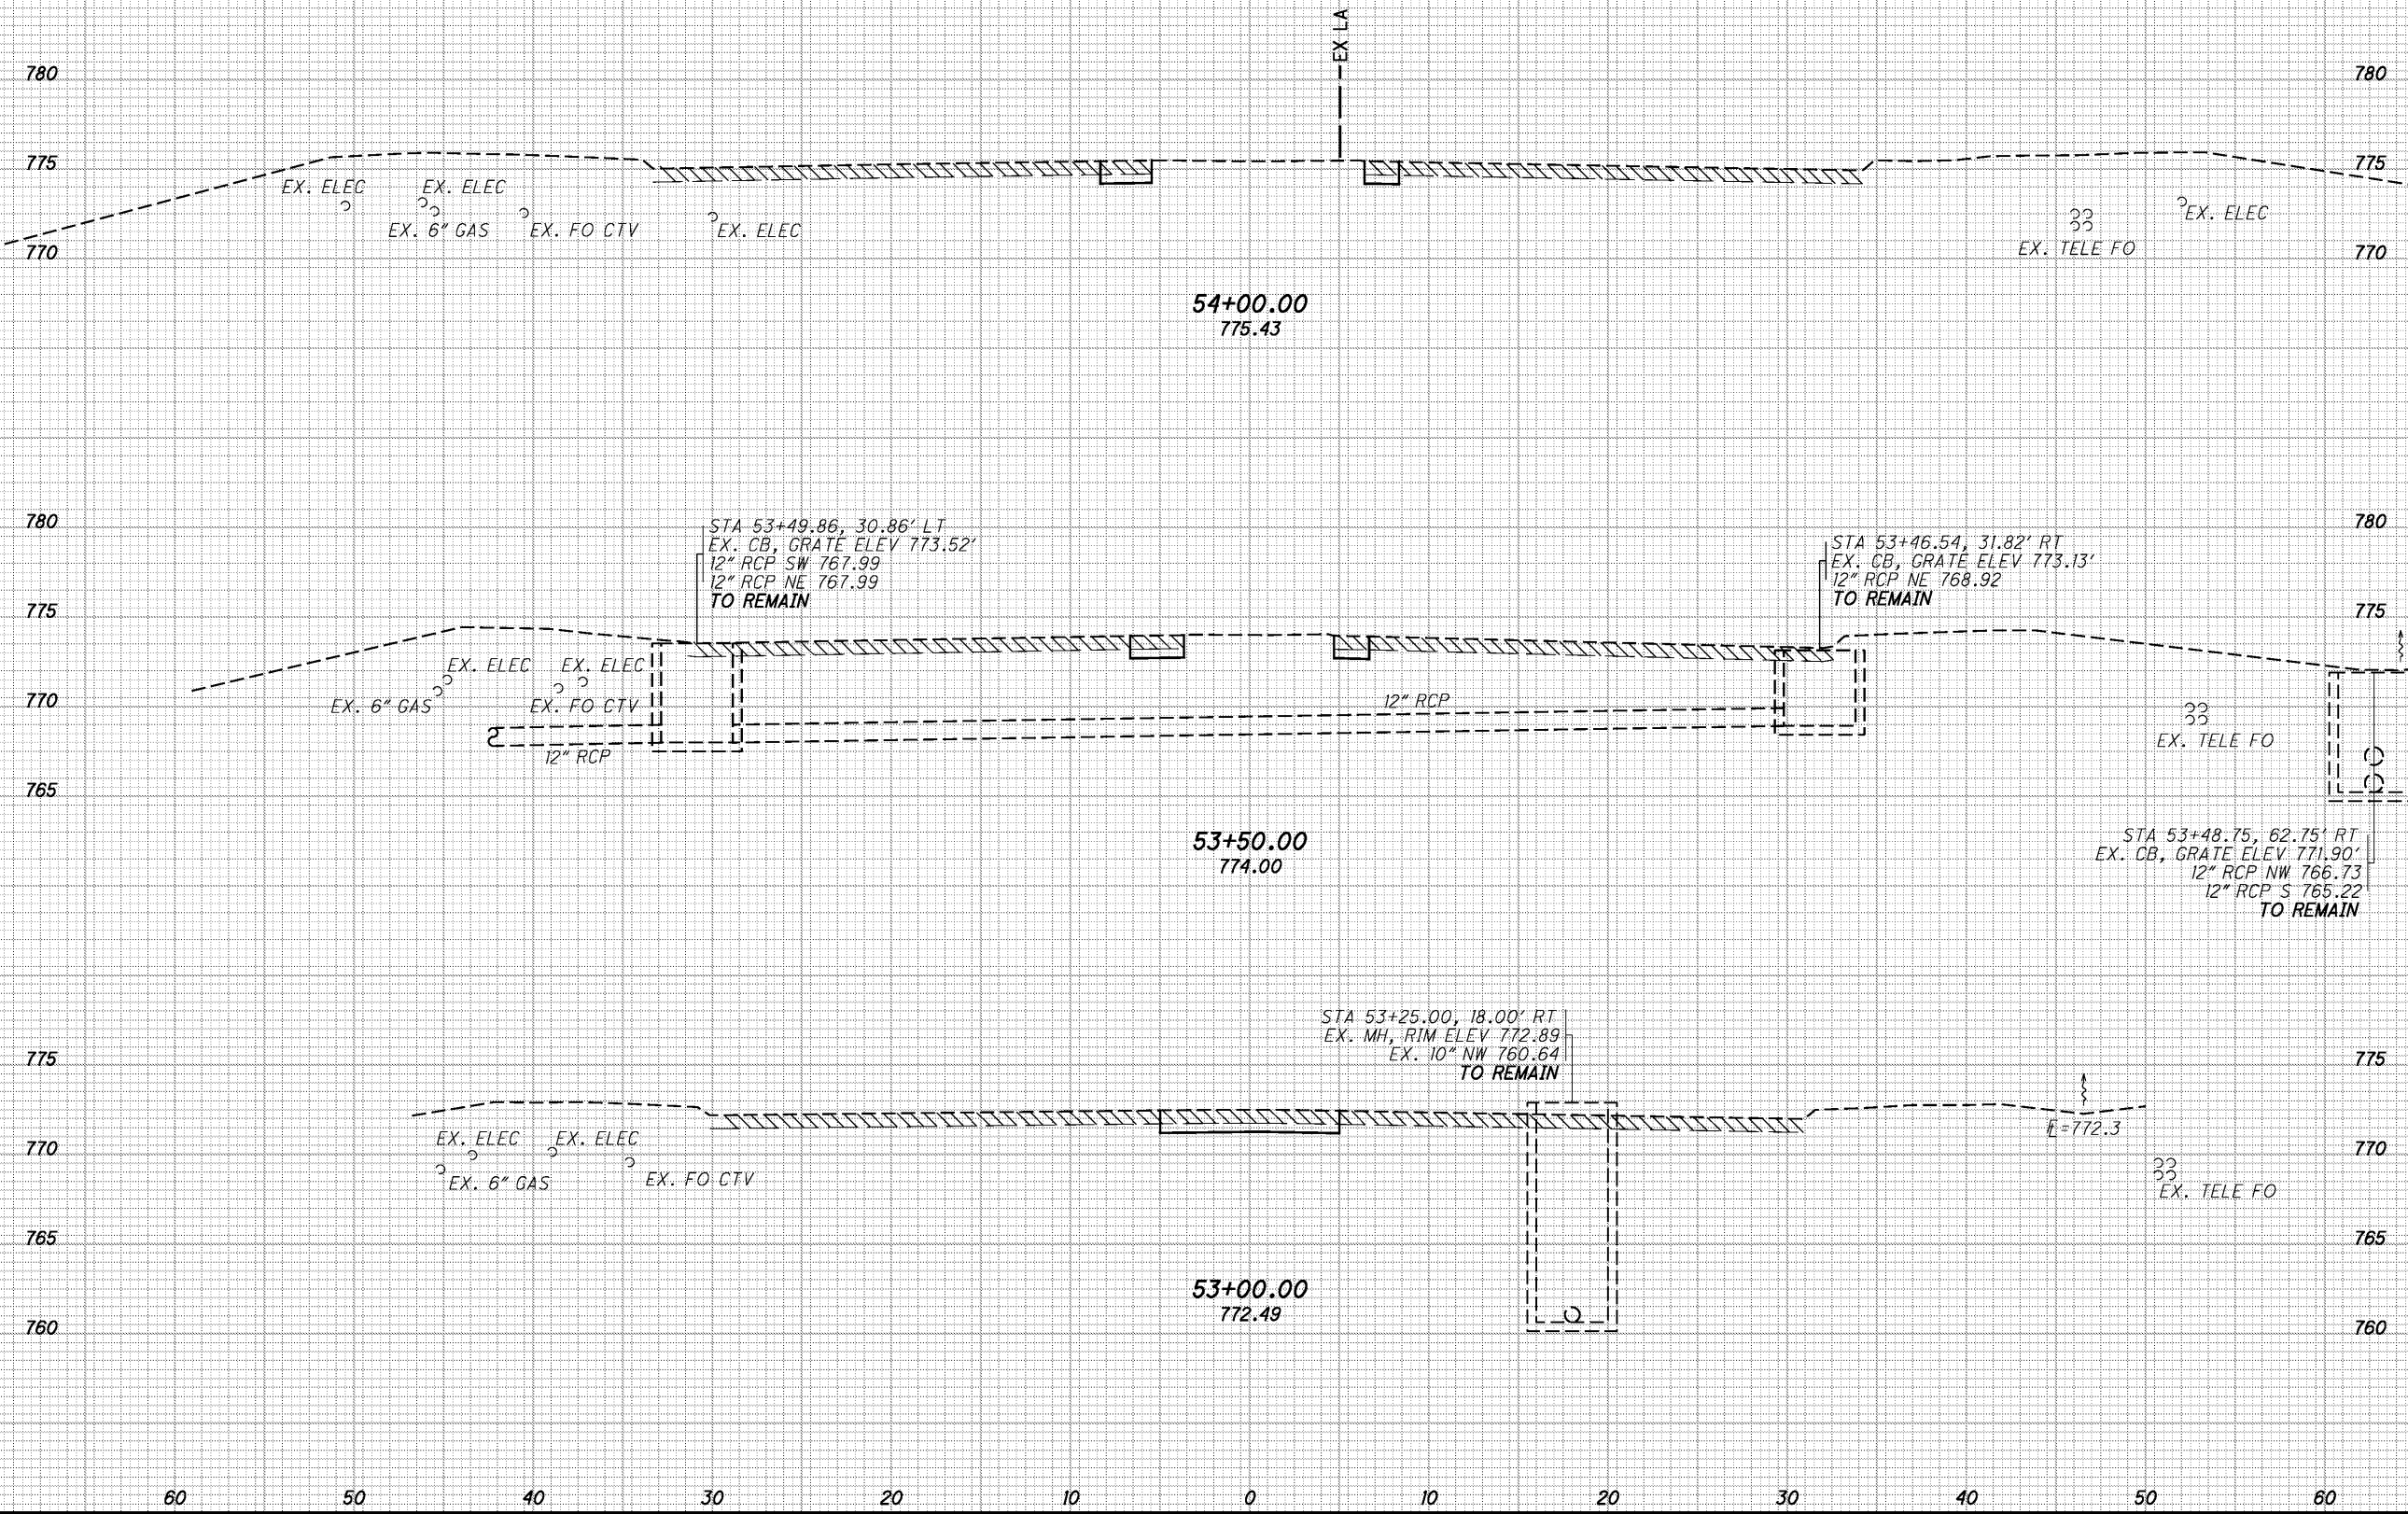

**CROSS SECTIONS TIEDEMAN ROAD**  
**STA. 53+00.00 TO STA. 54+00.00**

**CUY - 480 - 11.60**


56  
84

I:\Projects\18063\Roadway\Sheets\18063X5005.dgn 2/5/2015 10:29:08 AM michael\_j.\_thompson

SEEDING

END WIDTH	SO. YDS.

END AREA		VOLUME		CALCULATED	CHECKED
CUT	FILL	CUT	FILL	MEP	MAW

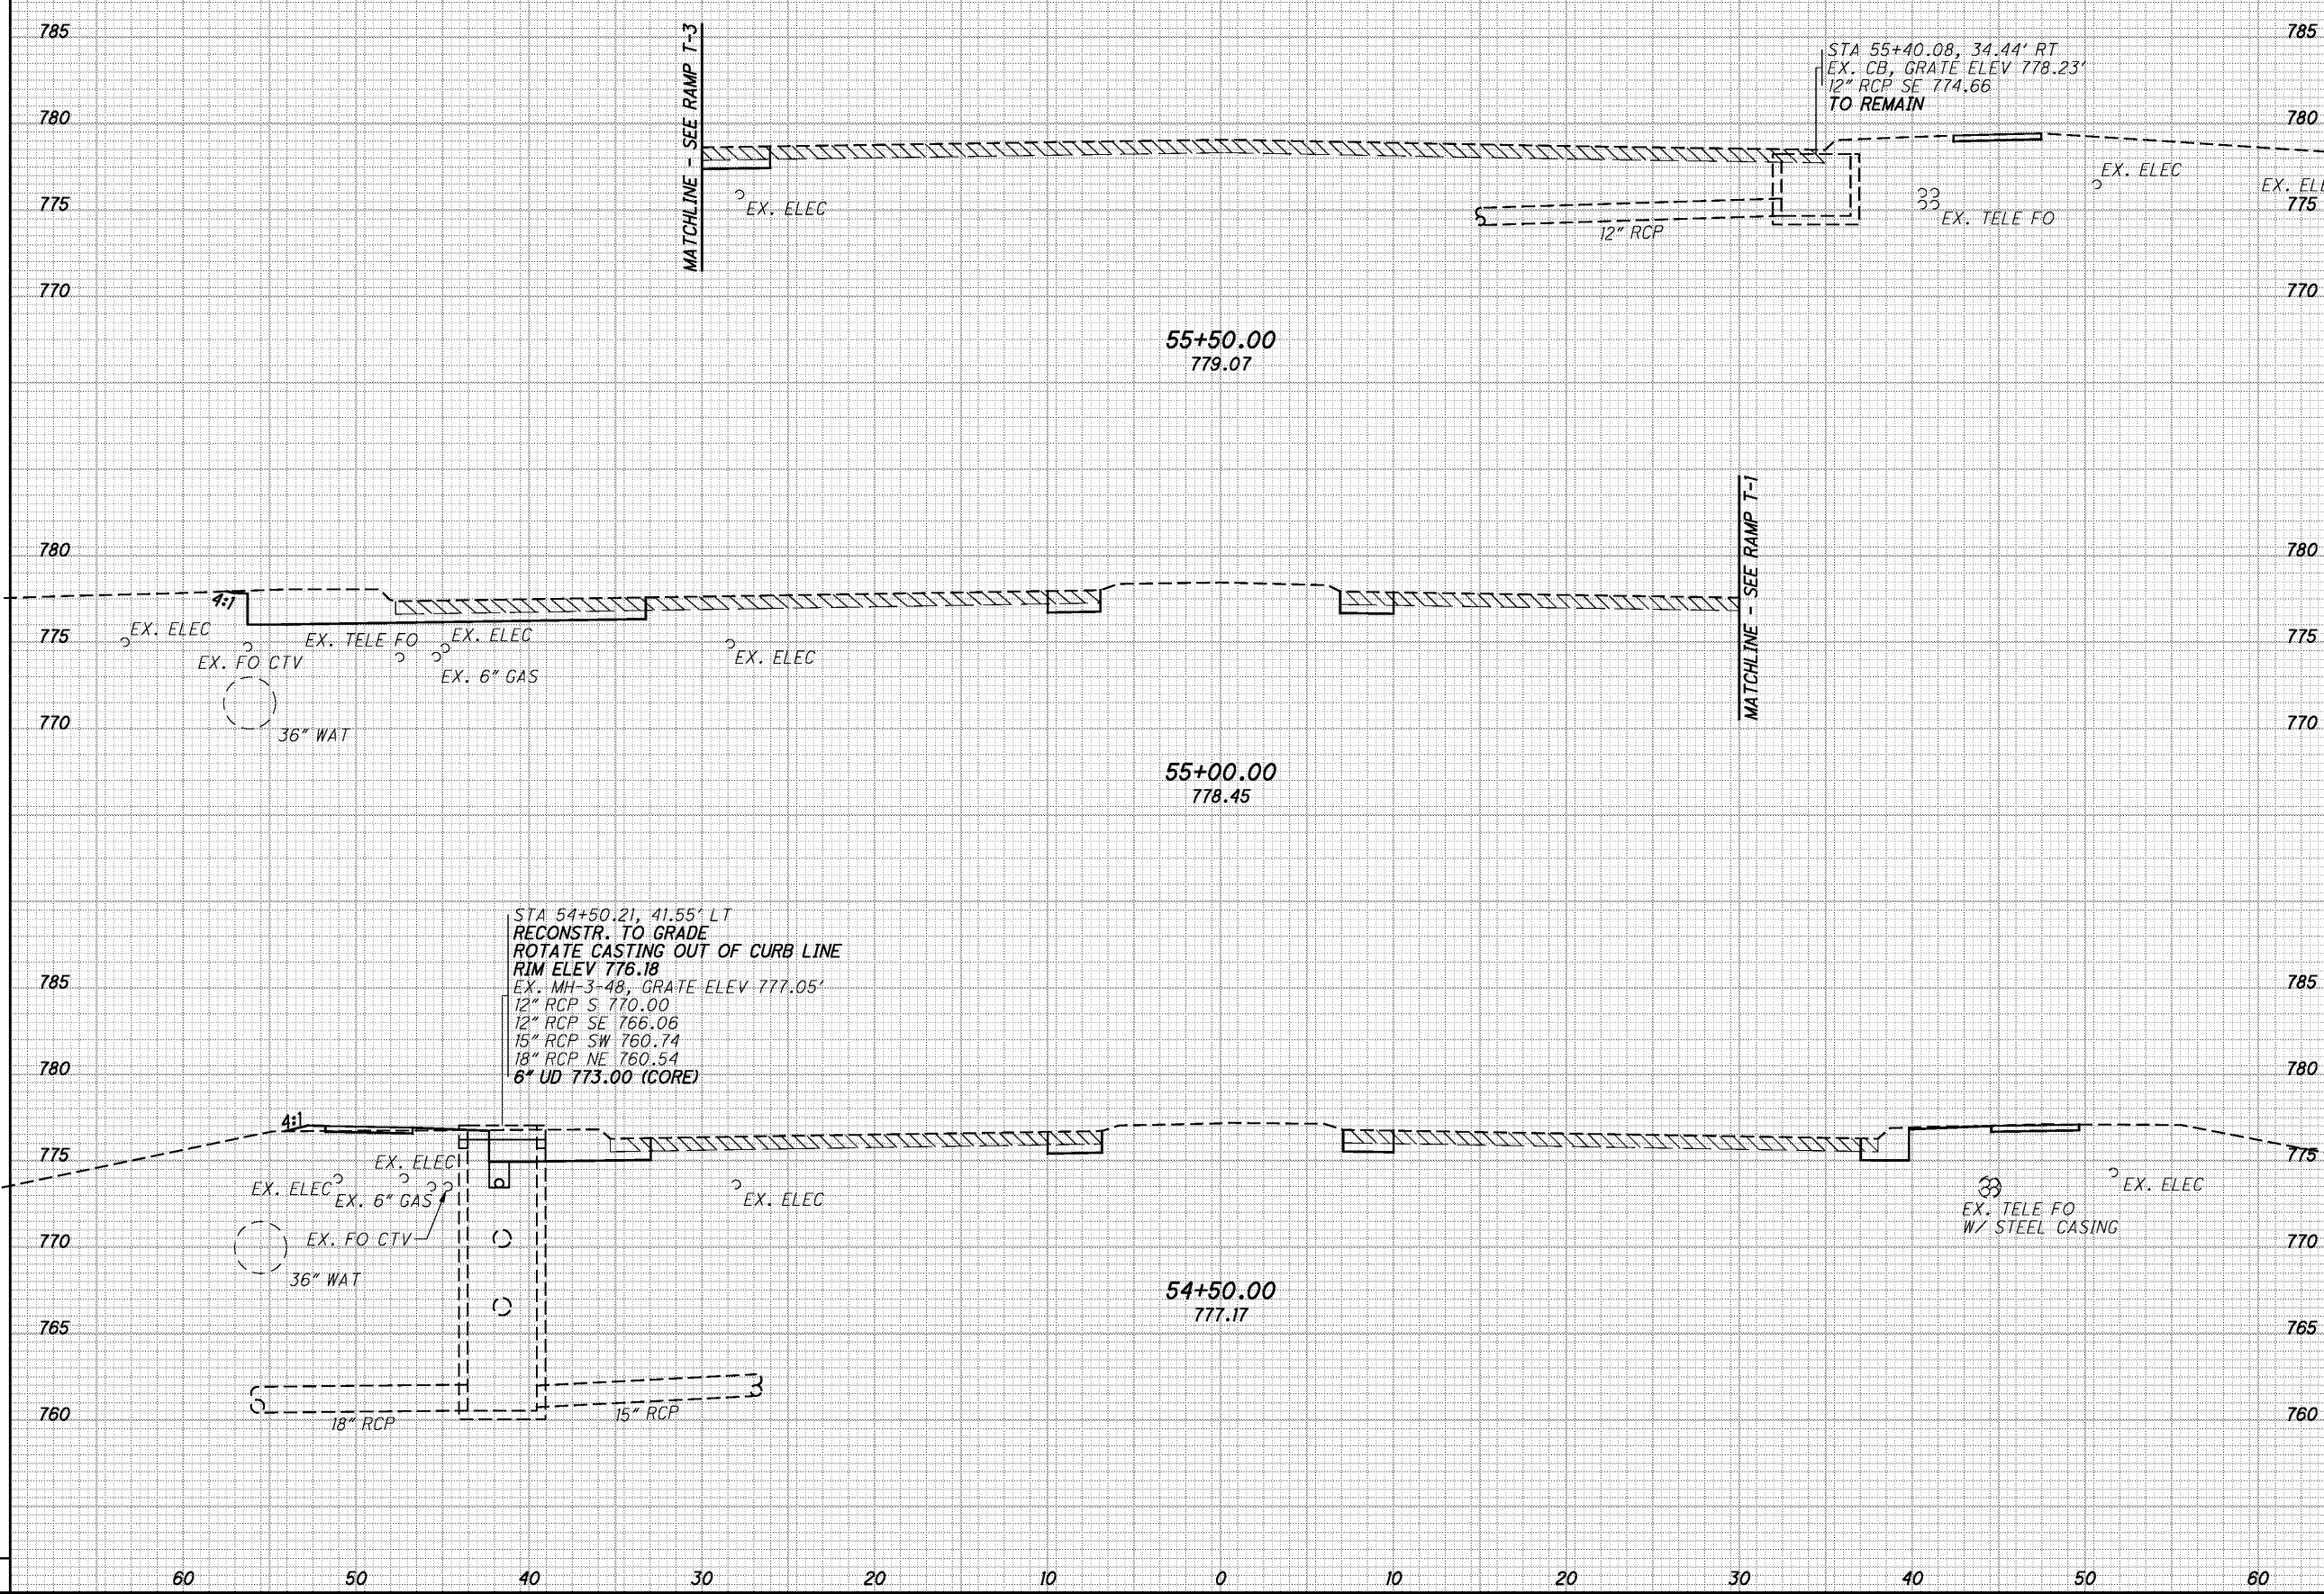


CROSS SECTIONS TIEDEMAN ROAD  
STA. 54+50.00 TO STA. 55+50.00

CUY - 480 - 11.60

57  
84

SEEDING  
END WIDTH SO. YDS.  
2/5/2015 10:29:08 AM michael\_j\_tompson

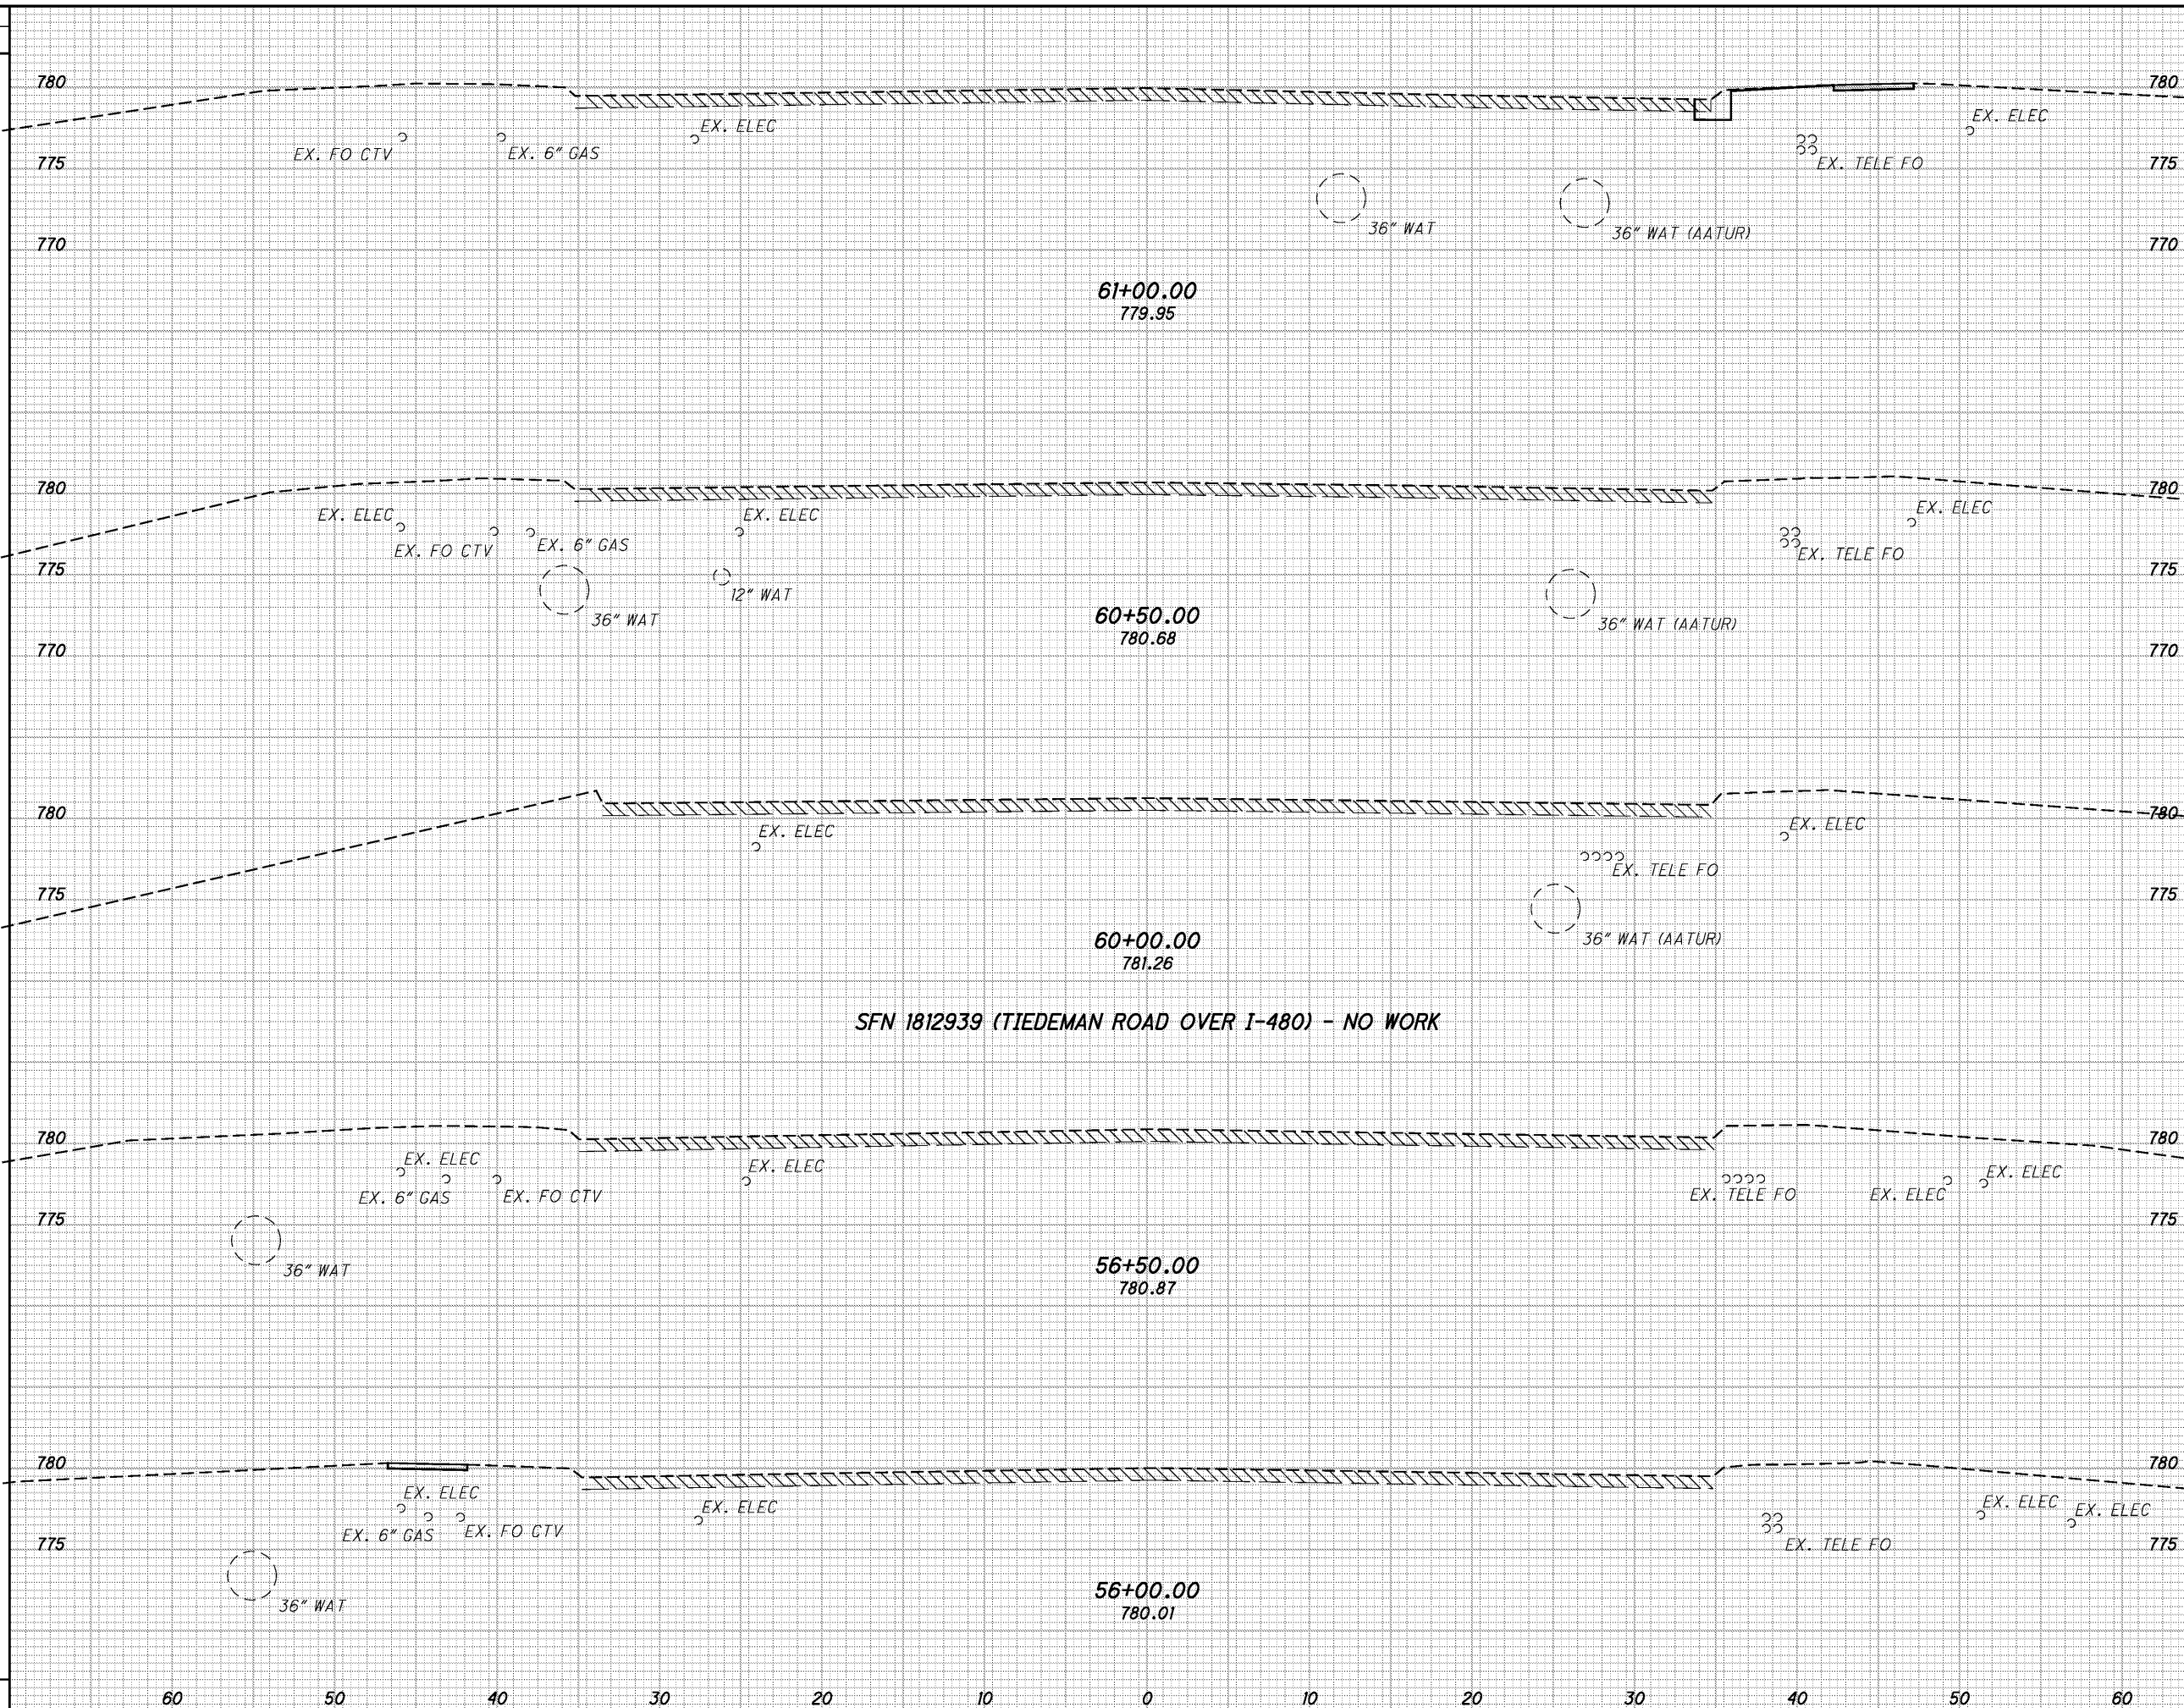

END AREA		VOLUME	
CUT	FILL	CUT	FILL


CROSS SECTIONS TIEDEMAN ROAD  
STA. 56+00.00 TO STA. 61+00.00  
CALCULATED MEP  
CHECKED MAW  
CUY-480-11.60  
58  
84

SFN 1812939 (TIEDEMAN ROAD OVER I-480) - NO WORK

SEEDING  
END SO.  
WIDTH YDS.

END AREA	VOLUME	CALCULATED	CHECKED	MAW					
					CUT	FILL	CUT	FILL	MEP

I:\Projects\18063\Roadway\Sheets\18063X5005.dgn 2/5/2015 10:29:09 AM michael\_j.\_thompson

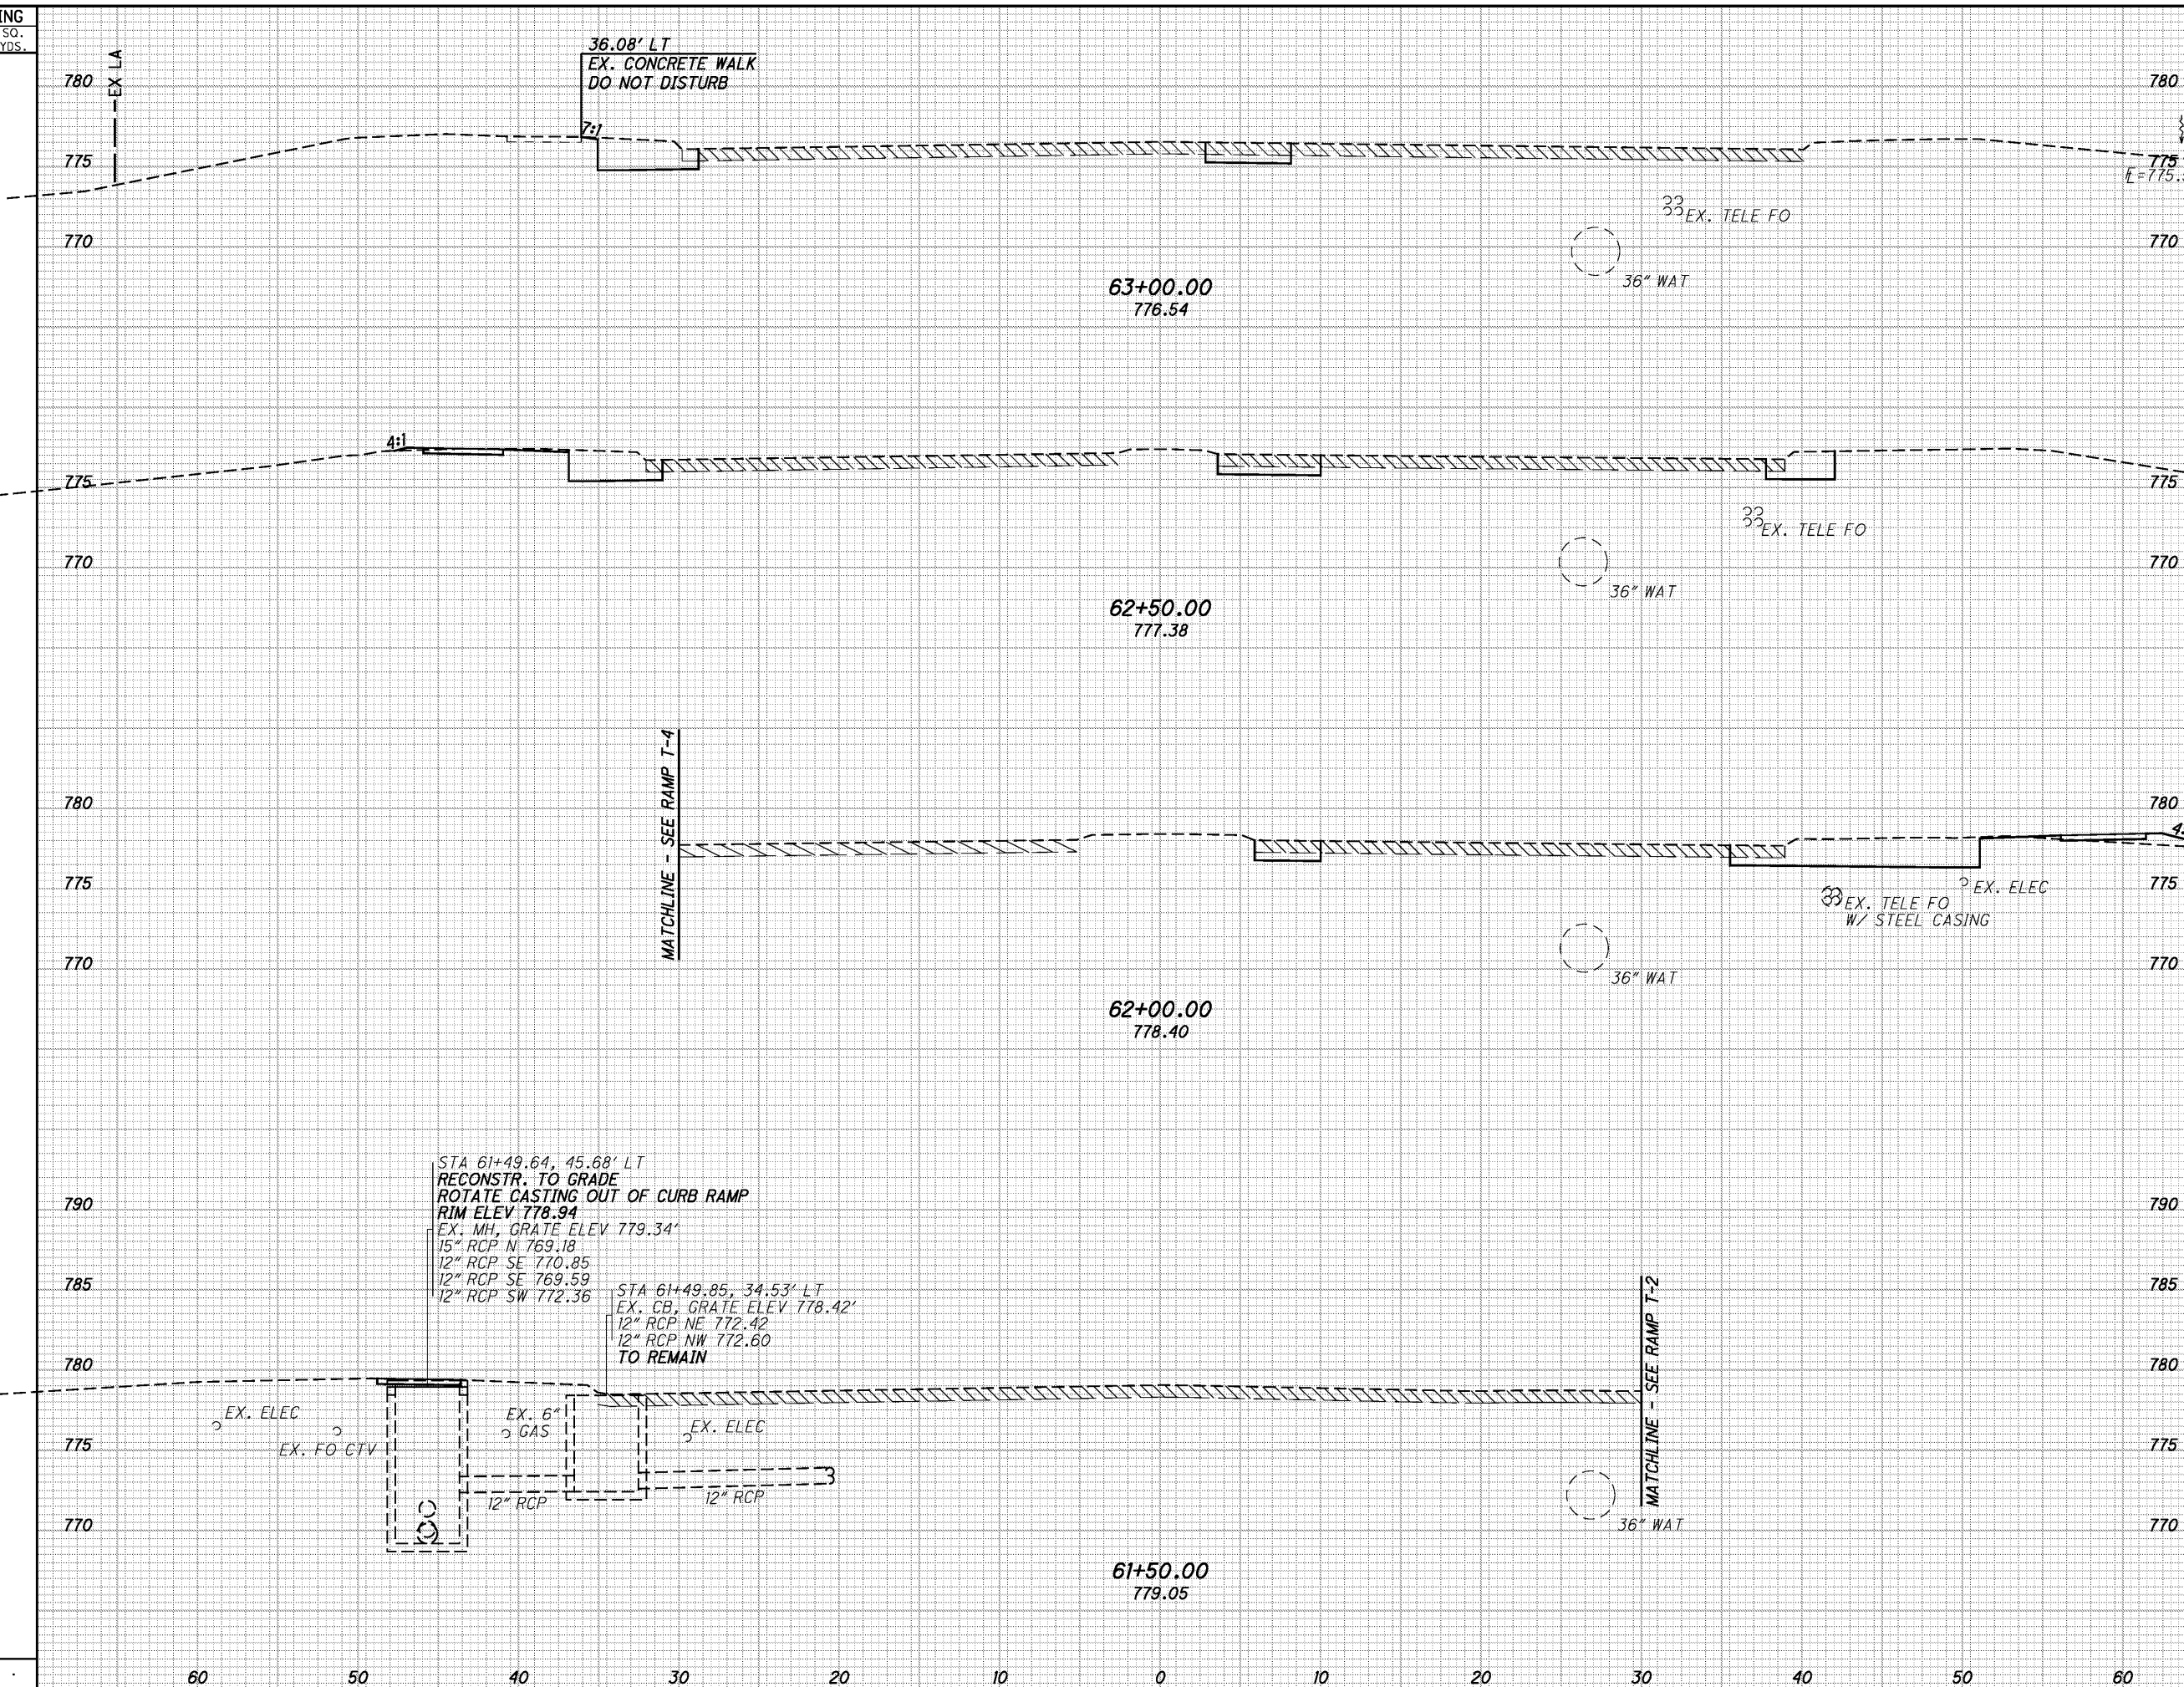

**CROSS SECTIONS TIEDEMAN ROAD  
STA. 61+50.00 TO STA. 63+00.00**

**CUY - 480 - 11.60**


59  
84

I:\Projects\18063\Roadway\Sheets\18063XS005.dgn 2/5/2015 10:29:09 AM michael\_j.\_thompson

**SEEDING**

END WIDTH	SO. YDS.

END AREA		VOLUME		CALCULATED MEP	CHECKED MAW
CUT	FILL	CUT	FILL		

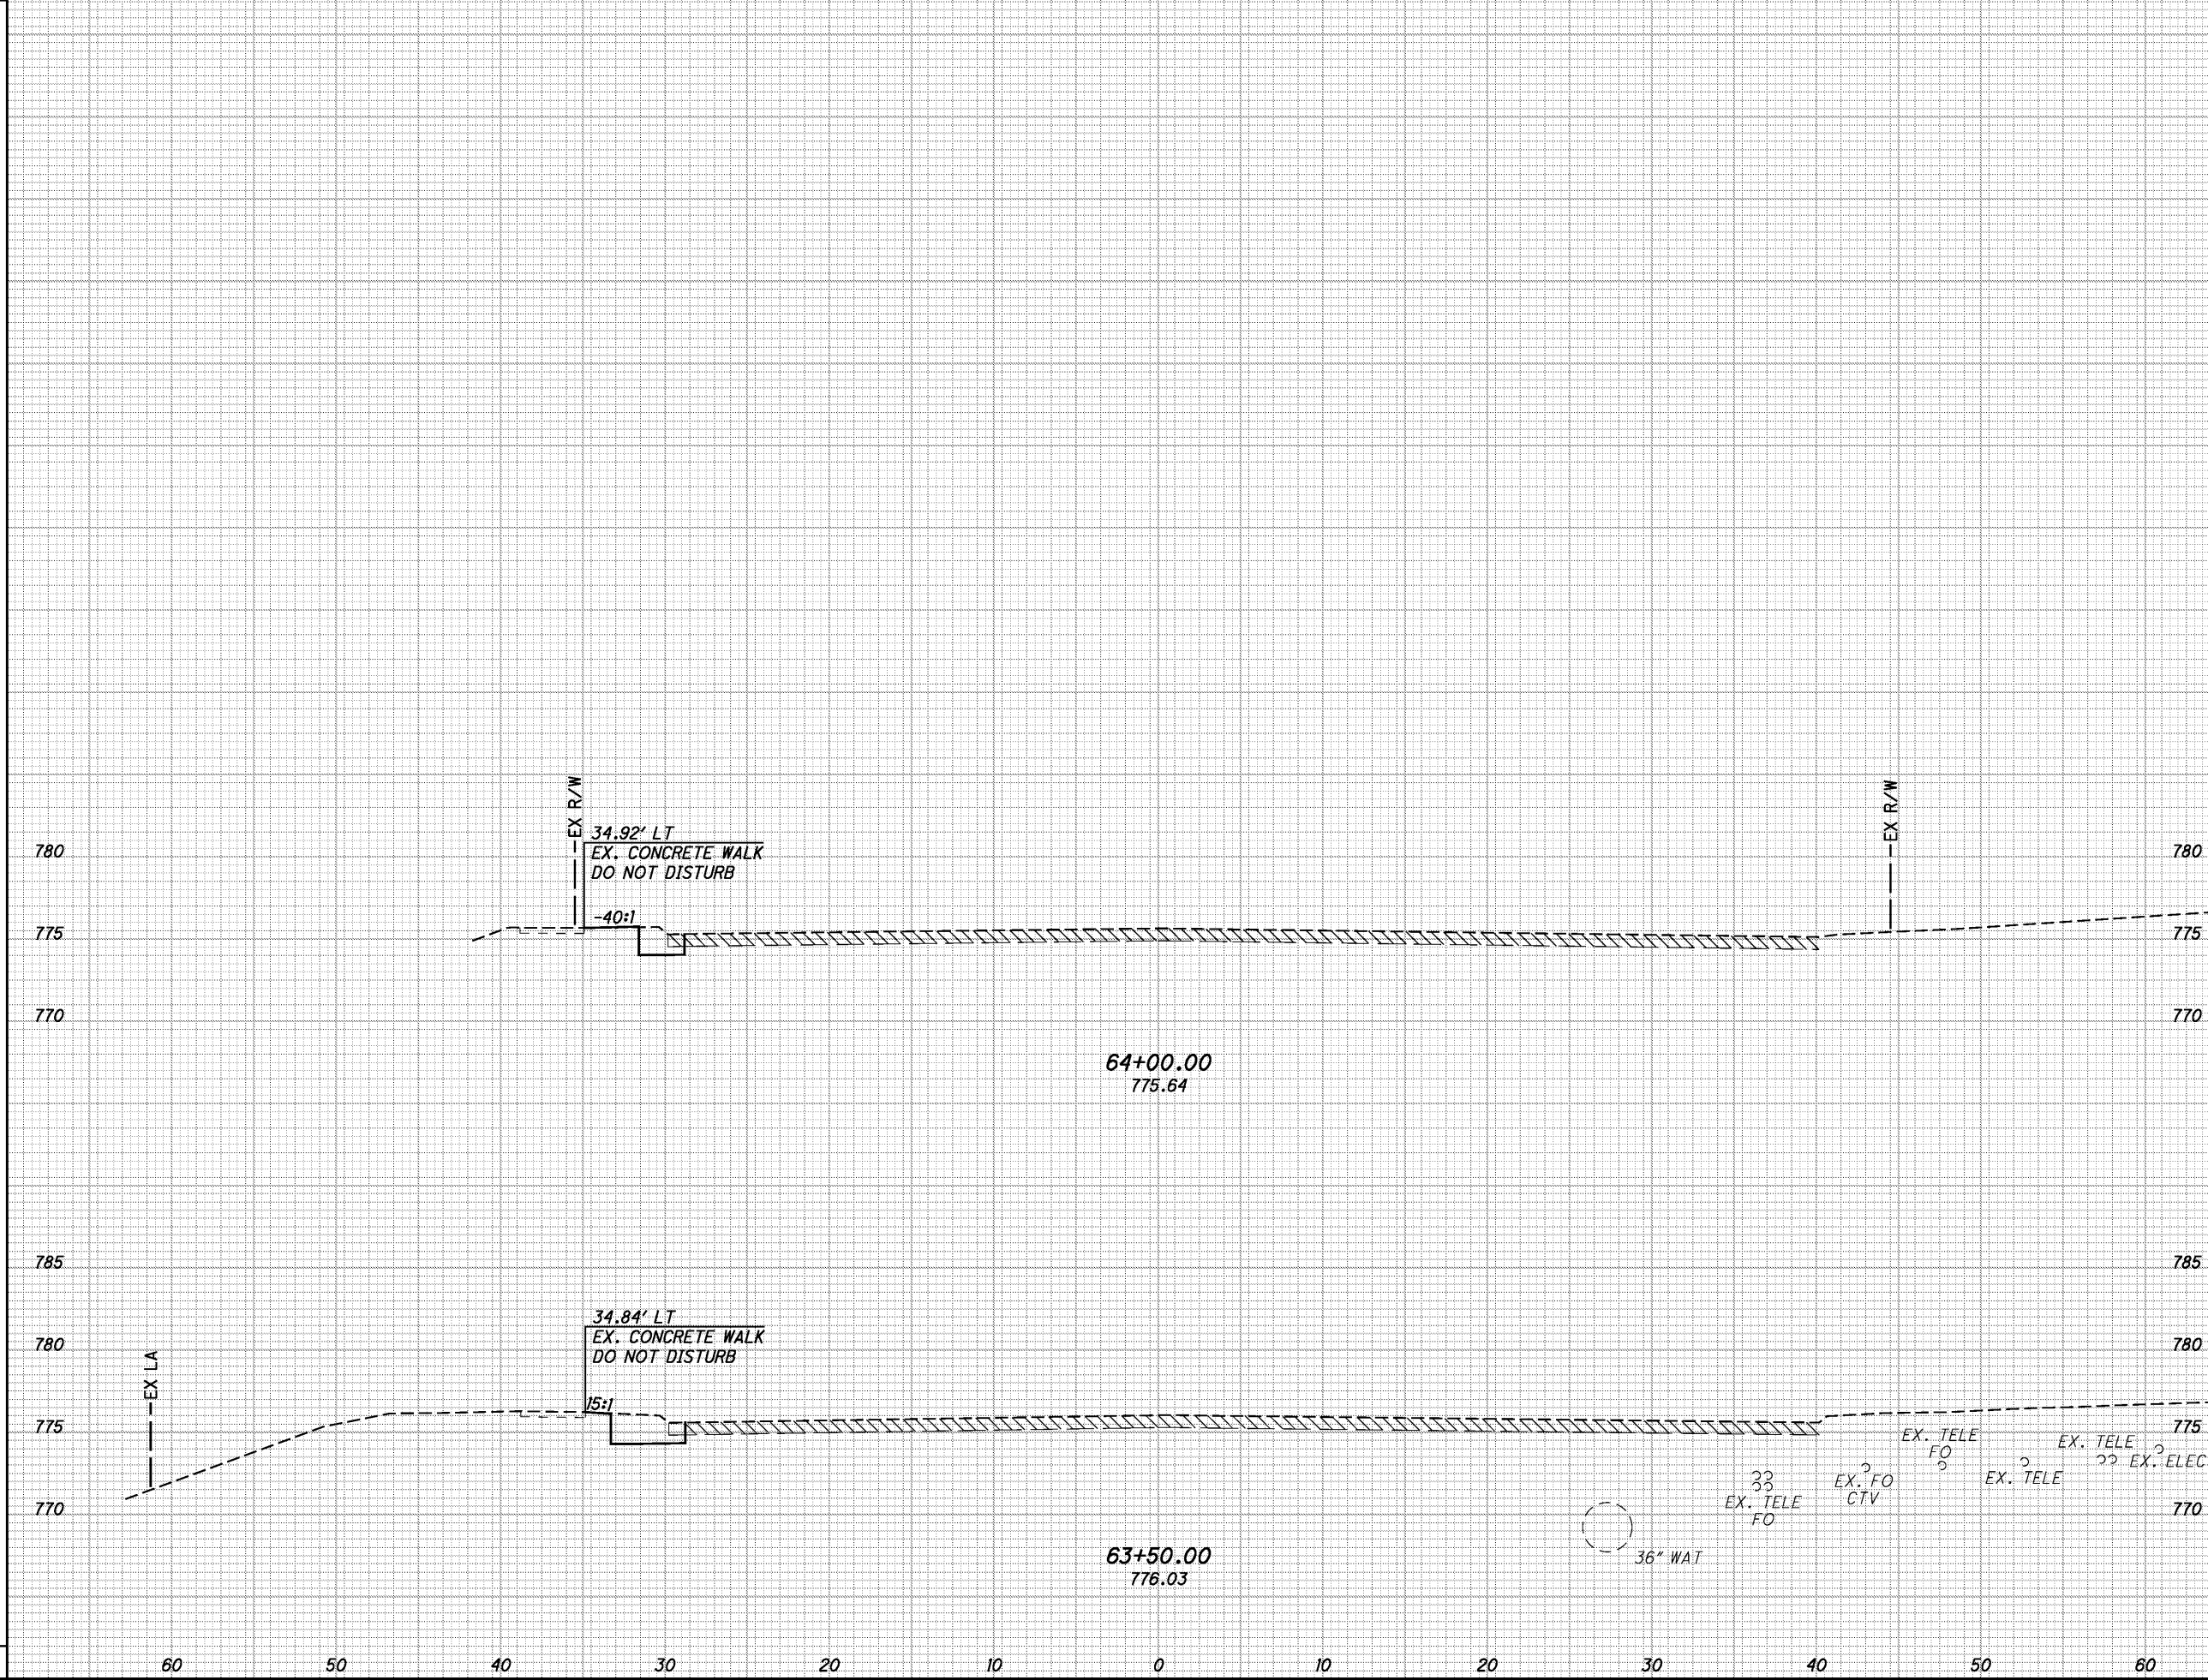

**CROSS SECTIONS TIEDEMAN ROAD  
STA. 63+50.00 TO STA. 64+00.00**

**CUY - 480 - 11.60**

60  
84



**RAMP T-2 - SUPERELEVATION TABLE**  
P.I. STA. 102+51.44      Dc = 3° 00' 00"  
P.I. STA. 107+36.82      Dc = 5° 00' 00"  
P.I. STA. 112+71.45      Dc = 2° 00' 00"

INSIDE SHOULDER			LANE			LANE			LANE			RAMP T-2			LANE			OUTSIDE SHOULDER			REMARKS
PROPOSED SHOULDER WIDTH	PROPOSED EDGE OF SHOULDER ELEVATION	PROPOSED SHOULDER CROSS-SLOPE	PROPOSED PAVEMENT WIDTH	PROPOSED EDGE OF PAVEMENT ELEVATION	PROPOSED PAVEMENT CROSS-SLOPE	PROPOSED PAVEMENT WIDTH	PROPOSED EDGE OF PAVEMENT ELEVATION	PROPOSED PAVEMENT CROSS-SLOPE	PROPOSED PAVEMENT WIDTH	PROPOSED EDGE OF PAVEMENT ELEVATION	PROPOSED PAVEMENT CROSS-SLOPE	BASELINE STATION	PROFILE GRADE ELEVATION	LONGITUDINAL SLOPE	PROPOSED PAVEMENT WIDTH	PROPOSED EDGE OF PAVEMENT ELEVATION	PROPOSED PAVEMENT CROSS-SLOPE	PROPOSED SHOULDER CROSS-SLOPE	PROPOSED EDGE OF SHOULDER ELEVATION	PROPOSED SHOULDER WIDTH	
									15.06	770.72	2.72%	103+00.00	770.31					-4.24%	769.94	8.72	
									15.25	770.39	2.95%	103+25.00	769.94	-1.48%				-4.17%	769.58	8.64	
									15.31	770.07	2.94%	103+50.00	769.62	-1.28%				-3.87%	769.29	8.52	
									15.46	769.73	2.91%	103+75.00	769.28	-1.36%				-3.95%	768.95	8.36	
2.52	769.39	1.59%							15.43	769.35	3.11%	104+00.00	768.87	-1.64%				-4.16%	768.52	8.42	MATCH EXISTING / BEGIN PROPOSED PROFILE
2.64	769.01	-3.10%							15.57	769.09	3.90%	104+25.00	768.48	-1.55%				-4.00%	768.17	7.82	F.S.
2.76	768.67	-3.10%							15.72	768.76	3.90%	104+50.00	768.14	-1.36%				-4.00%	767.85	7.21	
2.88	768.38	-3.10%							15.86	768.47	3.90%	104+75.00	767.85	-1.16%				-4.00%	767.59	6.61	
3.00	768.14	-3.10%							16.00	768.23	3.90%	105+00.00	767.61	-0.97%				-4.00%	767.37	6.00	P.T.
3.00	768.10	-3.10%							20.00	768.19	3.90%	105+25.00	767.41	-0.78%				-4.00%	767.17	6.00	
3.00	768.11	-3.10%							24.00	768.21	3.90%	105+50.00	767.27	-0.58%				-4.00%	767.03	6.00	
3.00	768.02	-3.10%				12.00	768.21	3.90%	12.00	767.74	3.90%	105+75.00	767.17	-0.39%				-4.00%	766.93	6.00	
3.00	767.97	-3.10%				12.00	768.11	3.90%	12.00	767.64	3.90%	106+00.00	767.13	-0.19%				-4.00%	766.89	6.00	
3.00	767.97	-3.10%				12.00	768.06	3.90%	12.00	767.59	3.90%	106+25.00	767.13	0.00%				-4.00%	766.89	6.00	
3.00	767.98	-3.10%				12.00	768.06	3.90%	12.00	767.59	3.90%	106+35.94	767.14	0.14%				-4.00%	766.90	6.00	P.C. / BEGIN SUPERELEVATION TRANSITION
3.00	768.02	-3.00%				12.00	768.08	3.90%	12.00	767.61	3.90%	106+40.45	767.15	0.20%				-4.00%	766.91	6.00	
3.00	768.02	-3.00%				12.00	768.11	4.00%	12.00	767.63	4.00%	106+50.00	767.17	0.26%				-4.00%	766.92	6.00	
3.00	768.10	-2.79%				12.00	768.19	4.21%	12.00	767.68	4.21%	106+75.00	767.27	0.39%				-4.21%	766.99	6.00	
3.00	768.35	-2.23%				12.00	768.42	4.77%	12.00	767.84	4.77%	106+90.00	767.35	0.55%				-4.77%	766.92	6.00	
3.00	768.52	-1.90%				12.00	768.58	5.10%	12.00	767.97	5.10%	107+00.00	767.42	0.64%	0.00	767.42	-5.10%	-5.10%	767.11	6.00	
3.00	768.59	-1.90%	0.00	768.64	5.10%	12.00	768.64	5.10%	12.00	768.03	5.10%	107+25.00	767.61	0.78%	6.00	767.31	-5.10%	-5.10%	767.00	6.00	
3.00	769.09	-1.90%	6.00	769.14	5.10%	12.00	768.84	5.10%	12.00	768.23	5.10%	107+50.00	767.86	0.97%	12.00	767.25	-5.10%	-5.10%	766.94	6.00	
3.00	769.64	-1.90%	12.00	769.69	5.10%	12.00	769.08	5.10%	12.00	768.47	5.10%	107+75.00	767.93	1.10%	12.00	767.32	-5.10%	-5.10%	767.02	6.00	F.S.
3.00	769.71	-1.90%	12.00	769.77	5.10%	12.00	769.16	5.10%	12.00	768.55	5.10%	108+00.00	768.49	1.36%	12.00	767.98	-4.27%	-4.27%	767.72	6.00	
3.00	769.79	-2.25%	12.00	769.86	4.75%	12.00	769.29	4.75%	12.00	768.72	4.75%	108+13.99	768.69	1.46%	12.00	768.21	-4.00%	-4.00%	767.97	6.00	
3.00	769.95	-2.73%	12.00	770.03	4.27%	12.00	769.51	4.27%	12.00	769.00	4.27%	108+25.00	768.86	1.46%	12.00	768.40	-3.79%	-4.00%	768.16	6.00	
3.00	770.04	-3.00%	12.00	770.13	4.00%	12.00	769.65	4.00%	12.00	769.17	4.00%	108+37.19	769.03	1.46%	12.00	768.61	-3.55%	-4.00%	768.37	6.00	P.T.
3.00	770.12	-3.21%	12.00	770.22	3.79%	12.00	769.76	3.79%	12.00	769.31	3.79%	108+50.00	769.22	1.46%	12.00	768.82	-3.30%	-4.00%	768.58	6.00	
3.00	770.21	-3.45%	12.00	770.31	3.55%	12.00	769.89	3.55%	12.00	769.46	3.55%	108+65.79	769.45	1.46%	12.00	769.09	-3.00%	-4.00%	768.85	6.00	
3.00	770.30	-3.70%	12.00	770.41	3.30%	12.00	770.01	3.30%	12.00	769.62	3.30%	108+75.00	769.59	1.46%	12.00	769.25	-2.82%	-4.00%	769.01	6.00	
3.00	770.41	-4.00%	12.00	770.53	3.00%	12.00	770.17	3.00%	12.00	769.81	3.00%	109+00.00	769.95	1.46%	12.00	769.67	-2.34%	-4.00%	769.43	6.00	
3.00	770.48	-4.00%	12.00	770.60	2.82%	12.00	770.26	2.82%	12.00	769.92	2.82%	109+25.00	770.32	1.46%	12.00	770.09	-1.86%	-4.00%	769.85	6.00	
3.00	770.67	-4.00%	12.00	770.79	2.34%	12.00	770.51	2.34%	12.00	770.23	2.34%	109+38.00	770.50	1.46%	12.00	770.31	-1.60%	-4.00%	770.07	6.00	A.C.
3.00	770.86	-4.00%	12.00	770.98	1.86%	12.00	770.76	1.86%	12.00	770.54	1.86%	109+50.00	770.68	1.46%	12.00	770.52	-1.37%	-4.00%	770.28	6.00	
3.00	770.96	-4.00%	12.00	771.08	1.60%	12.00	770.89	1.60%	12.00	770.70	1.60%	109+75.00	771.05	1.46%	12.00	770.94	-0.89%	-4.00%	770.70	6.00	
3.00	771.05	-4.00%	12.00	771.17	1.37%	12.00	771.01	1.37%	12.00	770.84	1.37%	110+00.00	771.41	1.46%	12.00	771.36	-0.41%	-4.00%	771.12	6.00	
3.00	771.25	-4.00%	12.00	771.37	0.89%	12.00	771.26	0.89%	12.00	771.15	0.89%	110+21.00	771.72	1.46%	12.00	771.72	0.00%	-4.00%	771.48	6.00	FLAT
3.00	771.44	-4.00%	12.00	771.56	0.41%	12.00	771.51	0.41%	12.00	771.46	0.41%										
3.00	771.60	-4.00%	12.00	771.72	0.00%	12.00	771.72	0.00%	12.00	771.72	0.00%										

198:1

188:1

216:1

CALCULATED  
MEP  
CHECKED  
FR

**SUPERELEVATION TABLE - RAMP T-2**

**CUY - 480 - 11.60**

**RAMP T-2 - SUPERELEVATION TABLE**  
P.I. STA. 102+51.44      Dc = 3° 00' 00"  
P.I. STA. 107+36.82      Dc = 5° 00' 00"  
P.I. STA. 112+71.45      Dc = 2° 00' 00"

INSIDE SHOULDER			LANE			LANE			LANE			RAMP T-2			LANE			OUTSIDE SHOULDER			REMARKS	
PROPOSED SHOULDER WIDTH	PROPOSED EDGE OF SHOULDER ELEVATION	PROPOSED SHOULDER CROSS-SLOPE	PROPOSED PAVEMENT WIDTH	PROPOSED EDGE OF PAVEMENT ELEVATION	PROPOSED PAVEMENT CROSS-SLOPE	PROPOSED PAVEMENT WIDTH	PROPOSED EDGE OF PAVEMENT ELEVATION	PROPOSED PAVEMENT CROSS-SLOPE	PROPOSED PAVEMENT WIDTH	PROPOSED EDGE OF PAVEMENT ELEVATION	PROPOSED PAVEMENT CROSS-SLOPE	BASELINE STATION	PROFILE GRADE ELEVATION	LONGITUDINAL SLOPE	PROPOSED PAVEMENT WIDTH	PROPOSED EDGE OF PAVEMENT ELEVATION	PROPOSED PAVEMENT CROSS-SLOPE	PROPOSED SHOULDER CROSS-SLOPE	PROPOSED EDGE OF SHOULDER ELEVATION	PROPOSED SHOULDER WIDTH		
3.00	771.60	-4.00%	12.00	771.72	0.00%	12.00	771.72	0.00%	12.00	771.72	0.00%	110+21.00	771.72	1.46%	12.00	771.72	0.00%	-4.00%	771.48	6.00	FLAT	
3.00	771.63	-4.00%	12.00	771.75	-0.07%	12.00	771.76	-0.07%	12.00	771.77	-0.07%	110+25.00	771.78	1.46%	12.00	771.78	0.07%	-4.00%	771.54	6.00		
3.00	771.82	-4.00%	12.00	771.94	-0.56%	12.00	772.01	-0.56%	12.00	772.07	-0.56%	110+50.00	772.14	1.46%	12.00	772.21	0.56%	-4.00%	771.97	6.00		
3.00	772.01	-4.00%	12.00	772.13	-1.04%	12.00	772.26	-1.04%	12.00	772.38	-1.04%	110+75.00	772.51	1.46%	12.00	772.63	1.04%	-4.00%	772.39	6.00		
3.00	772.19	-4.00%	12.00	772.31	-1.49%	12.00	772.49	-1.49%	12.00	772.67	-1.49%	110+98.48	772.85	1.46%	12.00	773.03	1.49%	-4.00%	772.79	6.00	P.C.	
3.00	772.20	-4.00%	12.00	772.32	-1.52%	12.00	772.50	-1.52%	12.00	772.69	-1.52%	111+00.00	772.87	1.46%	12.00	773.05	1.52%	-4.00%	772.81	6.00		
3.00	772.23	-4.00%	12.00	772.35	-1.60%	12.00	772.54	-1.60%	12.00	772.74	-1.60%	111+04.00	772.93	1.46%	12.00	773.12	1.60%	-4.00%	772.88	6.00	A.C.	
3.00	772.39	-4.00%	12.00	772.51	-2.00%	12.00	772.75	-2.00%	12.00	772.99	-2.00%	111+25.00	773.24	1.46%	12.00	773.48	2.00%	-4.00%	773.24	6.00		
3.00	772.43	-4.00%	12.00	772.55	-2.10%	12.00	772.80	-2.10%	12.00	773.06	-2.10%	111+30.00	773.31	1.46%	12.00	773.56	2.10%	-4.00%	773.32	6.00	F.S.	
3.00	772.72	-4.00%	12.00	772.84	-2.10%	12.00	773.10	-2.10%	12.00	773.35	-2.10%	111+50.00	773.60	1.46%	12.00	773.85	2.10%	-4.00%	773.61	6.00		
3.00	773.09	-4.00%	12.00	773.21	-2.10%	12.00	773.46	-2.10%	12.00	773.71	-2.10%	111+75.00	773.97	1.46%	12.00	774.22	2.10%	-4.00%	773.98	6.00		
3.00	773.45	-4.00%	12.00	773.57	-2.10%	12.00	773.83	-2.10%	12.00	774.08	-2.10%	112+00.00	774.33	1.46%	12.00	774.58	2.10%	-4.00%	774.34	6.00		
3.00	773.82	-4.00%	12.00	773.94	-2.10%	12.00	774.19	-2.10%	12.00	774.44	-2.10%	112+25.00	774.70	1.46%	12.00	774.95	2.10%	-4.00%	774.71	6.00		
3.00	774.18	-4.00%	12.00	774.30	-2.10%	12.00	774.56	-2.10%	12.00	774.81	-2.10%	112+50.00	775.06	1.46%	12.00	775.31	2.10%	-4.00%	775.07	6.00		
3.00	774.55	-4.00%	12.00	774.67	-2.10%	12.00	774.92	-2.10%	12.00	775.17	-2.10%	112+75.00	775.43	1.46%	12.00	775.68	2.10%	-4.00%	775.44	6.00		
3.00	774.91	-4.00%	12.00	775.03	-2.10%	12.00	775.29	-2.10%	12.00	775.54	-2.10%	113+00.00	775.79	1.46%	12.00	776.04	2.10%	-4.00%	775.80	6.00		
3.00	775.28	-4.00%	12.00	775.40	-2.10%	12.00	775.65	-2.10%	12.00	775.90	-2.10%	113+25.00	776.16	1.46%	12.00	776.41	2.10%	-4.00%	776.17	6.00		
3.00	775.64	-4.00%	12.00	775.76	-2.10%	12.00	776.02	-2.10%	12.00	776.27	-2.10%	113+50.00	776.52	1.46%	12.00	776.77	2.10%	-4.00%	776.53	6.00		
3.00	775.82	-4.00%	12.00	775.94	-2.10%	12.00	776.19	-2.10%	12.00	776.44	-2.10%	113+62.00	776.70	1.46%	12.00	776.95	2.10%	-4.00%	776.71	6.00	F.S.	
3.00	776.13	-4.00%	12.00	776.25	-1.78%	12.00	776.46	-1.78%	12.00	776.67	-1.78%	113+75.00	776.89	1.46%	12.00	777.10	1.78%	-4.00%	776.86	6.00		
3.00	776.29	-4.00%	12.00	776.41	-1.60%	12.00	776.60	-1.60%	12.00	776.80	-1.60%	113+82.00	776.99	1.46%	12.00	777.18	1.60%	-4.00%	776.94	6.00	A.C.	
3.00	776.72	-4.00%	12.00	776.84	-1.14%	12.00	776.98	-1.14%	12.00	777.11	-1.14%	114+00.00	777.25	1.46%	12.00	777.39	1.14%	-4.00%	777.15	6.00		
3.00	777.32	-4.00%	12.00	777.44	-0.49%	12.00	777.50	-0.49%	12.00	777.56	-0.49%	114+25.00	777.62	1.46%	12.00	777.67	0.49%	-1.79%	777.57	6.00		
3.00	777.86	-0.18%	12.00	777.87	0.00%	12.00	777.87	0.00%	12.00	777.87	0.00%	114+43.99	777.87	1.34%	12.00	777.87	0.00%	-0.12%	777.86	6.00	P.T. / FLAT	
3.00	777.89	0.03%	12.00	777.89	0.03%	12.00	777.89	0.03%	12.00	777.88	0.03%	114+45.00	777.88	1.20%	12.00	777.88	-0.03%	-0.03%	777.88	6.00	END SHOULDER / BEGIN CURB LT. & RT.	
3.00	778.00	0.16%	12.00	777.99	0.16%	12.00	777.98	0.16%	12.00	777.96	0.16%	114+50.00	777.94	1.16%	12.00	777.92	-0.16%	-0.16%	777.91	6.00		
3.00	778.35	0.61%	12.00	778.34	0.61%	12.00	778.26	0.61%	12.00	778.19	0.61%	114+67.55	778.12	1.02%	12.00	778.04	-0.61%	-0.61%	778.01	6.00	CURB RETURN P.C. LT.	
												0.80%	114+75.00	778.18	0.85%	12.00	778.08	-0.80%	-0.80%	778.04	6.00	CURB RETURN P.C. RT.
												0.97%	114+81.70	778.23	0.76%	12.00	778.12	-0.97%	-0.97%	778.06	6.00	
												1.45%	115+00.00	778.34	0.60%			-1.45%				
												1.60%	115+06.00	778.37	0.44%			-1.60%				F.S.
													115+25.00	778.42	0.27%							TIEDEMAN ROAD EDGE OF PAVEMENT
													115+27.03	778.42	0.15%							MATCH EXISTING / END PROPOSED PROFILE
													115+29.15	778.44	0.63%							

SEE INTERSECTION DETAIL

SEE INTERSECTION DETAIL

SEE INTERSECTION DETAIL

216:1

162:1

CALCULATED  
MEP  
CHECKED  
FR

**SUPERELEVATION TABLE - RAMP T-2**

**CUY - 480 - 11.60**

**SUPERELEVATION TABLE - RAMP T-3**

**CUY - 480 - 11.60**


**RAMP T-3 - SUPERELEVATION TABLE**  
P.I. STA. 203+42.04 Dc = 4° 45' 00"

OUTSIDE SHOULDER			LANE			LANE			RAMP T-3			LANE			LANE			INSIDE SHOULDER			REMARKS
PROPOSED SHOULDER WIDTH	PROPOSED EDGE OF SHOULDER ELEVATION	PROPOSED SHOULDER CROSS-SLOPE	PROPOSED PAVEMENT WIDTH	PROPOSED EDGE OF PAVEMENT ELEVATION	PROPOSED PAVEMENT CROSS-SLOPE	PROPOSED PAVEMENT WIDTH	PROPOSED EDGE OF PAVEMENT ELEVATION	PROPOSED PAVEMENT CROSS-SLOPE	BASELINE STATION	PROFILE GRADE ELEVATION	LONGITUDINAL SLOPE	PROPOSED PAVEMENT WIDTH	PROPOSED EDGE OF PAVEMENT ELEVATION	PROPOSED PAVEMENT CROSS-SLOPE	PROPOSED PAVEMENT WIDTH	PROPOSED EDGE OF PAVEMENT ELEVATION	PROPOSED PAVEMENT CROSS-SLOPE	PROPOSED SHOULDER CROSS-SLOPE	PROPOSED EDGE OF SHOULDER ELEVATION	PROPOSED SHOULDER WIDTH	
SEE INTERSECTION DETAIL																					MATCH EX. / BEGIN PROP. PROFILE / BEGIN TRANS. TIEDEMAN ROAD EDGE OF PAVEMENT
6.00	777.81	-0.88%	12.00	777.86	-0.88%	12.00	777.97	-0.88%	200+35.62	778.37				2.00%							
6.00	777.76	-0.63%	12.00	777.80	-0.63%	12.00	777.87	-0.63%	200+36.94	778.37	-0.29%			1.97%							
6.00	777.67	-0.34%	12.00	777.69	-0.34%	12.00	777.73	-0.34%	200+50.00	778.32	-0.37%			1.63%							
6.00	777.46	-1.29%	12.00	777.54	0.00%	12.00	777.54	0.00%	200+75.00	778.12	-0.80%			0.98%							
6.00	777.23	-2.17%	12.00	777.36	0.31%	12.00	777.32	0.31%	200+79.09	778.07	-1.14%			0.88%							
6.00	776.64	-4.00%	12.00	776.88	0.96%	12.00	776.77	0.96%	200+88.66	777.95	-1.30%	12.00	778.02	0.63%	12.00	778.10	0.63%	0.63%	778.12	3.00	CURB RETURN P.C. LT.
6.00	776.04	-4.00%	12.00	776.28	1.60%	12.00	776.09	1.60%	201+00.00	777.77	-1.54%	12.00	777.81	0.34%	12.00	777.85	0.34%	0.34%	777.86	3.00	CURB RETURN P.C. RT.
6.00	775.44	-4.00%	12.00	775.68	2.25%	12.00	775.41	2.25%	201+12.96	777.54	-1.82%	12.00	777.54	0.00%	12.00	777.54	0.00%	-1.91%	777.48	3.00	END CURB / BEGIN SHOULDER LT. & RT.
6.00	774.83	-4.00%	12.00	775.07	2.90%	12.00	774.72	2.90%	201+25.00	777.28	-2.11%	12.00	777.25	-0.31%	12.00	777.21	-0.31%	-4.00%	777.09	3.00	P.C. / FLAT
6.00	774.25	-3.46%	12.00	774.46	3.54%	12.00	774.42	3.54%	201+50.00	776.85	-2.53%	12.00	776.54	-0.96%	12.00	776.42	-0.96%	-4.00%	776.30	3.00	
6.00	774.03	-3.20%	12.00	774.22	3.80%	12.00	773.77	3.80%	201+75.00	775.90	-3.00%	12.00	775.71	-1.60%	12.00	775.51	-1.60%	-4.00%	775.39	3.00	
6.00	773.59	-3.20%	12.00	773.79	3.80%	12.00	773.33	3.80%	202+00.00	775.14	-3.05%	12.00	774.87	-2.25%	12.00	774.60	-2.25%	-4.00%	774.48	3.00	
6.00	772.90	-3.20%	12.00	773.10	3.80%	12.00	772.64	3.80%	202+25.00	774.37	-3.05%	12.00	774.03	-2.90%	12.00	773.68	-2.90%	-4.00%	773.56	3.00	
6.00	772.26	-3.20%	12.00	772.45	3.80%	12.00	772.00	3.80%	202+28.97	774.25	-3.05%	12.00	773.89	-3.00%	12.00	773.53	-3.00%	-4.00%	773.41	3.00	
6.00	771.67	-3.20%	12.00	771.86	3.80%	12.00	771.41	3.80%	202+50.00	773.61	-3.05%	12.00	773.19	-3.54%	12.00	772.76	-3.54%	-4.00%	772.64	3.00	
6.00	771.12	-3.20%	12.00	771.32	3.80%	12.00	770.86	3.80%	202+60.00	773.31	-3.01%	12.00	772.85	-3.80%	12.00	772.40	-3.80%	-4.00%	772.28	3.00	F.S.
6.00	770.82	-3.20%	12.00	771.01	3.80%	12.00	770.56	3.80%	202+75.00	772.87	-2.91%	12.00	772.42	-3.80%	12.00	771.96	-3.80%	-4.00%	771.84	3.00	
6.00	770.55	-3.46%	12.00	770.76	3.54%	12.00	770.33	3.54%	203+00.00	772.18	-2.76%	12.00	771.73	-3.80%	12.00	771.27	-3.80%	-4.00%	771.15	3.00	
6.00	770.01	-4.00%	12.00	770.25	3.00%	12.00	769.89	3.00%	203+25.00	771.54	-2.57%	12.00	771.09	-3.80%	12.00	770.63	-3.80%	-4.00%	770.51	3.00	
6.00	769.92	-4.00%	12.00	770.16	2.90%	12.00	769.81	2.90%	203+50.00	770.95	-2.37%	12.00	770.49	-3.80%	12.00	770.04	-3.80%	-4.00%	769.92	3.00	
6.00	769.36	-4.00%	12.00	769.60	2.25%	12.00	769.33	2.25%	203+75.00	770.40	-2.18%	12.00	769.95	-3.80%	12.00	769.49	-3.80%	-4.00%	769.37	3.00	
6.00	768.77	-4.00%				24.00	769.60		203+90.00	770.10	-2.02%	12.00	769.65	-3.80%	12.00	769.19	-3.80%	-4.00%	769.07	3.00	F.S.
6.00	768.22	-4.00%				20.00	769.01	1.60%	204+00.00	769.91	-1.93%	12.00	769.48	-3.54%	12.00	769.06	-3.54%	-4.00%	768.94	3.00	
6.00	767.56	-4.00%				16.00	768.46	0.96%	204+20.94	769.53	-1.81%	12.00	769.17	-3.00%	12.00	768.81	-3.00%	-4.00%	768.69	3.00	
6.00	767.24	-4.00%				16.00	767.80	0.31%	204+25.00	769.46	-1.71%	12.00	769.11	-2.90%	12.00	768.77	-2.90%	-4.00%	768.65	3.00	
6.00	766.89	-4.00%				16.00	767.48	0.00%	204+50.00	769.06	-1.60%	12.00	768.79	-2.25%	12.00	768.52	-2.25%	-4.00%	768.40	3.00	
6.00	766.61	-1.46%				15.61	766.71	-0.74%	204+75.00	768.69	-1.50%	12.00	768.49	-1.60%	6.00	768.40	-1.60%	-4.00%	768.28	3.00	
6.98	766.12	-0.05%				15.40	766.48	-0.97%	205+00.00	768.31	3.75%	12.00	768.20	-0.96%	0.00	768.20	-0.96%	-4.00%	768.08	3.00	
7.07	766.03	-0.05%				16.00	767.13	-0.34%	205+25.00	767.75	-1.88%	6.00	767.73	-0.31%				-4.00%	767.61	3.00	
7.04	765.68	-0.02%				16.00	767.13	-0.34%	205+37.00	767.48	-2.26%	3.12	767.48	0.00%				-4.00%	767.36	3.00	FLAT
						15.40	766.43	-1.29%	205+50.00	767.18	-2.26%	0.00	767.18	0.34%				-4.00%	767.06	3.00	
						15.61	766.71	-0.74%	205+65.73	766.83	-2.26%							-1.41%	766.66	3.64	P.T.
						15.40	766.48	-0.97%	205+74.45	766.63	-2.26%							0.02%	766.63	4.00	MATCH EXISTING APPROACH SLAB
						15.50	766.43	-1.29%	205+98.02	766.15	-2.03%							0.02%	766.63	4.02	SECTION ALONG EXISTING APPROACH SLAB
						15.40	765.83	-2.08%										0.52%	766.17	3.86	

I:\Projects\18063\Roadway\Sheets\18063GE003.dgn 2/5/2015 10:29:10 AM michael\_j\_thompson

162:1  
161:1

P.I. Sta. 112+71.45  
 $\Delta = 6^\circ 54' 37''$  (LT)  
 $Dc = 2^\circ 00' 00''$   
 $R = 2,864.79'$   
 $T = 172.97'$   
 $L = 345.52'$   
 $E = 5.22'$   
 $e_{MAX} = 0.021$   
 DESIGN SPEED = 35 MPH

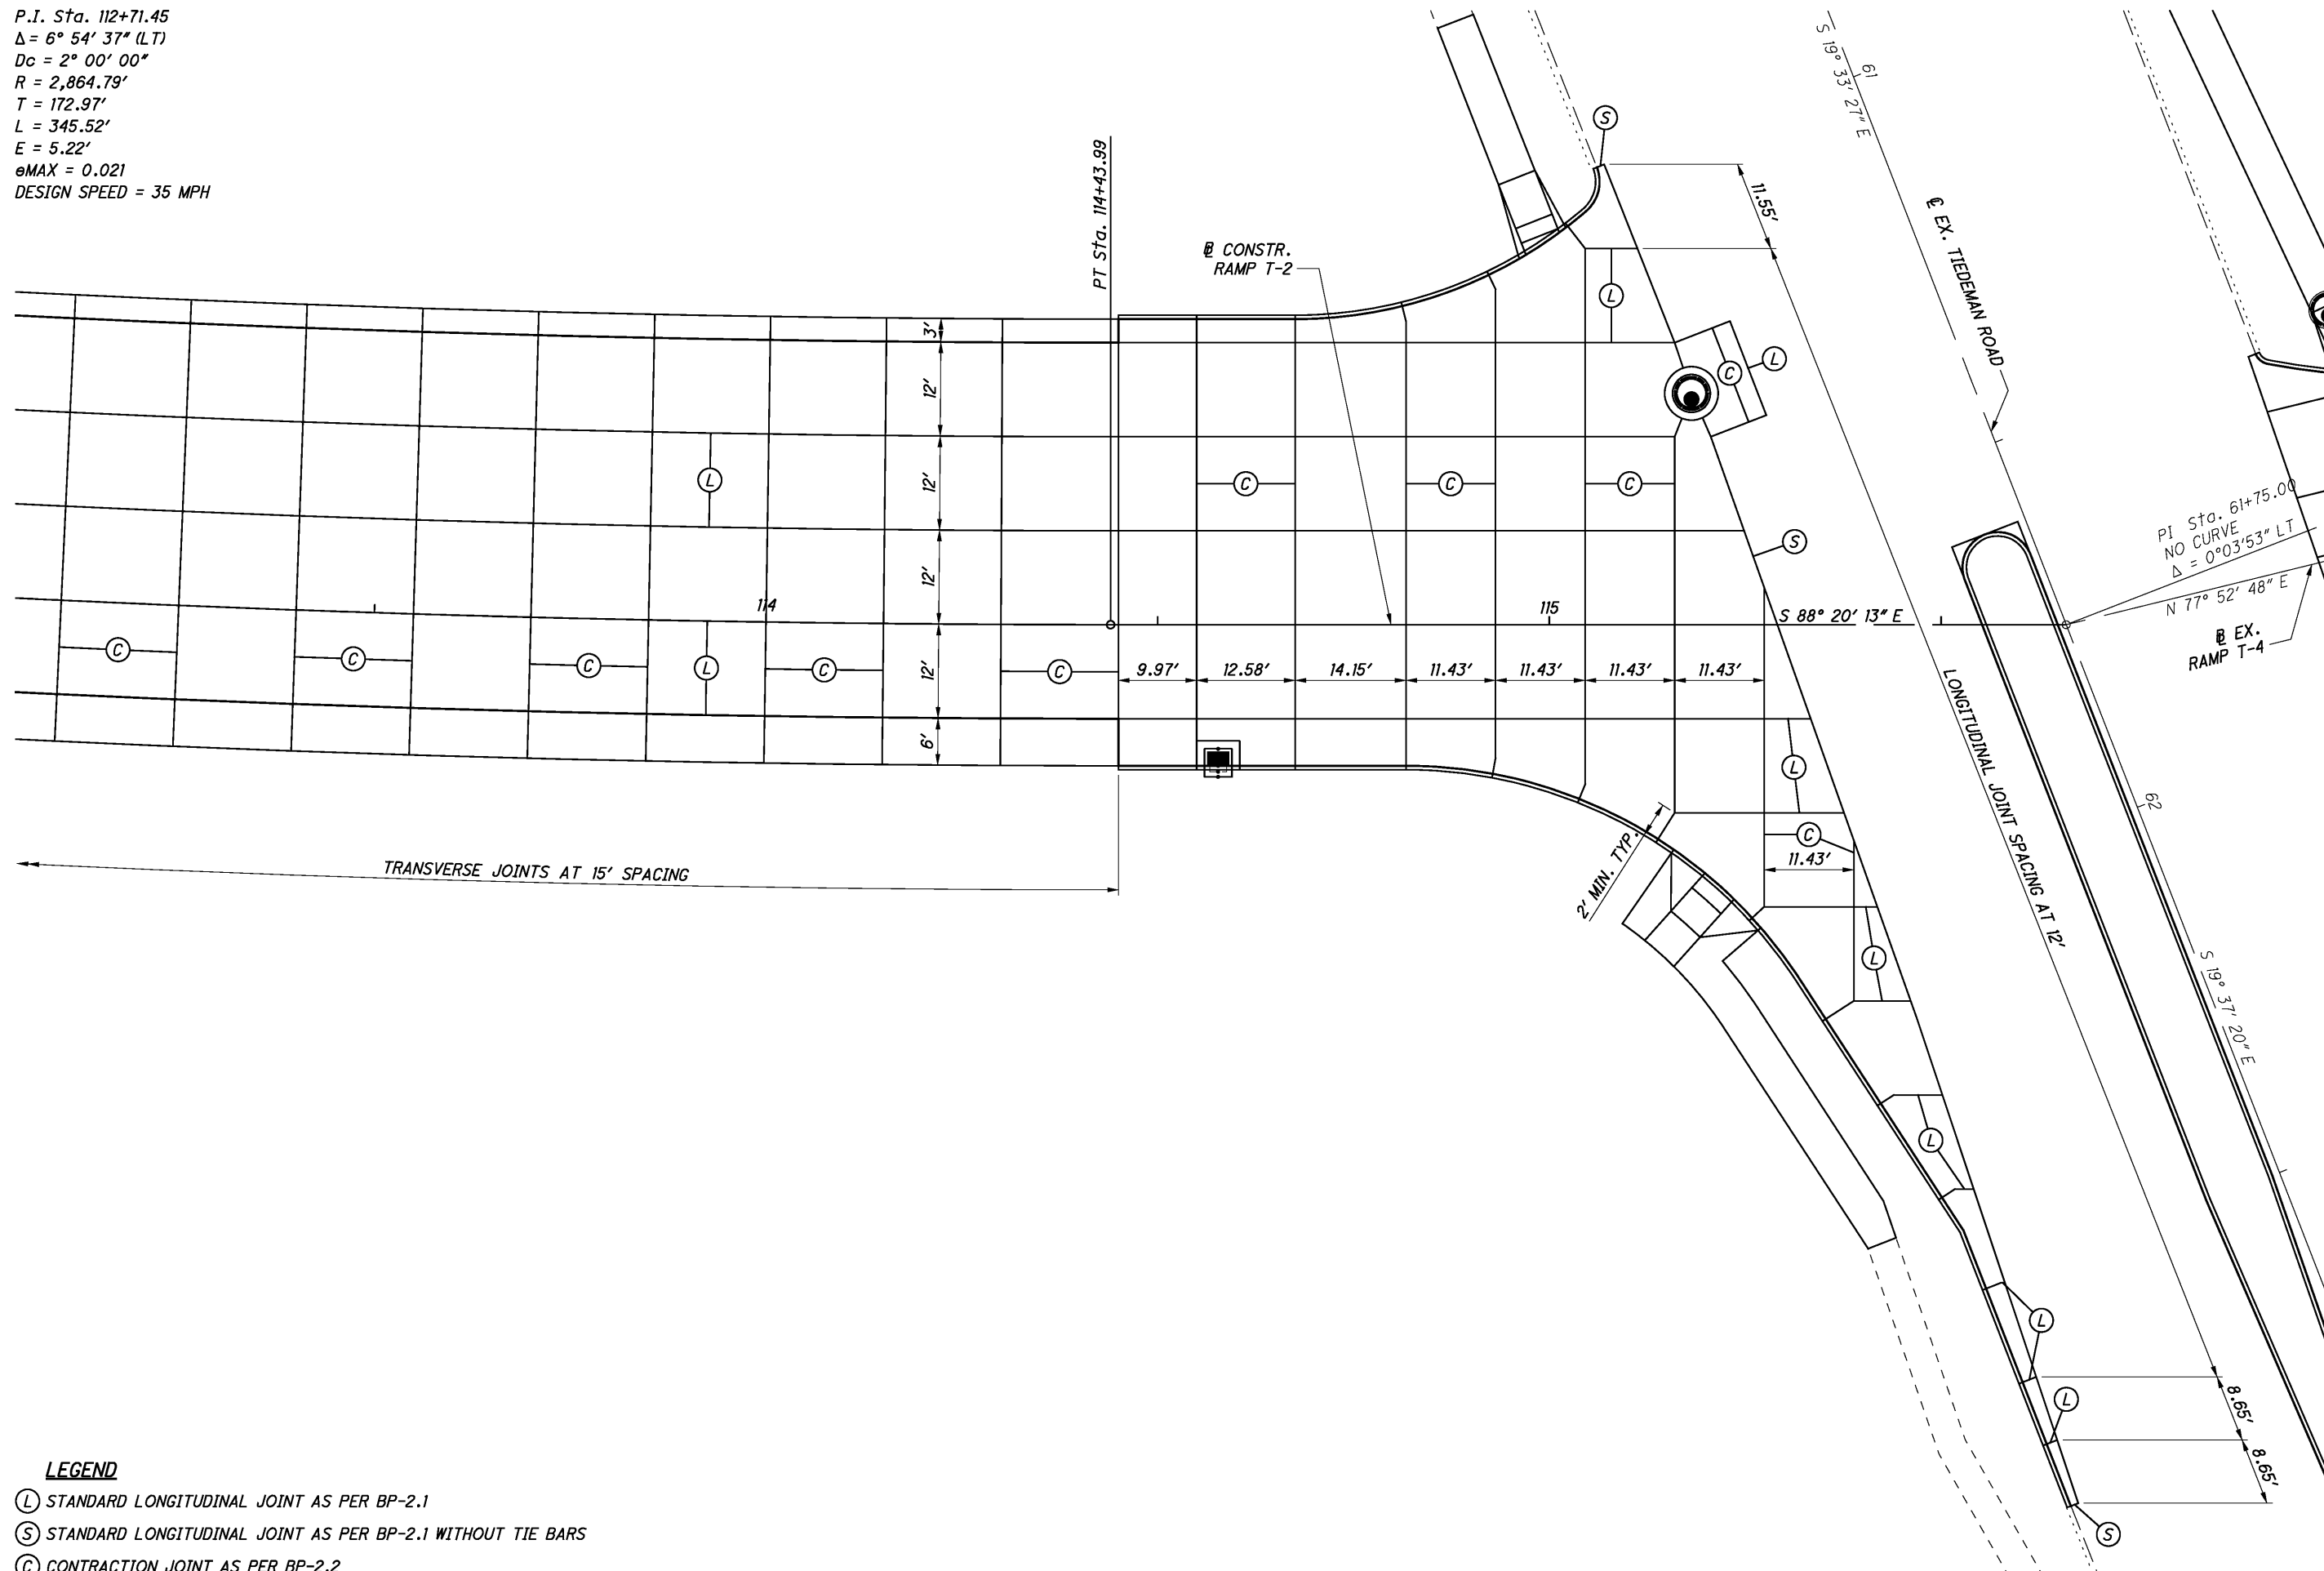

CALCULATED  
 MEP  
 CHECKED  
 FR

0 5 10 20  
 HORIZONTAL  
 SCALE IN FEET


PAVEMENT JOINT DETAIL  
 RAMP T-2

CUY - 480 - 11.60

I:\Projects\18063\Roadway\Sheets\18063GA002.dgn 2/5/2015 10:29:11 AM michael\_j\_thompson

- LEGEND**
- (L) STANDARD LONGITUDINAL JOINT AS PER BP-2.1
  - (S) STANDARD LONGITUDINAL JOINT AS PER BP-2.1 WITHOUT TIE BARS
  - (C) CONTRACTION JOINT AS PER BP-2.2

I:\Projects\18063\Roadway\Sheets\18063GA003.dgn 2/5/2015 10:29:11 AM michael.j.thompson

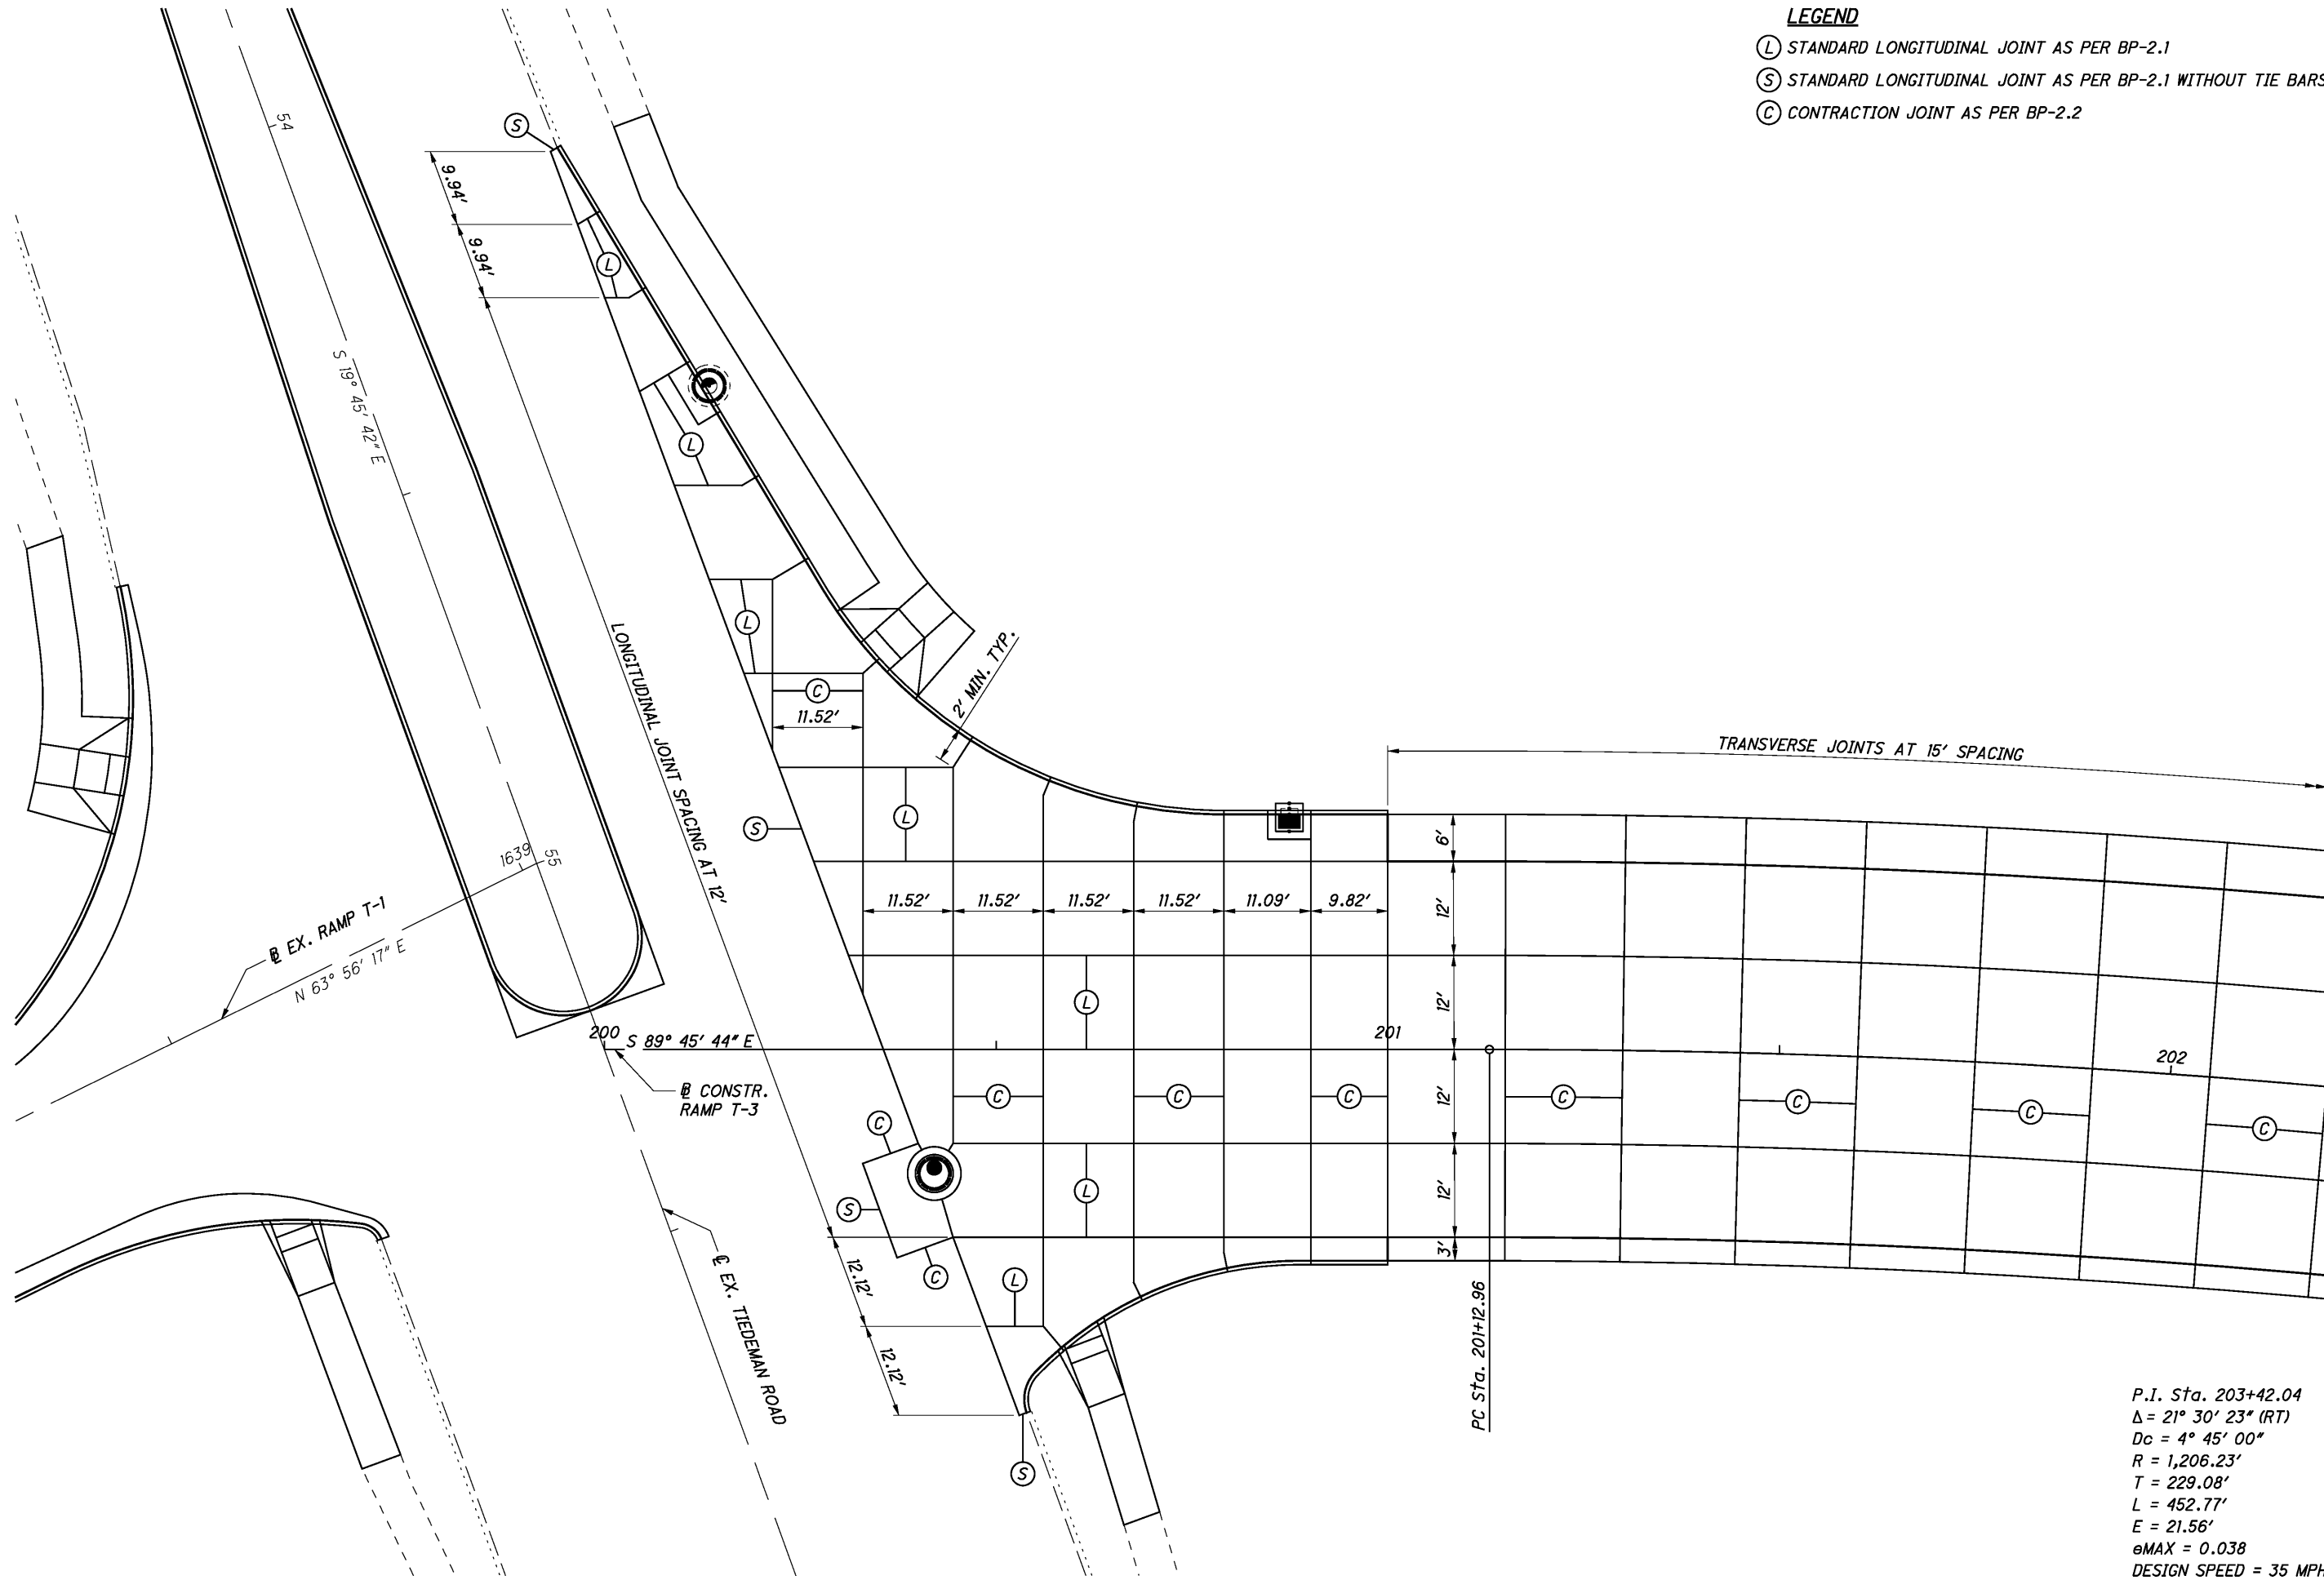

- LEGEND**
- (L) STANDARD LONGITUDINAL JOINT AS PER BP-2.1
  - (S) STANDARD LONGITUDINAL JOINT AS PER BP-2.1 WITHOUT TIE BARS
  - (C) CONTRACTION JOINT AS PER BP-2.2


CALCULATED  
MEP  
CHECKED  
FR

0 5 10 20  
HORIZONTAL  
SCALE IN FEET

**PAVEMENT JOINT DETAIL  
RAMP T-3**

P.I. Sta. 203+42.04  
 $\Delta = 21^\circ 30' 23''$  (RT)  
 $D_c = 4^\circ 45' 00''$   
 $R = 1,206.23'$   
 $T = 229.08'$   
 $L = 452.77'$   
 $E = 21.56'$   
 $e_{MAX} = 0.038$   
 DESIGN SPEED = 35 MPH

I:\Projects\18063\Roadway\Sheets\18063GA004.dgn 2/5/2015 10:29:12 AM michael\_j.thompson

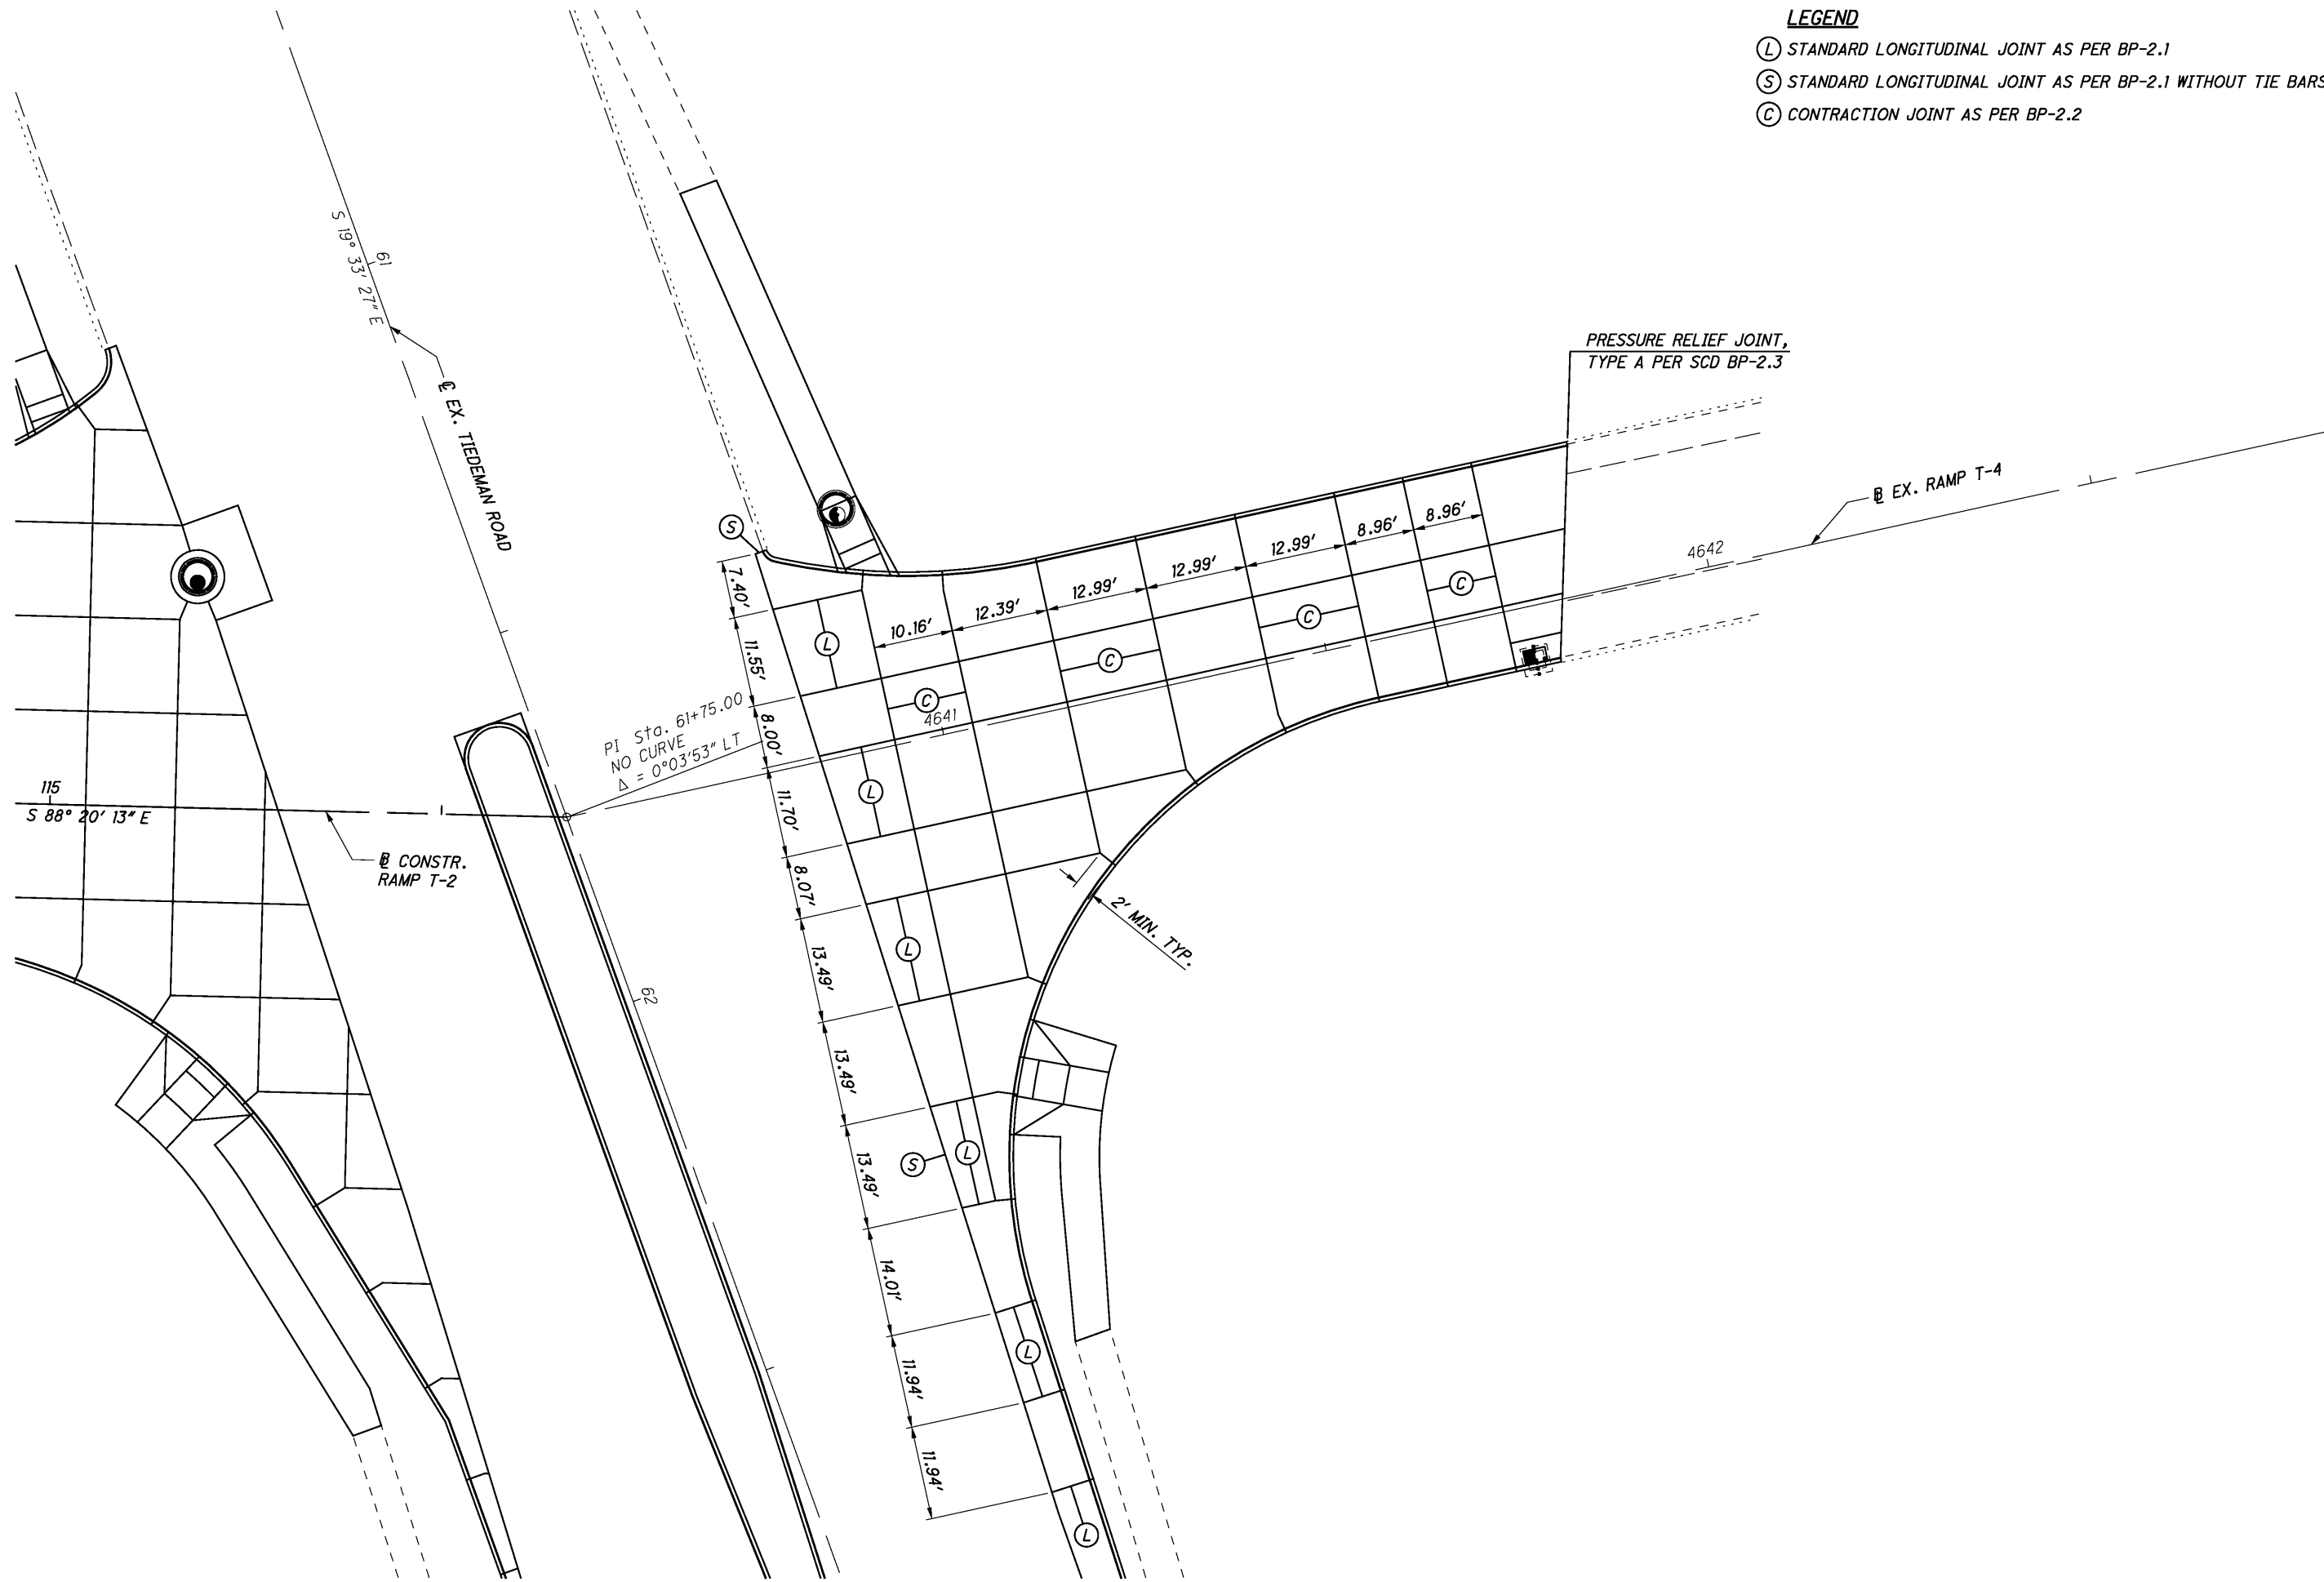

**LEGEND**

- (L) STANDARD LONGITUDINAL JOINT AS PER BP-2.1
- (S) STANDARD LONGITUDINAL JOINT AS PER BP-2.1 WITHOUT TIE BARS
- (C) CONTRACTION JOINT AS PER BP-2.2

CALCULATED  
MEP  
CHECKED  
FR

0 5 10 20  
HORIZONTAL  
SCALE IN FEET

**PAVEMENT JOINT DETAIL  
RAMP T-4**




0 5 10 20  
HORIZONTAL SCALE IN FEET

CALCULATED  
MEP  
CHECKED  
FR

INTERSECTION DETAILS  
RAMP T-1 AND TIEDEMAN ROAD

CUY-480-11.60

67  
84

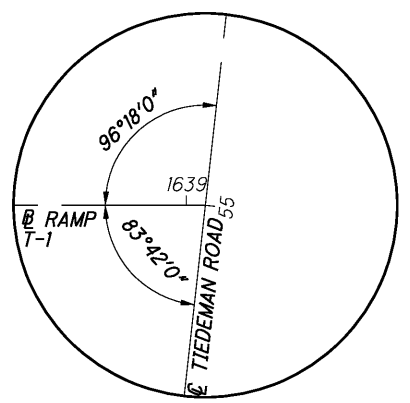


STA. 1638+06.81, 70.42' LT  
STA. 54+40.45, 102.34' RT  
 $\Delta = 76^\circ 29' 37''$   
 $R = 65.00'$   
 $L = 86.78'$

PROP. CB No. 3A  
STA. 1637+89.54, 5.42' LT  
GRATE ELEV 776.12

STA. 1638+24.40, 87.68' RT  
STA. 55+95.67, 67.5' RT  
 $\Delta = 33^\circ 29' 52''$   
 $R = 67.50'$   
 $L = 39.46'$

NOTES:  
ALL DIMENSIONS ARE MEASURED TO THE FACE OF THE CURB  
ELEVATIONS ARE AT 25' INTERVALS, UNLESS OTHERWISE SHOWN  
ALL ELEVATIONS ALONG THE CURB ARE FLOWLINE ELEVATIONS

(A)  
STA. 55+38.30, 38.02' RT @ EX. TIEDEMAN  
STA. 1638+60.00, 33.90' RT @ EX. RAMP T-1

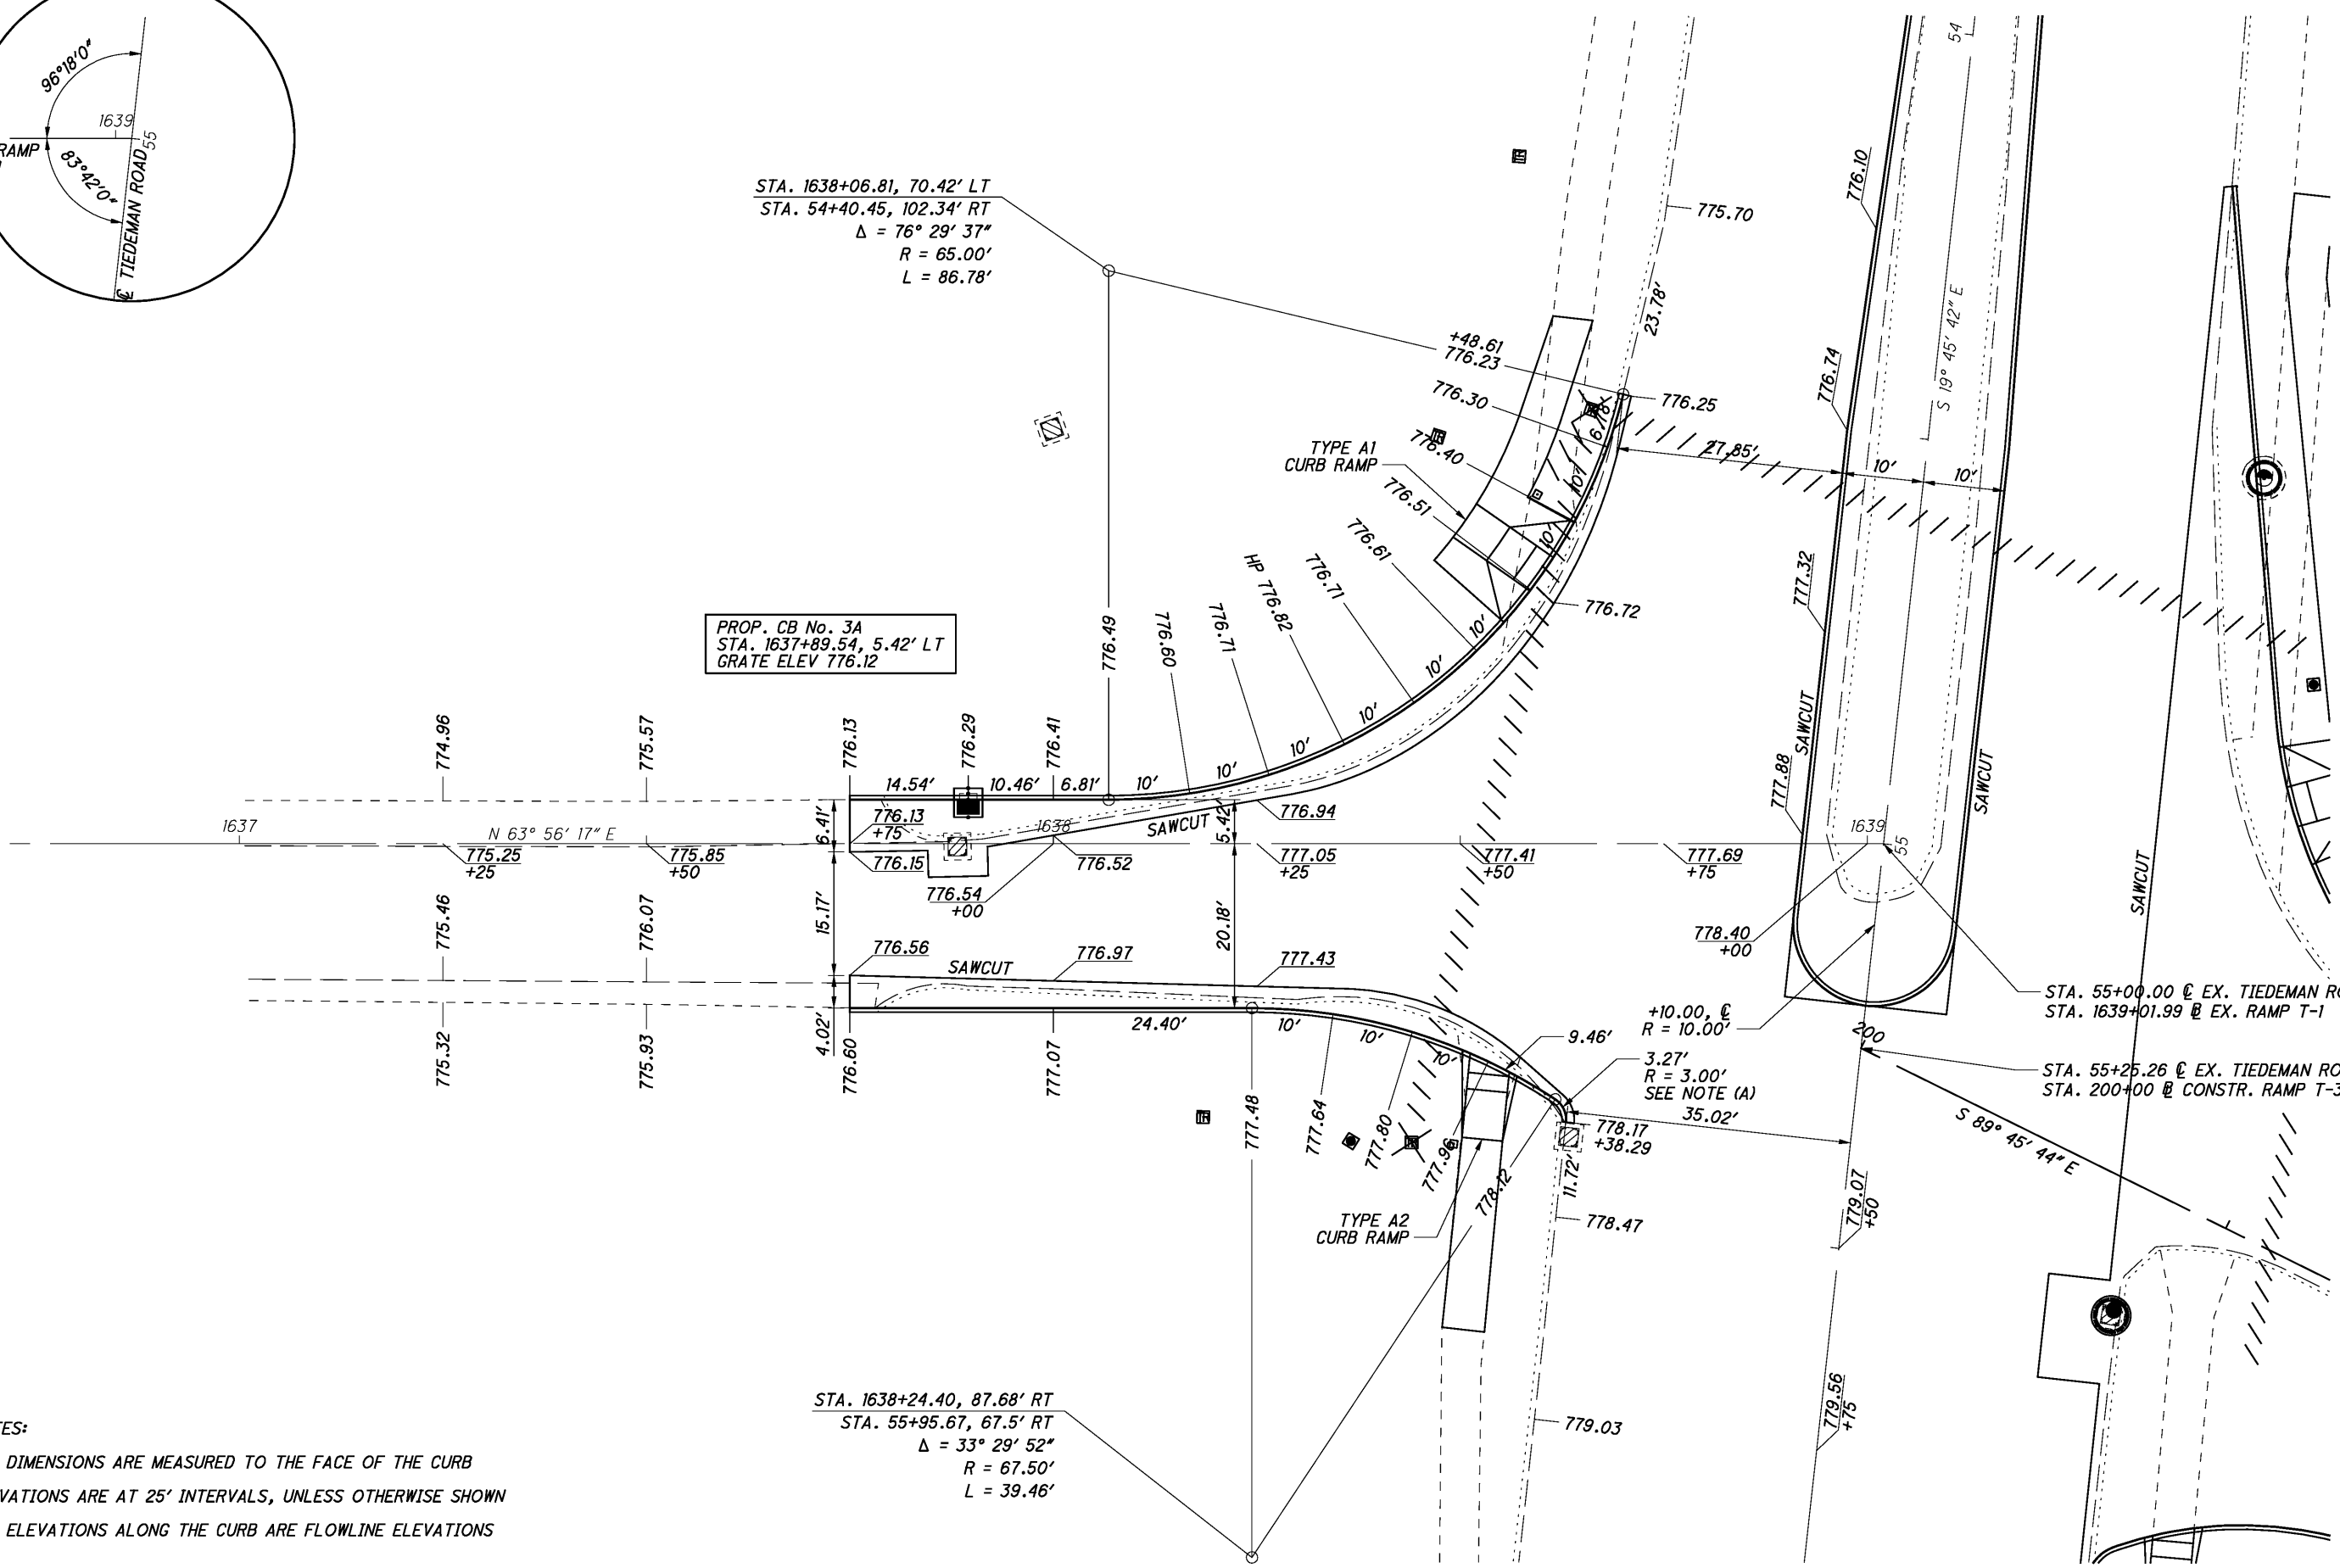

I:\Projects\18063\Roadway\Sheets\18063G001.dgn 2/5/2015 10:29:12 AM michael.j.\_thompson



P.I. STA. 112+71.45  
 $\Delta = 6^\circ 54' 37''$  (LT)  
 $D_c = 2^\circ 00' 00''$   
 $R = 2,864.79'$   
 $T = 172.97'$   
 $L = 345.52'$   
 $E = 5.22'$   
 $e_{MAX} = 0.021$   
 DESIGN SPEED = 35 MPH

STA. 114+67.55, 96' LT  
 STA. 60+49.88, 57' RT  
 $\Delta = 40^\circ 38' 03''$   
 $R = 57.00'$   
 $L = 40.42'$

PROP. CB No. 3A  
 STA. 114+57.72, 18.00' RT  
 GRATE ELEV 777.79

PROP. MH No. 3  
 STA. 115+18.14, 29.52' LT  
 STA. 61+30.17, 33.90' RT  
 RIM ELEV 778.67

STA. 114+81.70, 78' RT  
 STA. 62+17.08, 106.84' RT  
 $\Delta = 56^\circ 54' 50''$   
 $R = 60.00'$   
 $L = 59.60'$

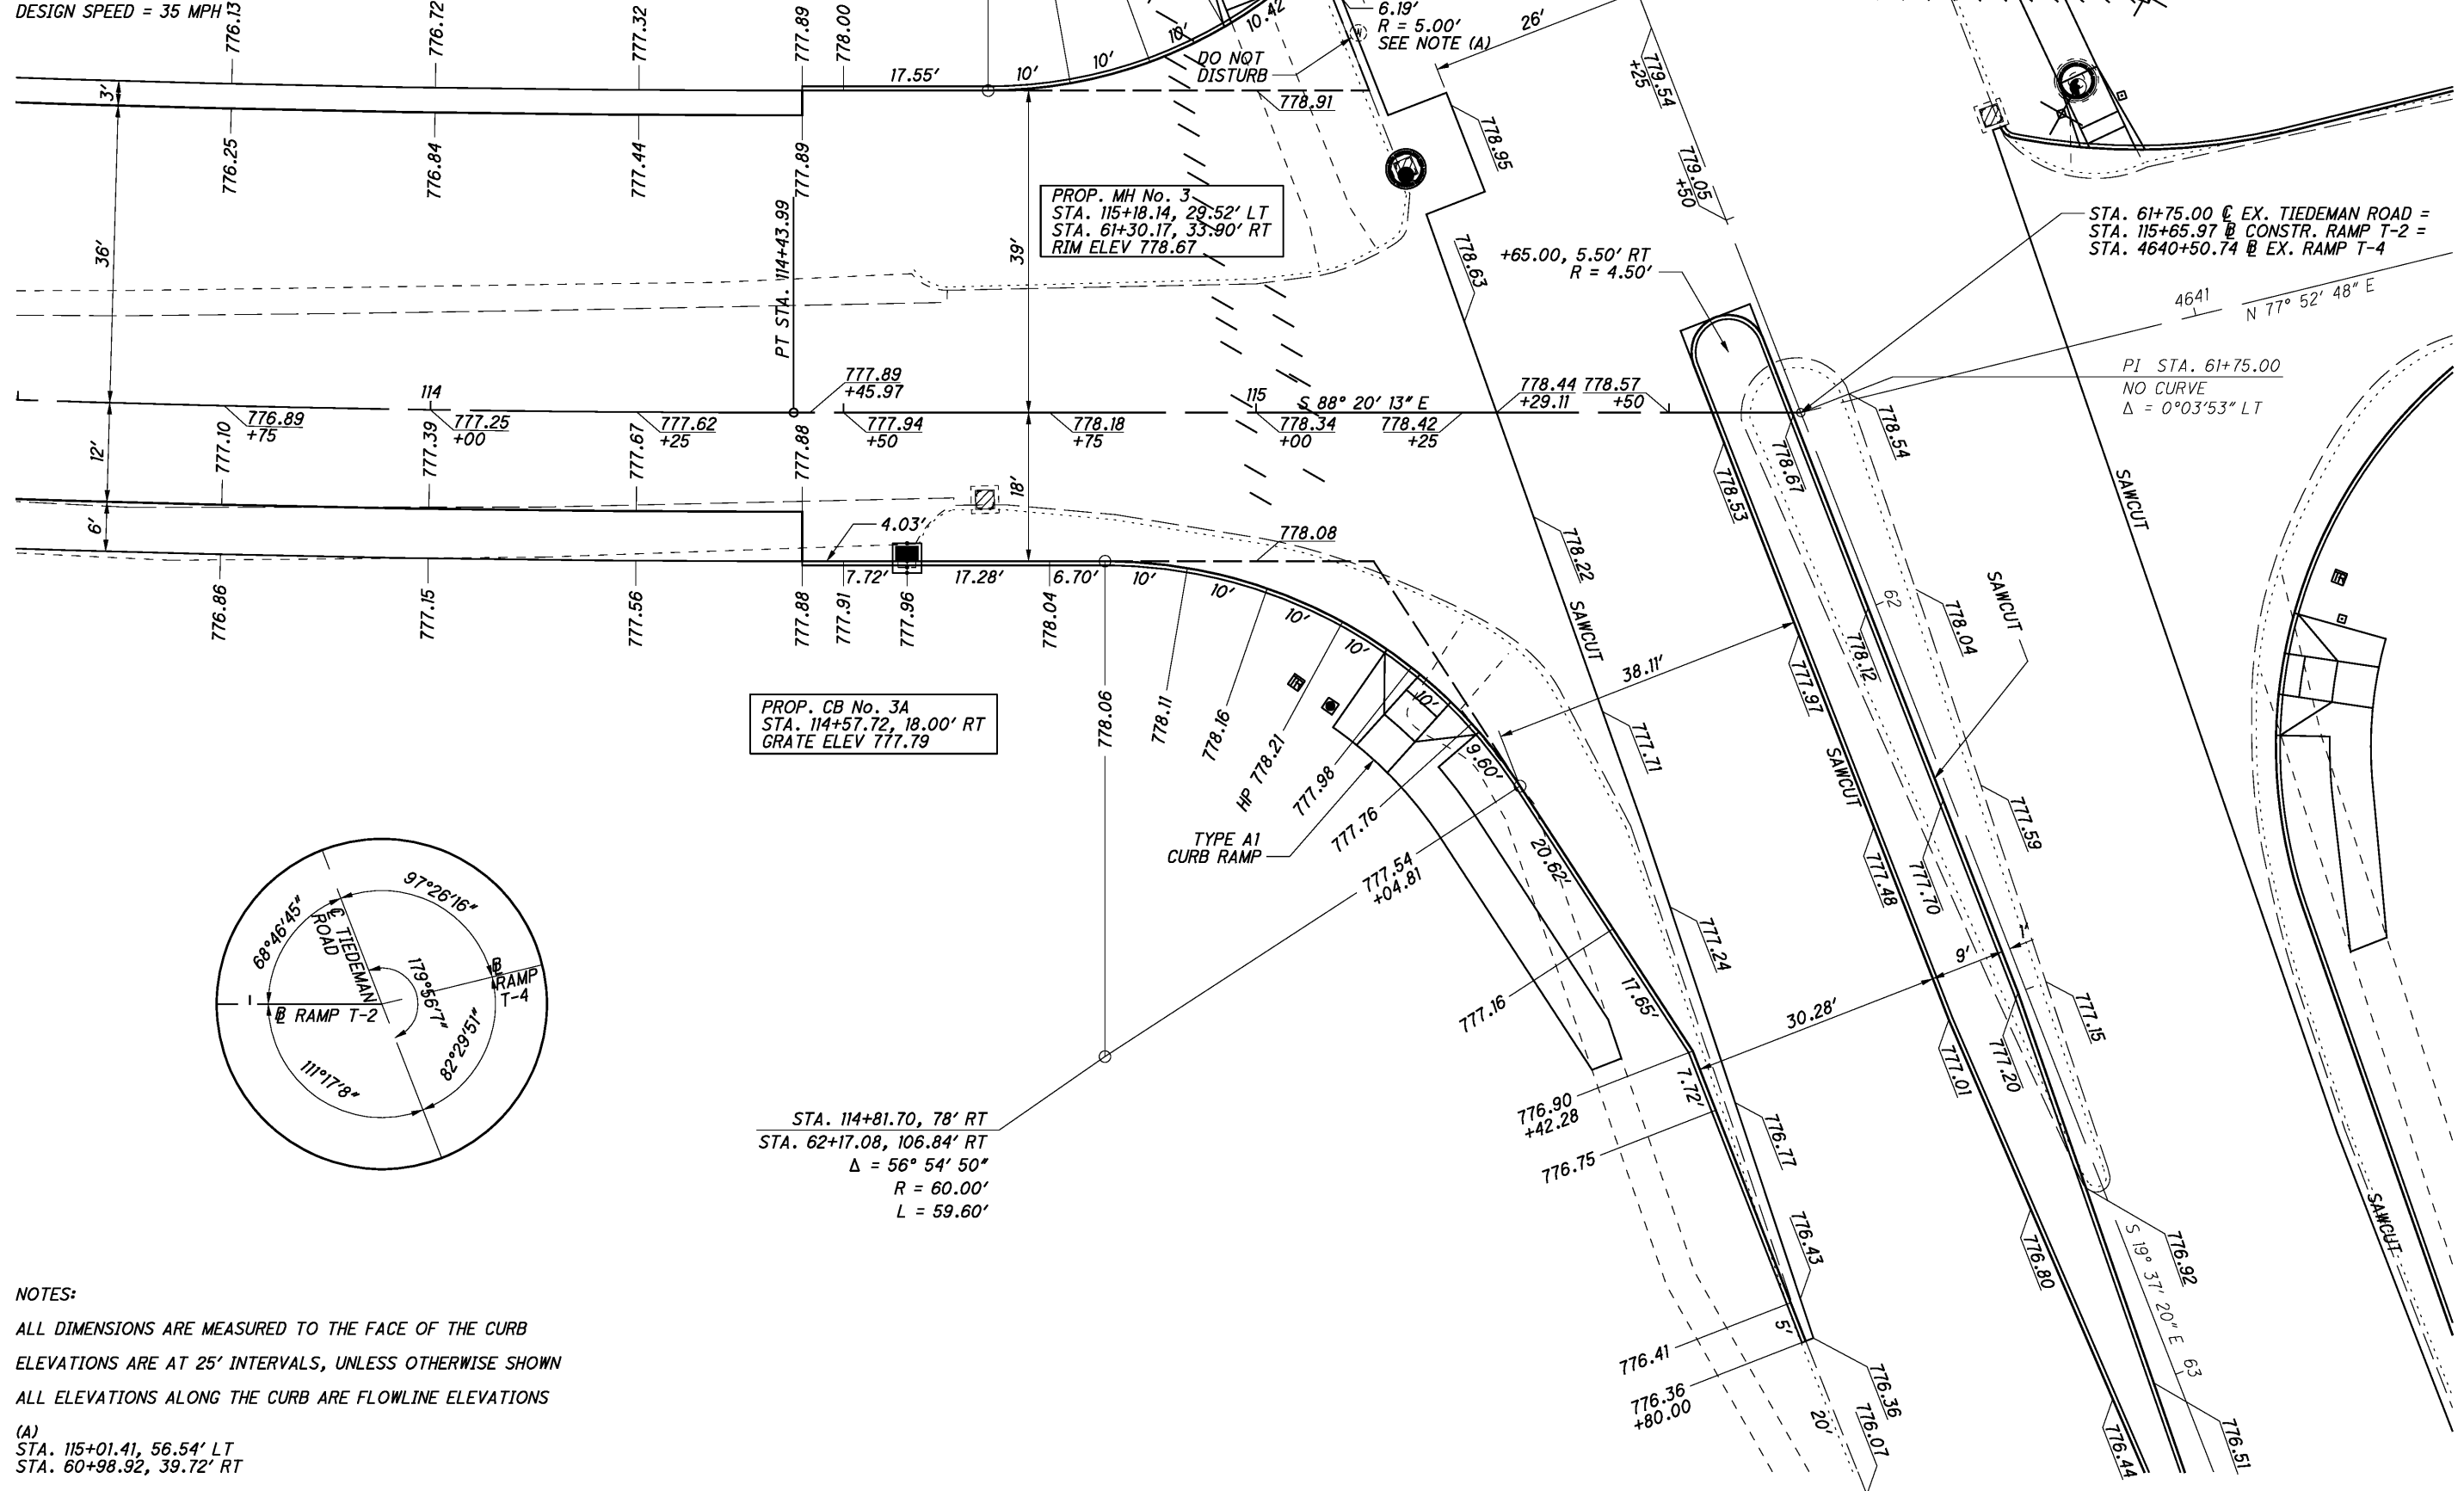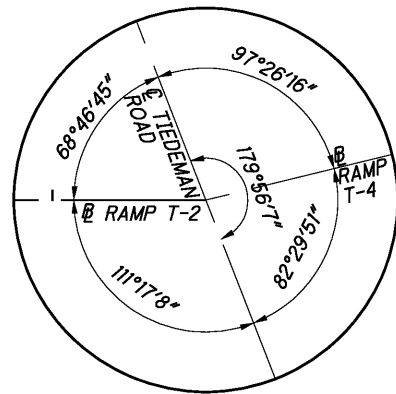

STA. 61+75.00 @ EX. TIEDEMAN ROAD =  
 STA. 115+65.97 @ CONSTR. RAMP T-2 =  
 STA. 4640+50.74 @ EX. RAMP T-4

PI STA. 61+75.00  
 NO CURVE  
 $\Delta = 0^\circ 03' 53''$  LT

NOTES:  
 ALL DIMENSIONS ARE MEASURED TO THE FACE OF THE CURB  
 ELEVATIONS ARE AT 25' INTERVALS, UNLESS OTHERWISE SHOWN  
 ALL ELEVATIONS ALONG THE CURB ARE FLOWLINE ELEVATIONS  
 (A)  
 STA. 115+01.41, 56.54' LT  
 STA. 60+98.92, 39.72' RT



CALCULATED  
 MEP  
 CHECKED  
 FR


INTERSECTION DETAILS  
 RAMP T-2 AND TIEDEMAN ROAD

CUY-480-11.60

I:\Projects\18063\Roadway\Sheets\18063G002.dgn 2/5/2015 10:29:13 AM michael\_j\_thompson



I:\Projects\18063\Roadway\Sheets\18063\003.dgn 2/5/2015 10:29:13 AM michael\_j.thompson

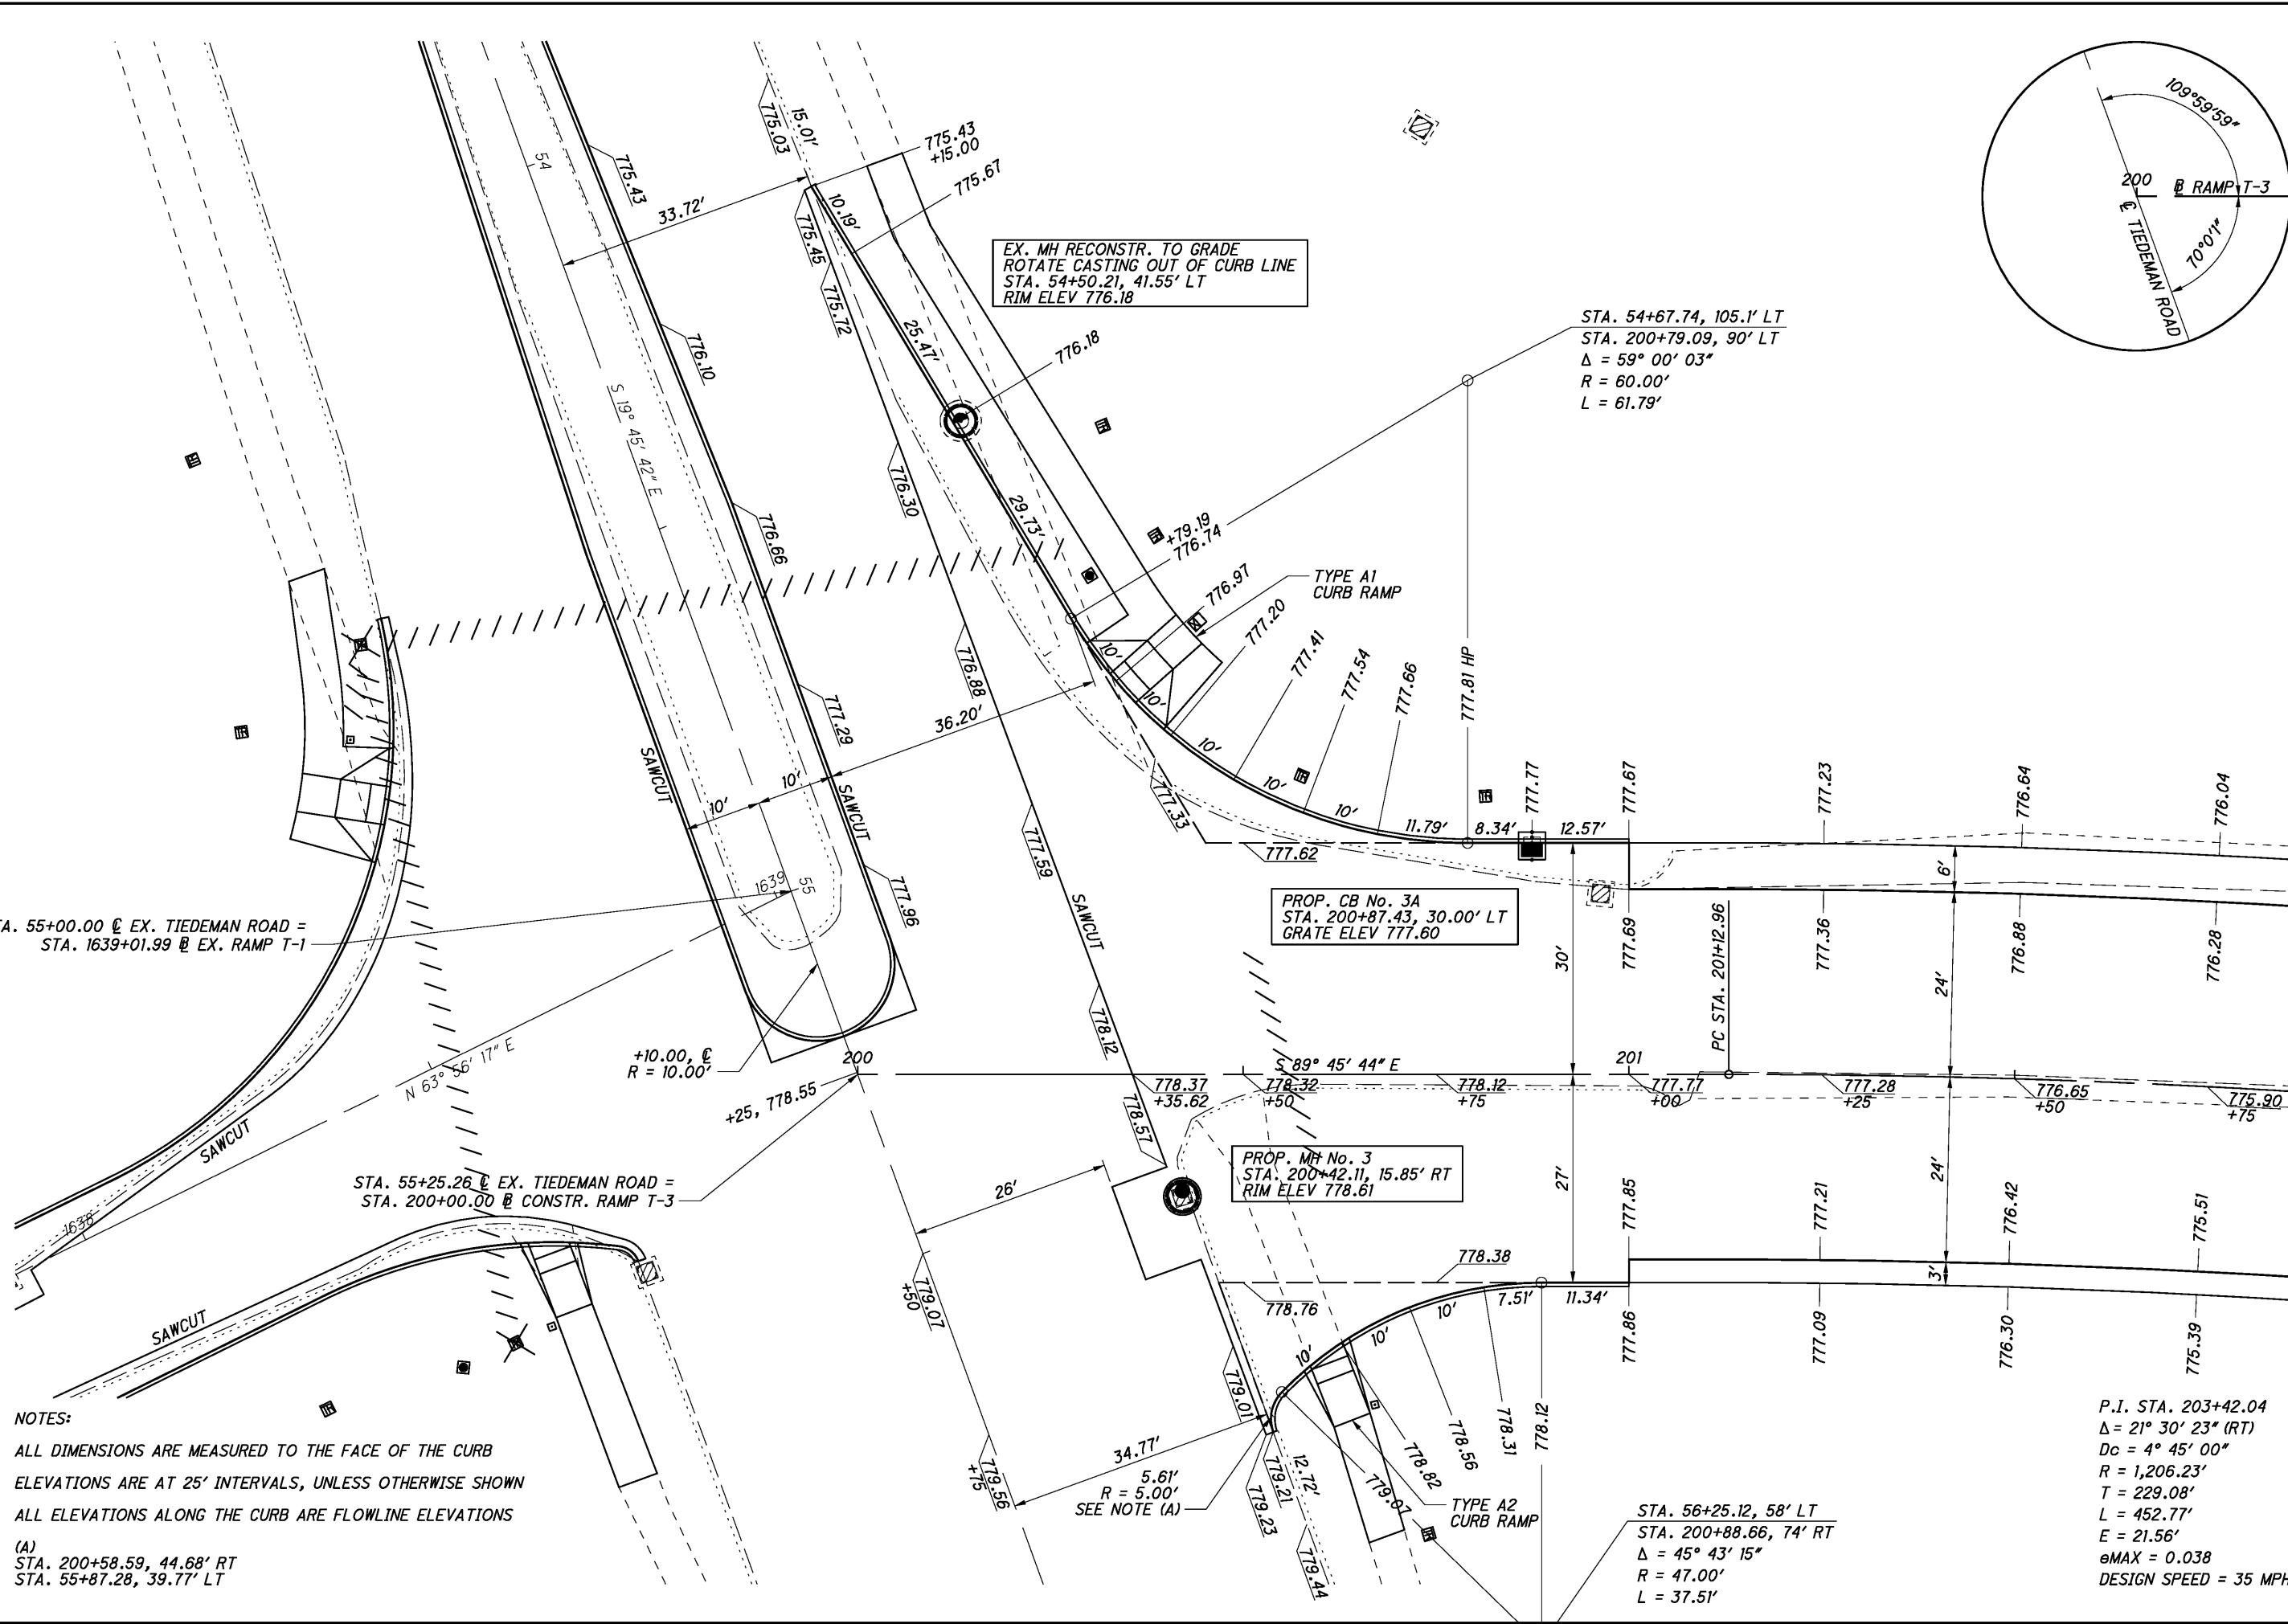

EX. MH RECONSTR. TO GRADE  
 ROTATE CASTING OUT OF CURB LINE  
 STA. 54+50.21, 41.55' LT  
 RIM ELEV 776.18

STA. 54+67.74, 105.1' LT  
 STA. 200+79.09, 90' LT  
 $\Delta = 59^\circ 00' 03''$   
 $R = 60.00'$   
 $L = 61.79'$


PROP. CB No. 3A  
 STA. 200+87.43, 30.00' LT  
 GRATE ELEV 777.60

PROP. MH No. 3  
 STA. 200+42.11, 15.85' RT  
 RIM ELEV 778.61

STA. 56+25.12, 58' LT  
 STA. 200+88.66, 74' RT  
 $\Delta = 45^\circ 43' 15''$   
 $R = 47.00'$   
 $L = 37.51'$

P.I. STA. 203+42.04  
 $\Delta = 21^\circ 30' 23''$  (RT)  
 $D_c = 4^\circ 45' 00''$   
 $R = 1,206.23'$   
 $T = 229.08'$   
 $L = 452.77'$   
 $E = 21.56'$   
 $e_{MAX} = 0.038$   
 DESIGN SPEED = 35 MPH


NOTES:  
 ALL DIMENSIONS ARE MEASURED TO THE FACE OF THE CURB  
 ELEVATIONS ARE AT 25' INTERVALS, UNLESS OTHERWISE SHOWN  
 ALL ELEVATIONS ALONG THE CURB ARE FLOWLINE ELEVATIONS  
 (A)  
 STA. 200+58.59, 44.68' RT  
 STA. 55+87.28, 39.77' LT

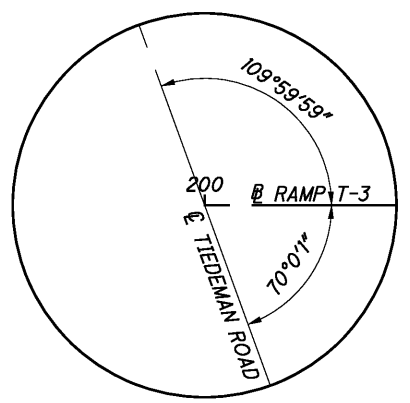

INTERSECTION DETAILS  
 RAMP T-3 AND TIEDEMAN ROAD



CALCULATED  
MEP  
CHECKED  
FR

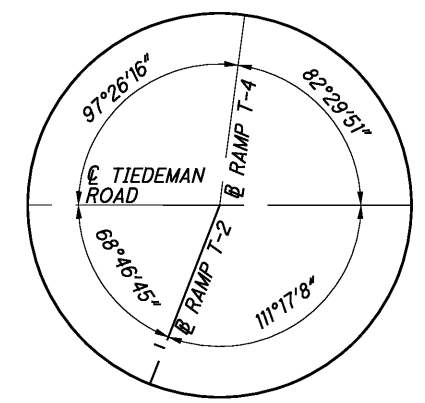

INTERSECTION DETAILS  
RAMP T-4 AND TIEDEMAN ROAD

CUY - 480 - 11.60

70  
84

NOTES:

ALL DIMENSIONS ARE MEASURED TO THE FACE OF THE CURB  
ELEVATIONS ARE AT 25' INTERVALS, UNLESS OTHERWISE SHOWN  
ALL ELEVATIONS ALONG THE CURB ARE FLOWLINE ELEVATIONS

(A)  
STA. 4640+84.45, 28.05' LT  
STA. 61+51.55, 37.06' LT


STA. 60+87.79, 77.5' LT  
STA. 4641+16.30, 96.5' LT  
 $\Delta = 24^\circ 56' 54''$   
 $R = 77.50'$   
 $L = 33.75'$

EX. CB ADJUST TO GRADE  
STA. 4641+75.93, 7.29' RT  
GRATE ELEV 775.80

STA. 62+55.35, 94.84' LT  
STA. 4641+55.26, 67.29' RT  
 $\Delta = 95^\circ 31' 37''$   
 $R = 60.00'$   
 $L = 100.04'$

STA. 61+75.00 @ EX. TIEDEMAN ROAD =  
STA. 115+65.97 @ CONSTR. RAMP T-2 =  
STA. 4640+50.74 @ EX. RAMP T-4

I:\Projects\18063\Roadway\Sheets\18063G004.dgn 2/5/2015 10:29:14 AM michael.j.thompson

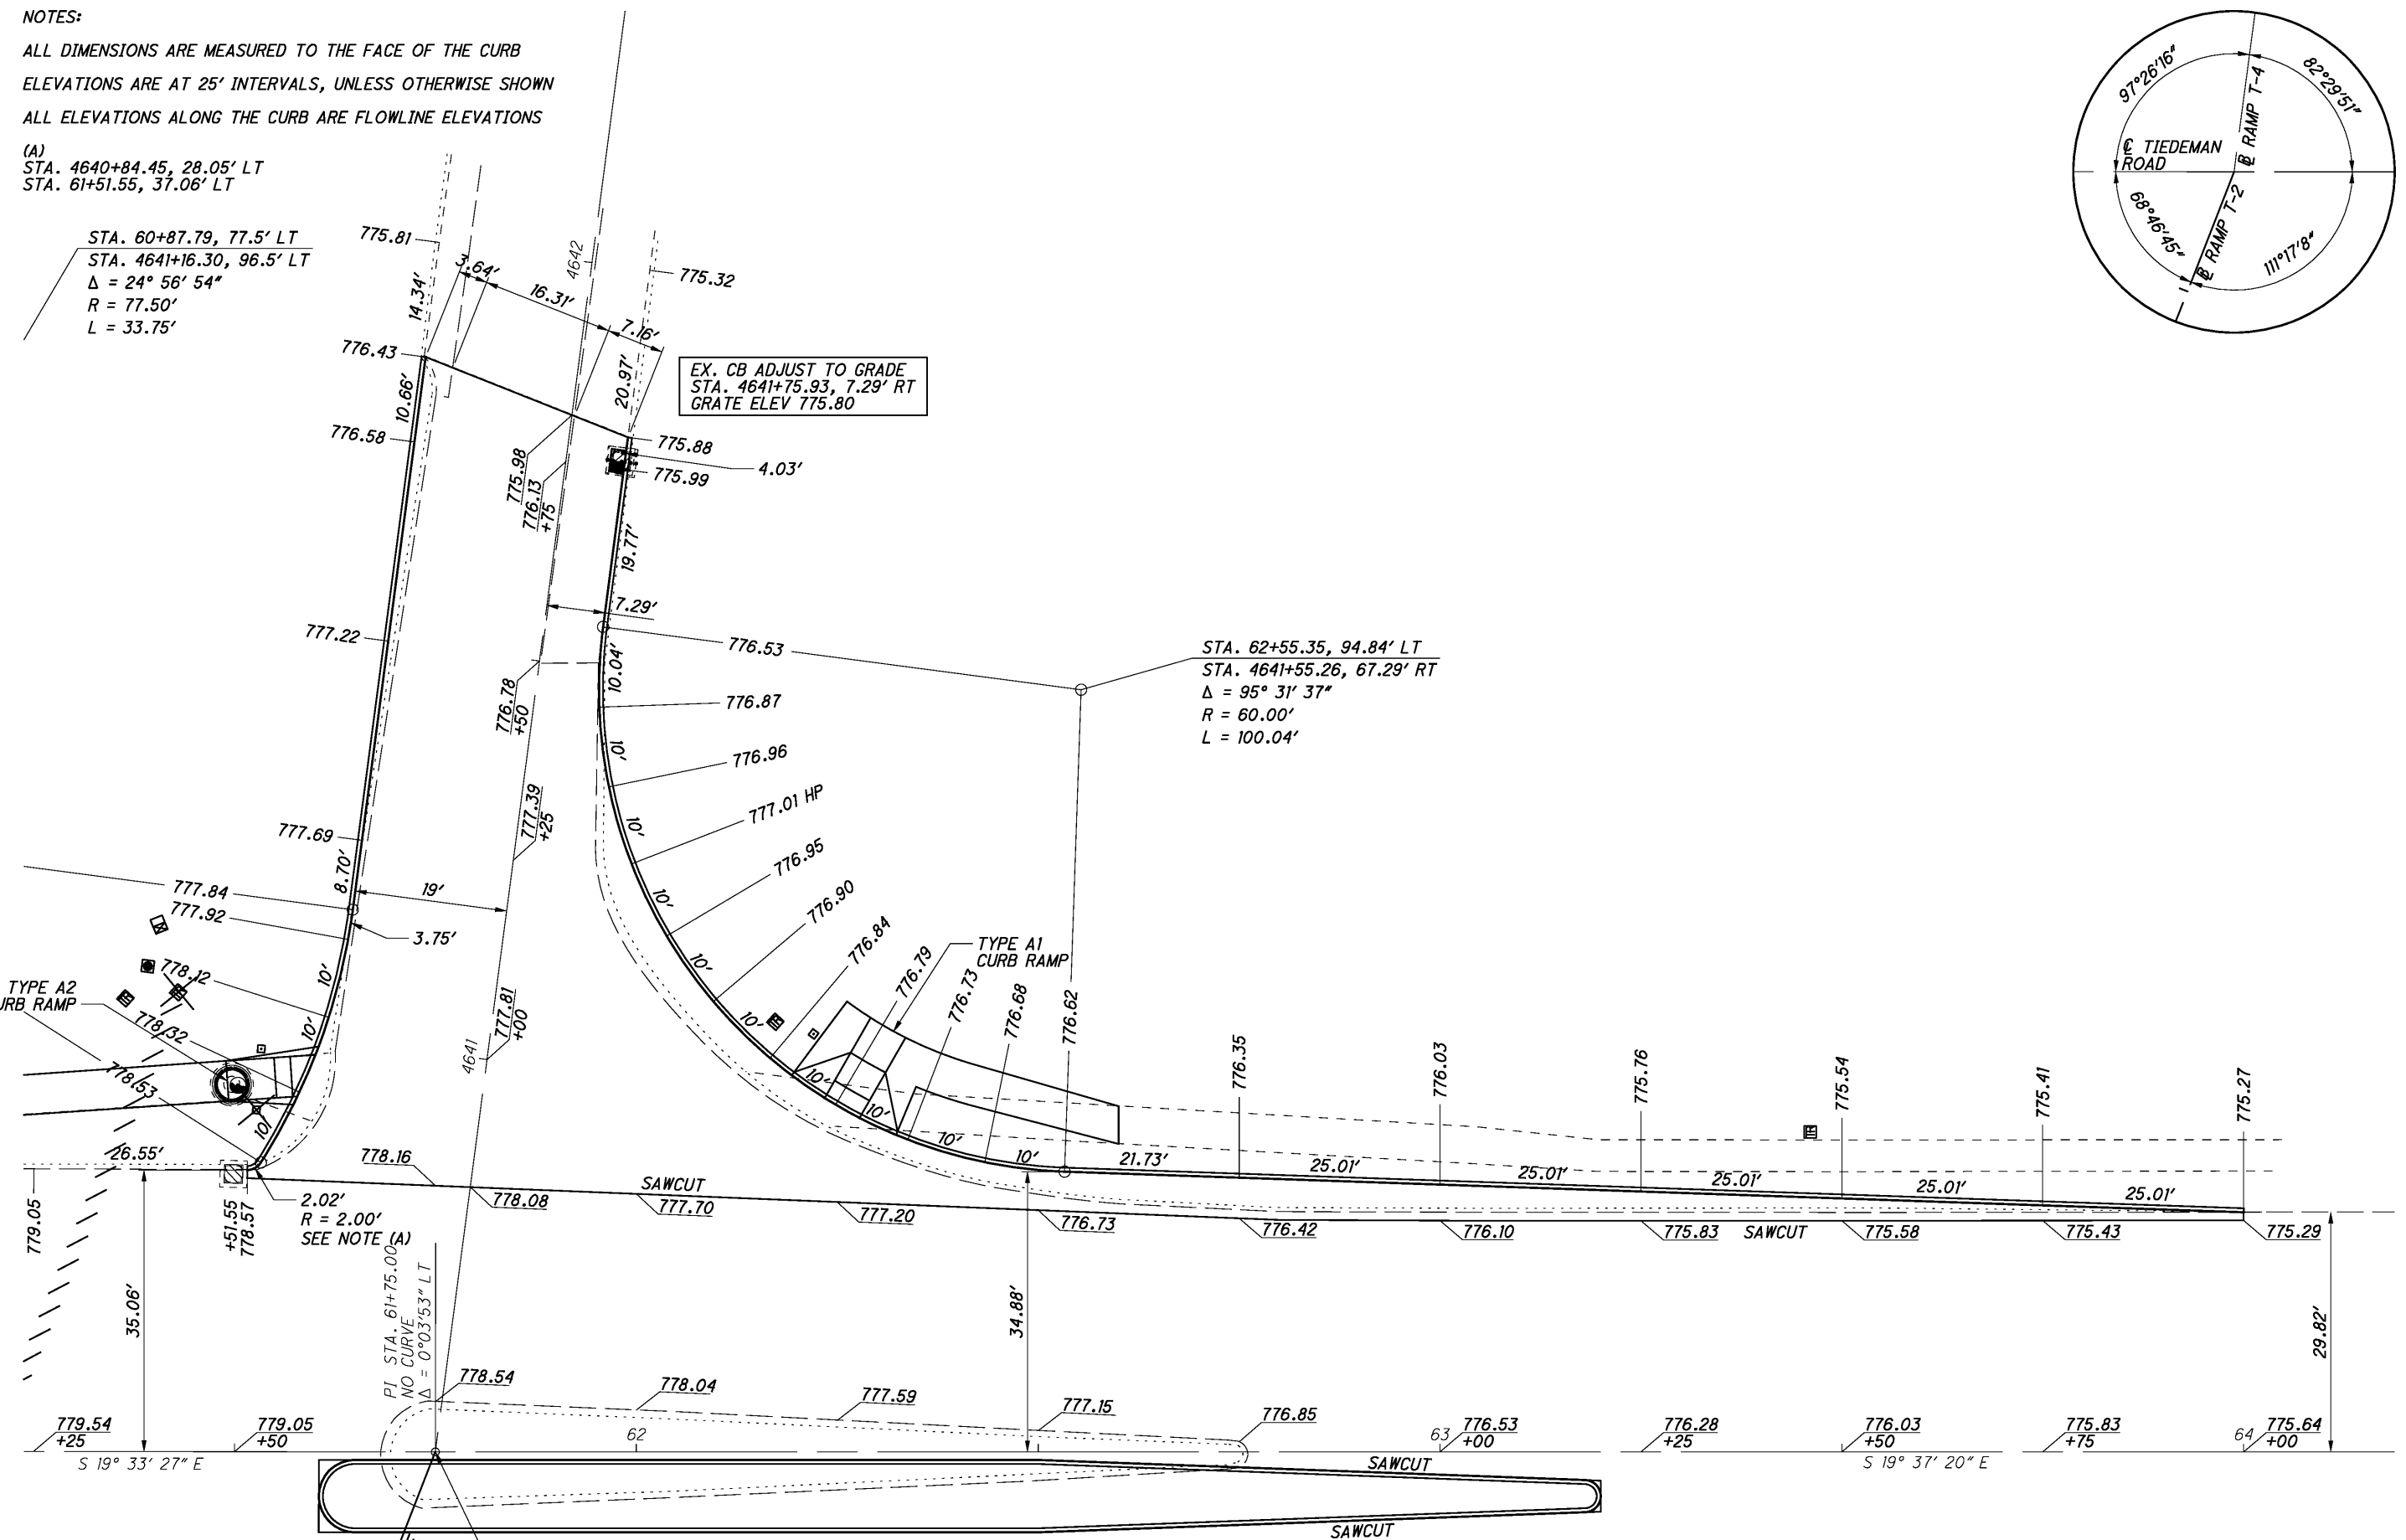

PAVEMENT MARKING LEGEND


- ↔ ITEM 646 - LANE ARROW, 96"
- ↔ ITEM 646 - LANE ARROW, 153"
- (C) ITEM 646 - CENTER LINE, DOUBLE YELLOW
- (CH) ITEM 646 - CHANNELIZING LINE
- (CW) ITEM 646 - CROSSWALK LINE
- (D) ITEM 646 - DOTTED LINE
- (EW) ITEM 646 - EDGE LINE, WHITE
- (EY) ITEM 646 - EDGE LINE, YELLOW
- (L) ITEM 646 - LANE LINE
- (S) ITEM 646 - STOP LINE
- (TW) ITEM 646 - TRANSVERSE LINE, WHITE
- (TY) ITEM 646 - TRANSVERSE LINE, YELLOW

SIGNING LEGEND

- EXISTING SIGN, NO WORK
- PROPOSED SIGN
- ▨ EXISTING SIGN TO BE REMOVED AND REERECTED
- ▩ EXISTING SIGN TO BE REMOVED

RAISED PAVEMENT MARKER (RPM) LEGEND

- ⊠ 2 WAY (WHITE/RED) @ 40' C/C (ON CHANNELIZING LINE)
- ⊠ 2 WAY (YELLOW/RED) @ 80' C/C (ON RAMP EDGE LINE, YELLOW)

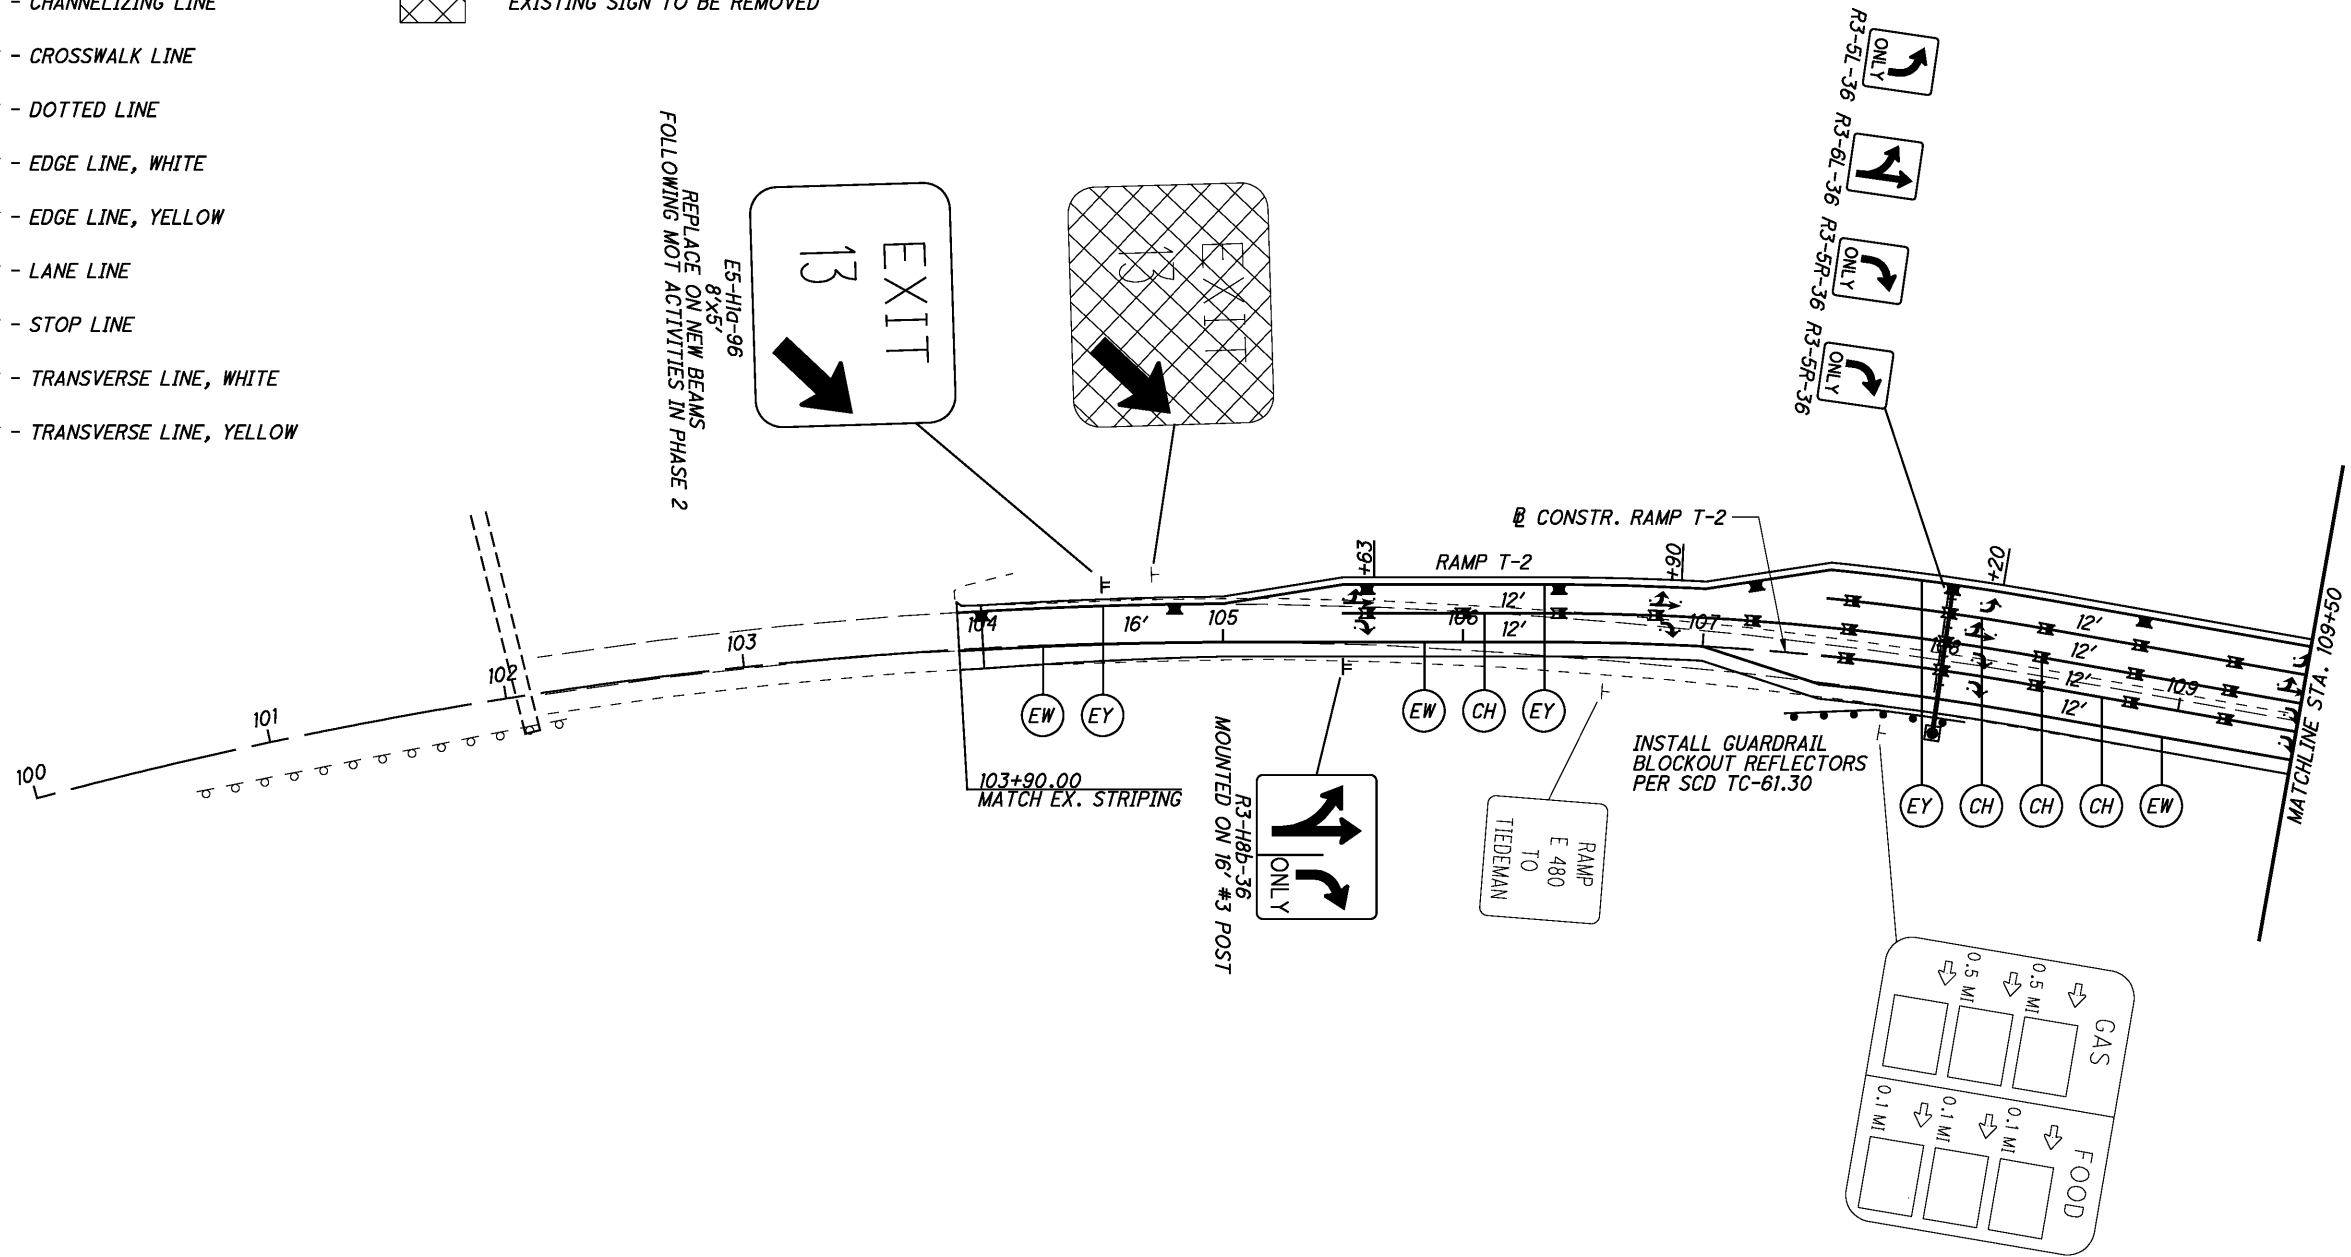


REPLACE ON NEW BEAMS  
8x5"  
E5-HI-96  
FOLLOWING MOT ACTIVITIES IN PHASE 2

103+90.00  
MATCH EX. STRIPING

R3-HB-36  
MOUNTED ON 18" #3 POST


INSTALL GUARDRAIL  
BLOCKOUT REFLECTORS  
PER SCD TC-61.30

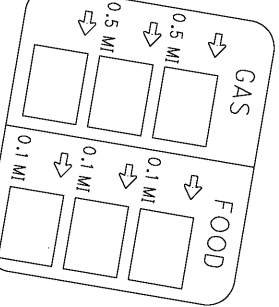

**NOTES:**

RAISED PAVEMENT MARKERS SHALL BE PLACED PER SCD TC-65.10, SCD TC-65.11 AND CMS 621.  
FOR OVERHEAD SIGN ELEVATION VIEW, SEE SHEET 77

FOR LEGEND, SEE SHEET 71

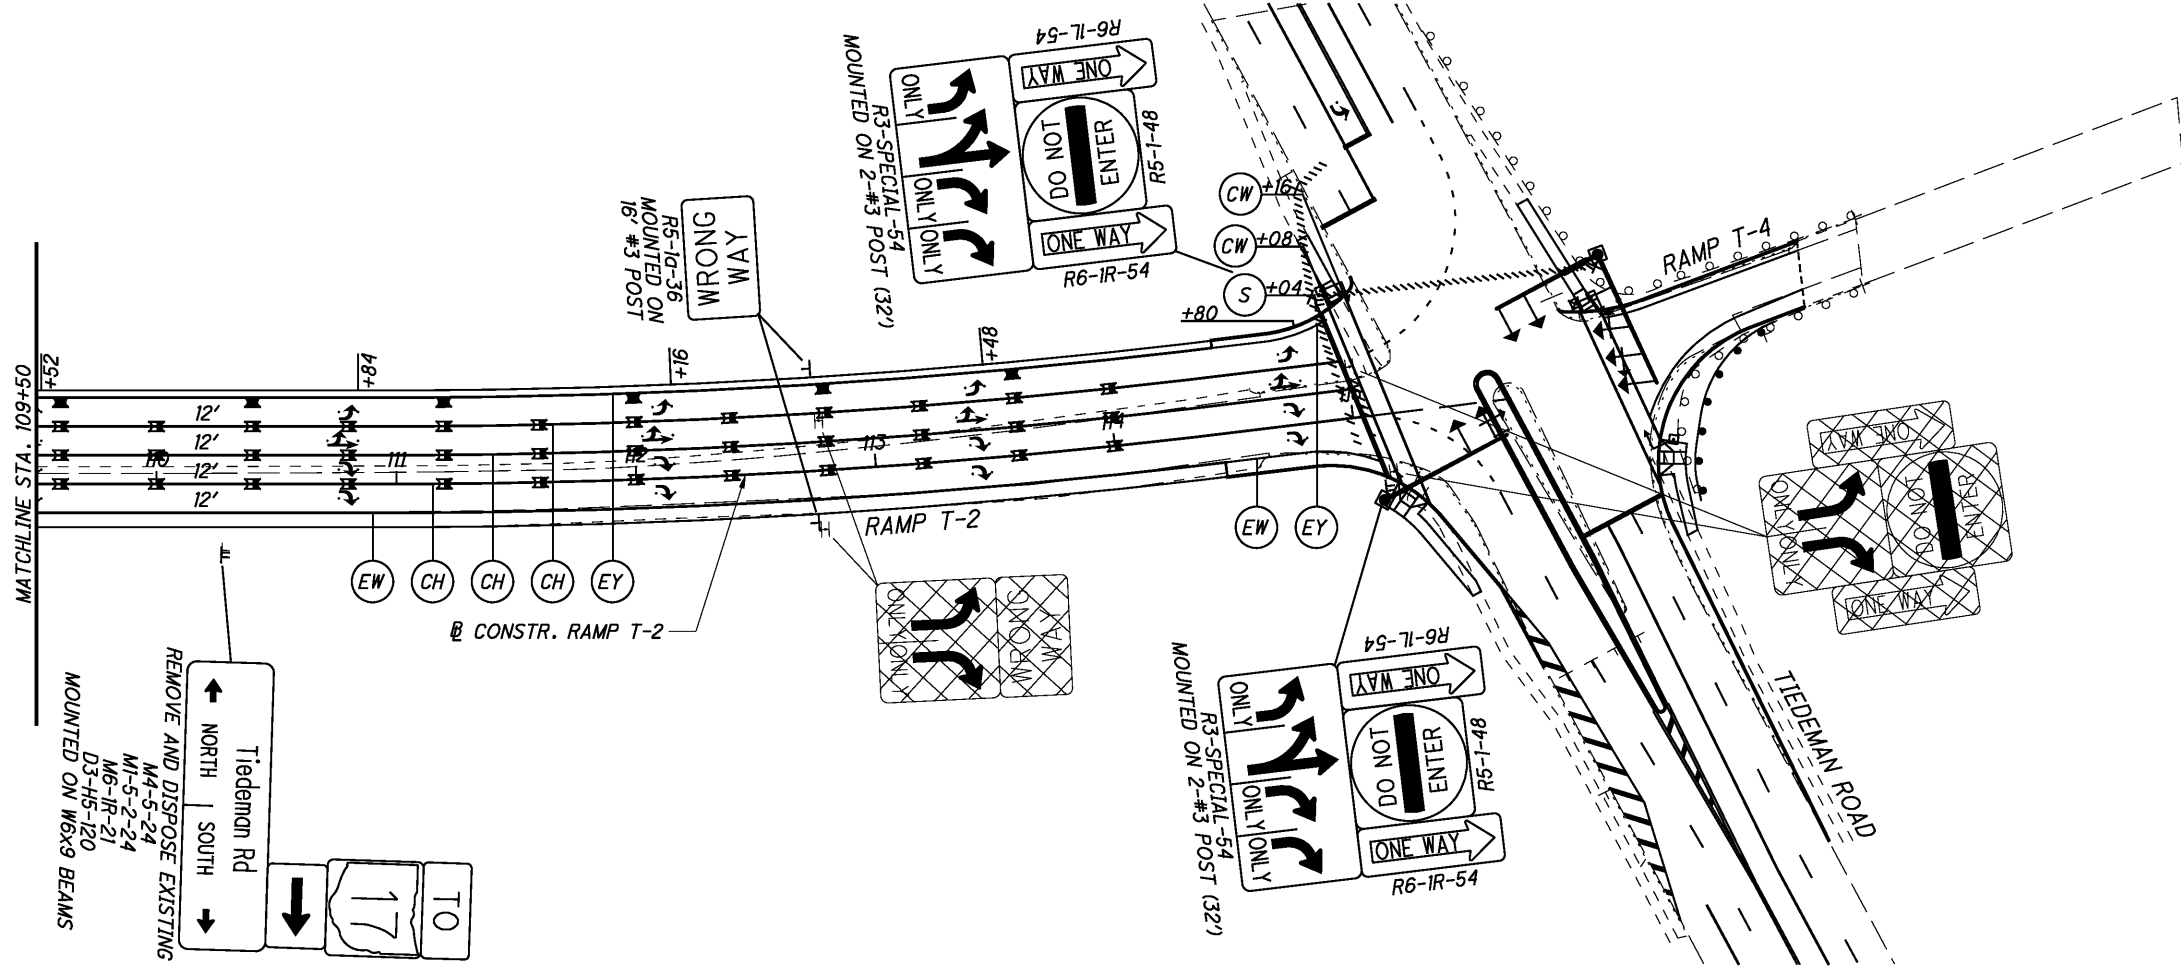

NOTES:

RAISED PAVEMENT MARKERS SHALL BE PLACED PER SCD TC-65.10, SCD TC-65.11 AND CMS 621.

I:\Projects\18063\Traffic\Sheets\18063TP002.dgn 2/5/2015 10:29:15 AM michael\_j.thompson


CALCULATED MEP CHECKED FR

0 20 40 80  
HORIZONTAL SCALE IN FEET

**SIGNING AND PAVEMENT MARKING PLAN**  
**RAMP T-2 - STA. 109+50 TO ENDING**

CUY - 480 - 11.60

FOR LEGEND, SEE SHEET 71

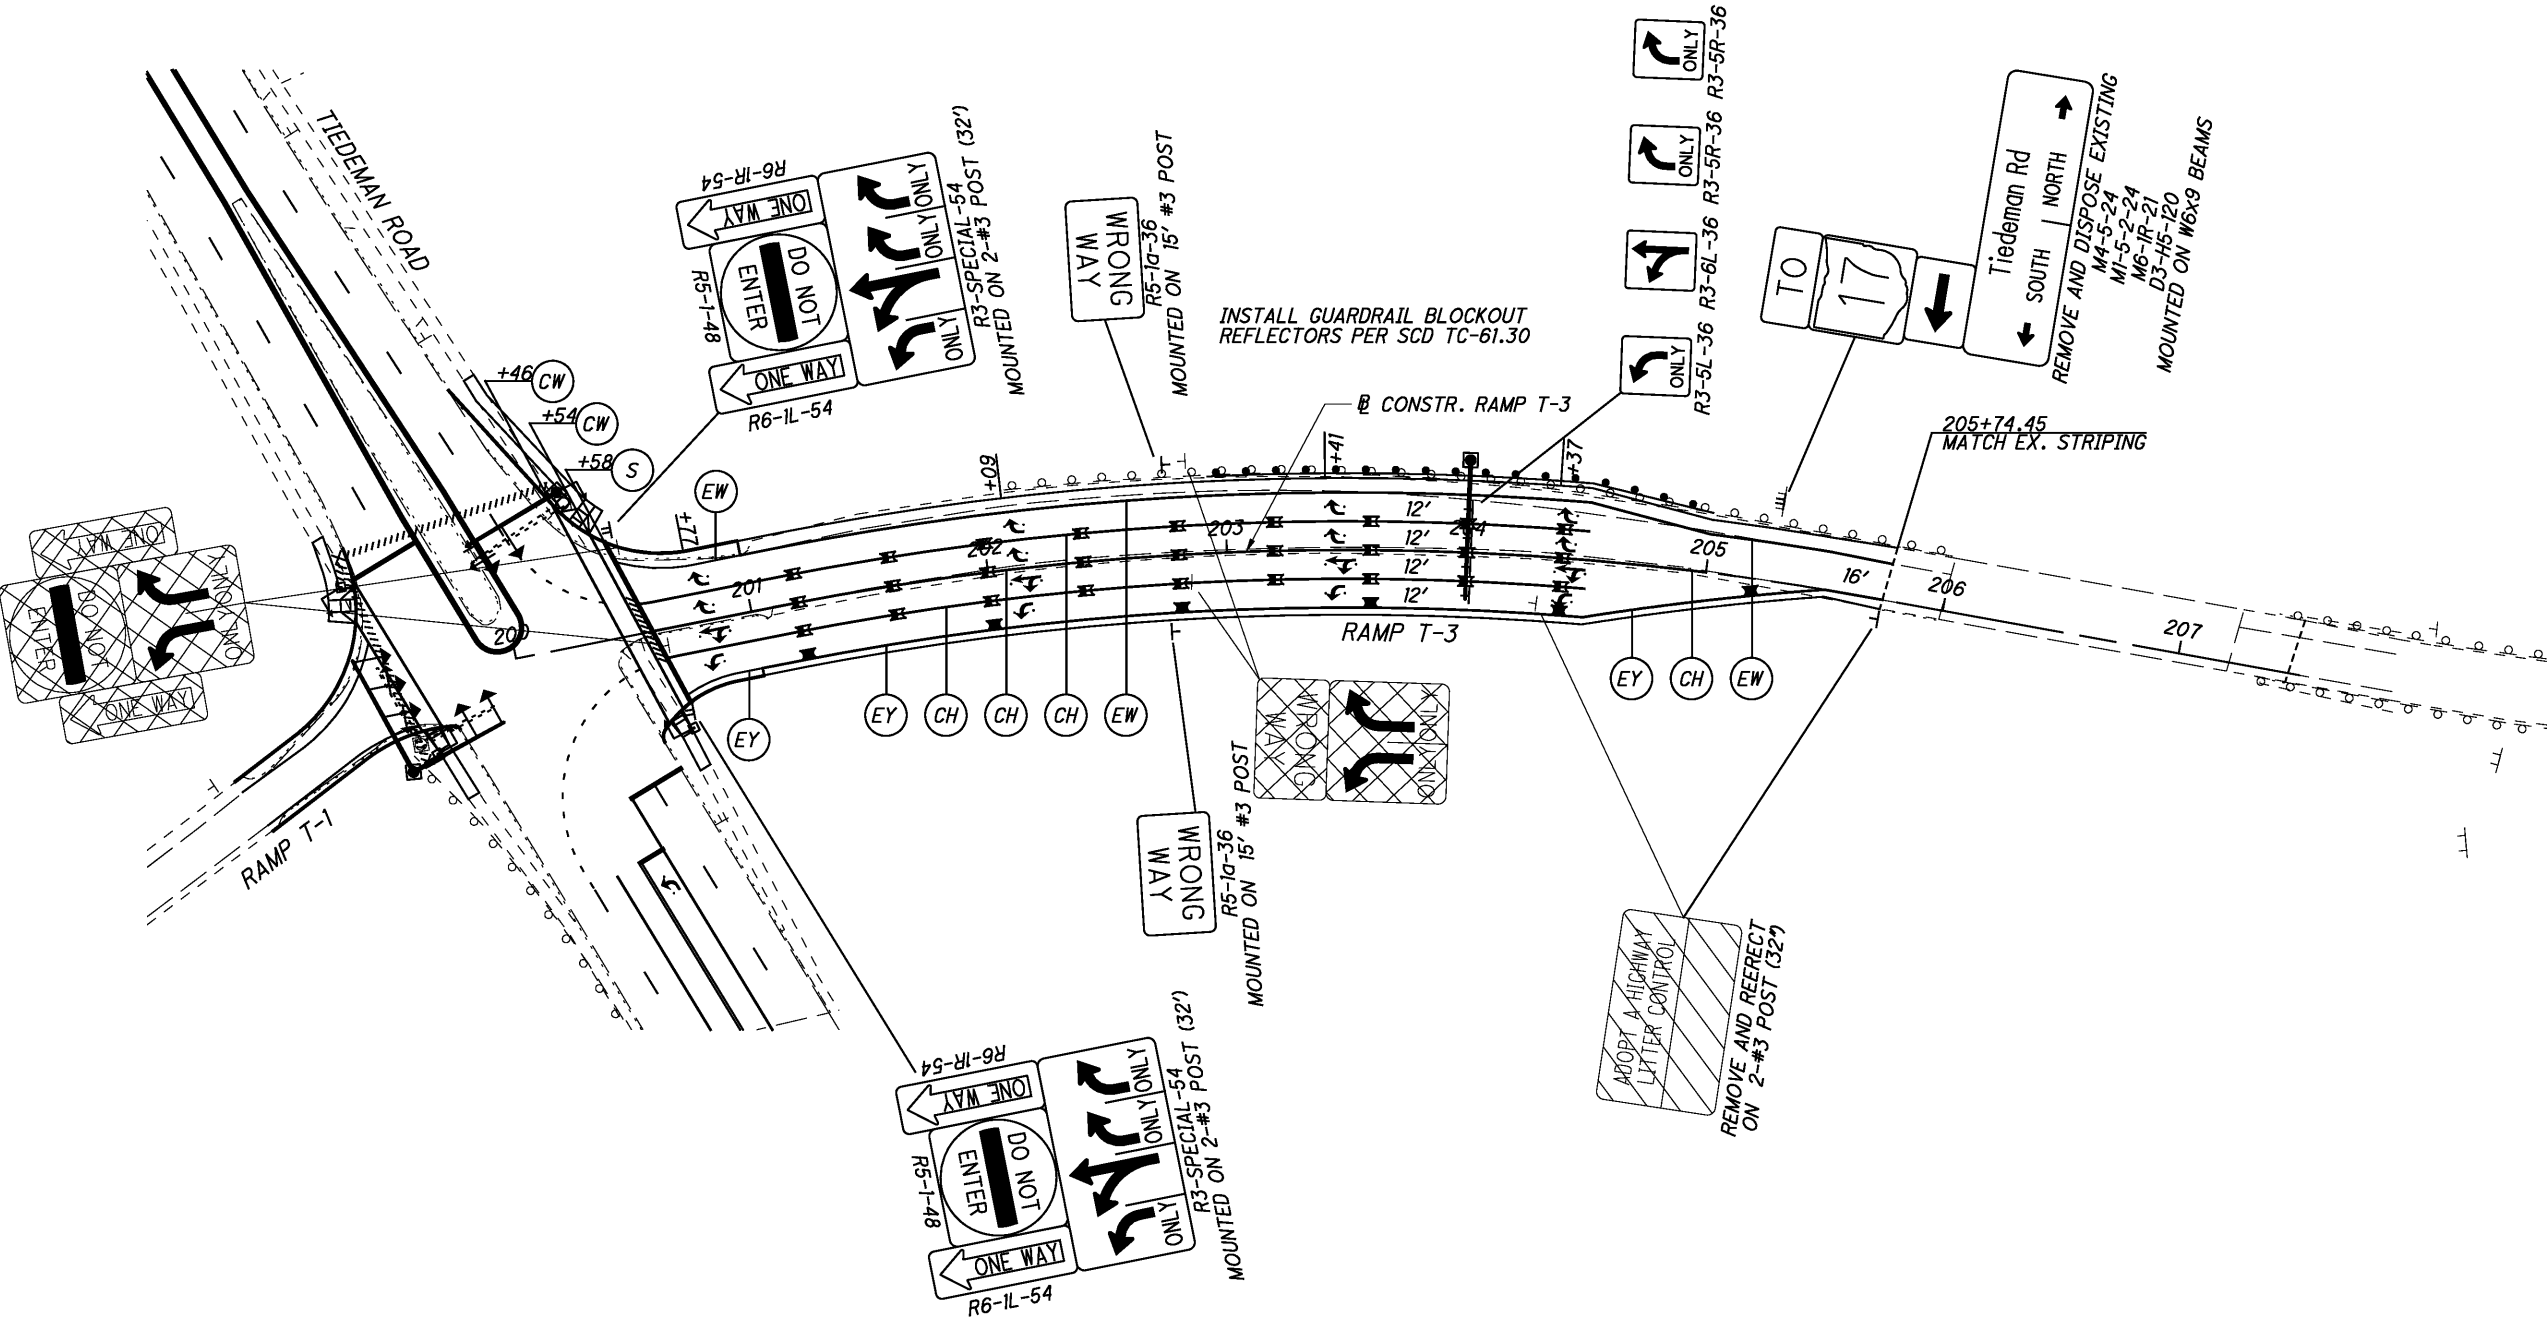

CALCULATED  
MEP  
CHECKED  
FR

0 20 40 80  
HORIZONTAL  
SCALE IN FEET


**SIGNING AND PAVEMENT MARKING PLAN**  
**RAMP T-3**

**CUY - 480 - 11.60**

**NOTES:**  
RAISED PAVEMENT MARKERS SHALL BE PLACED PER SCD TC-65.10, SCD TC-65.11 AND CMS 621.  
FOR OVERHEAD SIGN ELEVATION VIEW, SEE SHEET 78

I:\Projects\18063\Traffic\Sheets\18063TP003.dgn 2/5/2015 10:29:17 AM michael\_j.thompson

FOR LEGEND, SEE SHEET 71

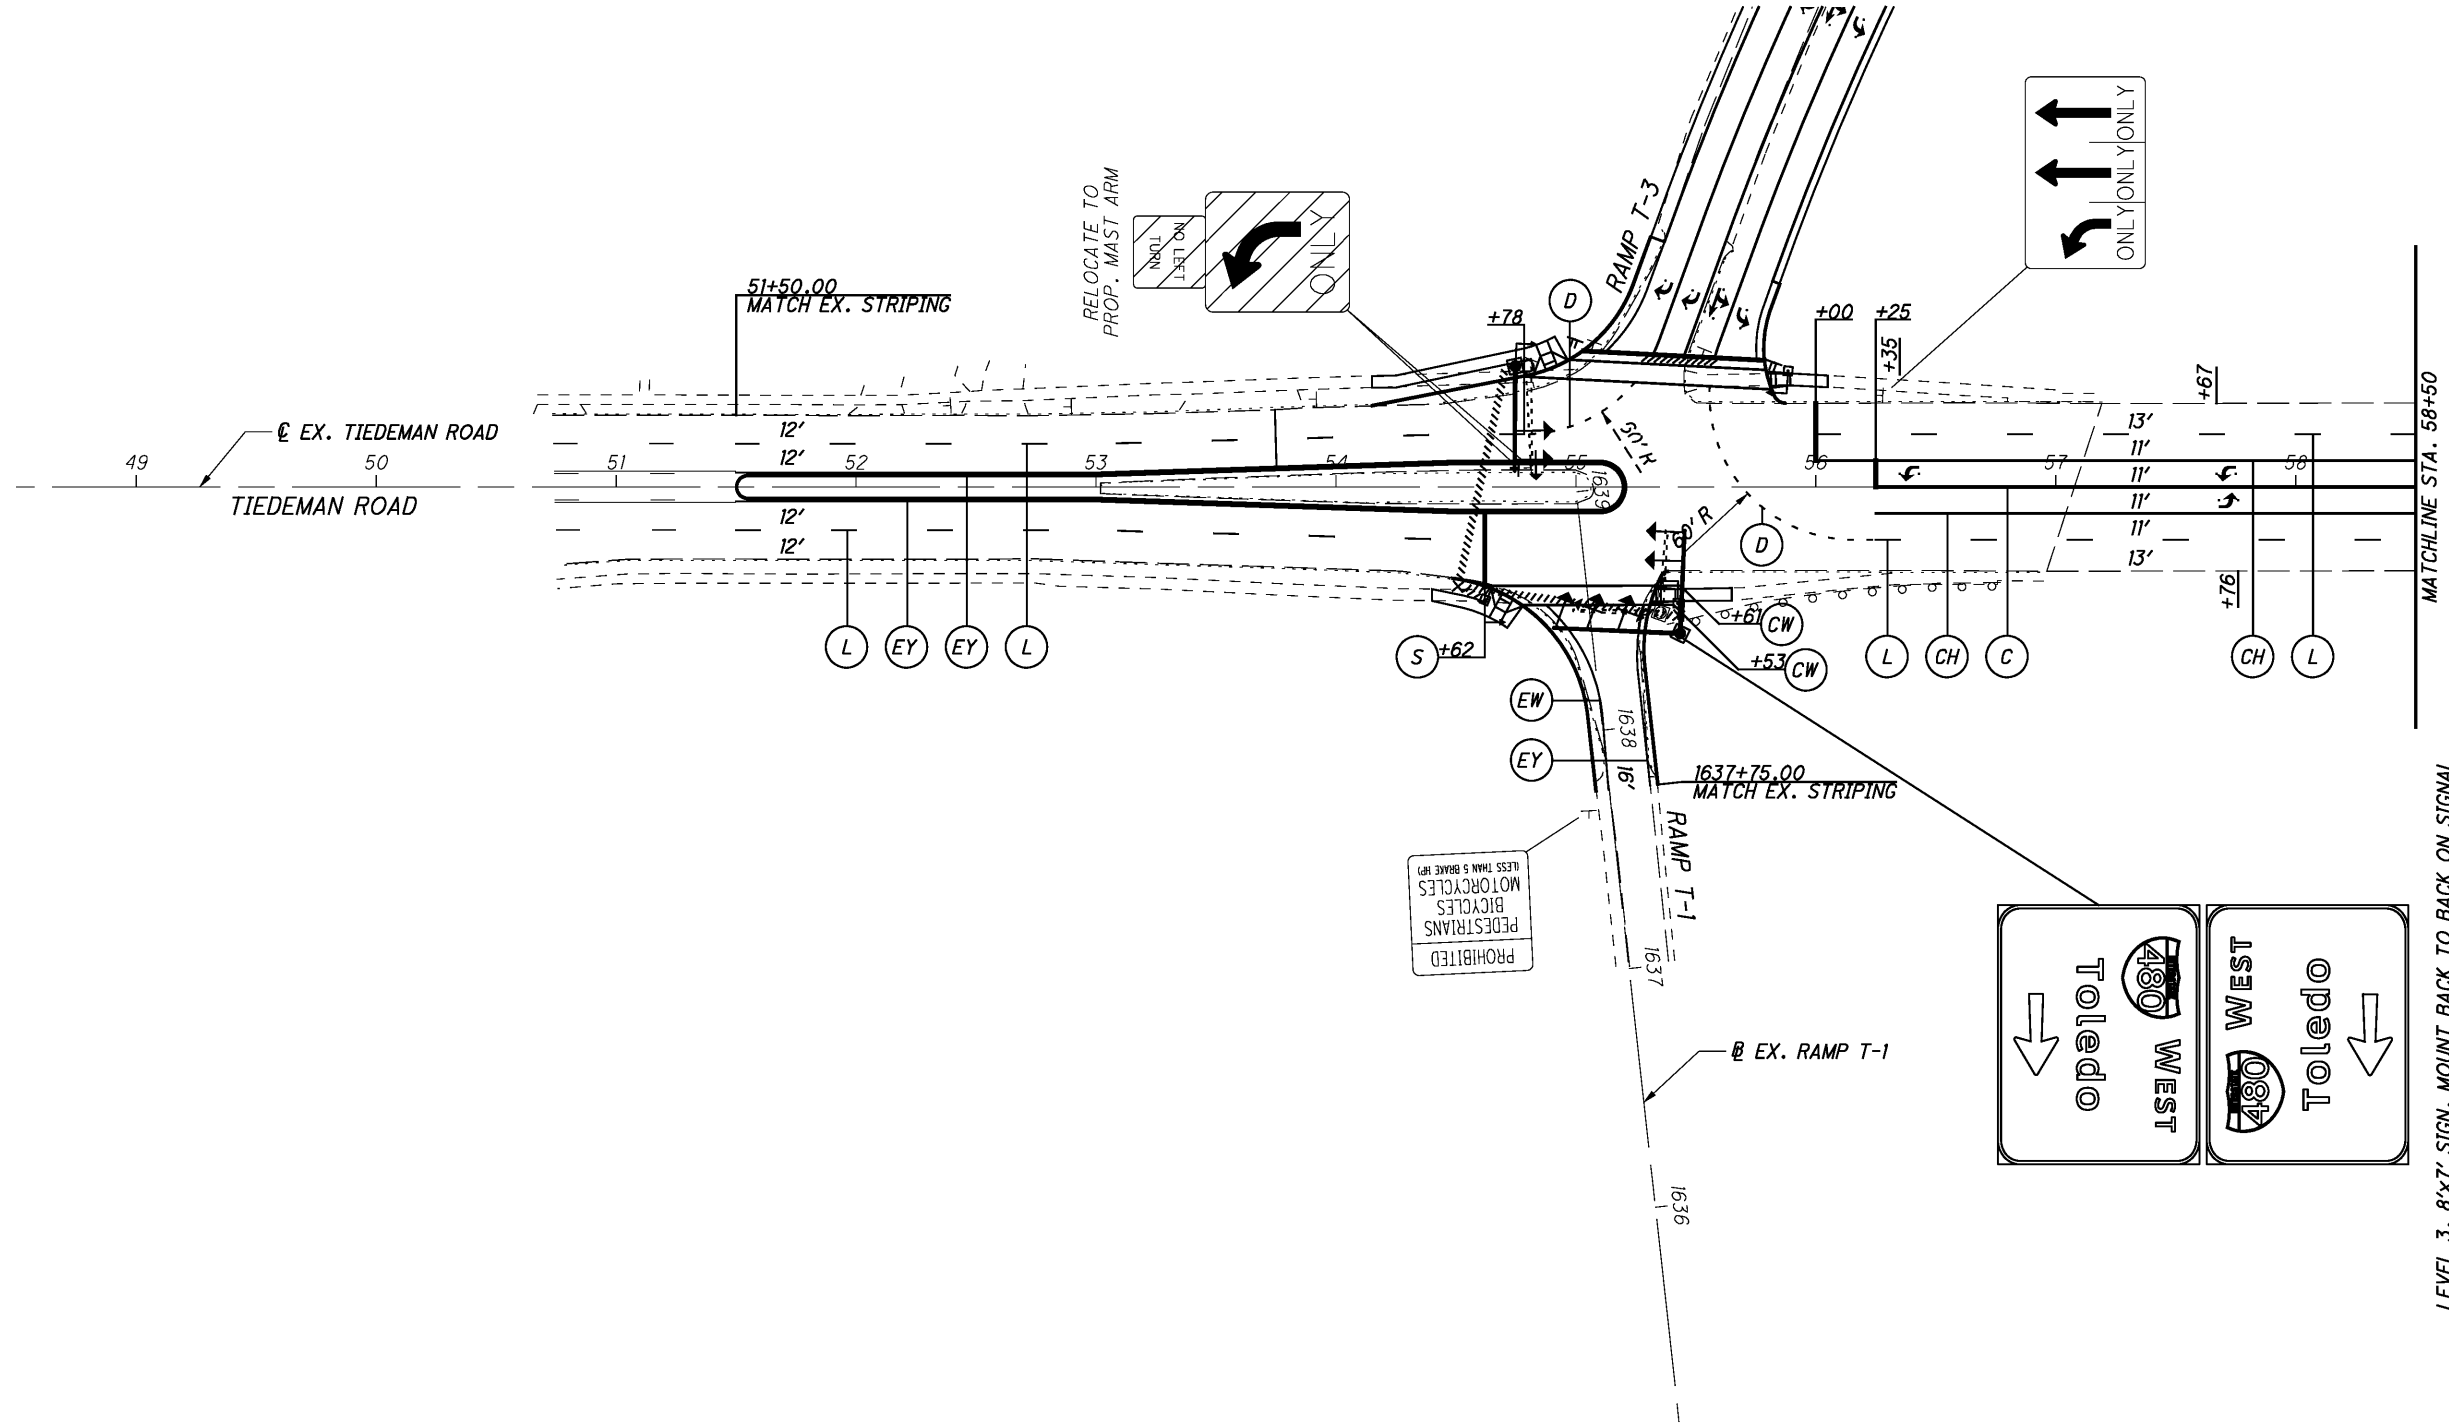

LEVEL 3, 8'x7' SIGN, MOUNT BACK TO BACK ON SIGNAL  
 SUPPORT SP-2 AT STA. 55+41  
 SEE SHEETS 76 AND 80  
 REMOVE AND DISPOSE OF LUMINAIRES,  
 STRUCTURAL STEEL TUBES AND GLARE SHIELDS  
 REMOVE SIGN WIRING BACK TO DISCONNECT SWITCH

CALCULATED  
MEP  
CHECKED  
FR



0 40 80  
HORIZONTAL  
SCALE IN FEET

**SIGNING AND PAVEMENT MARKING PLAN**  
**TIEDEMAN ROAD - BEGINNING TO STA. 58+50**

**CUY - 480 - 11.60**

I:\Projects\18063\Traffic\Sheets\18063TP004.dgn 2/5/2015 10:29:17 AM michael\_j.thompson

FOR LEGEND, SEE SHEET 71

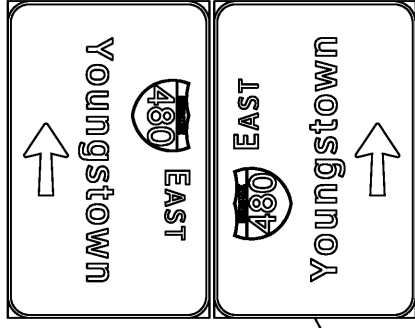
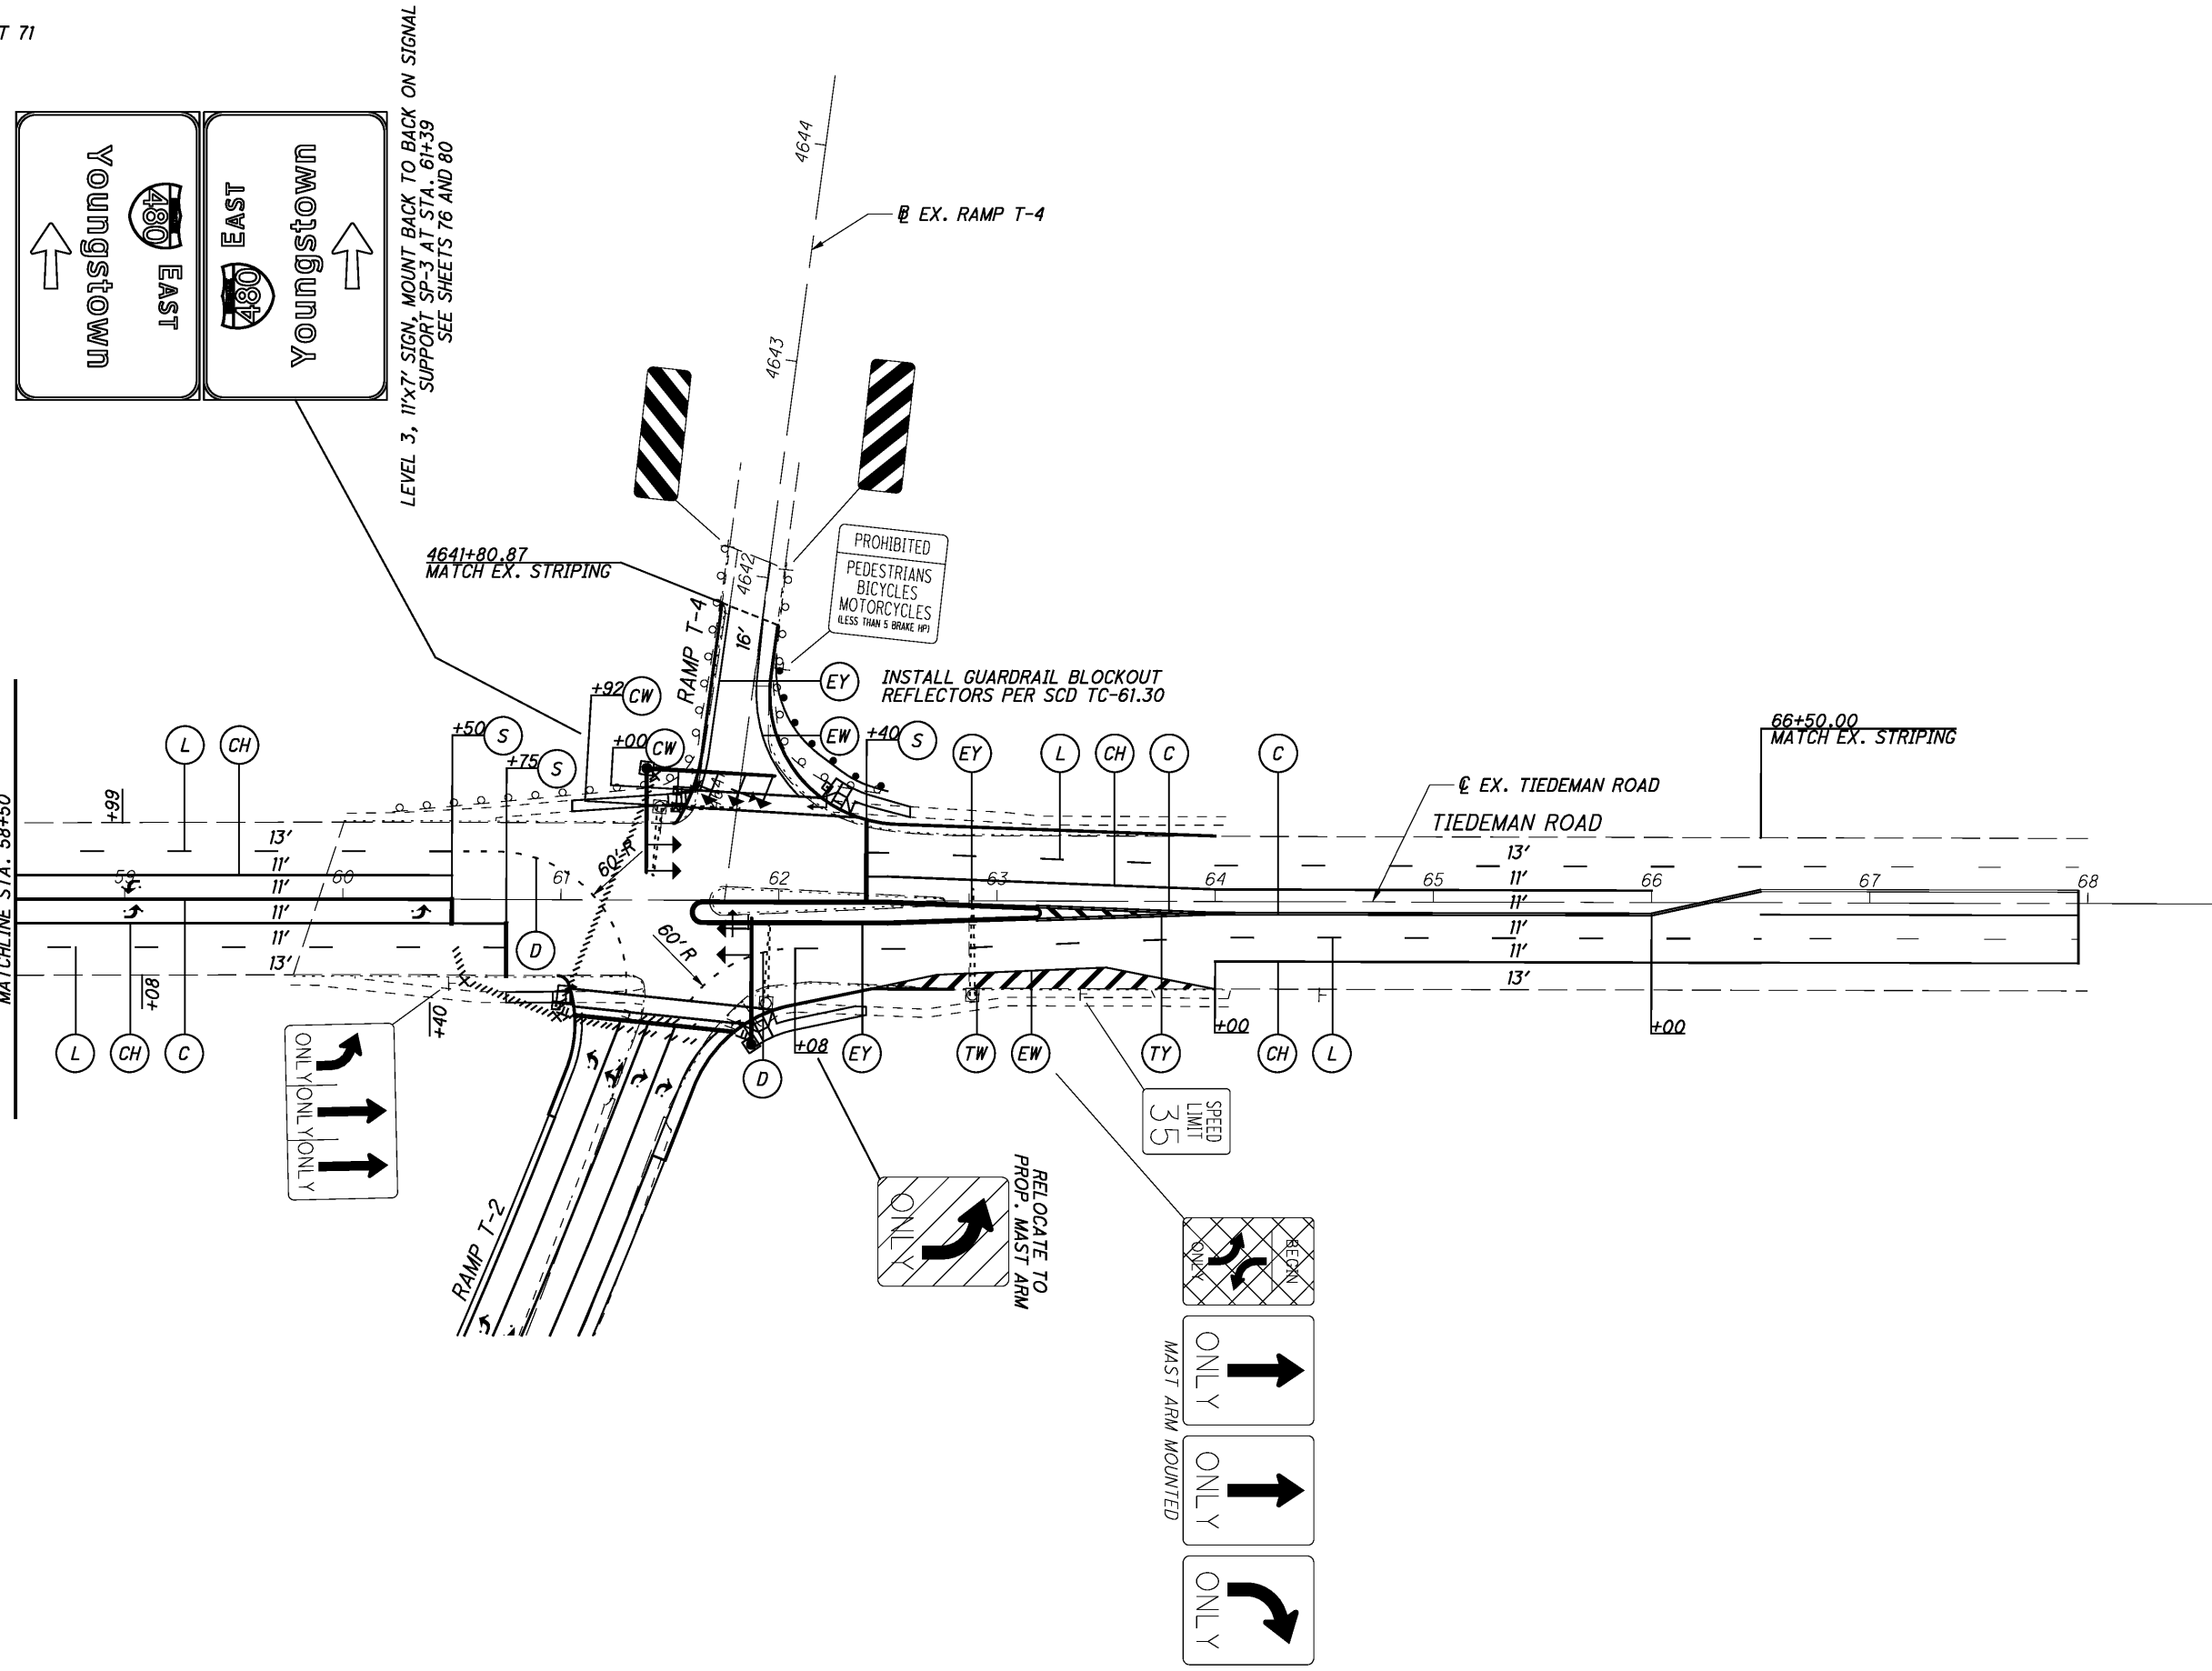


LEVEL 3, 11'x7' SIGN, MOUNT BACK TO BACK ON SIGNAL SUPPORT SP-3 AT STA. 61+39  
SEE SHEETS 76 AND 80

4641+80.87  
MATCH EX. STRIPING

PROHIBITED  
PEDESTRIANS  
BICYCLES  
MOTORCYCLES  
(LESS THAN 5 BRAKE HP)

RELocate TO  
PROP. MAST ARM

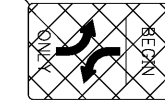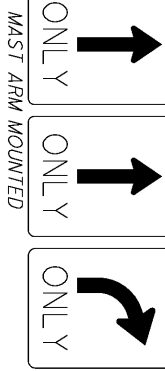

SPEED  
LIMIT  
35


66+50.00  
MATCH EX. STRIPING

CALCULATED	MEP	CHECKED	FR

0 20 40 80  
HORIZONTAL  
SCALE IN FEET

**SIGNING AND PAVEMENT MARKING PLAN  
TIEDEMAN ROAD - STA. 58+50 TO ENDING**


**CUY - 480 - 11.60**

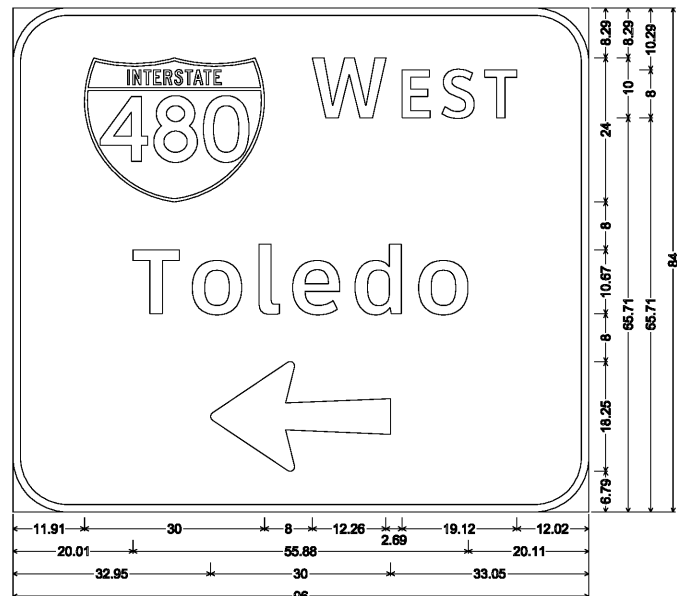

9.00" Radius, 1.25" Border, White on Green;  
 Interstate 480 M1-1; "W" Clearview/hwy-4-W; "EST" Clearview/hwy-4-W;  
 "Toledo" Clearview/hwy-5-W 80% spacing; Arrow A-3 - 30.00" 180";  
 Table of letter and object lefts.


W	E	S	T
11.91	49.91	64.86	71.51
20.01	29.89	41.04	46.63
32.95			

I-480 WEST SIGNS MOUNTED BACK TO BACK ON SIGNAL SUPPORT SP-2 AT RAMP T-3 AT STA. 55+41 AS PER TC-9.10, DESIGN 3.

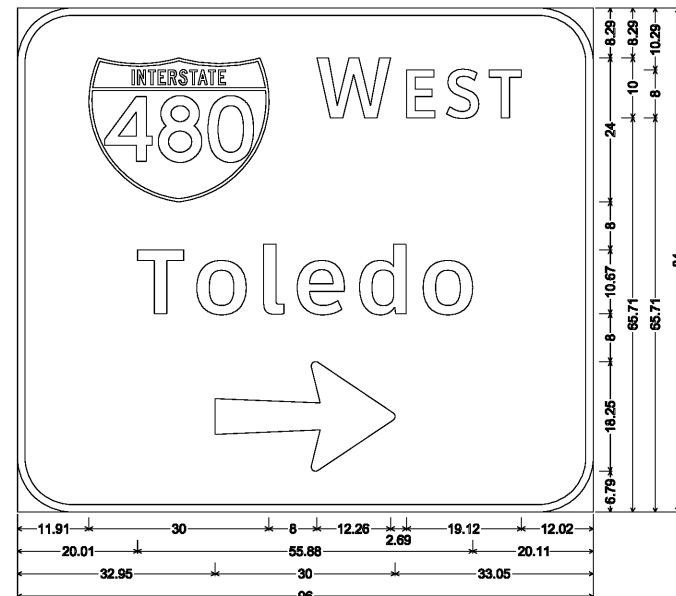

9.00" Radius, 1.25" Border, White on Green;  
 Interstate 480 M1-1; "W" Clearview/hwy-4-W; "EST" Clearview/hwy-4-W;  
 "Toledo" Clearview/hwy-5-W 80% spacing; Arrow A-3 - 30.00" 0";  
 Table of letter and object lefts.


W	E	S	T
11.91	49.91	64.86	71.51
20.01	29.89	41.04	46.63
32.95			

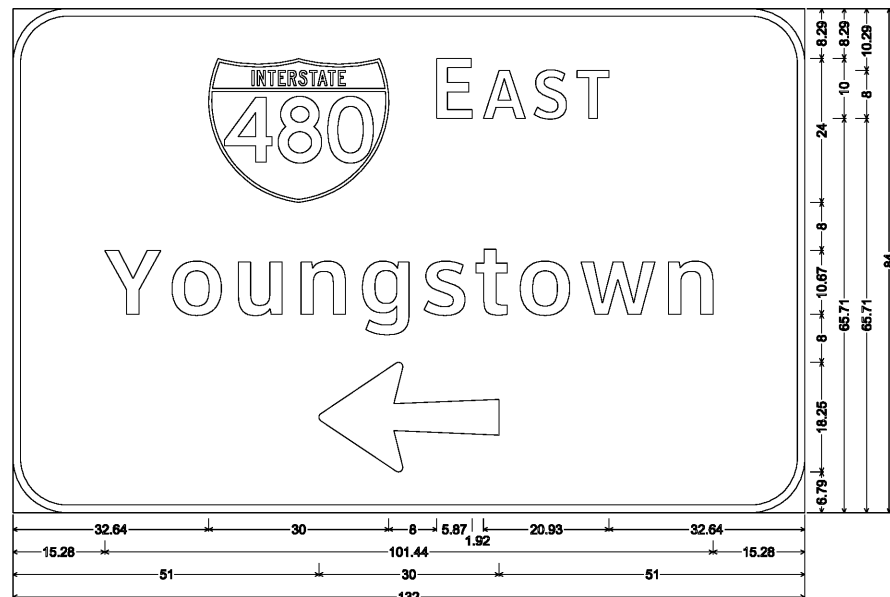

9.00" Radius, 1.25" Border, White on Green;  
 Interstate 480 M1-1; "E" Clearview/hwy-4-W; "AST" Clearview/hwy-4-W; "Youngstown" Clearview/hwy-5-W 78% spacing;  
 Arrow A-3 - 30.00" 180";  
 Table of letter and object lefts.

E	A	S	T
32.64	70.64	78.43	86.89
15.28	26.51	37.58	48.02
51.00			

I-480 EAST SIGNS MOUNTED BACK TO BACK ON SIGNAL SUPPORT SP-3 AT RAMP T-2 AT STA. 61+39 AS PER TC-9.10, DESIGN 3.

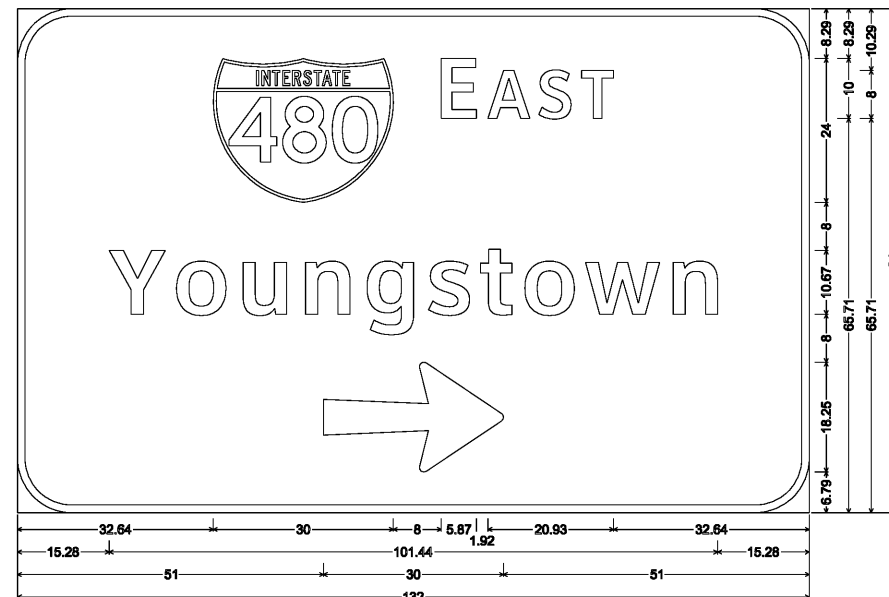


9.00" Radius, 1.25" Border, White on Green;  
 Interstate 480 M1-1; "E" Clearview/hwy-4-W; "AST" Clearview/hwy-4-W; "Youngstown" Clearview/hwy-5-W 78% spacing;  
 Arrow A-3 - 30.00" 0";  
 Table of letter and object lefts.

E	A	S	T
32.64	70.64	78.43	86.89
15.28	26.51	37.58	48.02
51.00			




I:\Projects\18063\Traffic\Sheets\18063TE001.dgn 2/5/2015 10:29:22 AM michael\_j.thompson

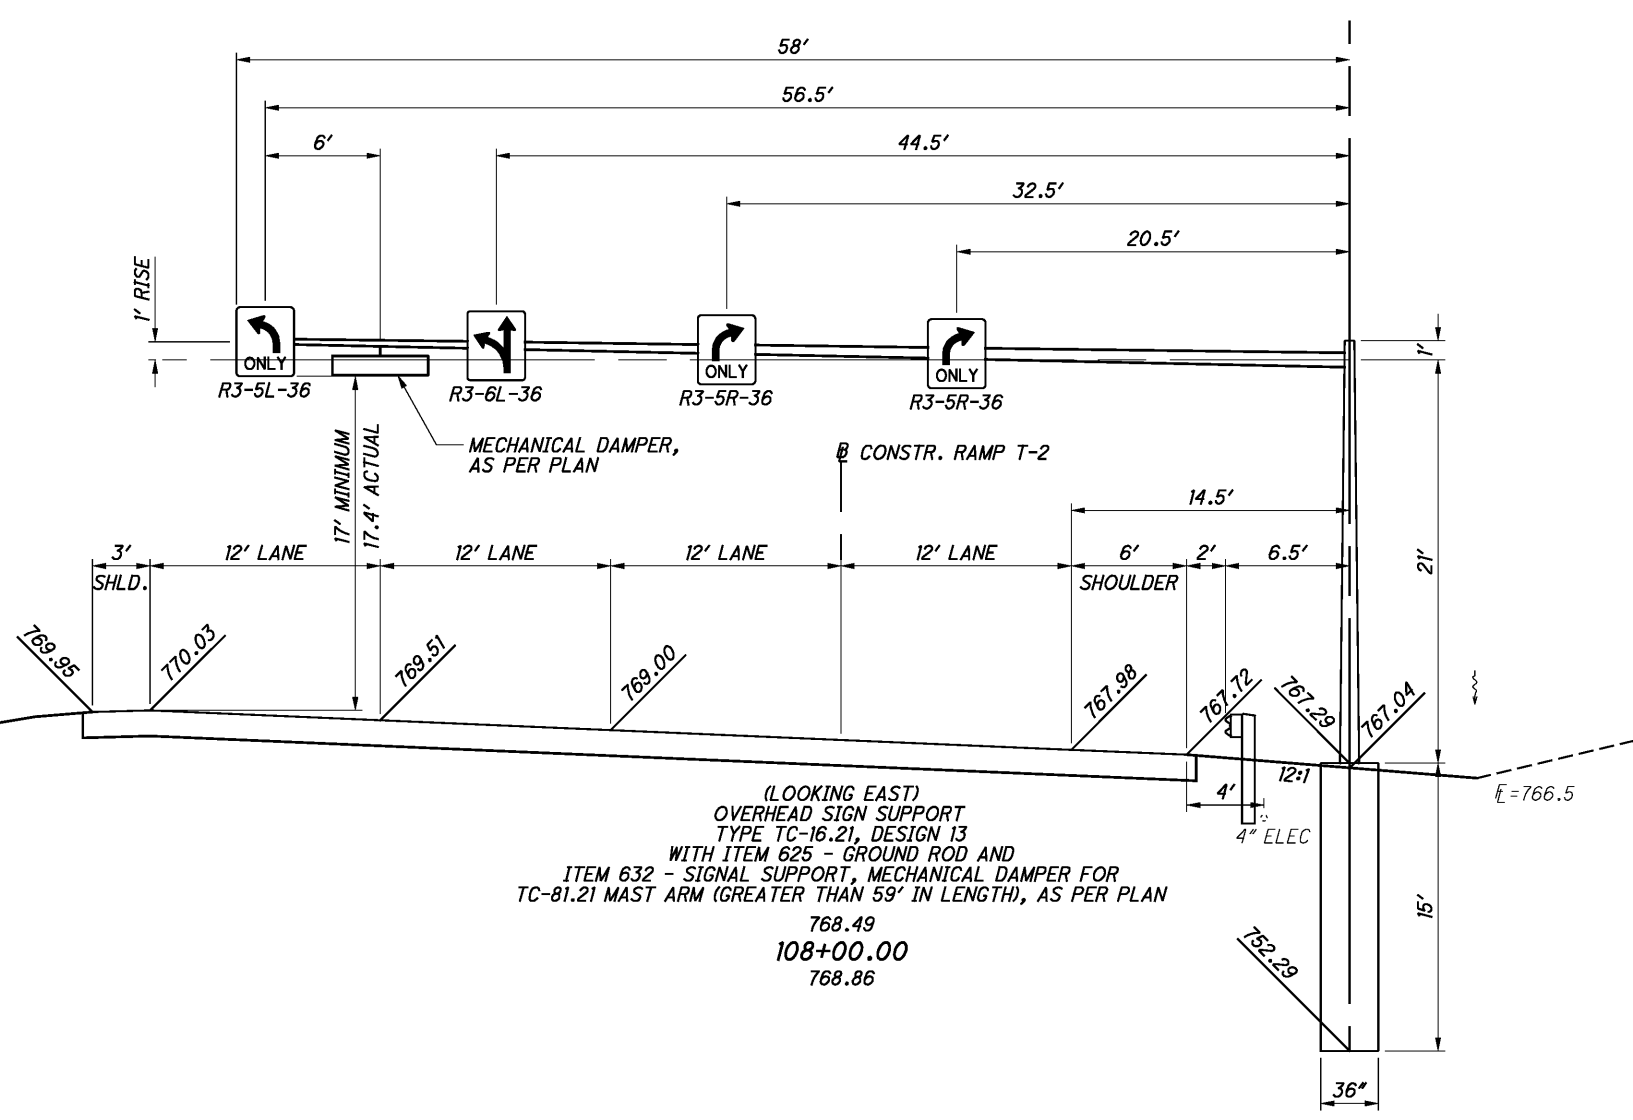

NOTES:  
DESIGN SPEED = 45mph  
REQUIRED CLEAR ZONE = 19-FEET

**OVERHEAD SIGN ELEVATION VIEW - RAMP T-3**

**CUY - 480 - 11.60**

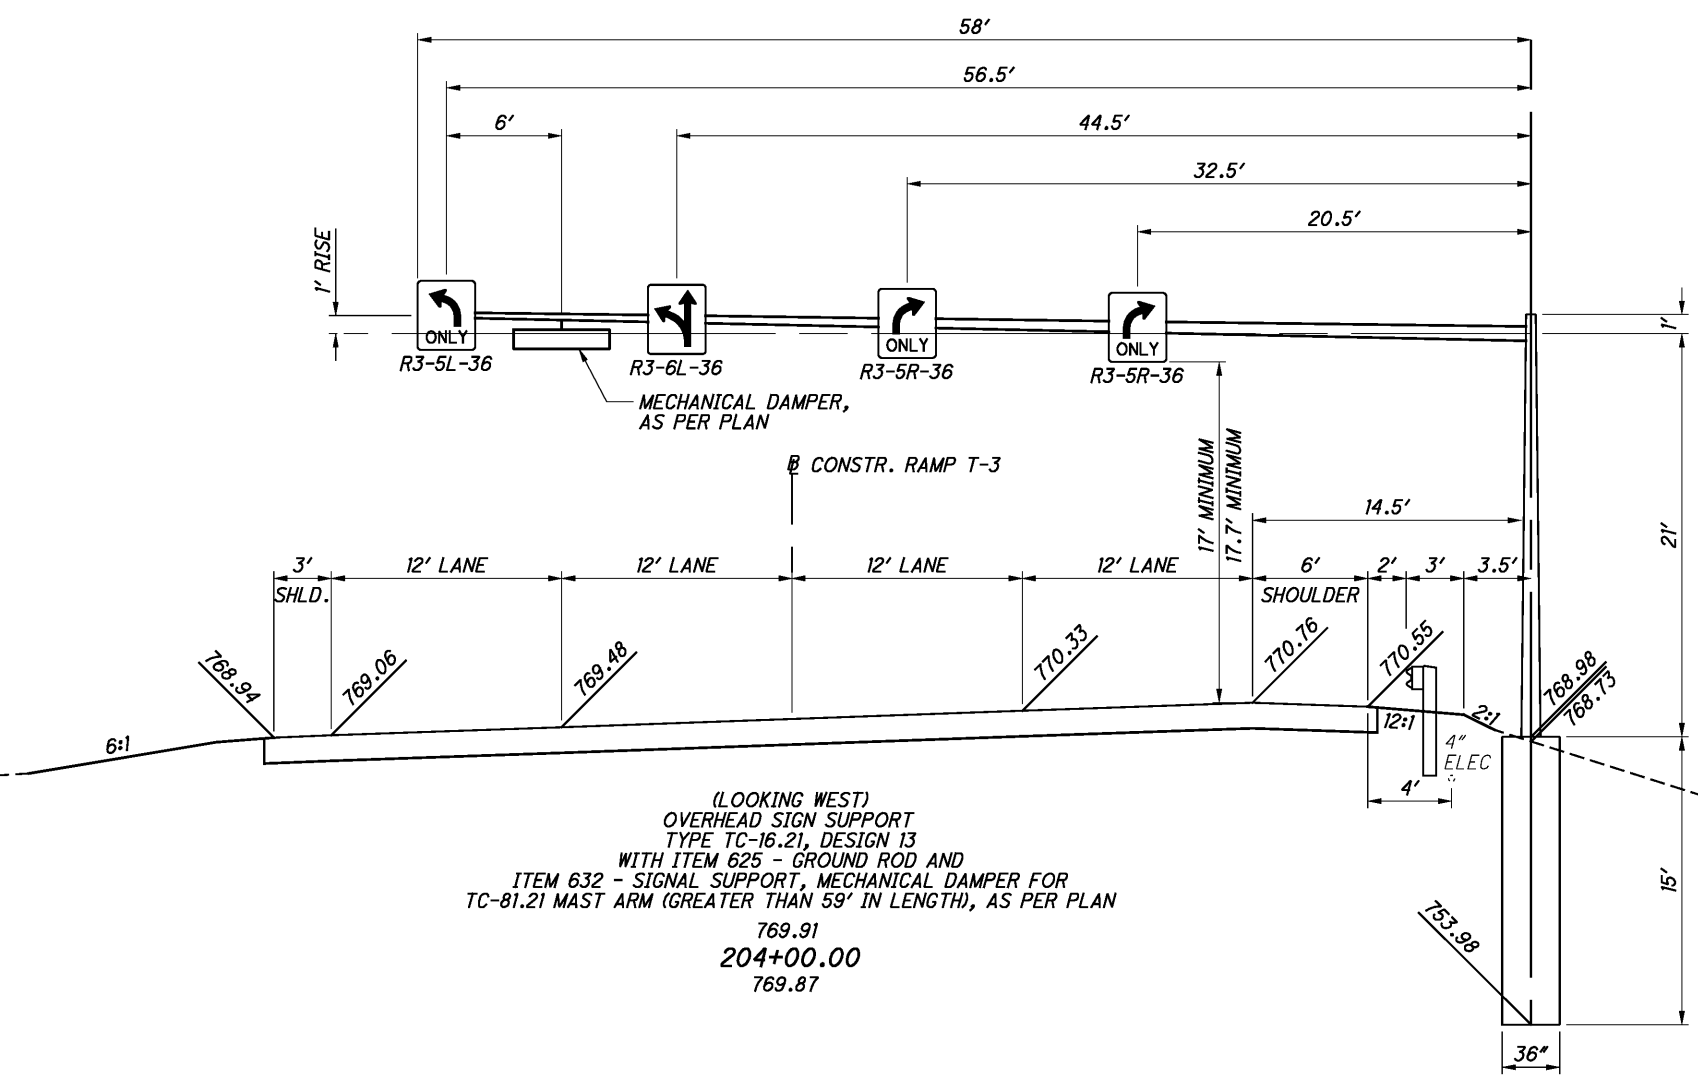

NOTES:  
 DESIGN SPEED = 35mph  
 REQUIRED CLEAR ZONE = 15-FEET

I:\Projects\18063\Traffic\Sheets\18063TE002.dgn 2/5/2015 10:29:23 AM michael.j.thompson




I:\Projects\18063\Traffic\Sheets\18063TE003.dgn 2/5/2015 10:29:23 AM michael\_j\_thompson


CALCULATED  
MEP  
CHECKED  
KPW

SIGN ELEVATION VIEWS - RAMP T-2 AND RAMP T-3

CUY-480-11.60


79  
84

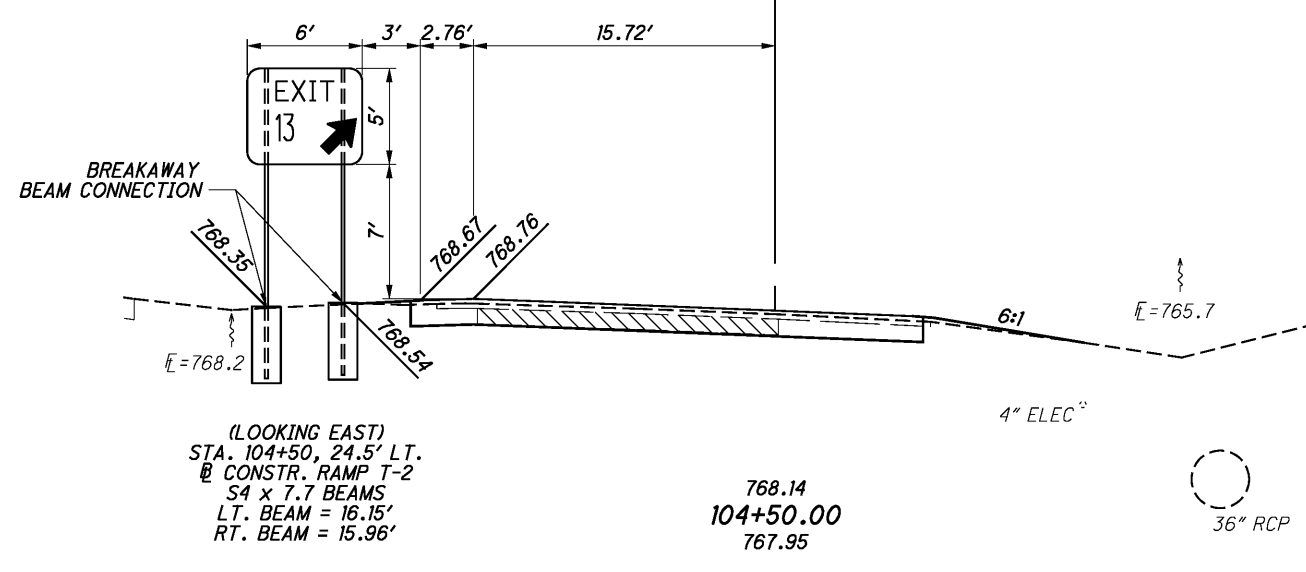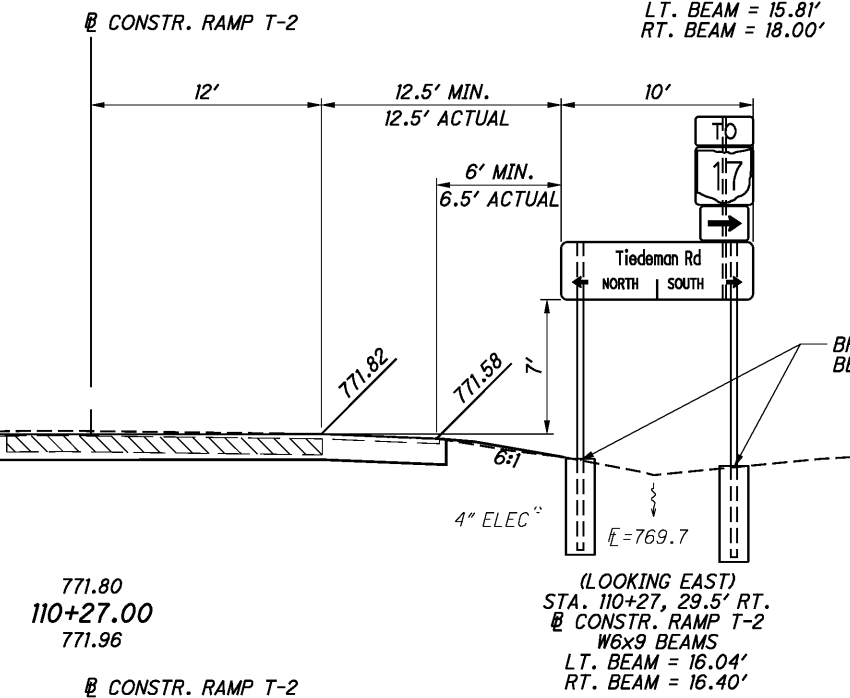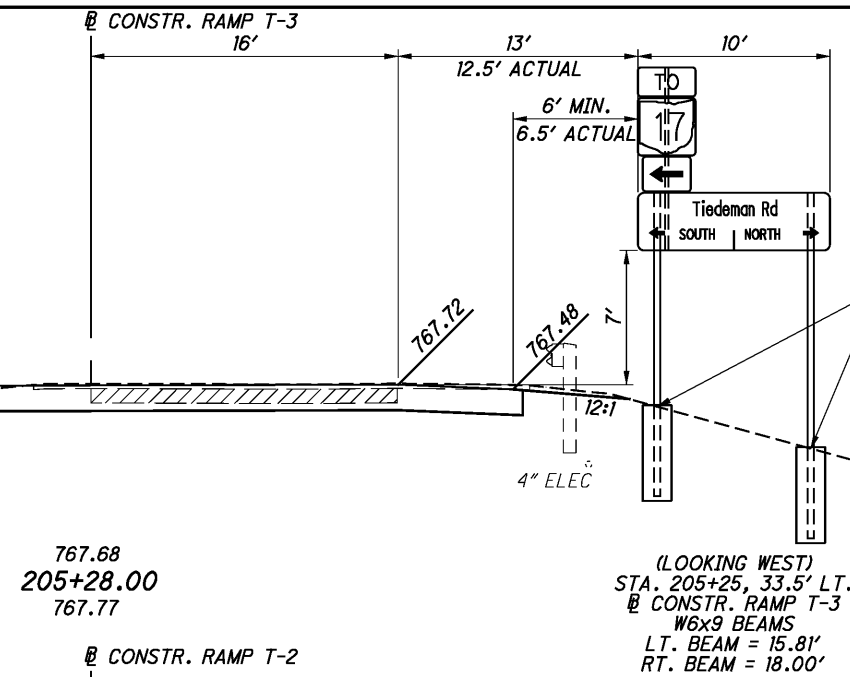

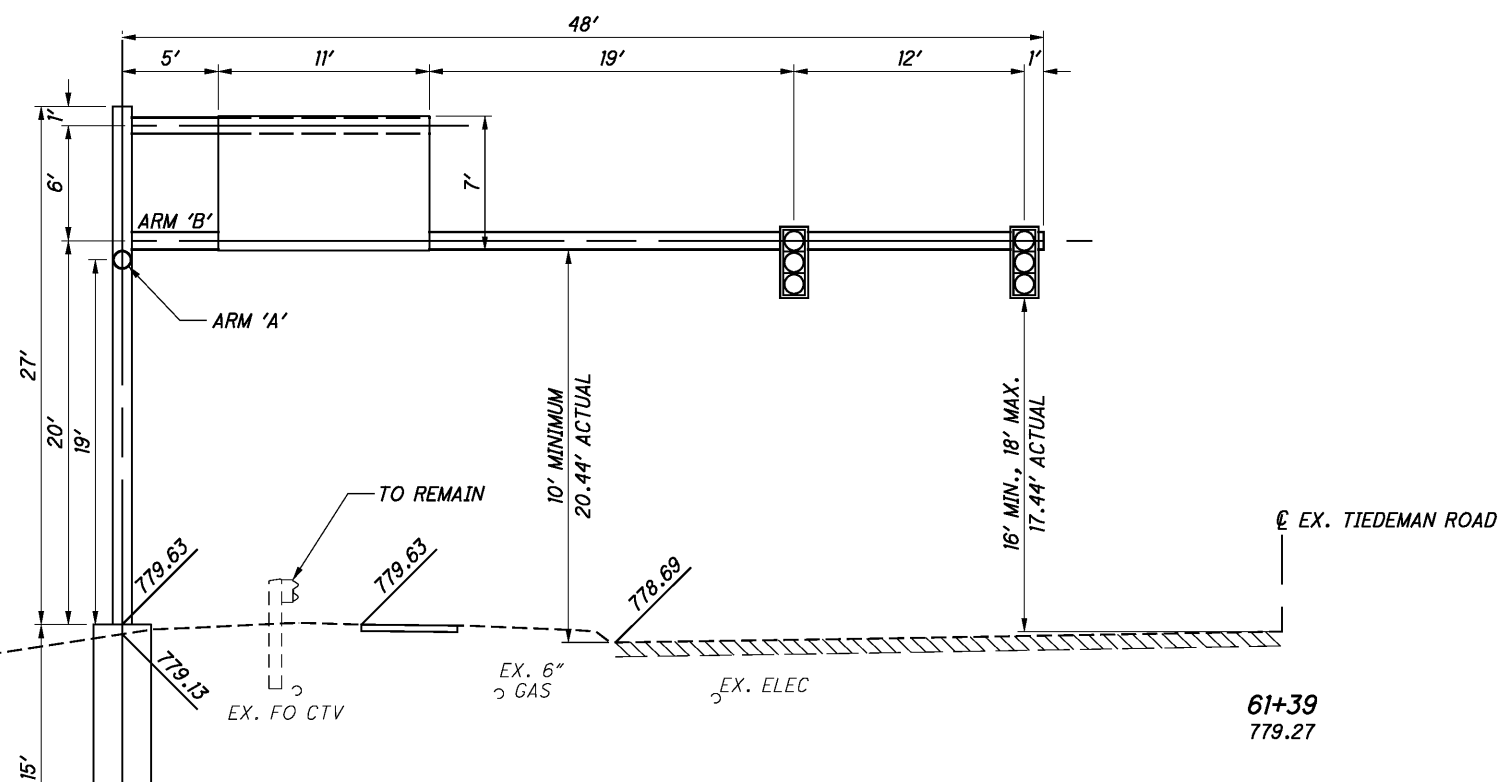

(LOOKING SOUTH)  
STA. 61+39, 60' LT.  
EX. TIEDEMAN ROAD  
COMBINATION SIGNAL AND SIGN SUPPORT  
POLE = TC-12.30, DESIGN 9  
SIGNAL ARMS = TC-81.21,  
DESIGN 13 (59') AND DESIGN 12 (48')  
SIGN ATTACHMENT = TC-12.30, DESIGN 5 ARM (16')  
(SEE TC-12.30 NOTE 2)  
SEE SHEET 76 FOR SIGN DETAILS

**ITEM - 632 COMBINATION SIGNAL SUPPORT,  
TYPE TC-12.30 AND SIGN SUPPORT, TC-12.30, NO. 1**  
THIS SUPPORT SHALL CONSIST OF A TC-12.30 DESIGN 9 POLE  
WITH A TC-81.21 DESIGN 13 AND DESIGN 12 SIGNAL ARM AND  
A TC-12.30 DESIGN 5 SIGN SUPPORT ARM. ALL SIGNAL  
SUPPORT ITEMS REQUIRED BY CMS ITEM 632 AND ALL SIGN  
SUPPORT ITEMS REQUIRED BY CMS ITEM 630 SHALL BE INCLUDED  
AS PART OF THIS SUPPORT. PAYMENT WILL BE AT THE  
CONTRACT UNIT PRICE AND WILL BE FULL COMPENSATION FOR  
ALL LABOR, MATERIALS, TOOLS, EQUIPMENT AND OTHER  
INCIDENTALS NECESSARY FOR EACH SUPPORT FURNISHED, IN  
PLACE, COMPLETE AND ACCEPTED.  
CONCRETE FOUNDATION SHALL BE PER SCD TC-21.20 EXCEPT  
THAT THE VERTICAL REINFORCEMENT SHALL USE 6 NO. 8 REBARS.




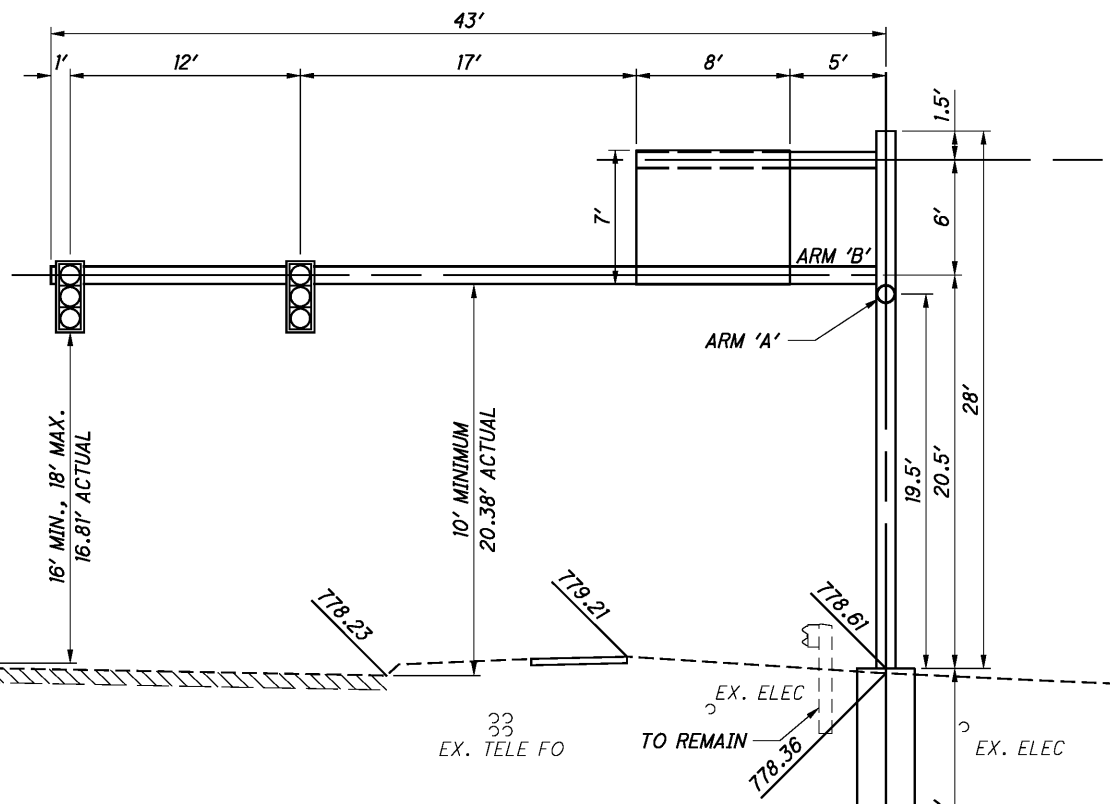


(LOOKING SOUTH)  
STA. 55+41, 61' RT.  
EX. TIEDEMAN ROAD  
COMBINATION SIGNAL AND SIGN SUPPORT  
POLE = TC-12.30, DESIGN 9  
SIGNAL ARMS = TC-81.21,  
DESIGN 13 (53') AND DESIGN 11 (43')  
SIGN ATTACHMENT = TC-12.30, DESIGN 5 ARM (13')  
(SEE TC-12.30 NOTE 2)  
SEE SHEET 76 FOR SIGN DETAILS

**ITEM - 632 COMBINATION SIGNAL SUPPORT,  
TYPE TC-12.30 AND SIGN SUPPORT, TC-12.30, NO. 2**  
THIS SUPPORT SHALL CONSIST OF A TC-12.30 DESIGN 9 POLE  
WITH A TC-81.21 DESIGN 13 AND DESIGN 11 SIGNAL ARM AND  
A TC-12.30 DESIGN 5 SIGN SUPPORT ARM. ALL SIGNAL  
SUPPORT ITEMS REQUIRED BY CMS ITEM 632 AND ALL SIGN  
SUPPORT ITEMS REQUIRED BY CMS ITEM 630 SHALL BE INCLUDED  
AS PART OF THIS SUPPORT. PAYMENT WILL BE AT THE  
CONTRACT UNIT PRICE AND WILL BE FULL COMPENSATION FOR  
ALL LABOR, MATERIALS, TOOLS, EQUIPMENT AND OTHER  
INCIDENTALS NECESSARY FOR EACH SUPPORT FURNISHED, IN  
PLACE, COMPLETE AND ACCEPTED.  
CONCRETE FOUNDATION SHALL BE PER SCD TC-21.20 EXCEPT  
THAT THE VERTICAL REINFORCEMENT SHALL USE 6 NO. 8 REBARS.

I:\Projects\18063\Traffic\Sheets\18063TE004.dgn 2/5/2015 10:29:23 AM michael.j.thompson

MJT	2/5/15	AS-BUILTS
REV. BY	DATE	DESCRIPTION

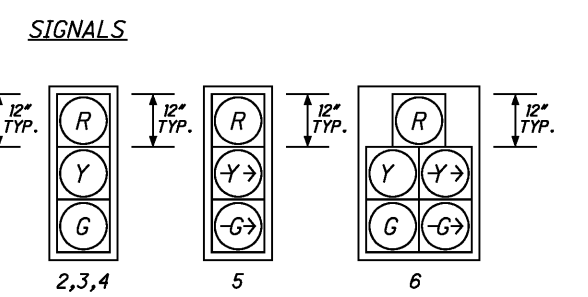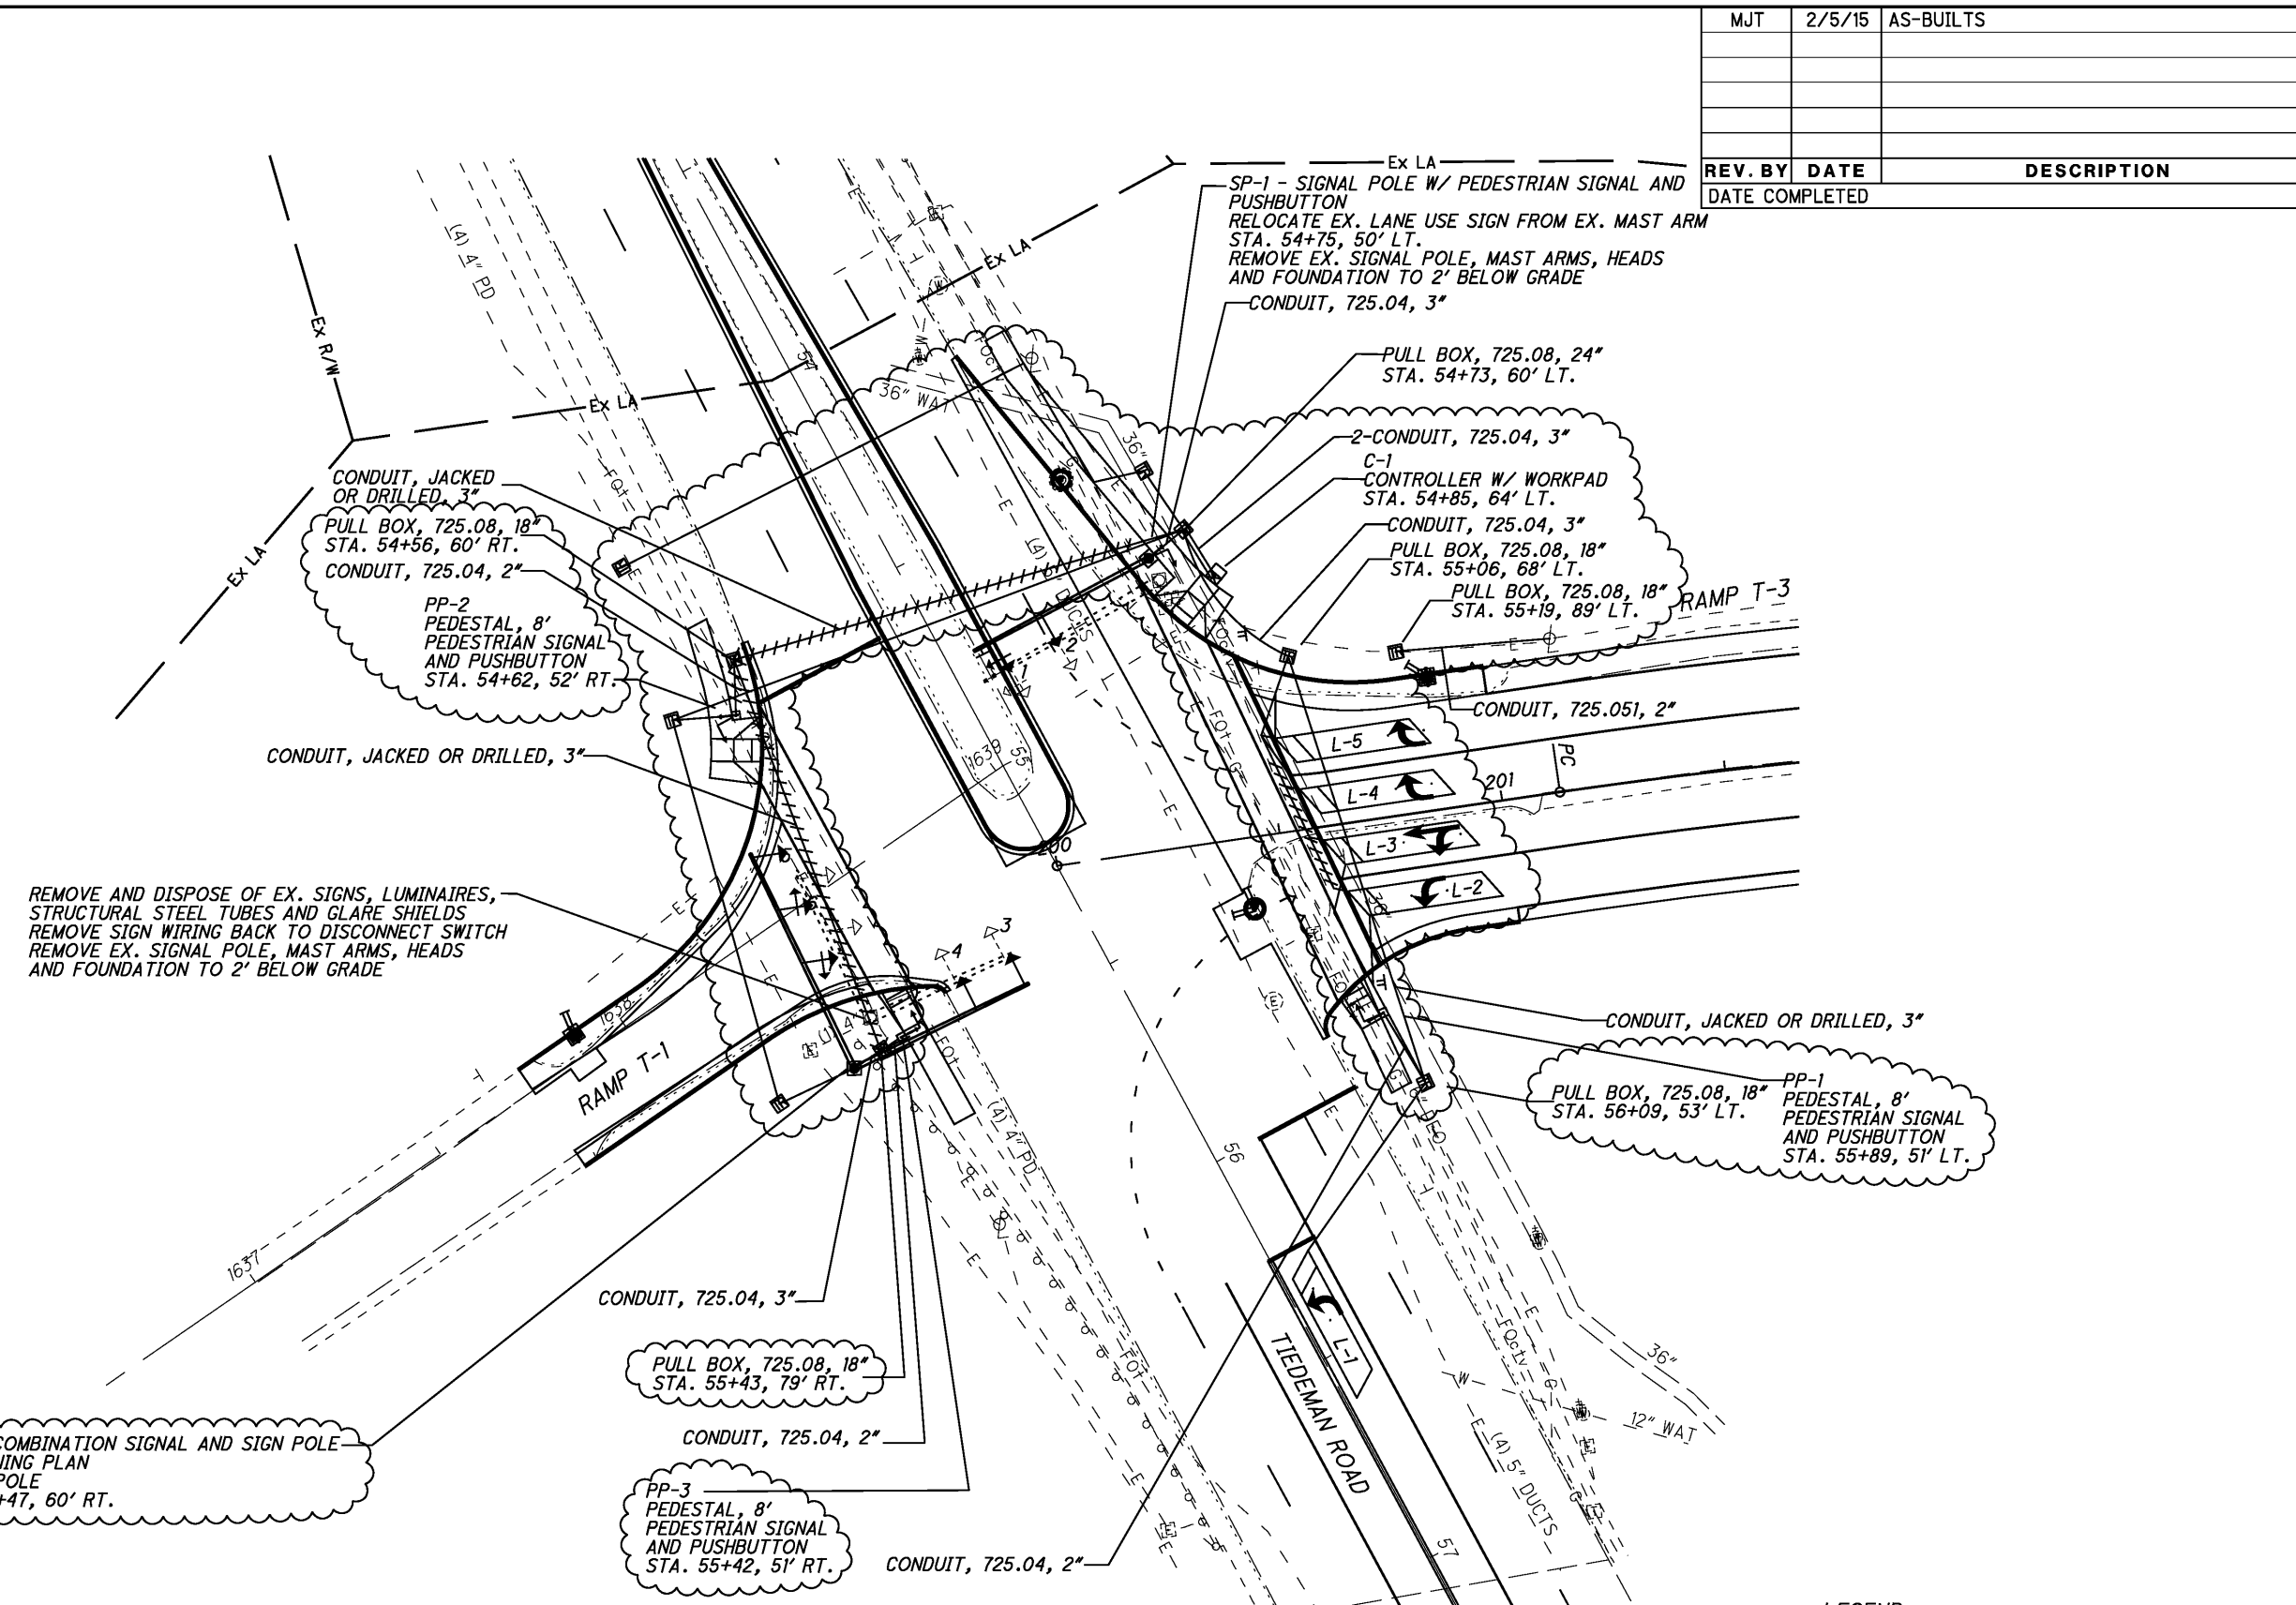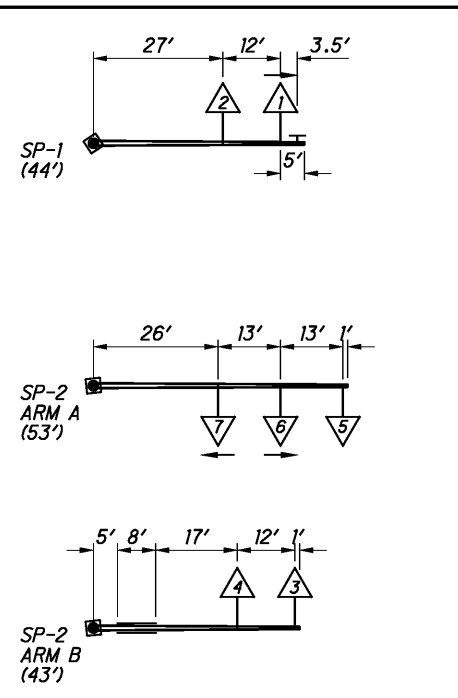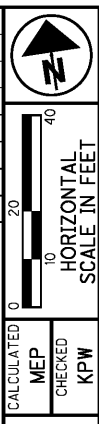

ALL PEDESTRIAN SIGNALS TYPE D-2 COUNTDOWN


- LEGEND**
- SIGNAL POLE
  - PEDESTAL
  - GROUND MOUNTED CONTROLLER W/WORK PAD
  - PULL BOX
  - 2 VEHICULAR SIGNAL 3-SECTION
  - 2 VEHICULAR SIGNAL 3-SECTION W/ARROW
  - 4 VEHICULAR SIGNAL 5-SECTION
  - B PEDESTRIAN SIGNAL WITH PUSHBUTTON
  - PEDESTRIAN SIGNAL
  - LOOP DETECTOR
  - CONDUIT

I:\Projects\18063\Signals\Sheets\18063CP001.dgn 2/5/2015 10:29:24 AM michael\_j.thompson

**TIMING CHART**

INTERVAL OR FEATURE	CONTROLLER MOVEMENT NUMBER							
	1	2	3	4	5	6	7	8
INTERSECTION MOVEMENT		NB			NB LT	SB		NB
MINIMUM GREEN (INITIAL) (SEC.)		28			5	28		7
VEHICLE EXTENSION (SEC.)		5			4	5		5
MAXIMUM GREEN (SEC.)		48			30	48		19
YELLOW CHANGE (SEC.)		3.6			2.9	3.6		3.6
ALL RED CLEARANCE (SEC.)		2.4			3.2	2.4		2.7
WALK (SEC.)		4			-	4		-
PEDESTRIAN CLEARANCE (SEC.)		23			-	23		-
RECALL	MAXIMUM (ON/OFF)	OFF			OFF	OFF		OFF
	MINIMUM (ON/OFF)	ON			OFF	ON		OFF
	PEDESTRIAN (ON/OFF)	OFF			OFF	OFF		OFF



**PHASING DIAGRAM**

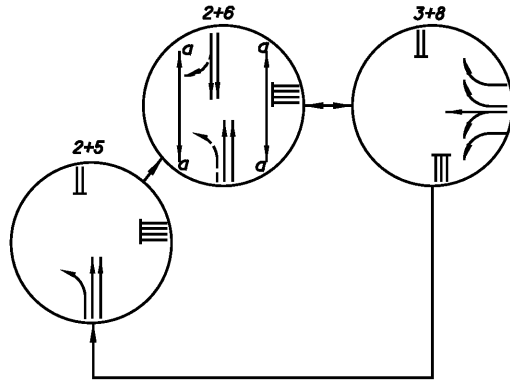

MJT	2/5/15	AS-BUILTS
REV. BY	DATE	DESCRIPTION
DATE COMPLETED		

**FIELD WIRING HOOK-UP CHART**

SIGNAL HEAD #	INDICATION	FIELD TERMINAL	FLASH
1 (NB LT)	R	φ2R	Y
	Y	φ2Y	
	G	φ2G	
	←Y	φ5Y	
2 (NB)	R	φ2R	Y
	Y	φ2Y	
	G	φ2G	
	←G	φ5G	
3 (SB)	R	φ6R	Y
	Y	φ6Y	
	G	φ6G	
	←G	φ5G	
4 (SB)	R	φ6R	Y
	Y	φ6Y	
	G	φ6G	
	←G	φ5G	
5 (WB RT)	R	φ8R	R
	←Y	φ8Y	
	←G	φ8G	
	←G	φ5G	
6 (WB)	R	φ8R	R
	Y	φ8Y	
	G	φ8G	
	←G	φ8G	
7 (WB LT)	R	φ8R	R
	Y	φ8Y	
	G	φ8G	
	←Y	φ3Y	
a-a (N-S)	DW	φ6R	OFF
	FDW	φ6Y	
	W	φ6G	

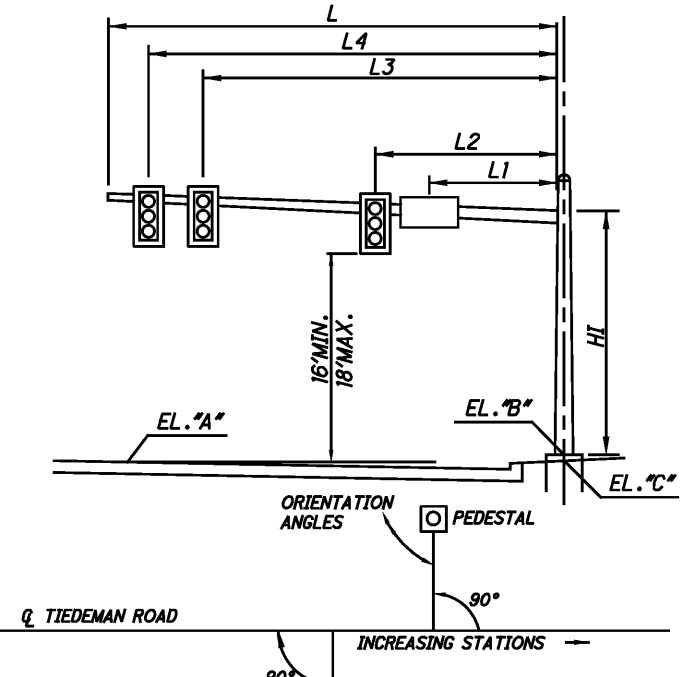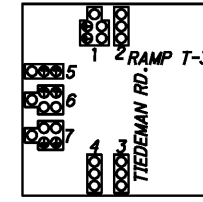


**DETECTOR CHART**

LOOP DESIGNATION	SIZE (FEET)	PULSE OR PRESENCE	DELAY (SECONDS)	EXTENSION (SECONDS)	ASSOCIATED CONTROLLER PHASE	REMARKS
L-1	6'x30'	PRESENCE	-	-	φ5	POWERHEAD
L-2	6'x30'	PRESENCE	-	-	φ3	POWERHEAD
L-3	6'x30'	PRESENCE	-	-	φ8	POWERHEAD
L-4	6'x30'	PRESENCE	-	-	φ8	POWERHEAD
L-5	6'x30'	PRESENCE	-	-	φ8	POWERHEAD

**TRAFFIC SYSTEM COORDINATION TIMING**

	PLAN 1	PLAN 2	PLAN 3	PLAN 4
CYCLE LENGTH	100 SEC	100 SEC	100 SEC	FREE
PHASE 1 SPLIT				
PHASE 2 SPLIT	60	60	67	
PHASE 3 SPLIT				
PHASE 4 SPLIT				
PHASE 5 SPLIT	25	26	33	
PHASE 6 SPLIT	35	34	34	
PHASE 7 SPLIT				
PHASE 8 SPLIT	40	40	33	
OFFSET	0	0	0	
TIME OF DAY SCHEDULE	5:00-10:00 M-F	10:00-14:00 M-F 18:00-22:00 M-F 8:00-20:00 SAT-SUN	14:00-18:00 M-F	ALL OTHER TIMES

NOTES:  
 1) ALL ANGLES MEASURED CLOCKWISE.  
 2) BASE PLATE IS ORIENTED SQUARE TO MAST ARM 'A' (LARGEST ARM) EVEN IF SUPPORT HAS TWO MAST ARMS.

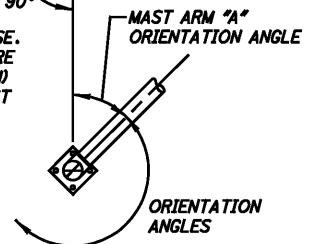

**SIGNAL SUPPORT TYPE TC-81.21**

ARM	POLE NO.	POLE DESIGN NO.	ARM DESIGN NO.	POLE HEIGHT (FT.)	HI	L	L1	L2	L3	L4	L5	L6	ELEVATIONS			ANGLES (DEG.) FROM MAST ARM 'A'				825 EACH	
													'A'	'B'	'C'	MAST ARM 'A' ORIENTATION ANGLE	HANDHOLE	MAST ARM 'B'	PEDESTRIAN SIGNAL HEAD		PEDESTRIAN PUSH BUTTON
	SP1	11	11	23	20'	44'	42.5'	27'	39'	22'			777.28	777.54	777.29	0	180	-	180	170	1
A	SP2	*	13	28	19.5'	53'		26'	39'	52'			777.71	778.61	778.36	270	180	90	-	-	1
B			11		20.5'	43'		30'	42'				778.88	778.61	778.36	-	-	-	-	-	
C			*			13'															
	PP1	-	-	8															0	0	
	PP2	-	-	8															180	190	
	PP3	-	-	8															0	0	


\* TC-12.30 POLE, DESIGN 9 WITH TC-81.21 ARMS \* TYPE TC-12.30 ARM, DESIGN 5

**WIRING DIAGRAM**

**WIRING LEGEND**

- VEHICULAR SIGNAL 5-SECTION
- VEHICULAR SIGNAL 3-SECTION OR 4-SECTION
- PEDESTRIAN PUSHBUTTON
- PEDESTRIAN SIGNAL
- LOOP DETECTOR
- POWER SERVICE POLE
- METER AND DISCONNECT SWITCH

POWER CABLE METER AND DISCONNECT SWITCH SHALL BE MOUNTED TO CONTROLLER CABINET


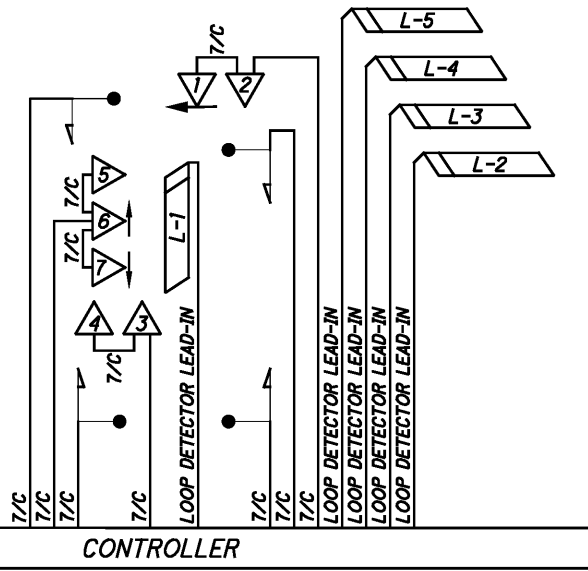


TRAFFIC SIGNAL DETAILS  
TIEDEMAN ROAD AND RAMP T-3


CUY-480-11.60

I:\Projects\18063\Signals\Sheets\18063GD001.dgn 2/5/2015 10:29:24 AM michael\_j.thompson

MJT	2/5/15	AS-BUILTS
REV. BY	DATE	DESCRIPTION
DATE COMPLETED		

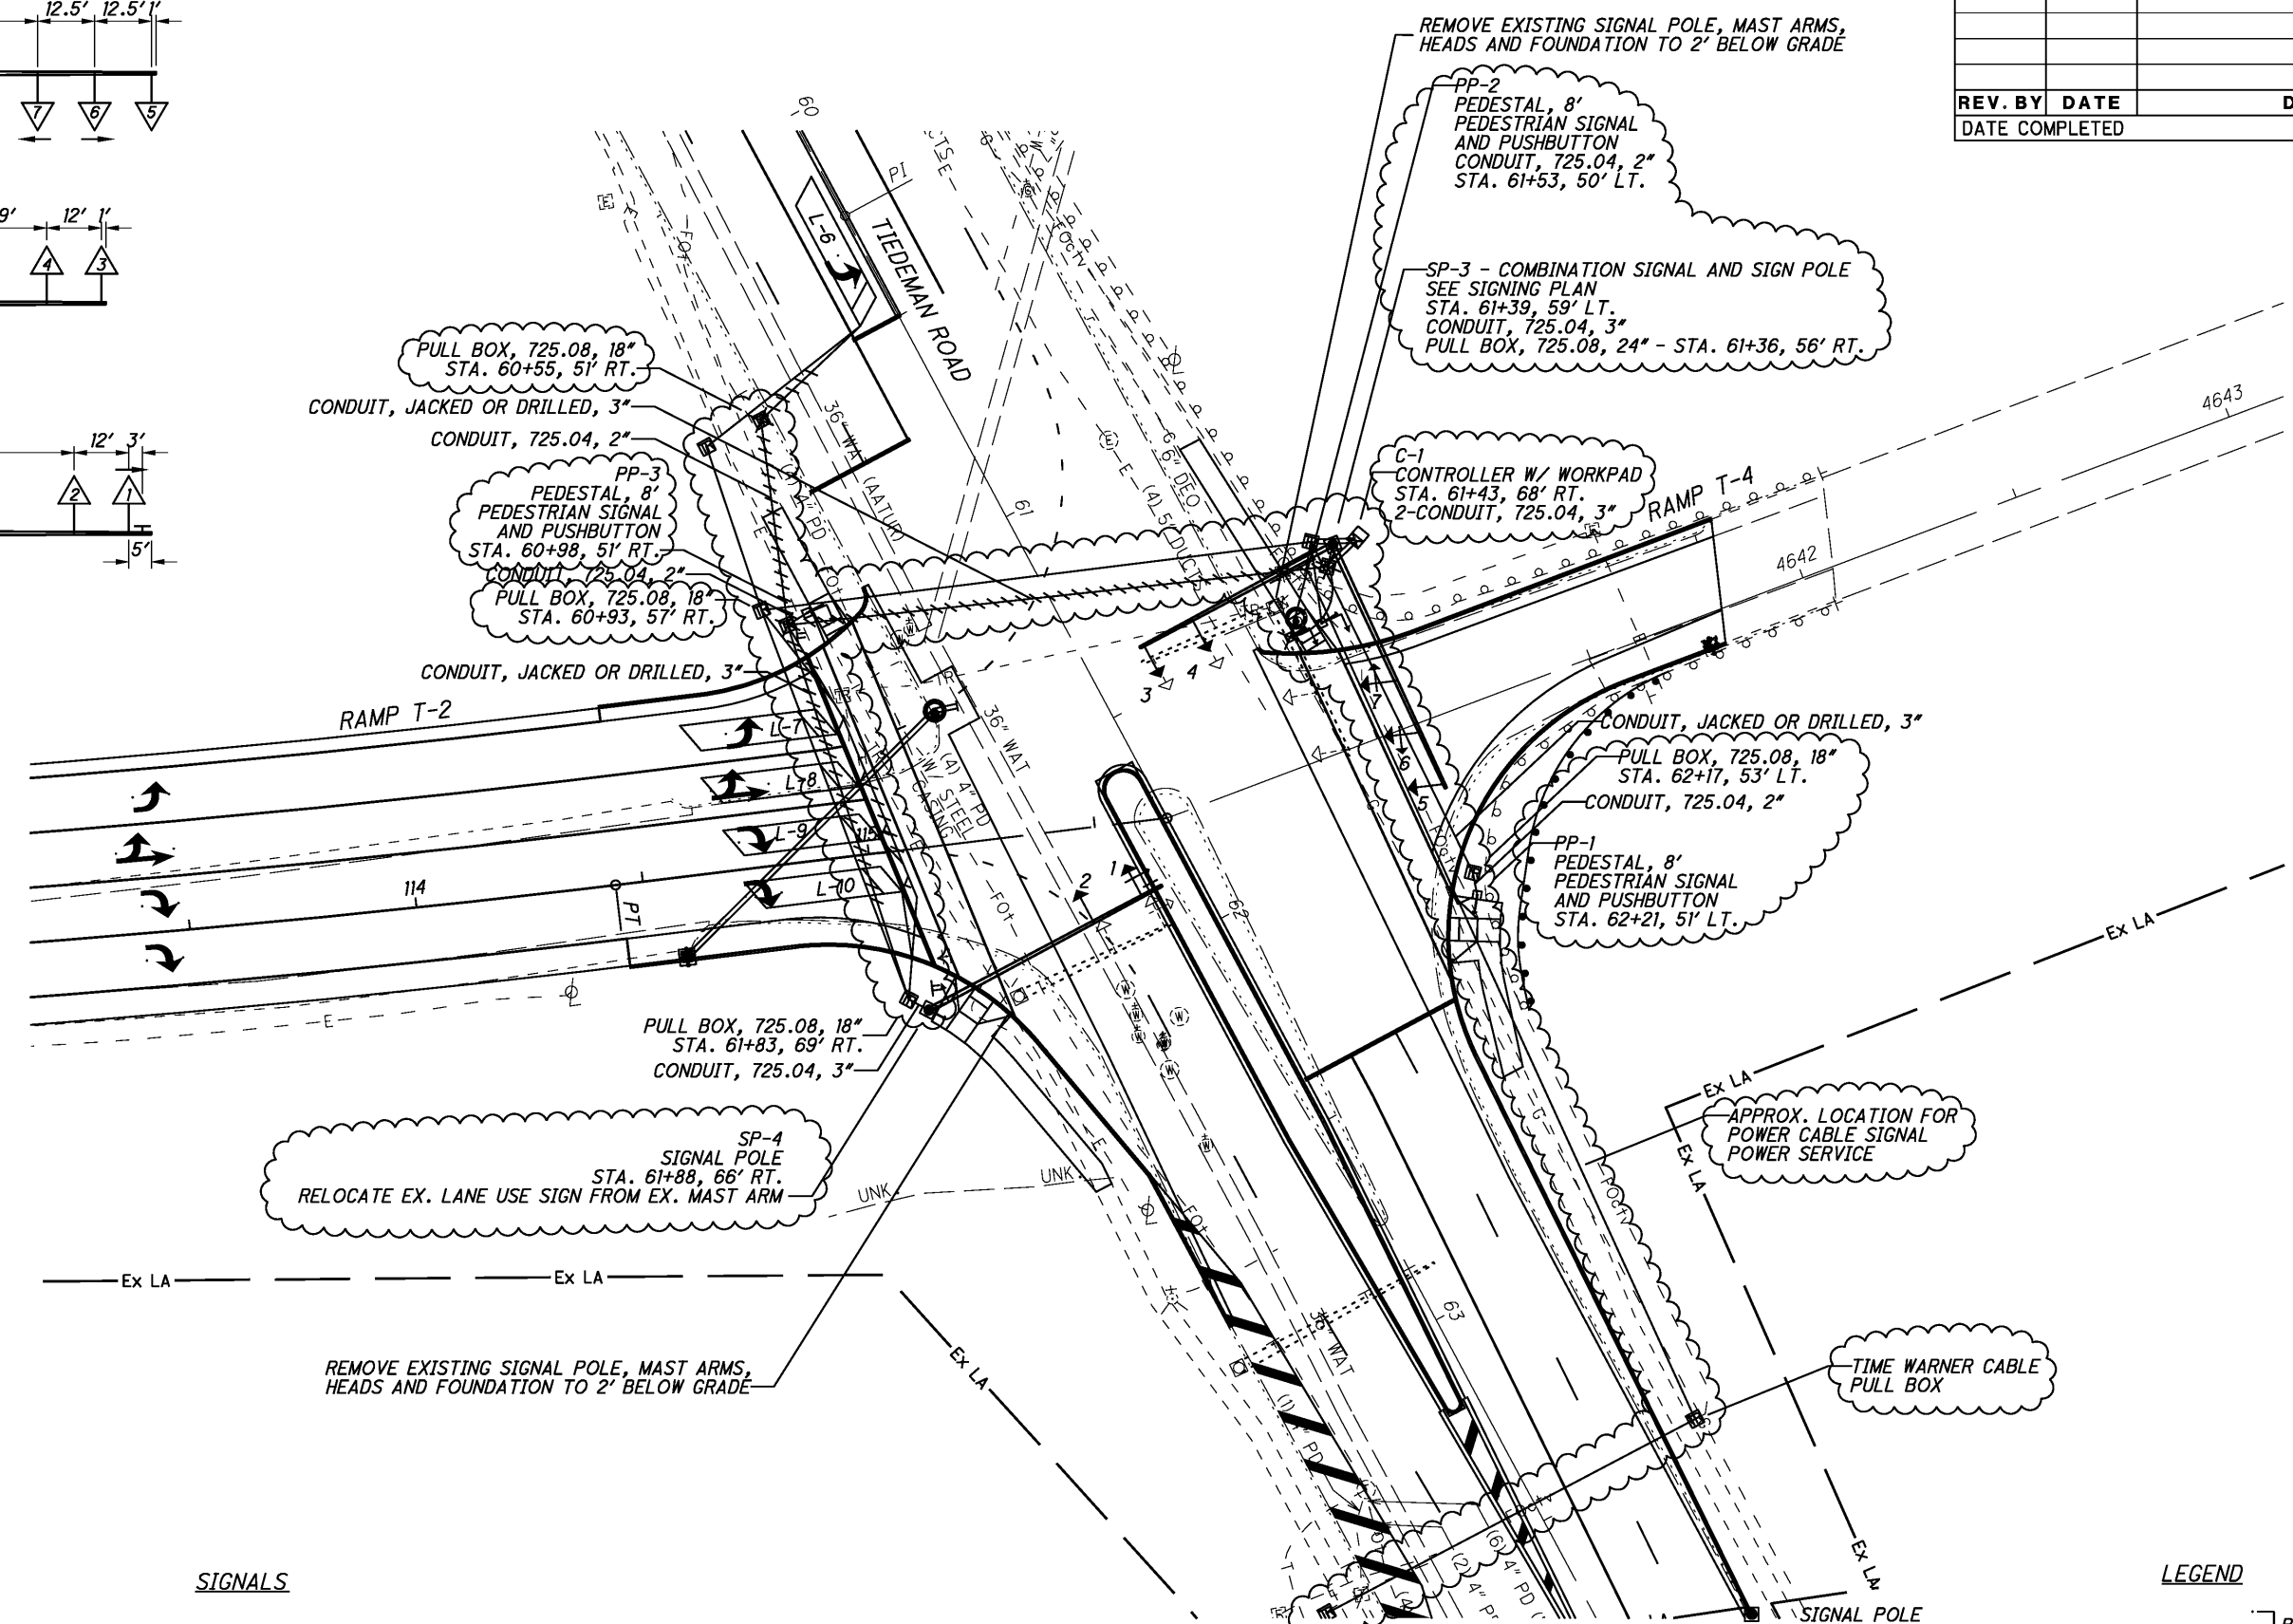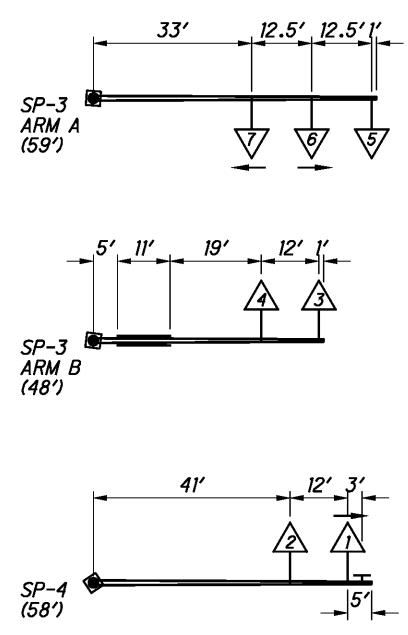

**SIGNALS**

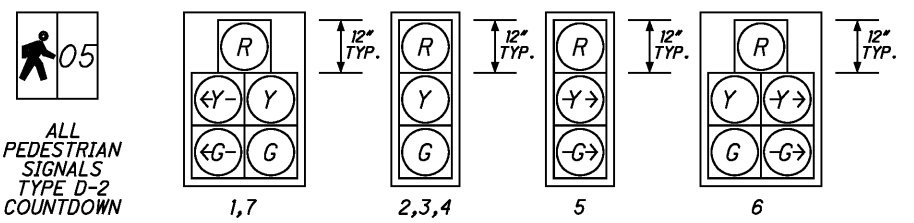

**LEGEND**

	SIGNAL POLE		PEDESTRIAN SIGNAL WITH PUSHBUTTON
	PEDESTAL		PEDESTRIAN SIGNAL
	GROUND MOUNTED CONTROLLER W/WORK PAD		LOOP DETECTOR
	PULL BOX		CONDUIT
	VEHICULAR SIGNAL 3-SECTION		
	VEHICULAR SIGNAL 3-SECTION W/ARROW		
	VEHICULAR SIGNAL 5-SECTION		

I:\Projects\18063\Signals\Sheets\18063GP002.dgn 2/5/2015 10:29:25 AM michael.j.thompson

**SIGNAL PLAN TIEDEMAN AND RAMP T-2**

**CUY-480-11.60**


MJT	2/5/15	AS-BUILTS
REV. BY	DATE	DESCRIPTION
DATE COMPLETED		

CALCULATED  
MEP  
CHECKED  
KPW

**TIMING CHART**



INTERVAL OR FEATURE	CONTROLLER MOVEMENT NUMBER							
	1	2	3	4	5	6	7	8
INTERSECTION MOVEMENT	SB LT	NB		EB		SB		
MINIMUM GREEN (INITIAL) (SEC.)	5	28		7		28		
VEHICLE EXTENSION (SEC.)	4	5		5		5		
MAXIMUM GREEN (SEC.)	30	48		19		48		
YELLOW CHANGE (SEC.)	2.9	3.6		3.6		3.6		
ALL RED CLEARANCE (SEC.)	3.8	2.7		2.7		2.7		
WALK (SEC.)	-	4		-		4		
PEDESTRIAN CLEARANCE (SEC.)	-	22		-		22		
RECALL								
MAXIMUM (ON/OFF)	OFF	OFF		OFF		OFF		
MINIMUM (ON/OFF)	OFF	ON		OFF		ON		
PEDESTRIAN (ON/OFF)	OFF	OFF		OFF		OFF		

**PHASING DIAGRAM**

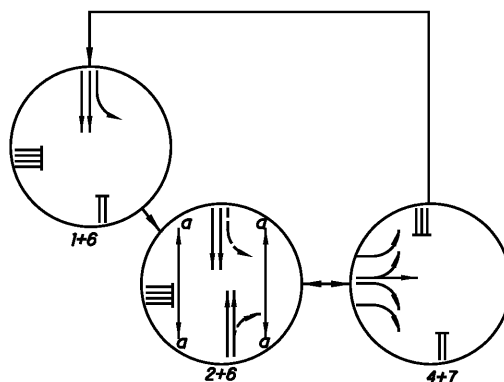

**FIELD WIRING HOOK-UP CHART**

SIGNAL HEAD #	INDICATION	FIELD TERMINAL	FLASH
1 (SB LT)	R	φ6R	Y
	Y	φ6Y	
	G	φ6G	
	←	φ1Y	
2 (SB)	R	φ6R	Y
	Y	φ6Y	
	G	φ6G	
3 (NB)	R	φ2R	Y
	Y	φ2Y	
4 (NB)	R	φ2R	Y
	Y	φ2Y	
5 (EB RT)	R	φ4R	R
	←	φ4Y	
	→	φ4G	
6 (EB)	R	φ4R	R
	Y	φ4Y	
	G	φ4G	
7 (EB LT)	R	φ4R	R
	Y	φ4Y	
	G	φ4G	
a-a (N-S)	DW	φ2R	OFF
	FDW	φ2Y	
	W	φ2G	

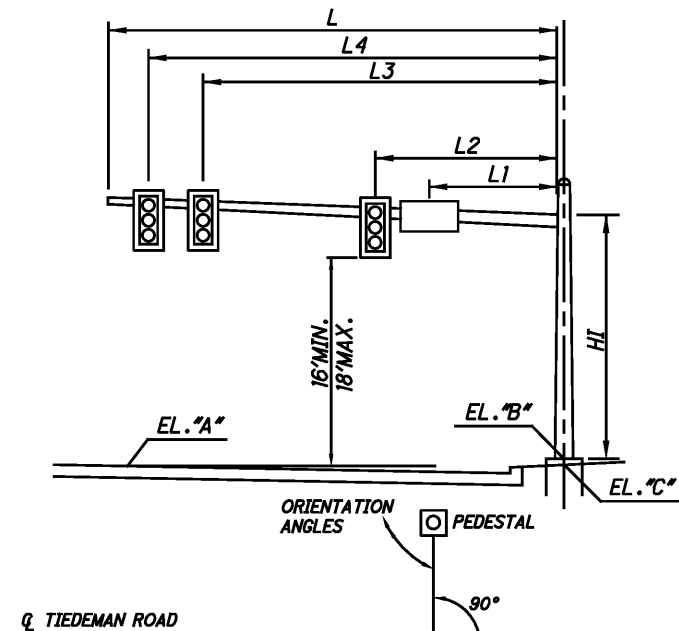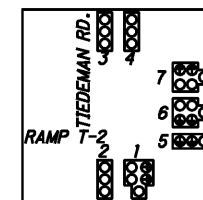


**DETECTOR CHART**

LOOP DESIGNATION	SIZE (FEET)	PULSE OR PRESENCE	DELAY (SECONDS)	EXTENSION (SECONDS)	ASSOCIATED CONTROLLER PHASE	REMARKS
L-6	6'x30'	PRESENCE	-	-	φ1	POWERHEAD
L-7	6'x30'	PRESENCE	-	-	φ7	POWERHEAD
L-8	6'x30'	PRESENCE	-	-	φ4	POWERHEAD
L-9	6'x30'	PRESENCE	-	-	φ4	POWERHEAD
L-10	6'x30'	PRESENCE	-	-	φ4	POWERHEAD

**TRAFFIC SYSTEM COORDINATION TIMING**

	PLAN 1	PLAN 2	PLAN 3	PLAN 4
CYCLE LENGTH	100 SEC	100 SEC	100 SEC	FREE
PHASE 1 SPLIT	28	25	25	
PHASE 2 SPLIT	35	45	45	
PHASE 3 SPLIT				
PHASE 4 SPLIT	37	30	30	
PHASE 5 SPLIT				
PHASE 6 SPLIT	63	70	70	
PHASE 7 SPLIT				
PHASE 8 SPLIT				
OFFSET	47	53	58	
TIME OF DAY SCHEDULE	5:00-10:00 M-F	10:00-14:00 M-F 18:00-22:00 M-F 8:00-20:00 SAT-SUN	14:00-18:00 M-F	ALL OTHER TIMES

NOTES:  
1) ALL ANGLES MEASURED CLOCKWISE.  
2) BASE PLATE IS ORIENTED SQUARE TO MAST ARM "A" (LARGEST ARM) EVEN IF SUPPORT HAS TWO MAST ARMS.

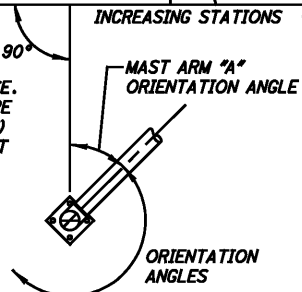

**SIGNAL SUPPORT TYPE TC-81.21**



ARM	POLE NO.	POLE DESIGN NO.	ARM DESIGN NO.	POLE HEIGHT (FT.)	HI	L	L1	L2	L3	L4	L5	L6	ELEVATIONS			ANGLES (DEG.) FROM MAST ARM "A"				825 EACH	
													"A"	"B"	"C"	MAST ARM "A" ORIENTATION ANGLE	HANDHOLE	MAST ARM "B"	PEDESTRIAN SIGNAL HEAD		PEDESTRIAN PUSH BUTTON
A	SP3	#	13	26	19'	59'	33'	45.5'	58'				778.02	779.63	779.13	270	180	90	-	-	1
B			12		20'	48'	35'	47'					779.27	779.63	779.13	-	-	-	-	-	-
C			#		16'																
	SP4	13	13	23	19.5'	58'	56'	41'	53'				778.25	779.47	778.97	0	180	-	0	45	1
	PP1	-	-	8															315	315	
	PP2	-	-	8															180	180	
	PP3	-	-	8															0	0	

\* TC-12.30 POLE, DESIGN 9 WITH TC-81.21 ARMS \* TYPE TC-12.30 ARM, DESIGN 5 PEDESTALS ANGLES ARE MEASURED PERPENDICULAR TO TIEDEMAN ROAD

**WIRING DIAGRAM**

**WIRING LEGEND**

- VEHICULAR SIGNAL 5-SECTION
- VEHICULAR SIGNAL 3-SECTION OR 4-SECTION
- PEDESTRIAN PUSHBUTTON
- PEDESTRIAN SIGNAL
- LOOP DETECTOR
- POWER SERVICE POLE
- METER AND DISCONNECT SWITCH

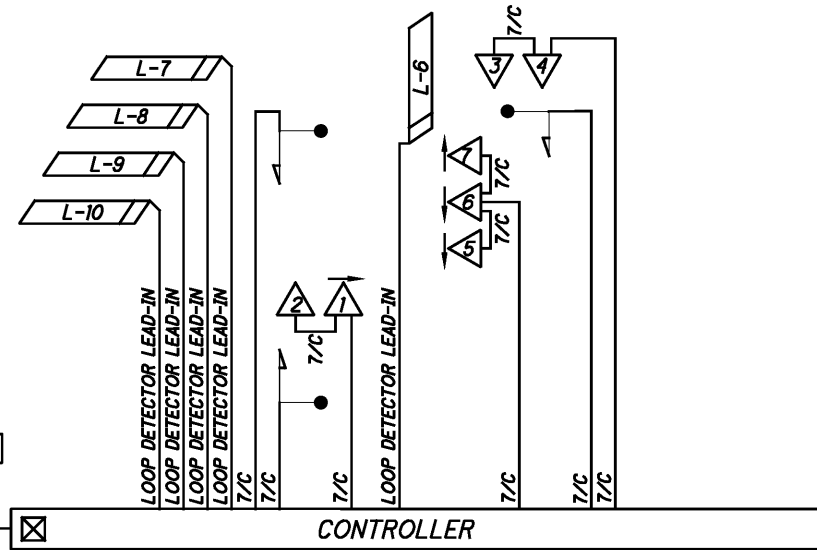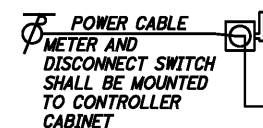

TRAFFIC SIGNAL DETAILS  
TIEDEMAN ROAD AND RAMP T-2

CUY-480-11.60

I:\Projects\18063\Signals\Sheets\18063GD002.dgn 2/5/2015 10:29:26 AM michael.j.thompson