


R:\17000\1726 - CUY-90-18.22_Culverts\Microstation Project\92069_CUY-90-18.22\Design\Roadway\Sheets\92069_DP501.dgn Sheet 9/10/2021 4:59:32 PM p.fingstern




PLACE ITEM 601 - CRUSHED AGGREGATE SLOPE PROTECTION ACROSS LIMITS OF PROPOSED GRADING

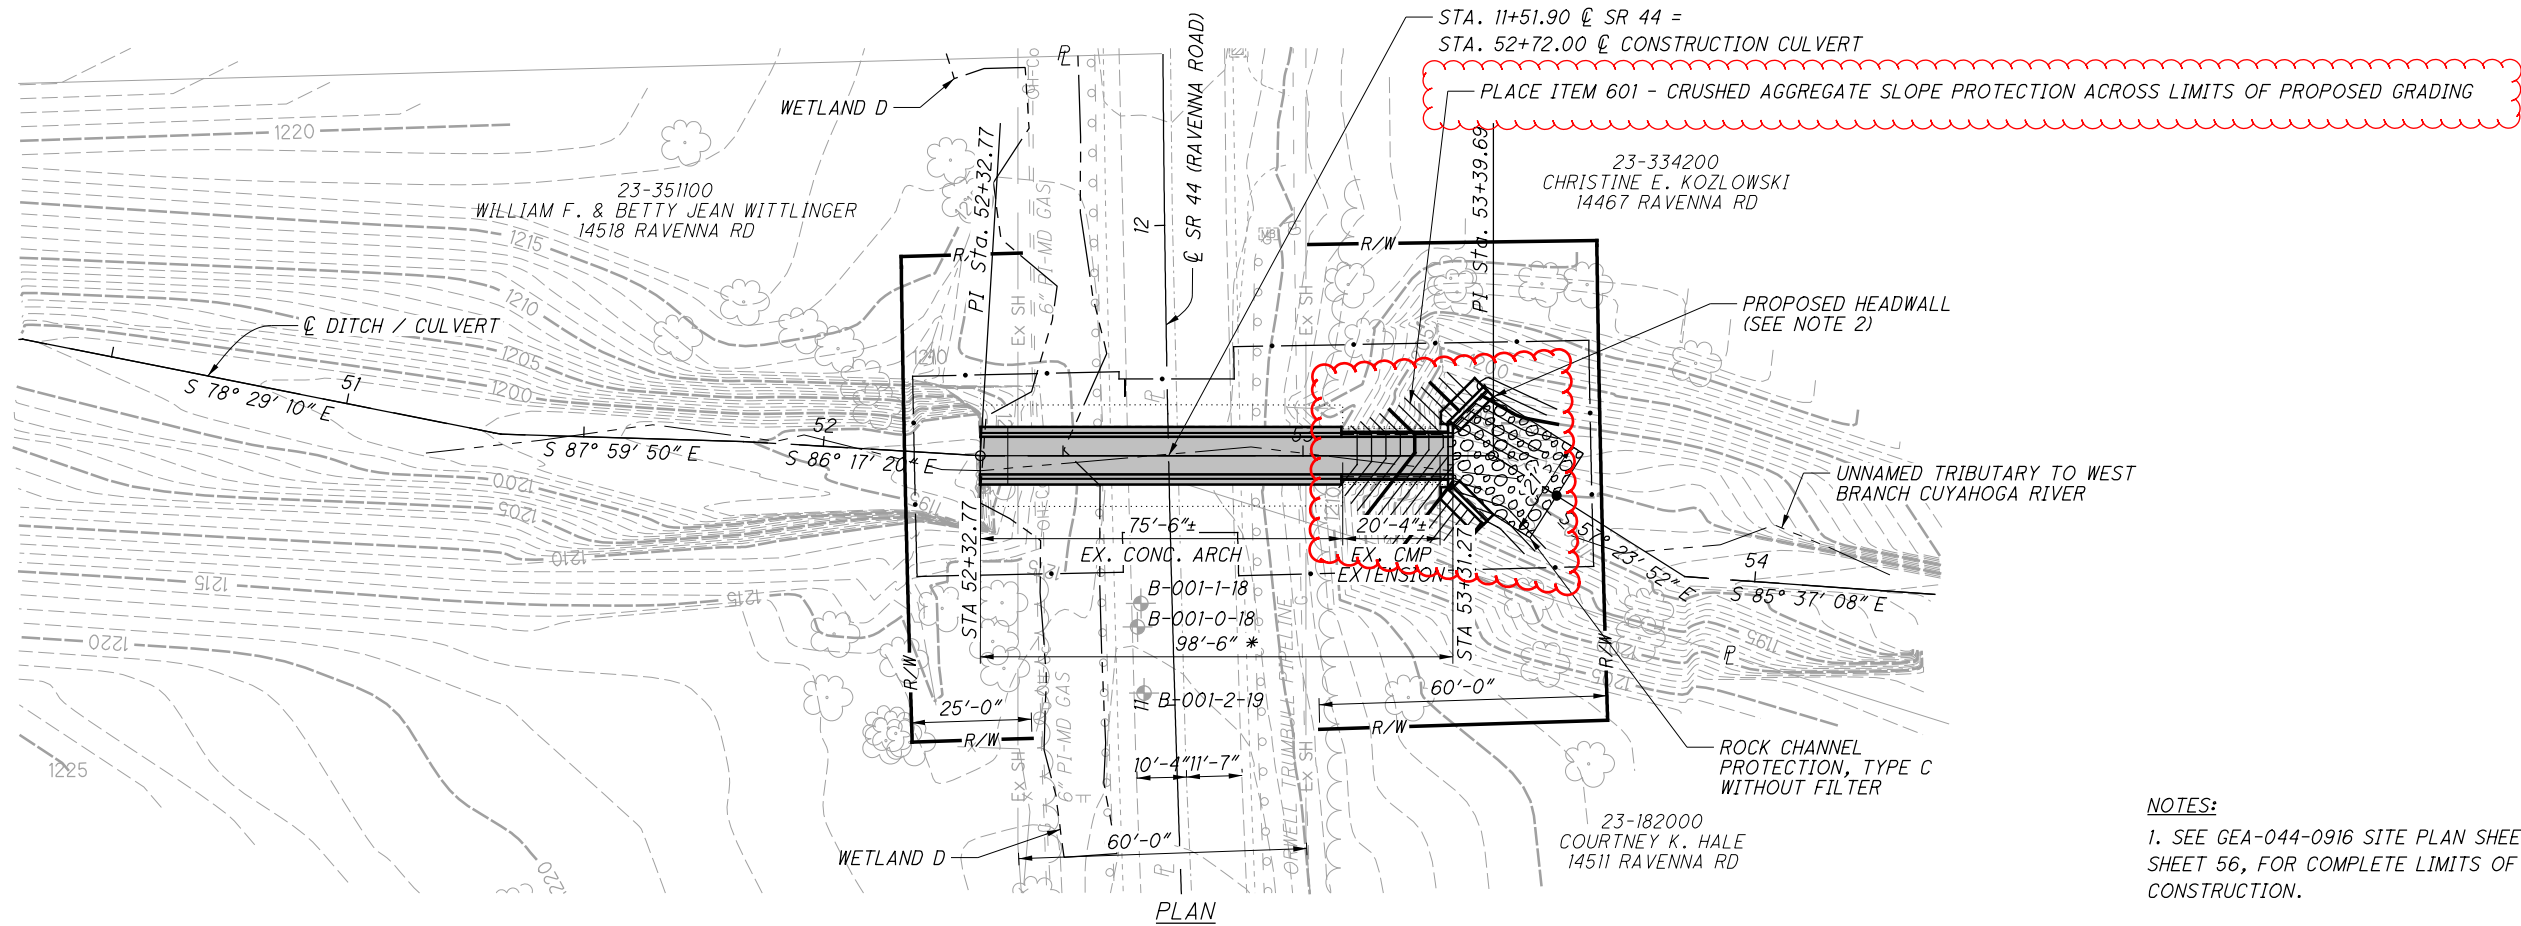

- NOTES:**
- SEE GEA-044-0916 SITE PLAN SHEET, SHEET 56, FOR COMPLETE LIMITS OF CONSTRUCTION.
 - SEE GEA-044-0916 DETAIL SHEET, SHEET 62, FOR ADDITIONAL HEADWALL DETAILS.

CULVERT PLAN AND PROFILE
SITE 5 - GEA-44-0916

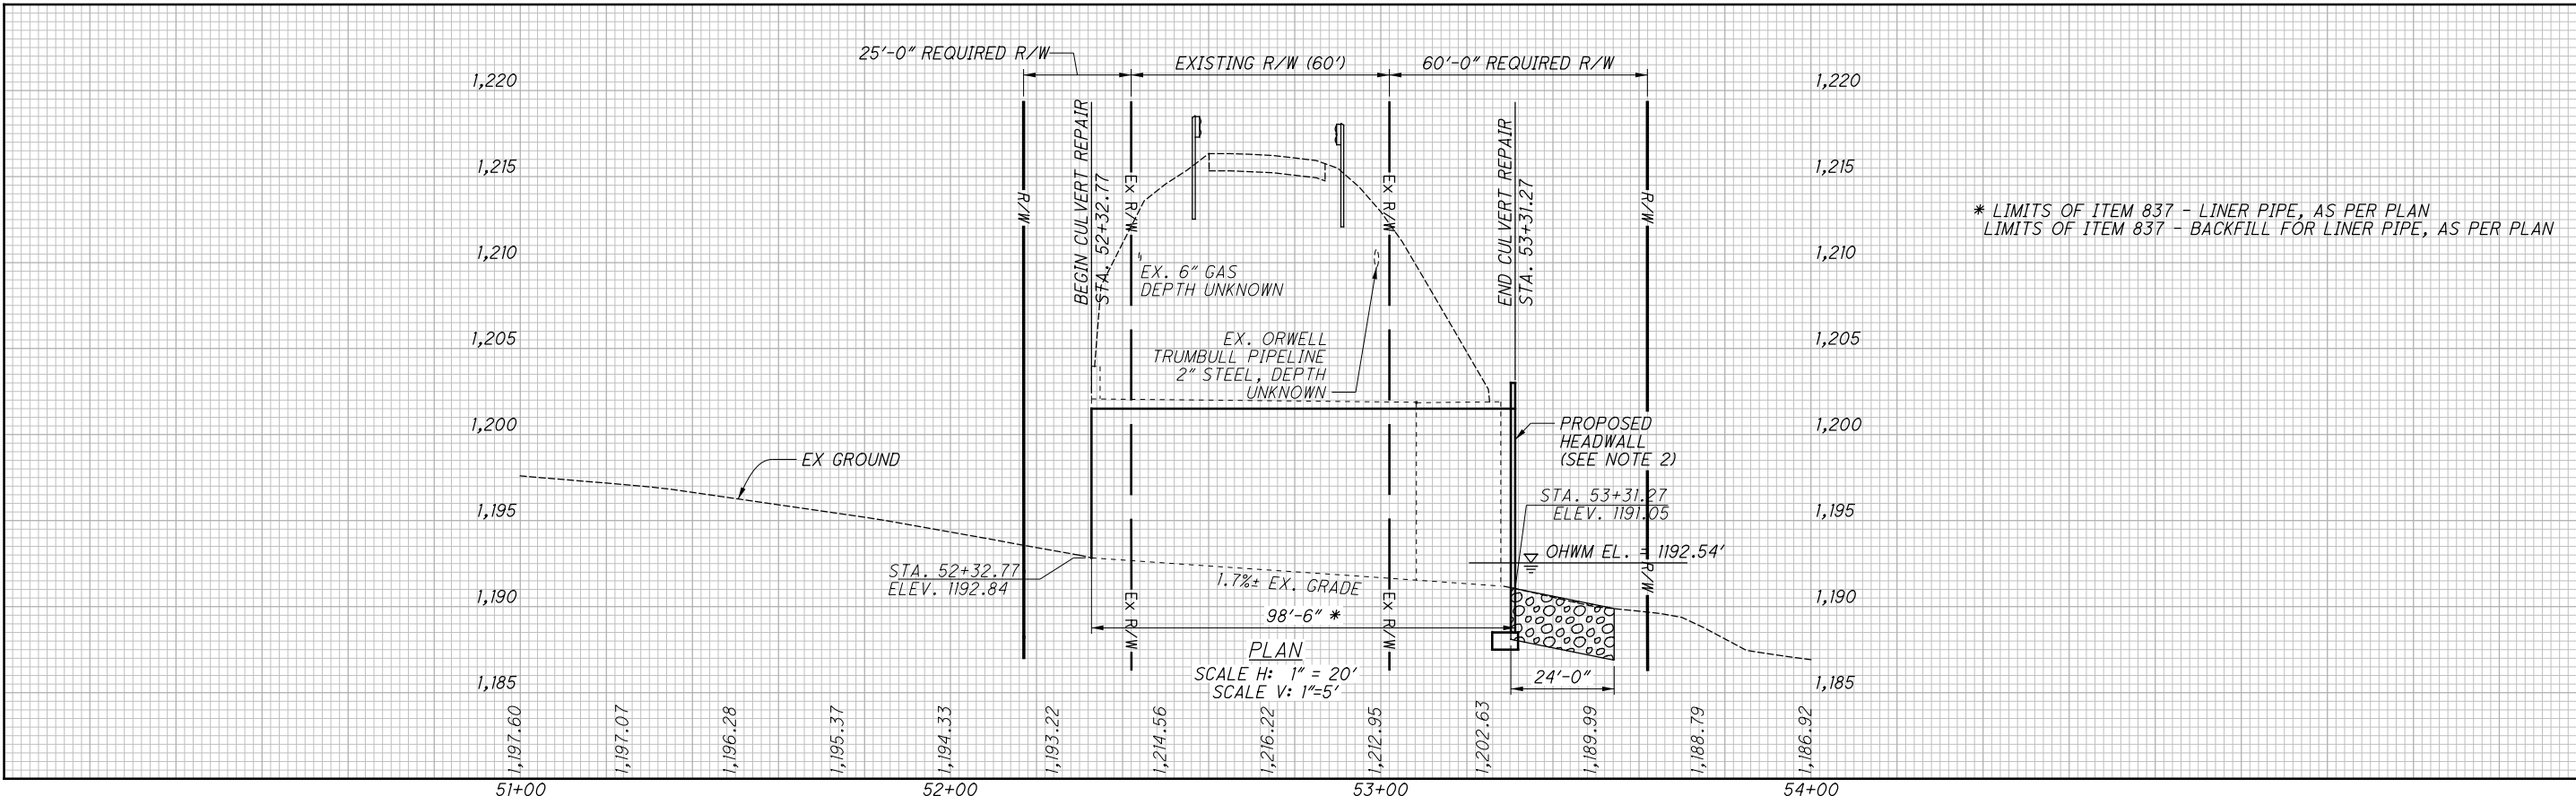

* LIMITS OF ITEM 837 - LINER PIPE, AS PER PLAN
LIMITS OF ITEM 837 - BACKFILL FOR LINER PIPE, AS PER PLAN