


D01 - PM FY21
 210013 PID - 101005
 Dist 1 1/14/2021

Contract Proposal available @
 www.contracts.dot.state.oh.us

I:\Project\dat\c\101005\Design\Roadway\Sheet\101005_G1001.dgn Sheet 8:19:01 10/19/2020 2:20:20 PM bolenba

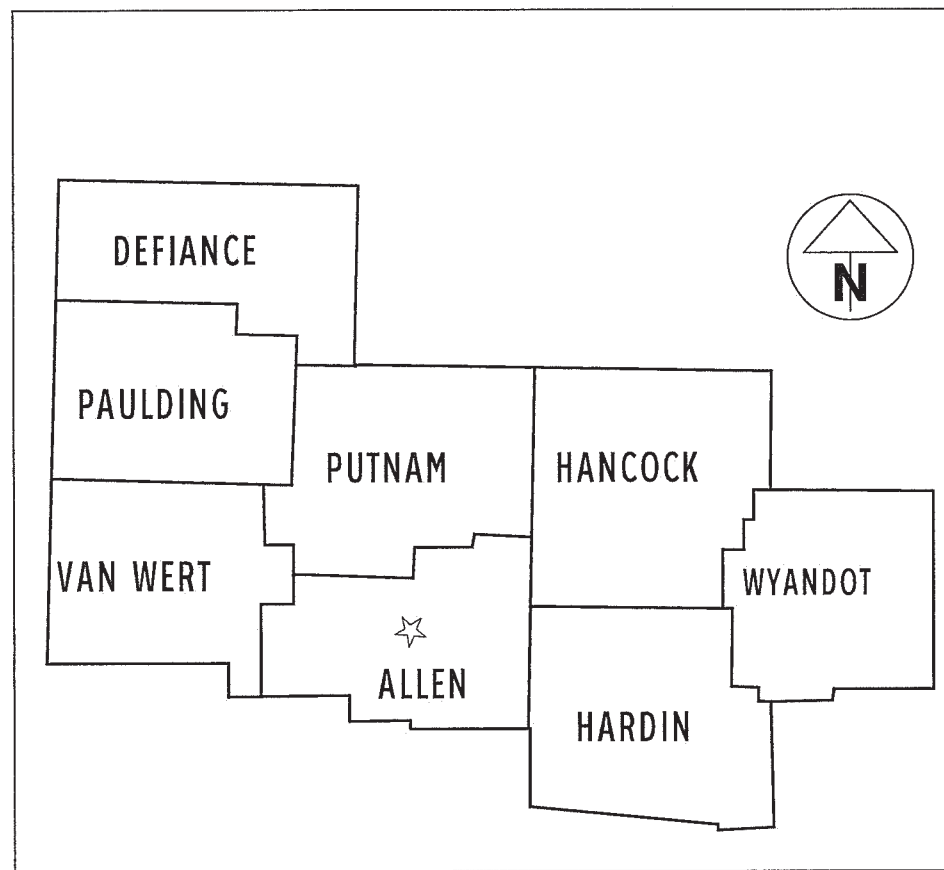

LOCATION MAP

LATITUDE: 40°42'30" LONGITUDE: 84°05'00"



DESIGN DESIGNATION

NONE

DESIGN EXCEPTIONS

NONE

UNDERGROUND UTILITIES
 Contact Two Working Days
 Before You Dig

OHIO811. 8-1-1, or 1-800-362-2764
 (Non-members must be called directly)

PLAN PREPARED BY:
 OHIO DEPARTMENT OF TRANSPORTATION
 DISTRICT ONE
 LIMA OHIO

ENGINEERS SEAL:

SIGNED: *Eric J. Scheckelhoff*
 DATE: October 16, 2020

STATE OF OHIO
 DEPARTMENT OF TRANSPORTATION

D01-PM-FY21

**DISTRICT ONE
 PAVEMENT MARKINGS**

INDEX OF SHEETS:

TITLE SHEET	1
GENERAL NOTES	2-3
MAINTENANCE OF TRAFFIC	4-6
GENERAL SUMMARY	7
SUBSUMMARIES	8-11

STANDARD CONSTRUCTION DRAWINGS						SUPPLEMENTAL SPECIFICATIONS	SPECIAL PROVISIONS
DM-4.3	1/15/16	MT-95.30	7/19/19	TC-41.20	10/18/13	800-2019	10/16/20
DM-4.4	1/15/16	MT-95.31	7/19/19	TC-42.10	10/18/13	821	4/20/12
		MT-95.32	4/19/19	TC-42.20	10/18/13	832	10/19/18
		MT-97.10	4/19/19	TC-52.10	10/18/13	921	4/20/12
		MT-98.10	1/17/20	TC-52.20	7/20/18		
		MT-98.11	1/17/20	TC-71.10	1/19/18		
		MT-98.20	4/19/19	TC-72.20	7/20/18		
		MT-99.20	4/19/19	TC-73.10	1/17/20		
		MT-105.10	1/17/20				

PROJECT DESCRIPTION

DISTRICT WIDE UPGRADE TO PAVEMENT MARKINGS AS SPECIFIED IN THE PLANS TO CURRENT STANDARDS

EARTH DISTURBED AREAS

PROJECT EARTH DISTURBED AREA:	ACRES
ESTIMATED CONTRACTOR EARTH DISTURBED AREA:	ACRES
NOTICE OF INTENT EARTH DISTURBED AREA:	ACRES

MAINTENANCE PROJECT

LIMITED ACCESS

THIS IMPROVEMENT IS ESPECIALLY DESIGNED FOR THROUGH TRAFFIC AND HAS BEEN DECLARED A LIMITED ACCESS HIGHWAY OR FREEWAY BY ACTION OF THE DIRECTOR IN ACCORDANCE WITH THE PROVISIONS OF SECTION 5511.02 OF THE OHIO REVISED CODE.

2019 SPECIFICATIONS

THE STANDARD SPECIFICATIONS OF THE STATE OF OHIO, DEPARTMENT OF TRANSPORTATION, INCLUDING SUPPLEMENTAL SPECIFICATIONS LISTED IN THE PLANS AND CHANGES LISTED IN THE PROPOSAL SHALL GOVERN THIS IMPROVEMENT.

APPROVED *Christopher A. Hughes*
 DATE 10/19/2020 DISTRICT DEPUTY DIRECTOR
 Digitally signed by Tom Pannett
 Date: 2020.12.04 10:40:09-05'00'
 APPROVED *Tom Pannett*
 DATE DIRECTOR, DEPARTMENT OF TRANSPORTATION

FEDERAL PROJECT NO.
 E210 017

PID NO.
 101005


CONSTRUCTION PROJECT NO.

RAILROAD INVOLVEMENT
 NONE

D01-PM-FY21

I:\Project\data\01005\Design\Roadway\Sheets\01005_IS004.dgn Sheet 12/18/2020 4:01:57 PM tboleba

Location				Funding Split	ITEM 643						ITEM 642			Early List	Location Description	Comment		
					Edge Line, 6"		Edge Line, 6" as per plan		Edge Line, 6" as per plan		Centerline	Lane Line	Lane Line				Wrong-Way Arrows	
					Miles	Miles	Mainline	Ramp	Mainline	Ramp	Miles	Miles	Miles					
County	Route	S.L.M. From	To	Miles	White	Yellow	White	Yellow	Miles	White	Black	EACH						
Van Wert	49	1.22	8.71	7.49	1	14.98							7.49		Y	US33 to US224		
Van Wert	49	19.83	22.32	2.49	1	4.98							2.49		Y	US30 to Paulding County Line		
Van Wert	117	0.00	3.11	3.11	1	6.22							3.11		Y	Mercer County Line to Allen County Line		
Van Wert	127	10.99	18.39	7.40	3	14.80							7.40		Y	US30 to Paulding County Line		
Van Wert	224	0.00	12.02	12.02	3	24.04							12.02		Y	Indiana State Line to US30		
Van Wert	637	0.00	4.01	4.01	1	8.02							4.01			US224 to Paulding County Line		
Van Wert	697	0.00	6.58	6.58	1	13.16							6.58		Y	SR116 to Delphos Corp.		
Van Wert	709	0.00	1.14	1.14	1	2.28							1.14		Y	SR118 to Township Hwy 58-A		
U.S.30 & Intersection																		
Tully Twp Rd	21	Klinger (South)																
County Rd	11	Benton (North)																8
Tully Twp Rd	71	Krick																8
Tully Twp Rd	27	Mentzer Church																8
Tully Twp Rd	214	Elm Sugar (West)																8
County Rd	214	Elm Sugar Grove Church (East)																8
Tully Twp Rd	37	Lare																8
Tully Twp Rd	208	Feasby-Wisener																8
Tully Twp Rd	47	S.R. 49 (North) & Payne																8
County Rd	192	Dixon Cavett																8
County Rd	55	S.R. 49 (South) & Convey Hellar																8
Union Twp Rd	65	Colwell																8
County Rd	168	Convoy																8
County Rd	75	Richey																8
County Rd	77	Liberty-Union																8
					Fund 1	49.64	0.00	0.00	0.00	0.00	0.00	24.82	0.00	0.00				
					Fund 2													
					Fund 3	38.84	0.00	0.00	0.00	0.00	0.00	19.42	0.00	0.00				104
								0.00	0.00	0.00	0.00							
Subtotal Van Wert County				36.75		88.48		0.00	0.00	0.00	0.00	44.24	0.00	0.00				104.00

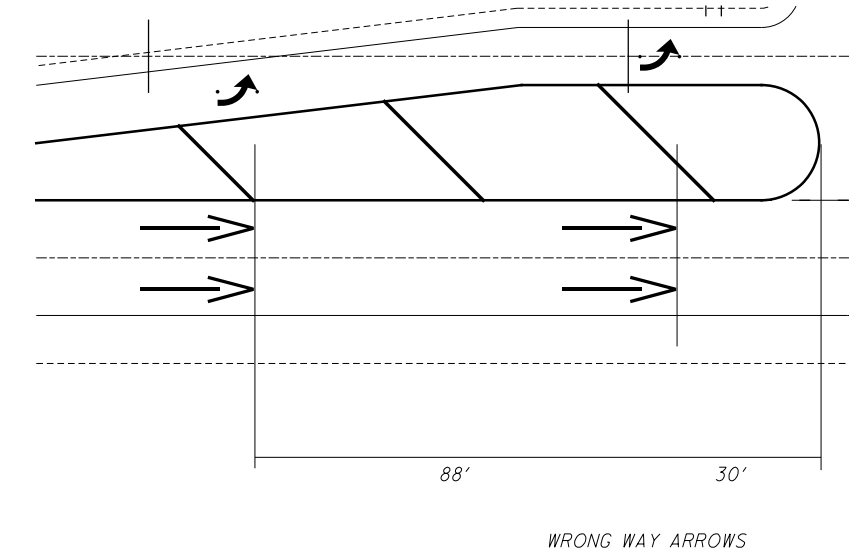

Location				Funding Split	ITEM 643						ITEM 642			Early List	Location Description	Comment		
					Edge Line, 6"		Edge Line, 6" as per plan		Edge Line, 6" as per plan		Centerline	Lane Line	Lane Line				Wrong-Way Arrows	
					Miles	Miles	Mainline	Ramp	Mainline	Ramp	Miles	Miles	Miles					
County	Route	S.L.M. From	To	Miles	White	Yellow	White	Yellow	Miles	White	Black	EACH						
Wyandot	30	17.86	24.56	6.70	2			13.40	2.63	13.40	2.63		13.40	13.40		US 23 to Crawford County Line	Four Lane Section w/Ramps (Concrete Section)	
Wyandot	67	0.00	14.42	14.42	3	28.84						14.42					Hardin County Line to SR53	
Wyandot	103	6.43	7.62	1.19	1	2.38						1.19			Y	US23 to SR199		
Wyandot	199	7.34	14.09	6.75	3	13.50						6.75			Y	Upper Sandusky Corp. to SR103		
Wyandot	231	0.00	10.33	10.33	3	20.66						10.33			Y	Marion County Line to CR330		
Wyandot	293	0.00	6.28	6.28	3	12.56						6.28			Y	SR53 to Cass Street		
Wyandot	294	0.00	15.89	15.89	3	31.78						15.89			Y	SR37 to SR231 (north intersection)		
Wyandot	294	17.60	18.35	0.75	3	1.50						0.75			Y	SR231 (south intersection) to Crawford County Line		
Wyandot	587	0.00	0.30	0.30	1	0.60						0.30				SR 53 to Seneca County Line		
					Fund 1	2.98	0.00	0.00	0.00	0.00	0.00	1.49	0.00	0.00				
					Fund 2	0.00	0.00	13.40	2.63	13.40	2.63	0.00	13.40	13.40				
					Fund 3	108.84	0.00	0.00	0.00	0.00	0.00	54.42	0.00	0.00				
								13.40	2.63	13.40	2.63							
Subtotal Wyandot County				55.91		111.82		16.03	16.03	55.91	13.40	13.40						

CALCULATED
TAB
CHECKED
EJS

TRAFFIC CONTROL SUBSUMMARY

D01-PM-FY21