



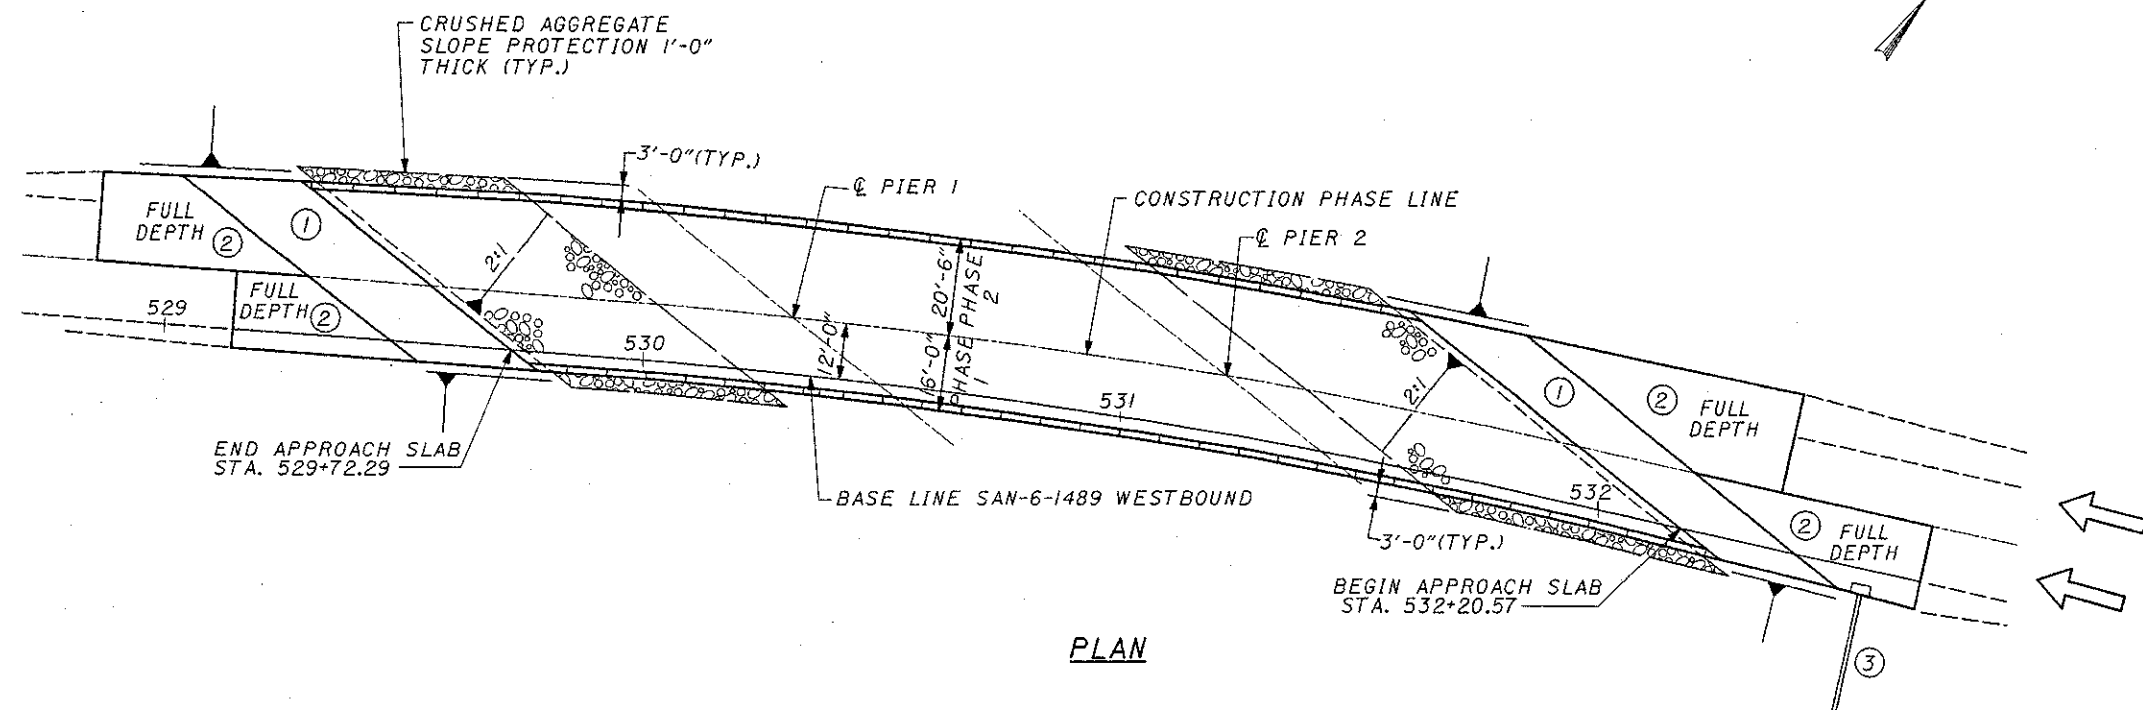

- ① FOR APPROACH SLAB DETAILS SEE SHEET 9
- ② FOR ROADWAY CONSTRUCTION DETAILS SEE SHEET 9
- ③ FOR CATCH BASIN AND DRAINAGE DETAILS SEE SHEET 11

VC DATA
PVI STA. 529+30
PVI EL. 647.93
LVC 60
G1 -0.467%
G2 -0.171%

VC DATA
PVI STA. 532+80
PVI EL. 647.33
LVC 80
G1 -0.171%
G2 +0.260%

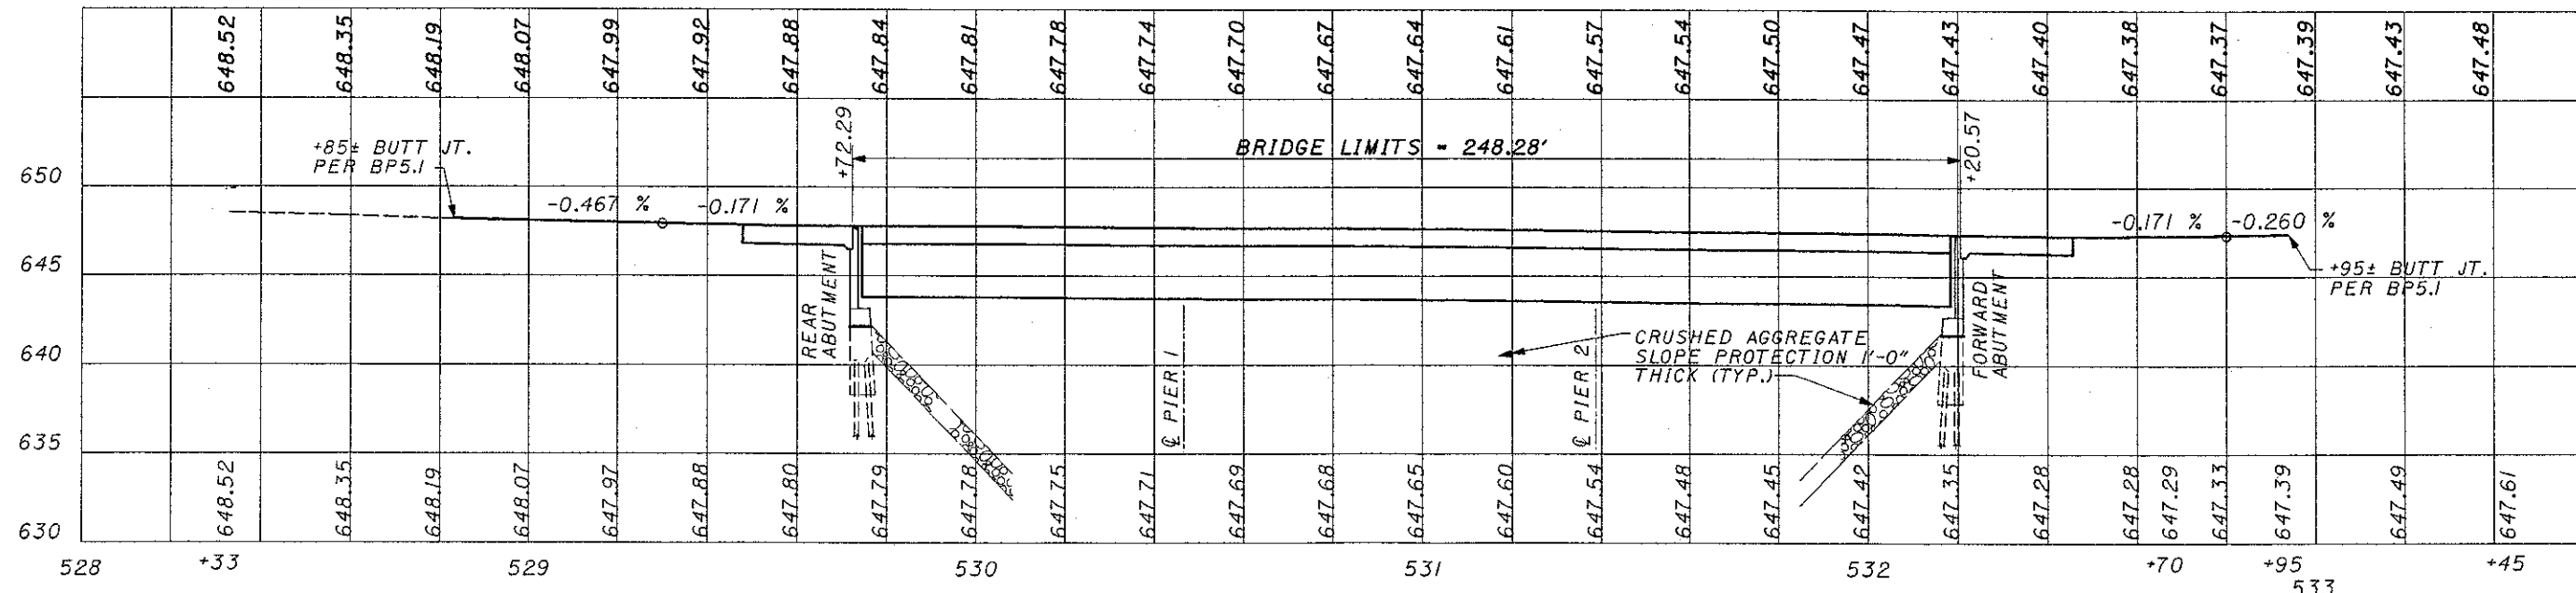

RECORD DRAWING