


Calc. by *SEM 7/52*
Chkd. by *EM 1/73*

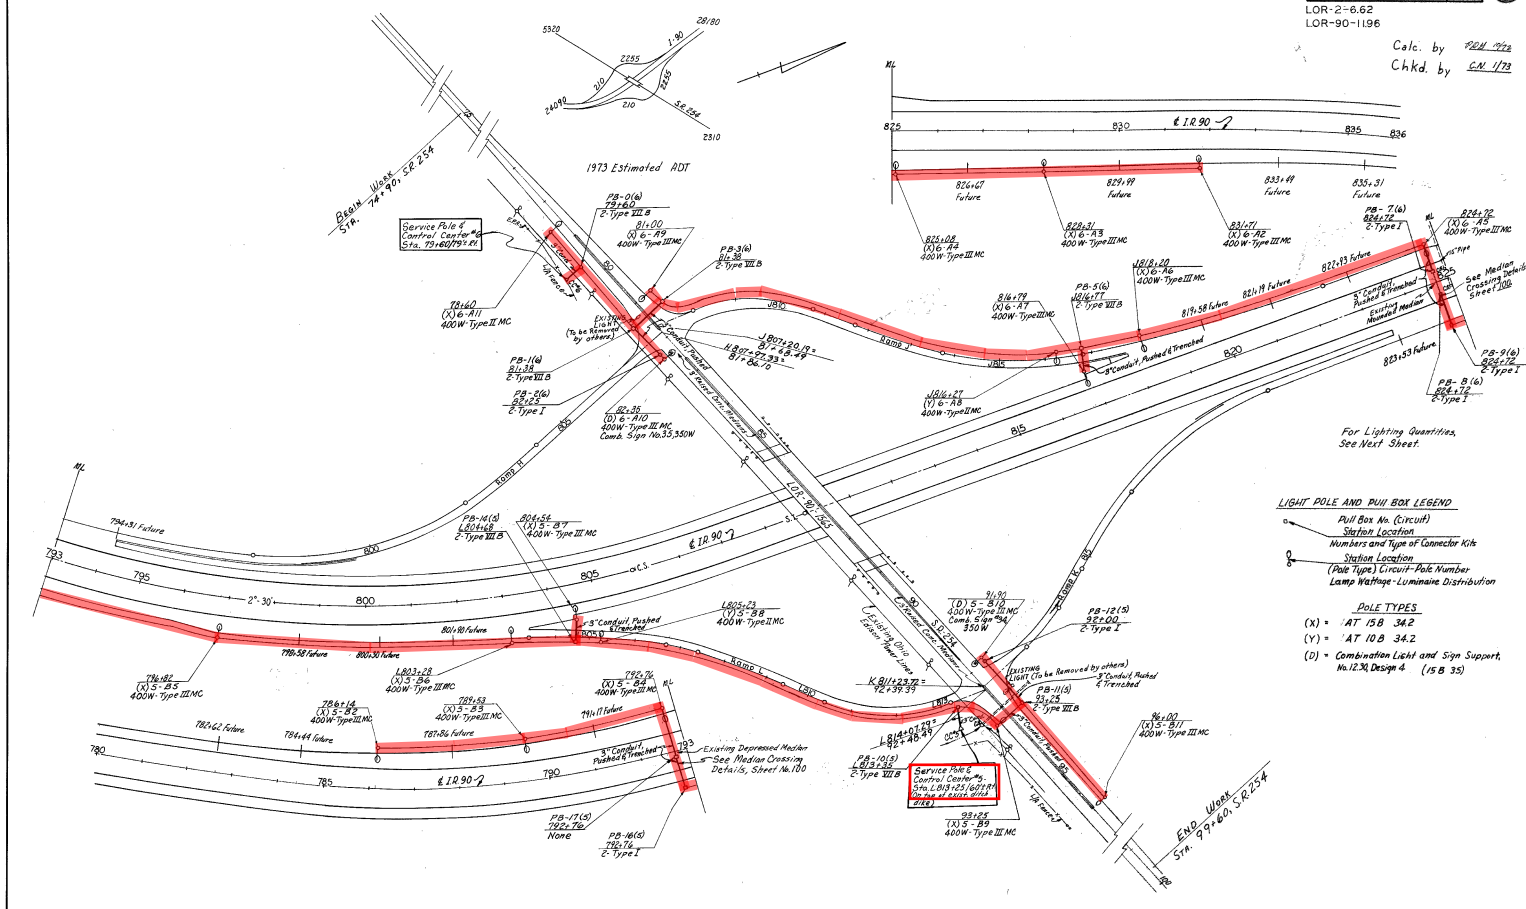

- For Lighting Quantities, See Next Sheet.
- LIGHT POLE AND PULL BOX LEGEND**
- Pull Box No. (Circuit)
 - Station Location
 - Numbers and Type of Connector Kots
 - Station Location
 - (Pole Type) Circuit-Pole Number
 - Lamp Waftage - Luminaire Distribution
- POLE TYPES**
- (X) - AT 15B 342
 - (Y) - AT 10B 342
 - (D) - Combination Light and Sign Support, No. 12, Design 4. (15 B 35)

SR 254 INTERCHANGE 780+00-836+00