

LOR-2 & BAUMHART ROAD EAST SIDE

D03-LG-FY2010


15
23

WORK DESCRIPTION

CONTRACTOR SHALL PERFORM THE FOLLOWING WORK ON THIS SHEET:
ADJUST TO GRADE LIGHT POLE FOUNDATIONS AT LOCATIONS CIRCLED
AND REPLACE POLE AND BRACKET CABLE.

ESTIMATED QUANTITIES

ITEM	UNIT	DESCRIPTION	QTY.
625	EACH	CONNECTOR KIT, TYPE II	8
625	EACH	CONNECTOR KIT, TYPE III	8
625	EACH	LIGHT POLE FOUNDATION, MISC: ADJUST TO GRADE, AS PER PLAN	8
625	FT	NO. 10 POLE AND BRACKET CABLE, AS PER PLAN	832
625	EACH	REMOVE AND REERECT EXISTING LIGHT POLE	8

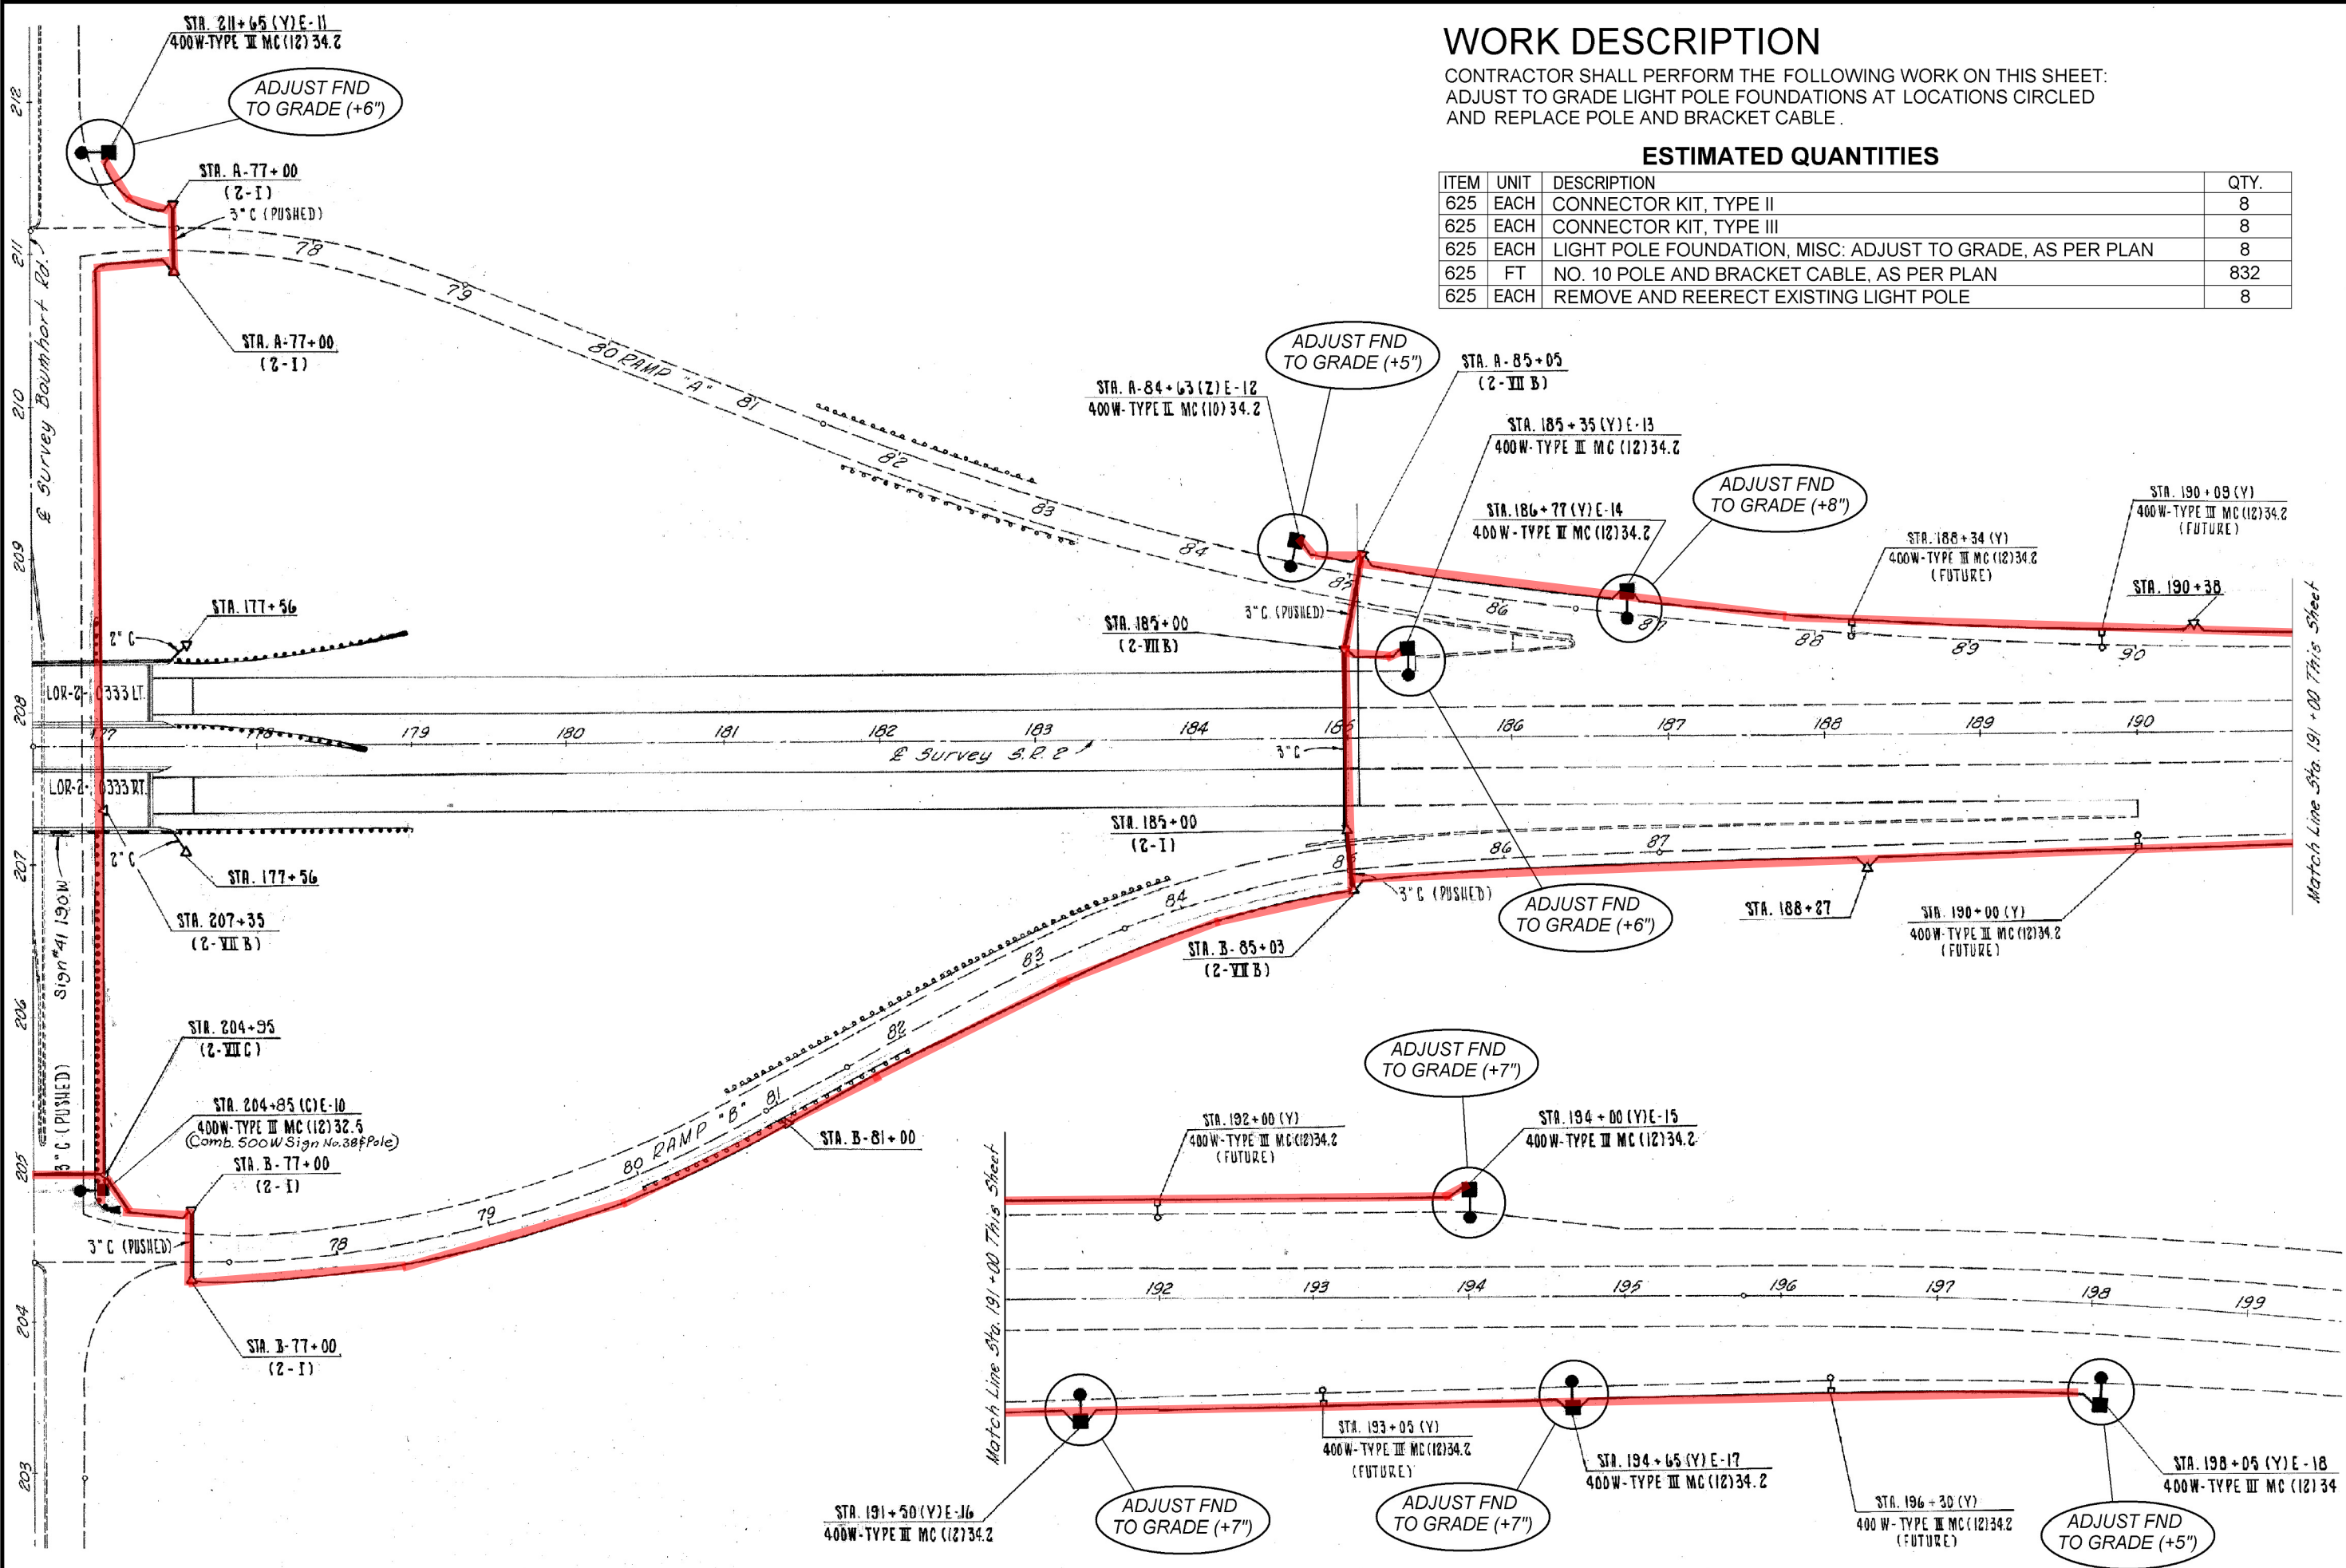

212
211
210
209
208
207
206
205
204
203

Match Line Sta. 191+00 This Sheet




Match Line Sta. 191+00 This Sheet

WORK DESCRIPTION

CONTRACTOR SHALL PERFORM THE FOLLOWING WORK ON THIS SHEET:
 ADJUST TO GRADE LIGHT POLE FOUNDATIONS AT LOCATIONS CIRCLED
 AND REPLACE POLE AND BRACKET CABLE.

ESTIMATED QUANTITIES

ITEM	UNIT	DESCRIPTION	QTY.
625	EACH	CONNECTOR KIT, TYPE II	7
625	EACH	CONNECTOR KIT, TYPE III	7
625	EACH	LIGHT POLE FOUNDATION, MISC: ADJUST TO GRADE, AS PER PLAN	7
625	FT	NO. 10 POLE AND BRACKET CABLE, AS PER PLAN	728
625	EACH	REMOVE AND REERECT EXISTING LIGHT POLE	7

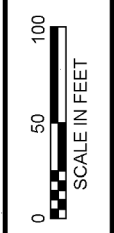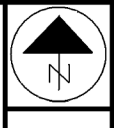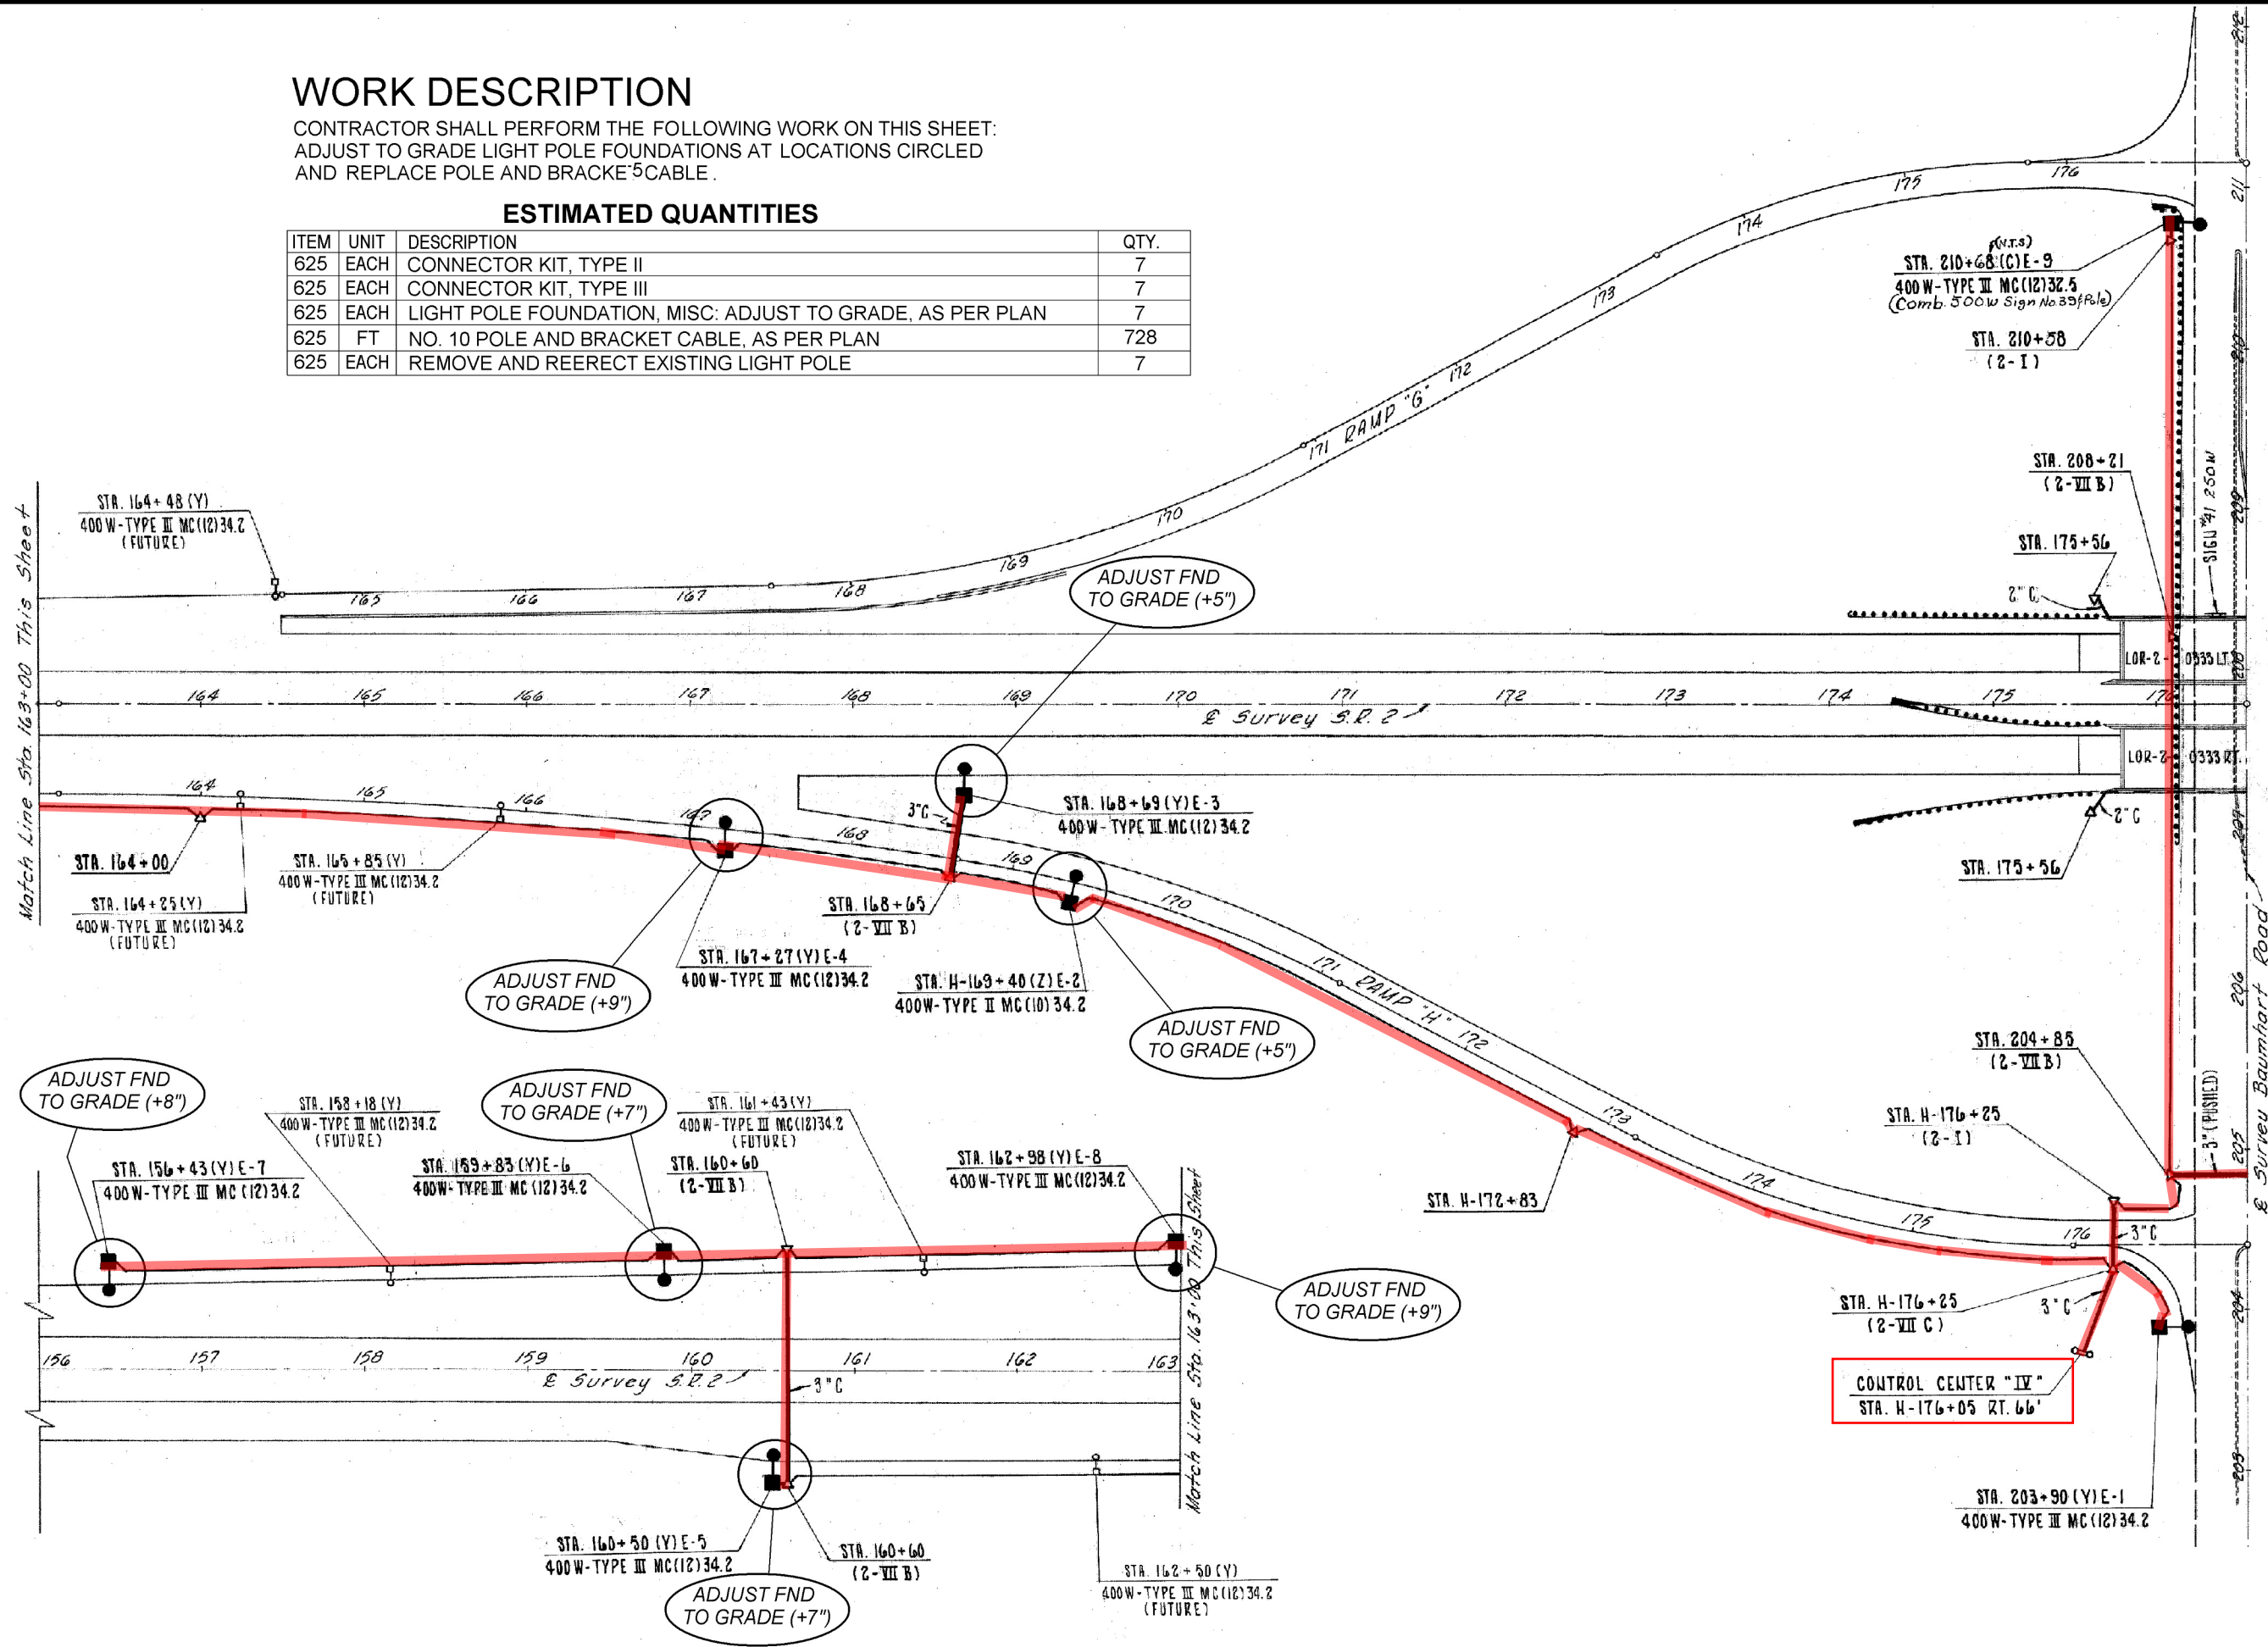

LOR-2 & BAUMHART ROAD WEST SIDE

D03-LG-FY2010

14
23