

**UTILITIES**

THERE ARE NO UNDERGROUND UTILITIES SHOWN ON THIS PLAN. THE NATURE OF THE WORK REQUIRED BY THIS PROJECT WILL NOT AFFECT ANY KNOWN UNDERGROUND UTILITIES THAT EXIST UNDER, OR ADJACENT TO, THE WORK AREA.

**WORK LIMITS**

THE WORK LIMITS SHOWN ON THESE PLANS ARE FOR PHYSICAL CONSTRUCTION ONLY. PROVIDE THE INSTALLATION AND OPERATION OF ALL WORK ZONE TRAFFIC CONTROL AND WORK ZONE TRAFFIC CONTROL DEVICES REQUIRED BY THESE PLANS WHETHER INSIDE OR OUTSIDE THESE WORK LIMITS.

**PAVEMENT MARKING LANE WIDTHS**

THE NORMAL LANE WIDTH FOR THE PAVEMENT MARKINGS ON THIS PROJECT SHALL BE AS FOLLOWS [AT LEAST 3 DAYS PRIOR TO PERFORMING THE WORK CONTACT THE TRAFFIC OFFICE AT 330-786-3147 TO CONFIRM THE WIDTHS]:

ROUTE	S.L.M. TO S.L.M.	LANE WIDTH
ATB-US-6	22.56 TO 23.17	12'
ATB-SR-534	23.54 TO 24.17	10'
ATB-SR-534	24.17 TO 24.60	12'
ATB-SR-534	24.60 TO 24.77	10'
ATB-SR-534	24.77 TO 25.26	12'
TRU-SR-46	23.64 TO 26.27	10'
TRU-SR-87	13.38 TO 15.35	12'
TRU-SR-87	15.35 TO 22.29	10'
TRU-SR-88	7.03 TO 12.32	12'

**PAVEMENT MARKING DETAILS**

THE PAVEMENT MARKING DETAIL SHEETS WILL BE SUPPLIED TO THE CONTRACTOR AT THE PRE-CONSTRUCTION MEETING. FOR ANY LOCATIONS THAT PAVEMENT MARKING DETAILS HAVE NOT BEEN MADE AVAILABLE TO THE CONTRACTOR, IT WILL BE THE CONTRACTORS RESPONSIBILITY TO PUT BACK NEW PAVEMENT MARKINGS IN THE ORIGINAL LOCATIONS.

**PROFILE AND ALIGNMENT**

PLACE THE PROPOSED PAVEMENT TO FOLLOW THE ALIGNMENT AND PROFILE OF THE EXISTING PAVEMENT. PLACE THE PROPOSED ASPHALT CONCRETE OVERLAY AS SHOWN ON THE TYPICAL SECTIONS.

**ITEM - REMOVAL OF PAVEMENT MARKING**

THIS ITEM OF WORK SHALL CONSIST OF REMOVING ALL PAVEMENT MARKINGS PRIOR TO THE APPLICATION OF ITEM 422, CHIP SEAL, UNDER THE DIRECTION OF THE ENGINEER. ALL EQUIPMENT, LABOR, TOOLS, AND INCIDENTALS NECESSARY TO COMPLETE THIS ITEM SHALL BE INCLUDED. THE FOLLOWING QUANTITIES HAVE BEEN CARRIED TO THE GENERAL SUMMARY:

**TOTALS**

- ITEM 644, REMOVAL OF PAVEMENT MARKING, 833 FEET **REVISED**
- ITEM 644, REMOVAL OF PAVEMENT MARKING, 62.15 MILES
- ITEM 644, REMOVAL OF PAVEMENT MARKING, 14 EACH
- ITEM 644, REMOVAL OF PAVEMENT MARKING, 171 SF


**PAVING AT RAILROAD CROSSING**

THE CONTRACTOR SHALL CHIP SEAL UP TO THE RAIL STOP BARS & NOT ACROSS THE RAILROAD

**ITEM 251 - PARTIAL DEPTH PAVEMENT REPAIR (441)**

A QUANTITY OF THIS ITEM SHALL BE PROVIDED FOR USE AS DIRECTED BY THE ENGINEER. THE ITEM SHALL CONSIST OF REPAIRING EXISTING LOCATIONS EXHIBITING SURFACE DETERIORATION AND PLACING ITEM 441 ASPHALT CONCRETE, TYPE 2. THE ASPHALT CONCRETE SHALL BE COMPACTED WITH A TYPE I PNEUMATIC TIRE ROLLER AND A STEEL WHEEL ROLLER AS PER 401.13. IT IS NOT THE INTENT TO REPAIR EVERY DETERIORATED AREA WITHIN THE PROJECT. PAVEMENT REPAIRS WILL BE MARKED IN THE FIELD BY THE PROJECT ENGINEER ACCORDING TO CMS 251.02. MINIMUM WIDTH IS 2'. UNLESS OTHERWISE DIRECTED BY THE ENGINEER, THIS ITEM SHALL BE PERFORMED AFTER THE COMPLETION OF MAINLINE PAVEMENT PLANING. ALSO, THIS ITEM SHALL COMMENCE WITHIN 7 DAYS OF THE COMPLETION OF MAINLINE PAVEMENT PLANING. PAYMENT SHALL BE BASED ON THE ACTUAL NUMBER OF SQUARE YARDS OF PAVEMENT REPAIR. THE FOLLOWING ESTIMATED QUANTITY HAS BEEN CARRIED TO THE GENERAL SUMMARY:


251, PARTIAL DEPTH PAVEMENT REPAIR (441), 3000 SQ. YD.

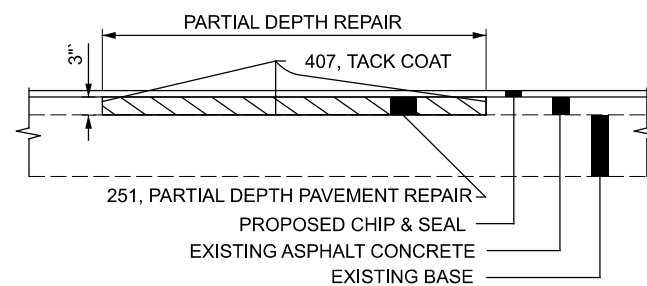

**PAVED MAILBOX APPROACHES**

ALL EXISTING MAIL BOX APPROACHES WILL BE PAVED. PAYMENT SHALL BE AS FOLLOWS:

ALL GRADING, TACK, TOOLS, EQUIPMENT, MATERIALS AND INCIDENTALS REQUIRED TO LAYOUT AND CONSTRUCT THE MAILBOX APPROACHES SHALL BE INCLUDED IN THE UNIT BID FOR ITEM 422, AGGREGATE, SINGLE CHIP SEAL, TYPE A AND ITEM 886, FOG SEAL.

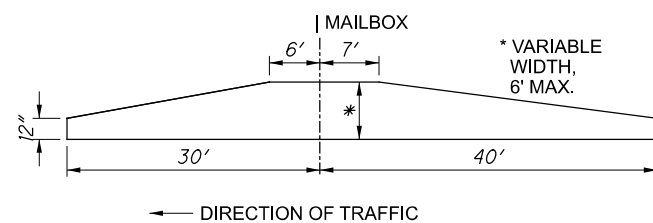

**STATE SCENIC GRAND RIVER/ASHTABULA RIVER/WEST BRANCH OF ASHTABULA RIVER/CONNEAUT CREEK/PYMATUNING CREEK**

THE CONTRACTOR SHALL NOT DISCHARGE TOXIC OR HAZARDOUS MATERIALS SUCH AS SEALANTS, PAINT, SOLVENTS, CLEANING AGENTS, EARTHEN MATERIALS, WASTE-WATER, FUELS OR DEBRIS OF ANY KIND TO A SCENIC RIVER, ITS TRIBUTARIES, OR DRAINAGE WAYS. IF REFUELING OF IMMOBILE EQUIPMENT IS NECESSARY WITHIN THE FLOODPLAIN OR NEAR ANY TRIBUTARY DRAINAGE WAYS, DITCHES, OR STREAM, THE CONTRACTOR SHALL PROVIDE SECONDARY CONTAINMENT WITH ENOUGH CAPACITY TO COMPLETELY CONTAIN AND COLLECT ALL POTENTIAL LIQUID WASTES IN THE EVENT OF A SPILL.

ANY AND ALL CONSTRUCTION DEBRIS, EARTHEN DEBRIS, EXCESS ASPHALT OR CONCRETE, WOOD DEBRIS FROM CLEARING, EXCESS FILL MATERIAL, AND TRASH SHOULD BE DISPOSED OF AT AN APPROVED ISLAND SITE OR LAND FILL ABOVE FEMA 100-YEAR FLOOD ELEVATIONS. DISPOSAL OF ANY SUCH MATERIALS WITHIN 1000 FEET OF THE STATE SCENIC PYMATUNING CREEK IS PROHIBITED.

IN ACCORDANCE WITH ORC 3750.06, REPORTABLE SPILLS MUST BE REPORTED TO THE LOCAL FIRE DEPARTMENT (911), THE LOCAL EMERGENCY COORDINATOR MIKE FITCHET, ASHTABULA COUNTY EMA DIRECTOR (440-576-0055) AND LINDA BEIL, TRUMBULL COUNTY EMA DIRECTOR (330-770-0222), AND THE OHIO SPILL LINE (1-800-282-9378)

THE CONTRACTOR SHALL KEEP ALL IDLE EQUIPMENT, FUELS, LUBRICANTS, AND ANY STORAGE FOR/OF POTENTIALLY TOXIC OR HAZARDOUS MATERIALS OUT OF THE FEMA DESIGNATED SPECIAL FLOOD HAZARD AREA AND NOT WITHIN 1000 FEET OF THE STATE SCENIC PYMATUNING CREEK.

THE CONTRACTOR SHALL NOTIFY THE PROJECT ENGINEER 40 DAYS PRIOR TO WORK WITHIN 1000 FEET OF THE STATE SCENIC PYMATUNING CREEK. THE PROJECT ENGINEER SHALL NOTIFY THE DISTRICT ENVIRONMENTAL COORDINATOR 35 DAYS PRIOR TO WORK WITHIN 1000 FEET OF THE SCENIC RIVER. THE DISTRICT ENVIRONMENTAL COORDINATOR SHALL COORDINATE WITH ODNR SCENIC RIVERS A MINIMUM OF 30 DAYS PRIOR TO ANY WORK WITHIN 1000 FEET OF STATE SCENIC PYMATUNING CREEK.

DESIGN AGENCY



DESIGNER

BCB

REVIEWER

RMM MM-DD-YY

PROJECT ID

109580

SHEET

TOTAL

4 | 10

**MAINTENANCE OF TRAFFIC**

THIS ITEM SHALL CONSIST OF MAINTENANCE OF TRAFFIC ON EXISTING ROADWAYS AND RAMPS IN ACCORDANCE WITH THE OHIO MANUAL OF UNIFORM TRAFFIC CONTROL DEVICES FOR STREETS AND HIGHWAYS, CURRENT EDITION, LATEST REVISION, THE SPECIFICATIONS AND THE FOLLOWING:

1. A MINIMUM OF ONE TEN FOOT BIDIRECTIONAL LANE SHALL BE MAINTAINED ON THE EXISTING PAVEMENT OR COMPLETED PAVEMENT DURING CONSTRUCTION OF THE WORK.
2. THE CONTRACTOR SHALL INFORM THE DISTRICT OFFICE (330) 786-2208, EIGHTEEN (18) DAYS PRIOR TO THE BEGINNING OF WORK.
3. LANE RESTRICTIONS OR LANE REDUCTIONS SHALL NOT BE PERMITTED AFTER NORMAL WORKING HOURS. NORMAL WORKING HOURS SHALL BE THOSE HOURS DURING WHICH THE CONTRACTOR HAS A FULL COMPLEMENT OF EMPLOYEES AND EQUIPMENT ACTIVELY REMOVING AND/OR PLACING PAVEMENT MATERIALS.
4. UNDER NO CIRCUMSTANCES SHALL THE CONTRACTOR BE PERMITTED TO HAVE SUCCESSIVE WORK ZONES UNLESS THE DISTANCE BETWEEN THE DRUMS, BARRICADES OR CONES EXCEEDS TWO (2) MILES RURAL OR ONE [1] MILE URBAN.
5. FOR ROUTES NOT ON THE PERMITTED LANE CLOSURE CHART, ONLY DURING OFF-PEAK PERIODS (ie ANY PERIOD OTHER THAN 6-8AM AND 3-6PM) SHALL THE CONTRACTOR INSTALL AND SUBSEQUENTLY RESET ALL TRAFFIC CONTROL NECESSARY FOR THE WORK ZONE FOR EACH CONSTRUCTION PHASE.
6. IN ADDITION TO THE REQUIREMENTS OF 614.11 WORK ZONE PAVEMENT MARKINGS, AT THE END OF EACH DAY OF WORK, THE CONTRACTOR SHALL REPLACE (WITH WORK ZONE MARKINGS) ALL LANE, CENTER, STOP OR CHANNELIZING LINES THAT WERE REMOVED OR COVERED DURING THE PAVEMENT REMOVAL OR PLACEMENT OPERATIONS. QUANTITIES FOR SUCH PLACEMENT ARE CARRIED AS PART OF THE ITEMS LISTED UNDER 614 WORK ZONE PAVEMENT MARKINGS.
7. A QUANTITY OF 10 CU. YDS. OF ITEM 614 ASPHALT CONCRETE FOR MAINTAINING TRAFFIC SHALL BE PROVIDED FOR USE IN MAINTAINING PAVEMENT, SHOULDERS AND OTHER LOCATIONS AS DIRECTED BY THE ENGINEER.
8. PRIOR TO OPENING TO TRAFFIC EACH LANE SHALL BE IN A SAFE, PASSABLE CONDITION. ALL TRANSVERSE JOINTS SHALL EXTEND ACROSS THE FULL LANE AND SHOULDER WIDTH AND EACH LANE SHALL BE FREE FROM UNEVEN LONGITUDINAL JOINTS. THE CONTRACTOR SHALL PROVIDE ASPHALT WEDGES FOR TRANSVERSE JOINTS WHEREVER THERE ARE PAVEMENT ELEVATION DIFFERENCES.

9. THE CONTRACTOR SHALL PLACE THE SIGNS: W8-1 [BUMP] PER OMUTCD 2C.28; W8-11 [UNEVEN LANES] PER OMUCTD 6F.45; AND W6-3 [TWO-WAY TRAFFIC] PER OMUTCD 6F.32. PAYMENT FOR THESE SIGNS SHALL BE INCIDENTAL TO THE LUMP SUM ITEM 614- MAINTAINING TRAFFIC. A QUANTITY OF ITEM 614 WORK ZONE MARKING SIGNS HAS BEEN INCLUDED IN THE PLANS PER CMS 614.04.

10. THE CONTRACTOR SHALL SET A WORK ZONE AT THE REQUEST OF THE ENGINEER TO ALLOW THE LAYOUT OF THE PARTIAL/FULL DEPTH PAVEMENT REPAIR AREAS. THIS WORK IS INCIDENTAL TO ITEM 614 MAINTAINING TRAFFIC.

SIGNS W8-H7 [LOOSE GRAVEL/ FRESH TAR], AND W13-1 [SPEED PLAQUE] SHALL BE PLACED PER STANDARD CONSTRUCTION DRAWING MT-97.12 (MT-97.11), AND PAYMENT FOR THESE SIGNS SHALL BE INCIDENTAL TO THE LUMP SUM ITEM 614- MAINTAINING TRAFFIC. A QUANTITY OF ITEM 614 WORK ZONE MARKING SIGNS HAS BEEN INCLUDED IN THE PLANS PER CMS 614.04.

THE FOLLOWING QUANTITIES SHALL BE USED FOR THE MAINTENANCE OF TRAFFIC ON THIS PROJECT:

PHASE I - ATB-6, ATB-534, TRU-46, TRU-87, TRU-88

- 614, WORK ZONE MARKING SIGN, 20 EACH
- 614, WORK ZONE CENTERLINE, CLASS III, 642 PAINT 23.83 MILE
- 614, WORK ZONE CHANNELIZING LINE, CLASS III, 642 PAINT 539 FT
- 614, WORK ZONE STOP LINE, CLASS III, 642 PAINT 154 FT

PHASE II - ATB-6, ATB-534, TRU-46, TRU-87, TRU-88

- 614, WORK ZONE MARKING SIGN, 20 EACH
- 614, WORK ZONE CENTERLINE, CLASS III, 642 PAINT 23.83 MILE
- 614, WORK ZONE CHANNELIZING LINE, CLASS III, 642 PAINT 539 FT
- 614, WORK ZONE STOP LINE, CLASS III, 642 PAINT 154 FT

PHASE III- ATB-6, ATB-534, TRU-46, TRU-87, TRU-88

- 614, WORK ZONE MARKING SIGN, 20 EACH
- 614, WORK ZONE CENTERLINE, CLASS III, 642 PAINT 23.83 MILE
- 614, WORK ZONE CHANNELIZING LINE, CLASS III, 642 PAINT 539 FT
- 614, WORK ZONE STOP LINE, CLASS III, 642 PAINT 154 FT

TO BE USED AS DIRECTED BY THE ENGINEER  
614, WORK ZONE EDGE LINE, CLASS III, 76.64 MILE

TOTALS WILL BE CARRIED TO THE GENERAL SUMMARY:

- 614, WORK ZONE MARKING SIGN, 60 EACH
- 614, WORK ZONE CENTERLINE, CLASS III, 642 PAINT 71.49 MILE
- 614, WORK ZONE CHANNELIZING LINE, CLASS III, 642 PAINT 1617 FT
- 614, WORK ZONE STOP LINE, CLASS III, 642 PAINT 462 FT
- 614, WORK ZONE EDGE LINE, CLASS III, 76.64 MILE

ADDED

**NOTIFICATION OF TRAFFIC RESTRICTIONS**

THROUGHOUT THE DURATION OF THE PROJECT, THE CONTRACTOR SHALL NOTIFY THE PROJECT ENGINEER IN WRITING OF ALL TRAFFIC RESTRICTIONS AND UPCOMING MAINTENANCE OF TRAFFIC CHANGES. THE CONTRACTOR SHALL ENSURE THE WRITTEN NOTIFICATION IS SUBMITTED IN A TIMELY MANNER TO ALLOW THE PROJECT ENGINEER TO MEET THE REQUIRED TIME FRAMES SET FORTH IN THE TABLE BELOW TO INFORM SPECIAL HAULING PERMITS SECTION (HAULING.PERMITS@DOT.OHIO.GOV) AND THE DISTRICT PUBLIC INFORMATION OFFICE (PIO). THIS NOTIFICATION SHALL BE RECEIVED BY THE PROJECT ENGINEER PRIOR TO THE PHYSICAL SETUP OF ANY APPLICABLE SIGNS OR MESSAGE BOARDS.

INFORMATION SHOULD INCLUDE, BUT IS NOT LIMITED TO, ALL CONSTRUCTION ACTIVITIES THAT IMPACT OR INTERFERE WITH TRAFFIC AND SHALL LIST THE SPECIFIC LOCATION, TYPE OF WORK, ROAD STATUS, DATE AND TIME OF RESTRICTION, DURATION OF RESTRICTION, NUMBER OF LANES MAINTAINED, NUMBER OF LANES CLOSED, MINIMUM VERTICAL CLEARANCE, MINIMUM WIDTH OF DRIVABLE PAVEMENT, DETOUR ROUTES, IF APPLICABLE, AND ANY OTHER INFORMATION REQUESTED BY THE PROJECT ENGINEER.

NOTIFICATION TIME TABLE		
ITEM	DURATION OF CLOSURE	NOTICE DUE TO PERMITS & PIO
ROAD & RAMP CLOSURES	>= 2WEEKS	21 CALENDAR DAYS PRIOR TO CLOSURE
	> 12 HOURS & < 2 WEEKS	14 CALENDAR DAYS PRIOR TO CLOSURE
	<12 HOURS	4 BUSINESS DAYS PRIOR TO CLOSURE
LANE CLOSURES & RESTRICTIONS	>=2 WEEKS	14 CALENDAR DAYS PRIOR TO CLOSURE
	< 2 WEEKS	2 BUSINESS DAYS PRIOR TO CLOSURE
START OF CONSTRUCTION & TRAFFIC PATTERNS CHANGES	N/A	14 CALENDAR DAYS PRIOR TO IMPLEMENTATION

ANY UNFORESEEN CONDITIONS NOT SPECIFIED IN THE PLANS REQUIRING TRAFFIC RESTRICTIONS SHALL ALSO BE REPORTED TO THE PROJECT ENGINEER USING THE NOTIFICATION TIME TABLE.

**ADVANCED NOTICE TO PAVE**

THE CONTRACTOR SHALL SUBMIT FOR APPROVAL TO THE DISTRICT CONSTRUCTION ENGINEER A DETAILED SCHEDULE 15 DAYS PRIOR TO THE PLACEMENT OF THE OVERLAY COURSES, ON HOW THEY PROPOSE TO PROSECUTE THE PAVING OPERATIONS. THE DETAILS SHALL SHOW THE ORDER OF PERFORMANCE OF EACH STAGE (START TO FINISH) OF THE WORK INCLUDING THE MAINTENANCE OF TRAFFIC THAT WILL BE USED.

**WORK RESTRICTIONS ON US 6 IN ANDOVER**

WORK ON US 6 SHALL BE COMPLETED BEFORE MAY 27TH. SHOULD INCLEMENT WEATHER OCCUR PREVENTING WORK BEFORE MAY 27TH, THERE SHALL BE NO WORK IN ANDOVER ON US 6 ON FRIDAYS

**INTERIM COMPLETION DATE - ATB-543**

WORK ON ATB-534 SHALL BE COMPLETED BEFORE MAY 30TH (MEMORIAL DAY). A DISINCENTIVE SHALL BE ASSESSED IN THE AMOUNT OF \$2000 PER DAY FOR EACH CALANDER DAY THE WORK CONTINUES BEYOND THE SPECIFIED LIMIT.

**TRAFFIC CONTROL INSPECTOR**

THE CONTRACTOR SHALL DESIGNATE AN INDIVIDUAL OTHER THAN THE SUPERINTENDENT AND SUBJECT TO THE APPROVAL OF THE ENGINEER, TO CONTINUOUSLY INSPECT ALL TRAFFIC CONTROL DEVICES WHENEVER CONSTRUCTION WORK IS BEING PERFORMED WITHIN THE WORK LIMITS OF THE PROJECT. THE DESIGNATED INDIVIDUAL SHALL ALSO INSPECT ALL TRAFFIC DEVICES AT THE BEGINNING AND AT THE END OF EACH WORK DAY. THE DESIGNATED INDIVIDUAL OR A QUALIFIED REPRESENTATIVE SHALL ALSO BE AVAILABLE ON AN AROUND THE CLOCK BASIS TO REPAIR AND/OR REPLACE DAMAGED OR MISSING TRAFFIC CONTROL DEVICES. THESE INDIVIDUALS SHALL BE EQUIPPED WITH CELLULAR PHONES AND THEIR NAMES AND PHONE NUMBERS SHALL BE GIVEN TO THE PROJECT ENGINEER AT THE PRE-CONSTRUCTION MEETING. THE DESIGNATED INDIVIDUAL MAY HAVE OTHER CONSTRUCTION RELATED DUTIES AS LONG AS IMMEDIATE ATTENTION IS GIVEN TO TRAFFIC CONTROL. PAYMENT FOR THE SERVICES OF THE TRAFFIC CONTROL INSPECTOR SHALL BE INCLUDED IN THE LUMP SUM PRICE BID FOR ITEM 614 MAINTAINING TRAFFIC.



SHEET NUM.											PART.		ITEM	ITEM EXT	GRAND TOTAL	UNIT	DESCRIPTION	SEE SHEET NO.
4	5	7	8	9	10	01/STR/PV	02/S<2/PV											
		11,879	33,933															
						41,239	4,573	886	11000	45,812	GAL	FOG SEAL						
						3,000		832	30000	3,000	EACH	EROSION CONTROL						
		3,000				2,700	300	251	01000	3,000	SY	PARTIAL DEPTH PAVEMENT REPAIR (441)						
			79,191	226,220		274,925	30,486	422	11000	305,411	SY	AGGREGATE, SINGLE CHIP SEAL, TYPE A						
			31,677	90,488		109,970	12,195	422	25000	122,165	GAL	EMULSION, CHIP SEAL						
								1,412		1,412	EACH	RPM						
								1,137		1,137	EACH	RAISED PAVEMENT MARKER REMOVED						
						38.32		34.88	3.44	642	00104	EDGE LINE, 6", TYPE 1						
						23.83		21.98	1.85	642	00300	CENTER LINE, TYPE 1						
						539		189	350	642	00400	CHANNELIZING LINE, 8", TYPE 1						
						154		154	642	00500	154	FT	STOP LINE, TYPE 1					
						140		140	642	00630	140	FT	CROSSWALK LINE, 24", TYPE 1					
						171		114	57	642	00900	171	SF	ISLAND MARKING, TYPE 1	<b>REVISED PAY ITEM AND QUANTITY</b>			
						2		2		642	01000	2	EACH	RAILROAD SYMBOL MARKING, TYPE 1				
						2		2		642	01124	2	EACH	SCHOOL SYMBOL MARKING, 120", TYPE 1	<b>DELETED TRANSVERSE DIAGONAL LINE</b>			
						10		4	6	642	01300	10	EACH	LANE ARROW, TYPE 1				
						833		483	350	644	30000	833	FT	REMOVAL OF PAVEMENT MARKING				
						62.15		56.86	5.29	644	30030	62.15	MILE	REMOVAL OF PAVEMENT MARKING				
						171		114	57	644	30010	171	SF	REMOVAL OF PAVEMENT MARKING				
						14		8	6	644	30020	14	EACH	REMOVAL OF PAVEMENT MARKING				
						60		60	614	12460	60	EACH	WORK ZONE MARKING SIGN					
						71.49		65.94	5.55	614	21550	71.49	MILE	WORK ZONE CENTER LINE, CLASS III, 642 PAINT				
						76.64		69.76	6.88	614	22360	76.64	MILE	WORK ZONE EDGE LINE, CLASS III, 6", 642 PAINT				
						1,617		567	1,050	614	23680	1,617	FT	WORK ZONE CHANNELIZING LINE, CLASS III, 8", 642 PAINT				
						462		462		614	26610	462	FT	WORK ZONE STOP LINE, CLASS III, 642 PAINT				
						10		10		614	13000	10	CY	ASPHALT CONCRETE FOR MAINTAINING TRAFFIC				
								LS	614	11000	LS							
								6	619	16010	6	MNTH	FIELD OFFICE, TYPE B					
								LS	623	10000	LS							
								LS	624	10000	LS							

833  
62.15  
171  
14

60  
71.49  
76.64  
1,617  
462  
10

REVISED QUANTITIES

60  
65.94  
69.76  
567  
462  
10

60  
71.49  
76.64  
1,617  
462  
10

REVISED PAY ITEM AND QUANTITY

DELETED TRANSVERSE DIAGONAL LINE

GENERAL SUMMARY

DESIGN AGENCY



DESIGNER

BCB

REVIEWER

RMM MM-DD-YY

PROJECT ID

109580

SHEET

6

TOTAL

10

**EDGE LINE**

GENERAL SPEC: 640  
MATERIAL TYPE: 642

CTY	ROUTE	TRUE LOG	FROM	TRUE LOG	TO	WHITE EDGE LINE, 6"			YELLOW EDGE LINE, 6"			COMMENTS
						TOTAL	HIGHWAY	RAMP	TOTAL	HIGHWAY	RAMP	
ATB	6	22.56	ANDOVER TOWNSHIP	23.17	OWEN HILL RD	1.22						
ATB	534	23.54	W MAPLE AVE	25.26	LAKE RD	3.44						
TRU	46	23.64	SR 87	26.27	ENTER ATB COUNTY	5.26						
TRU	87	13.38	SR 46	17.59	SR 193	8.42						
TRU	87	17.59	SR 193	22.29	SR 5	9.40						
TRU	88	7.03	SR 45	12.32	BAZETTA RD	10.58						
<b>TOTAL</b>						38.32			0			

**LANE LINE**

CTY	ROUTE	TRUE LOG	FROM	TRUE LOG	TO	TOTAL MILES	6" LANE LINE		COMMENTS
							DASHED	SOLID	
<b>TOTAL</b>									

**CENTER LINE**

CTY	ROUTE	TRUE LOG	FROM	TRUE LOG	TO	TOTAL MILES	EQUIVALENT SOLID LINE	COMMENTS
ATB	534	23.54	W MAPLE AVE	25.26	LAKE RD	1.85	3.26	
TRU	46	23.64	SR 87	26.27	ENTER ATB COUNTY	2.63	2.22	
TRU	87	13.38	SR 46	17.59	SR 193	4.37	3.52	
TRU	87	17.59	SR 193	22.29	SR 5	9.07	7.30	
TRU	88	7.03	SR 45	12.32	BAZETTA RD	5.30	3.35	
<b>TOTAL</b>						23.83	20.65	

**AUXILIARY**

CTY	ROUTE LOCATION	TRUE LOG	CHANNEL LINE, 8" FT	CHANNEL LINE, 12" FT	STOP LINE FT	CROSS WALK LINES FT	TRANSVERSE DIAGONAL LINES		ISLAND MARKING SF	SYMBOL MARKINGS				LANE ARROWS				REDUCT. ARROW EACH	WORD ON PVMT ONLY		DOTTED LINES, 6" FT	COMMENTS
							WHITE FT	YELLOW FT		R x R EACH	SCHOOL		TURN LEFT EACH	TURN RIGHT EACH	THRU EACH	COMB. EACH	72" EACH		96" EACH			
											72" EACH	120" EACH										
ATB	SR 534 @ LAKE ST./GENEVA STATE PARK	25.100	350						57					3	3							
TRU	SR 87 @ SR 11 SB RAMPS	15.054	94						57					2								
TRU	SR 87 @ SR 11 NB RAMPS	15.226	95						57					2								
TRU	SR 87 @ SR 193	17.580			57																	
TRU	SR 87 @ CONRAIL RAILROAD	19.315			24					2												
TRU	SR 87 @ SR 5	22.275			62																	
TRU	SR 88 @ BRISTOL HIGH SCHOOL	7.151				50										2						
TRU	SR 88 @ WESTERN RESERVE GREENWAY TRL	8.150				50																
ATB	US 6 @ ANDOVER SQUARE	22.560			11	40																
<b>TOTAL</b>			539		154	140			171	2		2	7	3								

REVISED


REMOVED

PAVEMENT MARKING QUANTITIES

D04-CHIP-FY2022

MODEL: Sheet PAPER SIZE: 17x11 (in.) DATE: 11/22/2021 TIME: 7:42:21 AM USER: jfzcl  
p:\vohodoc-pw-bentley.com\shhoboc-pw-02\Documents\01 Active Projects\District 04\_D04109580\Roadway\Sheets\109580\_PM001.dgn

DESIGN AGENCY



DESIGNER  
**BCB**

REVIEWER  
RMM MM-DD-YY

PROJECT ID  
109580

SHEET	TOTAL
10	10