



KNOX COUNTY

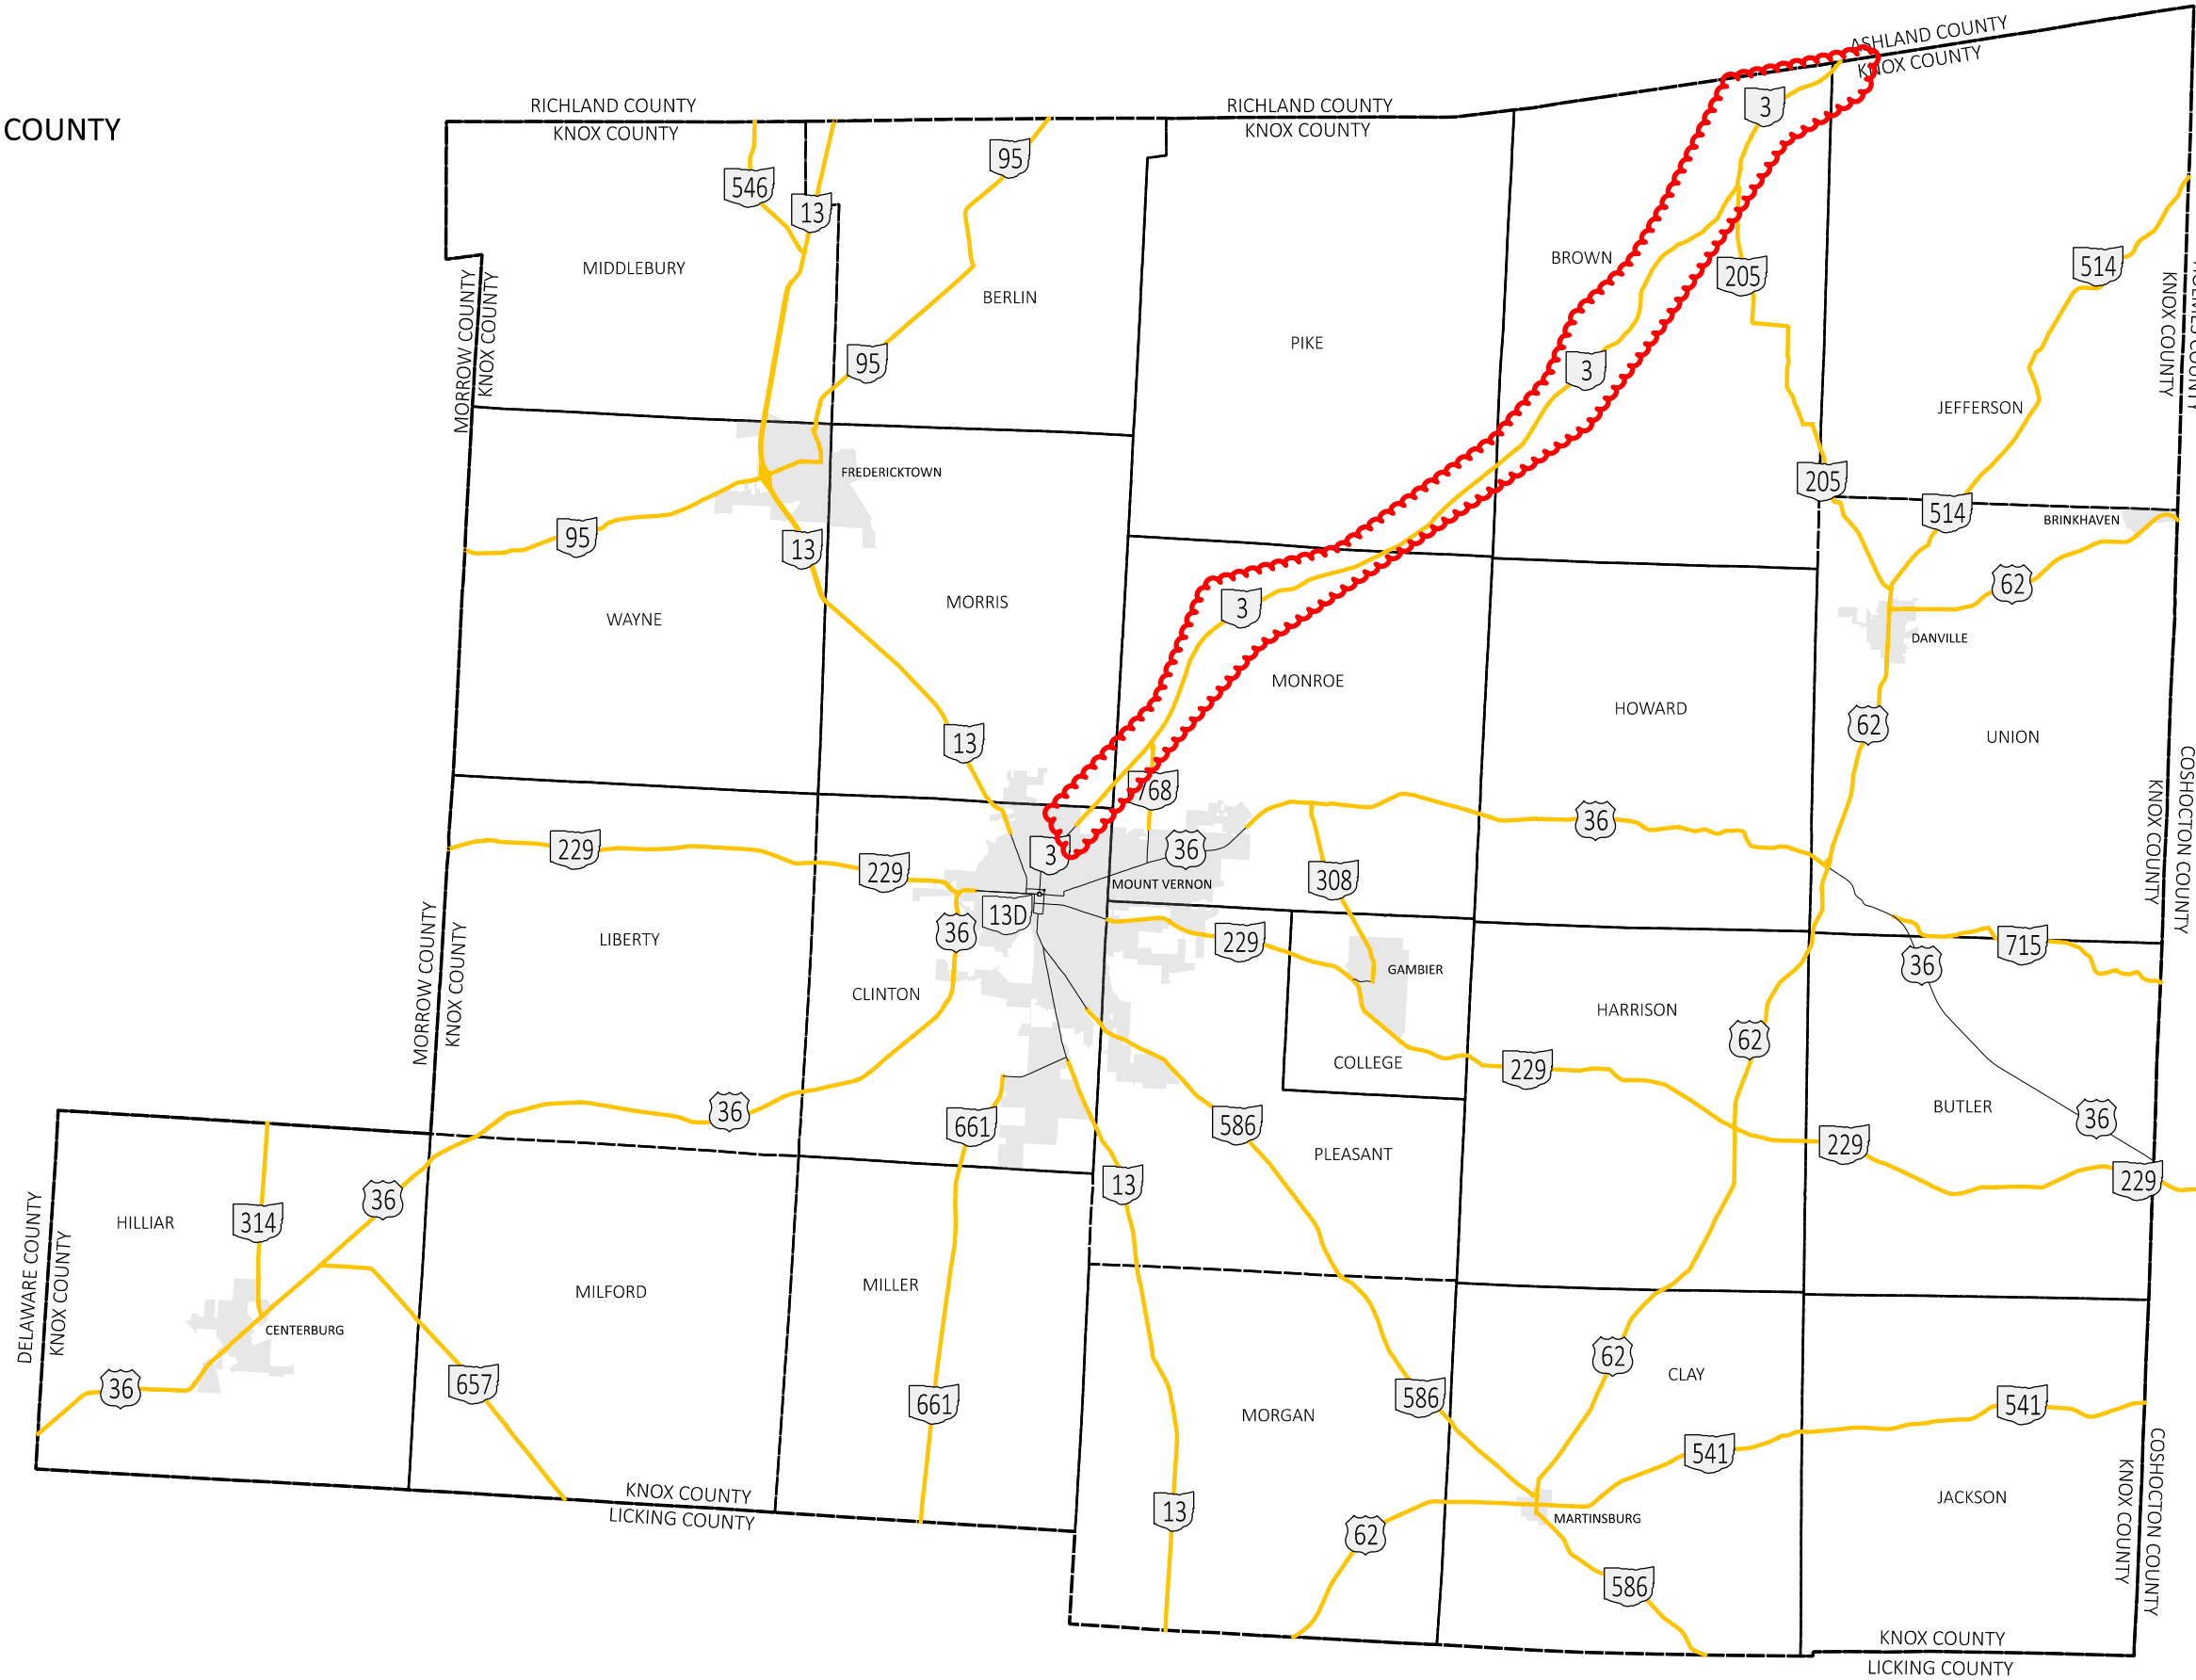

KNOX COUNTY MAP

MAPS ARE FOR CONVENIENCE ONLY,
DESIGNATED ROUTES AND LOCATIONS
SHALL BE GOVERNED BY THE DATA SHEETS.

PORTION TO BE IMPROVED

DESIGN AGENCY	
	
DESIGNER	LME
REVIEWER	JSL
PROJECT ID	107370
SHEET	TOTAL
5	16

ITEM 642 FAST DRY PAVEMENT MARKINGS

COUNTY	ROUTE	DESCRIPTION	EDGE LINE 6"		LANE LINE MILE	CENTER LINE MILE	EQUIVALENT SOLID CENTER LINE MILE	CHANNELIZING LINE		STOP LINE 24" FT	CROSSWALK LINE 12" FT	RAILROAD MARKING SYMBOL EACH	SCHOOL SYMBOL MARKING 96" EACH	LANE ARROW 96"					LANE REDUCTION ARROW EACH	WRONG WAY ARROW EACH	WORD ON PAVEMENT 96" ONLY EACH	DOTTED LINE 6" FT	SPEED MEASUREMENT MARKING, AS PER PLAN EACH					
			WHITE	YELLOW				8"	12"					LEFT	RIGHT	THRU/ LEFT	THRU/ RIGHT	THRU										
			MILE	MILE				FT	FT					EACH	EACH	EACH	EACH	EACH										
KNO	S.R. 3	18.95-34.71	31.52			15.76																						
KNO	S.R. 13	0.00-8.22 (MILLSTONE LN.)	16.44			8.22	11.11					2																1
		SKIP 8.22-12.06 (MT. VERNON)																										
		12.06 (JAMES ST.) -16.05	7.84			4.06	3.17																					
		16.05-20.68	9.26	9.26	8.89	0.51			642					7								8					4	
		S.R. 95 INTERCHANGE																										
		NE RAMP (NB ON-RAMP)	0.16	0.16					1,035																		365	
		NW RAMP (SB OFF-RAMP)	0.17	0.17					340	56												2				660		
		SE RAMP (NB OFF-RAMP)	0.17	0.17					380	56												2				595		
		SW RAMP (SB ON-RAMP)	0.19	0.19					1,320																	555		
		20.68-23.11	4.86			2.58	3.34	80						1										1				
KNO	U.S. 36	0.00-2.05	4.10			2.05																						
		2.05-10.14	14.90			8.29	22.58	225		109	576		2	2												1		
		10.14-14.17	8.06			4.03*																						
		14.17-16.80	3.64			1.82		240		48				2	2											1		
		SKIP 16.80-20.68 (MT. VERNON)																										
		20.68-20.85	0.34			0.17	14.62																					
		20.85-29.50	17.30			8.65		400			104		2	4												2		
KNO	U.S. 36C	0.00-0.12	0.24			0.12	0.24			71																		
KNO	U.S. 62	0.00-22.65	45.30			22.65	32.17	110		101	390		2		1											1		
KNO	S.R. 95	0.00-5.69	10.00			6.15	15.67	895		101	866		2	4	4													
		5.69-11.50	11.62			5.81																						
KNO	S.R. 205	0.00-0.26	0.52			0.26	12.50			18																		
		0.26-6.94	13.36			6.68				38																		
KNO	S.R. 229	0.00-6.60	13.20			6.60	12.59																					
		6.60-7.28	1.36			0.68				20																		
		SKIP 7.28-9.53 (MT. VERNON)																										
		9.53-13.03	7.00			3.50	2.70																					
		SKIP 13.03-13.27 (PID 115984)																										
		13.27-19.27 (U.S. 62)	12.00			6.00	11.53			27																		
		19.27-25.38	12.22			6.11	11.12			34																		
COS	S.R. 229	0.00-0.70	1.40			0.70	1.17			12																		
TOTALS CARRIED TO NEXT SHEET			247.17	9.95	8.89	121.40	154.51	1,950	3,717	691	1,936	2	8	20	7			5		4	14	2,175	5					

*CLOSE PASSING ZONE (DOUBLE-SOLID CENTER LINE FROM SLM 12.09 TO 12.25)

EDGE AND CENTER LINE ONLY

EDGE AND CENTER LINE ONLY WITH EXCEPTION OF STOP BAR AT U.S. 62

KNOX COUNTY DATA

DESIGN AGENCY

 DESIGNER
 LME
 REVIEWER
 JSL 10/11/23
 PROJECT ID
 107370
 SHEET TOTAL
 10 16

ITEM 642 FAST DRY PAVEMENT MARKINGS

COUNTY	ROUTE	DESCRIPTION	EDGE LINE 6"		LANE LINE MILE	CENTER LINE MILE	EQUIVALENT SOLID CENTER LINE MILE	CHANNELIZING LINE		STOP LINE 24" FT	CROSSWALK LINE 12" FT	RAILROAD MARKING SYMBOL EACH	SCHOOL SYMBOL MARKING 96" EACH	LANE ARROW 96"					LANE REDUCTION ARROW EACH	WRONG WAY ARROW EACH	WORD ON PAVEMENT 96" EACH	DOTTED LINE 6" FT	SPEED MEASUREMENT MARKING, AS PER PLAN EACH	
			WHITE	YELLOW				8"	12"					LEFT	RIGHT	THRU/ LEFT	THRU/ RIGHT	THRU						
			MILE	MILE				FT	FT					EACH	EACH	EACH	EACH	EACH						
		TOTALS FROM PREVIOUS SHEET	247.17	9.95	8.89	121.40	154.51	1,950	3,717	691	1,936	2	8	20	7			5		4	14	2175	5	
KNO	S.R. 308	SKIP 0.00-0.30 (PID 115984)																						
		0.30-3.00	5.40			2.70	5.06			66	496													
KNO	S.R. 314	0.00-2.73	5.46			2.73	3.77			18	44													
KNO	S.R. 514	0.00-0.26 (S.R. 205 OVERLAP)																						
		0.26-7.93	15.34			7.67	14.82																	
KNO	S.R. 541	0.00-8.92	17.84			8.92	14.79			14	144													
KNO	S.R. 546	0.00-2.15	4.30			2.15	3.93			41														
KNO	S.R. 586	0.00-3.28	6.56			3.28				12	68													
		3.28-3.41 (U.S. 62 OVERLAP)					19.91																	
		3.41-11.37	15.92			7.96				13	54													
		11.37-12.92	3.10			1.68		150					2								1			
KNO	S.R. 657	0.00-4.93	9.86			4.93	7.53			48														
KNO	S.R. 661	0.00-6.10	12.20			6.10	9.81																	
		6.10-6.46	0.72			0.36		116		16				2								1		
KNO	S.R. 715	0.00-4.26	8.52			4.26	8.01			12														
KNO	S.R. 768	0.48-1.70	2.44			1.22	1.47			17														
		SUB-TOTALS	354.83	9.95										22	9			5						
		TOTALS CARRIED TO GENERAL SUMMARY	364.78		8.89	175.36	243.61	2,216	3,717	948	2,742	2	8			36			4	16	2,175	5		



COUNTY TOTALS					PLAN SPLIT	ITEM	ITEM EXT.	GRAND TOTAL	UNIT	DESCRIPTION	SEE SHEET
NOTES	FAI	KNO	LIC	PER	01/NFP/21						
										TRAFFIC CONTROL	
	297.08	364.78	390.93	285.30	1,338.09	642	00104	1,338.09	MILE	EDGE LINE, 6", TYPE 1	
	57.00	8.89	69.36	4.97	140.22	642	00204	140.22	MILE	LANE LINE, 6", TYPE 1	
	101.65	175.36	142.27	143.43	562.71	642	00300	562.71	MILE	CENTER LINE, TYPE 1	
	766	2,216	9,220	4,325	16,527	642	00400	16,527	FT	CHANNELIZING LINE, 8", TYPE 1	
	27,846	3,717	27,756		59,319	642	00404	59,319	FT	CHANNELIZING LINE, 12", TYPE 1	
	826	948	2,145	1,121	5,040	642	00500	5,040	FT	STOP LINE, TYPE 1	
	2,019	2,742	2,159	2,385	9,305	642	00620	9,305	FT	CROSSWALK LINE, 12", TYPE 1	
	6	2	6	9	23	642	01000	23	EACH	RAILROAD SYMBOL MARKING, TYPE 1	
	9	8	6	8	31	642	01110	31	EACH	SCHOOL SYMBOL MARKING, 96", TYPE 1	
	46	36	153	52	287	642	01300	287	EACH	LANE ARROW, TYPE 1	
	4		3		7	642	01312	7	EACH	LANE REDUCTION ARROW, TYPE 1	
		4	8		12	642	01322	12	EACH	WRONG WAY ARROW, TYPE 1	
	19	16	62	15	112	642	01410	112	EACH	WORD ON PAVEMENT, 96", TYPE 1 (ONLY)	
			2		2	642	01410	2	EACH	WORD ON PAVEMENT, 96", TYPE 1 (MERGE)	
	18,912	2,175	23,352		44,439	642	01510	44,439	FT	DOTTED LINE, 6", TYPE 1	
			48		48	642	20802	48	FT	YIELD LINE, TYPE 1	
	4	5	5	2	16	642	40001	16	EACH	SPEED MEASUREMENT MARKING, AS PER PLAN	2
										MAINTENANCE OF TRAFFIC	
150					150	614	11110	150	HOURL	LAW ENFORCEMENT OFFICER WITH PATROL CAR FOR ASSISTANCE	
										INCIDENTALS	
LS	LS	LS	LS	LS	LS	614	11000	LS	LS	MAINTAINING TRAFFIC	
LS	LS	LS	LS	LS	LS	624	10000	LS	LS	MOBILIZATION	

