




**LOCATION MAP**

LATITUDE: 39°57'45" LONGITUDE: -82°59'53"

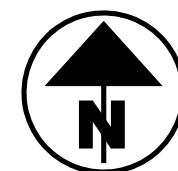

PORTION TO BE IMPROVED	-----	=====
INTERSTATE HIGHWAY	-----	=====
FEDERAL ROUTES	-----	=====
STATE ROUTES	-----	=====
COUNTY & TOWNSHIP ROADS	-----	=====
OTHER ROADS	-----	=====

**DESIGN EXCEPTIONS**

NONE REQUIRED

**ADA DESIGN WAIVERS**

NONE REQUIRED

**UNDERGROUND UTILITIES**  
Contact Two Working Days  
Before You Dig

**OHIO811.org**  
Before You Dig

OHIO 811, 8-1-1, or 1-800-362-2764  
(Non members must be called directly)

PLAN PREPARED BY:

**WOOLPERT, INC.**  
 4454 IDEA CENTER BLVD.  
 DAYTON, OH 45430

# STATE OF OHIO DEPARTMENT OF TRANSPORTATION

## D06 WRONG WAY DETECTION

### VARIOUS LOCATIONS FRANKLIN COUNTY, FAIRFIELD COUNTY

**INDEX OF SHEETS:**

TITLE SHEET	P.1, P.1A
SCHEMATIC PLAN	P.2, P.2A
GENERAL NOTES	P.3-P.6
MAINTENANCE OF TRAFFIC NOTES	P.7
GENERAL SUMMARY	P.8-P.9
TRAFFIC SURVEILLANCE SUBSUMMARY	P.10-P.11, P.11A-P.11B
SIGNING SUBSUMMARY	P.12-P.20, P.19A-P.19C
PAVEMENT MARKING SUBSUMMARY	P.21-P.23
TRAFFIC CONTROL LEGEND	P.24
POWER SERVICE	P.25, P.25A-P.25B
AERIAL SPLICE DETAILS	P.26-P.27, P.26A
TRAFFIC CONTROL PLAN	P.28-P.71, P.63A, P.71A-P.71B

**FEDERAL PROJECT NUMBER**

E220547

**RAILROAD INVOLVEMENT**

NONE

**PROJECT DESCRIPTION**

INSTALLATION OF WRONG WAY DETECTION  
CAMERAS AT VARIOUS EXIT RAMPS  
THROUGHOUT ODOT DISTRICT 6 AND DISTRICT 5

**EARTH DISTURBED AREAS**

PROJECT EARTH DISTURBED AREA: 0.3 ACRES \*  
 ESTIMATED CONTRACTOR EARTH DISTURBED AREA: 0.0 ACRES \*  
 NOTICE OF INTENT EARTH DISTURBED AREA: 0.3 ACRES  
 (NOI NOT REQUIRED)  
 \* 31 SEPARATE SITE (NOT CONTIGUOUS)  
 \* ROUTINE MAINTENANCE PROJECT

**LIMITED ACCESS**

THIS IMPROVEMENT IS ESPECIALLY DESIGNED FOR  
THROUGH TRAFFIC AND HAS BEEN DECLARED A LIMITED  
ACCESS HIGHWAY OR FREEWAY BY ACTION OF THE  
DIRECTOR IN ACCORDANCE WITH THE PROVISIONS OF  
SECTION 5511.02 OF THE OHIO REVISED CODE.

**2023 SPECIFICATIONS**

THE STANDARD SPECIFICATIONS OF THE STATE OF  
OHIO, DEPARTMENT OF TRANSPORTATION, INCLUDING  
SUPPLEMENTAL SPECIFICATIONS LISTED IN THE  
PLANS AND CHANGES LISTED IN THE PROPOSAL SHALL  
GOVERN THIS IMPROVEMENT.

I HEREBY APPROVE THESE PLANS AND DECLARE THAT  
THE MAKING OF THIS IMPROVEMENT WILL NOT REQUIRE  
THE CLOSING TO TRAFFIC OF THE HIGHWAY AND THAT  
PROVISIONS FOR THE MAINTENANCE AND SAFETY OF  
TRAFFIC WILL BE AS SET FORTH ON THE PLANS AND  
ESTIMATES.

Anthony C. Turowski, P.E.  
 District 06 Deputy Director

Jack Marchbanks, PhD  
 Director, Department of Transportation

FOR CITY OF COLUMBUS SIGNATURES, PLEASE SEE SHEET P.1A

**FLOODPLAIN INFORMATION**

FIRM PANEL NUMBER, FLOOD ZONE, EFFECTIVE DATE OF  
FIRM, BASE FLOOD INFORMATION AND FLOOD PLAIN  
IMPACTS FOR EACH OF THE 31 SEPARATE SITES ARE  
SUMMARIZED IN TABLE ON SHEET P.2A.

THERE IS NO FILL OR STRUCTURES PROPOSED IN  
FLOODWAY.


NO FILL WILL BE ADDED IN THE 100-YEAR FLOODPLAIN

**STREAM CORRIDOR PROTECTION ZONE**

NO PROPOSED WORK AT THE 31 SITES IS LOCATED  
WITHIN A STREAM CORRIDOR PROTECTION ZONE.

STANDARD CONSTRUCTION DRAWINGS				CITY OF COLUMBUS STD. DWG.	SUPPLEMENTAL SPECIFICATIONS	SPECIAL PROVISIONS
MGS-1.1	7/16/21	ITS-14.10	7/19/24	TC-41.20	10/18/13	4164 10/1/20 800-2023 7/19/24
MGS-2.1	1/19/18	ITS-14.11	7/19/24	TC-41.30	4/21/23	804 1/19/24
MGS-4.2	7/19/13	ITS-14.20	7/19/24	TC-41.40	10/18/13	809 7/19/24
MGS-5.2	7/15/16	ITS-14.50	7/19/24	TC-41.41	7/19/19	832 7/21/23
MGS-5.3	7/15/16	ITS-15.10	7/19/24	TC-41.50	10/18/13	904 7/15/22
		ITS-15.11	7/19/24	TC-42.20	10/18/13	909 7/19/24
HL-30.11	7/21/23	ITS-18.00	7/16/21	TC-52.10	10/18/13	
HL-30.21	4/17/20	ITS-50.10	7/15/22	TC-52.20	1/15/21	
HL-30.22	1/15/21	ITS-50.11	7/19/24	TC-61.30	7/19/24	
		ITS-50.12	7/19/24	TC-65.10	1/17/14	
ITS-10.10	7/19/24			TC-65.11	1/19/24	
ITS-10.11	7/19/24	MT-95.31	7/19/19	TC-73.20	7/19/24	
ITS-11.10	7/19/24	MT-98.28	1/17/20	TC-81.11	1/19/24	
ITS-12.10	7/15/22			TC-84.20	1/19/24	
ITS-12.50	7/19/24	TC-17.11	1/19/24	TC-84.21	10/18/13	
ITS-13.10	7/19/24	TC-21.11	7/16/21			

**ENGINEER'S SEAL**

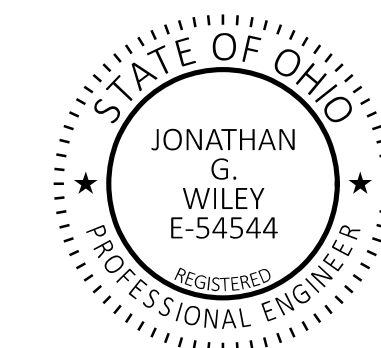

**3970-E**

DESIGN AGENCY

4454 IDEA CENTER BLVD.  
DAYTON, OH 45430  
T 937-461-5680  
F 937-461-0743

DESIGNER

AC

REVIEWER

JGW 09/13/24

PROJECT ID

117258

SHEET TOTAL

P.1 | 71

**ITEM 625 - CONDUIT, JACKED OR DRILLED, 725.04, 3", AS PER PLAN**

CONDUIT IS JACKED OR DRILLED UNDER PAVEMENT TO MINIMIZE DISRUPTION TO TRAFFIC AND THE PAVEMENT ITSELF. THIS INSTALLATION WILL CROSS UNDERGROUND UTILITIES AS SHOWN ON THE PLANS. THE CONTRACTOR SHALL ACCURATELY IDENTIFY THE PROPOSED LOCATION AND ROUTING OF THE CONDUIT TO BE JACKED OR DRILLED AS SHOWN IN THE PLANS.

THE CONTRACTOR SHALL IDENTIFY ALL CROSSINGS BASED ON THE FIELD MARKING OF UNDERGROUND UTILITY LOCATION AND PLANS. THE CONTRACTOR SHALL PERFORM A TEST HOLE AT EACH CROSSING TO VERIFY LOCATION AND DEPTH OF EXISTING UNDERGROUND UTILITY PRIOR TO JACKED OR DRILLED INSTALLATION OF CONDUIT.

WHEN CROSSING UNDERGROUND UTILITIES, THE CONTRACTOR MUST MAINTAIN A MINIMUM OF 12 INCH VERTICAL CLEARANCE WHEN JACKING OR DRILLING CONDUIT. WHEN 12 INCH CLEARANCE CANNOT BE MAINTAINED, THE CONDUIT MAY BE INSTALLED IN A TRENCH WITHIN THE VICINITY OF THE EXISTING UTILITY AS SHOWN IN ODOT TRAFFIC STANDARD CONSTRUCTION DRAWING HL-30.22 AND ITS-14-10.

THE COST FOR RESTORATION OF IMPACTED SIDEWALK AND OTHER PAVED SURFACES SHALL BE INCIDENTAL TO THE COST OF CONDUIT, 3", JACKED OR DRILLED, AS PER PLAN.

THE COST FOR TRENCH AND INSTALLATION OF CONDUIT IN THESE AREAS SHALL BE INCIDENTAL TO THE COST OF CONDUIT, 3", JACKED OR DRILLED, AS PER PLAN. THE CONTRACTOR WILL BE COMPENSATED FOR EACH TEST HOLE EXCAVATION ACCORDING TO THE BID PRICE FOR ITEM 632 TEST HOLE PERFORMED, CONDUIT, AS PER PLAN.

**ITEM 632 - TEST HOLE PERFORMED, CONDUIT, AS PER PLAN**

IT IS ANTICIPATED THAT THE CONTRACTOR WILL ENCOUNTER UNDERGROUND UTILITIES WHILE INSTALLING JACKED OR DRILLED CONDUIT.

IF, AFTER ACCURATELY IDENTIFYING THE PROPOSED LOCATION OF THE CONDUIT, AS SHOWN IN THE PLANS AND AFTER MODIFYING THAT LOCATION, IF NECESSARY, BASED ON THE FIELD MARKING OF UNDERGROUND UTILITY LOCATION, THE CONTRACTOR DISCOVERS A UTILITY CONFLICT DURING THE JACKED OR DRILLED OPERATION, THE CONTRACTOR WILL BE COMPENSATED FOR EACH PARTIAL EXCAVATION ACCORDING TO THE BID PRICE.

BEFORE THE CONTRACTOR BEGINS THE EXCAVATION AT THE MODIFIED LOCATION, THE CONTRACTOR SHALL VERIFY THAT THERE WILL BE NO OVERHEAD UTILITY CONFLICTS RESULTING FROM THE NEW CONDUIT LOCATION. NEW CONDUIT LOCATIONS ARE TO BE APPROVED BY THE ENGINEER.

THE WORK WILL INCLUDE BACKFILLING, COMPACTING, AND RESTORATION OF THE EXCAVATION TO THE SITE'S ORIGINAL CONDITION.

EXCAVATIONS SHALL NOT BE LEFT OPEN OVERNIGHT.

THE FOLLOWING QUANTITIES HAVE BEEN CARRIED TO THE GENERAL SUMMARY:

ITEM 632 TEST HOLE PERFORMED, CONDUIT, AS PER PLAN  
44 EACH

PAYMENT FOR THIS ITEM SHALL BE AT THE UNIT PRICE BID PER EACH ITEM 632 TEST HOLE PERFORMED, CONDUIT, AS PER PLAN TO BE USED AT THE DIRECTION OF THE ENGINEER.

**ITEM 632 - TEST HOLE PERFORMED, WORK PADS AND FOUNDATIONS, AS PER PLAN**

IT IS ANTICIPATED THAT THE CONTRACTOR WILL ENCOUNTER UNDERGROUND UTILITIES WHILE EXCAVATING FOR ITS WORK PADS, OR POLE FOUNDATIONS FOR ITS CAMERAS.

IF, AFTER ACCURATELY IDENTIFYING THE PROPOSED LOCATION OF THE WORK, AS SHOWN IN THE PLANS AND AFTER MODIFYING THAT LOCATION, IF NECESSARY, BASED ON THE FIELD MARKING OF UNDERGROUND UTILITY LOCATION, THE CONTRACTOR DISCOVERS A UTILITY CONFLICT DURING THE EXCAVATION OPERATION, THE CONTRACTOR WILL BE COMPENSATED FOR EACH PARTIAL FOUNDATION EXCAVATION ACCORDING TO THE BID PRICE.

BEFORE THE CONTRACTOR BEGINS THE EXCAVATION AT THE MODIFIED LOCATION, THE CONTRACTOR SHALL VERIFY THAT THERE WILL BE NO OVERHEAD UTILITY CONFLICTS RESULTING FROM THE NEW WORK LOCATION. NEW WORK LOCATIONS ARE TO BE APPROVED BY THE ENGINEER.

THE WORK WILL INCLUDE BACKFILLING, COMPACTING, AND RESTORATION OF THE EXCAVATION TO THE SITE'S ORIGINAL CONDITION.

EXCAVATIONS SHALL NOT BE LEFT OPEN OVERNIGHT.

THE FOLLOWING QUANTITIES HAVE BEEN CARRIED TO THE GENERAL SUMMARY:

ITEM 632 TEST HOLE PERFORMED, WORK PADS AND FOUNDATIONS, AS PER PLAN  
42 EACH

PAYMENT FOR THIS ITEM SHALL BE AT THE UNIT PRICE BID PER EACH ITEM 632 TEST HOLE PERFORMED, WORK PADS AND FOUNDATIONS TO BE USED AT THE DIRECTION OF THE ENGINEER.

**ITEM 809 - ITS CABINET, GROUND MOUNTED, AS PER PLAN**

IN ADDITION TO THE REQUIREMENTS OF SS 809/SS 909, THIS ITEM SHALL INCLUDE THE INSTALLATION OF A CONTROLLER WORK PAD FOR PROPOSED ITS DEVICES. REFERENCE SCD ITS-10.11.

CONSTRUCT WORK PAD PER DIMENSIONS FOUND IN THE FOLLOWING TABLE. FOR WORK PADS INCLUDING A CCTV POLE AND FOUNDATION, CONSTRUCT THE WORK PAD SEPARATELY FROM THE POLE/FOUNDATION.

**ITEM 809 - ITS CABINET, GROUND MOUNTED, AS PER PLAN (CONT.)**

THE FOLLOWING TABLE IDENTIFIES PROPOSED WORK PAD DIMENSIONS AND CCTV POLE TYPE (AS APPLICABLE):

LOC. #	WIDTH (W) (FT)	LENGTH (L) (FT)	POLE TYPE (WITHIN WORK PAD)
1	10	13	NO CCTV POLE
2	13	17	TC-81.11 DES. 8
3	13	17	TC-81.11 DES. 8
4	13	17	70 FT CCTV POLE
5	10	13	NO CCTV POLE
6	10	13	NO CCTV POLE
7	10	13	NO CCTV POLE
8	13	21	70 FT CCTV POLE
9	10	13	NO CCTV POLE
10	9	10	NO CCTV POLE
11	10	13	NO CCTV POLE
12			
13	10	13	NO CCTV POLE
14 (1)	10	13	NO CCTV POLE
14 (2)	10	20	ENCOMPASS EX. CCTV
15	13	17	TC-81.11 DES. 8
16			
17			
18			
19	6	18	NO CCTV POLE
20	10	13	NO CCTV POLE
21			
22	10	13	NO CCTV POLE
23			
24	10	13	NO CCTV POLE
25	10	13	NO CCTV POLE
26	10	13	NO CCTV POLE
27	10	13	NO CCTV POLE
28	13	17	TC-81.11 DES. 8
29	10	13	NO CCTV POLE
30	10	13	NO CCTV POLE
31	10	13	NO CCTV POLE

PAYMENT FOR EACH COMPLETE, INSTALLED, AND ACCEPTED WORK PAD SHALL BE MADE AT THE UNIT BID PRICE FOR ITEM 633, CONTROLLER WORK PAD, AS PER PLAN.

**1342-8 ITEM 809E24500: CONDUIT, 4", MULTICELL, HDPE WITH 4 - 1" INNERDUCTS**  
**ITEM 809E24000: CONDUIT, MULTICELL, JACKED OR DRILLED, 4" AS PER PLAN**

**DESCRIPTION**

THIS CONDUIT IS INTENDED FOR THE USE IN UNDERGROUND OR ENCASED SITUATIONS REQUIRING MORE THAN ONE SINGLE CONDUIT. THIS INCLUDES THE MAIN CONDUIT RACEWAY ALONG THE FREEWAY, CONNECTION FROM PULL BOXES TO THE ROAD SIDE CABINETS AND FOR RUNS OF CONDUIT FOR MULTIPLE PURPOSES, E.G., AT RAMP METER INSTALLATIONS, FOR LOOP LEAD-IN CABLE, SIGNALS CABLE FOR RAMP METER DISPLAYS, SIGNAL CABLE FOR RAMP METER SIGNING FLASHERS & ILLUMINATION AND POWER. THE CONTRACTOR SHALL PLUG ALL UNUSED CELLS WITH CONDUIT CAPS TO ASSURE AIR AND WATER INTEGRITY OF EACH INDIVIDUAL INNERDUCT.

**MATERIALS**

THE TRAFFIC SURVEILLANCE RACEWAY SHALL CONSIST OF A FACTORY-ASSEMBLED SYSTEM OF (4) INNERDUCTS ASSEMBLED WITHIN A PROTECTIVE OUTER DUCT HIGH DENSITY POLYETHYLENE OR APPROVED EQUIVALENT. THE INNERDUCTS SHALL BE A MINIMUM 1 INCH INSIDE DIAMETER. THE OUTER DUCT SHALL BE NOMINAL 4 INCH INSIDE DIAMETER AND A MAXIMUM OUTSIDE DIAMETER OF 4.8 INCH.

**1342-8 ITEM 809E24500: CONDUIT, 4", MULTICELL, HDPE WITH 4 - 1" INNERDUCTS (CON'T)**  
**ITEM 809E24000: CONDUIT, MULTICELL, JACKED OR DRILLED, 4" (CON'T)**

THE HDPE CONDUIT SHALL BE COILABLE ON REELS. WHERE INNERDUCT(S) WITHIN A MULTI-CELL DUCT ARE TO REMAIN EMPTY, ONE FLAT WOVEN POLYESTER TAPE WITH 2500 LB PULLING STRENGTH AND FOOTAGE MARKS SHALL BE INSTALLED IN EACH OF THE OPEN INNERDUCTS, THE ROPE WILL REMAIN TO BE USED FOR A FUTURE CABLE INSTALLATION. ALSO, EACH INNERDUCT SHALL BE PLUGGED TO MAINTAIN THE AIR AND WATER INTEGRITY. IN ADDITION, THE OUTER DUCT SHALL BE CAPPED TO MAINTAIN THE AIR AND WATER INTEGRITY OF THE ENTIRE SYSTEM.

**INSTALLATION IN TRENCH**

INSTALLATION WILL BE IN 30" DEEP TRENCH, DRILLED OR PLOWED TO A MINIMUM OF 30" DEEP, ENCASED INSIDE CONCRETE BARRIER WALL OR AS NOTED ON THE PLANS.

THE HDPE CONDUIT SHALL BE INSTALLED IN CONTINUOUS LENGTHS WITHOUT JOINTS OR COUPLINGS BETWEEN PULL BOXES OR JUNCTION BOXES.

WHEN ENTERING A PULL BOX, CONDUIT SHALL BE BROUGHT IN 3 INCHES MINIMUM AND A MAXIMUM OF 6 INCHES FROM THE EDGE OF THE PULL BOX AND KNOCKOUT.

**JACKED OR DRILLED INSTALLATION**

THIS INSTALLATION WILL CROSS UNDERGROUND UTILITIES AS SHOWN ON THE PLANS. THE CONTRACTOR SHALL ACCURATELY IDENTIFY THE PROPOSED LOCATION AND ROUTING OF THE CONDUIT TO BE JACKED OR DRILLED AS SHOWN IN THE PLANS.

FOR JACKED OR DRILLED INSTALLATION, THE CONTRACTOR SHALL IDENTIFY ALL CROSSINGS BASED ON THE FIELD MARKING OF UNDERGROUND UTILITY LOCATION AND PLANS. THE CONTRACTOR SHALL PERFORM A TEST HOLE AT EACH CROSSING TO VERIFY LOCATION AND DEPTH OF EXISTING UNDERGROUND UTILITY PRIOR TO JACKED OR DRILLED INSTALLATION.

WHEN CROSSING UNDERGROUND UTILITIES, THE CONTRACTOR MUST MAINTAIN A MINIMUM OF 12 INCH VERTICAL CLEARANCE WHEN JACKING OR DRILLING CONDUIT. WHEN 12 INCH CLEARANCE CANNOT BE MAINTAINED, THE CONDUIT MAY BE INSTALLED IN A TRENCH WITHIN THE VICINITY OF THE EXISTING UTILITY AS SHOWN IN ODOT TRAFFIC STANDARD CONSTRUCTION DRAWING HL-30.22 AND ITS-14-10.

THE COST FOR RESTORATION OF IMPACTED SIDEWALK AND OTHER PAVED SURFACES SHALL BE INCIDENTAL TO THE COST OF CONDUIT, MULTICELL, JACKED OR DRILLED, 4" AS PER PLAN.

THE COST FOR TRENCH AND INSTALLATION OF CONDUIT IN THESE AREAS SHALL BE INCIDENTAL TO THE COST OF CONDUIT, 4", MULTICELL, HDPE, JACKED OR DRILLED, AS PER PLAN. THE CONTRACTOR WILL BE COMPENSATED FOR EACH TEST HOLE EXCAVATION ACCORDING TO THE BID PRICE FOR ITEM 632 TEST HOLE PERFORMED, CONDUIT, AS PER PLAN.

**METHOD OF MEASUREMENT**

THE CONDUIT WILL BE MEASURED BY THE AMOUNT OF CONDUIT IN FEET FURNISHED AND INSTALLED, MEASURED FROM CENTER-TO-CENTER OF PULL BOXES, FOUNDATION, ETC., AND WILL INCLUDE ALL FITTING AND APPURTENANCES, JOINTS, BENDS, GROUNDS, AND CONCRETE ENCASEMENT WHERE SPECIFIED.

**BASIS OF PAYMENT**

THE PAYMENT FOR THESE ITEMS WILL BE MADE FOR THE ACCEPTED LINER FOOT QUANTITIES AT THE CONTRACT BID PRICE.

DESIGN AGENCY



DESIGNER

AC

REVIEWER

JGW 07/19/24

PROJECT ID

117258

SHEET TOTAL

P.5 71

**1342-9 UNDERGROUND WARNING/MARKING TAPE**

THE CONTRACTOR SHALL FURNISH AND INSTALL THIS ITEM ACCORDING TO ODOT SUPPLEMENTAL SPECIFICATIONS 804/904 AND CMS 725.22.

**1342-15 MAINTAINING ITS DURING CONSTRUCTION**

THE CONTRACTOR SHALL MAINTAIN ALL PREEXISTING OR NEWLY INSTALLED PERMANENT ITS/TRAFFIC DEVICES AND INFRASTRUCTURE DURING CONSTRUCTION ACCORDING TO ODOT SUPPLEMENTAL SPECIFICATION 809.

**1342-16 CCTV CONCRETE POLE WITH LOWERING UNIT, 70 FEET**

THE CONTRACTOR SHALL FURNISH AND INSTALL THIS ITEM ACCORDING TO ODOT SUPPLEMENTAL SPECIFICATION 809, AS WELL AS ANY STANDARD CONSTRUCTION DRAWINGS NOTED ON THE PLANS. IN ADDITION, THE CONTRACTOR SHALL INCLUDE A 1/2" ISOLATION JOINT MATERIAL BETWEEN THE CONCRETE POLE AND CONCRETE WORK PAD. THE CONTRACTOR SHALL PROVIDE 1 COMPLETE LOWERING UNIT TOOL ASSEMBLY PER CAMERA FOR LOWERING CAMERAS PER SUPPLEMENTAL SPECIFICATION 809 TO ODOT AT THE END OF THE PROJECT.

ODOT AND THE OFFICE OF GEOTECHNICAL ENGINEERING HAVE OBTAINED AND ANALYZED THE SOIL BORING DATA FOR THIS SITE, LOCATED AT LOCATION #4 AND LOCATION #8 (SEE TABLE BELOW), AND DETERMINED THAT THE POLE HEIGHT SHALL BE 70 FT ABOVE GROUND AND THE EMBEDMENT DEPTH SHALL BE 12 FT.

MIXED COHESIVE (SILT AND CLAY) AND GRANULAR (SAND AND GRAVEL) SOIL CONDITIONS. ALL BELOW THE LOCAL GROUND WATER TABLE WERE ENCOUNTERED IN THE NEARBY SOIL BORINGS. GRANULAR SOIL LAYERS WILL BE SATURATED AND SUBJECT TO POTENTIAL COLLAPSE AND MINING DURING DRILLING OPERATIONS. DRILLING BY THE 524.04.B WET CONSTRUCTION METHOD OR 524.04.C TEMPORARY CASING CONSTRUCTION METHOD SHOULD BE ANTICIPATED.

THE CONTRACTOR SHALL FURNISH/INSTALL POLES WITH THE CORRECT LENGTH/EMBEDMENT AND ALL COUPLINGS, HANDHOLES, ETC., IN THE APPROPRIATE LOCATION ABOVE GROUND ACCORDING TO SCD ITS-12.10. THE CONTRACTOR MAY FURNISH/INSTALL LONGER OVERALL LENGTH POLES AT A DEEPER EMBEDMENT DEPTH IF IT IS MORE BENEFICIAL FOR MANUFACTURING, SHIPPING, ETC., AS LONG AS ALL ABOVE GROUND COMPONENTS MAINTAIN APPROPRIATE HEIGHT LEVEL. IF NEEDED DUE TO UNFORESEEN CIRCUMSTANCES ARISING WITH BEDROCK, ETC., AND WITH APPROVAL FROM THE ODOT PROJECT ENGINEER, THE CONTRACTOR MAY FIELD CUT AN APPROPRIATE AMOUNT FROM THE BASE OF THE CONCRETE POLE WHICH WOULD REQUIRE LESS EMBEDMENT DEPTH IN ORDER TO MAINTAIN APPROPRIATE LEVELS ABOVE GROUND. IF A POLE IS CUT, THE CONTRACTOR SHALL TAKE ALL PRECAUTIONS NECESSARY TO NOT DAMAGE THE INTEGRITY OF THE POLE PER MANUFACTURER RECOMMENDATIONS AND ANY EXPOSED STEEL STRANDS SHALL BE COATED WITH EPOXY.

THE CONTRACTOR SHALL SUBMIT ALL POLE MANUFACTURER FABRICATION DRAWING SUBMITTALS, AS WELL AS INSTALLATION PROCEDURES AND BACKFILL MATERIAL, TO THE ODOT PROJECT ENGINEER FOR ACCEPTANCE BEFORE ORDERING.

PAYMENT FOR EACH POLE COMPLETE, INSTALLED, AND ACCEPTED CONCRETE POLE WITH LOWERING UNIT, SHALL BE MADE AT THE UNIT BID PRICE FOR ITEM 809, CCTV CONCRETE POLE WITH LOWERING UNIT, 70 FEET

SITE	LOCATION	LATITUDE	LONGITUDE	BORING TYPE	POLE LENGTH	FOUNDATION DEPTH	LENGTH
4	I-670 WB EXIT RAMP AT NEIL AVE.	39.973689	-83.009936	HISTORIC	70 FT.	12 FT.	82 FT.
8	I-70 WB EXIT RAMP AT S. CENTRAL AVE.	39.951256	-83.038903	HISTORIC	70 FT.	12 FT.	82 FT.

**ITEM 809E60070, EACH CCTV IP-CAMERA SYSTEM, WRONG WAY DETECTION**

THE CONTRACTOR SHALL PROVIDE AND INSTALL A FIXED VIEW CAMERA CAPABLE OF WRONG WAY ANALYTICS PER SUPPLEMENTAL SPECIFICATION 809 AND 909.

THE CAMERA SHALL HAVE A VARIFOCAL LENS WITH ADJUSTMENT BETWEEN 4MM AND 13MM. THE CAMERA SHALL BE INSTALLED AS SHOWN ON THE PLANS AND ORIENTED AND FOCUSED TO VIEW THE EXIT RAMP AS MUCH AS POSSIBLE, UNLESS OTHERWISE NOTED. THE CONTRACTOR SHALL CONNECT THE CAMERAS TO THE ITS CABINET WITH AN OUTDOOR ETHERNET CABLE (SEPARATE PAY ITEM) AND RJ-45 CONNECTORS WHICH SHALL BE TERMINATED IN ACCORDANCE WITH TIA-EIA-568-B.

UPON INSTALLATION, THE CONTRACTOR SHALL INSTALL THE CAMERA AND CONNECT THE ETHERNET CABLE INTO THE ODOT NETWORK SWITCH PORT, AS INFORMED BY ODOT ITS. THE CONTRACTOR SHALL CALL THE ODOT ITS LAB TO VERIFY THE CAMERA CONNECTION AND VIEWS WHILE ON SITE INSTALLING THE CAMERA. THE CONTRACTOR SHALL ADJUST THE CAMERA ORIENTATION OR LENSES AS NEEDED FOR OPTIMAL VIEWS.

**EROSION AND SEDIMENT CONTROL**

ALL PUBLIC AGENCIES AND PRIVATE CONTRACTORS PERFORMING PAVEMENT-CUTTING OPERATIONS ON CITY OF COLUMBUS STREETS AND ROADWAYS SHALL PROTECT THE ENVIRONMENT FROM DISCHARGES CREATED BY THEIR PAVEMENT CUTTING OPERATIONS. NOTE THAT COLUMBUS CITY CODE 1145 PROHIBITS NON-STORMWATER DISCHARGE INTO THE CITY OF COLUMBUS SEWER SYSTEM, CURB INLETS AND ANY PART OF ITS MS4 (MUNICIPAL SEPARATE STORM SEWER SYSTEM). THE REQUIREMENT INCLUDES BUT IS NOT LIMITED TO WET OR DRY SAW-CUTTING, JACK HAMMERING, EXCAVATION EQUIPMENT USE, ETC.

THE PUBLIC AGENCY AND/OR PRIVATE CONTRACTOR WORK CREWS SHALL RECOVER AND DISPOSE OF DETRITUS, POLLUTED WATERS, OR OTHER SUCH DISCHARGES RESULTING FROM THEIR PAVEMENT CUTTING OPERATIONS AND PROTECT ALL STORM SEWER INLETS FROM RECEIVING ANY DISCHARGES FROM THE CONSTRUCTION OPERATIONS. THE AGENCY OR CONTRACTOR RESPONSIBLE FOR EACH PAVEMENT CUTTING ACTIVITY SHALL BE SOLELY LIABLE FOR NOTICE OF VIOLATIONS (NOV/S) AND FINES ISSUED BY CITY OF COLUMBUS AND/OR STATE OF OHIO AUTHORITIES.

EQUIPMENT, MATERIALS AND METHODS SHALL BE PROVIDED BY THE RESPONSIBLE PUBLIC AGENCY AND/OR PRIVATE CONTRACTOR TO WORK CREWS PERFORMING THE PAVEMENT CUTTING ACTIVITY AND MADE AVAILABLE TO WORK CREWS FOR USE IN CLEANING UP DISCHARGES RESULTING FROM SUCH CUTTING ACTIVITIES AND PREVENTING RUNOFF. ALL WORK CREWS SHALL BE TRAINED TO EXERCISE AND EMPLOY EQUIPMENT, MATERIALS, AND ENVIRONMENTAL PROTECTIVE MEASURES TO PREVENT POLLUTED DISCHARGES FROM ENTERING THE CITY OF COLUMBUS STORM SEWER SYSTEM AND WATERS OF THE STATE OF OHIO.

THE PUBLIC AGENCY AND/OR PRIVATE CONTRACTOR IS SOLELY RESPONSIBLE FOR ENSURING THAT THE INLET PROTECTION IS ADEQUATE. THE MOST STRINGENT PROJECT PLANS, NOTES AND/OR DRAWINGS INCLUDING STORMWATER POLLUTION PREVENTION PLAN (SWP3) OR SPILL PREVENTION/REMEDIATION PLAN SHALL APPLY TO ALL PAVEMENT CUTTING, SAWING OR EXCAVATION OPERATIONS.

**EROSION AND SEDIMENT CONTROL (CON'T.)**


EROSION AND SEDIMENT CONTROL MEASURES SPECIFIC TO THIS SITE ARE TO BE PROVIDED BY ODOT SS-832. THE PROPOSED LAND DISTURBING ACTIVITIES WITHIN THE CITY OF COLUMBUS MUST COMPLY WITH ALL OF THE PROVISIONS OF THE DIVISION OF SEWERAGE AND DRAINAGE EROSION AND SEDIMENT CONTROL REGULATION.

ALL LAND DISTURBING ACTIVITIES SHALL BE SUBJECT TO INSPECTION AND SITE INVESTIGATION BY THE CITY OF COLUMBUS TO DETERMINE COMPLIANCE WITH CITY STANDARDS AND REGULATIONS. FAILURE TO COMPLY WITH THESE REGULATIONS MAY SUBJECT THE SITE TO ENFORCEMENT ACTION BY THE CITY. QUESTIONS REGARDING EROSION AND SEDIMENT CONTROL MAY BE REFERRED TO THE STORMWATER MANAGEMENT OFFICE AT 645-6311.

ON-SITE CONTACT:  
PHONE:  
FAX:  
E-MAIL: OEPA NPDES GENERAL PERMIT NOI NUMBER: N/A  
SITE IS TRIBUTARY TO : VARIOUS WATERCOURSES (MULTIPLE SITES)

THE PUMPING OR DIRECT DISCHARGE OF SEDIMENT-LADEN (MUDDY) WATER TO THE CITY'S SEWER SYSTEM OR RECEIVING STREAM IS A VIOLATION OF OHIO EPA AND CITY OF COLUMBUS REGULATIONS. ALL INLETS RECEIVING FLOW FROM RUNOFF, PUMPING ACTIVITIES, OR OTHER DIRECT DISCHARGES SHALL BE FITTED WITH AND INLET PROTECTION DEVICE THAT IS PROPERLY SIZED AND SECURED TO REDUCE THE DISCHARGE OF SEDIMENT INTO THE STORM SEWER AND RECEIVING STREAM. INLET PROTECTION IS REQUIRED ON ALL INLETS RECEIVING DISCHARGE REGARDLESS OF WHETHER OR NOT THE INLET IS TRIBUTARY TO ANY DOWNSTREAM EROSION AND SEDIMENT CONTROLS.

DISCHARGE HOSES USED DURING PUMPING ACTIVITIES SHALL BE FITTED WITH SEDIMENT BAGS THAT ARE PROPERLY SIZED PER THE MANUFACTURER'S RECOMMENDATIONS REGARDLESS OF WHAT OTHER SEDIMENT CONTROLS ARE IN PLACE FURTHER DOWNSTREAM. SEDIMENT BAGS MUST BE PROPERLY SECURED TO THE DISCHARGE HOSE AND PLACED OVER VEGETATED AREAS, WHERE FEASIBLE, DURING DISCHARGE. SEE DETAIL BELOW OF A TYPICAL SEDIMENT BAG INSTALLATION.

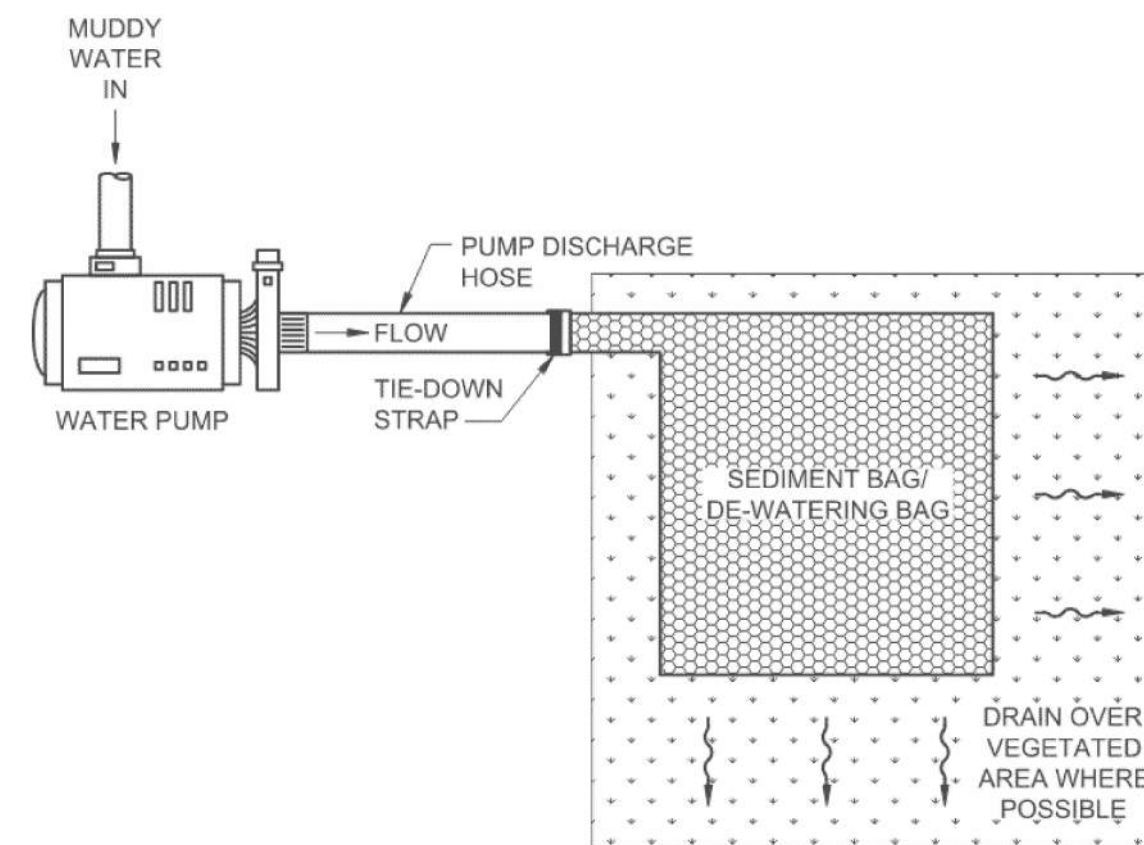

**CITY OF COLUMBUS WATER GENERAL NOTES**

FOR ANY EMERGENCIES INVOLVING THE WATER DISTRIBUTION SYSTEM, PLEASE CONTACT THE DIVISION OF WATER DISTRIBUTION MAINTENANCE OFFICE AT 614-645-7788.

WHEN CROSSING THE EXISTING WATER MAIN, AND LOW STRENGTH MORTAR (ITEM 613) IS TO BE USED AS BACKFILL, THE CONTRACTOR SHALL PROVIDE SIZE NO. 57 CRUSHED CARBONATE STONE (CCS) 1 FOOT BELOW TO 1 FOOT ABOVE THE EXISTING WATER MAIN.

IF DURING EXCAVATION, THE POLYETHYLENE ENCASEMENT ON THE EXISTING WATER MAIN BECOMES DAMAGED, THE CONTRACTOR SHALL REPAIR THE POLYETHYLENE ENCASEMENT PER MANUFACTURER'S SPECIFICATIONS AND DOW STANDARD DRAWINGS L-1003 AND L-1004, AT THEIR OWN EXPENSE. ENSURE THAT THE ENTIRE EXPOSED AREA IS COVERED WITH NEW POLYETHYLENE ENCASEMENT AND SECURELY TAPED, PRIOR TO BACKFILLING.

WHERE NEW CONDUIT IS PROPOSED TO CROSS AN EXISTING OR PROPOSED WATER MAIN OR WATER TAP/SERVICE LINE, A MINIMUM OF 12-INCHES OF VERTICAL CLEARANCE SHALL BE MAINTAINED BETWEEN THE CONDUIT AND THE WATER MAIN OR TAP/SERVICE LINE. A MINIMUM OF 3-FEET OF HORIZONTAL CLEARANCE (OUT TO OUT) IS REQUIRED AT LOCATIONS WHERE THE CONDUIT IS PARALLEL TO THE WATER MAIN AND AT LOCATIONS OF WATER MAIN THRUST BLOCKS.

A MINIMUM OF 3 FEET OF HORIZONTAL CLEARANCE (OUT TO OUT) SHALL BE MAINTAINED BETWEEN ALL EXISTING WATER MAINS AND FOUNDATIONS FOR POLES, PULL BOXES, PUSH BUTTON PEDESTALS, AND ANY OTHER MISCELLANEOUS ELECTRICAL STRUCTURE.

**ITEM 625 - PULL BOX, MISC.: PULL BOX, 12" X 18" (COC 725.06) TRAFFIC**

CONTRACTOR TO PROVIDE PULL BOX OF THE SIZE AND TYPE SPECIFIED, IN ACCORDANCE WITH CITY OF COLUMBUS TRAFFIC STANDARDS.

PROVIDE THE BODY OF THE BOX AS OFONE PIECE CONSTRUCTION. PROVIDE SMOOTH SURFACES OF THE BOX AND COVER AND THE COVER WITH A MOLDED SLIP RESISTANT SURFACE. LABEL THE COVER IN CLEARLY LEGIBLE BLOCK LETTERS 1 INCH TO 2 INCHES (25 MM - 50 MM) IN HEIGHT INTEGRAL TO THE COVER WITH THE WORD "TRAFFIC" TO DESIGNATE THE CIRCUIT(S) CONTAINED. MATERIAL TYPE, INSTALLATION AND PLACEMENT TO BE IN ACCORDANCE WITH ODOT AND CITY OF COLUMBUS STANDARD SPECIFICATIONS.

PAYMENT WILL BE MADE AT THE UNIT BID PRICE OF EACH FOR ITEM 625 - PULL BOX, MISC.: PULL BOX, 12" X 18" (CITY OF COLUMBUS 725.06) TRAFFIC WHICH SHALL BE FULL COMPENSATION FOR ALL LABOR, MATERIALS, AND INCIDENTALS REQUIRED TO COMPLETE THIS ITEM IN A SATISFACTORY AND WORKMANLIKE MANNER.

DESIGN AGENCY



DESIGNER  
AC


REVIEWER  
JGW 07/19/24

PROJECT ID  
117258

SHEET TOTAL  
P.6 | 71

SHEET NUM.						PART.	ITEM	ITEM	GRAND	UNIT	DESCRIPTION	SEE SHEET NO.
P.3	P.5	P.11	P.11B	P.42	P.68	01/SAF/21	EXT	TOTAL				
											<b>ROADWAY</b>	
							201	11000	LS		CLEARING AND GRUBBING	
					1	1	202	42206	1	EACH	ANCHOR ASSEMBLY REMOVED	
					350	350	606	15050	350	FT	GUARDRAIL, TYPE MGS	
					1	1	606	26150	1	EACH	ANCHOR ASSEMBLY, MGS TYPE E (MASH 2016)	
					2	2	606	26550	2	EACH	ANCHOR ASSEMBLY, MGS TYPE T	
											<b>EROSION CONTROL</b>	
515						515	659	00300	515	CY	TOPSOIL	
4,490						4,490	659	00500	4,490	SY	SEEDING AND MULCHING, CLASS 1	
141						141	659	00530	141	SY	SEEDING AND MULCHING, CLASS 3B	
0.4						0.4	659	20000	0.4	TON	COMMERCIAL FERTILIZER	
1						1	659	31000	1	ACRE	LIME	
12.5						12.5	659	35000	12.5	MGAL	WATER	
						1,000	832	30000	1,000	EACH	EROSION CONTROL	
											<b>PAVEMENT</b>	
				75		75	411	10000	75	CY	STABILIZED CRUSHED AGGREGATE	P.42
											<b>TRAFFIC SIGNALS</b>	
		177				177	625	00480	177	EACH	CONNECTION, UNFUSED PERMANENT	
		1,250				1,250	625	25408	1,250	FT	CONDUIT, 2", 725.051	
		956				956	625	25504	956	FT	CONDUIT, 3", 725.051	
		741				741	625	25903	741	FT	CONDUIT, JACKED OR DRILLED, 725.04, AS PER PLAN, 3"	P.5
		419				419	625	25910	419	FT	CONDUIT CLEANED AND CABLES REMOVED	
		5,126				5,126	625	29010	5,126	FT	TRENCH, 30" DEEP	
		48				48	625	30700	48	EACH	PULL BOX, 725.08, 18"	
		7				7	625	31506	7	EACH	PULL BOX REMOVED AND REPLACED	
		1				1	625	31600	1	EACH	PULL BOX, MISC.: PULL BOX, 12" X 18" (COC 725.06) TRAFFIC	P.6
		87				87	625	32000	87	EACH	GROUND ROD	
		5,126				5,126	625	36010	5,126	FT	UNDERGROUND WARNING/MARKING TAPE	
		1,068				1,068	632	29900	1,068	FT	MESSENGER WIRE, 7 STRAND, 1/4" DIAMETER WITH ACCESSORIES	
		9				9	632	64000	9	EACH	STRAIN POLE FOUNDATION	
	42					42	632	64951	42	EACH	TEST HOLE PERFORMED, WORK PADS AND FOUNDATIONS, AS PER PLAN	P.5
	44					44	632	64951	44	EACH	TEST HOLE PERFORMED, CONDUIT, AS PER PLAN	P.5
		2,746				2,746	632	68300	2,746	FT	POWER CABLE, 3 CONDUCTOR, NO. 6 AWG	
		74				74	632	68400	74	FT	POWER CABLE, 4 CONDUCTOR, NO. 6 AWG	
		3,014				3,014	632	69320	3,014	FT	POWER CABLE, 3 CONDUCTOR, NO. 2 AWG	
		3				3	632	70001	3	EACH	POWER SERVICE, AS PER PLAN (CONNECTION TO EXISTING CITY OF COLUMBUS POWER SERVICE)	P.25B
		5				5	632	70001	5	EACH	POWER SERVICE, AS PER PLAN (CONNECTION TO EXISTING CITY OF COLUMBUS TRAFFIC SIGNAL POWER METER CABINET)	P.25B
		5				5	632	70001	5	EACH	POWER SERVICE, AS PER PLAN (EXISTING ODOT POWER SERVICE, ODOT ITS CABINET)	P.25B
		7				7	632	70001	7	EACH	POWER SERVICE, AS PER PLAN (EXISTING ODOT POWER SERVICE)	P.25B
		1				1	632	70001	1	EACH	POWER SERVICE, AS PER PLAN (NEW CITY OF COLUMBUS POWER SERVICE)	P.25B
		16				16	632	70400	16	EACH	CONDUIT RISER, 2" DIAMETER	
		3				3	632	70600	3	EACH	CONDUIT RISER, 3" DIAMETER	
		8				8	632	86120	8	EACH	STRAIN POLE, TYPE TC-81.11, DESIGN 8	
		5				5	632	89300	5	EACH	WOOD POLE	
		1				1	632	90400	1	EACH	SIGNALIZATION, MISC.: POWER METER CABINET, TYPE I FOUNDATION (COC STD DWG 4164)	
											<b>TRAFFIC SURVEILLANCE</b>	
			35,336			35,336	804	32060	35,336	FT	DROP CABLE, 24 FIBER	
			27			27	804	34022	27	EACH	FIBER TERMINATION PANEL, 24 FIBER	
			3			3	804	37000	3	EACH	SPlice ENCLOSURE, BUTT STYLE	
			6			6	804	37001	6	EACH	SPlice ENCLOSURE, AS PER PLAN	P.26A
			61			61	809	02000	61	EACH	32" ITS PULL BOX WITH PAD AND STANDARD LID ASSEMBLY	
			4			4	809	02002	4	EACH	32" ITS PULL BOX WITH PAD AND HINGED LID ASSEMBLY	
			4			4	809	02066	4	EACH	48" ITS PULL BOX WITH PAD AND STANDARD LID ASSEMBLY, TYPE 2	
			3,887			3,887	809	24500	3,887	FT	CONDUIT, 4", MULTICELL, HDPE WITH 4 - 1" INNERDUCTS	
			2,163			2,163	809	25000	2,163	FT	CONDUIT, MULTICELL, MISC.: CONDUIT, MULTICELL, JACKED OR DRILLED, 4"	P.5

GENERAL SUMMARY

DESIGN AGENCY  
  
 4454 IDEA CENTER BLVD.  
 DAYTON, OH 45430  
 T 937-461-5680  
 F 937-461-0743

DESIGNER  
 AC

REVIEWER  
 JGW 09/13/24

PROJECT ID  
 117258

SHEET TOTAL  
 P.8 | 71





SHEET NO.	LOCATION	REFERENCE NO.	804	804	804	804		809	809	809	809	809	809	809	809	809	809	809	809	809																			
			FT	EACH	EACH	EACH		EACH	EACH	EACH	FT	FT	EACH	EACH	EACH	EACH	EACH	EACH	FT	EACH	EACH																		
P.55	LOCATION #17 I-71 SB AT SILVER DR/E HUDSON ST	P17-1	300					2	1	198	49			1																									
P.56	LOCATION #18 I-71 SB AT SILVER DR/E WEBER RD	P18-1	300					2	1	109	46			1																									
P.57	LOCATION #19 I-71 SB AT SINCLAIR RD	P19-1	1650	1				1		88	24			1																									
P.58	LOCATION #20 I-71 NB AT GEMINI PL	P20-1 P20-2	726	1				1		126				1																									
P.59	LOCATION #21 I-270 WB AT CLEVELAND AVE		600											1																									
P.60	LOCATION #22 SR 161 EB AT SUNBURY RD	P22-1	2185	1				1		290	230			1																									
P.63	LOCATION #23 SR 161 EB AT LITTLE TURTLE WAY		564 1611	1				1						1																									
P.64	LOCATION #24 SR 315 NB AT W GOODALE ST	P24-1	1341	1				1			23			1																									
P.65	LOCATION #25 SR 315 SB AT OLENTANGY RIVER RD	P25-1	787	1				1			32			1																									
P.66	LOCATION #26 SR 315 NB AT N BROADWAY/RIVERSIDE	P26-1	605	1		1		1		112	40			1																									
P.67	LOCATION #27 SR 315 NB AT N BROADWAY/OH HEALTH	P27-1	1026	1				1			13			1																									
P.68	LOCATION #28 SR 315 SB AT NB ENTRANCE/BROADWAY	P28-1 P28-2	672	1				1	1					2																									
P.69	LOCATION #29 SR 315 SB AT O.R./JASONWAY AVE	P29-1 P29-2	2450	1				1		112	250			1																									
P.70	LOCATION #30 SR 104 SB AT REFUGEE RD	P30-1 P30-2	983	1				1			48			1																									
P.71	LOCATION #31 I-70 WB AT E MOUND ST	P31-1	3368	1	1			1	2	73	271			1																									
TOTAL THIS SHEET			19168	12	2	2		25	3	4	1262	1638	0	16	0	0	4835	12	0																				
TOTAL FROM SHEET P.11A			16168	15	1	4		36	1	0	901	2249	1	16	2	2	4466	15	1																				
TOTALS CARRIED TO GENERAL SUMMARY			35336	27	3	6		61	4	4	2163	3887	1	32	2	2	9301	27	1																				

TRAFFIC SURVEILLANCE SUBSUMMARY

DESIGN AGENCY  
  
 WOOLPERT  
 4454 IDEA CENTER BLVD.  
 DAYTON, OH 45430  
 T 937-461-5680  
 F 937-461-0743

DESIGNER  
AC


REVIEWER  
JGW 09/13/24

PROJECT ID  
117258

SHEET TOTAL  
P.11B 71

**D06 WRONG WAY DETECTION**

MODEL: Sheet PAPER: 34x22 (in.) DATE: 9/18/2024 TIME: 5:44:01 PM USER: Soldana  
G:\DE\Projects\117258\117258\400-Engineering\Traffic\Drawings\117258\_117310.dgn

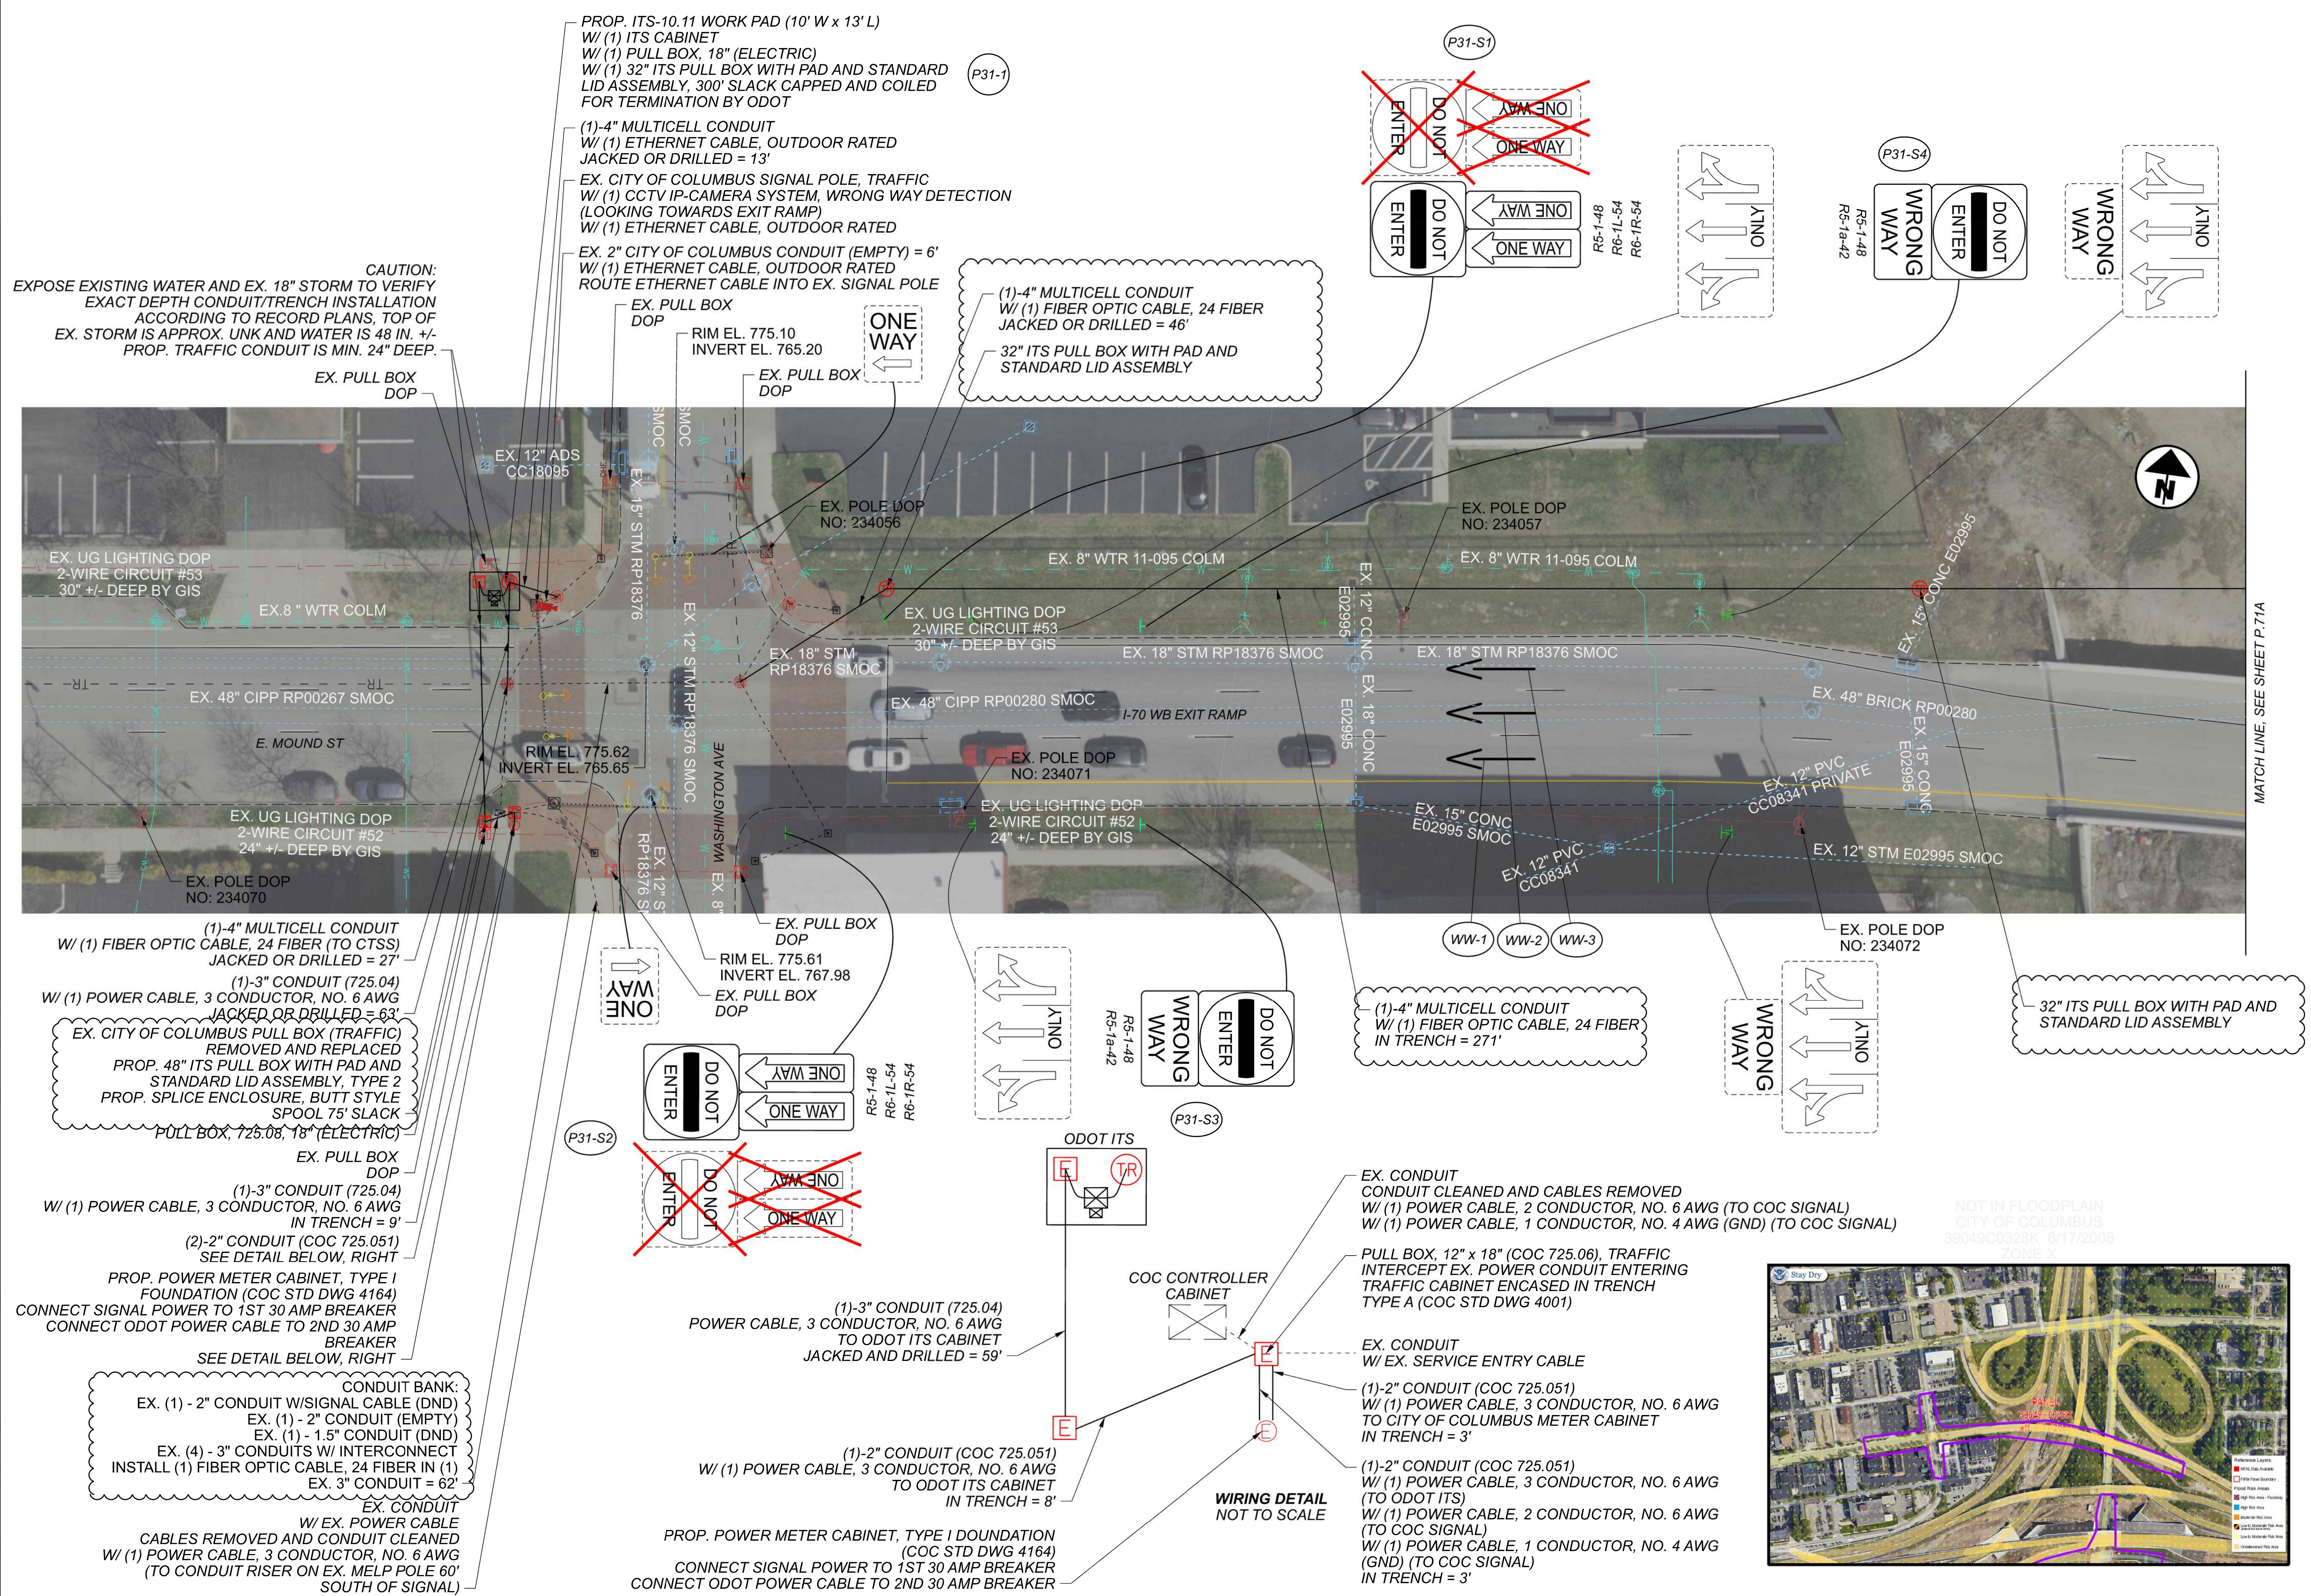

**CAUTION:**  
EXPOSE EXISTING WATER AND EX. 18" STORM TO VERIFY EXACT DEPTH CONDUIT/TRENCH INSTALLATION ACCORDING TO RECORD PLANS, TOP OF EX. STORM IS APPROX. UNK AND WATER IS 48 IN. +/- PROP. TRAFFIC CONDUIT IS MIN. 24" DEEP.

(1)-4" MULTICELL CONDUIT W/ (1) FIBER OPTIC CABLE, 24 FIBER JACKED OR DRILLED = 27'

(1)-3" CONDUIT (725.04) W/ (1) POWER CABLE, 3 CONDUCTOR, NO. 6 AWG JACKED OR DRILLED = 63'

EX. CITY OF COLUMBUS PULL BOX (TRAFFIC) REMOVED AND REPLACED PROP. 48" ITS PULL BOX WITH PAD AND STANDARD LID ASSEMBLY, TYPE 2 PROP. SPLICE ENCLOSURE, BUTT STYLE SPOOL 75' SLACK PULL BOX, 725.08, 18" (ELECTRIC)

EX. PULL BOX DOP

(1)-3" CONDUIT (725.04) W/ (1) POWER CABLE, 3 CONDUCTOR, NO. 6 AWG IN TRENCH = 9'

(2)-2" CONDUIT (COC 725.051) SEE DETAIL BELOW, RIGHT

PROP. POWER METER CABINET, TYPE I FOUNDATION (COC STD DWG 4164) CONNECT SIGNAL POWER TO 1ST 30 AMP BREAKER CONNECT ODOT POWER CABLE TO 2ND 30 AMP BREAKER SEE DETAIL BELOW, RIGHT

**CONDUIT BANK:**  
EX. (1) - 2" CONDUIT W/SIGNAL CABLE (DND)  
EX. (1) - 2" CONDUIT (EMPTY)  
EX. (1) - 1.5" CONDUIT (DND)  
EX. (4) - 3" CONDUITS W/ INTERCONNECT  
INSTALL (1) FIBER OPTIC CABLE, 24 FIBER IN (1) EX. 3" CONDUIT = 62'

EX. CONDUIT W/ EX. POWER CABLE CABLES REMOVED AND CONDUIT CLEANED W/ (1) POWER CABLE, 3 CONDUCTOR, NO. 6 AWG (TO CONDUIT RISER ON EX. MELP POLE 60' SOUTH OF SIGNAL)

(1)-3" CONDUIT (725.04) W/ (1) POWER CABLE, 3 CONDUCTOR, NO. 6 AWG TO ODOT ITS CABINET JACKED AND DRILLED = 59'

(1)-2" CONDUIT (COC 725.051) W/ (1) POWER CABLE, 3 CONDUCTOR, NO. 6 AWG TO ODOT ITS CABINET IN TRENCH = 8'

PROP. POWER METER CABINET, TYPE I FOUNDATION (COC STD DWG 4164) CONNECT SIGNAL POWER TO 1ST 30 AMP BREAKER CONNECT ODOT POWER CABLE TO 2ND 30 AMP BREAKER



**TRAFFIC CONTROL PLAN**  
**LOCATION #31 - I-70 WB AT E MOUND ST**

DESIGN AGENCY  
**WOOLPERT**


4454 IDEA CENTER BLVD.  
DAYTON, OH 45430  
T 937-461-5660  
F 937-461-0743

DESIGNER  
AC

REVIEWER  
JGW 07/19/24

PROJECT ID  
117258

SHEET TOTAL  
P.71 | 71


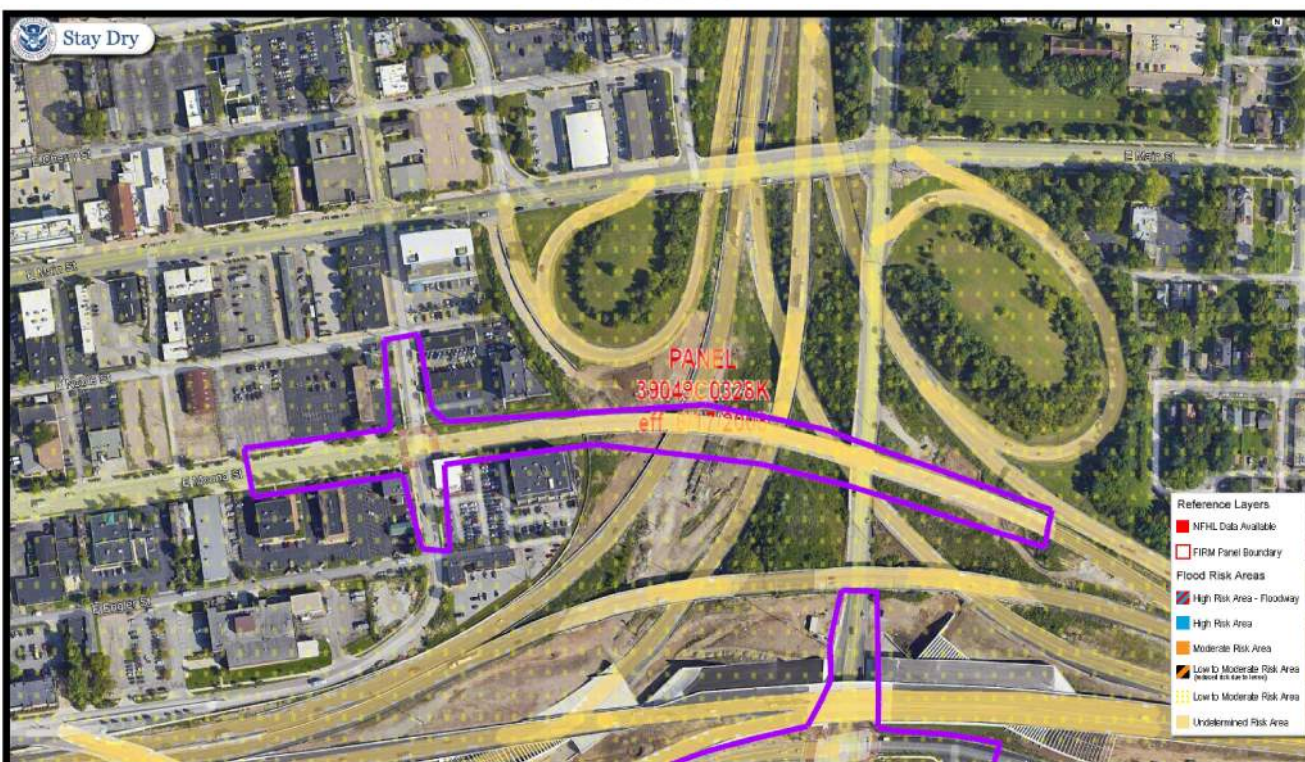


NOT IN FLOODPLAIN  
CITY OF COLUMBUS  
39049CD326K 6/17/2008



**D06 WRONG WAY DETECTION**

MODEL: Sheet PAPER: 34x22 (in.) DATE: 9/8/2024 TIME: 5:44:35 PM USER: Saidana  
 G:\DE\Clients\0001\Safety Design Projects\12342\Task 9 D6 Wrong Way Detection PID 117258\17258\400-Engineering\Traffic\Sheets\17258\_TP31.dgn

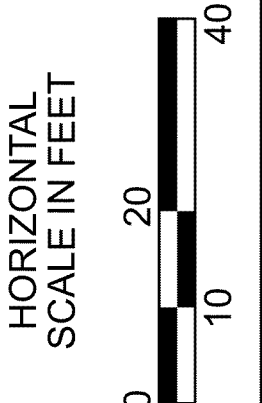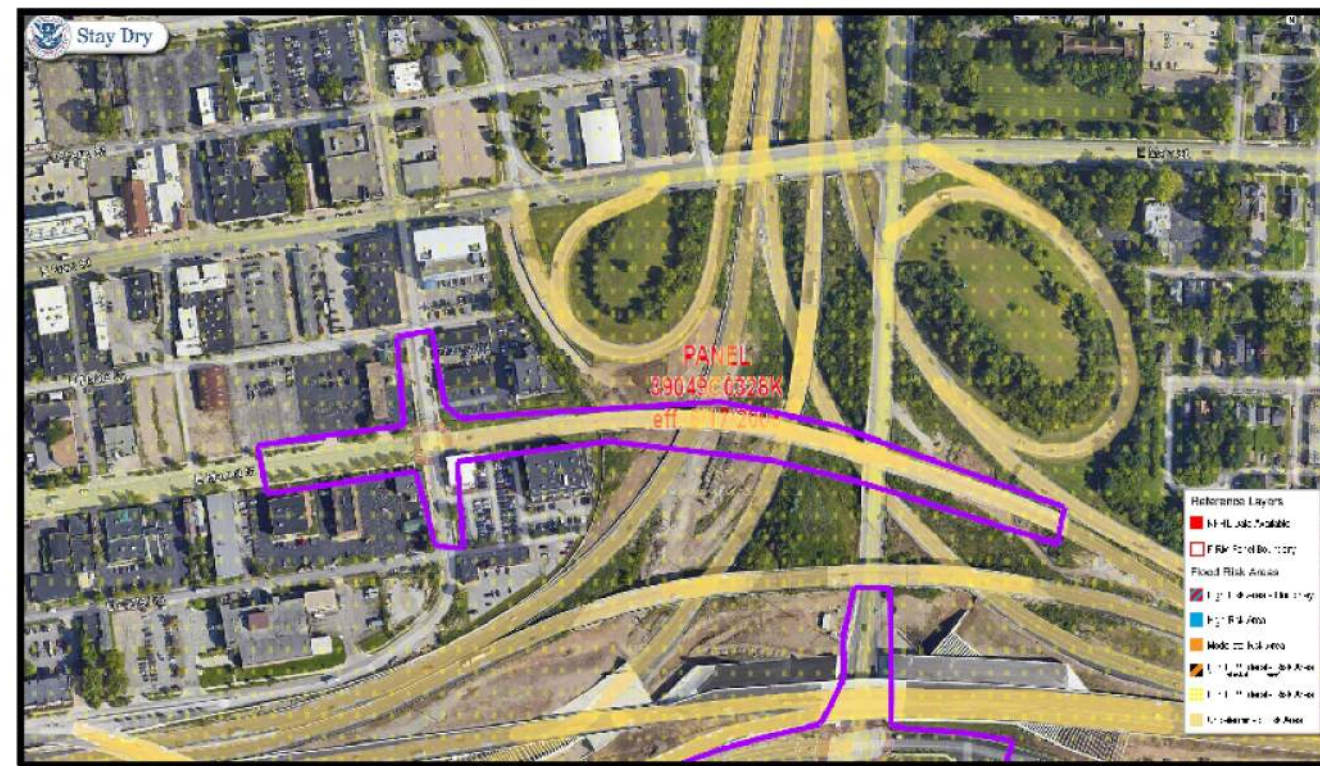

**TRAFFIC CONTROL PLAN**  
**LOCATION #31 - I-70 WB AT E MOUND ST**

DESIGN AGENCY



DESIGNER  
 AC


REVIEWER  
 JGW 09/13/24

PROJECT ID  
 117258

SHEET	TOTAL
P.71A	71

**D06 WRONG WAY DETECTION**

MODEL: Sheet PAPER: SIZE: 34x22 (in.) DATE: 9/8/2024 TIME: 5:44:49 PM USER: Saldana  
 G:\DE\Clients\0001\Safety Design Projects\12342\Task 9 D6 Wrong Way Detection PID 117258\17258\400-Engineering\Traffic\Sheets\17258\_TF312.dgn

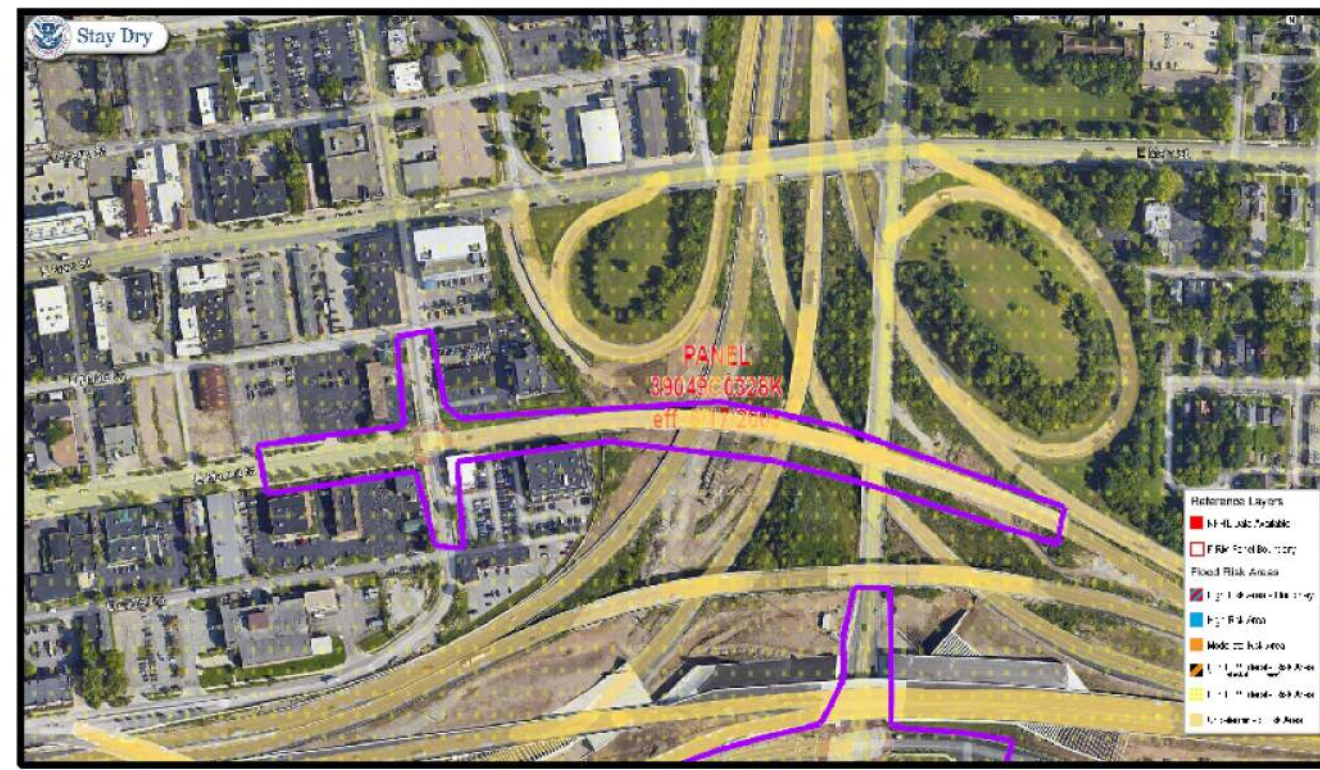

NOT IN FLOODPLAIN  
 CITY OF COLUMBUS  
 39049C0328K 8/17/2008  
 70N15 X


MATCH LINE, SEE SHEET P.71A



EX. ODOT ITS PULL BOX  
 EX. MULTICELL CONDUIT  
 W/ EX. ODOT FIBER  
 W/ (1) FIBER OPTIC CABLE, 24 FIBER IN EX. CONDUIT = 7'  
 EX. ODOT ITS PULL BOX  
 SPOOL 300' SLACK FOR FUTURE INTERCONNECT (BY ODOT)



**TRAFFIC CONTROL PLAN**  
**LOCATION #31 - I-70 WB AT E MOUND ST**

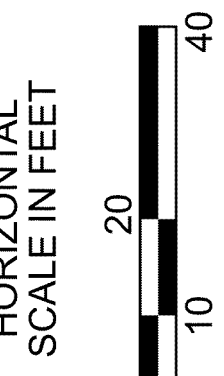

DESIGN AGENCY



DESIGNER  
 AC

REVIEWER  
 JGW 09/13/24

PROJECT ID  
 117258

SHEET	TOTAL
P.71B	71