

LATITUDE: N39°25'52" LONGITUDE: W84°17'03"

STATE OF OHIO DEPARTMENT OF TRANSPORTATION

D08-DELINEATOR-FY2025

BUTLER, CLERMONT, CLINTON, GREENE, HAMILTON, PREBLE AND WARREN COUNTIES

INDEX OF SHEETS:

TITLE SHEET LOCATION MAPS GENERAL NOTES GENERAL SUMMARY **DELINEATOR SUB-SUMMARY**

11-14

DESIGN DESIGNATION

NONE REQUIRED

DESIGN EXCEPTIONS

NONE REQUIRED


ADA DESIGN WAIVERS

NONE REQUIRED

UNDERGROUND UTILITIES Contact Two Working Days Before You Dig Before You Dig

OHIO811, 8-1-1, or 1-800-362-2764 (Non members must be called directly)

> PLAN PREPARED BY: **ODOT DISTRICT 8 TRAFFIC OPERATIONS** 505 SOUTH SR 741 LEBANON, OH 45036

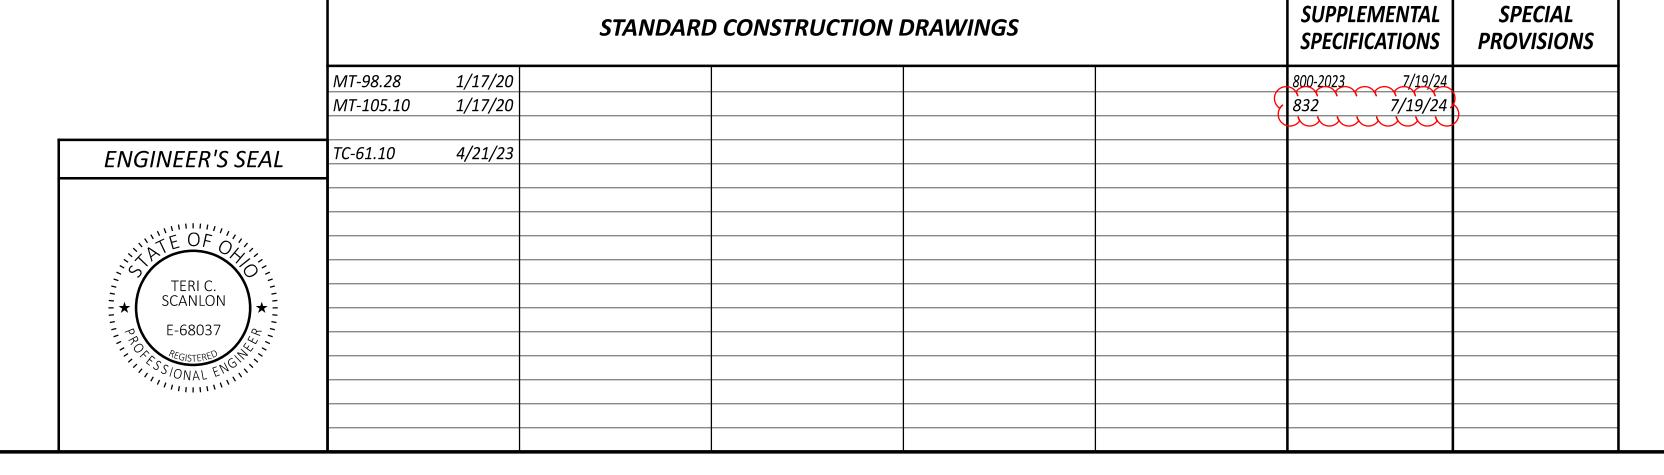

FEDERAL PROJECT NUMBER

NON-FEDERAL

RAILROAD INVOLVEMENT

NONE

PROJECT DESCRIPTION

THIS PROJECT CONSISTS OF REMOVING DEFICIENT ROADSIDE DELINEATORS ALONG RAMPS AND INSTALLING NEW DELINEATORS AT VARIOUS LOCATIONS IN DISTRICT 8.

EARTH DISTURBED AREAS

PROJECT EARTH DISTURBED AREA: N/A* N/A* ESTIMATED CONTRACTOR EARTH DISTURBED AREA: N/A* NOTICE OF INTENT EARTH DISTURBED AREA:

* MAINTENANCE PROJECT

LIMITED ACCESS

THIS IMPROVEMENT IS ESPECIALLY DESIGNED FOR THROUGH TRAFFIC AND HAS BEEN DECLARED A LIMITED ACCESS HIGHWAY OR FREEWAY BY ACTION OF THE DIRECTOR IN ACCORDANCE WITH THE PROVISIONS OF SECTION 5511.02 OF THE OHIO REVISED CODE.

2023 SPECIFICATIONS

THE STANDARD SPECIFICATIONS OF THE STATE OF OHIO, DEPARTMENT OF TRANSPORTATION, INCLUDING SUPPLEMENTAL SPECIFICATIONS LISTED IN THE PLANS, CHANGES LISTED IN THE PROPOSAL, AND THE SUPPLEMENTAL SPECIFICATION 800 VERSION INDICATED ON THE PROPOSAL SHALL GOVERN THIS IMPROVEMENT.

DISTRICT DEPUTY DIRECTOR

I HEREBY APPROVE THESE PLANS AND DECLARE THAT THE MAKING OF THIS IMPROVEMENT WILL NOT REQUIRE THE CLOSING TO TRAFFIC OF THE HIGHWAY AND THAT PROVISIONS FOR THE MAINTENANCE AND SAFETY OF TRAFFIC WILL BE AS SET FORTH ON THE PLANS AND ESTIMATES.

ESIGN AGENCY



ESIGNER TCS

REVIEWER ROJECT ID