DAR-PAVE-FY26

SEE SHEET 2 FOR LOCATION MAP

LOCATION MAP



PORTION TO BE IMPROVED ._____

ROUTE	LOCATION	ADT	TRUCKS			
DAR-127	SLM 22.20 TO 25.20	3,982	880			
DAR-319	SLM 0.00 TO 0.53	1,212	97			
DAR-705	SLM 9.00 TO 13.31	1,928	311			
DAR-118	SLM 12.30 TO 17.62	1,648	202			
DAR-716	SLM 0.00 TO 0.23	1,574	126			
DAR-36	SLM 3.37 TO 3.65	2,931	490			
DAR-47	SLM 10.04 TO 13.85	1,764	258			

DESIGN EXCEPTIONS

NONE

ADA DESIGN WAIVERS

REQUIRED



PLAN PREPARED BY: ODOT DISTRICT 7 - ENGINEERING 1001 ST. MARYS AVE. SIDNEY, OHIO

STATE OF OHIO DEPARTMENT OF TRANSPORTATION

DAR-PAVE-FY26

VILLAGES OF ANSONIA, BURKETTSVILLE, OSGOOD, PALESTINE & ROSSBURG

INDEX OF SHEETS:

TITLE SHEET	1
SCHEMATIC PLAN	2
TYPICAL SECTIONS	3
GENERAL NOTES	4-5
GENERAL SUMMARY	6
PAVEMENT SUBSUMMARY	7-9
DRIVE DETAILS	10
TRAFFIC CONTROL SUBSUMMARIES	11-14
STRUCTURES	15-16
CURB RAMPS	<i>17-33</i>

FEDERAL PROJECT NUMBER

E230616

RAILROAD INVOLVEMENT

PROJECT DESCRIPTION

THIS PROJECT CONSISTS OF RESURFACING WITH ASPHALT CONCRETE OF VARIOUS ROUTES IN DARKE COUNTY.

PROJECT LOCATIONS

PARTICIPATION 1 = 01/STR

DAR-47-SLM 10.04 TO 13.85 DAR-36-SLM 3.34 TO 3.65 DAR-127-SLM 22.20 TO 25.20 DAR-118-SLM 12.30 TO 17.60 DAR-705-SLM 9.00 TO 13.32 DAR-716-SLM 0.00 TO 0.26

PARTICIPATION 2 = 02/NFA

DAR-319-SLM 0.00 TO 0.51

EARTH DISTURBED AREAS

NA*ACRES PROJECT EARTH DISTURBED AREA: ESTIMATED CONTRACTOR EARTH DISTURBED AREA: NA*ACRES NOTICE OF INTENT EARTH DISTURBED AREA: NA*ACRES

*MAINTENANCE PROJECT


2023 SPECIFICATIONS

THE STANDARD SPECIFICATIONS OF THE STATE OF OHIO, DEPARTMENT OF TRANSPORTATION, INCLUDING SUPPLEMENTAL SPECIFICATIONS LISTED IN THE PLANS, CHANGES LISTED IN THE PROPOSAL, AND THE SUPPLEMENTAL SPECIFICATION 800 VERSION INDICATED ON THE PROPOSAL SHALL GOVERN THIS IMPROVEMENT.

I HEREBY APPROVE THESE PLANS AND DECLARE THAT THE MAKING OF THIS IMPROVEMENT WILL NOT REQUIRE THE CLOSING TO TRAFFIC OF THE HIGHWAY AND THAT PROVISIONS FOR THE MAINTENANCE AND SAFETY OF TRAFFIC WILL BE AS SET FORTH ON THE PLANS AND ESTIMATES.

De W. O'Brien John W. O'Brien District 07 Deputy Director

Director, Department of Transportation

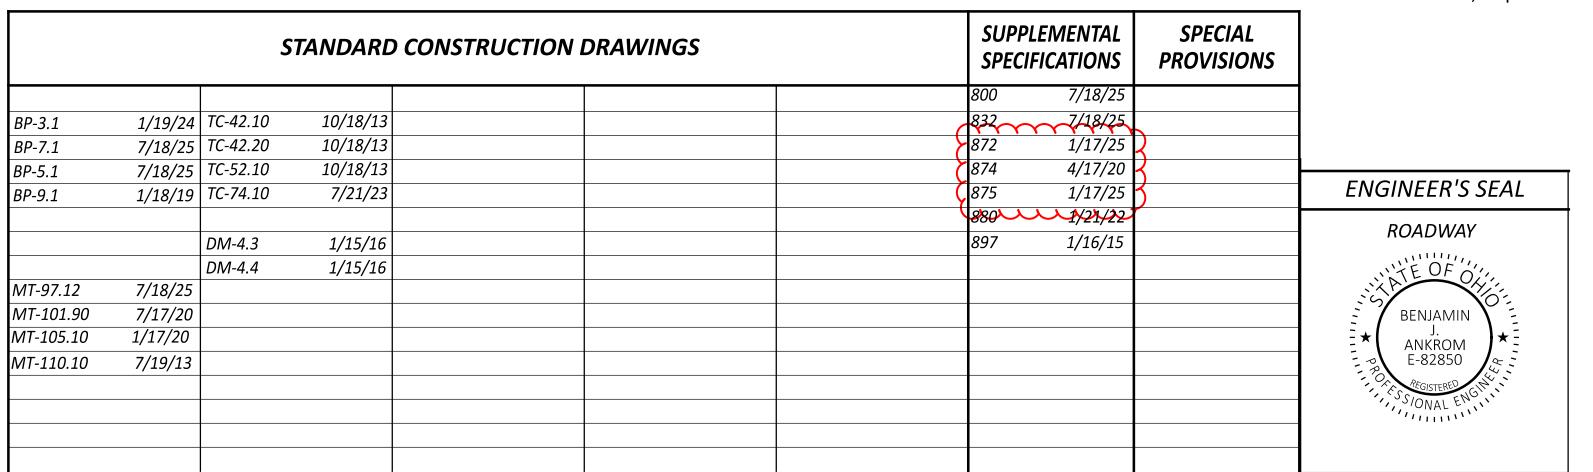

ESIGN AGENCY ENGINEERING ESIGNER

SHEET

LDB REVIEWER BJA 07-18-25

ROJECT ID 112494

P.01 33

ITEM 614 - MAINTAINING TRAFFIC

TRAFFIC SHALL BE MAINTAINED AT ALL TIMES. THE LENGTH OF RESTRICTED TRAFFIC ZONES SHALL BE KEPT TO A MINIMUM CONSISTENT WITH THE SPECIFICATION REQUIREMENTS FOR PROTECTION OF COMPLETED COURSES.

ALL WORK AND TRAFFIC CONTROL DEVICES SHALL BE IN ACCORDANCE WITH CMS 614 AND OTHER APPLICABLE PORTIONS OF THE SPECIFICATIONS, AS WELL AS THE OHIO MANUAL OF UNIFORM TRAFFIC CONTROL DEVICES.

THE CONTRACTOR SHALL BE REQUIRED TO FURNISH AND ERECT "GROOVED PAVEMENT" SIGNS FOR ANY PLANED SURFACE OF THE ROADWAY REMAINING OPENED AT THE CONCLUSION OF A WORK DAY.

WORK ZONE MARKINGS SHALL BE COMPLETE AND IN PLACE ON ALL PAVEMENT. INCLUDING RAMPS. BEFORE EXPOSING THE PAVEMENT TO TRAFFIC.

PAYMENT FOR ALL LABOR, EQUIPMENT AND MATERIALS SHALL BE INCLUDED IN THE LUMP SUM CONTRACT PRICE FOR ITEM 614, MAINTAINING TRAFFIC, UNLESS SEPARATELY ITEMIZED IN THE PLAN.

COORDINATION OF WORK

PID 116923-DAR-127-30.53

THE CONTRACTOR IS ADVISED THAT ADJACENT CONSTRUCTION PROJECTS WITHIN OR NEAR THE WORK LIMITS OF THIS PLAN MAY IMPACT THE PROJECT SCHEDULE, SEQUENCE OF CONSTRUCTION AND/OR TRAFFIC CONTROL BETWEEN ADJACENT ZONES. THE CONTRACTOR IS REQUIRED TO COORDINATE ALL MAINTENANCE OF TRAFFIC OPERATIONS WITH ADJACENT CONSTRUCTION PROJECTS. COOPERATION WITH THE ENGINEER. INSPECTORS AND ALL OTHER CONTRACTORS ON OR ADJACENT TO THE PROJECT IS REQUIRED PER CMS 105.08.

ITEM 614 - LAW ENFORCEMENT OFFICER (WITH PATROL CAR) FOR ASSISTANCE DURING CONSTRUCTION OPERATIONS

USE OF LAW ENFORCEMENT OFFICERS (LEOS) BY CONTRACTORS OTHER THAN THE USES SPECIFIED BELOW WILL NOT BE PERMITTED AT PROJECT COST. LEOS SHOULD NOT BE USED WHERE THE OMUTCO INTENDS THAT FLAGGERS BE USED.

IN ADDITION TO THE REQUIREMENTS OF C&MS 614 AND THE OMUTCD, A UNIFORMED LEO WITH AN OFFICIAL PATROL CAR (CAR WITH TOP-MOUNTED EMERGENCY FLASHING LIGHTS AND COMPLETE MARKINGS OF THE APPROPRIATE LAW ENFORCEMENT AGENCY) SHALL BE PROVIDED FOR THE FOLLOWING TRAFFIC CONTROL TASK:

* DURING THE ENTIRE ADVANCE PREPARATION AND CLOSURE SEQUENCE WHERE COMPLETE BLOCKAGE OF TRAFFIC IS REQUIRED.

IN ADDITION TO THE REQUIREMENT OF C&MS 614 AND THE OMUTCD, A UNIFORMED LEO WITH AN OFFICIAL PATROL CAR SHOULD BE PROVIDED FOR THE FOLLOWING TRAFFIC CONTROL TASKS AS APPROVED BY THE ENGINEER:

ITEM 614 - LAW ENFORCEMENT OFFICER (WITH PATROL CAR) FOR ASSISTANCE DURING CONSTRUCTION OPERATIONS (CONTINUED)

* FOR LANE CLOSURES: DURING INITIAL SET-UP PERIODS. TEAR DOWN PERIODS, SUBSTANTIAL SHIFTS OF A CLOSURE POINT OR WHEN NEW LANE SOURCE ARRANGEMENTS ARE INITIATED FOR LONG-TERM LANE CLOSURES/SHIFTS (FOR THE FIRST AND LAST DAY OF MAJOR CHANGES IN TRAFFIC CONTROL SETUP).

IN GENERAL. LEOS SHOULD BE POSITIONED IN ADVANCE OF AND ON THE SAME SIDE AS THE LANE RESTRICTION OR AT THE POINT OF ROAD CLOSURE, AND TO MANUALLY CONTROL TRAFFIC MOVEMENTS THROUGH SIGNALIZED INTERSECTIONS IN WORK ZONES.

LEOS SHOULD NOT FORGO THEIR TRAFFIC CONTROL RESPONSIBILITIES TO APPREHEND MOTORISTS FOR ROUTINE TRAFFIC VIOLATIONS, HOWEVER, IF A MOTORISTS ACTIONS ARE CONSIDERED TO BE RECKLESS, THEN PURSUIT OF THE MOTORIST IS APPROPRIATE.

THE LEOS WORK AT THE DIRECTION OF THE CONTRACTOR. THE CONTRACTOR IS RESPONSIBLE FOR SECURING THE SERVICES OF THE LEOS WITH THE APPROPRIATE AGENCIES AND COMMUNICATING THE INTENTIONS OF THE PLANS WITH RESPECT TO DUTIES OF THE LEOS. THE ENGINEER SHALL HAVE FINAL CONTROL OVER THE LEOS DUTIES AND PLACEMENT, AND WILL RESOLVE ANY ISSUES THAT MAY ARISE BETWEEN THE TWO PARTIES.

THE LEO SHALL REPORT IN TO THE CONTRACTOR PRIOR TO THE START OF THE SHIFT. IN ORDER TO RECEIVE INSTRUCTIONS REGARDING SPECIFIC WORK ASSIGNMENTS DURING HIS/HER SHIFT. THE LEO IS EXPECTED TO STAY AT THE PROJECT SITE FOR THE ENTIRE DURATION OF HIS/HER SHIFT. THE LEO SHALL REPORT TO THE CONTRACTOR AT THE END OF HIS/HER SHIFT. ONCE THE LEO HAS COMPLETED THE DUTIES DESCRIBED ABOVE AND STILL HAS TIME REMAINING ON HIS/HER SHIFT, THE LEO MAY BE ASKED TO PATROL THROUGH THE WORK ZONE (WITH FLASHING LIGHTS OFF) OR BE PLACED AT A LOCATION TO DETER MOTORISTS FROM SPEEDING, SHOULD IT BE NECESSARY TO LEAVE THE PROJECT SITE, THE LEO SHALL NOTIFY THE ENGINEER. THE CONTRACTOR SHALL PROVIDE THE LEO WITH A TWO-WAY COMMUNICATION DEVICE WHICH SHALL BE RETURNED TO THE CONTRACTOR AT THE END OF HIS/HER SHIFT.

LEOS (WITH PATROL CAR) REQUIRED BY THE TRAFFIC MAINTENANCE TASKS ABOVE SHALL BE PAID FOR ON A UNIT PRICE (HOURLY) BASIS UNDER ITEM 614, LAW ENFORCEMENT OFFICER (WITH PATROL CAR) FOR ASSISTANCE. THE FOLLOWING ESTIMATED QUANTITIES HAVE BEEN CARRIED TO THE GENERAL SUMMARY.

ITEM 614, LAW ENFORCEMENT OFFICER WITH PATROL CAR FOR ASSISTANCE 100 HOURS.

THE HOURS PAID SHALL INCLUDE ANY MINIMUM SHOW-UP TIME REQUIRED BY THE LAO ENFORCEMENT AGENCY INVOLVED.

AND ADDITIONAL COSTS (ADMINISTRATIVE OR OTHERWISE) INCURRED BY THE CONTRACTOR TO OBTAIN THE SERVICES OF A LEO ARE INCLUDED WITH THE BID UNIT PRICE FOR ITEM 614. LAW ENFORCEMENT OFFICER WITH PATROL CAR FOR ASSISTANCE.

NOTIFICATION OF TRAFFIC RESTRICTIONS

THROUGHOUT THE DURATION OF THE PROJECT. THE CONTRACTOR SHALL NOTIFY THE PROJECT ENGINEER IN WRITING OF ALL TRAFFIC RESTRICTIONS AND UPCOMING MAINTENANCE OF TRAFFIC CHANGES. THE CONTRACTOR SHALL ENSURE THE WRITTEN NOTIFICATION IS SUBMITTED IN A TIMELY MANNER TO ALLOW THE PROJECT ENGINEER TO MEET THE REQUIRED TIME FRAMES SET FORTH IN THE TABLE BELOW TO INFORM SPECIAL HAULING PERMITS SECTION (HAULING.PERMITS@DOT.OHIO.GOV) AND THE DISTRICT PUBLIC INFORMATION OFFICE (PIO). THIS NOTIFICATION SHALL BE RECEIVED BY THE PROJECT ENGINEER PRIOR TO THE PHYSICAL SETUP OF ANY APPLICABLE SIGNS OR MESSAGE BOARDS.

INFORMATION SHOULD INCLUDE. BUT IS NOT LIMITED TO. ALL CONSTRUCTION ACTIVITIES THAT IMPACT OR INTERFERE WITH TRAFFIC AND SHALL LIST THE SPECIFIC LOCATION, TYPE OF WORK, ROAD STATUS, DAY AND TIME OF RESTRICTION, DURATION OF RESTRICTION. NUMBER OF LANES MAINTAINED. NUMBER OF LANES CLOSED, MINIMUM WIDTH OF DRIVEABLE PAVEMENT DETOUR ROUTES, IF APPLICABLE, AND ANY OTHER INFORMATION REQUESTED BY THE ENGINEER.

NO NO	NOTIFICATION TIME TABLE								
ITEM	DURATION OF CLOSURE	NOTICE DUE TO D7 PERMITS & PIO							
	>= 2 WKS	21 CALENDAR DAYS PRIOR TO CLOSURE							
RAMP & ROAD CLOSURES	> 12 HRS & < 2 WKS	14 CALENDAR DAYS PRIOR TO CLOSURE							
	< 12 HRS	4 BUSINESS DAYS PRIOR TO CLOSURE							
LANE CLOSURES AND	>= 2 WKS	<i>14 CALENDAR DAYS</i> <i>PRIOR TO CLOSURE</i>							
RESTRICTIONS	< 2 WKS	5 BUSINESS DAYS PRIOR TO CLOSURE							
START OF CONSTRUCTION & TRAFFIC PATTERN CHANGES	N/A	14 CALENDAR DAYS PRIOR TO IMPLEMENTATION							

ITEM 618 - EDGE LINE RUMBLE STRIPE (ASPHALT CONCRETE) ITEM 618 - CENTER LINE RUMBLE STRIPE (ASPHALT CONCRETE)

DESCRIPTION: THIS WORK CONSISTS OF GRINDING DEPRESSIONS (RUMBLE STRIPES) IN THE PAVEMENT.

CONSTRUCT RUMBLE STRIPES ACCORDING TO TRAFFIC STANDARD DRAWING TC-64.10.

LOCATION AND PLACEMENT RESTRICTIONS OF RUMBLE STRIPES: RUMBLE STRIPES ARE NOT TO BE USED AT LOCATIONS WHERE THE LANE WIDTH IS LESS THAN 11 FEET AND THE POSTED SPEED LIMIT IS LESS THAN 50 MPH.

LOCATE RUMBLE STRIPES ON THE PAVEMENT PER THE SPECIFICATIONS OF STANDARD DRAWING TC-64.10.

METHOD OF MEASUREMENT: THE DEPARTMENT WILL MEASURE RUMBLE STRIPES IN THE UNIT OF MILES COMPLETED IN PLACE. THE DEPARTMENT WILL MEASURE QUANTITIES AS THE LENGTH OF COMPLETED GRINDING, INCLUDING THE GAPS FOR INTERSECTIONS AND OTHER SECTIONS OF PAVEMENT NOT BEING GROUND BETWEEN THE BEGINNING STRAIGHT LINE MILEAGE AND THE ENDING STRAIGHT LINE MILEAGE FOR THE SEGMENTS LISTED IN THE PLANS.

BASIS OF PAYMENT: THE DEPARTMENT WILL NOT PAY FOR REPAIRING SURFACE DAMAGE AND EXTRANEOUS MARKS CAUSED BY THE CONTRACTOR'S OPERATIONS. THE DEPARTMENT WILL PAY FOR THE PAVEMENT MARKINGS ITEM 642 TRAFFIC PAINT. SEPARATELY.

A QUANTITY OF 20.86 MILES OF ITEM 618 EDGE LINE, RUMBLE STRIPE (ASPHALT CONCRETE) HAS BEEN CARRIED TO THE GENERAL SUMMARY. THE SEGMENT LOCATIONS ARE:

(PART. 1) DAR-127 FROM SLM 22.10 TO SLM 25.20 (PART. 1) DAR-47 FROM SLM 11.15 TO SLM 13.85 (PART. 1) DAR-118 FROM SLM 12.97 TO SLM 17.60 NO RUMBLE STRIPES IN CROSSWALK AREAS.

A QUANTITY OF 10.57 MILES OF ITEM 618 CENTER LINE. RUMBLE STRIPE (ASPHALT CONCRETE) HAS BEEN CARRIED TO THE GENERAL SUMMARY. THE SEGMENT LOCATIONS ARE:

(PART. 1) DAR-127 FROM SLM 22.10 TO SLM 25.20 (PART. 1) DAR-47 FROM SLM 11.15 TO SLM 13.85 (PART. 1) DAR-118 FROM SLM 12.97 TO SLM 17.60 (PART. 2) DAR-319 FROM SLM 0.37 TO SLM 0.51

A QUANTITY OF 10.57 MILES OF ITEM 874, LONGITUDINAL JOINT PREPARATION HAS BEEN CARRIED TO THE GENERAL SUMMARY. THE SEGMENT LOCATIONS ARE:

 \sim

A QUANTITY OF 10.57 MILES OF ITEM 874, LONGITUDINAL JOINT PREPARATION HAS BEEN CARRIED TO THE GENERAL SUMMARY. THE SEGMENT LOCATIONS ARE:

(PART. 1) DAR-127 FROM SLM 22.10 TO SLM 25.20 (PART. 1) DAR-47 FROM SLM 11.15 TO SLM 13.85 (PART. 1) DAR-118 FROM SLM 12.97 TO SLM 17.60 (PART. 2) DAR-319 FROM SLM 0.37 TO SLM 0.51

PAVEMENT MARKINGS: THE RUMBLE STRIPE SHALL BE DUST-FREE AND DRY WHEN THE PAVEMENT MARKINGS ARE APPLIED.

ESIGN AGENCY



NOTES

ENERAL

ESIGNER LDB REVIEWER BJA MM-DD-Y PROJECT ID

112494 P. 05 33

				_	SHEET N	IUMBER				_		PA	RT.	ITEM	ITEM	GRAND	UNIT	DESCRIPTION	SEE SHEET	<u>:</u> T
4	5	7	8	9	11	12	13	14	15	17	18	01/STR	02/NFA	112141	EXT	TOTAL	01411		NO.	
										260	1 577	1 710	100	202	20000	1 027	CE	ROADWAY		
										360	1,577 263	232	219 31	202 202	30000 32500	1,937 263		WALK REMOVED CURB AND GUTTER REMOVED		\exists
										360	145	475	30	608	10000	505	SF	4" CONCRETE WALK		
										102	1,746	1,557	189	608	52000	1,746		CURB RAMP		_
										192	48	224	16	608	53020	240	SF	DETECTABLE WARNING		
1												1		623	39500	1	EACH	MONUMENT ASSEMBLY ADJUSTED TO GRADE		
											44	38	6	659	00500	44	SY	SEEDING AND MULCHING, CLASS 1		_
											44	1,000	0	832	30000	1,000		EROSION CONTROL		_
												,				,				
2.4												2.4		C11	00054	2.4	FACIL	DRAINAGE	4	
34												34		611	99654	34	EACH	MANHOLE ADJUSTED TO GRADE	4	
																		PAVEMENT		
4,050												3,600	450	251	01041	4,050		PARTIAL DEPTH PAVEMENT REPAIR (ASPHALT CONCRETE BASE), AS PER PLAN	4	
65											70	62	8	253	01001	70		PAVEMENT REPAIR, AS PER PLAN	17	
65		22,557	3,807	1,181								65 26,666	879	301 407	56001 20000	65 27,545		ASPHALT CONCRETE BASE, (449), AS PER PLAN, PG64-22 NON-TRACKING TACK COAT 0.085 Gal/SY	4	
		11,060	2,070	579								13,278	431	441	50100	13,709		ASPHALT CONCRETE SURFACE COURSE, TYPE 1, (448), PG70-22M, 1 ½" Thickness		-
		,	,									·				·				1
		441	57								36	36 489	^	609 617	12001 10100	36 408		COMBINATION CURB AND GUTTER, TYPE 2, AS PER PLAN	17	-
	20.86	441	5/									20.86	9	618	41000	498 20.86		COMPACTED AGGREGATE, 1" Ave Thickness RUMBLE STRIPES, EDGE LINE (ASPHALT CONCRETE)		_
~~~		~~~	~~~	~~~	~~~	~~~	~~~	~~~	$\sim$	~~~	m	10.43	~0,14~	~6 <del>1</del> 8~				RUMBLE STRIPES, CENTER-UNE-(ASPHALT-CONCRETE)	~~~	
	10.57											10.43	0.14	874	21000	10.57	MILE	LONGITUDINAL JOINT PREPARATION		Ų
		235,755	23,363	13,889								262,672	10,335	897	01010	273,007				$\widetilde{}$
		29,617	23,303	15,009								51,038	10,333	897	01010	51,038		PAVEMENT PLANING, ASPHALT CONCRETE, CLASS A, 1 ½" Depth PAVEMENT PLANING, ASPHALT CONCRETE, CLASS A, 1 ¼" Depth		-
300			,									300		897	02001	300		PATCHING PLANED SURFACE, AS PER PLAN	4	
																		WATER WORK		_
14												14		638	10800	14		WATER WORK VALVE BOX ADJUSTED TO GRADE		_
14												14		038	10000	14	LACII	VALVE BOX ADJUSTED TO GNADE		
																		TRAFFIC CONTROL		
								1,056				1,038	18	621	00100	1,056		RPM		_
					14.37	7.61	6	1,056				1,038 27.5	18 0.48	621 642	54000 00104	1,056 27.98		RAISED PAVEMENT MARKER REMOVED  EDGE LINE, 6", TYPE 1		_
					9.02	5.49	3.34					17.34	0.48	642	00300	17.85		CENTER LINE, TYPE 1	17	$\dashv$
						424						424		642	01200	424		PARKING LOT STALL MARKING, TYPE 1		
						2						2		C42	01702	2	FACIL	LIANDICAD CVAADOL NAADVING TVDE 1		_
					468	Z						468		642 644	01702 00404	468		HANDICAP SYMBOL MARKING, TYPE 1 CHANNELIZING LINE, 12"		_
					216	108	25					349		644	00500	349		STOP LINE		
					411	1,600	595					2,606		644	00620	2,606		CROSSWALK LINE, 12"		
					192	35	29					256		644	00630	256	FT	CROSSWALK LINE, 24"		_
					180							180		644	00700	180	FT	TRANSVERSE/DIAGONAL LINE		
					8							8		644	01300	8		LANE ARROW		
									00			0.0		F1C	21001	0.0	ГТ	STRUCTURE REPAIR (DAR-118-1303)	15	
									88			88		516	31001	88	FI	JOINT SEALER, AS PER PLAN	15	-
																		STRUCTURE REPAIR (DAR-118-1486)		
									80			80		516	31001	80	FT	JOINT SEALER, AS PER PLAN	15	
																		CTRUCTURE REPAIR (DAR 47 1206)		D
									80			80		516	31001	80	FT	JOINT SEALER, AS PER PLAN	15	-
																	· · ·	,		
	400											400			444.5	100		MAINTENANCE OF TRAFFIC		1
	100						5.8					100	Л	614 614	11110 12460	100 58	HOUR EACH	LAW ENFORCEMENT OFFICER WITH PATROL CAR FOR ASSISTANCE WORK ZONE MARKING SIGN	-	-
<u>I</u>					18.04	10.98	6.68					34.68	1.02	614	21100	35.7		WORK ZONE MARKING SIGN WORK ZONE CENTER LINE, CLASS I, 642 PAINT	<u> </u>	-
					936							936		614	23690	936		WORK ZONE CHANNELIZING LINE, CLASS III, 12", 642 PAINT		D
					432	216	50					698		614	26610	698	FT	WORK ZONE STOP LINE, CLASS III, 642 PAINT		_
						_		•	Ī		1				1					-
					16							16		617	30650	16	FV∪⊓	WORK ZONE ARROW CLASS III 642 PAINT		<u>_</u> _E
					16							16		614	30650	16	EACH	WORK ZONE ARROW, CLASS III, 642 PAINT  INCIDENTALS		<b>E</b>