



FIRST PART OF PHASE

WORK AREA	614	614	615	622	622
	EACH	MILE	SY	FT	FT
CULVERT 3	2	0.37	233	650	60
CULVERT 3A	2	0.48	640	650	60
CULVERT 4A	2	0.25	103	650	60
CULVERT 5	2	0.35	103	650	60
CULVERT 5A	2	0.35	103	650	60
CULVERT 6	2	0.35	103	650	60
TOTALS CARRIED TO GENERAL SUMMARY	12	2.25	1285	3900	360


CULVERTS SHALL BE CONSTRUCTED IN THE SAME PHASE AS THE ROAD RECONSTRUCTION/WIDENING. EXCAVATION SHALL BE PROTECTED WITH PORTABLE BARRIER IN ACCORDANCE WITH SCD MT-95.41 AND THIS SHEET.

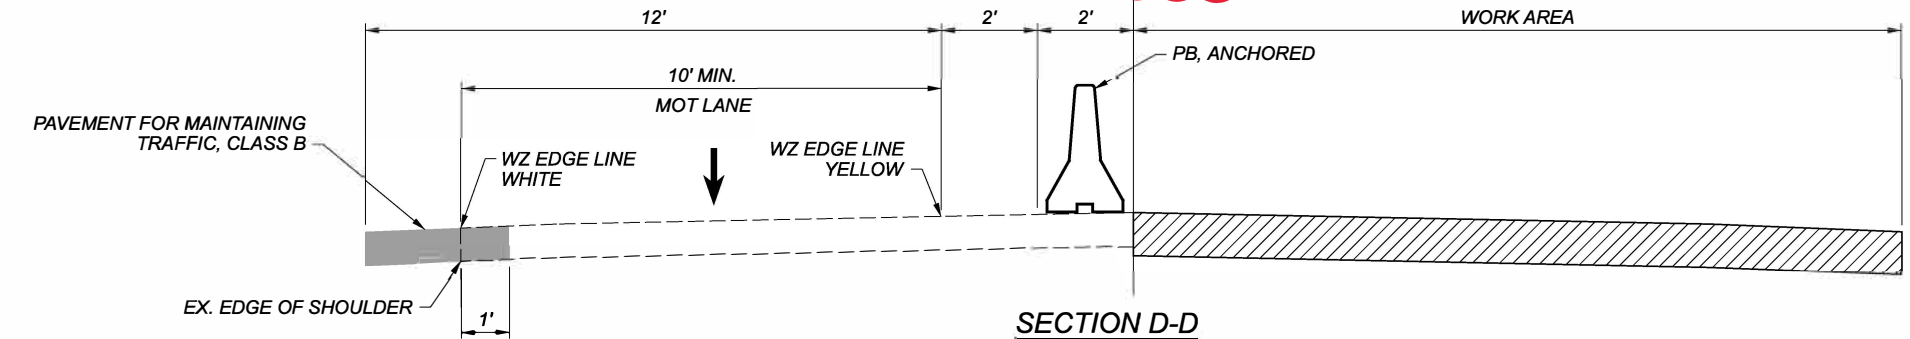

SECTION D-D

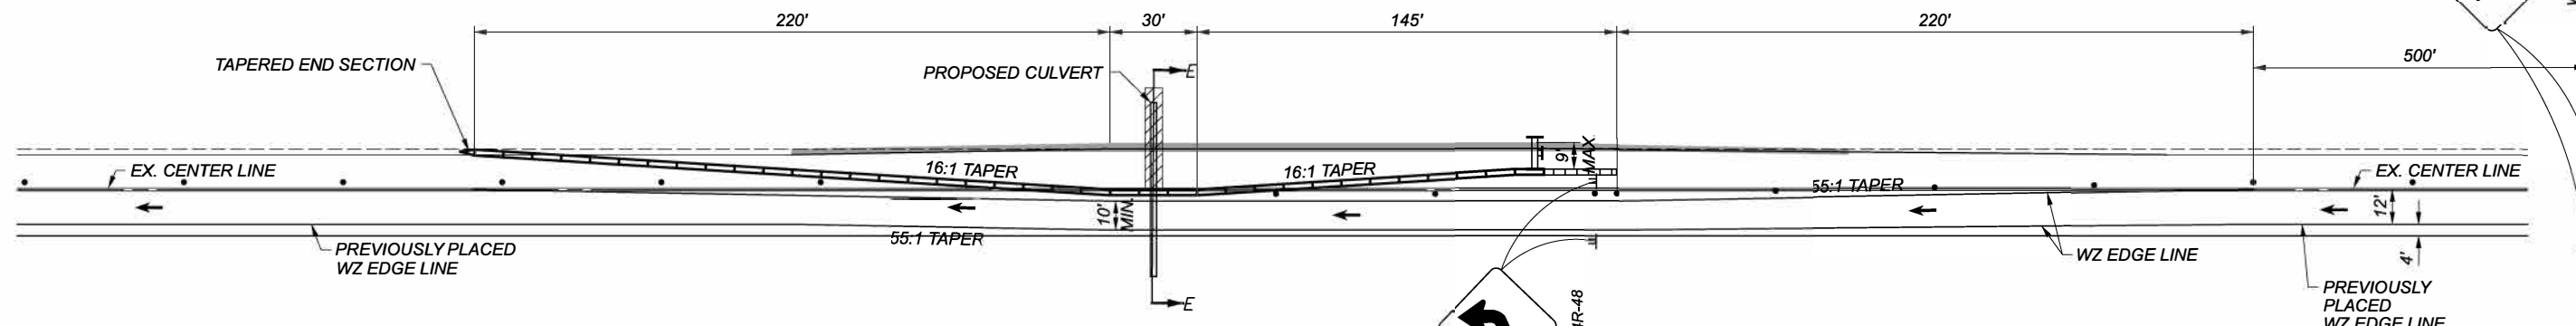


SECOND PART OF PHASE

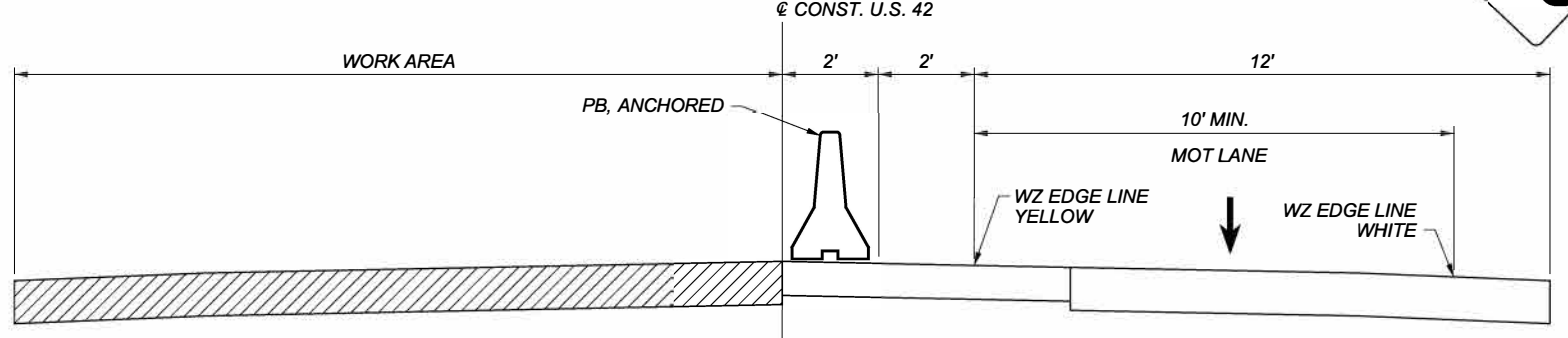

SECTION E-E

LEGEND

WORK AREA	
DRUMS	
REMOVE EXISTING MARKINGS	
DIRECTION OF TRAVEL	
TYPE III BARRICADE	
IMPACT ATTENUATOR	
PORTABLE BARRIER (PB)	

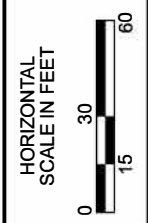

MAINTENANCE OF TRAFFIC
 CULVERT CONSTRUCTION

DESIGN AGENCY

JMT
 2800 Corporate Exchange Drive, Suite 250,
 Columbus, OH 43221

DESIGNER
 VLC

REVIEWER
 RJM 09/27/21

PROJECT ID
 109074

SHEET TOTAL
 17 153

