

ITEM 614 - PORTABLE CHANGEABLE MESSAGE SIGN, AS PER PLAN:
THE CONTRACTOR SHALL FURNISH, INSTALL, MAINTAIN, AND REMOVE WHEN NO LONGER NEEDED, CHANGEABLE MESSAGE SIGNS, ON SITE, FOR THE DURATION OF THE PROJECT. THE SIGN SHALL BE OF A TYPE SHOWN ON A LIST OF APPROVED PCMS UNITS MAINTAINED BY THE DIRECTOR. ONLY CLASS I OR II SIGNS WILL BE PERMITTED.

EACH SIGN SHALL BE TRAILER MOUNTED AND EQUIPPED WITH A FUNCTIONAL DIMMING MECHANISM TO DIM THE SIGN DURING DARKNESS AND A TAMPER AND VANDAL PROOF ENCLOSURE. EACH SIGN SHALL BE PROVIDED WITH APPROPRIATE TRAINING AND OPERATION INSTRUCTIONS TO ENABLE ON-SITE PERSONNEL TO OPERATE AND TROUBLE SHOOT THE UNIT. THE SIGN SHALL ALSO BE CAPABLE OF BEING POWERED BY AN ELECTRICAL SERVICE DROP FROM A LOCAL UTILITY COMPANY. PCMS TRAILERS SHOULD BE DELINEATED ON A PERMANENT BASIS BY AFFIXING RETRO REFLECTIVE MATERIAL, IN A CONTINUOUS LINE ON THE FACE OF THE TRAILER AS SEEN BY ONCOMING ROAD USERS.

A PCMS SHALL BE PLACED "AS DIRECTED BY THE PROJECT ENGINEER" IN CONJUNCTION WITH LANE CLOSURES. THE MESSAGES SHALL BE AS DIRECTED BY THE ENGINEER. THE PLACEMENT, OPERATION, MAINTENANCE, AND ALL ACTIVATION OF THE SIGNS BY THE CONTRACTOR SHALL BE AS DIRECTED BY THE ENGINEER. THE PCMS SHALL BE LOCATED IN A HIGHLY VISIBLE POSITION YET PROTECTED FROM TRAFFIC. THE CONTRACTOR SHALL, AT THE DIRECTION OF THE ENGINEER, RELOCATE THE PCMS TO IMPROVE VISIBILITY OR ACCOMMODATE CHANGED CONDITIONS. WHEN NOT IN USE, THE PCMS WILL BE OFF, FACING AWAY FROM ALL TRAFFIC, AND SHALL DISPLAY ONE OR MORE HIGH INTENSITY YELLOW REFLECTIVE SHEETING SURFACES OF 9" BY 15" MINIMUM, FACING TRAFFIC. THE ENGINEER SHALL BE PROVIDED ACCESS TO EACH SIGN UNIT AND SHALL BE PROVIDED WITH APPROPRIATE TRAINING AND OPERATION INSTRUCTIONS TO ENABLE ODOT PERSONNEL TO OPERATE AND TROUBLE SHOOT THE UNIT AND TO REVISE SIGN MESSAGES, IF NEEDED.

THE SIGN SHALL HAVE THE CAPABILITY TO STORE UP TO 99 MESSAGES. MESSAGE MEMORY OR PRE-PROGRAMMED DISPLAYS SHALL NOT BE LAST AS A RESULT OF POWER FAILURES TO THE ON BOARD COMPUTER. THE SIGN LEGEND SHALL BE CAPABLE OF BEING CHANGED IN THE FIELD. THREE-LINE PRESENTATION FORMATS WITH UP TO SIX MESSAGE PHASES SHOULD BE SUPPORTED, BUT NORMALLY, NOT MORE THAN TWO MESSAGE PHASES SHOULD BE EMPLOYED, ALTHOUGH THREE PHASES MAY BE USED IN UNUSUAL CONDITIONS. PCMS FORMAT SHALL PERMIT THE COMPLETE MESSAGE FOR EACH PHASE TO BE READ AT LEAST ONCE. THE PCMS SHALL CONTAIN AN ACCURATE CLOCK AND PROGRAMMING LOGIC, WHICH WILL ALLOW THE SIGN TO BE ACTIVATED, DEACTIVATED, OR MESSAGES CHANGED AUTOMATICALLY AT DIFFERENT TIMES FOR DIFFERENT DAYS OF THE WEEK.

THE CONTRACTOR, IN ACCORDANCE WITH THE PROVISIONS OF 614.03, SHALL MAINTAIN THE PCMS UNIT IN GOOD WORKING ORDER. THE CONTRACTOR SHALL, PRIOR TO ACTIVATING THE UNIT, MAKE ARRANGEMENTS WITH AN AUTHORIZED SERVICE AGENT FOR THE PCMS TO ENSURE PROMPT SERVICE IN THE EVENT OF A FAILURE. ANY FAILURE SHALL NOT RESULT IN AN ORDER TO STOP WORK AND OPEN ALL TRAFFIC LANES AND/OR IN THE DEPARTMENT TAKING APPROPRIATE ACTION TO SAFELY CONTROL TRAFFIC AND THE ENTIRE COST TO CONTROL TRAFFIC ACCRUED BY THE DEPARTMENT WILL BE DEDUCTED FROM MONEYS DUE, OR TO BECOME DUE TO THE CONTRACTOR ON THE CONTRACT.

THE CONTRACTOR SHALL BE RESPONSIBLE FOR 24 HOUR PER DAY OPERATIONS AND MAINTENANCE OF THESE SIGNS ON THE PROJECT FOR THE DURATION OF THE PHASES WHEN THE PLAN REQUIRES THEIR USE. THE REQUIREMENT TO FURNISH, INSTALL, MAINTAIN, AND REMOVE A PCMS UNIT ON THIS PROJECT SHALL NOT IN ANY WAY RELIEVE THE CONTRACTOR OF ITS RESPONSIBILITIES AS OUTLINED IN 104.04.

PAYMENT FOR THE ABOVE DESCRIBED ITEM SHALL BE AT THE CONTRACT BID PRICE PER MONTH FOR EACH ITEM 614 - PORTABLE CHANGEABLE MESSAGE SIGN, AS PER PLAN AND SHALL INCLUDE ALL LABOR, MATERIALS, EQUIPMENT, FUELS, LUBRICATING OILS, SOFTWARE, HARDWARE, AND INCIDENTALS TO PERFORM THE ABOVE DESCRIBED WORK.

THE FOLLOWING QUANTITY HAS BEEN PROVIDED AND HAS BEEN CARRIED TO THE GENERAL SUMMARY:

ITEM 614 - PORTABLE CHANGEABLE MESSAGE SIGN, AS PER PLAN
ASSUMING 2 SIGNS X 3 MONTHS = 6 SNMT

ITEM 614 - WORK ZONE PAVEMENT MARKING, CLASS III, 642 PAINT:
WORK ZONE CENTER LINE SHALL BE PLACED TO REFLECT THE PROPOSED CENTER LINE AS DETERMINED FROM THE PROPOSED MARKINGS WITHIN THE PROJECT LIMITS. AN ADDITIONAL QUANTITY HAS BEEN INCLUDED TO STRIPE PAVEMENT REPAIRS LOCATED ON THE CENTER LINE.

IT SHALL BE THE CONTRACTOR'S RESPONSIBILITY TO VERIFY THE LOCATION, SIZE, AND TYPE OF WORK ZONE MARKINGS NEEDED MEETING THE REQUIREMENTS OF ITEM 614 BEFORE THE REMOVAL OR RESURFACING OBLITERATES THE EXISTING.

THE FOLLOWING QUANTITIES HAVE BEEN PROVIDED AND CARRIED TO THE GENERAL SUMMARY:

ITEM 614 - WORK ZONE LANE LINE, CLASS III, 6", 642 PAINT = 0.80 MILE
ITEM 614 - WORK ZONE CENTER LINE, CLASS III, 642 PAINT = 3.76 MILE
ITEM 614 - WZ CHANNELIZING LINE, CLASS III, 8", 642 PAINT = 5345 FT
ITEM 614 - WORK ZONE STOP LINE, CLASS III, 642 PAINT = 873 FT

WORK ZONE PAVEMENT MARKINGS ARE NOT TO BE SUBSTITUTED FOR PERMANENT PAVEMENT MARKINGS.

COORDINATION WITH ADJACENT PROJECTS:
THE CONTRACTOR SHALL COORDINATE WORK WITH ODOT AND THE CONTRACTORS ON THE ADJACENT PROJECTS:
DEL-36-11.03 (THE POINT), PID 103626
US 36/LIBERTY RD SIGNAL, CITY OF DELAWARE
SOUTH HOUK ROAD PAVING, CITY OF DELAWARE

COORDINATION SHALL BE MADE TO PREVENT CONFLICTING ADVANCE WARNING SIGNS, CONFLICTING DETOUR ROUTES, OVERLAPING/CONFLICTING LANE CLOSURES, AND TO ENSURE THAT A MINIMUM DISTANCE OF 2 MILES BETWEEN ADJACENT LANE CLOSURES IS MAINTAINED. THIS IS NOT AN EXHAUSTIVE LIST OF COORDINATION ITEMS THAT MAY NEED TO BE RESOLVED BETWEEN PROJECTS. THE DEPARTMENT RESERVES THE RIGHT TO DECIDE WHICH PROJECT'S ACTIVITIES TAKE PRECEDENCE. PROJECTS THAT HAVE ACTIVITIES DELAYED DUE TO CONFLICTS WILL CONSIDER THIS AN EXCUSABLE, NON-COMPENSABLE DELAY PER 108.06.B. ON PROJECTS THAT HAVE ACTIVITIES DELAYED DUE TO CONFLICTS WHERE THE CONTRACTOR FAILED TO MEET THE NOTIFICATION REQUIREMENTS, THE DELAYS SHALL NOT BE CONSIDERED EXCUSABLE OR COMPENSABLE. ATTENDANCE AT DEPARTMENT ORDERED TRAFFIC COORDINATION MEETINGS BETWEEN ADJACENT PROJECTS SHALL BE CONSIDERED MANDATORY FOR EACH PROJECT'S SUPERINTENDENT AND WORKSITE TRAFFIC SUPERVISOR (WTS)*, AND INCIDENTAL TO THE LUMP SUM MAINTENANCE OF TRAFFIC PAYMENT ITEM.

*IF REQUIRED BY THE PROJECT

ITEM 614 - MAINTENANCE OF TRAFFIC: PAYMENT
NO ADDITIONAL COMPENSATION SHALL BE MADE BEYOND THE QUANTITIES LISTED ABOVE. ANY OTHER WORK SHALL BE PAID UNDER THE LUMP SUM PAY ITEM FOR ITEM 614, MAINTAINING TRAFFIC.

DESIGN AGENCY



DESIGNER

KLM

REVIEWER

XXX MM-DD-YY

PROJECT ID


111608



SHEET TOTAL

P.10 P.38

SHEET												PARTICIPATION			ITEM	EXT	TOTAL	UNIT	DESCRIPTION	SEE SHEET NO.	
P.6	P.8-P.10	P.13	P.14	P.15	P.34	P.35	P.36	P.37	P.38			01/S>2/05	02/S>2/05	03/S>2/05/DEL							
			119									103	16		209	60200	119	STA	ROADWAY		
																				LINEAR GRADING	
																				EROSION CONTROL	
289												250	39		659	00300	289	CY	TOPSOIL		
2644												2289	355		659	10000	2644	SY	SEEDING AND MULCHING		
132												114	18		659	14000	132	SY	REPAIR SEEDING AND MULCHING		
132												114	18		659	15000	132	SY	INTER-SEEDING		
0.36												0.31	0.05		659	20000	0.36	TON	COMMERCIAL FERTILIZER		
0.55												0.48	0.07		659	31000	0.55	ACRE	LIME		
14												12	2		659	35000	14	MGAL	WATER		
												866	134		832	30000	1000	EACH	EROSION CONTROL		
																				DRAINAGE	
4												4			611	99654	4	EACH	MANHOLE ADJUSTED TO GRADE		
																				PAVEMENT	
17		183												200	251	01041	200	SY	PARTIAL DEPTH PAVEMENT REPAIR (ASPHALT CONCRETE BASE), AS PER PLAN, 3.0"	P.6	
125		1875											100	1900	251	01041	2000	SY	PARTIAL DEPTH PAVEMENT REPAIR (ASPHALT CONCRETE BASE), AS PER PLAN, 4.5"	P.6	
24		126												150	253	01001	150	SY	PAVEMENT REPAIR, AS PER PLAN, 12.0"	P.6	
			83221	4371								83120	4472		254	01000	87592	SY	PAVEMENT PLANING, ASPHALT CONCRETE, 1.5"		
			7072	371								7062	381		407	20000	7443	GAL	NON-TRACKING TACK COAT		
			3468	183								3288	180		442	10000	3468	CY	ASPHALT CONCRETE SURFACE COURSE, 12.5 MM, TYPE A (446)		
				2								177	6		442	22100	183	CY	ASPHALT CONCRETE SURFACE COURSE, 12.5 MM, TYPE A (449)		
			78									70	10		617	10100	80	CY	COMPACTED AGGREGATE		
			1402	22								1246	178		617	20000	1424	SY	SHOULDER PREPARATION		
1												0.9	0.1		617	25000	1	MGAL	WATER		
																				WATER WORKS	
4												4			638	10800	4	EACH	VALVE BOX ADJUSTED TO GRADE		

GENERAL SUMMARY

DESIGN AGENCY

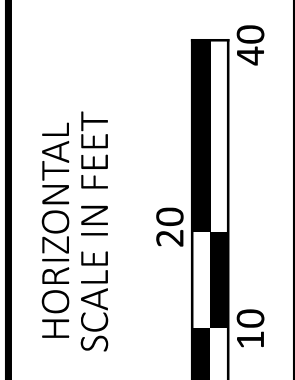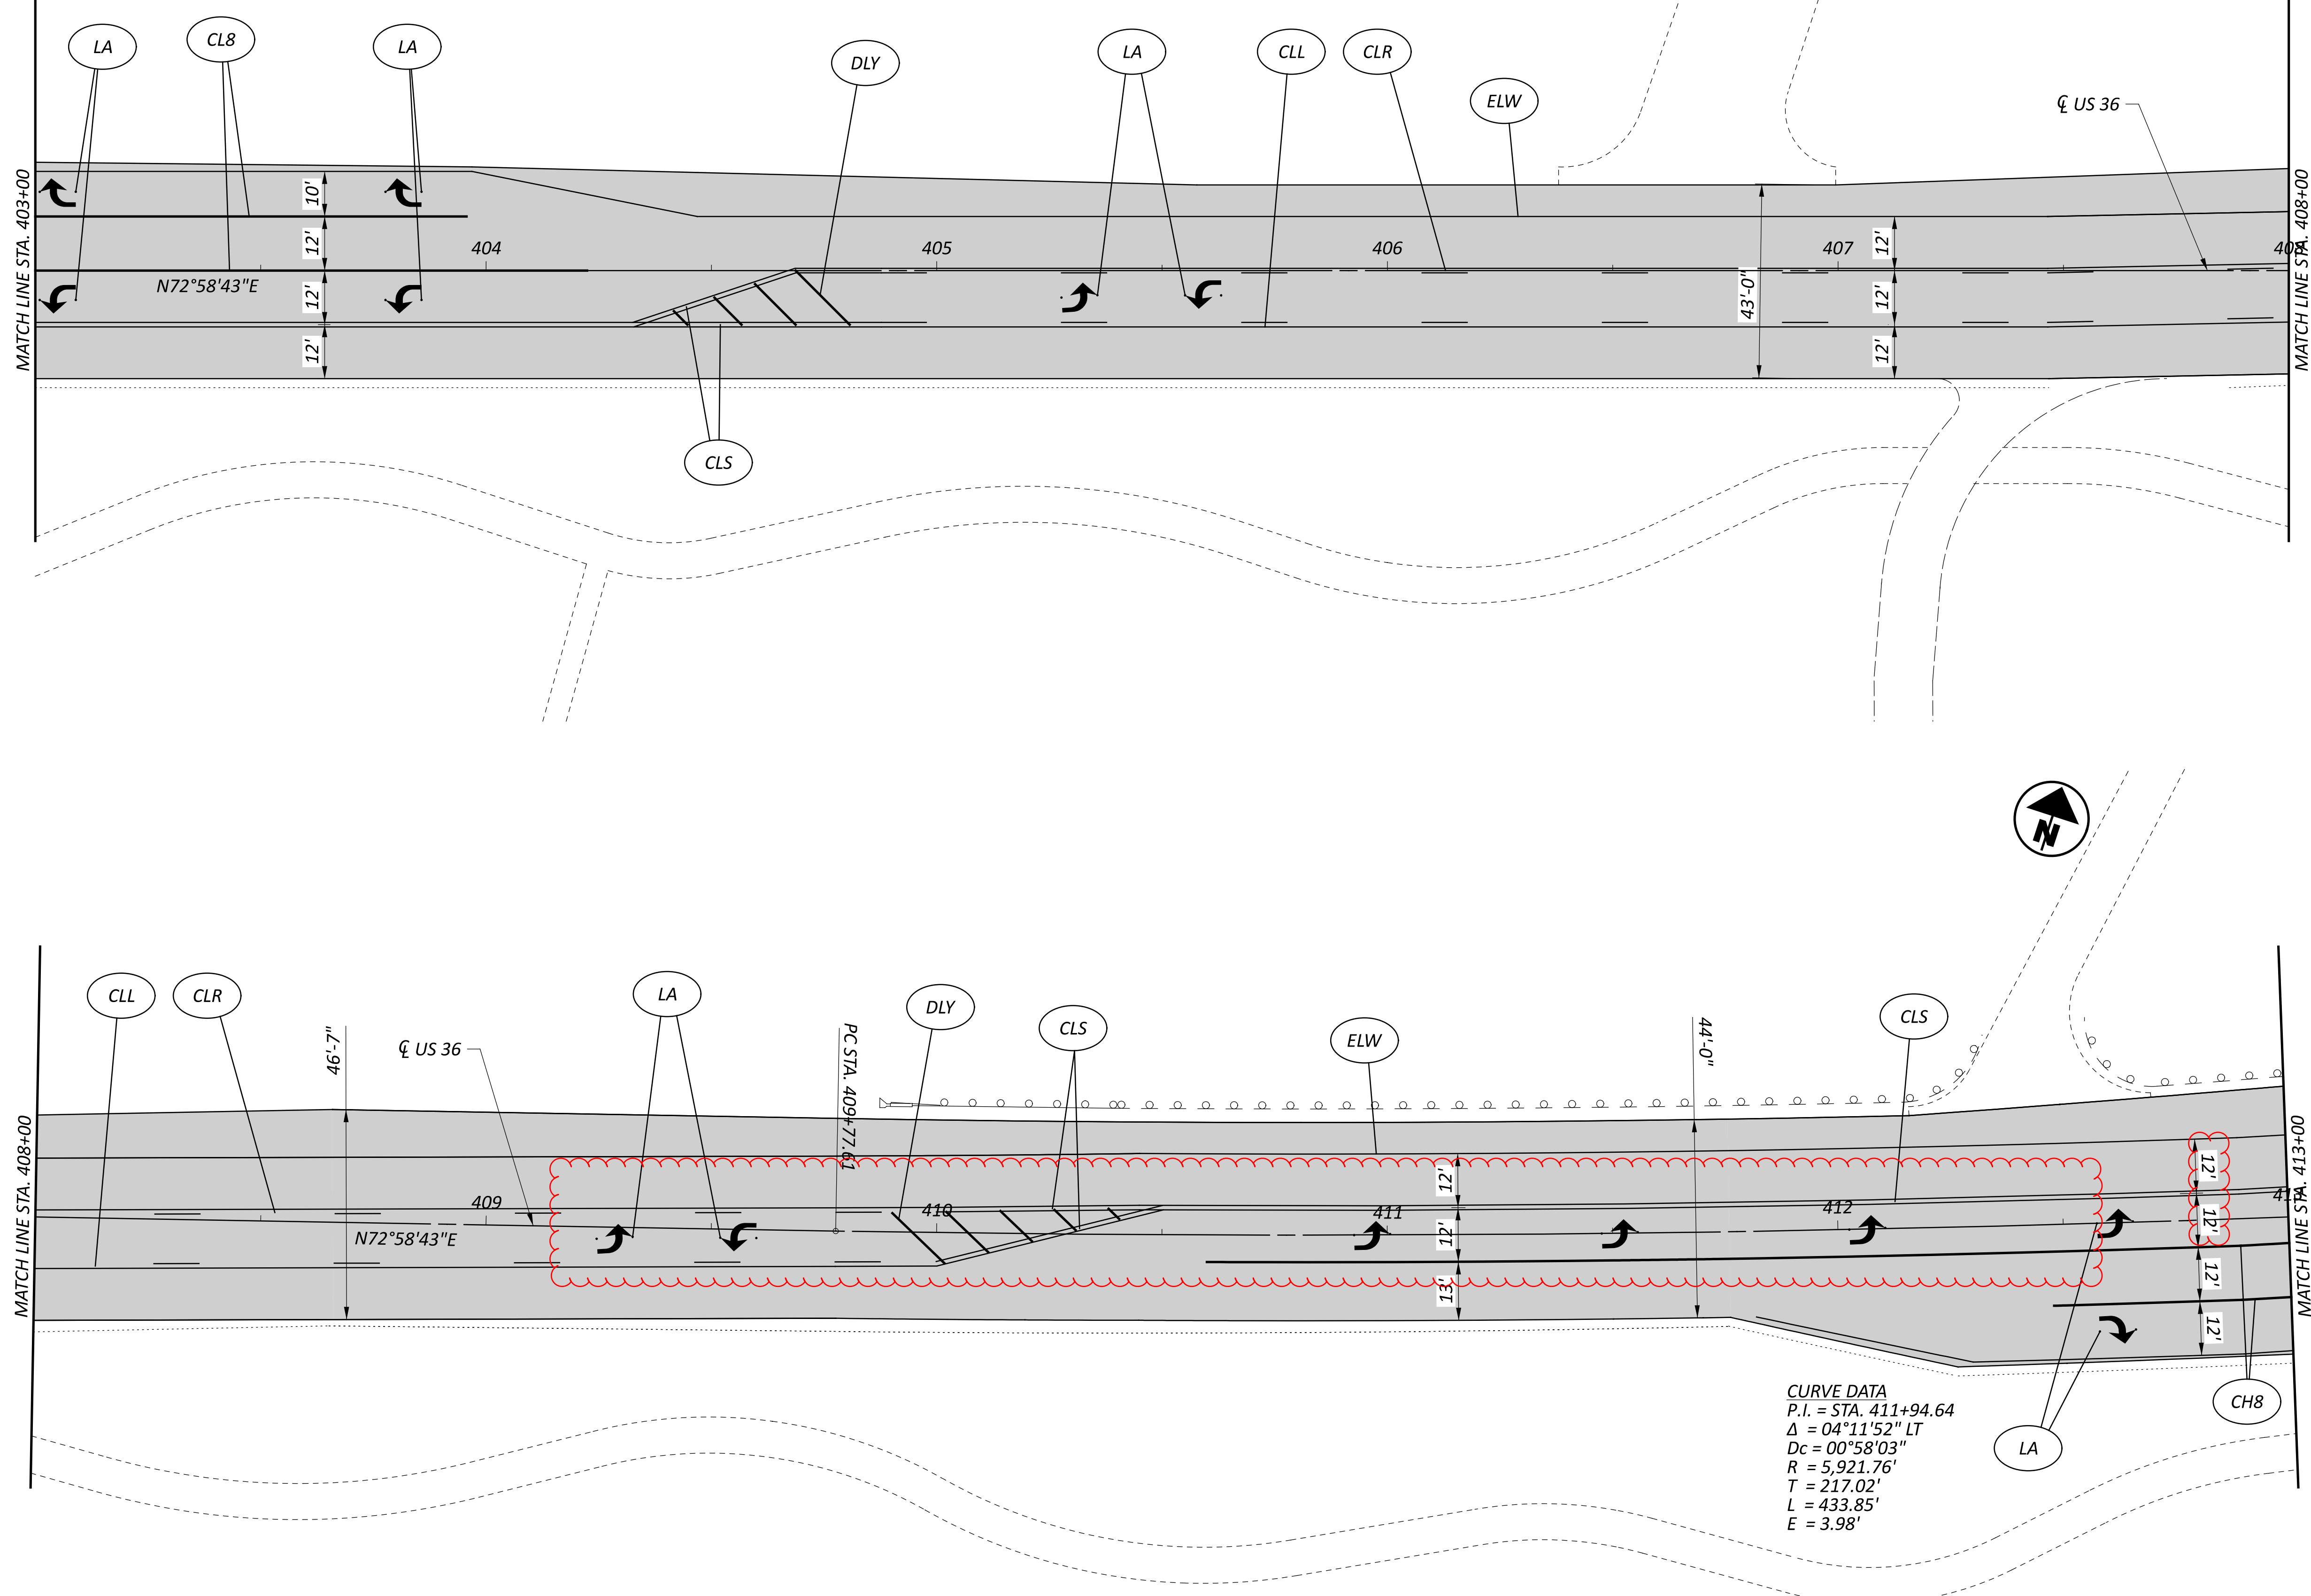 DESIGNER
 KLM
 REVIEWER
 XXX MM-DD-YY
 PROJECT ID
 111608
 SHEET TOTAL
 P.11 | P.38



DEL-36 PLAN
 STA. 403+00 TO STA. 413+00

DESIGN AGENCY





DESIGNER
 KLM

REVIEWER
 XXX MM-DD-YY

PROJECT ID
 111608

SHEET	TOTAL
P.18	P.38

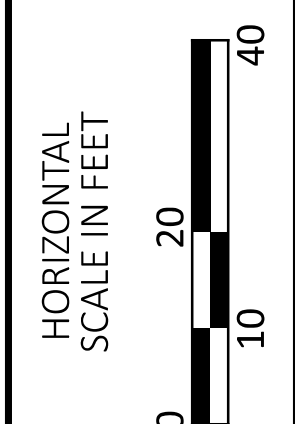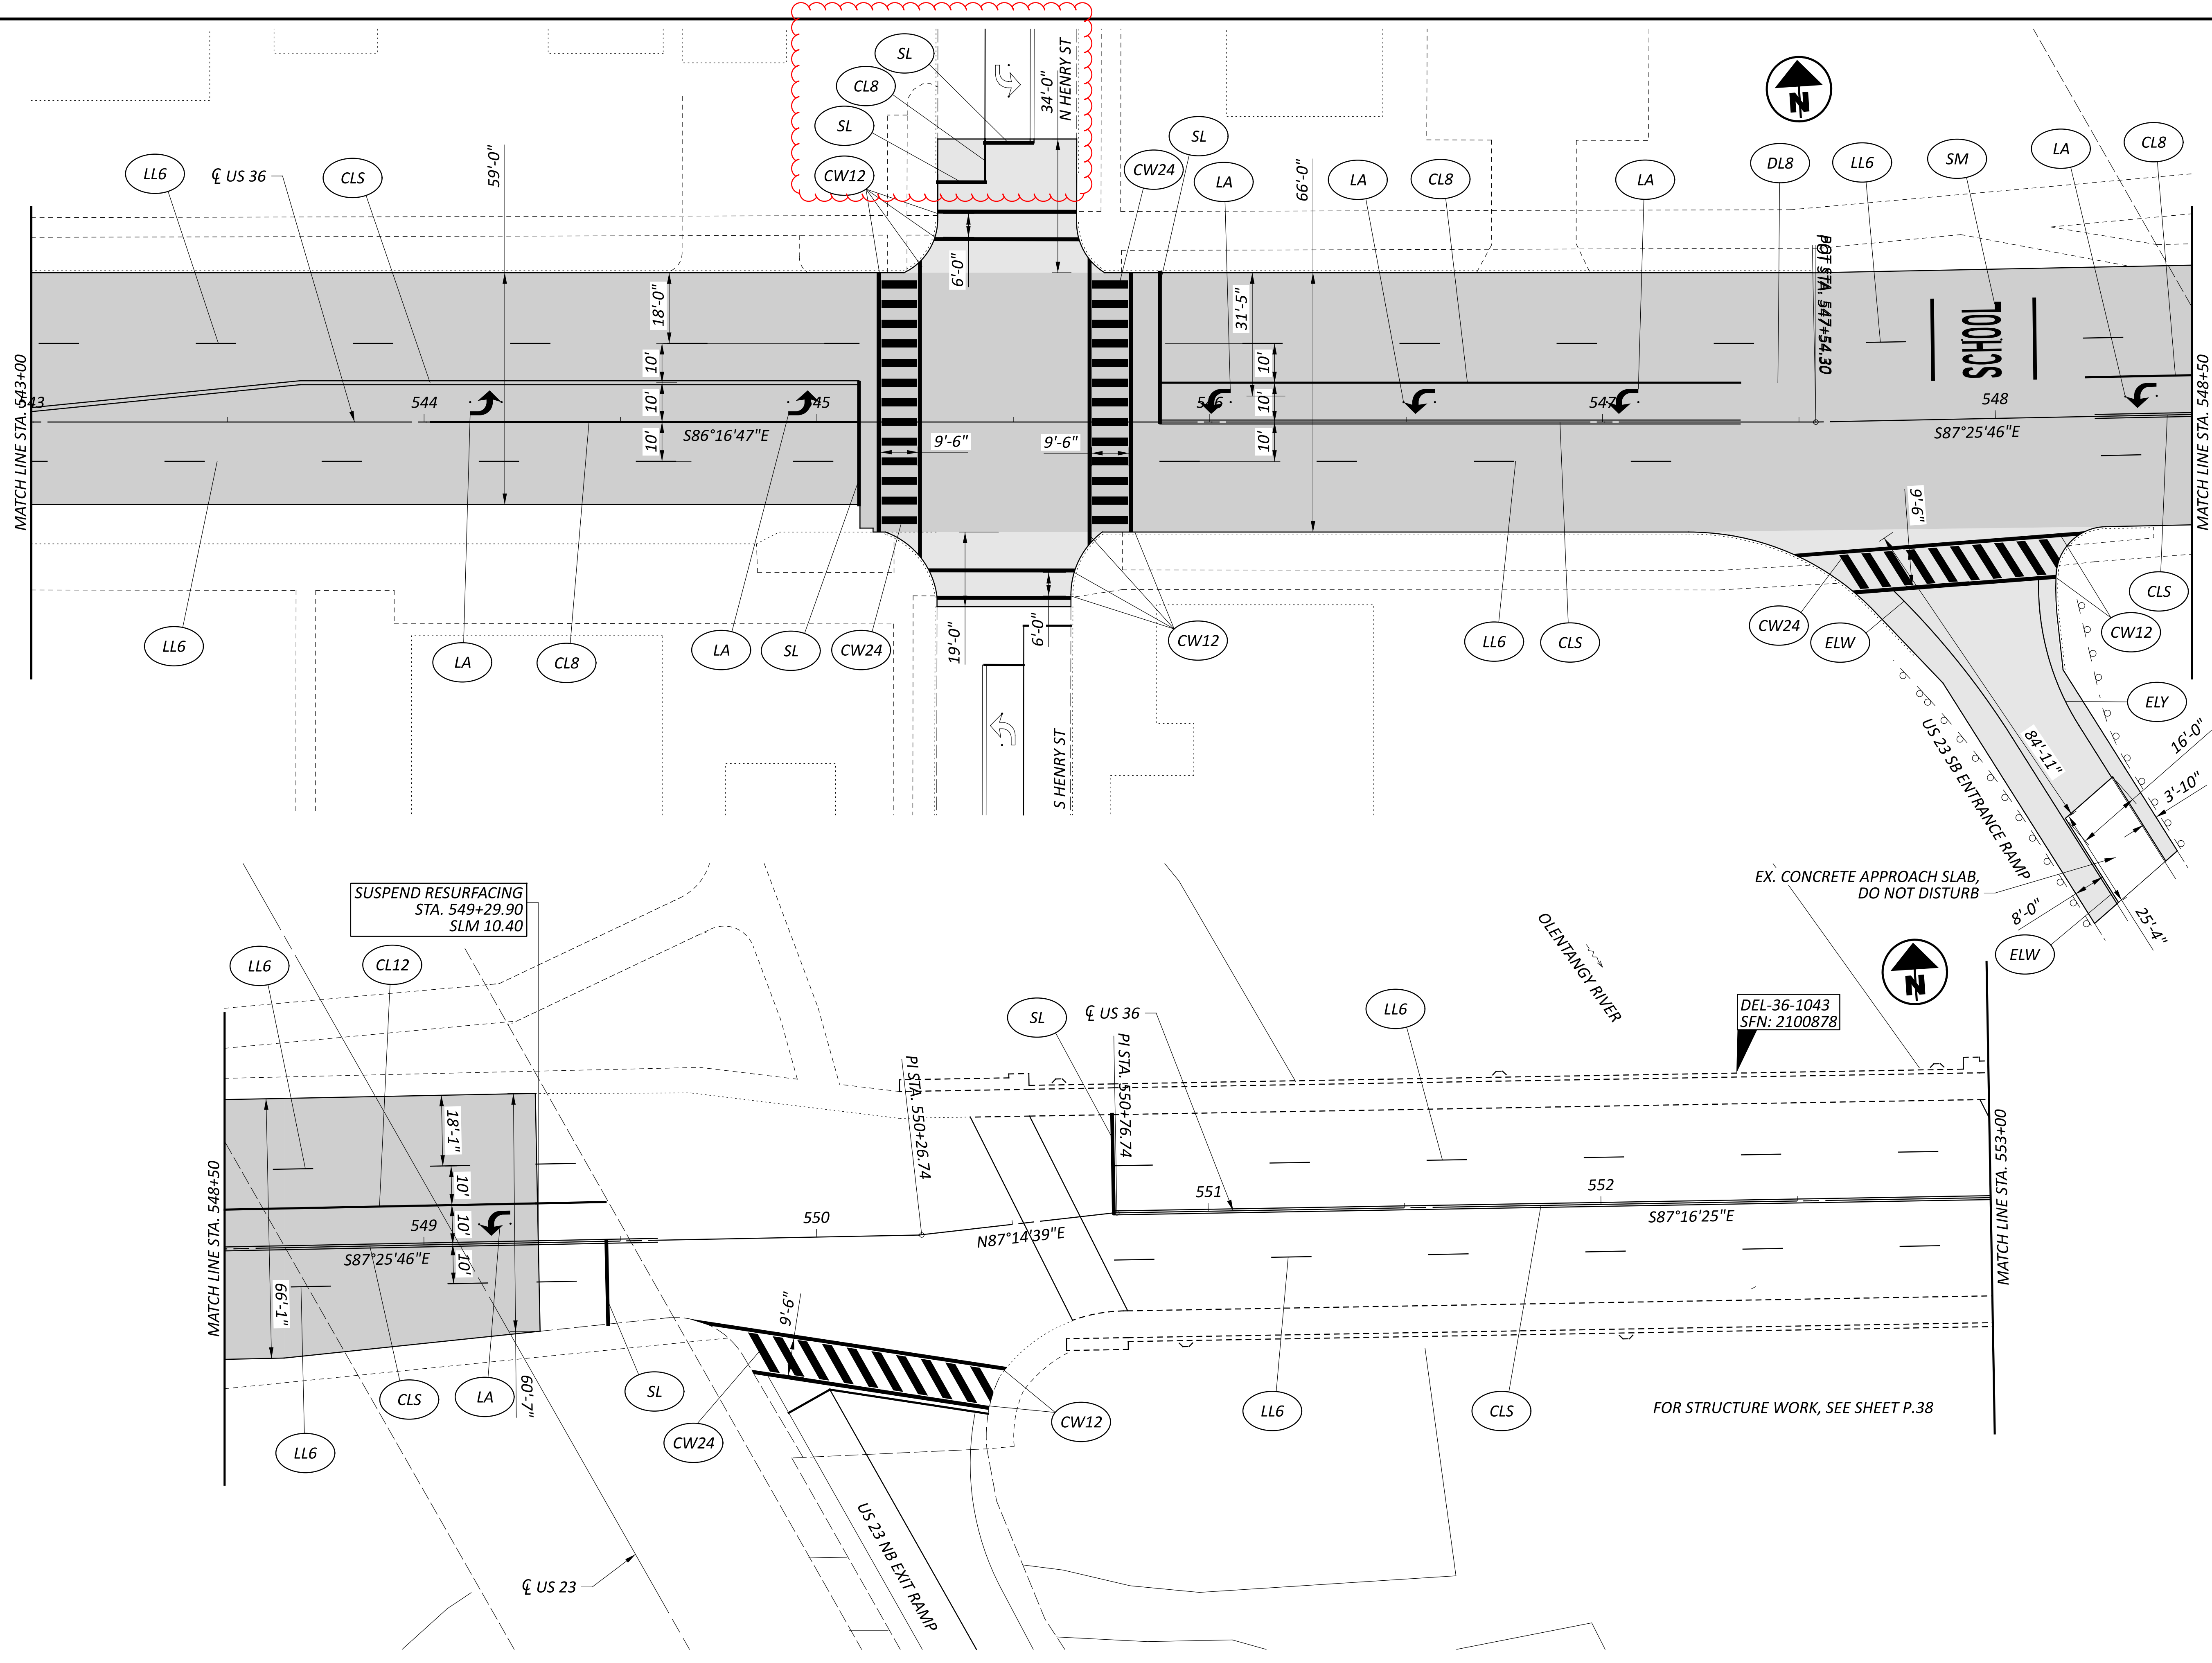

DEL-36 PLAN
STA. 543+00 TO STA. 553+00

DESIGN AGENCY	
DESIGNER	KLM
REVIEWER	
PROJECT ID	111608
SHEET	P.32
TOTAL	P.38

DEL-36-1043
SFN: 2100878

FOR STRUCTURE WORK, SEE SHEET P.38

