



COPY

Fairfield County Health Department  
108 North High Street  
Lancaster, Ohio 43130

Permit No. 1

SEWAGE DISPOSAL PERMIT

This is to certify that JAN ROGERS Denise Hresik 0130037600  
Address 3025 LANCASTER-KIRKERSVILLE RD. LANCASTER OHIO 43130  
is hereby granted a permit for the: Installation XXX Alteration       
Extension      of Sewage Disposal System XXX       
Privy      at SAME AS ABOVE

     in GREENFIELD Township,  
and owned by THOMAS F & JANET ROGERS

Work to be done by RICKETTS & FITZGERALD

This permit is issued upon the condition all work will be carried out according to the legal provisions regulating the installation and operation of privies, privy vaults, sewerage, and sewage disposal equipment. It may be revoked at any time for failure to comply with the orders and regulations of the Fairfield County Health Department. The permit expires one year from date of issuance, and may not be renewed. A final inspection is necessary to determine compliance.

Date JANUARY 3, 1983 Applicant Janet E. Rogers

Date 1-3-83 Sanitarian John H. Hresik

The plot plan required by these rules and regulations may be prepared on the reverse side. It shall show the following:

1. Shape and dimensions of the lot.
2. Size, location and construction of the privy, sewage tank or sewage disposal system.
3. Size, material, location and construction of all sewer lines.
4. The location of all leaching devices or filters.
5. The location of all water supplies within 100 feet of any of the sewage disposal equipment.

RECORD OF SIZES

Sewage Tank      Gal.

Leaching      sq. ft. Filter      sq. ft

Aeration Tank 1250 gal

Secondary Treatment upflow Sandfilter

Final Effluent to Chlorinator into

Tile

Permit Issued       
Date Final Inspection       
Satisfactory       
Conditionally Satisfactory       
NOT Satisfactory     

This permit is not transferrable.

~~Mrs. Snyder~~

~~Paul H. Snyder~~

~~1941 9/13~~

~~Frank~~


~~1941 10/10~~

~~1941 10/10~~

about  
dog

Conn

~~1941 5/28~~

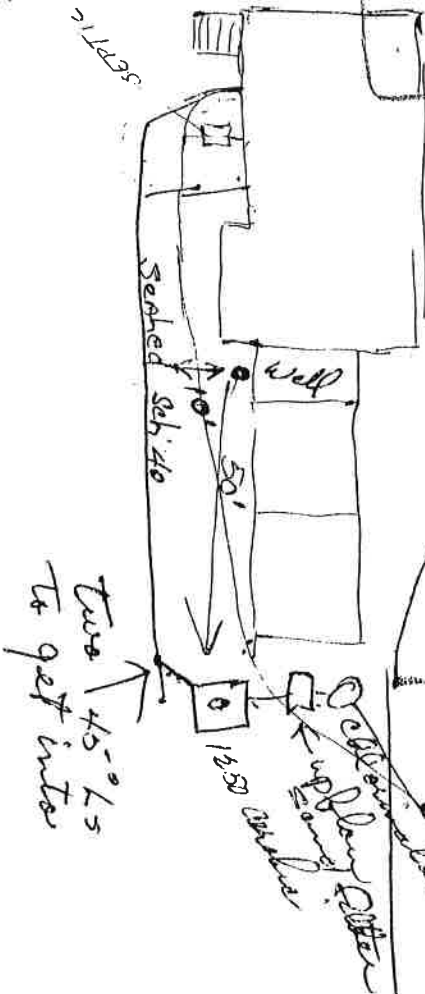

Sand filter  
1250 gal tank  
chlorinator

Discharge by driveway