

ALTERATION SEWAGE DISPOSAL PERMIT

EASE READ THE FOLLOWING CAREFULLY: SIGN AND DATE.

I agree to construct, install and operate the household sewage disposal system in accordance with rules 3701-29-01 to 3701-29-21 inclusive of the Ohio Administrative Code and with the Fairfield County Health Department's requirements and attached site plan. I understand the permit may be revoked at any time for failure to comply with the provisions of these regulations.

I acknowledge that this permit **expires one (1) year** from the date of issuance by the Fairfield County Health Department or upon completion of the household sewage disposal system, whichever comes first.

My household sewage disposal system or part thereof shall be covered or put into operation until the system has been inspected and approved by the Fairfield County Health Department.*

NOTE: 24-HOUR PRIOR NOTICE

Applicant's Signature  Date 5/30/97

FOR OFFICE AND SANITARIAN'S USE ONLY:

This is to certify that Rick Schaffner

Mailing Address: 106 Crown Ct., Lancaster, OH

I HEREBY GRANTED A PERMIT FOR THE ALTERATION OF A SEWAGE DISPOSAL SYSTEM (Circle One):

AERATOR

SEPTIC TANK

PRIVY

AT 2929 Lancaster Kirkersville Rd., Lancaster

LOCATED IN Greenfield TOWNSHIP, SECTION 23

Applicant's Name Rick Schaffner

Mailing Address 106 Crown Ct., Lancaster, OH

Installer of System Has a list

PERMIT ISSUED: 6-10-97

ISSUED BY: John Shreve RS

FINAL INSPECTION DATE: 7-8-97

BY: John Shreve RS

Satisfactory X

Not Satisfactory _____

NOT TRANSFERRABLE
FEE IS NON-REFUNDABLE

RECORD OF SIZES

Sewage Tank pump & crush
Leaching 300 Lineal Feet
Aeration Tank 500 gpd treatment capacity
Secondary Treatment filter & chlorinator
Final Effluent to roadside ditch
Comments add 12" concrete inspection box. No work shall begin until permission from ODOT granted.

Requirements for Leaching Tile Field Installation


Install 300 lineal feet of leaching, divided into two equal sections by an alternating switch box. Install trenches, 100 to 115 feet long, spaced 6 to 8 feet apart, 20-24 inches deep, and at least 12 inches wide. ~~Place 12 inches of clean gravel,~~ $\frac{3}{4}$ to $1\frac{1}{2}$ inches in size, in bottom of level trenches. Lay 4-inch leach pipe with holes, $\frac{1}{2}$ to $\frac{3}{4}$ inches in diameter, on gravel with grade not to exceed a fall of 6 inches in 100 feet. Place at least 2 inches of gravel over top of leach line. Cover gravel with 4 inches of straw.

Requirements for Curtain Drain Installation

Where curtain drains are required, they shall be installed not less than 6 inches below the leaching trench bottom, and shall be at least 8 feet from the center line of any leaching line. All curtain drains shall have 6" of gravel over the pipe

Call the Fairfield County Health Department at 653-4489 for final inspection and approval. 24 hours advance notice is requested for final inspection.

Install sewage system according to plot plan drawn below. If you need to make changes on system shown, notify the Health Department for approval, prior to installing.

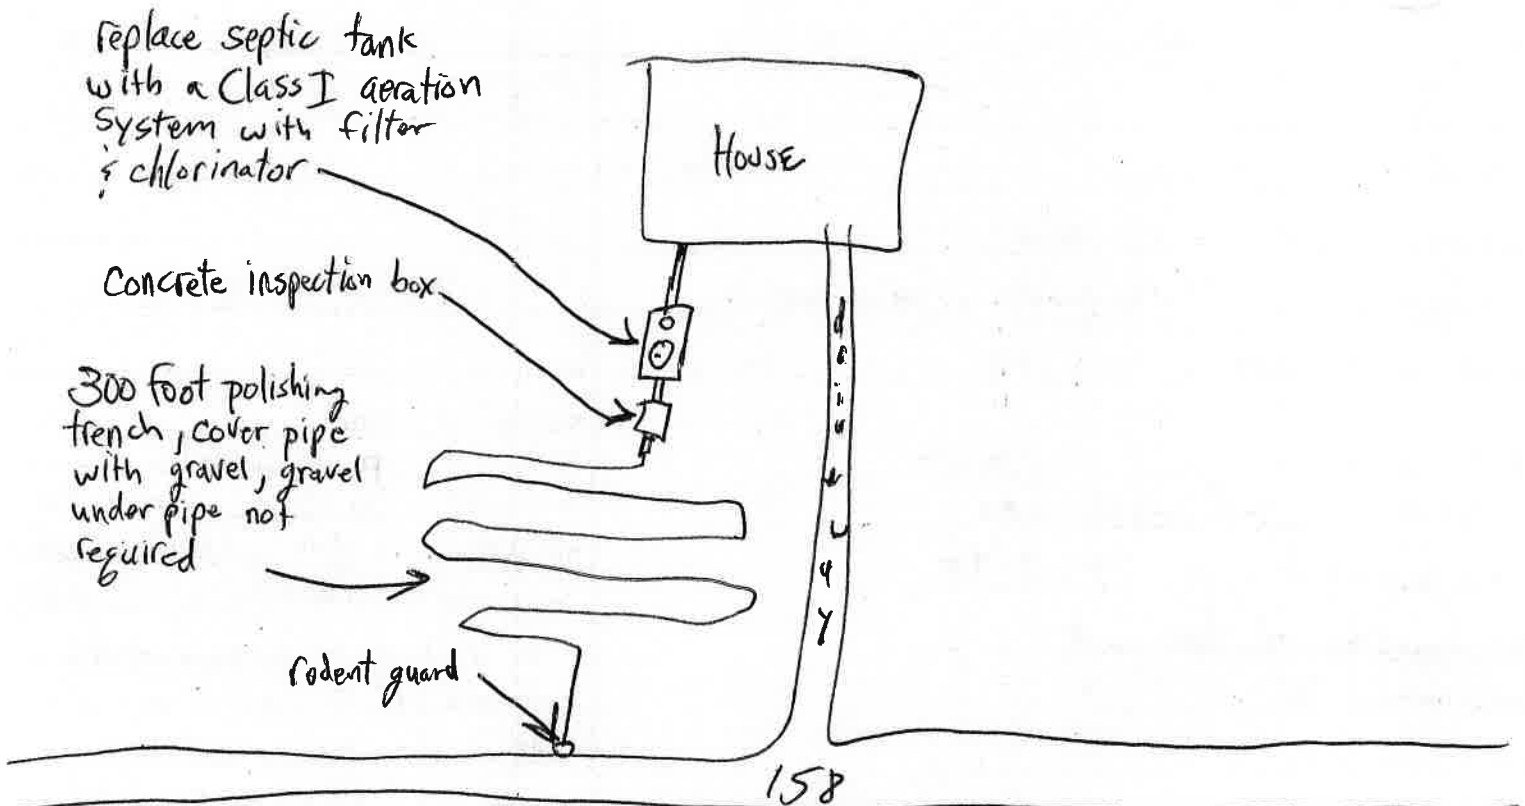

STP

APPLICATION / PERMIT FOR PRIVATE WATER SYSTEM

Permit #	96-443
Fee	138.00

Health District	FAIRFIELD
-----------------	-----------

CHECK ONE ITEM IN EACH BOX:

<input type="checkbox"/> New Installation	Water System Will Serve:	<input checked="" type="checkbox"/> Well	<input type="checkbox"/> Spring
<input checked="" type="checkbox"/> Alteration	<input checked="" type="checkbox"/> Single-family dwelling	<input type="checkbox"/> Test Hole	<input type="checkbox"/> Pond
	<input type="checkbox"/> Other	<input type="checkbox"/> Cistern	<input type="checkbox"/> Hauled Water Storage Tank

(Please type or print in ballpoint pen)

Owner	ROBERT H. KEMMERER		Phone No.	0130063100 (614) 653-3252	
Mailing Address	2966 LANCASTER KIRKERSVILLE RD	City	LANCASTER	Zip	43130
Location of Property					
Street Address	2966 LANCASTER KIRKERSVILLE RD		Township	GREENFIELD	
Name of Applicant	ROBERT H. KEMMERER		Phone No.	(614) 653-3252	
Address	2966 LANCASTER KIRKERSVILLE RD LANCASTER, OHIO 43130				

NOTICE TO APPLICANT: It may be your advantage to read the rules governing Private Water Systems, Chapter 3701-28 of the Administrative Code. This application will not be processed until the site plan is complete and this form bears the signature of the applicant and is accompanied by the appropriate fee.

I/we, the undersigned, hereby agree to install, construct, develop or alter the private water system named in this permit application in accordance with the attached site plan and all other applicable rules.

I/we also understand that the issuance of this permit is conditioned upon the right of the department to enter upon the premises of the private system named in this permit at any reasonable time prior to, during, or after completion of the work specified in this permit for the purpose of determining compliance with Chapter 3701-28 of the Administrative Code.

Applicant's Signature	Date
Robert H. Kemmerer	11/19/96

Site Plan Drawing NOT TO SCALE 	Indicate distances between water source and the following existing or proposed items: 144' Public roadway 51' Driveway 35' Property lines Easements Sewer lines 44' Sewage disposal system NA Other possible sources of contamination (i.e. buried fuel tank, manure pile, ditches etc.)	Buildings House Barn Outbuilding
---	---	---

Note: If the private water system will serve other than a single-family dwelling, detailed plans must also be submitted in compliance with rule 3701-28-03 of the Administrative Code.

DO NOT WRITE BELOW THIS LINE

Permit Approved by	Date

Note: Not valid without official audit number.

White, Property Owner-Pink, Water System Contractor-Canary, Health Dept.

Fairfield COUNTY HEALTH DEPARTMENT
Kirkersville Pike, Lancaster, OH
89 Hrs. 8 a.m. to 4 p.m. Weekdays

SEWAGE DISPOSAL PERMIT

PLEASE READ THE FOLLOWING CAREFULLY; SIGN AND DATE.

I agree to construct, install and operate the household sewage disposal system in accordance with rules 3701-29-01 to 3701-29-21 inclusive of the Ohio Administrative Code and with the Fairfield County Health Department's requirements and attached site plan. I understand the permit may be revoked at any time for failure to comply with the provisions of these regulations.

I acknowledge that this permit expires one (1) year from the date of issuance by the Fairfield County Health Department or upon completion of the household sewage disposal system, whichever comes first.

No household sewage disposal system or part thereof shall be covered or put into operation until the system has been inspected and approved by the Fairfield County Health Department*.

NOTE: 24-HOUR PRIOR NOTICE

Applicant's Signature Larry E. Wolfe Sandy K. Wolfe Date 8/9/99

FOR OFFICE AND SANITARIAN'S USE ONLY:

This is to certify that Larry E. & Sandy K. Wolfe

Dwelling Address: 2975 Lancaster Kirkersville Road, Lancaster, OH

I HEREBY GRANTED A PERMIT FOR THE: INSTALLATION XX ALTERATION

OF A SEWAGE DISPOSAL SYSTEM (Circle One): AERATOR SEPTIC TANK PRIVY

Located next to 2975 Lancaster Kirkersville Rd. 600' from southwest corner of Rt. 158

and Coonpath Rd.

LOCATED IN Greenfield TOWNSHIP, SECTION 23

Applicant's Name Larry E. & Sandy K. Wolfe

Dwelling Address 2975 Lancaster Kirkersville Rd., Lancaster

Installer of System Has a list

Permit Issued:

Issued by: John Shivers 8-13-99

FINAL INSPECTION: 10-29-99

By: John Shivers

Satisfactory X

Conditionally Satisfactory

Not Satisfactory

RECORD OF SIZES

Sewage Tank

Leaching 600 Lineal Ft

Aeration Tank 500 gpd treatment

Secondary Treatment

Final Effluent to

COMMENTS: perimeter drain with

gravel, drain 12" concrete inspection

box

This permit is not transferrable.

Requirements for Leaching Tile Field Installation

Install 600 lineal feet of leaching, divided into two equal sections by an alternating switch box. Install trenches, 100 to 115 feet long, spaced 6 to 8 feet apart, 24-30 inches deep, and at least 12 inches wide. Place 12 inches of clean gravel, $\frac{3}{4}$ to $1\frac{1}{2}$ inches in size, in bottom of leaching trenches. Lay 4-inch leach pipe with holes, $\frac{1}{2}$ to $\frac{3}{4}$ inches in diameter, on gravel with grade not to exceed a fall of 6 inches in 100 feet. Place at least 2 inches of gravel over top of leach line. Cover gravel with 4 inches of straw.




Requirements for Curtain Drain Installation

*gravel & straw
in trench*

Where curtain drains are required, they shall be installed not less than 6 inches below the leaching trench bottom, and shall be at least 8 feet from the center line of any leaching line.

Call the Fairfield County Health Department at 653-4489 for final inspection and approval. 24 hours advance notice is requested for final inspection.

Install sewage system according to plot plan drawn below. If you need to make changes on system shown, notify the Health Department for approval, prior to installing.

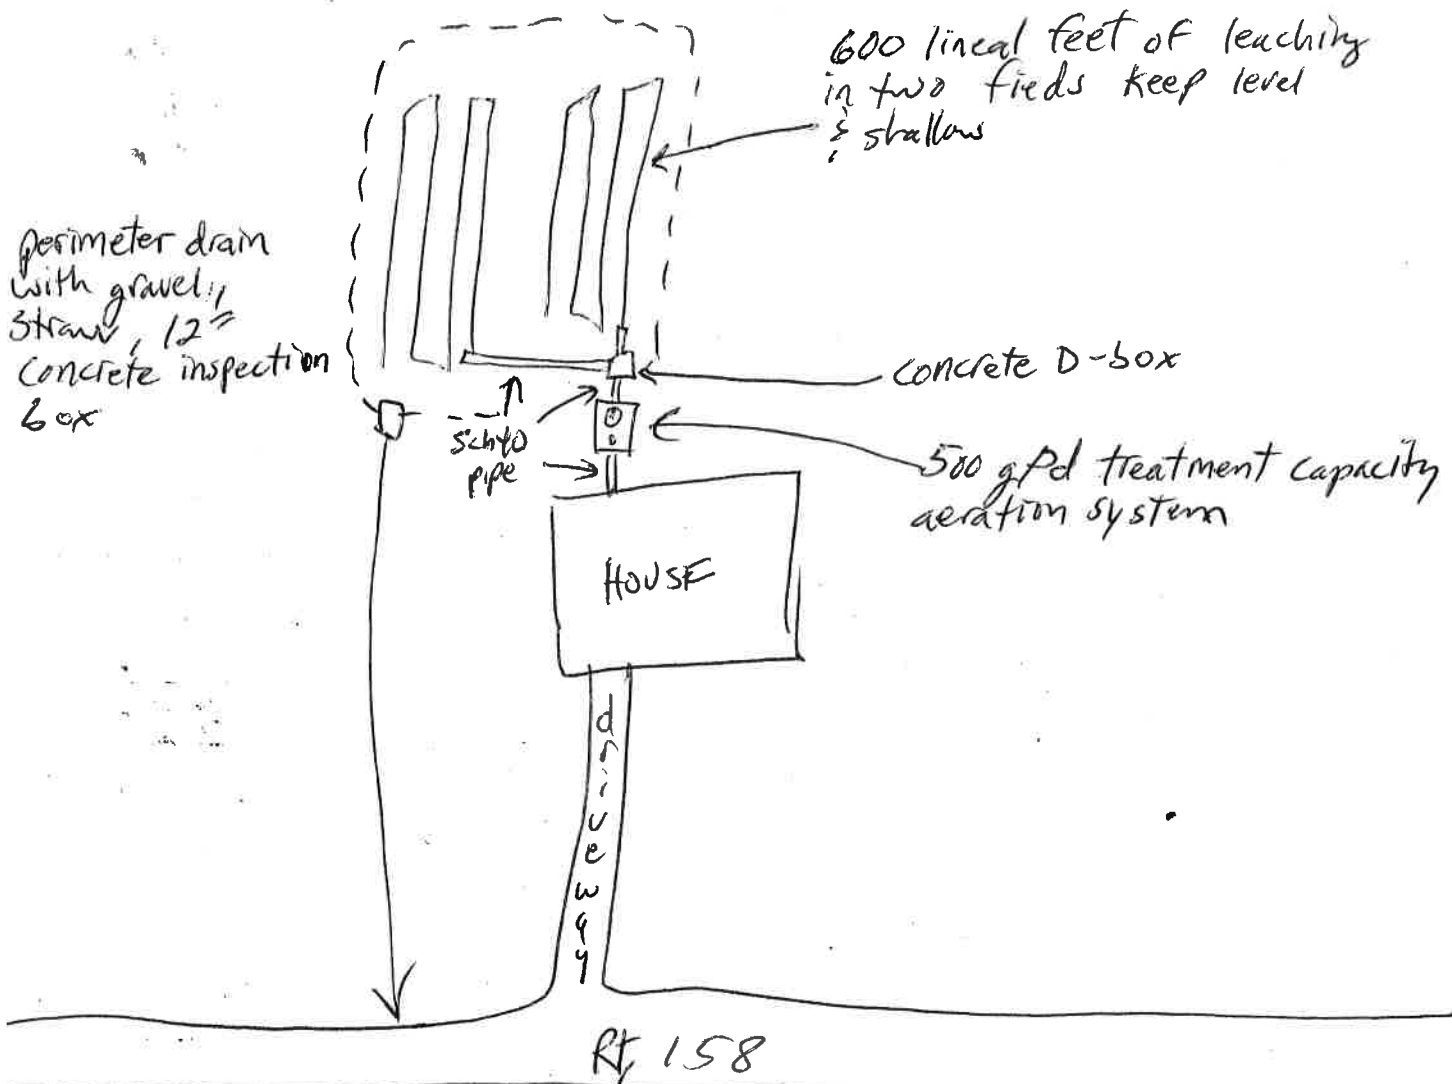

COPY

Fairfield County Health Department
108 North High Street
Lancaster, Ohio 43130

Permit No. 1

SEWAGE DISPOSAL PERMIT

This is to certify that JAN ROGERS Denise Hresik 0130037600
Address 3025 LANCASTER-KIRKERSVILLE RD. LANCASTER OHIO 43130
is hereby granted a permit for the: Installation XXX Alteration
Extension of Sewage Disposal System XXX
Privy at SAME AS ABOVE
 in GREENFIELD Township,
and owned by THOMAS F & JANET ROGERS
Work to be done by RICKETTS & FITZGERALD

This permit is issued upon the condition all work will be carried out according to the legal provisions regulating the installation and operation of privies, privy vaults, sewerage, and sewage disposal equipment. It may be revoked at any time for failure to comply with the orders and regulations of the Fairfield County Health Department. The permit expires one year from date of issuance, and may not be renewed. A final inspection is necessary to determine compliance.

Date JANUARY 3, 1983 Applicant Janet F. Rogers
Date 1-3-83 Sanitarian John Benning

The plot plan required by these rules and regulations may be prepared on the reverse side. It shall show the following:

1. Shape and dimensions of the lot.
2. Size, location and construction of the privy, sewage tank or sewage disposal system.
3. Size, material, location and construction of all sewer lines.
4. The location of all leaching devices or filters.
5. The location of all water supplies within 100 feet of any of the sewage disposal equipment.

RECORD OF SIZES

Sewage Tank Gal.
Leaching sq. ft. Filter sq. ft.
Aeration Tank 1250 gal
Secondary Treatment upflow Sand filter
Final Effluent to Chlorinator into
Tile

Permit Issued
Date Final Inspection
Satisfactory
Conditionally Satisfactory
NOT Satisfactory

This permit is not transferrable.

~~Mrs. S. J. S. S.~~

~~11/11/11~~
~~11/11/11~~

~~For a book~~
~~Long the 1000~~
~~1000~~

gibout
Dag

John

~~6245095~~

Seared Sch 40

well

True 45° 45'
to get into



 Robert J. Long

 1/250

2004 7 14

STR. 158

Sand filter
1250 gal tank
chlorinator

Discharge by driveway

ENTERED

Permit #

2002-187

Health District

Fee	
-----	--

9252.50

Solving 412-016

***NOTE:** If the private water system will serve other than a single-family dwelling, detailed plans must also be submitted in compliance with rule 3701-28-03 of the Ohio Administrative Code.

0130034400

****NOTE:** The name of the Private Water Systems contractor must be provided to the local health district before the installation of the well, spring, cistern or pond per OAC 3701-28-03.

I/we also understand that the issuance of this permit is conditioned upon the right of the department to enter upon the premises of the private system named in this permit at any reasonable time prior to, during, or after completion of the work specified in this permit for the purpose of determining compliance with Chapter 3701-28 of the Ohio Administrative Code.

Do NOT WRITE BELOW THIS LINE

Permit Extension

SEE COMMENTS ON BACK.

White—Property Owner Canary—Water System Contractor Pink—Health District

Note: Not valid without official Audit number attached


307838

Ohio Department of Health

Application/Permit for Private Water System Site Plan

Health district FAIRFIELD County Ohio	Permit number 2002-187
Owner/Applicant ANITA M. TURNER	
Location of property 3060 LANC-KIRK Rd NW, LANCASTER, OH 43130	
Site plan prepared by Sammy L Beam	

Clearly indicate the location or area of the proposed or existing private water system.
Please indicate scale.

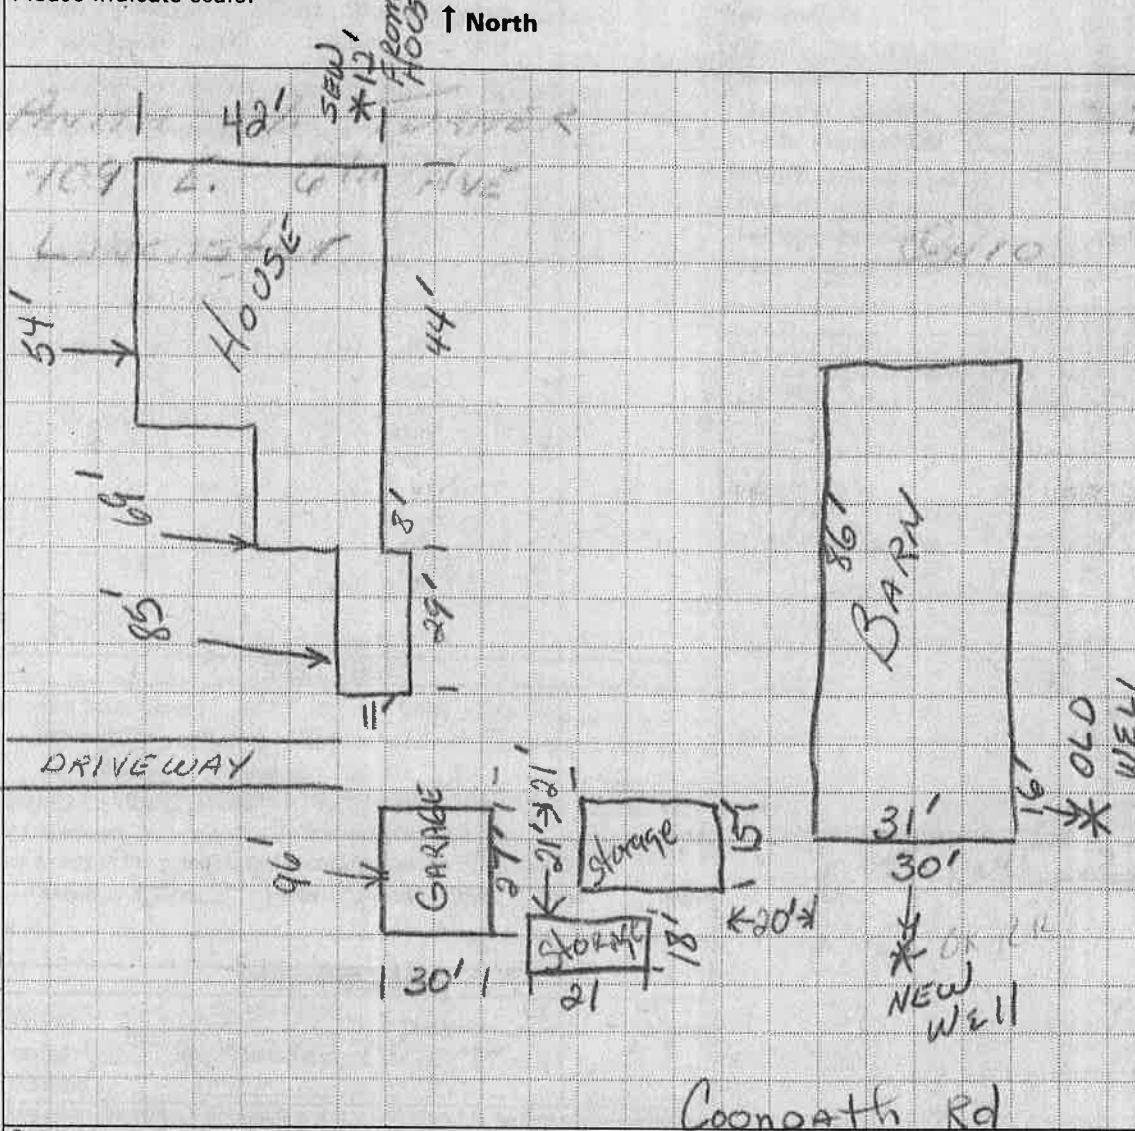

Indicate distances between water source and the following existing or proposed items on the map on left:

Check List

- ☐ Location of PWS or Test Hole
- ☐ Road right-of-ways
- ☐ Existing or properly sealed water wells
- ☐ Above or below ground storage tanks
- ☐ Property lines
- ☐ Public roadways
- ☐ Driveways
- ☐ Easements
- ☐ Sewer lines
- ☐ Sewage disposal systems
- ☐ Buildings
- ☐ Houses
- ☐ Barn or feed lots
- ☐ Outbuildings
- ☐ Oil and gas wells
- ☐ Streams, lake, ponds and ditches
- ☐ Manure ponds, lagoons or piles
- ☐ Lot lines
- ☐ Land fills
- ☐ Other possible sources of contamination

Comments

FARM consists of approx 112 ac (m/L)
 This is approx 2.5 AC (m/L) on SW CORNER OF FARM
 • Must be 10 ft. from property line

PLEASE NOTE: Any changes to the site plan must be approved by the local health district