

**US Army Corps  
of Engineers**

**Huntington District**

---

# **As-Constructed Plans**

## **Phase IIIA – LOCAL PROTECTION PROJECT WEST COLUMBUS, OHIO**


Note: Phase IIIA was constructed under two separate contracts. Project Features between Stations 227+18.00 and 240+38.40 were constructed by Lionel Construction. Project Features between Stations 247+15.38 and 260+92.50 were constructed by Alan Stone Company.

**November 2002**

**CC-13138**

**NOTE: REDUCED 50%**



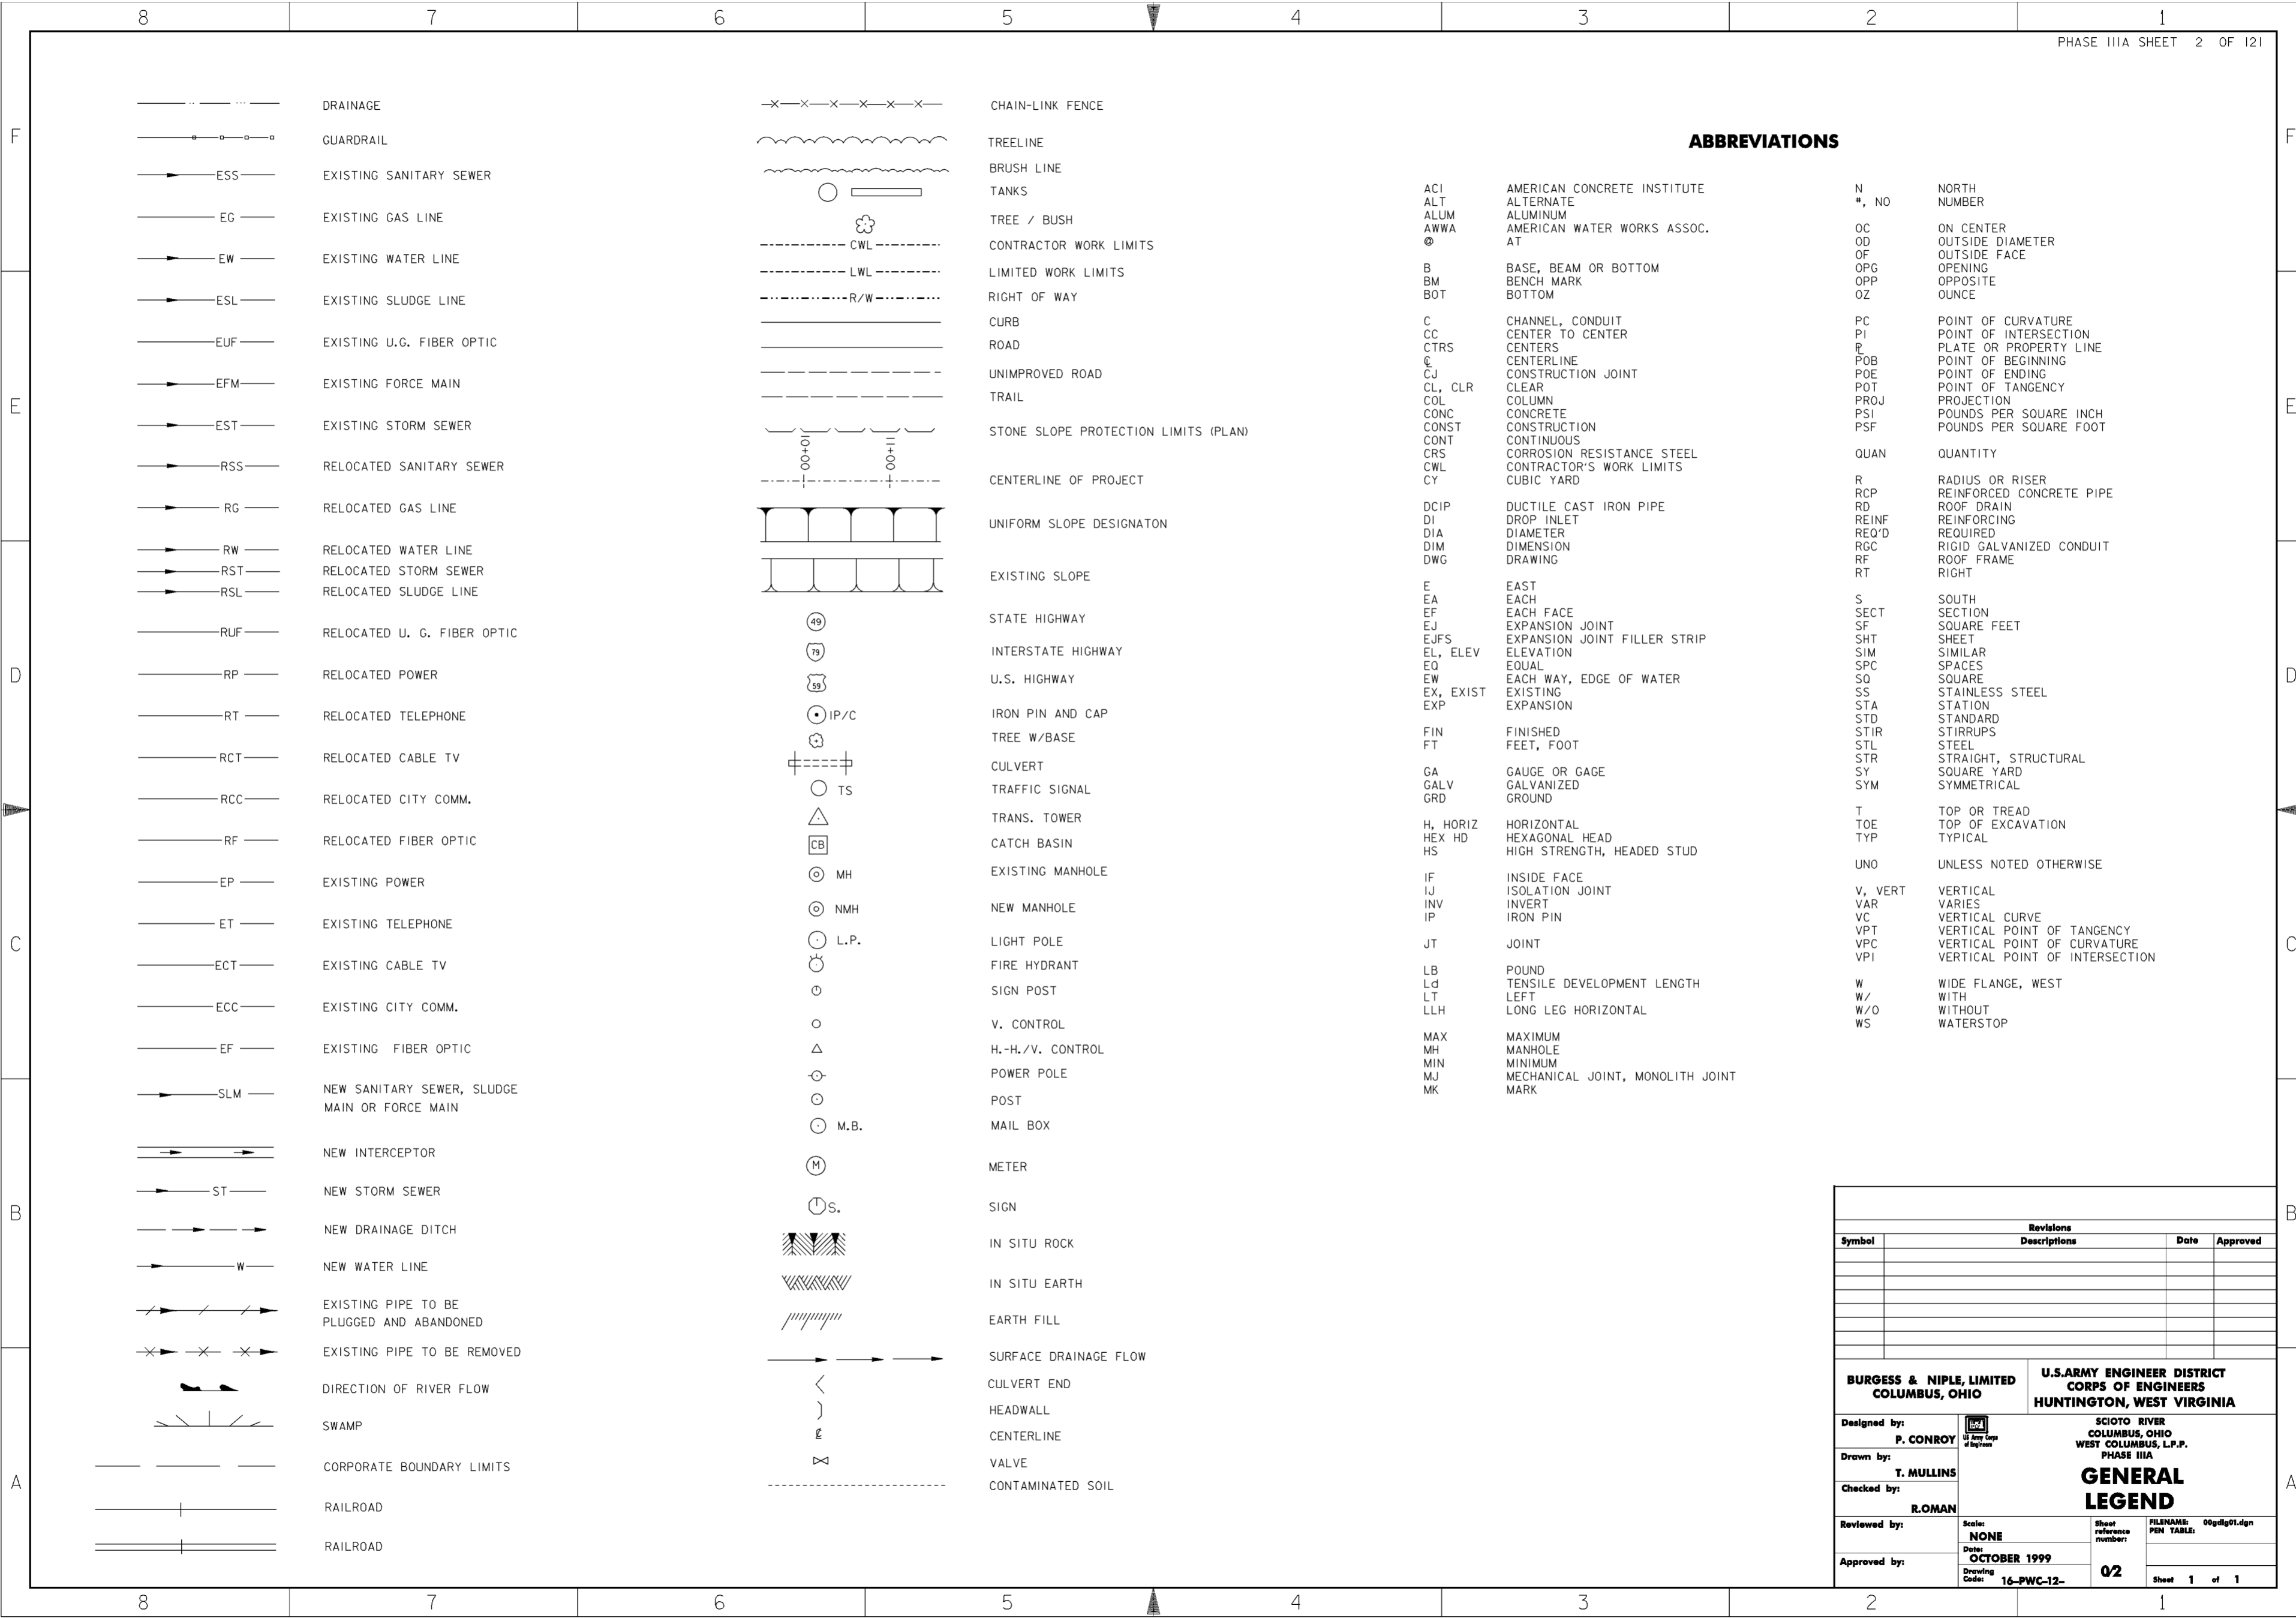

**ABBREVIATIONS**

ACI	AMERICAN CONCRETE INSTITUTE	N	NORTH
ALT	ALTERNATE	#, NO	NUMBER
ALUM	ALUMINUM	OC	ON CENTER
AWWA	AMERICAN WATER WORKS ASSOC.	OD	OUTSIDE DIAMETER
@	AT	OF	OUTSIDE FACE
B	BASE, BEAM OR BOTTOM	OPG	OPENING
BM	BENCH MARK	OPP	OPPOSITE
BOT	BOTTOM	OZ	OUNCE
C	CHANNEL, CONDUIT	PC	POINT OF CURVATURE
CC	CENTER TO CENTER	PI	POINT OF INTERSECTION
CTRS	CENTERS	P	PLATE OR PROPERTY LINE
CL	CENTERLINE	POB	POINT OF BEGINNING
CJ	CONSTRUCTION JOINT	POE	POINT OF ENDING
CL, CLR	CLEAR	POT	POINT OF TANGENCY
COL	COLUMN	PROJ	PROJECTION
CONC	CONCRETE	PSI	POUNDS PER SQUARE INCH
CONST	CONSTRUCTION	PSF	POUNDS PER SQUARE FOOT
CONT	CONTINUOUS	QUAN	QUANTITY
CRS	CORROSION RESISTANCE STEEL	R	RADIUS OR RISER
CWL	CONTRACTOR'S WORK LIMITS	RCP	REINFORCED CONCRETE PIPE
CY	CUBIC YARD	RD	ROOF DRAIN
DCIP	DUCTILE CAST IRON PIPE	REINF	REINFORCING
DI	DROP INLET	REQ'D	REQUIRED
DIA	DIAMETER	RGC	RIGID GALVANIZED CONDUIT
DIM	DIMENSION	RF	ROOF FRAME
DWG	DRAWING	RT	RIGHT
E	EAST	S	SOUTH
EA	EACH	SECT	SECTION
EF	EACH FACE	SF	SQUARE FEET
EJ	EXPANSION JOINT	SHT	SHEET
EJFS	EXPANSION JOINT FILLER STRIP	SIM	SIMILAR
EL, ELEV	ELEVATION	SPC	SPACES
EQ	EQUAL	SQ	SQUARE
EW	EACH WAY, EDGE OF WATER	SS	STAINLESS STEEL
EX, EXIST	EXISTING	STA	STATION
EXP	EXPANSION	STD	STANDARD
FIN	FINISHED	STIR	STIRRUPS
FT	FEET, FOOT	STL	STEEL
GA	GAUGE OR GAGE	STR	STRAIGHT, STRUCTURAL
GALV	GALVANIZED	SY	SQUARE YARD
GRD	GROUND	SYM	SYMMETRICAL
H, HORIZ	HORIZONTAL	T	TOP OR TREAD
HEX HD	HEXAGONAL HEAD	TOE	TOP OF EXCAVATION
HS	HIGH STRENGTH, HEADED STUD	TYP	TYPICAL
IF	INSIDE FACE	UNO	UNLESS NOTED OTHERWISE
IJ	ISOLATION JOINT	V, VERT	VERTICAL
INV	INVERT	VAR	VARIES
IP	IRON PIN	VC	VERTICAL CURVE
JT	JOINT	VPT	VERTICAL POINT OF TANGENCY
LB	POUND	VPC	VERTICAL POINT OF CURVATURE
Ld	TENSILE DEVELOPMENT LENGTH	VPI	VERTICAL POINT OF INTERSECTION
LT	LEFT	W	WIDE FLANGE, WEST
LLH	LONG LEG HORIZONTAL	W/	WITH
MAX	MAXIMUM	W/O	WITHOUT
MH	MANHOLE	WS	WATERSTOP
MIN	MINIMUM		
MJ	MECHANICAL JOINT, MONOLITH JOINT		
MK	MARK		

Revisions			
Symbol	Descriptions	Date	Approved

<b>BURGESS &amp; NIPLE, LIMITED</b> COLUMBUS, OHIO	<b>U.S. ARMY ENGINEER DISTRICT</b> CORPS OF ENGINEERS HUNTINGTON, WEST VIRGINIA
Designed by: <b>P. CONROY</b>	<p><b>GENERAL LEGEND</b></p>
Drawn by: <b>T. MULLINS</b>	
Checked by: <b>R. ROMAN</b>	
Reviewed by:	
Approved by:	Scale: <b>NONE</b> Date: <b>OCTOBER 1999</b> Drawing Code: <b>16-PWC-12-</b>
	Sheet reference number: <b>02</b> FILENAME: 00pdlg01.dgn PIN TABLE: Sheet 1 of 1

**SURVEY**

1. CURVE DATA SHOWN IS BASED ON ARC DEFINITION.

**CONSTRUCTION PROCEDURE**

- 2. THE CONTRACTOR SHALL OBTAIN AND PAY FOR A STREET EXCAVATION AND OCCUPANCY PERMIT FROM THE DIVISION OF ENGINEERING AND CONSTRUCTION PRIOR TO OPEN CUT ON ANY PAVEMENT IN THE CITY OF COLUMBUS. (614) 645-7113
- 3. THE WORD FLOODWALL IN THIS SET OF DRAWINGS IS USED AS A GENERIC TERM TO INDICATE FLOODWALL OR LEVEE.
- 4. STRIPPED MATERIAL SUITABLE FOR USE AS FILL, BACKFILL OR TOPSOIL SHALL BE STOCKPILED AT A LOCATION PROVIDED BY THE CONTRACTOR AND APPROVED BY THE CONTRACTING OFFICER.
- 5. THE PROCEDURES FOR THE HANDLING OF SEWERS AND OTHER UTILITIES ENCOUNTERED DURING CONSTRUCTION WHICH ARE NOT SHOWN ON THE DRAWINGS SHALL BE DIRECTED BY THE CONTRACTING OFFICER. ACTIVE SEWERS TO BE ABANDONED SHALL BE ADJUSTED AS NECESSARY TO FACILITATE CONSTRUCTION AND FILLED ALONG THE ENTIRE PIPE LENGTH. SEWERS DETERMINED TO BE ALREADY ABANDONED SHALL BE REMOVED AS NECESSARY. BROKEN PIECES AND PORTIONS OF PIPE OR TILE SHALL BE REMOVED UNTIL A WHOLE LENGTH IS ENCOUNTERED, AND PLUGGED WITH CONCRETE FOR A MINIMUM DISTANCE OF TWO FEET HORIZONTALLY, UNLESS OTHERWISE NOTED.
- 6. THE CONTRACTOR SHALL REPLACE, AT HIS OWN EXPENSE, ANY ITEM NOT SPECIFICALLY INDICATED FOR REMOVAL THAT IS DAMAGED OR DESTROYED BY HIS OPERATIONS.
- 7. THE CONTRACTOR IS RESPONSIBLE FOR OBTAINING AND PAYING FOR ALL FEES SUCH AS (BUT NOT LIMITED TO) STREET OPENING PERMITS, TAP FEES, PARKING METER FEES, WATER METERS AND CONSTRUCTION MATERIALS TESTING.
- 8. TO FACILITATE CONSTRUCTION, HORIZONTAL STEM REINFORCEMENT IN FLOODWALL MONOLITHS MAY BE PLACED ON EITHER SIDE OF VERTICAL REINFORCEMENT PROVIDED THE REQUIRED CONCRETE COVER ON THE VERTICAL REINFORCING BARS IS MAINTAINED.

**MAINTENANCE OF TRAFFIC**

- 9. ALL TEMPORARY TRAFFIC CONTROL DEVICES SHALL BE FURNISHED, ERECTED, MAINTAINED, AND REMOVED BY THE CONTRACTOR IN ACCORDANCE WITH THE OHIO MANUAL OF TRAFFIC CONTROL DEVICES FOR CONSTRUCTION AND MAINTENANCE OPERATIONS, COPIES OF WHICH ARE AVAILABLE FROM THE OHIO DEPARTMENT OF TRANSPORTATION, BUREAU OF TRAFFIC, 1980 WEST BROAD STREET, COLUMBUS, OHIO 43223.
- 10. THE TRAFFIC ENGINEERING AND PARKING DIVISION CONSTRUCTION MANAGER (645-6269) AND THE COLUMBUS PAVING THE WAY PROGRAM (645-3970) SHALL BE NOTIFIED A MINIMUM OF FIVE (5) WORKING DAYS PRIOR TO STARTING WORK AND/OR PRIOR TO EACH PHASE OR MAJOR CHANGE IN TRAFFIC PATTERNS, EITHER PERMANENT OR TEMPORARY, WITHIN THE ROADWAY RIGHT-OF-WAY.
- 11. STEADY-BURNING, TYPE "C" LIGHTS SHALL BE REQUIRED ON ALL BARRICADES, DRUMS, AND SIMILAR TRAFFIC CONTROL DEVICES IN USE AT NIGHT. CONES ARE NOT APPROVED FOR USE AT NIGHT.

**UTILITIES RELOCATION**

- 12. RELOCATION OF UTILITIES FOR THE CONVENIENCE OF THE CONTRACTOR SHALL BE AT THE CONTRACTOR'S EXPENSE.
- 13. THE CONTRACTOR SHALL NOTIFY THE OHIO UTILITIES PROTECTION SERVICES (TELEPHONE 1-800-362-2764 TOLL FREE) AND THE OWNERS OF UNDERGROUND UTILITY FACILITIES SHOWN ON THE PLANS WHO ARE NOT MEMBERS OF A REGISTERED UNDERGROUND PROTECTION SERVICES IN ACCORDANCE WITH THE OHIO REVISED CODE. THE ABOVE MENTIONED NOTICE SHALL BE GIVEN AT LEAST 2 WORKING DAYS PRIOR TO START OF CONSTRUCTION.
- 14. THE CONTRACTOR SHALL NOTIFY THE FOLLOWING DIVISIONS AT LEAST 48 HOURS PRIOR TO CONSTRUCTION:

SEWERAGE AND DRAINAGE	645-8156 AND 645-6311
WATER	645-7788
ELECTRICITY	645-7627

15. THE FOLLOWING IS A LIST OF UTILITIES AND OWNERS:

American Electric Power  
1 Riverside Plaza  
Columbus, Ohio 43215-2373  
(614) 223-1515

Columbus Division of Electricity  
Utilities Complex  
910 Dublin Road  
Columbus, Ohio 43215-1116  
(614) 645-7627

Columbus Division of  
Sewerage & Drainage  
Utilities Complex  
910 Dublin Road  
Columbus, Ohio 43215-1116  
(614) 645-7175

Ohio Department of Transportation  
District 6  
400 East William Street  
Delaware, Ohio 43015  
(740) 363-1251

**MAPPING**

- 16. ELEVATIONS ARE EXPRESSED IN FEET AND REFER TO THE NATIONAL GEODETIC VERTICAL DATUM OF 1929.
- 17. HORIZONTAL COORDINATES ARE EXPRESSED IN FEET AND REFER TO THE OHIO STATE PLANE COORDINATE SYSTEM SOUTH ZONE, BASED ON THE NORTH AMERICAN DATUM OF 1927.
- 18. TOPOGRAPHY DOES NOT REFLECT RECENT BUILDING REMOVAL, CONSTRUCTION OR GRADING.
- 19. THE MAPPING OF THE PROJECT SITE WAS COMPILED FROM PHOTOGRAPHY FLOWN MARCH 1997.

**RIGHT OF WAY /WORKING LIMITS**

- 20. WORKING AREA AVAILABLE TO THE CONTRACTOR IS INDICATED BY THE CONTRACTOR WORK LIMITS (CWL). ANY ADDITIONAL AREA NEEDED BY THE CONTRACTOR SHALL BE ACQUIRED AT HIS OWN EXPENSE.
- 21. THE AREA DESIGNATED AS LIMITED WORK LIMITS (LWL) SHALL BE USED AS A CONTRACTOR LAYDOWN AREA. THE CONTRACTOR SHALL PROVIDE ANY SECURITY MEASURES NECESSARY TO PROTECT EQUIPMENT AND MATERIALS.


**SPOIL MATERIAL**

- 22. THE CONTRACTOR SHALL DISPOSE OF SPOIL MATERIALS OFF-SITE IN ACCORDANCE WITH PART 3 OF SECTION 02221 EXCAVATION, OF THE SPECIFICATIONS.


**GENERAL**

- 23. THE CURRENT CITY OF COLUMBUS CONSTRUCTION AND MATERIAL SPECIFICATIONS AND STANDARD DRAWINGS, INCLUDING ALL SUPPLEMENTS THERETO, SHALL GOVERN ALL CONSTRUCTION ITEMS AND UTILITIES WITHIN PUBLIC RIGHT-OF-WAY WITH RESPECT TO ROADWAY WORK AND UTILITIES.
- 24. WHERE NEW WORK IS TO BE ACCURATELY JOINED TO EXISTING WORK, THE CONTRACTOR SHALL VERIFY THE DIMENSIONS, GRADES AND ELEVATIONS OF ALL EXISTING CONSTRUCTION. ELEVATIONS FOR TOP AND BOTTOM OF CATCH BASINS AND GATEWELLS SHALL ALSO BE VERIFIED PRIOR TO ORDERING.
- 25. THE CONTRACTOR SHALL MAKE PROVISIONS TO WORK AROUND THE CITY OF COLUMBUS, DIVISION OF ELECTRICITY FACILITIES THAT EXIST ON THE EAST SIDE OF I-71 (FROM I-70 TO GREENLAWN AVENUE). SERVICE SHALL NOT BE INTERRUPTED AND CIRCUITS SHALL NOT BE DEENERGIZED.
- 26. THE CONTRACTOR SHALL PROTECT TREES AS NECESSARY WHEN WORKING BETWEEN THE ODOT RIGHT-OF-WAY FENCE AND SCIOTO RIVER'S WATERS EDGE AS OUTLINED IN SPECIFICATION SECTION 02050. ANY TREE DAMAGED AS A RESULT OF THE CONTRACTOR'S OPERATIONS SHALL BE REPLACED IN KIND.

Revisions			
Symbol	Descriptions	Date	Approved


<b>BURGESS &amp; NIPLE, LIMITED COLUMBUS, OHIO</b>		<b>U.S. ARMY ENGINEER DISTRICT CORPS OF ENGINEERS HUNTINGTON, WEST VIRGINIA</b>	
		SCIOTO RIVER COLUMBUS, OHIO WEST COLUMBUS, L.P.P. PHASE IIIA <b>GENERAL NOTES</b>	
Designed by: <b>P.CONROY</b>		Scale: <b>NONE</b>	Sheet reference number: <b>03</b>
Drawn by: <b>T.MULLINS</b>		Date: <b>OCTOBER 1999</b>	FILENAME: <b>00qdn01.dgn</b>
Checked by: <b>R.OMAN</b>		Drawing Code: <b>16-PWC-12-</b>	PEN TABLE: Sheet <b>1</b> of <b>1</b>
Reviewed by:			
Approved by:			



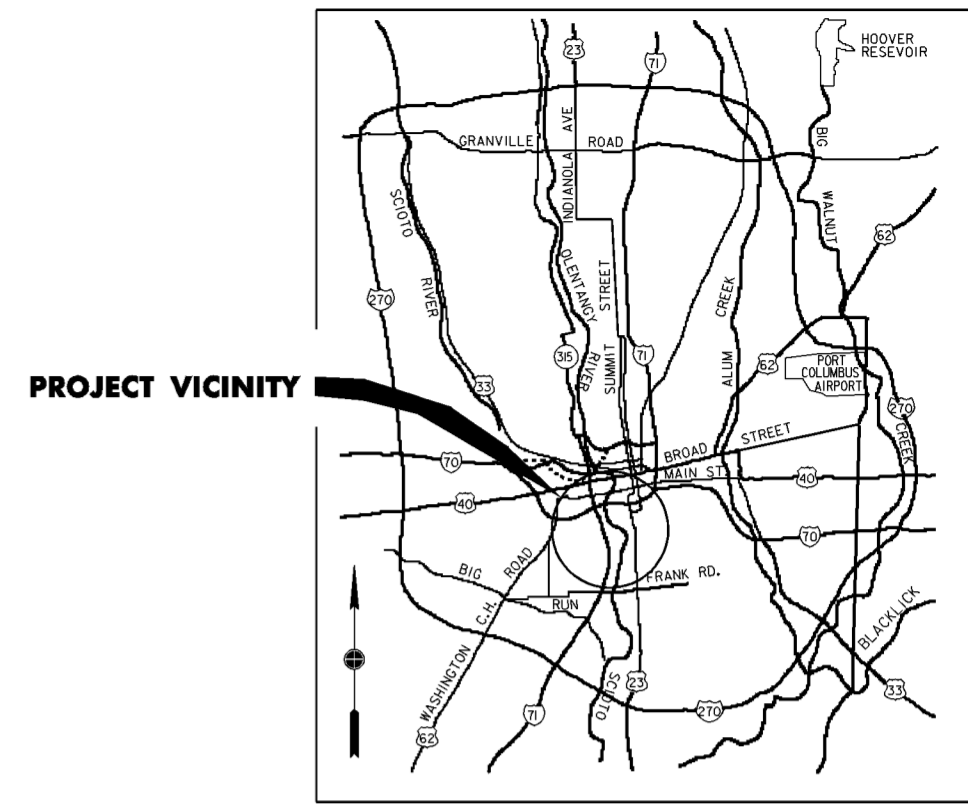

**VICINITY MAP**  
N.T.S.

**LOCATION MAP**  
N.T.S.

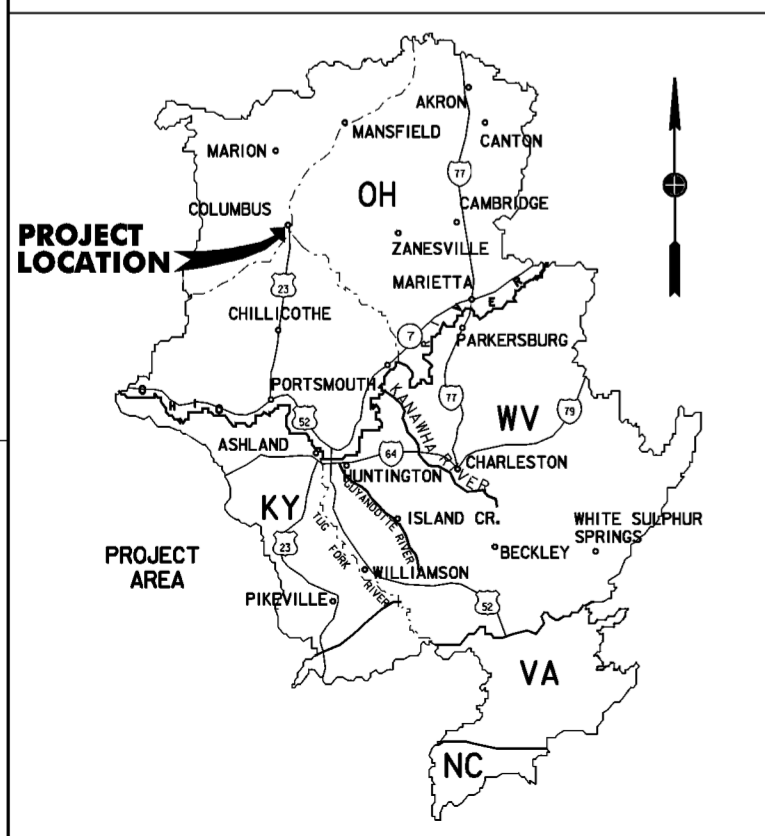


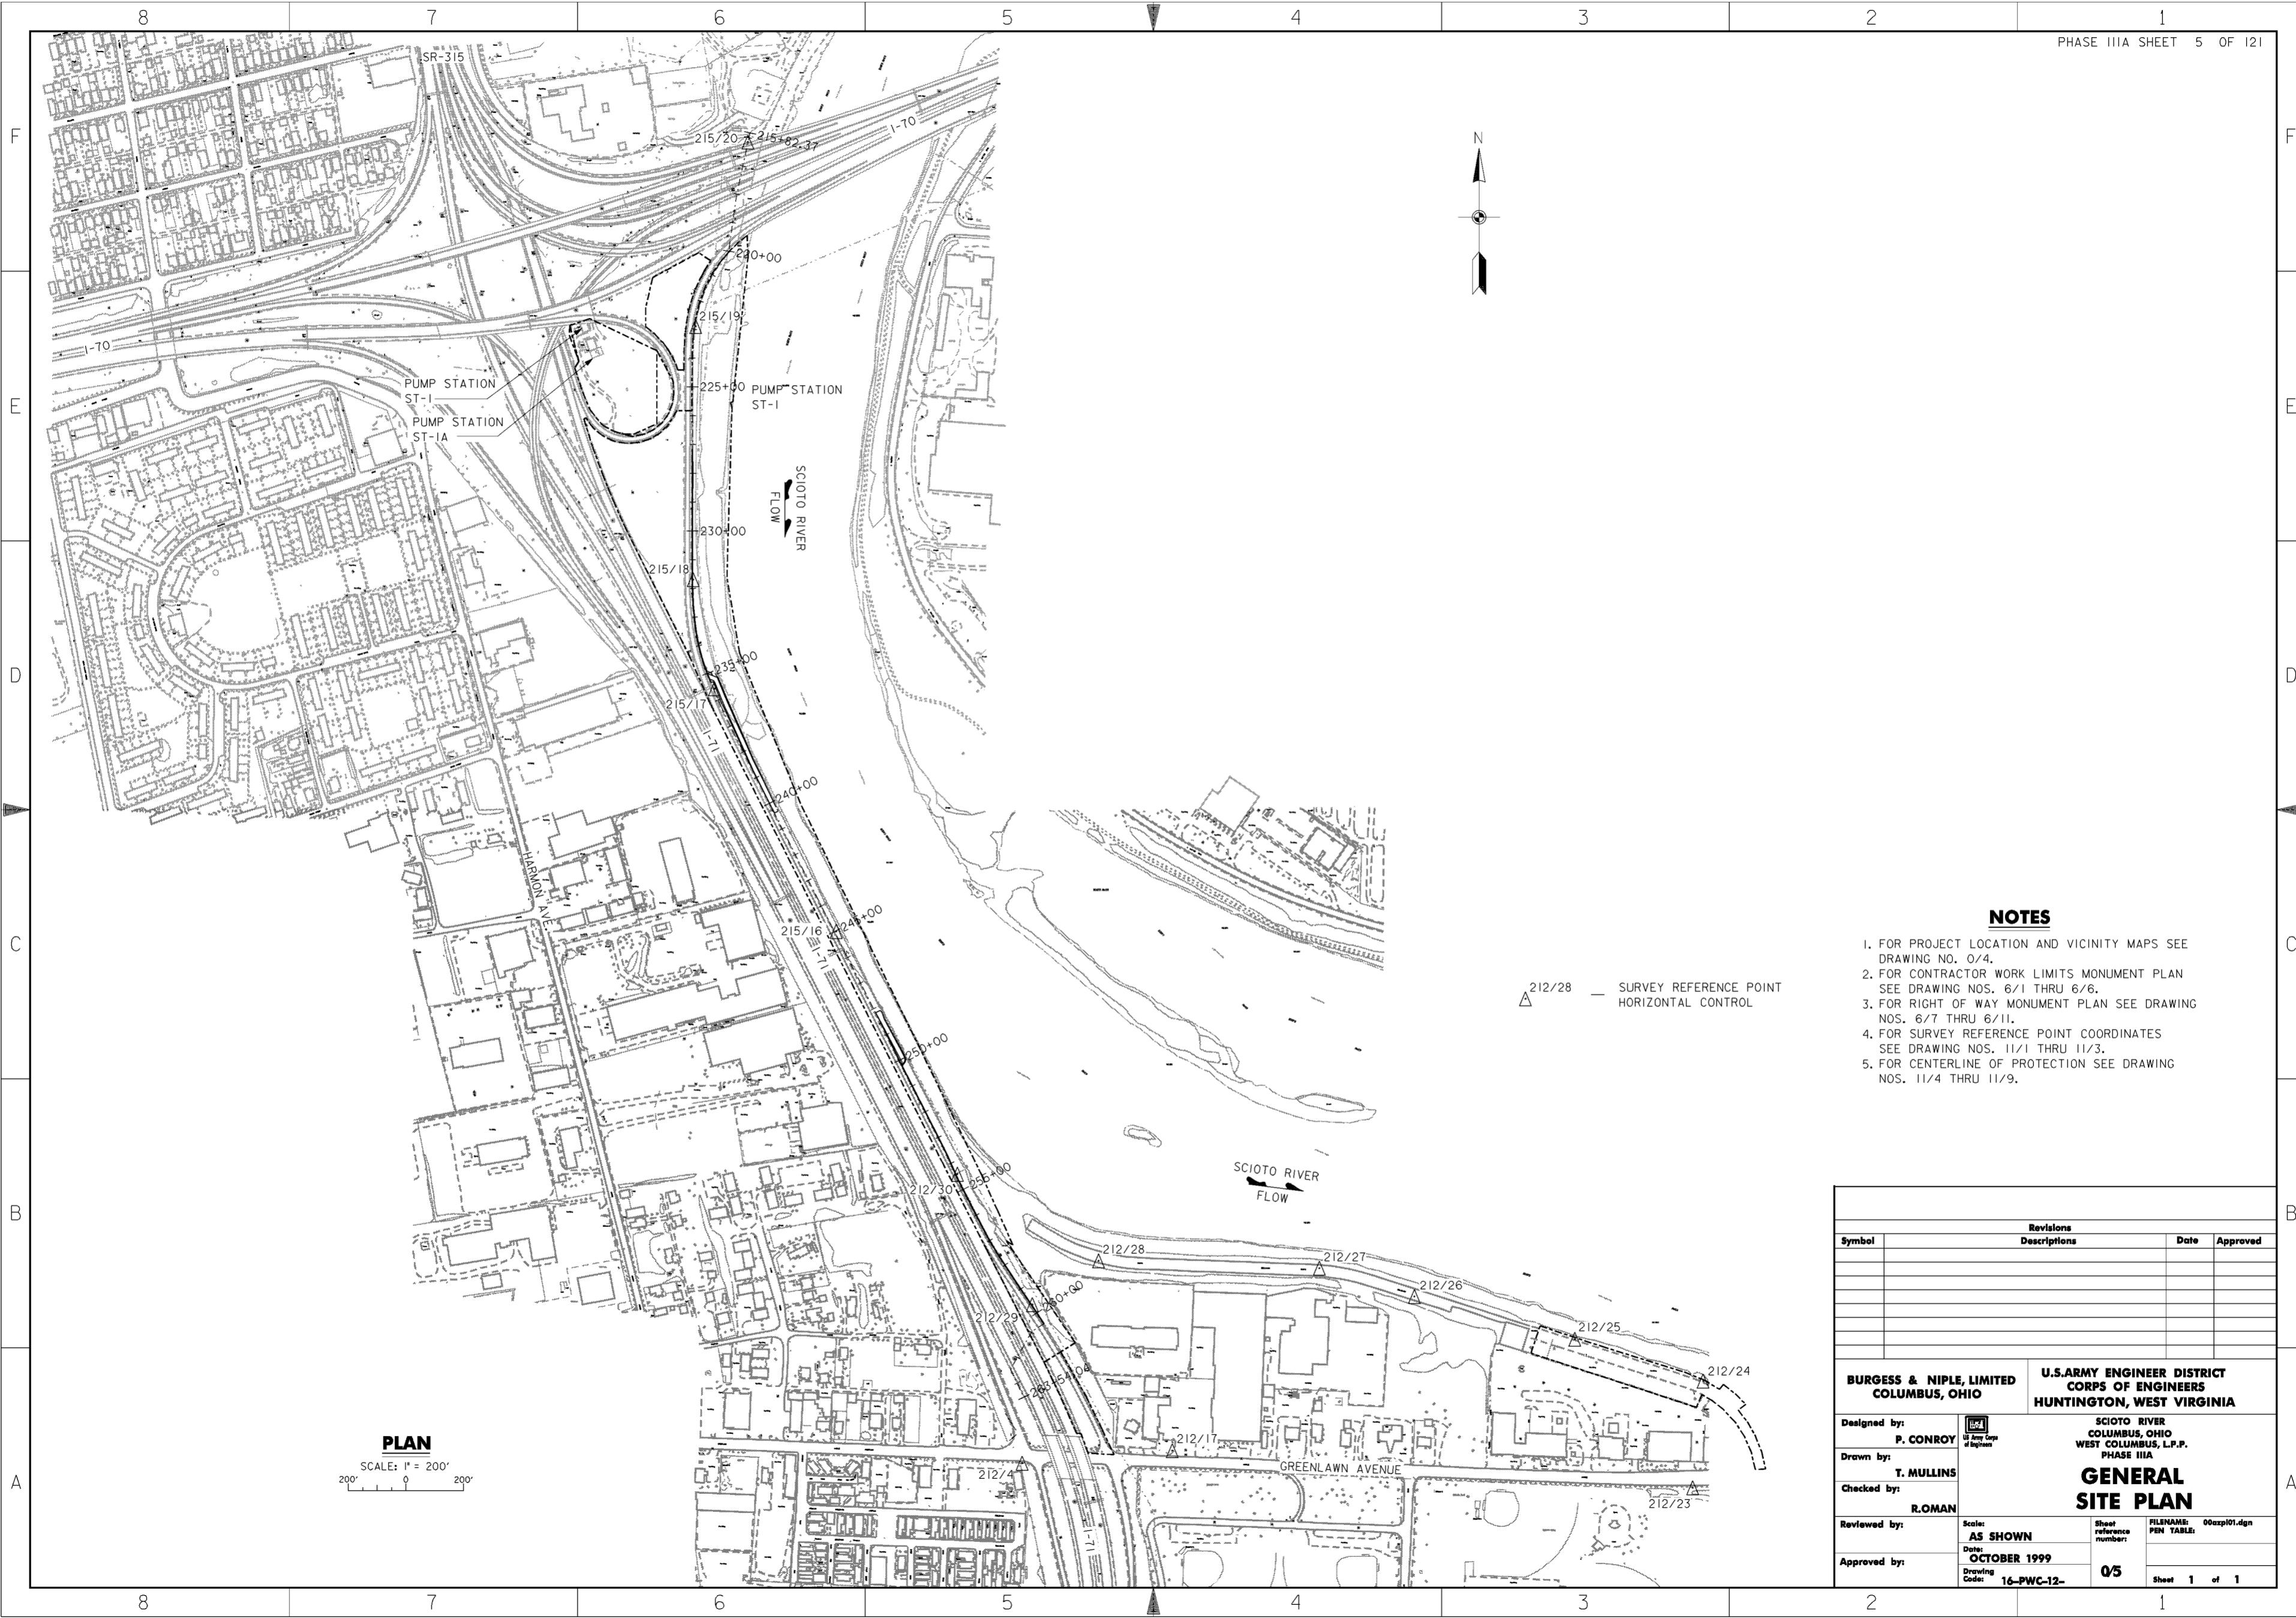
**PROJECT MAP**  
SCALE: 1" = 500'  
500' 0 500'

**LEGEND**

 PHASE III-A PROJECT AREA

Revisions			
Symbol	Descriptions	Date	Approved

<b>BURGESS &amp; NIPL, LIMITED</b> COLUMBUS, OHIO		<b>U.S. ARMY ENGINEER DISTRICT</b> CORPS OF ENGINEERS HUNTINGTON, WEST VIRGINIA	
Designed by: <b>P. CONROY</b>		SCIO TO RIVER COLUMBUS, OHIO WEST COLUMBUS, L.P.P. PHASE IIIA	
Drawn by: <b>T. MULLINS</b>		<b>GENERAL PROJECT MAPS</b>	
Checked by: <b>R. ROMAN</b>		Scale: <b>AS SHOWN</b>	Sheet reference number: <b>0/4</b>
Reviewed by:		Date: <b>OCTOBER 1999</b>	FILENAME: PIN TABLE: 00azpm01.dgn
Approved by:		Drawing Code: <b>16-PWC-12-</b>	Sheet 1 of 1



**NOTES**


1. FOR PROJECT LOCATION AND VICINITY MAPS SEE DRAWING NO. 0/4.
2. FOR CONTRACTOR WORK LIMITS MONUMENT PLAN SEE DRAWING NOS. 6/1 THRU 6/6.
3. FOR RIGHT OF WAY MONUMENT PLAN SEE DRAWING NOS. 6/7 THRU 6/11.
4. FOR SURVEY REFERENCE POINT COORDINATES SEE DRAWING NOS. 11/1 THRU 11/3.
5. FOR CENTERLINE OF PROTECTION SEE DRAWING NOS. 11/4 THRU 11/9.

△ 212/28 — SURVEY REFERENCE POINT  
 ————— HORIZONTAL CONTROL

**PLAN**  
 SCALE: 1" = 200'  
 200' 0 200'

Revisions			
Symbol	Descriptions	Date	Approved

<b>BURGESS &amp; NIPL, LIMITED</b> COLUMBUS, OHIO	 <b>U.S. ARMY ENGINEER DISTRICT</b> CORPS OF ENGINEERS HUNTINGTON, WEST VIRGINIA	SCIOTO RIVER COLUMBUS, OHIO WEST COLUMBUS, L.P.P. PHASE IIIA	
		<b>GENERAL SITE PLAN</b>	
Designed by: <b>P. CONROY</b>	 U.S. Army Corps of Engineers	Scale: <b>AS SHOWN</b>	Sheet reference number: <b>0/5</b>
Drawn by: <b>T. MULLINS</b>	<b>GENERAL SITE PLAN</b>	Date: <b>OCTOBER 1999</b>	FILENAME: 00azp101.dgn PEN TABLE:
Checked by: <b>R.ROMAN</b>		Drawing Code: <b>16-PWC-12-</b>	Sheet 1 of 1
Reviewed by:	Approved by:		

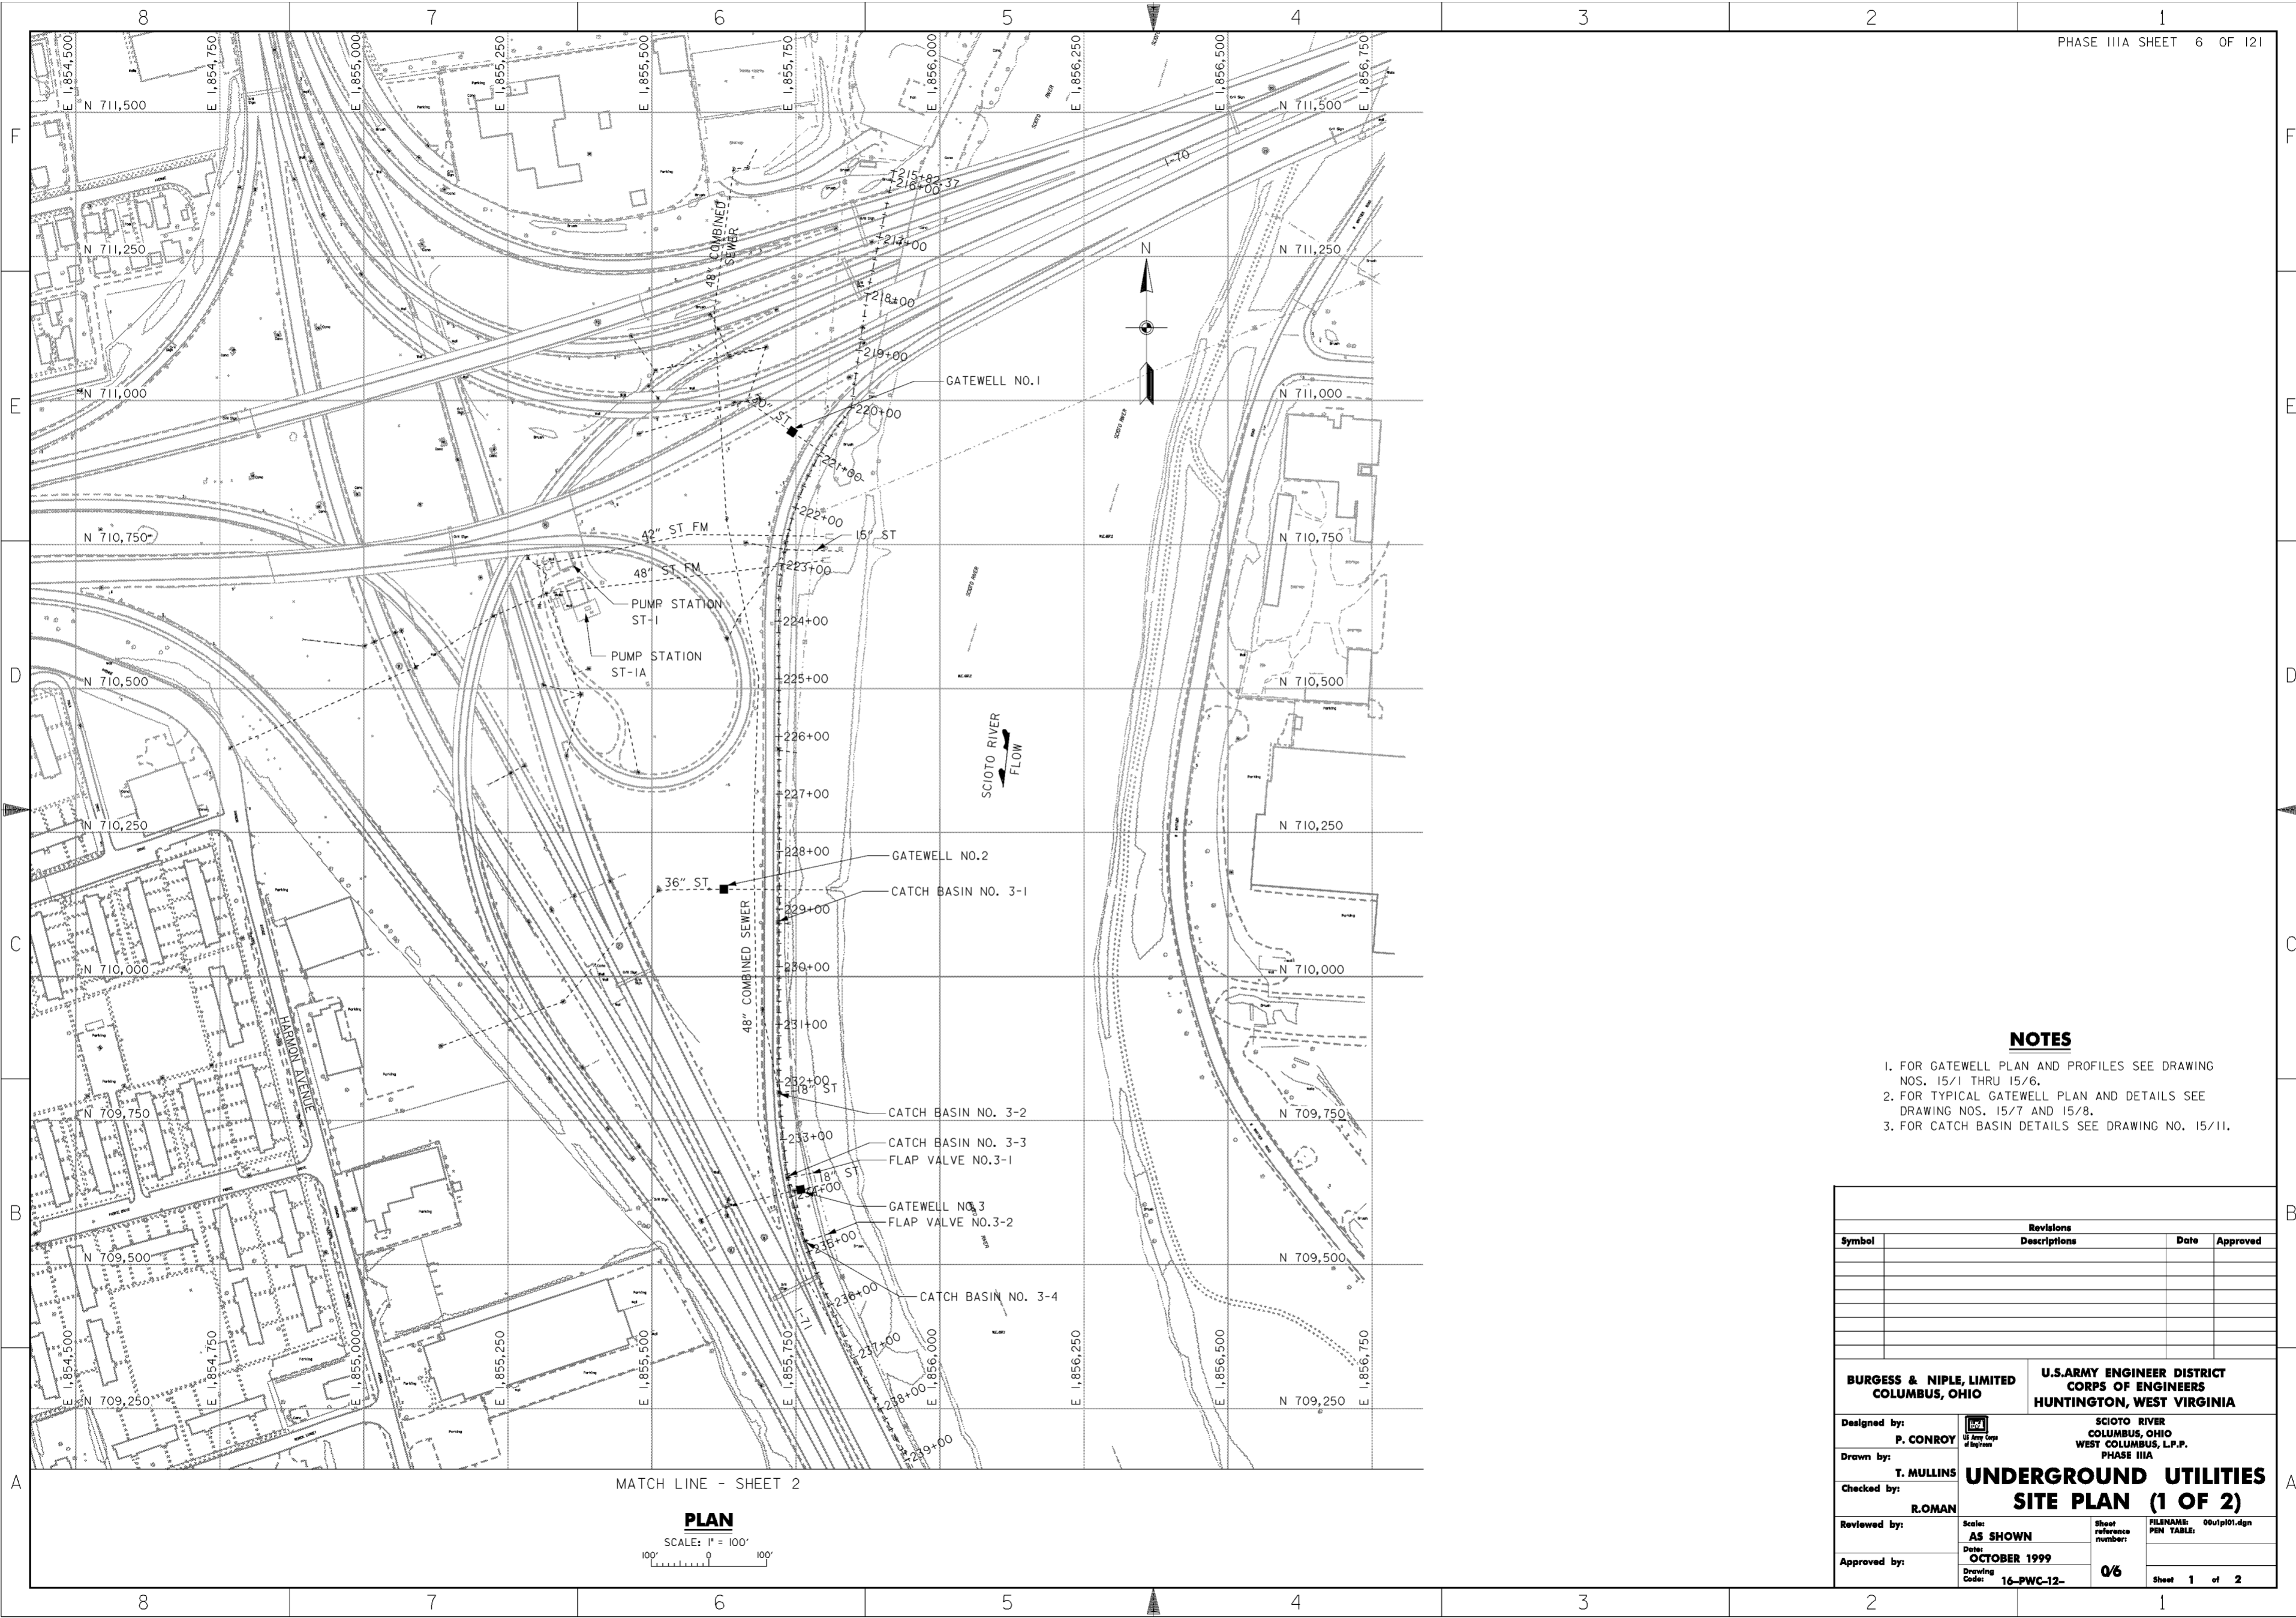

**NOTES**


1. FOR GATEWELL PLAN AND PROFILES SEE DRAWING NOS. 15/1 THRU 15/6.
2. FOR TYPICAL GATEWELL PLAN AND DETAILS SEE DRAWING NOS. 15/7 AND 15/8.
3. FOR CATCH BASIN DETAILS SEE DRAWING NO. 15/11.

Revisions			
Symbol	Descriptions	Date	Approved


<b>BURGESS &amp; NIPL, LIMITED</b> COLUMBUS, OHIO	<b>U.S. ARMY ENGINEER DISTRICT</b> CORPS OF ENGINEERS HUNTINGTON, WEST VIRGINIA	SCIOTO RIVER COLUMBUS, OHIO WEST COLUMBUS, L.P.P. PHASE IIIA	
		<b>UNDERGROUND UTILITIES</b> <b>SITE PLAN (1 OF 2)</b>	
Designed by: <b>P. CONROY</b>		Scale: <b>AS SHOWN</b>	Sheet reference number: <b>0/6</b>
Drawn by: <b>T. MULLINS</b>		Date: <b>OCTOBER 1999</b>	FILENAME: 00utp101.dgn
Checked by: <b>R.ROMAN</b>	Reviewed by:	Drawing Code: <b>16-PWC-12-</b>	Sheet 1 of 2
Approved by:	Approved by:	Approved by:	Approved by:

MATCH LINE - SHEET 2



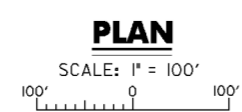

MATCH LINE - SHEET 1

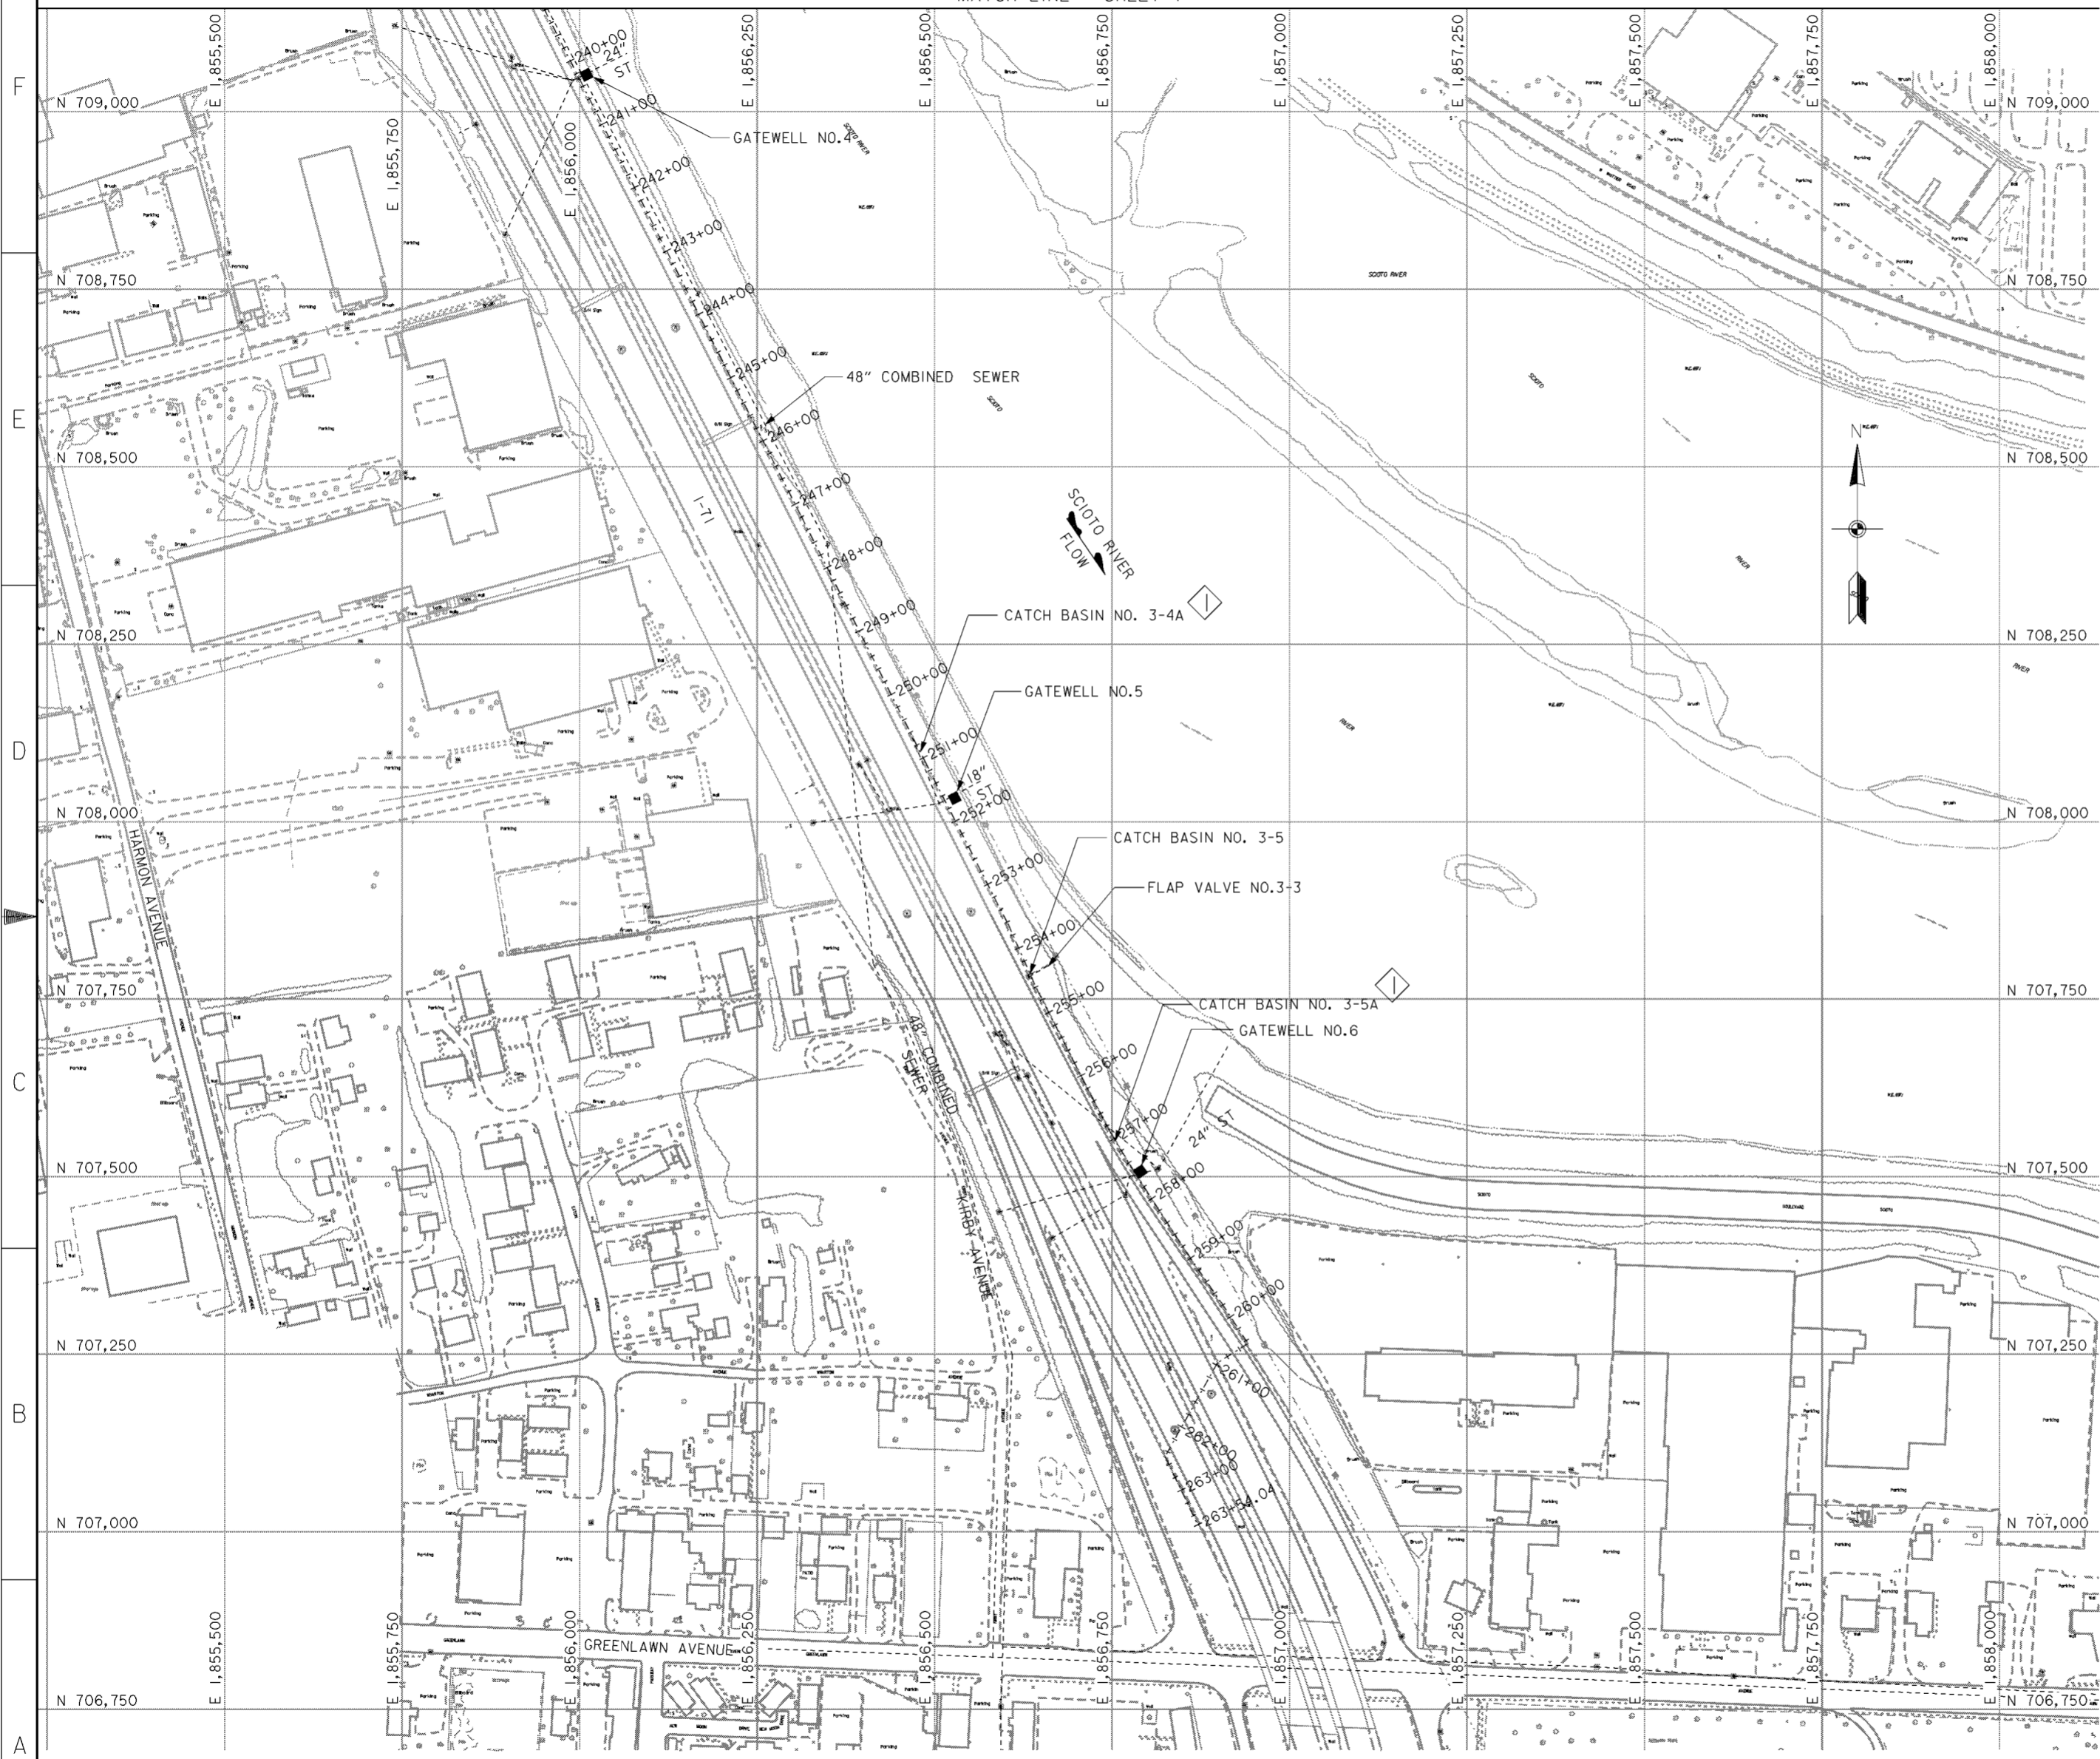


**PLAN**

SCALE: 1" = 100'

**NOTES**

1. FOR GATEWELL PLAN AND PROFILES SEE DRAWING NOS. 15/1 THRU 15/6.
2. FOR TYPICAL GATEWELL PLAN AND DETAILS SEE DRAWING NOS. 15/7 AND 15/8.
3. FOR CATCH BASIN DETAILS SEE DRAWING NO. 15/11.

Revisions			
Symbol	Descriptions	Date	Approved
◇ REVISED AS CONSTRUCTED - PHASE IIIA SOUTH 4/01 P.O.C.			
<b>BURGESS &amp; NIPL, LIMITED</b> COLUMBUS, OHIO		<b>U.S. ARMY ENGINEER DISTRICT</b> CORPS OF ENGINEERS HUNTINGTON, WEST VIRGINIA	
Designed by: <b>P. CONROY</b>		<b>SCIO TO RIVER</b> COLUMBUS, OHIO WEST COLUMBUS, L.P.P. PHASE IIIA	
Drawn by: <b>T. MULLINS</b>			
Checked by: <b>R.ROMAN</b>	<b>UNDERGROUND UTILITIES</b> <b>SITE PLAN (2 OF 2)</b>		
Reviewed by:	Scale: <b>AS SHOWN</b>	Sheet reference number: <b>07</b>	FILENAME: a07p102.dgn
Approved by:	Date: <b>OCTOBER 1999</b>	Drawing Code: <b>16-PWC-12-</b>	Sheet <b>2</b> of <b>2</b>

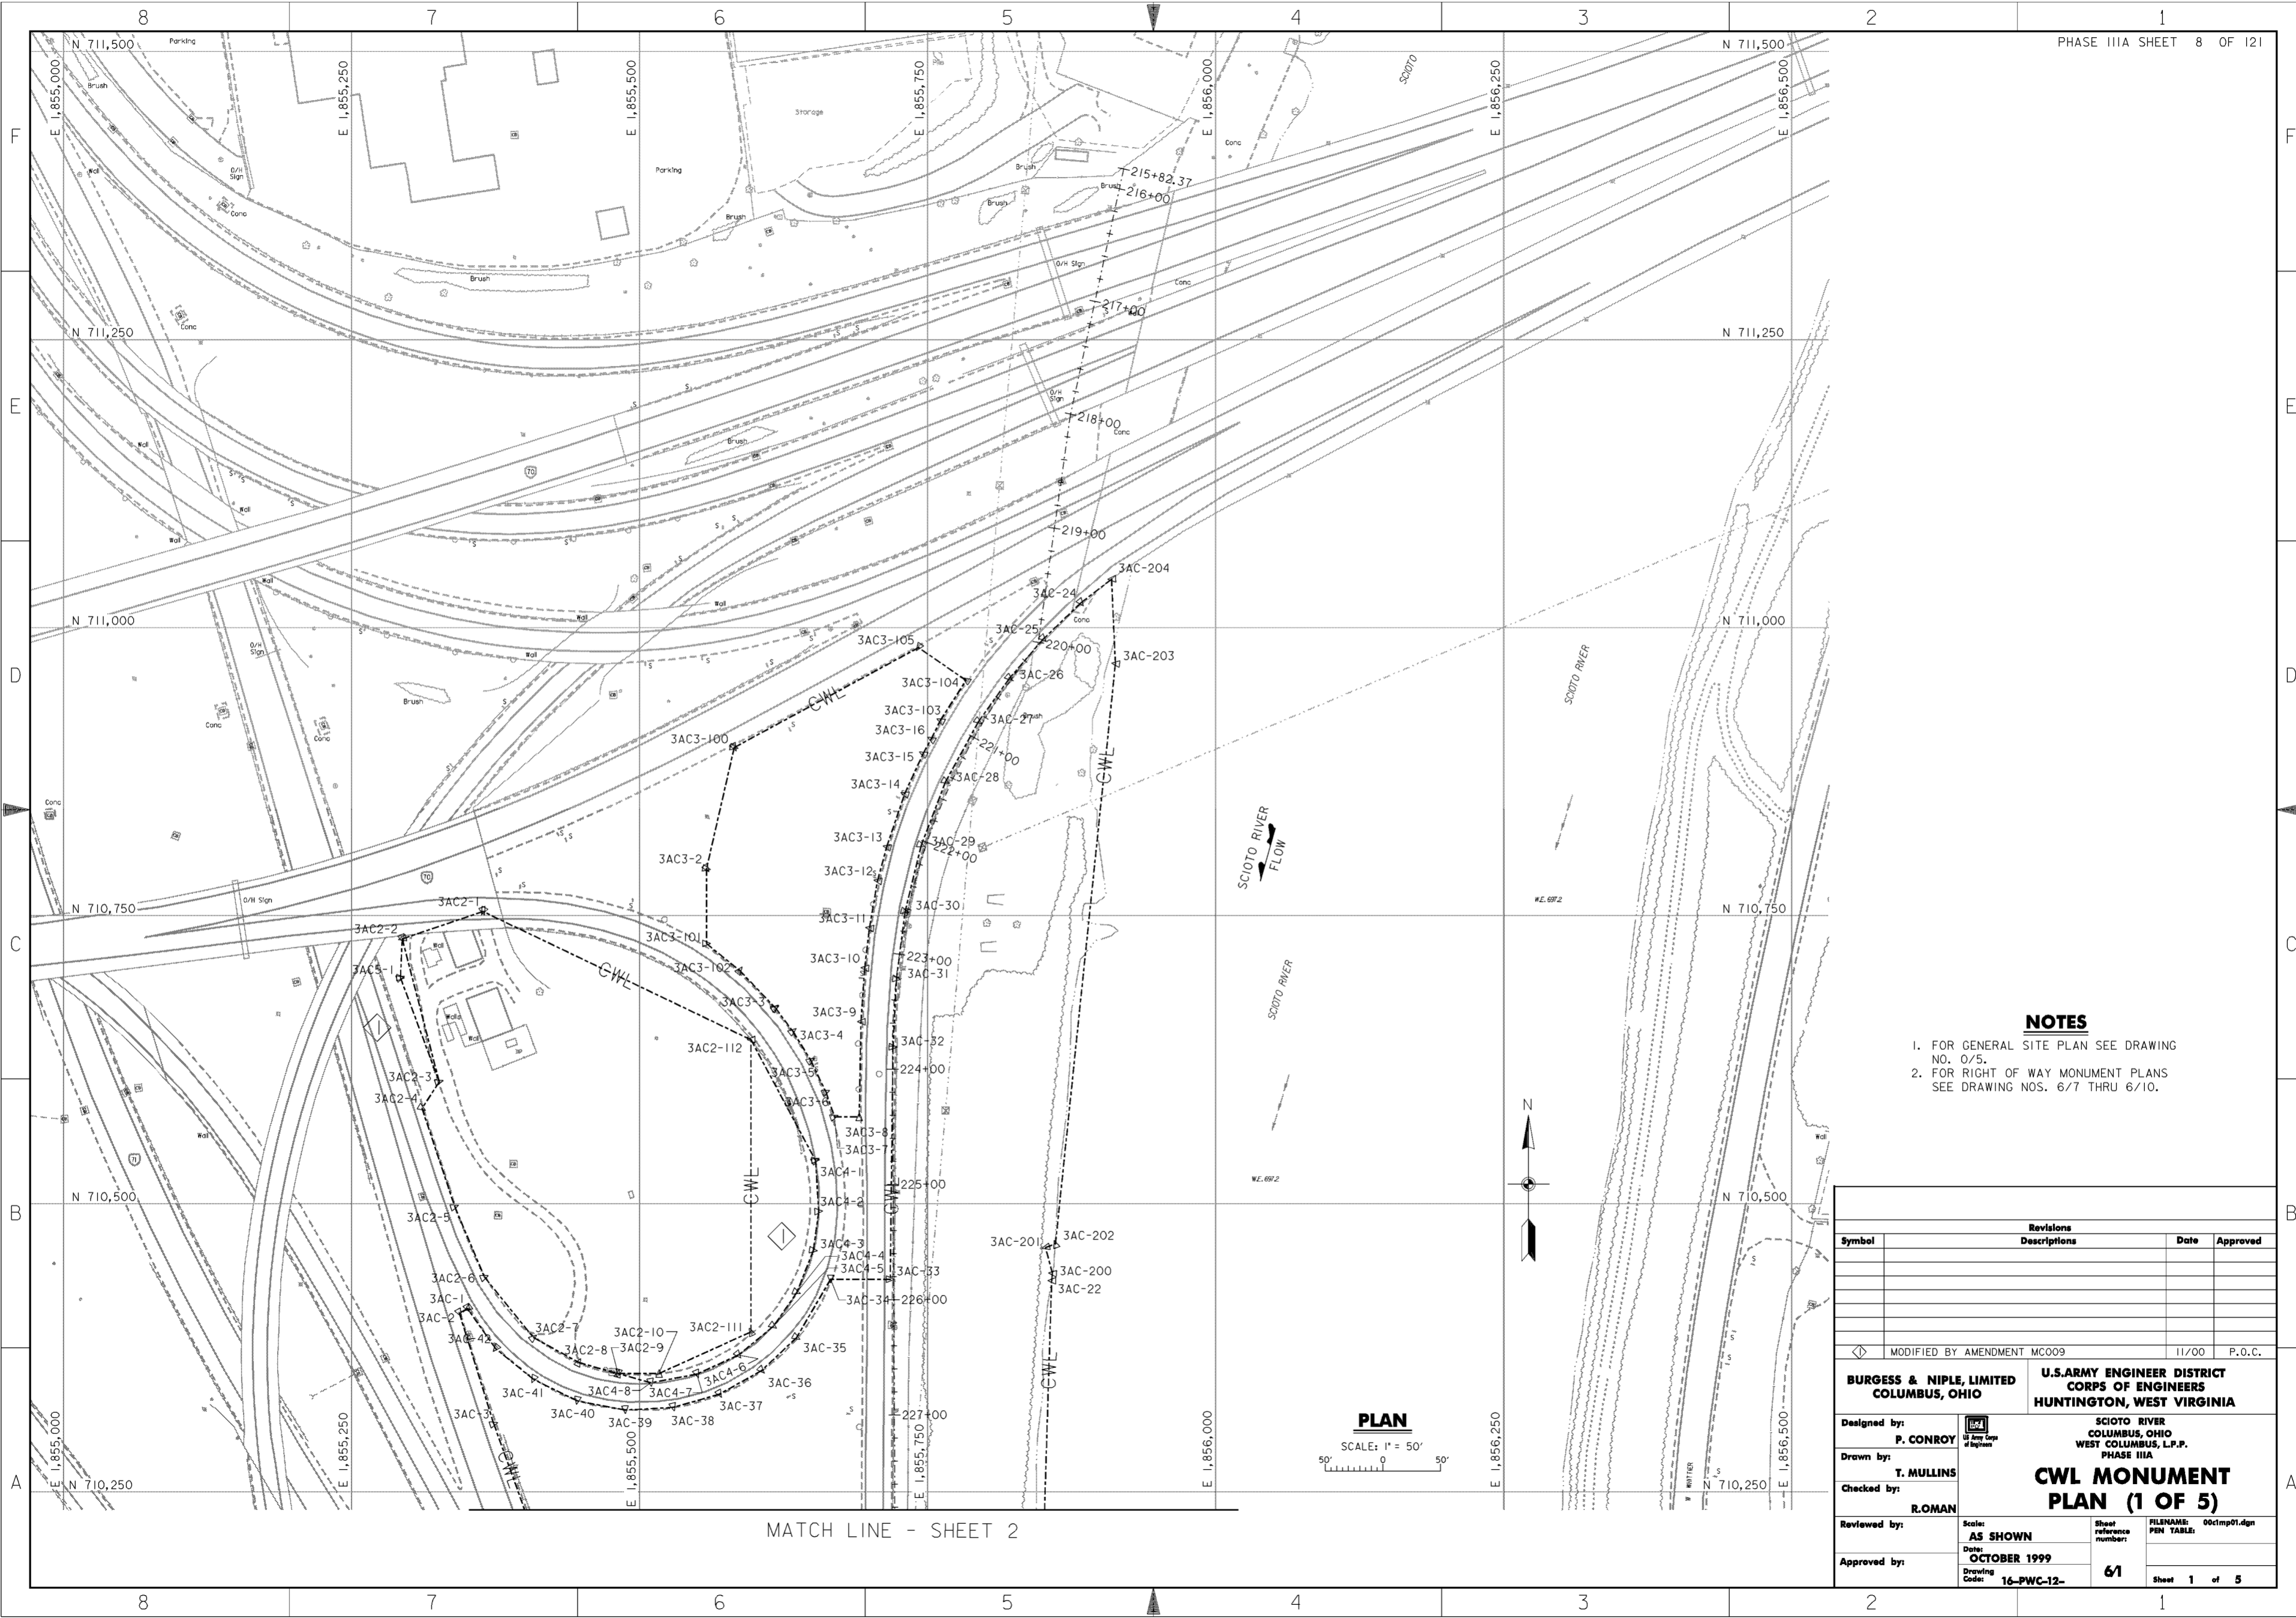


- NOTES**
1. FOR GENERAL SITE PLAN SEE DRAWING NO. 0/5.
  2. FOR RIGHT OF WAY MONUMENT PLANS SEE DRAWING NOS. 6/7 THRU 6/10.

Revisions			
Symbol	Descriptions	Date	Approved
MODIFIED BY AMENDMENT MC009		11/00	P.O.C.
<b>BURGESS &amp; NIPL, LIMITED COLUMBUS, OHIO</b>		<b>U.S. ARMY ENGINEER DISTRICT CORPS OF ENGINEERS HUNTINGTON, WEST VIRGINIA</b>	
Designed by: <b>P. CONROY</b>	SCIO TO RIVER COLUMBUS, OHIO WEST COLUMBUS, L.P.P. PHASE IIIA		
Drawn by: <b>T. MULLINS</b>	<b>CWL MONUMENT PLAN (1 OF 5)</b>		
Checked by: <b>ROMAN</b>	Scale: <b>AS SHOWN</b>	Sheet reference number: <b>61</b>	FILENAME: 00c1mp01.dgn
Reviewed by:	Date: <b>OCTOBER 1999</b>	PEN TABLE:	
Approved by:	Drawing Code: <b>16-PWC-12-</b>	Sheet 1 of 5	

MATCH LINE - SHEET 2

MATCH LINE - SHEET 1

MATCH LINE - SHEET 3

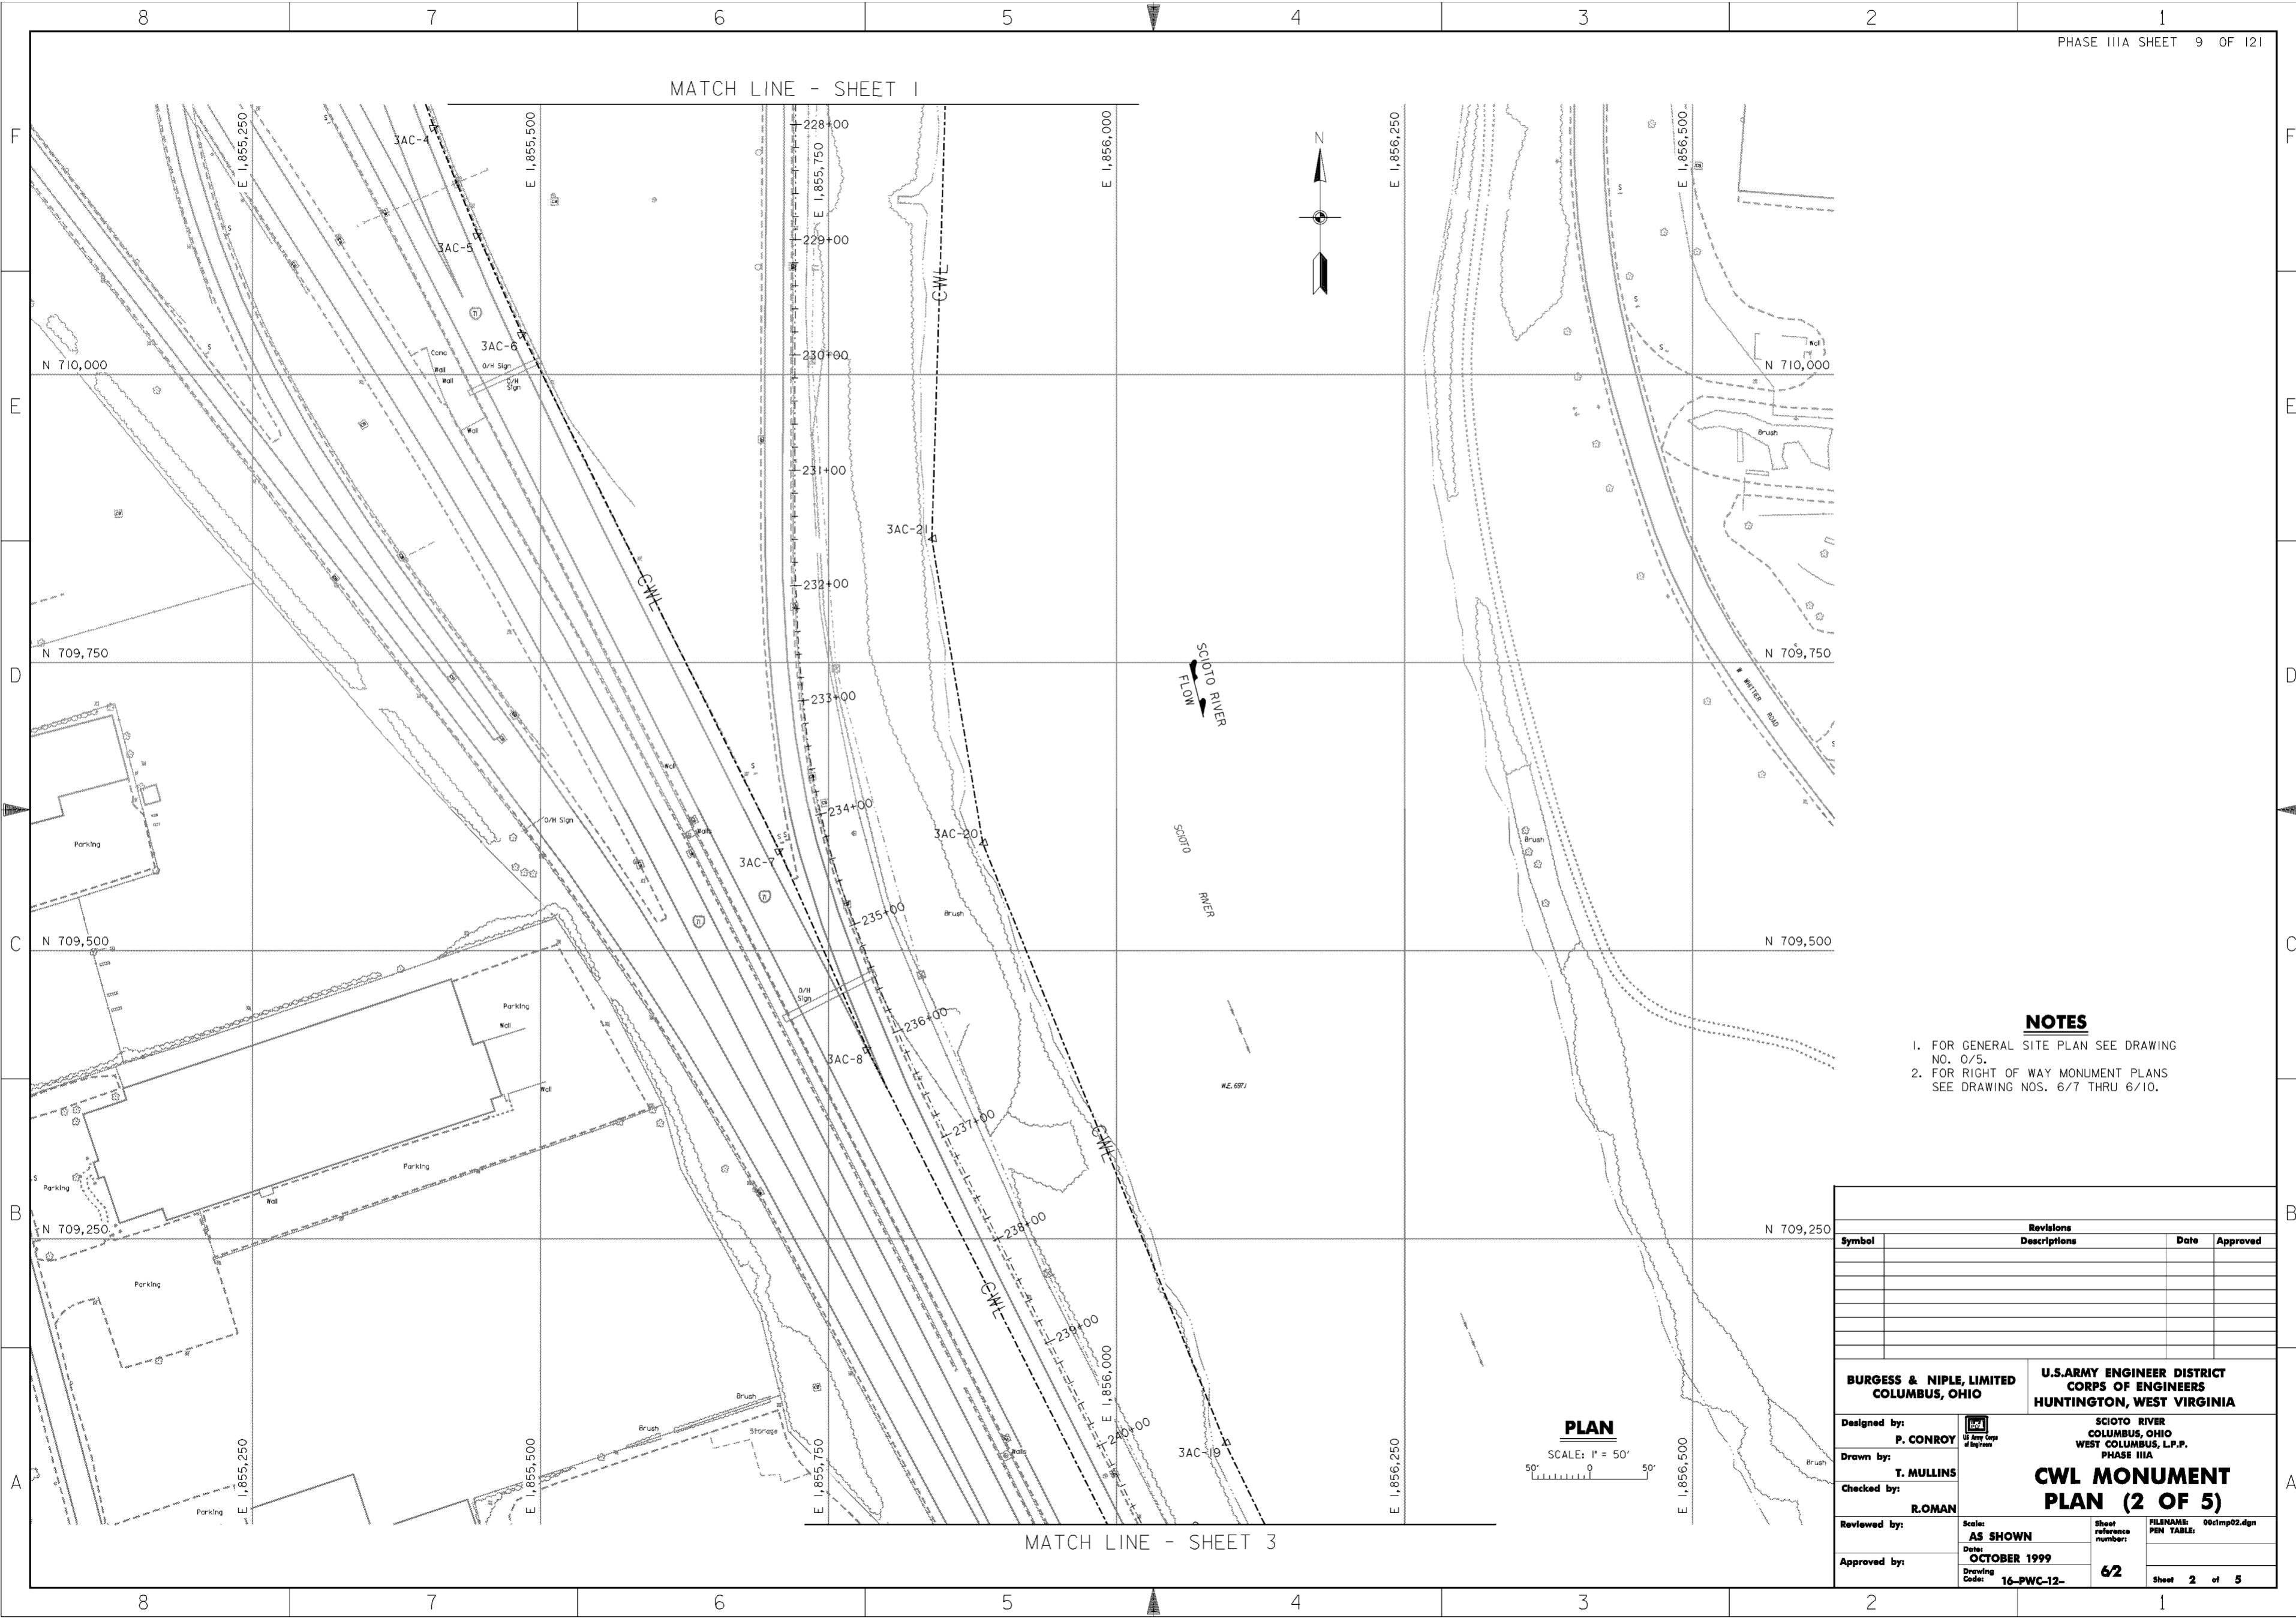

**NOTES**

1. FOR GENERAL SITE PLAN SEE DRAWING NO. 0/5.
2. FOR RIGHT OF WAY MONUMENT PLANS SEE DRAWING NOS. 6/7 THRU 6/10.

**PLAN**

SCALE: 1" = 50'  
50' 0 50'

Revisions			
Symbol	Descriptions	Date	Approved

<b>BURGESS &amp; NIPL, LIMITED</b> COLUMBUS, OHIO	<b>U.S. ARMY ENGINEER DISTRICT</b> CORPUS OF ENGINEERS HUNTINGTON, WEST VIRGINIA	SCIOTO RIVER COLUMBUS, OHIO WEST COLUMBUS, L.P.P. PHASE IIIA	
		<b>CWL MONUMENT</b> <b>PLAN (2 OF 5)</b>	
Designed by: <b>P. CONROY</b>	Drawn by: <b>T. MULLINS</b>	Checked by: <b>ROMAN</b>	Reviewed by:
Approved by:	Scale: <b>AS SHOWN</b>	Sheet reference number: <b>62</b>	FILENAME: PIN TABLE: 00c1mp02.dgn
Date: <b>OCTOBER 1999</b>	Drawing Code: <b>16-PWC-12-</b>	Sheet <b>2</b> of <b>5</b>	Sheet <b>2</b> of <b>5</b>

MATCH LINE - SHEET 2

MATCH LINE - SHEET 4



**NOTES**

1. FOR GENERAL SITE PLAN SEE DRAWING NO. 0/5.
2. FOR RIGHT OF WAY MONUMENT PLANS SEE DRAWING NOS. 6/7 THRU 6/10.

Revisions			
Symbol	Descriptions	Date	Approved


<b>BURGESS &amp; NIPL, LIMITED</b> COLUMBUS, OHIO	<b>U.S. ARMY ENGINEER DISTRICT</b> CORPS OF ENGINEERS HUNTINGTON, WEST VIRGINIA	SCIOTO RIVER COLUMBUS, OHIO WEST COLUMBUS, L.P.P. PHASE IIIA	
		<b>CWL MONUMENT</b> <b>PLAN (3 OF 5)</b>	
Designed by: <b>P. CONROY</b>		Scale: <b>AS SHOWN</b>	FILENAME: 00cimp03.dgn
Drawn by: <b>T. MULLINS</b>	Date: <b>OCTOBER 1999</b>	Sheet reference number: <b>6/3</b>	PEN TABLE: Sheet 3 of 5
Checked by: <b>ROMAN</b>	Drawing Code: <b>16-PWC-12-</b>		
Reviewed by:			
Approved by:			

**PLAN**  
SCALE: 1" = 50'



MATCH LINE - SHEET 3

MATCH LINE - SHEET 5

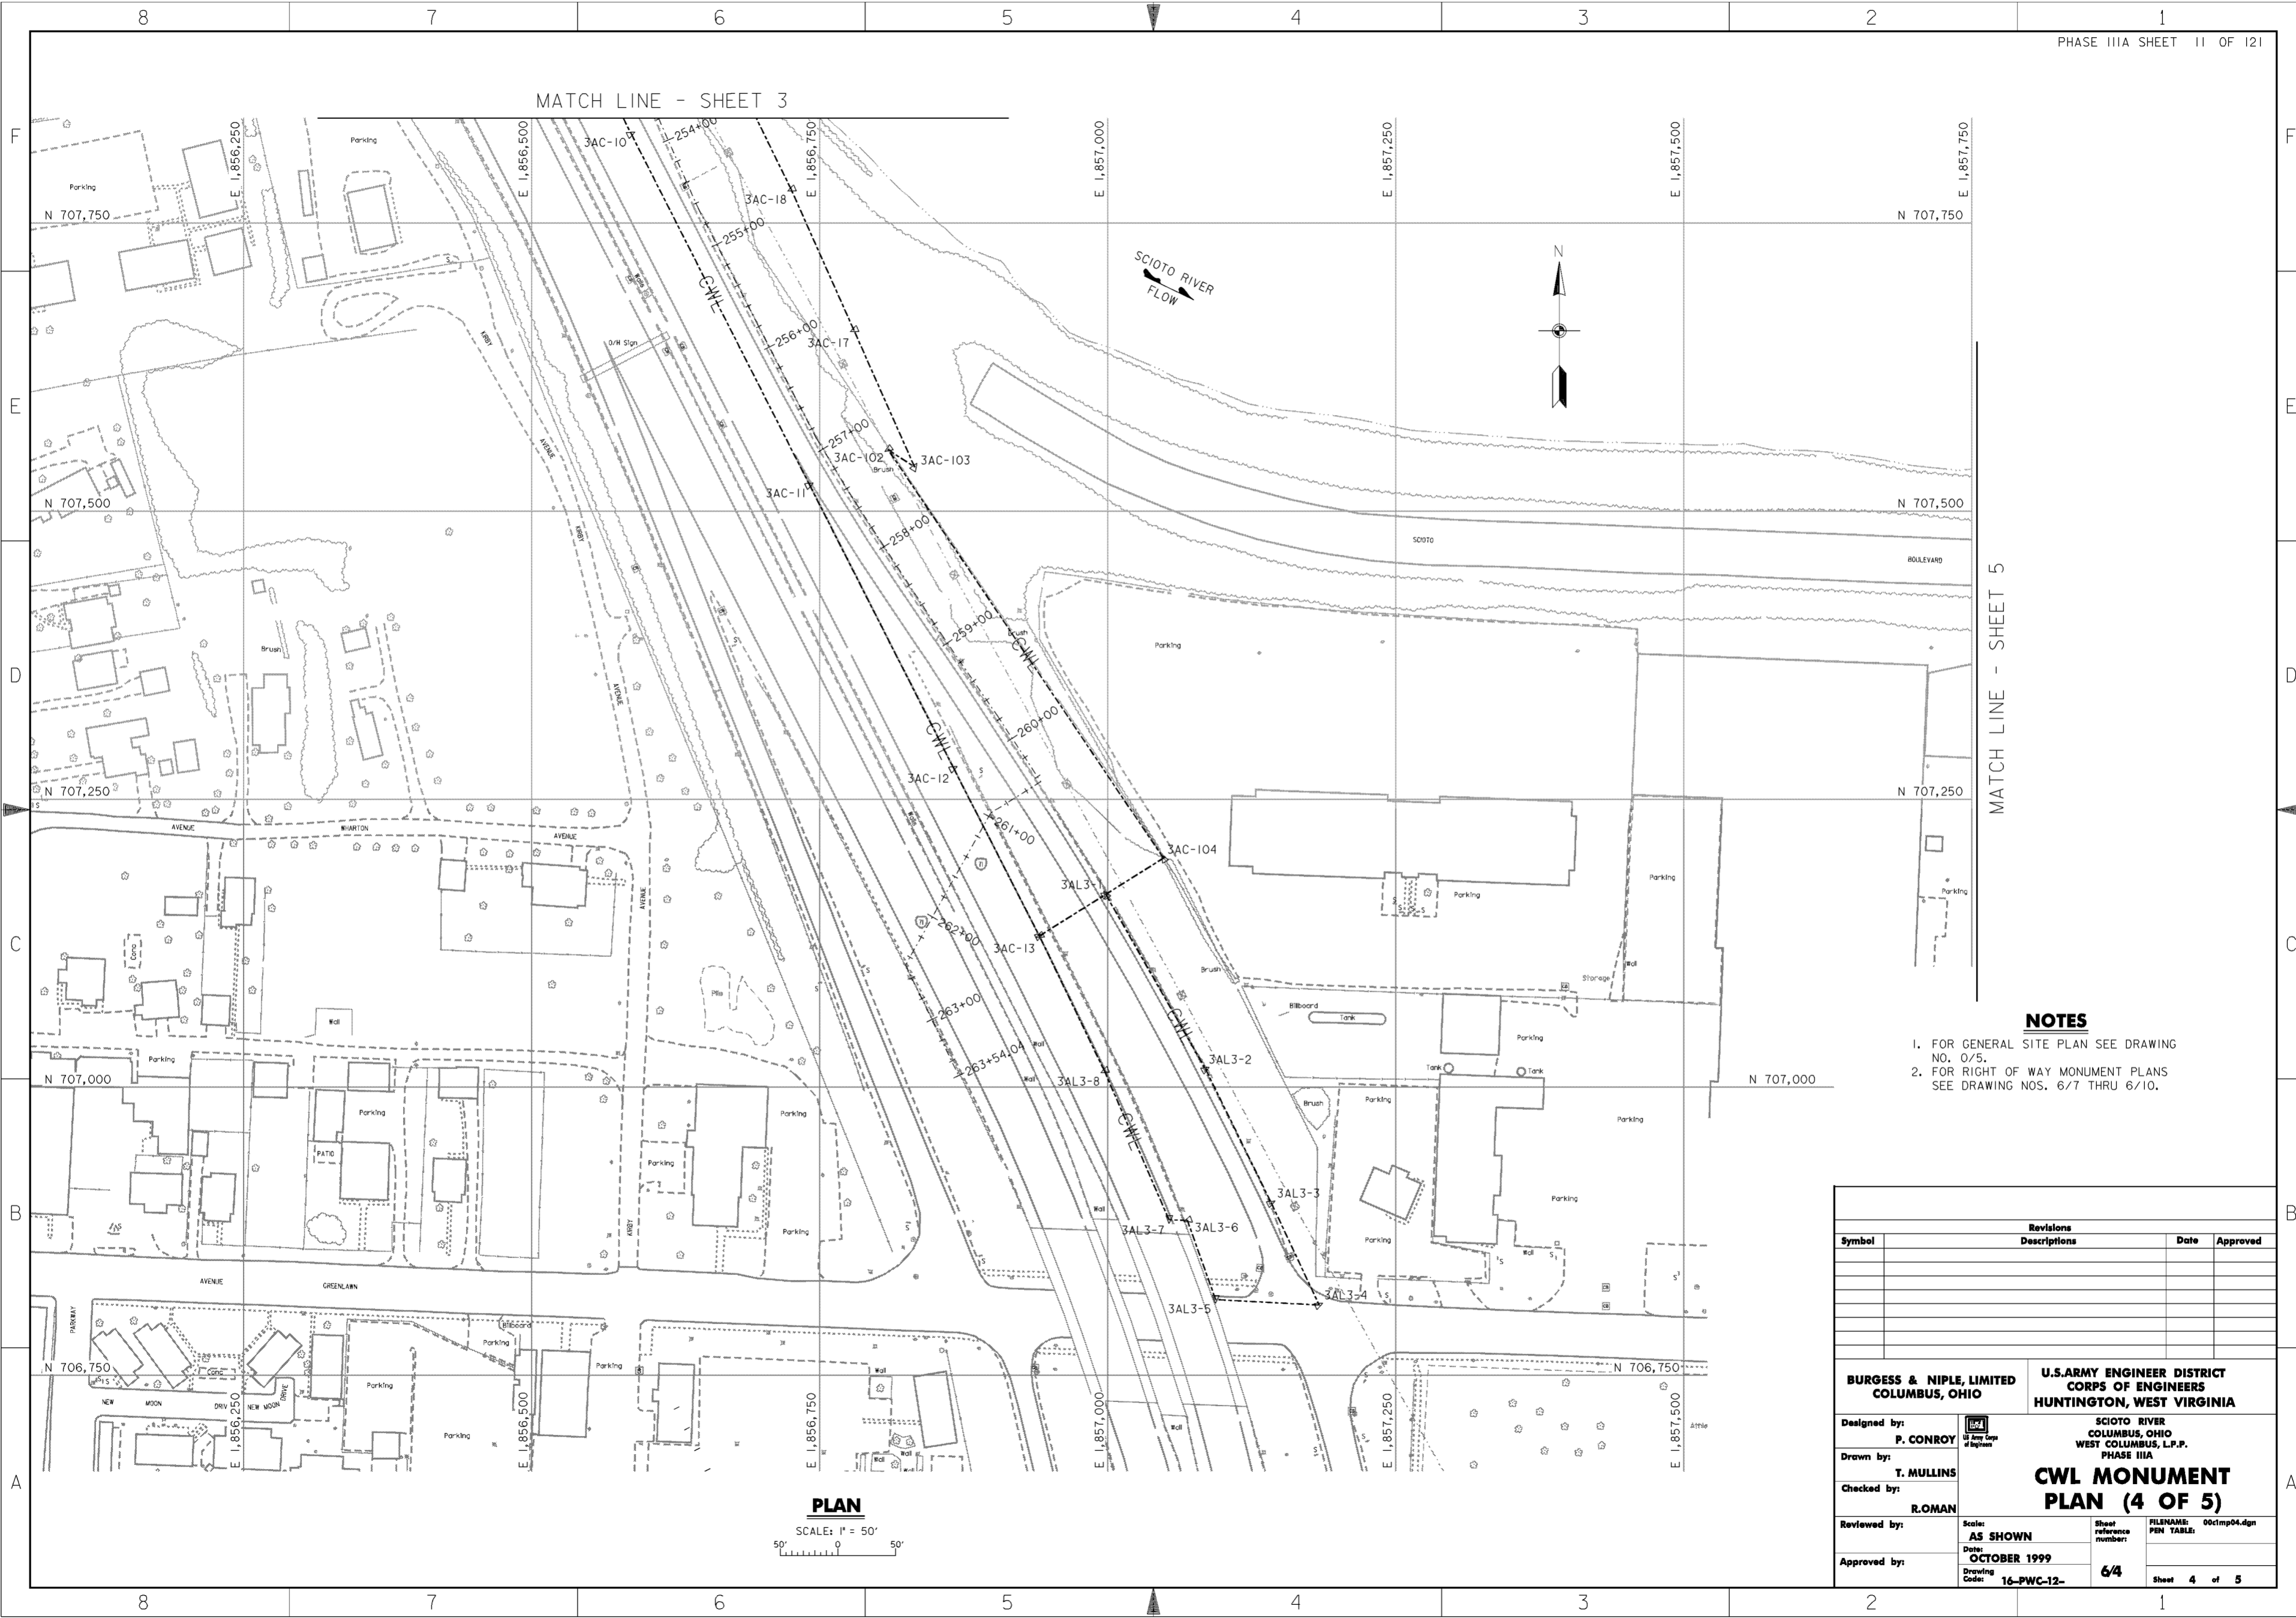

**NOTES**

1. FOR GENERAL SITE PLAN SEE DRAWING NO. 0/5.
2. FOR RIGHT OF WAY MONUMENT PLANS SEE DRAWING NOS. 6/7 THRU 6/10.

**PLAN**


SCALE: 1" = 50'  
 50' 0' 50'

Revisions			
Symbol	Descriptions	Date	Approved

<b>BURGESS &amp; NIPL, LIMITED</b> COLUMBUS, OHIO	<b>U.S. ARMY ENGINEER DISTRICT</b> CORPS OF ENGINEERS HUNTINGTON, WEST VIRGINIA	SCIOTO RIVER COLUMBUS, OHIO WEST COLUMBUS, L.P.P. PHASE IIIA	
		<b>CWL MONUMENT</b> <b>PLAN (4 OF 5)</b>	
Designed by: <b>P. CONROY</b>	Scale: <b>AS SHOWN</b>	Sheet reference number: <b>6/4</b>	FILENAME: 00c1mp04.dgn
Drawn by: <b>T. MULLINS</b>			
Checked by: <b>R.ROMAN</b>			
Reviewed by: Date: <b>OCTOBER 1999</b>			
Approved by:	Drawing Code: <b>16-PWC-12-</b>	Sheet <b>4</b> of 5	PIN TABLE:



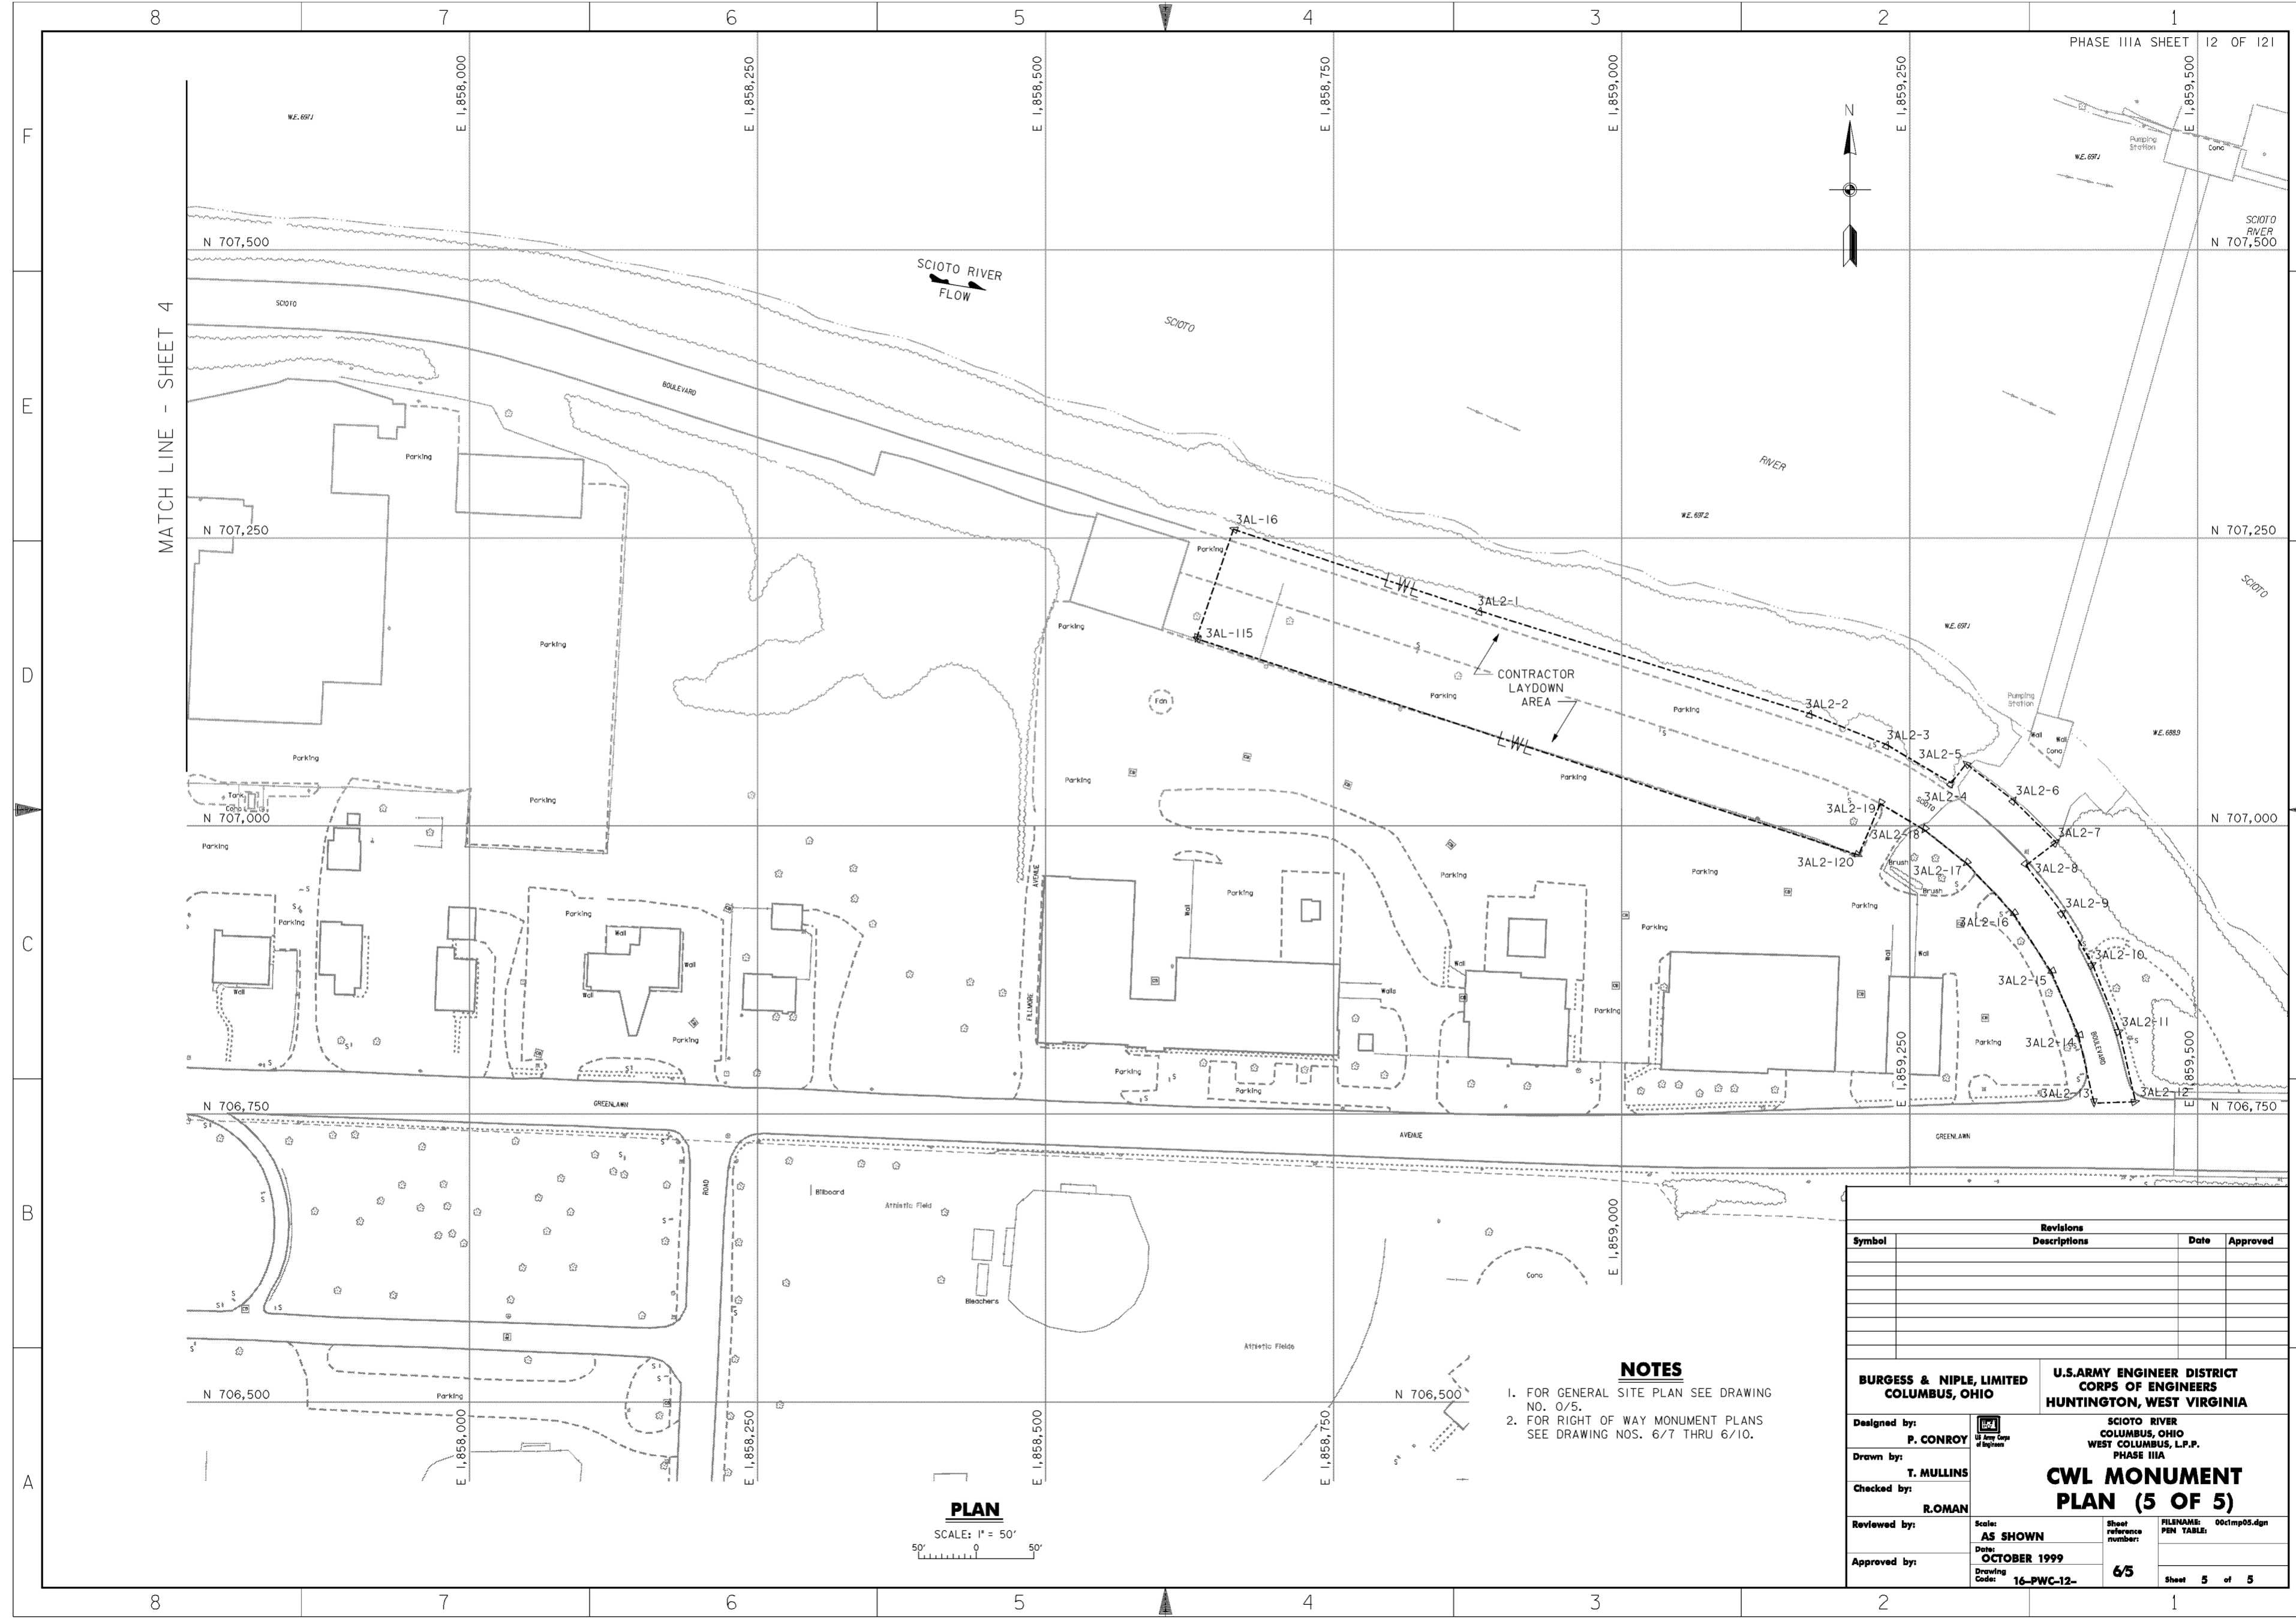

MATCH LINE - SHEET 4

SCIOTO RIVER  
FLOW

**NOTES**

1. FOR GENERAL SITE PLAN SEE DRAWING NO. 0/5.
2. FOR RIGHT OF WAY MONUMENT PLANS SEE DRAWING NOS. 6/7 THRU 6/10.

**PLAN**  
SCALE: 1" = 50'  
50' 0 50'

Revisions			
Symbol	Descriptions	Date	Approved

<b>BURGESS &amp; NIPLE, LIMITED</b> COLUMBUS, OHIO	U.S. ARMY ENGINEER DISTRICT CORPS OF ENGINEERS HUNTINGTON, WEST VIRGINIA		
		SCIOTO RIVER COLUMBUS, OHIO WEST COLUMBUS, L.P.P. PHASE IIIA	
Designed by: <b>P. CONROY</b>	<b>CWL MONUMENT</b> <b>PLAN (5 OF 5)</b>		
Drawn by: <b>T. MULLINS</b>			
Checked by: <b>R.ROMAN</b>			
Reviewed by: AS SHOWN			
Approved by:	Date: <b>OCTOBER 1999</b>	Sheet reference number: <b>6/5</b>	FILENAME: 00c1mp05.dgn PIN TABLE: Sheet 5 of 5
Drawing Code: <b>16-PWC-12-</b>	Scale: <b>AS SHOWN</b>	Date: <b>OCTOBER 1999</b>	Sheet reference number: <b>6/5</b>

**WORK AS CONSTRUCTED**

CWL MONUMENT TABLES

Table with columns: LEVEE/FLOODWALL NO.1, POINT, EASTING, NORTHING, BEARING, DISTANCE. Contains data for points 3AC-1 through 3AC-42.

Table with columns: LEVEE/FLOODWALL NO.2, POINT, EASTING, NORTHING, BEARING, DISTANCE. Contains data for points 3AL3-1 through 3AL3-13.

Table with columns: ACCESS NO.1, POINT, EASTING, NORTHING, BEARING, DISTANCE. Contains data for points 3AL-115 through 3AL2-120.

Table with columns: FILL AREA NO.3, POINT, EASTING, NORTHING, BEARING, DISTANCE. Contains data for points 3AC3-100 through 3AC3-105.

Table with columns: FILL AREA NO.1/DECELERATION LANE, POINT, EASTING, NORTHING, BEARING, DISTANCE. Contains data for points 3AC4-1 through 3AC4-112.

Table with columns: FILL AREA NO.1/PUMP STATION ACCESS ROAD, POINT, EASTING, NORTHING, BEARING, DISTANCE. Contains data for points 3AC5-1 through 3AC2-2.

Table with columns: FILL AREA NO.1, POINT, EASTING, NORTHING, BEARING, DISTANCE. Contains data for points 3AC2-1 through 3AC2-112.

NOTES

- 1. FOR SITE PLAN SEE DRAWING NO. 0/5.
2. FOR CENTERLINE OF PROTECTION PLAN SEE DRAWING NOS. 11/4 THRU 11/9.

Professional stamp area containing: Revisions table, project name (BURGESS & NIPL, LIMITED), engineer name (P.CONROY), date (OCTOBER 1999), and drawing code (16-PWC-12-6/6).



MATCH LINE - SHEET 1

MATCH LINE - SHEET 3



- NOTES**
1. FOR GENERAL SITE PLAN SEE DRAWING NO. 0/5.
  2. FOR CONTRACTOR WORK LIMITS MONUMENT PLANS SEE DRAWING NOS. 6/1 THRU 6/5.

**PLAN**  
SCALE: 1" = 50'  
50' 0 50'

Revisions			
Symbol	Descriptions	Date	Approved

<b>BURGESS &amp; NIPL, LIMITED</b> COLUMBUS, OHIO	<b>U.S. ARMY ENGINEER DISTRICT</b> CORPUS OF ENGINEERS HUNTINGTON, WEST VIRGINIA	SCIOTO RIVER COLUMBUS, OHIO WEST COLUMBUS, L.P.P. PHASE IIIA	
		<b>RW MONUMENT</b> <b>PLAN (2 OF 4)</b>	
Designed by: <b>P. CONROY</b>		Scale: <b>AS SHOWN</b>	Sheet reference number: <b>6/8</b>
Drawn by: <b>T. MULLINS</b>		Date: <b>OCTOBER 1999</b>	FILENAME: 00r1mp02.dgn
Checked by: <b>ROMAN</b>	Reviewed by:	Drawing Code: <b>16-PWC-12-</b>	Sheet <b>2</b> of <b>4</b>
Approved by:	Approved by:	Approved by:	Approved by:

MATCH LINE - SHEET 2

MATCH LINE - SHEET 4



**NOTES**

1. FOR GENERAL SITE PLAN SEE DRAWING NO. 0/5.
2. FOR CONTRACTOR WORK LIMITS MONUMENT PLANS SEE DRAWING NOS. 6/1 THRU 6/5.

Revisions			
Symbol	Descriptions	Date	Approved


<b>BURGESS &amp; NIPL, LIMITED</b> COLUMBUS, OHIO		<b>U.S. ARMY ENGINEER DISTRICT</b> CORPS OF ENGINEERS HUNTINGTON, WEST VIRGINIA	
Designed by: <b>P. CONROY</b>		<b>SCIOTO RIVER</b> COLUMBUS, OHIO WEST COLUMBUS, L.P.P. PHASE IIIA <b>RW MONUMENT</b> <b>PLAN (3 OF 4)</b>	
Drawn by: <b>T. MULLINS</b>			
Checked by: <b>R. ROMAN</b>		Scale: <b>AS SHOWN</b>	Sheet reference number: <b>69</b>
Reviewed by:		Date: <b>OCTOBER 1999</b>	FILENAME: 00r1mp03.dgn
Approved by:		Drawing Code: <b>16-PWC-12-</b>	PIN TABLE: Sheet <b>3</b> of <b>4</b>

**PLAN**  
SCALE: 1" = 50'  
50' 0 50'

**WORK AS CONSTRUCTED**



MATCH LINE - SHEET 3

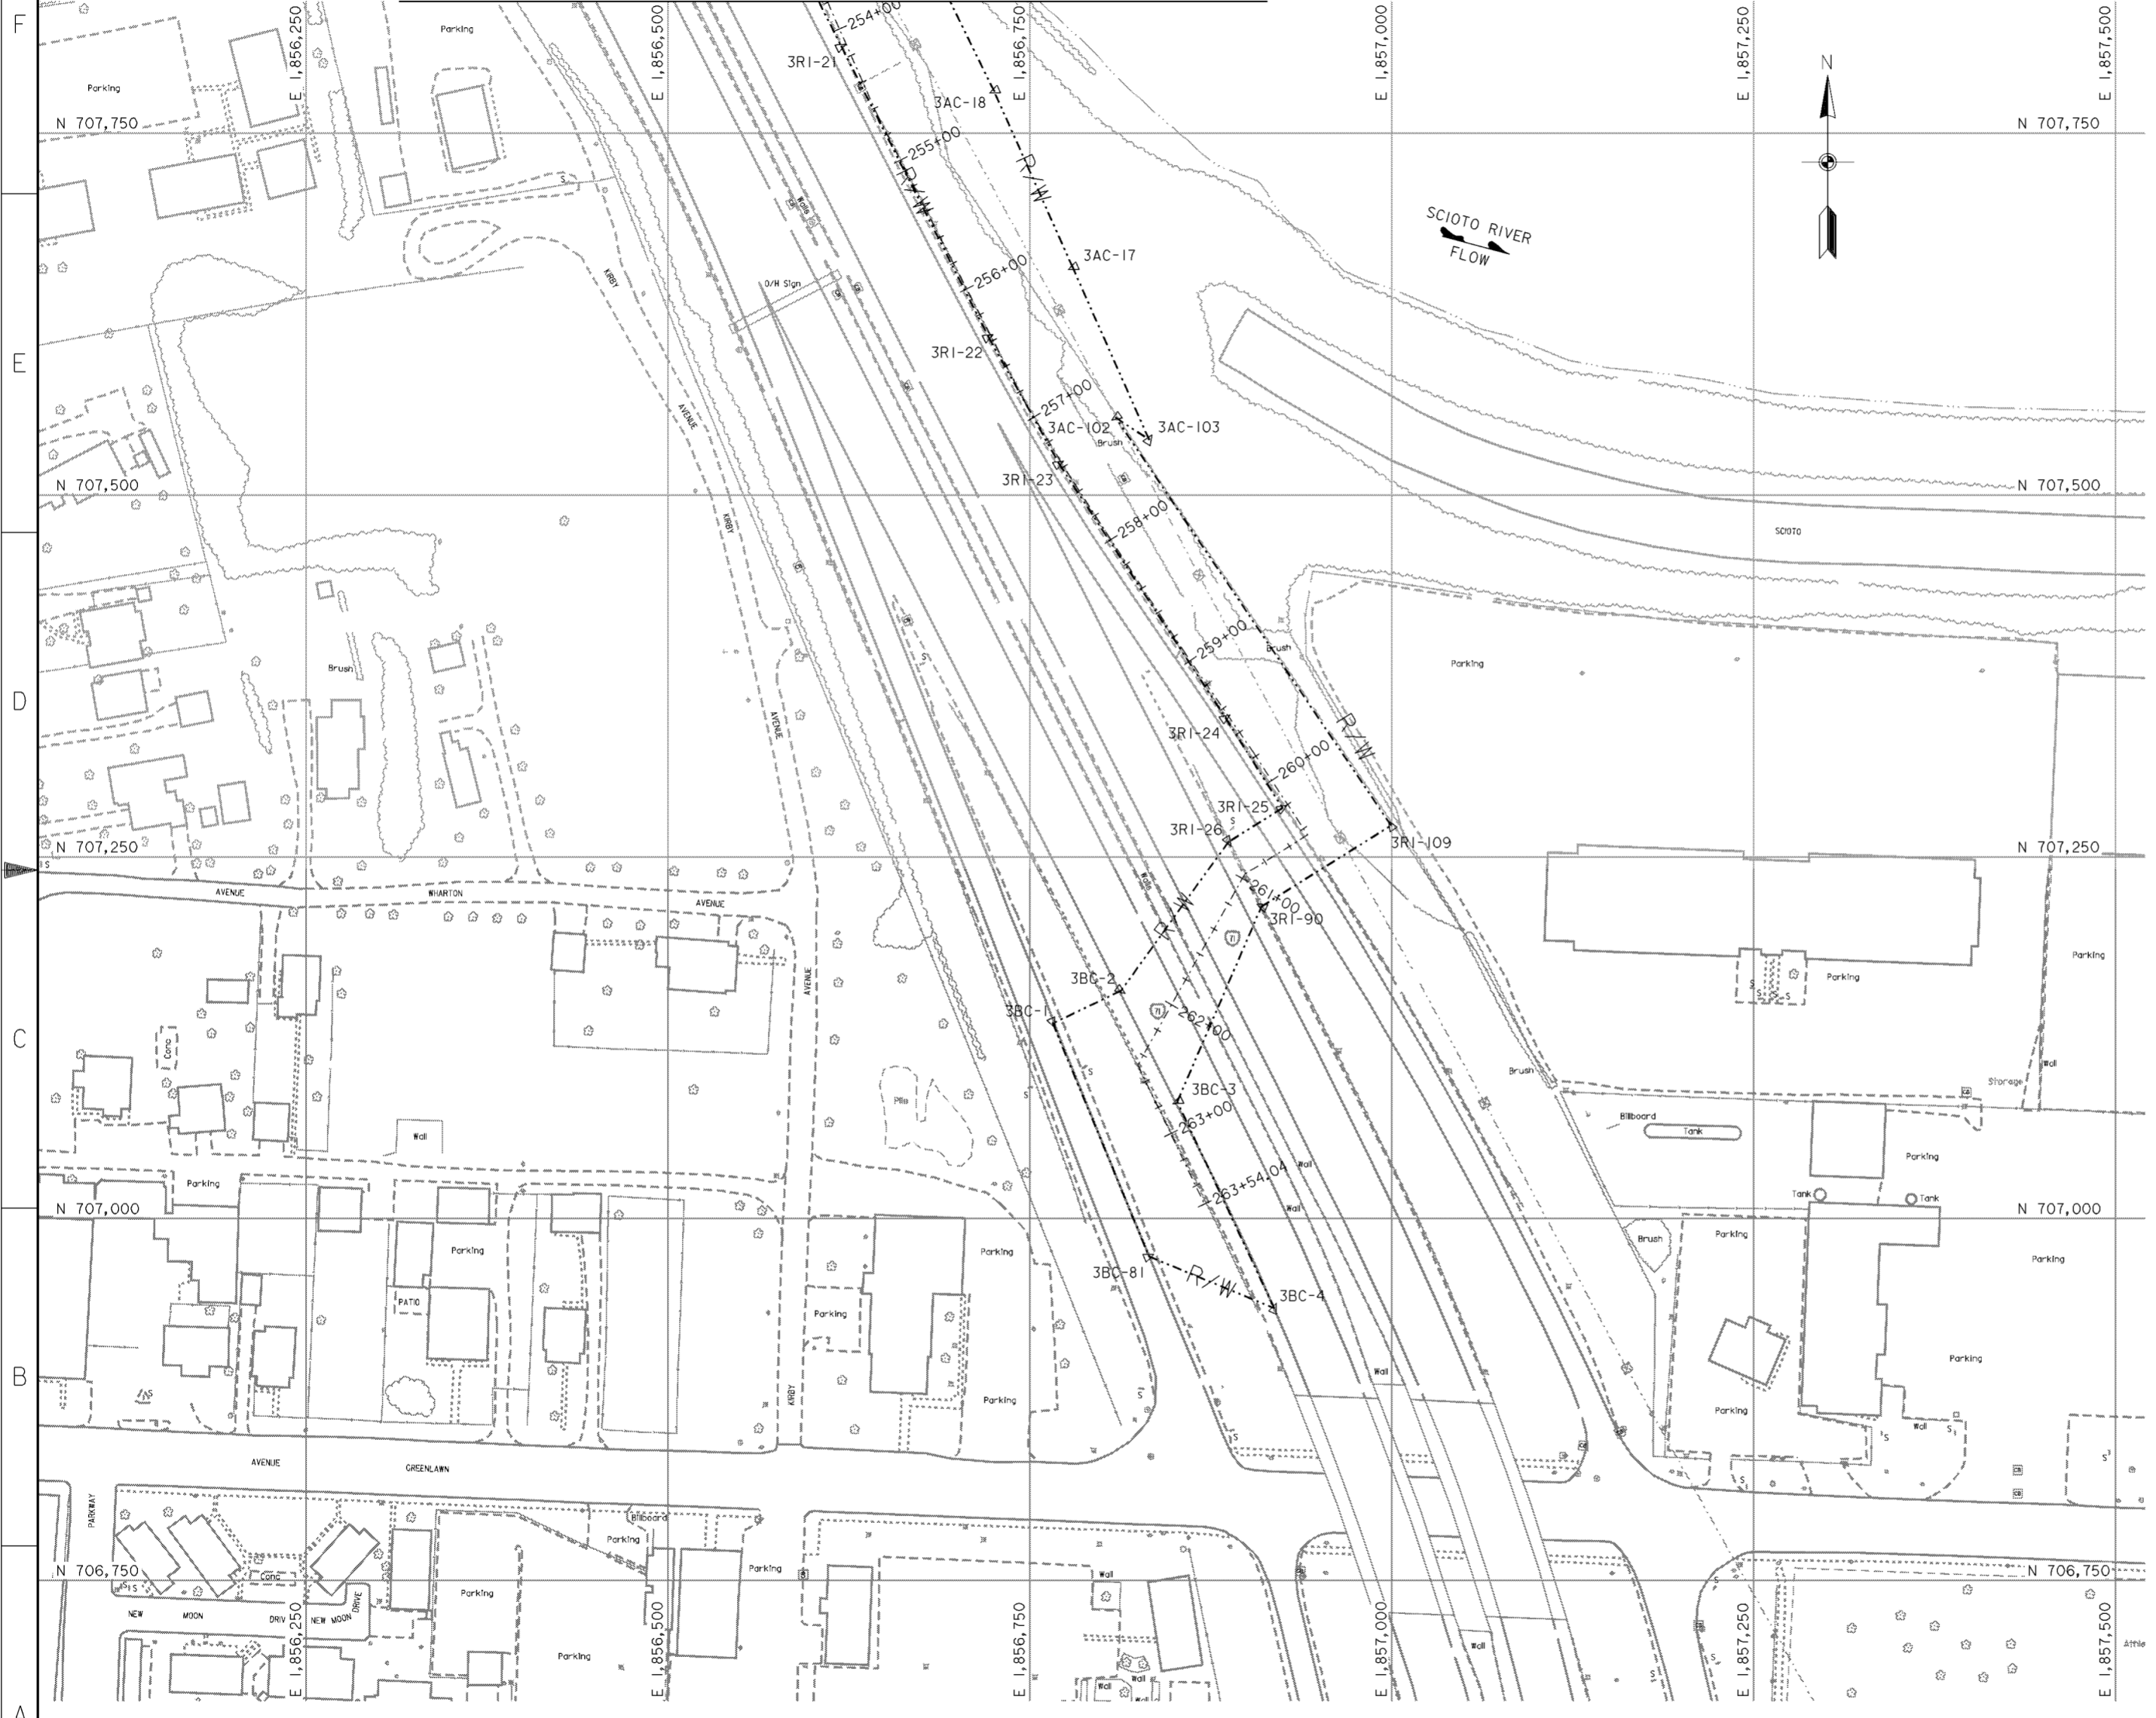


- NOTES**
1. FOR GENERAL SITE PLAN SEE DRAWING NO. 0/5.
  2. FOR CONTRACTOR WORK LIMITS MONUMENT PLANS SEE DRAWING NOS. 6/1 THRU 6/5.

**PLAN**  
SCALE: 1" = 50'  
50' 0 50'

Revisions			
Symbol	Descriptions	Date	Approved

<b>BURGESS &amp; NIPL, LIMITED</b> COLUMBUS, OHIO		<b>U.S. ARMY ENGINEER DISTRICT</b> CORPS OF ENGINEERS HUNTINGTON, WEST VIRGINIA	
Designed by: <b>P. CONROY</b>	 SCIOTO RIVER COLUMBUS, OHIO WEST COLUMBUS, L.P.P. PHASE IIIA <b>RW MONUMENT</b> <b>PLAN (4 OF 4)</b>	FILENAME: 00r1mp04.dgn PEN TABLE:	
Drawn by: <b>T. MULLINS</b>		Scale: <b>AS SHOWN</b>	Sheet reference number: <b>6/10</b>
Checked by: <b>R.ROMAN</b>		Date: <b>OCTOBER 1999</b>	Drawing Code: <b>16-PWC-12-</b>
Reviewed by:		Approved by:	Sheet 4 of 4

**RIGHT OF WAY  
MONUMENT TABLES**



FILL AREA NO.1/PUMP STATION ACCESS ROAD

LEVEE/FLOODWALL NO.1  
POINT EASTING NORTHING BEARING DISTANCE

FILL AREA NO.1  
POINT EASTING NORTHING BEARING DISTANCE

POINT EASTING NORTHING BEARING DISTANCE

POINT	EASTING	NORTHING	BEARING	DISTANCE
3R1-1	1855894.15	711030.47	S 52°13'23.85" W	14.37
3AC-24	1855882.79	711021.67	S 46°07'04.67" W	31.24
3R1-2	1855860.28	711000.01	N 8°01'47.49" E	128.84
3R1-3	1855878.28	711127.59	N 8°01'44.89" E	52.89
3R1-4	1855885.66	711179.96	N 12°13'35.73" E	196.88
3R1-5	1855927.36	711372.37	S 85°48'08.18" W	26.22
3R1-6	1855901.21	711370.45	S 12°13'35.99" W	188.37
3R1-7	1855861.32	711186.36	S 8°01'45.19" W	55.82
3R1-8	1855853.52	711131.08	S 8°01'46.58" W	165.21
3R1-9	1855830.45	710967.49	S 36°48'23.31" W	60.89
3AC-27	1855793.97	710918.74	S 28°40'17.70" W	59.32
3AC-28	1855765.50	710866.69	S 21°03'07.46" W	59.32
3AC-29	1855744.19	710811.33	S 13°40'56.26" W	59.17
3AC-30	1855730.20	710753.84	S 7°09'34.83" W	59.05
3AC-31	1855722.84	710695.25	S 3°00'43.65" W	59.17
3AC-32	1855719.73	710636.17	S 0°39'14.20" W	201.61
3AC-33	1855717.43	710434.57	S 0°21'42.06" W	240.00
3R1-10	1855715.91	710194.58	S 0°12'34.46" W	260.00
3R1-11	1855714.96	709934.58	S 0°43'27.98" E	125.44
3R1-12	1855716.55	709809.15	S 4°30'52.69" E	111.63
3R1-13	1855725.34	709697.86	S 11°44'17.07" E	111.46
3R1-14	1855748.01	709588.73	S 18°50'50.34" E	111.16
3R1-15	1855783.92	709483.53	S 22°57'49.44" E	111.00
3R1-16	1855827.23	709381.33	S 26°53'36.24" E	350.00
3R1-17	1855985.54	709069.18	S 26°36'23.14" E	270.00
3R1-18	1856106.47	708827.77	S 27°03'18.71" E	350.00
3R1-19	1856265.66	708516.07	S 26°40'11.28" E	500.00
3R1-20	1856490.09	708069.27	S 26°32'43.57" E	290.00
3R1-21	1856619.69	707809.84	S 26°51'46.69" E	225.00
3R1-22	1856721.36	707609.12	S 29°07'01.96" E	100.00
3R1-23	1856770.02	707521.76	S 33°15'13.20" E	210.00
3R1-24	1856885.17	707346.14	S 32°13'50.18" E	73.59
3R1-25	1856924.42	707283.89	S 57°54'26.40" W	44.12
3R1-26	1856887.04	707260.46	S 35°45'00.64" W	126.88
3BC-2	1856812.92	707157.48	S 64°28'32.91" W	52.27
3BC-1	1856765.75	707134.96	S 22°28'38.49" E	174.09
3BC-81	1856832.31	706974.10	S 67°30'01.14" E	93.59
3BC-4	1856918.77	706938.28	N 25°09'35.79" W	157.50
3BC-3	1856851.81	707080.84	N 23°17'10.62" E	146.88
3R1-90	1856909.88	707215.75	N 57°54'26.87" E	105.64
3R1-109	1856999.38	707271.88	N 34°00'04.80" W	339.81
3AC-102	1856809.35	707553.59	S 56°50'49.76" E	27.45
3AC-103	1856832.33	707538.58	N 23°59'37.13" W	129.76
3AC-17	1856779.56	707657.13	N 23°59'36.66" W	133.50
3AC-18	1856725.28	707779.09	N 26°00'22.96" W	1438.89
3AC-19	1856094.37	709072.29	N 22°01'39.45" W	561.62
3AC-20	1855883.73	709592.91	N 9°29'13.55" W	268.04
3AC-21	1855839.55	709857.29	N 1°46'20.13" E	576.33
3AC-22	1855857.38	710433.34	N 5°54'40.18" E	6.46
3AC-200	1855858.04	710439.76	N 14°47'57.98" W	23.27
3AC-201	1855852.10	710462.26	N 70°13'23.66" E	9.13
3AC-202	1855860.69	710465.35	N 5°54'40.18" E	506.21
3AC-203	1855912.82	710968.86	N 2°39'06.80" W	73.51
3AC-204	1855909.42	711042.30	S 52°13'25.53" W	19.32
3R1-1	1855894.15	711030.47	S 52°13'23.85" W	14.37

POINT	EASTING	NORTHING	BEARING	DISTANCE
3AC2-111	1855596.38	710389.03	S 65°35'56.61" W	87.53
3AC2-10	1855516.66	710352.87	N 89°48'35.84" W	35.58
3AC2-9	1855481.09	710352.99	N 74°13'28.21" W	35.58
3AC2-8	1855446.85	710362.66	N 61°24'37.28" W	44.60
3AC2-7	1855407.69	710384.00	N 39°04'57.09" W	67.44
3AC2-6	1855365.18	710436.35	N 22°50'51.89" W	66.45
3AC2-5	1855339.37	710497.59	N 18°22'11.04" W	90.01
3AC2-4	1855311.00	710583.02	N 32°53'47.95" E	27.34
3AC2-3	1855325.85	710605.98	N 14°31'43.40" W	128.25
3AC2-2	1855293.68	710730.12	N 71°22'34.29" E	74.16
3AC2-1	1855363.96	710753.81	S 64°26'07.07" E	257.64
3AC2-112	1855596.38	710642.63	S 0°00'00.00" E	253.59
3AC2-111	1855596.38	710389.03	S 65°35'56.61" W	87.53

FILL AREA NO.2  
POINT EASTING NORTHING BEARING DISTANCE

POINT	EASTING	NORTHING	BEARING	DISTANCE
3R4-1	1855484.03	710035.08	N 24°08'05.75" W	94.29
3R4-2	1855445.48	710121.13	N 22°11'10.97" W	100.74
3R4-3	1855407.44	710214.41	N 19°47'10.18" W	100.74
3R4-4	1855373.34	710309.20	N 17°23'10.16" W	100.74
3R4-5	1855343.24	710405.34	N 61°21'52.77" E	8.27
3R4-6	1855350.49	710409.30	S 35°55'13.29" E	42.28
3R4-7	1855375.29	710375.06	S 49°55'19.82" E	42.28
3R4-8	1855407.64	710347.85	S 63°55'15.76" E	42.28
3R4-9	1855445.62	710329.26	S 77°55'19.87" E	42.28
3R4-10	1855486.96	710320.42	N 88°04'40.40" E	42.28
3R4-11	1855529.21	710321.83	N 73°22'45.44" E	35.78
3R4-100	1855563.49	710332.07	N 65°57'48.13" E	36.00
3R4-101	1855596.38	710346.73	S 43°56'42.60" E	79.28
3R4-102	1855651.39	710289.65	S 0°00'00.00" E	254.57
3R4-103	1855651.39	710035.08	S 90°00'00.00" W	77.17
3R4-12	1855574.22	710035.08	S 90°00'00.00" W	90.19
3R4-1	1855484.03	710035.08	N 24°08'05.75" W	94.29

FILL AREA NO.3  
POINT EASTING NORTHING BEARING DISTANCE

POINT	EASTING	NORTHING	BEARING	DISTANCE
3AC3-100	1855581.86	710896.17	S 12°47'55.70" W	108.02
3AC3-2	1855557.93	710790.84	S 0°00'00.00" E	64.91
3AC3-101	1855557.93	710725.93	S 51°10'24.64" E	36.85
3AC3-102	1855586.64	710702.82	S 43°26'36.68" E	44.97
3AC3-3	1855617.56	710670.18	S 37°01'35.85" E	25.37
3AC3-4	1855632.84	710649.92	S 31°41'53.01" E	29.76
3AC3-5	1855648.48	710624.60	S 25°34'08.49" E	30.51
3AC3-6	1855661.64	710597.07	S 18°34'18.66" E	22.63
3AC3-7	1855668.85	710575.62	N 90°00'00.00" E	21.50
3AC3-8	1855690.35	710575.62	N 1°08'43.45" E	82.44
3AC3-9	1855692.00	710658.05	N 3°51'39.04" E	46.69
3AC3-10	1855695.14	710704.63	N 6°45'30.61" E	34.94
3AC3-11	1855699.26	710739.33	N 9°41'42.14" E	41.65
3AC3-12	1855706.27	710780.39	N 15°12'26.59" E	30.43
3AC3-13	1855714.25	710809.75	N 18°33'35.14" E	48.63
3AC3-14	1855729.73	710855.85	N 24°34'25.70" E	38.38
3AC3-15	1855745.69	710890.75	N 29°07'46.51" E	14.47
3AC3-16	1855752.74	710903.40	N 26°25'06.94" E	18.11
3AC3-103	1855760.80	710919.62	N 32°29'35.39" E	41.53
3AC3-104	1855783.11	710954.65	N 55°31'28.92" W	50.00
3AC3-105	1855741.89	710982.95	S 61°31'51.92" W	182.05
3AC3-100	1855581.86	710896.17	S 12°47'55.70" W	108.02

**NOTES**

- FOR SITE PLAN SEE DRAWING NO. 0/5.
- FOR CENTERLINE OF PROTECTION PLAN SEE DRAWING NOS. 11/4 THRU 11/9.

Revisions			
Symbol	Descriptions	Date	Approved
	MODIFIED BY AMENDMENT MCO09	11/00	P.O.C.
<b>BURGESS &amp; NIPL, LIMITED COLUMBUS, OHIO</b>		<b>U.S.ARMY ENGINEER DISTRICT CORPS OF ENGINEERS HUNTINGTON, WEST VIRGINIA</b>	
Designed by: <b>P.CONROY</b>		<b>SCIOTO RIVER COLUMBUS, OHIO WEST COLUMBUS, L.P.P. PHASE IIIA <b>RW MONUMENT TABLES</b></b>	
Drawn by: <b>T.MULLINS</b>			
Checked by: <b>R.ROMAN</b>			
Reviewed by:	Scale: <b>NONE</b>	Sheet reference number: <b>6/11</b>	FILENAME: 00r1m01.dgn
Approved by:	Date: <b>OCTOBER 1999</b>	Drawing Code: <b>16-PWC-12-</b>	PIN TABLE: Sheet 1 of 1


COUNTRY	TYPE OF MARK	STATION	ELEVATION	
U.S.A.	IP&C	212/4	706.914	(FT)
U.S.A.	IP&C	212/15	710.399	(FT)
U.S.A.	IP&C	212/17	1811.179	(FT)
U.S.A.	IP&C	212/23	372.084	(FT)
U.S.A.	IP&C	212/24	468.091	(FT)
U.S.A.	IP&C	212/25	576.706	(FT)
U.S.A.	IP&C	212/26	344.197	(FT)

W. COLUMBUS OHIO  
PHASE IIIA UTILITIES  
HORIZ CONTROL PT.  
212/4 IP&C

SEPT. 11, 1997  
JOB 41/7

CEN-S  
212

G. JONES PC  
C. HUNDLEY III  
E. ROMANS &

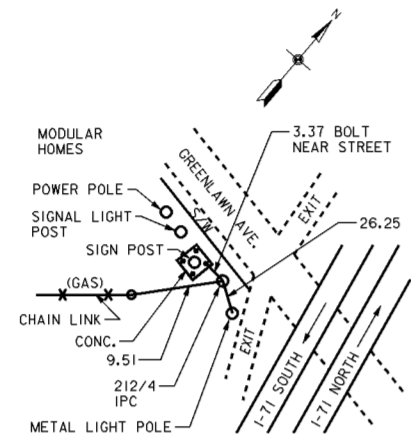


COUNTRY	TYPE OF MARK	STATION	ELEVATION	
U.S.A.	IP&C	212/15	710.399	(FT)
U.S.A.	IP&C	212/17	1811.179	(FT)
U.S.A.	IP&C	212/23	372.084	(FT)
U.S.A.	IP&C	212/24	468.091	(FT)
U.S.A.	IP&C	212/25	576.706	(FT)
U.S.A.	IP&C	212/26	344.197	(FT)

W. COLUMBUS OHIO  
PHASE IIIA UTILITIES  
HORIZ CONTROL PT.  
212/15 IP&C

SEPT. 23, 1997  
JOB 41/7

CEN-S  
212

JONES & CREW

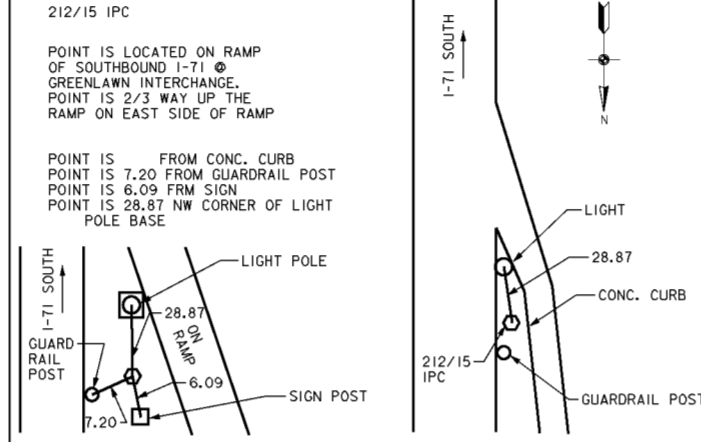


COUNTRY	TYPE OF MARK	STATION	ELEVATION	
U.S.A.	IP&C	212/17	1811.179	(FT)
U.S.A.	IP&C	212/23	372.084	(FT)
U.S.A.	IP&C	212/24	468.091	(FT)
U.S.A.	IP&C	212/25	576.706	(FT)
U.S.A.	IP&C	212/26	344.197	(FT)

W. COLUMBUS OHIO  
PHASE IIIA UTILITIES  
HORIZ CONTROL PT.  
212/17 IP&C

SEPT. 30, 1997  
JOB 41/7

CEN-S  
212

JONES & CREW

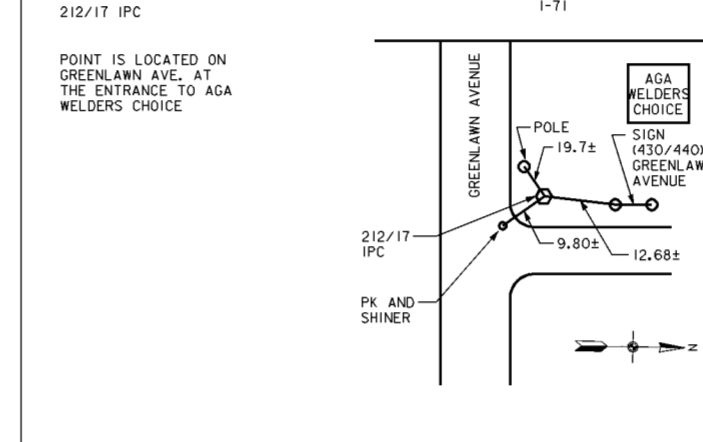


COUNTRY	TYPE OF MARK	STATION	ELEVATION	
U.S.A.	IP&C	212/23	372.084	(FT)
U.S.A.	IP&C	212/24	468.091	(FT)
U.S.A.	IP&C	212/25	576.706	(FT)
U.S.A.	IP&C	212/26	344.197	(FT)

W. COLUMBUS OHIO  
LPP REFERENCES TO  
HORIZ CONTROL PT.  
212/23 IP&C

OCT. 7, 1997  
JOB 41/7

CEN-S  
212

JONES & CREW

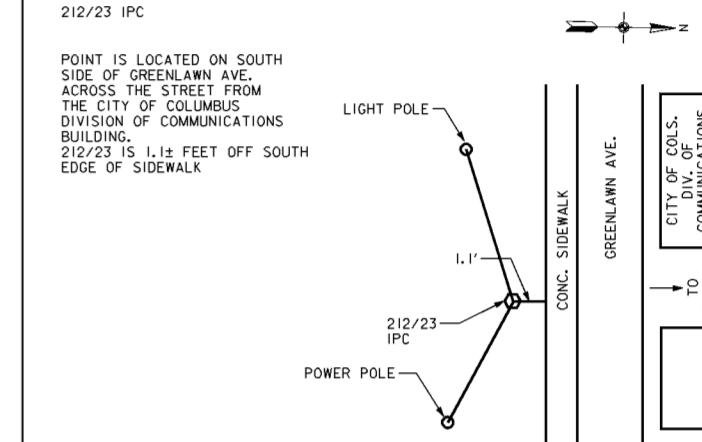


COUNTRY	TYPE OF MARK	STATION	ELEVATION	
U.S.A.	IP&C	212/24	468.091	(FT)
U.S.A.	IP&C	212/25	576.706	(FT)
U.S.A.	IP&C	212/26	344.197	(FT)

W. COLUMBUS OHIO  
LPP REFERENCE TO  
HORIZ CONTROL PT.  
212/24 IP&C

OCT. 7, 1997  
JOB 41/7

CEN-S  
212

JONES & CREW

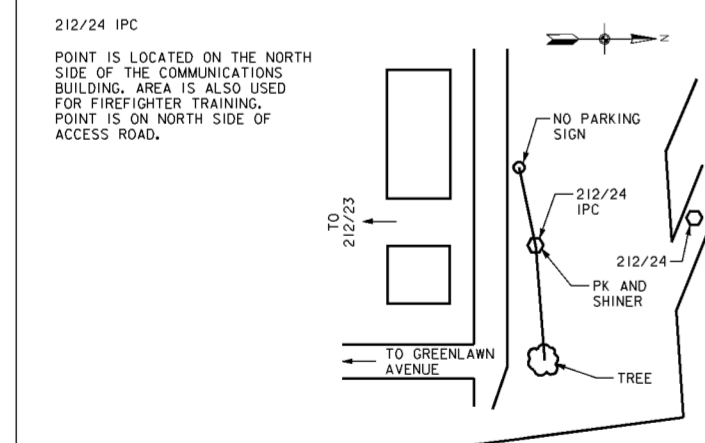


COUNTRY	TYPE OF MARK	STATION	ELEVATION	
U.S.A.	IP&C	212/25	576.706	(FT)
U.S.A.	IP&C	212/26	344.197	(FT)

W. COLUMBUS OHIO  
LPP REFERENCE TO  
HORIZ CONTROL PT.  
212/25 IP&C

OCT. 7, 1997  
JOB 41/7

CEN-S  
212

JONES & CREW

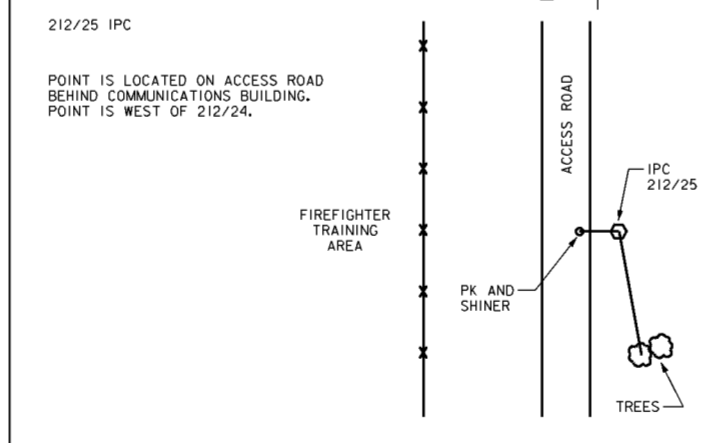


COUNTRY	TYPE OF MARK	STATION	ELEVATION	
U.S.A.	MINE SPIKE	212/26	344.197	(FT)

W. COLUMBUS OHIO  
LPP REFERENCE TO  
HORIZ CONTROL PT.

OCT. 7, 1997  
JOB 41/7

CEN-S  
212

JONES & CREW

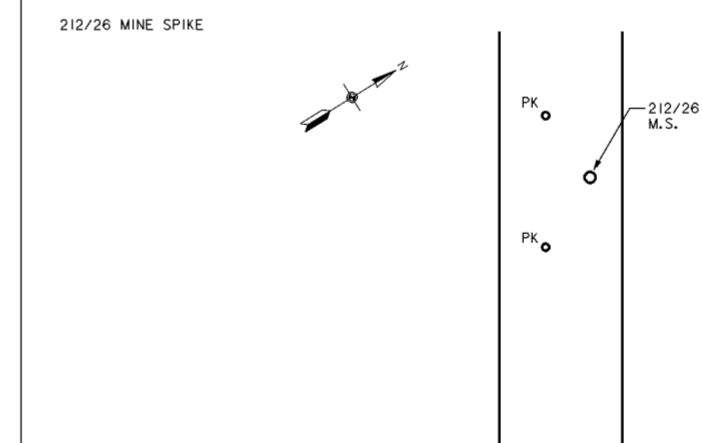

**NOTES**


1. FOR GENERAL SITE PLAN SEE DRAWING NO. 0/5.

Symbol	Revisions Descriptions	Date	Approved


<b>BURGESS &amp; NIPL, LIMITED</b> COLUMBUS, OHIO		<b>U.S. ARMY ENGINEER DISTRICT</b> CORPS OF ENGINEERS HUNTINGTON, WEST VIRGINIA	
Designed by:	<b>COE</b>	SCIOTO RIVER COLUMBUS, OHIO WEST COLUMBUS, L.P.P. PHASE IIIA	
Drawn by:	<b>T.MULLINS</b>	<b>SURVEY</b>	
Checked by:	<b>P.CONROY</b>	<b>REFERENCES (1 OF 3)</b>	
Reviewed by:	<b>Scale: NONE</b>	Sheet reference number:	FILENAME: 00aur01.dgn
Approved by:	<b>Date: OCTOBER 1999</b>	Sheet number:	PIN TABLE:
	<b>Drawing Code: 16-PWC-12-</b>	<b>1/1</b>	Sheet 1 of 3




COUNTRY	TYPE OF MARK	STATION	AGENCY (CAST IN MARKS)	ELEVATION (FT)
U.S.A.	MINE SPIKE	212/27	N/A	N/A
LOCALITY	STAMPING ON MARK	AGENCY (CAST IN MARKS)	ELEVATION (FT)	
FRANKLIN COUNTY	212/27	N/A	N/A	
LATITUDE	LONGITUDE	DATUM	DATUM	
		NAD 27		
(NORTHING) (EASTING)	(NORTHING) (EASTING)	GRID AND ZONE	ESTABLISHED BY (AGENCY)	
707457.544	1857896.208	OHIO/SOUTH	C.O.E.	
(NORTHING) (EASTING)	(NORTHING) (EASTING)	GRID AND ZONE	DATE	ORDER
			10/97	
TO OBTAIN GRID AZ. (ADDSUB) TO THE GEODETIC AZIMUTH				
TO OBTAIN	GRID AZ. (ADDSUB)	TO THE GEODETIC AZIMUTH		
OBJECT	AZIMUTH OR DIRECTION (GEODETIC/GRID)	BACK AZIMUTH	GEOD. DISTANCE (METERS)	GRID DISTANCE (FEET)
212/28	271°54'03.0"			766.872
212/26	106°33'59.3"			344.197

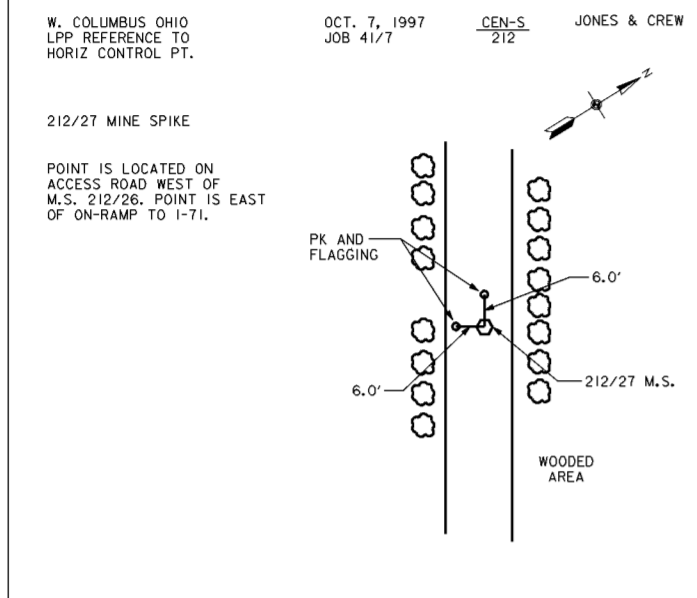


COUNTRY	TYPE OF MARK	STATION	AGENCY (CAST IN MARKS)	ELEVATION (FT)
U.S.A.	MINE SPIKE	212/28	N/A	N/A
LOCALITY	STAMPING ON MARK	AGENCY (CAST IN MARKS)	ELEVATION (FT)	
FRANKLIN COUNTY	212/28	N/A	N/A	
LATITUDE	LONGITUDE	DATUM	DATUM	
		NAD 27		
(NORTHING) (EASTING)	(NORTHING) (EASTING)	GRID AND ZONE	ESTABLISHED BY (AGENCY)	
707482.981	1857129.758	OHIO/SOUTH	C.O.E.	
(NORTHING) (EASTING)	(NORTHING) (EASTING)	GRID AND ZONE	DATE	ORDER
			10/97	
TO OBTAIN GRID AZ. (ADDSUB) TO THE GEODETIC AZIMUTH				
TO OBTAIN	GRID AZ. (ADDSUB)	TO THE GEODETIC AZIMUTH		
OBJECT	AZIMUTH OR DIRECTION (GEODETIC/GRID)	BACK AZIMUTH	GEOD. DISTANCE (METERS)	GRID DISTANCE (FEET)
212/29	236°37'11.4"			275.117
212/27	91°54'03.0"			766.872

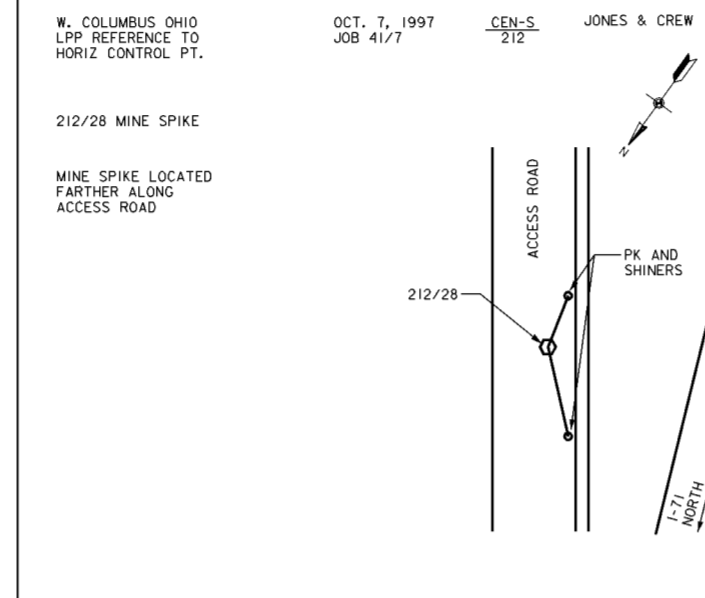


COUNTRY	TYPE OF MARK	STATION	AGENCY (CAST IN MARKS)	ELEVATION (FT)
U.S.A.	IP&C	212/29	N/A	N/A
LOCALITY	STAMPING ON MARK	AGENCY (CAST IN MARKS)	ELEVATION (FT)	
FRANKLIN COUNTY	212/29	N/A	N/A	
LATITUDE	LONGITUDE	DATUM	DATUM	
		NAD 27		
(NORTHING) (EASTING)	(NORTHING) (EASTING)	GRID AND ZONE	ESTABLISHED BY (AGENCY)	
707331.614	1856900.025	OHIO/SOUTH	C.O.E.	
(NORTHING) (EASTING)	(NORTHING) (EASTING)	GRID AND ZONE	DATE	ORDER
			10/97	
TO OBTAIN GRID AZ. (ADDSUB) TO THE GEODETIC AZIMUTH				
TO OBTAIN	GRID AZ. (ADDSUB)	TO THE GEODETIC AZIMUTH		
OBJECT	AZIMUTH OR DIRECTION (GEODETIC/GRID)	BACK AZIMUTH	GEOD. DISTANCE (METERS)	GRID DISTANCE (FEET)
212/30	330°03'10.8"			522.099
212/28	56°37'11.4"			275.117

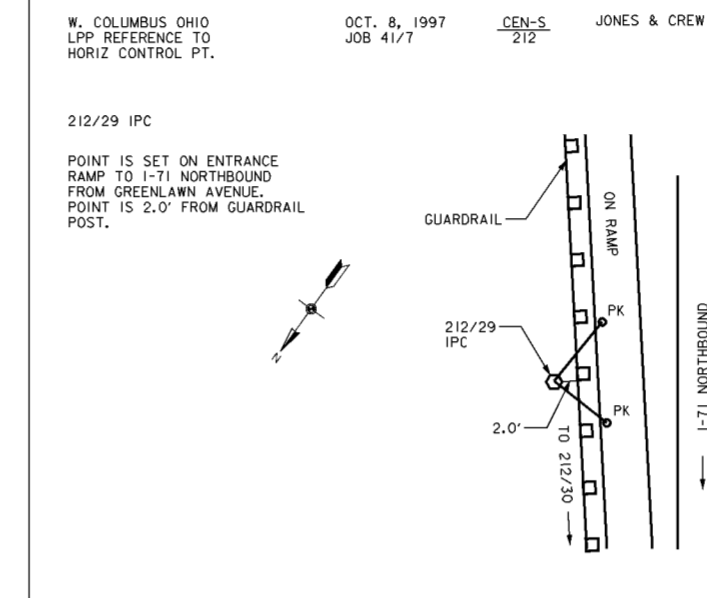


COUNTRY	TYPE OF MARK	STATION	AGENCY (CAST IN MARKS)	ELEVATION (FT)
U.S.A.	IP&C	212/30	N/A	N/A
LOCALITY	STAMPING ON MARK	AGENCY (CAST IN MARKS)	ELEVATION (FT)	
FRANKLIN COUNTY	212/30	N/A	N/A	
LATITUDE	LONGITUDE	DATUM	DATUM	
		NAD 27		
(NORTHING) (EASTING)	(NORTHING) (EASTING)	GRID AND ZONE	ESTABLISHED BY (AGENCY)	
707784.006	1856639.394	OHIO/SOUTH	C.O.E.	
(NORTHING) (EASTING)	(NORTHING) (EASTING)	GRID AND ZONE	DATE	ORDER
			10/97	
TO OBTAIN GRID AZ. (ADDSUB) TO THE GEODETIC AZIMUTH				
TO OBTAIN	GRID AZ. (ADDSUB)	TO THE GEODETIC AZIMUTH		
OBJECT	AZIMUTH OR DIRECTION (GEODETIC/GRID)	BACK AZIMUTH	GEOD. DISTANCE (METERS)	GRID DISTANCE (FEET)
215/16	333°29'02.6"			941.613
212/29	150°03'10.8"			522.099

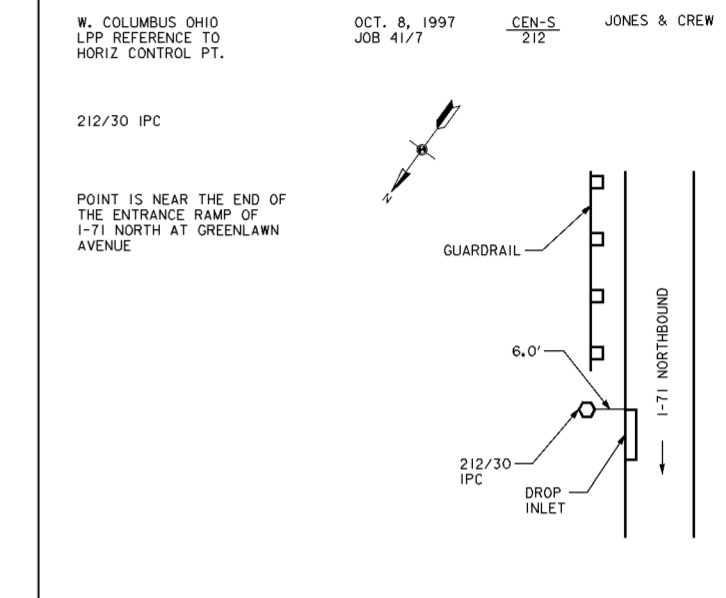


COUNTRY	TYPE OF MARK	STATION	AGENCY (CAST IN MARKS)	ELEVATION (FT)
U.S.A.	IP&C	215/16	N/A	N/A
LOCALITY	STAMPING ON MARK	AGENCY (CAST IN MARKS)	ELEVATION (FT)	
FRANKLIN COUNTY	215/16	N/A	N/A	
LATITUDE	LONGITUDE	DATUM	DATUM	
		NAD 27		
(NORTHING) (EASTING)	(NORTHING) (EASTING)	GRID AND ZONE	ESTABLISHED BY (AGENCY)	
708626.571	1856219.014	OHIO/SOUTH	C.O.E.	
(NORTHING) (EASTING)	(NORTHING) (EASTING)	GRID AND ZONE	DATE	ORDER
			10/97	
TO OBTAIN GRID AZ. (ADDSUB) TO THE GEODETIC AZIMUTH				
TO OBTAIN	GRID AZ. (ADDSUB)	TO THE GEODETIC AZIMUTH		
OBJECT	AZIMUTH OR DIRECTION (GEODETIC/GRID)	BACK AZIMUTH	GEOD. DISTANCE (METERS)	GRID DISTANCE (FEET)
215/17	333°21'36.6"			942.684
212/30	153°29'02.6"			941.613

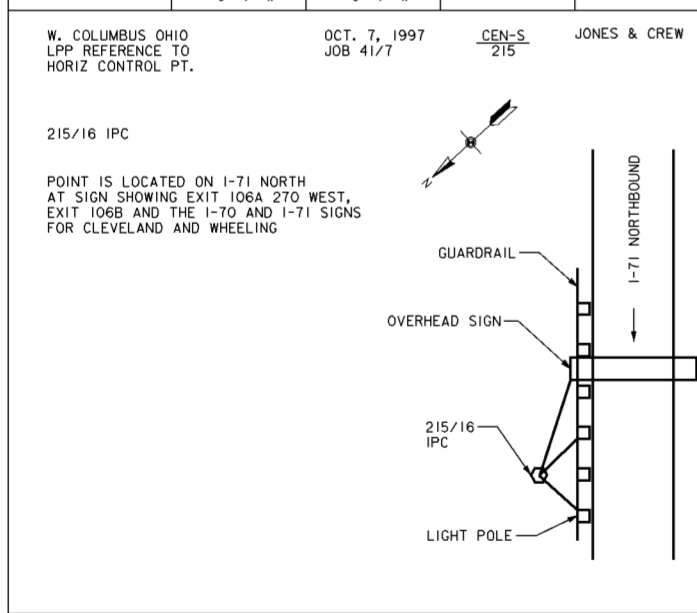

COUNTRY	TYPE OF MARK	STATION	AGENCY (CAST IN MARKS)	ELEVATION (FT)
U.S.A.	IP&C	215/17	N/A	N/A
LOCALITY	STAMPING ON MARK	AGENCY (CAST IN MARKS)	ELEVATION (FT)	
FRANKLIN COUNTY	215/17	N/A	N/A	
LATITUDE	LONGITUDE	DATUM	DATUM	
		NAD 27		
(NORTHING) (EASTING)	(NORTHING) (EASTING)	GRID AND ZONE	ESTABLISHED BY (AGENCY)	
709469.182	1855796.333	OHIO/SOUTH	C.O.E.	
(NORTHING) (EASTING)	(NORTHING) (EASTING)	GRID AND ZONE	DATE	ORDER
			10/97	
TO OBTAIN GRID AZ. (ADDSUB) TO THE GEODETIC AZIMUTH				
TO OBTAIN	GRID AZ. (ADDSUB)	TO THE GEODETIC AZIMUTH		
OBJECT	AZIMUTH OR DIRECTION (GEODETIC/GRID)	BACK AZIMUTH	GEOD. DISTANCE (METERS)	GRID DISTANCE (FEET)
215/18	348°56'06.6"			385.787
215/16	153°21'36.6"			942.684

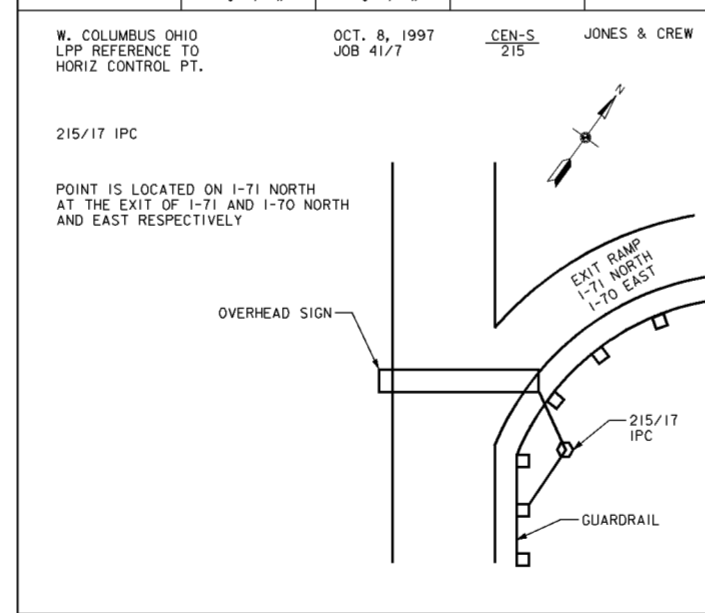

COUNTRY	TYPE OF MARK	STATION	AGENCY (CAST IN MARKS)	ELEVATION (FT)
U.S.A.	IP&C	215/18	N/A	N/A
LOCALITY	STAMPING ON MARK	AGENCY (CAST IN MARKS)	ELEVATION (FT)	
FRANKLIN COUNTY	215/18	N/A	N/A	
LATITUDE	LONGITUDE	DATUM	DATUM	
		NAD 27		
(NORTHING) (EASTING)	(NORTHING) (EASTING)	GRID AND ZONE	ESTABLISHED BY (AGENCY)	
709847.797	1855722.293	OHIO/SOUTH	C.O.E.	
(NORTHING) (EASTING)	(NORTHING) (EASTING)	GRID AND ZONE	DATE	ORDER
			10/97	
TO OBTAIN GRID AZ. (ADDSUB) TO THE GEODETIC AZIMUTH				
TO OBTAIN	GRID AZ. (ADDSUB)	TO THE GEODETIC AZIMUTH		
OBJECT	AZIMUTH OR DIRECTION (GEODETIC/GRID)	BACK AZIMUTH	GEOD. DISTANCE (METERS)	GRID DISTANCE (FEET)
215/19	00°34'15.4"			878.821
215/17	168°56'06.6"			385.787

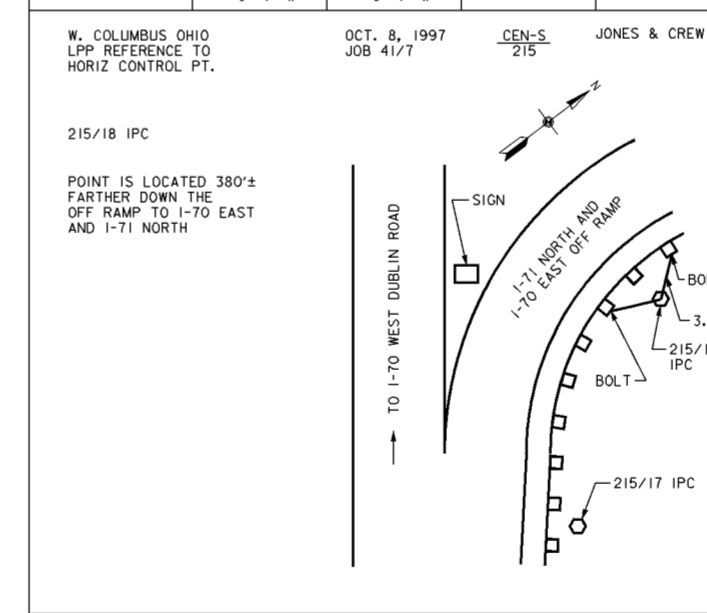

**NOTES**


1. FOR GENERAL SITE PLAN SEE DRAWING NO. 0/5.

Revisions			
Symbol	Descriptions	Date	Approved


  

<b>BURGESS &amp; NIPL, LIMITED</b> COLUMBUS, OHIO		<b>U.S. ARMY ENGINEER DISTRICT</b> CORPS OF ENGINEERS HUNTINGTON, WEST VIRGINIA	
Designed by:	COE	SCIOTO RIVER COLUMBUS, OHIO WEST COLUMBUS, L.P.P. PHASE IIIA	
Drawn by:	T.MULLINS	<b>SURVEY</b>	
Checked by:	P.CONROY	<b>REFERENCES (2 OF 3)</b>	
Reviewed by:		Scale:	Sheet reference number:
Approved by:		NONE	11/2
		Date:	FILENAME: 00aur02.dgn
		OCTOBER 1999	PIN TABLE:
		Drawing Code: 16-PWC-12-	Sheet 2 of 3

COUNTRY U.S.A.	TYPE OF MARK IP&C	STATION 215/19	
LOCALITY FRANKLIN COUNTY	STAMPING ON MARK 215/19	AGENCY (EAST IN MARKS) N/A	ELEVATION (FT) N/A
LATITUDE	LONGITUDE	DATUM NAD 27	DATUM
(NORTHING) (EASTING) (FT) (MM)	(EASTING) (NORTHING) (FT) (MM)	GRID AND ZONE OHIO/SOUTH	ESTABLISHED BY (AGENCY) C.O.E.
710726.574	1855731.050		
(NORTHING) (EASTING) (FT) (MM)	(EASTING) (NORTHING) (FT) (MM)	GRID AND ZONE OHIO/SOUTH	DATE 10/97
710726.574	1855731.050		
TO OBTAIN GRID AZIMUTH ADD " " " " TO THE GEODETIC AZIMUTH			
TO OBTAIN GRID AZ. (ADDSUB) " " " " TO THE GEODETIC AZIMUTH			
OBJECT	AZIMUTH OR DIRECTION (DEGREES) (CHORD) (MAGNETIC)	BACK AZIMUTH	GRID DISTANCE (FEET)
215/20	15°48'56.9"	" "	665.045
215/18	180°34'15.4"	" "	878.821

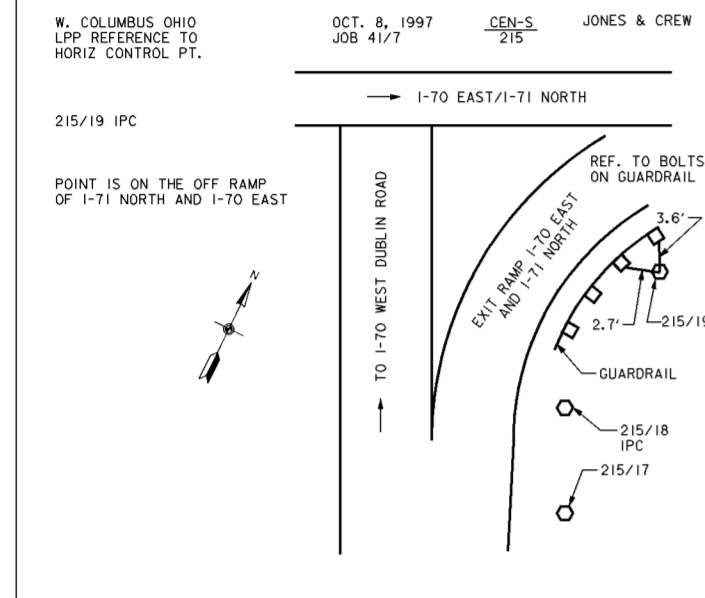

COUNTRY U.S.A.	TYPE OF MARK IP&C	STATION 215/20	
LOCALITY FRANKLIN COUNTY	STAMPING ON MARK 215/20	AGENCY (EAST IN MARKS) N/A	ELEVATION (FT) N/A
LATITUDE	LONGITUDE	DATUM NAD 27	DATUM
(NORTHING) (EASTING) (FT) (MM)	(EASTING) (NORTHING) (FT) (MM)	GRID AND ZONE OHIO/SOUTH	ESTABLISHED BY (AGENCY) C.O.E.
711366.442	1855912.305		
(NORTHING) (EASTING) (FT) (MM)	(EASTING) (NORTHING) (FT) (MM)	GRID AND ZONE OHIO/SOUTH	DATE 10/97
711366.442	1855912.305		
TO OBTAIN GRID AZIMUTH ADD " " " " TO THE GEODETIC AZIMUTH			
TO OBTAIN GRID AZ. (ADDSUB) " " " " TO THE GEODETIC AZIMUTH			
OBJECT	AZIMUTH OR DIRECTION (DEGREES) (CHORD) (MAGNETIC)	BACK AZIMUTH	GRID DISTANCE (FEET)
215/19	195°48'56.9"	" "	665.045
17/12	32°08'06.4"	" "	735.471

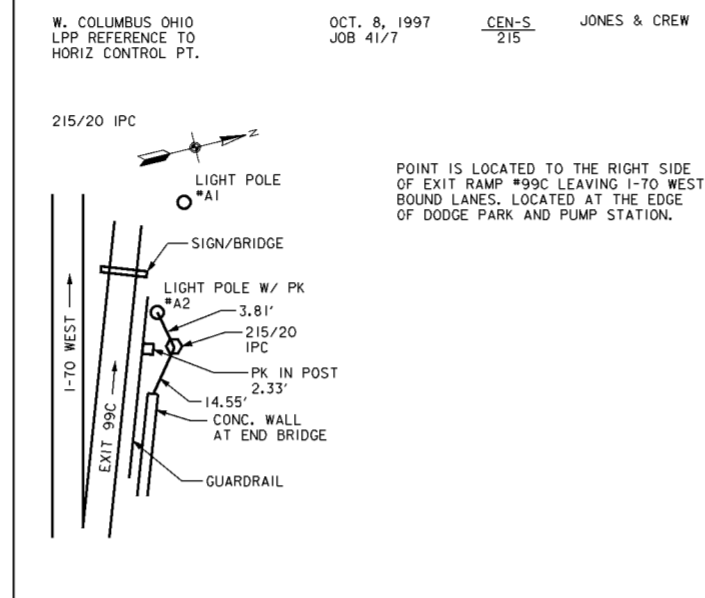

LEVELMAN : PETRUCCI/STROLL (KENC)	PROJECT NO. 59/9 MOD-1
DATE : OCT.-NOV. 1989	DESC. WEST COLUMBUS, OHIO - L.P.P.
BOOK NO. : CEN-S/AS SHOWN	SOUNDING/SECTIONS
COMPUTED BY : CORNWELL	(VERTICAL BASE-FOR FLOOD SURVEYS)
CHECKED BY : POPLIN	VERTICAL DATUM : 1929 NGS

T.B.M. : 11/19-1 ELEV. : 702.955 DESC. : DISK QUAD. : S.W. COLUMBUS COORD. : N. = E. =	LOCATION : DISK SET IN N. END OF GAS PUMP ISLAND OF CERTIFIED GAS STATION. AT POINT OF HARMON AVE. & ENIG ST. 400'± S. OF STIMMEL ROAD  TOPO SHEET NO. :
T.B.M. : 11/19-2 ELEV. : 701.575 DESC. : DISK QUAD. : S.W. COLUMBUS COORD. : N. = E. =	LOCATION : DISK SET IN N.E. CORNER OF CONC. PAD OF STEEL LIGHT POLE 90'± S. OF CENTER LINE OF STIMMEL RD. 35'± W. OF DECKEBACH RD. EXTENDED 0'± W. OF W. EDGE PAVED PARKING LOT.  TOPO SHEET NO. :
T.B.M. : 11/20-1 ELEV. : 720.482 DESC. : DISK QUAD. : S.W. COLUMBUS COORD. : N. = E. =	LOCATION : DISK SET IN CONC. WALK ON WEST SIDE OF FLAGPOLE. 100'± W. OF SCIOTO BLVD. & 12'± N. OF GREENLAWN AVE. AT BLDG. FOR CITY OF COLUMBUS RECREATION AND PARKS DEPT.  TOPO SHEET NO. : 12
T.B.M. : 11/20-2 ELEV. : 709.128 DESC. : DISK QUAD. : S.W. COLUMBUS COORD. : N. = E. =	LOCATION : DISK SET IN S.W. CORNER OF CONC. PAD OF "UPPER DECK SPORTSBAR AND GRILL" SIGN 60'± OF CENTERLINE OF DECKEBACH AVE. 12'± N. OF GREENLAWN AVE.  TOPO SHEET NO. :
T.B.M. : 11/22-1 ELEV. : 702.313 DESC. : DISK QUAD. : S.W. COLUMBUS COORD. : N. = E. =	LOCATION : DISK SET IN CONC. PAD OF MANHOLE 12'± N. OF EDGE OF STIMMEL RD. 80'± W. OF "G" ST.  TOPO SHEET NO. :

LEVELMAN : PETRUCCI/STROLL (KENC)	PROJECT NO. 59/9 MOD-1
DATE : OCT.-NOV. 1989	DESC. WEST COLUMBUS, OHIO - L.P.P.
BOOK NO. : CEN-S/AS SHOWN	SOUNDING/SECTIONS
COMPUTED BY : CORNWELL	(VERTICAL BASE-FOR FLOOD SURVEYS)
CHECKED BY : POPLIN	VERTICAL DATUM : 1929 NGS

T.B.M. : 86/11 ELEV. : 705.961 DESC. : DISK QUAD. : S.W. COLUMBUS COORD. : N. = E. =	LOCATION : DISK SET AT NORTHWEST CORNER W. MOUND ST. & CYPRESS ST. AT ENT. TO 1082 MOUND ST. IN CONC. SIDEWALK AND S. OF BUILDING  TOPO SHEET NO. :
T.B.M. : 86/12 ELEV. : 705.571 DESC. : DISK QUAD. : S.W. COLUMBUS COORD. : N. = E. =	LOCATION : DISK SET IN CONC. SIDEWALK AT S.E. CORNER W. MOUND ST. AND MT. CALVARY AVE. 7'± S. OF S. CURB OF MOUND ST. & 1'± E. OF E. CURB OF MT. CALVARY AVE.  TOPO SHEET NO. :
T.B.M. : 86/12-1 ELEV. : 710.783 DESC. : DISK QUAD. : S.W. COLUMBUS COORD. : N. = E. =	LOCATION : DISK SET ON TOP OF N.E. CORNER OF CONC. PAD OF STEEL LIGHT POLE ON S.W. CORNER OF BUCHANAN DR. AND VAN BUREN DR.  TOPO SHEET NO. :
T.B.M. : 86/12-2 ELEV. : 711.687 DESC. : DISK QUAD. : S.W. COLUMBUS COORD. : N. = E. =	LOCATION : DISK SET ON TOP OF S.W. CORNER OF CONC. PAD OF STEEL LIGHT POLE. 50'± E. OF INTERSECTION OF PIERCE DR. AND VAN BUREN DR. ON N. SIDE OF VAN BUREN DR.  TOPO SHEET NO. :
T.B.M. : 86/13 ELEV. : 706.636 DESC. : DISK QUAD. : S.W. COLUMBUS COORD. : N. = E. =	LOCATION : DISK SET ON TOP OF S.W. CORNER OF CONC. PAD OF STEEL LIGHT POLE ON S.W. CORNER OF HARMON AVE. AND BUCHANAN DR.  TOPO SHEET NO. :

LEVELMAN : PETRUCCI/STROLL (KENC)	PROJECT NO. 59/9 MOD-1
DATE : OCT.-NOV. 1989	DESC. WEST COLUMBUS, OHIO - L.P.P.
BOOK NO. : CEN-S/AS SHOWN	SOUNDING/SECTIONS
COMPUTED BY : CORNWELL	(VERTICAL BASE-FOR FLOOD SURVEYS)
CHECKED BY : POPLIN	VERTICAL DATUM : 1929 NGS

T.B.M. : 86/14 ELEV. : 714.266 DESC. : DISK QUAD. : S.W. COLUMBUS COORD. : N. = E. =	LOCATION : DISK SET IN S. SIDE CONC. DR. 100'± S. OF CENTERLINE OF GRIGGS AVE. 10'± E. OF E. EDGE OF HARMON AVE. NEAR 154 HARMON AVE.  TOPO SHEET NO. :
T.B.M. : 86/14-1 ELEV. : 716.129 DESC. : DISK QUAD. : S.W. COLUMBUS COORD. : N. = E. =	LOCATION : DISK SET IN TOP OF S.W. CORNER OF CONC. VALVE PIT BOX 20'± E. OF HARMON AVE. 6'± S. OF EDGE OF PAVED DR. ENT. TO "CLARK FORKLIFT OF COLUMBUS" ACROSS FROM 849 HARMON AVE.  TOPO SHEET NO. :
T.B.M. : 86/14-2 ELEV. : 708.916 DESC. : DISK QUAD. : COORD. : N. = E. =	LOCATION : DISK SET IN N. EDGE CONC. DR. AT 938 HARMON AVE. AT S. END CONC. BLOCK WALL 12'± E. OF EDGE OF HARMON AVE. AND 115'± N. OF CENTERLINE OF WHARTON AVE.  TOPO SHEET NO. :
T.B.M. : 86/17 ELEV. : 704.188 DESC. : DISK QUAD. : S.W. COLUMBUS COORD. : N. = E. =	LOCATION : DISK SET IN E. END OF CONC. CURB AT N.E. CORNER OF GREENLAWN AVE. AND GREENFIELD DR. 30'± E. OF CENTERLINE OF GREENFIELD DR. NEAR ST. RITA'S HOME AT 880 GREENLAWN AVE.  TOPO SHEET NO. :
T.B.M. : 86/19 ELEV. : 713.831 DESC. : DISK QUAD. : S.W. COLUMBUS COORD. : N. = E. =	LOCATION : DISK SET IN TOP OF CONC. CLRB INLET PAD ON N.W. CORNER OF GREENFIELD DR. AND PAVED DR. TO PARKING LOT FOR APTS. 200'± S. OF CANNON BX PLACE  TOPO SHEET NO. :

LEVELMAN : PETRUCCI/STROLL (KENC)	PROJECT NO. 59/9 MOD-1
DATE : OCT.-NOV. 1989	DESC. WEST COLUMBUS, OHIO - L.P.P.
BOOK NO. : CEN-S/AS SHOWN	SOUNDING/SECTIONS
COMPUTED BY : CORNWELL	(VERTICAL BASE-FOR FLOOD SURVEYS)
CHECKED BY : POPLIN	VERTICAL DATUM : 1929 NGS


T.B.M. : 11/22-2 ELEV. : 713.098 DESC. : DISK QUAD. : S.W. COLUMBUS COORD. : N. = E. =	LOCATION : DISK SET IN TOP OF N.W. CORNER OF CONC. CURB AT "RAM" BUSINESS AT 1191 STIMMEL RD. 33'± S. OF STIMMEL RD.  TOPO SHEET NO. :
T.B.M. : 11/23 ELEV. : 706.125 DESC. : DISK QUAD. : S.W. COLUMBUS COORD. : N. = E. =	LOCATION : DISK SET IN N.E. CORNER OF CONC. CURB AT "RAM" BUSINESS AT 1247 STIMMEL RD. 35'± S. OF STIMMEL RD.  TOPO SHEET NO. :
T.B.M. : ELEV. : DESC. : QUAD. : COORD. : N. = E. =	LOCATION :  TOPO SHEET NO. : 12
T.B.M. : ELEV. : DESC. : QUAD. : COORD. : N. = E. =	LOCATION :  TOPO SHEET NO. : 12
T.B.M. : ELEV. : DESC. : QUAD. : COORD. : N. = E. =	LOCATION :  TOPO SHEET NO. : 12

**NOTES**

1. FOR GENERAL SITE PLAN SEE DRAWING NO. 0/5.

Revisions			
Symbol	Descriptions	Date	Approved

<b>BURGESS &amp; NIPL, LIMITED</b> COLUMBUS, OHIO	<b>U.S. ARMY ENGINEER DISTRICT</b> CORPS OF ENGINEERS HUNTINGTON, WEST VIRGINIA		
		SCIOTO RIVER COLUMBUS, OHIO WEST COLUMBUS, L.P.P. PHASE IIIA	
Designed by: COE	<b>SURVEY</b> <b>REFERENCES (3 OF 3)</b>		
Drawn by: T.MULLINS			
Checked by: P.CONROY			
Reviewed by:			
Approved by:	Scale: NONE Date: OCTOBER 1999 Drawing Code: 16-PWC-12-	Sheet reference number: 11/3	FILENAME: PIN TABLE: 00aur03.dgn

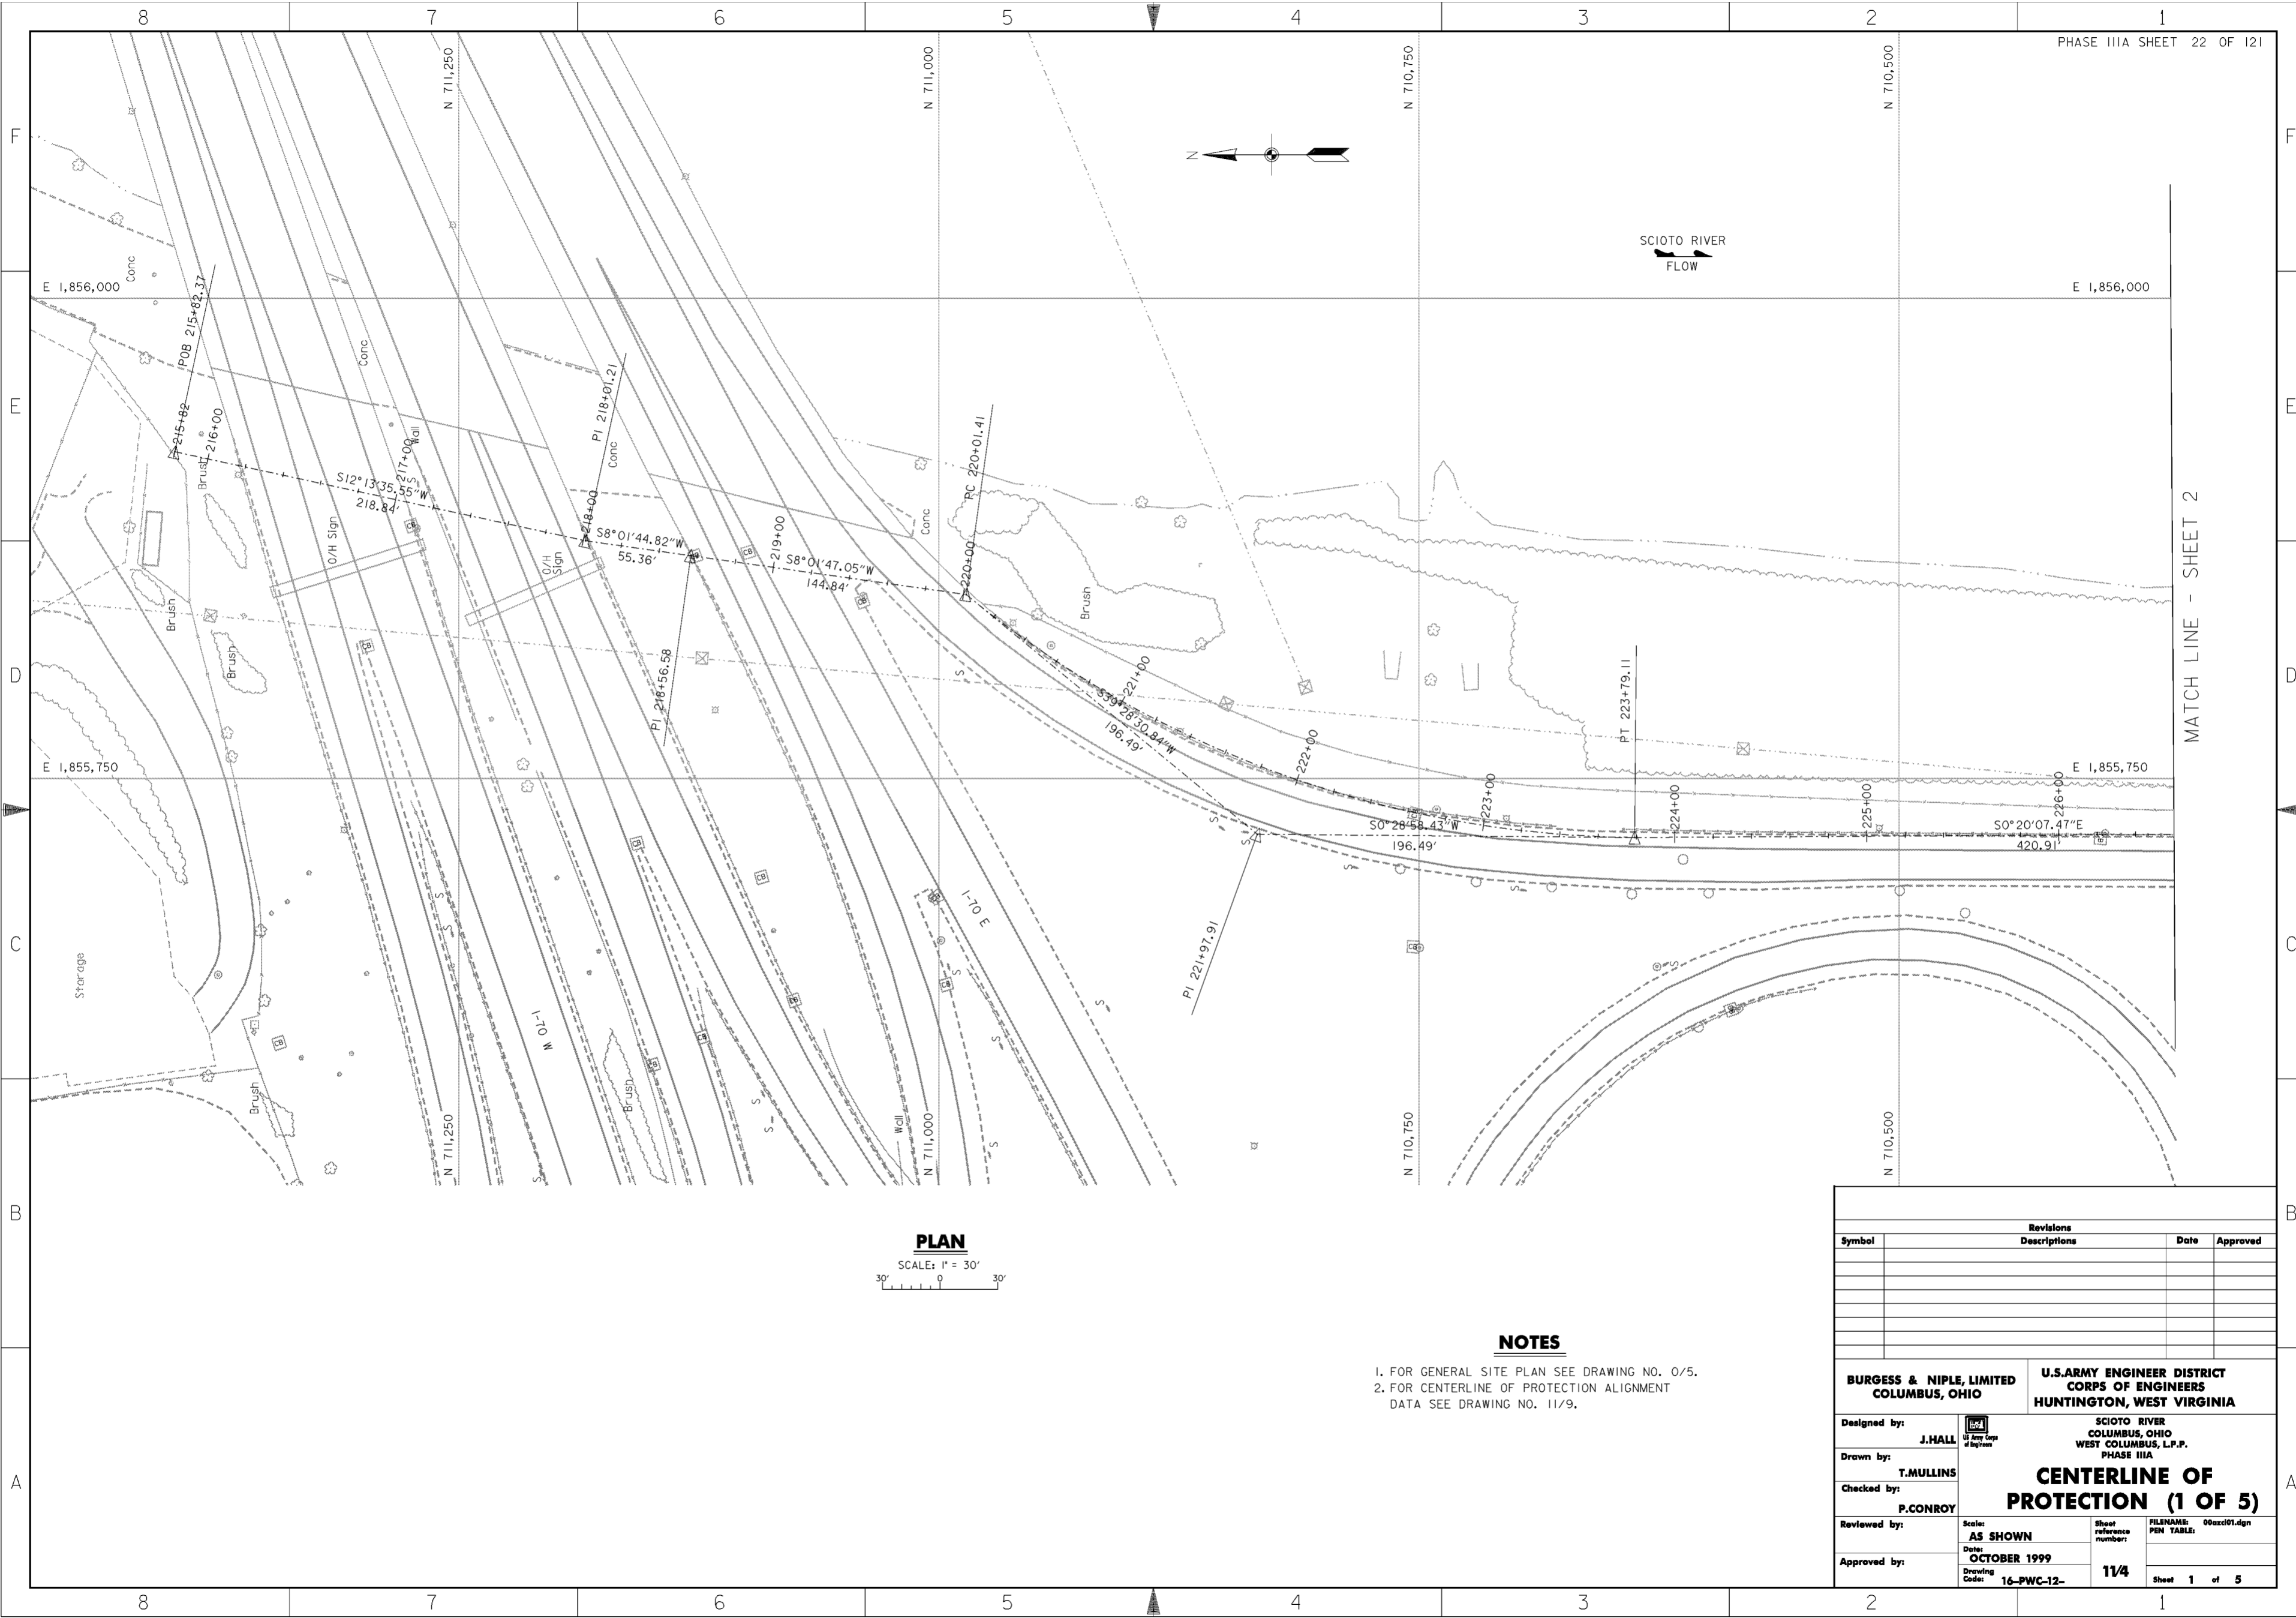

**PLAN**  
SCALE: 1" = 30'


**NOTES**

1. FOR GENERAL SITE PLAN SEE DRAWING NO. 0/5.
2. FOR CENTERLINE OF PROTECTION ALIGNMENT DATA SEE DRAWING NO. 11/9.

Revisions			
Symbol	Descriptions	Date	Approved


  

<b>BURGESS &amp; NIPL, LIMITED</b> COLUMBUS, OHIO	<b>U.S. ARMY ENGINEER DISTRICT</b> CORPS OF ENGINEERS HUNTINGTON, WEST VIRGINIA
Designed by: <b>J. HALL</b>	<p align="center"><b>CENTERLINE OF PROTECTION (1 OF 5)</b></p> FILENAME: 00axd01.dgn PEN TABLE:
Drawn by: <b>T. MULLINS</b>	
Checked by: <b>P. CONROY</b>	
Reviewed by:	
Approved by:	
Scale: <b>AS SHOWN</b>	Sheet reference number: <b>11/4</b>
Date: <b>OCTOBER 1999</b>	Drawing Code: <b>16-PWC-12-</b>
Sheet 1 of 5	

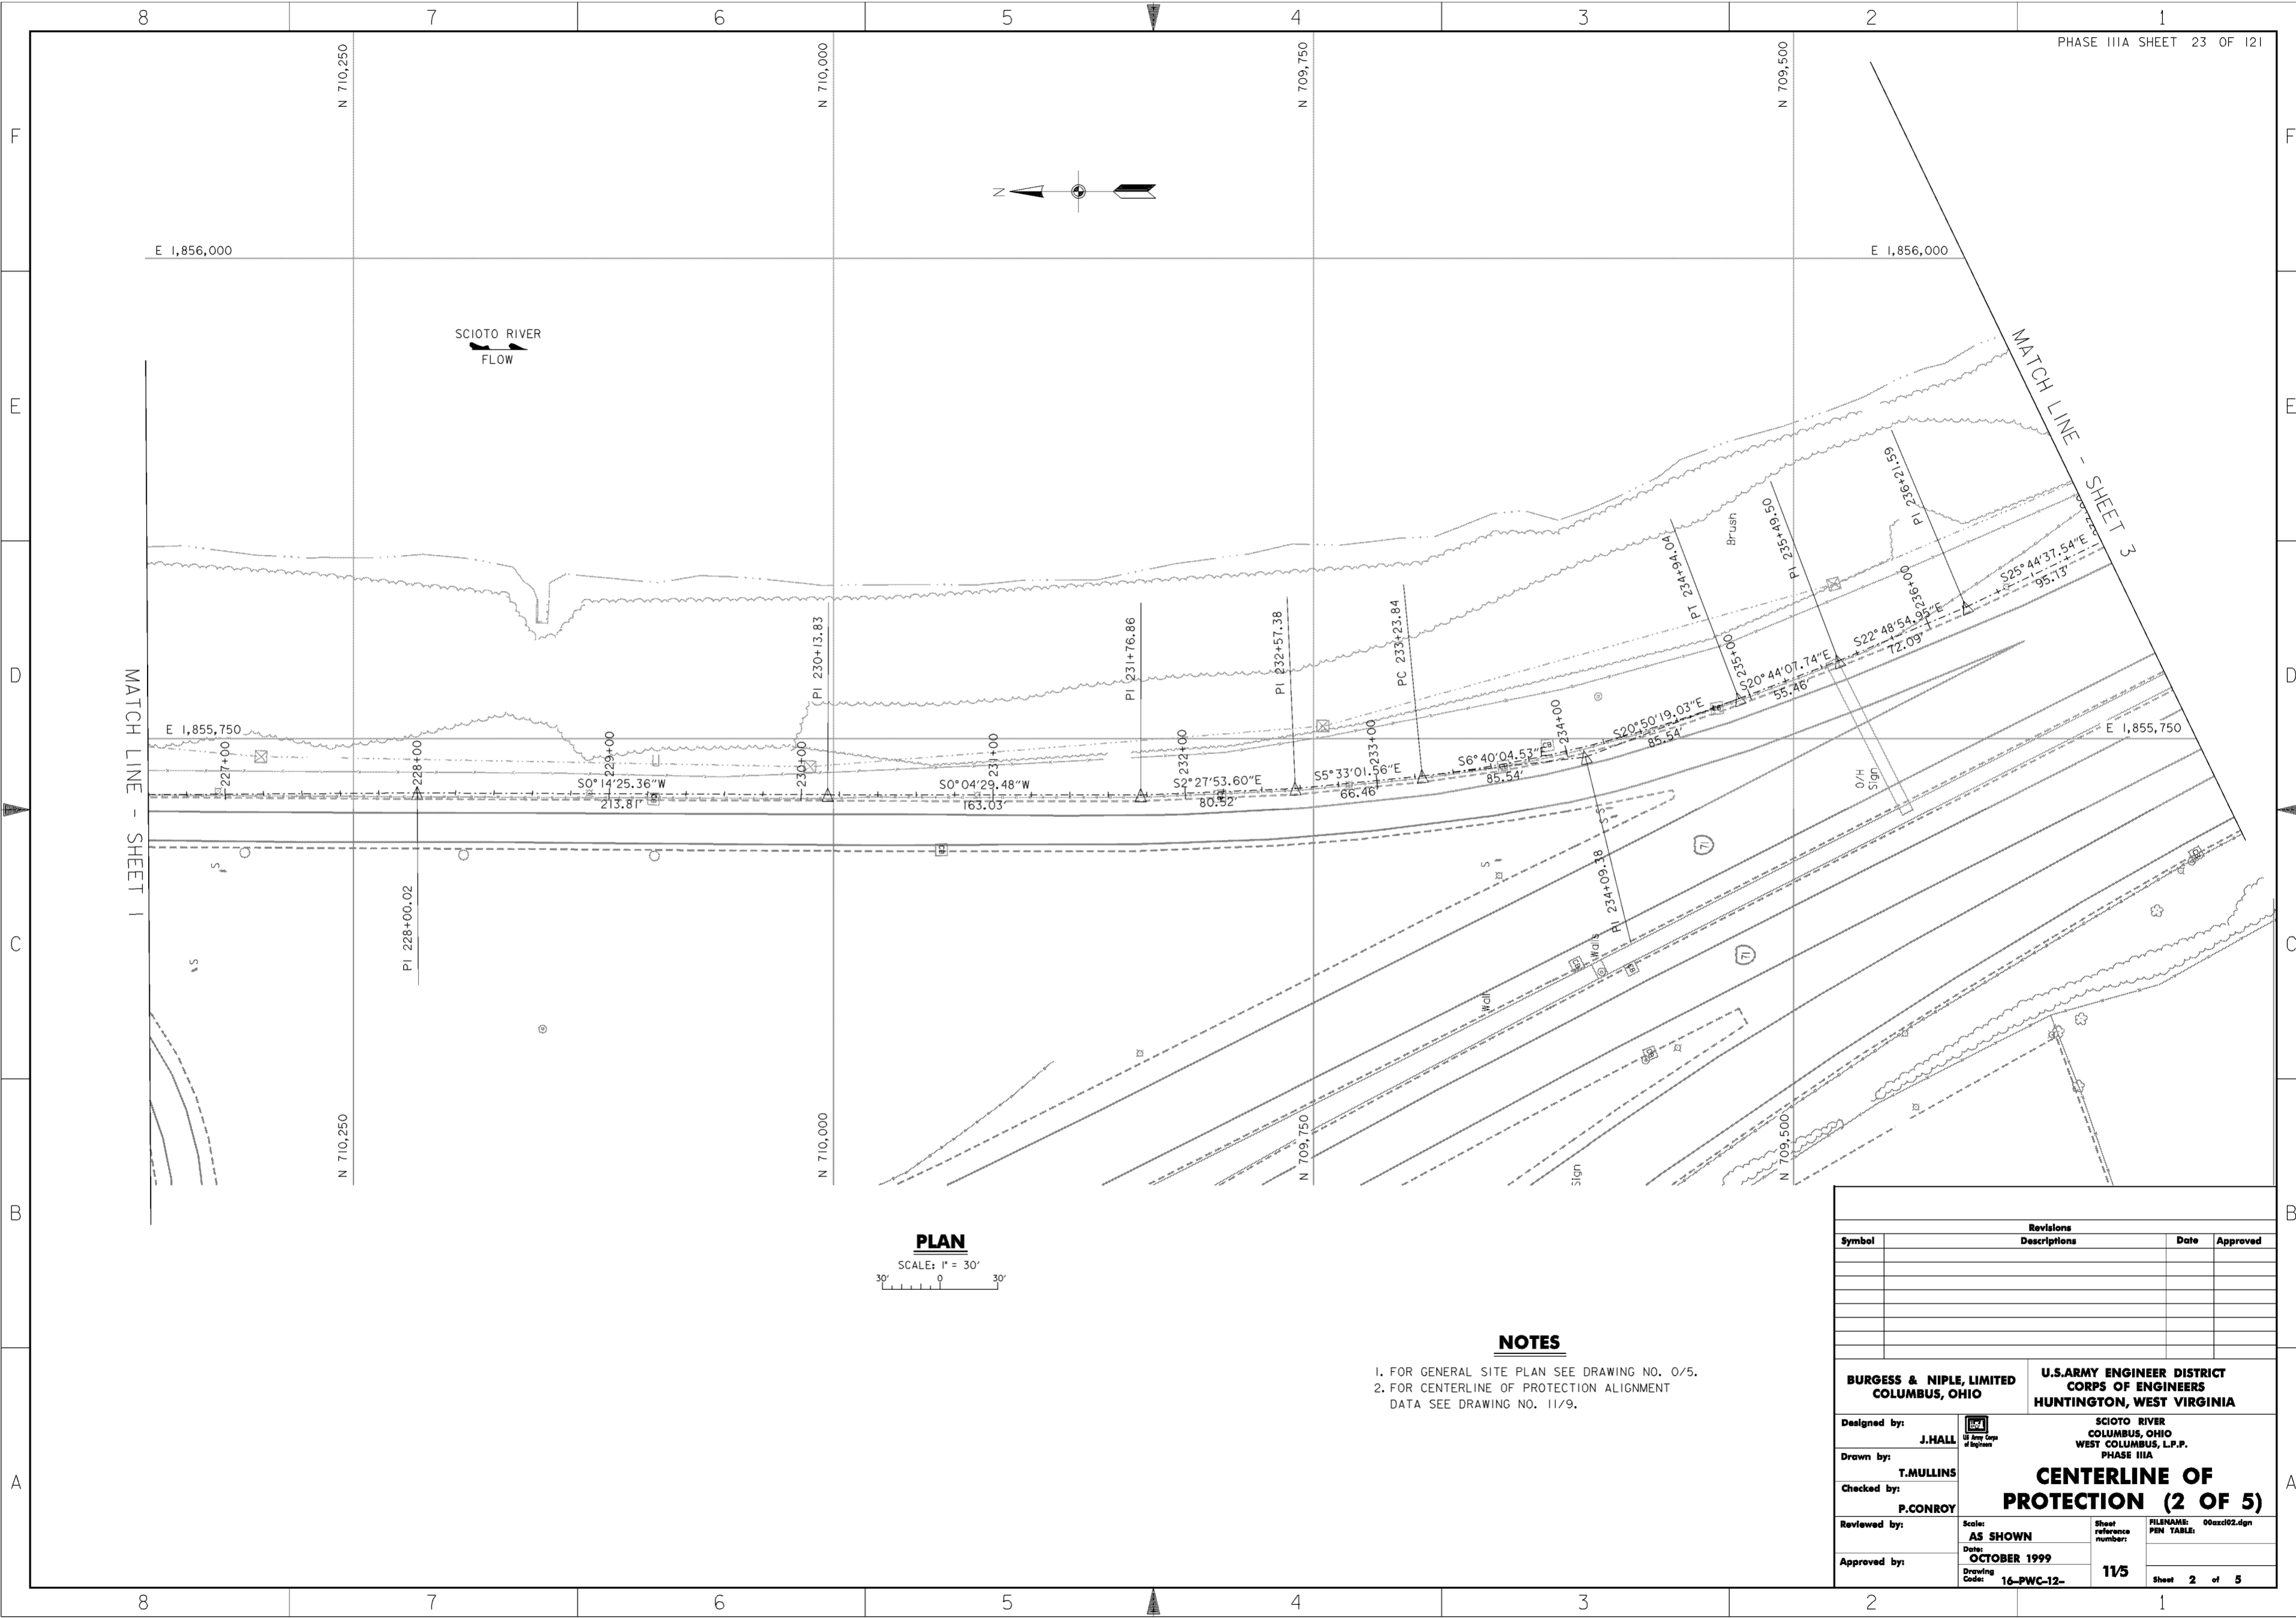

MATCH LINE - SHEET 1

MATCH LINE - SHEET 3

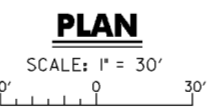

**NOTES**


1. FOR GENERAL SITE PLAN SEE DRAWING NO. 0/5.
2. FOR CENTERLINE OF PROTECTION ALIGNMENT DATA SEE DRAWING NO. 11/9.

Revisions			
Symbol	Descriptions	Date	Approved

<b>BURGESS &amp; NIPLE, LIMITED</b> COLUMBUS, OHIO	<b>U.S. ARMY ENGINEER DISTRICT</b> CORPS OF ENGINEERS HUNTINGTON, WEST VIRGINIA	SCIOTO RIVER COLUMBUS, OHIO WEST COLUMBUS, L.P.P. PHASE IIIA		
		<b>CENTERLINE OF PROTECTION (2 OF 5)</b>		
Designed by: <b>J. HALL</b>		Drawn by: <b>T. MULLINS</b>	FILENAME: 00axd02.dgn SHEET REFERENCE: PIN TABLE:	
Checked by: <b>P. CONROY</b>				
Reviewed by: <b>AS SHOWN</b>		Scale: <b>AS SHOWN</b>		Sheet reference number: <b>11/5</b>
Approved by:		Date: <b>OCTOBER 1999</b>		Drawing Code: <b>16-PWC-12-</b>
Sheet <b>2</b> of <b>5</b>				

**WORK AS CONSTRUCTED**

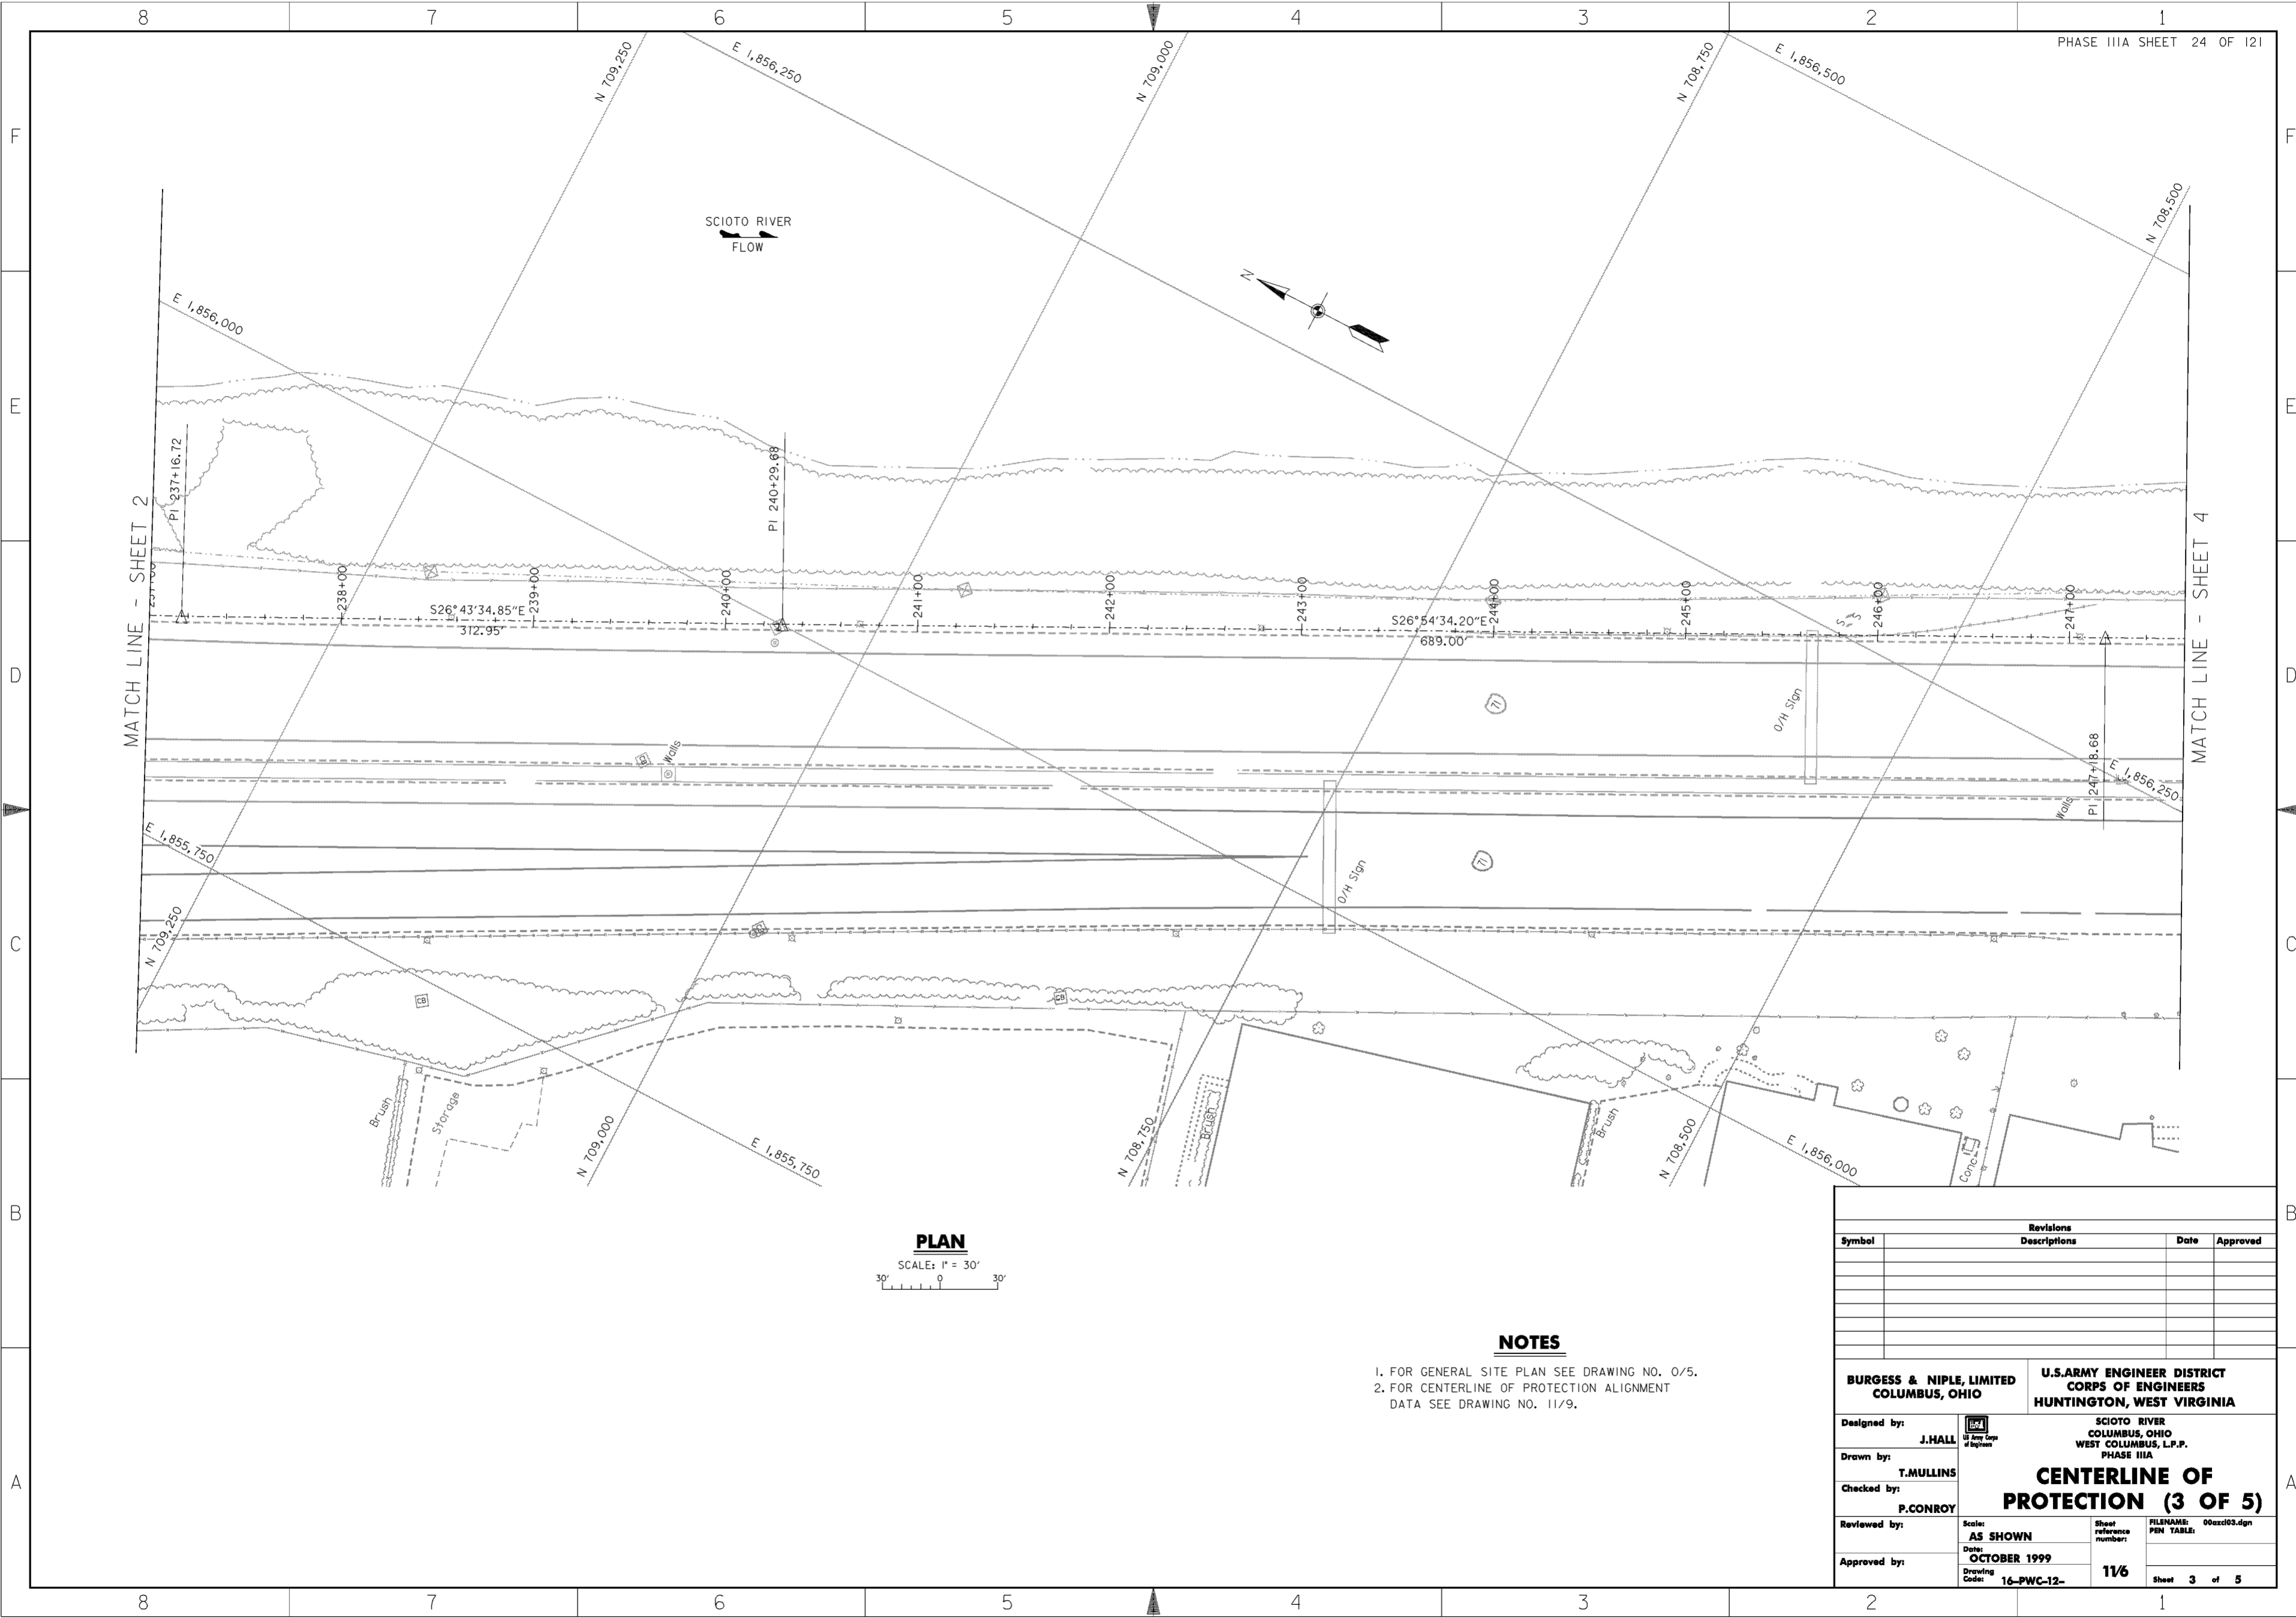

**PLAN**  
SCALE: 1" = 30'


**NOTES**

1. FOR GENERAL SITE PLAN SEE DRAWING NO. 0/5.
2. FOR CENTERLINE OF PROTECTION ALIGNMENT DATA SEE DRAWING NO. 11/9.

Revisions			
Symbol	Descriptions	Date	Approved

<b>BURGESS &amp; NIPLE, LIMITED</b> COLUMBUS, OHIO	<b>U.S. ARMY ENGINEER DISTRICT</b> CORPS OF ENGINEERS HUNTINGTON, WEST VIRGINIA
Designed by: <b>J. HALL</b>	<p align="center"><b>CENTERLINE OF PROTECTION (3 OF 5)</b></p> FILENAME: 00axc03.dgn PIN TABLE:
Drawn by: <b>T. MULLINS</b>	
Checked by: <b>P. CONROY</b>	
Reviewed by:	
Approved by:	
Scale: <b>AS SHOWN</b>	Sheet reference number: <b>11/6</b>
Date: <b>OCTOBER 1999</b>	Drawing Code: <b>16-PWC-12-</b>
Sheet 3 of 5	

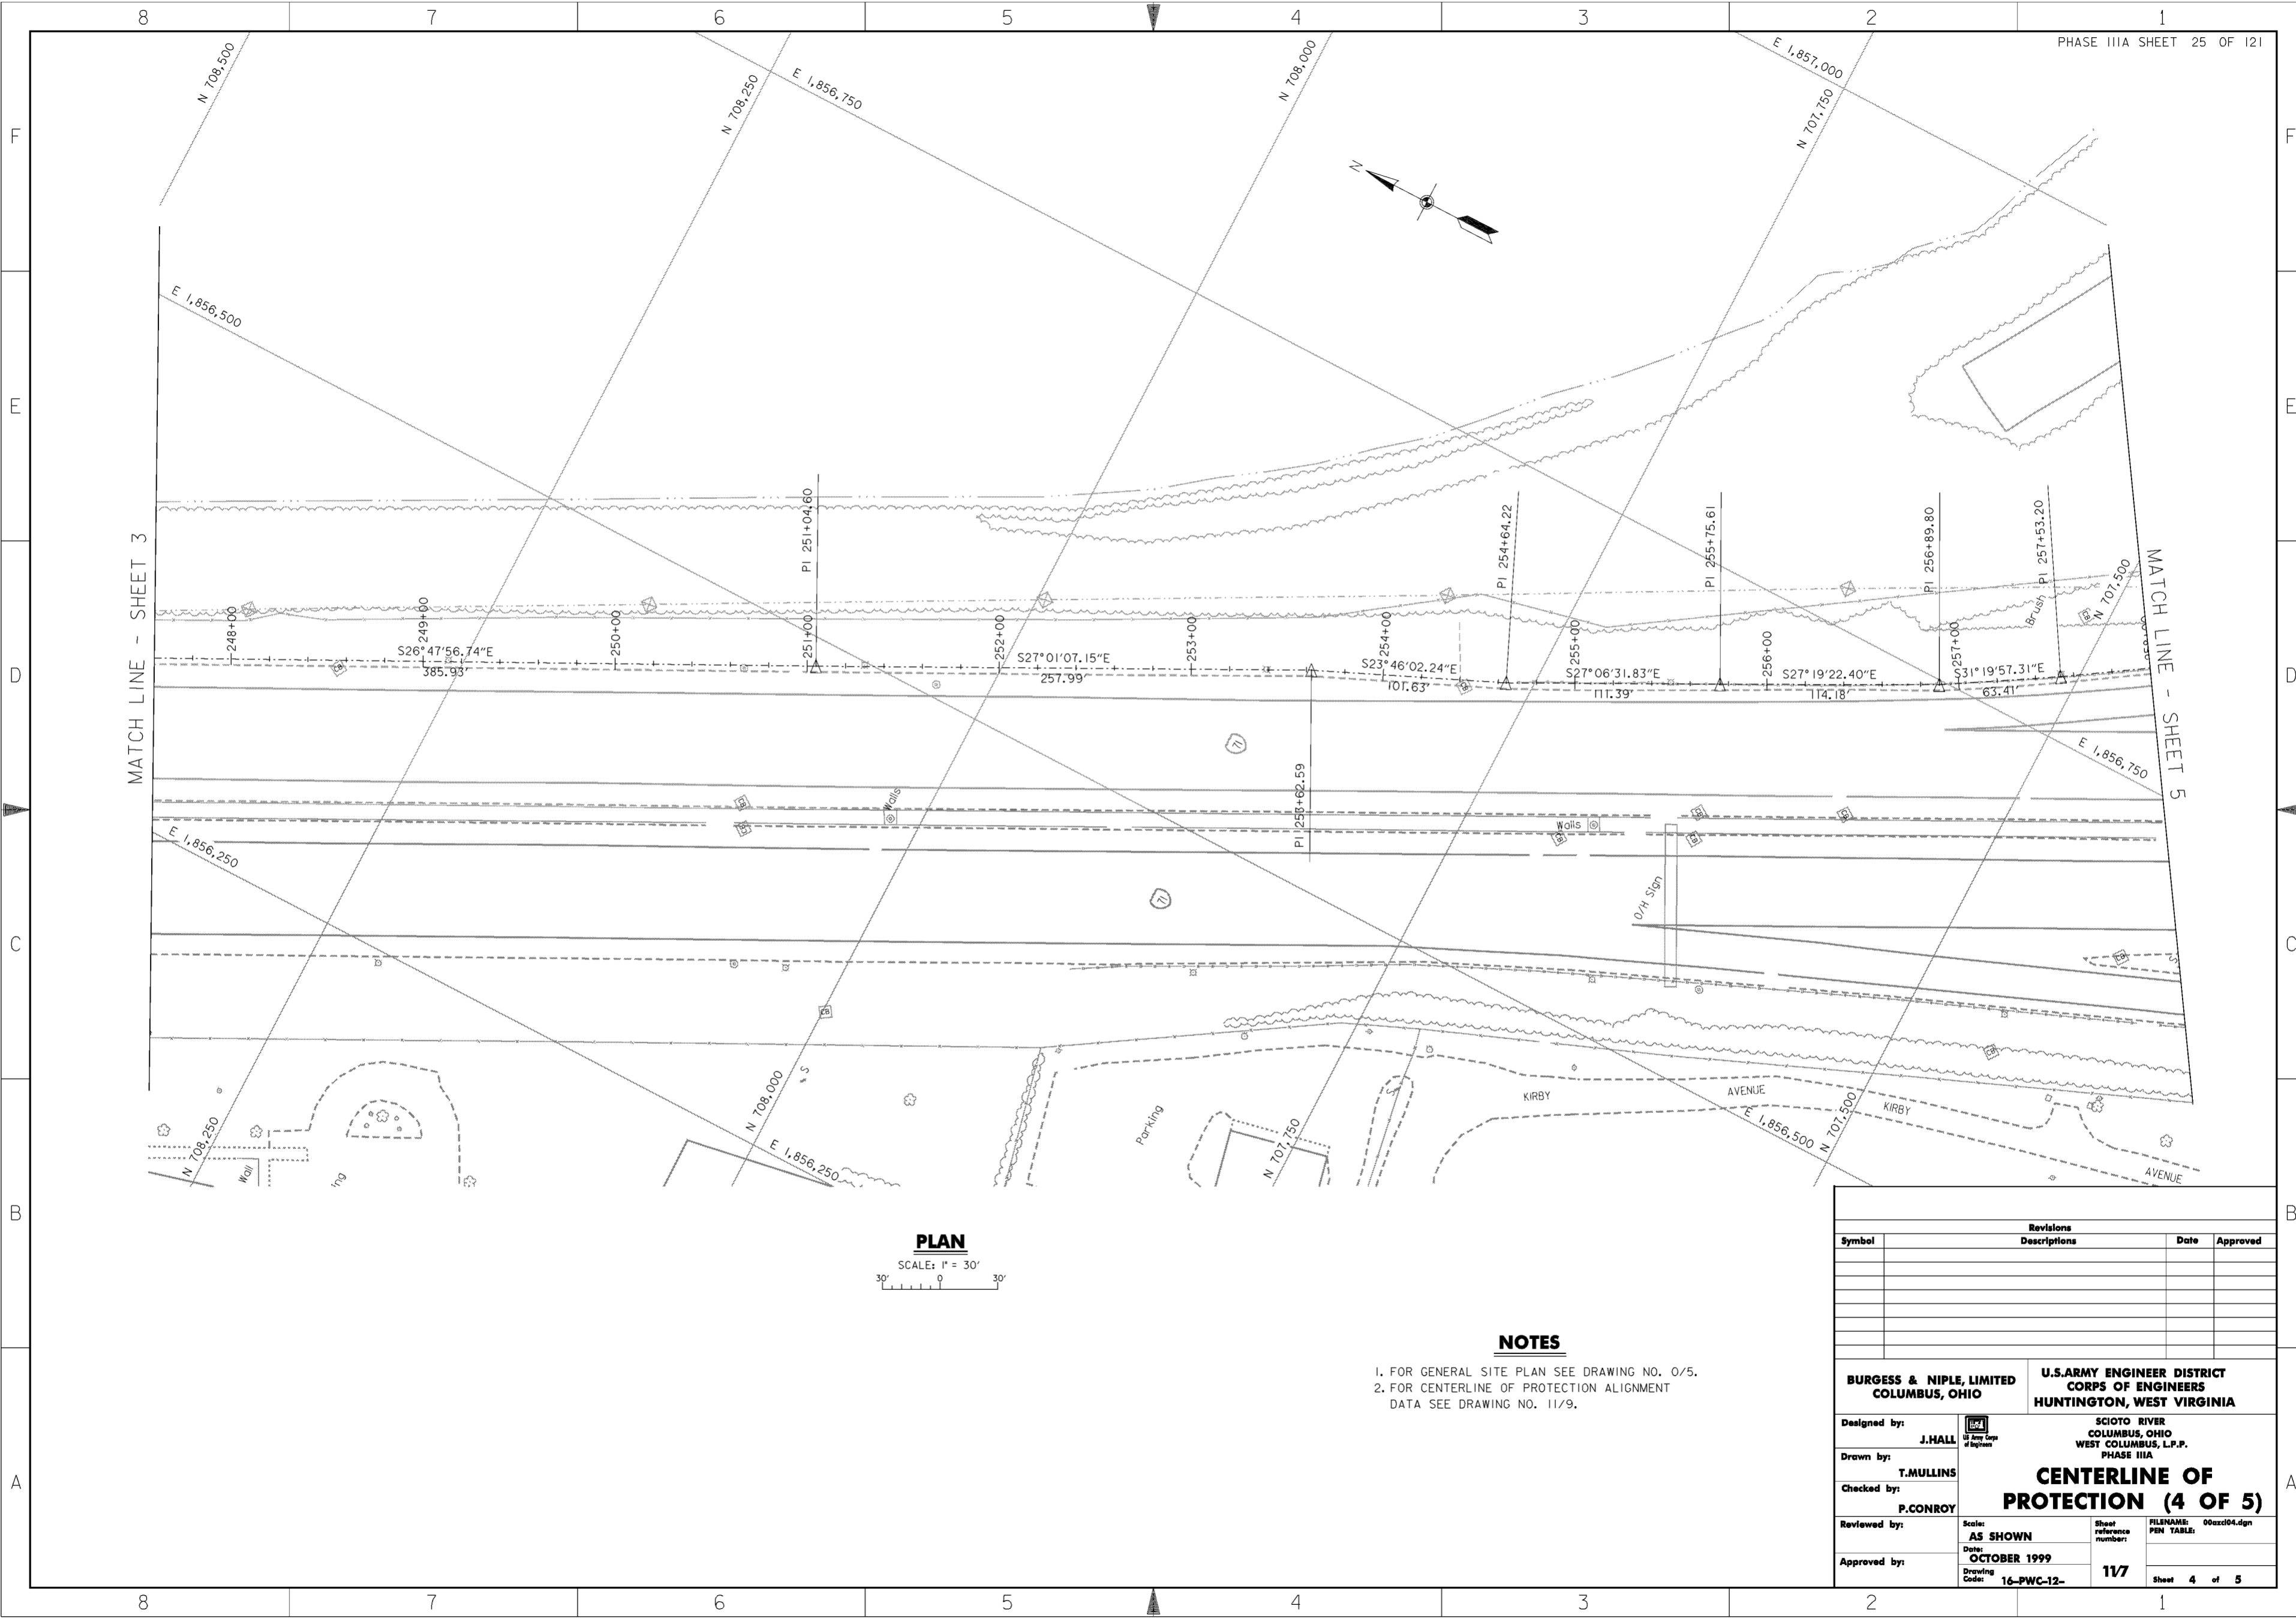

**PLAN**  
SCALE: 1" = 30'


**NOTES**

1. FOR GENERAL SITE PLAN SEE DRAWING NO. 0/5.
2. FOR CENTERLINE OF PROTECTION ALIGNMENT DATA SEE DRAWING NO. 11/9.

Revisions			
Symbol	Descriptions	Date	Approved

<b>BURGESS &amp; NIPLE, LIMITED</b> COLUMBUS, OHIO	<b>U.S. ARMY ENGINEER DISTRICT</b> CORPS OF ENGINEERS HUNTINGTON, WEST VIRGINIA	SCIOTO RIVER COLUMBUS, OHIO WEST COLUMBUS, L.P.P. PHASE IIIA	
		<b>CENTERLINE OF PROTECTION (4 OF 5)</b>	
Designed by: <b>J. HALL</b>	Scale: <b>AS SHOWN</b> Date: <b>OCTOBER 1999</b> Drawing Code: <b>16-PWC-12-</b>	Sheet reference number: <b>11/7</b>	FILENAME: PIN TABLE: <b>00axd04.dgn</b>
Drawn by: <b>T. MULLINS</b>		Sheet 4 of 5	
Checked by: <b>P. CONROY</b>		Approved by:	
Reviewed by:		Approved by:	

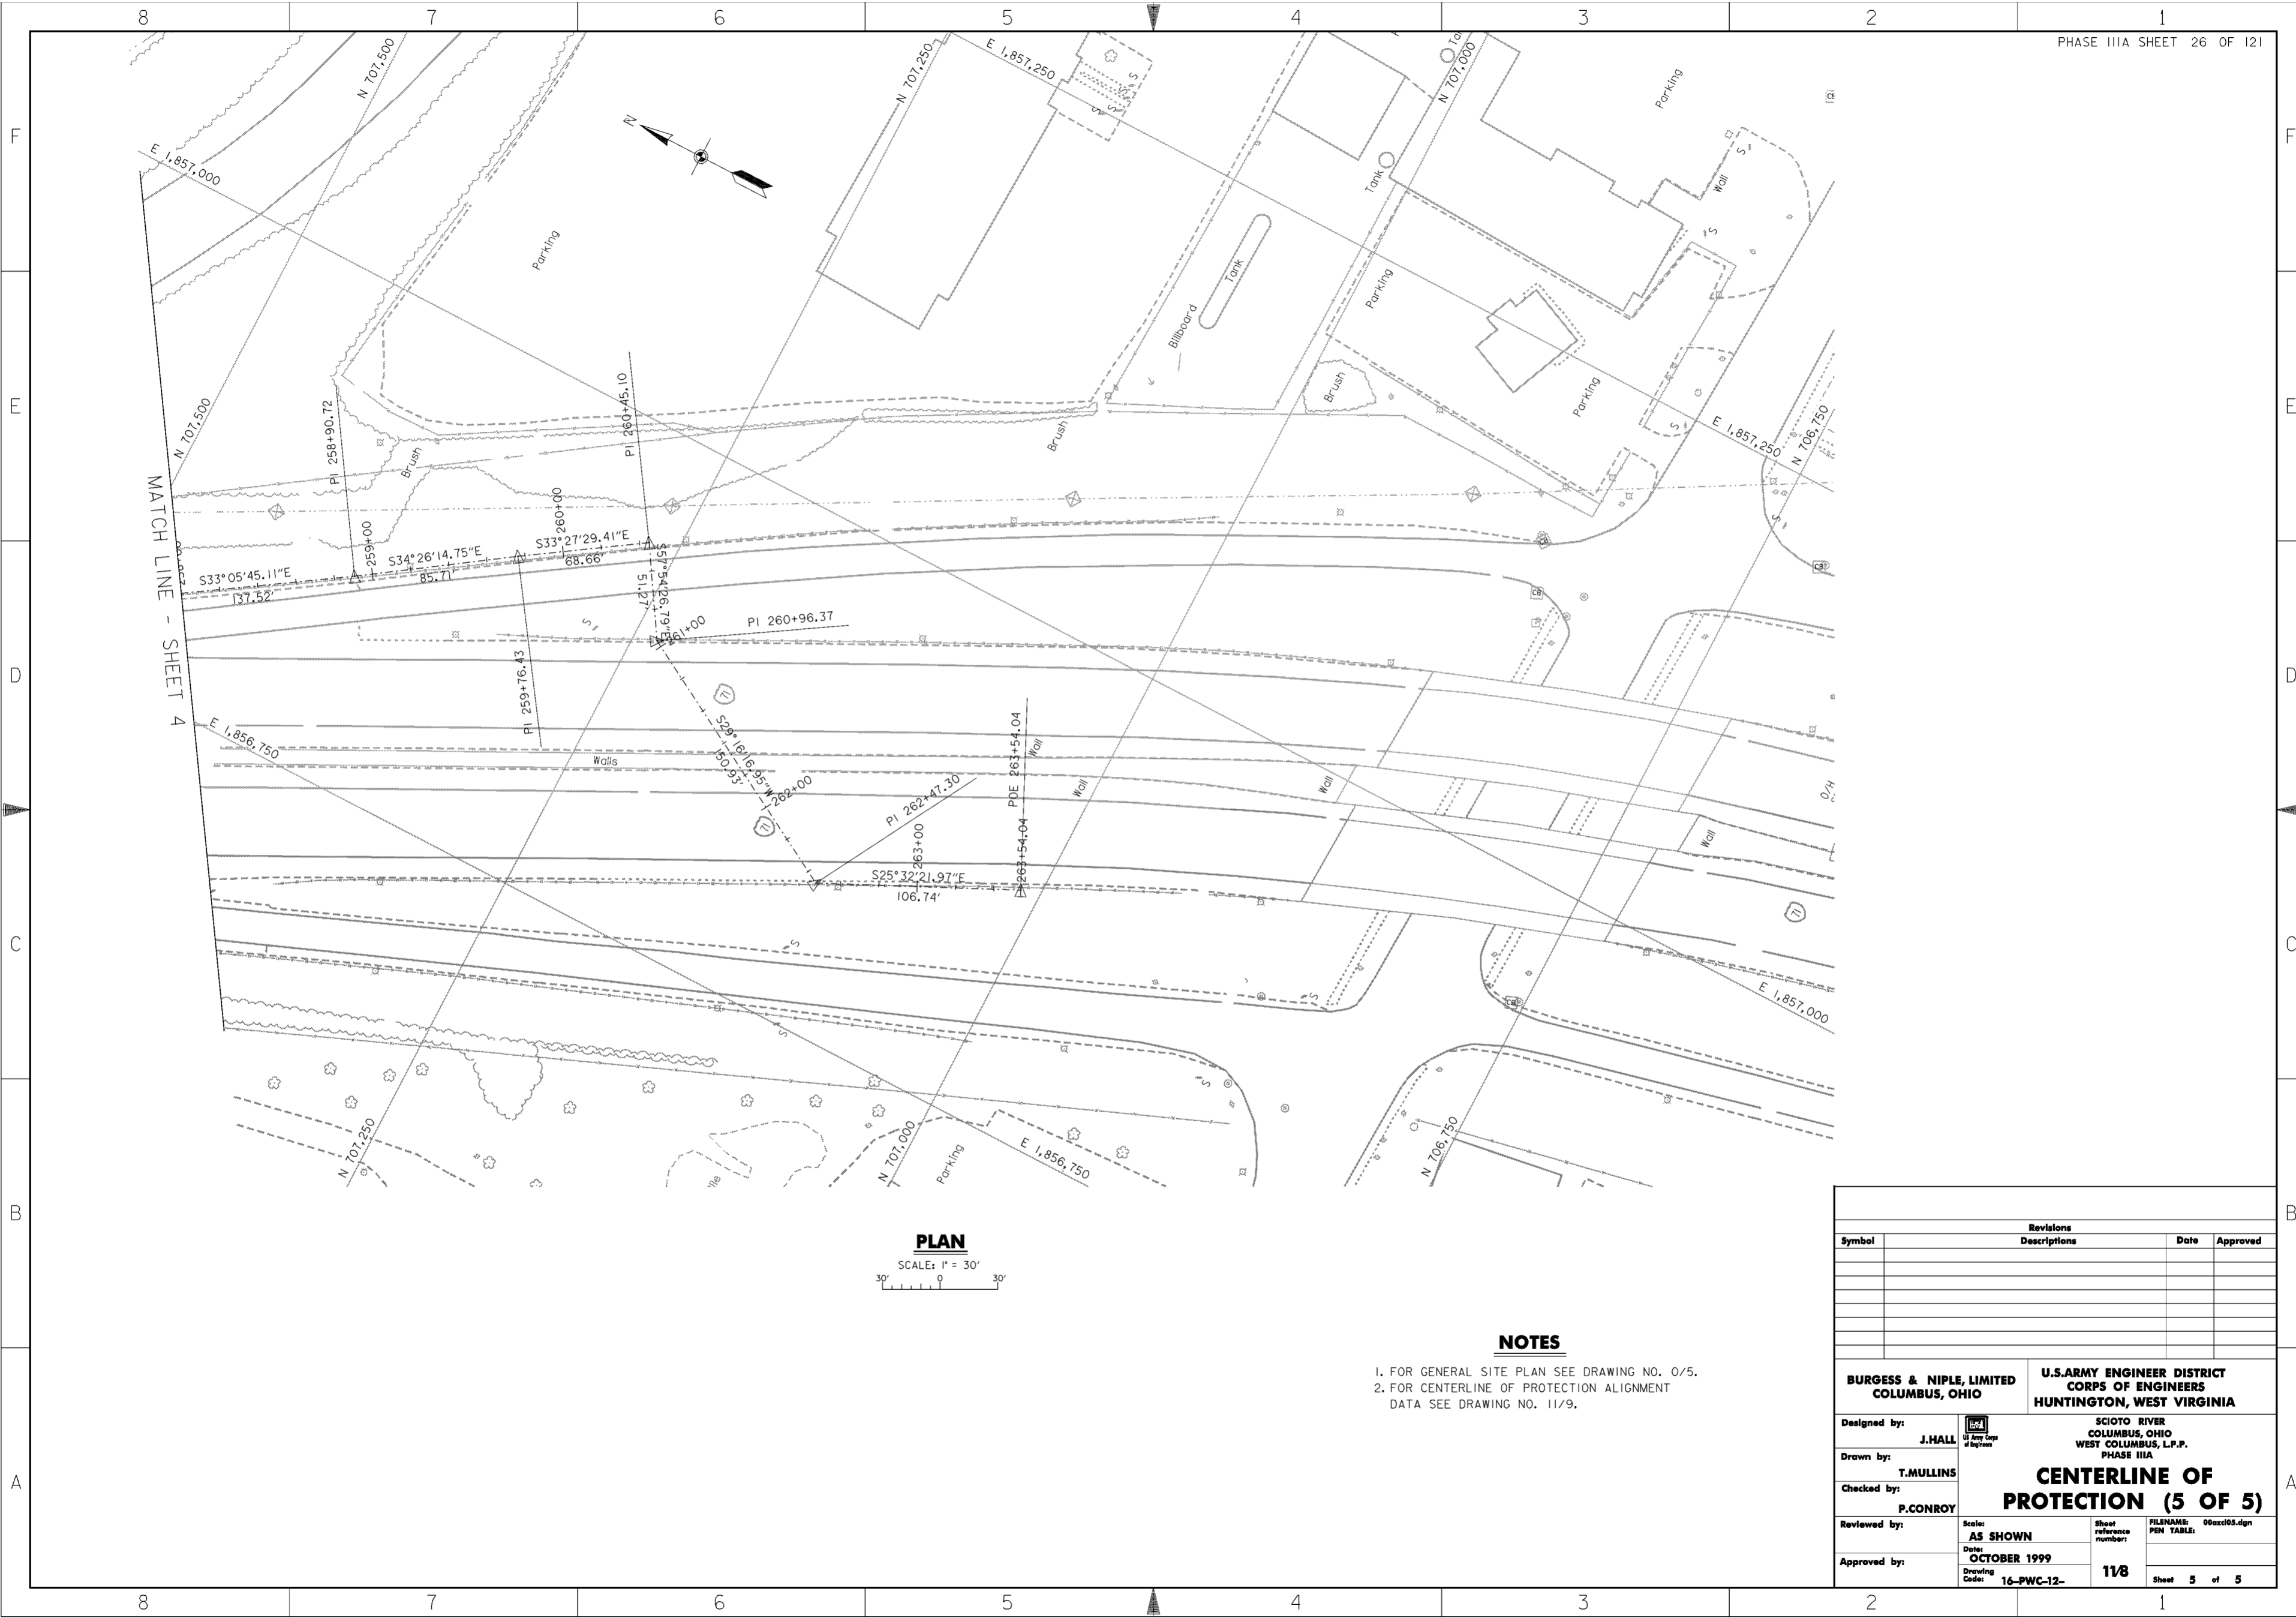


**PLAN**  
SCALE: 1" = 30'

**NOTES**

1. FOR GENERAL SITE PLAN SEE DRAWING NO. 0/5.
2. FOR CENTERLINE OF PROTECTION ALIGNMENT DATA SEE DRAWING NO. 11/9.

Revisions			
Symbol	Descriptions	Date	Approved

<b>BURGESS &amp; NIPLE, LIMITED</b> COLUMBUS, OHIO	<b>U.S. ARMY ENGINEER DISTRICT</b> CORPS OF ENGINEERS HUNTINGTON, WEST VIRGINIA	SCIOTO RIVER COLUMBUS, OHIO WEST COLUMBUS, L.P.P. PHASE IIIA		
		<b>CENTERLINE OF PROTECTION (5 OF 5)</b>		
Designed by: <b>J. HALL</b>		Drawn by: <b>T. MULLINS</b>	FILENAME: 00ax03.dgn PIN TABLE:	
Checked by: <b>P. CONROY</b>				
Reviewed by:		Scale: <b>AS SHOWN</b>		Sheet reference number: <b>11/8</b>
Approved by:		Date: <b>OCTOBER 1999</b>		Drawing Code: <b>16-PWC-12-</b>
Sheet 5 of 5				



**HORIZONTAL ALIGNMENT DATA FOR CENTERLINE OF PROTECTION**

F  
E  
D  
C  
B  
A

Element	STATION	NORTH(Y)	EAST(X)
Element: LINEAR	POB 215+82.37 PI 218+01.21 Tangent Direction: S 12°13'35.55" W Tangent Length: 218.843	711398.036 711184.157	1855919.978 1855873.632
Element: LINEAR	PI 218+01.21 PI 218+56.58 Tangent Direction: S 8°01'44.82" W Tangent Length: 55.364	711184.157 711129.336	1855873.632 1855865.899
Element: LINEAR	PI 218+56.58 PC 220+01.41 Tangent Direction: S 8°01'47.05" W Tangent Length: 144.838	711129.336 710985.918	1855865.899 1855845.667
Element: CIRCULAR CURVE	PC 220+01.41 PI 221+97.91 CC 710633.086 PT 223+79.11 Curve Radius: -554.991 Curve Length: 377.696 Total Central Angle: 38°59'32.41" 1st Subtangent Distance: 196.491 2nd Subtangent Distance: 196.491	710985.918 710834.247 710633.086 710637.763	1855845.667 1855720.749 1856274.064 1855719.093
Element: LINEAR	PT 223+79.11 PI 228+00.02 Tangent Direction: S 0°20'07.47" E Tangent Length: 420.913	710637.763 710216.857	1855719.093 1855721.557
Element: LINEAR	PI 228+00.02 PI 230+13.83 Tangent Direction: S 0°14'25.36" W Tangent Length: 213.806	710216.857 710003.053	1855721.557 1855720.660
Element: LINEAR	PI 230+13.83 PI 231+76.86 Tangent Direction: S 0°04'29.48" W Tangent Length: 163.031	710003.053 709840.022	1855720.660 1855720.447
Element: LINEAR	PI 231+76.86 PI 232+57.38 Tangent Direction: S 2°27'53.60" E Tangent Length: 80.522	709840.022 709759.575	1855720.447 1855723.910
Element: LINEAR	PI 232+57.38 PC 233+23.84 Tangent Direction: S 5°33'01.56" E Tangent Length: 66.459	709759.575 709693.428	1855723.910 1855730.338
Element: CIRCULAR CURVE	PC 233+23.84 PI 234+09.38 CC 709773.335 PT 234+94.04 Curve Radius: -688.171 Curve Length: 170.202 Total Central Angle: 14°10'14.50" 1st Subtangent Distance: 85.537 2nd Subtangent Distance: 85.537	709693.428 709608.469 709773.335 709528.527	1855730.338 1855740.270 1856413.854 1855770.699
Element: LINEAR	PT 234+94.04 PI 235+49.50 Tangent Direction: S 20°44'07.74" E Tangent Length: 55.460	709528.527 709476.659	1855770.699 1855790.335
Element: LINEAR	PI 235+49.50 PI 236+21.59 Tangent Direction: S 22°48'54.95" E Tangent Length: 72.088	709476.659 709410.211	1855790.335 1855818.288

Element: LINEAR	PI 236+21.59 PI 237+16.72 Tangent Direction: S 25°44'37.54" E Tangent Length: 95.129	709410.211 709324.524	1855818.288 1855859.607
Element: LINEAR	PI 237+16.72 PI 240+29.68 Tangent Direction: S 26°43'34.85" E Tangent Length: 312.955	709324.524 709045.004	1855859.607 1856000.352
Element: LINEAR	PI 240+29.68 PI 247+18.68 Tangent Direction: S 26°54'34.20" E Tangent Length: 689.004	709045.004 708430.604	1856000.352 1856312.183
Element: LINEAR	PI 247+18.68 PI 251+04.60 Tangent Direction: S 26°47'56.74" E Tangent Length: 385.926	708430.604 708086.129	1856312.183 1856486.183
Element: LINEAR	PI 251+04.60 PI 253+62.59 Tangent Direction: S 27°01'07.15" E Tangent Length: 257.988	708086.129 707856.298	1856486.183 1856603.382
Element: LINEAR	PI 253+62.59 PI 254+64.22 Tangent Direction: S 23°46'02.24" E Tangent Length: 101.627	707856.298 707763.290	1856603.382 1856644.340
Element: LINEAR	PI 254+64.22 PI 255+75.61 Tangent Direction: S 27°06'31.83" E Tangent Length: 111.393	707763.290 707664.134	1856644.340 1856695.100
Element: LINEAR	PI 255+75.61 PI 256+89.80 Tangent Direction: S 27°19'22.40" E Tangent Length: 114.184	707664.134 707562.689	1856695.100 1856747.511
Element: LINEAR	PI 256+89.80 PI 257+53.20 Tangent Direction: S 31°19'57.31" E Tangent Length: 63.407	707562.689 707508.529	1856747.511 1856780.483
Element: LINEAR	PI 257+53.20 PI 258+90.72 Tangent Direction: S 33°05'45.11" E Tangent Length: 137.517	707508.529 707393.323	1856780.483 1856855.573
Element: LINEAR	PI 258+90.72 PI 259+76.43 Tangent Direction: S 34°26'14.75" E Tangent Length: 85.713	707393.323 707322.632	1856855.573 1856904.044
Element: LINEAR	PI 259+76.43 PI 260+45.10 Tangent Direction: S 33°27'29.41" E Tangent Length: 68.663	707322.632 707265.347	1856904.044 1856941.900
Element: LINEAR	PI 260+45.10 PI 260+96.37 Tangent Direction: S 57°54'26.79" W Tangent Length: 51.275	707265.347 707238.105	1856941.900 1856898.460


Element: LINEAR	PI 260+96.37 PI 262+47.30 Tangent Direction: S 29°16'16.95" W Tangent Length: 150.929	707238.105 707106.448	1856898.460 1856824.664
Element: LINEAR	PI 262+47.30 POE 263+54.04 Tangent Direction: S 25°32'21.97" E Tangent Length: 106.735	707106.448 707010.142	1856824.664 1856870.681

**NOTES**


- FOR SITE PLAN SEE DRAWING NO. 0/5.
- FOR CENTERLINE OF PROTECTION PLAN SEE DRAWING NOS. 11/4 THRU 11/8.

Revisions			
Symbol	Descriptions	Date	Approved

<b>BURGESS &amp; NIPLE, LIMITED</b> COLUMBUS, OHIO	<b>U.S. ARMY ENGINEER DISTRICT</b> CORPS OF ENGINEERS HUNTINGTON, WEST VIRGINIA
Designed by: <b>J.HALL</b>	 <p><b>HORIZONTAL ALIGNMENT</b></p>
Drawn by: <b>T.MULLINS</b>	
Checked by: <b>P.CONROY</b>	
Reviewed by:	
Approved by:	Scale: <b>NONE</b> Date: <b>OCTOBER 1999</b> Drawing Code: <b>16-PWC-12-</b>
	Sheet reference number: <b>11/9</b> FILENAME: 00azm01.dgn PIN TABLE: Sheet <b>1</b> of <b>1</b>




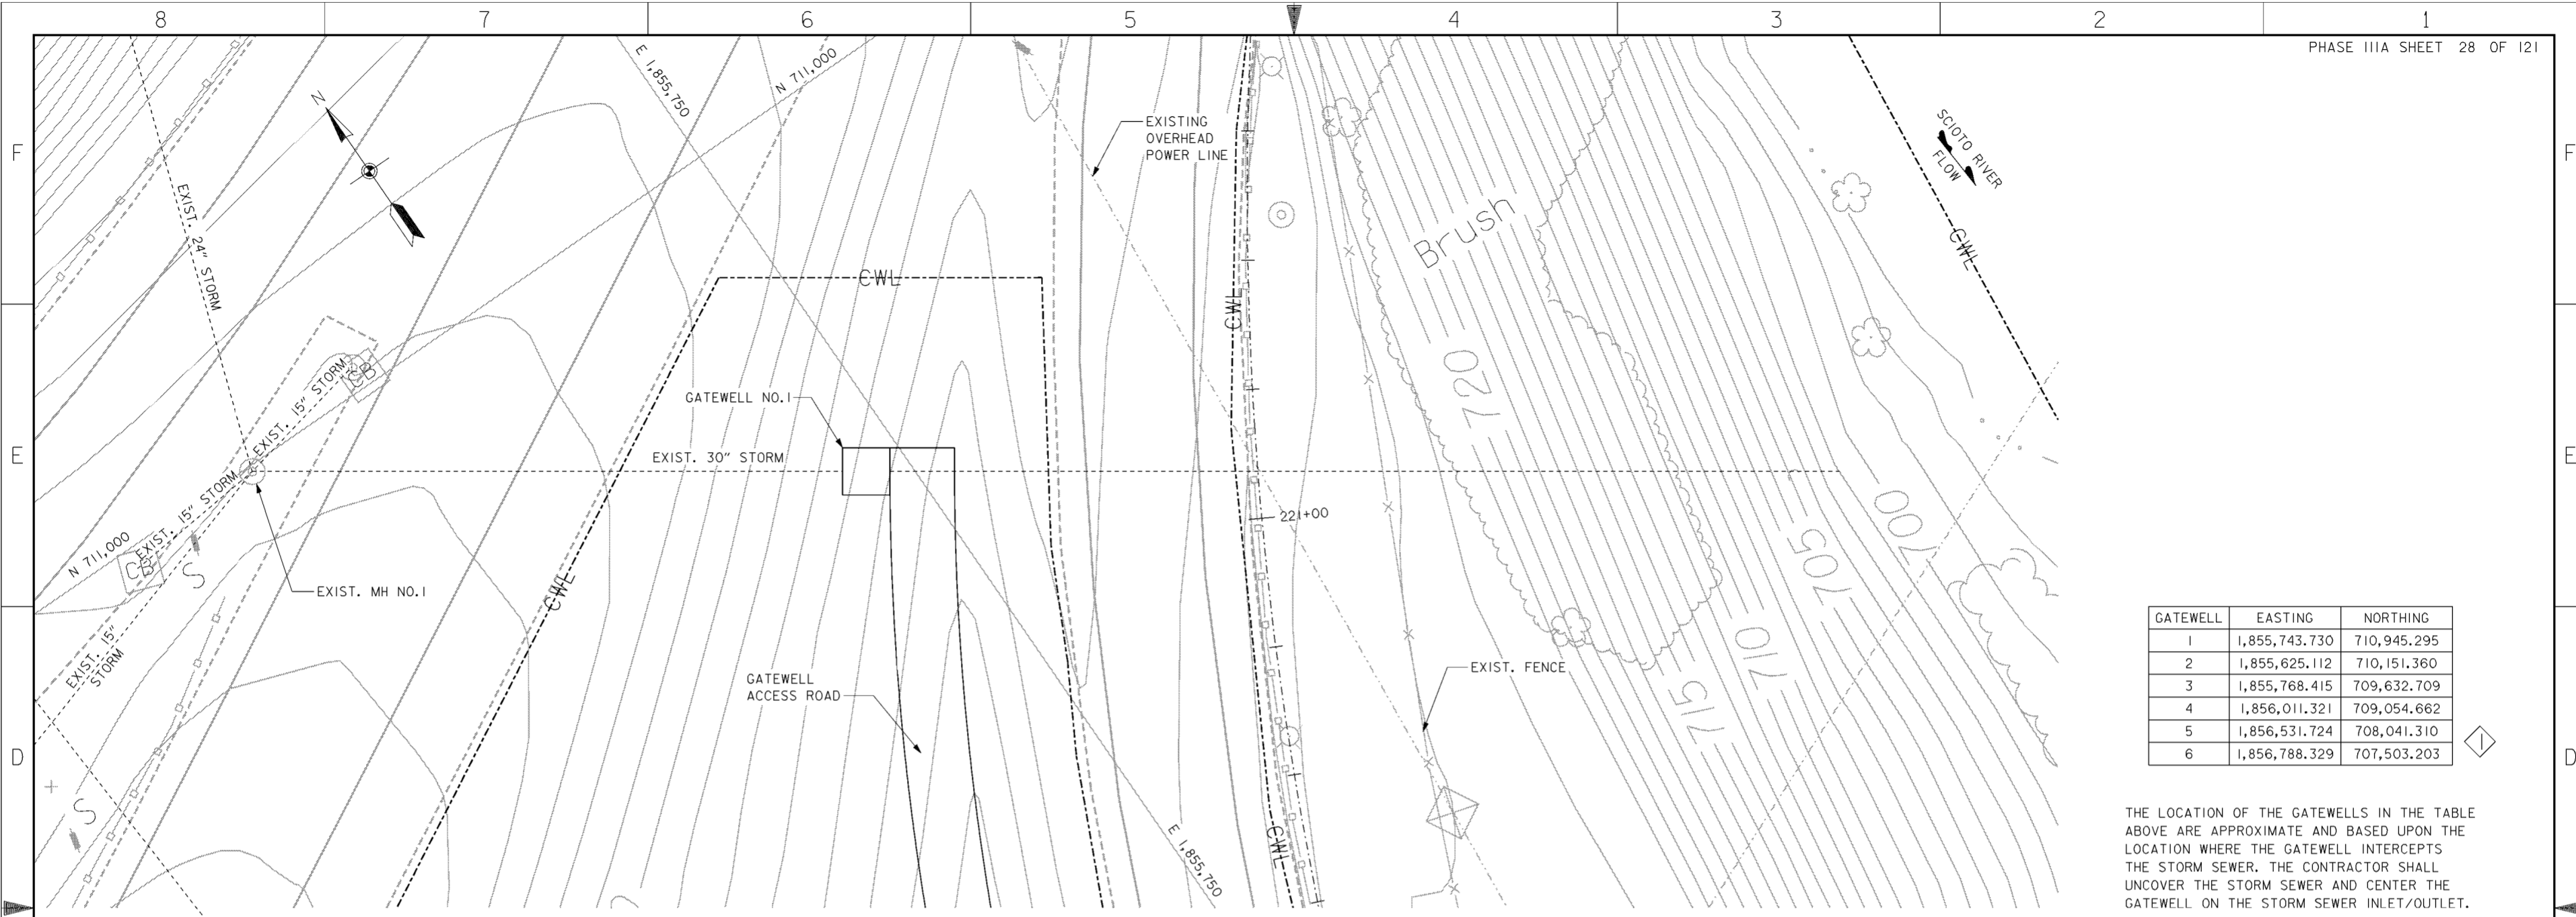

GATEWELL	EASTING	NORTHING
1	1,855,743.730	710,945.295
2	1,855,625.112	710,151.360
3	1,855,768.415	709,632.709
4	1,856,011.321	709,054.662
5	1,856,531.724	708,041.310
6	1,856,788.329	707,503.203

THE LOCATION OF THE GATEWELLS IN THE TABLE ABOVE ARE APPROXIMATE AND BASED UPON THE LOCATION WHERE THE GATEWELL INTERCEPTS THE STORM SEWER. THE CONTRACTOR SHALL UNCOVER THE STORM SEWER AND CENTER THE GATEWELL ON THE STORM SEWER INLET/OUTLET.

**PLAN**  
SCALE: 1" = 10'

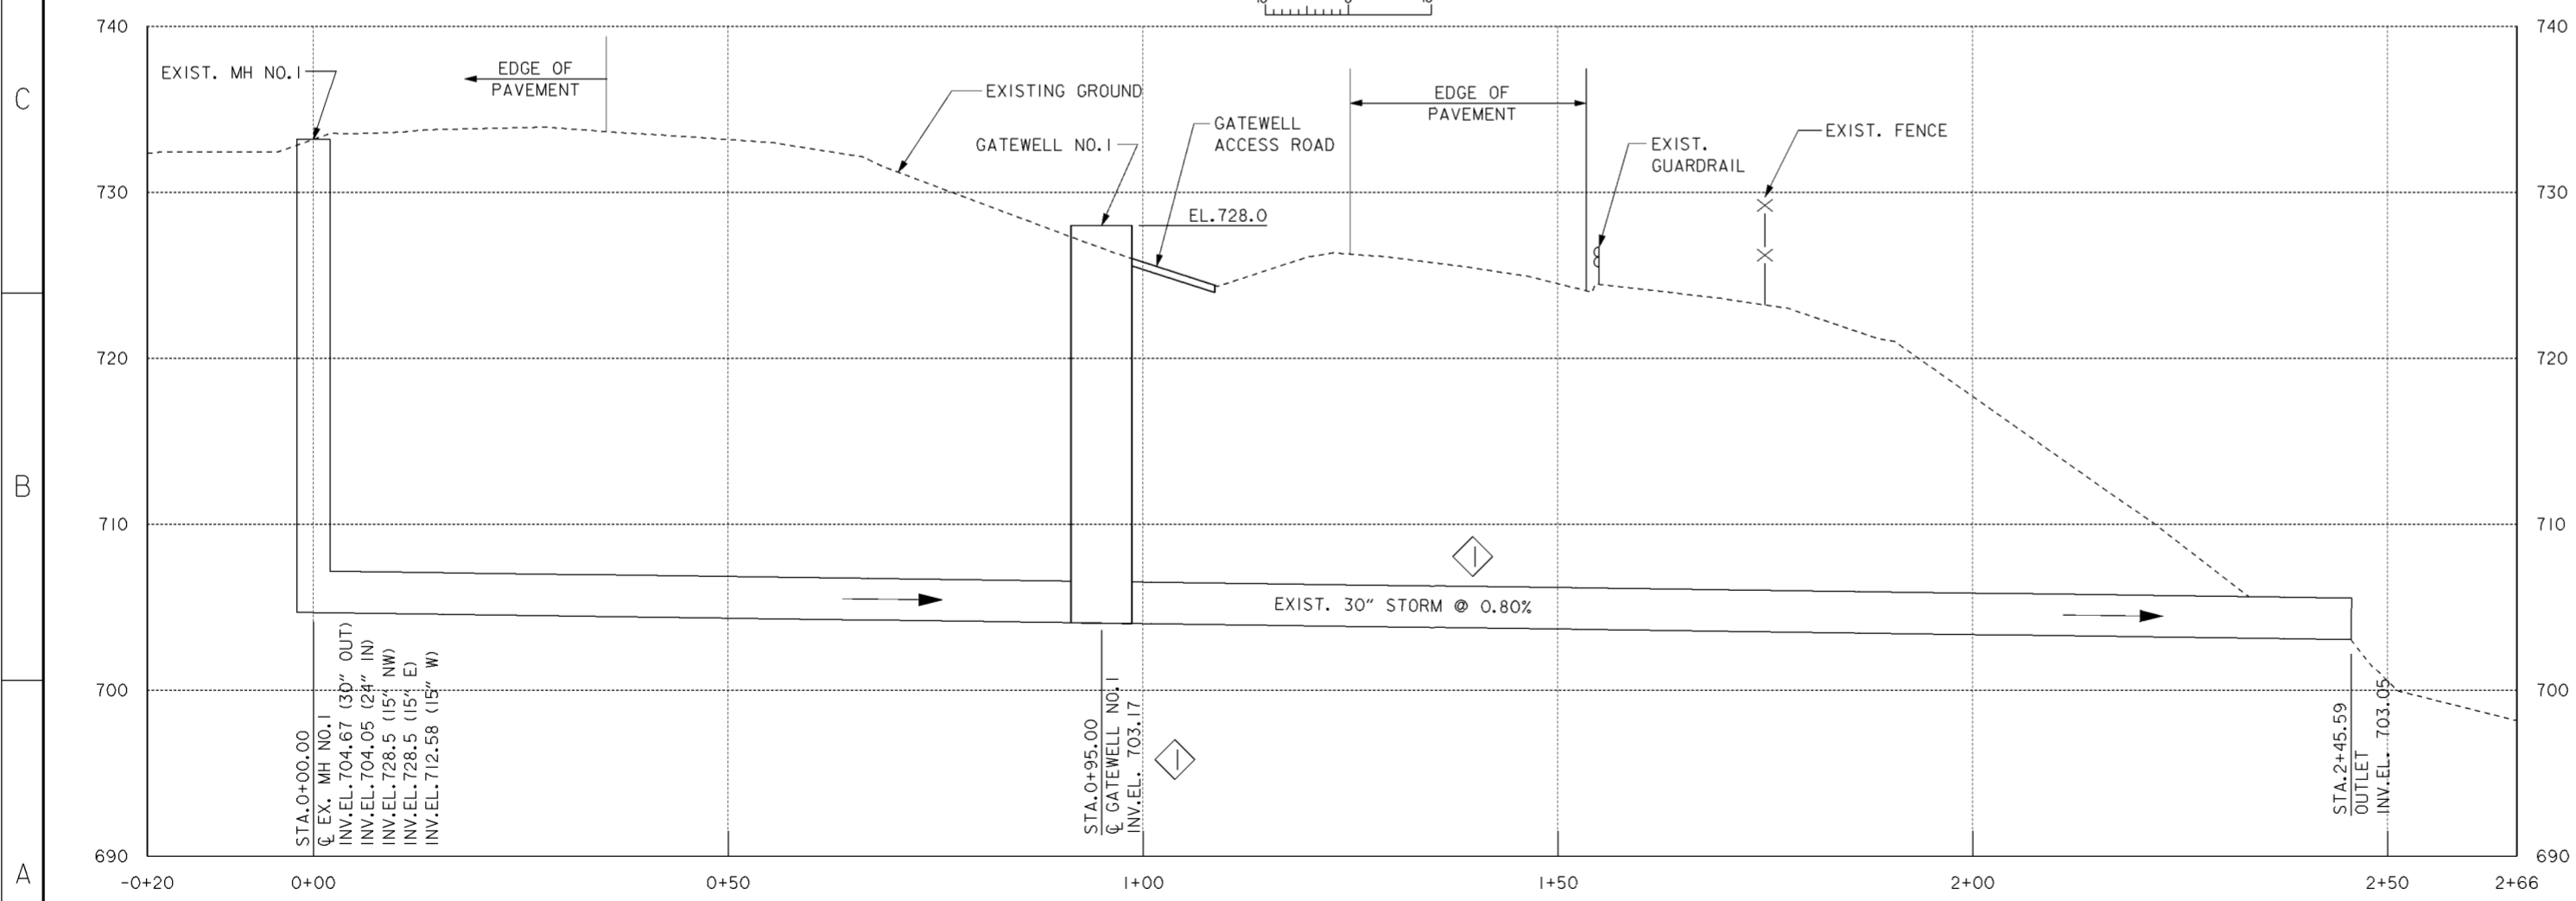


**PROFILE**  
SCALE IN FEET

**NOTES**

1. FOR CONTRACTOR WORK LIMITS SEE DRAWING NOS. 6/1 THRU 6/5.
2. FOR TYPICAL GATEWELL PLAN AND DETAILS SEE DRAWING NOS. 15/7 AND 15/8.
3. FOR GATEWELL REINFORCING STEEL SEE DRAWING NO. 15/9.
4. REMOVE DISTURBED STORM SEWER PIPE TO NEAREST JOINT AND PROVIDE NEW CONNECTIONS TO THE GATEWELL.
5. FOR GATEWELL ACCESS ROAD TYPICAL SECTION SEE DRAWING NO.15/8.
6. FOR GATEWELL NO.1 SHORING SEE DRAWING NO.20.3/4.
7. FOR ACCESS ROAD SEE DRAWING NO.20.2/2.

Revisions			
Symbol	Descriptions	Date	Approved
◇	REVISED AS CONSTRUCTED - PHASE IIIA NORTH	4/01	P.O.C.

<b>BURGESS &amp; NIPL, LIMITED</b> COLUMBUS, OHIO	<b>U.S. ARMY ENGINEER DISTRICT</b> CORPS OF ENGINEERS HUNTINGTON, WEST VIRGINIA
Designed by: <b>P.CONROY</b>	SCIO TO RIVER COLUMBUS, OHIO WEST COLUMBUS, L.P.P. PHASE IIIA
Drawn by: <b>T.MULLINS</b>	<b>GATEWELL NO.1</b> <b>PLAN AND PROFILE</b>
Checked by: <b>R.ROMAN</b>	Scale: <b>AS SHOWN</b>
Reviewed by:	Date: <b>OCTOBER 1999</b>
Approved by:	Drawing Code: <b>16-PWC-12-</b>
	Sheet reference number: <b>15/1</b>
	FILENAME: a0d6pp01.dgn
	PIN TABLE:
	Sheet 1 of 1

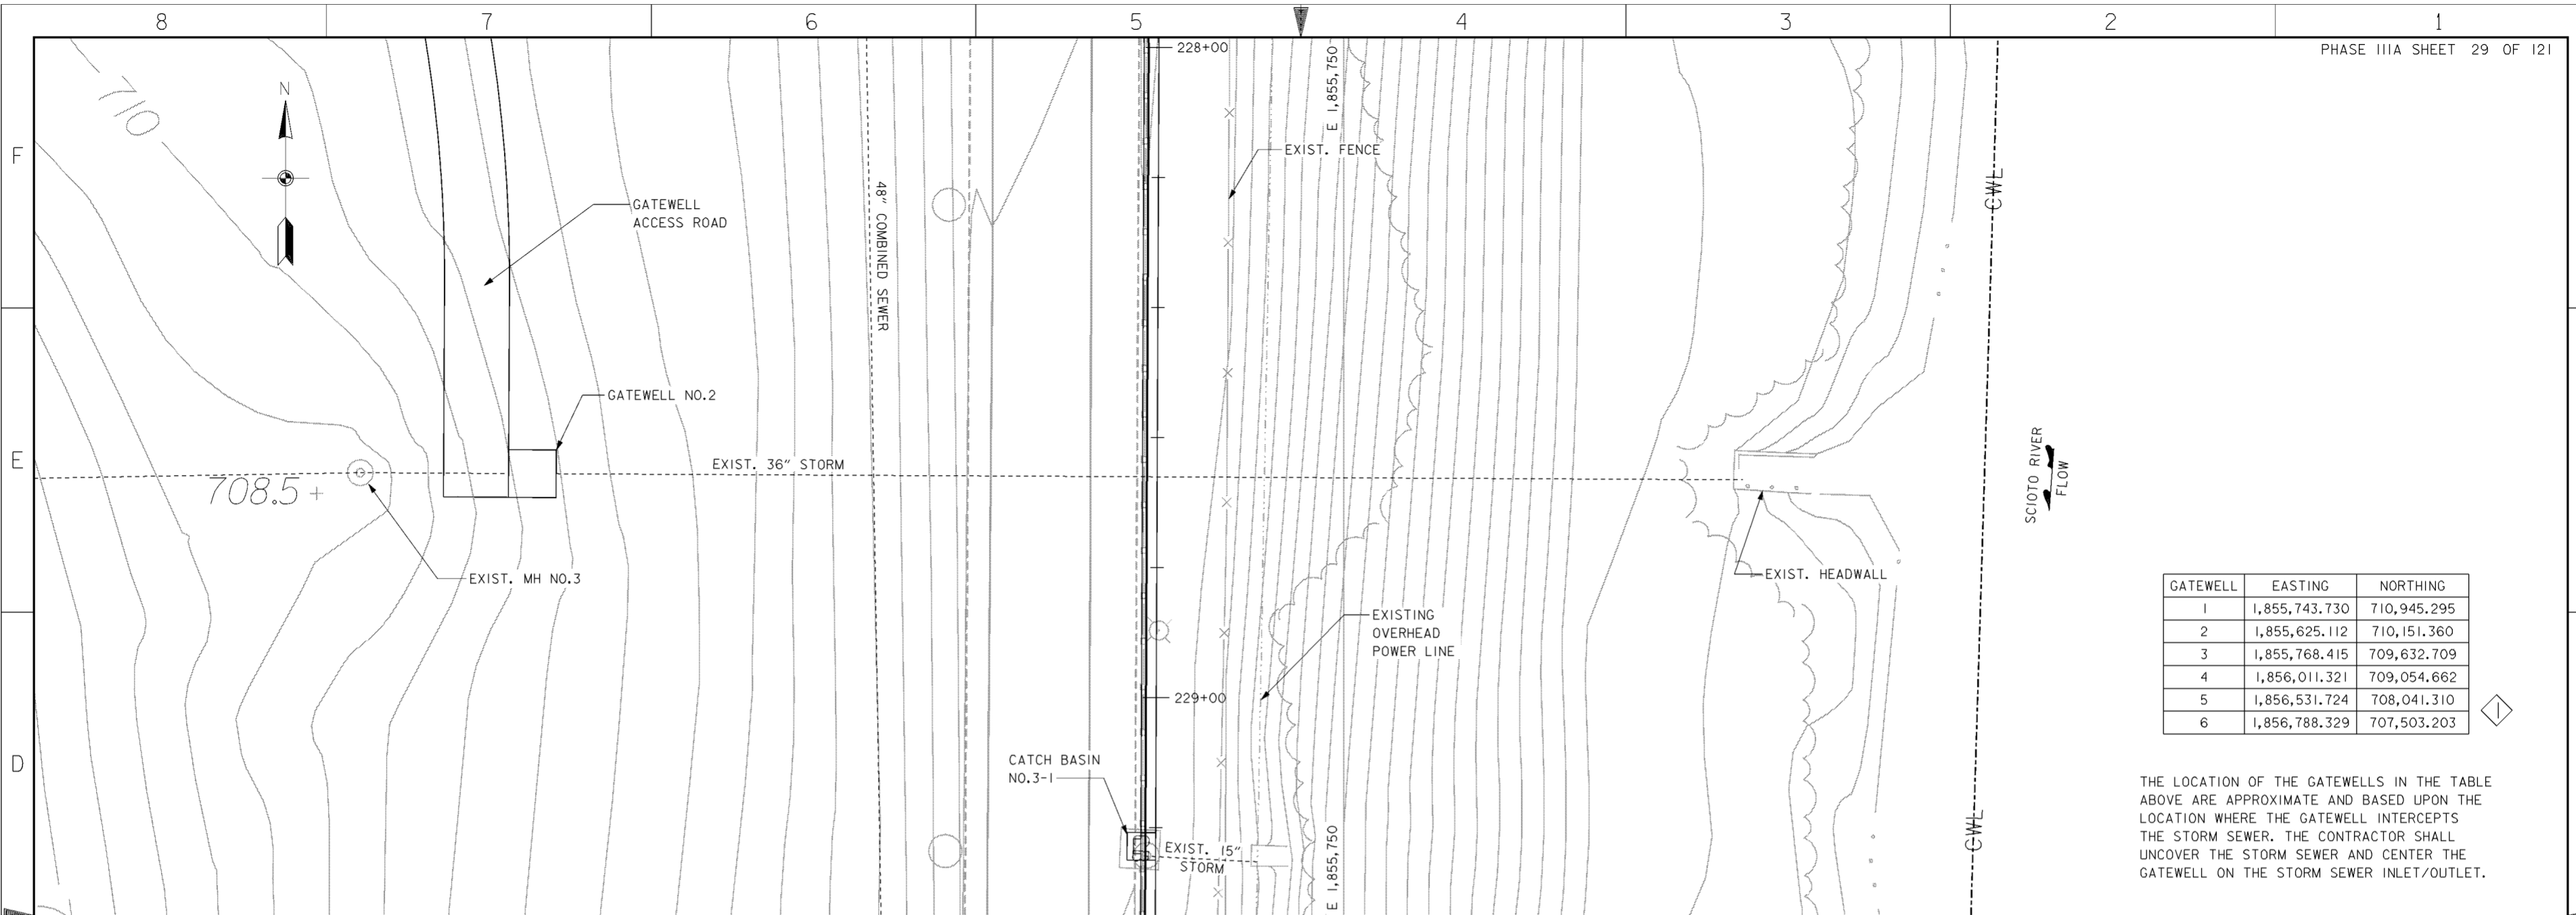

SCIOTO RIVER  
FLOW


GATEWELL	EASTING	NORTHING
1	1,855,743.730	710,945.295
2	1,855,625.112	710,151.360
3	1,855,768.415	709,632.709
4	1,856,011.321	709,054.662
5	1,856,531.724	708,041.310
6	1,856,788.329	707,503.203

THE LOCATION OF THE GATEWELLS IN THE TABLE ABOVE ARE APPROXIMATE AND BASED UPON THE LOCATION WHERE THE GATEWELL INTERCEPTS THE STORM SEWER. THE CONTRACTOR SHALL UNCOVER THE STORM SEWER AND CENTER THE GATEWELL ON THE STORM SEWER INLET/OUTLET.

**PLAN**  
SCALE: 1" = 10'

**NOTES**

- FOR CONTRACTOR WORK LIMITS SEE DRAWING NOS. 6/1 THRU 6/5.
- FOR TYPICAL GATEWELL PLAN AND DETAILS SEE DRAWING NOS. 15/7 AND 15/8.
- FOR GATEWELL REINFORCING STEEL SEE DRAWING NO. 15/9.
- REMOVE DISTURBED STORM SEWER PIPE TO NEAREST JOINT AND PROVIDE NEW CONNECTIONS TO THE GATEWELL.
- FOR GATEWELL ACCESS ROAD TYPICAL SECTION SEE DRAWING NO. 15/8.
- FOR GATEWELL ACCESS ROAD SEE DRAWING NO. 20.2/2.

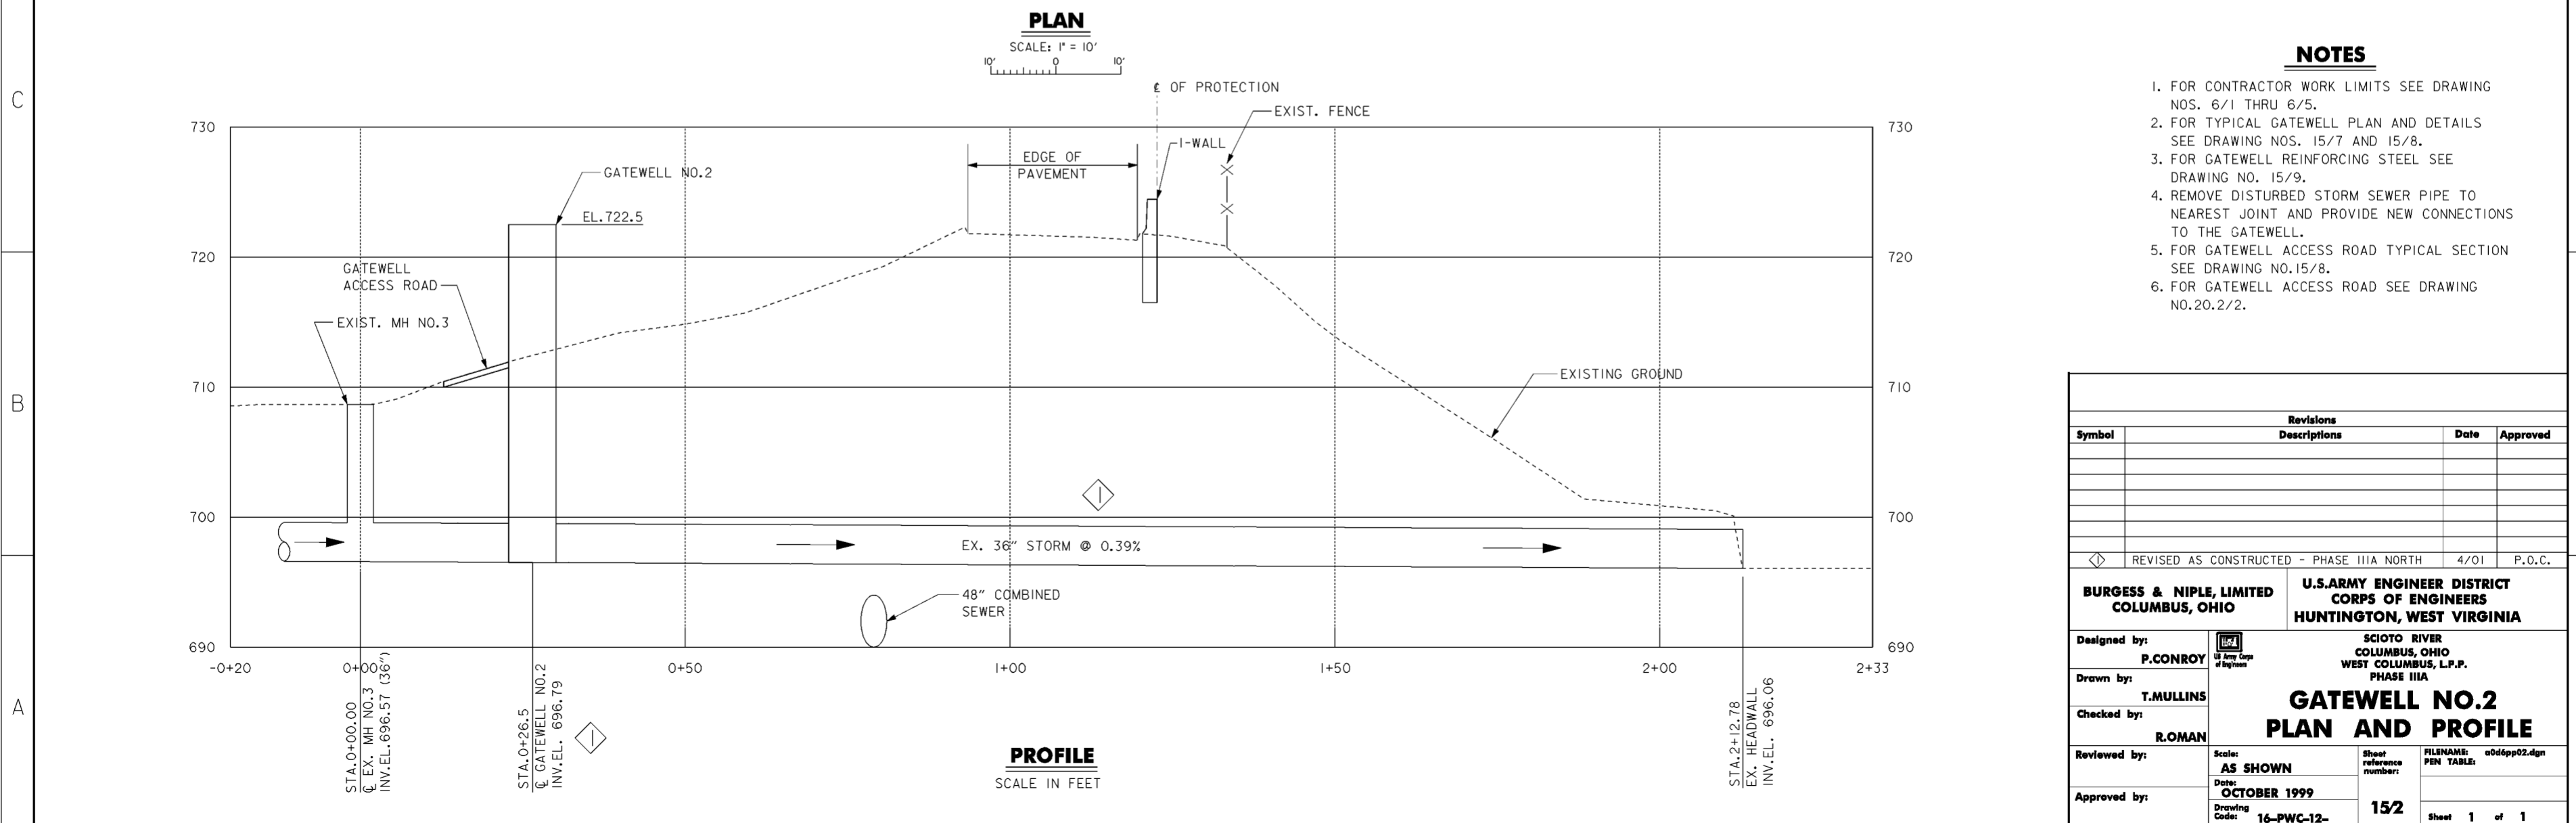

**PROFILE**  
SCALE IN FEET

Revisions			
Symbol	Descriptions	Date	Approved

REVISED AS CONSTRUCTED - PHASE IIIA NORTH 4/01 P.O.C.

**BURGESS & NIPLE, LIMITED**  
COLUMBUS, OHIO

Designed by: **P. CONROY**  
Drawn by: **T. MULLINS**  
Checked by: **R. ROMAN**  
Reviewed by:

**U.S. ARMY ENGINEER DISTRICT**  
CORPUS OF ENGINEERS  
HUNTINGTON, WEST VIRGINIA

SCIOTO RIVER  
COLUMBUS, OHIO  
WEST COLUMBUS, L.P.P.  
PHASE IIIA


**GATEWELL NO. 2**  
**PLAN AND PROFILE**

Scale: **AS SHOWN**  
Date: **OCTOBER 1999**  
Drawing Code: **16-PWC-12-**

Sheet reference number: **152**  
FILENAME: a04pp02.dgn  
PIN TABLE:


Sheet 1 of 1



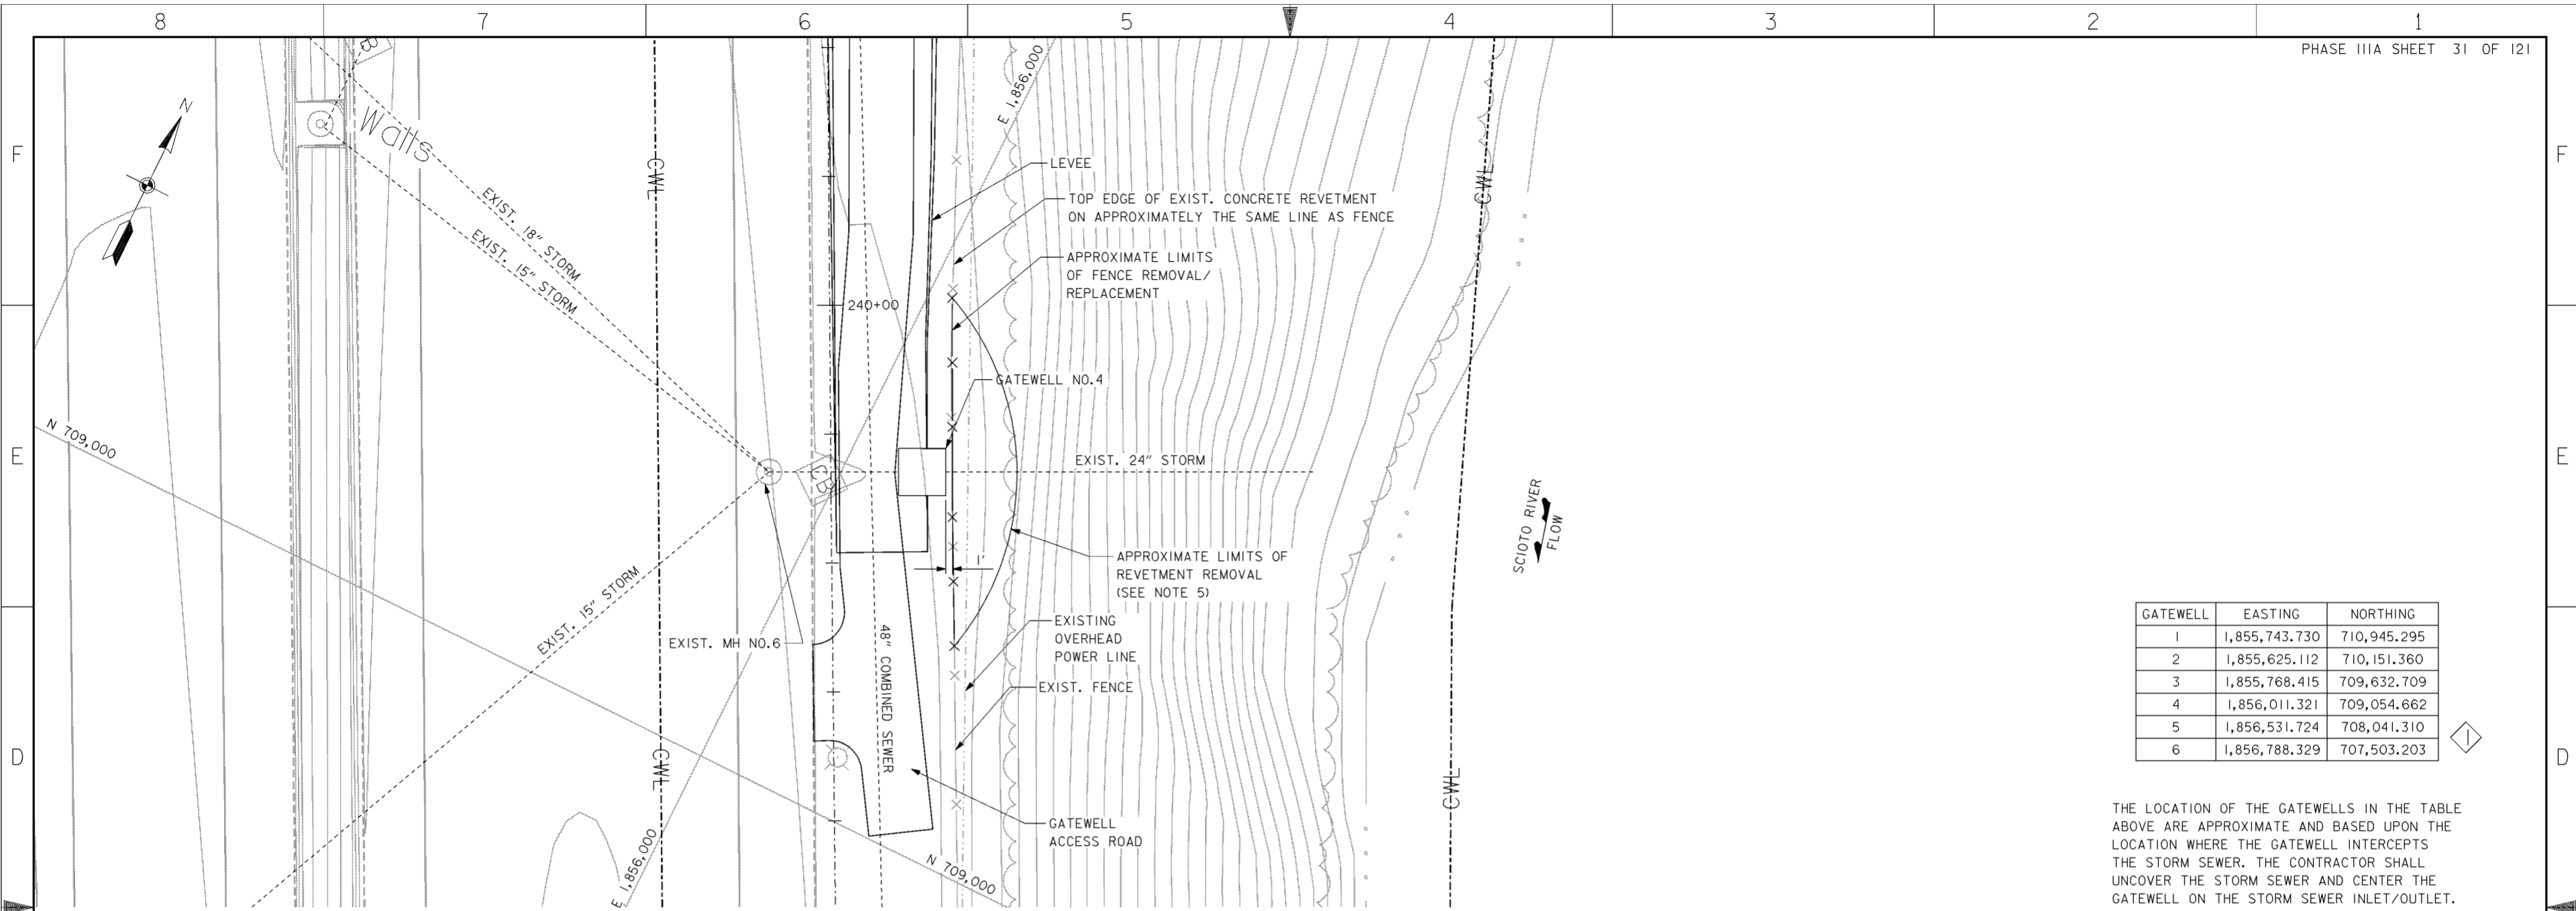

GATEWELL	EASTING	NORTHING
1	1,855,743.730	710,945.295
2	1,855,625.112	710,151.360
3	1,855,768.415	709,632.709
4	1,856,011.321	709,054.662
5	1,856,531.724	708,041.310
6	1,856,788.329	707,503.203


THE LOCATION OF THE GATEWELLS IN THE TABLE ABOVE ARE APPROXIMATE AND BASED UPON THE LOCATION WHERE THE GATEWELL INTERCEPTS THE STORM SEWER. THE CONTRACTOR SHALL UNCOVER THE STORM SEWER AND CENTER THE GATEWELL ON THE STORM SEWER INLET/OUTLET.

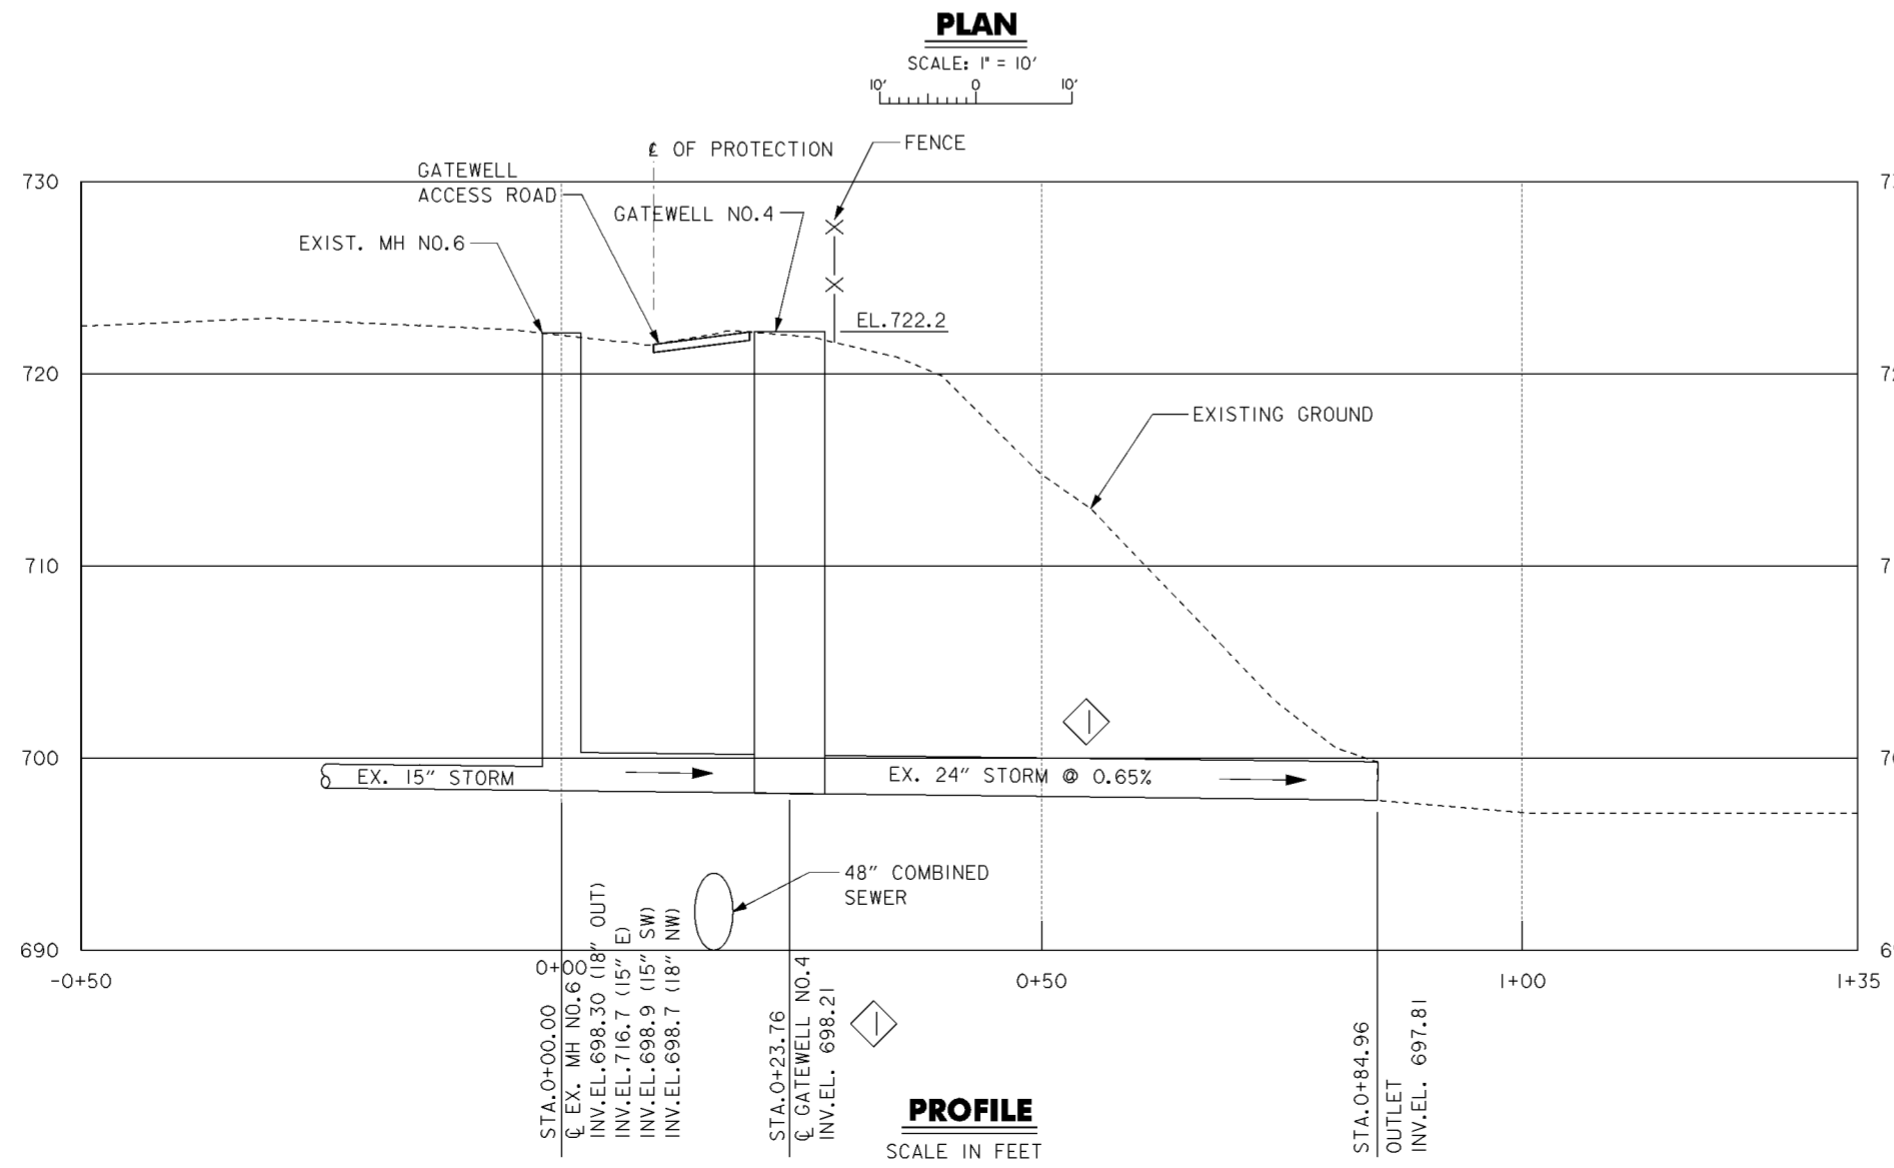

**NOTES**

1. FOR CONTRACTOR WORK LIMITS SEE DRAWING NOS. 6/1 THRU 6/5.
2. FOR TYPICAL GATEWELL PLAN AND DETAILS SEE DRAWING NOS. 15/7 AND 15/8.
3. FOR GATEWELL REINFORCING STEEL SEE DRAWING NO. 15/9.
4. REMOVE DISTURBED STORM SEWER PIPE TO NEAREST JOINT AND PROVIDE NEW CONNECTIONS TO THE GATEWELL.
5. SAWCUT AND REMOVE EXISTING REVETMENT TO ALLOW FOR CONSTRUCTION OF GATEWELL. REGRADE AND SEED DISTURBED AREAS.
6. FOR GATEWELL ACCESS ROAD TYPICAL SECTION SEE DRAWING NO. 15/8.
7. FOR GATEWELL NO. 4 SHORING SEE DRAWING NO. 20.3/5.


Revisions			
Symbol	Descriptions	Date	Approved
◇ REVISED AS CONSTRUCTED - PHASE IIIA NORTH		4/01	P.O.C.
<b>BURGESS &amp; NIPLE, LIMITED</b> COLUMBUS, OHIO		<b>U.S. ARMY ENGINEER DISTRICT</b> CORPS OF ENGINEERS HUNTINGTON, WEST VIRGINIA	
Designed by:	<b>P. CONROY</b>	SCIOTO RIVER COLUMBUS, OHIO WEST COLUMBUS, L.P.P. PHASE IIIA <b>GATEWELL NO. 4                  PLAN AND PROFILE</b>	
Drawn by:	<b>T. MULLINS</b>		
Checked by:	<b>R. ROMAN</b>		
Reviewed by:			
Approved by:		Scale: <b>AS SHOWN</b>	Sheet reference number: <b>15/4</b>
		Date: <b>OCTOBER 1999</b>	FILENAME: a04pp04.dgn
		Drawing Code: <b>16-PWC-12-</b>	PIN TABLE:
			Sheet <b>1</b> of <b>1</b>

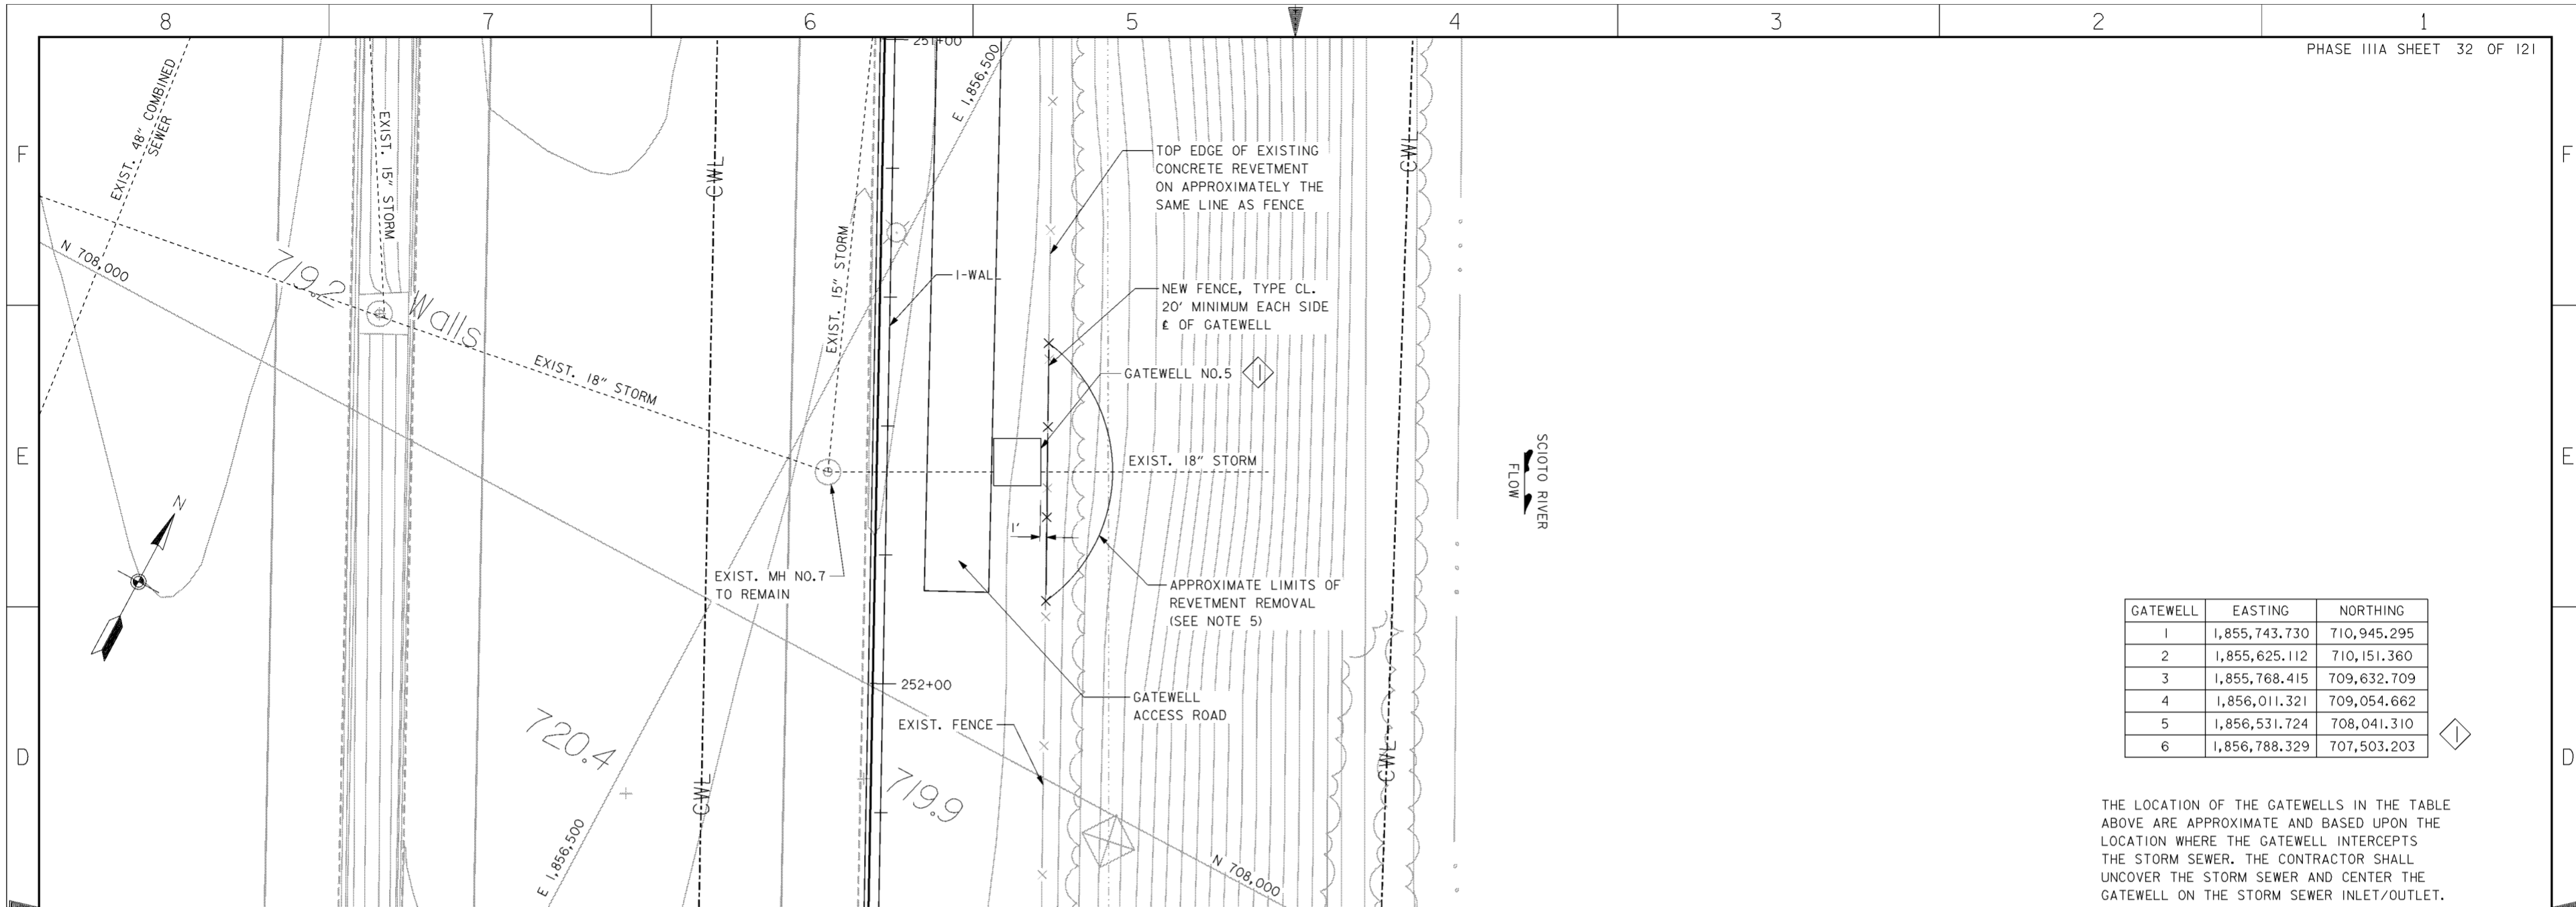

GATEWELL	EASTING	NORTHING
1	1,855,743.730	710,945.295
2	1,855,625.112	710,151.360
3	1,855,768.415	709,632.709
4	1,856,011.321	709,054.662
5	1,856,531.724	708,041.310
6	1,856,788.329	707,503.203

THE LOCATION OF THE GATEWELLS IN THE TABLE ABOVE ARE APPROXIMATE AND BASED UPON THE LOCATION WHERE THE GATEWELL INTERCEPTS THE STORM SEWER. THE CONTRACTOR SHALL UNCOVER THE STORM SEWER AND CENTER THE GATEWELL ON THE STORM SEWER INLET/OUTLET.

**PLAN**  
SCALE: 1" = 10'

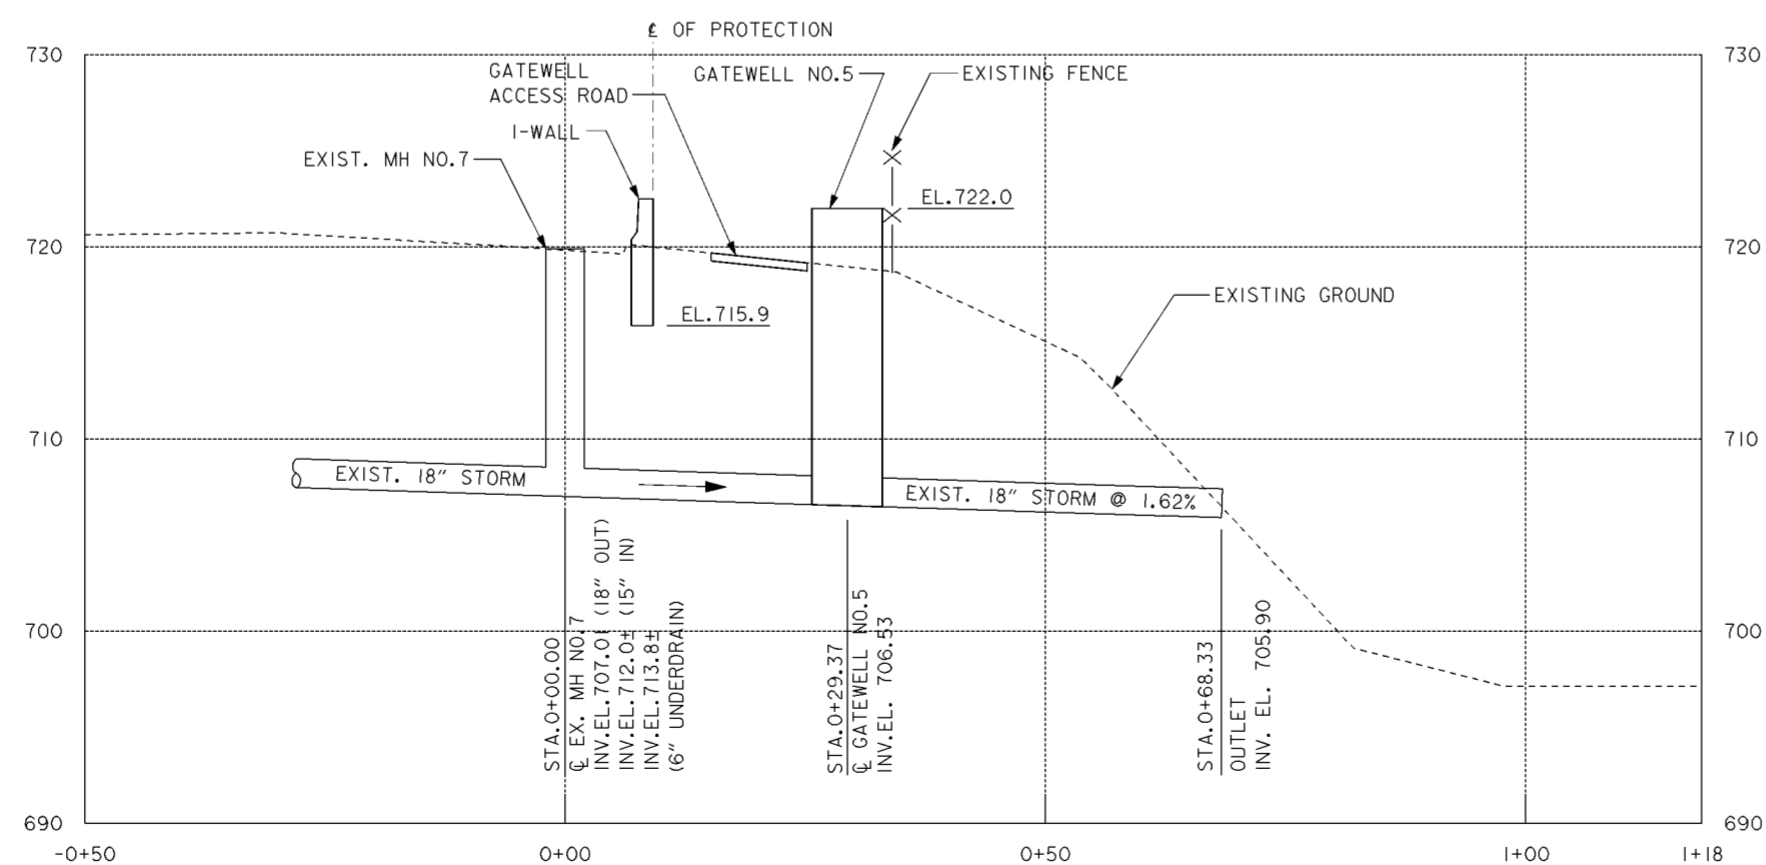

**PROFILE**  
SCALE IN FEET

**NOTES**


- FOR CONTRACTOR WORK LIMITS SEE DRAWING NOS. 6/1 THRU 6/5.
- FOR TYPICAL GATEWELL PLAN AND DETAILS SEE DRAWING NOS. 15/7 AND 15/8.
- FOR GATEWELL REINFORCING STEEL SEE DRAWING NO. 15/9.
- REMOVE DISTURBED STORM SEWER PIPE TO NEAREST JOINT AND PROVIDE NEW CONNECTIONS TO THE GATEWELL.
- SAWCUT AND REMOVE EXISTING REVETMENT TO ALLOW FOR CONSTRUCTION OF GATEWELL. REGRADE AND SEED DISTURBED AREAS.
- FOR GATEWELL ACCESS ROAD TYPICAL SECTION SEE DRAWING NO. 15/8.

Revisions			
Symbol	Descriptions	Date	Approved
◇	REVISED AS CONSTRUCTED - PHASE IIIA SOUTH	4/01	P.O.C.

<b>BURGESS &amp; NIPL, LIMITED</b> COLUMBUS, OHIO	<b>U.S. ARMY ENGINEER DISTRICT</b> CORPS OF ENGINEERS HUNTINGTON, WEST VIRGINIA
Designed by: P. CONROY	SCIOTO RIVER COLUMBUS, OHIO WEST COLUMBUS, L.P.P. PHASE IIIA
Drawn by: T. MULLINS	<b>GATEWELL NO. 5</b>
Checked by: R. ROMAN	<b>PLAN AND PROFILE</b>
Reviewed by:	Scale: <b>AS SHOWN</b>
Approved by:	Date: <b>OCTOBER 1999</b>

Sheet reference number: <b>15/5</b>	FILENAME: PEN TABLE: a04pp05.dgn
Drawing Code: 16-PWC-12-	Sheet 1 of 1




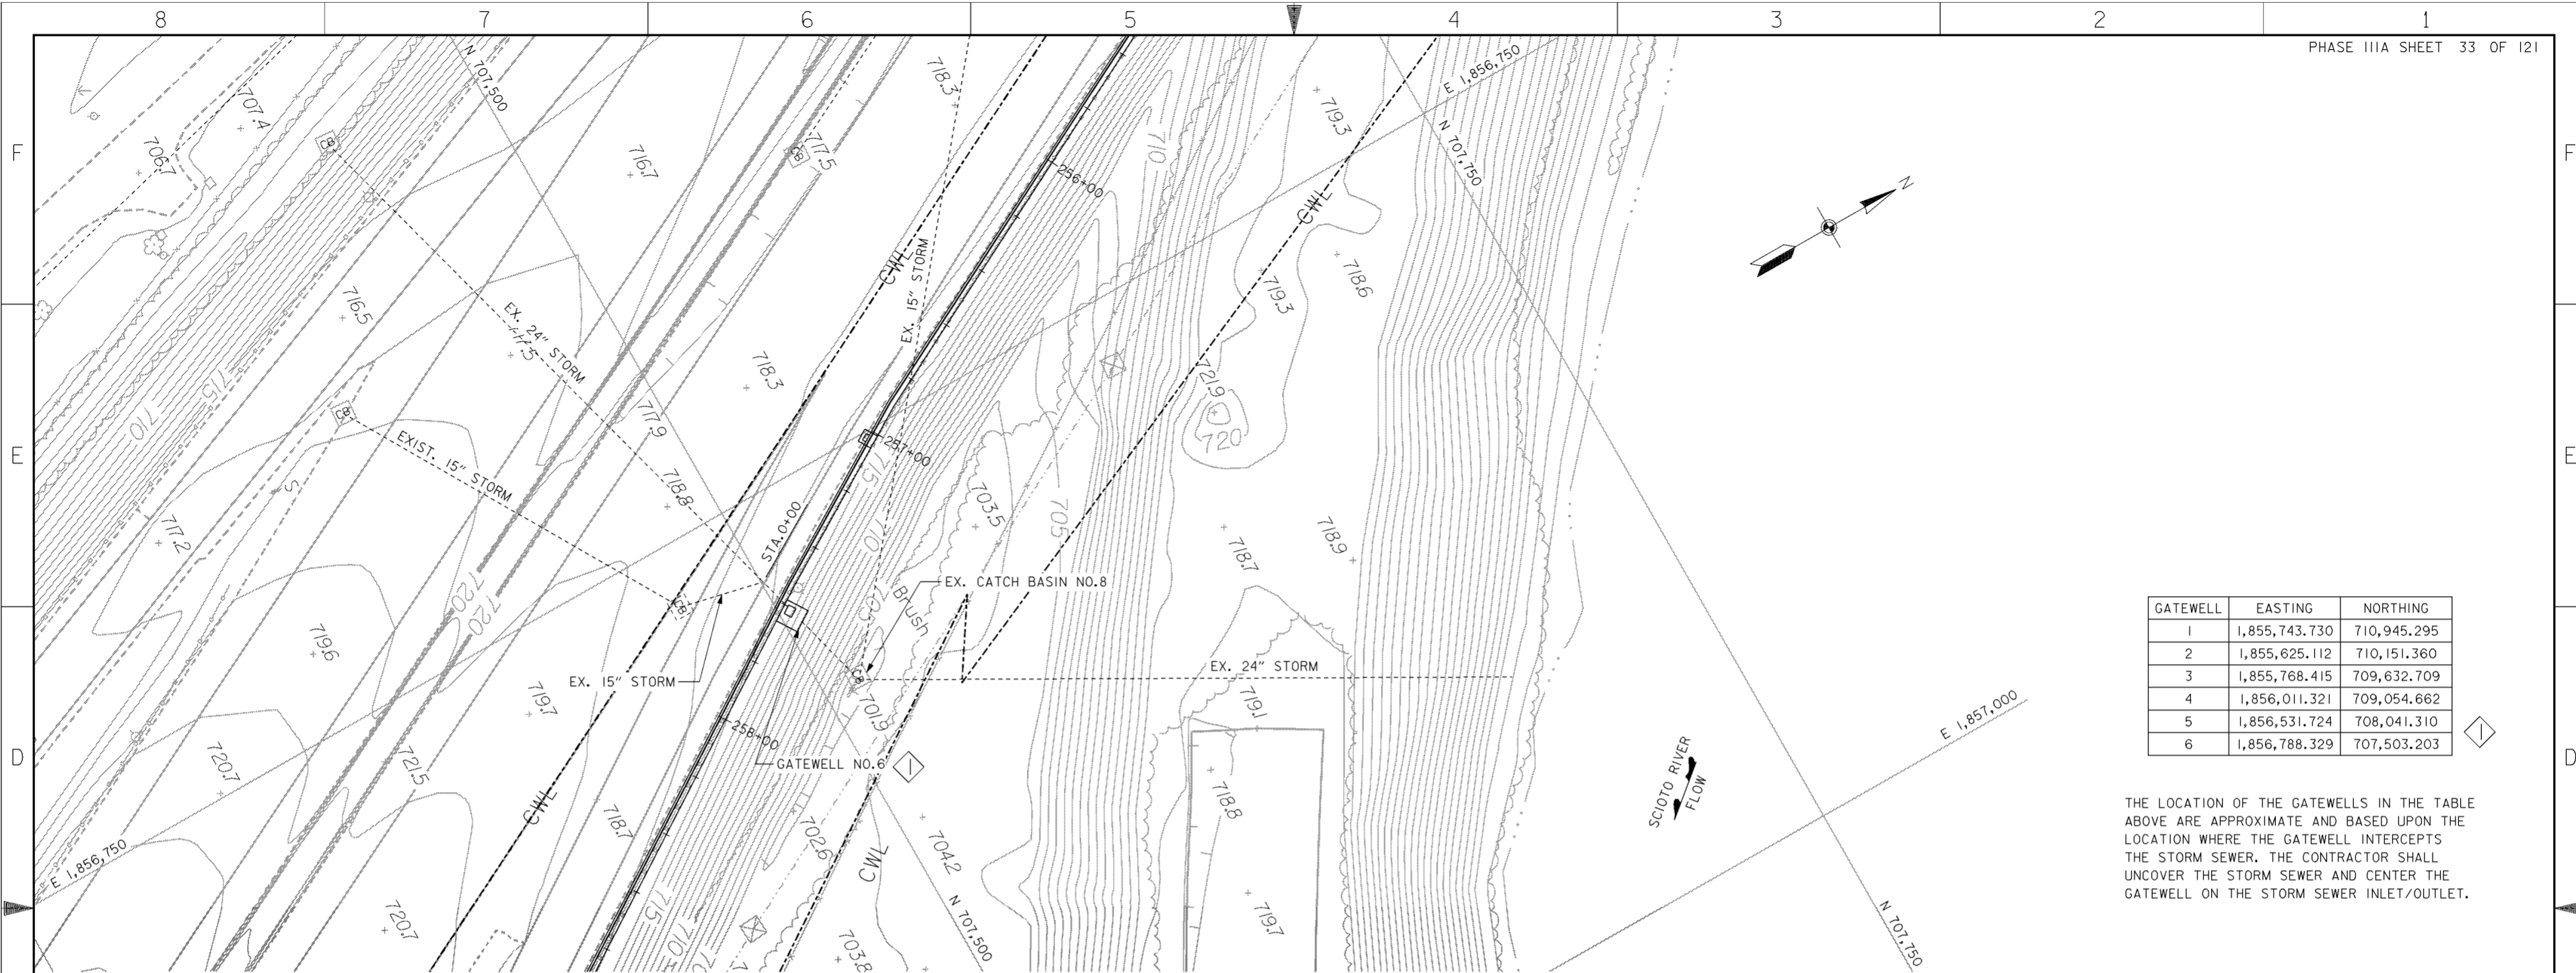

**PLAN**  
SCALE: 1" = 20'

GATEWELL	EASTING	NORTHING
1	1,855,743.730	710,945.295
2	1,855,625.112	710,151.360
3	1,855,768.415	709,632.709
4	1,856,011.321	709,054.662
5	1,856,531.724	708,041.310
6	1,856,788.329	707,503.203

THE LOCATION OF THE GATEWELLS IN THE TABLE ABOVE ARE APPROXIMATE AND BASED UPON THE LOCATION WHERE THE GATEWELL INTERCEPTS THE STORM SEWER. THE CONTRACTOR SHALL UNCOVER THE STORM SEWER AND CENTER THE GATEWELL ON THE STORM SEWER INLET/OUTLET.

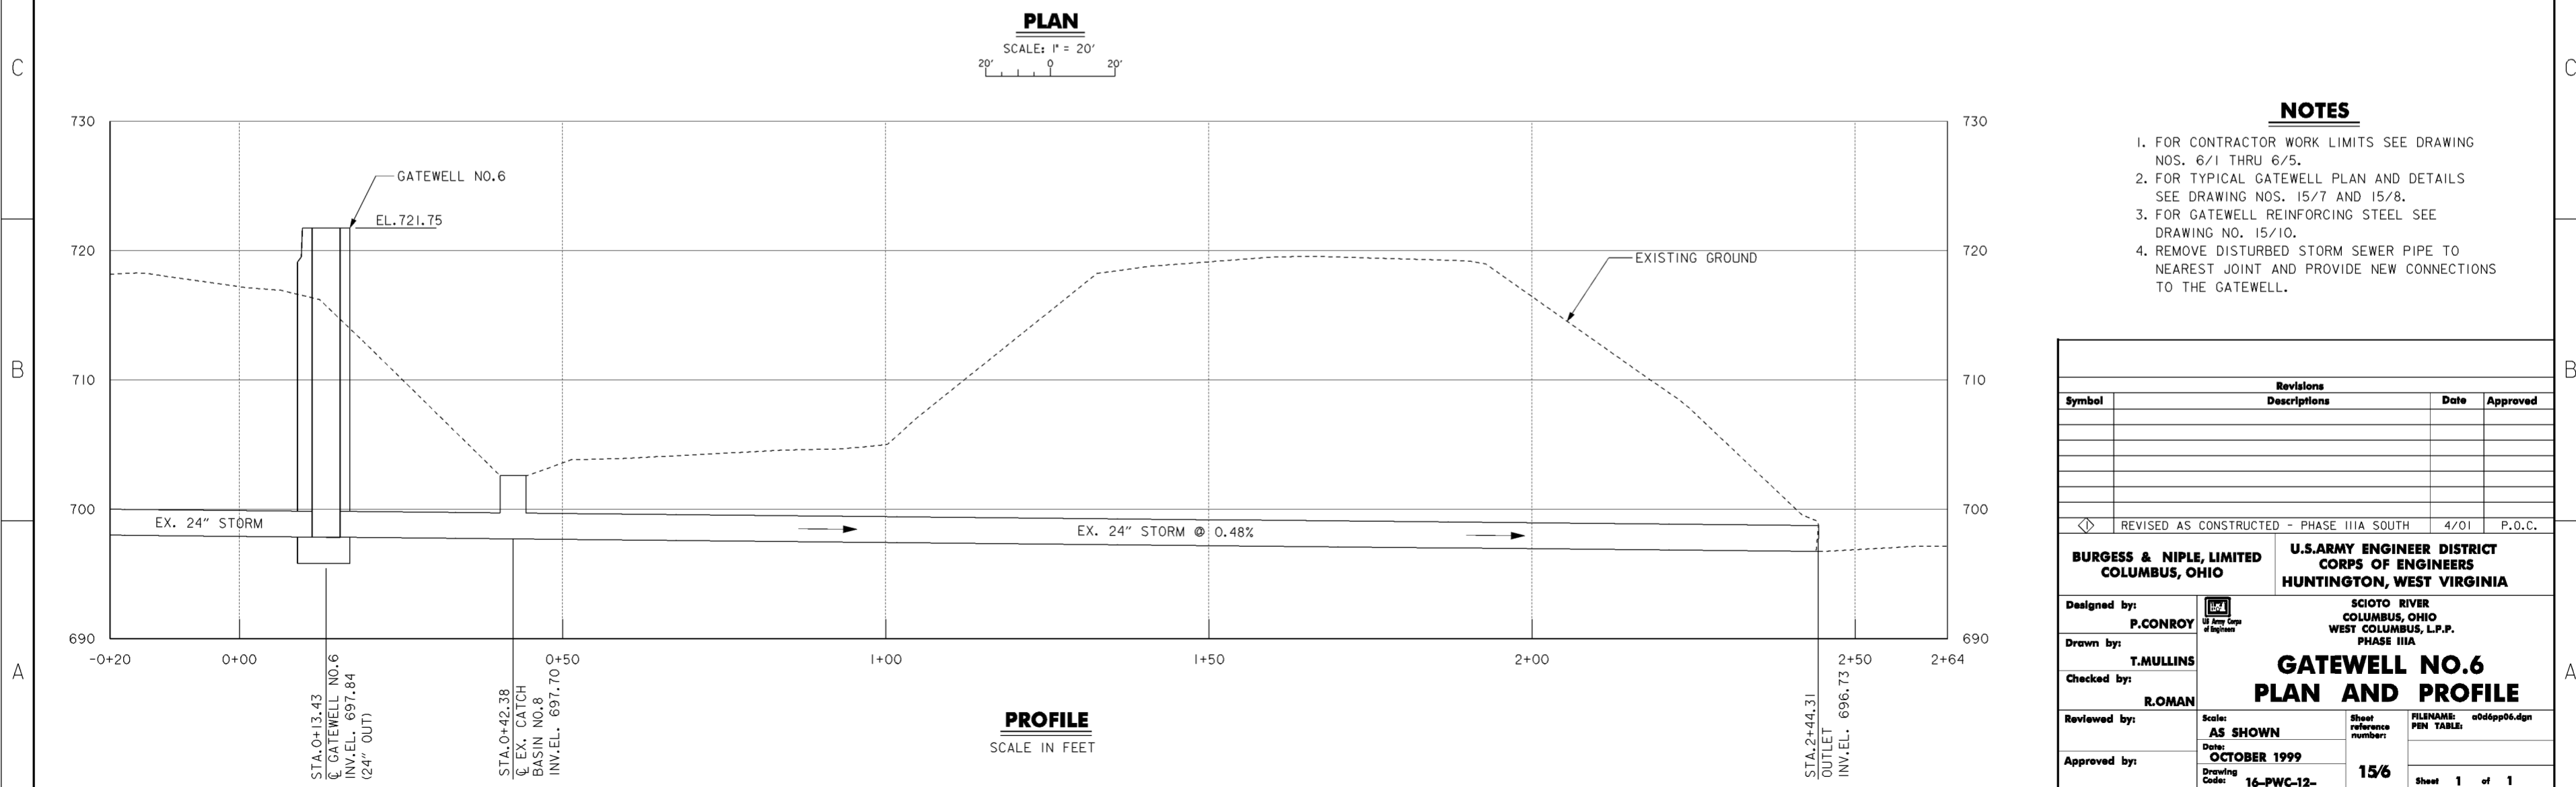

**PROFILE**  
SCALE IN FEET







**NOTES**

1. FOR CONTRACTOR WORK LIMITS SEE DRAWING NOS. 6/1 THRU 6/5.
2. FOR TYPICAL GATEWELL PLAN AND DETAILS SEE DRAWING NOS. 15/7 AND 15/8.
3. FOR GATEWELL REINFORCING STEEL SEE DRAWING NO. 15/10.
4. REMOVE DISTURBED STORM SEWER PIPE TO NEAREST JOINT AND PROVIDE NEW CONNECTIONS TO THE GATEWELL.


Revisions			
Symbol	Descriptions	Date	Approved

REVISED AS CONSTRUCTED - PHASE IIIA SOUTH 4/01 P.O.C.

<b>BURGESS &amp; NIPL, LIMITED</b> COLUMBUS, OHIO	<b>U.S. ARMY ENGINEER DISTRICT</b> CORPS OF ENGINEERS HUNTINGTON, WEST VIRGINIA
Designed by: <b>P. CONROY</b>	SCIOTO RIVER COLUMBUS, OHIO WEST COLUMBUS, L.P.P. PHASE IIIA
Drawn by: <b>T. MULLINS</b>	<b>GATEWELL NO. 6</b> <b>PLAN AND PROFILE</b>
Checked by: <b>R. ROMAN</b>	Scale: <b>AS SHOWN</b> Date: <b>OCTOBER 1999</b> Drawing Code: <b>16-PWC-12-</b>
Reviewed by:	Sheet reference number: <b>15/6</b> FILENAME: <b>a06app06.dgn</b> PIN TABLE:
Approved by:	Sheet <b>1</b> of <b>1</b>

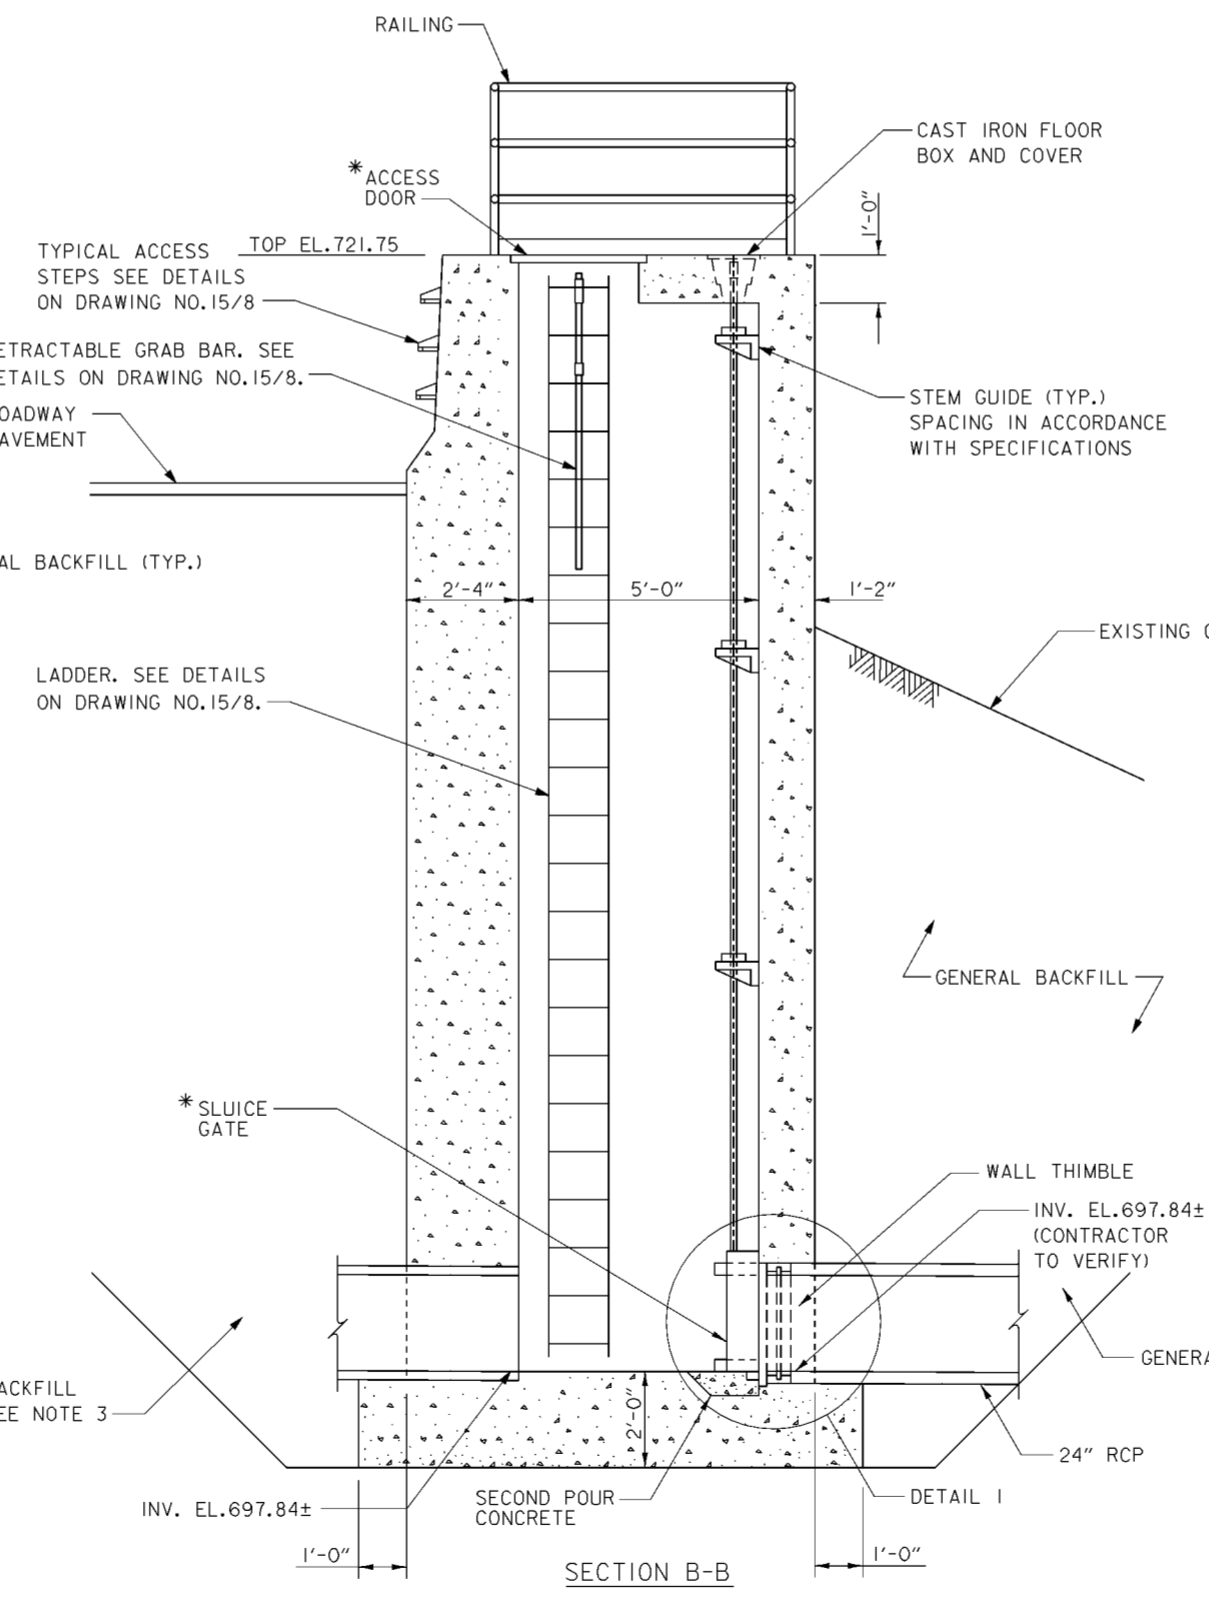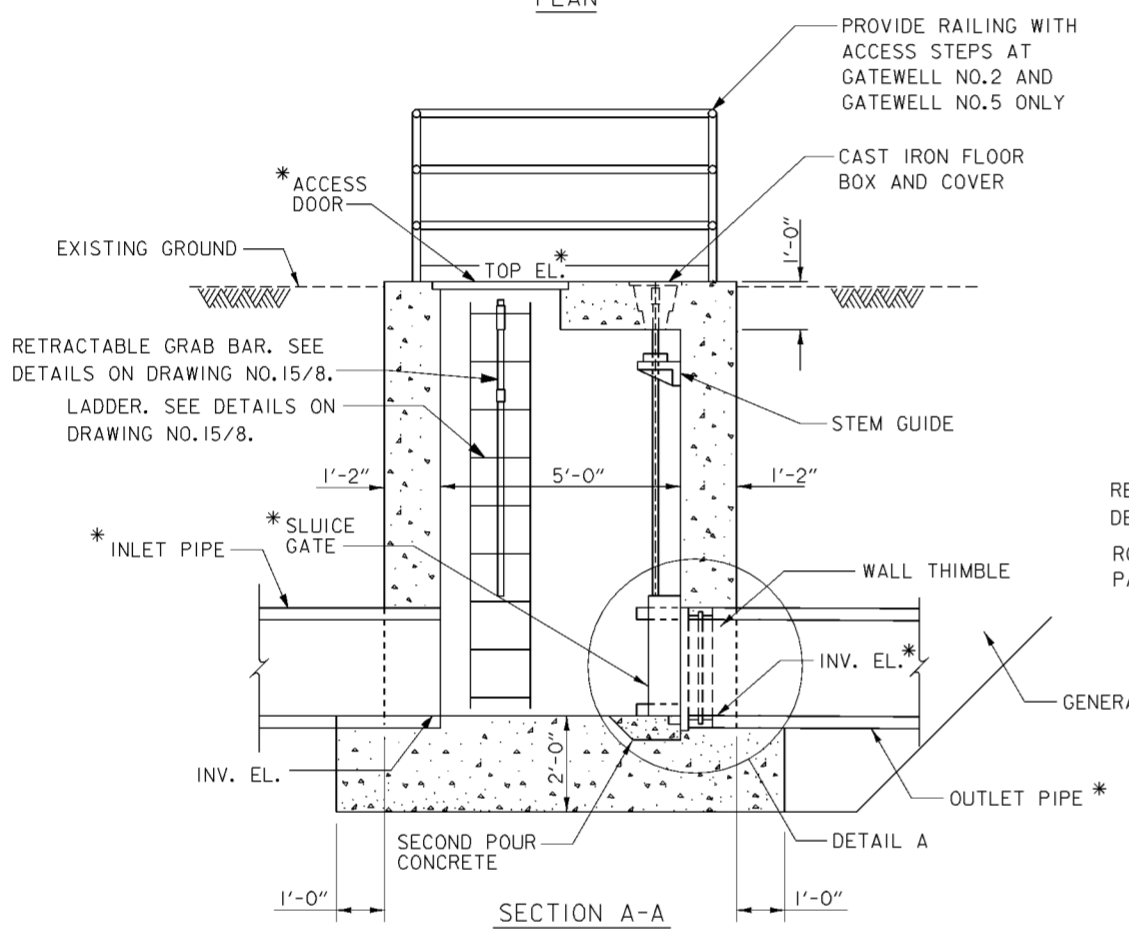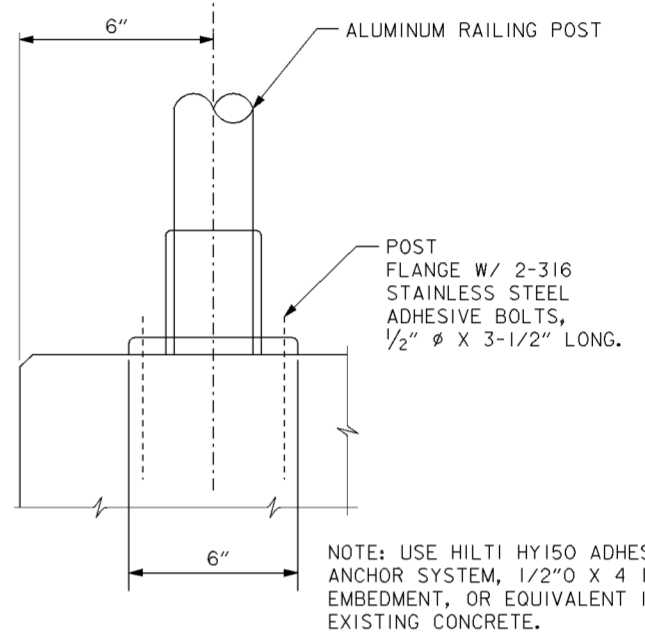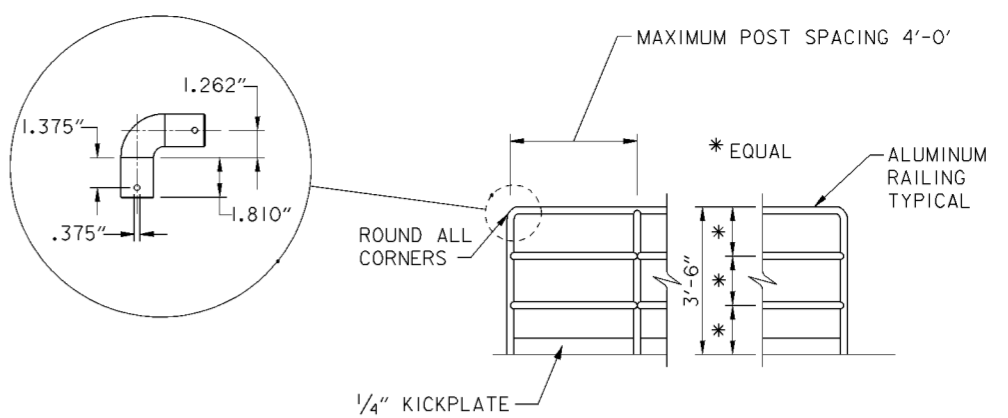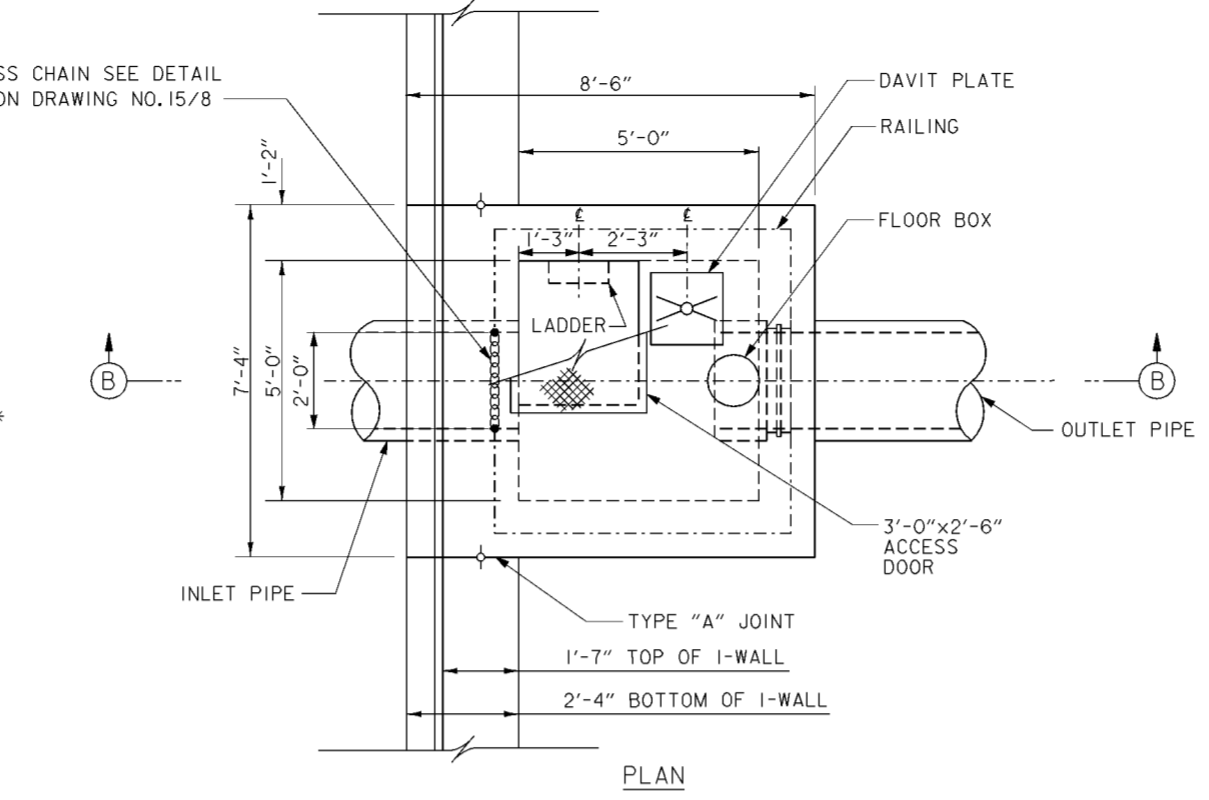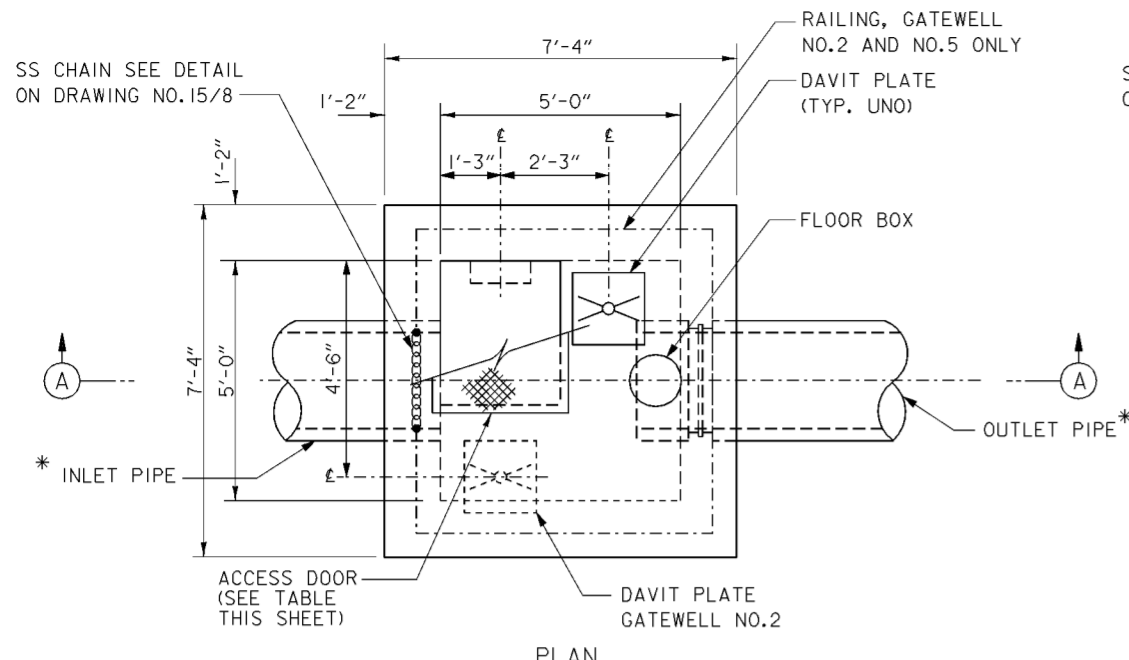

GATEWELL No.	INLET/OUTLET PIPE SIZE	TOP EL.	INVERT EL.	SLUICE GATE	ACCESS DOOR
1	30"	728.00	703.17±	30"x30"	3'-0"x2'-6"
2	36"	722.5	696.79±	36"x36"	3'-6"x3'-6"
3	18"	721.2	705.92±	18"x18"	3'-0"x2'-6"
4	24"	722.2	698.21±	24"x24"	3'-0"x2'-6"
5	18"	722.0	706.53±	18"x18"	3'-0"x2'-6"
6	24"	721.75	697.84±	24"x24"	3'-0"x2'-6"

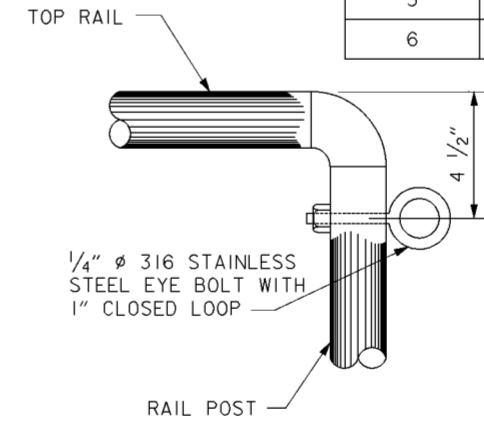

**NOTES**

- FOR GATEWELL DETAILS SEE DRAWING NO. 15/8.
- FOR TYPICAL CHAIN AND DAVIT PLATE DETAILS SEE DRAWING NO. 15/8.
- WHERE BACKFILL SUPPORTS PAVEMENT, BACKFILL SHALL CONSIST OF MATERIALS MEETING THE REQUIREMENTS OF GRANULAR EMBANKMENT MATERIALS INSTALLED IN ACCORDANCE WITH THE REQUIREMENTS FOR STRUCTURE BACKFILL.

Symbol	Revisions Descriptions	Date	Approved

REVISED AS CONSTRUCTED - PHASE IIIA SOUTH 4/01 P.O.C.

**BURGESS & NIPLÉ, LIMITED**  
COLUMBUS, OHIO

**U.S. ARMY ENGINEER DISTRICT**  
CORPS OF ENGINEERS  
HUNTINGTON, WEST VIRGINIA







Designed by: **P. CONROY**  
Drawn by: **A. PUMMELL**  
Checked by: **R. ROMAN**  
Reviewed by: **AS SHOWN**  
Approved by: **OCTOBER 1999**

SCIO TO RIVER  
COLUMBUS, OHIO  
WEST COLUMBUS, L.P.P.  
PHASE IIIA



**TYPICAL GATEWELL PLAN AND SECTIONS**

Scale: **AS SHOWN**  
Date: **OCTOBER 1999**  
Drawing Code: **16-PWC-12-**



Sheet reference number: **157**  
FILENAME: a06d401.dgn  
PIN TABLE:  
Sheet 1 of 1

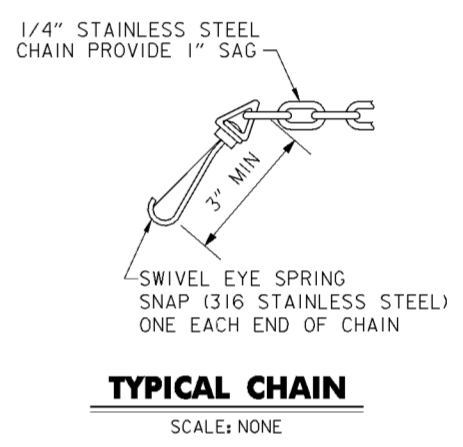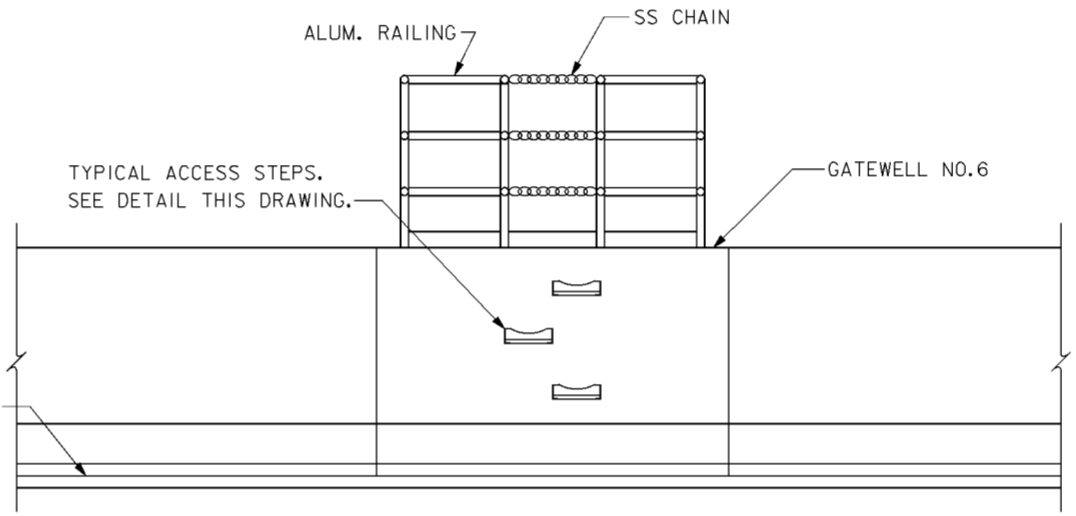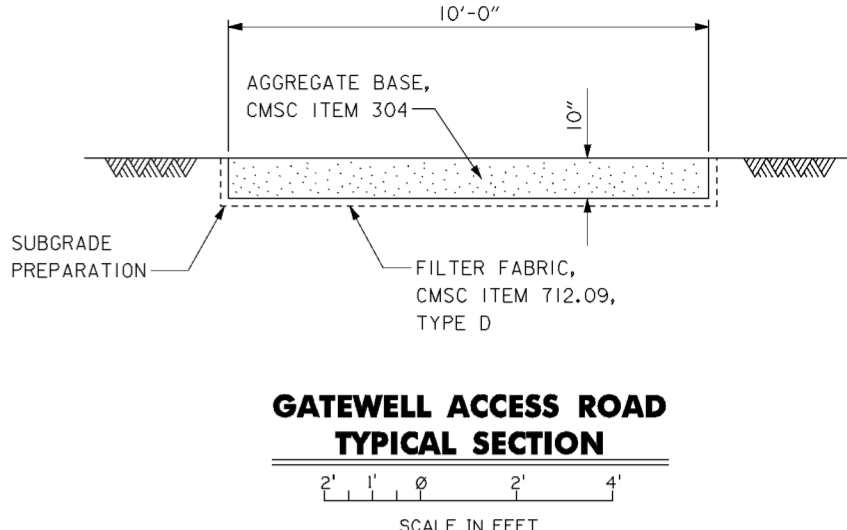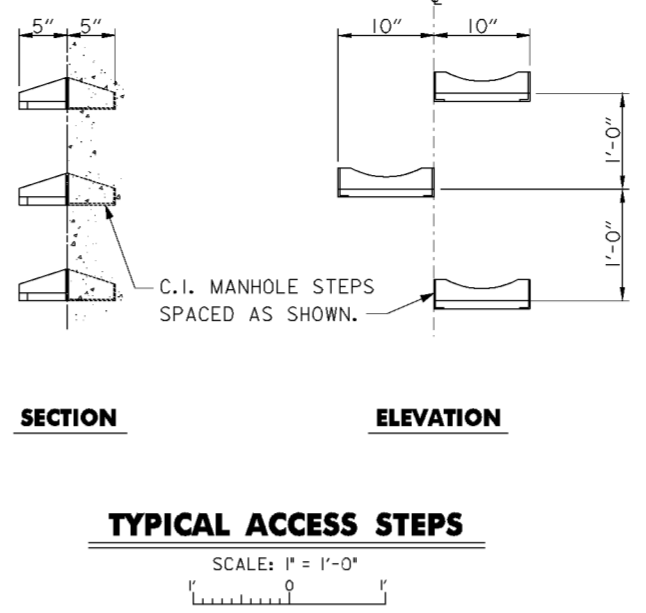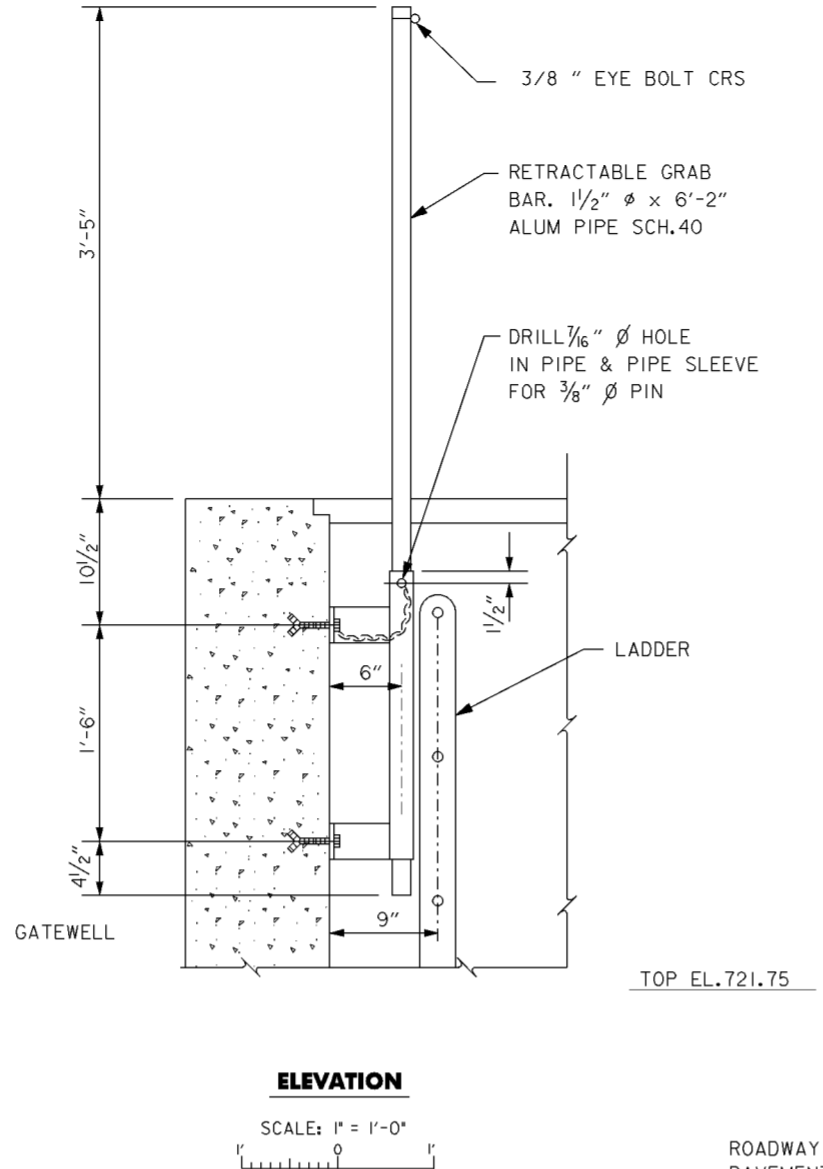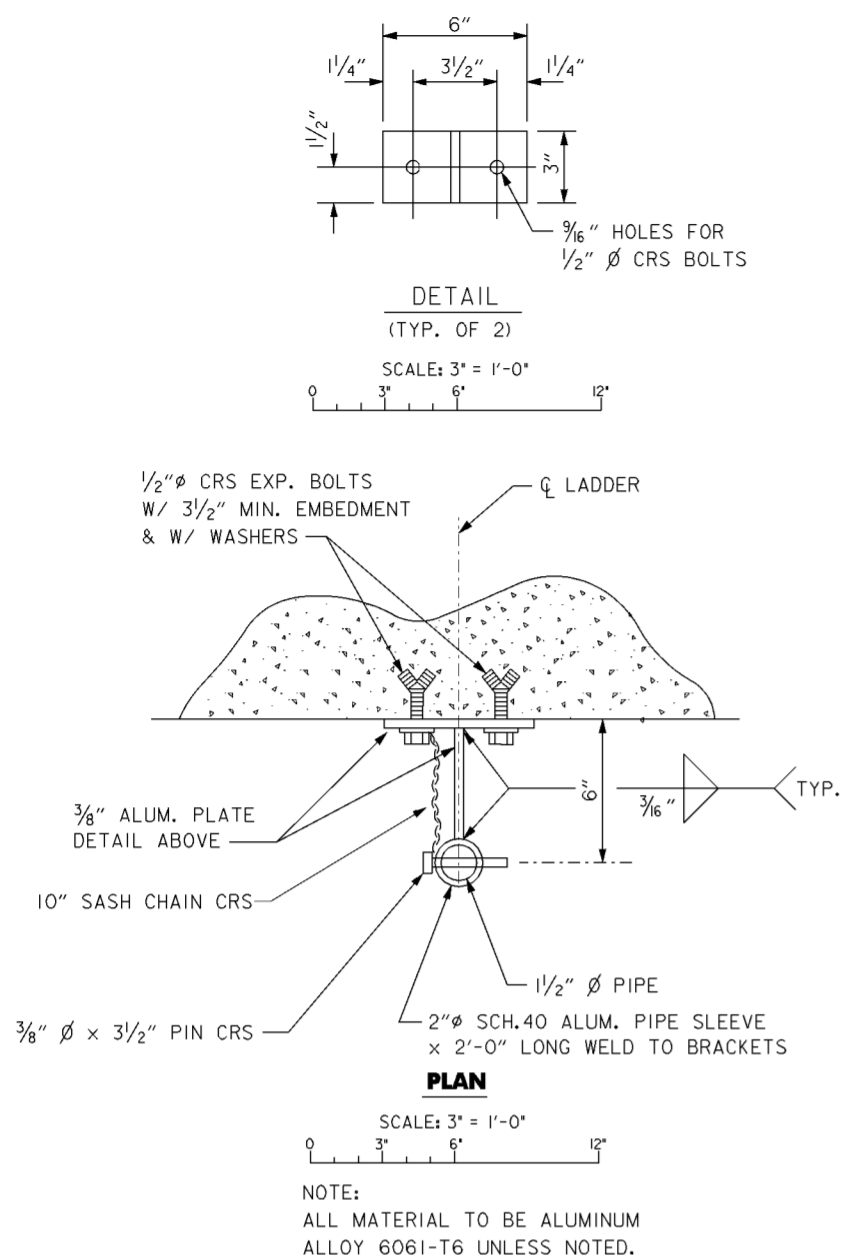

**RETRACTABLE GRAB BAR**

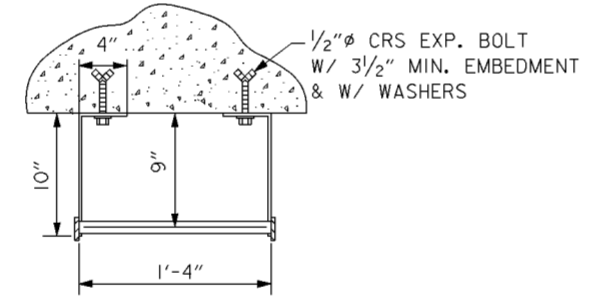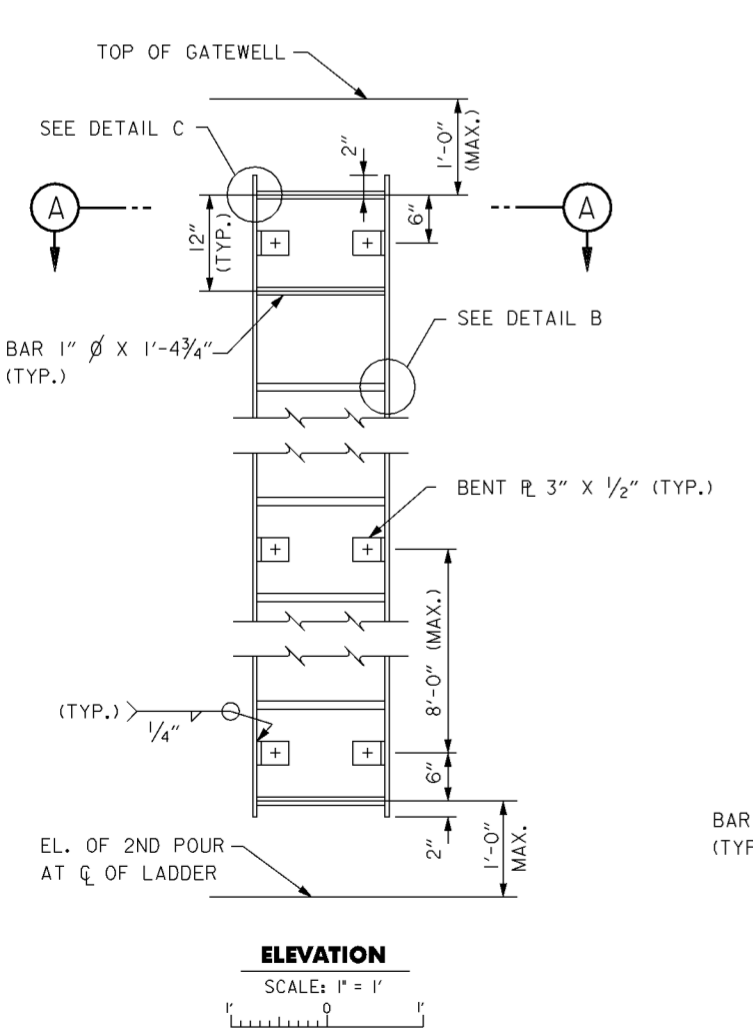


NOTE:  
ALL MATERIAL TO BE ALUMINUM  
ALLOY 6061-T6 UNLESS NOTED.

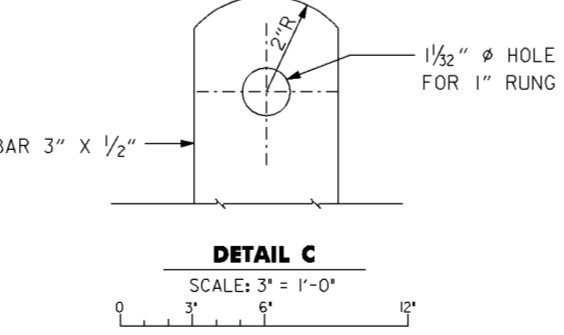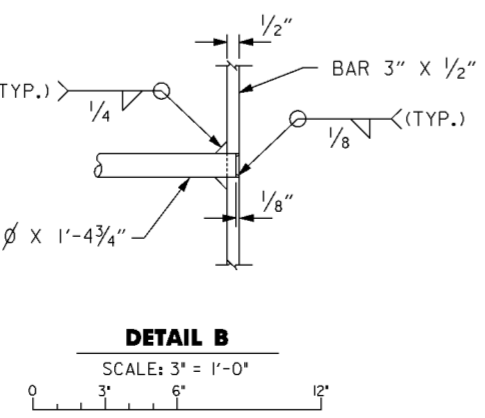

**LADDER DETAILS**

- INSTALLATION NOTES:
1. PROVIDE 8-1/2" Ø SS ADHESIVE ANCHORS ON 16 1/2" Ø BOLT CIRCLE W/ SS LOCK WASHERS AND HEX HEAD NUTS FOR EACH BASE.
  2. PROVIDE 6 3/8" MIN. CONCRETE EMBEDMENT FOR ALL ANCHORS.

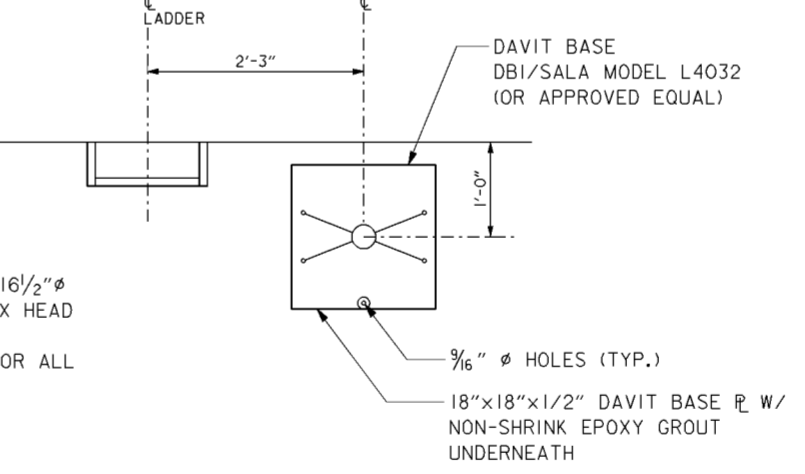

**NOTES**


1. EXPANSION BOLTS SHALL BE 1/2" Ø TYPE 316 STAINLESS STEEL WITH 6" MIN. EMBEDMENT "KWICK BOLT II" BY HILTI OR EQUAL.
2. EYE BOLTS SHALL BE 3/8" SHANK DIA. SHOULDER EYE BOLT TYPE 316 STAINLESS STEEL.
3. ALL ALUMINUM SURFACES WHICH COMES IN CONTACT WITH CONCRETE AND/OR STEEL SHALL BE PAINTED WITH A HEAVY COAT OF BITUMINOUS PAINT.
4. WELD 3/8" FLANGE R TO LADDER AND RAILING. ATTACH FLANGE R TO CONC. W/ 2 - 3/8" SS EXPANSION BOLTS W/ 4" MIN. EMBEDMENT.

Revisions			
Symbol	Descriptions	Date	Approved


<b>BURGESS &amp; NIPL, LIMITED</b> COLUMBUS, OHIO	<b>U.S. ARMY ENGINEER DISTRICT</b> CORPS OF ENGINEERS HUNTINGTON, WEST VIRGINIA	SCIOTO RIVER COLUMBUS, OHIO WEST COLUMBUS, L.P.P. PHASE IIIA	
		<b>GATEWELL DETAILS</b>	
Designed by: <b>P. CONROY</b>	Scale: <b>AS SHOWN</b> Date: <b>OCTOBER 1999</b> Drawing Code: <b>16-PWC-12-</b>	Checked by: <b>R. ROMAN</b>	Sheet reference number: <b>15/8</b>
Drawn by: <b>T. MULLINS</b>		FILENAME: PIN TABLE: 00d6d02.dgn	
Reviewed by:		Sheet 1 of 1	
Approved by:		15/8	
Date:		15/8	



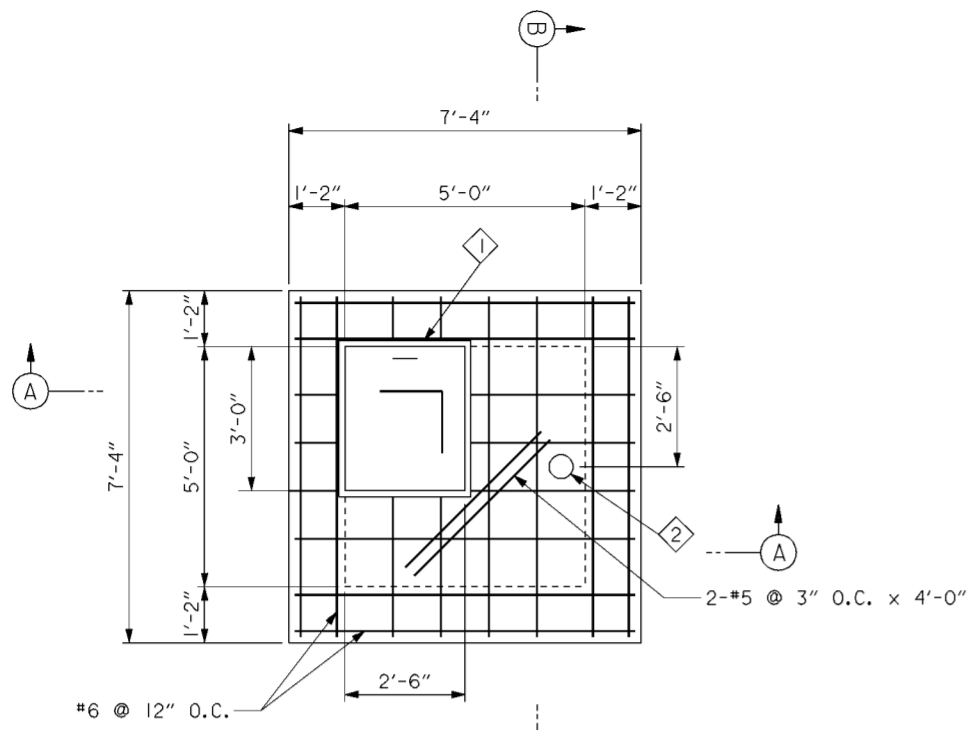

**UPPER PLAN**


SCALE: 1/2" = 1'-0"  
 12' 0 1 2 3 4

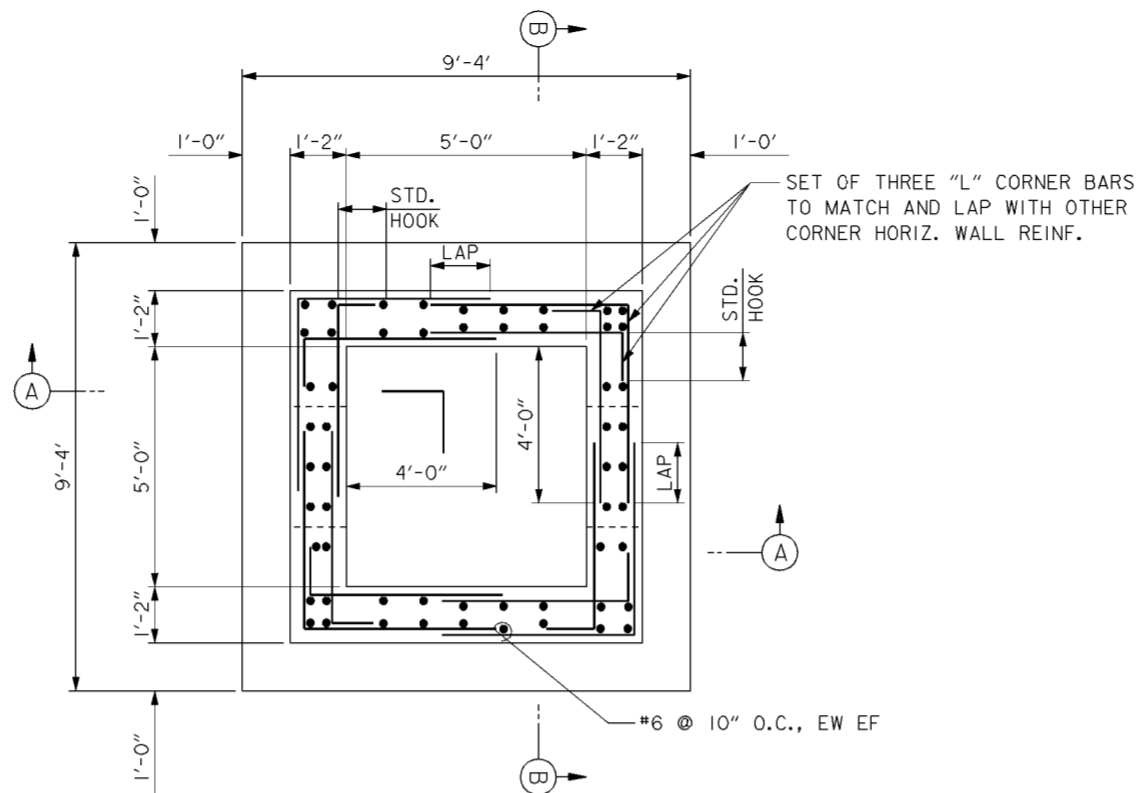

**LOWER PLAN**


SCALE: 1/2" = 1'-0"  
 12' 0 1 2 3 4

GATEWELL NO.	INLET/OUTLET PIPE SIZE	TOP OF GATEWELL EL.	BOTTOM OF GATEWELL EL.	SLUICE GATE
1	30"	728.0	703.17±	30"x30"
2	36"	722.5	696.79±	36"x36"
3	18"	721.2	705.92±	18"x18"
4	24"	722.2	698.21±	24"x24"
5	18"	722.0	706.53±	18"x18"
6	24"	721.75	697.84±	24"x24"

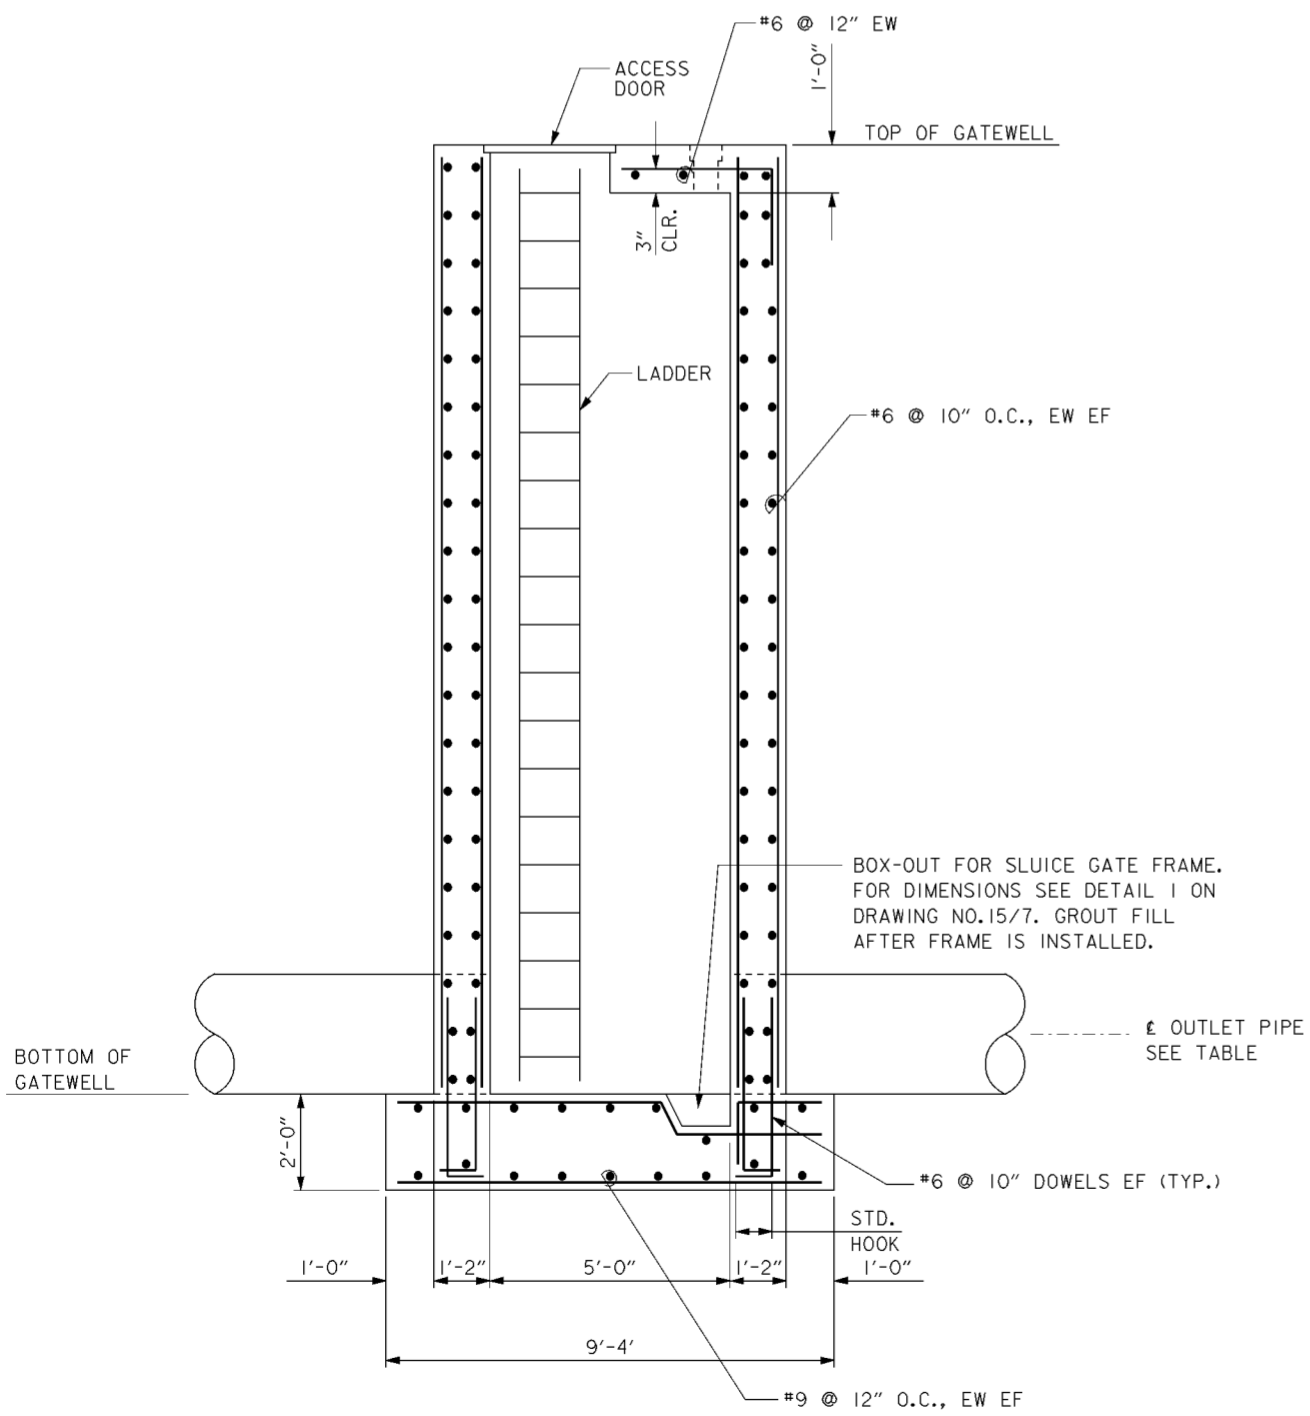


**SECTION A-A**

SCALE: 1/2" = 1'-0"  
 12' 0 1 2 3 4

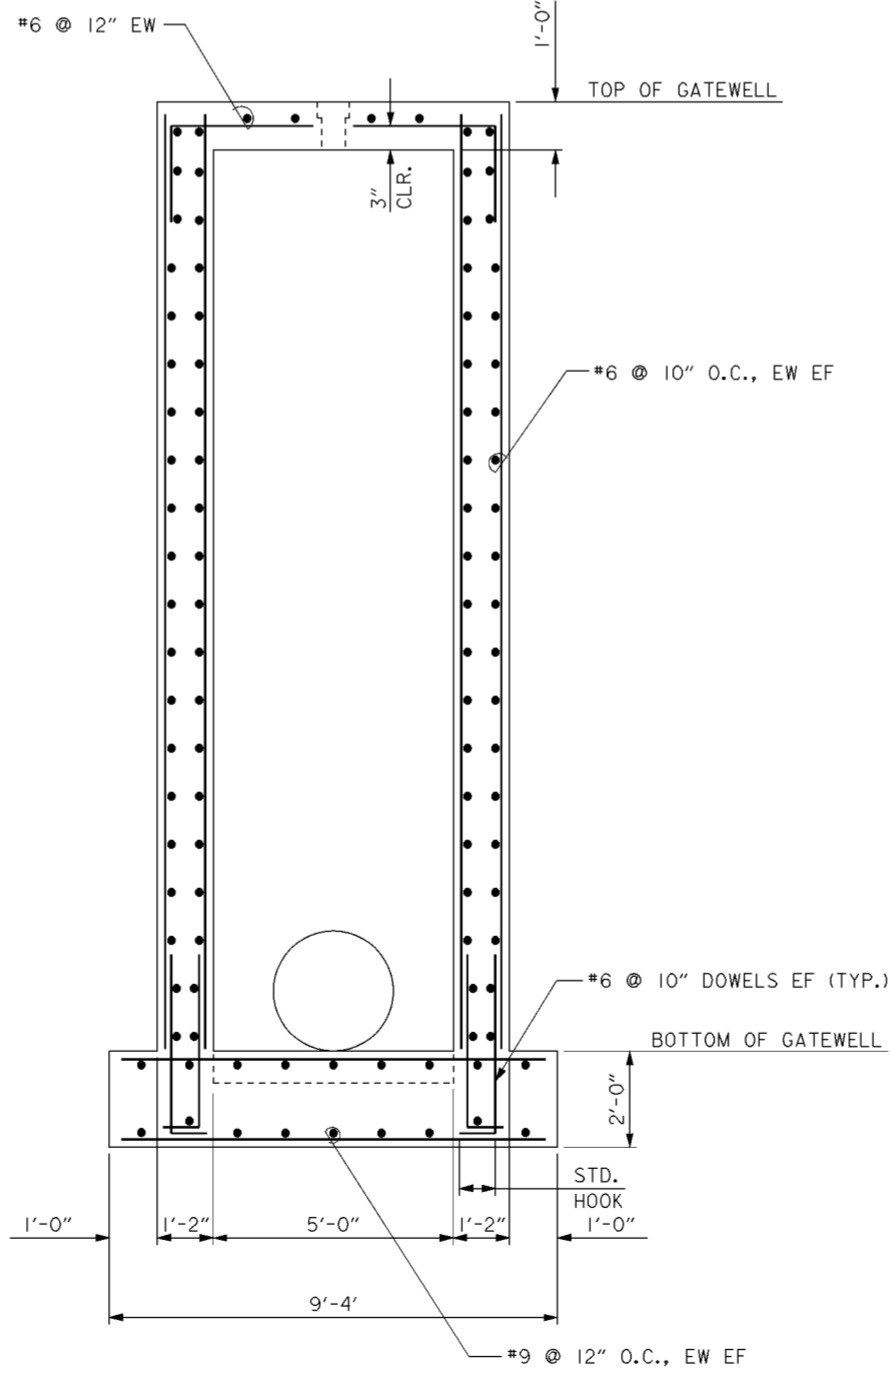

**SECTION B-B**

SCALE: 1/2" = 1'-0"  
 12' 0 1 2 3 4

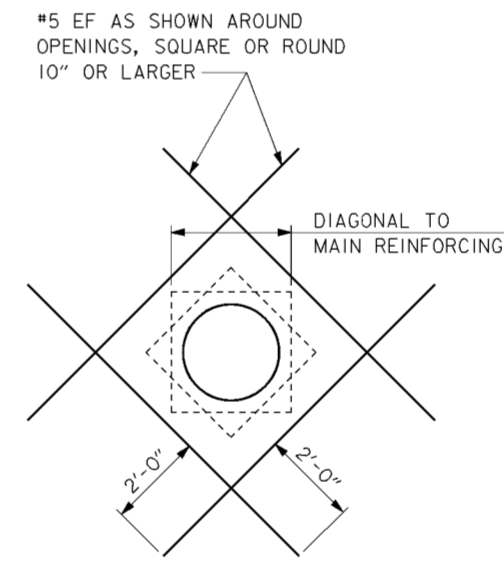

**TYPICAL OPENING DETAIL**

SCALE: NONE


**CODED NOTES**

- ① 3'-0"x2'-6" ACCESS DOOR
- ② 6" FLOOR BOX

**NOTES**



1. FOR GATEWELL DETAILS SEE DRAWING NOS. 15/7 AND 15/8.
2. FOR STRUCTURAL GENERAL NOTES, SEE DRAWING NO. 20.1/2

Revisions			
Symbol	Descriptions	Date	Approved
◇ REVISED AS CONSTRUCTED - PHASE IIIA SOUTH 4/01 P.O.C.			
<b>BURGESS &amp; NIPLE, LIMITED</b> COLUMBUS, OHIO		<b>U.S. ARMY ENGINEER DISTRICT</b> CORPS OF ENGINEERS HUNTINGTON, WEST VIRGINIA	
Designed by:	J.VARGISH	SCIOTO RIVER COLUMBUS, OHIO WEST COLUMBUS, L.P.P. PHASE IIIA	
Drawn by:	T.MULLINS	<b>GATEWELL NOS.1 THRU 5</b> <b>REINFORCING STEEL</b>	
Checked by:	D.TRAINA	Scale:	AS SHOWN
Reviewed by:		Date:	OCTOBER 1999
Approved by:		Drawing Code:	16-PWC-12-
		Sheet reference number:	15/9
		FILENAME:	a06d403.dgn
		PIN TABLE:	
		Sheet	1 of 1

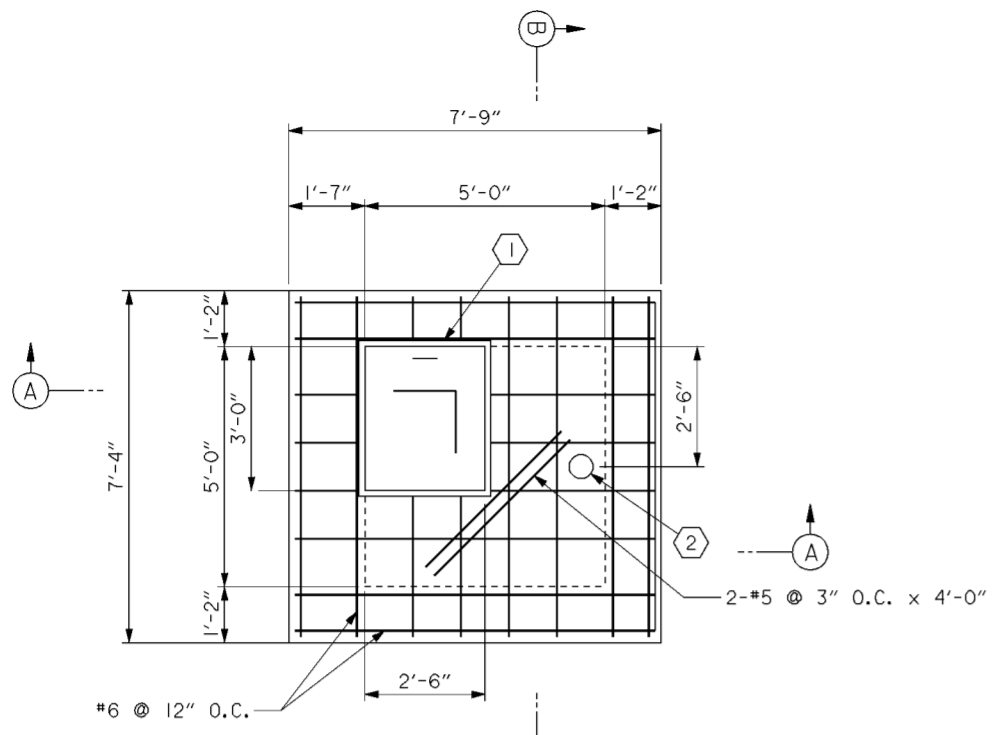


**UPPER PLAN**

SCALE: 1/2" = 1'-0"

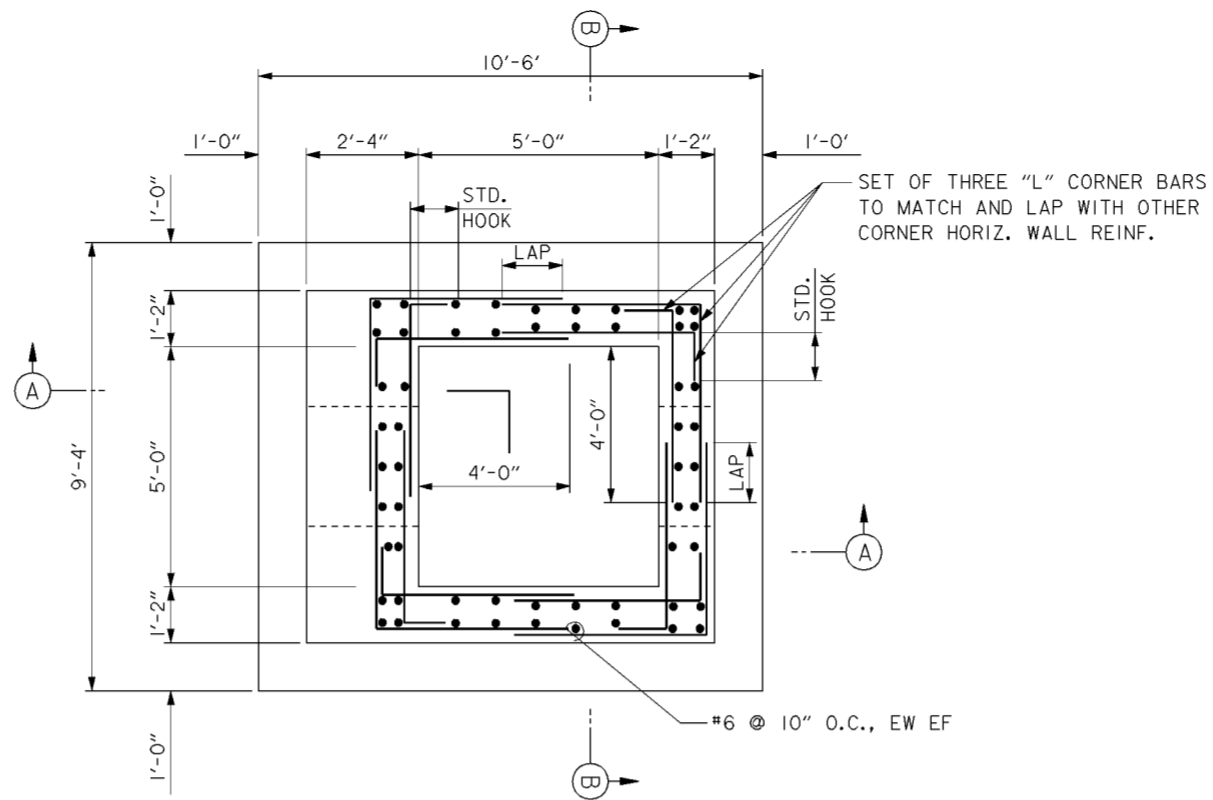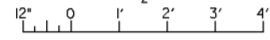


**LOWER PLAN**

SCALE: 1/2" = 1'-0"


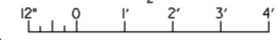


GATEWELL NO.	INLET/OUTLET PIPE SIZE	TOP OF GATEWELL EL.	BOTTOM OF GATEWELL EL.	SLUICE GATE
1	30"	728.0	703.17±	30"x30"
2	36"	722.5	696.79±	36"x36"
3	18"	721.2	705.92±	18"x18"
4	24"	722.2	698.21±	24"x24"
5	18"	722.0	706.53±	18"x18"
6	24"	721.75	697.84±	24"x24"

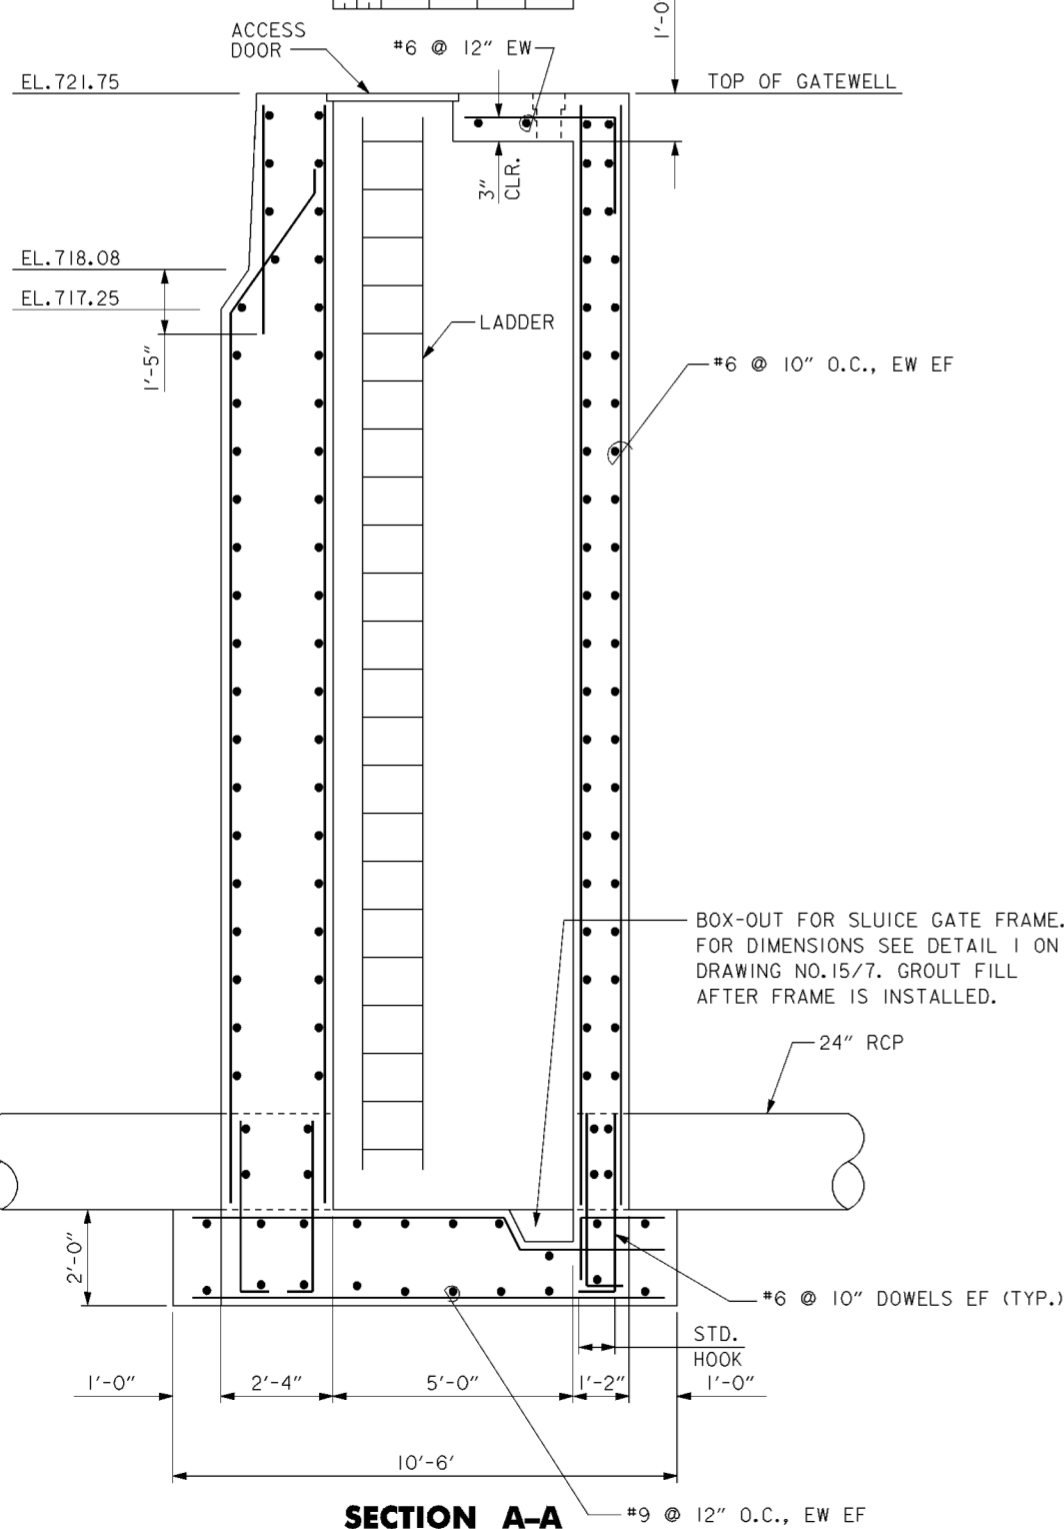



**SECTION A-A**

SCALE: 1/2" = 1'-0"

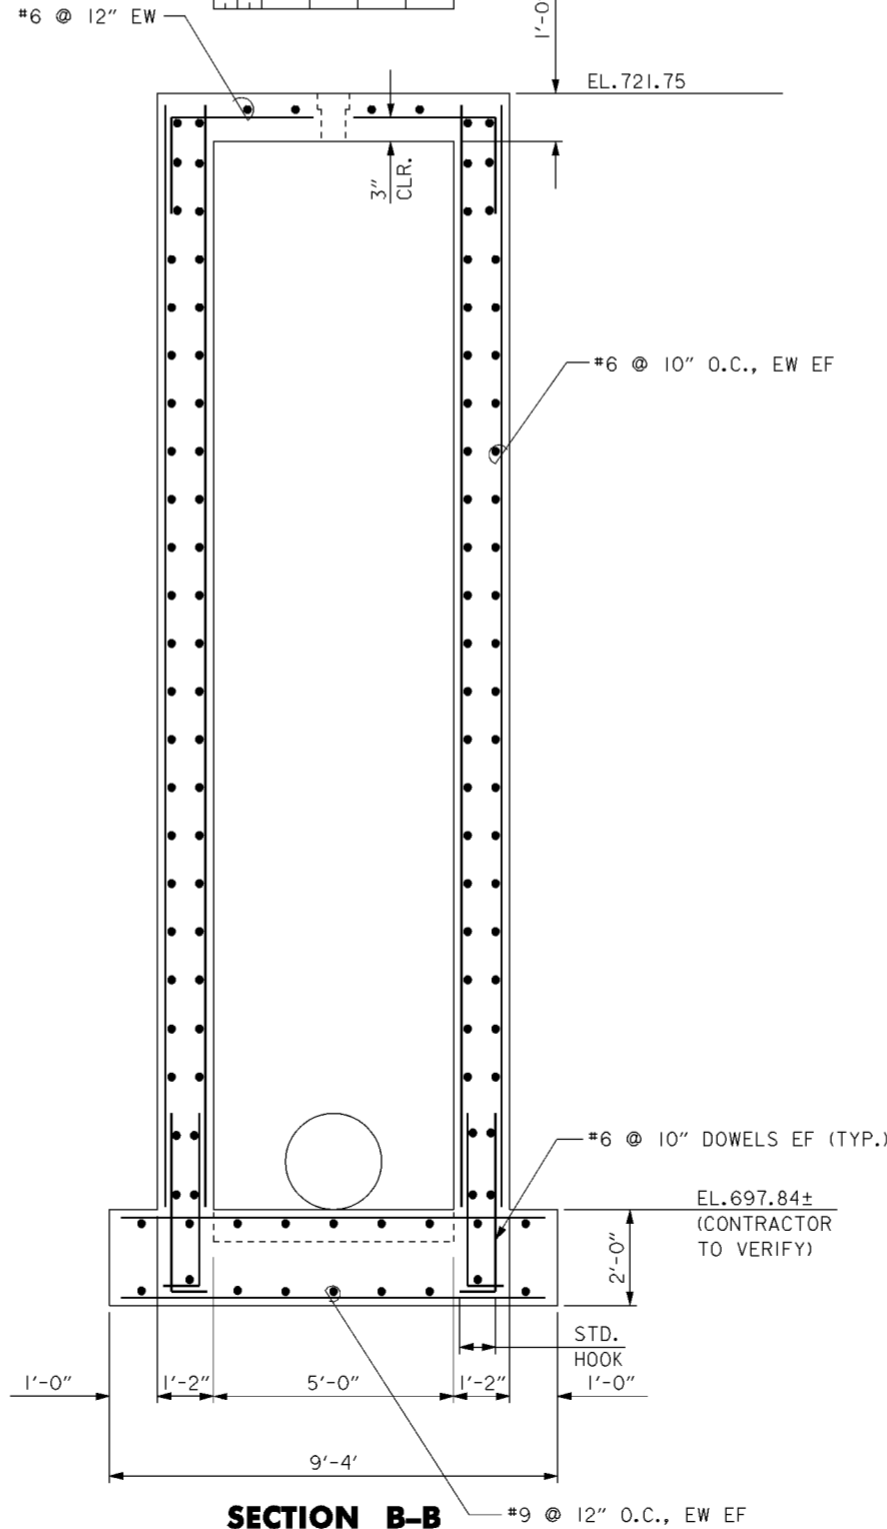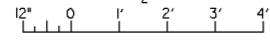

**SECTION B-B**

SCALE: 1/2" = 1'-0"

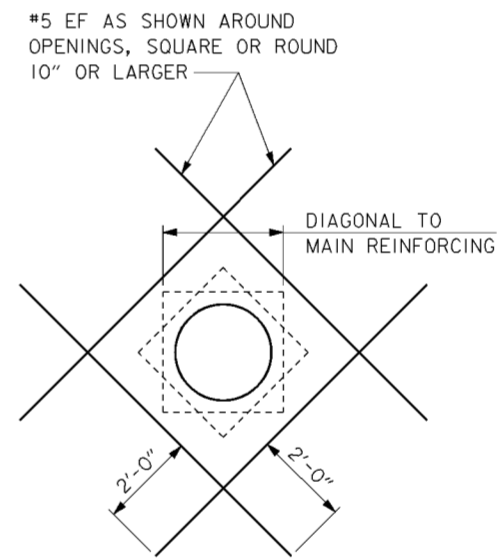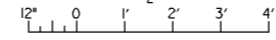

**TYPICAL OPENING DETAIL**

SCALE: NONE

**CODED NOTES**

- ① 3'-0"x2'-6" ACCESS DOOR
- ② 6" FLOOR BOX








**NOTES**

- 1. FOR GATEWELL DETAILS SEE DRAWING NOS. 15/7 AND 15/8.
- 2. FOR STRUCTURAL GENERAL NOTES, SEE DRAWING NO. 20.1/2.

Revisions			
Symbol	Descriptions	Date	Approved

◊ REVISED AS CONSTRUCTED - PHASE IIIA SOUTH 4/01 P.O.C.

<b>BURGESS &amp; NIPL, LIMITED</b> COLUMBUS, OHIO	<b>U.S. ARMY ENGINEER DISTRICT</b> CORPS OF ENGINEERS HUNTINGTON, WEST VIRGINIA
Designed by: <b>J.VARGISH</b> Drawn by: <b>T.MULLINS</b> Checked by: <b>D.TRAINA</b> Reviewed by:	SCIO TO RIVER COLUMBUS, OHIO WEST COLUMBUS, L.P.P. PHASE IIIA <b>GATEWELL NO. 6</b> <b>REINFORCING STEEL</b>
Approved by:	Scale: <b>AS SHOWN</b> Date: <b>OCTOBER 1999</b> Drawing Code: <b>16-PWC-12-</b>
FILENAME: a0d6d104.dgn SHEET REFERENCE: PIN TABLE: <b>15/10</b> Sheet 1 of 1	

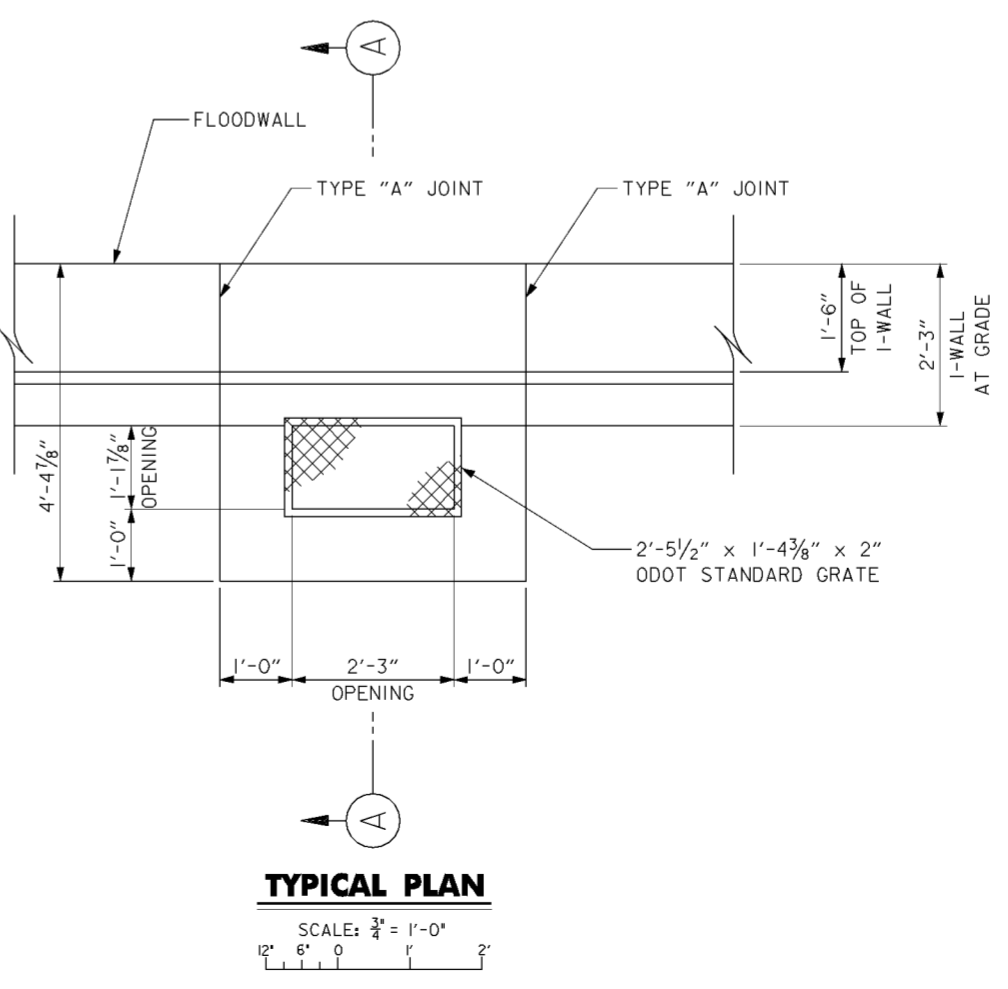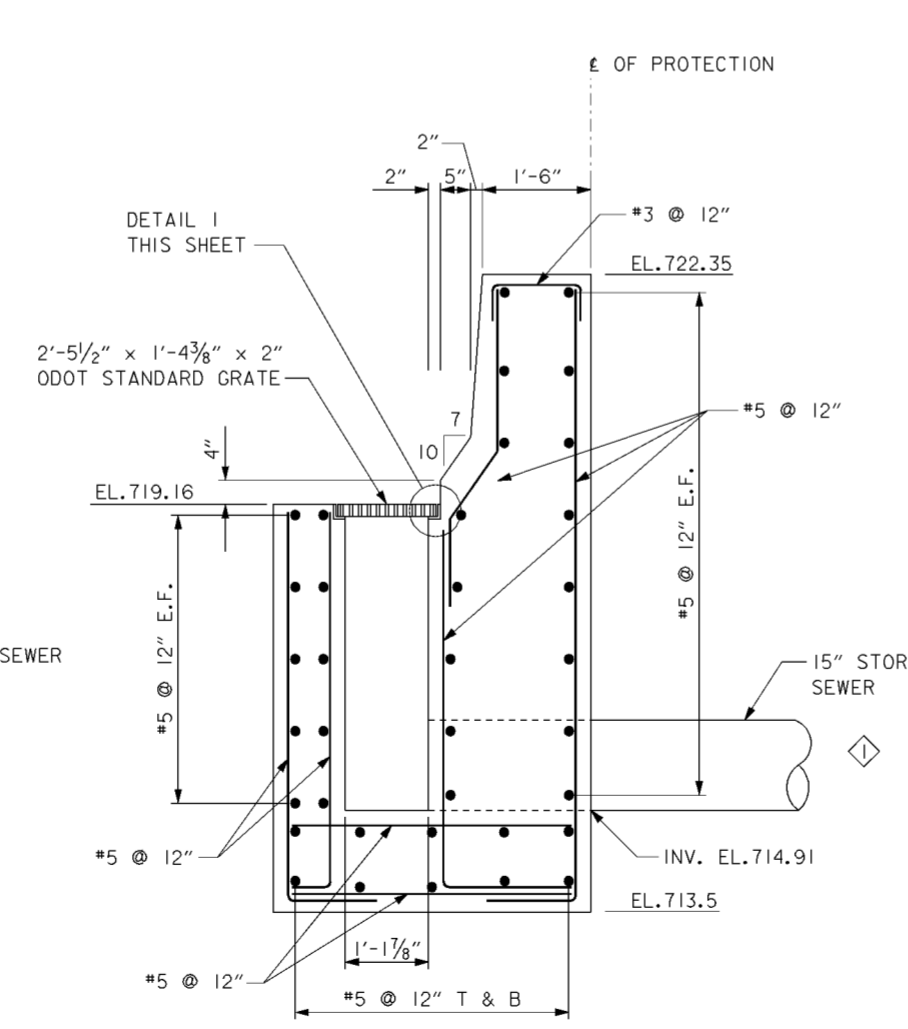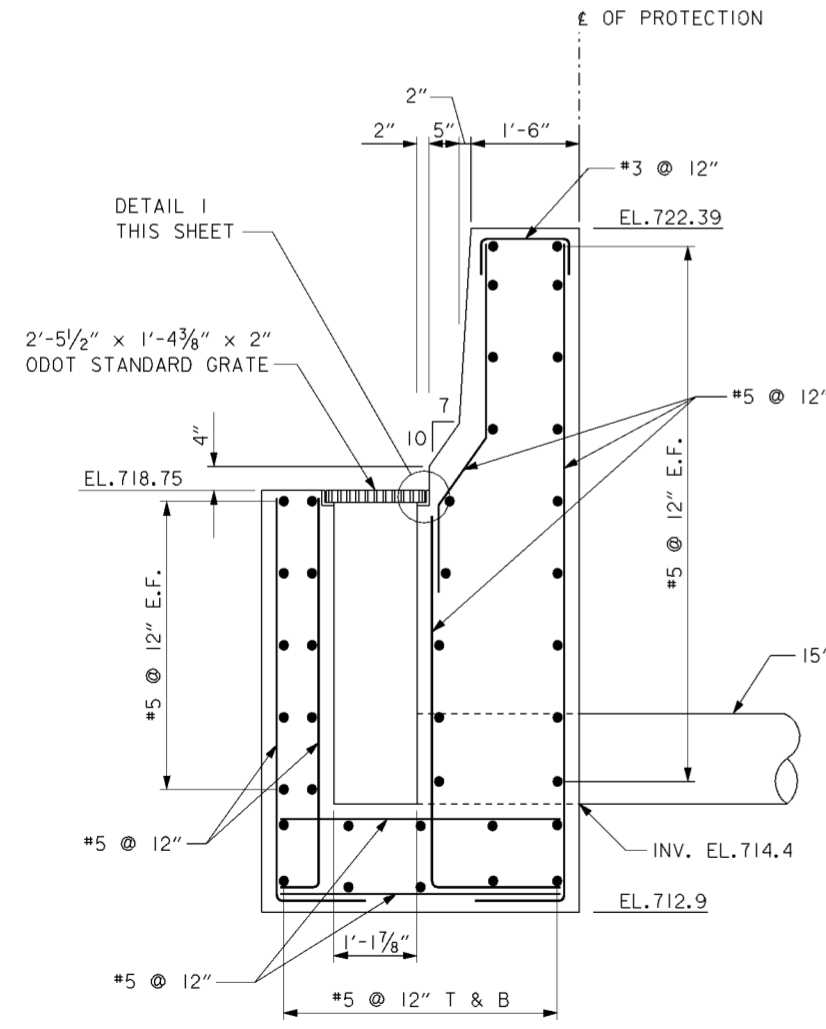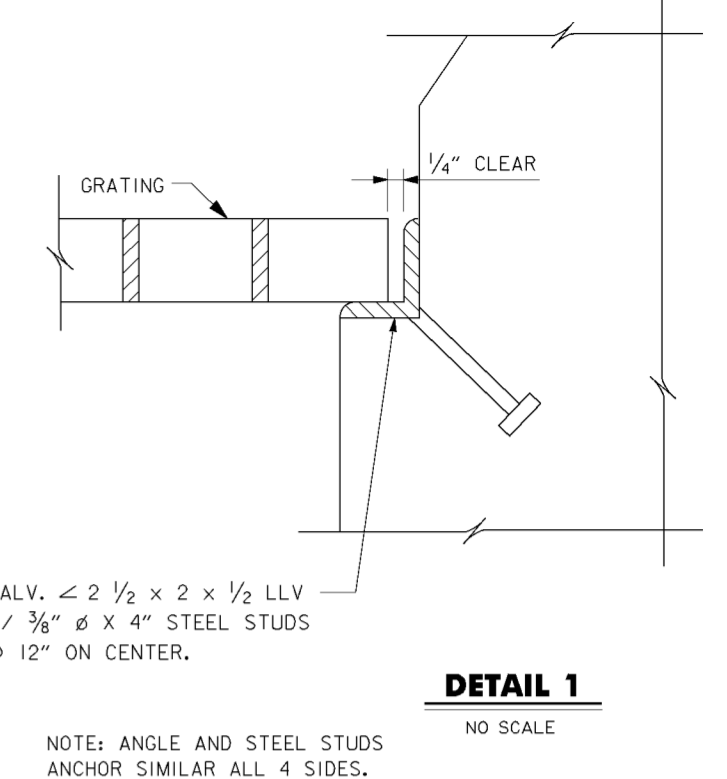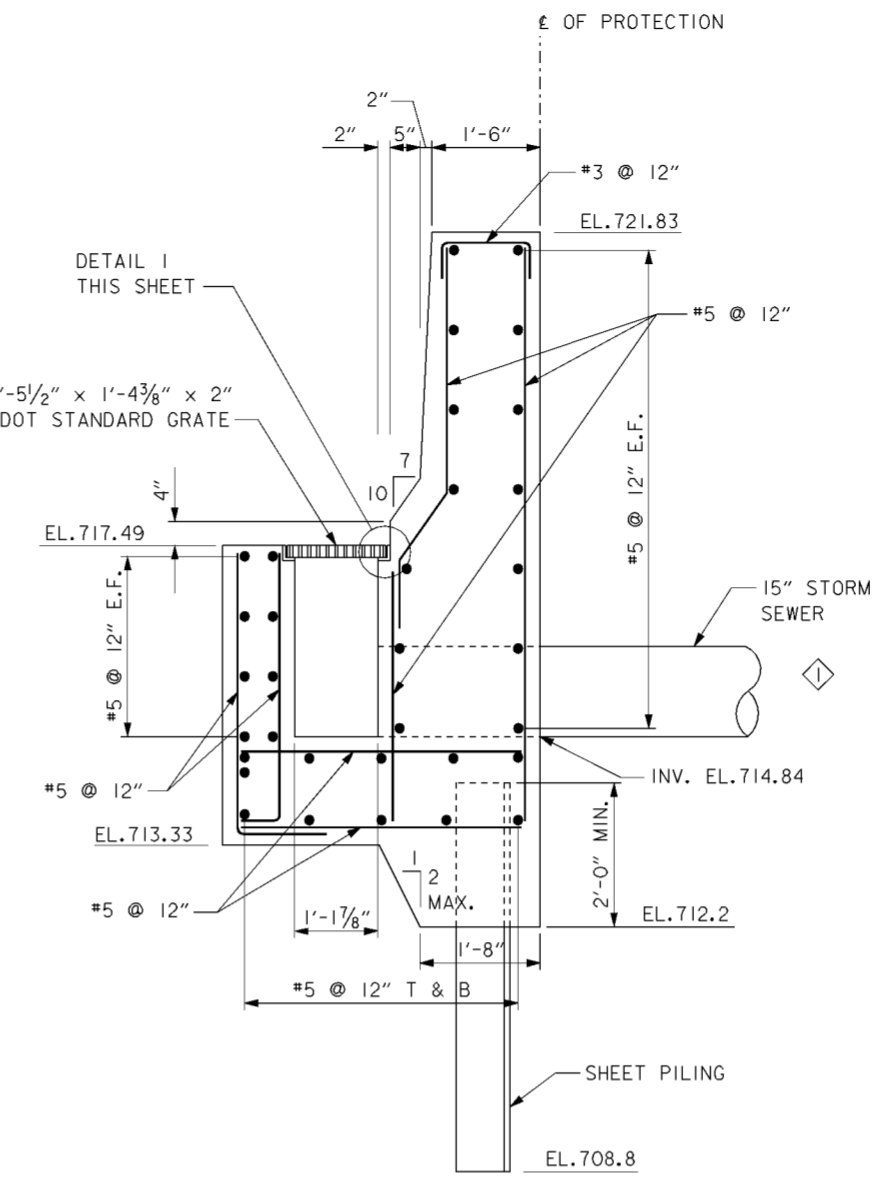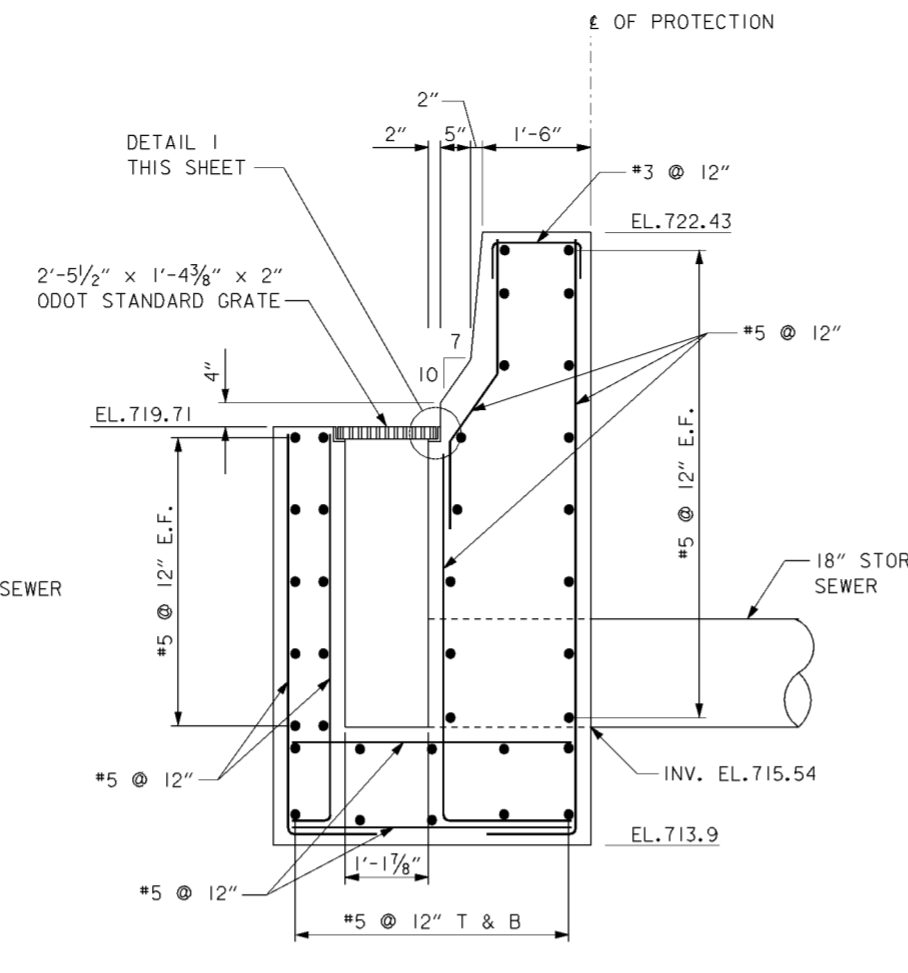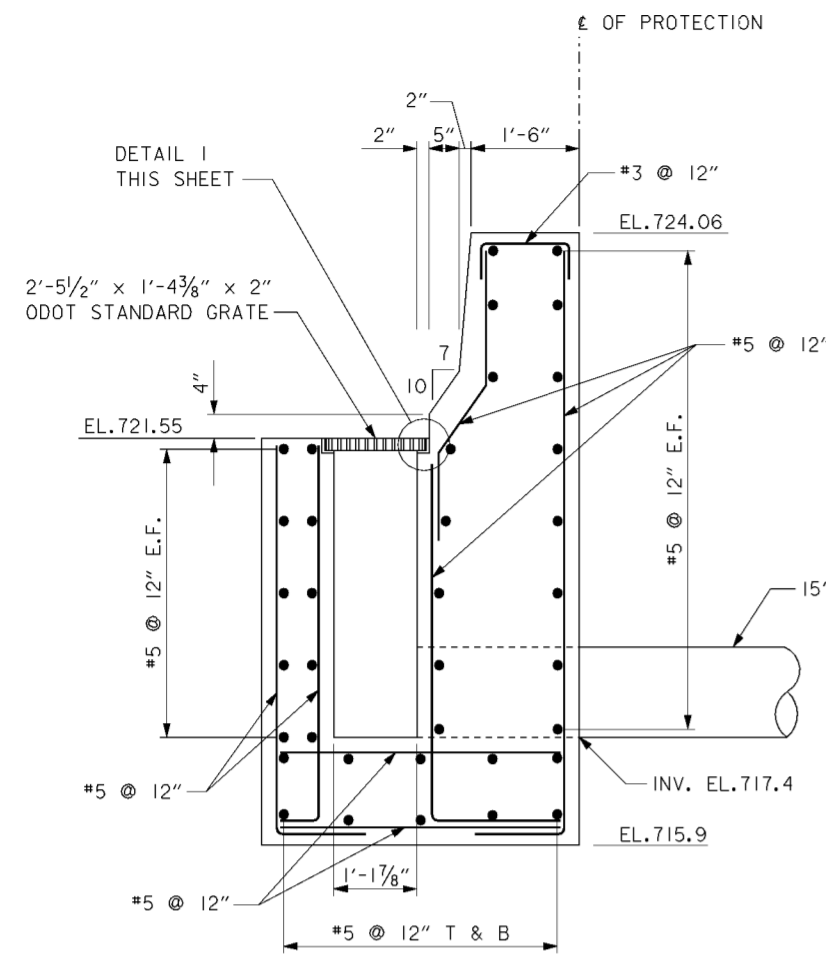


**CODED NOTES**  
◇ NEW FLAP VALVE ON OUTLET PIPE REQUIRED SEE SPECIFICATIONS

**NOTES**  
1. FOR STRUCTURAL GENERAL NOTES SEE DRAWING NO. 20.1/2.  
2. PROVIDE 3" CLEAR COVER ON ALL REINFORCING.

Revisions			
Symbol	Descriptions	Date	Approved


  

<b>BURGESS &amp; NIPLE, LIMITED</b> COLUMBUS, OHIO	U.S. ARMY ENGINEER DISTRICT CORPS OF ENGINEERS HUNTINGTON, WEST VIRGINIA	SCIOTO RIVER COLUMBUS, OHIO WEST COLUMBUS, L.P.P. PHASE IIIA	
		<b>CATCH BASINS PLAN AND SECTIONS</b>	
Designed by: <b>P. CONROY</b>		Scale: <b>AS SHOWN</b>	FILENAME: 00d2p01.dgn
Drawn by: <b>T. MULLINS</b>	Date: <b>OCTOBER 1999</b>	Sheet reference number: <b>15/11</b>	PEN TABLE:
Checked by: <b>R. ROMAN</b>	Drawing Code: <b>16-PWC-12-</b>	Sheet 1 of 1	

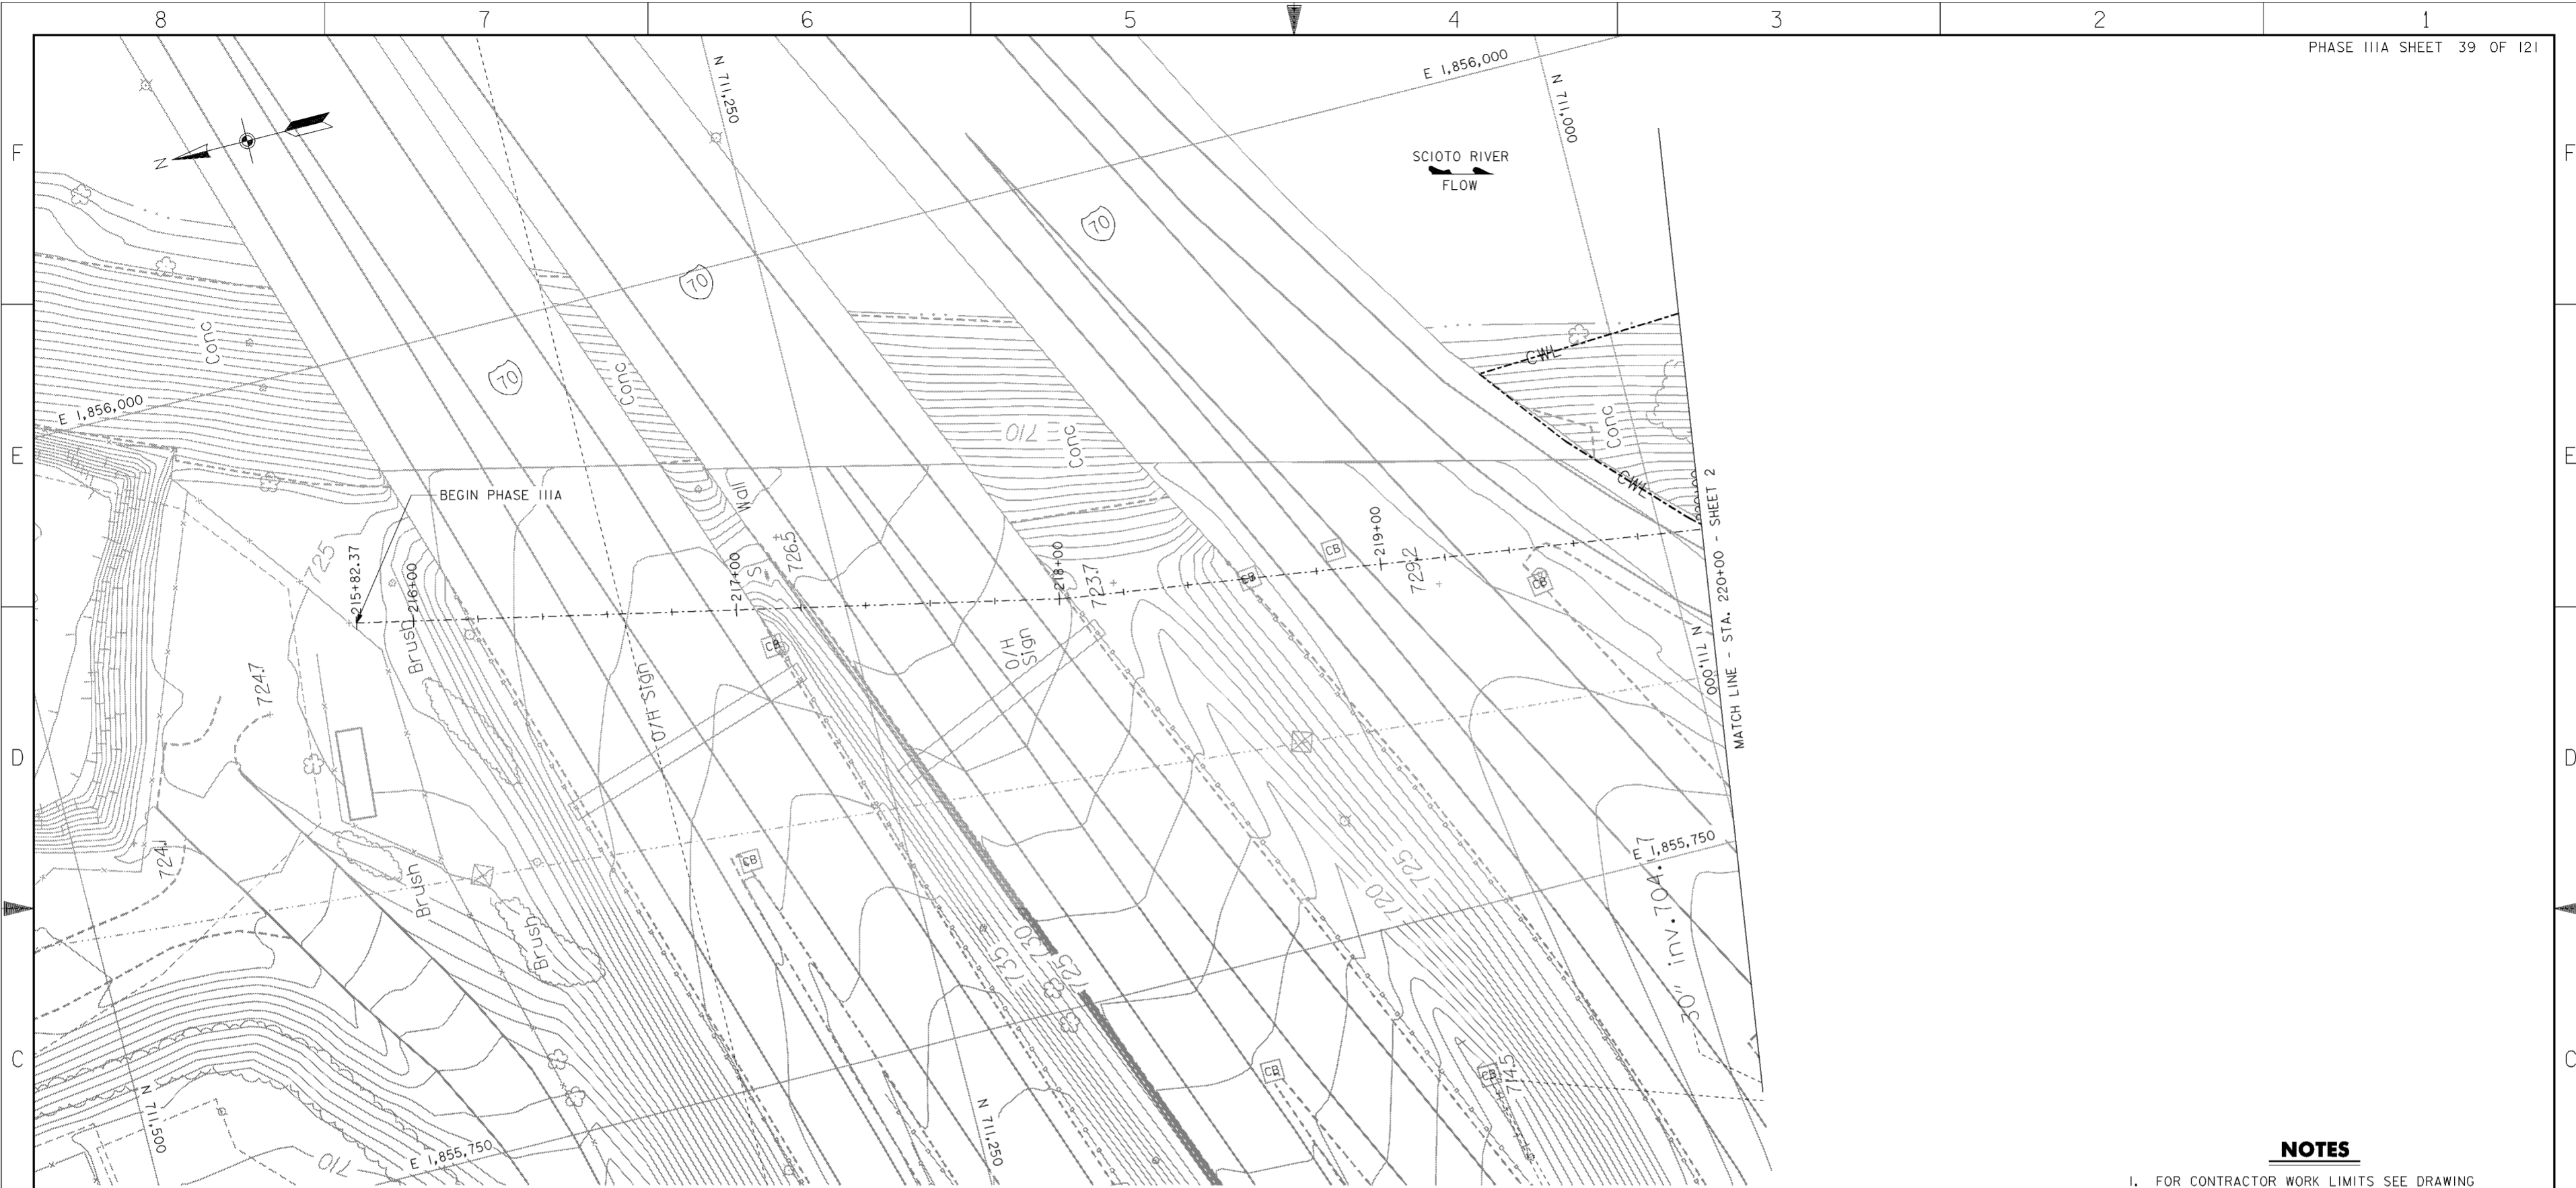

**NOTES**


- 1. FOR CONTRACTOR WORK LIMITS SEE DRAWING NOS. 6/1 THRU 6/5.

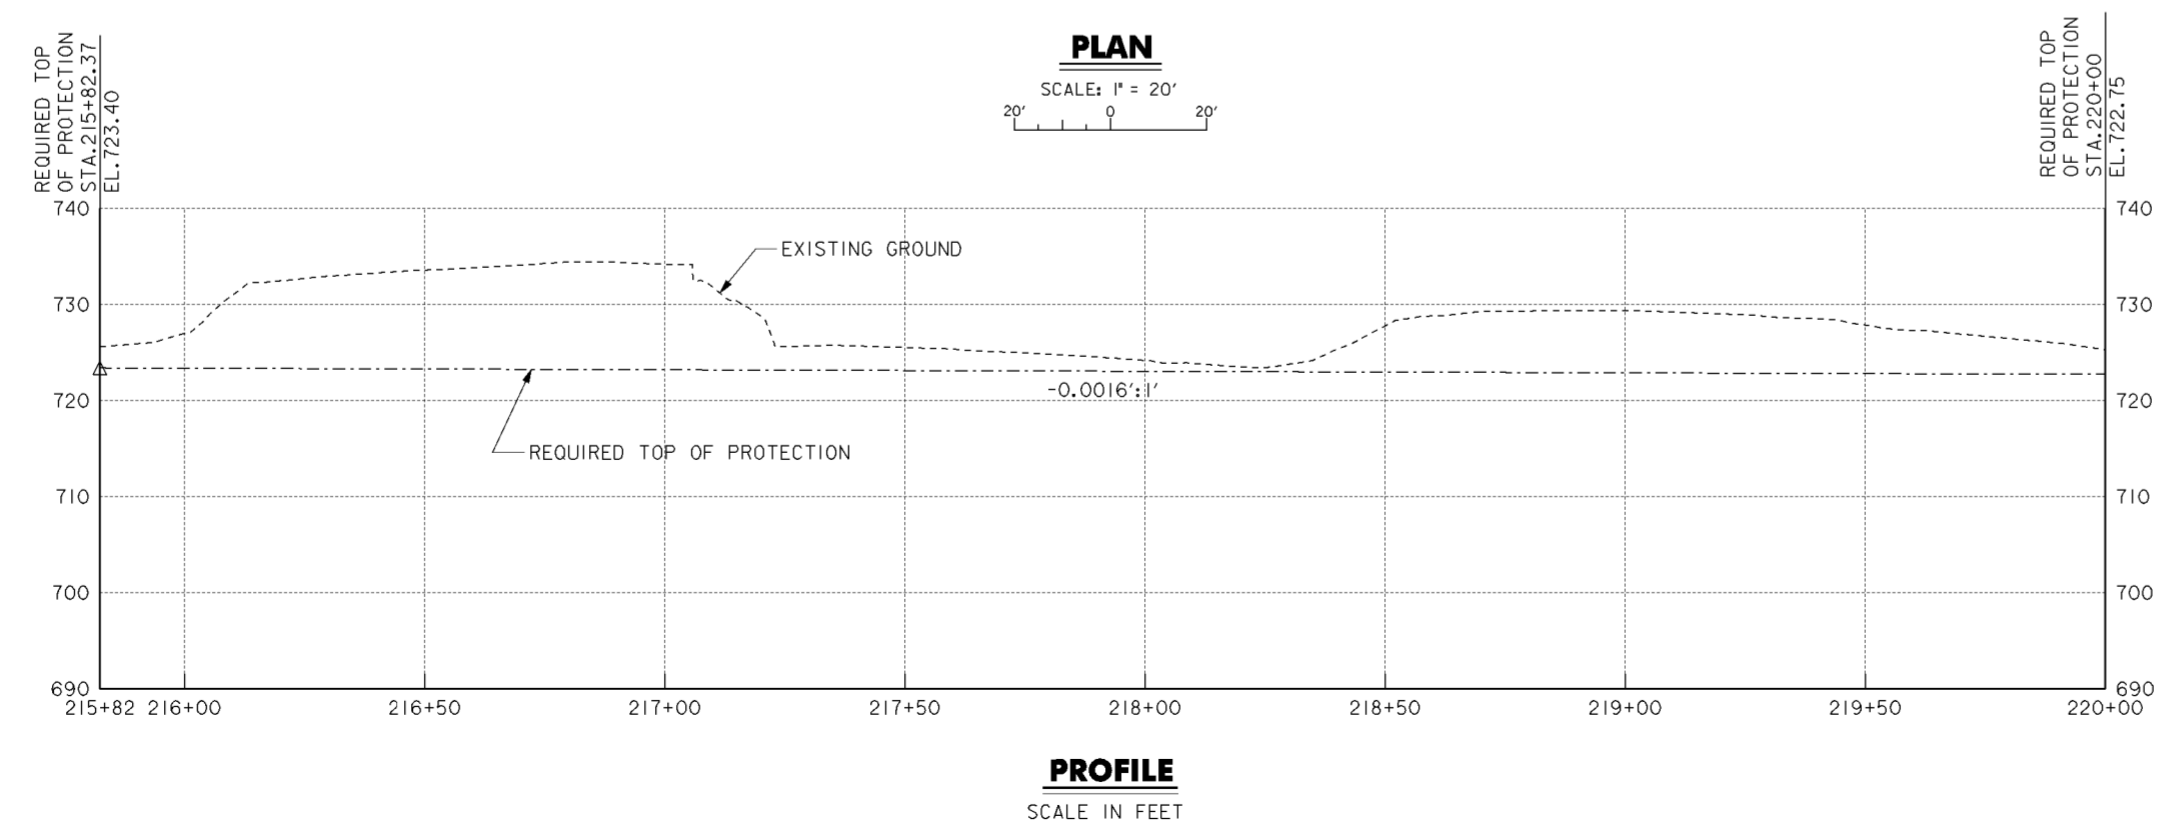

Revisions			
Symbol	Descriptions	Date	Approved


  

<b>BURGESS &amp; NIPLE, LIMITED</b> COLUMBUS, OHIO	<b>U.S. ARMY ENGINEER DISTRICT</b> CORPS OF ENGINEERS HUNTINGTON, WEST VIRGINIA	Designed by: <b>J. HALL</b>	SCIOTO RIVER COLUMBUS, OHIO WEST COLUMBUS, L.P.P. PHASE IIIA
		Drawn by: <b>T. MULLINS</b>	
Checked by: <b>P. CONROY</b>		<b>PLAN AND PROFILE</b> <b>STA 215 + 82.37 TO 220 + 00</b>	
Reviewed by:	Scale: <b>AS SHOWN</b>	Sheet reference number: <b>16/1</b>	FILENAME: PIN TABLE: 00azpp01.dgn
Approved by:	Date: <b>OCTOBER 1999</b>	Drawing Code: <b>16-PWC-12-</b>	Sheet 1 of 10

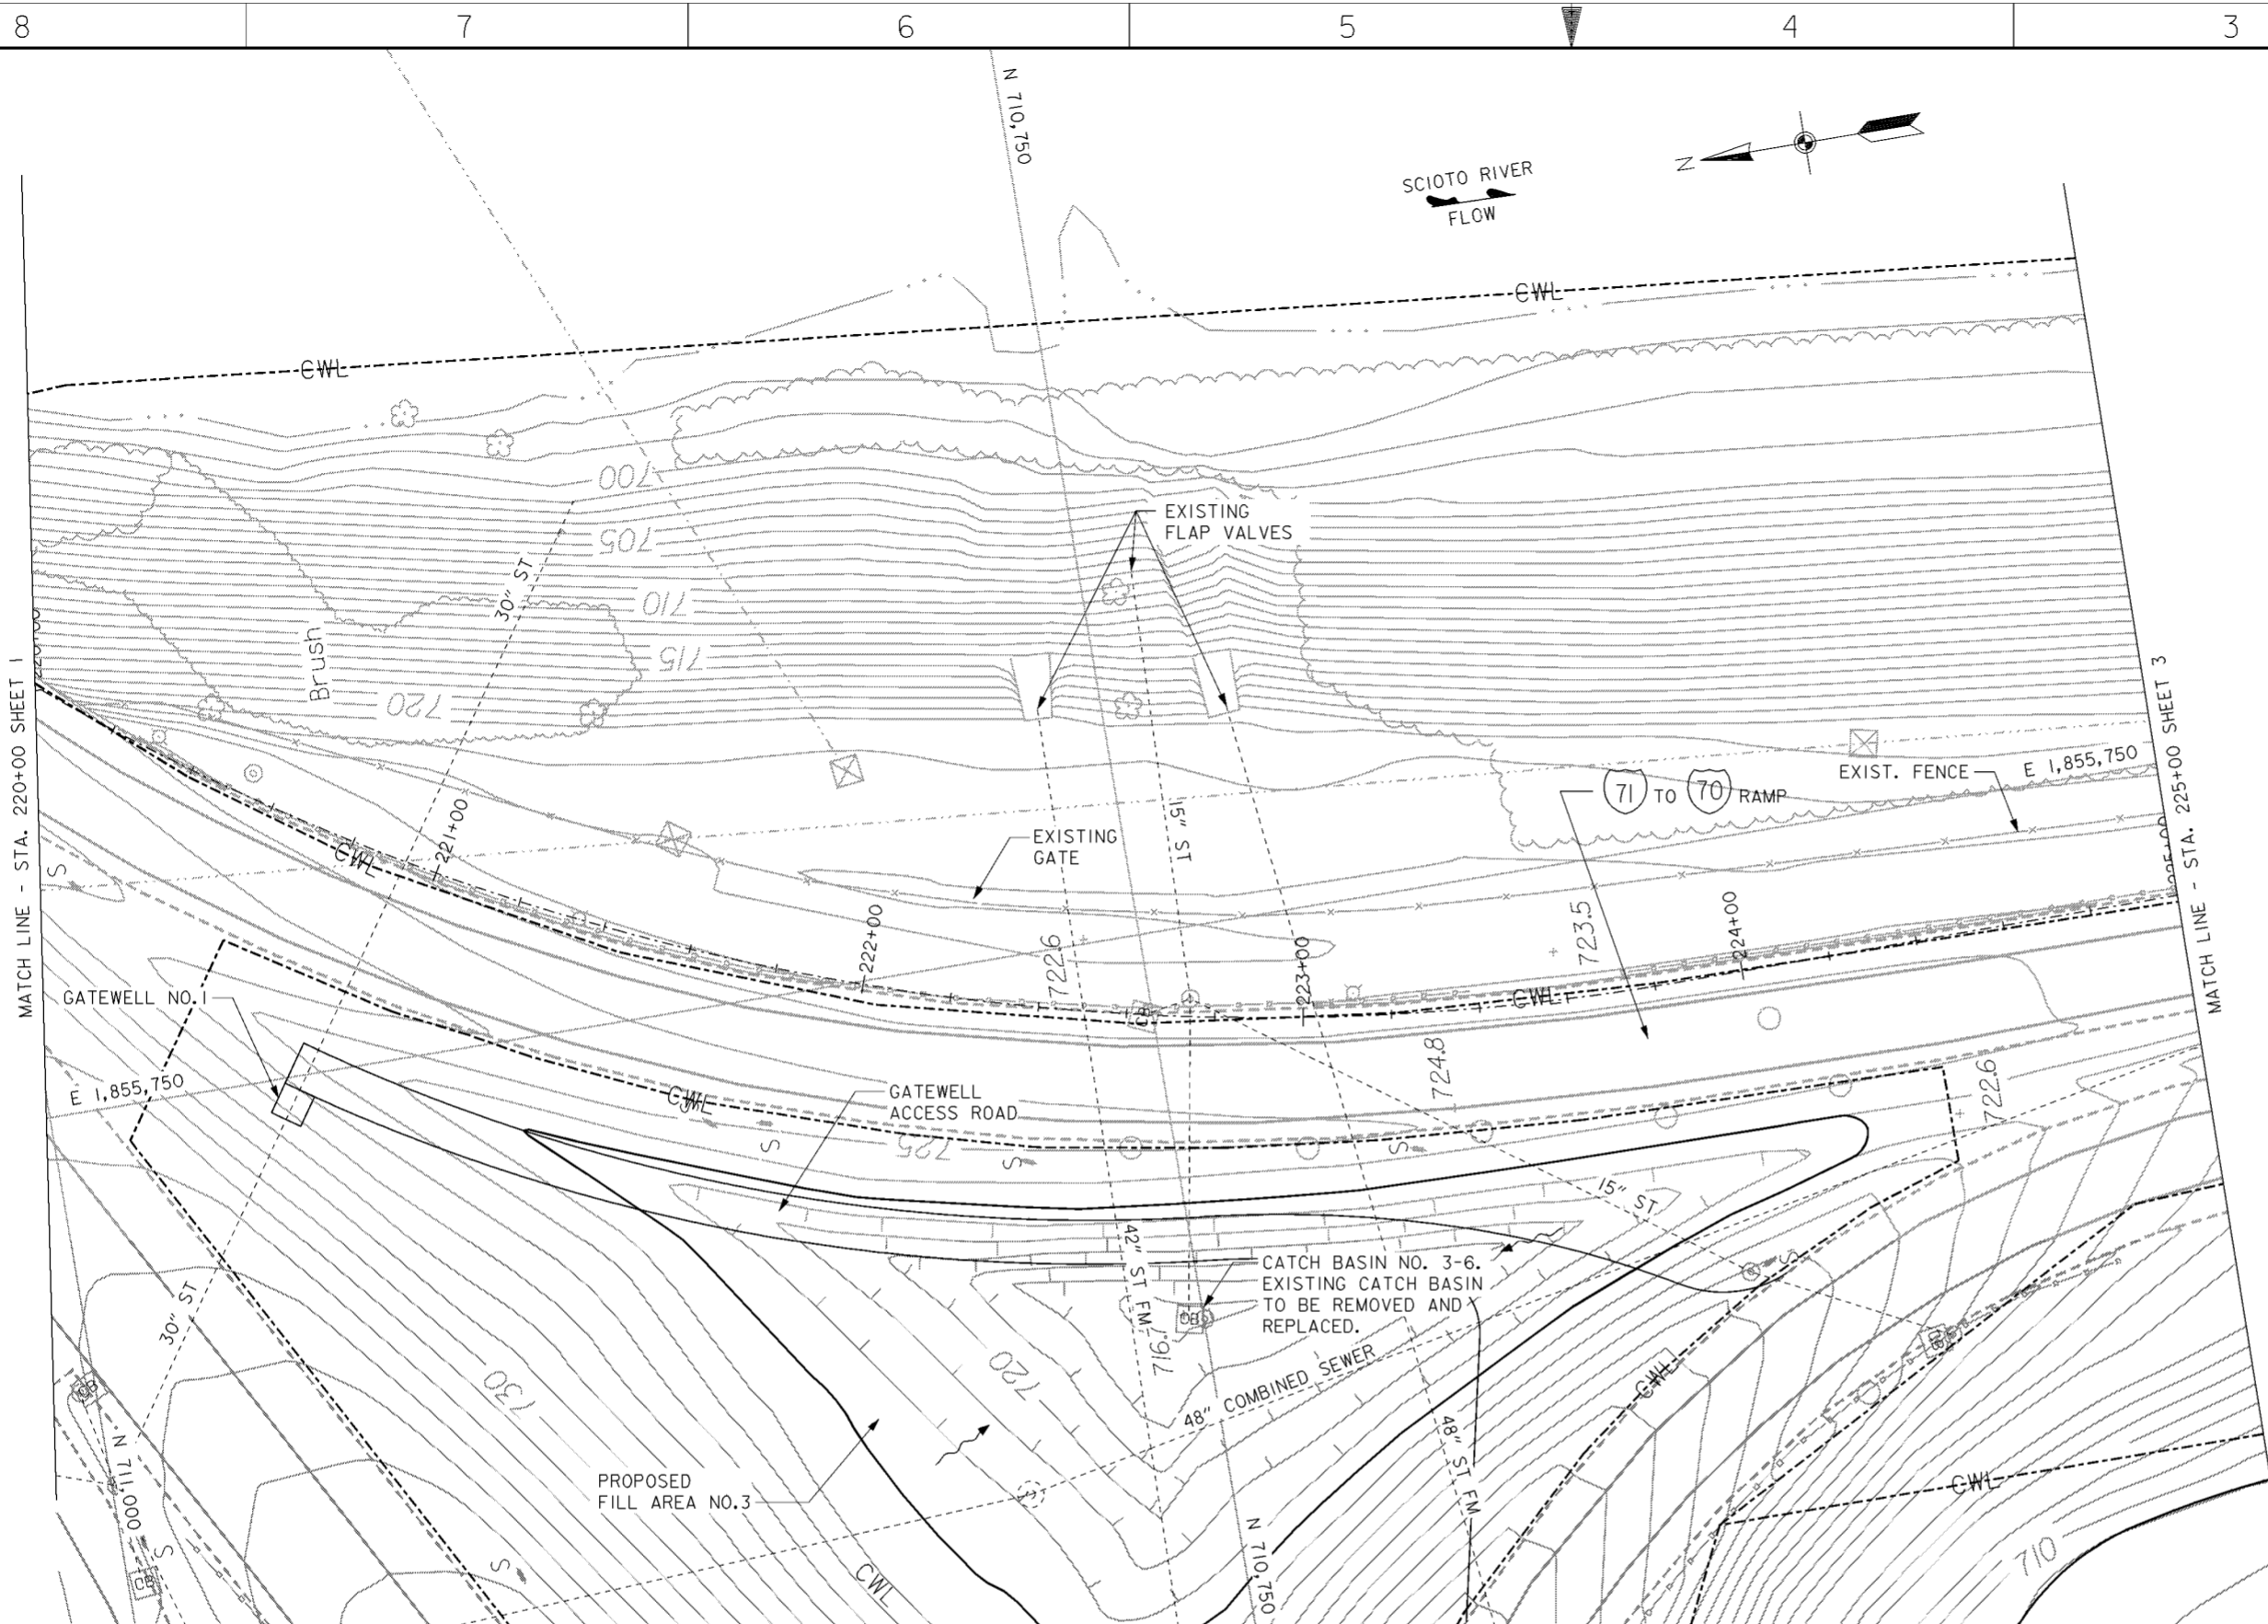

**PLAN**

SCALE: 1" = 20'

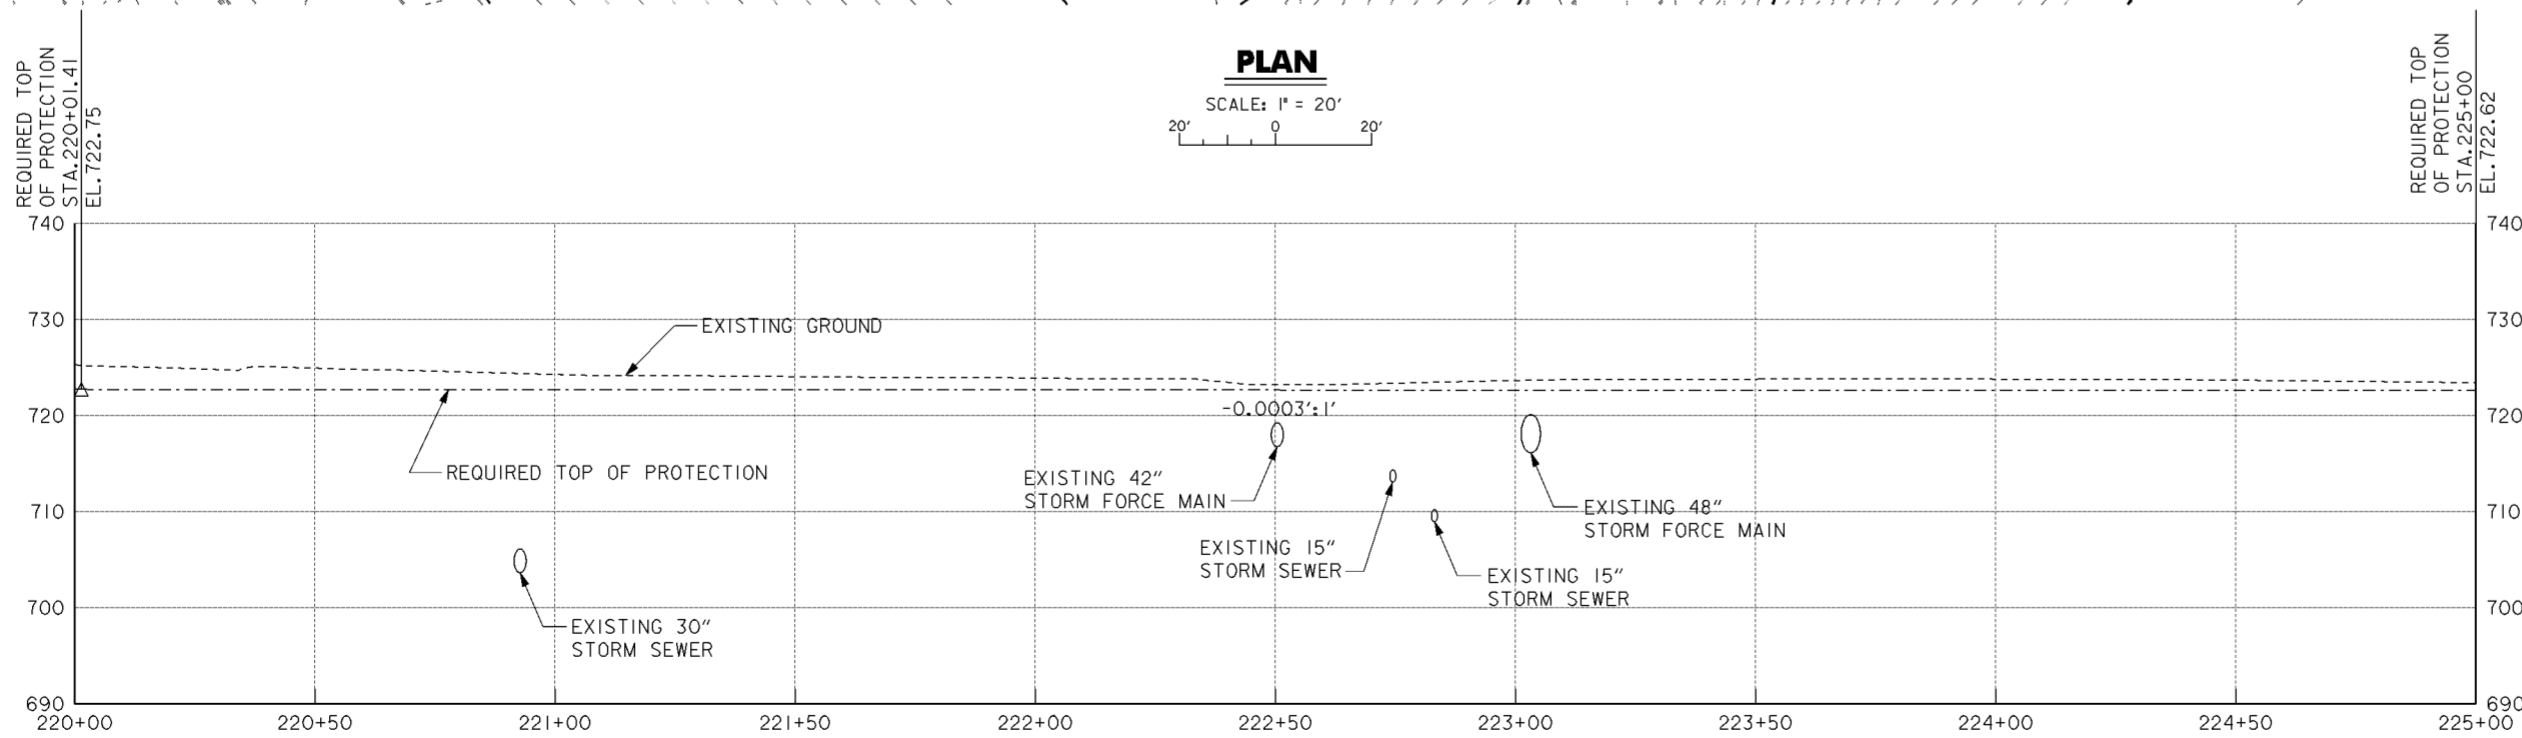

**PROFILE**

SCALE IN FEET

**NOTES**



1. FOR CONTRACTOR WORK LIMITS SEE DRAWING NOS. 6/1 THRU 6/5.
2. FOR FILL AREA NO.3 SITE PLAN SEE DRAWING NO. 20.2/2.
3. FOR GATEWELL ACCESS ROAD TYPICAL SECTION SEE DRAWING NO. 15/8.
4. FOR GATEWELL NO.1 SEE DRAWING NO. 15/1.

Revisions			
Symbol	Descriptions	Date	Approved

<b>BURGESS &amp; NIPLE, LIMITED</b> COLUMBUS, OHIO	<b>U.S. ARMY ENGINEER DISTRICT</b> CORPS OF ENGINEERS HUNTINGTON, WEST VIRGINIA	SCIOTO RIVER COLUMBUS, OHIO WEST COLUMBUS, L.P.P. PHASE IIIA	
		<b>PLAN AND PROFILE</b> <b>STA. 220+00 TO 225+00</b>	
Designed by: <b>J. HALL</b>	Drawn by: <b>T. MULLINS</b>	Checked by: <b>P. CONROY</b>	Reviewed by: Scale: <b>AS SHOWN</b>
Approved by:	Date: <b>OCTOBER 1999</b>	Drawing Code: <b>16-PWC-12-</b>	Sheet reference number: <b>162</b>
FILENAME: PIN TABLE: 00azpp02.dgn		Sheet <b>2</b> of <b>10</b>	



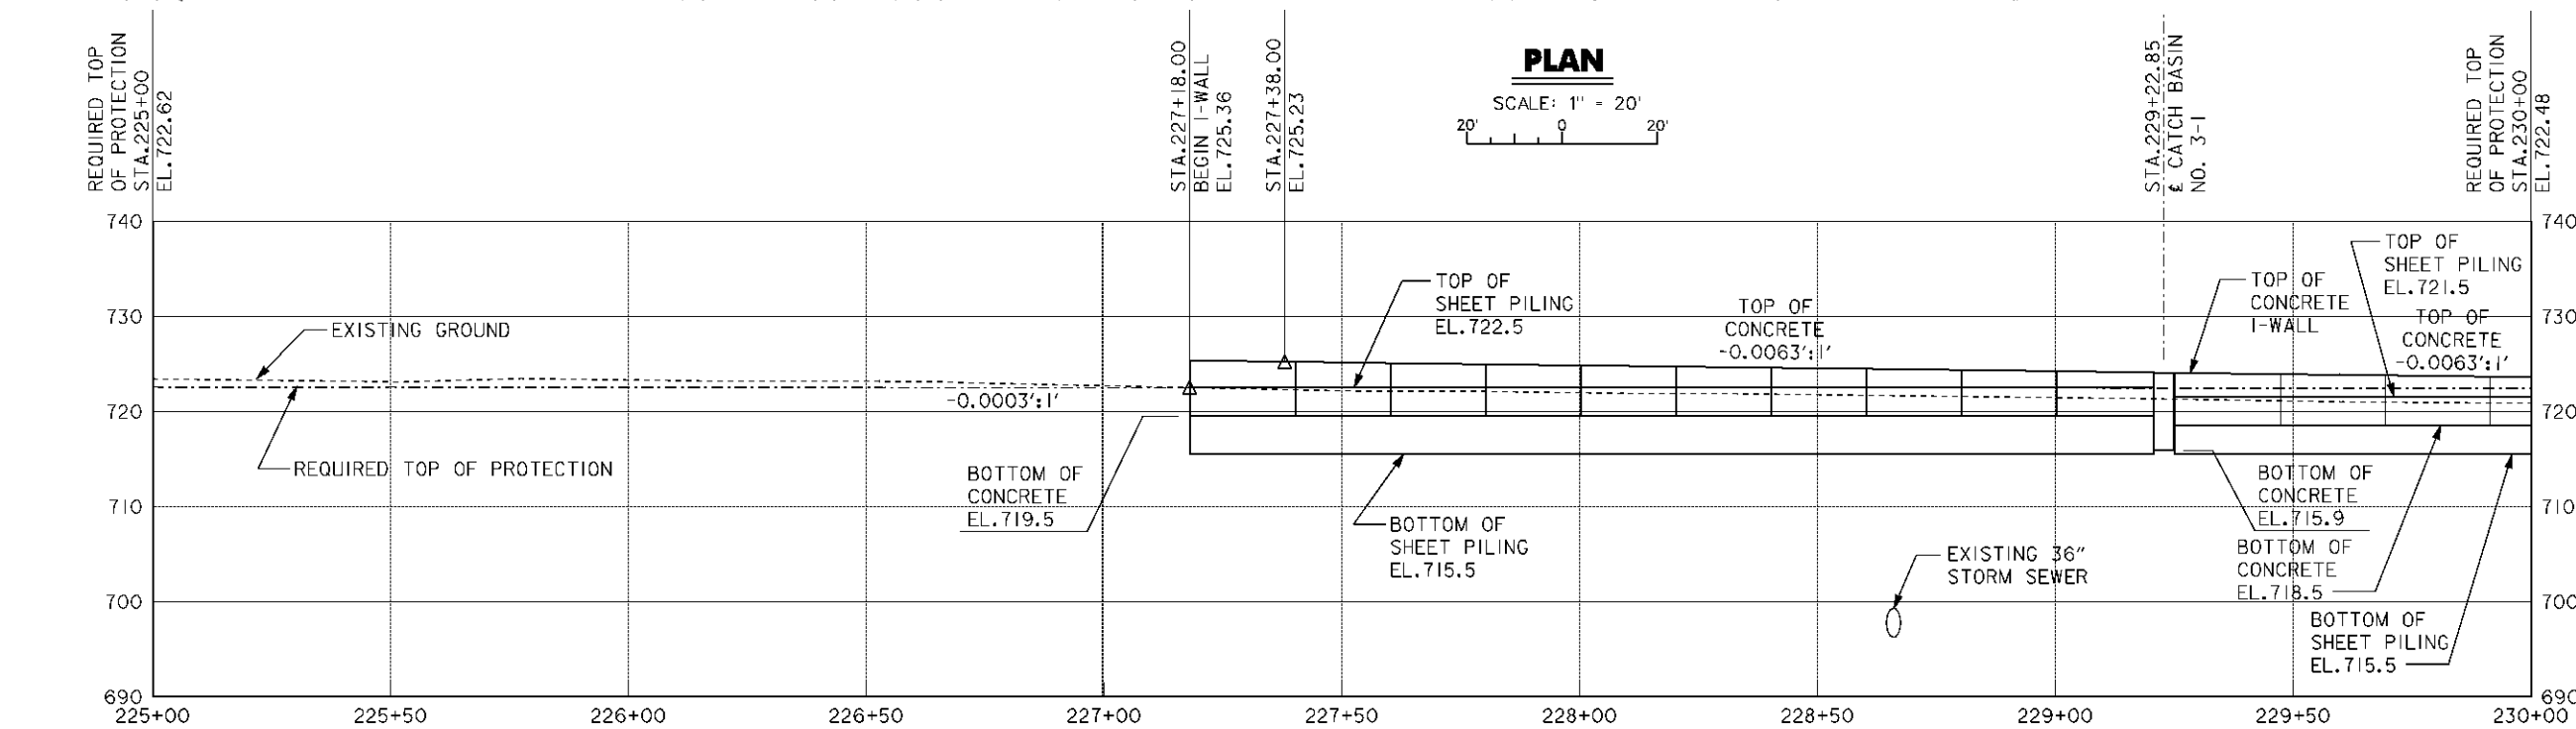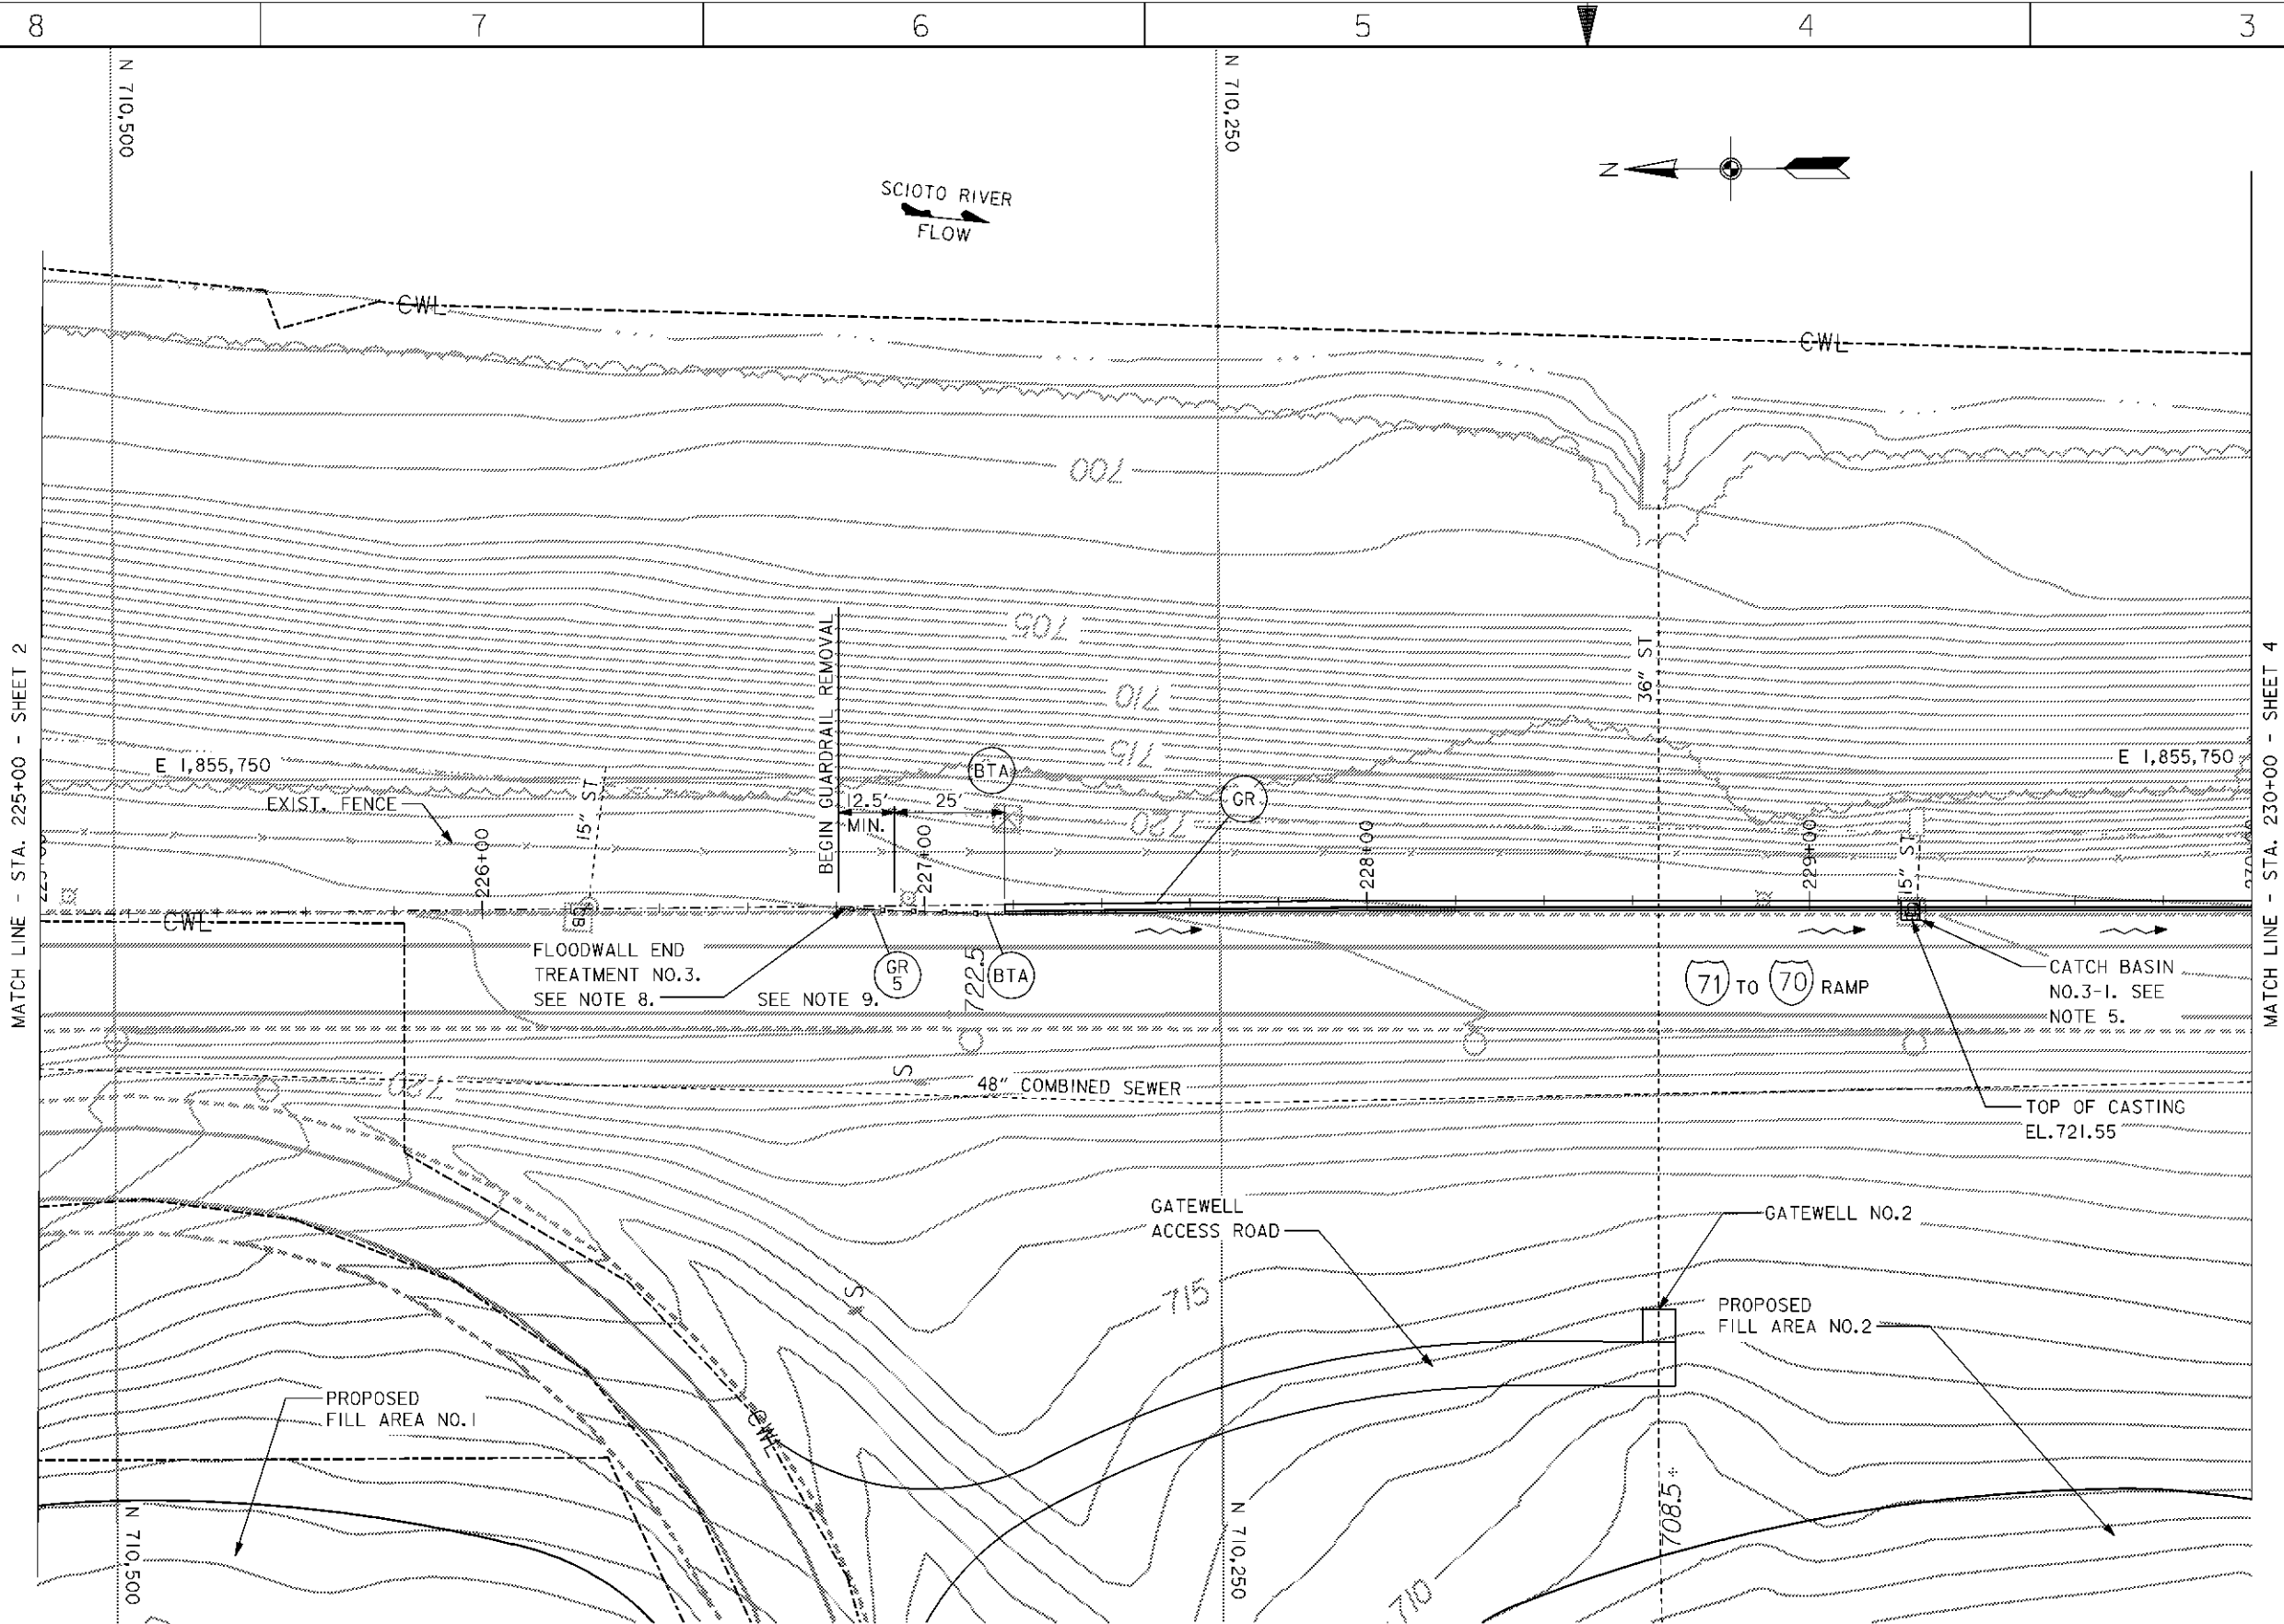


- LEGEND**
- BTA BRIDGE TERMINAL ASSEMBLY, TYPE 1
  - GR 5 GUARDRAIL, TYPE 5
  - GR GUARDRAIL REMOVAL

- NOTES**
1. FOR CONTRACTOR WORK LIMITS SEE DRAWING NOS. 6/1 THRU 6/5.
  2. FOR CATCH BASIN DETAILS SEE DRAWING NO. 15/11.
  3. FOR TAPERED END SECTION DETAILS SEE DRAWING NO. 20.1/3.
  4. FOR TYPICAL I-WALL SECTIONS SEE DRAWING NO. 20.3/1.
  5. EXISTING CATCH BASIN REMOVED FOR CONSTRUCTION OF I-WALL AND REPLACED WITH CATCH BASIN NO.3-1.
  6. FOR PAVEMENT SECTIONS AND PAVEMENT GRADING SEE DRAWING NO. 20.3/2.
  7. I-WALL JOINTS DEPICTED AS DARK ON THE PROFILE ARE TYPE "A" ALL OTHERS ARE TYPE "B". FOR JOINT STATIONS SEE DRAWING NOS. 20.1/5 AND 20.1/6.
  8. FLOODWALL END TREATMENT NO.3 INCLUDES BRIDGE TERMINAL ASSEMBLY (TYPE 1) AND GUARDRAIL (TYPE 5).
  9. PROVIDE A MINIMUM OF 12.5' SECTION OF NEW GUARDRAIL TO TRANSITION TO EXISTING GUARDRAIL.
  10. FOR GATEWELL ACCESS ROAD TYPICAL SECTION SEE DRAWING NO.15/8.
  11. FOR GATEWELL NO.2 SEE DRAWING NO.15/2.

Revisions			
Symbol	Descriptions	Date	Approved
◇	REV. IN ACCORDANCE WITH MODIFICATION MC003	5/17/00	P.O.C.

<b>BURGESS &amp; NIPL, LIMITED</b> COLUMBUS, OHIO	<b>U.S. ARMY ENGINEER DISTRICT</b> CORPS OF ENGINEERS HUNTINGTON, WEST VIRGINIA
Designed by: <b>J. HALL</b>	<small>SEI</small> SCIO TO RIVER COLUMBUS, OHIO WEST COLUMBUS, L.P.P. PHASE IIIA
Drawn by: <b>T. MULLINS</b>	<b>PLAN AND PROFILE</b> <b>STA. 225+00 TO 230+00</b>
Checked by: <b>P. CONROY</b>	Scale: <b>AS SHOWN</b>
Reviewed by:	Sheet reference number: <b>163</b>
Approved by:	FILENAME: 00app03.dgn
Date: <b>OCTOBER 1999</b>	PEN TABLE:
Drawing Code: <b>16-PWC-12-</b>	Sheet <b>3</b> of <b>10</b>

**WORK AS CONSTRUCTED**

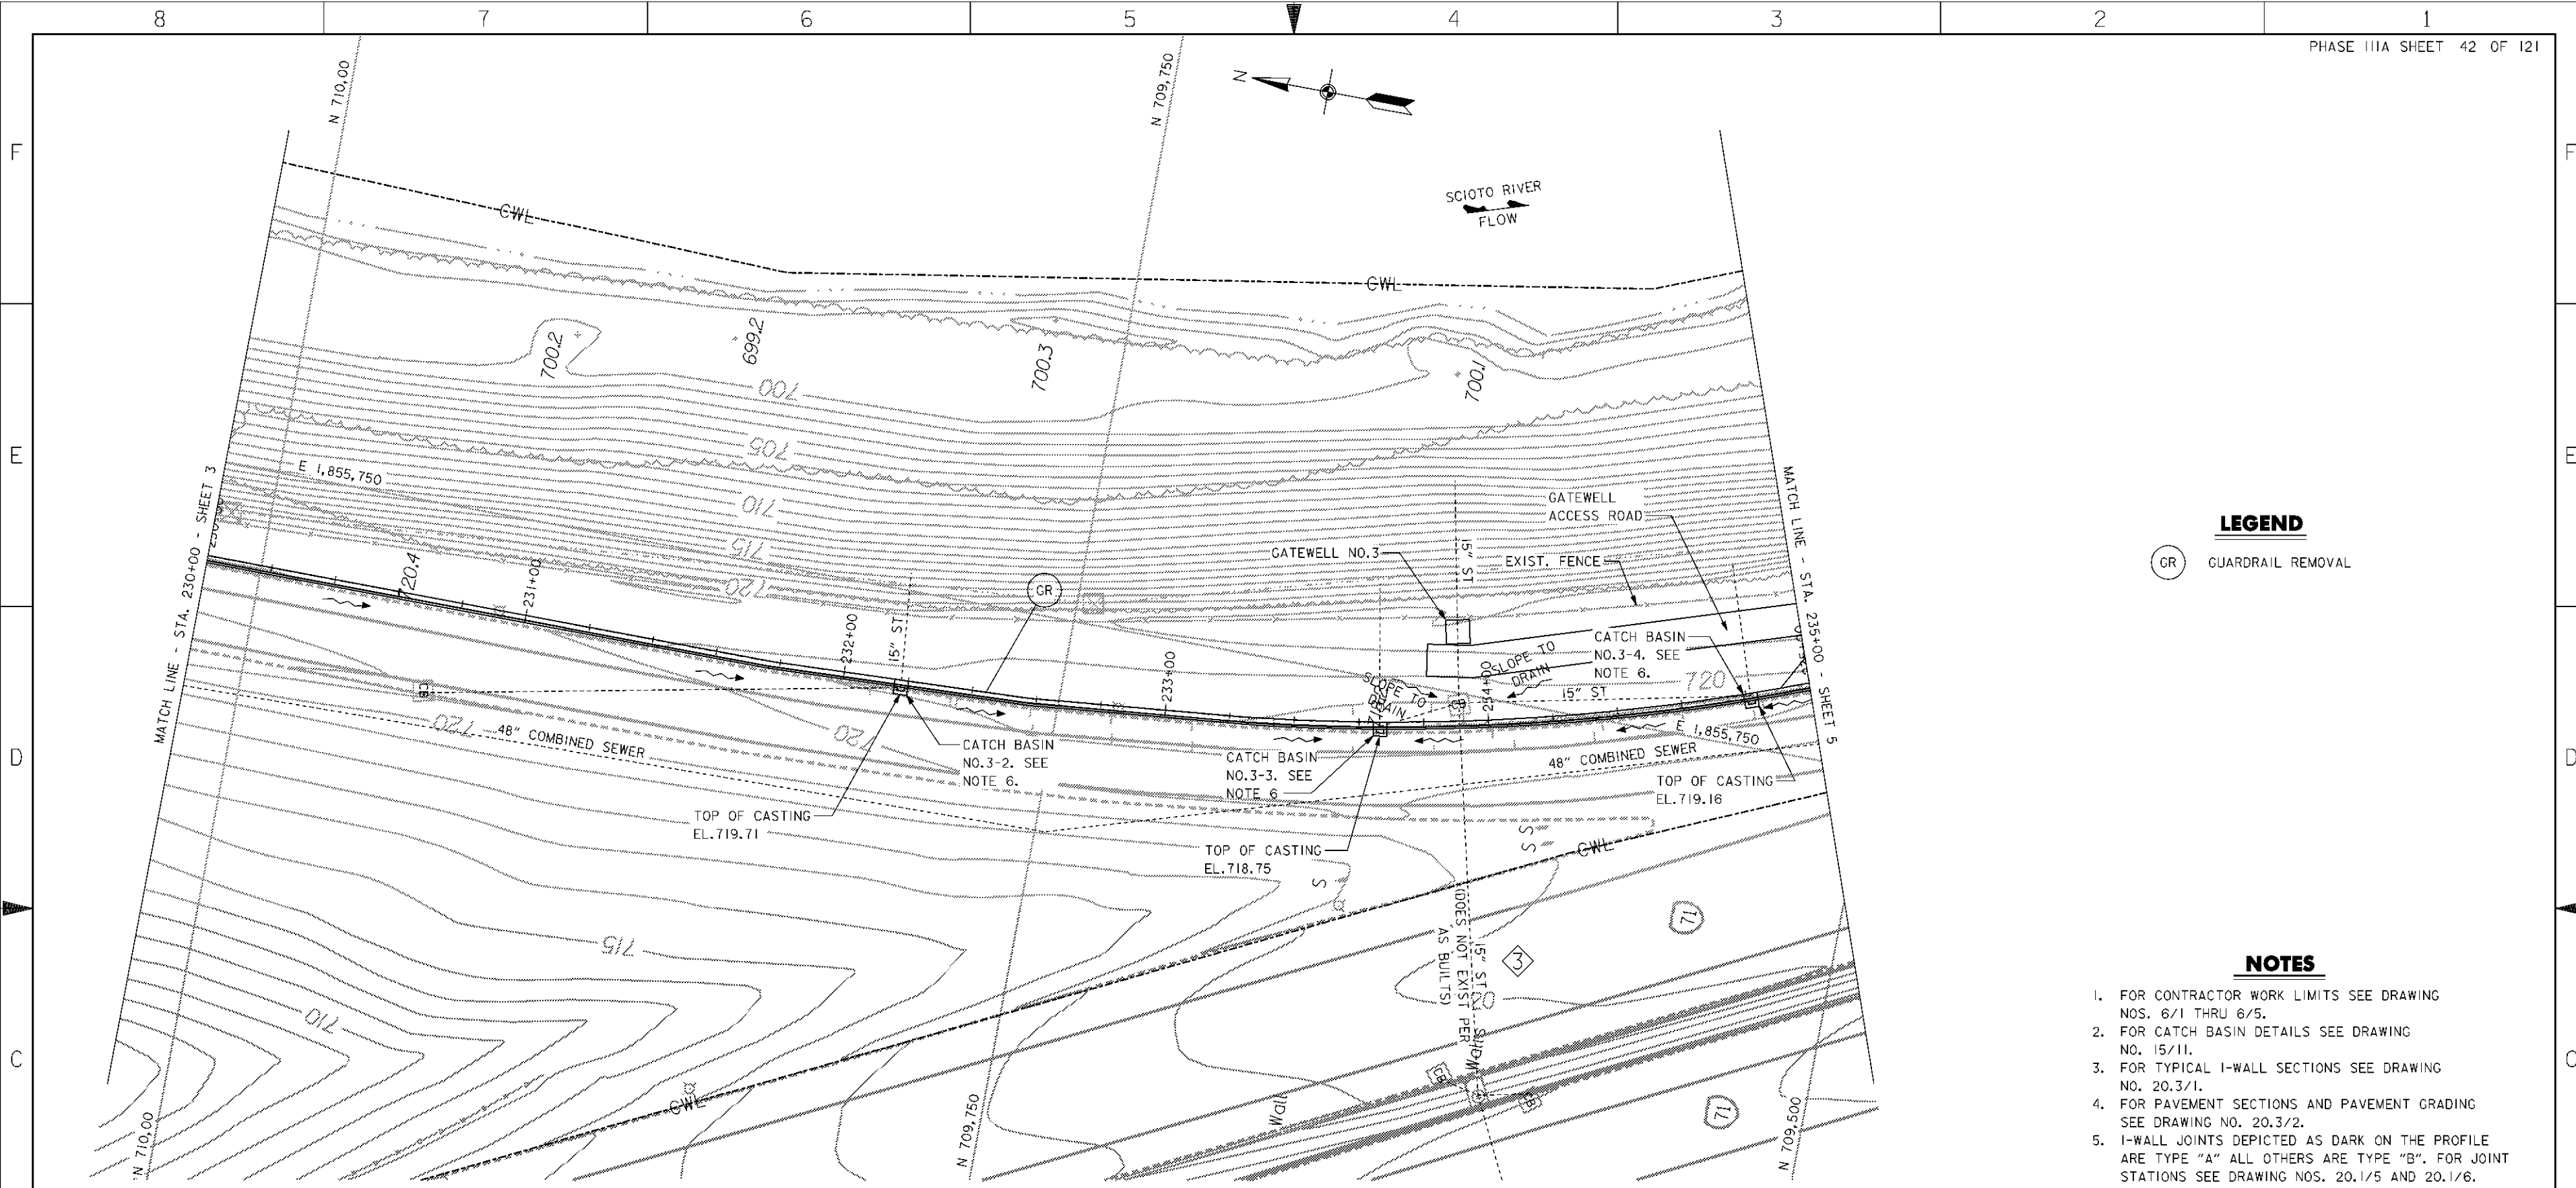


**LEGEND**  
 (GR) GUARDRAIL REMOVAL

**NOTES**

1. FOR CONTRACTOR WORK LIMITS SEE DRAWING NOS. 6/1 THRU 6/5.
2. FOR CATCH BASIN DETAILS SEE DRAWING NO. 15/11.
3. FOR TYPICAL I-WALL SECTIONS SEE DRAWING NO. 20.3/1.
4. FOR PAVEMENT SECTIONS AND PAVEMENT GRADING SEE DRAWING NO. 20.3/2.
5. I-WALL JOINTS DEPICTED AS DARK ON THE PROFILE ARE TYPE "A" ALL OTHERS ARE TYPE "B". FOR JOINT STATIONS SEE DRAWING NOS. 20.1/5 AND 20.1/6.
6. EXISTING CATCH BASINS REMOVED FOR CONSTRUCTION OF I-WALL AND REPLACED WITH CATCH BASIN NOS. 3-2 THRU 3-4.
7. FOR GATEWELL ACCESS ROAD TYPICAL SECTION SEE DRAWING NO.15/8.
8. FOR GATEWELL NO.3 SEE DRAWING NO.15/3.

**PLAN**  
 SCALE: 1" = 20'

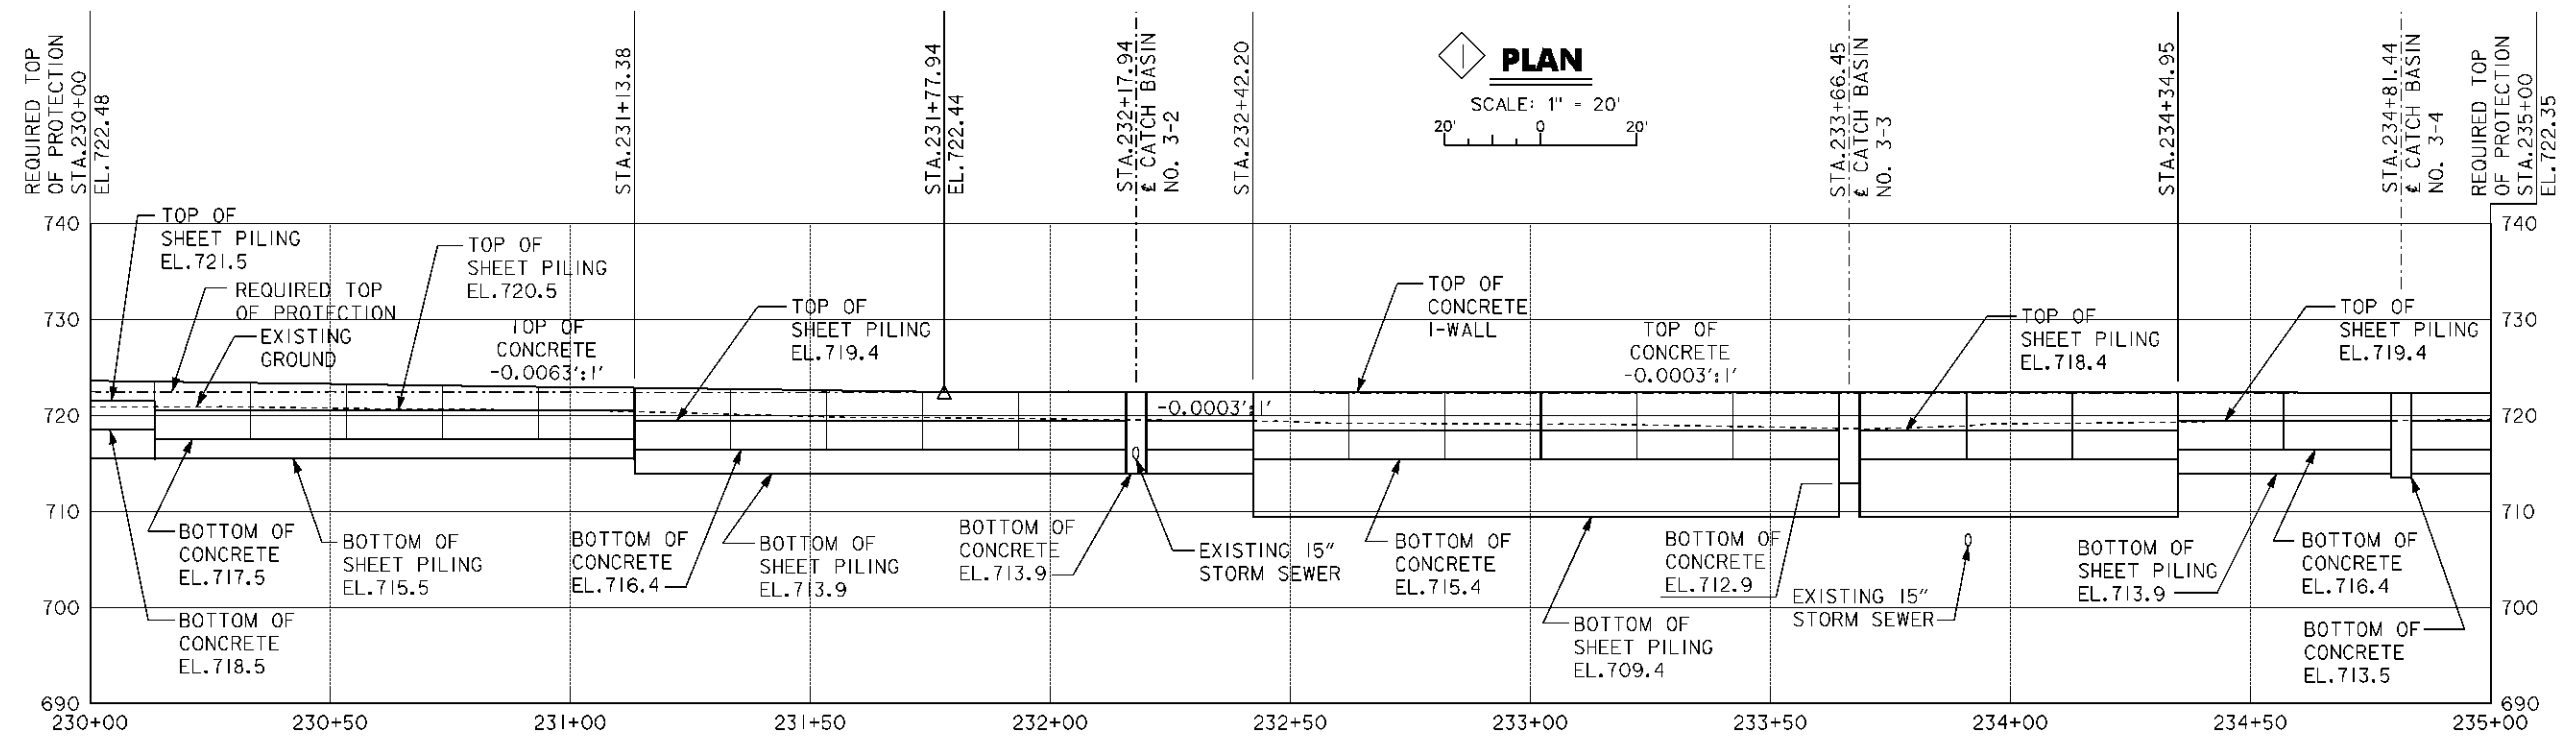


**PROFILE**  
 SCALE IN FEET

Symbol	Revisions Descriptions	Date	Approved
◊	REVISED AS CONSTRUCTED - PHASE IIIA NORTH	4/01	P.O.C.
◊	REV. IN ACCORDANCE WITH MODIFICATION MC003	5/17/00	P.O.C.
◊	REV. IN ACCORDANCE WITH AMENDMENT MC001	2/28/00	P.O.C.

<b>BURGESS &amp; NIPL, LIMITED</b> COLUMBUS, OHIO		<b>U.S. ARMY ENGINEER DISTRICT</b> CORPS OF ENGINEERS HUNTINGTON, WEST VIRGINIA	
Designed by: <b>J. HALL</b>		<b>SCIO TO RIVER</b> COLUMBUS, OHIO WEST COLUMBUS, L.P.P. PHASE IIIA	
Drawn by: <b>T. MULLINS</b>			
Checked by: <b>P. CONROY</b>		<b>PLAN AND PROFILE</b> <b>STA. 230 + 00 TO 235 + 00</b>	
Reviewed by:	Scale: <b>AS SHOWN</b>	Sheet reference number: <b>16/4</b>	FILENAME: PEN TABLE: atemp04.dgn
Approved by:	Date: <b>OCTOBER 1999</b>	Drawing Code: <b>16-PWC-12-</b>	Sheet <b>4</b> of <b>10</b>

**WORK AS CONSTRUCTED**

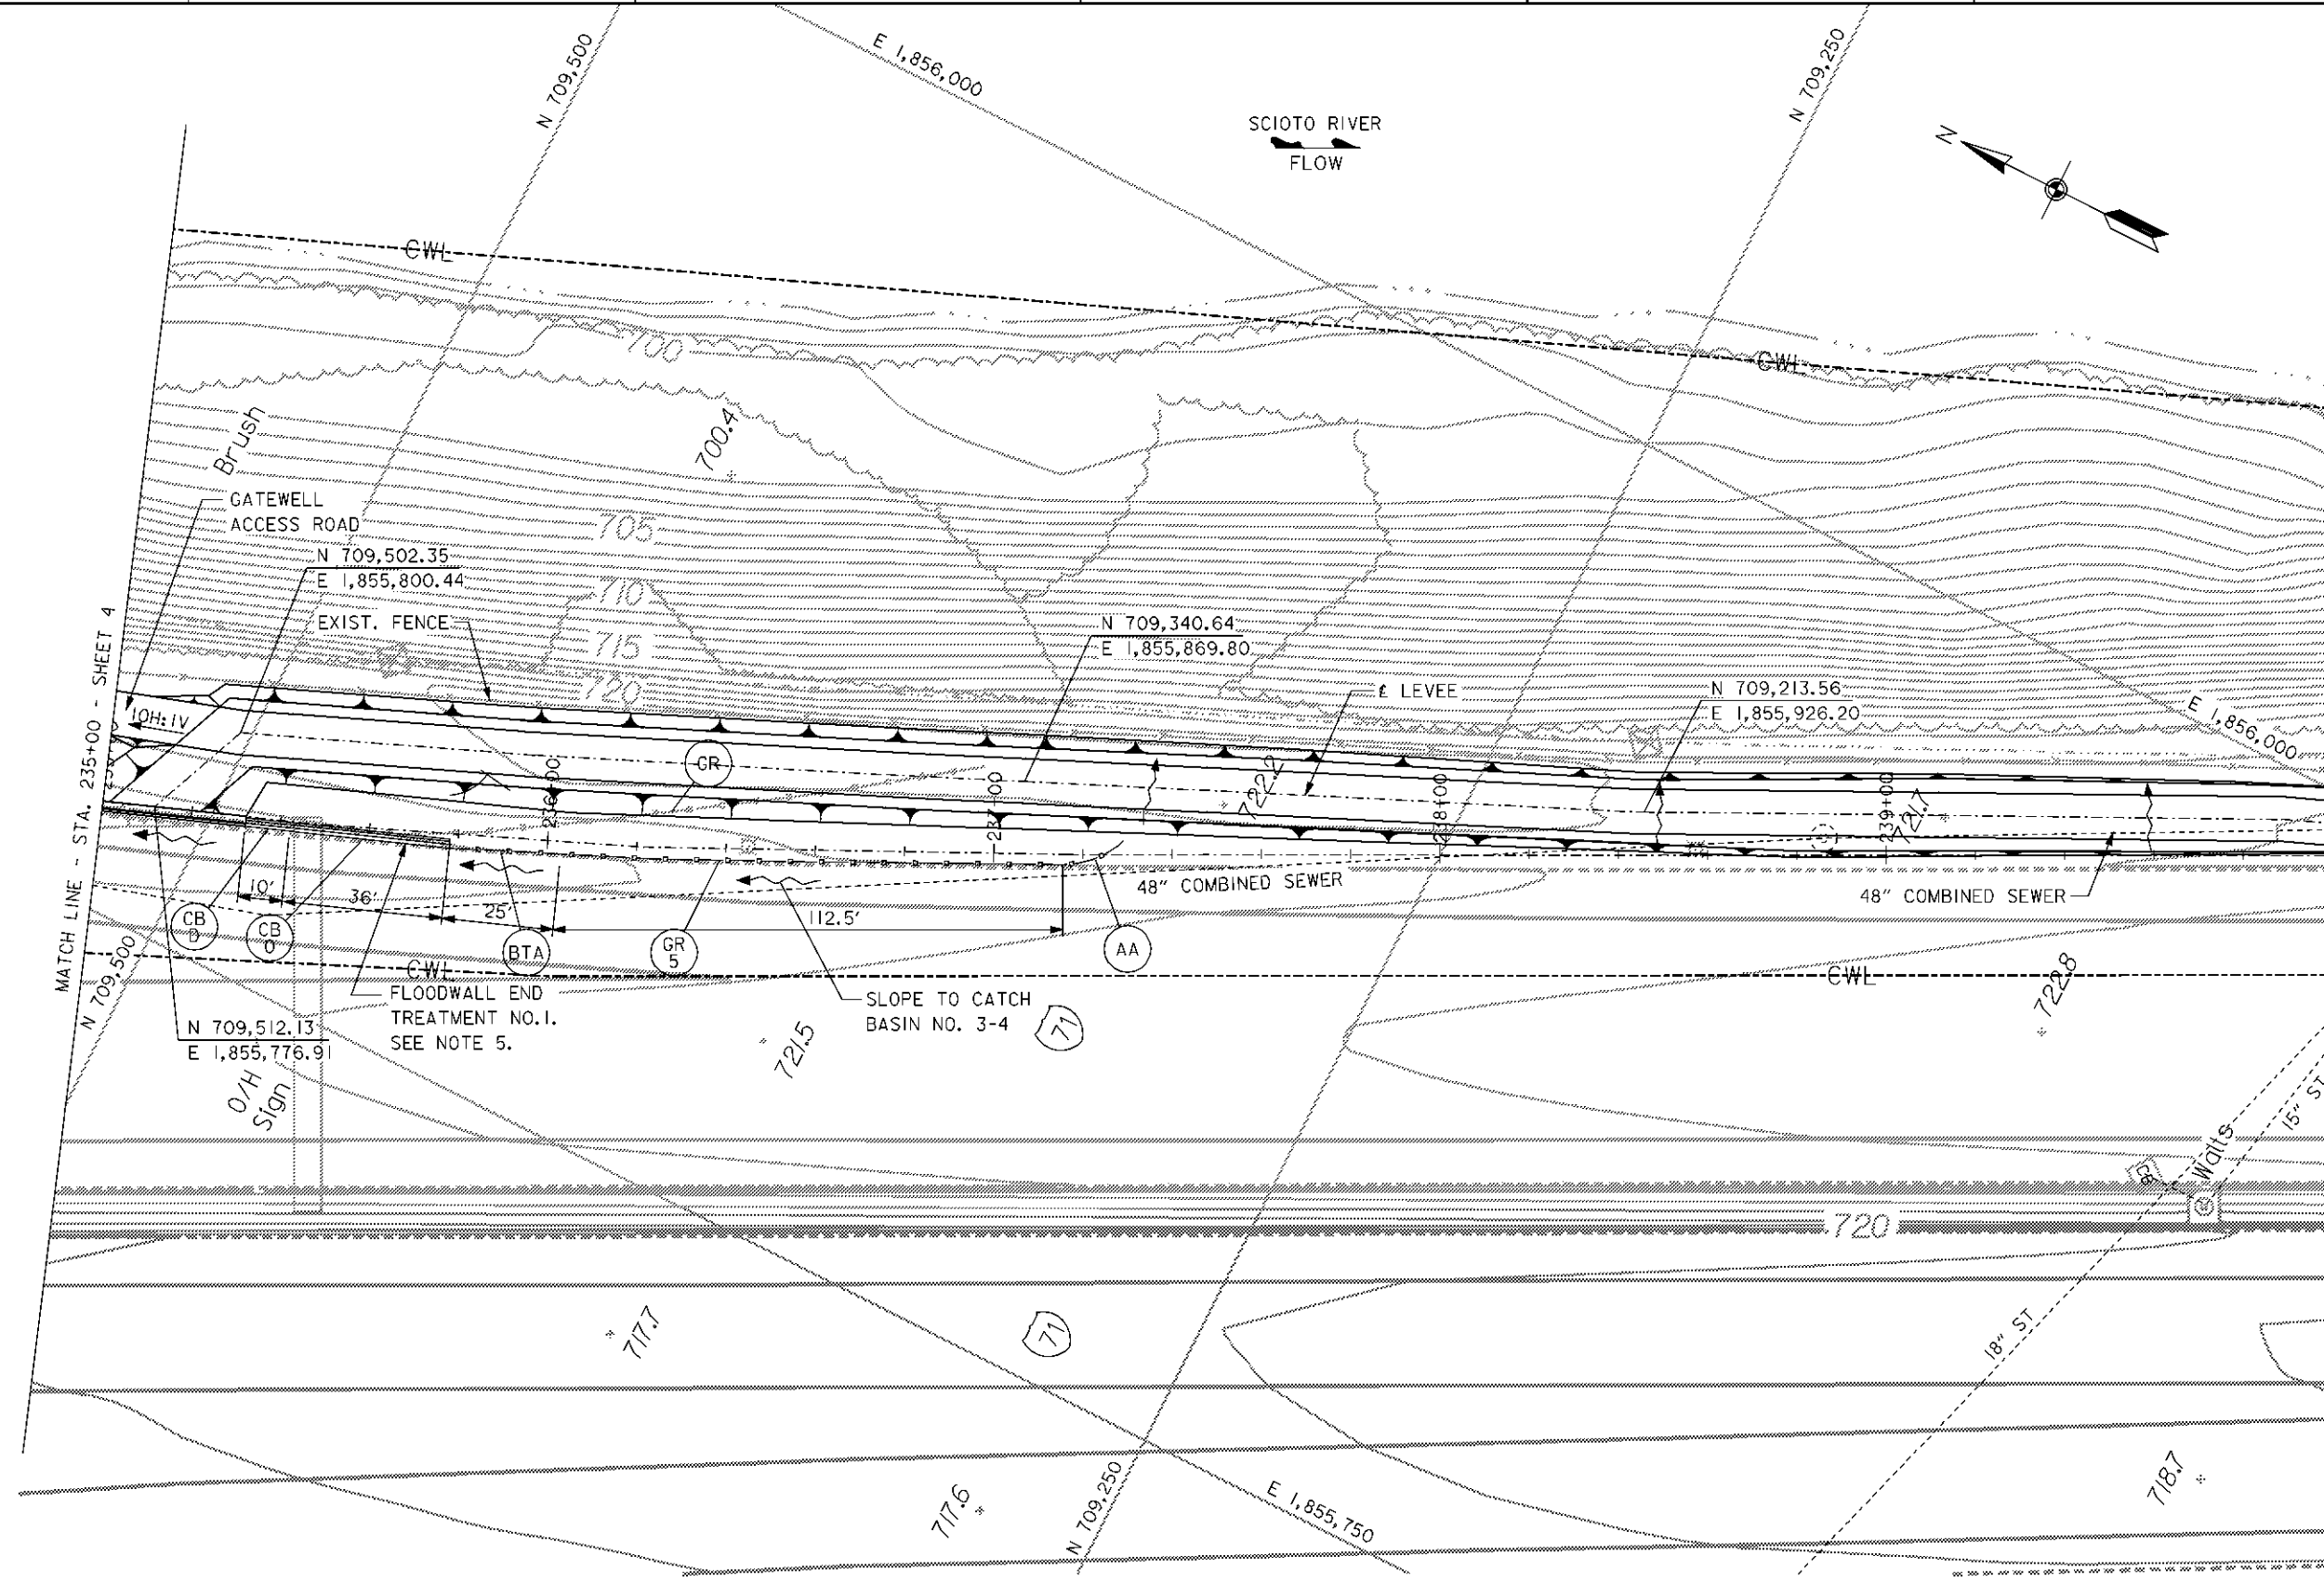


**LEGEND**

- ⊙ GR GUARDRAIL REMOVAL
- ⊙ CB D CONCRETE BARRIER, TYPE D. ODOT STANDARD DRAWING RM-4.3M
- ⊙ CB O CONCRETE BARRIER, AT OBSTRUCTION, TYPE D. ODOT STANDARD DRAWING RM-4.5M
- ⊙ BTA BRIDGE TERMINAL ASSEMBLY, TYPE I. ODOT STANDARD DRAWING CR-3.1M
- ⊙ GR 5 GUARDRAIL, TYPE 5. ODOT STANDARD DRAWING CR-2.1M
- ⊙ AA ANCHOR ASSEMBLY, TYPE B. ODOT STANDARD DRAWING CR-4.3M

**NOTES**

1. FOR CONTRACTOR WORK LIMITS SEE DRAWING NOS. 6/1 THRU 6/5.
2. FOR TYPICAL I-WALL AND LEVEE SECTIONS SEE DRAWING NO. 20.3/1.
3. FOR PAVEMENT SECTIONS AND PAVEMENT GRADING SEE DRAWING NO. 20.3/2.
4. I-WALL JOINTS DEPICTED AS DARK ON THE PROFILE ARE TYPE "A" ALL OTHERS ARE TYPE "B". FOR JOINT STATIONS SEE DRAWING NOS. 20.1/5 AND 20.1/6.
5. FLOODWALL END TREATMENT NO. 1 INCLUDES CONCRETE BARRIER, TYPE D, BRIDGE TERMINAL ASSEMBLY (TYPE I), GUARDRAIL (TYPE 5) AND ANCHOR ASSEMBLY (TYPE B).
6. FOR GATEWELL ACCESS ROAD TYPICAL SECTION SEE DRAWING NO. 15/8.

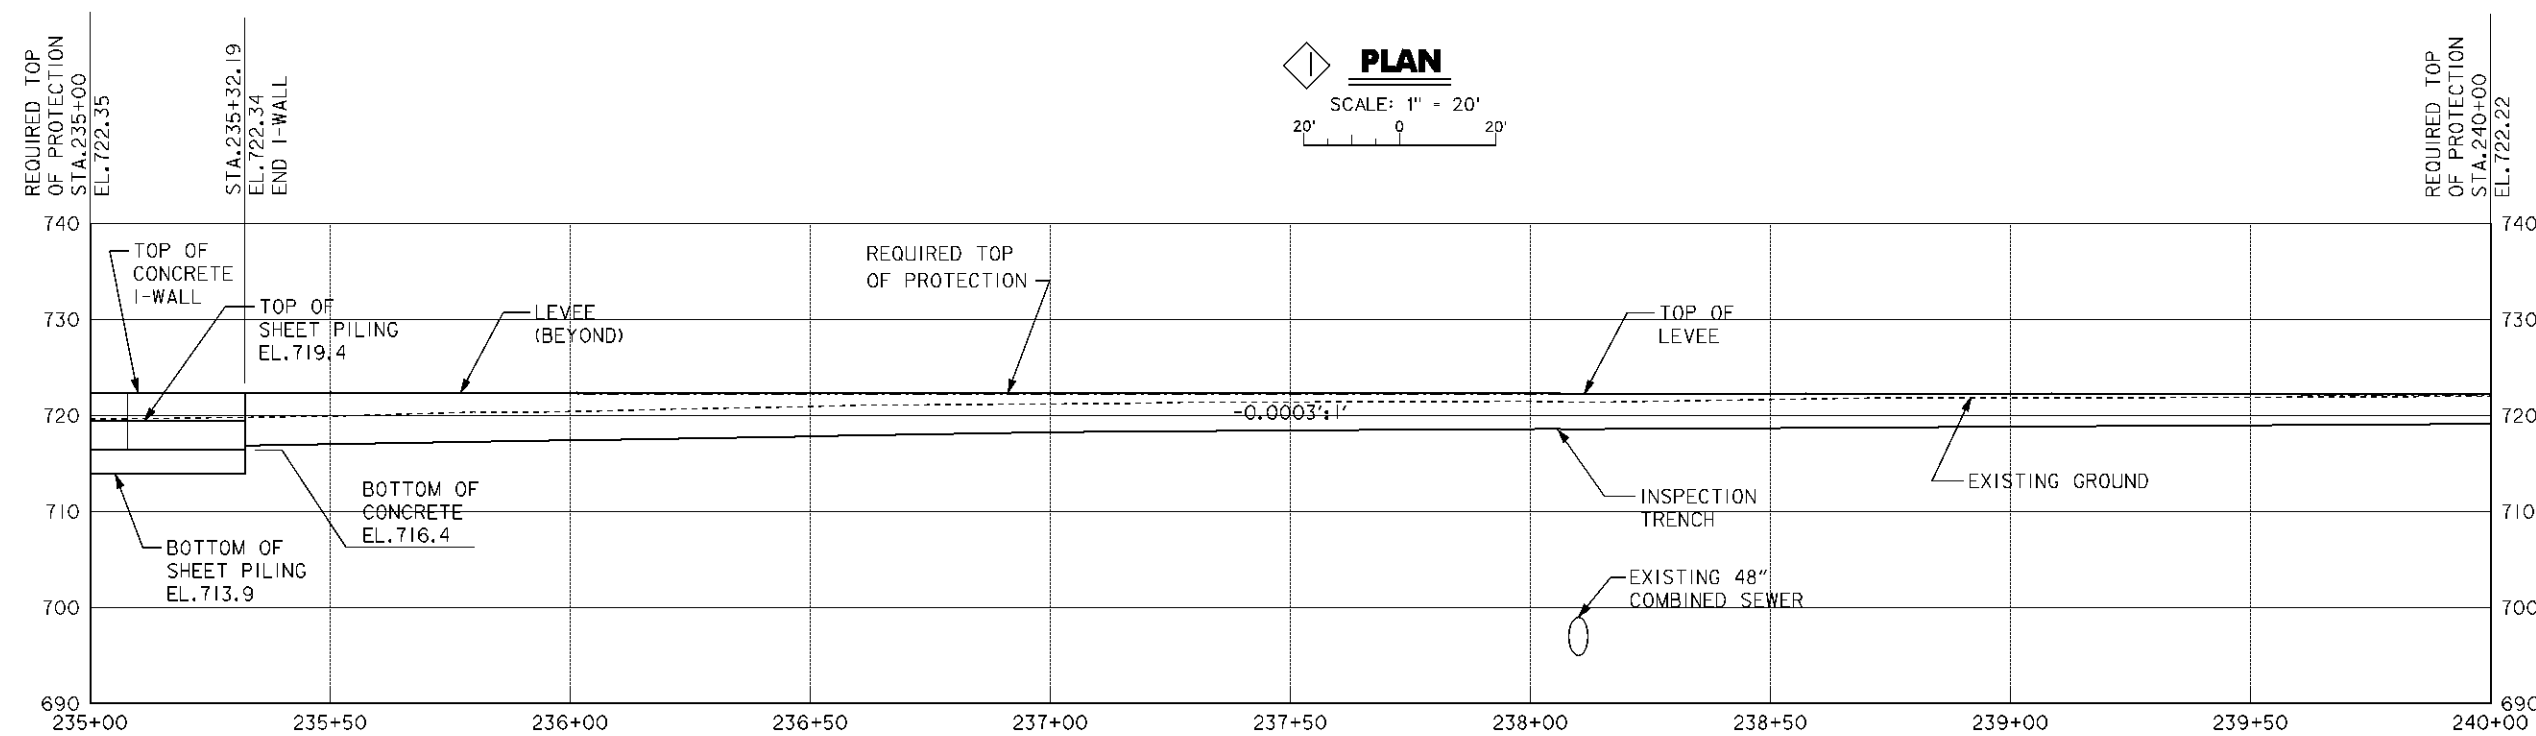



**PLAN**  
SCALE: 1" = 20'

**PROFILE**  
SCALE IN FEET

Revisions			
Symbol	Descriptions	Date	Approved
◇	REV. IN ACCORDANCE WITH MODIFICATION MCO03	5/17/00	P.O.C.
◇	REV. IN ACCORDANCE WITH AMENDMENT MCO01	2/28/00	P.O.C.



<b>BURGESS &amp; NIPL, LIMITED</b> COLUMBUS, OHIO	<b>U.S. ARMY ENGINEER DISTRICT</b> CORPS OF ENGINEERS HUNTINGTON, WEST VIRGINIA		
Designed by: <b>J. HALL</b>	SCIO TO RIVER COLUMBUS, OHIO WEST COLUMBUS, L.P.P. PHASE IIIA		
Drawn by: <b>T. MULLINS</b>	<b>PLAN AND PROFILE</b> <b>STA. 235 + 00 TO 240 + 00</b>		
Checked by: <b>P. CONROY</b>			
Reviewed by:	Scale: <b>A5 SHOWN</b>	Sheet reference number: <b>165</b>	FILENAME: 00cupp03.dgn
Approved by:	Date: <b>OCTOBER 1999</b>	Drawing Code: <b>16-PWC-12-</b>	PEN TABLE: Sheet 5 of 10

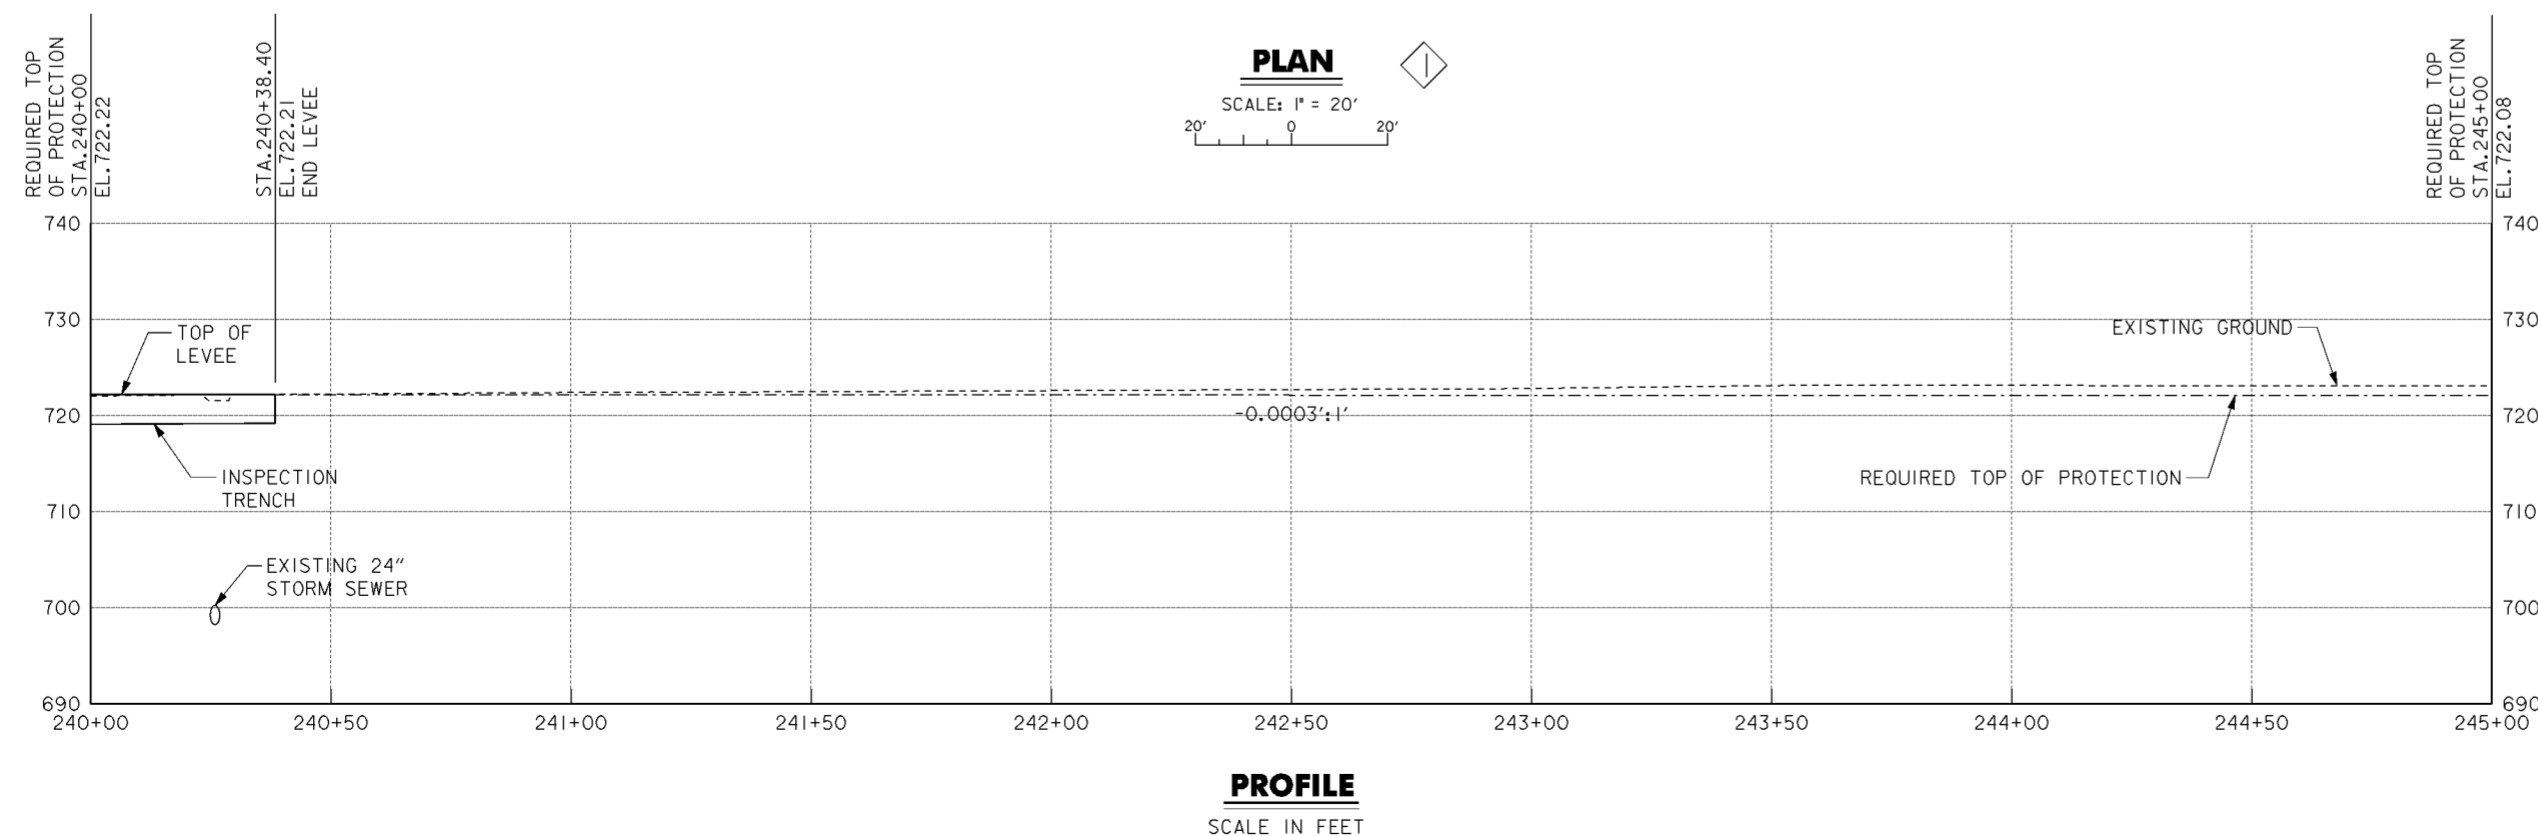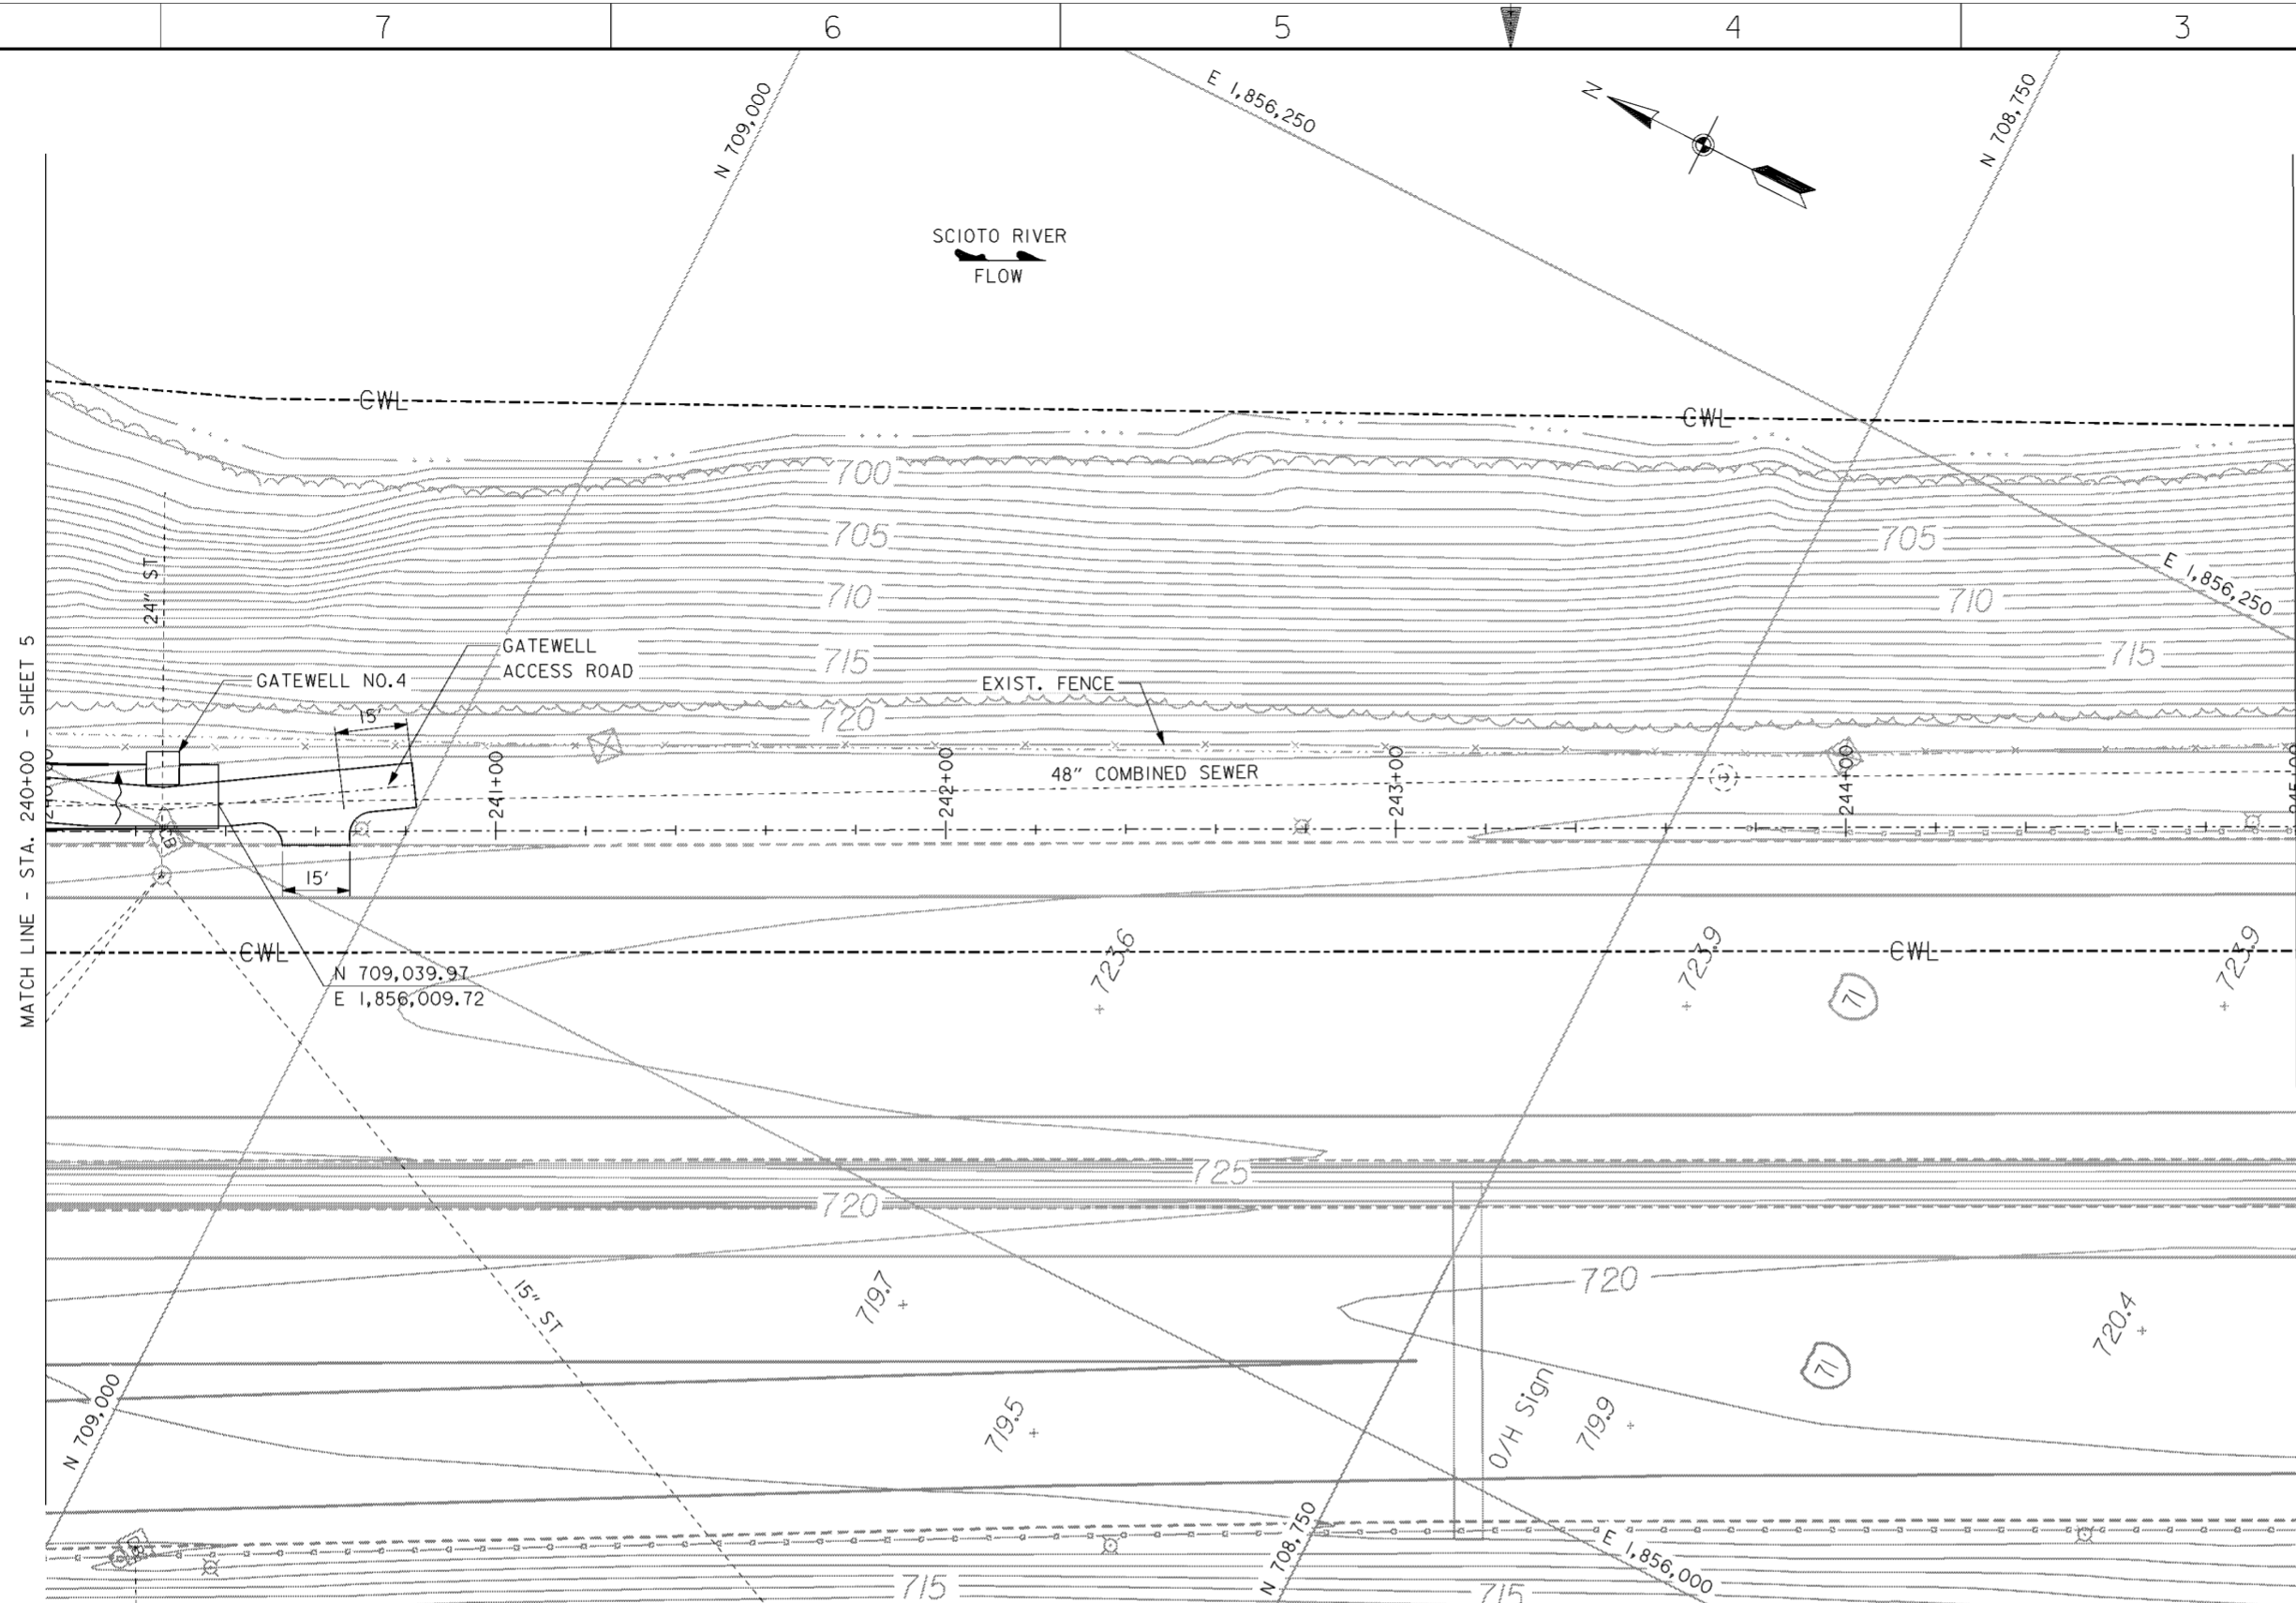

- NOTES**
1. FOR CONTRACTOR WORK LIMITS SEE DRAWING NOS. 6/1 THRU 6/5.
  2. FOR TYPICAL LEVEE SECTION SEE DRAWING NO. 20.3/1.
  3. FOR GATEWELL ACCESS ROAD TYPICAL SECTION SEE DRAWING NO. 15/8.
  4. FOR GATEWELL NO. 4 SEE DRAWING NO. 15/4.

Revisions			
Symbol	Descriptions	Date	Approved
REV. IN ACCORDANCE WITH AMENDMENT MC001 2/28/00 P.O.C.			
<b>BURGESS &amp; NIPLE, LIMITED</b> COLUMBUS, OHIO		<b>U.S. ARMY ENGINEER DISTRICT</b> CORPS OF ENGINEERS HUNTINGTON, WEST VIRGINIA	
Designed by: <b>J. HALL</b>	SCIOTO RIVER COLUMBUS, OHIO WEST COLUMBUS, L.P.P. PHASE IIIA		
Drawn by: <b>T. MULLINS</b>	<b>PLAN AND PROFILE</b> <b>STA. 240+00 TO 245+00</b>		
Checked by: <b>P. CONROY</b>	Scale: <b>AS SHOWN</b>	Sheet reference number: <b>16/6</b>	FILENAME: PIN TABLE: 00azpp06.dgn
Reviewed by: _____	Date: <b>OCTOBER 1999</b>	Drawing Code: <b>16-PWC-12-</b>	
Approved by: _____	Sheet 6 of 10		

**WORK AS CONSTRUCTED**

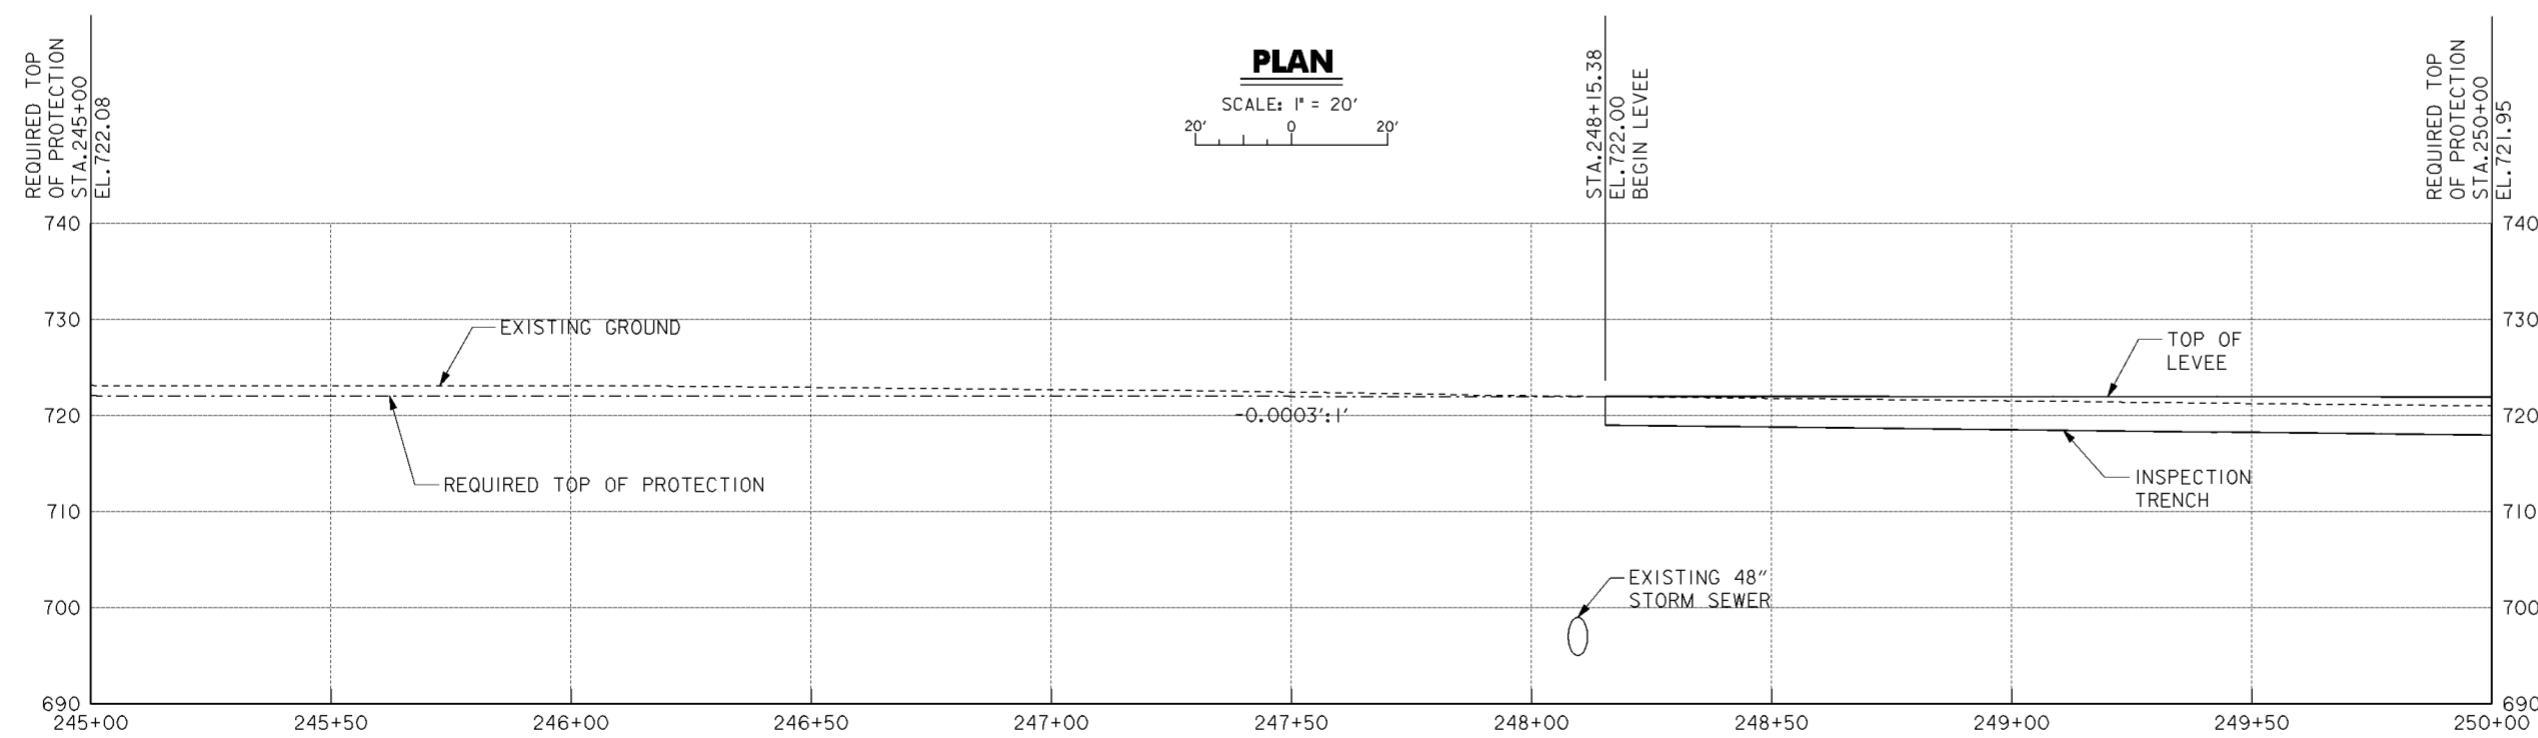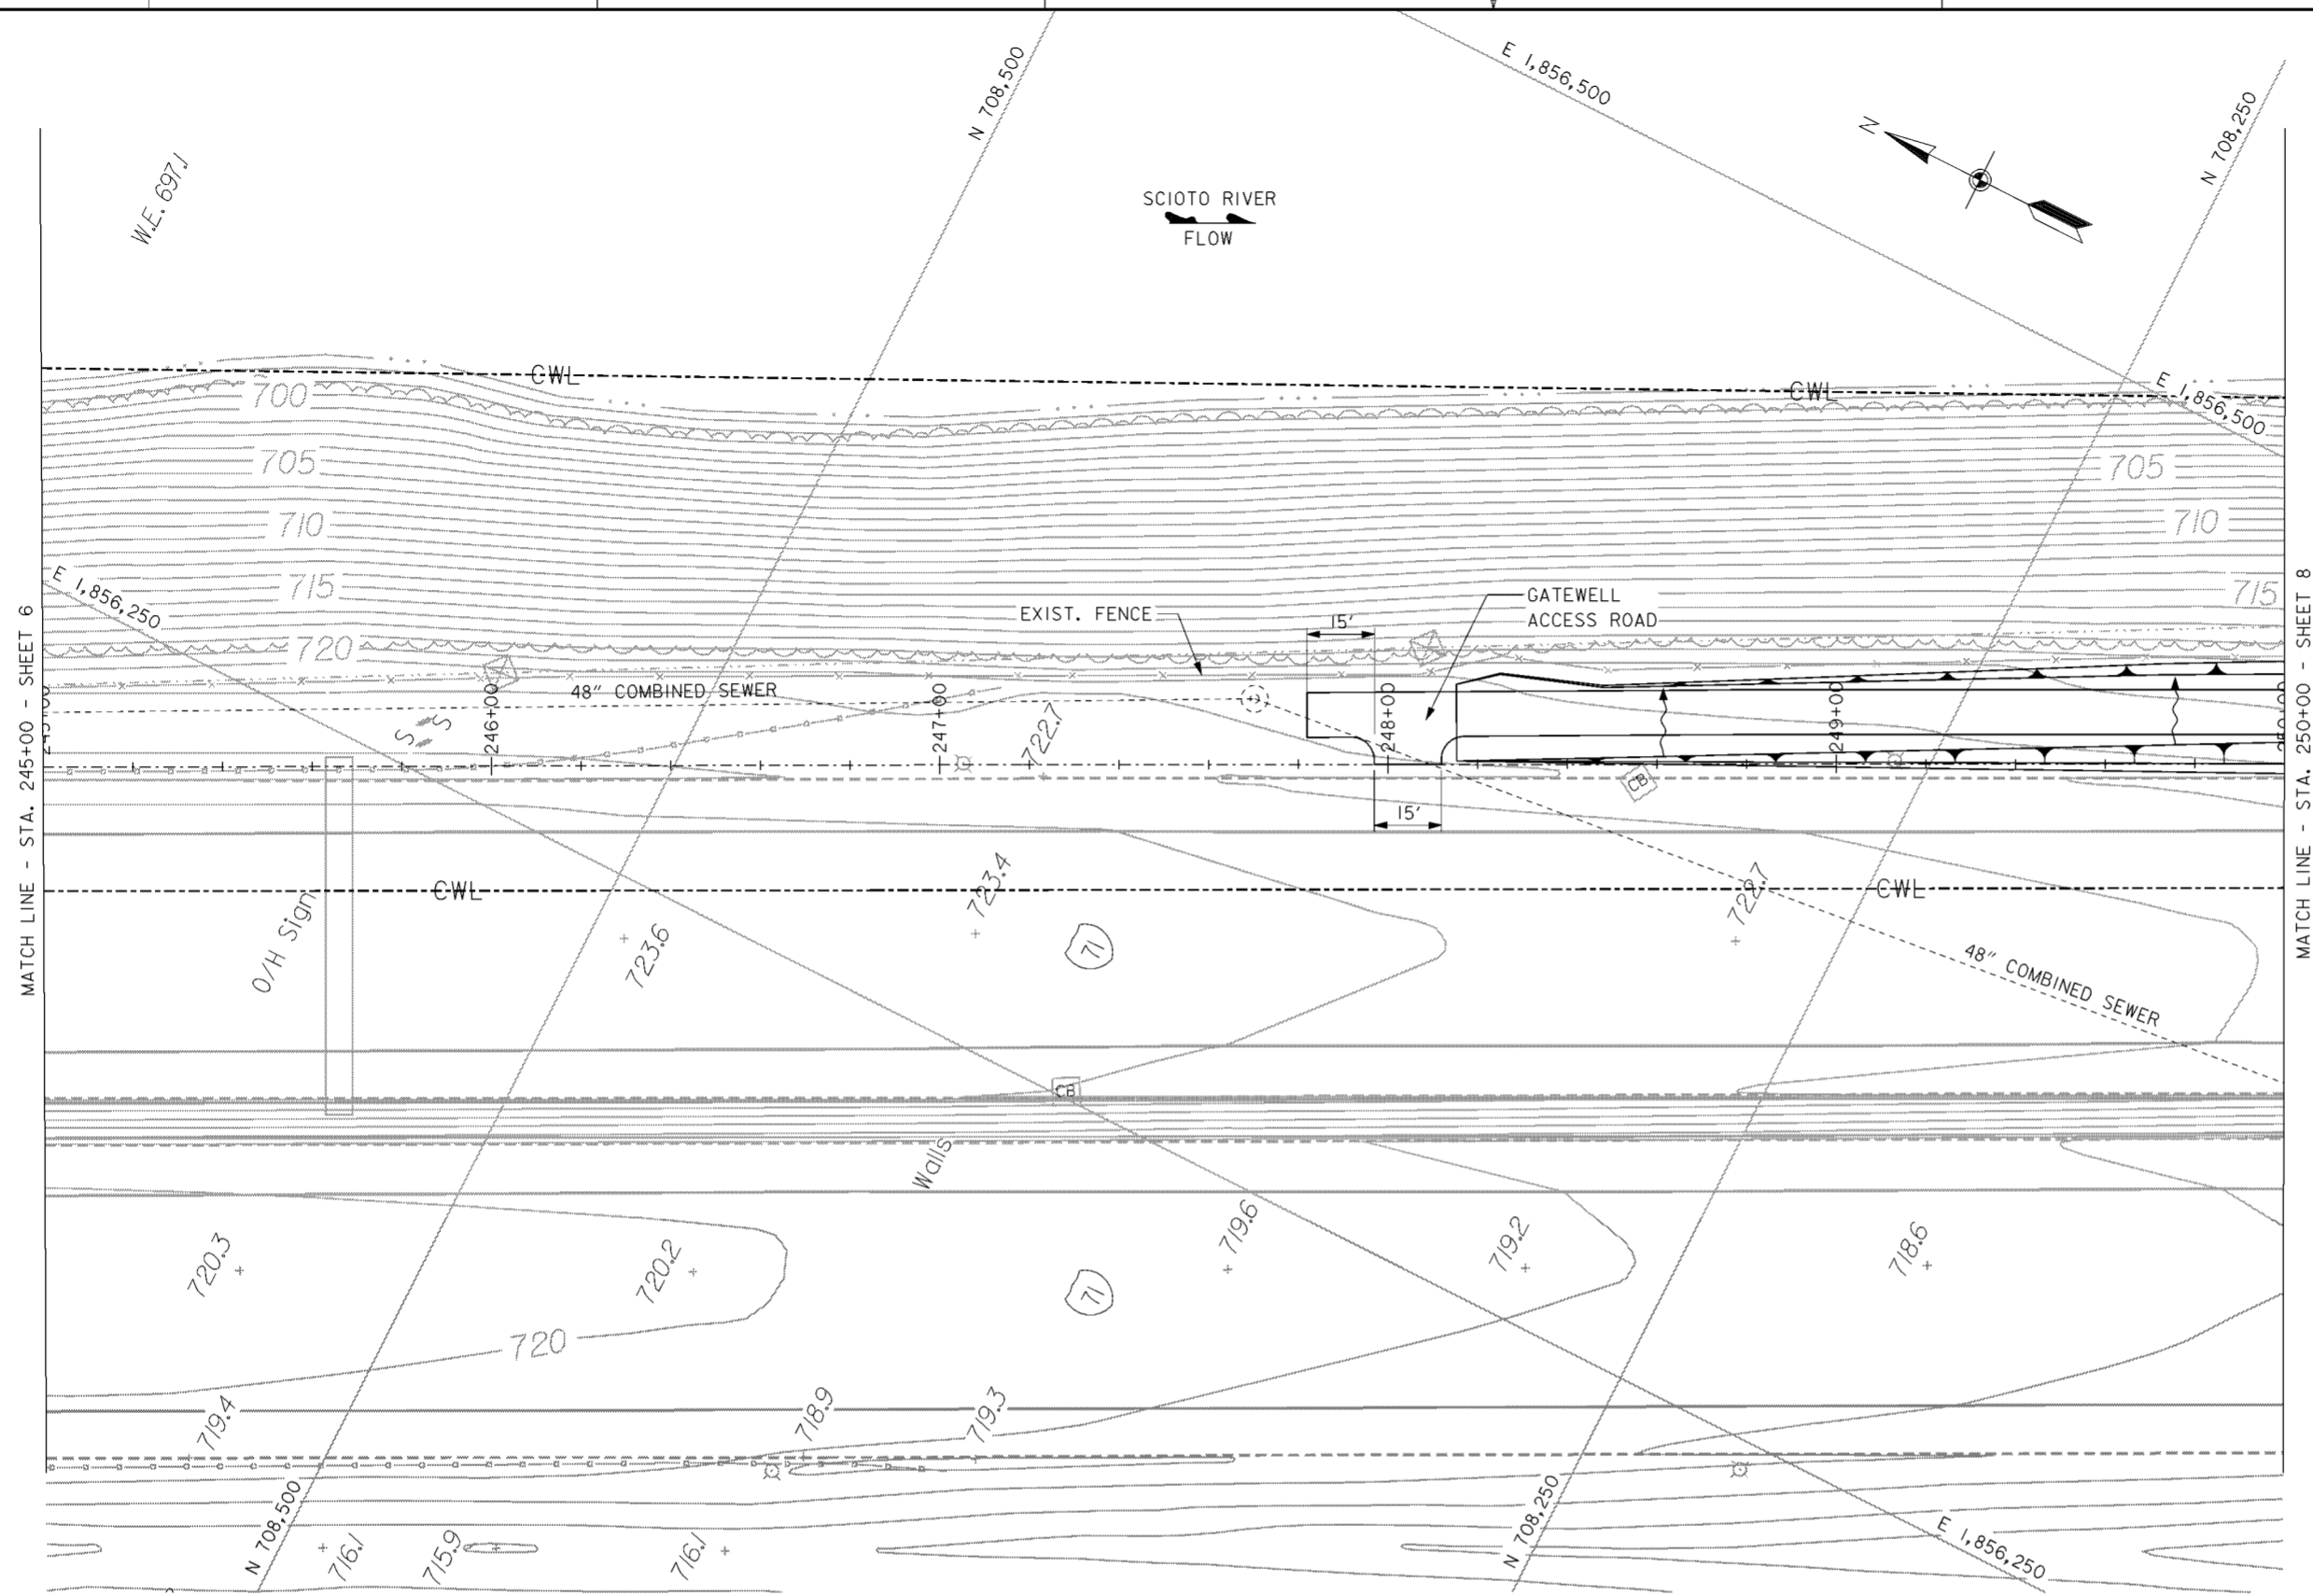

**PLAN**  
SCALE: 1" = 20'

**PROFILE**  
SCALE IN FEET



- NOTES**
1. FOR CONTRACTOR WORK LIMITS SEE DRAWING NOS. 6/1 THRU 6/5.
  2. FOR TYPICAL LEVEE SECTIONS SEE DRAWING NO. 20.3/1.
  3. FOR GATEWELL ACCESS ROAD TYPICAL SECTION SEE DRAWING NO. 15/8.

Revisions			
Symbol	Descriptions	Date	Approved



<b>BURGESS &amp; NIPLE, LIMITED</b> COLUMBUS, OHIO	<b>U.S. ARMY ENGINEER DISTRICT</b> CORPS OF ENGINEERS HUNTINGTON, WEST VIRGINIA	SCIOTO RIVER COLUMBUS, OHIO WEST COLUMBUS, L.P.P. PHASE IIIA	
		<b>PLAN AND PROFILE</b> <b>STA. 245 + 00 TO 250 + 00</b>	
Designed by: <b>J. HALL</b>	Drawn by: <b>T. MULLINS</b>	Checked by: <b>P. CONROY</b>	Reviewed by: Scale: <b>AS SHOWN</b> Date: <b>OCTOBER 1999</b> Drawing Code: <b>16-PWC-12-</b>
Approved by:	Sheet reference number: <b>16/7</b>	FILENAME: PIN TABLE: 00azpp07.dgn	Sheet <b>7</b> of <b>10</b>



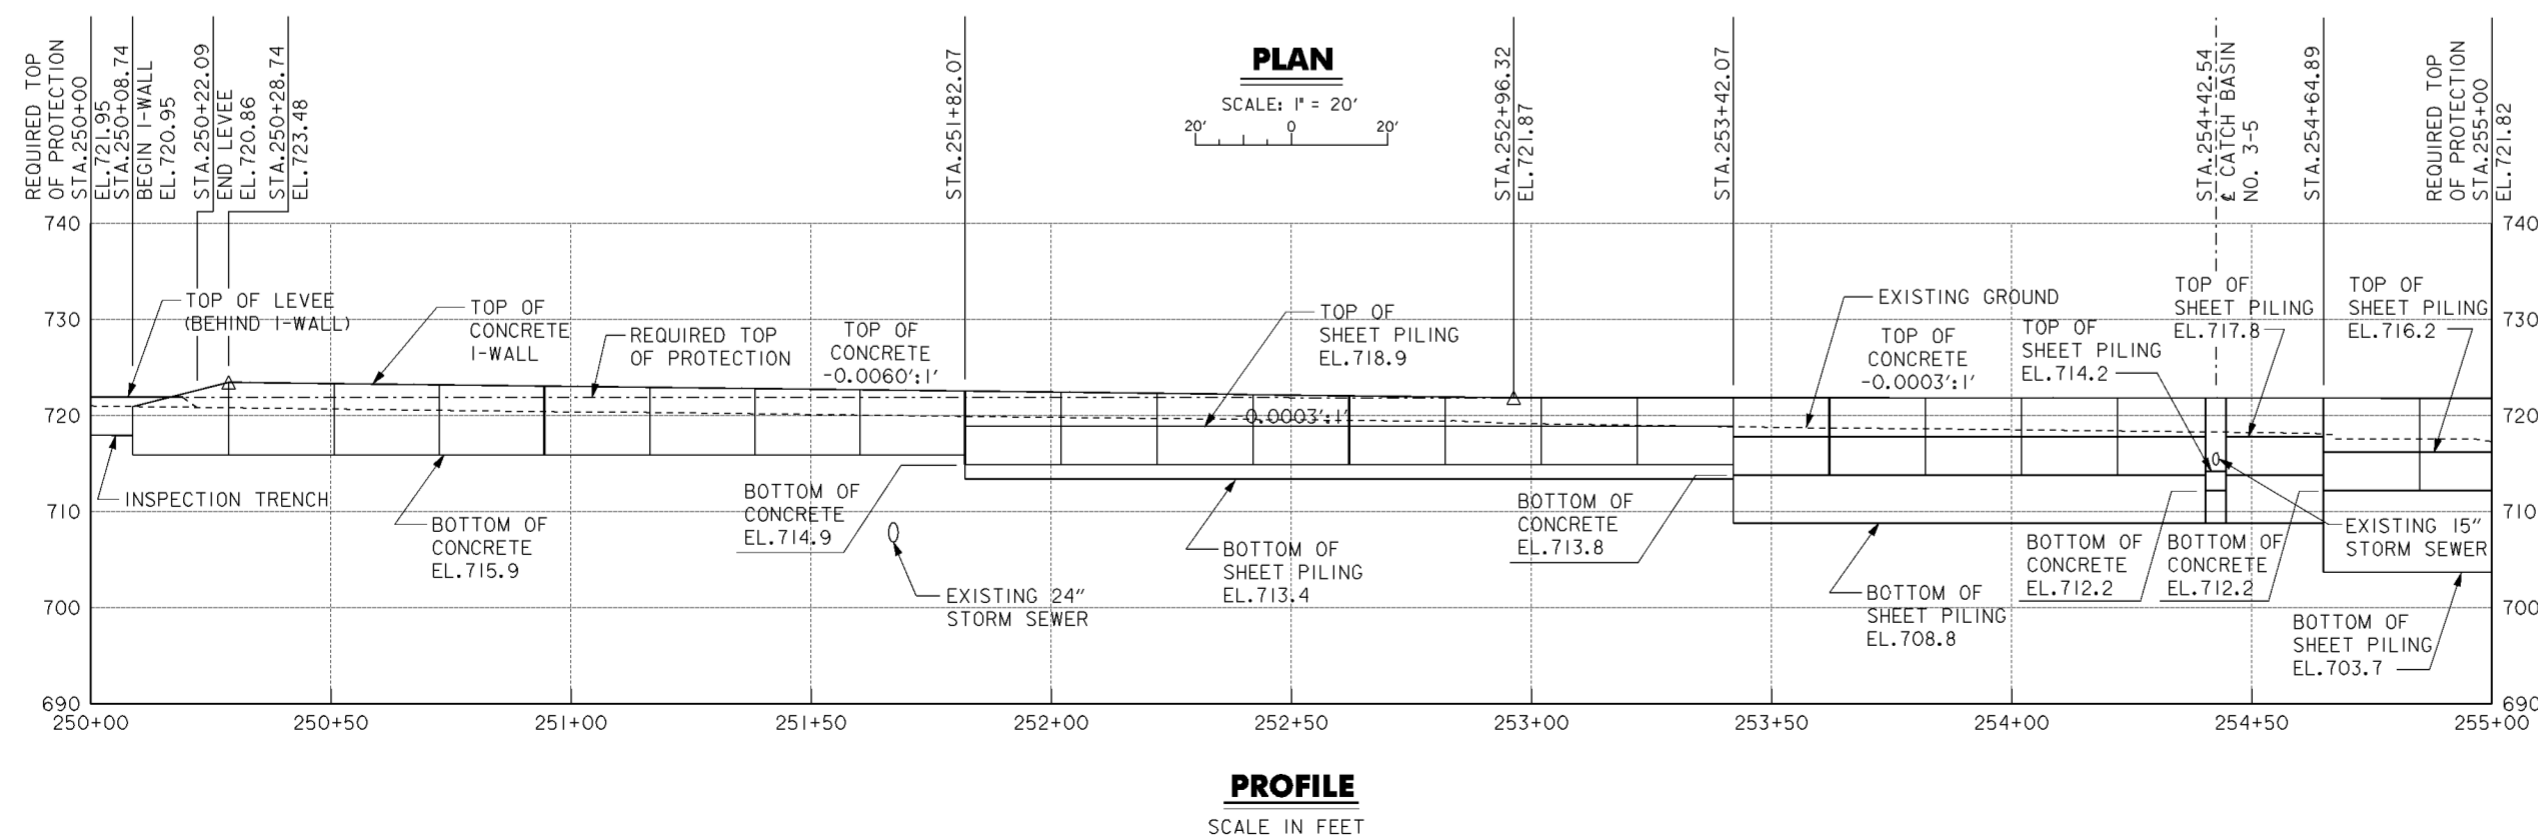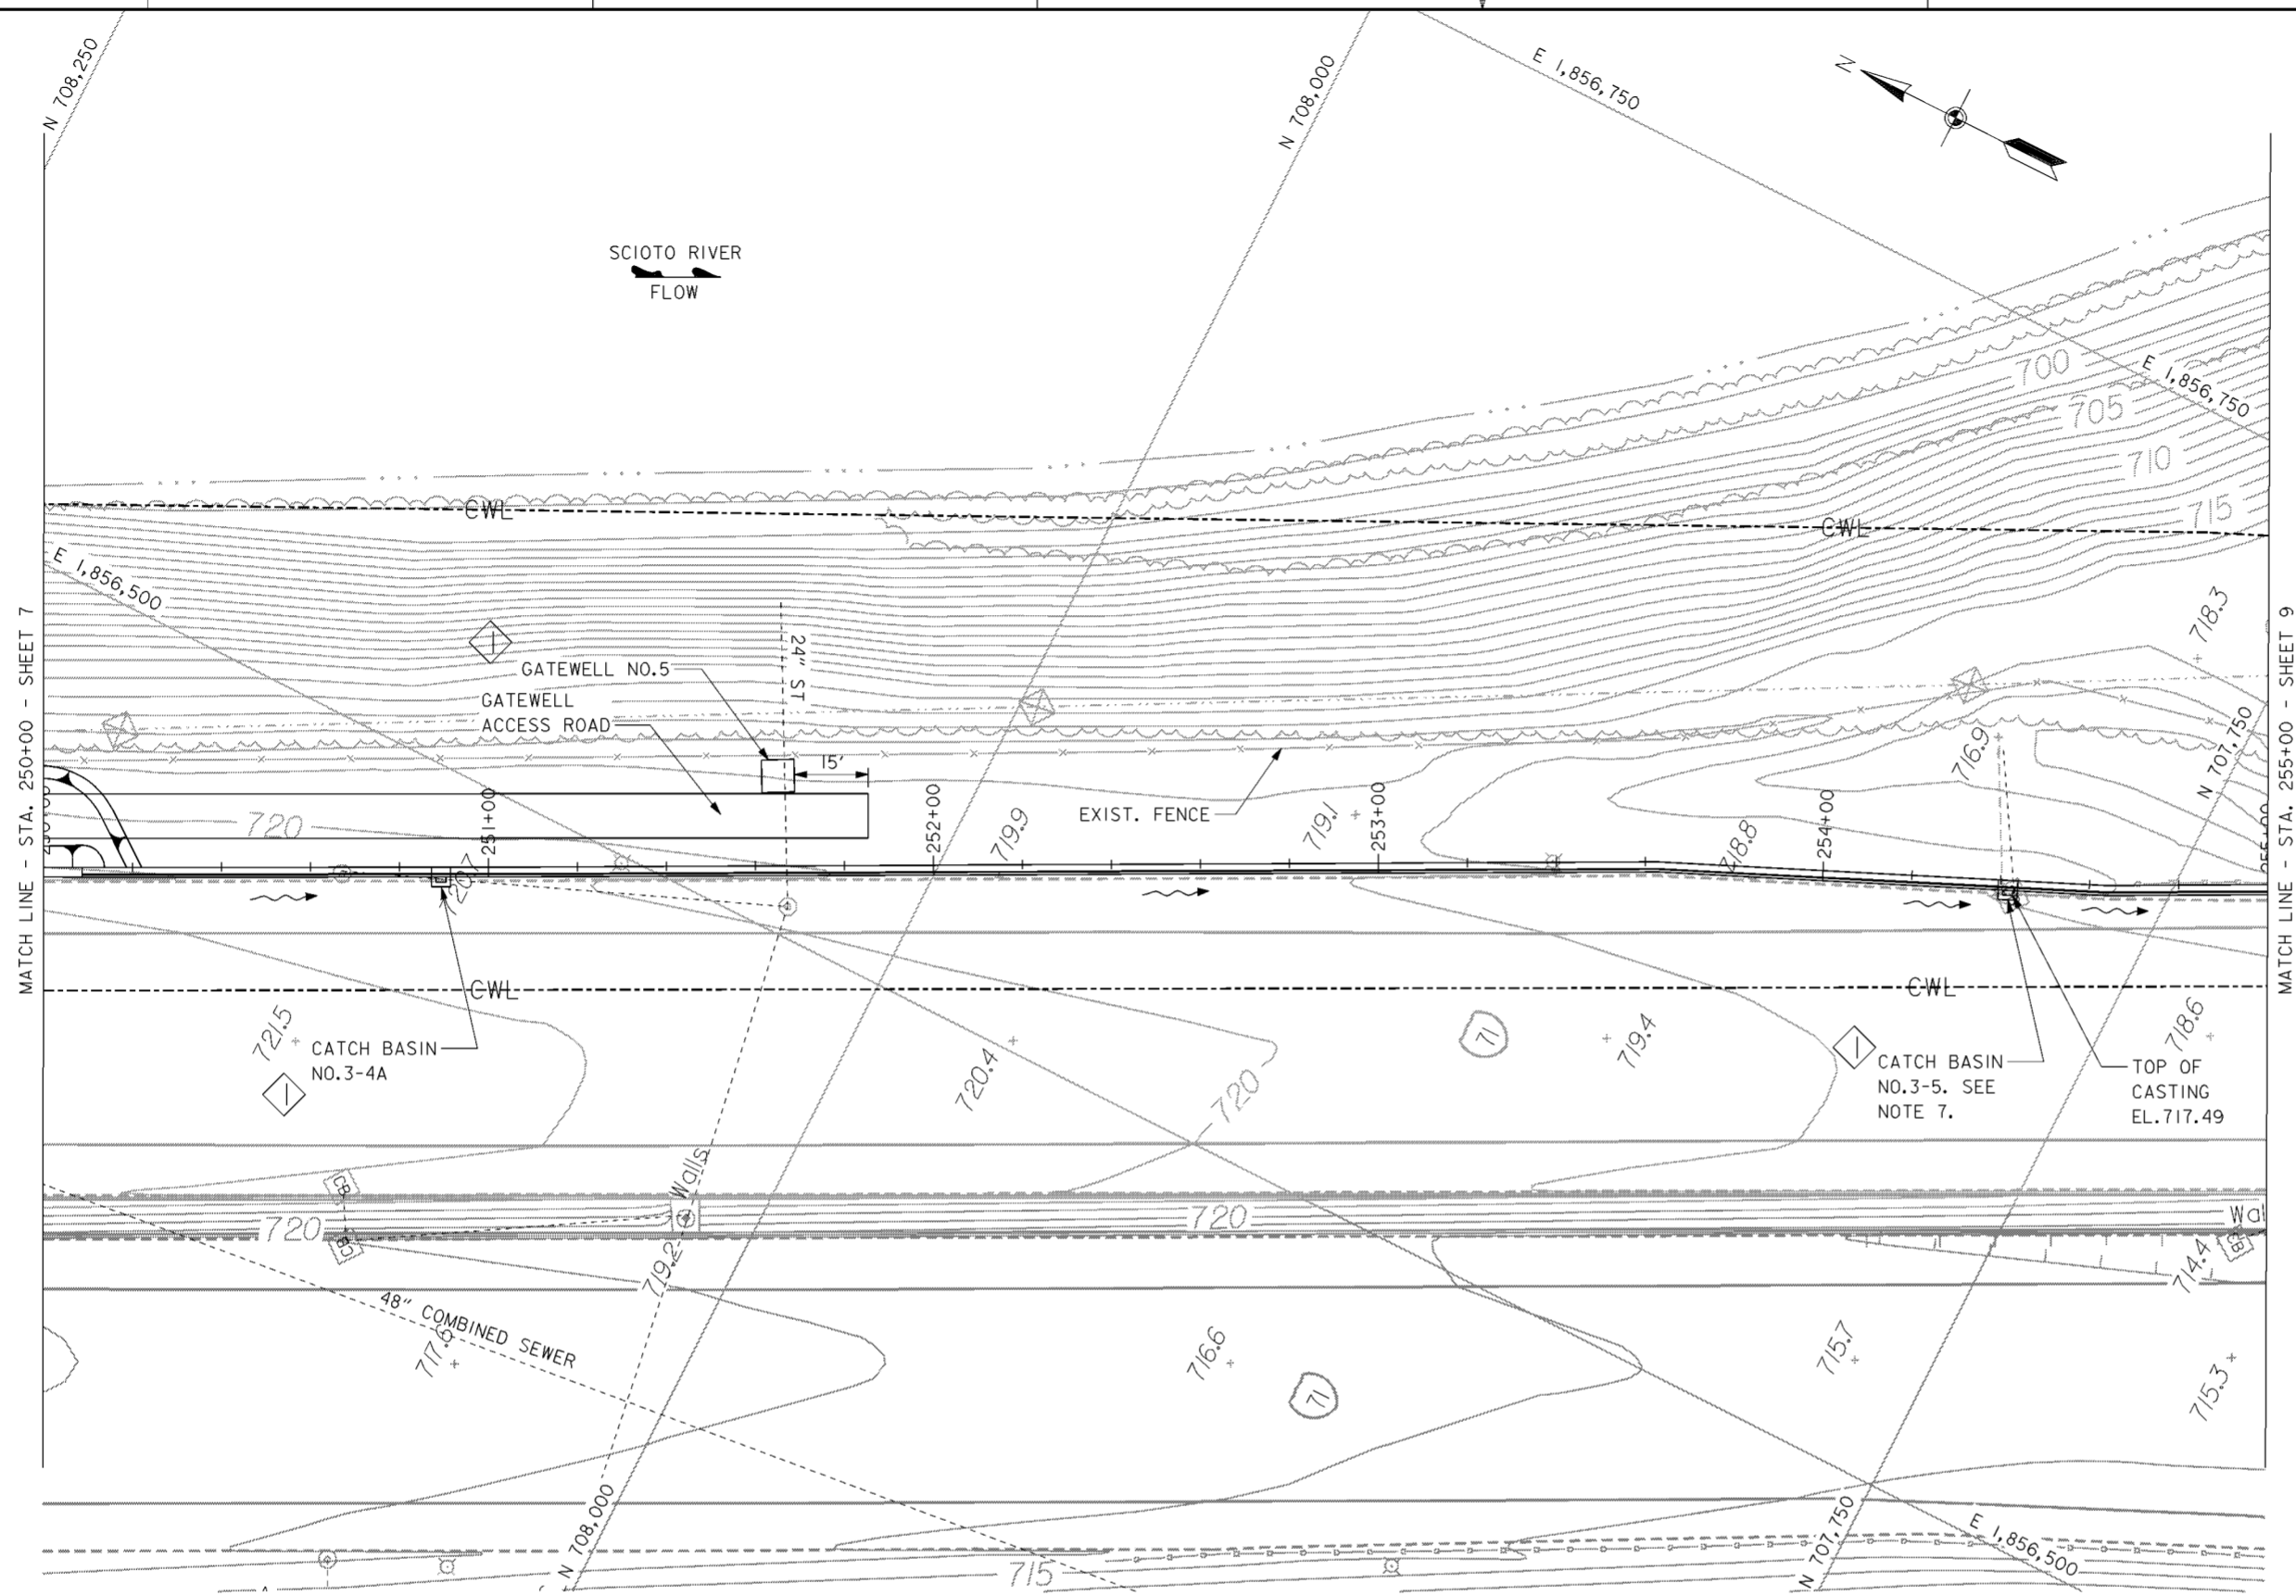


- NOTES**
1. FOR CONTRACTOR WORK LIMITS SEE DRAWING NOS. 6/1 THRU 6/5.
  2. FOR CATCH BASIN DETAILS SEE DRAWING NO. 15/11.
  3. FOR TAPERED END SECTION DETAILS SEE DRAWING NO. 20.1/3.
  4. FOR TYPICAL I-WALL AND LEVEE SECTIONS SEE DRAWING NO. 20.3/1.
  5. FOR PAVEMENT SECTIONS AND PAVEMENT GRADING SEE DRAWING NO. 20.3/2.
  6. I-WALL JOINTS DEPICTED AS DARK ON THE PROFILE ARE TYPE "A" ALL OTHERS ARE TYPE "B". FOR JOINT STATIONS SEE DRAWING NOS. 20.1/7 AND 20.1/8.
  7. EXISTING CATCH BASIN REMOVED FOR CONSTRUCTION OF I-WALL AND REPLACED WITH CATCH BASIN NO. 3-5.
  8. FOR GATEWELL ACCESS ROAD TYPICAL SECTION SEE DRAWING NO. 15/8.
  9. FOR GATEWELL NO.5 SEE DRAWING NO. 15/5.

Revisions			
Symbol	Descriptions	Date	Approved
REVISED AS CONSTRUCTED - PHASE IIIA SOUTH 4/01 P.O.C.			
<b>BURGESS &amp; NIPL, LIMITED</b> COLUMBUS, OHIO		<b>U.S. ARMY ENGINEER DISTRICT</b> CORPS OF ENGINEERS HUNTINGTON, WEST VIRGINIA	
Designed by: <b>J. HALL</b>	SCIOTO RIVER COLUMBUS, OHIO WEST COLUMBUS, L.P.P. PHASE IIIA		
Drawn by: <b>T. MULLINS</b>	<b>PLAN AND PROFILE</b> <b>STA. 250+00 TO 255+00</b>		
Checked by: <b>P. CONROY</b>	Scale: <b>AS SHOWN</b>	Sheet reference number: <b>16/8</b>	FILENAME: PIN TABLE: a0zpp08.dgn
Reviewed by:	Date: <b>OCTOBER 1999</b>	Drawing Code: <b>16-PWC-12-</b>	
Approved by:	Sheet 8 of 10		

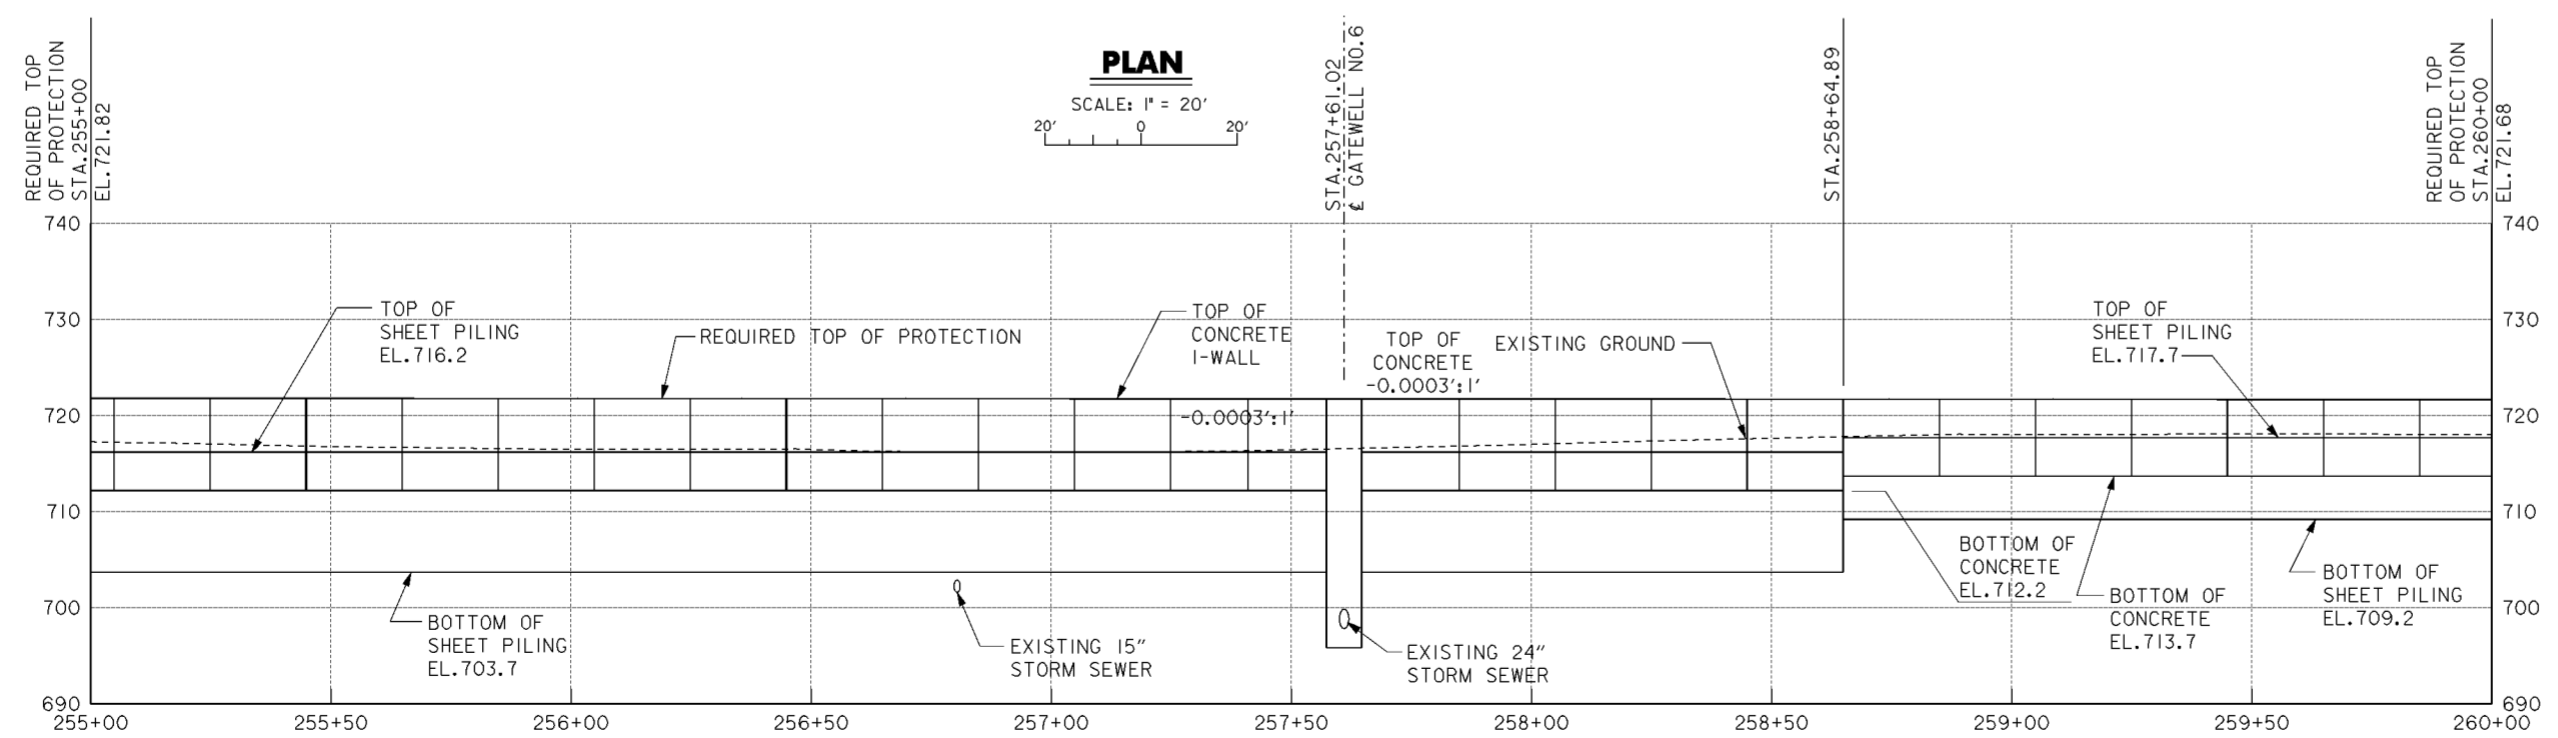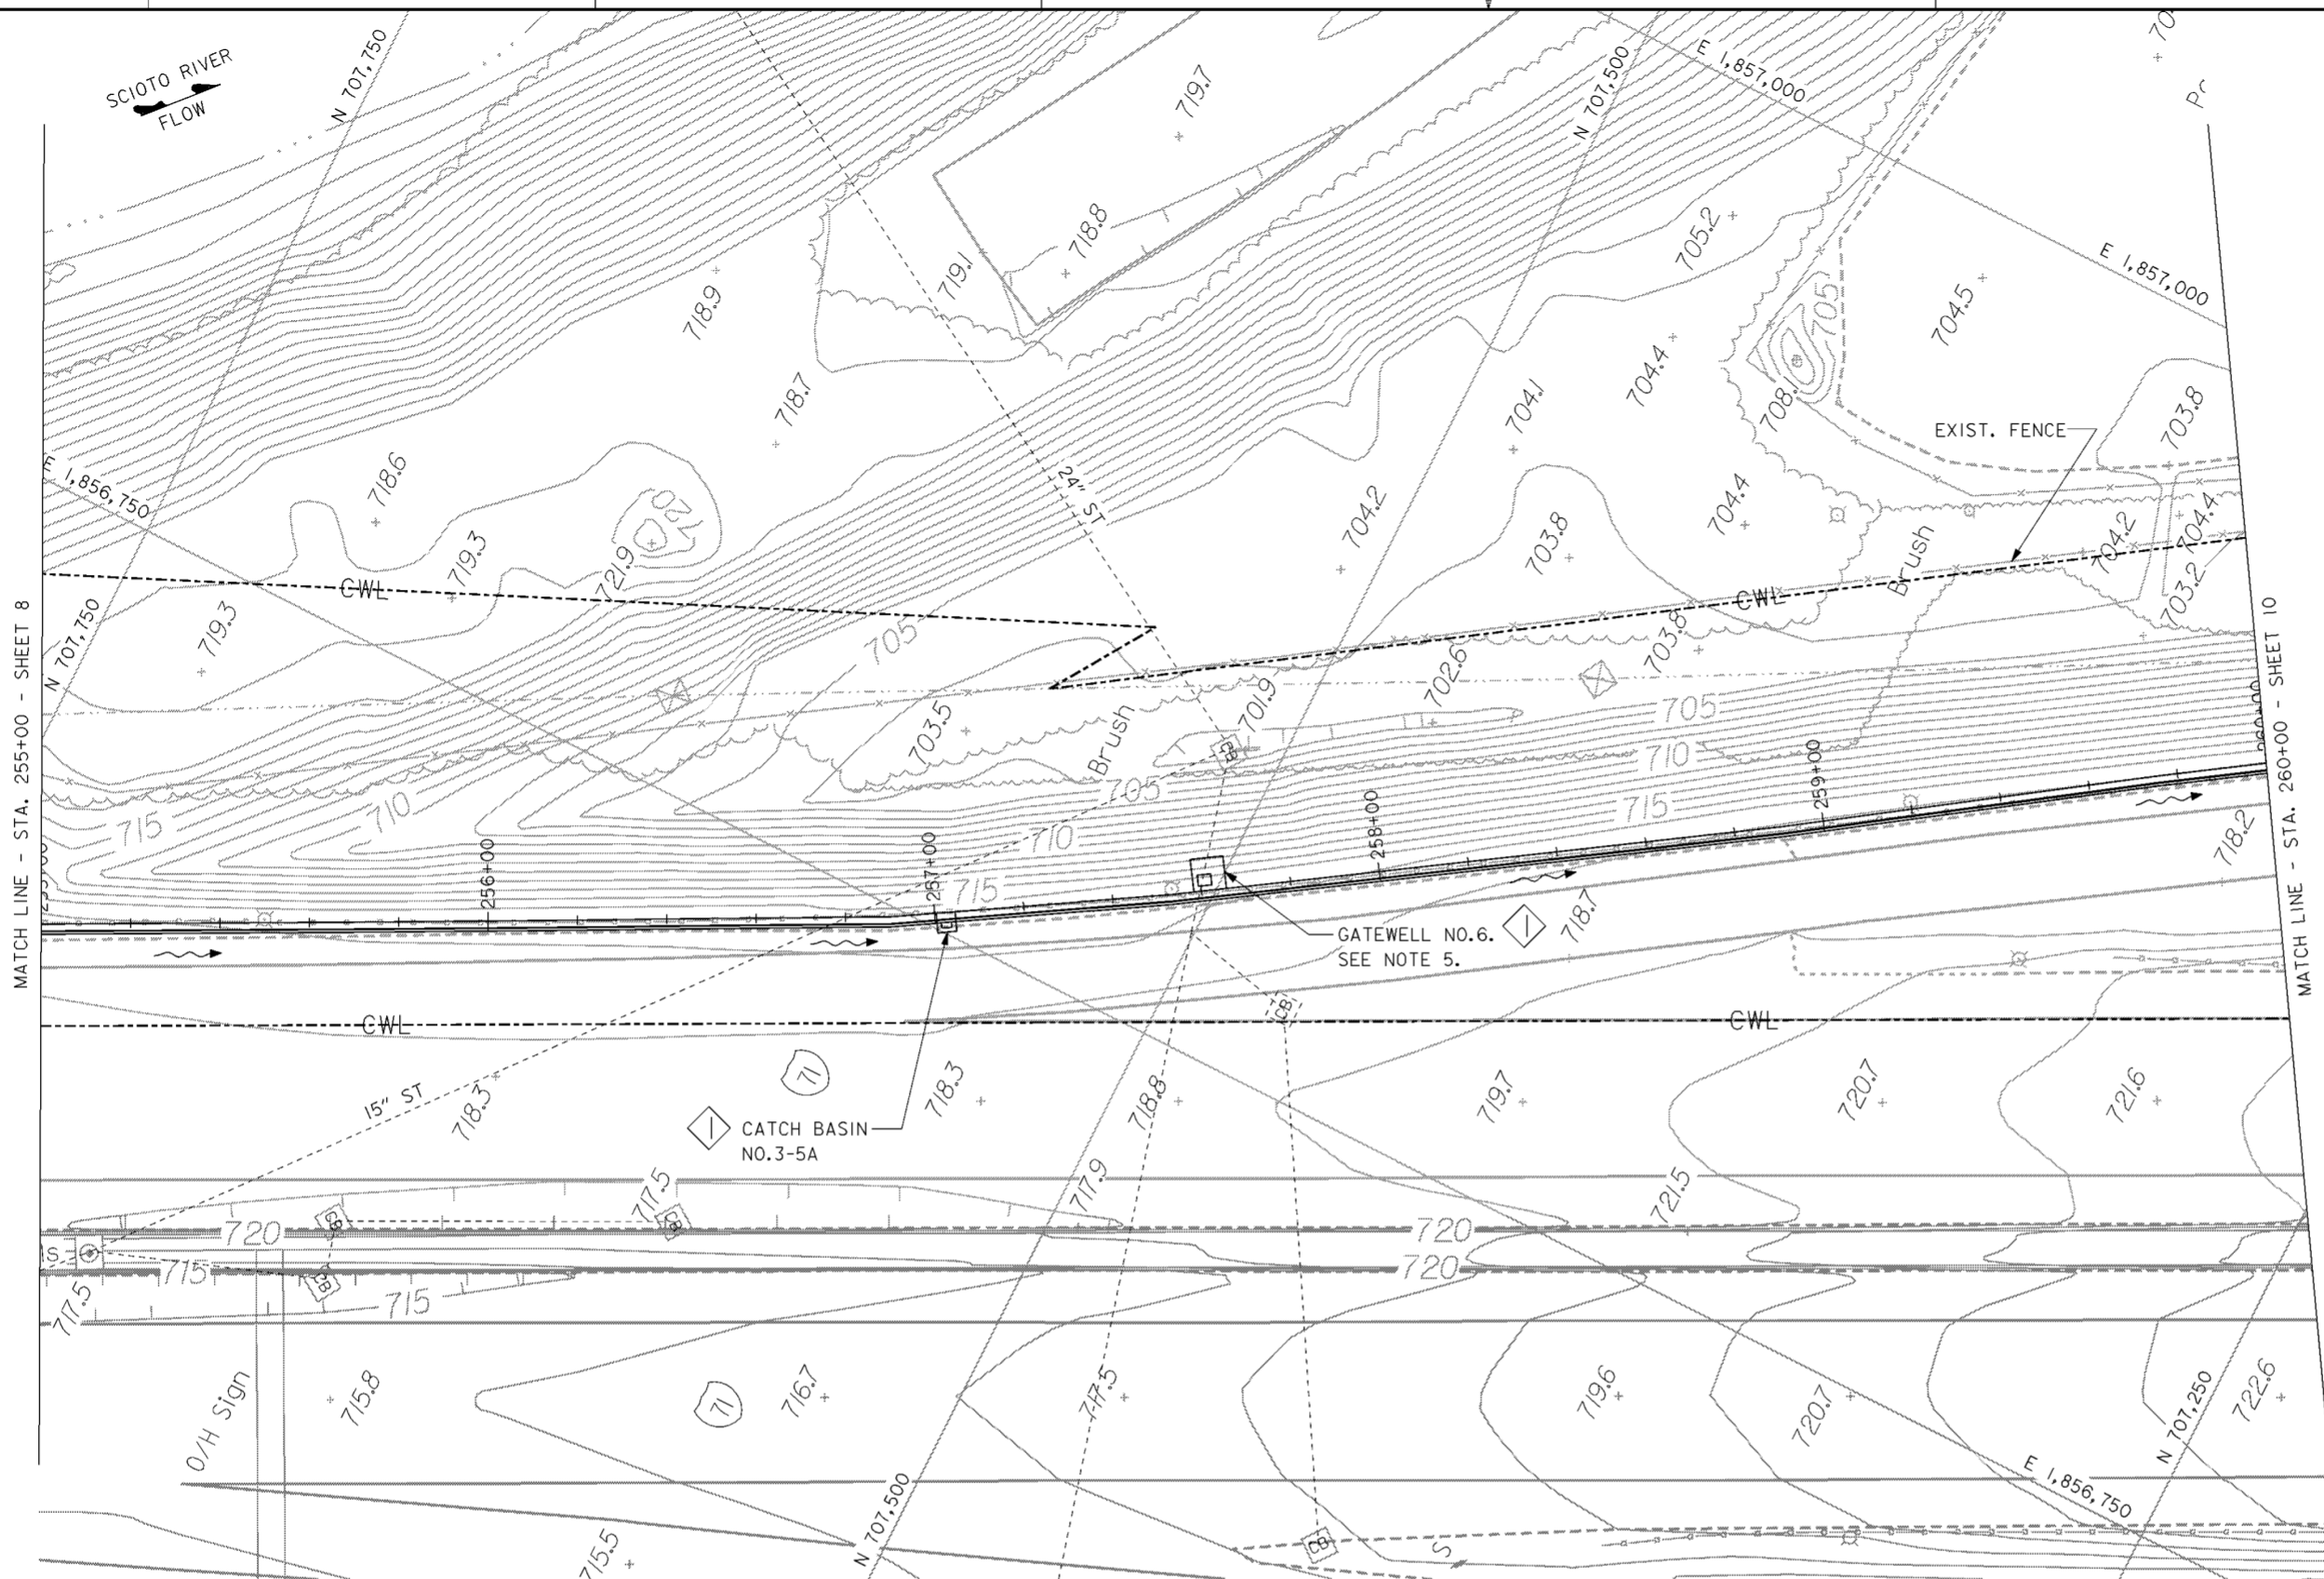

**PLAN**  
SCALE: 1" = 20'


**PROFILE**  
SCALE IN FEET

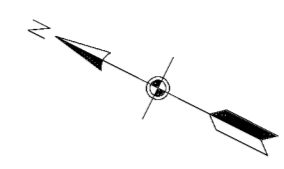

**NOTES**

1. FOR CONTRACTOR WORK LIMITS SEE DRAWING NOS. 6/1 THRU 6/5.
2. FOR TYPICAL I-WALL SECTIONS SEE DRAWING NO. 20.3/1.
3. FOR PAVEMENT SECTIONS AND PAVEMENT GRADING SEE DRAWING NO. 20.3/2.
4. I-WALL JOINTS DEPICTED AS DARK ON THE PROFILE ARE TYPE "A" ALL OTHERS ARE TYPE "B". FOR JOINT STATIONS SEE DRAWING NOS. 20.1/7 AND 20.1/8.
5. FOR GATEWELL NO. 6 DETAILS SEE DRAWING NOS. 15/7 AND 15/10.

Revisions			
Symbol	Descriptions	Date	Approved
◊ REVISED AS CONSTRUCTED - PHASE IIIA SOUTH 4/01 P.O.C.			
<b>BURGESS &amp; NIPLE, LIMITED</b> COLUMBUS, OHIO		<b>U.S. ARMY ENGINEER DISTRICT</b> CORPS OF ENGINEERS WEST COLUMBUS, L.P.P. PHASE IIIA	
Designed by: <b>J. HALL</b>	SCIOTO RIVER COLUMBUS, OHIO WEST COLUMBUS, L.P.P. PHASE IIIA		
Drawn by: <b>T. MULLINS</b>	<b>PLAN AND PROFILE</b> <b>STA. 255 + 00 TO 260 + 00</b>		
Checked by: <b>P. CONROY</b>	Scale: <b>AS SHOWN</b>	Sheet reference number: <b>16/9</b>	FILENAME: a0azpp09.dgn
Reviewed by: _____	Date: <b>OCTOBER 1999</b>	PEN TABLE: _____	
Approved by: _____	Drawing Code: <b>16-PWC-12-</b>	Sheet <b>9</b> of <b>10</b>	

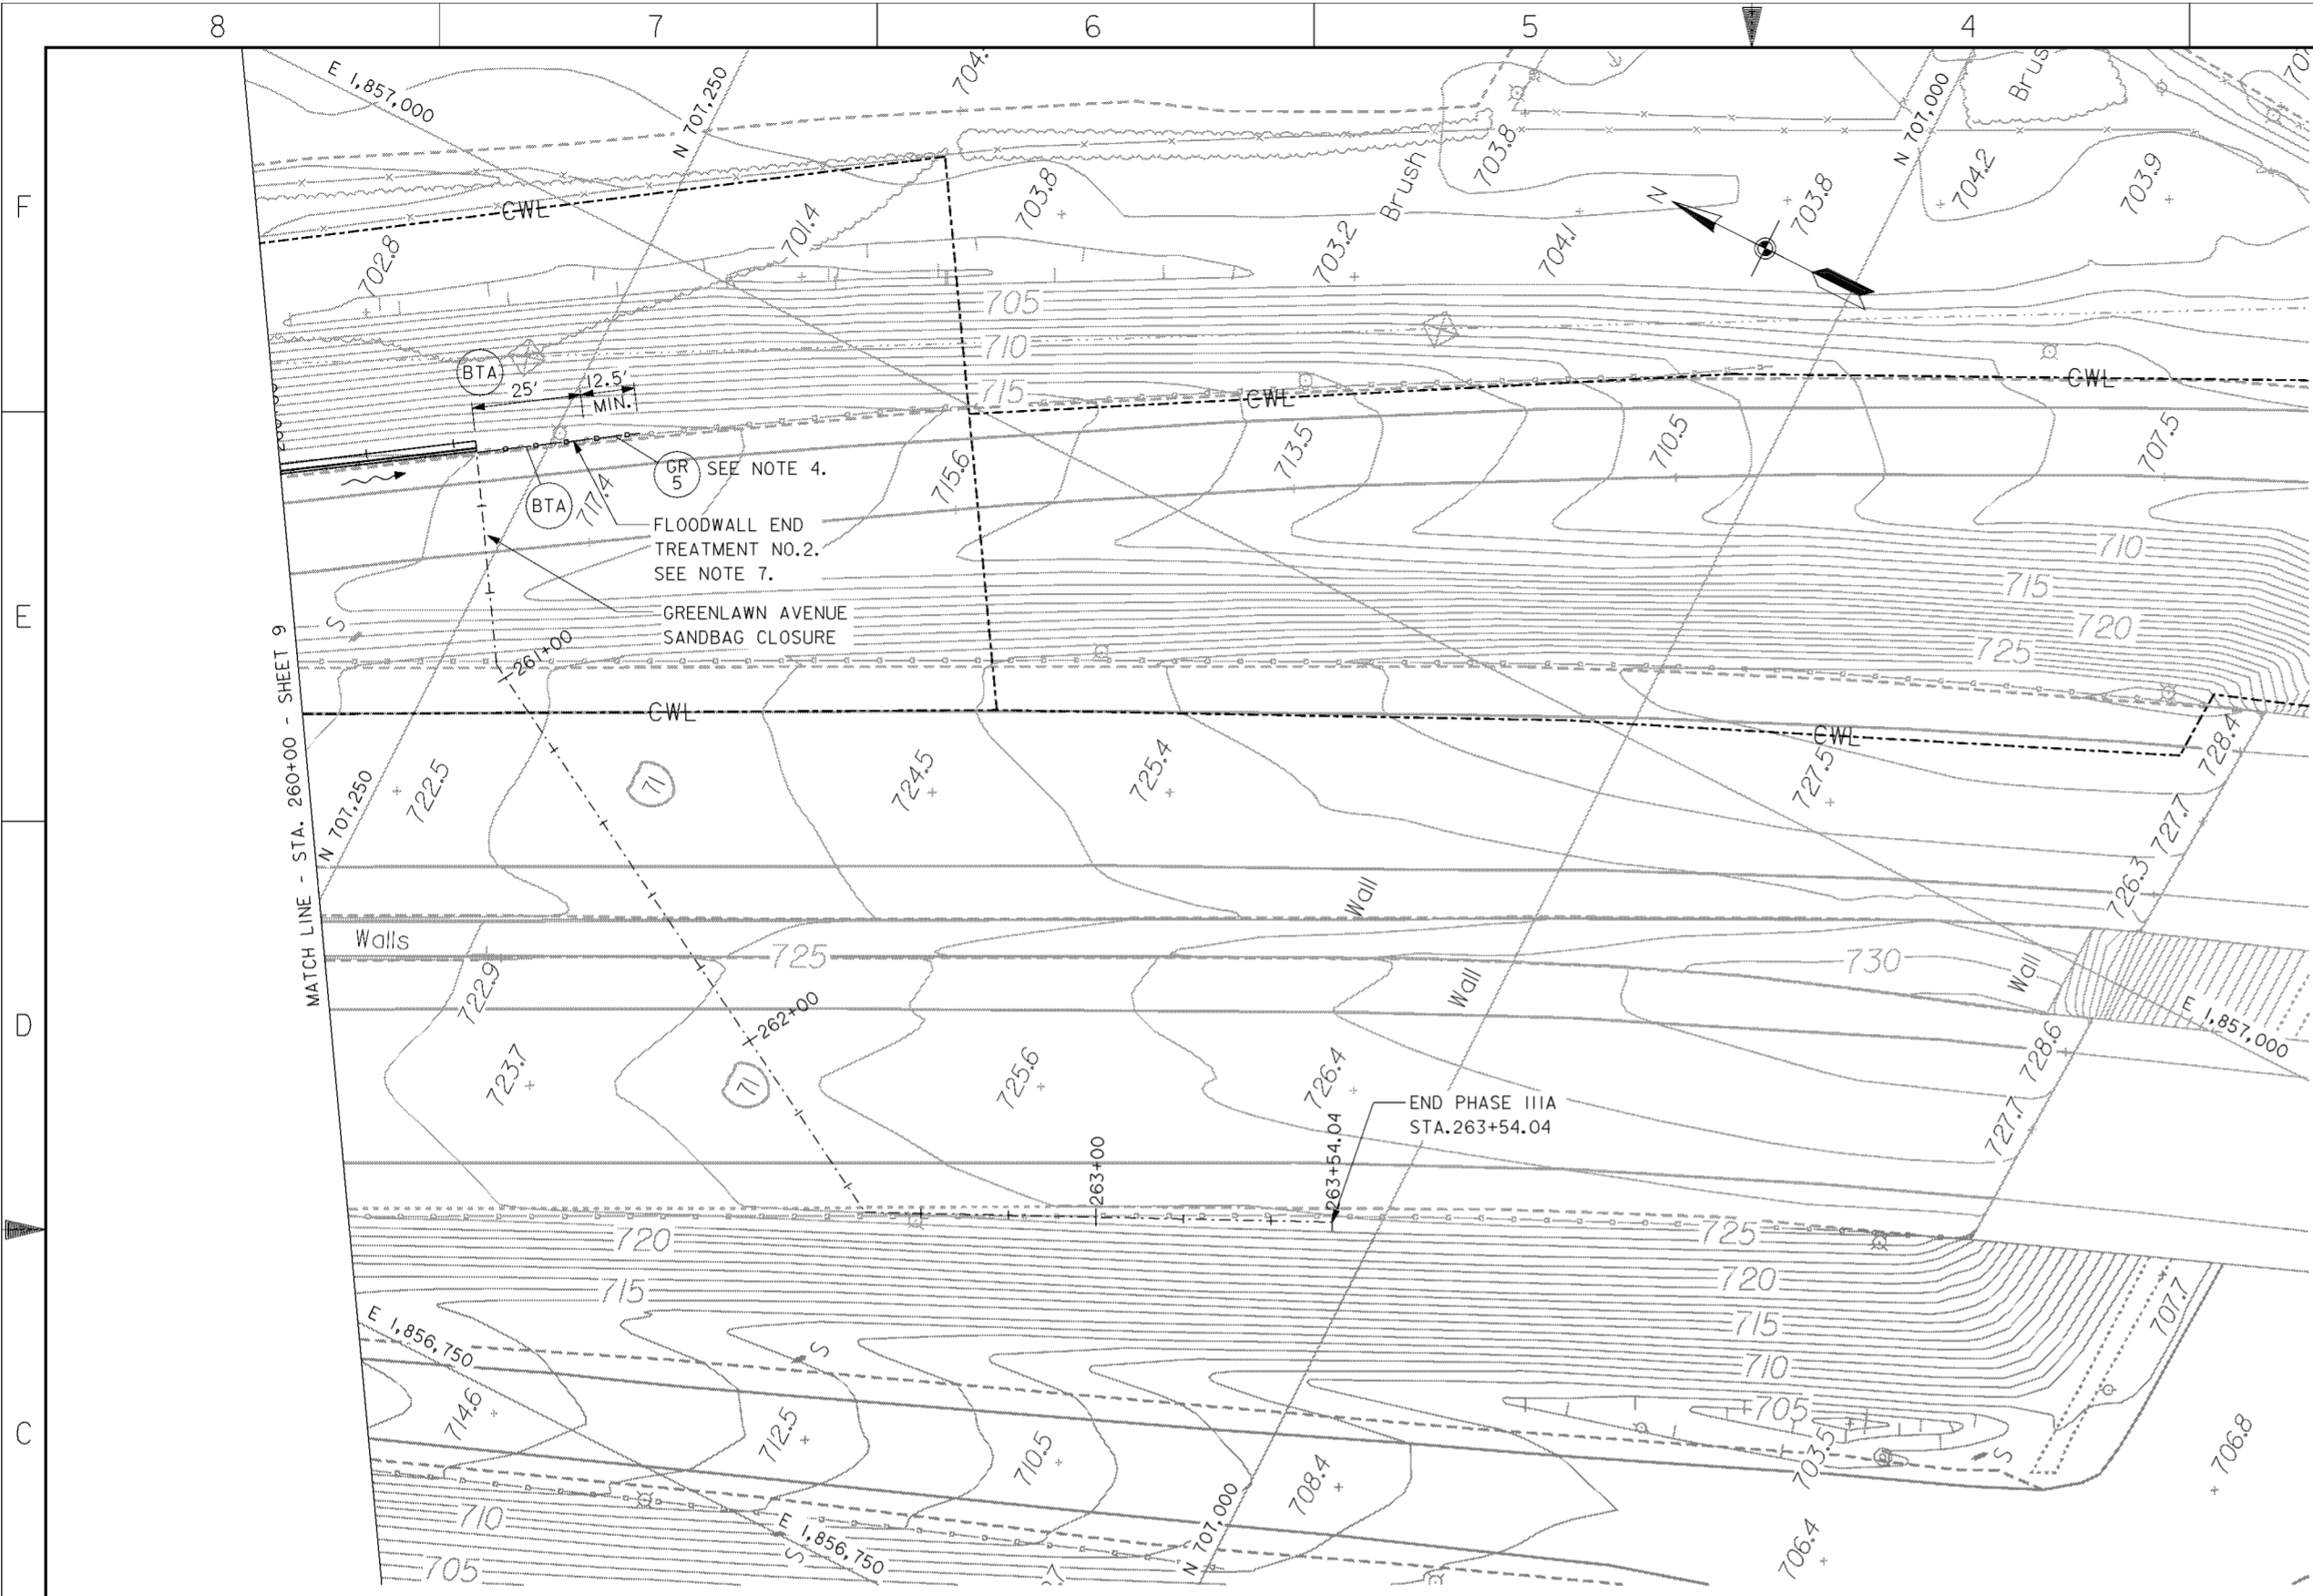


**LEGEND**

- (BTA) BRIDGE TERMINAL ASSEMBLY, TYPE 1
- (GR 5) GUARDRAIL, TYPE 5

**NOTES**

1. FOR CONTRACTOR WORK LIMITS SEE DRAWING NOS. 6/1 THRU 6/5.
2. FOR TYPICAL I-WALL SECTIONS SEE DRAWING NO. 20.3/1.
3. FOR GREENLAWN AVENUE SANDBAG CLOSURE SEE DRAWING NO. 20.2/1.
4. PROVIDE A MINIMUM OF 12.5' SECTION OF NEW GUARDRAIL TO TRANSITION TO EXISTING GUARDRAIL.
5. FOR PAVEMENT SECTIONS AND PAVEMENT GRADING SEE DRAWING NO. 20.3/2.
6. I-WALL JOINTS DEPICTED AS DARK ON THE PROFILE ARE TYPE "A" ALL OTHERS ARE TYPE "B". FOR JOINT STATIONS SEE DRAWING NOS. 20.1/7 AND 20.1/8.
7. FLOODWALL END TREATMENT NO.2 INCLUDES BRIDGE TERMINAL ASSEMBLY (TYPE 1) AND GUARDRAIL (TYPE 5).

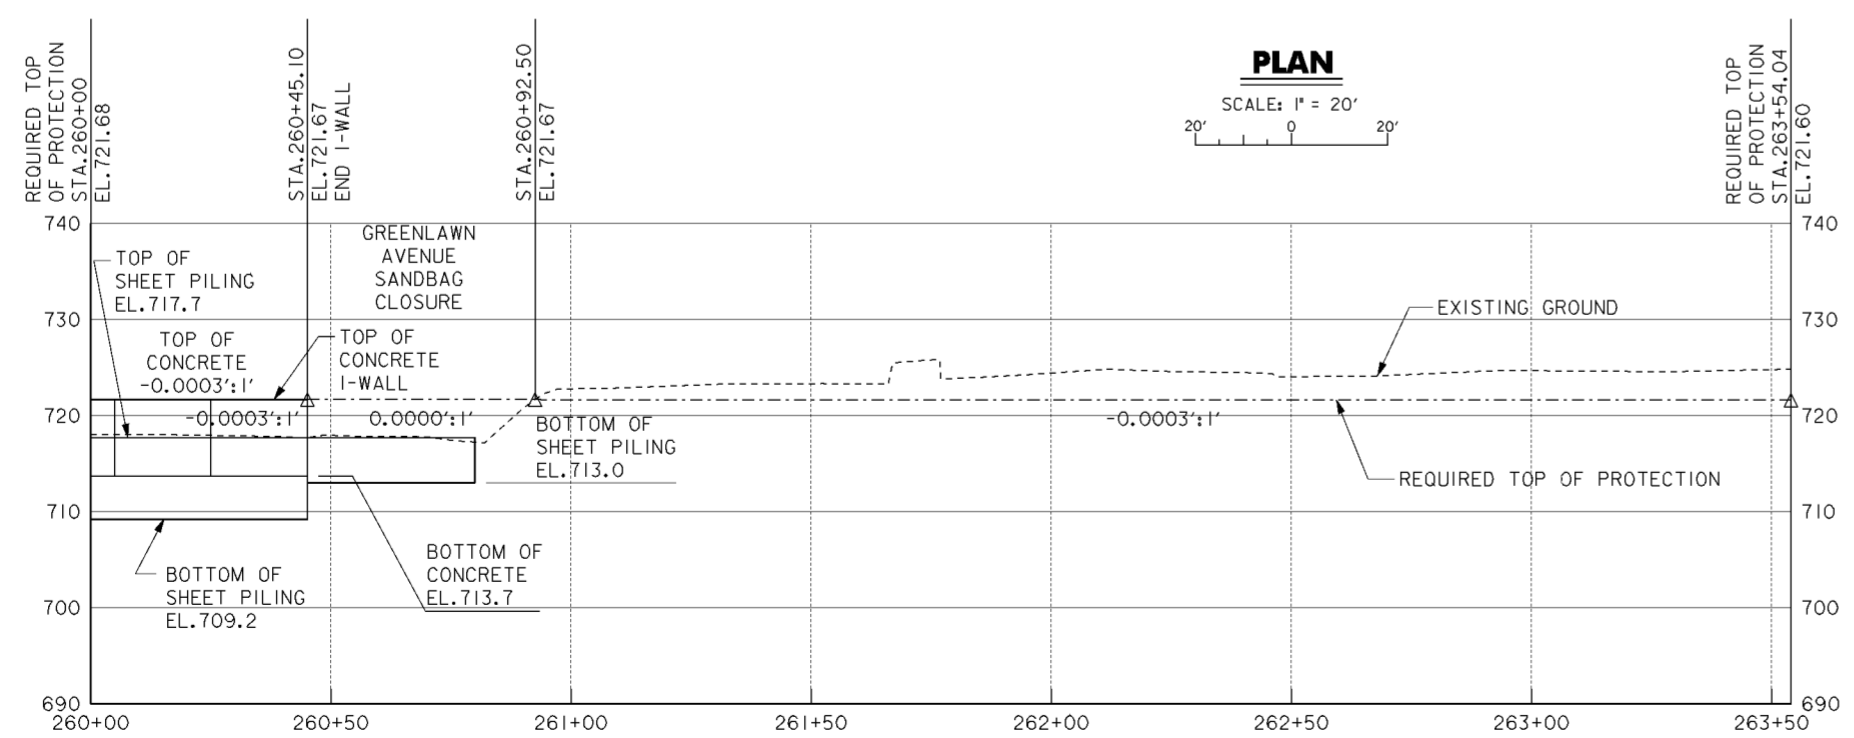


**PROFILE**  
SCALE IN FEET

Revisions			
Symbol	Descriptions	Date	Approved

<b>BURGESS &amp; NIPLE, LIMITED</b> COLUMBUS, OHIO	<b>U.S. ARMY ENGINEER DISTRICT</b> CORPS OF ENGINEERS HUNTINGTON, WEST VIRGINIA	Designed by: <b>J. HALL</b>	SCIOTO RIVER COLUMBUS, OHIO WEST COLUMBUS, L.P.P. PHASE IIIA
		Drawn by: <b>T. MULLINS</b>	
Checked by: <b>P. CONROY</b>	<b>PLAN AND PROFILE</b> <b>STA 260 + 00 TO 263 + 54.04</b>		
Reviewed by:	Scale: <b>AS SHOWN</b>	Sheet reference number: <b>16/10</b>	FILENAME: PIN TABLE: 00azpp10.dgn
Approved by:	Date: <b>OCTOBER 1999</b>	Drawing Code: <b>16-PWC-12-</b>	Sheet <b>10</b> of <b>10</b>

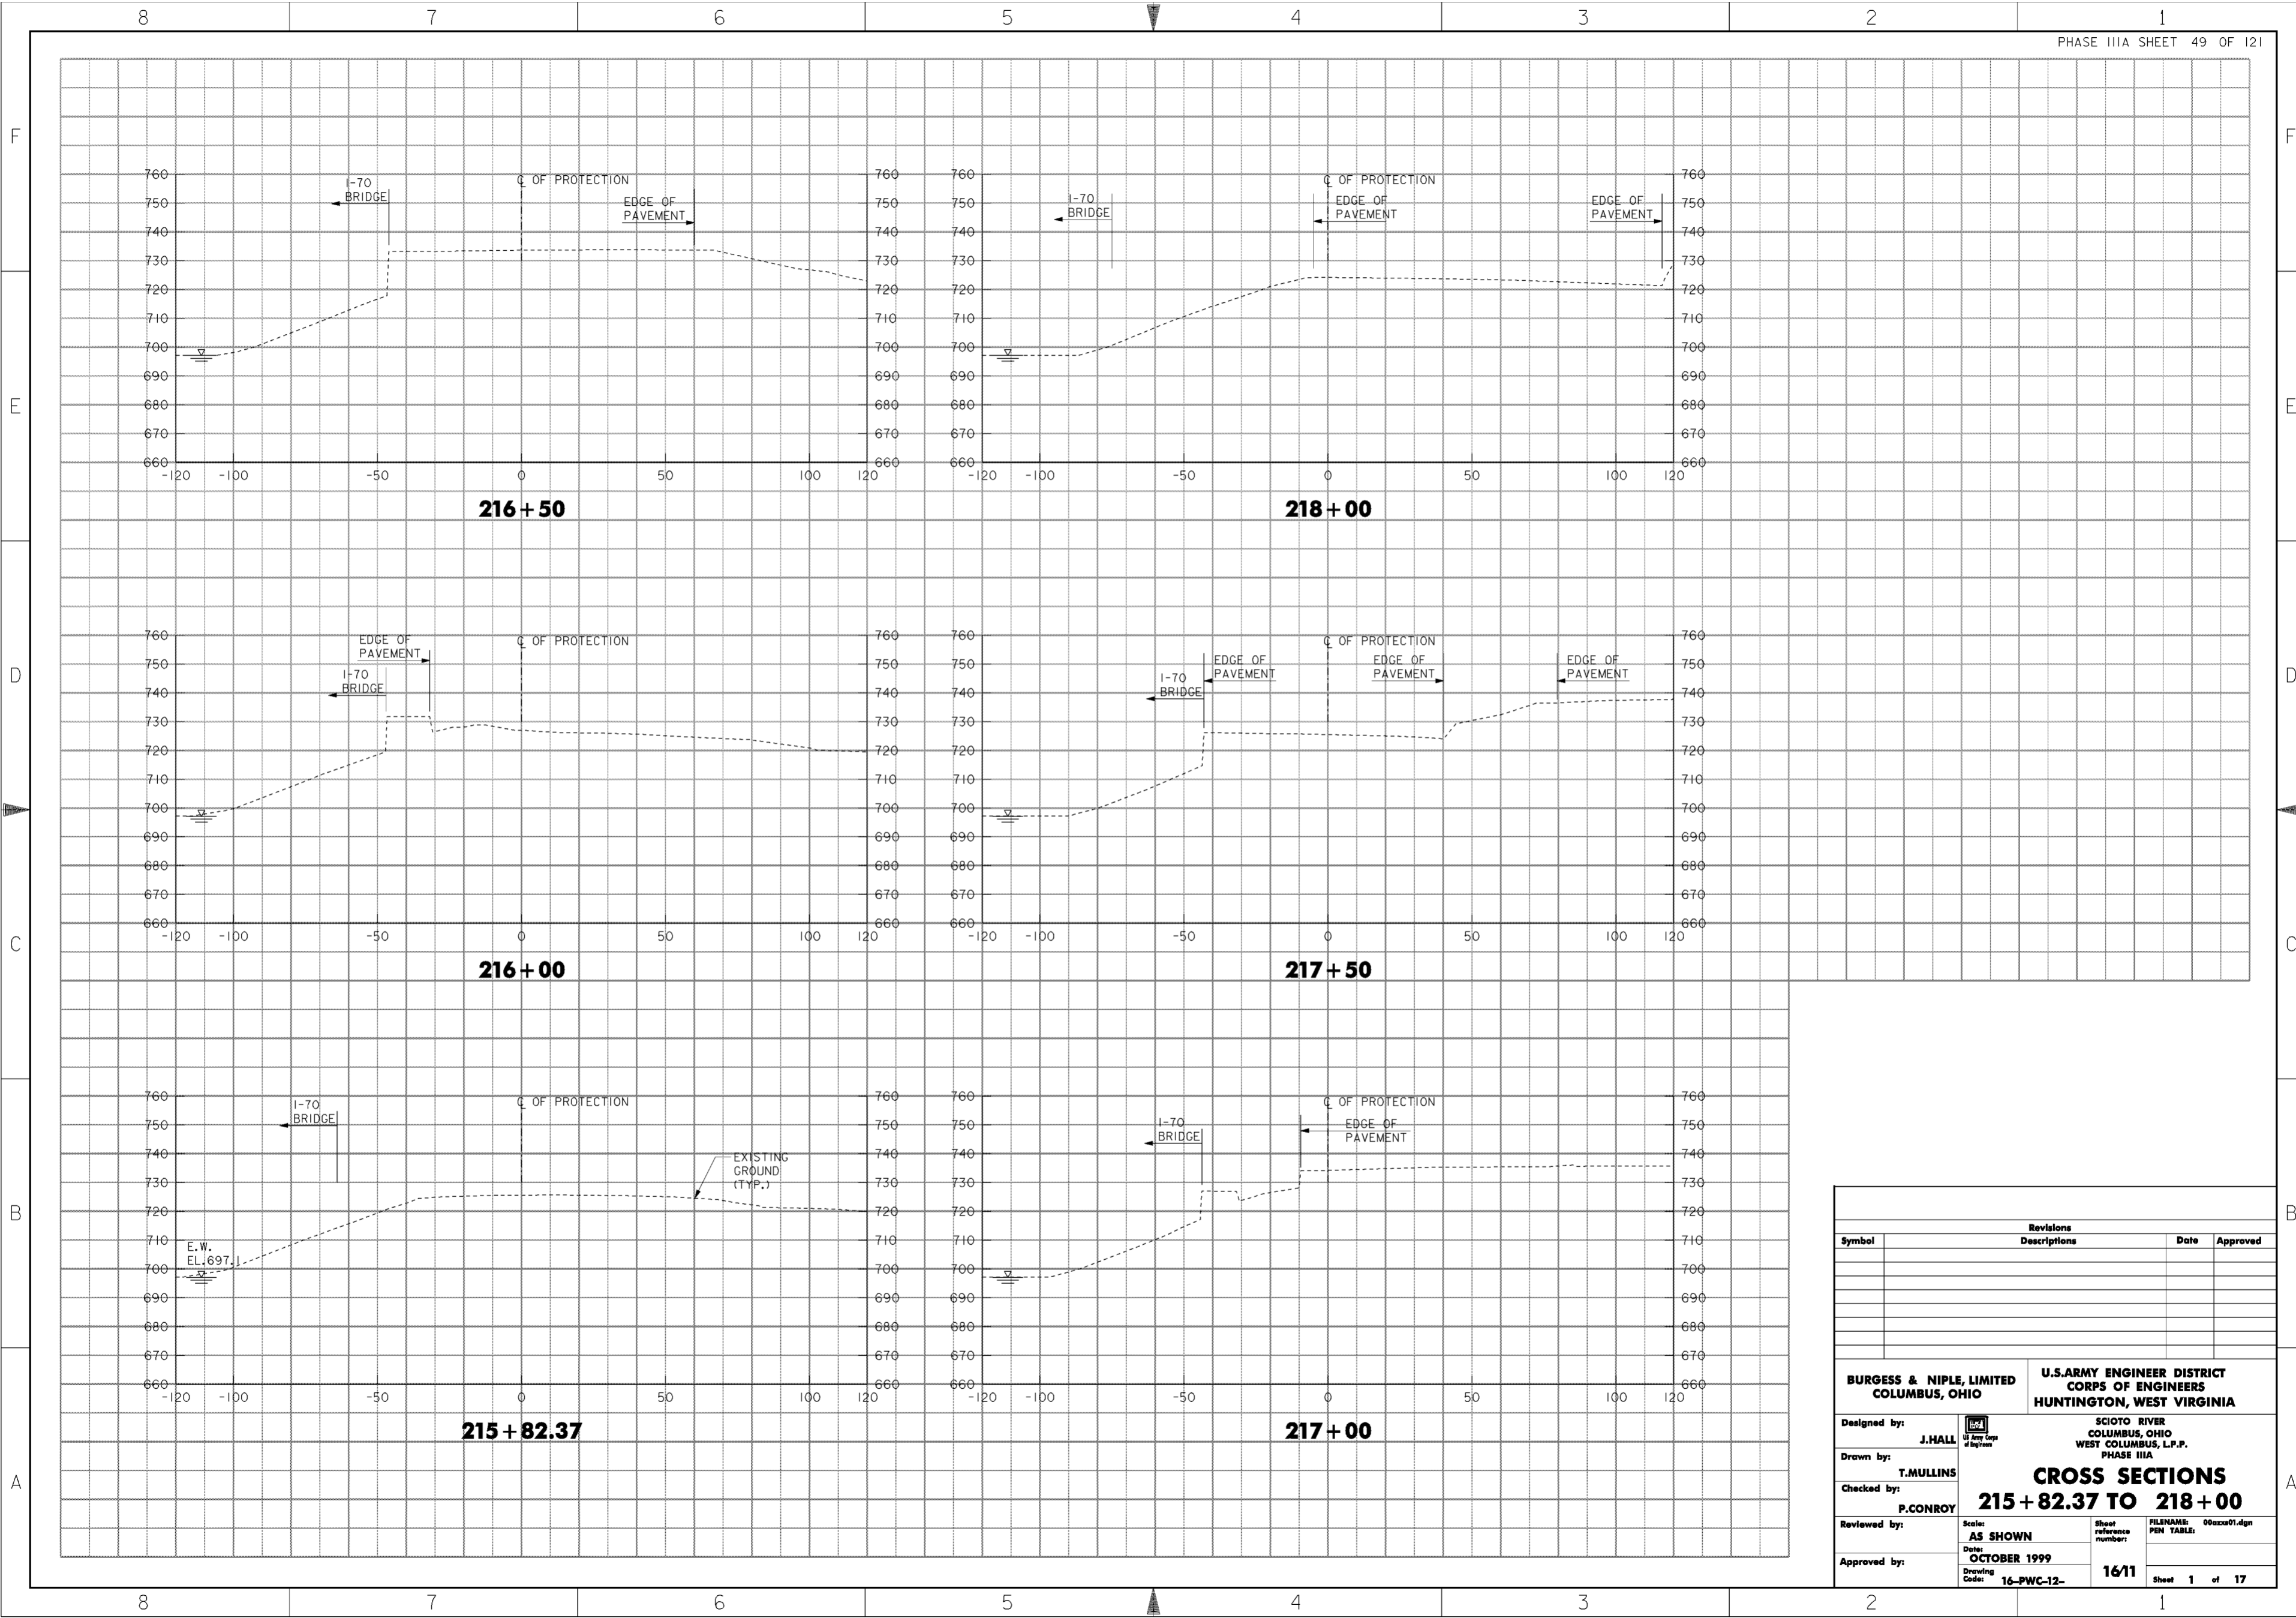


Revisions			
Symbol	Descriptions	Date	Approved

<b>BURGESS &amp; NIPLE, LIMITED</b> COLUMBUS, OHIO	<b>U.S. ARMY ENGINEER DISTRICT</b> CORPS OF ENGINEERS HUNTINGTON, WEST VIRGINIA	SCIOTO RIVER COLUMBUS, OHIO WEST COLUMBUS, L.P.P. PHASE IIIA	
		<b>CROSS SECTIONS</b> <b>215 + 82.37 TO 218 + 00</b>	
Designed by: <b>J. HALL</b>		Scale: <b>AS SHOWN</b>	FILENAME: 00axx01.dgn
Drawn by: <b>T. MULLINS</b>		Date: <b>OCTOBER 1999</b>	Sheet reference number: <b>16/11</b>
Checked by: <b>P. CONROY</b>	Approved by:	Drawing Code: <b>16-PWC-12-</b>	Sheet 1 of 17

**WORK AS CONSTRUCTED**



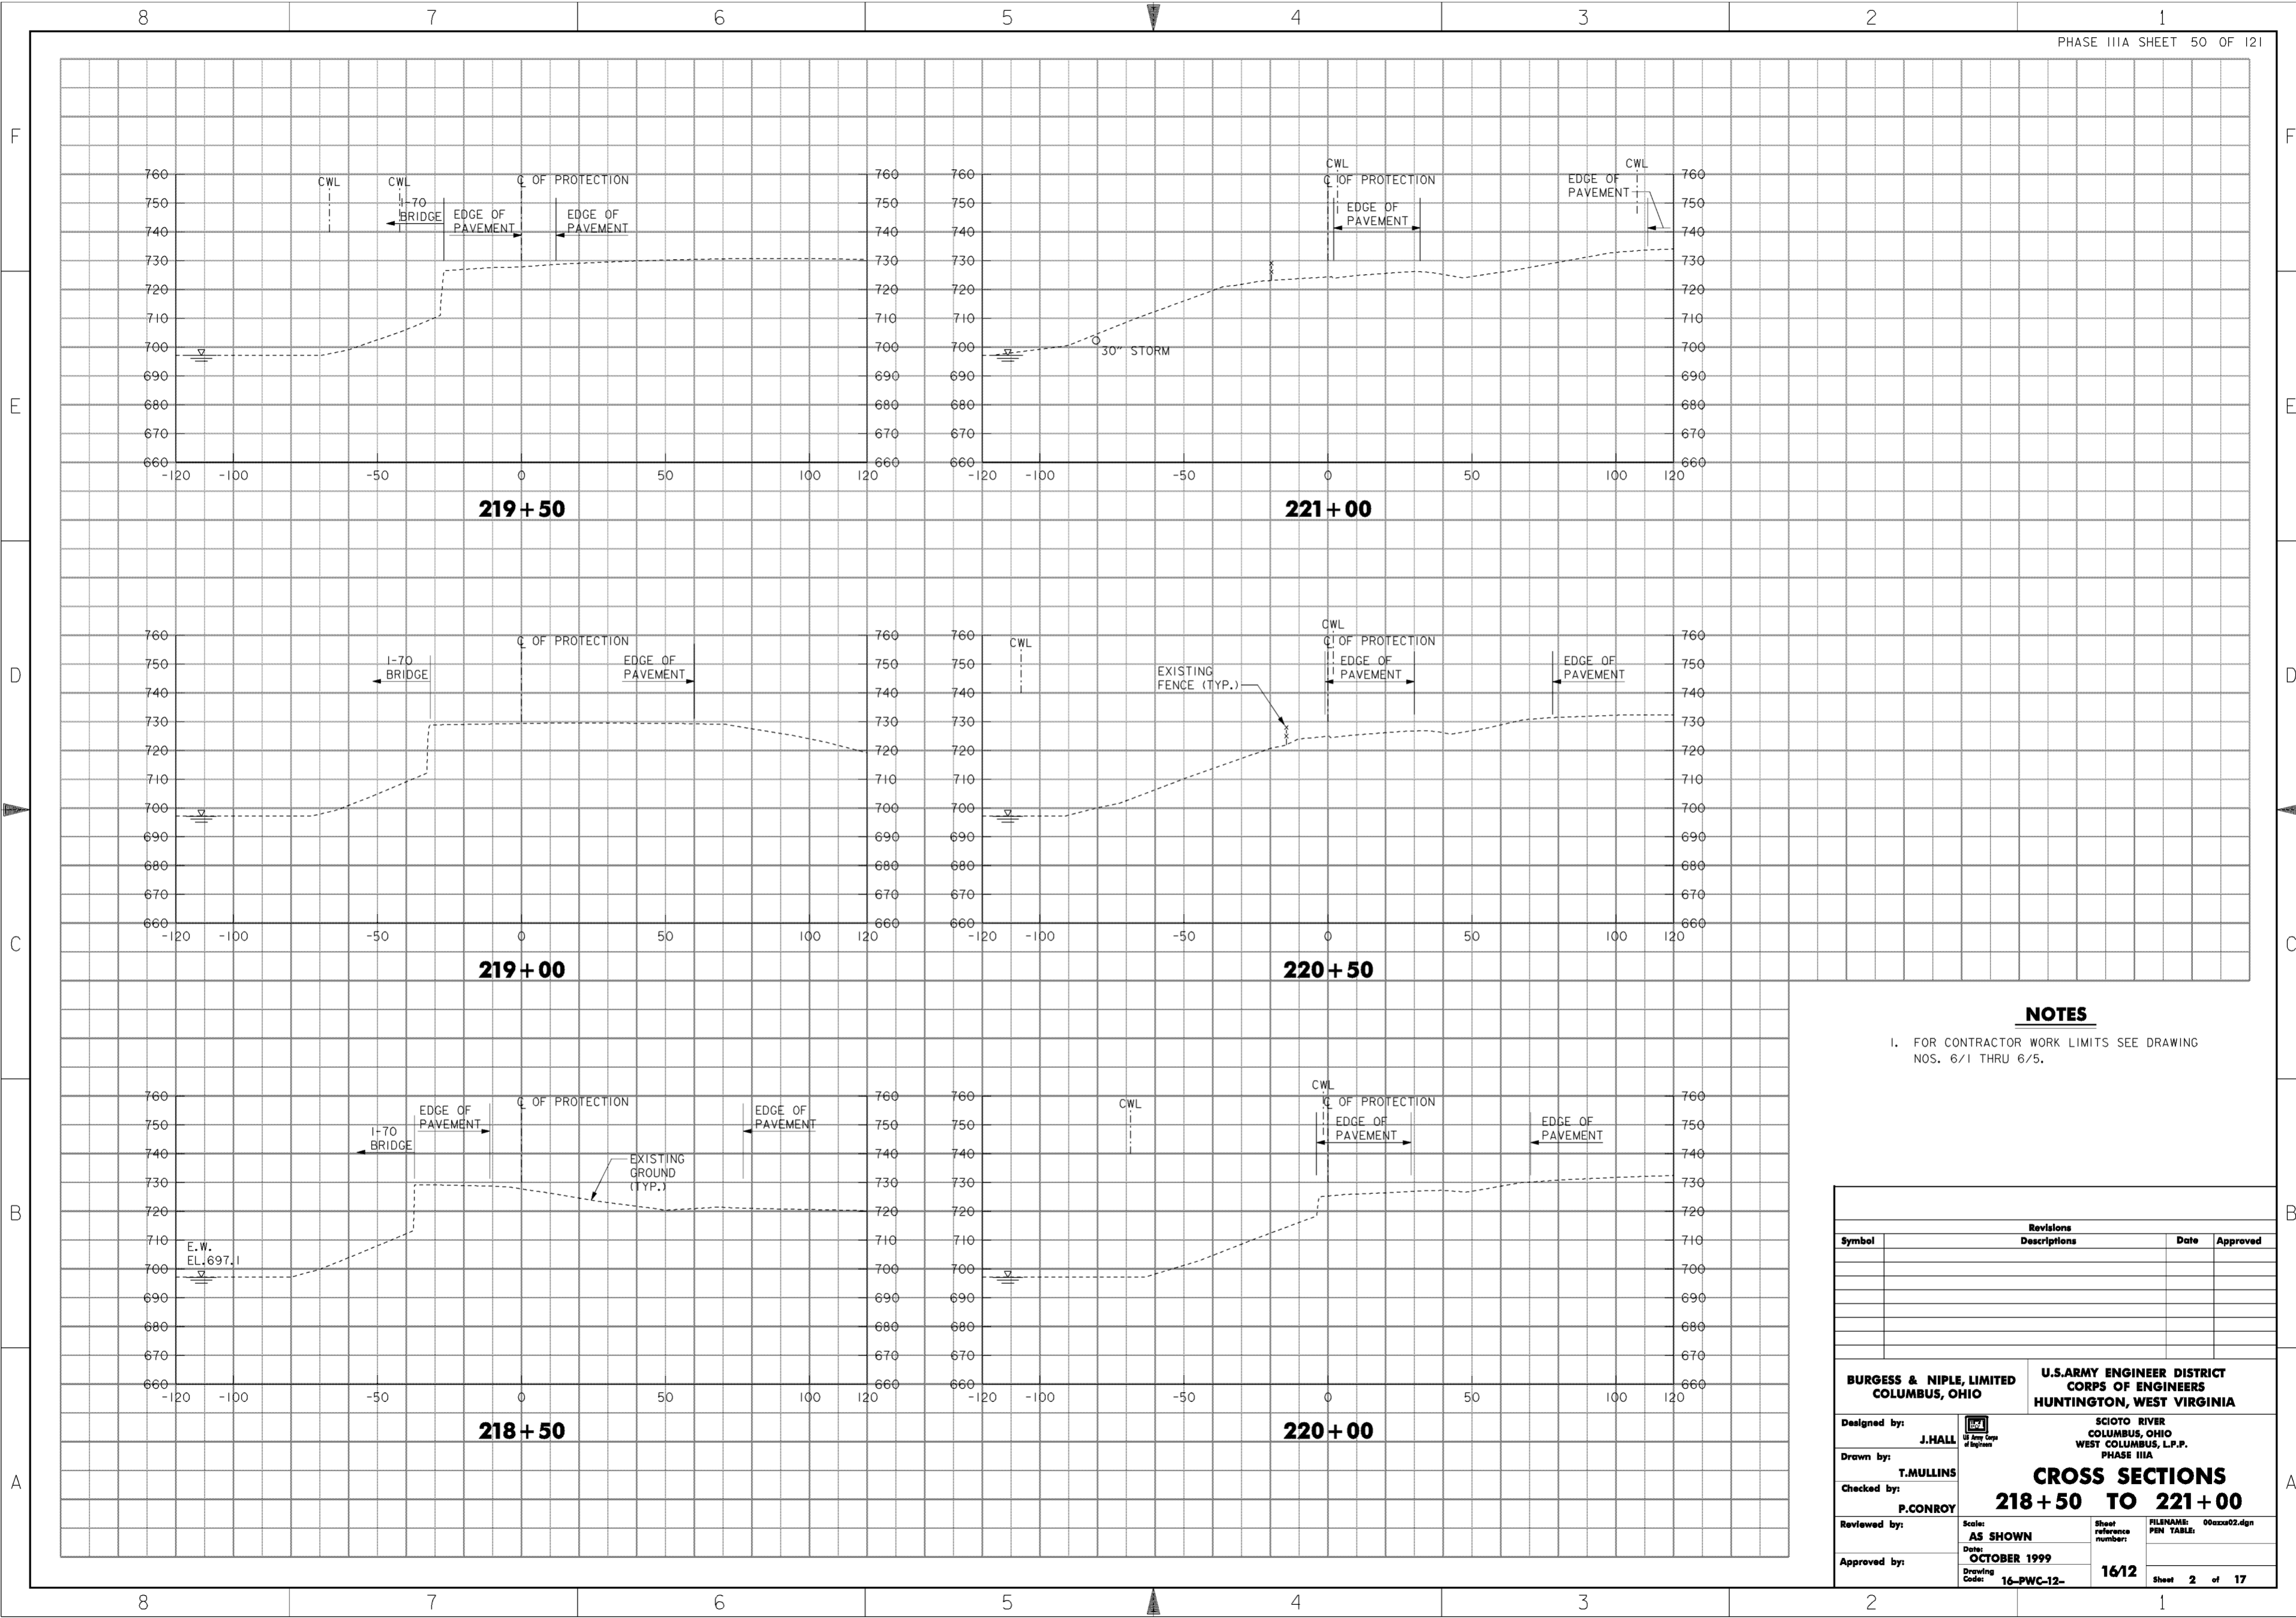


**NOTES**

1. FOR CONTRACTOR WORK LIMITS SEE DRAWING NOS. 6/1 THRU 6/5.

Revisions			
Symbol	Descriptions	Date	Approved

<b>BURGESS &amp; NIPLE, LIMITED</b> COLUMBUS, OHIO		<b>U.S. ARMY ENGINEER DISTRICT</b> CORPS OF ENGINEERS HUNTINGTON, WEST VIRGINIA	
Designed by:	<b>J. HALL</b>	SCIOTO RIVER COLUMBUS, OHIO WEST COLUMBUS, L.P.P. PHASE IIIA	
Drawn by:	<b>T. MULLINS</b>	<b>CROSS SECTIONS</b> <b>218 + 50 TO 221 + 00</b>	
Checked by:	<b>P. CONROY</b>	Scale:	<b>AS SHOWN</b>
Reviewed by:		Date:	<b>OCTOBER 1999</b>
Approved by:		Drawing Code:	<b>16-PWC-12-</b>
		Sheet reference number:	<b>16/12</b>
		FILENAME:	00axx02.dgn
		PIN TABLE:	
			Sheet <b>2</b> of <b>17</b>



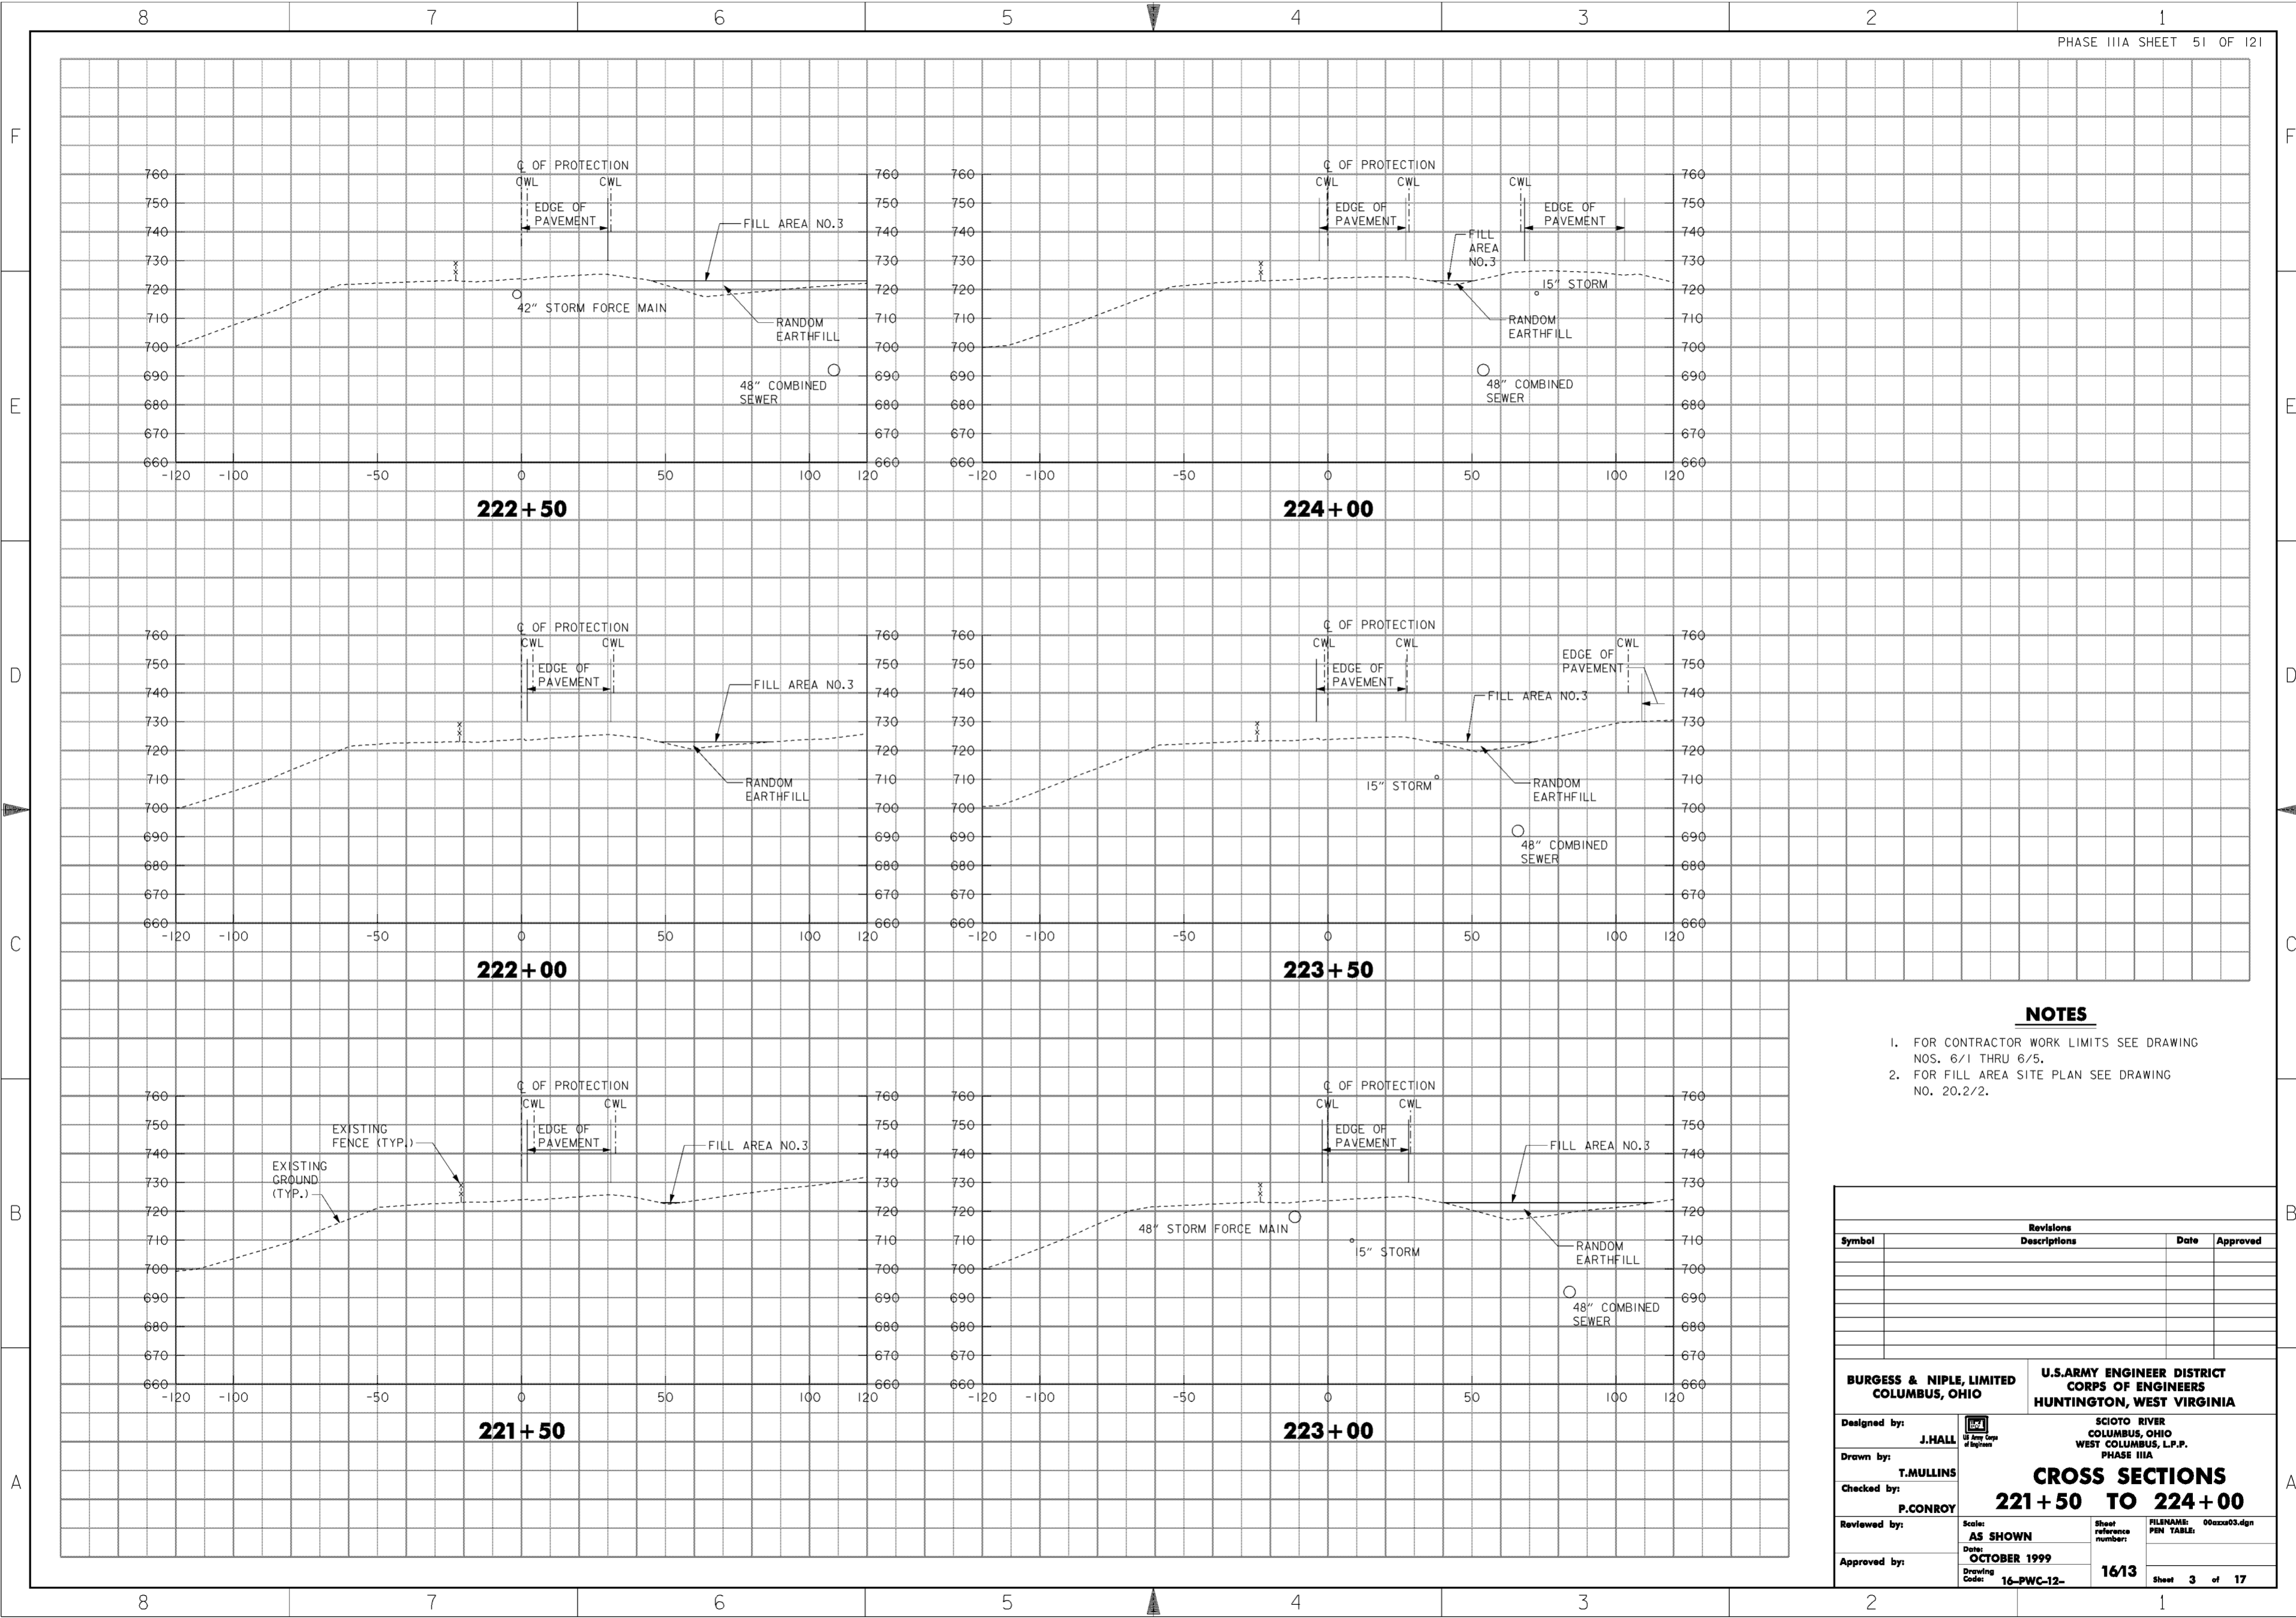


**NOTES**


1. FOR CONTRACTOR WORK LIMITS SEE DRAWING NOS. 6/1 THRU 6/5.
2. FOR FILL AREA SITE PLAN SEE DRAWING NO. 20.2/2.

Revisions			
Symbol	Descriptions	Date	Approved

<b>BURGESS &amp; NIPLE, LIMITED</b> COLUMBUS, OHIO	 U.S. ARMY ENGINEER DISTRICT CORPS OF ENGINEERS HUNTINGTON, WEST VIRGINIA		
		SCIOTO RIVER COLUMBUS, OHIO WEST COLUMBUS, L.P.P. PHASE IIIA	
Designed by: <b>J. HALL</b>	<p align="center"><b>CROSS SECTIONS</b>  <b>221 + 50 TO 224 + 00</b></p>		
Drawn by: <b>T. MULLINS</b>			
Checked by: <b>P. CONROY</b>			
Reviewed by:			
Approved by:	Scale: <b>AS SHOWN</b>	Sheet reference number: <b>16/13</b>	FILENAME: PIN TABLE: 00axx05.dgn
Date: <b>OCTOBER 1999</b>	Drawing Code: <b>16-PWC-12-</b>	Sheet <b>3</b> of <b>17</b>	

**WORK AS CONSTRUCTED**

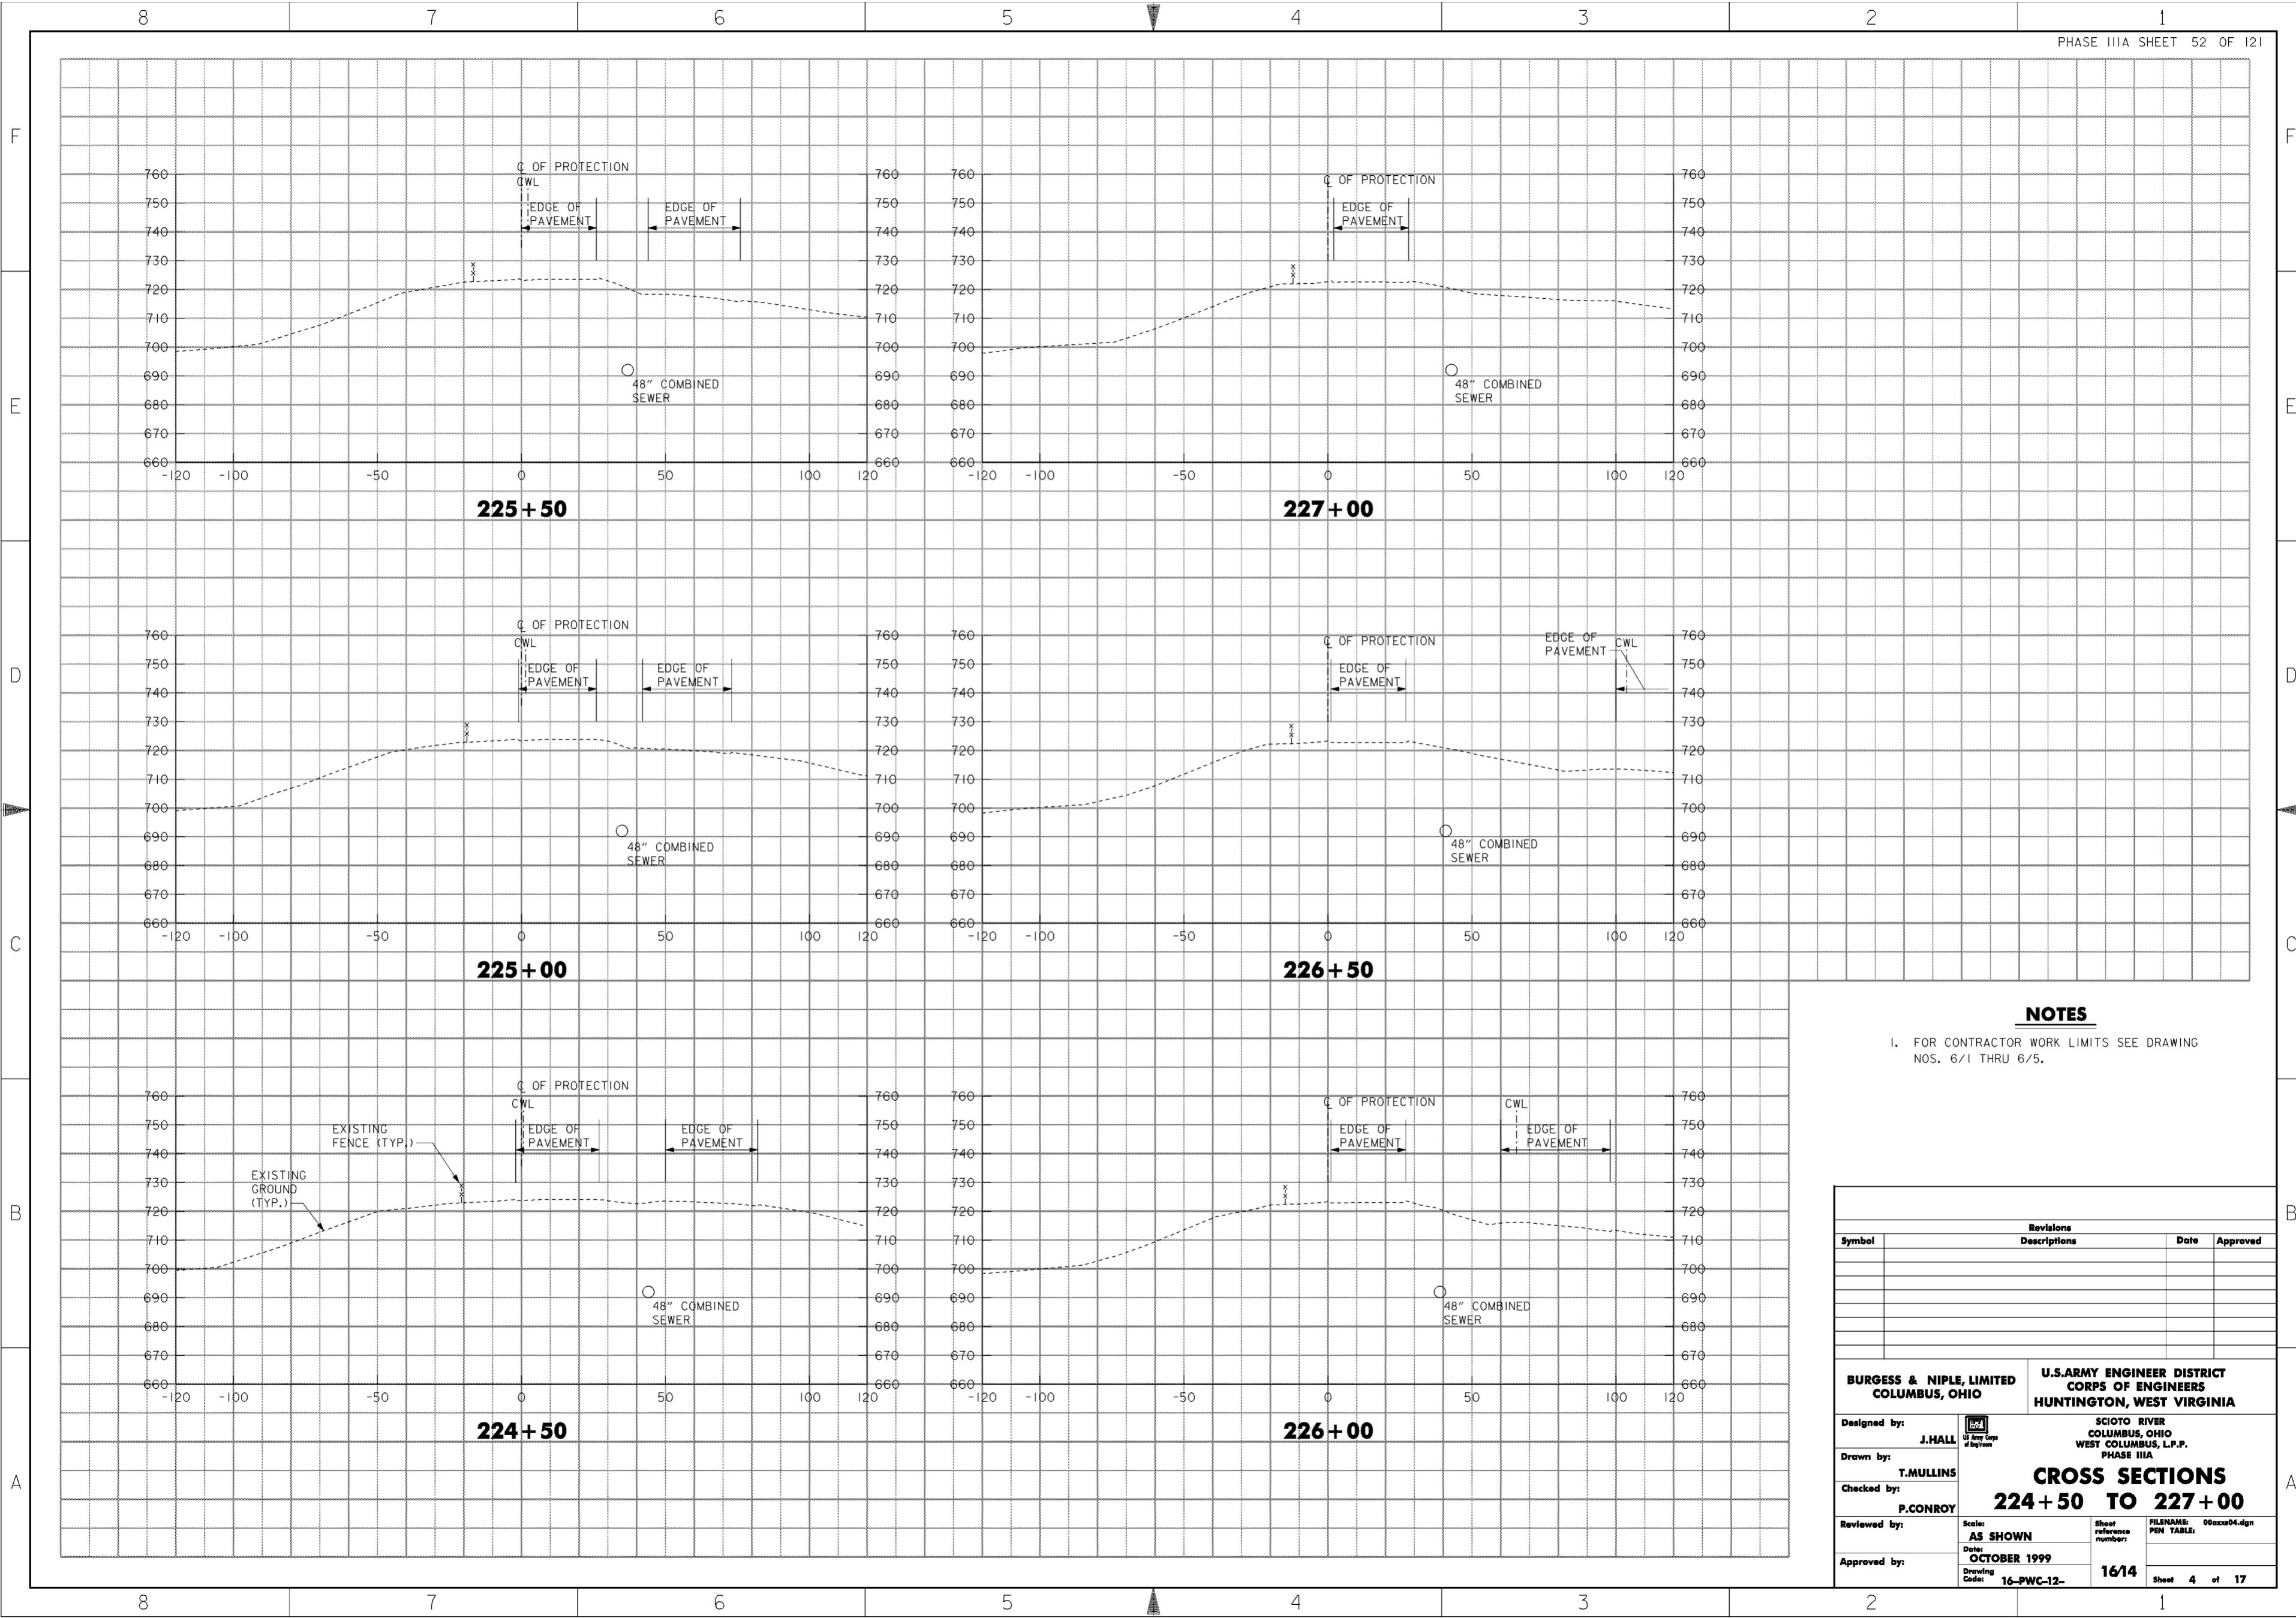


**NOTES**

1. FOR CONTRACTOR WORK LIMITS SEE DRAWING NOS. 6/1 THRU 6/5.

Revisions			
Symbol	Descriptions	Date	Approved

<b>BURGESS &amp; NIPLE, LIMITED</b> COLUMBUS, OHIO	<b>U.S. ARMY ENGINEER DISTRICT</b> CORPS OF ENGINEERS HUNTINGTON, WEST VIRGINIA	SCIOTO RIVER COLUMBUS, OHIO WEST COLUMBUS, L.P.P. PHASE IIIA	
		<b>CROSS SECTIONS</b> <b>224 + 50 TO 227 + 00</b>	
Designed by: <b>J. HALL</b>		Drawn by: <b>T. MULLINS</b>	Checked by: <b>P. CONROY</b>
Reviewed by: AS SHOWN		Date: <b>OCTOBER 1999</b>	Drawing Code: <b>16-PWC-12-</b>
Approved by:	Sheet reference number: <b>16/14</b>	FILENAME: 00axx04.dgn	PEN TABLE: Sheet 4 of 17

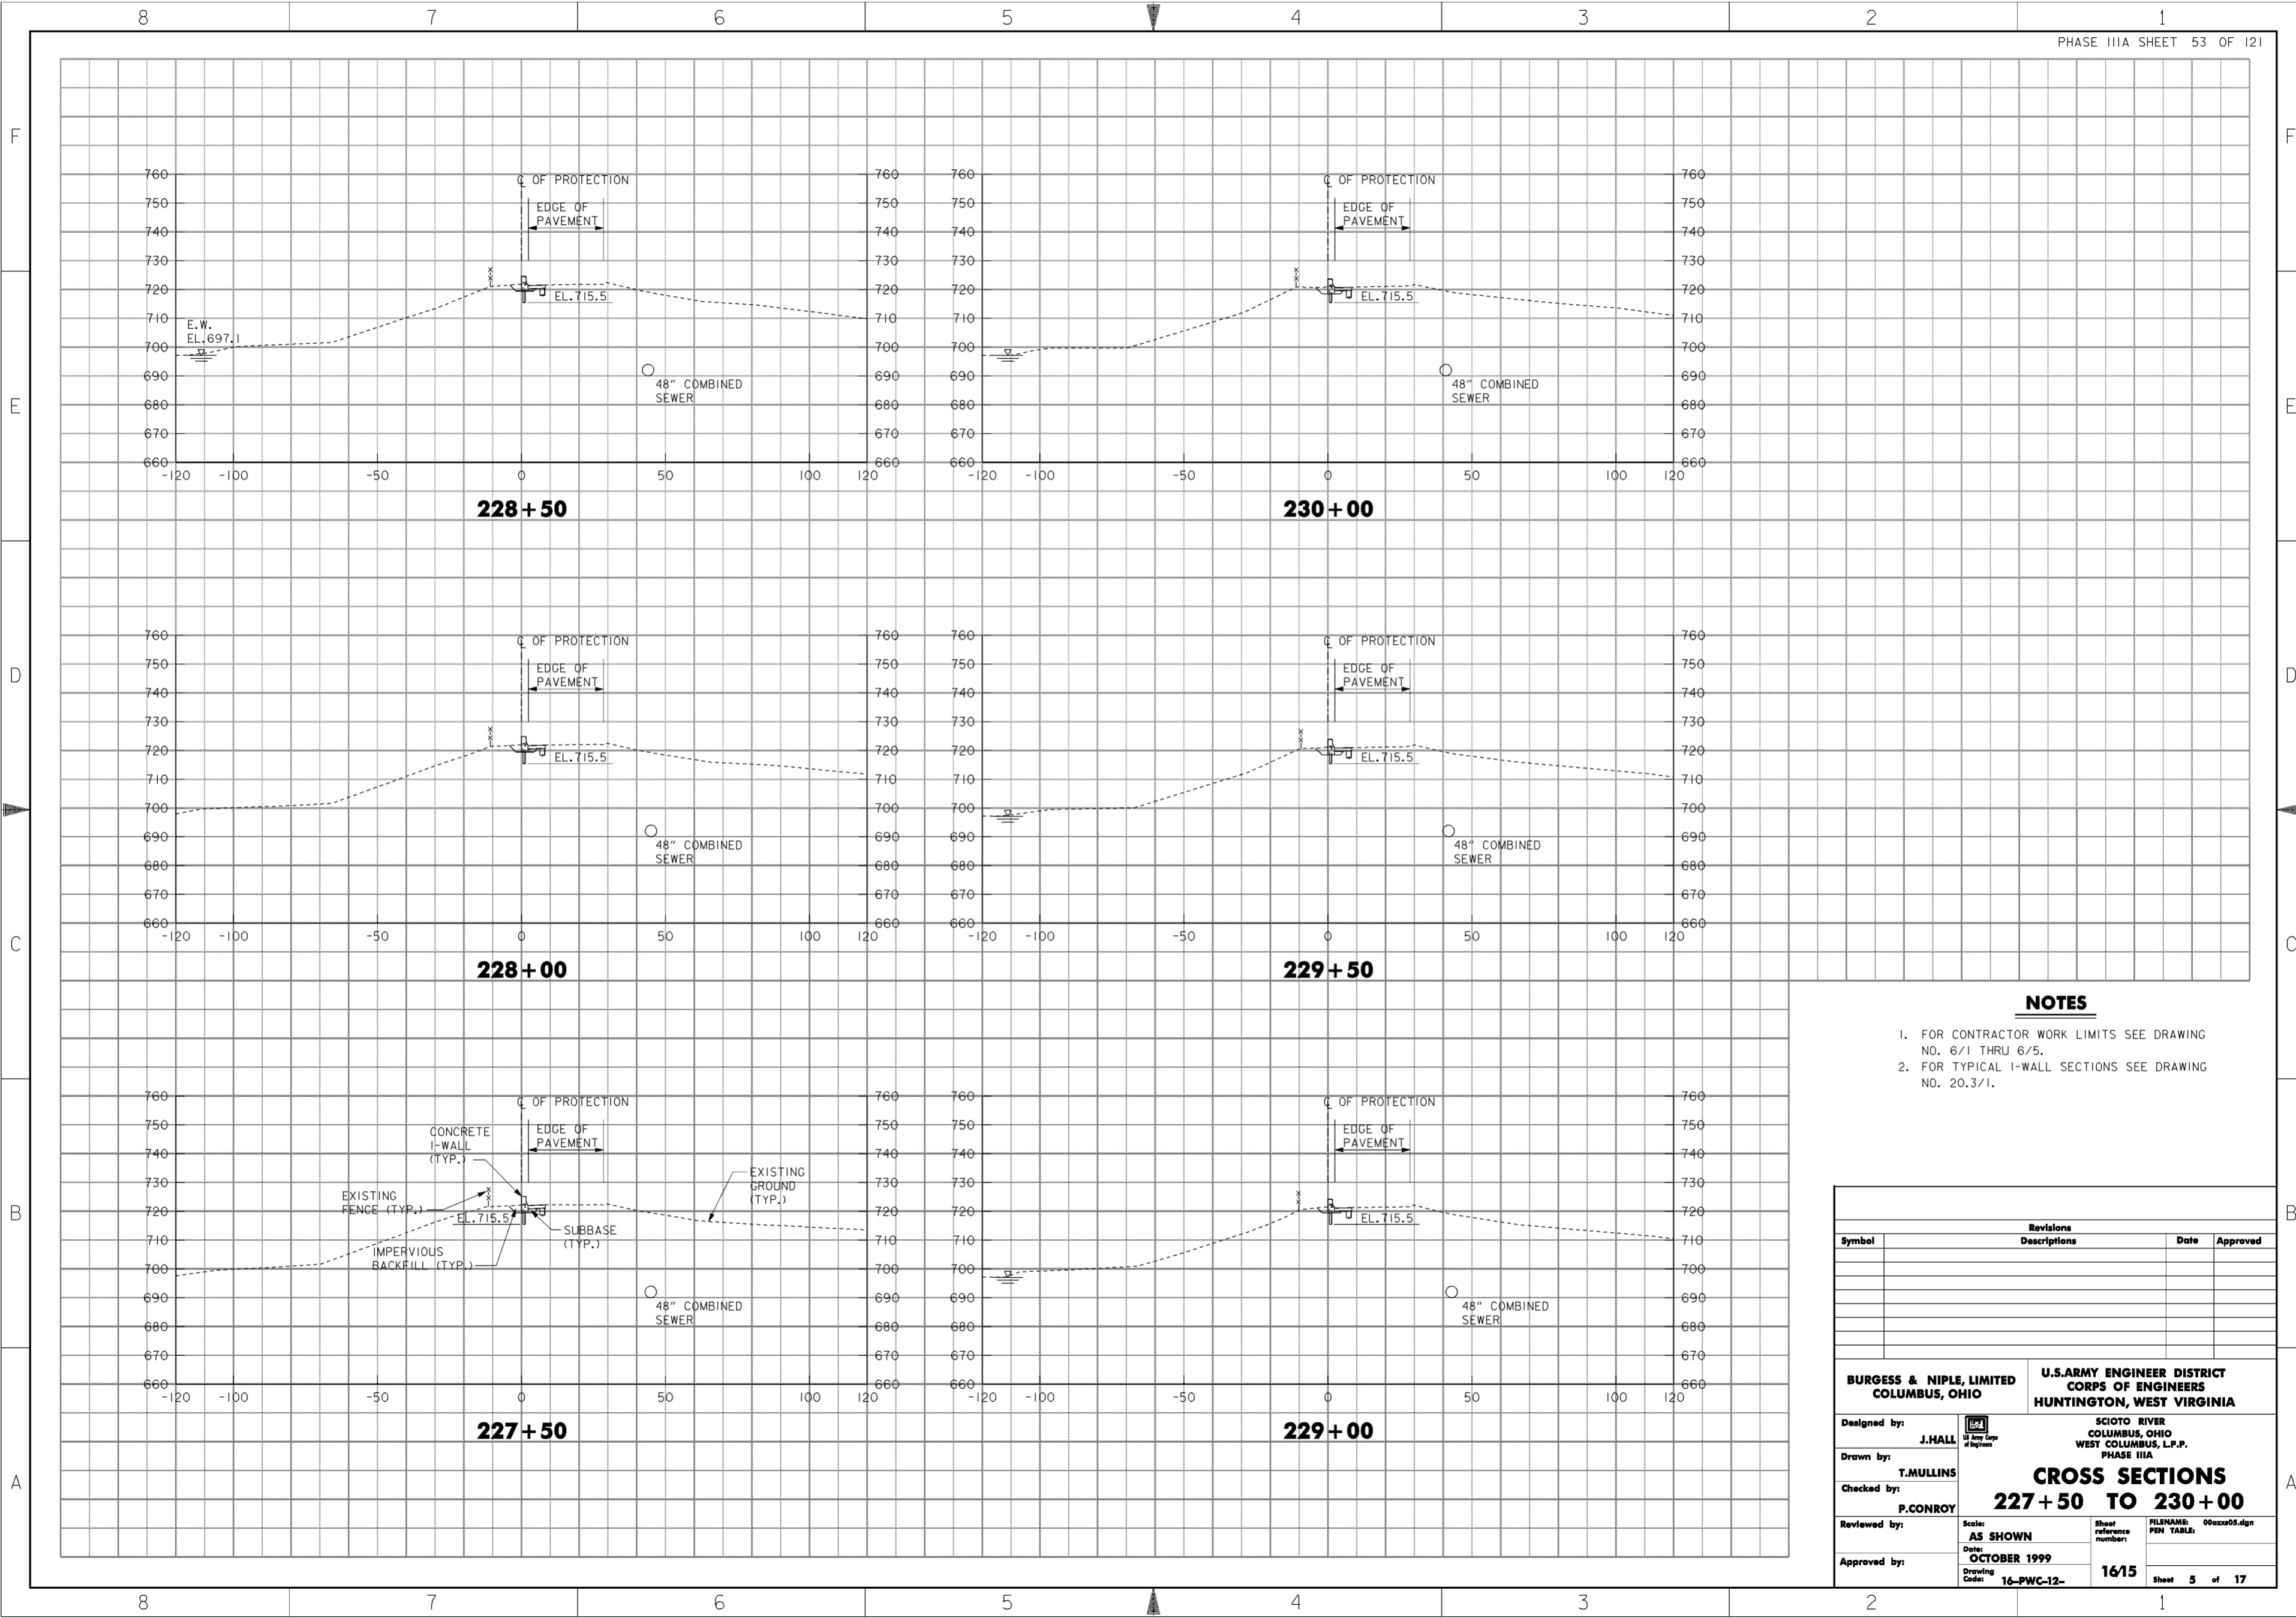

**NOTES**


1. FOR CONTRACTOR WORK LIMITS SEE DRAWING NO. 6/1 THRU 6/5.
2. FOR TYPICAL I-WALL SECTIONS SEE DRAWING NO. 20.3/1.

Revisions			
Symbol	Descriptions	Date	Approved

<b>BURGESS &amp; NIPLE, LIMITED</b> COLUMBUS, OHIO	<b>U.S. ARMY ENGINEER DISTRICT</b> CORPS OF ENGINEERS HUNTINGTON, WEST VIRGINIA	SCIOTO RIVER COLUMBUS, OHIO WEST COLUMBUS, L.P.P. PHASE IIIA		
		<b>CROSS SECTIONS</b> <b>227 + 50 TO 230 + 00</b>		
Designed by: <b>J. HALL</b>		Drawn by: <b>T. MULLINS</b>	FILENAME: 00axx05.dgn PEN TABLE:	
Checked by: <b>P. CONROY</b>				
Reviewed by:		Scale: <b>AS SHOWN</b>		Sheet reference number: <b>16/15</b>
Approved by:		Date: <b>OCTOBER 1999</b>		Drawing Code: <b>16-PWC-12-</b>



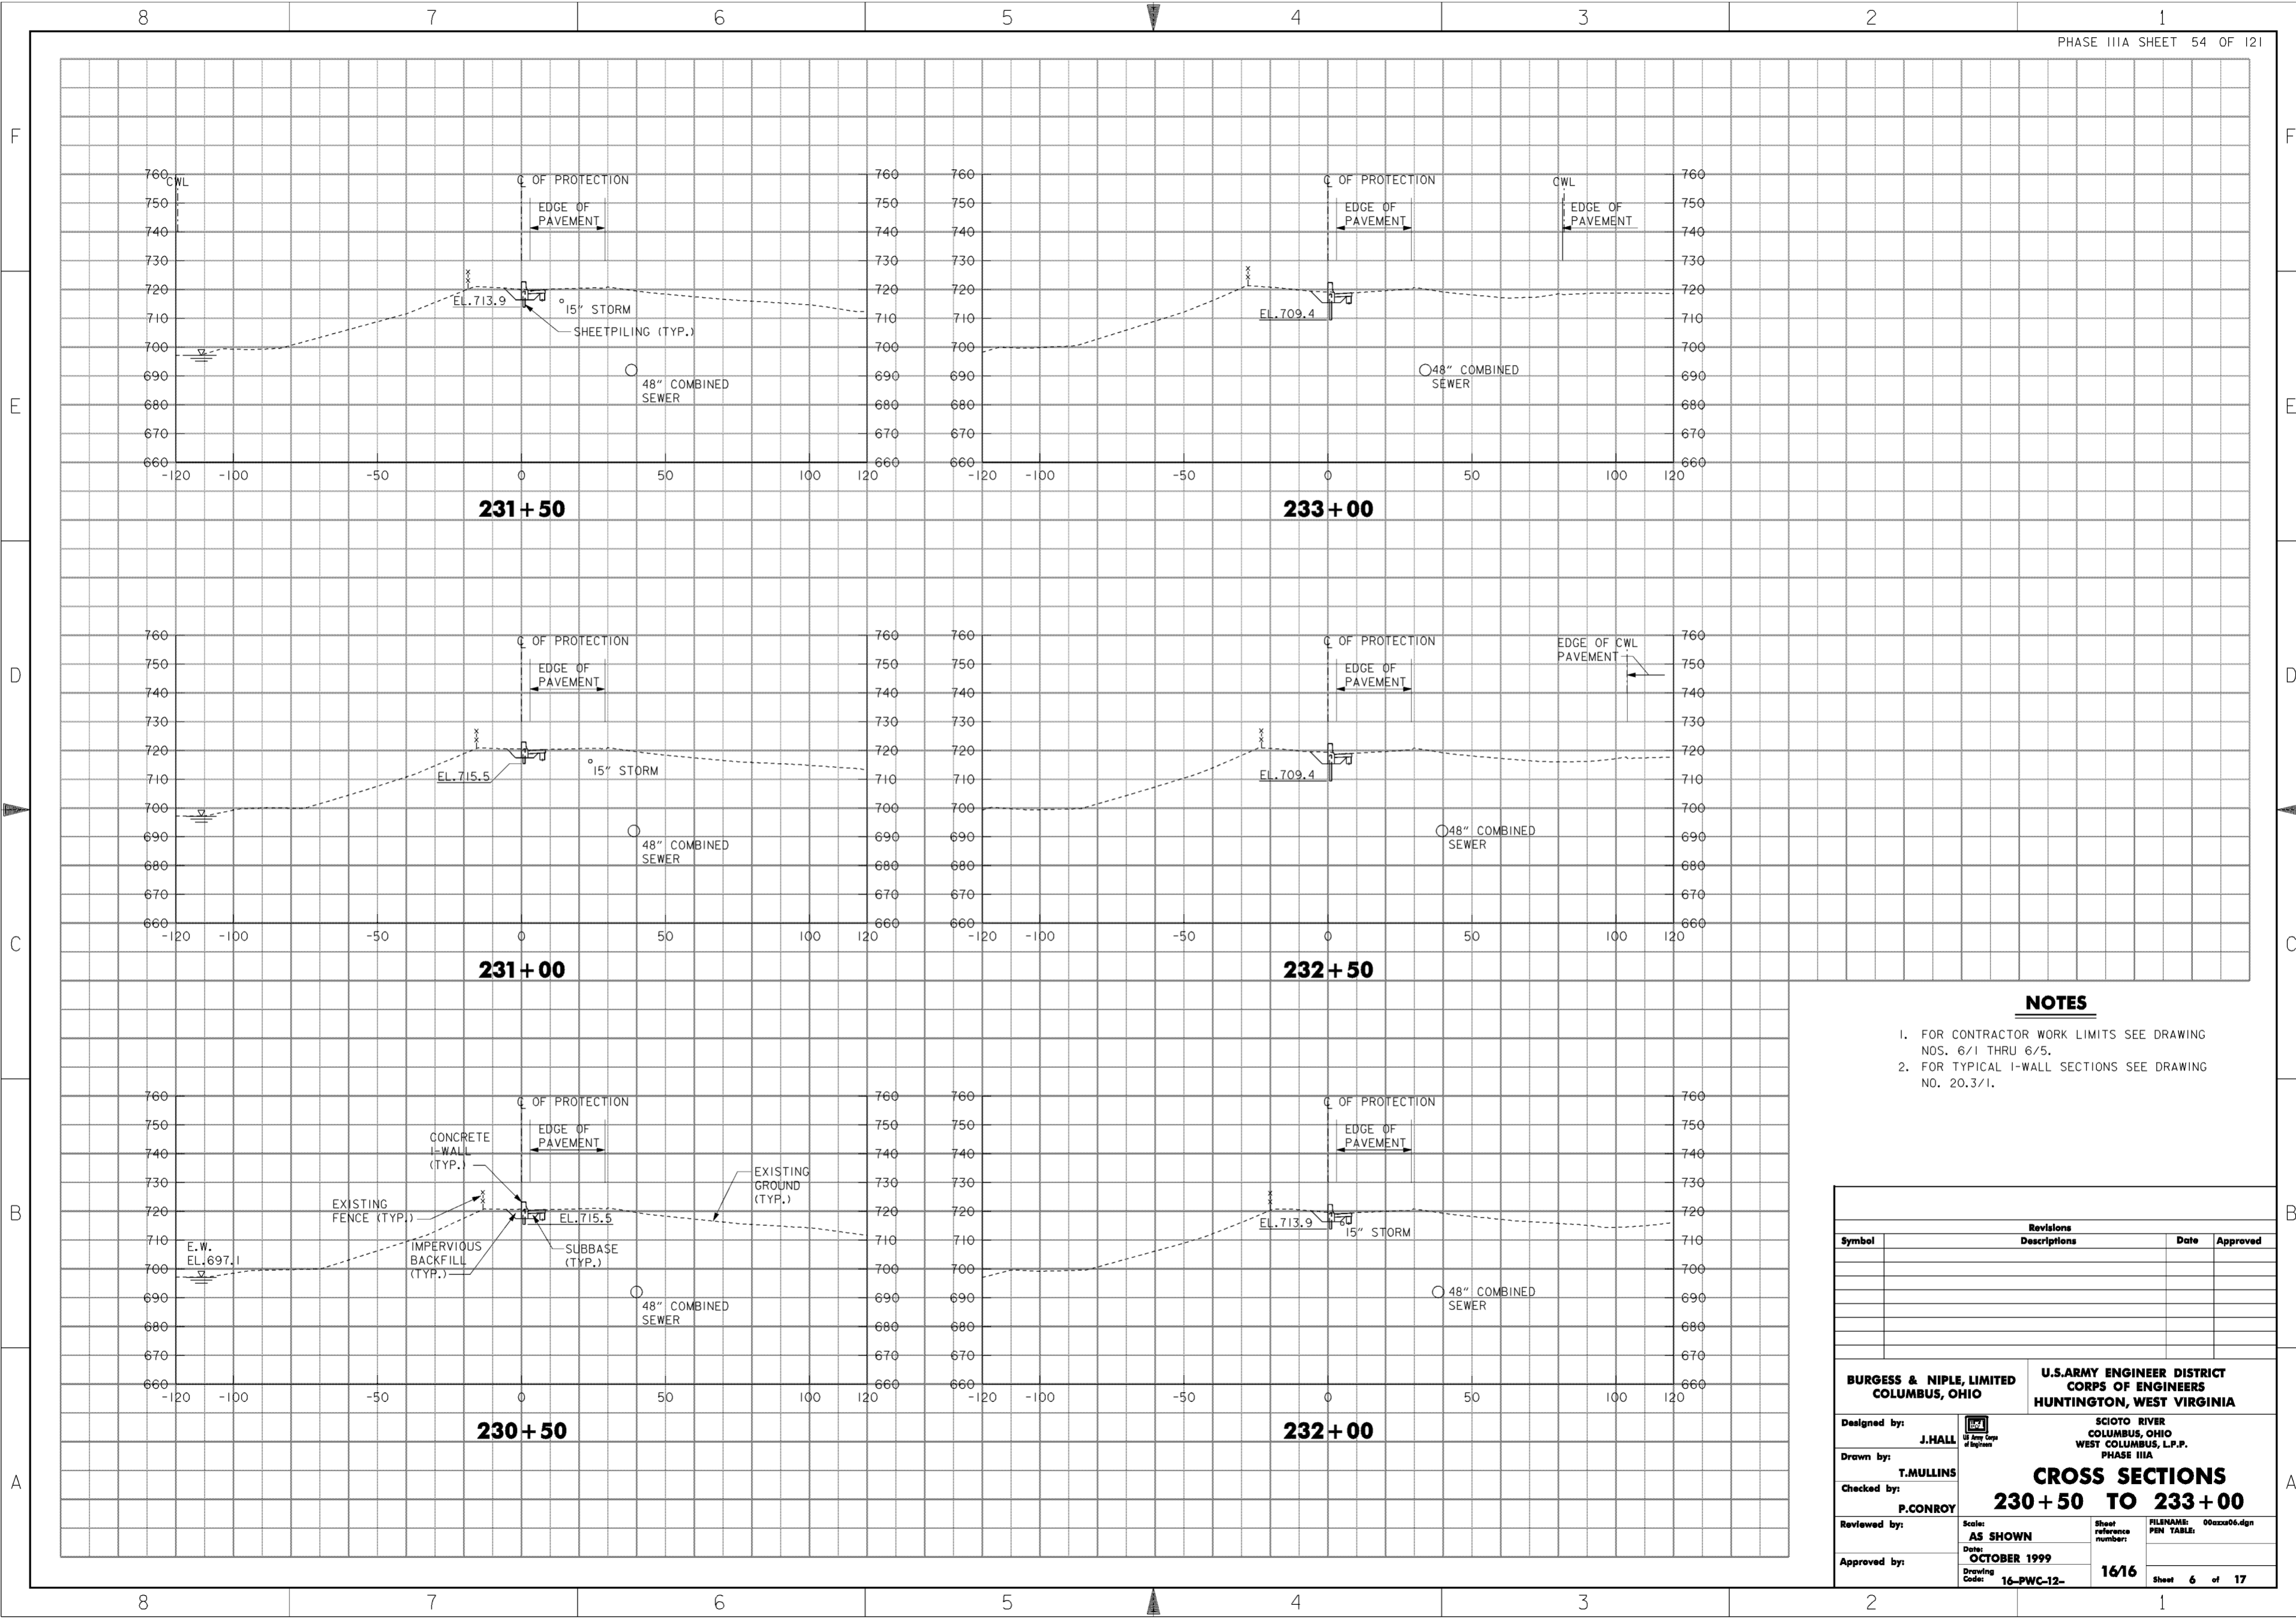


**NOTES**

1. FOR CONTRACTOR WORK LIMITS SEE DRAWING NOS. 6/1 THRU 6/5.
2. FOR TYPICAL I-WALL SECTIONS SEE DRAWING NO. 20.3/1.

Revisions			
Symbol	Descriptions	Date	Approved

<b>BURGESS &amp; NIPLE, LIMITED</b> COLUMBUS, OHIO	<b>U.S. ARMY ENGINEER DISTRICT</b> CORPS OF ENGINEERS HUNTINGTON, WEST VIRGINIA		
		SCIOTO RIVER COLUMBUS, OHIO WEST COLUMBUS, L.P.P. PHASE IIIA	
Designed by: <b>J. HALL</b>	<b>CROSS SECTIONS</b> <b>230 + 50 TO 233 + 00</b>		
Drawn by: <b>T. MULLINS</b>			
Checked by: <b>P. CONROY</b>			
Reviewed by:			
Approved by:	Scale: <b>AS SHOWN</b>	Sheet reference number: <b>16/16</b>	FILENAME: 00axxx06.dgn
Date: <b>OCTOBER 1999</b>	Drawing Code: <b>16-PWC-12-</b>	Sheet <b>6</b> of <b>17</b>	

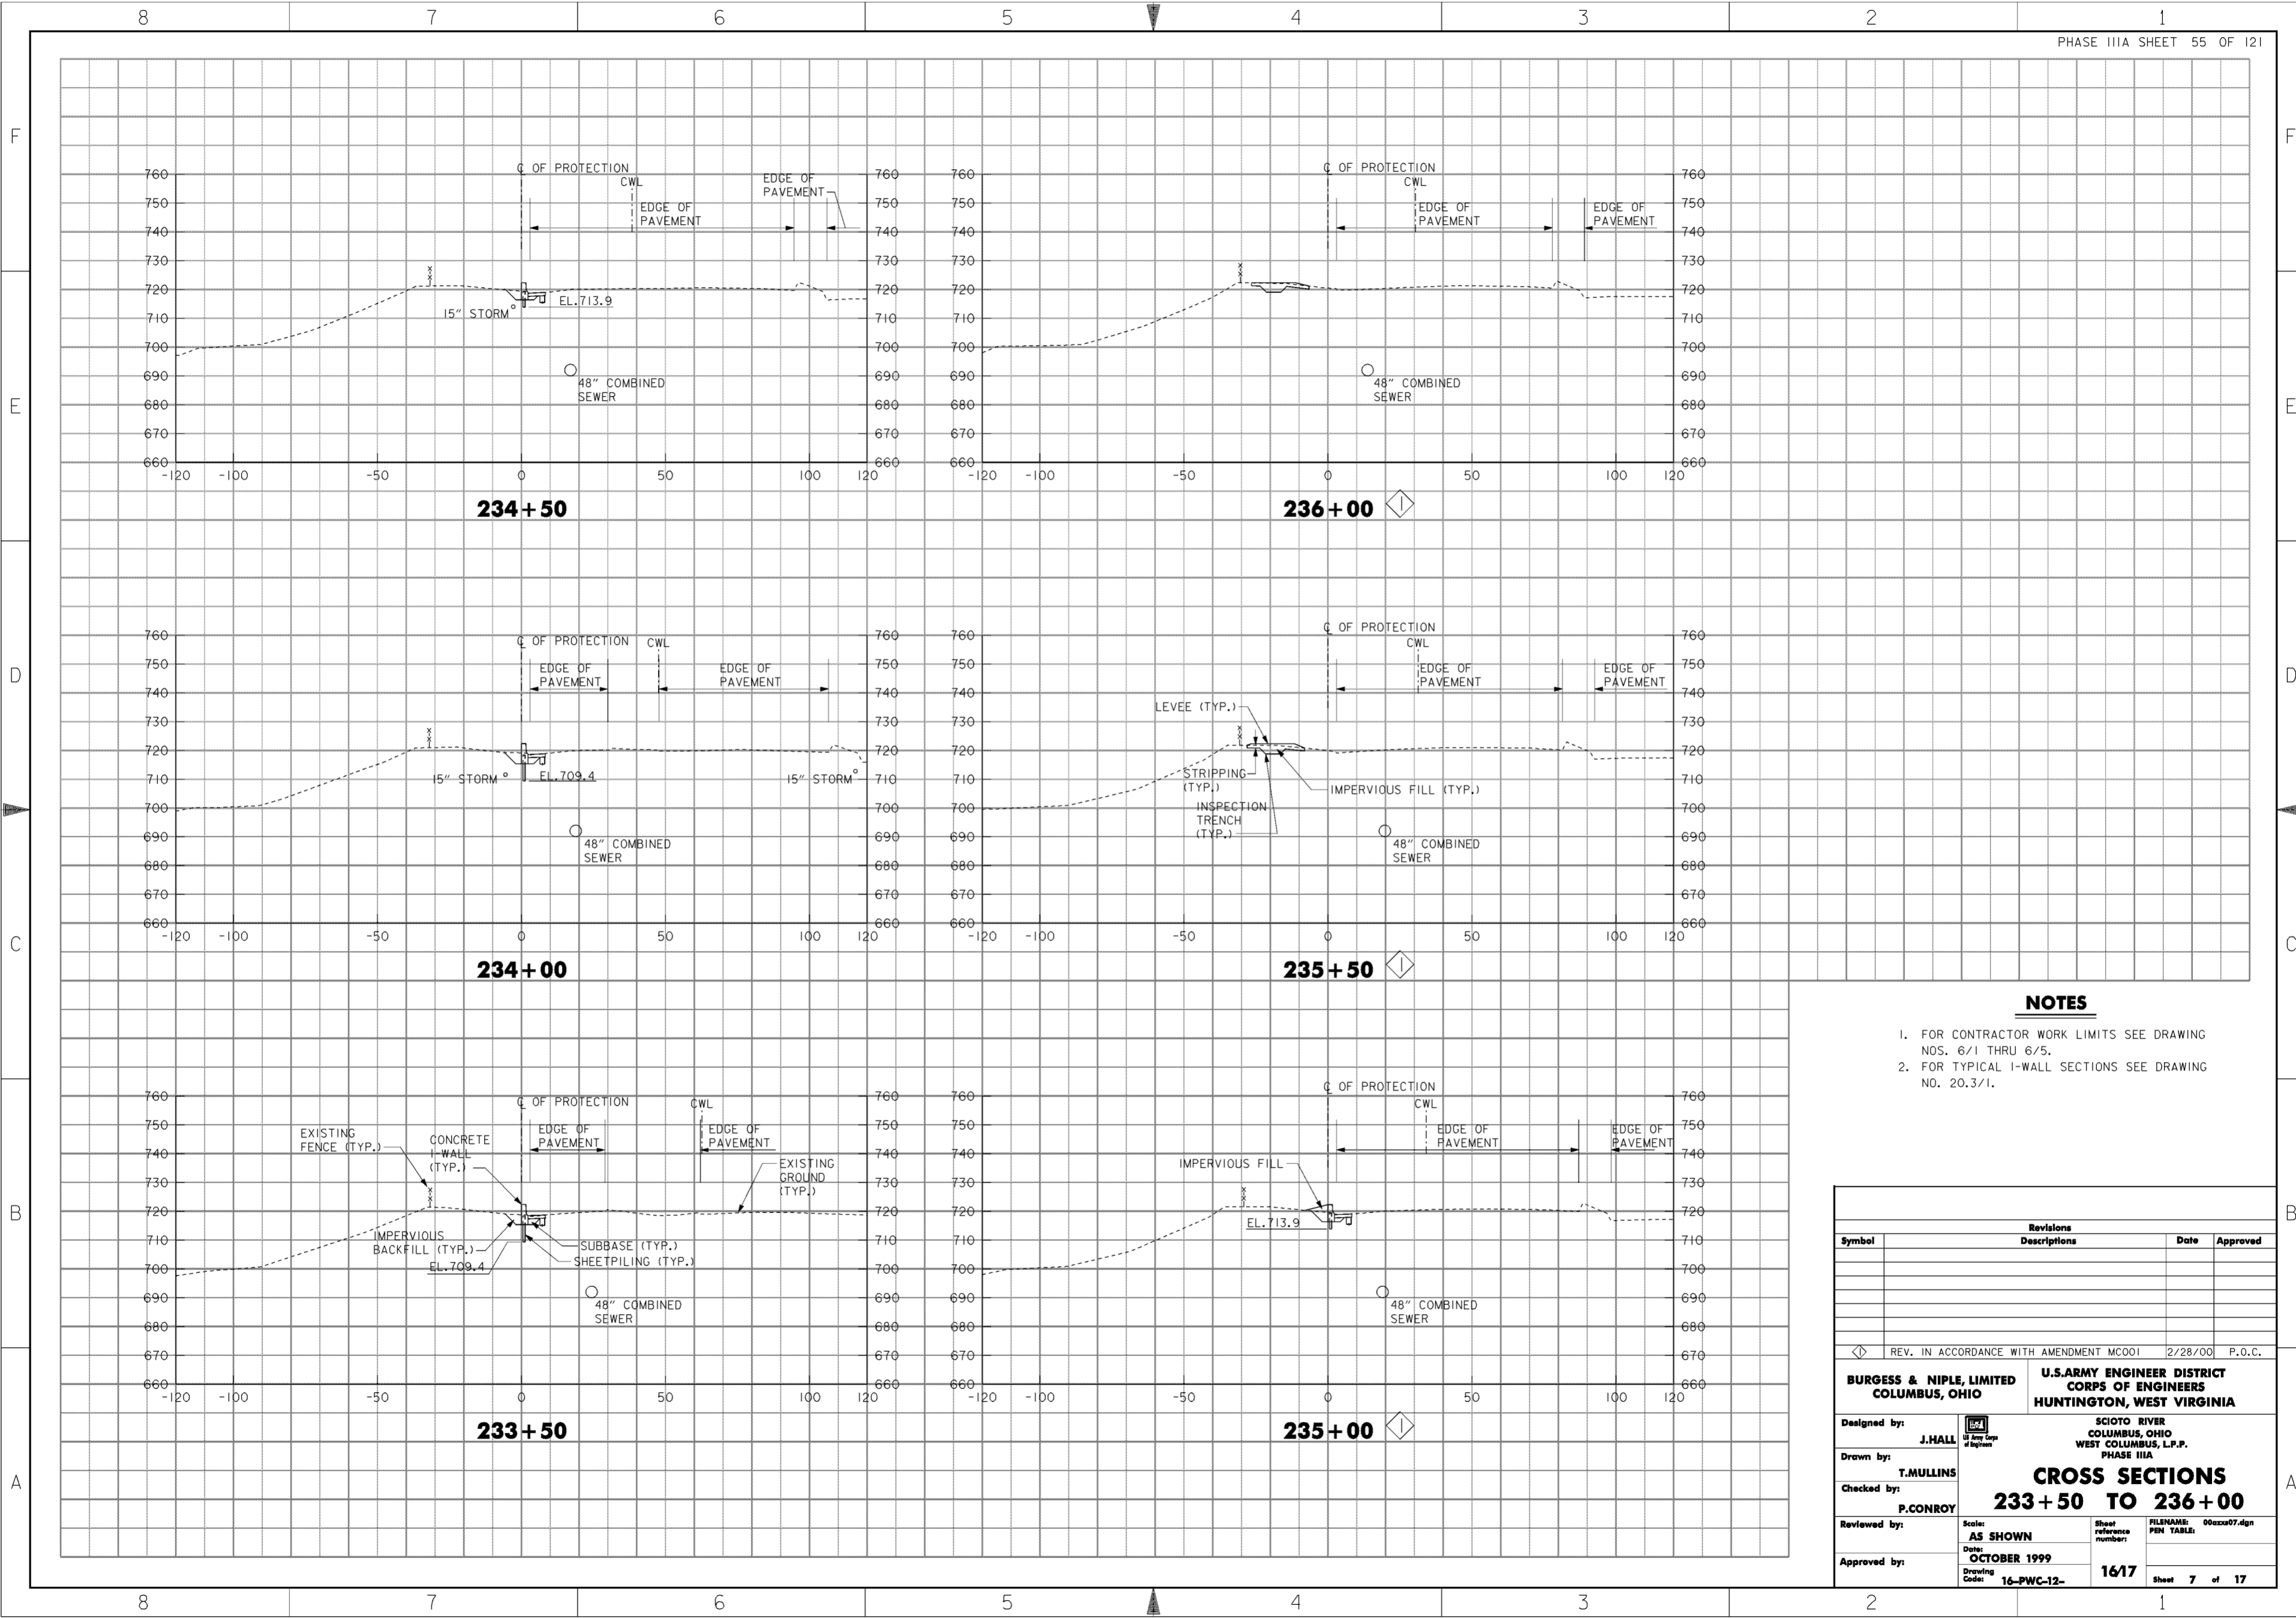

**NOTES**

1. FOR CONTRACTOR WORK LIMITS SEE DRAWING NOS. 6/1 THRU 6/5.
2. FOR TYPICAL I-WALL SECTIONS SEE DRAWING NO. 20.3/1.

Revisions			
Symbol	Descriptions	Date	Approved
◊	REV. IN ACCORDANCE WITH AMENDMENT MC001	2/28/00	P.O.C.


  

<b>BURGESS &amp; NIPL, LIMITED</b> COLUMBUS, OHIO	<b>U.S. ARMY ENGINEER DISTRICT</b> CORPS OF ENGINEERS HUNTINGTON, WEST VIRGINIA
Designed by: <b>J. HALL</b>	SCIO TO RIVER COLUMBUS, OHIO WEST COLUMBUS, L.P.P. PHASE IIIA
Drawn by: <b>T. MULLINS</b>	<b>CROSS SECTIONS</b> <b>233 + 50 TO 236 + 00</b>
Checked by: <b>P. CONROY</b>	Scale: <b>AS SHOWN</b>
Reviewed by:	Date: <b>OCTOBER 1999</b>
Approved by:	Drawing Code: <b>16-PWC-12-</b>
	Sheet reference number: <b>16/17</b>
	FILENAME: 00axx07.dgn
	PIN TABLE:
	Sheet <b>7</b> of <b>17</b>

**WORK AS CONSTRUCTED**





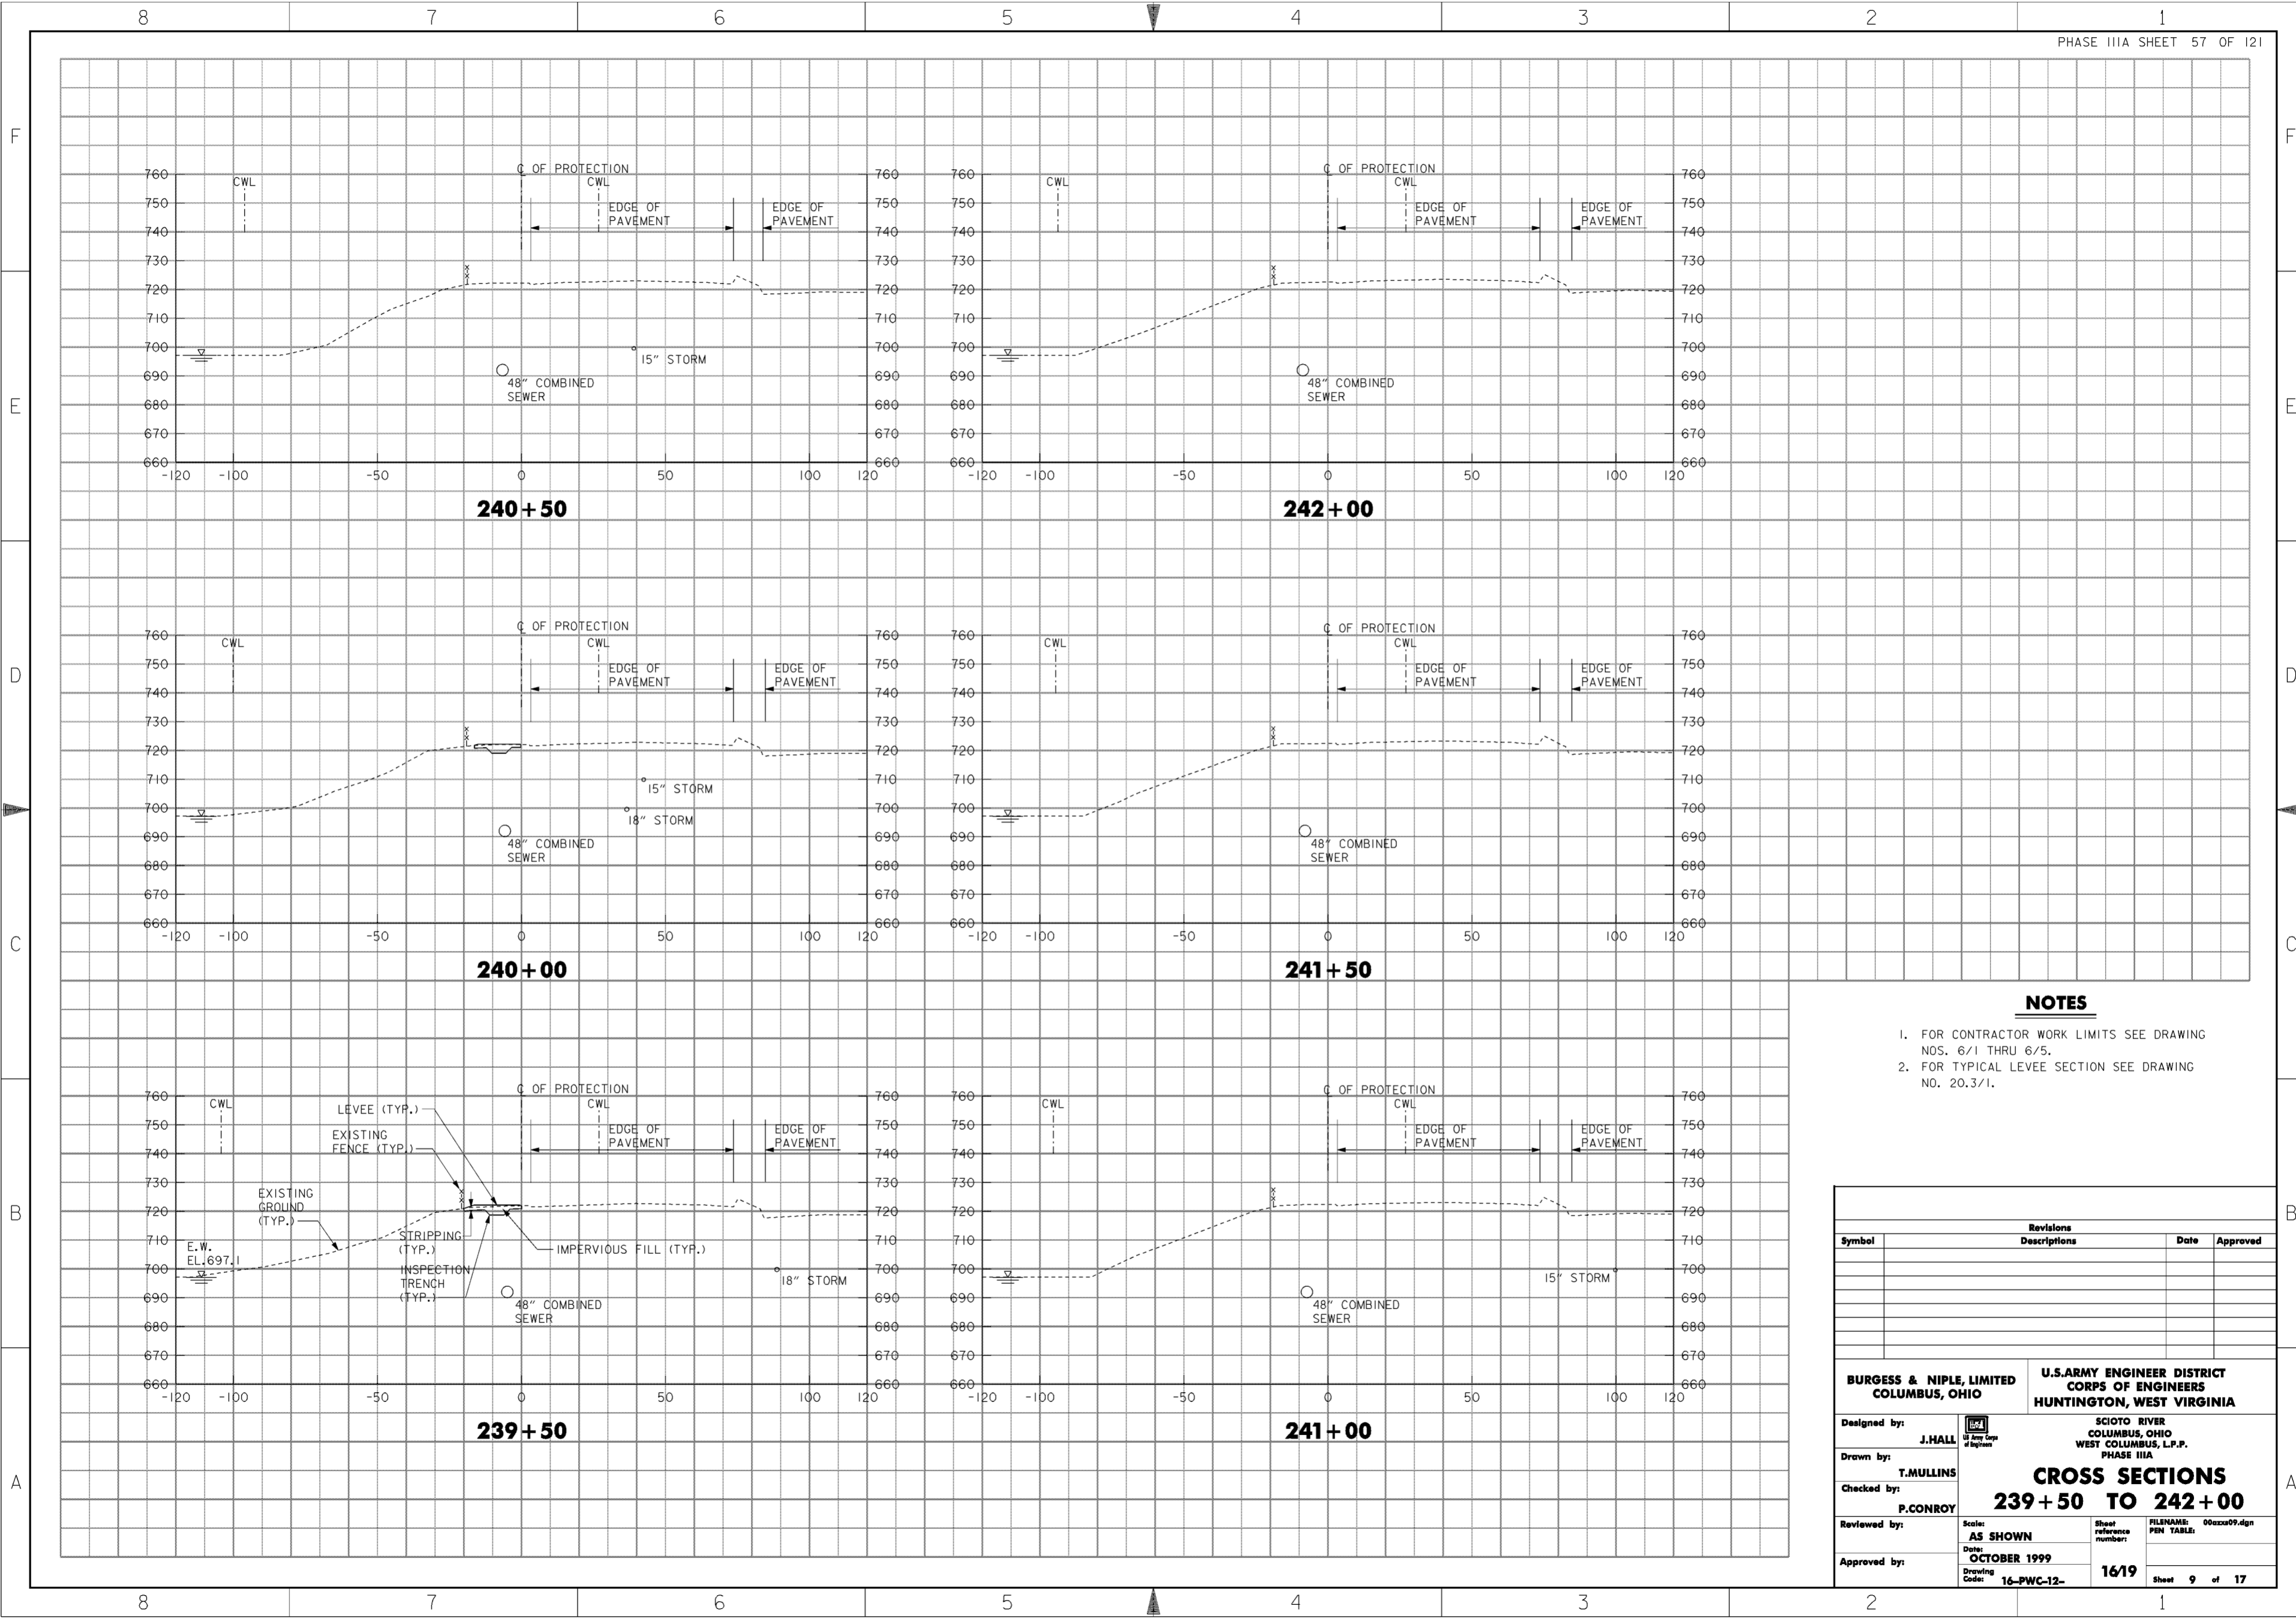

**NOTES**

1. FOR CONTRACTOR WORK LIMITS SEE DRAWING NOS. 6/1 THRU 6/5.
2. FOR TYPICAL LEVEE SECTION SEE DRAWING NO. 20.3/1.

Revisions			
Symbol	Descriptions	Date	Approved


  

<p><b>BURGESS &amp; NIPLE, LIMITED</b> COLUMBUS, OHIO</p> <p>Designed by: <b>J.HALL</b></p> <p>Drawn by: <b>T.MULLINS</b></p> <p>Checked by: <b>P.CONROY</b></p> <p>Reviewed by:</p> <p>Approved by:</p>	<p style="text-align: center;"><b>U.S.ARMAY ENGINEER DISTRICT</b> <b>CORPS OF ENGINEERS</b> HUNTINGTON, WEST VIRGINIA</p> <p style="text-align: center;">SCIOTO RIVER COLUMBUS, OHIO WEST COLUMBUS, L.P.P. PHASE IIIA</p> <p style="text-align: center;"><b>CROSS SECTIONS</b> <b>239 + 50 TO 242 + 00</b></p> <p>Scale: <b>AS SHOWN</b></p> <p>Date: <b>OCTOBER 1999</b></p> <p>Drawing Code: <b>16-PWC-12-</b></p>
--	--

<p>Sheet reference number: <b>1619</b></p>	<p>FILENAME: 00axx09.dgn</p> <p>PEN TABLE:</p> <p>Sheet <b>9</b> of <b>17</b></p>
--	---

**WORK AS CONSTRUCTED**

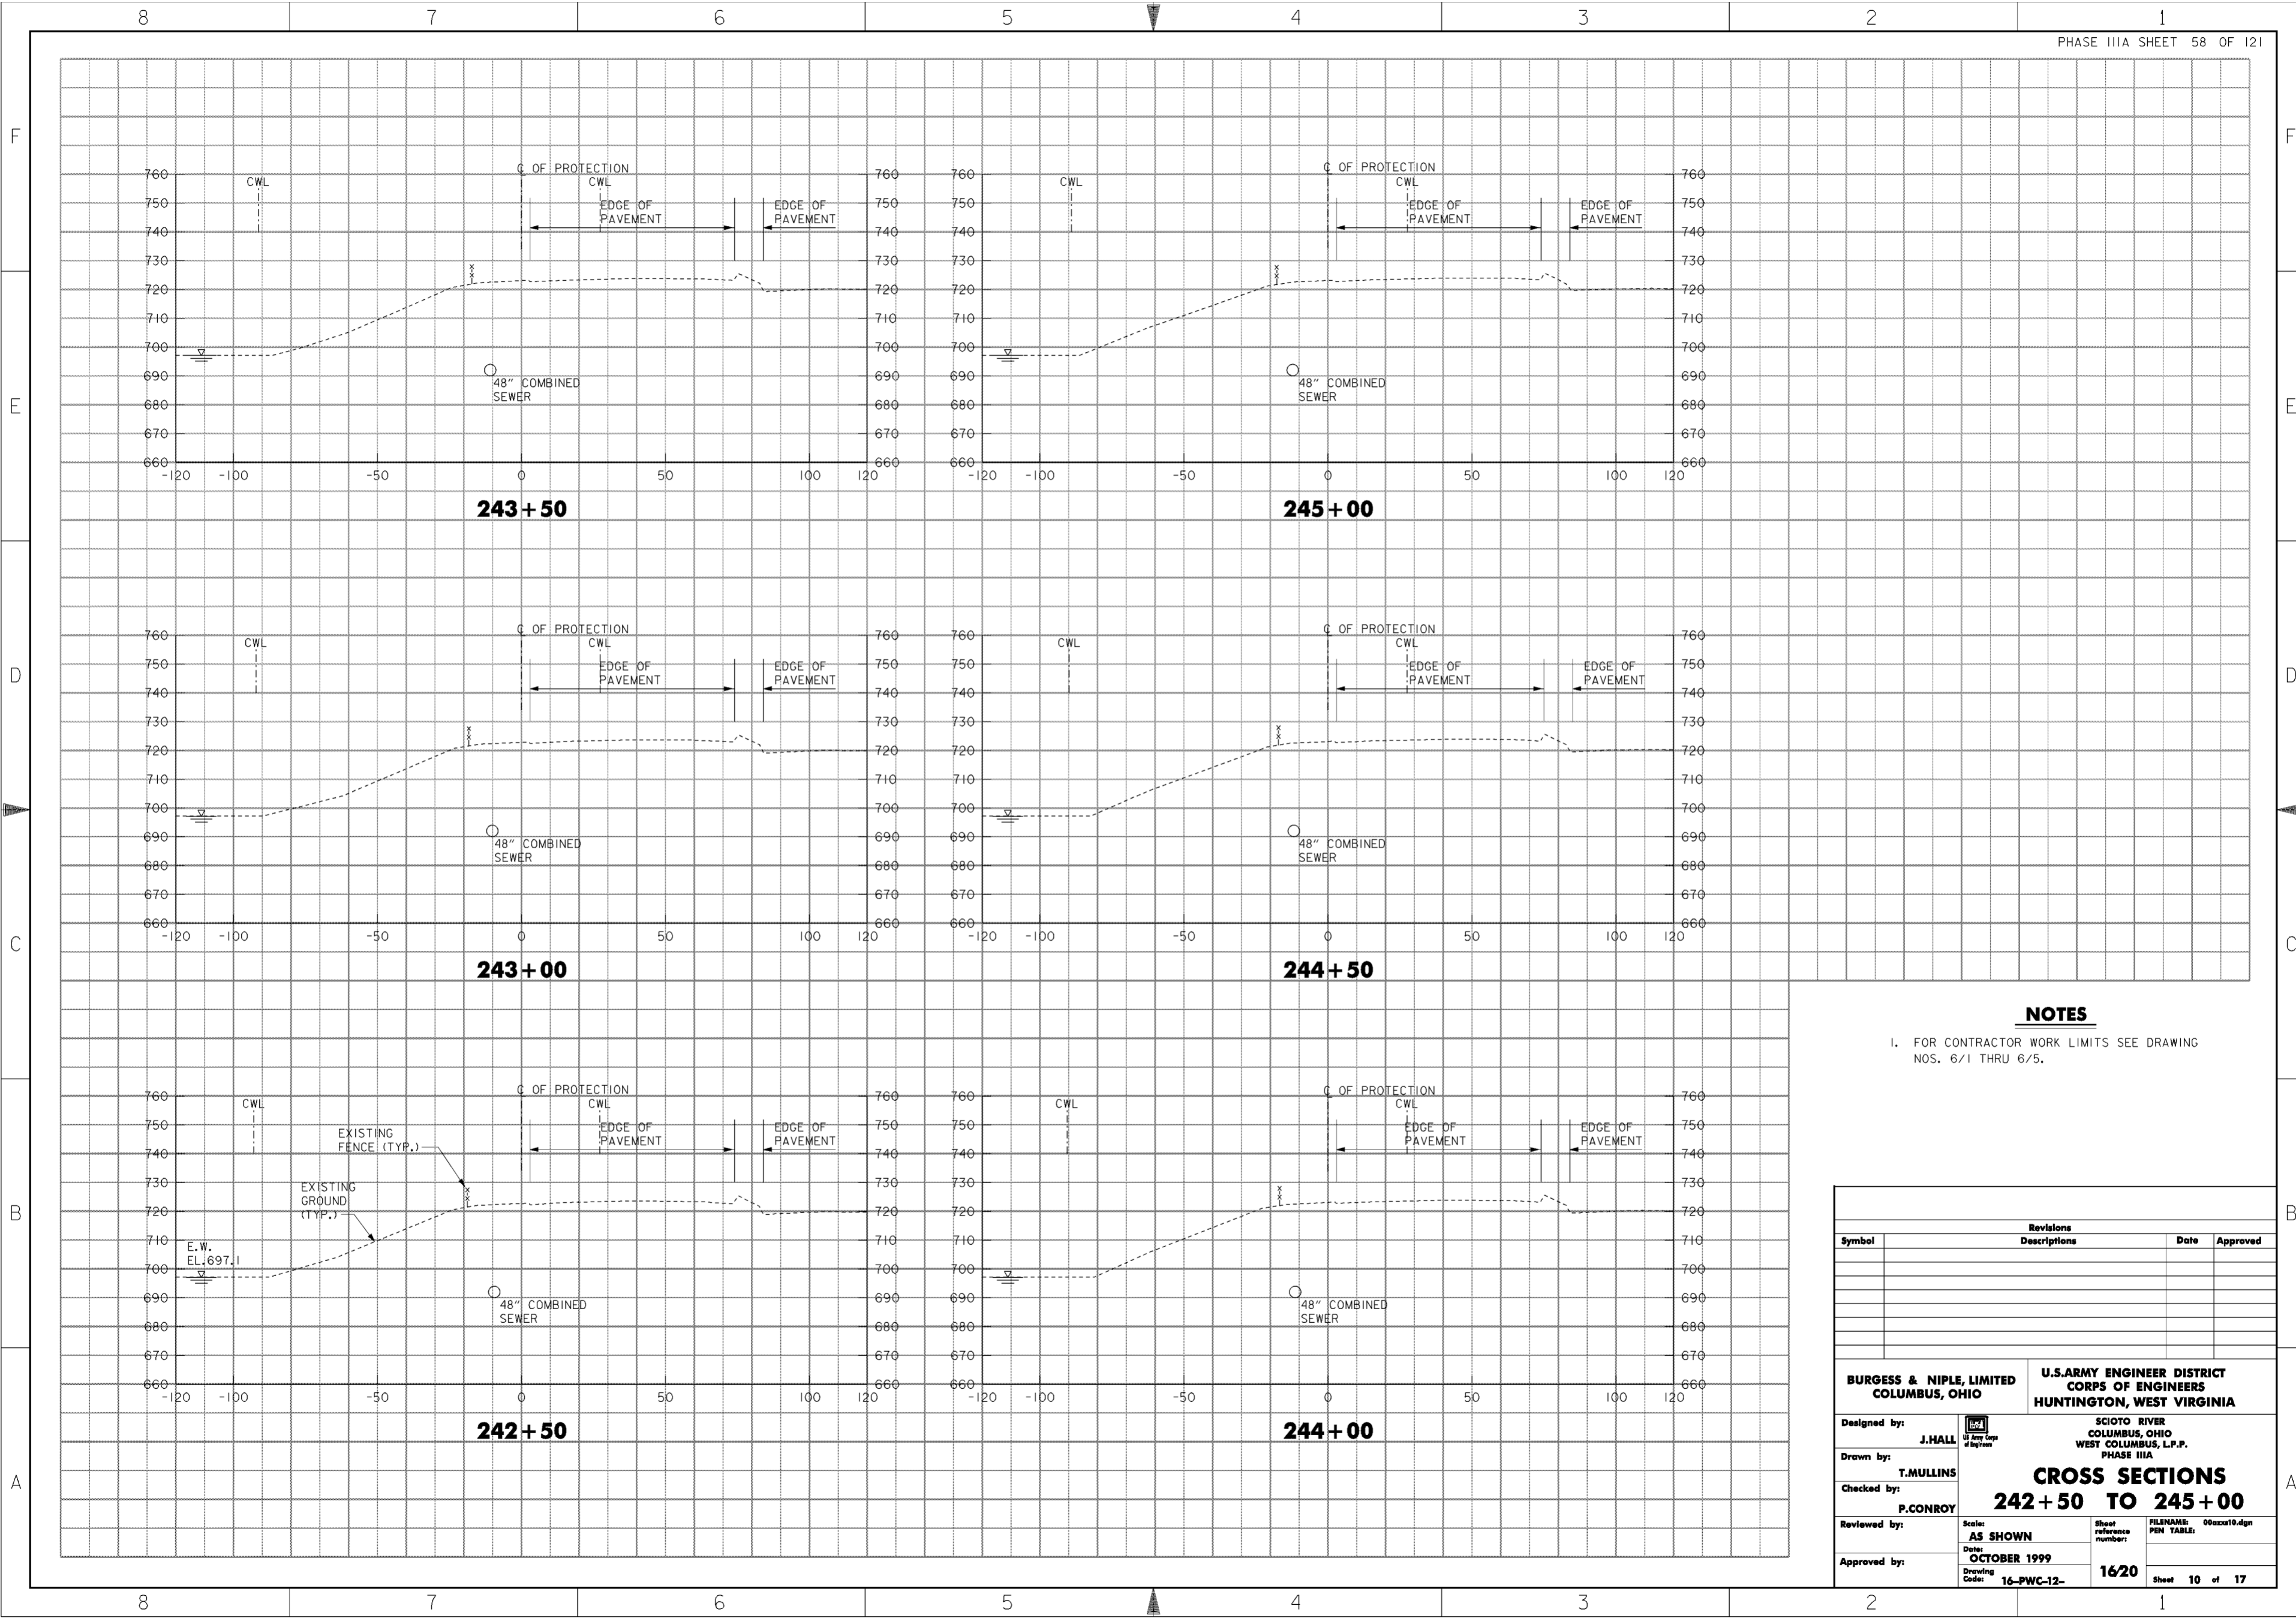

**NOTES**


1. FOR CONTRACTOR WORK LIMITS SEE DRAWING NOS. 6/1 THRU 6/5.

Revisions			
Symbol	Descriptions	Date	Approved

<b>BURGESS &amp; NIPLE, LIMITED</b> COLUMBUS, OHIO	<b>U.S. ARMY ENGINEER DISTRICT</b> CORPS OF ENGINEERS HUNTINGTON, WEST VIRGINIA	SCIOTO RIVER COLUMBUS, OHIO WEST COLUMBUS, L.P.P. PHASE IIIA	
		<b>CROSS SECTIONS</b> <b>242 + 50 TO 245 + 00</b>	
Designed by: <b>J. HALL</b>	Drawn by: <b>T. MULLINS</b>	Checked by: <b>P. CONROY</b>	Reviewed by: Scale: <b>AS SHOWN</b>
Approved by:	Date: <b>OCTOBER 1999</b>	Drawing Code: <b>16-PWC-12-</b>	Sheet reference number: <b>1620</b>
FILENAME: 00axx10.dgn		PEN TABLE:	
Sheet 10 of 17		WORK AS CONSTRUCTED	



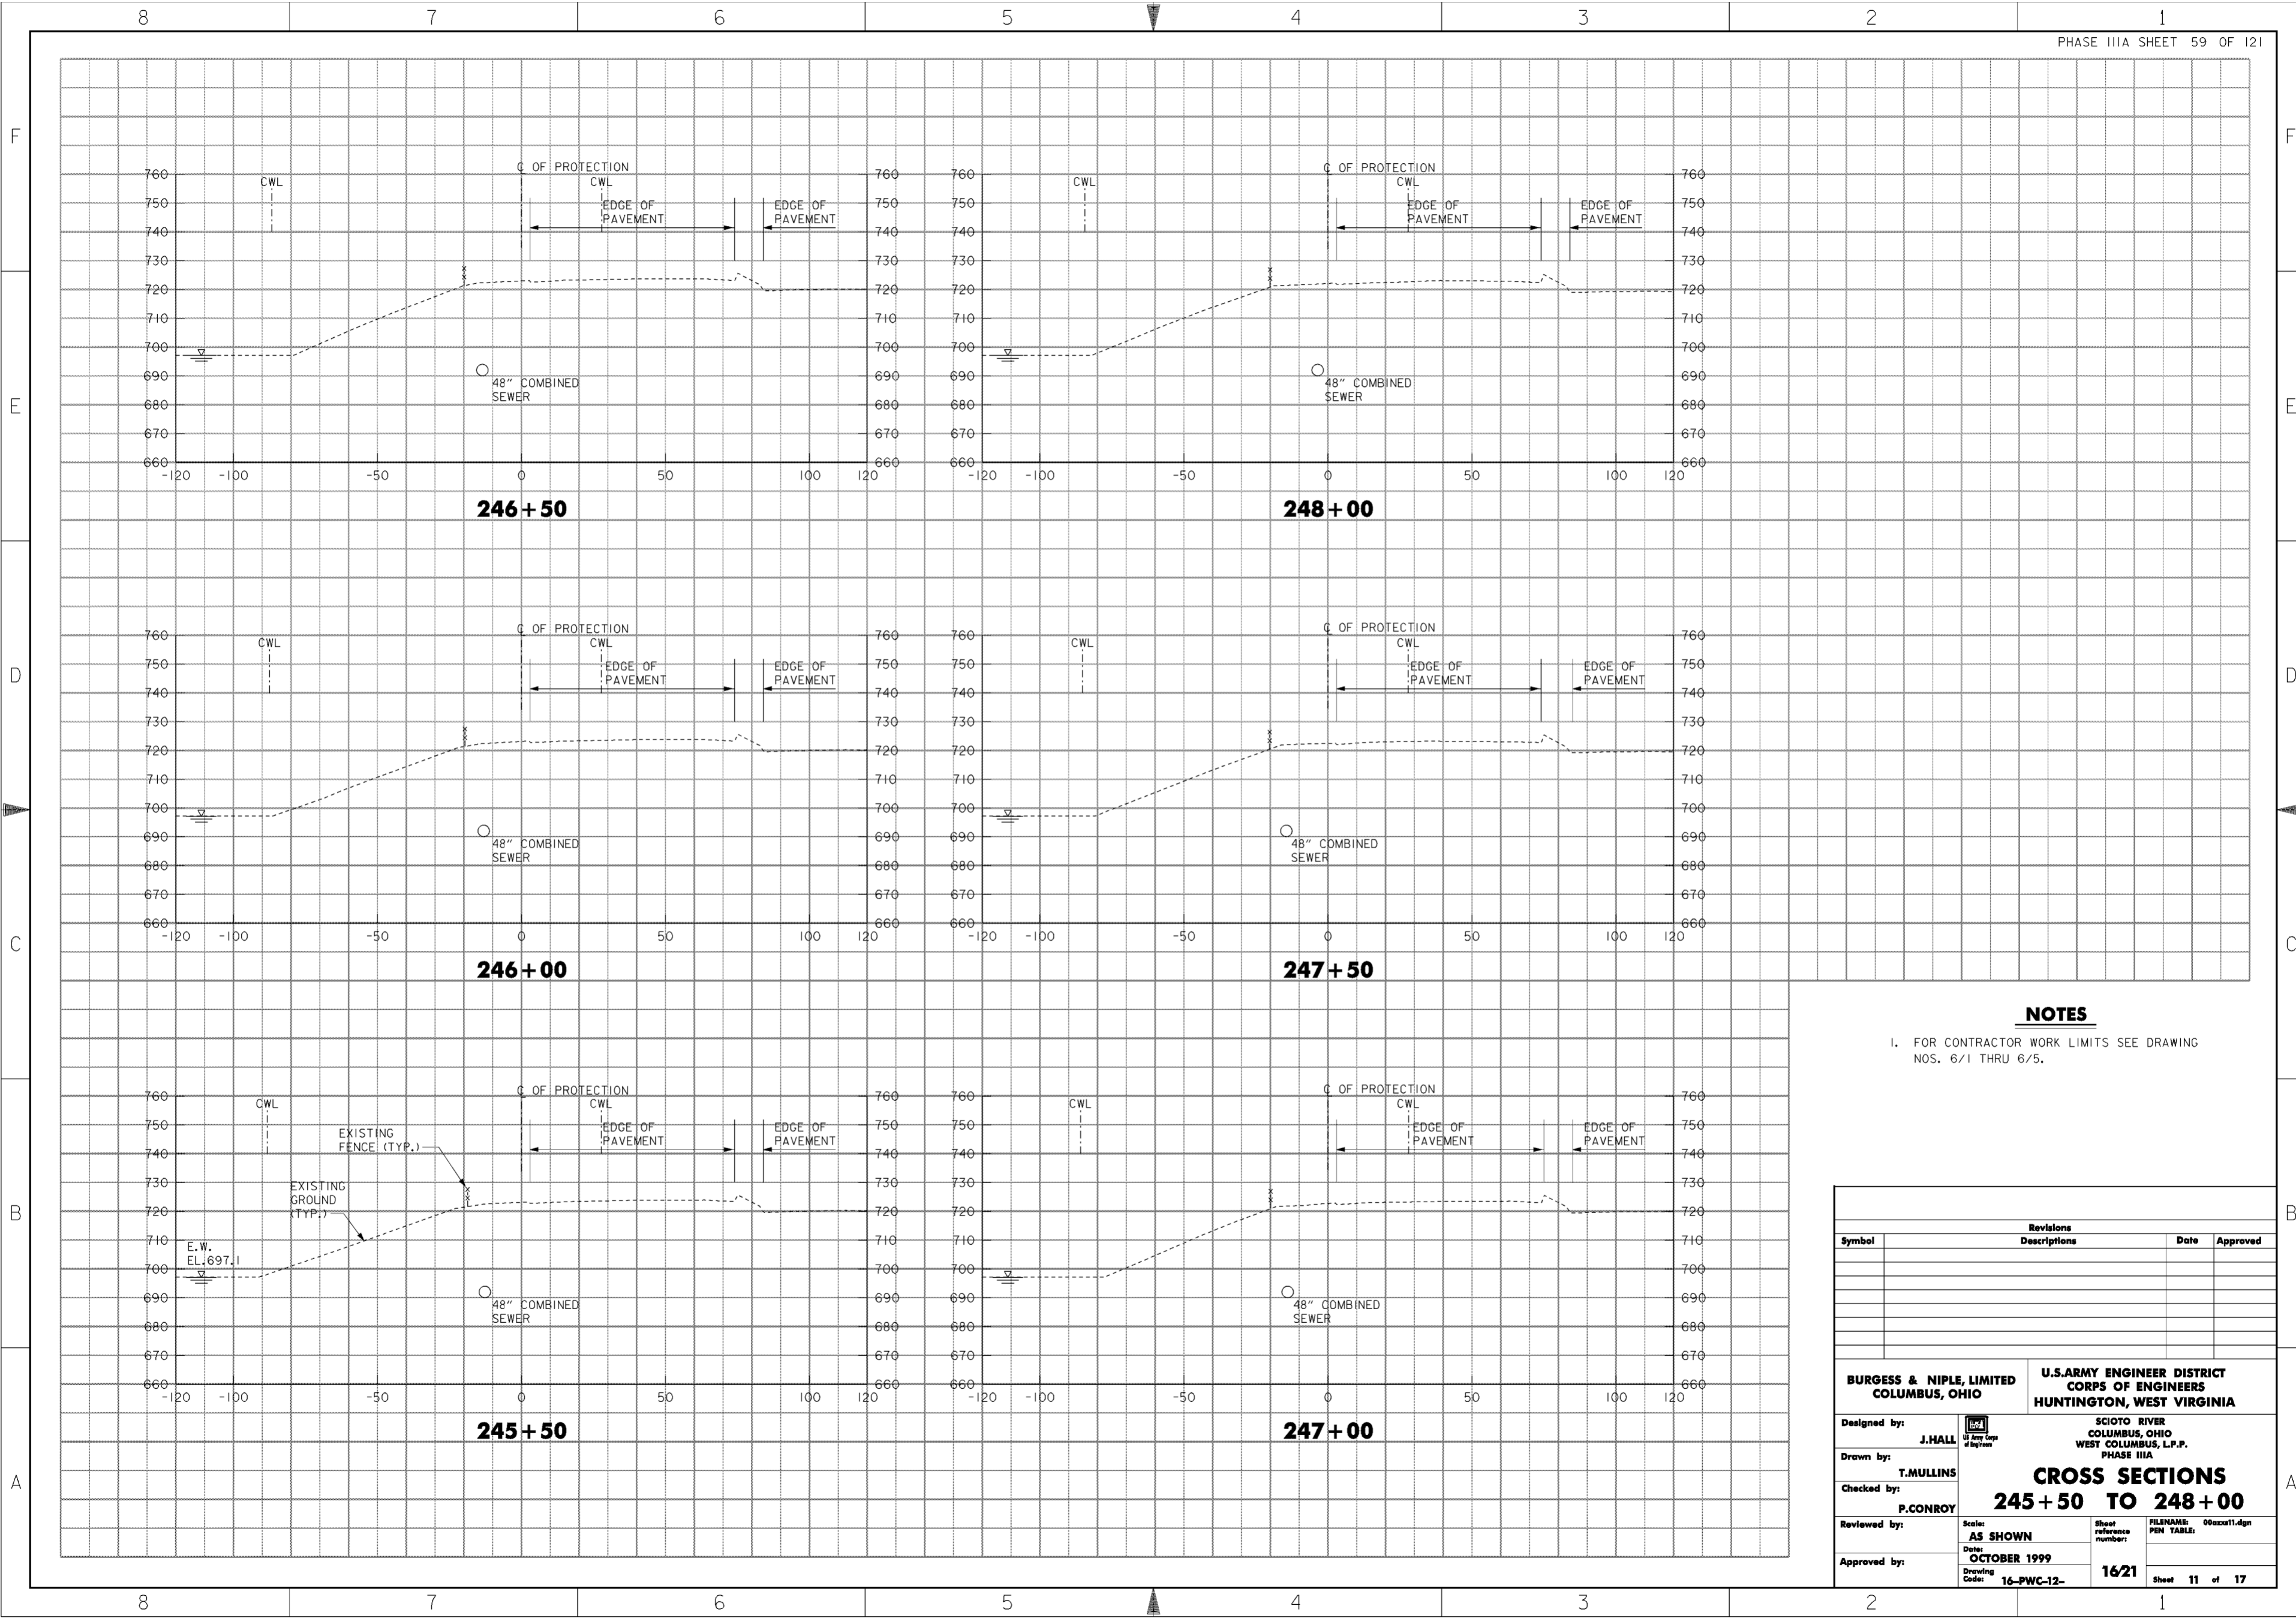

**NOTES**


1. FOR CONTRACTOR WORK LIMITS SEE DRAWING NOS. 6/1 THRU 6/5.

Revisions			
Symbol	Descriptions	Date	Approved

<b>BURGESS &amp; NIPLE, LIMITED</b> COLUMBUS, OHIO	<b>U.S. ARMY ENGINEER DISTRICT</b> CORPS OF ENGINEERS HUNTINGTON, WEST VIRGINIA	SCIOTO RIVER COLUMBUS, OHIO WEST COLUMBUS, L.P.P. PHASE IIIA		
		<b>CROSS SECTIONS</b> <b>245 + 50 TO 248 + 00</b>		
Designed by: <b>J. HALL</b>		Drawn by: <b>T. MULLINS</b>	FILENAME: 00axx11.dgn PEN TABLE:	
Checked by: <b>P. CONROY</b>		Reviewed by:		
Approved by:		Scale: <b>AS SHOWN</b>		Sheet reference number: <b>16/21</b>
Date: <b>OCTOBER 1999</b>		Drawing Code: <b>16-PWC-12-</b>		Sheet <b>11</b> of <b>17</b>

**WORK AS CONSTRUCTED**

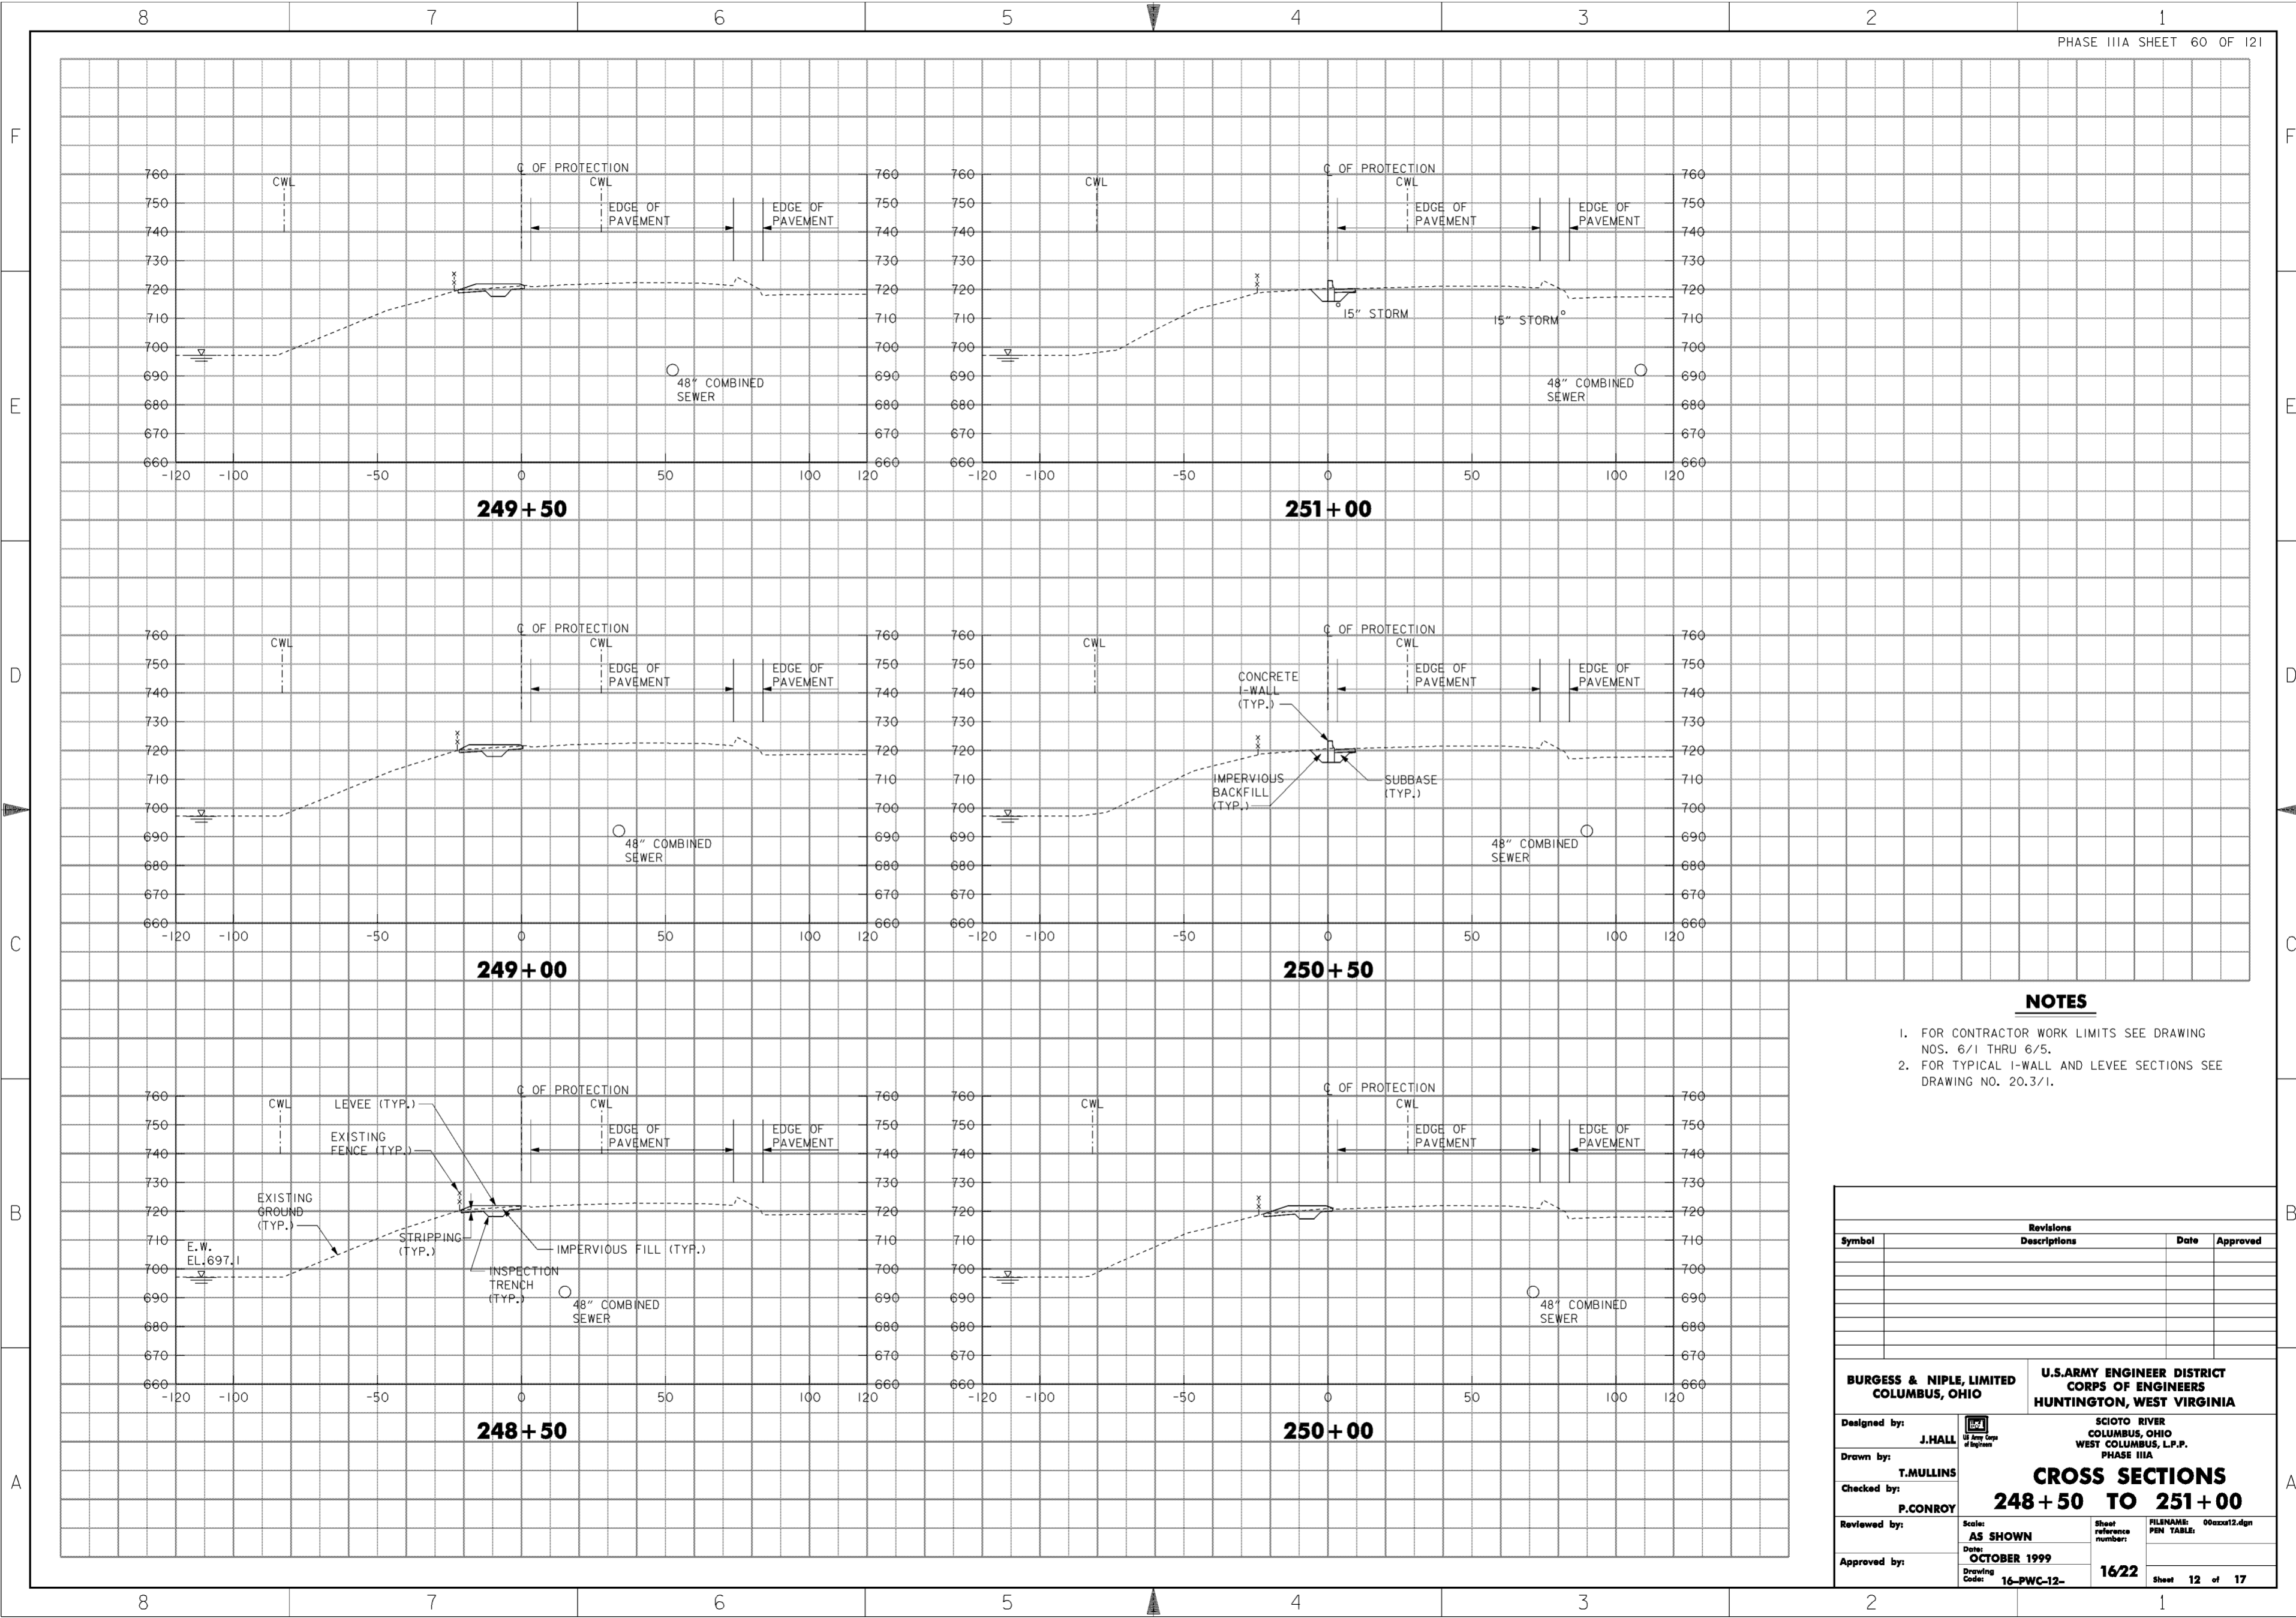

**NOTES**


1. FOR CONTRACTOR WORK LIMITS SEE DRAWING NOS. 6/1 THRU 6/5.
2. FOR TYPICAL I-WALL AND LEVEE SECTIONS SEE DRAWING NO. 20.3/1.

Revisions			
Symbol	Descriptions	Date	Approved

<b>BURGESS &amp; NIPLE, LIMITED</b> COLUMBUS, OHIO	<b>U.S. ARMY ENGINEER DISTRICT</b> CORPS OF ENGINEERS HUNTINGTON, WEST VIRGINIA		
		SCIOTO RIVER COLUMBUS, OHIO WEST COLUMBUS, L.P.P. PHASE IIIA	
Designed by: <b>J. HALL</b>	<b>CROSS SECTIONS</b> <b>248 + 50 TO 251 + 00</b>		
Drawn by: <b>T. MULLINS</b>			
Checked by: <b>P. CONROY</b>			
Reviewed by:			
Approved by:	Scale: <b>AS SHOWN</b>	Sheet reference number: <b>1622</b>	FILENAME: 00axxx12.dgn PEN TABLE:
Date: <b>OCTOBER 1999</b>	Drawing Code: <b>16-PWC-12-</b>	Sheet <b>12</b> of <b>17</b>	



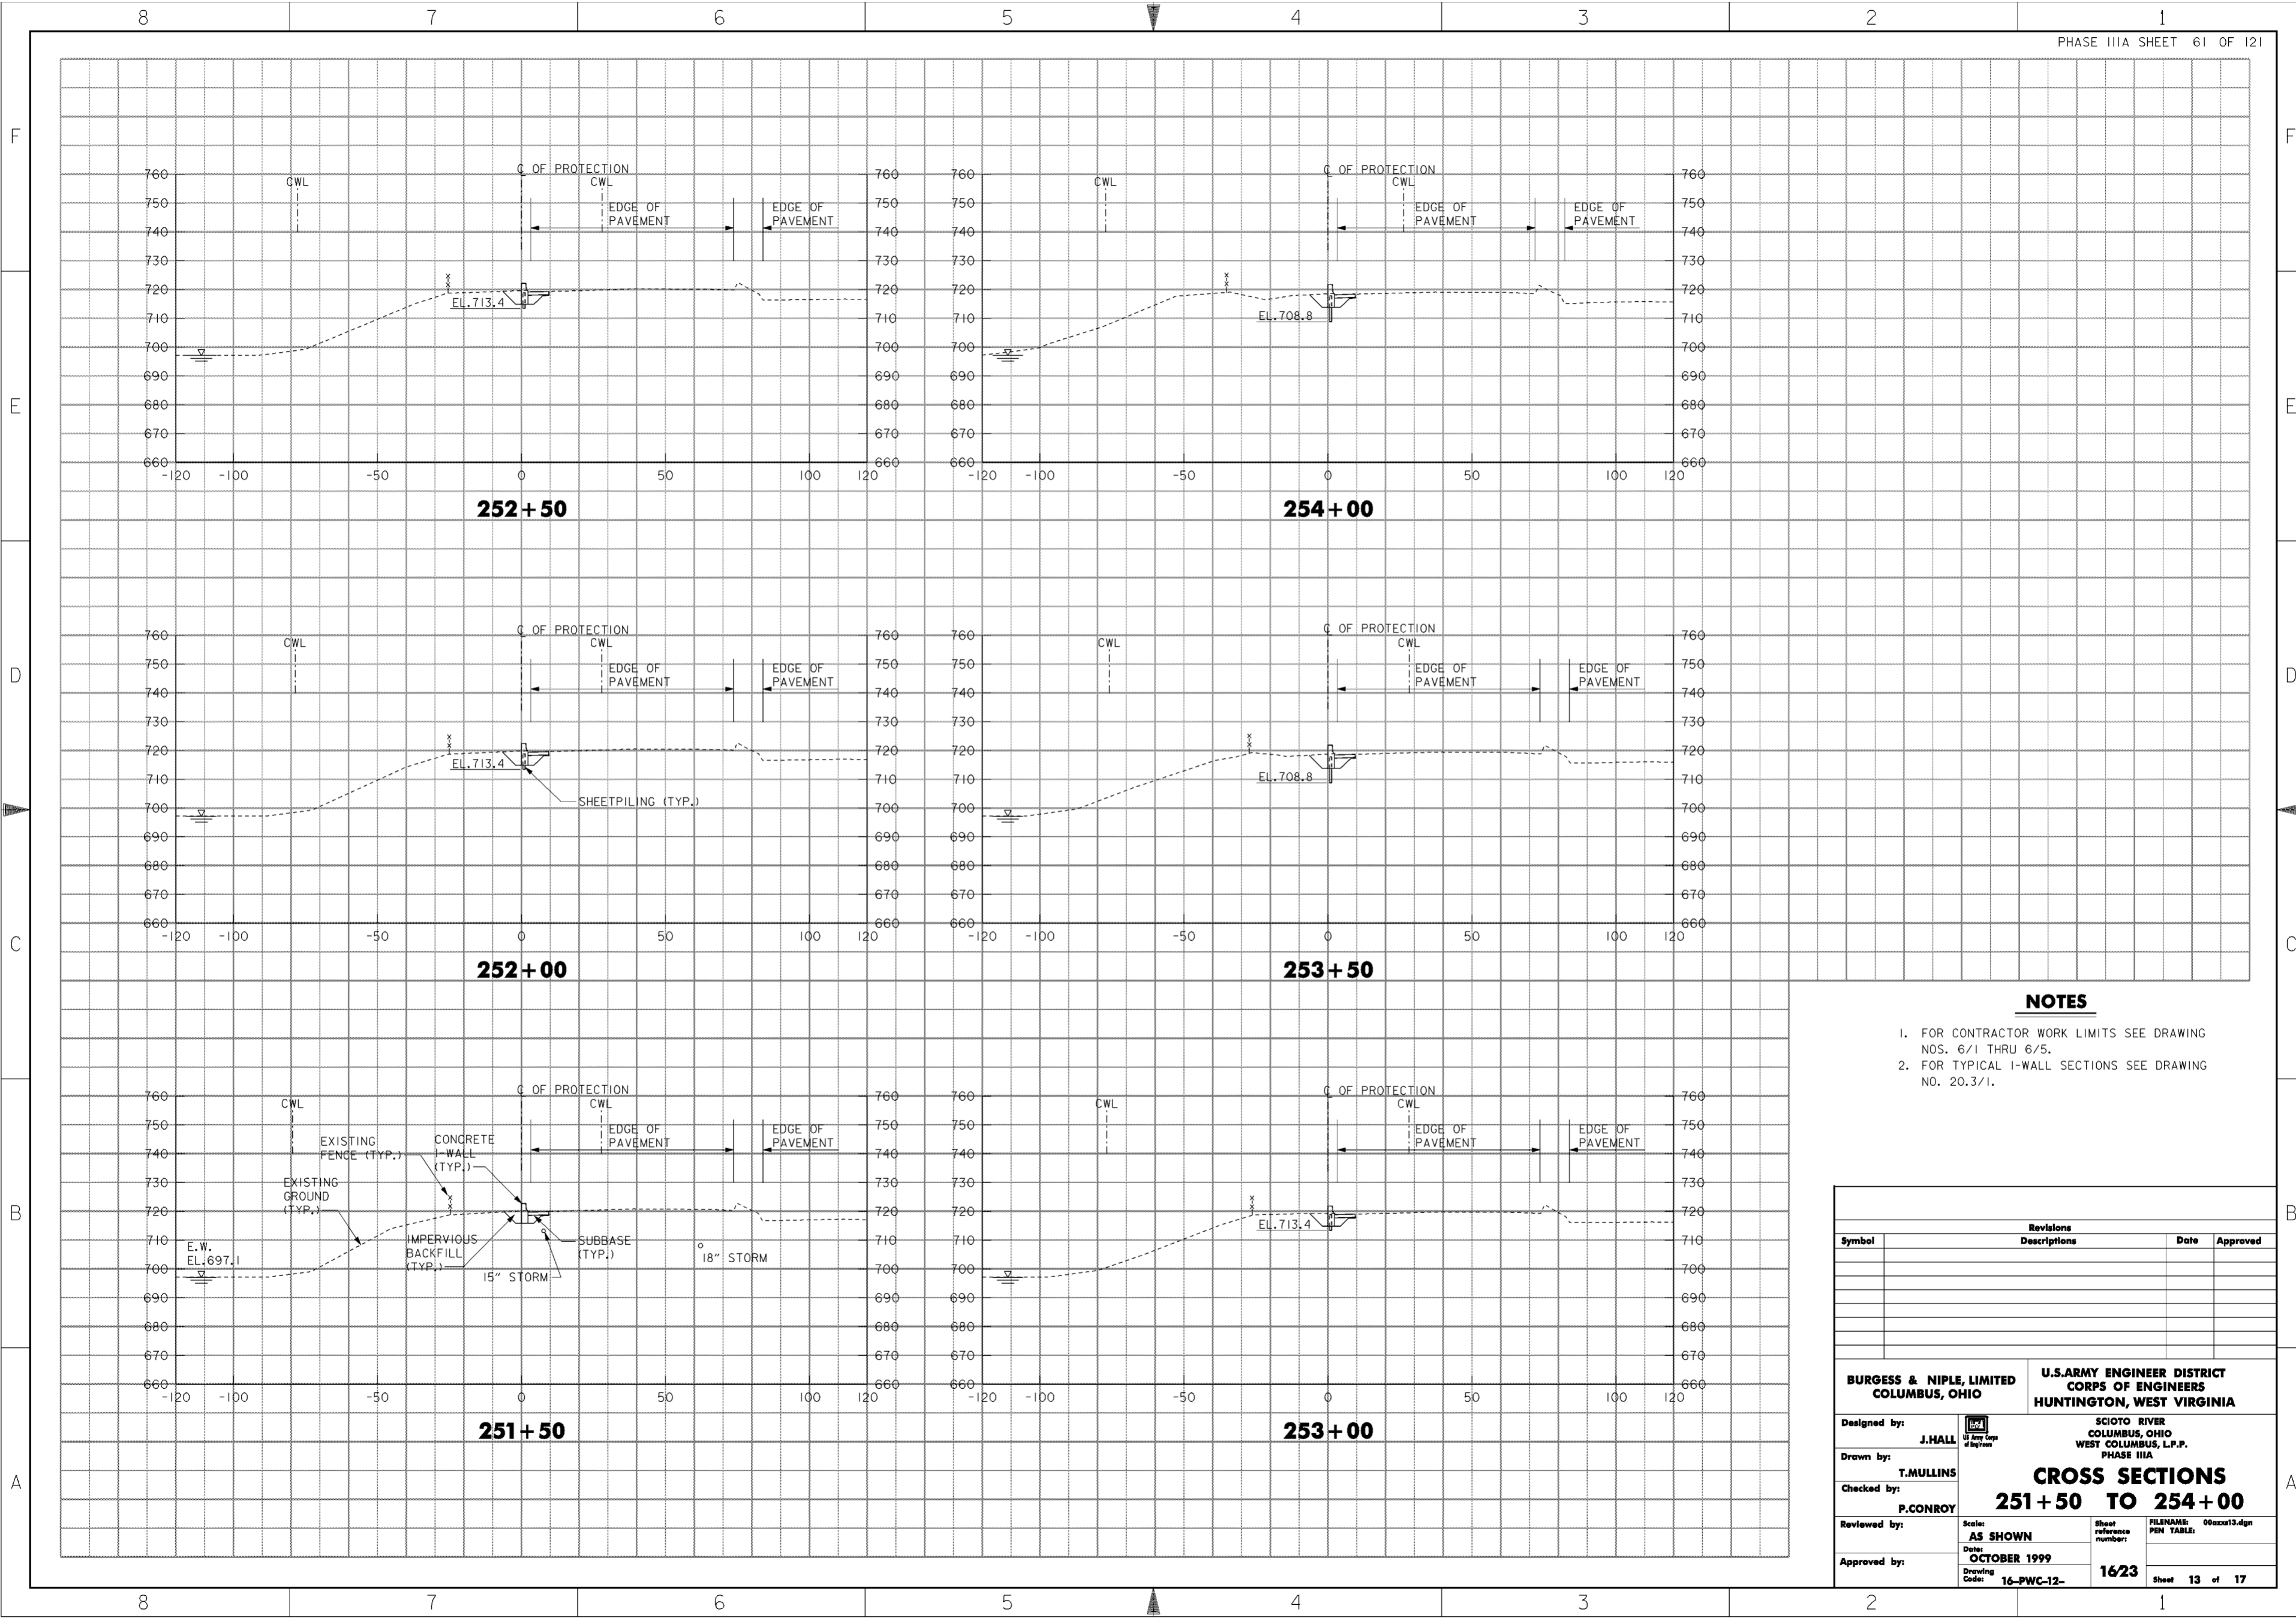


**NOTES**

1. FOR CONTRACTOR WORK LIMITS SEE DRAWING NOS. 6/1 THRU 6/5.
2. FOR TYPICAL I-WALL SECTIONS SEE DRAWING NO. 20.3/1.

Revisions			
Symbol	Descriptions	Date	Approved

<b>BURGESS &amp; NIPLE, LIMITED</b> COLUMBUS, OHIO		<b>U.S. ARMY ENGINEER DISTRICT</b> CORPS OF ENGINEERS HUNTINGTON, WEST VIRGINIA	
Designed by: <b>J. HALL</b>		SCIO TO RIVER COLUMBUS, OHIO WEST COLUMBUS, L.P.P. PHASE IIIA	
Drawn by: <b>T. MULLINS</b>		<b>CROSS SECTIONS</b> <b>251 + 50 TO 254 + 00</b>	
Checked by: <b>P. CONROY</b>	Reviewed by:	Scale: <b>AS SHOWN</b>	Sheet reference number: <b>1623</b>
Approved by:	Date: <b>OCTOBER 1999</b>	Drawing Code: <b>16-PWC-12-</b>	FILENAME: 00axxx13.dgn PEN TABLE: Sheet <b>13</b> of <b>17</b>

**WORK AS CONSTRUCTED**

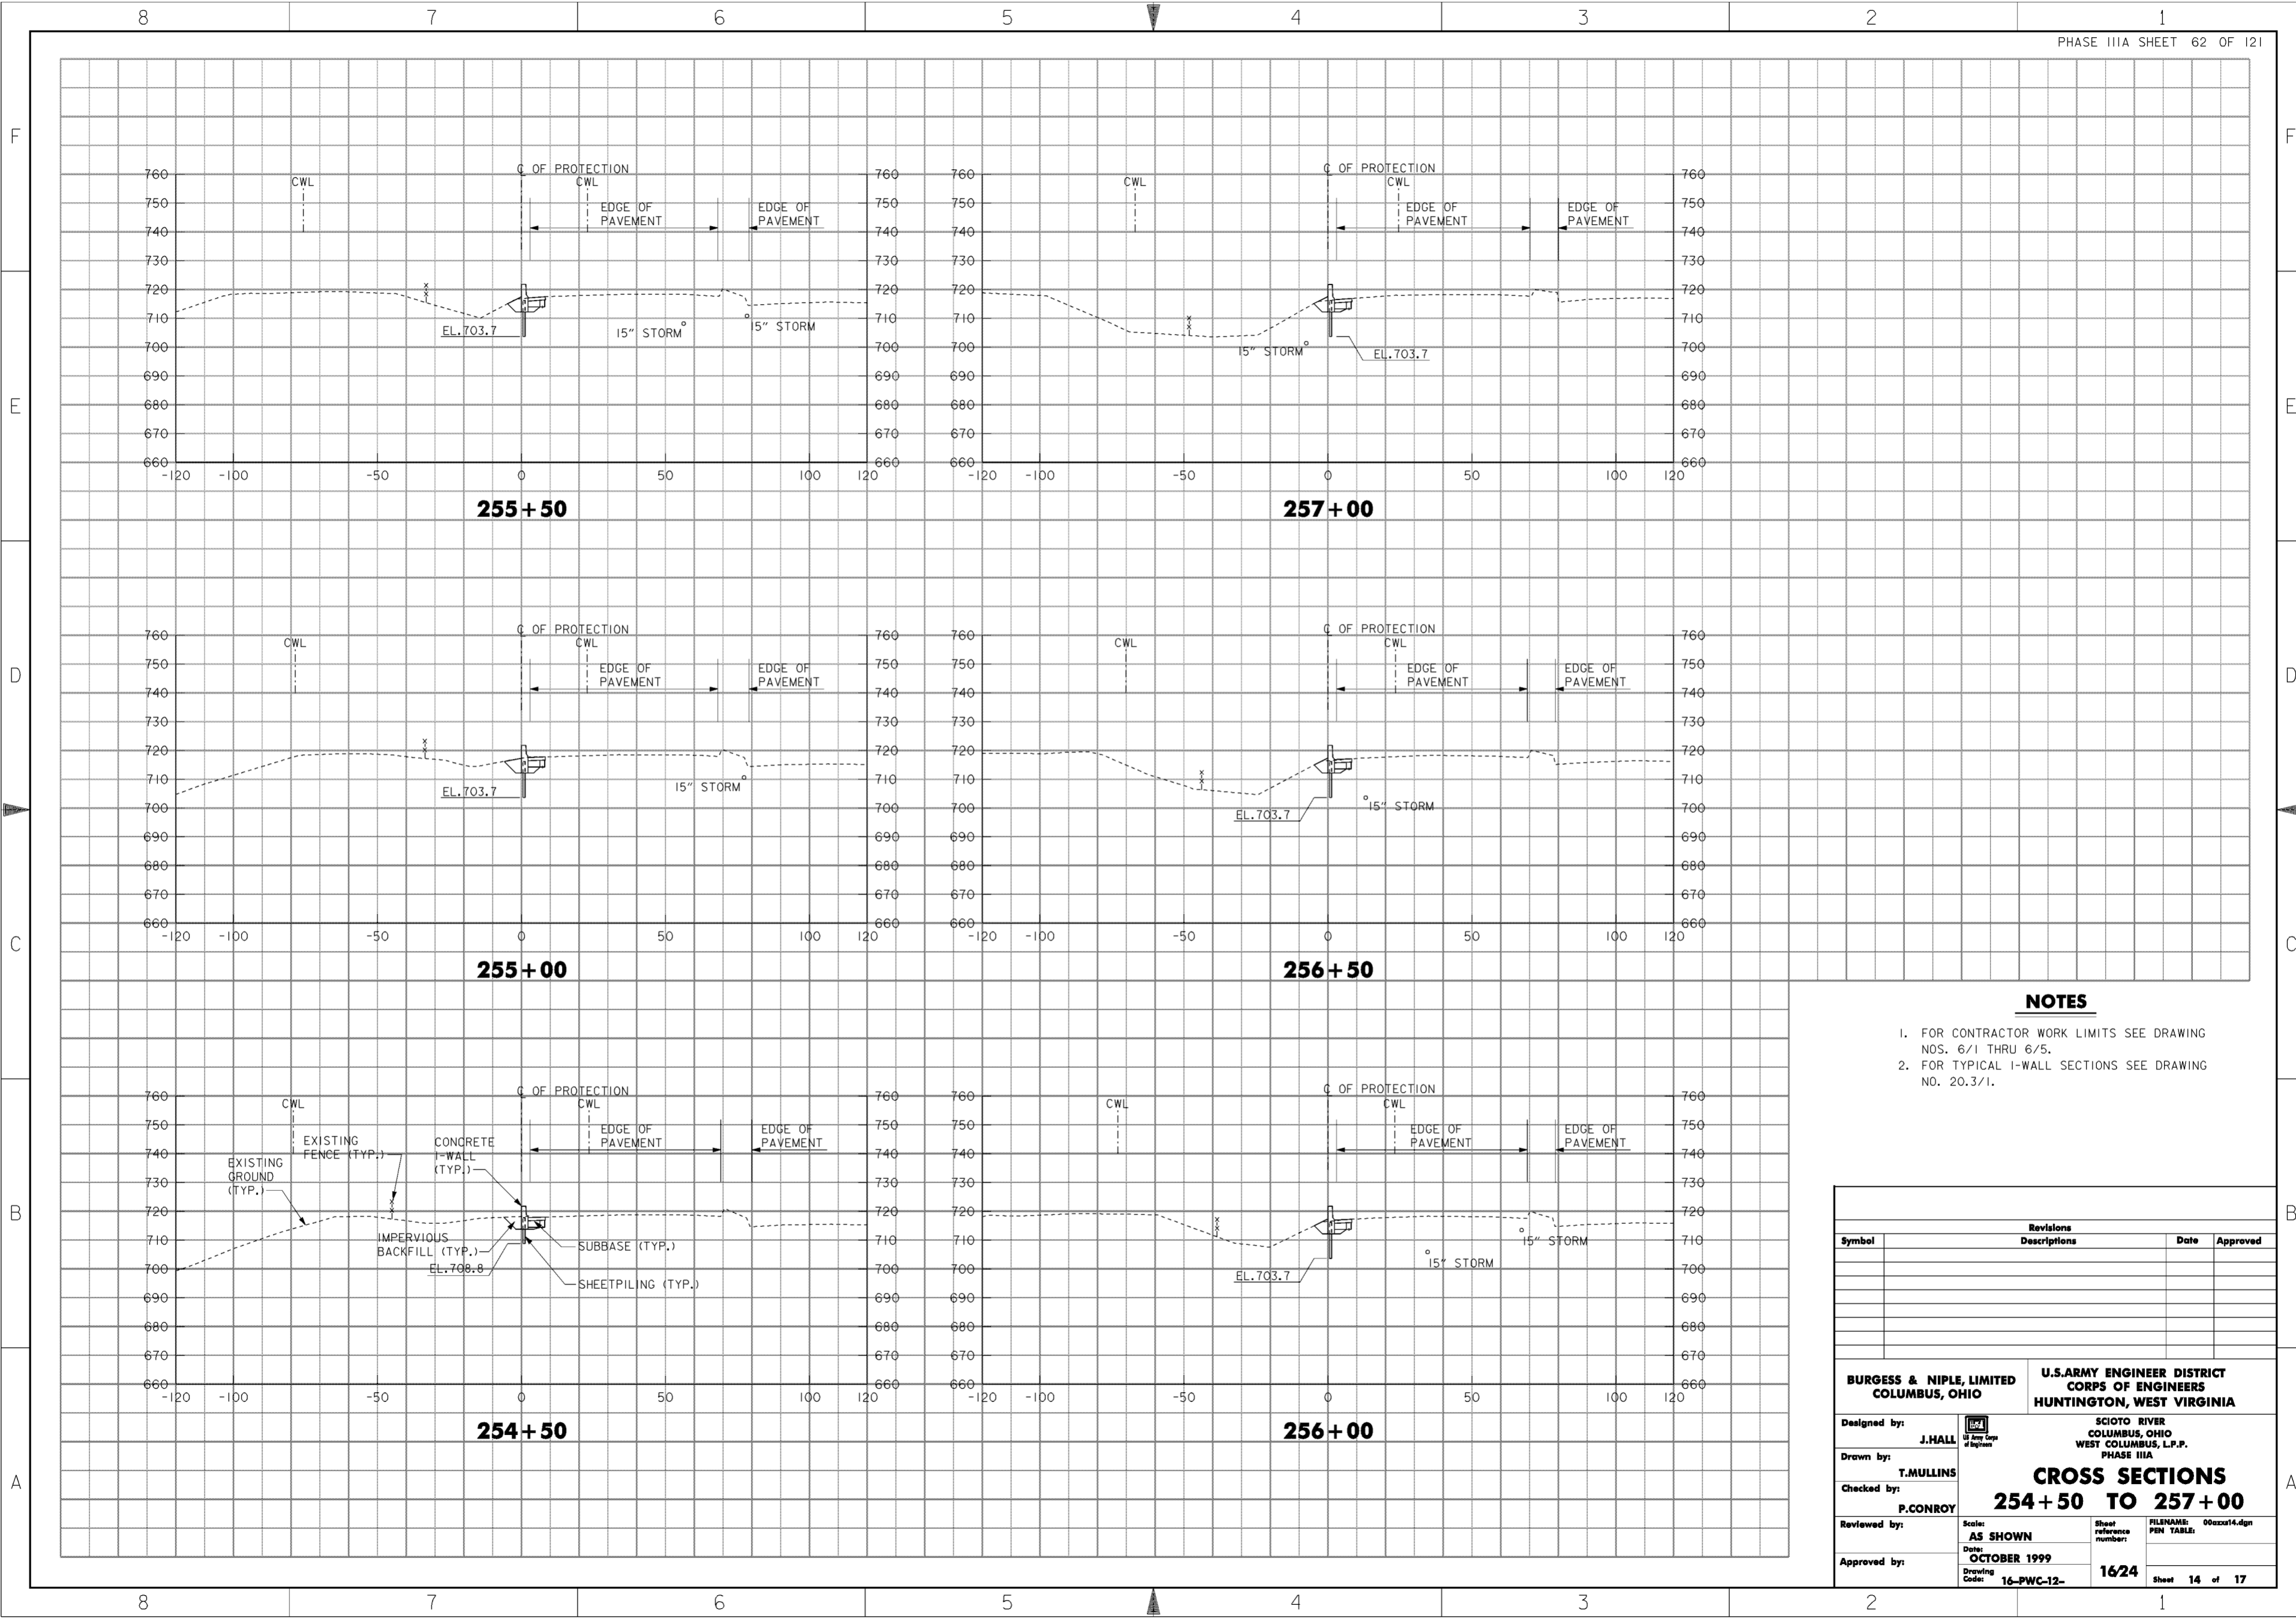


**NOTES**

1. FOR CONTRACTOR WORK LIMITS SEE DRAWING NOS. 6/1 THRU 6/5.
2. FOR TYPICAL I-WALL SECTIONS SEE DRAWING NO. 20.3/1.

Revisions			
Symbol	Descriptions	Date	Approved

<b>BURGESS &amp; NIPLE, LIMITED</b> COLUMBUS, OHIO		<b>U.S. ARMY ENGINEER DISTRICT</b> CORPS OF ENGINEERS HUNTINGTON, WEST VIRGINIA	
Designed by: <b>J. HALL</b>		SCIOTO RIVER COLUMBUS, OHIO WEST COLUMBUS, L.P.P. PHASE IIIA	
Drawn by: <b>T. MULLINS</b>		<b>CROSS SECTIONS</b> <b>254 + 50 TO 257 + 00</b>	
Checked by: <b>P. CONROY</b>	Reviewed by:	Scale: <b>AS SHOWN</b>	Sheet reference number: <b>1624</b>
Approved by:	Date: <b>OCTOBER 1999</b>	Drawing Code: <b>16-PWC-12-</b>	FILENAME: 00axx14.dgn PEN TABLE: Sheet <b>14</b> of <b>17</b>

**WORK AS CONSTRUCTED**

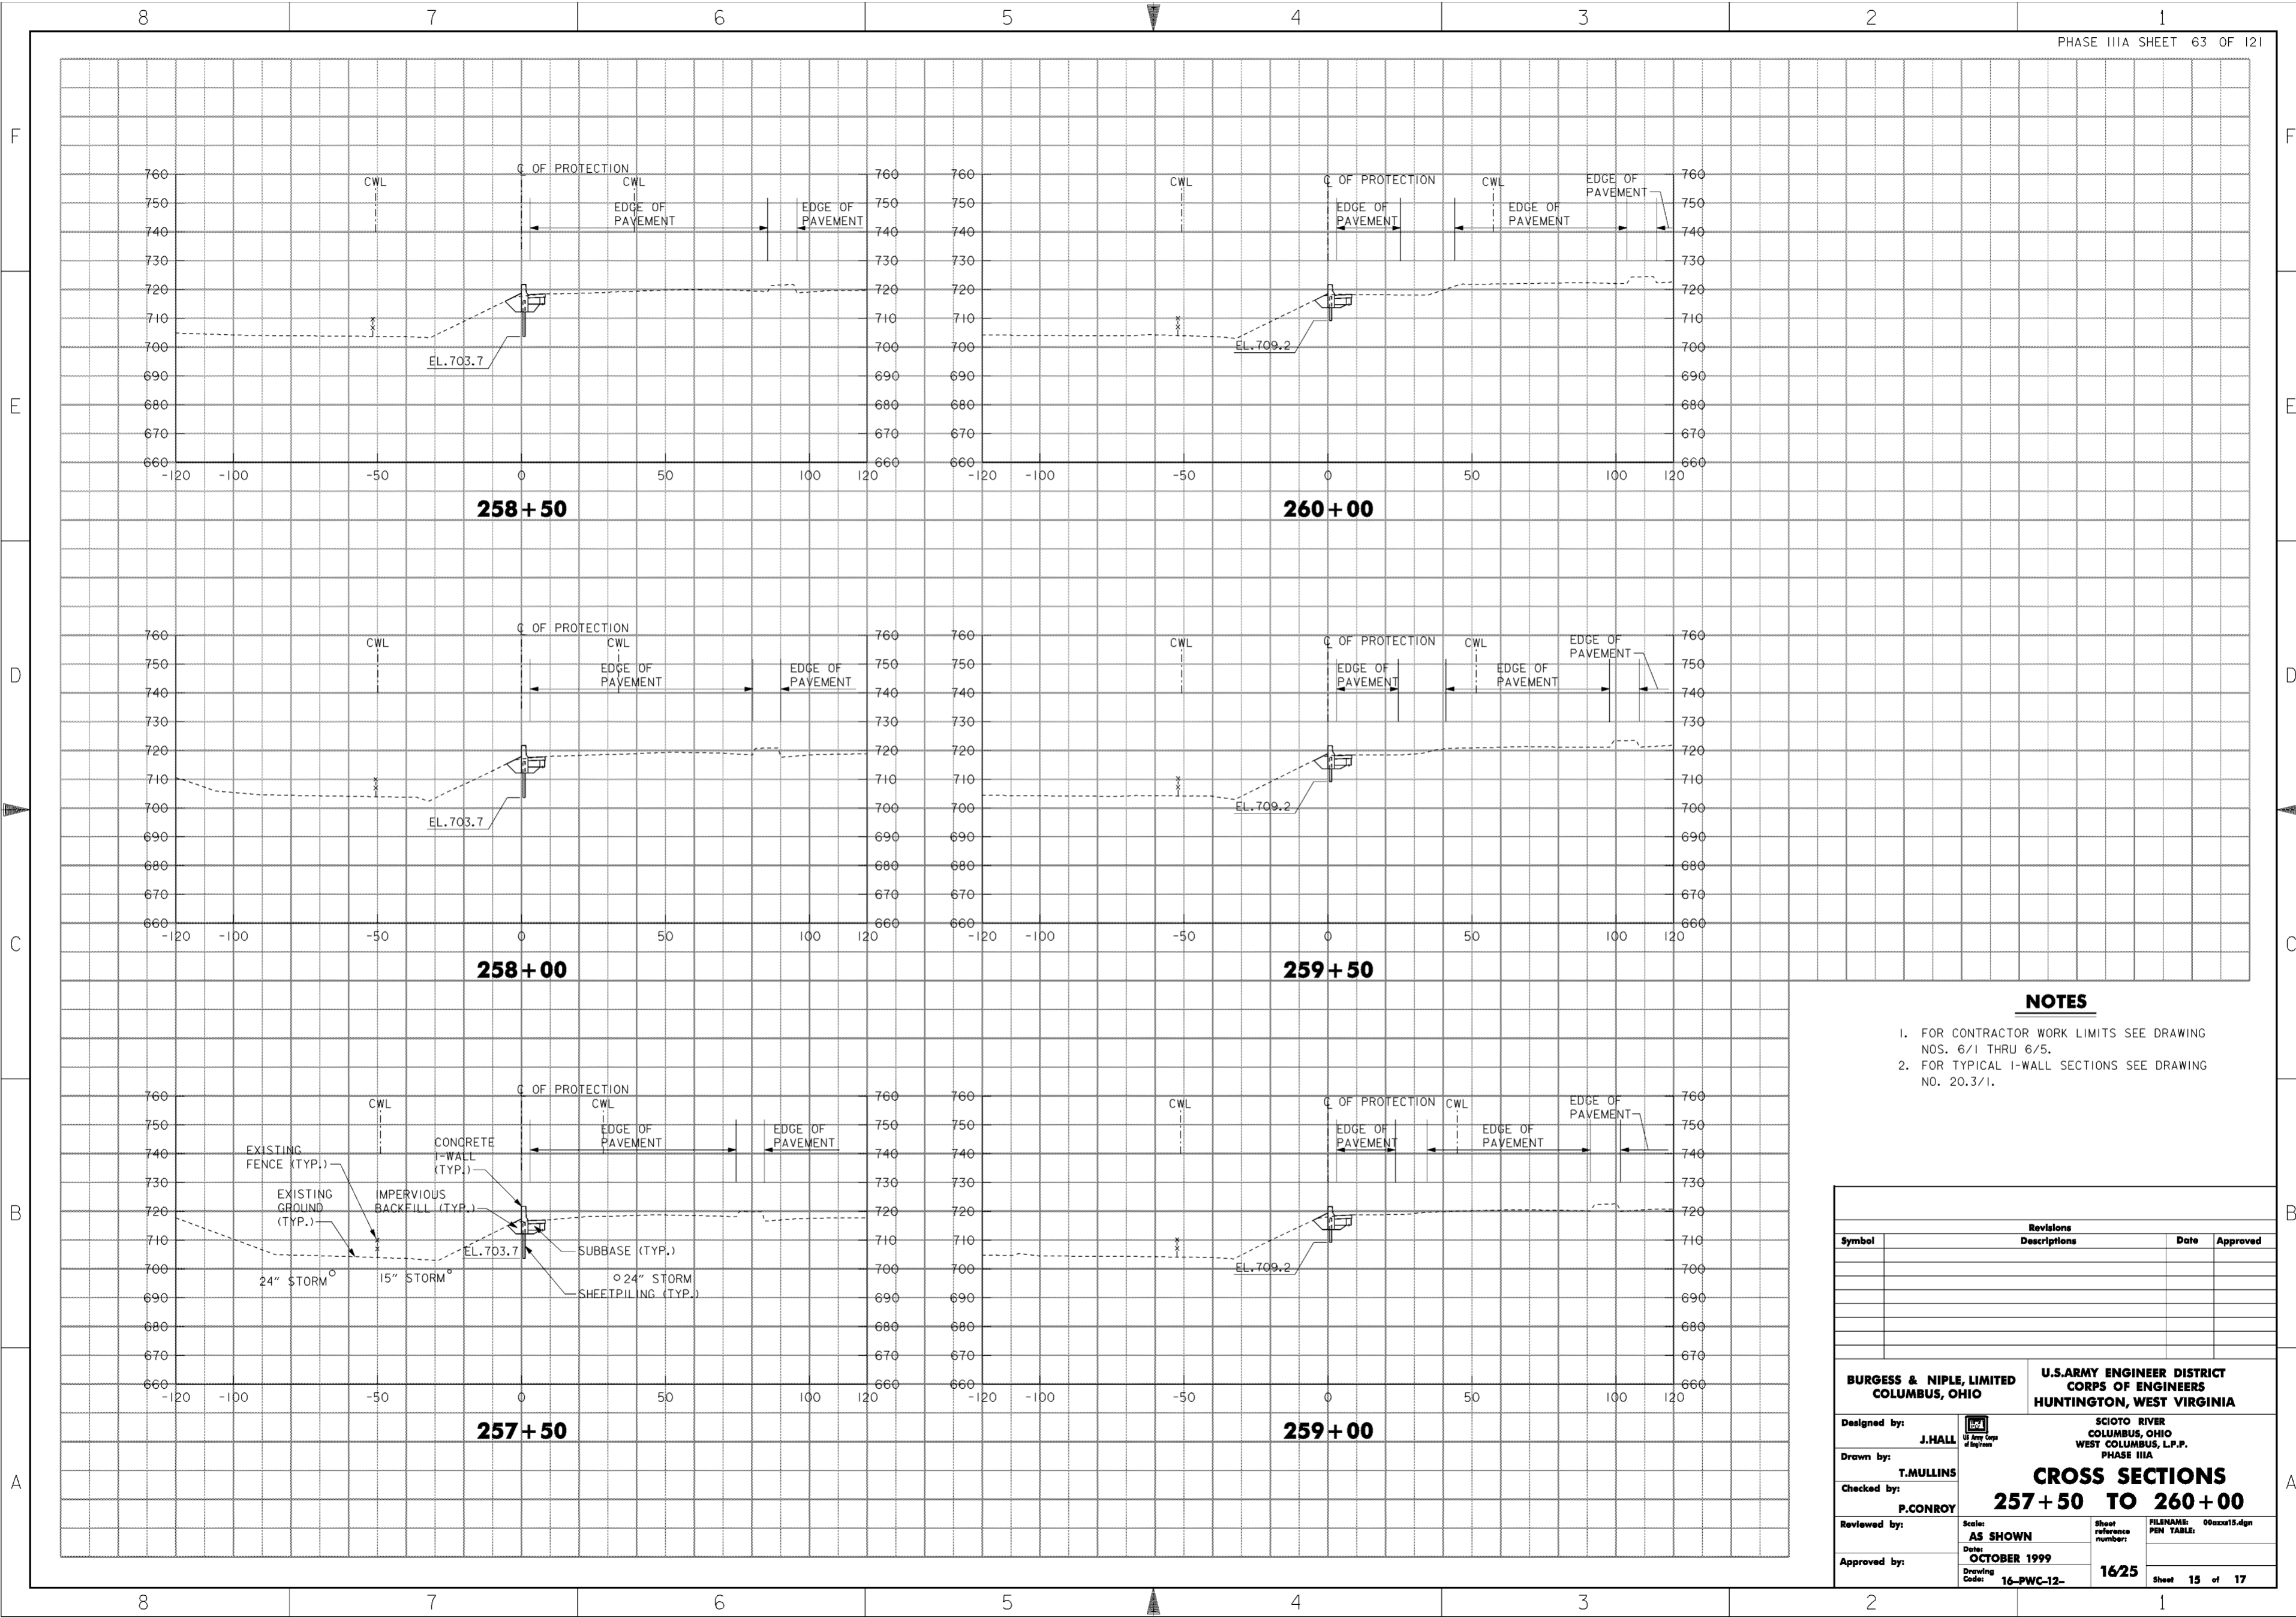


**NOTES**


1. FOR CONTRACTOR WORK LIMITS SEE DRAWING NOS. 6/1 THRU 6/5.
2. FOR TYPICAL I-WALL SECTIONS SEE DRAWING NO. 20.3/1.

Revisions			
Symbol	Descriptions	Date	Approved

<b>BURGESS &amp; NIPLE, LIMITED</b> COLUMBUS, OHIO	<b>U.S. ARMY ENGINEER DISTRICT</b> CORPS OF ENGINEERS HUNTINGTON, WEST VIRGINIA	SCIOTO RIVER COLUMBUS, OHIO WEST COLUMBUS, L.P.P. PHASE IIIA		
		<b>CROSS SECTIONS</b> <b>257+50 TO 260+00</b>		
Designed by: <b>J. HALL</b>		Drawn by: <b>T. MULLINS</b>	FILENAME: 00axx15.dgn PEN TABLE:	
Checked by: <b>P. CONROY</b>				
Reviewed by:		Scale: <b>AS SHOWN</b>		Sheet reference number: <b>1625</b>
Approved by:		Date: <b>OCTOBER 1999</b>		Drawing Code: <b>16-PWC-12-</b>



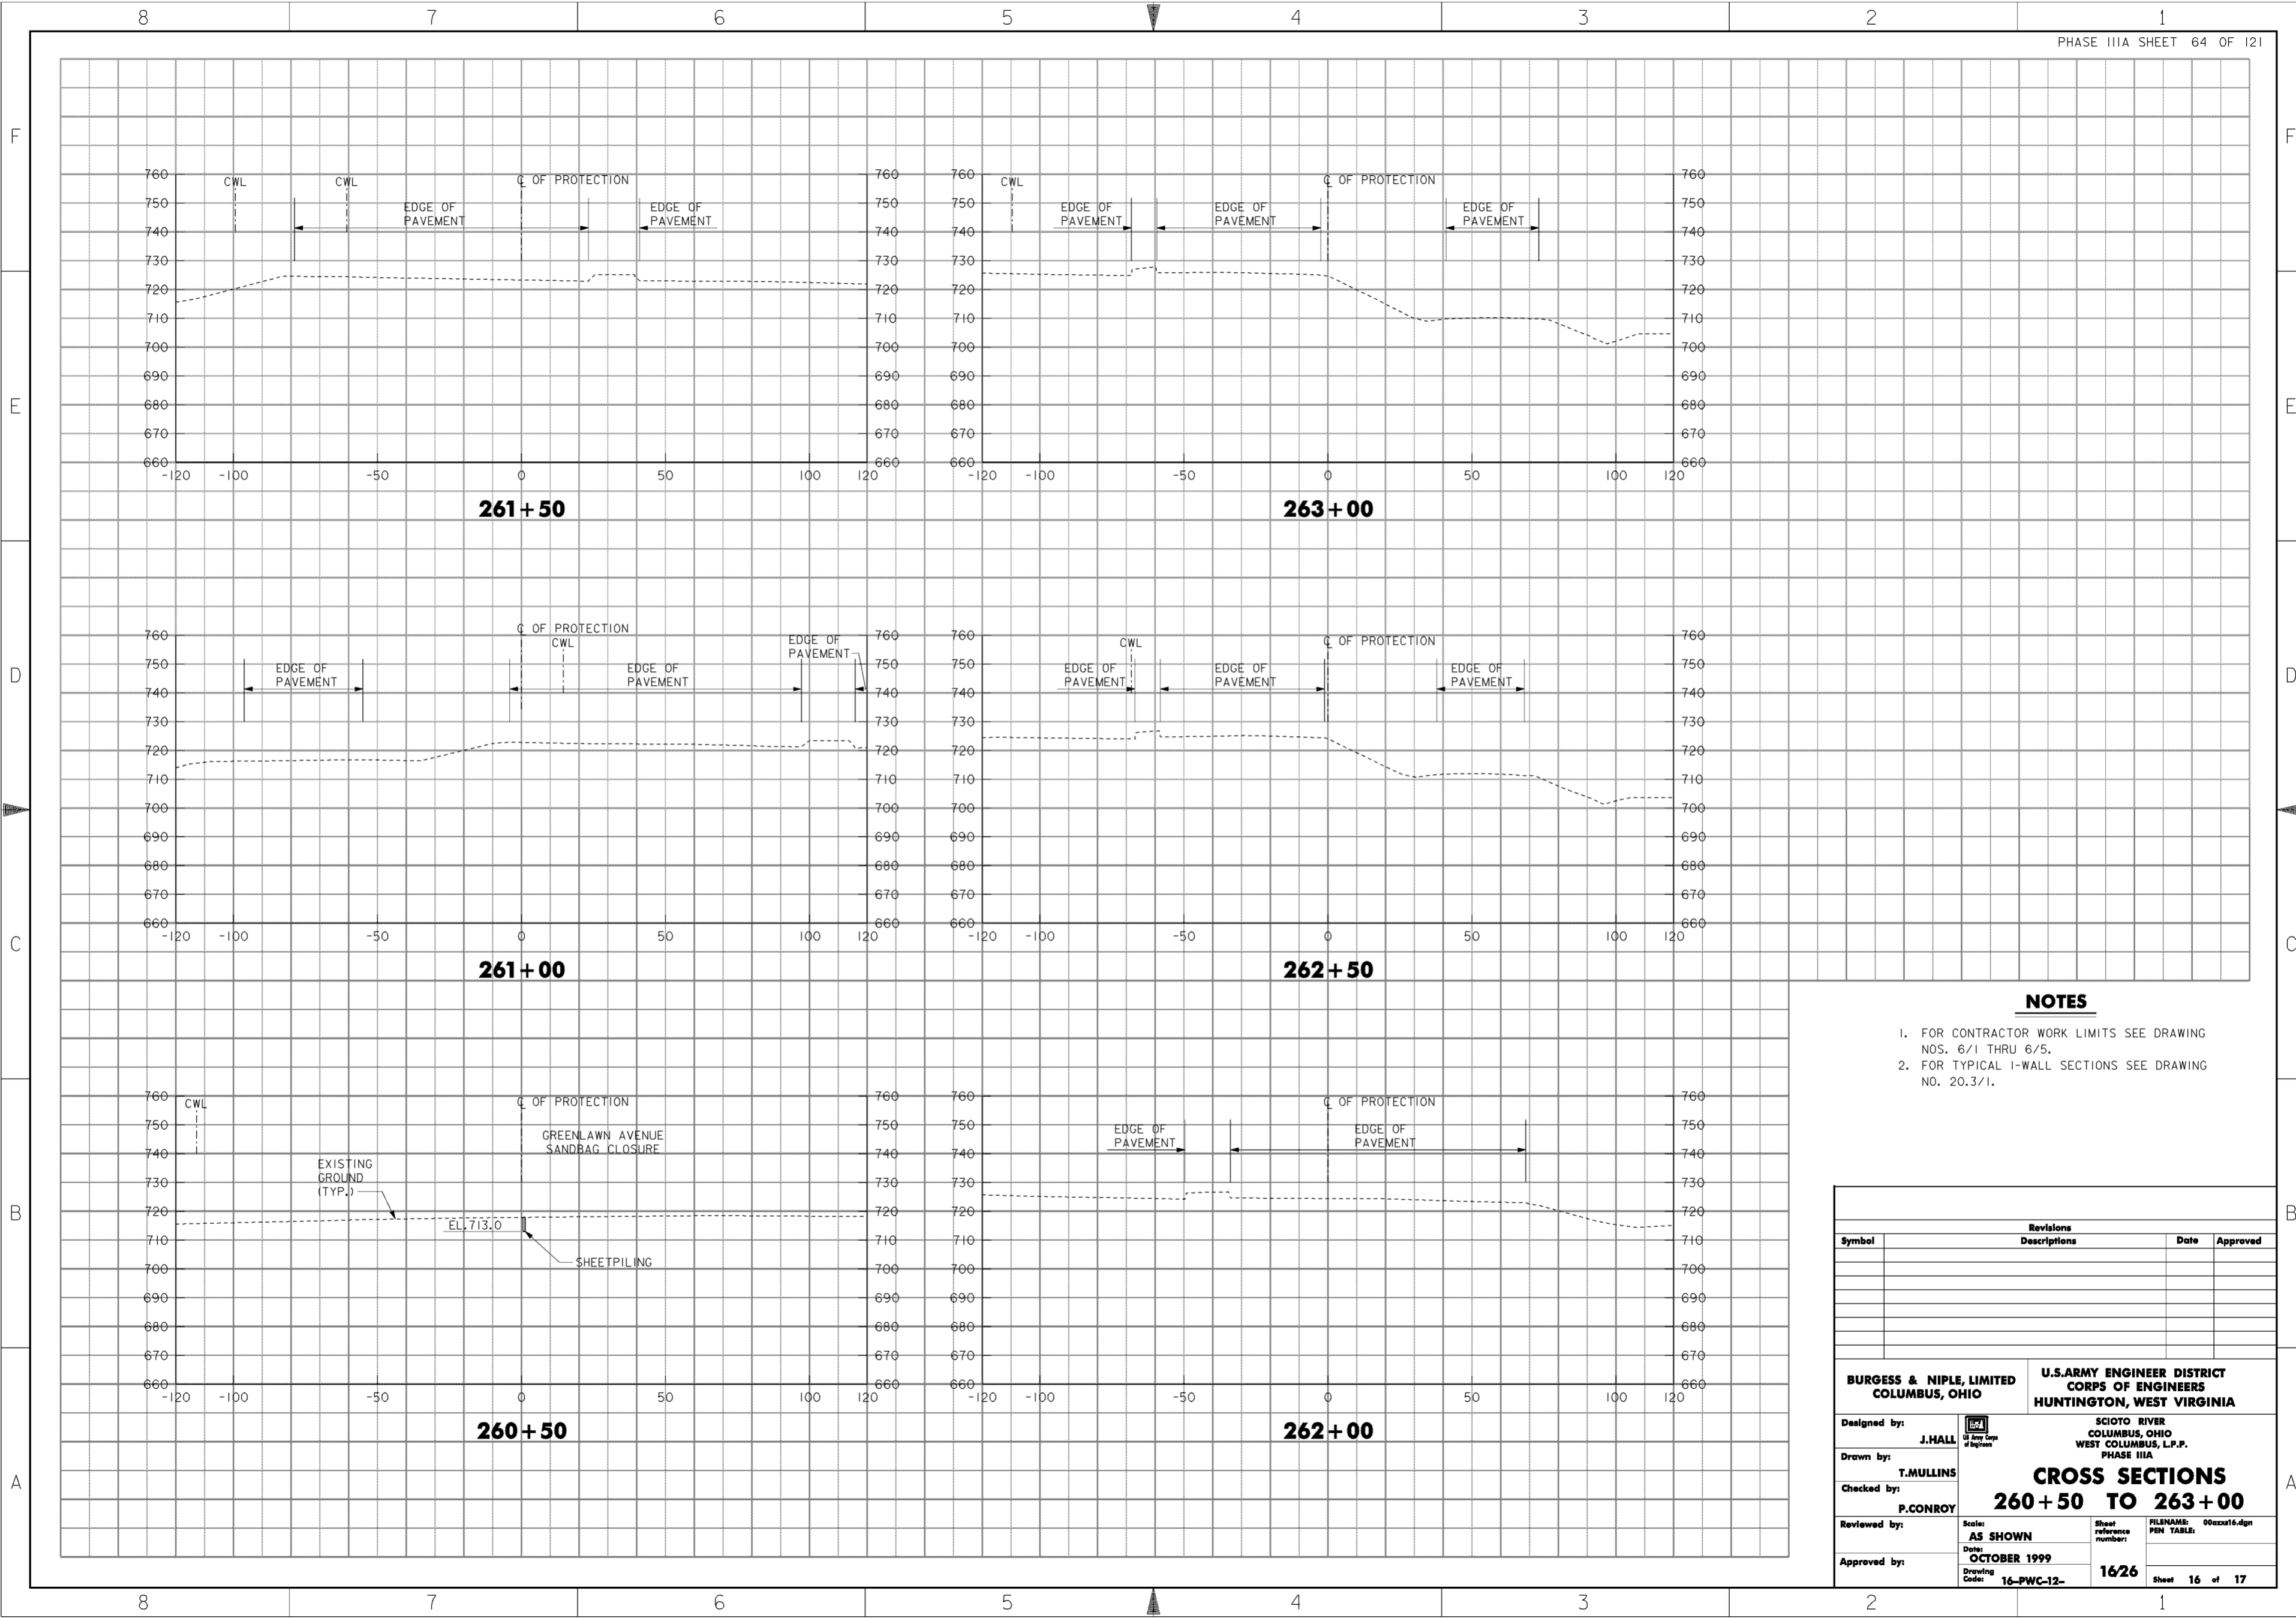


**NOTES**

1. FOR CONTRACTOR WORK LIMITS SEE DRAWING NOS. 6/1 THRU 6/5.
2. FOR TYPICAL I-WALL SECTIONS SEE DRAWING NO. 20.3/1.

Revisions			
Symbol	Descriptions	Date	Approved

<b>BURGESS &amp; NIPLE, LIMITED</b> COLUMBUS, OHIO		<b>U.S. ARMY ENGINEER DISTRICT</b> CORPS OF ENGINEERS HUNTINGTON, WEST VIRGINIA	
Designed by:	<b>J. HALL</b>	SCIOTO RIVER COLUMBUS, OHIO WEST COLUMBUS, L.P.P. PHASE IIIA	
Drawn by:	<b>T. MULLINS</b>	<b>CROSS SECTIONS</b> <b>260 + 50 TO 263 + 00</b>	
Checked by:	<b>P. CONROY</b>		
Reviewed by:		Scale:	AS SHOWN
Approved by:		Date:	OCTOBER 1999
		Drawing Code:	16-PWC-12-
		Sheet reference number:	1626
		FILENAME:	00axx16.dgn
		PIN TABLE:	
		Sheet 16 of 17	

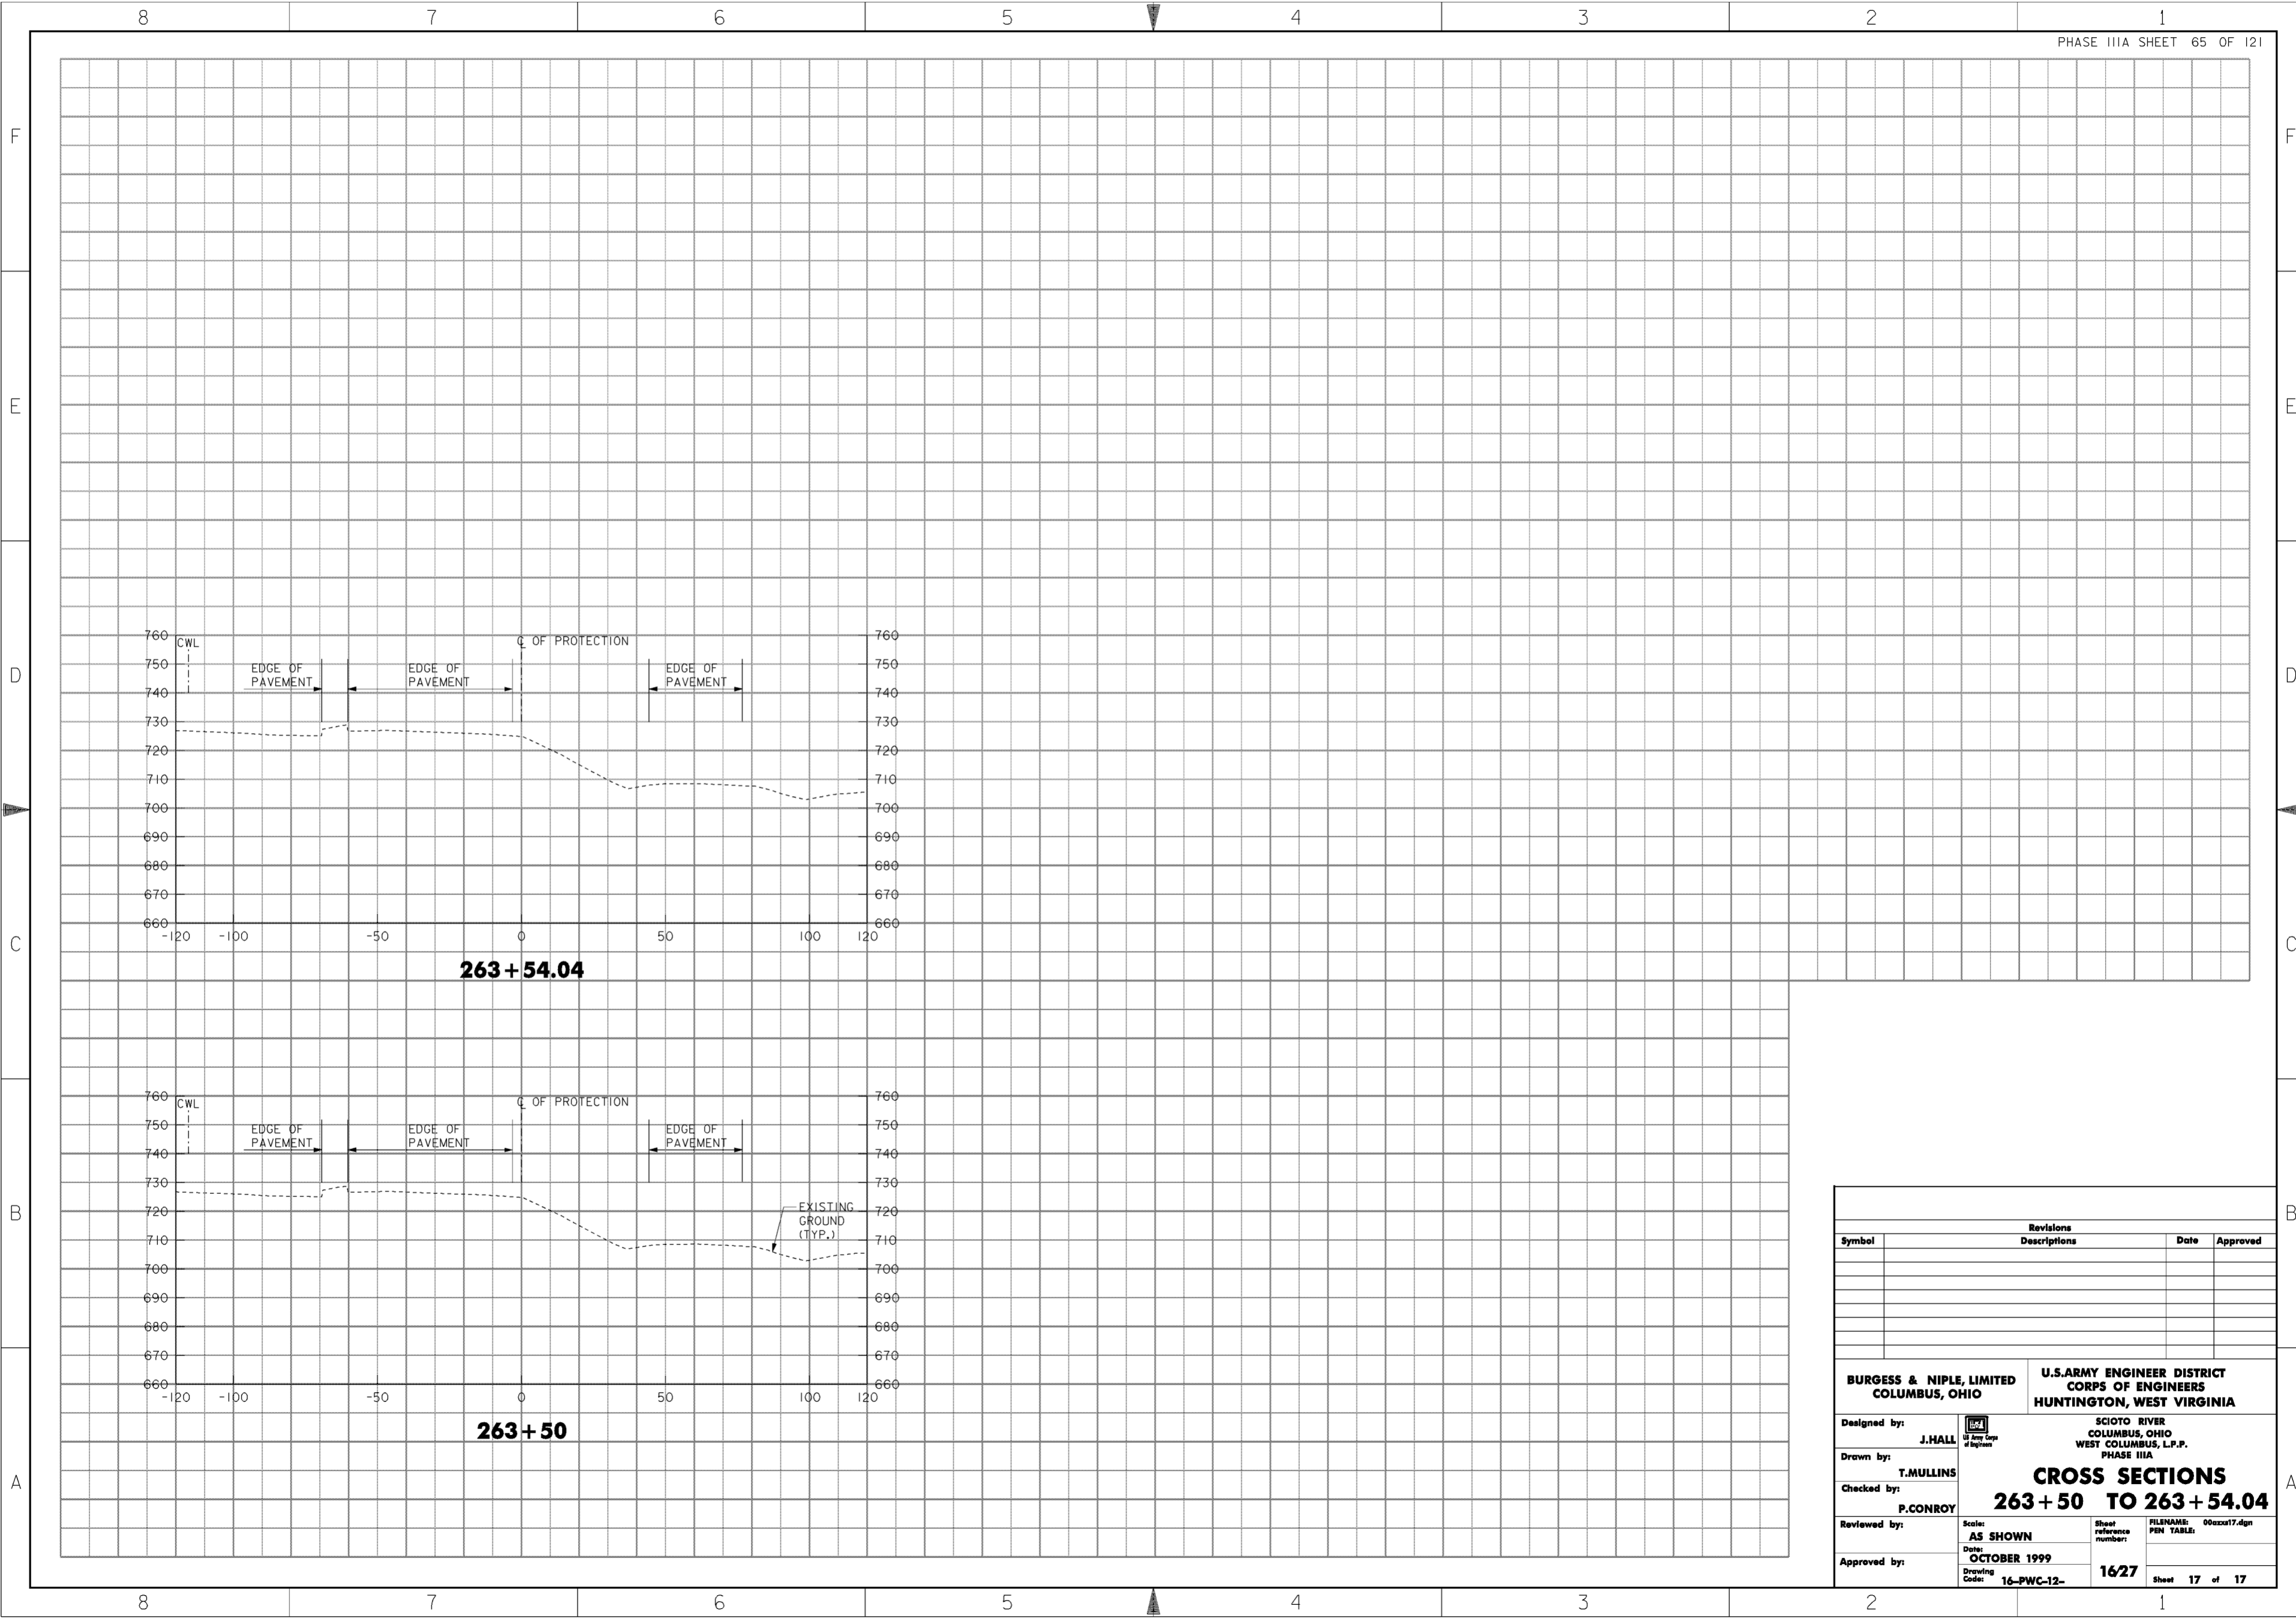

Revisions			
Symbol	Descriptions	Date	Approved


<b>BURGESS &amp; NIPLE, LIMITED</b> COLUMBUS, OHIO	<b>U.S. ARMY ENGINEER DISTRICT</b> CORPUS OF ENGINEERS HUNTINGTON, WEST VIRGINIA	SCIOTO RIVER COLUMBUS, OHIO WEST COLUMBUS, L.P.P. PHASE IIIA	
		<b>CROSS SECTIONS</b> <b>263 + 50 TO 263 + 54.04</b>	
Designed by: <b>J. HALL</b>		Drawn by: <b>T. MULLINS</b>	Checked by: <b>P. CONROY</b>
Reviewed by:		Scale: <b>AS SHOWN</b>	Sheet reference number: <b>16/27</b>
Approved by:		Date: <b>OCTOBER 1999</b>	FILENAME: PIN TABLE:
Drawing Code: <b>16-PWC-12-</b>		Sheet <b>17</b> of <b>17</b>	

**WORK AS CONSTRUCTED**








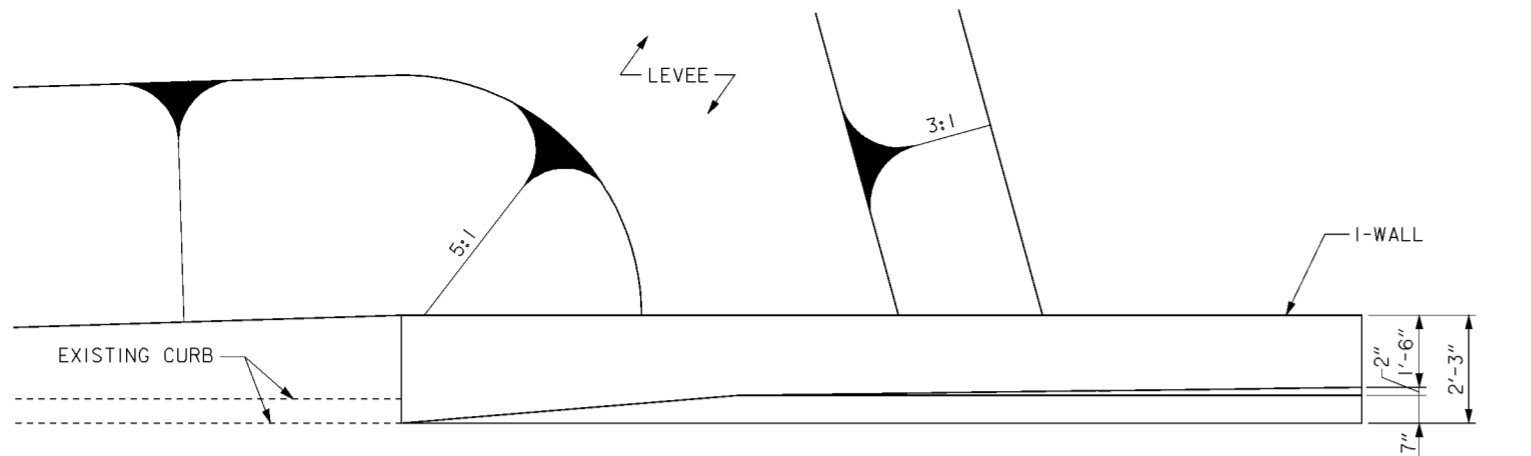


PLAN

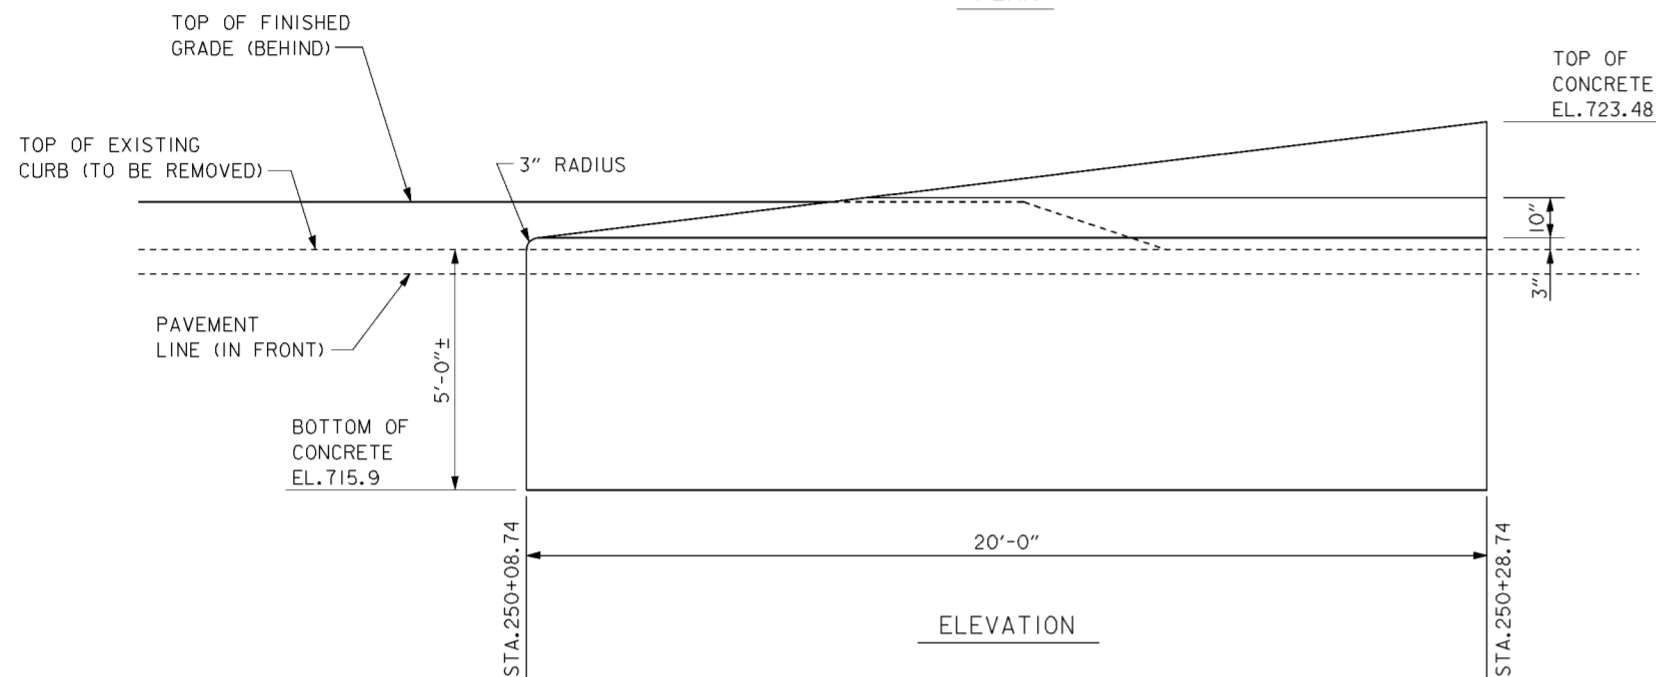


ELEVATION

**TAPERED END**  
STA. 250+08.74 TO 250+28.74  
SCALE: 1/2" = 1'-0"

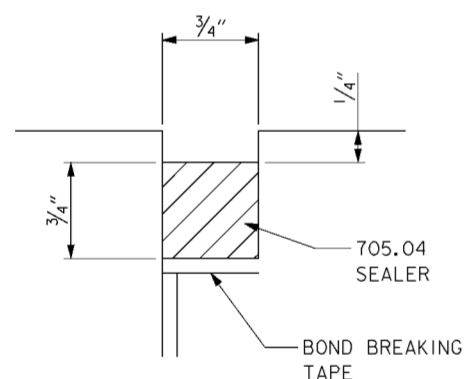


**JOINT SEALER DETAIL**  
SCALE: NONE

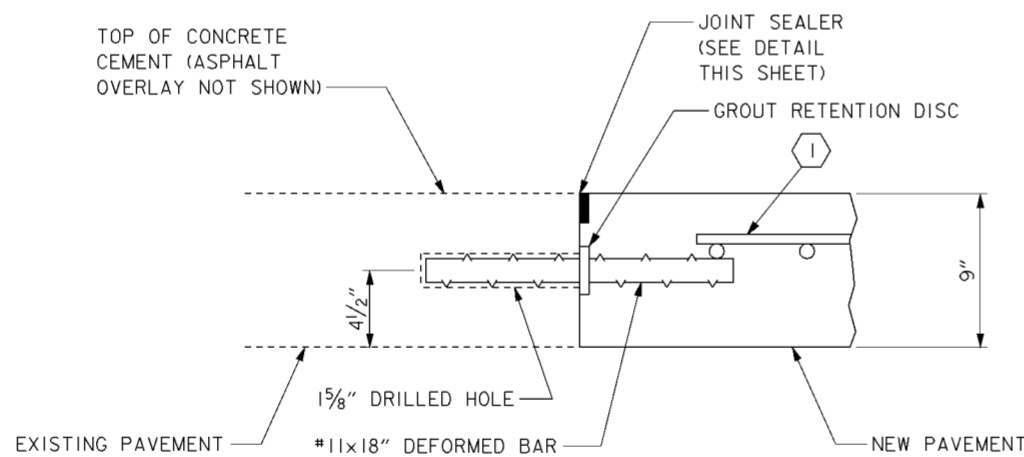


**SECTION - TYPE T**  
(TIED)  
SCALE: NONE

WELDED WIRE FABRIC SHALL CONSIST OF W8.5 OR D8.5 LONGITUDINAL WIRES SPACED 6" C/C AND W4 OR D4 TRANSVERSE WIRES SPACED 12" C/C, FLAT SHEETS. THE CLEARANCE FROM THE END OF THE WIRE FABRIC TO THE EDGE OF PAVEMENT, NEW LONGITUDINAL JOINT, OR EDGES OF REPLACEMENT SHALL BE 4"±2".

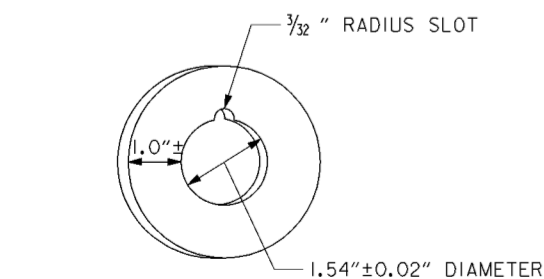

**NYLON OR PLASTIC GROUT RETENTION DISCS FOR DOWEL/TIE BARS**  
(1/16" MIN. THICKNESS, CLEAR IN COLOR)  
SCALE: NONE

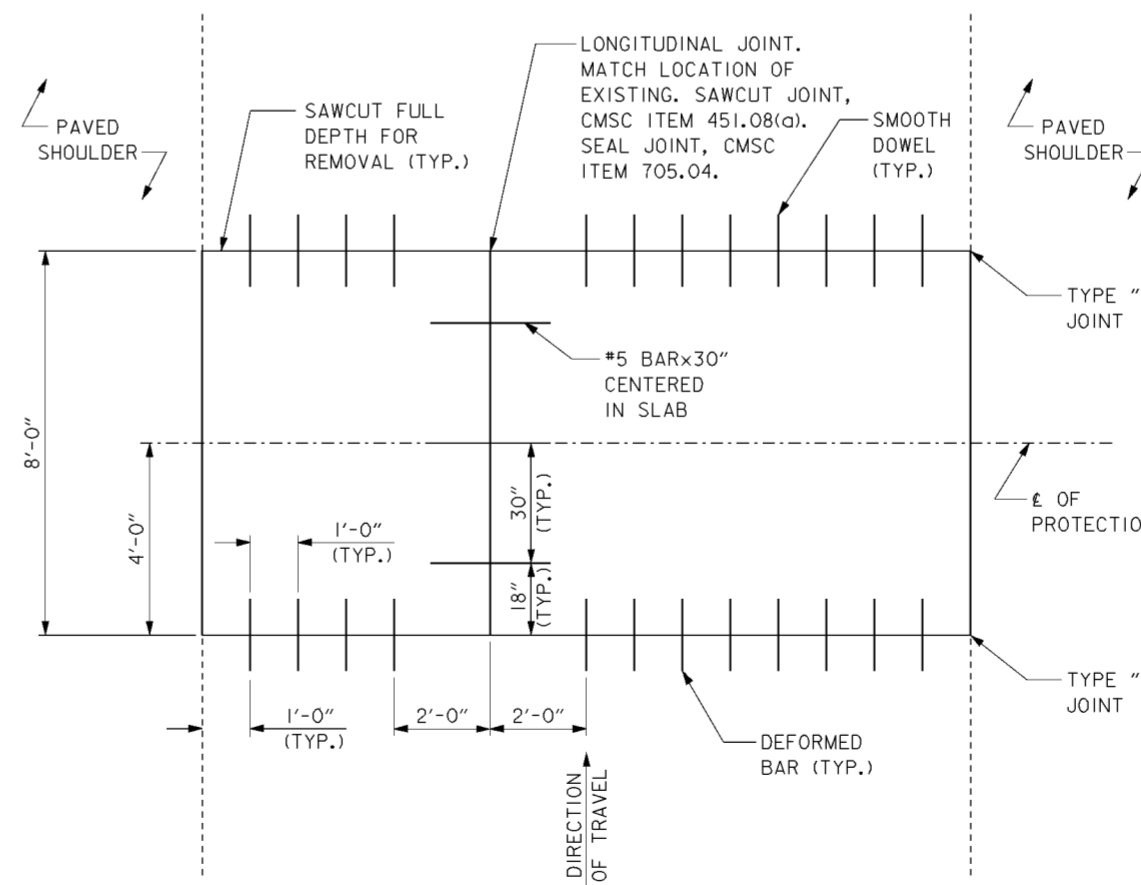

**DOWEL BAR PLACEMENT DETAIL**  
**PORTLAND CEMENT CONCRETE PAVEMENT REPLACEMENT**

SCALE: 1/2" = 1'-0"

**NOTES**

1. SEE DRAWING NO. 20.2/1 FOR LOCATION OF PAVEMENT REPLACEMENT AT GREENLAWN AVENUE SANDBAG CLOSURE.


Revisions			
Symbol	Descriptions	Date	Approved

<b>BURGESS &amp; NIPLE, LIMITED</b> COLUMBUS, OHIO		<b>U.S. ARMY ENGINEER DISTRICT</b> CORPS OF ENGINEERS HUNTINGTON, WEST VIRGINIA	
Designed by: <b>J. HALL</b>		SCIO TO RIVER COLUMBUS, OHIO WEST COLUMBUS, L.P.P. PHASE IIIA	
Drawn by: <b>T. MULLINS</b>		<b>MISCELLANEOUS</b> <b>DETAILS</b>	
Checked by: <b>P. CONROY</b>		Scale: <b>AS SHOWN</b>	Sheet reference number: <b>20.13</b>
Reviewed by:		Date: <b>OCTOBER 1999</b>	FILENAME: 00add103.dgn
Approved by:		Drawing Code: <b>16-PWC-12-</b>	PIN TABLE: Sheet 1 of 1







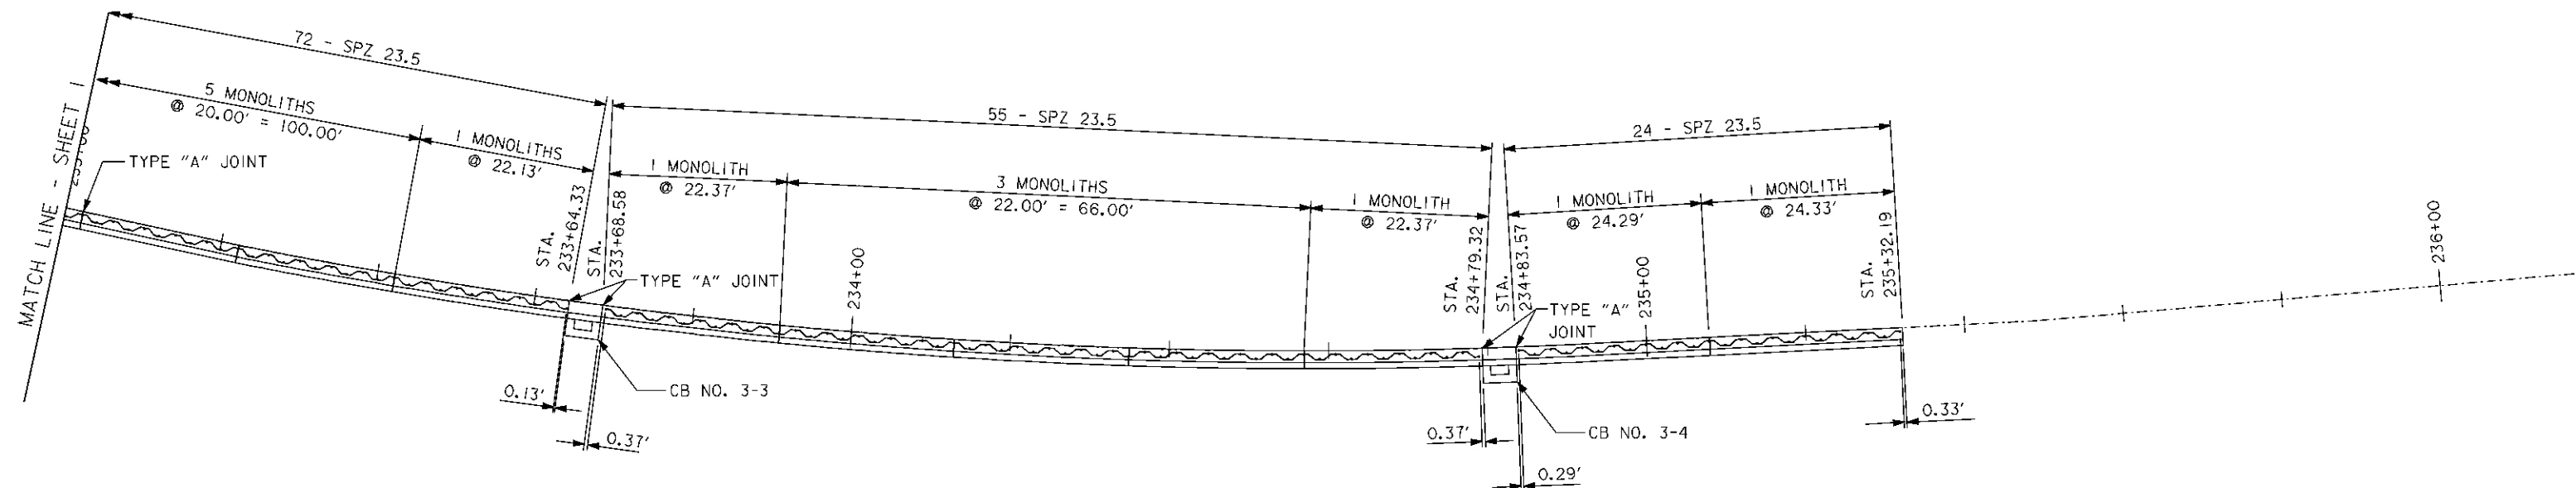

**PLAN**  
SCALE: 1" = 10'

WALL JOINTS			
STATION	TYPE	STATION	TYPE
227+40.33	B	232+20.06	A
227+60.33	B	232+42.20	B
227+80.33	B	232+62.20	B
227+00.33	B	232+82.20	B
228+20.33	A	233+02.20	A
228+40.33	B	233+22.20	B
228+60.33	B	233+42.20	B
228+80.33	B	233+64.33	A
229+00.33	B	233+68.58	A
229+20.73	A	233+90.95	B
229+24.98	A	234+12.95	B
229+47.38	B	234+34.95	B
229+69.38	B	234+56.95	B
229+91.38	B	234+79.32	A
230+13.38	A	234+83.57	A
230+33.38	B	235+07.86	B
230+53.38	B		
230+73.38	B		
230+93.38	B		
231+13.38	A		
231+33.38	B		
231+53.38	B		
231+73.38	B		
231+93.38	B		
232+15.81	A		

**NOTES**



1. TYPE "A" JOINTS ARE REQUIRED AT CATCH BASINS AND WHERE SHOWN.
2. FOR TYPE AND LOCATIONS OF MONOLITH JOINTS SEE TABLE ON THIS DRAWING.
3. FOR TYPE "A" AND TYPE "B" MONOLITH JOINT DETAILS SEE DRAWING NO. 20.1/2.
4. ALL CONCRETE MONOLITH JOINTS SHALL ALIGN WITH SHEET PILING JOINTS.
5. FOR WATERSTOP SHEET PILING CONNECTION AND CLAMP BAR DETAILS SEE DRAWING NO. 20.1/2.
6. FOR CORNER MONOLITH REINFORCING SEE DRAWING NO. 20.1/1.
7. SHEET PILING LAYOUT WAS BASED UPON THE PROPERTIES FOR SPZ-23.5 COLD-ROLLED STEEL SHEET PILING BY SYRO, INC. OTHER MANUFACTURERS OF STEEL SHEET PILING ARE ACCEPTABLE IF THEY MEET THE MINIMUM SECTION PROPERTIES OF Z-TYPE SHEET PILING GIVEN IN SPECIFICATION 02411. THE CONTRACTOR SHALL SUBMIT FOR APPROVAL REVISED WALL MONOLITH JOINT SPACING THAT IS MODULAR WITH WIDTH OF THE PILES PROVIDED.
8. WALL MONOLITHS SHALL NOT EXCEED 22 FEET UNLESS NOTED OR APPROVED BY THE CONTRACTING OFFICER. THE DISTANCE BETWEEN TYPE "A" JOINTS SHALL NOT EXCEED 111 FEET.

Revisions			
Symbol	Descriptions	Date	Approved
◇	REV. IN ACCORDANCE WITH MODIFICATION MC003	5/17/00	P.O.C.
◇	REV. IN ACCORDANCE WITH AMENDMENT MC001	2/28/00	P.O.C.

<b>BURGESS &amp; NIPLE, LIMITED</b> COLUMBUS, OHIO	<b>U.S. ARMY ENGINEER DISTRICT</b> CORPS OF ENGINEERS HUNTINGTON, WEST VIRGINIA
Designed by: <b>P. CONROY</b>	SCOTO RIVER COLUMBUS, OHIO WEST COLUMBUS, L.P.P. PHASE IIIA
Drawn by: <b>T. MULLINS</b>	<b>FLOODWALL PLAN</b>
Checked by: <b>L. LINZELL</b>	<b>STA. 233+00 TO 237+00</b>
Reviewed by:	Scale: <b>AS SHOWN</b>
Approved by:	Date: <b>OCTOBER 1999</b>
	Drawing Code: <b>16-PWC-12-</b>
	Sheet reference number: <b>20.1/6</b>
	FILENAME: 00app02.dgn
	PEN TABLE:
	Sheet <b>2</b> of <b>4</b>





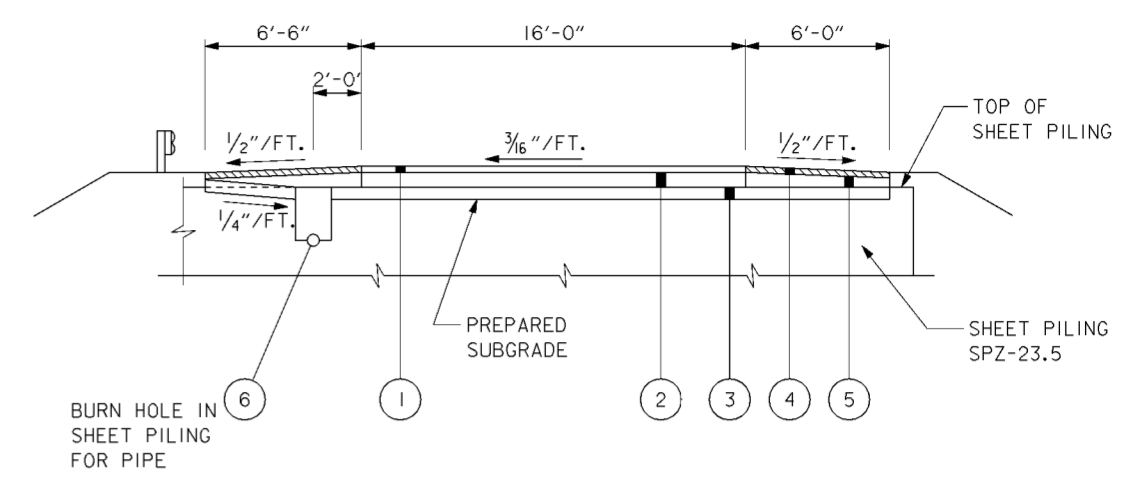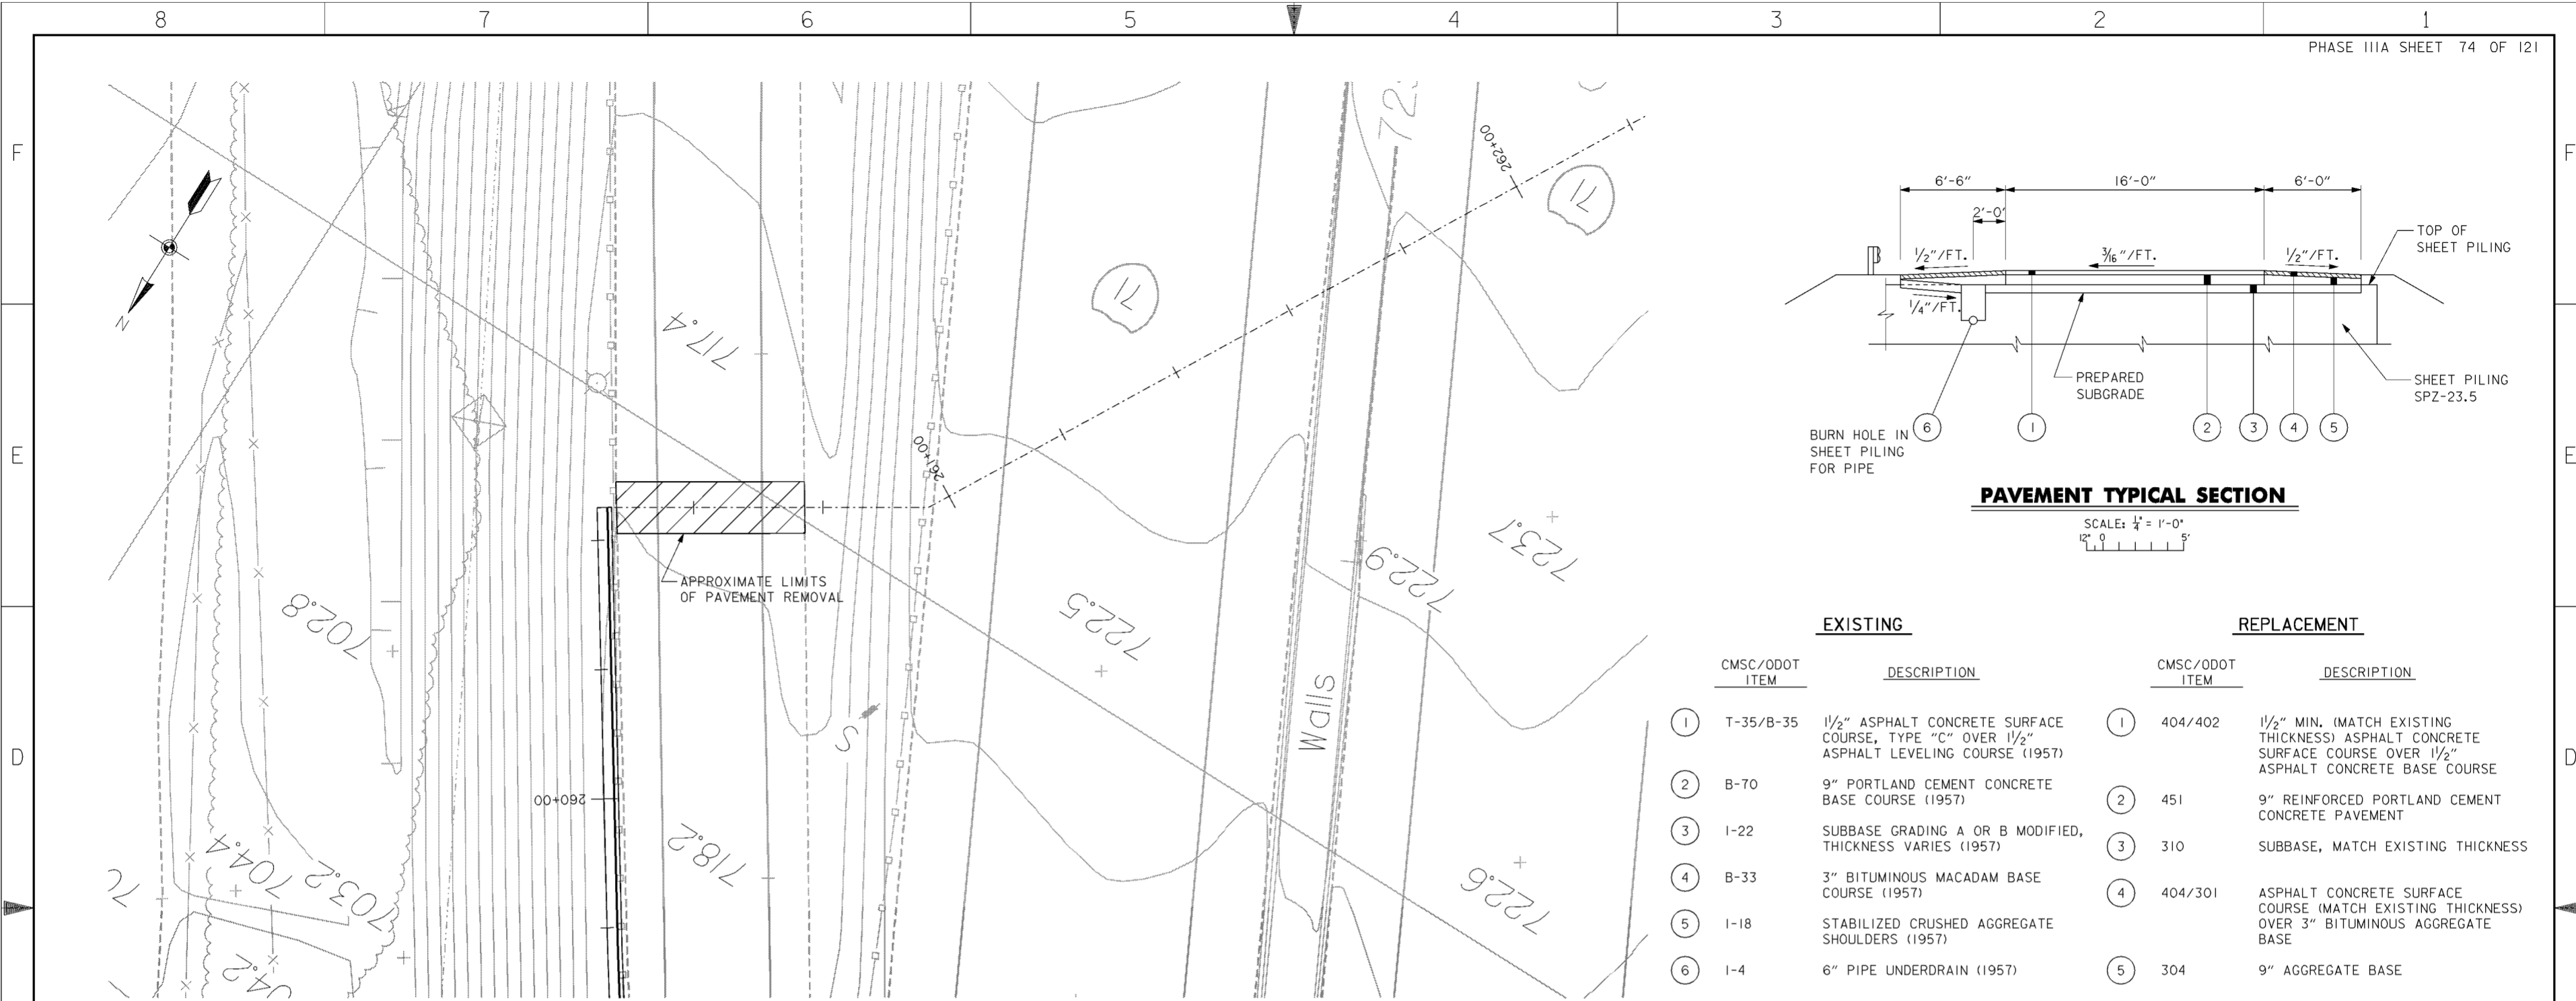


**PAVEMENT TYPICAL SECTION**  
SCALE: 1/4" = 1'-0"  
12" 0 5"

EXISTING		REPLACEMENT	
CMSC/ODOT ITEM	DESCRIPTION	CMSC/ODOT ITEM	DESCRIPTION
①	T-35/B-35 1/2" ASPHALT CONCRETE SURFACE COURSE, TYPE "C" OVER 1/2" ASPHALT LEVELING COURSE (1957)	①	404/402 1/2" MIN. (MATCH EXISTING THICKNESS) ASPHALT CONCRETE SURFACE COURSE OVER 1/2" ASPHALT CONCRETE BASE COURSE
②	B-70 9" PORTLAND CEMENT CONCRETE BASE COURSE (1957)	②	451 9" REINFORCED PORTLAND CEMENT CONCRETE PAVEMENT
③	I-22 SUBBASE GRADING A OR B MODIFIED, THICKNESS VARIES (1957)	③	310 SUBBASE, MATCH EXISTING THICKNESS
④	B-33 3" BITUMINOUS MACADAM BASE COURSE (1957)	④	404/301 ASPHALT CONCRETE SURFACE COURSE (MATCH EXISTING THICKNESS) OVER 3" BITUMINOUS AGGREGATE BASE
⑤	I-18 STABILIZED CRUSHED AGGREGATE SHOULDERS (1957)	⑤	304 9" AGGREGATE BASE
⑥	I-4 6" PIPE UNDERDRAIN (1957)	⑥	605 6" PIPE UNDERDRAIN

NOTE: SURFACE TO RECEIVE TACK COAT, CMSC ITEM 407, WITHOUT COVER AGGREGATE PRIOR TO EACH APPLICATION OF BITUMINOUS PAVING.

**NOTES**

1. FOR ADDITIONAL PAVEMENT REPLACEMENT AND DOWEL DETAILS SEE DRAWING NO.20.1/3.

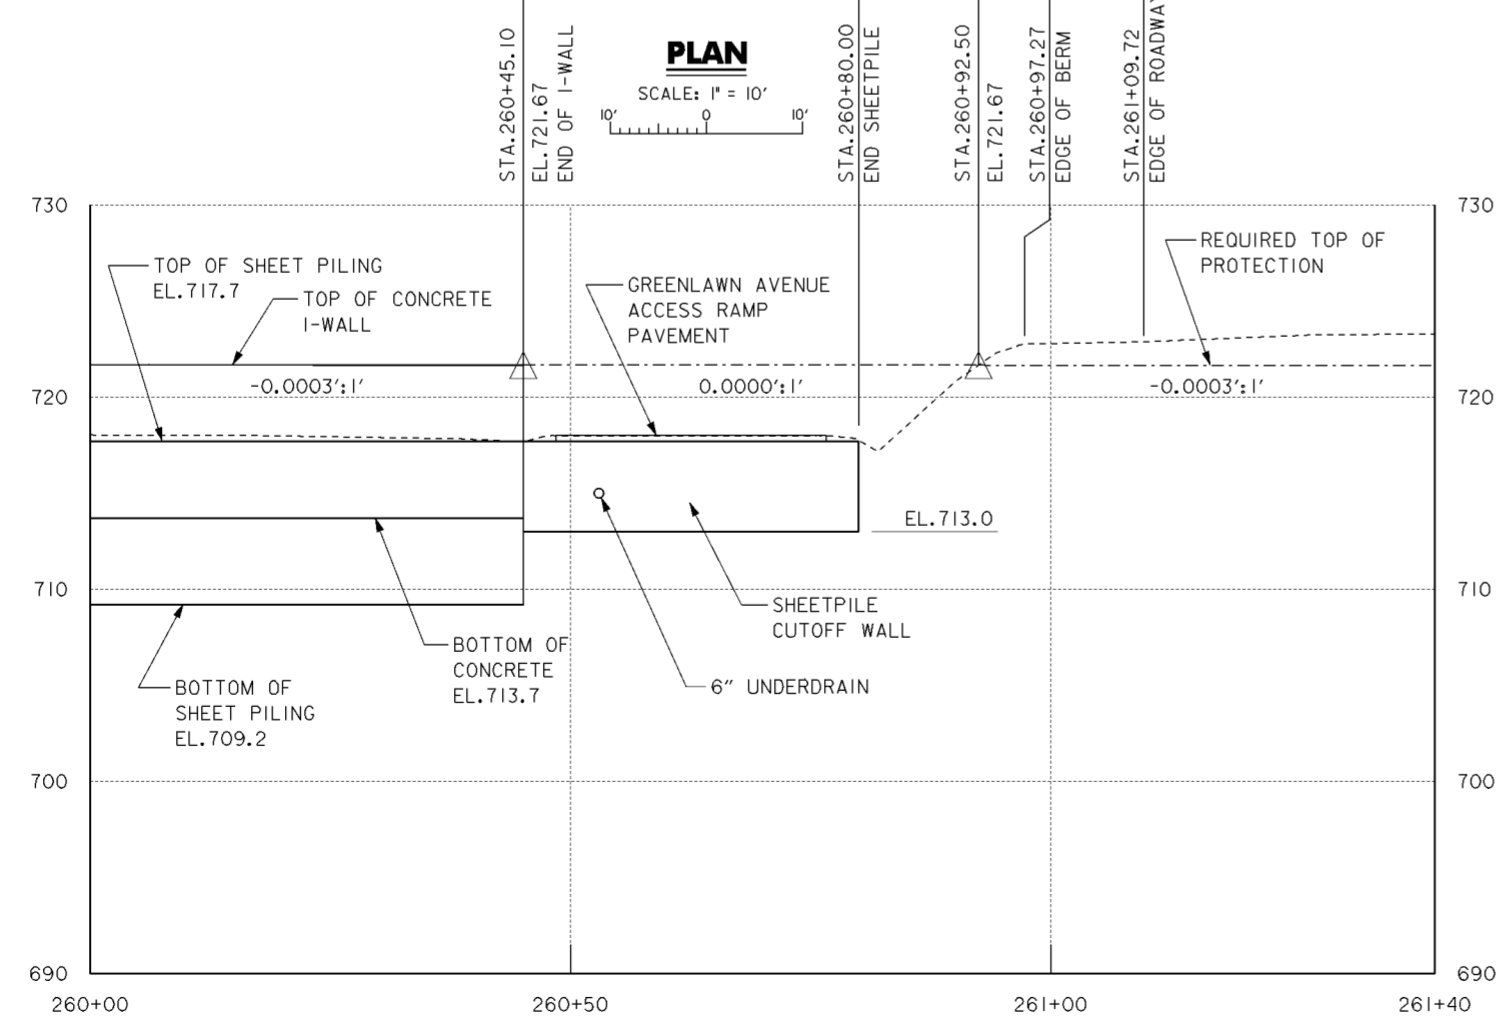


**PROFILE**  
SCALE IN FEET

**LEGEND**


PAVEMENT REMOVAL LIMITS

Revisions			
Symbol	Descriptions	Date	Approved

<b>BURGESS &amp; NIPLE, LIMITED</b> COLUMBUS, OHIO	<b>U.S. ARMY ENGINEER DISTRICT</b> CORPS OF ENGINEERS HUNTINGTON, WEST VIRGINIA		
Designed by: <b>J. HALL</b>	SCIO TO RIVER COLUMBUS, OHIO WEST COLUMBUS, L.P.P. PHASE IIIA		
Drawn by: <b>T. MULLINS</b>	<b>GREENLAWN AVENUE</b> <b>CLOSURE PLAN &amp; PROFILE</b>		
Checked by: <b>P. CONROY</b>			
Reviewed by:	Scale: <b>AS SHOWN</b>	Sheet reference number: <b>20.21</b>	FILENAME: 00g1pp01.dgn
Approved by:	Date: <b>OCTOBER 1999</b>	Drawing Code: <b>16-PWC-12-</b>	PIN TABLE: <b>20.21</b>
			Sheet 1 of 1

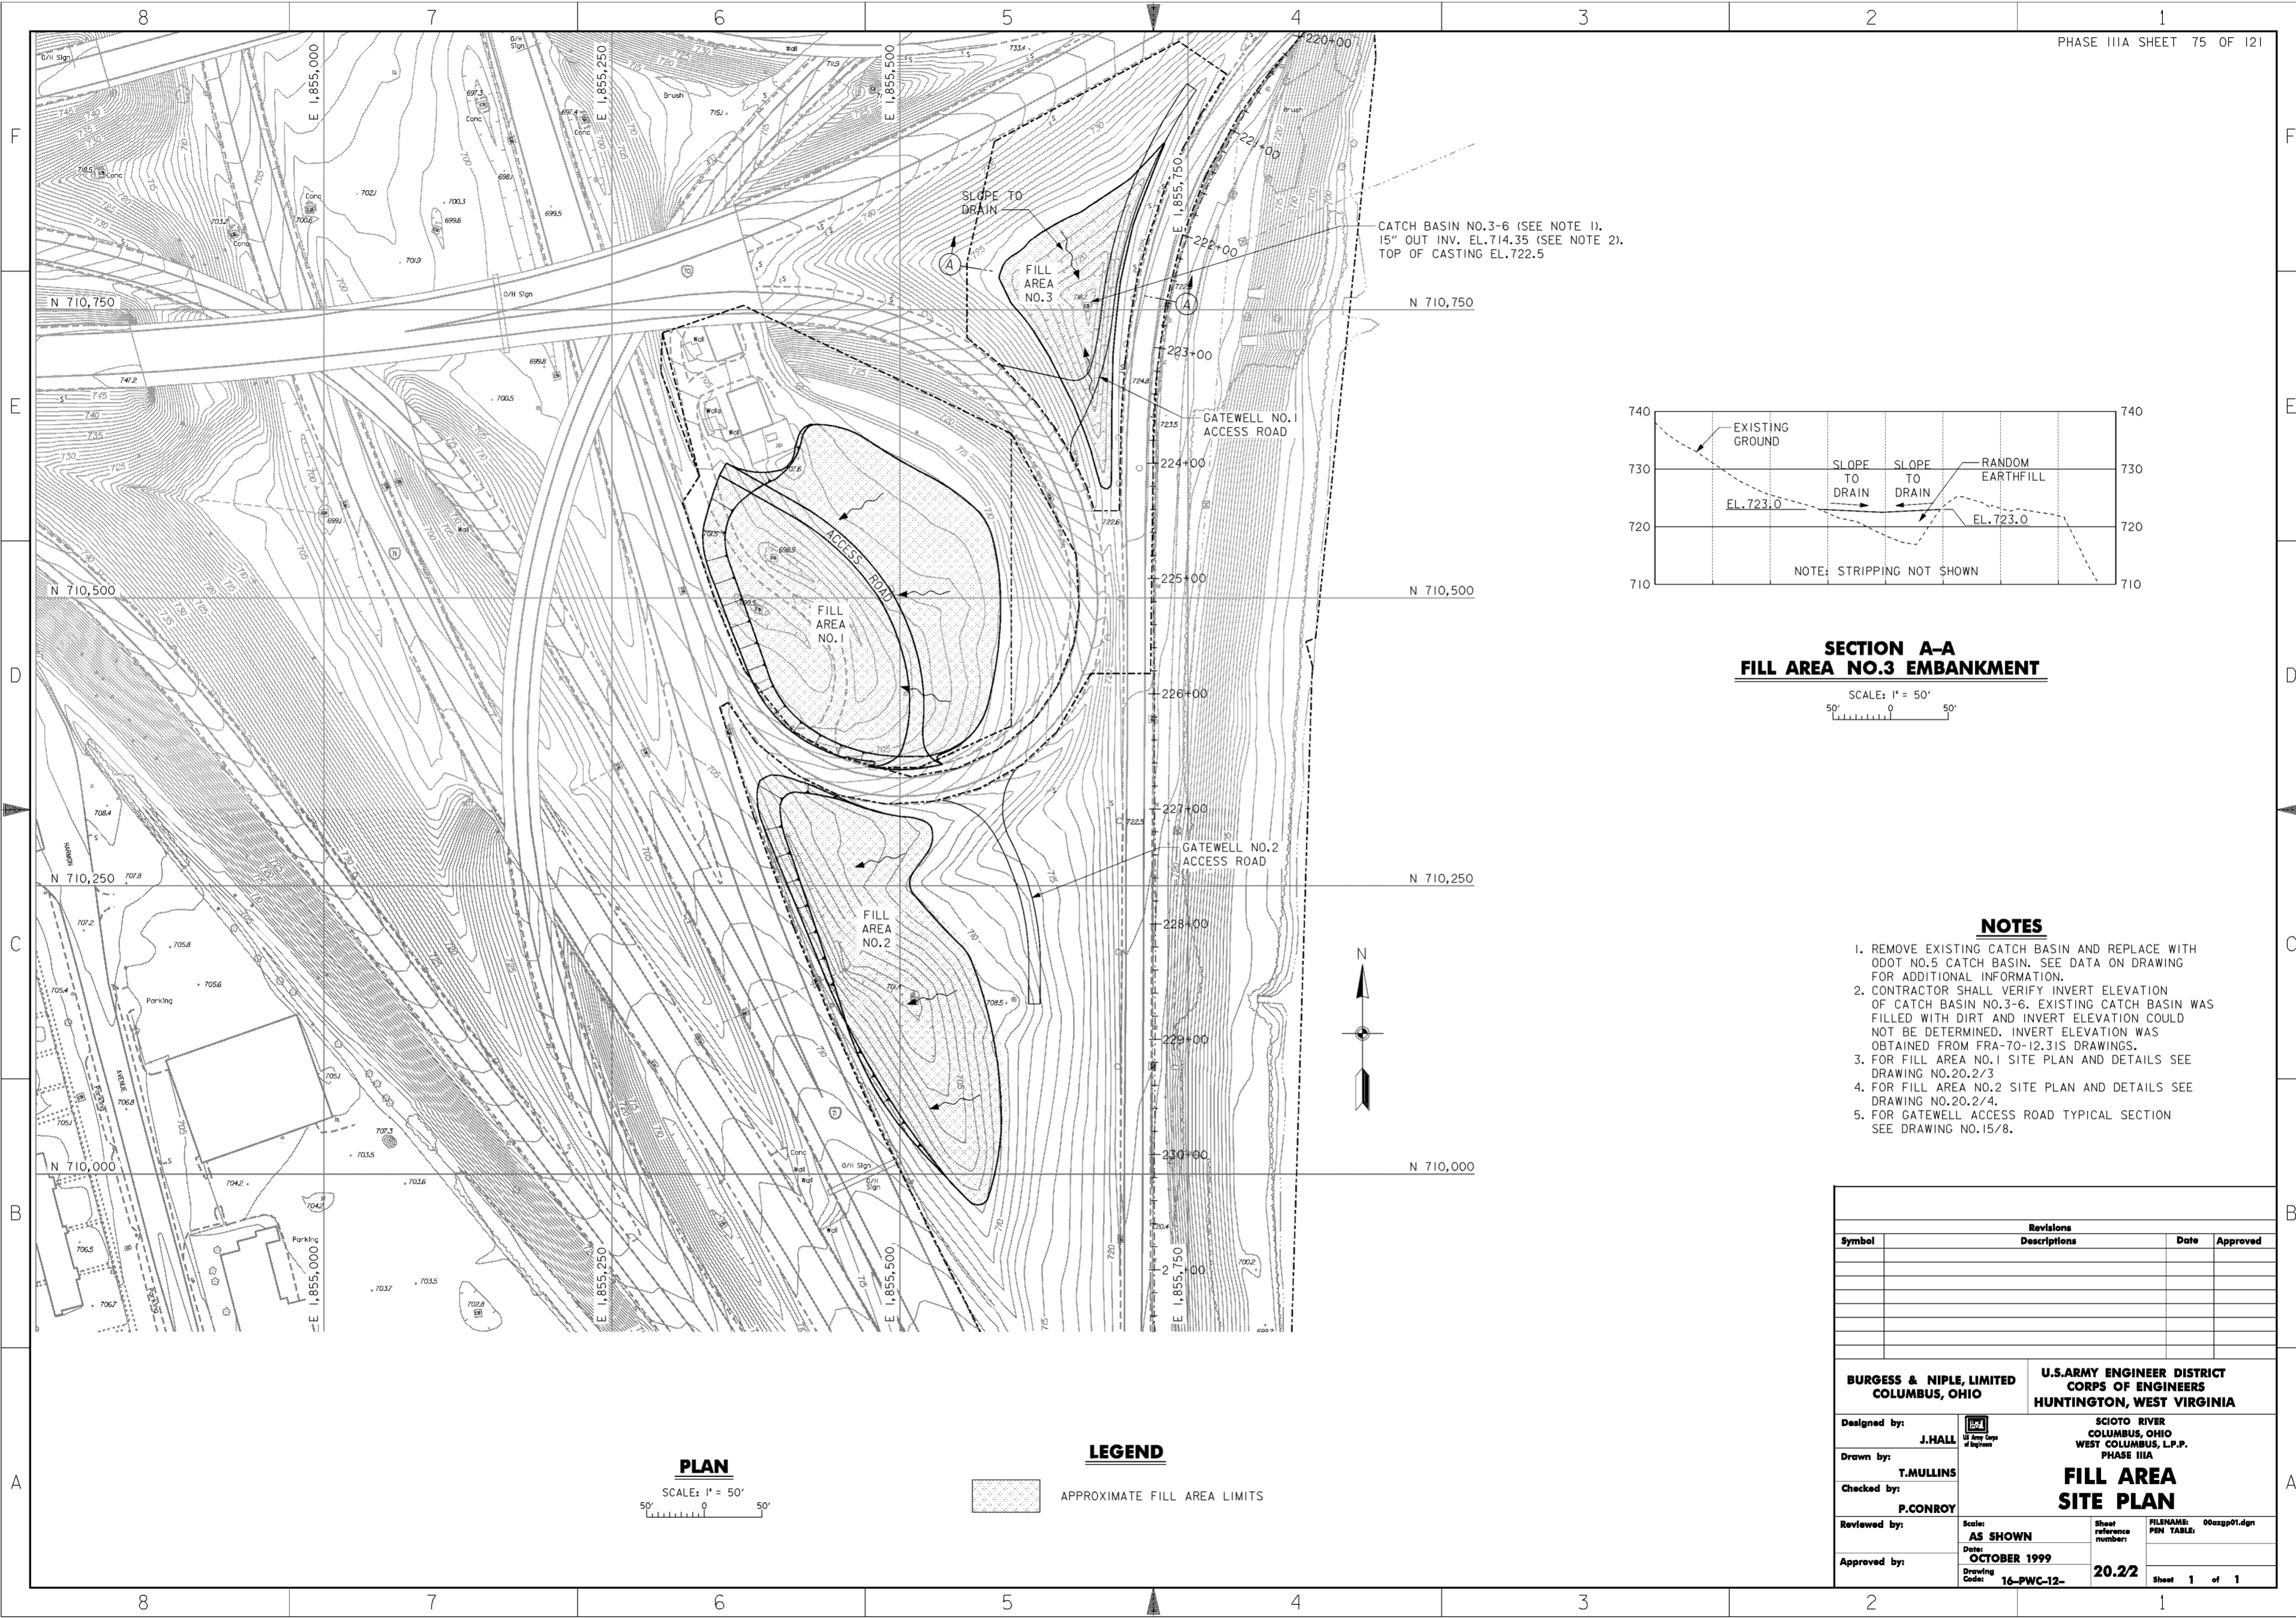

CATCH BASIN NO.3-6 (SEE NOTE 1).  
15" OUT INV. EL.714.35 (SEE NOTE 2).  
TOP OF CASTING EL.722.5

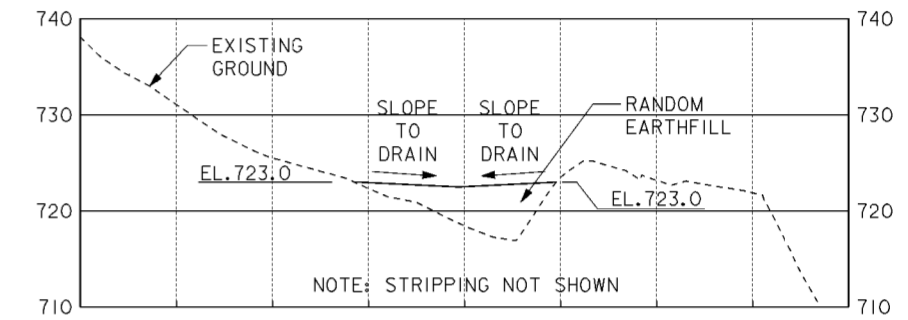

**SECTION A-A  
FILL AREA NO.3 EMBANKMENT**

SCALE: 1" = 50'  
50' 0 50'

**NOTES**

1. REMOVE EXISTING CATCH BASIN AND REPLACE WITH ODOT NO.5 CATCH BASIN. SEE DATA ON DRAWING FOR ADDITIONAL INFORMATION.
2. CONTRACTOR SHALL VERIFY INVERT ELEVATION OF CATCH BASIN NO.3-6. EXISTING CATCH BASIN WAS FILLED WITH DIRT AND INVERT ELEVATION COULD NOT BE DETERMINED. INVERT ELEVATION WAS OBTAINED FROM FRA-70-12.31S DRAWINGS.
3. FOR FILL AREA NO.1 SITE PLAN AND DETAILS SEE DRAWING NO.20.2/3
4. FOR FILL AREA NO.2 SITE PLAN AND DETAILS SEE DRAWING NO.20.2/4.
5. FOR GATEWELL ACCESS ROAD TYPICAL SECTION SEE DRAWING NO.15/8.

**PLAN**

SCALE: 1" = 50'  
50' 0 50'

**LEGEND**

APPROXIMATE FILL AREA LIMITS



Revisions			
Symbol	Descriptions	Date	Approved

<b>BURGESS &amp; NIPL, LIMITED</b> COLUMBUS, OHIO	<b>U.S. ARMY ENGINEER DISTRICT</b> CORPS OF ENGINEERS HUNTINGTON, WEST VIRGINIA	SCIOTO RIVER COLUMBUS, OHIO WEST COLUMBUS, L.P.P. PHASE IIIA	
		<b>FILL AREA SITE PLAN</b>	
Designed by: <b>J. HALL</b>		Drawn by: <b>T. MULLINS</b>	FILENAME: 00azp01.dgn PIN TABLE:
Checked by: <b>P. CONROY</b>			
Reviewed by: <b>AS SHOWN</b>		Sheet reference number: <b>20.22</b>	
Approved by: Date: <b>OCTOBER 1999</b>		Drawing Code: <b>16-PWC-12-</b>	
Sheet <b>1</b> of <b>1</b>			





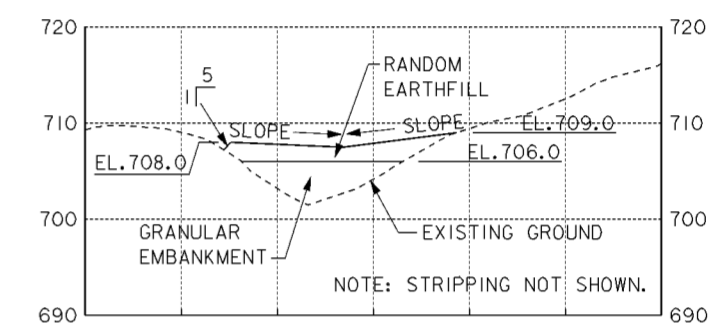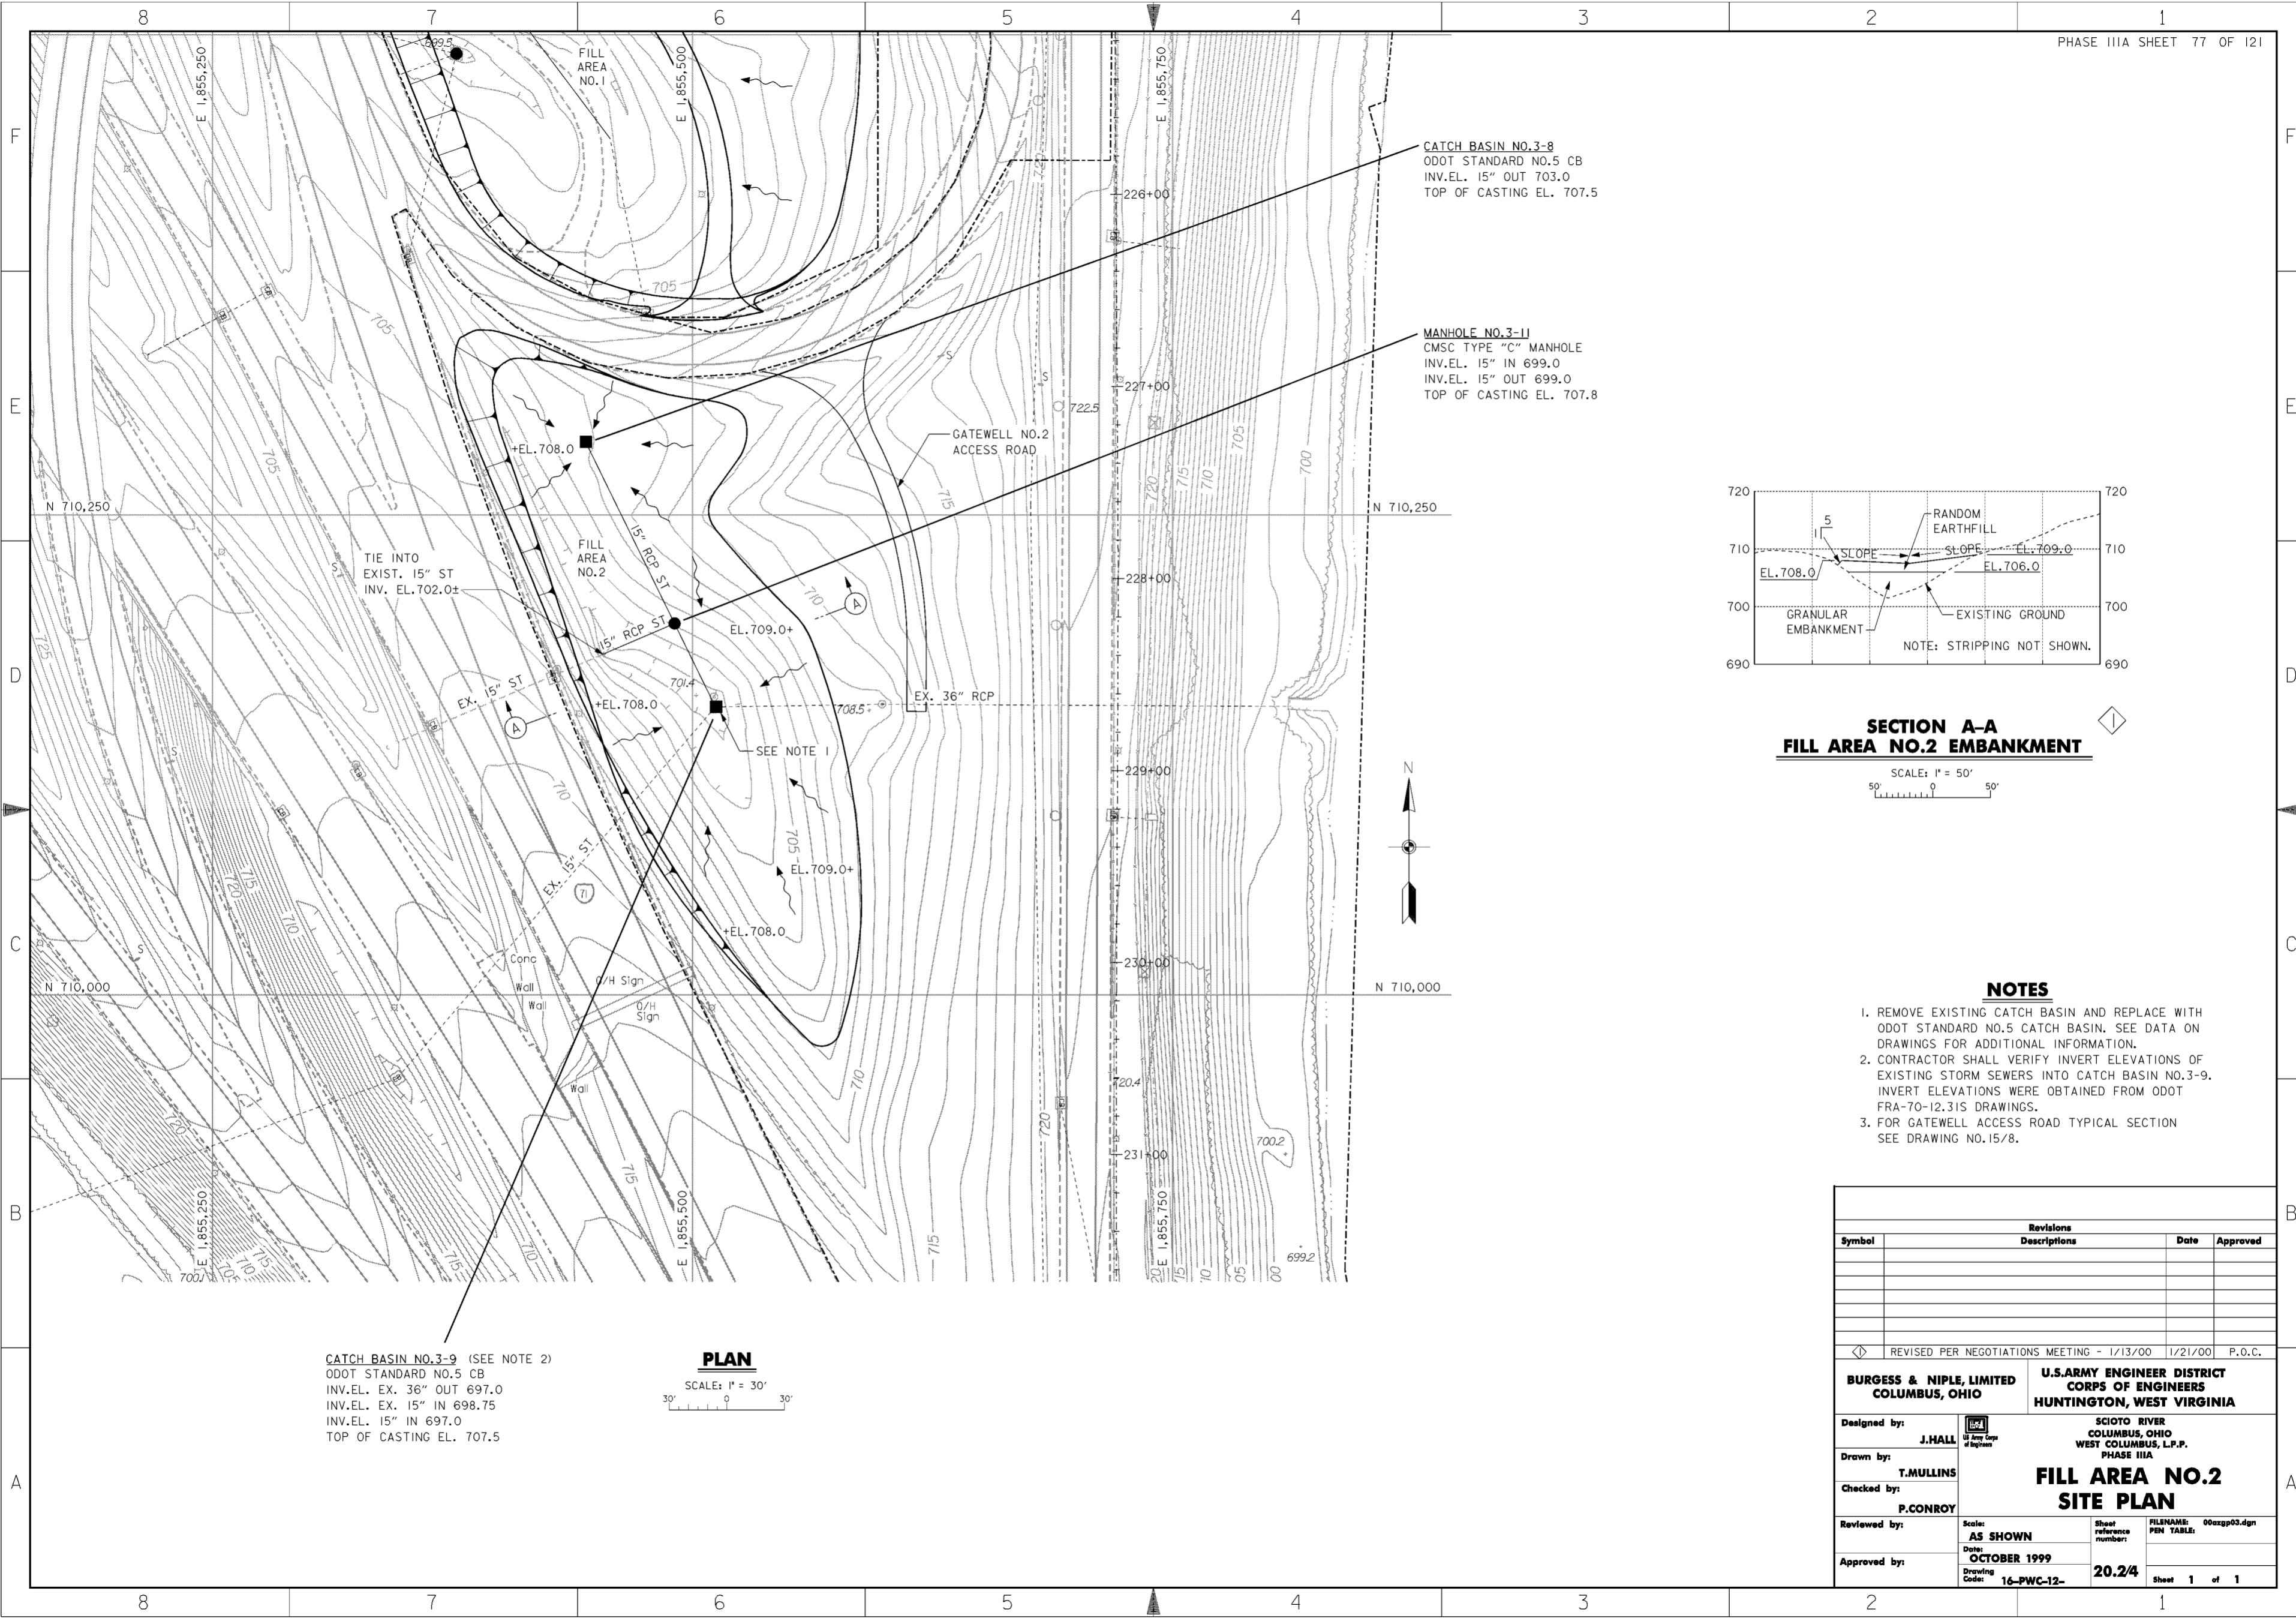

**SECTION A-A**  
**FILL AREA NO.2 EMBANKMENT**

SCALE: 1" = 50'  
50' 0 50'





**NOTES**

1. REMOVE EXISTING CATCH BASIN AND REPLACE WITH ODOT STANDARD NO.5 CATCH BASIN. SEE DATA ON DRAWINGS FOR ADDITIONAL INFORMATION.
2. CONTRACTOR SHALL VERIFY INVERT ELEVATIONS OF EXISTING STORM SEWERS INTO CATCH BASIN NO.3-9. INVERT ELEVATIONS WERE OBTAINED FROM ODOT FRA-70-12.31S DRAWINGS.
3. FOR GATEWELL ACCESS ROAD TYPICAL SECTION SEE DRAWING NO.15/8.

**CATCH BASIN NO.3-9 (SEE NOTE 2)**  
ODOT STANDARD NO.5 CB  
INV.EL. EX. 36" OUT 697.0  
INV.EL. EX. 15" IN 698.75  
INV.EL. 15" IN 697.0  
TOP OF CASTING EL. 707.5

**PLAN**  
SCALE: 1" = 30'  
30' 0 30'

Revisions			
Symbol	Descriptions	Date	Approved
◁ REVISED PER NEGOTIATIONS MEETING - 1/13/00 1/21/00 P.O.C.			
<b>BURGESS &amp; NIPL, LIMITED</b> COLUMBUS, OHIO		<b>U.S. ARMY ENGINEER DISTRICT</b> CORPS OF ENGINEERS HUNTINGTON, WEST VIRGINIA	
Designed by:	<b>J. HALL</b>	SCIO TO RIVER COLUMBUS, OHIO WEST COLUMBUS, L.P.P. PHASE IIIA	
Drawn by:	<b>T. MULLINS</b>	<b>FILL AREA NO.2</b>	
Checked by:	<b>P. CONROY</b>	<b>SITE PLAN</b>	
Reviewed by:		Scale:	Sheet reference number:
Approved by:		AS SHOWN	00azpp03.dgn
		Date:	FILENAME:
		OCTOBER 1999	PIN TABLE:
		Drawing Code:	20.2/4
		16-PWC-12-	Sheet 1 of 1

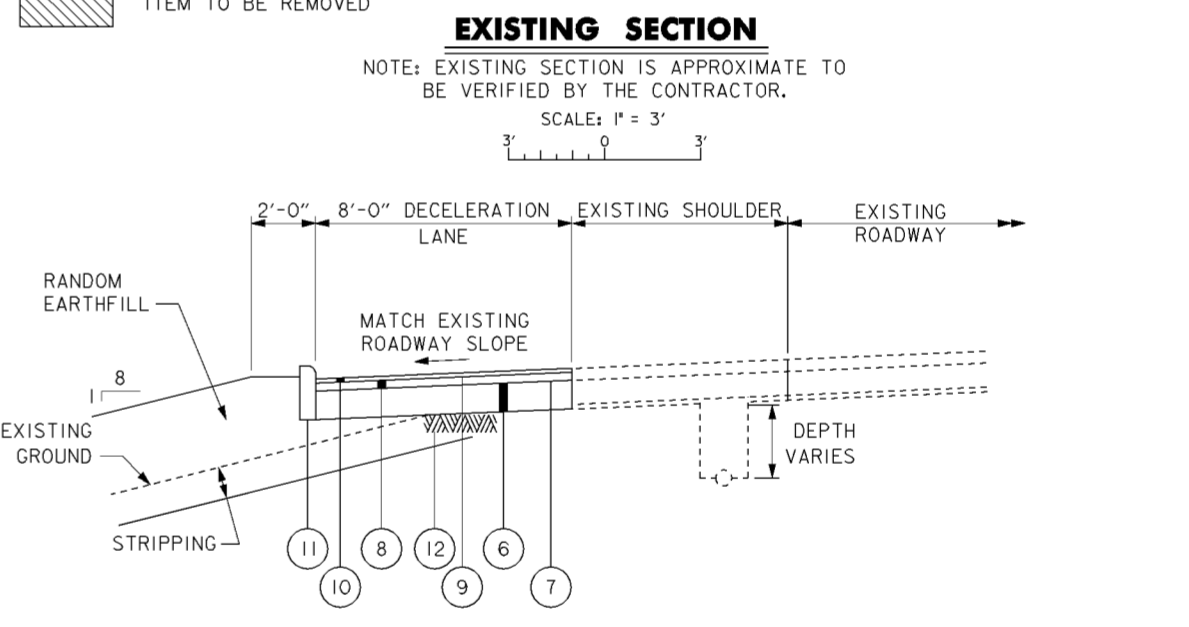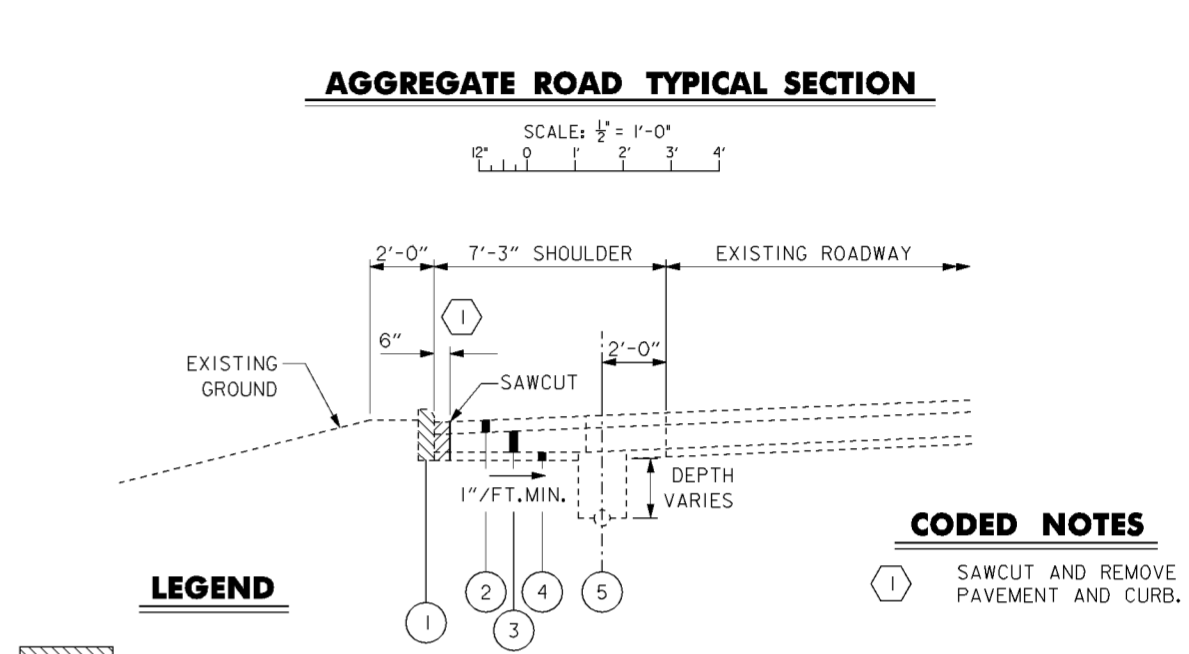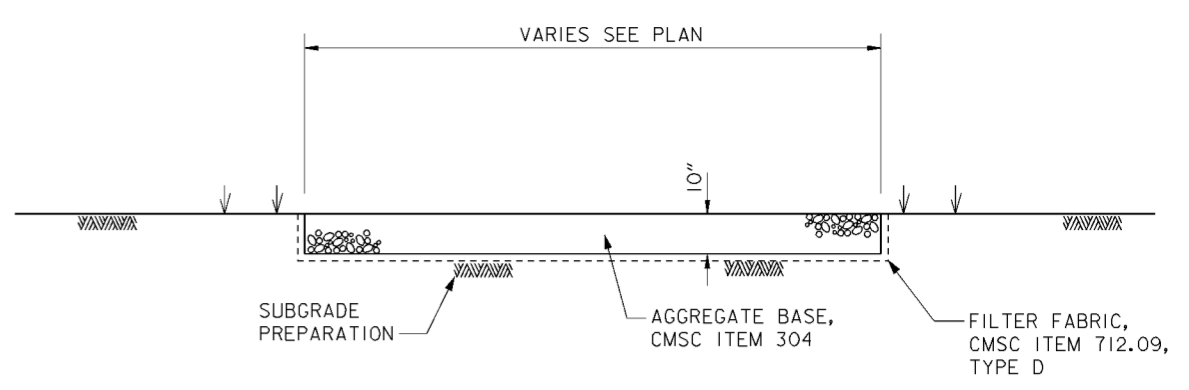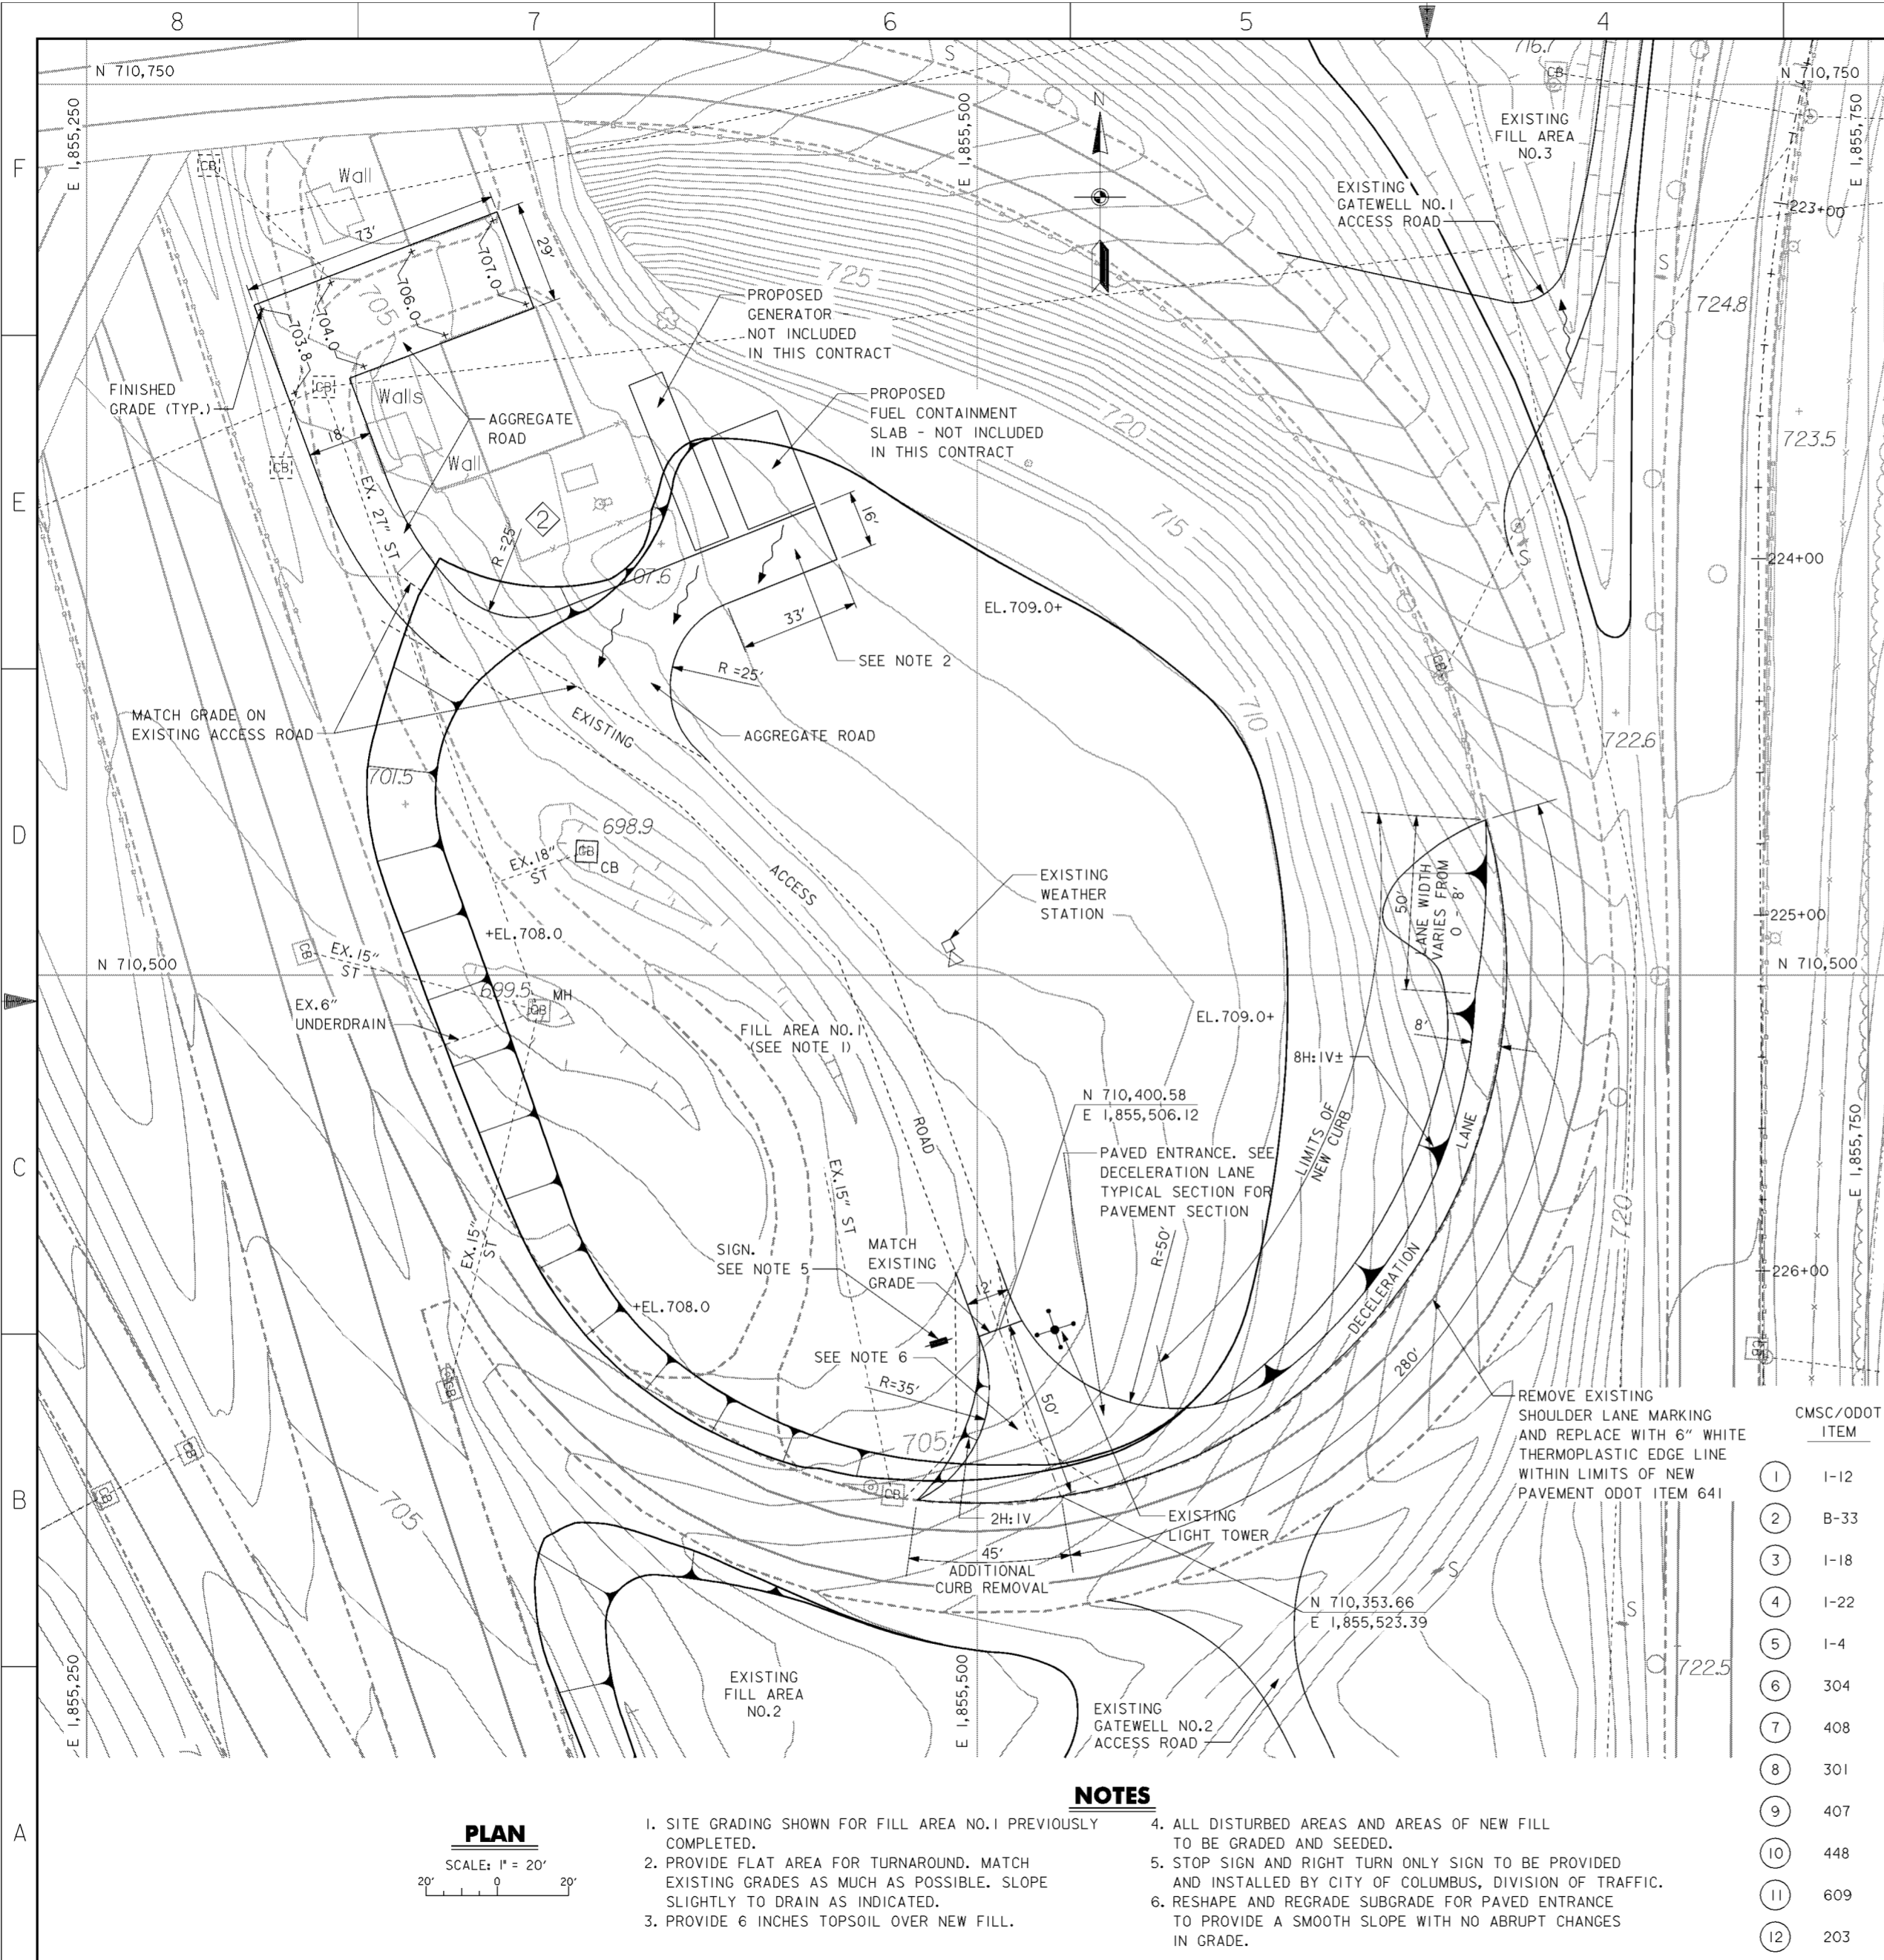


CMSC/ODOT ITEM

1	1-12	TYPE 6 CURB (1957)
2	B-33	3" BITUMINOUS AGGREGATE BASE (1957)
3	1-18	STABILIZED CRUSHED AGGREGATE SHOULDERS (1957)
4	1-22	SUBBASE, GRADING A OR B MODIFIED, THICKNESS VARIES (1957)
5	1-4	6" PIPE UNDERDRAIN (1957)
6	304	4" AGGREGATE BASE
7	408	PRIME COAT
8	301	6" BITUMINOUS AGGREGATE BASE
9	407	TACK COAT
10	448	ASPHALT CONCRETE SURFACE COURSE TYPE 1, MATCH EXISTING THICKNESS (1 1/2" MIN.)
11	609	TYPE 6 CURB
12	203	PREPARED SUBGRADE

**NOTES**

- SITE GRADING SHOWN FOR FILL AREA NO.1 PREVIOUSLY COMPLETED.
- PROVIDE FLAT AREA FOR TURNAROUND. MATCH EXISTING GRADES AS MUCH AS POSSIBLE. SLOPE SLIGHTLY TO DRAIN AS INDICATED.
- PROVIDE 6 INCHES TOPSOIL OVER NEW FILL.
- ALL DISTURBED AREAS AND AREAS OF NEW FILL TO BE GRADED AND SEEDED.
- STOP SIGN AND RIGHT TURN ONLY SIGN TO BE PROVIDED AND INSTALLED BY CITY OF COLUMBUS, DIVISION OF TRAFFIC.
- RESHAPE AND REGRADE SUBGRADE FOR PAVED ENTRANCE TO PROVIDE A SMOOTH SLOPE WITH NO ABRUPT CHANGES IN GRADE.

**PLAN**

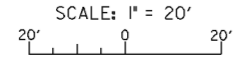

Revisions			
Symbol	Descriptions	Date	Approved
◇	REVISED AS CONSTRUCTED - PHASE IIIA NORTH	4/01	P.O.C.
◇	ADDED BY MODIFICATION M0009	11/00	P.O.C.

**BURGESS & NIPL, LIMITED**  
COLUMBUS, OHIO

**U.S. ARMY ENGINEER DISTRICT**  
CORPS OF ENGINEERS  
WEST COLUMBUS, WEST VIRGINIA

Designed by: **J. HALL**  
Drawn by: **T. MULLINS**  
Checked by: **P. CONROY**  
Reviewed by: **AS SHOWN**  
Approved by: **OCTOBER 1999**

SCIO TO RIVER  
COLUMBUS, OHIO  
WEST COLUMBUS, L.P.P.  
PHASE IIIA

**DECELERATION LANE AND ACCESS ROAD**

Scale: **AS SHOWN**  
Date: **OCTOBER 1999**  
Drawing Code: **16-PWC-12-**

Sheet reference number: **20.2/4A**  
FILENAME: **a02pp04A.dgn**  
P.O.C. TABLE:  
Sheet **1** of **1**



**EXISTING LIGHT POLE LOCATION AND DESCRIPTION SCHEDULE**

①	STA. 220+30	250-II-AT10B34.2 13B
②	STA. 221+34	250-II-AT10B34.2 13A
③	STA. 223+11	250-II-AT10B34.2 13
④	STA. 225+06	250-II-AT10B34.2 12
⑤	STA. 226+96	250-II-AT10B34.2 11. REMOVE EXISTING LINE SIDE CABLE AND CONNECTOR KITS. CLEAN CONDUIT AND PLUG TEMPORARILY UNTIL NEW CONDUCTORS ARE PULLED IN.
⑥	STA. 227+38	PULLBOX FOR EXISTING CIRCUIT "I" FEEDER
⑦	STA. 228+90	250-II-AT10B34.2 19
⑧	STA. 230+92	250-II-AT10B34.2 110
⑨	STA. 232+85	310-II-AT10B41.7 111
⑩	STA. 234+60	FOUNDATION ONLY. LIGHTPOLE AND LUMINARE MISSING.
⑪	STA. 235+51	DISCONNECT EXISTING SIGN CIRCUIT IN EXISTING PULL BOX. REMOVE EXISTING ROADWAY LIGHTING CIRCUIT TO NORTH FROM BOX.
⑫	STA. 236+45	310-III-AT15B41.7 113
⑬	STA. 238+57	310-III-AT15B41.7 114

**LEGEND**


- EXISTING LIGHT POLE AND FOUNDATION TO REMAIN
- EXISTING LIGHT POLE AND FOUNDATION TO BE REMOVED
- EXISTING UNDERGROUND LIGHTING CIRCUIT TO REMAIN IN USE
- EXISTING UNDERGROUND LIGHTING CIRCUIT TO BE ABANDONED
- CONTRACTOR WORK LIMITS
- EXISTING PULL BOX TO REMAIN
- EXISTING PULL BOX TO BE REMOVED
- EXISTING LIGHT TOWER

**NOTES**


- REFER TO SPECIFICATIONS SECTION 16528.3.16 FOR MAINTENANCE OF EXISTING LIGHTING DURING CONSTRUCTION.
- SEE LIGHT POLE DESIGN NUMBER DESIGNATIONS ON DRAWING NO. 20.2/9.

Revisions			
Symbol	Descriptions	Date	Approved
REV. IN ACCORDANCE WITH AMENDMENT MC001 2/28/00 P.O.C.			
<b>BURGESS &amp; NIPL, LIMITED</b> COLUMBUS, OHIO		<b>U.S. ARMY ENGINEER DISTRICT</b> CORPS OF ENGINEERS HUNTINGTON, WEST VIRGINIA	
Designed by:	J.AYRES	SCIOTO RIVER COLUMBUS, OHIO WEST COLUMBUS, L.P.P. PHASE IIIA <b>ROADWAY LIGHTING                  REMOVAL (1 OF 2)</b>	
Drawn by:	T.MULLINS		
Checked by:	D.SCHAMP		
Reviewed by:	AS SHOWN		
Approved by:	OCTOBER 1999	Sheet reference number:	FILENAME: 00uSep01.dgn
	Drawing Code: 16-PWC-12-	20.2/5	Sheet 1 of 2

MATCH LINE - SHEET 2

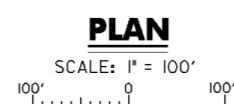

MATCH LINE - SHEET 1

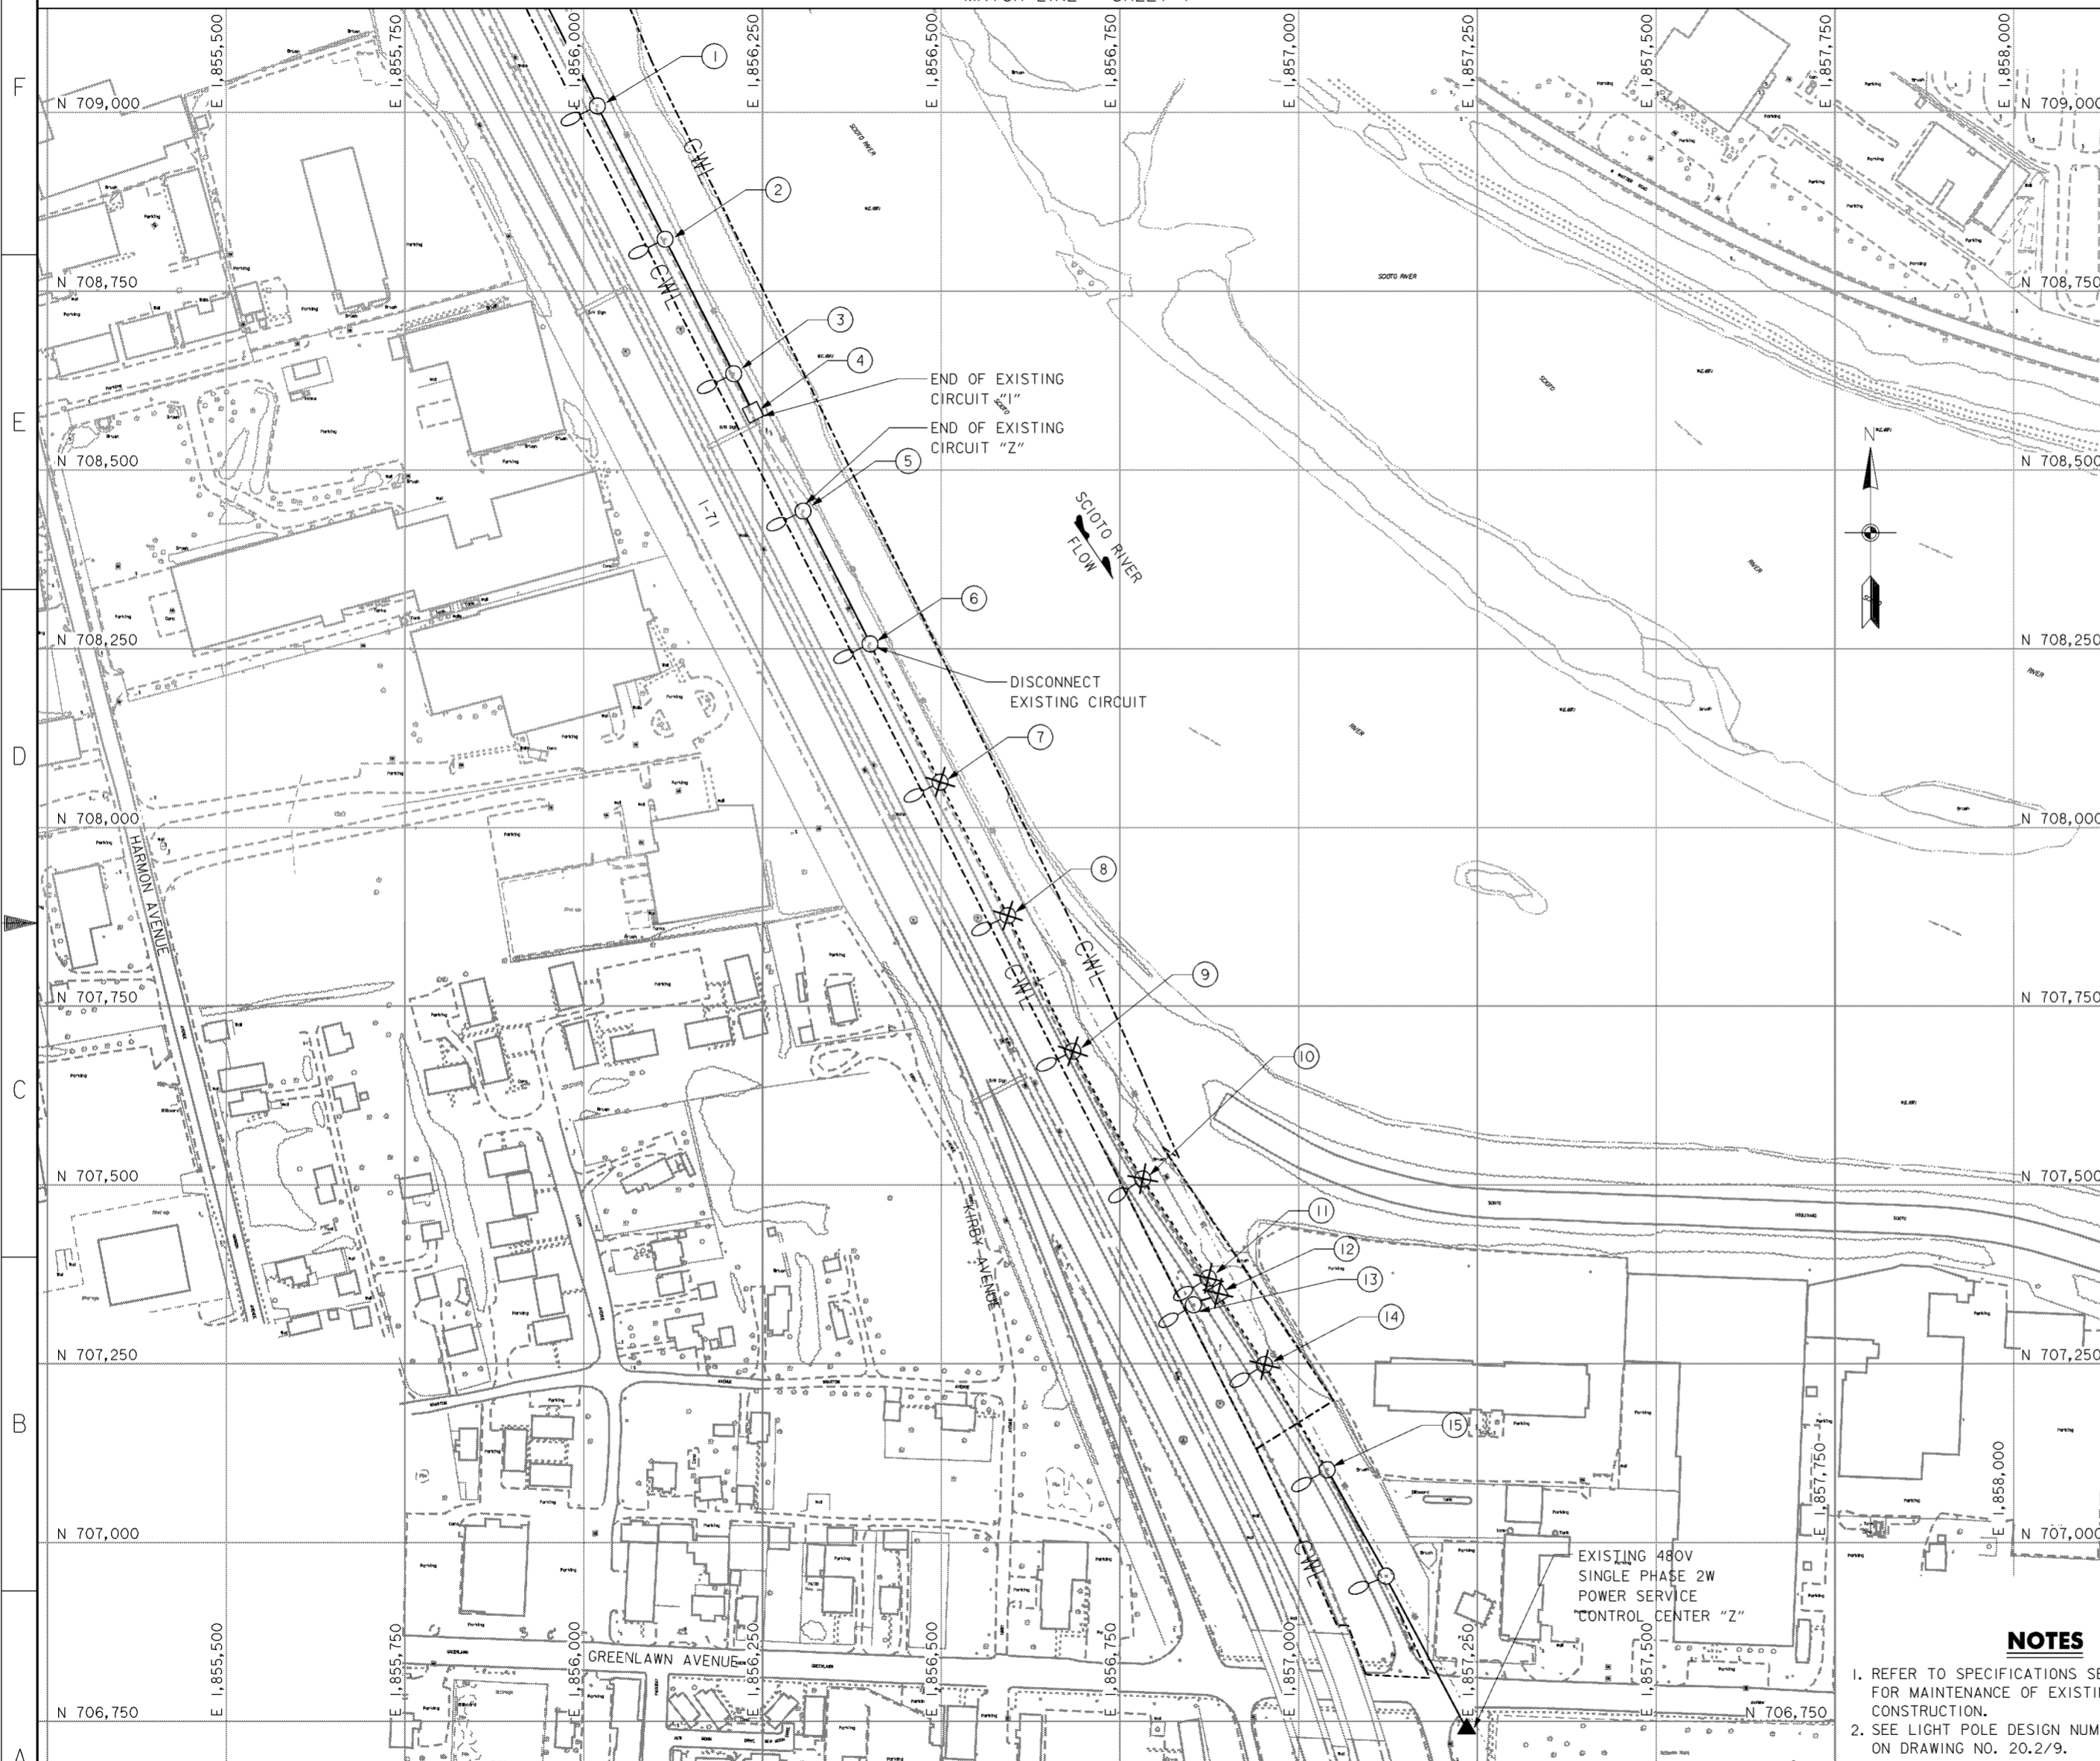

**EXISTING LIGHT POLE LOCATION AND DESCRIPTION SCHEDULE**

- ① STA. 240+70 310-III-AT15B41.7 114
- ② STA. 242+79 310-III-AT15B41.7 115
- ③ STA. 244+90 310-III-AT15B41.7 116
- ④ STA. 245+51 PULL BOX FOR EXISTING TRUSS SIGN.
- ⑤ STA. 247+05 310-III-AT15B41.7 Z10
- ⑥ STA. 249+13 310-III-AT15B41.7 Z9. REMOVE EXISTING LINE SIDE CABLE AND CONNECTOR KITS. CLEAN CONDUIT AND PLUG TEMPORARILY UNTIL NEW CONDUCTORS ARE PULLED IN.
- ⑦ STA. 251+30 310-III-AT15B41.7 Z8
- ⑧ STA. 253+39 310-III-AT15B41.7 Z7
- ⑨ STA. 255+50 310-III-AT15B41.7 Z6
- ⑩ STA. 257+53 310-III-AT15B41.7 Z5
- ⑪ STA. 259+20 310-III-AT15B41.7 Z4
- ⑫ STA. 259+40 PULL BOX. REMOVE SPLICE KITS AND CONDUCTORS TO ITEM 13.
- ⑬ STA. 259+40 310-III-AT15B41.7 Z3. REMOVE EXISTING LINE SIDE CABLE AND CONNECTOR KITS. CLEAN CONDUIT AND PLUG TEMPORARILY UNTIL CONDUIT IS EXTENDED TO NEW PULLBOX.
- ⑭ STA. 260+45 250-II-AT10B34.2
- ⑮ 250-II-AT10B34.2. REMOVE EXISTING LOAD SIDE CABLE AND CONNECTOR KITS. CLEAN CONDUIT AND PLUG TEMPORARILY UNTIL NEW CONDUCTORS ARE PULLED IN.

**LEGEND**

- EXISTING LIGHT POLE AND FOUNDATION TO REMAIN
- EXISTING LIGHT POLE AND FOUNDATION TO BE REMOVED
- EXISTING UNDERGROUND LIGHTING CIRCUIT TO REMAIN IN USE
- EXISTING UNDERGROUND LIGHTING CIRCUIT TO BE ABANDONED
- CONTRACTOR WORK LIMITS
- EXISTING PULL BOX TO REMAIN
- EXISTING PULL BOX TO BE REMOVED

**NOTES**

1. REFER TO SPECIFICATIONS SECTION 16528.3.16 FOR MAINTENANCE OF EXISTING LIGHTING DURING CONSTRUCTION.
2. SEE LIGHT POLE DESIGN NUMBER DESIGNATIONS ON DRAWING NO. 20.2/9.

**PLAN**

SCALE: 1" = 100'

Revisions			
Symbol	Descriptions	Date	Approved

<b>BURGESS &amp; NIPL, LIMITED</b> COLUMBUS, OHIO		<b>U.S. ARMY ENGINEER DISTRICT</b> CORPS OF ENGINEERS HUNTINGTON, WEST VIRGINIA	
Designed by: <b>J. AYRES</b>		SCIO TO RIVER COLUMBUS, OHIO WEST COLUMBUS, L.P.P. PHASE IIIA	
Drawn by: <b>T. MULLINS</b>		<b>ROADWAY LIGHTING</b> <b>REMOVAL (2 OF 2)</b>	
Checked by: <b>D. SCHAMP</b>		Scale: <b>AS SHOWN</b>	Sheet reference number: <b>20.2/6</b>
Reviewed by:		Date: <b>OCTOBER 1999</b>	FILENAME: 00usep02.dgn
Approved by:		Drawing Code: <b>16-PWC-12-</b>	PIN TABLE: <b>20.2/6</b>
			Sheet <b>2</b> of <b>2</b>


 







**WORK AS CONSTRUCTED**



**PROPOSED LIGHT POLE LOCATION AND DESCRIPTION SCHEDULE**


- ① STA. 226+96 2.0'L EXISTING LIGHT POLE. PROVIDE (1) TYPE II AND (1) TYPE III CONNECTOR KITS AND RECONNECT EXISTING CIRCUIT CONDUCTORS AND POLE AND BRACKET CABLE TO NEW CONNECTOR KITS.
- ② STA. 227+38 2.0'L 18" SQUARE CONCRETE PULL BOX. RECONNECT TO EXISTING 3" RGC UNDER RAMP AND PULL IN NEW 2-#4 AWG 5000 VOLT CABLES TO EXISTING PULL BOX. PROVIDE (2) SPLICE KITS. SEE NOTE 2 BELOW.
- ③ STA. 228+90 2.0'L 250-II-AT12B34.2 WITH TYPE II AND TYPE III CONNECTOR KITS CIRCUIT 19.
- ④ STA. 230+92 2.0'L 250-II-AT12B34.2 WITH TYPE II AND TYPE III CONNECTOR KITS CIRCUIT 110.
- ⑤ STA. 232+85 2.0'L 250-II-AT12B34.2 WITH TYPE II AND TYPE III CONNECTOR KITS CIRCUIT 111.
- ⑥ STA. 234+60 2.0'L 310-II-AT12B41.7 WITH TYPE II AND TYPE III CONNECTOR KITS CIRCUIT 112.
- ⑦ STA. 235+51 2.0'L EXISTING CONCRETE PULL BOX. PROVIDE (2) SPLICE KITS AND RECONNECT EXISTING SIGN SERVICE AND ROADWAY LIGHTING CIRCUIT TO THE SOUTH.

 **LEGEND**

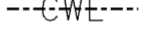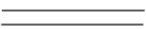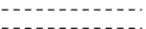
-  EXISTING LIGHT POLE AND FOUNDATION TO BE RECONNECTED
-  PROPOSED LIGHT POLE AND FOUNDATION. SEE DETAILS ON DRAWING NOS. 20.2/9 THRU 20.2/12
-  PROPOSED 18" SQUARE CONCRETE PULL BOX WITH CAST IRON COVER. SEE DETAIL ON DRAWING NO. 20.2/13
-  1/2" DUCT-CABLE WITH TWO NO.4 AWG 5000 VOLT CABLES IN 24" DEEP TRENCH. SEE DETAIL ON DRAWING NO. 20.2/12
-  CONTRACTOR WORK LIMITS
-  EXISTING PULL BOX
-  PROPOSED 3" RIGID CONDUIT
-  EXISTING CONDUIT
-  PROPOSED CONTROL CENTER AND 18" SQUARE CONCRETE PULLBOX


**NOTES**

1. SEE LIGHT POLE DESIGN NUMBER DESIGNATIONS ON DRAWING NO. 20.2/9.
2. IN THE EVENT THAT THE EXISTING CONDUIT UNDER THE RAMP IS NOT SUITABLE FOR RE-USE, PROVIDE 3" RGC JACKED OR DRILLED UNDER PAVEMENT PER DETAIL ON DRAWING NO. 20.2/13.

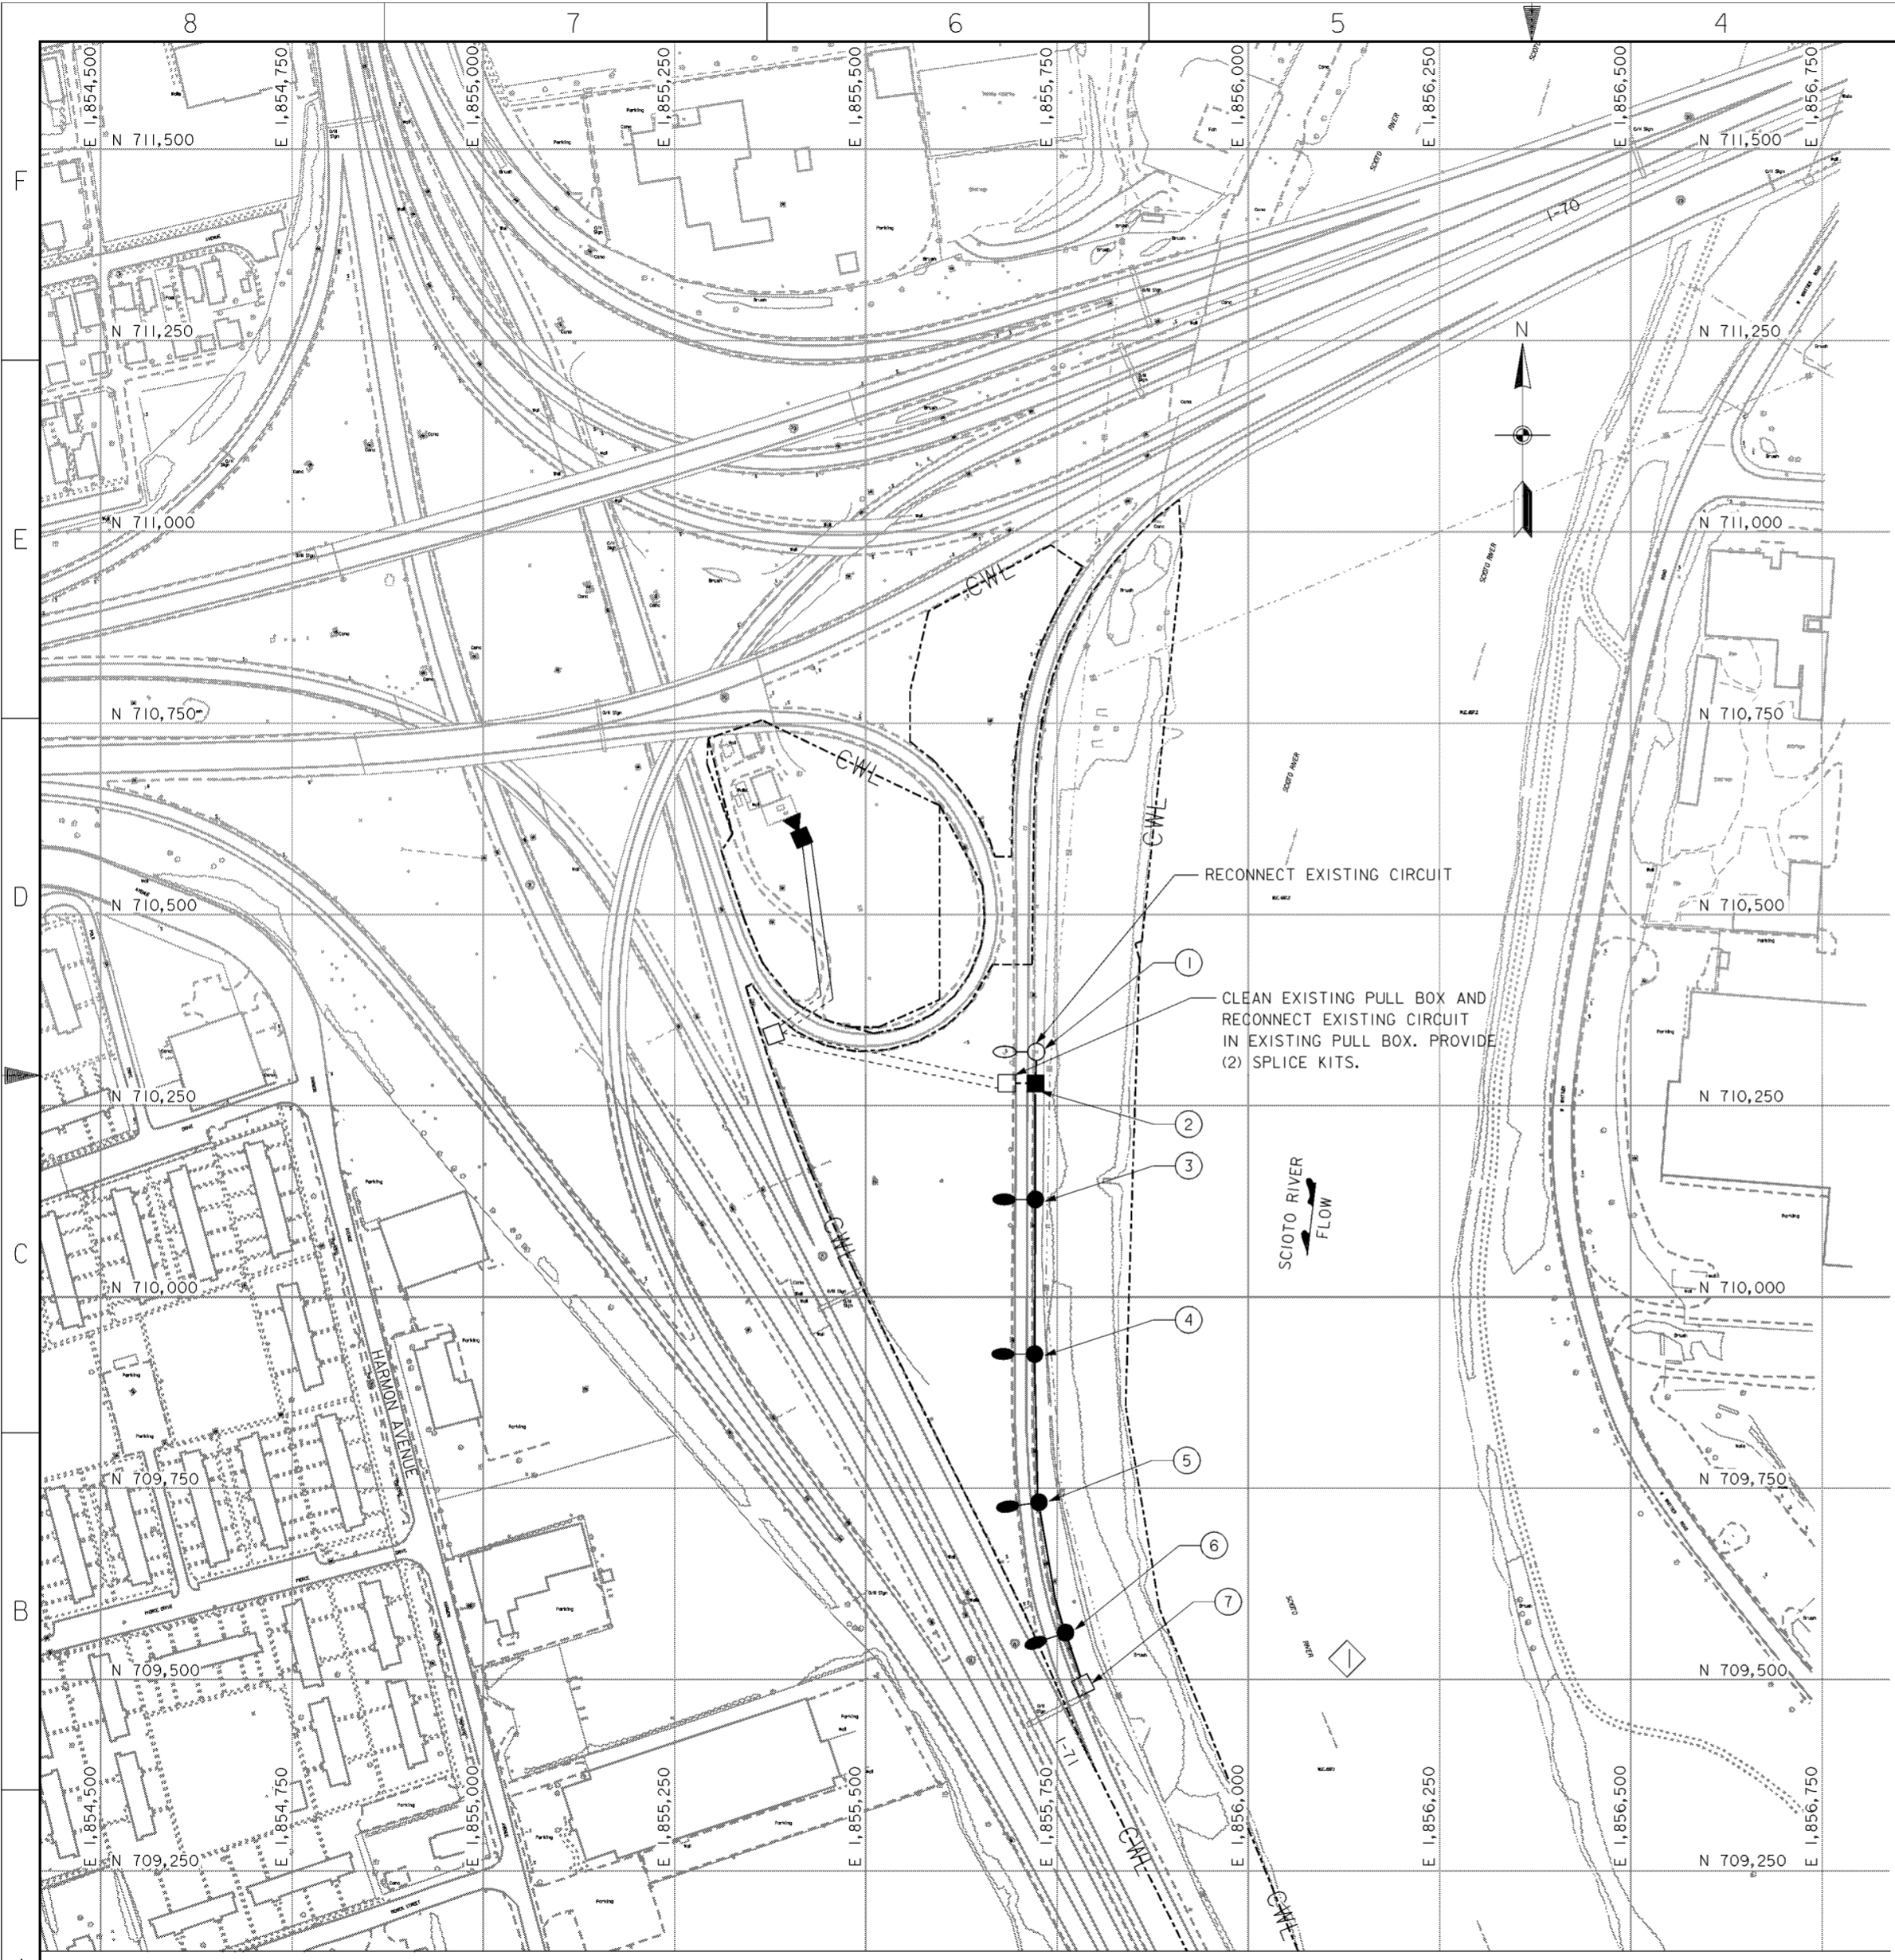


MATCH LINE - SHEET 2

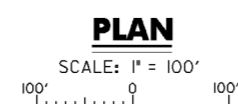

Revisions			
Symbol	Descriptions	Date	Approved
REV. IN ACCORDANCE WITH AMENDMENT MC001 2/28/00 P.O.C.			
<b>BURGESS &amp; NIPLÉ, LIMITED</b> COLUMBUS, OHIO		<b>U.S. ARMY ENGINEER DISTRICT</b> CORPS OF ENGINEERS HUNTINGTON, WEST VIRGINIA	
Designed by:	J. AYRES	 SCIOTO RIVER COLUMBUS, OHIO WEST COLUMBUS, L.P.P. PHASE IIIA <b>ROADWAY LIGHTING</b> <b>REPLACEMENT(1 OF 2)</b>	
Drawn by:	T. MULLINS		
Checked by:	D. SCHAMP		
Reviewed by:			
Approved by:		Scale: AS SHOWN	Sheet reference number: 20.2/7
Date: OCTOBER 1999		FILENAME: 00uSep03.dgn	P.O. TABLE: 
Drawing Code: 16-PWC-12-		20.2/7	Sheet 1 of 2

MATCH LINE - SHEET 1

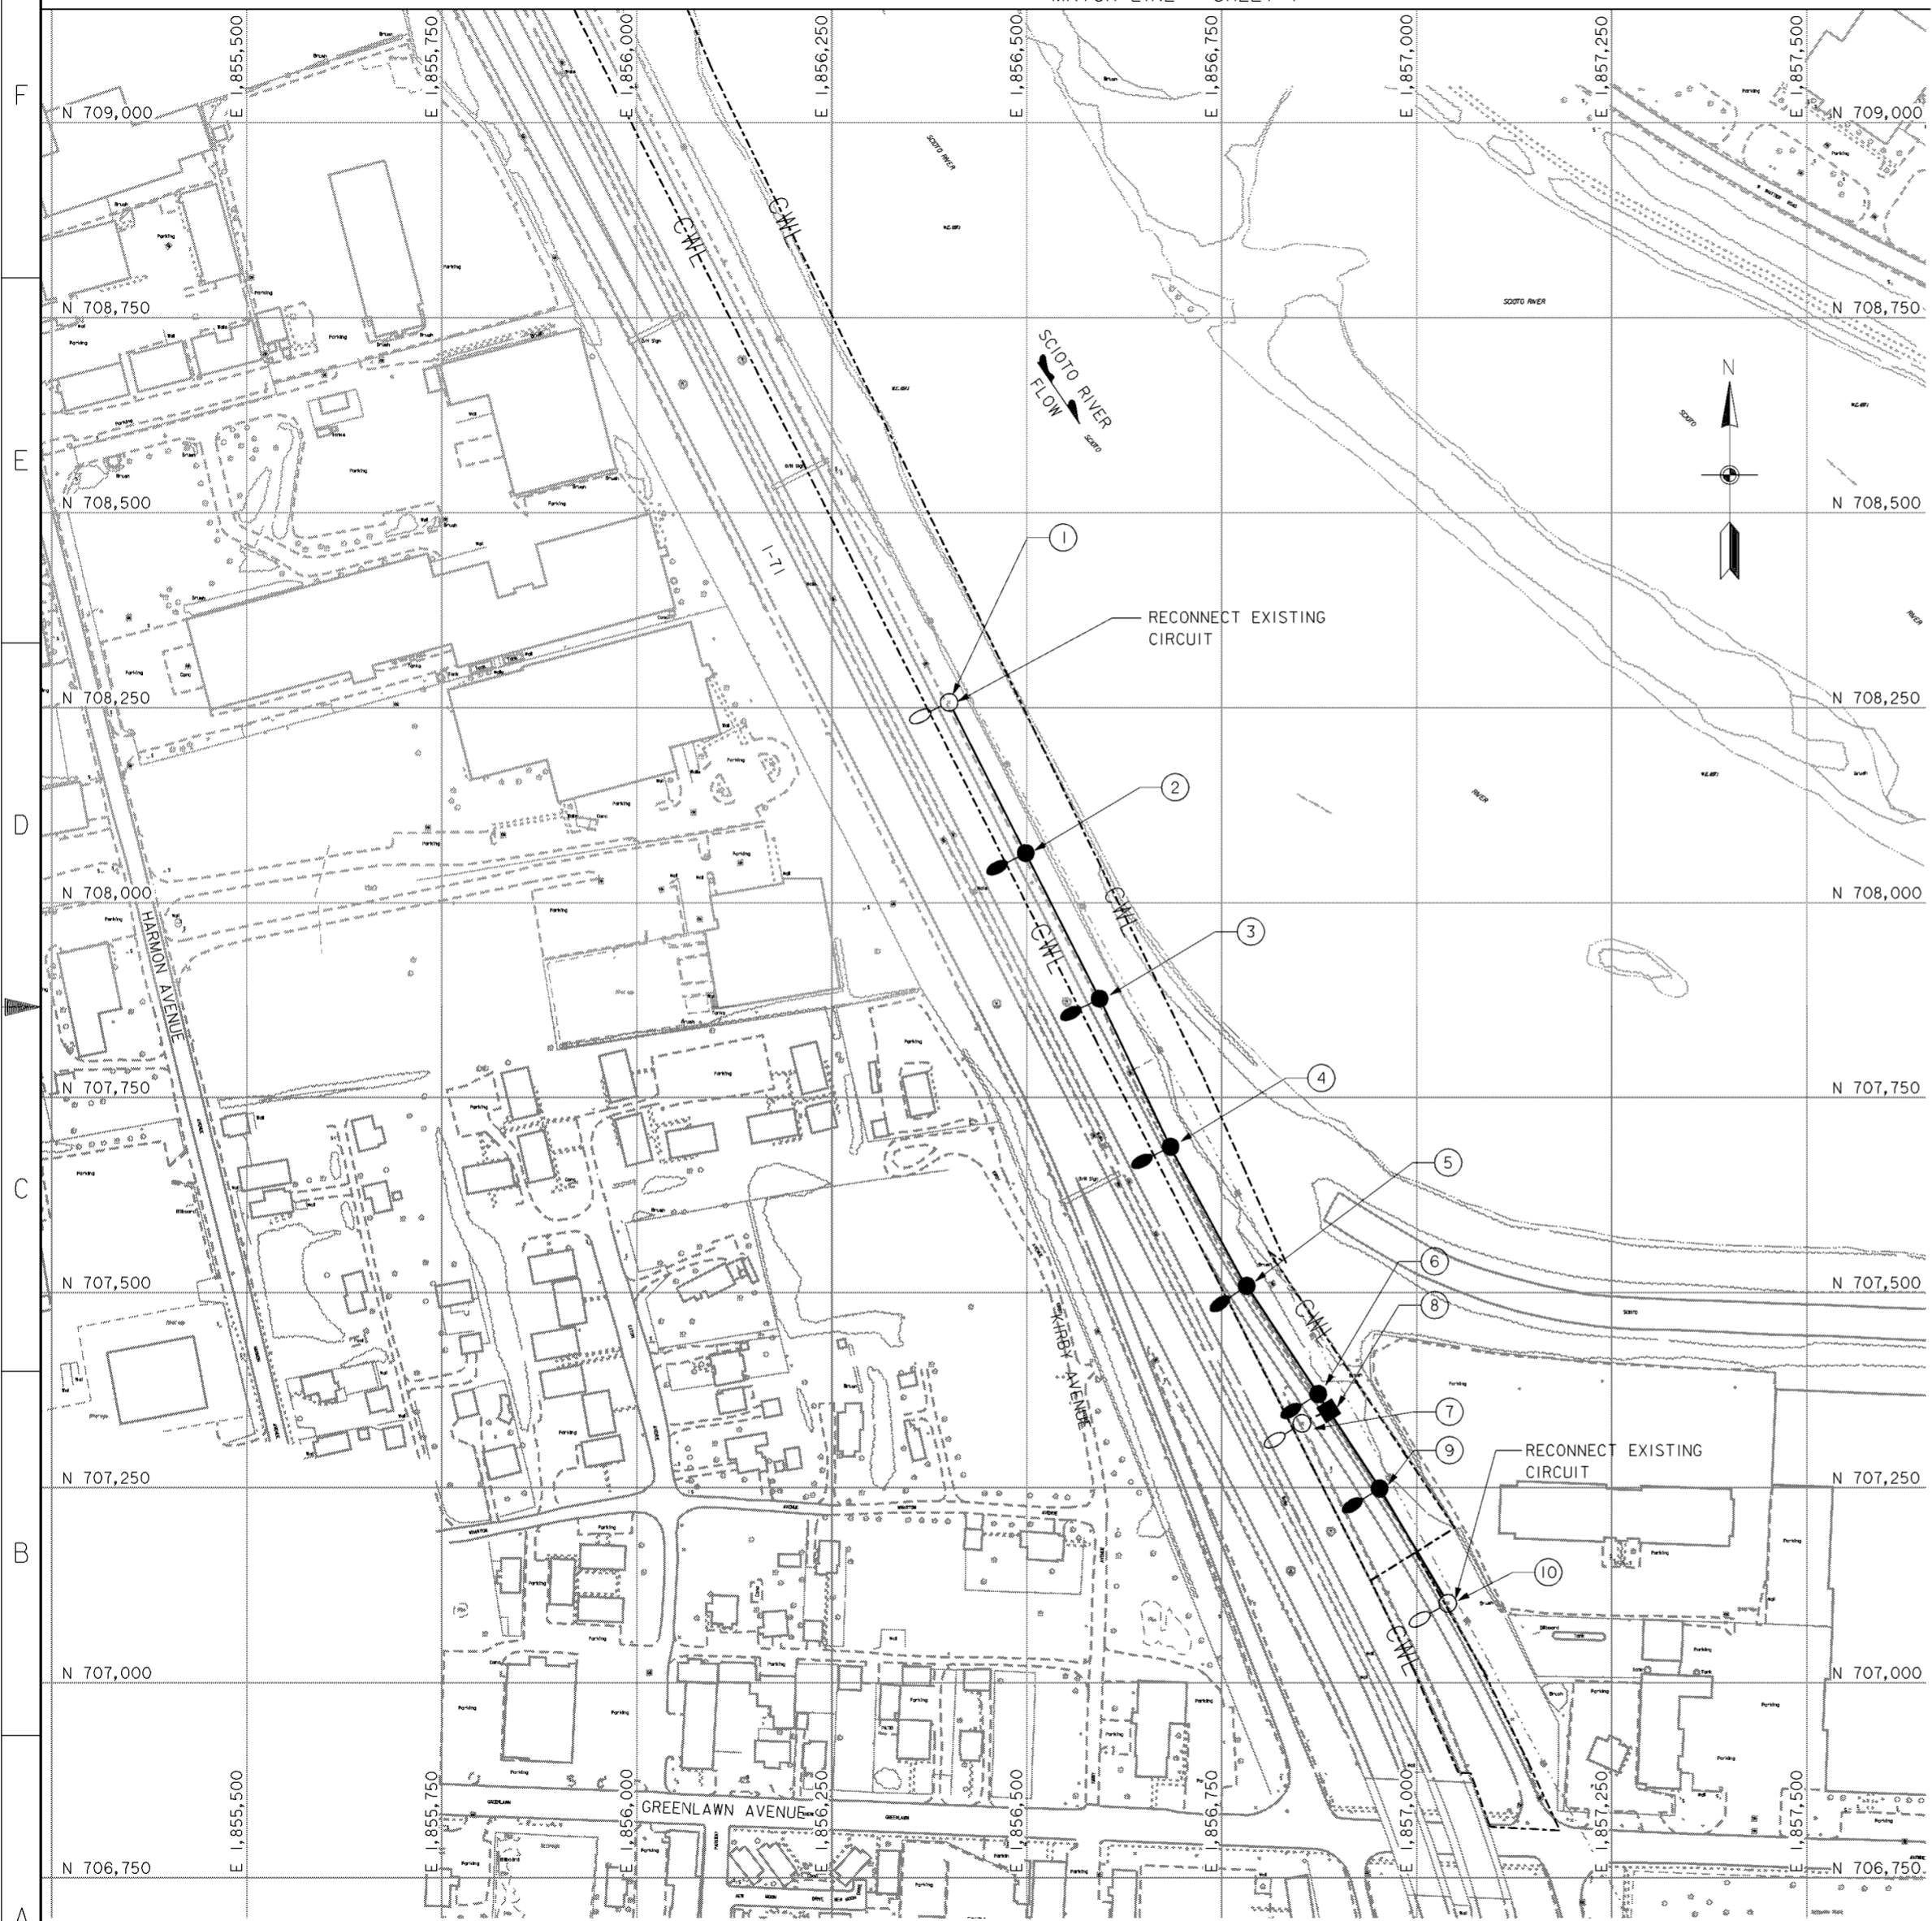

**PROPOSED LIGHT POLE LOCATION AND DESCRIPTION SCHEDULE**

- ① STA. 249+18 0.9'L EXISTING LIGHT POLE. PROVIDE (1) TYPE II AND (1) TYPE III CONNECTOR KITS AND RECONNECT EXISTING CIRCUIT CONDUCTORS AND POLE AND BRACKET CABLE TO NEW CONNECTOR KITS.
- ② STA. 251+40 2.57'L 310-III-AT18B41.7 WITH TYPE II AND TYPE III CONNECTOR KITS CIRCUIT Z8.
- ③ STA. 253+99 0.11'L 310-III-AT18B41.7 WITH TYPE II AND TYPE III CONNECTOR KITS CIRCUIT Z7.
- ④ STA. 255+51 2.38'L 310-III-AT18B41.7 WITH TYPE II AND TYPE III CONNECTOR KITS CIRCUIT Z6.
- ⑤ STA. 257+54 2.53'L 310-III-AT20B41.7 WITH TYPE II AND TYPE III CONNECTOR KITS CIRCUIT Z5.
- ⑥ STA. 259+20 2.37'L 250-II-AT12B34.2 WITH TYPE II AND TYPE III CONNECTOR KITS CIRCUIT Z4.
- ⑦ STA. 259+40 EXISTING LIGHT POLE. PROVIDE (1) TYPE II AND (1) TYPE III CONNECTOR KITS AND RECONNECT EXISTING POLE AND BRACKET CABLE TO NEW CONNECTOR KITS.
- ⑧ STA. 259+40 2.0'L 18" SQUARE CONCRETE PULL BOX. RECONNECT TO EXISTING 3" RGC UNDER RAMP AND PULL IN NEW 2-\*4 AWG 5000 VOLT CABLES TO LIGHT POLE ITEM 7. PROVIDE (2) SPLICE KITS. SEE NOTE 2 BELOW.
- ⑨ STA. 260+47 2.05'L 250-II-AT12B34.2 WITH TYPE II AND TYPE III CONNECTOR KITS CIRCUIT Z3.
- ⑩ EXISTING LIGHT POLE. PROVIDE (1) TYPE II AND (1) TYPE III CONNECTOR KITS AND RECONNECT EXISTING CIRCUIT CONDUCTORS AND POLE AND BRACKET CABLE TO NEW CONNECTOR KITS.

**LEGEND**

- ○ EXISTING LIGHT POLE AND FOUNDATION
- ● PROPOSED LIGHT POLE AND FOUNDATION. SEE DETAILS ON DRAWING NOS. 20.2/9 THRU 20.2/12
- PROPOSED 18" SQUARE CONCRETE PULL BOX WITH CAST IRON COVER. SEE DETAIL ON DRAWING NO. 20.2/13
- 1/2" DUCT-CABLE WITH TWO NO.4 AWG 5000 VOLT CABLES IN 24" DEEP TRENCH. SEE DETAIL ON DRAWING NO. 20.2/12
- CWL--- CONTRACTOR WORK LIMITS
- EXISTING PULL BOX

**NOTES**

1. SEE LIGHT POLE DESIGN NUMBER DESIGNATIONS ON DRAWING NO. 20.2/9.
2. IN THE EVENT THAT THE EXISTING CONDUIT UNDER THE RAMP IS NOT SUITABLE FOR RE-USE, PROVIDE 3" RGC JACKED OR DRILLED UNDER PAVEMENT PER DETAIL ON DRAWING NO. 20.2/13.


Revisions			
Symbol	Descriptions	Date	Approved
◇	REVISED AS CONSTRUCTED - PHASE IIIA SOUTH	4/01	P.O.C.
<b>BURGESS &amp; NIPLE, LIMITED</b> COLUMBUS, OHIO		<b>U.S. ARMY ENGINEER DISTRICT</b> CORPS OF ENGINEERS HUNTINGTON, WEST VIRGINIA	
Designed by:	J.AYRES	SCIOTO RIVER COLUMBUS, OHIO WEST COLUMBUS, L.P.P. PHASE IIIA	
Drawn by:	T.MULLINS	<b>ROADWAY LIGHTING</b> <b>REPLACEMENT(2 OF 2)</b>	
Checked by:	D.SCHAMP	Scale:	AS SHOWN
Reviewed by:		Date:	OCTOBER 1999
Approved by:		Sheet reference number:	20.2/8
		Drawing Code:	16-PWC-12-
		FILENAME:	a05ep04.dgn
		PIN TABLE:	
		Sheet	2 of 2

**PLAN**

SCALE: 1" = 100'





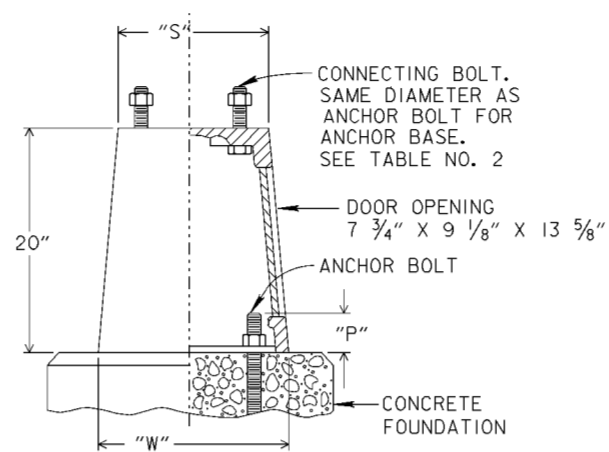


**NOTES**

1. FOR POLE GROUNDING DETAILS SEE DRAWING NO. 20.2/14.
2. TYPE AT-A BASE SHALL NORMALLY BE USED WITH ANCHOR BASE POLES HAVING DIAMETERS OF 6 INCHES THROUGH 9.2 INCHES INCLUSIVE, AND MOUNTING HEIGHTS THROUGH 41.7 FEET.
3. TYPE AT-C BASE MUST BE USED FOR ANCHOR BASE POLES HAVING DIAMETERS OF 9.5 INCHES AND 10 INCHES AND MOUNTING HEIGHTS THROUGH 51.7 FEET.
4. REFER TO SPECIFICATIONS SECTION 16528, 2.15.4, FOR TRANSFORMER TYPE BASES.

TABLE NO. 2 TRANSFORMER BASE ANCHOR BOLTS			
SHAFT SIZE	STEEL POLE GAUGE NO.		
6.5"	11	7	3
7"	1" $\phi$ X 40"	1" $\phi$ X 40"	1 1/4" $\phi$ X 40"
7.5"			
8"			
8.5"			
9"	1 1/4" $\phi$ X 48"	1" $\phi$ X 48"	1 1/4" $\phi$ X 48"
9.5"			
10"			

40" BOLTS INCLUDE 4" BEND  
48" AND 60" BOLTS INCLUDE 6" BEND

TABLE NO. 3 ALUMINUM TRANSFORMER BASES					
TYPE	"P"	"S"	"W"	BOLT CIRCLE	SHAFT SIZE
AT-A	4 1/2"	13"	16 3/8"	15"	SEE NOTE 2
AT-C	4 1/2"	14 5/8"	17 1/4"	17 1/4"	SEE NOTE 3



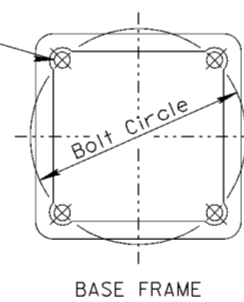


**CAST ALUMINUM TRANSFORMER BASES**

Revisions			
Symbol	Descriptions	Date	Approved

<b>BURGESS &amp; NIPLE, LIMITED</b> COLUMBUS, OHIO	<b>U.S. ARMY ENGINEER DISTRICT</b> CORPS OF ENGINEERS HUNTINGTON, WEST VIRGINIA		
Designed by: <b>ODOZJ.AYRES</b>	SCIO TO RIVER COLUMBUS, OHIO WEST COLUMBUS, L.P.P. PHASE IIIA		
Drawn by: <b>T.FAHERTY</b>	<b>ROADWAY LIGHTING</b> <b>DETAILS (3 OF 6)</b>		
Checked by: <b>D.SCHAMP</b>			
Reviewed by:	Scale: <b>NONE</b>	Sheet reference number:	FILENAME: 00usd103.dgn
Approved by:	Date: <b>OCTOBER 1999</b>	Drawing Code: <b>16-PWC-12-</b>	PIN TABLE: <b>20.2/11</b>
		Sheet <b>3</b> of <b>6</b>	



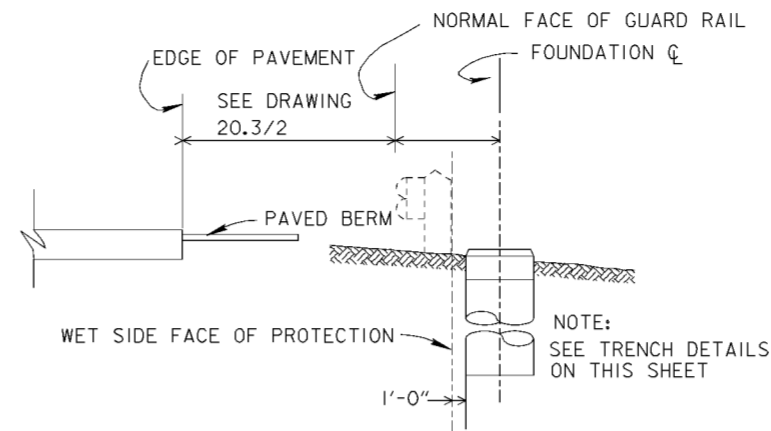
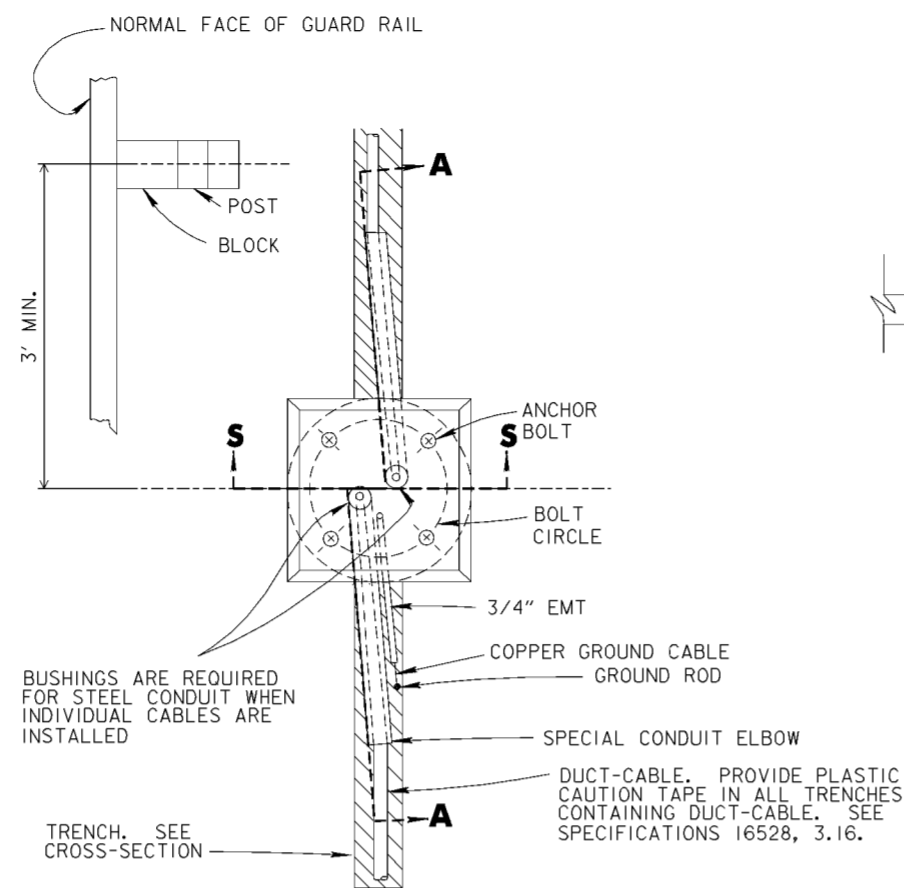
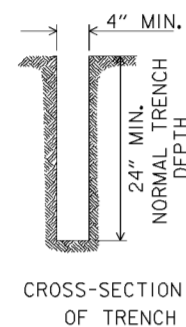


**NORMAL LOCATION OF LIGHT POLE FOUNDATION**

OPPOSITE HAND FOR POLES MOUNTED ON LEFT SIDE OF PAVEMENT

**NOTES**

- FOUNDATION  
MINIMUM DEPTHS TO BE AS FOLLOWS:  
6 FEET FOR POLES HAVING A MOUNTING HEIGHT LESS THAN 40 FT.  
8 FEET FOR POLES HAVING A MOUNTING HEIGHT 40 FT. THRU 44 FT.  
NO. 4 TIE BARS REQUIRED AS FOLLOWS:  
4 NO. 4 TIE BARS FOR 6 FT. DEPTH  
5 NO. 4 TIE BARS FOR 8 FT. DEPTH  
ROTATE BARS TO CLEAR CONDUITS.
- COPPER GROUND CABLE:  
NO. 4 AWG, STRANDED INSULATED COPPER GROUND CABLE SHALL BE USED. EXOTHERMICALLY WELD CABLE TO GROUND ROD. RUN FREE END THROUGH 3/4" EMT AND CONNECT AS SHOWN ON DRAWING NO. 20.2/14.  
USE TWO COATS OF INSULATING VARNISH OVER EXOTHERMIC WELD AND EXPOSED CONDUCTOR.
- ANCHOR BOLT DATA:  
FOR ANCHOR BOLT DATA SEE DRAWING NO. 20.2/11, POLE BASE DETAILS.
- CONDUIT:  
WHERE 2" OR 3" DIAMETER CONDUIT TERMINATES IN A FOUNDATION THE CONDUIT ELBOWS IN THE FOUNDATION SHALL BE THE SAME SIZE AS THE CONDUIT. THE ENDS OF THE CONDUIT ELBOWS CONTAINING DISTRIBUTION CABLE SHALL BE CLOSED AS DESCRIBED IN THE SPECIFICATIONS.  
WHEN THE TERMINATING CONDUIT IS STEEL, THE CONDUIT ELBOWS IN THE POLE FOUNDATION SHALL ALSO BE STEEL.
- GROUND RODS:  
WHEN A SECOND GROUND ROD IS REQUIRED IT SHALL BE INSTALLED IN THE CABLE TRENCH.
- REINFORCING STEEL:  
REINFORCING STEEL MAY BE ASSEMBLED IN CAGES BY APPROVED WELDING OF BARS. SUBJECT TO APPROVAL OF THE CONTRACTING OFFICER'S REPRESENTATIVE, CAGES MAY BE ASSEMBLED IN A SPIRAL CONFORMATION.
- REFER TO SPECIFICATIONS SECTION 16528, 2.14, FOR GROUND RODS AND 3.5 FOR THEIR INSTALLATION AND TESTING.

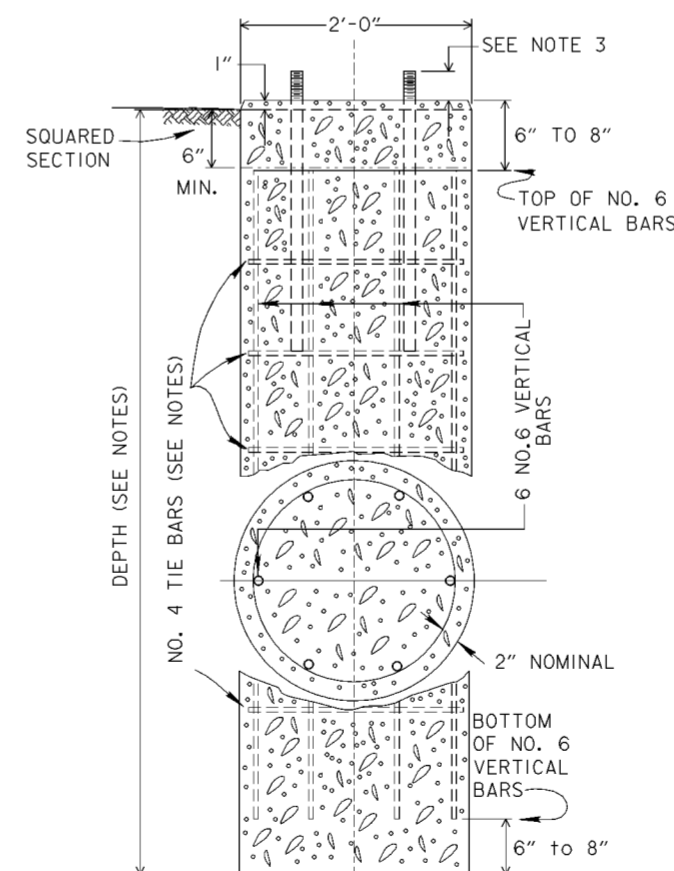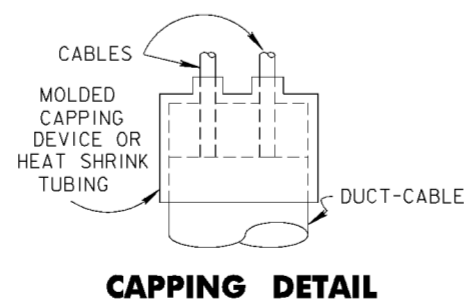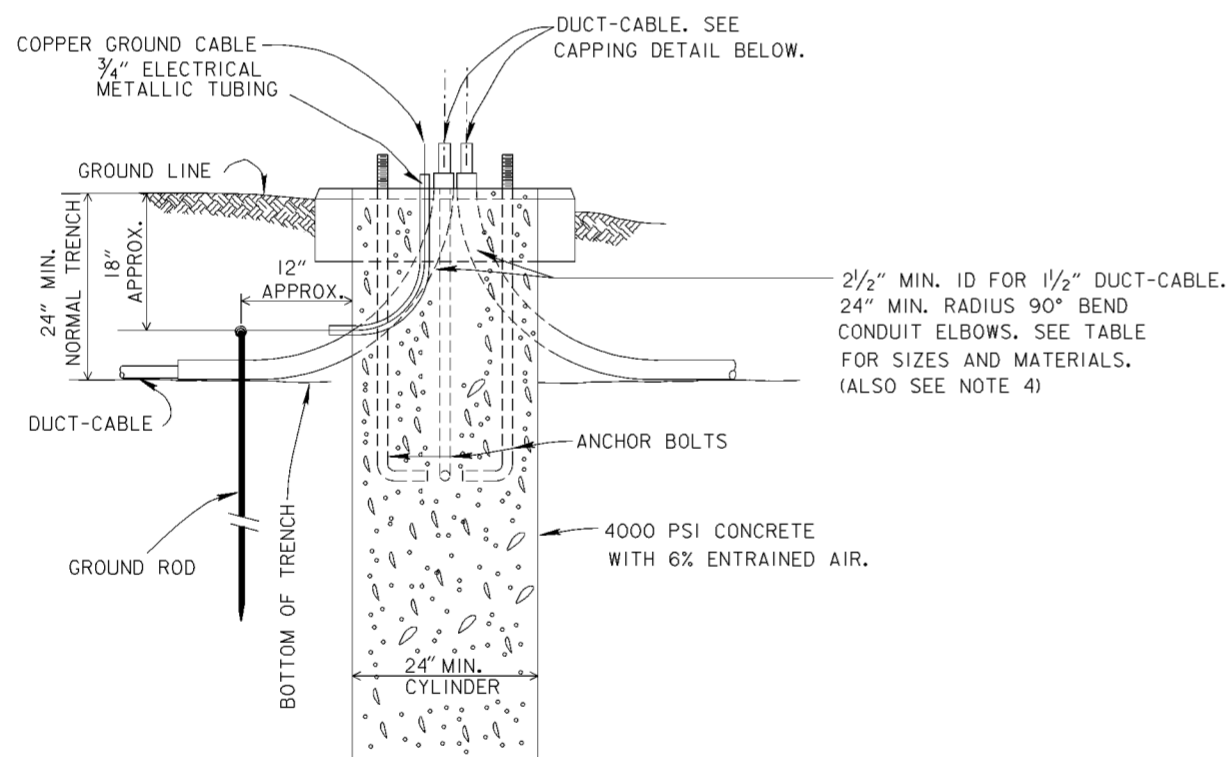

SPECIAL CONDUIT ELBOWS 90° BENDS						
2", 2 1/2" & 3" RGC			3" PVC			
R	S	Y	R	S	Y	
24"	11"	35"	24"	8"	32"	
30"	11"	41"				
36"	11"	47"	36"	2"	38"	
42"	12"	54"				
48"	12"	60"				

Revisions			
Symbol	Descriptions	Date	Approved


<b>BURGESS &amp; NIPLE, LIMITED</b> COLUMBUS, OHIO	<b>U.S. ARMY ENGINEER DISTRICT</b> <b>CORPS OF ENGINEERS</b> HUNTINGTON, WEST VIRGINIA
Designed by: <b>ODOT/J.AYRES</b>	SCIO TO RIVER COLUMBUS, OHIO WEST COLUMBUS, L.P.P. PHASE IIIA
Drawn by: <b>T.FAHERTY</b>	<b>ROADWAY LIGHTING</b> <b>DETAILS (4 OF 6)</b>
Checked by: <b>D.SCHAMP</b>	Scale: <b>NONE</b> Date: <b>OCTOBER 1999</b> Drawing Code: <b>16-PWC-12-</b>
Reviewed by:	Sheet reference number: <b>20.2/12</b> FILENAME: 00usd104.dgn PIN TABLE:
Approved by:	Sheet 4 of 6



**NOTES**

1. PROVIDE SUFFICIENT SLACK IN ALL CABLES TO PERMIT BRINGING KITS OUTSIDE OF POLE BASE THROUGH HANDHOLE OF ANCHOR BASE POLES OR DOOR IN TRANSFORMER BASE POLES.


2. FUSES FOR CONNECTOR KITS SHALL BE AS FOLLOWS:

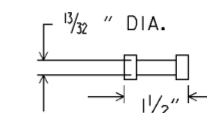

ANY STANDARD MIDGET FERRULE TYPE FUSE, (EXCEPT CLASS TUBE) MAY BE USED IN THIS CONNECTION.


FUSES RATED 600 VOLTS AND 10 AMPERES, MINIMUM SHALL BE USED UNLESS OTHERWISE SPECIFIED.

3. REFER TO SPECIFICATIONS SECTION 16528, 2.4.2, FOR CABLE CONNECTOR KITS.

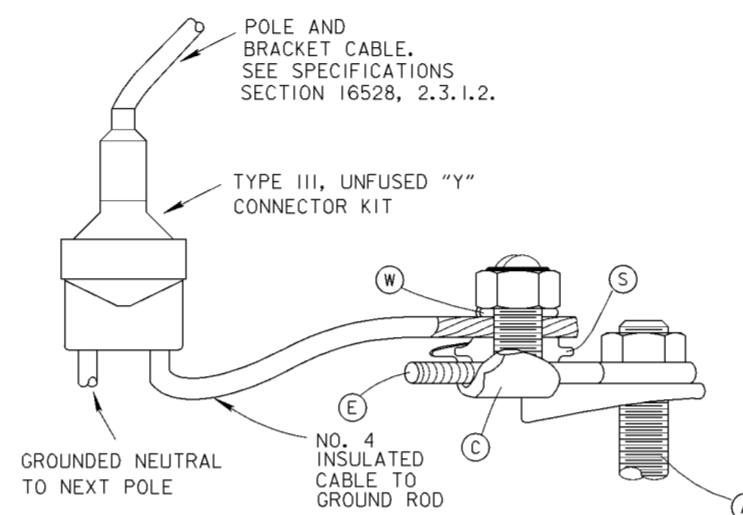

**DETAIL "A"**

2-WIRE, GROUNDED NEUTRAL TRANSFORMER BASE POLE

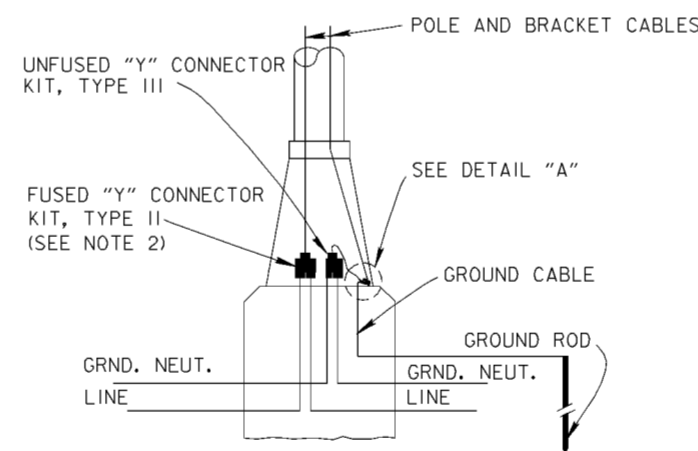

**TRANSFORMER BASE POLE**


**480 VOLT, TWO-WIRE, GROUNDED NEUTRAL**

**LEGEND OF ITEMS COMMON TO DETAIL "A"**

- (A) ANCHOR BOLT
- (C) TIN PLATED COPPER SPLIT BOLT CONNECTOR WITH THE FOLLOWING COMPONENTS:
- (S) SPACER (TIN PLATED)
- (W) WASHER
- (E) GALV. STEEL EYEBOLT

Revisions			
Symbol	Descriptions	Date	Approved

<b>BURGESS &amp; NIPLE, LIMITED</b> COLUMBUS, OHIO		<b>U.S. ARMY ENGINEER DISTRICT</b> CORPS OF ENGINEERS HUNTINGTON, WEST VIRGINIA	
Designed by: <b>ODO/J.AYRES</b>		SCIOTO RIVER COLUMBUS, OHIO WEST COLUMBUS, L.P.P. PHASE IIIA	
Drawn by: <b>T.FAHERTY</b>		<b>ROADWAY LIGHTING</b> <b>DETAILS (6 OF 6)</b>	
Checked by: <b>D.SCHAMP</b>	Reviewed by:	Scale: <b>NONE</b>	Sheet reference number: <b>20.2/14</b>
Approved by:	Date: <b>OCTOBER 1999</b>	FILENAME: PIN TABLE: 00usd106.dgn	Sheet <b>6</b> of <b>6</b>
Drawing Code: <b>16-PWC-12-</b>			

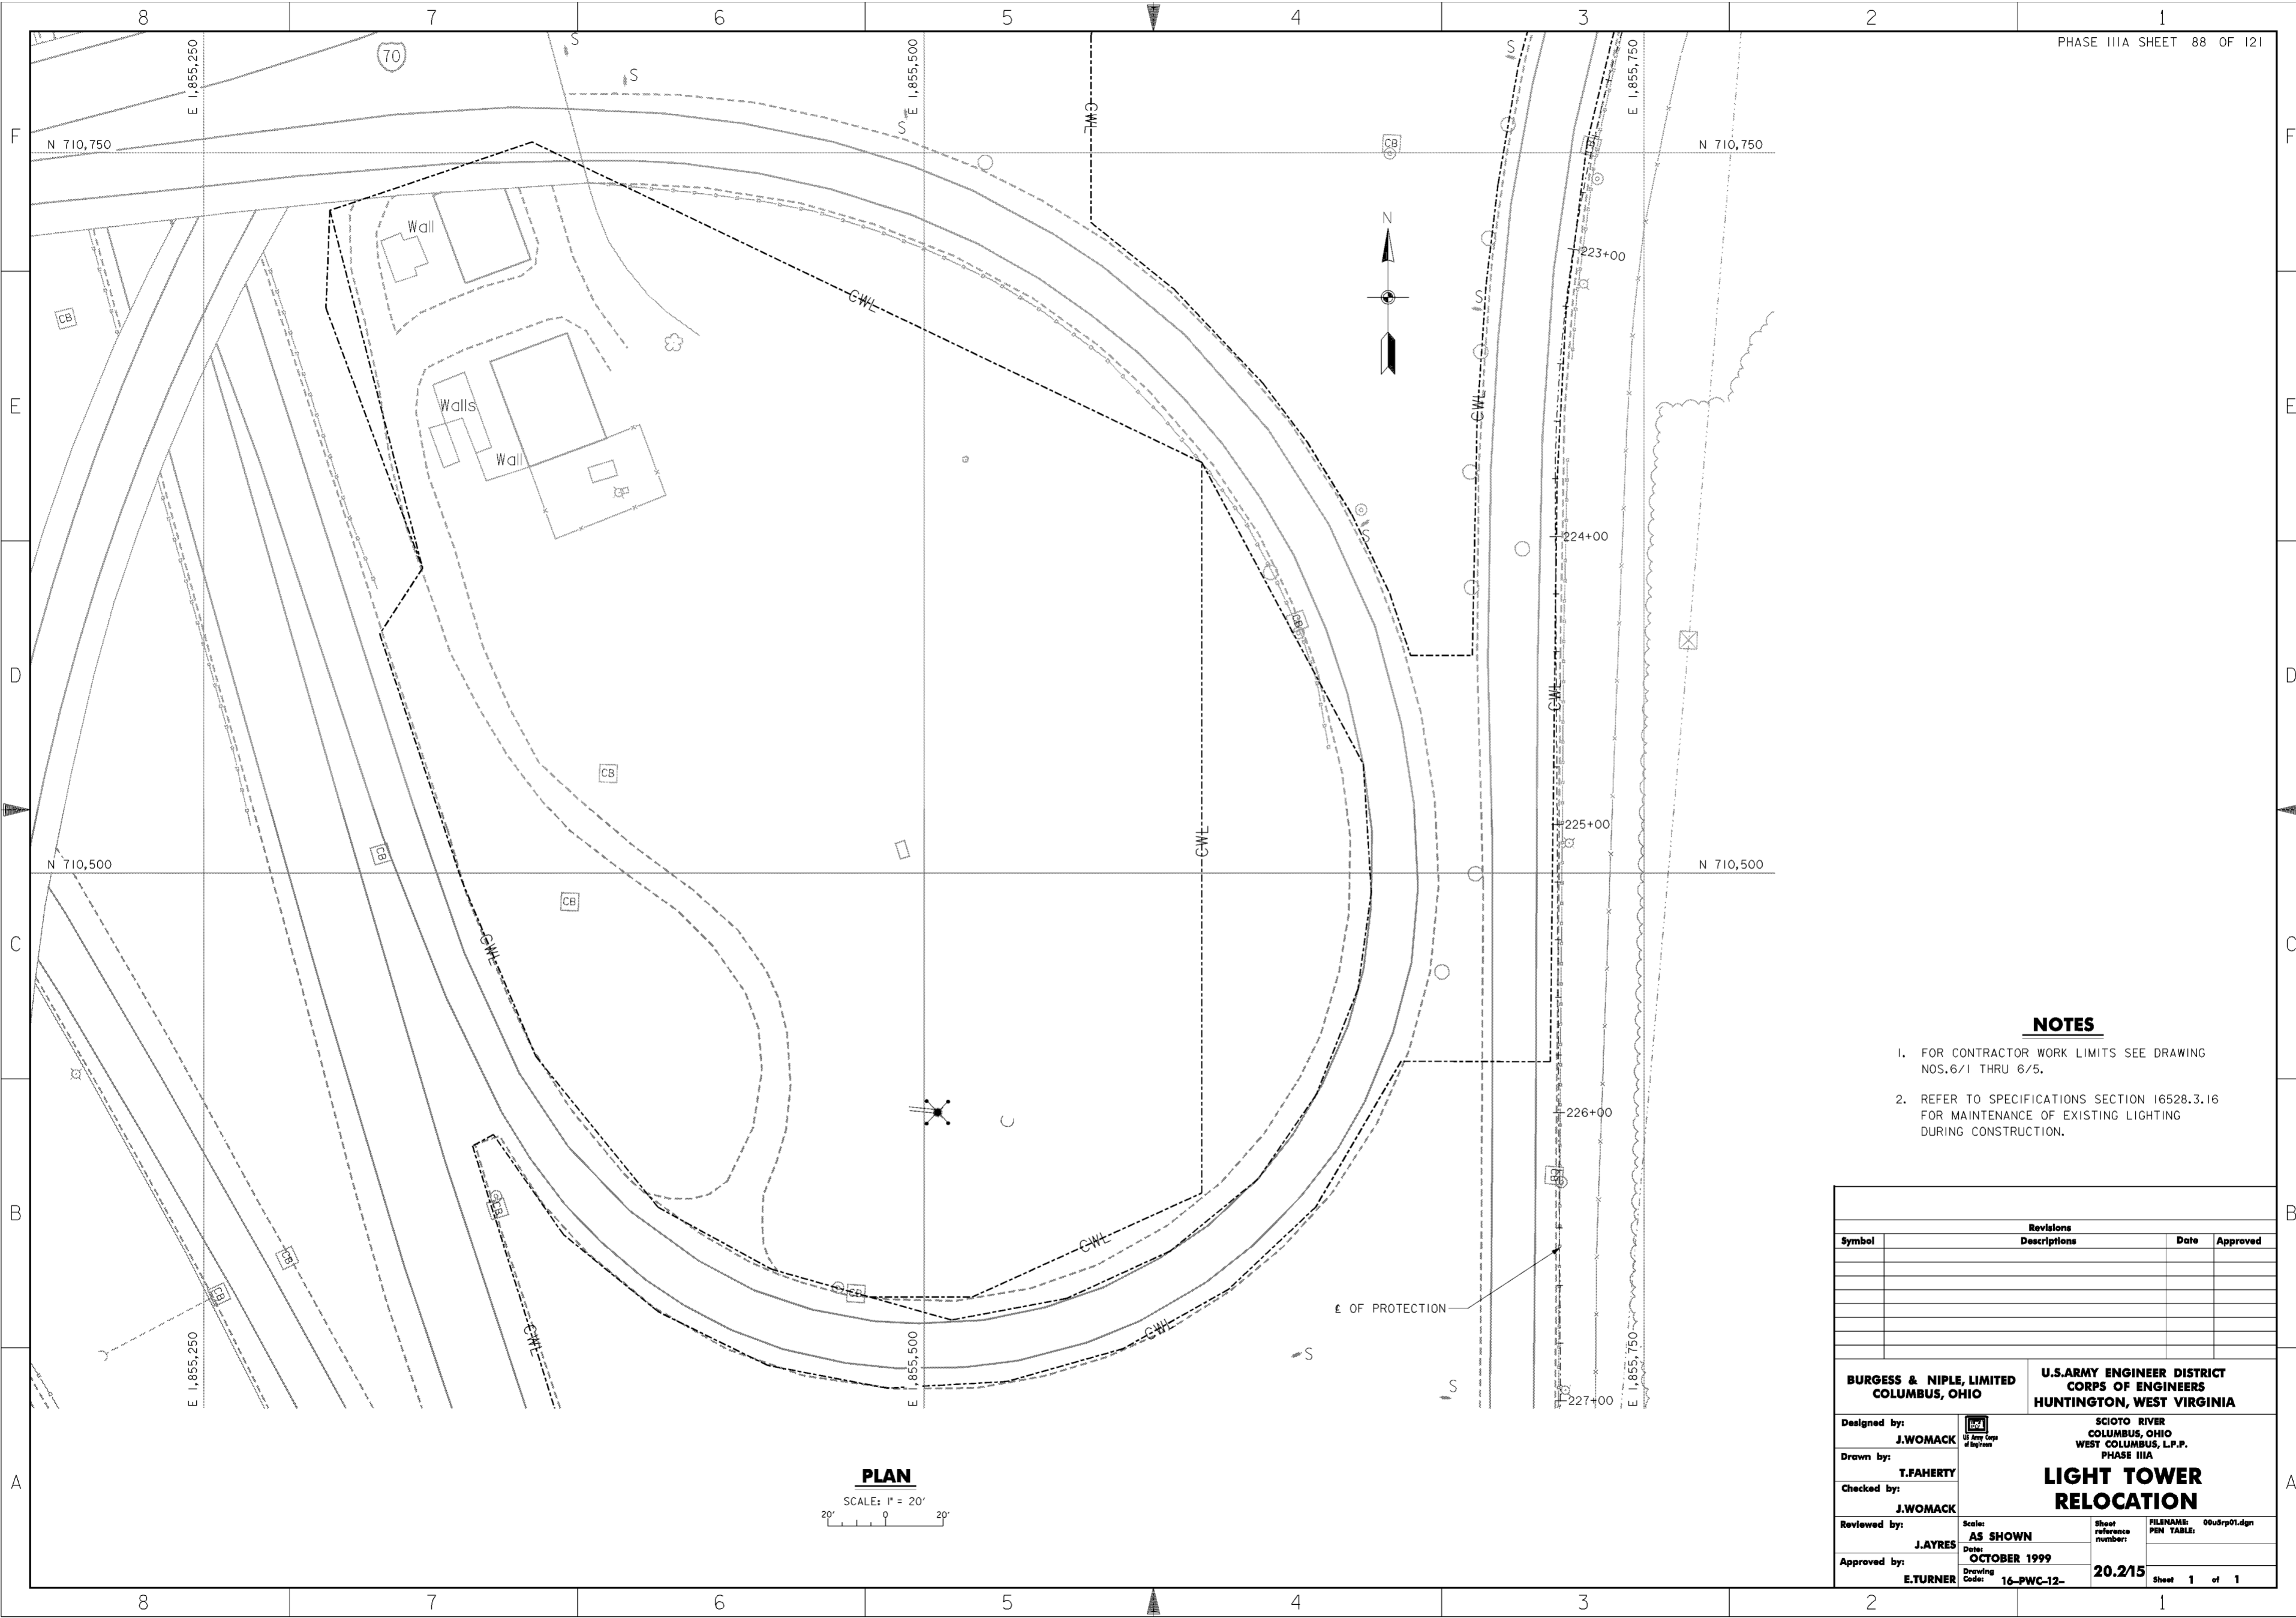

**NOTES**

1. FOR CONTRACTOR WORK LIMITS SEE DRAWING NOS. 6/1 THRU 6/5.
2. REFER TO SPECIFICATIONS SECTION 16528.3.16 FOR MAINTENANCE OF EXISTING LIGHTING DURING CONSTRUCTION.

Revisions			
Symbol	Descriptions	Date	Approved

<b>BURGESS &amp; NIPLE, LIMITED</b> COLUMBUS, OHIO		<b>U.S. ARMY ENGINEER DISTRICT</b> CORPS OF ENGINEERS HUNTINGTON, WEST VIRGINIA	
Designed by: <b>J.WOMACK</b>		SCIOTO RIVER COLUMBUS, OHIO WEST COLUMBUS, L.P.P. PHASE IIIA	
Drawn by: <b>T.FAHERTY</b>		<b>LIGHT TOWER</b> <b>RELOCATION</b>	
Checked by: <b>J.WOMACK</b>	Reviewed by: <b>J.AYRES</b>	Scale: <b>AS SHOWN</b>	Sheet reference number: <b>20.2/15</b>
Approved by: <b>E.TURNER</b>	Date: <b>OCTOBER 1999</b>	Drawing Code: <b>16-PWC-12-</b>	FILENAME: PIN TABLE: 00usrp01.dgn
		Sheet 1 of 1	

**WORK AS CONSTRUCTED**

GENERAL

THIS PROJECT SHALL CONSIST OF DISCONNECTING AND ABANDONING THE CIRCUITS AT PULLBOX # 70 (PB70) FOR EXISTING LIGHT TOWER #5, AND THE PORTION OF THE CIRCUIT TO PB71 ON CIRCUIT C, FEEDING TOWER #2. CONTROL CENTER 3 WILL BE DISTURBED BY THE CONSTRUCTION, AND SHALL BE REPLACED WITH A NEW 480 VOLT, 2-WIRE, SINGLE PHASE SYSTEM MOUNTED ON A WOOD POLE, TOGETHER WITH THE RELOCATED WEATHER SENSOR UNIT, AND LOCATED NEAR THE EXISTING PUMP STATION AWAY FROM THE PROPOSED FILL. IN ADDITION, PB70 AND PB63 SHALL BE REMOVED.

A PORTION OF THE CIRCUIT AND CONDUIT FEEDING PB74 SHALL BE REPLACED WITH NEW 3-INCH RIGID CONDUIT ORIGINATING FROM THE NEW CONTROL CENTER. LIGHTING FOR TOWERS #5 AND #2 SHALL BE MAINTAINED BY INSTALLING A 1-1/2", TWO CONDUCTOR, NO. 4 AWG DUCT CABLE EACH IN 3-INCH RIGID CONDUIT. THE CIRCUIT SHALL ORIGINATE FROM THE NEW CONTROL CENTER, AND SHALL BE ADJUSTED FOR EACH STAGE OF THE FILL IN ORDER TO MAINTAIN EXISTING LIGHTING.

THE EXISTING FOUNDATION FOR TOWER #5 SHALL BE ABANDONED, AND A NEW FOUNDATION SHALL BE CONSTRUCTED IN A LOCATION AT LEAST 5 FEET TO THE EAST OF THE EXISTING FOUNDATION. DURING THE CONCRETE POUR, THE CONTRACTOR SHOULD HAVE THE FORM LEFT IN PLACE IN ORDER TO MAKE THE ELEVATION 1 FOOT ABOVE THE PROPOSED GROUND LINE. THE CONDUIT ELLS SHALL PROTRUDE AT THE STANDARD 24 INCHES BELOW THE PROPOSED GRADE, WITH A TEMPORARY CAP OVER THEM.

THE TOWER SHALL BE MOVED TO THE NEW FOUNDATION AFTER THE LUMINAIRE MOUNTING RING HAS BEEN LOWERED, AND THE LUMINAIRES HAVE BEEN INSPECTED AND CLEANED.

POWER SERVICE REMOVED, AS PER PLAN

THIS ITEM OF WORK INCLUDES THE REMOVAL OF THE LIGHTING CONTACTOR AND ENCLOSURE, AND ALL OTHER PORTIONS OF THE EXISTING POWER SERVICE NOT BEING REUSED. AN INVENTORY OF THE REMOVED ITEMS SHALL BE KEPT BY THE CONTRACTOR, FOR PURCHASE OF IDENTICAL HARDWARE FOR INSTALLATION OF THE NEW CONTROL CENTER. EXISTING UNDERGROUND CONDUIT AND WIRING MAY BE ABANDONED IN PLACE EXCEPT WHERE NEW WIRING IS TO BE PLACED IN EXISTING CONDUITS OR PULL BOXES. IN THIS LATTER CASE, THE OLD WIRES SHALL BE REMOVED. REMOVED MATERIALS SHALL BECOME THE PROPERTY OF THE CONTRACTOR AND SHALL BE REMOVED FROM THE PROJECT SITE. ALL DISTURBED AREAS SHALL BE RESTORED SO AS TO MATCH THE SURROUNDING AREA.

THIS ITEM SHALL ALSO COMPENSATE THE CONTRACTOR FOR COORDINATING WITH THE POWER COMPANY TO INSURE THAT THEY DISCONNECT AND REMOVE ANY OF THEIR ITEMS THAT ARE PART OF THE POWER SERVICE. IT ALSO INCLUDES RETURNING TO THE POWER COMPANY ANY ITEMS BELONGING TO THEM THAT WERE REMOVED BY THE CONTRACTOR.

CITY OF COLUMBUS WEATHER SENSOR UNIT RELOCATED, AS PER PLAN

THIS ITEM OF WORK INCLUDES THE REMOVAL AND STORAGE OF THE WEATHER SENSOR UNIT TOWER AND ALL OTHER PORTIONS OF THE EXISTING WEATHER SENSOR UNIT. EXISTING UNDERGROUND CONDUIT AND WIRING MAY BE ABANDONED IN PLACE EXCEPT WHERE NEW WIRING IS TO BE PLACED IN EXISTING CONDUITS. IN THIS LATTER CASE, THE OLD WIRES SHALL BE REMOVED. REMOVED WIRING AND COMMUNICATION MATERIALS SHALL BECOME THE PROPERTY OF THE CONTRACTOR AND SHALL BE REMOVED FROM THE PROJECT SITE. ALL DISTURBED AREAS SHALL BE RESTORED SO AS TO MATCH THE SURROUNDING AREA.

THIS ITEM SHALL ALSO COMPENSATE THE CONTRACTOR FOR COORDINATING WITH THE CITY OF COLUMBUS AND POWER COMPANY TO INSURE THAT THEY DISCONNECT, REMOVE, AND STORE ANY OF THEIR ITEMS THAT ARE PART OF THE WEATHER SENSOR UNIT FOR RELOCATION.

POWER SERVICE

THE POWER SUPPLYING AGENCY FOR THIS PROJECT IS:

CITY OF COLUMBUS M.E.L.P.  
DIVISION OF ELECTRICITY  
910 DUBLIN ROAD  
COLUMBUS, OHIO 43215  
(614) 645-8371

ELECTRICAL SERVICE IS 480 VOLTS, SINGLE PHASE, 2-WIRE, GROUNDED NEUTRAL. THE CONTRACTOR SHALL INSURE THAT THE NEW CONTROL CENTER ITEMS, INCLUDING THE CABINET AND CONTACTOR, ARE IDENTICAL TO THE ORIGINAL EQUIPMENT. THIS ITEM OF WORK SHALL ALSO INCLUDE REINSTALLATION OF THE CITY OF COLUMBUS WEATHER SENSOR TOWER AND RELATED APPURTENANCES TO THE SATISFACTION OF THE CITY OF COLUMBUS.

AFTER ACCEPTANCE OF THE LIGHTING, THE POWER SERVICE ELECTRICAL ENERGY ACCOUNT SHALL BE TRANSFERRED TO THE MAINTAINING AGENCY NOTED IN THE PLANS.

PULLBOX REMOVED, AS PER PLAN

THIS ITEM OF WORK WILL CONSIST OF REMOVING AN EXISTING PULL BOX, WHICH WILL THEN BE PROPERLY DISPOSED OF. THE RESULTANT OPENING SHALL THEN BE BACKFILLED TO GRADE WITH SUITABLE COMPACTED SOIL AND RESTORED TO MATCH THE SURROUNDING AREA.

DISCONNECT EXISTING CIRCUIT, AS PER PLAN

THIS ITEM OF WORK SHALL CONSIST OF THE DISCONNECTION OF AN EXISTING LIGHT CIRCUIT AT A LIGHT TOWER, PULL BOXES, AND POWER SERVICE.

DISCONNECTION AT PULL BOXES PB71 AND PB74 SHALL INVOLVE THE REMOVAL OF THAT PART OF CABLE THAT IS TO BE REPLACED.

LIGHTING MISC.: CONNECT TO EXISTING CIRCUIT

THIS ITEM OF WORK SHALL CONSIST OF FEEDING DUCT CABLE INTO THE EMPTY CONDUIT BEND OF THE EXISTING CONDUIT, AT PULL BOXES PB71 AND PB74.

THE WORK SHALL INCLUDE EXCAVATING TO ACCESS THE STUBBED-OUT CONDUIT BEND, CLEANING AND REMOVING MUD AND DEBRIS FROM THE CONDUIT, FEEDING DUCT CABLE THROUGH CONDUIT.

LIGHT TOWER FOUNDATION REMOVED, AS PER PLAN

THIS ITEM OF WORK SHALL CONSIST OF REMOVING A LIGHT TOWER FOUNDATION. ANY PORTION OF THE EXISTING FOUNDATION, WHICH INTERFERES WITH THE PROPOSED CONSTRUCTION, SHALL BE REMOVED. IN ADDITION THE FOUNDATION SHALL BE REMOVED TO A MINIMUM OF ONE FOOT BELOW FINISHED GRADE. THE RESULTANT DEPRESSION SHALL BE BACKFILLED WITH COMPACTED SOIL AND THE DISTURBED AREA SHALL BE RESTORED TO NORMAL CONDITIONS TO THE SATISFACTION OF THE ENGINEER. IN ADDITION, WHERE A NEW FOUNDATION IS TO BE LOCATED WITHIN A TEN FOOT RADIUS OF A REMOVED FOUNDATION, THE RESULTANT OPENING LEFT BY A REMOVED LIGHT TOWER FOUNDATION SHALL BE BACKFILLED AND COMPACTED AS THOUGH IT WERE SUBGRADE FOR A ROADWAY.

LUMINAIRES REMOVED FOR STORAGE, AS PER PLAN


THIS ITEM OF WORK SHALL CONSIST OF REMOVING THE EXISTING LUMINAIRES AND STORING THEM FOR REERECTION.

REERECT EXISTING LUMINAIRES, AS PER PLAN


THIS ITEM OF WORK SHALL CONSIST OF CLEANING THE EXISTING LUMINAIRES REFLECTORS AND LENSES, REPLACING THE LAMPS, MAKING REPAIRS IF NECESSARY, VERIFYING THAT THE LUMINAIRES ARE IN OPERATING CONDITION, AND REERECTING THE LUMINAIRES ONTO THE RELOCATED TOWER.

REERECT EXISTING LIGHT TOWER, AS PER PLAN


THIS ITEM OF WORK SHALL CONSIST OF THE REERECTION OF THE EXISTING LIGHT TOWER ON A NEW FOUNDATION. THE POLE SHALL BE WASHED AND RESTORED TO WORKING ORDER BEFORE REERECTION. NEW ANCHOR BOLTS SHALL BE PROVIDED AS PART OF THIS ITEM.

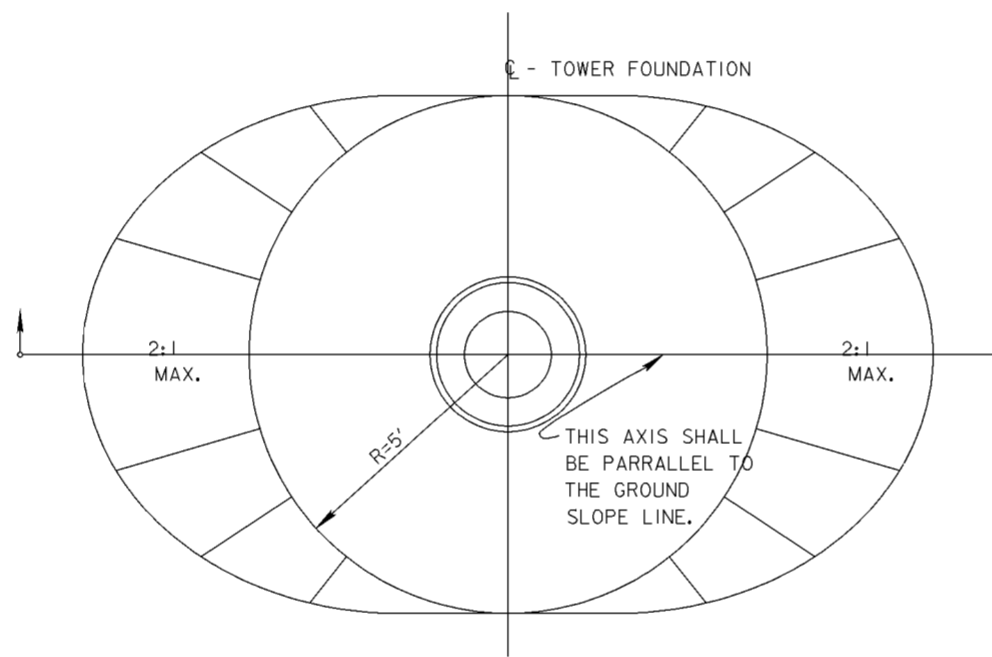

GRADING PLAN

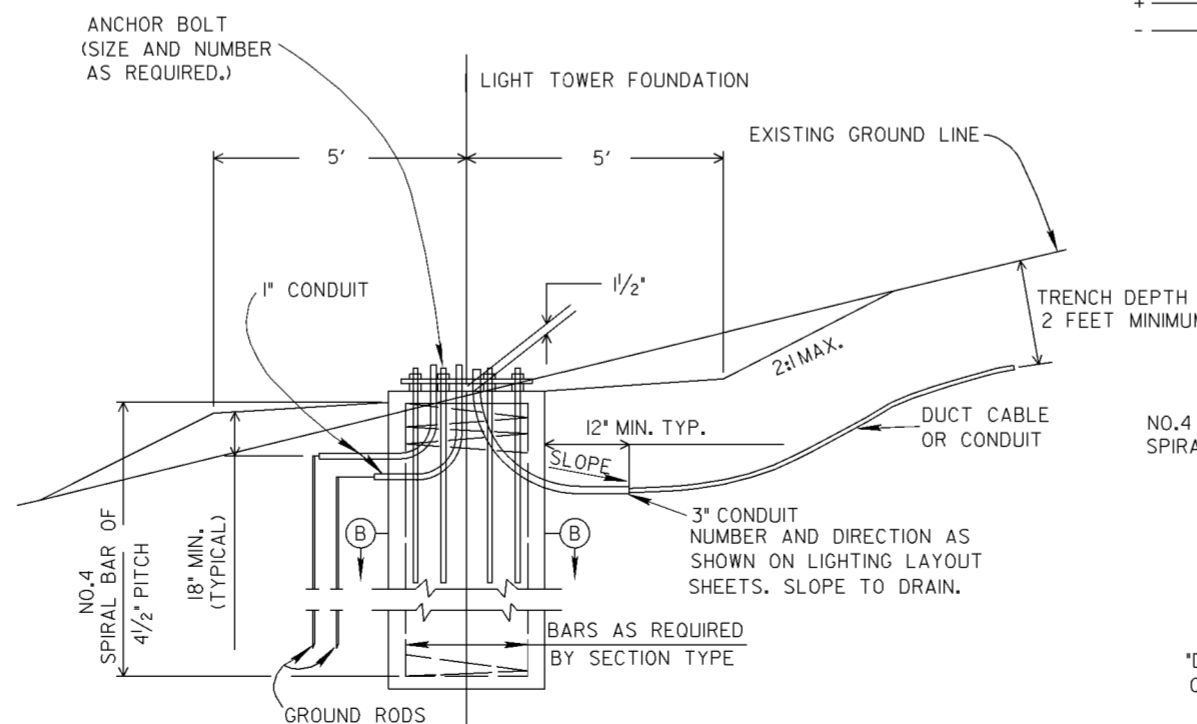


FOUNDATION WITHOUT MAINTENANCE PLATFORM

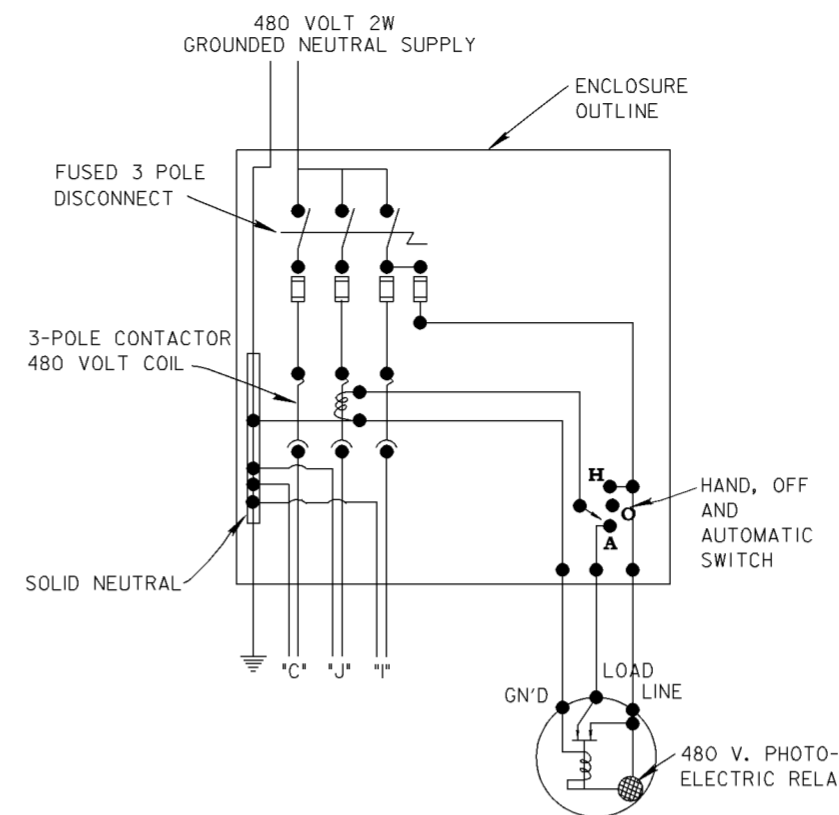


480 VOLT, 2-WIRE GROUNDED NEUTRAL SINGLE UNIT

FOUNDATION DATA			
TYPE	D	B	BC MAX
I	36"	31"	26"
II	42"	37"	32"

TABLE #1

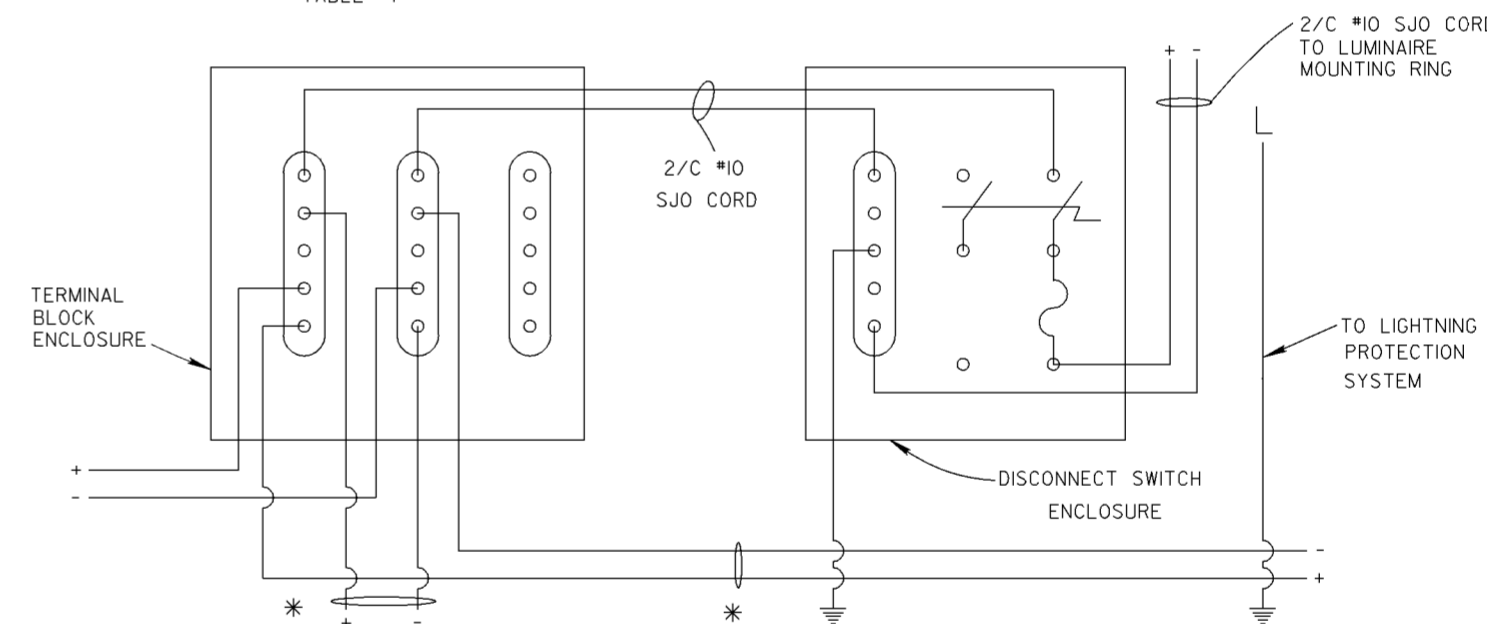

480 VOLT, 2-WIRE GROUNDED

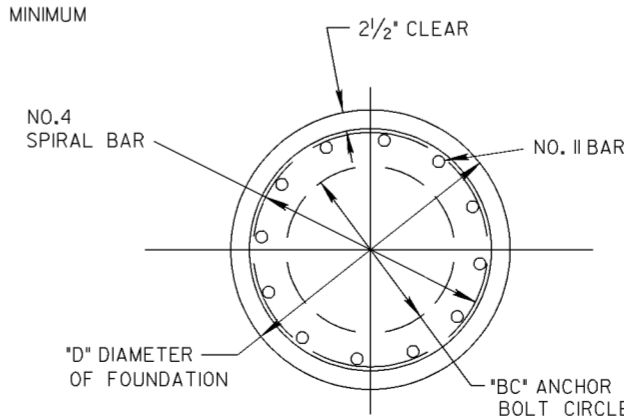

SECTION B-B

DETAIL NOTES

- FOUNDATIONS ARE DESIGNED FOR STRUCTURES WITH ROUND TAPERED SHAFTS DESIGNED IN ACCORDANCE WITH THE LATEST AASHTO "STANDARD SPECIFICATIONS FOR STRUCTURAL SUPPORTS FOR HIGHWAY SIGNS, LUMINAIRES AND TRAFFIC SIGNALS", FOR A 90 MPH WIND ZONE WHEN SUPPORTING THE FOLLOWING:  
  
SIX (6) CYLINDRICAL LUMINAIRES WITH PROJECTED AREA OF 3.5 SQUARE FEET AND WEIGHING 75 POUNDS EACH.  
  
ONE (1) CYLINDRICAL HEAD WITH PROJECTED AREA OF 5.3 SQUARE FEET AND 340 POUNDS TOP LATCHED LOWERING DEVICE.
- TOWER HAND HOLES SHALL BE ON DOWN-SLOPE SIDE OF TOWER.
- ANCHOR BOLT SIZE AND SPACING TO FIT MOUNTING PLATE SUPPLIED WITH TOWER. HOWEVER, BOLT CIRCLE SHALL BE EQUAL TO OR LESS THAN THE MAXIMUM BOLT CIRCLE PERMITTED IN TABLE NO.1. THE MINIMUM LENGTH ANCHOR BOLT SHALL BE 60" AND THE BOLTS SHALL HAVE EITHER A 6 INCH "L" BEND OR A 5" X 5" PLATE ON THE EMBEDDED END.
- THE LENGTH "L" OF THE 1/2" NO.4 SPIRAL BAR IS THE FOUNDATION EMBEDMENT DEPTH WITH A 3" CLEARANCE AT EACH END. FOUR STEEL CHANNELS, TEE OR ANGLE SPACERS, WEIGHING APPROXIMATELY 0.80 POUNDS PER FOOT OF SPACER SHALL BE PROVIDED FOR EACH SPIRAL UNIT. THEY SHALL BE EQUALLY SPACED ALONG THE PERIPHERY OF THE COIL. THE NUMBER OF TURNS OF THE NO.4 SPIRAL BAR SHALL INCLUDE A FULL UNPITCHED TURN AT EACH END.
- CONCRETE SHALL BE AS PER 499, CLASS "C".
- CONDUITS IN THE FOUNDATION SHALL CONFORM TO 625 AND 713. THE FOUNDATION CONDUIT SHALL BE OF THE SAME MATERIAL AS THAT USED TO PROTECT THE CIRCUIT EXTENSION BEYOND THE FOUNDATION.

Revisions			
Symbol	Descriptions	Date	Approved


<b>BURGESS &amp; NIPL, LIMITED</b> COLUMBUS, OHIO	<b>U.S. ARMY ENGINEER DISTRICT</b> CORPS OF ENGINEERS HUNTINGTON, WEST VIRGINIA
Designed by: <b>J.WOMACK</b>	SCIO TO RIVER COLUMBUS, OHIO WEST COLUMBUS, L.P.P. PHASE IIIA
Drawn by: <b>T.FAHERTY</b>	<b>TOWER LIGHTING</b> <b>NOTES AND DETAILS</b>
Checked by: <b>J.WOMACK</b>	Scale: <b>NONE</b>
Reviewed by: <b>J.AYRES</b>	Date: <b>OCTOBER 1999</b>
Approved by: <b>E.TURNER</b>	Drawing Code: <b>16-PWC-12-</b>
Sheet reference number:	FILENAME: 00u5gn01.dgn
	PIN TABLE:
	<b>20.2/16</b>
	Sheet 1 of 1











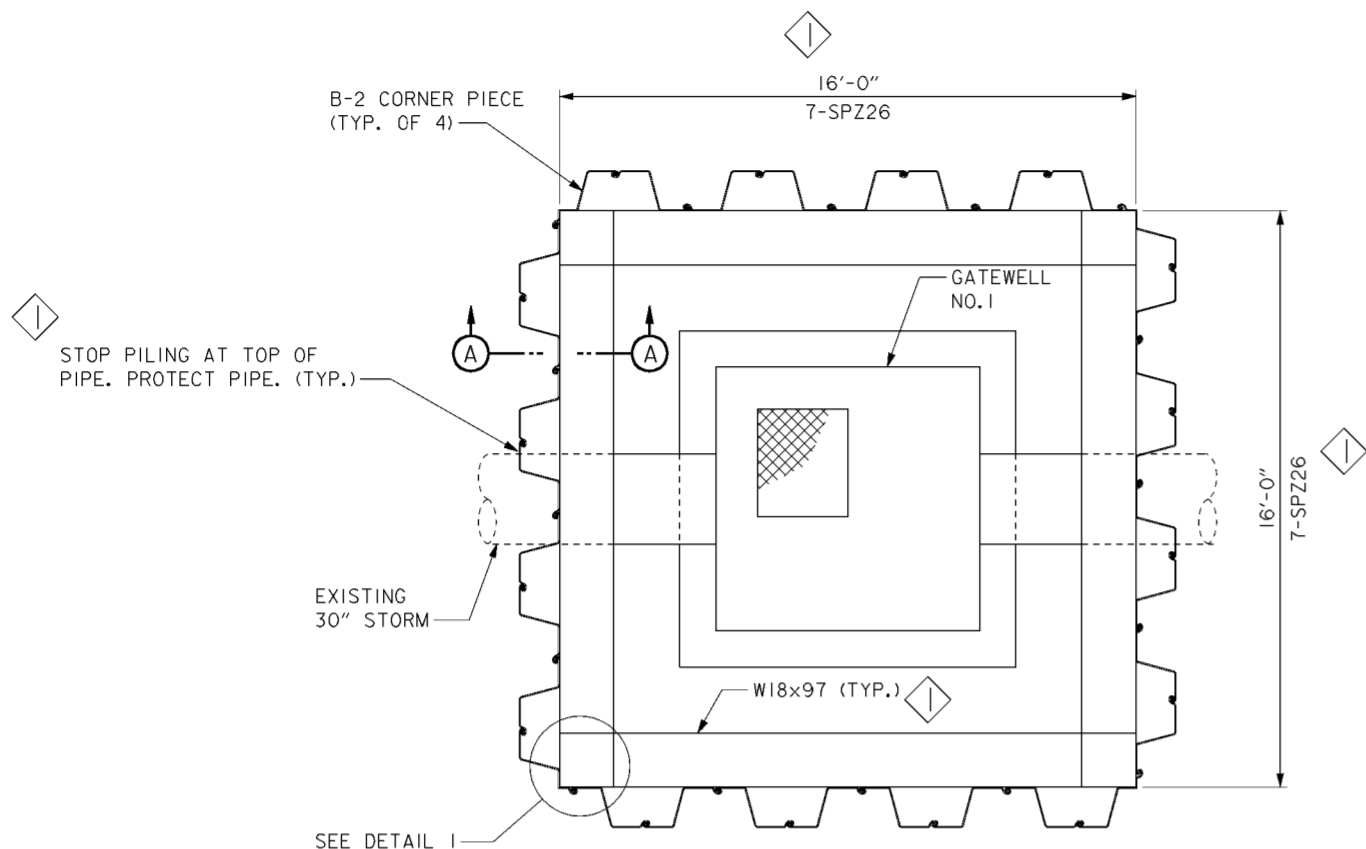


**SHORING PLAN**

SCALE:  $\frac{3}{8}'' = 1'-0''$

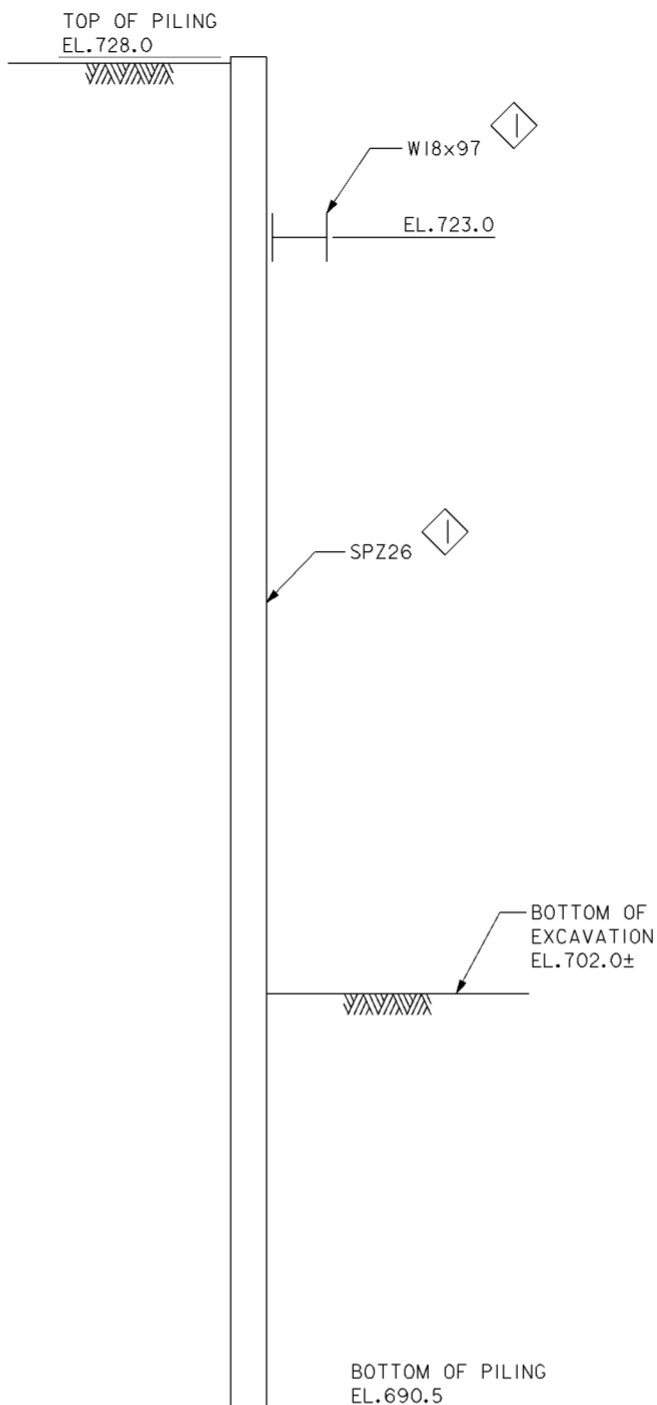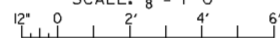

**SECTION A-A**


SCALE:  $\frac{3}{8}'' = 1'-0''$

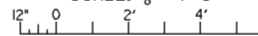

**NOTE**


- NO EXCAVATION BELOW EL. 722.0 SHALL OCCUR UNTIL ALL BRACING HAS BEEN INSTALLED.
- SHEET PILING LAYOUT WAS BASED UPON THE PROPERTIES FOR THE SPZ26 COLD-ROLLED SHEET PILING MANUFACTURED BY SYRO, INC. OTHER MANUFACTURERS OF SHEET PILING ARE ACCEPTABLE IF THEY MEET THE MINIMUM SECTION PROPERTIES FOR Z-TYPE SHEET PILING GIVEN BELOW.
 

SECTION	WEB THICKNESS (IN.)	MODULUS (PER LIN. FEET OF WALL)	STEEL GRADE
SPZ26	0.375	34.82	A572 GR50
- FOR GATEWELL NO.2 SEE DRAWING NOS. 15/1, 15/7 AND 15/8.

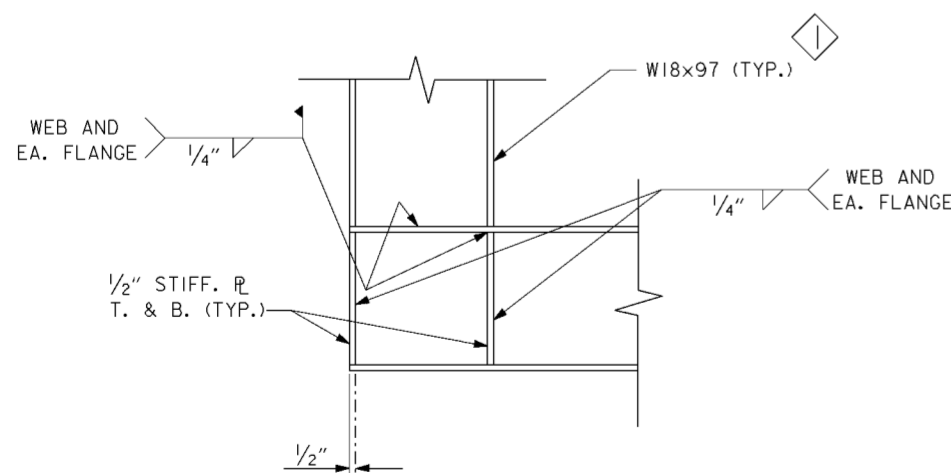


**DETAIL 1**

SCALE: 1" = 1'

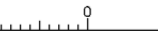


\* TYPICAL 4 LOCATIONS

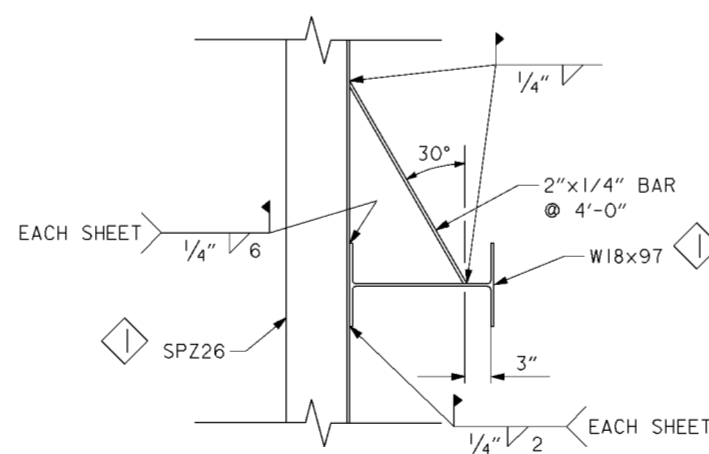

**TYPICAL WALE CONNECTION**

SCALE: 1" = 1'

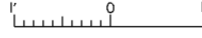


Revisions			
Symbol	Descriptions	Date	Approved
◇	REV. IN ACCORDANCE WITH AMENDMENT 0001	12/99	P.O.C.


<b>BURGESS &amp; NIPLE, LIMITED</b> COLUMBUS, OHIO		<b>U.S. ARMY ENGINEER DISTRICT</b> CORPS OF ENGINEERS HUNTINGTON, WEST VIRGINIA	
Designed by:	<b>J. HALL</b>	SCIOTO RIVER COLUMBUS, OHIO WEST COLUMBUS, L.P.P. PHASE IIIA	
Drawn by:	<b>T. MULLINS</b>	<b>GATEWELL NO. 1</b> <b>SHORING PLAN</b>	
Checked by:	<b>P. CONROY</b>		
Reviewed by:	<b>AS SHOWN</b>	Scale:	Sheet reference number:
Approved by:	<b>OCTOBER 1999</b>	Date:	20.3/4
	Drawing Code: <b>16-PWC-12-</b>	FILENAME: 00app102.dgn	PIN TABLE:
		Sheet 1 of 1	





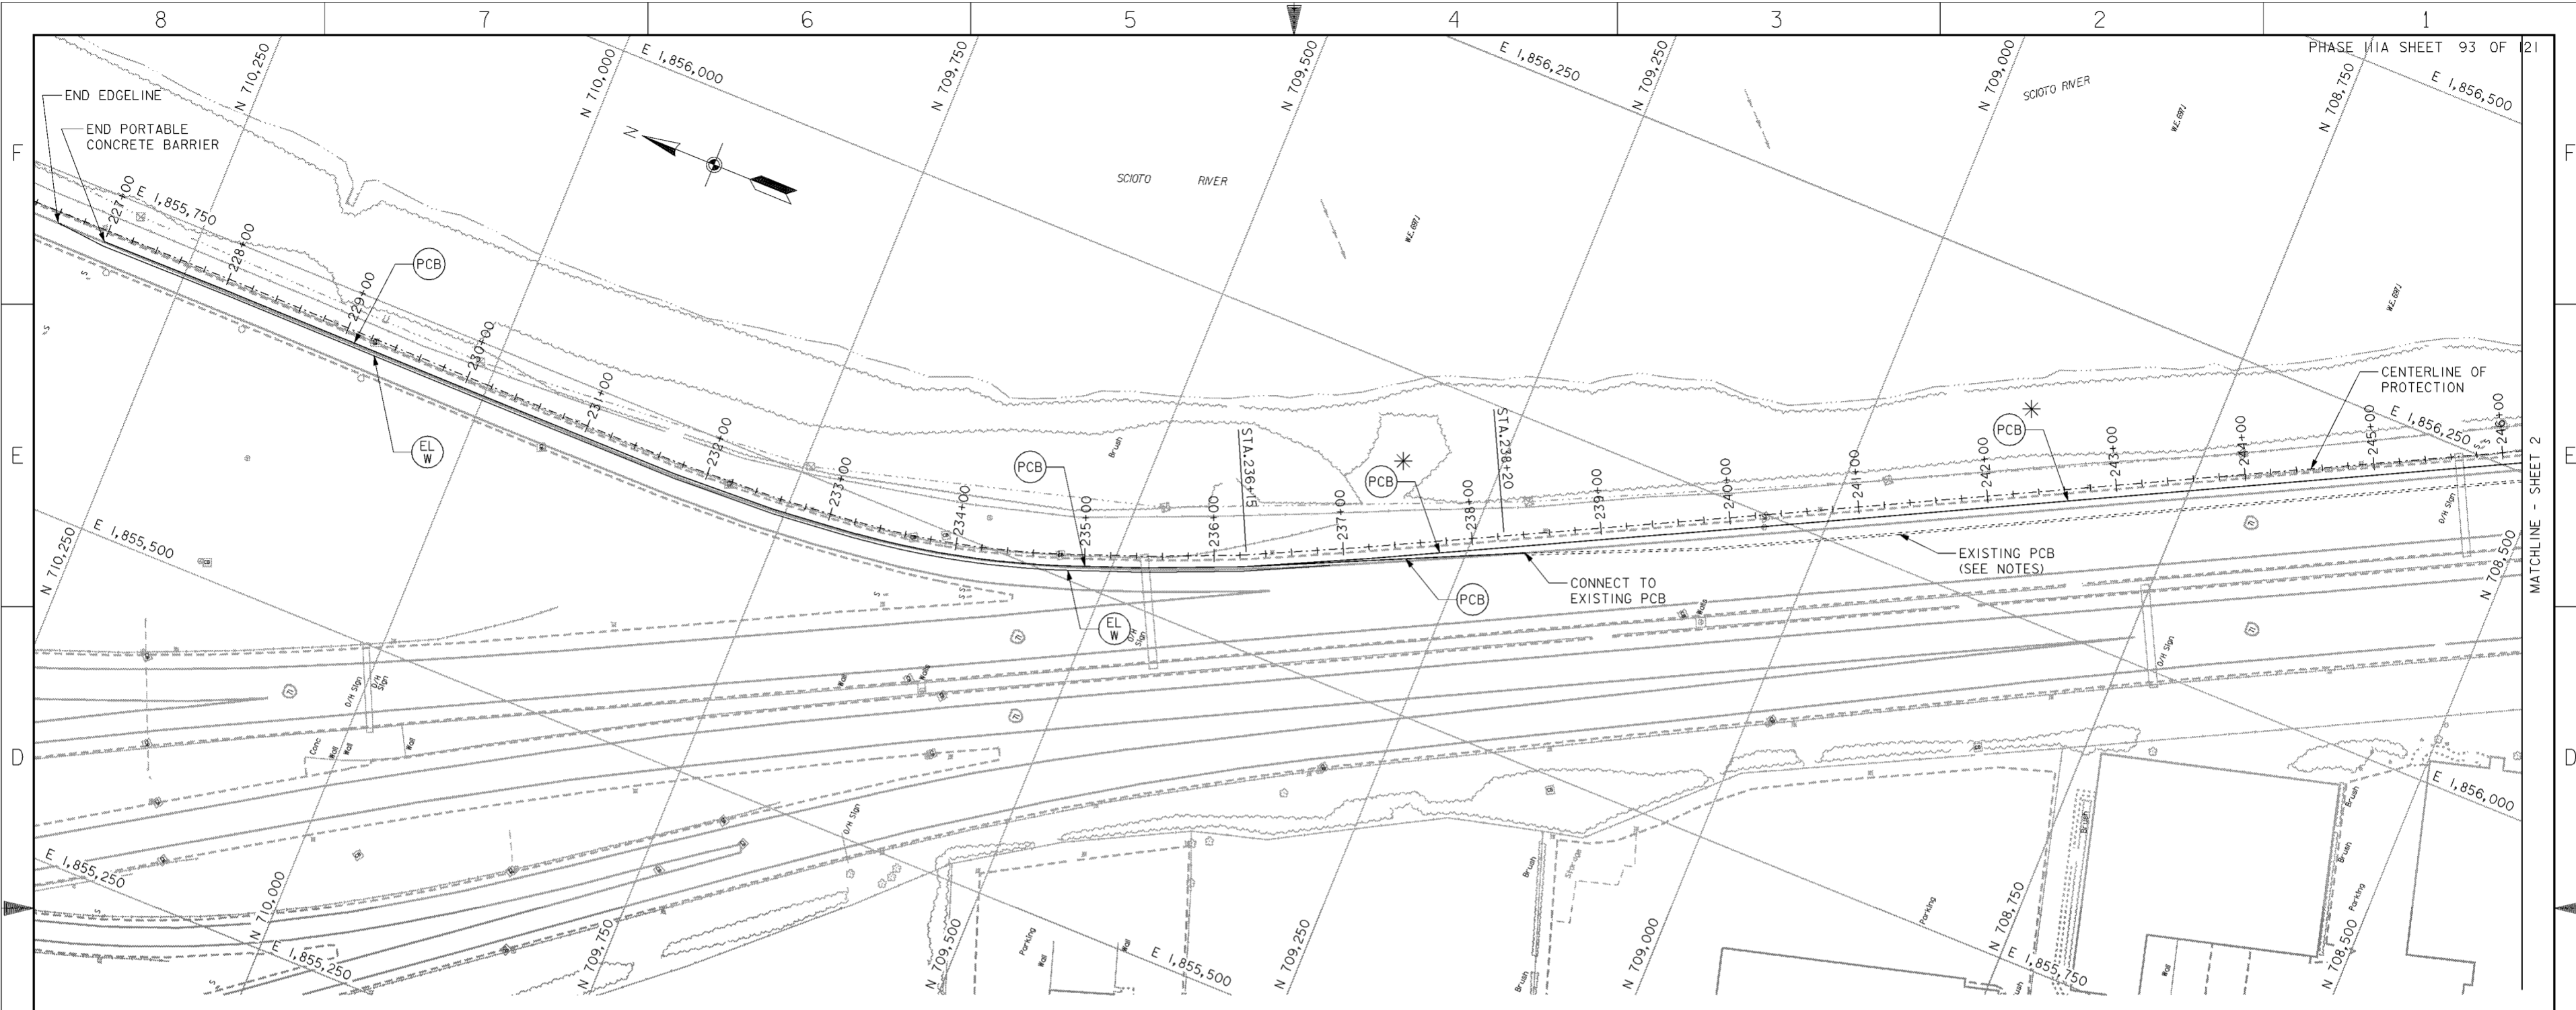

**PLAN**

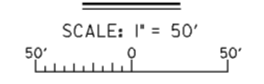


**NOTES**

- 1. MAINTENANCE OF TRAFFIC**  
TRAFFIC SHALL BE MAINTAINED PER THE REQUIREMENTS OF THE OHIO DEPARTMENT OF TRANSPORTATION (ODOT) "CONSTRUCTION AND MATERIAL SPECIFICATIONS" ITEM 614 AND OTHER APPLICABLE PORTIONS OF THE ODOT SPECIFICATIONS, AS WELL AS THE "OHIO MANUAL OF UNIFORM TRAFFIC CONTROL DEVICES". THE CONTRACTOR SHALL CONTACT THE OHIO DEPARTMENT OF TRANSPORTATION DISTRICT 6 AND THE CITY OF COLUMBUS TRAFFIC DIVISION 14 DAYS PRIOR TO BEGINNING THIS WORK.  
  
ALL LANES OF I-71 SHALL REMAIN OPEN TO TRAFFIC AND I-71 TRAFFIC SHALL NOT BE BLOCKED OR IMPEDED IN ANY WAY DURING THE CONSTRUCTION OF THIS PROJECT. NO CONSTRUCTION ACCESS SHALL BE ALLOWED FROM I-71. THERE SHALL BE NO OPENINGS IN THE PORTABLE CONCRETE BARRIER AT ANY TIME.
- 2. TEMPORARY PAVEMENT MARKINGS**  
THIS ITEM SHALL BE PERFORMED PER THE ODOT "CONSTRUCTION AND MATERIALS SPECIFICATIONS" ITEM 614.
- 3. PORTABLE CONCRETE BARRIERS**  
THIS ITEM SHALL BE PERFORMED PER THE ODOT "CONSTRUCTION AND MATERIALS SPECIFICATIONS" ITEM 622 AND ODOT STANDARD CONSTRUCTION DRAWING RM-4.2M (10-21-97). THE BARRIER SHALL BE DELINEATED AS DESCRIBED IN ODOT STANDARD CONSTRUCTION DRAWING MT-95.40M (4-25-94).
- 4. EXISTING PORTABLE CONCRETE BARRIER**  
THE EXISTING PORTABLE CONCRETE BARRIER IS IN PLACE TO CLOSE THE NORTHBOUND RIGHT LANE OF I-71 AS PART OF THE SPRING-SANDUSKY INTERCHANGE PROJECT. IT IS ANTICIPATED THAT THIS BARRIER WILL BE IN PLACE UNTIL LATE 1999. AS LONG AS THIS BARRIER IS IN PLACE IT SHALL BE UTILIZED AS SHOWN ON THIS PLAN. IF THIS BARRIER IS NOT IN PLACE AT THE BEGINNING OF THIS PROJECT OR IS REMOVED DURING THE CONSTRUCTION OF THIS PROJECT, ADDITIONAL BARRIER, DRUMS, AND STRIPING WILL BE REQUIRED AS SHOWN ON THIS PLAN.



- 5. CLOSURE OF EXISTING GREENLAWN AVE. RAMP TO I-71**  
WORK REQUIRING CLOSURE OF THE ON-RAMP FROM GREENLAWN AVE. TO I-71 SHALL BE PERFORMED SO THAT THE EXISTING CLOSURE (PART OF THE SPRING-SANDUSKY INTERCHANGE PROJECT) MAY BE UTILIZED. IT IS ANTICIPATED THAT THE RAMP CLOSURE AND DETOUR WILL BE IN PLACE UNTIL LATE 1999. IF THE RAMP CLOSURE AND DETOUR FROM THE MENTIONED PROJECT IS NOT IN PLACE, THE CONTRACTOR SHALL CLOSE THE RAMP AND SIGN A DETOUR MATCHING THE CLOSURE AND DETOUR THAT WAS IN PLACE DURING THE SPRING-SANDUSKY INTERCHANGE PROJECT. IF IT IS REQUIRED TO CLOSE THE GREENLAWN AVE. RAMP FOR THIS PROJECT, THE RAMP SHALL NOT BE CLOSED FOR MORE THAN 21 DAYS.

**LEGEND**

- \* THESE ITEMS ONLY TO BE PERFORMED IF EXISTING PCB IS NOT IN PLACE. (SEE NOTES)
- (PCB) PORTABLE CONCRETE BARRIER
- (EL W) TEMPORARY EDGE LINE, WHITE

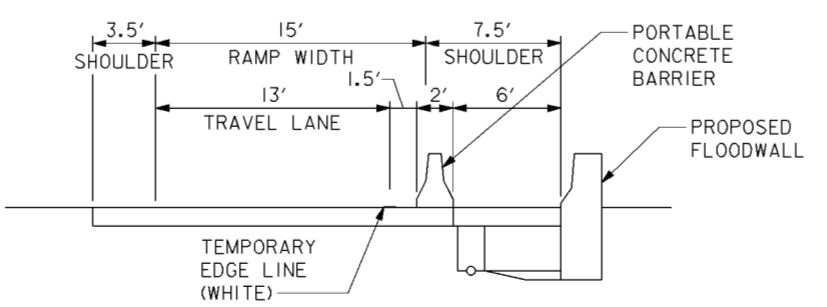

**STATION 227+00 TO 238+20**

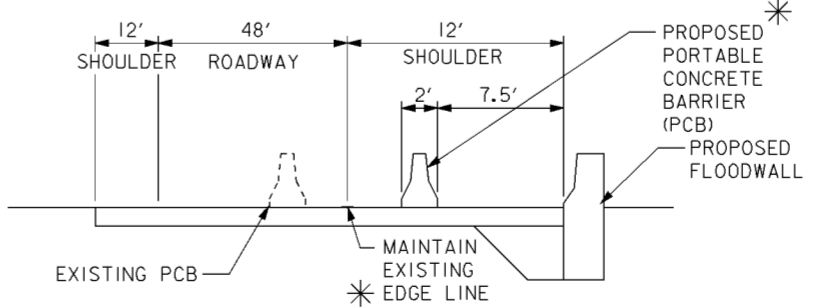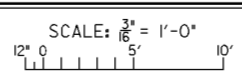


**STATION 238+20 TO 253+63**

SCALE: NONE

Revisions			
Symbol	Descriptions	Date	Approved
◇	REV. IN ACCORDANCE WITH AMENDMENT 0001	12/99	P.O.C.

<b>BURGESS &amp; NIPL, LIMITED</b> COLUMBUS, OHIO	<b>U.S. ARMY ENGINEER DISTRICT</b> CORPS OF ENGINEERS HUNTINGTON, WEST VIRGINIA
Designed by: <b>S.THIEKEN</b>	SCIO TO RIVER COLUMBUS, OHIO WEST COLUMBUS, L.P.P. PHASE IIIA
Drawn by: <b>T.MULLINS</b>	<b>MAINTENANCE OF TRAFFIC (1 OF 2)</b>
Checked by: <b>M.LOVE</b>	Scale: <b>AS SHOWN</b>
Reviewed by:	Date: <b>OCTOBER 1999</b>
Approved by:	Drawing Code: <b>16-PWC-12-</b>
	Sheet reference number: <b>921</b>
	FILENAME: 00h1p101.dgn
	PEN TABLE:
	Sheet 1 of 2

**WORK AS CONSTRUCTED**

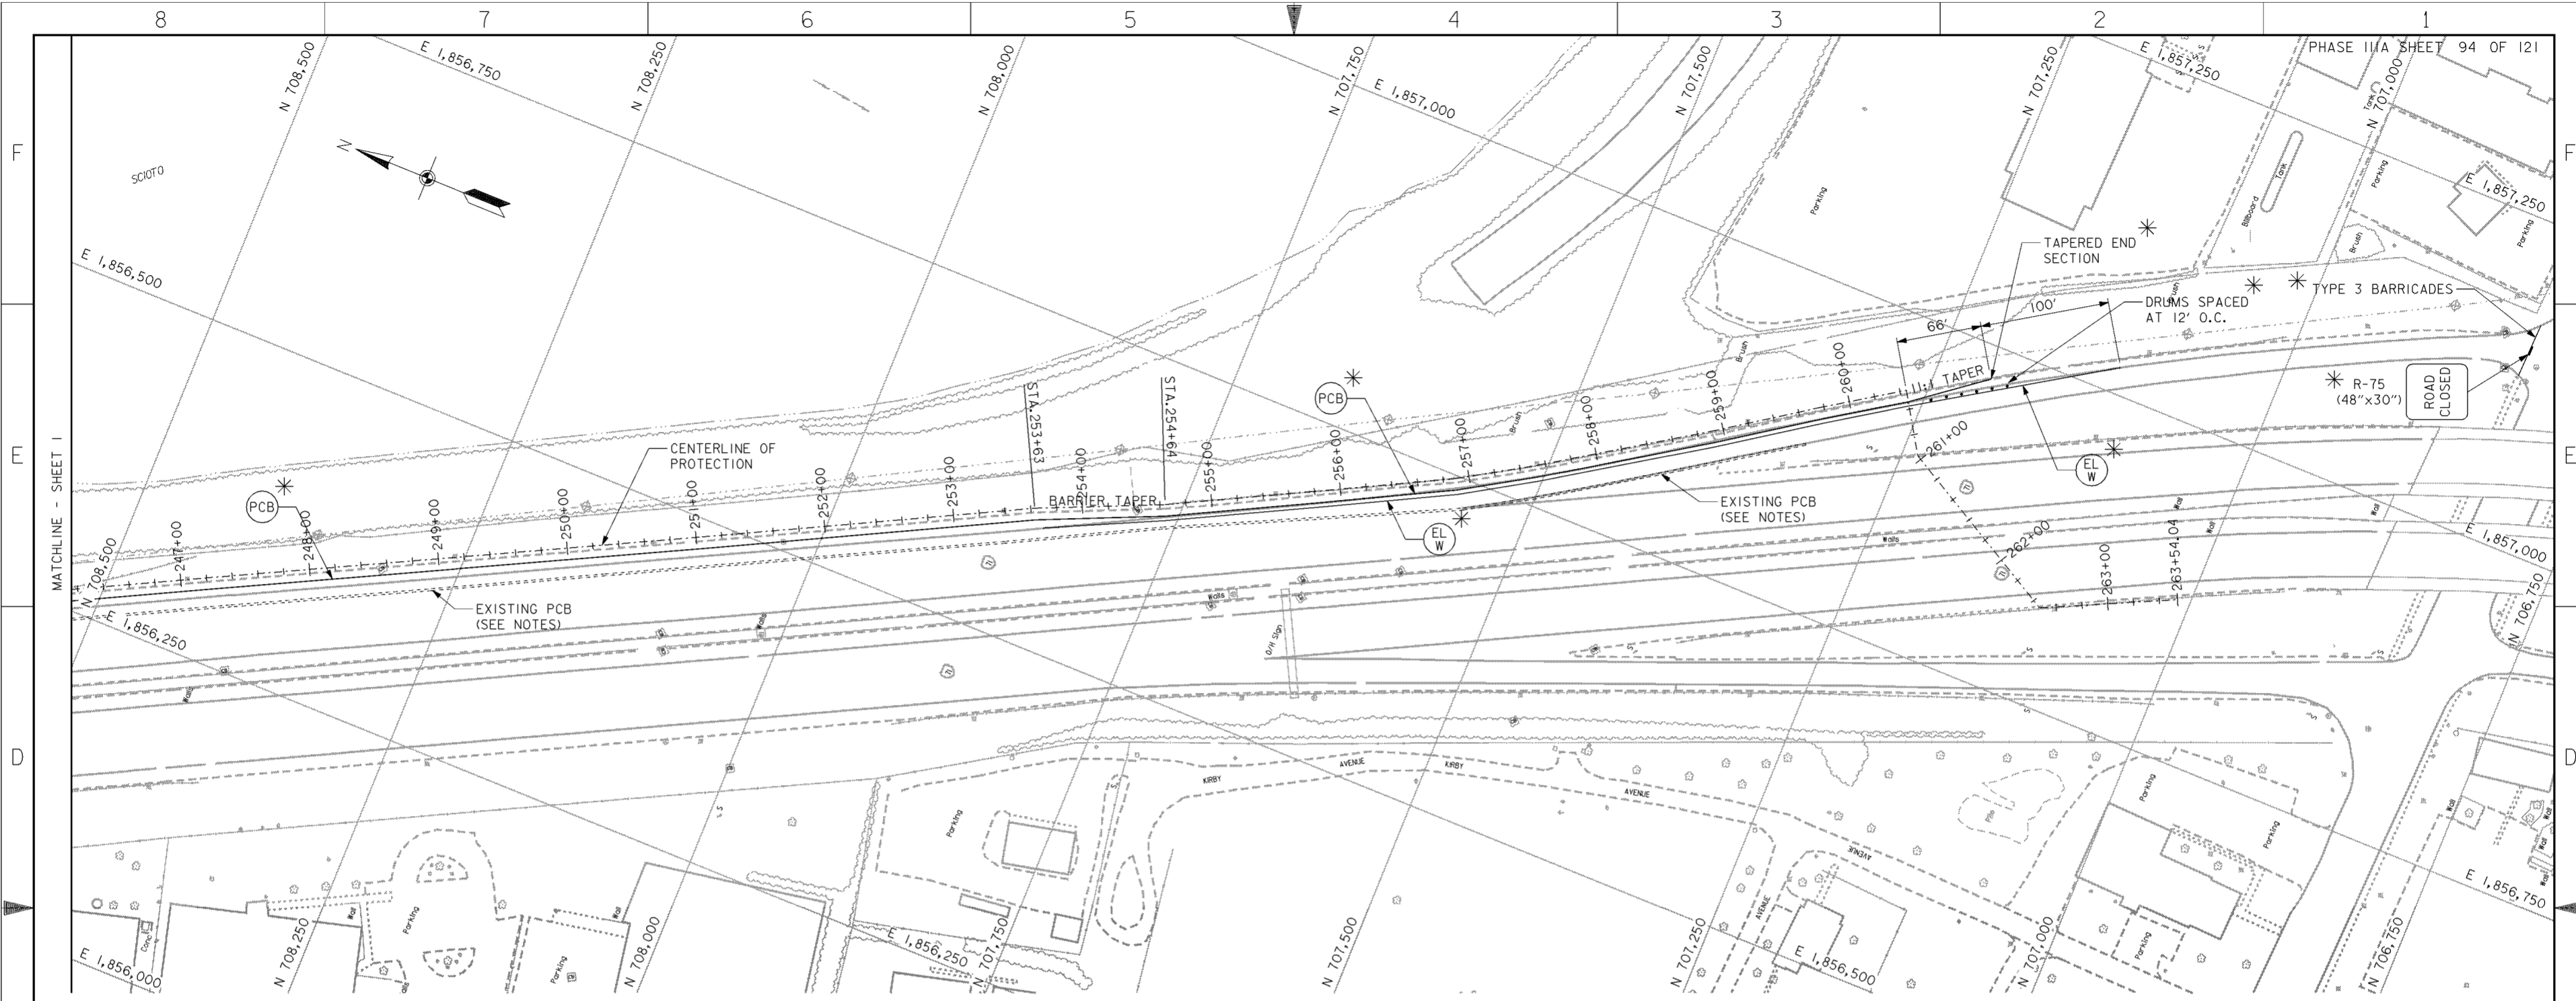


**PLAN**  
SCALE: 1" = 50'

**NOTES**

- MAINTENANCE OF TRAFFIC**  
TRAFFIC SHALL BE MAINTAINED PER THE REQUIREMENTS OF THE OHIO DEPARTMENT OF TRANSPORTATION (ODOT) "CONSTRUCTION AND MATERIAL SPECIFICATIONS" ITEM 614 AND OTHER APPLICABLE PORTIONS OF THE ODOT SPECIFICATIONS, AS WELL AS THE "OHIO MANUAL OF UNIFORM TRAFFIC CONTROL DEVICES". THE CONTRACTOR SHALL CONTACT THE OHIO DEPARTMENT OF TRANSPORTATION DISTRICT 6 AND THE CITY OF COLUMBUS TRAFFIC DIVISION 14 DAYS PRIOR TO BEGINNING THIS WORK.  
  
ALL LANES OF I-71 SHALL REMAIN OPEN TO TRAFFIC AND I-71 TRAFFIC SHALL NOT BE BLOCKED OR IMPEDED IN ANY WAY DURING THE CONSTRUCTION OF THIS PROJECT. NO CONSTRUCTION ACCESS SHALL BE ALLOWED FROM I-71. THERE SHALL BE NO OPENINGS IN THE PORTABLE CONCRETE BARRIER AT ANY TIME.
- TEMPORARY PAVEMENT MARKINGS**  
THIS ITEM SHALL BE PERFORMED PER THE ODOT "CONSTRUCTION AND MATERIALS SPECIFICATIONS" ITEM 614.
- PORTABLE CONCRETE BARRIERS**  
THIS ITEM SHALL BE PERFORMED PER THE ODOT "CONSTRUCTION AND MATERIALS SPECIFICATIONS" ITEM 622 AND ODOT STANDARD CONSTRUCTION DRAWING RM-4.2M (10-21-97). THE BARRIER SHALL BE DELINEATED AS DESCRIBED IN ODOT STANDARD CONSTRUCTION DRAWING MT-95.40M (4-25-94).
- EXISTING PORTABLE CONCRETE BARRIER**  
THE EXISTING PORTABLE CONCRETE BARRIER IS IN PLACE TO CLOSE THE NORTHBOUND RIGHT LANE OF I-71 AS PART OF THE SPRING-SANDUSKY INTERCHANGE PROJECT. IT IS ANTICIPATED THAT THIS BARRIER WILL BE IN PLACE UNTIL LATE 1999. AS LONG AS THIS BARRIER IS IN PLACE IT SHALL BE UTILIZED AS SHOWN ON THIS PLAN. IF THIS BARRIER IS NOT IN PLACE AT THE BEGINNING OF THIS PROJECT OR IS REMOVED DURING THE CONSTRUCTION OF THIS PROJECT, ADDITIONAL BARRIER, DRUMS, AND STRIPING WILL BE REQUIRED AS SHOWN ON THIS PLAN.

- CLOSURE OF EXISTING GREENLAWN AVE. RAMP TO I-71**  
WORK REQUIRING CLOSURE OF THE ON-RAMP FROM GREENLAWN AVE. TO I-71 SHALL BE PERFORMED SO THAT THE EXISTING CLOSURE (PART OF THE SPRING-SANDUSKY INTERCHANGE PROJECT) MAY BE UTILIZED. IT IS ANTICIPATED THAT THE RAMP CLOSURE AND DETOUR WILL BE IN PLACE UNTIL LATE 1999. IF THE RAMP CLOSURE AND DETOUR FROM THE MENTIONED PROJECT IS NOT IN PLACE, THE CONTRACTOR SHALL CLOSE THE RAMP AND SIGN A DETOUR MATCHING THE CLOSURE AND DETOUR THAT WAS IN PLACE DURING THE SPRING-SANDUSKY INTERCHANGE PROJECT. IF IT IS REQUIRED TO CLOSE THE GREENLAWN AVE. RAMP FOR THIS PROJECT, THE RAMP SHALL NOT BE CLOSED FOR MORE THAN 21 DAYS.

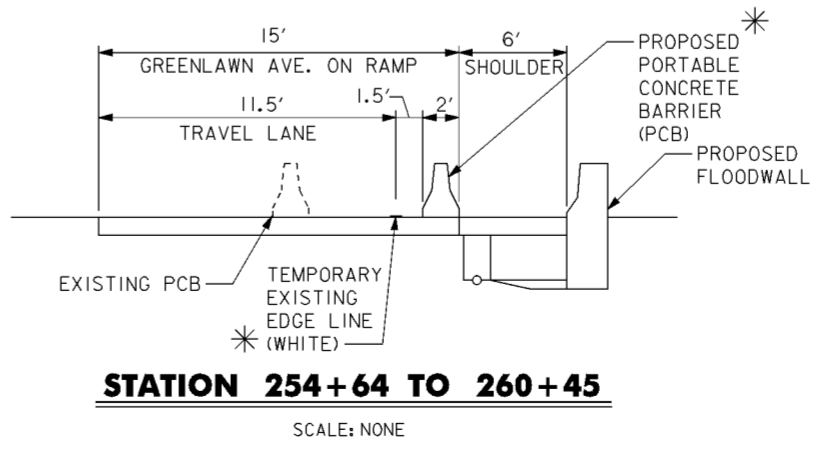

**LEGEND**


- \* THESE ITEMS ONLY TO BE PERFORMED IF EXISTING PCB IS NOT IN PLACE. (SEE NOTES)
- (PCB) PORTABLE CONCRETE BARRIER
- (EL W) TEMPORARY EDGE LINE, WHITE

Revisions			
Symbol	Descriptions	Date	Approved
◊	REV. IN ACCORDANCE WITH AMENDMENT 0001	12/99	P.O.C.

<b>BURGESS &amp; NIPL, LIMITED</b> COLUMBUS, OHIO	<b>U.S. ARMY ENGINEER DISTRICT</b> CORPS OF ENGINEERS HUNTINGTON, WEST VIRGINIA
Designed by: <b>S.THIEKEN</b>	SCIO TO RIVER COLUMBUS, OHIO WEST COLUMBUS, L.P.P. PHASE IIIA
Drawn by: <b>T.MULLINS</b>	<b>MAINTENANCE OF TRAFFIC (2 OF 2)</b>
Checked by: <b>M.LOVE</b>	Scale: <b>AS SHOWN</b>
Reviewed by:	Date: <b>OCTOBER 1999</b>
Approved by:	Drawing Code: <b>16-PWC-12-</b>
	Sheet reference number: <b>922</b>
	FILENAME: PIN TABLE: 00h1p102.dgn
	Sheet <b>2</b> of <b>2</b>

**WORK AS CONSTRUCTED**



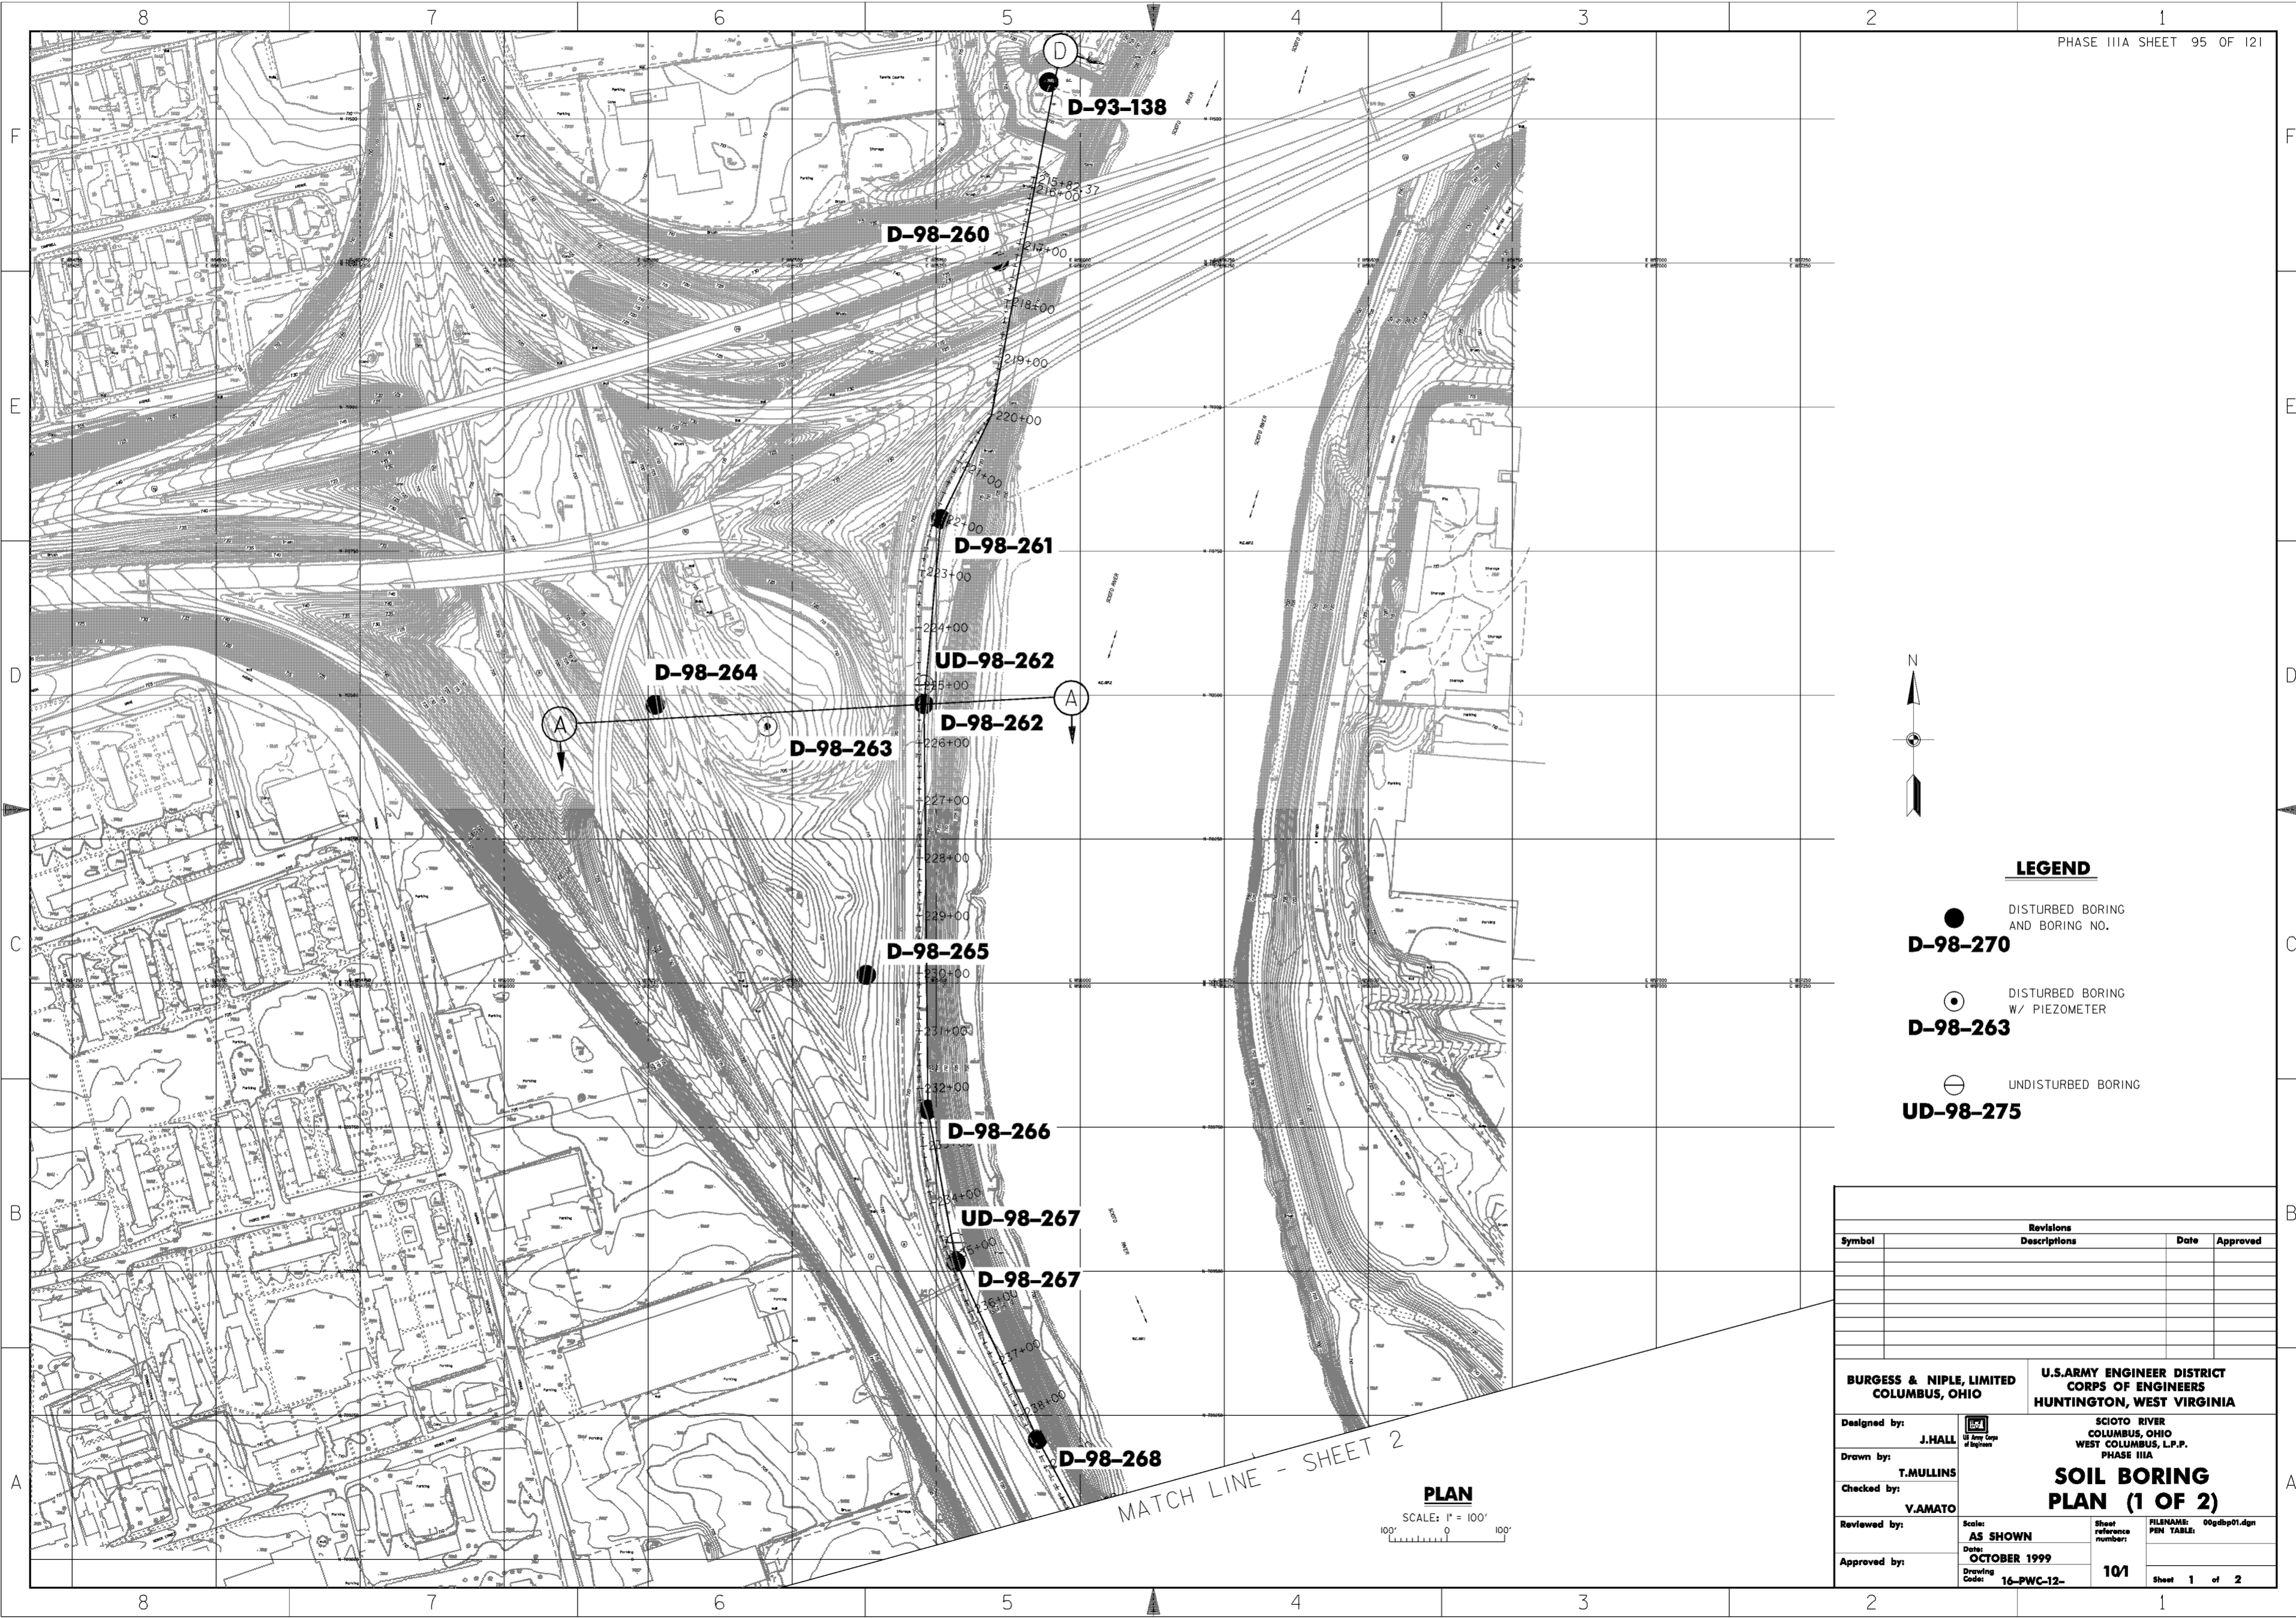

**LEGEND**

- DISTURBED BORING AND BORING NO.  
**D-98-270**
- ⊙ DISTURBED BORING W/ PIEZOMETER  
**D-98-263**
- ⊖ UNDISTURBED BORING  
**UD-98-275**


Revisions			
Symbol	Descriptions	Date	Approved

<b>BURGESS &amp; NIPLE, LIMITED</b> COLUMBUS, OHIO		<b>U.S. ARMY ENGINEER DISTRICT</b> CORPS OF ENGINEERS HUNTINGTON, WEST VIRGINIA	
Designed by: <b>J. HALL</b>		<b>SCIOTO RIVER</b> COLUMBUS, OHIO WEST COLUMBUS, L.P.P. PHASE IIIA <b>SOIL BORING PLAN (1 OF 2)</b>	
Drawn by: <b>T. MULLINS</b>			
Checked by: <b>V. AMATO</b>		Scale: <b>AS SHOWN</b>	Sheet reference number: <b>10/1</b>
Reviewed by:		Date: <b>OCTOBER 1999</b>	FILENAME: PEN TABLE: <b>00gdbp01.dgn</b>
Approved by:		Drawing Code: <b>16-PWC-12-</b>	Sheet <b>1</b> of <b>2</b>

MATCH LINE - SHEET 2

**PLAN**  
SCALE: 1" = 100'



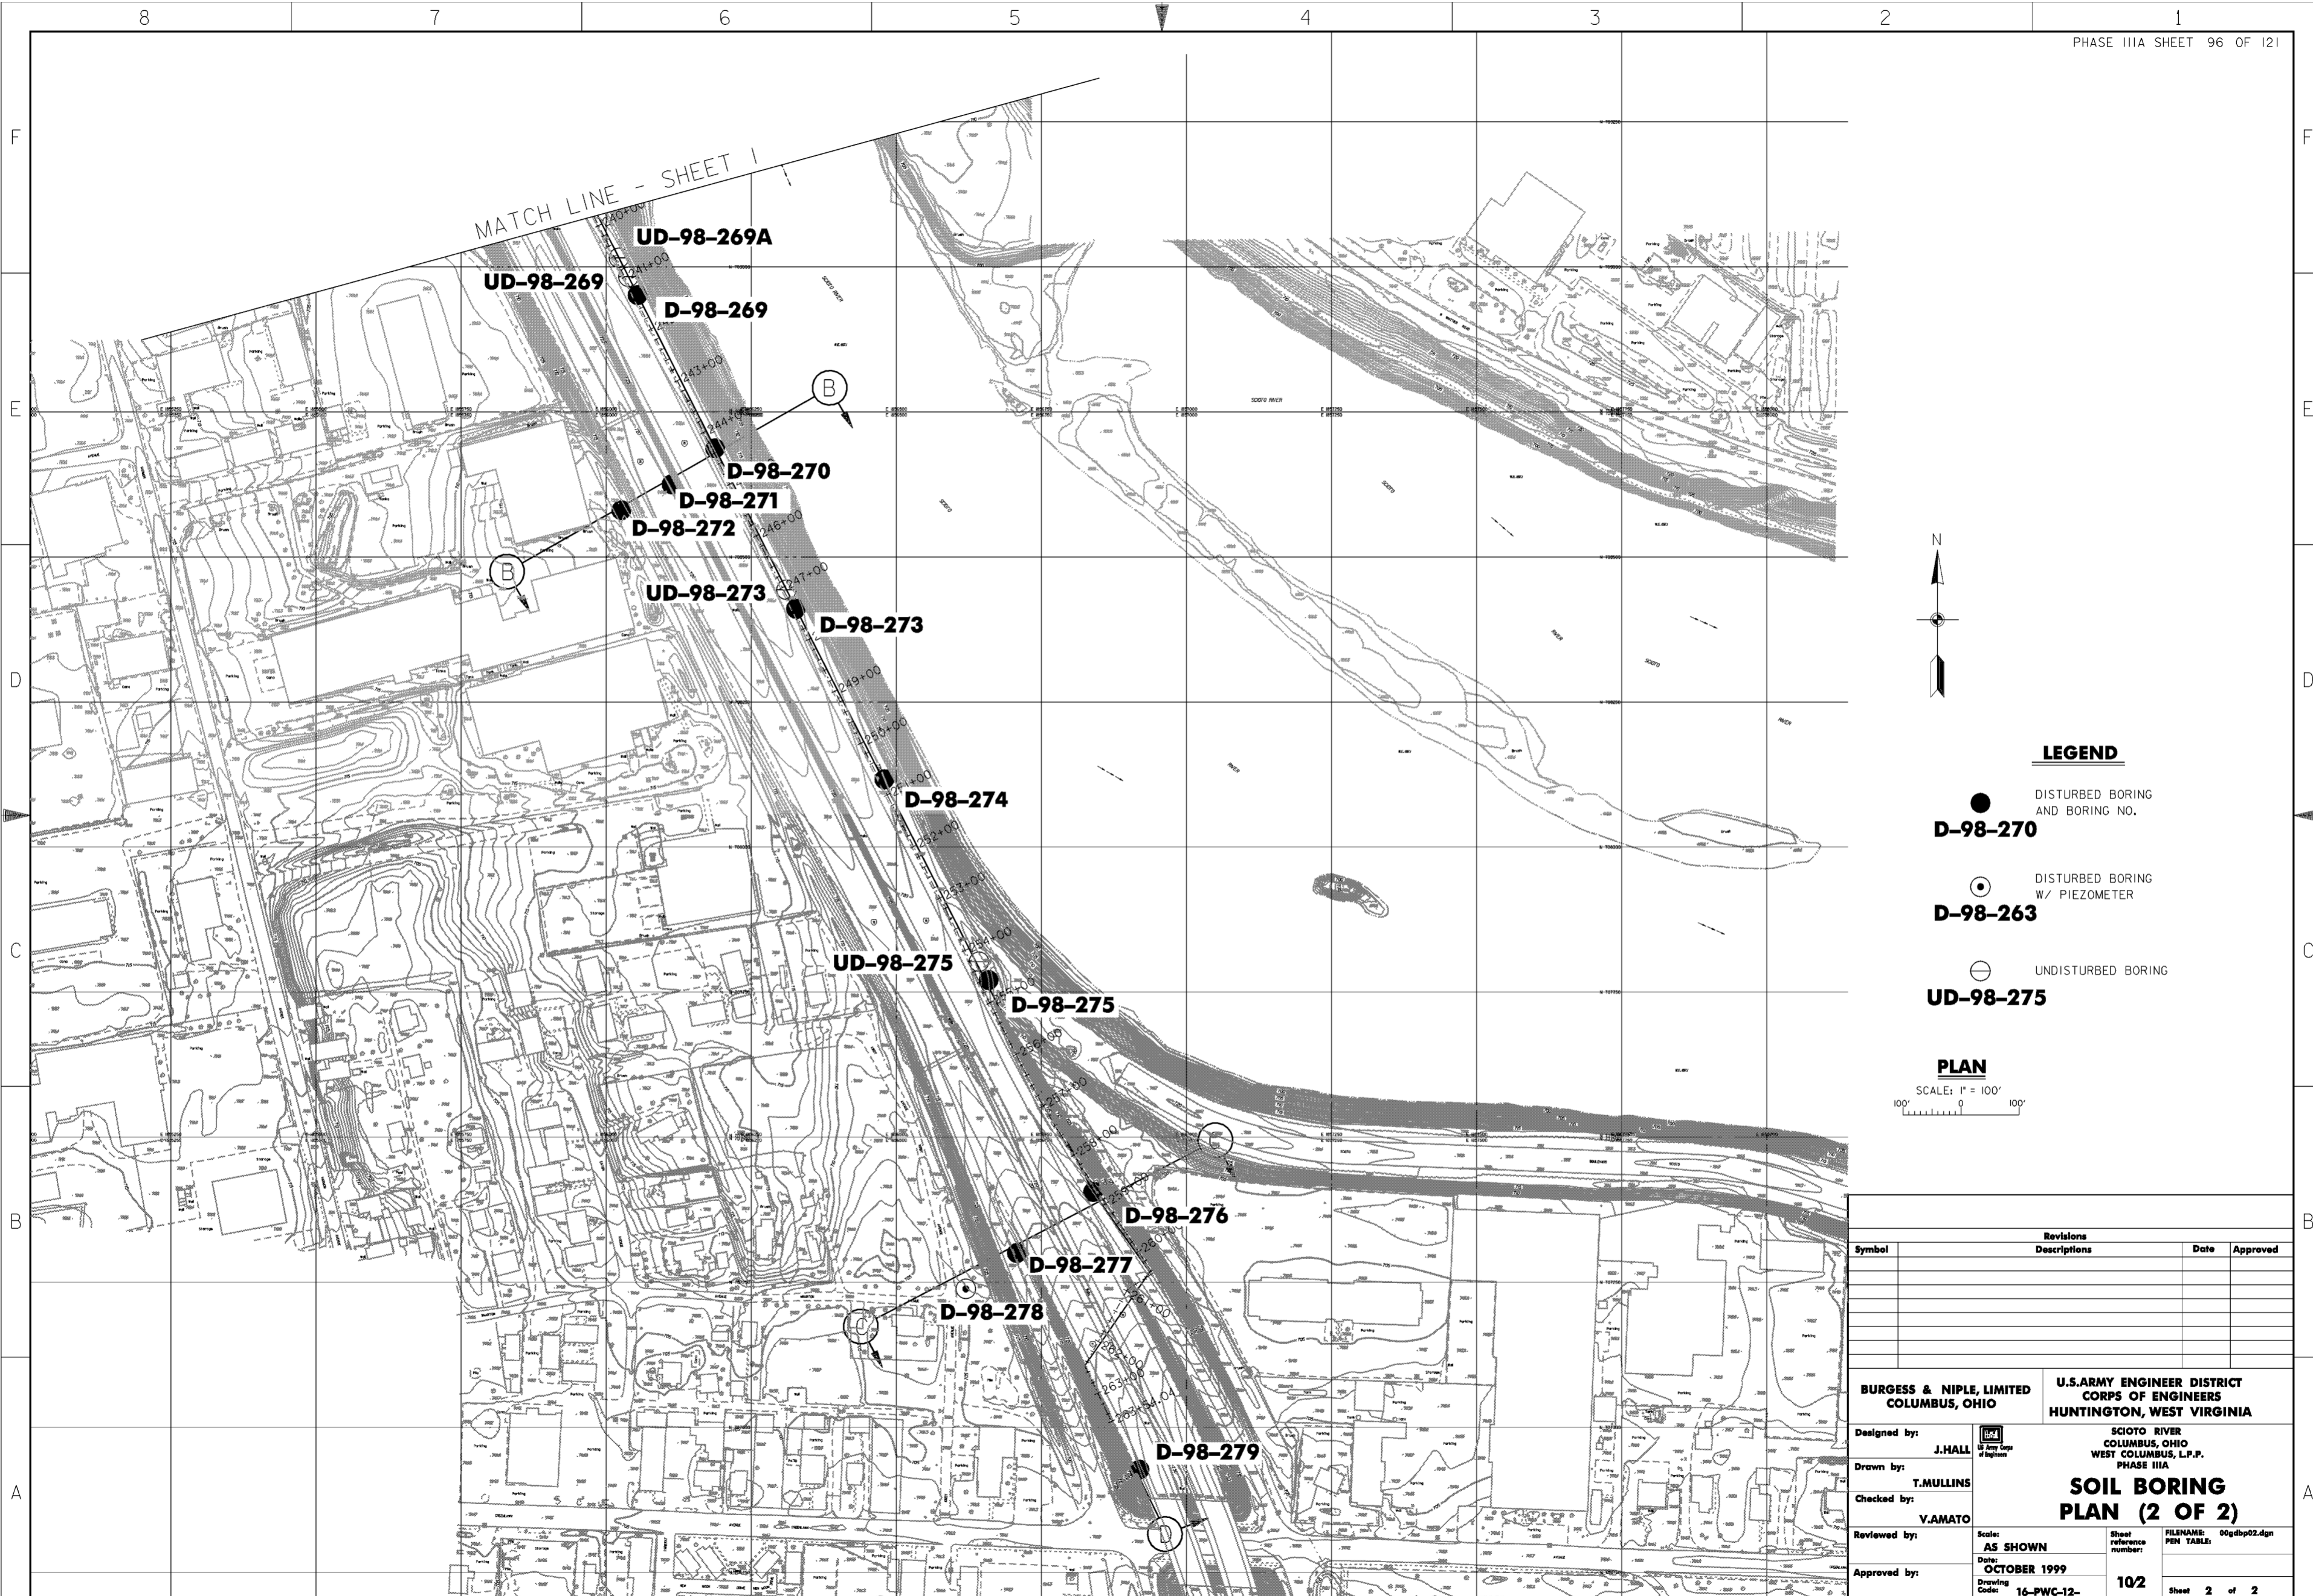

**LEGEND**

- DISTURBED BORING AND BORING NO.  
**D-98-270**
- ⊙ DISTURBED BORING W/ PIEZOMETER  
**D-98-263**
- ⊖ UNDISTURBED BORING  
**UD-98-275**

**PLAN**

SCALE: 1" = 100'  
100' 0 100'

Revisions			
Symbol	Descriptions	Date	Approved

<b>BURGESS &amp; NIPL, LIMITED</b> COLUMBUS, OHIO		<b>U.S. ARMY ENGINEER DISTRICT</b> CORPS OF ENGINEERS HUNTINGTON, WEST VIRGINIA	
Designed by: <b>J. HALL</b>		SCIO TO RIVER COLUMBUS, OHIO WEST COLUMBUS, L.P.P. PHASE IIIA	
Drawn by: <b>T. MULLINS</b>		<b>SOIL BORING PLAN (2 OF 2)</b>	
Checked by: <b>V. AMATO</b>		Scale: <b>AS SHOWN</b>	Sheet reference number: <b>102</b>
Reviewed by:		Date: <b>OCTOBER 1999</b>	FILENAME: 00gdbp02.dgn
Approved by:		Drawing Code: <b>16-PWC-12-</b>	PEN TABLE: Sheet <b>2</b> of <b>2</b>

**UNIFIED SOIL CLASSIFICATION**  
Including Identification and Description

MAJOR DIVISIONS	GROUP SYMBOLS	TYPICAL NAMES	FIELD IDENTIFICATION PROCEDURES	INFORMATION REQUIRED FOR DESCRIBING SOILS	LABORATORY CLASSIFICATION CRITERIA		
COARSE - GRAINED SOILS More than half of material is larger than No. 200 sieve size	GRAVELS More than half of coarse fraction is smaller than No. 4 sieve size. (For visual classification, the 1/4-inch size may be used as equivalent to the No. 4 sieve size.)	GW	Well - graded gravels, gravel - sand mixtures, little or no fines.	Wide range in grain sizes and substantial amounts of all intermediate particle sizes.	For undisturbed soils add information on stratification, degree of compactness, cementation, moisture conditions and drainage characteristics.	$C_u = \frac{D_{60}}{D_{10}}$ Greater than 4 $C_c = \frac{(D_{30})^2}{D_{10} D_{60}}$ Between one and 3 Not meeting all gradation requirements for GW Atterberg limits below "A" line or PI less than 4 Atterberg limits above "A" line with PI greater than 7 $C_u = \frac{D_{60}}{D_{10}}$ Greater than 6 $C_c = \frac{(D_{30})^2}{D_{10} D_{60}}$ Between one and 3 Not meeting all gradation requirements for SW Atterberg limits below "A" line or PI less than 4 Atterberg limits above "A" line with PI greater than 7 Limits plotting in hatched zone with PI between 4 and 7 are borderline cases requiring use of dual symbols.	
		GP	Poorly - graded gravels, gravel - sand mixtures, little or no fines.	Predominantly one size or a range of sizes with some intermediate sizes missing.	Give typical name; indicate approximate percentage sand and gravel, max. size; angularity, surface condition, and hardness of the coarse grains; local or geologic name and other pertinent descriptive information; and symbol in parentheses.		
		GM	Silty gravels, gravel - sand - silt mixtures.	Nonplastic fines or fines with low plasticity (for identification procedures see ML below).			
		GC	Clayey gravels, gravel - sand - clay mixtures.	Plastic fines (for identification procedures see CL below).			
	SW	Well - graded sands, gravelly sands, little or no fines.	Wide range in grain size and substantial amounts of all intermediate particle sizes.				
	SP	Poorly - graded sands, gravelly sands, little or no fines.	Predominantly one size or a range of sizes with some intermediate sizes missing.				
	SM	Silty sands, sand - silt mixtures.	Nonplastic fines or fines with low plasticity (for identification procedures see ML below).				
	FINE - GRAINED SOILS More than half of material is smaller than No. 200 sieve size	SANDS More than half of coarse fraction is smaller than No. 4 sieve size. (For visual classification, the 1/4-inch size may be used as equivalent to the No. 4 sieve size.)	SC	Clayey sands, sand - clay mixtures.	Plastic fines (for identification procedures see CL below).		EXAMPLE Silty sand, gravelly; about 20% hard, angular gravel particles 1/2-in. max. size; rounded and subangular sand grains coarse to fine; about 15% nonplastic fines with low dry strength; well compacted and moist in place; alluvial sand (SM).  EXAMPLE Clayey silt, brown, slightly plastic, small percentage of fine sand, numerous vertical root holes, firm and dry in place (ML).  EXAMPLE Clayey silt, brown, slightly plastic, small percentage of fine sand, numerous vertical root holes, firm and dry in place (ML).
			SH	Sandy silts, silty sands or silty clays.	Nonplastic fines or fines with low plasticity (for identification procedures see ML below).		
		SILTS AND CLAYS Liquid Limit Less than 50	ML	Inorganic silts and very fine sands, rock flour, silty or clayey fine sands or clayey silts with slight plasticity.	None to slight		
CL			Inorganic clays of low to medium plasticity, gravelly clays, sandy clays, silty clays, lean clays.	Medium to high	None to slow	Medium	
OL			Organic silts and organic silty clays of low plasticity.	Slight to medium	Slow	Slight	
MH			Inorganic silts, micaceous or diatomaceous fine sandy or silty soils, elastic silts.	Slight to medium	Slow to none	Slight to medium	
SILTS AND CLAYS Liquid Limit Greater than 50	CH	Inorganic clays of high plasticity, fat clays.	High to very high	None	High		
	OH	Organic clays of medium to high plasticity, organic silts.	Medium to high	None to very slow	Slight to medium		
Highly Organic Soils	Pt	Peat and other highly organic soils.	Readily identified by color, odor, spongy feel and frequently by fibrous texture.				

(1) Boundary classifications: Soils possessing characteristics of two groups are designated by combinations of group symbols. For example GW-GC, well-graded gravel-sand mixture with clay binder (2) All sieve sizes on this chart are U.S. standard.

**FIELD IDENTIFICATION PROCEDURES FOR FINE - GRAINED SOILS OR FRACTIONS**

These procedures are to be performed on the minus No. 40 sieve size particles, approximately 1/84 in. for field classification purposes, screening is not intended, simply remove by hand the coarse particles that interfere with the tests.

**DILATANCY (reaction to shaking)**

After removing particles larger than No. 40 sieve size, prepare a pat of moist soil with a volume of about one-half cubic inch. Add enough water if necessary to make the soil soft but not sticky. Place the pat in the open palm of one hand and shake horizontally, striking vigorously against the other hand several times. A positive reaction consists of the appearance of water on the surface of the pat which changes to a livery consistency and becomes glossy. When the sample is squeezed between the fingers, the water and gloss disappear from the surface, the pat stiffens, and finally cracks or crumbles. The rapidity of appearance of water during shaking and of its disappearance during squeezing assist in identifying the character of the fines in a soil. Very fine clean sands give the quickest and most distinct reaction whereas a plastic clay has no reaction. Inorganic silts, such as a typical rock flour show a moderately quick reaction.

Adopted by the Corps of Engineers and Bureau of Reclamation, January 1952.

**DRY STRENGTH (crushing characteristics)**

After removing particles larger than No. 40 sieve size, mold a pat of soil to the consistency of putty, adding water, if necessary. Allow the pat to dry completely by oven, sun, or air drying, and then test its strength by breaking and crumbling between the fingers. This strength is a measure of the character and quantity of the colloidal fraction contained in the soil. The dry strength increases with increasing plasticity. High dry strength is characteristic for clays of the CH group. A typical inorganic silt possesses only very slight dry strength. Silty fine sands and silts have about the same slight dry strength, but can be distinguished by the feel when powdering the dried specimen. Fine sand feels gritty whereas a typical silt has the smooth feel of flour.

**TOUGHNESS (consistency near plastic limit)**

After removing particles larger than the No. 40 sieve size, a specimen of soil about one-half inch cube in size, is molded to the consistency of putty. If too dry, water must be added and if sticky, the specimen should be spread out in a thin layer and allowed to lose some moisture by evaporation. Then the specimen is rolled out by hand on a smooth surface or between the palms into a thread about one-eighth inch in diameter. The thread is then folded and rolled repeatedly. During this manipulation the moisture content is gradually reduced and the specimen stiffens, finally loses its plasticity, and crumbles, when the plastic limit is reached. After the thread crumbles, the pieces should be lumped together and a slight kneading action continued until the lump crumbles. The tougher the thread near the plastic limit and the stiffer the lump when it finally crumbles, the more potent is the colloidal clay fraction in the soil. Weakness of the thread at the plastic limit and quick loss of coherence of the lump below the plastic limit indicate either inorganic clay of low plasticity, or materials such as kaolin-type clays and organic clays which occur below the A-line. Highly organic clays have a very weak and spongy feel at the plastic limit.

**ABBREVIATIONS**

a. alternate(ly)(ing)	f. fine	mot. mottled	str. stringer(s)
amt. amount	fer. ferruginous	mat. matrix	sty. styrolite(s)
ang. angular	fi. fissile		t. thin
approx. approximate(ly)	fil. fill(ed)(ing)		th. throughout
arg. argillaceous	fm. firm	n. nass	tk. thick
aren. arenaceous	fo. fossil(iferous)	nod. nodule(s)	tr. trace
asp. asphaltic	frac. fracture(d)	num. numerous	v. variably
	fraga. fragment(s)(al)	o. open	var. variegated
	fri. friable	od. odor	veg. vegetation
b. bone	FP fixed-plaston	occ. occasional(ly)	ver. vertical(ly)
ba. banded(ing)	FW free water	occ. occurring	vug. vuggy
bd. bedrock	g. grain(ed)	org. organic	w. water
bf. buff	gen. generally	pa. parting(s)	w/ with
bk. black	gn. green(ish)	part. particle(s)	w/o without
bky. blocky	gr. gray	perc. percent(age)	wc water content
brn. broken	gr. gravelly	pl. piece	wd. weathered
bl. blue	grad. grading(ed)	pl. plastic limit	wh. weight of hammer
bot. bottom	gr. grading(ed)	pl. plastic limit	whl. white
bou. boulder(s)	GW groundwater	pk. pink	WL water level
bre. breccia(ied)	h. hard	pk. pocket(s)	wo. wood
br. brown(ish)	ha. high angle	pit. pit(ted)(ing)	
	hor. horizontal(ly)	plan. planar(s)	
c. coarse	ic. initial contact	por. porous	x-bd. cross-bedded(ing)
ca. calcareous	inc. included, inclusions	pt. part(ly)	y. yellow(ish)
carb. carbonaceous	inc. increasing(ly)	pyr. pyrite(lic)	z. zone
cav. cavern, cavity	int. interlaminated	q. quartz(itic)	
cbl. cobble(ly)	int. interbedded	r. red(dish)	
ch. chert	ir. irregular	ro. rock(s)	
cl. clay(ey)	jt. joint(ed)	rot. rot(ted)(n)	
cl. clay(s)	l. low	rou. round(ed)	
cl. clay(s)	ll. little	rou. root(s)(ite)	
cl. clean	la. low angle	s. soft	
coa. coal(ed)(ing)	la. laminat(ed)(ions)	ss. split spoon	
comp. compact	lay. layer(s)	ss. sandy	
con. contains	le. lean	sat. saturated	
conc. concretion	lea. leached	scat. scattered	
cong. conglomerate(lic)	len. lense(s)	se. seams	
cont. continuous	lg. large	sev. several(ly)	
crust. crustal	ll. liquid limit	sh. shaly	
crm. crumbly	los. loose	sh. shaly	
cat. crystal(ine)	lt. light	sh. shaly	
cem. cement(ed)	m. medium	sil. siliceous	
	ma. many	sl. silty	
de. decayed	mas. massively	slk. slickensided	
di. diameter	mat. material	sm. small	
diag. diagonal	mic. micaceous	so. soil	
disc. discontinuous	min. mineralized	sol. solution	
dis. disseminated	mod. moderate(ly)	sta. stain(ed)	
dk. dark	moa. mostly	stf. stiff	
dn. dense		stka. streak(s)	
dmp. damp			
ext. extremely			
elem. elements			


**NUMBER AND TYPE OF EXPLORATIONS**

CODE	YEAR	HOLE NO.	DESIGNATION
C	91	39	● Core hole in bedrock
D	91	39	○ Disturbed sample boring
CD	91	39	○ Disturbed sample boring (Percussion Drill/Cable Tool Drill)
UD	91	39	● Undisturbed sample boring
A	91	39	○ Auger hole hand or power auger, 2" to 24" diameter
			◆ Core hole in bedrock, hydraulic pressure tested
			● Indicates angle boring shows direction
			○ Boring with Piezometer
			⊕ Boring with inclinometer
TP	91	42	■ Test Pit in overburden
TT	91	7 - 135	⊔ Test Trench in overburden (TT-91-7), soils classified at stationing as shown (135 feet)
UD	91	39	⊕ Undisturbed sample boring with Piezometer

**ROCK**

NAME	ABBREVIATION
SANDSTONE	SS.
CONGLOMERATE	CONG.
SHALE	SH.
SILTSTONE	SLS.
CLAYSTONE	CLS.
LIMESTONE	LS.
COAL	C.
INDURATED CLAY	ICL.
DOLOMITE	DO.

**ROCK & GRAPHIC LOG OF BORING LEGEND**

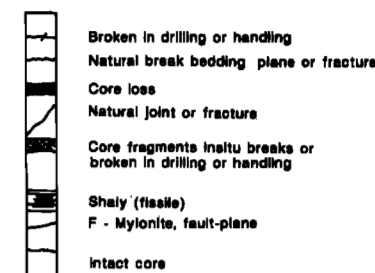

**GRAPHIC LOG OF BORING**

Vertical or Degrees From \_\_\_\_\_  
Drill Hole Compass Direction \_\_\_\_\_

Core Size - 4-inch  
Batter - Vertical  
Direction \_\_\_\_\_  
Date Started 26 Oct. 1979  
Completed 1 Nov. 1979

PROJECT SAMPLE LOG  
HOLE NO. C-87-39  
Sampler 2' S.S.  
Drop 30"  
Hammer 140#  
Coordinates N. 557,955.2  
E. 1735,407.9

ELEVATION (Feet)	SYMBOL	DESCRIPTION OF MATERIALS	REMARKS
549.1			
541.8	CL	CLAY (CL), br. pl. mat. w/ f.g.-c.g. SAND, rc. frag. to 1"	W.C. 41 P.L. 19 L.L. 18.3
535.1	GM	SILTY SANDY GRAVEL (GM), gr. non pl. dmp., f.g.-c.g. ang. to subangular GRAVEL, f.g.-c.g. SAND	W.C. 42 P.L. 33 L.L. 25
529.1	NS	DRILLING W/O SAMPLING	
525.2	NS	SAMPLED - NO RECOVERY	
516.9	SH	Shale, silty, soft to mod. hard, gray, poorly fissile with clayey zones. 0.8' sandy SILTSTONE zone at 523.3 to 522.7. 0.5' partially broken along vertical fracture from 521.2 to 520.7. Unweathered, vertical fracture from 518.2 to 517.1.	TOP OF ROCK - W.C. 26.0 P.L. 14 L.L. 1.1 L.D.W. 31.0 R.D.W. 18 41.0
	SS	SANDSTONE, hard, fine to medium grained, gray, micaceous, thick bedded with micaceous, laminations. Very fine grained and silty to 513.2. 1.8' zone with numerous micaceous laminations from 512.9 to 511.3. 0.3' broken, very friable zone & unweathered fracture from 509.2 to 508.9.	Pressure Test Data - Gage Pressure (Pounds per Square Inch) - Water Take (Cubic Feet per Minute) - Lost Drill Water - % Loss - Rock Quality Designation (% per Run) - Core Loss (Feet per Run) - Bottom of Pressure Test (Increment Feet) - Regained Drill Water

Drilling Without Sampling \_\_\_\_\_  
Sampling With No Recovery \_\_\_\_\_

Rock Symbol \_\_\_\_\_  
Rock Structural Element \_\_\_\_\_

TOP OF ROCK \_\_\_\_\_  
BOTTOM OF HOLE \_\_\_\_\_

SHEET 1 OF 1

Symbol	Revisions	Descriptions	Date	Approved

DESIGNED BY: G.HENSLEY  
DRAWN BY: G.HENSLEY  
CHECKED BY: M.NIELD  
REVIEWED BY: \_\_\_\_\_  
APPROVED BY: \_\_\_\_\_

Scale: NONE  
Date: OCTOBER 1999  
Drawing Code: 16-PWC-12-

U.S. ARMY ENGINEER DISTRICT  
CORPS OF ENGINEERS  
HUNTINGTON, WEST VIRGINIA

SCIO TO RIVER  
COLUMBUS, OHIO  
WEST COLUMBUS, L.P.P.  
PHASE IIIA

**GEOLOGY AND SOILS LEGEND**

FILENAME: legend.dgn  
PEN TABLE:  
Sheet 1 of 1







CORE SIZE		BATTER		PROJECT		SAMPLER		DIRECTION		DATE		STARTED		COMPLETED	
NX		VERTICAL		WEST COLUMBUS LPP		2" SPLITSPOON		DROP 30"		HAMMER 140#		1-9-98		HOLE NO. D-98-275	
ELEVATION (FEET)		SYMBOL		DESCRIPTION OF MATERIALS		REMARKS OR TEST RESULTS		WC		LL		PL		BLOWS	
717.0	OL	SILTY CLAY (OL), dk. br., sil. pl., org. occ. r.t. (topsoil)												4	10
714.0	CL	SILTY CLAY (CL), br., sil. pl., dmp., w/ sand, occ. r.t.		4.5'-6.0'										8	9
711.0	GC	SILTY CLAYEY SANDY GRAVEL (GC), br., sil. pl., dmp., occ. r.t. and coal frags.		7.5'-9.0'										4	6
708.0	CL	SILTY SANDY CLAY (CL), br., sil. pl., dmp.												8	8
706.0	SC	CLAYEY SAND (SC), br., sil. pl., mat., f.g. to c.g.												6	5
705.5	CH	GRAVELLY SANDY SILTY CLAY (CH), dk. br., pla., dmp., occ. shale frags.		13.5' to 15.0'										5	10
702.0	GC	CLAYEY SANDY GRAVEL (GC), lt. br., sil. pl., dmp., c.g.		19.5' - 21.0'										12	12
694.5	CL	GRAVELLY SANDY SILTY CLAY (CL), lt. br. to gr., sil. pl., mat.												7	6
691.5	NS	DRILLING W/O SAMPLING													
690.0	GP-GM	SILTY SANDY GRAVEL (GP-GM), br., non pl., wet, f.g. to c.g.												12	29
685.5	GM	SILTY SANDY GRAVEL (GM), br., non pl., wet, c.g.		34.0'										21	20
679.5	NS	DRILLING W/O SAMPLING													
677.0	GW	SANDY GRAVEL (GW), gy., non pl., wet, c.g.												89	30
676.2	CL	SILTY CLAY (CL), gr., pl., dmp., w/ gravel		43.0'-43.7'										40	32
672.5	CL	SILTY CLAY (CL), gy., sil. pl., dmp., w/ sand and gravel		2" silt lens, 45.5'										25	42

CONTINUATION OF HOLE NO. D-98-275

CORE SIZE		BATTER		PROJECT		SAMPLER		DIRECTION		DATE		STARTED		COMPLETED	
NX		VERTICAL		WEST COLUMBUS LPP		2" SPLITSPOON		DROP 30"		HAMMER 140#		1-19-98		HOLE NO. D-98-276	
ELEVATION (FEET)		SYMBOL		DESCRIPTION OF MATERIALS		REMARKS OR TEST RESULTS		WC		LL		PL		BLOWS	
667.0		SAME AS ABOVE												24	50
666.4	NS	BEDROCK OVERBURDEN													
665.6	SS	DRILLING W/O SAMPLING													
665.2	DO	SANDSTONE (DO), gr., f. loc., f. g.				BEGAN CORING									
665.0	CL	DOLOMITE (CL), dk. gr., f. cst.													
664.2	SS	SANDSTONE (SS), gr., h., f.g., pyr., occ. c.g. inc., occ. diag. frag.												11	11
BOTTOM OF HOLE															

CORE SIZE		BATTER		PROJECT		SAMPLER		DIRECTION		DATE		STARTED		COMPLETED	
NX		VERTICAL		WEST COLUMBUS LPP		2" SPLITSPOON		DROP 30"		HAMMER 140#		1-19-98		HOLE NO. D-98-276	
ELEVATION (FEET)		SYMBOL		DESCRIPTION OF MATERIALS		REMARKS OR TEST RESULTS		WC		LL		PL		BLOWS	
718.1	GM	DRILLING W/O SAMPLING, asphalt												10	14
717.0	CL	SANDY GRAVEL (CL), non pl., dmp., f.g. to c.g.												6	7
714.0	CL	GRAVELLY SANDY SILTY CLAY (CL), lt. br. to dk. br., sil. pl., dmp.												21	48
713.7	CL	SILTY CLAY (CL), dk. br., pla. dmp., w/ gravel and sand												21	9
711.0	GM	SANDY SILTY GRAVEL (GM), lt. br., non pl., dmp., w/ clay, f.g. to c.g.												19	18
711.0	GC	SANDY SILTY CLAYEY GRAVEL (GC), br. gr. to br., sil. pl., dmp., f.g. to c.g., rou.												13	13
702.0	NS	SAMPLED - NO RECOVERY													
700.5	CL	SANDY SILTY CLAY (CL), br., sil. pl., dmp.												7	8
697.5	CL-ML	CLAYEY SILT (CL-ML), br., sil. pl., dmp.												22	48
695.5	GM-GM	CLAYEY SILTY SANDY GRAVEL (GM-GM), lt. br. gr., non pl. to sil. pl., dmp.												19	19
693.0	NS	SAMPLED - NO RECOVERY													
691.5	GM	SILTY SANDY GRAVEL (GM), br., non pl., dmp. to wet, w/ clay												13	33
687.0	SM	inc. clay 31.5'												22	33
687.0	SM	SILTY SANDY GRAVEL (SM), br. to gr., non pl., wet, f.g. to c.g.												63	24
679.9	SP	1' clayey sand se. at 37.5'												14	20
675.0		SILTY SAND (SM), gr., non pl., wet, c.g. f.g., w/ f. gra.												19	65
BOTTOM OF HOLE															

CORE SIZE		BATTER		PROJECT		SAMPLER		DIRECTION		DATE		STARTED		COMPLETED	
NX		VERTICAL		WEST COLUMBUS LPP		2" SPLITSPOON		DROP 30"		HAMMER AUTOMATIC		2-2-98		HOLE NO. D-98-277	
ELEVATION (FEET)		SYMBOL		DESCRIPTION OF MATERIALS		REMARKS OR TEST RESULTS		WC		LL		PL		BLOWS	
716.8	DL	SILTY CLAY (DL), dk. br., sil. pl., dmp., (topsoil)												2	6
713.8	CL	SILTY CLAY (CL), br., sil. pl. to pl., dmp. to mat., w/ f.g. to c.g. gravel and sand												4	5
712.3	SM	LIMESTONE FRAGS., c.g.												6	6
710.8	SM	SILTY SAND (SM), br., non pl., dmp. to mat., c.g. w/ f.g. gra.												8	13
709.3	NS	SAMPLED - NO RECOVERY													
706.3	CH	SANDY GRAVELLY SILTY CLAY (CH), br., pl., dmp., inc. c.g. gravel, s'												16	74
703.3	GM	SILTY SANDY GRAVEL (GM), dk. br., sil. pl., dmp., f.g. to c.g., rou., w/ clay												24	28
698.7	GM-GM	SILTY SANDY GRAVEL (GM-GM), lt. br., non pl., dry to dmp., c.g. to f.g., w/ clay												66	23
697.3	GM	CLAYEY SILTY GRAVEL (GM), br. gr., sil. pl., dmp., w/ sand												7	8
694.3	GM	SILTY SANDY GRAVEL (GM), lt. gr., non pl., dmp. w/ clay												61	24
692.8	SM	SILTY GRAVELLY SAND (SM), br., non pl., dry, c.g. f.g. br. clay se., 22.8' to 23.0'												28	42
BOTTOM OF HOLE															


CORE SIZE		BATTER		PROJECT		SAMPLER		DIRECTION		DATE		STARTED		COMPLETED	
NX		VERTICAL		WEST COLUMBUS LPP		2" SPLITSPOON		DROP 30"		HAMMER AUTOMATIC		1-27-98		HOLE NO. D-98-278	
ELEVATION (FEET)		SYMBOL		DESCRIPTION OF MATERIALS		REMARKS OR TEST RESULTS		WC		LL		PL		BLOWS	
705.5	OH	SILTY CLAY (OH), dk. br., sil. pl., mat., org. soot. r.t. (topsoil)												1	3
700.5	CH	SANDY SILTY CLAY (CH), br., sil. pl., dmp.												22	60
699.0	GM	SILTY SANDY GRAVEL (GM-GM), br. gr., non pl., dmp., f.g. to c.g.												27	31
693.0	GM	SILTY SANDY GRAVEL (GM), br. gr., non pl., dmp. to wet, f.g. to c.g.												6	6
681.5	NS	SAMPLED - NO RECOVERY													
680.0	GM	SILTY SANDY GRAVEL (GM), br., non pl., wet, f.g. to c.g.												1	85
679.5	SM	SILTY SAND (SM), gr., non pl., wet, w/ f.g. gravel												1	14
BOTTOM OF HOLE															

CORE SIZE		BATTER		PROJECT		SAMPLER		DIRECTION		DATE		STARTED		COMPLETED	
NX		VERTICAL		WEST COLUMBUS LPP		2" SPLITSPOON		DROP 30"		HAMMER AUTOMATIC		1-31-98		HOLE NO. D-98-279	
ELEVATION (FEET)		SYMBOL		DESCRIPTION OF MATERIALS		REMARKS OR TEST RESULTS		WC		LL		PL		BLOWS	
725.8	NS	DRILLING W/O SAMPLING, 6" asphalt & 12" base													
724.3	SM	SILTY SAND (SM), br. to gr., non pl., dmp., f.g. to c.g.												5	6
723.1	SC	SILTY CLAYEY GRAVELLY SAND (SC), dk. br. to bk., sil. pl., dmp.												18	18
719.8	GC	SANDY CLAYEY GRAVEL (GC), gr. br., sil. pl., dmp., w/silt												25	85
718.3	NS	SAMPLED - NO RECOVERY													
716.8	CL	SILTY CLAY (CL), dk. gr. to bk., sil. pl., dmp., org., soot. c.g. r.t. frags.												18	8
715.3	GM	SILTY SANDY GRAVEL (GM), gr. br., non pl., dry, c.g. to f.g.												8	13
710.8	GM	SANDY SILTY GRAVEL (GM), mat. gr. and br., non pl. to sil. pl., dmp. w/ clay, inc. org., 16.5'-18.5'												6	9
707.8	CL	SANDY GRAVELLY CLAY (CL), dk. gr., sil. pl., dmp. w/ silt												17	21
704.8	GC	SANDY CLAYEY GRAVEL (GC), gr., non pl., dmp.												16	20
703.3	CL	SANDY GRAVELLY CLAY (CL), dk. gr., sil. pl., dmp., occ. w/ silt												17	9
702.8	CL	GRAVELLY SAND (SM), gr. to br., non pl., dmp., occ. burnt w. frags.												22	6
700.3	CH	CLAYEY SILT (CL-ML), dk. gy., sil. pl., dmp., org., occ. brick frags.												26	55
698.8	CL	SILTY CLAY (CL), dk. gr., sil. pl., dmp., soot. org.												25	49
694.3	SM	GRAVELLY SILTY SAND (SM), br. to bk., non pl., dmp. to mat., f.g. to c.g., w/ clay												22	22
690.8	GM	SILTY SANDY GRAVEL (GM), gr. to br., non pl., dmp. to wet, c.g. to f.g.												13	11
688.3		BOTTOM OF HOLE												16	22


CONTINUATION OF HOLE NO. D-98-279


CORE SIZE		BATTER		PROJECT		SAMPLER		DIRECTION		DATE		STARTED		COMPLETED	
NX		VERTICAL		WEST COLUMBUS LPP		2" SPLITSPOON		DROP 30"		HAMMER AUTOMATIC		1-31-98		HOLE NO. D-98-279	
ELEVATION (FEET)		SYMBOL		DESCRIPTION OF MATERIALS		REMARKS OR TEST RESULTS		WC		LL		PL		BLOWS	
687.0	NS	SAMPLED - NO RECOVERY													
685.5	GM	SILTY SANDY GRAVEL (GM), br., non pl., wet, c.g.												12	29
685.5	GM	SILTY SANDY GRAVEL (GM), br., non pl., wet, c.g.		34.0'										21	20
679.5	NS	DRILLING W/O SAMPLING													
677.0	GW	SANDY GRAVEL (GW), gy., non pl., wet, c.g.												89	30
676.2	CL	SILTY CLAY (CL), gr., pl., dmp., w/ gravel		43.0'-43.7'										40	32
672.5	CL	SILTY CLAY (CL), gy., sil. pl., dmp., w/ sand and gravel		2" silt lens, 45.5'										25	42

CORE SIZE		BATTER		PROJECT		SAMPLER		DIRECTION		DATE		STARTED		COMPLETED	
NX		VERTICAL		WEST COLUMBUS LPP		2" SPLITSPOON		DROP 30"		HAMMER AUTOMATIC		1-31-98		HOLE NO. D-98-279	
ELEVATION (FEET)		SYMBOL		DESCRIPTION OF MATERIALS		REMARKS OR TEST RESULTS		WC							

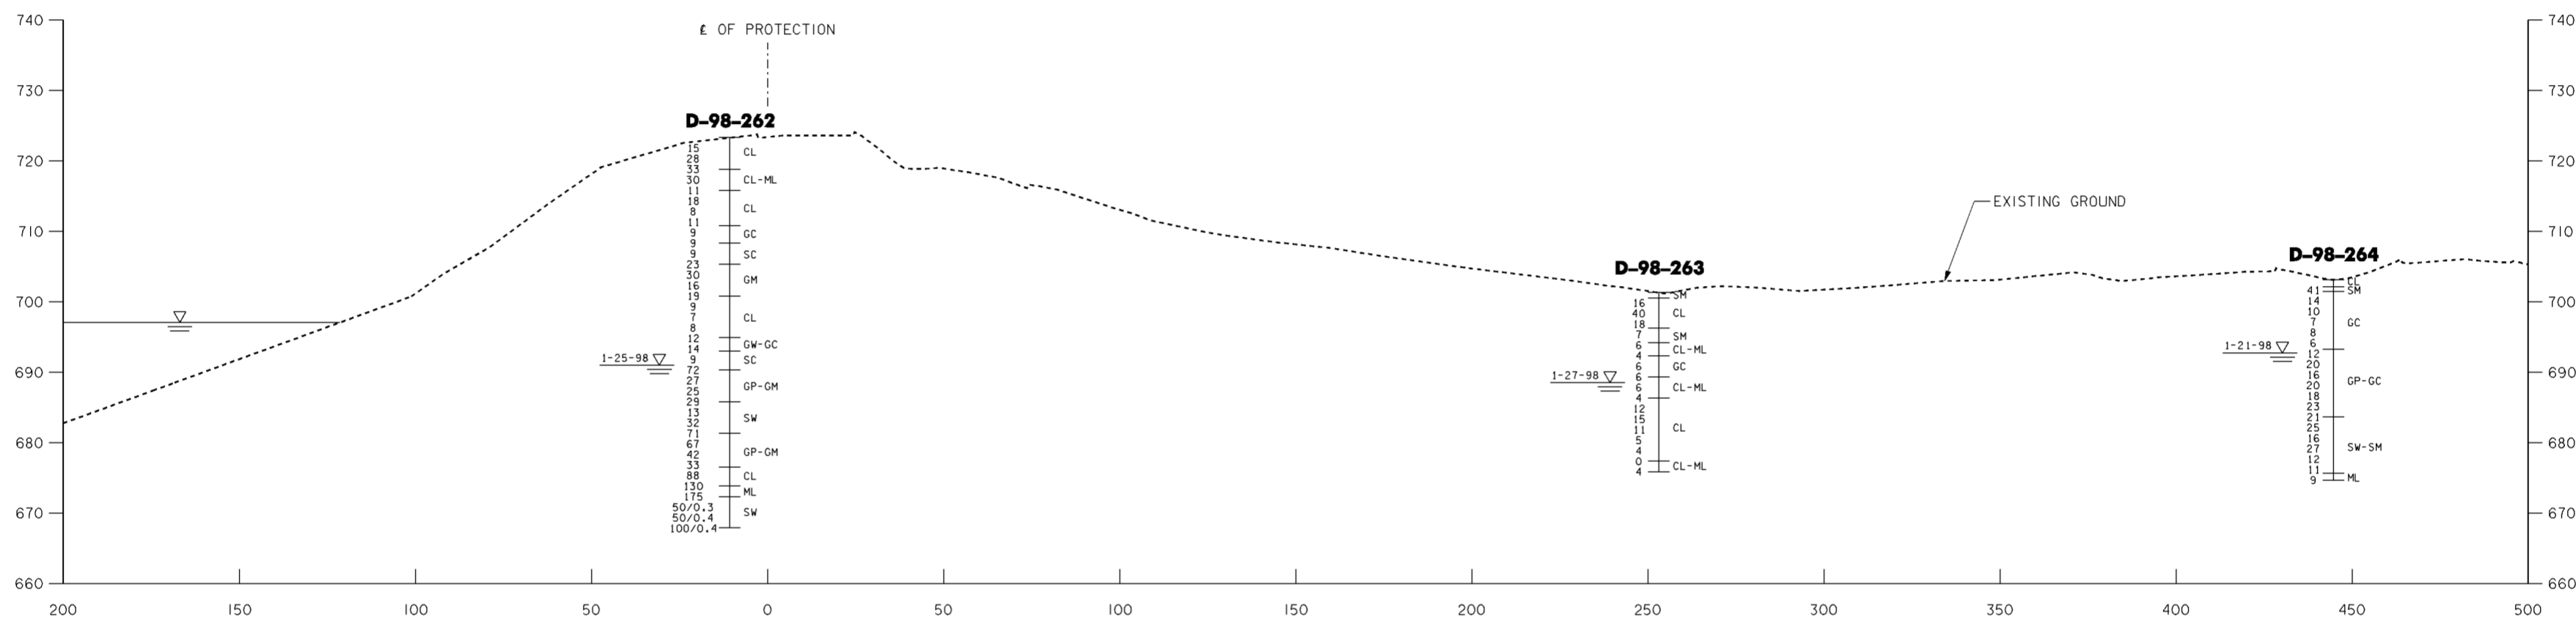


Revisions			
Symbol	Descriptions	Date	Approved

<b>BURGESS &amp; NIPLE, LIMITED</b> COLUMBUS, OHIO	<b>U.S. ARMY ENGINEER DISTRICT</b> CORPS OF ENGINEERS HUNTINGTON, WEST VIRGINIA		
Designed by: <b>C. CLARKE</b>	 SCIOTO RIVER COLUMBUS, OHIO WEST COLUMBUS, L.P.P. PHASE IIIA		
Drawn by: <b>T. MULLINS</b>			
Checked by: <b>J. HALL</b>			
Reviewed by:			
Approved by:	Scale: <b>AS SHOWN</b>	Sheet reference number: <b>107</b>	FILENAME: 00gpc01.dgn PIN TABLE: Sheet 1 of 3
	Date: <b>OCTOBER 1999</b>	Drawing Code: <b>16-PWC-12-</b>	

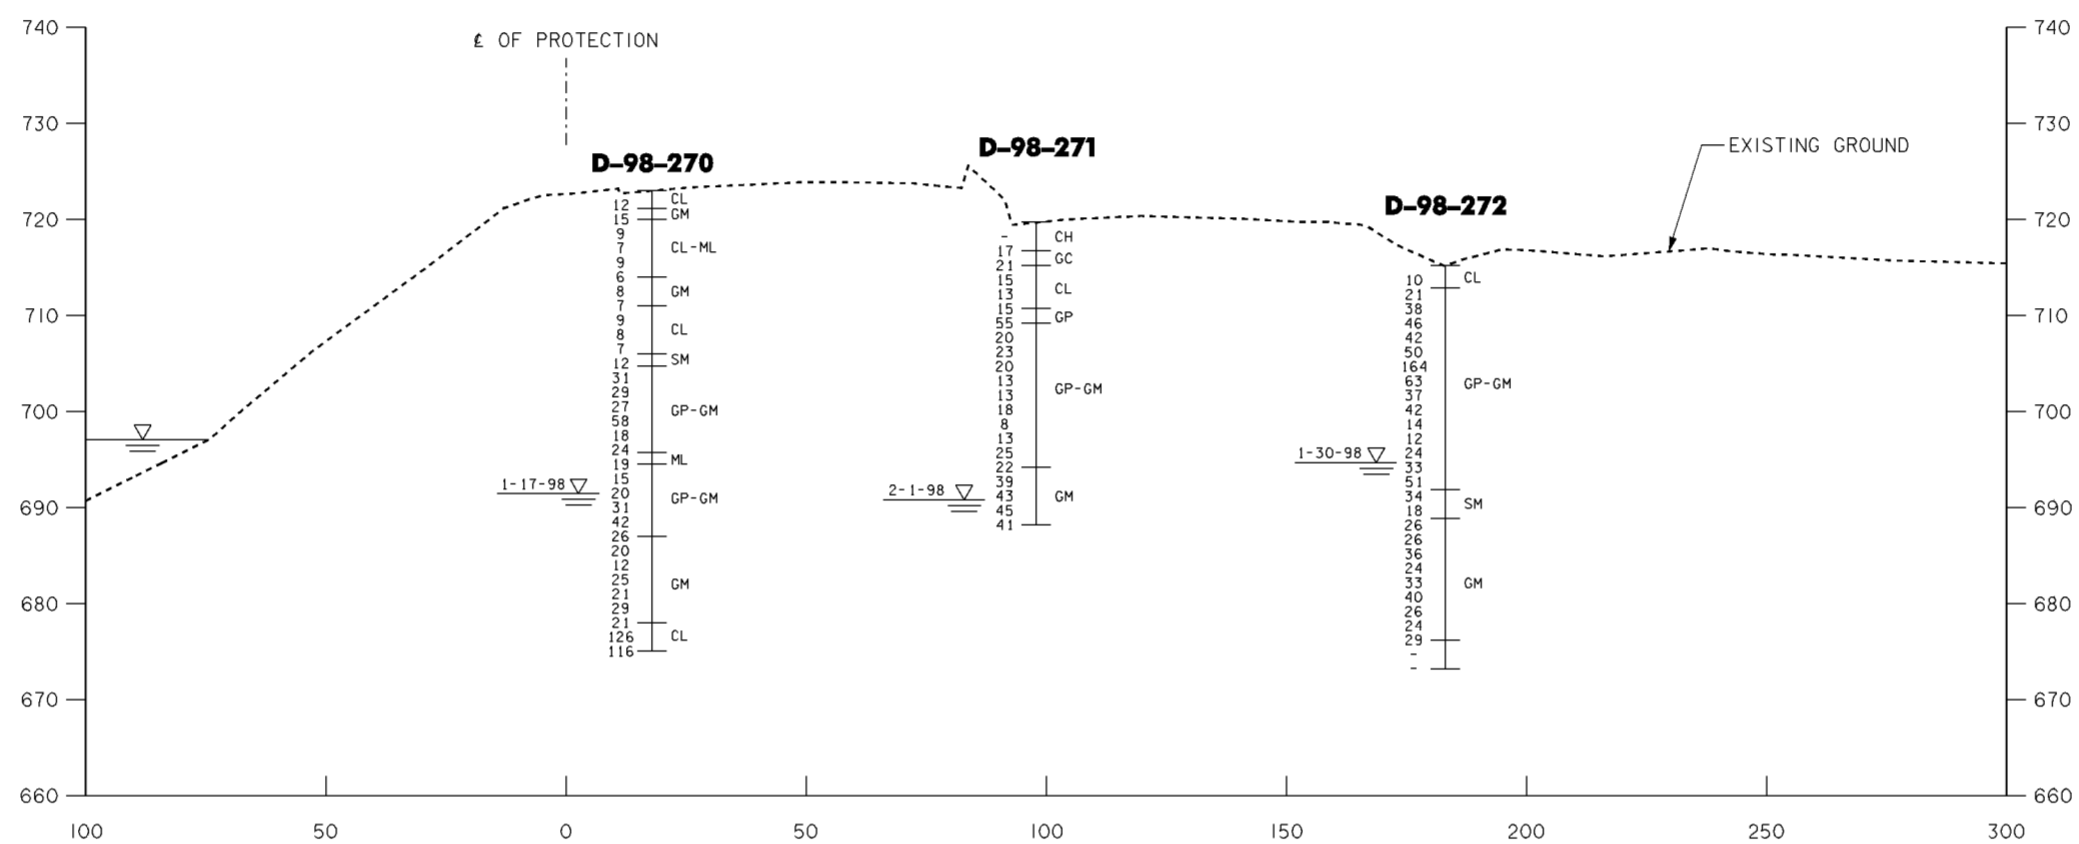


Revisions			
Symbol	Descriptions	Date	Approved

<b>BURGESS &amp; NIPLE, LIMITED</b> COLUMBUS, OHIO		<b>U.S. ARMY ENGINEER DISTRICT</b> CORPS OF ENGINEERS HUNTINGTON, WEST VIRGINIA	
Designed by: <b>C. CLARKE</b>	 SCIOTO RIVER COLUMBUS, OHIO WEST COLUMBUS, L.P.P. PHASE IIIA	<b>GEOLOGIC SECT B-B</b> <b>STA. 244 + 42</b>	
Drawn by: <b>T. MULLINS</b>			
Checked by: <b>J. HALL</b>			
Reviewed by:			
Approved by:	Scale: <b>AS SHOWN</b>	Sheet reference number: <b>10/8</b>	FILENAME: 00gpc02.dgn
	Date: <b>OCTOBER 1999</b>		PIN TABLE:
	Drawing Code: <b>16-PWC-12-</b>		Sheet <b>2</b> of <b>3</b>



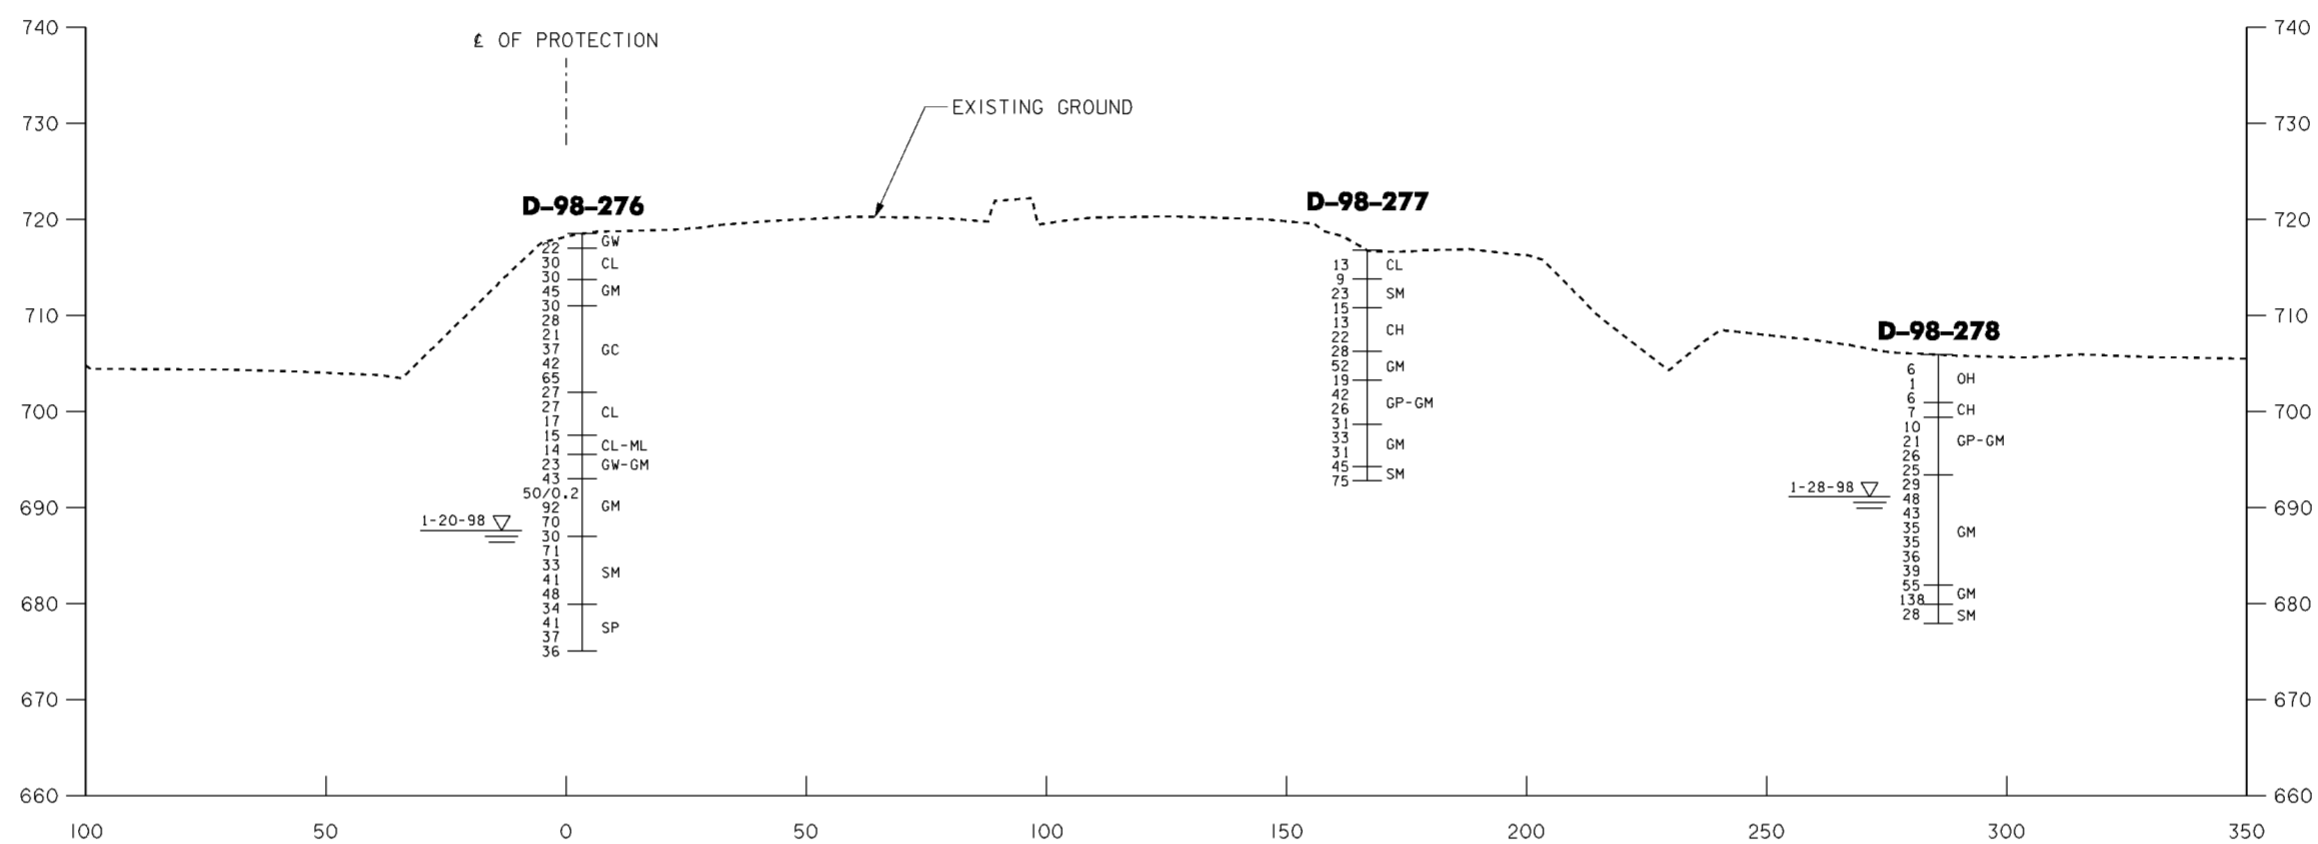


Revisions			
Symbol	Descriptions	Date	Approved

<b>BURGESS &amp; NIPLE, LIMITED</b> COLUMBUS, OHIO	<b>U.S. ARMY ENGINEER DISTRICT</b> CORPS OF ENGINEERS HUNTINGTON, WEST VIRGINIA		
Designed by: <b>C. CLARKE</b>	SCIOTO RIVER COLUMBUS, OHIO WEST COLUMBUS, L.P.P. PHASE IIIA		
Drawn by: <b>T. MULLINS</b>	<b>GEOLOGIC SECT C-C</b> <b>STA. 258 + 92</b>		
Checked by: <b>J. HALL</b>			
Reviewed by:	Scale: <b>AS SHOWN</b>	Sheet reference number:	FILENAME: 00gpc03.dgn
Approved by:	Date: <b>OCTOBER 1999</b>	10/9	PIN TABLE:
	Drawing Code: <b>16-PWC-12-</b>		Sheet <b>3</b> of <b>3</b>







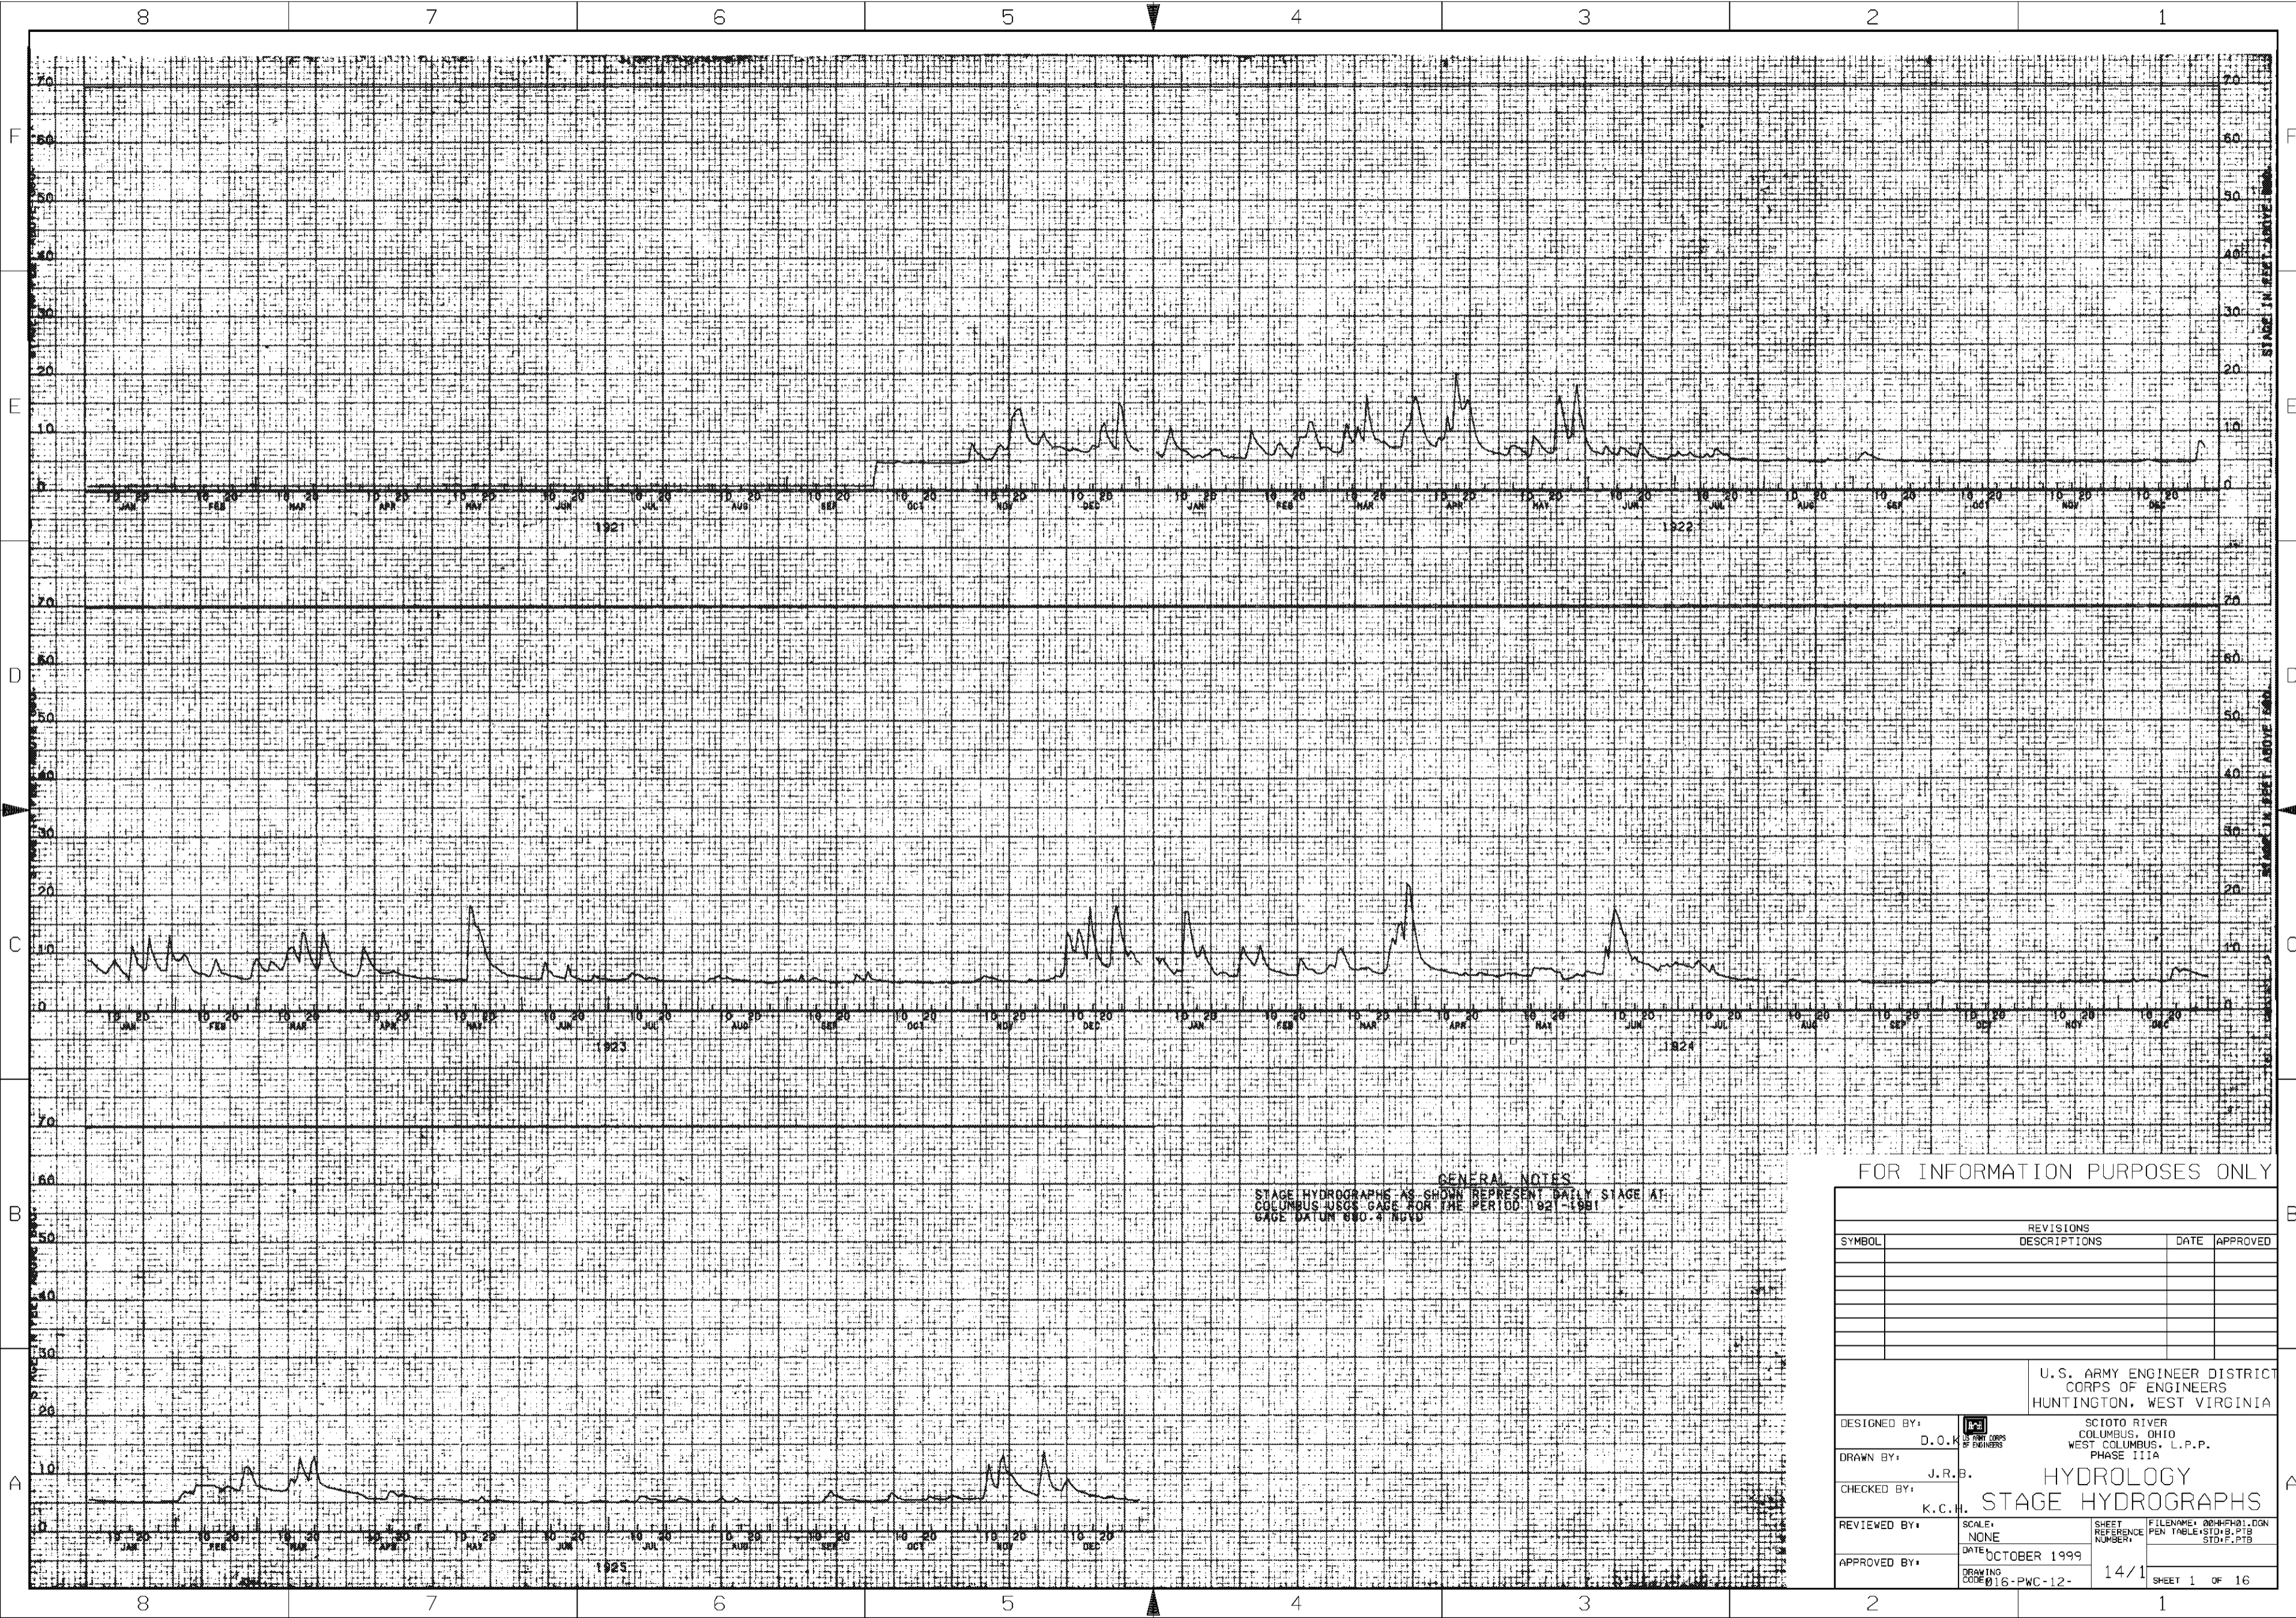


GENERAL NOTES  
 STAGE HYDROGRAPHS AS SHOWN REPRESENT DAILY STAGE AT  
 COLUMBUS DSGT GAGE FOR THE PERIOD 1921-1991  
 GAGE DATUM 810.4 NGVD

FOR INFORMATION PURPOSES ONLY

SYMBOL	REVISIONS		DATE	APPROVED
	DESCRIPTIONS			

U.S. ARMY ENGINEER DISTRICT  
 CORPS OF ENGINEERS  
 HUNTINGTON, WEST VIRGINIA

DESIGNED BY: D.O.K. 

DRAWN BY: J.R.B.

CHECKED BY: K.C.H.

REVIEWED BY:

APPROVED BY:

SCALE: NONE

DATE: OCTOBER 1999

DRAWING CODE: 16-PWC-12-

U.S. ARMY ENGINEER DISTRICT  
 CORPS OF ENGINEERS  
 COLUMBUS, OHIO  
 WEST COLUMBUS, L.P.P.  
 PHASE IIIA

HYDROLOGY  
 STAGE HYDROGRAPHS

SHEET REFERENCE NUMBER: 14/1

FILENAME: 004HF01.DGN  
 PEN TABLE: STD.B.PTB  
 STD.F.PTB

SHEET 1 OF 16



8

7

6


5

4

3

2

1

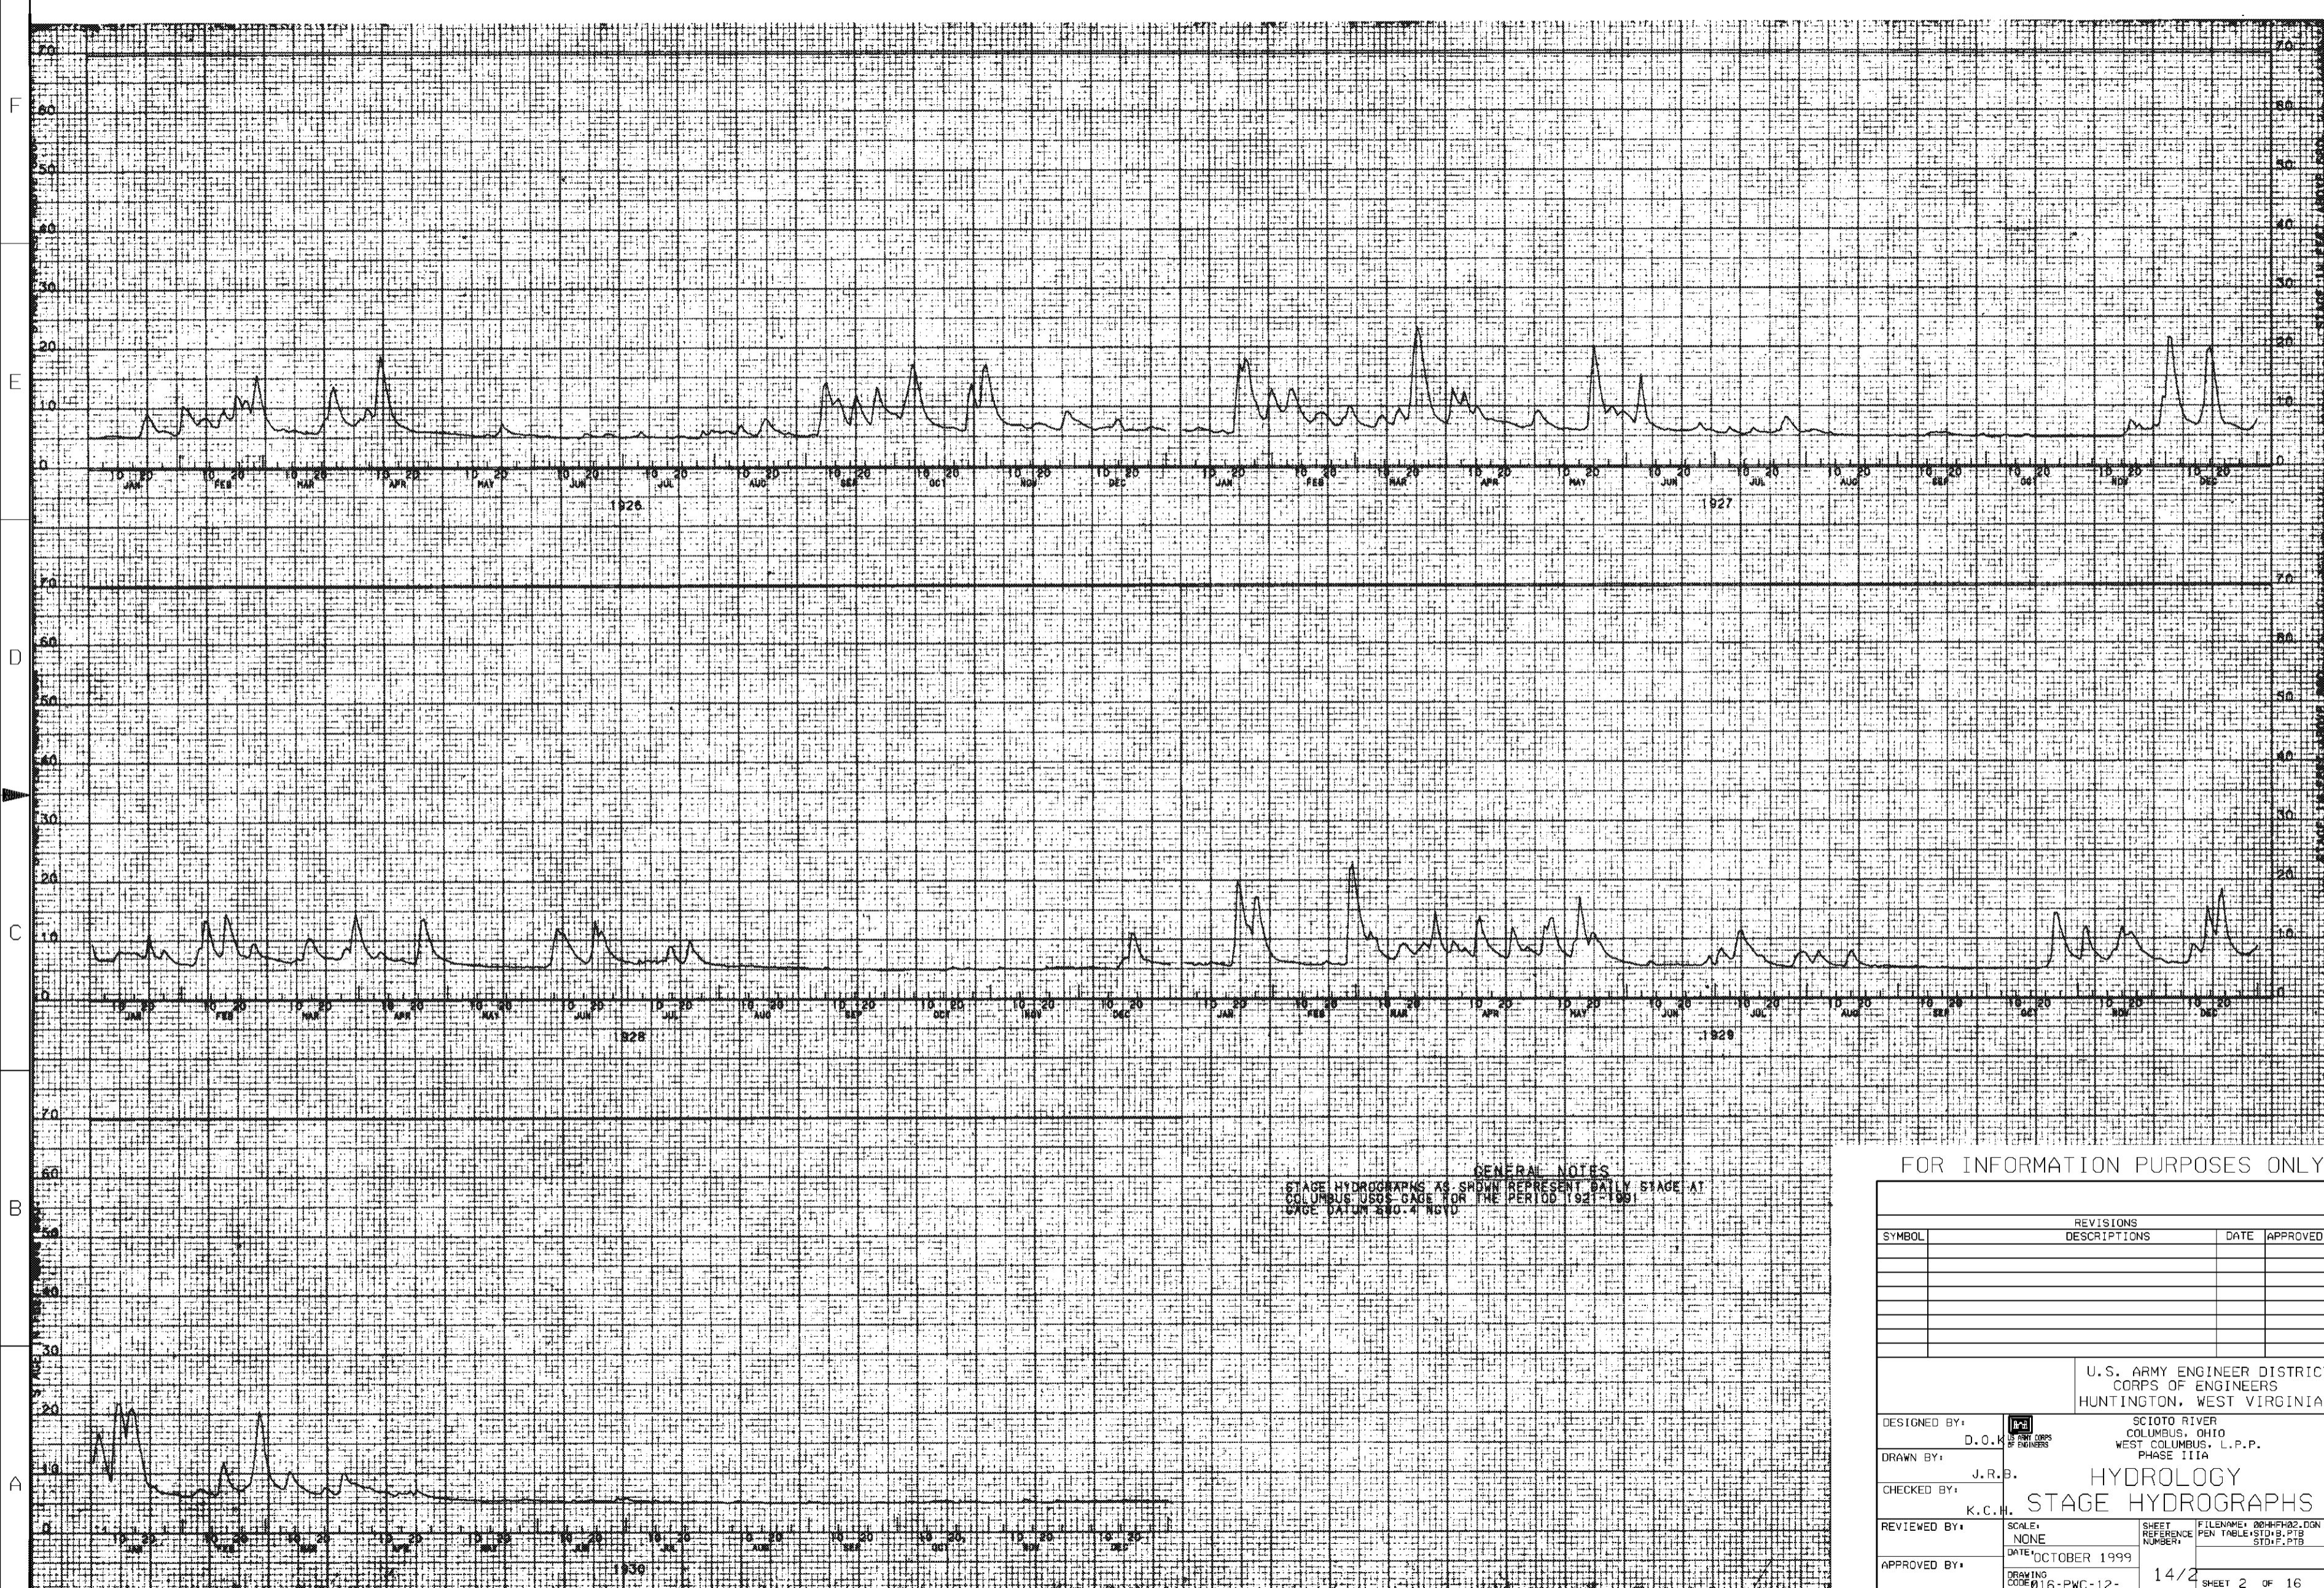

GENERAL NOTES  
 STAGE HYDROGRAPHS AS SHOWN REPRESENT DAILY STAGE AT  
 COLUMBUS USGS GAGE FOR THE PERIOD 1921-1991  
 GAGE DATUM 840.4 NGVD

FOR INFORMATION PURPOSES ONLY

SYMBOL	REVISIONS		DATE	APPROVED
	DESCRIPTIONS			

U.S. ARMY ENGINEER DISTRICT  
 CORPS OF ENGINEERS  
 HUNTINGTON, WEST VIRGINIA

DESIGNED BY: D.O.K.

DRAWN BY: J.R.B.

CHECKED BY: K.C.H.

REVIEWED BY:

APPROVED BY:

SCIO TO RIVER  
 COLUMBUS, OHIO  
 WEST COLUMBUS, L.P.P.  
 PHASE IIIA

HYDROLOGY  
 STAGE HYDROGRAPHS

SCALE: NONE  
 DATE: OCTOBER 1999  
 DRAWING CODE: 16-PWC-12-

SHEET REFERENCE NUMBER: 14/2  
 FILENAME: 004HFH02.DGN  
 PEN TABLE: STD.B.PTB  
 STD.F.PTB

SHEET 2 OF 16

8

7

6

5


4

3

2

1



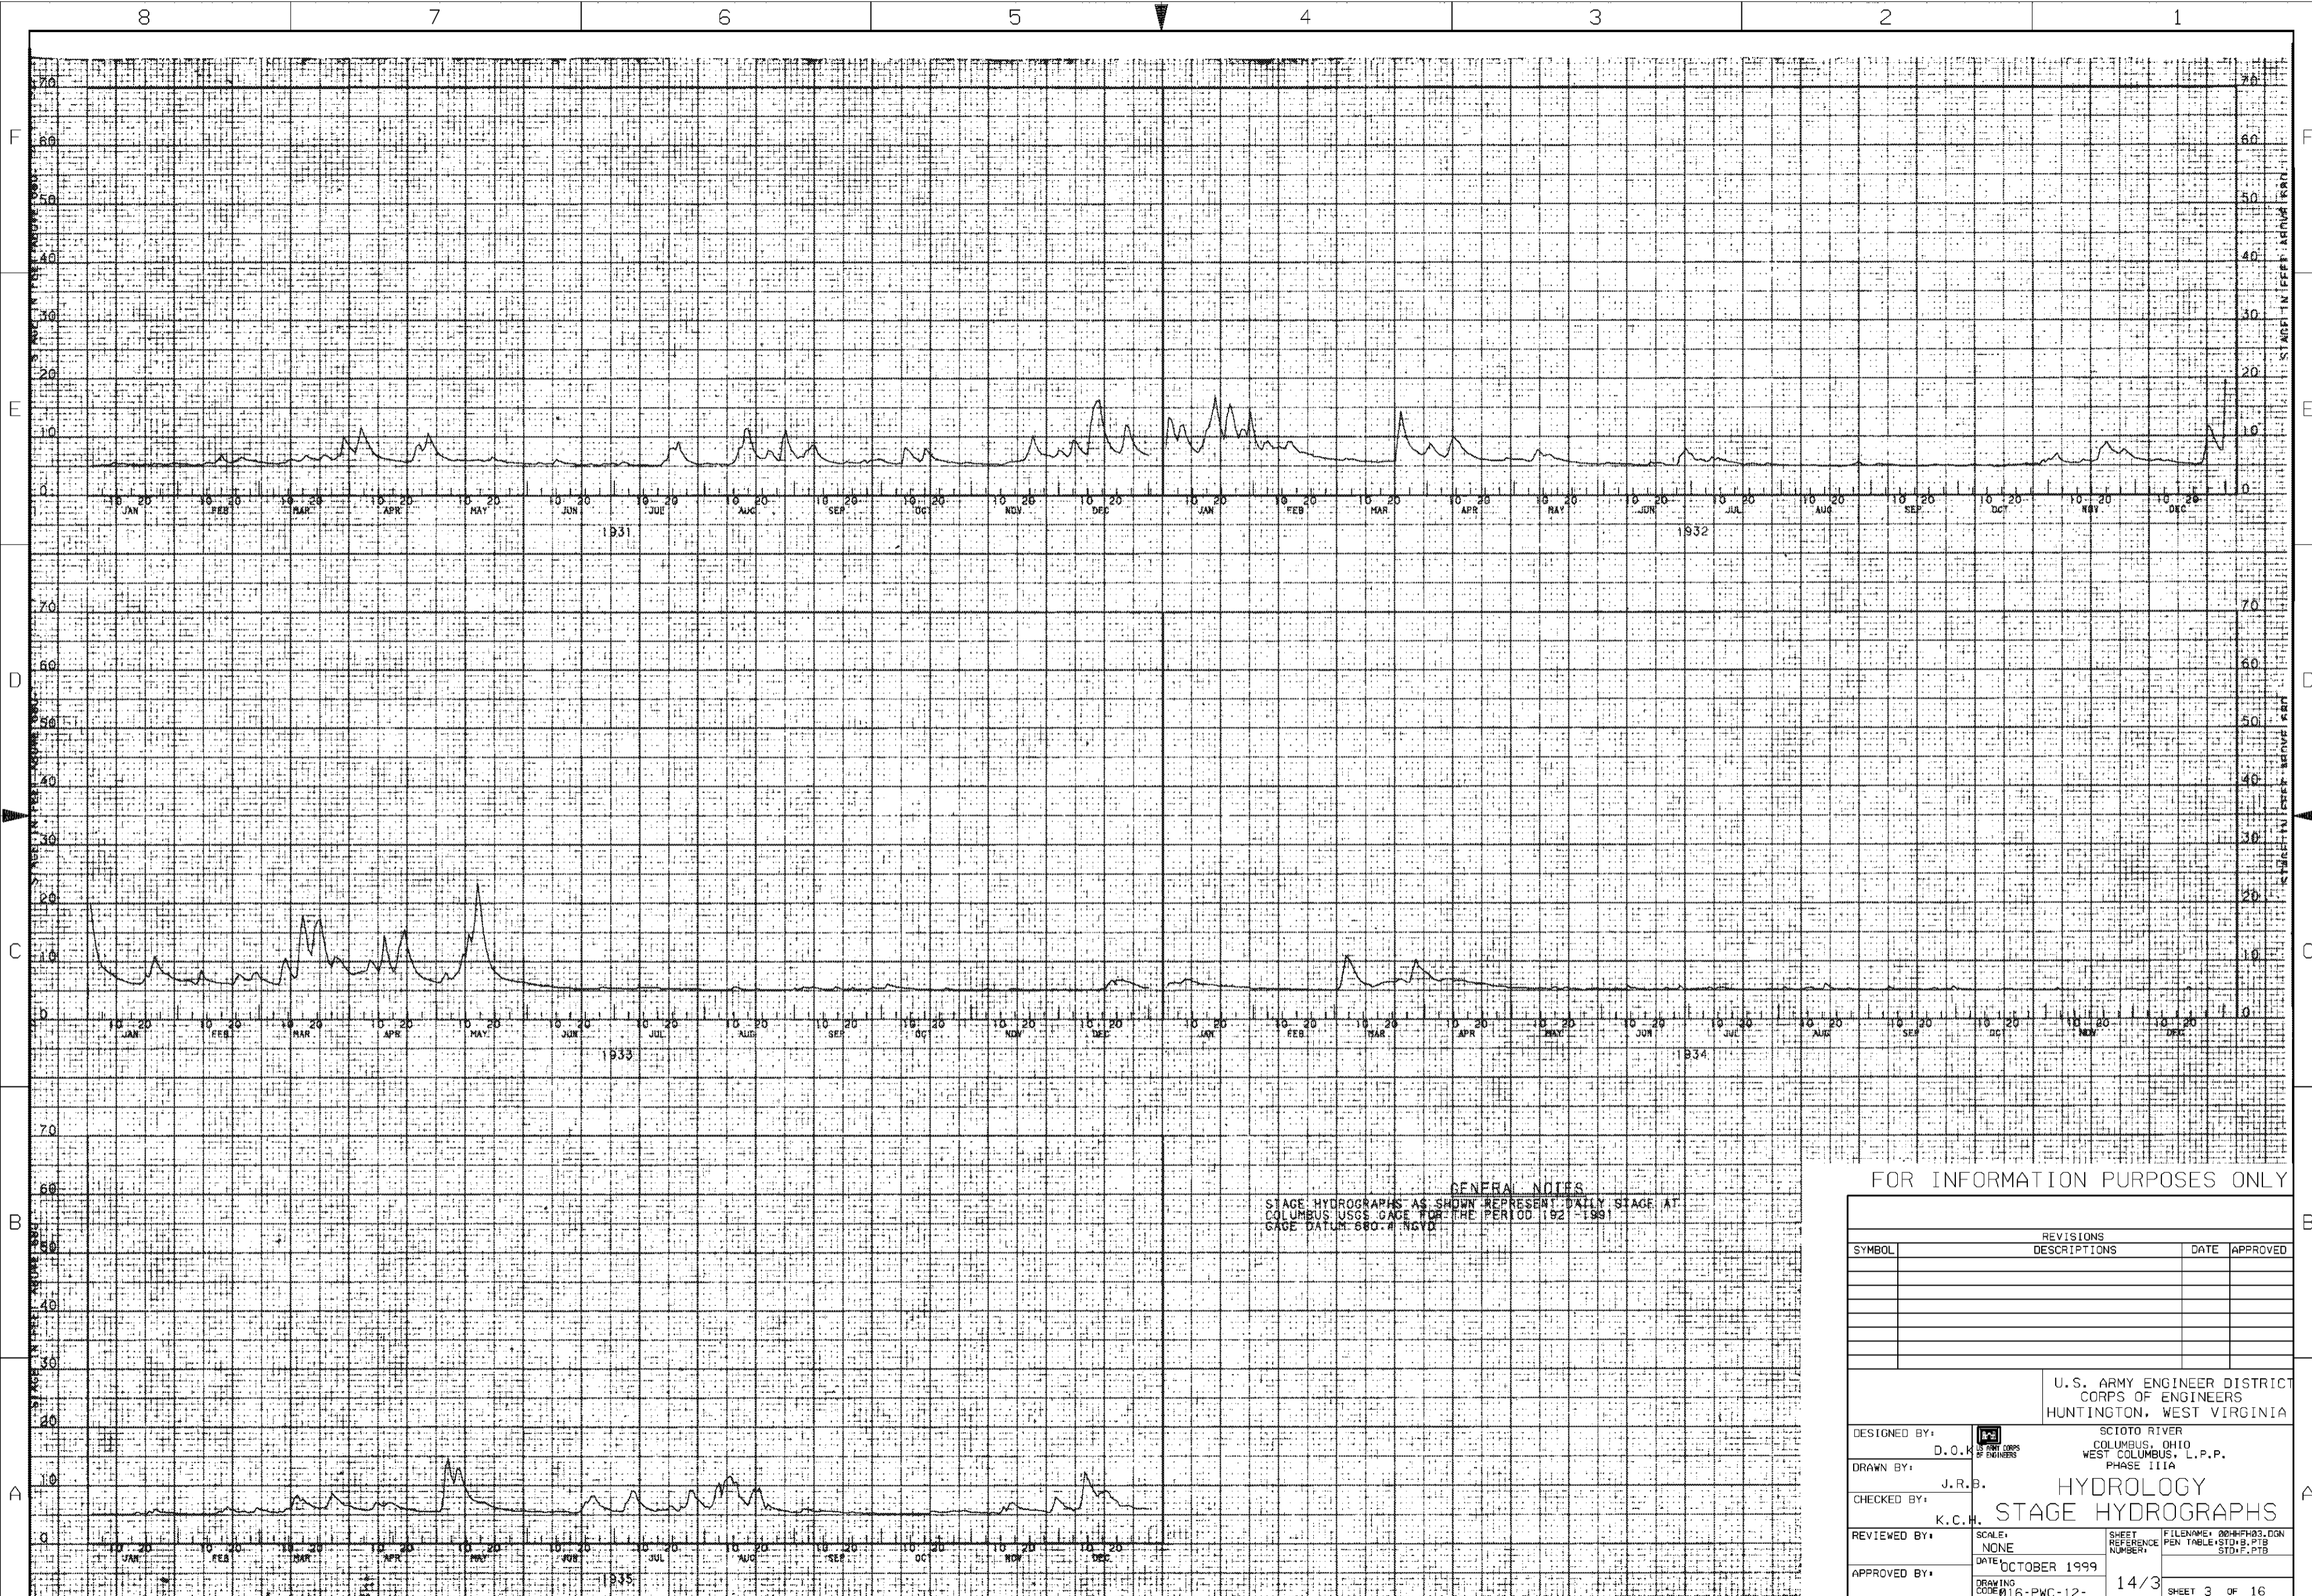

**GENERAL NOTES**  
 STAGE HYDROGRAPHS AS SHOWN REPRESENT DAILY STAGE AT  
 COLUMBUS USGS GAGE FOR THE PERIOD 1922-1999  
 GAGE DATUM 880-A NGVD

FOR INFORMATION PURPOSES ONLY

SYMBOL	REVISIONS		DATE	APPROVED
	DESCRIPTIONS			

U.S. ARMY ENGINEER DISTRICT CORPS OF ENGINEERS HUNTINGTON, WEST VIRGINIA			
DESIGNED BY:	D.O.K.	SCIOTO RIVER COLUMBUS, OHIO WEST COLUMBUS, L.P.P. PHASE IIIA	
DRAWN BY:	J.R.B.	HYDROLOGY STAGE HYDROGRAPHS	
CHECKED BY:	K.C.H.	SCALE:	NONE
REVIEWED BY:		DATE:	OCTOBER 1999
APPROVED BY:		DRAWING CODE:	16-PWC-12-
		SHEET REFERENCE NUMBER:	14/3
		FILENAME:	004HF03.DGN
		PEN TABLE:	STD.B.PTB
		STD.F.PTB	
		SHEET 3 OF 16	



8

7

6


5

4

3

2

1

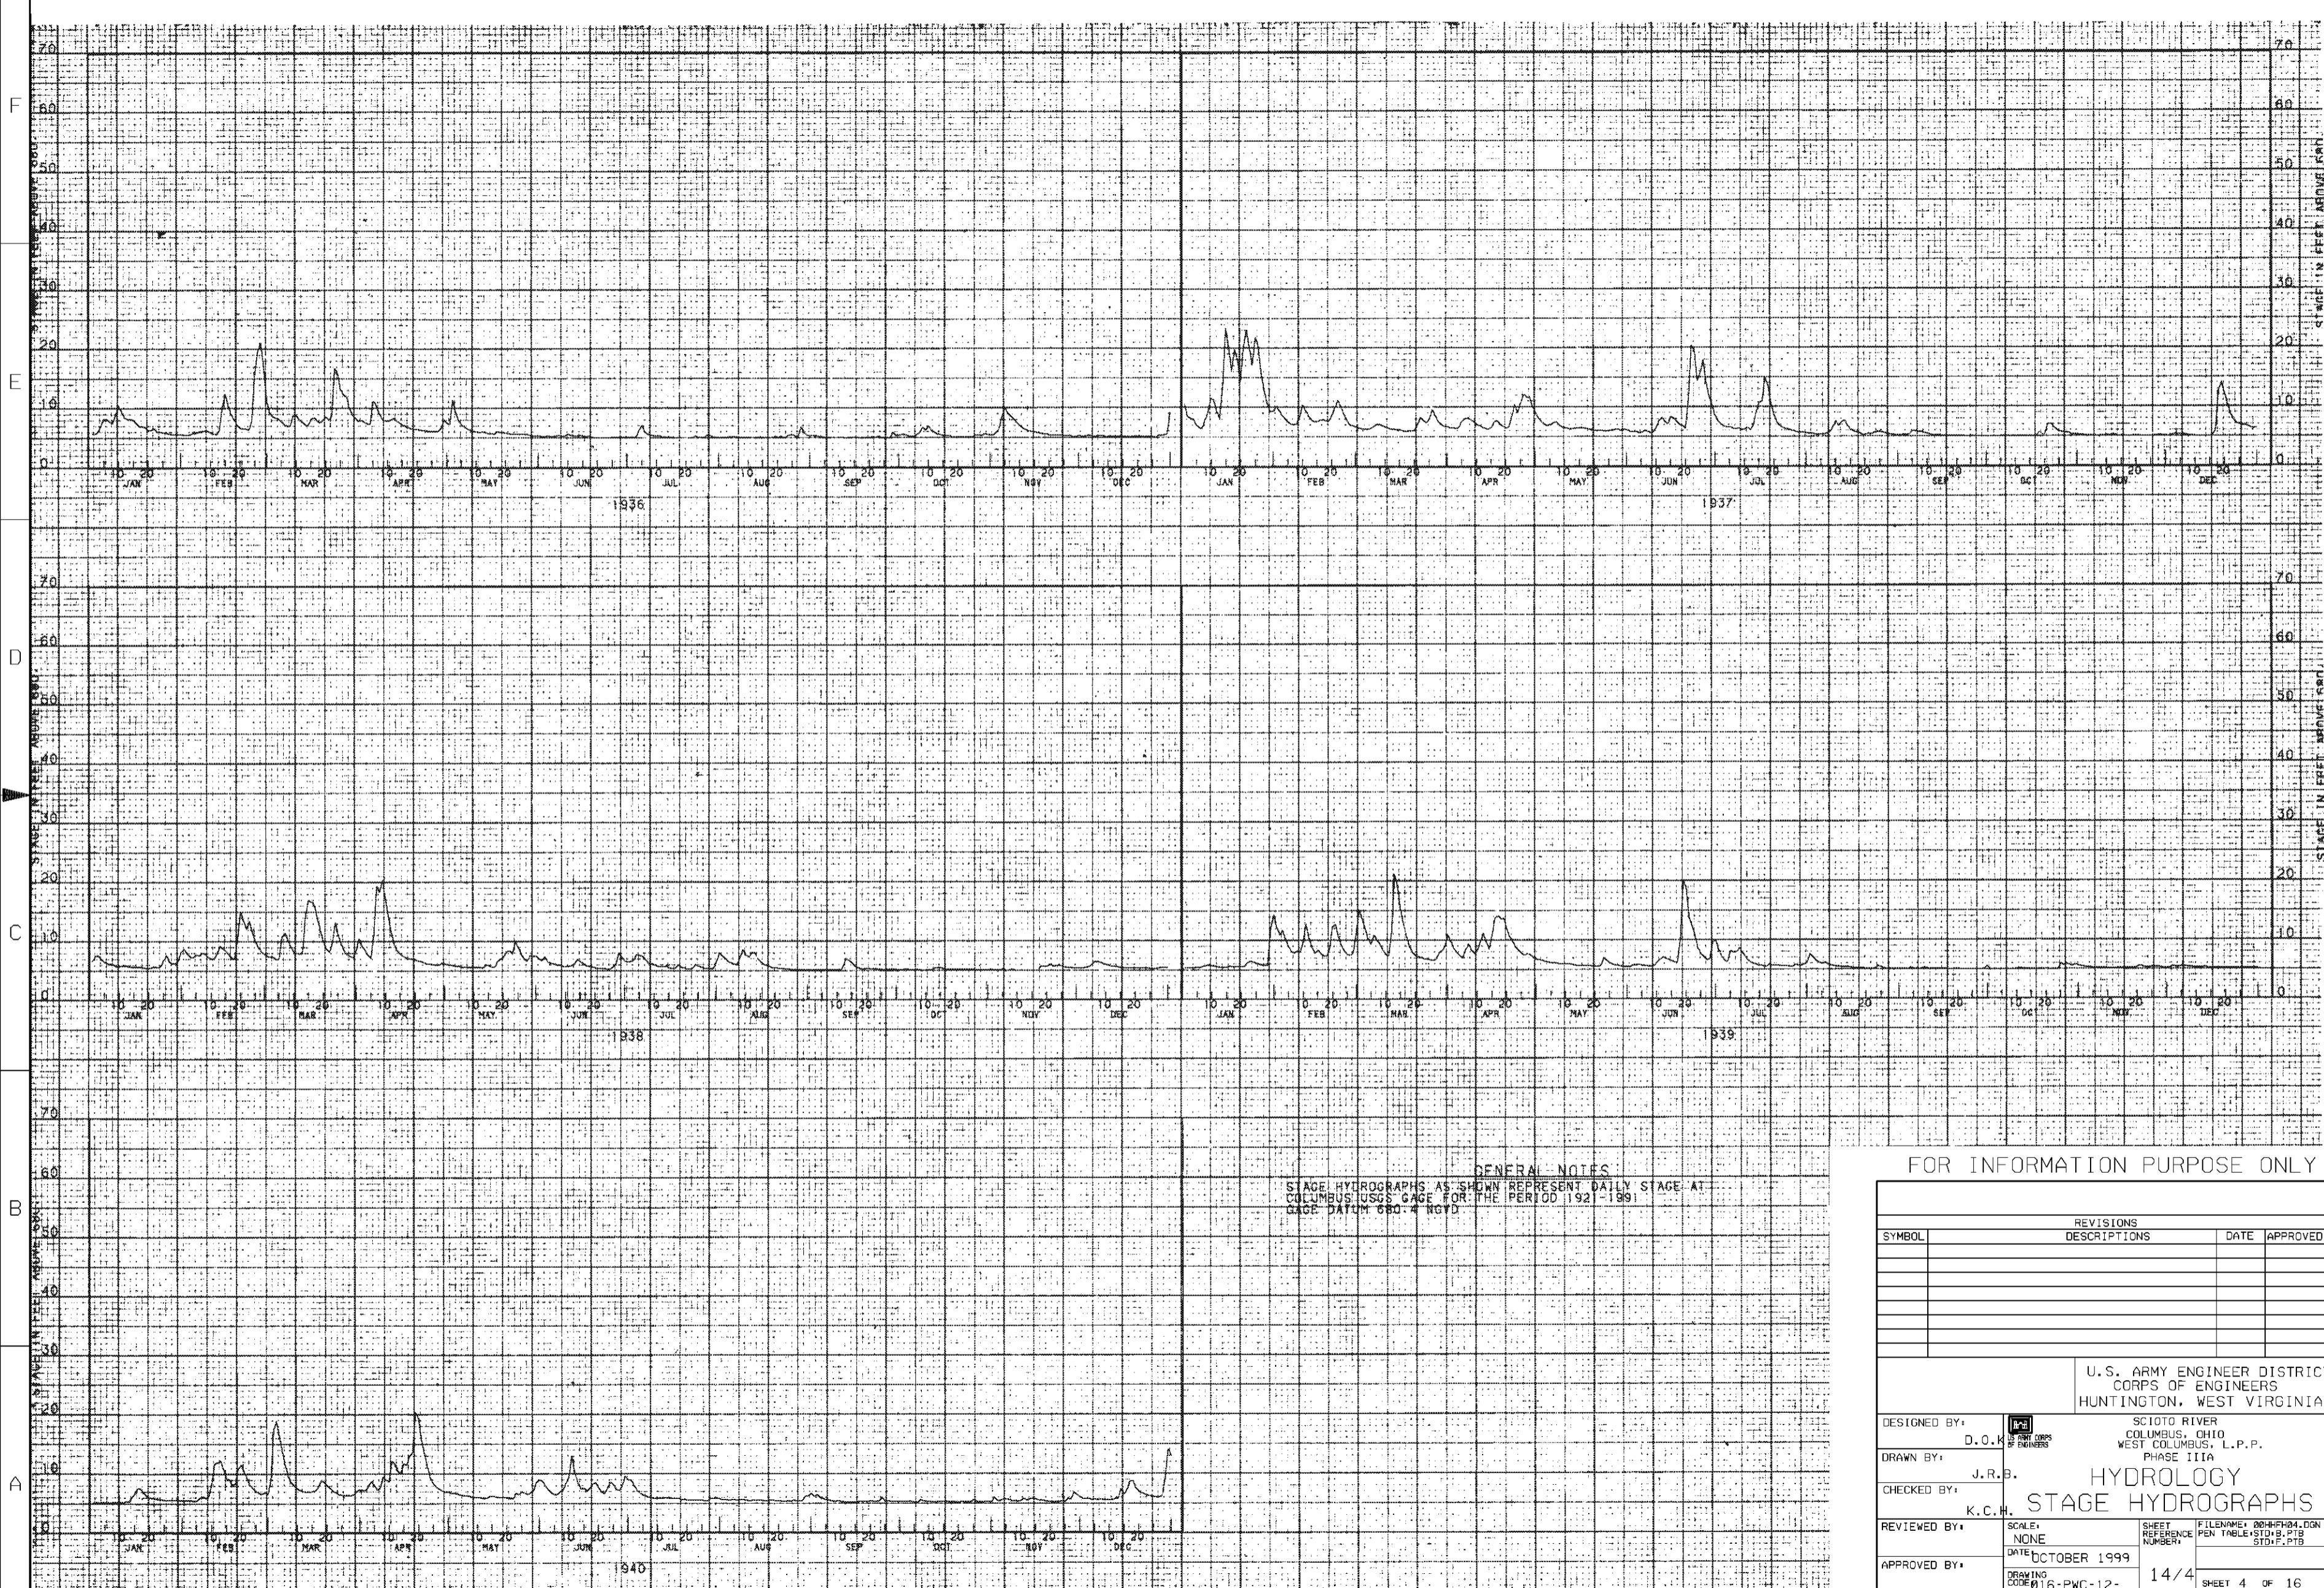


GENERAL NOTES  
 STAGE HYDROGRAPHS AS SHOWN REPRESENT DAILY STAGE AT  
 COLUMBUS USGS GAGE FOR THE PERIOD 1921-1991  
 GAGE DATUM 680.4 NGVD

FOR INFORMATION PURPOSE ONLY

REVISIONS			
SYMBOL	DESCRIPTIONS	DATE	APPROVED

U.S. ARMY ENGINEER DISTRICT  
 CORPS OF ENGINEERS  
 HUNTINGTON, WEST VIRGINIA

DESIGNED BY: D.O.K. 

DRAWN BY: J.R.B.

CHECKED BY: K.C.H.

REVIEWED BY:

APPROVED BY:

SCIO TO RIVER  
 COLUMBUS, OHIO  
 WEST COLUMBUS, L.P.P.  
 PHASE IIIA

**HYDROLOGY**  
**STAGE HYDROGRAPHS**

SCALE: NONE  
 DATE: OCTOBER 1999  
 DRAWING CODE: 16-PWC-12-

SHEET REFERENCE NUMBER: 14/4  
 FILENAME: 004HFH04.DGN  
 PEN TABLE: STD.B.PTB  
 STD.F.PTB

SHEET 4 OF 16

8

7

6

5


4

3

2

1



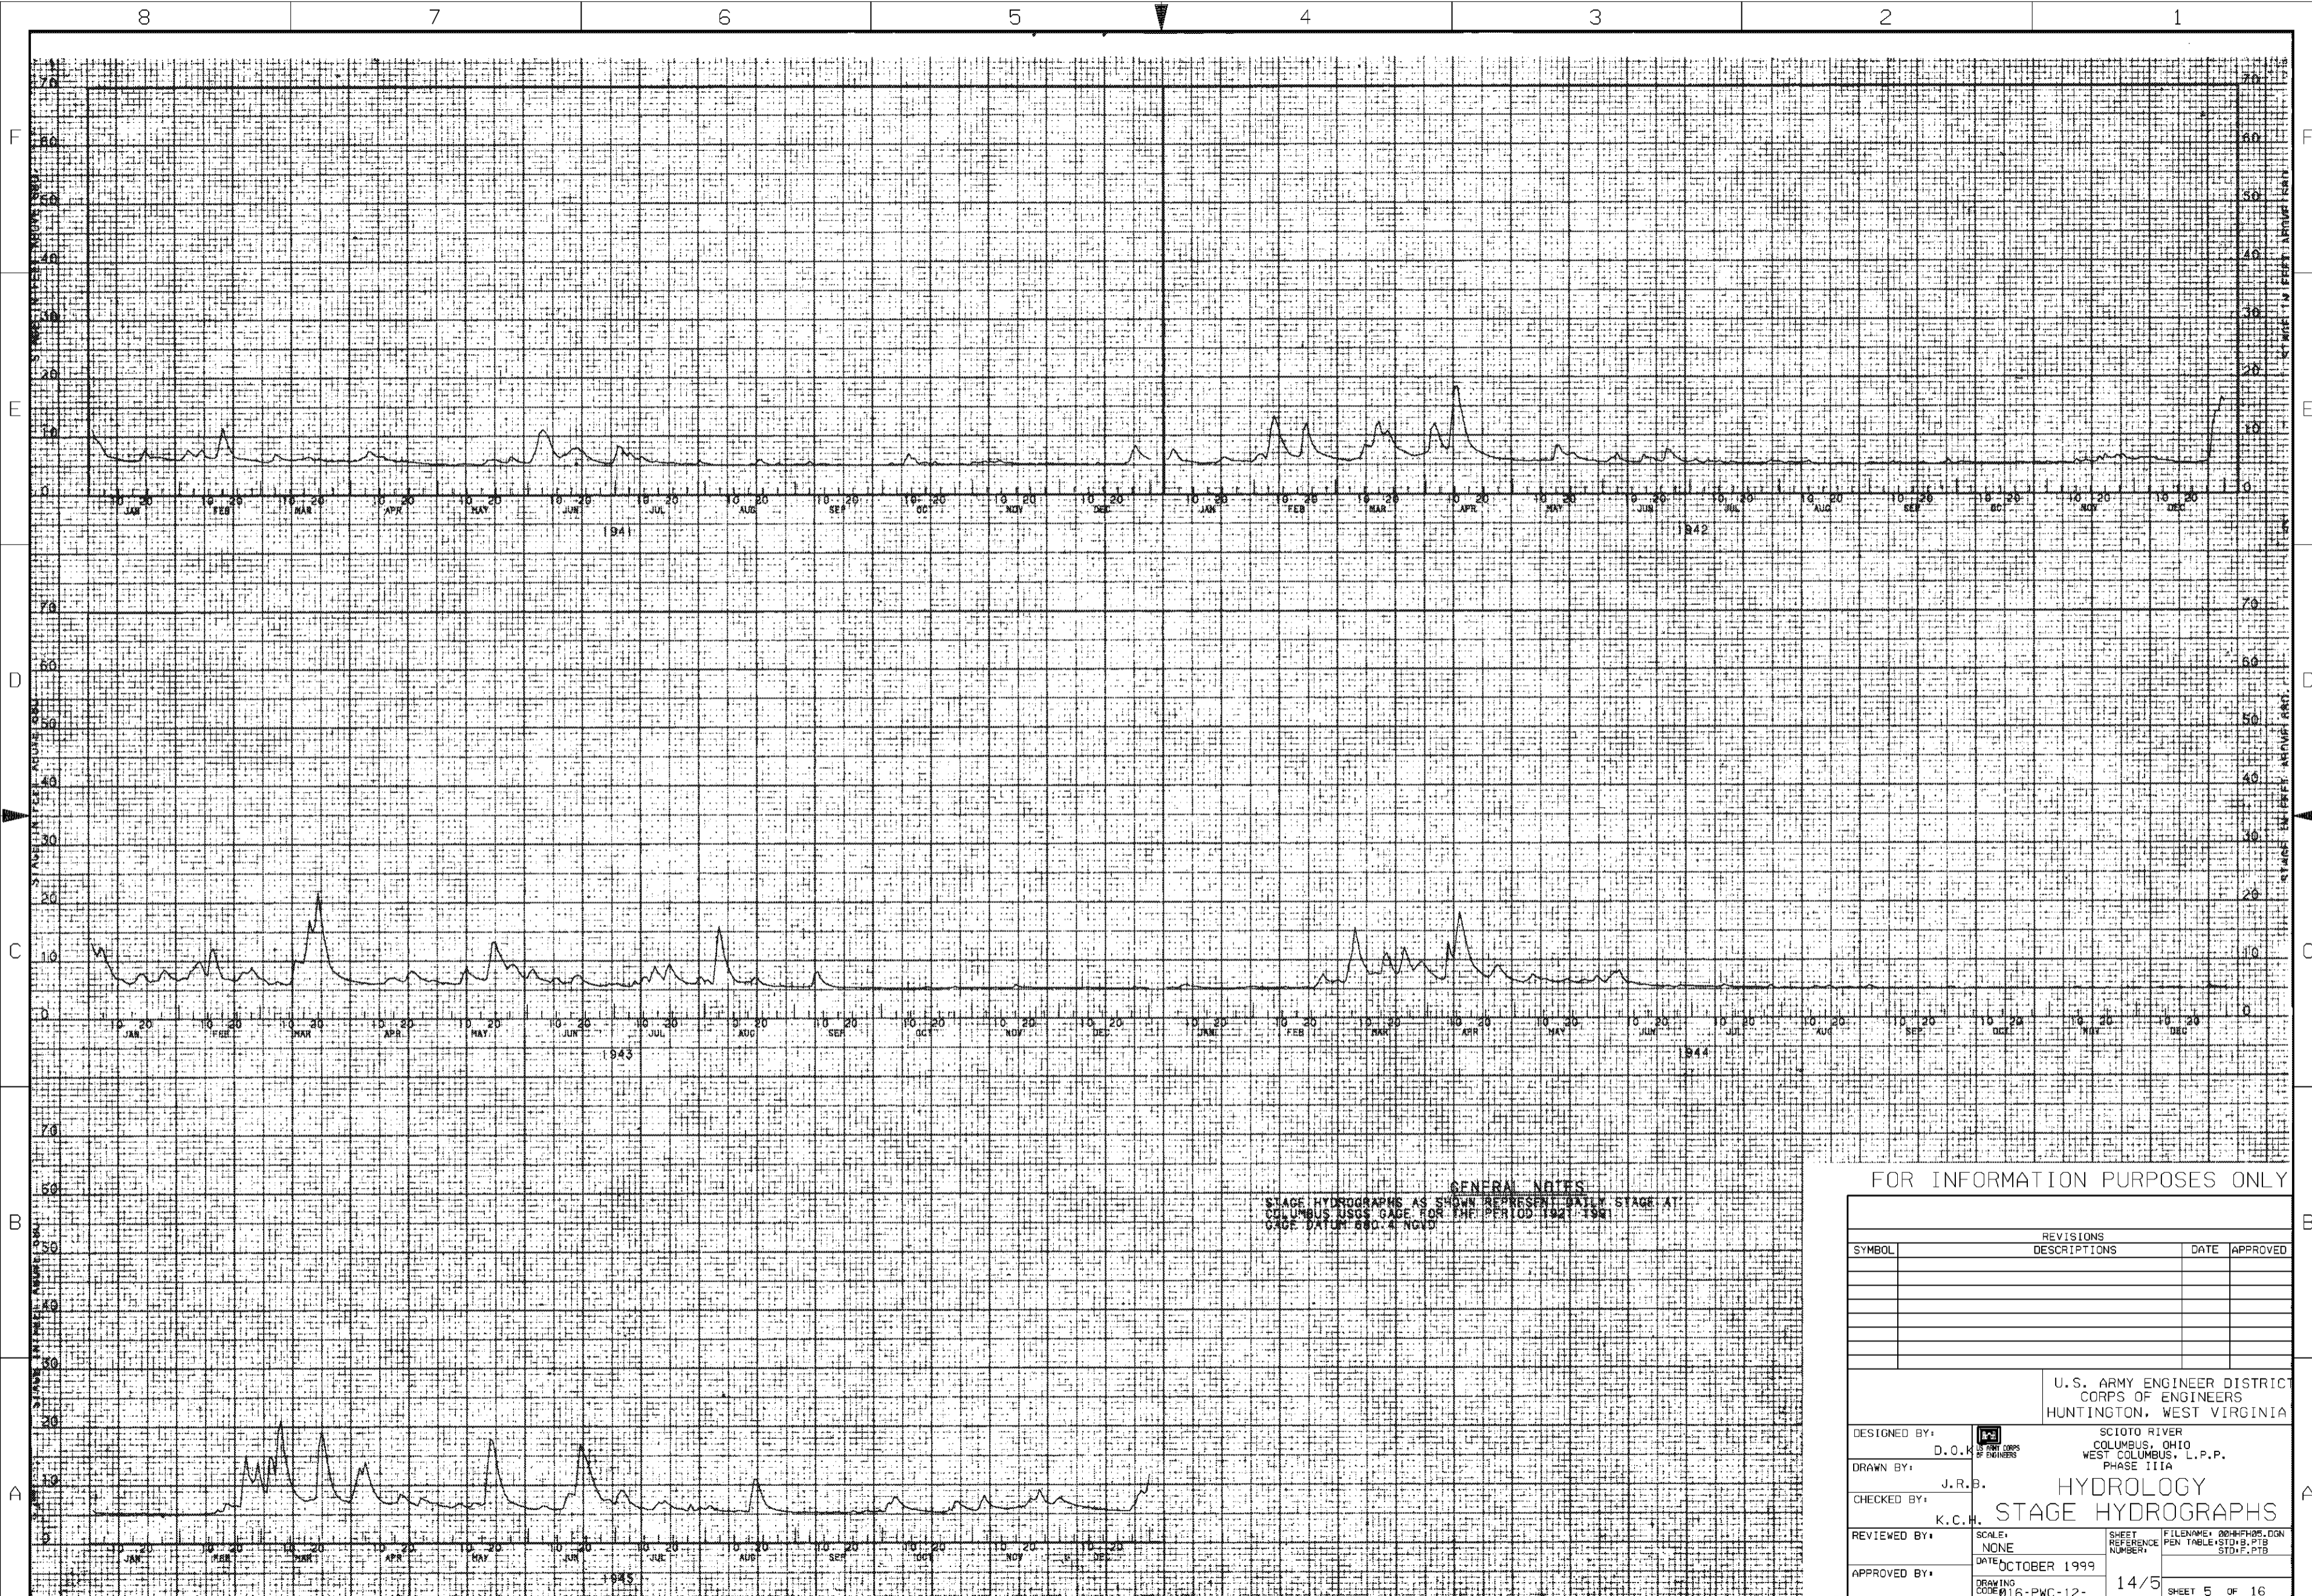


**GENERAL NOTES**  
 STAGE HYDROGRAPHS AS SHOWN REPRESENT DAILY STAGE AT  
 COLUMBUS USGS GAGE FOR THE PERIOD 1941-1945

FOR INFORMATION PURPOSES ONLY

SYMBOL	REVISIONS		DATE	APPROVED
	DESCRIPTIONS			

U.S. ARMY ENGINEER DISTRICT  
 CORPS OF ENGINEERS  
 HUNTINGTON, WEST VIRGINIA

DESIGNED BY: D.O.K. 

DRAWN BY: J.R.B.

CHECKED BY: K.C.H.

REVIEWED BY:

APPROVED BY:

SCIO TO RIVER  
 COLUMBUS, OHIO  
 WEST COLUMBUS, L.P.P.  
 PHASE IIIA

**HYDROLOGY  
 STAGE HYDROGRAPHS**

SCALE: NONE  
 DATE: OCTOBER 1999

SHEET REFERENCE NUMBER: 14/5

FILENAME: 004HFD05.DGN  
 PEN TABLE: STD.B.PTB  
 STD.F.PTB

DRAWING CODE: 16-PWC-12-14/5

SHEET 5 OF 16





**GENERAL NOTES**  
 STAGE HYDROGRAPHS AS SHOWN REPRESENT DAILY STAGE AT  
 COLUMBUS USGS GAGE FOR THE PERIOD 1952-1991  
 GAGE DATUM 680.4 NGVD

FOR INFORMATION PURPOSES ONLY

SYMBOL	REVISIONS		DATE	APPROVED
	DESCRIPTIONS			

U.S. ARMY ENGINEER DISTRICT  
 CORPS OF ENGINEERS  
 HUNTINGTON, WEST VIRGINIA

DESIGNED BY: D.O.K.

DRAWN BY: J.R.B.

CHECKED BY: K.C.H.

REVIEWED BY:

APPROVED BY:

SCOTO RIVER  
 COLUMBUS, OHIO  
 WEST COLUMBUS, L.P.P.  
 PHASE IIIA

**HYDROLOGY**  
**STAGE HYDROGRAPHS**

SCALE: NONE  
 DATE: OCTOBER 1999  
 DRAWING CODE: 16-PWC-12-

SHEET REFERENCE: PEN TABLE STD-B, PTB STD-F, PTB  
 NUMBER: 14/8

FILENAME: 004HFH08.DGN  
 SHEET 8 OF 16



8

7

6


5

4

3

2

1

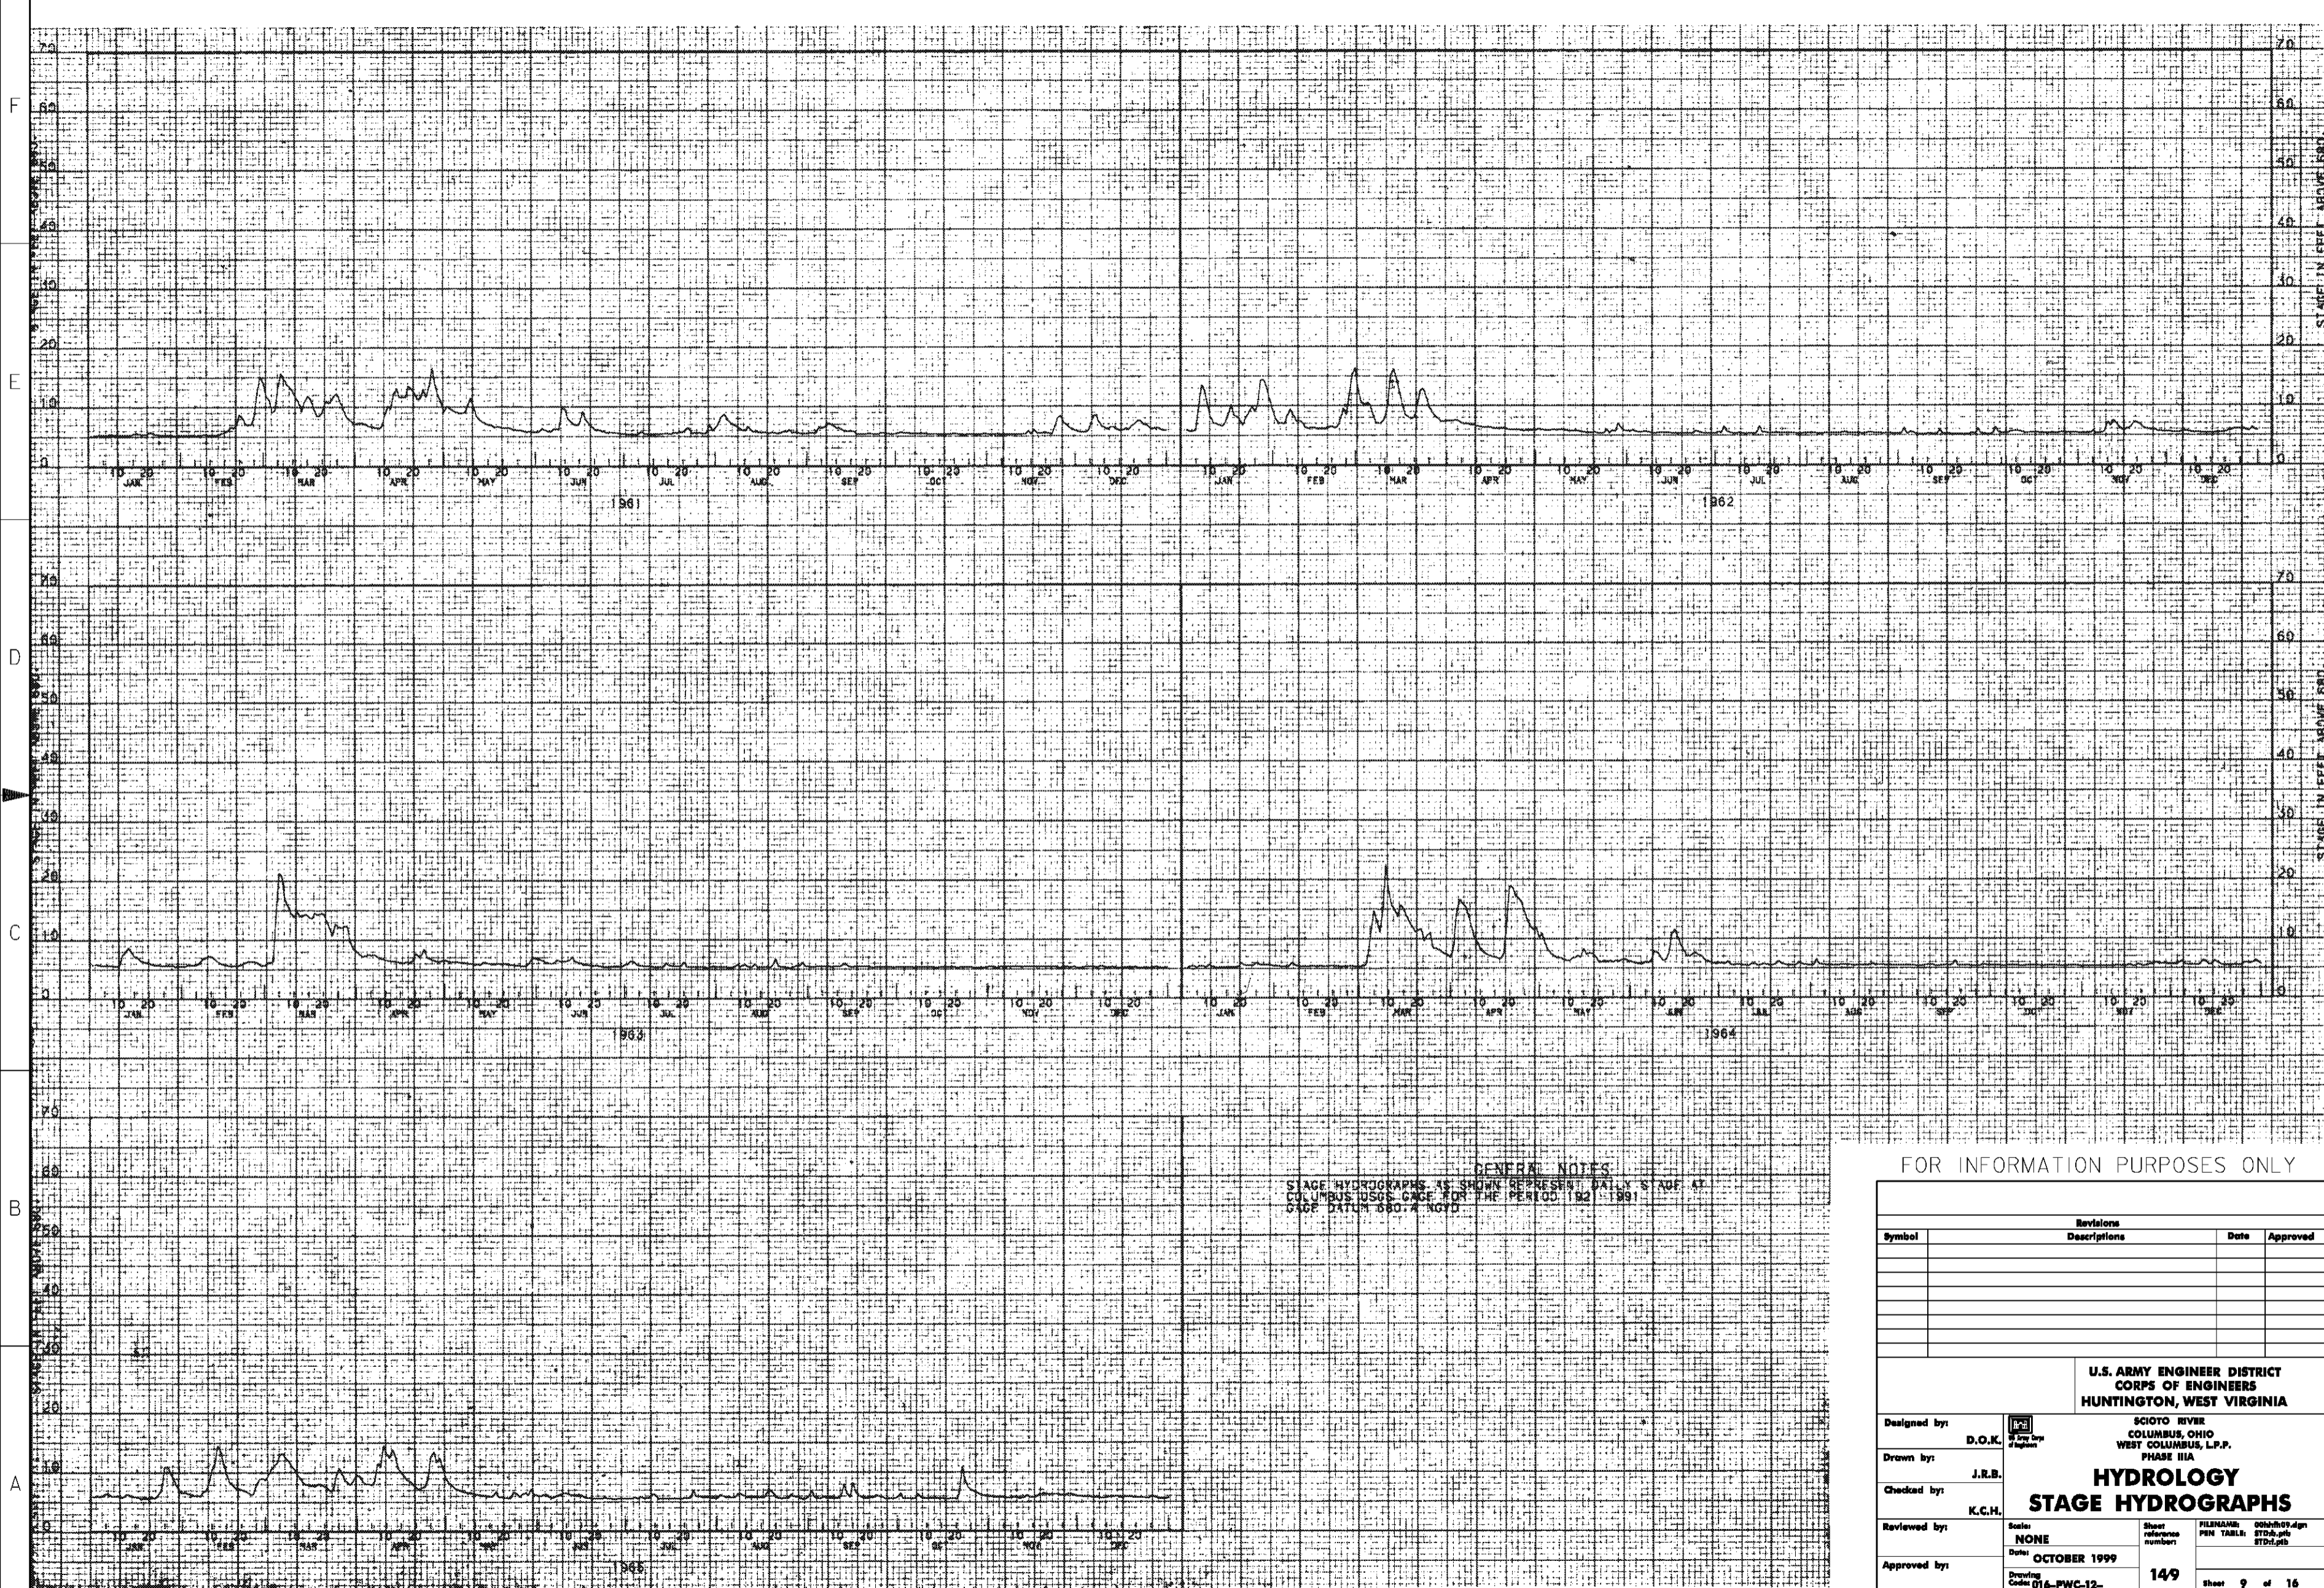

GENERAL NOTES  
 STAGE HYDROGRAPHS AS SHOWN REPRESENT DAILY STAGE AT  
 COLUMBUS USGS GAGE FOR THE PERIOD 1961-1991  
 GAGE DATUM 580.4 NGVD

FOR INFORMATION PURPOSES ONLY

Symbol	Revisions Descriptions	Date	Approved

**U.S. ARMY ENGINEER DISTRICT  
 CORPS OF ENGINEERS  
 HUNTINGTON, WEST VIRGINIA**

SCIO TO RIVER  
 COLUMBUS, OHIO  
 WEST COLUMBUS, L.P.P.  
 PHASE IIIA

**HYDROLOGY  
 STAGE HYDROGRAPHS**

Designed by: <b>D.O.K.</b>		Sheet reference number: <b>NONE</b>	FILENAME: 0001109.dgn PEN TABLE: STD0.tbl STD1.tbl
Drawn by: <b>J.R.B.</b>			
Checked by: <b>K.C.H.</b>	Date: <b>OCTOBER 1999</b>	<b>149</b>	Sheet 9 of 16
Reviewed by:	Drawing Code: <b>016-PWC-12-</b>		

8

7

6

5

4

3

2

1





GENERAL NOTES  
 STAGE HYDROGRAPHS AS SHOWN REPRESENT DAILY STAGE AT  
 COLUMBUS USGS GAGE FOR THE PERIOD 1921-1981  
 GAGE DATUM 680.4 NGVD

FOR INFORMATION PURPOSES ONLY

Revisions			
Symbol	Descriptions	Date	Approved

**U.S. ARMY ENGINEER DISTRICT  
 CORPS OF ENGINEERS  
 HUNTINGTON, WEST VIRGINIA**


SCIO TO RIVER  
 COLUMBUS, OHIO  
 WEST COLUMBUS, L.P.P.  
 PHASE IIIA

**HYDROLOGY  
 STAGE HYDROGRAPHS**

Designed by: <b>D.O.K.</b>		Sheet reference number: <b>NONE</b>	FILENAME: 000h110.dgn PEN TABLE: STDh.tbl STDt.tbl
Drawn by: <b>J.R.B.</b>		Date: <b>OCTOBER 1999</b>	
Checked by: <b>K.C.H.</b>		<b>1410</b>	Sheet 10 of 16
Reviewed by:			
Approved by:			

**WORK AS CONSTRUCTED**



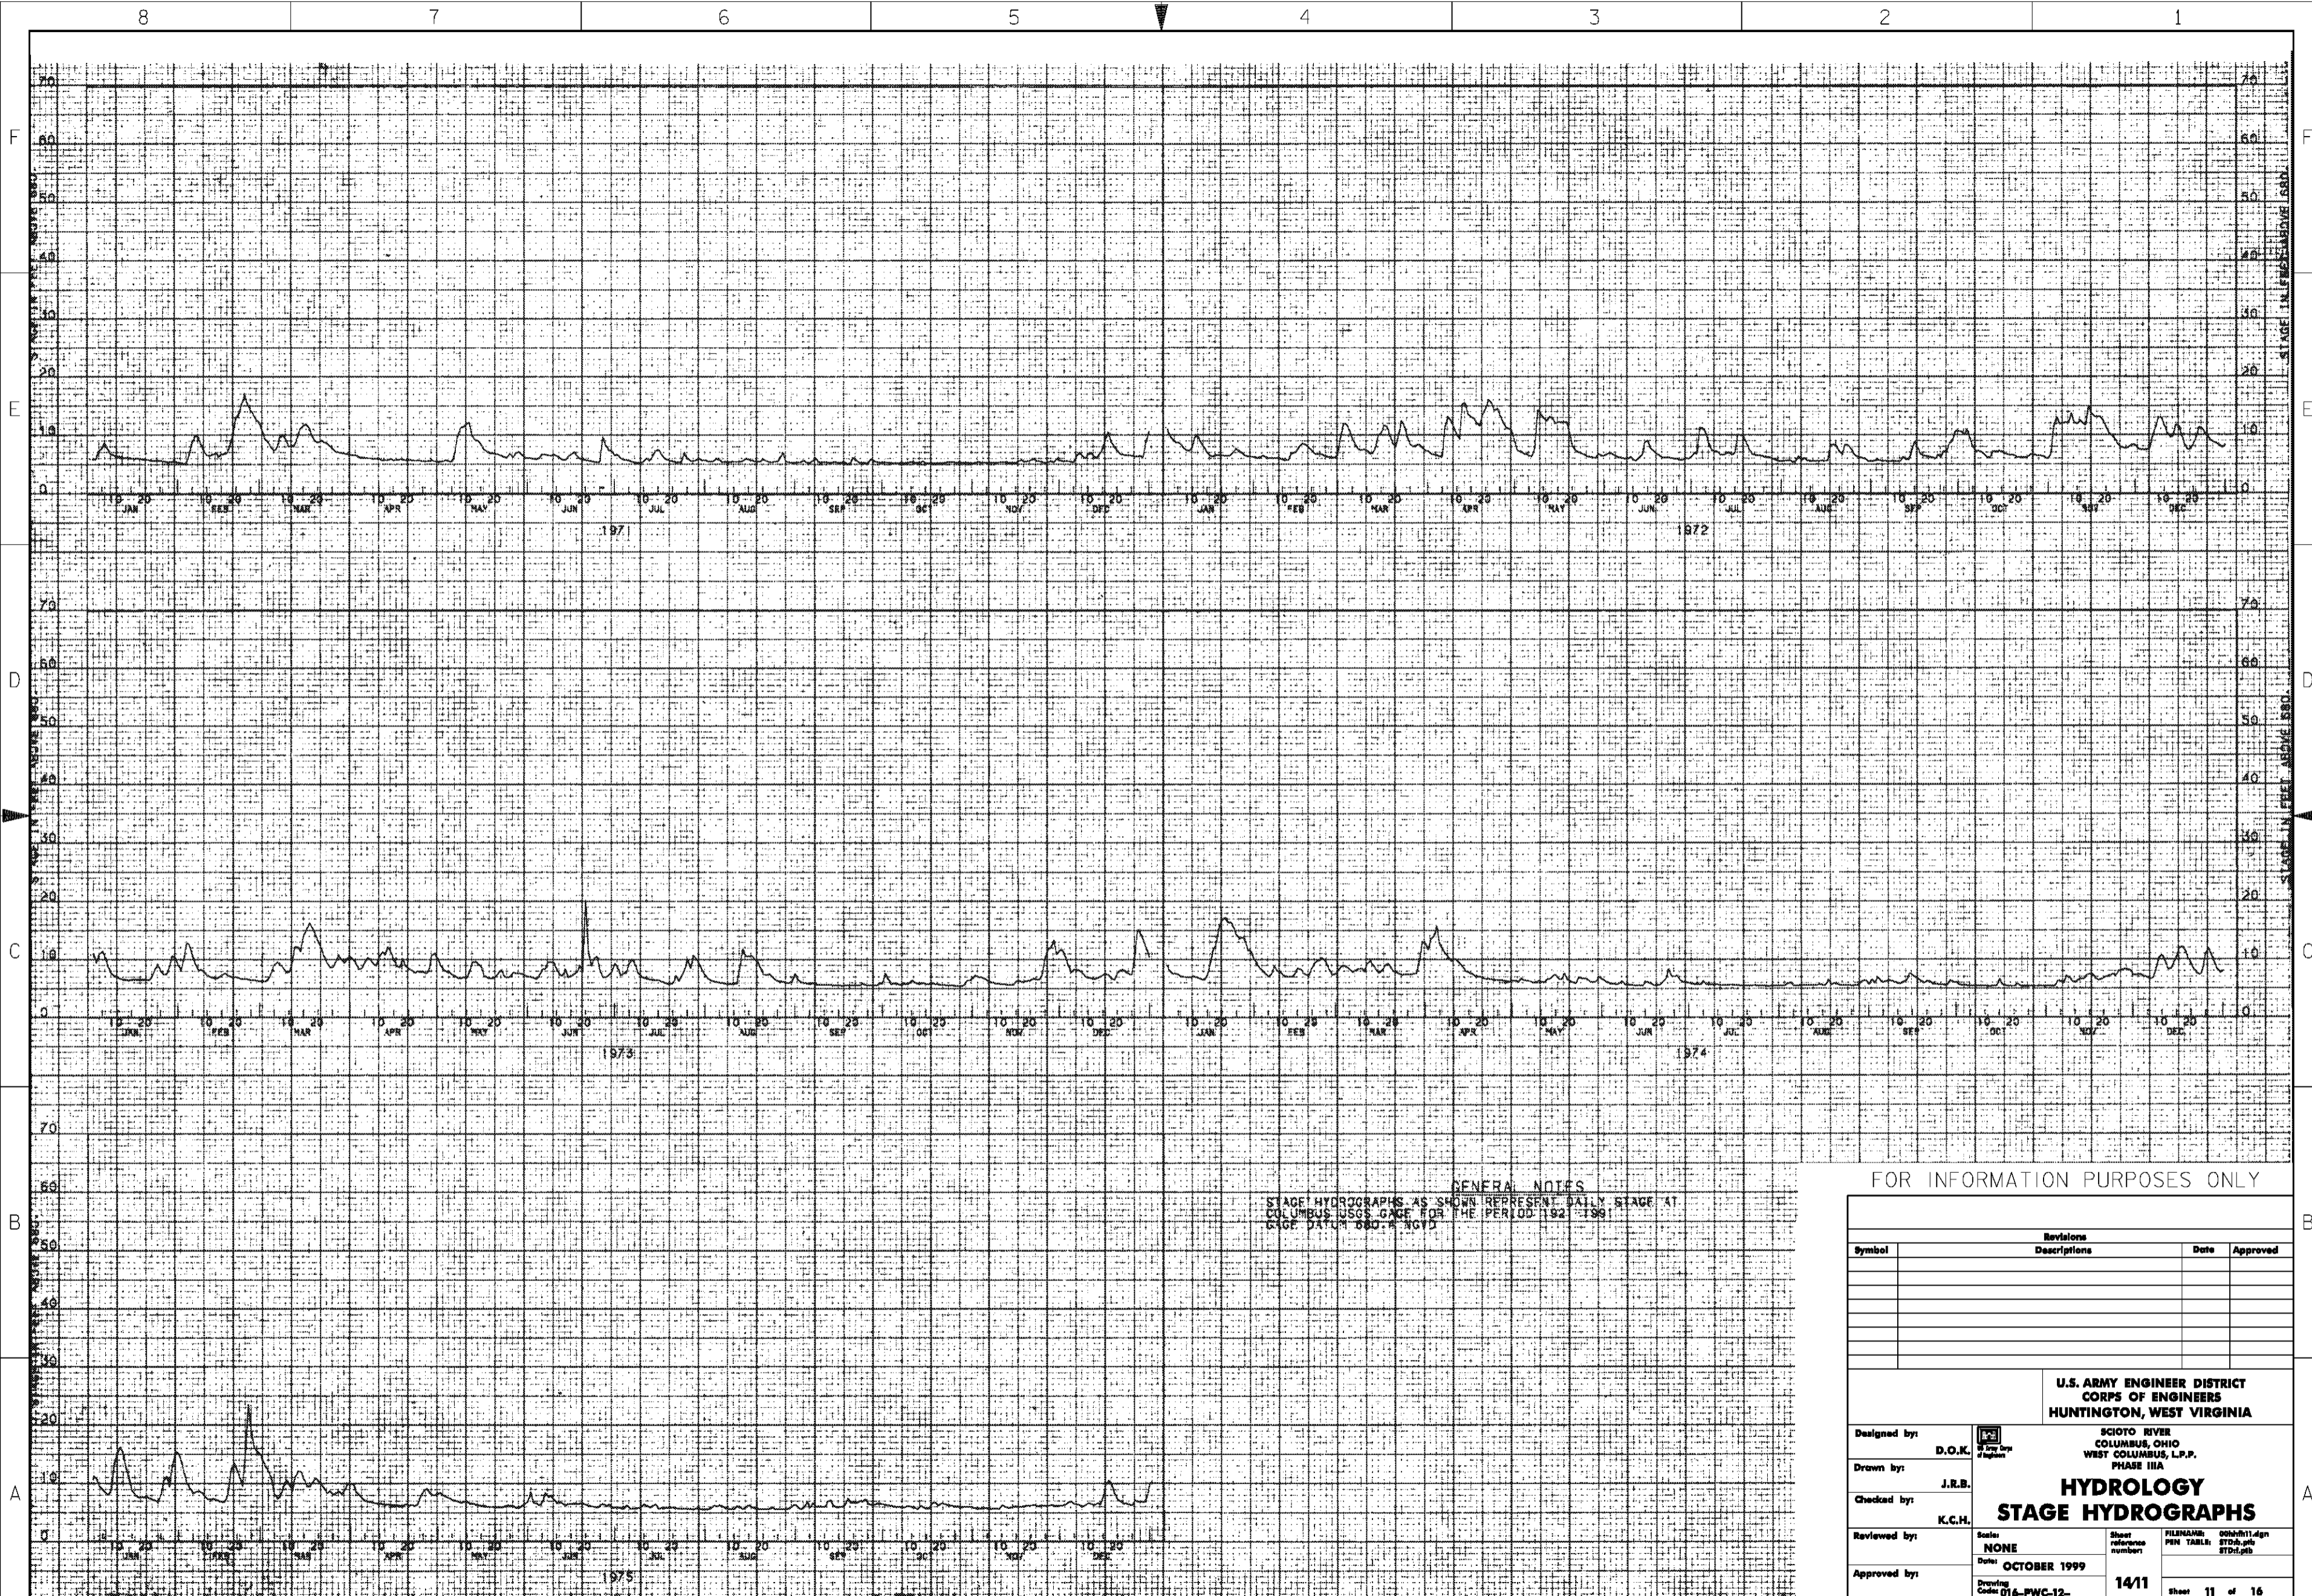

**GENERAL NOTES**  
 STAGE HYDROGRAPHS AS SHOWN REPRESENT DAILY STAGE AT  
 COLUMBUS USGS GAGE FOR THE PERIOD 1921-1991  
 GAGE DATUM 880.4 NGVD

FOR INFORMATION PURPOSES ONLY

Revisions			
Symbol	Descriptions	Date	Approved

**U.S. ARMY ENGINEER DISTRICT  
 CORPS OF ENGINEERS  
 HUNTINGTON, WEST VIRGINIA**

SCOTO RIVER  
 COLUMBUS, OHIO  
 WEST COLUMBUS, L.P.P.  
 PHASE IIIA

**HYDROLOGY  
 STAGE HYDROGRAPHS**

Designed by: <b>D.O.K.</b>		Sheet reference number: <b>NONE</b>	FILENAME: 000411.dgn
Drawn by: <b>J.R.B.</b>			
Checked by: <b>K.C.H.</b>	Date: <b>OCTOBER 1999</b>	PEN TABLE: STD0.tbl STD1.tbl	Sheet 11 of 16
Reviewed by:	Drawing Code: <b>016-PWC-12-</b>		
Approved by:			





GENERAL NOTES  
 STAGE HYDROGRAPHS AS SHOWN REPRESENT DAILY STAGE AT  
 COLUMBUS USGS GAGE FOR THE PERIOD 1977-1991.  
 GAGE DATUM 880.4 NGVD

FOR INFORMATION PURPOSES ONLY

Symbol	Revisions Descriptions	Date	Approved

**U.S. ARMY ENGINEER DISTRICT  
 CORPS OF ENGINEERS  
 HUNTINGTON, WEST VIRGINIA**

SCOTO RIVER  
 COLUMBUS, OHIO  
 WEST COLUMBUS, L.P.F.  
 PHASE IIIA

**HYDROLOGY  
 STAGE HYDROGRAPHS**

Designed by: <b>D.O.K.</b>		Scale: <b>NONE</b>	Sheet reference number: <b>1412</b>	FILENAME: 000h117.dgn
Drawn by: <b>J.R.B.</b>		Date: <b>OCTOBER 1999</b>	Sheet reference number: <b>1412</b>	PEN TABLE: STD0.tbl STD1.tbl
Checked by: <b>K.C.H.</b>		Drawing Code: <b>016-PWC-12-</b>		Sheet 12 of 16
Reviewed by:				
Approved by:				



8 7 6 5 4 3 2 1



**GENERAL NOTES**  
 STAGE HYDROGRAPHS AS SHOWN REPRESENT DAILY STAGE AT  
 COLUMBUS USGS GAGE FOR THE PERIOD 1921-1991.  
 GAGE DATUM 580.4 NGVD

FOR INFORMATION PURPOSES ONLY

Revisions			
Symbol	Descriptions	Date	Approved

**U.S. ARMY ENGINEER DISTRICT  
CORPS OF ENGINEERS  
HUNTINGTON, WEST VIRGINIA**

SCOTO RIVER  
COLUMBUS, OHIO  
WEST COLUMBUS, L.P.P.  
PHASE IIIA


**HYDROLOGY  
STAGE HYDROGRAPHS**

Designed by: <b>D.O.K.</b>		Scale: <b>NONE</b>	Sheet reference number: <b>1413</b>	FILENAME: 000h113.dgn
Drawn by: <b>J.R.B.</b>		Date: <b>OCTOBER 1999</b>	PEN TABLE: STD0.tbl STD1.tbl	
Checked by: <b>K.C.H.</b>				
Reviewed by:				
Approved by:				

Sheet 13 of 16

8 7 6 5 4 3 2 1



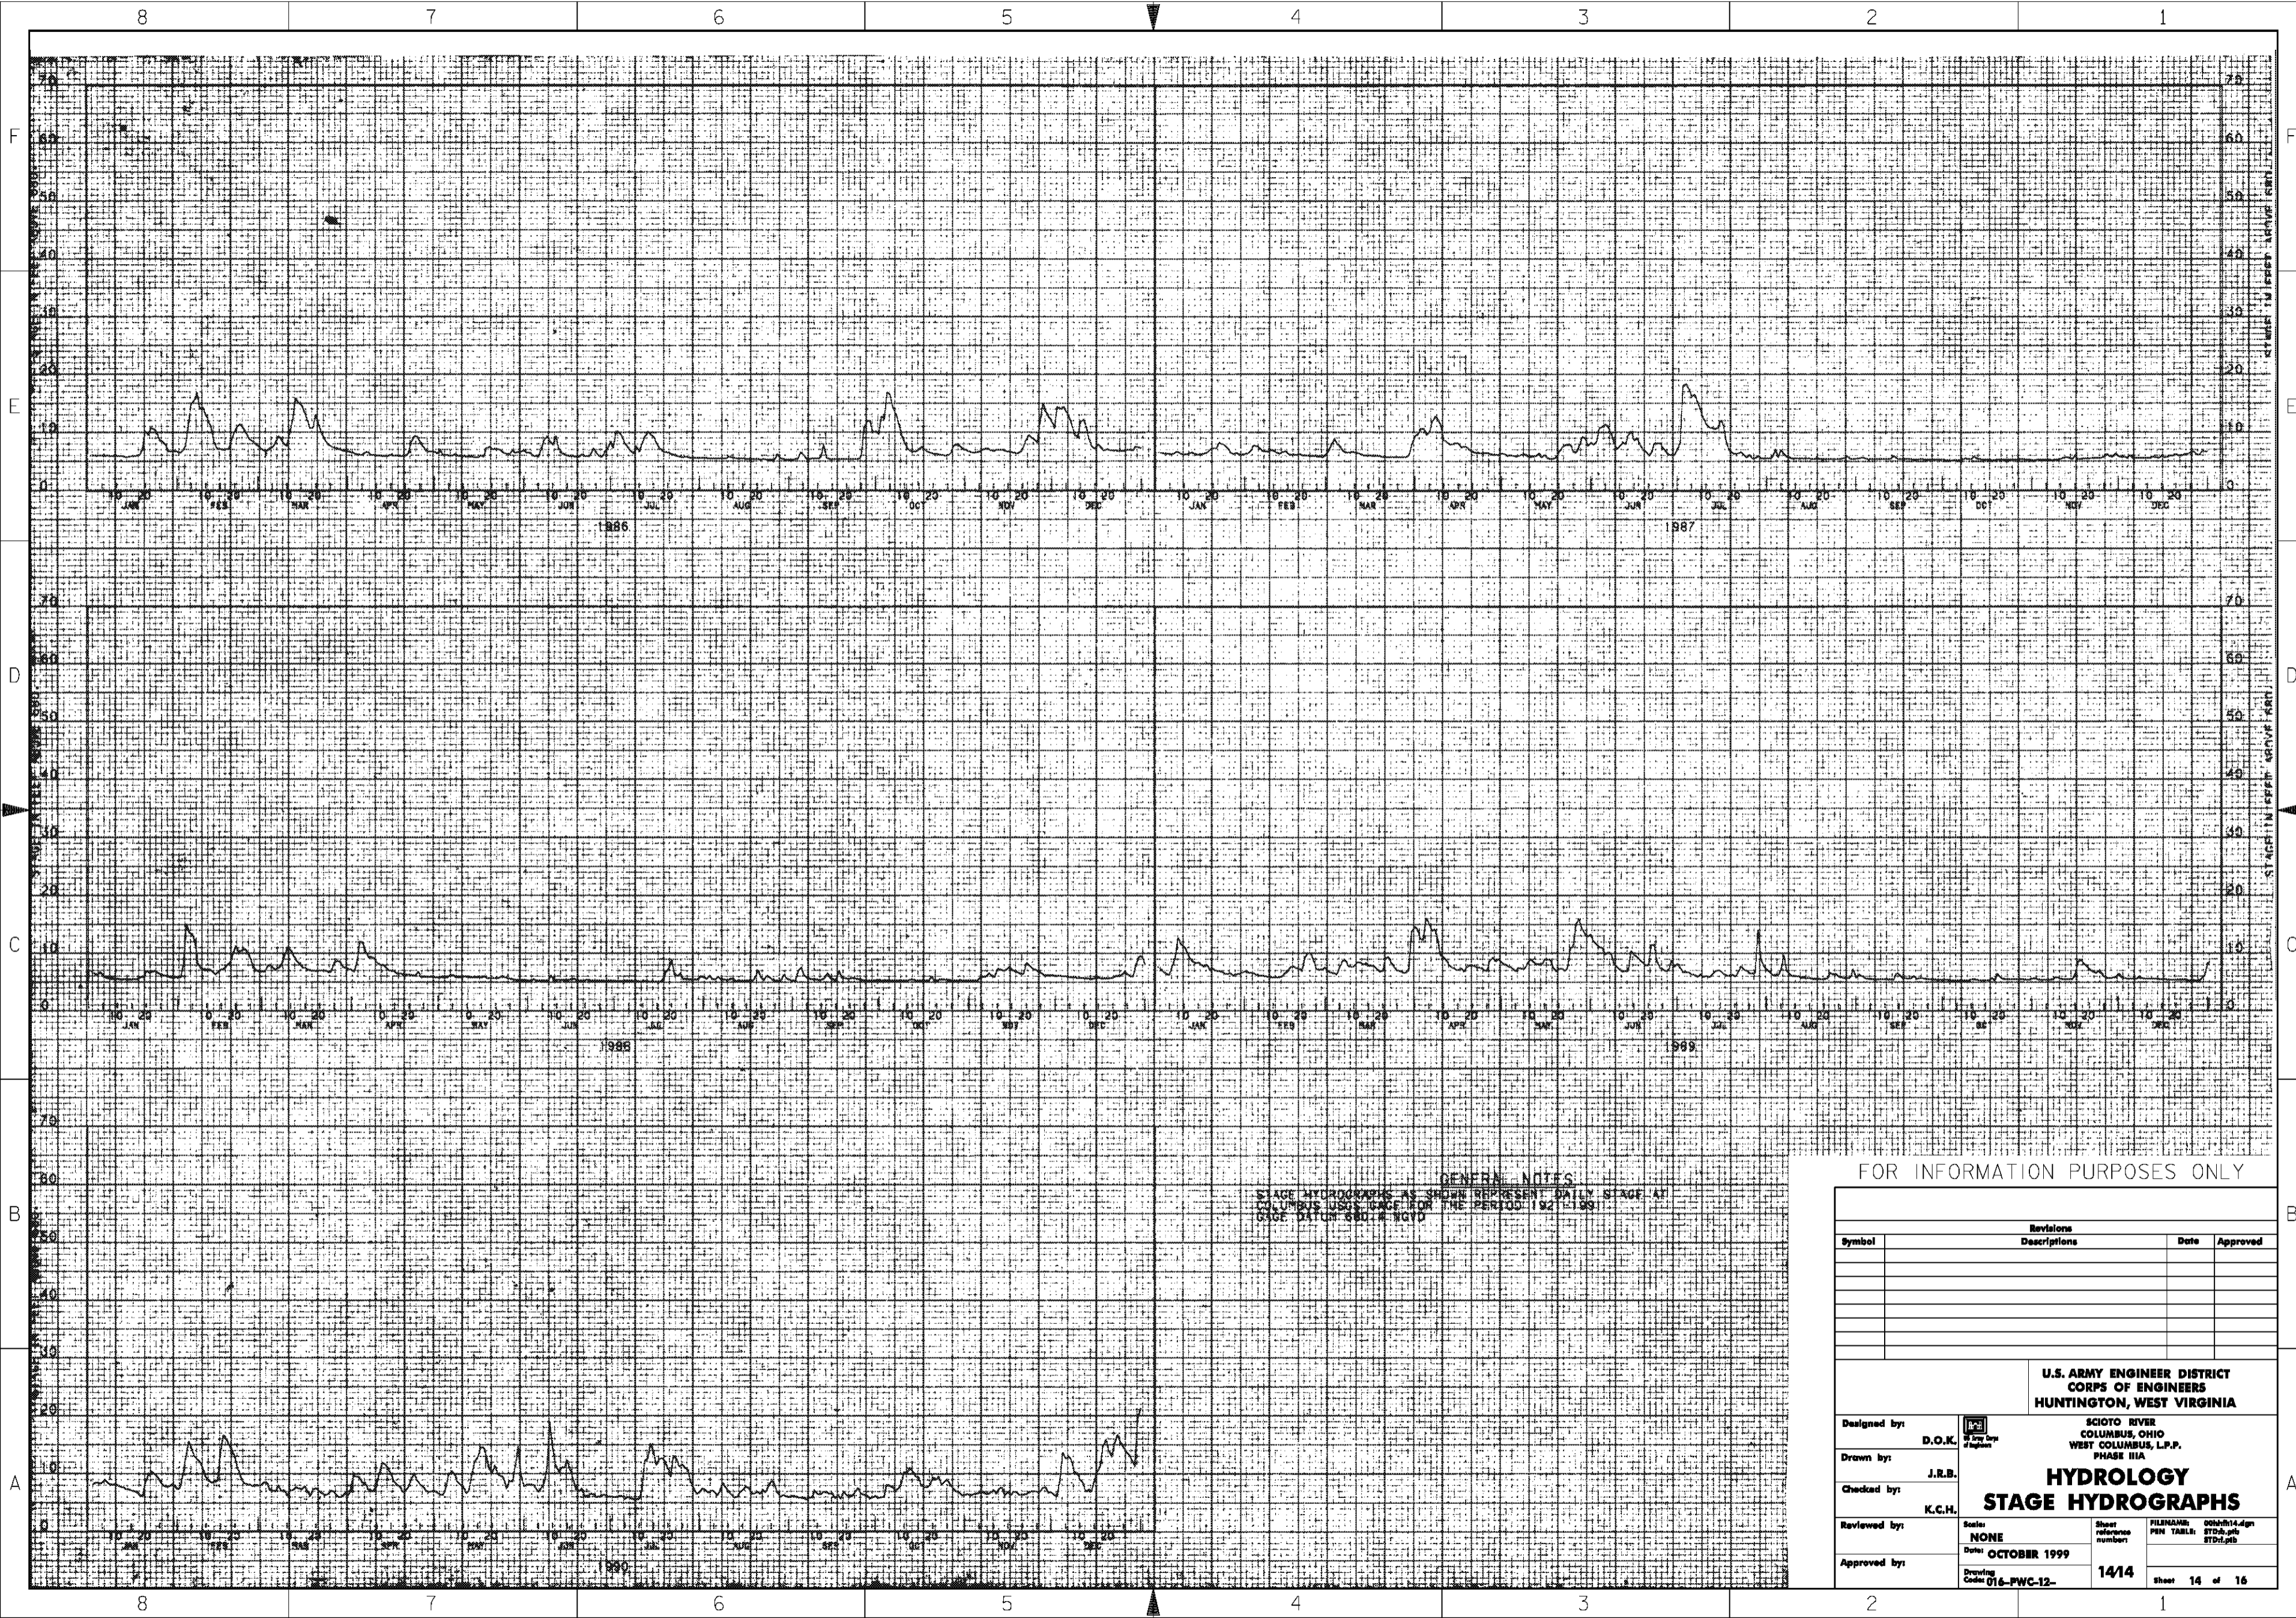

GENERAL NOTES  
 STAGE HYDROGRAPHS AS SHOWN REPRESENT DAILY STAGE AT  
 COLUMBUS JUSTICE FOR THE PERIODS 1987-1989  
 GAGE DATUM 800.2 NGVD

FOR INFORMATION PURPOSES ONLY

Symbol	Revisions Descriptions	Date	Approved

**U.S. ARMY ENGINEER DISTRICT  
 CORPS OF ENGINEERS  
 HUNTINGTON, WEST VIRGINIA**

SCIO TO RIVER  
 COLUMBUS, OHIO  
 WEST COLUMBUS, L.P.P.  
 PHASE IIIA

**HYDROLOGY  
 STAGE HYDROGRAPHS**

Designed by: <b>D.O.K.</b>		Sheet reference number: <b>NONE</b>	FILENAME: 00N114.dgn	
Drawn by: <b>J.R.B.</b>		Date: <b>OCTOBER 1999</b>	PEN TABLE: STD0.pjt STD1.pjt	
Checked by: <b>K.C.H.</b>		Drawing Code: <b>016-PWC-12-</b>	<b>14/14</b>	Sheet 14 of 16
Reviewed by:		Approved by:		

8

7

6

5

4

3

2

1

F

E





D

C

B

A

STAGE IN FEET ABOVE 680.4

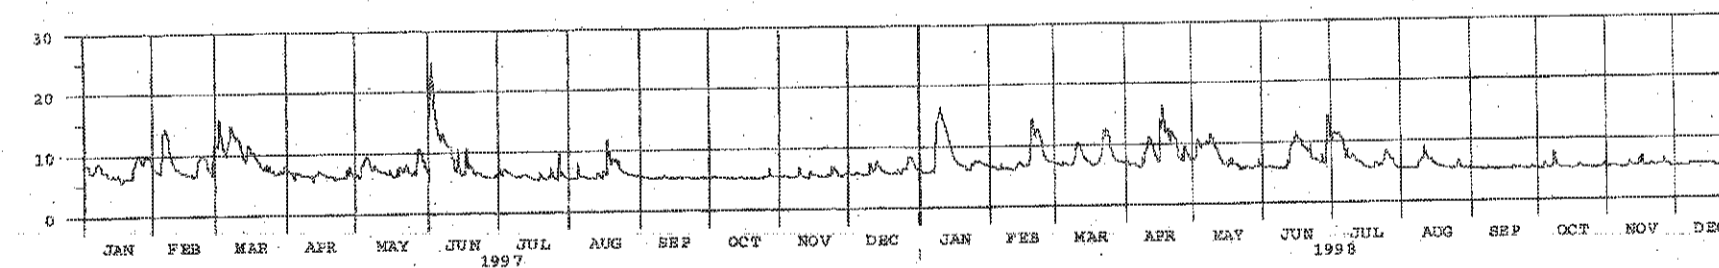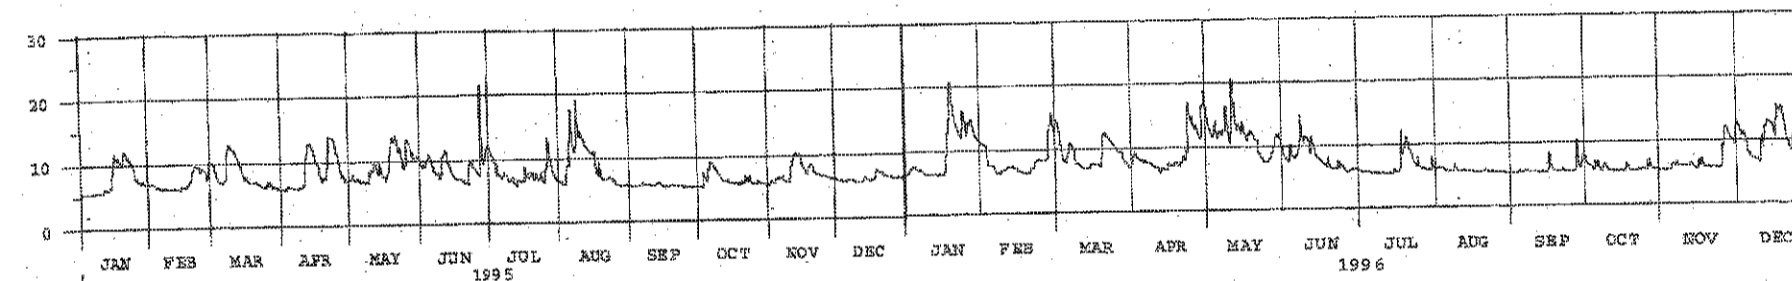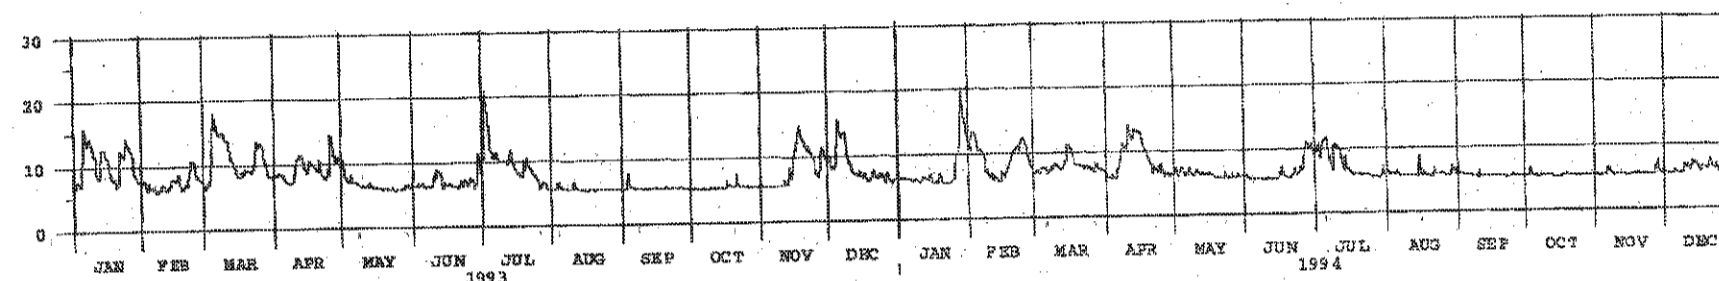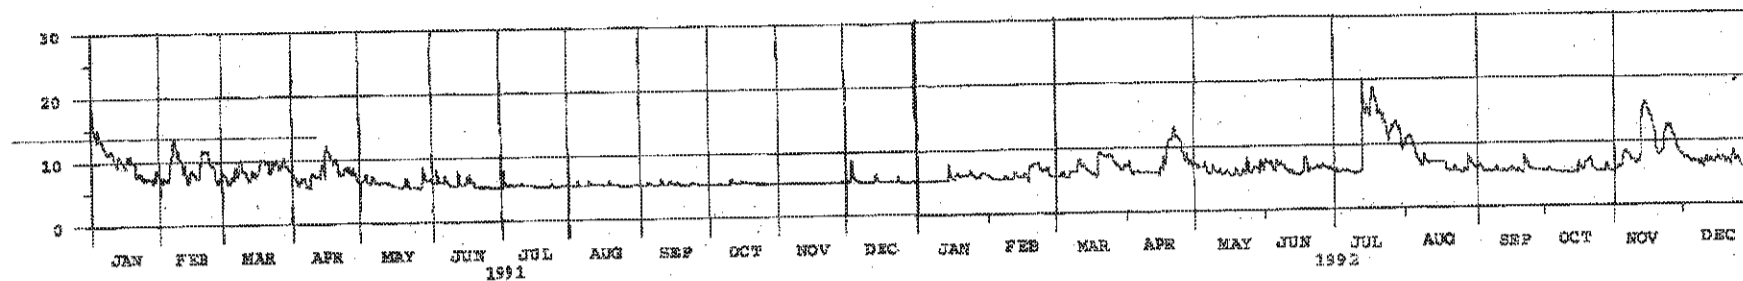

**NOTES**

STAGE HYDROGRAPHS AS SHOWN REPRESENT DAILY STAGE AT COLUMBUS USGS GAGE FOR THE PERIOD 1921-1998 GAGE DATUM 680.4 NGVD.  
 PLOTS OBTAINED FROM SCANNED IMAGES OF CELRH-EC-WW SATELLITE DATA W/VERTICAL SCALE RANGE 0-100.

FOR INFORMATION PURPOSES ONLY

Revisions			
Symbol	Descriptions	Date	Approved

<b>U.S. ARMY ENGINEER DISTRICT CORPS OF ENGINEERS HUNTINGTON, WEST VIRGINIA</b>				
Designed by:	V.L.P.	SCIOTO RIVER COLUMBUS, OHIO WEST COLUMBUS, L.P.P. PHASE IIIA <b>HYDROLOGY STAGE HYDROGRAPHS</b>		
Drawn by:	J.R.B.			
Checked by:	K.C.H.			
Reviewed by:				
Approved by:		Scale: NONE Date: OCTOBER 1999 Drawing Code: 016-PWC-12-	Sheet reference numbers: 1415 FILENAME: 00N0115.dgn PEN TABLE: STD: h.plt STD: l.plt	Sheet 15 of 16

8

7

6

5


4

3

2

1



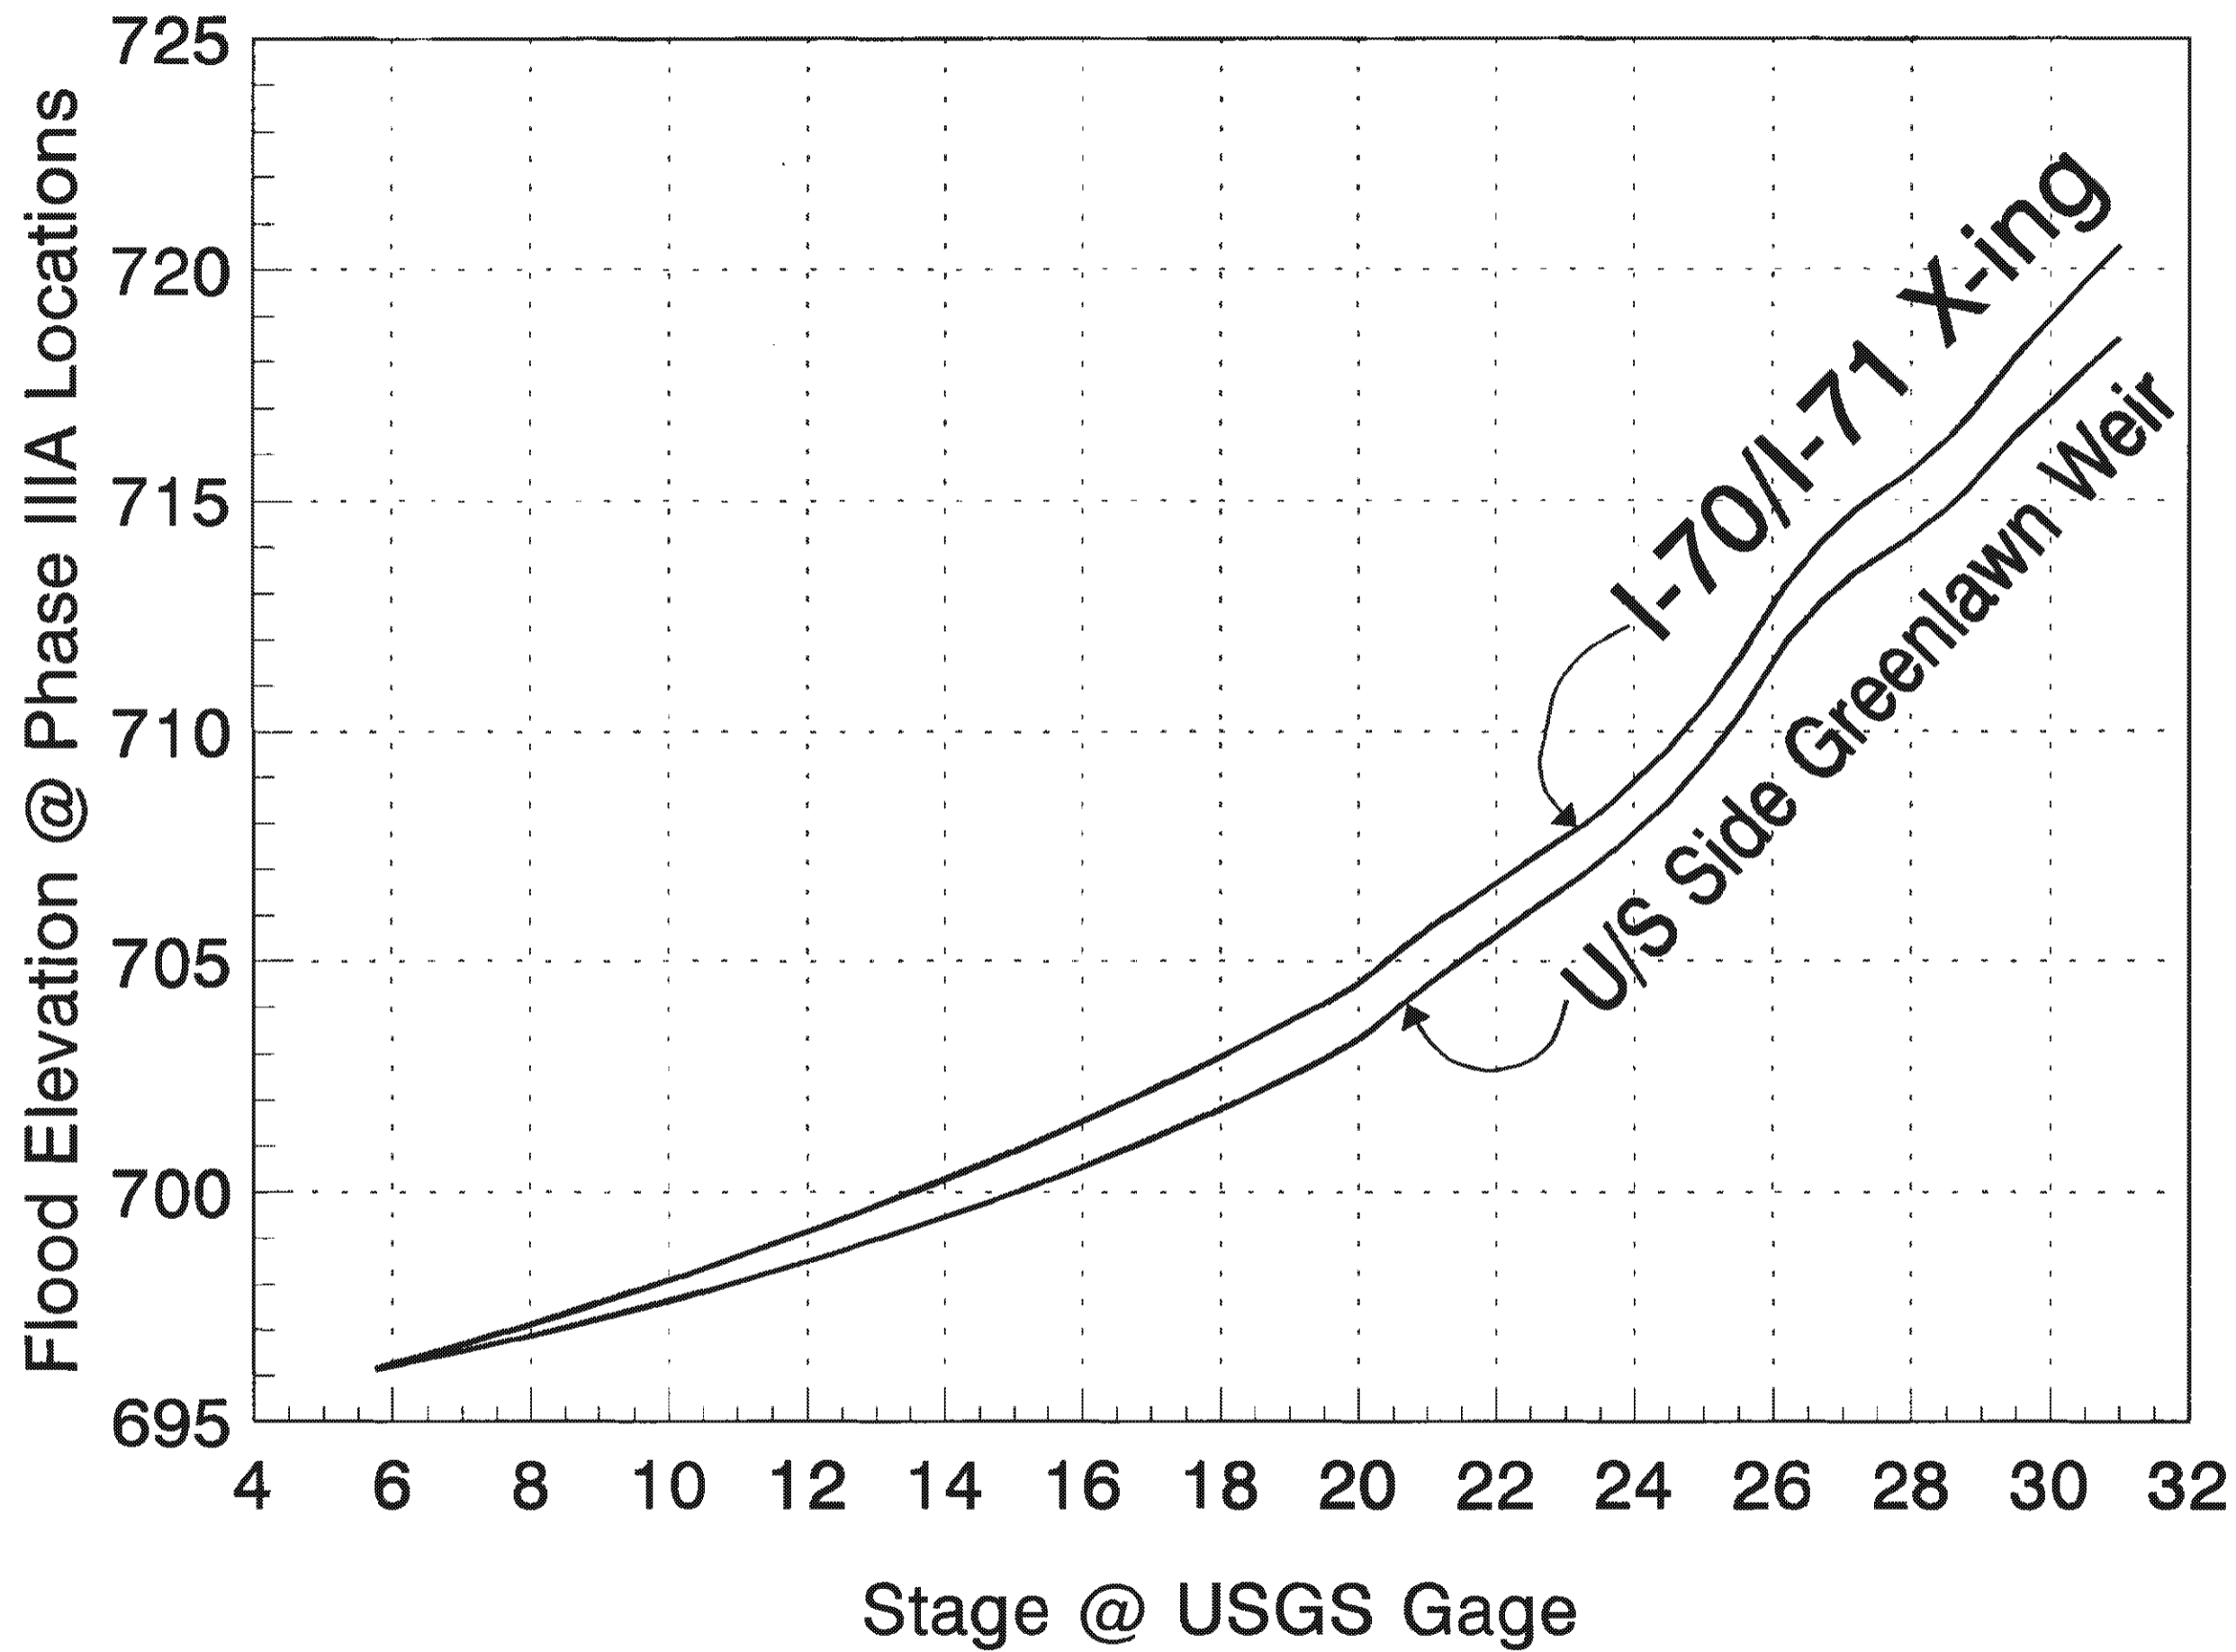


Correlation from USGS Gage to Greenlawn Weir & Vicinity (Phase IIIA)

FOR INFORMATION PURPOSES ONLY


Revisions			
Symbol	Descriptions	Date	Approved

U.S. ARMY ENGINEER DISTRICT CORPUS OF ENGINEERS HUNTINGTON, WEST VIRGINIA			
Designed by: <b>K.C.H.</b>	SCOTO RIVER COLUMBUS, OHIO WEST COLUMBUS, L.P.P. PHASE IIIA <b>HYDROLOGY                  CORRELATION CURVE</b>	Reviewed by: NONE	Sheet reference number: 1416
Drawn by: <b>J.R.B.</b>		Date: OCTOBER 1999	FILENAME: 00N016.dgn PEN TABLE: STD0.tbl STD1.tbl
Checked by: <b>C.W.M.</b>		Drawing Code: 016-PWC-12-	Sheet 16 of 16
Approved by:		1416	Sheet 16 of 16




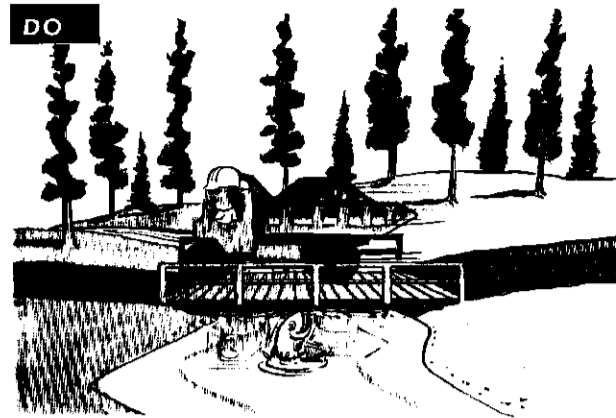


**DO**  
EPM No. 20.—Where frequent stream crossings are necessary, temporary culverts or bridges shall be provided.

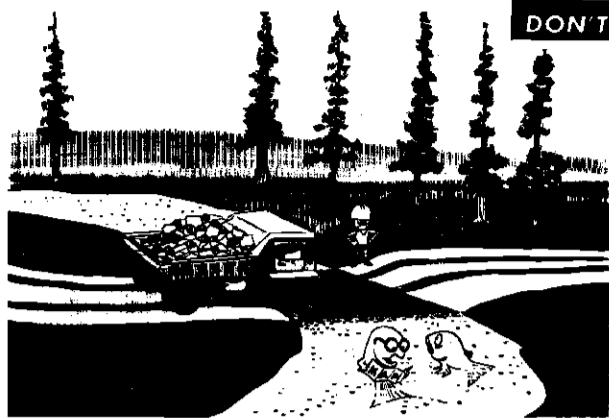


**DON'T**  
EPM No. 21.—The Contractor shall perform all work in a manner to prevent any interference or disturbance to the safe passage and spawning of game fish.

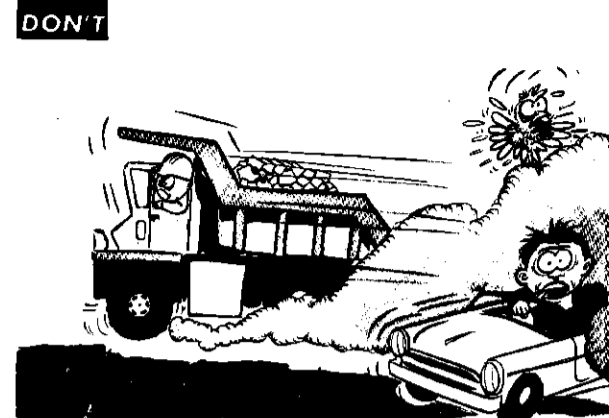


**DON'T**  
EPM No. 22.—The Contractor shall maintain all excavations, embankments, stockpiles, roads, plant sites, waste areas, borrow areas, and all other work areas within or without the project boundaries free from dust which would cause a hazard or nuisance to others.

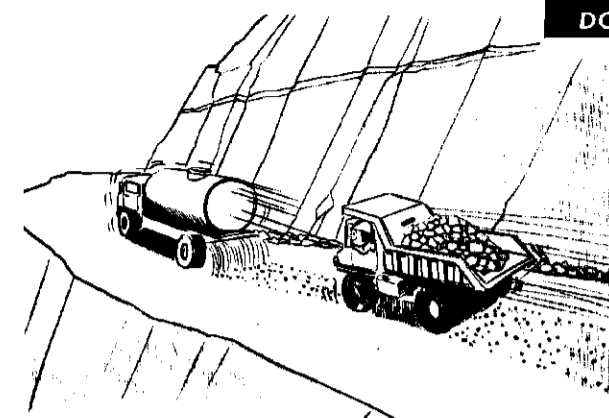


**DO**  
EPM No. 23.—Approved temporary methods of stabilization consisting of sprinkling, chemical treatment, light bituminous treatment or equal methods shall be provided to control dust.

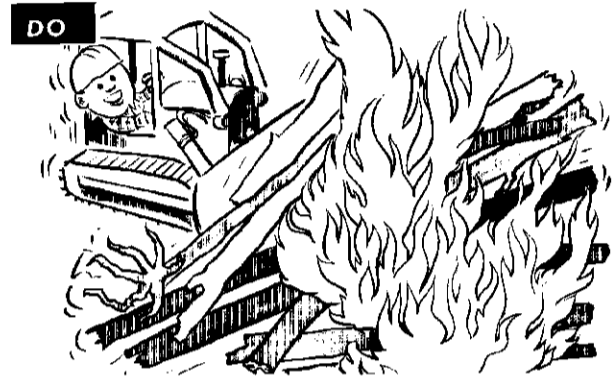

**DO**  
EPM No. 24.—Except as restricted by the Fire Control Officer, burning shall assure continuous, rapid and complete combustion. To meet this requirement, burning piles shall be kept under constant attendance by heavy equipment and operators who shall stack or push in burning piles from the edges, or shall feed fire with additional combustibles.

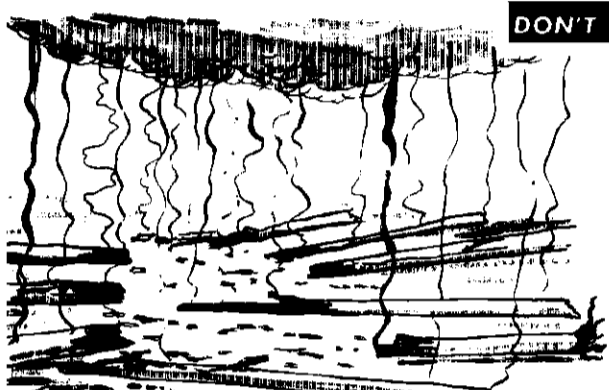


**DON'T**  
EPM No. 25.—Burn piles and individual pieces of burned material shall not be allowed to smolder.

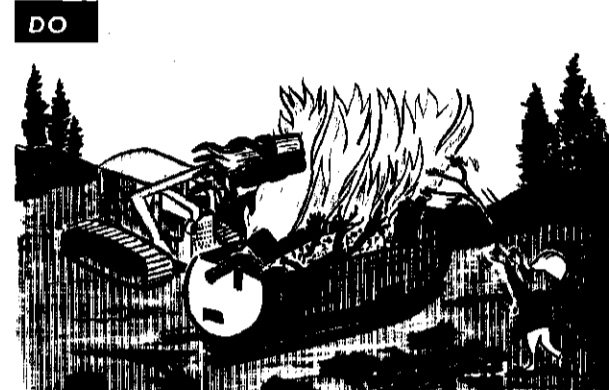


**DO**  
EPM No. 26.—High heat burning shall be done in burning boxes, portable incinerators, open pits or trenches.




**DON'T**  
EPM No. 27.—Waste materials shall not be dumped on slopes.

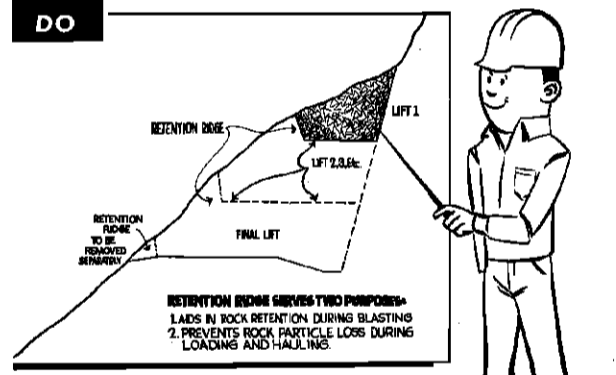


EPM No. 28.—The pattern of drilling and the depth, size and loading of holes along the outer edge of bench cut shall be such as to provide retention ridges of rock to act as a restraint against loss of material down the slope.

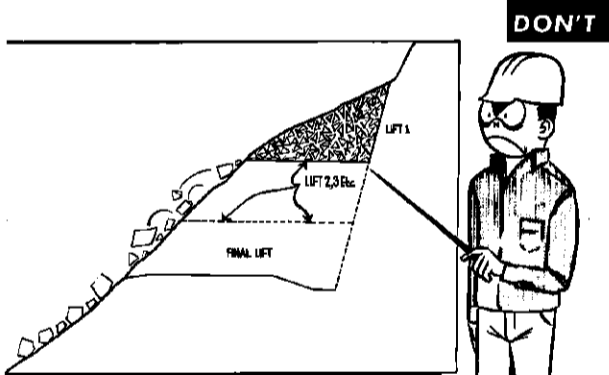

EPM No. 29.—The pattern of drilling and the depth, size and loading of holes along the outer edge of bench cut shall be such as to provide retention ridges of rock to act as a restraint against loss of material down the slope. (See DO for proper procedure.)

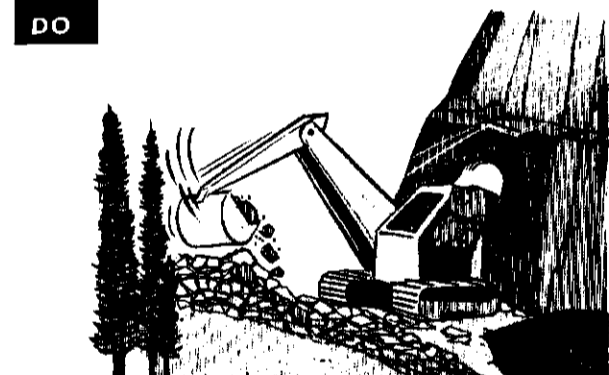


**DO**  
EPM No. 29.—Excavation of blasted material shall be conducted in such a manner that operation of excavation equipment does not contribute to loss of material down the slope.

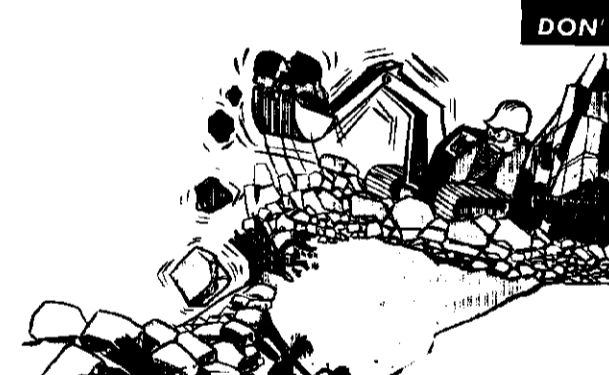

**DON'T**  
EPM No. 29.—Excavation of blasted material shall be conducted in such a manner that operation of excavation equipment does not contribute to loss of material down the slope. (See DO for proper procedure.)



**DO**  
EPM No. 30.—Full U-blades shall be used on dozers excavating on slopes.

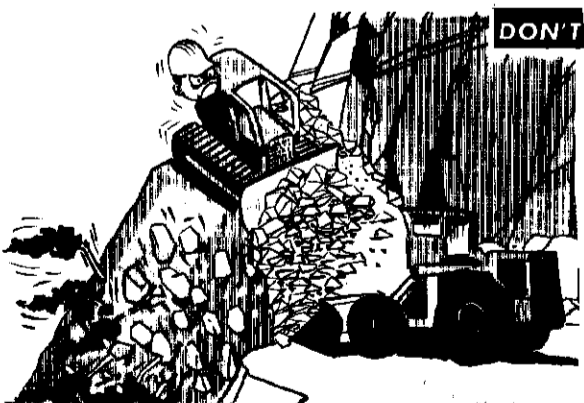


**DON'T**  
EPM No. 30.—Full U-blades shall be used on dozers excavating on slopes. (See DO for proper procedure.)




**DON'T**  
EPM No. 31.—In other than solid rock, the tops of excavated slopes shall be rounded off as shown on the contract drawings.



**DO**

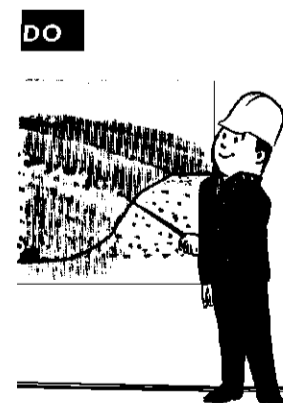

**DO**

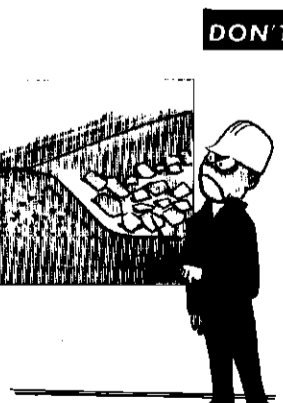

**DON'T**  
EPM No. 32.—Loose rocks, cobbles and boulders falling outside the defined slopes shall be removed where operations for removal of such material will not deface the landscape.

FOR INFORMATION ONLY

Revisions			
Symbol	Descriptions	Date	Approved

**U.S. ARMY ENGINEER DISTRICT  
COLUMBUS, OHIO  
WEST COLUMBUS, L.P.P.  
PHASE IIIA**


**ENVIRONMENTAL PROTECTION  
MEASURES**

Designed by:		SCOTO RIVER COLUMBUS, OHIO WEST COLUMBUS, L.P.P. PHASE IIIA	
Drawn by:		ENVIRONMENTAL PROTECTION MEASURES	
Checked by:		Sheet reference number	FILENAME: PEN TABLE: STD7.plt STD8.plt
Reviewed by:		NONE	Z2 107/1
Approved by:		Date: OCTOBER 1999	Sheet 1 of 2



DO

**EPM No. 1.**—The Contractor shall conduct frequent on the job training courses, not less than monthly, for the purpose of emphasizing the environmental protection requirements of the contract. He shall emphasize that prevention of damage to the environment is the primary goal and that restoration should be necessary only when damage is unavoidable.

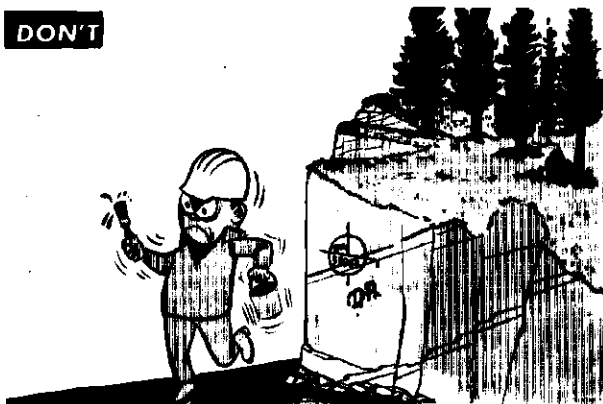


DON'T

**EPM No. 2.**—Rock faces and other interesting geologic features, including natural boat landings, which will be exposed by drawdown of the reservoir shall be preserved.



DON'T


**EPM No. 3.**—Survey lines shall be located to avoid cutting large trees and to minimize clearing beyond established clearing limits. Clearing of brush and branches for sight lines shall be held to the minimum practical limits.

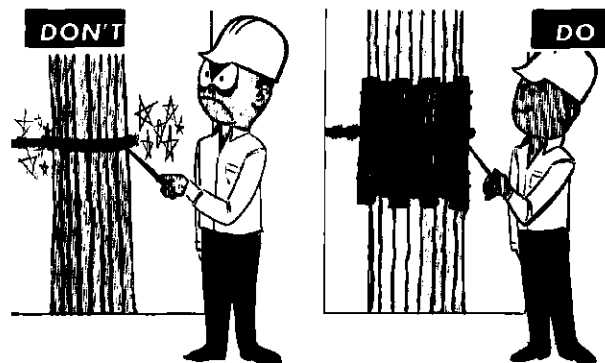

DON'T

DO

**EPM No. 4.**—Except in areas to be cleared, ropes, cables or guys shall be fastened to or attached to trees unless specifically authorized by the Contracting Officer. Where such anchorage is permitted, the trunk shall first be wrapped with not less than 4 layers of bark or equivalent padding over which softwood cleats shall be tied before any rope, cable or wire is placed.

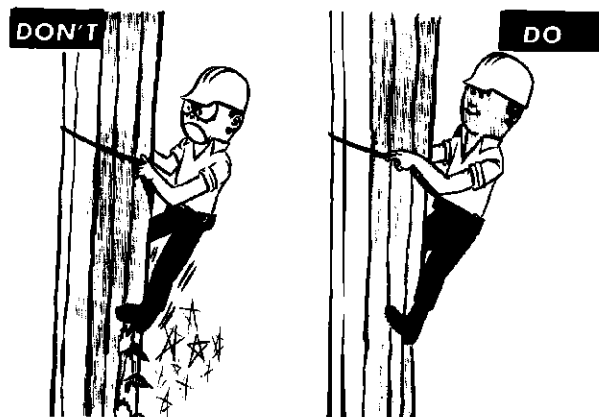

DON'T


DO

**EPM No. 5.**—Where tree climbing is necessary, the use of climber spurs will not be permitted.




DON'T

**EPM No. 6.**—During clearing operations, trees and debris shall not be allowed to fall outside the clearing limits where such fall would damage or injure trees and shrubs which are to remain and where operations for removal of fallen materials will damage or injure trees and shrubs which are to remain.

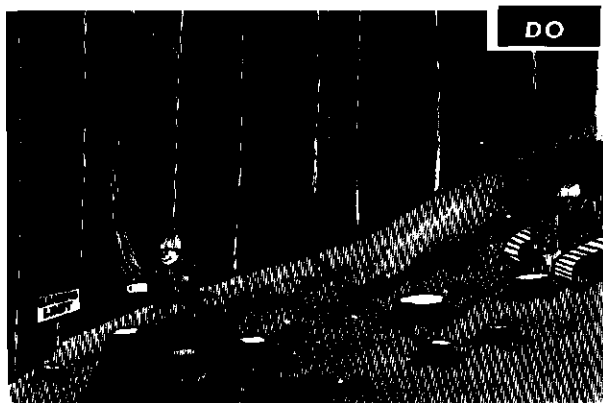

DO

**EPM No. 7.**—Ropes, guys or other means shall be used where necessary to restrain materials from damaging trees or shrubs which are to remain.

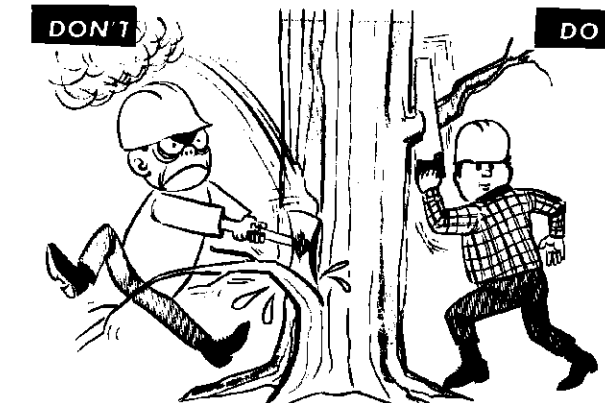

DON'T

DO

**EPM No. 8.**—All trimming or pruning shall be done with saws or pruning shears. Tree trimming with axes will not be permitted.



DO

**EPM No. 9.**—All treated wounds and specified pruning cuts shall be painted with an approved tree pruning compound of a color approximately matching the color of the bark.



DON'T

**EPM No. 10.**—Where game trails or hiking trails cross construction areas, such trails shall not be covered by debris and shall be maintained in a safe and passable condition at all times.



DO

**EPM No. 11.**—Ramps shall be constructed in cut areas or trails shall be resealed to provide access. Location of rerouted trails shall be subject to the approval of the Contracting Officer. Traffic warning signs shall be provided at hiking trails and maintained during construction operations.




DON'T

**EPM No. 12.**—When work is completed, whether on Government-owned lands or on private lands, all camp, storage and other contractor's buildings shall be removed, and the sites restored to a neat and presentable condition appropriate to the landscape, unless otherwise specified.




DO

**EPM No. 13.**—The contractor shall erect log barriers in specified locations to prevent excavated material from escaping down the slope. The log barriers shall be placed at the edge of the cleared area or in other locations up the slope as approved by the Contracting Officer.

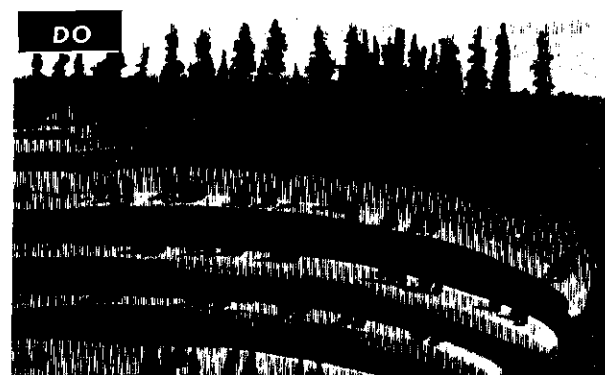


DO

**EPM No. 14.**—Development and reclamation of borrow areas shall be in accordance with the approved borrow area reclamation plan.

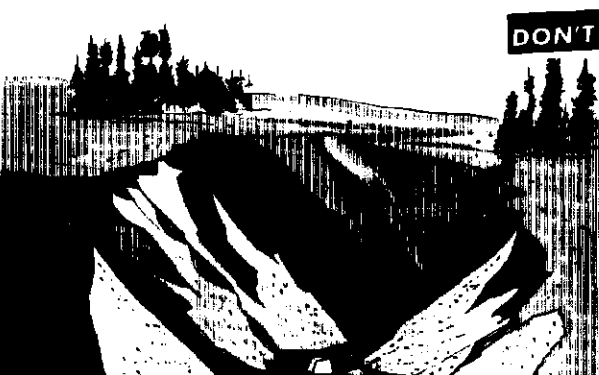


DON'T

**EPM No. 15.**—Slopes of the borrow site shall be graded and dressed to blend with the adjacent terrain.

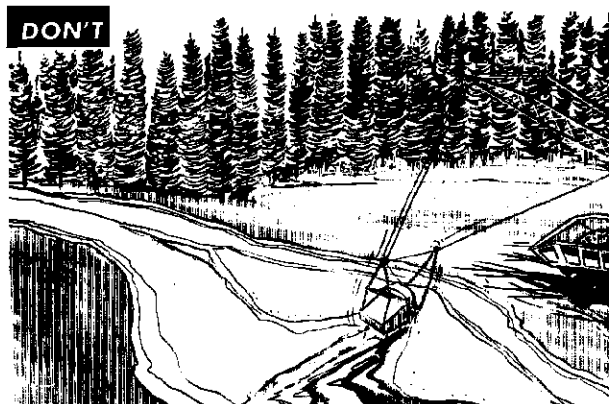


DON'T

**EPM No. 16.**—Borrow areas shall not be located in or adjacent to live streams.

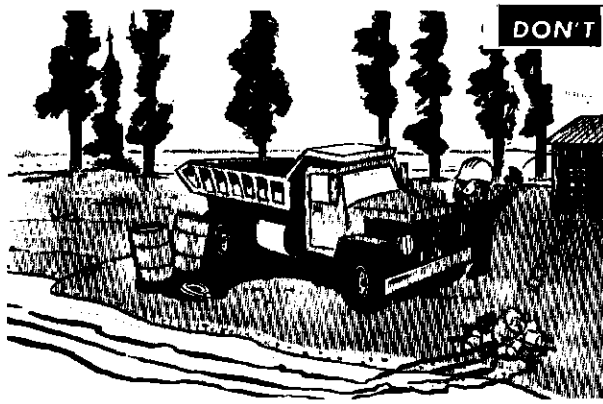

DON'T

**EPM No. 17.**—At all times of the year, special measures shall be taken to prevent chemicals, fuels, oils, greases, bituminous materials, waste washings, herbicides, insecticides, lime, wet concrete, cement, silt or organic or other deleterious material from entering waterways.

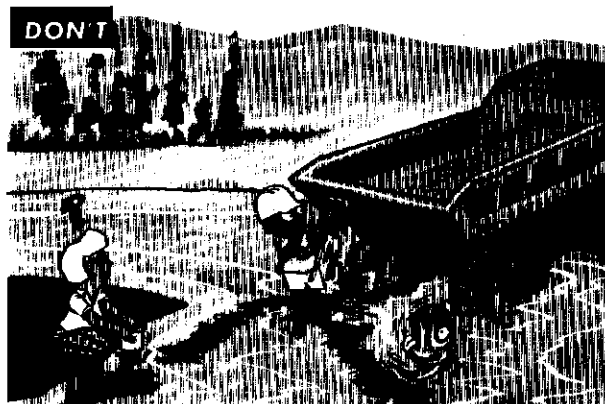

DON'T

**EPM No. 18.**—Waters used to wash down equipment shall be disposed of in a manner to prevent their entry into a waterway.




DON'T

**EPM No. 19.**—The use of equipment within streams shall be held to that necessary for preparing a base for culverts and for channel diversion only.

FOR INFORMATION ONLY

Revisions			
Symbol	Descriptions	Date	Approved

<b>U.S. ARMY ENGINEER DISTRICT CORPS OF ENGINEERS HUNTINGTON, WEST VIRGINIA</b>			
Designed by:	 SCIOTO RIVER COLUMBUS, OHIO WEST COLUMBUS, L.P.P. PHASE IIIA <b>ENVIRONMENTAL PROTECTION            MEASURES</b>	Sheet reference number:	FILENAME: EDC00evd02.dgn
Drawn by:		None	STD.rpt
Checked by:		DATE:	STD.rpt
Reviewed by:		OCTOBER 1999	Z2 107/2
Approved by:		Drawing Code:	Sheet 2 of 2