

STATE OF OHIO
DEPARTMENT OF TRANSPORTATION
FRA/DEL-745-0.69/0.00
CITY OF DUBLIN
WASHINGTON/CONCORD TOWNSHIPS
FRANKLIN/DELAWARE COUNTIES

FEDERAL PROJECT NUMBER

E230165

RAILROAD INVOLVEMENT

NONE

PROJECT DESCRIPTION

PLANING AND RESURFACING OF 3.09 MILES OF SR 745 IN FRANKLIN AND DELAWARE COUNTIES, FROM SLM 0.69 (FRANKLIN COUNTY) TO SLM 0.84 (DELAWARE COUNTY). PROJECT INCLUDES BRIDGE JOINT SEALING & CURB RAMP RECONSTRUCTION.

EARTH DISTURBED AREAS


PROJECT EARTH DISTURBED AREA: 0.00* ACRES
ESTIMATED CONTRACTOR EARTH DISTURBED AREA: 0.00* ACRES
NOTICE OF INTENT EARTH DISTURBED AREA: 0.00* ACRES
*NOT REQUIRED FOR ROUTINE MAINTENANCE PROJECT

TRAFFIC NOT REROUTED

I HEREBY APPROVE THESE PLANS AND DECLARE THAT THE MAKING OF THIS IMPROVEMENT WILL NOT REQUIRE THE CLOSING TO TRAFFIC OF THE HIGHWAY AND THAT PROVISIONS FOR THE MAINTENANCE AND SAFETY OF TRAFFIC WILL BE AS SET FORTH ON THE PLANS AND ESTIMATES.

2019 SPECIFICATIONS

THE STANDARD SPECIFICATIONS OF THE STATE OF OHIO, DEPARTMENT OF TRANSPORTATION, INCLUDING SUPPLEMENTAL SPECIFICATIONS LISTED IN THE PLANS AND CHANGES LISTED IN THE PROPOSAL SHALL GOVERN THIS IMPROVEMENT.

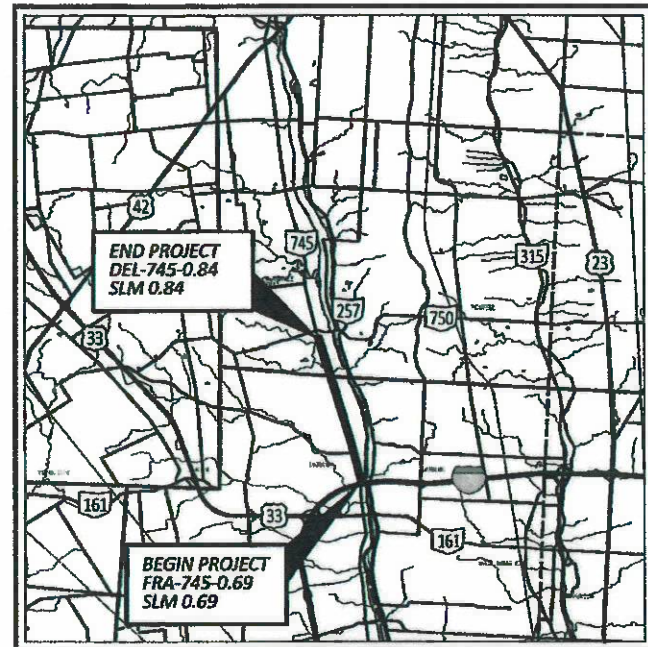

LOCATION MAP
LATITUDE: 40° 50' 51.53" LONGITUDE: 83° 07' 41.22"
SCALE IN MILES
0 1 2 4

PORTION TO BE IMPROVED	_____
INTERSTATE HIGHWAY	_____
FEDERAL ROUTES	_____
STATE ROUTES	_____
COUNTY & TOWNSHIP ROADS	_____
OTHER ROADS	_____

DESIGN DESIGNATION

CURRENT ADT (2023)	16,340
DESIGN YEAR ADT (2035)	20,262
DESIGN HOURLY VOLUME (2035)	845
DIRECTIONAL DISTRIBUTION	50%
TRUCKS (24 HOUR B&C)	2% (318)
DESIGN SPEED	45
LEGAL SPEED	45
DESIGN FUNCTIONAL CLASSIFICATION:	
URBAN MINOR ARTERIAL	
NHS PROJECT	NO

DESIGN EXCEPTIONS

NONE

ADA DESIGN WAIVERS

NONE

UNDERGROUND UTILITIES
Contact Two Working Days Before You Dig

OHIO811, 8-1-1, or 1-800-382-2764 (Non members must be called directly)

PLAN PREPARED BY:
COMPASS INFRASTRUCTURE GROUP
2800 CORPORATE EXCHANGE DRIVE, SUITE 100
COLUMBUS, OH 43231

ENGINEER'S SEAL:

SIGNED: *James A. Hamilton*
DATE: 12/05/2022

INDEX OF SHEETS:

TITLE SHEET	1
SCHEMATIC	2
TYPICAL SECTIONS	3
TYPICAL DETAILS	4
PAVEMENT DETAILS	5-7
GENERAL NOTES	8-9
MAINTENANCE OF TRAFFIC NOTES	10-12
GENERAL SUMMARY	13-14
ESTIMATED QUANTITIES	15-16
TRAFFIC CONTROL DETAILS	17-18
STRUCTURE NOTES	19

STANDARD CONSTRUCTION DRAWINGS				SUPPLEMENTAL SPECIFICATIONS	SPECIAL PROVISIONS
BP-3.1	1/21/22	TC-65.10	1/17/14		
BP-5.1	7/15/22	TC-65.11	7/15/22		
BP-7.1	1/21/22	TC-71.10	7/15/22	800-2019 832 7/15/22 897 1/16/15	
RM-1.1	1/15/21	TC-74.10	1/21/22		
		TC-82.10	7/19/19		
MT-97.10	4/19/19				
MT-97.11	1/20/17				
MT-99.20	4/19/19				
MT-101.90	7/17/20				
MT-105.10	1/17/20				

DIRECTOR, DEPARTMENT OF TRANSPORTATION

Josh Madant

APPROVED *YCW*
DATE 2/9/23 DISTRICT DEPUTY DIRECTOR

APPROVED *Paul A. Hamilton*
DATE 2.9.2023 CITY OF DUBLIN, ENGINEER

TITLE SHEET

REVISION 1: 55832 ADDED (02/08/2023)

DESIGN AGENCY

DESIGNER
ATJ
REVIEWER
JAH 12-02-22
PROJECT ID
111618
SHEET TOTAL
1 19

FRA/DEL-745-0.69/0.00
MODEL: Sheet_Surf_PAPER/DATE: 2/6/2023 TIME: 3:28:28 PM USER: jhamilton
Z:\p\jhamilton\111618\00-Engineering\Roadway\Sheet\111618_01.dgn