

FRA-161-15.80 NOISE ABATEMENT

MODEL: GG001 PAPER SIZE: 34x22 (in.) DATE: 9/20/2024 TIME: 3:00:53 PM USER: watf1428
 p:\arcadis-us-pw\benley.com\arcadis-us-01\Documents\01 Active Projects\143720\400_CAD\400-Engineering\Roadway\Sheets\117607_GG001.dgn

SHEET NUM.						PART.			ITEM	ITEM	GRAND	UNIT	DESCRIPTION	SEE SHEET NO.
P.9	P.10	P.26	P.27	P.28	P.222				EXT	TOTAL				
							01/NHS/20						ROADWAY	
LS							LS	201	11001	LS			CLEARING AND GRUBBING, AS PER PLAN	P.9
		3					3	202	22900	3	SY		APPROACH SLAB REMOVED	
		486					486	202	23000	486	SY		PAVEMENT REMOVED	
			1,262				1,262	202	38000	1,262	FT		GUARDRAIL REMOVED	
			1				1	202	42040	1	EACH		ANCHOR ASSEMBLY REMOVED, TYPE T	
			4,001				4,001	202	75000	4,001	FT		FENCE REMOVED	
			1,229	2,069			3,298	203	10000	3,298	CY		EXCAVATION	
				684			684	203	20000	684	CY		EMBANKMENT	
				67			67	203	98000	67	CY		ROADWAY, MISC.: TEMPORARY OVER-STEEPENED FILL	P.10
		362					362	606	15050	362	FT		GUARDRAIL, TYPE MGS	
		3					3	606	26150	3	EACH		ANCHOR ASSEMBLY, MGS TYPE E (MASH 2016)	
		4					4	606	35002	4	EACH		MGS BRIDGE TERMINAL ASSEMBLY, TYPE 1	
							1	606	35102	1	EACH		MGS BRIDGE TERMINAL ASSEMBLY, TYPE 2	
							1	606	60022	1	EACH		IMPACT ATTENUATOR, TYPE 2 (UNIDIRECTIONAL)	
			201				201	607	35000	201	FT		FENCE REMOVED AND REBUILT	
			80				80	607	98000	80	FT		FENCE, MISC.: WHITE SPLIT RAIL FENCE	P.10
							4,202	607	98000	4,202	FT		FENCE, MISC.: TEMPORARY FENCE	P.9
		3,743					3,743	622	90000	3,743	FT		BARRIER, MISC.: 81" SINGLE SLOPE BARRIER	P.224
		29					29	622	90200	29	EACH		BARRIER, MISC.: 81" SINGLE SLOPE BARRIER END ANCHORAGE, REINFORCED	P.224
		6					6	622	90200	6	EACH		BARRIER, MISC.: BARRIER DRAINAGE WINDOW SECTION	P.230
		6					6	622	90200	6	EACH		BARRIER, MISC.: 81" CONCRETE BARRIER END SECTION	P.223
							LS	878	25000	LS			INSPECTION AND COMPACTION TESTING OF UNBOUND MATERIALS	
													EROSION CONTROL	
1							1	659	00100	1	EACH		SOIL ANALYSIS TEST	
887			1,012				1,899	659	00300	1,899	CY		TOPSOIL	
			955				955	659	00590	955	SY		SEEDING AND MULCHING, CLASS 6	
7,985							7,985	659	10000	7,985	SY		SEEDING AND MULCHING	
400							400	659	14000	400	SY		REPAIR SEEDING AND MULCHING	
400							400	659	15000	400	SY		INTER-SEEDING	
1.08							1.08	659	20000	1.08	TON		COMMERCIAL FERTILIZER	
1.65							1.65	659	31000	1.65	ACRE		LIME	
45							45	659	35000	45	MGAL		WATER	
			9,090				9,090	670	00500	9,090	SY		SLOPE EROSION PROTECTION	
							LS	832	15000	LS			STORM WATER POLLUTION PREVENTION PLAN	
							LS	832	15002	LS			STORM WATER POLLUTION PREVENTION INSPECTIONS	
							LS	832	15010	LS			STORM WATER POLLUTION PREVENTION INSPECTION SOFTWARE	
							142,257	832	30000	142,257	EACH		EROSION CONTROL	
													DRAINAGE	
	10		237				247	601	21050	247	SY		TIED CONCRETE BLOCK MAT WITH TYPE 1 UNDERLAYMENT	
							2,43	602	20000	2,43	CY		CONCRETE MASONRY	
	50		9,333				9,383	605	13300	9,383	FT		6" UNCLASSIFIED PIPE UNDERDRAINS	
	50						50	605	31100	50	FT		AGGREGATE DRAINS	
	25		532				557	611	00510	557	FT		6" CONDUIT, TYPE F FOR UNDERDRAIN OUTLETS	
							339	611	06100	339	FT		15" CONDUIT, TYPE C	
							83	611	06700	83	FT		15" CONDUIT, TYPE F	
							11	611	99500	11	EACH		INLET, MISC.: INLET NO. 3 FOR 81" SINGLE SLOPE BARRIER	P.226
	5		26				31	611	99710	31	EACH		PRECAST REINFORCED CONCRETE OUTLET	
													PAVEMENT	
		4,822					4,822	254	01000	4,822	SY		PAVEMENT PLANING, ASPHALT CONCRETE, 3"	
		4,401					4,401	255	20000	4,401	FT		FULL DEPTH PAVEMENT SAWING	
		998					998	304	20000	998	CY		AGGREGATE BASE	
		219					219	407	10000	219	GAL		TACK COAT	
		760					760	407	20000	760	GAL		NON-TRACKING TACK COAT	
							189	442	22101	189	CY		ASPHALT CONCRETE SURFACE COURSE, 12.5 MM, TYPE A (449) AS PER PLAN, PG70-22M	P.10
							189	442	22300	189	CY		ASPHALT CONCRETE INTERMEDIATE COURSE, 12.5 MM, TYPE A (449)	
							430	452	12010	430	SY		8" NON-REINFORCED CONCRETE PAVEMENT, CLASS QC 1P	
							1,915	452	13010	1,915	SY		9" NON-REINFORCED CONCRETE PAVEMENT, CLASS QC 1P	
							108	609	24000	108	FT		CURB, TYPE 4-A	
							4,401	872	10000	4,401	FT		VOID REDUCING ASPHALT MEMBRANE (VRAM)	
													NOISE BARRIERS	
							4	519	11101	4	SF		PATCHING CONCRETE STRUCTURE, AS PER PLAN	P.222
							115,010	SPECIAL	60610210	115,010	SF		NOISE BARRIER (REFLECTIVE)	P.9

- 8-12-2024 - ADDED TEMPORARY FENCE ITEM
- 9-05-2024 - UPDATED QUANTITY OF 15" TYPE C PIPE, CONCRETE MASONRY, 8" CONCRETE PAVEMENT, AND 9" CONCRETE PAVEMENT. UPDATED ASPHALT DENSITY ACCEPTANCE
- 9-09-2024 - REVISED IMPACT ATTENUATOR TO TYPE 2
- 9-11-2024 - ADDED APPROACH SLAB REMOVED, PAVEMENT REMOVED & SAWCUTTING, REVISED EXCAVATION, CONCRETE BASE

GENERAL SUMMARY

DESIGN AGENCY
ARCADIS
 8101 NORTH HIGH ST SUITE 100
 COLUMBUS, OHIO 43235
 (614) 884-6000
 www.arcadis.com

DESIGNER
JMK
 REVIEWER
JDH 05-22-24
 PROJECT ID
117607
 SHEET TOTAL
P.24 P.297

FRA-161-15.80 NOISE ABATEMENT

MODEL: GS001 PAPER: 34x22 (in.) DATE: 9/20/2024 TIME: 10:16:56 AM USER: watf4128
 p:\arcadis-us-pw\benley.com\arcadis-us-01\Documents\143720400_CAD\400-Engineering\Roadway\Sheets\117607_GS001.dgn

SHEET NO.	REF. NO.	STATION		SIDE	606	606	606	606	606	622	622	622	622	602	611	611	611	202	202	254	255	304	407	407	442	442	452	452	609	872	606	
		FROM	TO		FT	EACH	EACH	EACH	EACH	EACH	FT	EACH	EACH	EACH	EACH	CY	FT	FT	EACH	SY	SY	SY	FT	CY	GAL	GAL	CY	CY	SY	SY	FT	FT
WALL 3 / BARRIER 3																																
P.33 - P.34	NW-3	300+00.00	305+76.00	LT																												8064
P.34 - P.35	B-3	3000+00.00	3006+99.96	LT	100	1	1	1		532	5	1	1	0.27	15		1	78			700	120	22	156	32	32	299	1	3	27	700	
WALL 6 / BARRIER 6																																
P.36 - P.37	B-6	5999+90.38	6008+25.00	LT	50	1	1			574	5			2	0.81	160	1	4	90	3	1326	835	145	26	189	39	39		331	27	835	
P.37 - P.38	NW-6	600+00.00	605+28.00	LT																											7392	
WALL 8 / BARRIER 8																																
P.39 - P.40	B-8	8000+00.00	8007+00.00	RT	187			1		512	5	1	1	0.54	60		2	78			1117	700	120	61	68	30	30		288	27	700	
P.40 - P.43	NW-8	800+00.00	818+08.00	RT																											25312	
WALL 9																																
P.44 - P.46	NW-9	900+16.00	912+70.00	LT																											17556	
BARRIER 10																																
P.47 - P.50	B-10	1000+00.00	1012+70.07	LT						1	1312	11	3	1	0.54	104	15	3	141		1962	1270	227	41	270	57	57		610	1270		
		1012+70.07	1014+15.44	LT																		16		5	7	2	2		83	145		
		1014+15.44	1016+49.64	LT																									48			
WALL 11																																
P.51 - P.54	NW-11	1100+00.00	1115+60.00	RT																											21840	
WALL 12 / BARRIER 12																																
P.55 - P.56	B-12	1200+00.00	1202+97.05	RT	25	1	1			633	3			1	0.27		38	1	33			297	129	25	38	14	14		441	27	297	
		1202+97.05	1205+23.39	RT																			25		32	21	12	12		144	226	
		1205+23.39	1207+51.00	RT																			25		7	11	3	3		101	228	
P.56 - P.57	NW-12	120+00.00	124+97.00	RT																											6958	
WALL 15																																
P.58 - P.62	NW-15	1500+00.00	1502+40.00	RT																											3360	
		1504+27.00	1518+43.00	RT																											19824	
		1518+90.00	1522+26.00	RT																												4704
TOTALS					362	3	4	1	1	3,563	29	5	6	2.43	339	83	11	486	3	4,822	4,401	998	219	760	189	189	430	1,915	108	4,401	115,010	

SHEET NO.	REF. NO.	STATION		SIDE	630	630	630	630	630	630	630	630	630	630	807	
		FROM	TO		FT	FT	EACH	EACH	EACH	EACH	EACH	EACH	EACH	EACH	EACH	MILE
P.36	LL-1	2126+70	2150+50	LT												0.45
P.37	S-1	2188+00		LT	3.7									1		
P.37	S-2	6008+00		LT		20.0	19.9						1	2		
P.47	S-3	2232+50		LT	3									1		
P.56	S-4	1207+00		RT										1		
TOTALS					6.7	39.9	1	2	1	2	1	3	1	2	2	0.45

- 1 9-05-2024 - UPDATED QUANTITY OF 15" TYPE C PIPE, CONCRETE MASONRY, 8" CONCRETE PAVEMENT, AND 9" CONCRETE PAVEMENT. UPDATED ASPHALT DENSITY ACCEPTANCE
- 2 9-09-2024 - UPDATED IMPACT ATTENUATOR TO TYPE 2
- 3 9-11-2024 - ADDED SAWCUTTING, PAVEMENT REMOVED AND APPROACH SLAB REMOVED, UPDATED CONCRETE BASE

SHEET NO.	REF. NO.	STATION		SIDE	614	614	614	614	614	622		
		FROM	TO		MILE	FT	EACH	EACH	EACH	FT		
WALL 3 / BARRIER 3												
P.15	PB-1	2135+33	2143+97	LT					1	18	18	870
P.15	WE-1	2126+70	2150+50	LT	0.45							
P.15	WD-1	2142+70	2150+50	LT						780		
WALL 6 / BARRIER 6												
P.16	PB-2	2187+50	2198+46	LT					1	22	22	3300
WALL 8 / BARRIER 8												
P.16	PB-3	2191+84	2200+50	RT					1	18	18	2610
BARRIER 10												
P.17	PB-4	2229+85	2247+50	LT					1	38	38	4670
P.17	WE-2	2236+68	2246+05	LT	0.18							
WALL 12 / BARRIER 12												
P.17	PB-5	2230+34	2241+78	RT					1	23	23	2250
TOTALS					0.63	780	5	119	119	13,700		

SUBSUMMARY

FRA-161-15.80 NOISE ABATEMENT

MODEL: GS002 PAPER SIZE: 34x22 (in.) DATE: 9/20/2024 TIME: 10:17:28 AM USER: watl4128
 p:\arcadis-us-pw\entlery.com\arcadis-us-01\Documents\01 Active Projects\143720\400_CAD\400-Engineering\Roadway\Sheets\117607_GS003.dgn

SHEET NO.	203	203	203
	EXCAVATION	EMBANKMENT	ROADWAY, MISC.: TEMPORARY OVER- STEEPENED FILL
	CY	CY	CY
WALL 3 / 81" SSB 3			
P.63			
P.64			
P.65			
P.66			
P.67			
P.68			
P.69			
P.70	20	6	
P.71	16	14	
P.72	29	14	
P.73	22	8	
P.74	14	13	
P.75	24	22	
SUBTOTAL	125	77	0
SHEET NO.	203	203	203
EXCAVATION	EMBANKMENT	ROADWAY, MISC.: TEMPORARY OVER- STEEPENED FILL	
	CY	CY	CY
WALL 6 / 81" SSB 6			
P.76	2		
P.77	44	4	
P.78	44	2	
P.79	44	2	
P.80	44	2	
P.81	44	1	
P.82	44	1	
P.83	44		
P.84	44	1	
P.85	11		
P.86			
P.87			
P.88			
P.89			
P.90			
P.91			
P.92			
P.93			
SUBTOTAL	365	13	0

SHEET NO.	203	203	203
	EXCAVATION	EMBANKMENT	ROADWAY, MISC.: TEMPORARY OVER- STEEPENED FILL
	CY	CY	CY
81" SSB 8 / WALL 8			
P.94			
P.95			
P.96			
P.97			
P.98			
P.99			
P.100			
P.101			
P.102			
P.103			
P.104			
P.105			
P.106			
P.107			
P.108			
P.109			
P.110			
P.111			
P.112			
P.113			
P.114			
P.115			
P.116			
P.117			
P.118			
P.119			
P.120			
P.121			
P.122			
P.123			
SUBTOTAL	200	20	0
SHEET NO.	203	203	203
EXCAVATION	EMBANKMENT	ROADWAY, MISC.: TEMPORARY OVER- STEEPENED FILL	
	CY	CY	CY
WALL 9			
P.124			
P.125			
P.126			
P.127			
P.128			
P.129			
P.130			
P.131			
P.132			
P.133			
P.134			
P.135			
P.136			
P.137			
P.138			
P.139			
SUBTOTAL	0	0	0

SHEET NO.	203	203	203
	EXCAVATION	EMBANKMENT	ROADWAY, MISC.: TEMPORARY OVER- STEEPENED FILL
	CY	CY	CY
81" SSB 10			
P.140			
P.141	44	2	
P.142	68	2	
P.143	72		
P.144	72		
P.145	46		
P.146	45	1	
P.147	42	2	
P.148	41	2	
P.149	40	2	
P.150	20	1	
P.151	39	4	
P.152	39	3	
P.153	48	2	
P.154	58	3	
P.155	71	4	
P.156	33	1	
SUBTOTAL	778	29	0
SHEET NO.	203	203	203
EXCAVATION	EMBANKMENT	ROADWAY, MISC.: TEMPORARY OVER- STEEPENED FILL	
	CY	CY	CY
WALL 11			
P.140			
P.141			
P.142			
P.143			
P.144			
P.145			
P.146			
P.147			
P.148			
P.149			
P.150			
P.151			
P.152			
P.153			
P.154			
P.155			
P.156			
SUBTOTAL	0	0	0

SHEET NO.	203	203	203
	EXCAVATION	EMBANKMENT	ROADWAY, MISC.: TEMPORARY OVER- STEEPENED FILL
	CY	CY	CY
81" SSB 12 / WALL 12			
P.174	72	11	
P.175	81	9	
P.176	62	4	
P.177	44	5	
P.178	88	74	14
P.179	180	200	27
P.180	160	180	22
P.181	74	62	4
P.182			
P.183			
P.184			
P.185			
P.186			
P.187			
P.188			
P.189			
SUBTOTAL	761	545	67
SHEET NO.	203	203	203
EXCAVATION	EMBANKMENT	ROADWAY, MISC.: TEMPORARY OVER- STEEPENED FILL	
	CY	CY	CY
WALL 15			
P.190			
P.191			
P.192			
P.193			
P.194			
P.195			
P.196			
P.197			
P.198			
P.199			
P.200			
P.201			
P.202			
P.203			
P.204			
P.205			
P.206			
P.207			
P.208			
P.209			
P.210			
P.211			
P.212			
P.213			
SUBTOTAL	0	0	0
TOTAL (CADD GENERATED VALUES)	2,229	684	67
CADD VALUE REDUCTION PER THE VOLUME OF ITEM 202 - PAVEMENT REMOVED	160	0	0
TOTAL CARRIED TO GENERAL SUMMARY	2,069	684	67

TOTAL (CADD GENERATED VALUES)
 2,229 684 67

CADD VALUE REDUCTION PER THE VOLUME OF ITEM 202 - PAVEMENT REMOVED
 160 0 0

TOTAL CARRIED TO GENERAL SUMMARY
 2,069 684 67

SUBSUMMARY

DESIGN AGENCY
ARCADIS
 8101 NORTH HIGH ST SUITE 100
 COLUMBUS, OHIO 43225
 (614) 885-6000
 www.arcadis.com

DESIGNER
JMK




REVIEWER
 JDH 05-22-24

PROJECT ID
117607

SHEET TOTAL
 P.28 | P.297

9-11-2024 - REVISED EXCAVATION QUANTITY
 BASED UPON REVISED PAVEMENT REMOVED QUANTITY


10D CURVE DATA
 CONST. 81" BARRIER 10
 P.I. = STA. 1014+82.35
 $\Delta = 15^\circ 41' 58''$ LT
 $D_c = 04^\circ 46' 29''$
 $R = 1,200.00'$
 $T = 165.44'$
 $L = 328.81'$
 $E = 11.35'$

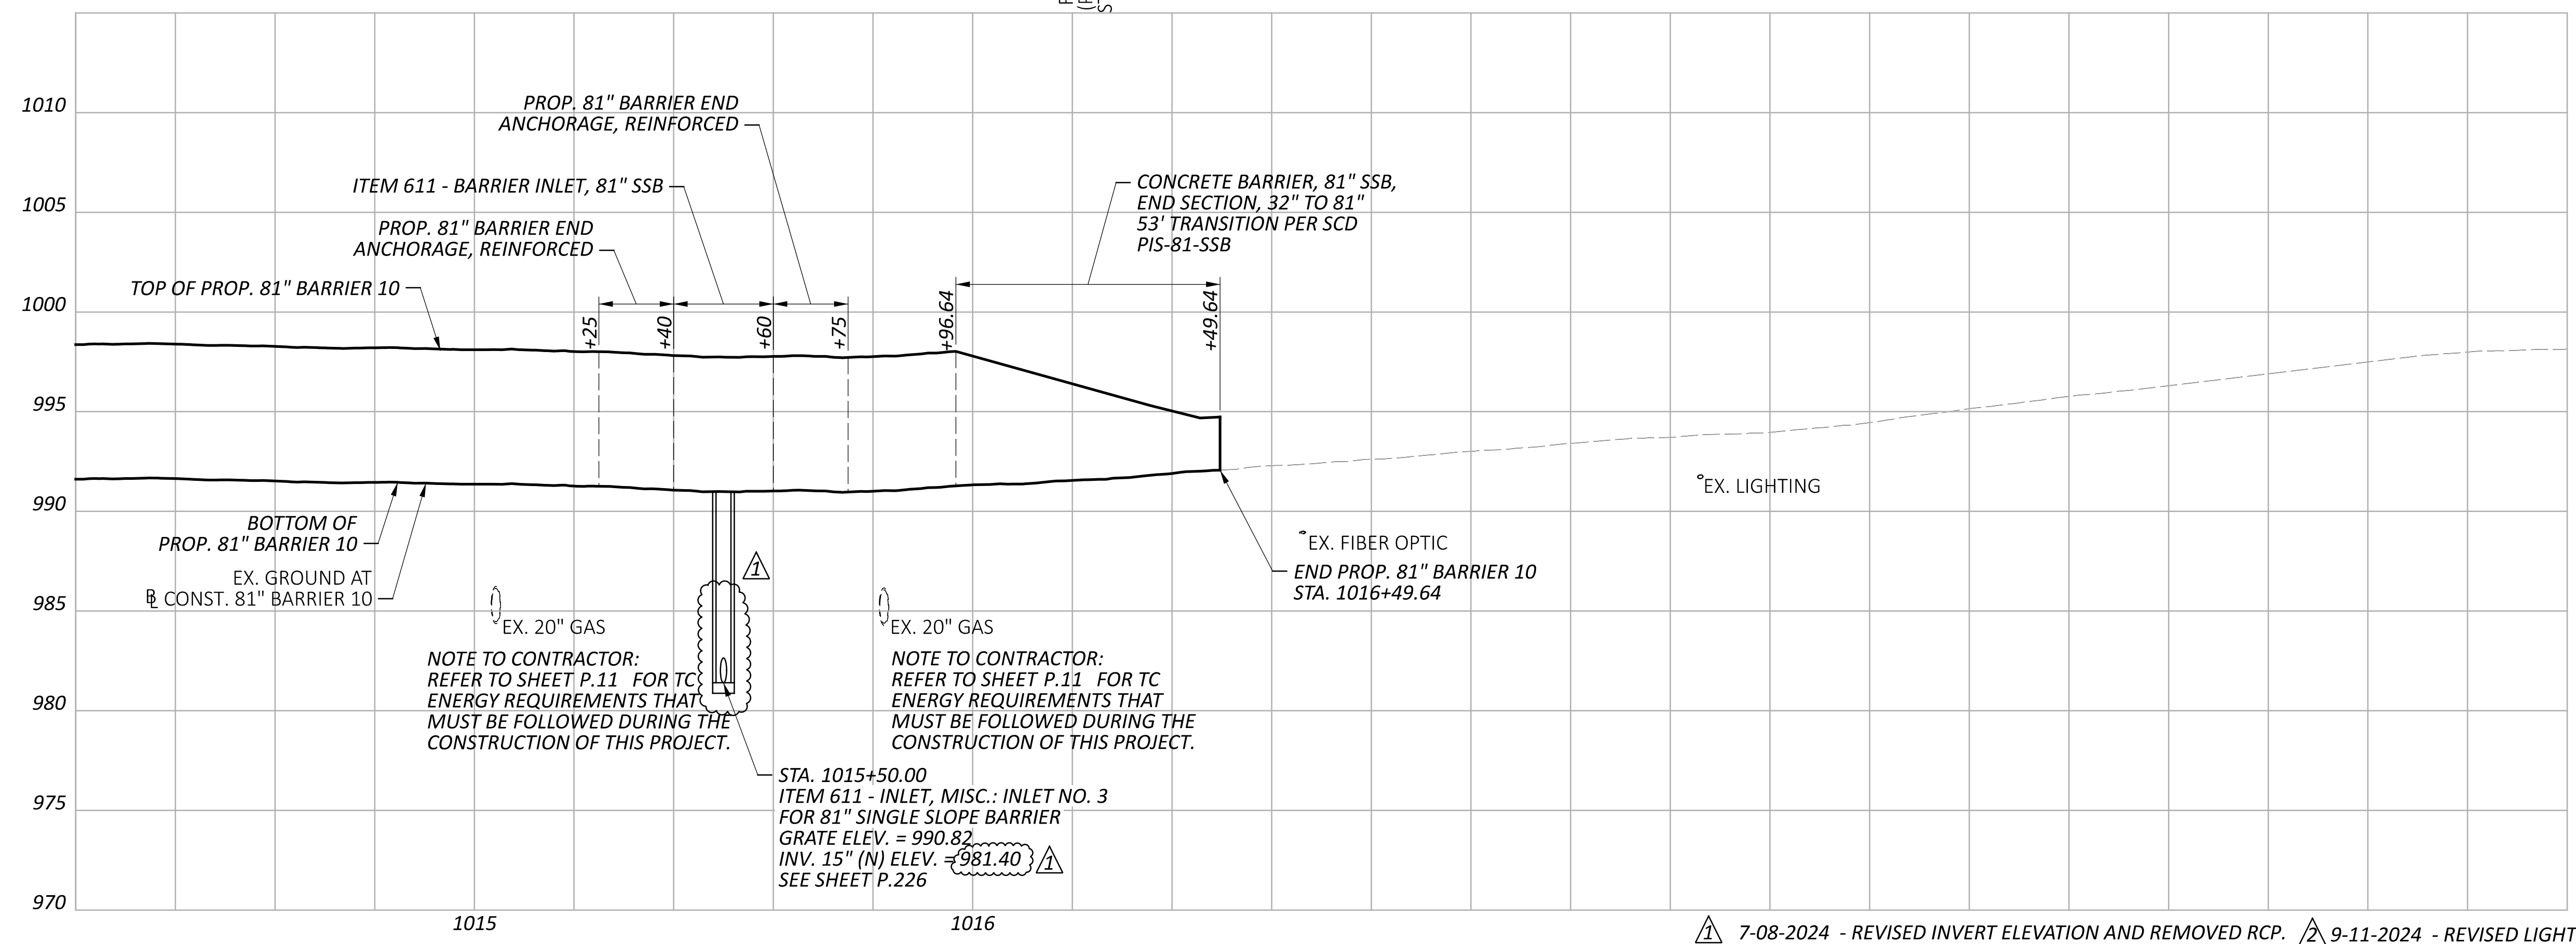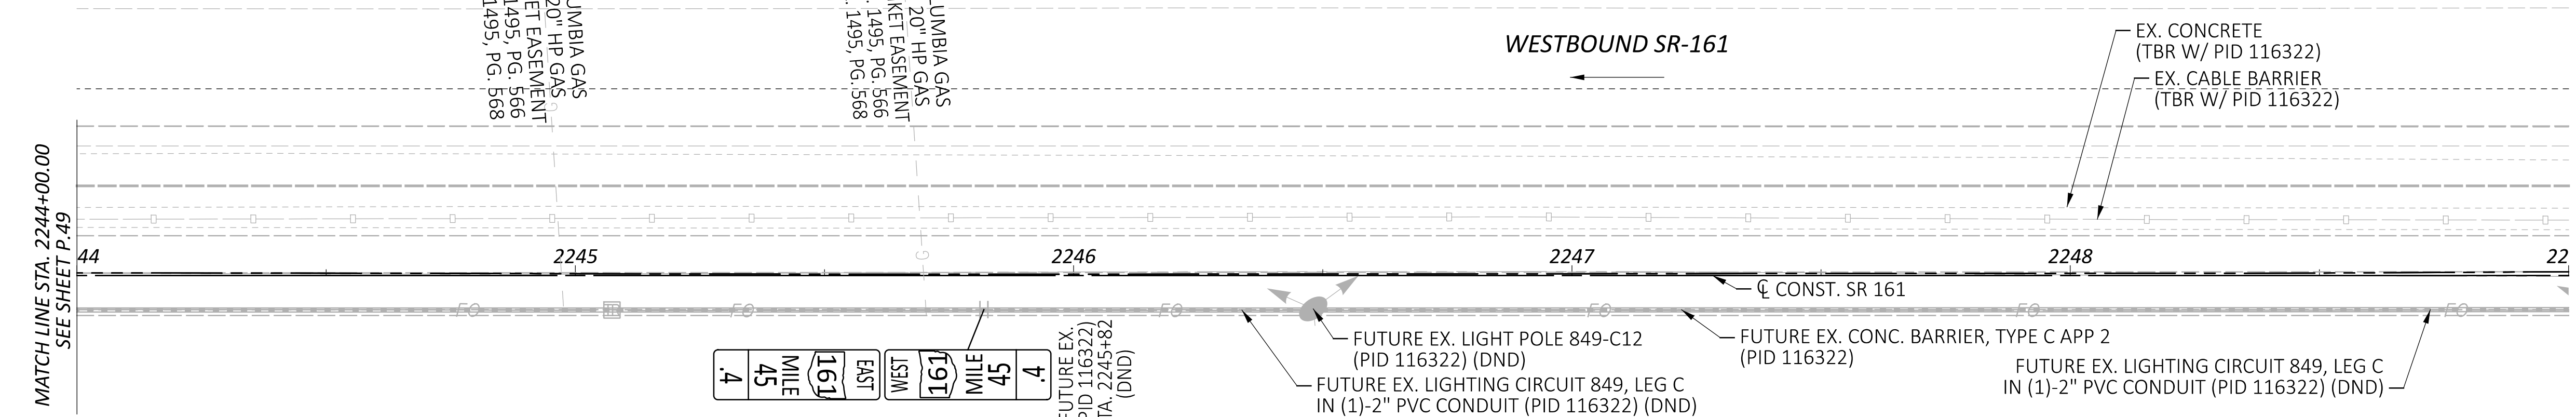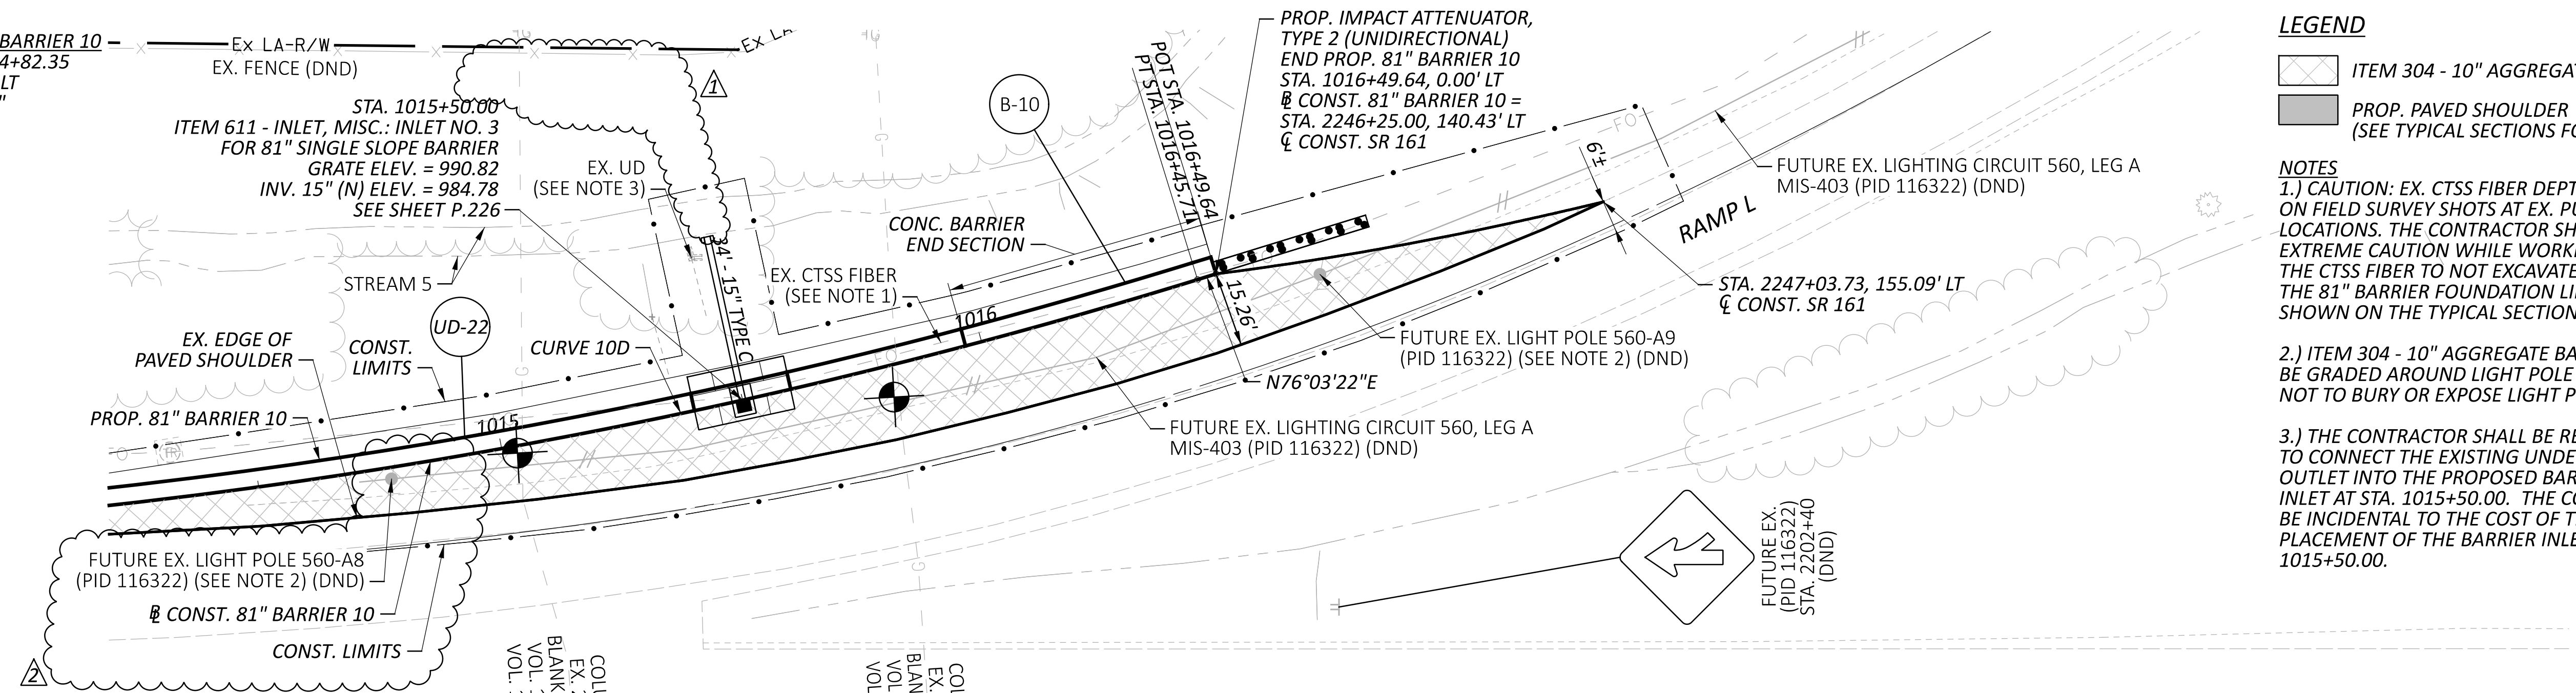

LEGEND

 ITEM 304 - 10" AGGREGATE BASE
 PROP. PAVED SHOULDER (SEE TYPICAL SECTIONS FOR PAVEMENT BUILDUP)



NOTES
 1.) CAUTION: EX. CTSS FIBER DEPTH BASED ON FIELD SURVEY SHOTS AT EX. PULL BOX LOCATIONS. THE CONTRACTOR SHALL USE EXTREME CAUTION WHILE WORKING NEAR THE CTSS FIBER TO NOT EXCAVATE BELOW THE 81" BARRIER FOUNDATION LIMITS SHOWN ON THE TYPICAL SECTIONS.
 2.) ITEM 304 - 10" AGGREGATE BASE SHALL BE GRADED AROUND LIGHT POLE SO AS NOT TO BURY OR EXPOSE LIGHT POLE BASE.
 3.) THE CONTRACTOR SHALL BE REQUIRED TO CONNECT THE EXISTING UNDERDRAIN OUTLET INTO THE PROPOSED BARRIER INLET AT STA. 1015+50.00. THE COST SHALL BE INCIDENTAL TO THE COST OF THE PLACEMENT OF THE BARRIER INLET AT STA. 1015+50.00.

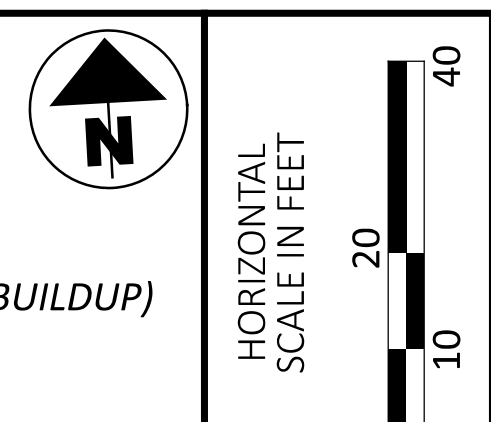

PLAN & PROFILE - 81" BARRIER 10
 STA. 2244+00.00 TO STA. 2249+00.00


DESIGN AGENCY	
ARCADIS	
8101 NORTH HIGGINS AVE. SUITE 100 COLUMBIA, MO 65203 616.441.4900 www.arcadis.com	
DESIGNER	
JMK	
REVIEWER	
JDH 05-22-24	
PROJECT ID	
117607	
SHEET	TOTAL
P.50	P.297

7-08-2024 - REVISED INVERT ELEVATION AND REMOVED RCP. 9-11-2024 - REVISED LIGHT POLE 560-A8 LOCATION

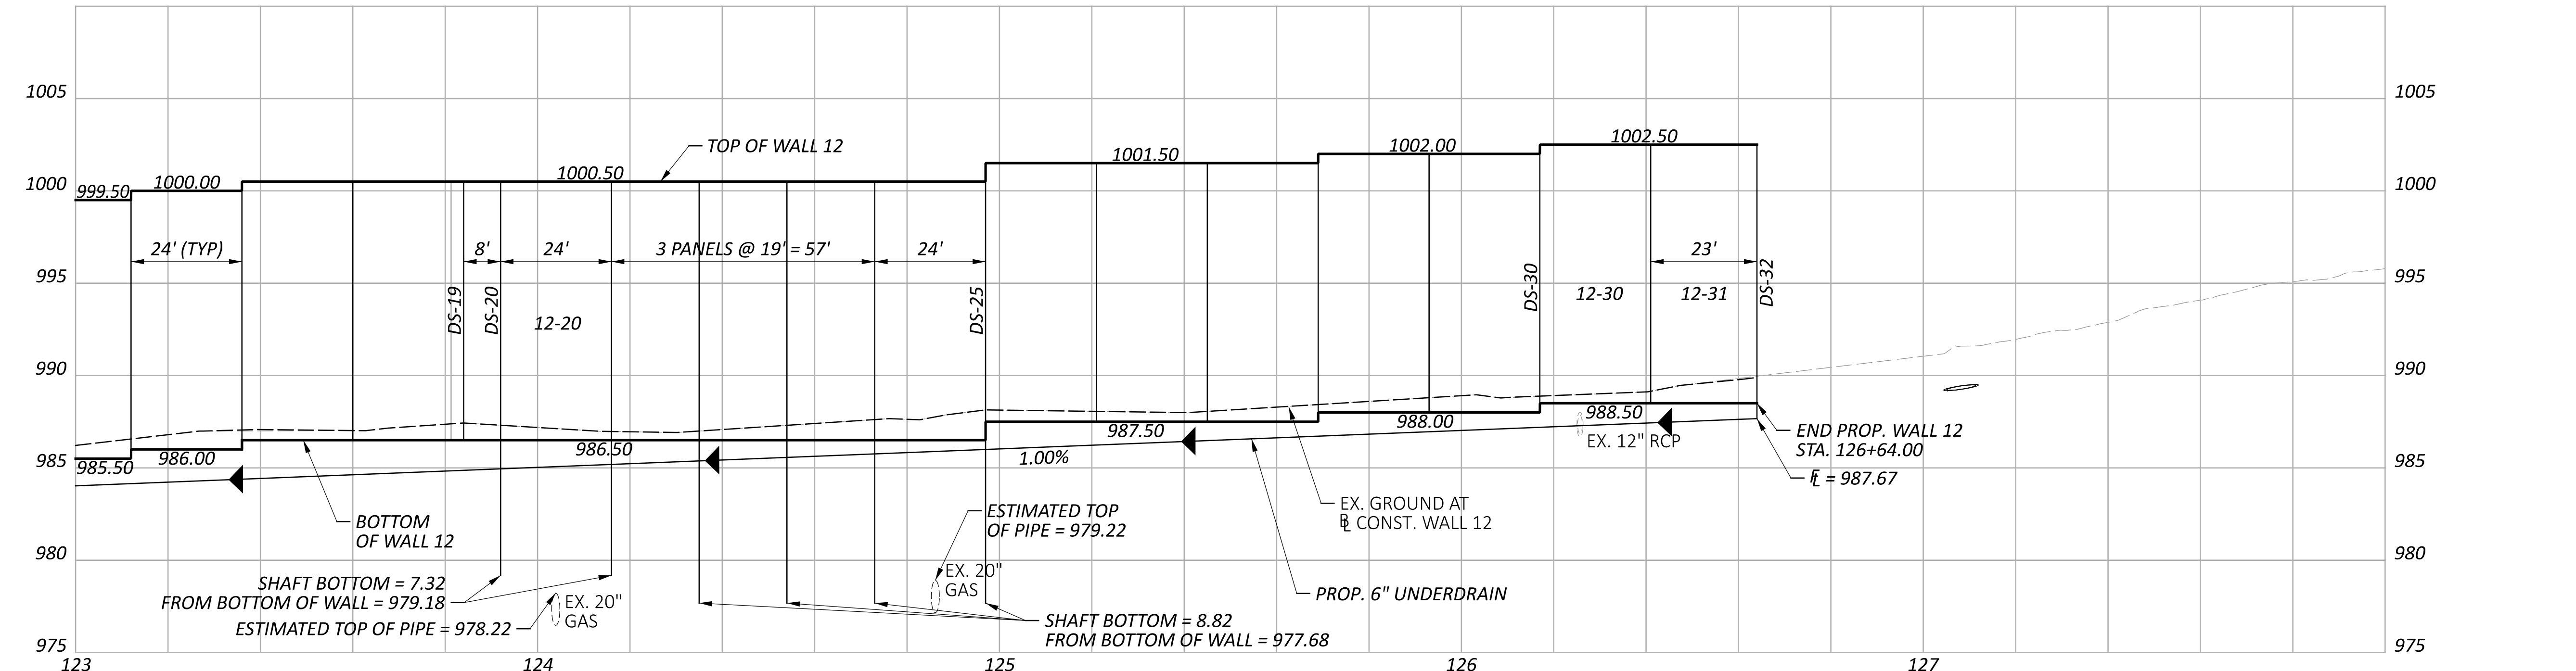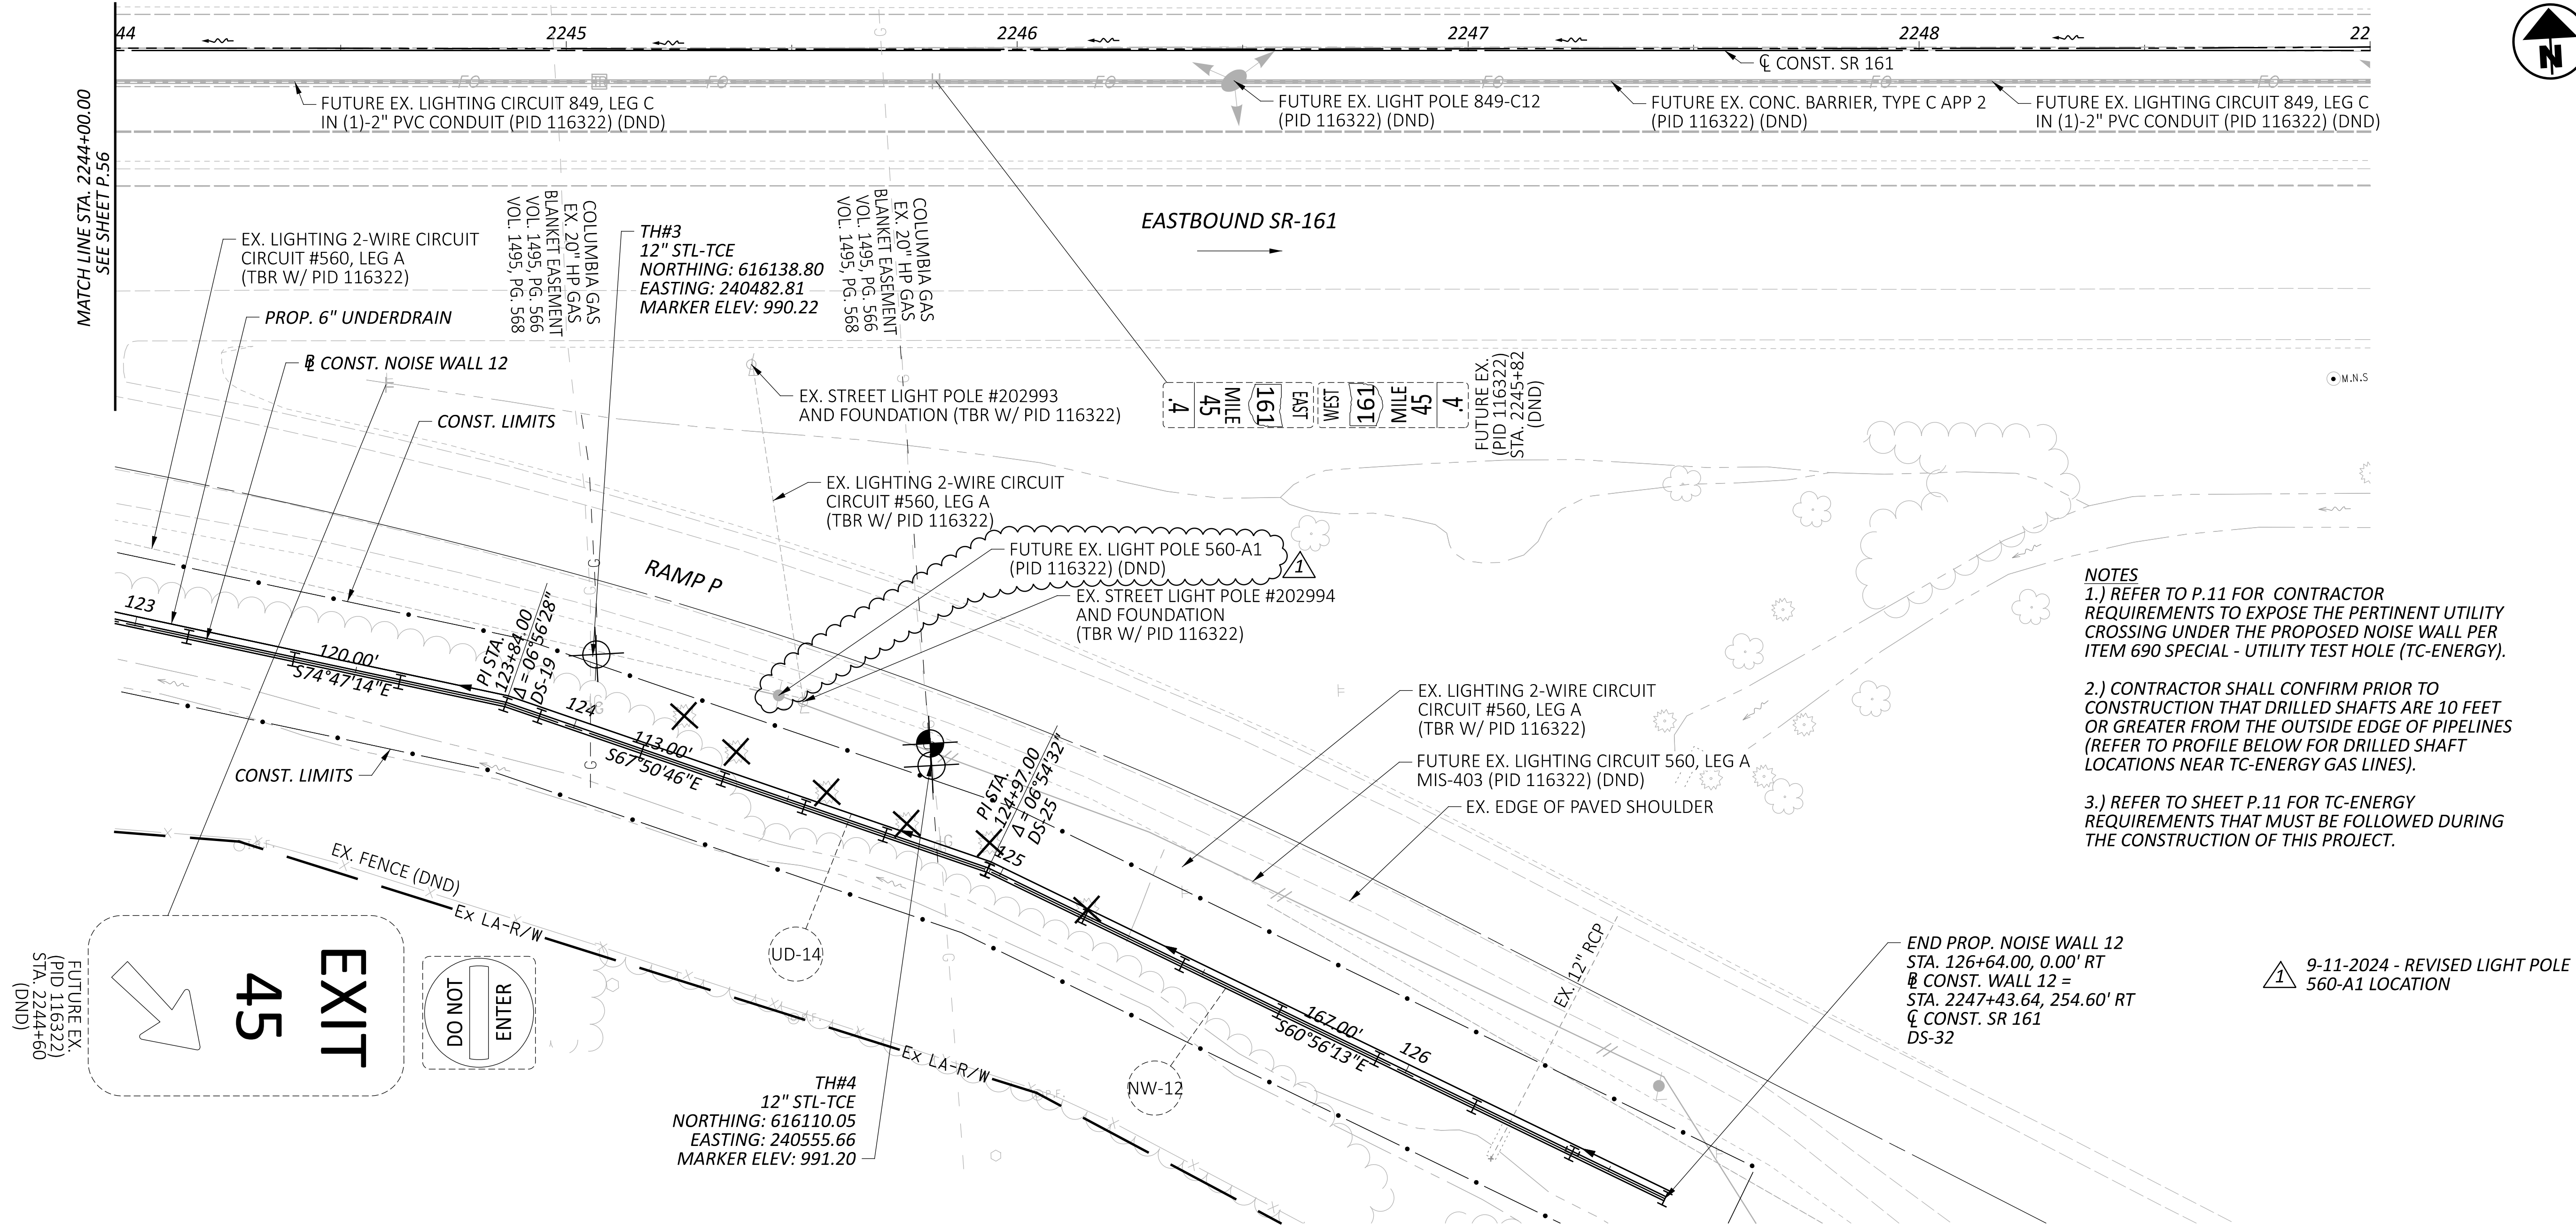


NOTES

- 1.) REFER TO P.11 FOR CONTRACTOR REQUIREMENTS TO EXPOSE THE PERTINENT UTILITY CROSSING UNDER THE PROPOSED NOISE WALL PER ITEM 690 SPECIAL - UTILITY TEST HOLE (TC-ENERGY).
- 2.) CONTRACTOR SHALL CONFIRM PRIOR TO CONSTRUCTION THAT DRILLED SHAFTS ARE 10 FEET OR GREATER FROM THE OUTSIDE EDGE OF PIPELINES (REFER TO PROFILE BELOW FOR DRILLED SHAFT LOCATIONS NEAR TC-ENERGY GAS LINES).
- 3.) REFER TO SHEET P.11 FOR TC-ENERGY REQUIREMENTS THAT MUST BE FOLLOWED DURING THE CONSTRUCTION OF THIS PROJECT.

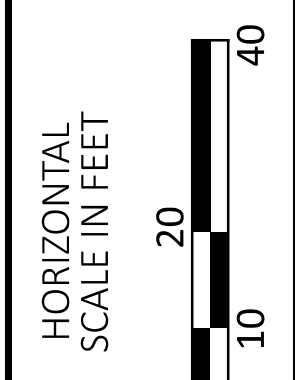


PLAN & PROFILE - WALL 12
STA. 2244+00.00 TO STA. 2249+00.00


DESIGN AGENCY	
ARCADIS	
8101 NORTH HIGGINS AVE. SUITE 100 COLUMBIA, MO 65203 616.448.8100-4900 www.arcadis.com	
DESIGNER	
JMK	
REVIEWER	
JDH 05-22-24	
PROJECT ID	
117607	
SHEET	TOTAL
P.57	P.297

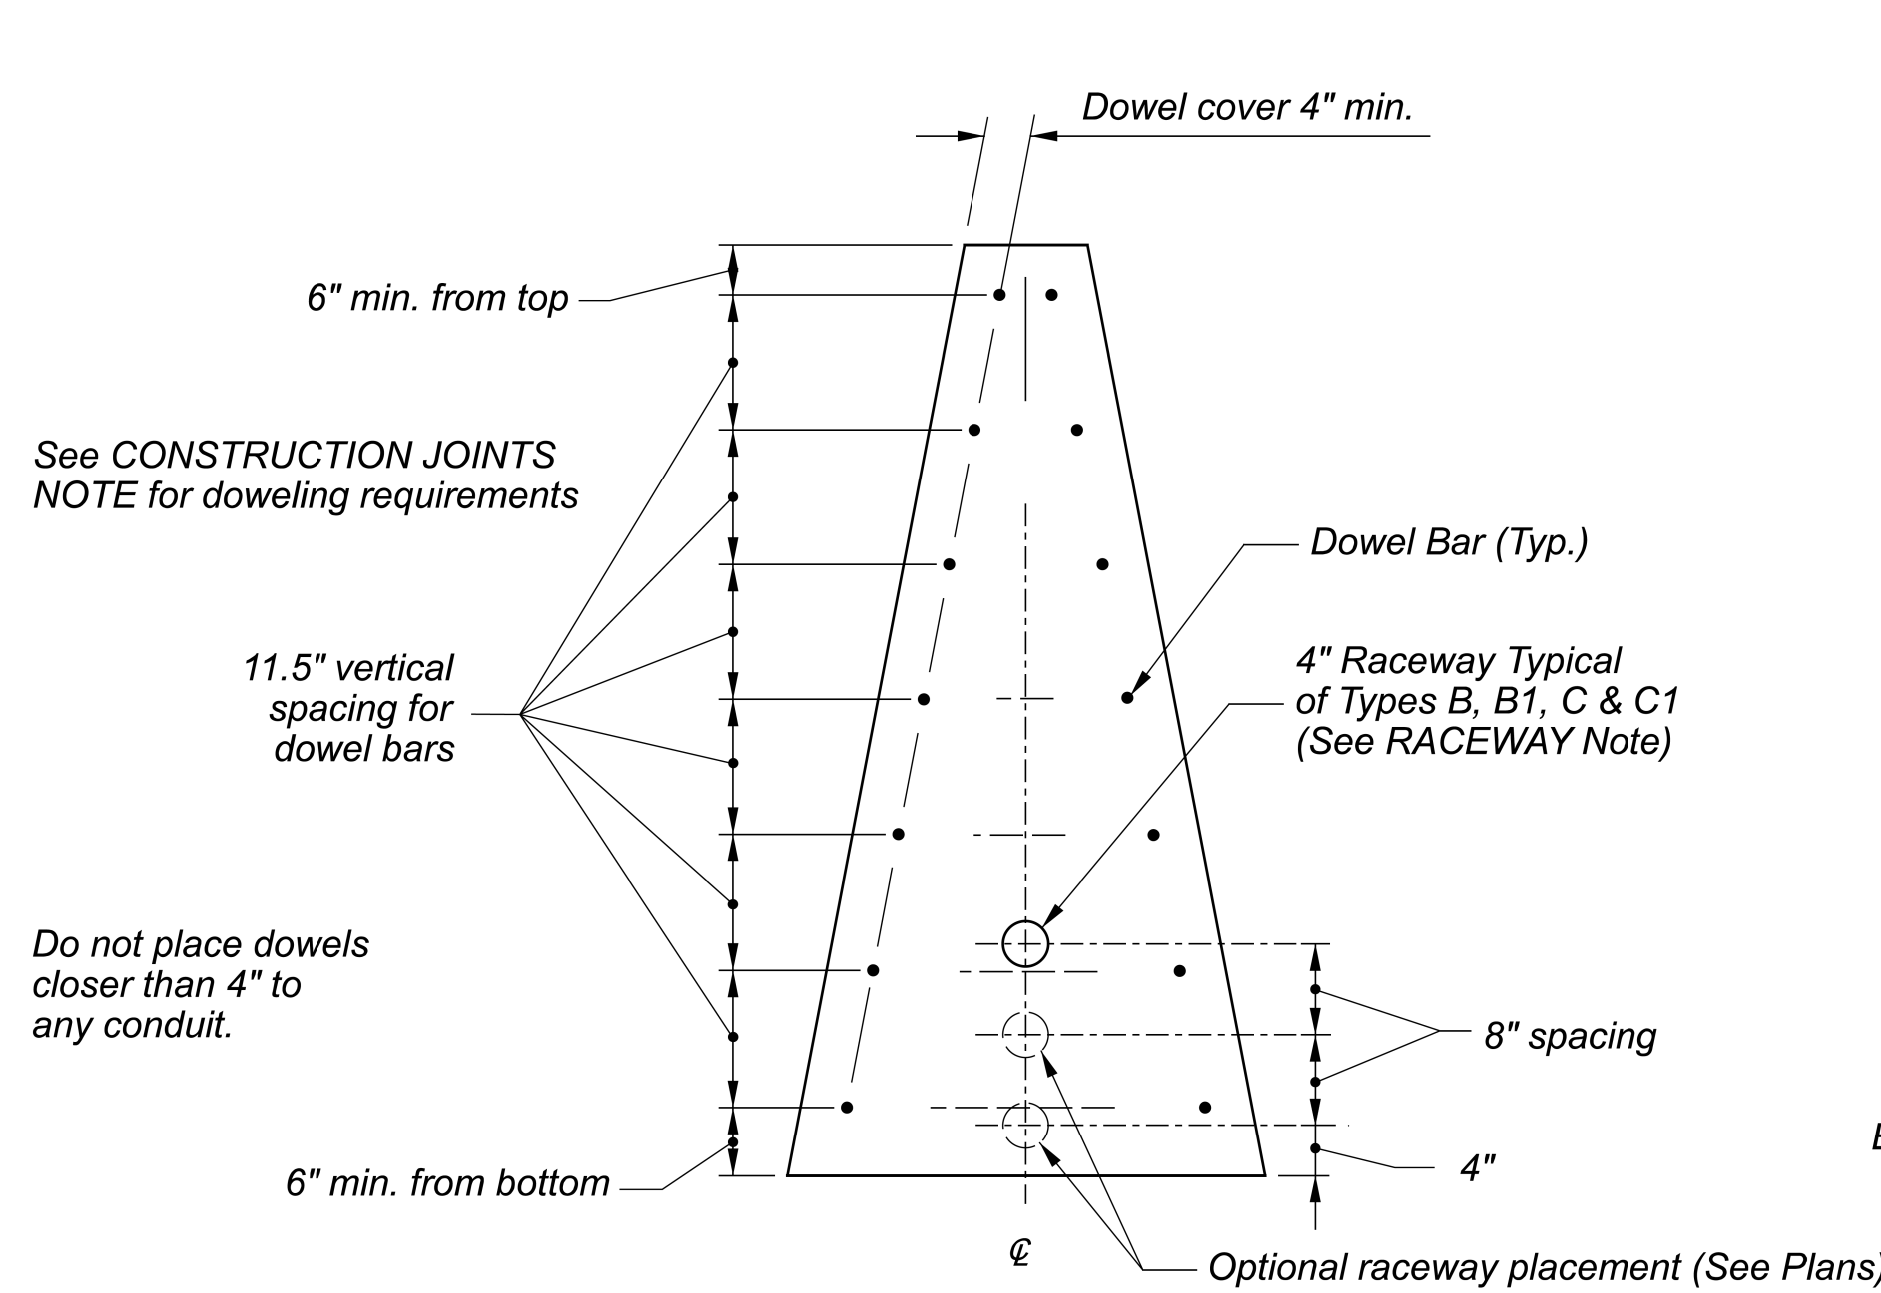


RACEWAY AND DOWEL BAR PLACEMENT

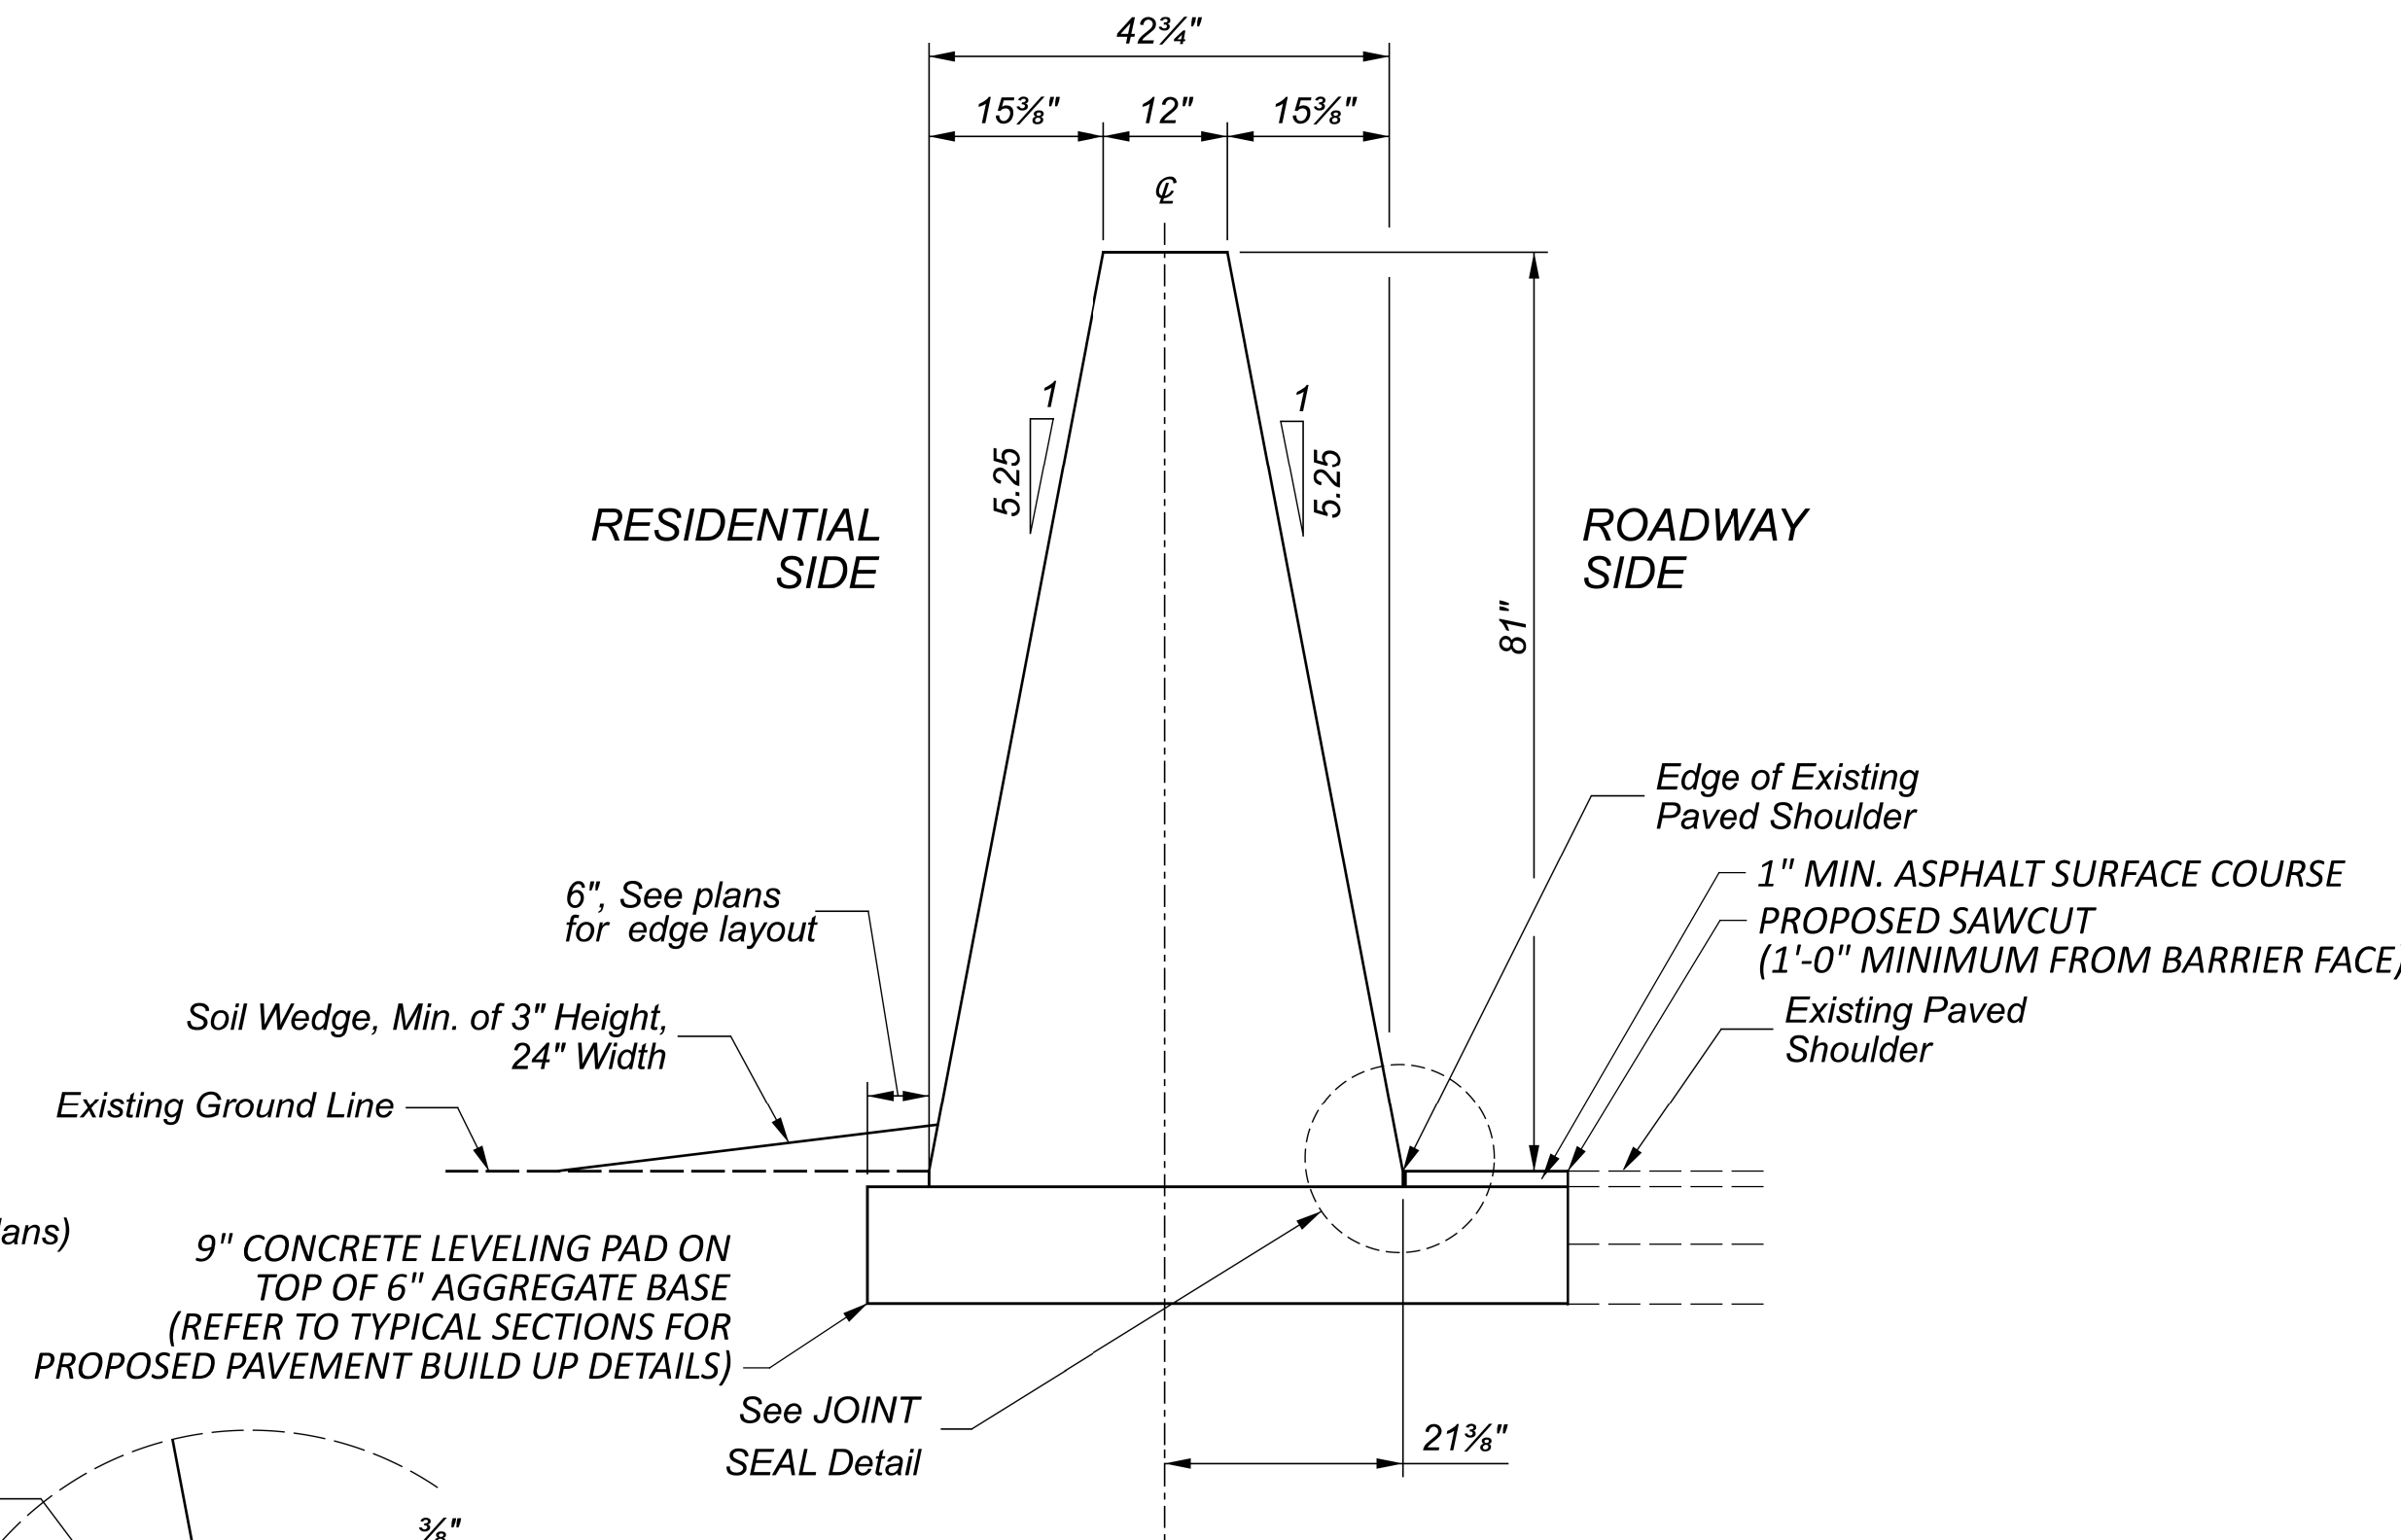


DETAIL FOR INSTALLATION ADJACENT TO ADJOINING PAVEMENT

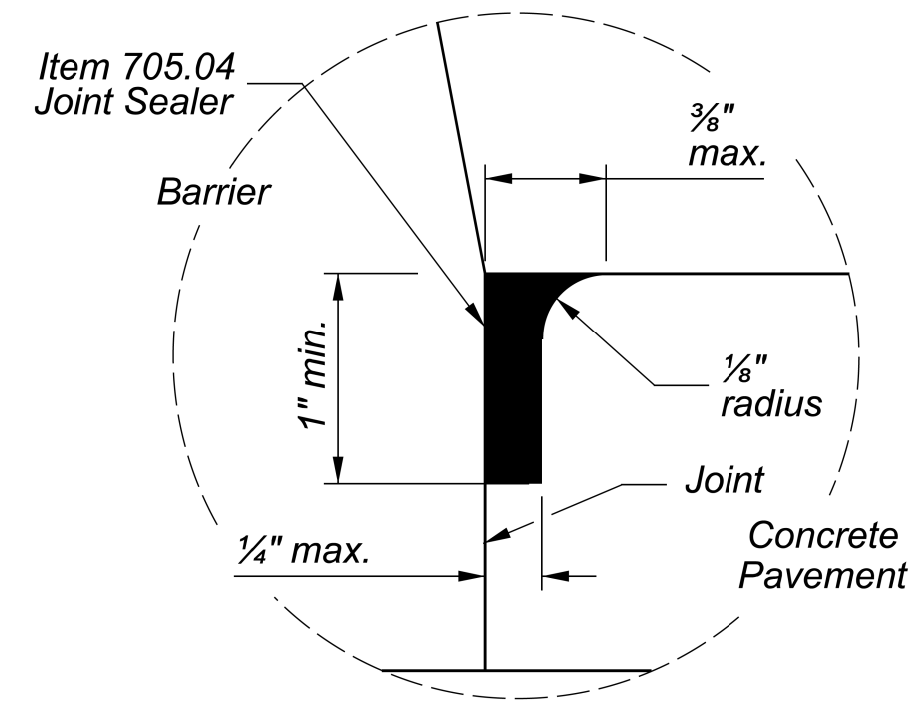


JOINT SEAL DETAIL (FOR USE WITH CONCRETE PAVEMENT)

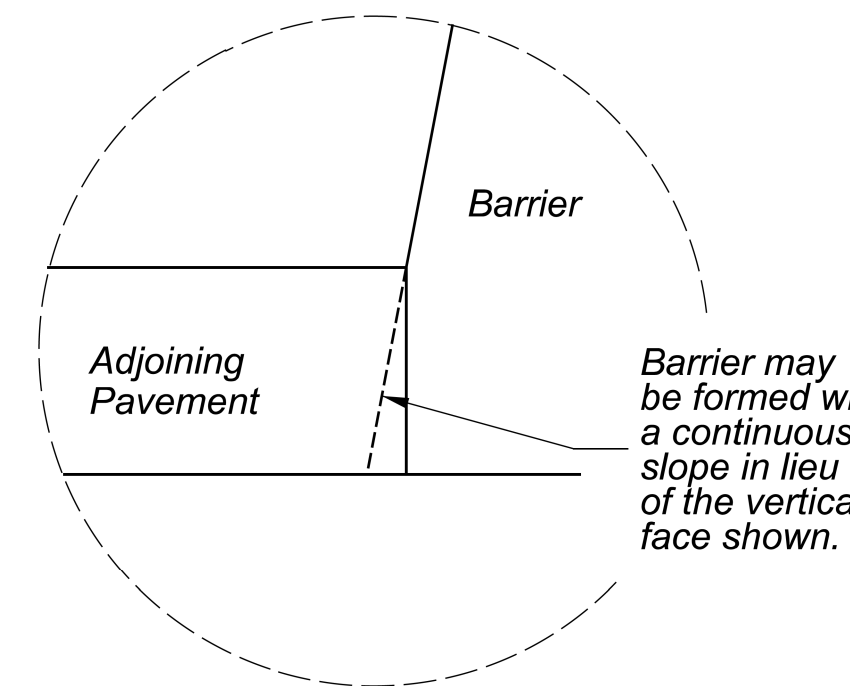

ALTERNATE TOE DETAIL

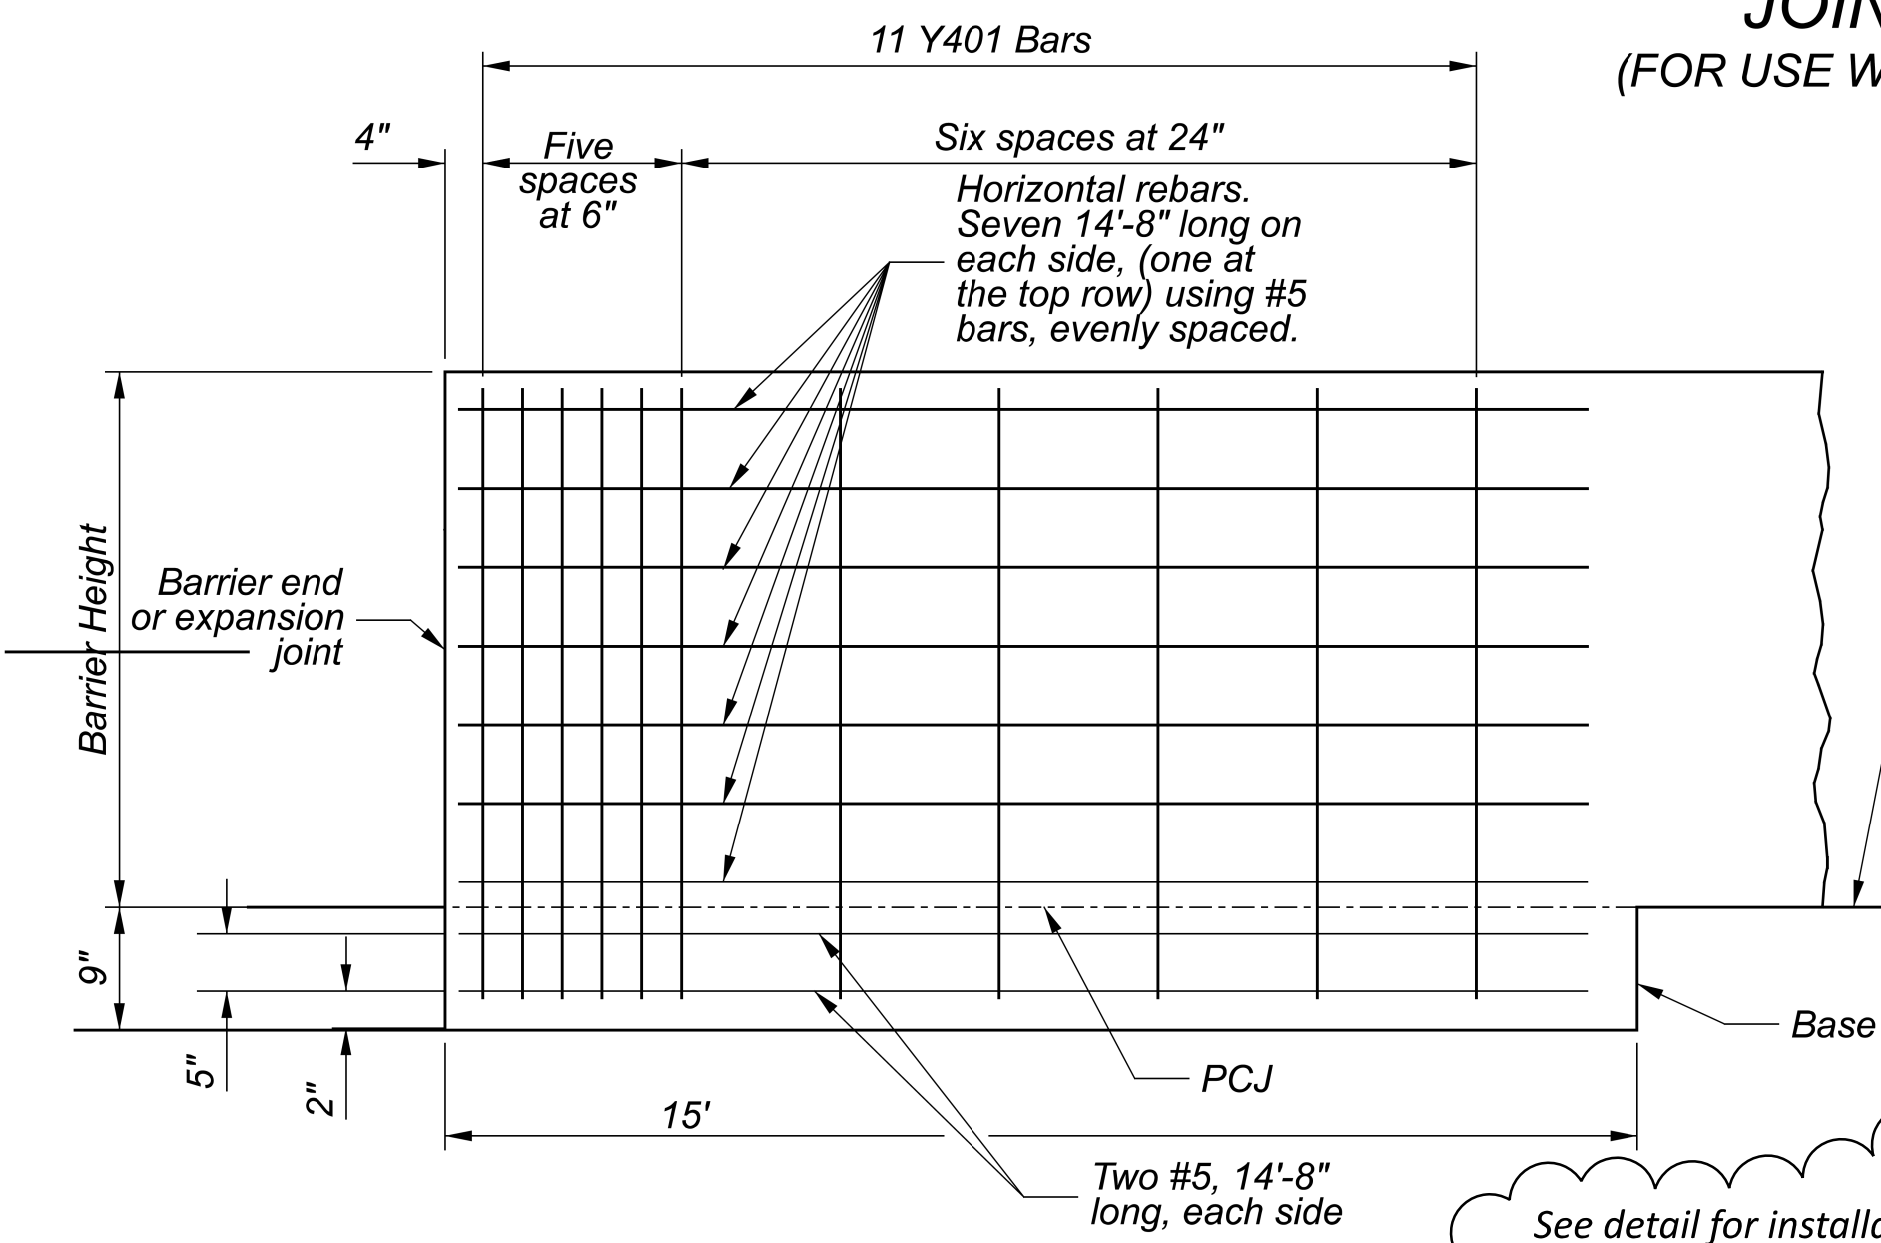

ELEVATION

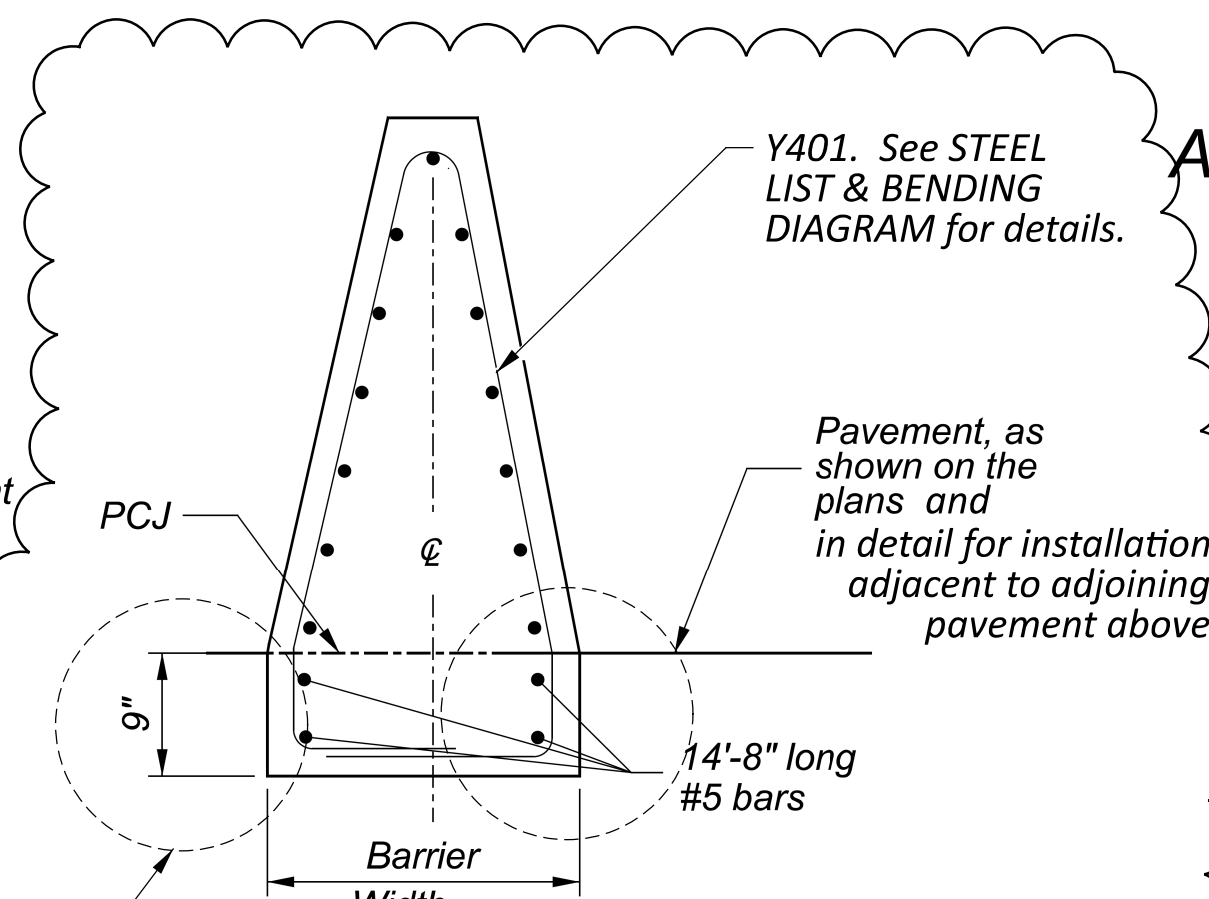

SECTION


END ANCHORAGE

Dimensions for Y401 (English)

x	y	z	Length
74"	37"	9"	18'-8"

Y401 STEEL LIST & BENDING DIAGRAM

REINFORCED END ANCHORAGES are required at the ends of concrete barrier runs and at interruptions in barrier caused by expansion joints. When barrier does not abut another barrier run, construct the last 15' using the END ANCHORAGE Detail as shown here. At expansion joints, construct an End Anchorage on both sides of joint, with a maximum gap of 2" for the open joint. The maximum expansion joint spacing shall be 800'. This anchorage is not needed at construction joints, provide dowel bar connections instead. See CONSTRUCTION JOINT NOTE for doweling details.

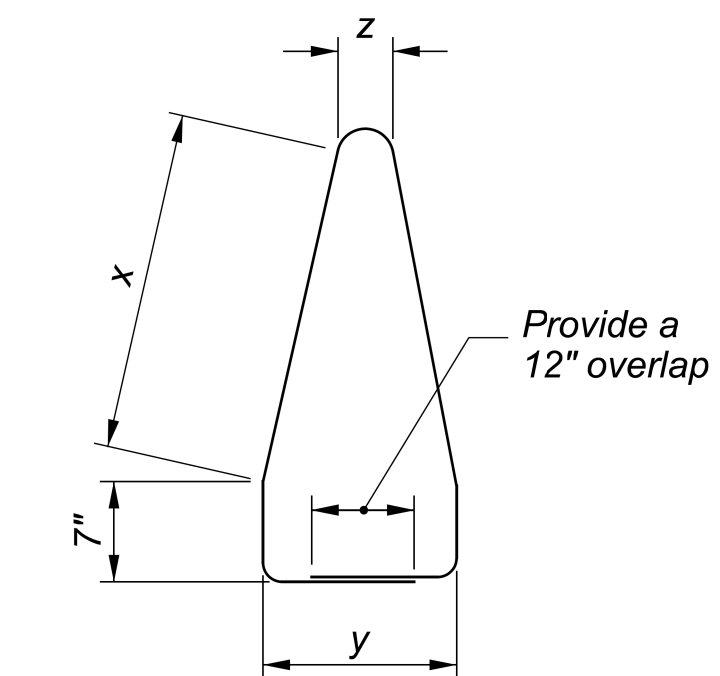

Y401 #4

NOTES

SINGLE SLOPE CONCRETE BARRIER may be cast-in-place or slip formed. See SCD RM-4.3 for Type B, B1, C, and C1 barrier. See SCD RM-4.5 for Type D barrier. See SCD RM-4.6 for End Sections.

MATERIALS: Construct using concrete with a minimum design strength of 4000 psi conforming to the requirements of CMS 499. Construct top and end edges with either a 1" radius or 3/4" chamfer, except at light pole foundations.

CONTRACTION JOINTS: Maximum allowable spacing of unsealed joints is 20' throughout the run of the barrier. Construct joints by using metal inserts inside the forms, preformed full width joint filler, a grooving tool, or by sawing. Inserts, tooled, or sawed joints will have a 3" depth. Construct all joints for the full height of the barrier. Saw as soon as curing will allow to prevent spalling. When used in conjunction with concrete pavement, match joints to those in the concrete pavement but not exceeding the maximum allowable spacing.

ADJOINING PAVEMENT: When the barrier is constructed in conjunction with new pavement (asphalt or concrete), the concrete leveling pad shall match the thickness of the proposed asphalt or concrete pavement. The leveling pad shall be placed on 6" of aggregate base. The barrier shall then be doweled in to the concrete leveling pad. Barrier constructed next to existing pavement shall have a 9" thick concrete leveling pad placed on 6" of aggregate base. The barrier shall then be doweled in to the concrete leveling pad. Compacted soil on the back side must be placed against the barrier at a minimum height of 3" and extend for a minimum of 2' prior to the breakpoint of the slope.

SEALING JOINTS: Use a butt longitudinal joint between the barrier and adjoining concrete pavement sealed with CMS 705.04 joint sealer. See detail on RM-4.3

TRANSITIONS: Make linear transitions between different types of barrier within a 20' length.

CONSTRUCTION JOINTS: Barrier runs with abutting vertical surfaces at either required or permissible construction joints are to be doweled to each other by use of 3/4" dia. by 18" long epoxy coated deformed dowel bars as per CMS 622.02. Bars are to be placed as shown on the RACEWAY and DOWEL BAR PLACEMENT detail on this sheet. Provide a 4" clearance to barrier surfaces and to any raceways.


STATION MARKINGS: Impress markings in the "green" concrete on both sides at the top of the barrier. The cost is incidental to the unit cost bid for this barrier.

RACEWAY: Raceway not to be included on this project.

PAYMENT: will be made at the unit price bid per Foot for ITEM 622 - BARRIER, MISC.: 81" SSB. Include all reinforcement, materials, labor, raceways, dowel holes, markings and other incidentals necessary to construct the barrier.



Payment for any reinforced end anchors, as shown on the END ANCHORAGE details will be made at the unit price bid per Each for ITEM 622 - BARRIER, MISC.: 81" SSB, END ANCHORAGE, REINFORCED. This includes all materials, labor, and other incidentals necessary to construct this anchor.

9-11-2024 - REVISED DETAILS TO INCLUDE BASE DIMENSIONS, NO RACEWAYS

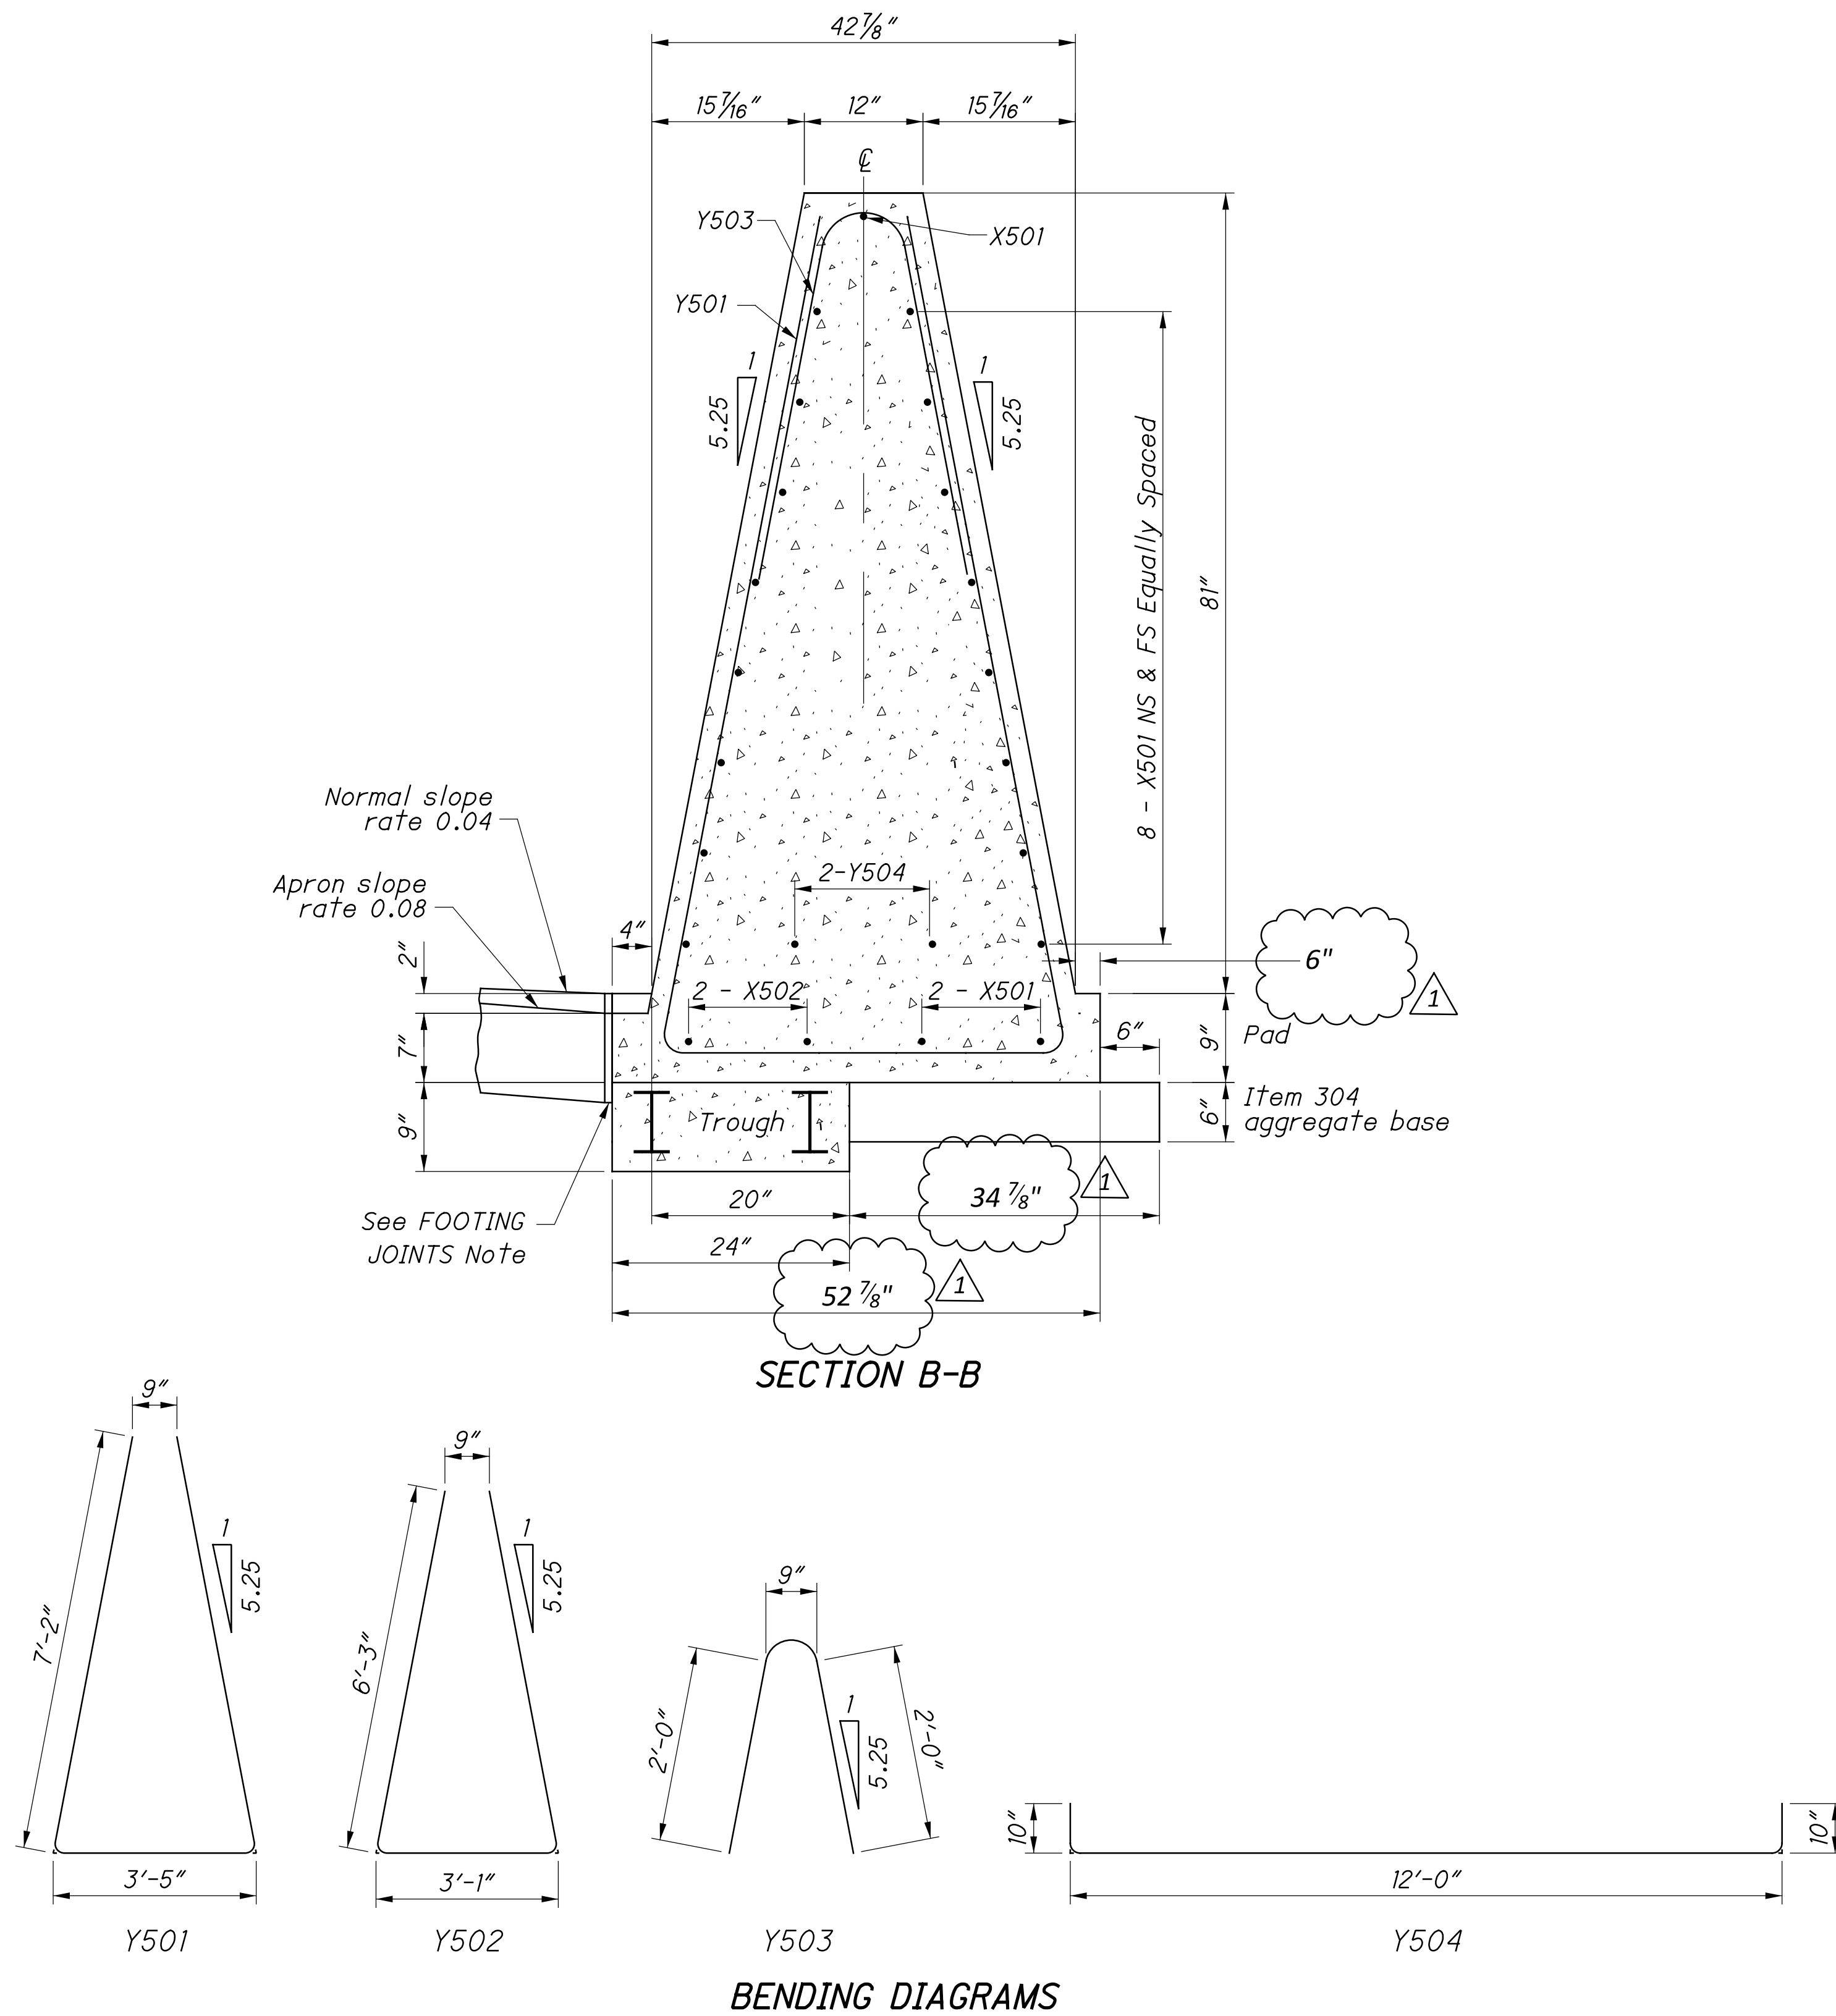

STEEL LIST (For Estimating Purposes Only)


X501 #5 Bar		X502 #5 Bar		X503 #5 Bar		X504 #5 Bar		Y501 #5 Bar		Y502 #5 Bar		Y503 #5 Bar		Y504 #5 Bar	
Straight		Straight		Straight		Straight		Bent		Bent		Bent		Bent	
No.	Length	No.	Length	No.	Length	No.	Length	No.	Length	No.	Length	No.	Length	No.	Length
19	19'-8"	4	4'-8"	8	3'-5"	5	2'-2"	8	17'-6"	5	19'-8"	13	8'-11"	2	13'-5"

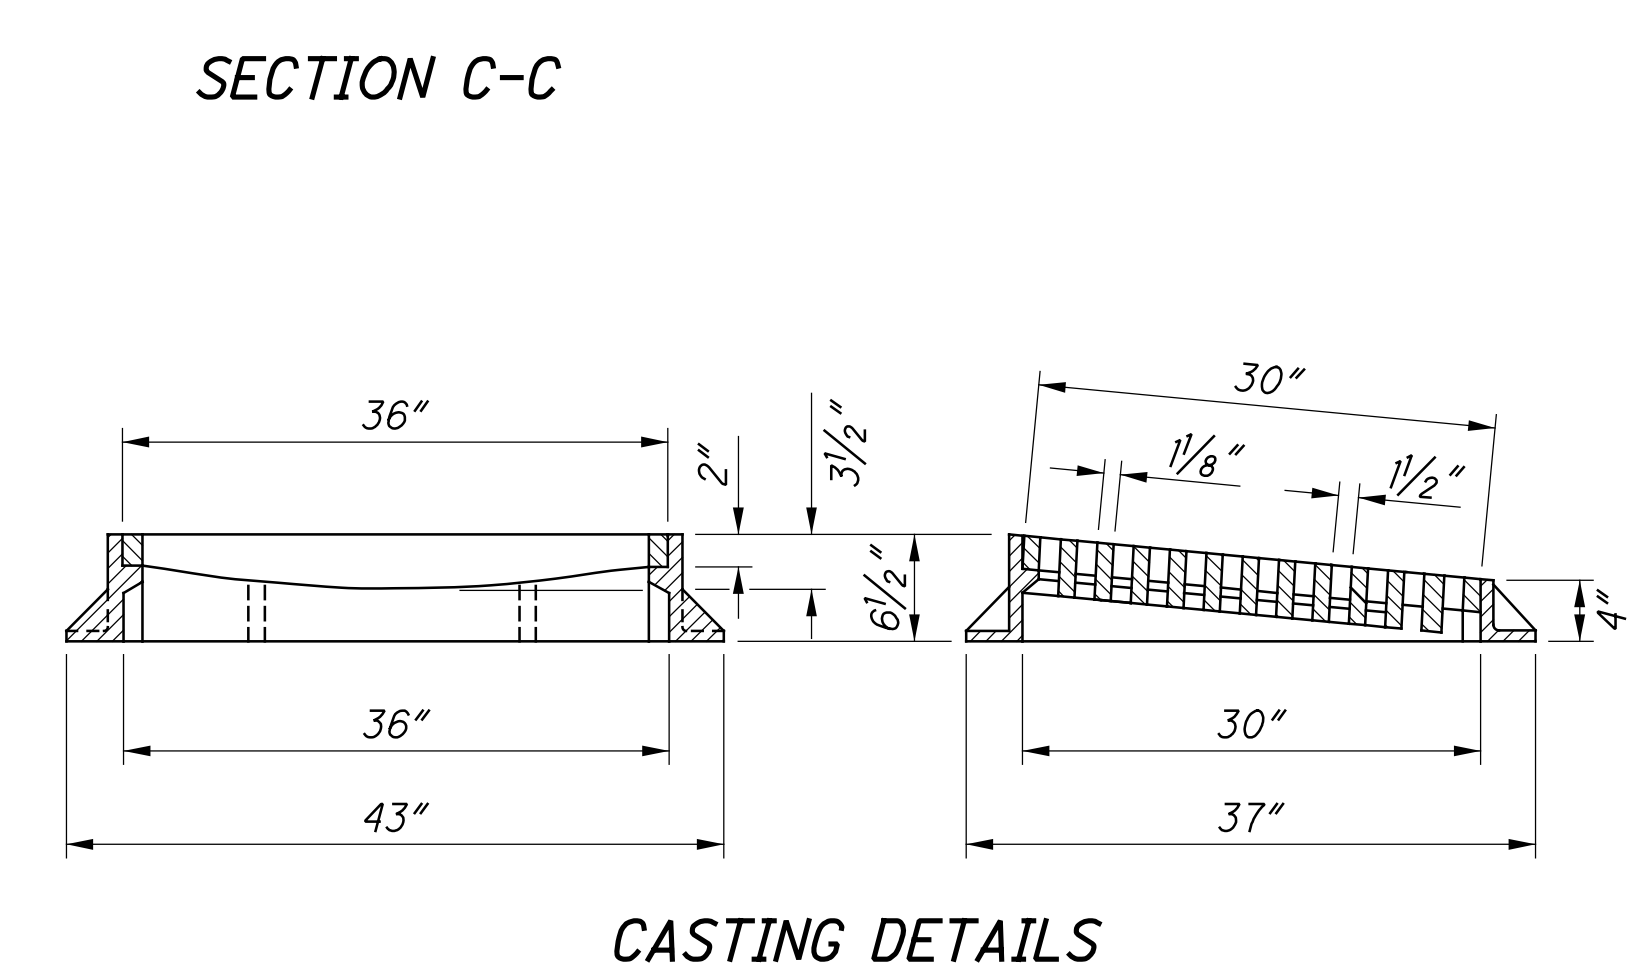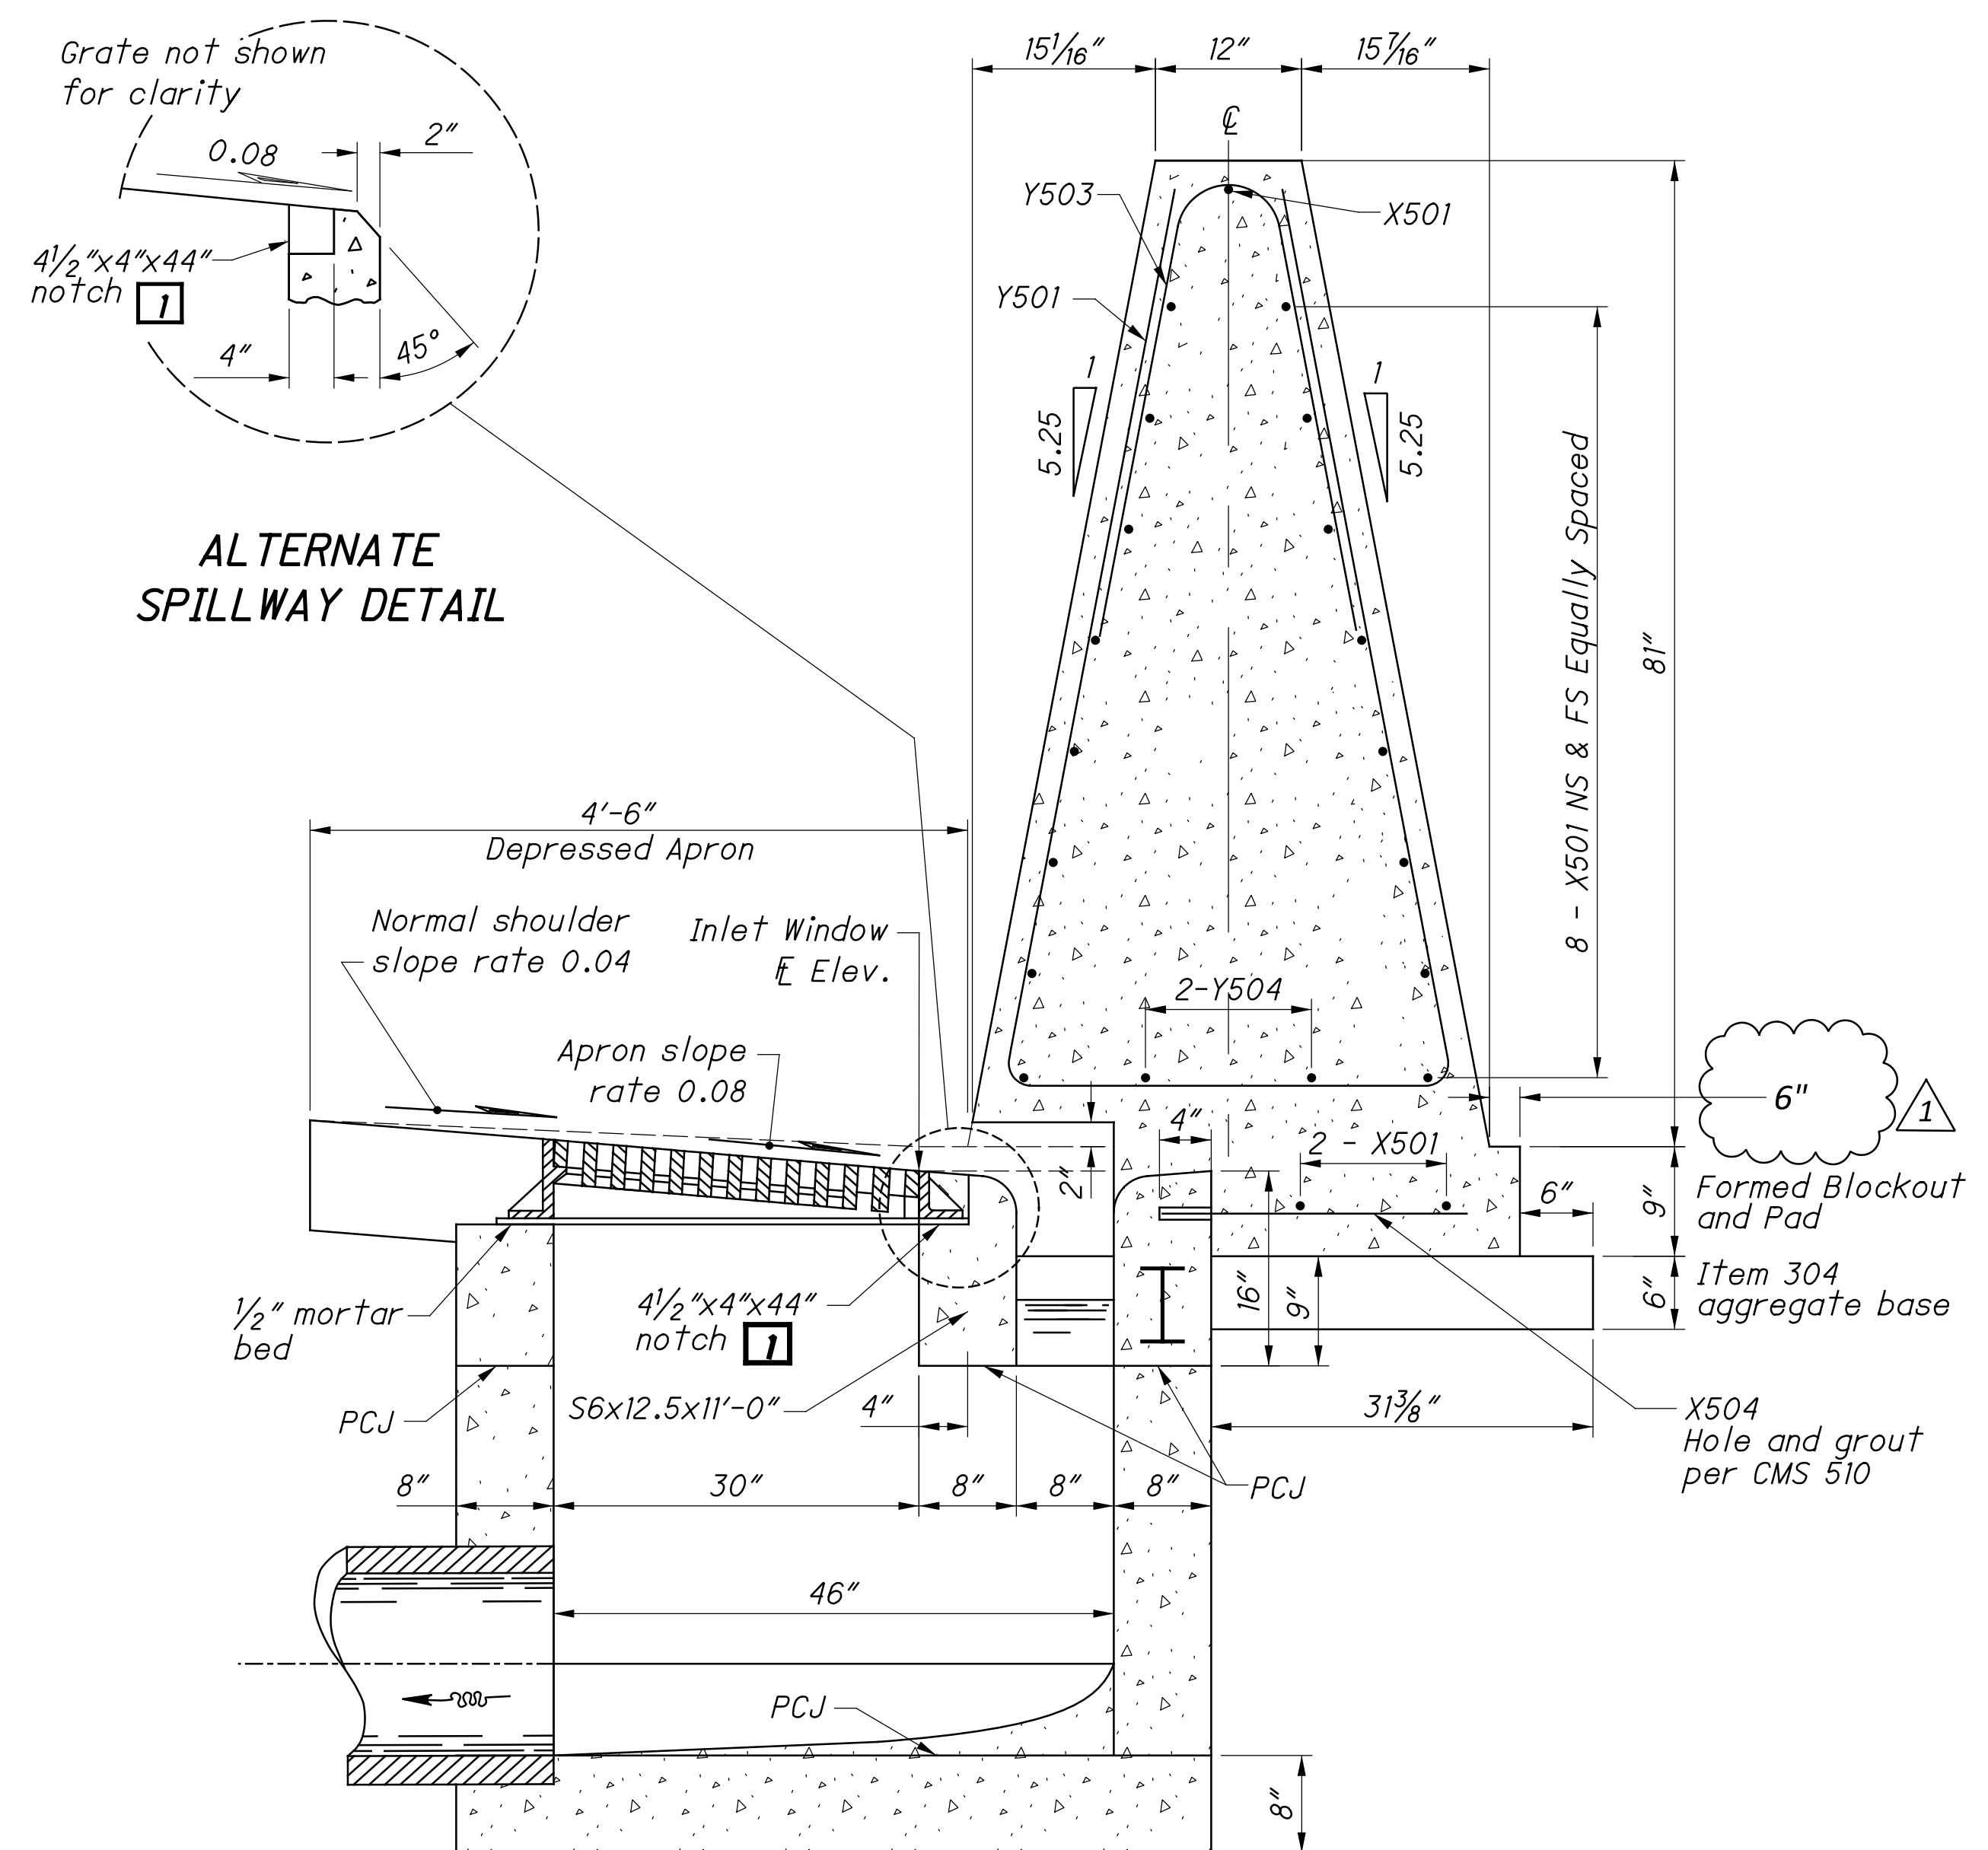

See Sheet 1 For NOTES, LEGEND and PLAN VIEW

9-11-2024 - REVISED DETAILS TO INCLUDE BASE DIMENSIONS


STEEL LIST (For Estimating Purposes Only)											
X501		X502		X503		Y501		Y502		Y503	
#5 Bar		#5 Bar		#5 Bar		#5 Bar		#5 Bar		#5 Bar	
Straight		Straight		Straight		Bent		Bent		Bent	
No.	Length	No.	Length	No.	Length	No.	Length	No.	Length	No.	Length
4	19'-8"	19	19'-6"	5	4'-0"	8	17'-6"	5	15'-4"	13	5'-2"

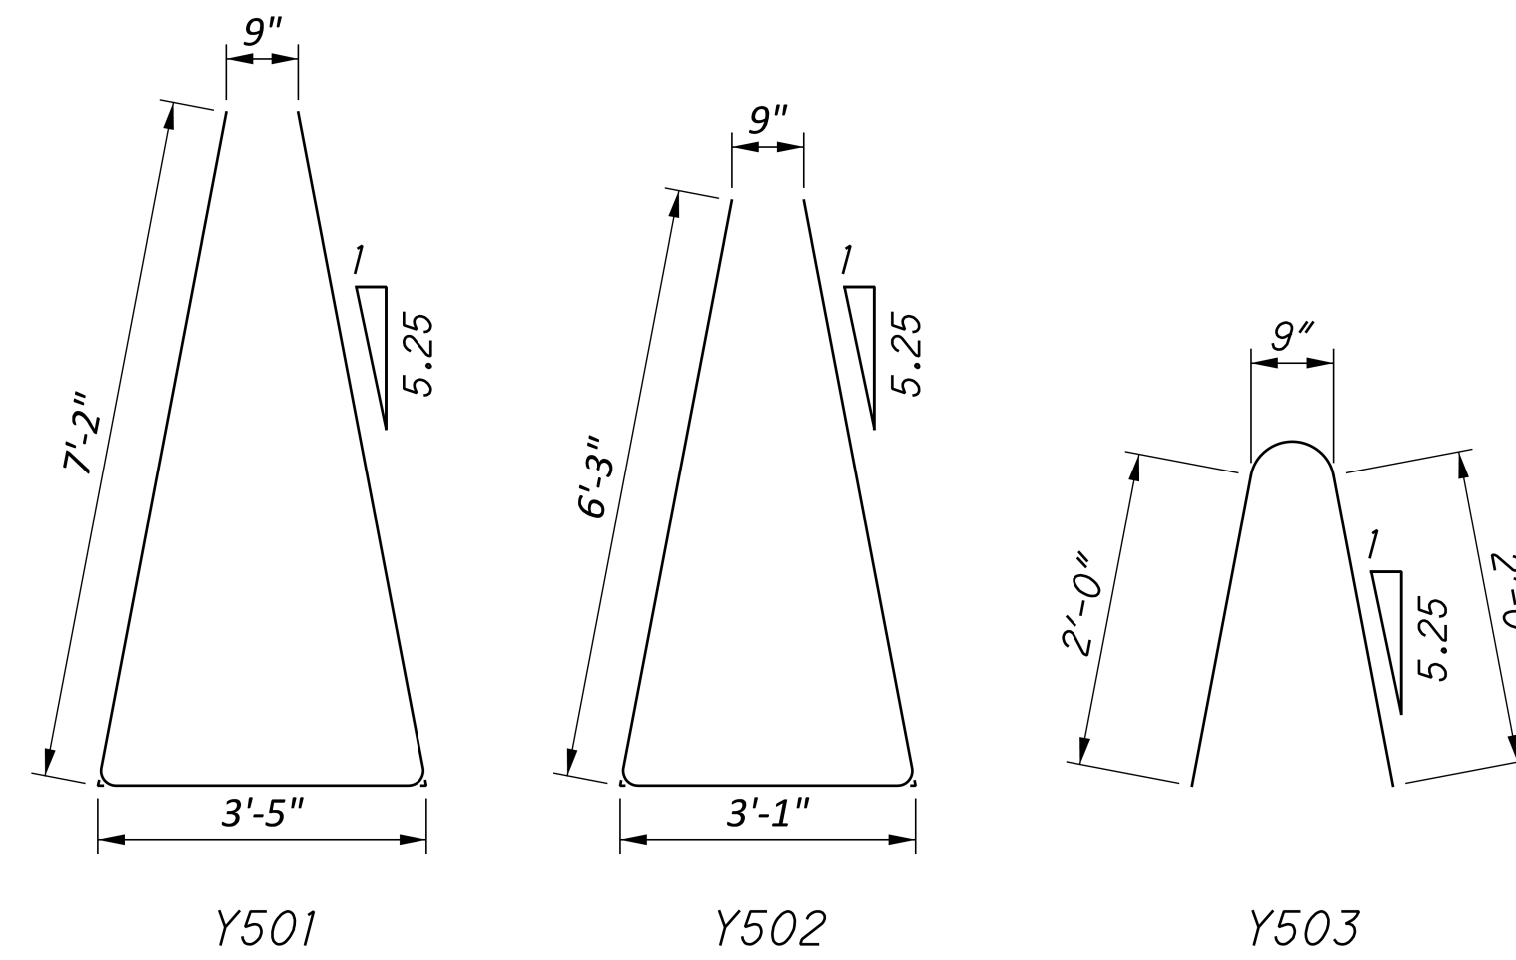


BENDING DIAGRAMS

NOTES


- For additional notes and details, see SCD I-3B.
- For location of sections A-A, B-B & C-C, see sheet P.229
- Reinforcing Steel: Provide epoxy coated reinforcing steel in accordance with CMS 509.09.
- Raceway not to be included on this project.

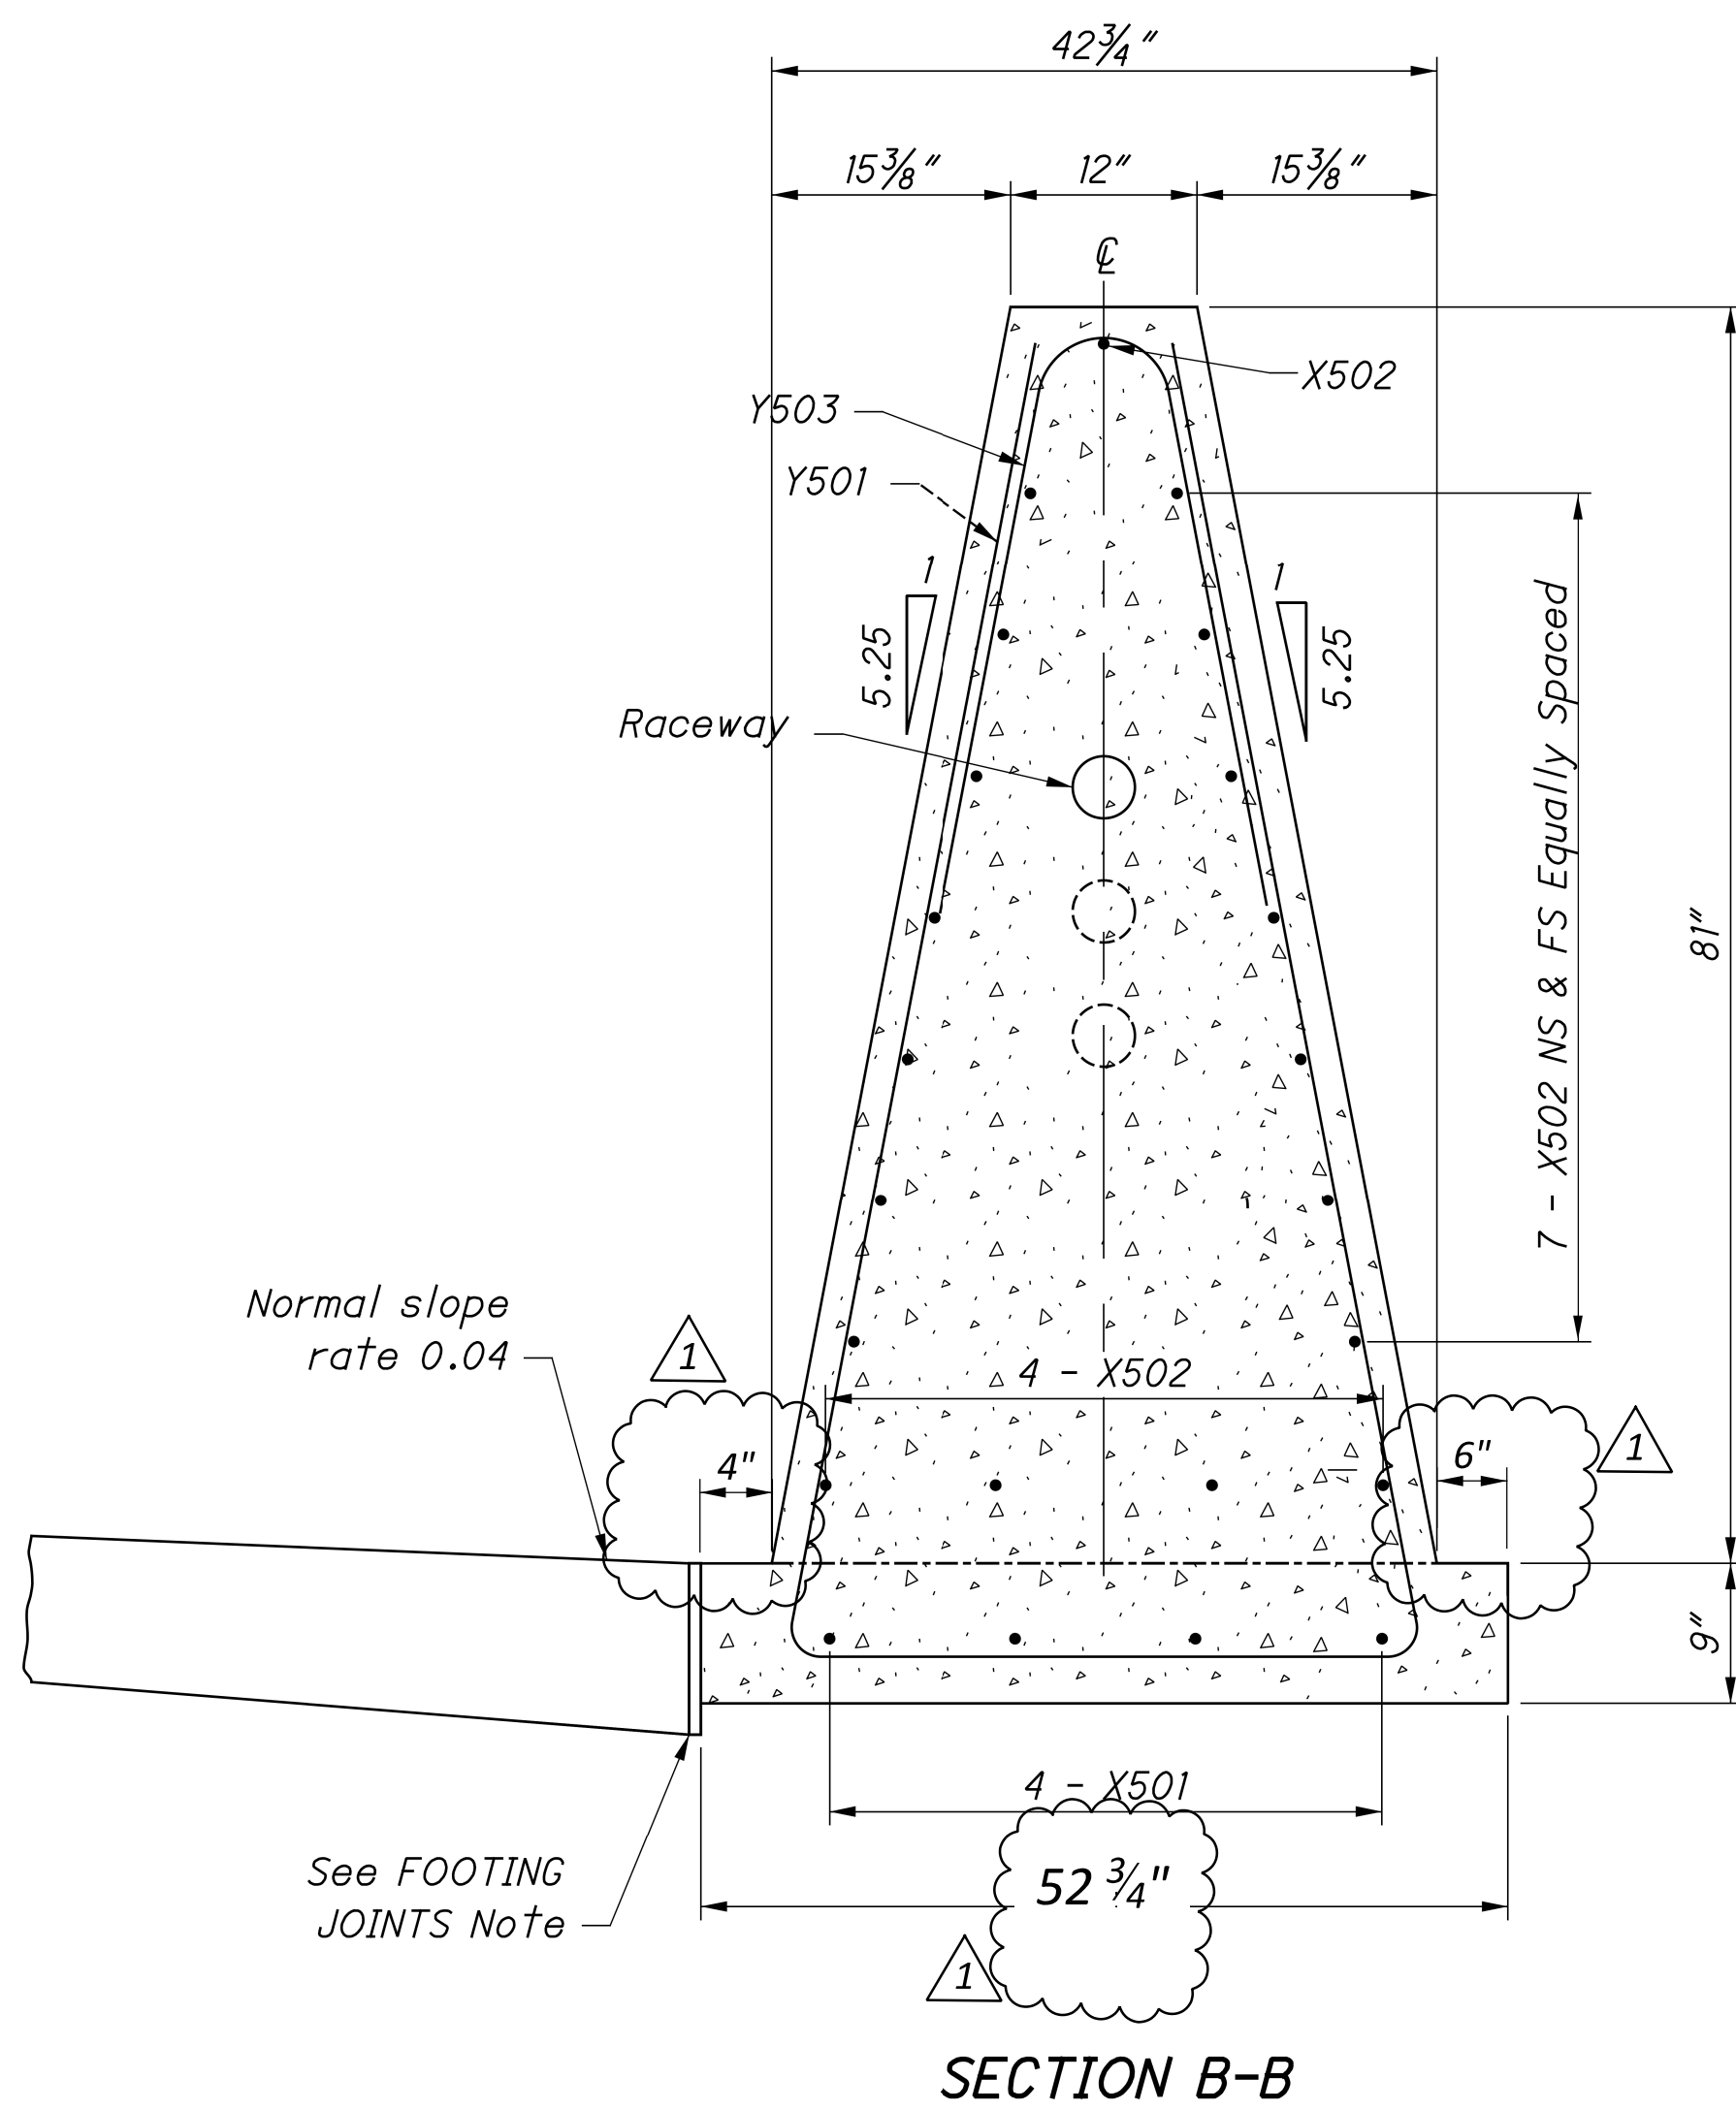

SECTION B-B

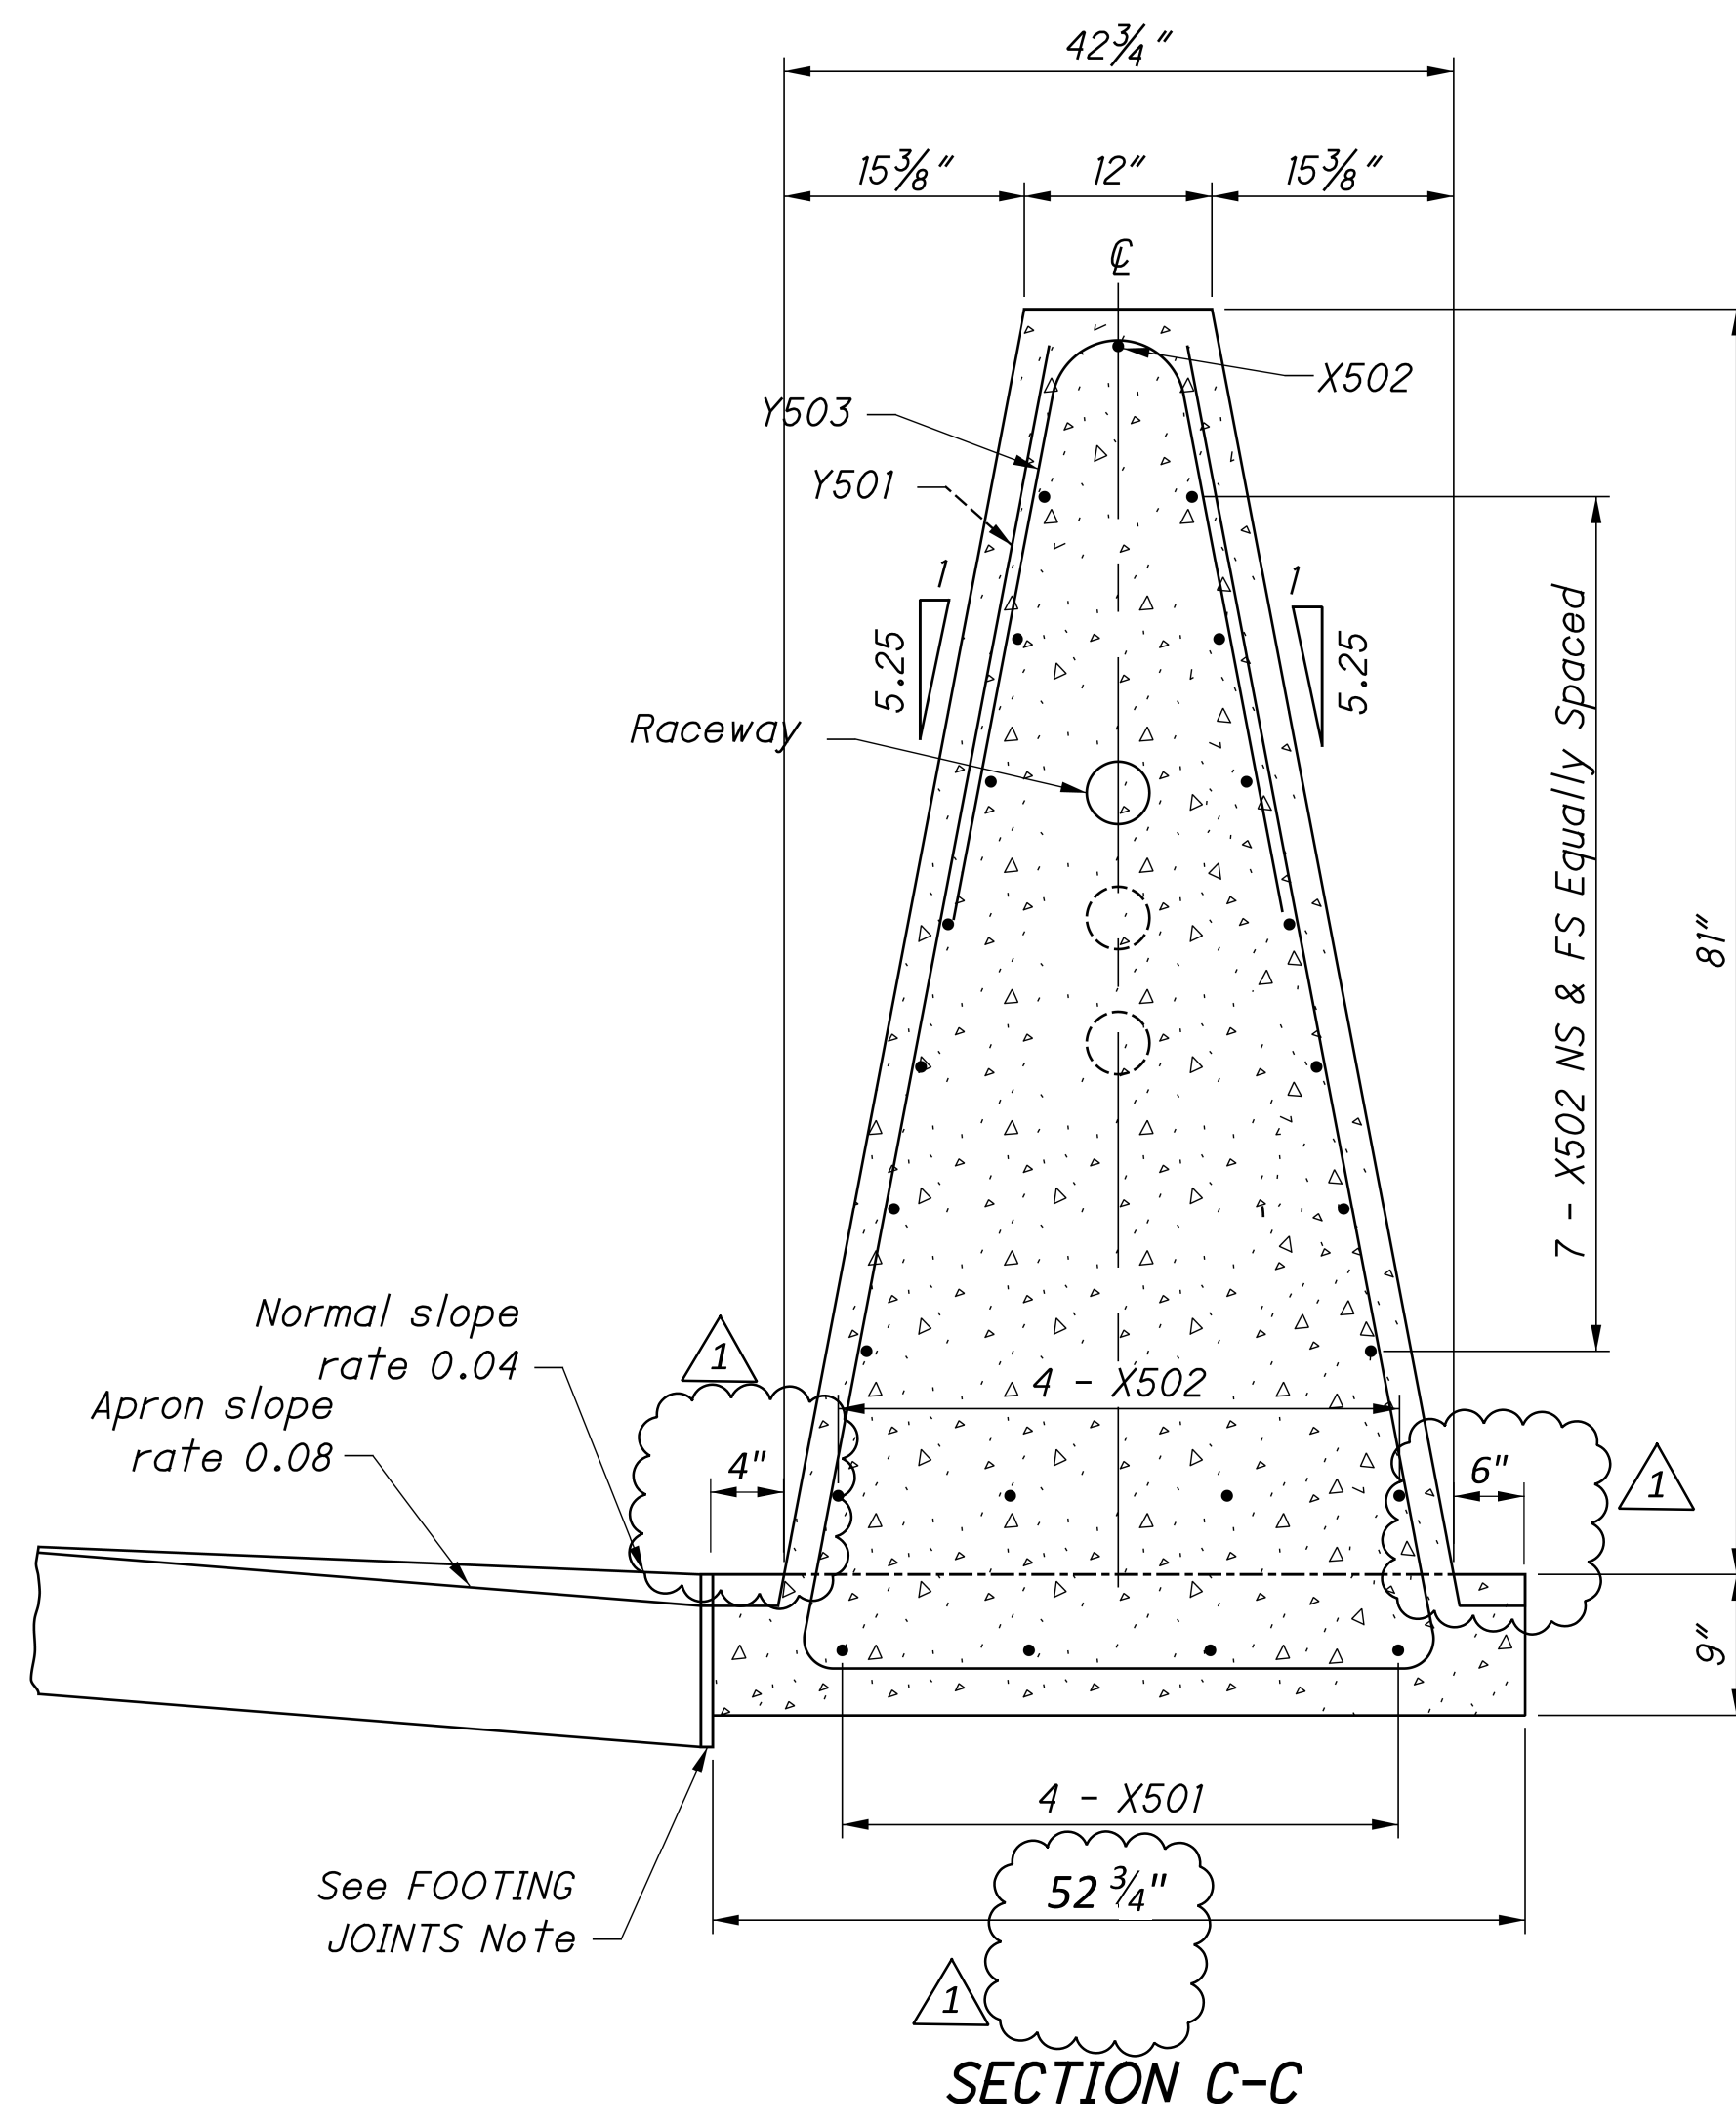

SECTION C-C

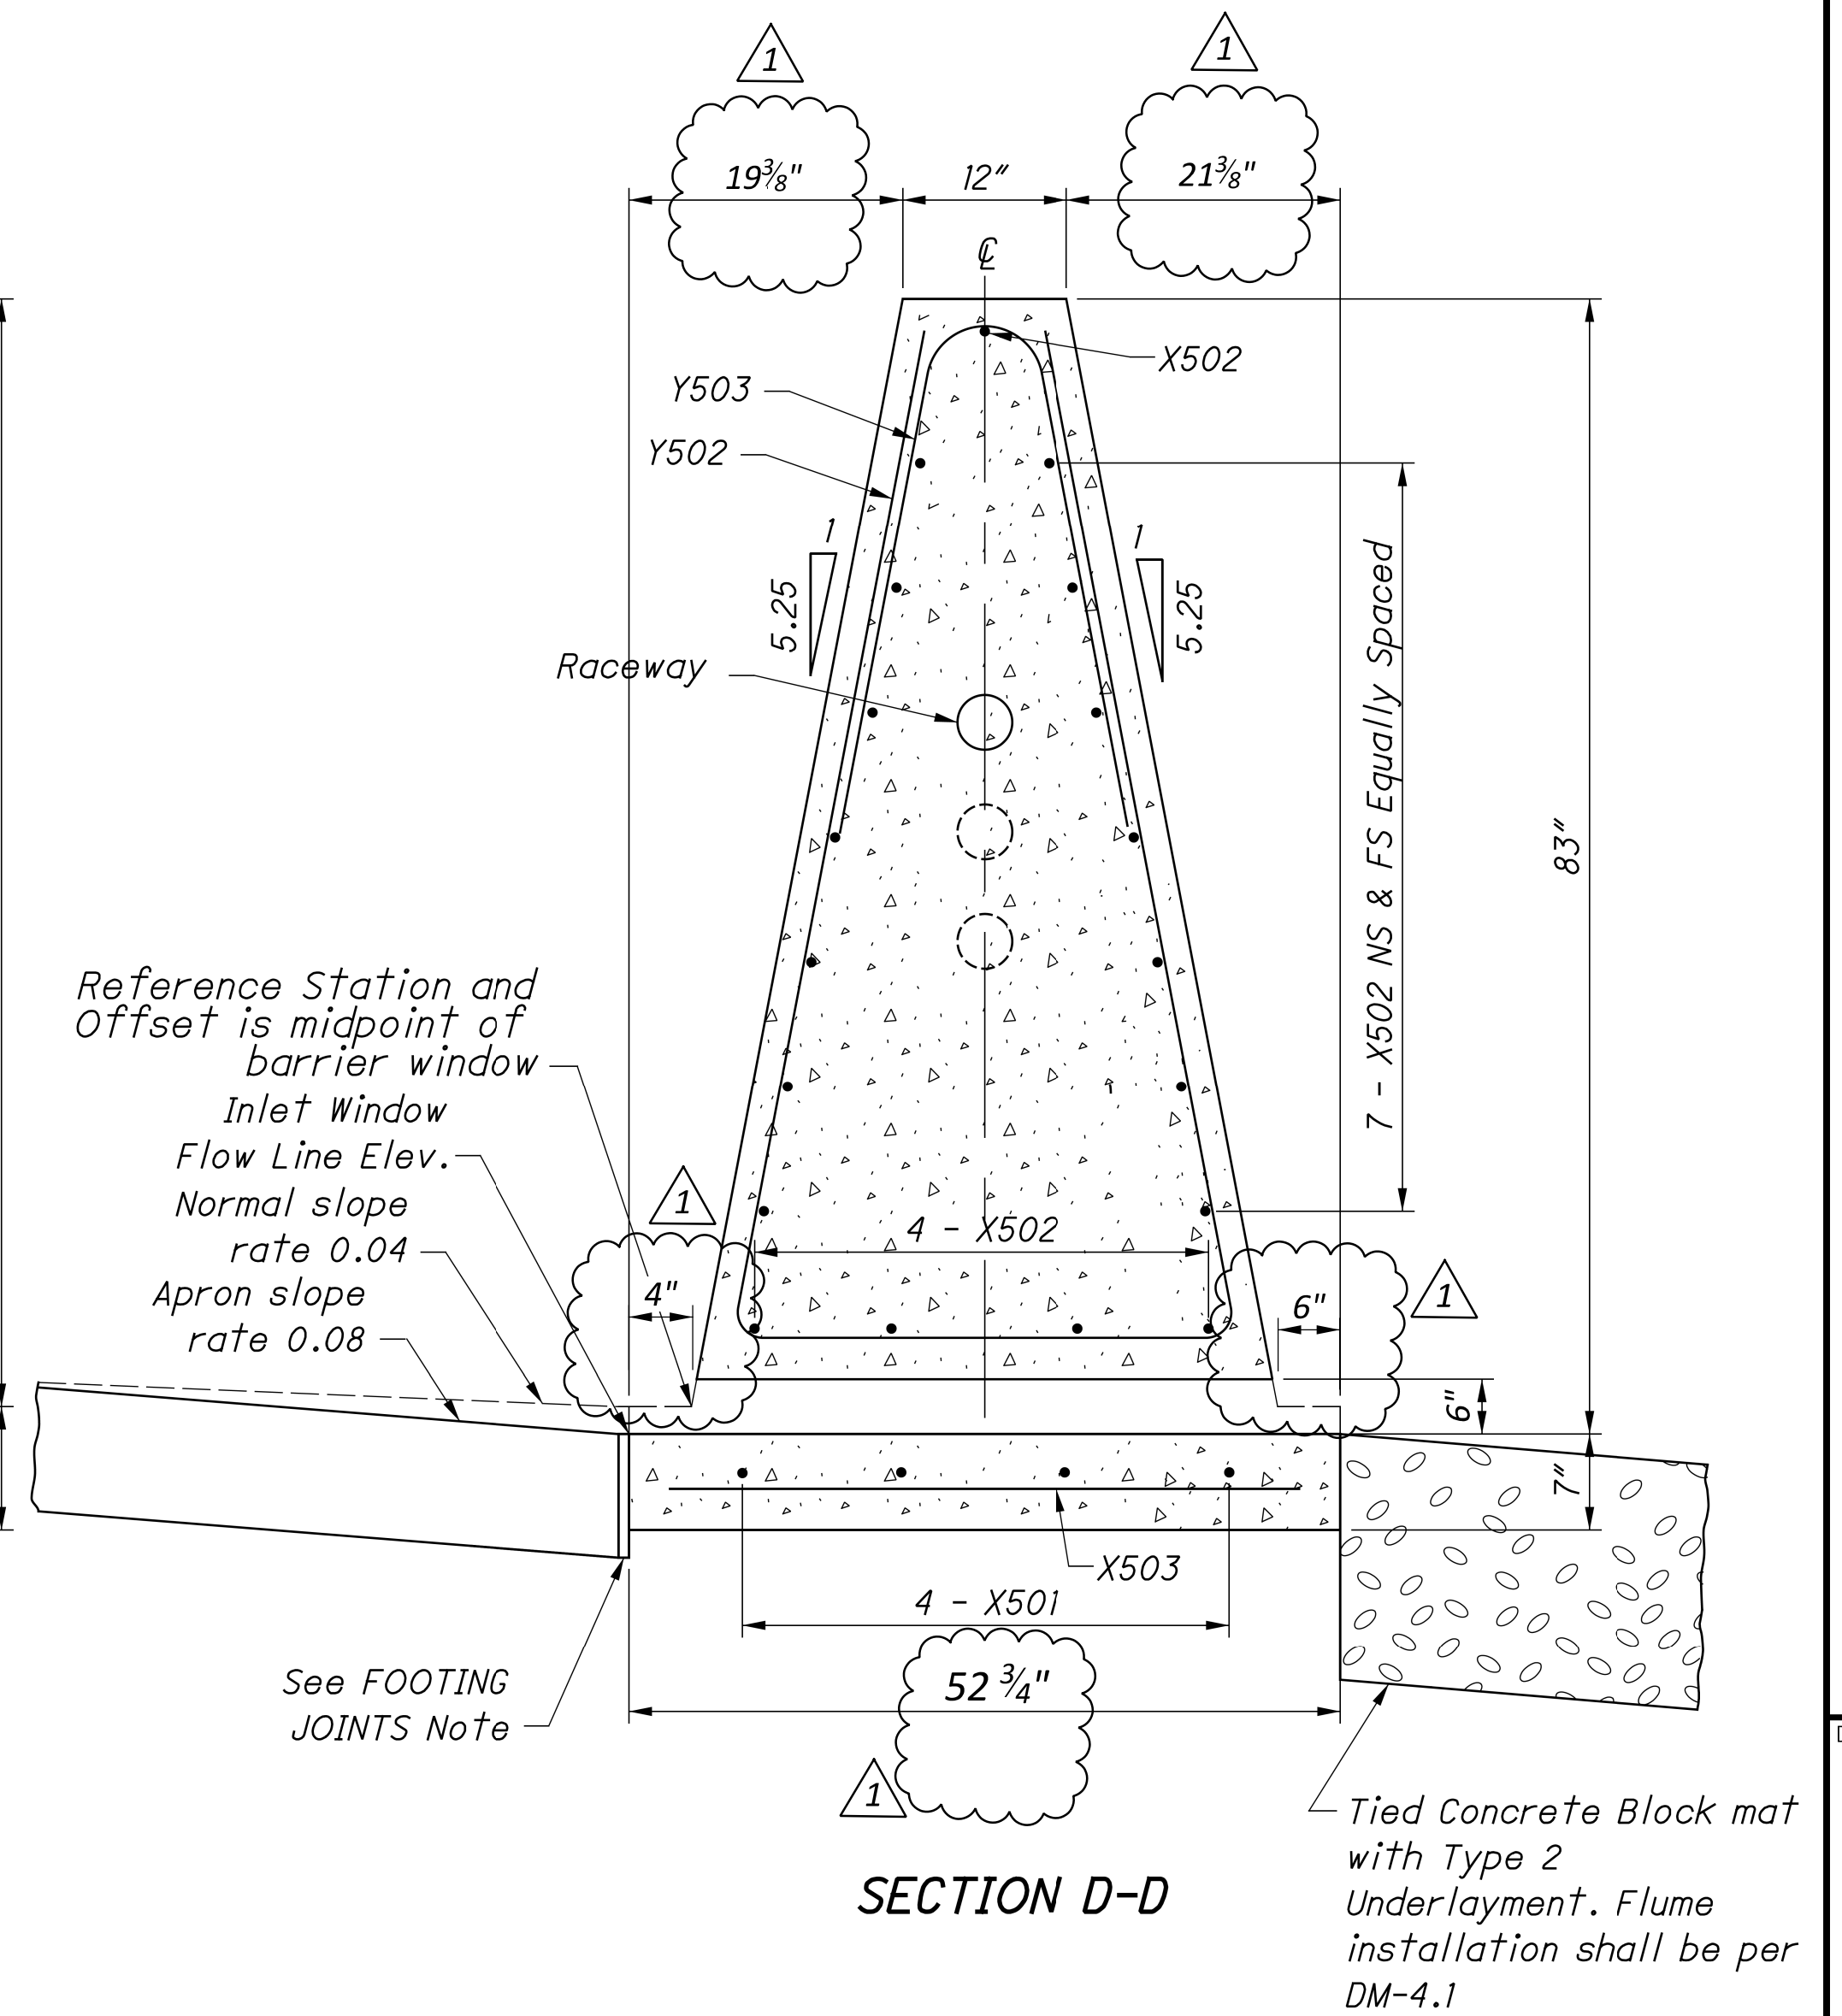

SECTION D-D