



VARIOUS LOCATIONS
SEE SHEET P.2

LOCATION MAP

STATE OF OHIO
DEPARTMENT OF TRANSPORTATION

FRA-BRIDGE PARAPET REPAIRS

CITY OF COLUMBUS
CITY OF GAHANNA

MIFFLIN TOWNSHIP

FRANKLIN COUNTY

INDEX OF SHEETS:

TITLE SHEET	P.1
LOCATION MAPS	P.2
GENERAL NOTES	P.3 - P.4
MAINTENANCE OF TRAFFIC	P.5 - P.28
GENERAL SUMMARY	P.29 - P.30
STRUCTURES (OVER 20 FOOT SPAN)	
BRIDGE GENERAL NOTES	P.31
FRA-00315-13.020	P.32 - P.37
FRA-00315-15.160	P.38 - P.41
FRA-00062-21.830R	P.42 - P.43
FRA-C0171-03.168	P.44 - P.49

FEDERAL PROJECT NUMBER

E260516

RAILROAD INVOLVEMENT

NONE

PROJECT DESCRIPTION

GENERAL BRIDGE MAINTENANCE PROJECT TO REPAIR CONCRETE PARAPET
RAILING ON SEVERAL BRIDGES IN THE DISTRICT.

EARTH DISTURBED AREAS - FRA-00315-13.020

PROJECT EARTH DISTURBED AREA:	0.0 ACRES
ESTIMATED CONTRACTOR EARTH DISTURBED AREA:	0.0 ACRES
NOTICE OF INTENT EARTH DISTURBED AREA:	N/A (NOI NOT REQUIRED)

EARTH DISTURBED AREAS - FRA-00315-15.160

PROJECT EARTH DISTURBED AREA:	0.0 ACRES
ESTIMATED CONTRACTOR EARTH DISTURBED AREA:	0.0 ACRES
NOTICE OF INTENT EARTH DISTURBED AREA:	N/A (NOI NOT REQUIRED)

EARTH DISTURBED AREAS - FRA-00062-21.830R

PROJECT EARTH DISTURBED AREA:	0.0 ACRES
ESTIMATED CONTRACTOR EARTH DISTURBED AREA:	0.0 ACRES
NOTICE OF INTENT EARTH DISTURBED AREA:	N/A (NOI NOT REQUIRED)

EARTH DISTURBED AREAS - FRA-C0171-03.168

PROJECT EARTH DISTURBED AREA:	0.0 ACRES
ESTIMATED CONTRACTOR EARTH DISTURBED AREA:	0.0 ACRES
NOTICE OF INTENT EARTH DISTURBED AREA:	N/A (NOI NOT REQUIRED)

LIMITED ACCESS

THIS IMPROVEMENT IS ESPECIALLY DESIGNED FOR THROUGH TRAFFIC AND
HAS BEEN DECLARED A LIMITED ACCESS HIGHWAY OR FREEWAY BY ACTION
OF THE DIRECTOR IN ACCORDANCE WITH THE PROVISIONS OF SECTION
5511.02 OF THE OHIO REVISED CODE.

2023 SPECIFICATIONS

THE STANDARD SPECIFICATIONS OF THE STATE OF OHIO, DEPARTMENT OF
TRANSPORTATION, INCLUDING SUPPLEMENTAL SPECIFICATIONS LISTED IN
THE PLANS AND CHANGES LISTED IN THE PROPOSAL SHALL GOVERN THIS
IMPROVEMENT.

DESIGN EXCEPTIONS

NONE REQUIRED

ADA DESIGN WAIVERS

NONE REQUIRED

UNDERGROUND UTILITIES

Contact Two Working Days
Before You Dig


Before You Dig

OHIO811, 8-1-1, or 1-800-362-2764
(Non members must be called directly)


PLAN PREPARED BY:

CARPENTER
MARTY

6612 SINGLETREE DRIVE COLUMBUS, OH 43229
614.656.2424 * WWW.CMTRAN.COM

ENGINEER'S SEAL

MAINTENANCE OF TRAFFIC

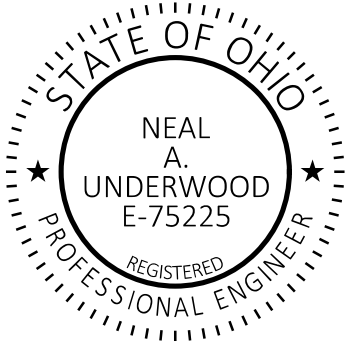

ENGINEER'S SEAL

BRIDGE




STANDARD CONSTRUCTION DRAWINGS						SUPPLEMENTAL SPECIFICATIONS	SPECIAL PROVISIONS
ODOT							
HL-30.31	07/18/25	TC-41.20	10/18/13			800	01/16/26
		TC-42.20	10/18/13			821	04/20/13
MT-95.30	07/18/25	TC-52.10	10/18/13			832	07/17/26
MT-95.40	07/18/25	TC-52.20	01/15/21			896	07/21/17
MT-95.45	07/21/23	TC-61.30	07/19/24			921	07/19/24
MT-99.60	07/19/24					996	07/21/23
MT-101.70	07/19/24	SBR-1-20	07/19/24				
MT-101.75	07/21/23	VPF-1-24	01/17/25				
MT-102.10	07/21/23						
MT-105.10	01/17/20						

I HEREBY APPROVE THESE PLANS AND DECLARE THAT THE MAKING OF THIS
IMPROVEMENT WILL NOT REQUIRE THE CLOSING TO TRAFFIC OF THE HIGHWAY
AND THAT PROVISIONS FOR THE MAINTENANCE AND SAFETY OF TRAFFIC
WILL BE AS SET FORTH ON THE PLANS AND ESTIMATES.



Anthony C. Turowski, P.E.
District 06 Deputy Director

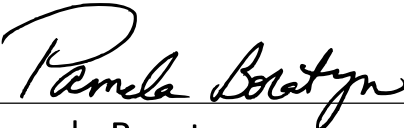

Pamela Boratyn
Director, Department of Transportation

DOW#: 26-027

DESIGN AGENCY



DESIGNER

CTF

REVIEWER

NAU 07/01/26

PROJECT ID

125023

SHEET

P.1

TOTAL

49