

SHEET NUMBER					PARTICIPATION					ITEM	ITEM EXT.	GRAND TOTAL	UNIT	DESCRIPTION	SEE SHEET NO.
P1/158	P2/37	P3/188	P4/152	P5/13	01/IMS/04	02/IMS/11	05/IMS/14	06/MPO/04	07/NHS/04/COL						
LS	LS		LS	LS							201	11000	LS	CLEARING AND GRUBBING	P1,P2,P4
1		1	2		4						202	20010	4	EACH	HEADWALL REMOVED
32580	3886	21016	43428		100910						202	23000	100910	SY	PAVEMENT REMOVED
	9050	3016	18064		30130						202	30000	30130	SF	WALK REMOVED
	9				9						202	30200	9	FT	STEPS REMOVED
		114			114						202	30600	114	SY	CONCRETE MEDIAN REMOVED
1406		5525	3687		10618						202	30700	10618	FT	CONCRETE BARRIER REMOVED
175					175						202	30701	175	FT	CONCRETE BARRIER REMOVED, AS PER PLAN "4A"
		1280			1280						202	30701	1280	FT	CONCRETE BARRIER REMOVED, AS PER PLAN "6A"
2870	1001	5724	4809	2230	14404	1820	410				202	32000	16634	FT	CURB REMOVED
		271			271						202	32500	271	FT	CURB AND GUTTER REMOVED
		655			655						202	32800	655	SY	CONCRETE SLOPE PROTECTION REMOVED
835	60	2324	2381	54	5600	54					202	35100	5654	FT	PIPE REMOVED, 24" AND UNDER
4722		5283	1745	1647	11750	1222	425				202	38000	13397	FT	GUARDRAIL REMOVED
1		4			5						202	47800	5	EACH	IMPACT ATTENUATOR REMOVED
2		9	1		12						202	58000	12	EACH	MANHOLE REMOVED
13	2	10	13	3	38	3					202	58100	41	EACH	CATCH BASIN REMOVED
4		33	13		50						202	58200	50	EACH	INLET REMOVED
		1			1						202	58201	1	EACH	INLET REMOVED, AS PER PLAN
			1		1						202	58400	1	EACH	INLET ABANDONED
			3		3						202	58401	3	EACH	INLET ABANDONED, AS PER PLAN
1			1		2						202	58500	2	EACH	CATCH BASIN ABANDONED
			4		4						202	58501	4	EACH	CATCH BASIN ABANDONED, AS PER PLAN
			323		323						SPECIAL	20270000	323	FT	FILL AND PLUG EXISTING CONDUIT, 12"
162			50		212						SPECIAL	20270000	212	FT	FILL AND PLUG EXISTING CONDUIT, 15"
126					126						SPECIAL	20270000	126	FT	FILL AND PLUG EXISTING CONDUIT, 18"
740	428	1156	1222		3546						202	75000	3546	FT	FENCE REMOVED
2		1			3						202	75250	3	EACH	GATE REMOVED
		1			1						202	75255	1	EACH	GATE REMOVED FOR REUSE, AS PER PLAN
			4		4						202	75610	4	EACH	VALVE BOX REMOVED
		3	6		9						202	98100	9	EACH	REMOVAL MISC.: TRASH RECEPTACLES
		2			2						202	98100	2	EACH	REMOVAL MISC.: INSPECTION WELL
1070		1272	428		2770						202	98200	2770	FT	REMOVAL MISC.: PORTABLE BARRIER
739					739						202	98200	739	FT	REMOVAL MISC.: PORTABLE BARRIER WITH VANDAL FENCE
	303				303						202	98200	303	FT	REMOVAL MISC.: CURB REMOVED FOR STORAGE
		100			100						202	98200	100	FT	REMOVAL MISC.: MISC CONDUIT
		101			101						202	98200	101	FT	REMOVAL MISC.: TRENCH DRAIN
	4845		307		5152						202	98400	5152	SF	REMOVAL MISC.: BRICK PAVERS REMOVED
19022	623	44689	44578	1149	108912	953	196				203	10000	110061	CY	EXCAVATION
35175	7648	94130	45546	6658	182499	6658					203	20000	189157	CY	EMBANKMENT
3977		24962		5561	28939	5561					203	20001	34500	CY	EMBANKMENT, AS PER PLAN
3360					3360						203	35000	3360	CY	GRANULAR EMBANKMENT
4592					4592						203	35001	4592	CY	GRANULAR EMBANKMENT, AS PER PLAN
		2806			2806						203	35110	2806	CY	GRANULAR MATERIAL, TYPE B
24495	4558	29583	6606		64994			248			204	10000	65242	SY	SUBGRADE COMPACTION
250	975		1923		3148						204	13000	3148	CY	EXCAVATION OF SUBGRADE
		172			172						204	13001	172	CY	EXCAVATION OF SUBGRADE, AS PER PLAN
250	975		1923		3148						204	30010	3148	CY	GRANULAR MATERIAL, TYPE B
28	4	12	32	4	74	4		2			204	45000	80	hour	PROOF ROLLING
		1			1						204	45001	1	hour	PROOF ROLLING, AS PER PLAN
500	3868		6338		10501			205			204	50000	10706	SY	GEOTEXTILE FABRIC
		1032			1032						204	50001	1032	SY	GEOTEXTILE FABRIC, AS PER PLAN
500	3868		6338		10501			205			204	51000	10706	SY	GEOGRID

NO.	DESCRIPTION	REV. BY	DATE
1	REVISED PART 5	CWL	10-2-23
3	REVISED PART 3	CWL	10-23-23

BIG BUILD MASTER GENERAL SUMMARY

FRA-70-13.11

141  
1151

D:\2012\2012048\FRA\77372\ROADWAY\SHEETS\7737255901.DGN  
10/23/2023 12:14:54 PM  
GDDTV16151D.LUSER





SHEET NUMBER					PARTICIPATION					ITEM	ITEM EXT.	GRAND TOTAL	UNIT	DESCRIPTION	SEE SHEET NO.	CALCULATED CJC	CHECKED CWL
P1/65	P2/40	P3/197B	P4/49	P5/14B	01/IMS/04	02/IMS/11											
6000					6000					254	01000	6000	SY	PAVEMENT PLANING, ASPHALT CONCRETE, 1.5"			P1
200					200					410	12000	200	CY	TRAFFIC COMPACTED SURFACE, TYPE A OR B			P1
1000			1000		2000					607	30001	2000	FT	FENCE, SNOW, AS PER PLAN			P1,P4
174					174					611	05900	174	FT	15" CONDUIT, TYPE B			
1405					1405					611	97010	1405	FT	SLOTTED DRAIN, TYPE 2, 12"			
1					1					611	98150	1	EACH	CATCH BASIN, NO. 3			
3					3					611	98370	3	EACH	CATCH BASIN, NO. 6			
5					5					611	99500	5	EACH	INLET, MISC.: INLET, CAPPED BELOW GRADE			
2400		944	2000		5344					614	11110	5344	hour	LAW ENFORCEMENT OFFICER WITH PATROL CAR FOR ASSISTANCE			P1
			2		2					SPECIAL	61411300	2	EACH	WORK ZONE TRAFFIC SIGNAL			P4
17120			27376		44496					614	11630	44496	FT	INCREASED BARRIER DELINEATION			P1
12		19	13	4	44	4				614	12380	48	EACH	WORK ZONE IMPACT ATTENUATOR, 24" WIDE HAZARDS, (UNIDIRECTIONAL)			P1
LS		LS	LS		LS					614	12420	LS		DETOUR SIGNING			P1
			11		11					614	12470	11	EACH	WORK ZONE SPEED LIMIT SIGN			P1
6		9	10		25					614	12484	25	EACH	WORK ZONE INCREASED PENALTIES SIGN			
50		20	50		120					614	12500	120	EACH	REPLACEMENT SIGN			P1
300		50	300		650					614	12600	650	EACH	REPLACEMENT DRUM			P1
			2		2					614	12756	2	EACH	WORK ZONE CROSSOVER LIGHTING SYSTEM			
			3645		3645					614	12800	3645	EACH	WORK ZONE RAISED PAVEMENT MARKER			
193		3504			3697					614	12801	3697	EACH	WORK ZONE RAISED PAVEMENT MARKER, AS PER PLAN			P1,P3
				120		120				614	13310	120	EACH	BARRIER REFLECTOR, TYPE 1 (ONE WAY)			
349		1566			1915					614	13310	1915	EACH	BARRIER REFLECTOR, TYPE 1, ONE-WAY			P1
			1440		1,440					614	13310	1440	EACH	BARRIER REFLECTOR, TYPE 1, BIDIRECTIONAL			
		29			29					614	13312	29	EACH	BARRIER REFLECTOR, TYPE 2, ONE-WAY			
349		548		40	897	40				614	13350	937	EACH	OBJECT MARKER, ONE WAY			P1
				4		4				614	13600	4	EACH	MAINTENANCE OF TRAFFIC, ONE LANE CLOSURE ON A TWO LANE HIGHWAY			
50000					50000					614	18000	50000	EACH	MAINTAINING TRAFFIC, MISC.: BRIDGE DECK AND PAVEMENT PATCHING			P1
1000					1000					614	18030	1000	FT	MAINTAINING TRAFFIC, MISC.: CONSTRUCTION FENCE			P1
		1000			1000					614	18030	1000	FT	MAINTAINING TRAFFIC, MISC.: PORTABLE WATER FILLED BARRIER PROTECTED PEDESTRIAN WALKWAY			P3
144		89	48		281					614	18601	281	SNMT	PORTABLE CHANGEABLE MESSAGE SIGN, AS PER PLAN			P1,P3,P4
2.21					2.21					614	20011	2.21	MILE	WORK ZONE LANE LINE, CLASS I, 6", AS PER PLAN, SPRAY THERMOPLASTIC			P1
4.30		12.87	3.41		20.58					614	20056	20.58	MILE	WORK ZONE LANE LINE, CLASS I, 6", 807 PAINT			
			0.62		0.62					614	20200	0.62	MILE	WORK ZONE LANE LINE, CLASS I, 4", 740.06, TYPE I			
		0.11			0.11					614	21050	0.11	MILE	WORK ZONE CENTER LINE, CLASS I, 807 PAINT, DOUBLE SOLID, WHITE			
0.51					0.51					614	21100	0.51	MILE	WORK ZONE CENTER LINE, CLASS I, 642 PAINT			
5.98					5.98					614	22011	5.98	MILE	WORK ZONE EDGE LINE, CLASS I, 6", AS PER PLAN, SPRAY THERMOPLASTIC			P1
9.22		25.10	13.08		47.40					614	22056	47.40	MILE	WORK ZONE EDGE LINE, CLASS I, 6", 807 PAINT			
			1.42		1.42					614	22200	1.42	MILE	WORK ZONE EDGE LINE, CLASS I, 4", 740.06, TYPE I			
11491					11491					614	23011	11491	FT	WORK ZONE CHANNELIZING LINE, CLASS I, 12", AS PER PLAN, SPRAY THERMOPLASTIC			P1
13094		64782	30704		108580					614	23110	108580	FT	WORK ZONE CHANNELIZING LINE, CLASS I, 12", 807 PAINT			
			275		275					614	23400	275	FT	WORK ZONE CHANNELIZING LINE, CLASS I, 8", 740.06, TYPE I			
3302					3302					614	24001	3302	FT	WORK ZONE DOTTED LINE, CLASS I, AS PER PLAN, SPRAY THERMOPLASTIC			P1
1401			7974		9375					614	24100	9375	FT	WORK ZONE DOTTED LINE, CLASS I, 4", 807 PAINT			
		11051			11051					614	24102	11051	FT	WORK ZONE DOTTED LINE, CLASS I, 6", 807 PAINT			
			857		857					614	24400	857	FT	WORK ZONE DOTTED LINE, CLASS I, 740.06, TYPE I			
95			1159		1159					614	25000	1159	FT	WORK ZONE TRANSVERSE/DIAGONAL LINE, CLASS I			
					95					614	26200	95	FT	WORK ZONE STOP LINE, CLASS I, 642 PAINT			
			53		53					614	26400	53	FT	WORK ZONE STOP LINE, CLASS I, 740.06 TYPE I			
639			466		1105					614	27070	1105	FT	WORK ZONE CROSSWALK LINE, CLASS I, 12", 740.06, TYPE I			
6		2026			2026					614	28400	2026	FT	WORK ZONE GORE MARKING, CLASS II, 740.06, TYPE I			
					6					614	30200	6	EACH	WORK ZONE ARROW, CLASS I, 642 PAINT			
		8	12		20					614	30400	20	EACH	WORK ZONE ARROW, CLASS I, 740.06, TYPE I			
		73			73					614	98200	73	EACH	WORK ZONE PAVEMENT MARKING, MISC.: ROUTE SHIELDS			P3

BIG BUILD MASTER GENERAL SUMMARY

FRA-70-13.11

156  
1151


D:\2012\2012048\FRA\7732\ROADWAY\SHEETS\773250916.DGN  
10/23/2023  
12:10:42 PM  
GDDTV615TD\_USER

NO.	DESCRIPTION	REV. BY	DATE
2	TEMP FENCE/BRICK X-WALK TEMP	CWL	10-13-23
3	REVISED P5 SHEET #	CWL	10-23-23

PROVIDE FLANGE WELD AT STIFFENERS CONNECTED TO CROSSFRAMES ONLY. TYP. TOP & BOT.

\*\* 5/16 WELD, EXCEPT WHERE THE 1B OR 2B CROSSFRAMES CONNECT, PROVIDE 3/8 WELD.

PL 1 3/8" x 10 1/2" (CVN) BEARING STIFFENER AT PIER NO.1 THRU NO.4  
PL 7/8" x 9" BEARING STIFFENER AT REAR & FRWD. ABUT.

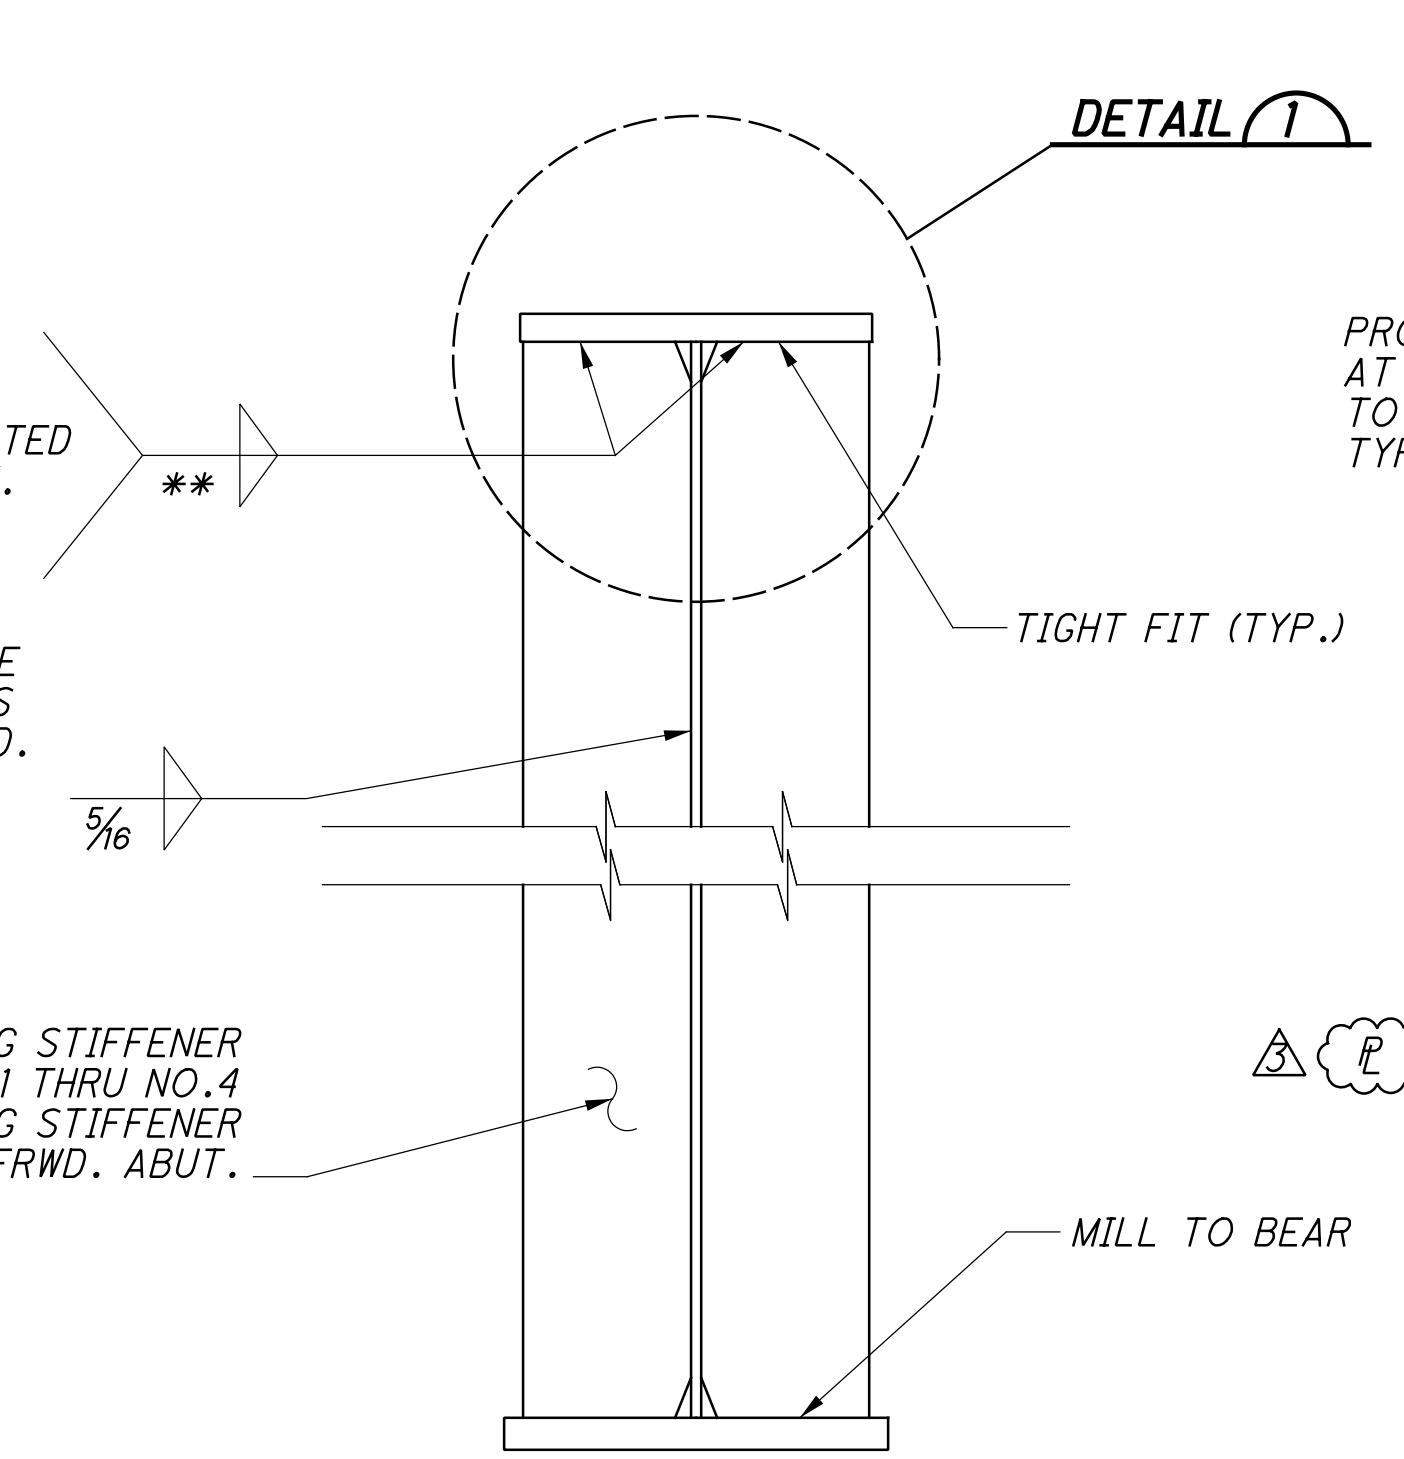


**BEARING STIFFENER**

PLACE BEARING STIFFENERS NORMAL TO GIRDER

PROVIDE FLANGE WELD AT STIFFENERS CONNECTED TO CROSSFRAMES ONLY. TYP. TOP & BOT.


PL 1" x 9" (CVN) JACKING STIFFENER AT PIER NO.1 THRU NO.4

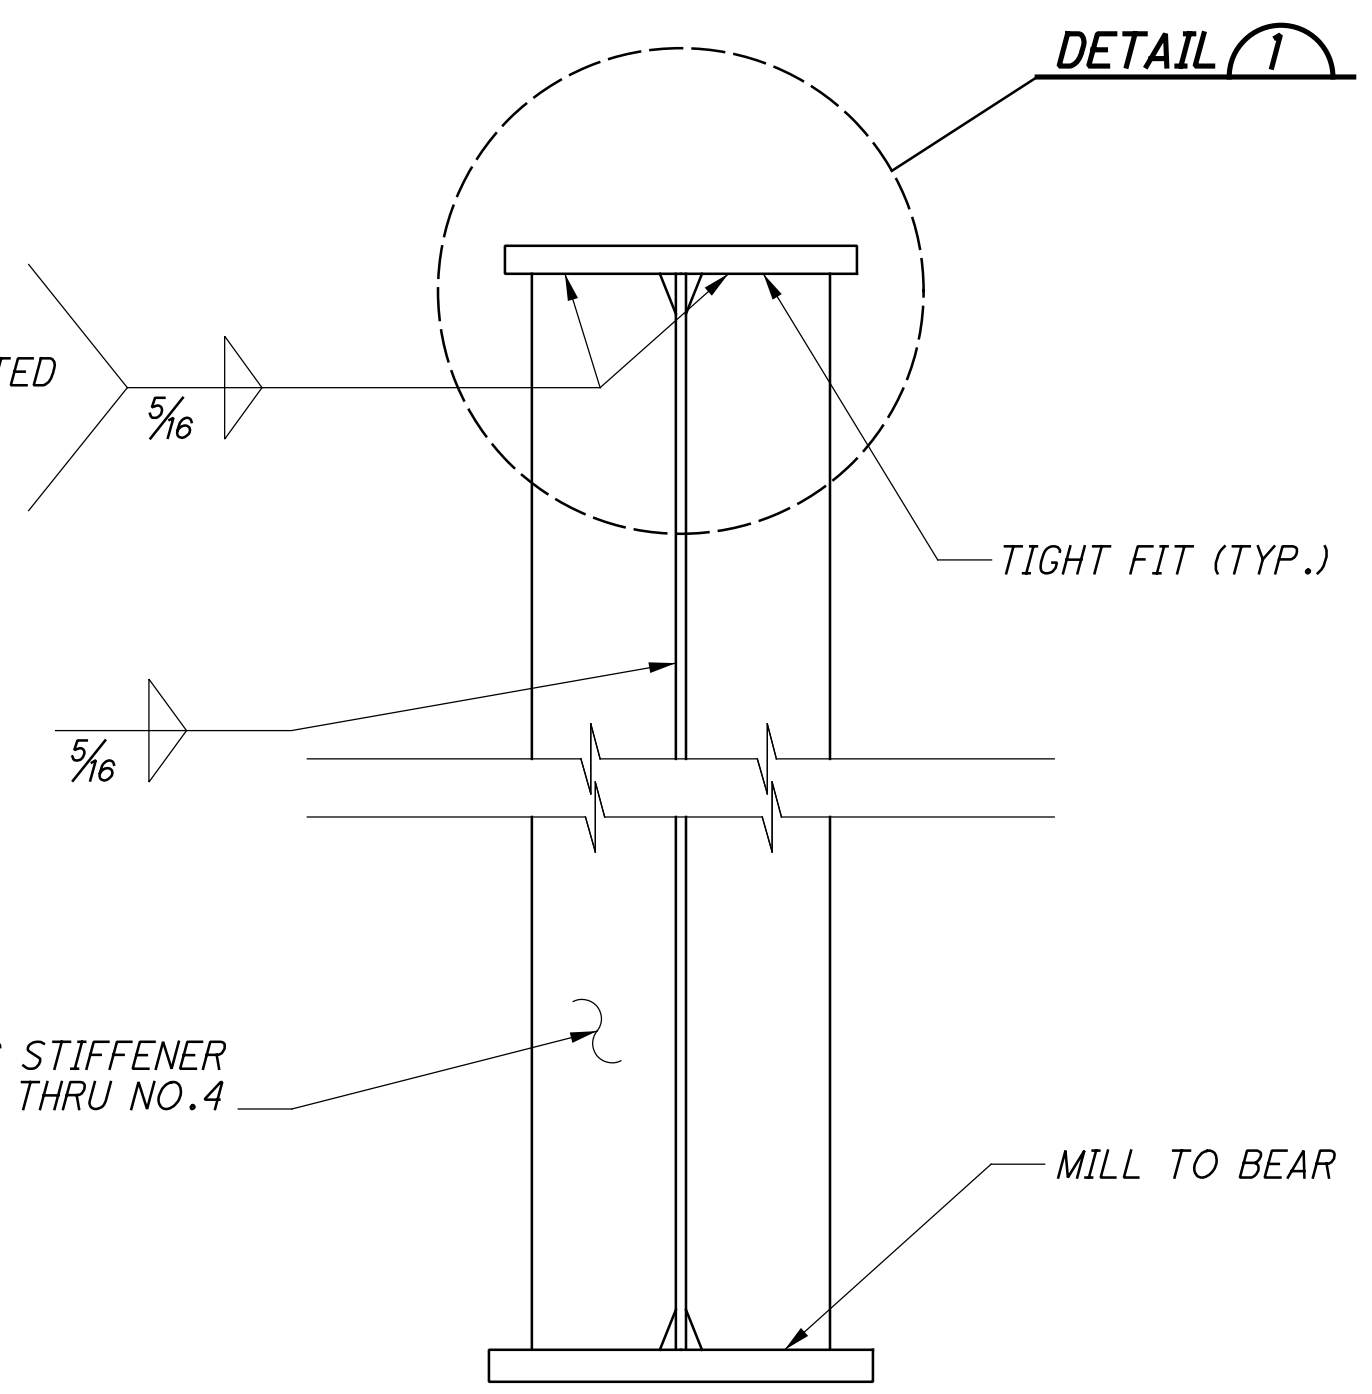

**JACKING STIFFENER**


PLACE JACKING STIFFENERS NORMAL TO GIRDER

\* 5/16 WELD TYPE 1A & 2A CROSSFRAME  
3/8 WELD TYPE 1B & 2B CROSSFRAME

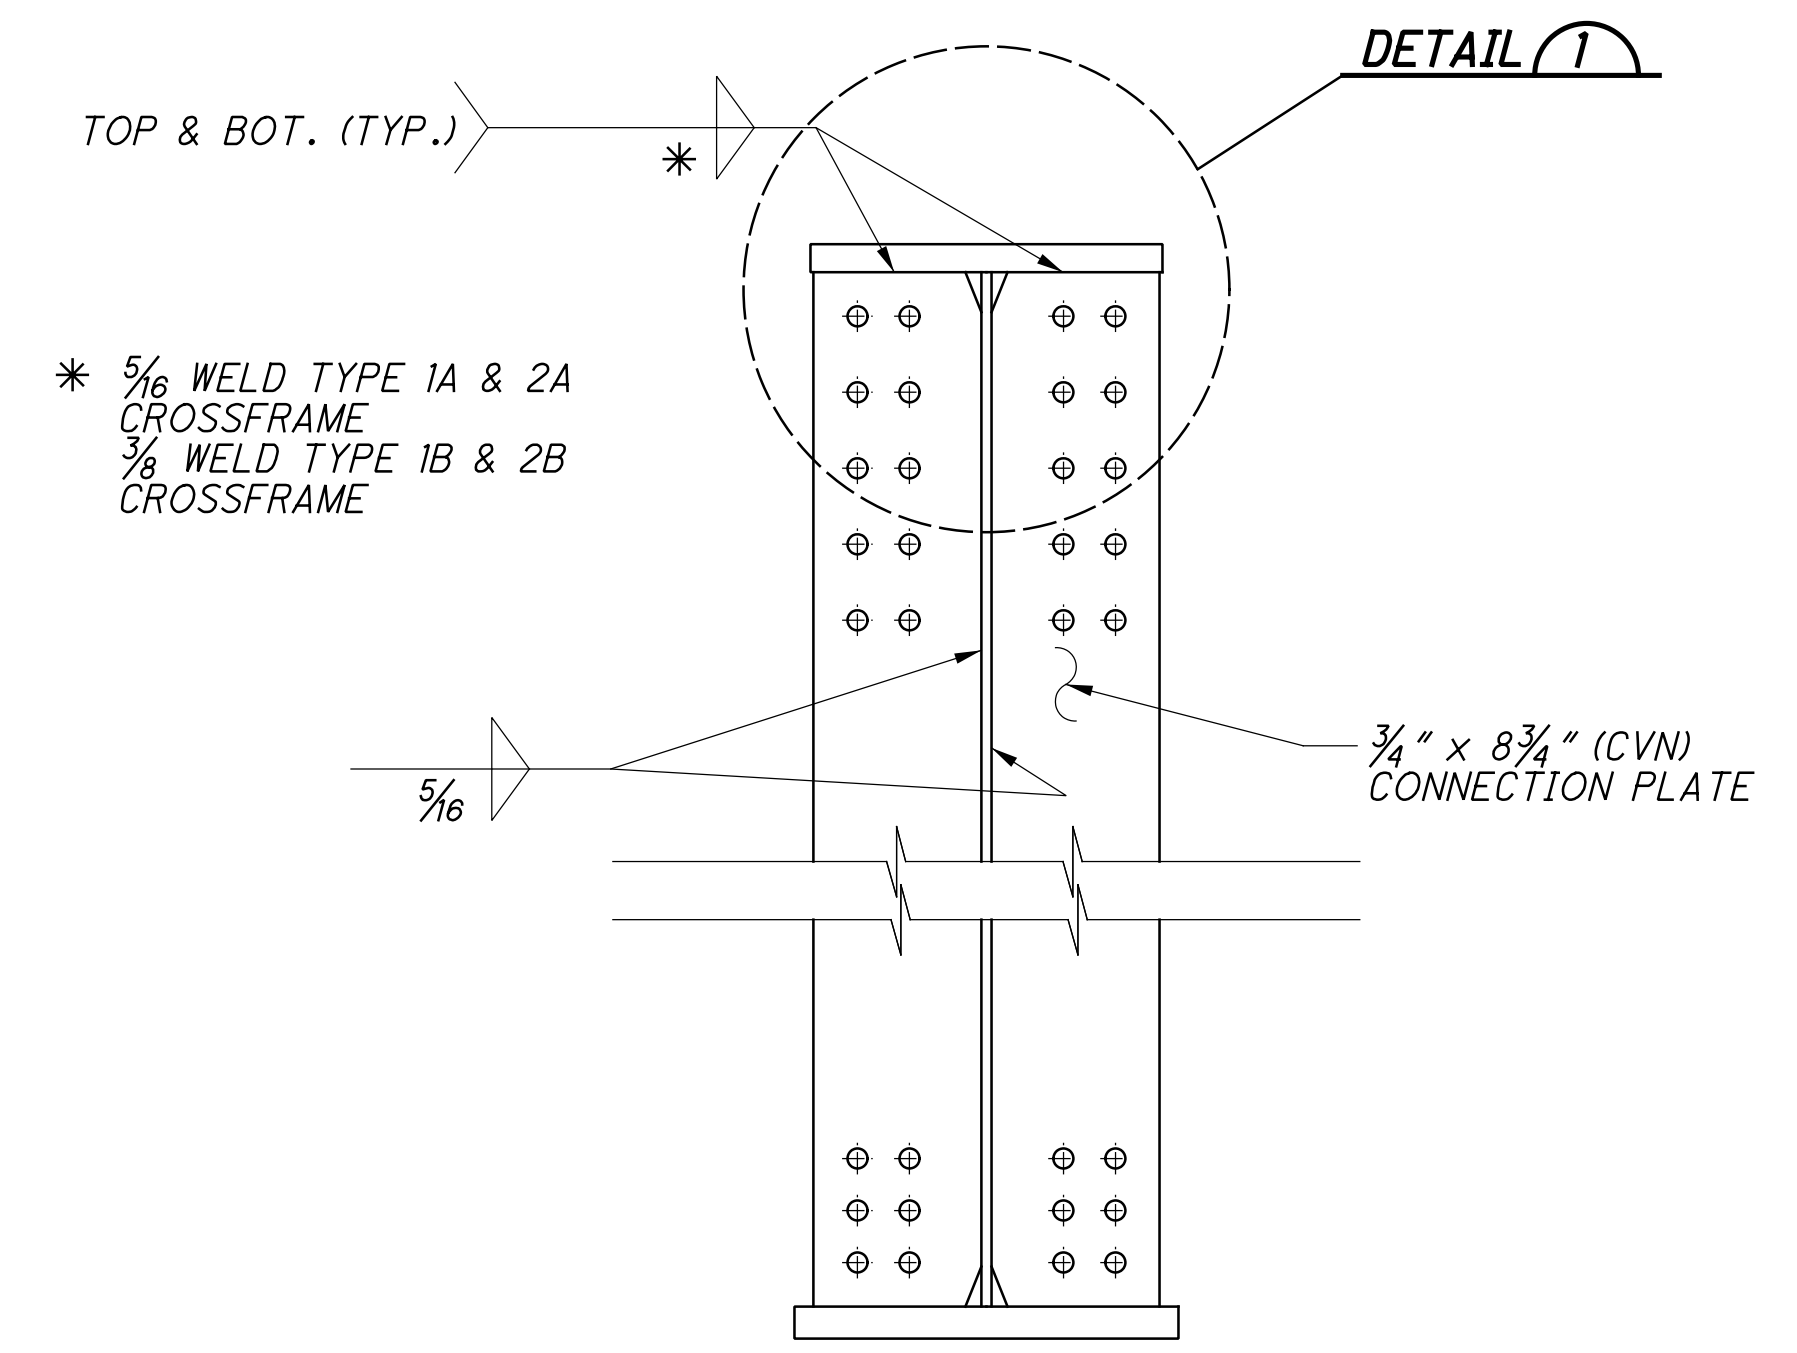


**INTERMEDIATE CROSSFRAME CONNECTION PLATES**

FOR BOLT HOLE LOCATIONS, SEE INTERMEDIATE CROSSFRAME DETAILS.

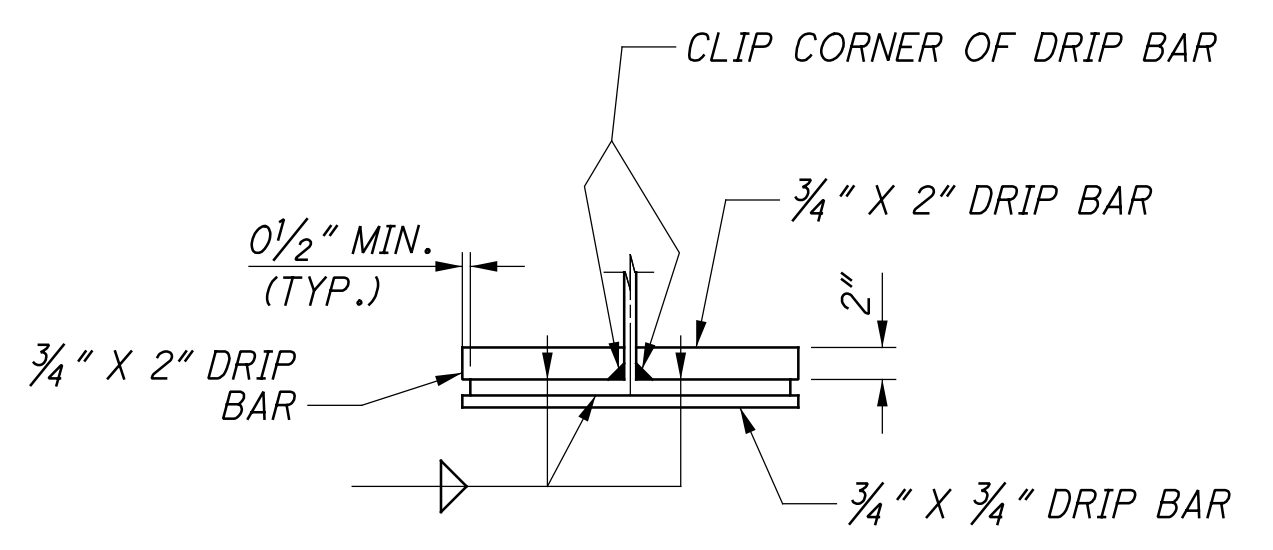


**SECTION C**

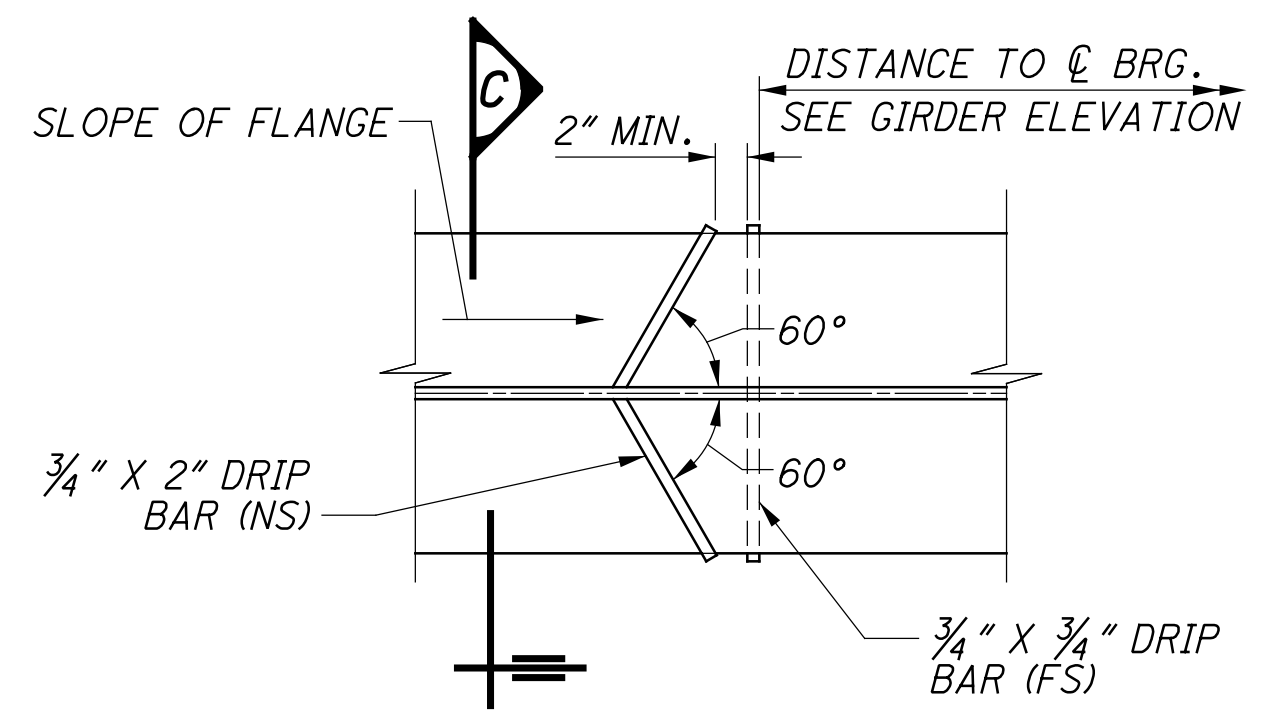

**DRIP BAR DETAIL**

WELD TOP & BOT. FLANGE WITHIN CURVED GIRDER SEGMENTS. WELD TO COMPRESSION FLANGE IN STRAIGHT SEGMENTS.

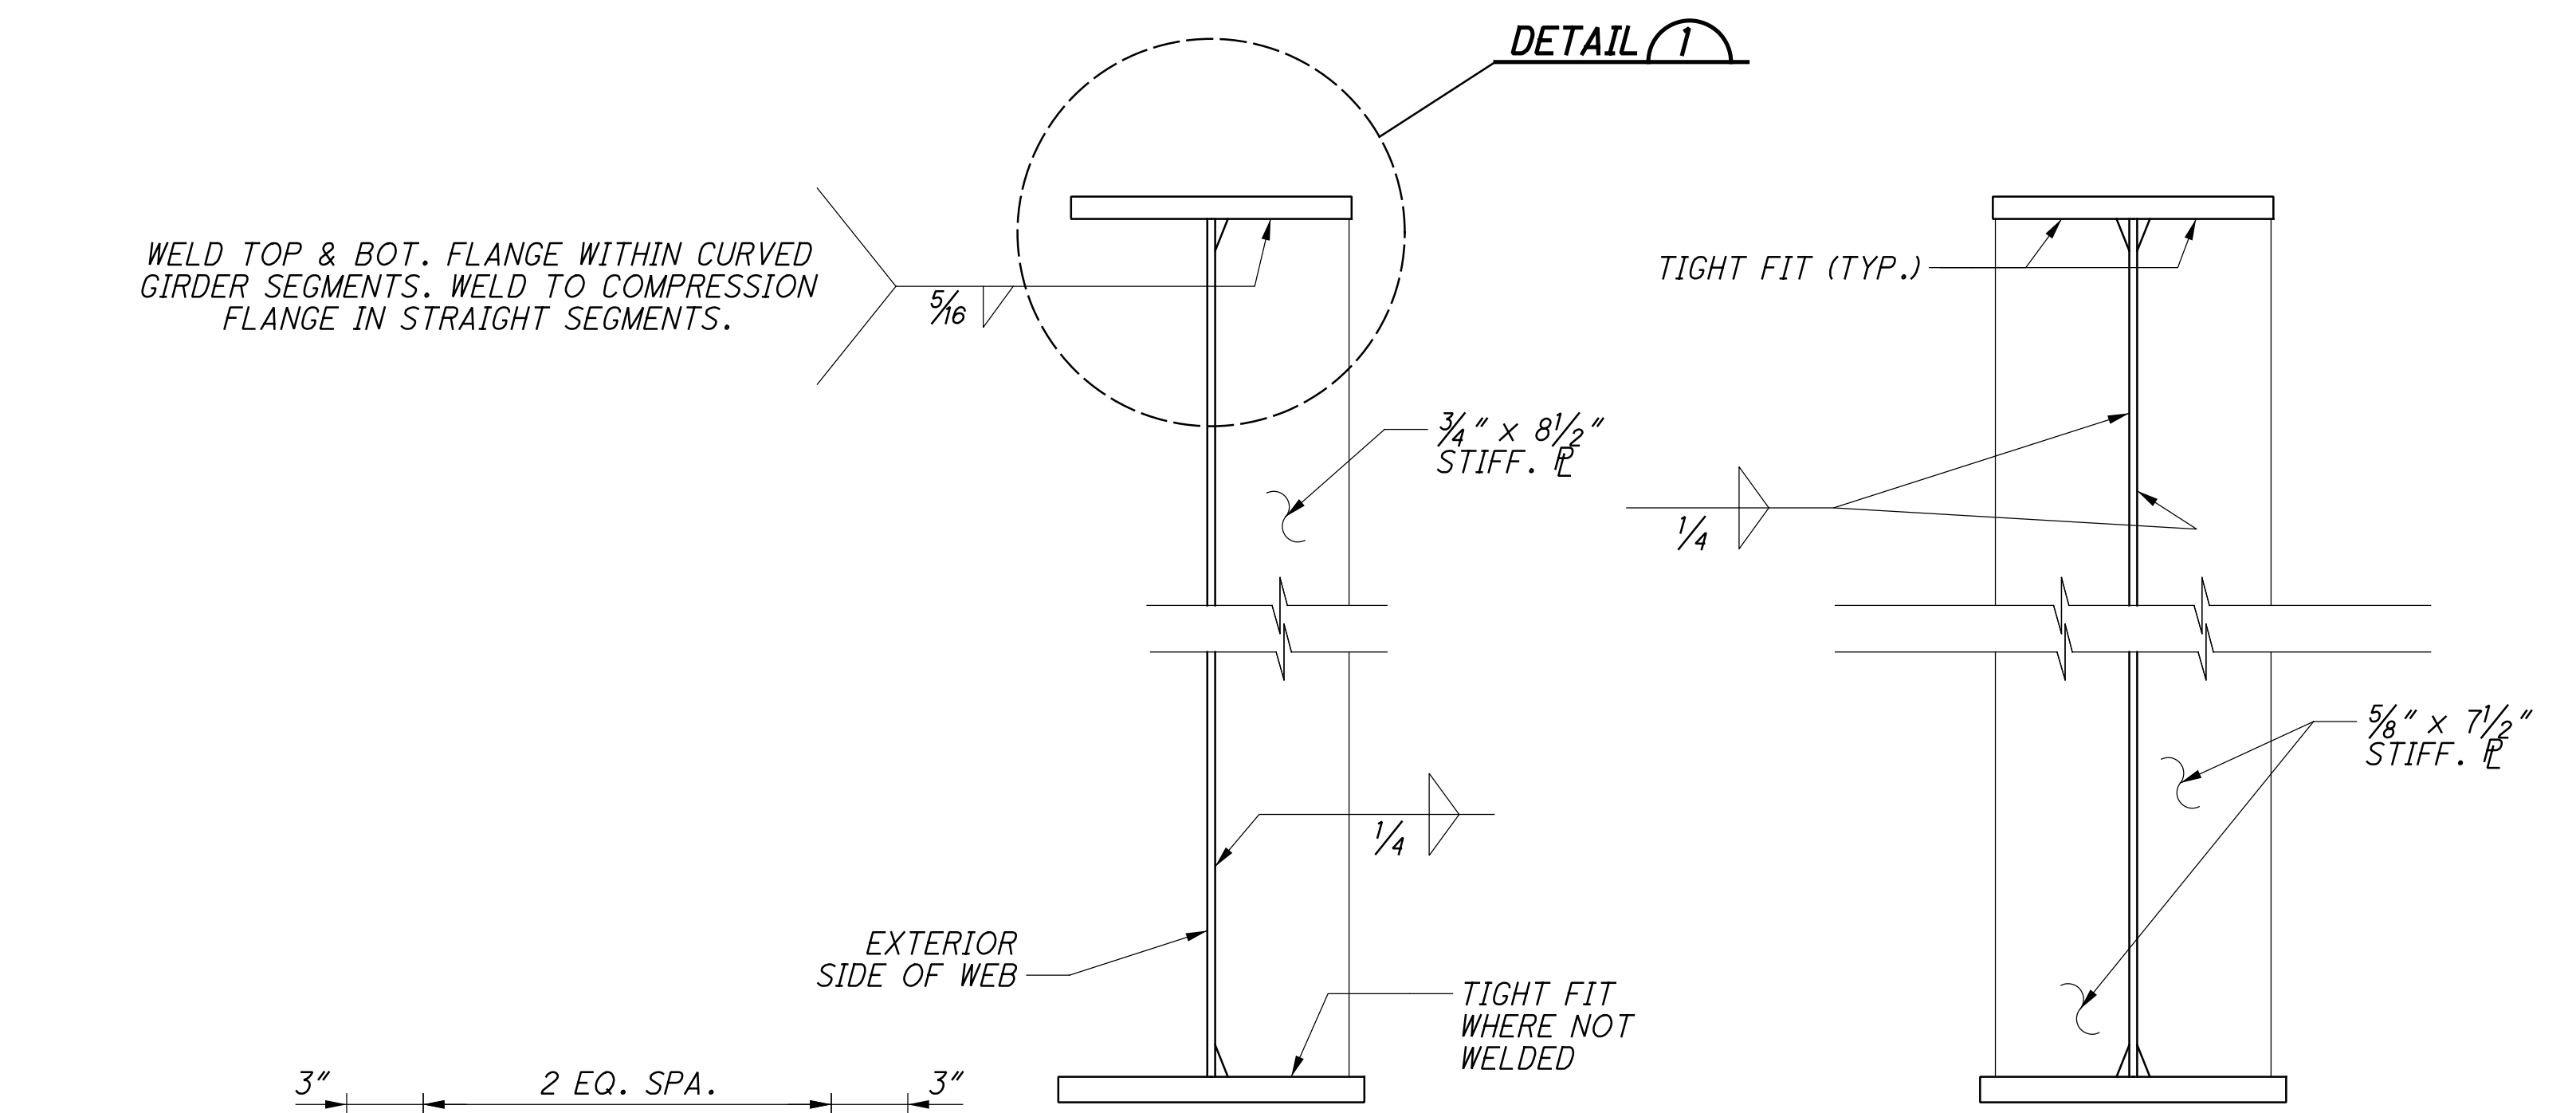


**FASCIA GIRDERS**

**INTERIOR GIRDERS**

**INTERMEDIATE TRANSVERSE STIFFENER PLATES**

PLACE STIFFENER PLATES NORMAL TO GIRDER

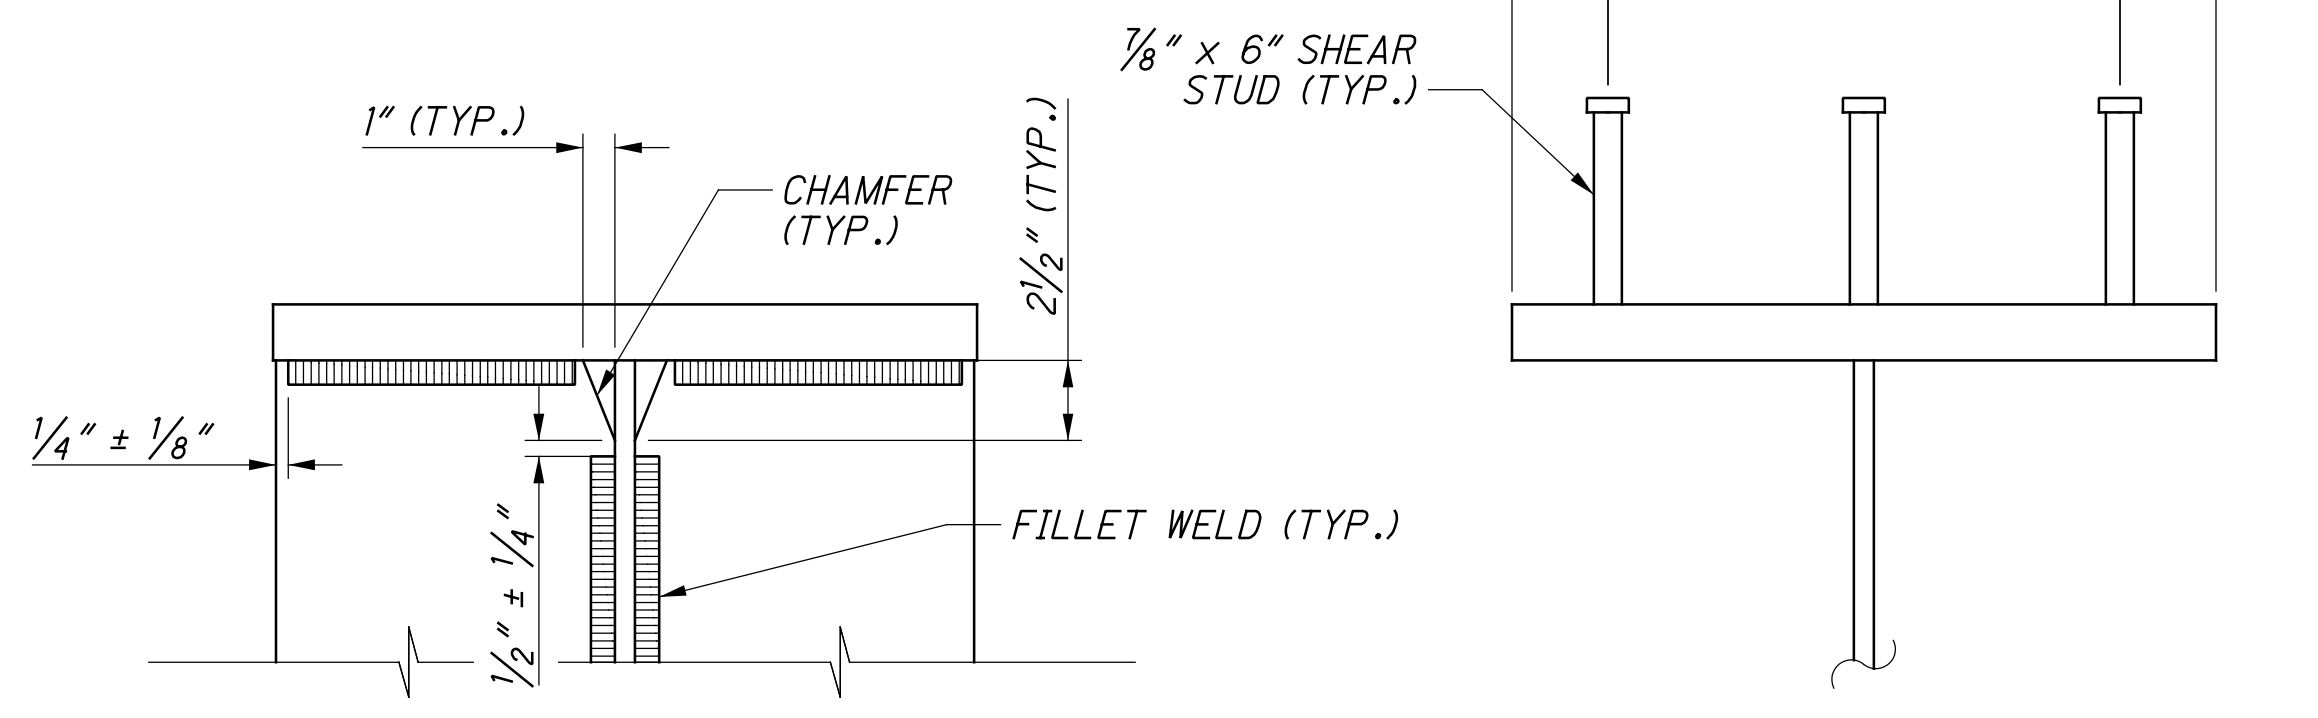

**DETAIL 1**

**SHEAR STUD CONNECTION LAYOUT**

**NOTES:**

1. CVN: WHERE A SHAPE OR PLATE IS DESIGNATED (CVN), FURNISH MATERIAL THAT MEETS THE MINIMUM NOTCH TOUGHNESS REQUIREMENTS AS SPECIFIED IN 711.01.
2. INSTALL STIFFENERS IN ACCORDANCE WITH CMS 513.13 AND AS SPECIFIED HERE IN.

NO.	DESCRIPTION	REV. BY	DATE
3	PLATE SIZE REVISED	DJC	10-23-23

01-2012-2012048 VFRAY7372-STRUCTURES\FR070\_1321R SHEETS\070\_1321RSD015.DGN  
 10/20/2023 11:27:31 PM  
 ODOT\B1STD\_LUSER


**DESIGN AGENCY**  
**GPD GROUP**  
 1000 Wilderness Drive, Suite 200, Co. (PH 423) 854-2025  
 Copyright © 2012, GPD Group, Inc.

**DATE** 4-21-23  
**REVIEWED** RHC  
**STRUCTURE FILE NUMBER** 2510016  
**DESIGNED** TJW/DGN  
**CHECKED** DJC  
**DRAWN** JLH  
**REVISED**


**MISCELLANEOUS GIRDER DETAILS**  
 BRIDGE NO. FRA-70-1321R  
 I-70 E.B. OVER THE SCIOTO RIVER

**FRA-70-13-11**  
**PID No. 77372**

52 / 101  
 475  
 1151

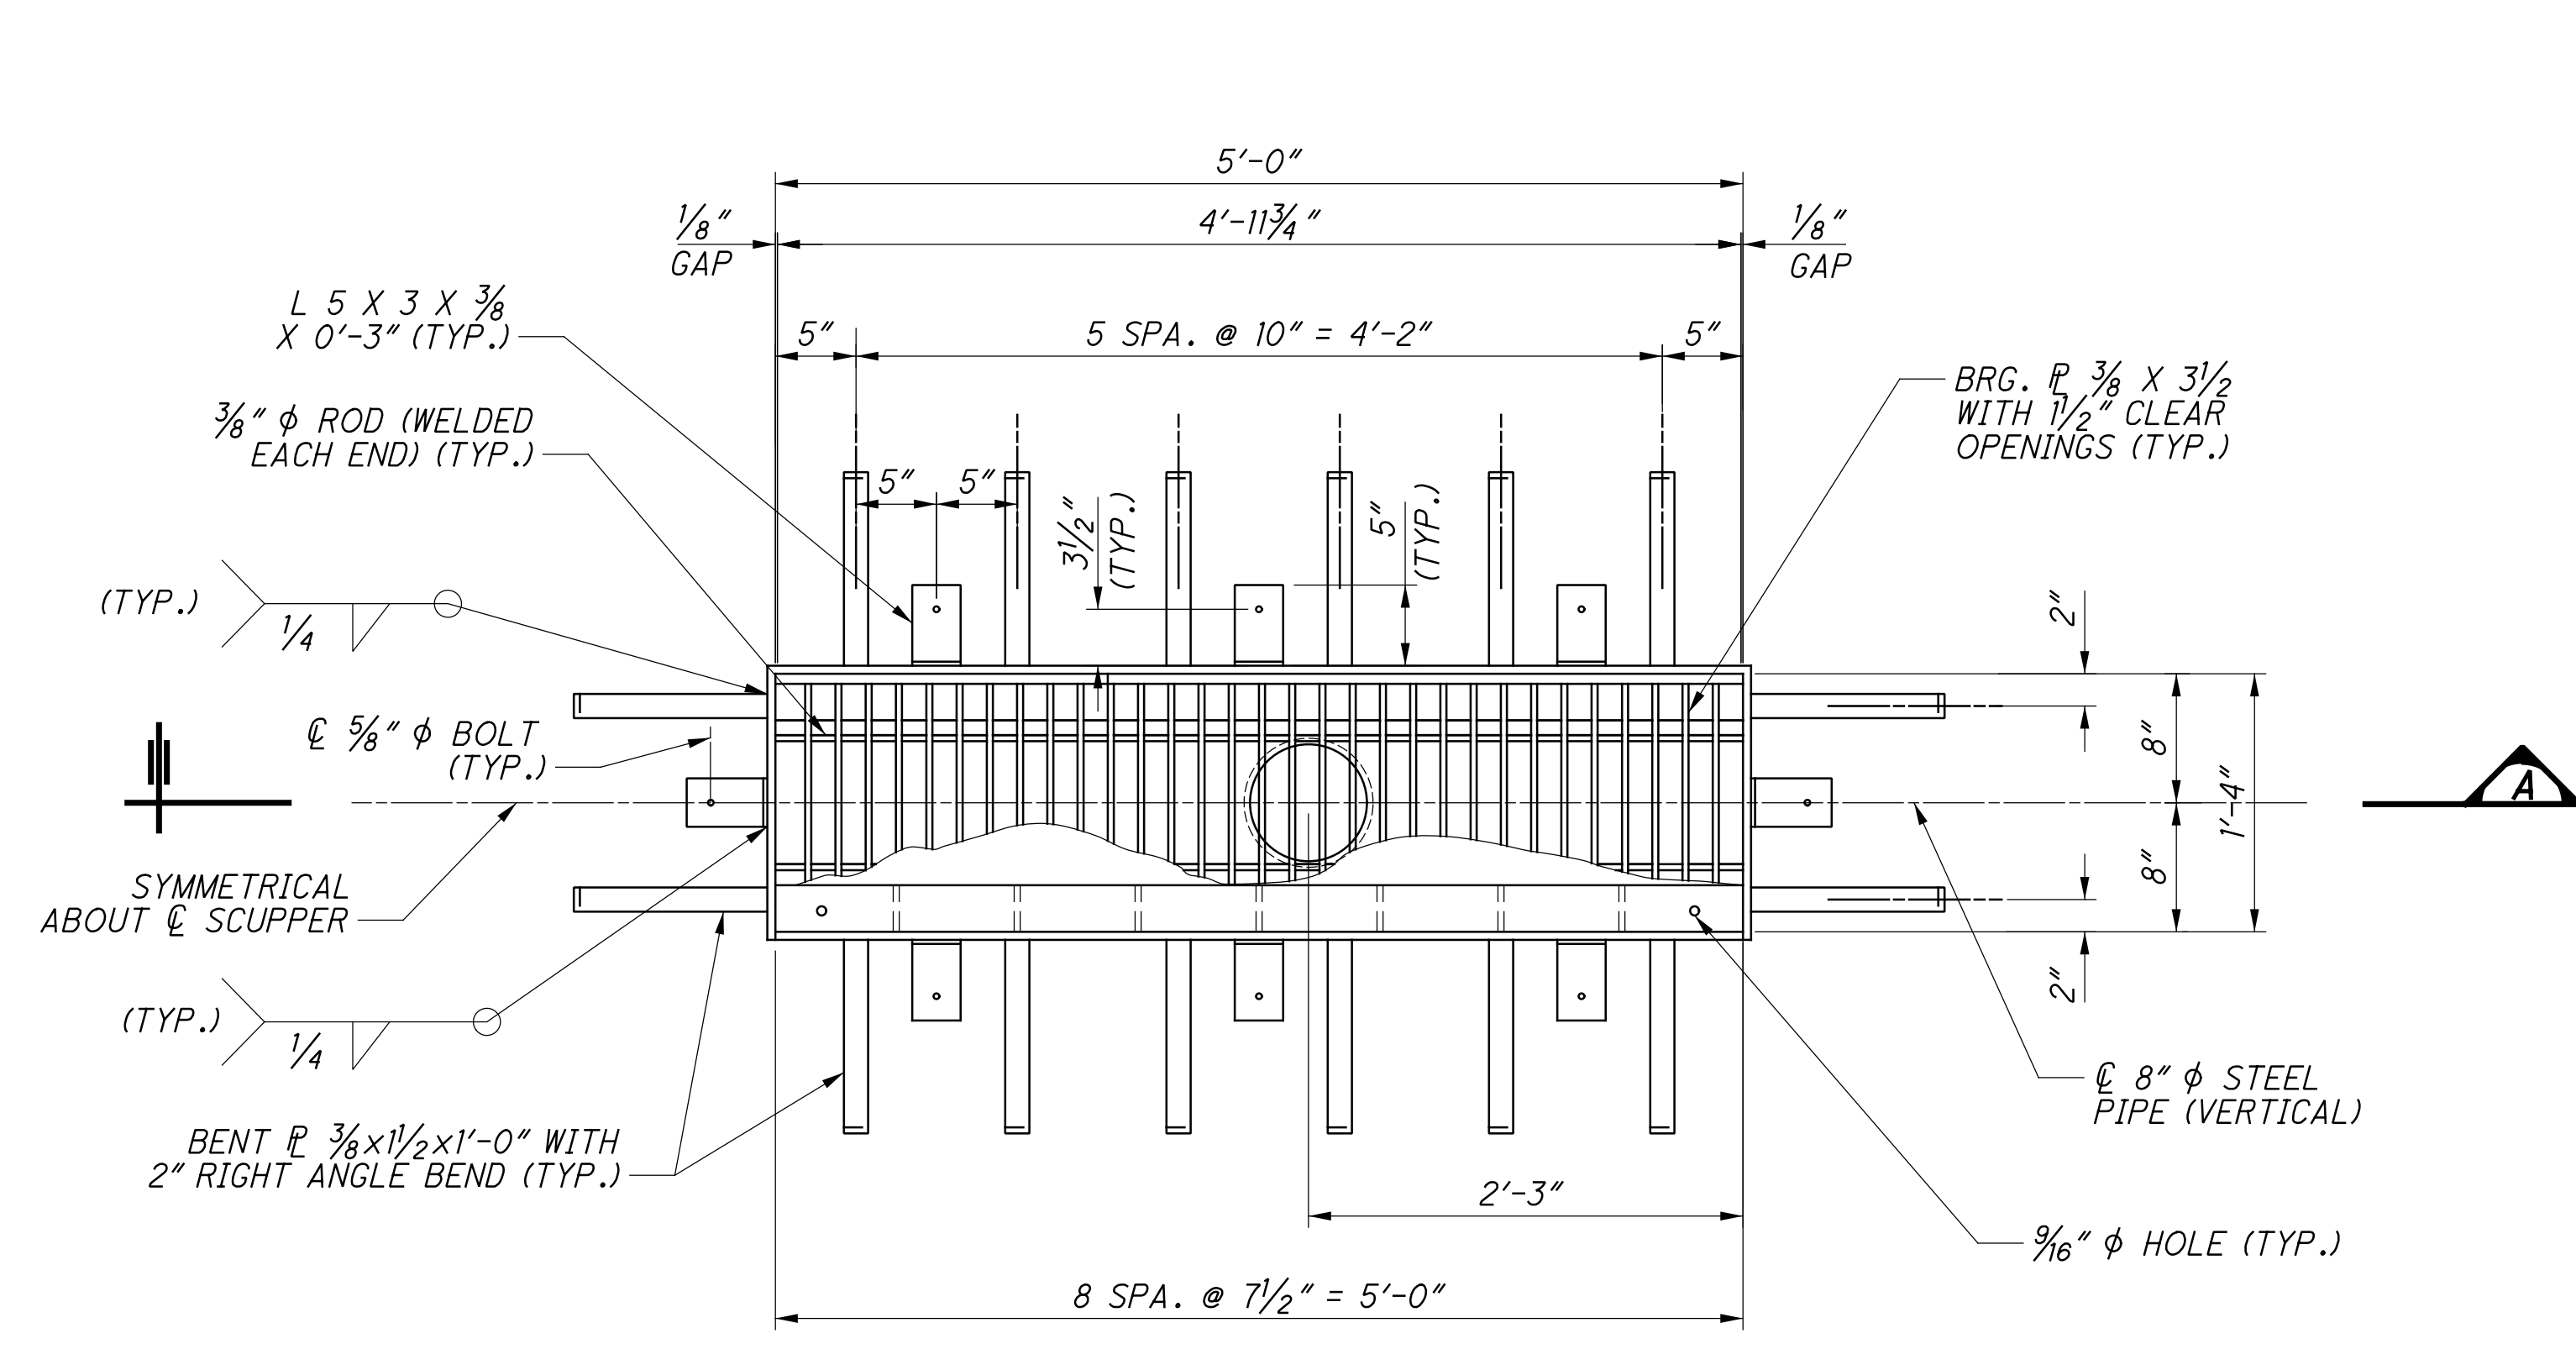


PLAN - TYPICAL SCUPPER

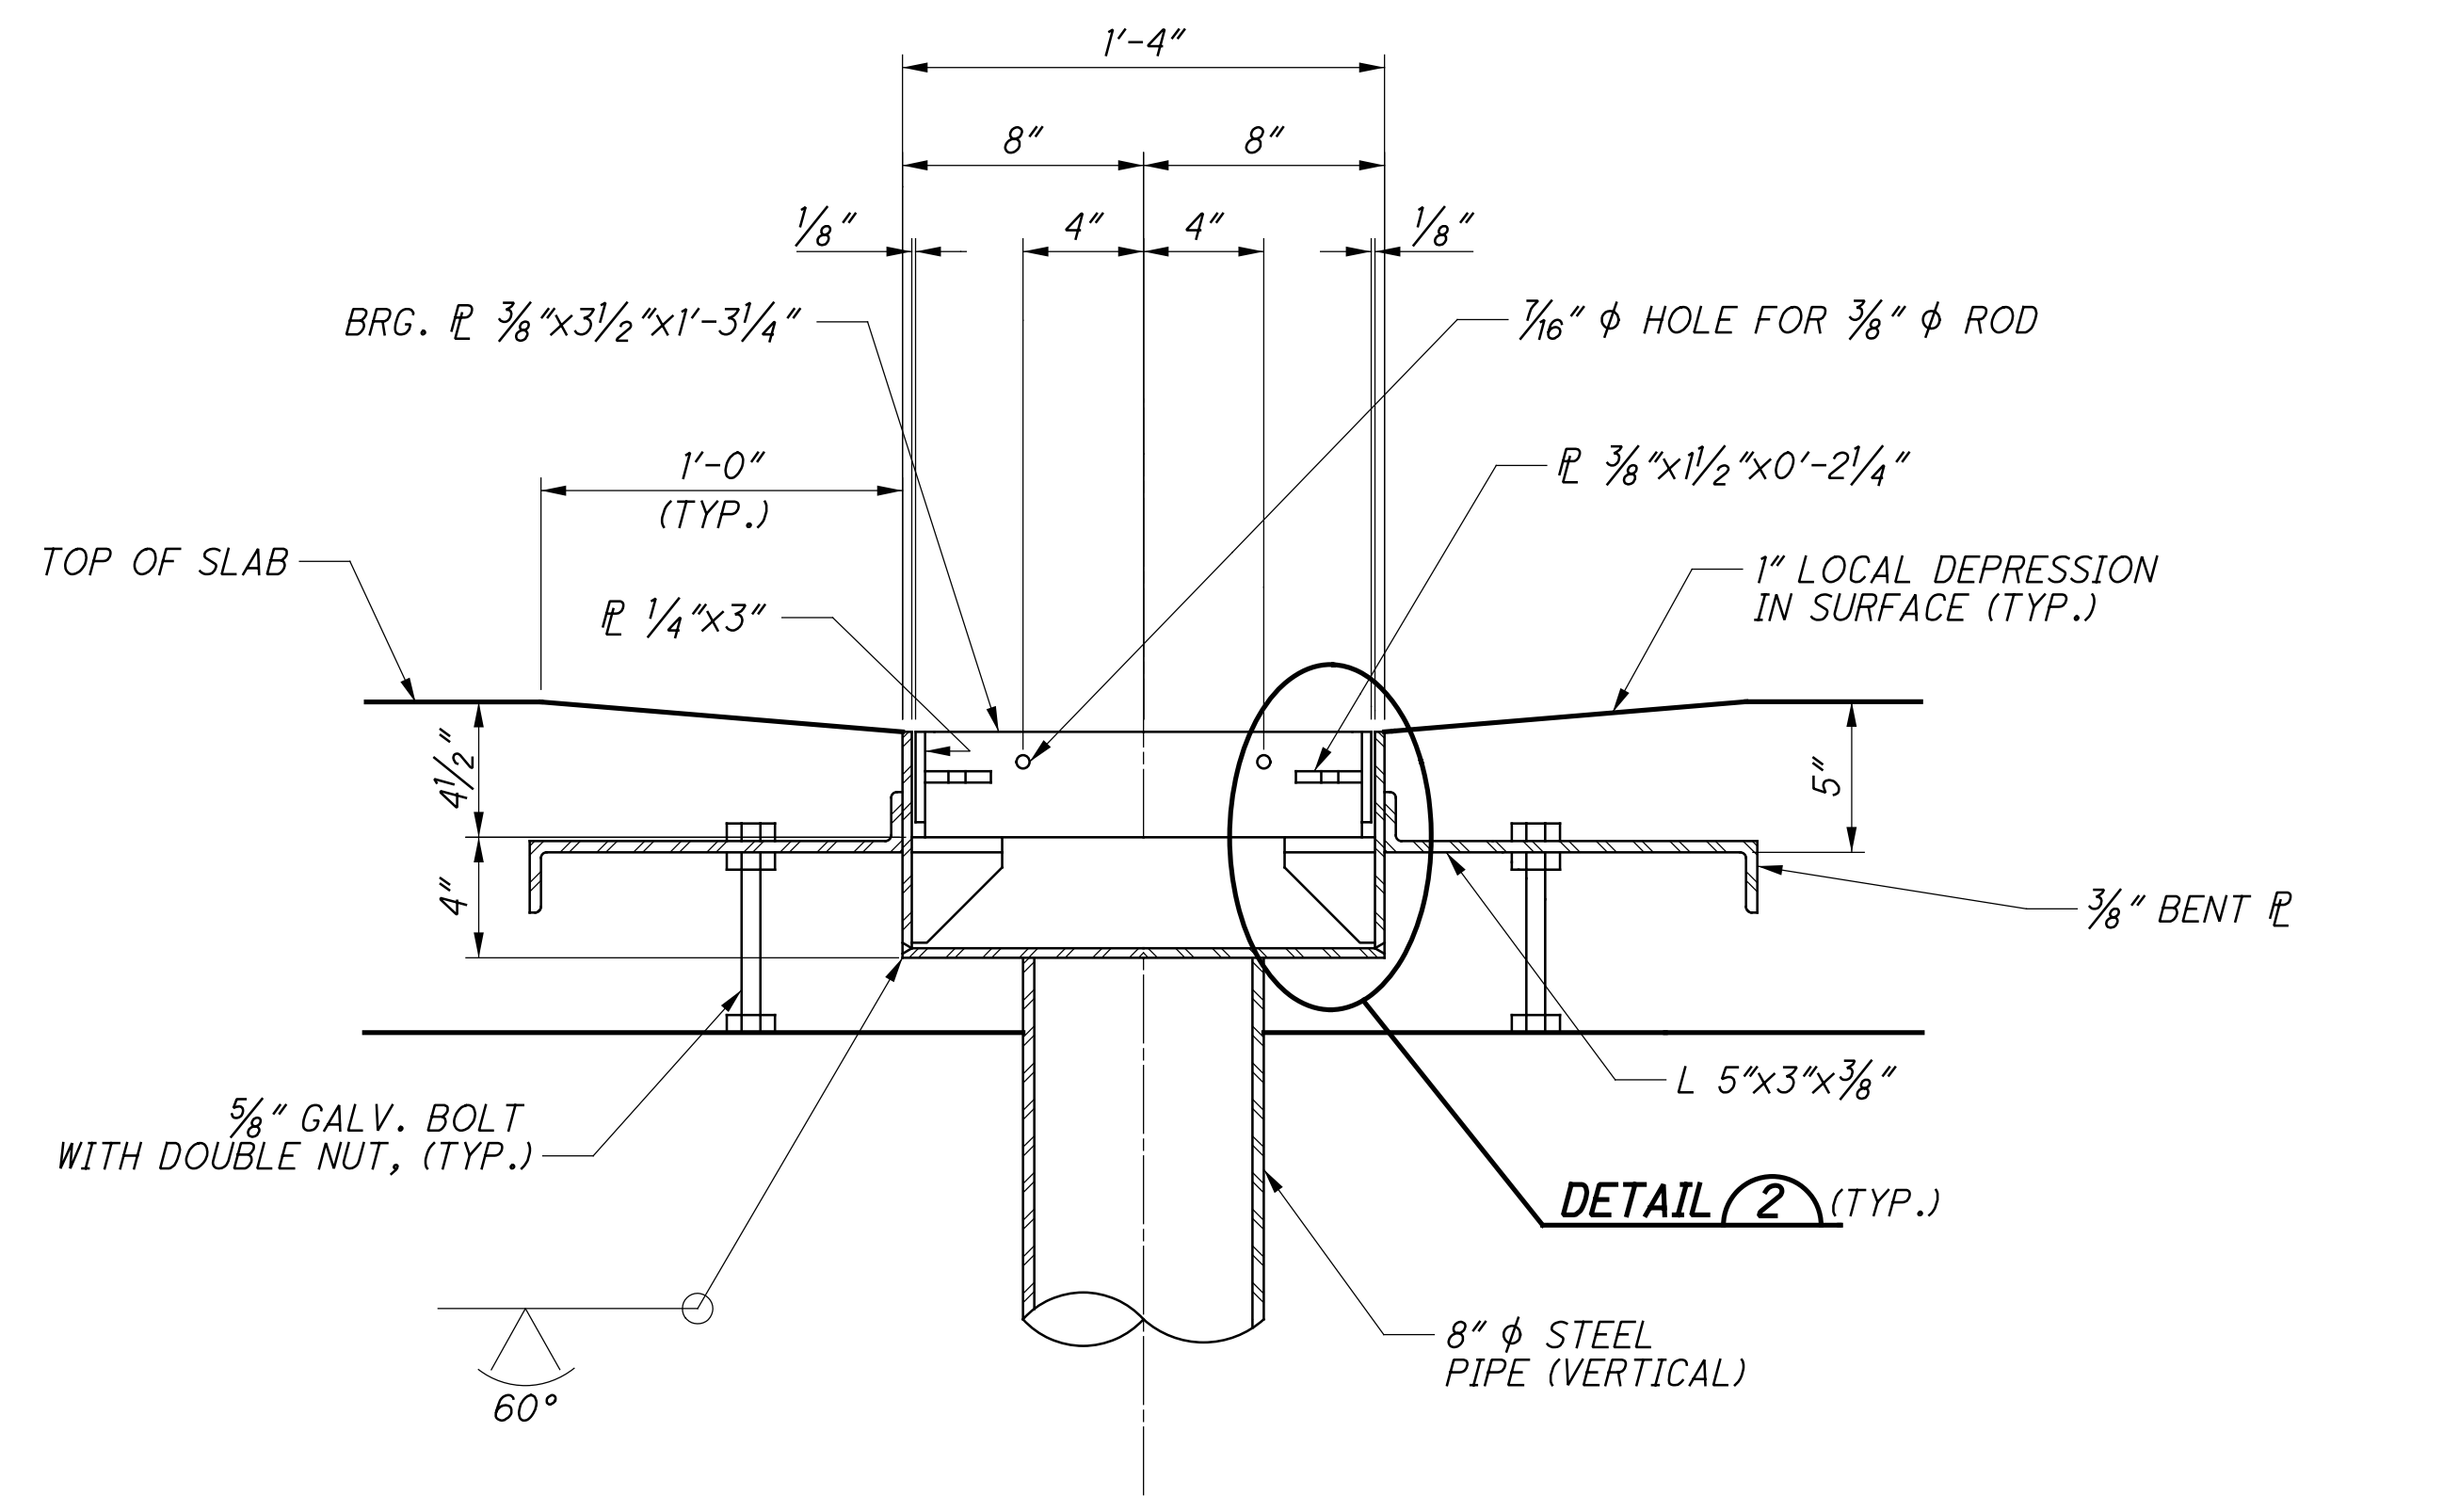


SECTION B

SCUPPER CROSS SLOPE TABLE	
SCUPPER LOCATION	CROSS SLOPE (FT/FT)
148+40 LT	0.0160
<b>149+40 LT</b>	0.0160
151+39 LT	0.0160

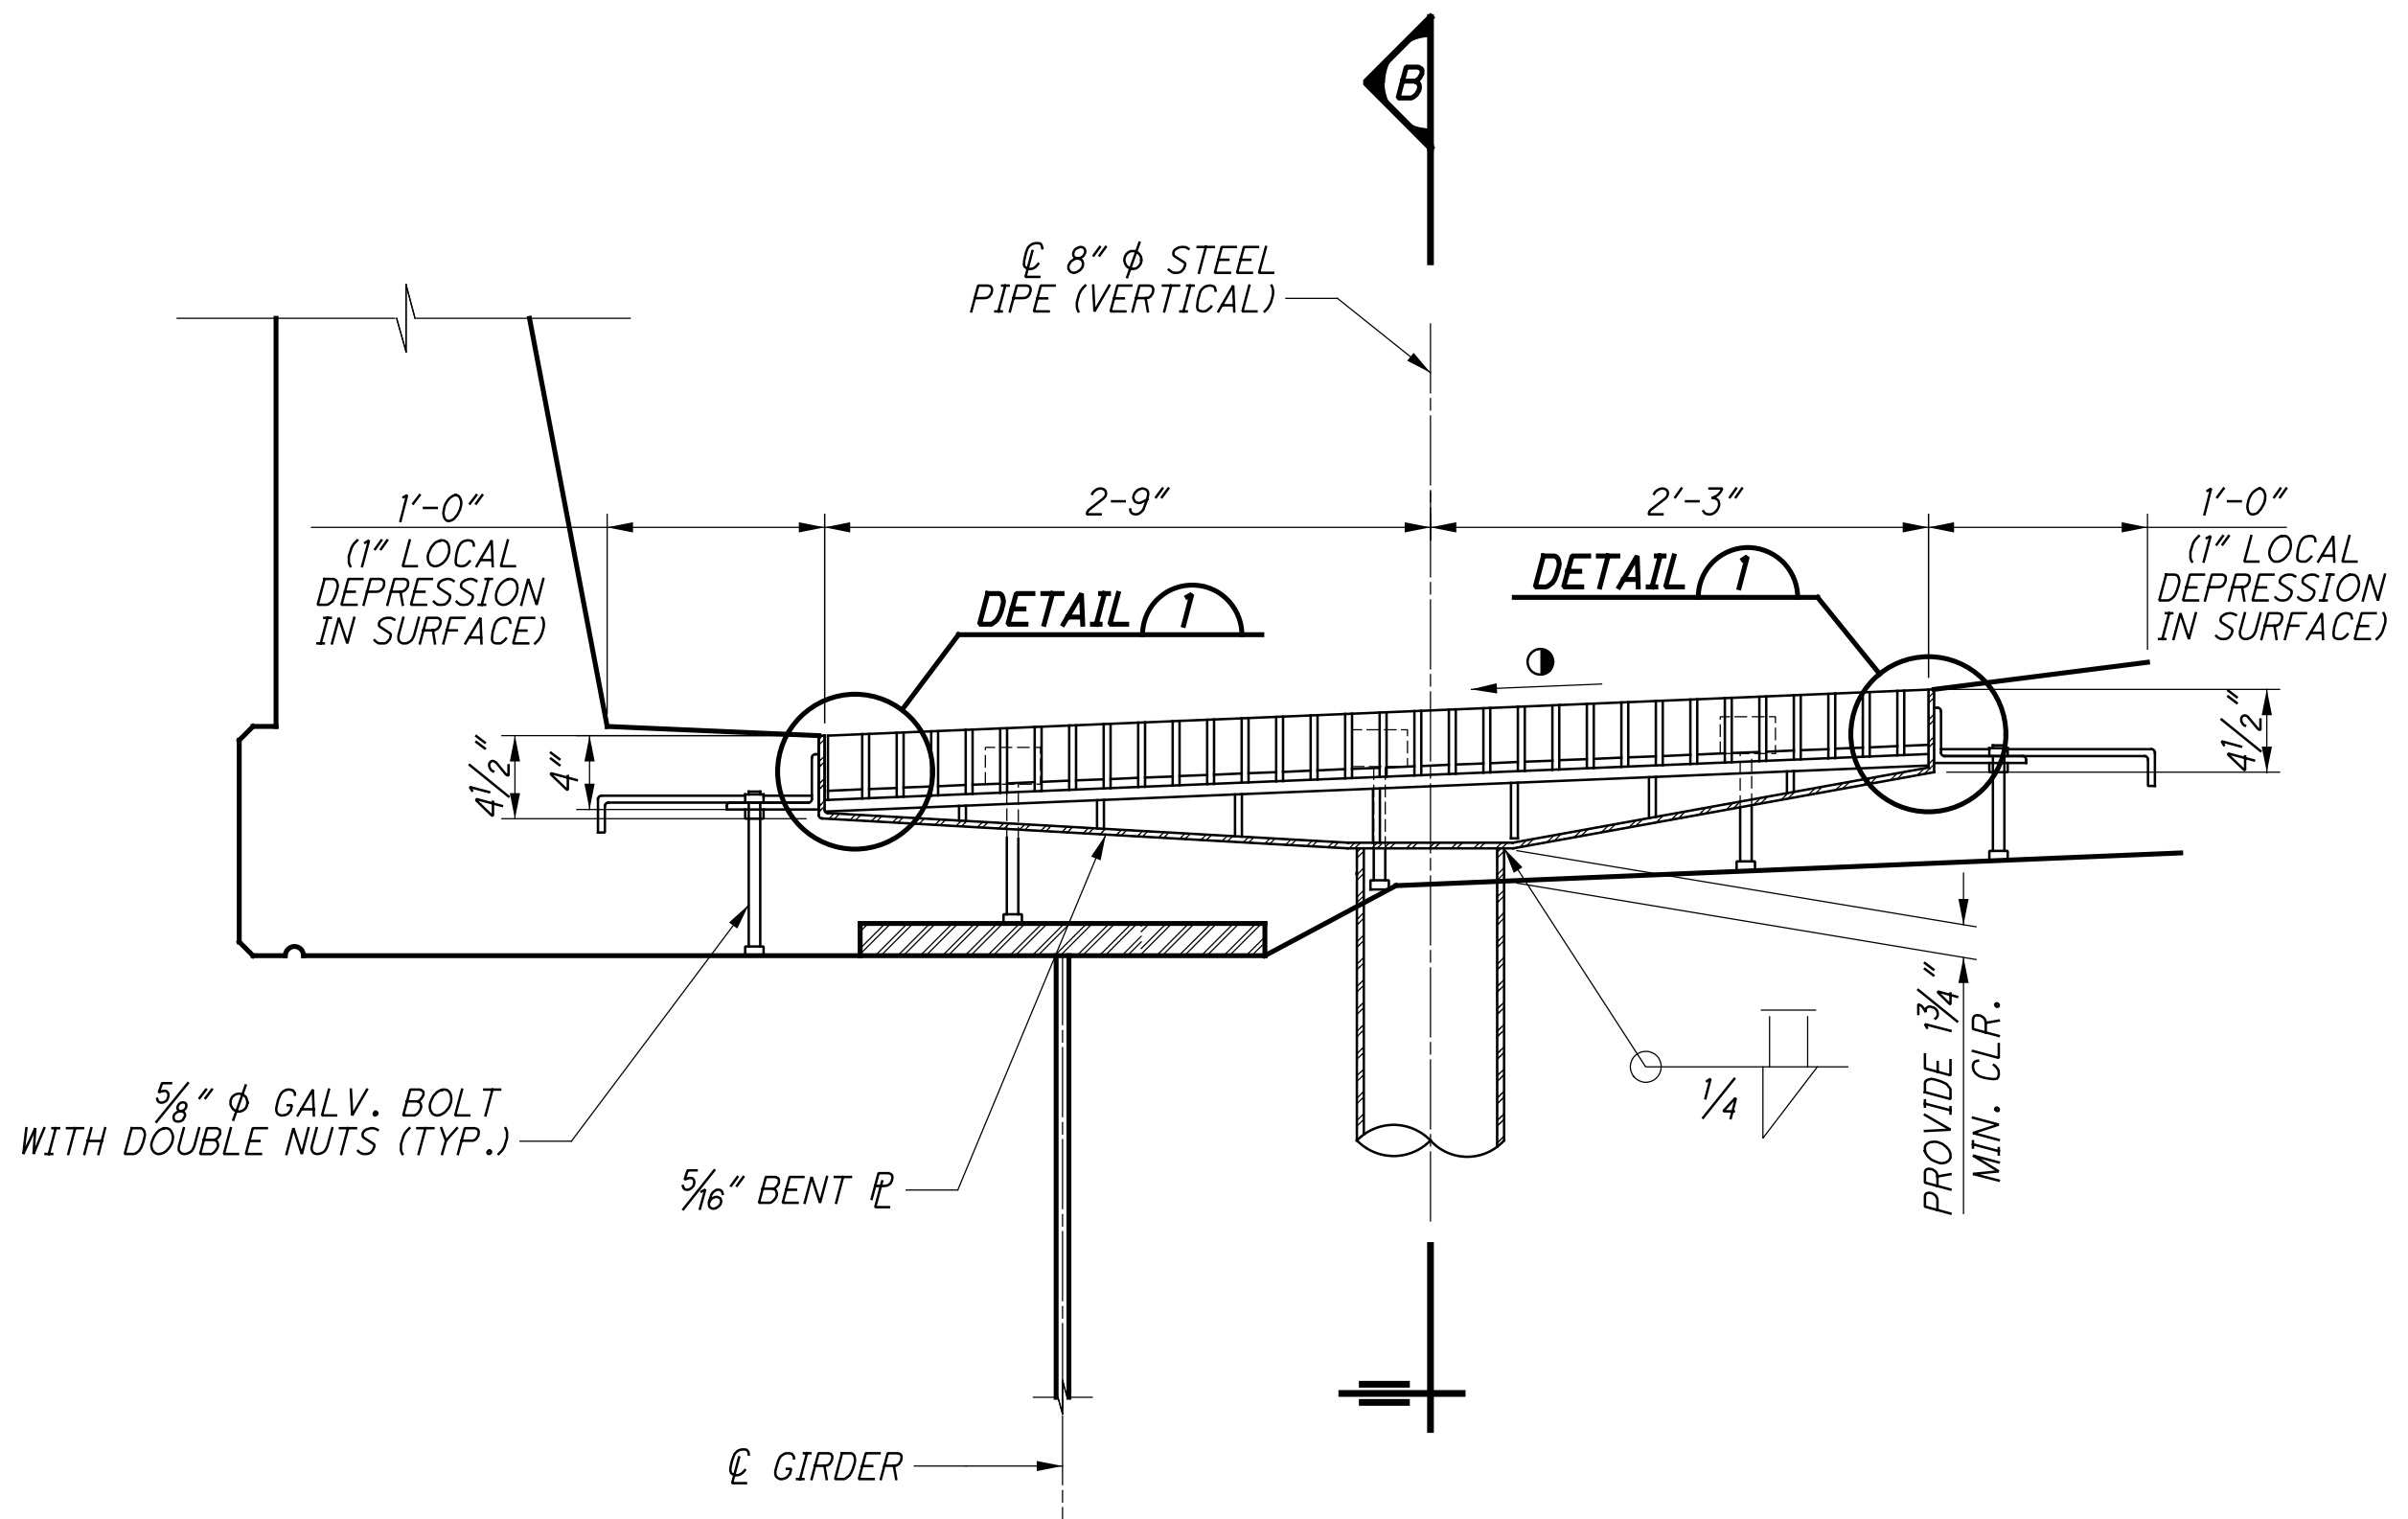

SECTION A

SEE TABLE FOR CROSS SLOPE TO BE PROVIDED IN SCUPPER SURFACE. OUTLET PIPE SHALL BE VERTICAL AFTER ERECTION.

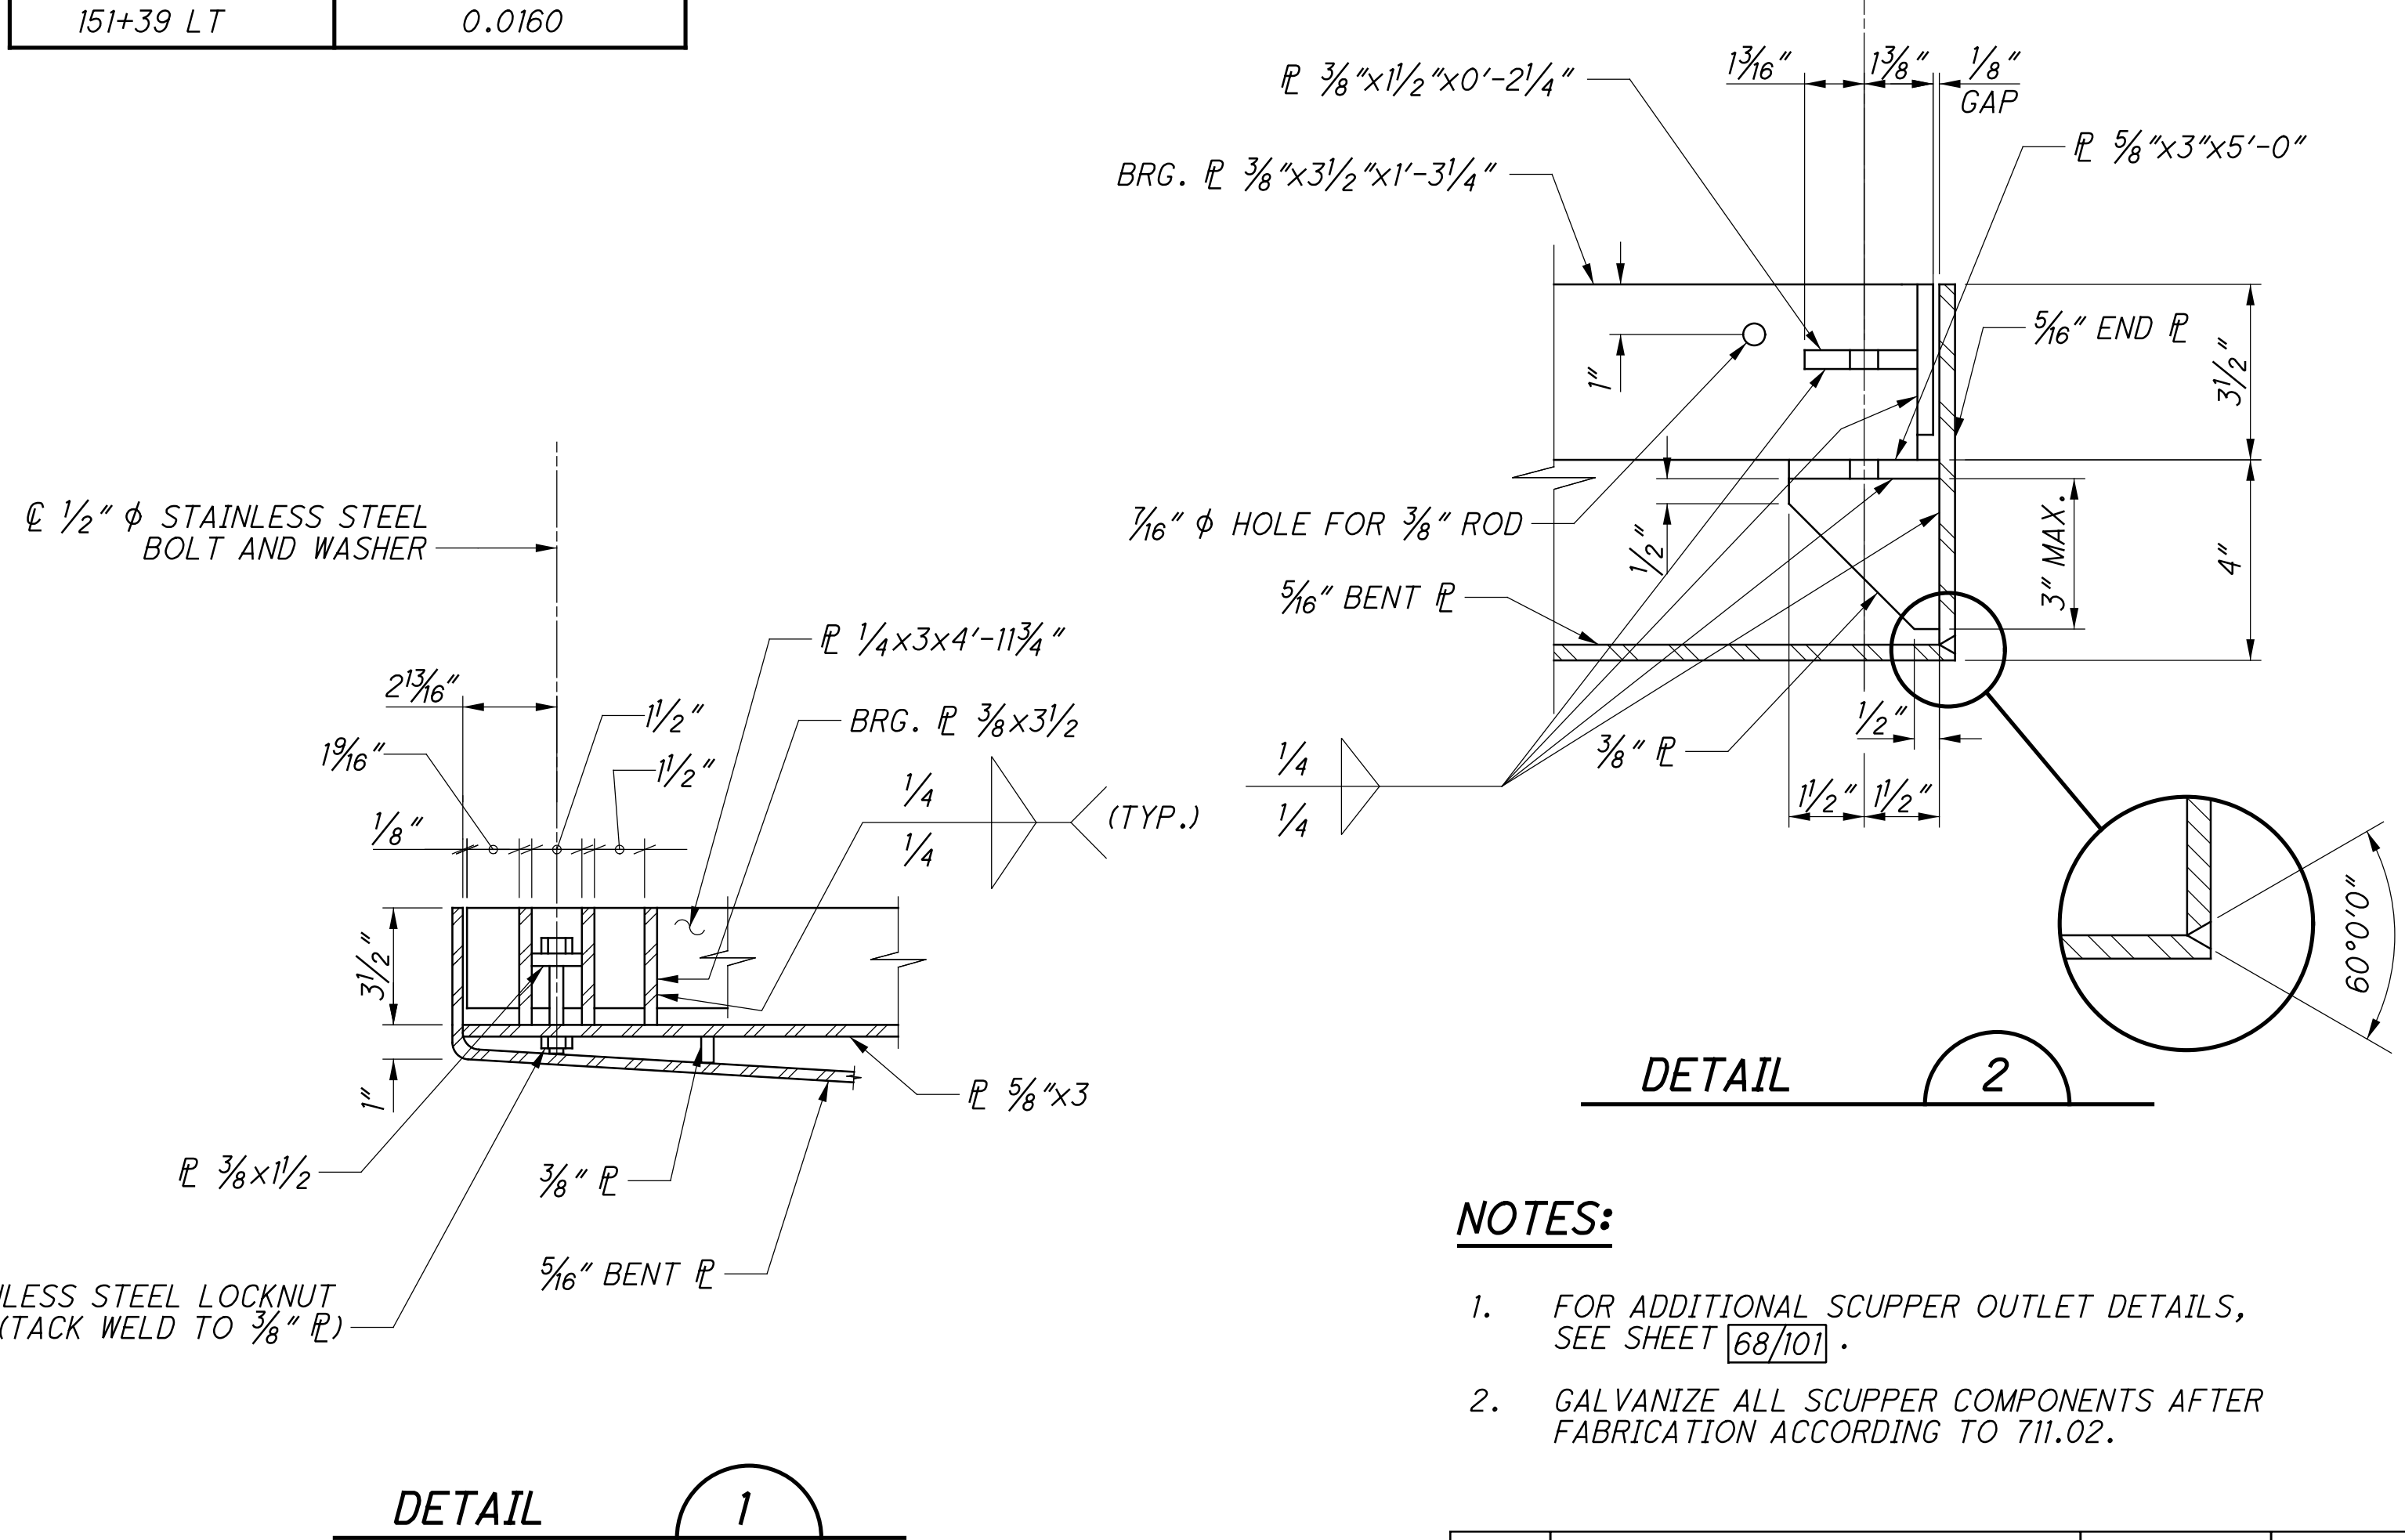

DETAIL 1

DETAIL 2

- NOTES:**
- FOR ADDITIONAL SCUPPER OUTLET DETAILS, SEE SHEET [68/101].
  - GALVANIZE ALL SCUPPER COMPONENTS AFTER FABRICATION ACCORDING TO 711.02.

NO.	DESCRIPTION	REV. BY	DATE
3	TABLE REVISED	DJC	10-23-23

01-2012-2012048 FRA70-1321R STRUCTURES FRA70-1321R SHEETS 070-1321RSD007.DGN  
 10/20/2023 11:57:41 AM  
 ODOT\B1STD\_LJSEB

01\_2012\_20120416\FRA\105596\STRUCTURES\FRA070\_1495C\SHEET\070\_1\_495CE0001.DGN  
 10/20/2023 7:50:34 AM  
 ODOT\B1STD\_USER

ITEM	EXT.	TOTAL	PARTICIPATION			UNITS	DESCRIPTION	ABUTMENT	PIER	SUPER-STRUCTURE	GENERAL	REFERENCE SHEET NO.
			01/IMS/04	02/IMS/11	09/IMS/17/COL							
202	11003	LS		LS			STRUCTURE REMOVED, OVER 20 FOOT SPAN, AS PER PLAN					5
202	22900	400		400		SY	APPROACH SLAB REMOVED				400	
202	23500	1,932		1,932		SY	WEARING COURSE REMOVED				1,932	
503	11101	LS		LS			COFFERDAMS AND EXCAVATION BRACING, AS PER PLAN					4
503	21100	2,175		2,175		CY	UNCLASSIFIED EXCAVATION	1,518	657			
509	10000	318,451		318,451		LB	EPOXY COATED REINFORCING STEEL	86,021	84,244	148,186		
511	34446	544		544		CY	CLASS QC2 CONCRETE WITH QC/QA, BRIDGE DECK			544		
511	41012	252		252		CY	CLASS QC1 CONCRETE WITH QC/QA, PIER ABOVE FOOTINGS		252			
511	44113	572		572		CY	CLASS QC1 CONCRETE WITH QC/QA, ABUTMENT NOT INCLUDING FOOTING, AS PER PLAN	572				4
511	46512	532		532		CY	CLASS QC1 CONCRETE WITH QC/QA, FOOTING	374	158			
511	51513	98		98		CY	CLASS QC2 CONCRETE WITH QC/QA, SIDEWALK, AS PER PLAN			98		4
512	10050	640		640		SY	SEALING OF CONCRETE SURFACES (NON-EPOXY)	13		627		
512	10100	1,071		1,071		SY	SEALING OF CONCRETE SURFACES (EPOXY-URETHANE)	744	327			
512	33000	42		42		SY	TYPE 2 WATERPROOFING	42				
513	10200	12,292	12,292			LB	STRUCTURAL STEEL MEMBERS, LEVEL UF (COC, COC DOT, AND ODOT DUCT BANK SUPPORT)			12,292		
513	10200	12,292			12,292	LB	STRUCTURAL STEEL MEMBERS, LEVEL UF (AT&T DUCT BANK SUPPORT)			12,292		
513	10200	11,837			11,837	LB	STRUCTURAL STEEL MEMBERS, LEVEL UF (AEP DUCT BANK SUPPORT)			11,837		
513	10280	639,400			639,400	LB	STRUCTURAL STEEL MEMBERS, LEVEL 4			639,400		
513	20000	6,090			6,090	EACH	WELDED STUD SHEAR CONNECTORS			6,090		
514	00060	32,100		32,100		SF	FIELD PAINTING STRUCTURAL STEEL, INTERMEDIATE COAT			32,100		
514	00066	32,100		32,100		SF	FIELD PAINTING STRUCTURAL STEEL, FINISH COAT			32,100		
516	10010	166		166		FT	ARMORLESS PREFORMED JOINT SEAL				166	
516	11210	189		189		FT	STRUCTURAL EXPANSION JOINT INCLUDING ELASTOMERIC STRIP SEAL			189		
516	13600	1,215		1,215		SF	1" PREFORMED EXPANSION JOINT FILLER	464	751			
516	13900	189		189		SF	2" PREFORMED EXPANSION JOINT FILLER		189			
516	44101	10		10		EACH	ELASTOMERIC BEARING WITH INTERNAL LAMINATES AND LOAD PLATE (NEOPRENE) 9 1/2" x 1'-4" x 2.67" PAD WITH 10 1/2" x 1'-10" BEVELED PLATE, AS PER PLAN			10		32
516	44101	10		10		EACH	ELASTOMERIC BEARING WITH INTERNAL LAMINATES AND LOAD PLATE (NEOPRENE) 10 1/2" x 1'-5" x 2.67" PAD WITH 11 1/2" x 1'-10" BEVELED PLATE, AS PER PLAN			10		32
516	44201	10		10		EACH	ELASTOMERIC BEARING WITH INTERNAL LAMINATES AND LOAD PLATE (NEOPRENE) 1'-5" x 2'-2" x 3.21" PAD WITH 1'-6" x 2'-11" BEVELED PLATE, AS PER PLAN			10		32
518	21200	146		146		CY	POROUS BACKFILL WITH GEOTEXTILE FABRIC	146				
518	40000	290		290		FT	6" PERFORATED CORRUGATED PLASTIC PIPE	290				
524	94997	1,056		1,056		FT	DRILLED SHAFTS, 96" DIAMETER, ABOVE BEDROCK, AS PER PLAN	1,056				4
524	95100	1		1		EACH	DRILLED SHAFTS, MISC.: CSL TESTING, 96" DIAMETER SHAFT	1				4
526	25011	196		196		SY	REINFORCED CONCRETE APPROACH SLABS WITH QC/QA (T=15"), AS PER PLAN				196	49
526	30011	216		216		SY	REINFORCED CONCRETE APPROACH SLABS WITH QC/QA (T=17"), AS PER PLAN				216	49
526	90031	170		170		FT	TYPE C INSTALLATION, AS PER PLAN				170	49
622	10160	185		185		FT	CONCRETE BARRIER, SINGLE SLOPE, TYPE D		185			
622	25050	2		2		EACH	CONCRETE BARRIER, END ANCHORAGE, REINFORCED, TYPE D		2			
625	10620	5		5		EACH	LIGHT POLE ANCHOR BOLTS, MISC.: LIGHT POLE AND PEDESTRIAN POLE ANCHOR BOLT ASSEMBLIES EMBEDDED IN CONCRETE BRIDGE DECK			5		5
867	00100	LS		LS			TEMPORARY WIRE FACED MECHANICALLY STABILIZED EARTH WALL					
894	10000	12		12			THERMAL INTEGRITY PROFILER (T.I.P.) TEST	12				
SPECIAL	53000200	LS		LS			STRUCTURES: LUMEN COMMUNICATION DUCT BANK COMPLETE					5
SPECIAL	53000200	LS	LS				STRUCTURES: CITY OF COLUMBUS DUCT BANK COMPLETE					5
SPECIAL	53000200	LS	LS				STRUCTURES: CITY OF COLUMBUS (DEPARTMENT OF TECH) DUCT BANK COMPLETE					5
SPECIAL	53000200	LS	LS				STRUCTURES: ODOT DUCT BANK COMPLETE					5
SPECIAL	53000200	LS		LS			STRUCTURES: AT&T DUCT BANK COMPLETE					5
SPECIAL	53000200	LS		LS			STRUCTURES: TEMPORARY UTILITY SUPPORTS					5
SPECIAL	53000200	LS		LS			STRUCTURES: AEP DUCT BANK COMPLETE					5
SPECIAL	53000600	2,866		2,866		SF	STRUCTURES: PRECAST FACADE PANELS	2,866				5

CALCULATED: RHC  
 DATE: 6-25-20  
 CHECKED: MOJ  
 DATE: 6-26-20

NO.	DESCRIPTION	REV. BY	DATE
3	QUANTITY REVISED	DJC	10-23-23

FRA-70-14.05C  
 PID No. 105596


6/55  
 207  
 395

ESTIMATED QUANTITIES  
 BRIDGE NO. FRA-70-1405C  
 S. HIGH STREET (U.S. 23D) OVER I-70/71

DESIGNED	MOJ	CHECKED	RHC
DRAWN	MOJ	REVISED	
REVIEWED	DGN	STRUCTURE FILE NUMBER	2510024
DATE	4-21-23		

DESIGN AGENCY  
**GPD GROUP**  
 100 Watermark Drive, Suite 200, Columbus, OH 43240  
 614.202.0751

01\_2012\_20120416\FRA\105596\STRUCTURES\FRA070\_1\_405C\SHEET\070\_1\_405CSD003.DGN  
 10/19/2023 5:03:14 PM  
 ODOT\B1STD\LUSER

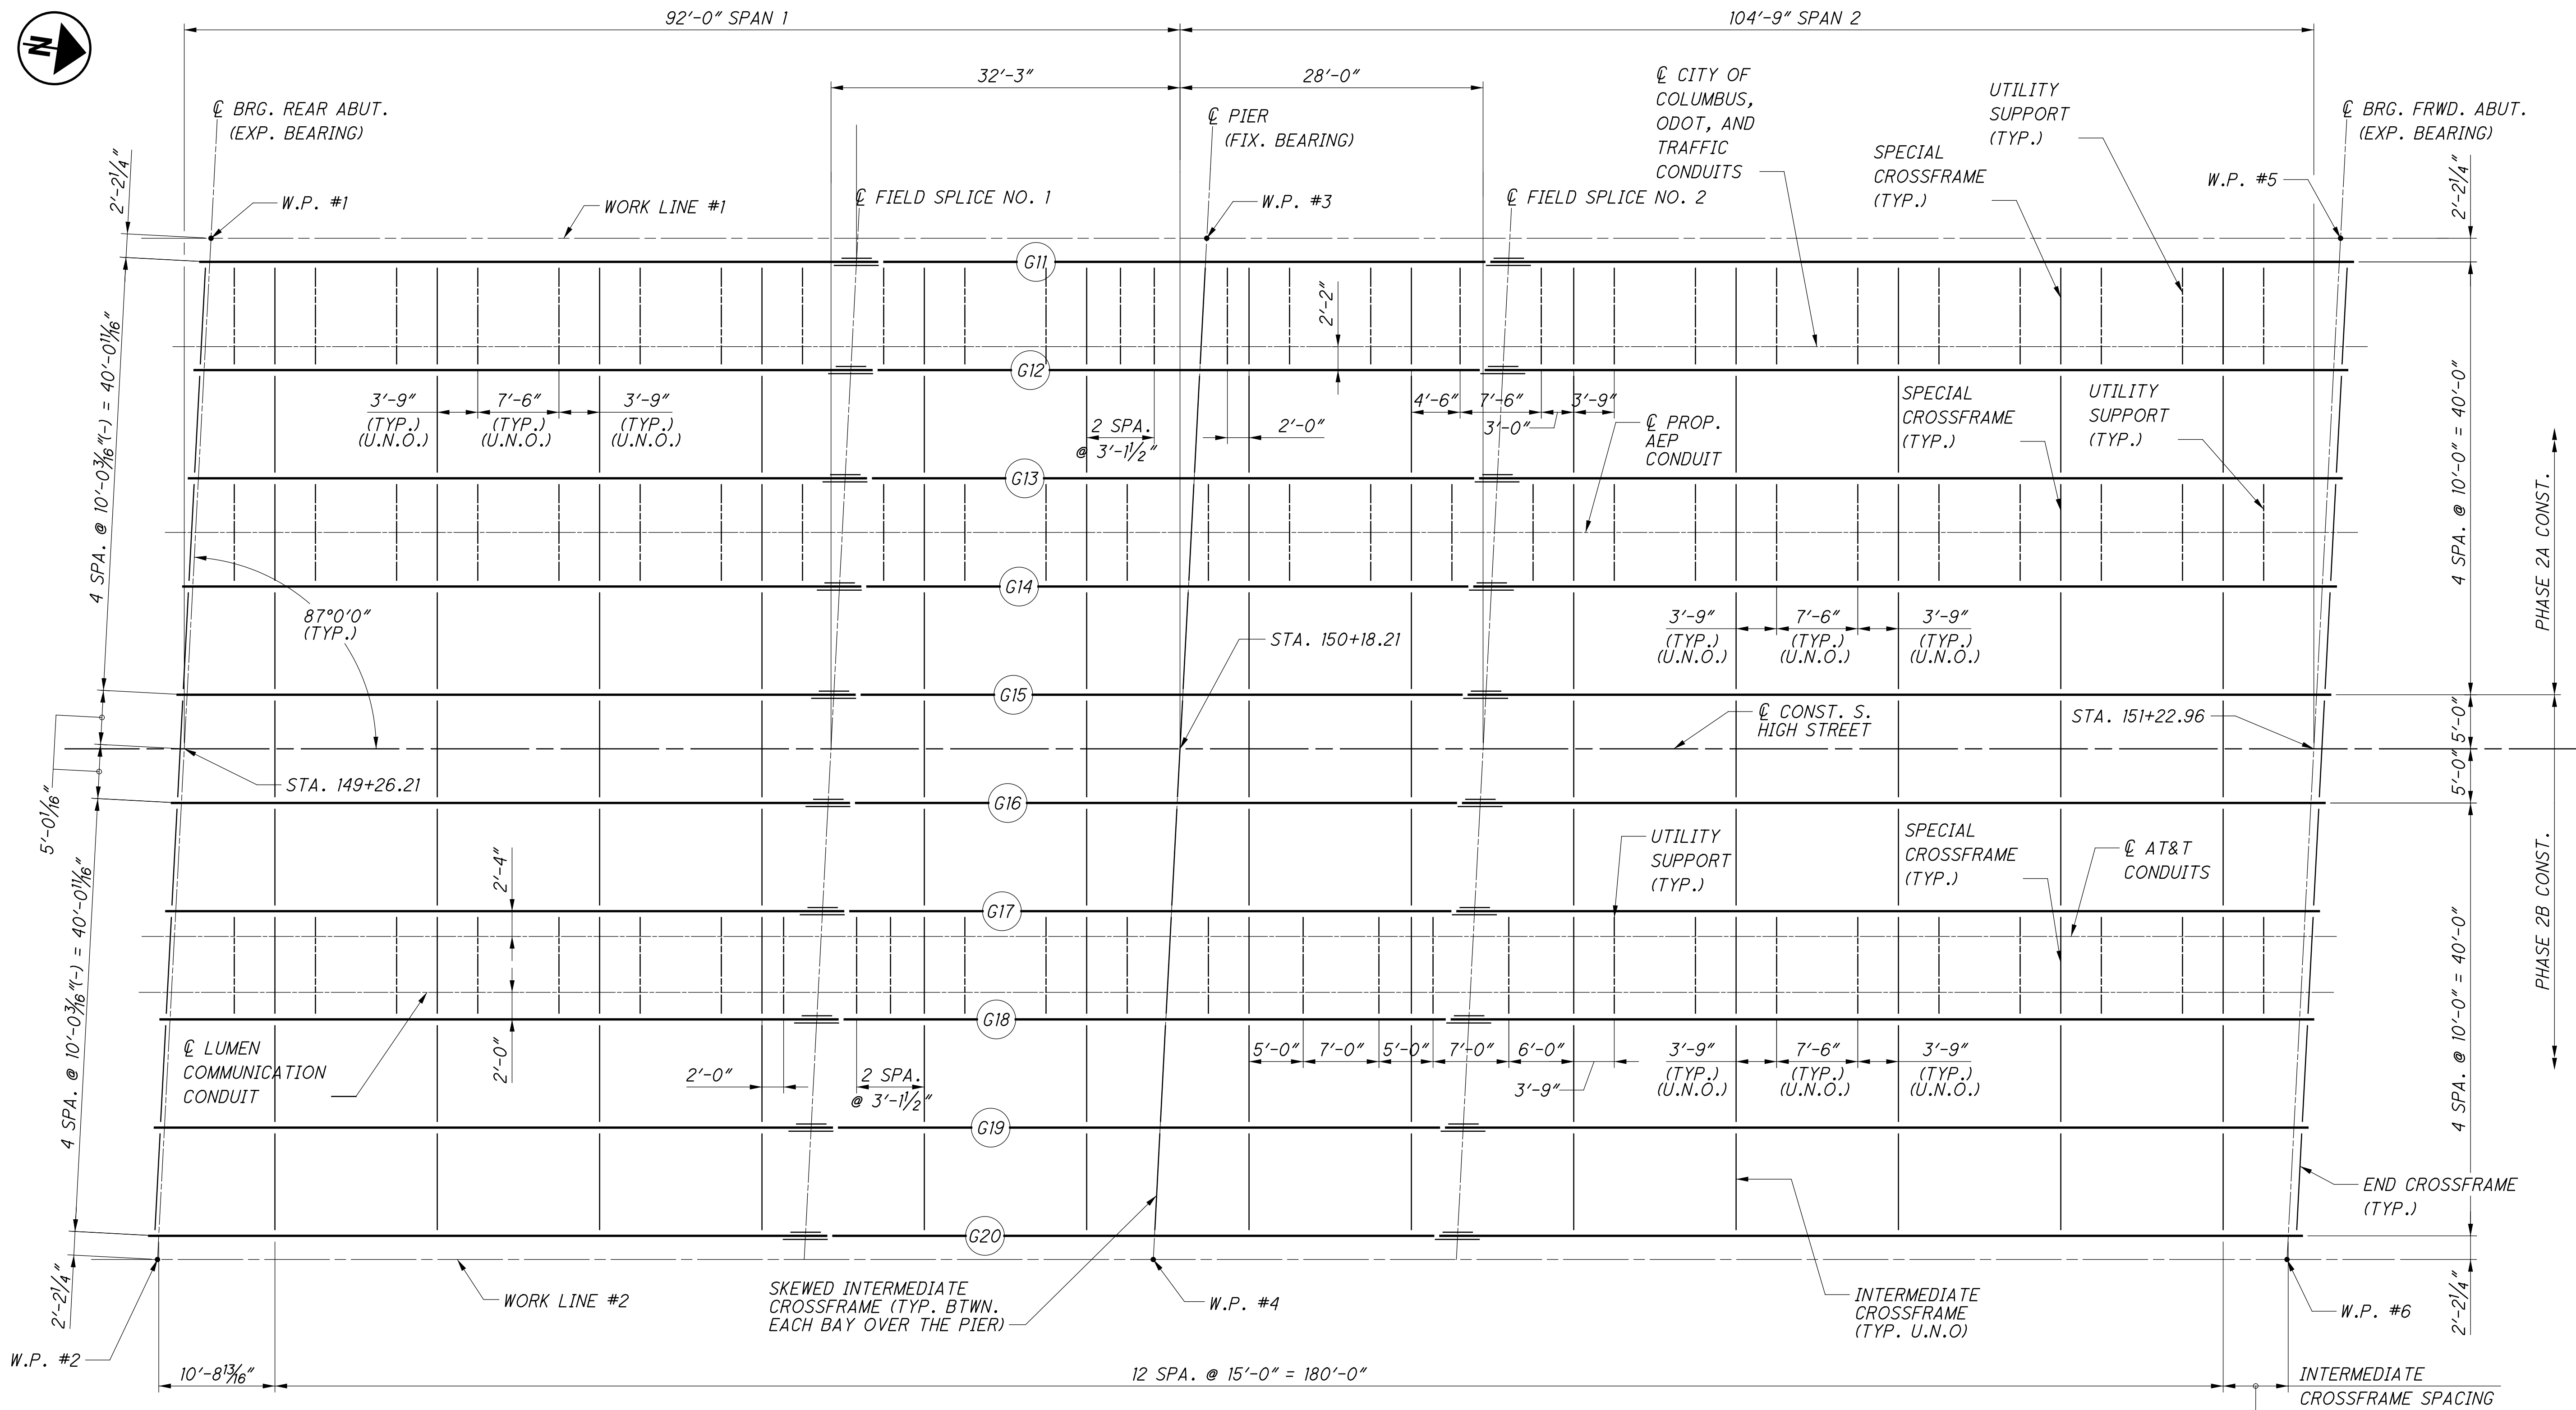

**FRAMING PLAN**

NO.	DESCRIPTION	REV. BY	DATE
3	REVISED CROSSFRAME TYPE	DJC	10-23-23

**NOTES:**

- INTERMEDIATE CROSSFRAMES SHALL BE TYPE B USING L4" x 4" x 3/8" ANGLES AS DETAILED IN STD. DWG. GSD-119. AT SKEWED INTERMEDIATE CROSSFRAME, PROVIDE 1/2" THICK BENT PLATE CONNECTED TO BEARING STIFFENERS.
- FOR CAMBER & DEFLECTION TABLE, SEE SHT. NOS. 38/55 & 39/55.
- FOR SPECIAL CROSSFRAME DETAILS, SEE SHT. NOS. 36/55 & 36A/55.
- FOR UTILITY SUPPORT DETAILS, SEE SHT. NOS. 36B/55 & 37/55.

**DESIGN AGENCY**  
**GPD GROUP**  
 1000 Wilderness Drive, Suite 200, Columbus, OH 43215  
 (614) 231-0751  
 Copyright © 2023, GPD Group, Inc.

**DATE** 4-21-23  
**REVIEWED** TJW  
**STRUCTURE FILE NUMBER** 2510024  
**DESIGNED** RHC  
**CHECKED** DGN  
**DRAWN** RPR  
**REVISED**

**FRAMING PLAN**  
 BRIDGE NO. FRA-70-1405C  
 S. HIGH STREET (U.S. 23D) OVER I-70/71

**FRA-70-14.05C**  
**PID No. 105596**

34/55  
 235  
 395





**ESTIMATED QUANTITIES**

CALCULATED BY: RHC      DATE: 6-25-20  
 CHECKED BY: MOJ      DATE: 6-29-20

ITEM	EXT.	TOTAL	PARTICIPATION		UNITS	DESCRIPTION	ABUTMENT	PIER	SUPER-STRUCTURE	GENERAL	REFERENCE SHEET NO.
			02/IMS/11	07/NHS/04/COL							
503	11100	LS	LS			COFFERDAMS AND EXCAVATION BRACING					
503	21100	2,872	2,048	824	CY	UNCLASSIFIED EXCAVATION	2,048	824			
509	10000	455,505	142,506	312,999	LB	EPOXY COATED REINFORCING STEEL	142,506	101,063	211,936		
511	34447	728		728	CY	CLASS QC2 CONCRETE WITH QC/QA, BRIDGE DECK, AS PER PLAN			728		2
511	34451	118		118	CY	CLASS QC2 CONCRETE WITH QC/QA, BRIDGE DECK (PARAPET), AS PER PLAN			118		2
511	41012	320		320	CY	CLASS QC1 CONCRETE WITH QC/QA, PIER ABOVE FOOTINGS		320			
511	44113	873	873		CY	CLASS QC1 CONCRETE WITH QC/QA, ABUTMENT NOT INCLUDING FOOTING, AS PER PLAN	873				2
511	46512	722	521	201	CY	CLASS QC1 CONCRETE WITH QC/QA, FOOTING	521	201			
511	53012	18		18	CY	CLASS QC2 CONCRETE, MISC.: EXPANSION DEVICE SLAB			18		
511	53012	33		33	CY	CLASS QC2 CONCRETE, MISC.: TRELLIS BASE AND STAIR BASE			33		
512	10050	608	85	523	SY	SEALING OF CONCRETE SURFACES (NON-EPOXY)	85		523		
512	10100	1,669	1,093	576	SY	SEALING OF CONCRETE SURFACES (EPOXY-URETHANE)	1,093	576			
512	33000	25	25		SY	TYPE 2 WATERPROOFING	25				
513	10200	14,970		14,970	LB	STRUCTURAL STEEL MEMBERS, LEVEL UF (CITY OF COLUMBUS DUCT BANK SUPPORT)			14,970		
513	10280	1,928,660		1,928,660	LB	STRUCTURAL STEEL MEMBERS, LEVEL 4			1,928,660		
513	20000	8,460		8,460	EACH	WELDED STUD SHEAR CONNECTORS			8,460		
514	00060	69,100		69,100	SF	FIELD PAINTING STRUCTURAL STEEL, INTERMEDIATE COAT			69,100		
514	00066	69,100		69,100	SF	FIELD PAINTING STRUCTURAL STEEL, FINISH COAT			69,100		
516	11210	639		639	FT	STRUCTURAL EXPANSION JOINT INCLUDING ELASTOMERIC STRIP SEAL			639		
516	13600	327	327		SF	1" PREFORMED EXPANSION JOINT FILLER	327				
516	44101	20		20	EACH	ELASTOMERIC BEARING WITH INTERNAL LAMINATES AND LOAD PLATE (NEOPRENE) 11 1/2" x 1'-6" x 2.36" PAD WITH 1'-0 1/2" x 2'-1" BEVELED PLATE, AS PER PLAN			20		21
516	44101	20		20	EACH	ELASTOMERIC BEARING WITH INTERNAL LAMINATES AND LOAD PLATE (NEOPRENE) 1'-1" x 1'-8" x 2.59" PAD WITH 1'-2" x 2'-1" BEVELED PLATE, AS PER PLAN			20		21
516	44301	20		20	EACH	ELASTOMERIC BEARING WITH INTERNAL LAMINATES AND LOAD PLATE (NEOPRENE) 1'-9" x 2'-2" x 4.36" PAD WITH 1'-10" x 2'-11" BEVELED PLATE, AS PER PLAN			20		21
518	21200	140	140		CY	POROUS BACKFILL WITH GEOTEXTILE FABRIC	140				
518	40000	470	470		FT	6" PERFORATED CORRUGATED PLASTIC PIPE	470				
524	94997	1,848	1,848		FT	DRILLED SHAFTS, 96" DIAMETER, ABOVE BEDROCK, AS PER PLAN	1,848				2
524	95100	2	2		EACH	DRILLED SHAFTS, MISC.: CSL TESTING, 96" DIAMETER SHAFT	2				
SPECIAL	53000200	LS		LS		STRUCTURES: CITY OF COLUMBUS DUCT BANK COMPLETE					3
SPECIAL	53000600	7,809	7,809		SF	STRUCTURES: PRECAST FACADE PANELS	7,809				3
607	98000	60	60		FT	FENCE, MISC.: WALL MOUNTED TYPE A (W/ VANDAL MESH)	60				
594	10000	16	16		EACH	THERMAL INTEGRITY PROFILING (TIP) TEST	16				

G:\2012\2012048\FRA\105596\STRUCTURES\FRA070\_1495C\SHEETS-CAP\072\_1495C0001.DGN  
 10/20/2023 7:58:35 AM  
 ODOT\B1STD\USER




DESIGN AGENCY: GPD GROUP  
 DATE: 4-21-23  
 REVIEWED: TJW  
 STRUCTURE FILE NUMBER: 2510032/2510034  
 DRAWN: MOJ  
 CHECKED: RHC

**ESTIMATED QUANTITIES**  
 BRIDGE NO. FRA-70-1405E/W - CAPS  
 S. HIGH STREET (U.S. 23D) OVER I-70/71

**FRA-70-14.05C**  
 PID No. 105596


NO.	DESCRIPTION	REV. BY	DATE
3	QUANTITY REVISED	DJC	10-23-23

260  
 395

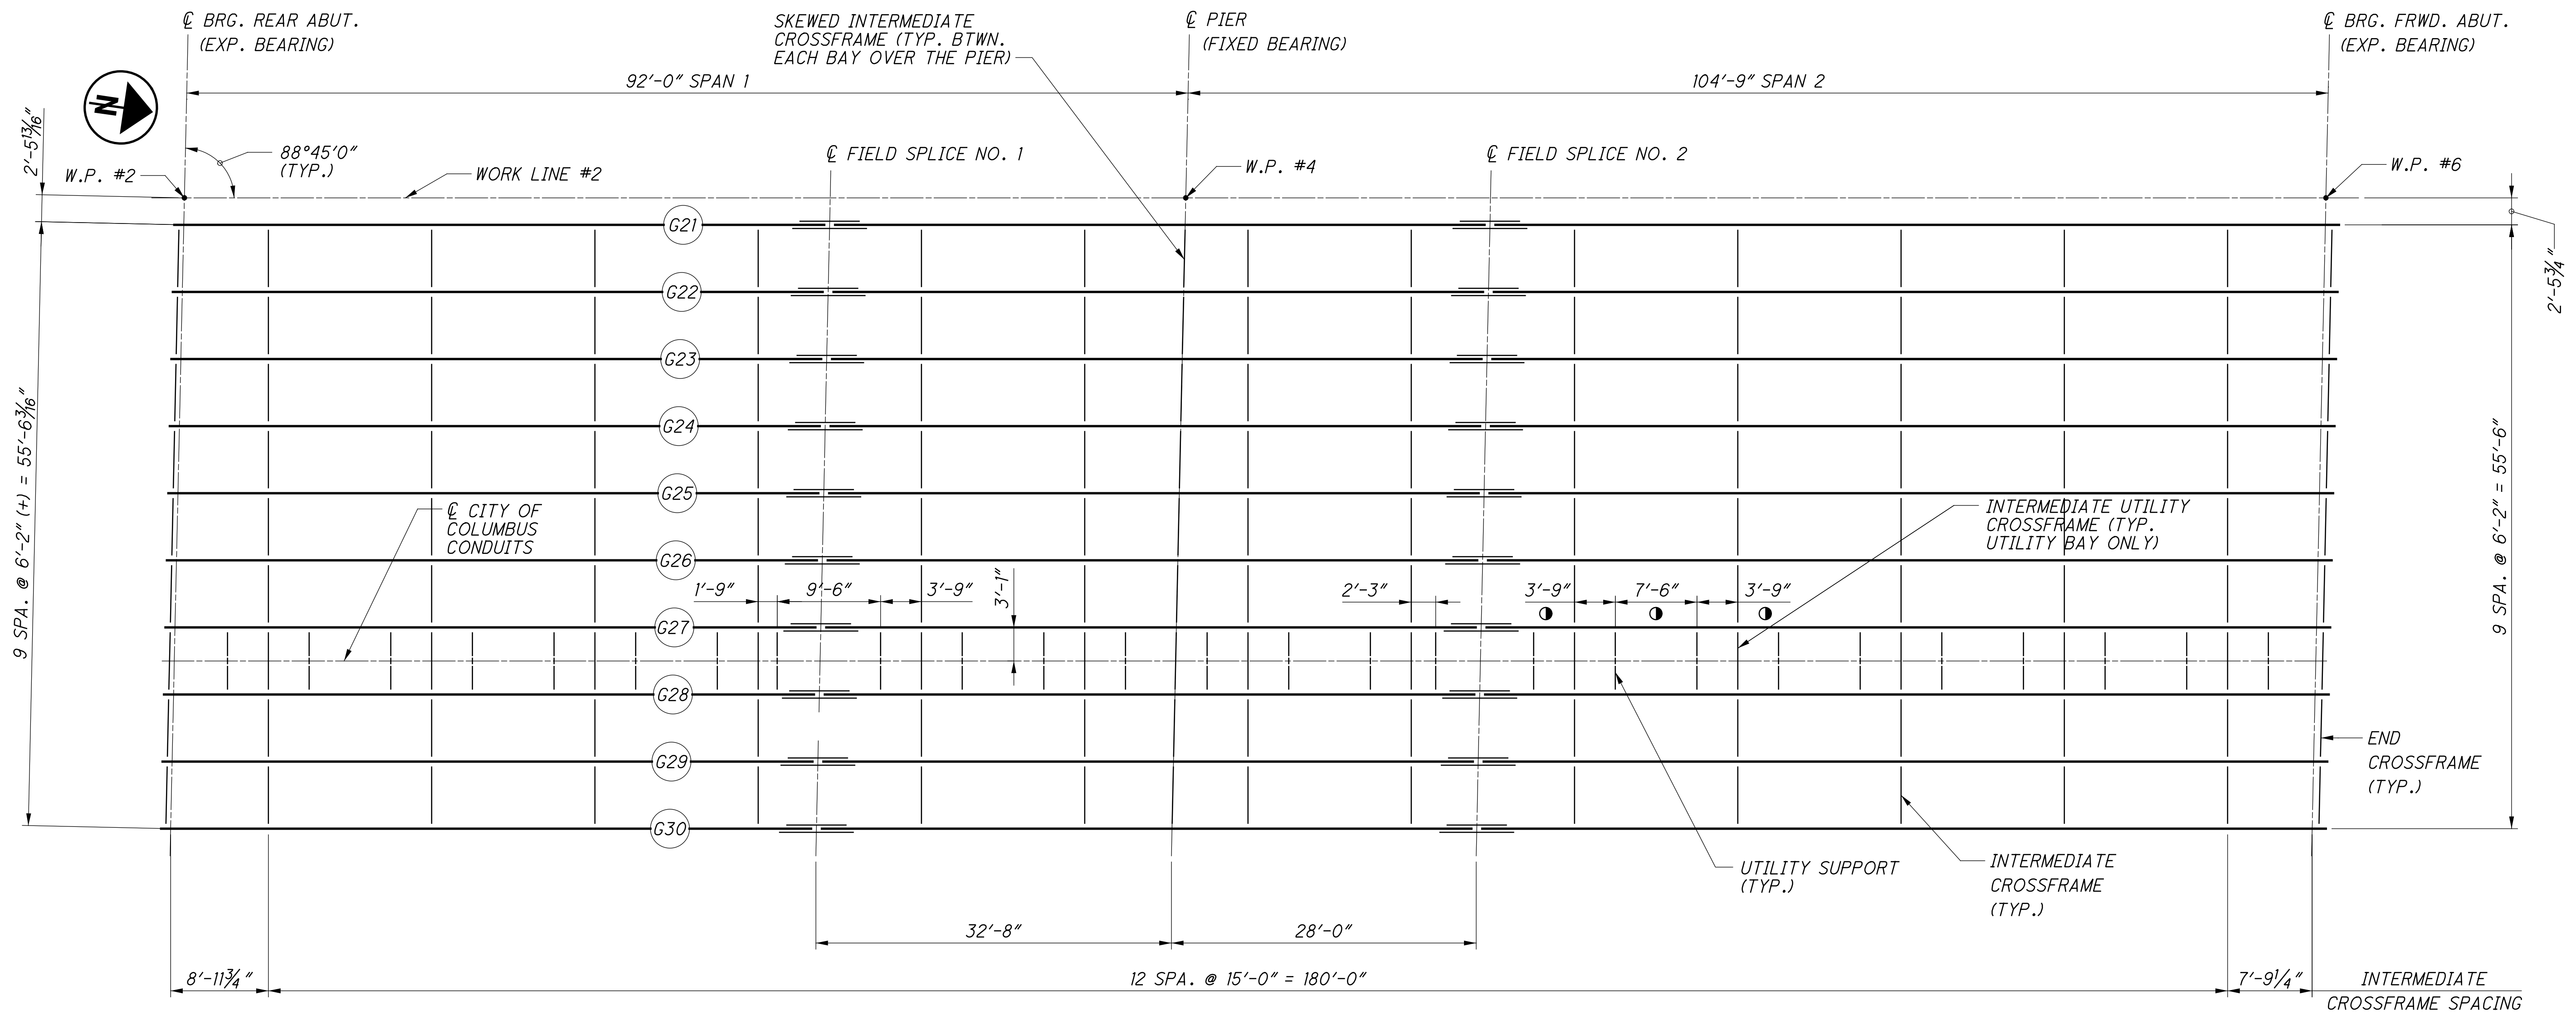


**LEGEND:**

● TYPICAL UNLESS NOTED OTHERWISE

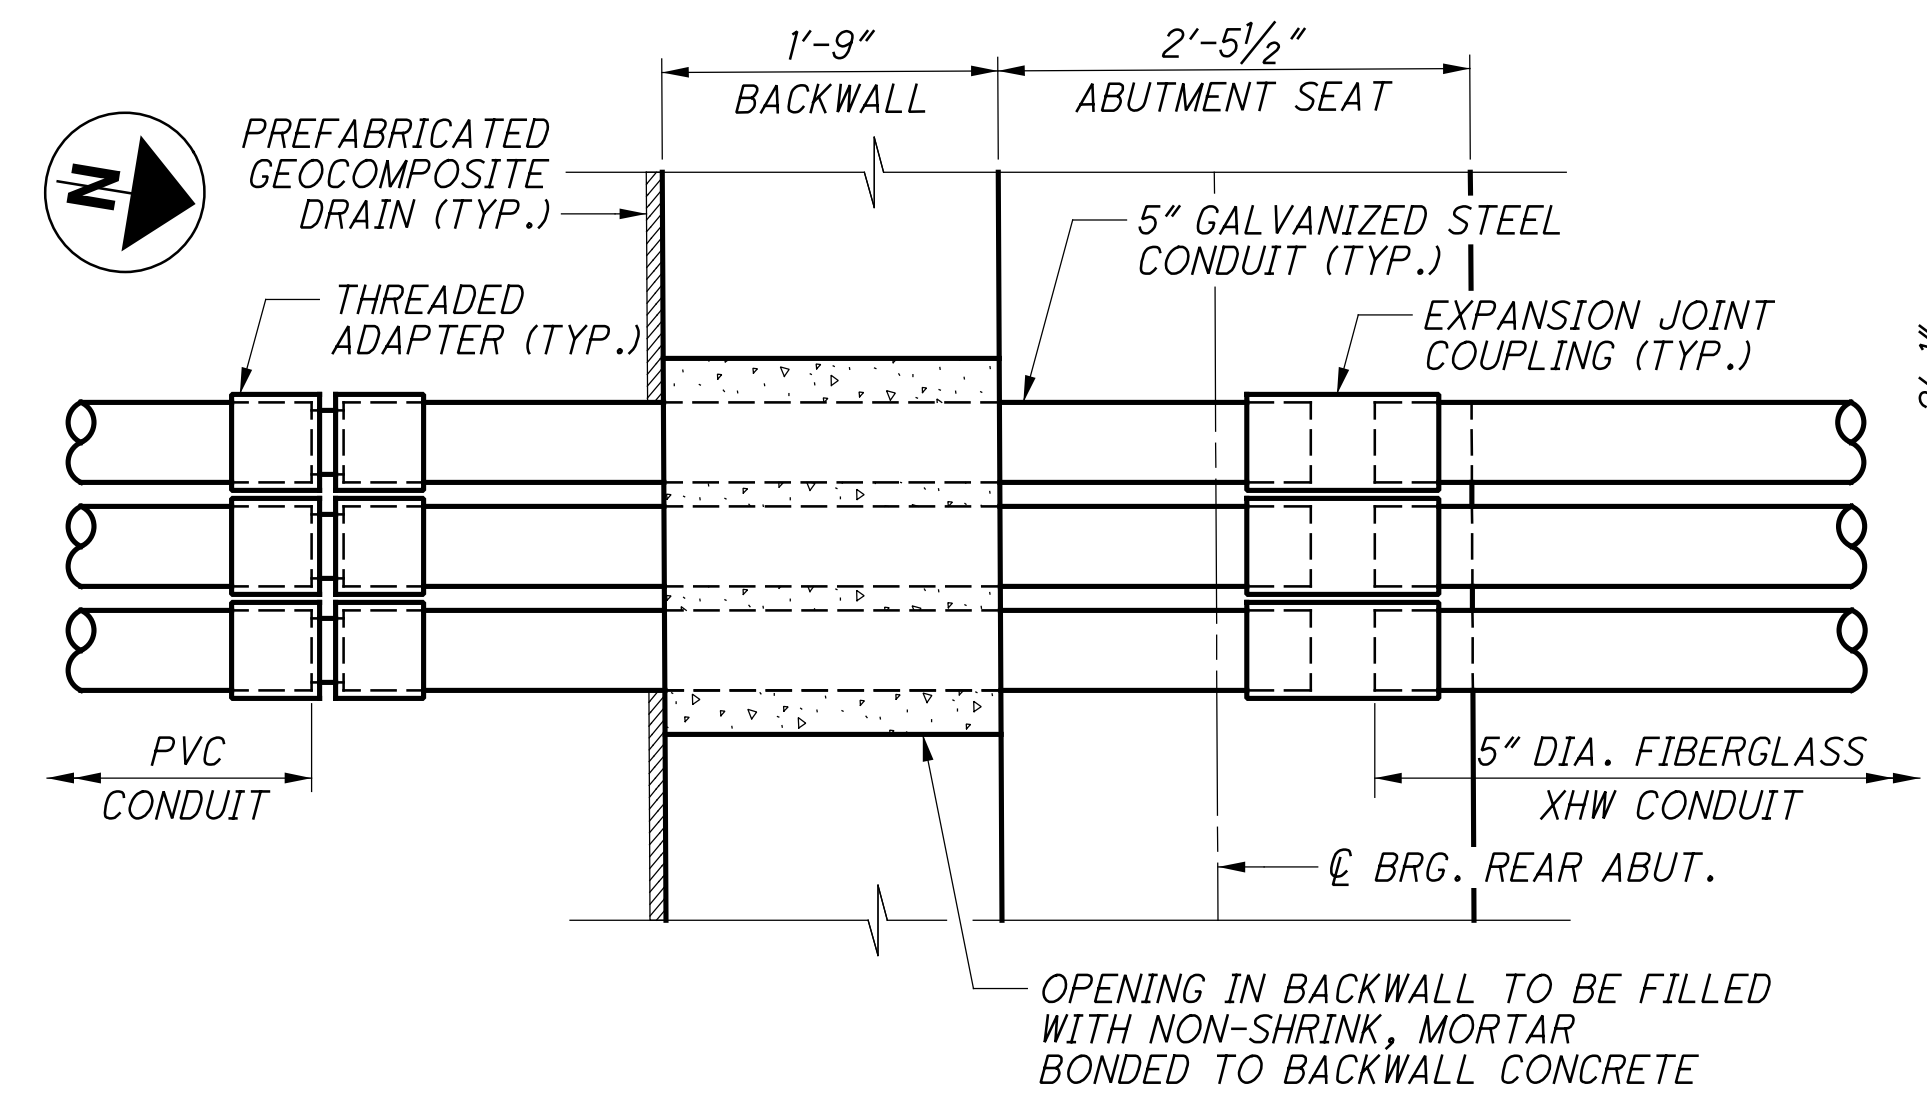


**CITY OF COLUMBUS CONDUIT EXPANSION JOINT DETAILS**

REAR ABUTMENT SHOWN, FORWARD ABUTMENT SIMILAR.

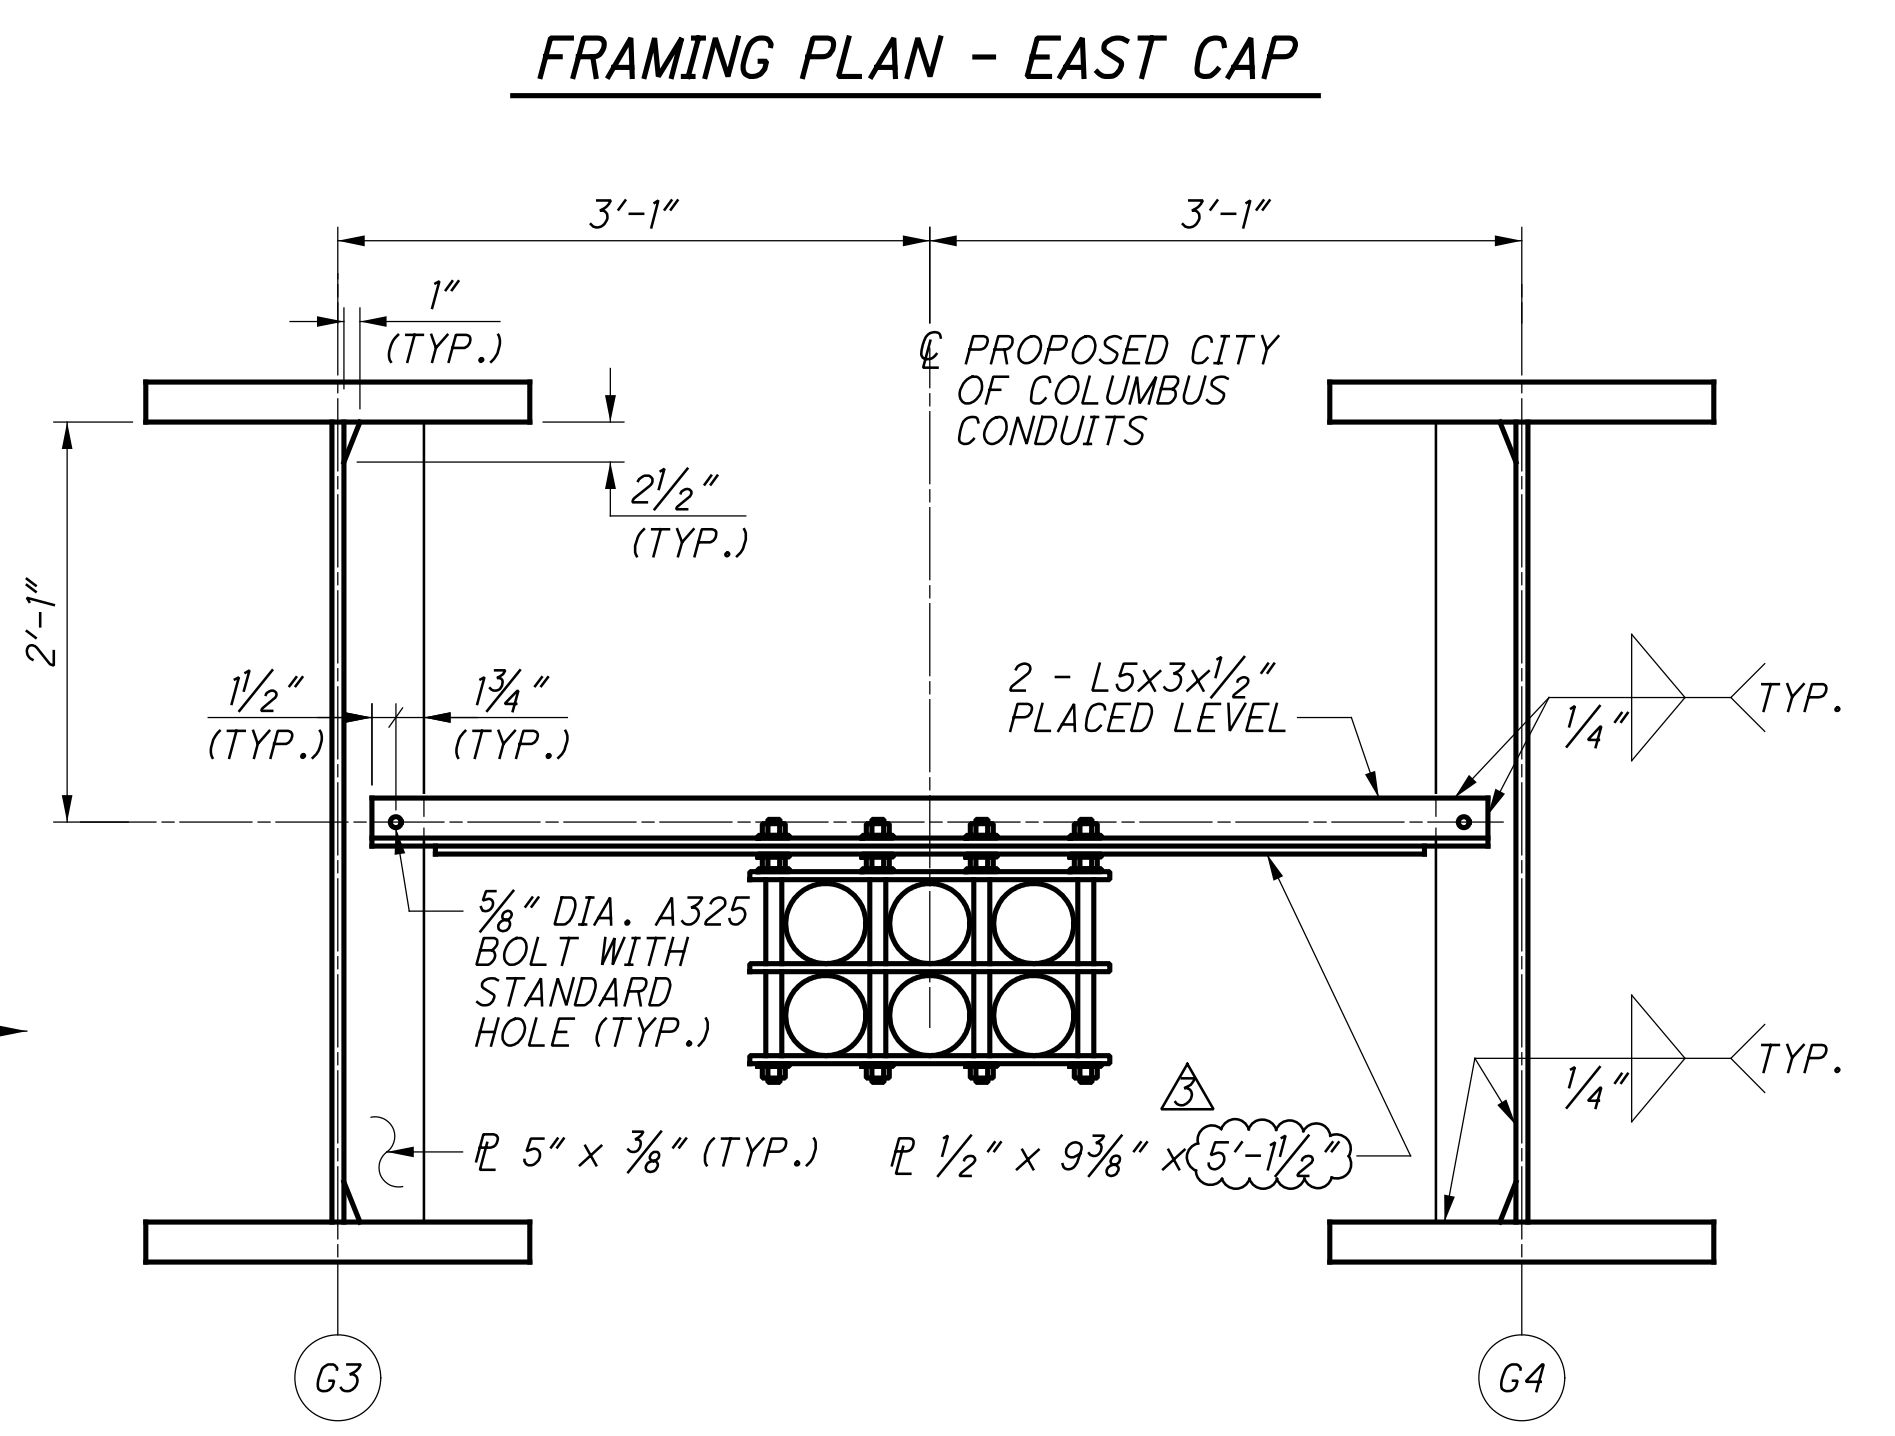

**CITY OF COLUMBUS CONDUIT UTILITY SUPPORT DETAIL**

BAY BETWEEN G3 AND G4 SHOWN, BAY BETWEEN G27 AND G28 SIMILAR

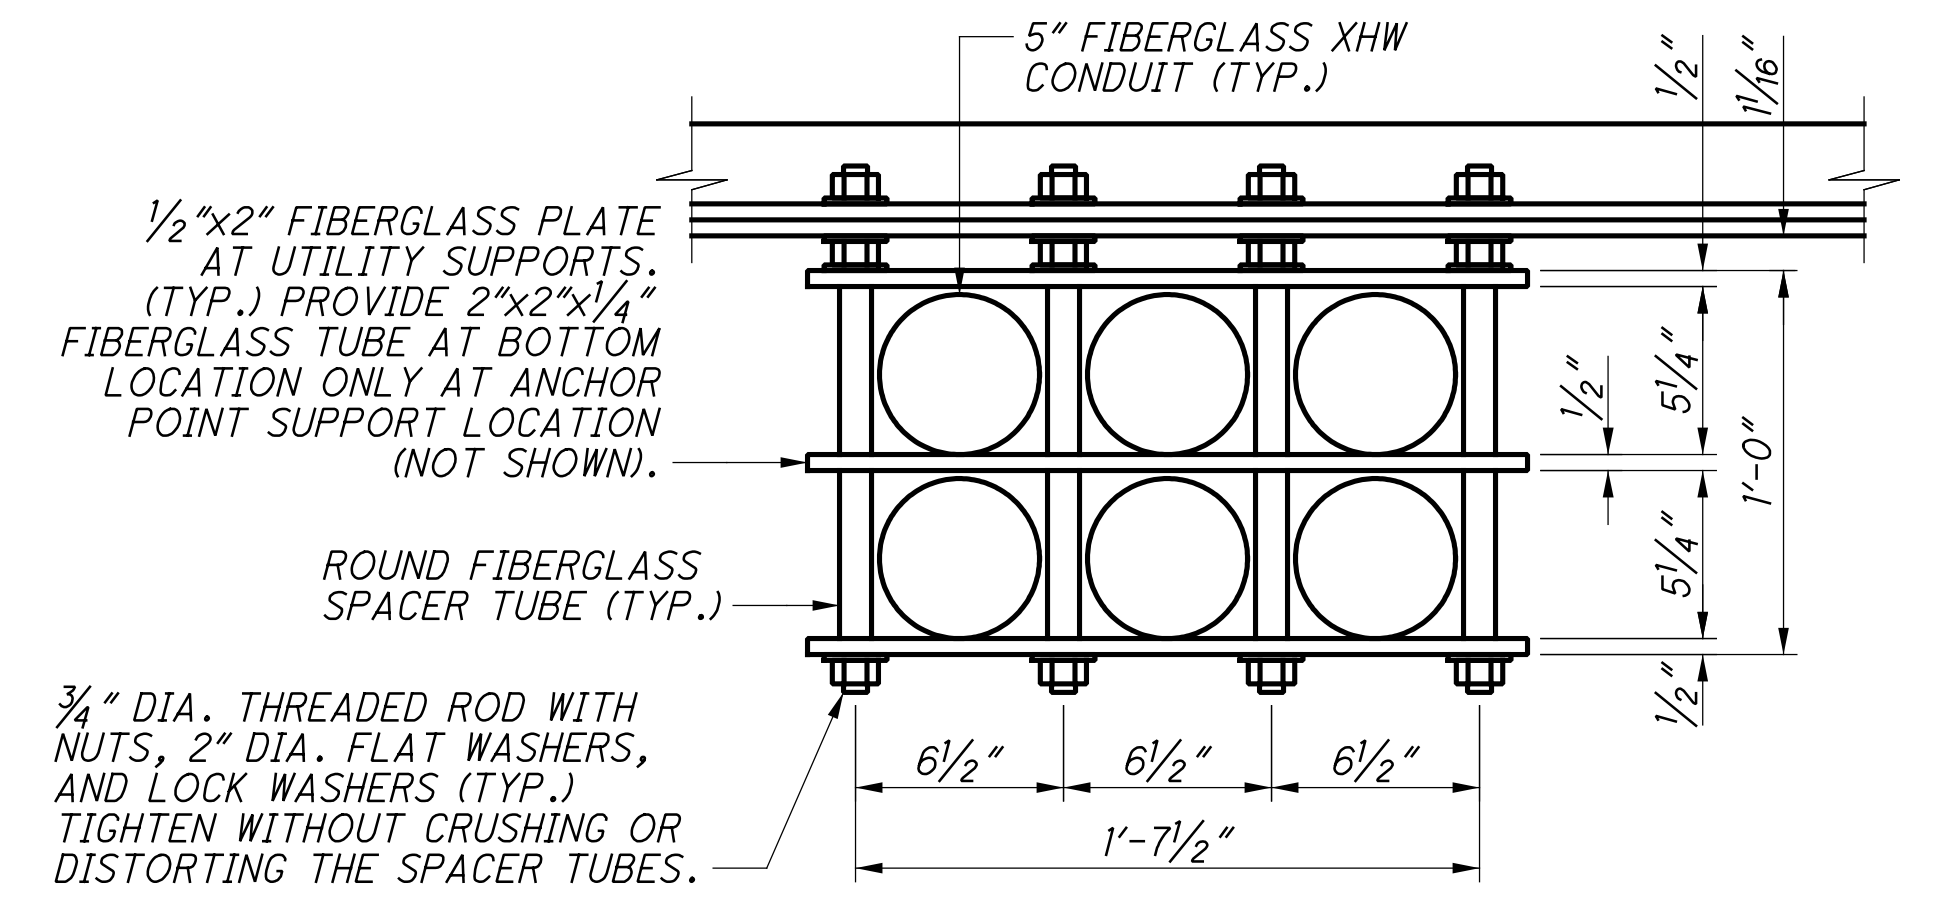


**NOTES: CITY OF COLUMBUS CONDUIT RACK DETAIL**

- INTERMEDIATE CROSSFRAMES MEMBERS SHALL BE L4x4x1/2" FOR ADDITIONAL DETAILS, SEE STD. DWG. GSD-1-19. AT SKEWED INTERMEDIATE CROSSFRAME, PROVIDE 1/2" THICK BENT PLATE CONNECTED TO BEARING STIFFENERS.
- FOR CAMBER AND DEFLECTION TABLE, SEE SHEETS [26/52] THROUGH [28/52].
- FOR WORK POINT STATIONS AND OFFSETS, SEE GEOMETRY PLAN ON SHEET [15/55] FROM HIGH STREET BRIDGE.
- FOR OVERALL FRAMING PLAN, SEE SHEET [33/55] FROM HIGH STREET BRIDGE.
- FOR ADDITIONAL END CROSSFRAME NOTES & DETAILS, SEE ODOT STD. DWG. GSD-1-19.


NO.	DESCRIPTION	REV. BY	DATE
3	REVISED PLATE LENGTH CALLOUT	DJC	10-23-23

01\_201212012048\FRA\105596\STRUCTURES\FRA070\_1405C\SHEETS-CAP\072\_1405CSD0004.DGN  
 10/19/2023 5:32:42 PM ODOT\B1STD\USER

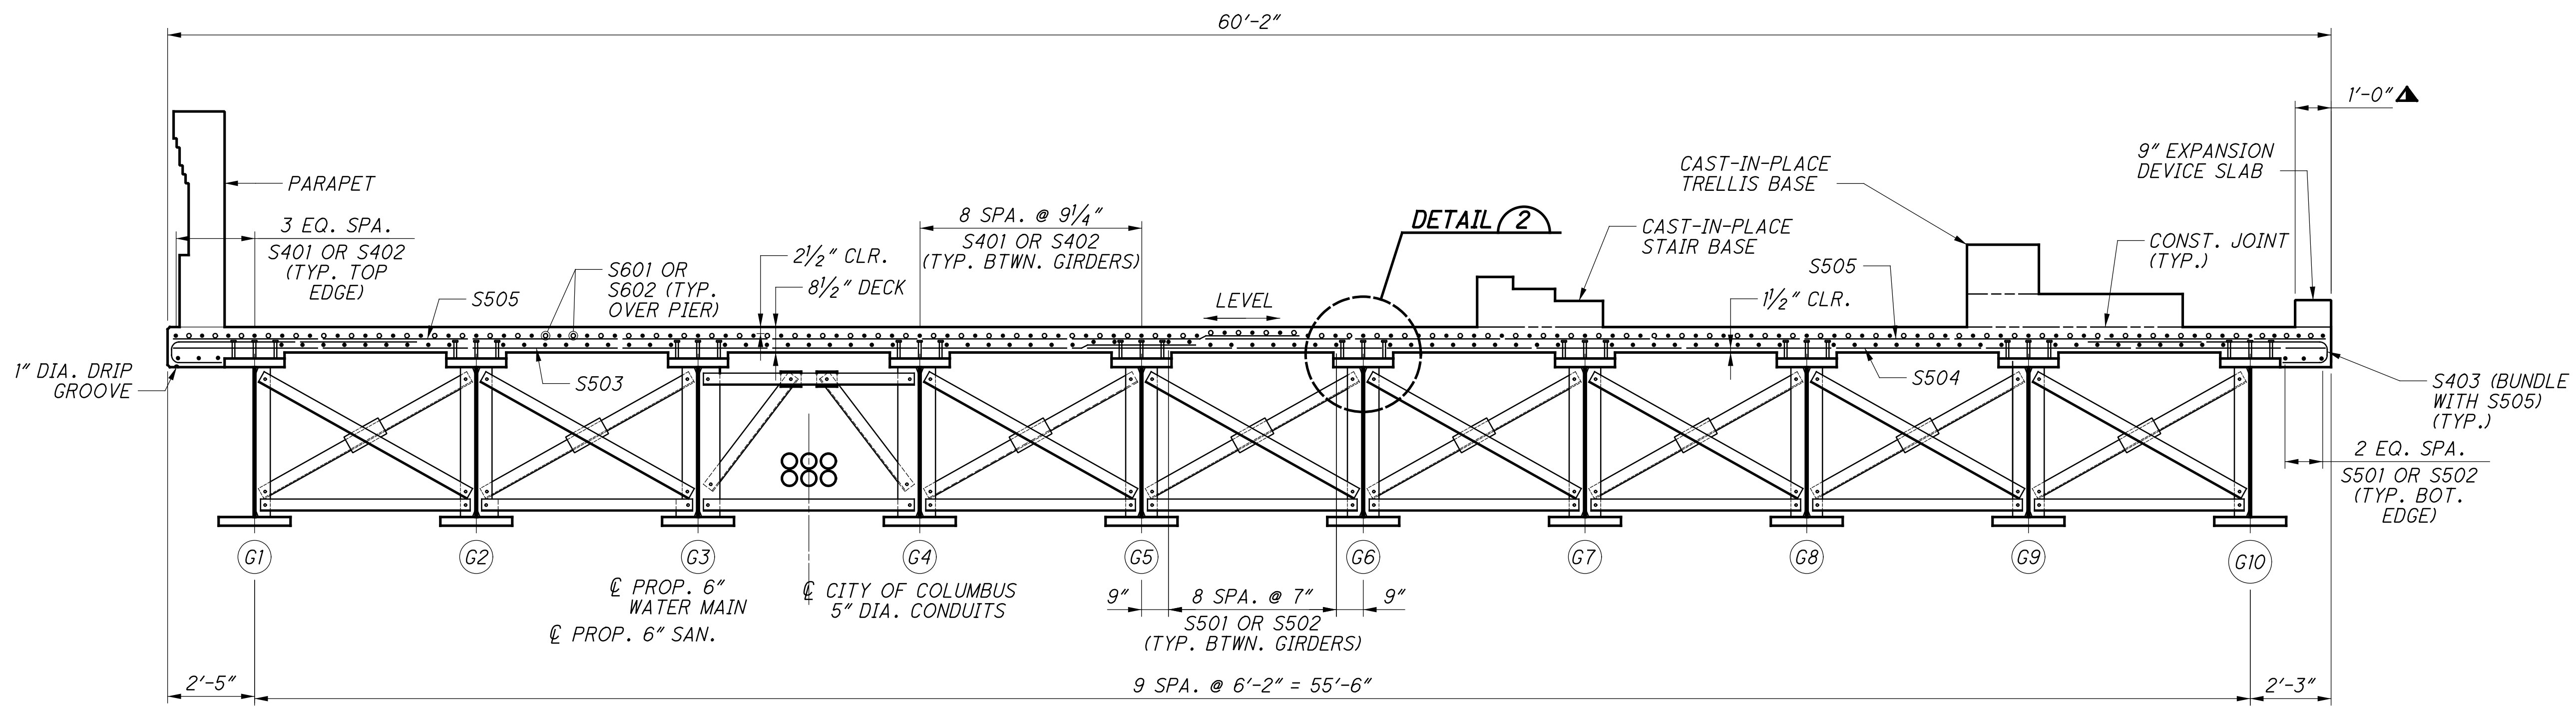

**TRANSVERSE SECTION - WEST CAP**

PARAPET, STAIR BASE, TRELLIS BASE, AND EXPANSION DEVICE REINFORCING NOT SHOWN

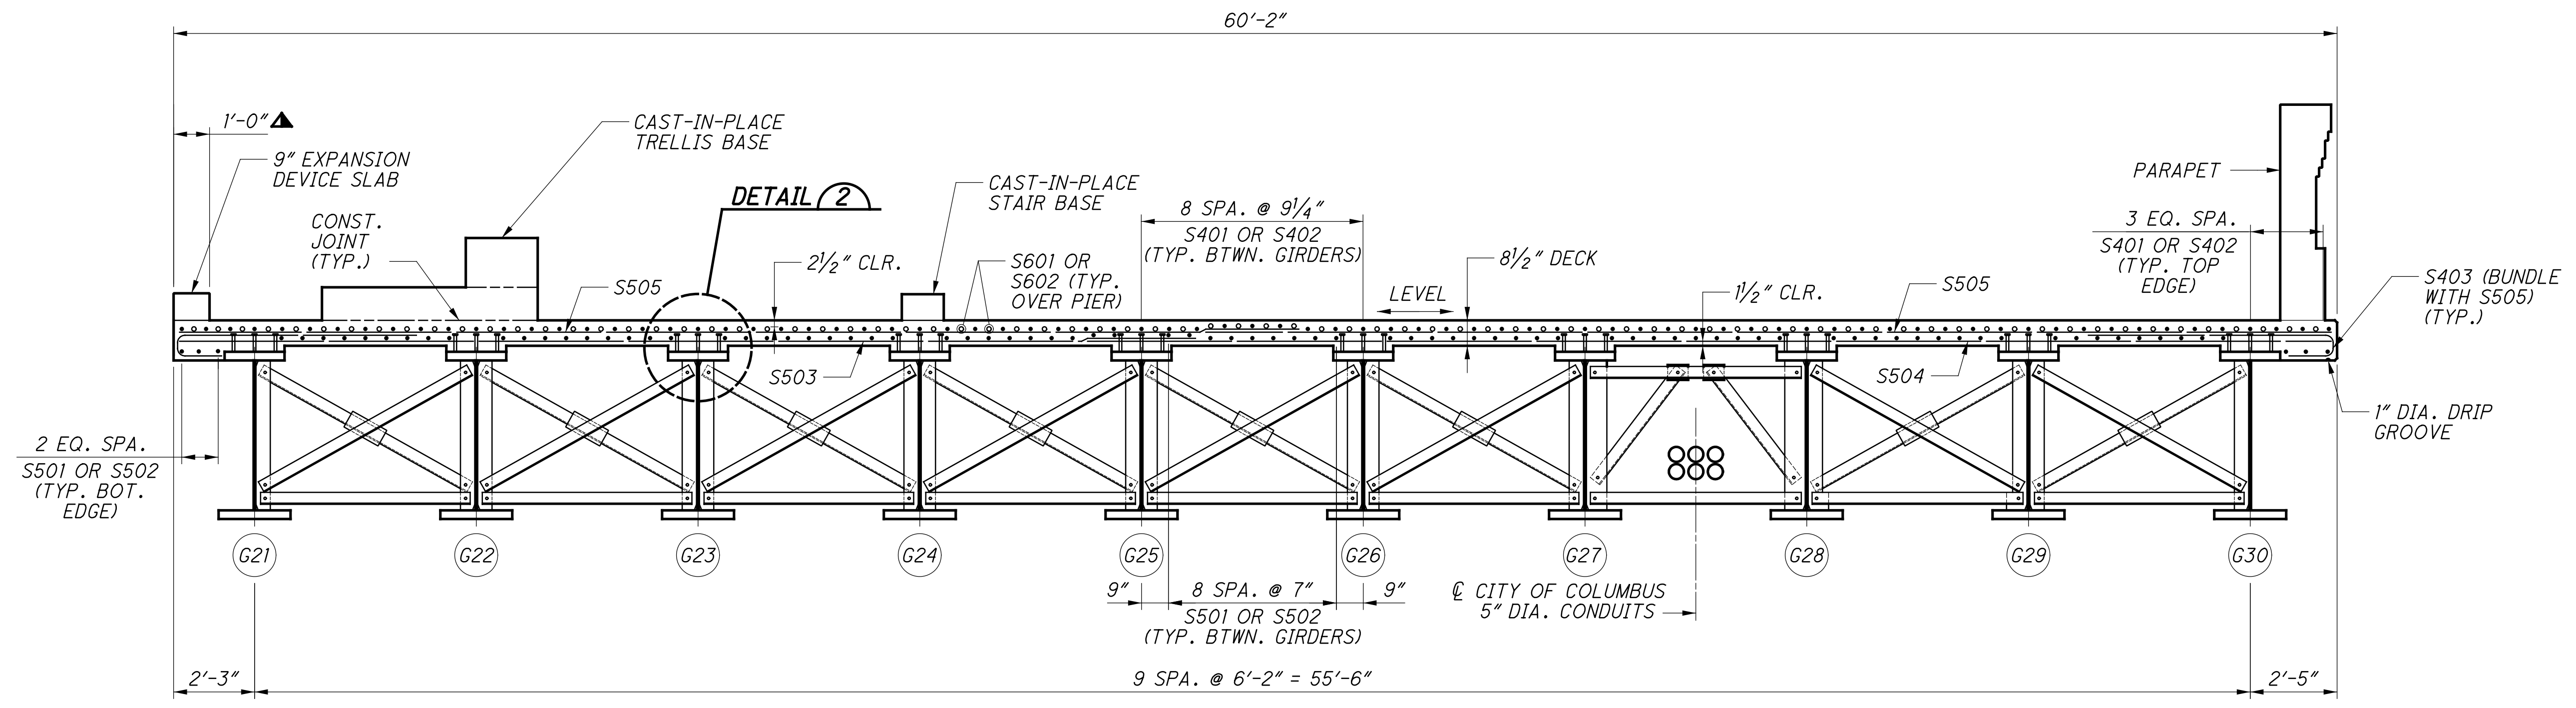

**TRANSVERSE SECTION - EAST CAP**


PARAPET, STAIR BASE, TRELLIS BASE, AND EXPANSION DEVICE REINFORCING NOT SHOWN

**NOTES:**

- DECK SLAB CONCRETE QUANTITY: THE ESTIMATED QUANTITY OF DECK SLAB CONCRETE IS BASED ON THE CONSTANT DECK SLAB THICKNESS, AS SHOWN, PLUS THE QUANTITY OF CONCRETE THAT FORMS EACH GIRDER HAUNCH. THE ESTIMATE ASSUMES A CONSTANT HAUNCH THICKNESS OF 4 7/8 INCHES AND A CONSTANT HAUNCH WIDTH OUTSIDE THE EDGE OF EACH GIRDER FLANGE OF 9 INCHES. DEVIATE FROM THIS HAUNCH THICKNESS AS NECESSARY TO PLACE THE DECK SURFACE AT THE FINISHED GRADE. THE ALLOWABLE TOLERANCE FOR THE HAUNCH WIDTH OUTSIDE THE EDGE OF EACH GIRDER FLANGE IS ± 3 INCHES.  
  
THE HAUNCH THICKNESS WAS MEASURED AT THE CENTERLINE OF THE GIRDER, FROM THE SURFACE OF THE DECK TO THE BOTTOM OF THE TOP FLANGE MINUS THE DECK SLAB THICKNESS. THE AREA OF ALL EMBEDDED STEEL PLATES HAS BEEN DEDUCTED FROM THE HAUNCH QUANTITY IN ACCORDANCE WITH 511.24.
- FOR PARAPET DETAILS AND SEALING LIMITS (INCLUDING PILASTER AND PYLONS), SEE SHEETS [38/52] THROUGH [45/52].
- FOR C.I.P. STAIR BASE DETAILS, SEE SHEET [36/52] AND [37/52].
- FOR TRELLIS BASE DETAILS, SEE SHEET [35/52].
- FOR EXPANSION DEVICE SLAB DETAILS, SEE SHEET [34/52].
- FOR SCREED, TOP OF HAUNCH, AND FINISHED ELEVATIONS, SEE SHEETS [48/52] THROUGH [49/52].
- FOR ADDITIONAL (TYPE B) INTERMEDIATE CROSSFRAME DETAILS, SEE STD. DWG. GSD-1-19.
- FOR UTILITY CROSSFRAME AND SUPPORT DETAILS, SEE SHEETS [23/52] & [24/52].

**LEGEND:**

▲ INDICATES LIMITS OF ITEM 512 - SEALING OF CONCRETE SURFACES (NON-EPOXY)

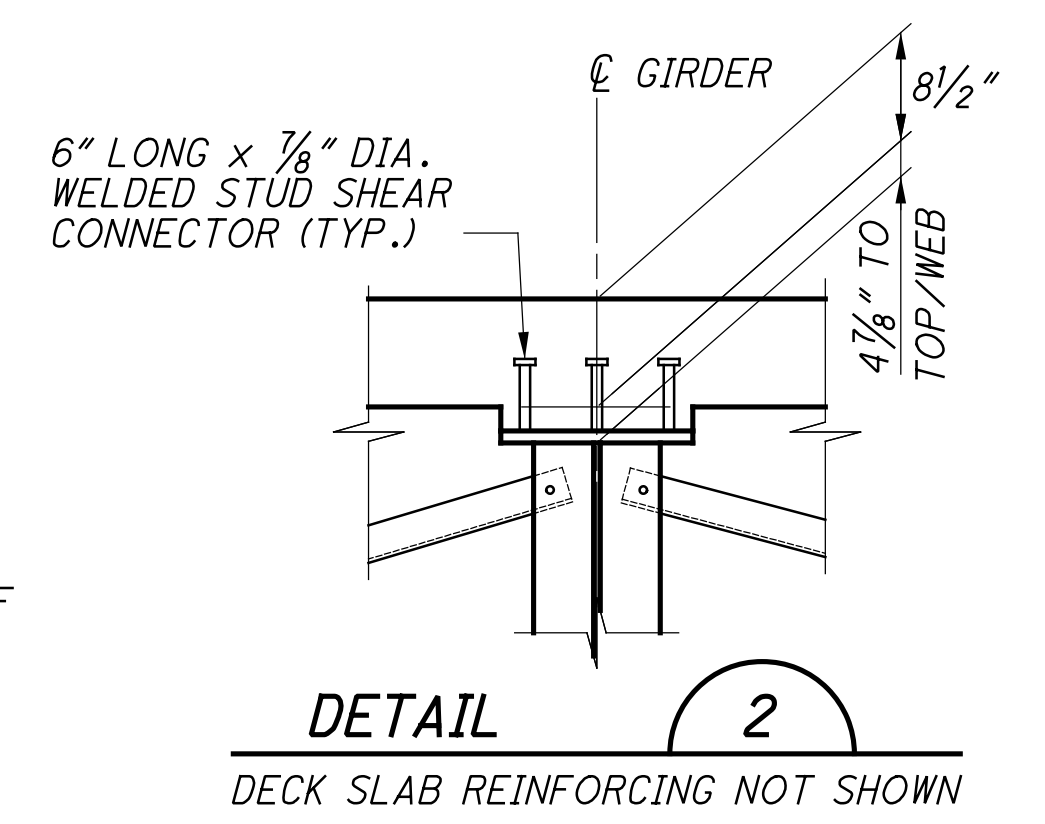

NO.	DESCRIPTION	REV. BY	DATE
3	REVISED CROSSFRAME TYPE	DJC	10-23-23

01\_2012\_2012046\_VFR1\_105596\_STRUCTURES\FRA070\_1405C\_SHEETS-CAP\072\_1405C19001.DGN  
 10/19/2023 5:20:21 PM  
 ODOT\B1STD\_USER



ms consultants, inc.  
msconsultants.com

Ohio DOT Workspace  
70171 East Interchange 6A  
www.msconsultants.com



Batchplot Spec: \\msconsultants.com\files\production\03\60\06634\_6A\standards\plotdrv\batchplot.dwg  
Pen Table: \\msconsultants.com\files\standards\usin\ohdot\18\ms\plotting\pen\18\_ms\_std.dwg  
Plot Driver: \\msconsultants.com\files\standards\usin\ohdot\18\ms\plotting\PDF.plt

View: FENCE\_VEW1  
By: white  
Printed: 10/20/2023 12:52:50 PM  
File: \\msconsultants.com\files\production\03\60\06634\_6A\roadway\sheet\89464GC001.dgn

34" x 22"

SHEET NUM.

PART.

ITEM

ITEM

GRAND

UNIT

DESCRIPTION

SEE SHEET NO.

CALCULATED  
T.A.Z.  
CHECKED  
L.M.

33	36	52	59E	117	122	159	167B	198	199	200	693	Office	01/MS/04	ITEM	ITEM	GRAND	UNIT	DESCRIPTION	SEE SHEET NO.	
													EXT	TOTAL						
								1					1	202	20010	1	EACH	ROADWAY HEADWALL REMOVED		
								219					21,016	202	23000	21,016	SY	PAVEMENT REMOVED		
								3,016					3,016	202	30000	3,016	SF	WALK REMOVED		
								114					114	202	30600	114	SY	CONCRETE MEDIAN REMOVED		
				313	384		205	4,623					5,525	202	30700	5,525	FT	CONCRETE BARRIER REMOVED		
		1,280						1,280					1,280	202	30701	1,280	FT	CONCRETE BARRIER REMOVED, AS PER PLAN	52	
					236			5,488					5,724	202	32000	5,724	FT	CURB REMOVED		
								271					271	202	32500	271	FT	CURB AND GUTTER REMOVED		
								655					655	202	32800	655	SY	CONCRETE SLOPE PROTECTION REMOVED		
					230			2,013					2,324	202	35100	2,324	FT	PIPE REMOVED, 24" AND UNDER		
								5,283					5,283	202	38000	5,283	FT	GUARDRAIL REMOVED		
								4					4	202	47800	4	EACH	IMPACT ATTENUATOR REMOVED		
								9	9				9	202	58000	9	EACH	MANHOLE REMOVED		
								1	9				10	202	58100	10	EACH	CATCH BASIN REMOVED		
				1					32				33	202	58200	33	EACH	INLET REMOVED		
				1									1	202	58201	1	EACH	INLET REMOVED, AS PER PLAN	117	
									1,156				1,156	202	75000	1,156	FT	FENCE REMOVED		
								1					1	202	75250	1	EACH	GATE REMOVED		
								1					1	202	75255	1	EACH	GATE REMOVED FOR REUSE, AS PER PLAN	35	
	2												2	202	98100	2	EACH	REMOVAL MISC.: INSPECTION WELL	36	
	100												100	202	98200	100	FT	REMOVAL MISC.: MISC CONDUIT	36	
										1,272			1,272	202	98200	1,272	FT	REMOVAL MISC.: PORTABLE BARRIER		
				101									101	202	98200	101	FT	REMOVAL MISC.: TRENCH DRAIN	117	
				9	56	2,773	29					41,822	44,689	203	10000	44,689	CY	EXCAVATION		
					19	143						93,968	94,130	203	20000	94,130	CY	EMBANKMENT		
	50											24,912	24,962	3	20001	24,962	3	CY	EMBANKMENT, AS PER PLAN	35
												2,806	2,806	2	35110	2,806	3	CY	GRANULAR MATERIAL, TYPE B	
												29,583	29,583	204	10000	29,583	SY	SUBGRADE COMPACTION		
												172	172	204	13001	172	CY	EXCAVATION OF SUBGRADE, AS PER PLAN	42	
												12	12	204	45000	12	HOUR	PROOF ROLLING	38	
												1	1	204	45001	1	HOUR	PROOF ROLLING, AS PER PLAN	42	
												1,032	1,032	204	50001	1,032	SY	GEOTEXTILE FABRIC, AS PER PLAN	42	
												380	380	206	10500	380	TON	CEMENT		
												14,684	14,684	206	11000	14,684	SY	CURING COAT		
												14,684	14,684	206	15010	14,684	SY	CEMENT STABILIZED SUBGRADE, 12 INCHES DEEP		
												7	7	206	20000	7	HOUR	TEST ROLLING		
												LUMP	LUMP	206	30000	LS		MIXTURE DESIGN FOR CHEMICALLY STABILIZED SOILS		
												LUMP	LUMP	208	14001	LS		VIBRATION CONTROL AND MONITORING, AS PER PLAN		
										3,063			3,063	606	15050	3,063	FT	GUARDRAIL, TYPE MGS	33	
										1			3	606	26150	3	EACH	ANCHOR ASSEMBLY, MGS TYPE E (MASH 2016)		
										1			1	606	26550	1	EACH	ANCHOR ASSEMBLY, MGS TYPE T		
													2	606	35000	2	EACH	BRIDGE TERMINAL ASSEMBLY, TYPE 1		
													1	606	35002	1	EACH	MGS BRIDGE TERMINAL ASSEMBLY, TYPE 1		
													5	606	35102	5	EACH	MGS BRIDGE TERMINAL ASSEMBLY, TYPE 2		
													1	606	60041	1	EACH	IMPACT ATTENUATOR, TYPE 3 UNIDIRECTIONAL, AS PER PLAN "A", 62 MPH, 69.0" WIDTH	37	
													1	606	60041	1	EACH	IMPACT ATTENUATOR, TYPE 3 UNIDIRECTIONAL, AS PER PLAN "A", 62 MPH, 90.0" WIDTH	37	
													1	606	60041	1	EACH	IMPACT ATTENUATOR, TYPE 3 UNIDIRECTIONAL, AS PER PLAN, 62 MPH, 24.0" WIDTH	37	
										1,434			1,434	607	23000	1,434	FT	FENCE, TYPE CLT		
										228			228	607	98000	228	FT	FENCE, MISC.: 6' CHAIN LINK FENCING	383	
										1			1	607	98100	1	EACH	FENCE, MISC.: 30 INDUSTRIAL GATE	383	

GENERAL SUMMARY

FRA - 70-13.10

NO.	DESCRIPTION	REV. BY	DATE
3	QUANTITY CHANGES	ACW	0/20/23

Batchplot Spec: \\msconsultants.com\files\production\03\60\06634\_6A\standards\plotdrv\batchplot.dwg  
 Pen Table: \\msconsultants.com\files\standards\user\ahad\1\81\ms\plotling\pen\181.ms\_std.plt  
 Plot Driver: \\msconsultants.com\files\standards\user\ahad\1\81\ms\plotling\PDF.plt  
 Ohio DOT Workspace  
 70\71 East Interchange 6A  
 www.msconsultants.com  
 Ohio 001  
 60-06634-6A\_Columbus  
 0 0.5' 1'  
 34" x 22"  
 View: FENCE - NEW!  
 By: white  
 10/20/2023 1:58:33 PM  
 \\msconsultants.com\files\production\03\60\06634\_6A\roadway\sheet\89464\007.dgn

SHEET NUM.										PART.	ITEM	ITEM	GRAND	UNIT	DESCRIPTION	SEE SHEET NO.
668	671	680								01/MS/04	EXT	TOTAL				
<b>RETAINING WALLS (E2)</b>																
261										261	203	20000	261	CY	EMBANKMENT	
1,112										1,112	203	35110	1,112	CY	GRANULAR MATERIAL, TYPE B	
2										2	SPECIAL	20365000	2	EACH	SETTLEMENT PLATFORM	
273										273	203	98100	273	SY	ROADWAY, MISC.: COLUMN SUPPORTED WALLS	
45										45	601	21000	45	SY	CONCRETE SLOPE PROTECTION	
LUMP										LUMP	503	11101	LS		COFFERDAMS AND EXCAVATION BRACING, AS PER PLAN	
129										129	512	10001	129	SY	SEALING OF CONCRETE SURFACES, AS PER PLAN (PERMANENT GRAFFITI PROTECTION)	660
168										168	512	10100	168	SY	SEALING OF CONCRETE SURFACES (EPOXY-URETHANE)	660
121										121	516	13200	121	SF	1/2" PREFORMED EXPANSION JOINT FILLER	
2,115										2,115	840	20001	2,115	SF	MECHANICALLY STABILIZED EARTH WALL, AS PER PLAN	660
298										298	840	21000	298	CY	WALL EXCAVATION	
368										368	840	22000	368	SY	FOUNDATION PREPARATION	
1,851										1,851	840	23000	1,851	CY	SELECT GRANULAR BACKFILL	
312										312	840	25010	312	FT	6" DRAINAGE PIPE, PERFORATED	
135										135	840	26000	135	FT	CONCRETE COPING	
2,115										2,115	840	26050	2,115	SF	AESTHETIC SURFACE TREATMENT	
5										5	840	27000	5	DAY	ON-SITE ASSISTANCE	
<b>RETAINING WALLS (E3)</b>																
	73									73	203	20000	73	CY	EMBANKMENT	
	LUMP									LUMP	503	11101	LS		COFFERDAMS AND EXCAVATION BRACING, AS PER PLAN	660
	27,989									27,989	509	10001	27,989	LB	EPOXY COATED REINFORCING STEEL, AS PER PLAN	660
	196									196	511	53012	196	CY	CLASS QC2 CONCRETE, MISC.: PARAPET INCLUDING SLEEPER SLAB WITH QC/QA	
	618									618	512	10100	618	SY	SEALING OF CONCRETE SURFACES (EPOXY-URETHANE)	
	670									670	516	13900	670	SF	2" PREFORMED EXPANSION JOINT FILLER	
	3,854									3,854	840	20001	3,854	SF	MECHANICALLY STABILIZED EARTH WALL, AS PER PLAN	660
	443									443	840	22000	443	SY	FOUNDATION PREPARATION	
	1,097									1,097	840	23000	1,097	CY	SELECT GRANULAR BACKFILL	
	709									709	840	25010	709	FT	6" DRAINAGE PIPE, PERFORATED	
	335									335	840	26000	335	FT	CONCRETE COPING	
	3,854									3,854	840	26050	3,854	SF	AESTHETIC SURFACE TREATMENT	
	5									5	840	27000	5	DAY	ON-SITE ASSISTANCE	
<b>RETAINING WALLS (E4)</b>																
	1,334									1,334	203	20000	1,334	CY	EMBANKMENT	
	919									919	203	35110	919	CY	GRANULAR MATERIAL, TYPE B	
	2									2	SPECIAL	20365000	2	EACH	SETTLEMENT PLATFORM	661
	1,393									1,393	203	98100	1,393	SY	ROADWAY, MISC.: COLUMN SUPPORTED WALLS	664
	LUMP									LUMP	503	11101	LS		COFFERDAMS AND EXCAVATION BRACING, AS PER PLAN	660
	49,546									49,546	509	10001	49,546	LB	EPOXY COATED REINFORCING STEEL, AS PER PLAN	660
	332									332	511	53012	332	CY	CLASS QC2 CONCRETE, MISC.: PARAPET INCLUDING SLEEPER SLAB WITH QC/QA	
	216									216	512	10001	216	SY	SEALING OF CONCRETE SURFACES, AS PER PLAN (PERMANENT GRAFFITI PROTECTION)	660
	1,841									1,841	512	10100	1,841	SY	SEALING OF CONCRETE SURFACES (EPOXY-URETHANE)	
	70									70	516	13200	70	SF	1/2" PREFORMED EXPANSION JOINT FILLER	
	35									35	601	21000	35	SY	CONCRETE SLOPE PROTECTION	
	1,241									1,241	516	13900	1,241	SF	2" PREFORMED EXPANSION JOINT FILLER	
	14,829									14,829	840	20001	14,829	SF	MECHANICALLY STABILIZED EARTH WALL, AS PER PLAN	660
	1,098									1,098	840	21000	1,098	CY	WALL EXCAVATION	
	1,511									1,511	840	22000	1,511	SY	FOUNDATION PREPARATION	
	7,391									7,391	840	23000	7,391	CY	SELECT GRANULAR BACKFILL	
	1,172									1,172	840	25010	1,172	FT	6" DRAINAGE PIPE, PERFORATED	
	707									707	840	26000	707	FT	CONCRETE COPING	
	123									123	840	26001	123	FT	CONCRETE COPING, AS PER PLAN	686
	14,829									14,829	840	26050	14,829	SF	AESTHETIC SURFACE TREATMENT	
	5									5	840	27000	5	DAY	ON-SITE ASSISTANCE	

CALCULATED TAZ CHECKED DEA

GENERAL SUMMARY

FRA - 70 - 13.10

194  
702

NO.	DESCRIPTION	REV. BY	DATE
3	QUANTITY CHANGES	ACW	02/20/23



Ohio DOT Workspace  
70171 East Interchange 6A  
www.msconsultants.com

Batchplot Spec: \\msconsultants.com\files\production\03\60\06634\_6A\standards\plotdrv\batchplot.dwg  
Pen Table: \\msconsultants.com\files\standards\usin\ohdot\18\ms\plotting\pen.tbl  
Plot Driver: \\msconsultants.com\files\standards\usin\ohdot\18\ms\plotting\PDF.plt

Model: Sheet  
Printed: 10/24/2023 @ 11:02:15 AM  
By: onhite  
File: \\msconsultants.com\files\production\03\60\06634\_6A\roadway\sheet\89464\GC008.dgn

View: FENCE\_VEW1  
34" x 22"

0 0.5'

0 0.5'

SHEET NUM.

PART.

ITEM

ITEM

GRAND

UNIT

DESCRIPTION

SEE SHEET NO.

CALCULATED  
T.A.Z.  
CHECKED  
DEA

480	693	696								01/IMS/04	04/NHS/10	ITEM	ITEM EXT	GRAND TOTAL	UNIT	DESCRIPTION	SEE SHEET NO.
<b>RETAINING WALLS (E7)</b>																	
	12,305									12,305		SPECIAL	20302000	12,305	CY	ENGINEERED FILL: LIGHTWEIGHT CELLULAR CONCRETE FILL, CLASS II	
	758									758		SPECIAL	20302000	758	CY	ENGINEERED FILL: LIGHTWEIGHT CELLULAR CONCRETE FILL, CLASS III	
	18									18		203	20000	18	CY	EMBANKMENT	
	691									691		203	35110	691	CY	GRANULAR MATERIAL, TYPE B	
	2									2		SPECIAL	20365000	2	EACH	SETTLEMENT PLATFORM	
	3,117									3,117		203	98000	3,117	CY	ROADWAY, MISC.: EPS GEOFOAM FILL	
	LUMP									LUMP		503	11101	LS	COFFERDAMS AND EXCAVATION BRACING, AS PER PLAN	660	
	87									87		511	53012	87	CY	CLASS QC2 CONCRETE, MISC.: LOAD DISTRIBUTION SLAB	
	281									281		512	10100	281	SY	SEALING OF CONCRETE SURFACES (EPOXY-URETHANE)	
	16									16		601	21000	16	SY	CONCRETE SLOPE PROTECTION	
	68									68		516	13200	68	SF	1/2" PREFORMED EXPANSION JOINT FILLER	
	59									59		516	13900	59	SF	2" PREFORMED EXPANSION JOINT FILLER	
	2,906									2,906		840	20001	2,906	SF	MECHANICALLY STABILIZED EARTH WALL, AS PER PLAN	660
	1,300									1,300		840	21000	1,300	CY	WALL EXCAVATION	
	315									315		840	22000	315	SY	FOUNDATION PREPARATION	
	2,660									2,660		840	23000	2,660	CY	SELECT GRANULAR BACKFILL	
	97									97		840	26000	97	FT	CONCRETE COPING	
	2,906									2,906		840	26050	2,906	SF	AESTHETIC SURFACE TREATMENT	
	5									5		840	27000	5	DAY	ON-SITE ASSISTANCE	
<b>RETAINING WALLS (E9)</b>																	
	1,523									1,523		203	20000	1,523	CY	EMBANKMENT	
	1,229									1,229		203	35110	1,229	CY	GRANULAR MATERIAL, TYPE B	
	LUMP									LUMP		503	11101	LS	COFFERDAMS AND EXCAVATION BRACING, AS PER PLAN	660	
	3,766									3,766		509	10001	3,766	LB	EPOXY COATED REINFORCING STEEL, AS PER PLAN	660
	24									24		511	53012	24	CY	CLASS QC2 CONCRETE, MISC.: (PERMANENT GRAFFITI PROTECTION)	
	41									41		512	10001	41	SY	SEALING OF CONCRETE SURFACES, AS PER PLAN	660
	500									500		512	10100	500	SY	SEALING OF CONCRETE SURFACES (EPOXY-URETHANE)	
	70									70		516	13200	70	SF	1/2" PREFORMED EXPANSION JOINT FILLER	
	195									195		516	13900	195	SF	2" PREFORMED EXPANSION JOINT FILLER	
	17									17		601	21000	17	SY	CONCRETE SLOPE PROTECTION	
	5,574									5,574		840	20001	5,574	SF	MECHANICALLY STABILIZED EARTH WALL, AS PER PLAN	660
	2,754									2,754		840	21000	2,754	CY	WALL EXCAVATION	
	502									502		840	22000	502	SY	FOUNDATION PREPARATION	
	13,143									13,143		840	23000	13,143	CY	SELECT GRANULAR BACKFILL	
	334									334		840	25010	334	FT	6" DRAINAGE PIPE, PERFORATED	
	169									169		840	26000	169	FT	CONCRETE COPING	
	5,574									5,574		840	26050	5,574	SF	AESTHETIC SURFACE TREATMENT	
	5									5		840	27000	5	DAY	ON-SITE ASSISTANCE	
<b>STRUCTURE OVER 20 FOOT SPAN (FRA-070-1322L)</b>																	
	565									565		503	21101	565	CY	UNCLASSIFIED EXCAVATION, AS PER PLAN	477
	LUMP									LUMP		505	11100	LS	PILE DRIVING EQUIPMENT MOBILIZATION		
	3,300									3,300		507	00100	3,300	FT	STEEL PILES HP10X42, FURNISHED	
	3,055									3,055		507	00150	3,055	FT	STEEL PILES HP10X42, DRIVEN	
	49									49		507	93300	49	EACH	STEEL POINTS OR SHOES	
	618,934									618,934		509	10001	618,934	LB	EPOXY COATED REINFORCING STEEL, AS PER PLAN	477
	1,328									1,328		511	34447	1,328	CY	CLASS QC2 CONCRETE WITH QC/QA, BRIDGE DECK, AS PER PLAN	477
	325									325		511	34450	325	CY	CLASS QC2 CONCRETE WITH QC/QA, BRIDGE DECK (PARAPET)	
	253									253		511	44112	253	CY	CLASS QC1 CONCRETE WITH QC/QA, ABUTMENT NOT INCLUDING FOOTING	
	477									477		511	45602	477	CY	CLASS QC4 MASS CONCRETE, SUBSTRUCTURE WITH QC/QA	
	22									22		511	46012	22	CY	CLASS QC1 CONCRETE WITH QC/QA, RETAINING/WINGWALL NOT INCLUDING FOOTING	
	146									146		511	46512	146	CY	CLASS QC1 CONCRETE WITH QC/QA, FOOTING	
	254									254		512	10001	254	SY	SEALING OF CONCRETE SURFACES, AS PER PLAN (PERMANENT GRAFFITI PROTECTION)	477
	2,927									2,927		512	10100	2,927	SY	SEALING OF CONCRETE SURFACES (EPOXY-URETHANE)	
	300,500									300,500		513	10280	300,500	LB	STRUCTURAL STEEL MEMBERS, LEVEL 4	
	1,634,600									1,634,600		513	10401	1,634,600	LB	STRUCTURAL STEEL MEMBERS, HYBRID GIRDER, LEVEL SIX (6) FABRICATION, AS PER PLAN	479
	9,471									9,471		513	20000	9,471	EACH	WELDED STUD SHEAR CONNECTORS	
	27,528									27,528		514	00060	27,528	SF	FIELD PAINTING STRUCTURAL STEEL, INTERMEDIATE COAT	
	27,528									27,528		514	00066	27,528	SF	FIELD PAINTING STRUCTURAL STEEL, FINISH COAT	
	111									111		SPECIAL	51612400	111	FT	MODULAR EXPANSION JOINT	478

GENERAL SUMMARY

FRA - 70 - 13.10

NO.	DESCRIPTION	REV. BY	DATE
3	QUANTITY CHANGES	ACW	10/20/23

195  
702

Batchplot Spec: \\msconsultants.com\files\production\03\60\06634\_6A\standards\plotdrv\batchplot.dwg  
 Pen Table: \\msconsultants.com\files\standards\usin\ohio\1\81\ms\plotting\pen\181.ms\_std.plt  
 Plot Driver: \\msconsultants.com\files\standards\usin\ohio\1\81\ms\plotting\PDF.plt  
 Ohio DOT Workspace  
 70\71 East Interchange 6A  
 www.msconsultants.com  
 Model: Sheet  
 Printed: 10/23/2023 @ 4:54:07 PM  
 By: onhite  
 File: \\msconsultants.com\files\production\03\60\06634\_6A\roadway\sheet\894646G0010.dgn  
 View: FENCE - NEW!  
 34" x 22"

SHEET NUM.				PART.	ITEM	ITEM	GRAND	UNIT	DESCRIPTION	SEE SHEET NO.
619	636			04/NHS/10		EXT	TOTAL			
									<b>STRUCTURE OVER 20 FOOT SPAN (FRA-070-1358L)</b>	
	LUMP			LUMP	202	11003	LS		STRUCTURE REMOVED, OVER 20 FOOT SPAN, AS PER PLAN	602
	645			645	202	22900	645	SY	APPROACH SLAB REMOVED	
	645			645	202	23500	645	SY	WEARING COURSE REMOVED	
	LUMP			LUMP	505	11100	LS		PILE DRIVING EQUIPMENT MOBILIZATION	
	5,490			5,490	507	00200	5,490	FT	STEEL PILES HP12X53, FURNISHED	
	219			219	503	21100	219	CY	UNCLASSIFIED EXCAVATION	
	5,185			5,185	507	00250	5,185	FT	STEEL PILES HP12X53, DRIVEN	
	2,210			2,210	507	00300	2,210	FT	STEEL PILES HP14X73, FURNISHED	
	2,040			2,040	507	00350	2,040	FT	STEEL PILES HP14X73, DRIVEN	
	95			95	507	93300	95	EACH	STEEL POINTS OR SHOES	
	334,495			334,495	509	10001	334,495	LB	EPOXY COATED REINFORCING STEEL, AS PER PLAN	602
	371			371	511	33418	371	CY	CLASS QC2 CONCRETE WITH QC/QA, SUPERSTRUCTURE	
	2			2	511	33501	2	EACH	SEMI-INTEGRAL DIAPHRAGM GUIDE, AS PER PLAN	602
	777			777	511	34446	777	CY	CLASS QC2 CONCRETE WITH QC/QA, BRIDGE DECK	
	98			98	511	34450	98	CY	CLASS QC2 CONCRETE WITH QC/QA, BRIDGE DECK (PARAPET)	
	377			377	511	40512	377	CY	CLASS QC1 CONCRETE WITH QC/QA, PIER ABOVE FOOTINGS	
	404			404	511	43512	404	CY	CLASS QC1 CONCRETE WITH QC/QA, ABUTMENT INCLUDING FOOTING	
	104			104	511	46512	104	CY	CLASS QC1 CONCRETE WITH QC/QA, FOOTING	
	2,548			2,548	512	10100	2,548	SY	SEALING OF CONCRETE SURFACES (EPOXY-URETHANE)	
	95			95	512	33000	95	SY	TYPE 2 WATERPROOFING	
	24			24	515	15130	24	EACH	DRAPED STRAND PRESTRESSED CONCRETE BRIDGE I-BEAM MEMBERS, LEVEL 3, TYPE WF72-49, 135' - 1.25" BEAM LENGTH	
	66			66	515	20000	66	EACH	INTERMEDIATE DIAPHRAGMS	
	232			232	516	10010	232	FT	ARMORLESS PREFORMED JOINT SEAL	
	356			356	516	13900	356	SF	2" PREFORMED EXPANSION JOINT FILLER	
	328			328	516	14020	328	FT	SEMI-INTEGRAL ABUTMENT EXPANSION JOINT SEAL	
	12			12	516	44301	12	EACH	ELASTOMERIC BEARING WITH INTERNAL LAMINATES AND LOAD PLATE (NEOPRENE), AS PER PLAN 1'-3" X 4 1/2" X 2'-4" PAD, 1'-4" X 2" X 2'-5" STEEL LOAD PLATE	602
	12			12	516	44301	12	EACH	ELASTOMERIC BEARING WITH INTERNAL LAMINATES AND LOAD PLATE (NEOPRENE), AS PER PLAN 1'-3" X 4 1/2" X 2'-4" PAD, BEVELED 1'-4" X 3" X 2'-5" STEEL LOAD PLATE	602
	12			12	516	44301	12	EACH	ELASTOMERIC BEARING WITH INTERNAL LAMINATES AND LOAD PLATE (NEOPRENE), AS PER PLAN 1'-4" X 1 1/2" X 2' 6" PAD, 1' 5" X 2" X 2' 7" STEEL LOAD PLATE	602
	12			12	516	44301	12	EACH	ELASTOMERIC BEARING WITH INTERNAL LAMINATES AND LOAD PLATE (NEOPRENE), AS PER PLAN 1'-4" X 4 1/2" X 2'-6" PAD, BEVELED 1'-5" X 2" X 2'-7" STEEL LOAD PLATE	602
	204			204	518	21200	204	CY	POROUS BACKFILL WITH GEOTEXTILE FABRIC	
	283			283	518	40000	283	FT	6" PERFORATED CORRUGATED PLASTIC PIPE	
	131			131	518	40010	131	FT	6" NON-PERFORATED CORRUGATED PLASTIC PIPE, INCLUDING SPECIALS	
	784			784	526	30000	784	SY	REINFORCED CONCRETE APPROACH SLABS (T=17")	
	232			232	526	90030	232	FT	TYPE C INSTALLATION	
	114			114	605	14000	114	FT	6" BASE PIPE UNDERDRAINS	
	470			470	607	39900	470	FT	VANDAL PROTECTION FENCE, 6' STRAIGHT, COATED FABRIC	
									<b>STRUCTURE OVER 20 FOOT SPAN (FRA-070-1373L)</b>	
	LUMP			LUMP	202	11203	LS		PORTIONS OF STRUCTURE REMOVED, OVER 20 FOOT SPAN, AS PER PLAN	635
	335			335	202	22900	335	SY	APPROACH SLAB REMOVED	
	897			897	202	23500	897	SY	WEARING COURSE REMOVED	
	28			28	202	98100	28	EACH	REMOVAL MISC.: PILE REMOVED, EXISTING STRUCTURE FRA-70-1379S	
	LUMP			LUMP	503	11100	LS		COFFERDAMS AND EXCAVATION BRACING	
	LUMP			LUMP	505	11100	LS		PILE DRIVING EQUIPMENT MOBILIZATION	
	2,870			2,870	507	00200	2,870	FT	STEEL PILES HP12X53, FURNISHED	
	2,730			2,730	507	00250	2,730	FT	STEEL PILES HP12X53, DRIVEN	
	28			28	507	93300	28	EACH	STEEL POINTS OR SHOES	
	73,484			73,484	509	10001	73,484	LB	EPOXY COATED REINFORCING STEEL, AS PER PLAN	635
	120			120	511	33418	120	CY	CLASS QC2 CONCRETE WITH QC/QA, SUPERSTRUCTURE	
	2			2	511	33501	2	EACH	SEMI-INTEGRAL DIAPHRAGM GUIDE, AS PER PLAN	635
	155			155	511	34446	155	CY	CLASS QC2 CONCRETE WITH QC/QA, BRIDGE DECK	
	49			49	511	34450	49	CY	CLASS QC2 CONCRETE WITH QC/QA, BRIDGE DECK (PARAPET)	
	179			179	511	43512	179	CY	CLASS QC1 CONCRETE WITH QC/QA, ABUTMENT INCLUDING FOOTING	
	702			702	512	10100	702	SY	SEALING OF CONCRETE SURFACES (EPOXY-URETHANE)	
	50			50	512	33000	50	SY	TYPE 2 WATERPROOFING	
	7			7	515	15020	7	EACH	DRAPED STRAND PRESTRESSED CONCRETE BRIDGE I-BEAM MEMBERS, LEVEL 3, TYPE 4, 91' - 11" BEAM LENGTH	
	18			18	515	20001	18	EACH	INTERMEDIATE DIAPHRAGMS, AS PER PLAN	635
	136			136	516	10010	136	FT	ARMORLESS PREFORMED JOINT SEAL	

**GENERAL SUMMARY**

**FRA - 70 - 13.10**

NO.	DESCRIPTION	REV. BY	DATE
3	QUANTITY CHANGES	ACW	10/20/23



070\_1358LE0001.dgn Sheet 10/20/2023 9:44:32 AM 89464\_Half\_BW.pltcfgr 89464\_Pen\_BW.tbl Bluebeam PDF Jason.Centers@jacobs.com

ESTIMATED QUANTITIES										
ITEM	EXTENSION	TOTAL	UNIT	DESCRIPTION	ABUT.	PIERS	SUPER.	GEN.	SHEET #	
202	11003	1	LS	STRUCTURE REMOVED, OVER 20 FOOT SPAN, AS PER PLAN					LUMP	2/32
202	22900	645	SY	APPROACH SLAB REMOVED					645	
202	23500	645	SY	WEARING COURSE REMOVED					645	
503	21100	219	CY	UNCLASSIFIED EXCAVATION			219			
505	11100	1	LS	PILE DRIVING EQUIPMENT MOBILIZATION					LUMP	
507	00200	5490	FT	STEEL PILES HP12X53, FURNISHED	5490					
507	00250	5185	FT	STEEL PILES HP12X53, DRIVEN	5185					
507	00300	2210	FT	STEEL PILES HP14X73, FURNISHED		2210				
507	00350	2040	FT	STEEL PILES HP14X73, DRIVEN		2040				
507	93300	95	EACH	STEEL POINTS OR SHOES	61	34				
509	10001	334495	LB	EPOXY COATED REINFORCING STEEL, AS PER PLAN	28690	48172	257633			2/32
511	33418	371	CY	CLASS QC2 CONCRETE WITH QC/QA, SUPERSTRUCTURE			371			
511	33501	2	EACH	SEMI-INTEGRAL DIAPHRAGM GUIDE	2					2/32
511	34446	777	CY	CLASS QC2 CONCRETE WITH QC/QA, BRIDGE DECK			777			
511	34450	98	CY	CLASS QC2 CONCRETE WITH QC/QA, BRIDGE DECK (PARAPET)			98			
511	40512	377	CY	CLASS QC1 CONCRETE WITH QC/QA, PIER ABOVE FOOTINGS		377				
511	43512	404	CY	CLASS QC1 CONCRETE WITH QC/QA, ABUTMENT INCLUDING FOOTING	404					
511	46512	104	CY	CLASS QC1 CONCRETE WITH QC/QA, FOOTING		104				
512	10100	2548	SY	SEALING OF CONCRETE SURFACES (EPOXY-URETHANE)	273	698	1577			
512	33000	95	SY	TYPE 2 WATERPROOFING	95					
515	15130	24	EACH	DRAPED STRAND PRESTRESSED CONCRETE BRIDGE I-BEAM MEMBERS, LEVEL 3, TYPE WFT2-49, 135'-1 1/4" BEAM LENGTH				24		
515	20000	66	EACH	INTERMEDIATE DIAPHRAGMS				66		
516	10010	232	FT	ARMORLESS PREFORMED JOINT SEAL			232			
516	13900	356	SF	2" PREFORMED EXPANSION JOINT FILLER	356					
516	14020	328	FT	SEMI-INTEGRAL ABUTMENT EXPANSION JOINT SEAL	328					
516	44301	12	EACH	ELASTOMERIC BEARING WITH INTERNAL LAMINATES AND LOAD PLATE (NEOPRENE), (1'-3"x 4 1/2"x 2'-4" PAD, 1'-4"x 2"x 2'-5" STEEL LOAD PLATE), AS PER PLAN	12					2/32
516	44301	12	EACH	ELASTOMERIC BEARING WITH INTERNAL LAMINATES AND LOAD PLATE (NEOPRENE), (1'-4"x 4 1/2"x 2'-6" PAD, 1'-5"x 2"x 2'-7" STEEL LOAD PLATE), AS PER PLAN	12					2/32
516	44301	12	EACH	ELASTOMERIC BEARING WITH INTERNAL LAMINATES AND LOAD PLATE (NEOPRENE), (1'-3"x 4 1/2"x 2'-4" PAD, BEVELED 1'-4"x 3"x 2'-5" STEEL LOAD PLATE), AS PER PLAN		12				2/32
516	44301	12	EACH	ELASTOMERIC BEARING WITH INTERNAL LAMINATES AND LOAD PLATE (NEOPRENE), (1'-4"x 4 1/2"x 2'-6" PAD, BEVELED 1'-5"x 2"x 2'-7" STEEL LOAD PLATE), AS PER PLAN		12				2/32
518	21200	204	CY	POROUS BACKFILL WITH FILTER FABRIC	204					
518	40000	283	FT	6" PERFORATED CORRUGATED PLASTIC PIPE	283					
518	40010	131	FT	6" NON-PERFORATED CORRUGATED PLASTIC PIPE, INCLUDING SPECIALS	131					
526	30000	784	SY	REINFORCED CONCRETE APPROACH SLABS (T=17")			784			
526	90030	232	FT	TYPE C INSTALLATION			232			
605	14000	114	FT	6" BASE PIPE UNDERDRAINS				114		
607	39900	470	FT	VANDAL PROTECTION FENCE, 6' STRAIGHT, COATED FABRIC			470			

**ABBREVIATIONS**

THE FOLLOWING ABBREVIATIONS HAVE BEEN USED THROUGHOUT THESE PLANS:

- |  |  |  |  |   |   |
|--|--|--|--|---|---|
| <p>&amp; = AND<br/>         @ = AT<br/>         ° = DEGREES<br/>         ' = FEET OR MINUTES<br/>         " = INCHES OR SECONDS<br/>         ± = PLUS OR MINUS</p> <p>AASHTO = AMERICAN ASSOCIATION OF STATE HIGHWAY AND TRANSPORTATION OFFICIALS<br/>         ABUT. = ABUTMENT<br/>         ADT = AVERAGE DAILY TRAFFIC<br/>         ADTT = AVERAGE DAILY TRUCK TRAFFIC<br/>         A.P.P. = AS PER PLAN<br/>         APPR. = APPROACH<br/>         APPROX. = APPROXIMATE<br/>         ASTM = AMERICAN SOCIETY OF TESTING AND MATERIALS</p> <p>BM = BENCHMARK<br/>         BOT. = BOTTOM<br/>         BOT./FTG. = BOTTOM OF FOOTING<br/>         BRGS. = BEARINGS<br/>         B/W = BETWEEN</p> | <p>⊙ = CENTERLINE<br/>         C/C = CENTER TO CENTER<br/>         CFS = CUBIC FEET PER SECOND<br/>         CJ = CONSTRUCTION JOINT<br/>         CLR. = CLEAR<br/>         CMP = CORRUGATED METAL PIPE<br/>         CMS = CONSTRUCTION AND MATERIAL SPECIFICATIONS<br/>         CONSTR./CONST. = CONSTRUCTION<br/>         CON'T = CONTINUED<br/>         COL. = COLUMN<br/>         C.R./CR = COUNTY ROAD<br/>         CU = CUBIC<br/>         CVN = CHARPY V-NOTCH</p> <p>DEFL. = DEFLECTION<br/>         φ/DIA. = DIAMETER<br/>         DIM. = DIMENSION<br/>         DL = DEAD LOAD<br/>         DWG. = DRAWING</p> <p>E = EAST<br/>         EA. = EACH<br/>         EF = EACH FACE<br/>         EL./ELEV. = ELEVATION</p> | <p>EMBED. = EMBEDMENT<br/>         EQ. = EQUAL<br/>         EX./EXIST. = EXISTING<br/>         EXP. = EXPANSION<br/>         EXT. = EXTENSION</p> <p>F = FAHRENHEIT<br/>         FF = FAR FACE<br/>         F/F = FACE TO FACE<br/>         FS = FIELD SPLICE<br/>         FT. = FEET<br/>         FT/FT. = FOOT/FOOT<br/>         FT/S = FEET PER SECOND<br/>         FTG. = FOOTING<br/>         FWD. = FORWARD<br/>         FWS = FUTURE WEARING SURFACE</p> <p>GEN. = GENERAL</p> <p>HR = HOUR<br/>         HW = HIGH WATER</p> <p>IN. = INCHES<br/>         INT. = INTERMEDIATE</p> | <p>JT. = JOINT</p> <p>LF = LEFT FORWARD<br/>         LONG. = LONGITUDINAL<br/>         LT. = LEFT</p> <p>MAX. = MAXIMUM<br/>         MIN. = MINIMUM<br/>         MISC. = MISCELLANEOUS</p> <p>N = NORTH<br/>         NF = NEAR FACE<br/>         NPCPP = NON-PERFORATED CORRUGATED PLASTIC PIPE<br/>         #/NO. = NUMBER</p> <p>OHWM = ORDINARY HIGH WATER MARK<br/>         OUT/OUT = OUT TO OUT</p> <p>PEJF = PREFORMED EXPANSION JOINT FILLER<br/>         PCPP = PERFORATED CORRUGATED PLASTIC PIPE</p> | <p>P/PL = PLATE<br/>         PSF = POUND PER SQUARE FOOT<br/>         PSI = POUND PER SQUARE INCH<br/>         PT. = POINT<br/>         PVI = POINT OF VERTICAL INTERSECTION</p> <p>Q = FLOW</p> <p>R = RADIUS<br/>         REF. = REFERENCE<br/>         REINF. = REINFORCED<br/>         REQ'D. = REQUIRED<br/>         RF = RIGHT FORWARD<br/>         RT. = RIGHT</p> <p>SHLDR. = SHOULDER<br/>         SPA. = SPACING<br/>         SQ = SQUARE<br/>         STA. = STATION<br/>         STD. = STANDARD<br/>         STR. = STRAIGHT<br/>         SUPER = SUPERSTRUCTURE</p> | <p>T = THICKNESS<br/>         TBR = TO BE REMOVED<br/>         TELE = TELEPHONE<br/>         TRANS. = TRANSVERSE<br/>         TWP. = TOWNSHIP<br/>         TYP. = TYPICAL</p> <p>UBV = ULTIMATE BEARING VALUE</p> <p>V = VELOCITY<br/>         V.C. = VERTICAL CURVE<br/>         VERT. = VERTICAL</p> <p>W = WEST<br/>         W/ = WITH<br/>         W/O = WITHOUT<br/>         W.P. = WORKING POINT<br/>         WT. = WEIGHT</p> <p>YD = YARD</p> |
|--|--|--|--|---|---|

NO.	DESCRIPTION	REV. BY	DATE
3	ADDED UNCLASSIFIED EXCAVATION QUANTITY	JTC	10/20/23

DESIGN AGENCY: **ch2m**  
 1103 Schrock Road, Suite 400  
 Columbus, Ohio 43229  
 DATE: 5/15  
 STRUCTURE FILE NUMBER: 2510028  
 REVIEWED: JTC  
 DRAWN: JBA  
 DESIGNED: ZNG  
 CHECKED: VS  
 ESTIMATED QUANTITIES  
 BRIDGE NO. FRA-070-1358L  
 I-70 WB OVER CSX AND NS RAILROAD  
 FRA-70-13.10  
 PID No. 89464  
 6/32  
 606  
 702

\\s0n1.resourceinternational.com\two\projects\2013\W-13-072 FRA-70-13.10 6A\89464\structures\wall\_OE2\sheets\105588\_OE2WQ001.dgn 10/20/2023 10:53:17 AM meets


CALCULATED BY: MMS DATE: 11/18/2021  
 CHECKED BY: JGM DATE: 11/18/2021

ESTIMATED QUANTITIES					AS PER PLAN REFERENCE SHEET
ITEM	ITEM EXT.	TOTAL	UNIT	DESCRIPTION	
203	20000	261	CU YD	EMBANKMENT	
203	35110	1112	CU YD	GRANULAR MATERIAL, TYPE B	
203	65000	2	EACH	SPECIAL - SETTLEMENT PLATFORM	661
203	98100	273	SQ YD	ROADWAY MISC.: COLUMN SUPPORTED WALLS	664
503	11101	LS	LS	COFFERDAMS AND EXCAVATION BRACING, AS PER PLAN	660
512	10001	129	SQ YD	SEALING OF CONCRETE SURFACES, AS PER PLAN (PERMANENT GRAFFITI PROTECTION)	660
512	10100	168	SQ YD	SEALING OF CONCRETE SURFACES (EPOXY URETHANE)	
516	13200	121	SQ FT	1/2" PREFORMED EXPANSION JOINT FILLER	
601	21000	45	SY	CONCRETE SLOPE PROTECTION	
840	20001	2115	SQ FT	MECHANICALLY STABILIZED EARTH WALL, AS PER PLAN	660
840	21000	298	CU YD	WALL EXCAVATION	
840	22000	368	SQ YD	FOUNDATION PREPARATION	
840	23000	1851	CU YD	SELECT GRANULAR BACKFILL	
840	25010	312	FT	6" DRAINAGE PIPE, PERFORATED	
840	26000	156	SY	CONCRETE CURING	
840	26050	2115	SQ FT	AESTHETIC SURFACE TREATMENT	
840	27000	5	DAY	ON SITE ASSISTANCE	

3

3

NO.	DESCRIPTION	REV. BY	DATE
3	ADDED CONCRETE SLOPE PROTECTION QUANTITY	MMS	10-19-23
3	UPDATED QUANTIY	MMS	10-19-23

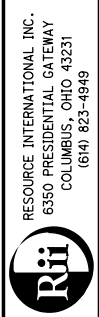

REVIEWED DATE 11/18/2021  
 NCK  
 STRUCTURE FILE NUMBER

DRAWN MMS  
 MMS  
 REVISIONS  
 CHECKED JGM

ESTIMATED QUANTITIES  
 RETAINING WALL E2  
 I-70/I-71 WEST INTERCHANGE PROJECT

FRA-70-13.10  
 PID No. 77372

1 / 3

668  
 702

G:\projects\2013\W-13-072\_FRA-70-13-10\_6A\89464\_structures\wall\_OE4\_sheets\105588\_OE4.WQ011.dgn 10/20/2023 10:53:18 AM meets

CALCULATED BY: JGM DATE: 11/18/2021  
 CHECKED BY: MMS DATE: 11/18/2021

ESTIMATED QUANTITIES					AS PER PLAN REFERENCE SHEET
ITEM	ITEM EXT.	TOTAL	UNIT	DESCRIPTION	
203	20000	1334	CU YD	EMBANKMENT	
203	35110	919	CU YD	GRANULAR MATERIAL, TYPE B	
203	98100	1393	SQ YD	ROADWAY MISC.: COLUMN-SUPPORTED WALLS *	664
203	65000	2	EACH	SPECIAL - SETTLEMENT PLATFORM	661
503	11101	LS	LS	COFFERDAMS AND EXCAVATION BRACING, AS PER PLAN	660
509	10001	49546	LB	EPOXY COATED REINFORCING STEEL, AS PER PLAN	660
511	53012	332	CU YD	CLASS QC2 CONCRETE, MISC.: PARAPET INCLUDING SLEEPER SLAB WITH QC/QA	
512	10001	216	SQ YD	SEALING OF CONCRETE SURFACES, (PERMANENT GRAFFITI PROTECTION), AS PER PLAN	660
512	10100	1841	SQ YD	SEALING OF CONCRETE SURFACES (EPOXY URETHANE)	
516	13200	70	SQ FT	1/2" PREFORMED EXPANSION JOINT FILLER	
516	13900	1241	SQ FT	2" PREFORMED EXPANSION JOINT FILLER	
601	21000	35	SY	CONCRETE SLOPE PROTECTION	
840	20001	14829	SQ FT	MECHANICALLY STABILIZED EARTH WALL, AS PER PLAN	660
840	21000	1098	CU YD	WALL EXCAVATION	
840	22000	1511	SQ YD	FOUNDATION PREPARATION	
840	23000	7391	CU YD	SELECT GRANULAR BACKFILL	
840	25010	1172	FT	6" DRAINAGE PIPE, PERFORATED	
840	26000	707	FT	CONCRETE COPING	
840	26001	123	FT	CONCRETE COPING, AS PER PLAN	666
840	26050	14829	SQ FT	AESTHETIC SURFACE TREATMENT	
840	27000	5	EA	ON-SITE ASSISTANCE	

\* - QUANTITY FOR COLUMN-SUPPORTED WALLS INCLUDES GROUND IMPROVEMENTS PERFORMED UNDER THIS SET OF PLANS. SEE SHEETS 692 FOR LIMITS.

NO.	DESCRIPTION	REV. BY	DATE
3	ADDED CONCRETE SLOPE PROTECTION QUANTITY	MMS	10-19-23
3	UPDATED QUANTITY	MMS	10-19-23

RESOURCE INTERNATIONAL, INC.  
 6350 PRESIDENTIAL GATEWAY  
 COLUMBUS, OHIO 43231  
 (614) 823-4949



REVIEWED DATE 11/18/2021  
 NCK  
 STRUCTURE FILE NUMBER

DRAWN MMS  
 REVISIONS

DESIGNED K SJ  
 CHECKED MMS

ESTIMATED QUANTITIES  
 RETAINING WALL E4  
 I-70/I-71 WEST INTERCHANGE PROJECT

FRA-70-13-10  
 PID No. 77372

1 / 13

680  
 702

CALCULATED BY: MMS DATE: 11/18/2021  
 CHECKED BY: JGM DATE: 11/18/2021

ESTIMATED QUANTITIES					AS PER PLAN REFERENCE SHEET
ITEM	ITEM EXT.	TOTAL	UNIT	DESCRIPTION	
203	02000	12305	CU YD	SPECIAL - ENGINEERED FILL: LIGHTWEIGHT CELLULAR CONCRETE FILL, CLASS II	663
203	02000	758	CU YD	SPECIAL - ENGINEERED FILL: LIGHTWEIGHT CELLULAR CONCRETE FILL, CLASS III	663
203	20000	18	CU YD	EMBANKMENT	
203	35110	691	CU YD	GRANULAR MATERIAL, TYPE B	
203	98000	3117	CU YD	ROADWAY MISC.: EPS GEOFOAM FILL	662
203	65000	2	EACH	SPECIAL - SETTLEMENT PLATFORM	661
503	11101	LS	LS	COFFERDAMS AND EXCAVATION, AS PER PLAN	660
511	53012	87	CU YD	CLASS QC2 CONCRETE, MISC.: LOAD DISTRIBUTION SLAB	660
512	10100	281	SQ YD	SEALING OF CONCRETE SURFACES (EPOXY URETHANE)	
516	13200	68	SQ FT	1/2" PREFORMED EXPANSION JOINT FILLER	
516	13900	59	SQ FT	2" PREFORMED EXPANSION JOINT FILLER	
601	21000	16	SQ YD	CONCRETE SLOPE PROTECTION	
840	20001	2906	SQ FT	MECHANICALLY STABILIZED EARTH WALL, AS PER PLAN	660
840	21000	1300	CU YD	WALL EXCAVATION	
840	22000	315	SQ YD	FOUNDATION PREPARATION	
840	23000	2660	CU YD	SELECT GRANULAR BACKFILL	
840	24000	97	FT	CONCRETE CURBING	
840	26050	2906	SQ FT	AESTHETIC SURFACE TREATMENT	
840	27000	5	SAF	ON-SITE ASSISTANCE	

ABOVE WALL QUANTITIES ALSO INCLUDE ROADWAY QUANTITIES LISTED BELOW BETWEEN STATION 177+17.60 TO 179+00.00. THE BELOW ROADWAY QUANTITIES ARE PAID FOR WITH WALL E7 AS THE PLAN NOTES INDICATE. THE TABLE BELOW IS FOR INFORMATION ONLY AND THE QUANTITIES ARE NOT CARRIED TO THE ROADWAY GENERAL SUMMARY.

ESTIMATED QUANTITIES - ROADWAYS					AS PER PLAN REFERENCE SHEET
ITEM	ITEM EXT.	TOTAL	UNIT	DESCRIPTION	
203	02000	7941	CU YD	SPECIAL - ENGINEERED FILL: LIGHTWEIGHT CELLULAR CONCRETE FILL, CLASS II	663
203	02000	555	CU YD	SPECIAL - ENGINEERED FILL: LIGHTWEIGHT CELLULAR CONCRETE FILL, CLASS III	663
203	35110	564	CU YD	GRANULAR MATERIAL, TYPE B	
203	98000	3117	CU YD	ROADWAY MISC.: EPS GEOFOAM FILL	662

NO.	DESCRIPTION	REV. BY	DATE
3	ADDED CONCRETE SLOPE PROTECTION QUANTITY	MMS	10-19-23
3	UPDATED QUANTIY	MMS	10-19-23
3	UPDATED NOTE	MMS	10-19-23
3	REMOVED LOAD DISTRIBUTION SLAB QUANTITY	MMS	10-19-23

RESOURCE INTERNATIONAL INC.  
 6350 PRESIDENTIAL GATEWAY  
 COLUMBUS, OHIO 43231  
 (614) 827-4949



REVIEWED DATE 11/18/2021  
 NCK STRUCTURE FILE NUMBER

DRAWN MMS  
 MMS REVISED


DESIGNED JGM  
 JGM CHECKED MMS

ESTIMATED QUANTITIES  
 RETAINING WALL E7  
 I-70/I-71 WEST INTERCHANGE PROJECT


FRA-70-13-10  
 PID No. 77372

G:\projects\2013\W-13-072\_FRA-70-13-10\_6A\89464\structures\wall\_QE7\_6A\sheets\105588\_QE7W001.dgn 10/20/2023 10:53:18 AM meets

G:\projects\2013\W-13-072\_FRA-70-13-10\_6A\89464\_structures\wall\_OE7\_6A\sheets\105588\_OE7WD017.dgn 10/20/2023 10:53:42 AM meets

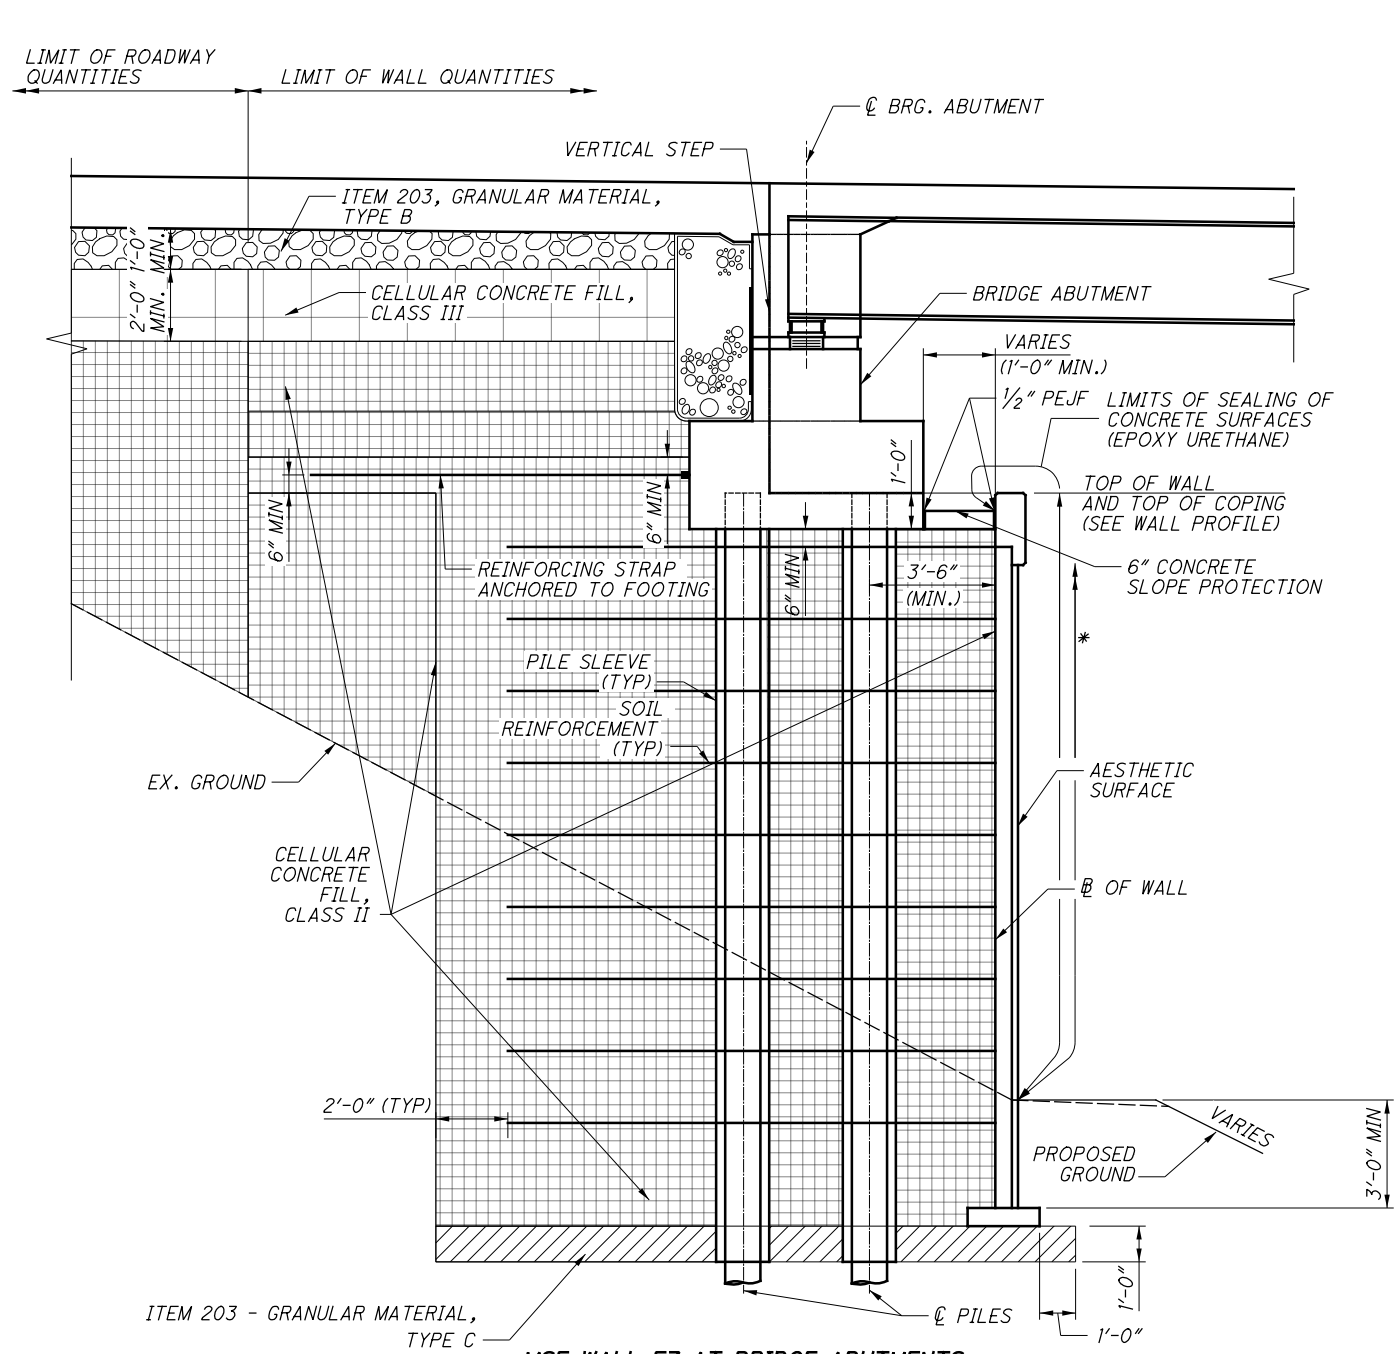

**MSE WALL E7 AT BRIDGE ABUTMENTS**  
WALL E7 STA. 705+60.87 TO STA. 706+28.57

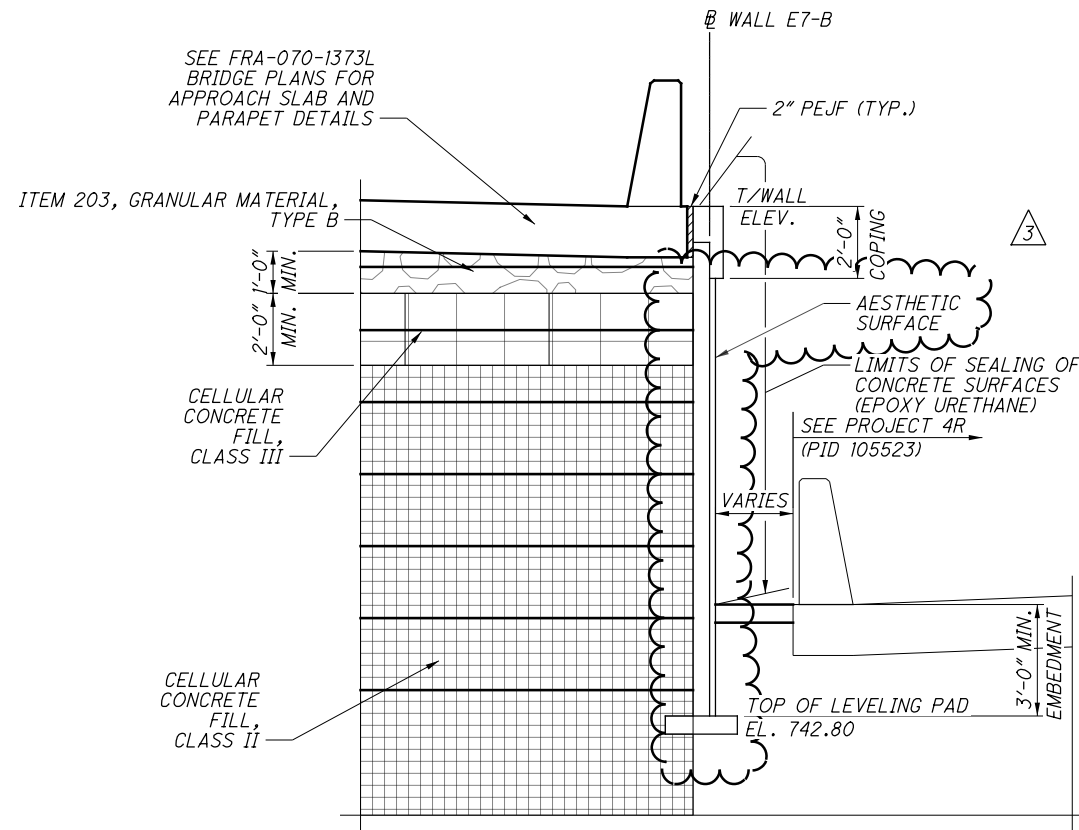

**WALL SECTION E7-B**

NO.	DESCRIPTION	REV. BY	DATE
3	UPDATED AESTHETIC SURFACE TREATMENT	MMS	10-19-23


**LEGEND:**

\* - LIMITS OF ITEM 512 - SEALING OF CONCRETE SURFACES, AS PER PLAN (PERMANENT GRAFFITI PROTECTION) SEAL ALL EXPOSED SURFACES EXTENDING 10'-0" VERTICAL FROM GROUND LINE.


- CELLULAR CONCRETE FILL, CLASS II
- CELLULAR CONCRETE FILL, CLASS III
- GRANULAR MATERIAL, TYPE B
- GRANULAR MATERIAL, TYPE C
- EXCAVATION LIMITS

**NOTES:**

1. SEE BRIDGE PLANS FOR ADDITIONAL ABUTMENT AND WINGWALL DETAILS.
2. SOIL REINFORCEMENT SHALL BE CONSTRUCTED SO AS TO AVOID INTERFERENCE WITH BRIDGE PILING.
3. FOR ABBREVIATION LEGEND, SEE SHEET 660.
4. COPING EXPANSION JOINT SHALL BE SPACED NO MORE THAN 20 FEET APART AND ALIGNED WITH JOINTS BETWEEN FACING PANELS.

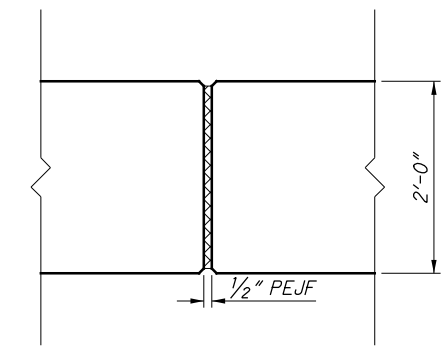

**COPING EXPANSION JOINTS**

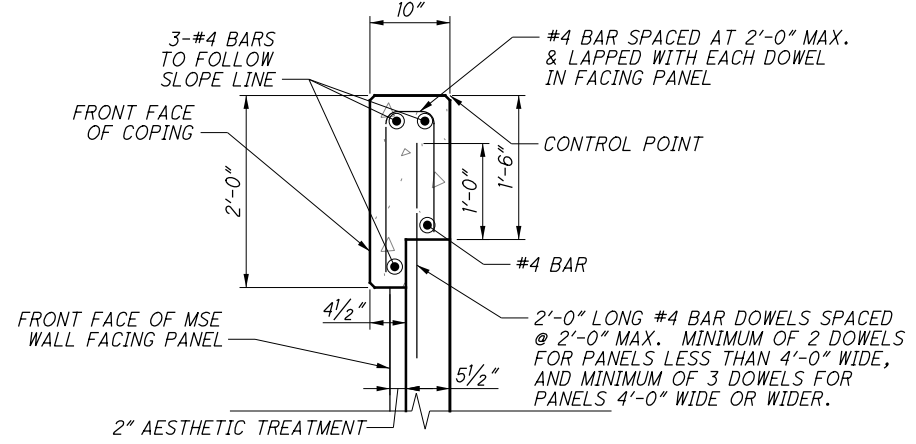

**COPING DETAIL**

CALCULATED BY: MMS DATE: 11/18/2021  
 CHECKED BY: JGM DATE: 11/18/2021

ESTIMATED QUANTITIES

AS PER PLAN  
 REFERENCE  
 SHEET


ITEM	ITEM EXT.	TOTAL	UNIT	DESCRIPTION	AS PER PLAN REFERENCE SHEET
203	20000	1523	CU YD	EMBANKMENT	
203	35110	1229	CU YD	GRANULAR MATERIAL, TYPE B	
503	11101	LS	LS	COFFERDAMS AND EXCAVATION, AS PER PLAN	660
509	10001	3766	LB	EPOXY COATED REINFORCING STEEL, AS PER PLAN	660
511	53012	24	CU YD	CLASS QC2 CONCRETE, MISC.: PARAPET INCLUDING SLEEPER SLAB WITH QC/QA	
512	10001	41	SQ YD	SEALING OF CONCRETE SURFACES, (PERMANENT GRAFFITI PROTECTION), AS PER PLAN	660
512	10100	500	SQ YD	SEALING OF CONCRETE SURFACES (EPOXY URETHANE)	
516	13200	70	SQ FT	1/2" PREFORMED EXPANSION JOINT FILLER	
516	13900	195	SQ FT	2" PREFORMED EXPANSION JOINT FILLER	
601	21000	17	SY	CONCRETE SLOPE PROTECTION	
840	20001	5574	SQ FT	MECHANICALLY STABILIZED EARTH WALL, AS PER PLAN	660
840	21000	2754	CU YD	WALL EXCAVATION	
840	22000	502	SQ YD	FOUNDATION PREPARATION	
840	23000	13143	CU YD	SELECT GRANULAR BACKFILL	
840	25010	334	FT	6" DRAINAGE PIPE, PERFORATED	
840	26000	165	FT	CONCRETE CURBS	
840	26050	5574	SQ FT	AESTHETIC SURFACE TREATMENT	
840	27000	5	DAY	ON SITE ASSISTANCE	

3

3

NO.	DESCRIPTION	REV. BY	DATE
3	ADDED CONCRETE SLOPE PROTECTION QUANTITY	MMS	10-19-23
3	UPDATED QUANTIY	MMS	10-19-23

G:\projects\2013\W-13-072\_FRA-70-13-10\_6A\89464\_structures\wall\_OE9\sheets\105588\_OE9W0001.dgn 10/20/2023 10:53:43 AM meets

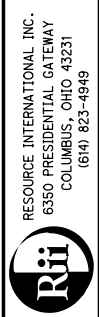

REVIEWED DATE 11/18/2021  
 NCK  
 STRUCTURE FILE NUMBER

DRAWN MMS  
 CHECKED JGM  
 REVISIONS

ESTIMATED QUANTITIES  
 RETAINING WALL E9  
 I-70/I-71 WEST INTERCHANGE PROJECT

FRA-70-13-10  
 PID No. 77372

1/6

696  
 702



SHEET NO.	SPECIAL						638				SPECIAL	SPECIAL	SPECIAL	SPECIAL		SPECIAL		638	SPECIAL	SPECIAL	SPECIAL	CALCULATED CJC CHECKED CWL
	INCREASE OR DECREASE IN EXCAVATION AND BACKFILL (COLUMBUS 811) CY						WATER WORK, MISC.: 24" x 24" TAPPING SLEEVE AND VALVE AND APPURTENANCES EACH				24" BUTTERFLY VALVE WITH VALVE BOX (COLUMBUS 802) EACH	12" WATER MAIN DIP AND FITTINGS (COLUMBUS 801) FT	24" WATER MAIN DIP AND FITTINGS (COLUMBUS 801) FT	12" GATE VALVE WITH VALVE BOX (COLUMBUS 802) EACH		42" STEEL PIPE ENCASEMENT, BORED OR JACKED (COLUMBUS 806) FT		WATER WORK, MISC.: CORROSION PROTECTION (20" DIAMETER & GREATER) (COLUMBUS 801) LUMP	CUT AND PLUG EXISTING 12" WATER LINE (COLUMBUS 808) EACH	CUT AND PLUG EXISTING 16" WATER LINE (COLUMBUS 808) EACH	CUT AND PLUG EXISTING 24" WATER LINE (COLUMBUS 808) EACH	
175	01/IMS/04						01/IMS/04				01/IMS/04	01/IMS/04	01/IMS/04	01/IMS/04		01/IMS/04		01/IMS/04	01/IMS/04	01/IMS/04	01/IMS/04	
							1				4	9	698	1		207		LS	3	3	2	
<b>TOTALS CARRIED TO GENERAL SUMMARY</b>		40					1				4	9	698	1		207		LS	3	3	2	
SHEET NO.	638	638	638	638	611			638	638			SPECIAL		SPECIAL	SPECIAL	638	638	SPECIAL	SPECIAL	611	611	
	WATER WORK, MISC.: 16" WATER MAIN ABANDONED (COLUMBUS 808) EACH	WATER WORK, MISC.: 24" WATER MAIN ABANDONED (COLUMBUS 808) EACH	WATER WORK, MISC.: 12" WATER MAIN ABANDONED (COLUMBUS 808) EACH	WATER WORK, MISC.: 1/2 INCH WATER SERVICE LINE TRANSFER (COLUMBUS 805) EACH	MANHOLE ADJUSTED TO GRADE, AS PER PLAN EACH		WATER WORK, MISC.: FIRE HYDRANT, RELOCATED (COLUMBUS 809) EACH	FIRE HYDRANT ADJUSTED TO GRADE EACH		VALVE BOX ADJUSTED TO GRADE (COLUMBUS 807) EACH		DUCTILE IRON FITTINGS, INCREASE OR DECREASE (COLUMBUS 801) LB	CITY OF COLUMBUS MANHOLE, TYPE C (44-S102) EACH	WATER WORK, MISC.: DRY STANDPIPE FT	WATER WORK, MISC.: FIRE DEPARTMENT CONNECTION EACH	CITY OF COLUMBUS 6" PIPE, 801.03, WITH TYPE 1 BEDDING, WITH ITEM 912 COMPACTED GRANULAR MATERIAL FT	CITY OF COLUMBUS 8" C905 PIPE, WITH TYPE 1 BEDDING, WITH ITEM 912 COMPACTED GRANULAR MATERIAL FT	CITY OF COLUMBUS 8" C905 PIPE, WITH TYPE 1 BEDDING, WITH ITEM 912 COMPACTED GRANULAR MATERIAL, AS PER PLAN FT	MANHOLE ADJUSTED TO GRADE, AS PER PLAN (SANITARY) EACH	MANHOLE RECONSTRUCTED TO GRADE, AS PER PLAN (SANITARY) EACH		
171	01/IMS/04	01/IMS/04	01/IMS/04	01/IMS/04	01/IMS/04		01/IMS/04	01/IMS/04		01/IMS/04		01/IMS/04	07/NHS/04/COL	01/IMS/04	01/IMS/04	07/NHS/04/COL	01/IMS/04	07/NHS/04/COL	07/NHS/04/COL	01/IMS/04	01/IMS/04	
175	1	1	1	1									3			21		267	31	4	1	
176	1				1		2	1		16					288	2						
<b>TOTALS CARRIED TO GENERAL SUMMARY</b>		1	1	1	1		2	1		16			500	3	288	2	21	267	31	4	1	

NO.	DESCRIPTION	REV. BY	DATE
3	REVISED 16" ABAND	CWL	10-20-23

**WATER WORK & SANITARY SUBSUMMARY**





**DRILLED SHAFTS (4W16, 4W17, 4W18)**

CONCRETE FOR THE DRILLED SHAFTS: THE COARSE AGGREGATE SIZE FOR ALL DRILLED SHAFTS SHALL BE A MAXIMUM OF NO. 8.

LOADS: THE MAXIMUM FACTORED LOAD TO BE SUPPORTED BY EACH DRILLED SHAFT IS INDICATED IN THE TABLES BELOW FOR EACH SHAFT SIZE. VERTICAL LOAD IS RESISTED BY TIP RESISTANCE AS NOTED HERE.

THE DESIGN OF THE WALL AND TANGENT DRILLED SHAFTS IS GENERALLY GOVERNED BY LATERAL SOIL PRESSURE ACTING ON THE SHAFTS. RESISTANCE IS PROVIDED THROUGH LATERAL SOIL RESISTANCE AND EMBEDMENT OF THE DRILLED SHAFTS. THE MAXIMUM FACTORED LATERAL LOAD TO BE SUPPORTED BY EACH DRILLED SHAFT IS INDICATED IN THE TABLE BELOW FOR EACH SHAFT SIZE. TIP RESISTANCE IS PROVIDED FOR THE AXIAL LOADS THAT ARE PRESENT, AS INDICATED IN THE TABLE. SIDE RESISTANCE IS NEGLECTED.

WALL 4W16				
SHAFT SIZE (DIAMETER)	SHAFT ID	MAX FACTORED LATERAL LOAD (KIPS)	MAX FACTORED VERTICAL LOAD (KIPS)	FACTORED TIP RESISTANCE (KIPS)
60"	#1 TO #56, #59 TO #73 & #76 TO #89	228	169	530
72"	#57, #74, #75 & #58	304	211	763

WALL 4W17				
SHAFT SIZE (DIAMETER)	SHAFT ID	MAX FACTORED LATERAL LOAD (KIPS)	MAX FACTORED VERTICAL LOAD (KIPS)	FACTORED TIP RESISTANCE (KIPS)
48"	#59	-	108	339
60"	#1 TO #58 & #60	190	162	530

WALL 4W18				
SHAFT SIZE (DIAMETER)	SHAFT ID	MAX FACTORED LATERAL LOAD (KIPS)	MAX FACTORED VERTICAL LOAD (KIPS)	FACTORED TIP RESISTANCE (KIPS)
30"	#9	-	31	133
42"	#1 TO #8 & #10	83	63	189

**ITEM 511 - CLASS QC1 CONCRETE, MISC.: CAST-IN-PLACE CONCRETE WALL (4W16)**

THIS ITEM SHALL INCLUDE THE CONSTRUCTION OF THE CONCRETE WALL AT THE LOCATIONS INDICATED IN THE PLANS FOR WALLS 4W16 AND 4W17. ALL CONCRETE WORK SHALL BE DONE IN ACCORDANCE WITH CMS 511. THE SHEAR STUDS INSTALLATION SHALL BE IN ACCORDANCE WITH ITEM 513.

METHOD OF MEASUREMENT: THE DEPARTMENT WILL MEASURE THE APPROPRIATE CONCRETE ITEM BY THE NUMBER OF CUBIC YARDS DETERMINED BY CALCULATIONS FROM PLAN DIMENSION, IN PLACE, COMPLETED AND ACCEPTED.

PAYMENT: ALL LABOR EQUIPMENT AND MATERIALS INCLUDING THE SHEAR STUDS NECESSARY TO COMPLETE THE WORK SHALL BE INCLUDED IN THE CONTRACT BID PRICE FOR ITEM 511 - CLASS QC1 CONCRETE, MISC.: CAST-IN-PLACE CONCRETE WALL.

**ITEM 511 - CLASS QC1 CONCRETE, MISC.: DRILLED SHAFT CAP WITH QC/QA (4W16, 4W17, 4W18)**

THIS ITEM SHALL INCLUDE THE CONSTRUCTION OF THE REINFORCED CONCRETE DRILLED SHAFT CAP, RETAINING WALL, AND COPING ABOVE THE PRECAST FACADE PANELS. ALL CONCRETE WORK SHALL BE DONE IN ACCORDANCE WITH CMS 511.

METHOD OF MEASUREMENT: THE DEPARTMENT WILL MEASURE THE APPROPRIATE CONCRETE ITEM BY THE NUMBER OF CUBIC YARDS DETERMINED BY CALCULATIONS FROM PLAN DIMENSION, IN PLACE, COMPLETED AND ACCEPTED.

PAYMENT: ALL LABOR, EQUIPMENT, AND MATERIALS NECESSARY TO COMPLETE THE WORK SHALL BE INCLUDED IN THE CONTRACT BID PRICE FOR ITEM 511-CLASS QC1 CONCRETE, MISC.: DRILLED SHAFT CAP WITH QC/QA.

**ITEM 524 - DRILLED SHAFTS, 42" DIAMETER, ABOVE BEDROCK WITH QC/QA, AS PER PLAN: (4W18)**

**ITEM 524 - DRILLED SHAFTS, 60" DIAMETER, ABOVE BEDROCK WITH QC/QA, AS PER PLAN: (4W16, 4W17)**

THE DRILLED SHAFT CAP AND P.E.J.F. JOINTS SHALL BE ACCURATELY PLACED ACCORDING TO THE DESIGN PLAN. IF THE LOCATIONS OF THE INSTALLED DRILLED SHAFTS VARY FROM THE DESIGN PLAN AND RESULT IN THE P.E.J.F. IN THE DRILLED SHAFT CAP FALLING OVER A DRILLED SHAFT INSTEAD OF BETWEEN SHAFTS, ALL VERTICAL SHAFT BARS INTERFERING WITH, OR CROSSING, THE CAP JOINT SHALL BE CUT FLUSH WITH THE TOP OF THE DRILLED SHAFT SO THAT BOTH SIDES OF THE CAP ARE NOT TIED TOGETHER BY SHAFT REINFORCING STEEL. THE CONTRACTOR SHALL OBTAIN APPROVAL FROM THE ENGINEER PRIOR TO CUTTING ANY REINFORCING STEEL. THE DEPARTMENT WILL CONSIDER THIS WORK AS INCIDENTAL AND SHALL BE INCLUDED WITH ITEM 524 FOR PAYMENT.

**ITEM 524 - DRILLED SHAFTS, 72" DIAMETER, ABOVE BEDROCK WITH QC/QA, AS PER PLAN (4W16)**

ALL WORK SHALL BE IN ACCORDANCE WITH ITEM 524. AT SHAFT NUMBERS 57, 58, 74, AND 75, STEEL CASING WITHIN THE LIMITS OF THE CAST-IN-PLACE CONCRETE WALL SHALL BE LEFT IN PLACE AND BE INCLUDED FOR PAYMENT WITH ITEM 524.

**ITEM SPECIAL - STRUCTURE, MISC.: PRECAST WALL PANELS (4W13, 4W14, 4W15)**

THIS BID ITEM CONSISTS OF PRECAST PANELS MANUFACTURED AND CONSTRUCTED IN ACCORDANCE WITH THIS SPECIFICATION AND DESIGNED IN ACCORDANCE WITH THE 8TH EDITION OF THE "LRFD BRIDGE DESIGN SPECIFICATIONS" ADOPTED BY AASHTO, AND THE ODOT BRIDGE DESIGN MANUAL, 2019.

**DESIGN STRESSES:**

CONCRETE - COMPRESSIVE STRENGTH 4,000 PSI  
REINFORCING STEEL - GRADE 60

**MATERIALS - CONCRETE:**

THE CONCRETE FOR THE WALL SECTIONS SHALL BE COMPOSED OF PORTLAND CEMENT, FINE & COARSE AGGREGATES, ADMIXTURES, AND WATER. PORTLAND CEMENT SHALL CONFORM TO THE REQUIREMENTS OF ASTM SPECIFICATION C150, TYPE I, II, OR III. THE AIR ENTRAINING ADMIXTURE SHALL CONFORM TO AASHTO M154. THE CONCRETE SHALL CONTAIN 6% ±2% ENTRAINED AIR, AND SLUMP SHALL BE MAINTAINED WITHIN THE RANGE OF 1" TO 4". THE SLUMP MAY BE INCREASED TO 7" PROVIDED THE INCREASE IS ACHIEVED BY THE ADDITION OF A CHEMICAL WATER-REDUCING ADMIXTURE APPROVED BY THE ENGINEER.

**MATERIALS - REINFORCING AND HARDWARE:**

REINFORCEMENT SHALL CONSIST OF WELDED WIRE FABRIC CONFORMING TO ASTM A185 OR A497, OR DEFORMED BILLET-STEEL BARS CONFORMING TO ASTM A615, A616, OR A617, GRADE 60.

**SHOP DRAWING REQUIREMENTS:**

THE MANUFACTURER SHALL SUBMIT SHOP DRAWINGS FOR REVIEW AND APPROVAL PRIOR TO MANUFACTURE. THE SHOP DRAWINGS SHALL INCLUDE THE FOLLOWING:

- ALL STRUCTURAL DESIGN AND LOADING INFORMATION.
- A PLAN VIEW.
- ALL ELEVATION VIEWS.
- ALL DIMENSIONS.

MANUFACTURING SHALL NOT BEGIN UNTIL WRITTEN APPROVAL OF THE SUBMITTED SHOP DRAWINGS HAS BEEN RECEIVED.

**TESTING AND INSPECTION:**

ACCEPTABILITY OF THE CONCRETE FOR THE PRECAST PANELS WILL BE DETERMINED ON THE BASIS OF COMPRESSION TESTS, CERTIFICATIONS AND VISUAL INSPECTION. THE CONCRETE STRENGTH REQUIREMENTS FOR THE PRECAST PANELS SHALL BE CONSIDERED ATTAINED REGARDLESS OF CURING AGE WHEN COMPRESSION TEST RESULTS INDICATE STRENGTH WILL CONFORM TO 28-DAY SPECIFICATIONS AS STATED BELOW. THE MANUFACTURER SHALL FURNISH FACILITIES AND PERFORM ALL NECESSARY SAMPLING AND TESTING IN AN EXPEDITIOUS AND SATISFACTORY MANNER. PANELS UTILIZING TYPE I OR II CEMENT SHALL BE CONSIDERED ACCEPTABLE FOR PLACEMENT IN THE WALL WHEN 7-DAY INITIAL STRENGTHS EXCEED 85% OF 28-DAY REQUIREMENTS. PANELS UTILIZING TYPE III CEMENT SHALL BE CONSIDERED ACCEPTABLE FOR PLACEMENT IN THE WALL PRIOR TO 28 DAYS ONLY WHEN COMPRESSIVE STRENGTH TEST RESULTS INDICATE THAT THE STRENGTH EXCEEDS THE 28-DAY SPECIFICATION.

**MANUFACTURE:**

THE AGGREGATES, CEMENT, AND WATER SHALL BE PROPORTIONED AND MIXED IN A BATCH MIXER TO PRODUCE A HOMOGENEOUS CONCRETE MEETING THE STRENGTH REQUIREMENTS OF THESE NOTES. THE PROPORTION OF PORTLAND CEMENT IN THE MIXTURE SHALL NOT BE LESS THAN 564 POUNDS PER CUBIC YARD OF CONCRETE.

THE WALL SECTIONS SHALL BE CURED FOR A SUFFICIENT LENGTH OF TIME SO THAT THE CONCRETE WILL DEVELOP THE SPECIFIED COMPRESSIVE STRENGTH IN 28 DAYS OR LESS. ANY ONE OF THE METHODS OF CURING OR COMBINATION THEREOF SHALL BE USED:

STEAM CURING - THE SECTIONS MAY BE LOW PRESSURE, STEAM CURED BY A SYSTEM THAT WILL MAINTAIN A MOIST ATMOSPHERE.

WATER CURING - THE SECTIONS MAY BE WATER CURED BY ANY METHOD THAT WILL KEEP THE SECTIONS MOIST.

THE FORMS USED IN MANUFACTURE SHALL BE SUFFICIENTLY RIGID AND ACCURATE TO MAINTAIN THE SECTION DIMENSIONS WITHIN THE PERMISSIBLE VARIATIONS GIVEN IN THESE NOTES. ALL CASTING SURFACES SHALL BE OF SMOOTH MATERIAL.

THE WALL SECTIONS SHALL BE STORED IN SUCH A MANNER TO PREVENT CRACKING OR DAMAGES.

THE FRONT FACE OF THE REINFORCED CONCRETE PANELS SHALL HAVE A SMOOTH CONCRETE FINISH AND INCORPORATE THE PATTERNS SHOWN IN THE STRUCTURE AESTHETIC DETAIL PLANS. CAULKING BETWEEN PRECAST PANELS SHALL BE IN ACCORDANCE WITH THE PLAN DETAILS. THE BACK SIDE OF THE REINFORCED CONCRETE PANELS SHALL HAVE AN UNFORMED SURFACE FINISH AND SHALL BE ROUGH SCREED TO ELIMINATE OPEN POCKETS OF AGGREGATE AND SURFACE DISTORTIONS IN EXCESS OF 1/4".

ALL PANELS SHALL BE MANUFACTURED WITH ALL PANEL DIMENSIONS WITHIN 1/4"

**COMPRESSIVE STRENGTH:**

ACCEPTANCE OF THE CONCRETE PANELS WITH RESPECT TO COMPRESSIVE STRENGTH WILL BE DETERMINED ON THE BASIS OF PRODUCTION LOTS. A PRODUCTION LOT IS DEFINED AS A GROUP OF PANELS THAT WILL BE REPRESENTED BY A SINGLE COMPRESSIVE STRENGTH SAMPLE AND WILL CONSIST OF EITHER 6 PANELS OR A SINGLE DAY'S PRODUCTION, WHICHEVER IS LESS.

DURING THE PRODUCTION OF THE CONCRETE PANELS, THE MANUFACTURER WILL RANDOMLY SAMPLE THE CONCRETE IN ACCORDANCE WITH ASTM C172. A SINGLE COMPRESSIVE STRENGTH SAMPLE, CONSISTING OF A MINIMUM OF FOUR CYLINDERS, WILL BE RANDOMLY SELECTED FOR EVERY PRODUCTION LOT.

CYLINDERS FOR COMPRESSIVE STRENGTH TESTS SHALL BE 6" DIA. X 1'-0" SPECIMENS PREPARED IN ACCORDANCE WITH ASTM C31. FOR EVERY COMPRESSIVE STRENGTH SAMPLE, A MINIMUM OF 2 CYLINDERS WILL BE CURED IN THE SAME MANNER AS THE PANELS AND TESTED AT APPROXIMATELY 7 DAYS. THE AVERAGE COMPRESSIVE STRENGTH OF THESE CYLINDERS, WHEN TESTED IN ACCORDANCE WITH ASTM C39, WILL PROVIDE A TEST RESULT WHICH WILL DETERMINE THE INITIAL STRENGTH OF THE CONCRETE. IN ADDITION, 2 CYLINDERS SHALL BE CURED IN ACCORDANCE WITH ASTM C31 AND TESTED AT 28 DAYS. THE AVERAGE COMPRESSIVE STRENGTH OF THESE TWO CYLINDERS, WHEN TESTED IN ACCORDANCE WITH ASTM C39, WILL PROVIDE A COMPRESSIVE STRENGTH TEST RESULT WHICH WILL DETERMINE THE COMPRESSIVE STRENGTH OF THE PRODUCTION LOT.

IF THE INITIAL STRENGTH TEST RESULTS INDICATE A COMPRESSIVE STRENGTH IN EXCESS OF 4,000 PSI, THEN THESE TEST RESULTS WILL BE UTILIZED AS THE COMPRESSIVE STRENGTH TEST RESULT FOR THE PRODUCTION LOT AND THE REQUIREMENT FOR TESTING AT 28 DAYS WILL BE WAIVED FOR THAT PARTICULAR PRODUCTION LOT.

ACCEPTANCE OF A PRODUCTION LOT WILL BE MADE IF THE COMPRESSIVE STRENGTH TEST RESULT IS GREATER THAN OR EQUAL TO 4,000 PSI. IF THE RESULT IS LESS THAN 4,000 PSI, THE ACCEPTANCE OF THE PRODUCTION LOT WILL BE BASED ON ITS MEETING THE FOLLOWING THREE ACCEPTANCE CRITERIA: - 90% OF THE COMPRESSIVE STRENGTH TEST RESULTS FOR THE OVERALL PRODUCTION SHALL EXCEED 4,000 PSI. - THE AVERAGE OF ANY SIX CONSECUTIVE COMPRESSIVE STRENGTH TEST RESULTS SHALL EXCEED 4,000 PSI. - NO INDIVIDUAL COMPRESSIVE STRENGTH TEST RESULT SHALL FALL BELOW 3,600 PSI.

IN THE EVENT THAT A PRODUCTION LOT FAILS TO MEET THE SPECIFIED COMPRESSIVE STRENGTH REQUIREMENTS, THE PRODUCTION LOT SHALL BE REJECTED. SUCH REJECTION SHALL PREVAIL UNLESS THE MANUFACTURER, AT HIS OWN EXPENSE, OBTAINS AND SUBMITS EVIDENCE ACCEPTABLE TO THE ENGINEER THAT THE STRENGTH AND QUALITY OF THE CONCRETE PLACED WITHIN THE PANELS OF THE PRODUCTION LOT IS ACCEPTABLE. IF SUCH EVIDENCE CONSISTS OF TESTS MADE ON CORES TAKEN FROM THE PANELS WITHIN THE PRODUCTION LOT, THE CORES SHALL BE OBTAINED AND TESTED IN ACCORDANCE WITH THE SPECIFICATIONS OF ASTM C42.

**REJECTION:**

PANELS SHALL BE SUBJECT TO REJECTION BECAUSE OF FAILURE TO MEET ANY OF THE REQUIREMENTS SPECIFIED ABOVE. IN ADDITION, ANY OR ALL OF THE FOLLOWING DEFECTS MAY BE SUFFICIENT CAUSE FOR REJECTION:

- DEFECTS THAT INDICATE IMPERFECT MOLDING.
- DEFECTS INDICATING HONEYCOMBED OR OPEN TEXTURED CONCRETE.
- DEFECTS IN THE PHYSICAL CHARACTERISTICS OF THE CONCRETE, SUCH AS BROKEN OR CHIPPED CONCRETE.
- STAINED FORM FACE, DUE TO EXCESS FORM OIL OR OTHER CONTAMINATIONS.
- SIGNS OF AGGREGATE SEGREGATION.
- BROKEN OR CRACKED CORNERS.
- LIFTING INSERTS NOT USABLE.
- EXPOSED REINFORCING STEEL.
- INSUFFICIENT CONCRETE COMPRESSIVE STRENGTH.

THE ENGINEER WILL DECIDE IF AN ATTEMPT MAY BE MADE TO REPAIR A DEFECTIVE PANEL. THE CONTRACTOR OR MANUFACTURER SHALL MAKE THE REPAIRS. IF THE REPAIRS ARE MADE TO THE ENGINEER'S SATISFACTION, THE PANEL WILL BE ACCEPTABLE.

**MARKING:**

THE DATE OF MANUFACTURE, THE PRODUCTION LOT NUMBER, AND THE PIECE MARK SHALL BE CLEARLY SCRIBED ON THE BACK SURFACE OF EACH PANEL.

**CONCRETE LEVELING PAD:**

THE CONCRETE LEVELING PAD (MUD SLAB) SHALL BE CONSTRUCTED AS SHOWN IN THE PLANS WITH CONCRETE HAVING A STRENGTH THAT IS NOT LESS THAN 3,500 PSI AND SHALL HAVE SUFFICIENT STRENGTH TO ADEQUATELY SUPPORT THE PANELS AT THE BOTTOM OF THE WALL IN A LEVEL POSITION DURING INSTALLATION. THE PAD SHALL BE CURED A MINIMUM OF 24 HOURS BEFORE PLACING WALL PANELS ON THE LEVELING PAD.

**FOUNDATION PREPARATION:**

PRIOR TO WALL CONSTRUCTION, THE FOUNDATION, IF NOT IN ROCK, SHALL BE LEVELED AND ROLLED WITH A SMOOTH WHEEL VIBRATORY ROLLER. ANY FOUNDATION SOILS FOUND TO BE UNSUITABLE SHALL BE REMOVED AND REPLACED, AS DIRECTED BY THE ENGINEER.

**WALL ERECTION:**

PANELS ARE HANDLED BY MEANS OF A LIFTING DEVICE CONNECTED TO THE LIFTING INSERT WHICH IS CAST INTO THE UPPER EDGE OR BACK SIDE OF THE PANELS. ALL PANELS SHALL BE BRACED TO RESIST THE TEMPORARY CONSTRUCTION LOADS INCLUDING WIND LOADS, PRIOR TO FOOTING CONSTRUCTION.

**PAYMENT:**

PAYMENT FOR ITEM SPECIAL - STRUCTURE, MISC.: PRECAST WALL PANELS COVERS ALL LABOR, MATERIAL, AND INCIDENTALS NECESSARY TO COMPLETE THE WORK DESCRIBED ABOVE.

01-2015-2015370-FRA-96053-STRUCTURES-GENERAL-SHEETS-96053-WALL-NOTES.DGN  
 10/23/2023  
 2:13:10 PM  
 ODOT\B15TD\USER

NO.	DESCRIPTION	REV. BY	DATE
3	REVISED ITEM DESCRIPTION	DJC	10-23-23

DESIGN AGENCY

GPD GROUP  
 1800 Westwood Drive, Suite 200, Coon Rapids, MN 55433  
 (763) 424-0051

DATE

4-21-23

REVIEWED

DGN

STRUCTURE FILE NUMBER

DRAWN

MOJ

REVISED

DESIGNED

MOJ

CHECKED

DJC

RETAINING WALL GENERAL NOTES

AND/OR PRECAST PANEL WALLS

DRILLED SHAFT

FRA - 70 - 14.05

PID No. 96053

5 / 6


304

855

**ESTIMATED QUANTITIES**

CALCULATED: RFV DATE: 10-2-19  
 CHECKED: TJW DATE: 4-3-20

ITEM	EXT.	PARTICIPATION		UNITS	DESCRIPTION	A.P.P REFERENCE SHEET NO.
		TOTAL	01/IMS/04			
503	11100			LS	COFFERDAMS AND EXCAVATION BRACING	
503	21100	1,142	1,142	CY	UNCLASSIFIED EXCAVATION	
507	98020			LS	PILING, MISC.: SOLDIER PILES	301
509	10000	63,829	63,829	LB	EPOXY COATED REINFORCING STEEL	
511	34451	70	70	CY	CLASS QC2 CONCRETE WITH QC/QA, BRIDGE DECK (PARAPET), AS PER PLAN	301
511	46512	115	115	CY	CLASS QC1 CONCRETE WITH QC/QA, FOOTING	
511	53010	45	45	CY	CLASS QC1 CONCRETE, MISC.: CAST-IN-PLACE CONCRETE WALL	304
511	53010	556	556	CY	CLASS QC1 CONCRETE, MISC.: DRILLED SHAFT CAP (WITH QC/QA)	304
511	81200			LS	CONCRETE, MISC.: PRECAST LAGGING	301
512	10050	314	314	SY	SEALING OF CONCRETE SURFACES (NON-EPOXY)	
512	10100	1,392	1,392	SY	SEALING OF CONCRETE SURFACES (EPOXY-URETHANE)	
512	33000	203	203	SY	TYPE 2 WATERPROOFING	
516	13600	586	586	SF	1" PREFORMED EXPANSION JOINT FILLER	
518	21200	246	246	CY	POROUS BACKFILL WITH GEOTEXTILE FABRIC	
518	40000	1,002	1,002	FT	6" PERFORATED CORRUGATED PLASTIC PIPE	
524	95472	6,016	6,016	FT	DRILLED SHAFTS, 60" DIAMETER, ABOVE BEDROCK WITH QC/QA, AS PER PLAN	304
524	95492	292	292	FT	DRILLED SHAFTS, 72" DIAMETER, ABOVE BEDROCK WITH QC/QA. AS PER PLAN	304
894	10000	86	86	EACH	THERMAL INTEGRITY PROFILING (TIP) TEST	
SPECIAL	20302000	926	926	CY	ENGINEERED FILL (LIGHTWEIGHT CELLULAR CONCRETE FILL), PERVIOUS	302
SPECIAL	53000600	12,867	12,867	SF	STRUCTURES - PRECAST FACADE PANELS	305
SPECIAL	60798000	498	498	FT	FENCE, MISC.: WALL MOUNTED TYPE A (W/ VANDAL MESH)	301

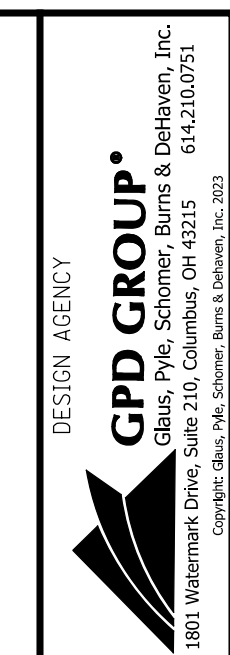

DESIGNED	RHC	CHECKED	DJC
DRAWN	JJB	REVISED	
REVIEWED	DGN	STRUCTURE FILE NUMBER	
DATE	4-21-23		

**ESTIMATED QUANTITIES**  
 TANGENT DRILLED SHAFT WALL 4W16  
 NORTHSIDE OF I-70 WB FROM FRA-70-1405C TO FRA-33-1747C

**FRA-70-14.05**  
**PID No. 96053**

NO.	DESCRIPTION	REV. BY	DATE
3	REVISED ITEM DESCRIPTION	DJC	10-23-23

336  
855

**ESTIMATED QUANTITIES**

CALCULATED: RFV DATE: 10-2-19  
 CHECKED: TJW DATE: 4-3-20

ITEM	EXT.	TOTAL	PARTICIPATION	UNITS	DESCRIPTION	A.P.P. REFERENCE SHEET NO.
			01/IMS/04			
503	11100			LS	COFFERDAMS AND EXCAVATION BRACING	
503	21100	1,065	1,065	CY	UNCLASSIFIED EXCAVATION	
509	10000	29,151	29,151	LB	EPOXY COATED REINFORCING STEEL	
511	34451	43	43	CY	CLASS QC2 CONCRETE WTH QC/QA, BRIDGE DECK (PARAPET), AS PER PLAN	301
511	46512	67	67	CY	CLASS QC1 CONCRETE WITH QC/QA, FOOTING	
511	53010	336	336	CY	CLASS QC1 CONCRETE, MISC.: DRILLED SHAFT CAP WITH QC/QA	304
512	10050	191	191	SY	SEALING CONCRETE SURFACES (NON-EPOXY)	
512	10100	826	826	SY	SEALING CONCRETE SURFACES (EPOXY-URETHANE)	
512	33000	121	121	SY	TYPE 2 WATERPROOFING	
516	13600	302	302	SF	1" PREFORMED EXPANSION JOINT FILLER	
518	21200	118	118	CY	POROUS BACKFILL WITH GEOTEXTILE FABRIC	
518	40000	442	442	FT	6" PERFORATED CORRUGATED PLASTIC PIPE	
524	95453	74	74	FT	DRILLED SHAFTS, 48" DIAMETER, ABOVE BEDROCK WITH QC/QA, AS PER PLAN	304
524	95472	4,347	4,347	FT	DRILLED SHAFTS, 60" DIAMETER, ABOVE BEDROCK WITH QC/QA, AS PER PLAN	304
SPECIAL	53000600	8,451	8,451	SF	STRUCTURES: PRECAST FACADE PANELS	305
607	98000	303	303	FT	FENCE, MISC.: WALL MOUNTED TYPE A (W/ VANDAL MESH)	301
894	10000	60	60	EACH	THERMAL INTEGRITY PROFILING (TIP) TEST	



DESIGNED	TJW	CHECKED	RHC
DRAWN	RPR	REVISED	
REVIEWED	DGN	STRUCTURE FILE NUMBER	
DATE	4-21-23		

**ESTIMATED QUANTITIES**  
 TANGENT DRILLED SHAFT WALL 4W17  
 NORTHSIDE OF I-70 WB FROM FRA-33-1747C TO FRA-23-1075C

**FRA - 70 - 14.05**  
**PID No. 96053**


1 / 11

NO.	DESCRIPTION	REV. BY	DATE
3	REVISED ITEM DESCRIPTION	DJC	10-23-23

358  
855

**ESTIMATED QUANTITIES**

CALCULATED BY: MOJ DATE: 4-2-20  
 CHECKED BY: TJW DATE: 4-3-20

ITEM	EXT.	TOTAL	PARTICIPATION	UNITS	DESCRIPTION	REFERENCE SHEET NO. --- / 855
			01/IMS/04			
503	11100	LS	LS	LS	COFFERDAMS AND EXCAVATION BRACING	
503	21101	125	125	CY	UNCLASSIFIED EXCAVATION, AS PER PLAN	301
509	10000	3,256	3,256	LB	EPOXY COATED REINFORCING STEEL	
511	34451	4	4	CY	CLASS QC2 CONCRETE WTH QC/QA, BRIDGE DECK (PARAPET), AS PER PLAN	693
511	46512	8	8	CY	CLASS QC1 CONCRETE WITH QC/QA, FOOTING	
511	53010	31	31	CY	CLASS QC1 CONCRETE, MISC.: DRILLED SHAFT CAP (WITH QC/QA) 	304
512	10050	24	24	SY	SEALING OF CONCRETE SURFACES (NON-EPOXY)	693
512	10100	75	75	SY	SEALING OF CONCRETE SURFACES (EPOXY-URETHANE)	693
512	33000	23	23	SY	TYPE 2 WATERPROOFING	
516	13600	25	25	SF	1" PREFORMED EXPANSION JOINT FILLER	
518	21200	18	18	CY	POROUS BACKFILL WITH GEOTEXTILE FABRIC	
518	40000	71	71	FT	6" PERFORATED CORRUGATED PLASTIC PIPE	
524	95422	23	23	FT	DRILLED SHAFTS, 30" DIAMETER, ABOVE BEDROCK WITH QC/QA	
524	95443	431	431	FT	DRILLED SHAFTS, 42" DIAMETER, ABOVE BEDROCK WITH QC/QA, AS PER PLAN	304
SPECIAL	53000600	720	720	SF	STRUCTURES: PRECAST FACADE PANELS	305
607	98000	39	39	FT	FENCE, MISC.: WALL MOUNTED TYPE A (W/O VANDAL MESH)	693
894	10000	1	1	EACH	THERMAL INTEGRITY PROFILING (TIP) TEST	



DESIGNED	MOJ	CHECKED	TJW
DRAWN	MOJ	REVISED	
REVIEWED	DGN	STRUCTURE FILE NUMBER	
DATE	4-21-23		

**ESTIMATED QUANTITIES**  
 TANGENT DRILLED SHAFT WALL 4W18  
 NORTH SIDE OF I-70 WB - EAST OF FRA-23-1075C

**FRA - 70 - 14.05**  
**PID No. 96053**

1 / 8  
 369 / 855

NO.	DESCRIPTION	REV. BY	DATE
3	REVISED ITEM DESCRIPTION	DJC	10-23-23





CALCULATED  
ATR  
CHECKED  
CWL

PLAN AND PROFILE  
24' WATER LINE ALONG LIVINGSTON AVE

FRA-70-14.05

387  
855

- 1 24" x 12" REDUCER  
STA. 200+10.84  
STA. 214+26.65, 19.05' LT. (LIVINGSTON)
- 2 22.5° HORIZ. BEND  
STA. 200+20.84  
STA. 214+36.37, 19.35' LT. (LIVINGSTON)
- 3 24" x 24" TEE W/ 24" VALVE  
STA. 200+28.84  
STA. 214+43.71, 22.40' LT. (LIVINGSTON)
- 5 22.5° HORIZ. BEND  
STA. 200+60.40  
STA. 214+72.87, 34.48' LT. (LIVINGSTON)
- 6 22.5° HORIZ. BEND  
STA. 200+89.22  
STA. 215+01.68, 34.48' LT. (LIVINGSTON)
- 7 22.5° HORIZ. BEND  
STA. 201+08.98  
STA. 215+19.94, 26.92' LT. (LIVINGSTON)
- 8 22.5° HORIZ. BEND  
STA. 202+27.29  
STA. 216+38.25, 26.92' LT. (LIVINGSTON)
- 9 22.5° HORIZ. BEND  
STA. 202+53.97  
STA. 216+62.90, 37.13' LT. (LIVINGSTON)
- 10 45° HORIZ. BEND  
STA. 202+77.22  
STA. 216+86.15, 37.13' LT. (LIVINGSTON)
- 11 12" x 24" TEE  
STA. 202+86.43  
STA. 216+92.66, 30.61' LT. (LIVINGSTON)
- 12 24" SOLID SLEEVE  
STA. 202+94.29  
STA. 216+98.22, 25.05' LT. (LIVINGSTON)

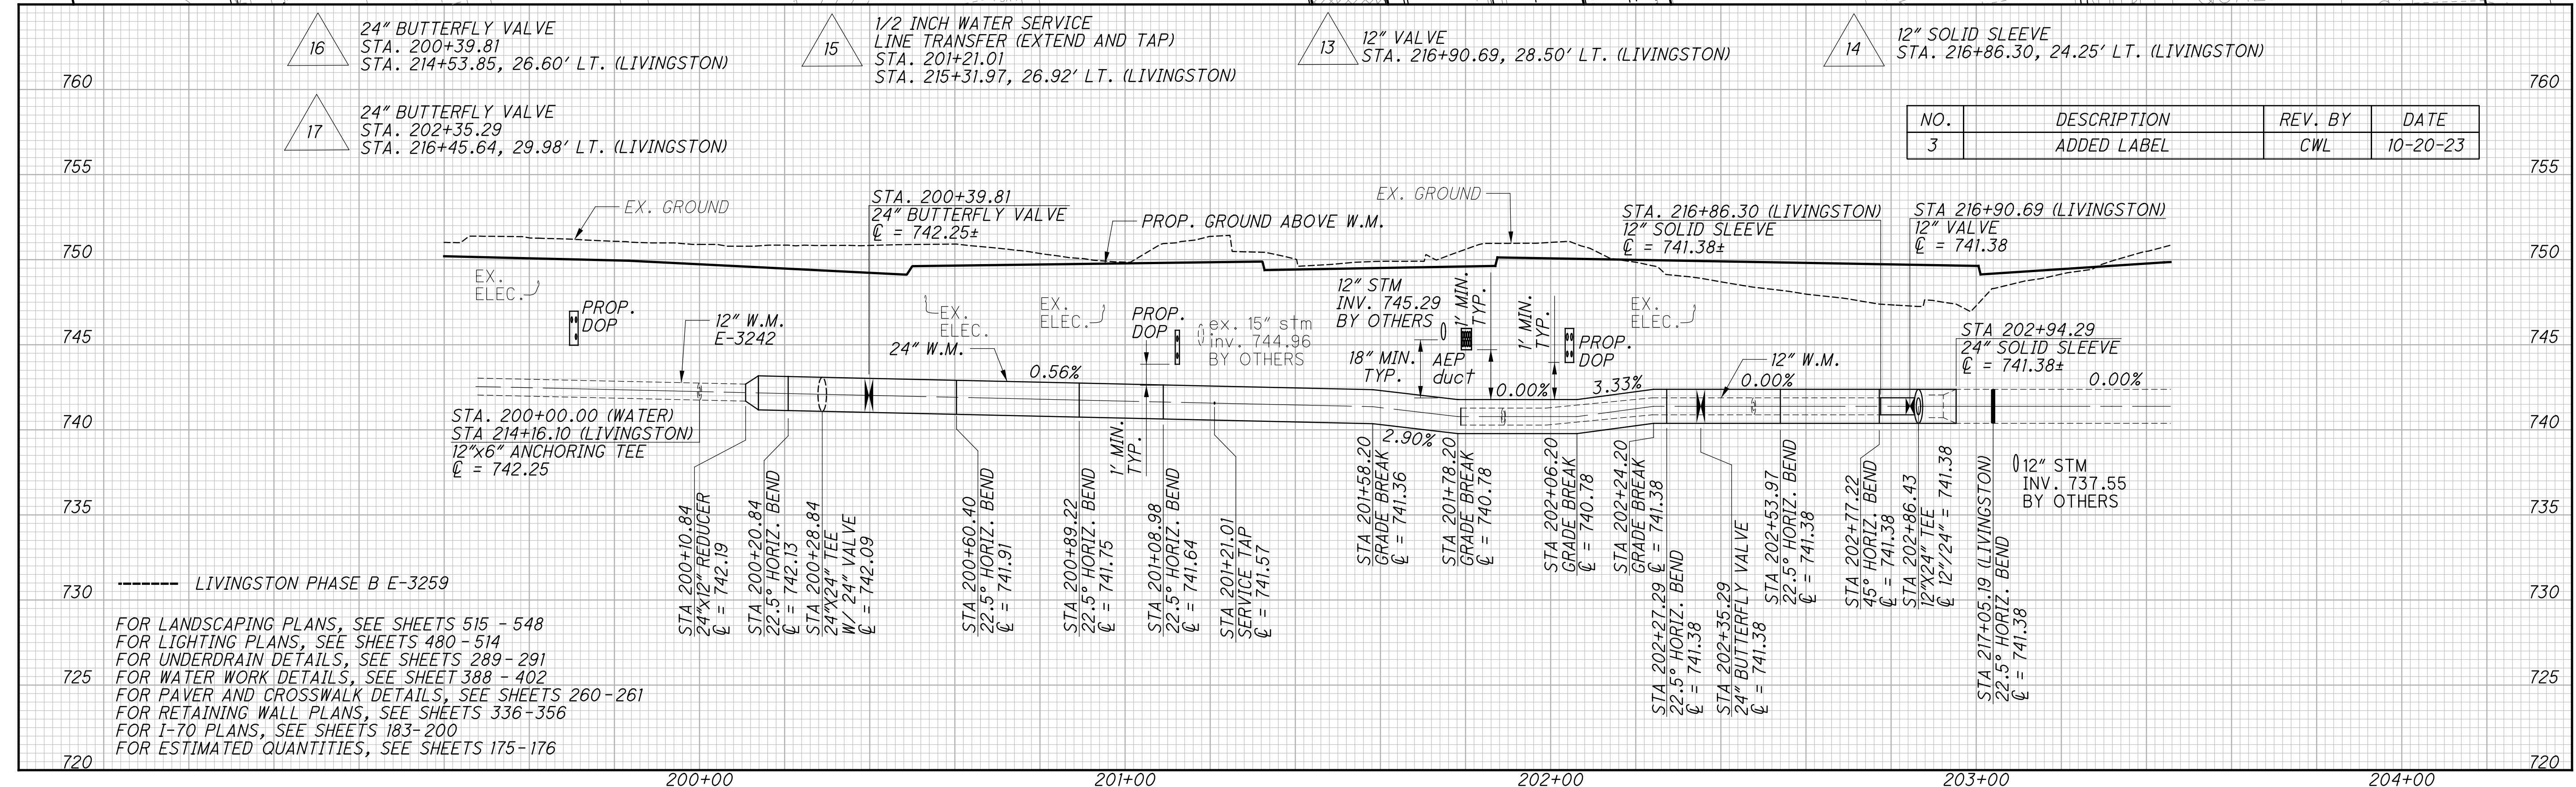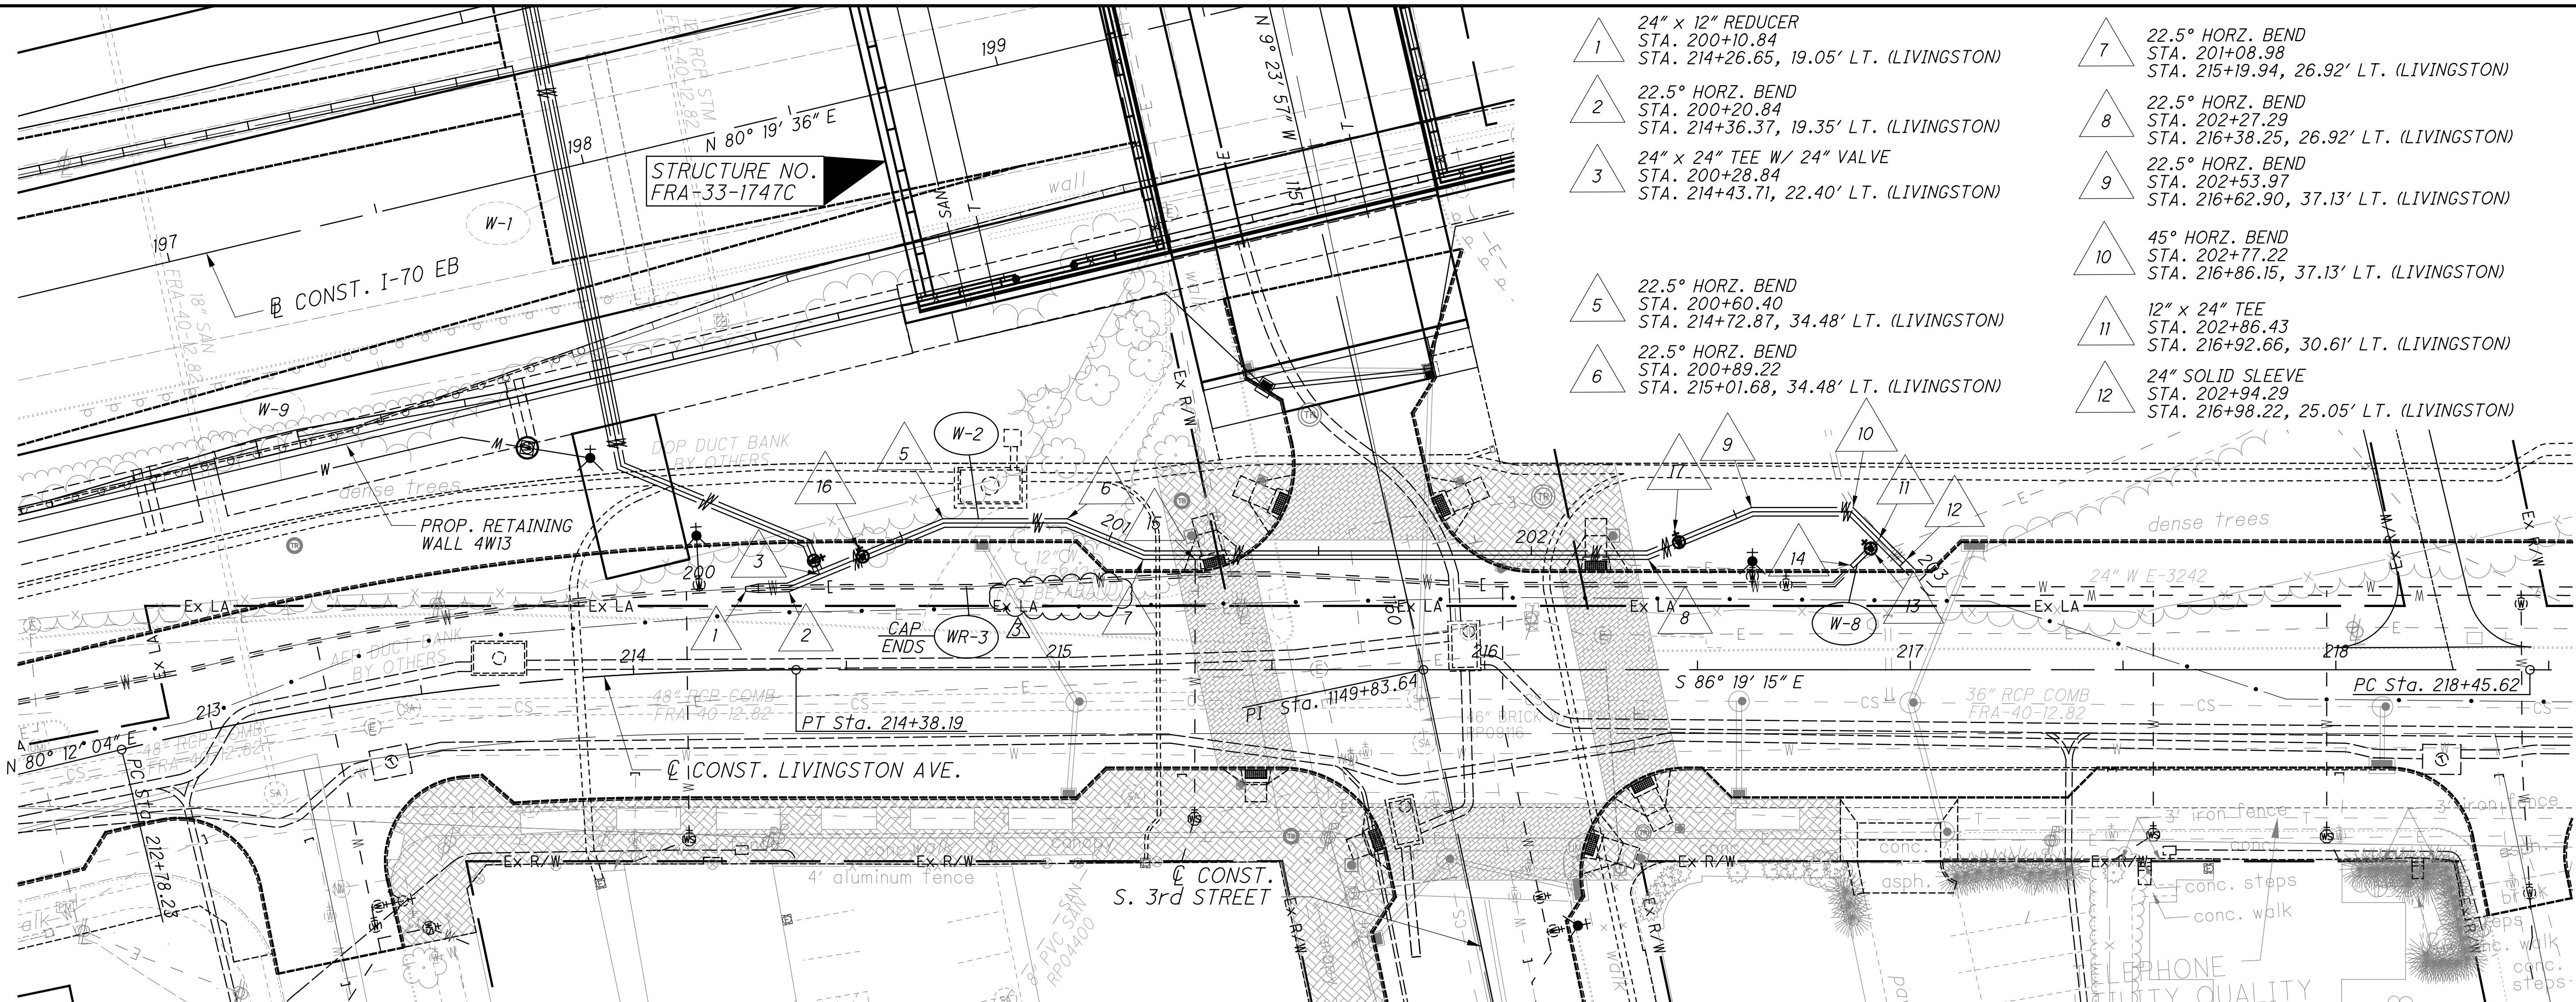


FOR LANDSCAPING PLANS, SEE SHEETS 515 - 548  
 FOR LIGHTING PLANS, SEE SHEETS 480 - 514  
 FOR UNDERDRAIN DETAILS, SEE SHEETS 289 - 291  
 FOR WATER WORK DETAILS, SEE SHEET 388 - 402  
 FOR PAVEMENT AND CROSSWALK DETAILS, SEE SHEETS 260 - 261  
 FOR RETAINING WALL PLANS, SEE SHEETS 336 - 356  
 FOR I-70 PLANS, SEE SHEETS 183 - 200  
 FOR ESTIMATED QUANTITIES, SEE SHEETS 175 - 176

01-2015-2015370 FRA 16085 UTILITIES SHEETS 16085UP006.DGN  
 10/20/2023  
 9:56:12 AM  
 DDDTY81STD\_USER

01\_2015\_2015370\_VFR\_16065\UTILITIES\SHEETS\96053UP002.DGN  
 10/20/2023  
 8:49:38 AM  
 DDDTY81STD\_USER

FOR LANDSCAPING PLANS, SEE SHEETS 515 - 548  
 FOR LIGHTING PLANS, SEE SHEETS 480 - 514  
 FOR UNDERDRAIN DETAILS, SEE SHEETS 289 - 291  
 FOR WATER WORK DETAILS, SEE SHEET 388 - 402  
 FOR PAVEMENT AND CROSSWALK DETAILS, SEE SHEETS 260 - 261  
 FOR RETAINING WALL PLANS, SEE SHEETS 336 - 356  
 FOR I-70 PLANS, SEE SHEETS 183 - 200  
 FOR ESTIMATED QUANTITIES, SEE SHEETS 175 - 176

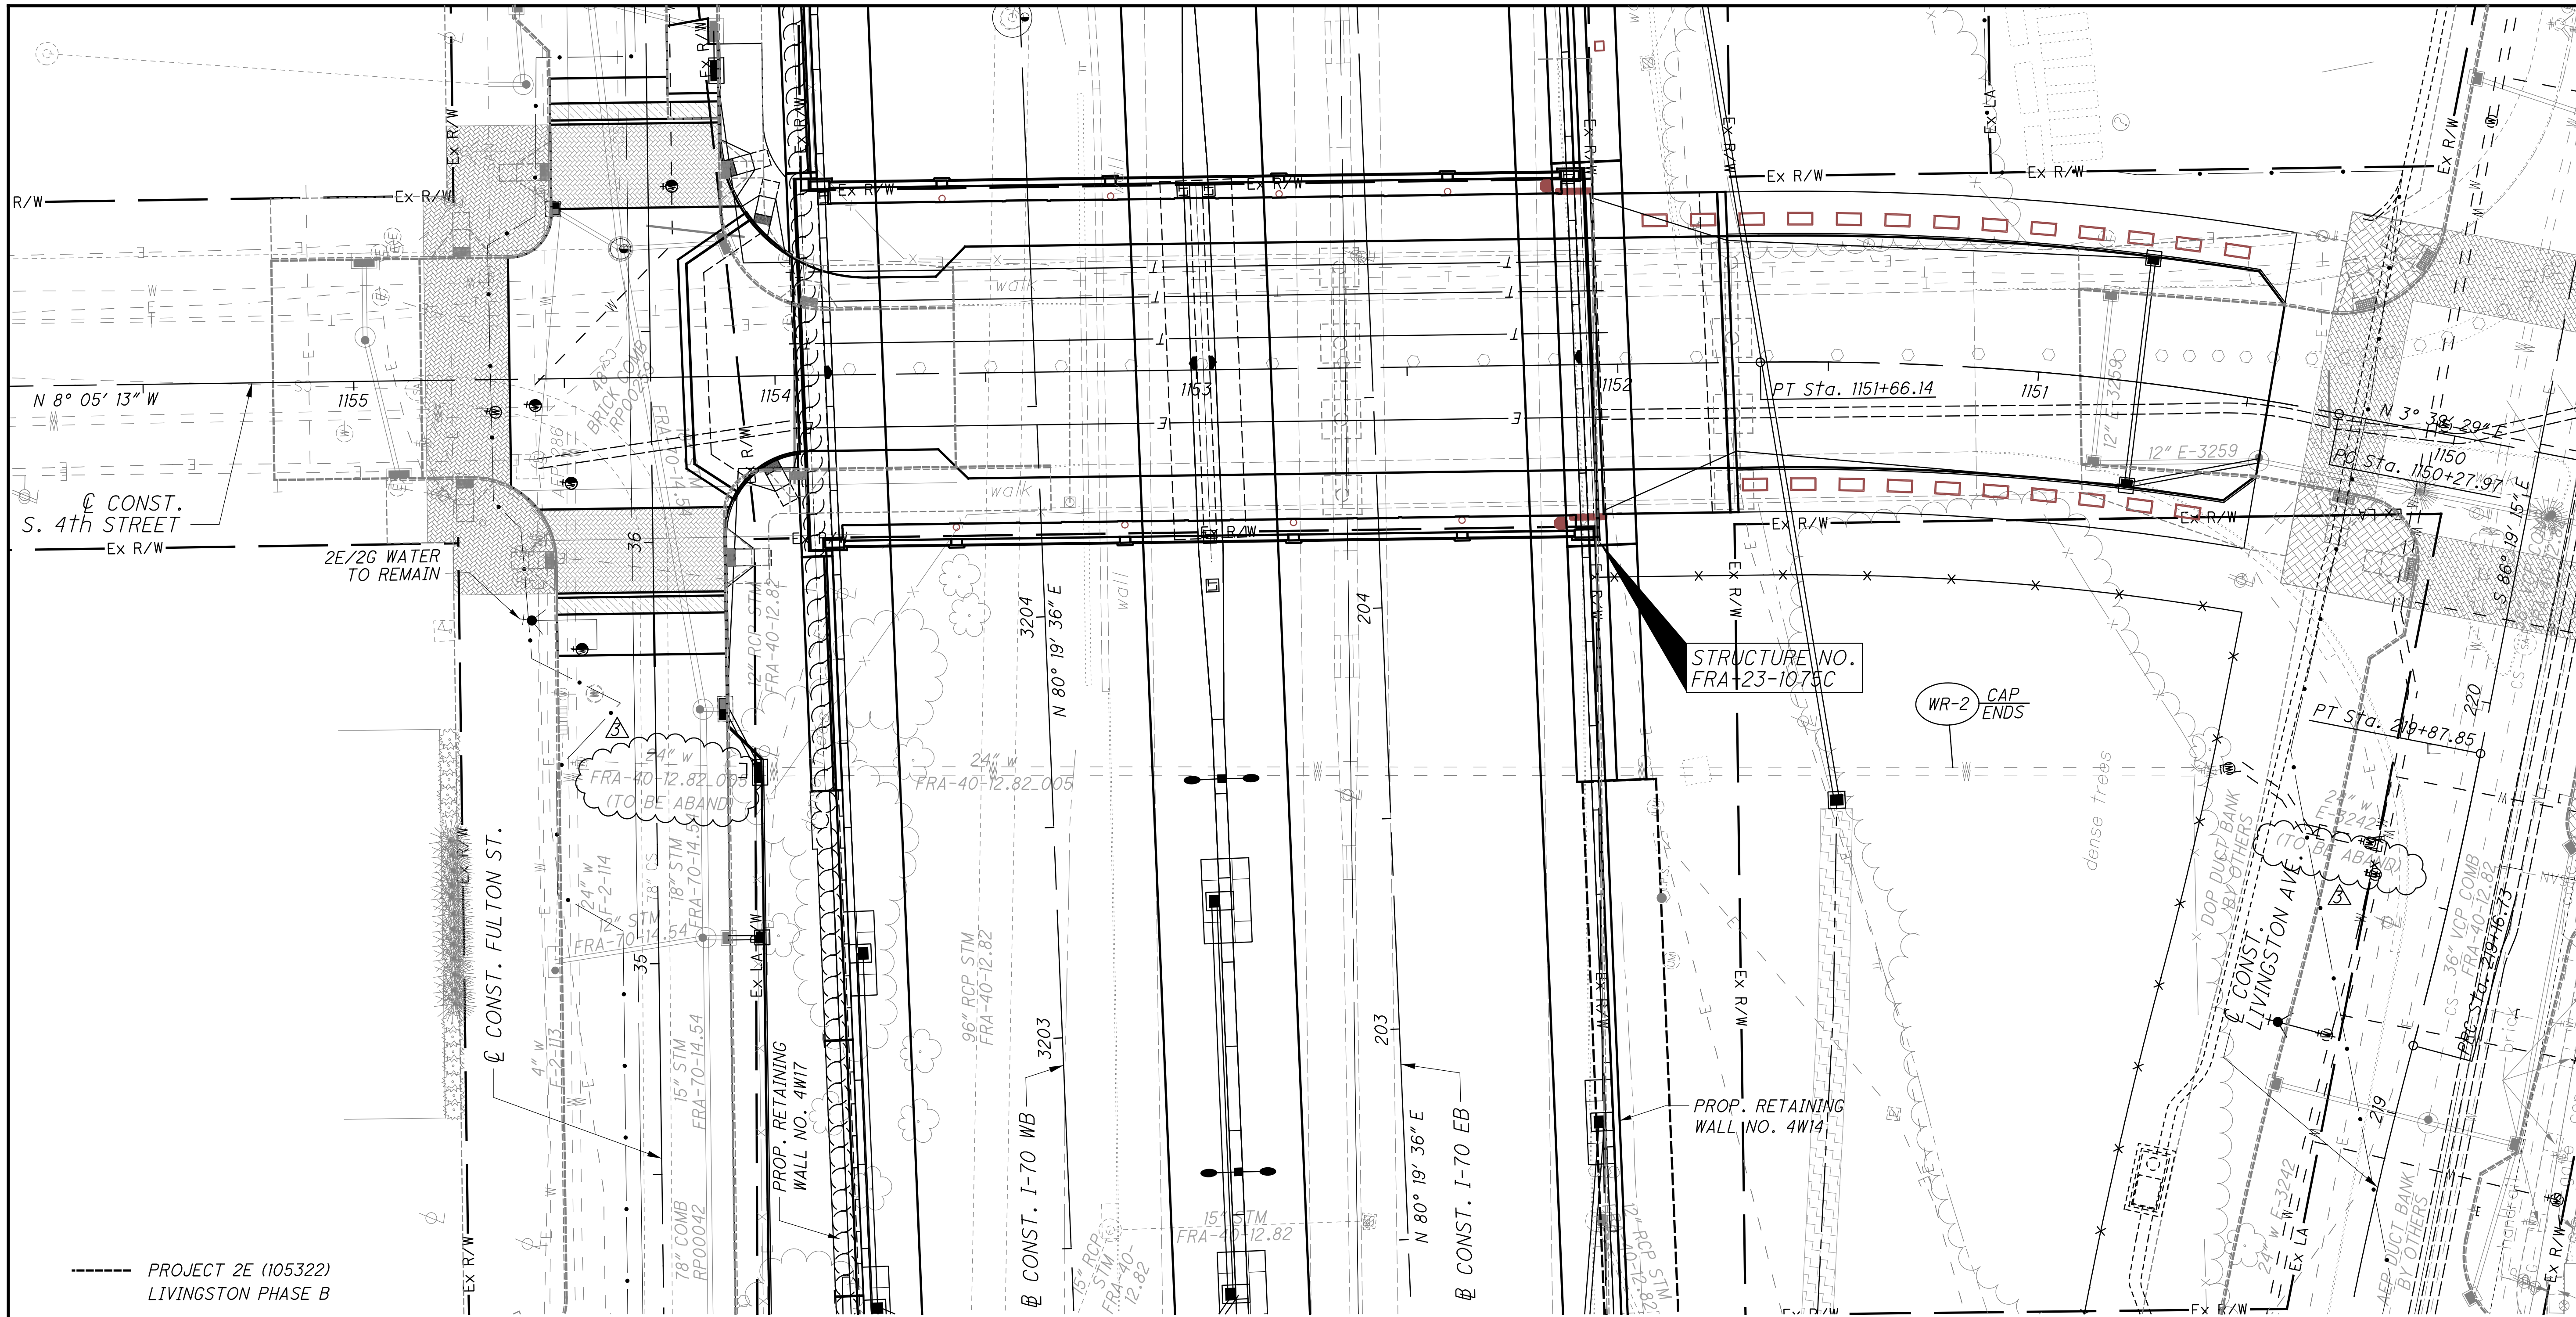


--- PROJECT 2E (105322)  
 LIVINGSTON PHASE B

STRUCTURE NO.  
 FRA-23-1073C

WR-2  
 GAP  
 ENDS

PROP. RETAINING  
 WALL NO. 4W14

NO.	DESCRIPTION	REV. BY	DATE
3	ADDED LABEL	CWL	10-20-23

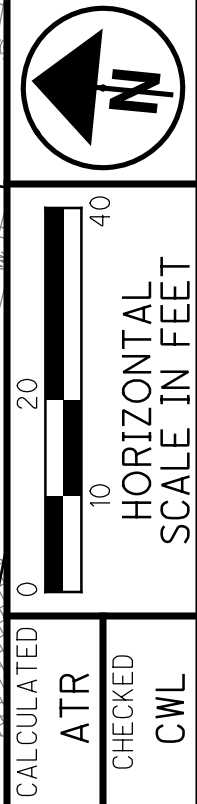

PLAN  
 EXISTING 24" WATERLINE ABANDONMENT


FRA-70-14.05

389  
 855

**ESTIMATED QUANTITIES**

CALCULATED BY: RHC DATE: 7-5-22  
 CHECKED BY: DJC DATE: 7-7-22

ITEM	EXT.	TOTAL	PARTICIPATION			UNITS	DESCRIPTION	ABUTMENT	PIER	SUPER-STRUCTURE	GENERAL	REFERENCE SHEET NO.
			01/IMS/04	02/IMS/11	09/IMS/17/ COL							
202	11002	LS		LS								
202	22900	370		370		SY					370	
202	23500	731		731		SY					731	
503	11100	LS		LS								
503	21100	1,872		1,872		CY		1,479	393			
509	10000	188,244		188,244		LB		41,330	50,212	96,702		
511	34446	357		357		CY				357		
511	41012	119		119		CY			119			
511	44113	336		336		CY		336				3
511	46512	278		278		CY		155	123			
511	51513	91		91		CY				91		3
512	10050	602		602		SY		12		590		3
512	10100	456		456		SY		350	106			3
512	33000	23		23		SY		23				
513	10200	11,219	11,219			LB				11,219		
513	10200	11,219			11,219	LB				11,219		
513	10280	410,900		410,900		LB				410,900		
513	20000	4,872		4,872		EACH				4,872		
514	00060	23,000		23,000		SF				23,000		
514	00066	23,000		23,000		SF				23,000		
514	10000	14		14		EACH				14		
516	10010	116		116		FT					116	
516	11210	128		128		FT				128		
516	13600	344		344		SF		344				
516	13900	136		136		SF		136				
516	44101	14		14		EACH				14		21
516	44201	7		7		EACH				7		21
518	12301	2		2		EACH				2		27
518	20000	227		227		SY		227				
518	21200	35		35		CY		35				
518	40000	220		220		FT		220				
518	40012	45		45		FT		45				
518	60031	70		70		FT				70		
524	95472	984		984		FT		984				3
526	25011	104		104		SY					104	36 TO 39
526	30011	214		214		SY					214	36 TO 39
526	90031	120		120		FT					120	38
625	10620	6		6		EACH				6		3
SPECIAL	53000200	LS	LS									4
SPECIAL	53000200	LS	LS									4
SPECIAL	53000200	LS	LS									4
SPECIAL	53000200	LS		LS								4
SPECIAL	53000600	1,460		1,460		SF		1,460				4
894	10000	15		15		EACH		15				

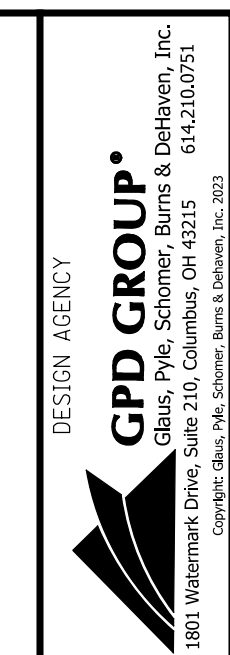

DESIGN AGENCY  
 DATE: 4-21-23  
 REVISION: DGN  
 STRUCTURE FILE NUMBER: 2501554

DRAWN: MOJ  
 CHECKED: RHC

DESIGNED: MOJ  
 CHECKED: RHC

**ESTIMATED QUANTITIES**  
 BRIDGE NO. FRA-33-1747C  
 S. 3RD STREET (U.S. 33) OVER I-70/71

**FRA-70-14.05**  
 PID No. 96053



5 / 42

NO.	DESCRIPTION	REV. BY	DATE
3	QUANTITY REVISED	DJC	10-23-23


563  
855

O:\2015\2015370\FRA\6065\STRUCTURES\FRA03\_1747C\SHEETS\03\_1174CE0001.DGN  
 10/20/2023 11:18:01 AM  
 ODOT\B1STD\USER



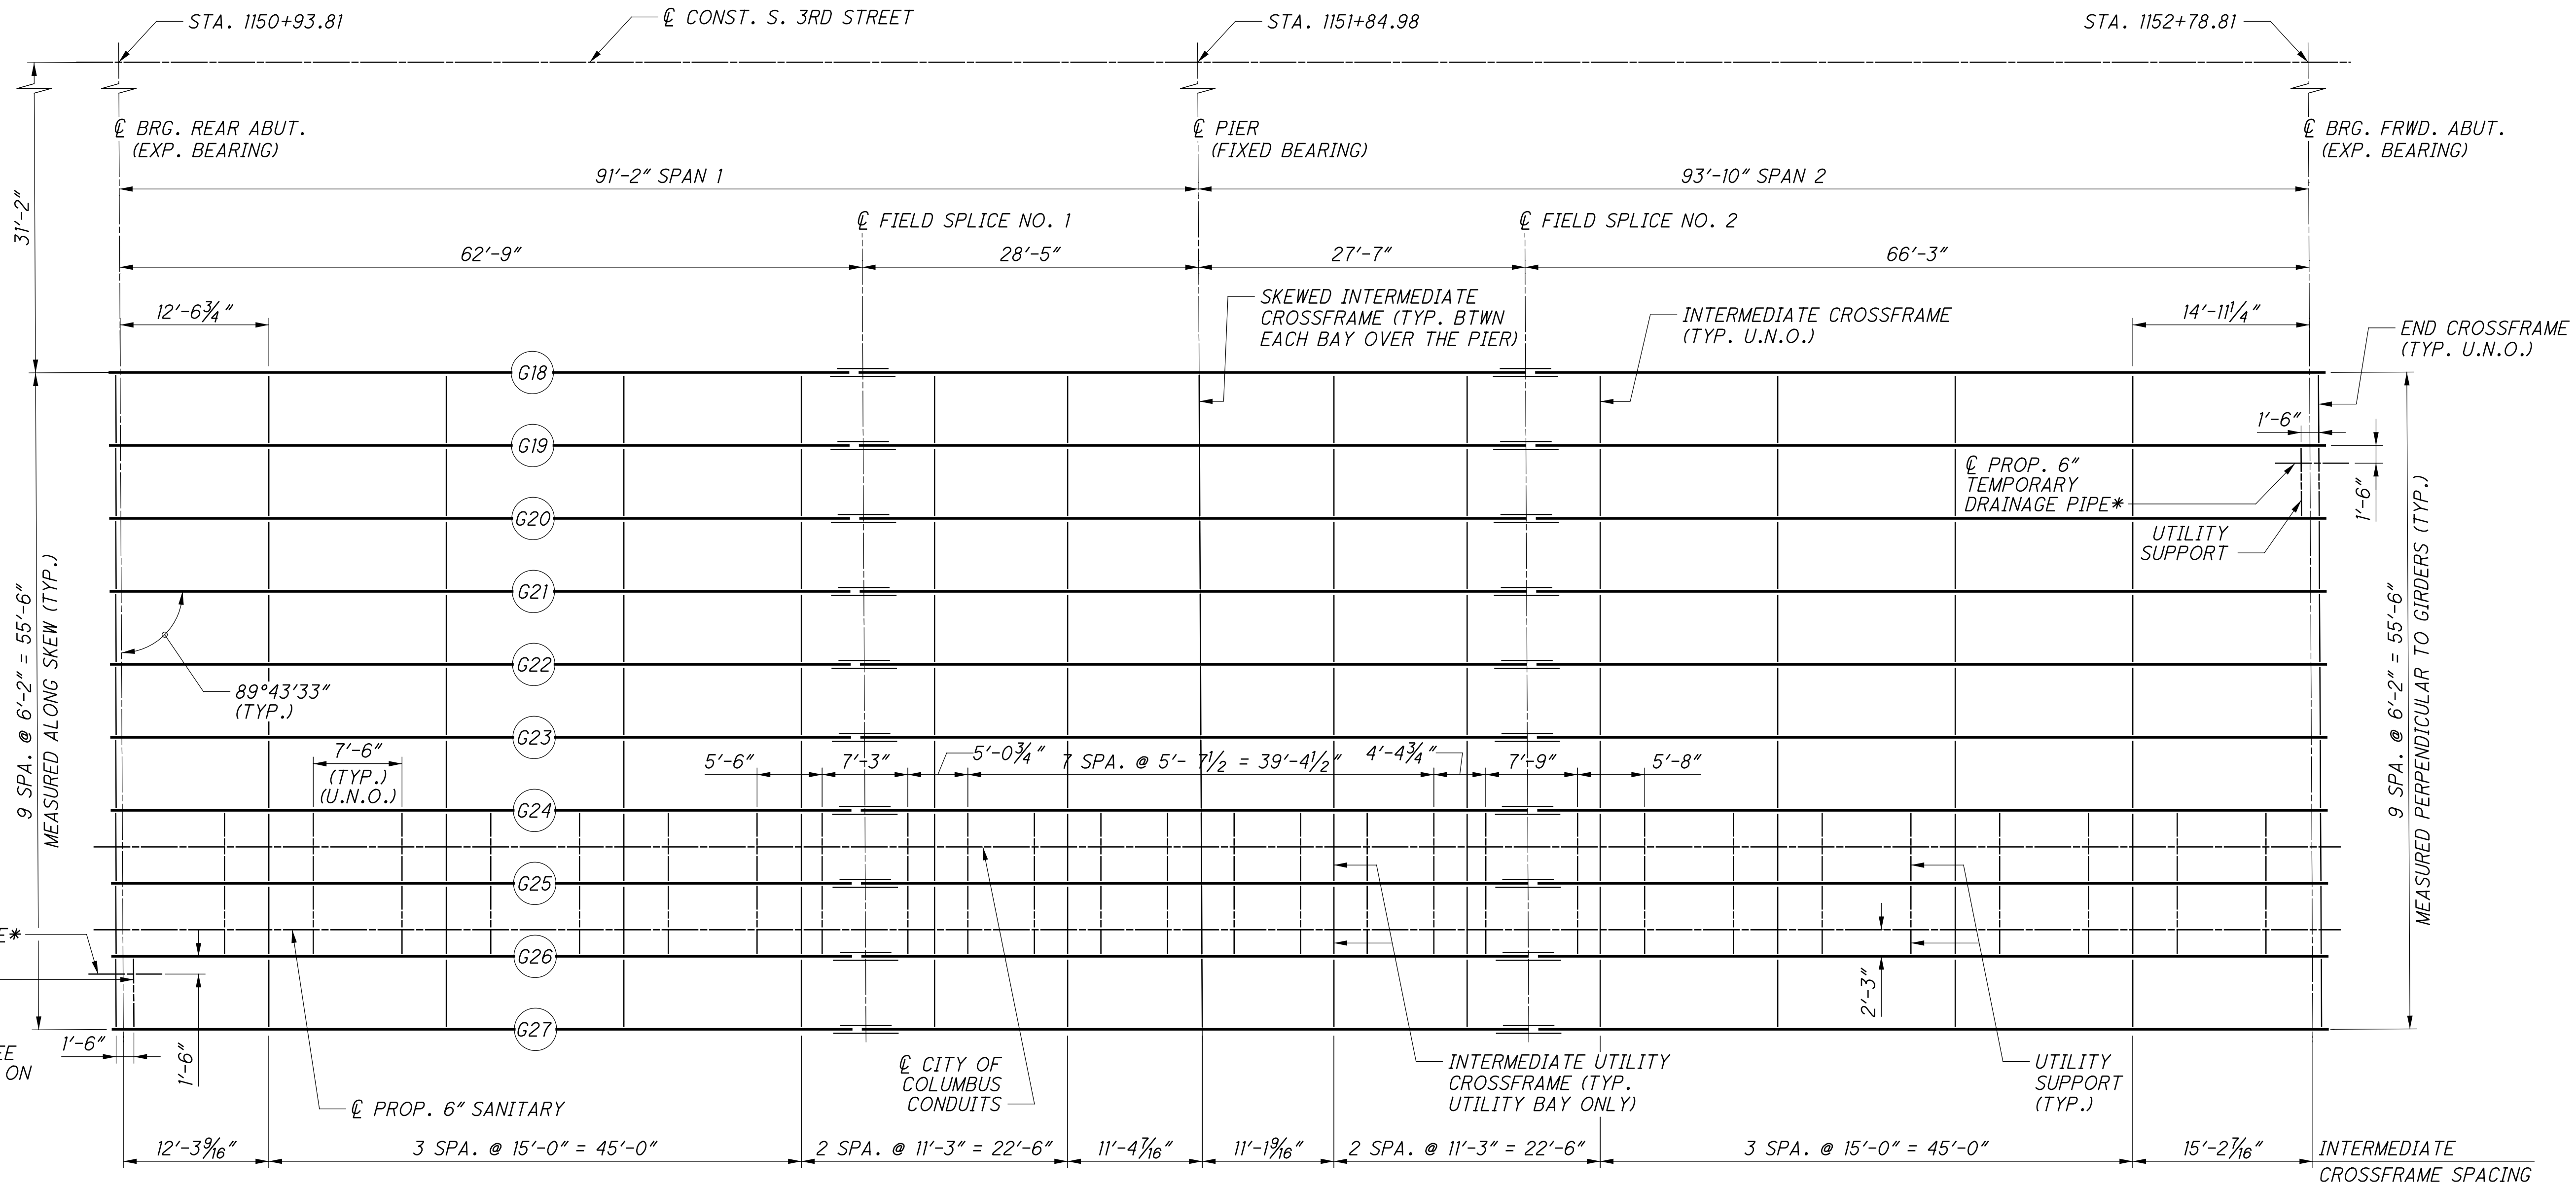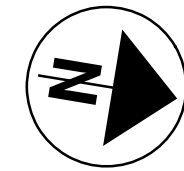


**FRAMING PLAN - EAST CAP**

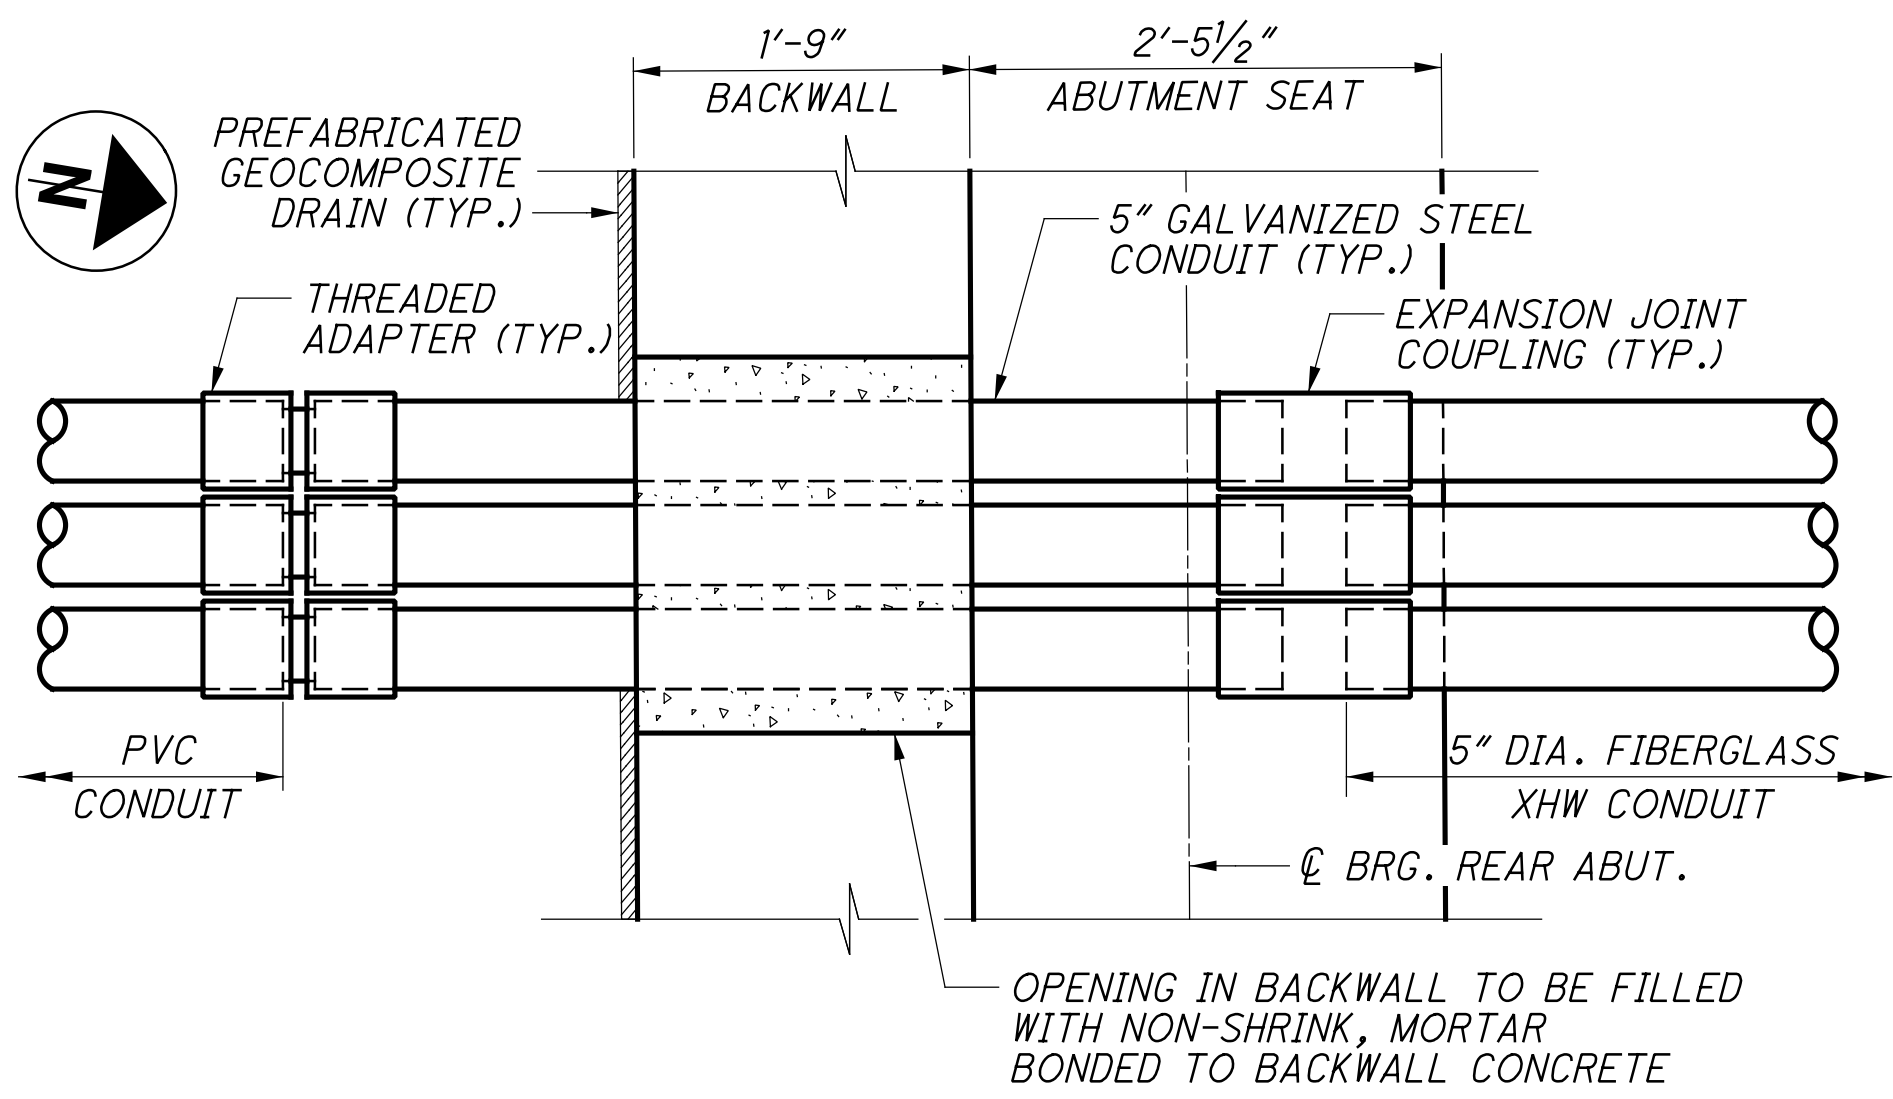


**CITY OF COLUMBUS CONDUIT EXPANSION JOINT DETAILS**

REAR ABUTMENT SHOWN, FORWARD ABUTMENT SIMILAR.

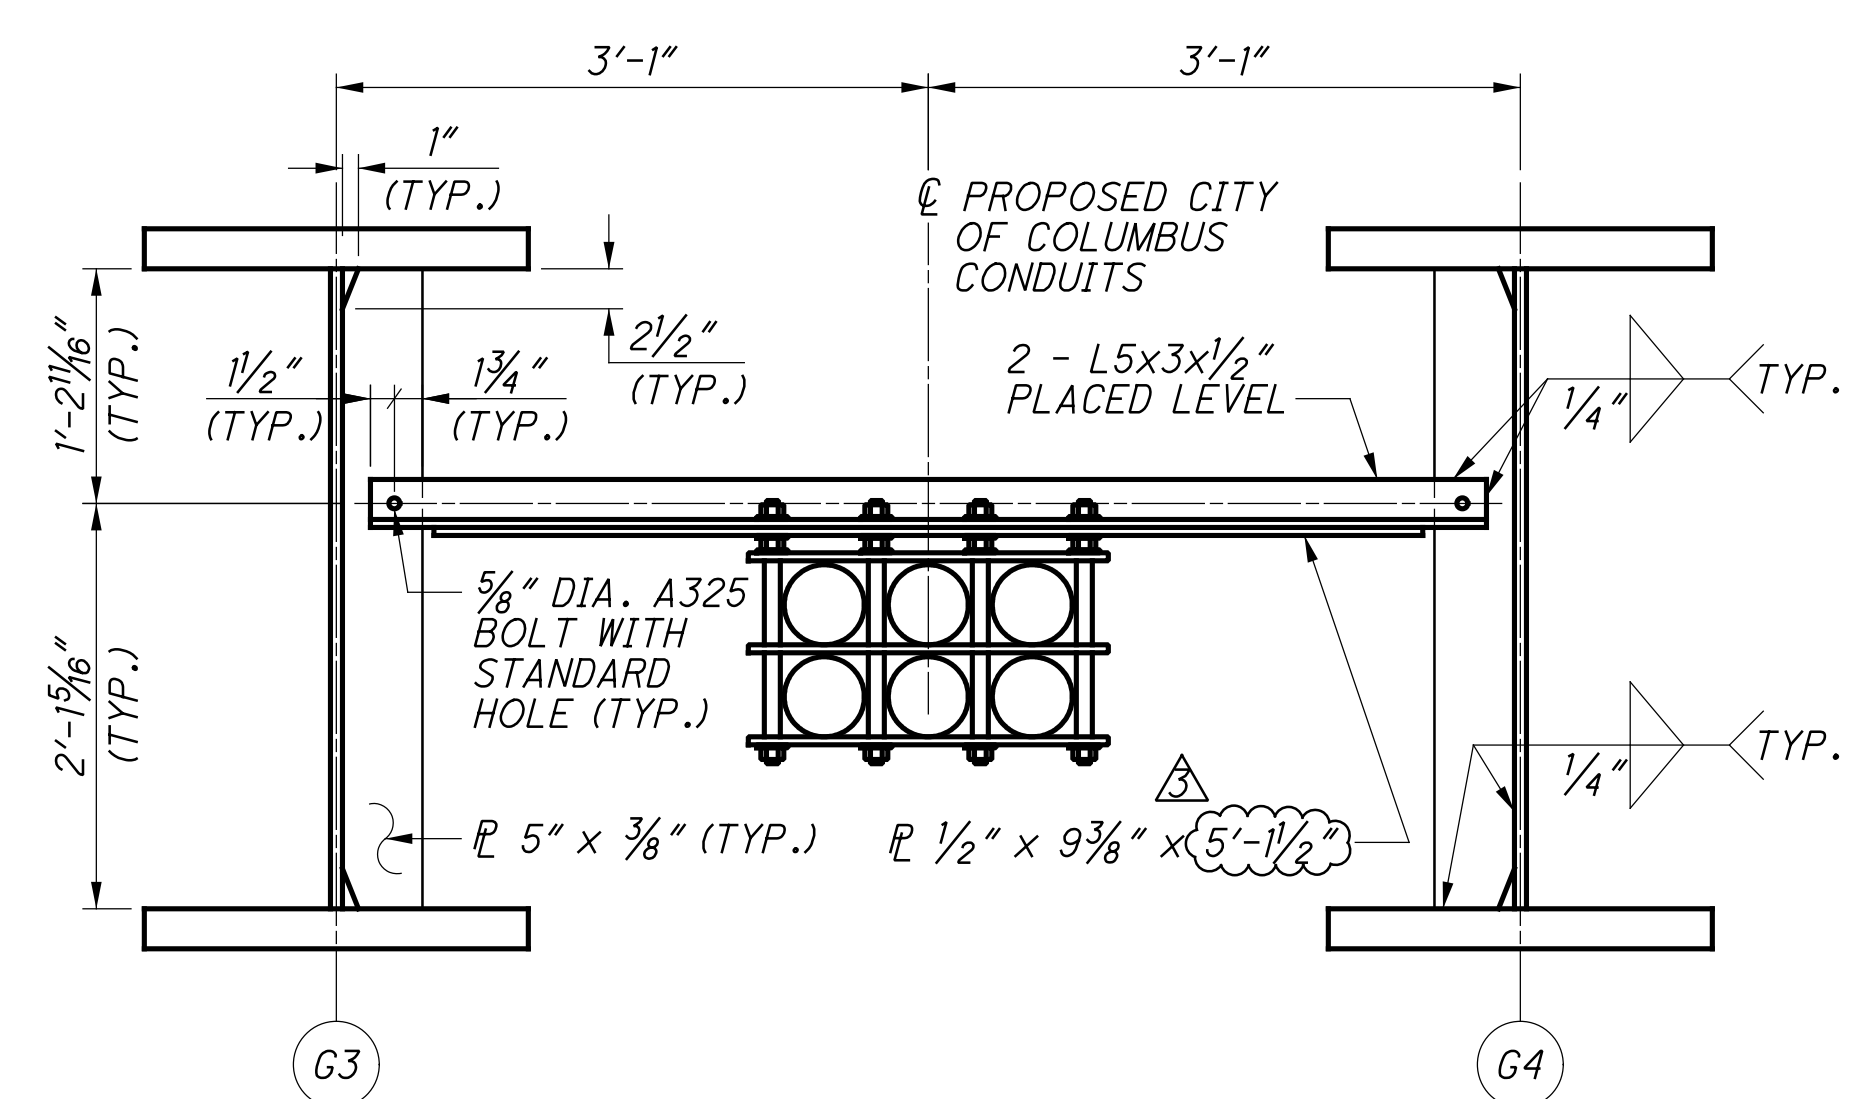

**CITY OF COLUMBUS CONDUIT SUPPORT DETAIL**

BAY BETWEEN G3 AND G4 SHOWN, BAY BETWEEN G24 AND G25 SIMILAR

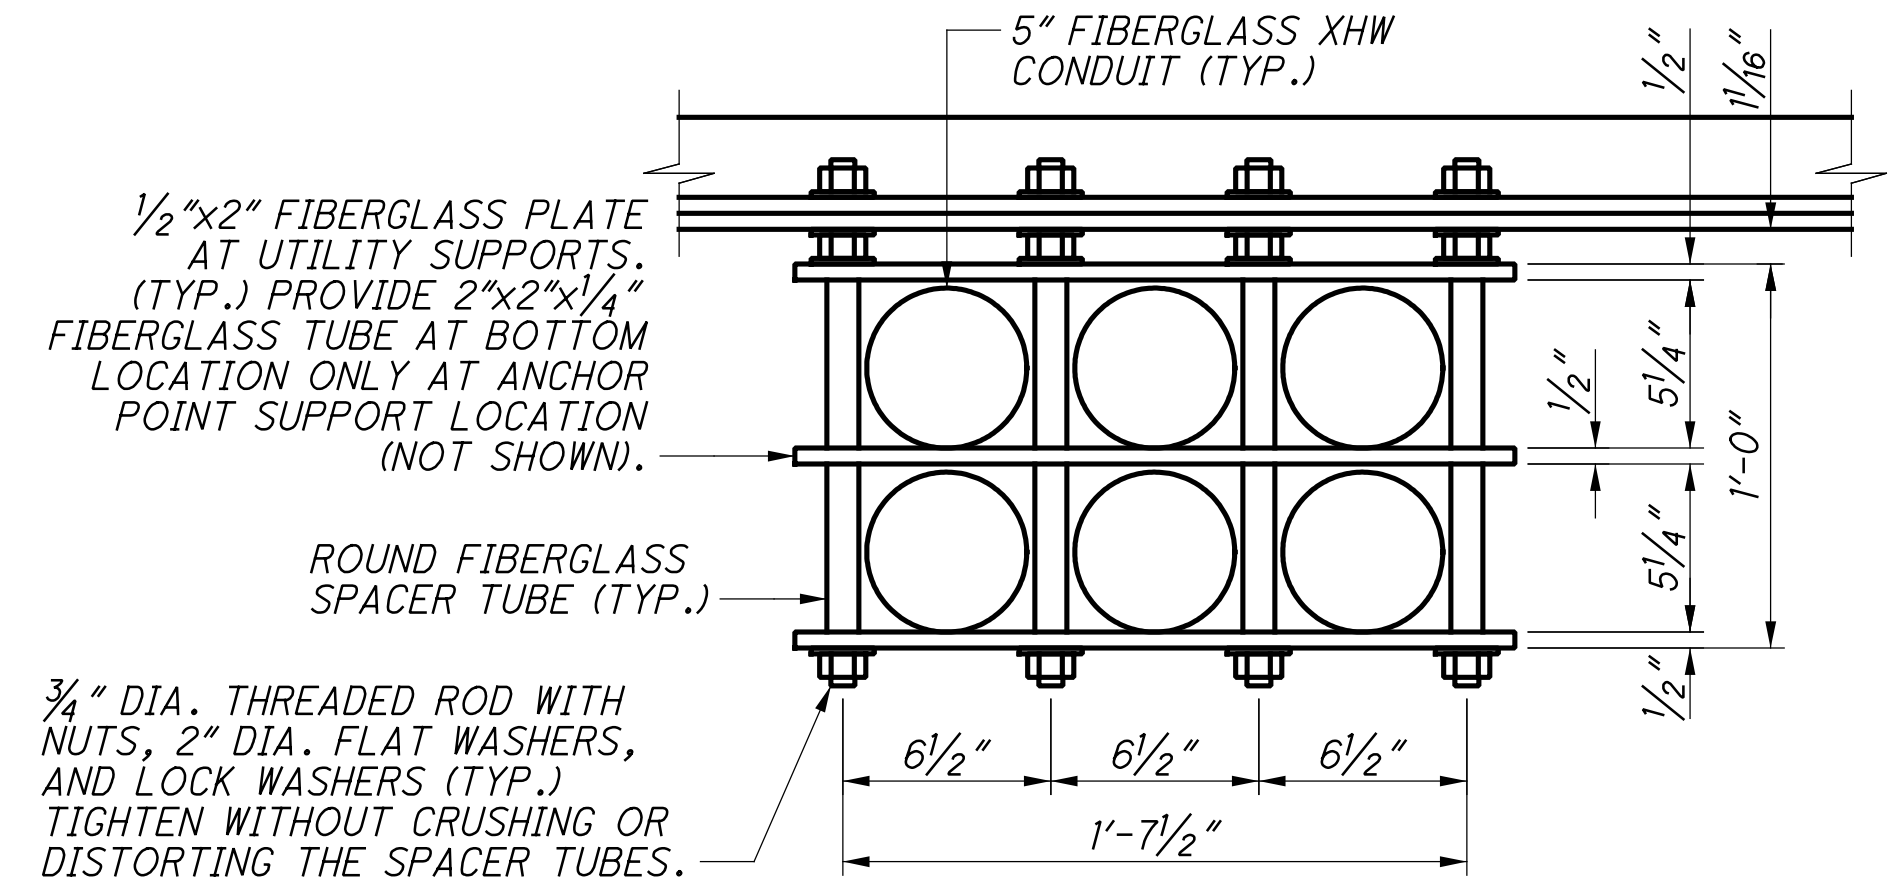

**CITY OF COLUMBUS CONDUIT RACK DETAIL**

**NOTES:**

1. INTERMEDIATE CROSSFRAMES SHALL BE TYPE A USING L4X4X1/2" ANGLES AS DETAILED IN STD. DWG. GSD-1-19.
2. FOR CAMBER AND DEFLECTION TABLE, SEE SHT. NO. [25/38] THRU [27/38].
3. FOR ADDITIONAL UTILITY SUPPORT DETAILS, SEE SHT. NO. [22/38].
4. FOR UTILITY BAY INTERMEDIATE CROSSFRAME DETAILS, SEE SHT. NO. [22/38].

01-2015-2015370 VFA 96065 STRUCTURES\FRA03-1747C SHEETS CAPS\03-1174CS0001.DGN  
 10/20/2023 10:44:54 AM  
 ODOT\B1STD\_USER

NO.	DESCRIPTION	REV. BY	DATE
3	REVISED PLATE LENGTH CALLOUT	DJC	10-23-23


**DESIGN AGENCY**  
**GPD GROUP**  
 1000 Waterford Drive, Suite 200, Columbus, OH 43240  
 (614) 231-0001

**DATE** 4-21-23  
**REVIEWED** T J W  
**STRUCTURE FILE NUMBER** 2501554  
**DESIGNED** MOJ  
**CHECKED** DGN  
**DRAWN** MLS  
**REVISED**


**FRAMING PLAN - EAST CAP**  
 BRIDGE NO. FRA-33-1747C - CAPS  
 S. 3RD STREET (U.S. 33) OVER I-70/71

**FRA-70-14.05**  
**PID No. 96053**

23 / 38  
 623 / 855

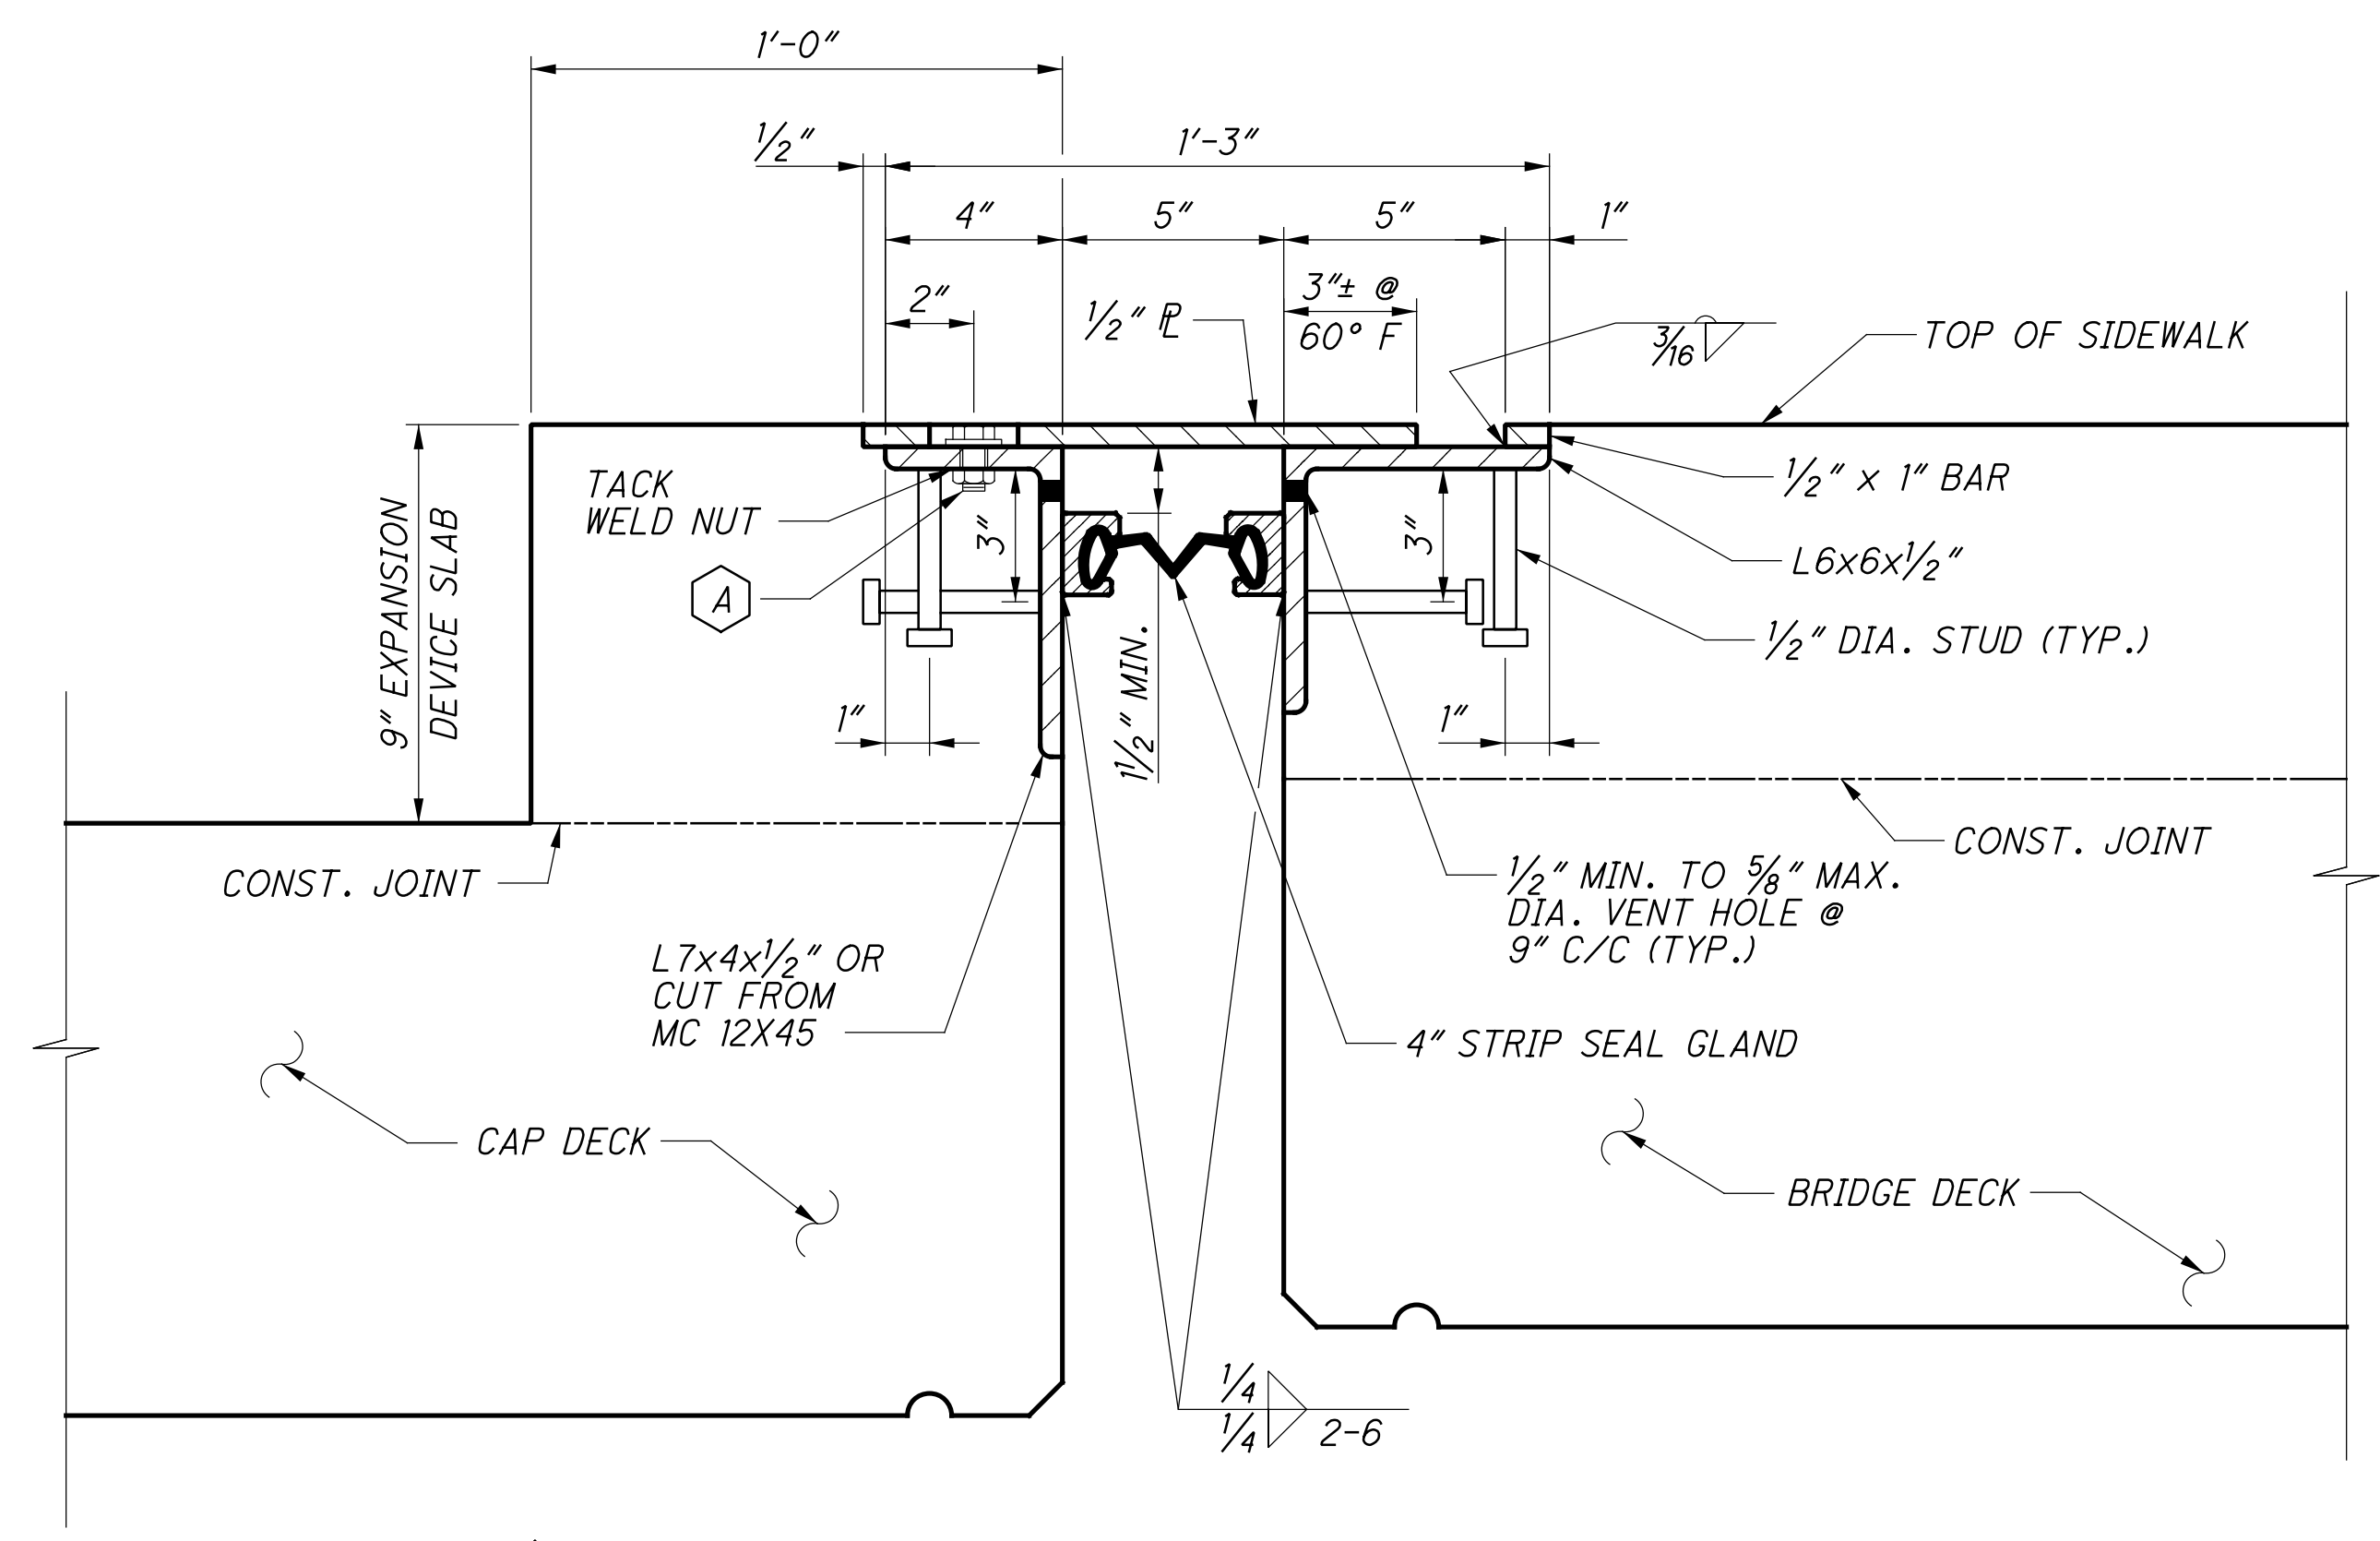

**LONGITUDINAL EXPANSION JOINT DETAIL**  
REINFORCING NOT SHOWN

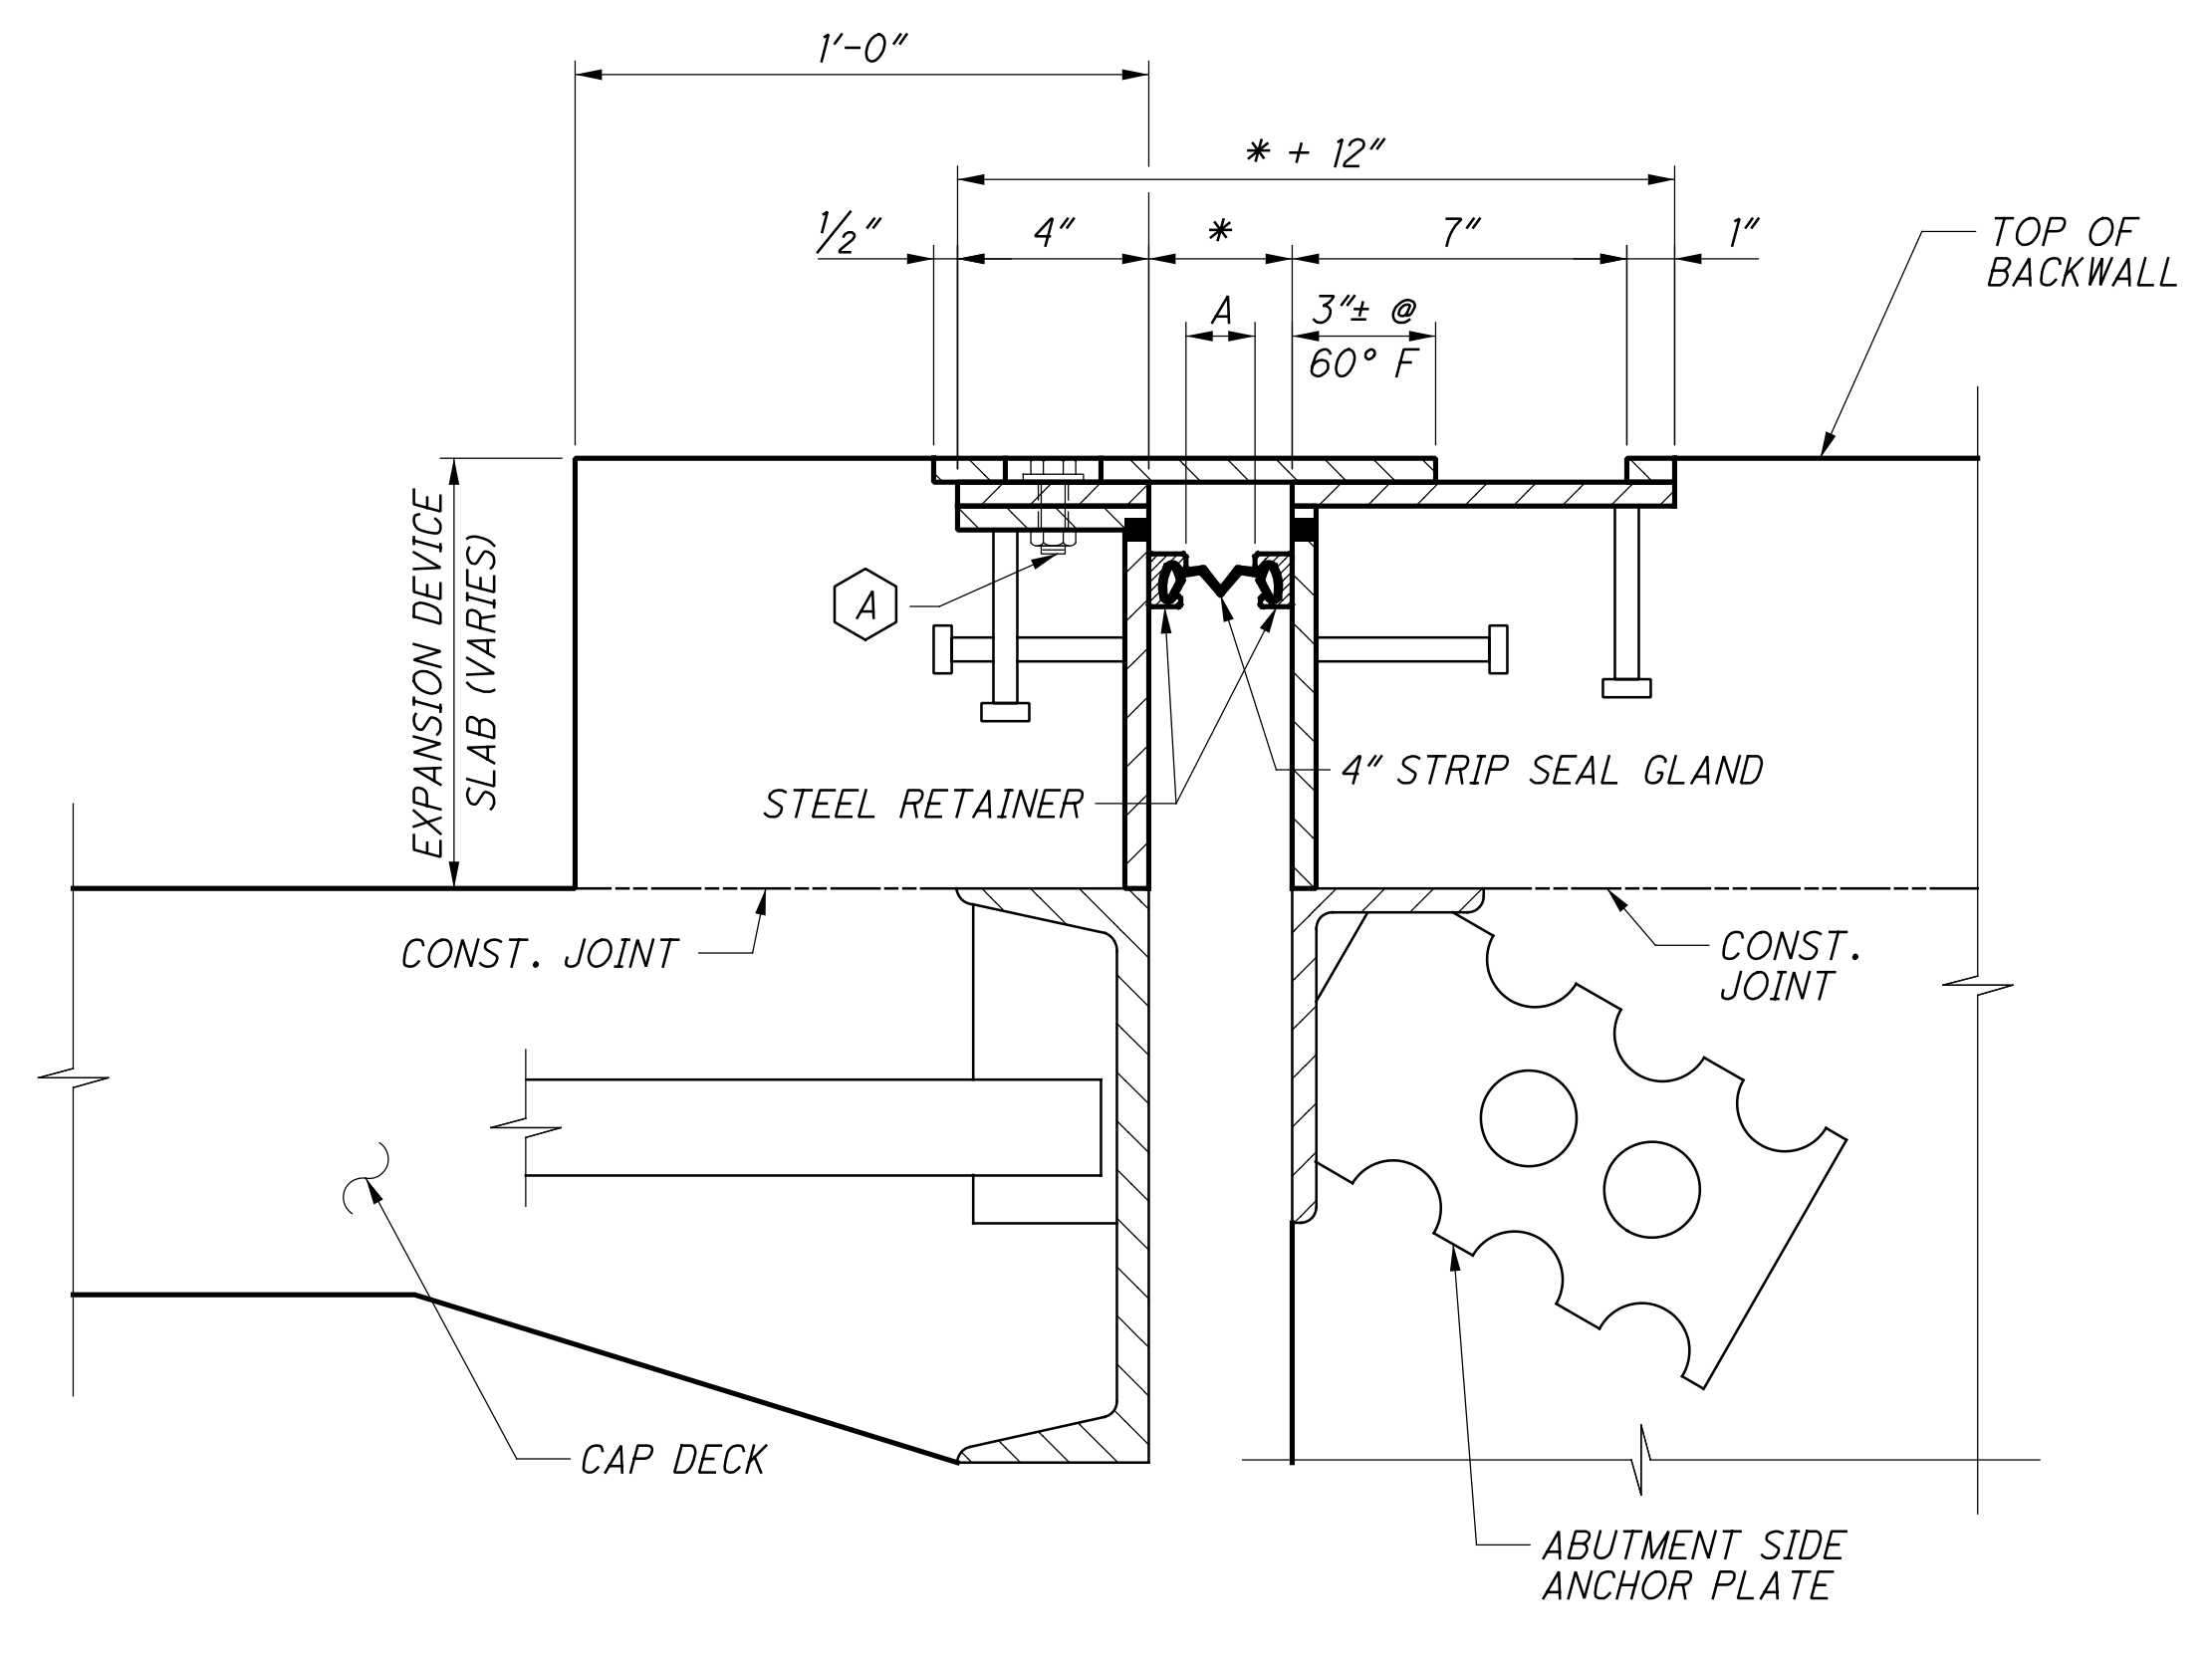

**ABUTMENT EXPANSION JOINT DETAIL**  
REINFORCING NOT SHOWN

REAR ABUTMENT	
4" STRIP SEAL JOINT WIDTH	
AMBIENT TEMPERATURE	DIMENSION "A"
90°	1 3/8"
80°	1 1/2"
70°	1 9/16"
60°	1 5/8"
50°	1 3/4"
40°	1 7/16"
30°	1 7/8"

FORWARD ABUTMENT	
4" STRIP SEAL JOINT WIDTH	
AMBIENT TEMPERATURE	DIMENSION "A"
90°	1 3/8"
80°	1 1/2"
70°	1 9/16"
60°	1 5/8"
50°	1 3/4"
40°	1 7/16"
30°	1 7/8"

**LEGEND:**

- \* THIS DIMENSION IS THE SUM OF (2 X "STEEL RETAINER WIDTH" + DIM. "A")
- 1/2" DIA. x 1 1/2" STAINLESS STEEL SOCKET FLAT HEAD SCREWS, ASTM F879 SPACED AT 6" MAX. C/C WITH ANTI-SEIZE LUBRICANT. PLACE IN COUNTERSUNK HOLE FLUSH WITH PLATE SURFACE. DRILL 5/8" DIA. HOLES IN L7x4x1/2".

**NOTES:**

- FOR ADDITIONAL DETAILS, SEE STD. DWG. EXJ-4-87.
- THE ELASTOMERIC STRIP SEAL SHALL BE ONE PIECE ACROSS THE ENTIRE WIDTH OF THE STRUCTURE. NO SPLICES ARE ACCEPTABLE.

NO.	DESCRIPTION	REV. BY	DATE
3	TITLE REVISED	MOJ	10-23-23

G:\2015\2015370\FRA\96053\STRUCTURES\FRA03\_1747C\SHEETS CAPS\03\_1174CS0003.DGN  
 10/20/2023 11:46:57 AM  
 ODOT\B15TD\LSEB

**EXPANSION JOINT DETAILS**  
 BRIDGE NO. FRA-33-1747C - CAPS  
 S. 3RD STREET (U.S. 33) OVER I-70/71

DESIGNED	MOJ	CHECKED	RHC
DRAWN	MOJ	REVISED	
REVIEWED	DGN	STRUCTURE FILE NUMBER	2501554
DATE	4-21-23		

**FRA-70-14.05**  
**PID No. 96053**

28 / 38  
 628  
 855

DESIGN AGENCY  
**GPD GROUP**  
 1001 Watermark Drive, Suite 700, Cary, NC 27513  
 Copyright © 2023, GPD Group, Inc.

D:\2015\2015370\FRA\6065\STRUCTURES\FRA023\_1075C\SHEETS\023\_1075CE0001.DGN  
 10/20/2023  
 9:17:43 AM  
 ODOT\B1STD\_USER

ITEM	EXT.	TOTAL	PARTICIPATION			UNITS	DESCRIPTION	ABUTMENT	PIER	SUPER-STRUCTURE	GENERAL	REFERENCE SHEET NO.
			01/IMS/04	02/IMS/11	09/IMS/17/COI							
202	11002	LS		LS			STRUCTURE REMOVED, OVER 20 FOOT SPAN					2
202	22900	219		219		SY	APPROACH SLAB REMOVED				219	
202	23500	906		906		SY	WEARING COURSE REMOVED				906	
503	11100	LS		LS			COFFERDAMS AND EXCAVATION BRACING					
503	21100	3,173		3,173		CY	UNCLASSIFIED EXCAVATION	2,438	735			
509	10000	357,555		357,555		LB	EPOXY COATED REINFORCING STEEL	127,946	74,285	155,324		
511	34446	485		485		CY	CLASS QC2 CONCRETE WITH QC/QA, BRIDGE DECK			485		
511	34451	145		145		CY	CLASS QC2 CONCRETE WITH QC/QA, BRIDGE DECK (PARAPET), AS PER PLAN			145		2
511	41012	183		183		CY	CLASS QC1 CONCRETE WITH QC/QA, PIER ABOVE FOOTINGS		183			
511	44113	1,186		1,186		CY	CLASS QC1 CONCRETE WITH QC/QA, ABUTMENT NOT INCLUDING FOOTING, AS PER PLAN	1,186				2
511	46512	604		604		CY	CLASS QC1 CONCRETE WITH QC/QA, FOOTING	443	161			
511	51513	98		98		CY	CLASS QC2 CONCRETE WITH QC/QA, SIDEWALK, AS PER PLAN			98		2
512	10050	1,236		1,236		SY	SEALING OF CONCRETE SURFACES (NON-EPOXY)	165		1,071		2
512	10100	1,393		1,393		SY	SEALING OF CONCRETE SURFACES (EPOXY-URETHANE)	1,171	222			2
512	33000	193		193		SY	TYPE 2 WATERPROOFING	193				
513	10200	5,360		5,360		LB	STRUCTURAL STEEL MEMBERS, LEVEL UF (PIPE HORIZONTAL CONDUCTOR)			5,360		
513	10200	4,840	4,840			LB	STRUCTURAL STEEL MEMBERS, LEVEL UF (COC, COC DOT, AND ODOT DUCT BANK SUPPORT)			4,840		
513	10200	4,740	4,740			LB	STRUCTURAL STEEL MEMBERS, LEVEL UF (COC: DOT - TELECOM DUCT BANK SUPPORT)			4,740		
513	10200	12,510			12,510	LB	STRUCTURAL STEEL MEMBERS, LEVEL UF (AEP DUCT BANK SUPPORT)			12,510		
513	10200	12,510			12,510	LB	STRUCTURAL STEEL MEMBERS, LEVEL UF (AT&T DUCT BANK SUPPORT)			12,510		
513	10280	553,000		553,000		LB	STRUCTURAL STEEL MEMBERS, LEVEL 4			553,000		
513	20000	6,507		6,507		EACH	WELDED STUD SHEAR CONNECTORS			6,507		
514	00060	24,600		24,600		SF	FIELD PAINTING STRUCTURAL STEEL, INTERMEDIATE COAT			24,600		
514	00066	24,600		24,600		SF	FIELD PAINTING STRUCTURAL STEEL, FINISH COAT			24,600		2
514	10000	25		25		EACH	FINAL INSPECTION REPAIR			25		
516	10010	155		155		FT	ARMORLESS PREFORMED JOINT SEAL				155	
516	11210	177		177		FT	STRUCTURAL EXPANSION JOINT INCLUDING ELASTOMERIC STRIP SEAL (3")			177		
516	13600	584		584		SF	1" PREFORMED EXPANSION JOINT FILLER	584				
516	44101	18		18		EACH	ELASTOMERIC BEARING WITH INTERNAL LAMINATES AND LOAD PLATE (NEOPRENE) 9 1/2" x 1'-4" x 2.67" PAD WITH 10 1/2" x 1'-10" BEVELED PLATE, AS PER PLAN			18		28
516	44201	9		9		EACH	ELASTOMERIC BEARING WITH INTERNAL LAMINATES AND LOAD PLATE (NEOPRENE) 1'-5" x 2'-2" x 3.21" PAD WITH 1'-6" x 2'-11" BEVELED PLATE, AS PER PLAN			9		28
518	12301	2		2		EACH	SCUPPERS, AS PER PLAN			2		37
518	20000	655		655		SY	PREFABRICATED GEOCOMPOSITE DRAIN	655				
518	21200	104		104		CY	POROUS BACKFILL WITH GEOTEXTILE FABRIC	104				
518	40000	650		650		FT	6" PERFORATED CORRUGATED PLASTIC PIPE	650				
518	40012	40		40		FT	6" NON-PERFORATED CORRUGATED PLASTIC PIPE	40				
518	60031	90		90		FT	PIPE HORIZONTAL CONDUCTOR, AS PER PLAN (8")			90		2 & 37
524	95472	2,602		2,602		FT	DRILLED SHAFTS, 60" DIAMETER, ABOVE BEDROCK WITH QC/QA, AS PER PLAN	2,602				2
526	25010	153		153		SY	REINFORCED CONCRETE APPROACH SLABS WITH QC/QA (T=15")				153	
526	30011	254		254		SY	REINFORCED CONCRETE APPROACH SLABS WITH QC/QA (T=17"), AS PER PLAN				254	49
526	90031	160		160		FT	TYPE C INSTALLATION, AS PER PLAN				160	49
625	10620	6		6		EACH	LIGHT POLE ANCHOR BOLTS, MISC.: LIGHT POLE ANCHOR BOLT ASSEMBLIES EMBEDDED IN CONCRETE BRIDGE DECK			6		2
SPECIAL	53000200	LS	LS			LS	STRUCTURES: CITY OF COLUMBUS DUCT BANK COMPLETE					3
SPECIAL	53000200	LS	LS			LS	STRUCTURES: CITY OF COLUMBUS (DEPARTMENT OF TECH) DUCT BANK COMPLETE					3
SPECIAL	53000200	LS		LS		LS	STRUCTURES: AEP DUCT BANK COMPLETE					3
SPECIAL	53000200	LS		LS		LS	STRUCTURES: AT&T DUCT BANK COMPLETE					3
SPECIAL	53000200	LS	LS			LS	STRUCTURES: ODOT DUCT BANK COMPLETE					3
SPECIAL	53000200	LS		LS		LS	STRUCTURES: TEMPORARY UTILITY SUPPORTS					3
SPECIAL	53000600	3,639		3,639		SF	STRUCTURES: PRECAST FACADE PANELS	3,639				3
607	98000	112		112		FT	FENCE, MISC.: WALL MOUNTED TYPE A (W/ VANDAL MESH)	112				2
607	98000	135		135		FT	FENCE, MISC.: WALL MOUNTED TYPE A (W/O VANDAL MESH)	135				2
894	10000	43		43		EACH	THERMAL INTEGRITY PROFILING (TIP) TEST	43				

NO.	DESCRIPTION	REV. BY	DATE
3	QUANTITIES REVISD	DJC	10-23-23

CALCULATED BY: RHC DATE: 7-5-22  
 CHECKED BY: DJC DATE: 7-7-22



DESIGNED	ML	CHECKED	RHC
DRAWN	MLS	REVISED	
REVIEWED	DGN	FILE NUMBER	2502620
DATE	4-21-23		

**ESTIMATED QUANTITIES**  
 BRIDGE NO. FRA-23-1075C  
 S. 4TH STREET (U.S. 23) OVER I-70/71

**FRA - 70 - 14.05**  
**PID No. 96053**

4 / 54

642  
855



**UTILITIES**

PRIOR TO EXCAVATION, THE CONTRACTOR SHALL GIVE A 48 HOUR NOTICE TO THE OHIO UTILITIES PROTECTION SERVICE (OUPS) NOW DOING BUSINESS AS OHIO 811 BY CALLING 811 OR (800-362-2764).

LISTED BELOW ARE THE UTILITIES LOCATED WITHIN THE PROJECT CONSTRUCTION LIMITS TOGETHER WITH THEIR RESPECTIVE OWNERS:

**ELECTRIC**

AMERICAN ELECTRIC POWER (TRANSMISSION)  
ATTN: MICHAEL CARR  
8600 SMITHS MILL ROAD  
NEW ALBANY, OH 43054  
OFFICE: 380-205-5072  
TL\_PUBLICPROJECTS@AEP.COM

AMERICAN ELECTRIC POWER (CITY PROJECTS/DISTRIBUTION)  
ATTN: PAUL PAXTON  
777 HOPEWELL DRIVE  
HEATH, OHIO 43056  
OFFICE: 740-348-5322  
AEP SOLUTION CENTER:  
800-277-2177  
PTPAXTON@AEP.COM  
ALSO COPY:  
UNA BLANUSA  
OHFIBERRELOCATE@AEP.COM

CITY OF COLUMBUS  
DIVISION OF POWER  
ATTN: CHARLES HORNER  
3500 INDIANOLA AVENUE  
COLUMBUS, OHIO 43214  
614-645-7569  
CRHORNER@COLUMBUS.GOV

**WATER**

CITY OF COLUMBUS  
DIVISION OF WATER  
910 DUBLIN ROAD  
COLUMBUS, OHIO 43215  
OFFICE: 614-645-7788

**CABLE**

CHARTER COMMUNICATIONS/  
SPECTRUM  
(AKA TIME WARNER COMMUNICATIONS)  
3760 INTERCHANGE ROAD  
COLUMBUS, OH 43204  
DL-MOH-CONSTRUCTION-FRELO-  
TEAM@CHARTER.COM

BREEZELINE (FKA WOW)  
3675 CORPORATE DRIVE  
COLUMBUS, OH 43231  
ADD BOTH:  
DL\_CMHFR@ATLANTICBB.COM  
MFREY@BREEZELINE.COM

**GAS**

COLUMBIA GAS OF OHIO  
ATTN: ROB CALDWELL  
LEADER FIELD ENGINEERING  
3550 JOHNNY APPLESEED CT.  
COLUMBUS, OHIO 43231  
OFFICE: 614-818-2104  
CELL: 614-370-1906  
CUSTOMER SERVICE: 1-800-344-4077  
DAMAGE PREVENTION: 1-866-632-6243  
COLUMBIAGAS.COLUMBUSENG@NISOURCE.COM  
ALSO COPY: RCALDWELL@NISOURCE.COM

**TELEPHONE/  
TELECOMMUNICATIONS**

LUMEN (FKA CENTURYLINK/  
LEVEL 3 COMMUNICATIONS/  
TW TELECOM/QWEST)  
250 W. OLD WILSON BRIDGE  
SUITE 130  
WORTHINGTON, OH 43085  
PLEASE SEND PLANS ELECTRONICALLY  
TO: RELOCATIONS@LUMEN.COM  
RELOCATIONS@BRIGHTSPEED.COM  
HALEY.WOOD@LUMEN.COM

AT&T (FKA SBC)  
ATTN: DONALD G. MARSHALL JR.  
MANAGER OSP PLANNING  
111 N 4TH ST  
COLUMBUS, OHIO 43215  
CELL: 614-216-2396  
AT&T REPAIR SERVICE: 888-611-4466  
DAMAGE PREVENTION: 937-296-3929  
dm619w@ATT.COM  
ALSO COPY:  
G01553@ATT.COM  
KG1963@ATT.COM  
BT2178@ATT.COM

WINDSTREAM-KDL INC. (MCLEODUSA)  
ATTN: LEON TAYLOR  
2165 STATE ROUTE 133 SOUTH  
BLANCHESTER, OHIO 45107  
CELL: 937-725-5358  
LEON.TAYLOR@WINDSTREAM.COM

ZAYO GROUP (FKA CITY NET)  
ATTN: ERIC L. ALEXANDER  
251 NEILSTON STREET  
COLUMBUS, OH 43215  
CELL: 614-989- 9655  
ERIC.ALEXANDER@ZAYO.COM

COGENT COMMUNICATIONS  
(fka SPRINT/T-MOBILE)  
ATTN: STEVEN HUGHES  
OSP ENGINEER II  
11370 ENTERPRISE PARK DR.  
SHARONVILLE, OH 45241  
513-459-5796  
513-462-7221 CELL  
SHUGHES@COGENTCO.COM

VERIZON BUSINESS (AKA MCI/XO)  
757 COMMERCE CT  
LEWIS CENTER, OH 43035  
CELL: 614-593-6685 (MAURICE JONES)  
CELL: 614-816-0361 (BOB DILLOW)  
VZ.NET.COLUMBUS@VERIZON.COM  
ALSO COPY:  
JOHN.CORNELL@VERIZONWIRELESS.COM  
MICHAEL.HENNON@VERIZONWIRELESS.COM  
MICHAEL.BONDY@VERIZONWIRELESS.COM  
SVEN.CHRISTIANSON@VERIZONWIRELESS.COM

EVERSTREAM  
ATTN: SCOTT LANCIA  
240 N 5TH ST. SUITE 168  
COLUMBUS, OH 43215  
OFFICE: 380-204-5465  
CELL: 614-515-3479  
SLANCIA@EVERSTREAM.NET  
SSALEH@EVERSTREAM.NET  
KKHAY@EVERSTREAM.NET

CROWN CASTLE FIBER  
AKA (FIBERTECH & LIGHTOWER)  
ATTN: JOHN TARNOWSKI  
COLUMBUS / DAYTON / CINCINNATI  
T: (585) 445-5813  
M: (614) 940-2462  
2 EASTON OVAL - SUITE 425  
COLUMBUS OH 43219  
JON.TARNOWSKI@CROWNCastle.COM

**SEWER**

DPU - DIVISION OF SEWERAGE & DRAINAGE  
SEWER MAINTENANCE MANAGER  
1250 FAIRWOOD AVE.  
COLUMBUS, OHIO 43206  
OFFICE: 614-645-7102

ODOT ITS  
1606 W. BROAD ST.  
COLUMBUS, OH 43223  
614-387-4113  
CEN.ITS.LAB@DOT.OHIO.GOV  
NOTE: ODOT ITS IS NOT  
CURRENTLY AN OUPS MEMBER.  
ALL REQUESTS FOR LOCATES  
OF ITS INFRASTRUCTURE SHOULD  
BE SENT TO THE ABOVE EMAIL  
ADDRESS.

\* THE FOLLOWING CITY OF COLUMBUS UTILITIES MAY BE LOCATED WITHIN THE WORK LIMITS OF THIS PROJECT AND DO NOT SUBSCRIBE TO A REGISTERED UNDERGROUND PROTECTION SERVICE.

FAX REQUEST FOR MARKINGS TWO (2) BUSINESS DAYS PRIOR TO WORKING IN THIS AREA.

THE UNDERGROUND UTILITIES ON THIS PLAN HAVE BEEN LOCATED USING A SUBSURFACE UTILITY ENGINEERING COMPANY (SUE) AND EXISTING PLANS AS SUPPLIED BY THE RESPECTIVE UTILITY OWNERS, AS REQUIRED BY SECTION 153.64 O.R.C.

CITY OF COLUMBUS \*  
DEPARTMENT OF TECHNOLOGY  
CABLE INTERCONNECT SECTION  
ATTN: DAVE MCNALLY  
1355 MCKINLEY AVENUE  
BUILDING C  
COLUMBUS, OHIO 43222  
OFFICE: 614-645-1501  
CONTRACTOR LINE: 614-645-7756  
CABLE LOCATES FAX: 614-645-6627  
DWMCNALLY@COLUMBUS.GOV  
ALSO COPY  
DARRYL JOYCE AT DHJOYCE@COLUMBUS.GOV

CITY OF COLUMBUS \*  
DAMAGE PREVENTION SUPERVISOR  
TRAFFIC SIGNALS  
ATTN: BRAD HEGWOOD  
1820 E. 17TH AVE.  
COLUMBUS, OHIO 43219  
OFFICE: 614-560-0839  
BDHEGWOOD@COLUMBUS.GOV

CITY OF COLUMBUS \*  
SUPPORT SERVICES DIVISION  
(COMMUNICATIONS)  
4211 GROVES ROAD  
COLUMBUS, OH 43232  
JOHN GREMBOWSKI  
(RADIO) JAGEMBOWSKI@COLUMBUS.GOV  
OFFICE: 614-724-4006  
WILLIAM GRIFFITH  
WRGRIFFITH@COLUMBUS.GOV  
OFFICE: 614-645-7344 EXT. 100

**CROSSINGS AND CONNECTIONS TO EXISTING PIPES AND UTILITIES**

WHERE PLANS PROVIDE FOR A PROPOSED CONDUIT TO BE CONNECTED TO, OR CROSS OVER OR UNDER AN EXISTING SEWER OR UNDERGROUND UTILITY, THE CONTRACTOR SHALL LOCATE THE EXISTING PIPES OR UTILITIES BOTH AS TO LINE AND GRADE BEFORE STARTING TO LAY THE PROPOSED CONDUIT.

IF IT IS DETERMINED THAT THE ELEVATION OF THE EXISTING CONDUIT, OR EXISTING APPURTENANCE TO BE CONNECTED, DIFFERS FROM THE PLAN ELEVATION OR RESULTS IN A CHANGE IN THE PLAN CONDUIT SLOPE, THE ENGINEER SHALL BE NOTIFIED BEFORE STARTING CONSTRUCTION OF ANY PORTION OF THE PROPOSED CONDUIT WHICH WILL BE AFFECTED BY THE VARIANCE IN THE EXISTING ELEVATIONS.

IF IT IS DETERMINED THAT THE PROPOSED CONDUIT WILL INTERSECT AN EXISTING SEWER OR UNDERGROUND UTILITY IF CONSTRUCTED AS SHOWN ON THE PLAN, THE ENGINEER SHALL BE NOTIFIED BEFORE STARTING CONSTRUCTION OF ANY PORTION OF THE PROPOSED CONDUIT WHICH WOULD BE AFFECTED BY THE INTERFERENCE WITH AN EXISTING FACILITY.

PAYMENT FOR ALL THE OPERATIONS DESCRIBED ABOVE SHALL BE INCLUDED IN THE CONTRACT PRICE FOR THE PERTINENT 611 CONDUIT ITEM.

**REVIEW OF DRAINAGE FACILITIES**

BEFORE ANY WORK IS STARTED ON THE PROJECT AND AGAIN BEFORE FINAL ACCEPTANCE BY THE STATE, REPRESENTATIVES OF THE STATE AND THE CONTRACTOR, ALONG WITH LOCAL REPRESENTATIVES, SHALL MAKE AN INSPECTION OF ALL EXISTING SEWERS WHICH ARE TO REMAIN IN SERVICE AND WHICH MAY BE AFFECTED BY THE WORK. THE CONDITION OF THE EXISTING CONDUITS AND THEIR APPURTENANCE SHALL BE DETERMINED FROM FIELD OBSERVATIONS. RECORDS OF THE INSPECTION SHALL BE KEPT IN WRITING BY THE STATE.

ALL NEW CONDUITS, INLETS, CATCH BASINS, AND MANHOLES CONSTRUCTED AS A PART OF THE PROJECT SHALL BE FREE OF ALL FOREIGN MATTER AND IN A CLEAN CONDITION BEFORE THE PROJECT WILL BE ACCEPTED BY THE STATE.

ALL EXISTING SEWERS INSPECTED INITIALLY BY THE ABOVE MENTIONED PARTIES SHALL BE MAINTAINED AND LEFT IN A CONDITION REASONABLY COMPARABLE TO THAT DETERMINED BY THE ORIGINAL INSPECTION. ANY CHANGE IN THE CONDITION RESULTING FROM THE CONTRACTOR'S OPERATIONS SHALL BE CORRECTED BY THE CONTRACTOR TO THE SATISFACTION OF THE ENGINEER.

PAYMENT FOR ALL OPERATIONS DESCRIBED ABOVE SHALL BE INCLUDED IN THE CONTRACT PRICE FOR THE PERTINENT 611 CONDUIT ITEMS.

**ODOT CONCRETE BARRIER INLETS**

PER ODOT'S STANDARD CONSTRUCTION DRAWINGS FOR CONCRETE BARRIER INLET DETAILS, THE STATION AND OFFSET IS CALLED OUT TO THE CENTER OF THE GRATE. THE GRATE ELEVATION CALLED OUT IN THE STORM SEWER PROFILES AND CROSS SECTIONS ARE TO THE CENTER EDGE OF THE GRATE WHERE IT ABUTS TO THE FACE OF THE BARRIER.

**SURVEY PARAMETERS**

USE THE FOLLOWING PROJECT CONTROL, VERTICAL POSITIONING, AND HORIZONTAL POSITIONING PARAMETERS FOR ALL SURVEYING:

**VERTICAL POSITIONING**

ORTHOMETRIC HEIGHT DATUM: NAVD 88  
GEOID: GEOID 99

**HORIZONTAL POSITIONING**

HORIZONTAL DATUM: NAD 83 (1986)  
COORDINATE SYSTEM: OHIO STATE PLAN - SOUTH ZONE  
COMBINED SCALE FACTOR: 1.000043907  
ORIGIN OF COORDINATE SYSTEM:  
FRANKLIN COUNTY MONUMENT "FRANK 143"  
NORTHING = 711726.0754  
EASTING = 1840542.0310

USE THE POSITIONING METHODS AND MONUMENTS TYPE USED IN THE ORIGINAL SURVEY TO RESTORE ALL MONUMENTS RELATED TO PRIMARY PROJECT CONTROL THAT ARE DAMAGED OR DESTROYED BY CONSTRUCTION ACTIVITIES. RESTORE THE DAMAGED OR DESTROYED MONUMENTS IN ACCORDANCE WITH SUPPLEMENTAL SPECIFICATION 823.

UNITS ARE IN U.S. SURVEY FEET. USE THE FOLLOWING CONVERSION FACTOR: 1 METER = 3.280833333 U.S. SURVEY FEET.

CALCULATED  
GAIN  
CHECKED  
CWB

GENERAL NOTES

FRA-70-13.01

8  
137

NO.	DESCRIPTION	REV. BY	DATE
3	CONTACT INFO CHANGED	ACW	10/23/23

N:\03\60\08353\105430\_FRA-70-13.01\Design\Roadway\Sheets\05430\_GN001.dgn Sheet 10/23/2023 5:43:23 PM awhite









N:\03\60\08353\05430\_FRA-70-13.0\Design\Structures\FRA070\_1301L\Sheets\070\_1301L\_S0001.dgn Sheet 10/23/2023 6:20:20 PM awn:ite

ESTIMATED QUANTITIES						CALC.	DATE	CHK'D	DATE
ITEM	ITEM EXT.	TOTAL	UNIT	DESCRIPTION	ABUT.	DBL/ATM	10/4/2021	ELP/ATM	11/9/2021
						PIERS	SUPER.	GEN.	SHEET REF.
202	11203	LS		PORTIONS OF STRUCTURE REMOVED, OVER 20 FOOT SPAN, AS PER PLAN					4/30
202	22900	225	SY	APPROACH SLAB REMOVED				225	
503	21300	LS		UNCLASSIFIED EXCAVATION					
509	10000	270,460	LB	EPOXY COATED REINFORCING STEEL	3,914		265,721	825	
510	10000	332	EACH	DOWEL HOLES WITH NONSHRINK, NONMETALLIC GROUT	332				
511	34446	858	CY	CLASS QC2 CONCRETE WITH QC/QA, BRIDGE DECK			858		
511	34451	222	CY	CLASS QC2 CONCRETE WITH QC/QA, BRIDGE DECK (PARAPET), AS PER PLAN			222		4/30, 24/30
511	44110	20	CY	CLASS QC1 CONCRETE, ABUTMENT NOT INCLUDING FOOTING	20				
512	10100	1,570	SY	SEALING OF CONCRETE SURFACES (EPOXY - URETHANE)			1,570		
513	20000	11970	EACH	WELDED STUD SHEAR CONNECTORS			11970		
513	21600	2,520	LB	STRUCTURAL STEEL FOR REHABILITATION, AS PER PLAN			2,520		4/30
514	00050	630	SF	SURFACE PREPARATION OF EXISTING STRUCTURAL STEEL			630		
514	00056	630	SF	FIELD PAINTING OF EXISTING STRUCTURAL STEEL, PRIME COAT			630		
514	00060	630	SF	FIELD PAINTING OF STRUCTURAL STEEL, INTERMEDIATE COAT			630		
514	00066	630	SF	FIELD PAINTING OF STRUCTURAL STEEL, FINISH COAT			630		
516	11210	128	FT	STRUCTURAL EXPANSION JOINT INCLUDING ELASTOMERIC STRIP SEAL				128	
516	13600	62	SF	1" PREFORMED EXPANSION JOINT FILLER	62				
516	46701	12	EACH	RESET BEARING, AS PER PLAN				12	4/30
516	47001	LS		JACKING AND TEMPORARY SUPPORT OF SUPERSTRUCTURE, AS PER PLAN					4/30
519	11100	200	SF	PATCHING CONCRETE STRUCTURE, AS PER PLAN	200				4/30
526	25010	225	SY	REINFORCED CONCRETE APPROACH SLABS WITH QC/QA (T=15")				225	
526	90010	81	FT	TYPE A INSTALLATION				81	
530	00200	LS		SPECIAL - STRUCTURES: ACCESS DOOR					13/30
846	00110	34	CF	POLYMER MODIFIED ASPHALT EXPANSION JOINT SYSTEM				34	



DESIGNED DATE 3/8/2023  
 DBL/ATM YSU  
 CHECKED STRUCTURE FILE NUMBER 2504677  
 DE A

DESIGNED DATE 3/8/2023  
 DBL/ATM YSU  
 CHECKED STRUCTURE FILE NUMBER 2504677  
 DE A

DESIGNED DATE 3/8/2023  
 DBL/ATM YSU  
 CHECKED STRUCTURE FILE NUMBER 2504677  
 DE A

ESTIMATED QUANTITIES  
 BRIDGE NO. FRA-70-1301L  
 WESTBOUND I-70 OVER S.R. 315


FRA-70-13.01  
 PID No. 77372

5/30


54  
 137

NO.	DESCRIPTION	REV. BY	DATE
3	QUANTITY CHANGED	ACW	10/23/23


N:\03\60\08353\105430\_FRA-70-13.0\DesignStructures\FRA070\_130IR\_Sheets\070\_130IR\_SS005.dgn\_Sheet 10/23/2023 6:30:23 PM awhite

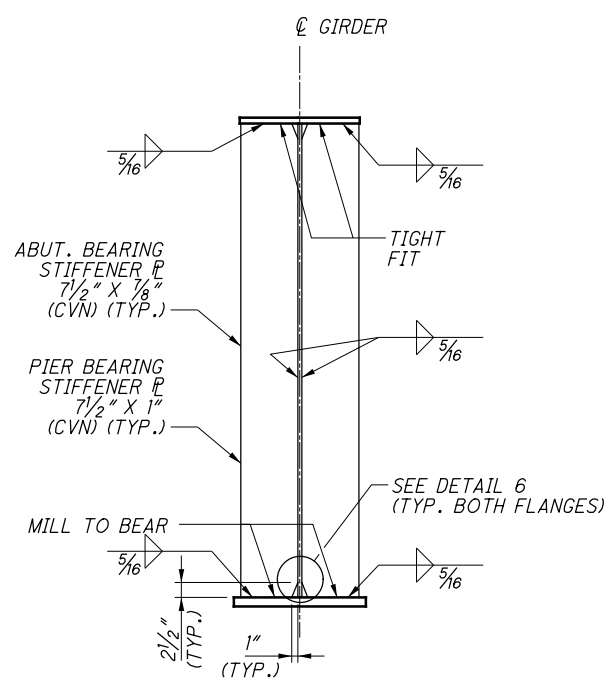


**BEARING STIFFENER  
DETAIL**

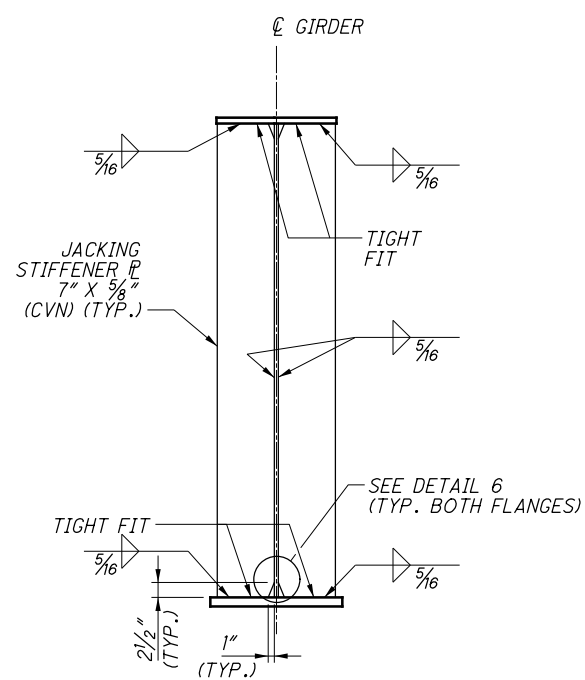


**JACKING STIFFENER  
DETAIL**

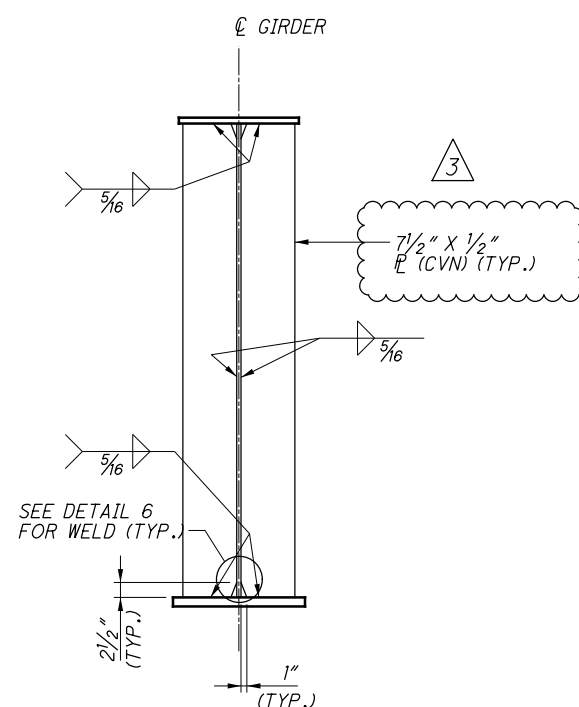


**CROSSFRAME CONNECTION PLATE DETAIL  
(INTERIOR GIRDER SHOWN)**

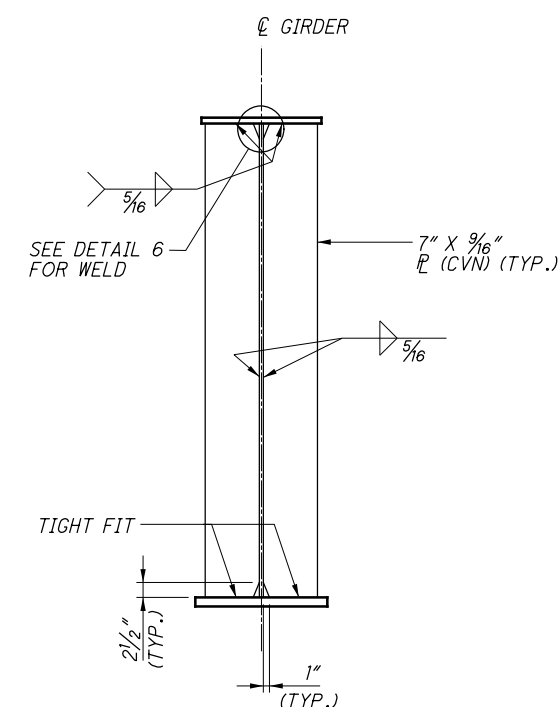


**INTERMEDIATE TRANSVERSE STIFFENER DETAIL  
(INTERIOR GIRDER SHOWN)**

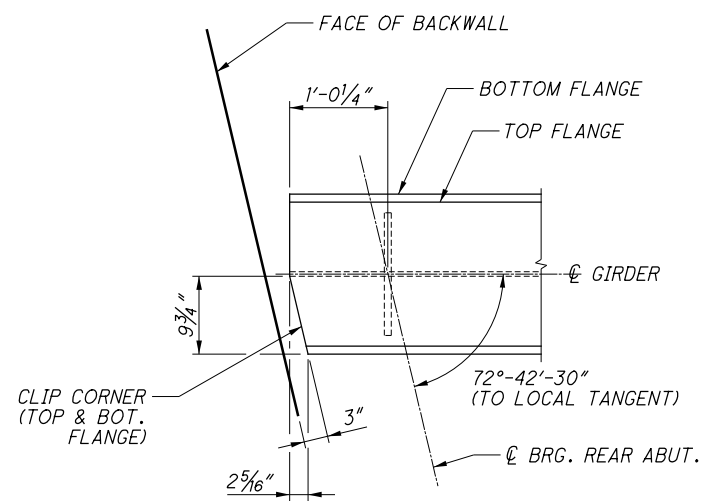

**VIEW A-A  
(REAR ABUTMENT)**

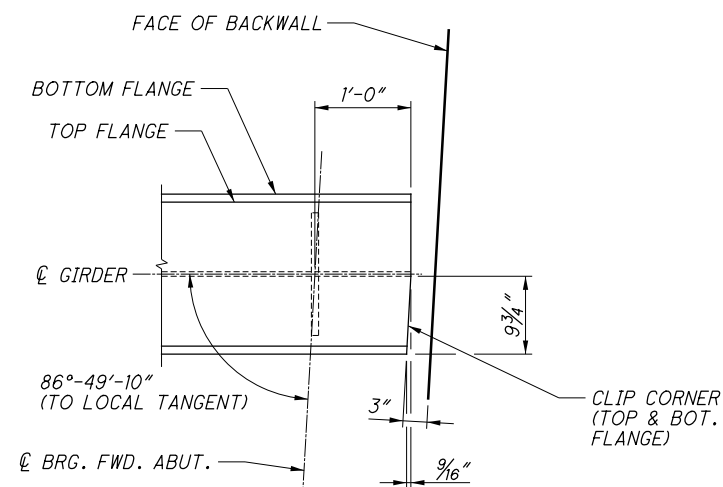

**VIEW B-B  
(FORWARD ABUTMENT)**

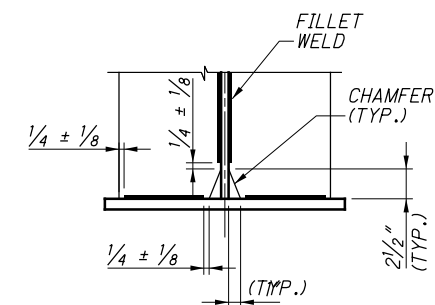

**DETAIL 6  
(BOTTOM FLANGE SHOWN,  
TOP FLANGE SIMILAR)**

**NOTES:**

- FOR FRAMING PLAN, SEE SHEETS 26/58 AND 27/58.
- FOR GIRDER ELEVATION, SEE SHEET 28/58.
- FOR CROSSFRAME DETAILS, SEE SHEETS 31/58 AND 32/58.
- FOR LOCATION OF VIEWS A-A AND B-B, SEE SHEET 28/58.
- BEARING STIFFENERS AND JACKING STIFFENERS SHALL BE INSTALLED ON BOTH SIDES OF THE GIRDER WEB FOR BOTH INTERIOR AND EXTERIOR GIRDERS.
- CROSSFRAME CONNECTION PLATES SHALL BE INSTALLED ON BOTH SIDES OF THE GIRDER WEB FOR INTERIOR GIRDERS AND ONLY ON THE INSIDE OF THE GIRDER WEB FOR THE EXTERIOR GIRDERS.

NO.	DESCRIPTION	REV. BY	DATE
3	DIMENSION CHANGED	ACW	10/23/23

DESIGN AGENCY  
**ms consultants, inc.**  
2221 Schrock Road  
Columbus, Ohio 43229

DATE  
11/5/2021

REVIEWED  
YSJ

DRAWN  
ATM

DESIGNED  
SUR

STRUCTURE FILE NUMBER  
2504767

CHECKED  
ATM/DEA

REVISOR

GIRDER DETAILS  
BRIDGE NO. FRA-70-130IR  
EASTBOUND I-70 OVER S.R. 315

FRA-70-13.01  
PID No. 105430

30/58

109  
137