

ITEM 614 PORTABLE CHANGEABLE MESSAGE SIGN, AS PER PLAN

THE CONTRACTOR SHALL FURNISH, INSTALL, MAINTAIN AND REMOVE, WHEN NO LONGER NEEDED, A PORTABLE CHANGEABLE MESSAGE SIGN. THE SIGN SHALL BE OF A TYPE SHOWN ON A LIST OF APPROVED PCMS UNITS AVAILABLE ON THE OFFICE OF MATERIALS MANAGEMENT WEB PAGE. THE LIST CONTAINS CLASS A AND B UNITS WITH MINIMUM LEGIBILITY DISTANCES OF 800 FEET AND 650 FEET, RESPECTIVELY.

EACH SIGN SHALL BE TRAILER-MOUNTED AND EQUIPPED WITH A FUNCTIONAL DIMMING MECHANISM, TO DIM THE SIGN DURING DARKNESS, AND A TAMPER AND VANDAL PROOF ENCLOSURE. EACH SIGN SHALL BE PROVIDED WITH APPROPRIATE TRAINING AND OPERATION INSTRUCTIONS TO ENABLE ON-SITE PERSONNEL TO OPERATE AND TROUBLESHOOT THE UNIT. THE SIGN SHALL ALSO BE CAPABLE OF BEING POWERED BY AN ELECTRICAL SERVICE DROP FROM A LOCAL UTILITY COMPANY. THE PCMS SHALL BE DELINEATED IN ACCORDANCE WITH C&MS 614.03.

THE PROBABLE PCMS LOCATIONS AND WORK LIMITS FOR THOSE LOCATIONS ARE SHOWN ON THE SHEETS OF THE PLAN. PLACEMENT, OPERATION, MAINTENANCE AND ALL ACTIVATION OF THE SIGNS BY THE CONTRACTOR SHALL BE AS DIRECTED BY THE ENGINEER. THE PCMS SHALL BE LOCATED IN A HIGHLY VISIBLE POSITION YET PROTECTED FROM TRAFFIC. THE CONTRACTOR SHALL, AT THE DIRECTION OF THE ENGINEER, RELOCATE THE PCMS TO IMPROVE VISIBILITY OR ACCOMMODATE CHANGED CONDITIONS. WHEN NOT IN USE, THE PCMS SHALL BE TURNED OFF. ADDITIONALLY, WHEN NOT IN USE FOR EXTENDED PERIODS OF TIME, THE PCMS SHALL BE TURNED, FACING AWAY FROM ALL TRAFFIC.

THE ENGINEER SHALL BE PROVIDED ACCESS TO EACH SIGN UNIT AND SHALL BE PROVIDED WITH APPROPRIATE TRAINING AND OPERATION INSTRUCTIONS TO ENABLE ODOT PERSONNEL TO OPERATE AND TROUBLESHOOT THE UNIT, AND TO REVISE SIGN MESSAGES, IF NECESSARY.

ALL MESSAGES TO BE DISPLAYED ON THE SIGN WILL BE PROVIDED BY THE ENGINEER. A LIST OF ALL REQUIRED PRE-PROGRAMMED MESSAGES WILL BE GIVEN TO THE CONTRACTOR AT THE PROJECT PRECONSTRUCTION CONFERENCE. THE SIGN SHALL HAVE THE CAPABILITY TO STORE UP TO 99 MESSAGES. MESSAGE MEMORY OR PRE-PROGRAMMED DISPLAYS SHALL NOT BE LOST AS A RESULT OF POWER FAILURES TO THE ON-BOARD COMPUTER. THE SIGN LEGEND SHALL BE CAPABLE OF BEING CHANGED IN THE FIELD. THREE-LINE PRESENTATION FORMATS WITH UP TO SIX MESSAGE PHASES SHALL BE SUPPORTED. PCMS FORMAT SHALL PERMIT THE COMPLETE MESSAGE FOR EACH PHASE TO BE READ AT LEAST TWICE.

THE PCMS SHALL CONTAIN AN ACCURATE CLOCK AND PROGRAMMING LOGIC WHICH WILL ALLOW THE SIGN TO BE ACTIVATED, DEACTIVATED OR MESSAGES CHANGED AUTOMATICALLY AT DIFFERENT TIMES OF THE DAY FOR DIFFERENT DAYS OF THE WEEK.

THE PCMS SHALL CONTAIN A CELLULAR TELEPHONE LINK WHICH WILL ALLOW REMOTE SIGN ACTIVATION, MESSAGE CHANGES, MESSAGE ADDITIONS AND REVISIONS TO TIME OF DAY PROGRAMS. THE SYSTEM SHALL ALSO PERMIT VERIFICATION OF CURRENT AND PROGRAMMED MESSAGES. ONE REMOTE DATA INPUT DEVICE (LAPTOP COMPUTER PLUS MODEM OR EQUIVALENT) SHALL BE FURNISHED FOR USE BY THE DISTRICT TRAFFIC ENGINEER, OR EQUIVALENT, AND SHALL BE INSURED AGAINST THEFT.

THE PCMS UNIT SHALL BE MAINTAINED IN GOOD WORKING ORDER BY THE CONTRACTOR IN ACCORDANCE WITH THE PROVISIONS OF CMS 614.07. THE CONTRACTOR SHALL, PRIOR TO ACTIVATING THE UNIT, MAKE ARRANGEMENTS, WITH AN AUTHORIZED SERVICE AGENT FOR THE PCMS, TO ASSURE PROMPT SERVICE IN THE EVENT OF FAILURE. ANY FAILURE SHALL NOT RESULT IN THE SIGN BEING OUT OF SERVICE FOR MORE THAN 12 HOURS, INCLUDING WEEKENDS. FAILURE TO COMPLY MAY RESULT IN AN ORDER TO STOP WORK AND OPEN ALL TRAFFIC LANES AND/OR IN THE DEPARTMENT TAKING APPROPRIATE ACTION TO SAFELY CONTROL TRAFFIC. THE ENTIRE COST TO CONTROL TRAFFIC, ACCRUED BY THE DEPARTMENT DUE TO THE CONTRACTOR'S NONCOMPLIANCE, WILL BE DEDUCTED FROM MONEYS DUE, OR TO BECOME DUE THE CONTRACTOR ON HIS CONTRACT.

THE CONTRACTOR SHALL BE RESPONSIBLE FOR 24-HOUR-PER DAY OPERATION AND MAINTENANCE OF THESE SIGNS ON THE PROJECT FOR THE DURATION OF THE PHASES WHEN THE PLAN REQUIRES THEIR USE.

PAYMENT FOR THE ABOVE DESCRIBED ITEM SHALL BE AT THE CONTRACT UNIT PRICE. PAYMENT SHALL INCLUDE ALL LABOR, MATERIALS, EQUIPMENT, FUELS, LUBRICATING OILS, SOFTWARE, HARDWARE AND INCIDENTALS TO PERFORM THE ABOVE DESCRIBED WORK.

ITEM 614, PORTABLE CHANGEABLE MESSAGE SIGN, AS PER PLAN
 144 SIGN MONTH

ITEM 614 PORTABLE CHANGEABLE MESSAGE SIGN, AS PER PLAN

THE NUMBER OF PCMS AND DURATIONS WILL VARY THROUGHOUT CONSTRUCTION. SEE TABLE BELOW FOR DETAILS.

DETOUR	MOT PHASE	PCMS DETAILS
315S TO 70E	1-3	1 PCMS FOR 1 MONTH 6 PCMS FOR DURATION OF PHASES 1-3
71N	2	7 PCMS FOR 1 MONTH
71S	2	9 PCMS FOR 1 MONTH
70E	2	12 PCMS FOR 1 MONTH
70W	2	7 PCMS FOR 1 MONTH
1 PCMS FOR 6 MONTHS TO BE USED AT PROJECT ENGINEER'S DISCRETION		

ITEM 614 - BARRIER REFLECTORS AND/OR OBJECT MARKERS

BARRIER REFLECTORS AND OBJECT MARKERS SHALL BE INSTALLED ON ALL PORTABLE BARRIER (PB) USED FOR TRAFFIC CONTROL AND ON PERMANENT CONCRETE BARRIER (INCLUDING BRIDGE PARAPETS) LOCATED WITHIN 5 FEET OF THE EDGE OF THE ADJACENT TRAVEL LANE.

BARRIER REFLECTORS SHALL CONFORM TO C&MS 626, EXCEPT THAT THE SPACING SHALL BE AS PER TRAFFIC SCD MT-101.70. OBJECT MARKERS AND THEIR INSTALLATION SHALL CONFORM TO C&MS 614.03 AND SCD MT-101.70. WHEN THE PB CONTAINS GLARE SCREEN, ONE SET OF THREE VERTICAL STRIPES OF SHEETING SHALL BE CONSIDERED EQUIVALENT TO AN OBJECT MARKER, ONE-WAY.

THE INCREASED BARRIER DELINEATION SHALL CONSIST OF THE TRIPLE STACKING OF WORK ZONE BARRIER REFLECTORS. TRIPLE-STACKED BARRIER REFLECTORS SHALL CONSIST OF ALIGNING THREE BARRIER REFLECTORS VERTICALLY, AT LOCATIONS WHERE A SINGLE BARRIER REFLECTOR WOULD BE OTHERWISE ATTACHED. THERE SHALL BE NO OPEN SPACE BETWEEN THE ADJACENT BARRIER REFLECTORS. THE TRIPLE-STACKED BARRIER REFLECTORS SHALL CONFORM TO C&MS 626, EXCEPT THAT THEY SHALL BE SPACED AND ALIGNED PER TRAFFIC SCD MT-101.70.

THE FOLLOWING ESTIMATED QUANTITIES HAVE BEEN INCLUDED IN THE PLANS AND CARRIED TO THE GENERAL SUMMARY:

ITEM 614, BARRIER REFLECTOR, TYPE 1, ONE-WAY 352 EACH
 ITEM 614, OBJECT MARKER, ONE-WAY 352 EACH
 ITEM 614, INCREASED BARRIER DELINEATION 17,120 FEET

PAYMENT SHALL BE FULL COMPENSATION FOR ALL MATERIAL, LABOR, INCIDENTALS AND EQUIPMENT NECESSARY FOR FURNISHING, INSTALLING, MAINTAINING AND REMOVING EACH OF THE ABOVE ITEMS.

ALONG RUNS OF INCREASED BARRIER DELINEATION WHERE THIS ITEM IS PROVIDED, THE QUANTITY SHALL BE MEASURED AS THE ENTIRE LENGTH OF THE RUN OF INCREASED BARRIER DELINEATION, INCLUDING THE SPACES BETWEEN THE INDIVIDUAL DELINEATION PANELS OR STACKS OF BARRIER REFLECTORS.

ITEM 614 - REPLACEMENT SIGN

FLATSHEET SIGNS FURNISHED BY THE CONTRACTOR IN ACCORDANCE WITH THE REQUIREMENTS OF THE PLANS, SPECIFICATIONS AND PROPOSAL WHICH BECOME DAMAGED BY TRAFFIC FOR REASONS BEYOND THE CONTROL OF THE CONTRACTOR SHALL BE REPLACED IN KIND WHEN ORDERED BY THE ENGINEER. REPLACEMENT SIGNS SHALL BE NEW. OTHER MATERIALS MAY BE USED, BUT GOOD, CONDITION SUBJECT TO APPROVAL BY THE ENGINEER.

PAYMENT FOR THE NEW SIGNS SHALL BE MADE AT THE CONTRACT PRICE PER EACH FOR ITEM 614, REPLACEMENT SIGN, AND SHALL INCLUDE THE COST OF REMOVING AND DISPOSING OF DAMAGED SIGNS, HARDWARE AND SUPPORTS, AND PROVIDING THE NECESSARY REPLACEMENT HARDWARE, SUPPORTS, ETC.

AN ESTIMATED QUANTITY OF 50 EACH HAS BEEN CARRIED TO THE GENERAL SUMMARY.

DRIVEWAYS/PROPERTY ACCESS

VEHICULAR AND PEDESTRIAN ACCESS TO ALL PROPERTY PARCELS, INCLUDING OTHER COMMERCIAL CONSTRUCTION ENTRANCES ABUTTING THE PROJECT SHALL BE MAINTAINED AT ALL TIMES. IF A PARCEL HAS MORE THAN ONE DRIVEWAY, AT LEAST ONE DRIVEWAY MUST BE MAINTAINED AT ALL TIMES DURING CONSTRUCTION. WHERE A PARCEL IS SERVED BY ONLY ONE DRIVEWAY, THE AFFECTED DRIVEWAY MUST BE CONSTRUCTED IN STAGES AND/OR SUPPLEMENTED WITH ITEM 410 IF AUTHORIZED BY THE ENGINEER, SO THAT ACCESS IS NOT DISRUPTED. ITEM 410, TRAFFIC COMPACTED SURFACE, TYPE B SHALL BE ITEMIZED SEPARATELY FOR AUTHORIZATION ONLY BY THE ENGINEER. AN ESTIMATED QUANTITY OF 75 CUBIC YARDS HAS BEEN CARRIED TO THE GENERAL SUMMARY.

SHORT-TERM CLOSURE OF DRIVEWAYS WILL BE PERMITTED IN ACCORDANCE WITH THE SPECIFICATION REQUIREMENTS FOR THE PROTECTIONS OF COMPLETED ASPHALT COURSES. IT SHALL BE THE RESPONSIBILITY OF THE CONTRACTOR TO COORDINATE CONSTRUCTION ACTIVITIES WITH THE ENGINEER AND WITH THE OWNERS AND TENANTS OF ABUTTING PROPERTIES IN ADVANCE OF ANY OPERATIONS WHICH AFFECT ACCESS.

THE CONTRACTOR SHALL NOT AT ANY TIME DURING CONSTRUCTION CLOSE A DRIVEWAY TO THE NATIONWIDE CHILDRENS HOSPITAL PROPERTY.

PRIOR TO ANY DRIVEWAY CLOSURES FOR EXCAVATION, THE CONTRACTOR SHALL COORDINATE WITH THE PRIVATE PROPERTY OWNERS AND TENANTS. THE CONTRACTOR SHALL SUBMIT IN WRITING A SCHEDULE TO THE PROPERTY OWNERS AND TENANTS AFFECTED BY THE WORK. A COPY OF THE LETTER SHALL BE PROVIDED TO THE PROJECT ENGINEER.

UPON INSTALLATION OF CONCRETE APRON AND PAVEMENT AT DRIVES, THE CONTRACTOR SHALL HAVE FIVE (5) DAYS TO COMPLETE THE DRIVEWAY WORK AND REOPEN THE DRIVE. DURING THIS TIME, THE CONTRACTOR SHALL MAINTAIN A SECONDARY ACCESS OR CONSTRUCT THE DRIVE IN PORTIONS IN COMPLIANCE WITH THE PROPERTY OWNERS NEEDS FOR DRIVEWAY ACCESSIBILITY.

THE CONTRACTOR SHALL SUBMIT A LETTER NOTIFYING THE BUSINESSES, OWNERS AND TENANTS AFFECTED BY DRIVEWAY REPLACEMENT ONE WEEK PRIOR TO DRIVEWAY REPLACEMENT.

ITEM 304. BACKFILL OR STEEL PLATES

* THIS NOTE IS APPLICABLE TO CITY STREETS ONLY. *

DURING ALL PARTS OF CONSTRUCTION, TRAFFIC SHALL BE MAINTAINED WHEN L.E.O.'S OR FLAGGERS ARE NOT PRESENT WITH A MINIMUM OF ONE 10 FOOT LANE (NUMBER OF LANES AS SPECIFIED ON THE PLAN SHEETS) USING THE EXISTING, TEMPORARY OR FINAL PAVEMENT. THE CONTRACTOR SHALL COORDINATE WITH THE RELOCATION OF THE EXISTING UTILITIES IN CONFLICT WITHIN THE LOCATION OF THE PROPOSED ROADWAY WIDENING CONSTRUCTION AND INSTALL PROPOSED UTILITIES WHERE APPLICABLE. ALL TRENCHES SHALL BE SECURELY PLATED AND PINNED TO THE PAVEMENT PRIOR TO SHIFTING TRAFFIC ONTO STEEL PLATES.

THE CONTRACTOR SHALL ENSURE THAT ALL DRUMS ARE PLACED ON STABILIZED MATERIAL. USE OF CMS ITEM 304 TO CONSTRUCT TEMPORARY SHOULDERS SHALL BE THE CONTRACTOR'S RESPONSIBILITY AT THE CONTRACTOR'S EXPENSE. STABILIZED AGGREGATE SHOULDER MATERIAL SHALL BE INSTALLED IN ACCORDANCE WITH CMS ITEM 304 AND MAY BE REUSED AS THE PAVEMENT AGGREGATE BASE.

PER CITY ORDINANCE, STEEL PLATES ARE NOT PERMITTED DURING WINTER MONTHS. THE CONTRACTOR SHALL BACKFILL ALL TRENCHES IN WINTER MONTHS (DEC. 1 THROUGH MARCH 31).

DUST CONTROL

THE CONTRACTOR SHALL FURNISH AND APPLY WATER FOR DUST CONTROL AS DIRECTED BY THE ENGINEER. THE FOLLOWING ESTIMATED QUANTITY HAS BEEN INCLUDED FOR DUST CONTROL PURPOSES:

ITEM 616 - WATER 325 M. GAL.

ITEM 614 - WORK ZONE RAISED PAVEMENT MARKER, AS PER PLAN

WORK ZONE RAISED PAVEMENT MARKERS, AS PER PLAN, AND THEIR INSTALLATION SHALL CONFORM TO C&MS 614 OR C&MS 621 AS SPECIFIED HEREIN.

- RAISED PAVEMENT MARKERS IN USE DURING THE SNOW-PLOWING SEASON SHALL CONFORM TO 621.
 - RAISED PAVEMENT MARKERS IN USE DURING THE NON-SNOW-PLOW SEASON SHALL CONFORM TO EITHER 614 OR TO 621.

THE SNOW-PLOWING SEASON SHALL RUN FROM OCTOBER 15 THROUGH APRIL 1.

IF PROJECT DELAYS, NOT THE FAULT OF ODOT, CAUSE THE WORK TO EXTEND INTO THE SNOW-PLOWING SEASON, THE CONTRACTOR SHALL BE RESPONSIBLE FOR REPLACING WORK ZONE RAISED PAVEMENT MARKERS (WZRPMS) CONFORMING TO C&MS 614, WITH RAISED PAVEMENT MARKERS CONFORMING TO 621, AS DETERMINED BY THE ENGINEER, AT THE CONTRACTOR'S EXPENSE.

THIS ITEM SHALL INCLUDE PURCHASE, INSTALLATION AND REMOVAL OF ITEM 614 WORK ZONE RAISED PAVEMENT MARKER, AS PER PLAN, INCLUDING FILLING OF ANY DEPRESSIONS CREATED IN THE PAVEMENT AS PER C&MS 621.08.

RESURFACING OF THE TRANSITION AREAS SHALL BE PERFORMED AT THE TIME THAT THE SURFACE COURSE IS BEING APPLIED TO THE ENTIRE PROJECT. PRIOR TO APPLICATION OF THE SURFACE COURSE ON THE PROJECT, THE EXISTING PAVEMENT WITHIN THE TRANSITION AREA SHALL BE REMOVED TO A DEPTH NECESSARY TO REACH THE LEVEL OF THE INTERMEDIATE COURSE OF THE PAVEMENT, AS DETERMINED BY THE ENGINEER.

THE FOLLOWING BID ITEMS SHOULD BE INCLUDED IN THE PLANS:

ITEM 254 PAVEMENT PLANING, ASPHALT CONCRETE 6,000 SQ YD
 ITEM 614 WORK ZONE RAISED PAVEMENT MARKER, AS PER PLAN 193 EACH

PAYMENT FOR RESURFACING WITHIN THE TRANSITION AREA SHALL BE PAID FOR UNDER THE APPROPRIATE BID ITEMS FOR THE WORK REQUIRED, AS PROVIDED FOR IN THE PLANS.

SPRAY THERMOPLASTIC, AS PER PLAN

THE CONTRACTOR SHALL PLACE THE WORK ZONE PAVEMENT MARKINGS, SPRAY THERMOPLASTIC, AS PER PLAN PER ODOT SPECIFICATION 614.11 AND ODOT SPECIFICATION 648 WITH THE EXCEPTION ODOT SPECIFICATION 648.05 SHALL BE MODIFIED TO ALLOW PLACEMENT OF THE MATERIAL AT THE TEMPERATURE OF NOT LESS THAN 35 DEGREES FAHRENHEIT.

THE FOLLOWING ESTIMATED QUANTITIES HAVE BEEN CARRIED TO THE GENERAL SUMMARY FOR USE AT LOCATIONS AND AT TIMES AS DIRECTED BY THE ENGINEER FOR WORK ZONE PAVEMENT MARKINGS PER THE REQUIREMENTS OF C&MS 614.11.

ITEM 614 WORK ZONE LANE LINE, CLASS I SPRAY THERMOPLASTIC, AS PER PLAN 2.21 MILE
 ITEM 614 WORK ZONE EDGE LINE, CLASS I SPRAY THERMOPLASTIC, AS PER PLAN 5.98 MILE
 ITEM 614 WORK ZONE CHANNELIZING LINE, CLASS I, SPRAY THERMOPLASTIC, AS PER PLAN 11,491 FEET
 ITEM 614 WORK ZONE DOTTED LINE, CLASS I, SPRAY THERMOPLASTIC, AS PER PLAN 3,302 FEET

ITEM 614 - REPLACEMENT DRUM

DRUMS FURNISHED BY THE CONTRACTOR IN ACCORDANCE WITH THE REQUIREMENTS OF THE PLANS, SPECIFICATIONS AND PROPOSAL WHICH BECOME DAMAGED BY TRAFFIC FOR REASONS BEYOND THE CONTROL OF THE CONTRACTOR SHALL BE REPLACED IN KIND WHEN ORDERED BY THE ENGINEER. REPLACEMENT DRUMS SHALL BE NEW.

PAYMENT FOR THE NEW DRUMS SHALL BE MADE AT THE CONTRACT PRICE PER EACH FOR ITEM 614, REPLACEMENT DRUM, AND SHALL INCLUDE THE COST OF REMOVING AND DISPOSING OF THE DAMAGED DRUM, AND PROVIDING AND MAINTAINING THE REPLACEMENT DRUM IN ACCORDANCE WITH THE CONTRACT REQUIREMENTS FOR THE ORIGINAL DRUM.

AN ESTIMATED QUANTITY OF 300 EACH HAS BEEN CARRIED TO THE GENERAL SUMMARY.

NO.	DESCRIPTION	REV. BY	DATE
5	QUANTITY CHANGES	EMK	11-2-2023

P:\PR51781\Fra\7372\motsheets\Project 4A\7372_MN404.dgn \$dd12/2023 3:20:05 PM albey

P:\PR51781\fra\7372\mot\sheet\Project_4A\7372_MS400.dgn \$dd162/2023 \$:20:50 PM alibey

ITEM	EXTENSION	FUNDING SPLIT 01/IMS/PV	TOTAL	UNIT	DESCRIPTION	SEE SHEET
254	01000	6000	6000	SY	PAVEMENT PLANING, ASPHALT CONCRETE, 1.5"	59
410	12000	200	200	CY	TRAFFIC COMPACTED SURFACE, TYPE A OR B	59
607	30001	1000	1000	FT	FENCE, SNOW, AS PER PLAN	58
611	05900	174	174	FT	15" CONDUIT, TYPE B	
611	97010	1405	1405	FT	SLOTTED DRAIN, TYPE 2, 12"	
611	98150	1	1	EACH	CATCH BASIN, NO. 3	
611	98370	3	3	EACH	CATCH BASIN, NO. 6	
611	99500	5	5	EACH	INLET, MISC.: INLET, CAPPED BELOW GRADE	63
614	11000		LS		MAINTAINING TRAFFIC	54
614	11110	2400	2400	HOURL	LAW ENFORCEMENT OFFICER WITH PATROL CAR FOR ASSISTANCE	58
614	11630	17120	17120	FT	INCREASED BARRIER DELINEATION	59
614	12380	12	12	EACH	WORK ZONE IMPACT ATTENUATOR, 24" WIDE HAZARDS, (UNIDIRECTIONAL)	58
614	12420		LS		DETOUR SIGNING	60
614	12484	6	6	EACH	WORK ZONE INCREASED PENALTIES SIGN	60
614	12500	50	50	EACH	REPLACEMENT SIGN	59
614	12600	300	300	EACH	REPLACEMENT DRUM	59
614	12801	352	352	EACH	WORK ZONE RAISED PAVEMENT MARKER, AS PER PLAN	59
614	13310	352	352	EACH	BARRIER REFLECTOR, TYPE 1, ONE-WAY	59
614	13350	352	352	EACH	OBJECT MARKER, ONE WAY	59
614	18000	50000	50000	EACH	MAINTAINING TRAFFIC, MISC.: BRIDGE DECK AND PAVEMENT PATCHING	62
614	18030	1000	1000	FT	MAINTAINING TRAFFIC, MISC.: CONSTRUCTION FENCE	62
614	18601	144	144	SNMT	PORTABLE CHANGEABLE MESSAGE SIGN, AS PER PLAN	59
614	20011	2.21	2.21	MILE	WORK ZONE LANE LINE, CLASS I, 6" SPRAY THERMOPLASTIC, AS PER PLAN	59
614	20356	4.30	4.30	MILE	WORK ZONE LANE LINE, CLASS I, 6" 807 PAINT	
614	20560	1.69	1.69	MILE	WORK ZONE LANE LINE, CLASS III, 6", 642 PAINT	
614	21100	0.51	0.51	MILE	WORK ZONE CENTER LINE, CLASS I, 6" 807 PAINT	
614	22011	5.88	5.88	MILE	WORK ZONE EDGE LINE, CLASS I, 6" SPRAY THERMOPLASTIC, AS PER PLAN	59
614	22056	9.22	9.22	MILE	WORK ZONE EDGE LINE, CLASS I, 6", 807 PAINT	
614	22360	1.22	1.22	MILE	WORK ZONE EDGE LINE, CLASS III, 6", 642 PAINT	
614	23011	1.42	1.42	MILE	WORK ZONE CHANNELIZING LINE, CLASS I, 6" SPRAY THERMOPLASTIC, AS PER PLAN	59
614	23110	12539	12539	FT	WORK ZONE CHANNELIZING LINE, CLASS I, 6" 807 PAINT	
614	23690	3126	3126	FT	WORK ZONE CHANNELIZING LINE, CLASS III, 6", 642 PAINT	
614	24001	3302	3302	FT	WORK ZONE DOTTED LINE, CLASS I SPRAY THERMOPLASTIC, AS PER PLAN	59
614	24100	1525	1525	FT	WORK ZONE DOTTED LINE, CLASS I, 6" 807 PAINT	
614	24612	2409	2409	FT	WORK ZONE DOTTED LINE, CLASS III, 6", 642 PAINT	
614	26200	95	95	FT	WORK ZONE STOP LINE, CLASS I, 6" 807 PAINT	
614	30200	6	6	EACH	WORK ZONE ARROW, CLASS I, 642 PAINT	
615	10000		LS		ROADS FOR MAINTAINING TRAFFIC	
615	25000	1545	1545	SY	PAVEMENT FOR MAINTAINING TRAFFIC, CLASS B	
615	25001	100	100	SY	PAVEMENT FOR MAINTAINING TRAFFIC, CLASS B, AS PER PLAN, TYPE 1	62
615	25001	50	50	SY	PAVEMENT FOR MAINTAINING TRAFFIC, CLASS B, AS PER PLAN, TYPE 2	62
615	25001	20	20	SY	PAVEMENT FOR MAINTAINING TRAFFIC, CLASS B, AS PER PLAN, TYPE 3	62
615	25001	20	20	SY	PAVEMENT FOR MAINTAINING TRAFFIC, CLASS B, AS PER PLAN, TYPE 4	62
616	10000	325	325	MGAL	WATER	59
622	41100	16790	16790	FT	PORTABLE BARRIER, UNANCHORED	
622	41110	1030	1030	FT	PORTABLE BARRIER, ANCHORED	
622	41050	1	1	EACH	PORTABLE BARRIER, "Y" CONNECTOR	
808	18700	72	72	SNMT	DIGITAL SPEED LIMIT (DSL) SIGN ASSEMBLY	60
829	00100	32	32	SNMT	WORK ZONE EGRESS WARNING SYSTEM	60
896	00010	108	108	SNMT	PORTABLE NON-INTRUSIVE TRAFFIC SENSOR, CLASS I	62
896	00021	36	36	SNMT	PORTABLE CHANGEABLE MESSAGE SIGN, AS PER PLAN	62

NO.	DESCRIPTION	REV. BY	DATE
5	QUANTITY CHANGES	EMK	11-2-2023

MAINTENANCE OF TRAFFIC PHASE	614	614	614	614	614	614	614	614	614	614	614	614	614	614	614	614	615	622	622	622
	WORK ZONE IMPACT ATTENUATOR (UNIDIRECTIONAL), 24" WIDE HAZARDS	WORK ZONE RAISED PAVEMENT MARKER, AS PER PLAN	BARRIER REFLECTOR, TYPE 1, ONE WAY	OBJECT MARKER, ONE WAY	INCREASED BARRIER DELINEATION	WORK ZONE LANE LINE, CLASS I, 6", 807 PAINT	WORK ZONE LANE LINE, CLASS III, 6", 642 PAINT	WORK ZONE CENTER LINE, CLASS I, 642 PAINT	WORK ZONE EDGE LINE, CLASS I, 6", 807 PAINT	WORK ZONE EDGE LINE, CLASS III, 6", 642 PAINT	WORK ZONE CHANNELIZING LINE, CLASS I, 12", 807 PAINT	WORK ZONE CHANNELIZING LINE, CLASS III, 6", 642 PAINT	WORK ZONE DOTTED LINE, CLASS I, 4", 807 PAINT	WORK ZONE DOTTED LINE, CLASS III, 6", 642 PAINT	WORK ZONE STOP LINE, CLASS I, 642 PAINT	WORK ZONE ARROW, CLASS I, 642 PAINT	PAVEMENT FOR MAINTAINING TRAFFIC, CLASS B	PORTABLE BARRIER, UNANCHORED	PORTABLE BARRIER, ANCHORED	PORTABLE BARRIER, "Y" CONNECTOR
	EACH	EACH	EACH	EACH	FT	MILE	MILE	MILE	MILE	MILE	FT	FT	FT	FT	FT	EACH	SY	FT	FT	EACH
PHASE 1	3	139	95	95	4720	1.51			4.44		7958		1110				1545	4720		1
PHASE 2	2	54	74	74	3990	0.70			1.14									3390	600	
PHASE 2A	2	5	7	7			0.26	0.32		193		198		34	3		130	230		
PHASE 2B	2		7	7			0.24	0.25		326		217		61	3		140	200		
PHASE 3A	2		129	129	6430	1.10	0.00	1.69		2139								6430		
PHASE 3B	1		40	40	1980	1.41	0.00	1.64		1923								1980		
PHASE 3C							1.69			1.22		3126		2409						
TOTALS	12	193	352	352	17120	4.73	1.69	0.51	9.48	1.22	12539	3126	1525	2409	95	6	1545	16790	1030	1

PHASE 3C

NO.	DESCRIPTION	REV. BY	DATE
5	QUANTITY CHANGES	EMK	11-2-2023

CALCULATED
EMW
CHECKED
RMK

MAINTENANCE OF TRAFFIC SUBSUMMARY

FRA-70-13.11

SHEET NUMBER							PARTICIPATION					ITEM	ITEM EXT.	GRAND TOTAL	UNIT	DESCRIPTION	SEE SHEET NO.	CALCULATED CJC	CHECKED CWL	
P1/160	P2/38	P3/190	P4/154	P5/13			01/IMS/04	02/IMS/11												
	0.6		2.0		1.0		2.6	1.0				602	20000	3.6	CY	DRAINAGE CONCRETE MASONRY				
			13040				13040					605	05110	13040	FT	4" SHALLOW PIPE UNDERDRAINS WITH GEOTEXTILE FABRIC				
		1504		1873			3377					605	06000	3377	FT	4" BASE PIPE UNDERDRAINS				
			6952				6952					605	06020	6952	FT	4" BASE PIPE UNDERDRAINS WITH GEOTEXTILE FABRIC				
	5960			8005			13965					605	11110	13965	FT	6" SHALLOW PIPE UNDERDRAINS WITH GEOTEXTILE FABRIC				
			200				200					605	13300	200	FT	6" UNCLASSIFIED PIPE UNDERDRAINS				
	925	50		1468			2443					605	13410	2443	FT	6" UNCLASSIFIED PIPE UNDERDRAINS WITH GEOTEXTILE FABRIC				
		75					75					605	14000	75	FT	6" BASE PIPE UNDERDRAINS				
	12555			13514	3703		26069	3703				605	14020	29772	FT	6" BASE PIPE UNDERDRAINS WITH GEOTEXTILE FABRIC				
							62					611	00100	62	FT	4" CONDUIT, TYPE B				
			100				100					611	00400	100	FT	4" CONDUIT, TYPE E, MISC FOR DRAINAGE DISCHARGE CONTINUANCE				
			200				200					611	00406	200	FT	4" CONDUIT, TYPE F				
			100				100					611	00406	100	FT	4" CONDUIT, TYPE F, MISC FOR DRAINAGE DISCHARGE CONTINUANCE				
		30	810	187			1027					611	00410	1027	FT	4" CONDUIT, TYPE F FOR UNDERDRAIN OUTLET				
	355			280	20		635	20				611	00510	655	FT	6" CONDUIT, TYPE F FOR UNDERDRAIN OUTLETS				
	446	50	21	680			1197					611	00900	1197	FT	6" CONDUIT, TYPE B				
	50	50	7	50			157					611	01100	157	FT	6" CONDUIT, TYPE C				
	50	50		50			150					611	01400	150	FT	6" CONDUIT, TYPE E				
	150	100		250			500					611	01500	500	FT	6" CONDUIT, TYPE F				
			224				224					611	01800	224	FT	8" CONDUIT, TYPE B				
			100				100					611	01800	100	FT	8" CONDUIT, TYPE B, MISC FOR DRAINAGE DISCHARGE CONTINUANCE				
			100				100					611	02000	100	FT	8" CONDUIT, TYPE C, MISC FOR DRAINAGE DISCHARGE CONTINUANCE				
			5				5					611	03300	5	FT	10" CONDUIT, TYPE C				
			21				21					611	03700	21	FT	10" CONDUIT, TYPE F				
			109				109					611	04400	109	FT	12" CONDUIT, TYPE B				
				23			23					611	04400	23	FT	12" CONDUIT, TYPE B, 748.02				
				10			10					611	04600	10	FT	12" CONDUIT, TYPE C				
	578		1807	1125	12		3510	12				611	05900	3522	FT	15" CONDUIT, TYPE B				
			67				67					611	05900	67	FT	15" CONDUIT, TYPE B, 706.02, JOINTS PER 706.11				
	112			244			356					611	05901	356	FT	15" CONDUIT, TYPE B, AS PER PLAN			P1,P4	
	101	△	951	138	69		1190	69				611	06100	1259	△	FT	15" CONDUIT, TYPE C			
	20			85			105					611	06101	105	FT	15" CONDUIT, TYPE C, AS PER PLAN			P1,P4	
					40							611	06700	40	FT	15" CONDUIT, TYPE F				
	209	△	450	29			688					611	07400	688	△	FT	18" CONDUIT, TYPE B			
				12			12					611	07400	12	FT	18" CONDUIT, TYPE B, 748.06				
	121						121					611	07401	121	FT	18" CONDUIT, TYPE B, AS PER PLAN			P1	
			413				413					611	07600	413	FT	18" CONDUIT, TYPE C				
			50	5			50					611	08900	55	FT	21" CONDUIT, TYPE B				
			56				56					611	09100	56	FT	21" CONDUIT, TYPE C				
			86				86					611	09700	86	FT	21" CONDUIT, TYPE F				
			129	10			139					611	10400	139	FT	24" CONDUIT, TYPE B				
				48			48					611	10400	48	FT	24" CONDUIT, TYPE B, 706.02 WITH 706.11 JOINTS				
				50			50					611	13400	50	FT	30" CONDUIT, TYPE B				
				28			28					611	19400	28	FT	42" CONDUIT, TYPE B, 748.06				
	2				1		2	1				611	98150	3	EACH	CATCH BASIN, NO. 3				
	4						4					611	98180	4	EACH	CATCH BASIN, NO. 3A				
	3		13				16					611	98370	16	EACH	CATCH BASIN, NO. 6				
	1						1					611	98371	1	EACH	CATCH BASIN, NO. 6, AS PER PLAN			P1	
			8				8					611	98410	8	EACH	CATCH BASIN, NO. 8				
	3						3					611	98411	3	EACH	CATCH BASIN, NO. 8, AS PER PLAN			P1	
				2			2					611	98430	2	EACH	CATCH BASIN, NO. 8 WITHOUT APRON				
			1				1					611	98470	1	EACH	CATCH BASIN, NO. 2-2B				
	3				1		3	1				611	98630	4	EACH	CATCH BASIN ADJUSTED TO GRADE				
		1		5			6					611	98631	6	EACH	CATCH BASIN ADJUSTED TO GRADE, AS PER PLAN			P2,P4	

BIG BUILD MASTER GENERAL SUMMARY

FRA-70-13.11

NO.	DESCRIPTION	REV. BY	DATE
5	REVISED P-156	CWL	10-31-23

D:\2012\2012048\FRA\7732\ROADWAY\SHEETS\773256904.DGN
10/31/2023
1:31:55 PM
CDDTV615TD_USER

SHEET NUMBER							PARTICIPATION					ITEM	ITEM EXT.	GRAND TOTAL	UNIT	DESCRIPTION	SEE SHEET NO.	CALCULATED CJC	CHECKED CWL
P1/371	P2/111	P3/193	P4/407	P4/408	P5/14		01/IMS/04	02/IMS/11	05/IMS/14										
TRAFFIC CONTROL (CONTINUED)																			
		571			68		571	68				644	00700	639	FT	TRANSVERSE/DIAGONAL LINE			
337			400				737					644	00720	737	FT	CHEVRON MARKING			
	48		80				128					644	01200	128	FT	PARKING LOT STALL MARKING			
	12		20				32					644	01300	32	EACH	LANE ARROW			
2			2				4					644	01350	4	EACH	LANE REDUCTION ARROW			
	7		8				15					644	01630	15	EACH	BIKE LANE SYMBOL MARKING			
	7						7					644	19000	7	EACH	SHARED LANE MARKING			
		14					14					644	30000	14	FT	REMOVAL OF PAVEMENT MARKING			
	2		1				3					644	50100	3	EACH	PAVEMENT MARKING, MISC.: BIKE DETECTOR MARKING			P2,P4
	299		505				804					644	50300	804	FT	PAVEMENT MARKING, MISC.: BIKE LANE DOTTED LINE, 6"			P2,P4
	706		584				1290					644	50300	1290	FT	PAVEMENT MARKING, MISC.: CHANNELIZING LINE, 12"			P2,P4
	126		205				331					644	50300	331	FT	PAVEMENT MARKING, MISC.: STOP LINE, 24"			P2,P4
	575		244				819					644	50300	819	FT	PAVEMENT MARKING, MISC.: TRANSVERSE / DIAGONAL LINE, 24"			P2,P4
	123						123					644	50300	123	FT	PAVEMENT MARKING, MISC.: DOTTED LINE, 6"			P2
	0.67		0.93				1.60					644	50400	1.60	MILE	PAVEMENT MARKING, MISC.: EDGE LINE, 6"			P2,P4
	0.57		0.92				1.49					644	50400	1.49	MILE	PAVEMENT MARKING, MISC.: LANE LINE, 6"			P2,P4
	0.23						0.23					644	50400	0.23	MILE	PAVEMENT MARKING, MISC.: CENTER LINE, 4"			P2
		0.05					0.05					644	50400	0.05	MILE	PAVEMENT MARKING, MISC.: CENTER LINE, DOUBLE SOLID, 4"			P3
			0.31				0.31					645	90000	0.31	MILE	PAVEMENT MARKING, MISC.: EDGE LINE, 6", TYPE A1, WITH CONTRAST			P4
	0.06		0.12				0.18					645	90000	0.18	MILE	PAVEMENT MARKING, MISC.: LANE LINE, 6", TYPE A1, WITH CONTRAST			P2,P4
	0.05						0.05					645	90000	0.05	MILE	PAVEMENT MARKING, MISC.: CENTER LINE, 4", TYPE A1			P2
	280		239				519					645	98000	519	FT	PAVEMENT MARKING, MISC.: CHANNELIZING LINE, 12", TYPE A1, WITH CONTRAST			P2,P4
		316			204		316	204				646	10600	520	FT	TRANSVERSE/DIAGONAL LINE			
185							185					646	10620	185	FT	CHEVRON MARKING			
	15		6				21					646	20300	21	EACH	LANE ARROW			
	8			6			14					647	20610	14	EACH	LANE ARROW, TYPE B90			
				8			8					647	20910	8	EACH	BIKE LANE SYMBOL MARKING, TYPE B90			
	2						2					647	20940	2	EACH	SHARED LANE MARKING, TYPE B90			
				4			4					647	50100	4	EACH	PAVEMENT MARKING, MISC.: TURN QUEUE BOX, TYPE B90			P4
				2			2					647	50100	2	EACH	PAVEMENT MARKING, MISC.: LANE REDUCTION ARROW WITH CONTRAST			P3
				634			634					647	50120	634	FT	PAVEMENT MARKING, MISC.: DOTTED LINE, 6", TYPE B90			P4
				16			16					647	50120	16	FT	PAVEMENT MARKING, MISC.: BIKE LANE DOTTED LINE, 6", TYPE B90			P4
	252			199			451					647	50120	451	FT	PAVEMENT MARKING, MISC.: CROSSWALK LINE, 12", TYPE B90			P2,P4
	57			45			102					647	50120	102	FT	PAVEMENT MARKING, MISC.: STOP LINE, 24", TYPE B90			P2,P4
				618			618					647	60020	618	SF	GREEN COLORED PAVEMENT FOR BIKES, TYPE B90			
	1.72		2.03	0.06	0.46		3.81	0.27	0.19			807	12010	4.27	MILE	WET REFLECTIVE EPOXY PAVEMENT MARKING, EDGE LINE, 6"			
	1.14		0.76	0.12	0.23		2.02	0.13	0.10			807	12110	2.25	MILE	WET REFLECTIVE EPOXY PAVEMENT MARKING, LANE LINE, 6"			
	5007		4316				9323					807	12310	9323	FT	WET REFLECTIVE EPOXY PAVEMENT MARKING, CHANNELIZING LINE, 12"			
	351		1649				2000					807	12410	2000	FT	WET REFLECTIVE EPOXY PAVEMENT MARKING, DOTTED LINE, 6"			
	4.75		5.96	4.00	0.53		14.71	0.15	0.38			807	14010	15.24	MILE	WET REFLECTIVE THERMOPLASTIC PAVEMENT MARKING, EDGE LINE, 6"			
	2.13		4.76	5.69	0.27		12.58	0.07	0.20			807	14110	12.85	MILE	WET REFLECTIVE THERMOPLASTIC PAVEMENT MARKING, LANE LINE, 6"			
	0.11		0.11				0.22					807	14200	0.22	MILE	WET REFLECTIVE THERMOPLASTIC PAVEMENT MARKING, CENTER LINE			
	10284		12495	5427			28206					807	14310	28206	FT	WET REFLECTIVE THERMOPLASTIC PAVEMENT MARKING, CHANNELIZING LINE, 12"			
	2816		3361	8414			14591					807	14410	14591	FT	WET REFLECTIVE THERMOPLASTIC PAVEMENT MARKING, DOTTED LINE, 6"			
	7.09		10.91	9.69	0.8		27.69	0.22	0.58			850	10010	28.49	MILE	GROOVING FOR 6" RECESSED PAVEMENT MARKING, (ASPHALT)			
	2816		3361	8414			14591					850	10110	14591	FT	GROOVING FOR 6" RECESSED PAVEMENT MARKING, (ASPHALT)			
	10284		12495	5427			28206					850	10130	28206	FT	GROOVING FOR 12" RECESSED PAVEMENT MARKING, (ASPHALT)			
	2.86		2.80	0.18	0.69		5.84	0.40	0.29			850	20010	6.53	MILE	GROOVING FOR 6" RECESSED PAVEMENT MARKING, (CONCRETE)			
	351		1649				2000					850	20110	2000	FT	GROOVING FOR 6" RECESSED PAVEMENT MARKING, (CONCRETE)			
	5007		4316				9323					850	20130	9323	FT	GROOVING FOR 12" RECESSED PAVEMENT MARKING, (CONCRETE)			

BIG BUILD MASTER GENERAL SUMMARY

FRA-70-13.11

NO.	DESCRIPTION	REV. BY	DATE
1	REVISED PART 5	CWL	10-2-23
5	REVISED PARTS 1,3 & CITY LINES	CWL	11-3-23

SHEET NUMBER						PARTICIPATION				ITEM	ITEM EXT.	GRAND TOTAL	UNIT	DESCRIPTION	SEE SHEET NO.	CALCULATED CJC	CHECKED CWL
P1/65	P2/40	P3/197B	P4/49	P5/14B		01/IMS/04	02/IMS/11										
														MAINTENANCE OF TRAFFIC			
6000						6000						254	01000	PAVEMENT PLANING, ASPHALT CONCRETE, 1.5"	P1		
200						200						410	12000	TRAFFIC COMPACTED SURFACE, TYPE A OR B	P1		
1000			1000			2000						607	30001	FENCE, SNOW, AS PER PLAN	P1, P4		
174						174						611	05900	15" CONDUIT, TYPE B			
1405						1405						611	97010	SLOTTED DRAIN, TYPE 2, 12"			
1						1						611	98150	CATCH BASIN, NO. 3			
3						3						611	98370	CATCH BASIN, NO. 6			
5						5						611	99500	INLET, MISC.: INLET, CAPPED BELOW GRADE			
2400		944	2000			5344						614	11110	LAW ENFORCEMENT OFFICER WITH PATROL CAR FOR ASSISTANCE	P1		
			2			2						SPECIAL	61411300	WORK ZONE TRAFFIC SIGNAL	P4		
17120			27376			44496						614	11630	INCREASED BARRIER DELINEATION	P1		
12		19	13	4		44	4					614	12380	WORK ZONE IMPACT ATTENUATOR, 24" WIDE HAZARDS, (UNIDIRECTIONAL)	P1		
LS		LS	LS			LS						614	12420	DETOUR SIGNING	P1		
			11			11						614	12470	WORK ZONE SPEED LIMIT SIGN	P1		
6		9	10			25						614	12484	WORK ZONE INCREASED PENALTIES SIGN			
50		20	50			120						614	12500	REPLACEMENT SIGN	P1		
300		50	300			650						614	12600	REPLACEMENT DRUM	P1		
			2			2						614	12756	WORK ZONE CROSSOVER LIGHTING SYSTEM			
			3645			3645						614	12800	WORK ZONE RAISED PAVEMENT MARKER			
193		3504				3697						614	12801	WORK ZONE RAISED PAVEMENT MARKER, AS PER PLAN	P1, P3		
				120			120					614	13310	BARRIER REFLECTOR, TYPE 1 (ONE WAY)			
352		1566				1918						614	13310	BARRIER REFLECTOR, TYPE 1, ONE-WAY	P1		
			1440			1440						614	13310	BARRIER REFLECTOR, TYPE 1, BIDIRECTIONAL			
			29			29						614	13312	BARRIER REFLECTOR, TYPE 2, ONE-WAY			
352		548		40		900	40					614	13350	OBJECT MARKER, ONE WAY	P1		
				4			4					614	13600	MAINTENANCE OF TRAFFIC, ONE LANE CLOSURE ON A TWO LANE HIGHWAY			
50000						50000						614	18000	MAINTAINING TRAFFIC, MISC.: BRIDGE DECK AND PAVEMENT PATCHING	P1		
1000						1000						614	18030	MAINTAINING TRAFFIC, MISC.: CONSTRUCTION FENCE	P1		
		1000				1000						614	18030	MAINTAINING TRAFFIC, MISC.: PORTABLE WATER FILLED BARRIER PROTECTED PEDESTRIAN WALKWAY	P3		
144		89	48			281						614	18601	PORTABLE CHANGEABLE MESSAGE SIGN, AS PER PLAN	P1, P3, P4		
2.21						2.21						614	20011	WORK ZONE LANE LINE, CLASS I, 6", AS PER PLAN, SPRAY THERMOPLASTIC	P1		
4.30		12.87	3.41			20.58						614	20056	WORK ZONE LANE LINE, CLASS I, 6", 807 PAINT			
			0.62			0.62						614	20200	WORK ZONE LANE LINE, CLASS I, 4", 740.06, TYPE I			
1.69			6.24			7.93						614	20560	WORK ZONE LANE LINE, CLASS III, 6", 642 PAINT			
		0.11				0.11						614	21050	WORK ZONE CENTER LINE, CLASS I, 807 PAINT, DOUBLE SOLID, WHITE			
0.51						0.51						614	21100	WORK ZONE CENTER LINE, CLASS I, 642 PAINT			
5.98						5.98						614	22011	WORK ZONE EDGE LINE, CLASS I, 6", AS PER PLAN, SPRAY THERMOPLASTIC	P1		
9.22		25.10	13.08			47.40						614	22056	WORK ZONE EDGE LINE, CLASS I, 6", 807 PAINT			
			1.42			1.42						614	22200	WORK ZONE EDGE LINE, CLASS I, 4", 740.06, TYPE I			
1.22			4.46			5.68						614	22360	WORK ZONE EDGE LINE, CLASS III, 6", 642 PAINT			
11491						11491						614	23011	WORK ZONE CHANNELIZING LINE, CLASS I, 12", AS PER PLAN, SPRAY THERMOPLASTIC	P1		
12539		64782	30704			108025						614	23110	WORK ZONE CHANNELIZING LINE, CLASS I, 12", 807 PAINT			
			275			275						614	23400	WORK ZONE CHANNELIZING LINE, CLASS I, 8", 740.06, TYPE I			
3126			5427			8553						614	23690	WORK ZONE CHANNELIZING LINE, CLASS III, 12", 642 PAINT			
3302						3302						614	24001	WORK ZONE DOTTED LINE, CLASS I, AS PER PLAN, SPRAY THERMOPLASTIC	P1		
1525			7974			9499						614	24100	WORK ZONE DOTTED LINE, CLASS I, 4", 807 PAINT			
		11051				11051						614	24102	WORK ZONE DOTTED LINE, CLASS I, 6", 807 PAINT			
			857			857						614	24400	WORK ZONE DOTTED LINE, CLASS I, 740.06, TYPE I			
2409			8872			11281						614	24612	WORK ZONE DOTTED LINE, CLASS III, 6", 642 PAINT			
			1159			1159						614	25000	WORK ZONE TRANSVERSE/DIAGONAL LINE, CLASS I			
95						95						614	26200	WORK ZONE STOP LINE, CLASS I, 642 PAINT			
			53			53						614	26400	WORK ZONE STOP LINE, CLASS I, 740.06 TYPE I			
			80			80						614	26610	WORK ZONE STOP LINE, CLASS III, 642 PAINT			
			466			1105						614	27070	WORK ZONE CROSSWALK LINE, CLASS I, 12", 740.06, TYPE I			
												614	28400	WORK ZONE GORE MARKING, CLASS II, 740.06, TYPE I			
6		2026				2026						614	30200	WORK ZONE ARROW, CLASS I, 642 PAINT			
						6						614	30400	WORK ZONE ARROW, CLASS I, 740.06, TYPE I			
		8	12			20						614	30650	WORK ZONE ARROW, CLASS III, 642 PAINT			
			2			2						614	98200	WORK ZONE PAVEMENT MARKING, MISC.: 814 INTERSTATE ELONGATED ROUTE SHIELD SYMBOL MARKING	P3		
		3				3						614					

BIG BUILD MASTER GENERAL SUMMARY

FRA-70-13.11

156
1151

D:\2012\2012048\FRA\77372\ROADWAY\SHEETS\773726916.DGN
11/16/2012 7:33:57 AM
CDDTV61STD_USER

SHEET NUMBER							PARTICIPATION				ITEM	ITEM EXT.	GRAND TOTAL	UNIT	DESCRIPTION	SEE SHEET NO.
P1/65	P1/163	P2/40	P3/197B	P4/49	P4/158		01/IMS/04	02/IMS/11	03/NHS/10	04/NHS/10						
MAINTENANCE OF TRAFFIC (CONTINUED)																
				LS 4600			LS 4600					615	10000	LS	ROADS FOR MAINTAINING TRAFFIC	
							4032					615	20000	SY	PAVEMENT FOR MAINTAINING TRAFFIC, CLASS A	
							4032					615	20001	SY	PAVEMENT FOR MAINTAINING TRAFFIC, CLASS A, AS PER PLAN	
1545		695	4032	629			2869					615	25000	SY	PAVEMENT FOR MAINTAINING TRAFFIC, CLASS B	
100		100	200	200			400					615	25001	SY	PAVEMENT FOR MAINTAINING TRAFFIC, CLASS B, AS PER PLAN, TYPE 1	
50		50	200	200			300					615	25001	SY	PAVEMENT FOR MAINTAINING TRAFFIC, CLASS B, AS PER PLAN, TYPE 2	
20			20	200			240					615	25001	SY	PAVEMENT FOR MAINTAINING TRAFFIC, CLASS B, AS PER PLAN, TYPE 3	
20				200			220					615	25001	SY	PAVEMENT FOR MAINTAINING TRAFFIC, CLASS B, AS PER PLAN, TYPE 4	
325				550			875					616	10000	MGAL	WATER	
			4				4					622	10201	EACH	BARRIER TRANSITION, AS PER PLAN	
			7279				7279					622	41011	FT	PORTABLE BARRIER, 50", AS PER PLAN	
1				2			3					622	41050	EACH	PORTABLE BARRIER, "Y" CONNECTOR	
16790			11575	2884			28365					622	41100	FT	PORTABLE BARRIER, UNANCHORED	
							28884					622	41101	FT	PORTABLE BARRIER, UNANCHORED, AS PER PLAN	
1030							1030					622	41110	FT	PORTABLE BARRIER, ANCHORED	
72			288	48			408					808	18700	SNMT	DIGITAL SPEED LIMIT (DSL) SIGN ASSEMBLY	
32							32					829	00100	SNMT	WORK ZONE EGRESS WARNING SYSTEM	
108				48			156					896	00010	SNMT	PORTABLE NON-INTRUSIVE TRAFFIC SENSOR, CLASS I	
				48			48					896	00020	SNMT	PORTABLE CHANGEABLE MESSAGE SIGN	
36							36					896	00021	SNMT	PORTABLE CHANGEABLE MESSAGE SIGN, AS PER PLAN	
INCIDENTALS																
	143000						143000					100	51100	EACH	DEPARTMENT'S SHARE OF THE DISPUTE RESOLUTION BOARD	
	LS						LS					108	10000	LS	CPM PROGRESS SCHEDULE	
	7000						7000					SPECIAL	1110100	EACH	DEPARTMENTS SHARE FACILITATED PARTNERING COSTS	
	LS		LS		LS		LS					614	11000	LS	MAINTAINING TRAFFIC	
	LS	LS	LS		LS		LS					623	10000	LS	CONSTRUCTION LAYOUT STAKES AND SURVEYING	
	LS	LS	LS		LS		LS					624	10000	LS	MOBILIZATION	
	675000						225000	225000	225000			900	00100	EACH	RAILROAD FLAGGING SERVICES	

NO.	DESCRIPTION	REV. BY	DATE
1	ADDED RR FLAGGING	CWL	10-2-23
2	BRICK X-WALK/REV. RR FLAGGING	CWL	10-16-23
5	REVISED PB	CWL	11-6-23

BIG BUILD MASTER GENERAL SUMMARY

FRA-70-13.11

D:\2012\2012048\FRA\7732\ROADWAY\SHEETS\77326917.DGN
11/16/2023
7:36:34 AM
DDGTV181STD_USER

SHEET NUMBER							PARTICIPATION							ITEM	ITEM EXT.	GRAND TOTAL	UNIT	DESCRIPTION	SEE SHEET NO.
		51		166															
				0.6									602	20000	0.6	CY	CONCRETE MASONRY		
				5960									605	11110	5960	FT	6" SHALLOW PIPE UNDERDRAINS WITH GEOTEXTILE FABRIC		
		100		825									605	13410	925	FT	6" UNCLASSIFIED PIPE UNDERDRAINS WITH GEOTEXTILE FABRIC		
				12555									605	14020	12555	FT	6" BASE PIPE UNDERDRAINS WITH GEOTEXTILE FABRIC		
				355									611	00510	355	FT	6" CONDUIT, TYPE F FOR UNDERDRAIN OUTLETS		
		50		396									611	00900	446	FT	6" CONDUIT, TYPE B		
		50											611	01100	50	FT	6" CONDUIT, TYPE C		
		50											611	01400	50	FT	6" CONDUIT, TYPE E		
		150											611	01500	150	FT	6" CONDUIT, TYPE F		
				578									611	05900	578	FT	15" CONDUIT, TYPE B		
				112									611	05901	112	FT	15" CONDUIT, TYPE B, AS PER PLAN	44	
				101									611	06100	101	FT	15" CONDUIT, TYPE C		
				20									611	06101	20	FT	15" CONDUIT, TYPE C, AS PER PLAN	44	
				209									611	07400	209	FT	18" CONDUIT, TYPE B		
				121									611	07401	121	FT	18" CONDUIT, TYPE B, AS PER PLAN	44	
				2									611	98150	2	EACH	CATCH BASIN, NO. 3		
				4									611	98180	4	EACH	CATCH BASIN, NO. 3A		
				3									611	98370	3	EACH	CATCH BASIN, NO. 6		
				1									611	98371	1	EACH	CATCH BASIN, NO. 6, AS PER PLAN	44	
				3									611	98411	3	EACH	CATCH BASIN, NO. 8, AS PER PLAN	44	
				3									611	98630	3	EACH	CATCH BASIN ADJUSTED TO GRADE		
				2									611	98634	2	EACH	CATCH BASIN RECONSTRUCTED TO GRADE		
				4									611	98840	4	EACH	INLET, NO. 2-A-6		
				1									611	98870	1	EACH	INLET, NO. 2-A-12		
				1									611	98880	1	EACH	INLET, NO. 2-A-14		
				2									611	99111	2	EACH	INLET, NO. 3 FOR SINGLE SLOPE BARRIER, TYPE C1, AS PER PLAN "4A"	44	
				5									611	99114	5	EACH	INLET, NO. 3 FOR SINGLE SLOPE BARRIER, TYPE D		
				1									611	99150	1	EACH	INLET ADJUSTED TO GRADE		
				3									611	99154	3	EACH	INLET RECONSTRUCTED TO GRADE		
				2									611	99575	2	EACH	MANHOLE, NO. 3, AS PER PLAN "A"	44	
				2									611	99654	2	EACH	MANHOLE ADJUSTED TO GRADE		
				2									611	99655	2	EACH	MANHOLE ADJUSTED TO GRADE, AS PER PLAN "A"	44	
				1									611	99660	1	EACH	MANHOLE RECONSTRUCTED TO GRADE		
				1									611	99661	1	EACH	MANHOLE RECONSTRUCTED TO GRADE, AS PER PLAN "A"	44	
		2		3									611	99710	5	EACH	PRECAST REINFORCED CONCRETE OUTLET		
		500											SPECIAL	61199820	500	LB	MISCELLANEOUS METAL	43	
				223									839	29000	223	FT	TRENCH DRAIN, TYPE A WITH STANDARD GRATE		

NO.	DESCRIPTION	REV. BY	DATE
5	REVISED P-156	CWL	10-31-23


4A PART 1 GENERAL SUMMARY

FRA-70-13.11

CALCULATED
CJC
CHECKED
CWL

01:2012\2012048\FRA\7732\ROADWAY\SHEETS\773255003.DGN
10/31/2023
11:25:51 PM
GDDTV61STD_USER

SHEET NO.	602	605		605		605		611		611		611		611		611		611		611		611		611		611		611		611		611		611			
	CONCRETE MASONRY	6" SHALLOW PIPE UNDERDRAINS WITH GEOTEXTILE FABRIC		6" UNCLASSIFIED PIPE UNDERDRAINS WITH GEOTEXTILE FABRIC		6" BASE PIPE UNDERDRAINS WITH GEOTEXTILE FABRIC		6" CONDUIT, TYPE F FOR UNDERDRAIN OUTLETS		6" CONDUIT, TYPE B		15" CONDUIT, TYPE C, AS PER PLAN		15" CONDUIT, TYPE B		15" CONDUIT, TYPE C		18" CONDUIT, TYPE B		18" CONDUIT, TYPE B, AS PER PLAN						CATCH BASIN, NO. 3		CATCH BASIN, NO. 3A		CATCH BASIN, NO. 6		CATCH BASIN, NO. 6, AS PER PLAN					
	CY	FT		FT		FT		FT		FT		FT		FT		FT		FT		FT						EACH		EACH		EACH		EACH					
	01/IMS /04	01/IMS /04	170																										1	1	2	2	1	1	1					
171																																					
174	0.4	0.2									5	3	12	8	347	231	67	45	61	40	125	84	73	48													
176			1700	1134	276	184	2456	1637	104	69	108	72																									
177			1274	850	219	146	4023	2682	60	40	104	70																									
178			601	401			1054	703	49	33	20	14																									
TOTALS CARRIED TO GENERAL SUMMARY	0.4	0.2	3575	2385	495	330	7533	5022	213	142	237	159	12	8	347	231	67	45	61	40	125	84	73	48			1	1	2	2	2	1	1				
SHEET NO.	611		611		611		611		611		611		611		611		611		611		611		611		611		611		611		839						
	CATCH BASIN, NO. 8, AS PER PLAN		CATCH BASIN ADJUSTED TO GRADE		CATCH BASIN RECONSTRUCTED TO GRADE				INLET, NO. 2-A-6		INLET, NO. 2-A-12		INLET, NO. 2-A-14		INLET, NO. 3 FOR SINGLE SLOPE BARRIER, TYPE C1, AS PER PLAN		INLET, NO. 3 FOR SINGLE SLOPE BARRIER, TYPE D		INLET ADJUSTED TO GRADE		INLET RECONSTRUCTED TO GRADE		MANHOLE ADJUSTED TO GRADE, AS PER PLAN "A"		MANHOLE, NO. 3, AS PER PLAN "A"		MANHOLE ADJUSTED TO GRADE		MANHOLE RECONSTRUCTED TO GRADE		MANHOLE RECONSTRUCTED TO GRADE, AS PER PLAN "A"		PRECAST REINFORCED CONCRETE OUTLET		TRENCH DRAIN, TYPE A WITH STANDARD GRATE		
	EACH		EACH		EACH		EACH		EACH		EACH		EACH		EACH		EACH		EACH		EACH		EACH		EACH		EACH		EACH		EACH		FT				
	01/IMS /04	01/IMS /04	170	2	1							1	1	1		1	1	3	2																					
171			2	1	1	1			1	1							1		2	1	1	1					1	1	1				134	89			
176																																					
178																																					
TOTALS CARRIED TO GENERAL SUMMARY	2	1	2	1	1	1			2	2	1		1	1	3	2	1		2	1	1	1				1	1	1	1	1			2	1	134	89	

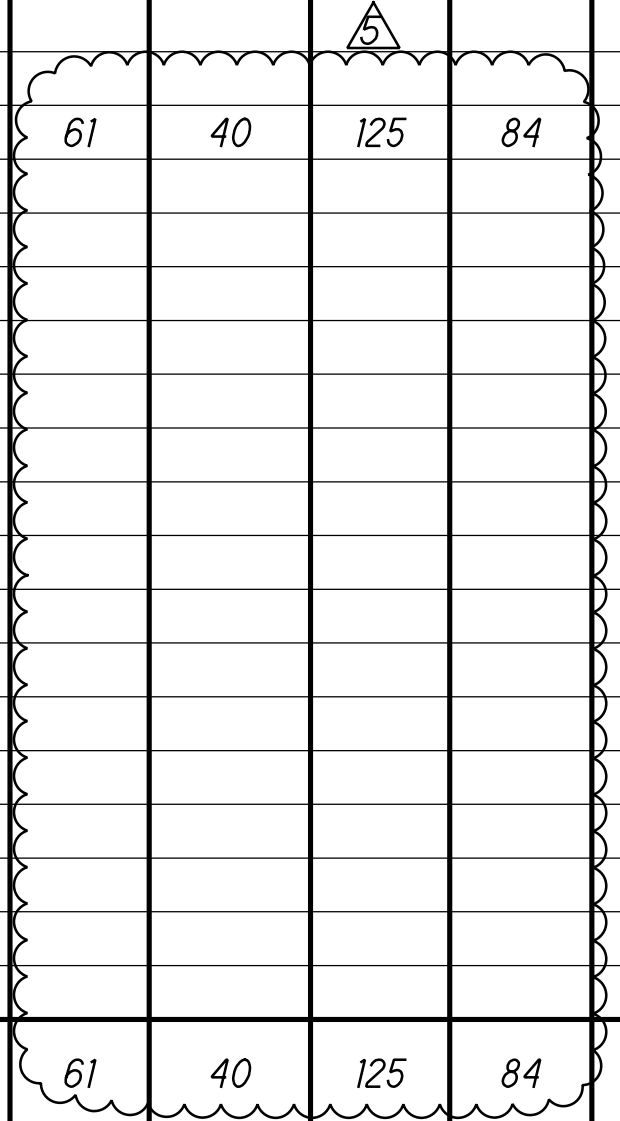

NO.	DESCRIPTION	REV. BY	DATE
5	REVISED P-156	CWL	10-31-23

CALCULATED CJC
 CHECKED CWL
DRAINAGE SUBSUMMARY
FRA-70-13.11
 166
 1151

0:\2012\2012048\FRA\7372\ROADWAY\SHEETS\775750006.DGN
 10/31/2023
 11:22:11 PM
 QDQTV615TD_USER

REF. NO.	SHEET NO.	STATION		SIDE	202		202		602		611		611		611		611		611		611		611		
		FROM	TO		GUARDRAIL REMOVED	HEADWALL REMOVED	CONCRETE MASONRY	6" CONDUIT, TYPE B	15" CONDUIT, TYPE B	15" CONDUIT, TYPE B, AS PER PLAN	15" CONDUIT, TYPE C, AS PER PLAN	15" CONDUIT, TYPE C	18" CONDUIT, TYPE B	18" CONDUIT, TYPE B, AS PER PLAN											
					01/IMS/0 4	01/IMS/0 4	01/IMS/0 4	01/IMS/0 4	01/IMS/0 4	01/IMS/0 4	01/IMS/0 4	01/IMS/0 4	01/IMS/0 4	01/IMS/0 4	01/IMS/0 4	01/IMS/0 4	01/IMS/0 4	01/IMS/0 4	01/IMS/0 4	01/IMS/0 4	01/IMS/0 4	01/IMS/0 4	01/IMS/0 4		
GR-1	185	144+49.80 (I-70 EB)	145+75.83 (I-70 EB)	LT	126																				
GR-2	191 , 193	157+86.69 (I-70 EB)	166+33.54 (I-70 EB)	RT	842																				
GR-3	195	169+94.90 (I-70 EB)	170+86.94 (I-70 EB)	RT	95																				
GR-4	201 , 203	183+86.61 (I-70 EB)	191+59.66 (I-70 EB)	RT	789																				
GR-5	205 , 207	192+70.64 (I-70 EB)	197+46.72 (I-70 EB)	RT	479																				
GR-6	213 , 215	265+50.32 (I-71 NB)	270+82.56 (I-71 NB)	RT	518																				
GR-7	219 , 221	45+08.00 (RAMP B5)	148+54.11 (I-70 EB)	LT/RT	343																				
GR-8	223	6004+94.45 (RAMP C6)	6006+06.34 (RAMP C6)	LT	112																				
GR-9	223 , 225	6005+70.08 (RAMP C6)	175+29.31 (I-70 EB)	RT/RT	469																				
GR-10	219	45+08.00 (RAMP B5)	45+35.92 (RAMP B5)	RT	30																				
GR-11	213 , 215	263+12.50 (I-71 NB)	272+00.77 (I-71 NB)	LT	919																				
HR-1	215	269+32.19 (I-71 NB)		LT			1																		
HW-1	213	265+99.00 (I-71 NB)		RT				0.27																	
HW-250	215	270+99.98 (I-71 NB)		LT				0.33																	
P-1	213	D-1	HW-1	RT														27							
P-105	191	D-105	D-106	RT								20													
P-106	191	D-106	D-110	RT														68							
P-107	191	D-110	D-107	RT/LT								101													
P-109	191	D-107	D-109	LT								75													
P-112	193	DJ-52	D-112	RT								11													
P-150	203	D-150	D-151	RT								78													
P-151	203	D-151	EX-255	RT/LT										74											
P-152	203	D-152	D-256	RT/LT								76													
P-156	203	D-256	D-156	LT																					
P-158	219	D-158	DJ-246	RT																			45		
P-163	203	D-163	D-164	LT								76													
P-164	203	D-164	188+99.70 (I-70 EB)	LT								7													
P-242	219	D-242	D-243	LT								47													
P-243	219	D-243	D-158	LT/RT																			34		
P-244	219	D-244	DJ-246	RT																					
P-245	185	D-244	D-245	LT																					
P-249	215	D-250	D-249	RT																					
P-250	215	D-250	HW-250	LT/RT																			72 95		
P-256	203	EX-255	D-256	LT																			76		
P-260	223	D-260	D-55	RT																					
P-270	197	D-270	D-271	RT																					
P-271	197	D-271	DJ-35	LT/RT																					
P-995	219	D-995	D-158	RT								49													
P-996	219	D-996	D-243	LT								31													
TOTALS CARRIED TO SUBSUMMARY ON SHEETS 164.166					2833	1889	1		0.4	0.2		5	3	347	231	67	45	12	8	61	40	125	84	73	48

ESTIMATED QUANTITIES


FRA-70-13.11

CALCULATED
ATR
CHECKED
CWL


NO.	DESCRIPTION	REV.	BY	DATE
5	REVISED P-156			10-31-23

174
1151

01_201212012048\FRA\7372\ROADWAY SHEETS\73720P015.DGN
 10/31/2023
 9:40:35 AM
 DDD\TY81STD\USER

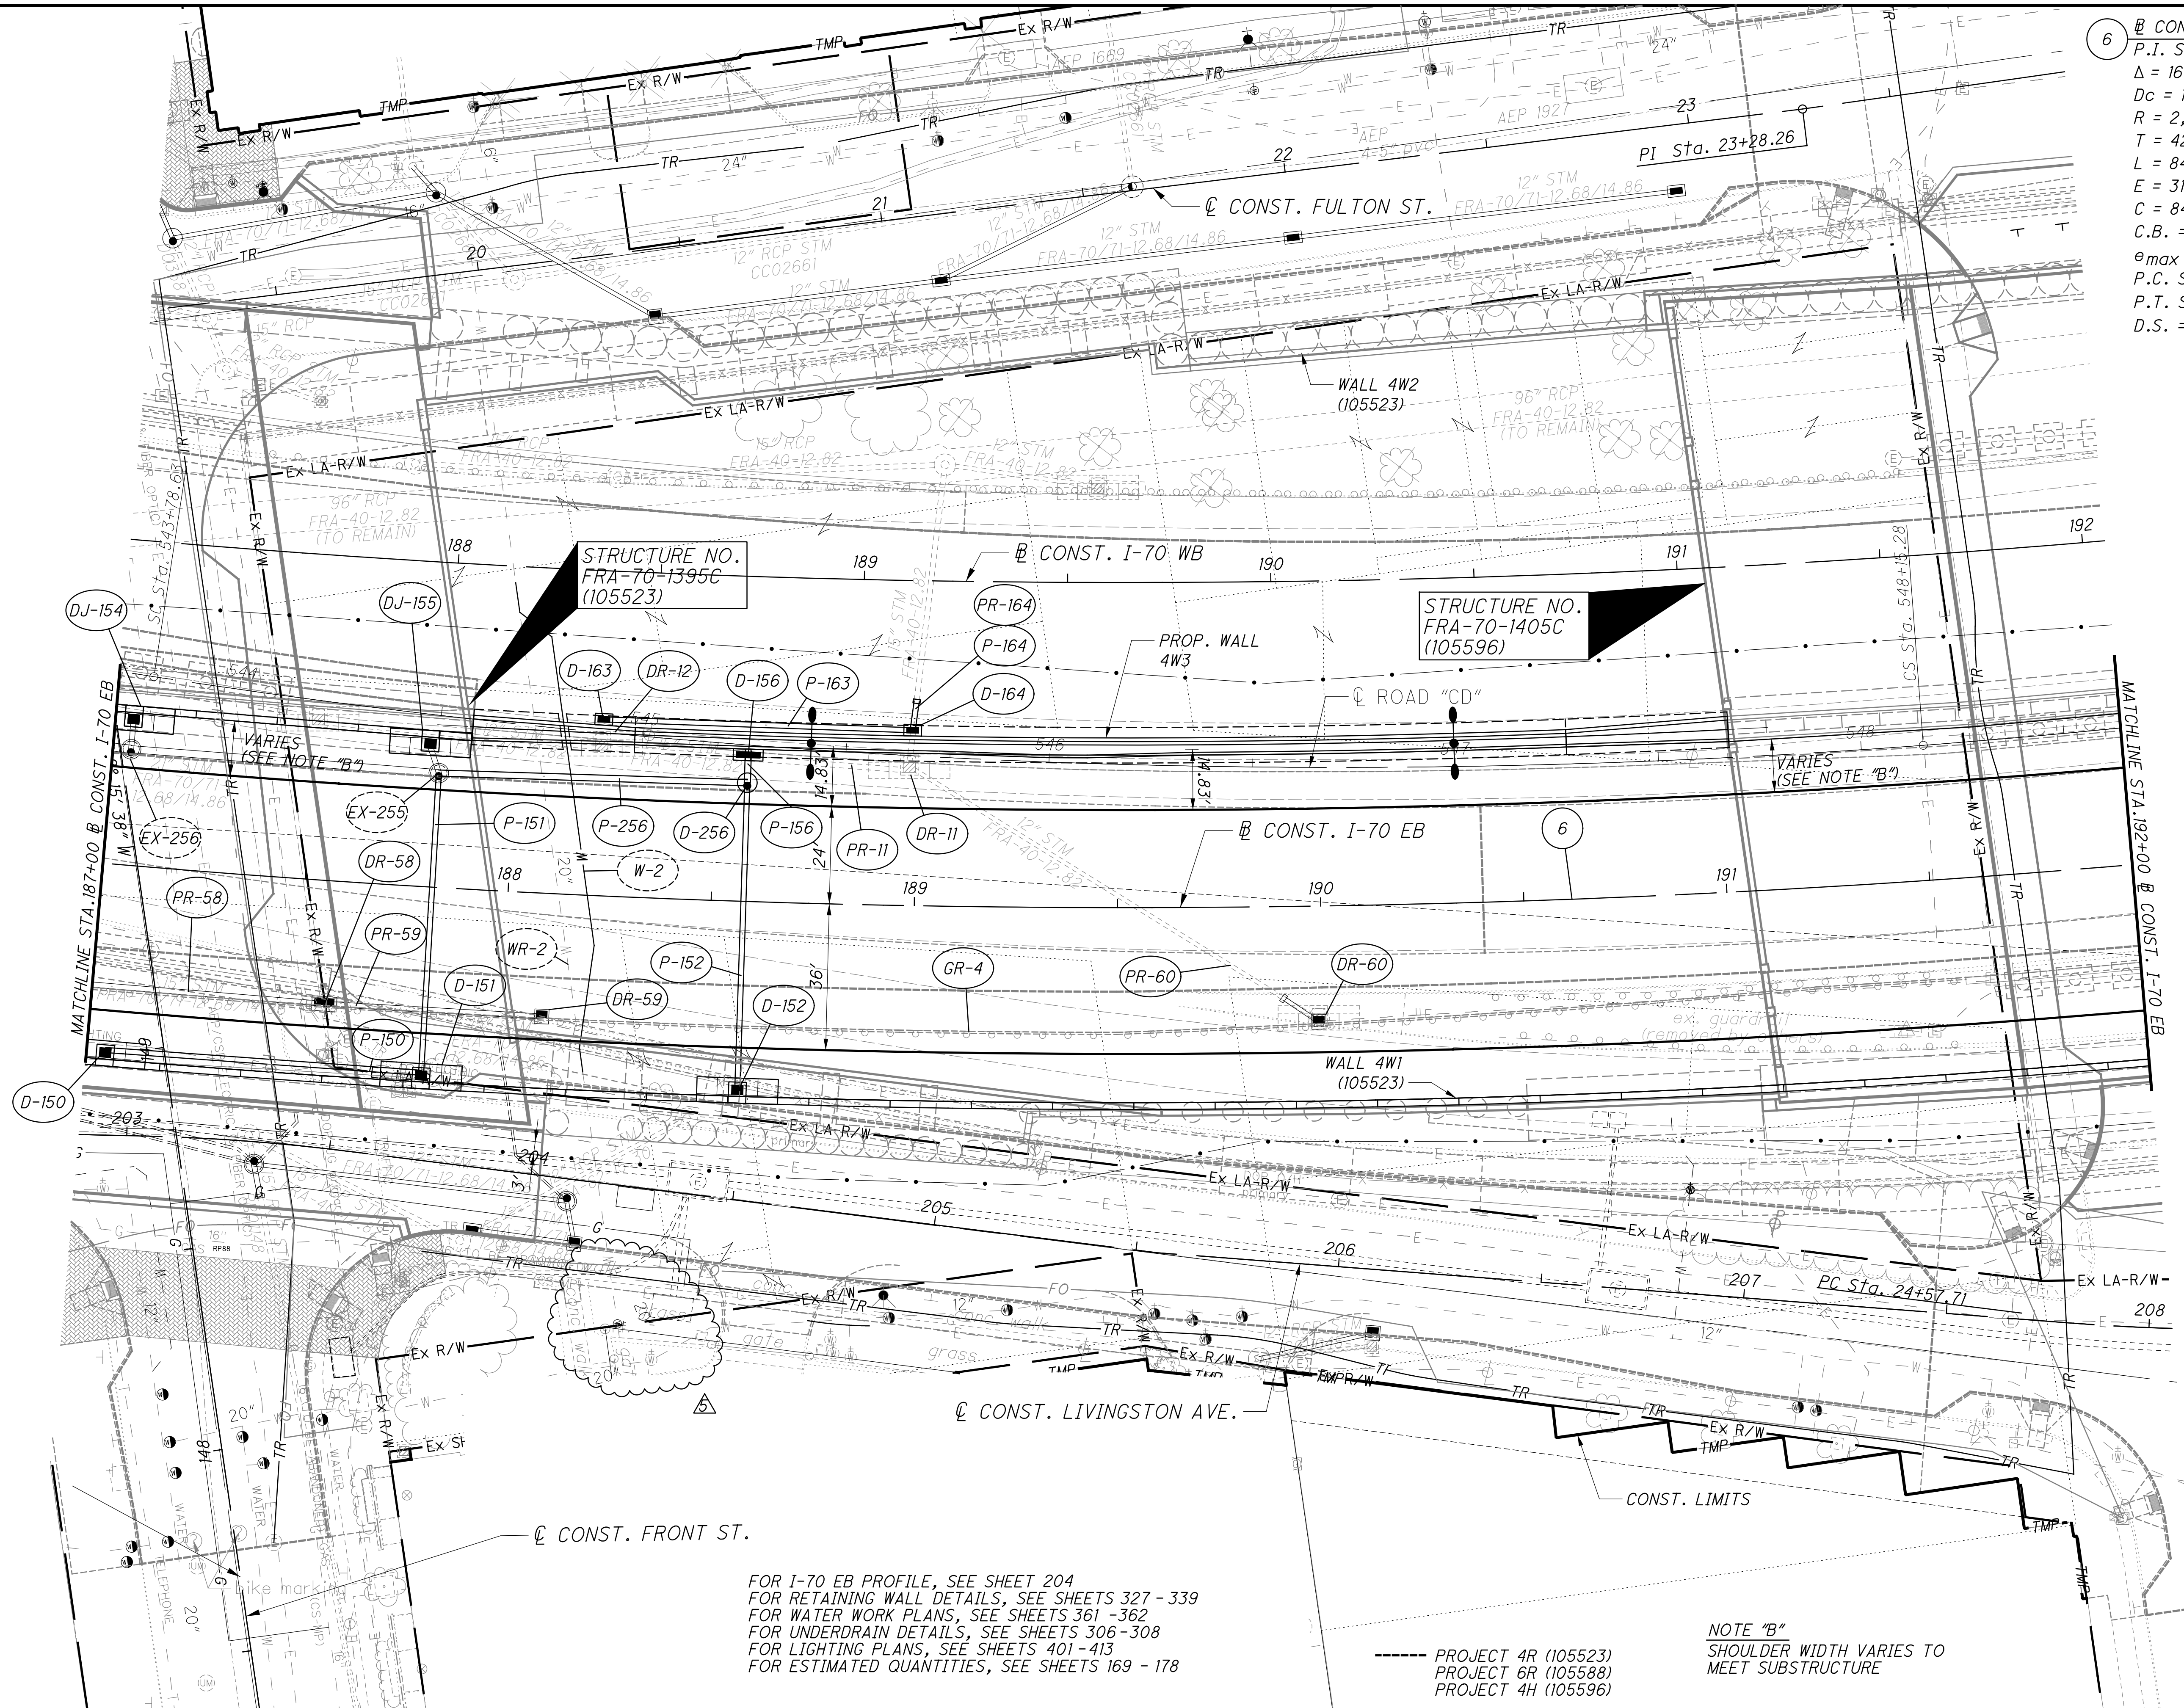

6 CONST. I-70 EB
 P.I. Sta. 190+20.00
 $\Delta = 16^\circ 45' 00''$ (LT)
 $Dc = 1^\circ 58' 21''$
 $R = 2,904.79'$
 $T = 427.65'$
 $L = 849.20'$
 $E = 31.31'$
 $C = 846.17'$
 $C.B. = N 88^\circ 42' 06'' E$
 $e_{max} = 0.045$
 P.C. Sta. 185+92.35
 P.T. Sta. 194+41.55
 D.S. = 60 MPH

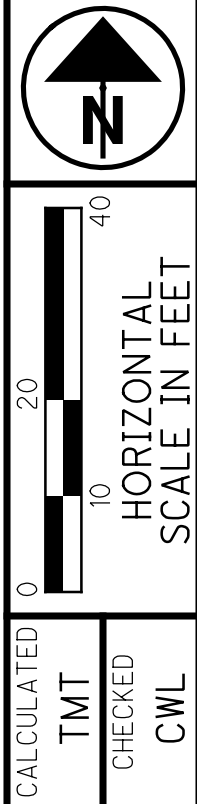

PLAN - I-70 EASTBOUND
 STA. 187+00.00 TO STA. 192+00.00

NO.	DESCRIPTION	REV. BY	DATE
5	ADDED 105523 WV	CWL	10-31-23


FRA-70-13.11

203
1151

FOR I-70 EB PROFILE, SEE SHEET 204
 FOR RETAINING WALL DETAILS, SEE SHEETS 327 - 339
 FOR WATER WORK PLANS, SEE SHEETS 361 - 362
 FOR UNDERDRAIN DETAILS, SEE SHEETS 306 - 308
 FOR LIGHTING PLANS, SEE SHEETS 401 - 413
 FOR ESTIMATED QUANTITIES, SEE SHEETS 169 - 178

----- PROJECT 4R (105523)
 ----- PROJECT 6R (105588)
 ----- PROJECT 4H (105596)


NOTE "B"
 SHOULDER WIDTH VARIES TO
 MEET SUBSTRUCTURE

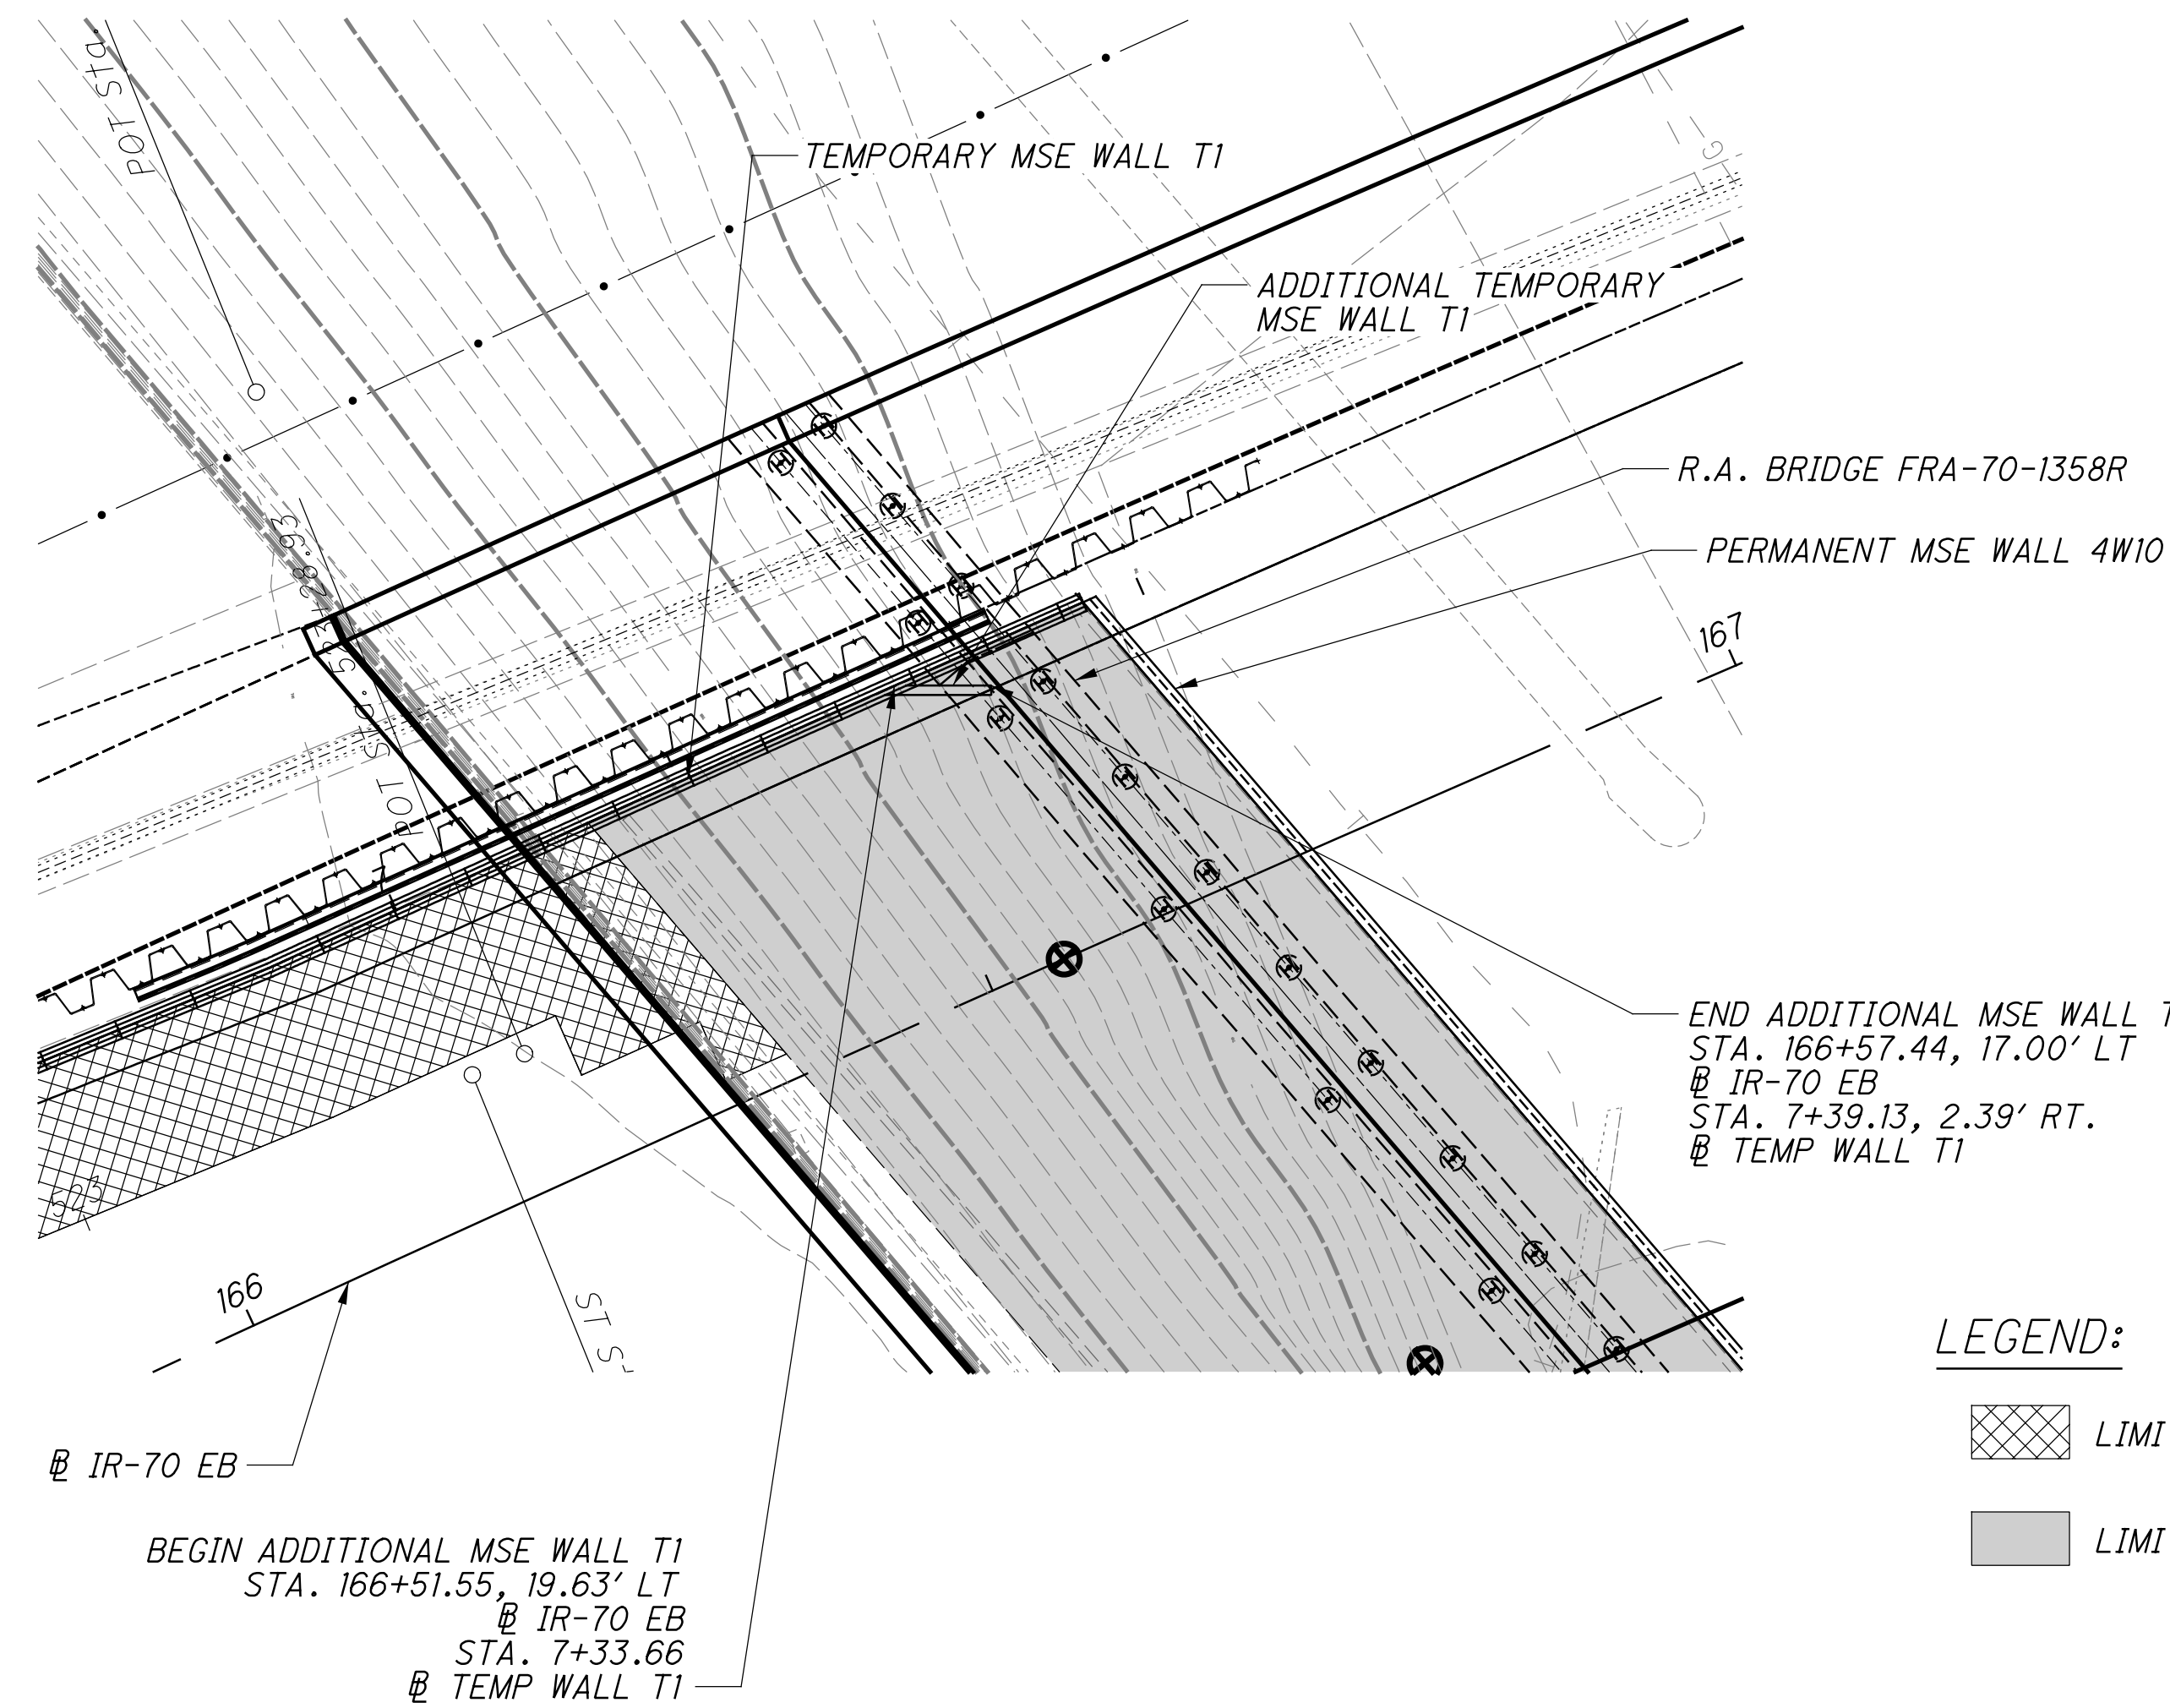

ADDITIONAL TEMPORARY WIRE FACED MSE WALL T1 PLAN

LEGEND:


- LIMITS OF TEMPORARY WALL T1 EXCAVATION
- LIMITS OF PERMANENT WALL 4W10 EXCAVATION

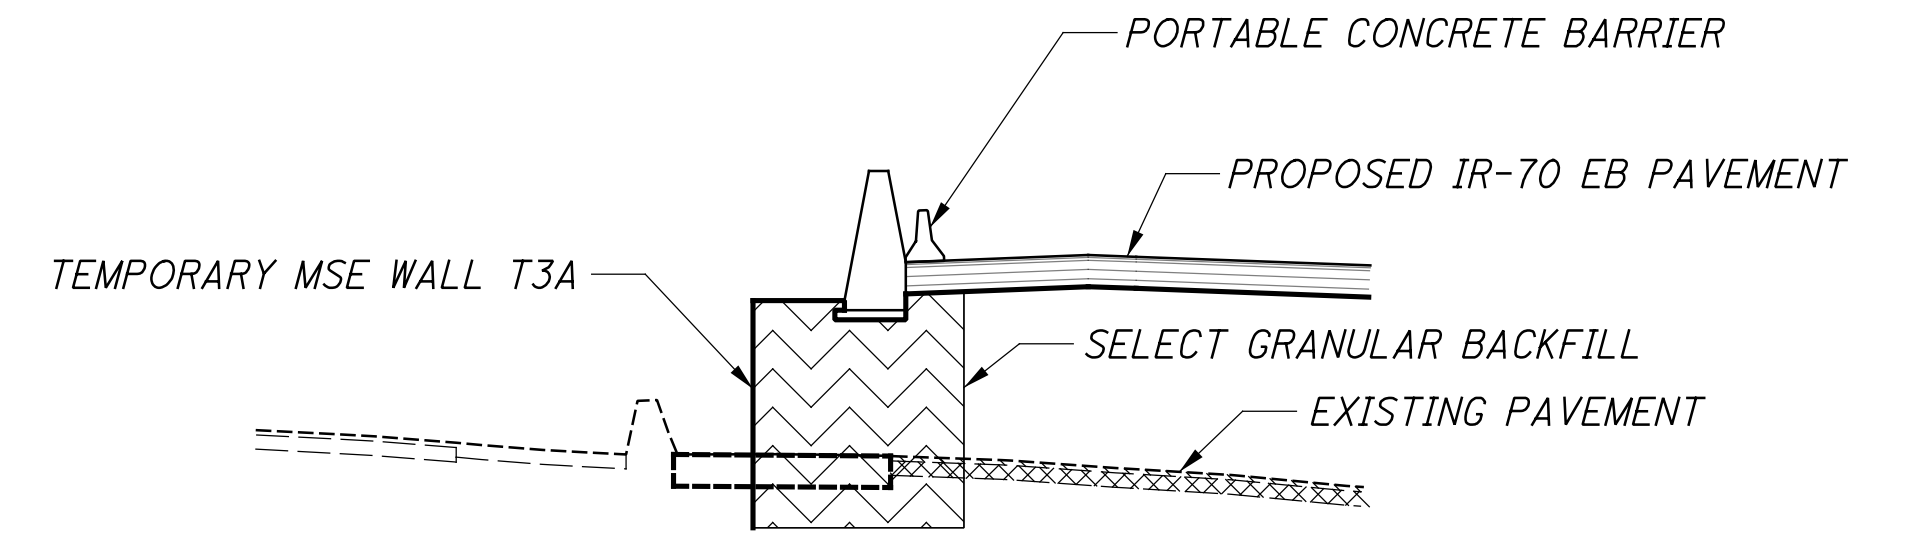

TYPICAL SECTION FOR TEMPORARY MSE WALL T1

NOTE:

SEE SHEET 322 PLAN NOTE ITEM 867 - TEMPORARY WIRE FACED MECHANICALLY STABILIZED EARTH WALL.

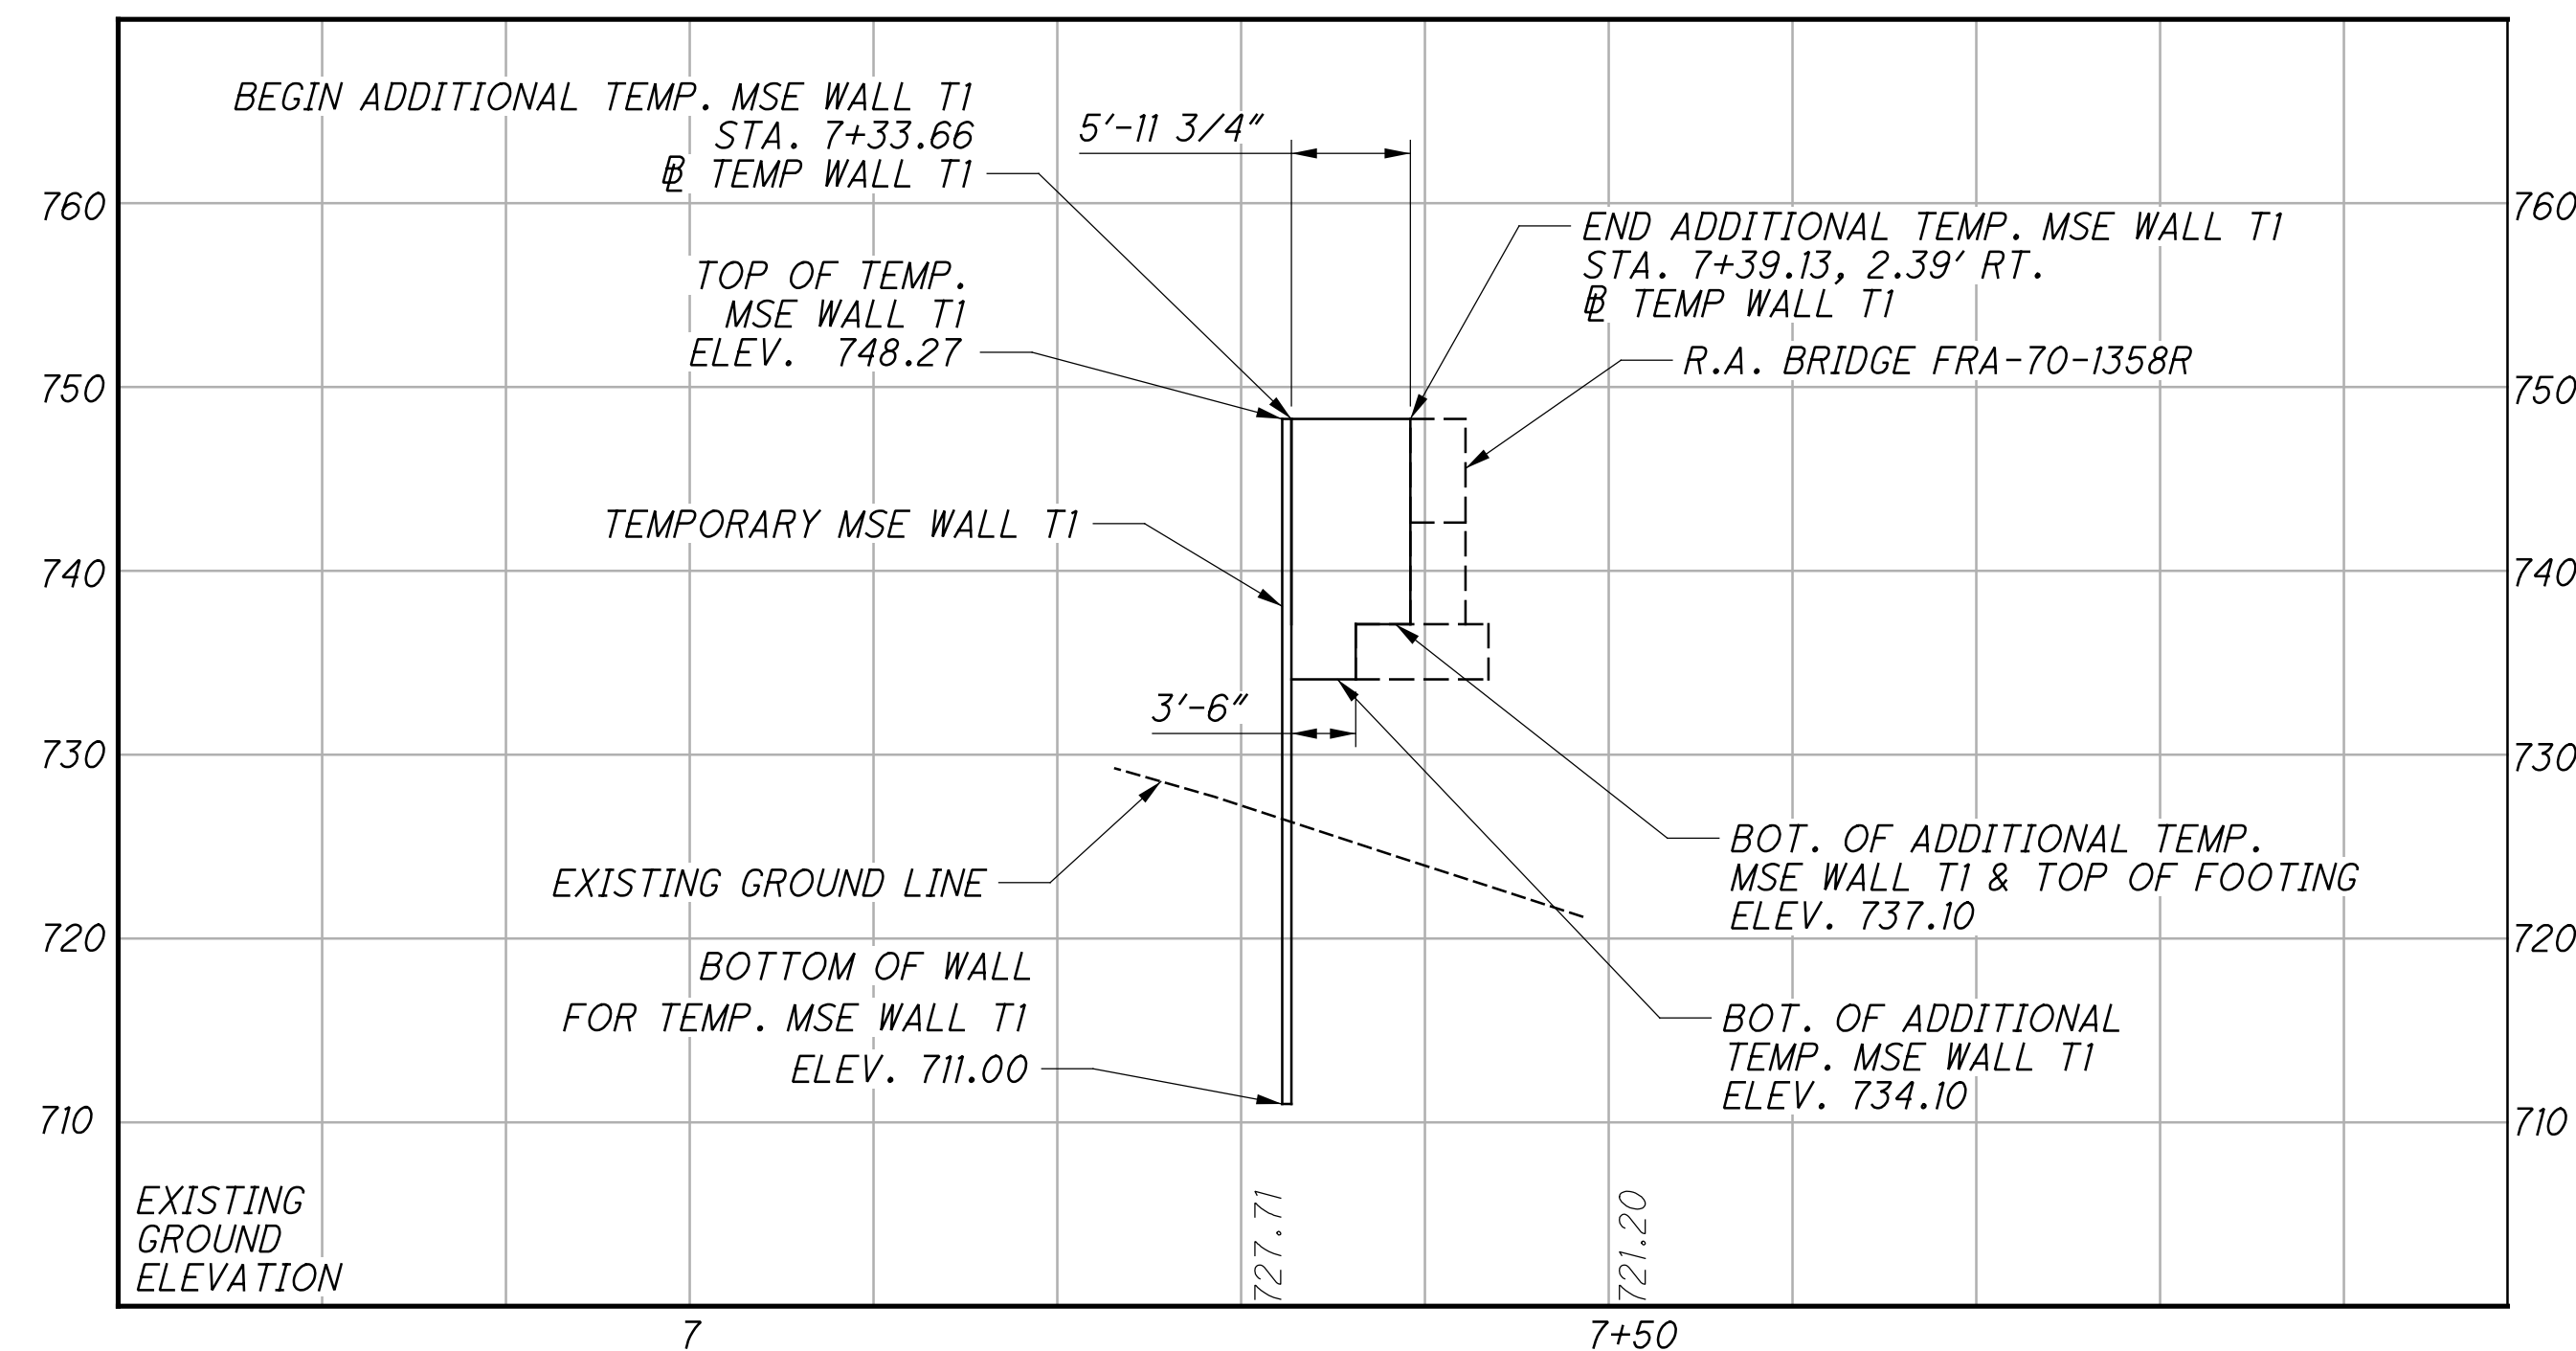


ADDITIONAL TEMPORARY WIRE FACED MSE WALL T1 PROFILE
 (ALONG @ ADDITIONAL TEMPORARY WALL T1)

NOTES:

FOR CP DATA, SEE SHEETS 353, 354 & 355 / 1151


NO.	DESCRIPTION	REV. BY	DATE
5	REMOVED NOTE 1	WCB	11/1/2023

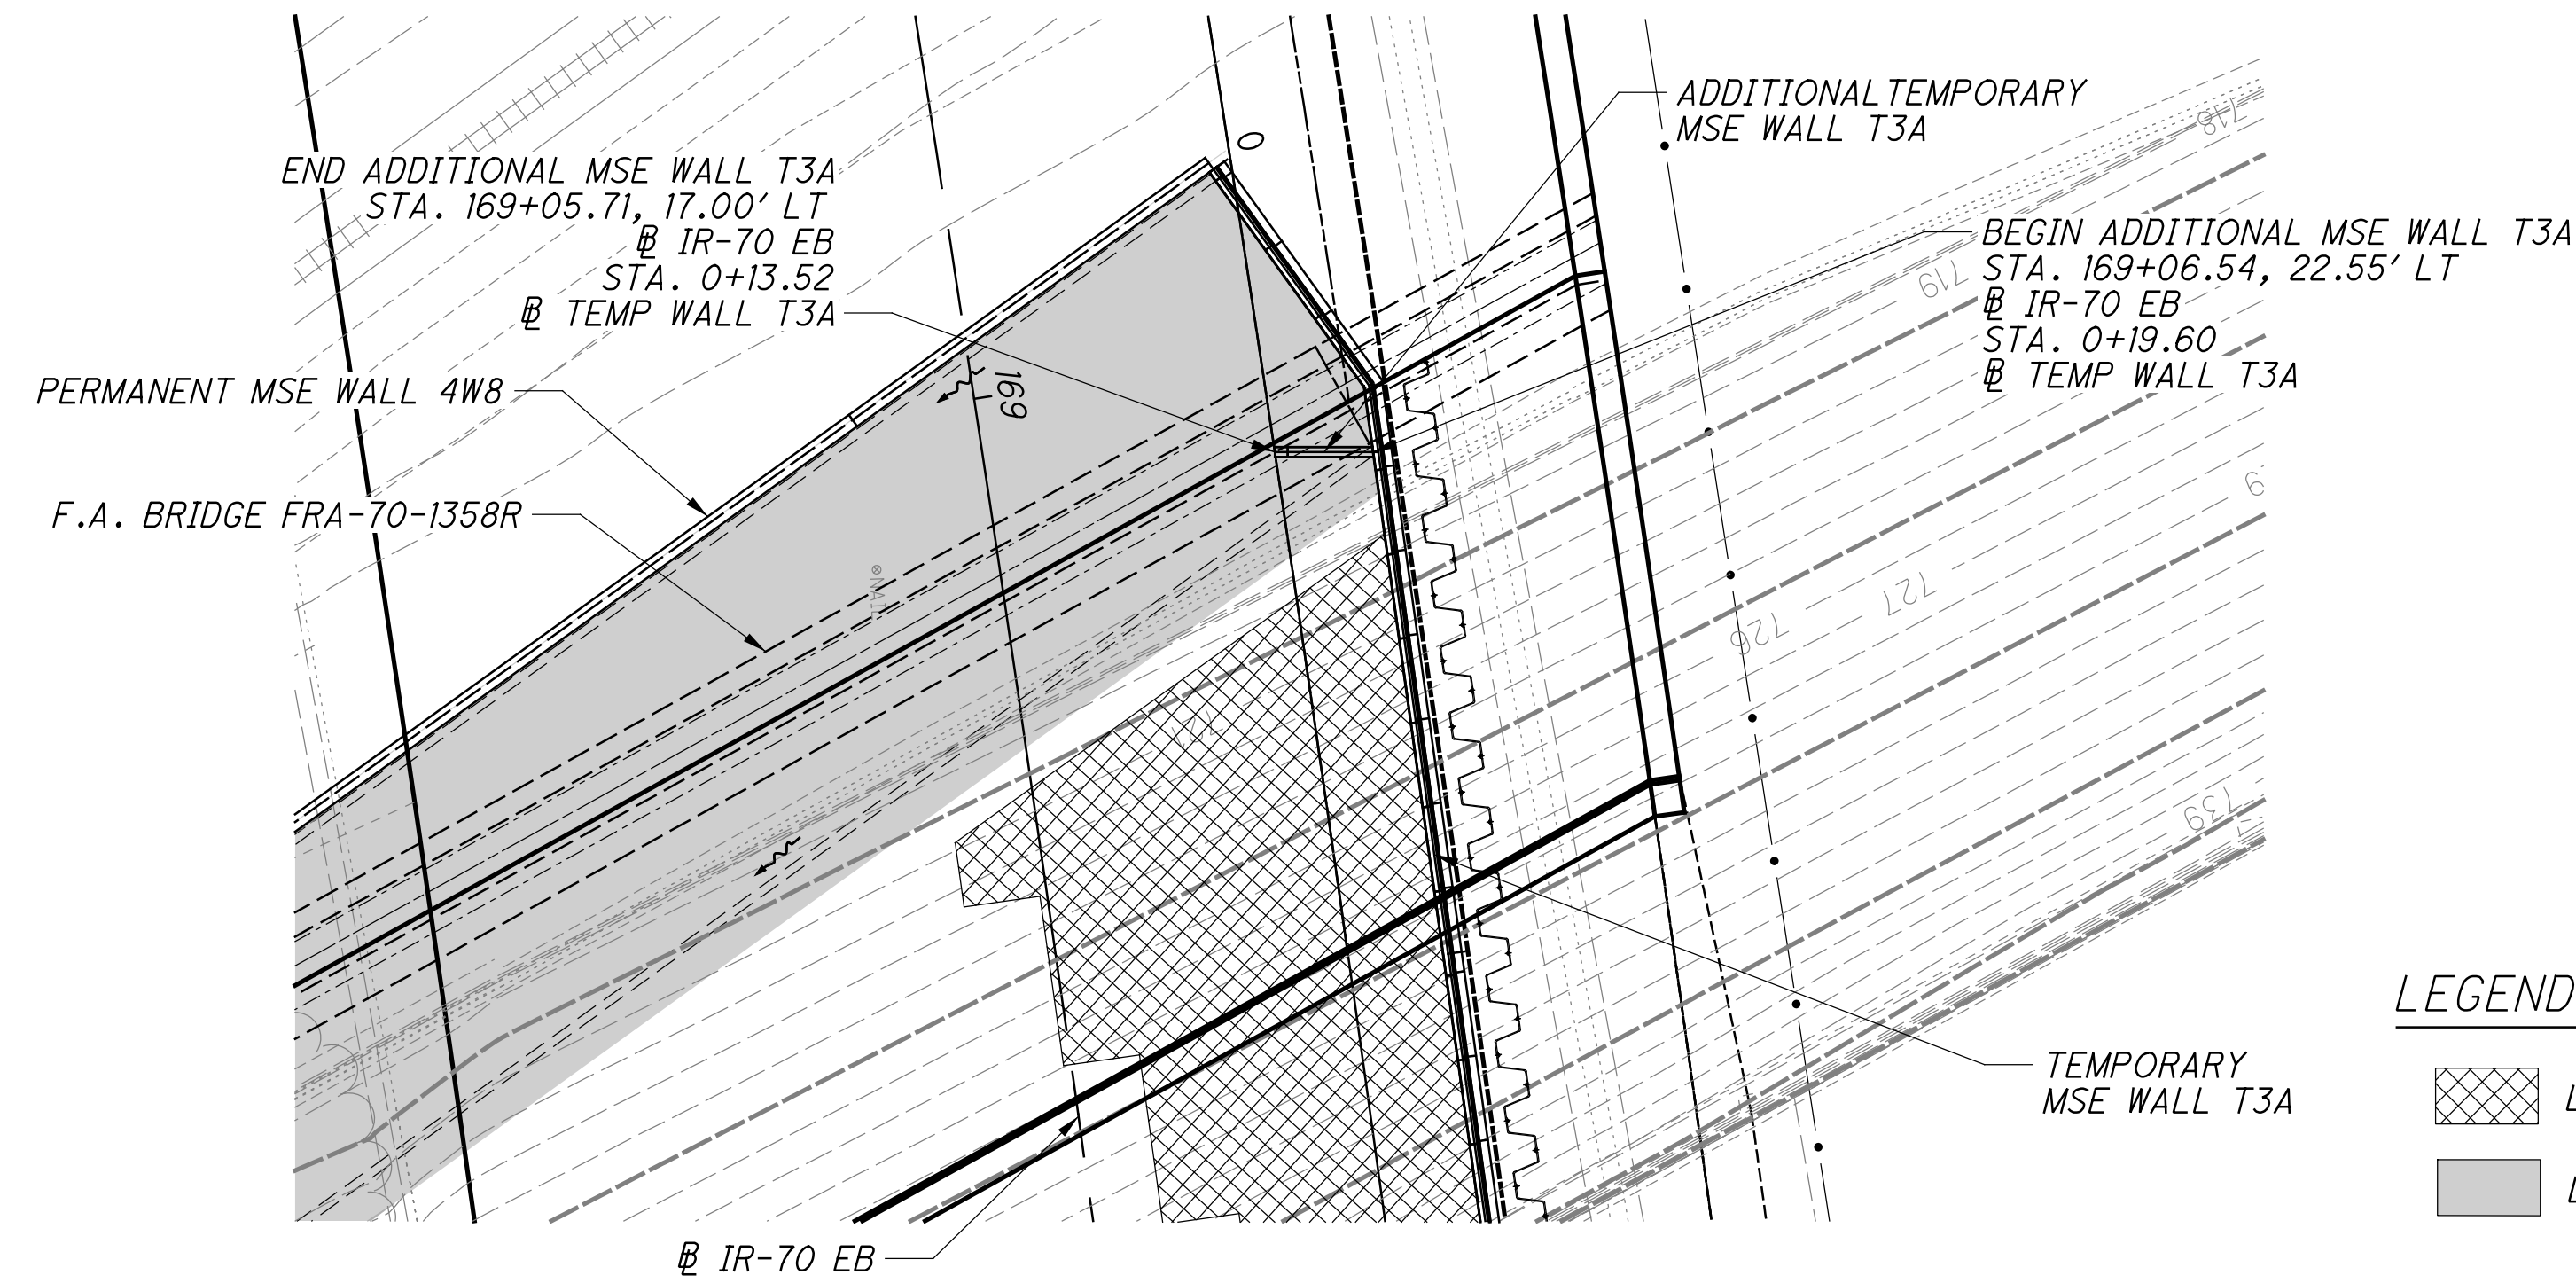

ADDITIONAL TEMPORARY WIRE FACED MSE WALL T3A PLAN


LEGEND:

- LIMITS OF TEMPORARY WALL T3A EXCAVATION
- LIMITS OF PERMANENT WALL 4W8 EXCAVATION

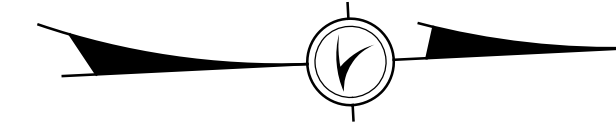


ADDITIONAL WALL T3A BASELINE COORDINATES

0+13.52 N 711835.92 E 1826348.71
 0+19.60 N 711829.85 E 1826348.41

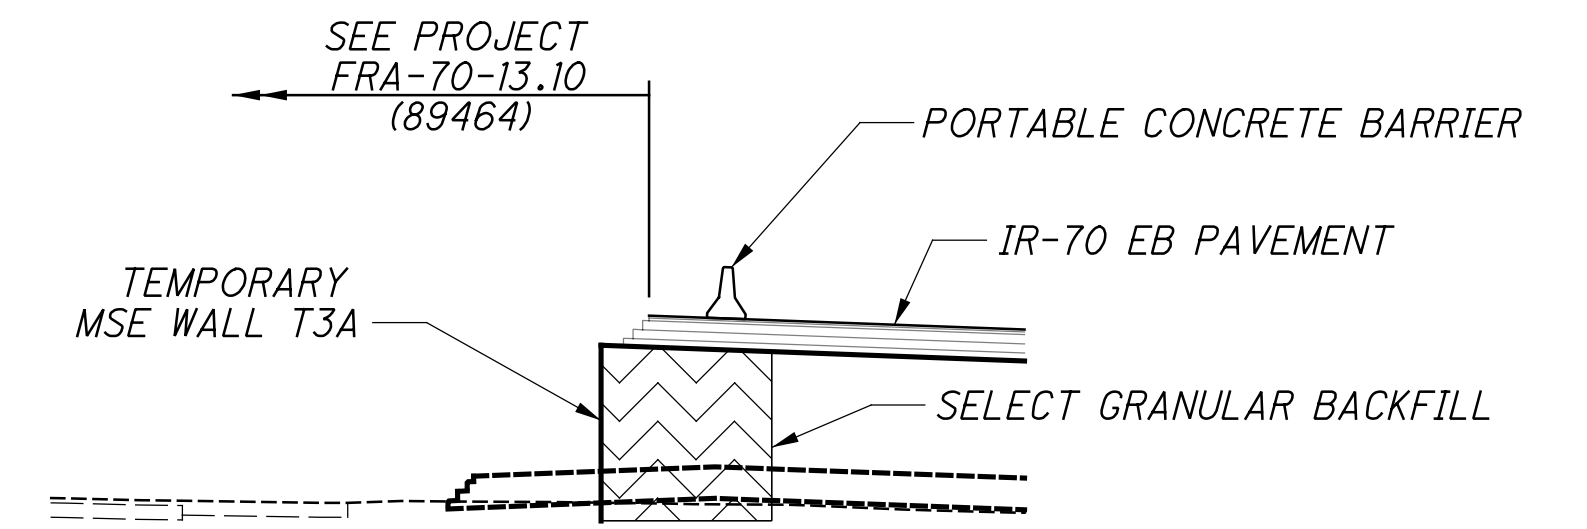

ADDITIONAL TEMPORARY MSE WALL T3A PLAN

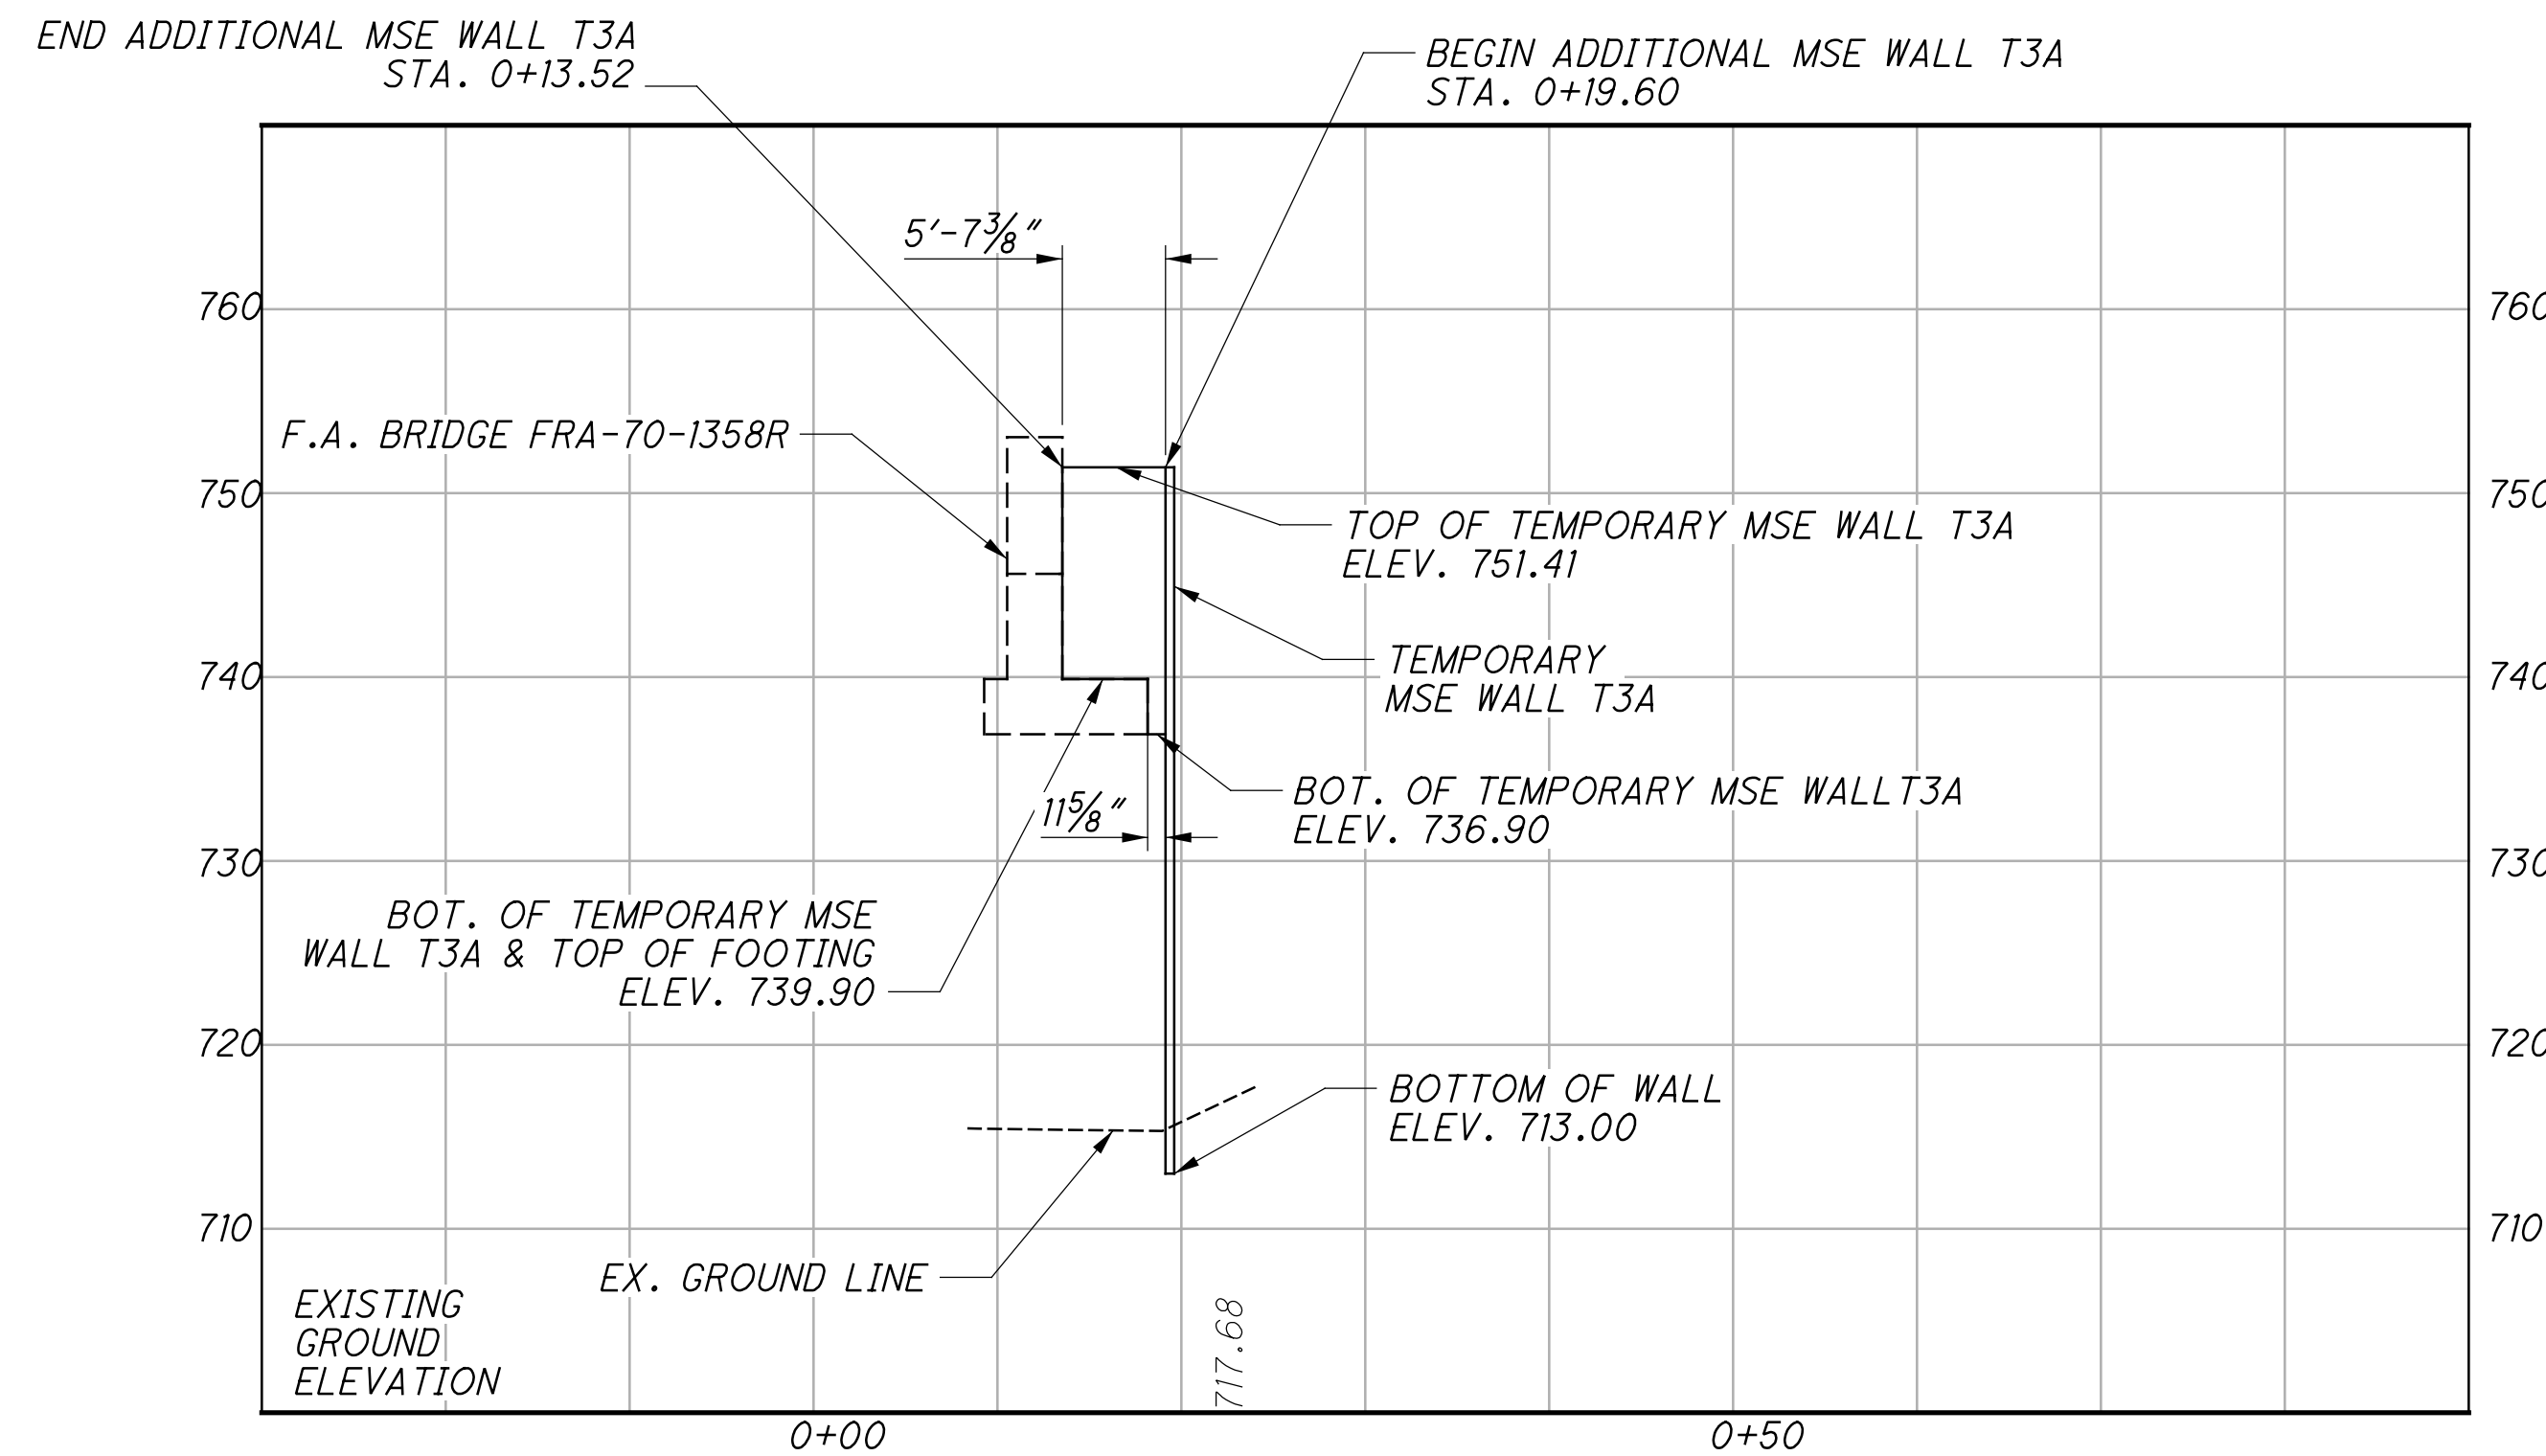


ADDITIONAL TEMPORARY WIRE FACED MSE WALL T3A PROFILE
 (ALONG @ ADDITIONAL TEMPORARY WALL T3A)

NOTE:

SEE SHEET 322 PLAN NOTE "ITEM 867 - TEMPORARY WIRE FACED MECHANICALLY STABILIZED EARTH WALL."

NOTES:


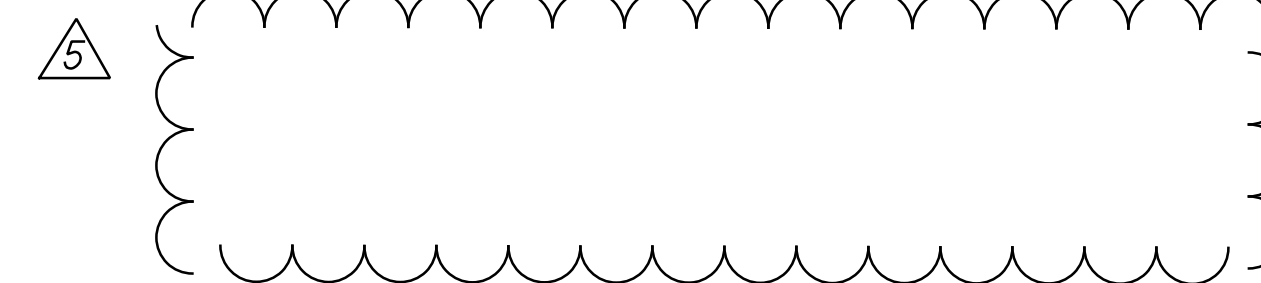


FOR CP DATA, SEE SHEETS 357, 358 & 359 / 1151

NO.	DESCRIPTION	REV. BY	DATE
5	REMOVED NOTE 1	WCB	11/1/2023



NO.	DESCRIPTION	REV. BY	DATE
5	ADDED 105523 MW & TEST NOTE	CWL	10-31-23

FOR I-70 EB PLANS, SEE SHEETS 183 - 210
 FOR RETAINING WALL DETAILS, SEE SHEETS 327 - 339
 FOR ESTIMATED QUANTITIES, SEE SHEETS 169 - 178

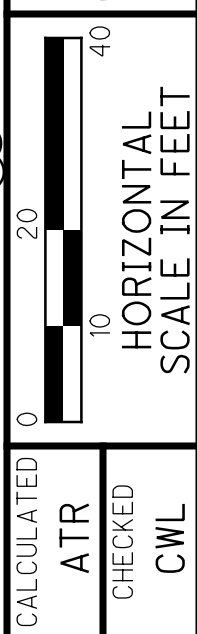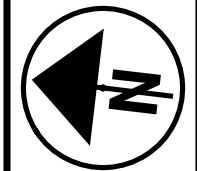

PROJECT 4R (105523)
 NOTES:
 1. CITY TESTING LIMITS FOR 20" WATER MAIN TO INCLUDE BETWEEN VALVES INSTALLED IN 4R 105523 PART 1:
 FULTON - 19+42.63, 28.56' LT.
 LIVINGSTON - 204+25.66, 33.89' RT.

- 1 11+21.32, C (WATERLINE)
20" SOLID SLEEVE
- 2 11+28.70, C (WATERLINE)
45° HORZ. BEND
(ROTATED TO GRADE)
- 3 11+38.60, C (WATERLINE)
45° HORZ. BEND
- 4 12+15.33, C (WATERLINE)
22.5° HORZ. BEND
(ROTATED TO GRADE)
- 5 12+40.73, C (WATERLINE)
22.5° HORZ. BEND
(ROTATED TO GRADE)
- 6 12+46.73, C (WATERLINE)
20" SOLID SLEEVE

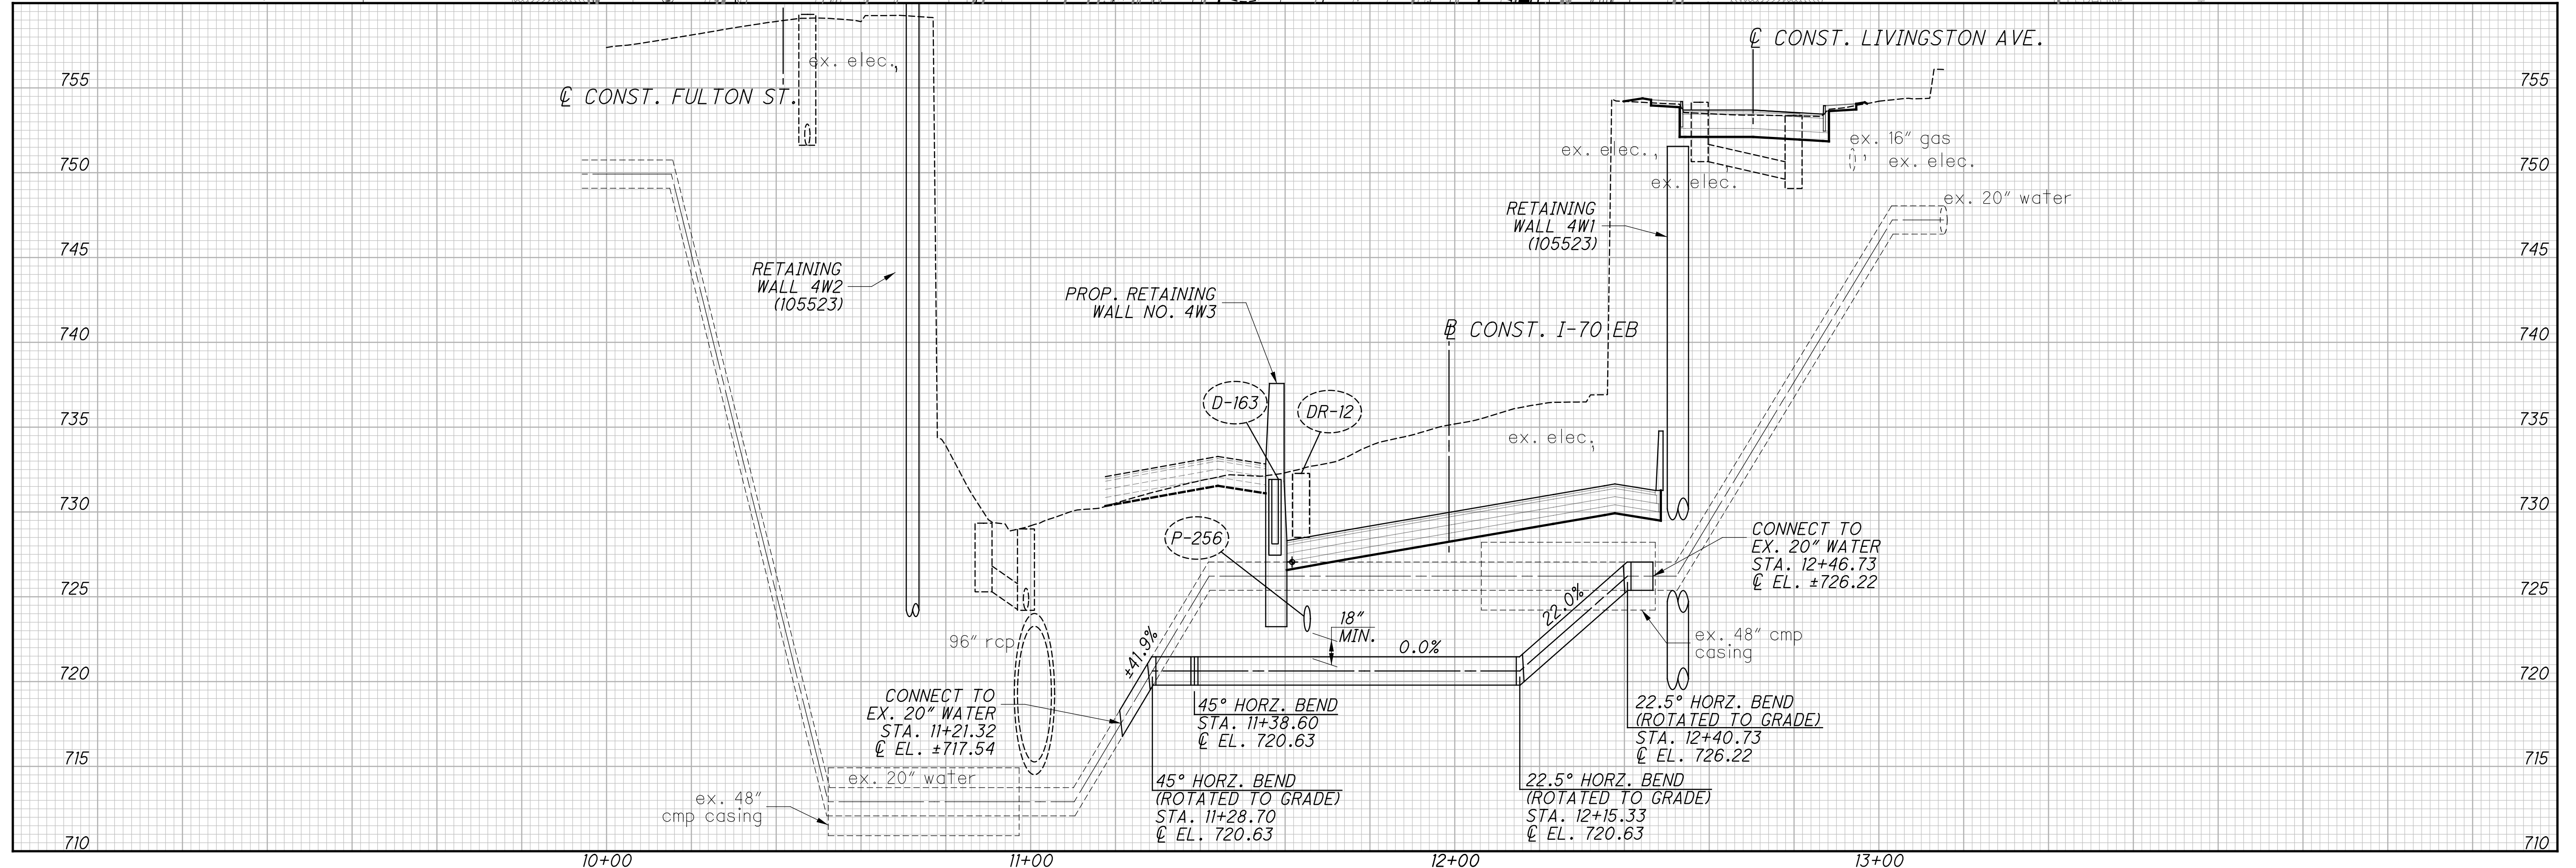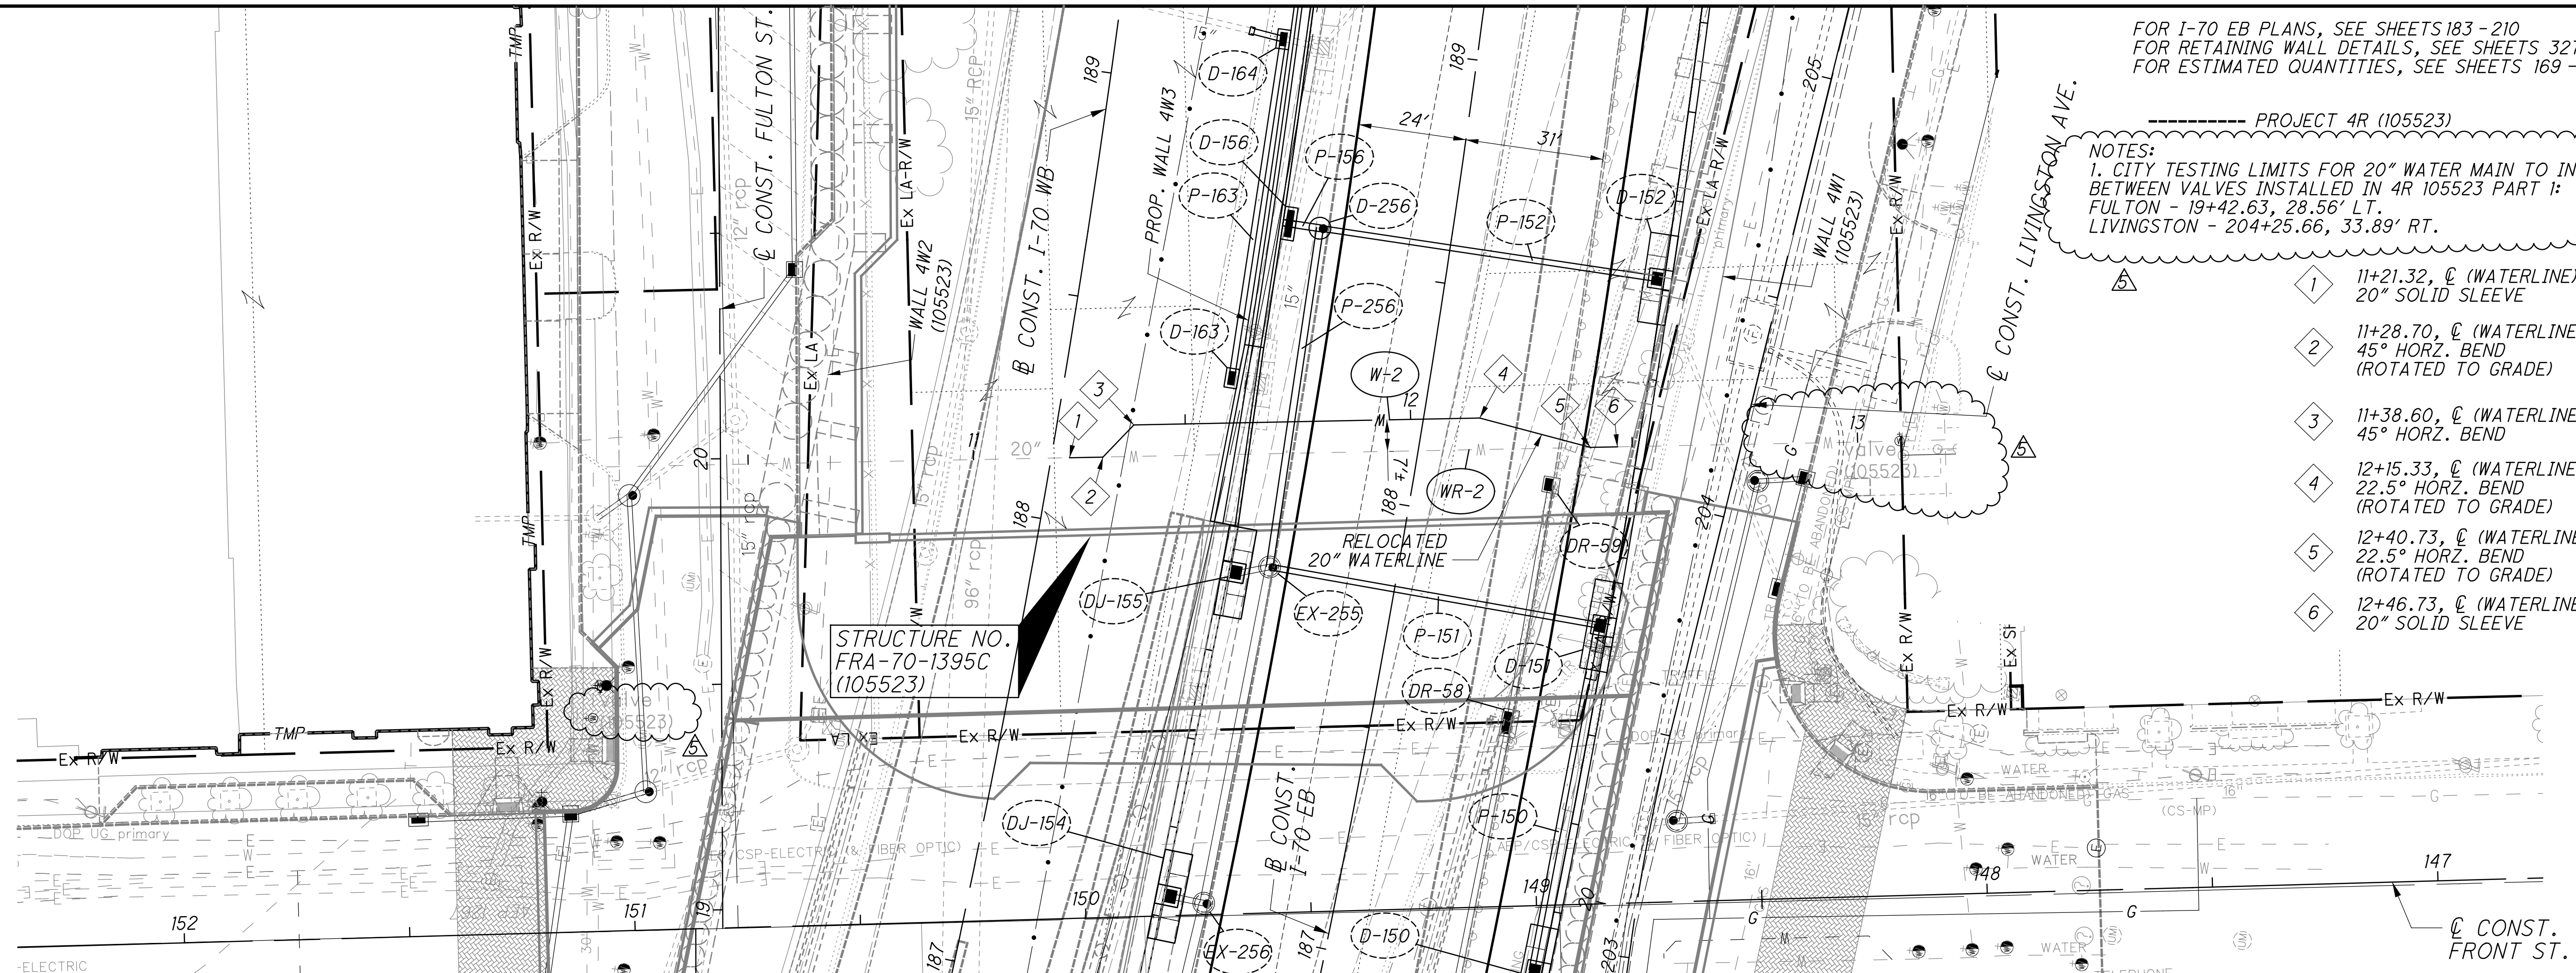

WATER WORK PLAN AND PROFILE
20" WATERLINE

FRA-70-13.11

361
1151

D:\2012\2013048\FRA\7372\UTILITIES\SHEETS\7372UP001.DGN
 10/31/2023
 9:53:08 AM
 DDDTV81STD_USER

SHEET NUMBER										PARTICIPATION			ITEM	ITEM EXT.	GRAND TOTAL	UNIT	DESCRIPTION	SEE SHEET NO.
164	372	373	374	375	376	377	378	379		01/IMS/04								
	494												621	00100	494	EACH	RPM	
	494												621	54000	494	EACH	RAISED PAVEMENT MARKER REMOVED	
								4					625	32000	4	EACH	GROUND ROD	
113													626	00102	113	EACH	BARRIER REFLECTOR, TYPE 1, ONE-WAY	
72													626	00110	72	EACH	BARRIER REFLECTOR, TYPE 2, ONE-WAY	
							153.5						630	02100	153.5	FT	GROUND MOUNTED SUPPORT, NO. 2 POST	
							193.2						630	03100	193.2	FT	GROUND MOUNTED SUPPORT, NO. 3 POST	
							62.0						630	04101	62.0	FT	GROUND MOUNTED SUPPORT, NO. 4 POST, AS PER PLAN	370
							10						630	08600	10	EACH	SIGN POST REFLECTOR	
								1					630	72410	1	EACH	OVERHEAD SIGN SUPPORT, TYPE TC-15.116, DESIGN 1	
								1					630	72420	1	EACH	OVERHEAD SIGN SUPPORT, TYPE TC-15.116, DESIGN 2	
								15					630	75000	15	EACH	SIGN ATTACHMENT ASSEMBLY	
							235.8	12.5					630	80100	248.3	SF	SIGN, FLAT SHEET	
								537.0					630	80224	537.0	SF	SIGN, OVERHEAD EXTRUSHEET	
								9					630	82000	9	EACH	SIGN BACKING ASSEMBLY	
								1					630	84000	1	EACH	CONCRETE BARRIER MEDIAN OVERHEAD SIGN SUPPORT FOUNDATION, TC-21.40	
								1					630	84010	1	EACH	CONCRETE BARRIER MEDIAN OVERHEAD SIGN SUPPORT FOUNDATION, TC-21.50	
								2					630	84510	2	EACH	RIGID OVERHEAD SIGN SUPPORT FOUNDATION	
							15						630	84900	15	EACH	REMOVAL OF GROUND MOUNTED SIGN AND DISPOSAL	
							27						630	86002	27	EACH	REMOVAL OF GROUND MOUNTED POST SUPPORT AND DISPOSAL	
								11					630	87100	11	EACH	REMOVAL OF OVERHEAD MOUNTED SIGN AND REERECTION	
								3					630	87400	3	EACH	REMOVAL OF OVERHEAD MOUNTED SIGN AND DISPOSAL	
								1					630	89706	1	EACH	REMOVAL OF OVERHEAD SIGN SUPPORT AND DISPOSAL, TYPE TC-12.30	
								1					630	89802	1	EACH	REMOVAL OF OVERHEAD SIGN SUPPORT AND DISPOSAL, TYPE TC-7.65	
		249		12					76				644	00720	337	FT	CHEVRON MARKING	
			1						1				644	01350	2	EACH	LANE REDUCTION ARROW	
		83		27	75								646	10620	185	FT	CHEVRON MARKING	
		0.25	0.92	0.36	0.19								807	12010	1.72	MILE	WET REFLECTIVE EPOXY PAVEMENT MARKING, EDGE LINE, 6"	
		0.04	0.35	0.54	0.21								807	12110	1.14	MILE	WET REFLECTIVE EPOXY PAVEMENT MARKING, LANE LINE, 6"	
		266	3796	268	677								807	12310	5007	FT	WET REFLECTIVE EPOXY PAVEMENT MARKING, CHANNELIZING LINE, 12"	
			351										807	12410	351	FT	WET REFLECTIVE EPOXY PAVEMENT MARKING, DOTTED LINE, 6"	
		1.30	0.39	0.37	0.39	2.30							807	14010	4.75	MILE	WET REFLECTIVE THERMOPLASTIC PAVEMENT MARKING, EDGE LINE, 6"	
		0.53	0.10	0.78	0.58	0.14							807	14110	2.13	MILE	WET REFLECTIVE THERMOPLASTIC PAVEMENT MARKING, LANE LINE, 6"	
		0.11											807	14200	0.11	MILE	WET REFLECTIVE THERMOPLASTIC PAVEMENT MARKING, CENTER LINE	
		4492	295	820	1950	2727							807	14310	10284	FT	WET REFLECTIVE THERMOPLASTIC PAVEMENT MARKING, CHANNELIZING LINE, 12"	
			249			2567							807	14410	2816	FT	WET REFLECTIVE THERMOPLASTIC PAVEMENT MARKING, DOTTED LINE, 6"	
		2.04	0.49	1.15	0.97	2.44							850	10010	7.09	MILE	GROOVING FOR 6" RECESSED PAVEMENT MARKING, (ASPHALT)	
			249			2567							850	10110	2816	FT	GROOVING FOR 6" RECESSED PAVEMENT MARKING, (ASPHALT)	
		4492	295	820	1950	2727							850	10130	10284	FT	GROOVING FOR 12" RECESSED PAVEMENT MARKING, (ASPHALT)	
		0.29	1.27	0.90	0.40								850	20010	2.86	MILE	GROOVING FOR 6" RECESSED PAVEMENT MARKING, (CONCRETE)	
			351										850	20110	351	FT	GROOVING FOR 6" RECESSED PAVEMENT MARKING, (CONCRETE)	
		266	3796	268	677								850	20130	5007	FT	GROOVING FOR 12" RECESSED PAVEMENT MARKING, (CONCRETE)	

TRAFFIC CONTROL GENERAL SUMMARY

FRA-70-13.11

NO.	DESCRIPTION	REV. BY	DATE
5	REVISED QUANTITY	AKF	11-2-23

371
1151

SHEET NO.	REF. NO.	LOCATION	STATION		SIDE	MARKING DESCRIPTIONS																				CALCULATED SLB CHECKED AKF
			FROM	TO		644	644	646	807	807	807	807	807	807	807	807	807	807	807	850	850	850	850	850	850	
			FT	FT		FT	FT	FT	FT	FT	FT	FT	FT	FT	FT	FT	FT	FT	FT	FT	FT	FT	FT	FT	FT	
382	CH	I-70 EB	103+31	111+67	RT																					
382	CH	I-70 EB	103+31	111+67	RT																					
382	EW	I-70 EB	103+31	117+00	RT																					
382	LL	I-70 EB	111+67	117+00	RT																					
382	CDW	I-70 EB	114+43	117+00	CEN																					
382	LL	I-70 EB	114+43	117+00	LT																					
382	EY	I-70 EB	114+43	117+00	RT																					
383	EY	I-70 EB	117+00	126+96	LT																					
383	EY	I-70 EB	126+96	128+00	LT																					
383	LL	I-70 EB	117+00	126+96	LT																					
383	LL	I-70 EB	126+96	128+00	LT																					
383	CDW	I-70 EB	117+00	120+00	CEN																					
383	CH	I-70 EB	117+00	126+96	RT																					
383	CH	I-70 EB	126+96	128+00	RT																					
383	CH	I-70 EB	117+00	126+96	RT																					
383	CH	I-70 EB	126+96	128+00	RT																					
383	CM	I-70 EB	117+00	126+96	RT	213																				
383	CM	I-70 EB	126+96	128+00	RT			83																		
383	LL	I-70 EB	117+00	126+96	RT																					
383	LL	I-70 EB	126+96	128+00	RT																					
383	EW	I-70 EB	117+00	126+96	RT																					
383	EW	I-70 EB	126+96	128+00	RT																					
384	EY	I-70 EB	128+00	128+28	LT																					
384	LL	I-70 EB	128+00	128+28	LT																					
384	CH	I-70 EB	128+00	128+28	RT																					
384	CH	RAMP C5	5032+37	5032+68	LT																					
384	EY	RAMP C5	5032+68	5041+58	LT																					
384	EY	RAMP C5	5041+58	5046+65	LT																					
384	CH	RAMP C5	5032+38	5032+68	CEN																					
384	CH	RAMP C5	5032+68	5039+05	CEN																					
384	EW	RAMP C5	5039+05	5041+58	CEN																					
384	EW	RAMP C5	5041+58	5046+65	CEN																					
384	CH	RAMP C5	5037+14	5039+05	RT																					
384	CM	RAMP C5	5037+14	5039+05	RT	36																				
384	EW	RAMP C5	5032+39	5032+68	RT																					
384	EW	RAMP C5	5032+68	5037+68	RT																					
384	EY	RAMP C5	3004+39	3011+71	LT																					
384	EW	RAMP C5	3003+00	3011+71	CEN																					
TOTAL						249		83	639	640	236	266		2875	3989	2782	557	4492		10760	4492	1515		266		
TOTAL MILES									0.25	0.04				1.30	0.53	0.11				2.04		0.29				
TOTALS CARRIED TO TRAFFIC CONTROL GENERAL SUMMARY						249		83	0.25	0.04		266		1.30	0.53	0.11	4492			2.04		0.29		266		

NO.	DESCRIPTION	REV. BY	DATE
5	REVISED QUANTITY	AKF	11-2-23

01-2012-2012048 VFA\7372\TRAFFIC SHEETS\7372\S013.DGN
 11/2/2023 7:03:30 AM
 DDC\Y81STD\USER

SHEET NO.	REF. NO.	LOCATION	STATION		SIDE	MARKING DESCRIPTIONS																					CALCULATED SLB CHECKED AKF
			FROM	TO		644	644	646	807	807	807	807	807	807	807	807	807	807	807	850	850	850	850	850	850		
			FT	FT		FT	FT	FT	FT	FT	FT	FT	FT	FT	FT	FT	FT	FT	FT	FT	FT	FT	FT	FT	FT	FT	
386	EY	I-70 EB	155+00	159+16	LT				416															416			
386	EY	I-70 EB	159+16	166+31	LT																						
386	EY	I-70 EB	166+31	168+00	LT																						
386	LL	I-70 EB	155+00	159+10	LT																						
386	LL	I-70 EB	159+10	166+34	LT																						
386	LL	I-70 EB	166+34	168+00	LT																						
386	LL	I-70 EB	155+00	158+98	RT																						
386	LL	I-70 EB	158+98	166+38	RT																						
386	LL	I-70 EB	166+38	168+00	RT																						
386	LL	I-70 EB	155+00	158+87	RT																						
386	LL	I-70 EB	158+87	166+41	RT																						
386	LL	I-70 EB	166+41	168+00	RT																						
386	LL	I-70 EB	155+00	158+75	RT																						
386	LL	I-70 EB	158+75	166+45	RT																						
386	LL	I-70 EB	166+45	168+00	RT																						
386	EY	RAMP C5	5059+85	5062+41	LT																						
386	EY	RAMP C5	5062+41	5071+09	LT																						
386	EY	RAMP C5	5071+09	5072+49	LT																						
386	LL	RAMP C5	5059+85	5062+27	LT																						
386	LL	RAMP C5	5062+27	5064+56	LT																						
386	CH	RAMP C5	5064+56	5071+13	LT																						
386	CH	RAMP C5	5071+13	5072+49	LT																						
386	LL	RAMP C5	5059+84	5062+13	CEN																						
386	LL	RAMP C5	5062+13	5071+17	CEN																						
386	LL	RAMP C5	5071+17	5072+49	CEN																						
386	CH	RAMP C5	5069+54	5071+17	LT																						
386	CH	RAMP C5	5071+17	5072+49	LT																						
386	CM	RAMP C5	5069+54	5071+17	LT	12																					
386	CM	RAMP C5	5071+17	5072+49	LT			27																			
386	EW	RAMP C5	5059+83	5061+99	RT																						
386	EW	RAMP C5	5061+99	5071+20	RT																						
386	EW	RAMP C5	5071+20	5072+49	RT																						
TOTAL						12		27	981	921	2815	268			1583	345	4121		820		6049		820	4717		268	
TOTAL MILES									0.36	0.54					0.37		0.78				1.15			0.90			
TOTALS CARRIED TO TRAFFIC CONTROL GENERAL SUMMARY						12		27	△ 0.36	0.54	268			0.37		0.78	△	820		1.15		820		0.90		268	

PAVEMENT MARKING SUBSUMMARY - SHEET 3 OF 5

FRA-70-13.11

375
1151

GENERAL NOTES

REFER TO THE FOLLOWING STANDARD BRIDGE DRAWINGS:

AS-1-15	REVISED	7-17-15
AS-2-15	REVISED	1-18-19
GSD-1-19	REVISED	1-15-21
SBR-1-13	REVISED	7-20-18
SBR-2-13	REVISED	7-20-18

AND THE FOLLOWING SUPPLEMENTAL SPECIFICATIONS:

800	DATED	1-20-23
832	DATED	10-19-18
869	DATED	10-17-14
894	DATED	4-16-21

DESIGN SPECIFICATIONS

THIS STRUCTURE CONFORMS TO THE "LRFD BRIDGE DESIGN SPECIFICATIONS" ADOPTED BY THE AMERICAN ASSOCIATION OF STATE HIGHWAY AND TRANSPORTATION OFFICIALS, 7TH EDITION, 2014 AND THE ODOT BRIDGE DESIGN MANUAL, 2007 EDITION, INCLUDING REVISIONS THROUGH JULY 2015.

SPECIAL DESIGN SPECIFICATIONS

THIS BRIDGE REQUIRED THE USE OF OF A THREE DIMENSIONAL MODEL USING THE FINITE ELEMENT DESIGN METHOD TO ANALYZE THE STRUCTURE. THE COMPUTER PROGRAM USED FOR STRUCTURAL ANALYSIS WAS MIDAS CIVIL 2015 (VERSION 2.2, BUILD 4/14/2015). THIS PROGRAM WAS USED TO CALCULATE FORCES FOR THE DESIGN OF THE STEEL GIRDERS, CROSSFRAMES AND GIRDER END DIAPHRAGMS AND TO CALCULATE REACTIONS FOR THE DESIGN OF THE BEARINGS AND SUBSTRUCTURES.

DEAD LOAD DISTRIBUTION: THE WEIGHT OF THE STEEL SUPERSTRUCTURE AND CONCRETE DECK WAS APPLIED TO EACH ELEMENT IN THE MODEL BASED ON LOCAL SECTION PROPERTIES AND TRIBUTARY AREA. THE WEIGHT OF THE FUTURE WEARING SURFACE WAS APPLIED EQUALLY TO EACH GIRDER WITHIN A GIVEN SPAN. PARAPET WEIGHT WAS APPLIED TO THE EXTERIOR GIRDERS ONLY WITHIN THE 3D DESIGN MODEL.

LIVE LOAD DISTRIBUTION: THE DESIGN ANALYSIS WAS CARRIED OUT BY APPLYING TRUCK AND LANE LOADS DIRECTLY TO THE FINITE ELEMENT MODEL, RATHER THAN BY USING CALCULATED DISTRIBUTION FACTORS.

OPERATIONAL IMPORTANCE: A LOAD MODIFIER OF 1.05 HAS BEEN ASSUMED FOR THE DESIGN OF THIS STRUCTURE IN ACCORDANCE WITH AASHTO LRFD BRIDGE DESIGN SPECIFICATIONS, ARTICLE 1.3.5 AND ODOT BRIDGE DESIGN MANUAL, 2007.

DESIGN LOADING: HL-93
FUTURE WEARING SURFACE (FWS) = 0.060 KSF

DESIGN DATA:

CONCRETE CLASS QC2 (SUPERSTRUCTURE) - COMPRESSIVE STRENGTH 4.5KSI
 CONCRETE CLASS QC5 - COMPRESSIVE STRENGTH 4.0 KSI (DRILLED SHAFT)
 CONCRETE CLASS QC1 (SUBSTRUCTURE) - COMPRESSIVE STRENGTH 4.0 KSI (ABUTMENT)
 MASS CONCRETE CLASS QC4 (SUBSTRUCTURE) - COMPRESSIVE STRENGTH 4.0 KSI (PIER CAPS AND COLUMNS)
 REINFORCING STEEL - MINIMUM YIELD STRENGTH 60 KSI
 STRUCTURAL STEEL - ASTM A709 GRADE 50W - YIELD STRENGTH 50 KSI (GIRDERS, CROSSFRAMES, DIAPHRAGMS, STIFFENERS, FIELD SPLICES)
 STRUCTURAL STEEL - ASTM A709 GRADE HPS70W - YIELD STRENGTH 70 KSI (TOP AND BOTTOM FLANGES OF HYBRID GIRDER SECTIONS NOTED AS SUCH IN THE PLANS)
 STRUCTURAL STEEL - ASTM A709 GRADE 50 - YIELD STRENGTH 50 KSI (MODULAR JOINTS AND PARAPET SLIDING PLATE JOINTS)
 STEEL H-PILES - ASTM A572 GRADE 50 - YIELD STRENGTH 50 KSI

DECK PROTECTION METHOD:

EPOXY COATED REINFORCING STEEL
2 1/2" CONCRETE COVER
CLASS QC2 CONCRETE

MONOLITHIC WEARING SURFACE IS ASSUMED, FOR DESIGN PURPOSES, TO BE 1 INCH THICK.

ITEM 202 - STRUCTURE REMOVED, OVER 20' SPAN

THE EXISTING STRUCTURE SHALL BE REMOVED IN ACCORDANCE WITH CMS ITEM 202. PRIOR TO DEMOLITION OF THE STRUCTURE, THE CONTRACTOR SHALL VERIFY THAT THE EXISTING CITY OF COLUMBUS ELECTRICAL POWER LINE, CARRIED ACROSS THE EXISTING STRUCTURE, HAS BEEN DE-ENERGIZED AND RELOCATED (NEW CONDUIT CONSTRUCTED ONTO FRA-70-1321A STRUCTURE IN PROJECT 4R 105523 PART 1).

PILES TO BEDROCK:

DRIVE PILES TO REFUSAL ON BEDROCK. THE DEPARTMENT WILL CONSIDER REFUSAL TO BE OBTAINED WHEN THE PILE PENETRATION IS AN INCH OR LESS AFTER RECEIVING AT LEAST 20 BLOWS FROM THE PILE HAMMER. SELECT THE HAMMER SIZE TO ACHIEVE THE REQUIRED DEPTH TO BEDROCK AND REFUSAL.

THE TOTAL FACTORED LOAD PER PILE AND THE ORDER LENGTHS ARE AS FOLLOWS:

LOCATION	SIZE	ORDER LENGTH (FEET)	FACTORED LOAD (KIPS)
REAR ABUT.	HP 12x53	75	341
FRWD. ABUT.	HP 12x53	75	325

USE STEEL POINTS TO PROTECT THE TIPS OF THE PROPOSED STEEL H-PILES AT THE REAR AND FORWARD ABUTMENTS.

PILE SPLICES: IN LIEU OF USING THE FULL PENETRATION BUTT WELDS SPECIFIED IN CMS 507.09 TO SPLICE STEEL H-PILES, THE CONTRACTOR MAY USE A MANUFACTURED H-PILE SPLICER. FURNISH SPLICERS FROM THE FOLLOWING MANUFACTURER:

ASSOCIATED PILE AND FITTING CORPORATION
8 WOOD HOLLOW RD. PLAZA 1
PARSIPPANY, NEW JERSEY 07054

INSTALL AND WELD THE SPLICER TO THE PILE SECTIONS IN ACCORDANCE WITH THE MANUFACTURER'S WRITTEN ASSEMBLY PROCEDURE SUPPLIED TO THE ENGINEER BEFORE THE WELDING IS PERFORMED.

**DRILLED SHAFTS, 66" DIAMETER, INTO BEDROCK, AS PER PLAN
DRILLED SHAFTS, 72" DIAMETER, ABOVE BEDROCK, AS PER PLAN**

MAXIMUM FACTORED LOADS TO BE SUPPORTED BY EACH DRILLED SHAFT AND FACTORED RESISTANCE PROVIDED BY EACH DRILLED SHAFT AT PIERS ARE LISTED BELOW. THIS LOAD IS RESISTED BY TIP RESISTANCE ONLY. CONCRETE FOR DRILLED SHAFTS SHALL BE PER CMS REQUIREMENTS EXCEPT THAT THE MAXIMUM COARSE AGGREGATE SIZE TO BE USED IS NO. 8.

LOCATION	FACTORED LOAD (KIPS)	FACTORED TIP RESISTANCE (KIPS)
PIER 1	3,054	8,992
PIER 2	2,786	8,992
PIER 3	2,611	8,879
PIER 4	2,702	8,879

ITEM 509 - EPOXY COATED REINFORCING STEEL, AS PER PLAN:

IN ADDITION TO THE PROVISIONS OF ITEM 509, FIELD BEND AND/OR CUT THE REINFORCING STEEL DESIGNATED IN THE PLANS, AS NECESSARY, IN ORDER TO MAINTAIN THE REQUIRED CLEARANCES AND BAR SPACINGS. REPAIR ALL DAMAGE TO THE EPOXY COATING, AS A RESULT OF THIS WORK, ACCORDING TO 509.

GLASS FIBER REINFORCED POLYMER (GFRP) PARAPET STIFFENING BARS SHALL ALSO BE INCLUDED IN THIS ITEM. SEE SHEET [90/101], [91/101] & [92/101] FOR QUANTITIES AND DETAILS.

ITEM 511, CLASS QC2 CONCRETE WITH QC/QA, BRIDGE DECK, AS PER PLAN

LOCATE THE LOWER CONTACT POINT OF THE OVERHANG FALSEWORK NO MORE THAN 17 INCHES ± 2 IN. ABOVE THE TOP OF THE GIRDER'S BOTTOM FLANGE. THE BRACKET CONTACT POINT LOCATION REQUIREMENTS OF C&MS 508 DO NOT APPLY.

ITEM 513 - STRUCTURAL STEEL MEMBERS, HYBRID GIRDER, LEVEL SIX (6) FABRICATION, AS PER PLAN:

1. DESCRIPTION

- A. THIS WORK CONSIST OF FURNISHING ALL NECESSARY LABOR, MATERIALS AND EQUIPMENT TO FURNISH AND ERECT STRUCTURAL STEEL MEMBERS, DESIGNED AS A HYBRID/ MIX OF STEEL MATERIALS CONSISTING OF: ASTM A709, HIGH PERFORMANCE GRADE HSP70W IN COMBINATION WITH GRADE 50W STEEL.
- B. THIS WORK SHALL BE PERFORMED PER ITEM 513 STRUCTURAL STEEL MEMBER, LEVEL SIX(6) EXCEPT AS MODIFIED BY THE JUNE, 2011 3RD EDITION OF THE GUIDE FOR HIGHWAY BRIDGE FABRICATION WITH HPS70W STEEL (HPS485W), A SUPPLEMENT TO ANSI/AASHTO AWS D1.5" AND AS MODIFIED BY THESE PLAN NOTES.

NO.	DESCRIPTION	REV. BY	DATE
5	REVISED NOTE	CWL	11-6-23

2. MATERIALS

A. STEEL FOR GIRDER WEBS AND FLANGES SHALL BE A COMBINATION OF ASTM A709 GRADE HPS70W MANUFACTURED BY THE THERMO-MECHANICAL CONTROLLED PROCESSING (TMCP) OR QUENCHED AND TEMPERED HEAT TREATMENT PROCESSING ALONG WITH ASTM A588/709 GRADE 50W. ALL OTHER STEEL SHALL BE ASTM A709 GRADE 50W.

B. STEEL DESIGNATED CVN SHALL BE IMPACT TESTED TO EXCEED THE TEST VALUES OF ASTM A709 TABLE S1.2 "NON-FRACTURE CRITICAL IMPACT TEST REQUIREMENTS" FOR ZONE 2, TEMPERATURE RANGE.

3. ADDITIONAL FABRICATION RESTRICTIONS / WARNINGS:

A. APPLICATION OF HEAT FOR CURVING AND STRAIGHTENING APPLICATIONS, CAMBER AND SWEEP ADJUSTMENT, OR OTHER REASON HEATING IS LIMITED TO 1100°F/590 C MAXIMUM, AND MUST BE DONE BY PROCEDURES APPROVED BY THE DIRECTOR OR HIS AUTHORIZED REPRESENTATIVE.

B. THE MATCHING SUBMERGED ARC WELDING CONSUMABLES ESAB ENI4 ELECTRODE IN COMBINATION WITH LINCOLN MIL800H, RECOMMENDED IN APPENDIX A OF THE AASHTO GUIDE FOR HIGHWAY BRIDGE FABRICATION WITH HPS70W STEEL, HAS PRODUCED WELDMENT CONTAINING UNACCEPTABLE DISCONTINUITIES IN A SUBSTANTIAL NUMBER OF COMPLETE PENETRATION GROOVE WELDS IN ONE STRUCTURE, BASED ON THE PARAMETERS USED AND EXPERIENCE OF ONE FABRICATOR. EXTREME CAUTION SHOULD BE EXERCISED WHEN USING THIS ELECTRODE/FLUX COMBINATION.

C. CONSIDERATION WILL BE GIVEN TO OTHER WELDING PROCESSES IF A WRITTEN REQUEST IS SUBMITTED TO THE OFFICE OF MATERIALS MANAGEMENT IN ACCORDANCE WITH CMS 108.05. OTHER WELDING PROCESSES MUST BE QUALIFIED AND TESTED AS REQUIRED BY THE REFERENCED SPECIFICATIONS AND THESE NOTES.

D. IN ADDITION TO THE REQUIREMENTS OF ANSI/AASHTO/AWS D1.5 SECTION 5.17. ALL PROCEDURE QUALIFICATION TESTS MUST BE ULTRASONICALLY TESTED IN CONFORMANCE WITH THE REQUIREMENTS OF AWS D1.5, SECTION 6, PART C. EVALUATION MUST BE IN ACCORDANCE WITH AWS D1.5, TABLE 6.3, ULTRASONIC ACCEPTANCE REJECTION CRITERIA TENSILE STRESS. INDICATIONS FOUND AT THE INTERFACE OF THE BACKING BAR MAY BE DISREGARDED, REGARDLESS OF THE DEFECT RATING.

E. WHENEVER MAGNETIC PARTICLE TESTING IS DONE, ONLY THE YOKE TECHNIQUE WILL BE ALLOWED, AS DESCRIBED IN SECTION 6.7.6.2 OF THE ANSI/AASHTO/AWS D1.5 BRIDGE WELDING CODE, MODIFIED TO TEST USING ALTERNATING CURRENT ONLY. THE PROD TECHNIQUE WILL NOT BE ALLOWED.

4. BASIS OF PAYMENT:

PAYMENT FOR THE ABOVE COMPLETED AND ACCEPTED QUANTITIES WILL BE MADE AT THE CONTRACT BID PRICE FOR:

ITEM	EXT	UNITS	DESCRIPTION
513	10401	POUND	STRUCTURAL STEEL MEMBERS, HYBRID GIRDER, LEVEL SIX (6) FABRICATION, AS PER PLAN.

ITEM 513 - STRUCTURAL STEEL, MISC.: PARAPET SLIDING PLATE JOINT:

THIS WORK CONSISTS OF FURNISHING, FABRICATING, COATING AND ERECTING STRUCTURAL STEEL PARAPET SLIDING PLATE JOINT ASSEMBLIES PLACED ADJACENT TO, AND IN CONJUNCTION WITH, BRIDGE DECK MODULAR EXPANSION JOINTS FURNISHED UNDER A SEPARATE ITEM. ALL WORK SHALL BE IN ACCORDANCE WITH CMS 513 AND THE PLAN DETAILS. COAT PARAPET SLIDING PLATE ASSEMBLIES IN ACCORDANCE WITH CMS 516.03.

PAYMENT SHALL BE MADE FOR ACCEPTED QUANTITIES AT THE CONTRACT PRICE PER EACH PARAPET JOINT ASSEMBLY UNDER ITEM 513 - STRUCTURAL STEEL, MISC.: PARAPET SLIDING PLATE JOINT WHICH PRICE SHALL INCLUDE ALL LABOR, MATERIALS, TOOLS AND INCIDENTALS FOR A COMPLETE FUNCTIONING ASSEMBLY.

ITEM 516 - SPECIAL - MODULAR EXPANSION JOINT

ABUTMENT JOINTS SHALL BE WATSON BOWMAN ACME (WABO MODULAR), DS BROWN (STEELFLEX MODULAR), OR APPROVED ALTERNATE.

THE MANUFACTURER SHALL SUBMIT DESIGN CALCULATIONS SHOWING THAT THE DEVICE CAN MEET THE IMPACT AND FATIGUE DESIGN REQUIREMENTS SET FORTH BY THE CURRENT AASHTO LRFD BRIDGE DESIGN SPECIFICATIONS.

01-2012-2012048 VFRAY7372-STRUCTURES\FRA70-1321R SHEETS\070-1321R\0001.DGN
11/6/2023 10:45:19 AM
ODDTV81STD.LJSEB



DESIGNED	TJW	CHECKED	RHC
DRAWN	JLH	REVISED	
REVIEWED	DGN	DATE	4-21-23
STRUCTURE FILE NUMBER		FILE NUMBER	2510016

GENERAL NOTES
BRIDGE NO. FRA-70-1321R
I-70 E.B. OVER THE SCIOTO RIVER

FRA-70-13-11
PID No. 77372
9/101
432
1151

LAYOUT OF PAVEMENT MARKINGS FOR MAINTENANCE OF TRAFFIC RESTORATION

ALTHOUGH PERMANENT PAVEMENT MARKINGS ARE TO BE INSTALLED AT THE END OF CONSTRUCTION, PAVEMENT MARKING PLAN SHEETS HAVE NOT BEEN INCLUDED IN THE CONTRACT PLANS FOR THE AREAS OF PAVEMENT MARKING RESTORATION DUE TO MAINTENANCE OF TRAFFIC LIMITS ON THE SURFACE STREETS. IN LIEU OF A PAVEMENT MARKING PLAN, THE CONTRACTOR SHALL, PRIOR TO THE START OF CONSTRUCTION, PREPARE AN INVENTORY LOG OF ALL EXISTING PAVEMENT MARKINGS FOR USE IN RESTORING THE MARKINGS AT THE END OF CONSTRUCTION. THE CONTRACTOR SHALL DELIVER TWO (2) COPIES OF THE INVENTORY AND LOG TO THE DISTRICT BEFORE BEGINNING ANY PAVEMENT REMOVALS.


THE CONTRACTOR SHALL BE RESPONSIBLE FOR THE LAYOUT OF THE VARIOUS FINAL PAVEMENT MARKINGS IN ACCORDANCE WITH SECTION 641.06.

UNLESS DIRECTED OTHERWISE BY THE DISTRICT, THE FINAL PAVEMENT MARKINGS SHALL BE RESTORED IN THEIR ORIGINAL PATTERNS AND LOCATION. FINAL LOCATION OF ALL PAVEMENT MARKINGS (PRE-LINE LAYOUT) SHALL BE APPROVED BY THE DISTRICT IN THE FIELD.

THE TABLE TO THE RIGHT PROVIDES ESTIMATED QUANTITIES BASED ON THE PRESENT LOCATIONS OF THE EXISTING PAVEMENT MARKINGS WITHIN THE PROJECT MAINTENANCE OF TRAFFIC LIMITS.

THE COST OF LOGGING AND PREMARKING SHALL BE INCLUDED FOR THE VARIOUS PAVEMENT MARKING ITEMS. NO SEPARATE PAYMENT SHALL BE MADE.

REF. NO.	LOCATION	STATION		SIDE	644	644	644	644	644	644	644	644	646
		FROM	TO		PARKING LOT STALL MARKING	LANE ARROW	BIKE LANE SYMBOL MARKING	PAVEMENT MARKING, MISC.: BIKE LANE DOTTED LINE, 6"	PAVEMENT MARKING, MISC.: CHANNELIZING LINE, 12"	PAVEMENT MARKING, MISC.: TRANSVERSE / DIAGONAL LINE, 24"	PAVEMENT MARKING, MISC.: EDGE LINE, 6"	PAVEMENT MARKING, MISC.: LANE LINE, 6"	LANE ARROW
					FT	EACH	EACH	FT	FT	FT	FT	FT	EACH
LA	RAMP C5	5084+74		LT									1
LA	RAMP C5	5085+47		LT									1
LA	RAMP C5	5086+08		LT									1
LA	RAMP C5	5086+73		LT									1
LA	RAMP C5	5087+40		LT									1
LA	RAMP C5	5088+06		LT									1
LA	RAMP C5	5088+06		LT									1
LA	RAMP C5	5088+70		LT									1
LA	RAMP C5	5088+70		LT									1
LA	RAMP C5	5089+36		LT									1
LA	RAMP C5	5089+36		LT									1
LA	RAMP C5	5090+02		LT									1
LA	RAMP C5	5090+02		LT									1
LA	RAMP C5	5090+69		LT									1
LA	RAMP C5	5090+69		LT									1
LL	FULTON ST	19+47	22+10	LT								263	
LL	FULTON ST	19+47	22+10	RT								263	
EW	FULTON ST	19+47	22+10	LT							263		
EW	FULTON ST	19+47	22+10	LT							263		
BI	FULTON ST	19+72		LT			1						
TW	FULTON ST	19+54	19+75	LT						113			
PS	FULTON ST	20+73		RT	8								
PS	FULTON ST	20+96		RT	8								
PS	FULTON ST	21+19		RT	8								
PS	FULTON ST	21+42		RT	8								
PS	FULTON ST	21+65		RT	8								
PS	FULTON ST	21+88		RT	8								
BI	FULTON ST	27+25		LT			1						
EW	FULTON ST	26+50	30+00	LT							350		
LL	FULTON ST	26+50	30+00	LT								350	
EW	FULTON ST	26+50	30+99	CEN							449		
EW	FULTON ST	26+50	30+99	RT							449		
EW	FULTON ST	26+88	29+40	RT							268		
BI	FULTON ST	29+75		LT			1						
EW	FULTON ST	29+75	30+99	RT							124		
DW	FULTON ST	30+00	30+99	LT				99					
CH	FULTON ST	30+00	30+99	LT					99				
LA	FULTON ST	30+21		LT			1						
LA	FULTON ST	30+70		LT			1						
LA	FULTON ST	30+70		LT			1						
TOTALS					48	3	3	99	99	113	2166	876	15
TOTALS (MILE)											0.42	0.17	
TOTALS CARRIED TO TRAFFIC CONTROL GENERAL SUMMARY					48	3	3	99	99	113	0.42	0.17	15

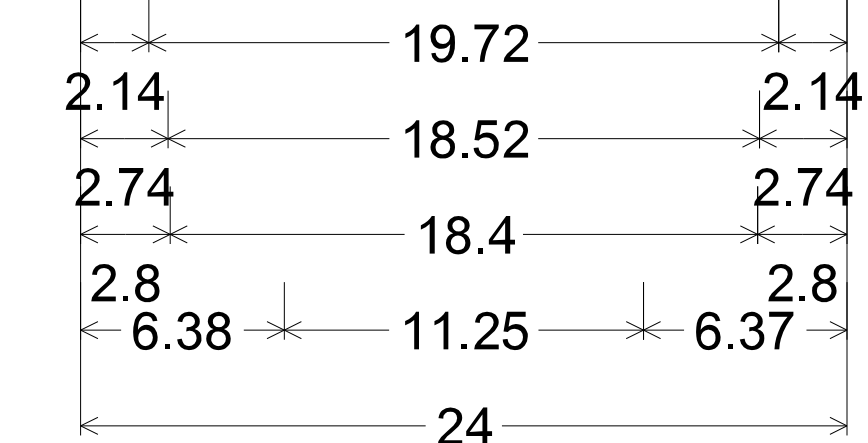

1.50" Radius, 0.63" Border, 0.38" Indent, White on Brown;
 [BREWERY] C 2K;
 [DISTRICT] C 2K;
 [PARKING] C 2K;
 Standard Arrow Custom 11.25" X 4.00" 0°;

SIGNCAD DETAIL
 ALL DIMENSIONS SHOWN ARE IN INCHES.

NO.	DESCRIPTION	DATE	REV. BY
5	REVISED WIDTH	AKF	11-1-23

SHEET NUMBER											PARTICIPATION			ITEM	ITEM EXT.	GRAND TOTAL	UNIT	DESCRIPTION	SEE SHEET NO.
109		112	113	114		115	116	117	148	01/IMS/04									
						12	123.7	49.5			185.2		630	02100	185.2	FT	GROUND MOUNTED SUPPORT, NO. 2 POST		
							91.7	175.8			267.5		630	03100	267.5	FT	GROUND MOUNTED SUPPORT, NO. 3 POST		
								29.2			29.2		630	08004	29.2	FT	ONE WAY SUPPORT, NO. 3 POST		
								4			4		630	08600	4	EACH	SIGN POST REFLECTOR		
									4		4		630	79101	4	EACH	SIGN HANGER ASSEMBLY, MAST ARM, AS PER PLAN	130	
							3				11		630	79501	11	EACH	SIGN SUPPORT ASSEMBLY, POLE MOUNTED, AS PER PLAN	130	
						2.3	78.7	108.9			213.9		630	80100	213.9	SF	SIGN, FLAT SHEET		
											8		630	80500	8	EACH	SIGN, DOUBLE FACED, STREET NAME		
						19	19				38		630	84900	38	EACH	REMOVAL OF GROUND MOUNTED SIGN AND DISPOSAL		
						2					2		630	85100	2	EACH	REMOVAL OF GROUND MOUNTED SIGN AND REERECTION		
						6	14				20		630	86002	20	EACH	REMOVAL OF GROUND MOUNTED POST SUPPORT AND DISPOSAL		
						3	2				5		630	87500	5	EACH	REMOVAL OF POLE MOUNTED SIGN AND DISPOSAL		
									LS	LS			630	97800	LS		SIGNING, MISC.: TRAFFIC SIGNAL SIGNS	130	
48											48		644	01200	48	FT	PARKING LOT STALL MARKING		
3		2	3	4							12		644	01300	12	EACH	LANE ARROW		
3			4								7		644	01630	7	EACH	BIKE LANE SYMBOL MARKING		
		6	1								7		644	19000	7	EACH	SHARED LANE MARKING		
			2								2		644	50100	2	EACH	PAVEMENT MARKING, MISC.: BIKE DETECTOR MARKING	108	
99			120	80							299		644	50300	299	FT	PAVEMENT MARKING, MISC.: BIKE LANE DOTTED LINE, 6"	108	
99		38	152	417							706		644	50300	706	FT	PAVEMENT MARKING, MISC.: CHANNELIZING LINE, 12"	108	
		33	93								126		644	50300	126	FT	PAVEMENT MARKING, MISC.: STOP LINE, 24"	108	
113		185	236	41							575		644	50300	575	FT	PAVEMENT MARKING, MISC.: TRANSVERSE / DIAGONAL LINE, 24"	108	
		123									123		644	50300	123	FT	PAVEMENT MARKING, MISC.: DOTTED LINE, 6"	108	
0.42		0.05	0.18	0.02							0.67		644	50400	0.67	MILE	PAVEMENT MARKING, MISC.: EDGE LINE, 6"	108	
0.17		0.13	0.12	0.15							0.57		644	50400	0.57	MILE	PAVEMENT MARKING, MISC.: LANE LINE, 6"	108	
		0.16	0.04	0.03							0.23		644	50400	0.23	MILE	PAVEMENT MARKING, MISC.: CENTER LINE, 4"	108	
		0.04	0.02								0.06		645	90000	0.06	MILE	PAVEMENT MARKING, MISC.: LANE LINE, 6", TYPE A1, WITH CONTRAST	108	
		0.03	0.02								0.05		645	90000	0.05	MILE	PAVEMENT MARKING, MISC.: CENTER LINE, 4", TYPE A1	108	
		173	107								280		645	98000	280	FT	PAVEMENT MARKING, MISC.: CHANNELIZING LINE, 12", TYPE A1, WITH CONTRAST	108	
15											15		646	20300	15	EACH	LANE ARROW		
		5	3								8		647	20610	8	EACH	LANE ARROW, TYPE B90		
		1	1								2		647	20940	2	EACH	SHARED LANE MARKING, TYPE B90		
		126	126								252		647	50120	252	FT	PAVEMENT MARKING, MISC.: CROSSWALK LINE, 12", TYPE B90	108	
		34	23								57		647	50120	57	FT	PAVEMENT MARKING, MISC.: STOP LINE, 24", TYPE B90	108	

TRAFFIC CONTROL GENERAL SUMMARY

FRA - 70 - 14.05C

NO.	DESCRIPTION	DATE	REV. BY
5	REVISED WIDTH	AKF	11-1-23

D:\2012\20120418\FRA\105596\TRAFFIC\SHEETS\105596T001.DGN
11/1/2023 9:31:23 AM
DDCTV81STD_USER

01-2012\20120418\FRA\105596\TRAFFIC\SHEETS\105596TS001.DGN
 11/1/2023
 9:52:36 AM
 DDCUY81STD_USER

SHEET NO.	REF. NO.	LOCATION	STATION		SIDE	644		644		644		644		644		644		645		645		647		647							
			FROM	TO		LANE ARROW	BIKE LANE SYMBOL MARKING	SHARED LANE MARKING	PAVEMENT MARKING, MISC.: BIKE DETECTOR MARKING	PAVEMENT MARKING, MISC.: BIKE LANE DOTTED LINE, 6"	PAVEMENT MARKING, MISC.: CHANNELIZING LINE, 12"	PAVEMENT MARKING, MISC.: STOP LINE, 24"	PAVEMENT MARKING, MISC.: TRANSVERSE / DIAGONAL LINE, 24"	PAVEMENT MARKING, MISC.: DOTTED LINE, 6"	PAVEMENT MARKING, MISC.: EDGE LINE, 6"	PAVEMENT MARKING, MISC.: LANE LINE, 6"	PAVEMENT MARKING, MISC.: CENTER LINE, 4"	PAVEMENT MARKING, MISC.: LANE LINE, 6", TYPE A1, WITH CONTRAST	PAVEMENT MARKING, MISC.: CENTER LINE, 4", TYPE A1	PAVEMENT MARKING, MISC.: CHANNELIZING LINE, 12", TYPE A1, WITH CONTRAST	LANE ARROW, TYPE B90	SHARED LANE MARKING, TYPE B90	PAVEMENT MARKING, MISC.: CROSSWALK LINE, 12", TYPE B90	PAVEMENT MARKING, MISC.: STOP LINE, 24", TYPE B90							
118	BS-1	HIGH ST.	145+98		LT			1																							
118	BS-2	HIGH ST.	146+02		RT																										
118	TLY-1	HIGH ST.	145+69	146+50	LT/RT							10																			
118	TLW-5	HIGH ST.	145+38	145+66	RT							34																			
118	LL-1	HIGH ST.	145+40	145+69	LT										29																
118	LL-2	HIGH ST.	143+00	146+50	RT										350																
118	CDS-1	HIGH ST.	145+69	146+50	LT											81															
118	CDS-2	HIGH ST.	143+00	146+50	LT/RT											350															
118	ELW-22	HIGH ST.	145+40	146+50	RT									110																	
118	DL-1	HIGH ST.	145+69	146+50	LT							81																			
119	ELW-23	HIGH ST.	146+50	148+02	RT									152																	
119	LA-1	HIGH ST.	147+73		RT	1																									
119	LA-2	HIGH ST.	147+90		RT	1																									
119	BS-3	HIGH ST.	146+58		LT			1																							
119	BS-4	HIGH ST.	147+78		LT			1																							
119	BS-5	HIGH ST.	146+62		RT			1																							
119	BS-6	HIGH ST.	147+87		RT			1																							
119	CL-1	HIGH ST.	147+64	148+02	RT					38																					
119	SL-1	HIGH ST.	148+04		RT						33																				
119	TLW-7	HIGH ST.	146+50	148+02	RT							108																			
119	TLY-2	HIGH ST.	146+50	147+52	LT/RT							33																			
119	LL-3	HIGH ST.	146+92	148+02	LT										110																
119	LL-4	HIGH ST.	146+50	148+02	RT										152																
119	CDS-3	HIGH ST.	146+50	148+04	LT											154															
119	CDS-4	HIGH ST.	146+50	147+52	RT/LT											102															
119	LL-5	HIGH ST.	149+22	150+50	LT												128														
119	LL-6	HIGH ST.	149+22	150+05	RT												83														
119	CDS-5	HIGH ST.	149+22	150+50	RT													128													
119	CL-2	HIGH ST.	149+22	150+50	LT														128												
119	CL-2A	HIGH ST.	150+05	150+50	RT														45												
119	DL-2	HIGH ST.	146+50	146+92	LT							42																			
119	LA-3	HIGH ST.	149+52		CEN																	1									
119	LA-3A	HIGH ST.	149+95		CEN																		1								
119	LA-4	HIGH ST.	150+36		CEN																		1								
119	LA-4A	HIGH ST.	150+26		RT																		1								
119	LA-4B	HIGH ST.	150+26		RT																			1							
119	BS-7	HIGH ST.	149+70		RT																			1							
119	CWL-1	HIGH ST.	148+99		LT/RT																			1							
119	SL-2	HIGH ST.	149+20		LT/RT																				126			34			
119	CDS-6	LIVINGSTON AVE.	206+34	207+54	CEN																										
TOTAL FEET							2						38	33	185	123	262	641	807	211	128	173	5	1	126	34					
TOTAL MILES																	0.05	0.13	0.16	0.04	0.03										
TOTALS CARRIED TO TRAFFIC CONTROL GENERAL SUMMARY							2						38	33	185	123	0.05	0.13	0.16	0.04	0.03	173	5	1	126	34					

NO.	DESCRIPTION	DATE	REV. BY
5	REVISED WIDTH	AKF	11-7-23

01-2012\20120416\FRA\105916\TRAFFIC\SHEETS\105916\SUMMARY.DGN
 11/17/2023 9:53:24 AM
 DDD\TV8151D\LJSEB

SHEET NO.	REF. NO.	LOCATION	STATION		SIDE	644	644	644	644	644	644	644	644	644	644	645	645	645	647	647	647	647		
			LANE ARROW	BIKE LANE SYMBOL MARKING		SHARED LANE MARKING	PAVEMENT MARKING, MISC.: BIKE DETECTOR MARKING	PAVEMENT MARKING, MISC.: BIKE LANE DOTTED LINE, 6"	PAVEMENT MARKING, MISC.: CHANNELIZING LINE, 12"	PAVEMENT MARKING, MISC.: STOP LINE, 24"	PAVEMENT MARKING, MISC.: TRANSVERSE / DIAGONAL LINE, 24"	PAVEMENT MARKING, MISC.: DOTTED LINE, 6"	PAVEMENT MARKING, MISC.: EDGE LINE, 6"	PAVEMENT MARKING, MISC.: LANE LINE, 6"	PAVEMENT MARKING, MISC.: CENTER LINE, 4"	PAVEMENT MARKING, MISC.: LANE LINE, 6", TYPE A1, WITH CONTRAST	PAVEMENT MARKING, MISC.: CENTER LINE, 4", TYPE A1	PAVEMENT MARKING, MISC.: CHANNELIZING LINE, 12", TYPE A1, WITH CONTRAST	LANE ARROW, TYPE B90	SHARED LANE MARKING, TYPE B90	PAVEMENT MARKING, MISC.: CROSSWALK LINE, 12", TYPE B90	PAVEMENT MARKING, MISC.: STOP LINE, 24", TYPE B90		
			FROM	TO																				
					EACH	EACH	EACH	EACH	FT	FT	FT	FT	FT	FT	FT	FT	FT	FT	EACH	EACH	FT	FT		
119	BI-2	LIVINGSTON AVE.	207+48		RT		1																	
119	BS-10	LIVINGSTON AVE.	209+13		RT			1																
119	SL-3	LIVINGSTON AVE.	207+56		RT							21												
119	TLY-3	LIVINGSTON AVE.	208+98	209+53	LT							74												
119	TLW-1	LIVINGSTON AVE.	207+24	207+54	LT							25												
119	TLW-6	LIVINGSTON AVE.	209+08	209+55	RT							32												
119	ELW-3	LIVINGSTON AVE.	206+34	207+40	LT									106										
119	ELW-4	LIVINGSTON AVE.	206+34	207+54	LT									120										
119	ELW-5	LIVINGSTON AVE.	206+34	206+54	RT									20										
119	ELW-6	LIVINGSTON AVE.	206+92	207+54	RT									62										
119	ELW-7	LIVINGSTON AVE.	208+98	209+55	LT									57										
119	ELW-10	LIVINGSTON AVE.	209+08	209+55	RT									47										
119	BD-2	LIVINGSTON AVE.	207+53		RT				1															
119	LL-16	LIVINGSTON AVE.	208+98	209+55	RT									57										
119	BI-1	LIVINGSTON AVE.	207+35		LT		1																	
119	DL-2	LIVINGSTON AVE.	206+54	207+54	RT					100														
120	LA-6	HIGH ST.	152+68		CEN	1																		
120	LA-6A	HIGH ST.	153+09		CEN	1																		
120	LA-7	HIGH ST.	153+47		CEN	1																		
120	CL-4	HIGH ST.	152+38	153+70	LT						132													
120	SL-6	HIGH ST.	152+36		LT/RT							32												
120	LL-9	HIGH ST.	152+38	154+00	LT									162										
120	LL-10	HIGH ST.	152+38	154+00	RT									162										
120	CDS-9	HIGH ST.	152+38	154+00	RT									162										
120	LL-7	HIGH ST.	150+50	151+05	RT										55									
120	CDS-8	HIGH ST.	150+50	151+05	RT											55								
120	CL-3	HIGH ST.	150+50	151+02	LT												52							
120	CL-3A	HIGH ST.	150+50	151+05	RT												55							
120	LA-5	HIGH ST.	150+79		CEN													1						
120	LA-5A	HIGH ST.	150+75		RT													1						
120	LA-5B	HIGH ST.	150+75		RT													1						
120	BS-8	HIGH ST.	150+53		LT														1					
120	CWL-2	HIGH ST.	151+32		LT/RT															126				
120	SL-5	HIGH ST.	151+07		RT																23			
120	BI-3	FULTON ST.	23+07		LT		1																	
120	BI-4	FULTON ST.	24+87		LT		1																	
120	DL-3	FULTON ST.	23+00	23+20	LT				20															
120	CL-5	FULTON ST.	23+00	23+20	RT					20														
120	SL-7	FULTON ST.	23+22		LT/RT						40													
120	TLW-2	FULTON ST.	24+67	24+75	RT								23											
120	TLW-2A	FULTON ST.	24+72	26+00	LT								33											
120	TLW-4	FULTON ST.	26+00	26+50	RT								49											
120	ELW-15	FULTON ST.	23+00	23+08	LT									8										
120	ELW-18	FULTON ST.	24+67	26+50	LT									183										
120	ELW-18A	FULTON ST.	24+72	26+00	LT									128										
120	ELW-19	FULTON ST.	24+67	26+50	RT									183										
120	LL-11	FULTON ST.	23+00	23+20	LT										20									
120	LL-12	FULTON ST.	24+67	26+50	LT										183									
120	BD-1	FULTON ST.	22+19		LT				1															
TOTAL FEET						3	4	1	2	120	152	93	236		914	584	162	55	55	107	3	1	126	23
TOTAL MILES															0.18	0.12	0.04	0.02	0.02					
TOTALS CARRIED TO TRAFFIC CONTROL GENERAL SUMMARY						3	4	1	2	120	152	93	236		0.18	0.12	0.04	0.02	0.02	107	3	1	126	23

NO.	DESCRIPTION	DATE	REV. BY
5	REVISED WIDTH	AKF	11-1-23

PAVEMENT MARKING SUBSUMMARY - SHEET 2 OF 3

FRA - 70-14.05C

CALCULATED
SLB
CHECKED
AKF



SHEET NO.	REF. NO.	LOCATION	STATION		SIDE	644	644	644	644	644	644	644	644	644	644	645	645	645	647	647	647	647	
			LANE ARROW	BIKE LANE SYMBOL MARKING		SHARED LANE MARKING	PAVEMENT MARKING, MISC.: BIKE DETECTOR MARKING	PAVEMENT MARKING, MISC.: BIKE LANE DOTTED LINE, 6"	PAVEMENT MARKING, MISC.: CHANNELIZING LINE, 12"	PAVEMENT MARKING, MISC.: STOP LINE, 24"	PAVEMENT MARKING, MISC.: TRANSVERSE / DIAGONAL LINE, 24"	PAVEMENT MARKING, MISC.: DOTTED LINE, 6"	PAVEMENT MARKING, MISC.: EDGE LINE, 6"	PAVEMENT MARKING, MISC.: LANE LINE, 6"	PAVEMENT MARKING, MISC.: CENTER LINE, 4"	PAVEMENT MARKING, MISC.: LANE LINE, 6", TYPE A1, WITH CONTRAST	PAVEMENT MARKING, MISC.: CENTER LINE, 4", TYPE A1	PAVEMENT MARKING, MISC.: CHANNELIZING LINE, 12", TYPE A1, WITH CONTRAST	LANE ARROW, TYPE B90	SHARED LANE MARKING, TYPE B90	PAVEMENT MARKING, MISC.: CROSSWALK LINE, 12", TYPE B90	PAVEMENT MARKING, MISC.: STOP LINE, 24", TYPE B90	
			FROM	TO		EACH	EACH	EACH	EACH	FT	FT	FT	FT	FT	FT	FT	FT	EACH	EACH	FT	FT		
121	LA-8	HIGH ST.	154+68		CEN	1																	
121	LA-9	HIGH ST.	155+24		CEN	1																	
121	CL-6	HIGH ST.	154+00	155+81	RT					181													
121	CL-7	HIGH ST.	257+26	258+72	LT					146													
121	LL-13	HIGH ST.	154+00	259+20	LT									520									
121	LL-14	HIGH ST.	154+00	155+81	RT									181									
121	CDS-10	HIGH ST.	154+00	155+31	RT/LT										131								
122	LA-10	FULTON ST.	22+92		RT	1																	
122	LA-10A	FULTON ST.	22+44		RT	1																	
122	DL-4	FULTON ST.	22+20	23+00	LT				80														
122	CL-8	FULTON ST.	22+10	23+00	RT					90													
122	TLW-3	FULTON ST.	22+10	23+00	LT						41												
122	ELW-20	FULTON ST.	22+10	23+00	LT							90											
122	ELW-21	FULTON ST.	22+10	22+20	LT							10											
122	LL-15	FULTON ST.	22+10	23+00	LT								90										
TOTAL FEET						4				80	417	41	100	791	131								
TOTAL MILES													0.02	0.15	0.03								
TOTALS CARRIED TO TRAFFIC CONTROL GENERAL SUMMARY						4				80	417	41	0.02	0.15	0.03								

NO.	DESCRIPTION	DATE	REV. BY
5	REVISED WIDTH	AKF	11-1-23

PAVEMENT MARKING SUBSUMMARY - SHEET 3 OF 3

FRA - 70 - 14.05C

CALCULATED
SLB
CHECKED
AKF

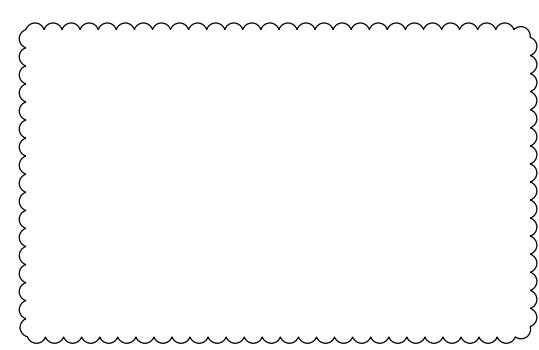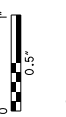

ODOT'S CONCRETE BARRIER INLETS

PER ODOT'S STANDARD CONSTRUCTION DRAWINGS FOR CONCRETE BARRIER INLET DETAILS, THE STATION AND OFFSET IS CALLED OUT TO THE CENTER OF THE GRATE. THE GRATE ELEVATION CALLED OUT IN THE STORM SEWER PROFILES AND CROSS SECTIONS ARE TO THE CENTER EDGE OF THE GRATE WHERE IT ABUTS TO THE FACE OF BARRIER.

BENCHING OF FOUNDATION SLOPES

ALTHOUGH CROSS-SECTIONS INDICATE SPECIFIC DIMENSIONS FOR PROPOSED BENCHING OF THE EMBANKMENT FOUNDATIONS IN CERTAIN AREAS, NO WAIVER OF THE SPECIFICATIONS IS INTENDED. BENCH ALL OTHER SLOPED EMBANKMENT AREAS AS SET FORTH IN 203.05. NO ADDITIONAL PAYMENT WILL BE MADE FOR BENCHING REQUIRED UNDER THE PROVISIONS OF 203.05

ITEM 607 - GATE REBUILT. AS PER PLAN

IN PROJECT 6R (FRA-71-14.36), THE GATES TO THE PUMP STATIONS, (1) AT THE SANITARY PUMP STATION, (2) AT THE STORM PUMP STATION, WHERE REMOVED AND STORED ON SITE AT SAID PUMP STATIONS, ARE TO BE REBUILT IN PROJECT 6A AS PART OF THE SITE AND ROADWAY RESTORATION. THE CONTRACTOR SHALL MAINTAIN ACCESS TO THE PUMP STATIONS BY CITY OFFICIALS AT ALL TIMES. NEW GATE POST SHALL BE USED, REPLACING EXISTING IN-KIND. SEE GATE DETAIL IN MISC. DETAIL SHEETS.

THE COST FOR THE ALL ABOVE LABOR AND MATERIAL FOR THE RECONSTRUCTION OF EXISTING GATES SHALL BE INCLUDED IN THE COST FOR:
ITEM - 607 GATE REBUILT, AS PER PLAN

ITEM 202 - GATE REMOVED FOR REUSE. AS PER PLAN

THE CONTRACTOR SHALL TAKE CARE IN REMOVING THE EXISTING GATE FOR STORAGE (ON SITE ST THE PUMP STATION IT WAS REMOVED FROM) UNTIL THE SITE IS READY FOR THE GATE TO BE REBUILT. IF THE GATE IS DAMAGED DURING THE CONSTRUCTION PROCESS, THE CONTRACTOR SHALL REPLACE THE DAMAGED SECTION OR GATE AT THE COST TO THE CONTRACTOR. THE CONTRACTOR SHALL MAINTAIN ACCESS TO PUMP STATION BY CITY OFFICIALS AT ALL TIMES.

THE COST FOR ALL OF THE ABOVE LABOR AND MATERIAL FOR THE REMOVAL AND STORAGE OF EXISTING GATES SHALL BE INCLUDED IN THE COST FOR:
ITEM 202 GATE REMOVED FOR REUSE, AS PER PLAN

ITEM 203 - EMBANKMENT. AS PER PLAN

PLACE AND COMPACT EMBANKMENT MATERIAL IN 6 INCH LIFTS FOR THE CONSTRUCTION OF THE BRIDGE ABUTMENT APPROACH EMBANKMENT AT THE FOLLOWING LOCATIONS:

Item 203 Embankment, as per Plan			
Alignment	Structure	Location	Embankment, as per Plan (CY)
BLPRD3	FRA-70-1323C	Forward	2984
BLPRD3	FRA-70-1358L	Rear	2345
BLPRD3	FRA-70-1323C	Rear	1961
BLPIO70WB	FRA-70-1322L	Forward	1840
BLPIO70WB	FRA-70-1358L	Rear	2565
BLPIO70WB	FRA-70-1358L	Forward	7220
BLPIO70WB	FRA-70-1373L	Rear	5073
BLPTEI70WB	FRA-70-1322L	Rear	924
TOTAL			24912

ITEM 202 - PORTIONS OF STRUCTURE REMOVED. AS PER PLAN "A"

FOR THE EXISTING RETAINING WALL BETWEEN TRANSITIONAL D3 (W) AND TRANSITIONAL I-70WB, THE CONTRACTOR SHALL REMOVE THE WALL THREE FEET BELOW THE PROPOSED GRADE.

THE COST FOR THE ALL ABOVE LABOR AND MATERIAL FOR THE REMOVAL OF A PORTION OF THE EXISTING WALL SHALL BE INCLUDED IN THE LUMP SUM (LS) COST FOR:
ITEM 202 - PORTIONS OF STRUCTURE REMOVED, AS PER PLAN "A"

ITEM 202 - PORTIONS OF STRUCTURE REMOVED. AS PER PLAN "B"

THE EXISTING MSE WALL BETWEEN I-71SB AND I-70WB, EAST OF SHORT STREET SHALL BE BURIED IN THIS PROJECT WITH THE FOLLOWING EXCEPTION. THE MOMENT SLAB WITH ADJOINING PARAPET SHALL BE REMOVED.

THE COST FOR THE ALL ABOVE LABOR AND MATERIAL FOR THE REMOVAL OF THE MSE WALL'S MOMENT SLAB AND PARAPET SHALL BE INCLUDED IN THE LUMP SUM (LS) COST FOR:
ITEM 202 - PORTIONS OF STRUCTURE REMOVED, AS PER PLAN "B"

ITEM 202 - PORTIONS OF STRUCTURE REMOVED. AS PER PLAN "C"

THE EXISTING SHEET PILING WALL RUNNING ALONG THE NORTH SIDE OF RAMP D7 SHALL BE REMOVED THREE FEET BELOW PROPOSED GRADE.

THE COST FOR THE ALL ABOVE LABOR AND MATERIAL FOR THE REMOVAL OF THE SHEET PILING WALL SHALL BE INCLUDED IN THE LUMP SUM (LS) COST FOR:
ITEM 202 - PORTIONS OF STRUCTURE REMOVED, AS PER PLAN "C"

ITEM 202 - STRUCTURE REMOVED OVER 20 FOOT SPAN. AS PER PLAN

THE CONTRACTOR SHALL REMOVE THE ENTIRE FRA-70-1309 BRIDGE STRUCTURE PER ODOT'S C&MS ITEM 202.03 WITH THE FOLLOWING EXCEPTIONS.

THE FORWARD AND REAR ABUTMENT BACKWALLS SHALL BE REMOVED DOWN TO THE BEAM SEAT AND ARE PART OF THE PAY ITEM.

FOR THE WING WALLS DISPOSITION AND REMOVAL LIMITS, SEE THE ROADWAY PLANS AND CROSS SECTIONS. THE WING WALLS WILL HAVE A SEPERATE PAY ITEM IF A REMOVAL IS REQUIRED.

THE COST FOR THE ALL ABOVE LABOR AND MATERIAL FOR THE REMOVAL OF THE STRUCTURE SHALL BE INCLUDED IN THE LUMP SUM (LS) COST FOR:
ITEM 202 - STRUCTURE REMOVED OVER 20 FOOT, AS PER PLAN

ITEM 202 - PORTIONS OF STRUCTURE REMOVED. AS PER PLAN

THE EXISTING WING WALLS FOR THE EXISTING RAMP BC (SR315SB TO I-70EB BRIDGE OVER I-71SB), BRIDGE NO. FRA-70-1309, THE CONTRACTOR SHALL REMOVE PORTIONS OF THE WALL THREE FEET BELOW THE PROPOSED GRADE AS CALLED OUT ON THE PLAN AND CROSS SECTIONS.

THE EXISTING SOLDIER PILE WALL FOR THE EXISTING PIER 5 FOR FRA-71-1503L, SOUTH OF EX. RAMP BC, SHALL BE REMOVED TO 3.0 FEET BELOW PROPOSED GRADE.

THE COST FOR THE ALL ABOVE LABOR AND MATERIAL FOR THE REMOVAL OF A PORTION OF THE EXISTING WALL SHALL BE INCLUDED IN THE LUMP SUM (LS) COST FOR:
ITEM 202 - PORTIONS OF STRUCTURE REMOVED, AS PER PLAN

ITEM 601 - SLOPE PROTECTION MISC.: VEGETATED GEOCELL. AS PER PLAN

THE CONTRACTOR SHALL FURNISH AND INSTALL A VEGETATED GEOCELL AND ALL APPURTENANCES FOR SLOPES GREATER THAN 2:1. THE CELL DEPTH SHALL BE 4". THE CONTRACTOR SHALL FOLLOW THE MANUFACTURER'S INSTALLATION DETAILS AND SPECIFICATIONS.

THE FOLLOWING SUPPLIERS CAN PROVIDE THE NEW GEOCELLS.

GEOWEB 3D VEGETATED SLOPE PROTECTION
PRESTO GEOSYSTEMS
670 N. PERKINS ST., P.O.BOX 2399
APPLETON, WISCONSIN 54912-2399
800-548-3424
EMAIL: INFO@PRESTOGRO.COM

BASELOK GEOCELL
INDUSTRIAL FABRICS, INC.
510 O'NEAL LANE EXT.
BATON ROUGE, LA 70819
800-848-4500
WWW.BASELOK.COM

TYPAR GEOCELL GS FOR SLOPE PROTECTION
BERRY GLOBAL INC.
70 OLD HICKORY BLVD.
OLD HICKORY, TN 37138
800-544-5519
EMAIL: GEOS@TYPAR.COM

(OR APPROVED EQUAL)

BASIS OF PAYMENT SHALL INCLUDE ALL MATERIALS AND LABOR REQUIRED TO INSTALL THE GEOCELLS AND BACKFILL WITH TOPSOIL. ALL COST SHALL BE INCLUDED IN THE SQUARE YARD UNIT PRICE OF ITEM 601 - SLOPE PROTECTION MISC.: VEGETATED GEOCELL, AS PER PLAN.

CALCULATED
CHECKED

GENERAL NOTES

FRA - 70 - 13.10

35
702

NO.	DESCRIPTION	REV. BY	DATE
5	NOTE REMOVED	ACW	11/6/23

TRAFFIC INCIDENT MANAGEMENT (TIM) DURING MOT

OHIO TIM IS OHIO'S TRAFFIC INCIDENT MANAGEMENT PROGRAM WHICH IS COMMITTED TO MAINTAINING THE SAFE AND EFFECTIVE FLOW OF TRAFFIC DURING EMERGENCIES AS TO PREVENT FURTHER DAMAGE, INJURY OR UNDUE DELAY OF THE MOTORING PUBLIC. IN ADDITION TO COMPLYING WITH THE PROVISION OF OMUTCD CHAPTER 6I, CONTROL OF TRAFFIC THROUGH TRAFFIC INCIDENT MANAGEMENT AREAS, THE CONTRACTOR SHALL ACTIVELY PARTICIPATE IN TIM PLANNING AND IMPLEMENTATION AS OUTLINED BELOW.

1. SUPERINTENDENT SHALL IDENTIFY THE INDIVIDUAL PERSONS ON THE PROJECT WHO WILL, OR MAY NEED TO, PERFORM THE DUTIES HEREIN. AT A MINIMUM, INCLUDE THE SUPERINTENDENT, FOREMEN AND SUPERVISORS (OR EQUIVALENT) AS WELL AS THE WORKSITE TRAFFIC SUPERVISOR (WTS; IF APPLICABLE TO THE PROJECT). THESE INDIVIDUALLY IDENTIFIED PERSONS SHALL COLLECTIVELY BE KNOWN AS CONTRACTOR TRAFFIC INCIDENT MANAGEMENT (TIM) CONTACTS. NOTIFY THE PROJECT ENGINEER OF THE CONTRACTOR TIM CONTACTS (ALONG WITH CONTACT INFORMATION FOR EACH) AT OR BEFORE THE PRECONSTRUCTION MEETING.

2. SUPERINTENDENT SHALL NOTIFY THE ENGINEER IMMEDIATELY IF ANY CONTRACTOR TIM CONTACT IS ADDED, REMOVED OR THE CONTACT INFORMATION CHANGES OVER THE COURSE OF THE PROJECT.

3. PRIOR THE FIRST DAY OF WORK IN THE FIELD, EACH CONTRACTOR TIM CONTACT ON THE PROJECT SHALL HAVE ATTENDED AND SUCCESSFULLY COMPLETED OHIO TIM TRAINING PROVIDED BY THE DEPARTMENT OR DESIGNEE. TRAINING INFORMATION CAN BE FOUND AT WWW.OHIOTIM.COM.

4. SUPERINTENDENT, AT A MINIMUM, SHALL ATTEND AND ACTIVELY PARTICIPATE IN A DEPARTMENT SCHEDULED TIM MEETING BEFORE CONSTRUCTION WORK BEGINS AND BEFORE EACH PHASE CHANGE. THESE MEETINGS WILL RESULT IN A DEPARTMENT ISSUED PROJECT SPECIFIC TRAFFIC INCIDENT MANAGEMENT PLAN (TIMP). AT THE TIM MEETINGS THE ATTENDING CONTRACTOR TIM CONTACTS SHALL:

- A. COLLABORATE WITH ODOT AND SAFETY FORCES;
- B. SHARE PROJECT SPECIFIC DETAILS THAT IMPACT TIM RESPONDERS; AND
- C. RECOMMEND WAYS TO INCORPORATE NECESSARY EMERGENCY ACCESS AND OTHER TIM ELEMENTS FOR TIM RESPONDERS GIVEN PROJECT SPECIFIC WORK BEING COMPLETED AND PROJECT SPECIFIC PHASING.

5. CONTRACTOR TIM CONTACTS SHALL IMPLEMENT COMPONENTS OF THE RESULTING TIMP (SUCH AS APPROVED EMERGENCY INGRESS/EGRESS POINTS, ETC), AS DIRECTED BY THE ENGINEER IN ACCORDANCE WITH 109.05.

6. CONTRACTOR TIM CONTACTS SHALL PERFORM, AT A MINIMUM, THE FOLLOWING FUNCTIONS WHEN AN INCIDENT/CRASH OCCURS:

- A. IF OBSERVED OR PRESENT WHEN OCCURS, CALL 911 AND THEN NOTIFY THE TRAFFIC MANAGEMENT CENTER (TMC) TO PROVIDE THE FOLLOWING:
 - I. LOCATION, INCLUDING MILEPOST NUMBER AND DIRECTION OF TRAVEL
 - II. NUMBER AND TYPE OF VEHICLES INVOLVED, IF KNOWN
 - III. ESTIMATED EXTENT OF DAMAGE OR INJURY, IF KNOWN
 - IV. ESTIMATED NUMBER OF PATIENTS INVOLVED, IF KNOWN

V. ANY POTENTIAL HAZARDOUS CONDITIONS, IF KNOWN

VI. THE PLACARD NUMBER ON ANY HAZARDOUS MATERIALS PLACARD FROM A SAFE DISTANCE, IF APPLICABLE AND VISIBLE

B. FOLLOWING AN INCIDENT/CRASH:

I. INITIATE TRAFFIC MANAGEMENT/PROVIDE TEMPORARY TRAFFIC CONTROL AS INDICATED IN THE TIMP, AS DIRECTED BY THE ENGINEER IN ACCORDANCE WITH 109.05.

II. RECOMMEND ROADWAY REPAIR NEEDS.

III. PROVIDE REPAIR RESOURCES AND INITIATE REPAIRS, AS DIRECTED BY THE ENGINEER IN ACCORDANCE WITH 109.05.

IV. ATTEND AND PARTICIPATE IN AN AFTER ACTION REVIEW (AAR).

ALL COSTS, UNLESS OTHERWISE SPECIFIED, RESULTING FROM THE ABOVE REQUIREMENTS SHALL BE CONSIDERED TO BE INCLUDED IN THE LUMP SUM PRICE FOR ITEM 614, MAINTAINING TRAFFIC. FAILURE TO PERFORM THE REQUIREMENTS OF THIS PLAN NOTE WILL RESULT IN A DAILY FINE OF 2% OF ITEM 614, MAINTAINING TRAFFIC AND MAY RESULT IN ONE OR MORE CONTRACTOR TIM CONTACTS BEING REMOVED FROM THE LIST OF OHIO TIM TRAINED INDIVIDUALS (AT THE SOLE DISCRETION OF THE OHIO TIM EXECUTIVE COMMITTEE). IN THE EVENT AN INDIVIDUAL IS REMOVED FROM THE OHIO TIM TRAINED LIST, THE INDIVIDUAL WILL BE REMOVED FROM CONTRACTOR TIM CONTACT RESPONSIBILITIES ON ALL PROJECTS.

ITEM 614 - WORK ZONE RAISED PAVEMENT MARKER, AS PER PLAN

WORK ZONE RAISED PAVEMENT MARKERS, AS PER PLAN, AND THEIR INSTALLATION SHALL CONFORM TO C&MS 614 OR C&MS 621 AS SPECIFIED HEREIN.

- RAISED PAVEMENT MARKERS IN USE DURING THE SNOW-PLOWING SEASON SHALL CONFORM TO 621.

- RAISED PAVEMENT MARKERS IN USE DURING THE NON-SNOW-PLOW SEASON SHALL CONFORM TO EITHER 614 OR 621.

THE SNOW-PLOWING SEASON SHALL RUN FROM OCTOBER 15 THROUGH APRIL 1.

IF PROJECT DELAYS, NOT THE FAULT OF ODOT, CAUSE THE WORK TO EXTEND INTO THE SNOW-PLOWING SEASON, THE CONTRACTOR SHALL BE RESPONSIBLE FOR REPLACING WORK ZONE RAISED PAVEMENT MARKERS (WZRPMS) CONFORMING TO C&MS 614, WITH RAISED PAVEMENT MARKERS CONFORMING TO 621, AS DETERMINED BY THE ENGINEER, AT THE CONTRACTOR'S EXPENSE.

THIS ITEM SHALL INCLUDE PURCHASE, INSTALLATION AND REMOVAL OF ITEM 614 WORK ZONE RAISED PAVEMENT MARKER, AS PER PLAN, INCLUDING FILLING ANY DEPRESSIONS CREATED IN THE PAVEMENT AS PER C&MS 621.08.

RESURFACING OF THE TRANSITION AREAS SHALL BE PERFORMED AT THE TIME THAT THE SURFACE COURSE IS BEING APPLIED TO THE ENTIRE PROJECT. PRIOR TO APPLICATION OF THE SURFACE COURSE ON THE PROJECT, THE EXISTING PAVEMENT WITHIN THE TRANSITION AREA SHALL BE REMOVED TO A DEPTH NECESSARY TO REACH THE LEVEL OF THE INTERMEDIATE COURSE OF THE PAVEMENT, AS DETERMINED BY THE ENGINEER.

AN ESTIMATED QUANTITY HAS BEEN PROVIDED IN THE MAINTENANCE OF TRAFFIC SUBSUMMARY.

PAYMENT FOR RESURFACING WITHIN THE TRANSITION AREA SHALL BE PAID FOR UNDER THE APPROPRIATE BID ITEMS FOR THE WORK REQUIRED, AS PROVIDED FOR IN THE PLANS.

ITEM 614 - WORK ZONE RAISED PAVEMENT MARKERS ON CONCRETE SURFACES

RAISED PAVEMENT MARKERS IN WORK ZONES, INSTALLED ON TO CONCRETE SURFACES, SHALL BE ITEM 614 WORK ZONE RAISED PAVEMENT MARKERS. WZRPMS ARE INTENDED FOR USE ONLY DURING THE NON-SNOW-PLOWING SEASON. WZRPMS SHALL NOT BE PROVIDED DURING THE SNOW-PLOWING SEASON.

THE SNOW-PLOWING SEASON SHALL RUN FROM OCTOBER 15 THROUGH APRIL 1.

WHERE A TEMPORARY ALIGNMENT WILL REMAIN IN USE THROUGH THE WINTER, THE WZRPMS SHALL BE REMOVED PRIOR TO THE BEGINNING OF THE SNOW-PLOWING SEASON AND REPLACED APPROXIMATELY APRIL 1, OR AS OTHERWISE DETERMINED BY THE ENGINEER.

THIS ITEM SHALL INCLUDE PURCHASE, INSTALLATION AND REMOVAL OF ITEM 614 WORK ZONE RAISED PAVEMENT MARKERS.

ESTIMATED QUANTITIES OF ITEM 614 WORK ZONE RAISED PAVEMENT MARKER HAVE BEEN PROVIDED IN THE MAINTENANCE OF TRAFFIC SUBSUMMARIES AND CARRIED TO THE GENERAL SUMMARY.

ITEM 614 - WORK ZONE PAVEMENT MARKING, MISC.: ROUTE SHIELDS

THIS ITEM SHALL COMPLY WITH ODOT SUPPLEMENTAL SPECIFICATION 814 AND SHALL INCLUDE THE REMOVAL OF THE ROUTE SHIELD MARKINGS UPON COMPLETION OF THE PROJECT, IF APPLICABLE.



APPROVED MAINTENANCE OF TRAFFIC (MOT) POLICY EXCEPTION(S)

PORTIONS OF THE MOT PLANS AS DESCRIBED BELOW HAVE APPROVED MOT EXCEPTION(S) PER TRAFFIC MANAGEMENT IN WORK ZONES POLICY (21-008(P)) AND STANDARD PROCEDURE (123-001(SP)).

APPROVED MOT EXCEPTION(S) INCLUDE:
 - 3 YEAR CLOSURE OF SR 315 SB TO I-70 EB RAMP.
 - 6 MONTH CLOSURE OF I-70 WB TO SR 315 NB
 - MONITOR TRAFFIC CONDITIONS FOR POSSIBLE CONFIGURATION ADJUSTMENTS AT THE I-670 EB TO I-71 SB RAMP.

A MAINTENANCE OF TRAFFIC MEETING SHALL BE HELD A MINIMUM OF 30 CALENDAR DAYS PRIOR TO IMPLEMENTATION OF EACH APPROVED MOT EXCEPTION. THIS MEETING SHALL INCLUDE THE DISTRICT WORK ZONE TRAFFIC MANAGER AND CITY OF COLUMBUS WORK ZONE TRAFFIC MANAGER AS WELL AS THE CONTRACTOR, WORKSITE TRAFFIC SUPERVISOR (WTS) AND ANY SUBCONTRACTORS INVOLVED WITH TEMPORARY TRAFFIC CONTROL.

IN ADDITION TO ANY NOTIFICATIONS REQUIRED IN OTHER NOTES, THE CONTRACTOR SHALL NOTIFY THE PROJECT ENGINEER AT LEAST 3 BUSINESS DAYS IN ADVANCE OF IMPLEMENTATION OF THE APPROVED MOT EXCEPTION(S) REFERENCED ABOVE SO THAT THE PROJECT ENGINEER CAN SEND EMAIL NOTIFICATION TO THE OFFICE OF ROADWAY ENGINEERING, STATEWIDE TMC, DWZTM AND SPECIAL HAULING PERMITS AT LEAST 2 BUSINESS DAYS IN ADVANCE OF THE IMPLEMENTATION OF THE APPROVED MOT EXCEPTION(S) REFERENCED ABOVE. REFERENCE "EXCEPTION REQUEST APPROVAL DATED 01/24/2023 FOR PID 77372" IN THE NOTIFICATION AND OTHER CORRESPONDENCE.

ANY CHANGES TO THE MOT THAT IMPACT THE PREVIOUSLY APPROVED MOT EXCEPTION(S) LISTED ABOVE SHALL BE APPROVED IN WRITING BY THE MOT EXCEPTION COMMITTEE (MOTEC). IN THE EVENT THAT SUCH CHANGES ARE PROPOSED, THE REQUEST SHALL BE COORDINATED THROUGH THE DISTRICT WORK ZONE TRAFFIC MANAGER (DWZTM) A MINIMUM OF 30 CALENDAR DAYS PRIOR TO THE DESIRED IMPLEMENTATION DATE. IF THE DISTRICT AGREES WITH THE PROPOSED CHANGES THE DWZTM SHALL SEEK APPROVAL FROM THE MOTEC. IN THE EVENT THE PROPOSED CHANGES ARE APPROVED IN WRITING, THE CLOSURES ARE STILL SUBJECT TO NOTIFICATION REQUIREMENTS WITHIN THIS NOTE PRIOR TO IMPLEMENTATION.

NOTIFICATIONS DURING CLOSURE REQUIRED

A DESIGNATED ON-SITE POINT OF CONTACT SHOULD COMMUNICATE WITH THE TMC AS THE STATUS OF THE CLOSURE CHANGES.

CONTACT THE TMC:
 - IF THE CLOSURE IS POSTPONED OR CANCELLED
 - AT THE TIME THE CLOSURE IS IMPLEMENTED
 - AT THE TIME THE CLOSURE IS REMOVED AND ALL LANES RESTORED
 - IF THE CLOSURE WILL NOT BE OPENING ON TIME


CONTACT CAN BE MADE WITH THE TMC IN THE FOLLOWING WAYS:
 - PHONE: 1-614-387-2438 OR 1-800-884-4030
 - EMAIL: STATEWIDETMC@DOT.OHIO.GOV
 - RADIO: XDOT MAIN

NO.	DESCRIPTION	REV. BY	DATE
5	NOTE REVISED	KWR	11/6/23



ms consultants, inc.
msconsultants.com

www.msconsultants.com

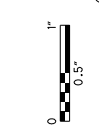

Batchplot Spec: \\msconsultants.com\files\production\03\60\06634_6A\standards\plotdrv\batchplot.dwg
Pen Table: \\msconsultants.com\files\production\03\60\06634_6A\deliverables\00_Current_Approvals\Plotting\PFDF.plt
Plot Driver: \\msconsultants.com\files\standards\usin\dotplot\ms\plotting\PFDF.plt


Model: Sheet
Printed: 11/6/2023 10:30:37 AM
View: FENCE - NEW
By: kryan

34" x 22"

PLOT.CEL

Ohio DOT Workspace
Project: V98-00634-6A-6A
File: V98-00634-6A-6A.plt

SHEET NO.	LOCATION	STATION TO STATION		614 EACH	614 EACH	614 EACH	614 EACH	614 FT/MI	614 FT/MI	614 FT/MI	614 FT	614 FT	614 FT	614 FT/MI	614 EACH	622 FT	622 FT	622 EACH	630 EACH	630 SF	630 EACH	630 EACH	690 FT	606 EACH	606 EACH												
PHASE 1																																					
100	SCIOTO BIKEWAY																																				
101	SCIOTO BIKEWAY	2+00 CL	4+38 CL																					159													
105	I-70 EB	108+67 LT	109+67 LT										10																								
106	I-70 EB	109+67 LT	119+62 CL																																		
		109+67 LT	119+62 RT																																		
		111+66 LT	119+62 LT																																		
		111+66 RT	118+23 RT																																		
		112+00 CL																																			
107	I-70 EB	119+62 LT	130+00 LT																																		
		119+62 CL	130+00 LT																																		
		119+62 RT	127+76 RT																																		
		121+28 LT												1																							
		121+47 CL																																			
		121+60 LT	127+00 LT																																		
		124+56 RT	128+19 RT																																		
108	I-70 EB	128+19 RT	130+00 RT																																		
		123+59 RT	127+41 RT																																		
108	I-70 EB	130+00 RT	133+59 RT																																		
		130+00 RT	136+60 CL																																		
		130+00 LT	133+59 LT																																		
111	I-70 EB	193+17 LT																																			
		193+42 LT	197+88 LT																																		
		193+00 RT	198+00 RT																																		
		193+91 RT	198+00 RT																																		
111	I-70 WB	194+00 CL																																			
		198+00 LT	199+60 LT																																		
		198+00 LT	208+00 LT																																		
112	I-70 WB	199+60 LT																																			
		208+00 RT	3218+00 RT																																		
		3210+38 RT	3218+00 LT																																		
113	I-70 WB	3213+40 LT	3218+00 LT																																		
		3218+00 LT	3226+40 LT																																		
		3218+00 LT	3220+19 LT																																		
114	I-70 WB	3218+00 LT	3223+20 LT																																		
		3218+00 LT	3220+19 LT																																		
		3218+00 RT	3220+19 RT																																		
		3220+20 LT	3226+78 LT																																		
		3226+40 LT	3226+78 LT																																		
PHASE 2																																					
129	SR 315 SB	376+80 RT	386+00 RT																																		
		376+80 RT	382+80 RT																																		
		378+50 CL																																			
129	SR 315 NB	376+34 RT	377+91 RT																																		
		379+80 RT	382+20 RT																																		
130	SR 315 SB	386+00 RT	396+00 RT																																		
		391+00 CL																																			
		392+93 RT	396+00 RT																																		
TOTALS THIS SHEET																																					
TOTALS CARRIED TO SHEET 59E				6	186	62	561	0.23	1.30																												

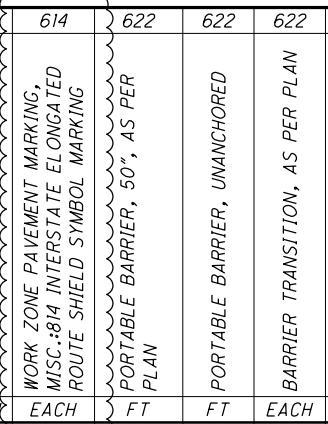

CALCULATED
MJB
CHECKED
JML

MAINTENANCE OF TRAFFIC SUBSUMMARY

NO. 5
DESCRIPTION
ITEM REVISD

REV. BY
KWR

DATE
11/6/23

FRA - 70 - 13.10

55
702

NO.	DESCRIPTION	REV. BY	DATE	614	614	614	614	614	614	614	614	614	614	614	614	614	622	622	622	630	630	630	630	630	690	606	606	
5	ITEM-REVISED	KWR	11/6/23	EACH	EACH	EACH	EACH	FT/MI	FT/MI	FT/MI	FT	FT	FT	FT/MI	EACH	FT	FT	EACH	EACH	SF	EACH	EACH	FT	EACH	EACH			
131	SR 315 SB																											
	SR 315 SB/NB																											
134	I-70 EB																											
135	I-70 EB																											
136	I-70 EB																											
137	I-70 EB																											
138	I-70 EB																											
139	I-70 EB																											
	I-70 WB																											
140	I-70 EB																											
	I-70 WB																											
141	I-71 NB TO I-70 WB																											
	I-70 WB																											
TOTALS THIS SHEET																												
TOTALS CARRIED TO SHEET 59E																												
				2	69	23	702	1.03	0.87	0.18	9065	1379	408															

NO.	DESCRIPTION	REV. BY	DATE
5	ITEM-REVISED	KWR	11/6/23


FRA -70-13.10

56
702

MAINTENANCE OF TRAFFIC SUBSUMMARY

CALCULATED
MJB
CHECKED
JML

Batchplot Spec: \\msconsultants.com\files\production\03\60\06634_6A\standards\plotdrv\batchplot.dwg
 Pen Table: \\msconsultants.com\files\production\03\60\06634_6A\deliverables\00 Current Applications\Standards\Addendum RS\04\VT East Interchange 6A
 Plot Driver: \\msconsultants.com\files\standards\usin\ohdot\18\ms\plotting\PDF.plt.crg
 View: FENCE - NEWT By: kryan
 Model: Sheet 11/6/2023 10:37:43 AM
 File: \\msconsultants.com\files\production\03\60\06634_6A\mot\sheet\89464_45003.dgn

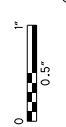

34" x 22"

SHEET NO.	LOCATION	STATION TO STATION		614	614	614	614	614	614	614	614	614	614	614	614	614	622	622	622	630	630	630	630	690	606	606			
		WORK ZONE IMPACT ATTENUATOR, 24" WIDE HAZARDS, (UNIDIRECTIONAL)	BARRIER REFLECTOR, TYPE I, ONE WAY	OBJECT MARKER, ONE WAY	WORK ZONE RAISED PAVEMENT MARKER, AS PER PLAN	WORK ZONE EDGE LINE, CLASS I, 6", 807 PAINT, WHITE	WORK ZONE EDGE LINE, CLASS I, 6", 807 PAINT, YELLOW	WORK ZONE LANE LINE, CLASS I, 6", 807 PAINT	WORK ZONE CHANNELIZING LINE, CLASS I, 12", 807 PAINT	WORK ZONE DOTTED LINE, CLASS I, 6", 807 PAINT	WORK ZONE GORE MARKING, CLASS II, 740.06, TYPE I	WORK ZONE CENTER LINE, CLASS I, 807 PAINT, DOUBLE SOLID, WHITE	WORK ZONE ARROW, CLASS I, 740.06, TYPE I	WORK ZONE PAVEMENT MARKING, MISC.-814 INTERSTATE ELONGATED ROUTE SHIELD SYMBOL MARKING	PORTABLE BARRIER, 50", AS PER PLAN	PORTABLE BARRIER, UNANCHORED	BARRIER TRANSITION, AS PER PLAN	SIGN ATTACHMENT ASSEMBLY	SIGN, TEMPORARY OVERLAY	REMOVAL OF STRUCTURE MOUNTED SIGN AND REERECTION	REMOVAL OF TEMPORARY OVERLAY SIGN AND DISPOSAL	SPECIAL -COVERED WALKWAY SYSTEM	ANCHOR ASSEMBLY, MGS TYPE E (MASH 2016)	BRIDGE TERMINAL ASSEMBLY, TYPE I					
		EACH	EACH	EACH	EACH	FT/MI	FT/MI	FT/MI	FT	FT	FT	FT/MI	EACH	EACH	FT	FT	EACH	EACH	SF	EACH	EACH	FT	EACH	EACH					
PHASE 2																													
141	I-70 EB	5034+37 LT	5044+41 LT					9		1004	1004																		
		5034+37 RT	5039+05 RT					12				468																	
		5034+37 RT	5037+14 RT							277																			
		5039+05 RT	5044+41 RT							536																			
142	I-70 WB	140+00 RT	148+00 RT					800		800																			
		140+28 CL																											
		145+90 LT																											
		5044+41 LT	5052+91 LT					7	850		850																		
		5044+41 RT	5051+59 RT								718																		
		5051+59 RT	5052+91 RT					4					132																
143	I-70 WB	148+00 LT	158+00 LT					1000																					
		148+00 RT	158+00 RT			120	40			1000																			
	I-70 EB	3041+50 CL																											
		3048+24 CL																											
		148+53 RT	158+00 RT									947																	
	I-70 EB TO I-70EB/I-71NB	150+29 RT	158+00 RT					771																					
		5052+91 LT	5056+60 LT							369																			
		5052+91 LT	5055+20 LT					2			229																		
		5052+91 RT	5055+20 RT					6			229																		
	I-71 SB	5057+76 CL																											
	I-71 SB	253+26 RT	257+93 RT					24		467	467																		
144	I-70 WB	158+00 RT	168+00 RT			120	40			1000	1000																		
		161+25 CL																											
	I-70 EB	162+50 RT	168+00 RT			33	11																						
		158+00 RT	168+00 RT							1000	1000																		
	I-70 EB TO I-70EB/I-71NB	5064+85 LT	5072+49 LT					7			764																		
		5067+40 LT	5072+49 LT								509																		
		5069+55 CL																											
	I-71 SB	5071+67 LT	5072+49 LT					2			82																		
		257+95 RT	266+77 RT					22			860																		
		257+95 RT	268+53 RT								1058																		
145	I-71 SB	268+53 RT	279+06 RT								1053																		
		272+95 LT	279+06 LT																										
		277+90 RT	279+06 RT					9	3																				
	I-70 WB	168+00 RT	175+10 RT			45	15																						
		168+00 RT	178+00 RT			120	40	100	1000	1000																			
		169+50 RT	178+00 RT					42				850																	
		170+52 CL																											
		175+10 RT																											
	I-70 EB	168+00 RT	178+00 RT								1000																		
		168+00 RT	170+66 RT								266																		
	I-71 NB	174+50 CL																											
		170+66 RT	178+00 RT								32																		
		5072+49 LT	5075+07 LT									258																	
		5072+49 LT	5073+96 LT								2																		
		5072+49 LT	5074+89 LT								6																		
		5075+07 LT	5078+25 LT								11																		
		5073+96 LT	5082+25 LT								34																		
	5074+89 LT	5082+25 LT									736																		
TOTALS THIS SHEET										8847	12183	2994																	
TOTALS CARRIED TO SHEET 59E										1	447	149	415	1.68	2.31	0.57	6421	0											

NO.	DESCRIPTION	REV. BY	DATE
5	ITEM-REVISED	KWR	11/6/23

FRA - 70-13.10


CALCULATED	MJB
CHECKED	JML

57
702

SHEET NO.	LOCATION	STATION TO STATION		614	614	614	614	614	614	614	614	614	614	614	614	614	622	622	622	630	630	630	630	690	606	606		
		EACH	EACH	EACH	EACH	FT/MI	FT/MI	FT/MI	FT	FT	FT	FT/MI	EACH	EACH	FT	FT	EACH	EACH	SF	EACH	EACH	FT	EACH	EACH				
PHASE 3																												
170	I-70 WB	251+89 LT	129+68 LT				979																					
		251+89 LT	125+45 LT			5		586																				
		251+89 LT	130+00 LT			8		1011																				
		251+89 LT	126+82 RT			6		693																				
		251+89 LT	130+00 LT					1011																				
		123+60 RT	127+41 RT	24	8																							
		125+45 LT	129+70 LT			11		425																				
		125+45 LT	130+00 LT			11		455																				
		126+82 RT	130+00 LT			16		636																				
		121+83 LT	130+00 RT	1	48	16																						
171	I-70 WB	3023+33 RT	3025+46 RT			5		213																				
		3023+33 RT	3033+09 RT			8		976																				
		3023+33 RT	3026+04 RT			6		271																				
		3025+46 RT	3033+09 RT					763																				
		3026+04 RT	3033+09 RT					705																				
		I-71 NB TO I-70 WB	130+00 LT	133+47 LT			8		347																			
172	I-70 EB	I-70 EB TO I-70EB/I-71NB	5034+37 LT	5034+97 LT	3	1																						
		145+00 LT	146+26 LT					126																				
		145+00 CL	148+00 CL			3		300																				
		145+00 RT	148+00 RT					300																				
	I-70 WB	146+26 LT	148+00 LT						174																			
		3033+09 LT	3039+51 LT					642																				
	I-70 WB TO SR 315 NB	3033+09 RT	3040+41 RT			6		732	732																			
		3039+51 LT	3040+41 LT			4			90																			
	I-70 WB TO SR 315 NB	3035+29 RT	147+66 LT					539																				
		3035+29 RT	147+66 RT					539																				
146+67 LT		147+66 RT																										
836+00 CL		840+27 CL					427																					
I-70 WB TO RICH/TOWN ST	836+00 RT	839+53 RT					353																					
	839+53 RT	840+27 RT			2			74																				
	3039+51 LT	3040+41 LT																										
I-71NB/I-70 EB	5051+63 LT	5052+91 RT					128																					
	5051+66 LT	5052+91 RT																										
SR 315 SB TO I-70 EB	55+04 CL	63+00 CL			10		796																					
	55+04 LT	56+79 LT			4			175																				
	56+79 LT	63+00 LT					621																					
TOTALS THIS SHEET							4271	4737	4298																			
TOTALS CARRIED TO SHEET 59E				1	75	25	113	0.81	0.90	0.81	2860	224	42															

CALCULATED		MJB		CHECKED		JML	
MAINTENANCE OF TRAFFIC SUBSUMMARY							
NO.	DESCRIPTION	REV.	BY	DATE			
5	ITEM REVISED	KWR		11/16/23			
FRA - 70-13.10							
59A 702							

Batchplot Spec: \\msconsultants.com\files\production\03\60\06634_6A\standards\plotdrv\batchplot.dwg
 Pen Table: \\msconsultants.com\files\production\03\60\06634_6A\deliverables\00_Current_Applications\Standards\Addendum RS\03\60\06634_6A\Columbus
 Plot Driver: \\msconsultants.com\files\standards\ustin\ohdot\18\ms\plotting\PDF_plt.crg
 View: FENCE - NEW! By: krjan
 Model: Sheet
 Printed: 11/16/2023 10:56:58 AM
 File: \\msconsultants.com\files\production\03\60\06634_6A\mot\sheet\89464_45007.dgn

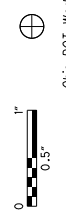

34" x 22"

SHEET NO.	LOCATION	STATION TO STATION		614	614	614	614	614	614	614	614	614	614	614	614	614	622	622	622	630	630	630	630	690	606	606		
		614	614	614	614	614	614	614	614	614	614	614	614	614	614	614	614	614	614	614	614	614	614	614	614	614	614	
		WORK ZONE IMPACT ATTENUATOR, 24" WIDE HAZARDS, (UNIDIRECTIONAL)	BARRIER REFLECTOR, TYPE 1, ONE WAY	OBJECT MARKER, ONE WAY	WORK ZONE RAISED PAVEMENT MARKER, AS PER PLAN	WORK ZONE EDGE LINE, CLASS 1, 6", 807 PAINT, WHITE	WORK ZONE EDGE LINE, CLASS 1, 6", 807 PAINT, YELLOW	WORK ZONE LANE LINE, CLASS 1, 6", 807 PAINT	WORK ZONE CHANNELIZING LINE, CLASS 1, 12", 807 PAINT	WORK ZONE DOTTED LINE, CLASS 1, 6", 807 PAINT	WORK ZONE CORE MARKING, CLASS II, 740.06, TYPE I	WORK ZONE CENTER LINE, CLASS 1, 807 PAINT, DOUBLE SOLID, WHITE	WORK ZONE ARROW, CLASS 1, 740.06, TYPE I	WORK ZONE PAVEMENT MARKING, MISC.:814 INTERSTATE ELONGATED ROUTE SHIELD SYMBOL MARKING	PORTABLE BARRIER, 50", AS PER PLAN	PORTABLE BARRIER, UNANCHORED	BARRIER TRANSITION, AS PER PLAN	SIGN ATTACHMENT ASSEMBLY	SIGN, TEMPORARY OVERLAY	REMOVAL OF STRUCTURE MOUNTED SIGN AND REERECTION	REMOVAL OF TEMPORARY OVERLAY SIGN AND DISPOSAL	SPECIAL -COVERED WALKWAY SYSTEM	ANCHOR ASSEMBLY, MGS TYPE E (MASH 2016)	BRIDGE TERMINAL ASSEMBLY, TYPE I				
		EACH	EACH	EACH	EACH	FT/MI	FT/MI	FT/MI	FT	FT	FT	FT/MI	EACH	EACH	FT	FT	EACH	EACH	SF	EACH	EACH	FT	EACH	EACH				
173	I-70 EB	148+00 LT	158+00 LT				1000																					
		148+00 LT	153+17 LT		13				1034																			
		148+00 CL	158+00 RT		8			1000																				
		148+00 RT	148+53 RT			53	53																					
		148+00 RT	150+47 RT						247																			
		148+00 RT	158+00 RT				1000																					
		148+53 RT	155+00 RT		32				1249																			
		153+17 LT	158+00 LT		4				483																			
		155+00 RT	158+00 RT		3				300																			
	I-70 EB TO I-70EB/I-71 NB	5055+20 L/C	5062+77 L/C		12				1514																			
		5056+60 LT	5062+77 LT					617																				
		5056+70 RT	5062+77 RT			607																						
	I-70 WB	3040+41 LT	3050+51 LT			1010																						
		3040+41 LT	3041+42 CL		5				101		38																	
		3040+41 CL	3041+42 CL		5				101																			
		3040+41 RT	3050+51 RT		8		1010	1010																				
		3041+42 CL	3050+51 CL						909																			
	I-70 WB/I-71SB TO 315 NB	147+66 CL	157+78 CL			1012																						
		147+66 RT	154+39 RT					1012																				
		149+53 RT											1															
		154+39 RT											1															
	I-71 SB	154+39 RT	157+78 RT		3				339																			
		253+26 RT	257+92 RT		4				466		466																	
174	I-70 EB	158+00 LT	168+00 LT		8		1000	1000																				
		158+00 RT	168+00 RT		16	1000		2000																				
	I-70 EB TO FULTON ST	5062+77 LT	5072+49 LT					972																				
		5062+77 LT	5064+55 LT		1				178																			
		5062+77 CL	5072+49 CL		8				972																			
		5062+77 RT	5072+49 RT			972																						
		5064+55 LT	5072+49 LT		20				794																			
		5069+55 LT	5072+49 LT		7				294																			
	I-70 WB	3050+51 LT	3060+85 LT			1034																						
		3050+51 CL	3052+60 CL																									
		3050+51 RT	3060+85 LT		9			1034																				
		3050+51 RT	3058+07 RT					756																				
		3052+60 CL	3060+85 CL						825																			
		3054+59 CL	3060+85 LT		16				626																			
		3058+07 RT	3060+85 RT		7				278																			
	I-70 WB/I-71SB TO 315 NB	157+78 CL	165+25 CL			747																						
		157+78 RT	168+00 RT		9		1022	1022																				
		165+25 CL	168+00 CL		7																							
	I-71 SB	257+92 RT	268+53 RT		9				1061																			
		257+92 CL	260+10 CL																									
		260+10 CL	266+77 CL		6			667																				
		261+13 LT												1														
		264+21 LT												1														
		266+77 CL	268+53 CL						176																			
TOTALS THIS SHEET							7435	7442	13046																			
TOTALS CARRIED TO SHEET 59E					219	1.41	1.41	2.47	5753	2722	38		4															

NO.	DESCRIPTION	REV. BY	DATE
5	ITEM REVISED	KWR	11/16/23


FRA - 70-13.10

CALCULATED
MJB
CHECKED
JML

59B
702

ms consultants, inc.

Batchplot Spec: \\msconsultants.com\files\production\03\60\06634_6A\standards\plotdrv\batchplot.dwg
 Pen Table: \\msconsultants.com\files\production\03\60\06634_6A\deliverables\00 Current Applications\Addendum
 Plot Driver: \\msconsultants.com\files\standards\usin\ohdot\18\ms\plotting\PDF.plt.crg
 View: FENCE - NEWT
 By: kryan
 Model: Sheet
 Printed: 11/6/2023 11:00:07 AM
 File: \\msconsultants.com\files\production\03\60\06634_6A\mol\sheet\894f4_45008.dgn

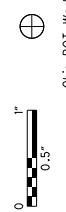

34" x 22"

SHEET NO.	LOCATION	STATION TO STATION		614	614	614	614	614	614	614	614	614	614	614	614	614	622	622	622	630	630	630	630	690	606	606	
		EACH	EACH	EACH	EACH	FT/MI	FT/MI	FT/MI	FT	FT	FT	FT/MI	EACH	EACH	FT	FT	EACH	EACH	SF	EACH	EACH	FT	EACH	EACH			
175	I-70 EB	168+00 LT	178+00 LT								1000																
		168+00 RT	178+00 RT																								
		168+00 RT	170+00 RT			24						200															
		170+00 RT	178+00 RT																								
	I-70 EB TO FULTON ST	5072+49 LT	5075+08 LT									259															
		5072+49 LT	5074+89 LT			4																					
		5074+89 LT	5082+25 LT									736															
		5075+08 LT	5082+25 LT																								
	FULTON ST OFF RAMP	5072+49 LT	5074+89 LT																								
		5072+49 CL	5074+89 CL			2						240															
		5072+49 RT	5074+89 RT									240															
	I-71 SB	268+47 RT	279+06 RT																								
		272+95 CL	279+06 CL			9						611															
		276+24 RT	279+06 RT																								
	MOUND ST TO I-70 WB	6999+76 CL	7007+00 CL									724															
6999+76 RT		7003+21 RT			9																						
7003+21 LT		7007+00 LT			5						379																
3060+85 CL		3064+27 CL																									
I-70 WB	3060+85 RT	178+22 CL																									
	3060+85 RT	173+10 RT			9																						
	3060+85 RT	173+10 RT			13																						
	3064+27 CL	178+22 CL									686																
	168+00 CL	173+10 CL			13																						
176	I-70 EB	178+00 LT	188+00 LT																								
		178+00 RT	188+00 RT			8						1000															
		178+00 RT	184+00 RT			16																					
		178+00 RT	188+00 RT			15																					
	I-70 WB	178+22 LT	178+97 LT									1000															
		178+22 CL	188+17 CL									75															
		178+22 RT	181+00 RT			8																					
		178+22 RT	188+17 RT			2																					
	I-70 WB TO I-71 SB	178+97 LT	186+00 LT																								
		279+06 CL	280+04 LT			18																					
279+06 RT		188+00 LT			3																						
279+06 RT		188+00 LT			8																						
RAMP D6	279+06 RT	279+78 RT									72																
	279+78 RT	285+87 LT			15																						
	280+04 LT	188+17 LT									896																
	186+00 LT	188+17 LT			2																						
177	I-70 EB	6000+65 CL	6002+77 CL								212																
		6000+65 RT	6001+63 RT			2																					
		6001+63 RT	6004+33 RT																								
	I-70 WB	188+00 LT	198+00 LT																								
		188+00 RT	193+30 RT			8						1000															
		188+00 RT	198+00 RT			4																					
	I-70 WB	193+06 LT	194+15 LT	1	9	3																					
		193+30 RT	198+00 RT																								
I-70 WB	188+17 LT	3198+00 RT									983																
	188+17 RT	3198+00 RT			8																						
		193+62 RT	197+90 RT			54	18																				
TOTALS THIS SHEET											7363	7262	17312														
TOTALS CARRIED TO SHEET 59E				1	63	21	280	1.39	1.38	3.28	8087	1470	126				428	109	2								




NO.	DESCRIPTION	REV. BY	DATE
5	ITEM REVISED	KWR	11/6/23

FRA - 70-13.10


CALCULATED	MJB
CHECKED	JML

Batchplot Spec: \\msconsultants.com\files\production\03\60\06634_6A\standards\plotdrv\batchplot.dwg
 Pen Table: \\msconsultants.com\files\production\03\60\06634_6A\deliverables\00_Current_Applications\Addendum
 Plot Driver: \\msconsultants.com\files\standards\usin\ohdot\18\ms\plotting\PDF_plt.ctb
 View: FENCE_NEWT
 Printed: 11/6/2023 8:11:03:18 AM
 By: kryan
 File: \\msconsultants.com\files\production\03\60\06634_6A\mot\sheet\894944_05009.dgn

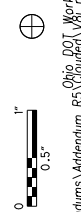

34" x 22"

SHEET NO.	LOCATION	STATION TO STATION		614												614	622	622	630	630	630	630	690	606	606	
		LT	RT	EACH	EACH	EACH	EACH	FT/MI	FT/MI	FT/MI	FT	FT	FT	FT/MI	EACH	FT	FT	EACH	EACH	SF	EACH	EACH	FT	EACH	EACH	
178	I-70 EB	198+00 LT	202+00 LT																							
		198+00 RT	202+00 RT																							
		198+00 RT	199+00 RT																							
		198+00 RT	202+00 RT																							
		198+00 RT	202+00 RT																							
		198+00 RT	202+00 RT																							
179	I-70 WB	3208+00 RT	3218+00 LT																							
		3208+00 RT	3218+00 RT																							
180	I-70 WB	3218+00 LT	3226+79 LT																							
		3218+00 LT	3226+79 LT																							
		3218+00 LT	3220+19 LT																							
		3218+00 RT	3223+19 RT																							
		3220+19 LT	3226+37 LT																							
		3226+37 LT	3226+79 LT																							
181	SR 315 SB	373+87 LT	381+50 CL																							
		376+81 LT	378+59 LT																							
		376+81 RT	381+50 RT																							
		378+59 LT	381+50 LT																							
		63+00 CL	70+98 CL																							
		63+00 LT	66+33 LT																							
182	SR 315 SB	381+50 LT	382+28 LT																							
		381+50 CL	385+15 CL																							
		381+50 RT	394+06 RT																							
183	I-70 EB	415+24 RT	424+00 RT																							
		209+00 RT	220+00 RT																							
		209+00 RT	213+57 RT																							
184	I-70 EB	424+00 RT	209+00 RT																							
		213+57 RT	217+98 RT																							
		217+98 RT	220+00 RT																							
185	I-70 EB	220+00 RT	231+00 RT																							
		220+00 RT	225+07 RT																							
		220+00 RT	225+07 RT																							
186	I-70 EB	220+00 RT	231+00 RT																							
		220+00 RT	225+07 RT																							
		220+00 RT	225+07 RT																							
TOTALS THIS SHEET																										
TOTALS CARRIED TO SHEET 59E																										

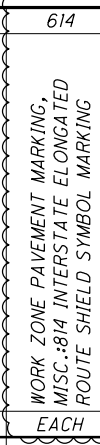

NO.	DESCRIPTION	REV. BY	DATE
5	ITEM REVISED	KWR	11/6/23

FRA - 70-13.10

CALCULATED
MJB
CHECKED
JML

SHEET NO.	LOCATION	STATION TO STATION	614	614	614	614	614	614	614	614	614	614	614	614	614	614	622	622	622	630	630	630	630	690	606	606	
			EACH	EACH	EACH	EACH	FT/MI	FT/MI	FT/MI	FT	FT	FT	FT/MI	EACH	EACH	FT	FT	EACH	EACH	SF	EACH	EACH	FT	EACH	EACH		
187	I-70 EB	231+00 RT				18		1100	2200																		
		231+00 RT						464																			
		235+64 RT														636											
		241+00 RT					3	100							100												
187A	I-70 EB	242+00 RT				8		1000	1000																		
		242+00 RT				4			479																		
		242+00 RT				5				402																	
		242+00 RT						808																			
		244+01 RT				7			799																		
		246+79 RT														521											
187B	I-70 EB	252+00 RT				9		1022	1022																		
		252+00 RT													37												
		252+00 RT				7			813																		
		252+00 RT						1014																			
		252+37 RT				20				819					319												
		252+37 RT				20				819																	
		128+19 CL						181																			
5032+14 L/C				5		205		205																			
187C	I-70 EB	130+00 L/R				8	1000	1000	1000																		
		5034+19 LT							1032																		
		5034+19 CL				12				486																	
187D	I-70 EB TO DOWNTOWN	5034+19 RT						553							486												
		3002+47 LT				5				189																	
		3004+36 LT				1		88																			
187E	I-70 EB TO I-71 SB	140+00 L/R				4	500	500	500																		
		5044+51 LT							726																		
		5044+51 CL						708																			
		5051+59 C/R				3				264																	
		5051+62 RT						129																			
		5051+72 LT				3				119																	
		5051+77 LT								114																	
		5051+79 LT				1		112																			
		5052+91 LT						369																			
		5052+91 LT				6				458																	
5052+91 C/R				6				470																			
5052+91 RT						19																					
TOTALS THIS SHEET						155	1.04	1.35	1.48	5081				319	0.11												
TOTALS FROM SHEET 55			6	186	62	561	0.23	1.30		8625	965						2943	1		155		8	443				
TOTALS FROM SHEET 56			2	69	23	702	1.03	0.87	0.18	9065	1379	408					1113			110		4					
TOTALS FROM SHEET 57			1	447	149	415	1.68	2.31	0.57	6421	0						3000			1124	4	14		1			
TOTALS FROM SHEET 58			3	579	193	520	1.93	1.66	0.45	11477	2171	969	4	5	3	3050	3629	5		169		5					
TOTALS FROM SHEET 59			5	147	46	288	0.74	0.60	0.07	3294	911	124				801	1164	1	10	30		1		1	2		
TOTALS FROM SHEET 59A			1	75	25	113	0.81	0.90	0.81	2860	224	42					1241										
TOTALS FROM SHEET 59B						219	1.41	1.41	2.47	5753	2722	38		4													
TOTALS FROM SHEET 59C			1	63	21	280	1.39	1.38	3.28	8087	1470	126				428	109	2									
TOTALS FROM SHEET 59D						251	1.44	1.62	3.56	4119	1209							5									
TOTALS CARRIED TO GENERAL SUMMARY			19	1566	519	3504	25.10	12.87	64782	11051	2026	0.11	8	3	7279	11575	4	10	1587	4	32	443	2	2			

NO.	DESCRIPTION	REV.	BY	DATE
5	ITEM & QTY REVISED	KWR		11/6/23
FRA - 70-13.10				
MAINTENANCE OF TRAFFIC SUBSUMMARY				
CALCULATED				MJB
CHECKED				JML



Ohio DOT Workspace
70171 East Interchange 6A
www.msconsultants.com



Batchplot Spec: \\msconsultants.com\files\production\03\60\06634_6A\standards\plotdrv\batchplot.dwg
Pen Table: \\msconsultants.com\files\standards\user\ohdot\18\ms\plotting\pen\18_ms_std.dwg
Plot Driver: \\msconsultants.com\files\standards\user\ohdot\18\ms\plotting\PDF.plt

34" x 22"

View: FENCE_VEW1
By: white
Model: Sheet
Printed: 11/6/2023 7:45:01 AM
File: \\msconsultants.com\files\production\03\60\06634_6A\roadway\sheet\89464GC006.dgn

SHEET NUM.											PART.	ITEM	ITEM	GRAND	UNIT	DESCRIPTION	SEE SHEET NO.
59E	117	167B	203	421	425	426	427	428			01/MS/04	EXT	TOTAL				
TRAFFIC CONTROL																	
					679						679	621	00100	679	EACH	RPM (TWO-WAY, WHITE/RED)	
							8				8	625	32000	8	EACH	GROUND ROD (TRAFFIC CONTROL)	
	6	6	174								186	626	00102	186	EACH	BARRIER REFLECTOR, TYPE 1, BIDIRECTIONAL	
			64								64	626	00110	64	EACH	BARRIER REFLECTOR, TYPE 2, BIDIRECTIONAL	
							72				72	630	02100	72	FT	GROUND MOUNTED SUPPORT, NO. 2 POST	
							189				189	630	03100	189	FT	GROUND MOUNTED SUPPORT, NO. 3 POST	
							31				31	630	04100	31	FT	GROUND MOUNTED SUPPORT, NO. 4 POST	
							38.8				38.8	630	06500	38.8	FT	GROUND MOUNTED STRUCTURAL BEAM SUPPORT, W6X9	
							22				22	630	07000	22	FT	GROUND MOUNTED STRUCTURAL BEAM SUPPORT, W8X18	
							8				8	630	08600	8	EACH	SIGN POST REFLECTOR	
							2				2	630	09000	2	EACH	BREAKAWAY STRUCTURAL BEAM CONNECTION	
							2				2	630	72410	2	EACH	OVERHEAD SIGN SUPPORT, TYPE TC-15.116, DESIGN 1	
							2				2	630	72420	2	EACH	OVERHEAD SIGN SUPPORT, TYPE TC-15.116, DESIGN 2	
10											10	630	75000	10	EACH	SIGN ATTACHMENT ASSEMBLY	
							2				2	630	79500	2	EACH	SIGN SUPPORT ASSEMBLY, POLE MOUNTED	
							1				1	630	79604	1	EACH	SIGN SUPPORT ASSEMBLY, BRIDGE MOUNTED, TYPE 2	
							155.3	4.5			159.8	630	80100	159.8	SF	SIGN, FLAT SHEET	
							96				96	630	80200	96	SF	SIGN, GROUND MOUNTED EXTRUSHEET	
							996.5				996.5	630	80224	996.5	SF	SIGN, OVERHEAD EXTRUSHEET	
1,587											1,587	630	80300	1,587	SF	SIGN, TEMPORARY OVERLAY	
							56.3				56.3	630	80400	56.3	SF	SIGN, PERMANENT OVERLAY	
							1				1	630	84010	1	EACH	CONCRETE BARRIER MEDIAN OVERHEAD SIGN SUPPORT FOUNDATION, TYPE TC-21.50	
							2				2	630	84500	2	EACH	GROUND MOUNTED STRUCTURAL BEAM SUPPORT FOUNDATION	
							7				7	630	84510	7	EACH	RIGID OVERHEAD SIGN SUPPORT FOUNDATION	
						9		1			10	630	84900	10	EACH	REMOVAL OF GROUND MOUNTED SIGN AND DISPOSAL	
						2					2	630	85400	2	EACH	REMOVAL OF GROUND MOUNTED MAJOR SIGN AND DISPOSAL	
						13		1			14	630	86002	14	EACH	REMOVAL OF GROUND MOUNTED POST SUPPORT AND DISPOSAL	
						5					5	630	86102	5	EACH	REMOVAL OF GROUND MOUNTED STRUCTURAL BEAM SUPPORT AND DISPOSAL	
4											4	630	86320	4	EACH	REMOVAL OF STRUCTURE MOUNTED SIGN AND REERECTION	
							3				3	630	87100	3	EACH	REMOVAL OF OVERHEAD MOUNTED SIGN AND REERECTION	
				1		15					16	630	87400	16	EACH	REMOVAL OF OVERHEAD MOUNTED SIGN AND DISPOSAL	
						1					1	630	87500	1	EACH	REMOVAL OF POLE MOUNTED SIGN AND DISPOSAL	
							1				1	630	89706	1	EACH	REMOVAL OF OVERHEAD SIGN SUPPORT AND DISPOSAL, TYPE TC-12.30	
							2				2	630	89802	2	EACH	REMOVAL OF OVERHEAD SIGN SUPPORT AND DISPOSAL, TYPE TC-7.65	
							2				2	630	89804	2	EACH	REMOVAL OF OVERHEAD SIGN SUPPORT AND DISPOSAL, TYPE TC-15.115	
32				3							35	630	89894	35	EACH	REMOVAL OF TEMPORARY OVERLAY SIGN AND DISPOSAL	
					571						571	644	00700	571	FT	TRANSVERSE/DIAGONAL LINE	
								14			14	644	30000	14	FT	REMOVAL OF PAVEMENT MARKING	
								0.05			0.05	644	50400	0.05	MILE	PAVEMENT MARKING, MISC.: CENTERLINE, DOUBLE SOLID 4"	
					316						316	646	10600	316	FT	TRANSVERSE/DIAGONAL LINE	
					2						2	647	50100	2	EACH	PAVEMENT MARKING, MISC.: LANE REDUCTION ARROW WITH CONTRAST	
					2.03						2.03	807	12010	2.03	MILE	WET REFLECTIVE EPOXY PAVEMENT MARKING, EDGE LINE, 6"	
					0.76						0.76	807	12110	0.76	MILE	WET REFLECTIVE EPOXY PAVEMENT MARKING, LANE LINE, 6"	
					4,316						4,316	807	12310	4,316	FT	WET REFLECTIVE EPOXY PAVEMENT MARKING, CHANNELIZING LINE, 12"	
					1,649						1,649	807	12410	1,649	FT	WET REFLECTIVE EPOXY PAVEMENT MARKING, DOTTED LINE, 6"	
					5.96						5.96	807	14010	5.96	MILE	WET REFLECTIVE THERMOPLASTIC PAVEMENT MARKING, EDGE LINE, 6"	
					4.76						4.76	807	14110	4.76	MILE	WET REFLECTIVE THERMOPLASTIC PAVEMENT MARKING, LANE LINE, 6"	
					0.11						0.11	807	14200	0.11	MILE	WET REFLECTIVE THERMOPLASTIC PAVEMENT MARKING, CENTER LINE	
					12,495						12,495	807	14310	12,495	FT	WET REFLECTIVE THERMOPLASTIC PAVEMENT MARKING, CHANNELIZING LINE, 12"	
					3,361						3,361	807	14410	3,361	FT	WET REFLECTIVE THERMOPLASTIC PAVEMENT MARKING, DOTTED LINE, 6"	
					10.91						10.91	850	10010	10.91	MILE	GROOVING FOR 6" RECESSED PAVEMENT MARKING, (ASPHALT)	
					3,361						3,361	850	10110	3,361	FT	GROOVING FOR 6" RECESSED PAVEMENT MARKING, (ASPHALT)	
					12,495						12,495	850	10130	12,495	FT	GROOVING FOR 12" RECESSED PAVEMENT MARKING, (ASPHALT)	
					2.8						2.8	850	20010	2.8	MILE	GROOVING FOR 6" RECESSED PAVEMENT MARKING, (CONCRETE)	
					1,649						1,649	850	20110	1,649	FT	GROOVING FOR 6" RECESSED PAVEMENT MARKING, (CONCRETE)	
					4,316						4,316	850	20130	4,316	FT	GROOVING FOR 12" RECESSED PAVEMENT MARKING, (CONCRETE)	

CALCULATED
T.A.Z.
CHECKED
J.M.L.

GENERAL SUMMARY

FRA-70-13.10


193
702

NO.	DESCRIPTION	REV. BY	DATE
5	ITEM/DESCRIPTION CHANGES	ACW	11/8/23



ms consultants, inc.
msconsultants.com

Ohio DOT Workspace
7077 East Interchange 6A
www.msconsultants.com

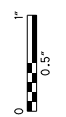

Batchplot Spec: \\msconsultants.com\files\production\03\60\06634_6A\standards\plotdrv\batchplot.dwg
Pen Table: \\msconsultants.com\files\standards\user\ahad\1\8\ms\plotting\pen\8\ms_std.tbl
Plot Driver: \\msconsultants.com\files\standards\user\ahad\1\8\ms\plotting\pdf\pdfc.g

34" x 22"

View: FENCE - NEW!
By: white
Printed: 11/6/2023 7:59:55 AM
File: \\msconsultants.com\files\production\03\60\06634_6A\roadway\sheet\89464GC009.dgn

SHEET NUM.										PART.	ITEM	ITEM	GRAND	UNIT	DESCRIPTION	SEE SHEET NO.
480	538									04/NHS/10	EXT	TOTAL				
STRUCTURE OVER 20 FOOT SPAN (FRA-070-1322L) (CONT.)																
16										16	516	13600	16	SF	1" PREFORMED EXPANSION JOINT FILLER	
238										238	516	13900	238	SF	2" PREFORMED EXPANSION JOINT FILLER	
5										5	518	12200	5	EACH	SCUPPERS, INCLUDING SUPPORTS	
120										120	518	21200	120	CY	POROUS BACKFILL WITH GEOTEXTILE FABRIC	
129										129	518	40000	129	FT	6" PERFORATED CORRUGATED PLASTIC PIPE	
39										39	518	40010	39	FT	6" NON-PERFORATED CORRUGATED PLASTIC PIPE, INCLUDING SPECIALS	
130										130	518	51200	130	FT	PIPE DOWNSPOUT, INCLUDING SPECIALS, (10")	
180										180	524	94919	180	FT	DRILLED SHAFTS, 60" DIAMETER, INTO BEDROCK, AS PER PLAN	479
537										537	524	94931	537	FT	DRILLED SHAFTS, 66" DIAMETER, ABOVE BEDROCK, AS PER PLAN	479
290										290	526	30010	290	SY	REINFORCED CONCRETE APPROACH SLABS WITH QC/QA (T=17")	
115										115	526	90010	115	FT	TYPE A INSTALLATION	
48										48	846	00110	48	CF	POLYMER MODIFIED ASPHALT EXPANSION JOINT SYSTEM	
24										24	869	00101	24	EACH	HIGH LOAD MULTI-ROTATIONAL (HLMR) BEARINGS, AS PER PLAN	479
12										12	894	10000	12	EACH	THERMAL INTEGRITY PROFILING (TIP) TEST	479
STRUCTURE OVER 20 FOOT SPAN (FRA-070-1323C)																
LUMP										LUMP	202	11003	LS		STRUCTURE REMOVED, OVER 20 FOOT SPAN, AS PER PLAN	535
745										745	202	22900	745	SY	APPROACH SLAB REMOVED	
10,500										10,500	202	23500	10,500	SY	WEARING COURSE REMOVED	
278										278	202	32800	278	SY	CONCRETE SLOPE PROTECTION REMOVED	
14										14	202	98100	14	EACH	REMOVAL MISC.: PILE REMOVED, EXSTING STRUCTURE	535
3,242										3,242	503	21101	3,242	CY	UNCLASSIFIED EXCAVATION, AS PER PLAN	535
LUMP										LUMP	505	11100	LS		PILE DRIVING EQUIPMENT MOBILIZATION	
6,350										6,350	507	00100	6,350	FT	STEEL PILES HP10X42, FURNISHED	
5,890										5,890	507	00150	5,890	FT	STEEL PILES HP10X42, DRIVEN	
92										92	507	93300	92	EACH	STEEL POINTS OR SHOES	
881,328										881,328	509	10001	881,328	LB	EPOXY COATED REINFORCING STEEL, AS PER PLAN	536
1,710										1,710	511	34447	1,710	CY	CLASS QC2 CONCRETE WITH QC/QA, BRIDGE DECK, AS PER PLAN	536
360										360	511	34450	360	CY	CLASS QC2 CONCRETE WITH QC/QA, BRIDGE DECK (PARAPET)	
394										394	511	44112	394	CY	CLASS QC1 CONCRETE WITH QC/QA, ABUTMENT NOT INCLUDING FOOTING	
596										596	511	45602	596	CY	CLASS QC4 MASS CONCRETE, SUBSTRUCTURE WITH QC/QA	
277										277	511	46012	277	CY	CLASS QC1 CONCRETE WITH QC/QA, RETAINING/WINGWALL NOT INCLUDING FOOTING	
579										579	511	46512	579	CY	CLASS QC1 CONCRETE WITH QC/QA, FOOTING	
843										843	512	10001	843	SY	SEALING OF CONCRETE SURFACES, AS PER PLAN (PERMANENT GRAFFITI PROTECTION)	536
2,389										2,389	512	10100	2,389	SY	SEALING OF CONCRETE SURFACES (EPOXY-URETHANE)	
51										51	512	33000	51	SY	TYPE 2 WATERPROOFING	
355,667										355,667	513	10300	355,667	LB	STRUCTURAL STEEL MEMBERS, LEVEL 5	
2,213,561										2,213,561	513	10401	2,213,561	LB	STRUCTURAL STEEL MEMBERS, HYBRID GIRDER, LEVEL SIX(6) FABRICATION, AS PER PLAN	536
12,801										12,801	513	20000	12,801	EACH	WELDED STUD SHEAR CONNECTORS	
29,490										29,490	514	00060	29,490	SF	FIELD PAINTING STRUCTURAL STEEL, INTERMEDIATE COAT	
29,490										29,490	514	00066	29,490	SF	FIELD PAINTING STRUCTURAL STEEL, FINISH COAT	
134										134	SPECIAL	51612400	134	FT	MODULAR EXPANSION JOINT	536
377										377	516	13600	377	SF	1" PREFORMED EXPANSION JOINT FILLER	
216										216	516	13900	216	SF	2" PREFORMED EXPANSION JOINT FILLER	
5										5	518	12200	5	EACH	SCUPPERS, INCLUDING SUPPORTS	
481										481	518	21200	481	CY	POROUS BACKFILL WITH GEOTEXTILE FABRIC	
361										361	518	40000	361	FT	6" PERFORATED CORRUGATED PLASTIC PIPE	
45										45	518	40010	45	FT	6" NON-PERFORATED CORRUGATED PLASTIC PIPE, INCLUDING SPECIALS	
49										49	518	51200	49	FT	PIPE DOWNSPOUT, INCLUDING SPECIALS (10")	
156										156	524	94919	156	FT	DRILLED SHAFTS, 60" DIAMETER, INTO BEDROCK, AS PER PLAN	537
496										496	524	94931	496	FT	DRILLED SHAFTS, 66" DIAMETER, ABOVE BEDROCK, AS PER PLAN	537
351										351	526	30010	351	SY	REINFORCED CONCRETE APPROACH SLABS WITH QC/QA (T=17")	
134										134	526	90010	134	FT	TYPE A INSTALLATION	
56										56	846	00110	56	CF	POLYMER MODIFIED ASPHALT EXPANSION JOINT SYSTEM	
30										30	869	00101	30	EACH	HIGH LOAD MULTI-ROTATIONAL (HLMR) BEARINGS, AS PER PLAN	537
12										12	894	10000	12	EACH	THERMAL INTEGRITY PROFILING (TIP) TEST	537

NO.	DESCRIPTION	REV. BY	DATE
4	QUANTITY CHANGES	ACW	10/30/23
5	QUANTITY CHANGES	ACW	11/6/23

CALCULATED TAZ CHECKED DEA

GENERAL SUMMARY

FRA - 70 - 13.10

196
702

ms consultants, inc.

SHEET NUM.												PART.	ITEM	ITEM	GRAND	UNIT	DESCRIPTION	SEE SHEET NO.
48	49	50	52	54	59E	117	167B	198	200	693	Office	01/MS/04	EXT	TOTAL				
MISCELLANEOUS STRUCTURE																		
								LUMP				LUMP	202	11000	LS	STRUCTURE REMOVED		
								LUMP				LUMP	202	11003	LS	STRUCTURE REMOVED, OVER 20 FOOT SPAN, AS PER PLAN	35	
								LUMP				LUMP	202	11201	LS	PORTIONS OF STRUCTURE REMOVED, AS PER PLAN	35	
								LUMP				LUMP	202	11201	LS	PORTIONS OF STRUCTURE REMOVED, AS PER PLAN "A"	35	
								LUMP				LUMP	202	11201	LS	PORTIONS OF STRUCTURE REMOVED, AS PER PLAN "B"	35	
								LUMP				LUMP	202	11201	LS	PORTIONS OF STRUCTURE REMOVED, AS PER PLAN "C"	35	
								218				218	202	22900	218	SY	APPROACH SLAB REMOVED	
									55			55	511	50211	55	CY	CLASS QC1 CONCRETE, SUBSTRUCTURE, AS PER PLAN	34
										87		87	511	53012	87	CY	CLASS QC2 CONCRETE, MISC.:LOAD DISTRIBUTION SLAB	695
						372	222					6,727	512	10000	6,727	SY	SEALING OF CONCRETE SURFACES	
					443							443	SPECIAL	69098100	443	FT	COVERED WALKWAY SYSTEM	52
MAINTENANCE OF TRAFFIC																		
		944										944	614	11110	944	hour	LAW ENFORCEMENT OFFICER WITH PATROL CAR FOR ASSISTANCE	
					19							19	614	12380	19	EACH	WORK ZONE IMPACT ATTENUATOR, 24" WIDE HAZARDS, (UNIDIRECTIONAL)	
	LUMP											LUMP	614	12420	LS	DETOUR SIGNING		
20	9											9	614	12484	9	EACH	WORK ZONE INCREASED PENALTIES SIGN	
												20	614	12500	20	EACH	REPLACEMENT SIGN	
50												50	614	12600	50	EACH	REPLACEMENT DRUM	
					3,504							3,504	614	12801	3,504	EACH	WORK ZONE RAISED PAVEMENT MARKER, AS PER PLAN	51
					1,566							1,566	614	13310	1,566	EACH	BARRIER REFLECTOR, TYPE 1, ONE WAY	
29												29	614	13312	29	EACH	BARRIER REFLECTOR, TYPE 2, ONE WAY	
29					519							548	614	13350	548	EACH	OBJECT MARKER, ONE WAY	
			1,000									1,000	614	18030	1,000	FT	MAINTAINING TRAFFIC, MISC.: PORTABLE WATER FILLED BARRIER PROTECTED PEDESTRIAN WALKWAY	52
	89											89	614	18601	89	SNMT	PORTABLE CHANGEABLE MESSAGE SIGN, AS PER PLAN	50
					12.87							12.87	614	20056	12.87	MILE	WORK ZONE LANE LINE, CLASS I, 6", 807 PAINT	
					0.11							0.11	614	21050	0.11	MILE	WORK ZONE CENTER LINE, CLASS I, 807 PAINT, DOUBLE SOLID, WHITE	
					25.1							25.1	614	22056	25.1	MILE	WORK ZONE EDGE LINE, CLASS I, 6", 807 PAINT	
					64,782							64,782	614	23110	64,782	FT	WORK ZONE CHANNELIZING LINE, CLASS I, 12", 807 PAINT	
					11,051							11,051	614	24102	11,051	FT	WORK ZONE DOTTED LINE, CLASS I, 6", 807 PAINT	
					2,026							2,026	614	28400	2,026	FT	WORK ZONE GORE MARKING, CLASS II, 740.06, TYPE I	
					8							8	614	30400	8	EACH	WORK ZONE ARROW, CLASS I, 740.06, TYPE I	
					3							3	614	98200	3	EACH	WORK ZONE PAVEMENT MARKING, MISC.: 814 INTERSTATE ELONGATED ROUTE SHIELD SYMBOL MARKING	51
				4,032								4,032	615	20001	4,032	SY	PAVEMENT FOR MAINTAINING TRAFFIC, CLASS A, AS PER PLAN	54
				100								100	615	25001	100	SY	PAVEMENT FOR MAINTAINING TRAFFIC, CLASS B, AS PER PLAN, TYPE 1	54
				50								50	615	25001	50	SY	PAVEMENT FOR MAINTAINING TRAFFIC, CLASS B, AS PER PLAN, TYPE 2	54
				20								20	615	25001	20	SY	PAVEMENT FOR MAINTAINING TRAFFIC, CLASS B, AS PER PLAN, TYPE 3	54
					4							4	622	10201	4	EACH	BARRIER TRANSITION, AS PER PLAN	52
					7,279							7,279	622	41011	7,279	FT	PORTABLE BARRIER, 50", AS PER PLAN	52
					11,575							11,575	622	41100	11,575	FT	PORTABLE BARRIER, UNANCHORED	
	288											288	808	18700	288	SNMT	DIGITAL SPEED LIMIT (DSL) SIGN ASSEMBLY	
INCIDENTALS																		
												LUMP	614	11000	LS	MAINTAINING TRAFFIC		
												LUMP	623	10000	LS	CONSTRUCTION LAYOUT STAKES AND SURVEYING		
												LUMP	624	10000	LS	MOBILIZATION		

CALCULATED TAZ CHECKED LM7/JML

GENERAL SUMMARY

FRA-70-13.10

NO.	DESCRIPTION	REV. BY	DATE
5	QUANTITY/DESCRIPTION CHANGES	ACW	11/6/23

197B
702



34" x 22"



Batchplot Spec: \\msconsultants.com\files\production\03\60\06634_6A\standards\pltdrv\batchpl...
 Pen Table: \\msconsultants.com\files\production\03\60\06634_6A\deliverables\00_Current_Appl...
 Plot Driver: \\msconsultants.com\files\standards\ustin\ohdot\18\ms\plotting\PDF.plt.cq
 View: FENCE_VEW1
 By: krjan
 8:45:16 AM
 11/6/2023
 \\msconsultants.com\files\production\03\60\06634_6A\traffic\sheet\894647\001.dgn

ITEM 630 - GROUND MOUNTED SUPPORT, NO. 4 POST

ITEM 630 - GROUND MOUNTED SUPPORT, NO. 4 POST SHALL BE AS PER C&MS 630 WITH THE CLARIFICATION THAT ALL POSTS SHALL BE SQUARE SHAPED. NO U-CHANNEL POSTS SHALL BE USED.

ITEM 644 - PAVEMENT MARKING, MISC. CENTER LINE, 4"

THIS ITEM SHALL BE AS PER CITY OF COLUMBUS SPECIFICATIONS 641 AND 644.

PAYMENT FOR THIS SHALL BE MADE AT THE CONTRACT UNIT PRICE BID PER MILE.

ITEM 647 - PAVEMENT MARKING, MISC.: LANE REDUCTION ARROW WITH CONTRAST

IN ADDITION TO THE REQUIREMENTS OF C&MS SECTION 647, THIS ITEM SHALL INCLUDE BLACK CONTRAST MARKINGS AROUND THE ARROW ACCORDING TO THE MANUFACTURERS RECOMMENDATION.

PAYMENT FOR THIS ITEM SHALL BE MADE AT THE CONTRACT UNIT PRICE BID PER EACH



REMOVAL OF EXISTING OVERHEAD SIGNS AND OVERLAYS

UPON REMOVAL OF THE MAINTENANCE OF TRAFFIC CONDITONS AND PLACING TRAFFIC INTO ITS FINAL ALIGNMENT, REMOVE AND DISPOSE OF THE EXISTING OVERHEAD GUIDE SIGN OVERLAYS FOR EAST I.R. 70 ON SOUTHBOUND S.R. 315 BETWEEN EXIT 3 AND THE NEIL AVE. EXIT. ALSO REMOVE AND DISPOSE OF THE EXISTING OVERHEAD GUIDE SIGN "TO I.R. 70 EAST LEFT LANE" LOCATED ON THE SIGN TRUSS SOUTH OF EXIT IF. THE FOLLOWING QUANTITIES HAVE BEEN CARRIED TO THE GENERAL SUMMARY:

- ITEM 630 - REMOVAL OF OVERHEAD MOUNTED SIGN AND DISPOSAL 1 EACH
- ITEM 630 - REMOVAL OF TEMPORARY OVERLAY SIGN AND DISPOSAL 3 EACH

NO.	DESCRIPTION	REV. BY	DATE
5	NOTES REVISED	KWR	11/6/23


CALCULATED
 CHECKED

TRAFFIC CONTROL GENERAL NOTES

FRA - 70 - 13.10

421
 702

Batchplot Spec: \\msconsultants.com\files\production\03\60\06634_6A\standards\plotdrv\batchplot.dgn
 Pen Table: \\msconsultants.com\files\production\03\60\06634_6A\deliverables\00_Current_Applications\Standards\Plot_Driver.dwg
 Plot Driver: \\msconsultants.com\files\standards\usin\ohdot\18\ms\plotting\PDF.plt
 View: FENCE - NEWT
 By: krjan
 Model: Sheet
 Printed: 11/6/2023 12:09:10 PM
 File: \\msconsultants.com\files\production\03\60\06634_6A\Traffic_Sheets\8946415001.dgn

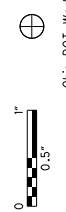

34" x 22"


NO.	DESCRIPTION	REV. BY	DATE
5	ITEM REVISED	KWR	11/6/23

SHEET NO.	LOCATION	STATION TO STATION																							
		621	621	621	644	646	647	807	807	807	807	807	807	807	807	807	807	850	850	850	850	850	850		
		RPM (TWO-WAY, WHITE/RED)	RPM (ONE WAY, WHITE)	RPM (TWO WAY, YELLOW/RED)	TRANSVERSE/DIAGONAL LINE	TRANSVERSE/DIAGONAL LINE	PAVEMENT MARKING, MISC.-LANE REDUCTION ARROW WITH CONTRAST	WET REFLECTIVE EPOXY PAVEMENT MARKING, EDGE LINE, 6" (WHITE)	WET REFLECTIVE EPOXY PAVEMENT MARKING, EDGE LINE, 6" (YELLOW)	WET REFLECTIVE EPOXY PAVEMENT MARKING, LANE LINE, 6"	WET REFLECTIVE EPOXY PAVEMENT MARKING, CHANNELIZING LINE, 12"	WET REFLECTIVE EPOXY PAVEMENT MARKING, DOTTED LINE, 6"	WET REFLECTIVE THERMOPLASTIC PAVEMENT MARKING, EDGE LINE, 6" (WHITE)	WET REFLECTIVE THERMOPLASTIC PAVEMENT MARKING, EDGE LINE, 6" (YELLOW)	WET REFLECTIVE THERMOPLASTIC PAVEMENT MARKING, LANE LINE, 6"	WET REFLECTIVE THERMOPLASTIC PAVEMENT MARKING, CENTER LINE, DOUBLE SOLID (WHITE)	WET REFLECTIVE THERMOPLASTIC PAVEMENT MARKING, CHANNELIZING LINE, 12"	WET REFLECTIVE THERMOPLASTIC PAVEMENT MARKING, DOTTED LINE, 6"	GROOVING FOR 6" RECESSED PAVEMENT MARKING, (ASPHALT)	GROOVING FOR 6" RECESSED PAVEMENT MARKING, (ASPHALT)	GROOVING FOR 12" RECESSED PAVEMENT MARKING, (ASPHALT)	GROOVING FOR 6" RECESSED PAVEMENT MARKING, (CONCRETE)	GROOVING FOR 6" RECESSED PAVEMENT MARKING, (CONCRETE)	GROOVING FOR 12" RECESSED PAVEMENT MARKING, (CONCRETE)	
		EACH	EACH	EACH	FT	FT	EACH	FT/MI	FT/MI	FT/MI	FT	FT	FT/MI	FT/MI	FT/MI	FT/MI	FT	FT	FT	FT	FT	FT	FT/MI	FT	
432	I-70 EB	FROM	TO																						
		BEGIN	211+00 RT																						
		BEGIN	211+00 RT																						
		BEGIN	211+00 RT																						
433	I-70 EB	211+00 RT	224+00 RT																						
		211+00 RT	224+00 RT																						
		211+00 RT	224+00 RT																						
		211+00 RT	213+57 RT																						
		213+57 RT	217+99 RT																						
		217+96 RT	224+00 RT																						
		217+99 RT	224+00 RT																						
		224+00 RT	104+00 LT																						
		224+00 RT	104+00 LT																						
		224+00 RT	104+00 LT																						
		224+00 RT	225+04 RT																						
		224+00 RT	103+30 RT																						
		103+30 RT	104+00 RT																						
434	I-70 EB	104+00 RT	116+00 LT																						
		104+00 RT	116+00 LT																						
		104+00 RT	114+43 LT																						
		104+00 RT	111+67 RT																						
		111+67 RT	116+00 RT																						
		111+67 RT	116+00 RT																						
		114+43 CL	116+00 CL																						
435	I-70 EB	116+00 LT	126+98 LT																						
		116+00 LT	126+98 LT																						
		116+00 CL	120+00 CL																						
		116+00 RT	5031+36 RT																						
		116+00 CL	5031+36 BL																						
		120+00 CL	126+98 CL/RT																						
		120+00 RT	5031+36 LT																						
		126+98 LT	128+00 LT																						
		126+98 LT	128+00 LT																						
		126+98 CL/RT	128+00 CL/RT																						
		5031+36 LT	5032+00 LT																						
		5031+36 BL	5032+00 BL																						
		5031+36 RT	5032+00 RT																						
		3012+60 RT	3018+51 RT																						
		3012+60 RT	3020+16 RT																						
		3012+60 RT	3020+55 RT																						
		3012+60 RT	3020+55 RT																						
		3012+60 RT	3020+55 RT																						
		3018+51 RT	3020+55 RT																						
		3020+16 RT	3020+55 RT																						
3020+55 RT	3021+19 RT																								
3020+55 RT	3021+19 RT																								
3020+55 RT	3021+19 RT																								
3021+19 RT	3022+00 RT																								
3021+19 RT	3022+00 RT																								
TOTAL FEET																									
TOTALS CARRIED TO SHEET 425		58	143		177	95		0.02	0.03	0.04	422			6470	7745	16237	557	3485	705	705	5.98	3485		524	422


CALCULATED MJB
 CHECKED DRB
PAVEMENT MARKING AND RPM SUBSUMMARY (ODOT)
FRA -70-13.10
 422
 702
 ms consultants, inc.

SHEET NO.	LOCATION	STATION TO STATION				PAVEMENT MARKING																						
		FROM		TO		621	621	621	644	646	647	807	807	807	807	807	807	807	807	807	807	850	850	850	850	850		
		NO.	DESCRIPTION	REV. BY	DATE	RPM (TWO-WAY, WHITE/RED)	RPM (ONE WAY, WHITE)	RPM (TWO WAY, YELLOW/RED)	TRANSVERSE/DIAGONAL LINE	TRANSVERSE/DIAGONAL LINE	PAVEMENT MARKING, MISC.-LANE REDUCTION ARROW WITH CONTRAST	WET REFLECTIVE EPOXY PAVEMENT MARKING, EDGE LINE, 6" (WHITE)	WET REFLECTIVE EPOXY PAVEMENT MARKING, EDGE LINE, 6" (YELLOW)	WET REFLECTIVE EPOXY PAVEMENT MARKING, LANE LINE, 6"	WET REFLECTIVE EPOXY PAVEMENT MARKING, CHANNELIZING LINE, 12"	WET REFLECTIVE EPOXY PAVEMENT MARKING, DOTTED LINE, 6"	WET REFLECTIVE THERMOPLASTIC PAVEMENT MARKING, EDGE LINE, 6" (WHITE)	WET REFLECTIVE THERMOPLASTIC PAVEMENT MARKING, EDGE LINE, 6" (YELLOW)	WET REFLECTIVE THERMOPLASTIC PAVEMENT MARKING, LANE LINE, 6"	WET REFLECTIVE THERMOPLASTIC PAVEMENT MARKING, CENTER LINE, DOUBLE SOLID (WHITE)	WET REFLECTIVE THERMOPLASTIC PAVEMENT MARKING, CHANNELIZING LINE, 12"	WET REFLECTIVE THERMOPLASTIC PAVEMENT MARKING, DOTTED LINE, 6"	GROOVING FOR 6" RECESSED PAVEMENT MARKING, (ASPHALT)	GROOVING FOR 6" RECESSED PAVEMENT MARKING, (ASPHALT)	GROOVING FOR 12" RECESSED PAVEMENT MARKING, (ASPHALT)	GROOVING FOR 6" RECESSED PAVEMENT MARKING, (CONCRETE)	GROOVING FOR 6" RECESSED PAVEMENT MARKING, (CONCRETE)	
5	ITEM REVISED	KWR	11/6/23	EACH	EACH	EACH	FT	FT	EACH	FT/MI	FT/MI	FT/MI	FT	FT	FT/MI	FT/MI	FT/MI	FT/MI	FT	FT	FT	FT	FT	FT	FT	FT	FT	
436	I-70 EB	128+00	LT	128+26	LT								26															26
		128+00	LT	128+26	LT		1						26															26
		128+00	CL	128+26	CL	2									26													
	I-70 WB	3022+00	RT	3022+85	RT												85										85	
		3022+00	RT	3022+85	RT	2															85							85
		3022+00	RT	3022+85	RT	2															85							85
		3022+00	RT	3022+85	RT	2															85							85
		3022+00	RT	3022+85	RT	2															85							85
		3022+00	RT	3026+70	RT			6											470								470	
		3022+00	RT	3028+13	RT		6												613								613	
		3022+85	RT	3028+13	RT												528										528	
		3022+85	RT	3028+13	RT													528									528	
		3022+85	RT	3026+70	RT												385										385	
	RAMP C5	5032+00	BL	5032+14	BL		1						14															14
		5032+00	LT	5032+56	LT	2							56															
		5032+14	BL	5032+67	BL	1							53															
		5032+56	LT	5032+67	LT			1					11								638						638	
		5032+67	BL	5039+05	BL	16																						
		5032+67	LT	5041+58	LT				11																			
		5039+05	BL	5041+58	BL												253											253
	RAMP C3	5041+58	LT	5044+00	LT			3					242	242														242
		5041+58	BL	5044+00	BL								242															242
		5032+00	RT	5032+67	RT								67															67
		5032+67	RT	3005+24	BL												716											716
	TRANS I-70 WB	5037+13	BL	3004+36	LT	5																192					192	
		5037+13	CL	3004+36	LT																							
		3004+36	LT	3005+24	LT			2																				
542+39		RT	548+60	RT			8																					
542+39		BL	548+79	BL												640											640	
546+44		BL	548+69	RT																								
548+60		RT	152+00	RT			4						340								225	225					340	
RAMP BC	548+79	BL	152+00	BL								321															321	
	548+69	RT	152+00	RT																					331		331	
RAMP C5	149+57	RT									1																	
	58+03	BL/LT	60+00	BL/LT			3					197	197														394	
	5044+00	LT	5051+75	LT			10						775														775	
	5044+00	BL	5051+54	BL								754															754	
	5051+72	LT	5055+29	LT							9																	
	5051+80	LT	5057+00	LT									520														520	
	5051+54	BL	5055+29	BL							9																	
RAMP A5	5051+75	LT	5055+29	LT							9																	
	5055+29	LT	5057+00	LT																								
	5055+29	BL	5057+00	BL									171														171	
TRANS RAMP D3 N	5017+36	LT	5055+29	RT			9																					
	5017+36	BL	5057+00	RT									542														542	
	831+90	BL	842+03	BL																								
	831+90	RT	832+71	RT			2																					
TRANS RAMP D3 W	832+71	RT	3039+37	LT																								
	3039+37	LT	3041+36	BL			5																					
	3041+36	BL	3041+94	BL																								
	842+03	BL	3044+00	LT										197													197	
	3037+68	BL	3039+37	BL																								
TOTALS CARRIED TO SHEET 425													2320	2332	595												5247	
																											221	
																											213	
																											206	
																											206	
TOTALS CARRIED TO SHEET 425					82	16	56	38		1	0.44	0.44	0.11	1589	537	0.72	0.70	0.20		1649	283	283	1.61	1649	537	0.99		

CALCULATED	MJB
	CHECKED
DBB	
PAVEMENT MARKING AND RPM SUBSUMMARY (ODOT)	
FRA-70-13.10	
423	702

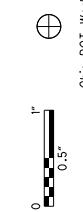

Batchplot Spec: \\msconsultants.com\files\production\03\60\06634_6A\standards\plotdrv\batchplot.dwg
Pen Table: \\msconsultants.com\files\production\03\60\06634_6A\deliverables\00_Current_Approvals\03\60\06634_6A\standards\plotdrv\batchplot.dwg
Plot Driver: \\msconsultants.com\files\production\03\60\06634_6A\standards\usin\ohdot\18\ms\plotting\PDF.plt
View: FENCE_VIEWT
By: kryan
Model: Sheet
Printed: 11/6/2023 12:15:57 PM
File: \\msconsultants.com\files\production\03\60\06634_6A\Traffic\Sheets\8946415003.dgn

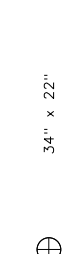

SHEET NO.	LOCATION	STATION TO STATION		621	621	621	644	646	647	807	807	807	807	807	807	807	807	807	850	850	850	850	850	
		FROM	TO	EACH	EACH	EACH	FT	FT	EACH	FT/MI	FT/MI	FT/MI	FT	FT	FT/MI	FT/MI	FT/MI	FT/MI	FT	FT	FT	FT/MI	FT	FT/MI
438	I-70 WB	152+00 BL	159+57 BL							757													757	
		152+00 RT	159+35 RT									735												735
		152+00 RT	154+39 RT													239								239
		154+39 RT	159+46 RT			4								507										507
		159+35 RT	164+00 RT															465						465
		159+46 RT	164+00 RT			4																		454
	RAMP C5	5057+00 LT	5062+47 LT																					547
		5057+00 LT	5062+33 LT			4							533											533
		5057+00 BL	5062+19 BL			4							519											519
		5057+00 RT	5062+06 RT								506													506
		5062+47 LT	5069+00 LT														653						653	
		5062+33 LT	5064+56 LT			2												223						223
		5062+19 BL	5069+00 BL			6												681						681
		5062+06 RT	5069+00 RT													694								694
	RAMP D3	3044+00 LT	3052+86 LT								886													886
		3044+00 BL	3052+55 BL																					855
3044+00 RT		3052+64 RT			7								864										864	
3044+00 RT		3052+53 RT									853												853	
3052+53 RT		3057+00 RT			4												447						447	
3052+55 BL		3052+75 BL	1																					
3052+64 RT		3057+00 RT			4													436					436	
3052+75 BL		3057+00 BL	11																			425	425	
439	I-71 SB	278+00 RT	279+00 RT																				100	
		278+00 LT	279+00 LT	3																			100	
		278+00 RT	279+00 RT			1		1										100						100
		278+00 RT	279+00 RT																100					100
	RAMP C5	5069+00 LT	5071+08 LT																					208
		5069+00 LT	5071+12 LT	5																				212
		5069+00 BL	5071+16 BL			2																		216
		5069+00 RT	5071+20 RT																					220
		5069+56 LT	5071+14 LT	4																				158
		5069+56 LT	5071+13 LT						11															
		5071+08 LT	5074+25 LT										317											317
		5071+12 LT	5074+29 LT	8																				317
		5071+13 LT	5074+34 LT							94														
		5071+14 LT	5074+37 LT	8																				
		5071+16 BL	5074+42 BL			3																		326
		RAMP D3/ RAMP D7	5071+20 RT	5074+47 RT										326										
5074+25 LT	5074+86 LT																						327	
5074+29 LT	5074+86 LT		1																				327	
5074+34 LT	5074+86 LT					30																		
5074+37 LT	5074+89 LT		1																					
5074+42 BL	5074+89 BL				1																			
5074+47 RT	5074+89 RT																							
3057+00 LT	3058+68 LT																							
3057+00 LT	3058+71 LT		4																					
3058+68 LT	3061+56 LT																							
3058+71 LT	3061+63 LT		7																					
3061+56 LT	7007+00 BL																							
3061+63 LT	3064+27 LT	7																						
3064+27 LT	7007+00 RT			5																				
TOTAL FEET										2764	2452	2749				2634	2319	2157					7965	
TOTALS CARRIED TO SHEET 425										77	42	10	41	94	1	0.52	0.46	0.52	952	1094	0.50	0.44	0.41	2228

5

CALCULATED
MJB
CHECKED
DBB

PAVEMENT MARKING AND RPM SUBSUMMARY (ODOT)


FRA-70-13.10

424
702

Batchplot Spec: \\msconsultants.com\files\production\03\60\06634_6A\standards\plotdrv\batchplot.dgn
 Pen Table: \\msconsultants.com\files\production\03\60\06634_6A\deliverables\00 Current Applications\gradings\Addendum RS\pen.tbl
 Plot Driver: \\msconsultants.com\files\standards\ustin\ohdot\18\ms\plotting\PDF.plt.crg
 www.msconsultants.com

Model: Sheet
 Printed: 11/6/2023 8:59:27 AM
 By: kryan
 View: FENCE_MEWT
 File: \\msconsultants.com\files\production\03\60\06634_6A\Traffic\sheets\894641M002.dgn

SIGNING REMOVALS
I-70/I-71 STA. 133+00 TO 150+00

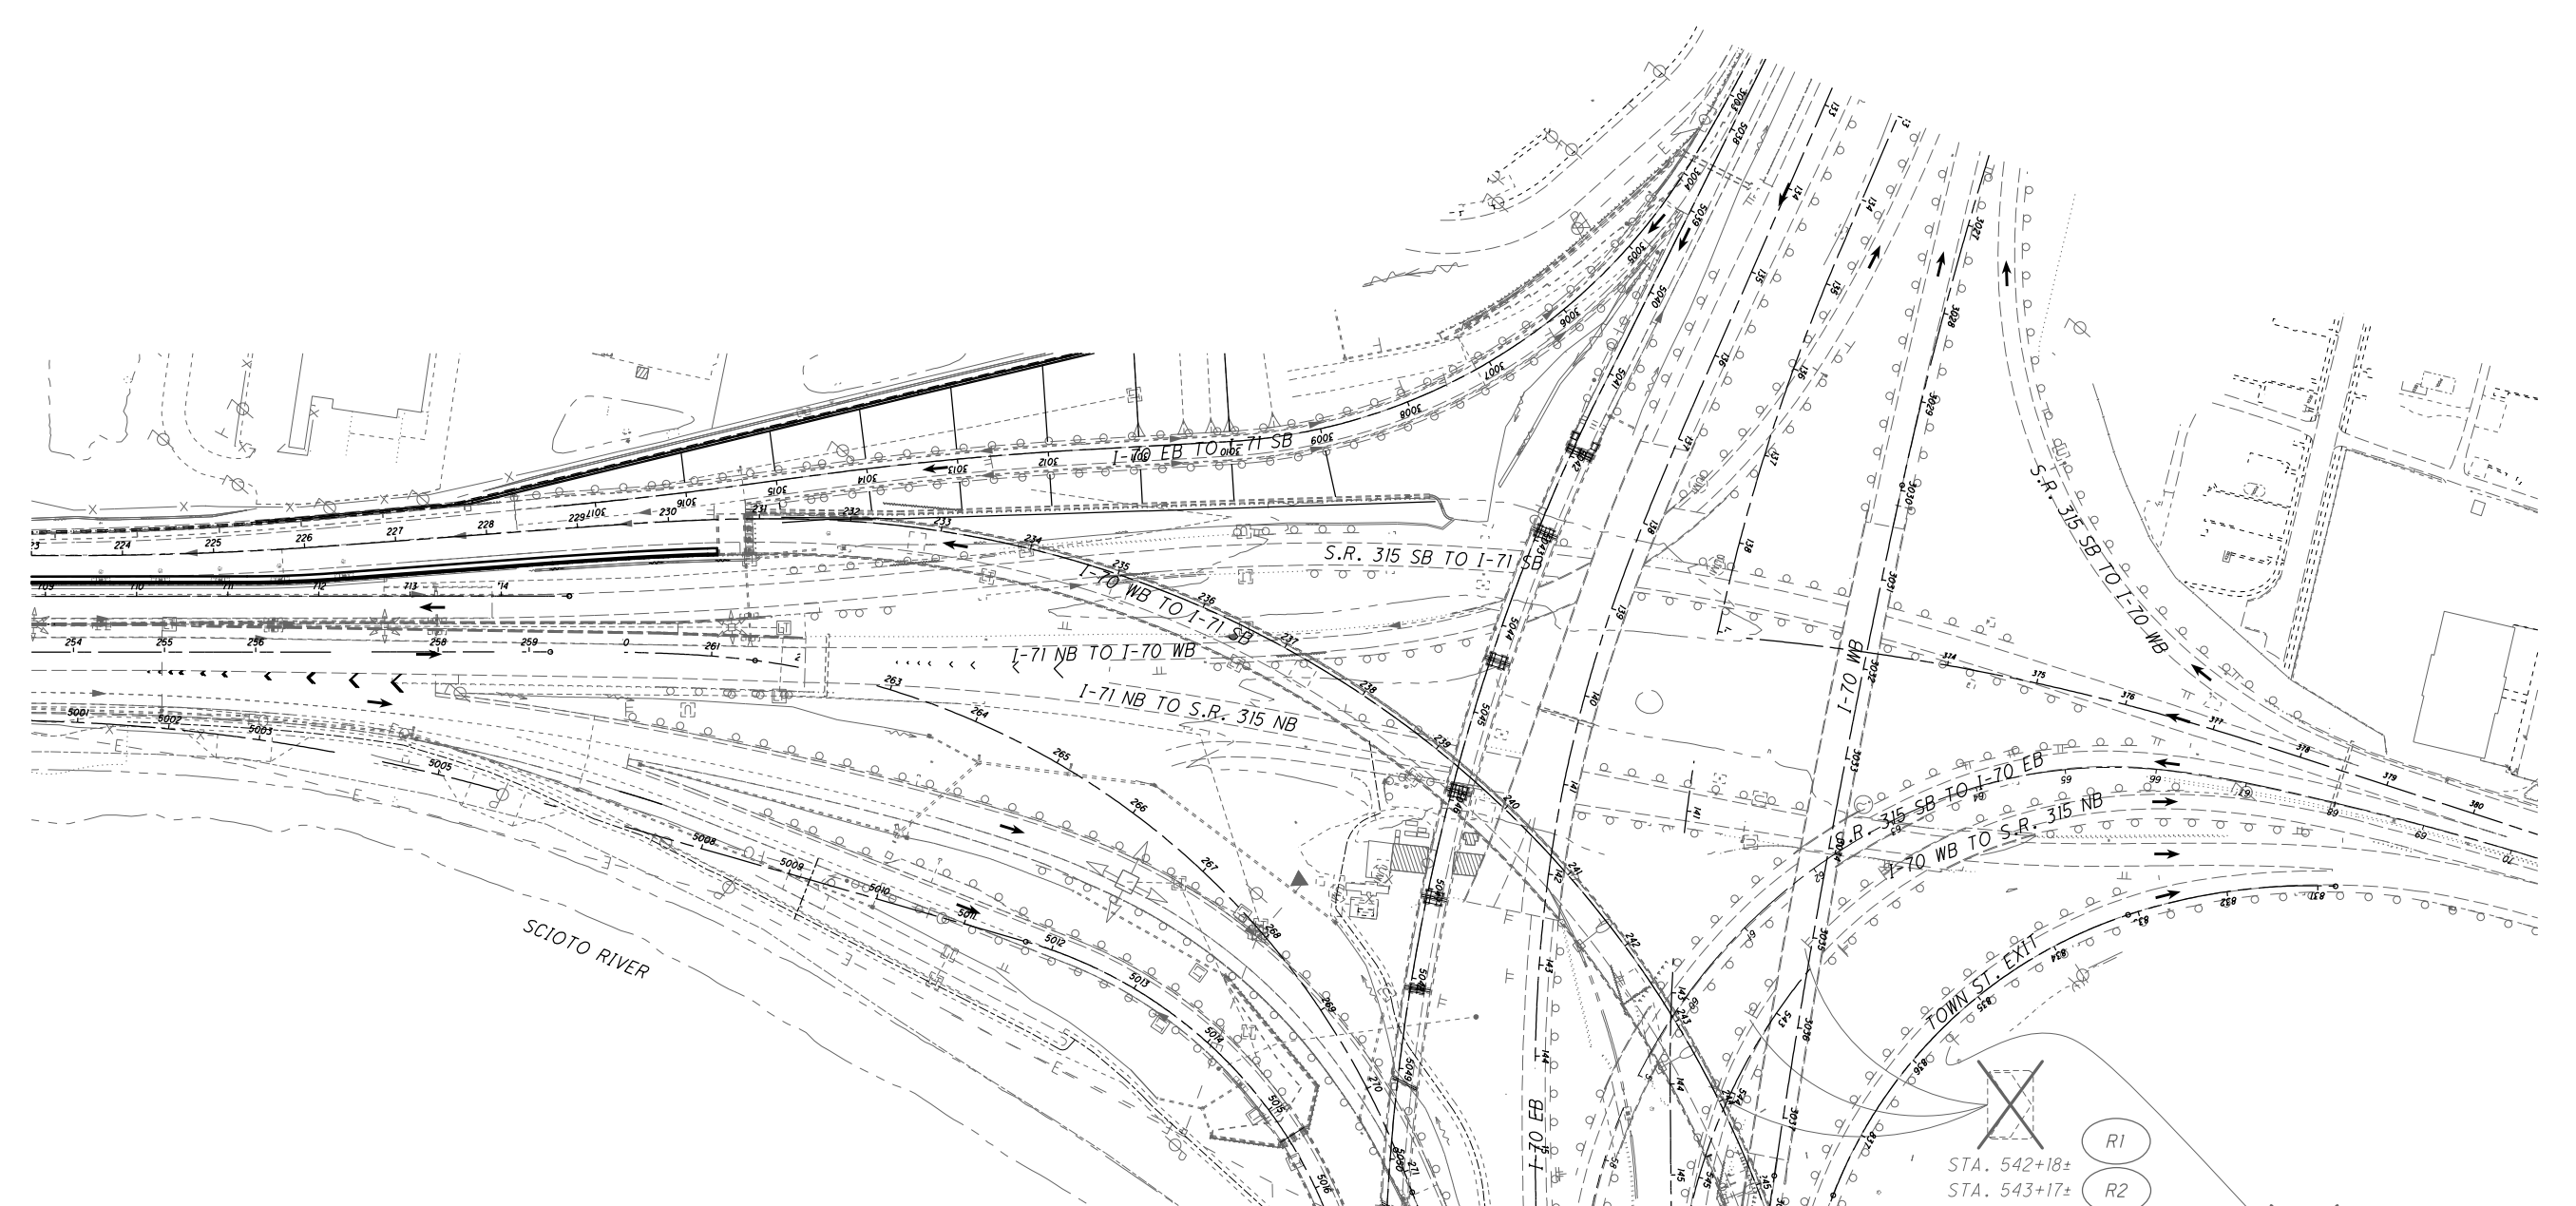

TRAFFIC CONTROL LEGEND


	FLOW ARROW		LL LANE LINE, 6"
	PROPOSED SIGN		CH CHANNELIZING LINE, 12"
	EXISTING SIGN TO REMAIN		WT TRANSVERSE LINE, WHITE
	EXISTING SIGN TO BE REMOVED		WD DOTTED LINE, 6", WHITE
	EXISTING SIGN TO BE REMOVED AND RE-ERECTED		CDW CENTERLINE, DOUBLE SOLID, WHITE
	WE EDGE LINE, 6", WHITE		LRA LANE REDUCTION ARROW
	YE EDGE LINE, 6", YELLOW		DY CENTERLINE, DOUBLE SOLID, YELLOW

NO.	DESCRIPTION	REV. BY	DATE
5	REVISED LEGEND	KWR	11/6/23

MATCH LINE STA. 150+00, SEE SHEET 430

- STA. 542+18±
- STA. 543+17±
- STA. 544+04±
- STA. 835+52±
- STA. 839+52±
- STA. 839+53± (BEAM MTD.)
- STA. 3041+07±
- STA. 149+01±
- STA. 3041+48± (END FRAME MTD.)
- STA. 3041+48± (TRUSS MTD.)

PLOT.CEL
 ms consultants, inc.
 msconsultants.com
 Batchplot Spec: \\msconsultants.com\files\production\03\60\06634_6A\standards\plotdrv\batchplot.dgn
 Pen Table: \\msconsultants.com\files\production\03\60\06634_6A\deliverables\00_Current_Approvals\18_Visit\18_Visit.tbl
 Plot Driver: \\msconsultants.com\files\standards\usin\ohdot\18\ms_plotting\PDF.plt
 View: FENCE - NEW1
 By: white
 9:05:49 AM
 11/6/2023
 \\msconsultants.com\files\production\03\60\06634_6A\structures\FRA70-1322L\sheet\070-1322L.SP003.dgn

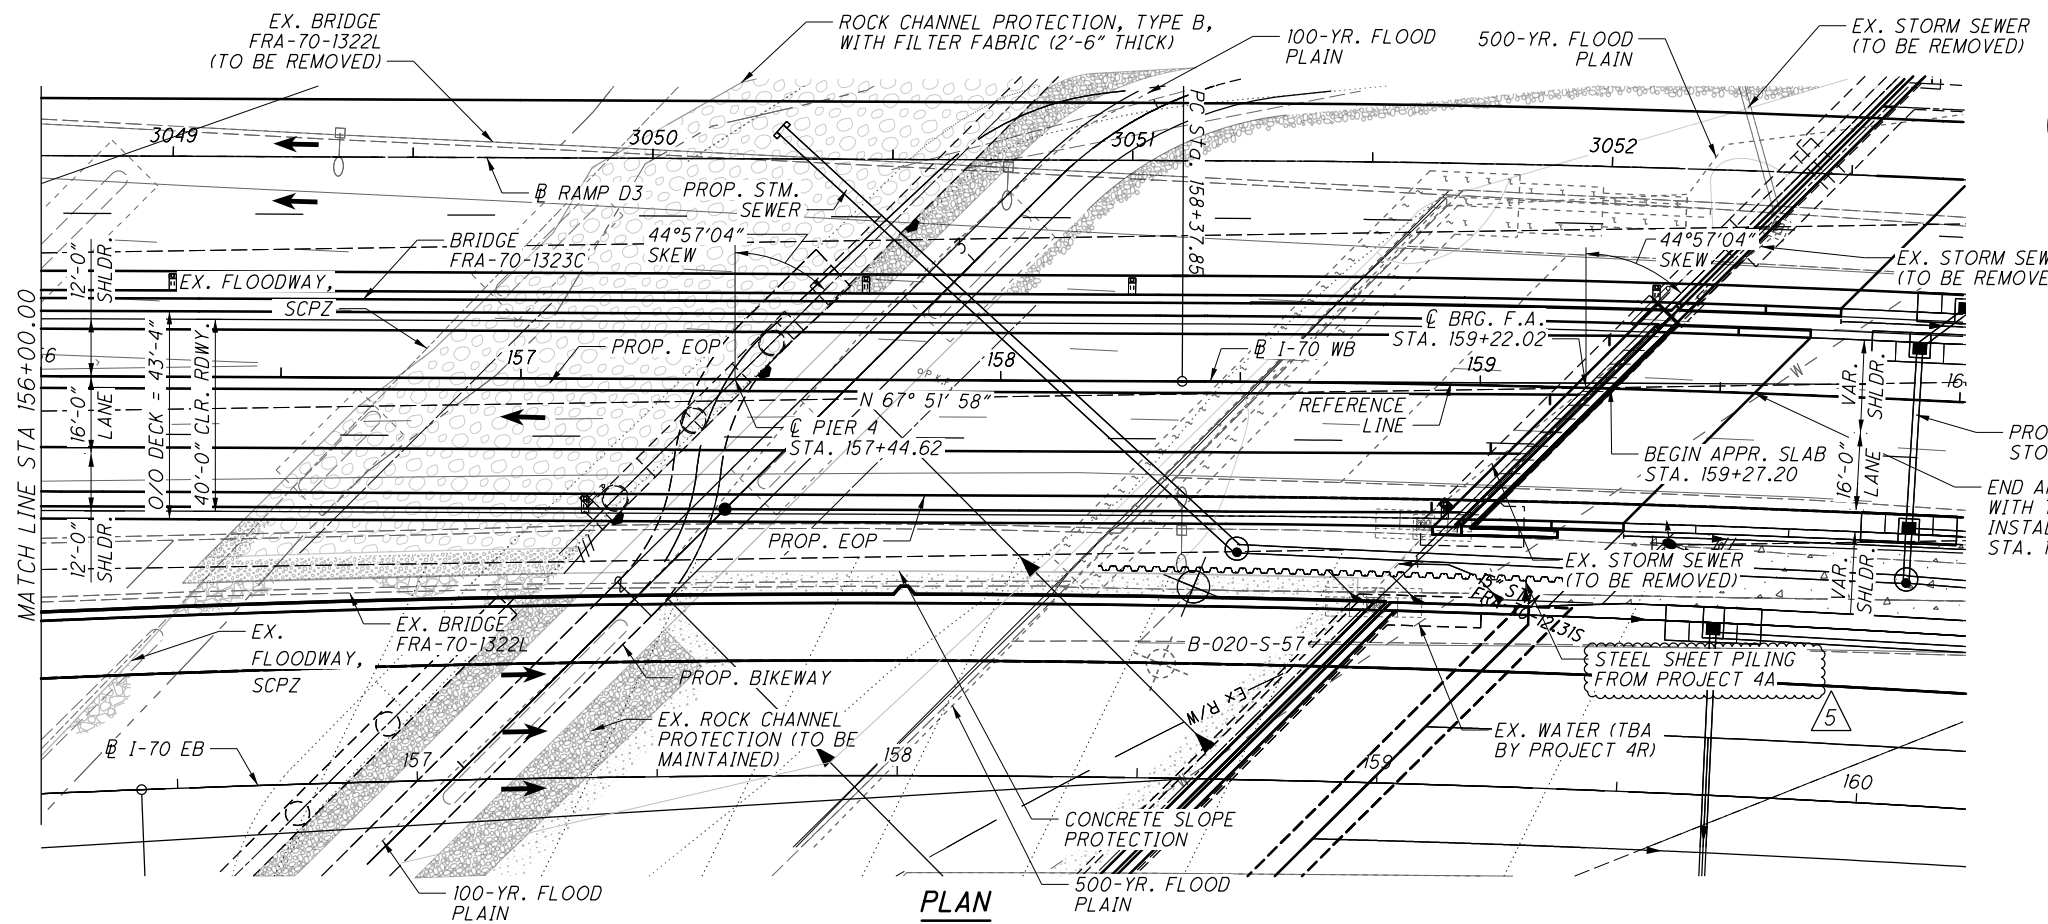


HORIZONTAL CURVE DATA

I-70 WB - CURVE C19
 P.I. Sta. 167+89.88
 $\Delta = 29^\circ 03' 49''$ (RT)
 $D_c = 1^\circ 33' 36''$
 $R = 3,672.81'$
 $T = 952.03'$
 $L = 1,863.05'$
 $E = 121.38'$
 PC Sta. 158+37.85
 PT Sta. 177+00.90
 V (des) = 60 MPH
 e (max) = 0.038
 WIDENING = N/A

● 10'-0" REQUIRED MINIMUM VERTICAL CLEARANCE
 POINT A = 21.64' ACTUAL MINIMUM VERTICAL CLEARANCE

LEGEND

- PROJECT BORING LOCATION
- HISTORIC BORING LOCATION
- * DISTANCE MEASURED ALONG REFERENCE LINE
- ** FOR BORING LOCATIONS, SEE BRIDGE NO. FRA-70-1323C PLANS
- △ ROCK CHANNEL PROTECTION, TYPE B WITH FABRIC FILTER CHANNEL PAID FOR UNDER ROADWAY ITEM 601.
- CONCRETE SLOPE PROTECTION
- ROCK CHANNEL SLOPE PROTECTION

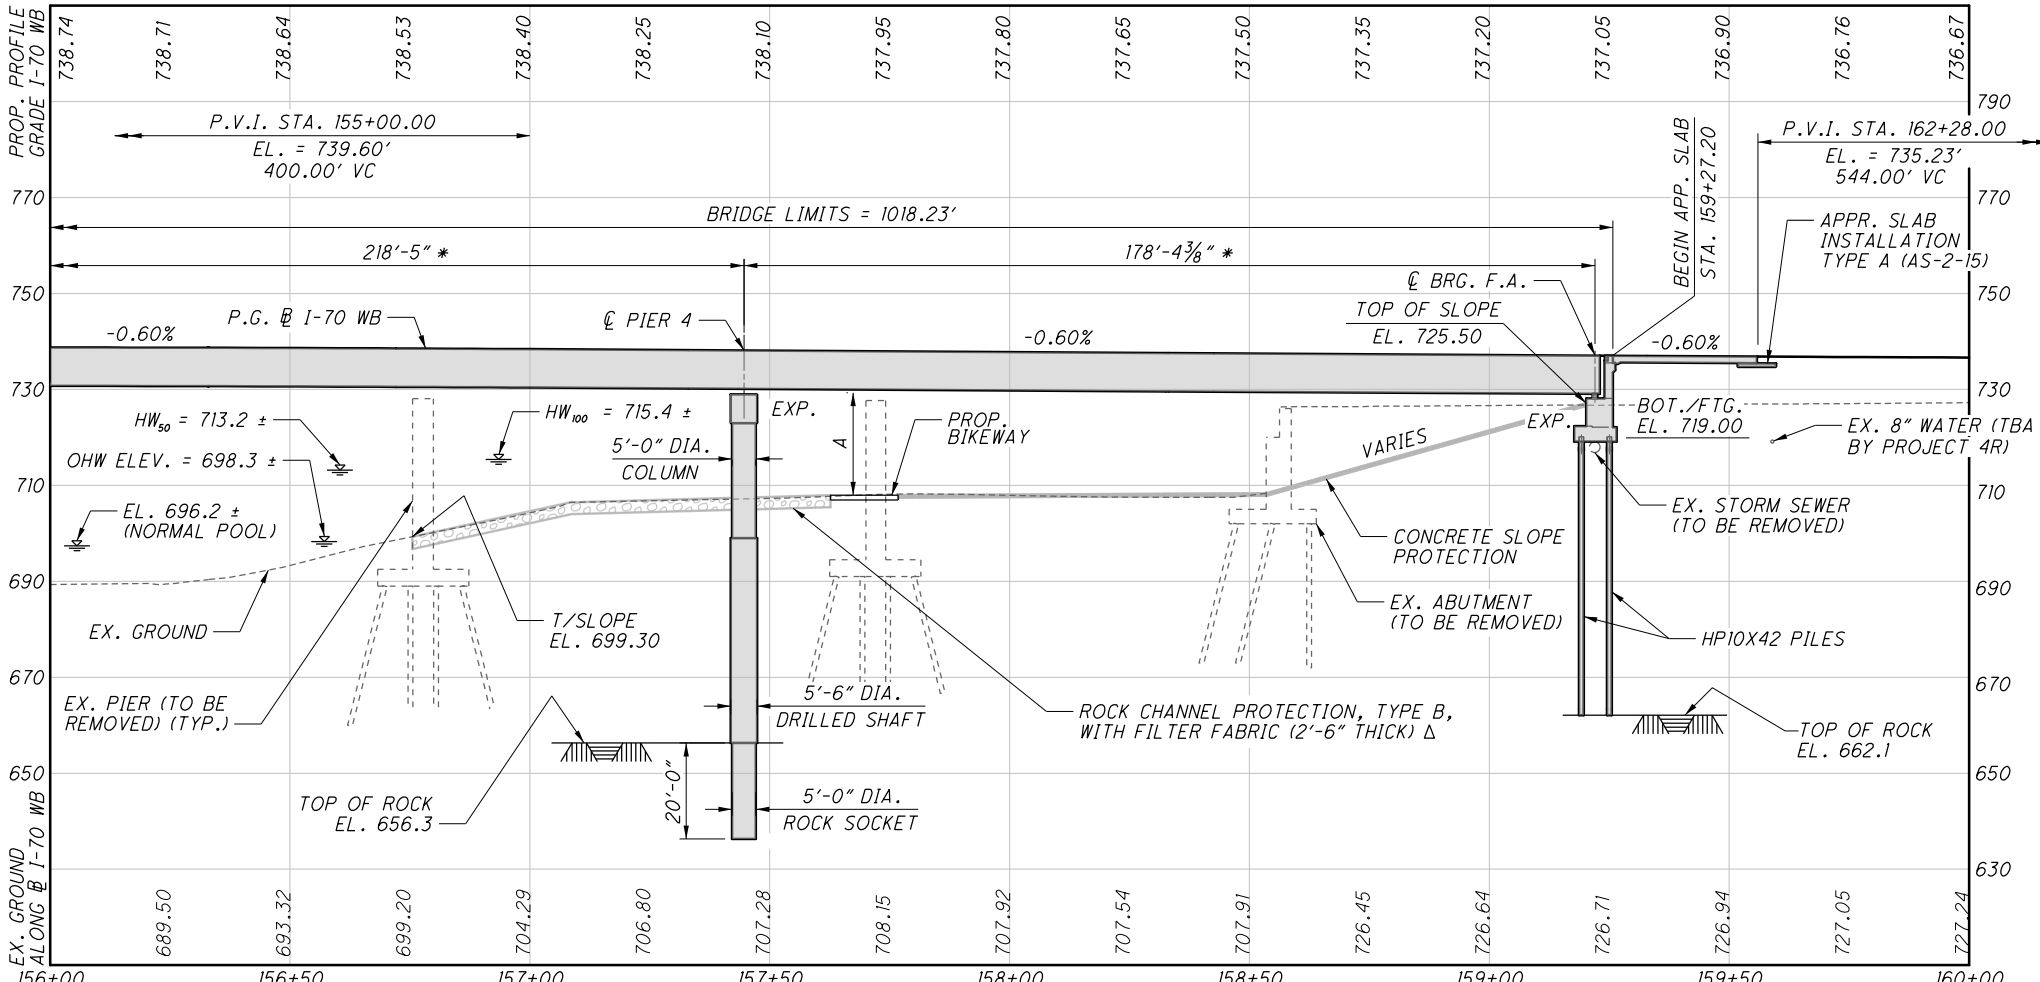

TOP OF ROCK ELEVATION (**)			
BORING	TOP OF BEDROCK	STATION	OFFSET
B-113-9-13	656.3	158+60.61	104.79' LT.
B-114-1-13	662.1	160+53.06	96.75' LT.

NO.	DESCRIPTION	REV. BY	DATE
5	EDITED CALLOUT	ACW	11/6/23

DESIGN AGENCY
ms consultants, inc.
 2221 Schrock Road
 Columbus, Ohio 43229

DATE
 3/06/23

DESIGNED
 LAW

DRAWN
 KRM

REVIEWED
 WER

STRUCTURE FILE NUMBER
 2510027

FRANKLIN COUNTY
 STA. 149+08.97
 STA. 159+27.20


SITE PLAN (3 OF 3)
 BRIDGE NO. FRA-70-1322L
 I-70 WB OVER SCIOTO RIVER

FRA-70-13-10
 PID No. 77372

3 / 58

(475)
 (702)

Batchplot Spec: \\msconsultants.com\files\production\03\60\06634_6A\standards\plotdrv\batchplot.dgn
 Pen Table: \\msconsultants.com\files\production\03\60\06634_6A\deliverables\00\Current\Adaptations\03\60\06634_6A\Columbus
 Plot Driver: \\msconsultants.com\files\standards\ustin\ohdot\18\ms\plotting\PDF.plt
 View: FENCE - NEWT
 By: white
 9:51:40 AM
 11/6/2023
 \\msconsultants.com\files\production\03\60\06634_6A\structures\FRA070-1322L\sheet\070-1322L\GF001.dgn

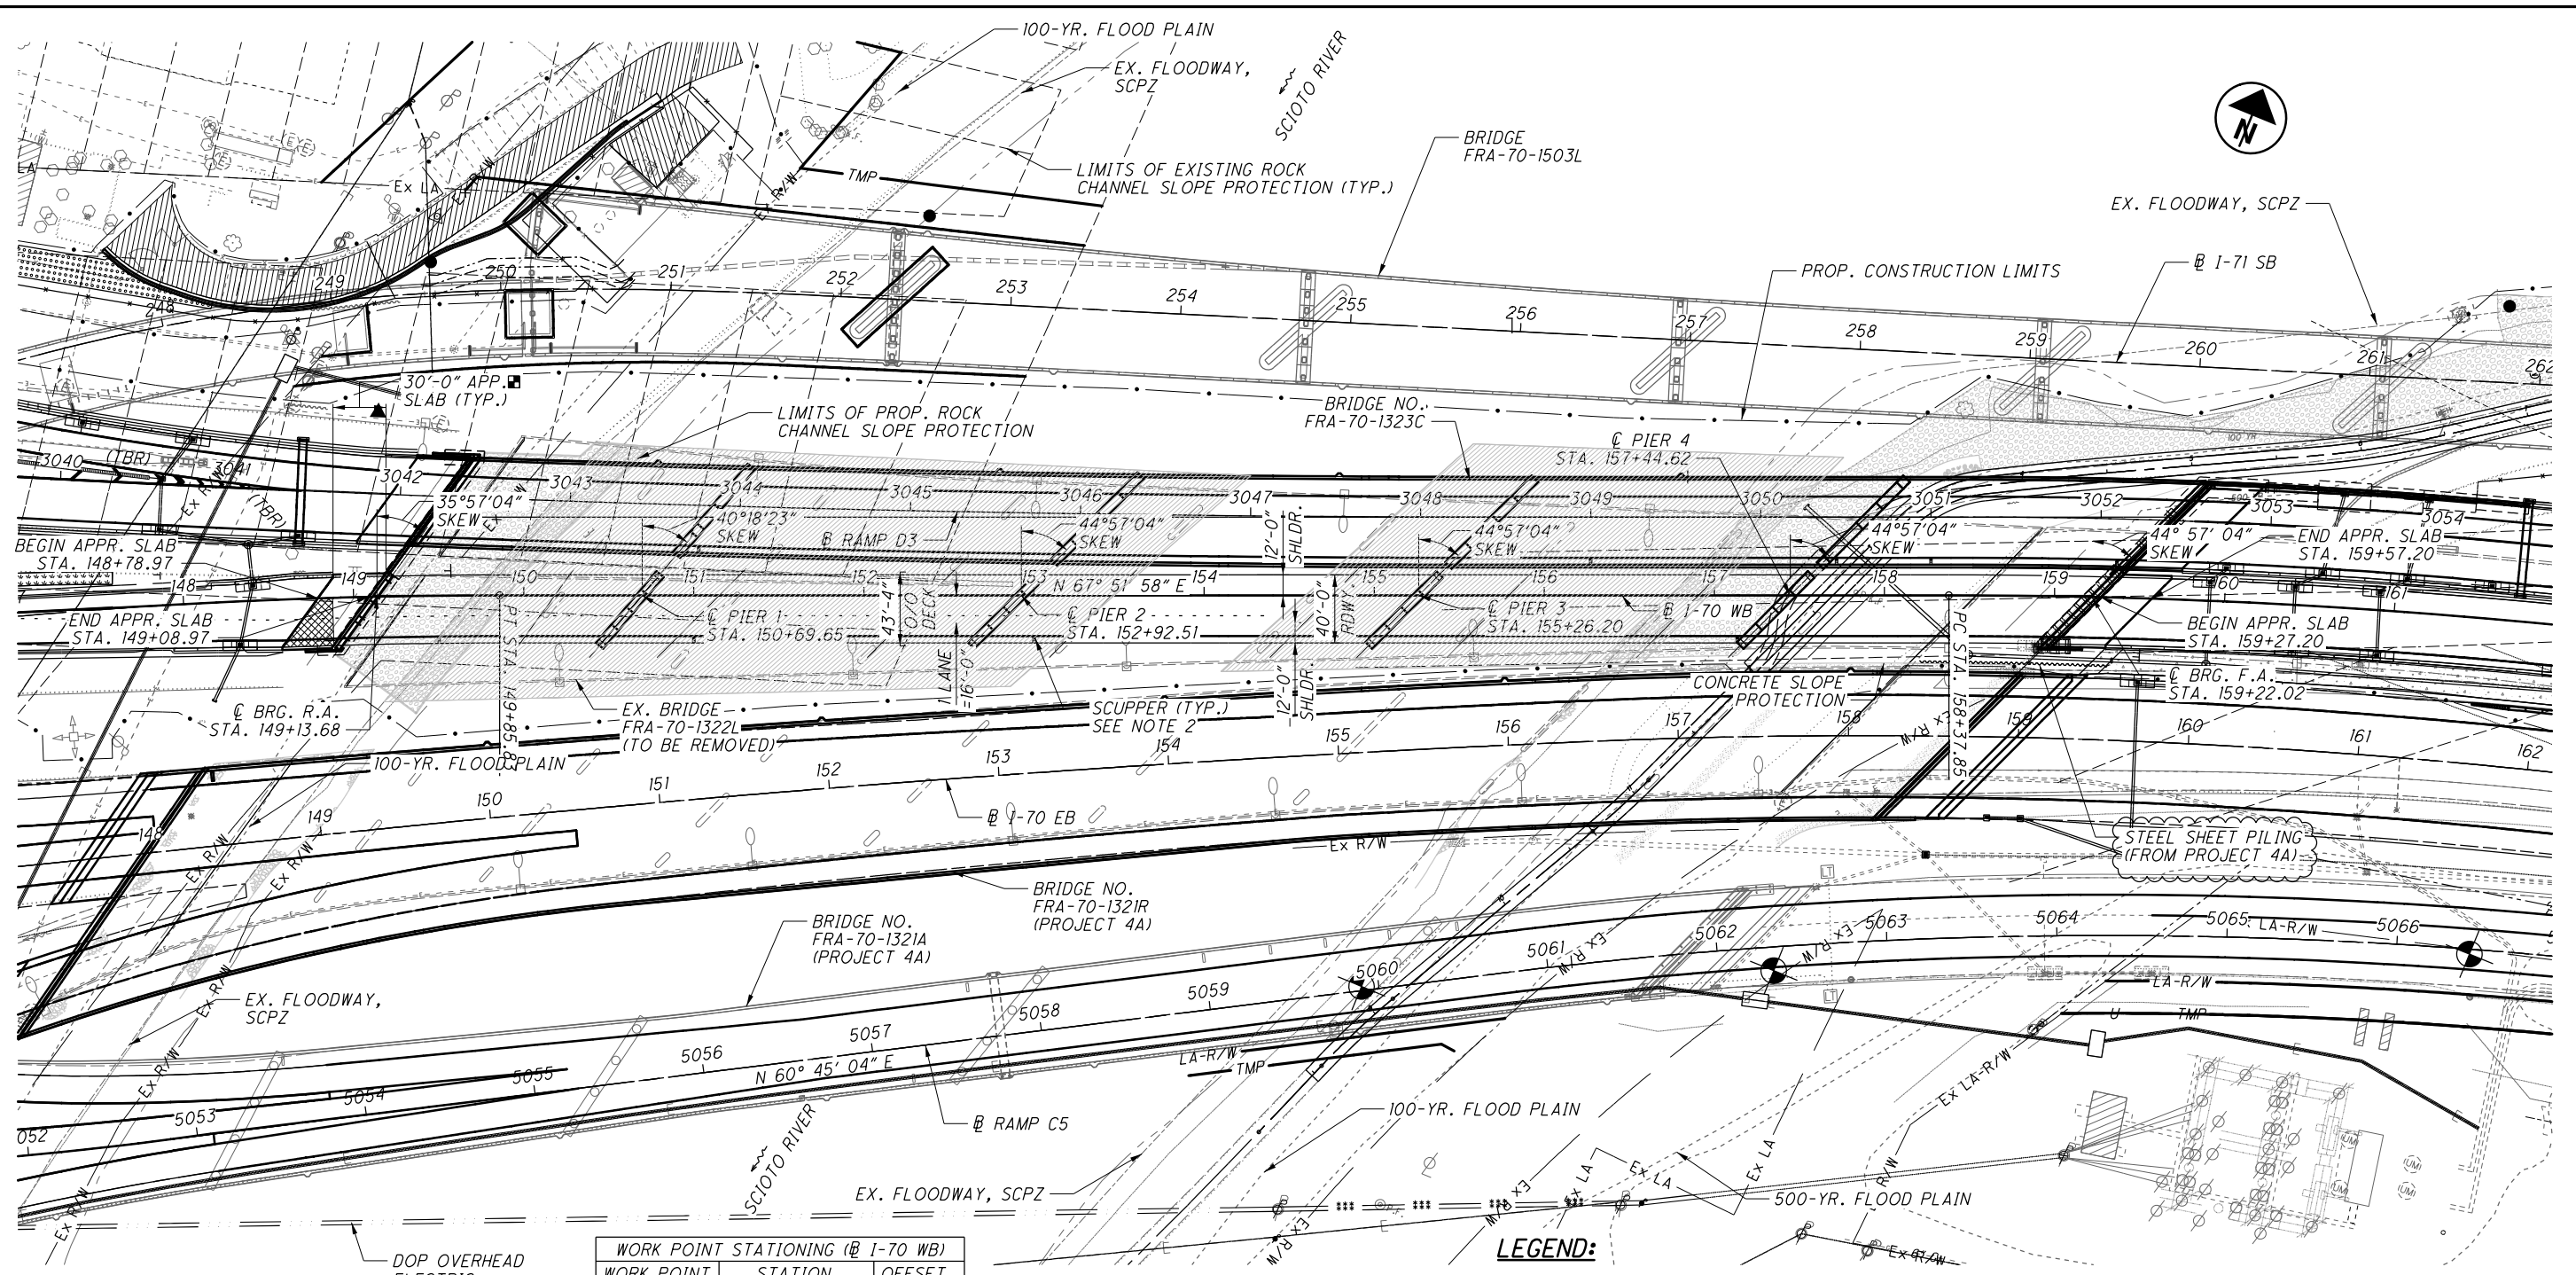


WORK POINT STATIONING (@ I-70 WB)		
WORK POINT	STATION	OFFSET
WP #1	149+14.28	0.78' LT.
WP #2	150+69.65	0.00'
WP #3	152+92.51	0.00'
WP #4	155+26.20	0.00'
WP #5	157+44.62	0.00'
WP #6	159+22.96	0.99' LT.

LEGEND:

- ◇ - DIMENSION FROM REFERENCE LINE TO @ I-70 W.B. MEASURED ALONG @ BEARINGS.
- * - MEASURED ALONG REFERENCE LINE
- - APPROACH SLAB LIMITS MEASURED ALONG @ I-70 WB
- ▨ - TEMPORARY ACCESS FILL

PLAN

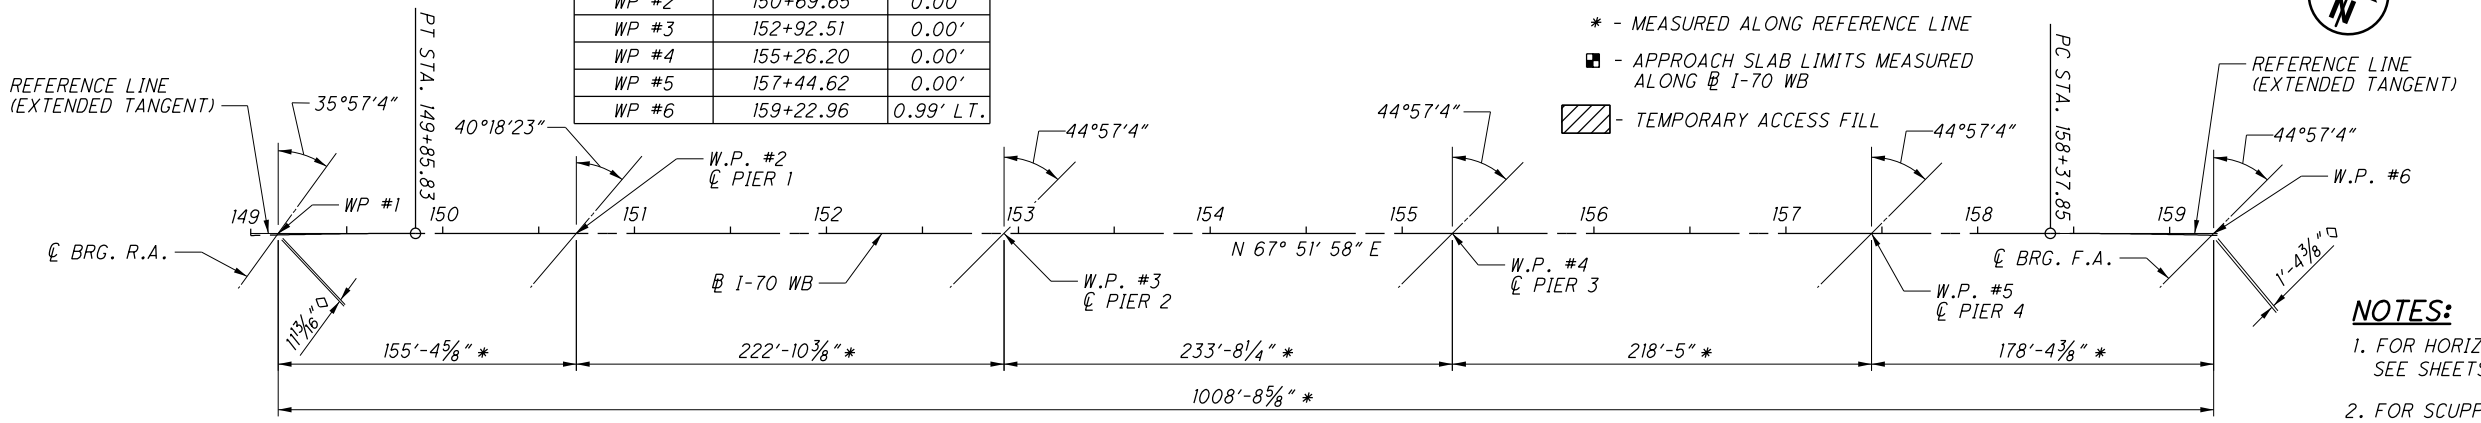

REFERENCE LINE DIAGRAM

NOTES:

1. FOR HORIZONTAL CURVE DATA, SEE SHEETS [1/58] THRU [3/58].
2. FOR SCUPPER LOCATIONS AND DETAILS SEE SHEETS [51/58] THRU [53/58].

NO.	DESCRIPTION	REV. BY	DATE
5	EDITED CALLOUT	ACW	11/6/23

DESIGN AGENCY
ms consultants, inc.
2221 Schrock Road
Columbus, Ohio 43229

DATE
3/06/23

REVIEWED
WER

STRUCTURE FILE NUMBER
2510027

DRAWN
KRM

CHECKED
TVB

DESIGNED
LAW

GENERAL PLAN AND REFERENCE LINE DIAGRAM
BRIDGE NO. FRA-70-1322L
I-70 WB OVER SCIOTO RIVER

FRA-70-13-10
PID No. 77372

4 / 58

476
702

ms consultants, inc.



Batchplot Spec: \\msconsultants.com\files\production\03\60\06634_6A\standards\plotdrv\batchplot.dwg
Pen Table: \\msconsultants.com\files\production\03\60\06634_6A\deliverables\00_Current_Applications\03\60\06634_6A\Columbus_Abridged.dwg
Plot Driver: \\msconsultants.com\files\standards\usin\ohdot\18\ms\plotting\PDF.plt

0 0.5' 1'
34" x 22"

Model: Sheet
Printed: 11/6/2023 10:05:14 AM
View: FENCE_VEW1
By: onhite

File: \\msconsultants.com\files\production\03\60\06634_6A\structures\VRA070_13230_sheets\070_13230E0001.dgn

34" x 22"

34" x 22"

ESTIMATED QUANTITIES

ESTIMATED QUANTITIES						CALC:	ELS/DBL	DATE:	12/07/21
						CHECK:	ATM	DATE:	12/07/21
ITEM	ITEM EXT.	TOTAL	UNIT	DESCRIPTION	ABUT.	PIERS	SUPER.	GEN.	SHEET REF.
202	11003	LS		STRUCTURE REMOVED, OVER 20 FOOT SPAN, AS PER PLAN				1	5/70
202	22900	745	SY	APPROACH SLAB REMOVED				745	
202	23500	10,500	SY	WEARING COURSE REMOVED				10,500	
202	32800	278	SY	CONCRETE SLOPE PROTECTION REMOVED	278				
202	98100	14	EACH	REMOVAL MISC.: PILE REMOVED, EXISTING STRUCTURE	14				
503	21101	3,242	CY	UNCLASSIFIED EXCAVATION, AS PER PLAN	3,242				6/70
505	11100	LS		PILE DRIVING EQUIPMENT MOBILIZATION				1	
507	00100	6,350	FT	STEEL PILES HPI0X42, FURNISHED	6,350				
507	00150	5,890	FT	STEEL PILES HPI0X42, DRIVEN	5,890				
507	93300	92	EACH	STEEL POINTS OR SHOES	92				
509	10001	881,328	LB	EPOXY COATED REINFORCING STEEL, AS PER PLAN	106,589	191,582	581,813	1,344	6/70 25/70 67/70
511	34447	1,710	CY	CLASS QC2 CONCRETE WITH QC/OA, BRIDGE DECK, AS PER PLAN			1,710		6/70
511	34450	360	CY	CLASS QC2 CONCRETE WITH QC/OA, BRIDGE DECK (PARAPET)			360		
511	44112	394	CY	CLASS QC1 CONCRETE WITH QC/OA, ABUTMENT NOT INCLUDING FOOTING	394				
511	45602	596	CY	CLASS QC4 MASS CONCRETE, SUBSTRUCTURE WITH QC/OA		596			
511	46012	277	CY	CLASS QC1 CONCRETE WITH QC/OA, RETAINING/WINGWALL NOT INCLUDING FOOTING	277				
511	46512	579	CY	CLASS QC1 CONCRETE WITH QC/OA, FOOTING	579				
512	10001	843	SY	SEALING OF CONCRETE SURFACES, AS PER PLAN (PERMANENT GRAFFITI PROTECTION)	751	92			6/70
512	10100	2,389	SY	SEALING OF CONCRETE SURFACES (EPOXY-URETHANE)		320	2,069		
512	33000	51	SY	TYPE 2 WATERPROOFING	51				
513	10300	355,667	LB	STRUCTURAL STEEL MEMBERS, LEVEL FIVE			355,667		6/70 32/70
513	10401	2,213,561	LB	STRUCTURAL STEEL MEMBERS, HYBRID GIRDER, LEVEL SIX (6) FABRICATION, AS PER PLAN			2,213,561		
513	20000	12,801	EACH	WELDED STUD SHEAR CONNECTORS			12,801		
514	00060	29,490	SF	FIELD PAINTING STRUCTURAL STEEL, INTERMEDIATE COAT			29,490		
514	00066	29,490	SF	FIELD PAINTING STRUCTURAL STEEL, FINISH COAT			29,490		
516	12400	134	FT	SPECIAL - MODULAR EXPANSION JOINT				134	6/70 7/70
516	13600	377	SF	1" PREFORMED EXPANSION JOINT FILLER				377	
516	13900	216	SF	2" PREFORMED EXPANSION JOINT FILLER				216	
518	12200	5	EACH	SCUPPERS, INCLUDING SUPPORTS			5		
518	21200	481	CY	POROUS BACKFILL WITH GEOTEXTILE FABRIC	481				
518	40000	361	FT	6" PERFORATED CORRUGATED PLASTIC PIPE	361				
518	40010	45	FT	6" NON-PERFORATED CORRUGATED PLASTIC PIPE, INCLUDING SPECIALS	45				
518	51200	49	FT	PIPE DOWNSPOUT, INCLUDING SPECIALS (10")			49		
524	94919	156	FT	DRILLED SHAFTS, 60" DIAMETER, INTO BEDROCK, AS PER PLAN		156			7/70
524	94931	496	FT	DRILLED SHAFTS, 66" DIAMETER, ABOVE BEDROCK, AS PER PLAN		496			7/70
526	30010	351	SY	REINFORCED CONCRETE APPROACH SLABS WITH QC/OA (T=17")				351	61/70 62/70
526	90010	134	FT	TYPE A INSTALLATION				134	
601	21000	280	SY	CONCRETE SLOPE PROTECTION *	280				
601	32104	4,358	CY	ROCK CHANNEL PROTECTION, TYPE B WITH GEOTEXTILE FABRIC *	995	3,363			
SPECIAL	690E98400	LS		SPECIAL - EMERGENCY ACTION PLAN COORDINATION **				1	5/70
846	00110	56	CF	POLYMER MODIFIED ASPHALT EXPANSION JOINT SYSTEM				56	
869	00101	30	EACH	HIGH LOAD MULTI-ROTATIONAL (HLMR) BEARINGS, AS PER PLAN	10	20			7/70
894	10000	12	EACH	THERMAL INTEGRITY PROFILING (TIP) TEST		12			7/70

LEGEND:

* QUANTITY CARRIED TO EROSION CONTROL IN THE GENERAL SUMMARY.

** QUANTITY CARRIED TO ROADWAY IN THE GENERAL SUMMARY.

NO.	DESCRIPTION	REV. BY	DATE
4	QUANTITY CHANGES	ACW	10/30/23
5	QUANTITY CHANGES	ACW	11/6/23

DESIGN AGENCY
ms consultants, inc.
2221 Schrock Road
Columbus, Ohio 43229

REVIEWED DATE
GLG/YSJ 03/08/23
STRUCTURE FILE NUMBER
2510026

DRAWN ELS
ELLS
REVISOR
ABD

DESIGNED ELS
CHECKED
ABD

ESTIMATED QUANTITIES
BRIDGE NO. FRA-70-1323C
RAMP D3 OVER SCIOTO RIVER

FRA-70-13.10
PID No. 77372

8 / 70

538
702

ITEM 614 - WORK ZONE INCREASED PENALTIES SIGN (R11-H5A)

R11-H5A-48 SIGNS SHALL BE FURNISHED, ERECTED, AND MAINTAINED IN GOOD CONDITION AND/OR REPLACED AS NECESSARY AND SUBSEQUENTLY REMOVED BY THE CONTRACTOR. SIGNS SHALL BE MOUNTED AT THE APPROPRIATE OFFSETS AND ELEVATIONS AS PRESCRIBED BY THE OHIO MANUAL OF UNIFORM TRAFFIC CONTROL DEVICES. THEY SHALL BE MAINTAINED ON SUPPORTS MEETING CURRENT SAFETY CRITERIA.

THE SIGNS MAY BE ERECTED OR UNCOVERED NO MORE THAN FOUR HOURS BEFORE THE ACTUAL START OF WORK. THE SIGNS SHALL BE REMOVED OR COVERED NO LATER THAN FOUR HOURS FOLLOWING RESTORATION OF ALL LANES TO TRAFFIC WITH NO RESTRICTIONS, OR SOONER AS DIRECTED BY THE ENGINEER. TEMPORARY SIGN COVERING AND UNCOVERING DUE TO TEMPORARY LANE RESTORATIONS SHALL BE GUIDED BY THE FOUR-HOUR LIMITATIONS STATED ABOVE. SUCH LANE RESTORATIONS SHOULD BE EXPECTED TO REMAIN IN EFFECT FOR 30 OR MORE CONSECUTIVE CALENDAR DAYS, SUCH AS DURING WINTER SHUT-DOWNS.

THE SIGNS ON THE MAINLINE SHALL BE DUAL MOUNTED UNLESS NOT PHYSICALLY POSSIBLE. THE FIRST SIGN SHALL BE PLACED BETWEEN THE ROAD WORK AHEAD (W20-1) SIGN AND THE NEXT SIGN IN THE SEQUENCE. SIGNS SHALL BE ERECTED ON EACH ENTRANCE RAMP AND EVERY 2 MILES THROUGH THE CONSTRUCTION WORK LIMITS. SIGNS ON THE MAINLINE SHALL BE R11-H5A-48. SIGNS USED ON THE RAMPS SHALL BE R11-H5A-24. R11-H5A-24 SIGNS MAY BE USED IN THE MEDIAN IN LIEU OF R11-H5A-48 SIGNS IF IT IS NOT PHYSICALLY POSSIBLE TO PROVIDE R11-H5A-48 SIGNS IN THE MEDIAN.

THE R11-H5a-48 SIGN SHALL BE MOUNTED ON 2 NO. 3 POSTS LOCATED WITHIN CLEAR ZONES.

THE CONTRACTOR MAY USE SIGNS AND SUPPORTS IN USED, BUT GOOD, CONDITION PROVIDED THE SIGNS MEET CURRENT ODOT SPECIFICATIONS. SIGN FACES SHALL BE RETROREFLECTORIZED WITH TYPE G SHEETING COMPLYING WITH THE REQUIREMENTS OF C&MS 730.19.

WORK ZONE INCREASED PENALTIES SIGNS AND SUPPORTS WILL BE MEASURED AS THE NUMBER OF SIGN INSTALLATIONS, INCLUDING THE SIGN AND NECESSARY SUPPORTS. IF A SIGN AND SUPPORT COMBINATION IS REMOVED AND REERECTED AT ANOTHER LOCATION AS DIRECTED BY THE ENGINEER, IT SHALL BE CONSIDERED ANOTHER UNIT.

PAYMENT FOR ACCEPTED QUANTITIES, COMPLETE, IN PLACE WILL BE MADE AT THE CONTRACT UNIT PRICE. PAYMENT SHALL BE FULL COMPENSATION FOR ALL MATERIALS, LABOR, INCIDENTALS AND EQUIPMENT FOR FURNISHING, ERECTING, MAINTAINING, COVERING DURING SUSPENSION OF WORK, AND REMOVAL OF THE SIGN AND SUPPORT.

ITEM 614, WORK ZONE INCREASED PENALTIES SIGN 10 EACH

ITEM 614 - DETOUR SIGNING

SIZE AND PLACEMENT OF DETOUR SIGNS (M4-9) SHOULD FOLLOW THE REQUIREMENTS OF THE OMUTCD SECTION 6F.03, SECTION 2A.11 AND TABLE 6F.01 UNLESS OTHERWISE SPECIFIED IN THE PLANS.

DETOUR SIGNING SHALL PROVIDED DRIVERS ADEQUATE TIME TO CLEARLY READ THE SIGNS AND MAKE THE PROPER DECISIONS AT EACH REQUIRED TURNING MOVEMENT. THE DESIGNATED DETOUR ROUTE SHALL BE SIGNED IN ACCORDANCE WITH THE REQUIREMENTS BELOW:

- APPROXIMATELY 1500 FEET PRIOR TO TIP OF THE PAINTED GORE AT AN INTERCHANGE WHEN EXITING A HIGH SPEED (45 MPH OR HIGHER) FACILITY.

- AT OR NEAR THE EXISTING SIGN IN THE GORE OF AN INTERCHANGE RAMP.

- AT OR NEAR THE FIRST EXISTING LANE ASSIGNMENT SIGN ON AN INTERCHANGE EXIT RAMP.

- AT OR NEAR THE EXISTING LANE ASSIGNMENT SIGN OR EXISTING ROUTE MARKER AT THE END OF AN EXIT RAMP.

- APPROXIMATELY 500 FEET PRIOR TO A REQUIRED TURN AT AN INTERSECTION NOT CONTROLLED BY A STOP SIGN (FOR 45 MPH OR HIGHER ONLY).

- AT OR NEAR THE EXISTING LANE ASSIGNMENT SIGN OR EXISTING ROUTE MARKER AT AN INTERSECTION.

- EVERY TWO BLOCKS ALONG A TANGENT SECTION BETWEEN TURNING MOVEMENTS WITHIN A CITY.

- AT ANY OTHER INTERSECTION OR DECISION POINT WHERE THE DETOUR ROUTE IS CONTRARY TO THE NORMAL, EXPECTED TURNING MANEUVER OR OTHERWISE UNCLEAR.

DETOUR SIGNS SHALL BE PLACED, WHEN POSSIBLE, NEXT TO BUT NOT BLOCKING EXISTING ROUTE MARKERS OR LANE ASSIGNMENT SIGNS. DETOUR SIGNS SHALL NOT OBSCURE OR BE OBSCURED BY OTHER EXISTING OR TEMPORARY SIGNS.

DETOUR SIGNS SHALL BE ERECTED AND/OR UNCOVERED PRIOR TO THE ROAD OR RAMP BEING CLOSED TO TRAFFIC BUT NO EARLIER THAN FOUR HOURS PRIOR TO THE CLOSURE. DETOUR SIGNS SHALL BE COVERED AND/OR REMOVED NO LATER THAN FOUR HOURS FOLLOWING THE ROAD OR RAMP RE-OPENING TO TRAFFIC.

PAYMENT FOR ACCEPTED QUANTITIES WILL BE MADE AT THE CONTRACT UNIT PRICE. PAYMENT SHALL BE FOR ALL MATERIALS, LABOR, INCIDENTALS, AND EQUIPMENT FOR FURNISHING, PROPER SIGN PLACEMENT AND SIZING, TIMELY ERECTING AND/OR UNCOVERING OF SIGNS, MAINTAINING SIGNS, AND TIMELY COVERING AND/OR REMOVING SIGNS AND SUPPORTS.

THE FOLLOWING ESTIMATED QUANTITIES HAVE BEEN CARRIED TO THE GENERAL SUMMARY.

ITEM 614 - DETOUR SIGNING LS

ITEM 622 - PORTABLE BARRIER, UNANCHORED, AS PER PLAN

THE CONTRACTOR SHALL INSTALL GLARE SHIELDS ON PORTABLE BARRIER WITH OPPOSING TRAFFIC RUNNING ON EACH SIDE OF THE BARRIER.

THE GLARE SCREEN SHALL BE CONSTRUCTED USING ONE OF THE SCREENS PROVIDED ON THE APPROVED LIST, AVAILABLE ON THE OFFICE OF ROADWAY ENGINEERING WEBSITE.

PADDLE OR INTERMITTENT TYPE GLARE SCREENS SHALL BE DESIGNED USING A 20 DEGREE CUT-OFF ANGLE BASED ON TANGENT ALIGNMENT. THAT SPACING SHALL BE USED THROUGHOUT THE BARRIER LENGTH WITHOUT REGARD TO BARRIER CURVATURE.

THE GLARE SCREEN SYSTEM SHALL BE SECURELY FASTENED TO THE 32-INCH PORTABLE BARRIER USING THE HARDWARE AND PROCEDURES SPECIFIED BY THE MANUFACTURER.

FOR DIRECTIONS ON HOW TO INSTALL THE GLARE SCREEN AND THE BARRIER, SEE THE MANUFACTURER'S INSTRUCTIONS.

PAYMENT SHALL INCLUDE ALL LABOR, MATERIAL, AND EQUIPMENT NECESSARY TO PERFORM THE WORK AND SHALL BE PAID FOR AT THE CONTRACT PRICE PER FOOT FOR ITEM 622 - PORTABLE BARRIER, UNANCHORED, AS PER PLAN.

WEEKLY MAINTENANCE OF TRAFFIC MEETING

AFTER THE INITIAL PRE-MAINTENANCE OF TRAFFIC MEETING, THE CONTRACTOR SHALL MEET WITH THE PROJECT ENGINEER ON A WEEKLY BASIS TO GO OVER A DETAILED MAINTENANCE OF TRAFFIC REPORT OF AT LEAST 7 CALENDAR DAYS. THIS MEETING SHOULD BE HELD ON THE SAME DAY AND TIME OF EACH WEEK.

THE CONTRACTOR WILL PROVIDE TO THE PROJECT ENGINEER A WRITTEN DETAIL OF THE INFORMATION REQUIRED BY THE NOTIFICATION OF TRAFFIC RESTRICTIONS NOTE PRIOR TO THE MEETING.

IN ADDITION TO THE DETAILED MAINTENANCE OF TRAFFIC REPORT THE CONTRACTOR SHALL GIVE A GENERAL LOOK AHEAD OF AN ADDITIONAL 2 WEEKS OF UPCOMING WORK ACTIVITIES. THIS WILL INCLUDE ANY NOTIFICATION REQUIREMENTS FOR RESTRICTIONS THAT HAVE A DURATION GREATER THAN 12 HOURS.

PRE-MAINTENANCE OF TRAFFIC MEETING

A PRE-MAINTENANCE OF TRAFFIC MEETING SHALL BE HELD (MINIMUM 14 WORK DAYS) PRIOR TO WORK BEGINNING OR ANY CHANGE OF PHASING. THIS MEETING SHALL INCLUDE THE DISTRICT WORK ZONE TRAFFIC MANAGER (d06.mot@dot.ohio.gov) AS WELL AS THE CONTRACTOR AND ANY OF HIS SUB-CONTRACTORS INVOLVED WITH TEMPORARY TRAFFIC CONTROL. FOR COLUMBUS SECTIONS OF ROADWAY, ALSO INCLUDE THE TEMPORARY CONTROL COORDINATOR (614-645-6269 OR 614-645-5845) FROM THE CITY OF COLUMBUS TRANSPORTATION DIVISION.

COORDINATION WITH ADJACENT PROJECTS

THE CONTRACTOR SHALL COORDINATE WORK WITH ODOT AND THE CONTRACTORS ON THE ADJACENT PROJECTS.

- FRA-70/71-12.68/14.86 PROJECT 4R PART 1 (PID 105523)
- FRA-71-14.36 PROJECT 6R PART 2 (PID 105523)
- FRA-70-13.11 PROJECT 4A PART 1 (PID 77372)
- FRA-70-14.05C PROJECT 4H PART 2 (PID 77372)
- FRA-70-13.01 PROJECT 6A PART 3 (PID 77372)
- FRA-70-13.01 (1301 BRIDGES OVER 315) PART 5 (PID 77372)

COORDINATION SHALL BE MADE TO PREVENT CONFLICTING ADVANCE WARNING SIGNS, CONFLICTING DETOUR ROUTES, OVERLAPING/CONFLICTING LANE CLOSURES, AND TO ENSURE THAT A MINIMUM DISTANCE OF 2 MILES BETWEEN ADJACENT LANE CLOSURES IS MAINTAINED. THIS IS NOT AN EXHAUSTIVE LIST OF COORDINATION ITEMS THAT MAY NEED TO BE RESOLVED BETWEEN PROJECTS. THE DEPARTMENT RESERVES THE RIGHT TO DECIDE WHICH PROJECT'S ACTIVITIES TAKE PRECEDENCE. PROJECTS THAT HAVE ACTIVITIES DELAYED DUE TO CONFLICTS WILL CONSIDER THIS AN EXCUSABLE, NON-COMPENSABLE DELAY PER 108.06.B. ON PROJECTS THAT HAVE ACTIVITIES DELAYED DUE TO CONFLICTS WHERE THE CONTRACTOR FAILED TO MEET THE NOTIFICATION REQUIREMENTS, THE DELAYS SHALL NOT BE CONSIDERED EXCUSABLE OR COMPENSABLE.

ATTENDANCE AT DEPARTMENT ORDERED TRAFFIC COORDINATION MEETINGS BETWEEN ADJACENT PROJECTS SHALL BE CONSIDERED MANDATORY FOR EACH PROJECT'S SUPERINTENDENT AND WORKSITE TRAFFIC SUPERVISOR (WTS), AND INCIDENTAL TO THE LUMP SUM MAINTENANCE OF TRAFFIC PAYMENT ITEM



ESTIMATED QUANTITIES

THE FOLLOWING QUANTITIES HAVE BEEN CARRIED TO THE MAINTENANCE OF TRAFFIC GENERAL SUMMARY FOR TEMPORARY PAVEMENT MARKINGS PLACED ON THE PROPOSED SURFACE COURSE IN THE PERMANENT TRAFFIC PATTERN PRIOR TO THE INSTALLATION OF THE PERMANENT PAVEMENT MARKINGS. TEMPORARY PAVEMENT MARKINGS SHALL BE INSTALLED PER THE REQUIREMENTS OF 614.11, AS DIRECTED BY THE ENGINEER.

ITEM 614 - WORK ZONE LANE LINE, CLASS III, 6", 642 PAINT	<u>6.24</u> MILE
ITEM 614 - WORK ZONE EDGE LINE, CLASS III, 6", 642 PAINT	<u>4.46</u> MILE
ITEM 614 - WORK ZONE CHANNELIZING LINE, CLASS III, 12", 642 PAINT	<u>5427</u> FT
ITEM 614 - WORK ZONE DOTTED LINE, CLASS III, 6", 642 PAINT	<u>8872</u> FT
ITEM 614 - WORK ZONE STOP LINE, CLASS III, 642 PAINT	<u>80</u> FT
ITEM 614 - WORK ZONE ARROW, CLASS III, 642 PAINT	<u>2</u> EACH

NO.	DESCRIPTION	DATE	REV. BY
5	ADDED NOTE	AKF	11-1-23

SHEET NUMBER										PARTICIPATION		ITEM	ITEM EXT.	GRAND TOTAL	UNIT	DESCRIPTION	SEE SHEET NO.
42	43	44	45	46	47	48	50		260	01/IMS/04							
	1,000									1000		607	30001	1000	FT	FENCE, SNOW, AS PER PLAN	44
	2000									2000		614	1110	2000	hour	LAW ENFORCEMENT OFFICER WITH PATROL CAR FOR ASSISTANCE	
2										2		SPECIAL	614E11300	2	EACH	WORK ZONE TRAFFIC SIGNAL	43
							27376			27376		614	11630	27376	FT	INCREASED BARRIER DELINEATION	
							13			13		614	12380	13	EACH	WORK ZONE IMPACT ATTENUATOR, 24" WIDE HAZARDS, (UNIDIRECTIONAL)	
				LS						LS		614	12420	LS		DETOUR SIGNING	
										11		614	12470	11	EACH	WORK ZONE SPEED LIMIT SIGN	
					10					10		614	12484	10	EACH	WORK ZONE INCREASED PENALTIES SIGN	
					50					50		614	12500	50	EACH	REPLACEMENT SIGN	
2	300									300		614	12600	300	EACH	REPLACEMENT DRUM	
										2		614	12756	2	EACH	WORK ZONE CROSSOVER LIGHTING SYSTEM	
							3645			3645		614	12800	3645	EACH	WORK ZONE RAISED PAVEMENT MARKER	
							1440			1440		614	13310	1440	EACH	BARRIER REFLECTOR, TYPE I, BIDIRECTIONAL	
						48				48		614	18601	48	SNMT	PORTABLE CHANGEABLE MESSAGE SIGN, AS PER PLAN	45
							3.41			3.41		614	20056	3.41	MILE	WORK ZONE LANE LINE, CLASS I, 6", 807 PAINT	
							0.62			0.62		614	20200	0.62	MILE	WORK ZONE LANE LINE, CLASS I, 4", 740.06, TYPE I	
							6.24			6.24		614	20560	6.24	MILE	WORK ZONE LANE LINE, CLASS III, 6", 642 PAINT	
							13.08			13.08		614	22056	13.08	MILE	WORK ZONE EDGE LINE, CLASS I, 6", 807 PAINT	
							1.42			1.42		614	22200	1.42	MILE	WORK ZONE EDGE LINE, CLASS I, 4", 740.06, TYPE I	
							4.46			4.46		614	22360	4.46	MILE	WORK ZONE EDGE LINE, CLASS III, 6", 642 PAINT	
							30704			30704		614	23110	30704	FT	WORK ZONE CHANNELIZING LINE, CLASS I, 12", 807 PAINT	
							275			275		614	23400	275	FT	WORK ZONE CHANNELIZING LINE, CLASS I, 8", 740.06, TYPE I	
							5427			5427		614	23690	5427	FT	WORK ZONE CHANNELIZING LINE, CLASS III, 12", 642 PAINT	
							7974			7974		614	24100	7974	FT	WORK ZONE DOTTED LINE, CLASS I, 4", 807 PAINT	
							857			857		614	24400	857	FT	WORK ZONE DOTTED LINE, CLASS I, 740.06, TYPE I	
							8872			8872		614	24612	8872	FT	WORK ZONE DOTTED LINE, CLASS III, 6", 642 PAINT	
							1159			1159		614	25000	1159	FT	WORK ZONE TRANSVERSE/DIAGONAL LINE, CLASS I	
							53			53		614	26400	53	FT	WORK ZONE STOP LINE, CLASS I, 740.06, TYPE I	
							80			80		614	26610	80	FT	WORK ZONE STOP LINE, CLASS III, 642 PAINT	
							466			466		614	27070	466	FT	WORK ZONE CROSSWALK LINE, CLASS I, 12", 740.06, TYPE I	
							12			12		614	30400	12	EACH	WORK ZONE ARROW, CLASS I, 740.06, TYPE I	
							2			2		614	30650	2	EACH	WORK ZONE ARROW, CLASS III, 642 PAINT	
LS										LS		615	10000	LS		ROADS FOR MAINTAINING TRAFFIC	
							4600			4600		615	20000	4600	SY	PAVEMENT FOR MAINTAINING TRAFFIC, CLASS A	
							255		374	629		615	25000	629	SY	PAVEMENT FOR MAINTAINING TRAFFIC, CLASS B	
							200			200		615	25001	200	SY	PAVEMENT FOR MAINTAINING TRAFFIC, CLASS B, AS PER PLAN, TYPE 1	48
							200			200		615	25001	200	SY	PAVEMENT FOR MAINTAINING TRAFFIC, CLASS B, AS PER PLAN, TYPE 2	48
							200			200		615	25001	200	SY	PAVEMENT FOR MAINTAINING TRAFFIC, CLASS B, AS PER PLAN, TYPE 3	48
							200			200		615	25001	200	SY	PAVEMENT FOR MAINTAINING TRAFFIC, CLASS B, AS PER PLAN, TYPE 4	48
							550			550		616	10000	550	MGAL	WATER	
							2			2		622	41050	2	EACH	PORTABLE BARRIER, "Y" CONNECTOR	
							28884			28884		622	41101	28884	FT	PORTABLE BARRIER, UNANCHORED, AS PER PLAN	46
							48			48		808	18700	48	SNMT	DIGITAL SPEED LIMIT (DSL) SIGN ASSEMBLY	
					48					48		896	00010	48	SNMT	PORTABLE NON-INTRUSIVE TRAFFIC SENSOR, CLASS I	
					48					48		896	00020	48	SNMT	PORTABLE CHANGEABLE MESSAGE SIGN	

MAINTENANCE OF TRAFFIC GENERAL SUMMARY


FRA - 70-14.05

NO.	DESCRIPTION	REV. BY	DATE
2	REV. NOTE/BRICK X-WALK TEMP.	CWL	10-13-23
5	ADDED WZ CLASS III	CWL	11-3-23

LIVINGSTON PHASE B
PROJECT 2E (105322)

LEGEND

ITEM 670 - CONCRETE
SLOPE PROTECTION

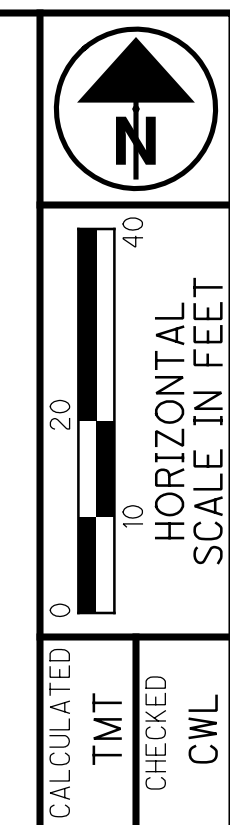


NO.	DESCRIPTION	REV. BY	DATE
5 <td>ADDED ABAND LABELS <td>CWL <td>10-31-23</td> </td></td>	ADDED ABAND LABELS <td>CWL <td>10-31-23</td> </td>	CWL <td>10-31-23</td>	10-31-23

PLAN - I-70
STA. 196+00.00 EB TO STA. 201+00.00 EB

FRA-70-14.05

187
855

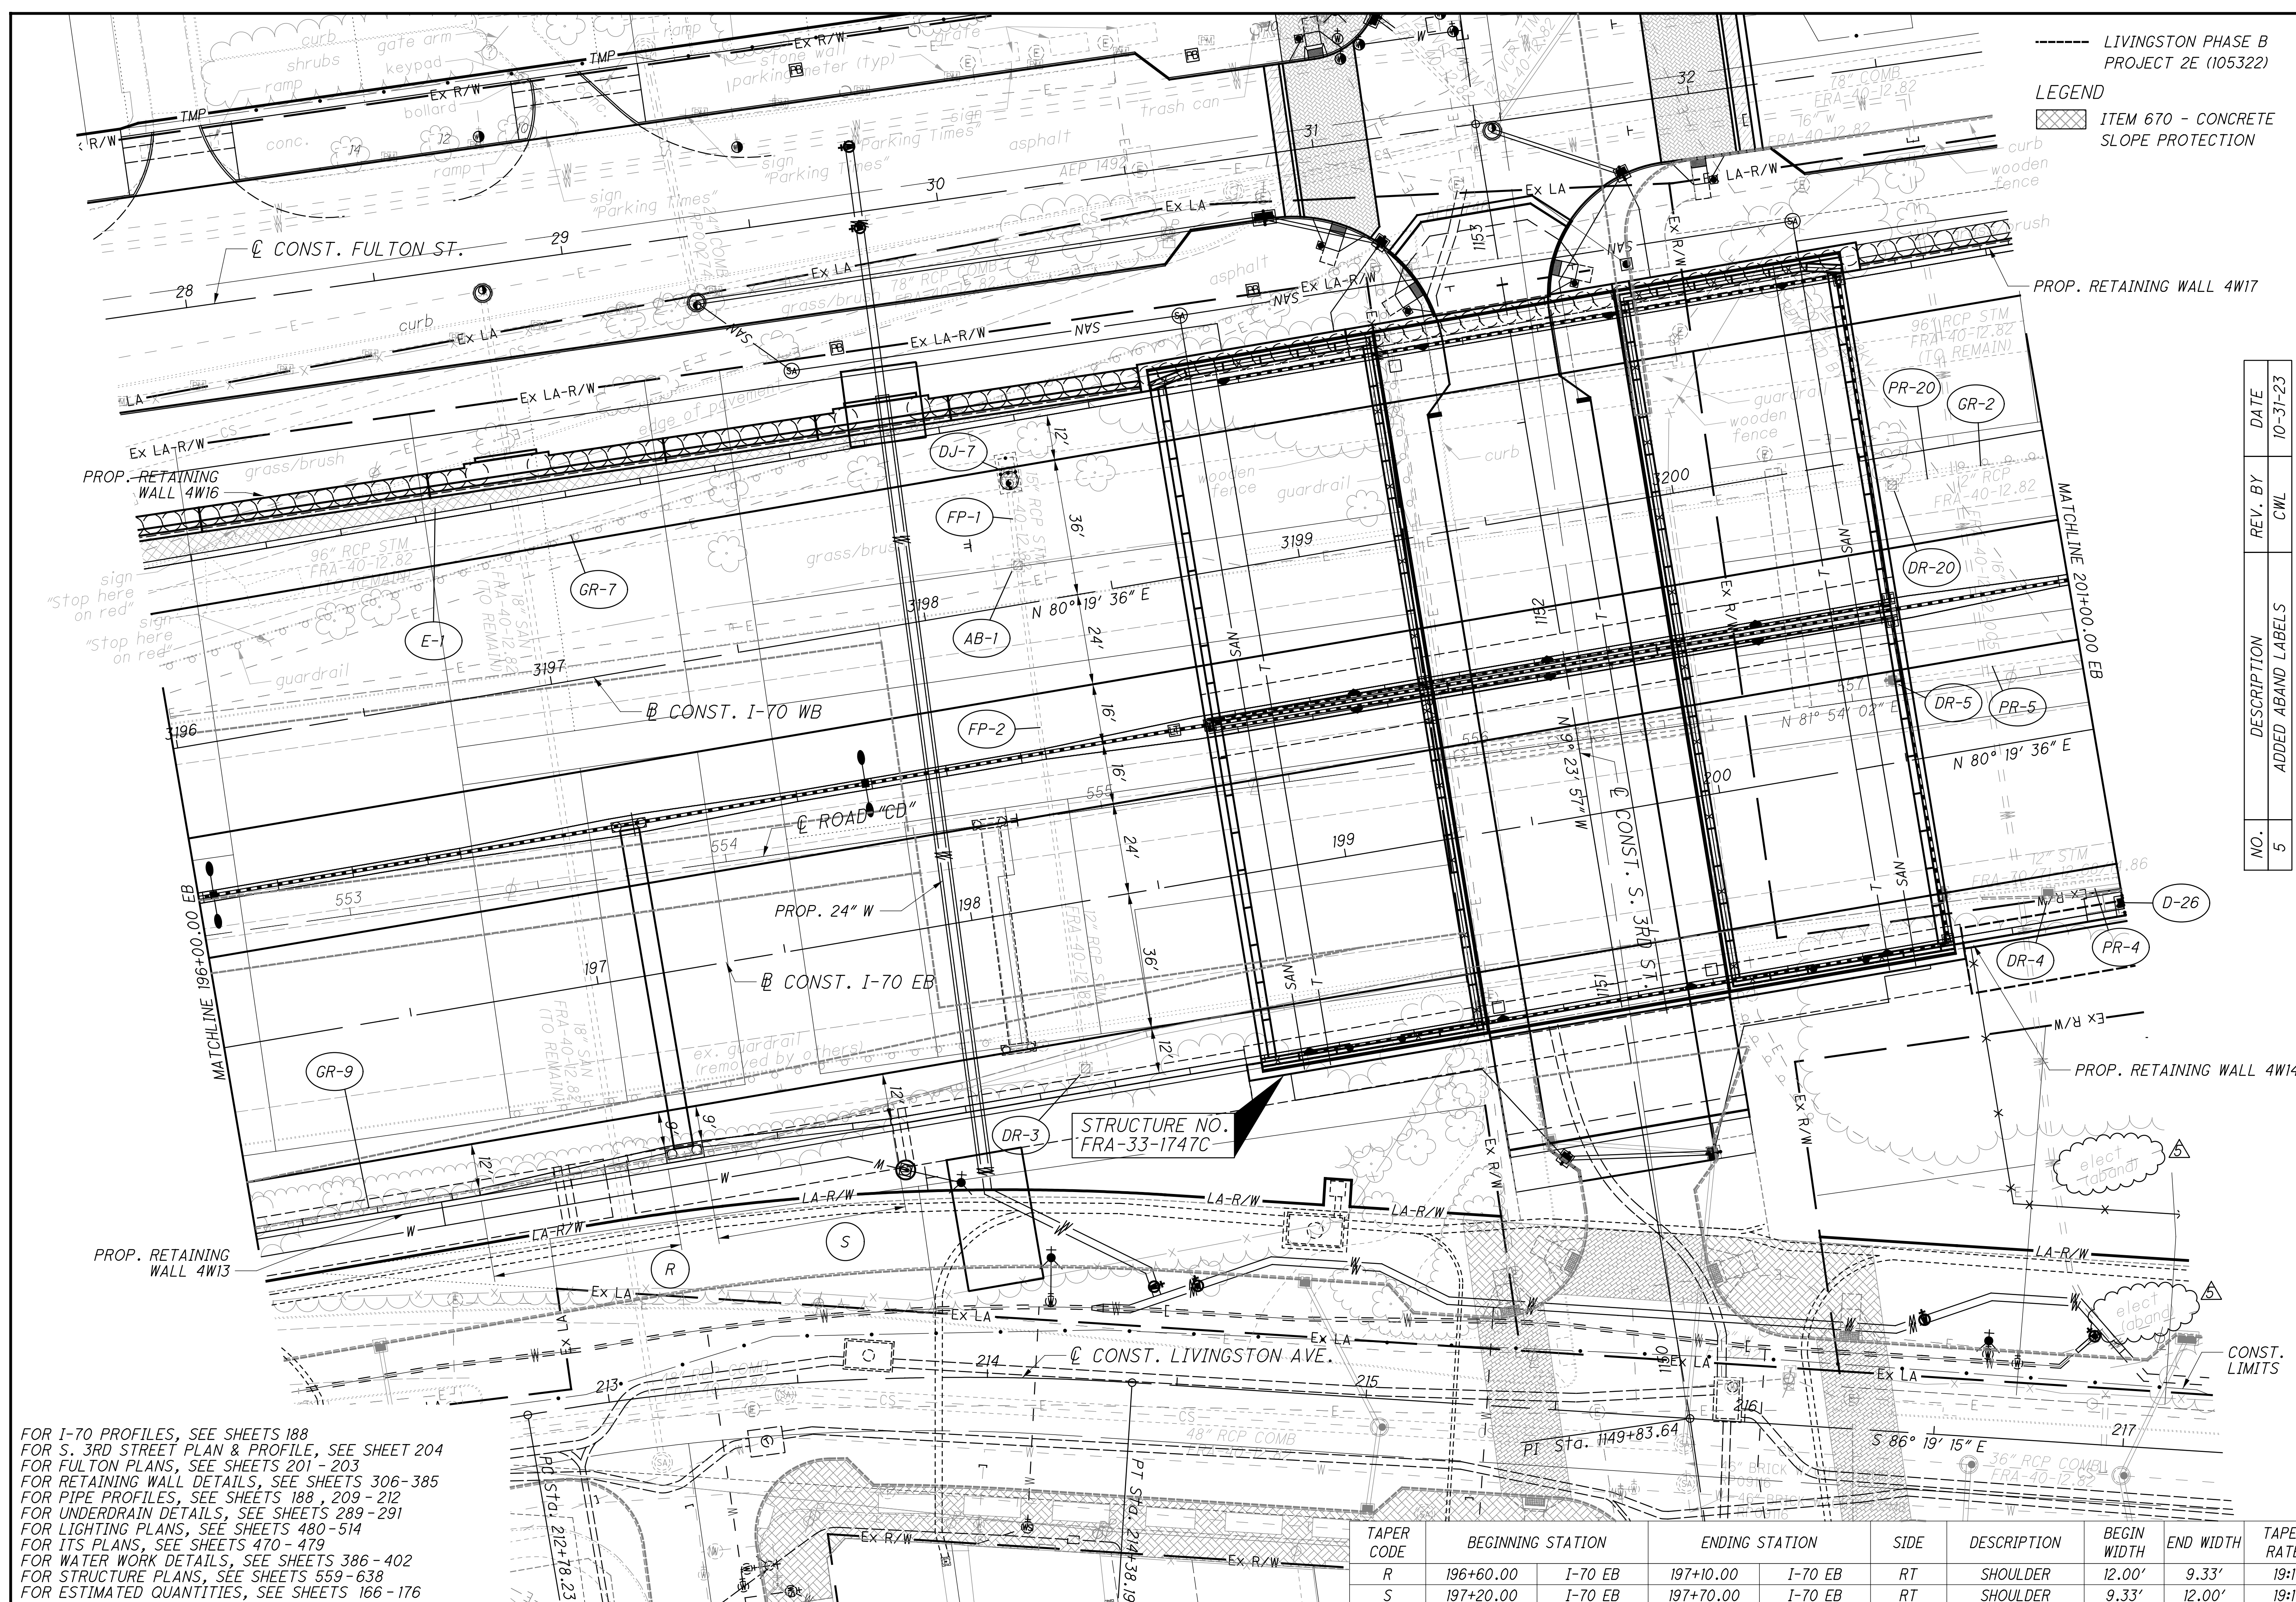

FOR I-70 PROFILES, SEE SHEETS 188
 FOR S. 3RD STREET PLAN & PROFILE, SEE SHEET 204
 FOR FULTON PLANS, SEE SHEETS 201 - 203
 FOR RETAINING WALL DETAILS, SEE SHEETS 306-385
 FOR PIPE PROFILES, SEE SHEETS 188, 209-212
 FOR UNDERDRAIN DETAILS, SEE SHEETS 289-291
 FOR LIGHTING PLANS, SEE SHEETS 480-514
 FOR ITS PLANS, SEE SHEETS 470-479
 FOR WATER WORK DETAILS, SEE SHEETS 386-402
 FOR STRUCTURE PLANS, SEE SHEETS 559-638
 FOR ESTIMATED QUANTITIES, SEE SHEETS 166-176

TAPER CODE	BEGINNING STATION	ENDING STATION	SIDE	DESCRIPTION	BEGIN WIDTH	END WIDTH	TAPER RATE
R	196+60.00	I-70 EB	RT	SHOULDER	12.00'	9.33'	19:1
S	197+20.00	I-70 EB	RT	SHOULDER	9.33'	12.00'	19:1

01:201512015370\FRA\66053\ROADWAY\SHETS\66053P003.DGN
 10/31/2023
 12:16:11 PM
 GDRV615TD\USER

TAPER CODE	BEGINNING STATION	ENDING STATION	SIDE	DESCRIPTION	BEGIN WIDTH	END WIDTH	TAPER RATE
T	3205+45.00	I-70 WB	I-70 WB	LT SHOULDER	12.00'	9.33'	19:1

PROJECT 2E (105322)



0 20 40
HORIZONTAL SCALE IN FEET


CALCULATED TMT CHECKED CWL

NO.	DESCRIPTION	REV. BY	DATE
5 <td>ADDED ABAND LABELS <td>CWL <td>10-31-23</td> </td></td>	ADDED ABAND LABELS <td>CWL <td>10-31-23</td> </td>	CWL <td>10-31-23</td>	10-31-23

PLAN - I-70
STA. 201+00.00 EB TO STA. 206+00.00 EB

FRA-70-14.05


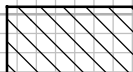


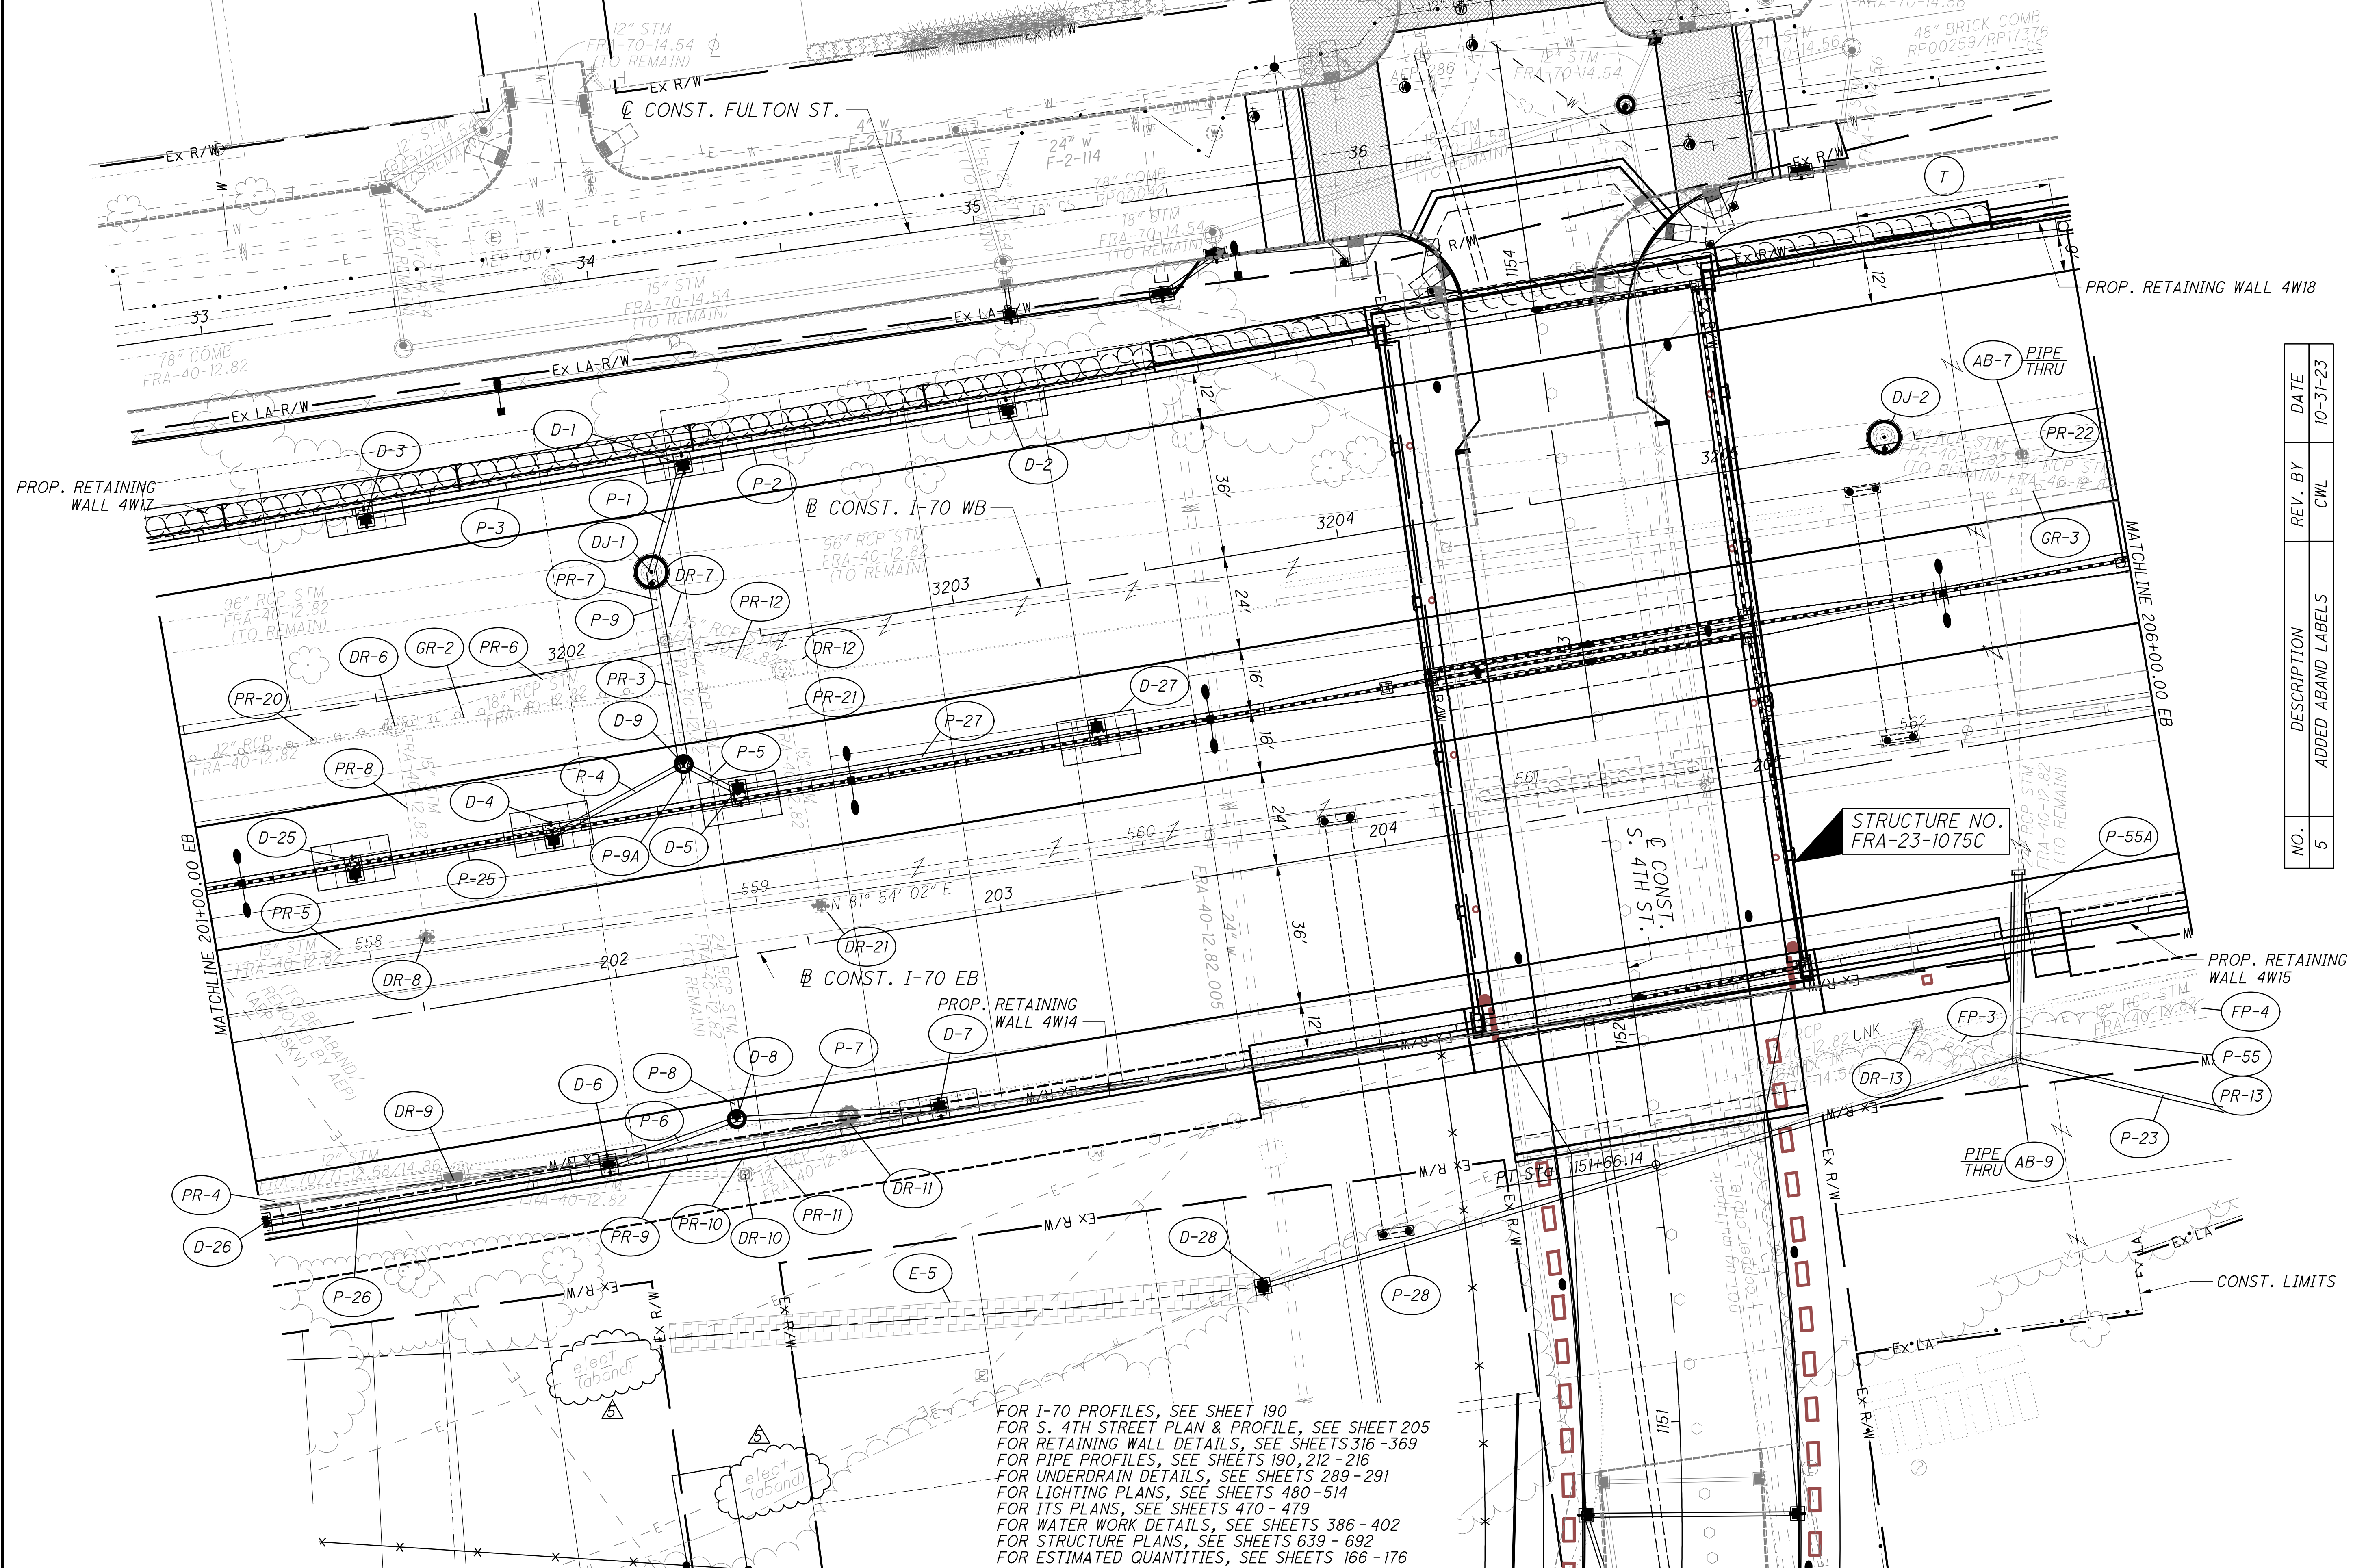189
855



FOR I-70 PROFILES, SEE SHEET 190
 FOR S. 4TH STREET PLAN & PROFILE, SEE SHEET 205
 FOR RETAINING WALL DETAILS, SEE SHEETS 316-369
 FOR PIPE PROFILES, SEE SHEETS 190, 212-216
 FOR UNDERDRAIN DETAILS, SEE SHEETS 289-291
 FOR LIGHTING PLANS, SEE SHEETS 480-514
 FOR ITS PLANS, SEE SHEETS 470-479
 FOR WATER WORK DETAILS, SEE SHEETS 386-402
 FOR STRUCTURE PLANS, SEE SHEETS 639-692
 FOR ESTIMATED QUANTITIES, SEE SHEETS 166-176

D:\2015\2015370\FRA\66253\ROADWAY\SHEETS\66253\FRA04.DGN
 10/31/2023
 12:19:12 PM
 G007V615TD_USER

SEEDING
END WIDTH SO. YDS.


-  ITEM 202 - PAVEMENT REMOVED
-  ITEM 202 - PAVEMENT REMOVED, ASPHALT
-  ITEM 206 - CEMENT STABILIZED SUBGRADE, 14" DEEP
-  PROJECT 4R (105523) LIVINGSTON (PHASE B)

END AREA		VOLUME		CALCULATED	ATR	CHECKED	TMT
CUT	FILL	CUT	FILL				
811	390	1557	787				
869	438	1556	767				
1614	0	2299	406				
		5412	1960				

CROSS SECTIONS I.R. 70
STA. 200+00.00 TO STA. 201+00.00

FRA-70-14.05

212
855


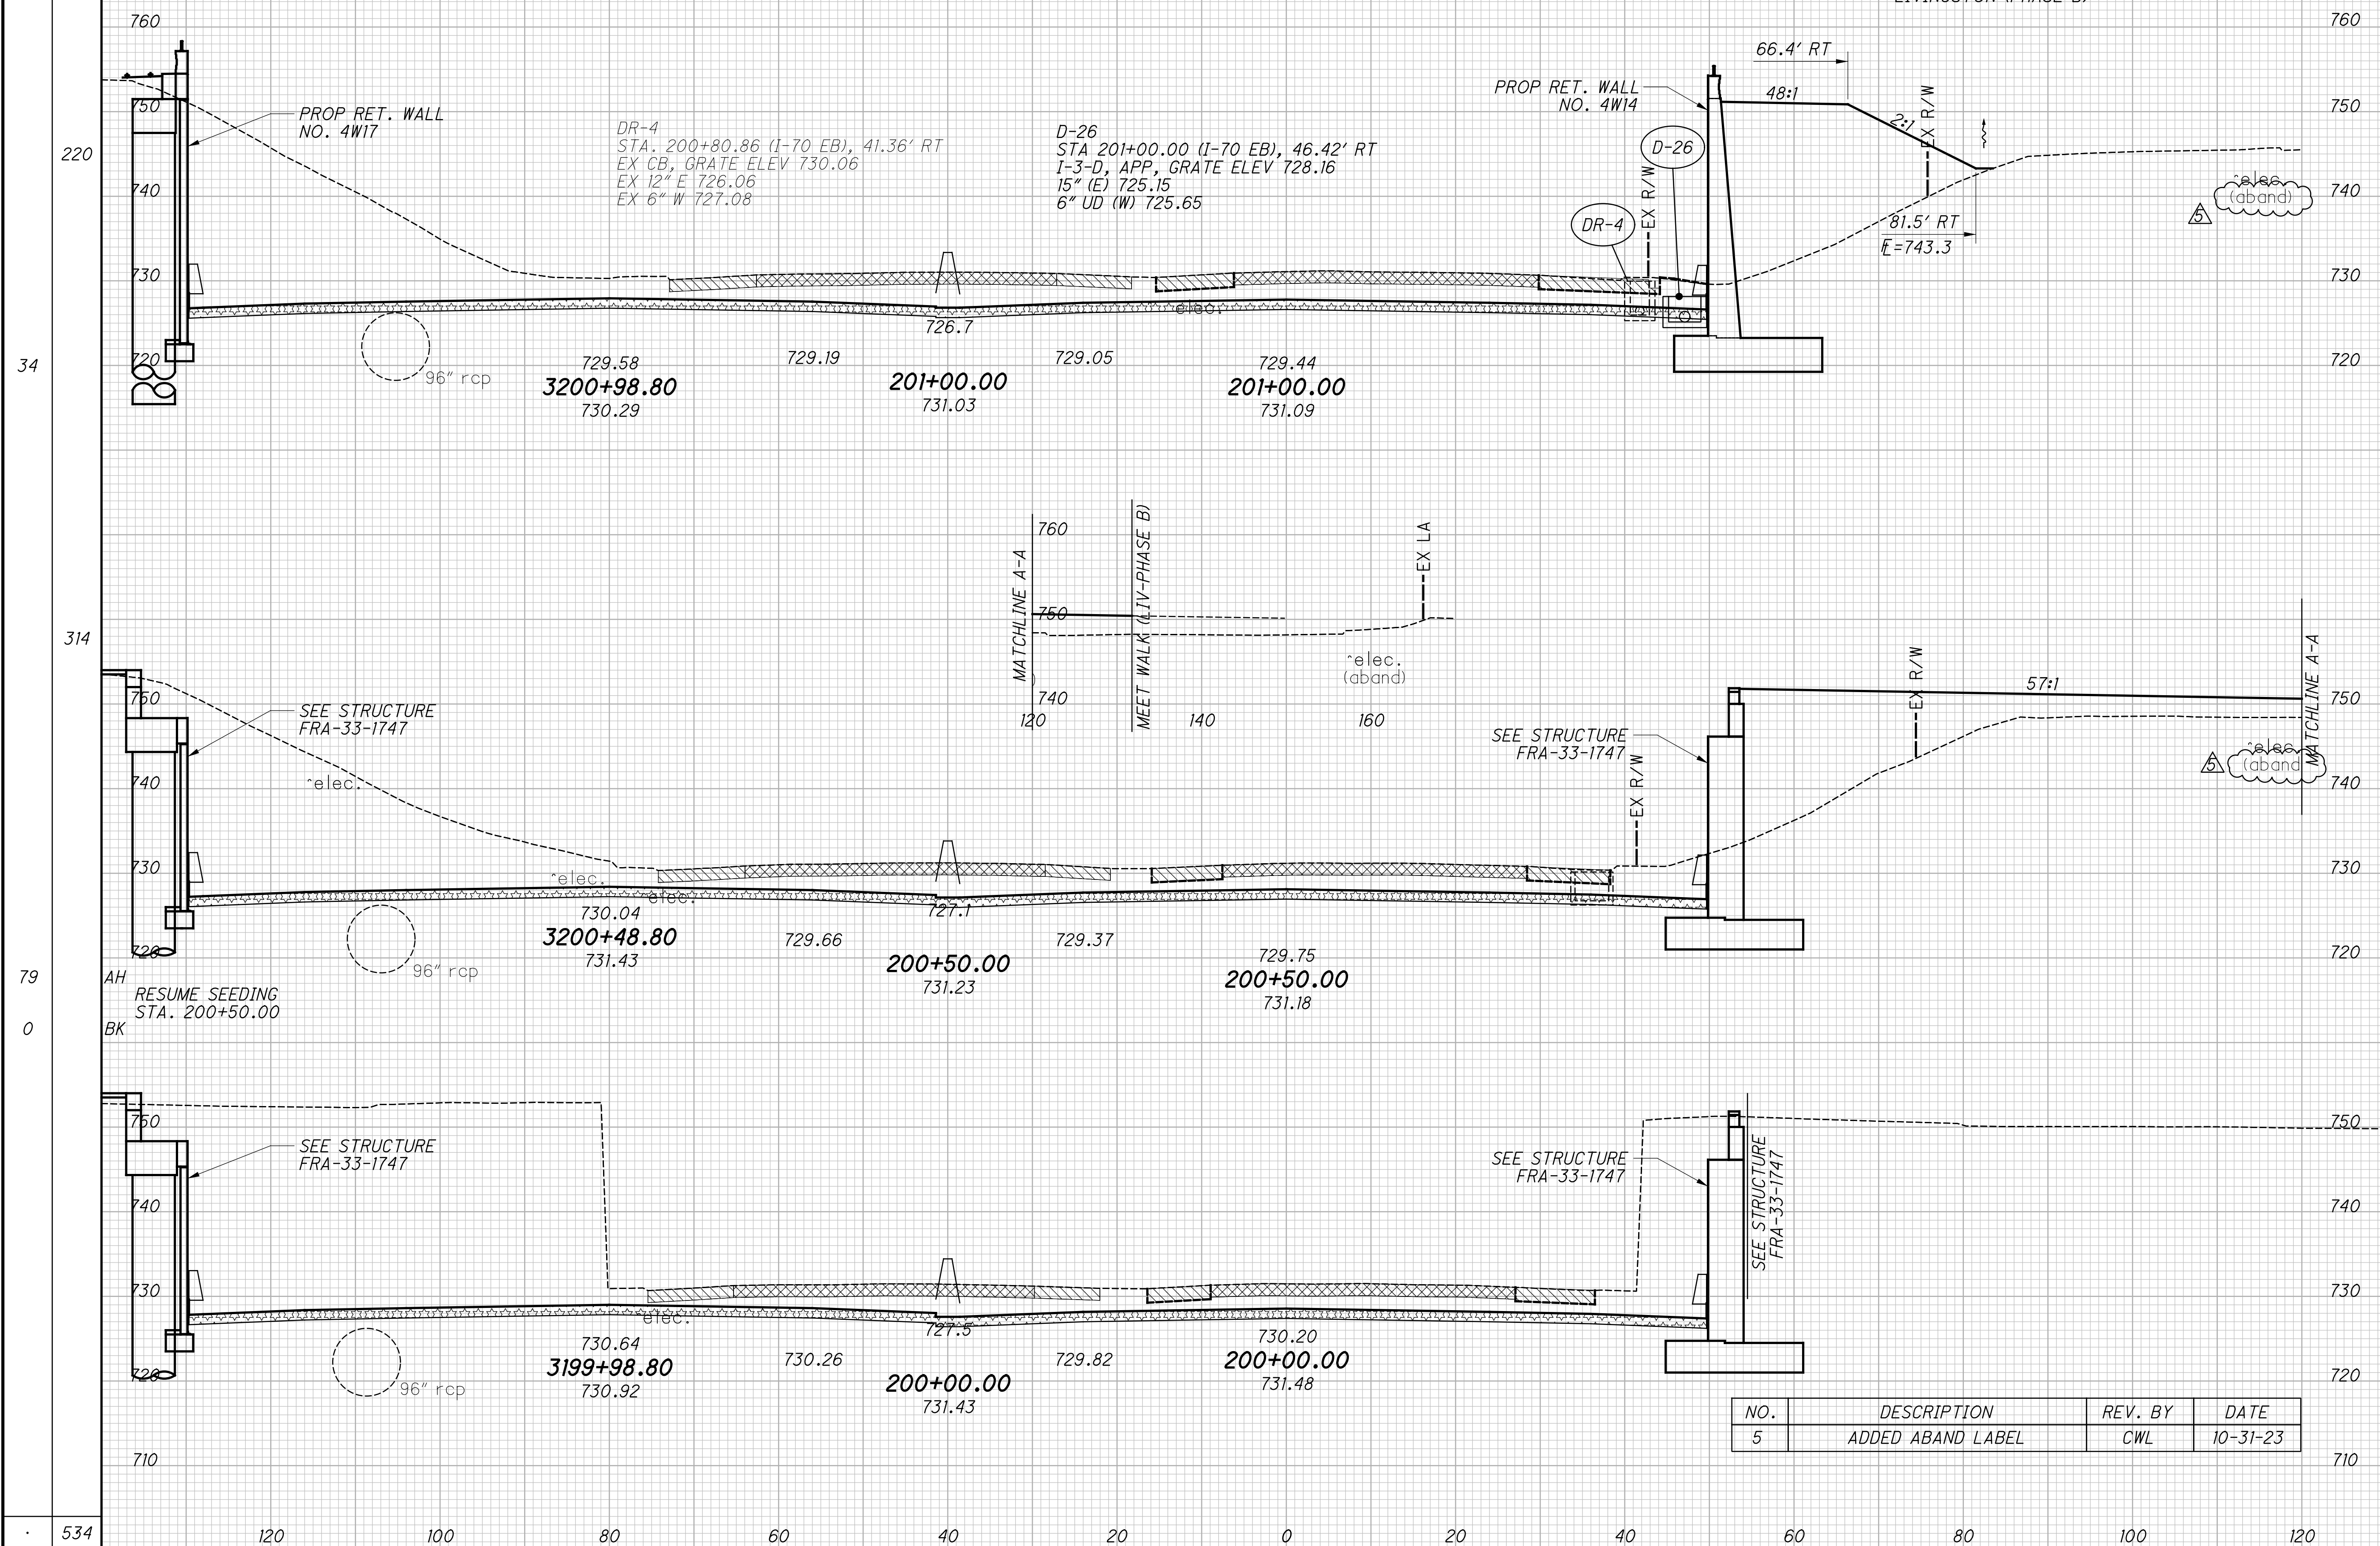



NO.	DESCRIPTION	REV. BY	DATE
5	ADDED ABAND LABEL	CWL	10-31-23

D:\2015\2015370\FRA\60653\ROADWAY SHEETS\60653\001.DGN
10/31/2023
12:53:54 PM
DDOTV81STD.LUSER

534 120 100 80 60 40 20 0 20 40 60 80 100 120

SEEDING		NO.	DESCRIPTION	REV. BY	DATE
END WIDTH	SO. YDS.				
		5	ADDED ABAND LABEL	CWL	10-31-23

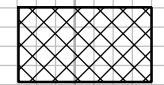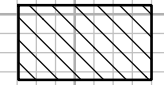
-  ITEM 202 - PAVEMENT REMOVED
-  ITEM 202 - PAVEMENT REMOVED, ASPHALT
-  ITEM 206 - CEMENT STABILIZED SUBGRADE, 14" DEEP

END AREA	VOLUME	CALCULATED	CHECKED	TMT
1782	1081			
908	579			
1700	1108			
928	618			
1665	998			
870	460			
5147	3187			

CROSS SECTIONS I.R. 70
STA. 201+50.00 TO STA. 202+50.00

FRA-70-14.05


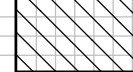

213
855

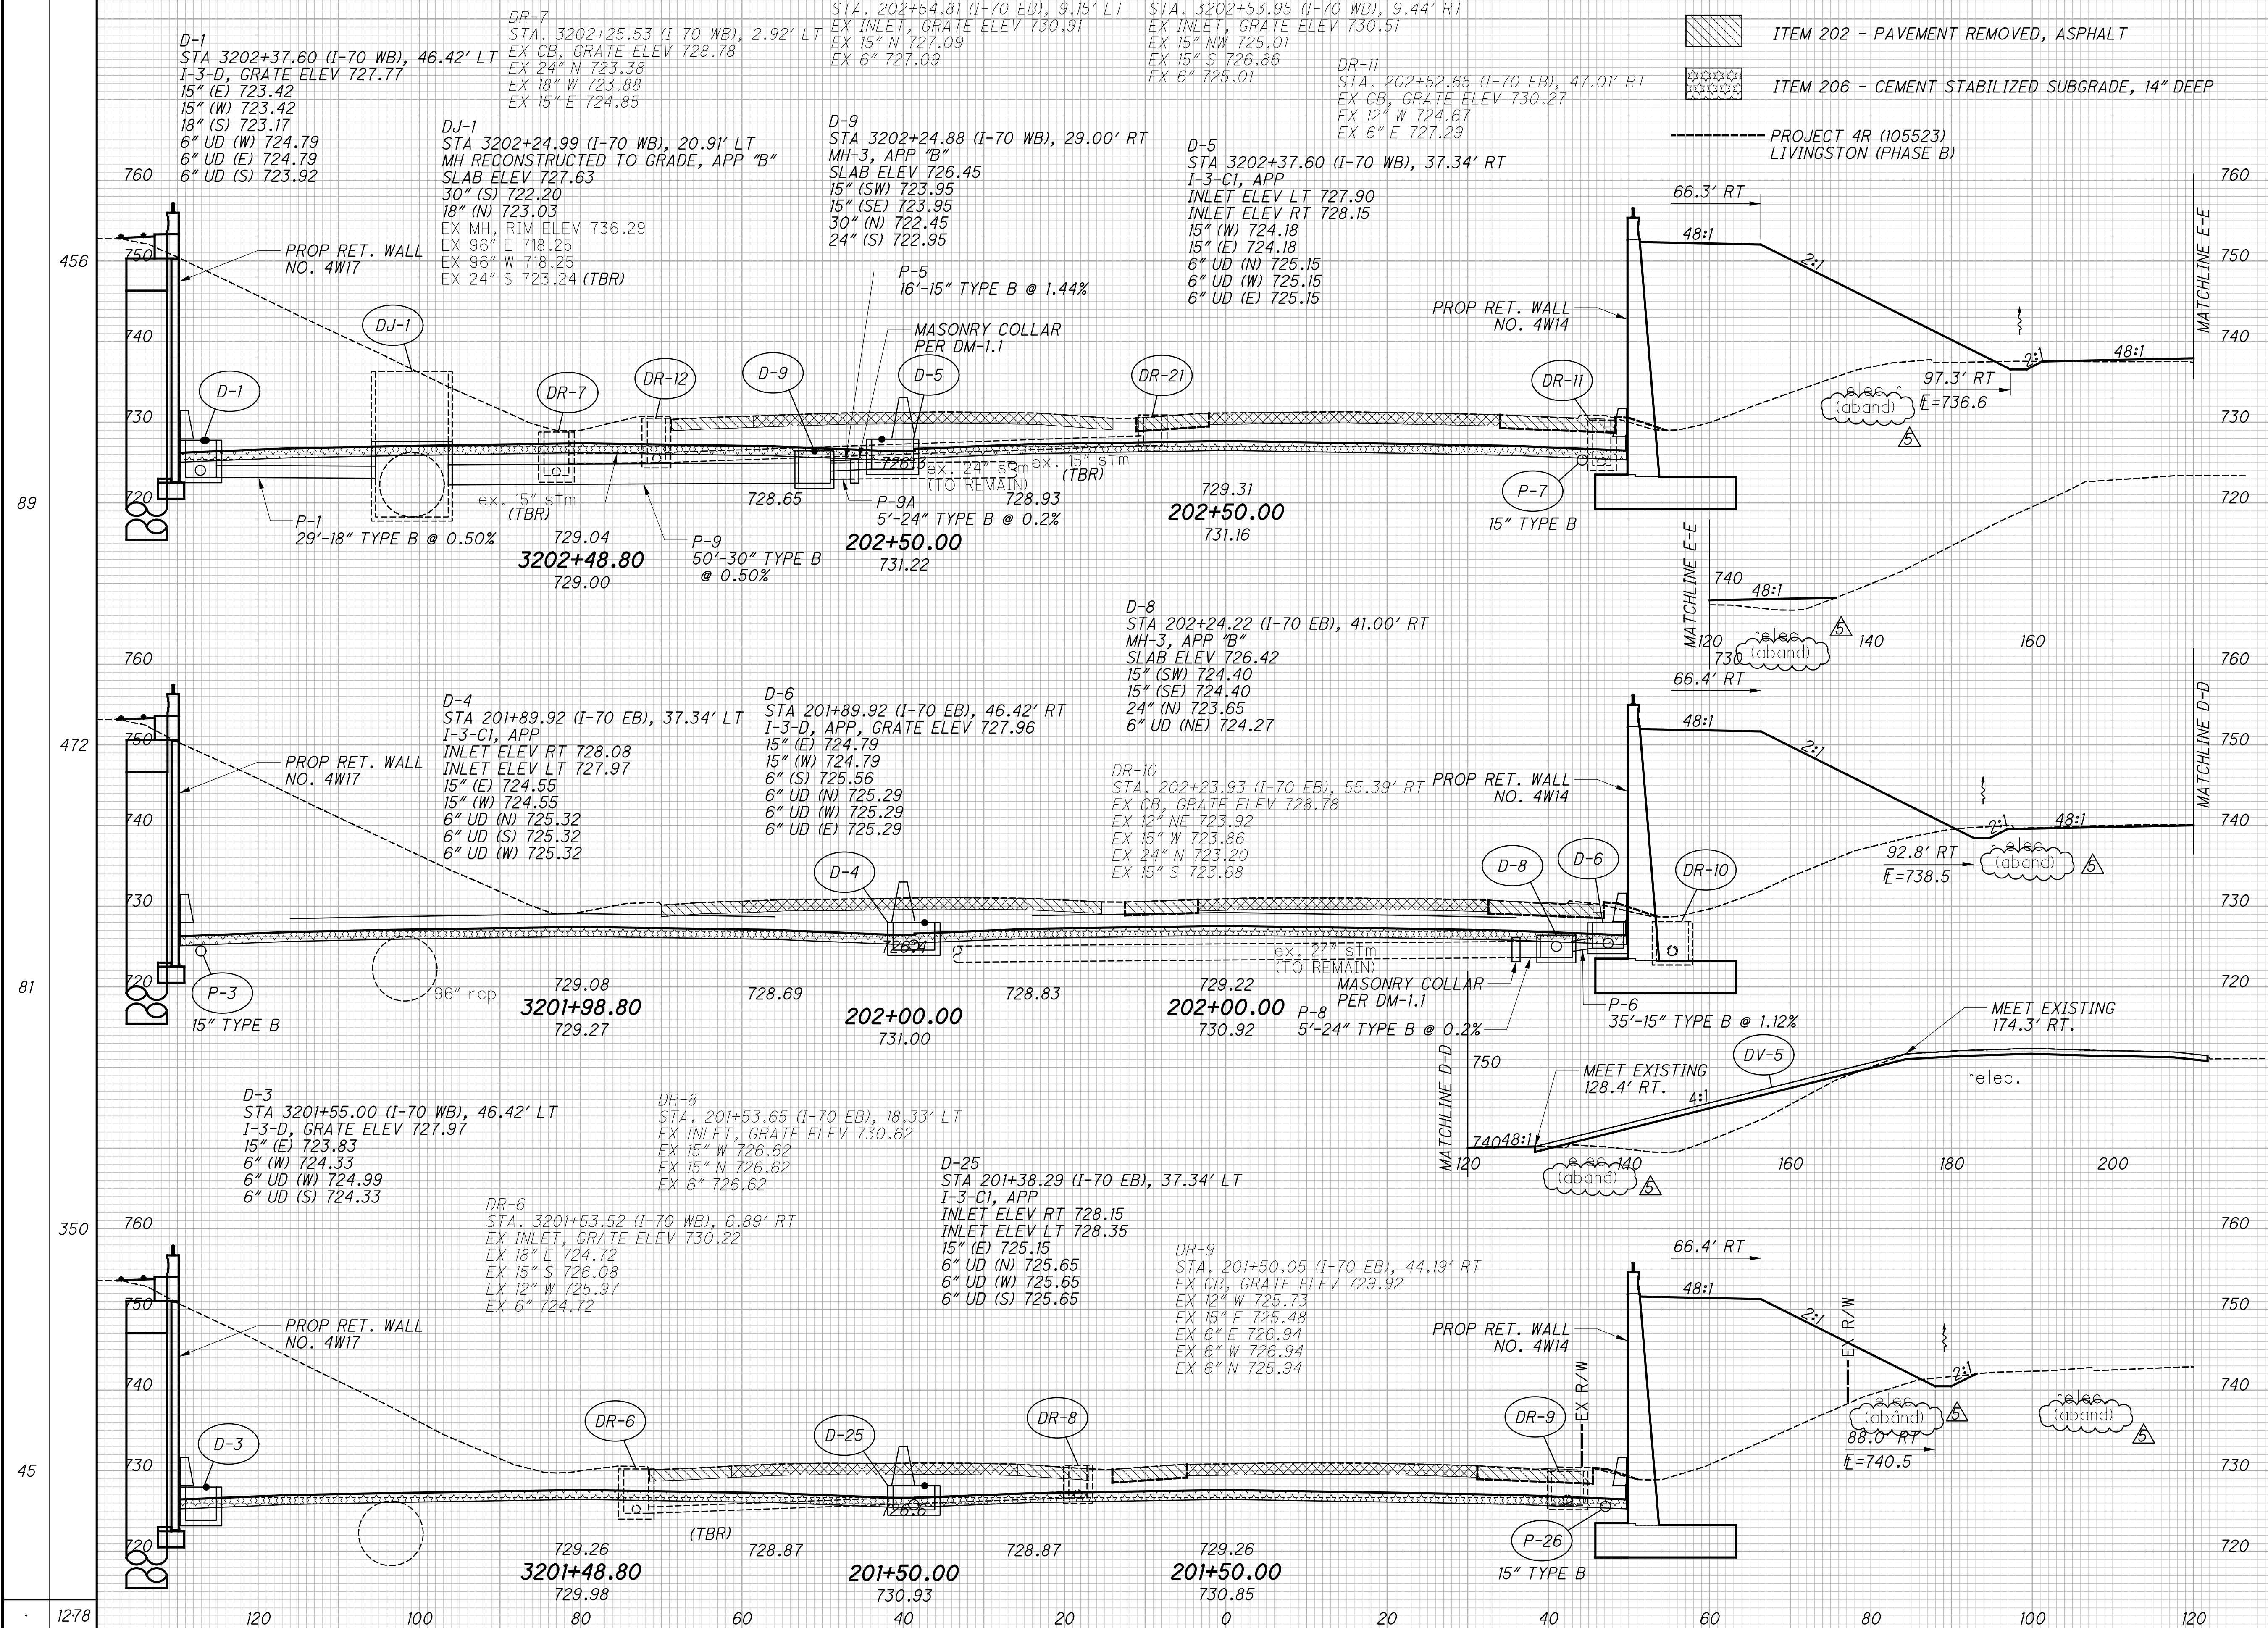


D:\2015\2015370\FRA\60655\ROADWAY SHEETS\60655\001.DGN
10/31/2023
12:54:12 PM
DDOT\Y81STD\USER

SEEDING	
END WIDTH	SO. YDS.

END AREA		VOLUME		CALCULATED	
CUT	FILL	CUT	FILL	ATR	TMT

-  ITEM 202 - PAVEMENT REMOVED
-  ITEM 202 - PAVEMENT REMOVED, ASPHALT
-  ITEM 206 - CEMENT STABILIZED SUBGRADE, 14" DEEP
- PROJECT 4R (105523)
LIVINGSTON (PHASE B)

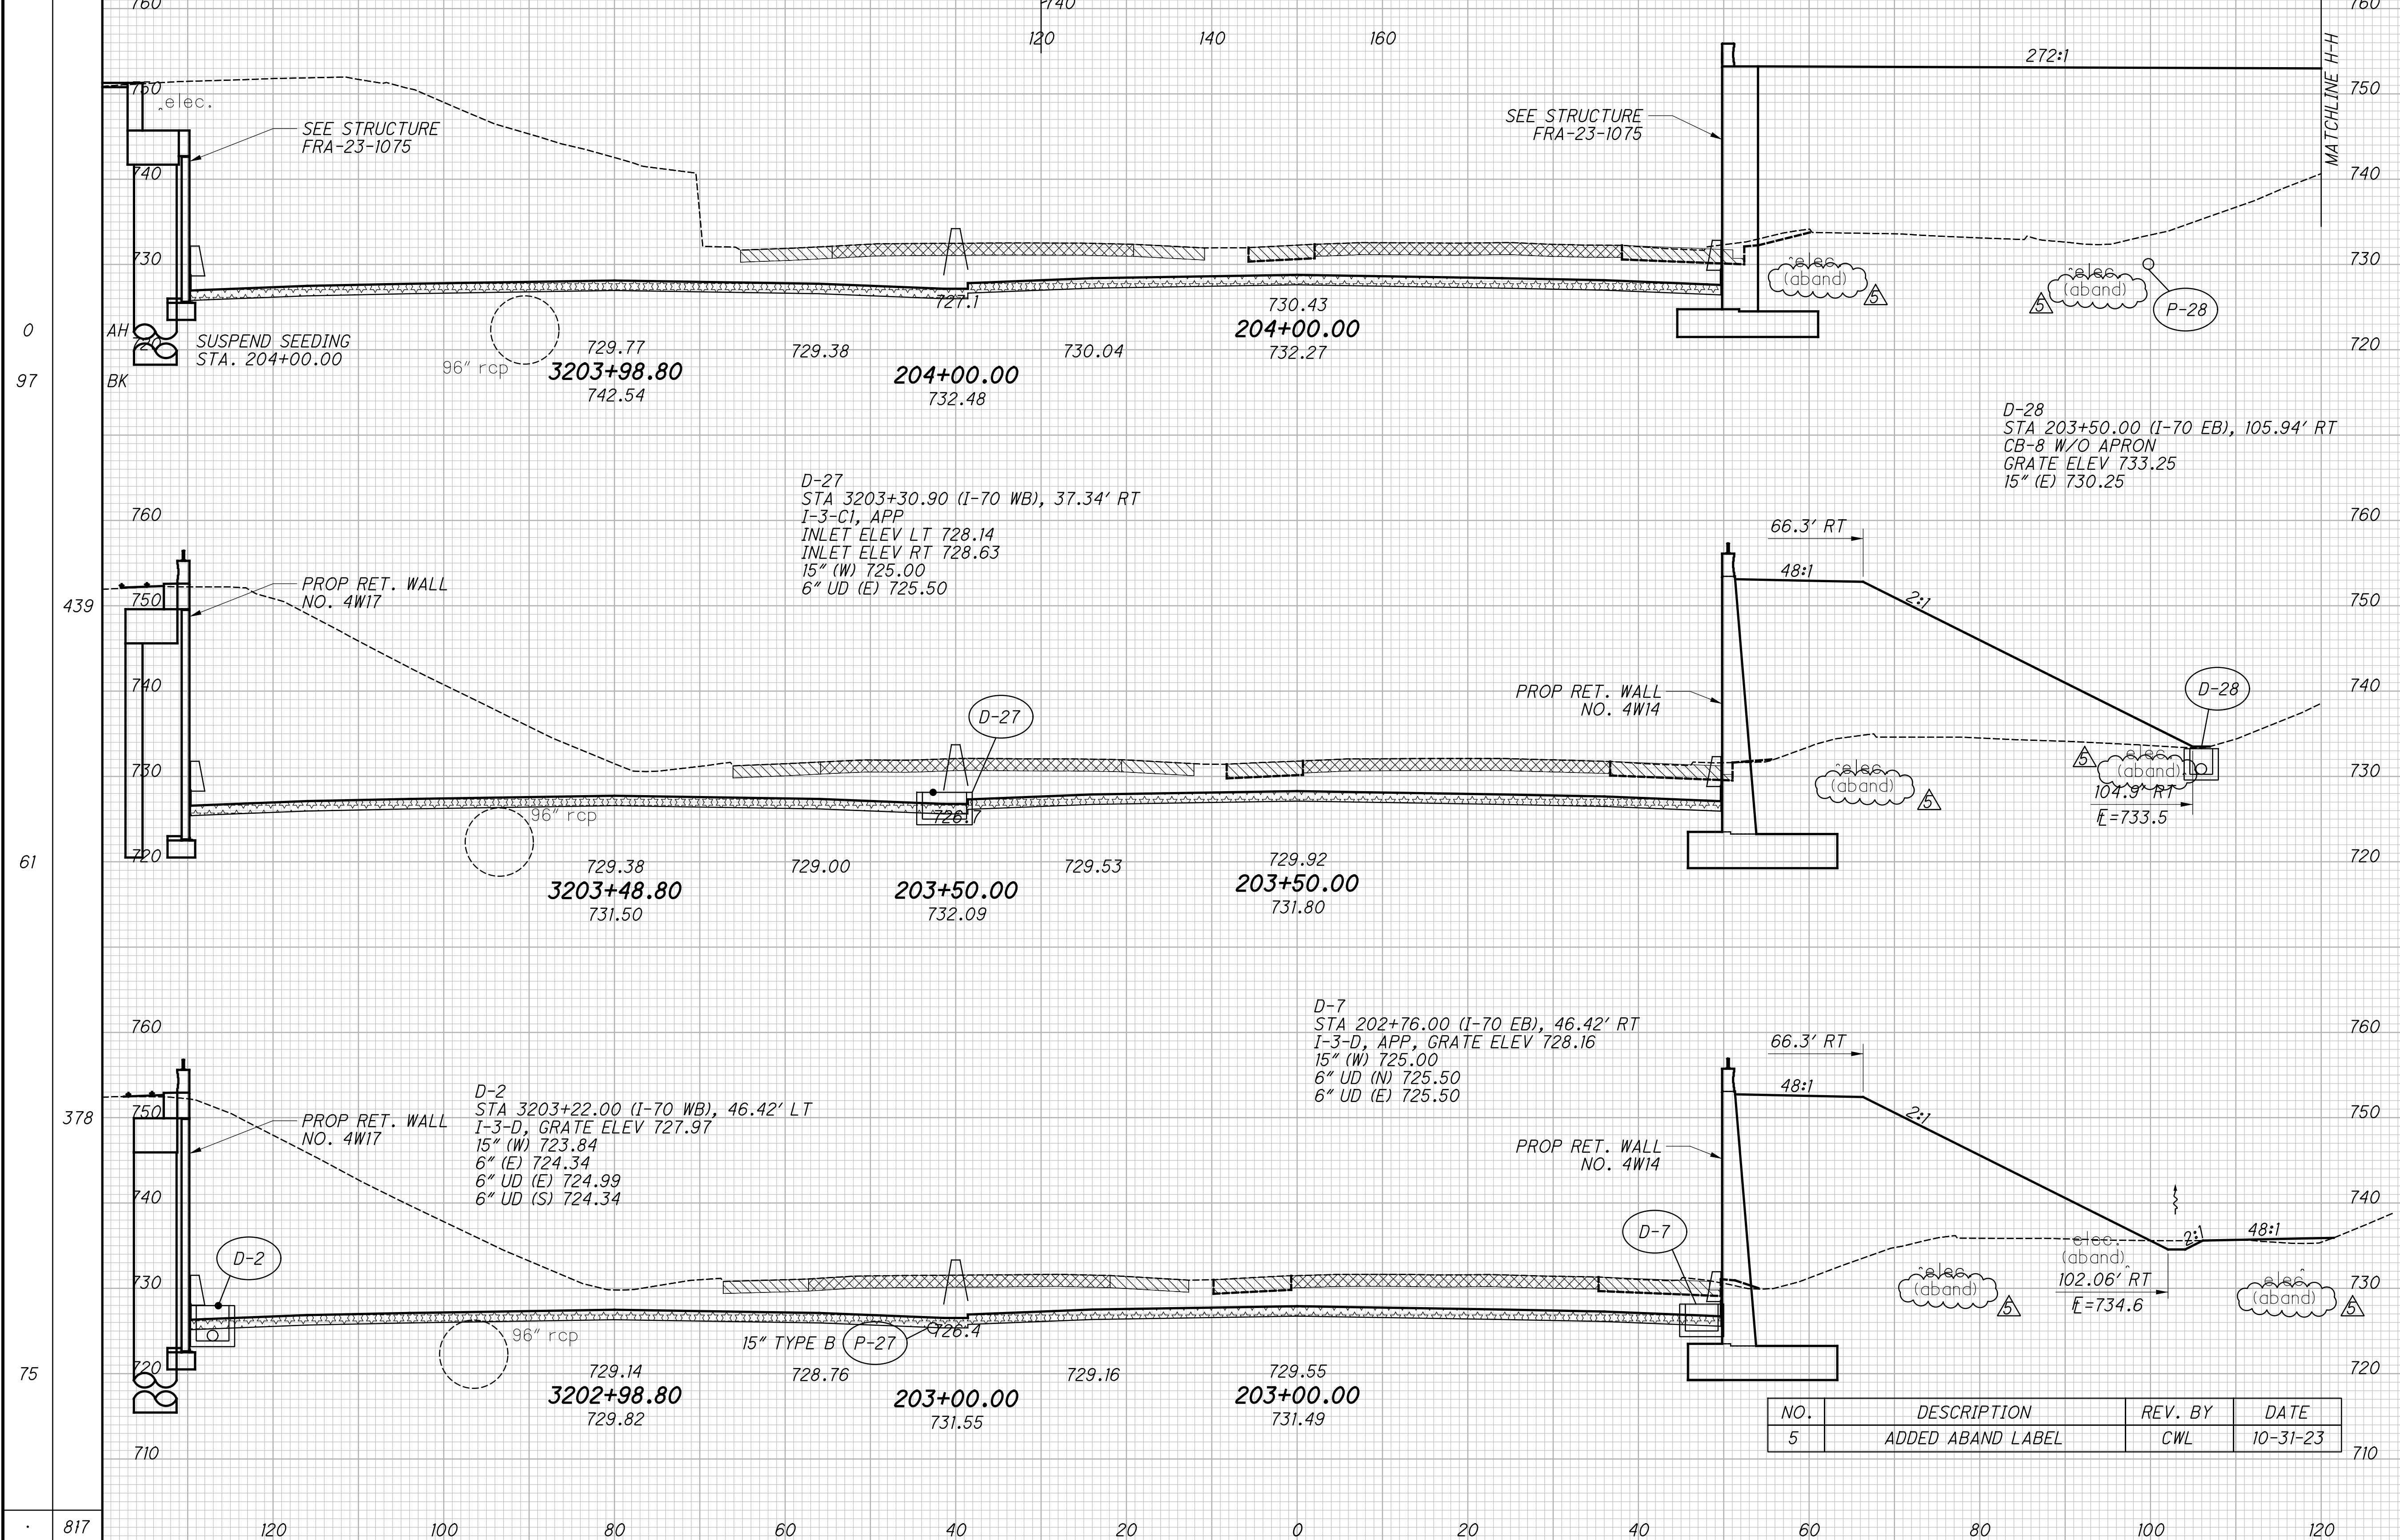

NO.	DESCRIPTION	REV. BY	DATE
5	ADDED ABAND LABEL	CWL	10-31-23

0	97	1562	1438	3083	0
61	61	1151	625	2512	1910
378	75	1017	588	2007	1123
817	817	7602	3033		

CROSS SECTIONS I.R. 70
STA. 203+00.00 TO STA. 204+00.00

FRA-70-14.05


214
 855

01-2015-2015370 FRA 16065 ROADWAY SHEETS 160653001.DGN
 10/31/2023 12:54:32 PM
 000TV81STD_LUSER

SEEDING
END WIDTH SO. YDS.

NO.	DESCRIPTION	REV. BY	DATE
5	ADDED ABAND LABEL	CWL	10-31-23

END AREA VOLUME
CUT FILL CUT FILL
CALCULATED
ATR
CHECKED
TMT

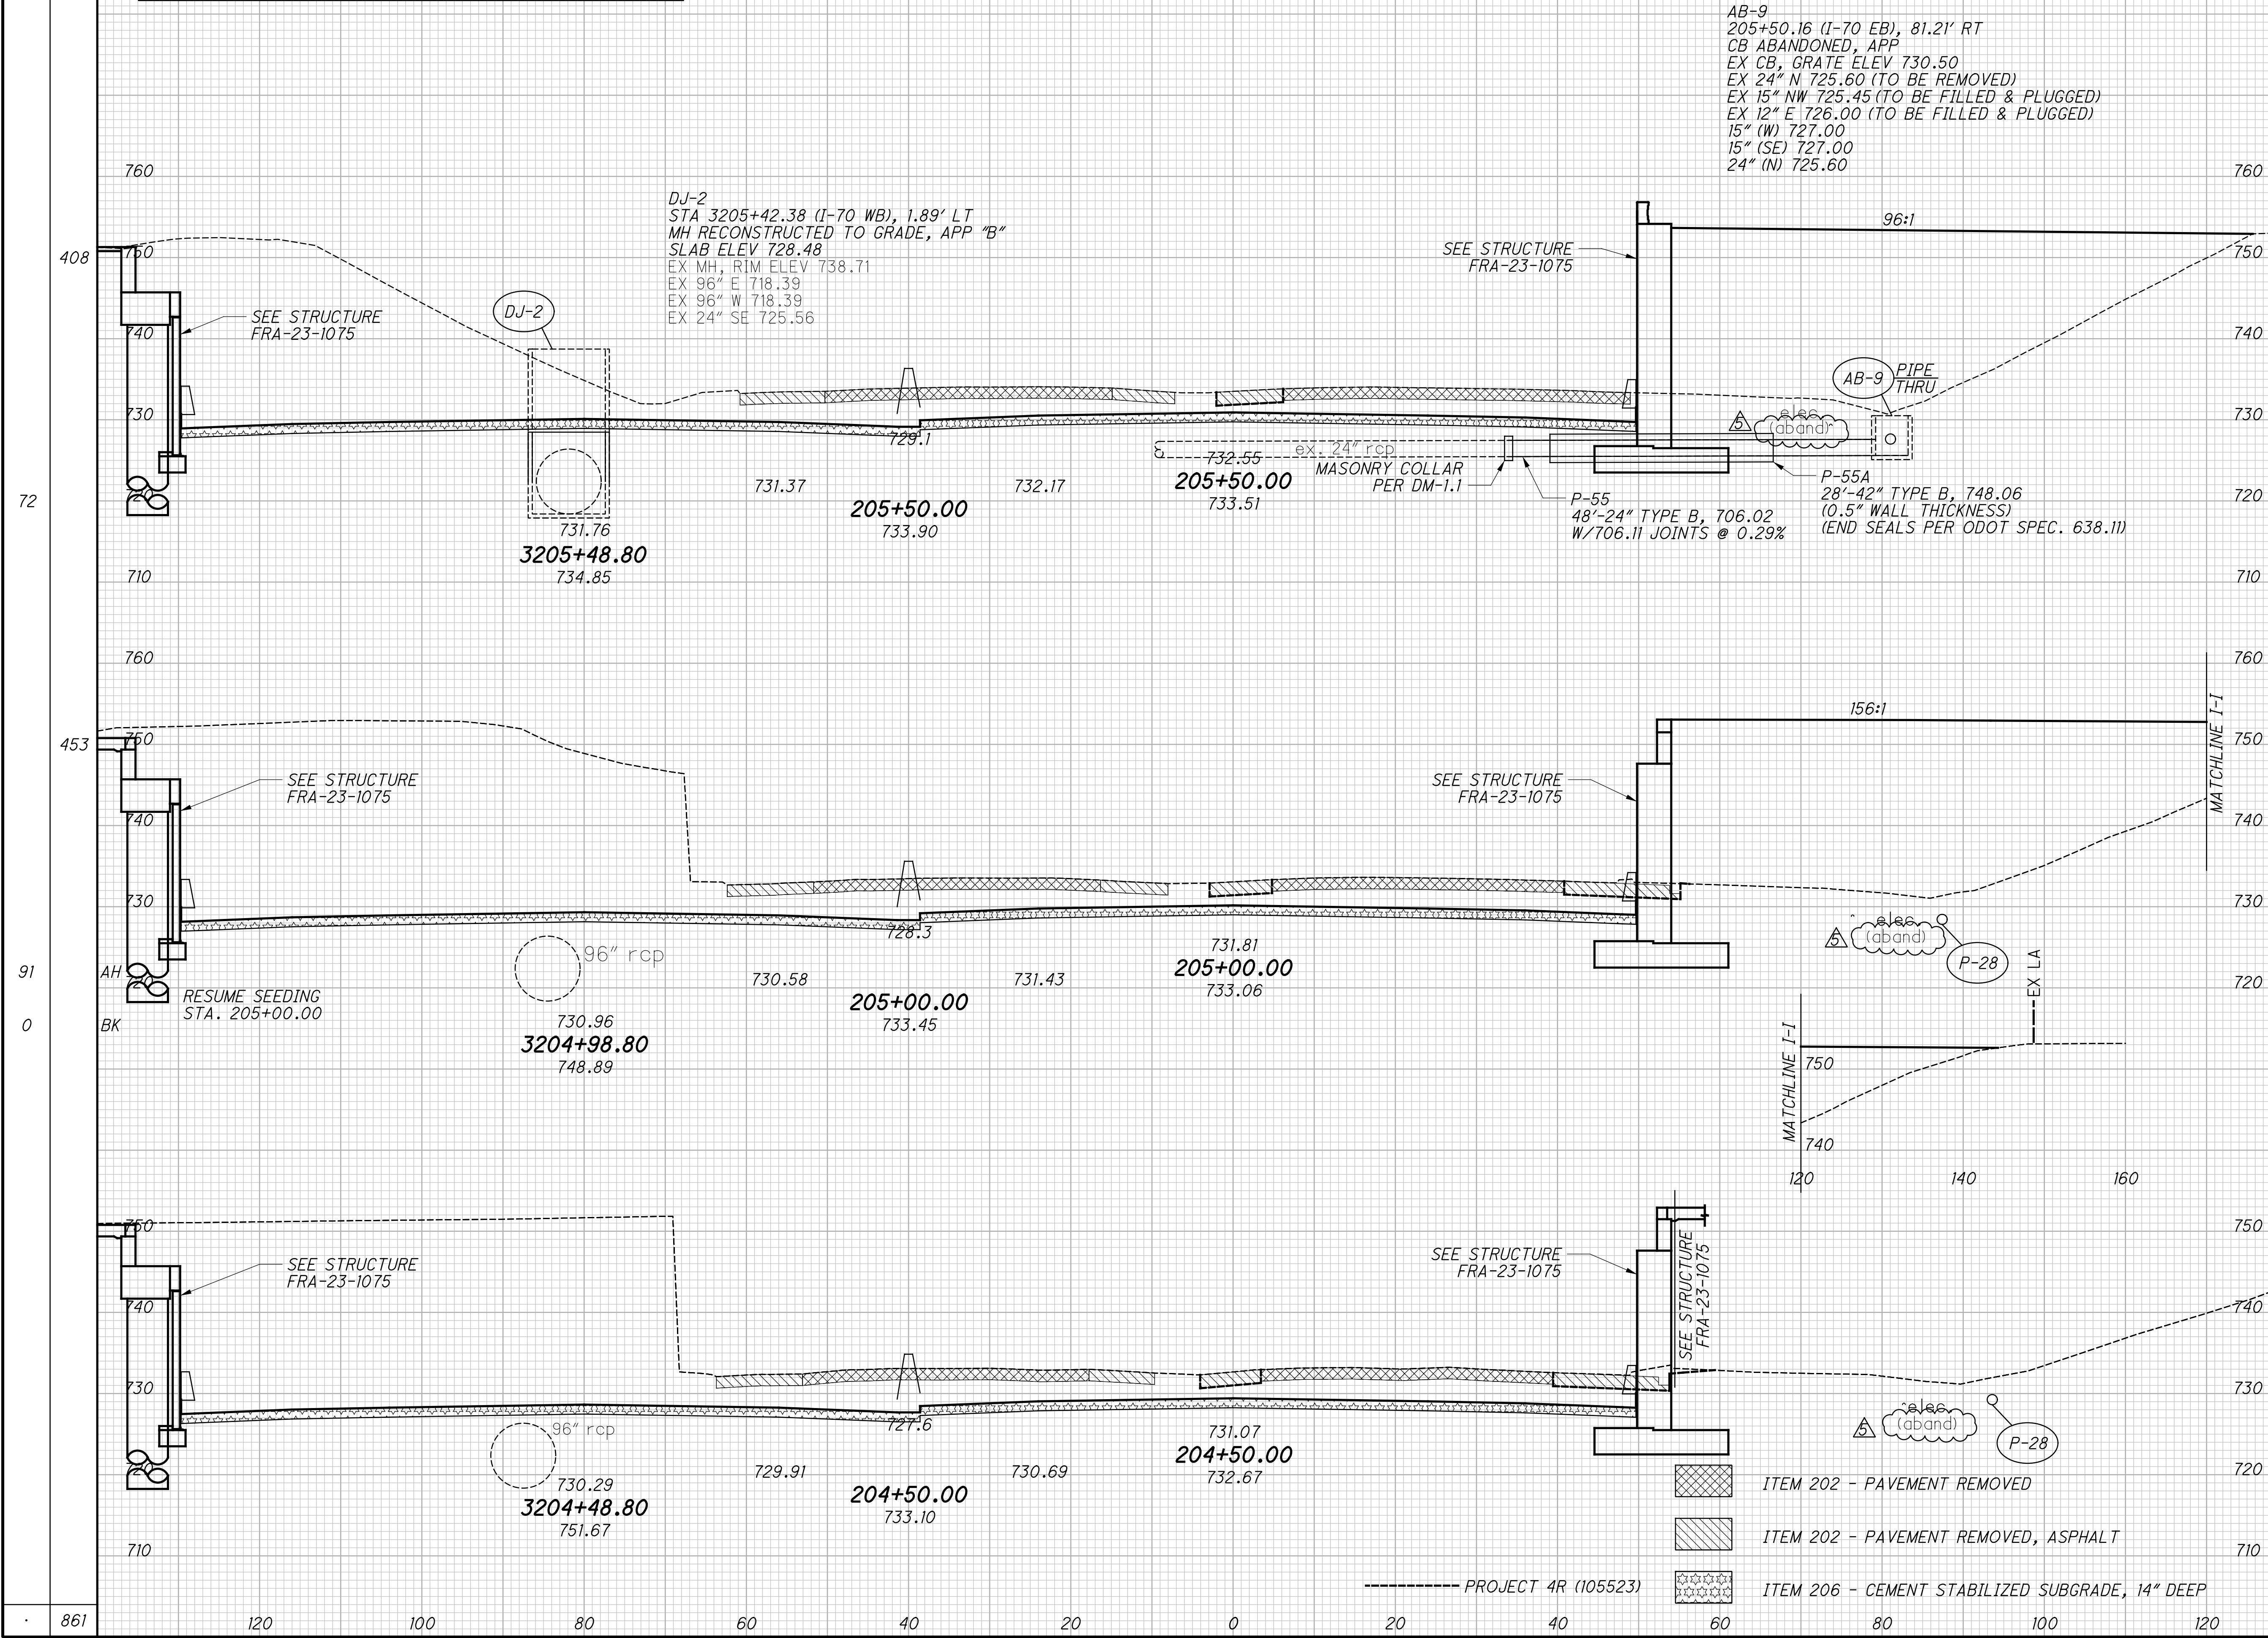

AB-9
205+50.16 (I-70 EB), 81.21' RT
CB ABANDONED, APP
EX CB, GRATE ELEV 730.50
EX 24" N 725.60 (TO BE REMOVED)
EX 15" NW 725.45 (TO BE FILLED & PLUGGED)
EX 12" E 726.00 (TO BE FILLED & PLUGGED)
15" (W) 727.00
15" (SE) 727.00
24" (N) 725.60

DJ-2
STA 3205+42.38 (I-70 WB), 1.89' LT
MH RECONSTRUCTED TO GRADE, APP "B"
SLAB ELEV 728.48
EX MH, RIM ELEV 738.71
EX 96" E 718.39
EX 96" W 718.39
EX 24" SE 725.56

156:1
MATCHLINE I-I
MATCHLINE LA

- ITEM 202 - PAVEMENT REMOVED
- ITEM 202 - PAVEMENT REMOVED, ASPHALT
- ITEM 206 - CEMENT STABILIZED SUBGRADE, 14" DEEP

END AREA	VOLUME	CALCULATED	CHECKED	TMT
CUT	FILL	CUT	FILL	
1981	2019			
1140	1091			
2648	2234			
1720	1322			
3230	0			
1768	0			
7859	4253			

CROSS SECTIONS I.R. 70
 STA. 204+50.00 TO STA. 205+50.00

FRA-70-14.05

215
855

01-2015-2015370 VFA 16065 ROADWAY SHEETS 1606535001.DGN
 10/31/2023
 12:55:10 PM
 ODOTV81STD_LUSER

SEEDING	END WIDTH	SQ. YDS.			
			417	73	406


NO.	DESCRIPTION	REV. BY	DATE
5	ADDED ABAND LABEL	CWL	10-31-23

END AREA	VOLUME	CALCULATED	CHECKED	TMT
463	1925			
274	1034			
562	1892			
333	1009			
1234	1944			
1000	1090			
		2259	5761	

CROSS SECTIONS I.R. 70
STA. 206+00.00 TO STA. 207+00.00

FRA-70-14.05

216
 855

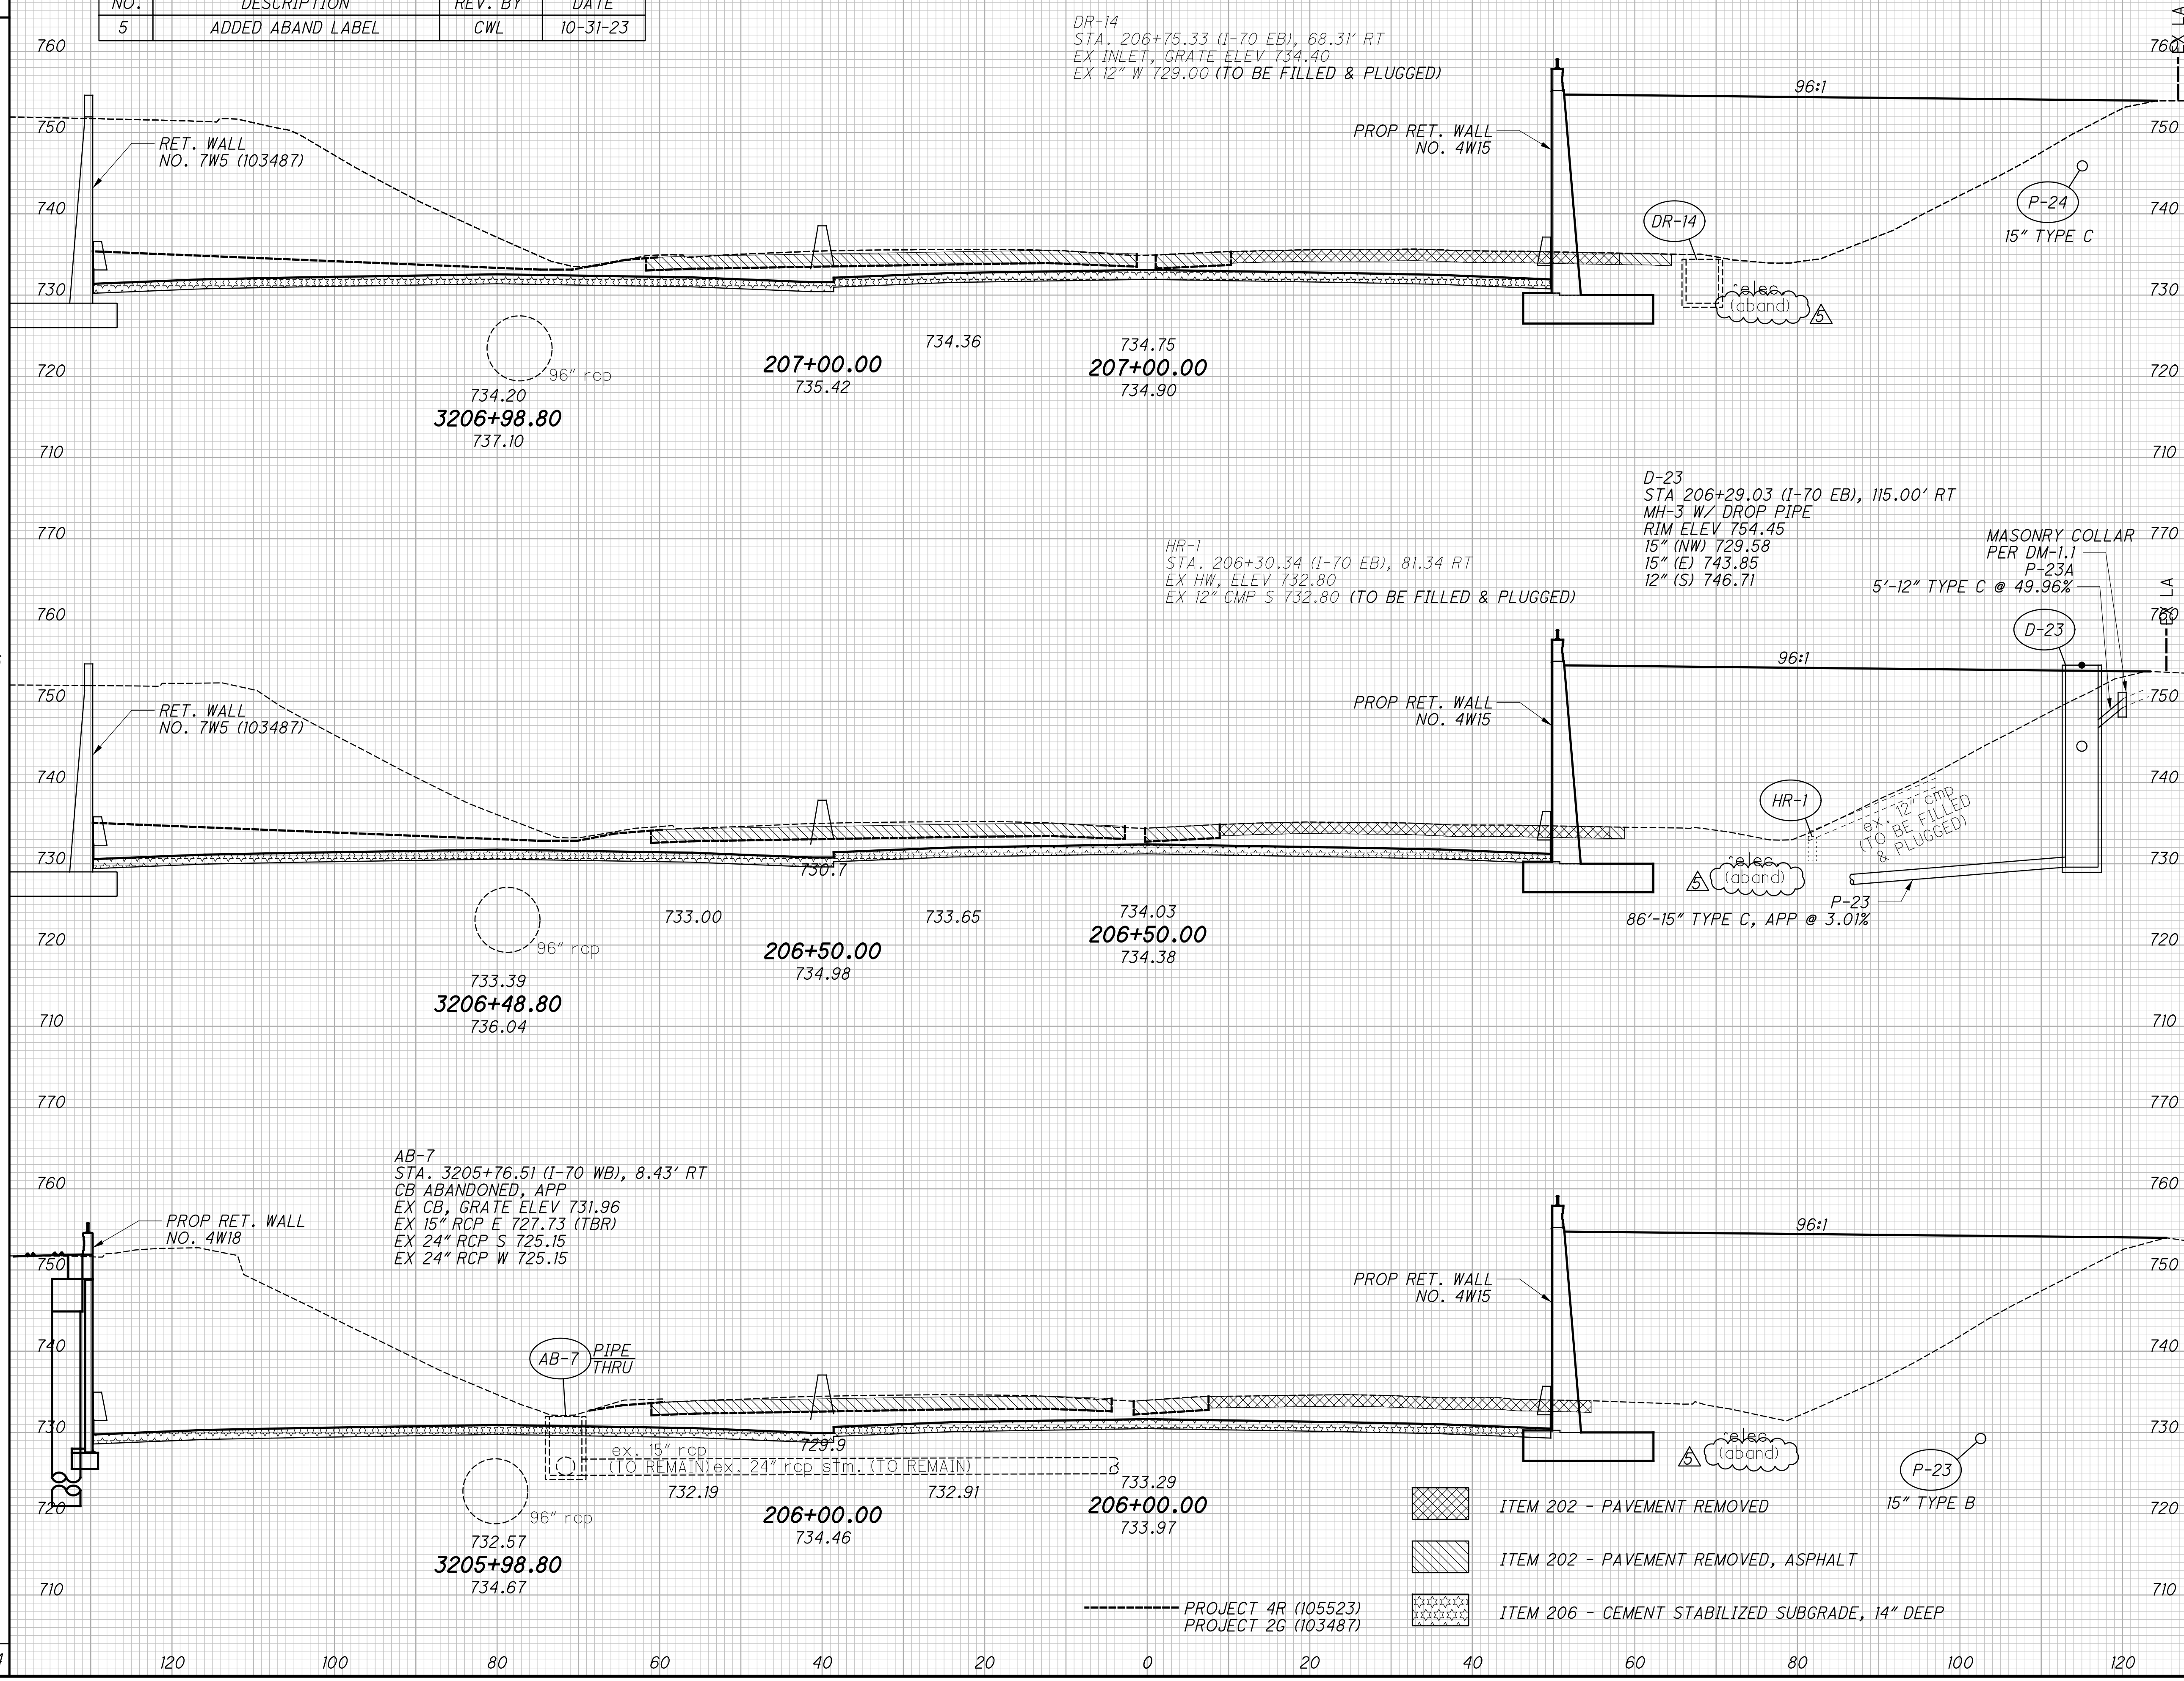

SEEDING
END WIDTH SO. YDS.


NO.	DESCRIPTION	REV. BY	DATE
5	ADDED ABAND LABEL	CWL	10-31-23

END AREA	VOLUME	CALCULATED	CHECKED	TMT
770	244	2064		
760				
750				
740				
730	104	1178		
720				
710				
700				
690				
680				
670				
660	166	1081		
650				
640				
250	250	2092		
240				
230				
1270				
120				
100				
80				
60				
40				
20				
0				
20				
40				
60				
80				
100				
120				
857		6125		

CROSS SECTIONS I.R. 70
STA. 207+50.00 TO STA. 208+50.00

FRA-70-14.05

217
855

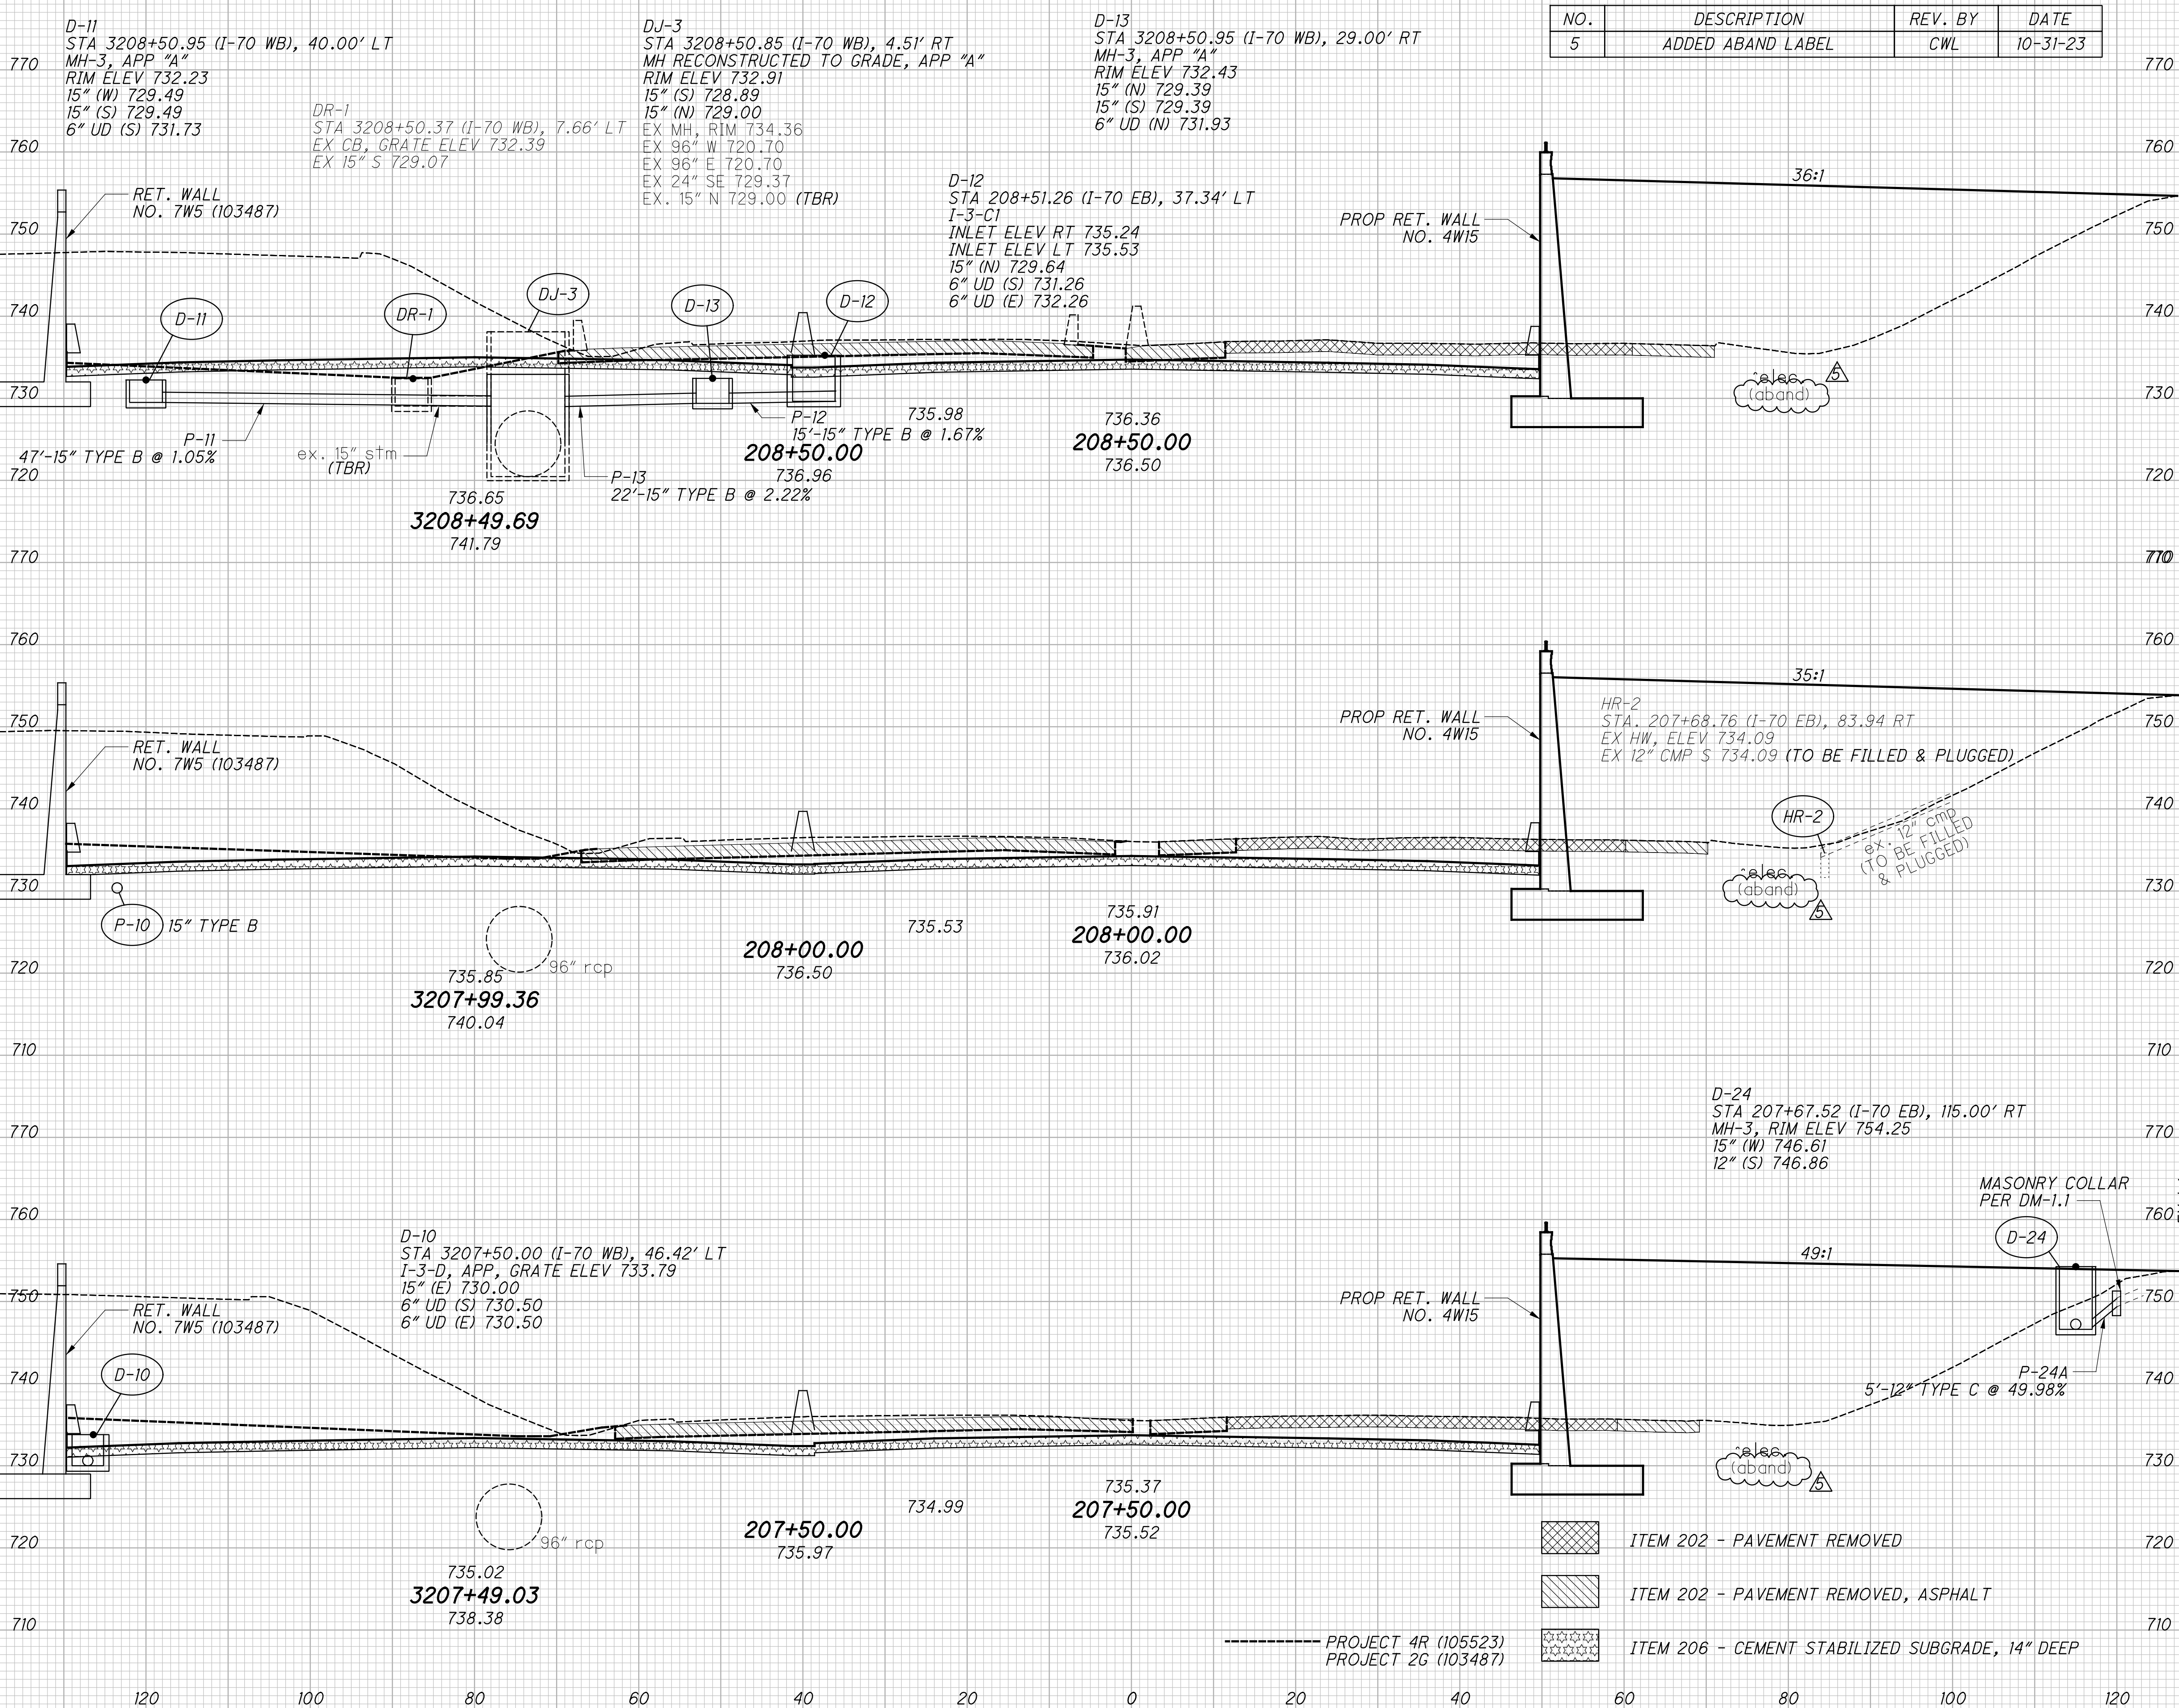

0:\2015\2015370\FRA\60655\ROADWAY SHEETS\60655\3001.DGN
10/31/2023
12:55:26 PM
DDOTV81STD_USER


NO.	DESCRIPTION	REV. BY	DATE
5	ADDED ABAND LABEL	CWL	10-31-23

END AREA	VOLUME	CALCULATED	CHECKED	TMT
191	348			
353	1181			
67	928			
386	1832			
72	1051			
904	3340			

CROSS SECTIONS I.R. 70
 STA. 209+00.00 TO STA. 210+00.00

FRA-70-14.05




218
 855

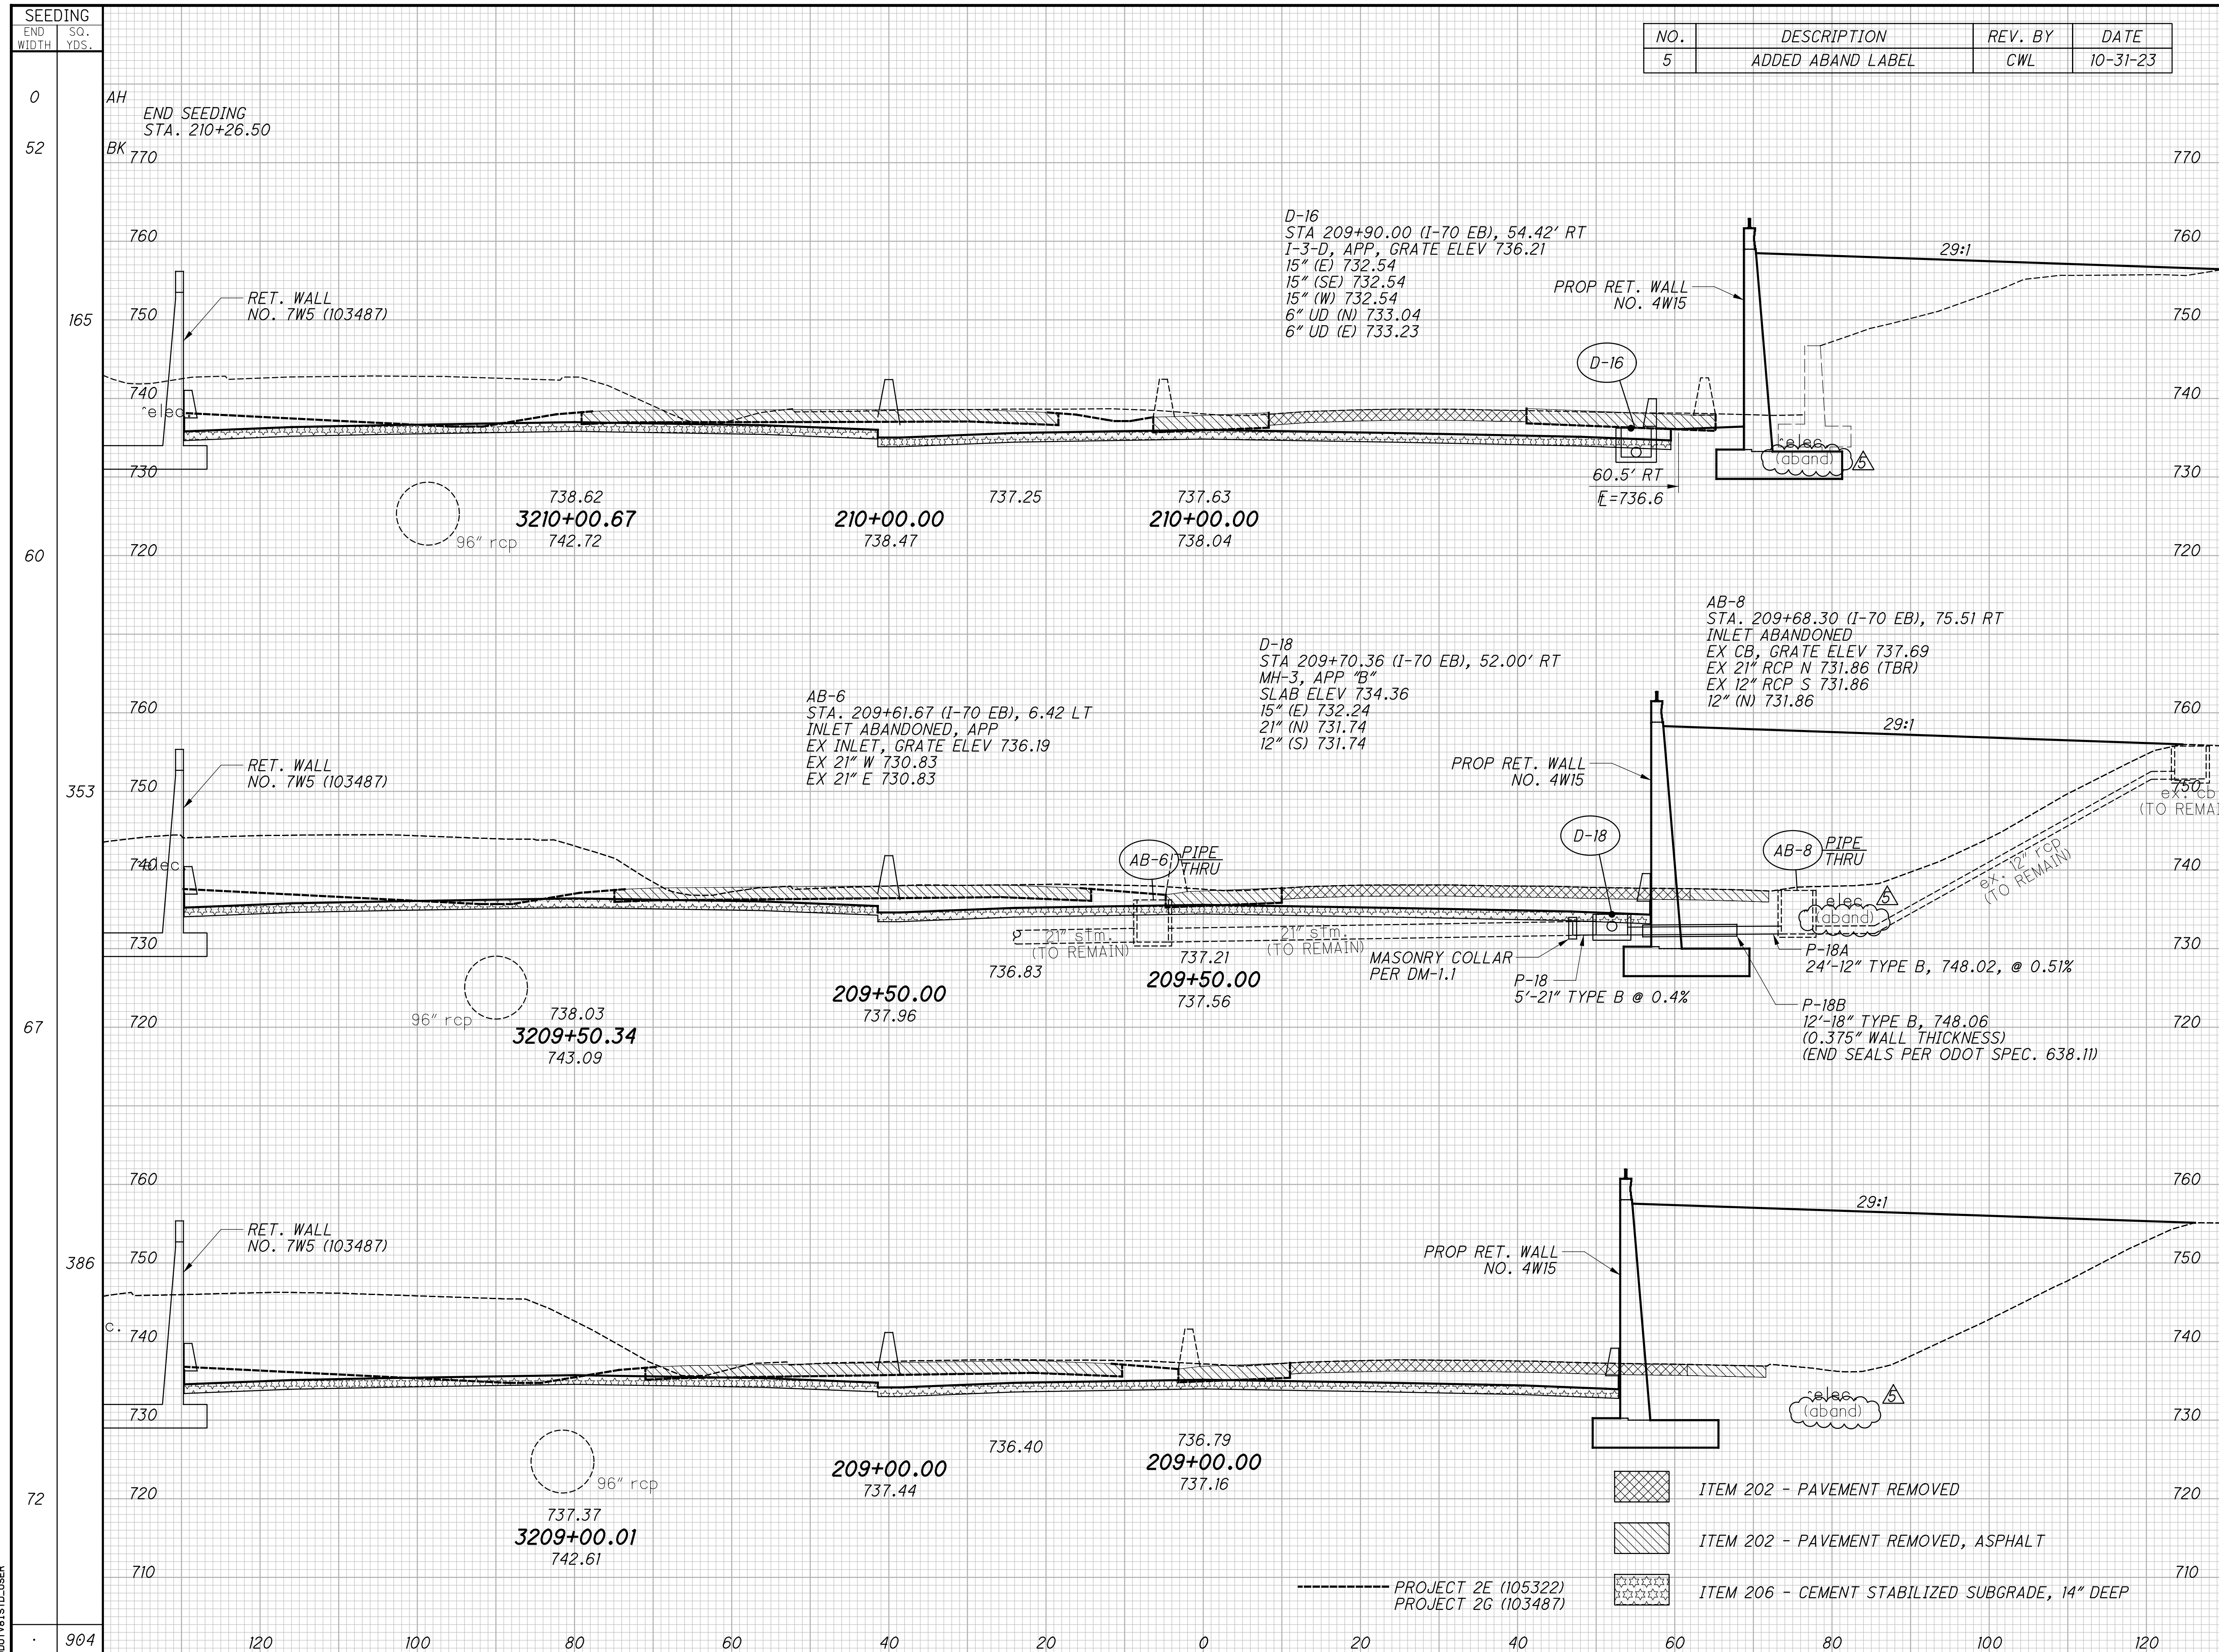


SEEDING
END WIDTH SO. YDS.

NO.	DESCRIPTION	REV. BY	DATE
5	ADDED ABAND LABEL	CWL	10-31-23

END AREA VOLUME
CUT FILL CUT FILL
CALCULATED ATR CHECKED TMT

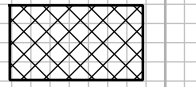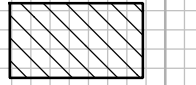-  ITEM 202 - PAVEMENT REMOVED
-  ITEM 202 - PAVEMENT REMOVED, ASPHALT
-  ITEM 206 - CEMENT STABILIZED SUBGRADE, 14" DEEP

PROJECT 2E (105322)
PROJECT 2G (103487)

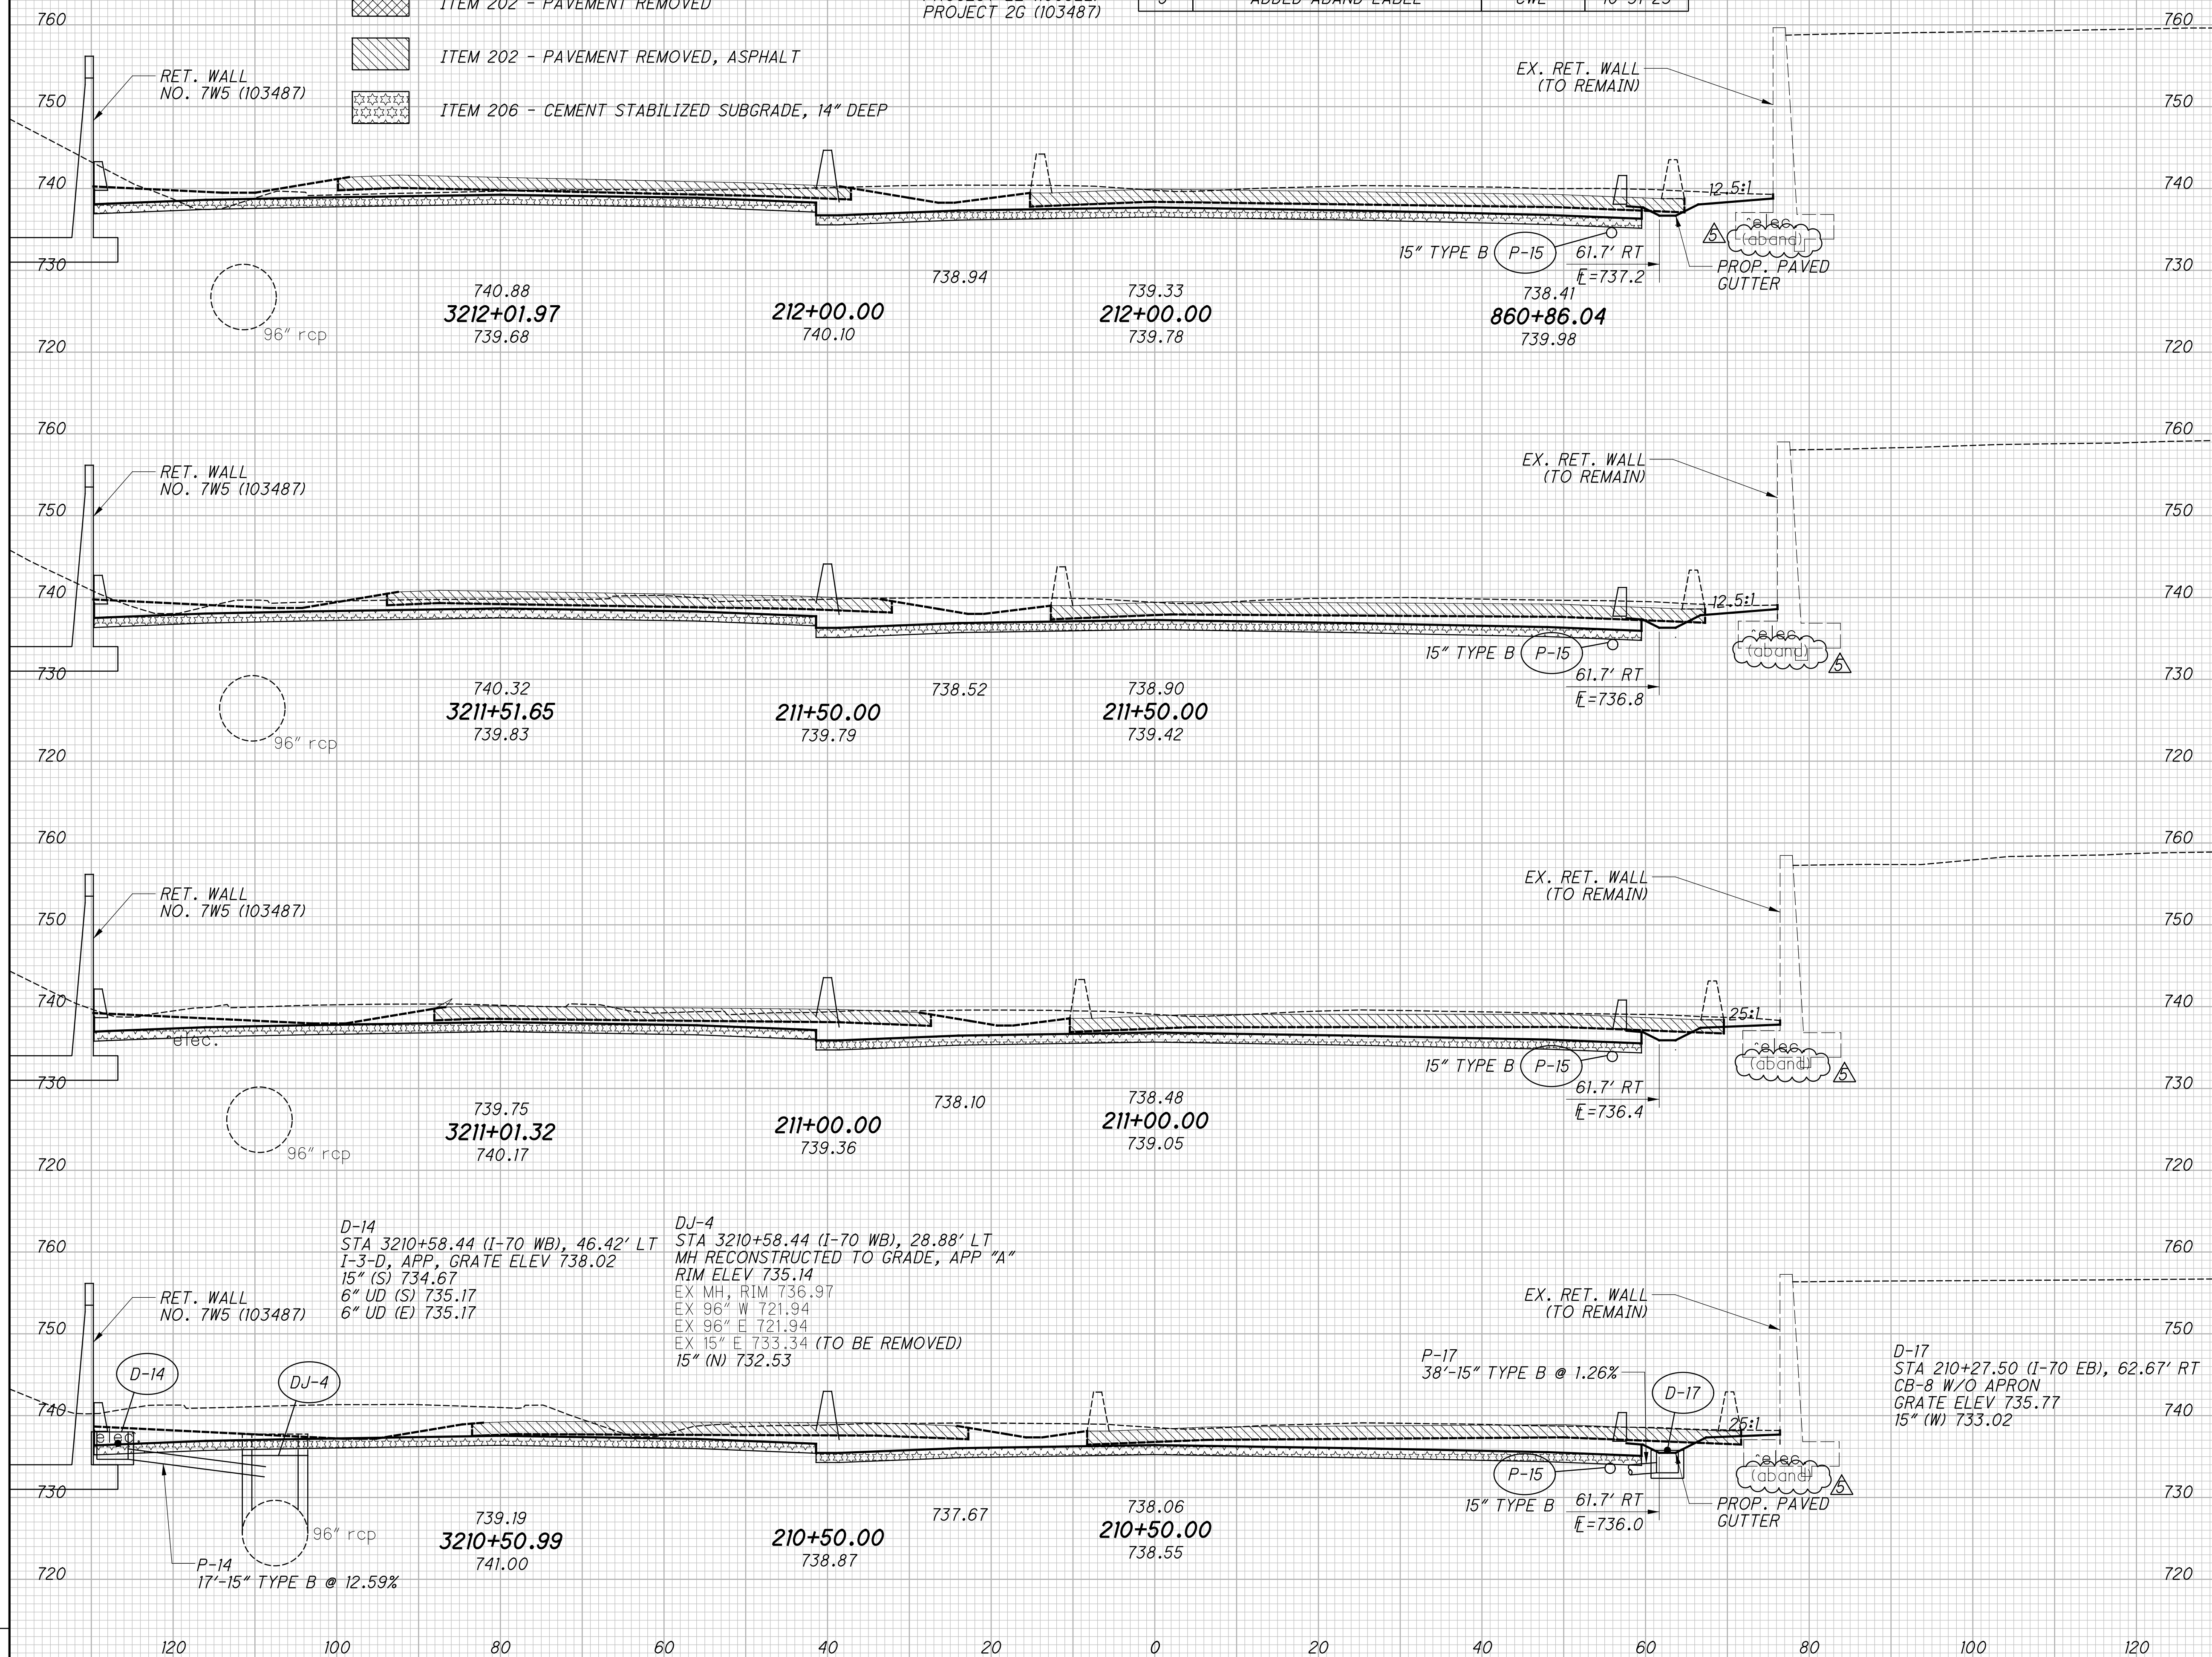

END AREA	VOLUME	CALCULATED	A	R	CHECKED	T	M
CUT	FILL	CUT	FILL				
331	4						
188	2						
356	4						
197	2						
370	5						
203	3						
375	7						
202	5						
		1432	20				


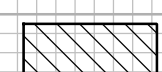
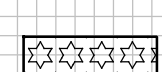
CROSS SECTIONS I.R. 70
STA. 210+50.00 TO STA. 212+00.00

FRA-70-14.05

219
855

01-2015-2015370 FRA 16065 ROADWAY SHEETS 160653001.DGN
 10/31/2023 12:55:59 PM
 DDDTY81STD.LSER

SEEDING
END SO.
WIDTH YDS.

-  ITEM 202 - PAVEMENT REMOVED
-  ITEM 202 - PAVEMENT REMOVED, ASPHALT
-  ITEM 206 - CEMENT STABILIZED SUBGRADE, 14" DEEP


----- PROJECT 2E (105322)
PROJECT 2G (103487)

END AREA	VOLUME	CALCULATED	CHECKED	TMT
246	21			
141	12			
286	17			
168	6			
306	8			
162	3			
307	5			
170	2			
		1145	51	

CROSS SECTIONS I.R. 70
STA. 212+50.00 TO STA. 214+00.00

FRA - 70 - 14.05

220
855

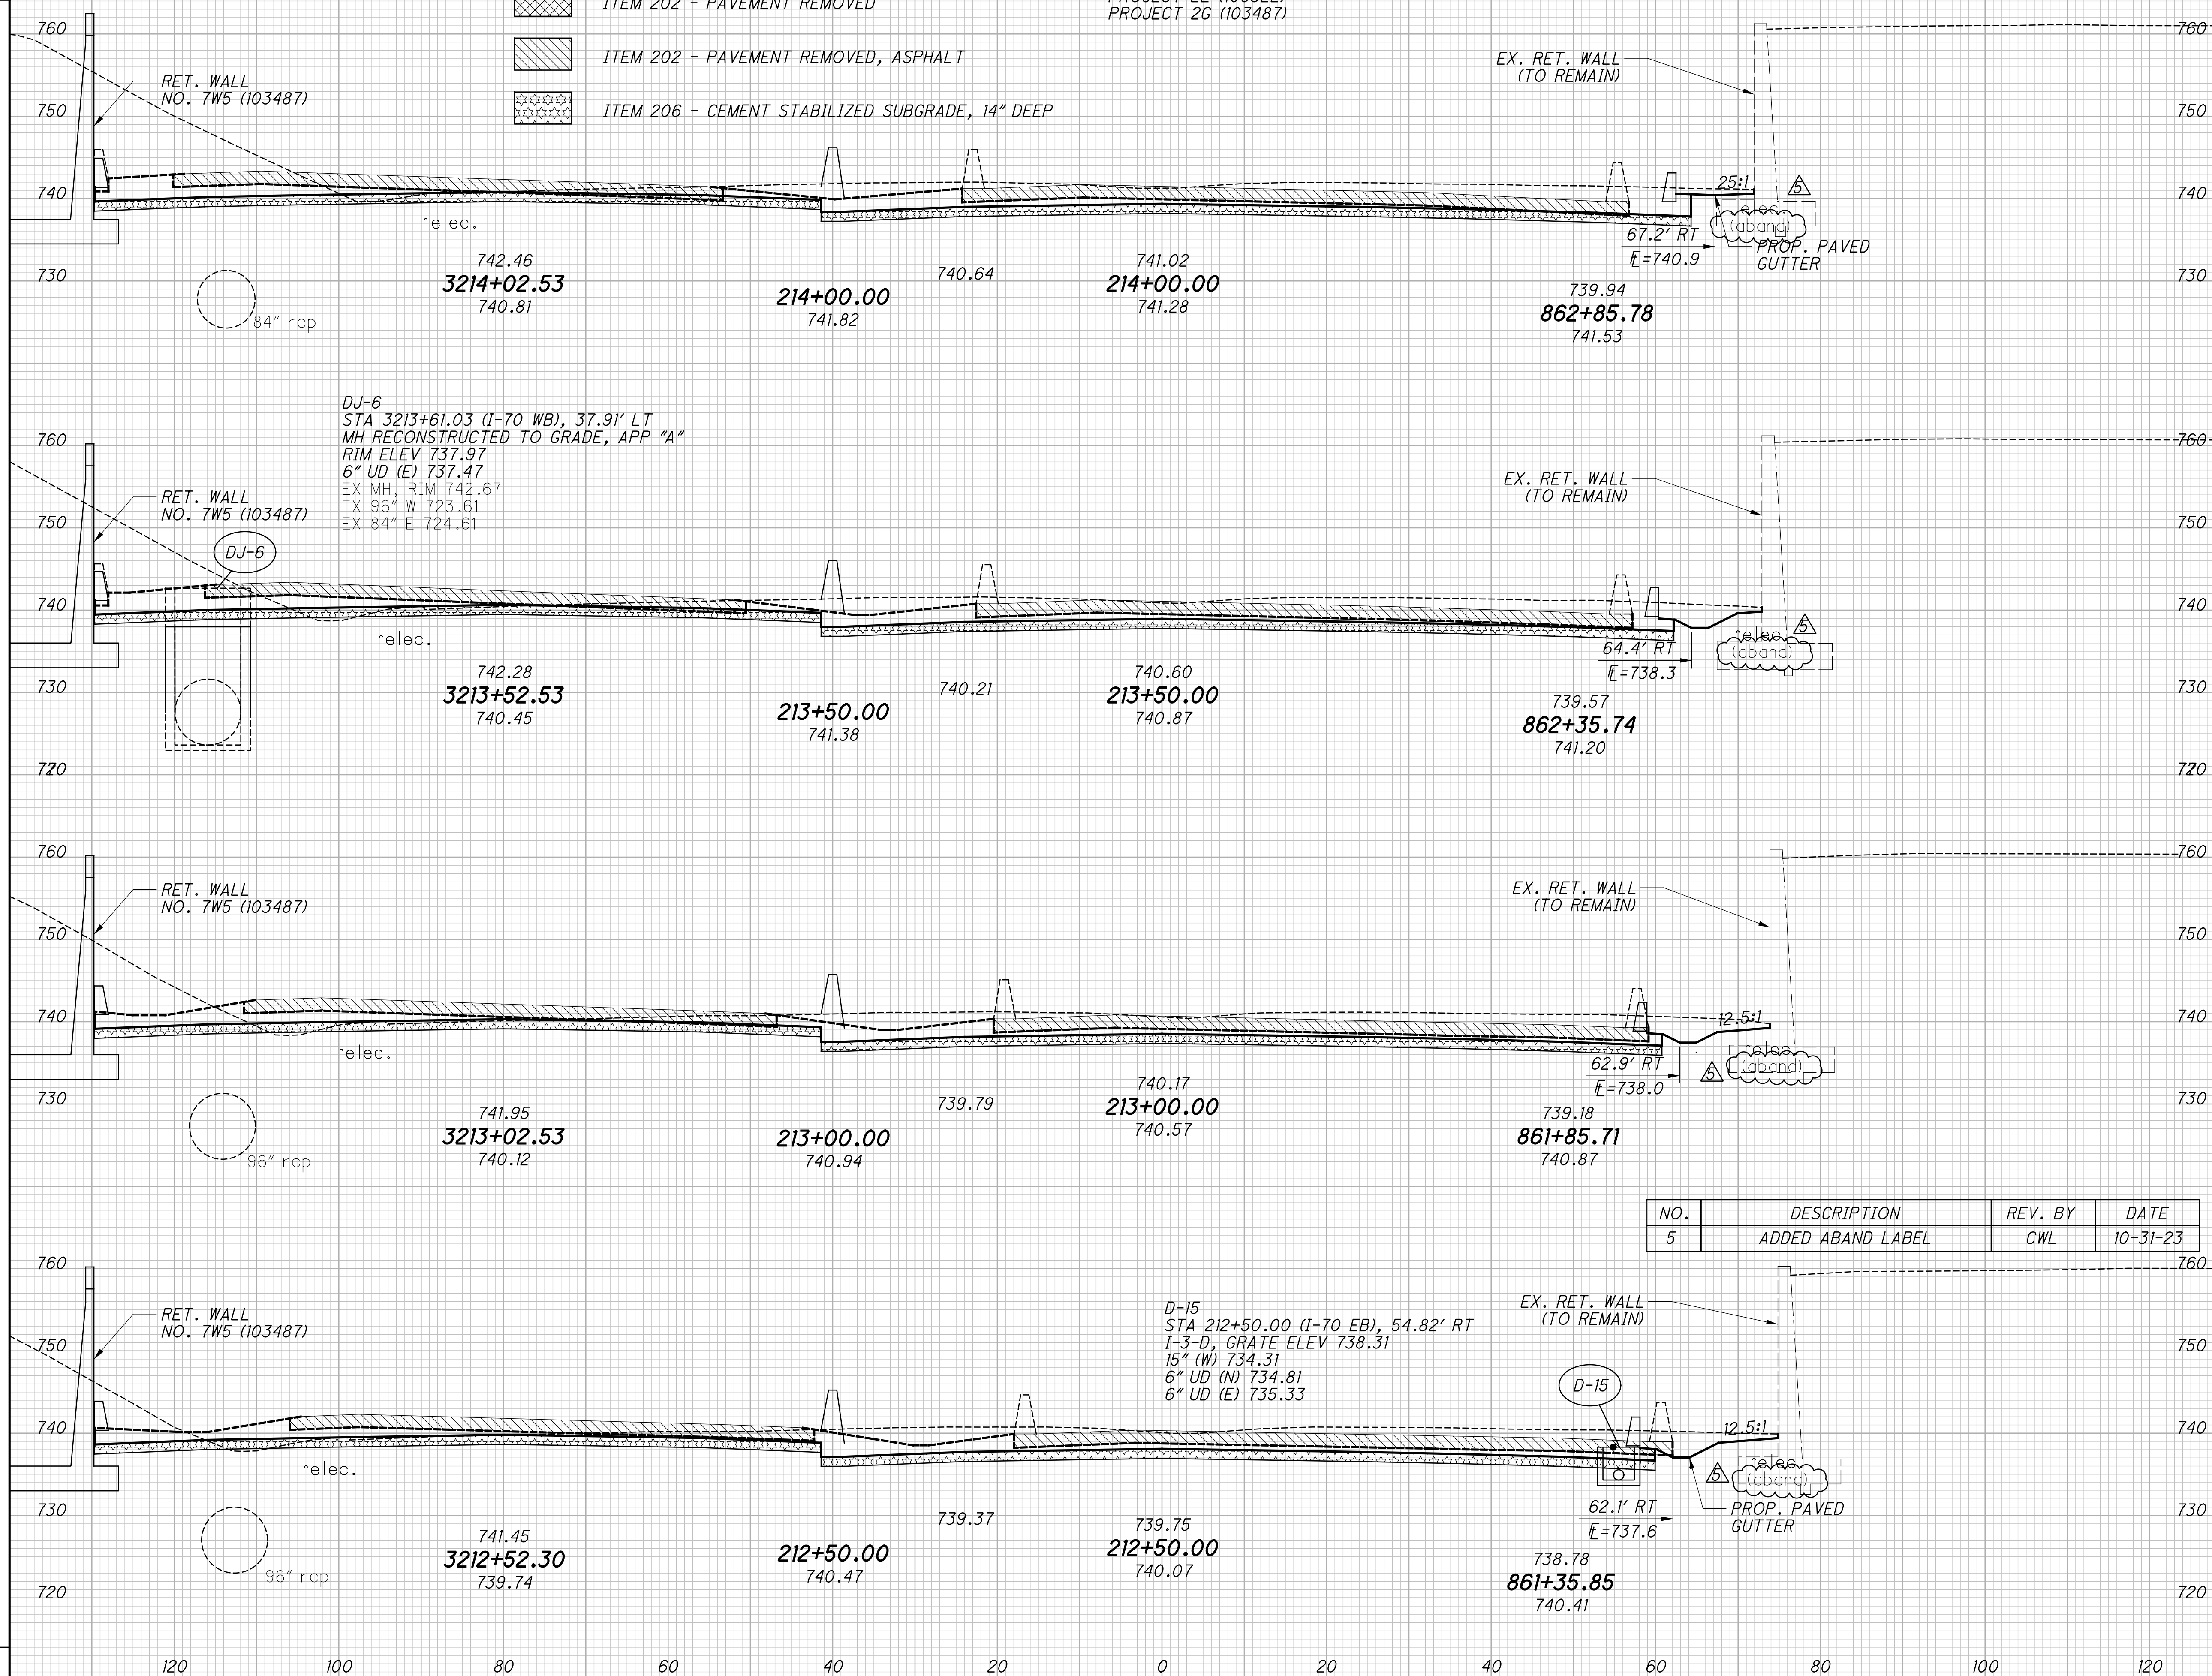

84" rcp

DJ-6
STA 3213+61.03 (I-70 WB), 37.91' LT
MH RECONSTRUCTED TO GRADE, APP "A"
RIM ELEV 737.97
6" UD (E) 737.47
EX MH, RIM 742.67
EX 96" W 723.61
EX 84" E 724.61

96" rcp

NO.	DESCRIPTION	REV. BY	DATE
5	ADDED ABAND LABEL	CWL	10-31-23

D-15
STA 212+50.00 (I-70 EB), 54.82' RT
I-3-D, GRATE ELEV 738.31
15" (W) 734.31
6" UD (N) 734.81
6" UD (E) 735.33


96" rcp

D:\2015\2015370\FRA\60653\ROADWAY SHEETS\60653\001.DGN
10/31/2023
12:56:17 PM
DDOTV81STD.LUSER

SEEDING
END WIDTH SO. YDS.

NO.	DESCRIPTION	REV. BY	DATE
5	ADDED ABAND LABEL	CWL	10-31-23

END AREA VOLUME
CUT FILL CUT FILL
CALCULATED
ATR
CHECKED
TMT

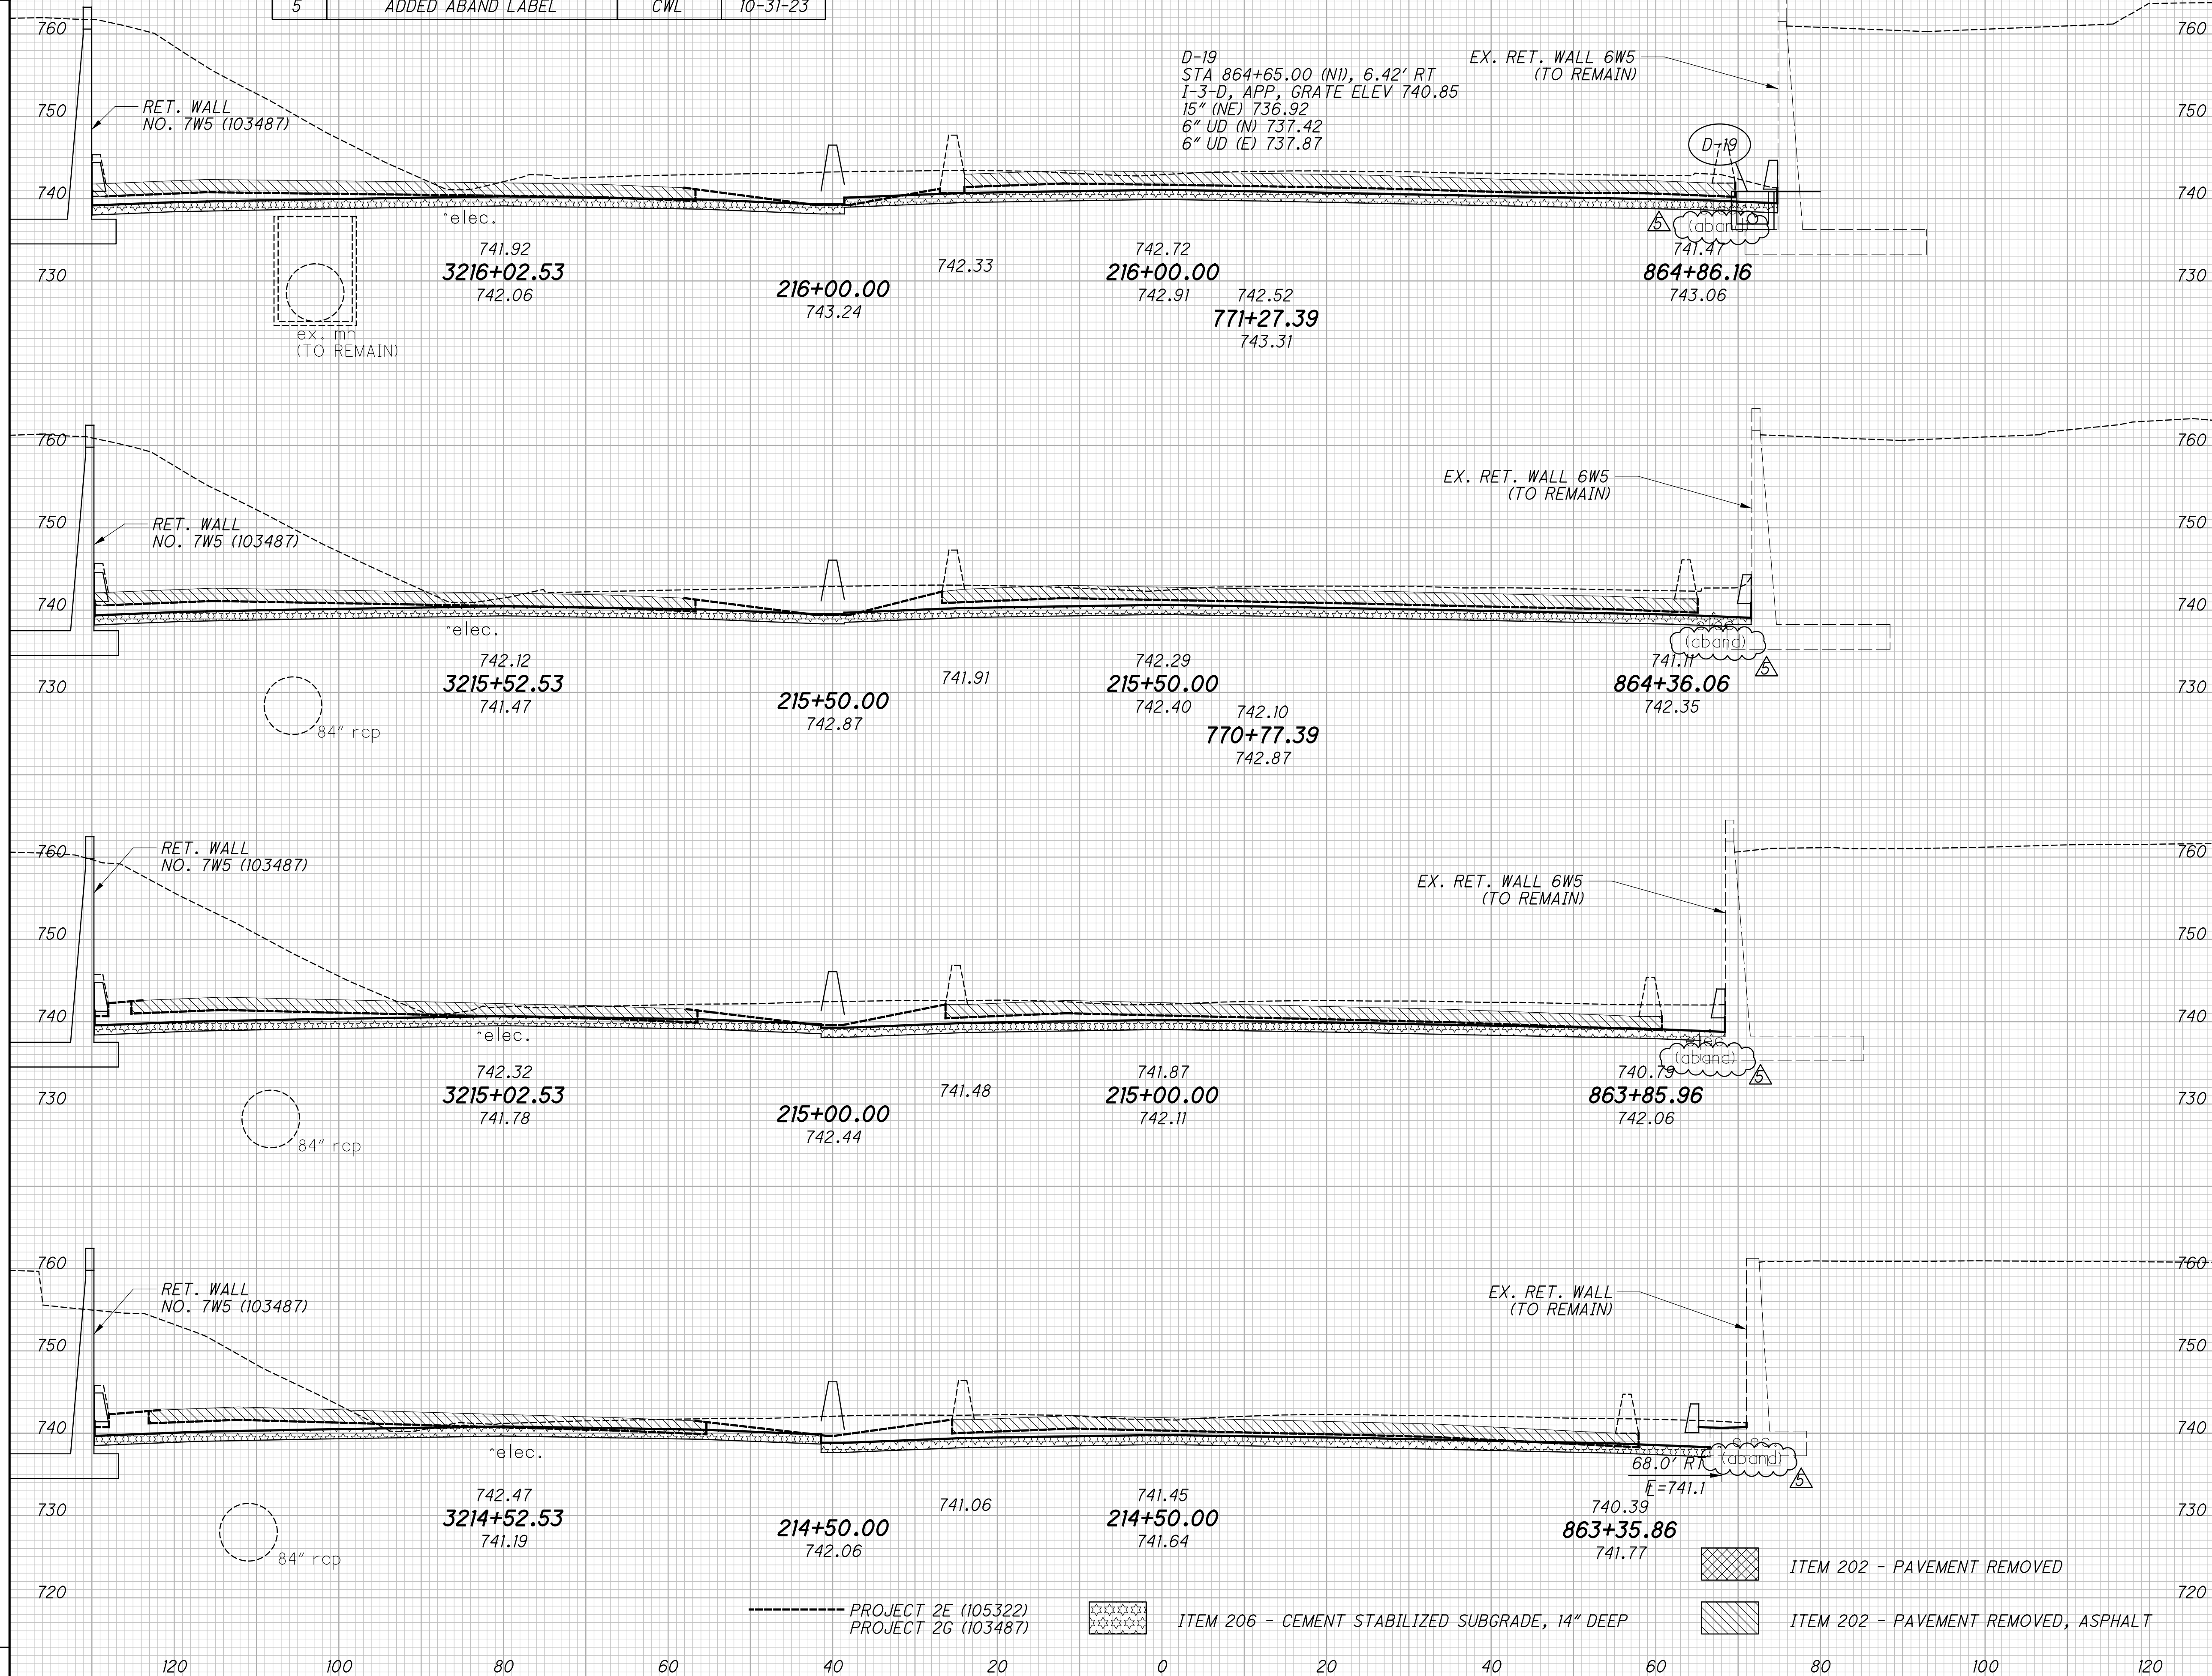

01:201512015370 FRA 160653 ROADWAY SHEETS 160653S001.DGN
 10/31/2023
 12:56:33 PM
 000TV81STD_LUSER

- - - - - PROJECT 2E (105322)
 - - - - - PROJECT 2G (103487)
 [Pattern] ITEM 206 - CEMENT STABILIZED SUBGRADE, 14" DEEP
 [Pattern] ITEM 202 - PAVEMENT REMOVED
 [Pattern] ITEM 202 - PAVEMENT REMOVED, ASPHALT

CROSS SECTIONS I.R. 70
 STA. 214+50.00 TO STA. 216+00.00

FRA-70-14.05

END AREA	VOLUME	CUT	FILL
207	12		
119	5		
127	3		
119	5		
125	11		
889	41		

221
855

SEEDING	
END WIDTH	SO. YDS.

NO.	DESCRIPTION	REV. BY	DATE
5	ADDED ABAND LABEL	CWL	10-31-23

D-22
 STA 3217+94.72 (I-70 WB), 37.34' RT
 I-3-C1
 INLET ELEV LT 740.41
 INLET ELEV RT 742.28
 15" (W) 735.01
 15" (E) 735.01
 6" UD (S) 736.43
 6" UD (E) 737.43


D-20
 STA 866+75.00 (NI), 6.75' RT
 I-3-D, APP, GRATE ELEV 741.58
 15" (NW) 738.42
 6" UD (N) 738.92
 6" UD (W) 738.92
 6" UD (E) 738.92

END AREA	VOLUME	CALCULATED	CHECKED	TMT
26	2			
55	7			
104	17			
57	11			
123	23			
76	14			
168	20			
105	8			
		421	62	

CROSS SECTIONS I.R. 70
 STA. 216+50.00 TO STA. 218+00.00

FRA-70-14.05

222
 855

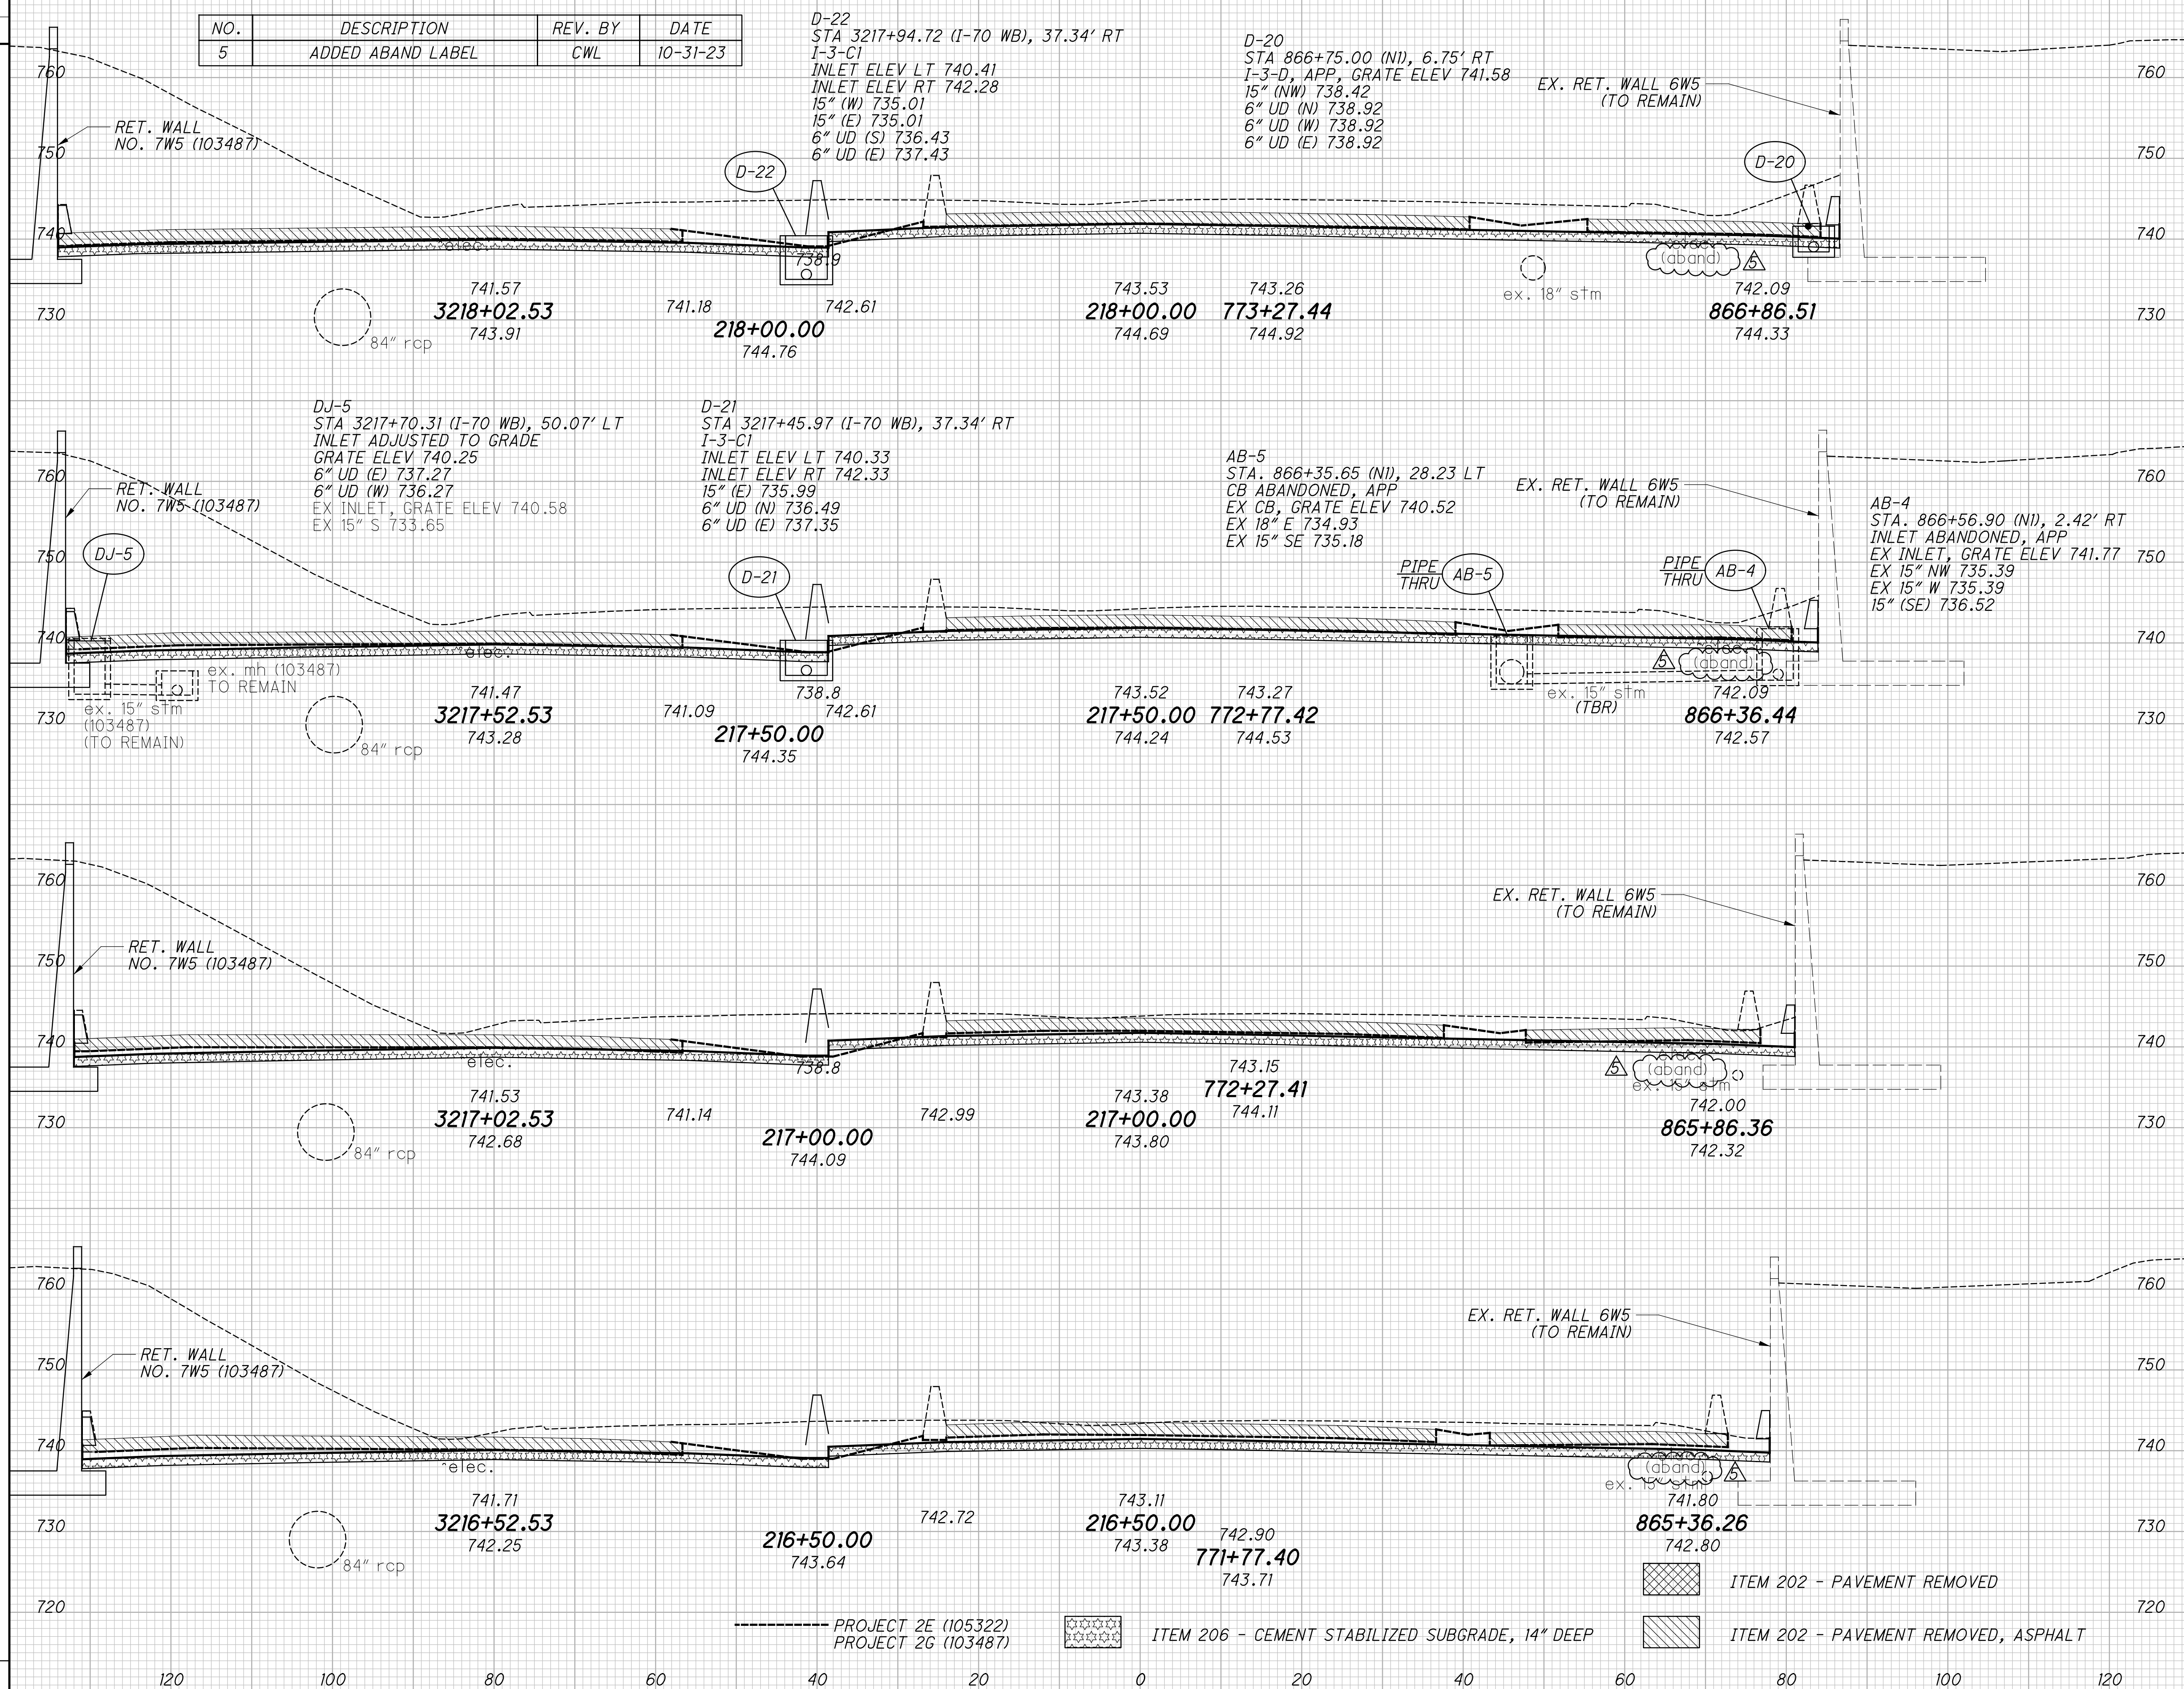

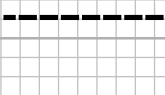


01-2015-2015370 FRA 16065 ROADWAY SHEETS 160653001.DGN
 10/31/2023 12:56:50 PM
 000TV81STD_LUSER

PROJECT 2E (105322) PROJECT 2G (103487) ITEM 206 - CEMENT STABILIZED SUBGRADE, 14" DEEP
 ITEM 202 - PAVEMENT REMOVED ITEM 202 - PAVEMENT REMOVED, ASPHALT

SEEDING

END WIDTH	SO. YDS.

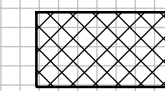-  ITEM 202 - PAVEMENT REMOVED
-  ITEM 202 - PAVEMENT REMOVED, ASPHALT
-  PROJECT 2E (105322)
PROJECT 2G (103487)


NO.	DESCRIPTION	REV. BY	DATE
5	ADDED ABAND LABEL	CWL	10-31-23

END AREA		VOLUME		CALCULATED	ATR	CHECKED	TMT
CUT	FILL	CUT	FILL				


CROSS SECTIONS I.R. 70
STA. 218+13.40

FRA - 70 - 14.05


223
855

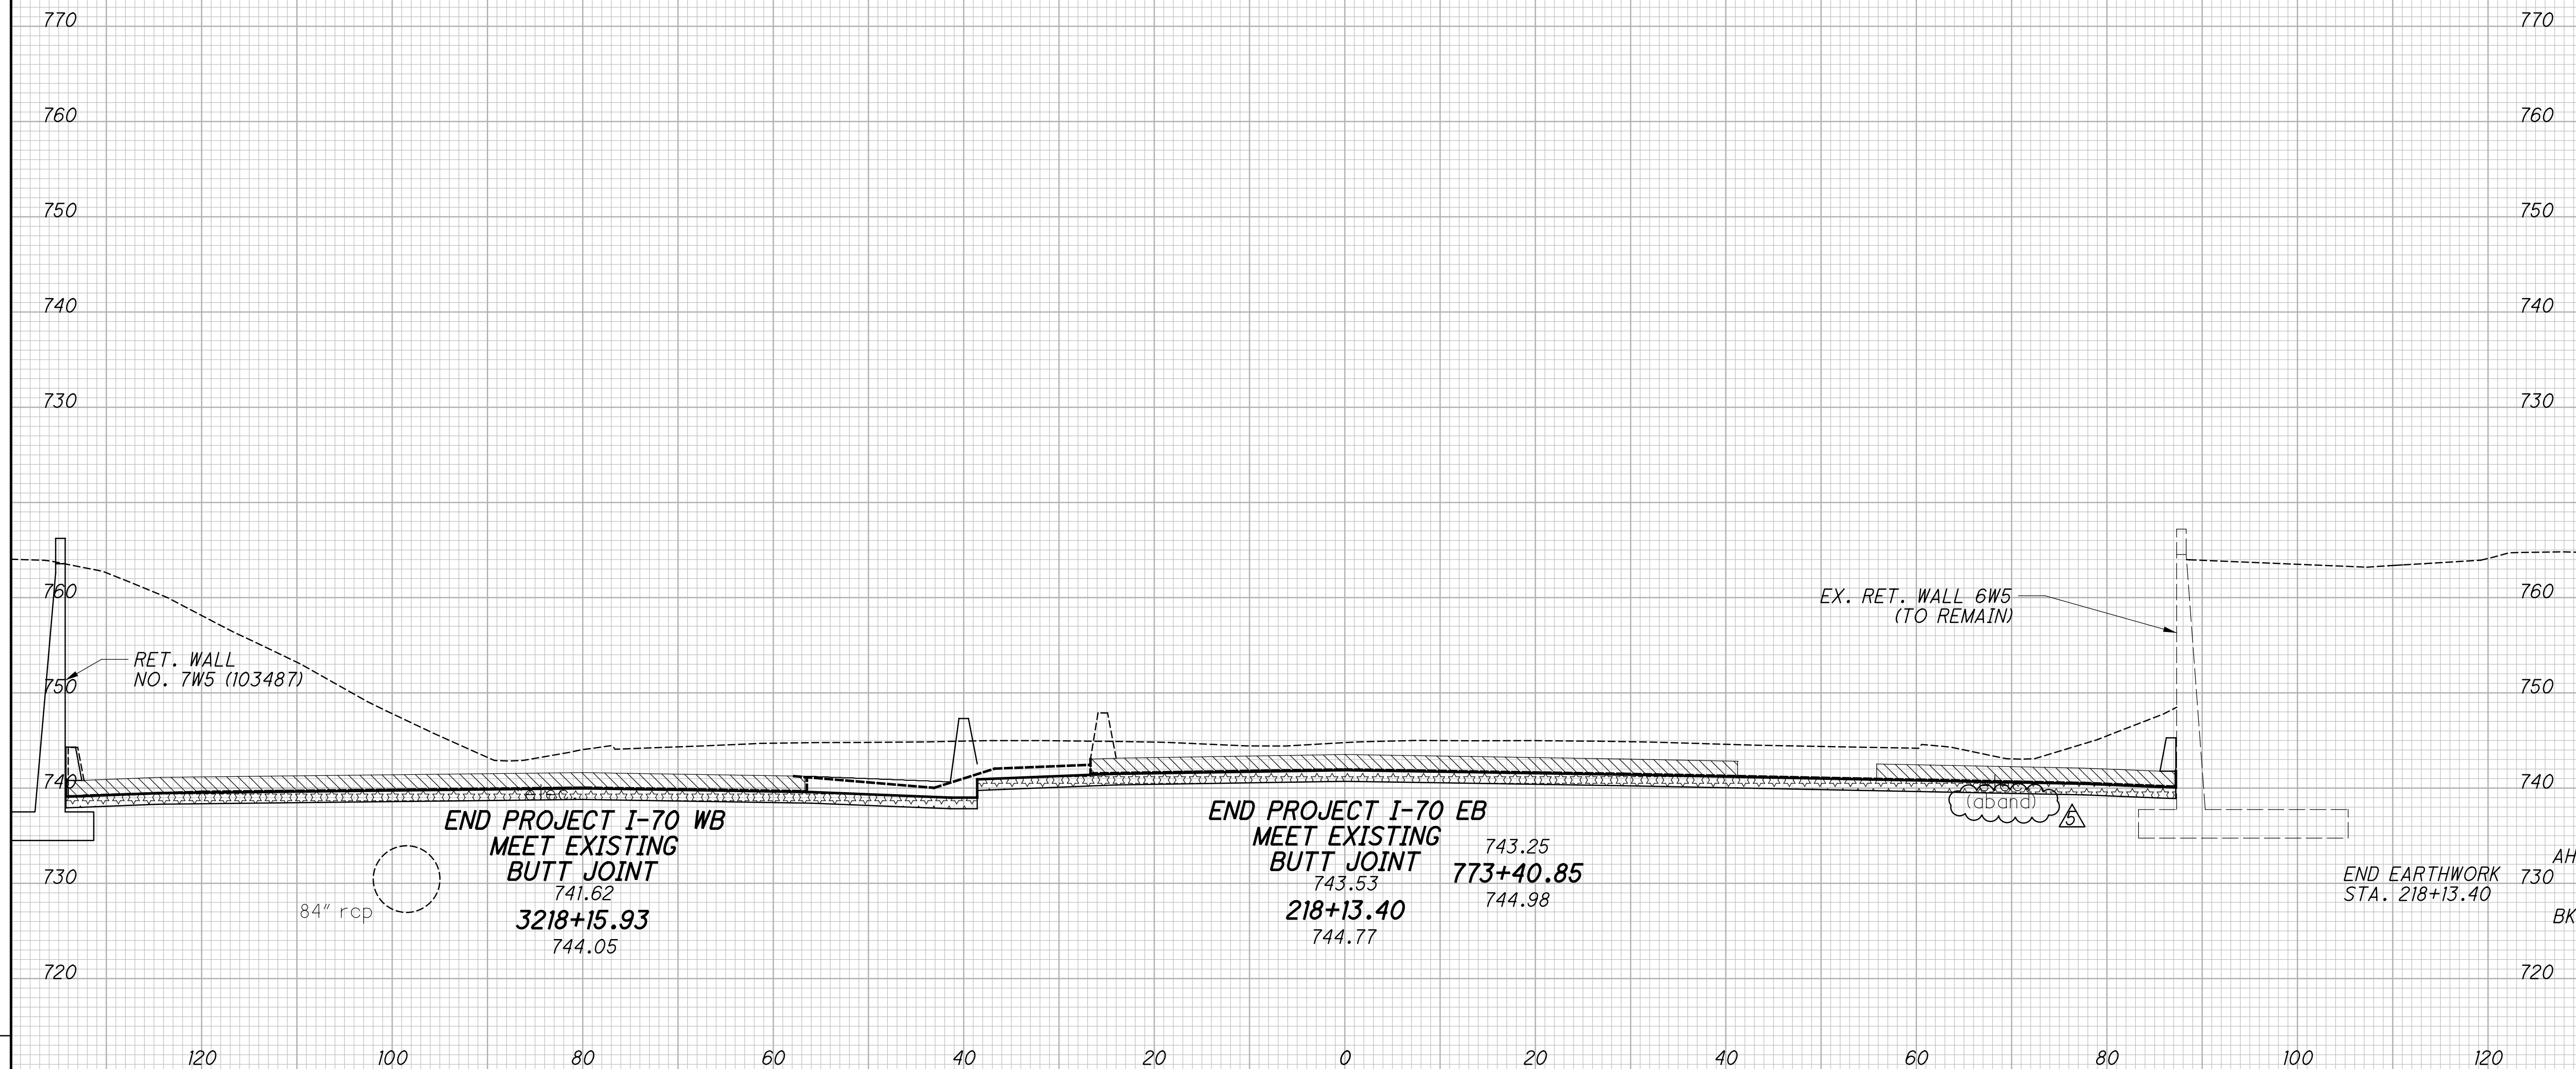

D:\2015\2015370\FRA\6065\ROADWAY SHEETS\6065\3001.DGN
10/31/2023
12:57:07 PM
DDOTV81STD.LIBER

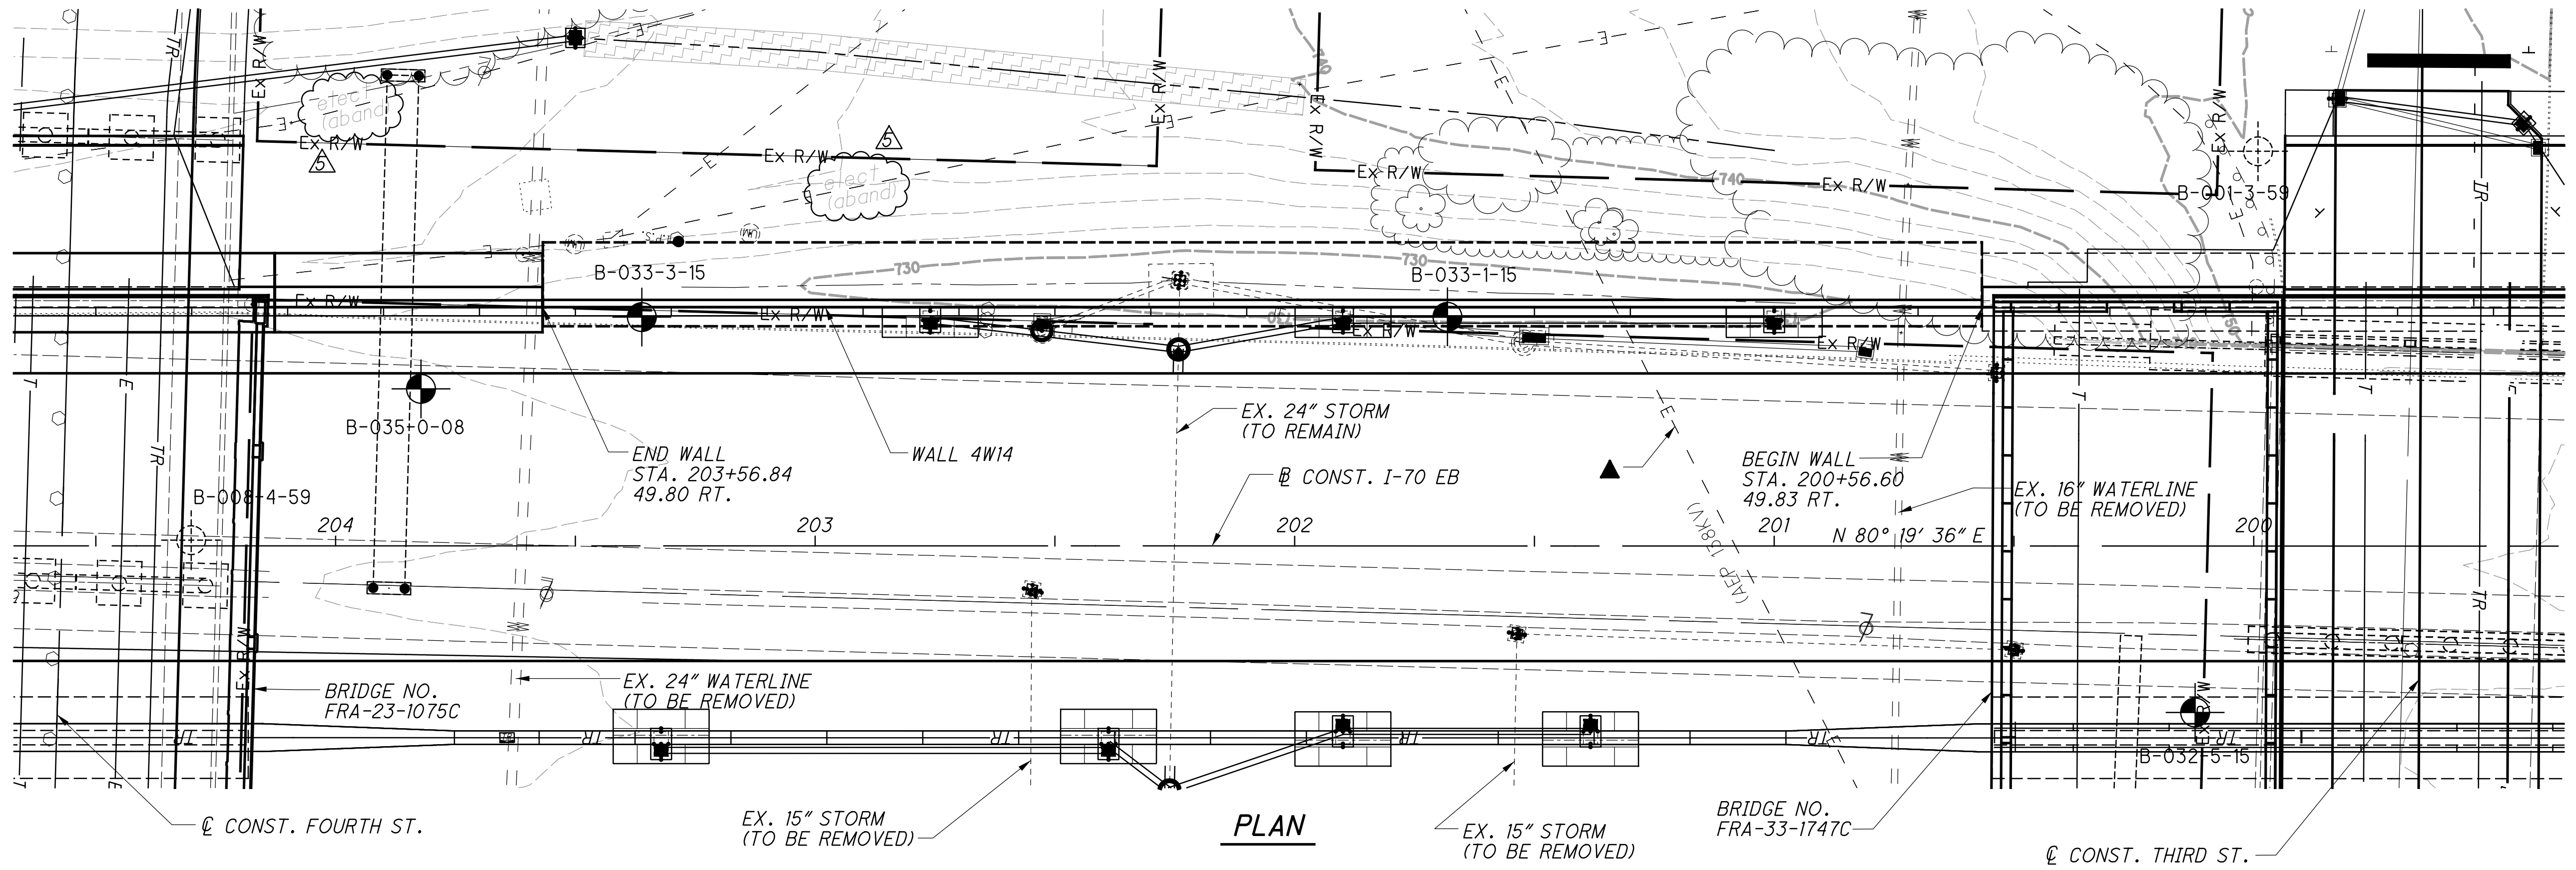

PLAN

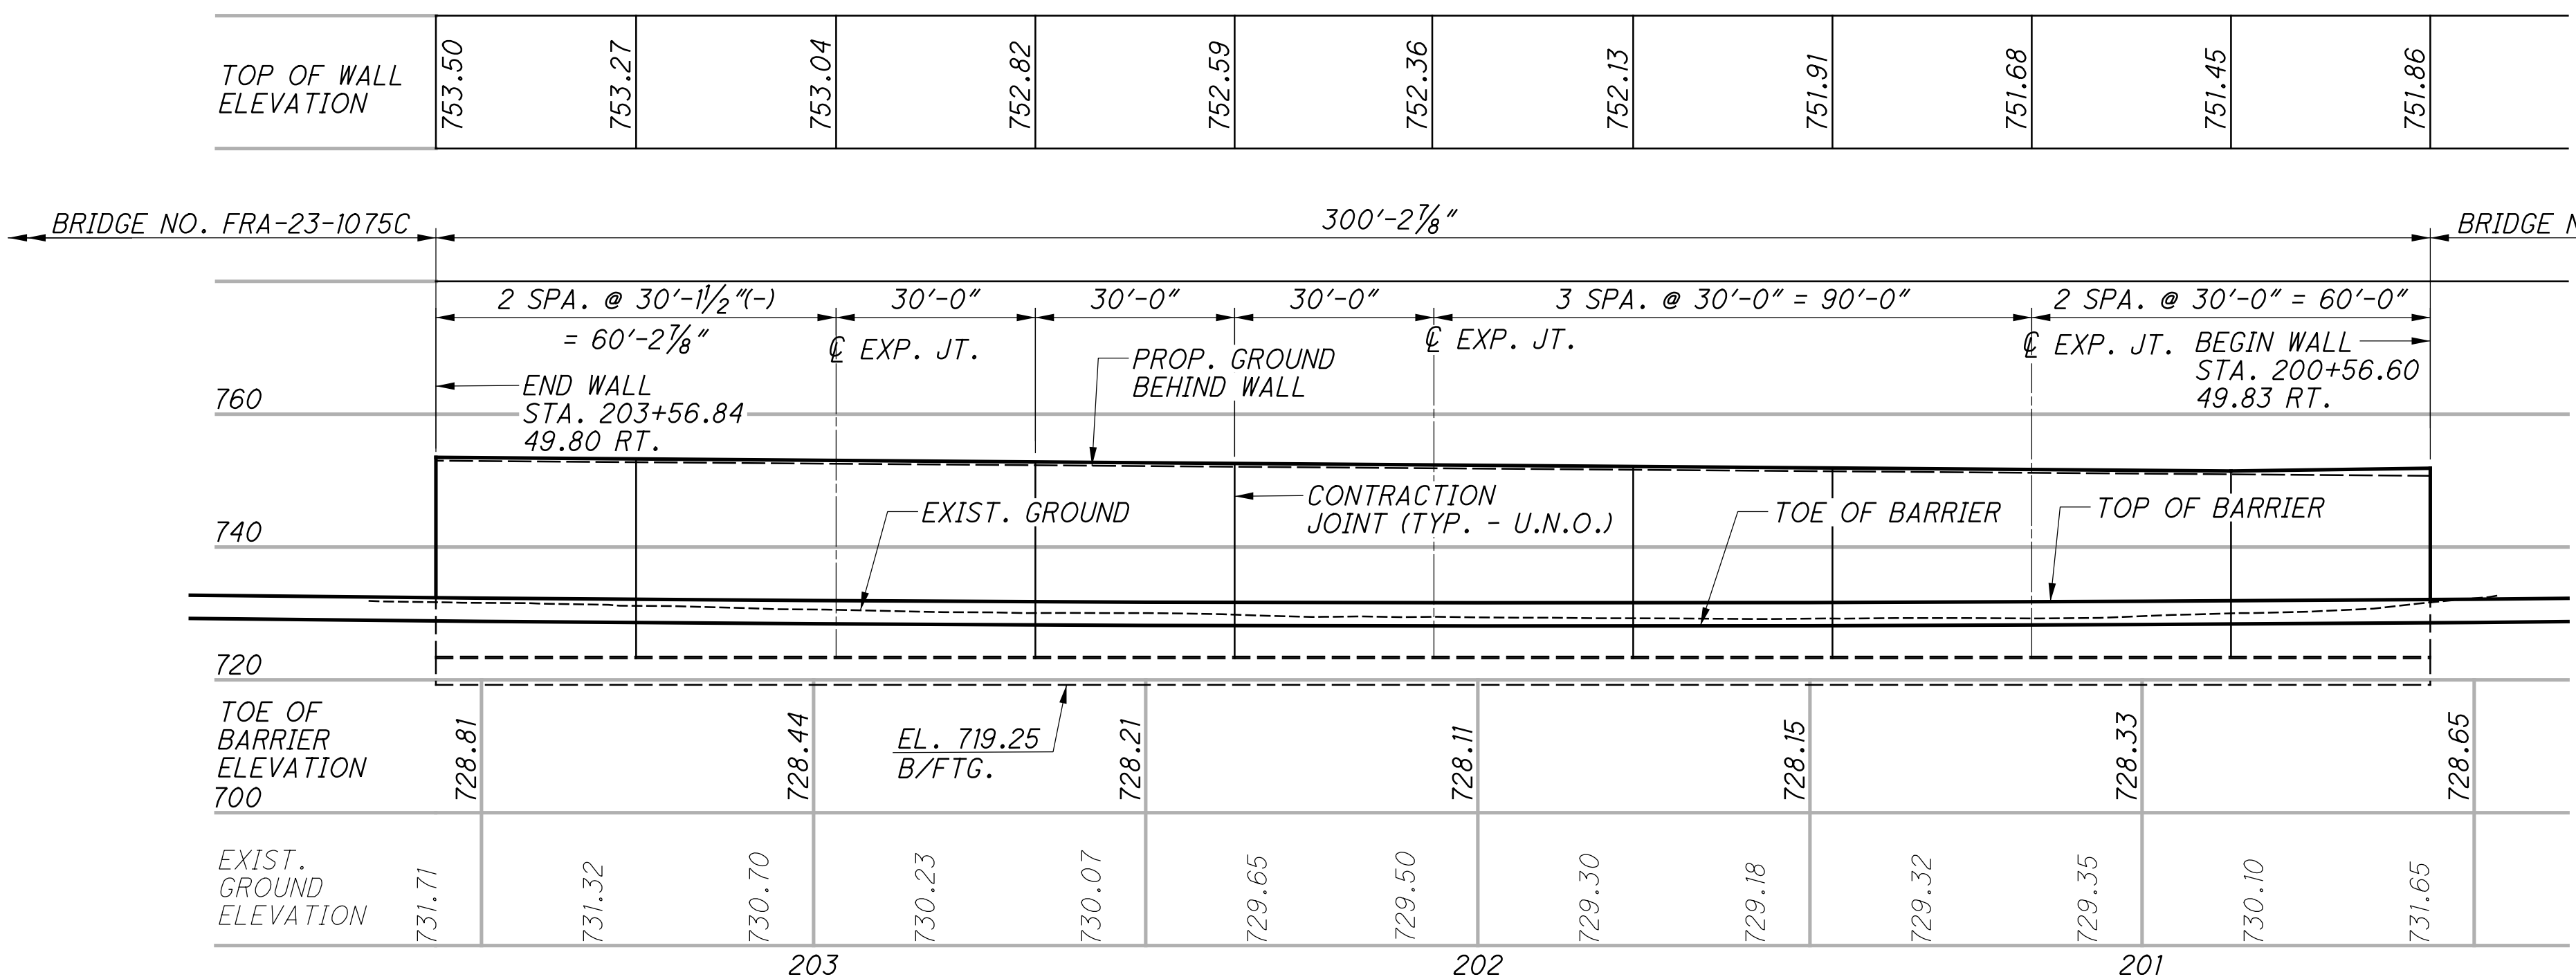

ELEVATION

LEGEND:

- ▲ INDICATES TO BE ABAND/REMOVED BY AEP
- PROJECT BORING LOCATION
- HISTORIC BORING LOCATION

NOTES:

1. NO VALUE ENGINEERING CHANGE PROPOSAL (VECP) SHALL BE CONSIDERED FOR THIS WALL TYPE.
2. STATIONS AND OFFSETS GIVEN TO \square OF CONST. I-70 EB.
3. TOP OF WALL ELEVATIONS GIVEN TO THE BOTTOM OF THE KNEEWALL AT CONTRACTION AND EXPANSION JOINT LOCATIONS.
4. FOR FENCE DETAILS ON TOP OF THE KNEE WALL, SEE THE AESTHETIC ENHANCEMENT PLANS.
5. WALL LIMITS INCLUDE 1" P.E.J.F. AT EACH END OF THE WALL.
6. SEE GENERAL RETAINING WALL DETAILS AND NOTES, STARTING ON SHEET.

NO.	DESCRIPTION	REV. BY	DATE
5	ADDED ABAND LABELS	CWL	10-31-23

300
855

D:\2015\2015370\FRA\96053\STRUCTURES\WALL_4W14\SHEETS\96053_4W14P001.DGN
 10/31/2023 11:09:20 PM
 ODOT\8151D\LUSER

TRAFFIC CONTROL LEGEND

- TRAFFIC FLOW
- ◇ PROPOSED SIGN
- ◇ EXISTING SIGN TO REMAIN
- ◇ EXISTING SIGN TO BE REERECTED
- + SIGN SUPPORT
- ▬ PROPOSED TRUSS SIGN SUPPORT
- ▬ PROPOSED CANTILEVER SIGN SUPPORT
- ▬ EXISTING TRUSS SIGN SUPPORT TO REMAIN
- ▬ EXISTING CANTILEVER SIGN SUPPORT TO REMAIN
- RPM (RAISED PAVEMENT MARKER)
- S-# PROPOSED SIGN
- R-# EXISTING SIGN TO BE REMOVED
- OSS-# OVERHEAD SIGN SUPPORT
- BI BICYCLE LANE SYMBOL MARKING
- CH CHANNELIZING LINE
- CM CHEVRON MARKING
- CW CROSSWALK LINE
- DW DOTTED LINE, WHITE
- EW EDGE LINE, WHITE
- EY EDGE LINE, YELLOW
- LA LANE ARROW
- LL LANE LINE
- SL STOP LINE
- TW TRANSVERSE/DIAGONAL LINE, WHITE
- QB TURN QUEUE BOX
- GP GREEN COLORED PAVEMENT FOR BIKE LANES
- BD BICYCLE DETECTOR MARKING
- LR LANE REDUCTION ARROW

ITEM 644 - PAVEMENT MARKING, MISC.: BIKE LANE DOTTED LINE, 6"
 ITEM 647 - PAVEMENT MARKING, MISC.: BIKE LANE DOTTED LINE, 6", TYPE B90

THIS ITEM SHALL BE 6" WIDE AND SHALL HAVE A 2' SEGMENT WITH A 6' GAP BETWEEN SEGMENTS.

PAYMENT FOR THIS ITEM SHALL BE MADE AT THE CONTRACT PRICE BID PER FEET.

ITEM 644 - PAVEMENT MARKING, MISC.: EDGE LINE, 6"
 ITEM 644 - PAVEMENT MARKING, MISC.: LANE LINE, 6"
 ITEM 645 - PAVEMENT MARKING, MISC.: EDGE LINE, 6", TYPE A1, WITH CONTRAST
 ITEM 645 - PAVEMENT MARKING, MISC.: LANE LINE, 6", TYPE A1, WITH CONTRAST

THIS ITEM SHALL BE 6" WIDE.

PAYMENT FOR THIS ITEM SHALL BE MADE AT THE CONTRACT PRICE BID PER MILE.

ITEM 630 - STREET NAME SIGN SUPPORT, AS PER PLAN

PAYMENT FOR THIS ITEM SHALL BE EACH AT THE CONTRACT UNIT PRICE FOR ITEM 630 - STREET NAME SIGN SUPPORT, AS PER PLAN AND SHALL INCLUDE FURNISHING AND INSTALLING THE SIGN SUPPORTS, FOUNDATIONS, AND ALL MISCELLANEOUS HARDWARE NEEDED TO COMPLETELY INSTALL THE ASSEMBLY.

THE DETAILS SHOWN ON SHEET 405 SHALL BE UTILIZED FOR THE STREET NAME SIGN SUPPORT.

ITEM 630 - SIGN SUPPORT ASSEMBLY, POLE MOUNTED, AS PER PLAN

FLAT SHEET SIGNS SHALL BE ATTACHED TO THE POLE USING CITY OF COLUMBUS STANDARD CONSTRUCTION DRAWING 4253.

PAYMENT FOR "ITEM 630 - SIGN SUPPORT ASSEMBLY, POLE MOUNTED, AS PER PLAN" SHALL BE MADE AT THE CONTRACT UNIT PRICE BID PER EACH. PAYMENT SHALL BE FULL COMPENSATION FOR ALL LABOR, MATERIALS, TOOLS, EQUIPMENT, AND ALL PARTS NECESSARY TO ATTACH ONE SIGN.

REFERENCE LOCATION SIGNS

THE LOCATION OF REFERENCE LOCATION SIGNS ON THE PLANS ARE APPROXIMATE AND A MORE PRECISE LOCATION WILL BE PROVIDED BY THE DEPARTMENT. THE CONTRACTOR SHALL NOTIFY THE ENGINEER AT LEAST 30 DAYS IN ADVANCE OF THE PLANNED DATE OF REFERENCE LOCATION SIGN INSTALLATION. THE ENGINEER WILL CONTACT THE OFFICE OF TECHNICAL SERVICES WHICH WILL LOCATE THE LONGITUDINAL POSITION OF REFERENCE LOCATION SIGNS BY MEANS OF A PAINT MARK ON THE PAVEMENT EDGE. ALTERNATE MARKS WILL NOT BE PROVIDED ON DIVIDED HIGHWAYS AND THE CONTRACTOR SHALL SET REFERENCE LOCATION SIGNS FOR THE OPPOSITE ROADWAY ACROSS FROM THE PROVIDED MARK. DELINEATORS WHOSE NORMAL POSITION FALLS WITHIN 50 FEET OF A REFERENCE LOCATION SIGN SHALL BE OMITTED.



ITEM 647 - PAVEMENT MARKING, MISC.: DOTTED LINE, 6", TYPE B90

THIS ITEM SHALL BE 6" WIDE AND SHALL HAVE A 3' SEGMENT WITH A 9' GAP BETWEEN SEGMENTS.

PAYMENT FOR THIS ITEM SHALL BE MADE AT THE CONTRACT PRICE BID PER FEET.

ITEM 644 - PAVEMENT MARKING, MISC.: CHANNELIZING LINE, 12"

ITEM 645 - PAVEMENT MARKING, MISC.: CHANNELIZING LINE, 12", TYPE A1, WITH CONTRAST

ITEM 647 - PAVEMENT MARKING, MISC.: CROSSWALK LINE, 12", TYPE B90

THIS ITEM SHALL BE 12" WIDE.

PAYMENT FOR THIS ITEM SHALL BE MADE AT THE CONTRACT PRICE BID PER FEET.

ITEM 644 - PAVEMENT MARKING, MISC.: STOP LINE, 24"

ITEM 644 - PAVEMENT MARKING, MISC.: TRANSVERSE/DIAGONAL LINE, 24"

ITEM 647 - PAVEMENT MARKING, MISC.: STOP LINE, 24", TYPE B90

THIS ITEM SHALL BE 24" WIDE.

PAYMENT FOR THIS ITEM SHALL BE MADE AT THE CONTRACT PRICE BID PER FEET.

ITEM 644 - PAVEMENT MARKING, MISC.: BIKE DETECTOR MARKING

THE BIKE DETECTOR MARKING SHALL BE PLACED IN THE DETECTED BIKE LANE PER CITY OF COLUMBUS STANDARD CONSTRUCTION DRAWING 4305.



PAID PARKING OUT OF SERVICE FEES

AS INDICATED IN THE MAINTENANCE OF TRAFFIC PLAN NOTES AND PER COLUMBUS CITY CODE CHAPTER 2155.055 FEES FOR PARKING METERS OUT OF SERVICE, FOR ALL PAID PARKING (WHICH MAY INCLUDE PARKING METERS, KIOSKS, AND MOBILE PAYMENT ONLY ZONES) THAT ARE TAKEN OUT OF SERVICE (BAGGED OR REMOVED) DUE TO THE CONSTRUCTION OF THIS PROJECT, THE COST IS THE RESPONSIBILITY OF THE CONTRACTOR AS A PART OF THIS CONTRACT. WHILE THE ACTUAL PAID PARKING TO BE TAKEN OUT OF SERVICE IS NOT LISTED OR INCLUDED IN THESE PLANS, THE CONTRACTOR IS TO IDENTIFY THE PAID PARKING TO BE REMOVED FROM SERVICE, AND DETERMINE THE COST.

THE CONTRACTOR IS RESPONSIBLE FOR PAYING THE DAILY LOST PAID PARKING REVENUE FOR EACH PAID PARKING SPACE TAKEN OUT OF SERVICE.

TO CALCULATE AN ESTIMATE FOR THE LOST REVENUE, VISIT THE PARKING CALCULATOR AT [HTTPS://GIS.COLUMBUS.GOV/PARKINGCALCULATOR](https://gis.columbus.gov/parkingcalculator). THE PARKING CALCULATOR IS A HELPFUL TOOL TO ASSIST IN PAID PARKING AREAS, ESPECIALLY IN AREAS WHERE THE PARKING SPACES ARE NOT DELINEATED WITH PAVEMENT MARKINGS. BELOW ARE INSTRUCTIONS FOR USING THE PARKING CALCULATOR:

1. SET VARIABLES FOR THE PARKING CALCULATOR:
 - FIND THE PROJECT LOCATION ON THE WEB MAP BY SEARCHING IN THE ADDRESS SEARCH BAR OR ZOOMING TO THE LOCATION.
 - DETERMINE IF THERE IS A MOBILE PAY ONLY ZONE, PARKING METERS ONLY OR BOTH IN THE PROJECT BOUNDARIES, THEN SELECT THE APPLICABLE BUTTON ON THE "PARKING COST REPORT".
 - USE THE DATE RANGE SELECTION TO SPECIFY WHEN METERS WILL BE OUT OF SERVICE. THE APPLICATION WILL AUTO-CALCULATE TO EXCLUDE SUNDAYS/HOLIDAYS WHEN METERS ARE OUT OF SERVICE.
2. SELECT THE AREA IMPACTED BY THE PROJECT:
 - SELECT THE POLYGON BUTTON AND DRAW OR OUTLINE THE AREA OF THE PAID PARKING THAT WILL BE OUT OF SERVICE. THE ERASER BUTTON (JUST BELOW THE POLYGON BUTTON) CAN BE USED TO CLEAR THE CURRENT DRAWING.
 - ONCE AN AREA IS SELECTED, THE CALCULATOR WILL OUTPUT THE TOTAL COST FOR THE DATE RANGE AND AREA SPECIFIED.
3. INTERPRET RESULTS:
 - ONCE YOU HAVE SELECTED YOUR AREA, VIEW THE PARKING COST REPORT, WHICH WILL PROVIDE THE AMOUNT OF PAID PARKING FEES DUE FOR THE LOCATION AND DURATION SELECTED.
 - THIS RATE ONLY INCLUDES THE LOST PAID PARKING REVENUE FEE AND DOES NOT INCLUDE ANY PERMIT FEES ASSESSED BY THE PERMIT OFFICE.

FOR QUESTIONS RELATED TO CALCULATING FEES, CONTACT THE CITY OF COLUMBUS, DIVISION OF PARKING SERVICES AT [PARKINGSERVICES@COLUMBUS.GOV](mailto:parkingservices@columbus.gov) FOR ASSISTANCE WITH ESTIMATING THE DAILY PAID PARKING REVENUE RATE. PROVIDE THE PROJECT ODOT PID AND CITY OF COLUMBUS E-PLAN IN THE SUBJECT LINE OF THE EMAIL.

ALL PAID PARKING SPACES ARE FREE ON SUNDAY AND CITY RECOGNIZED HOLIDAYS. THE FOLLOWING ARE CITY RECOGNIZED HOLIDAYS: NEW YEAR'S DAY, MARTIN LUTHER KING DAY, PRESIDENTS' DAY, MEMORIAL DAY, JUNETEENTH, INDEPENDENCE DAY, LABOR DAY, VETERANS DAY, THANKSGIVING DAY, AND CHRISTMAS DAY. ALL RATES ARE SUBJECT TO CHANGE BY THE CITY OF COLUMBUS. PLEASE NOTE, IF A HOLIDAY FALLS ON A SUNDAY BUT THE CITY RECOGNIZES THE HOLIDAY ON A MONDAY, THE PARKING IS FREE ON THE ACTUAL HOLIDAY, NOT THE DAY THE CITY RECOGNIZES THE HOLIDAY.

THIS COST IS TO BE INCLUDED IN THE BID FOR THIS PROJECT AS A PART OF ITEM 614 MAINTENANCE OF TRAFFIC, LUMP SUM.

AT THE TIME THE CONTRACTOR SUBMITS FOR THE STREET OCCUPANCY/EXCAVATION PERMIT, ALONG WITH THE PAID PARKING IDENTIFICATION NUMBERS TO BE INCLUDED ON THE PERMIT REQUEST FORM, THE CONTRACTOR IS TO PROVIDE A LISTING OF THE METER IDENTIFICATION NUMBERS AND MOBILE PAYMENT ZONE NUMBERS AND THE NUMBER OF DAYS THAT EACH PAID PARKING SPACE IS TO BE OUT OF SERVICE, TO THE DEPARTMENT OF PUBLIC SERVICE PERMIT OFFICE. THE PERMIT OFFICE WILL VERIFY THAT THE HOURLY RATES ARE CORRECT AND CALCULATE THE COST OF THE PERMIT.

ANY QUESTIONS ABOUT THIS SPECIAL PROVISION ARE TO BE SUBMITTED THROUGH THE OWNER AGENCY OFFERING THE SOLICITATION OF THIS BID AS A PRE-BID QUESTION.

EXISTING PARKING KIOSKS

THE EXISTING PARKING KIOSKS SHALL REMAIN IN PLAN WHILE ON-STREET PARKING IS PERMITTED. WHEN THE CONTRACTOR IS PLANNING TO RESTRICT ON-STREET PARKING FOR THE DURATION OF CONSTRUCTION, THE CONTRACTOR SHALL NOTIFY THE CITY OF COLUMBUS (614-645-3111) 2 WEEKS PRIOR TO THE RESTRICTION. THE CITY OF COLUMBUS WILL BE RESPONSIBLE TO REMOVING THE EXISTING PARKING KIOSKS.

NO.	DESCRIPTION	DATE	REV. BY
5	REVISED WIDTH	AKF	11-1-23

CALCULATED
SLB
CHECKED
AKF

TRAFFIC CONTROL NOTES / LEGEND

FRA - 70 - 14.05

403
855


ITEM 647 - PAVEMENT MARKING, MISC.: TURN QUEUE BOX, TYPE B90

THIS ITEM SHALL MEET THE REQUIREMENTS OF ITEM 647, TYPE B90.


PAYMENT FOR THIS ITEM SHALL BE EACH AT THE CONTRACT UNIT PRICE FOR ITEM 647 - PAVEMENT MARKING, MISC.: TURN QUEUE BOX, TYPE B90.

INCLUDED IN THE PAY ITEM SHALL BE THE ITEM 644 - 4" WHITE BORDER FOR ALL SIDES OF THE QUEUE BOX.


THE FOLLOWING DETAILS SHALL BE UTILIZED FOR THE TURN QUEUE BOXES.

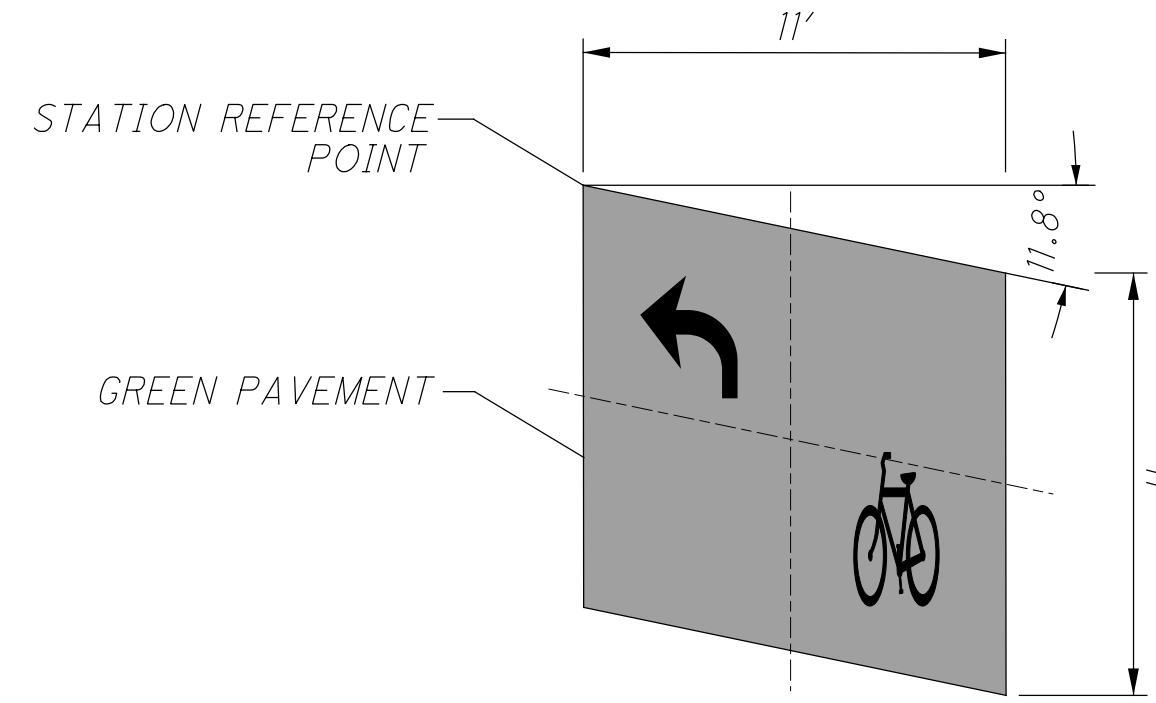

SKewed LEFT TURN QUEUE BOX
N.T.S.

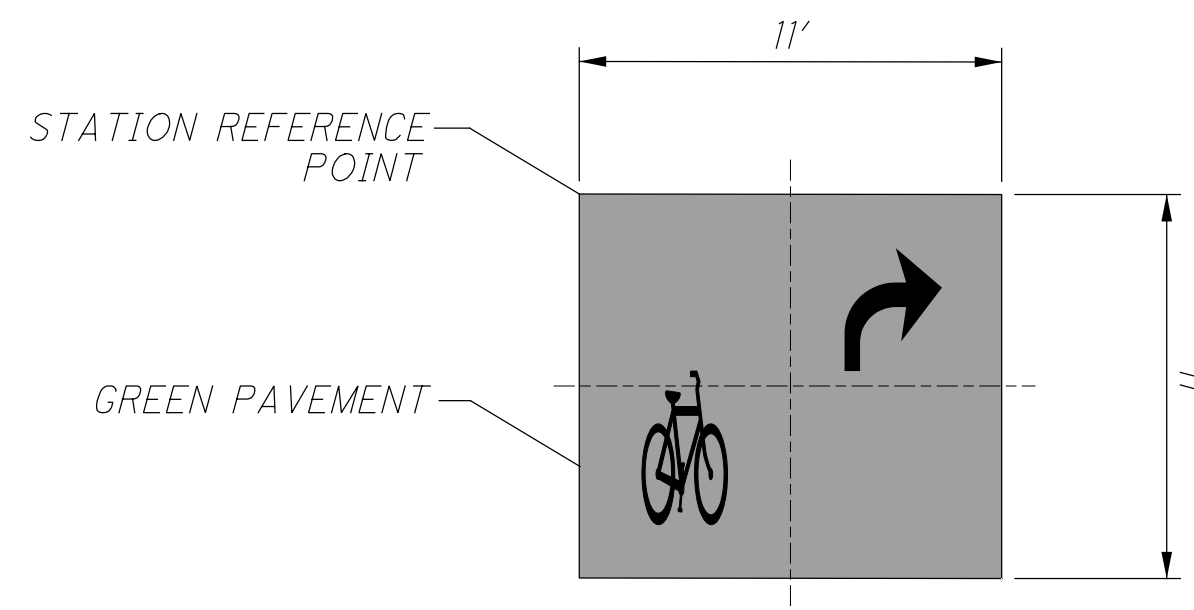

RIGHT TURN QUEUE BOX
N.T.S.

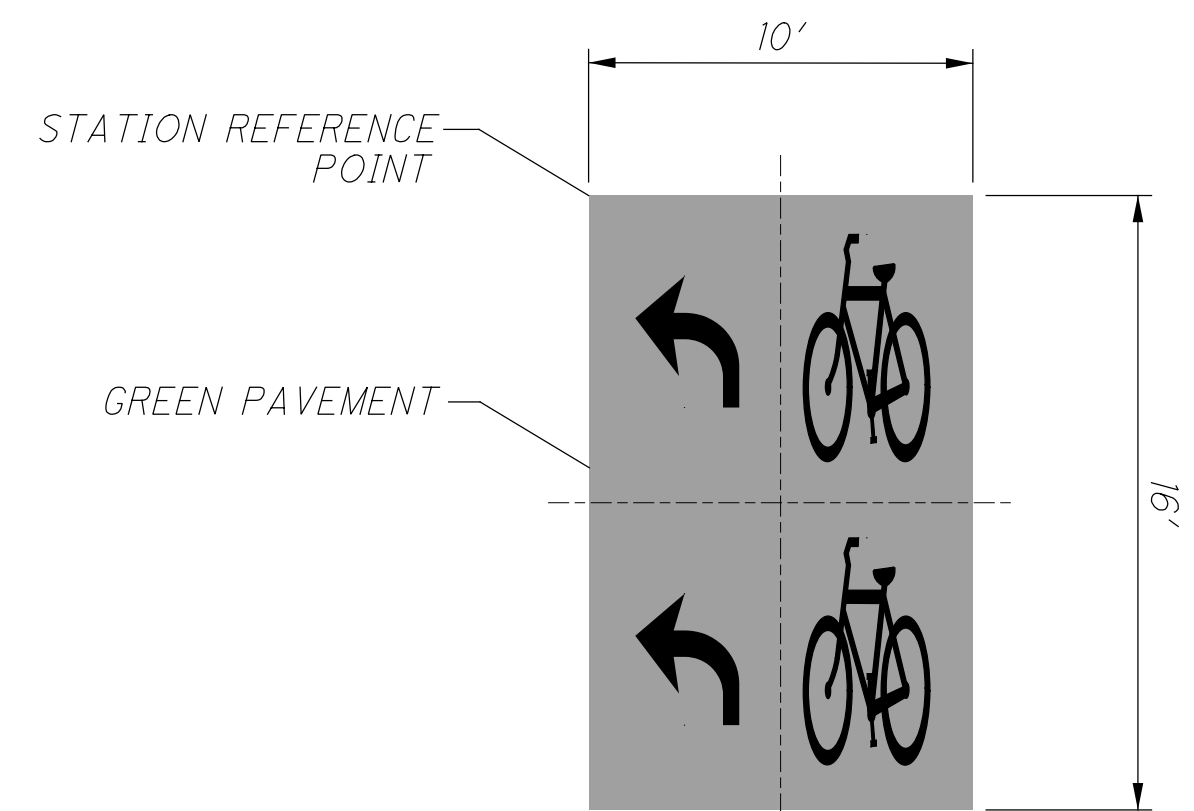

LEFT TURN QUEUE BOX
N.T.S.

LAYOUT OF PAVEMENT MARKINGS FOR MAINTENANCE OF TRAFFIC RESTORATION

ALTHOUGH PERMANENT PAVEMENT MARKINGS ARE TO BE INSTALLED AT THE END OF CONSTRUCTION, PAVEMENT MARKING PLAN SHEETS HAVE NOT BEEN INCLUDED IN THE CONTRACT PLANS FOR THE AREAS OF PAVEMENT MARKING RESTORATION DUE TO MAINTENANCE OF TRAFFIC LIMITS ON THE SURFACE STREETS. IN LIEU OF A PAVEMENT MARKING PLAN, THE CONTRACTOR SHALL, PRIOR TO THE START OF CONSTRUCTION, PREPARE AN INVENTORY LOG OF ALL EXISTING PAVEMENT MARKINGS FOR USE IN RESTORING THE MARKINGS AT THE END OF CONSTRUCTION. THE CONTRACTOR SHALL DELIVER TWO (2) COPIES OF THE INVENTORY AND LOG TO THE DISTRICT BEFORE BEGINNING ANY PAVEMENT REMOVALS.

THE CONTRACTOR SHALL BE RESPONSIBLE FOR THE LAYOUT OF THE VARIOUS FINAL PAVEMENT MARKINGS IN ACCORDANCE WITH SECTION 641.06.

UNLESS DIRECTED OTHERWISE BY THE DISTRICT, THE FINAL PAVEMENT MARKINGS SHALL BE RESTORED IN THEIR ORIGINAL PATTERNS AND LOCATION. FINAL LOCATION OF ALL PAVEMENT MARKINGS (PRE-LINE LAYOUT) SHALL BE APPROVED BY THE DISTRICT IN THE FIELD.

THE TABLE TO THE RIGHT PROVIDES ESTIMATED QUANTITIES BASED ON THE PRESENT LOCATIONS OF THE EXISTING PAVEMENT MARKINGS WITHIN THE PROJECT MAINTENANCE OF TRAFFIC LIMITS.

THE COST OF LOGGING AND PREMARKING SHALL BE INCLUDED FOR THE VARIOUS PAVEMENT MARKING ITEMS. NO SEPARATE PAYMENT SHALL BE MADE.

REF. NO.	LOCATION	STATION		SIDE	ITEM 644												646	647
		FROM	TO		PARKING LOT STALL MARKING	LANE ARROW	PAVEMENT MARKING, MISC.: BIKE LANE DOTTED LINE, 6"	PAVEMENT MARKING, MISC.: CHANNELIZING LINE, 12"	PAVEMENT MARKING, MISC.: STOP LINE, 24"	PAVEMENT MARKING, MISC.: TRANSVERSE / DIAGONAL LINE, 24"	PAVEMENT MARKING, MISC.: EDGE LINE, 6"	PAVEMENT MARKING, MISC.: LANE LINE, 6"	PAVEMENT MARKING, MISC.: EDGE LINE, 6", TYPE A1	PAVEMENT MARKING, MISC.: LANE LINE, 6", TYPE A1	LANE ARROW	BIKE LANE SYMBOL MARKING, TYPE B90		
		FT	FT		FT	EACH	FT	FT	FT	FT	FT	FT	FT	FT	FT	EACH	EACH	
LA	RAMP C5	5088+06		RT												1		
LA	RAMP C5	5088+72		RT												1		
LA	RAMP C5	5089+38		RT												1		
LA	RAMP C5	5090+70		RT												1		
PS	FULTON ST	22+80		RT	8													
PS	FULTON ST	22+57		RT	8													
PS	FULTON ST	22+34		RT	8													
PS	FULTON ST	22+11		RT	8													
PS	FULTON ST	21+88		RT	8													
PS	FULTON ST	21+65		RT	8													
PS	FULTON ST	21+42		RT	8													
PS	FULTON ST	21+19		RT	8													
PS	FULTON ST	20+96		RT	8													
PS	FULTON ST	20+73		RT	8													
LA	FULTON ST	21+26		RT		1												
LA	FULTON ST	21+84		RT		1												
LA	FULTON ST	22+40		RT		1												
LA	FULTON ST	22+98		RT		1												
DW	FULTON ST	23+58	24+43	LT			85											
DW	FULTON ST	23+58	24+43	LT			85											
DW	FULTON ST	23+58	24+43	LT			85											
DW	FULTON ST	40+27	41+27	LT			100											
CH	FULTON ST	21+03	23+28	RT				225										
SL	FULTON ST	23+32		LT/RT					48									
TW	FULTON ST	19+54	19+75	LT						12								
TW	FULTON ST	19+75	23+28	LT						164								
EW	FULTON ST	19+75	23+28	LT							353							
EW	FULTON ST	19+75	23+28	LT							353							
EW	FULTON ST	36+95	40+27	LT							332							
EW	FULTON ST	37+10	41+07	LT							397							
LL	FULTON ST	19+87	21+03	RT								116						
LL	FULTON ST	19+87	23+28	LT								341						
LL	FULTON ST	36+95	40+96	LT								401						
LL	FULTON ST	36+95	40+96	RT								401						
EW	FULTON ST	19+54	19+75	LT									21					
EW	FULTON ST	19+54	19+75	LT									21					
LL	FULTON ST	19+55	19+75	LT										20				
LL	FULTON ST	19+55	19+75	RT										20				
BI	FULTON ST	21+43		LT													1	
BI	FULTON ST	23+13		LT													1	
BI	FULTON ST	37+11		LT													1	
BI	FULTON ST	40+18		LT													1	
TW	3RD ST	1157+00	1157+80	LT						30								
EW	3RD ST	1157+00	1157+80	LT							80							
EW	3RD ST	1157+00	1157+80	LT							80							
LL	3RD ST	1155+63	1157+80	LT								217						
LL	3RD ST	1155+63	1157+80	RT								217						
LL	3RD ST	1155+63	1157+80	RT								217						
LA	3RD ST	1159+06		LT													1	
LA	3RD ST	1159+65		LT													1	
BI	3RD ST	1157+54		LT													1	
EW	4TH ST	1154+84	1155+19	LT							35							
EW	4TH ST	1154+84	1155+19	LT							35							
LL	4TH ST	1154+84	1156+75	RT								191						
LL	4TH ST	1154+84	1156+75	LT								191						
BI	4TH ST	1155+01		LT													1	
TOTALS					80	4	355	225	48	206	1665	2292	42	40	6	6		
TOTALS (MILE)											0.32	0.44	0.01	0.01				
TOTALS CARRIED TO TRAFFIC CONTROL GENERAL SUMMARY					80	4	355	225	48	206	0.32	0.44	0.01	0.01	6	6		

NO.	DESCRIPTION	DATE	REV. BY
5	REVISED WIDTH	AKF	11-1-23

01-2015-2015370-FRA-16065-TRAFFIC-SHEETS-16053TN002.DGN
 11/1/2023
 12:01:21 PM
 ODOT\B15TD\LSEB

SHEET NUMBER											PARTICIPATION			ITEM	ITEM EXT.	GRAND TOTAL	UNIT	DESCRIPTION	SEE SHEET NO.
OFFIC CALCS		404	409	413	414	415	416	417	418	458	01/IMS/04								
			438										621	00100	438	EACH	RPM		
			438										621	54000	438	EACH	RAISED PAVEMENT MARKER REMOVED		
									7				625	32000	7	EACH	GROUND ROD		
99													626	00102	99	EACH	BARRIER REFLECTOR, TYPE 1, ONE-WAY		
					50.0	135.6	218.0						630	02100	403.6	FT	GROUND MOUNTED SUPPORT, NO. 2 POST		
					64.8	106.4	99.6						630	03100	270.8	FT	GROUND MOUNTED SUPPORT, NO. 3 POST		
								79.4					630	07000	79.4	FT	GROUND MOUNTED STRUCTURAL BEAM SUPPORT, W8X18		
								150.8					630	07500	150.8	FT	GROUND MOUNTED STRUCTURAL BEAM SUPPORT, W10X22		
								39.5					630	07600	39.5	FT	GROUND MOUNTED STRUCTURAL BEAM SUPPORT, W10X12		
									197.6				630	08000	197.6	FT	GROUND MOUNTED STRUCTURAL BEAM SUPPORT, W12X30		
						28.7							630	08004	28.7	FT	ONE WAY SUPPORT, NO. 3 POST		
						3	2						630	08600	5	EACH	SIGN POST REFLECTOR		
								18					630	09000	18	EACH	BREAKAWAY STRUCTURAL BEAM CONNECTION		
								1					630	72330	1	EACH	OVERHEAD SIGN SUPPORT, TYPE TC-12.31, DESIGN 10		
									3				630	72420	3	EACH	OVERHEAD SIGN SUPPORT, TYPE TC-15.116, DESIGN 2		
									7				630	79101	7	EACH	SIGN HANGER ASSEMBLY, MAST ARM, AS PER PLAN	446	
					1								630	79500	1	EACH	SIGN SUPPORT ASSEMBLY, POLE MOUNTED		
							2		4				630	79501	6	EACH	SIGN SUPPORT ASSEMBLY, POLE MOUNTED, AS PER PLAN	403	
					112.0	102.7	102.3			46.8			630	80100	363.8	SF	SIGN, FLAT SHEET		
									1239.0				630	80200	1239.0	SF	SIGN, GROUND MOUNTED EXTRUSHEET		
									369.0				630	80224	369.0	SF	SIGN, OVERHEAD EXTRUSHEET		
									51.0				630	80400	51.0	SF	SIGN, PERMANENT OVERLAY		
										3			630	80500	3	EACH	SIGN, DOUBLE FACED, STREET NAME		
					4								630	81020	4	EACH	CONCRETE MEDIAN BARRIER SIGN BRACKET		
									12				630	82000	12	EACH	SIGN BACKING ASSEMBLY		
									3				630	84010	3	EACH	CONCRETE BARRIER MEDIAN OVERHEAD SIGN SUPPORT FOUNDATION, TC-21.50		
									18				630	84500	18	EACH	GROUND MOUNTED STRUCTURAL BEAM SUPPORT FOUNDATION		
									4				630	84510	4	EACH	RIGID OVERHEAD SIGN SUPPORT FOUNDATION		
					5	29	16						630	84900	50	EACH	REMOVAL OF GROUND MOUNTED SIGN AND DISPOSAL		
									1				630	85400	5	EACH	REMOVAL OF GROUND MOUNTED MAJOR SIGN AND DISPOSAL		
					9	24	7						630	86002	40	EACH	REMOVAL OF GROUND MOUNTED POST SUPPORT AND DISPOSAL		
									4				630	86102	4	EACH	REMOVAL OF GROUND MOUNTED STRUCTURAL BEAM SUPPORT AND DISPOSAL		
					17								630	87100	17	EACH	REMOVAL OF OVERHEAD MOUNTED SIGN AND REERECTION		
					4		5						630	87400	9	EACH	REMOVAL OF OVERHEAD MOUNTED SIGN AND DISPOSAL		
									11				630	87500	11	EACH	REMOVAL OF POLE MOUNTED SIGN AND DISPOSAL		
					1		1						630	89706	2	EACH	REMOVAL OF OVERHEAD SIGN SUPPORT AND DISPOSAL, TYPE TC-12.30		
					4		1						630	89802	5	EACH	REMOVAL OF OVERHEAD SIGN SUPPORT AND DISPOSAL, TYPE TC-7.65		
									LS				630	95000	LS		SIGNING, MISC.: TRAFFIC SIGNAL SIGNS	445	
													644	00720	400	FT	CHEVRON MARKING		
		80											644	01200	80	FT	PARKING LOT STALL MARKING		
		4											644	01300	20	EACH	LANE ARROW		
													644	01350	2	EACH	LANE REDUCTION ARROW		
													644	01630	8	EACH	BIKE LANE SYMBOL MARKING		
													644	50100	1	EACH	PAVEMENT MARKING, MISC.: BIKE DETECTOR MARKING	403	
		355											644	50300	505	FT	PAVEMENT MARKING, MISC.: BIKE LANE DOTTED LINE, 6"	403	
		225											644	50300	584	FT	PAVEMENT MARKING, MISC.: CHANNELIZING LINE, 12"	403	
		48											644	50300	205	FT	PAVEMENT MARKING, MISC.: STOP LINE, 24"	403	
		206											644	50300	244	FT	PAVEMENT MARKING, MISC.: TRANSVERSE / DIAGONAL LINE, 24"	403	
													644	50400	0.93	MILE	PAVEMENT MARKING, MISC.: EDGE LINE, 6"	403	
		0.32											644	50400	0.92	MILE	PAVEMENT MARKING, MISC.: LANE LINE, 6"	403	
													645	90000	0.31	MILE	PAVEMENT MARKING, MISC.: EDGE LINE, 6", TYPE A1, WITH CONTRAST	403	
		0.01											645	90000	0.12	MILE	PAVEMENT MARKING, MISC.: LANE LINE, 6", TYPE A1, WITH CONTRAST	403	
													645	98000	239	FT	PAVEMENT MARKING, MISC.: CHANNELIZING LINE, 12", TYPE A1, WITH CONTRAST	403	
													646	20300	6	EACH	LANE ARROW		

TRAFFIC CONTROL GENERAL SUMMARY

FRA - 70 - 14.05

NO.	DESCRIPTION	DATE	REV. BY
5	REVISED WIDTH	AKF	11-1-23

407
855

D:\2015\2015370\FRA\6065\TRAFFIC SHEETS\6065370001.DGN
11/1/2023 12:08:00 PM
DDOTV8151D\LSEB

SHEET NUMBER										PARTICIPATION			ITEM	ITEM EXT.	GRAND TOTAL	UNIT	DESCRIPTION	SEE SHEET NO.
404				413	414					01/IMS/04								
					6					6			647	20610	6	EACH	LANE ARROW, TYPE B90	
	6				2					8			647	20910	8	EACH	BIKE LANE SYMBOL MARKING, TYPE B90	
					4					4			647	50100	4	EACH	PAVEMENT MARKING, MISC.: TURN QUEUE BOX, TYPE B90	404
					634					634			647	50120	634	FT	PAVEMENT MARKING, MISC.: DOTTED LINE, 6", TYPE B90	403
					16					16			647	50120	16	FT	PAVEMENT MARKING, MISC.: BIKE LANE DOTTED LINE, 6", TYPE B90	403
					199					199			647	50120	199	FT	PAVEMENT MARKING, MISC.: CROSSWALK LINE, 12", TYPE B90	403
					45					45			647	50120	45	FT	PAVEMENT MARKING, MISC.: STOP LINE, 24", TYPE B90	403
					618					618			647	60020	618	SF	GREEN COLORED PAVEMENT FOR BIKES, TYPE B90	
					0.06					0.06			807	12010	0.06	MILE	WET REFLECTIVE EPOXY PAVEMENT MARKING, EDGE LINE, 6"	
					0.12					0.12			807	12110	0.12	MILE	WET REFLECTIVE EPOXY PAVEMENT MARKING, LANE LINE, 6"	
					4.00					4.00			807	14010	4.00	MILE	WET REFLECTIVE THERMOPLASTIC PAVEMENT MARKING, EDGE LINE, 6"	
					5.69					5.69			807	14110	5.69	MILE	WET REFLECTIVE THERMOPLASTIC PAVEMENT MARKING, LANE LINE, 6"	
					5427					5427			807	14310	5427	FT	WET REFLECTIVE THERMOPLASTIC PAVEMENT MARKING, CHANNELIZING LINE, 12"	
					8414					8414			807	14410	8414	FT	WET REFLECTIVE THERMOPLASTIC PAVEMENT MARKING, DOTTED LINE, 6"	
					9.69					9.69			850	10010	9.69	MILE	GROOVING FOR 6" RECESSED PAVEMENT MARKING, (ASPHALT)	
					8414					8414			850	10110	8414	FT	GROOVING FOR 6" RECESSED PAVEMENT MARKING, (ASPHALT)	
					5427					5427			850	10130	5427	FT	GROOVING FOR 12" RECESSED PAVEMENT MARKING, (ASPHALT)	
					0.18					0.18			850	20010	0.18	MILE	GROOVING FOR 6" RECESSED PAVEMENT MARKING, (CONCRETE)	

TRAFFIC CONTROL GENERAL SUMMARY

FRA - 70 - 14.05

NO.	DESCRIPTION	DATE	REV. BY
5	REVISED WIDTH & QUANTITY	AKF	11-1-23

01:2015\2015370\FRA\60653\TRAFFIC SHEETS\60653T0002.DGN
 11/1/2023 12:43:04 PM
 DDC\Y815TD\USER

SHEET NO.	REF. NO.	LOCATION	STATION		SIDE	644	644	644	644	644	644	644	644	644	644	807	807	807	807	807	807	807	850	850	850	850		
			CHEVRON MARKING	LANE ARROW		LANE REDUCTION ARROW	BIKE LANE SYMBOL MARKING	PAVEMENT MARKING, MISC.: BIKE DETECTOR MARKING	PAVEMENT MARKING, MISC.: BIKE LANE DOTTED LINE, 6"	PAVEMENT MARKING, MISC.: CHANNELIZING LINE, 12"	PAVEMENT MARKING, MISC.: STOP LINE, 24"	PAVEMENT MARKING, MISC.: TRANSVERSE / DIAGONAL LINE, 24"	PAVEMENT MARKING, MISC.: EDGE LINE, 6"	PAVEMENT MARKING, MISC.: LANE LINE, 6"	WET REFLECTIVE EPOXY PAVEMENT MARKING, EDGE LINE, 6" (WHITE)	WET REFLECTIVE EPOXY PAVEMENT MARKING, LANE LINE, 6"	WET REFLECTIVE THERMOPLASTIC PAVEMENT MARKING, EDGE LINE, 6" (YELLOW)	WET REFLECTIVE THERMOPLASTIC PAVEMENT MARKING, EDGE LINE, 6" (WHITE)	WET REFLECTIVE THERMOPLASTIC PAVEMENT MARKING, LANE LINE, 6"	WET REFLECTIVE THERMOPLASTIC PAVEMENT MARKING, CHANNELIZING LINE, 12"	WET REFLECTIVE THERMOPLASTIC PAVEMENT MARKING, DOTTED LINE, 6"	GROOVING FOR 6" RECESSED PAVEMENT MARKING, (ASPHALT)	GROOVING FOR 6" RECESSED PAVEMENT MARKING, (ASPHALT)	GROOVING FOR 12" RECESSED PAVEMENT MARKING, (ASPHALT)	GROOVING FOR 6" RECESSED PAVEMENT MARKING, (CONCRETE)			
			FROM	TO		FT	EACH	EACH	EACH	EACH	FT	FT	FT	FT	FT	FT	FT	FT	FT	FT	FT	FT	FT	FT	FT			
423	EY	I-70 EB	202+00	213+00	LT												1100					1100						
423	EW	I-70 EB	202+00	213+00	RT																	1100						
423	LL	I-70 EB	202+00	213+00	CEN																	1100						
423	LL	I-70 EB	202+00	213+00	RT																	1100						
423	DW	I-70 EB	202+00	213+00	RT																	1100						
423	DW	I-70 EB	208+60	213+00	RT																	440						
423	LR	I-70 EB	202+11		LT																							
423	EY	I-70 WB	3201+99	3213+03	RT																							
423	EW	I-70 WB	3201+99	3213+03	LT																							
423	LL	I-70 WB	3206+00	3213+03	RT																							
423	DW	I-70 WB	3201+99	3206+00	RT																							
423	LL	I-70 WB	3201+99	3213+03	CEN																							
423	LL	I-70 WB	3201+99	3213+03	LT																							
423	LL	I-70 WB	3206+00	3213+03	LT																							
423	DW	I-70 WB	3201+99	3206+00	LT																							
424	EY	I-70 EB	213+00	226+00	LT																							
424	EW	I-70 EB	213+00	213+84	RT																							
424	EW	I-70 EB	223+55	226+00	RT																							
424	LL	I-70 EB	213+00	226+00	CEN/LT																							
424	LL	I-70 EB	213+00	215+13	RT																							
424	CH	I-70 EB	213+84	215+13	RT																							
424	CH	I-70 EB	218+13	223+55	RT																							
424	TW	I-70 EB	218+13	223+55	RT	118																						
424	DW	I-70 EB	213+00	218+13	RT																							
424	DW	I-70 EB	213+00	213+84	RT																							
424	EW	RAMP C4	775+21	778+56	RT																							
424	LL	RAMP C4	770+41	778+56	RT/CEN																							
424	CH	RAMP C4	770+41	775+21	RT																							
424	CH	RAMP C4	773+41	778+56	LT																							
424	EY	RAMP N1	868+71	870+30	LT																							
424	EW	RAMP N1	862+68	870+30	CEN/RT																							
424	CH	RAMP N1	862+68	868+71	LT																							
424	TW	RAMP N1	862+68	868+71	LT	282																						
424	EY	I-70 WB	3213+03	3226+00	RT																							
424	EW	I-70 WB	3213+03	3226+00	LT																							
424	LL	I-70 WB	3213+03	3218+16	RT																							
424	LL	I-70 WB	3213+03	3226+00	CEN/RT																							
424	LL	I-70 WB	3213+03	3220+18	LT																							
424	LL	I-70 WB	3213+03	3226+00	LT																							
424	CH	I-70 WB	3220+18	3226+00																								
424	CH	I-70 WB	3220+18	3226+00																								
425	EY	I-70 EB	226+00	226+60	LT																							
425	EW	I-70 EB	226+00	226+60	LT																							
425	LL	I-70 EB	226+00	226+60	RT																							
425	EY	I-70 WB	3226+00	3228+00	RT/LT																							
425	EW	I-70 WB	3226+39	3228+00	LT																							
425	LL	I-70 WB	3226+00	3228+00	RT/LT																							
425	CH	I-70 WB	3226+00	3226+39	LT																							
425	EY	RAMP Q4	875+18	881+69	RT																							
425	EW	RAMP Q4	874+83	881+69	RT																							
425	LL	RAMP Q4	874+83	881+69	RT																							
425	CH	RAMP Q4	874+83	875+18	RT																							
TOTALS CARRIED TO SHEET 413						400		1										5871	5834	12910	3507	2939	24615	2939	3507			

NO.	DESCRIPTION	DATE	REV. BY
5	REVISED WIDTH	AKF	11-1-23

N:\03\60\08353\05430_FRA-70-13.0\Design\Roadway\Sheets\05430_GG004.dgn Sheet 11/6/2023 11:00:33 AM awhite

SHEET NUM.										PART.		ITEM	ITEM EXT	GRAND TOTAL	UNIT	DESCRIPTION	SEE SHEET NO.
										02/IMS/11	05/IMS/14						
								12	132	OFFICE CALCS							
RETAINING WALLS (MSE W6)																	
									122			512	10100	122	SY	SEALING OF CONCRETE SURFACES (EPOXY-URETHANE)	
									1,005			840	20000	1,005	SF	MECHANICALLY STABILIZED EARTH WALL	
									227			840	21000	227	CY	WALL EXCAVATION	
									111			840	22000	111	SY	FOUNDATION PREPARATION	
									479			840	23000	479	CY	SELECT GRANULAR BACKFILL	
									156			840	25010	156	FT	6" DRAINAGE PIPE, PERFORATED	
									24			840	25020	24	FT	6" DRAINAGE PIPE, NON-PERFORATED	
									73			840	26000	73	FT	CONCRETE COPING	
									1,005			840	26050	1,005	SF	AESTHETIC SURFACE TREATMENT	
									5			840	27000	5	DAY	ON-SITE ASSISTANCE	
									LS			840	28000	LS		SGB INSPECTION AND COMPACTION TESTING	
MAINTENANCE OF TRAFFIC																	
								4				614	12380	4	EACH	WORK ZONE IMPACT ATTENUATOR, 24" WIDE HAZARDS, (UNIDIRECTIONAL)	
								120				614	13310	120	EACH	BARRIER REFLECTOR, TYPE 1 (ONE WAY)	
								40				614	13350	40	EACH	OBJECT MARKER, ONE WAY	
								4				614	13600	4	EACH	MAINTENANCE OF TRAFFIC, ONE LANE CLOSURE ON A TWO LANE HIGHWAY	

CALCULATED
 DNO
 CHECKED
 DLT
GENERAL SUMMARY
FRA - 70 - 13.01
 14B
 137

NO.	DESCRIPTION	REV. BY	DATE
3	ADDED QUANTS FOR WALL	ACW	07/23/23
5	DELETED ITEM/QUANTITY	ACW	11/6/23

STANDARD DRAWINGS AND SUPPLEMENTAL SPECIFICATIONS

REFER TO THE FOLLOWING STANDARD BRIDGE DRAWINGS:
AS-1-15 DATED (REVISED) 7/17/15
AS-2-15 DATED (REVISED) 1/18/19
EXJ-4-87 DATED (REVISED) 1/19/18
SBR-1-13 DATED (REVISED) 7/20/18

DESIGN SPECIFICATIONS

THIS STRUCTURE CONFORMS TO THE 8TH EDITION OF THE "LRFD BRIDGE DESIGN SPECIFICATIONS" ADOPTED BY THE AMERICAN ASSOCIATION OF STATE HIGHWAY AND TRANSPORTATION OFFICIALS. 2017 AND THE ODOT BRIDGE DESIGN MANUAL, 2020.

DESIGN LOADINGS

HL-93 DESIGN LOADING
FUTURE WEARING SURFACE (FWS) OF 10 LBS./SQ. FT.

DESIGN DATA

CONCRETE CLASS QC2 - COMPRESSIVE STRENGTH 4500 PSI (SUPERSTRUCTURE)

CONCRETE CLASS QC1 - COMPRESSIVE STRENGTH 4000 PSI (SUBSTRUCTURE)

REINFORCING STEEL - ASTM A709, GRADE 60, MINIMUM YIELD STRENGTH 60,000 PSI

EXISTING STRUCTURAL STEEL - ASTM A36 - YIELD STRENGTH 20,000 PSI

DECK PROTECTION METHOD

CLASS HP CONCRETE
EPOXY COATED REINFORCING STEEL
2" CONCRETE COVER
SEALING OF CONCRETE SURFACES

MONOLITHIC WEARING SURFACE

MONOLITHIC WEARING SURFACE IS ASSUMED, FOR DESIGN PURPOSES, TO BE 1" THICK.

CUT LINE CONSTRUCTION JOINT PREPARATION

SAW CUT BOUNDARIES OF PROPOSED CONCRETE REMOVALS 1 INCH DEEP. REMOVE CONCRETE TO A ROUGH SURFACE. LEAVE THE EXISTING REINFORCING STEEL, IF REQUIRED IN THE PLANS, IN PLACE. INSTALL DOWEL BARS IF SPECIFIED. PRIOR TO CONCRETE PLACEMENT ABRASIVELY CLEAN JOINT SURFACES AND EXISTING EXPOSED REINFORCEMENT TO REMOVE LOOSE AND DISINTEGRATED CONCRETE AND LOOSE RUST. THOROUGHLY CLEAN THE JOINT SURFACE AND EXPOSED REINFORCEMENT OF ALL DIRT, DUST, RUST OR OTHER FOREIGN MATERIAL BY THE USE OF WATER, AIR UNDER PRESSURE, OR OTHER METHODS THAT PRODUCE SATISFACTORY RESULTS. EXISTING REINFORCING STEEL DOES NOT HAVE TO HAVE A BRIGHT STEEL FINISH, BUT REMOVE ALL PACK AND LOOSE RUST. THOROUGHLY DRENCH EXISTING CONCRETE SURFACES WITH CLEAN WATER AND ALLOW TO DRY TO A DAMP CONDITION BEFORE PLACING CONCRETE.

DECK PLACEMENT DESIGN ASSUMPTIONS

THE FOLLOWING ASSUMPTIONS OF CONSTRUCTION MEANS AND METHODS WERE MADE FOR THE ANALYSIS AND DESIGN OF THE SUPERSTRUCTURE. THE CONTRACTOR IS RESPONSIBLE FOR THE DESIGN OF THE FALSEWORK SUPPORT SYSTEM WITHIN THESE PARAMETERS AND WILL ASSUME RESPONSIBILITY FOR SUPERSTRUCTURE ANALYSIS FOR DEVIATION FROM THESE DESIGN ASSUMPTIONS.

AN EIGHT WHEEL FINISHING MACHINE WITH A MAXIMUM WHEEL LOAD OF 1.13 KIPS FOR A TOTAL MACHINE LOAD OF 9.0 KIPS.

A MINIMUM OUT-TO-OUT WHEEL SPACING AT EACH END OF THE MACHINE OF 103".

A MAXIMUM SPACING OF OVERHANG FALSEWORK BRACKETS OF 48 IN.

A MAXIMUM DISTANCE FROM THE CENTERLINE OF THE FASCIA BEAM TO THE FACE OF THE SAFETY HANDRAIL OF 65".

SUBSTRUCTURE CONCRETE REMOVAL

REMOVE CONCRETE BY MEANS OF APPROVED PNEUMATIC HAMMERS EMPLOYING POINTED AND BLUNT CHISEL TOOLS. HYDRAULIC HOE-RAM TYPE HAMMERS WILL NOT BE PERMITTED. THE WEIGHT OF THE HAMMER SHALL NOT BE MORE THAN 35 POUNDS FOR REMOVAL WITHIN 18 INCHES OF PORTIONS TO BE PRESERVED. OUTSIDE THE 18 INCH LIMIT, THE CONTRACTOR MAY USE HAMMERS NOT EXCEEDING 90 POUNDS UPON THE APPROVAL OF THE ENGINEER. DO NOT PLACE PNEUMATIC HAMMERS IN DIRECT CONTACT WITH REINFORCING STEEL THAT IS TO BE RETAINED IN THE REBUILT STRUCTURE.

UTILITY LINES

THE UTILITIES SHALL BORE ALL EXPENSE INVOLVED IN RELOCATING (INSTALLING) THE AFFECTED UTILITY LINES. THE CONTRACTOR AND UTILITIES ARE TO COOPERATE BY ARRANGING THEIR WORK IN SUCH A MANNER THAT INCONVENIENCE TO EITHER WILL BE HELD TO A MINIMUM.

ITEM 202, PORTIONS OF STRUCTURE REMOVED, OVER 20

FOOT SPAN, AS PER PLAN

THIS WORK CONSISTS OF THE REMOVAL OF CONCRETE DECKS INCLUDING PARAPETS, RAILINGS, DECK JOINTS AND OTHER APPURTENANCES FROM STEEL SUPPORTING SYSTEMS (BEAMS, CROSS FRAMES, ETC.). THE PROVISIONS OF ITEM 202 APPLY EXCEPT AS SPECIFIED BY THE FOLLOWING NOTES. PERFORM WORK CAREFULLY DURING DECK REMOVALS TO PROTECT PORTIONS OF SUCH SYSTEMS THAT ARE TO BE SALVAGED AND INCORPORATED INTO THE PROPOSED STRUCTURE. THE USE OF EXPLOSIVES, HEADACHE BALLS AND/OR HOE RAM TYPE OF EQUIPMENT IS PROHIBITED. SUBMIT CONSTRUCTION PLANS ACCORDING TO CMS 501.05.

PROTECTION OF STEEL SUPPORT SYSTEMS: BEFORE DECK SLAB CUTTING IS PERMITTED, DRAW THE OUTLINE OF PRIMARY STEEL MEMBERS IN CONTACT WITH THE BOTTOM OF THE DECK ON THE SURFACE OF DECK. DRILL SMALL DIAMETER PILOT HOLES 2 INCHES OUTSIDE THESE LINES TO CONFIRM THE LOCATION OF FLANGE EDGES. DECK CUTS OVER OR WITHIN 2 INCHES OF FLANGE EDGES SHALL NOT EXTEND LOWER THAN THE BOTTOM LAYER OF DECK SLAB REINFORCING STEEL. CUTS MADE OUTSIDE 2 INCHES OF FLANGE EDGES MAY EXTEND THE FULL DEPTH OF THE DECK. PERFORM WORK CAREFULLY DURING CUTTING OF THE DECK SLAB TO AVOID DAMAGING STEEL MEMBERS THAT ARE TO BE INCORPORATED INTO THE PROPOSED STRUCTURE. REPLACE OR REPAIR STEEL MEMBERS DAMAGED BY THE DECK SLAB CUTTING OPERATIONS AT NO COST TO THE PROJECT. AT LEAST 7 DAYS BEFORE PERFORMING REPAIR WORK, SUBMIT A PROPOSED REPAIR PLAN, DEVELOPED BY AN OHIO REGISTERED PROFESSIONAL ENGINEER TO THE DIRECTOR. OBTAIN THE DIRECTOR'S APPROVAL BEFORE PERFORMING REPAIR.

REMOVAL METHODS: THE CONTRACTOR MAY REMOVE CONCRETE BY CUTTING AND BY MEANS OF HAND OPERATED PNEUMATIC HAMMERS EMPLOYING POINTED OR BLUNTED CHISEL TYPE TOOLS. FOR REMOVALS OVER STRUCTURAL MEMBERS (STEEL BEAM), THE CONTRACTOR MAY USE A HAMMER HEAVIER THAN 35 POUNDS BUT NOT TO EXCEED 90 POUNDS UNLESS APPROVED BY THE ENGINEER. REMOVAL METHODS OVER STRUCTURAL MEMBERS SHALL ENSURE ADEQUATE DEPTH CONTROL AND PREVENT NICKING OR GOUGING THE PRIMARY STRUCTURAL MEMBERS.

DUE TO THE POSSIBLE PRESENCE OF ATTACHMENTS (E.G., FINISHING MACHINE, SCUPPER AND FORM SUPPORTS, ETC.) TO EXISTING STRUCTURAL MEMBERS, PERFORM WORK CAREFULLY DURING DECK REMOVAL TO AVOID DAMAGING STRUCTURAL MEMBERS THAT ARE TO REMAIN. REPLACE OR REPAIR STRUCTURAL MEMBERS DAMAGED BY THE REMOVAL OPERATIONS AT NO COST TO THE PROJECT. AT LEAST 7 DAYS BEFORE PERFORMING REPAIR WORK, SUBMIT A PROPOSED REPAIR PLAN, DEVELOPED BY AN OHIO REGISTERED PROFESSIONAL ENGINEER TO THE DIRECTOR. OBTAIN THE DIRECTOR'S APPROVAL BEFORE PERFORMING REPAIR.

EXISTING WELDED ATTACHMENTS: REMOVE EXISTING WELDED ATTACHMENTS (E.G., FINISHING MACHINE AND FORM SUPPORTS; AND SUPPORTS FOR SCUPPERS AND BULB ANGLES WHICH ARE TO BE REMOVED) LOCATED IN THE DESIGNATED TENSION PORTIONS OF THE TOP FLANGES OF EXISTING STEEL MEMBERS AND GRIND THE FLANGE SURFACES SMOOTH. CAREFULLY GRIND PARALLEL TO THE FLANGES.

MEASUREMENT & PAYMENT: THE DEPARTMENT WILL MEASURE THE QUANTITY OF REMOVALS ON A LUMP SUM BASIS. THE DEPARTMENT WILL PAY FOR THE ACCEPTED QUANTITIES OF REMOVALS AT THE CONTRACT PRICE FOR ITEM 202 - PORTIONS OF STRUCTURE REMOVED, OVER 20' SPAN, AS PER PLAN. FOR MODIFICATIONS TO OR EXTENSIONS OF EXISTING CONCRETE SUBSTRUCTURE MEMBERS WHERE AESTHETICS IS A CONCERN, INCLUDE THE FOLLOWING NOTES IN AN ITEM 202, AS PER PLAN NOTE.

EXISTING STRUCTURE VERIFICATION

DETAILS AND DIMENSIONS SHOWN ON THESE PLANS PERTAINING TO THE EXISTING STRUCTURE HAVE BEEN OBTAINED FROM PLANS OF THE EXISTING STRUCTURE AND FROM FIELD OBSERVATIONS AND MEASUREMENTS. CONSEQUENTLY, THEY ARE INDICATIVE OF THE EXISTING STRUCTURE AND THE PROPOSED WORK BUT THEY SHALL BE CONSIDERED TENTATIVE AND APPROXIMATE. THE CONTRACTOR IS REFERRED TO CMS SECTIONS 102.05, 105.02 AND 513.04. BASE CONTRACT BID PRICES UPON A RECOGNITION OF THE UNCERTAINTIES DESCRIBED ABOVE AND UPON A PREBID EXAMINATION OF THE EXISTING STRUCTURE. HOWEVER, THE DEPARTMENT WILL PAY FOR ALL PROJECT WORK BASED UPON ACTUAL DETAILS AND DIMENSIONS THAT HAVE BEEN VERIFIED IN THE FIELD.

ITEM 511 CLASS QC2 CONCRETE WITH QC/QA, BRIDGE DECK (PARAPET), AS PER PLAN

GLASS FIBER REINFORCED POLYMER (G.F.R.P.) BARS SHALL BE USED FOR DIAGONAL REINFORCEMENT AS SHOWN IN THE PLANS. PAYMENT FOR G.F.R.P. BARS SHALL BE INCIDENTAL TO THE COST OF ITEM 511 - CLASS QC2 CONCRETE WITH QC/QA, BRIDGE DECK (PARAPET), AS PER PLAN.

ITEM 513 - STRUCTURAL STEEL FOR REHABILITATION, AS PER PLAN

AN ALLOWANCE OF 2520 LBS IS INCLUDED IN THE CONTRACT DOCUMENTS FOR REMOVAL AND REPLACEMENT IN KIND OF DETERIORATED STEEL CROSSFRAMES AT BOTH ABUTMENTS AND INTERNAL HINGE. COST TO REMOVE DETERIORATED MEMBERS IS INCIDENTAL TO ITEM 513 - STRUCTURAL STEEL FOR REHABILITATION, AS PER PLAN.

ITEM 516 - RESET BEARING, AS PER PLAN

A CONTINGENCY QUANTITY OF 12 EACH IS INCLUDED IN THE CONTRACT DOCUMENTS FOR RESETTING OF ALL EXISTING BEARINGS AT BOTH ABUTMENTS. BEARINGS WILL BE RESET AS PER THE REQUIREMENTS OF ITEM 516 - RESET BEARING, AS PER PLAN.

ITEM 516 - JACKING AND TEMPORARY SUPPORT OF SUPERSTRUCTURE, AS PER PLAN

THIS WORK CONSISTS OF RAISING OR RE-POSITIONING EXISTING STRUCTURES TO THE DIMENSIONS AND REQUIREMENTS DEFINED IN THE PROJECT PLANS.

SUBMIT CONSTRUCTION PLANS IN ACCORDANCE WITH CMS 501.05.

IF, DURING THE JACKING OPERATIONS, CRACKING OF THE CONCRETE SUPERSTRUCTURE, SEPARATION OF THE CONCRETE DECK FROM THE STEEL STRINGERS, OR OTHER DAMAGE TO THE STRUCTURE IS VISUALLY OBSERVED, IMMEDIATELY CEASE THE JACKING OPERATION AND INSTALL SUPPORTS TO THE SATISFACTION OF THE ENGINEER. ANALYZE THE DAMAGE AND SUBMIT A METHOD OF CORRECTION TO THE ENGINEER FOR APPROVAL. EPOXY INJECT ALL BEAMS THAT SEPARATE FROM THE DECK FOR THE DISTANCE OF THE SEPARATION IN ACCORDANCE WITH CMS 512.07. THE DEPARTMENT WILL NOT PAY FOR THE COST OF THIS EPOXY INJECTION OR OTHER REQUIRED REPAIRS. THE BRIDGE BEARINGS SHALL BE FULLY SEATED AT ALL CONTACT AREAS. IF FULL SEATING IS NOT OBTAINED, SUBMIT A REPAIR PLAN TO THE ENGINEER. THE DEPARTMENT WILL NOT PAY FOR THE REPAIR COSTS TO ENSURE FULL SEATING ON BEARINGS.

ITEM 519 - PATCHING CONCRETE STRUCTURE, AS PER PLAN

PRIOR TO THE SURFACE CLEANING SPECIFIED IN 519.04 AND WITHIN 24 HOURS OF PLACING PATCHING MATERIAL, BLAST CLEAN ALL SURFACES TO BE PATCHED INCLUDING THE EXPOSED REINFORCING STEEL. ACCEPTABLE METHODS INCLUDE HIGH PRESSURE WATER BLASTING WITH OR WITHOUT ABRASIVES IN THE WATER, ABRASIVE BLASTING WITH CONTAINMENT, OR VACUUM ABRASIVE BLASTING. AN ALLOWANCE OF 200 S.F. IS INCLUDED IN THE CONTRACT DOCUMENTS TO PATCH DEFICIENT AREAS OF THE CONCRETE SUBSTRUCTURES. AREAS REQUIRING PATCHING WILL BE DETERMINED IN THE FIELD BY THE PROJECT ENGINEER AND REPAIRED AS PER THE REQUIREMENTS OF ITEM 519 - PATCHING CONCRETE STRUCTURE, AS PER PLAN.

INSPECTION OF EXISTING STRUCTURAL STEEL

THE ENGINEER WILL VISUALLY INSPECT ALL EXISTING BUTT-WELDED SPLICES AND/OR TOP FLANGE COVER PLATE FILLET WELDS TO ENSURE THE WELDS, PLATES AND BEAMS ARE FREE OF DEFECTS AND CRACKS. IF NECESSARY, REMOVE ALL DECK SLAB HAUNCH FORMS IMMEDIATELY ADJACENT TO SUCH WELDS THAT MAY INTERFERE WITH THE ENGINEER'S INSPECTION. THE INSPECTION WILL NOT TAKE PLACE UNTIL THE TOP FLANGES ARE CLEANED ACCORDING TO 511.10, BUT IT WILL BE DONE BEFORE THE DECK SLAB REINFORCEMENT IS INSTALLED. THE DEPARTMENT WILL PAY FOR THE COST ASSOCIATED WITH THIS INSPECTION WITH ITEM 511, CLASS QC2 CONCRETE WITH QC/QA, BRIDGE DECK. THE ENGINEER WILL REPORT ALL CRACKS FOUND TO THE OFFICE OF CONSTRUCTION ADMINISTRATION, BRIDGE CONSTRUCTION SPECIALIST, ALONG WITH SPECIFIC INFORMATION ON LOCATION OF THE CRACKS, LENGTH, AND DEPTH SO AN EVALUATION AND REPAIR OR REPLACEMENT RECOMMENDATION CAN BE MADE.

PAINTING AND SEALING OPERATIONS

THE CONTRACTOR SHALL TAKE ALL PRECAUTIONS NECESSARY TO PREVENT EPOXY-URETHANE SEALER, PAINT, OR OTHER MATERIALS USED TO REPAIR, CLEAN, SEAL, OR TREAT ANY BRIDGE STRUCTURE FROM ENTERING ANY STREAMS, WETLANDS OR OTHER WATERS OF THE UNITED STATES AND TAKE THE APPROPRIATE ACTIONS IN THE EVENT OF A RELEASE.

ITEM SPECIAL - MISC.: VERTICAL CLEARANCE

AFTER ALL CONSTRUCTION HAS BEEN COMPLETED, A REGISTERED SURVEYOR WILL TAKE VERTICAL CLEARANCE MEASUREMENTS AT LOCATIONS INDICATED ON THE APPROVED ODOT FORM (AVAILABLE IN THE DISTRICT 4 STRUCTURES AND PAVEMENT OFFICE). THE FINAL MEASUREMENTS SHALL BE RECORDED ON THE FORM AND SUBMITTED TO THE PROJECT ENGINEER AND THE DISTRICT 4 STRUCTURES AND PAVEMENT ENGINEER. THE RECORD SHALL BEAR THE SEAL OF THE LICENSED SURVEYOR WHO HAS TAKEN THE MEASUREMENTS.

ASBESTOS NOTIFICATION

AN ASBESTOS SURVEY OF THE FRA-70-1301L, SFN 2504677 AND FRA-70-1301R, SFN 2504766 BRIDGES WAS CONDUCTED BY A CERTIFIED ASBESTOS HAZARD EVALUATION SPECIALIST. THE SURVEY DETERMINED THAT ASBESTOS IS PRESENT AT THE BRIDGES.

A COPY OF THE OHIO ENVIRONMENTAL PROTECTION AGENCY (OEPA) NOTIFICATION OF DEMOLITION AND RENOVATION FORMS, PARTIALLY COMPLETED AND SIGNED BY THE BRIDGE OWNER, WILL BE PROVIDED TO THE SUCCESSFUL BIDDER. THE CONTRACTOR SHALL COMPLETE THE FORM AND SUBMIT IT TO:

OHIO EPA/DIVISION OF AIR POLLUTION CONTROL
CENTRAL DISTRICT OFFICE
P.O. BOX 1049
COLUMBUS, OHIO 43216-1049
KELLY TOTH
PHONE: 614-728-3778
FAX: 614-728-3898

AT LEAST TEN (10) WORKING DAYS PRIOR TO THE START OF ANY DEMOLITION AND/OR REHABILITATION. THE CONTRACTOR SHALL PROVIDE A COPY OF THE COMPLETED FORM TO THE ENGINEER.

INFORMATION REQUIRED ON THE FORM WILL INCLUDE: 1) THE CONTRACTORS NAME AND ADDRESS, 2) THE SCHEDULED DATES FOR THE START AND COMPLETION OF THE BRIDGE REMOVAL AND 3) A DESCRIPTION OF THE PLANNED DEMOLITION WORK AND THE METHOD(S) TO BE USED.

THE CONTRACTOR SHALL FURNISH ALL FEES, LABOR, AND MATERIAL NECESSARY TO COMPLETE AND SUBMIT THE OEPA NOTIFICATION FORM.

BASIS OF PAYMENT:
THE CONTRACTOR SHALL FURNISH ALL THE FEES LABOR, EQUIPMENT AND MATERIALS NECESSARY TO COMPLETE THE OEPA NOTIFICATION OF DEMOLITION AND RENOVATION FORM AND PROPERLY REMOVE, ENCAPSULATE, HANDLE, TRANSPORT AND DISPOSE OF ASBESTOS CONTAINING MATERIALS IN A LANDFILL LICENSED BY THE LOCAL HEALTH DEPARTMENT AND PERMITTED BY THE OHIO ENVIRONMENTAL PROTECTION AGENCY DIVISION OF AIR POLLUTION CONTROL TO ACCEPT ASBESTOS CONTAINING MATERIAL. PAYMENT FOR THIS WORK SHALL BE MADE AT THE CONTRACT PRICE BID OF LUMP SUM.

PAYMENT FOR THIS WORK SHALL BE INCLUDED IN ITEM 202 PORTIONS OF STRUCTURE REMOVED OVER 20 FOOT SPAN, AS PER PLAN.

5

PROPOSED WORK

REMOVE AND REPLACE CONCRETE DECK, APPROACH SLABS AND PARAPETS INCLUDING EXPANSION JOINTS.

INSTALL SHEAR STUDS TO EXISTING BEAMS AND GIRDERS.

REPLACE ACCESS DOORS TO STEEL BOX PIER CAP.

PATCH DETERIORATED CONCRETE AS DIRECTED BY THE ENGINEER.

REPLACE DETERIORATED STRUCTURAL STEEL AS DIRECTED BY THE ENGINEER.


RESET BEARINGS AS DIRECTED BY THE ENGINEER.

DESIGN AGENCY: ms consultants, inc. 2221 Schrock Road Columbus, Ohio 43229
DATE: 3/8/2023
REVIEWED: YSU
DRAWN: ATM
DESIGNED: ATM
CHECKED: DEA
STRUCTURE FILE NUMBER: 2504677
GENERAL NOTES: FRA-70-1301L BRIDGE NO. FRA-70-1301L WESTBOUND I-70 OVER S.R. 315
PID No. 77372
4/30
53
137


NO.	DESCRIPTION	REV. BY	DATE
5	UPDATED NOTE	ACW	11/6/23

N:\03\60\08353\105430_FRA-70-1301\Design\Structures\FRA070_1301L_Sheets\070_1301L_SN001.dgn Sheet 11/6/2023 12:52:48 PM awhite


N:\03\60\08353\105430_FRA-70-1301R_Sheets\070_1301R_S002.dgn_Sheet 11/6/2023 12:56:48 PM cwhite

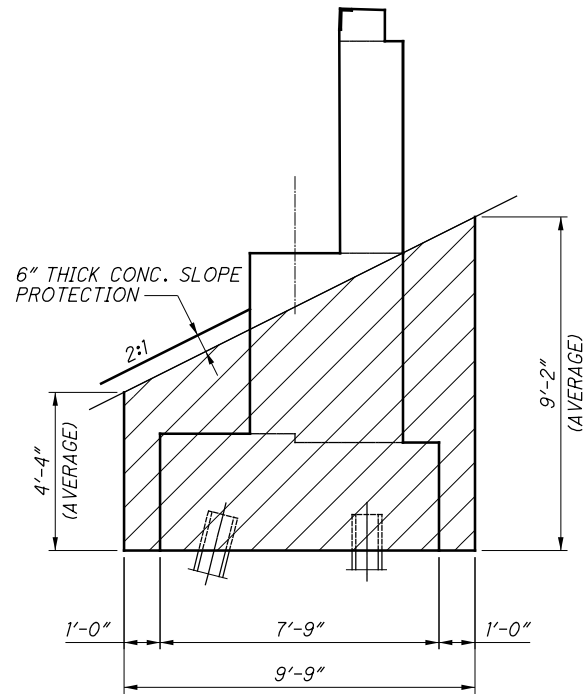

FORWARD ABUTMENT SECTION
LENGTH = 82'-0"

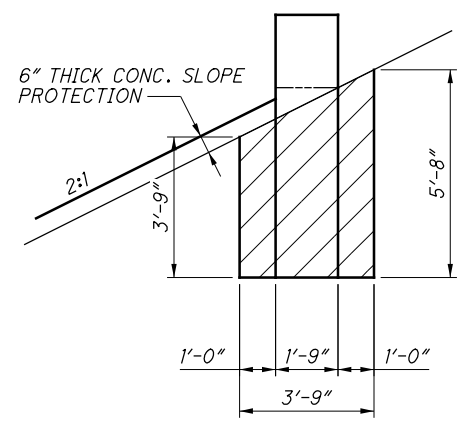

FORWARD ABUTMENT WINGWALL SECTION
LENGTH = 7'-11" (EACH SIDE)

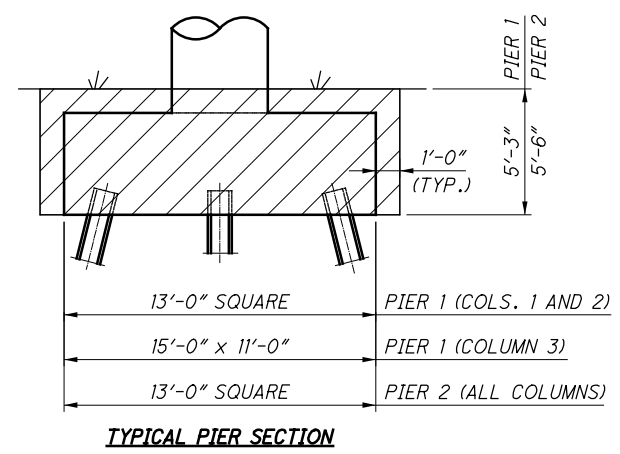

TYPICAL PIER SECTION

LIMITS OF EXCAVATION

- ITEM 503, UNCLASSIFIED EXCAVATION

ASBESTOS NOTIFICATION

AN ASBESTOS SURVEY OF THE FRA-70-1301R, SFN 2504677 AND FRA-70-1301R, SFN 2504766 BRIDGES WAS CONDUCTED BY A CERTIFIED ASBESTOS HAZARD EVALUATION SPECIALIST. THE SURVEY DETERMINED THAT ASBESTOS IS PRESENT AT THE BRIDGES.

A COPY OF THE OHIO ENVIRONMENTAL PROTECTION AGENCY (OEPA) NOTIFICATION OF DEMOLITION AND RENOVATION FORMS, PARTIALLY COMPLETED AND SIGNED BY THE BRIDGE OWNER, WILL BE PROVIDED TO THE SUCCESSFUL BIDDER. THE CONTRACTOR SHALL COMPLETE THE FORM AND SUBMIT IT TO:

OHIO EPA/DIVISION OF AIR POLLUTION CONTROL
CENTRAL DISTRICT OFFICE
P.O. BOX 1049
COLUMBUS, OHIO 43216-1049
KELLY TOH
PHONE: 614-728-3778
FAX: 614-728-3898

AT LEAST TEN (10) WORKING DAYS PRIOR TO THE START OF ANY DEMOLITION AND/OR REHABILITATION. THE CONTRACTOR SHALL PROVIDE A COPY OF THE COMPLETED FORM TO THE ENGINEER.

INFORMATION REQUIRED ON THE FORM WILL INCLUDE: 1) THE CONTRACTORS NAME AND ADDRESS, 2) THE SCHEDULED DATES FOR THE START AND COMPLETION OF THE BRIDGE REMOVAL AND 3) A DESCRIPTION OF THE PLANNED DEMOLITION WORK AND THE METHOD(S) TO BE USED.

BASIS OF PAYMENT:
THE CONTRACTOR SHALL FURNISH ALL THE FEES LABOR, EQUIPMENT AND MATERIALS NECESSARY TO COMPLETE THE OEPA NOTIFICATION OF DEMOLITION AND RENOVATION FORM AND PROPERLY REMOVE, ENCAPSULATE, HANDLE, TRANSPORT AND DISPOSE OF ASBESTOS CONTAINING MATERIALS IN A LANDFILL LICENSED BY THE LOCAL HEALTH DEPARTMENT AND PERMITTED BY THE OHIO ENVIRONMENTAL PROTECTION AGENCY DIVISION OF AIR POLLUTION CONTROL TO ACCEPT ASBESTOS CONTAINING MATERIAL. PAYMENT FOR THIS WORK SHALL BE MADE AT THE CONTRACT PRICE BID OF LUMP SUM.

PAYMENT FOR THIS WORK SHALL BE INCLUDED IN ITEM 202 PORTIONS OF STRUCTURE REMOVED OVER 20 FOOT SPAN, AS PER PLAN.

ITEM 513 - STRUCTURAL STEEL MEMBERS, LEVEL 5, AS PER PLAN

THE GIRDERS SHALL BE DETAILED FOR A NO-LOAD FIT (NLF).

GIRDERS MAY BE HEAT CURVED PER CMS 513.15 EXCEPT HEAT CURVING SHALL CONFORM TO THE AASHTO LRFD BRIDGE CONSTRUCTION SPECIFICATION, CURRENT EDITION. IF HEAT CURVING IS USED, THE FABRICATOR SHALL ACCOUNT FOR EXPECTED LOSS OF CAMBER PER THE AASHTO LRFD BRIDGE CONSTRUCTION SPECIFICATIONS, CURRENT EDITION.

ITEM SPECIAL - SETTLEMENT PLATFORMS:

SPECIFICATIONS:

DESCRIPTION:
THIS ITEM CONSISTS OF FURNISHING, CONSTRUCTING, AND MAINTAINING SETTLEMENT PLATFORMS AND OBTAINING SETTLEMENT READINGS AS REQUIRED BY THE PLANS OR AS DIRECTED BY THE ENGINEER. AT THE OPTION AND EXPENSE OF THE CONTRACTOR, ADDITIONAL SETTLEMENT PLATFORMS MAY BE INSTALLED AT ADDITIONAL LOCATIONS ACCEPTED BY ENGINEER.

SETTLEMENT READINGS SHALL BE TAKEN WEEKLY DURING CONSTRUCTION AND DURING ANY SPECIFIED WAITING PERIOD. THE READINGS SHALL BE PLOTTED UTILIZING THE SETTLEMENT PLATFORM READINGS EXCEL SPREADSHEET AS DEVELOPED BY ODOT'S OFFICE OF GEOTECHNICAL ENGINEERING. A COPY OF EACH CUMULATIVE PLOT SHALL BE SENT TO ODOT, AFTER EACH SETTLEMENT READING IS RECORDED.

VIBRATING WIRE SETTLEMENT MONITORING PLATFORMS MAY BE CONSIDERED IN LIEU OF THE CONVENTIONAL SETTLEMENT PLATFORMS. THE CONTRACTOR SHALL PROVIDE DETAILS OF THE PROPOSED VIBRATING WIRE SETTLEMENT PLATFORMS AS WELL AS DESIGN DRAWINGS OF THE PROPOSED PLATFORM AND CABLING LAYOUT TO ODOT AT LEAST 14 DAYS PRIOR TO CONSTRUCTION.

THE DESIGN DRAWINGS SHALL ILLUSTRATE THE PROPOSED SETTLEMENT VIBRATING WIRE SETTLEMENT PLATFORM LOCATIONS WITH ALL EXISTING AND PROPOSED SITE FEATURES TO VERIFY THE PROPOSED CABLING SHALL NOT CONFLICT WITH EXISTING FACILITIES, PROPOSED FACILITIES OR UTILITIES.

THE CONTRACTOR SHALL IDENTIFY, SET AND MAINTAIN AN APPROPRIATE NUMBER OF FIXED BENCHMARKS, REFERENCE POINTS, ETC. TO FACILITATE THE SURVEYING OF THE SETTLEMENT PLATFORMS.


MATERIALS:
SOUND LUMBER SUCH AS 3#4" EXTERIOR GRADE PLYWOOD SHALL BE USED FOR THE BASE. THE PIPE SHALL BE 2-1#2" STANDARD BLACK PIPE WITH THREADED FITTINGS AS SHOWN ON THE PLANS. A STEEL PLATE 3'-0"x 3'-0"x 1#8" MAY BE SUBSTITUTED FOR THE LUMBER, AT THE CONTRACTOR'S OPTION.

ITEM SPECIAL - SETTLEMENT PLATFORMS (CONTINUED):

CONSTRUCTION METHODS: THE PLATFORM SHALL CONFORM TO THE DETAILS SHOWN ON THE PLANS. SETTLEMENT PLATFORMS SHALL BE PLACED AT THE BOTTOM OF THE MSE WALL FILL AT THE LOCATION INDICATED BELOW, UNLESS OTHERWISE DIRECTED BY THE ENGINEER. IF EXISTING PAVEMENT IS ENCOUNTERED AT THE SPECIFIED LOCATIONS, THE PAVEMENT (INCLUDING ANY BASE MATERIAL) SHALL BE REMOVED AND THE SETTLEMENT PLATFORM SHALL BE SET ON THE EXPOSED SUBGRADE. THE PLATFORM SHALL BE SET ON A LEVEL SURFACE. THE PIPE SHALL BE FIRMLY SECURED TO THE PLATFORM AND SHALL BE MAINTAINED IN A PLUMB POSITION DURING CONSTRUCTION OF THE MSE WALL. THE PIPE SHALL BE MARKED AT INTERVALS TO FACILITATE MEASUREMENT OF THE DEPTH OF FILL. SETTLEMENT PLATFORMS SHALL BE ANCHORED BY STAKES DRIVEN AT EACH CORNER TO PREVENT OVERTURNING.

THE CONTRACTOR SHALL PROTECT SETTLEMENT PLATFORMS FROM CONSTRUCTION TRAFFIC/ACTIVITIES USING APPROPRIATE METHODS SUCH AS BARRICADES, CONES, GUARD-STAKES WITH HIGH VISIBILITY RIBBON, ETC. THE CONTRACTOR SHALL STOP WORK IN ANY LOCATION WHERE THE SETTLEMENT PLATFORM HAS BEEN DISTURBED OR DAMAGED. PLATFORMS OR PIPES DAMAGED OR DISPLACED DURING CONSTRUCTION SHALL BE RESTORED TO THEIR PROPER CONDITION AT CONTRACTOR'S EXPENSE.

PRIOR TO PAVING: THE TOP OF THE SETTLEMENT PLATFORM PIPE SHALL BE CUT OFF TWO FEET BELOW THE FINISHED SURFACE OF THE SUBGRADE OR FINISHED GROUND SURFACE. WHICHEVER IS APPLICABLE.

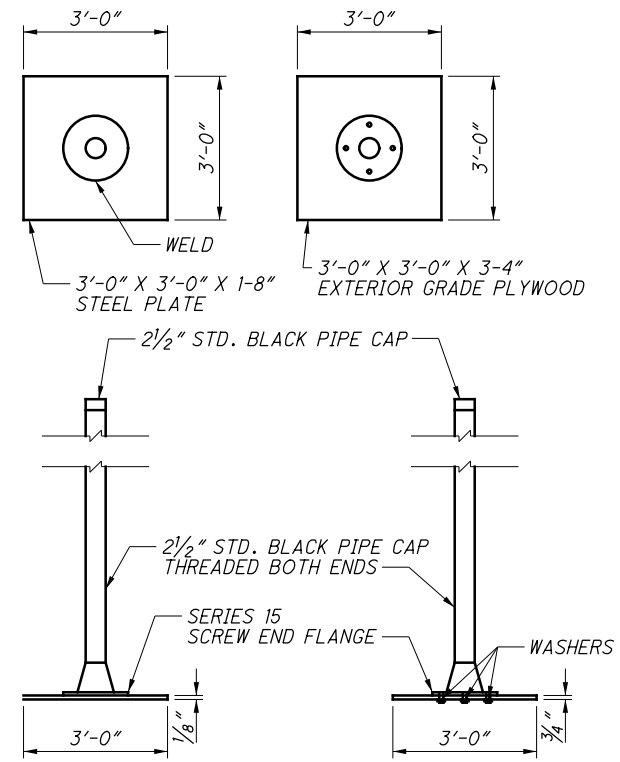

SETTLEMENT PLATFORM
NOT TO SCALE

WAITING PERIOD:
THE ENGINEER WILL CONSIDER THE WAITING PERIOD COMPLETE WHEN CONSECUTIVE SETTLEMENT READINGS, RECORDED AFTER WALL CONSTRUCTION IS COMPLETE AND AT LEAST ONE WEEK (168 HOURS) APART, RESULT IN ELEVATION DIFFERENCES EQUAL TO OR LESS THAN 1/8 INCH.

SEE PILE DRIVING CONSTRAINTS NOTES FROM STRUCTURE GENERAL NOTES SHEET FOR MORE INFORMATION REGARDING WAITING PERIOD.

METHOD OF MEASUREMENT:
THE DEPARTMENT WILL MEASURE SETTLEMENT PLATFORMS BY THE NUMBER EACH, COMPLETE IN PLACE.

BASIS OF PAYMENT:
THE UNIT PRICE BID FOR ITEM SPECIAL - SETTLEMENT PLATFORM SHALL INCLUDE FURNISHING, CONSTRUCTING, AND MAINTAINING SETTLEMENT PLATFORMS AND OBTAINING SETTLEMENT READINGS AS REQUIRED BY THE PLANS OR AS DIRECTED BY THE ENGINEER. PAYMENT SHALL NOT BE MADE FOR SETTLEMENT PLATFORMS WHICH BECOME USELESS DUE TO DAMAGE CAUSED BY THE CONTRACTOR'S OPERATIONS.

ITEM SPECIAL - SETTLEMENT PLATFORMS (CONTINUED):

LOCATION INFORMATION:

REAR ABUTMENT AT STA 137+20
FORWARD ABUTMENT AT STA 142+42

ITEM 256 - BONDED PATCHING OF PORTLAND CEMENT CONCRETE PAVEMENT, TYPE A, AS PER PLAN:

THIS ITEM CONSISTS OF PATCHING THE DECK AND APPROACH SLABS OF THE EXISTING BRIDGE TO MAINTAIN A SATISFACTORY RIDING SURFACE COURSE FOR TRAFFIC UNTIL THE EXISTING BRIDGE IS TO BE REMOVED. A CONTINGENCY QUANTITY OF 11,000 SF IS BASED ON PATCHING 10% OF THE EXISTING DECK EVERY YEAR FOR THREE YEARS. PATCHING QUANTITY SHALL BE USED AS DIRECTED BY THE ENGINEER. ALL PROVISIONS OF CMS 256 SHALL APPLY.

ABBREVIATIONS

ABUT. - ABUTMENT	N.T.S. - NOT TO SCALE
APPR. - APPROACH	NE - NORTHEAST
B.F. - BACK FACE	NO. - NUMBER
@ - BASELINE	NW - NORTHWEST
BOT. - BOTTOM	O/O - OUT-TO-OUT
BRG. - BEARING	P.E.J.F. - PREFORMED EXPANSION JOINT FILLER
C.J. - CONSTRUCTION JOINT	P.G. - PROPOSED GRADE
C.P.P. - CORRUGATED PLASTIC PIPE	P - PALTE
C/C - CENTER TO CENTER	PROP. - PROPOSED
CL - CENTERLINE	PT. - POINT
CLR. - CLEAR	R - RADIUS
CONN. - CONNECTION	R.A. - REAR ABUTMENT
CONSTR. - CONSTRUCTION	RT. - RIGHT
CONT. - CONTRACTION	SAN. - SANITARY
DIA. - DIAMETER	SB - SOUTHBOUND
E.F. - EACH FACE	SHLDR. - SHOULDER
EA. - EACH	SPA. - SPACES
EB - EASTBOUND	S.R. - STATE ROUTE
EL./ELEV. - ELEVATION	STA. - STATION
EOP - EDGE OF PAVEMENT	STD. - STANDARD
E.S. - EQUAL SPACING	SW - SOUTHWEST
EQ. - EQUAL	T/ROCK - TOP OF ROCK
EX. - EXISTING	T/SLOPE - TOP OF SLOPE
EXP. - EXPANSION	T/WALL. - TOP OF WALL
F.A. - FORWARD ABUTMENT	TEMP. - TEMPORARY
F.F. - FRONT FACE	TYP. - TYPICAL
FL - FLOW LINE	VAR. - VARIES
FWD. - FORWARD	W.P. - WORK POINT
JT. - JOINT	W.R.T. - WITH RESPECT TO
LT. - LEFT	W/ - WITH
MAX. - MAXIMUM	WB - WESTBOUND
MEAS. - MEASURED	WW - WINGWALL
MIN. - MINIMUM	

DESIGN AGENCY: ms consultants, inc. 2221 Schrock Road Columbus, Ohio 43229

DATE: 11/5/2021

REVIEWED: Y.S.J. STRUCTURE FILE NUMBER: 2504767

DRAWN: SURJ/ATM CHECKED: DEJ

GENERAL NOTES (2 OF 2)
BRIDGE NO. FRA-70-1301R
EASTBOUND I-70 OVER S.R. 315

FRA-70-13.01
PID No. 105430

5/58

84
137

NO.	DESCRIPTION	REV. BY	DATE
5	UPDATED NOTE	ACW	11/6/23

N:\03\60\08353\05430_FRA-70-13.0\DesignStructures\FRA070_130IR_Sheets\070_130IR_WE001.dgn Sheet 11/6/2023 10:34:28 AM awhite

ESTIMATED QUANTITIES					CALC.	DATE
					DBL	2/15/2023
					CHK'D	DATE
					ATM	2/21/2023
ITEM	ITEM EXT.	UNIT	DESCRIPTION	TOTAL	SHT. REF.	
MSE WALL W4						
203	20001	CY	EMBANKMENT, AS PER PLAN	6	4/58	
203	35110	CY	GRANULAR MATERIAL, TYPE B	427		
509	10000	LB	EPOXY COATED REINFORCING STEEL	9,226	55/58	58/58
511	53012	CY	CLASS QC2 CONCRETE, MISC.: MOMENT SLAB AND PARAPET WITH QC/QA	78	55/58	
512	10100	SY	SEALING OF CONCRETE SURFACES (EPOXY-URETHANE)	530	51/58	
516	13600	SF	1" PREFORMED EXPANSION JOINT FILLER	91		
516	13900	SF	2" PREFORMED EXPANSION JOINT FILLER	409		
601	21000	SY	CONCRETE SLOPE PROTECTION	20		
840	20000	SF	MECHANICALLY STABILIZED EARTH WALL	3,252		
840	21000	CY	WALL EXCAVATION	1,139		
840	22000	SY	FOUNDATION PREPARATION	491		
840	23000	CY	SELECT GRANULAR BACKFILL	1,666		
840	25010	FT	6" DRAINAGE PIPE, PERFORATED	543		
840	25020	FT	6" DRAINAGE PIPE, NON-PERFORATED	22		
840	26000	FT	CONCRETE COPING	277		
840	26050	SF	AESTHETIC SURFACE TREATMENT	3,252		
840	27000	DAY	ON-SITE ASSISTANCE	5		
840	28000	LS	SGB INSPECTION AND COMPACTION TESTING	LS		

ESTIMATED QUANTITIES					CALC.	DATE
					DBL	2/17/2023
					CHK'D	DATE
					ATM	2/21/2023
ITEM	ITEM EXT.	UNIT	DESCRIPTION	TOTAL	SHT. REF.	
MSE WALL W6						
512	10100	SY	SEALING OF CONCRETE SURFACES (EPOXY-URETHANE)	122	5	
840	20000	SF	MECHANICALLY STABILIZED EARTH WALL	1,005		
840	21000	CY	WALL EXCAVATION	227		
840	22000	SY	FOUNDATION PREPARATION	111		
840	23000	CY	SELECT GRANULAR BACKFILL	479		
840	25010	FT	6" DRAINAGE PIPE, PERFORATED	156		
840	25020	FT	6" DRAINAGE PIPE, NON-PERFORATED	24		
840	26000	FT	CONCRETE COPING	73		
840	26050	SF	AESTHETIC SURFACE TREATMENT	1,005		
840	27000	DAY	ON-SITE ASSISTANCE	5		
840	28000	LS	SGB INSPECTION AND COMPACTION TESTING	LS		

DESIGN AGENCY
ms consultants, inc.
2021 Schrock Road
Columbus, Ohio 43229

REVIEWED
Y.S.J.
DATE
11/5/2021
STRUCTURE FILE NUMBER
2504767

DRAWN
DBL
REVIS
DESIGNED
DBL
CHECKED
DEA

MSE WALL ESTIMATED QUANTITIES
BRIDGE NO. FRA-70-1301R
EASTBOUND I-70 OVER S.R. 315

FRA-70-13.01
PID No. 105430

53/58

132
137

NO.	DESCRIPTION	REV. BY	DATE
5	QUANTITY CHANGED	ACW	10/23/23