

AS BUILT - 4/22/2016

G:\projects\2014\W-14-039_FRA-270-49.00\83988\roadway\sheets\83988GT002.dgn 6/9/2016 3:32:36 PM colnr

STATE OF OHIO
DEPARTMENT OF TRANSPORTATION


FRA-270-49.00

VILLAGE OF OBETZ

FRANKLIN COUNTY

INDEX OF SHEETS:

TITLE SHEET	1
SCHEMATIC PLAN	2 -3
TYPICAL SECTIONS	4 -8
GENERAL NOTES	9
MAINTENANCE OF TRAFFIC GENERAL NOTES	10-12
PLAN INSERT SHEETS	13-14
MAINTENANCE OF TRAFFIC TYPICAL SECTIONS	15-16
MAINTENANCE OF TRAFFIC PLAN	17-26
GENERAL SUMMARY	27-29
MAINTENANCE OF TRAFFIC SUBSUMMARY	30
ROADWAY SUBSUMMARY	31
DRAINAGE SUBSUMMARY	32
PLAN AND PROFILE - ALUM CREEK DRIVE	33-37
CROSS SECTIONS - ALUM CREEK DRIVE	38-50
PLAN - I.R. 270	51-52
CROSS SECTIONS - I.R. 270	53-62
PLAN AND PROFILE - RAMPS T	63-66
CROSS SECTIONS - RAMPS T	67-74
PLAN AND PROFILE - RAMPS W	75-76
CROSS SECTIONS - RAMPS W	77-81
PLAN AND PROFILE - RAMPS X & Y1	82-83
CROSS SECTIONS - RAMPS X	84-85
CROSS SECTIONS - RAMPS Y1	86-87
SUPERELEVATION TABLES	88-89
INTERSECTION DETAILS	90
PAVEMENT ELEVATION DETAILS	91-93
MEDIAN DETAILS	94-95
NOISE WALL	96-105
EX. WATER MAIN PLAN AND PROFILE - RAMP T	106
TRAFFIC CONTROL	107-118
LIGHTING	119-146
BRIDGE PLAN	147-178
FENCE PLAN	179-182

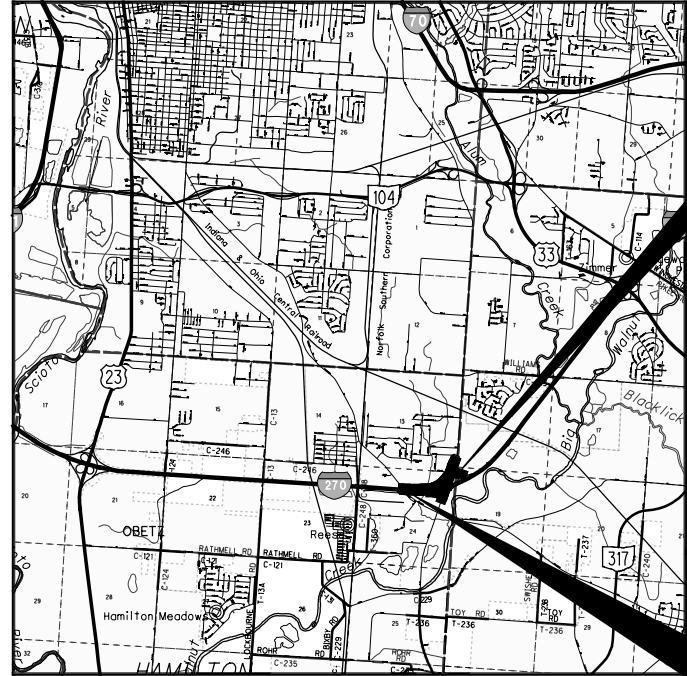

BEGIN PROJECT
STA 698+10
SLM 49.00

END PROJECT
STA 673+95.00
SLM 49.44

LOCATION MAP

LATITUDE: 39°52'18.39" LONGITUDE: 82°56'0.48"



PORTION TO BE IMPROVED	-----	=====
INTERSTATE HIGHWAY	-----	=====
FEDERAL ROUTES	-----	=====
STATE ROUTES	-----	=====
COUNTY & TOWNSHIP ROADS	-----	=====
OTHER ROADS	-----	=====

DESIGN DESIGNATION

	<u>IR-270</u>	<u>ALUM CREEK DRIVE</u>
CURRENT ADT (2016)	74,860	27,490
DESIGN YEAR ADT (2036)	108,150	43,970
DESIGN HOURLY VOLUME (2036)	10,750	3640
DIRECTIONAL DISTRIBUTION	52%	55%
TRUCKS (24 HOUR B&C)	11%	17%
DESIGN SPEED	70 M.P.H.	50 M.P.H.
LEGAL SPEED	65 M.P.H.	45 M.P.H.
DESIGN FUNCTIONAL CLASSIFICATION:	PRINCIPAL ARTERIAL INTERSTATE (URBAN)	MINOR ARTERIAL (URBAN)
NHS PROJECT	YES	NO

DESIGN EXCEPTIONS

NONE REQUIRED

AS BUILT APRIL 22, 2016

UNDERGROUND UTILITIES
CONTACT BOTH SERVICES
CALL TWO WORKING DAYS
BEFORE YOU DIG
CALL
1-800-362-2764
(TOLL FREE)
OHIO UTILITIES PROTECTION SERVICE
NON-MEMBERS
MUST BE CALLED DIRECTLY
OIL & GAS PRODUCERS UNDERGROUND
PROTECTION SERVICE CALL: **1-800-925-0988**

ENGINEERS SEAL:

SIGNED:
DATE: 04/13/2015

STANDARD CONSTRUCTION DRAWINGS						SUPPLEMENTAL SPECIFICATIONS		SPECIAL PROVISIONS	
BP-2.1	07/19/13	F-2.1	07/19/13	RM-3.1	07/19/13	800	07/18/14		
BP-2.2	07/18/08	F-3.4	07/19/13	RM-4.2	06/4/14	832	01/17/14		
BP-3.1	07/18/14			RM-4.3	07/18/14				
BP-5.1	07/19/13	I-2.3	01/17/14	RM-4.6	07/19/13				
CB-2.1	01/18/13	MGS-1.1	07/19/13	TC-61.10	01/17/14				
		MGS-2.1	07/19/13	TC-65.10	01/17/14				
DM-1.2	01/18/13	MGS-3.1	07/18/14	TC-65.11	07/18/14				
DM-1.4	01/18/13	MGS-3.2	01/18/13	TC-71.10	01/17/14				
DM-2.1	01/18/13	MGS-4.2	07/19/13	TC-72.20	07/18/14				
DM-4.1	07/19/13	MGS-5.3	07/19/13						
DM-4.2	07/20/12	MGS-6.2	01/18/13						
DM-4.3	07/19/13								
DM-4.4	07/20/12	MH-1.2	01/18/13						

PROJECT DESCRIPTION

THIS PROJECT CONSISTS OF THE CONSTRUCTION OF A NEW I-270 WESTBOUND ON-RAMP AT ALUM CREEK DRIVE, AS WELL AS THE WIDENING OF THE I-270 EASTBOUND OFF-RAMP AND MODIFICATION OF THE I-270 WESTBOUND OFF-RAMP. WIDENING OF SOUTHBOUND ALUMCREEK DRIVE FROM EAST HOWARD DRIVE TO THE I-270 EASTBOUND RAMP INTERSECTION AND WIDENING OF THE BRIDGE OVER I-270 TO PROVIDE FOR A THIRD SOUTHBOUND THROUGH LANE. ADDITION OF A NOISE WALL ALONG THE NORTHWEST CORNER OF THE INTERCHANGE AND UPGRADING THE LIGHTING AND TRAFFIC SIGNALS.

EARTH DISTURBED AREA

PROJECT EARTH DISTURBED AREA: 6.34 ACRES
ESTIMATED CONTRACTOR EARTH DISTURBED AREA: 0.25 ACRES
NOTICE OF INTENT EARTH DISTURBED AREA: 6.69 ACRES

LIMITED ACCESS

THIS IMPROVEMENT IS ESPECIALLY DESIGNED FOR THROUGH TRAFFIC AND HAS BEEN DECLARED A LIMITED ACCESS HIGHWAY OR FREEWAY BY ACTION OF THE DIRECTOR IN ACCORDANCE WITH THE PROVISIONS OF SECTION 5511.02 OF THE OHIO REVISED CODE.

2013 SPECIFICATIONS

THE STANDARD SPECIFICATIONS OF THE STATE OF OHIO, DEPARTMENT OF TRANSPORTATION, INCLUDING CHANGES AND SUPPLEMENTAL SPECIFICATIONS LISTED IN THE PROPOSAL SHALL GOVERN THIS IMPROVEMENT.

I HEREBY APPROVE THESE PLANS AND DECLARE THAT THE MAKING OF THIS IMPROVEMENT WILL NOT REQUIRE THE CLOSING TO TRAFFIC OF THE HIGHWAY AND THAT PROVISIONS FOR THE MAINTENANCE AND SAFETY OF TRAFFIC WILL BE AS SET FORTH ON THE PLANS AND ESTIMATE.

AS BUILT SHEETS
27, 32, 33, 34, 37, 41, 48, 49,
63, 64, 68, 69, 94, 108, 113

APPROVED _____
DATE _____ DISTRICT DEPUTY DIRECTOR


APPROVED _____
DATE _____ DIRECTOR, DEPARTMENT OF TRANSPORTATION

FEDERAL PROJECT NO. **E080 (912)**
CONSTRUCTION PROJECT NO. **83988**
RAILROAD INVOLVEMENT **NONE**
FRA-270-49.00
1/182

BU 4, 5, 6, 7, & 8 - RELEASED FOR CONSTRUCTION - 11/03/2014 - 11/19/2015

AS BUILT - 4/22/2016

G:\projects\2014\W-14-039_FRA-270-49.00\83988\roadway\sheet\83988\roadway\REV.dgn 5/23/2016 7:30:20 AM kevinj

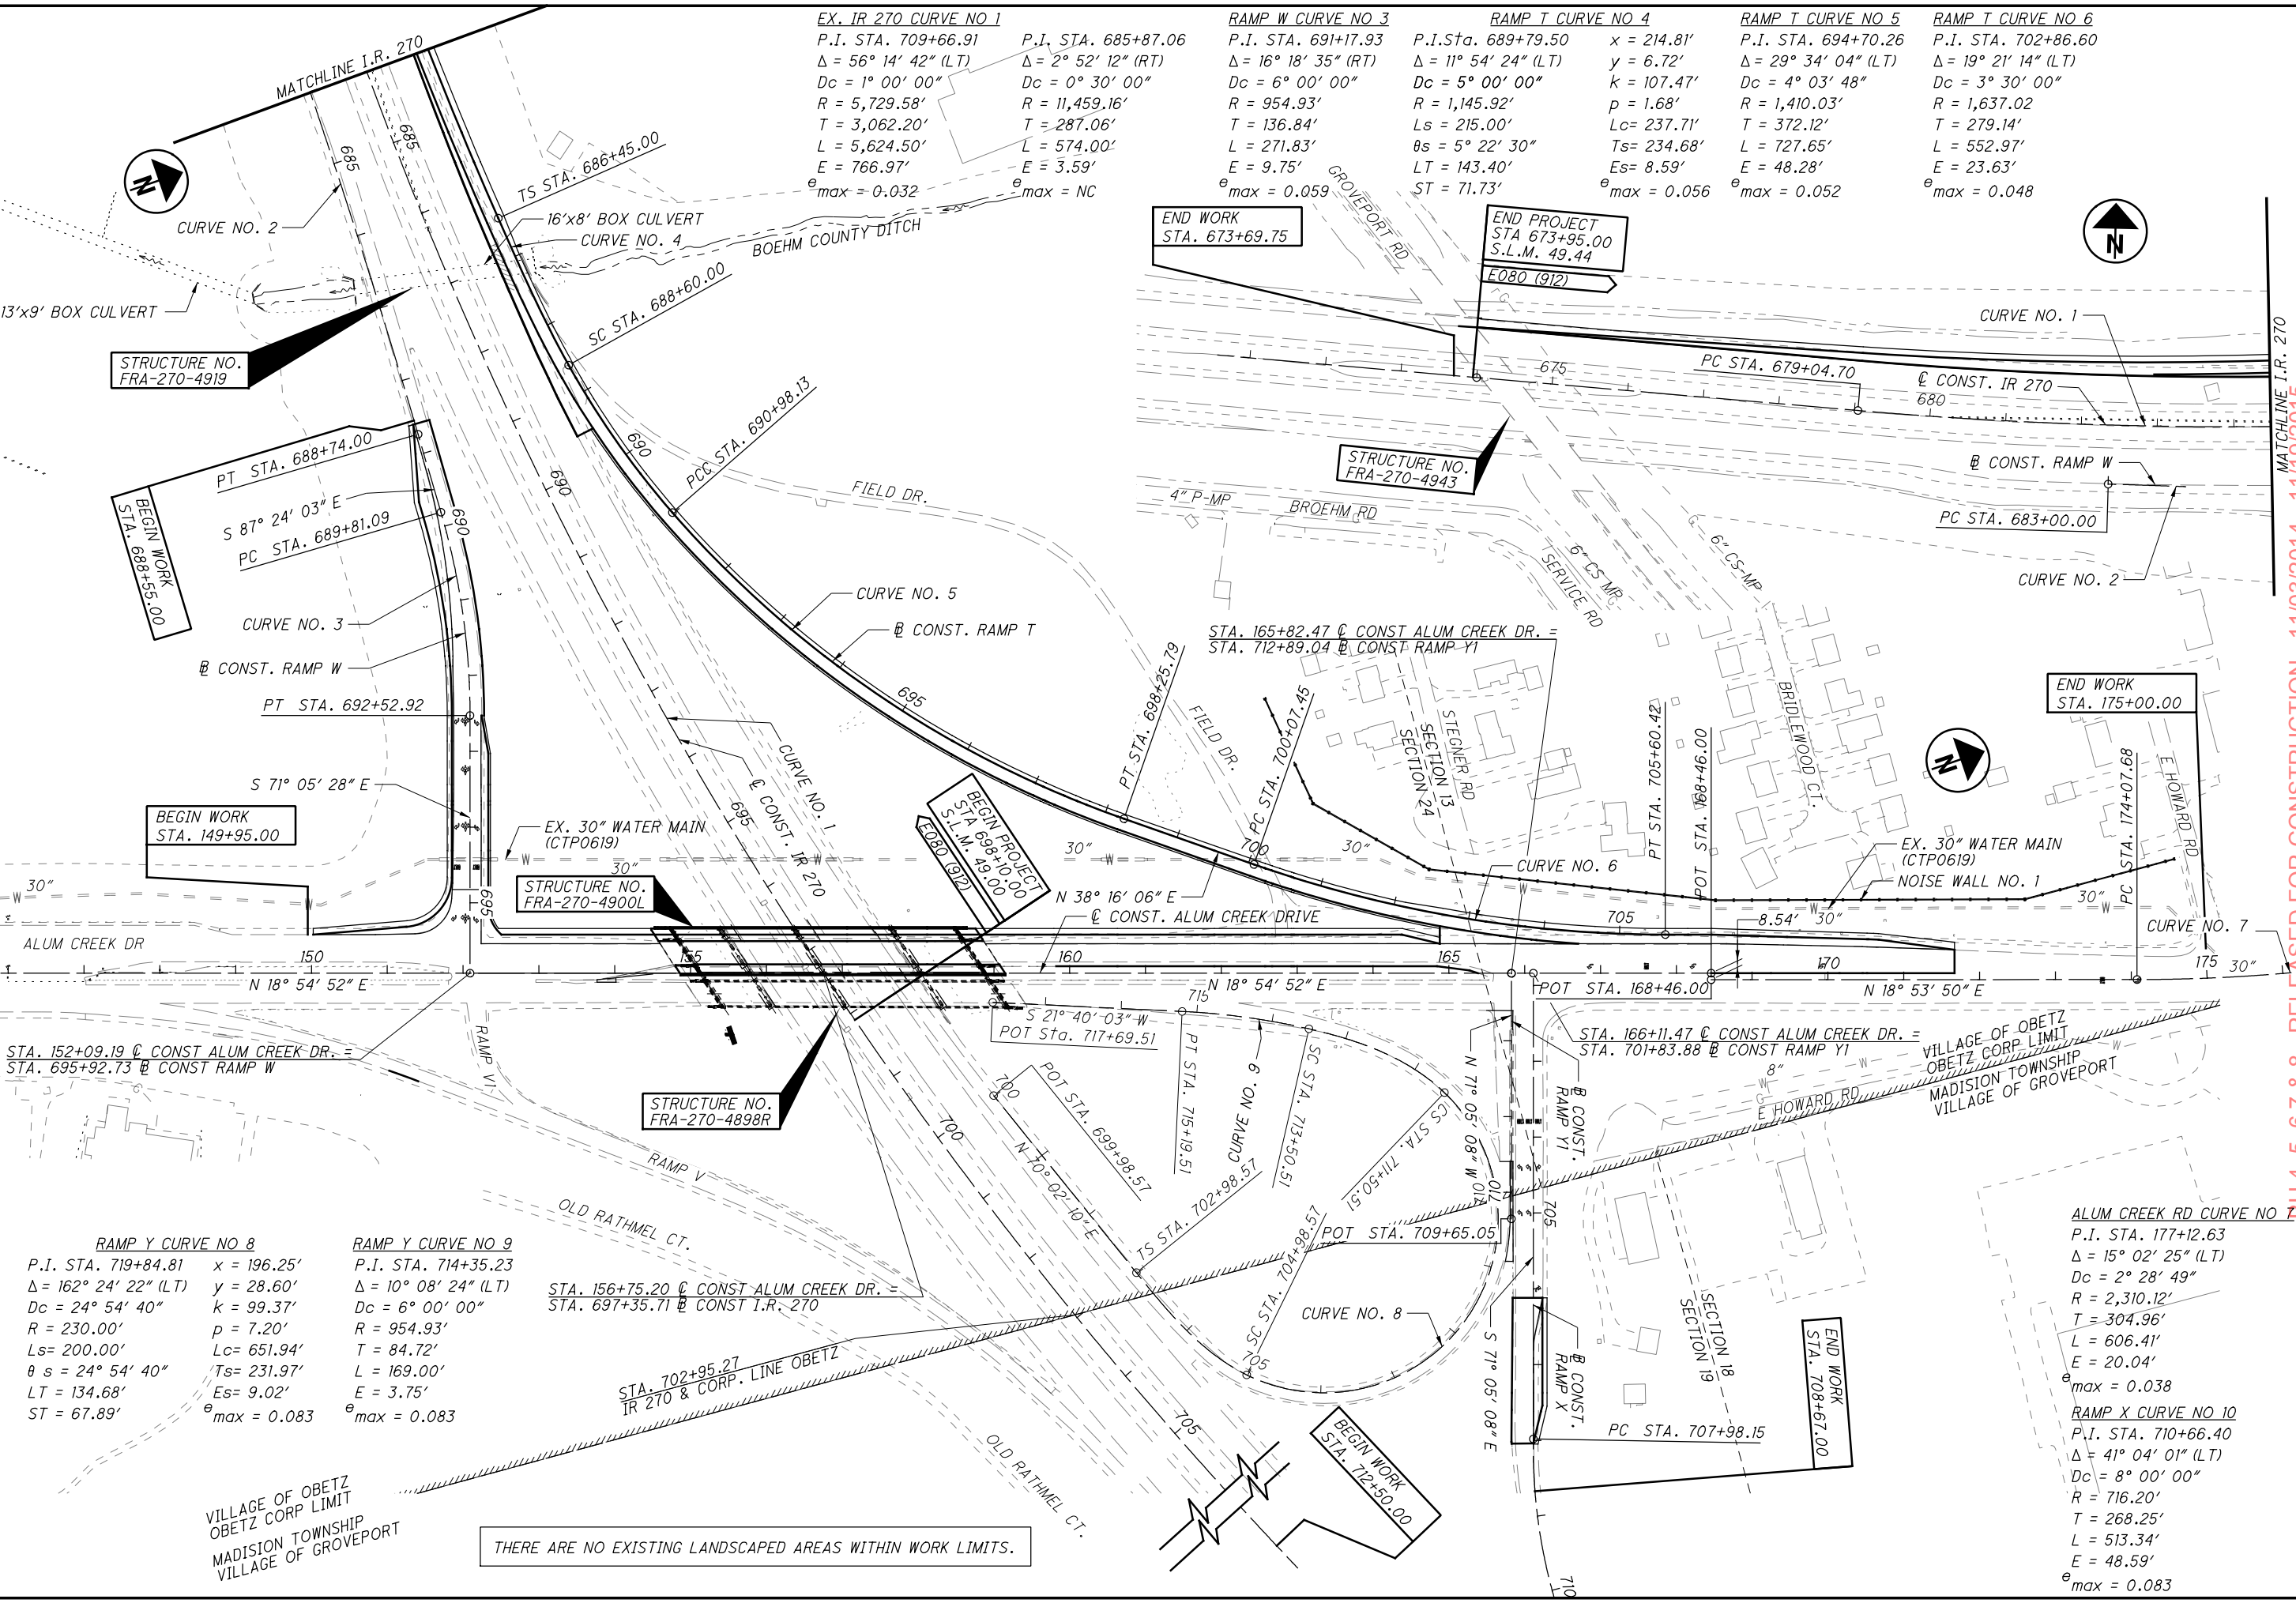

EX. IR 270 CURVE NO 1
 P.I. STA. 709+66.91
 $\Delta = 56^\circ 14' 42''$ (LT)
 $Dc = 1^\circ 00' 00''$
 $R = 5,729.58'$
 $T = 3,062.20'$
 $L = 5,624.50'$
 $E = 766.97'$
 $e_{max} = -0.032$

P.I. STA. 685+87.06
 $\Delta = 2^\circ 52' 12''$ (RT)
 $Dc = 0^\circ 30' 00''$
 $R = 11,459.16'$
 $T = 287.06'$
 $L = 574.00'$
 $E = 3.59'$
 $e_{max} = NC$

RAMP W CURVE NO 3
 P.I. STA. 691+17.93
 $\Delta = 16^\circ 18' 35''$ (RT)
 $Dc = 6^\circ 00' 00''$
 $R = 954.93'$
 $T = 136.84'$
 $L = 271.83'$
 $E = 9.75'$
 $e_{max} = 0.059$

RAMP T CURVE NO 4
 P.I. STA. 689+79.50
 $\Delta = 11^\circ 54' 24''$ (LT)
 $Dc = 5^\circ 00' 00''$
 $R = 1,145.92'$
 $Ls = 215.00'$
 $\theta s = 5^\circ 22' 30''$
 $LT = 143.40'$
 $ST = 71.73'$

RAMP T CURVE NO 5
 P.I. STA. 694+70.26
 $\Delta = 29^\circ 34' 04''$ (LT)
 $Dc = 4^\circ 03' 48''$
 $R = 1,410.03'$
 $T = 372.12'$
 $L = 727.65'$
 $E = 48.28'$
 $e_{max} = 0.052$

RAMP T CURVE NO 6
 P.I. STA. 702+86.60
 $\Delta = 19^\circ 21' 14''$ (LT)
 $Dc = 3^\circ 30' 00''$
 $R = 1,637.02'$
 $T = 279.14'$
 $L = 552.97'$
 $E = 23.63'$
 $e_{max} = 0.048$

RAMP Y CURVE NO 8
 P.I. STA. 719+84.81
 $\Delta = 162^\circ 24' 22''$ (LT)
 $Dc = 24^\circ 54' 40''$
 $R = 230.00'$
 $Ls = 200.00'$
 $\theta s = 24^\circ 54' 40''$
 $LT = 134.68'$
 $ST = 67.89'$
 $x = 196.25'$
 $y = 28.60'$
 $k = 99.37'$
 $p = 7.20'$
 $Lc = 651.94'$
 $Ts = 231.97'$
 $E_s = 9.02'$
 $e_{max} = 0.083$

RAMP Y CURVE NO 9
 P.I. STA. 714+35.23
 $\Delta = 10^\circ 08' 24''$ (LT)
 $Dc = 6^\circ 00' 00''$
 $R = 954.93'$
 $T = 84.72'$
 $L = 169.00'$
 $E = 3.75'$
 $e_{max} = 0.083$

STA. 156+75.20 @ CONST ALUM CREEK DR. =
 STA. 697+35.71 @ CONST I.R. 270

ALUM CREEK RD CURVE NO 10
 P.I. STA. 177+12.63
 $\Delta = 15^\circ 02' 25''$ (LT)
 $Dc = 2^\circ 28' 49''$
 $R = 2,310.12'$
 $T = 304.96'$
 $L = 606.41'$
 $E = 20.04'$
 $e_{max} = 0.038$
RAMP X CURVE NO 10
 P.I. STA. 710+66.40
 $\Delta = 41^\circ 04' 01''$ (LT)
 $Dc = 8^\circ 00' 00''$
 $R = 716.20'$
 $T = 268.25'$
 $L = 513.34'$
 $E = 48.59'$
 $e_{max} = 0.083$

THERE ARE NO EXISTING LANDSCAPED AREAS WITHIN WORK LIMITS.



BU 4.5, 6.7, 8 - RELEASED FOR CONSTRUCTION - 11/03/2014 - 11/19/2015

SCHEMATIC PLAN

FRA - 270-49.00

AS BUILT - 4/22/2016

G:\projects\2014\W-14-039_FRA-270-49.00\83988\roadway\sheets\83988GE002.dgn 5/23/2016 7:30:21 AM kevinj

IR 270 & ALUMCREEK DR. BENCHMARKS & HORIZONTAL CONTROL POINTS


BENCHMARK NO.	NORTHING	EASTING	ELEVATION	DESCRIPTION
BM 1	683725	1847453	746.074	SQUARE CUT ON SE CORNER OF CONCRETE BASE FOR LIGHT POLE, ±100' SOUTH OF EAST HOWARD ROAD, WEST SIDE OF ALUM CREEK DRIVE.
BM 2	681737	1846737	749.346	SQUARE CUT ON NE CORNER OF CONCRETE BASE FOR SIGNAL SUPPORT POLE AT THE NW CORNER OF ALUM CREEK DRIVE SOUTHBOUND AND RAMP W FROM IR 270 EASTBOUND.
BM 3	681810	1846742	742.920	"X" CUT ON NORTH SIDE OF CONCRETE BASE FOR HIGH MAST LIGHT POLE ±75' NORTH OF NW CORNER OF THE INTERSECTION OF ALUM CREEK DRIVE SOUTHBOUND AND RAMP W FROM IR 270 EASTBOUND.
BM 4	681872	1846329	732.192	"X" CUT ON THE NORTH SIDE OF THE STORM MANHOLE RIM IN GRASSY INFIELD BETWEEN IR 270 EASTBOUND AND EXIT RAMP W TO ALUM CREEK DRIVE, ±50' EAST NORTHEAST OF FOOD/LODGING SIGN.
BM 5	682052	1845946	727.773	SQUARE CUT ON SOUTHEAST CORNER OF HEADWALL FOR LARGE BOX CULVERT ACROSS IR 270, NORTH SIDE IR 270 WB.
BM IPINS 12	683676	1847436	746.061	IPINS
BM 14	682434	1847478	746.061	"X" CUT FOUND ON SOUTHWEST BOLT OF HIGH MAST LIGHT POLE AT NORTH SIDE OF IR 270 WESTBOUND AND RAMP Y FROM ALUM CREEK DRIVE NORTHBOUND.

REF. NO.	NORTHING GRID	EASTING GRID	ELEVATION LEVELED	PAF	NORTHING GROUND	EASTING GROUND	ELEVATION LEVELED ADJUSTED	DESCRIPTION
SV10	682800.795	1847501.91	739.784	1.000057522	682840.071	1847608.181	739.974	IPINS
SV11	682731.237	1847061.756	749.528	1.000057522	682770.509	1847168.002	749.718	MAGS
SV12	683636.315	1847329.453	745.871	1.000057522	683675.639	1847435.715	746.061	IPINS
SV13	682307.535	1846916.281	750.971	1.000057522	682346.782	1847022.519	751.161	MAGS
SV14	681683.491	1846647.222	750.204	1.000057522	681722.703	1846753.444	750.394	IPINS
SV15	681939.745	1846636.907	728.81	1.000057522	681978.971	1846743.129	729.000	IPINS
SV16	682285.141	1847148.93	725.021	1.000057522	682324.387	1847255.181	725.211	IPINS
SV17	681991.408	1845803.358	728.342	1.000057522	682030.637	1845909.532	728.532	IPINS

BU 4, 5, 6, 7, & 8 - RELEASED FOR CONSTRUCTION - 11/03/2014 - 11/19/2015

BENCHMARKS & HORIZONTAL CONTROL POINTS

FRA - 270 - 49.00

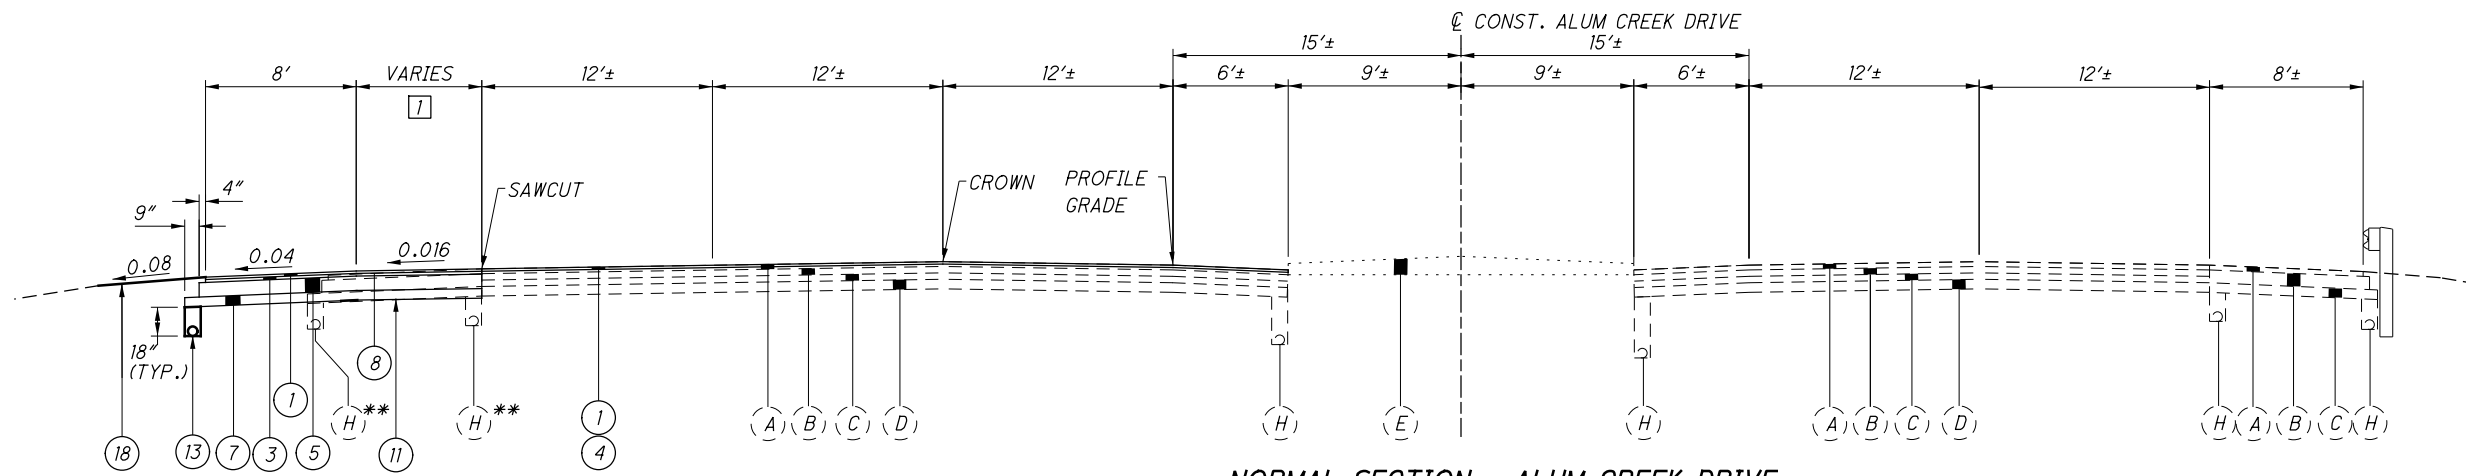


NORMAL SECTION - ALUM CREEK DRIVE

STA. 150+02.30 TO STA. 151+36.32
STA. 151+36.32 TO STA. 152+50.62 RAMP W INTERSECTION (TYPICAL NOT SHOWN)

** UNDERDRAIN TO REMAIN,
OUTLET TO BE CONNECTED
TO NEW UNDERDRAIN

- 1 VARIES 0' TO 10.90'
STA. 150+02.30 TO STA. 151+36.32
- 2 VARIES 7.55' TO 2.50'
STA. 154+01.50 TO STA. 154+50.00
2.50'
STA. 154+50.00 TO STA. 154+86.52
- 3 VARIES 0.98' TO 6.0'±
STA. 154+01.50 TO STA. 154+50.00
6.00'±
STA. 154+50.00 TO STA. 154+86.42
- A CONCRETE BARRIER TYPE B
STA. 153+76.50 TO STA. 154+01.50
CONCRETE BARRIER TYPE D
STA. 154+01.50 TO STA. 154+86.52

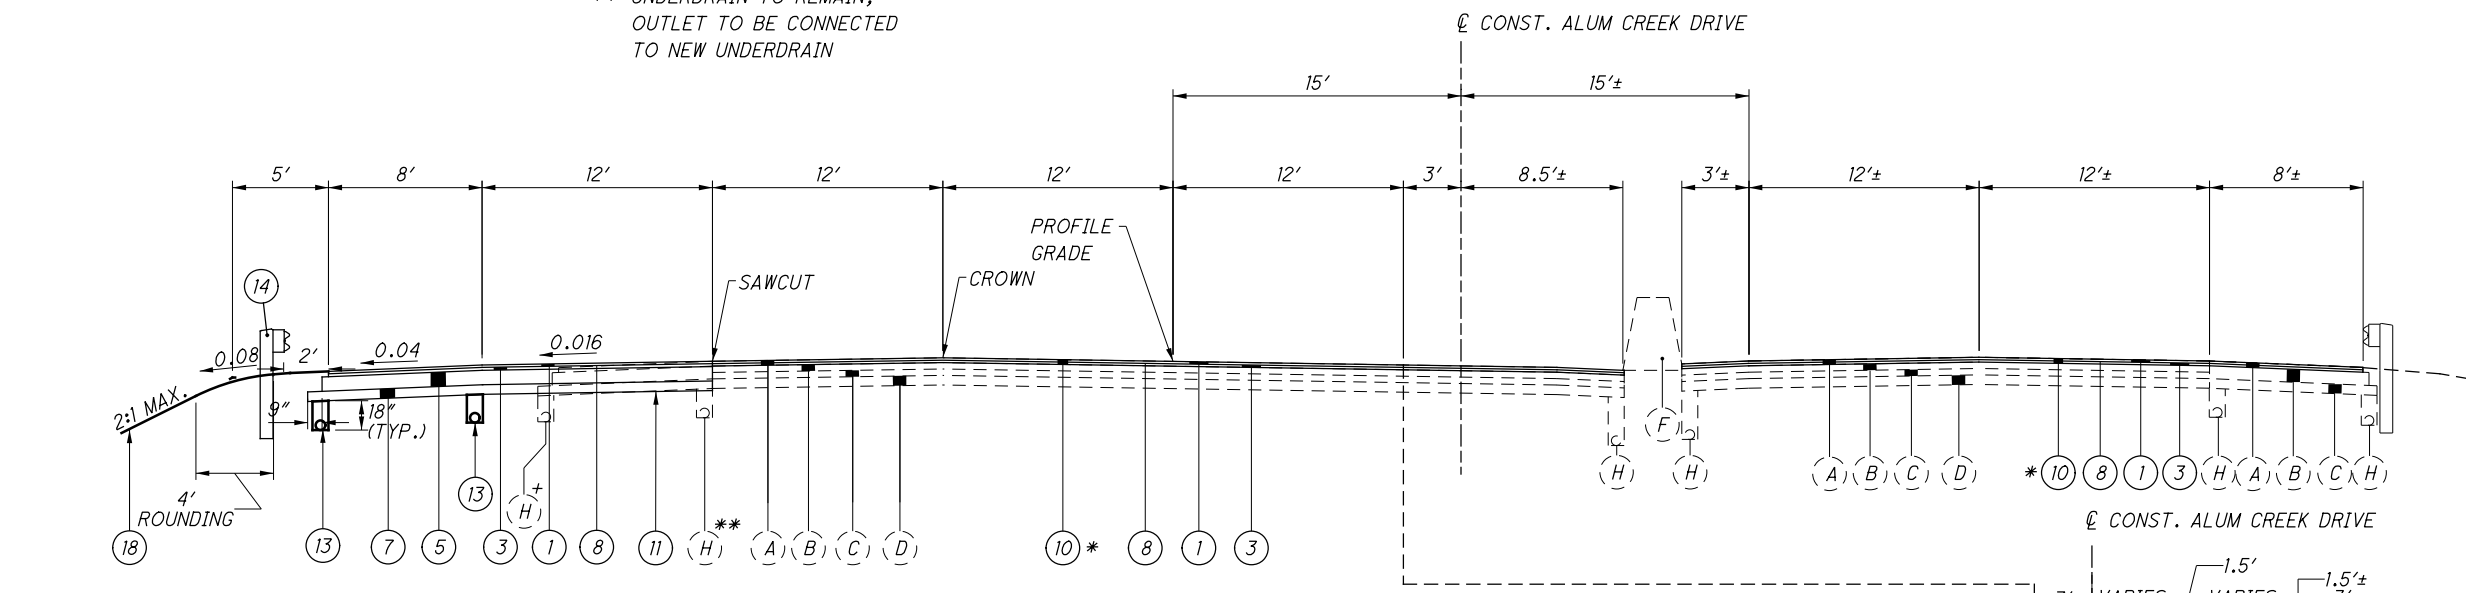


NORMAL SECTION - ALUM CREEK DRIVE

STA. 152+50.62 TO STA. 154+85.94


* BEGIN 3/4" MILL AND OVERLAY
STA. 152+32.00
SEE PLAN AND PROFILE SHEETS 10-14 FOR LIMITS
+ UNDERDRAIN TO BE REMOVED

LEGEND

- | | | | |
|---|---|--|--|
| 1 ITEM 442 - 1 1/2" ASPHALT CONCRETE SURFACE COURSE, 12.5MM, TYPE A, (446) | 12 ITEM 601 - PAVED GUTTER TYPE 1-2, AS PER PLAN | (A) EXISTING 3"± ASPHALT CONCRETE | (G) EXISTING CONCRETE FLUME |
| 2 ITEM 302 - VARIABLE DEPTH ASPHALT CONCRETE BASE, PG 64-22 | 13 ITEM 605 - 6" BASE PIPE UNDERDRAIN W/ FABRIC WRAP | (B) EXISTING 4"± - 9"± BITUMINOUS AGGREGATE BASE | (H) EXISTING UNDERDRAIN |
| 3 ITEM 442 - 1 3/4" ASPHALT CONCRETE INTERMEDIATE COURSE, 19MM, TYPE A, (446) | 14 ITEM 606 - GUARDRAIL, TYPE MGS | (C) EXISTING 4"± - 6"± AGGREGATE BASE | (I) EXISTING CURB |
| 4 ITEM 254 - 1/2" PAVEMENT PLANING, ASPHALT CONCRETE | 15 ITEM 609 - CONCRETE MEDIAN | (D) EXISTING 6"± SUBBASE | (J) EXISTING 9"± REINFORCED PORTLAND CEMENT CONCRETE |
| 5 ITEM 302 - 9" ASPHALT CONCRETE BASE, PG 64-22 | 16 ITEM 622 - CONCRETE BARRIER TYPE B | (E) EXISTING CONCRETE MEDIAN | (K) EXISTING REINFORCED CONCRETE APPROACH SLAB |
| 6 ITEM 302 - 11" ASPHALT CONCRETE BASE, PG 64-22 | 17 ITEM 622 - CONCRETE BARRIER TYPE D | (F) EXISTING CONCRETE BARRIER | (L) EXISTING 14"± CONCRETE SLAB |
| 7 ITEM 304 - 6" AGGREGATE BASE | 18 ITEM 659 - SEEDING AND MULCHING | | |
| 8 ITEM 407 - TACK COAT FOR INTERMEDIATE COURSE | 19 ITEM 526 - REINFORCED CONCRETE APPROACH SLAB (T=15") | | |
| 9 ITEM 452 - 13" NON-REINFORCED CONCRETE PAVEMENT, CLAS QC 1 WITH QC/QA | 20 ITEM 202 - PAVEMENT REMOVED | | |
| 10 ITEM 254 - 3/4" PAVEMENT PLANING, ASPHALT CONCRETE | | | |
| 11 ITEM 204 - SUBGRADE COMPACTION | | | |

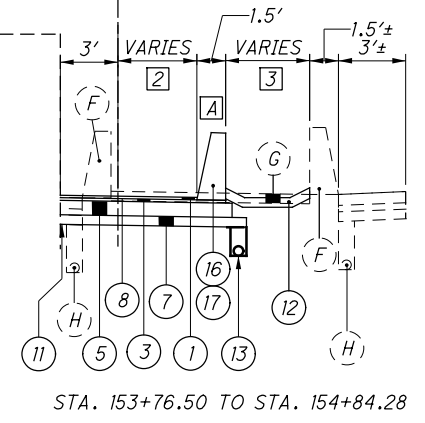

STA. 153+76.50 TO STA. 154+84.28

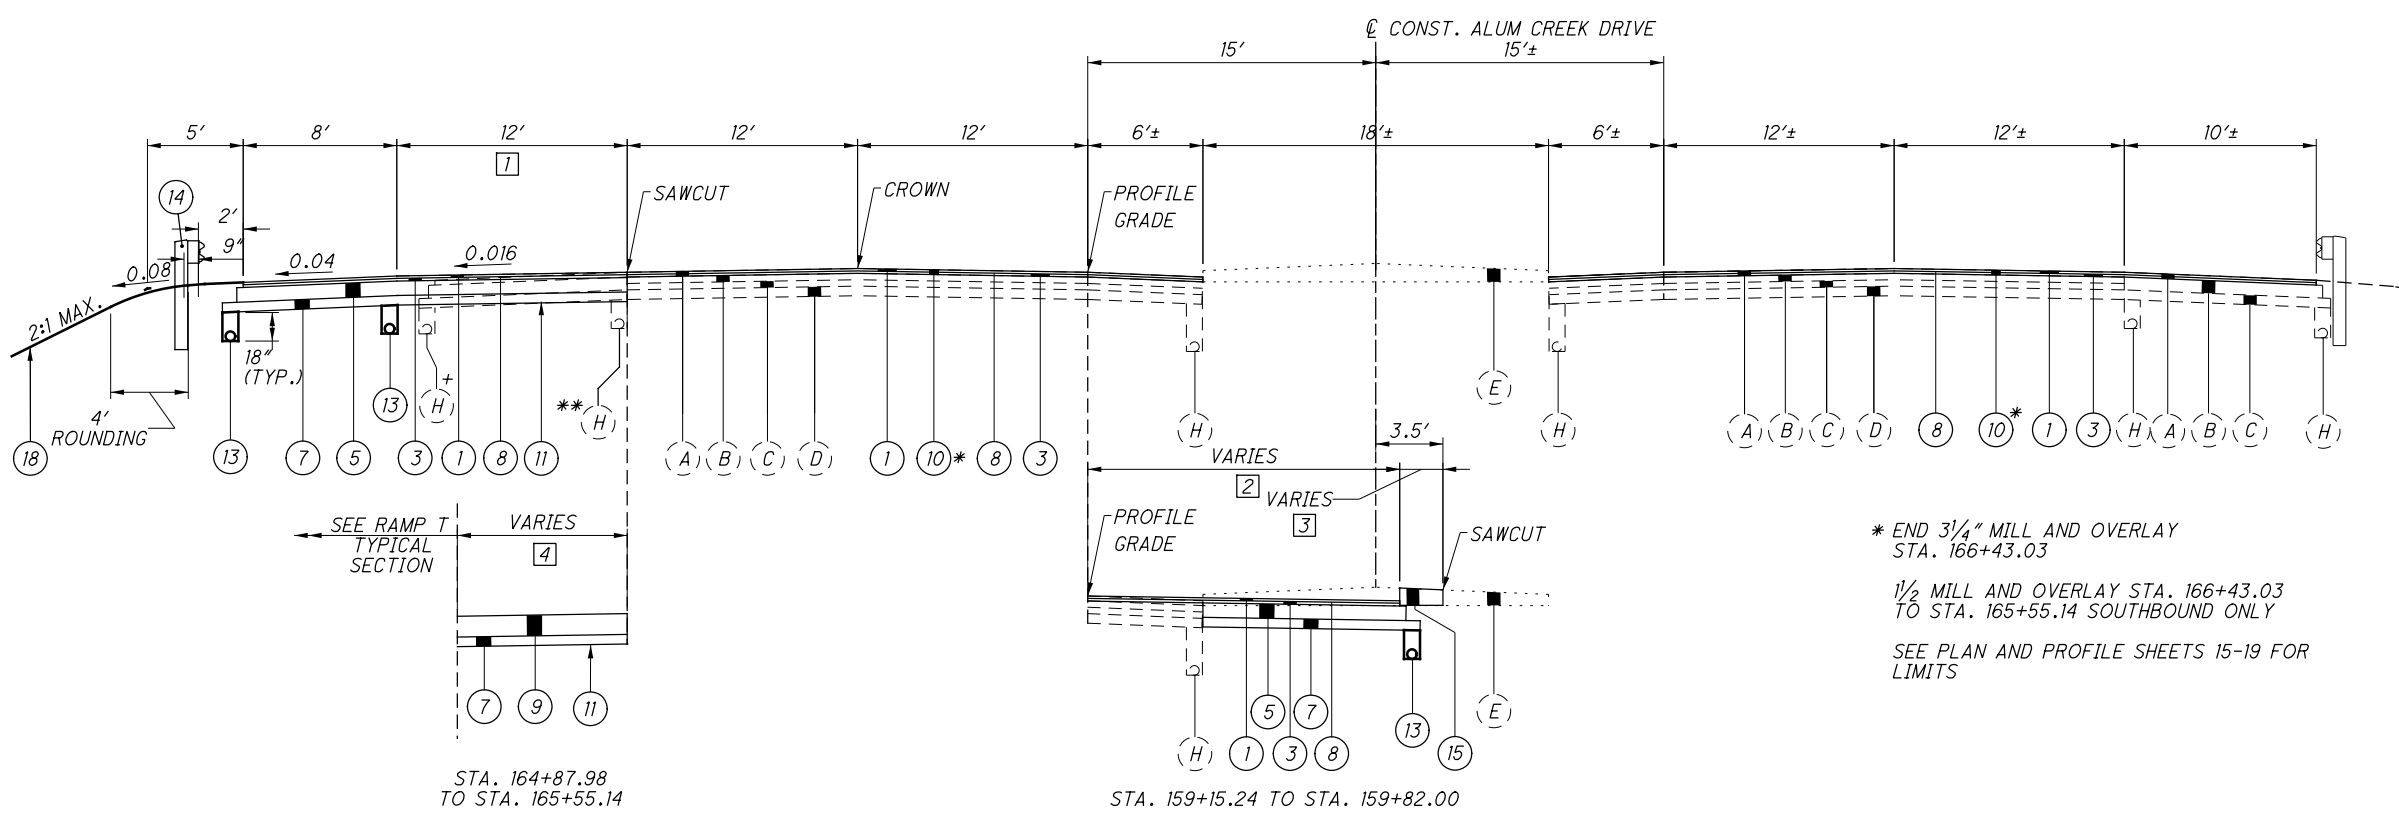

NORMAL SECTION - ALUM CREEK DRIVE

STA. 159+14.82 TO STA. 165+55.14

** UNDERDRAIN TO REMAIN,
OUTLET TO BE CONNECTED
TO NEW UNDERDRAIN


+ UNDERDRAIN TO BE REMOVED

* END 3/4" MILL AND OVERLAY
STA. 166+43.03

1/2" MILL AND OVERLAY STA. 166+43.03
TO STA. 165+55.14 SOUTHBOUND ONLY


SEE PLAN AND PROFILE SHEETS 15-19 FOR
LIMITS

- 1 VARIES 12' TO 0'
STA. 164+37.98 TO STA. 164+87.98
0'
STA. 164+87.98 TO STA. 165+55.14
- 2 16'
STA. 159+15.24 TO STA. 159+40.00
VARIES 16' TO 5.91'±
STA. 159+40.00 TO STA. 159+82.00
- 3 2.5'
STA. 159+15.24 TO STA. 159+40.00
VARIES 2.5' TO 12.59'
STA. 159+22.00 TO STA. 159+82.00
- 4 VARIES 23.00' TO 12.13'
STA. 164+87.98 TO STA. 165+55.14
- 5 STA. 165+55.14 TO STA. 168+46.00
- 6 STA. 168+54.54 TO STA. 171+67.00
- 7 VARIES 12.13' TO 0'
STA. 165+55.14 TO STA. 166+70.62
- 8 VARIES 23.54' TO 13.66'
STA. 168+46.00 TO STA. 171+67.00
- 9 VARIES 12.0' TO 1.53'
STA. 170+67.00 TO STA. 171+67.00
- 10 VARIES 8.0' TO 10.2'
STA. 170+67.00 TO STA. 171+67.00
- A PVMT CROSS SLOPE TRANSITIONS
0.028 TO 0.019
STA. 165+55.14 TO STA. 167+50.63
- B PVMT CROSS SLOPE TRANSITIONS
0.019 TO 0.016
STA. 167+50.63 TO STA. 167+75.00

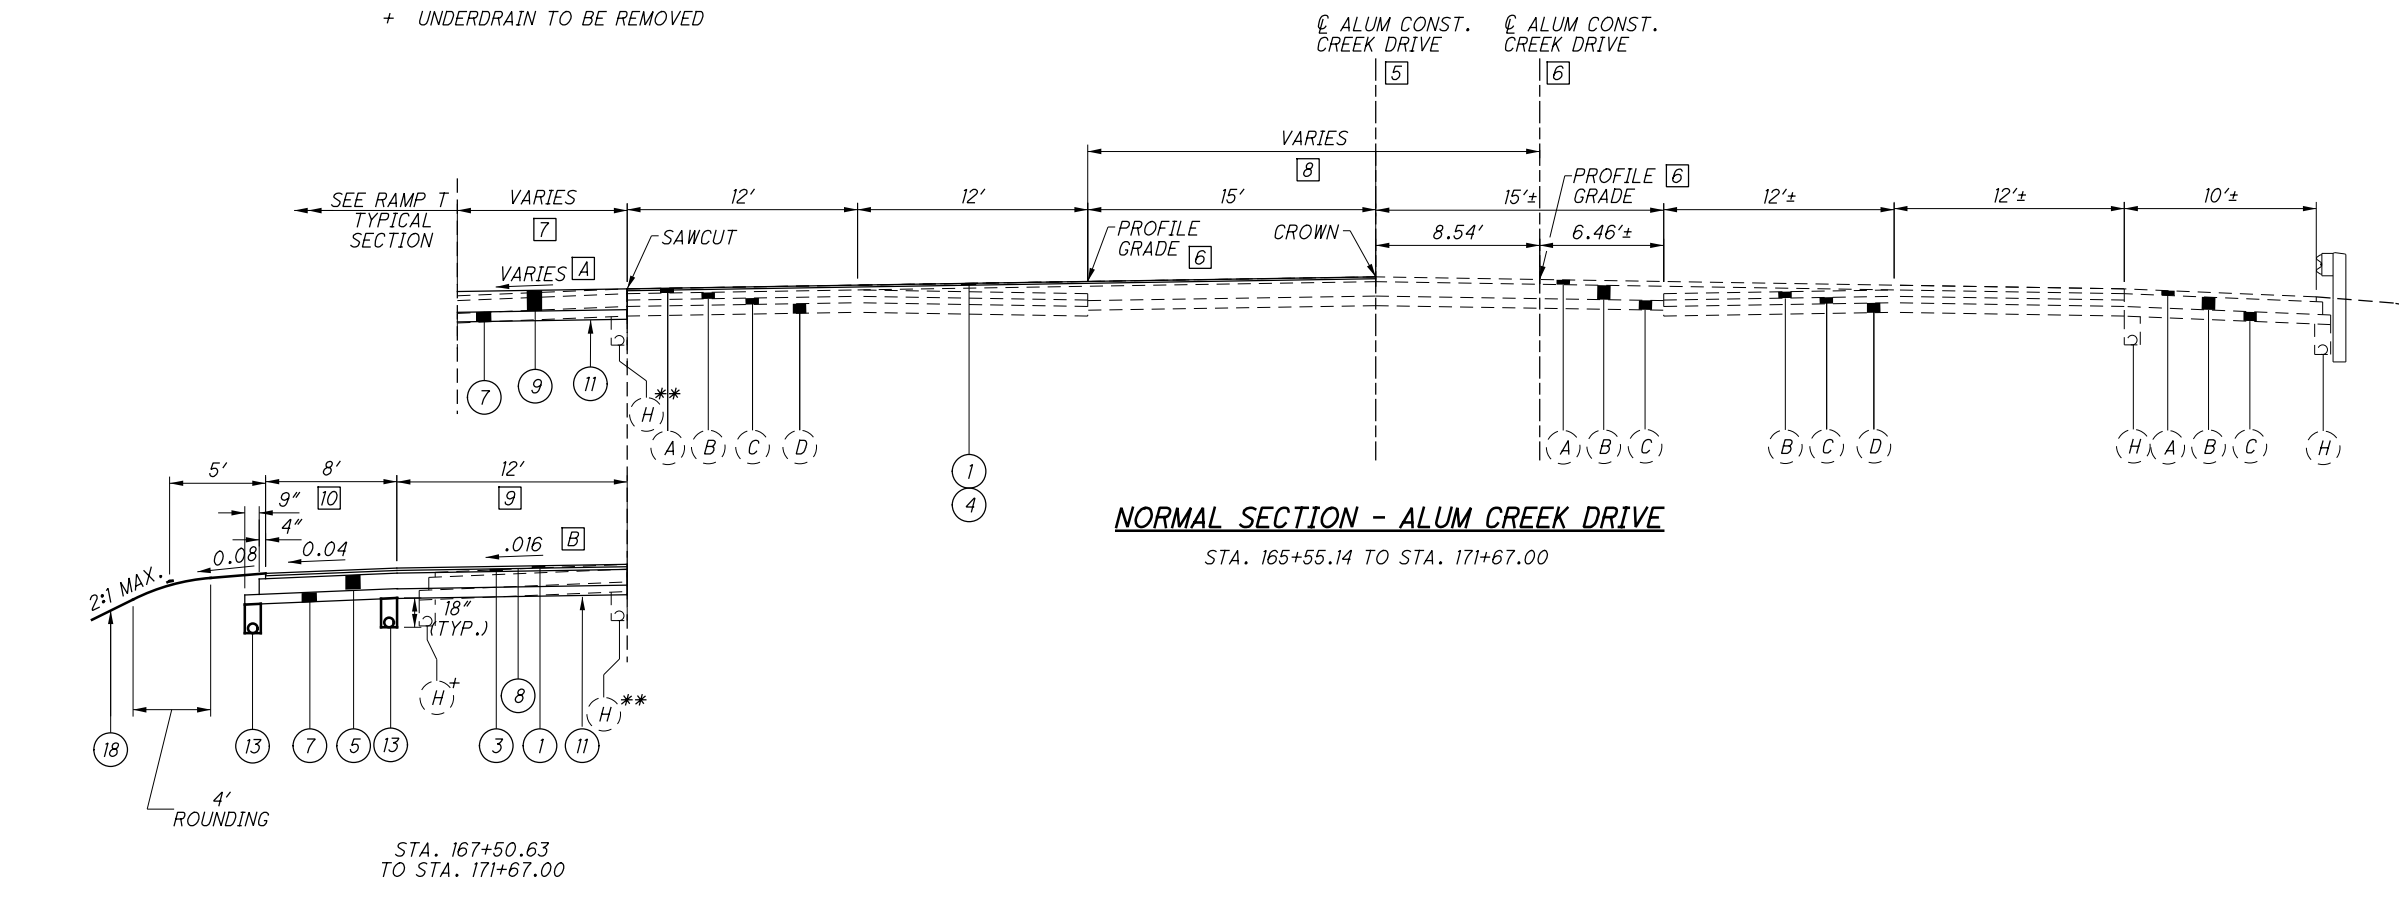


NORMAL SECTION - ALUM CREEK DRIVE

STA. 165+55.14 TO STA. 171+67.00

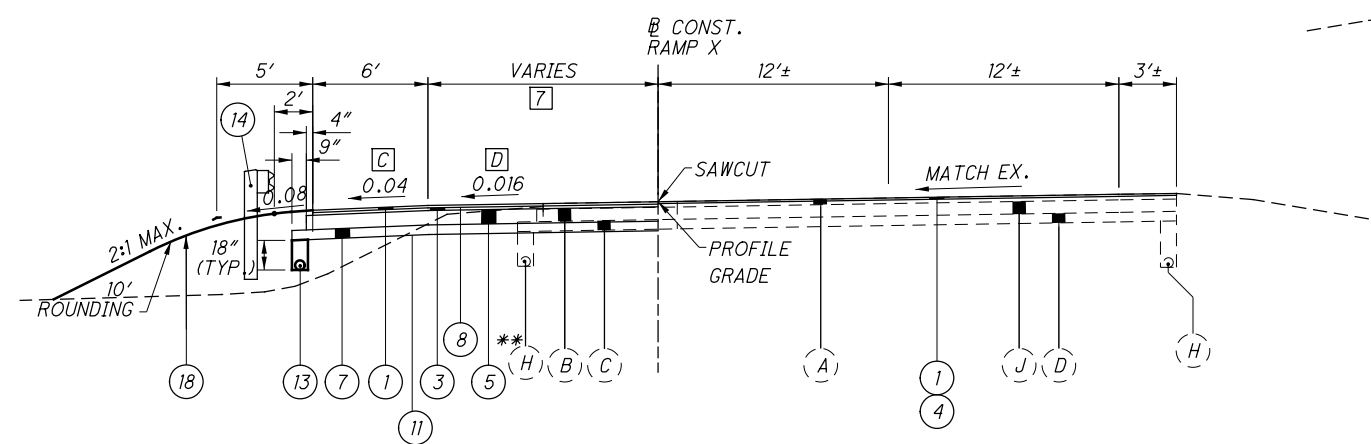


RAMP X WIDENING
STA. 706+12.00 TO STA. 708+04.00


** UNDERDRAIN TO REMAIN OUTLET TO BE CONNECTED TO NEW UNDERDRAIN

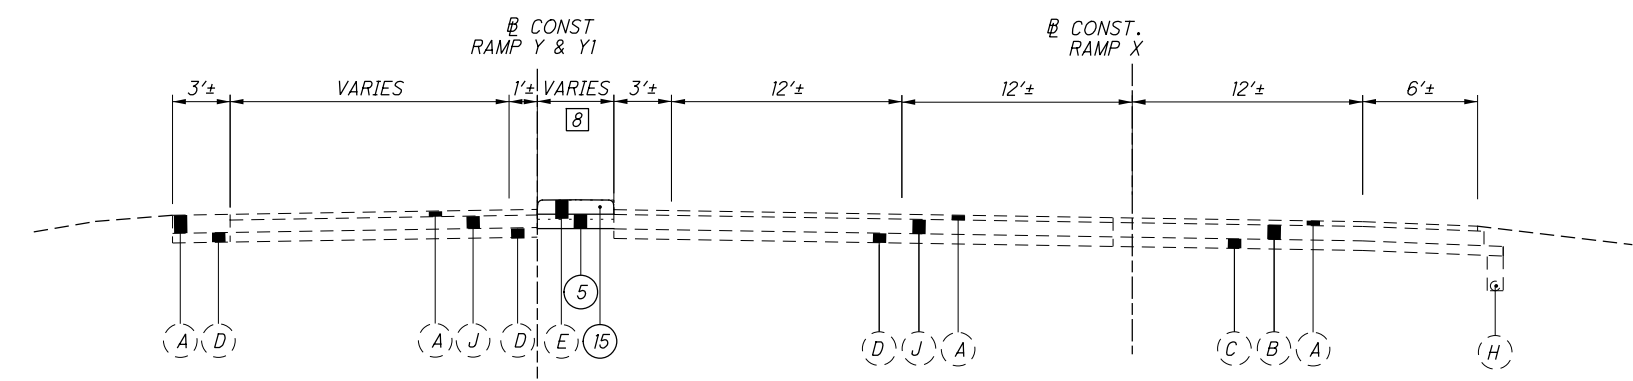


RAMP Y & Y1
STA. 709+11.69 (RAMP Y) TO STA. 710+40.65 (RAMP Y1)

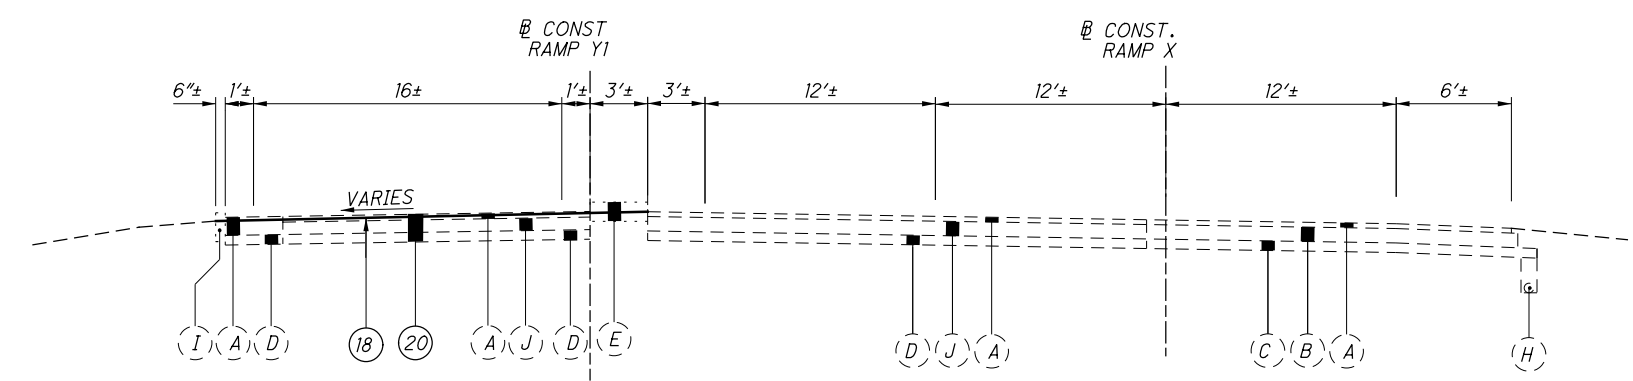

RAMP Y1 PAVEMENT REMOVAL
STA. 710+40.65 TO STA. 712+39.77

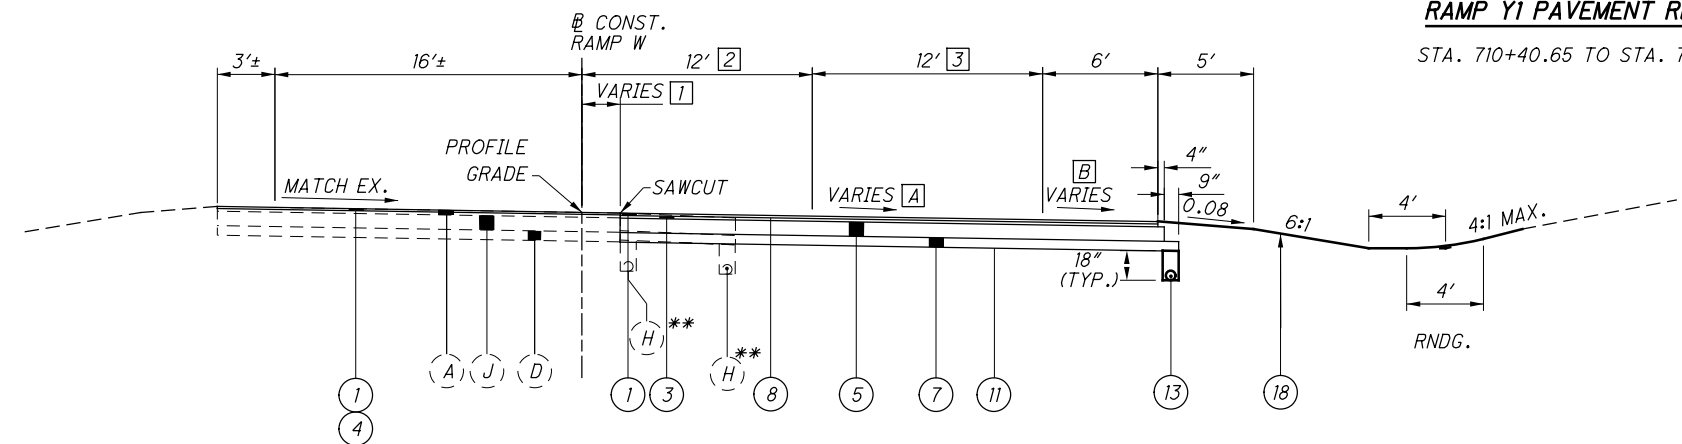


RAMP W WIDENING
STA. 688+60.00 TO STA. 692+53.00

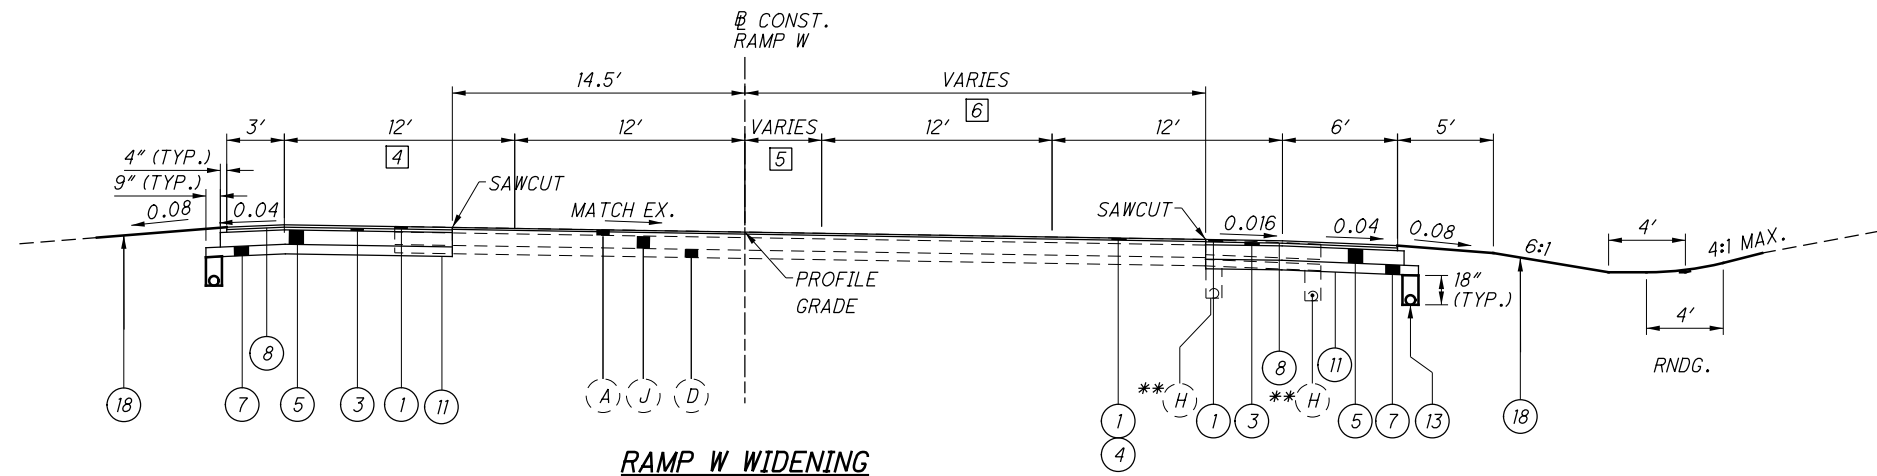


RAMP W WIDENING
STA. 692+53.00 TO STA. 695+17.78

- [1] VARIES 2.37' TO 21.49'
STA. 688+60.00 TO STA. 692+53.00
- [2] VARIES 2.37' TO 12'
STA. 688+60.00 TO STA. 689+10.00
- [3] VARIES 0' TO 12'
STA. 689+10.00 TO STA. 689+60.00
- [4] VARIES 0' TO 12'
STA. 692+53.00 TO 693+03.00
- [5] VARIES 0' TO 13.82'
STA. 694+66.67 TO STA. 695+14.31
- [6] 21.5'
STA. 692+53.00 TO STA. 693+50.00
VARIES 21.5' TO 23.0'
STA. 693+50.00 TO STA. 694+82.40
VARIES 23.0' TO 35.03'
STA. 694+82.40 TO STA. 695+17.78
- [7] VARIES 12' TO 0'
STA. 707+54.00 TO STA. 708+04.00
- [8] VARIES 10.4'± TO 3'±
STA. 709+11.93 TO STA. 709+65.05
3'±
STA. 709+65.05 TO STA. 710+40.65
- [A] PVMT CROSS SLOPE TRANSITIONS
0.016 TO 0.047
STA. 688+60.00 TO STA. 692+53.00
- [B] PVMT CROSS SLOPE TRANSITIONS
0.040 TO 0.047
STA. 688+60.00 TO STA. 692+53.00
- [C] PVMT CROSS SLOPE TRANSITIONS
0.040 TO 0.042
STA. 706+12.00 TO STA. 708+04.00
- [D] PVMT CROSS SLOPE TRANSITIONS
0.025 TO 0.042
STA. 706+12.00 TO 708+04.00


FOR LEGEND, SEE SHEET 4

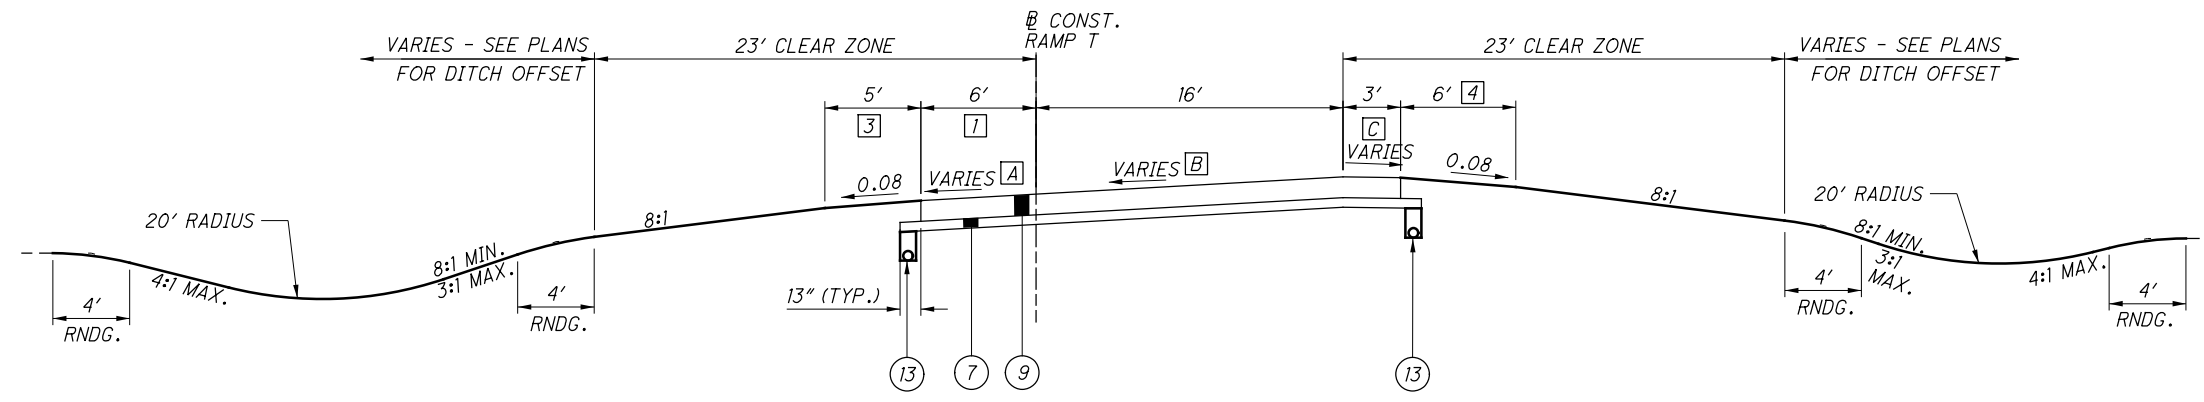

SUPERELEVATED SECTION - RAMP T
 STA. 689+47.37 TO STA. 702+64.15

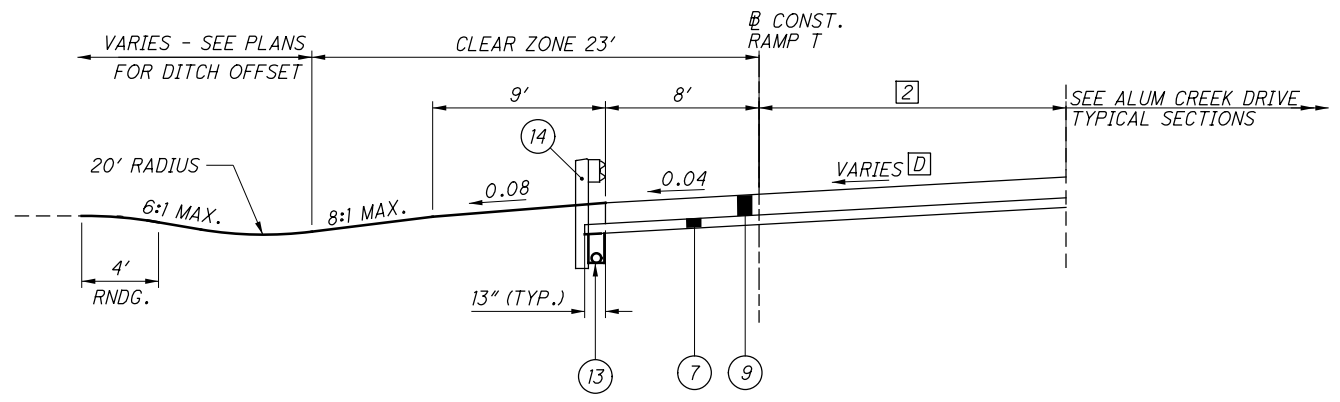

SUPERELEVATED SECTION - RAMP T
 STA. 702+64.15 TO STA. 705+60.42

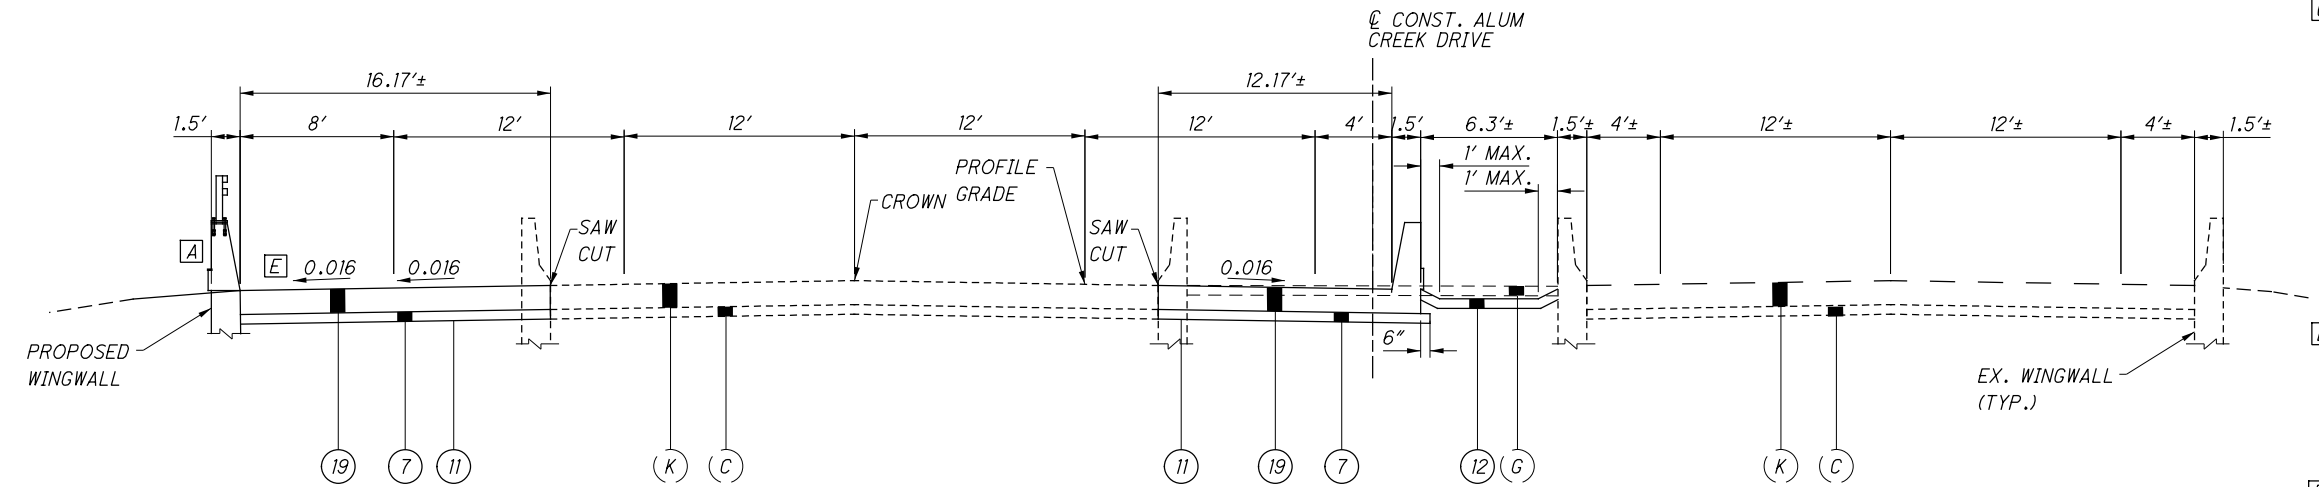

APPROACH SLAB SECTION - ALUM CREEK DRIVE
 STA. 154+85.94 TO STA. 155+10.94
 STA. 158+89.82 TO STA. 159+14.82

- [1] VARIES 6' TO 8'
STA. 702+14.15 TO STA. 702+64.15
- [2] 16'
STA. 702+64.15 TO STA. 704+46.54
VARIES 16' TO 12'
STA. 704+46.54 TO STA. 705+60.42
- [3] VARIES 6' TO 5'
STA. 689+47.37 TO STA. 689+50.00
5'
STA. 689+50.00 TO STA. 698+00.00
VARIES 5' TO 9'
STA. 698+00.00 TO STA. 698+50.00
9'
STA. 689+50.00 TO STA. 702+64.15
- [4] 6'
STA. 691+00.00 TO STA. 698+00.00
VARIES 6' TO 3'
STA. 698+00.00 TO STA. 698+50.00
3'
STA. 698+50.00 TO STA. 702+64.15
- [A] PVMT CROSS SLOPE TRANSITIONS
0.056
STA. 689+47.37 TO STA. 690+98.13
0.056 TO 0.052
STA. 690+98.13 TO STA. 691+10.93
0.052
STA. 691+10.93 TO STA. 697+70.32
0.052 TO 0.048
STA. 697+70.32 TO STA. 697+83.12
- [B] PVMT CROSS SLOPE TRANSITIONS
0.056
STA. 689+47.37 TO STA. 690+98.13
0.056 TO 0.052
STA. 690+98.13 TO STA. 691+10.93
0.052
STA. 691+10.93 TO STA. 697+70.32
0.052 TO 0.048
STA. 697+70.32 TO STA. 697+83.12
0.048
STA. 697+83.12 TO STA. 702+64.15
- [C] PVMT CROSS SLOPE TRANSITIONS
0.014
STA. 689+47.37 TO STA. 690+98.13
0.014 TO 0.018
STA. 690+98.13 TO STA. 691+10.93
0.018
STA. 691+10.93 TO STA. 697+70.32
0.018 TO 0.022
STA. 697+70.32 TO STA. 697+83.12
0.022
STA. 697+83.12 TO STA. 702+64.15
- [D] PVMT CROSS SLOPE TRANSITIONS
0.048
STA. 702+64.15 TO STA. 705+09.22
0.048 TO 0.032
STA. 705+09.22 TO STA. 705+60.42
- [E] PVMT CROSS SLOPE TRANSITIONS
0.040 TO 0.016
STA. 154+86.42 TO STA. 155+11.42
0.016 TO 0.040
STA. 158+89.64 TO STA. 159+14.64

FOR LEGEND, SEE SHEET 4

BU 4, 5, 6, 7 & 8 - RELEASED FOR CONSTRUCTION - 11/03/2014 - 11/19/2015

RAMP T TYPICAL SECTIONS

FRA - 270 - 49.00

ROUNDING

THE ROUNDING AT SLOPE BREAKPOINTS SHOWN ON THE TYPICAL SECTIONS APPLIES TO ALL CROSS-SECTIONS EVEN THOUGH OTHERWISE SHOWN.

UTILITIES

LISTED BELOW ARE ALL UTILITIES LOCATED WITHIN THE PROJECT CONSTRUCTION LIMITS TOGETHER WITH THEIR RESPECTIVE OWNERS.

AT&T 111 N. FOURTH STREET COLUMBUS, OH 43215 614-223-7162	COLUMBIA GAS OF OHIO 3550 JOHNNY APPELESEED COURT COLUMBUS, OH 43231 ATTN: BYYAN KOPACHY 614-818-2133
---	--

AMERICAN ELECTRIC POWER 850 TECH CENTER DRIVE GAHANNA, OH 43230 614-883-6831	COLUMBIA GAS TRANSMISSION 1440 MCNAUGHTEN ROAD COLUMBUS, OH 43232 ATTN: CHRIS PERRY 614-863-4658
--	---

TIME WARNER TELECOM 1015 OLENTANGY RIVER ROAD COLUMBUS, OH 43212 614-481-5263	TIME WARNER CABLE 3760 INTERCHANGE DRIVE COLUMBUS, OH 43204 614-255-6349
---	--

CITY OF COLUMBUS DIVISION OF WATER 910 DUBLIN RD. COLUMBUS, OH 43215 (614) 645-7788	WIDE OPEN WEST 3675 CORPORATE DRIVE COLUMBUS, OH 43231 614-948-4653
---	---

ODOT DISTRICT 6 TRAFFIC DEPARTMENT 400 E. WILLIAM STREET DELAWARE, OH 43015 740-833-8000	VILLAGE OF OBETZ MUNICIPAL BUILDING 4175 ALUM CREEK DRIVE OBETZ, OH 43207 614-491-7507
--	--

THE LOCATION OF THE UNDERGROUND UTILITIES SHOWN ON THE PLANS ARE AS OBTAINED FROM THE OWNERS AS REQUIRED BY SECTION 153.64 O.R.C.

SURVEYING PARAMETERS

USE THE FOLLOWING VERTICAL POSITIONING AND HORIZONTAL POSITIONING PARAMETERS FOR ALL SURVEYING:

VERTICAL POSITIONING
ORTHOMETRIC HEIGHT DATUM: NAVD 88
GEOID: GEOID US 2009

HORIZONTAL POSITIONING
REFERENCE FRAME: GRS 80

ELLIPSOID: NAD83 (2011)
MAP PROJECTION: LAMBERT CONFORMAL CONIC 2 PARALLEL
COORDINATE SYSTEM: OHIO SOUTH 3402 (OHIO STATE PLANE COORDINATE SYSTEM, SOUTH ZONE)
COMBINED SCALE FACTOR: 1.000057522

UNITS ARE IN U.S. SURVEY FEET. USE THE FOLLOWING CONVERSION FACTOR: 1 METER = 3.280833333 U.S. SURVEY FEET.

CLEARING AND GRUBBING

THE DEPARTMENT HAS NOT MARKED INDIVIDUAL TREES AND STUMPS FOR REMOVAL. UNLESS SPECIFICALLY DESIGNATED AS 'DO NOT DISTURB' IN THE PLANS, REMOVE ALL TREES AND STUMPS WITHIN THE CONSTRUCTION ACTIVITIES.

WORK LIMITS

THE WORK LIMITS SHOWN ON THESE PLANS ARE FOR PHYSICAL CONSTRUCTION ONLY. PROVIDE THE INSTALLATION AND OPERATION OF ALL WORK ZONE TRAFFIC CONTROL AND WORK ZONE TRAFFIC CONTROL DEVICES REQUIRED BY THESE PLANS WHETHER INSIDE OR OUTSIDE THESE WORK LIMITS.

BENCHING OF FOUNDATION SLOPES

ALTHOUGH CROSS-SECTIONS INDICATE SPECIFIC DIMENSIONS FOR PROPOSED BENCHING OF THE EMBANKMENT FOUNDATIONS IN CERTAIN AREAS, NO WAIVER OF THE SPECIFICATIONS IS INTENDED. BENCH ALL OTHER SLOPED EMBANKMENT AREAS AS SET FORTH IN 203.05. NO ADDITIONAL PAYMENT WILL BE MADE FOR BENCHING REQUIRED UNDER THE PROVISIONS OF 203.05.

ITEM 606 - ANCHOR ASSEMBLY, TYPE E

THIS ITEM SHALL CONSIST OF FURNISHING AND INSTALLING ANY OF THE GUARDRAIL END TERMINALS FOR TYPE MGS GUARDRAIL AS LISTED ON ROADWAY ENGINEERING'S WEB PAGE UNDER ROADSIDE SAFETY DEVICES FOR APPROVED GUARDRAIL END TREATMENTS. INSTALLATION SHALL BE AT THE LOCATIONS SPECIFIED IN THE PLANS, IN ACCORDANCE WITH THE MANUFACTURER'S SPECIFICATIONS.

THE FACE OF THE TYPE E IMPACT HEAD SHALL BE COVERED WITH A SHEET OF TYPE G REFLECTIVE SHEETING, PER CMS 730.19.

REFER TO THE MANUFACTURER'S INSTRUCTIONS REGARDING THE INSTALLATION OF, AND THE GRADING AROUND THE FOUNDATION TUBES AND GROUND STRUT. THE TOP OF ANY FOUNDATION TUBE SHOULD BE LESS THAN 4 INCHES ABOVE THE GROUND. THE PLACEMENT OF THE FOUNDATION TUBES SHOULD BE AN APPROPRIATE DEPTH BELOW THE LEVEL LINE IN ORDER TO MAINTAIN THE FINISHED GUARDRAIL HEIGHT OF 31 INCHES FROM THE EDGE OF THE SHOULDER.

ON-SITE GRADING IS REQUIRED IF THE TOP OF THE FOUNDATION TUBES OR TOP OF THE GROUND STRUT DOES PROJECT MORE THAN 4 INCHES ABOVE THE GROUND LINE.

SUBGRADE COMPACTION AND PROOF ROLLING

CONSTRUCT THE SUBGRADE AS FOLLOWS AND IN THE FOLLOWING SEQUENCE:

1. REMOVE AND STRIP THE TOPSOIL. SHAPE THE SUBGRADE TO WITHIN 0.2 FEET OF THE PLAN SUBGRADE ELEVATION.
2. PROOF ROLL THE SUBGRADE. IF UNSUITABLE MATERIAL AND /OR UNSTABLE IS ENCOUNTERED, FOLLOW THE FOLLOWING PROCEDURE:
 - A. REWORK / RECOMPACT - STRIP TOPSOIL FROM THE SITE AND SCARIFY AND SPREAD THE UNDERLYING SOIL TO A DEPTH UP TO 1.5 FEET AND ALLOW THE SOIL TO DRY OUT DURING A WARM, DRY PERIOD. ALLOW SUFFICIENT TIME TO PASS SUCH THAT THE SOIL REACHES A MOISTURE CONTENT THAT IS CLOSE TO OPTIMUM CONDITIONS. ONCE THE SOIL HAS BEEN DRIED BACK, THEN IT SHOULD BE REPLACED AND COMPACTED AS SPECIFIED IN THE CONTRACT DOCUMENTS. IF THE DRYING TIME IS A FACTOR, THEN THE OPTION B SHOULD BE CONSIDERED. UNSUITABLE MATERIALS SHALL BE REMOVED AS PER CMS 204.01.
 - B. GEOGRID / AGGREGATE - STRIP TOPSOIL FROM THE SITE AND USE GEOGRID PER ODOT SUPPLEMENTAL SPECIFICATION 861 OVER ODOT ITEM 204 GEOTEXTILE FABRIC, TYPE D, AS A SEPARATOR BETWEEN THE NATURAL SOIL AND THE GEOGRID AND THEN PLACE A MINIMUM UP TO 6.0 INCHES OF ODOT ITEM 204 GRANULAR MATERIAL, TYPE B, TO CREATE A STABLE WORKING PLATFORM ON WHICH TO BUILD THE EMBANKMENT.

3. COMPACT THE STABILIZED SUBGRADE ACCORDING TO 204.03.
4. PROOF ROLL THE COMPACTED SUBGRADE ACCORDING TO 204.06.
5. FINE GRADE THE SUBGRADE TO THE SPECIFIED GRADE.

REVIEW OF DRAINAGE FACILITIES

BEFORE ANY WORK IS STARTED ON THE PROJECT AND AGAIN BEFORE FINAL ACCEPTANCE BY THE STATE, REPRESENTATIVES OF THE STATE AND THE CONTRACTOR, ALONG WITH THE LOCAL REPRESENTATIVES, SHALL MAKE AN INSPECTION OF ALL EXISTING SEWERS WHICH ARE TO REMAIN IN SERVICE AND WHICH MAY BE AFFECTED BY THE WORK. THE CONDITION OF THE EXISTING CONDUITS AND THEIR APPURTENANCE SHALL BE DETERMINED FROM FIELD OBSERVATIONS. RECORDS OF THE INSPECTION SHALL BE KEPT IN WRITING BY THE STATE.

ALL NEW CONDUITS, INLETS, CATCH BASINS, AND MANHOLES CONSTRUCTED AS A PART OF THE PROJECT SHALL BE FREE OF ALL FOREIGN MATTER AND IN A CLEAN CONDITION BEFORE THE PROJECT WILL BE ACCEPTED BY THE STATE.

ALL EXISTING SEWERS INSPECTED INITIALLY BY THE ABOVE MENTIONED PARTIES SHALL BE MAINTAINED AND LEFT IN A CONDITION REASONABLY COMPARABLE TO THAT DETERMINED BY THE ORIGINAL INSPECTION. ANY CHANGE IN THE CONDITION RESULTING FROM THE CONTRACTOR'S OPERATIONS SHALL BE CORRECTED BY THE CONTRACTOR TO THE SATISFACTION OF THE ENGINEER.

PART-WIDTH CONSTRUCTION

BECAUSE OF THE NECESSITY TO BUILD THIS PROJECT UNDER TRAFFIC AND TO CONSTRUCT THE FULL PAVEMENT WIDTH IN STAGES, EXERCISE CARE TO PREVENT THE CONSTRUCTION OF A BUTT JOINT IN THE BASE COURSES. LAP LONGITUDINAL JOINTS AS SHOWN ON STANDARD CONSTRUCTION DRAWING BP-3.1

SEEDING AND MULCHING

SEEDING AND MULCHING SHALL BE APPLIED TO ALL AREAS OF EXPOSED SOIL BETWEEN THE RIGHT-OF-WAY LINES, AND WITHIN THE CONSTRUCTION LIMITS FOR AREAS OUTSIDE THE RIGHT-OF-WAY LINES COVERED BY WORK AGREEMENT OR SLOPE EASEMENT.

CONNECTION BETWEEN EXISTING AND PROPOSED GUARDRAIL

WHEN IT IS NECESSARY TO SPLICE PROPOSED GUARDRAIL TO EXISTING GUARDRAIL, ONLY THE EXISTING GUARDRAIL SHALL BE CUT, DRILLED, OR PUNCHED. THE CONNECTION SHALL BE MADE USING A W-BEAM, BEAM SPLICE AS SHOWN IN AASHTO M 180-12, EXCEPT THE BEAM WASHERS ARE NOT BE USED.

CROSSINGS AND CONNECTIONS TO EXISTING PIPES AND UTILITIES

WHERE PLANS PROVIDE FOR A PROPOSED CONDUIT TO BE CONNECTED TO, OR CROSS OVER OR UNDER AN EXISTING SEWER OR UNDERGROUND UTILITY, THE CONTRACTOR SHALL LOCATE THE EXISTING PIPES OR UTILITIES BOTH AS TO LINE AND GRADE BEFORE STARTING TO LAY THE PROPOSED CONDUIT.

IF IT IS DETERMINED THAT THE ELEVATION OF THE EXISTING CONDUIT, OR EXISTING APPURTENANCE TO BE CONNECTED, DIFFERS FROM THE PLAN ELEVATION OR RESULTS IN A CHANGE IN THE PLAN CONDUIT SLOPE, THE ENGINEER SHALL BE NOTIFIED BEFORE STARTING CONSTRUCTION OF ANY PORTION OF THE PROPOSED CONDUIT WHICH WILL BE AFFECTED BY THE VARIANCE IN THE EXISTING ELEVATIONS.

IF IT IS DETERMINED THAT THE PROPOSED CONDUIT WILL INTERSECT AN EXISTING SEWER OR UNDERGROUND UTILITY IF CONSTRUCTED AS SHOWN ON THE PLAN, THE ENGINEER SHALL BE NOTIFIED BEFORE STARTING CONSTRUCTION OF ANY PORTION OF THE PROPOSED CONDUIT WHICH WOULD BE AFFECTED BY THE INTERFERENCE WITH AN EXISTING FACILITY.


ITEM 606 - IMPACT ATTENUATOR, TYPE 1 (BIDIRECTIONAL)

THIS ITEM SHALL CONSIST OF FURNISHING AND INSTALLING ANY ONE OF THE TYPE 1 IMPACT ATTENUATORS AS LISTED ON THE OFFICE OF ROADWAY ENGINEERING'S WEB PAGE. INSTALLATION SHALL BE AT THE LOCATIONS SPECIFIED IN THE PLANS, IN ACCORDANCE WITH THE MANUFACTURER'S SPECIFICATIONS.

THE FACE OF THE TYPE 1 IMPACT HEAD SHALL BE COVERED WITH A SHEET OF TYPE G REFLECTIVE SHEETING, PER CMS 730.19.

POST CONSTRUCTION STORM WATER TREATMENT

THIS PLAN UTILIZES VEGETATED BIOFILTER BEST MANAGEMENT PRACTICES (BMP'S) FOR POST CONSTRUCTION STORM WATER TREATMENT.

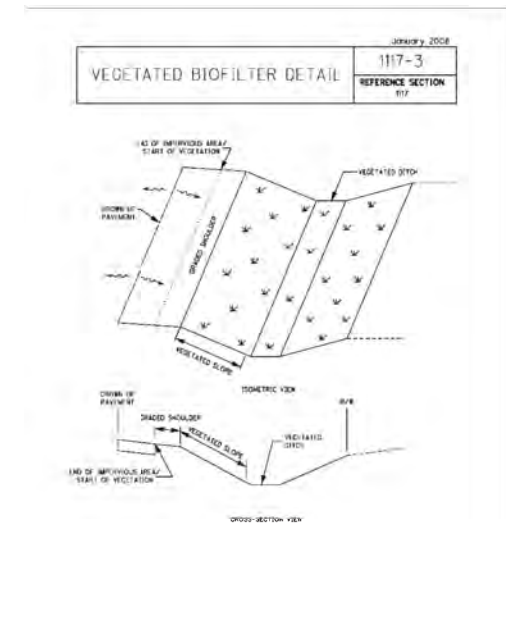

SEE ODOT'S DESIGN BUILD SCOPE OF SERVICES FOR ADDITIONAL REQUIREMENTS NOT REPEATED IN THESE GENERAL NOTES.

UNDERCUTTING

THE UNDERCUT OF THE SUBGRADE FOR THIS PROJECT, WHICH INCLUDES ALL AREA UNDER PAVEMENT OR FULL DEPTH REPLACEMENT, IS ESTIMATED AT APPROXIMATELY 1,014 CY.

IF THE ACTUAL QUANTITY IS MORE OR LESS, THE DEPARTMENT WILL PROCESS A PAYMENT OR CREDIT BASED ON THE 2013 STATE AVERAGE AWARD UNIT BID PRICE FOR ITEM 204-GRANULAR MATERIAL, TYPE B.

PAYMENT FOR THIS SHALL BE INCLUDED IN THE CONTRACT BID PRICE FOR ITEM 204-GRANULAR MATERIAL, TYPE B AND SHALL INCLUDE ADJUSTING UNDERDRAIN DEPTHS, PLACING ADDITIONAL GEOTEXTILE, OR OTHER INCIDENTALS.

DISCUSSION OF SEQUENCE OF OPERATIONS AND MOT PROCEDURES

CONSTRUCTION OF THE PROJECT HAS BEEN DIVIDED INTO TWO (2) MAJOR CONSTRUCTION SEASONS. FOR THIS PROJECT, A "CONSTRUCTION SEASON" DENOTES EACH ANTICIPATED CONSTRUCTION SEASON (YEAR). FOR EXAMPLE, CONSTRUCTION SEASON 1 EQUATES TO THE FIRST CONSTRUCTION SEASON.

A "TRAFFIC PHASE" DENOTES A TRAFFIC SHIFT TO A NEW LOCATION, WITHIN EACH CONSTRUCTION SEASON (TIME PERIOD), WHERE CHANGES IN TRAFFIC PATTERNS AND CONSTRUCTION ACTIVITIES ARE REQUIRED. A CONSECUTIVE NUMBERING SYSTEM IS USED FOR THE TRAFFIC PHASES.

AN ASSUMED DURATION OF SPECIFIC TRAFFIC CONTROL SET UP AND RELATED CONSTRUCTION ACTIVITIES HAVE BEEN INCLUDED FOR INFORMATION ONLY. THE CONTRACTOR CAN ELECT TO COMPLETE INDIVIDUAL CONSTRUCTION STAGES AND TRAFFIC PHASES ANY TIME DURING THE PROJECT CONTRACT, PROVIDED THE PREREQUISITES HAVE BEEN MET, AND INTERIM AND FINAL COMPLETION DATES ARE MET.

SEASON 1 PHASE 1 CONSTRUCTION

OBJECTIVE: WIDEN THE WESTERN SIDE OF SOUTHBOUND ALUM CREEK DRIVE AND THE WESTERN SIDE OF THE SOUTHBOUND BRIDGE OVER I-270. CONSTRUCT RAMP T. CONSTRUCT NOISE WALL ALONG RIGHT-OF-WAY NEAR RAMP T. WIDEN THE NORTHERN SIDES OF RAMP W AND RAMP X.

- FILL RUMBLE STRIPS ON IR 270. REMOVE CONFLICTING PAVEMENT MARKINGS AND RAISED PAVEMENT MARKERS AS DETAILED IN THESE PLANS FOR ALUM CREEK DRIVE, IR 270, RAMP W, AND RAMP X.
- INSTALL WORK ZONE STRIPING AS DETAILED IN THESE PLANS FOR ALUM CREEK DRIVE, IR 270, RAMP W, AND RAMP X. PLACE WORK ZONE PORTABLE BARRIERS AND WORK ZONE IMPACT ATTENUATORS ALONG NEW WORK ZONE EDGE LINES. SHIFT TRAFFIC.
- PLACE STORM WATER POLLUTION PREVENTION MEASURES AS DETAILED IN THE SWPPP PLANS.
- CONSTRUCT THE WIDENING OF THE WESTERN SIDE OF ALUM CREEK DRIVE AND THE WIDENING OF THE WESTERN SIDE OF THE BRIDGE. CONSTRUCT RAMP T AND ACCELERATION LANE ALONG WESTBOUND IR 270. CONSTRUCT THE WIDENING OF THE NORTHERN SIDES OF RAMP W AND RAMP X.
- TRAFFIC ON IR 270 WILL BE RESTRICTED TO TWO LANES PER THE UNAUTHORIZED LANE USE TABLE FOR BRIDGE PAINTING FOR BOTH EASTBOUND AND WESTBOUND TRAFFIC. IT WILL ALSO BE SHIFTED PER ODOT SCD MT-102.20. TRAFFIC ON IR 270 WILL BE RESTRICTED TO ONE LANE PER THE UNAUTHORIZED LANE USE TABLE FOR DECK REMOVAL AND BEAM ERECTION FOR BOTH EASTBOUND AND WESTBOUND TRAFFIC. ROLLING LANE CLOSURES PER ODOT PIS 209960 AS SHOWN ON SHEET 14 OF THE PLANS WILL ALSO BE REQUIRED FOR BEAM ERECTION AND DECK REMOVAL.
- CONSTRUCT NOISE WALL.

SEASON 2 PHASE 2 CONSTRUCTION

OBJECTIVE: WIDEN THE EASTERN SIDE OF THE SOUTHBOUND ALUM CREEK DRIVE BRIDGE. WIDEN THE SOUTHERN SIDE OF RAMP W. REMOVE THE PORTION OF RAMP Y THAT PROVIDES ACCESS FROM SOUTHBOUND ALUM CREEK DRIVE TO WESTBOUND IR 270 AS DETAILED IN BUILDABLE UNIT 6. INSTALL NEW TOWER LIGHTING, STREET LIGHTING, AND SIGNAL.

- INSTALL WORK ZONE STRIPING AS DETAILED IN BUILDABLE UNIT 6 FOR ALUM CREEK DRIVE, RAMP W, AND RAMP X. PLACE WORK ZONE PORTABLE BARRIERS AND WORK ZONE IMPACT ATTENUATORS ALONG NEW WORK ZONE EDGE LINES. SHIFT TRAFFIC.
- PLACE STORM WATER POLLUTION PREVENTION MEASURES AS DETAILED IN THE SWPPP PLANS.
- OPEN RAMP T TO TO TRAFFIC
- CONSTRUCT THE WIDENING OF THE EASTERN SIDE OF ALUM CREEK DRIVE BRIDGE OVER IR 270. CONSTRUCT THE WIDENING OF THE SOUTHERN SIDE OF RAMP W. REMOVE RAMP Y AS DETAILED IN BUILDABLE UNIT 6.
- INSTALL DECORATIVE RAILING ON THE OUTSIDE PARAPET OF NORTHBOUND AND SOUTHBOUND BRIDGES. LANE CLOSURE ON ALUM CREEK TO PROCEED WITH THIS WORK SHALL BE AS PER STANDARD DRAWING MT-95.30.
- TRAFFIC ON IR 270 WILL BE RESTRICTED TO ONE LANE PER THE UNAUTHORIZED LANE USE TABLE FOR DECK REMOVAL AND BEAM ERECTION FOR BOTH EASTBOUND AND WESTBOUND TRAFFIC. ROLLING LANE CLOSURES PER ODOT PIS 209960 AS SHOWN ON SHEET 14 OF THE PLANS WILL ALSO BE REQUIRED FOR BEAM ERECTION AND DECK REMOVAL.
- INSTALL NEW TOWER LIGHTING, STREET LIGHTING, AND TRAFFIC SIGNALS.

HAUL ROADS

- IR 270
- ALUM CREEK DRIVE

ITEM 614, MAINTAINING TRAFFIC

A MINIMUM OF 2 LANE(S) OF TRAFFIC IN EACH DIRECTION ON IR 270 AND A MINIMUM OF 1 LANE IN EACH DIRECTION ON ALUM CREEK DRIVE SHALL BE MAINTAINED AT ALL TIMES BY USE OF THE EXISTING PAVEMENT, THE COMPLETED PAVEMENT, AND TEMPORARY SURFACES USING ITEMS 410, AND 614. PERMITTED LANE CLOSURES ARE ACCEPTABLE AS FOLLOWS:

EXISTING NUMBER OF LANES PER DIRECTION	UNAUTHORIZED LANE USE TABLE - IR 270				DISINCENTIVE AMOUNTS PER MINUTE PER LANE
	LANE REDUCTION	MON TO FRI	SAT	SUN	
3	3 TO 2	5AM - 9AM & 3PM - 7PM	NO RESTRICTION	NO RESTRICTION	\$75
	3 TO 1	5AM - 8PM	6AM - 7PM	6AM - 7PM	\$75
SHORT TERM SHOULDER CLOSURES ARE NOT PERMITTED 5AM - 9AM AND 3PM - 7PM MONDAY - FRIDAY.					

RAMP CLOSURE RESTRICTIONS

INTERSTATE ROUTE 270 IN FRANKLIN COUNTY

SECONDARY ROUTE: ALUM CREEK DR SLM ALONG 270: 49.00 (SOUTH SIDE)

RAMP	MOVEMENT	NO CLOSURES ALLOWED		DETOUR ROUTES	
		MON TO FRI	SAT TO SUN	PRIMARY ROUTE	SECONDARY ROUTE
V	ALUM CREEK DR. NB TO I-270 EB	5AM - 8PM	8AM - 7PM	ALUM CREEK DR. N TO 270 W TO US-23 TO 270 E	NONE
W	I-270 EB TO ALUM CREEK DR.	5AM - 8PM	8AM - 7PM	270 E/N TO US-33 W TO 270 S TO ALUM CREEK DR. (RAMP X)	NONE
X	I-270 WB TO ALUM CREEK DR.	5AM - 7PM	8AM - 7PM	270 W TO US-23 TO 270 E TO ALUM CREEK DR. (RAMP W)	NONE
Y	ALUM CREEK DR. NB TO I-270 WB	5AM - 8PM	8AM - 7PM	NONE	ALUM CREEK DR. TO 270 N (RAMP V) TO US-33 W TO 270 S

DISINCENTIVE AMOUNT PER MINUTE PER LANE: \$75

ITEM 614, MAINTAINING TRAFFIC (LANES OPEN DURING HOLIDAYS OR SPECIAL EVENTS)

NO WORK SHALL BE PERFORMED AND THREE (3) LANES PER DIRECTION ON I-270, AT LEAST ONE (1) LANE ON ALUM CREEK DRIVE, AND ALL RAMPS SHALL BE OPEN TO TRAFFIC DURING THE FOLLOWING DESIGNATED HOLIDAYS:

CHRISTMAS FOURTH OF JULY
 NEW YEAR'S LABOR DAY
 MEMORIAL DAY THANKSGIVING

NO WORK SHALL BE PERFORMED AND THREE (3) LANES PER DIRECTION ON I-270, ONE (1) LANE PER DIRECTION ON ALUM CREEK DRIVE, AND ALL RAMPS SHALL BE OPEN TO TRAFFIC DURING THE WEEK OF THE ZUCCHINI FESTIVAL.

THE PERIOD OF TIME THAT THE LANES ARE TO BE OPEN DEPENDS ON THE DAY OF THE WEEK ON WHICH THE HOLIDAY FALLS. THE FOLLOWING SCHEDULE SHALL BE USED TO DETERMINE THIS PERIOD:

DAY OF HOLIDAY EVENT	TIME ALL LANES MUST BE OPEN TO TRAFFIC
SUNDAY	12:00 NOON FRIDAY THROUGH 6:00 AM MONDAY
MONDAY	12:00 NOON FRIDAY THROUGH 6:00 AM TUESDAY
TUESDAY	12:00 NOON MONDAY THROUGH 6:00 AM WEDNESDAY
WEDNESDAY	12:00 NOON TUESDAY THROUGH 6:00 AM THURSDAY
THURSDAY	12:00 NOON WEDNESDAY THROUGH 6:00 AM FRIDAY
THURSDAY (THANKSGIVING ONLY)	5:00 AM WEDNESDAY THROUGH 6:00 AM MONDAY
FRIDAY	12:00 NOON THURSDAY THROUGH 6:00 AM MONDAY
SATURDAY	12:00 NOON FRIDAY THROUGH 6:00 AM MONDAY

SHOULD THE CONTRACTOR FAIL TO MEET ANY OF THESE REQUIREMENTS, THE CONTRACTOR SHALL BE ASSESSED A DISINCENTIVE IN THE AMOUNT OF \$75 FOR EACH MINUTE THE ABOVE DESCRIBED LANE CLOSURE RESTRICTIONS ARE VIOLATED.

NO EXTENSIONS OF TIME SHALL BE GRANTED FOR DELAYS IN MATERIAL DELIVERIES, UNLESS SUCH DELAYS ARE INDUSTRY WIDE, OR FOR LABOR STRIKES, UNLESS SUCH STRIKES ARE AREA-WIDE.

ITEM 614, MAINTAINING TRAFFIC

ALL WORK AND TRAFFIC CONTROL DEVICES SHALL BE IN ACCORDANCE WITH CMS 614 AND OTHER APPLICABLE PORTIONS OF THE SPECIFICATIONS, AS WELL AS THE OHIO MANUAL OF UNIFORM TRAFFIC CONTROL DEVICES.

TRENCH FOR WIDENING

TRENCH EXCAVATION FOR BASE WIDENING SHALL BE ONLY ON ONE SIDE OF THE PAVEMENT AT A TIME. THE OPEN TRENCH SHALL BE ADEQUATELY MAINTAINED AND PROTECTED WITH DRUMS OR BARRICADES AT ALL TIMES. PLACEMENT OF PROPOSED SUBBASE AND BASE MATERIAL SHALL FOLLOW AS CLOSELY AS POSSIBLE BEHIND EXCAVATION OPERATIONS. THE LENGTH OF WIDENING TRENCH WHICH IS OPEN AT ANY ONE TIME SHALL BE HELD TO A MINIMUM AND SHALL AT ALL TIMES BE SUBJECT TO APPROVAL OF THE ENGINEER.

OVERNIGHT TRENCH CLOSING

THE BASE WIDENING SHALL BE COMPLETED TO A DEPTH OF NO MORE THAN 1.5 INCHES BELOW THE EXISTING PAVEMENT BY THE END OF EACH WORK DAY. NO TRENCH SHALL BE LEFT OPEN OVERNIGHT EXCEPT FOR A SHORT LENGTH (25 FEET OR LESS) OF A WORK SECTION AT THE END OF THE TRENCH. IN CASE WORK MUST BE SUSPENDED BECAUSE OF INCLEMENT WEATHER OR OTHER REASONS, THE TRENCH FOR THE UNCOMPLETED BASE WIDENING SHALL BE BACKFILLED AT THE DIRECTION OF THE ENGINEER.

DUST CONTROL

THE CONTRACTOR SHALL FURNISH AND APPLY WATER FOR DUST CONTROL AS DIRECTED BY THE ENGINEER.

ITEM 614, WORK ZONE IMPACT ATTENUATOR FOR 24" WIDE HAZARDS (UNIDIRECTIONAL OR BIDIRECTIONAL)

THIS ITEM SHALL CONSIST OF FURNISHING AND INSTALLING A NON-GATING IMPACT ATTENUATOR FROM THE OFFICE OF ROADWAY ENGINEERING'S APPROVED LIST FOR WORK ZONE IMPACT ATTENUATORS, FROM THE ROADWAY STANDARD'S WEB PAGE FOR ROADWAY STANDARDS APPROVED PRODUCTS.

INSTALLATION SHALL BE AT THE LOCATIONS SPECIFIED IN THE PLANS IN ACCORDANCE WITH THE MANUFACTURER'S SPECIFICATIONS.

THE CONTRACTOR SHALL REPAIR OR REPLACE A DAMAGED UNIT WITHIN 24 HOURS OF A DAMAGING IMPACT.

WHEN BIDIRECTIONAL DESIGNS ARE SPECIFIED, THE CONTRACTOR SHALL SUPPLY APPROPRIATE TRANSITIONS.

WHEN GATING IMPACT ATTENUATORS ARE DESIRED, THE CONTRACTOR SHALL SUBMIT DOCUMENTATION TO THE ENGINEER FOR ACCEPTANCE.

ITEM 614, WORK ZONE IMPACT ATTENUATOR, FOR HAZARDS OVER 24" AND LESS THAN 36" WIDE, (UNIDIRECTIONAL OR BIDIRECTIONAL)

THIS ITEM SHALL CONSIST OF FURNISHING AND INSTALLING A NON-GATING IMPACT ATTENUATOR FROM THE OFFICE OF ROADWAY ENGINEERING'S APPROVED LIST FOR WORK ZONE IMPACT ATTENUATORS, FROM THE ROADWAY STANDARD'S WEB PAGE FOR ROADWAY STANDARDS APPROVED PRODUCTS.

INSTALLATION SHALL BE AT THE LOCATIONS SPECIFIED IN THE PLANS, IN ACCORDANCE WITH THE MANUFACTURER'S SPECIFICATIONS.

THE CONTRACTOR SHALL REPAIR OR REPLACE A DAMAGED UNIT WITHIN 24 HOURS OF A DAMAGING IMPACT.

WHEN BIDIRECTIONAL DESIGNS ARE SPECIFIED, THE CONTRACTOR SHALL SUPPLY APPROPRIATE TRANSITIONS.

ITEM 614 - PORTABLE CHANGEABLE MESSAGE SIGN, AS PER PLAN

THE CONTRACTOR SHALL FURNISH, INSTALL, MAINTAIN AND REMOVE, WHEN NO LONGER NEEDED, AT LEAST TWO (2) PORTABLE CHANGEABLE MESSAGE SIGNS. THE SIGNS SHALL BE OF A TYPE SHOWN ON A LIST OF APPROVED PCMS UNITS AVAILABLE ON THE OFFICE OF MATERIALS MANAGEMENT WEB PAGE. THE LIST CONTAINS CLASS A AND B UNITS WITH MINIMUM LEGIBILITY DISTANCES OF 650 FT. AND 475 FT., RESPECTIVELY.

EACH SIGN SHALL BE TRAILER-MOUNTED AND EQUIPPED WITH A FUNCTIONAL DIMMING MECHANISM, TO DIM THE SIGN DURING DARKNESS, AND A TAMPER AND VANDAL PROOF ENCLOSURE. EACH SIGN SHALL BE PROVIDED WITH APPROPRIATE TRAINING AND OPERATION INSTRUCTIONS TO ENABLE ON-SITE PERSONNEL TO OPERATE AND TROUBLESHOOT THE UNIT. THE SIGN SHALL ALSO BE CAPABLE OF BEING POWERED BY AN ELECTRICAL SERVICE DROP FROM A LOCAL UTILITY COMPANY. THE PCMS SHALL BE DELINEATED IN ACCORDANCE WITH C&MS 614.03

THE PROBABLE PCMS LOCATIONS AND WORK LIMITS FOR THOSE LOCATIONS ARE SHOWN ON SHEET(S) 18 AND 20F THE PLANS. IN ADDITION TO THESE LOCATIONS PCMS SHALL ALSO BE PROVIDED ON US 33 WB AND IR 270 WB DURING BEAM ERECTION AND DECK REMOVAL ON IR 270 WB. PCMS SHALL BE PROVIDED ON IR 71 N, IR 270 EB, AND US 23 NB DURING BEAM ERECTION AND DECK REMOVAL ON IR 270 EB. THE MESSAGES SHALL NOTIFY MOTORISTS OF THE CLOSURES AND ADVISE THEM TO USE ALTERNATE ROUTES. PLACEMENT, OPERATION, MAINTENANCE AND ALL ACTIVATION OF THE SIGNS BY THE CONTRACTOR SHALL BE AS DIRECTED BY THE ENGINEER. THE PCMS SHALL BE LOCATED IN A HIGHLY VISIBLE POSITION YET PROTECTED FROM TRAFFIC. THE CONTRACTOR SHALL, AT THE DIRECTION OF THE ENGINEER, RELOCATE THE PCMS TO IMPROVE VISIBILITY OR ACCOMMODATE CHANGED CONDITIONS. WHEN NOT IN USE, THE PCMS SHALL BE TURNED OFF. ADDITIONALLY, WHEN NOT IN USE FOR EXTENDED PERIODS OF TIME, THE PCMS SHALL BE TURNED, FACING AWAY FROM ALL TRAFFIC.

THE ENGINEER SHALL BE PROVIDED ACCESS TO EACH SIGN UNIT AND SHALL BE PROVIDED WITH APPROPRIATE TRAINING AND OPERATION INSTRUCTIONS TO ENABLE ODOT PERSONNEL TO OPERATE AND TROUBLESHOOT THE UNIT, AND TO REVISE SIGN MESSAGES, IF NECESSARY.

(THE CONTRACTOR SHALL IMPLEMENT A SYSTEM WHEREBY CHANGEABLE MESSAGES WILL BE IMPLEMENTED WITHIN 4 HOURS FOLLOWING TELEPHONE NOTIFICATION FROM THE PROJECT ENGINEER TO A DESIGNATED PHONE.)

ALL MESSAGES TO BE DISPLAYED ON THE SIGN WILL BE PROVIDED BY THE ENGINEER. A LIST OF ALL REQUIRED PREPROGRAMMED MESSAGES WILL BE GIVEN TO THE CONTRACTOR AT THE PROJECT PRECONSTRUCTION CONFERENCE. THE SIGN SHALL HAVE THE CAPABILITY TO STORE UP TO 99 MESSAGES. MESSAGE MEMORY OR PRE-PROGRAMMED DISPLAYS SHALL NOT BE LOST AS A RESULT OF POWER FAILURES TO THE ON-BOARD COMPUTER. THE SIGN LEGEND SHALL BE CAPABLE OF BEING CHANGED IN THE FIELD. THREE-LINE PRESENTATION FORMATS WITH UP TO SIX MESSAGE PHASES SHALL BE SUPPORTED. PCMS FORMAT SHALL PERMIT THE COMPLETE MESSAGE FOR EACH PHASE TO BE READ AT LEAST TWICE.

THE PCMS SHALL CONTAIN AN ACCURATE CLOCK AND PROGRAMMING LOGIC WHICH WILL ALLOW THE SIGN TO BE ACTIVATED, DEACTIVATED OR MESSAGES CHANGED AUTOMATICALLY AT DIFFERENT TIMES OF THE DAY FOR DIFFERENT DAYS OF THE WEEK.

(THE PCMS SHALL CONTAIN A CELLULAR TELEPHONE DATA LINK WHICH WILL (IN ACTIVE CELLULAR PHONE AREAS) ALLOW REMOTE SIGN ACTIVATION, MESSAGE CHANGES, MESSAGE ADDITIONS AND REVISIONS TO TIME OF DAY PROGRAMS. THE SYSTEM SHALL ALSO PERMIT VERIFICATION OF CURRENT AND PROGRAMMED MESSAGES. ONE REMOTE DATA INPUT DEVICE (LAPTOP COMPUTER PLUS MODEM OR EQUIVALENT) SHALL BE FURNISHED FOR USE BY THE DISTRICT TRAFFIC ENGINEER, OR EQUIVALENT, AND SHALL BE INSURED AGAINST THEFT.)

THE PCMS UNIT SHALL BE MAINTAINED IN GOOD WORKING ORDER BY THE CONTRACTOR IN ACCORDANCE WITH THE PROVISIONS OF CMS 614.07. THE CONTRACTOR SHALL, PRIOR TO ACTIVATING THE UNIT, MAKE ARRANGEMENTS, WITH AN AUTHORIZED SERVICE AGENT FOR THE PCMS, TO ASSURE PROMPT SERVICE IN THE EVENT OF FAILURE. ANY FAILURE SHALL NOT RESULT IN THE SIGN BEING OUT OF SERVICE FOR MORE THAN 12 HOURS, INCLUDING WEEKENDS. FAILURE TO COMPLY MAY RESULT IN AN ORDER TO STOP WORK AND OPEN ALL TRAFFIC LANES AND/OR IN THE DEPARTMENT TAKING APPROPRIATE ACTION TO SAFELY CONTROL TRAFFIC. THE ENTIRE COST TO CONTROL TRAFFIC, ACCRUED BY THE DEPARTMENT DUE TO THE CONTRACTOR'S NONCOMPLIANCE, WILL BE DEDUCTED FROM MONEYS DUE, OR TO BECOME DUE THE CONTRACTOR ON HIS CONTRACT.

THE CONTRACTOR SHALL BE RESPONSIBLE FOR 24-HOUR-PER-DAY OPERATION AND MAINTENANCE OF THESE SIGNS ON THE PROJECT FOR THE DURATION OF THE PHASES WHEN THE PLAN REQUIRES THEIR USE.

ITEM 614 - WORK ZONE PAVEMENT MARKINGS

WORK ZONE PAVEMENT MARKINGS ARE TO BE REAPPLIED PRIOR TO 10/15. WORK ZONE PAVEMENT MARKINGS SHALL BE PER 740.02 TYPE 1A.

ITEM 614, WORK ZONE RAISED PAVEMENT MARKER, AS PER PLAN

WORK ZONE RAISED PAVEMENT MARKERS, AS PER PLAN, AND THEIR INSTALLATION SHALL CONFORM TO CMS 614 OR CMS 621 AS SPECIFIED HEREIN.

RAISED PAVEMENT MARKERS IN USE DURING THE SNOW-PLOWING SEASON SHALL CONFORM TO 621.

RAISED PAVEMENT MARKERS IN USE DURING THE NON-SNOW-PLOW SEASON SHALL CONFORM TO EITHER 614 OR TO 621.

THE SNOW-PLOWING SEASON SHALL RUN FROM OCTOBER 15 THROUGH APRIL 1.

IF PROJECT DELAYS, NOT THE FAULT OF ODOT, CAUSE THE WORK TO EXTEND INTO THE SNOW-PLOWING SEASON, THE CONTRACTOR SHALL BE RESPONSIBLE FOR REPLACING WORK ZONE RAISED PAVEMENT MARKERS (WZRPMS) CONFORMING TO CMS 614, WITH RAISED PAVEMENT MARKERS CONFORMING TO 621, AS DETERMINED BY THE ENGINEER, AT THE CONTRACTOR'S EXPENSE.

THIS ITEM SHALL INCLUDE PURCHASE, INSTALLATION AND REMOVAL OF ITEM 614 WORK ZONE RAISED PAVEMENT MARKER, AS PER PLAN, INCLUDING FILLING OF ANY DEPRESSIONS CREATED IN THE PAVEMENT AS PER CMS 621.08.

RESURFACING OF THE TRANSITION AREAS SHALL BE PERFORMED AT THE TIME THAT THE SURFACE COURSE IS BEING APPLIED TO THE ENTIRE PROJECT. PRIOR TO APPLICATION OF THE SURFACE COURSE ON THE PROJECT, THE EXISTING PAVEMENT WITHIN THE TRANSITION AREA SHALL BE REMOVED TO A DEPTH NECESSARY TO REACH THE LEVEL OF THE INTERMEDIATE COURSE OF THE PAVEMENT, AS DETERMINED BY THE ENGINEER.

ITEM 614, WORK ZONE RAISED PAVEMENT MARKERS ON CONCRETE SURFACES

RAISED PAVEMENT MARKERS IN WORK ZONES, INSTALLED ON TO CONCRETE SURFACES, SHALL BE ITEM 614 WORK ZONE RAISED PAVEMENT MARKERS. WZRPMS ARE INTENDED FOR USE ONLY DURING THE NONSNOW-PLOWING SEASON. WZRPMS SHALL NOT BE PROVIDED DURING THE SNOW-PLOWING SEASON.

THE SNOW-PLOWING SEASON SHALL RUN FROM OCTOBER 15 THROUGH APRIL 1.

WHERE A TEMPORARY ALIGNMENT WILL REMAIN IN USE THROUGH THE WINTER, THE WZRPMS SHALL BE REMOVED PRIOR TO THE BEGINNING OF THE SNOW-PLOWING SEASON AND REPLACED APPROXIMATELY APRIL 1, OR AS OTHERWISE DETERMINED BY THE ENGINEER.

THIS ITEM SHALL INCLUDE PURCHASE, INSTALLATION AND REMOVAL OF ITEM 614 WORK ZONE RAISED PAVEMENT MARKERS.

DELINEATION OF PORTABLE AND PERMANENT BARRIER

BARRIER REFLECTORS AND OBJECT MARKERS SHALL BE INSTALLED ON ALL PORTABLE BARRIER (PB) USED FOR TRAFFIC CONTROL AND ON PERMANENT CONCRETE BARRIER (INCLUDING BRIDGE PARAPETS) LOCATED WITHIN 5 FEET OF THE EDGE OF THE ADJACENT TRAVEL LANE.

BARRIER REFLECTORS SHALL CONFORM TO C&MS 626, EXCEPT THAT THE SPACING SHALL BE AS PER TRAFFIC SCD MT-101.70. OBJECT MARKER AND THEIR INSTALLATION SHALL CONFORM TO C&MS 614.03 AND SCD MT-101.70. WHEN THE PB CONTAINS GLARE SCREEN, ONE SET OF THREE VERTICAL STRIPES SHEETING SHALL BE CONSIDERED EQUIVALENT TO AN OBJECT MARKER, ONE-WAY.

[INCREASED BARRIER DELINEATION, AS SPECIFIED HEREIN, SHALL BE INSTALLED ON ALL PB AND CONCRETE PERMANENT BARRIER LOCATED WITHIN 5 FEET OF THE EDGE OF THE TRAVELED LANE ALONG TAPERS AND TRANSITION AREAS AND ALONG CURVES (OUTSIDE ONLY) WITH DEGREE OF CURVATURE GREATER THAN OR EQUAL TO 3 DEGREES.]

[THE INCREASED BARRIER DELINEATION SHALL CONSIST OF EITHER DELINEATION PANELS OR THE TRIPLE STACKING OF WORK ZONE BARRIER REFLECTORS.]

[DELINEATION PANELS SHALL CONSIST OF PANELS OF DELINEATION , APPROXIMATELY 34 INCHES LONG AND 6 INCHES WIDE AND SHALL BE "CRIMPED". PANELS SHALL BE INSTALLED AND SPACED PER TRAFFIC SCD MT-101.70.]

[TRIPLE STACKED BARRIER REFLECTORS SHALL CONSIST OF ALIGNING THREE BARRIER REFLECTORS VERTICALLY, AT LOCATIONS WHERE A SINGLE BARRIER REFLECTOR WOULD BE OTHERWISE ATTACHED. THERE SHALL BE NO OPEN SPACE BETWEEN THE ADJACENT BARRIER REFLECTORS. THE TRIPLE-STACKED BARRIER REFLECTORS SHALL C&MS 626, EXCEPT THAT THEY SHALL BE SPACED ALIGNED PER TRAFFIC SCD MT-101.70.]

DELINEATION OF TEMPORARY AND PERMANENT GUARDRAIL

BARRIER REFLECTORS SHALL BE INSTALLED ON ALL TEMPORARY GUARDRAIL USED FOR TRAFFIC CONTROL AND ON ALL PERMANENT GUARDRAIL LOCATED WITHIN 5 FEET OF THE EDGE OF THE ADJACENT TRAVEL LANE. BARRIER REFLECTORS SHALL CONFORM TO C&MS 626.

[OBJECT MARKERS SHALL BE INSTALLED ON ALL TEMPORARY AND PERMANENT GUARDRAIL LOCATED WITHIN 5 FEET OF THE EDGE OF THE ADJACENT TRAVEL LANE. GUARDRAIL-MOUNTING OF OBJECT MARKERS SHALL BE MADE BY INSTALLING THE OBJECT MARKERS ON THE EXTENSION BLOCKS RATHER THAN DIRECTLY ONTO THE GUARDRAIL ITSELF. OBJECT MARKER SHALL CONFORM TO C&MS 614.03 AND THE SPACING SHALL BE APPROXIMATELY 50 FEET.]

ITEM 614 - LAW ENFORCEMENT OFFICER (WITH PATROL CAR) FOR ASSISTANCE DURING CONSTRUCTION OPERATIONS

USE OF LAW ENFORCEMENT OFFICERS (LEOS) BY CONTRACTORS OTHER THAN THE USES SPECIFIED BELOW WILL NOT BE PERMITTED AT PROJECT COST. LEOS SHOULD NOT BE USED WHERE THE ODOT INTENDS THAT FLAGGERS BE USED.

IN ADDITION TO THE REQUIREMENTS OF CMS 614 AND THE ODOT, A UNIFORMED LEO WITH AN OFFICIAL PATROL CAR (CAR WITH TOP-MOUNTED EMERGENCY FLASHING LIGHTS AND COMPLETE MARKINGS OF THE APPROPRIATE LAW ENFORCEMENT AGENCY) SHALL BE PROVIDED FOR THE FOLLOWING TRAFFIC CONTROL TASKS:

- DURING THE ENTIRE ADVANCE PREPARATION AND CLOSURE SEQUENCE WHERE COMPLETE BLOCKAGE OF TRAFFIC IS REQUIRED.
- DURING A TRAFFIC SIGNAL WHEN IMPACTING THE NORMAL FUNCTION OF THE SIGNAL OR THE FLOW OF TRAFFIC OR WHEN TRAFFIC NEEDS TO BE DIRECTED THROUGH AN ENERGIZED TRAFFIC SIGNAL CONTRARY TO THE SIGNAL DISPLAY (E.G., DIRECTING MOTORISTS THROUGH A RED LIGHT).

IN ADDITION TO THE REQUIREMENTS OF CMS 614 AND THE ODOT, A UNIFORMED LEO WITH AN OFFICIAL PATROL CAR (CAR WITH TOP-MOUNTED EMERGENCY FLASHING LIGHTS AND COMPLETE MARKINGS OF THE APPROPRIATE LAW ENFORCEMENT AGENCY) SHOULD BE PROVIDED FOR THE FOLLOWING TRAFFIC CONTROL TASKS:




- FOR LANE CLOSURES: DURING INITIAL SET-UP PERIODS, TEAR DOWN PERIODS, SUBSTANTIAL SHIFTS OF A CLOSURE POINT OR WHEN NEW LANE CLOSURE ARRANGEMENTS ARE INITIATED FOR LONG-TERM LANE CLOSURES/ SHIFTS (FOR THE FIRST AND LAST DAY OF MAJOR CHANGES IN TRAFFIC CONTROL SETUP). IN GENERAL, LEOS SHOULD BE POSITIONED AT THE POINT OF LANE RESTRICTION OR ROAD CLOSURE AND TO MANUALLY CONTROL TRAFFIC MOVEMENTS THROUGH INTERSECTIONS IN WORK ZONES.
- WHEN CONSTRUCTION VEHICLES ARE ENTERING/EXITING THE ZONE DIRECTLY FROM/INTO AN OPEN LANE OF TRAFFIC. IF A LANE HAS BEEN CLOSED TO PROVIDE AN ACCELERATION/DECELERATION LANE FOR THE VEHICLE, THE LEO WILL NOT BE REQUIRED.

LEOS SHOULD NOT FORGO THEIR TRAFFIC CONTROL RESPONSIBILITIES TO APPREHEND MOTORISTS FOR ROUTINE TRAFFIC VIOLATIONS. HOWEVER, IF A MOTORIST'S ACTIONS ARE CONSIDERED TO BE RECKLESS, THEN PURSUIT OF THE MOTORIST IS APPROPRIATE.

THE LEOS WORK AT THE DIRECTION OF THE CONTRACTOR. THE CONTRACTOR IS RESPONSIBLE FOR SECURING THE SERVICES OF THE LEOS WITH THE APPROPRIATE AGENCIES AND COMMUNICATING THE INTENTIONS OF THE PLANS WITH RESPECT TO DUTIES OF THE LEOS. THE ENGINEER SHALL HAVE FINAL CONTROL OVER THE LEOS' DUTIES AND PLACEMENT, AND WILL RESOLVE ANY ISSUES THAT MAY ARISE BETWEEN THE TWO PARTIES.

THE LEO SHALL REPORT IN TO THE CONTRACTOR PRIOR TO THE START OF THE SHIFT, IN ORDER TO RECEIVE INSTRUCTIONS REGARDING SPECIFIC WORK ASSIGNMENTS DURING HIS/HER SHIFT. THE LEO IS EXPECTED TO STAY AT THE PROJECT SITE FOR THE ENTIRE DURATION OF HIS/HER SHIFT. THE LEO SHALL REPORT TO THE CONTRACTOR AT THE END OF HIS/HER SHIFT. ONCE THE LEO HAS COMPLETED THE DUTIES DESCRIBED ABOVE AND STILL HAS TIME REMAINING ON HIS/HER SHIFT, THE LEO MAY BE ASKED TO PATROL THROUGH THE WORK ZONE (WITH FLASHING LIGHTS OFF) OR BE PLACED AT A LOCATION TO DETER MOTORISTS FROM SPEEDING. SHOULD IT BE NECESSARY TO LEAVE THE PROJECT SITE, THE LEO SHALL NOTIFY THE ENGINEER. THE CONTRACTOR SHALL PROVIDE THE LEO WITH A TWO-WAY COMMUNICATION DEVICE WHICH SHALL BE RETURNED TO THE CONTRACTOR AT THE END OF HIS/HER SHIFT.

SEE ODOT'S DESIGN BUILD SCOPE OF SERVICES FOR ADDITIONAL MAINTENANCE OF TRAFFIC REQUIREMENTS NOT REPEATED IN THESE MOT GENERAL NOTES.

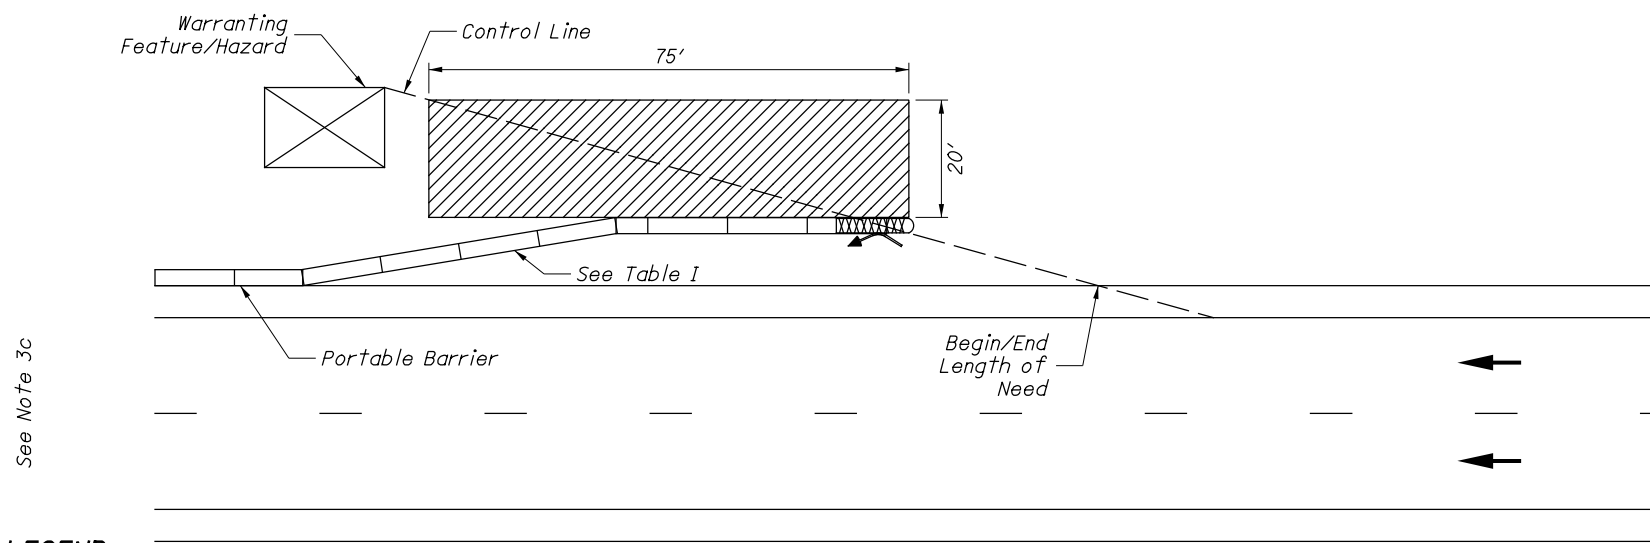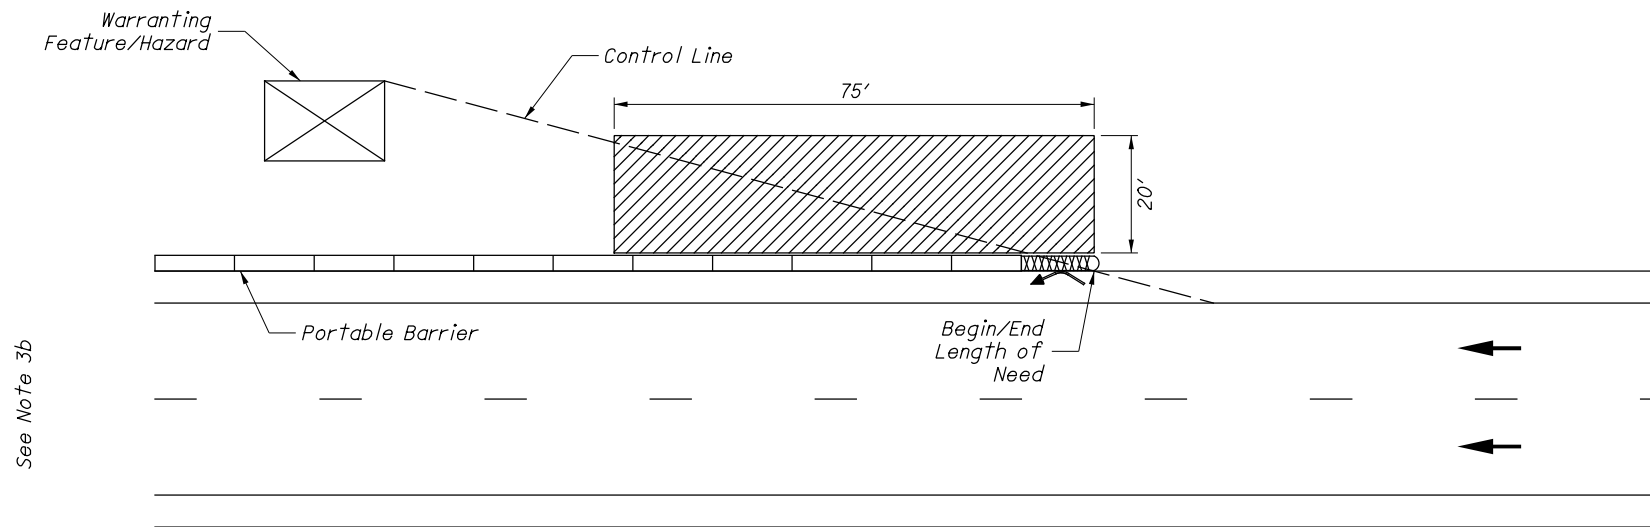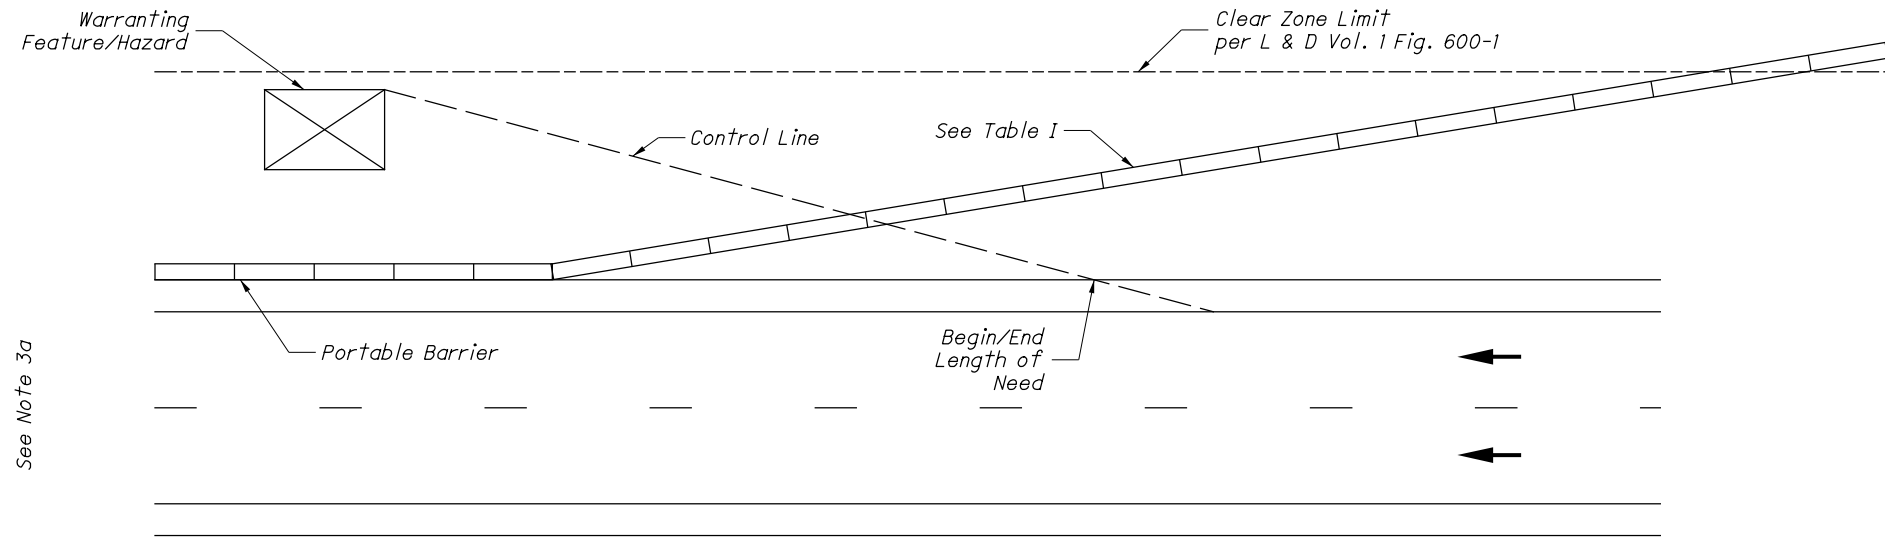

LEGEND

RECOVERY AREA	
PORTABLE BARRIER	
NON-GATING IMPACT ATTENUATOR	
DIRECTION OF TRAVEL	

NOTES:

- Attenuators shall be installed per the manufacturer's specifications.
- Recovery area shall have slopes 3:1 or flatter and be free of workers, hazards, equipment, drop-offs, and material storage.
- The Contractor shall select one of the three acceptable options for terminating portable barrier:
 - Terminate flared section of portable barrier outside clear zone with tapered end only where cross slopes are 10:1 or flatter.
 - Terminate portable barrier with an impact attenuator. A non-gating attenuator may be included in the length of need measurement.
 - Flare a section of portable barrier to the length of need control line and terminate with an impact attenuator. A non-gating impact attenuator may be included in the flared section of portable barrier.
- The Contractor shall submit documentation to the Engineer, 2 weeks prior to implementation, for acceptance when:
 - Deviating from the three acceptable options for terminating portable barrier.


Documentation shall explain any deviations and verify that the recovery area fulfills the manufacturer's specifications and Note 2.
 - Using a gating impact attenuator in lieu of a non-gating impact attenuator.

The gating impact attenuator length shall not be included as part of the length of need or recovery area requirements. Additional portable barrier will need to be added. The additional cost for the additional barrier required for a gating impact attenuator shall be included in the cost of the gating impact attenuator.

Documentation shall verify that the extended recovery area fulfills the manufacturer's specifications and Note 2.
- Gating impact attenuators shall not be used in gore locations or within the clear zone between bi-directional traffic.

TABLE I

SPEED LIMIT (MPH)	PB FLARE RATE MINIMUM
25	8:1
30	8:1
35	9:1
40	10:1
45	12:1
50	14:1
55	16:1
60	18:1
65	19:1
70	20:1

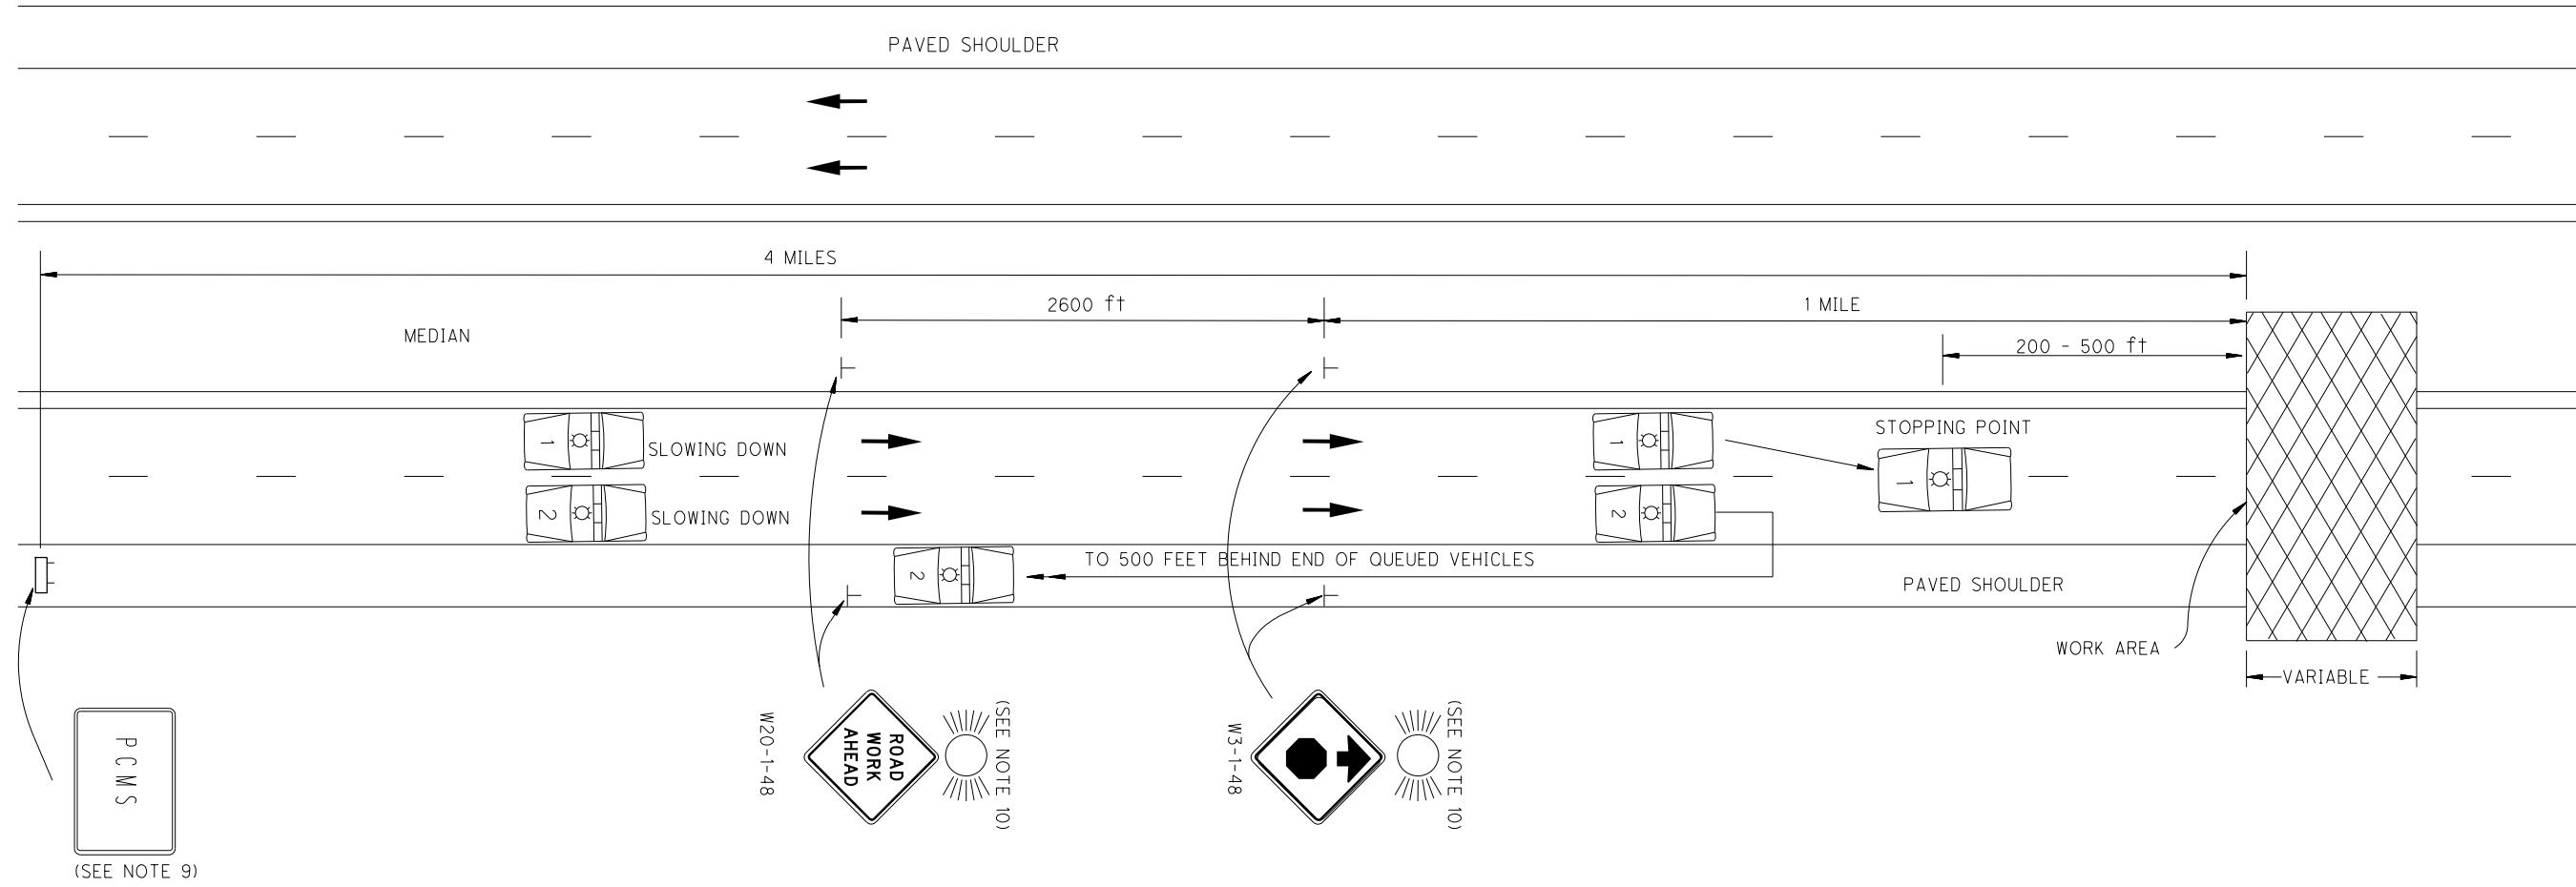

NOTES


1. This type of highway closure shall be used for all construction, maintenance and utility operations when the duration of closure will not exceed 15 minutes.
2. A minimum of two law enforcement officers (LEO) with patrol cars per direction shall be provided to block traffic and pace motorists to a stop. The number of patrol cars shall equal the number of lanes closed on the highway.
3. Patrol cars, with lights flashing, should enter the stream of traffic at approximately 3 miles before the point of closure. At approximately 2 miles before the point of closure, they should begin the gradual slow down. Traffic shall be brought to a complete stop a safe distance, between 200 and 500 feet, from the work area. This slowing operation shall take no more than 10 minutes. After traffic has been stopped, one patrol car shall travel along the roadway shoulder 500 feet behind the end of the queued vehicles.
4. The Contractor shall not begin work until traffic has been brought to a complete stop.
5. All entrance ramps located between the stopped traffic and the work area shall be closed.
6. After the highway has been closed and reopened via this procedure, both of the following requirements shall have been met before implementation of another short duration closure, except with the approval of the Engineer:
 - a) A minimum period of 15 minutes shall have elapsed; and
 - b) The queued traffic shall have dissipated.
7. The time frame for stopping traffic shall be specified.
8. The public shall be given advance notice of 5 calendar days of the upcoming closure by providing portable changeable message signs at the site in advance of the scheduled closing. Closure information should also be provided to the Engineer.
9. An ODOT-approved portable changeable message sign, Class 1, shall be provided during operation. The message sign shall be placed approximately 4 miles in advance of the closure or as directed by the Engineer. The message shall be ROAD CLOSED AHEAD (2 sec.), PREPARE TO STOP (2 sec.)
10. The Contractor shall erect and maintain 48-inch ROAD WORK AHEAD and Stop Ahead signs on each side of the highway. Each sign shall be equipped with one Type A flashing warning light and one flare. There shall be one flare at each sign on both sides of the roadway. The flare shall be replaced if it burns out.

DESIGNED	SHB
REVISION DATE	07/20/12
CHECKED	LAM


PIB NUMBER 209960

PLAN INSERT SHEET
SHORT-DURATION CLOSURE OF MULTI-LANE DIVIDED HIGHWAY


FRA - 270-49.00

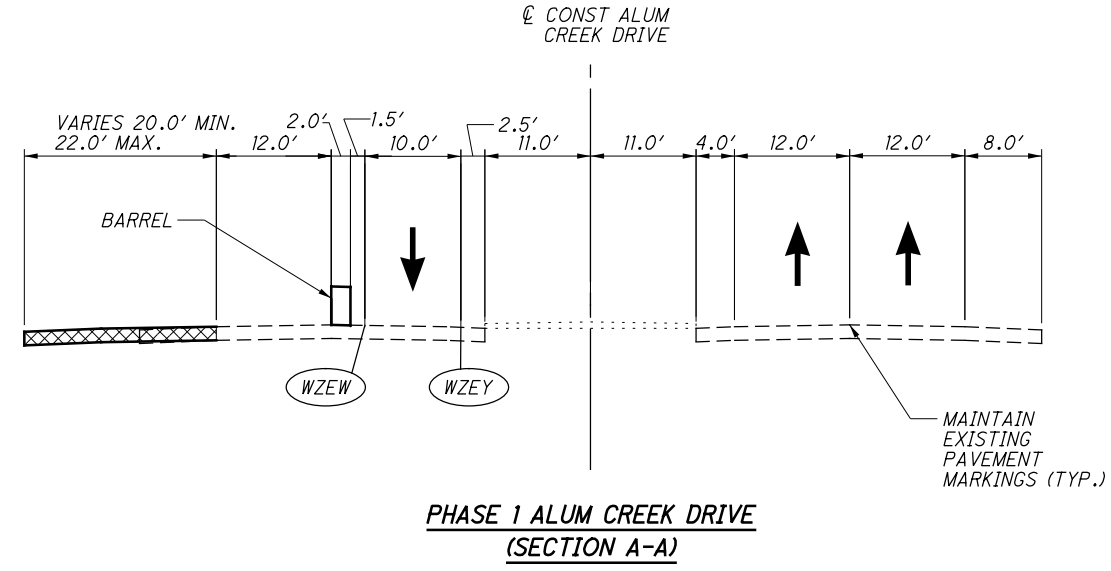



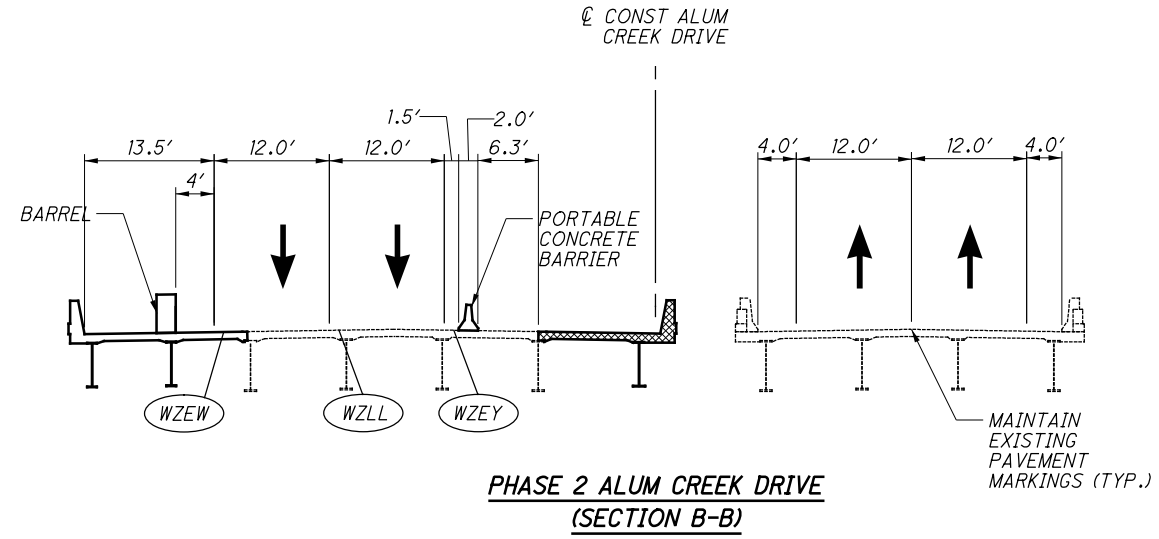




PHASE 1 ALUM CREEK DRIVE (SECTION A-A)

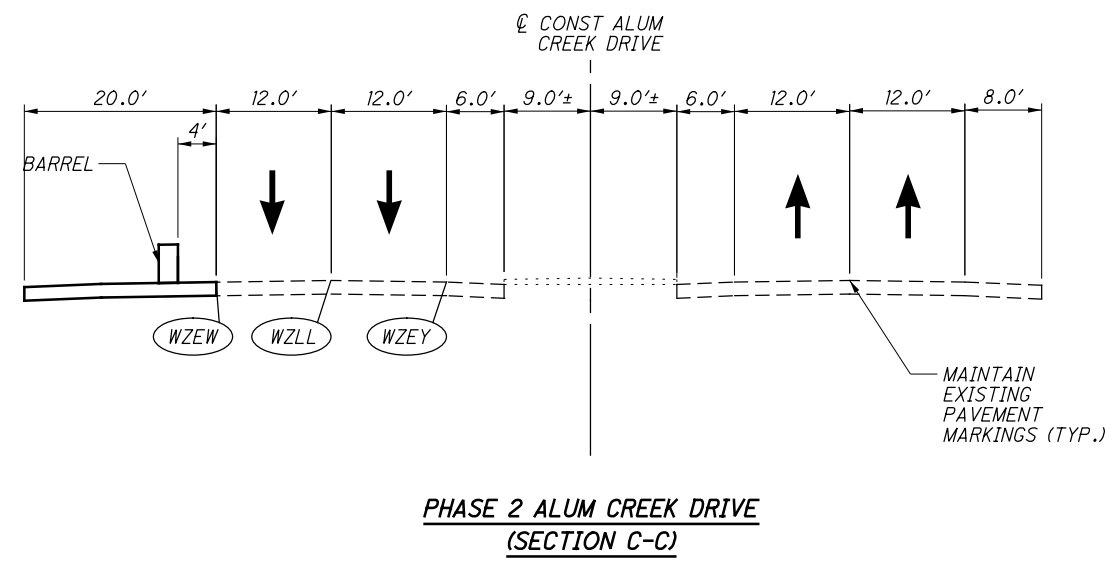


PHASE 2 ALUM CREEK DRIVE (SECTION B-B)

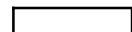


PHASE 2 ALUM CREEK DRIVE (SECTION C-C)

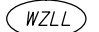
-  EXISTING PAVEMENT
-  PHASE CONSTRUCTION
-  WORK COMPLETED IN PRIOR PHASE CONSTRUCTION
-  WORK ZONE EDGE LINE, WHITE
-  WORK ZONE EDGE LINE, YELLOW
-  WORK ZONE LANE LINE
-  WORK ZONE CHANNELIZING LINE

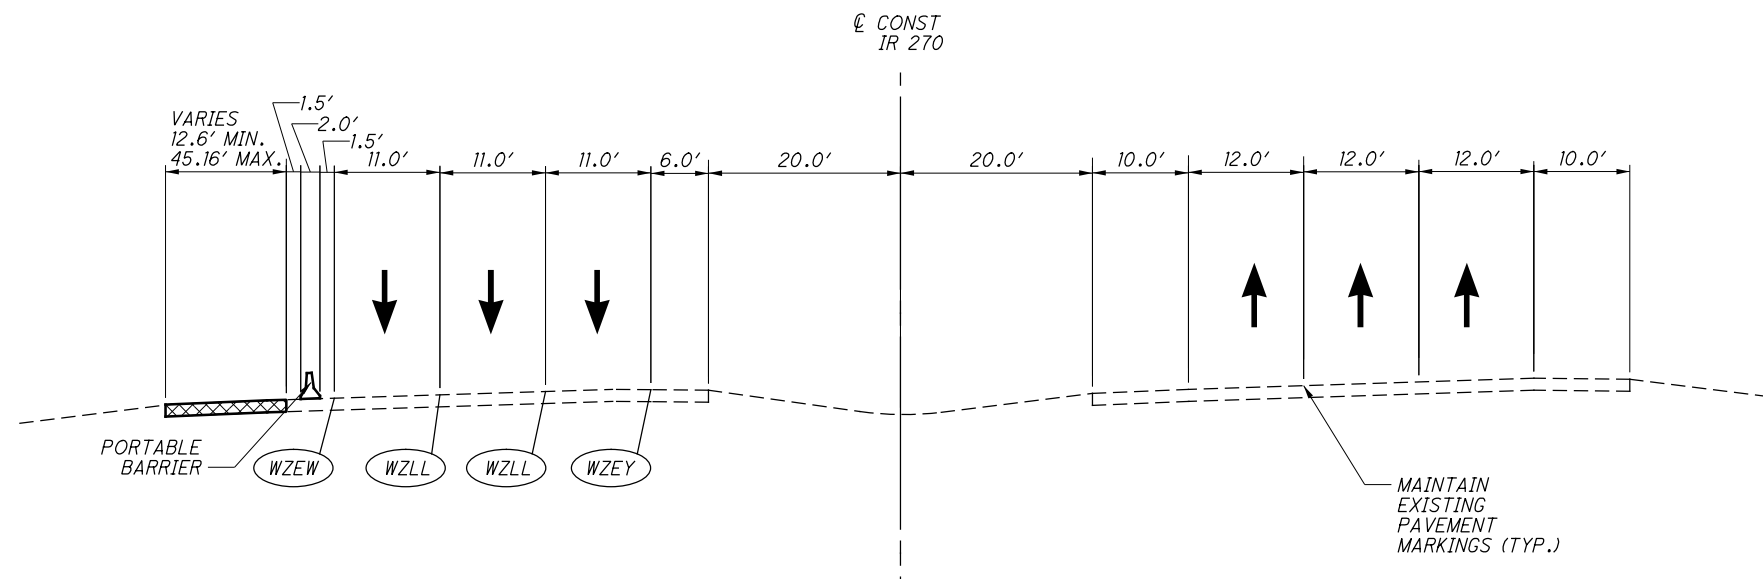


PHASE 1 IR 270 (SECTION D-D)

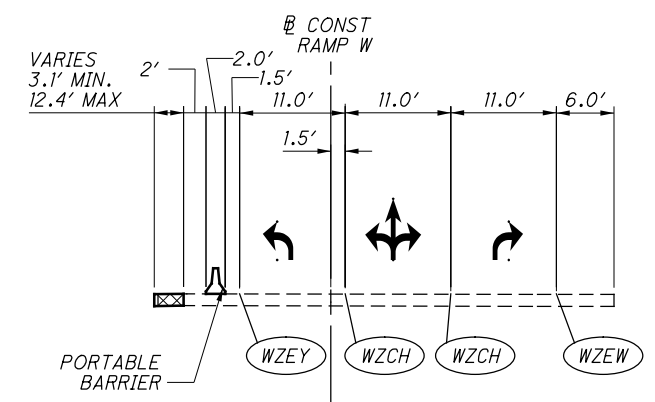


PHASE 1 RAMP W (SECTION E-E)

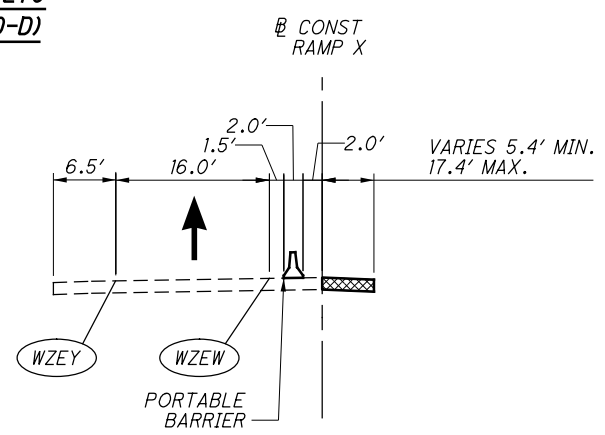

PHASE 1 RAMP X (SECTION G-G)

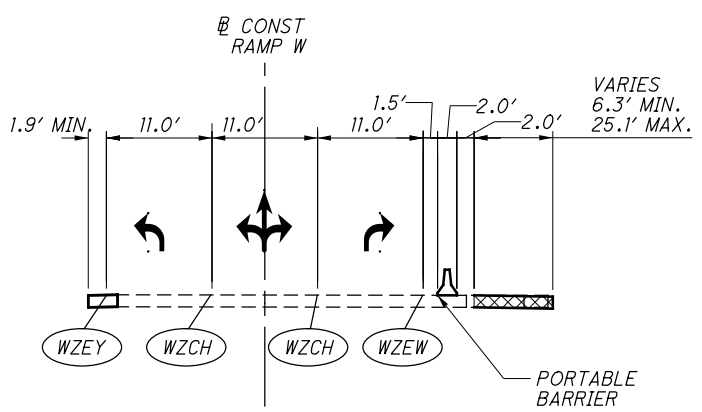


PHASE 2 RAMP W (SECTION F-F)

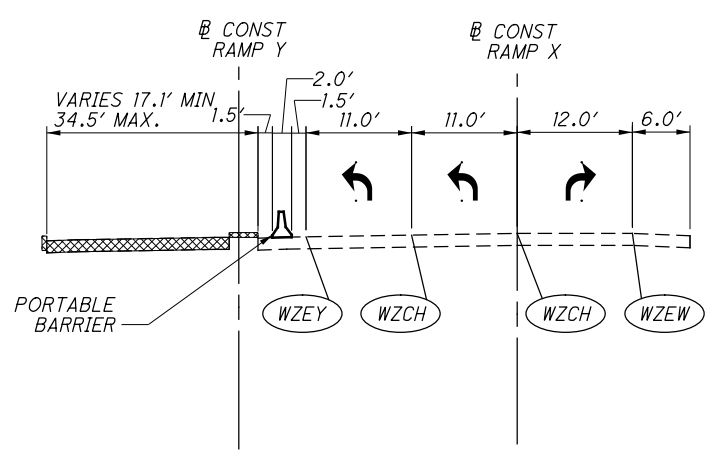

PHASE 2 RAMP X (SECTION H-H)

- EXISTING PAVEMENT
- PHASE CONSTRUCTION
- WORK COMPLETED IN PRIOR PHASE CONSTRUCTION
- WZEW WORK ZONE EDGE LINE, WHITE
- WZEY WORK ZONE EDGE LINE, YELLOW
- WZLL WORK ZONE LANE LINE
- WZCH WORK ZONE CHANNELIZING LINE

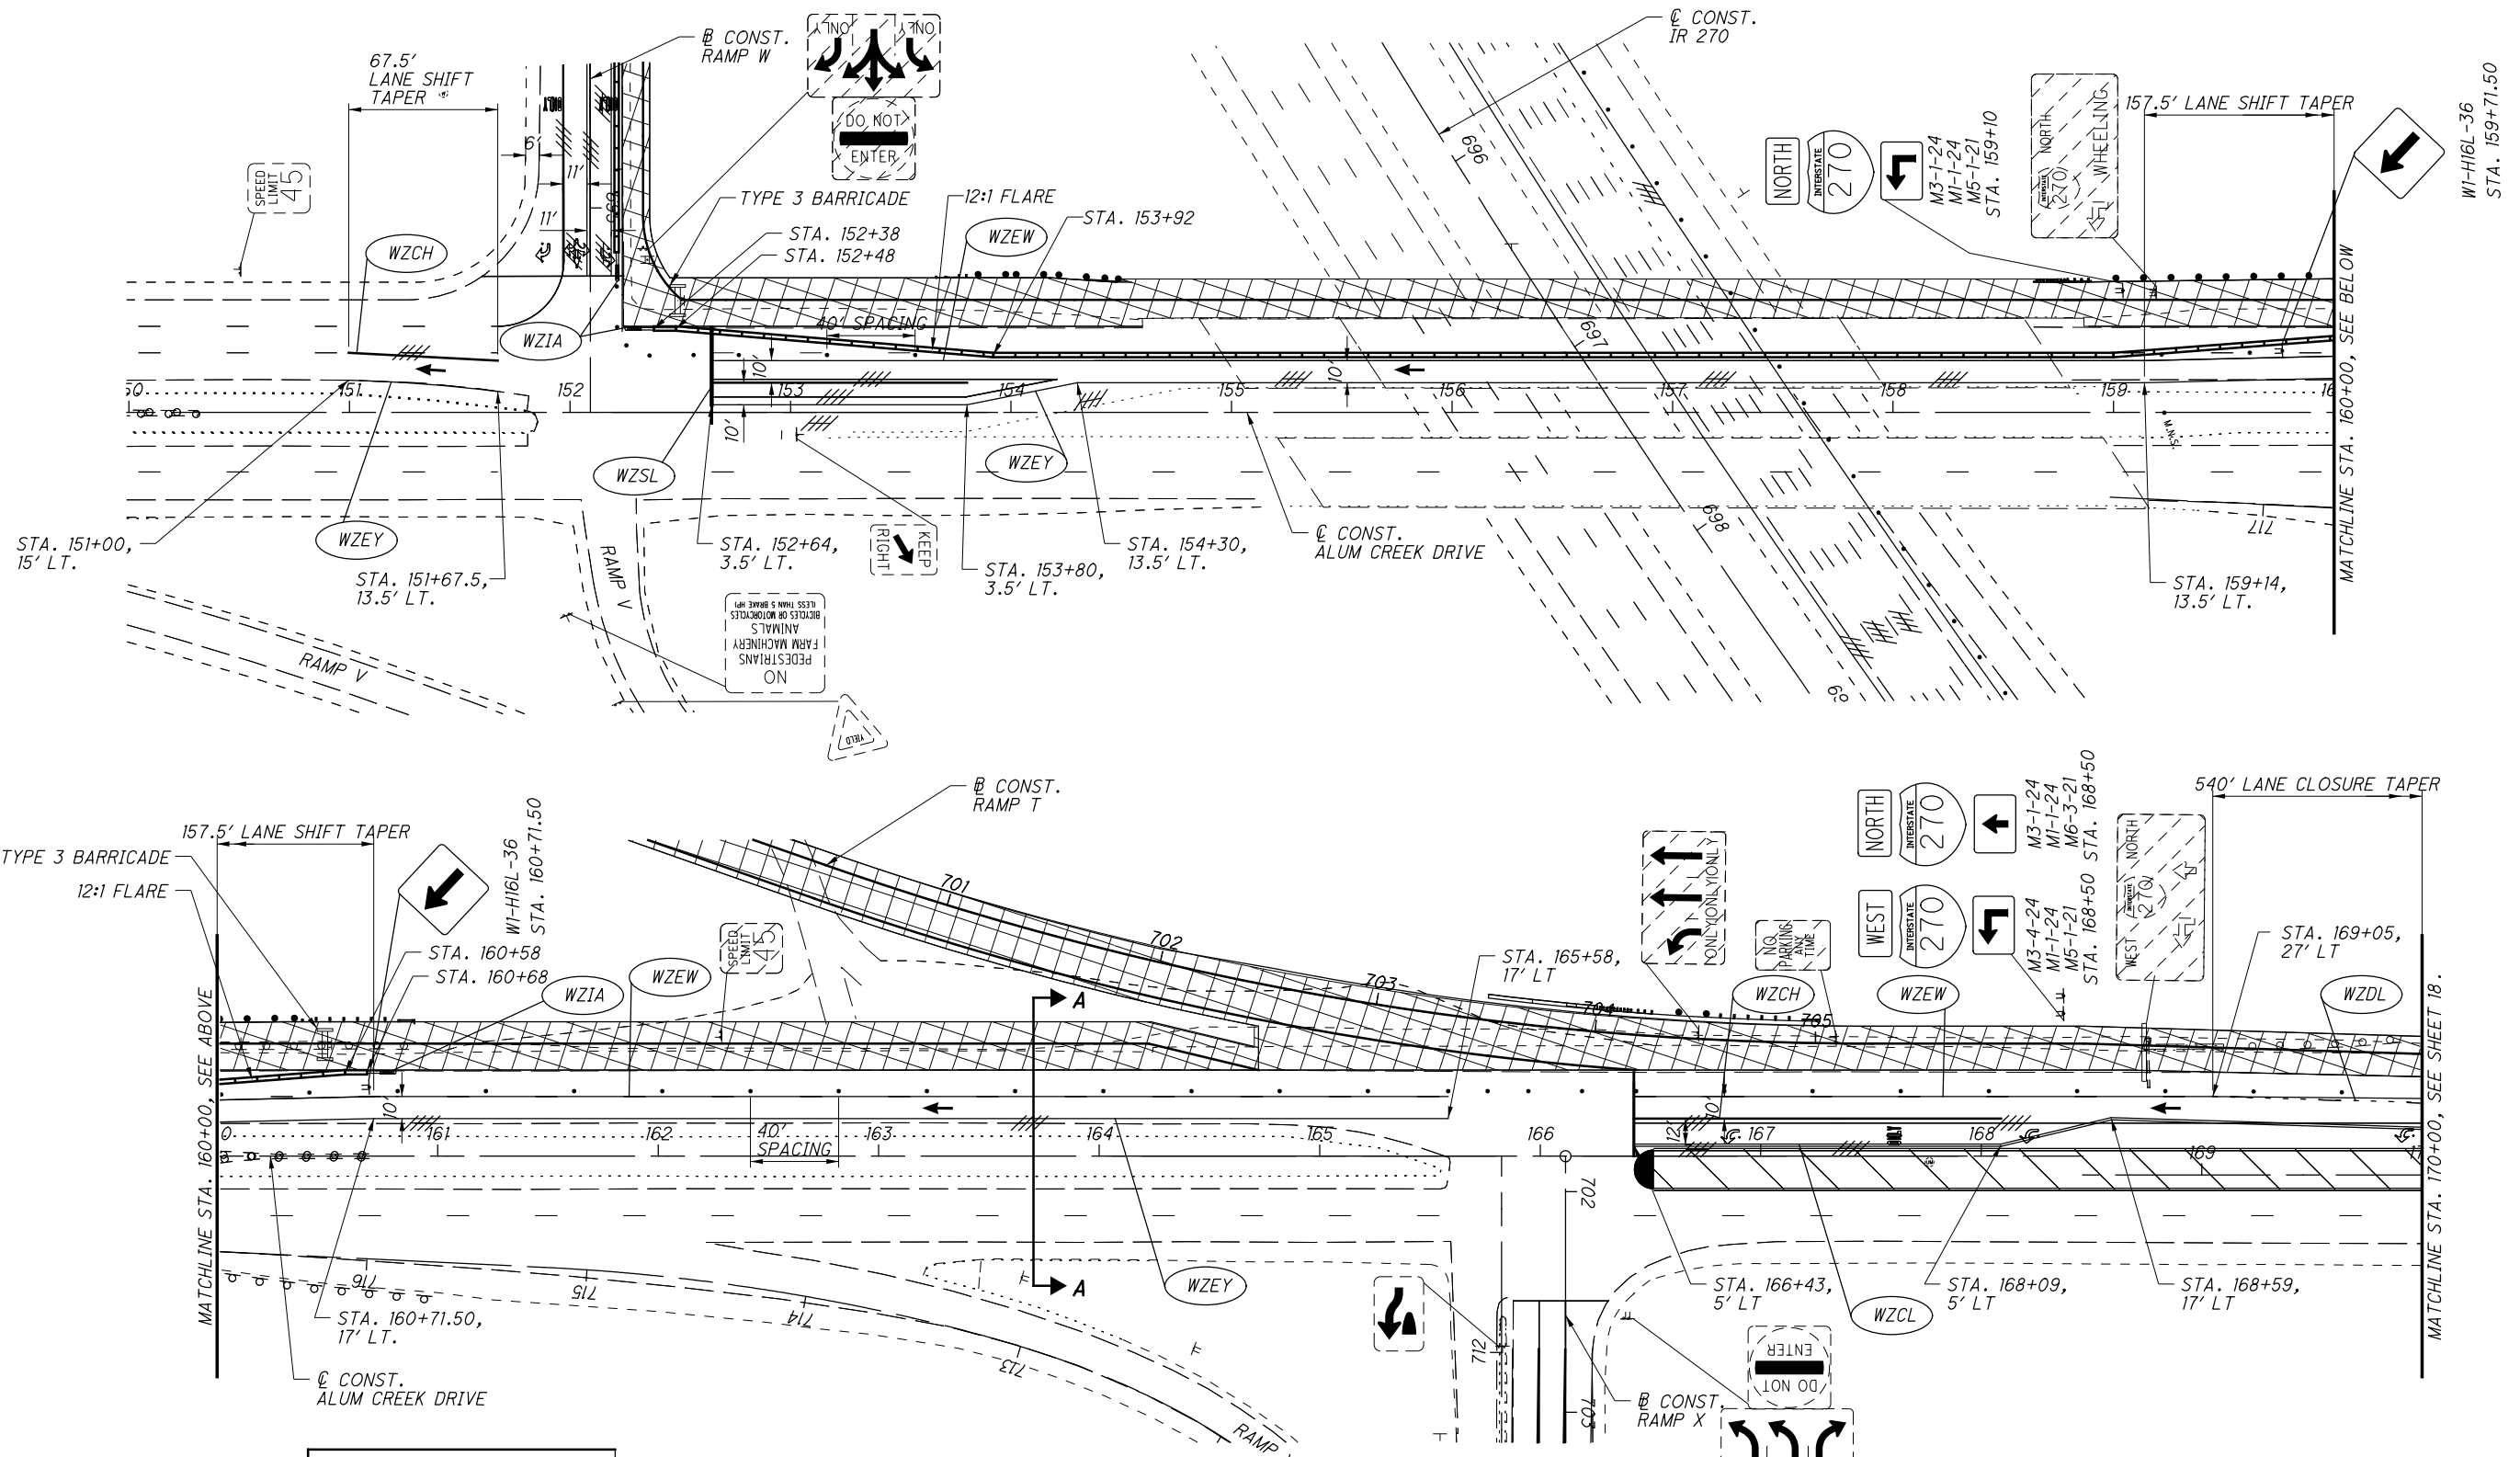

ADVANCE WARNING SIGN TABLE LOCATIONS

SIGN NUMBER	END ROAD WORK E5-H2b-48
STATIONS	141+00
SIDE	RT

LEGEND

•••••	DRUMS	WZCH	WORK ZONE CHANNELIZING LINE
—	32" PORTABLE BARRIER	WZDL	WORK ZONE DOTTED LINE
○ WZIA	WORK ZONE IMPACT ATTENUATOR	WZSL	WORK ZONE STOP LINE
○ WZEW	WORK ZONE EDGE LINE WHITE	WZCL	WORK ZONE CENTER LINE
○ WZEY	WORK ZONE EDGE LINE YELLOW		
○ WZLL	WORK ZONE LANE LINE		

NOTES:

☀	TYPE A, WARNING LIGHTS
///	EXISTING PAVEMENT MARKING AND RAISED PAVEMENT MARKER REMOVED
▨	PHASE CONSTRUCTION
▧	REMOVE OR COVER SIGN DURING THIS PHASE


- NOTES:
- 1.) SEE BUILDABLE UNIT 4 FOR BRIDGE PHASING DETAILS.
 - 2.) SEE BUILDABLE UNIT 6 FOR SIGNING PLANS.
 - 3.) SEE SHEET 22 FOR ADDITIONAL DETAILS FOR RAMPS X AND W.
 - 4.) SEE SHEETS 19 TO 21 FOR ADDITIONAL DETAILS FOR IR 270.






CALCULATED JLM
CHECKED SSK



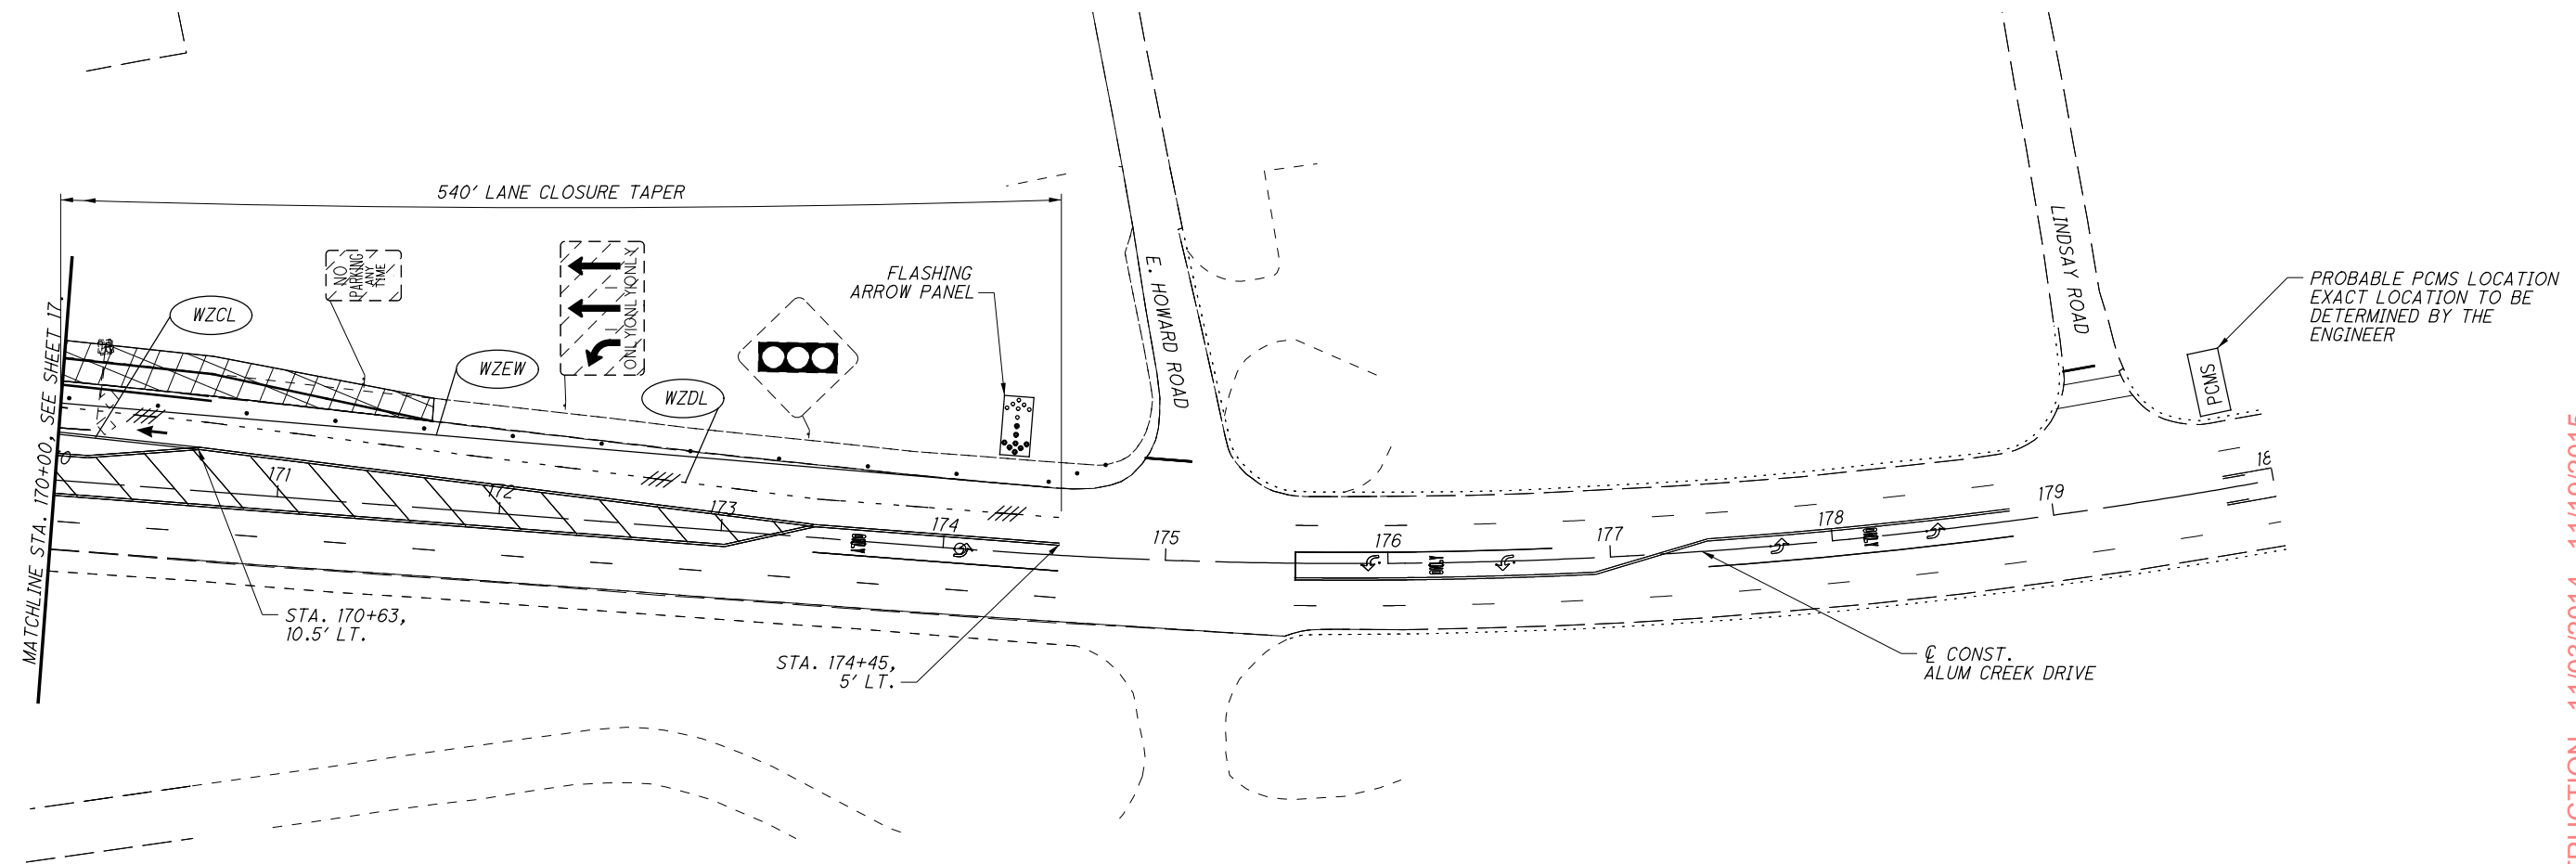






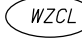

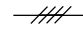

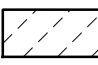
MAINTENANCE OF TRAFFIC PHASE 1
ALUM CREEK DRIVE STATION 150+00 TO STATION 170+00



FRA - 270-49.00



ADVANCE WARNING SIGN TABLE LOCATIONS

SIGN NUMBER			
	W4-2R-48	W20-5R-48	1/4 MILES W20-1-48 W16-3aP-30
STATIONS	179+45	184+45	189+45
SIDE	RT	RT	RT

- LEGEND**
-  DRUMS
 -  32" PORTABLE BARRIER
 -  WZIA WORK ZONE IMPACT ATTENUATOR
 -  WZEW WORK ZONE EDGE LINE WHITE
 -  WZEY WORK ZONE EDGE LINE YELLOW
 -  WZLL WORK ZONE LANE LINE
 -  WZCH WORK ZONE CHANNELIZING LINE
 -  WZDL WORK ZONE DOTTED LINE
 -  WZSL WORK ZONE STOP LINE
 -  WZCL WORK ZONE CENTER LINE
 -  TYPE A, WARNING LIGHTS
 -  EXISTING PAVEMENT MARKING AND RAISED PAVEMENT MARKER REMOVED
 -  PHASE CONSTRUCTION
 -  REMOVE OR COVER SIGN DURING THIS PHASE

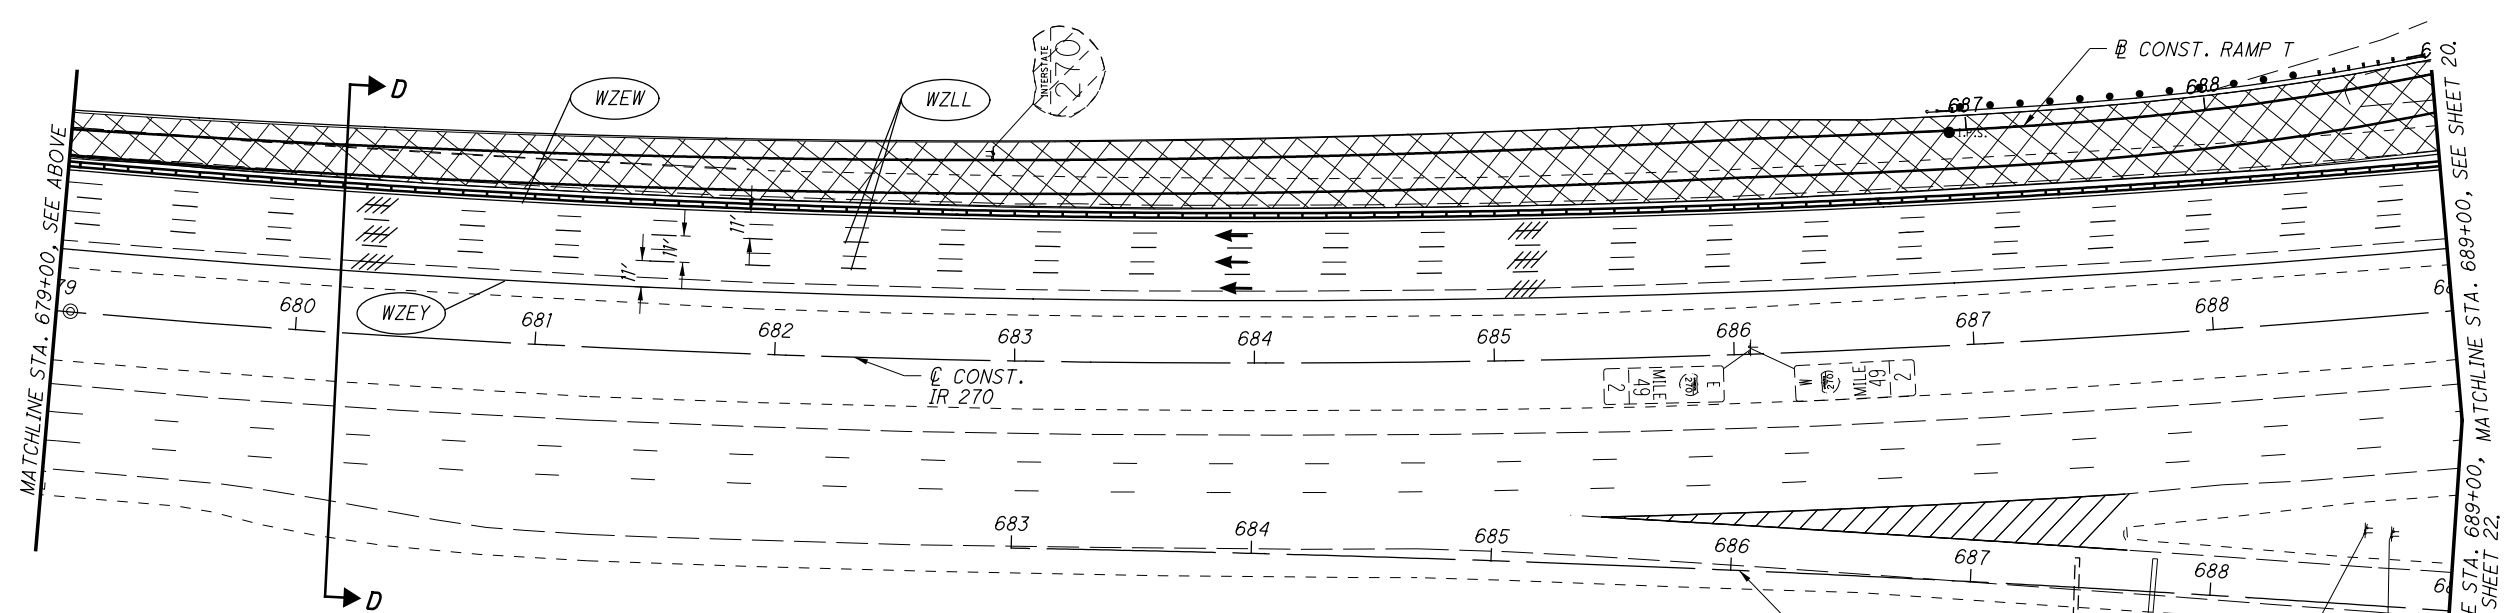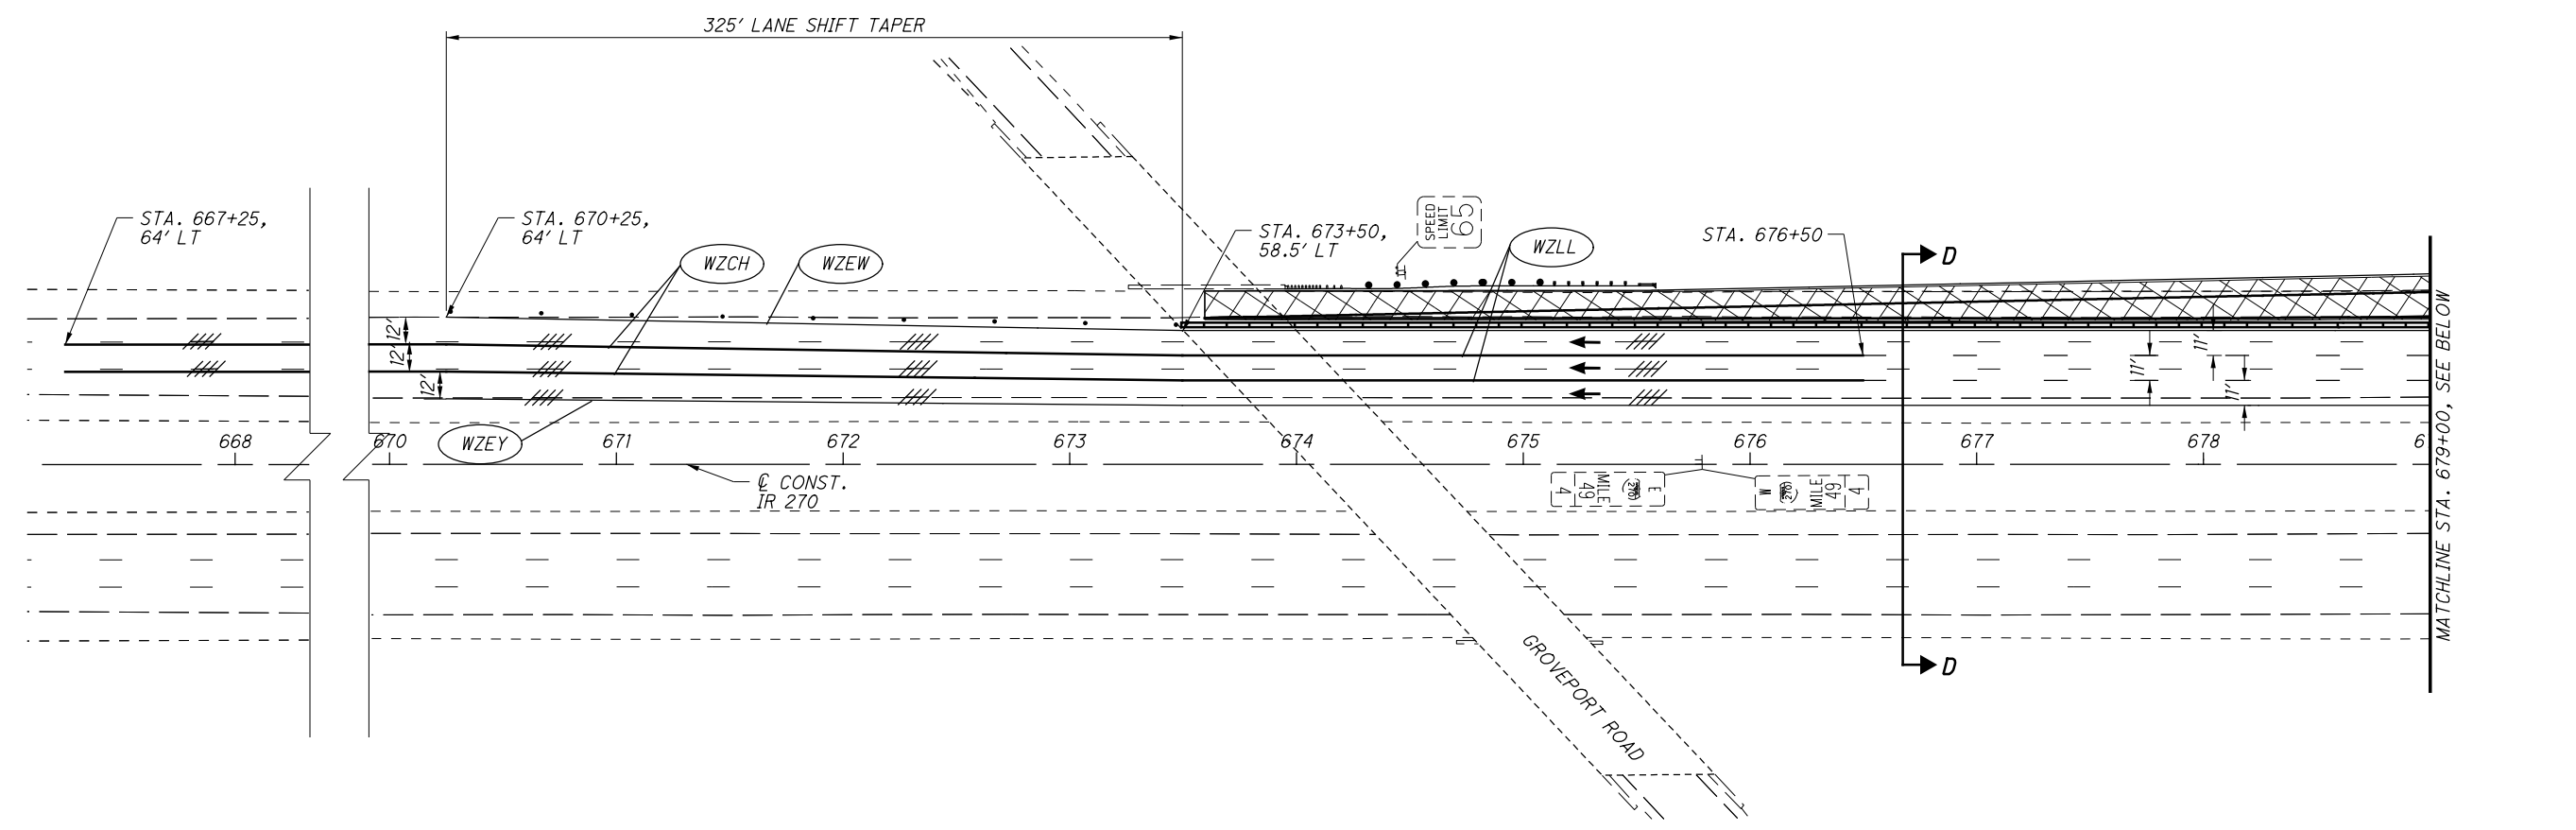

ADVANCE WARNING SIGN TABLE LOCATIONS


SIGN NUMBER	END ROAD WORK E5-H2b-48
STATIONS	660+25 WB
SIDE	LT/ RT

- LEGEND**
- DRUMS
 - 32" PORTABLE BARRIER
 - (WZIA) WORK ZONE IMPACT ATTENUATOR
 - (WZEW) WORK ZONE EDGE LINE WHITE
 - (WZEY) WORK ZONE EDGE LINE YELLOW
 - (WZLL) WORK ZONE LANE LINE
 - (WZCH) WORK ZONE CHANNELIZING LINE
 - (WZDL) WORK ZONE DOTTED LINE
 - (WZSL) WORK ZONE STOP LINE
 - (WZCL) WORK ZONE CENTER LINE
 - (Sun) TYPE A, WARNING LIGHTS
 - /// EXISTING PAVEMENT MARKING AND RAISED PAVEMENT MARKER REMOVED
 - (X) PHASE CONSTRUCTION
 - (Hatched) REMOVE OR COVER SIGN DURING THIS PHASE

CALCULATED JLM
CHECKED SSK

BU 4, 5, 6, 7, & 8 - RELEASED FOR CONSTRUCTION - 11/03/2014 - 11/19/2015

MAINTENANCE OF TRAFFIC PHASE 1
I.R. 270 STATION 667+25 TO STATION 689+00

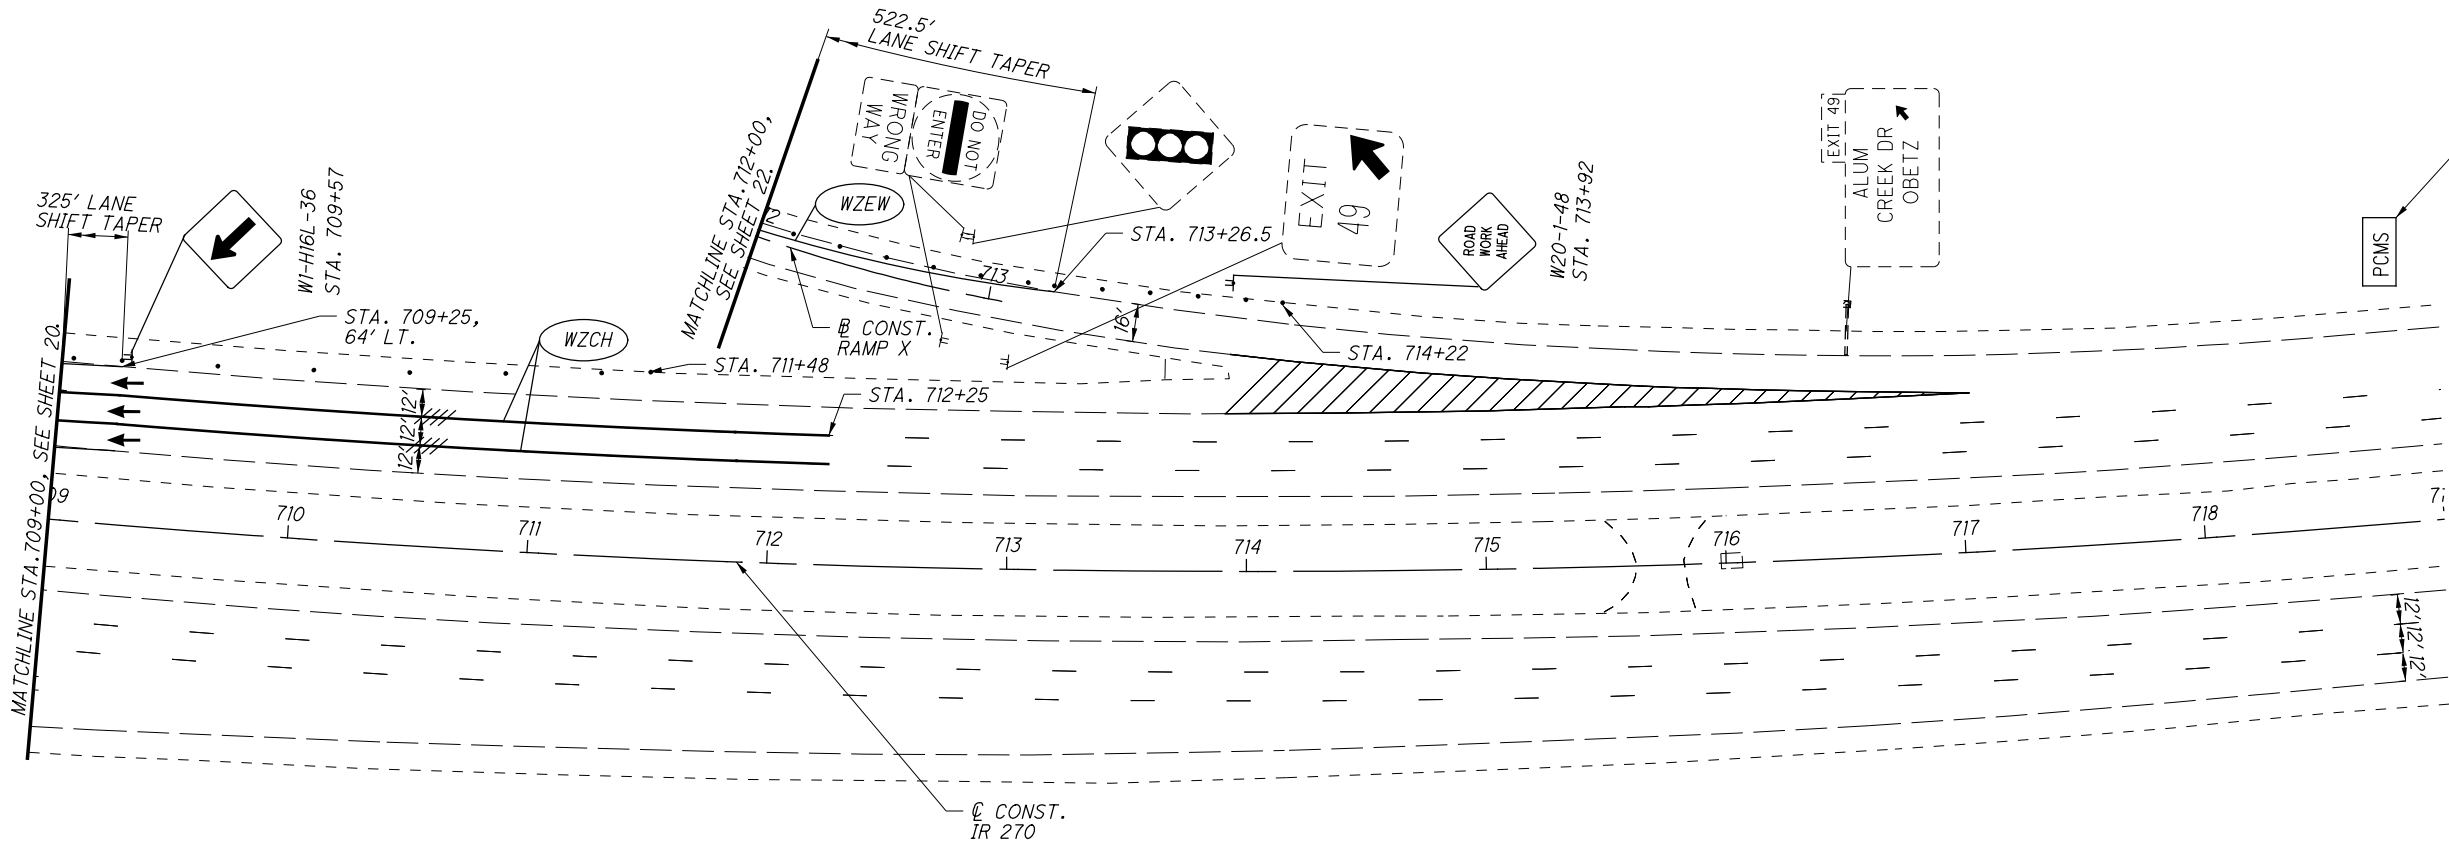

ADVANCE WARNING SIGN TABLE LOCATIONS				
SIGN NUMBER	W1-4bR-48	R4-9-36	R4-H5aR	W20-1-48
STATIONS	719+25 WB	729+25 WB	742+45 WB	755+65 WB
SIDE	LT/ RT	LT/ RT	LT/ RT	LT/ RT


- DRUMS
- 32" PORTABLE BARRIER
- WZIA WORK ZONE IMPACT ATTENUATOR
- WZEW WORK ZONE EDGE LINE WHITE
- WZEY WORK ZONE EDGE LINE YELLOW
- WZLL WORK ZONE LANE LINE

- WZCH WORK ZONE CHANNELIZING LINE
- WZDL WORK ZONE DOTTED LINE
- WZSL WORK ZONE STOP LINE
- WZCL WORK ZONE CENTER LINE

- PHASE CONSTRUCTION
- REMOVE OR COVER SIGN DURING THIS PHASE

CALCULATED JLM
CHECKED SSK

0 20 40 80
HORIZONTAL SCALE IN FEET

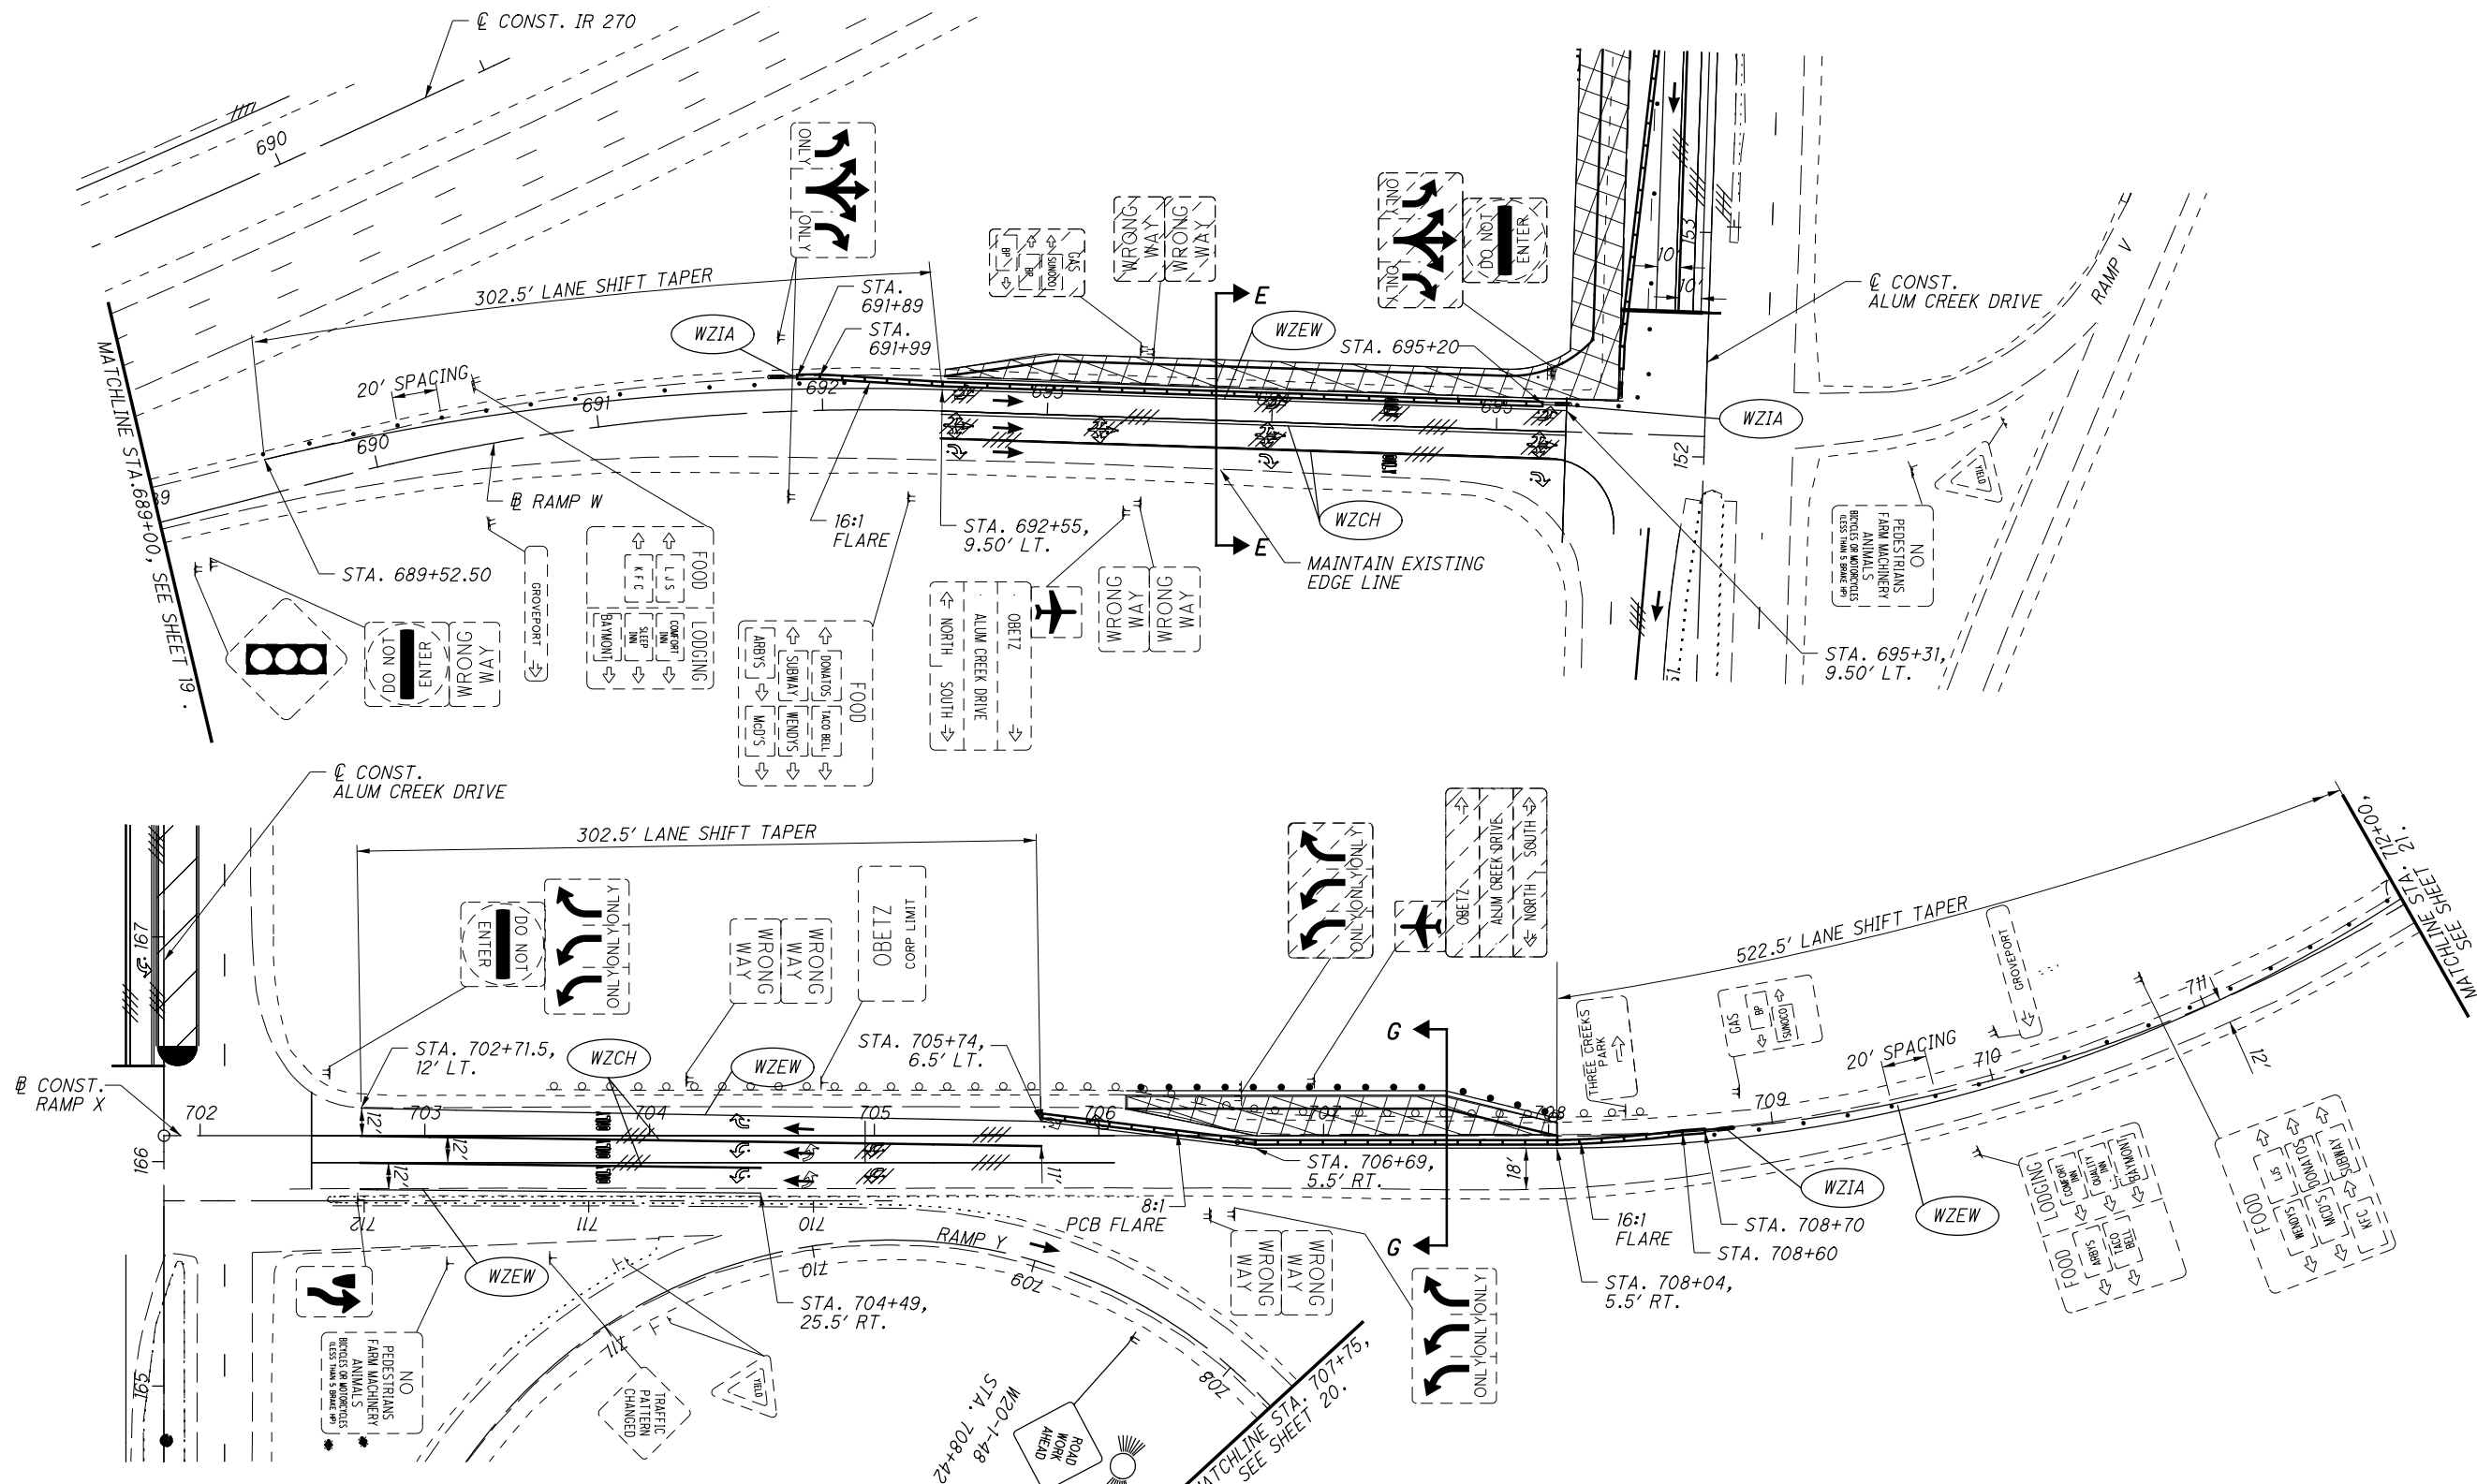

- DRUMS
- 32" PORTABLE BARRIER
- (WZIA) WORK ZONE IMPACT ATTENUATOR
- (WZEW) WORK ZONE EDGE LINE WHITE
- (WZEY) WORK ZONE EDGE LINE YELLOW
- (WZLL) WORK ZONE LANE LINE

LEGEND

- (WZCH) WORK ZONE CHANNELIZING LINE
- (WZDL) WORK ZONE DOTTED LINE
- (WZSL) WORK ZONE STOP LINE
- (WZCL) WORK ZONE CENTER LINE



- ☀ TYPE A, WARNING LIGHTS
- /// EXISTING PAVEMENT MARKING AND RAISED PAVEMENT MARKER REMOVED
- ▨ PHASE CONSTRUCTION
- ▨ REMOVE OR COVER SIGN DURING THIS PHASE

NOTES:
1.) SEE BUILDABLE UNIT 6 FOR SIGNING PLANS.

CALCULATED JLM
CHECKED SSK

0 20 40 80
HORIZONTAL SCALE IN FEET

MAINTENANCE OF TRAFFIC PHASE 1
RAMPS W AND X STATION 689+00 TO STATION 712+00

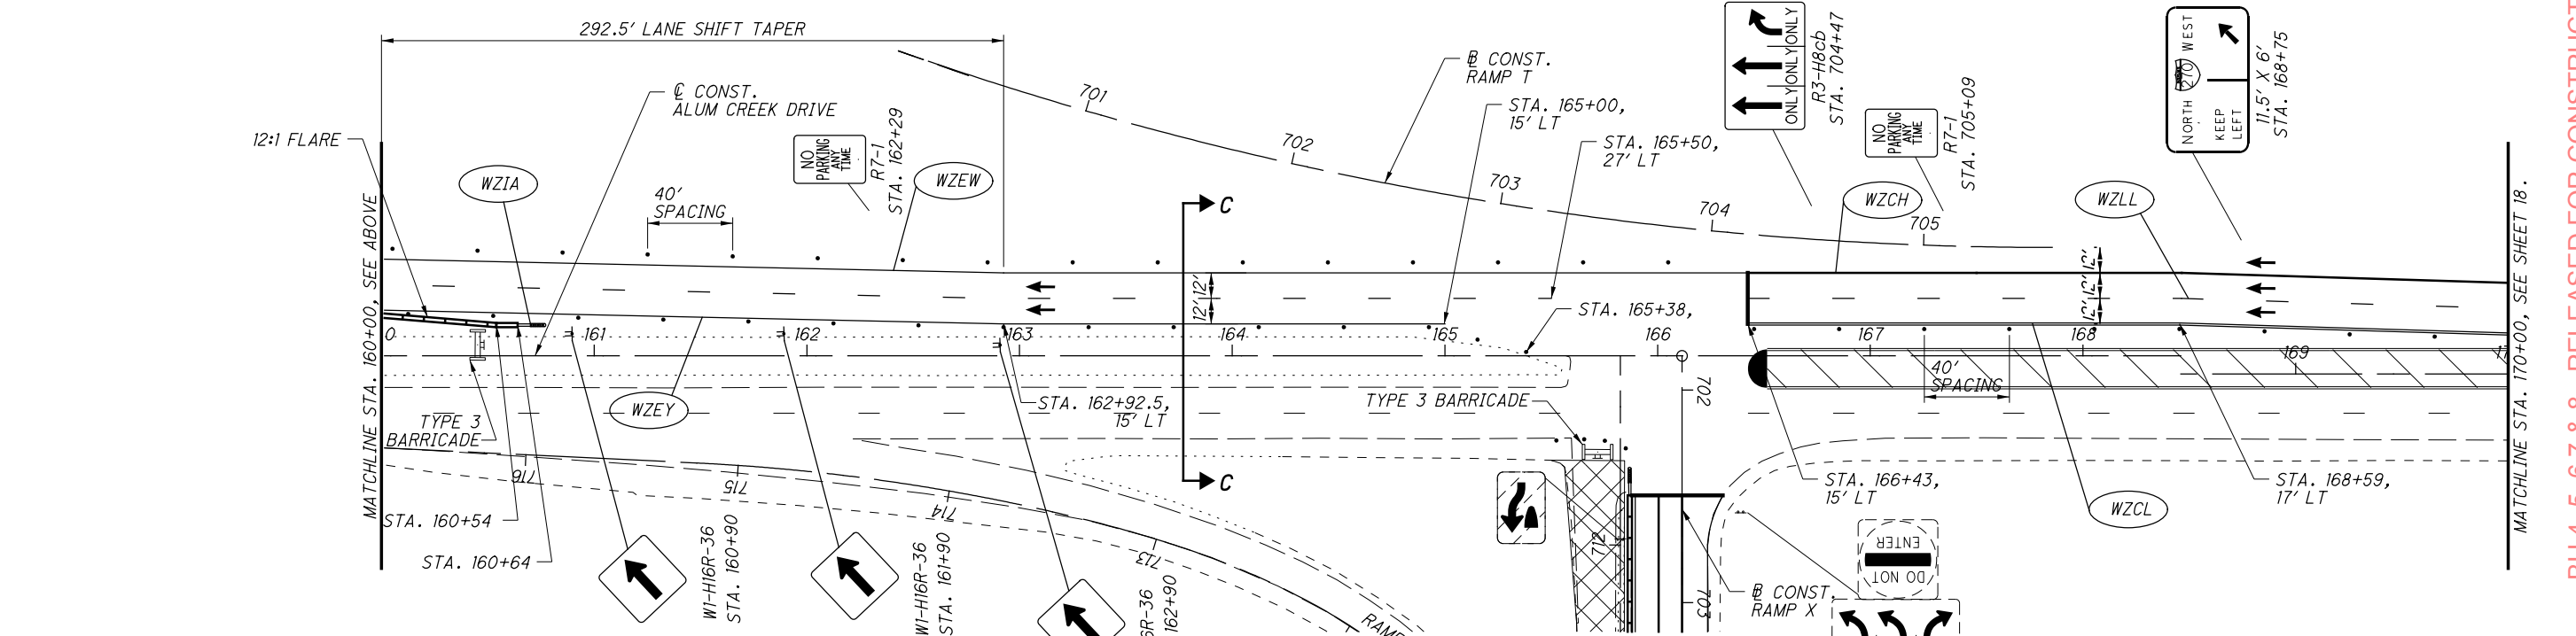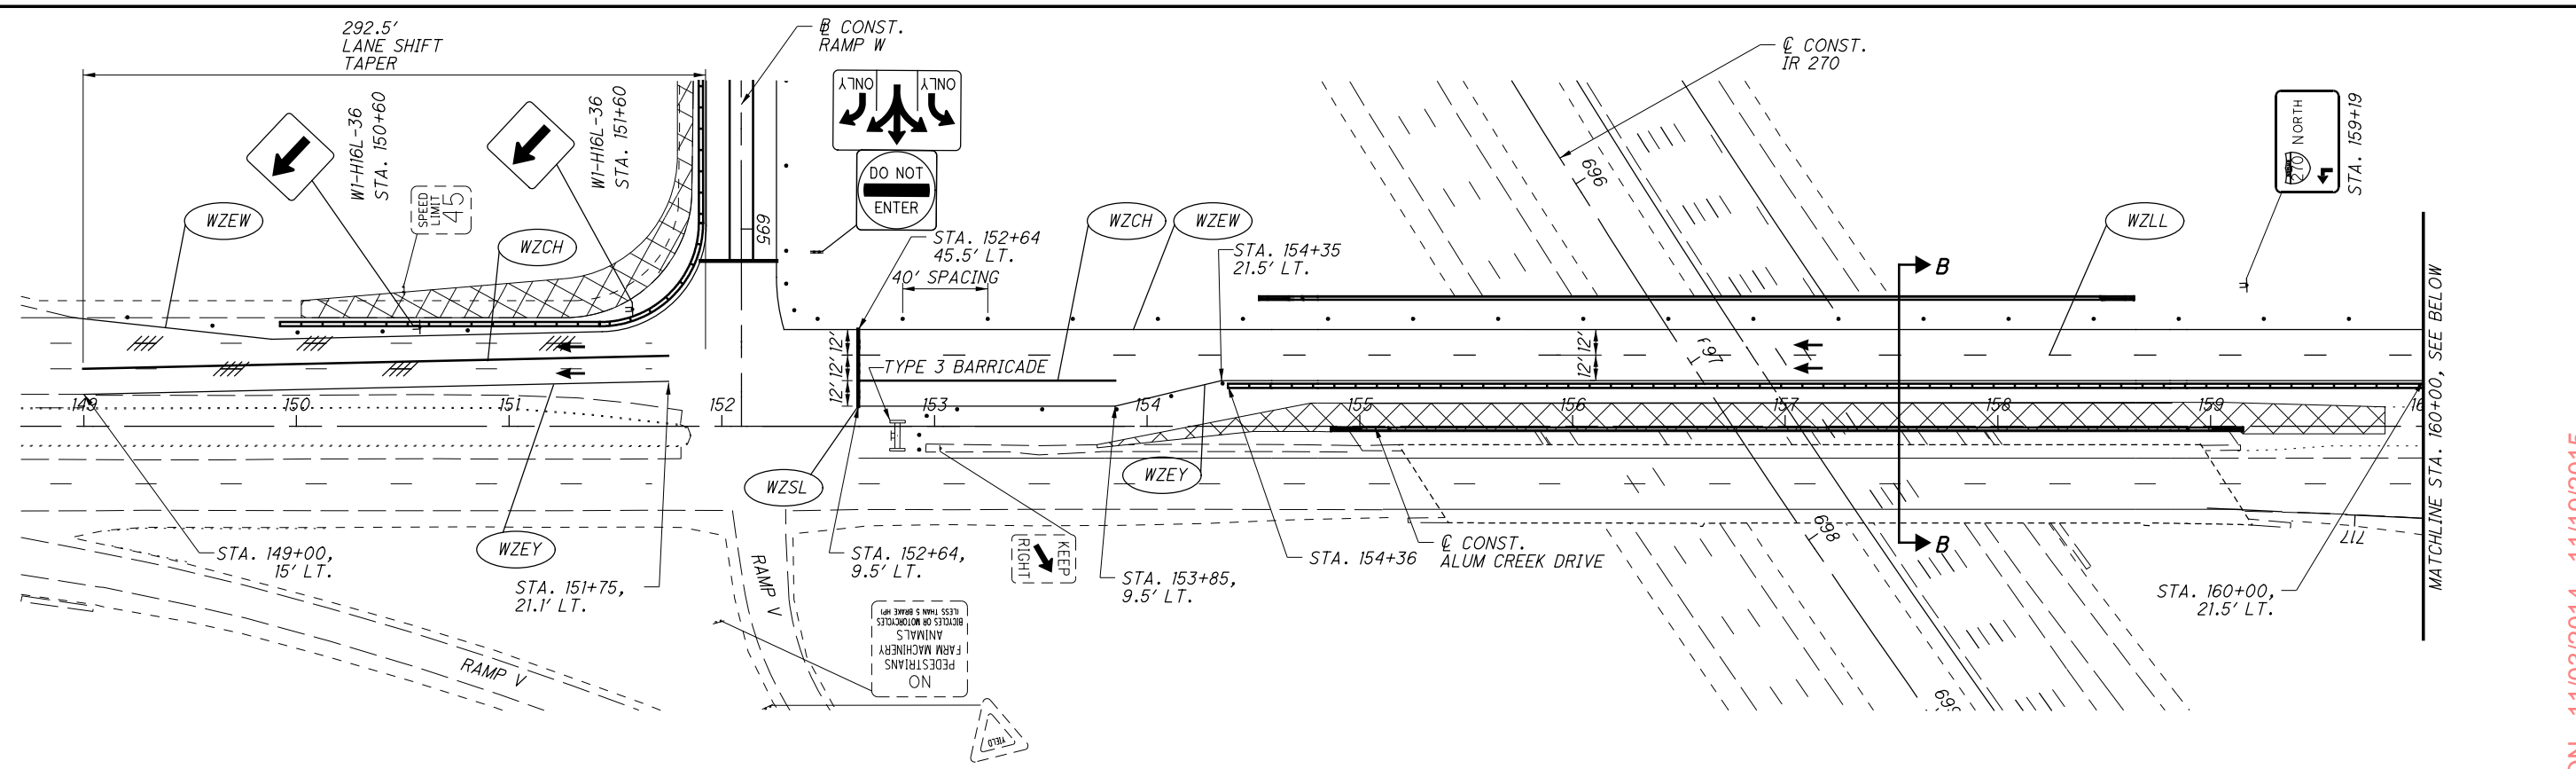


ADVANCE WARNING SIGN TABLE LOCATIONS	
SIGN NUMBER	END ROAD WORK E5-H2b-48
STATIONS	141+00
SIDE	RT


LEGEND




- DRUMS
- 32" PORTABLE BARRIER
- WZIA WORK ZONE IMPACT ATTENUATOR
- WZEW WORK ZONE EDGE LINE WHITE
- WZEY WORK ZONE EDGE LINE YELLOW
- WZLL WORK ZONE LANE LINE
- WZCH WORK ZONE CHANNELIZING LINE
- WZDL WORK ZONE DOTTED LINE
- WZSL WORK ZONE STOP LINE
- WZCL WORK ZONE CENTER LINE
- ☀ TYPE A, WARNING LIGHTS
- /// EXISTING PAVEMENT MARKING AND RAISED PAVEMENT MARKER REMOVED
- ▨ PHASE CONSTRUCTION
- ▨ REMOVE OR COVER SIGN DURING THIS PHASE

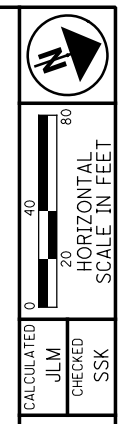- NOTES:**
- 1.) SEE BUILDABLE UNIT 4 FOR BRIDGE PHASING DETAILS.
 - 2.) SEE BUILDABLE UNIT 6 FOR SIGNING PLANS.
 - 3.) SEE SHEET 26 FOR ADDITIONAL DETAILS FOR RAMPS X AND W.



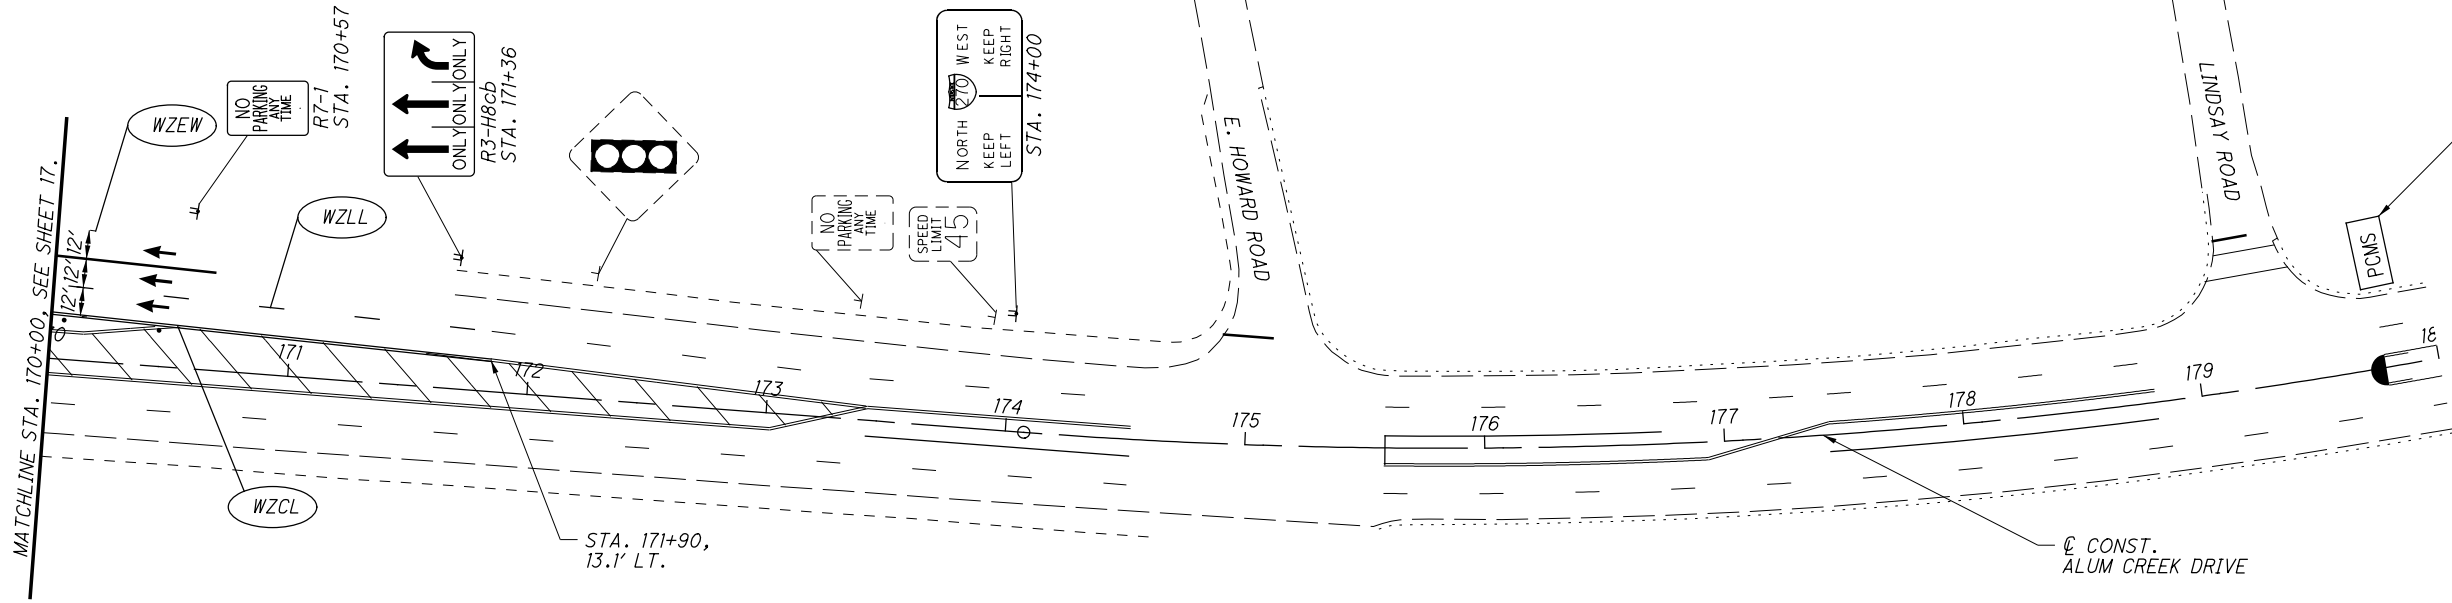



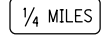




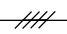




MAINTENANCE OF TRAFFIC PHASE 2
ALUM CREEK DRIVE STATION 149+00 TO STATION 170+00



ADVANCE WARNING SIGN TABLE LOCATIONS	
SIGN NUMBER	   W20-1-48 W16-3aP-30
STATIONS	189+45
SIDE	RT


LEGEND

-  DRUMS
-  32" PORTABLE BARRIER
-  WZIA WORK ZONE IMPACT ATTENUATOR
-  WZEW WORK ZONE EDGE LINE WHITE
-  WZEY WORK ZONE EDGE LINE YELLOW
-  WZLL WORK ZONE LANE LINE
-  WZCH WORK ZONE CHANNELIZING LINE
-  WZDL WORK ZONE DOTTED LINE
-  WZSL WORK ZONE STOP LINE
-  WZCL WORK ZONE CENTER LINE
-  TYPE A, WARNING LIGHTS
-  EXISTING PAVEMENT MARKING AND RAISED PAVEMENT MARKER REMOVED
-  PHASE CONSTRUCTION
-  REMOVE OR COVER SIGN DURING THIS PHASE



CALCULATED JLM
 CHECKED SSK
MAINTENANCE OF TRAFFIC PHASE 2
ALUM CREEK DRIVE STATION 170+00 TO STATION 180+00

BU 4, 5, 6, 7, & 8 - RELEASED FOR CONSTRUCTION - 11/03/2014 - 11/19/2015
FRA-270-49.00
 24
 182

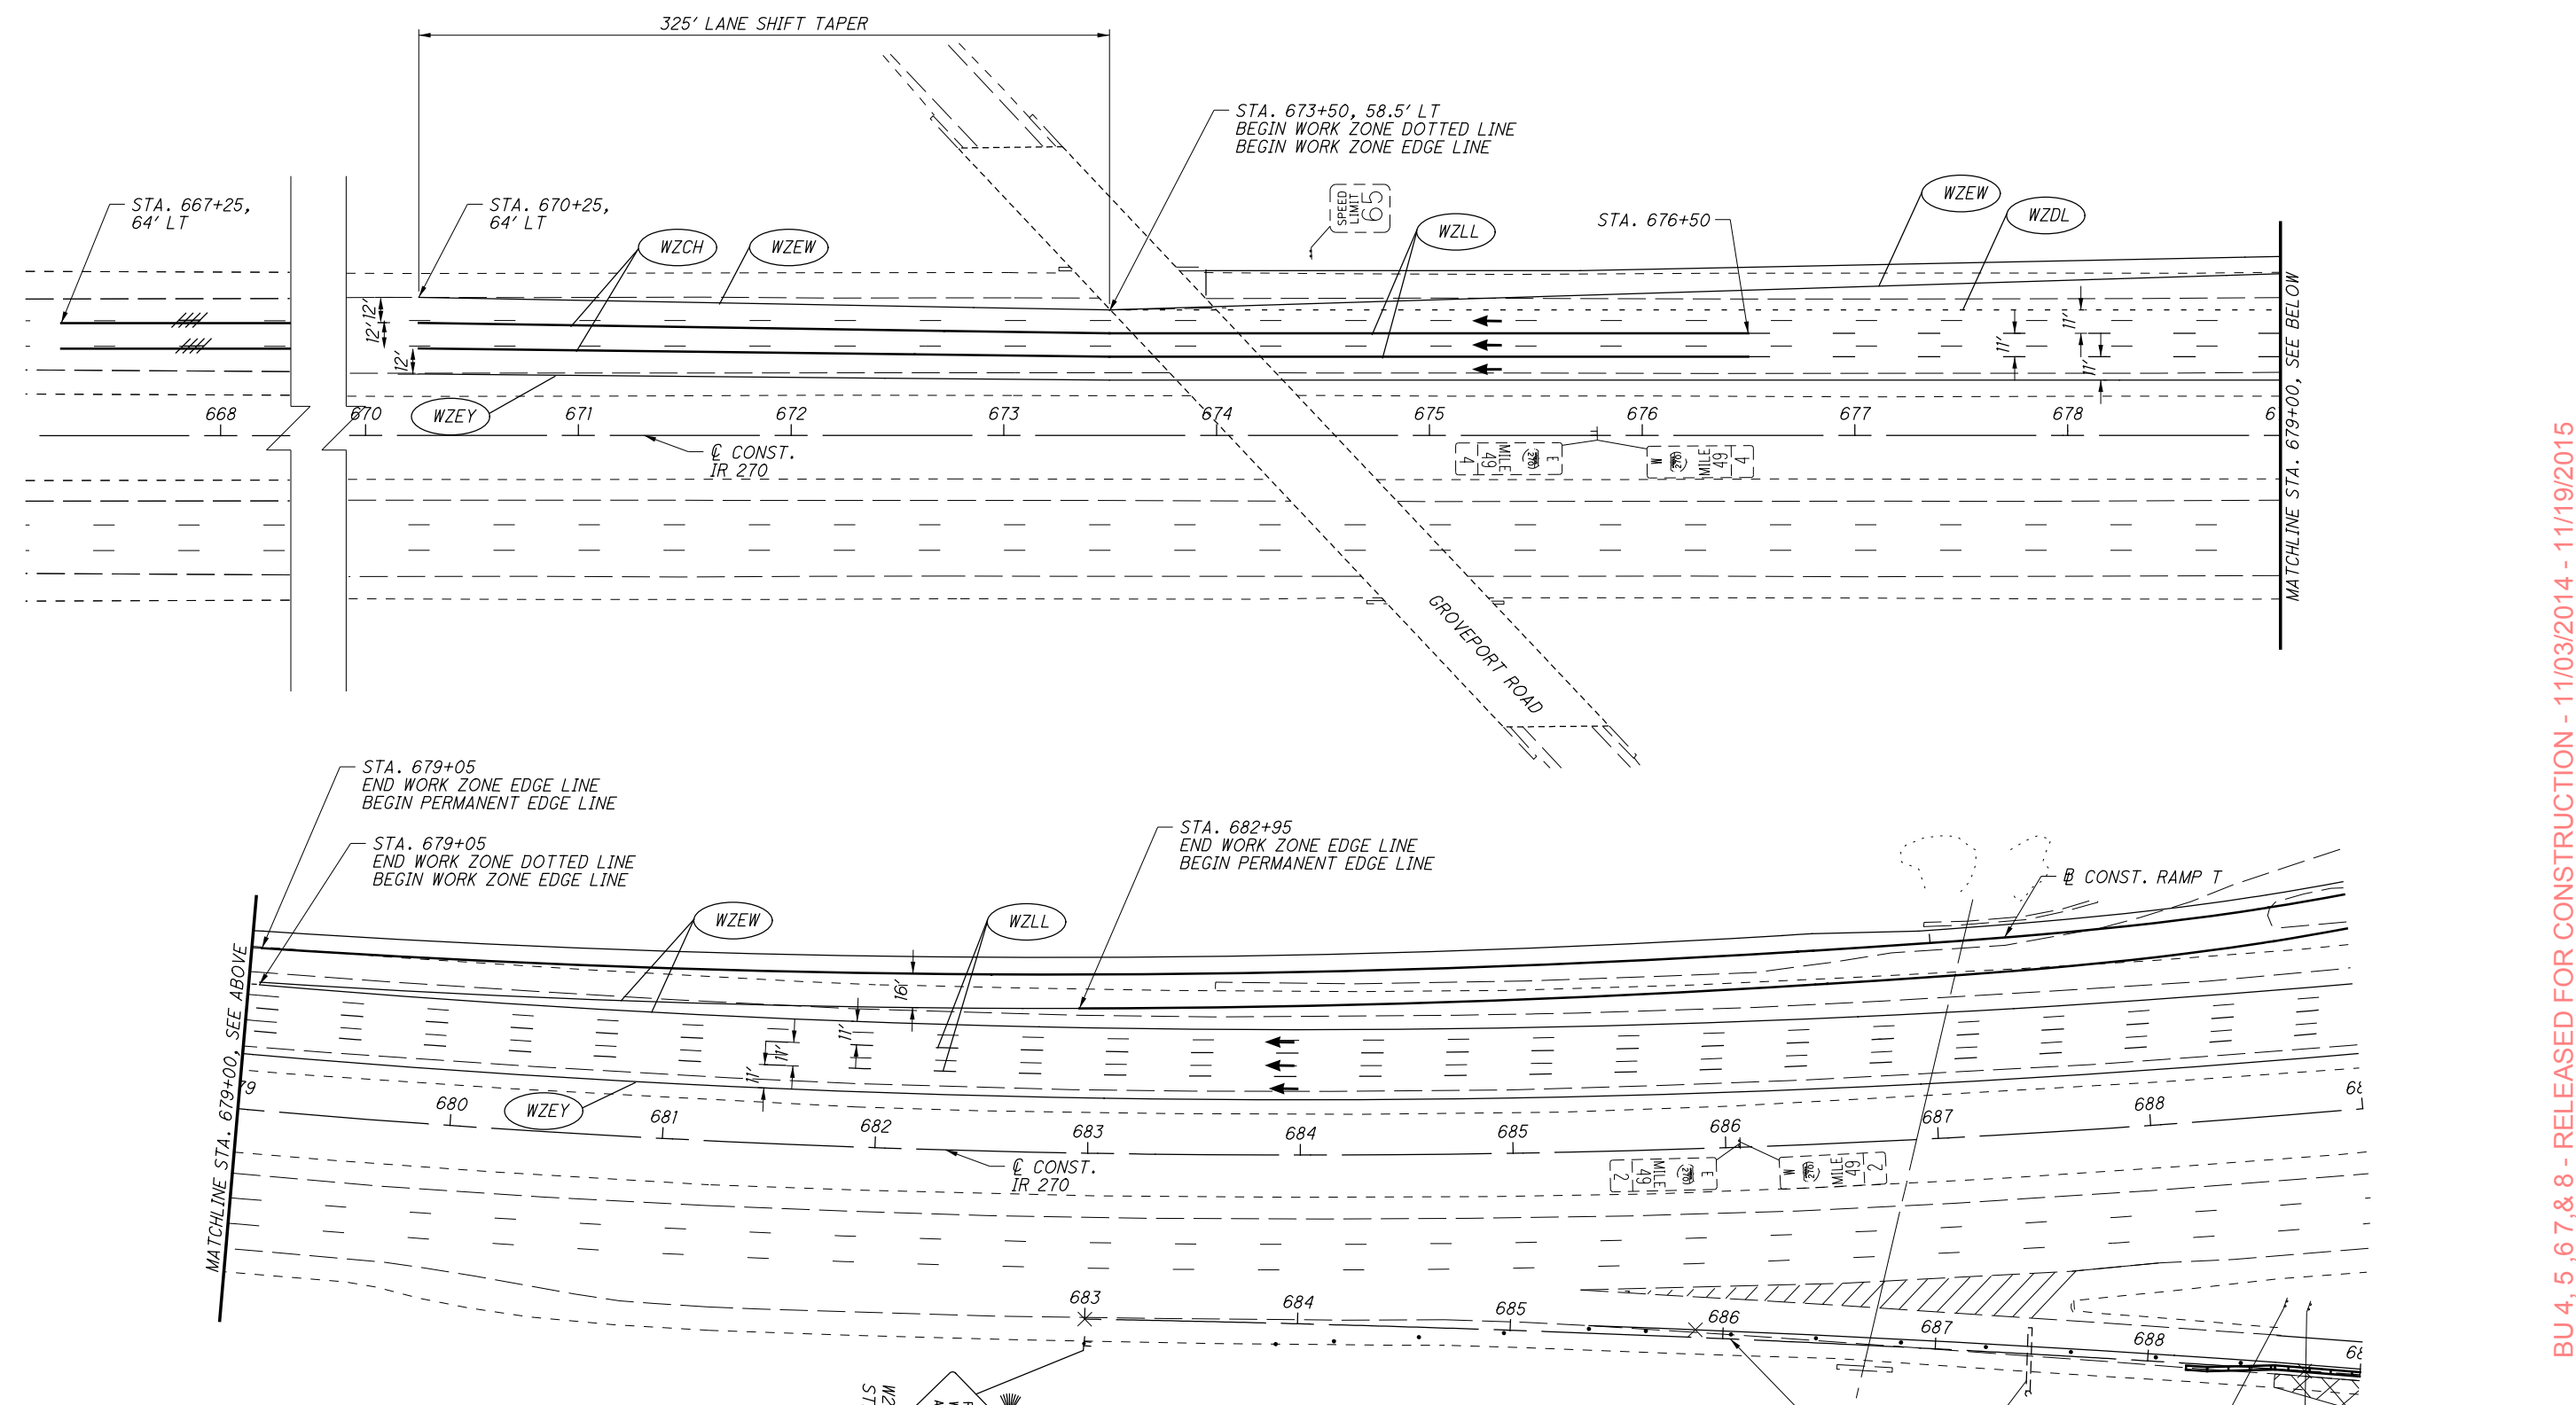

ADVANCE WARNING SIGN TABLE LOCATIONS


SIGN NUMBER	END ROAD WORK E5-H2b-48
STATIONS	660+25 WB
SIDE	LT/ RT

- LEGEND**
- DRUMS
 - 32" PORTABLE BARRIER
 - (WZIA) WORK ZONE IMPACT ATTENUATOR
 - (WZEW) WORK ZONE EDGE LINE WHITE
 - (WZEY) WORK ZONE EDGE LINE YELLOW
 - (WZLL) WORK ZONE LANE LINE
 - (WZCH) WORK ZONE CHANNELIZING LINE
 - (WZDL) WORK ZONE DOTTED LINE
 - (WZSL) WORK ZONE STOP LINE
 - (WZCL) WORK ZONE CENTER LINE
 - (Type A) TYPE A, WARNING LIGHTS
 - (Hatched) EXISTING PAVEMENT MARKING AND RAISED PAVEMENT MARKER REMOVED
 - (Cross-hatched) PHASE CONSTRUCTION
 - (Diagonal lines) REMOVE OR COVER SIGN DURING THIS PHASE

CALCULATED JLM
CHECKED SSK

0 20 40 80
HORIZONTAL SCALE IN FEET

↑ N

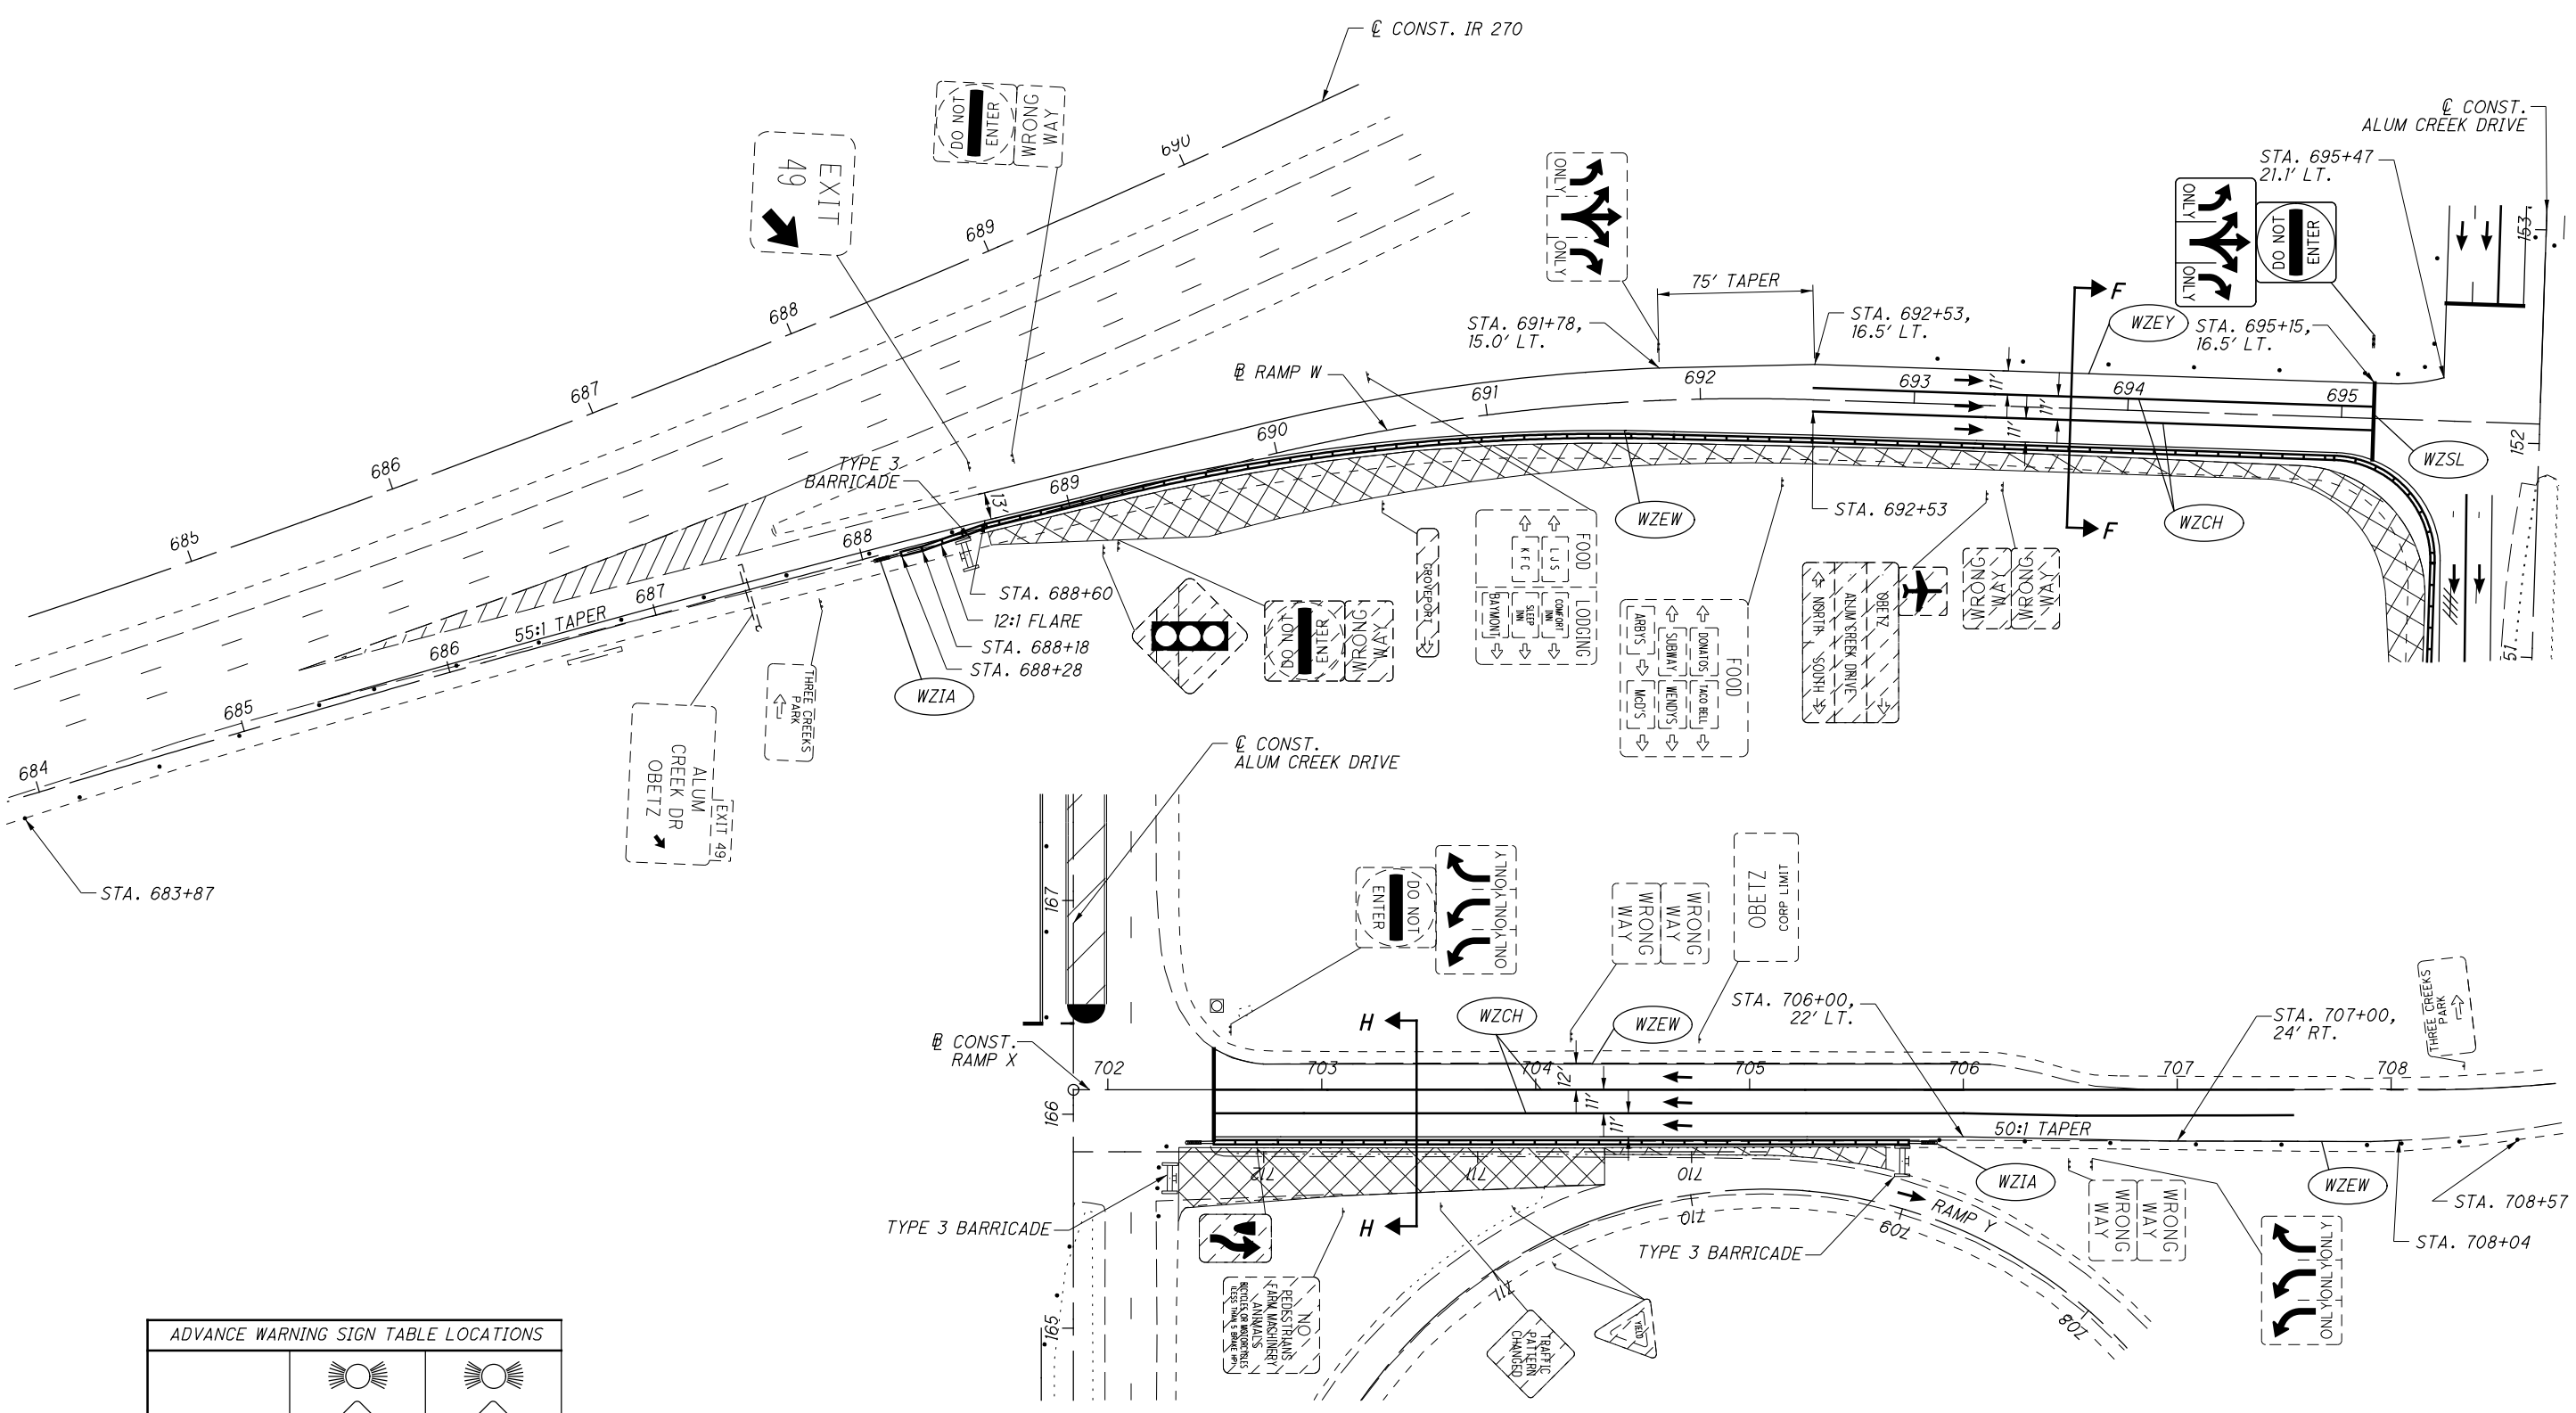

ADVANCE WARNING SIGN TABLE LOCATIONS

SIGN NUMBER		
	W20-1-48	W20-1-48
STATIONS	RAMP W STA. 683+00	RAMP X STA. 713+00
SIDE	RT	RT

- LEGEND**
- DRUMS
 - 32" PORTABLE BARRIER
 - WZIA WORK ZONE IMPACT ATTENUATOR
 - WZEW WORK ZONE EDGE LINE WHITE
 - WZEY WORK ZONE EDGE LINE YELLOW
 - WZLL WORK ZONE LANE LINE

- WZCH WORK ZONE CHANNELIZING LINE
- WZDL WORK ZONE DOTTED LINE
- WZSL WORK ZONE STOP LINE
- WZCL WORK ZONE CENTER LINE

- TYPE A, WARNING LIGHTS
- EXISTING PAVEMENT MARKING AND RAISED PAVEMENT MARKER REMOVED
- PHASE CONSTRUCTION
- REMOVE OR COVER SIGN DURING THIS PHASE

NOTES:
1.) SEE BUILDABLE UNIT 6 FOR SIGNING PLANS.

CALCULATED JLM
CHECKED SSK

0 20 40 80
HORIZONTAL SCALE IN FEET

BU 4, 5, 6, 7, & 8 - RELEASED FOR CONSTRUCTION - 11/03/2014 - 11/19/2015

MAINTENANCE OF TRAFFIC PHASE 2



RAMPS W AND X STATION 689+00 TO STATION 712+00

FRA-270-49.00

AS BUILT - 4/22/2016

G:\projects\2014-W-14-039-FRA-270-49.00\83988\drainage\sheets\83988D5001.dgn 5/23/2016 7:30:45 AM kevinj

LOCATION	STATION TO STATION		SIDE	202		601		602	605		611							670		836					
	SQ YD	FT		EACH	SQ YD	SQ YD	CU YD	FT	FT	FT	FT	FT	FT	EACH	EACH	EACH	EACH	EACH	SQ YD	SQ YD	SQ YD				
ALUM CREEK DRIVE	150+02.00	151+36.32							134																
ALUM CREEK DRIVE	152+50.62	154+85.94							470	17															
ALUM CREEK DRIVE	153+76.50	154+84.28							108																
ALUM CREEK DRIVE	153+89.74	154+99.64	MED	115																					
ALUM CREEK DRIVE	154+01.50	154+99.64	MED		54																				
ALUM CREEK DRIVE	154+74.13		MED			1											1								
ALUM CREEK DRIVE	158+93.40		LT				156																		
ALUM CREEK DRIVE	159+38.69	159+75.37	MED									38		1											
ALUM CREEK DRIVE	167+85.52	171+67.00							762																
ALUM CREEK DRIVE	170+24.15	171+50.50	LT								120						2								
IR 270	673+95.00	689+54.08							1559	106															
RAMP T	689+47.37	702+64.15							2534	97															
RAMP T	690+50.00	692+00.00	LT																						
RAMP T	690+50.00	692+42.00	RT																						
RAMP T	690+79.99	692+48.15	RT			20		0.43																	
RAMP T	693+00.00	694+50.00	LT																						
RAMP T	695+00.00	697+50.00	LT																						
RAMP T	697+50.00	698+50.00	RT																						
RAMP T	698+00.00	698+50.00	LT																						
RAMP T	699+50.00	700+00.00	LT																						
RAMP T	701+00.00	701+50.00	RT																						
RAMP T	702+00.00	703+72.39	LT																						
RAMP T	702+64.15	705+60.42							296																
RAMP W	688+60.00	695+17.78							658	10															
RAMP W	690+00.00	690+50.00	RT																						
RAMP W	691+00.00	691+50.00	RT																						
RAMP W	692+00.00	692+50.00	RT																						
RAMP W	692+50.00	693+00.00	RT																						
RAMP W	693+00.00	693+50.00	RT																						
RAMP X	706+12.00	708+04.00							192																
TOTALS CARRIED TO GENERAL SUMMARY				115	20	1	54	156	0.43	6713	230	120	38	50	121	1	1	2	1	1	5	810	429	42	

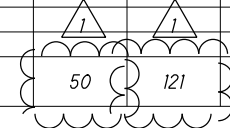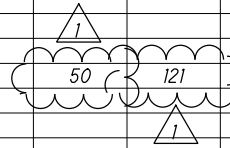

1	DATE	DESCRIPTION
	4/22/16	AS BUILT

BUJ 4, 5, 6, 7, & 8 - RELEASED FOR CONSTRUCTION - 11/03/2014 - 11/19/2015

DRAINAGE SUBSUMMARY



FRA - 270 - 49.00

CALCULATED	JLM
CHECKED	SSK

AS BUILT - 4/22/2016

5/23/2016 7:30:47 AM kevinj

G:\projects\2014\14-039 FRA-270-49.00\83988\roadway\sheets\83988FP001_Rev.dgn

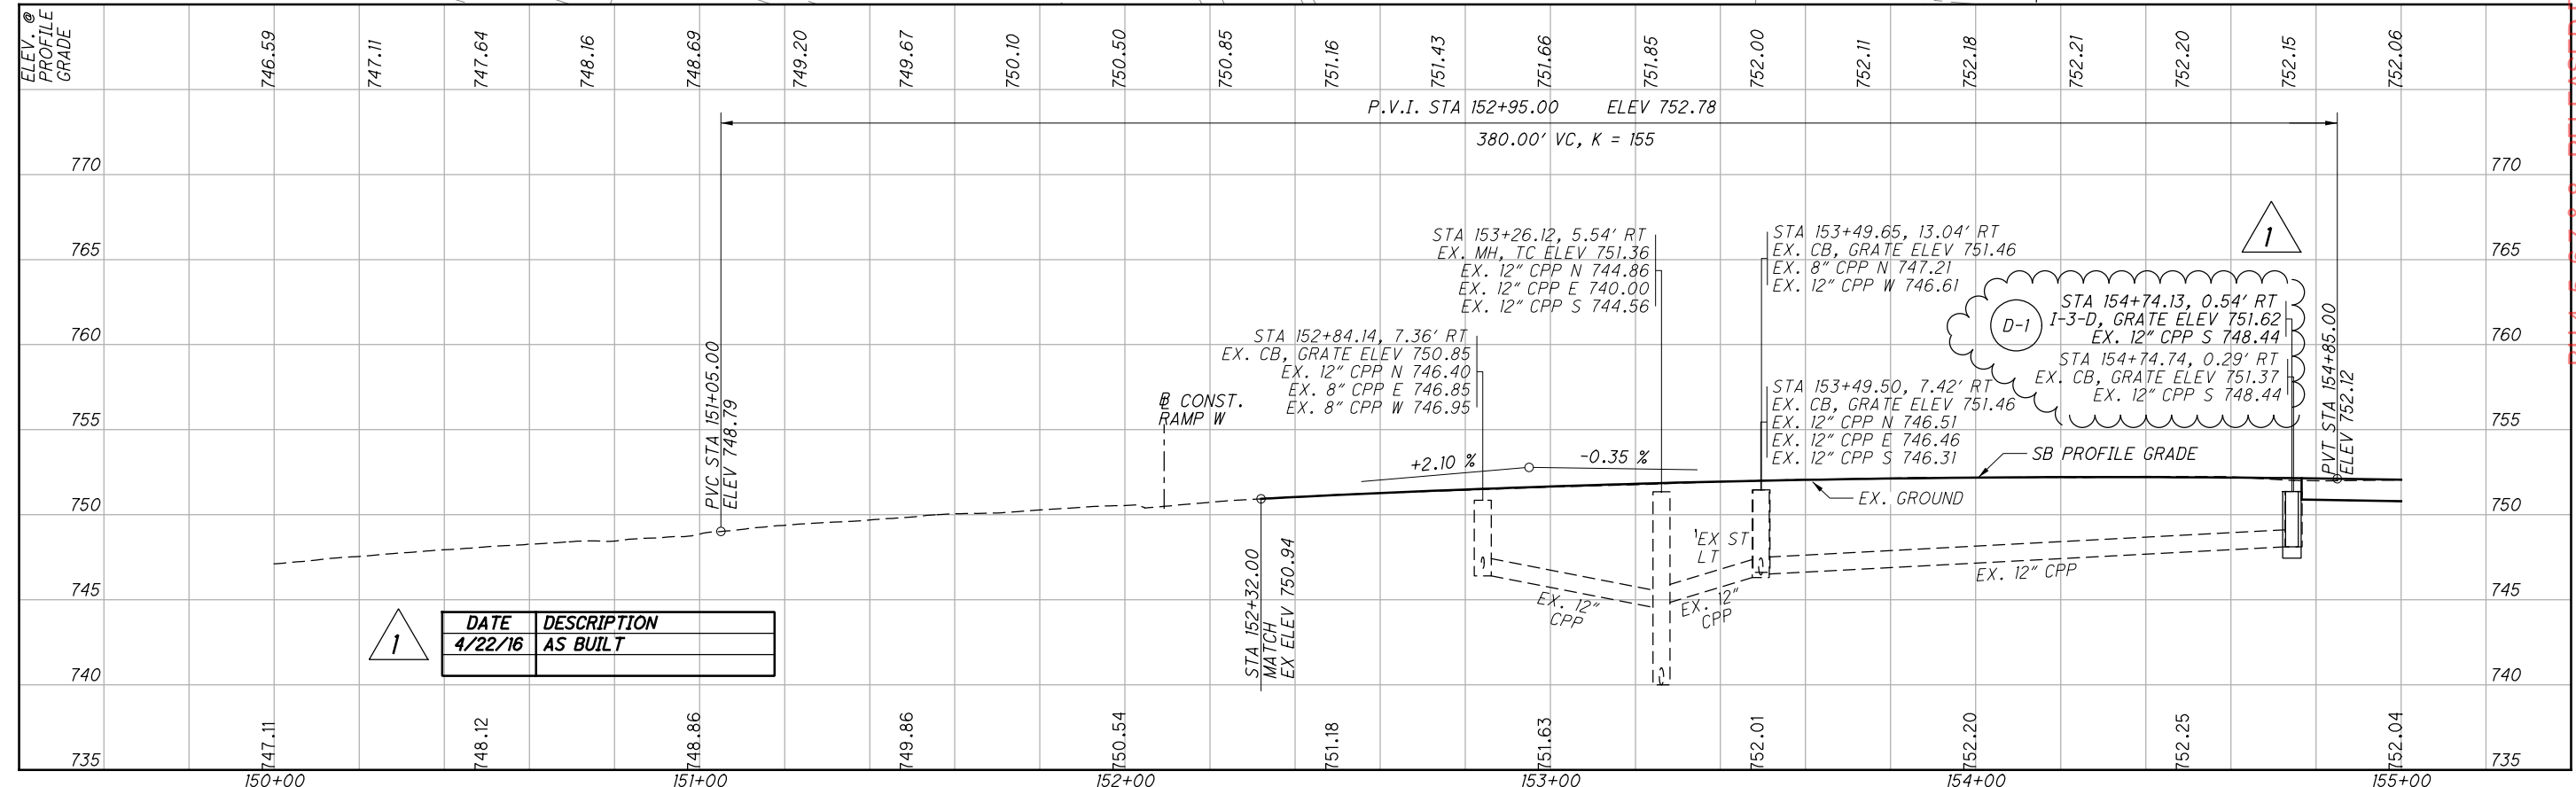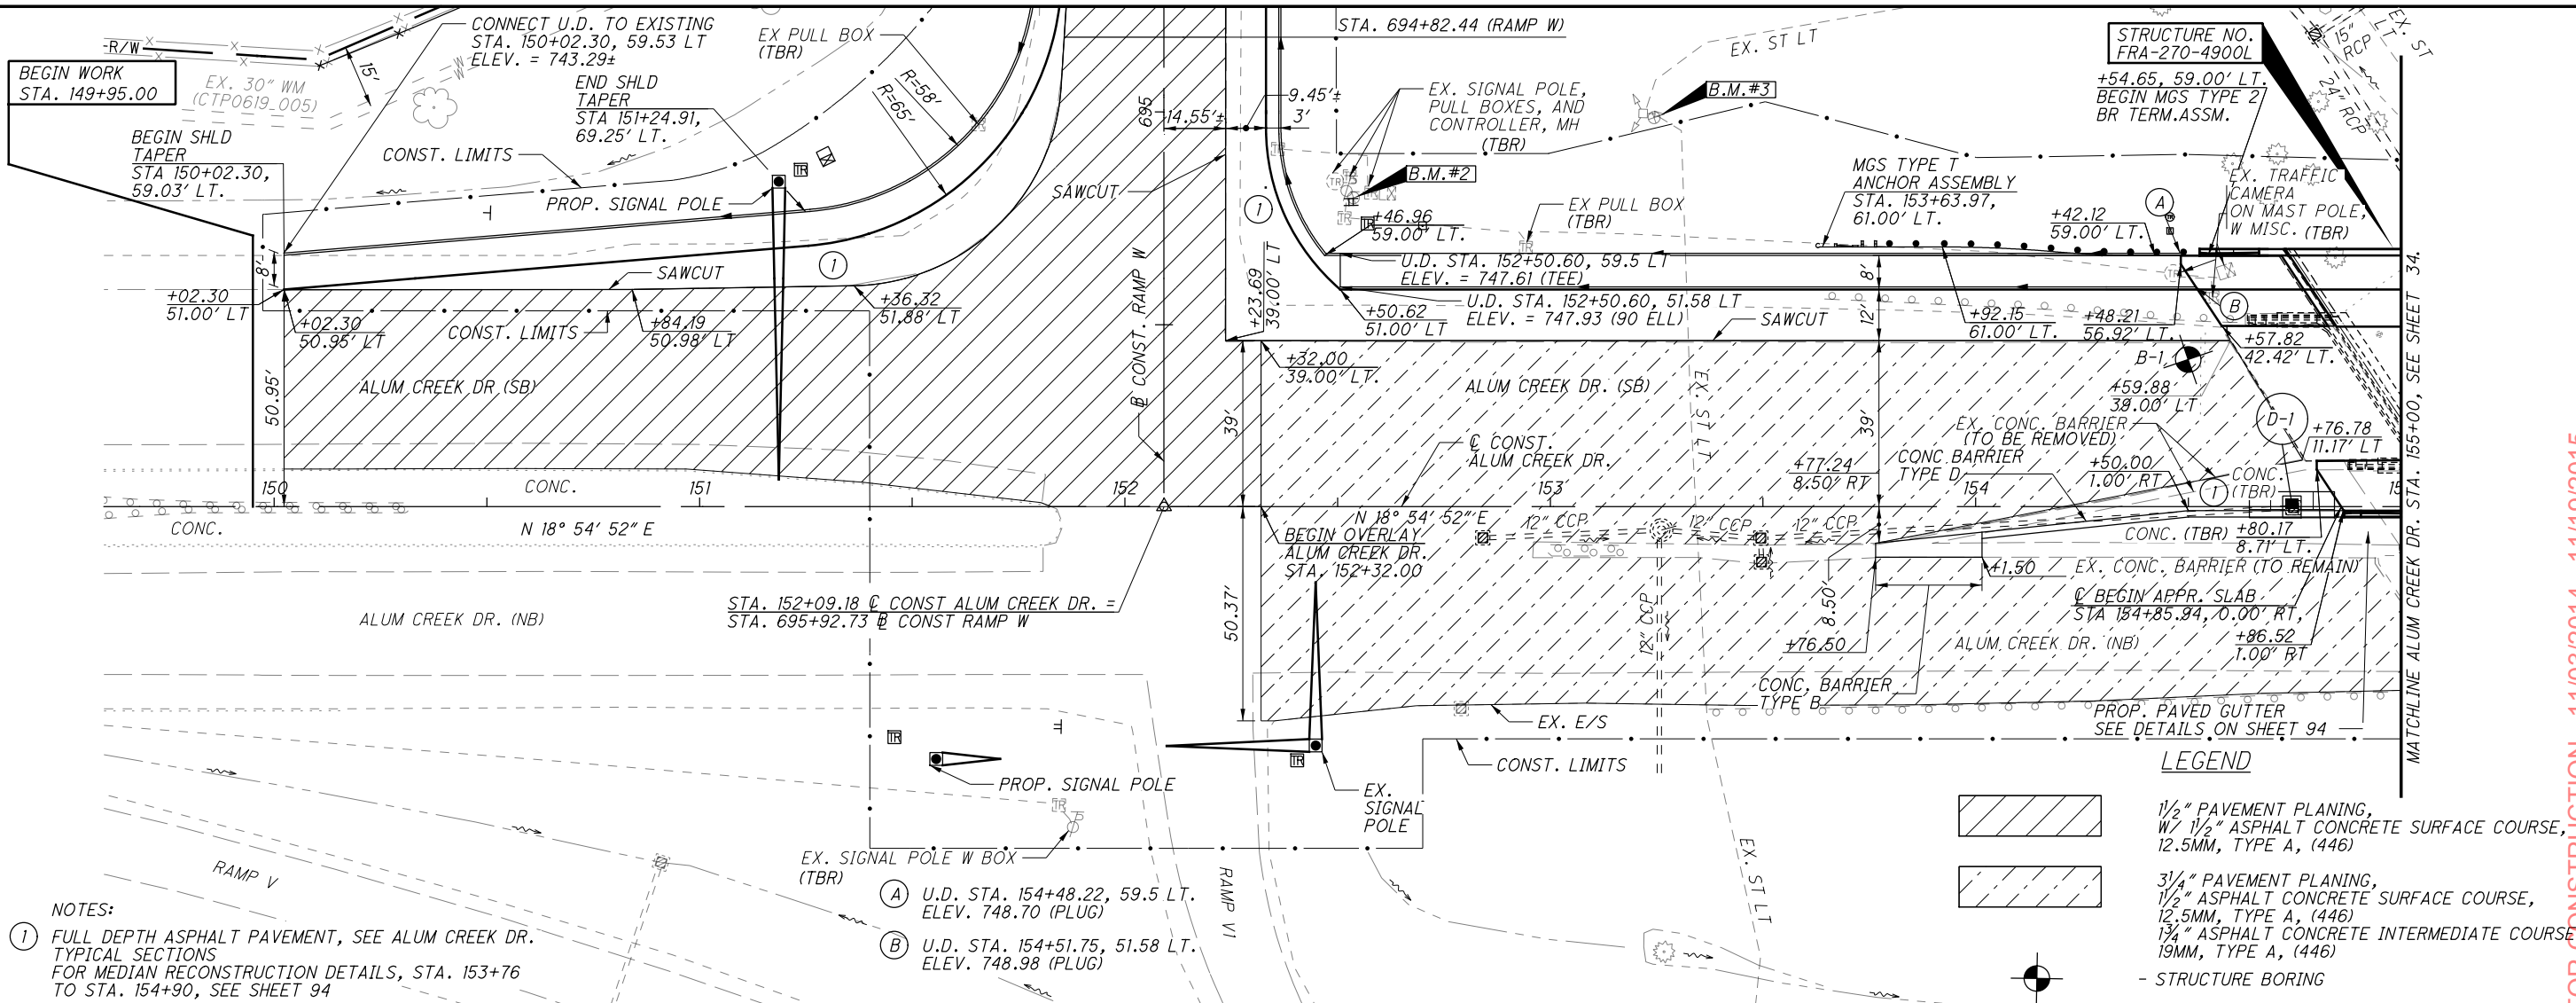

DATE	DESCRIPTION
4/22/16	AS BUILT

LEGEND

1/2" PAVEMENT PLANING, W/ 1/2" ASPHALT CONCRETE SURFACE COURSE, 12.5MM, TYPE A, (446)

3/4" PAVEMENT PLANING, 1/2" ASPHALT CONCRETE SURFACE COURSE, 12.5MM, TYPE A, (446) 1/4" ASPHALT CONCRETE INTERMEDIATE COURSE, 19MM, TYPE A, (446)

- STRUCTURE BORING



RELEASED FOR CONSTRUCTION - 11/03/2014 - 11/19/2015

PLAN AND PROFILE ALUM CREEK DR.

STA. 150+00 TO STA. 155+00



FRA - 270 - 49.00

33 / 182

AS BUILT - 4/22/2016

5/23/2016 7:30:48 AM kevinj

G:\projects\2014\W-14-039 FRA-270-49.00\83988\roadway\sheets\83988GF002_Rev.dgn

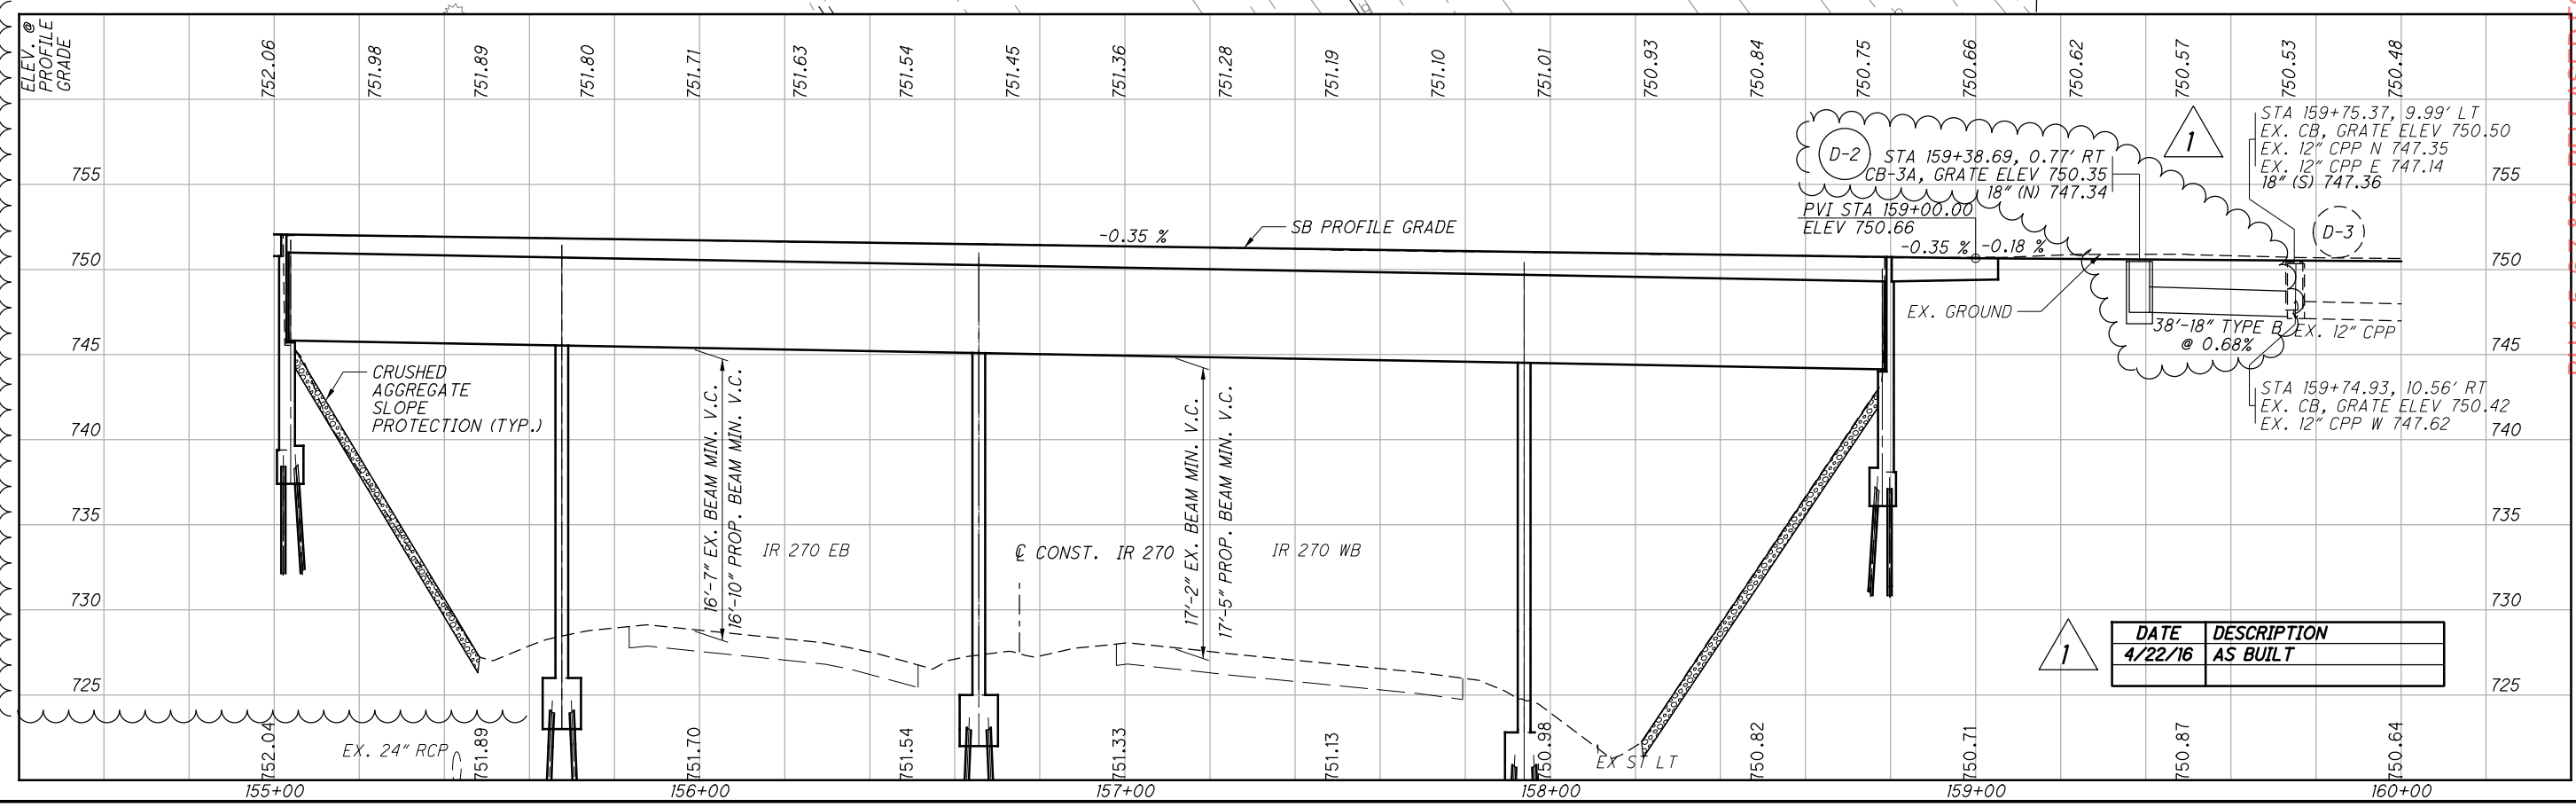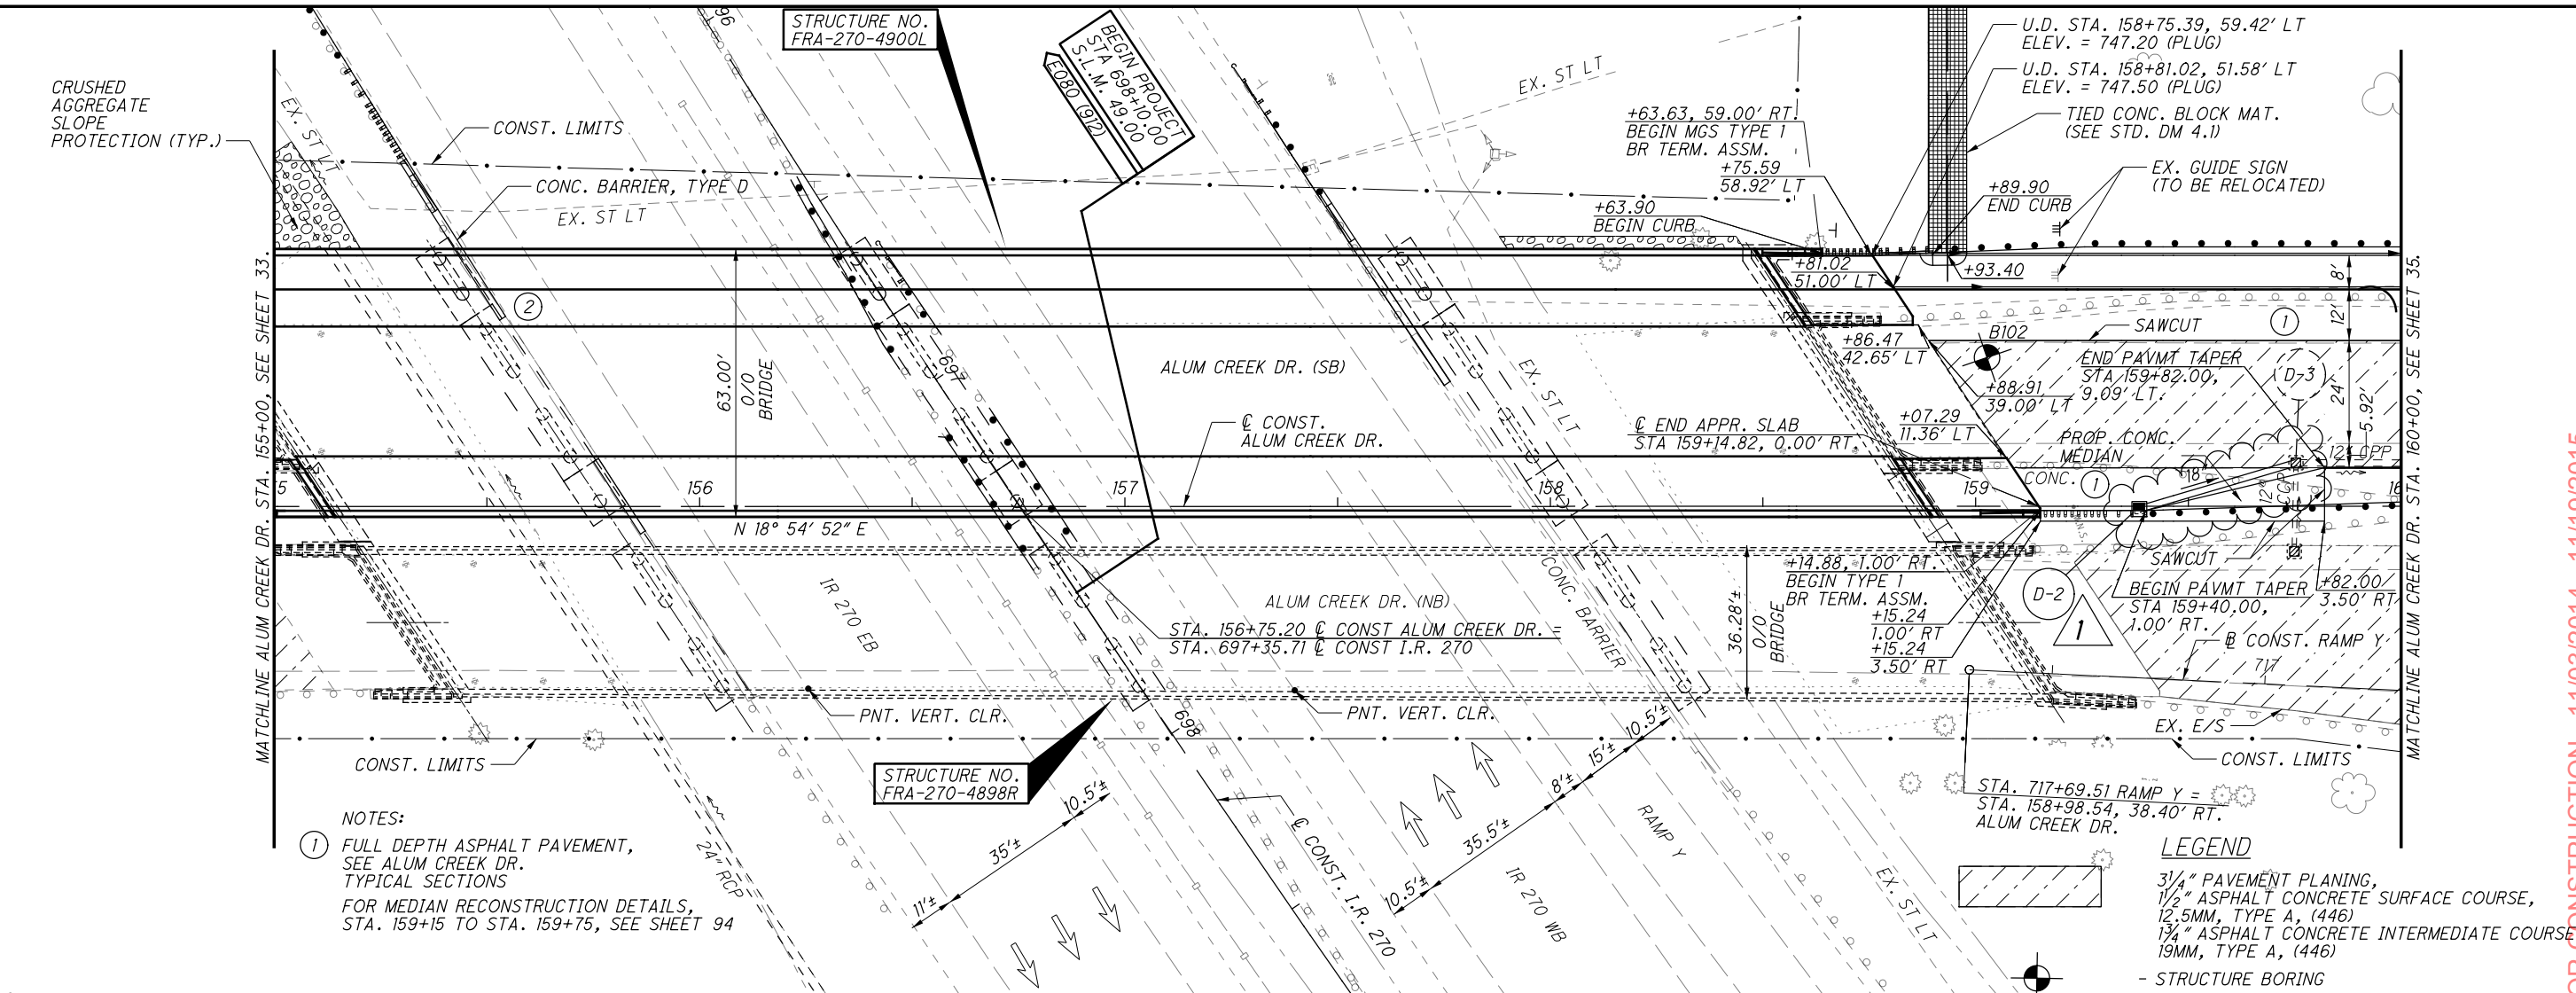

PLAN AND PROFILE ALUM CREEK DR.
 STA. 155+00 TO STA. 160+00


FRA-270-49.00

34
182

AS BUILT - 4/22/2016

5/23/2016 7:30:49 AM kevinj


G:\projects\2014\W-14-039 FRA-270-49.00\83988\roadway\sheets\83988FP03_Rev.dgn

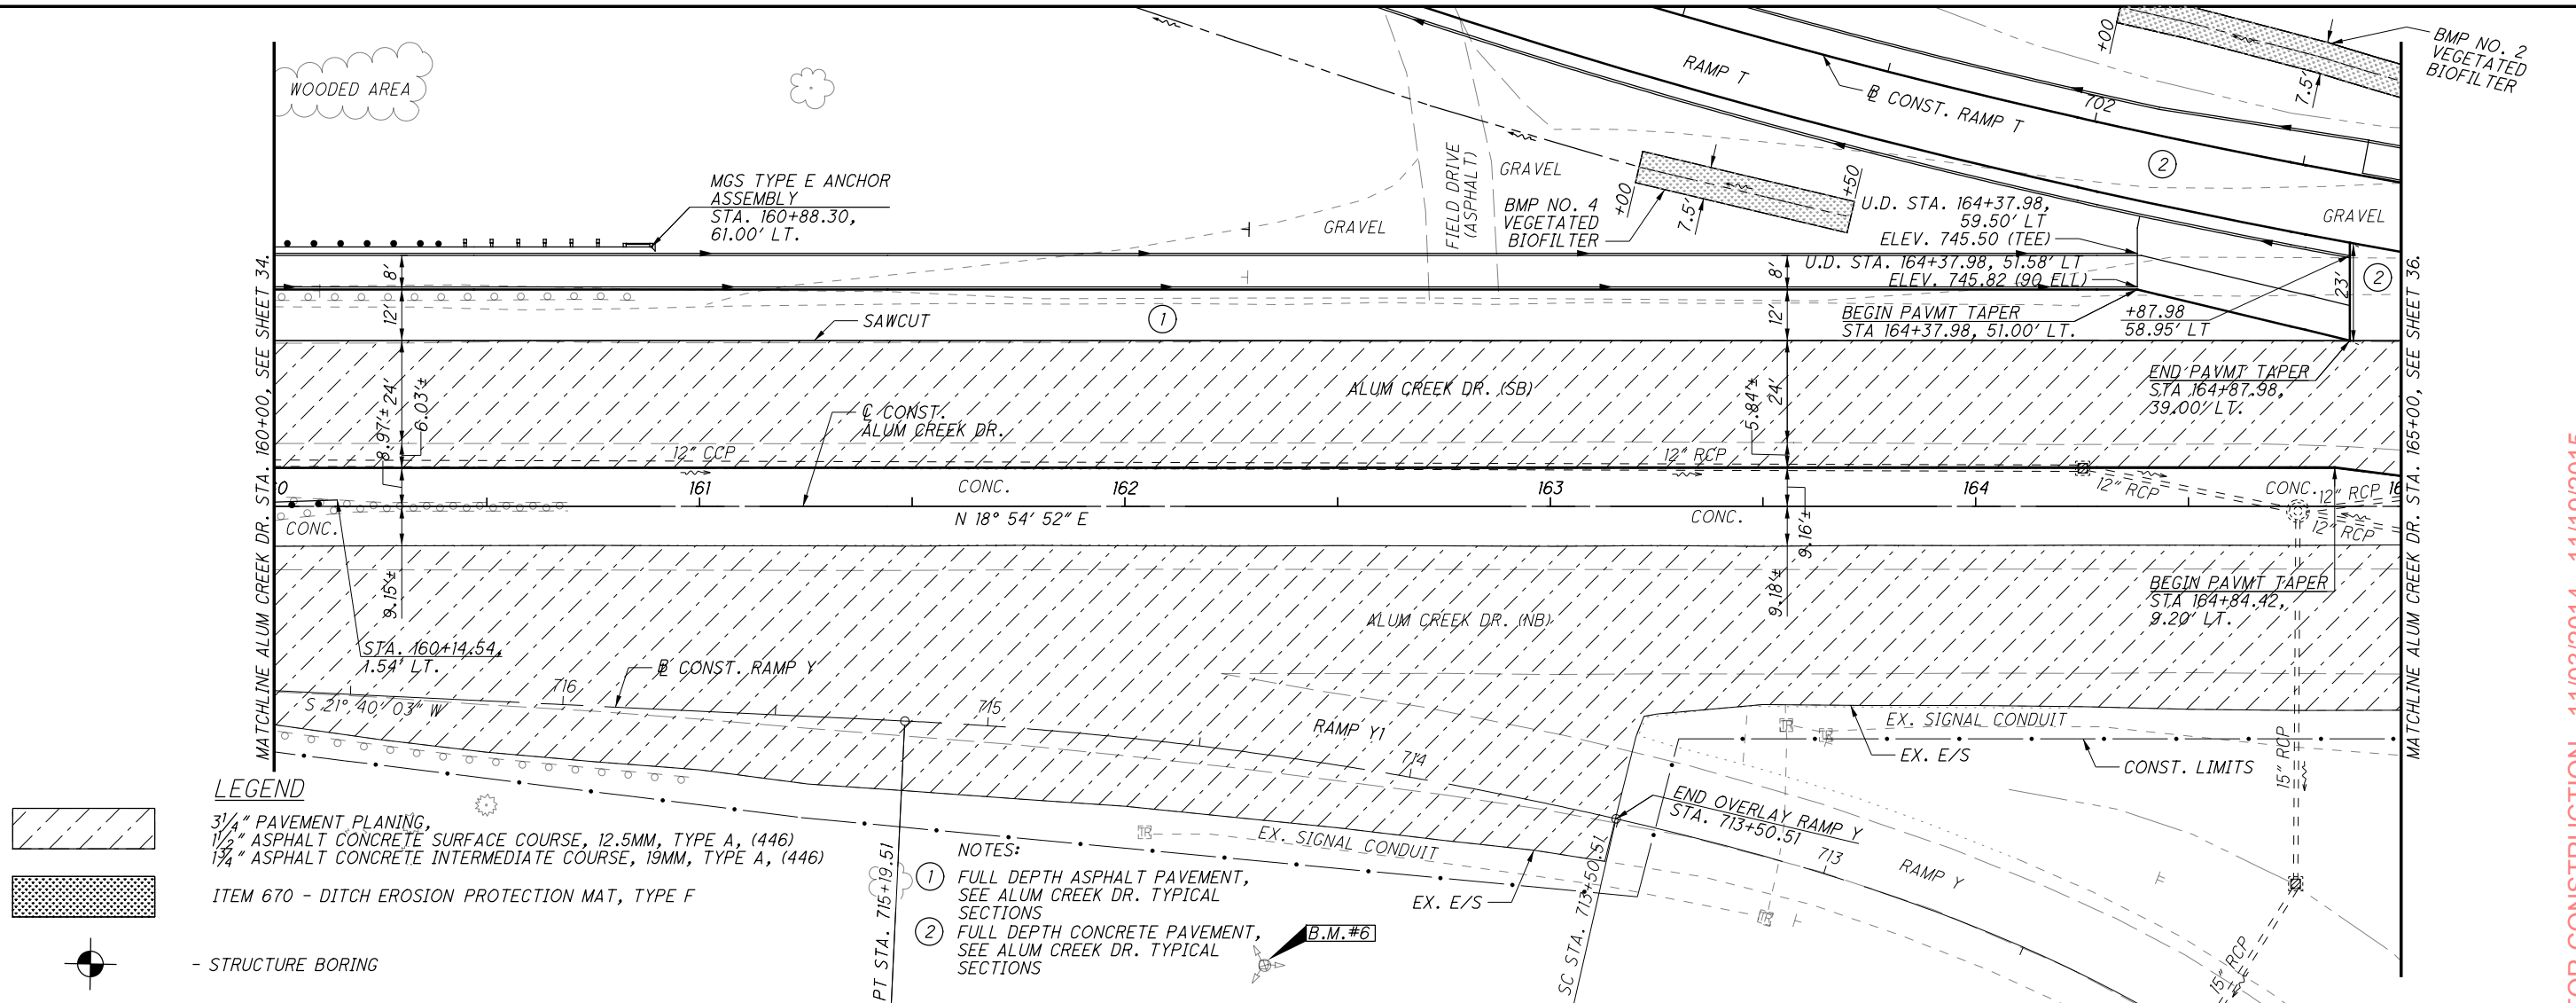

LEGEND

- 3 1/4" PAVEMENT PLANING, 1 1/2" ASPHALT CONCRETE SURFACE COURSE, 12.5MM, TYPE A, (446)
- 1 1/4" ASPHALT CONCRETE INTERMEDIATE COURSE, 19MM, TYPE A, (446)
- ITEM 670 - DITCH EROSION PROTECTION MAT, TYPE F
- STRUCTURE BORING

- NOTES:
- FULL DEPTH ASPHALT PAVEMENT, SEE ALUM CREEK DR. TYPICAL SECTIONS
 - FULL DEPTH CONCRETE PAVEMENT, SEE ALUM CREEK DR. TYPICAL SECTIONS

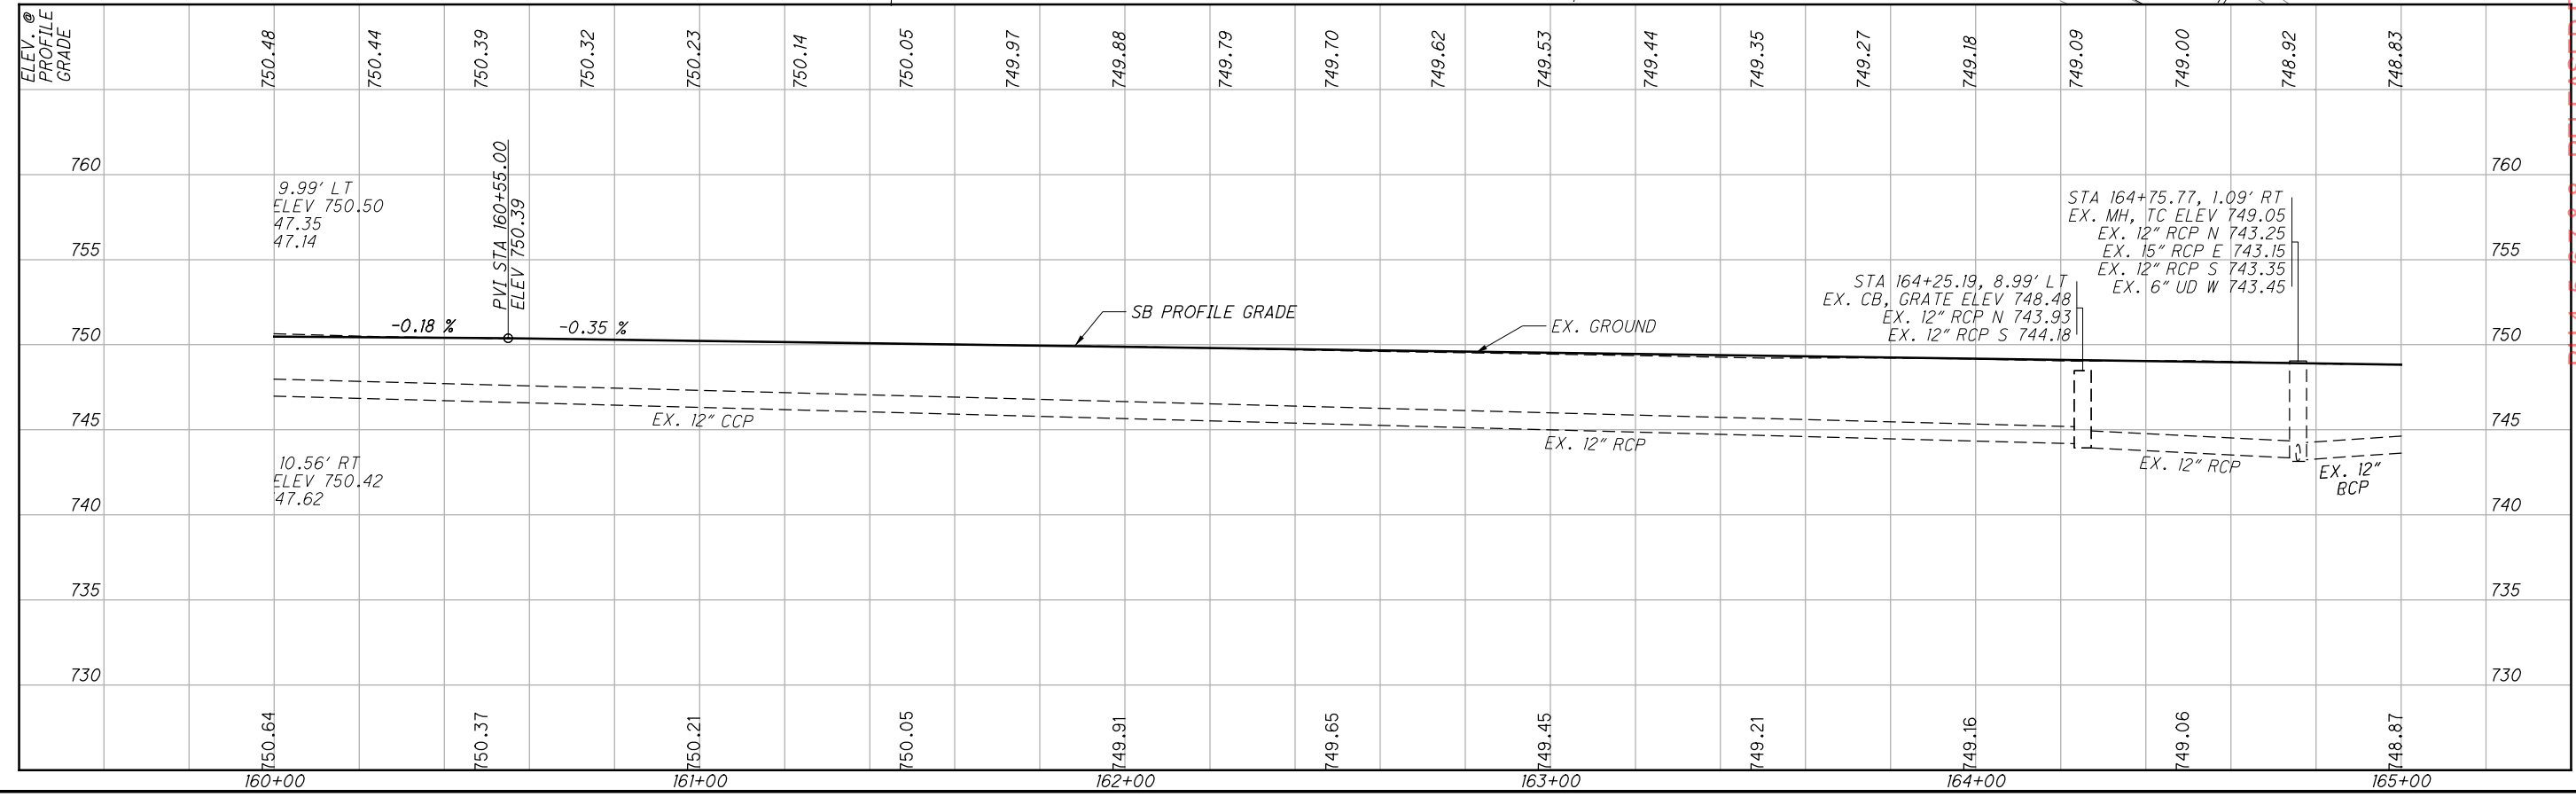

CALCULATED
CFR
CHECKED
SSK

PLAN AND PROFILE ALUM CREEK DR.
STA. 160+00 TO STA. 165+00



FRA - 270-49.00
35
182

BU 4, 5, 6, 7 & 8 - RELEASED FOR CONSTRUCTION - 11/03/2014 - 11/19/2015

AS BUILT - 4/22/2016

5/23/2016 7:30:50 AM kevinj

G:\projects\2014\W-14-039_FRA-270-49.00\83988\roadway\sheets\83988GF004_Rev.dgn

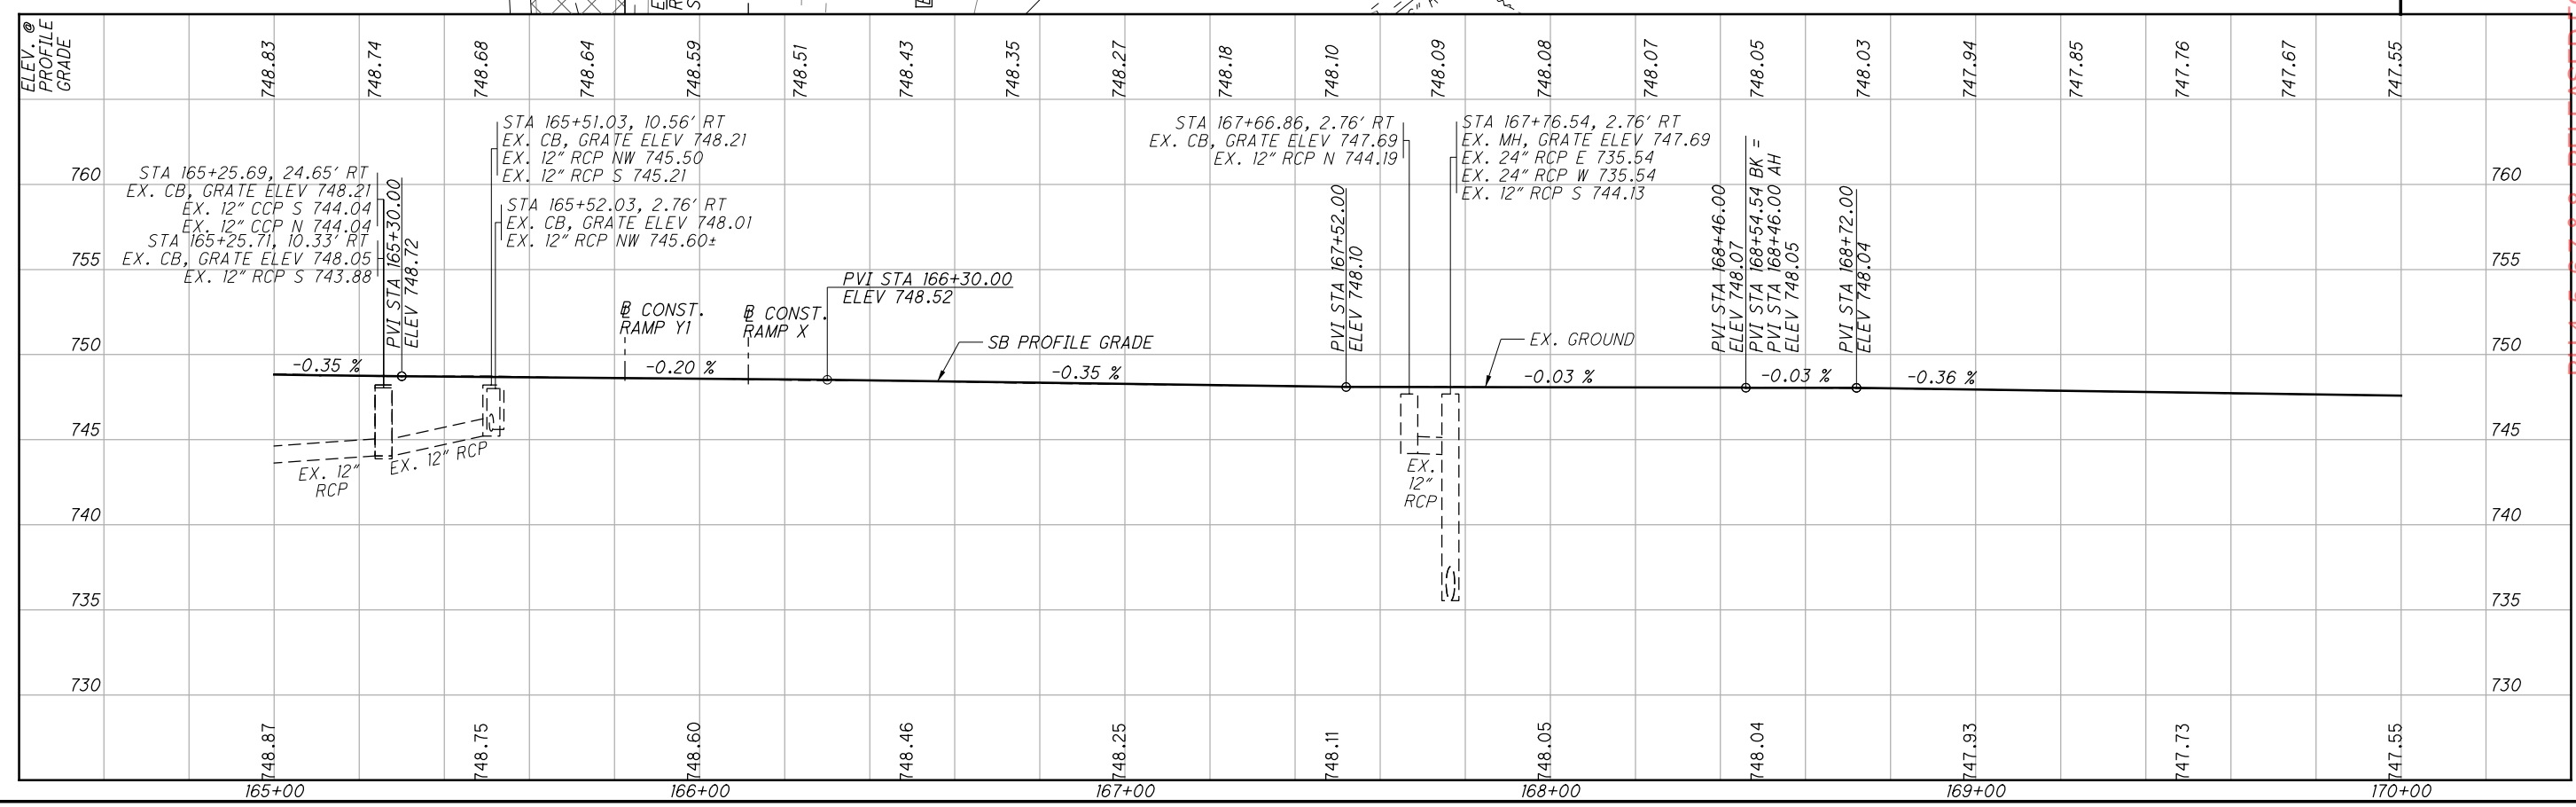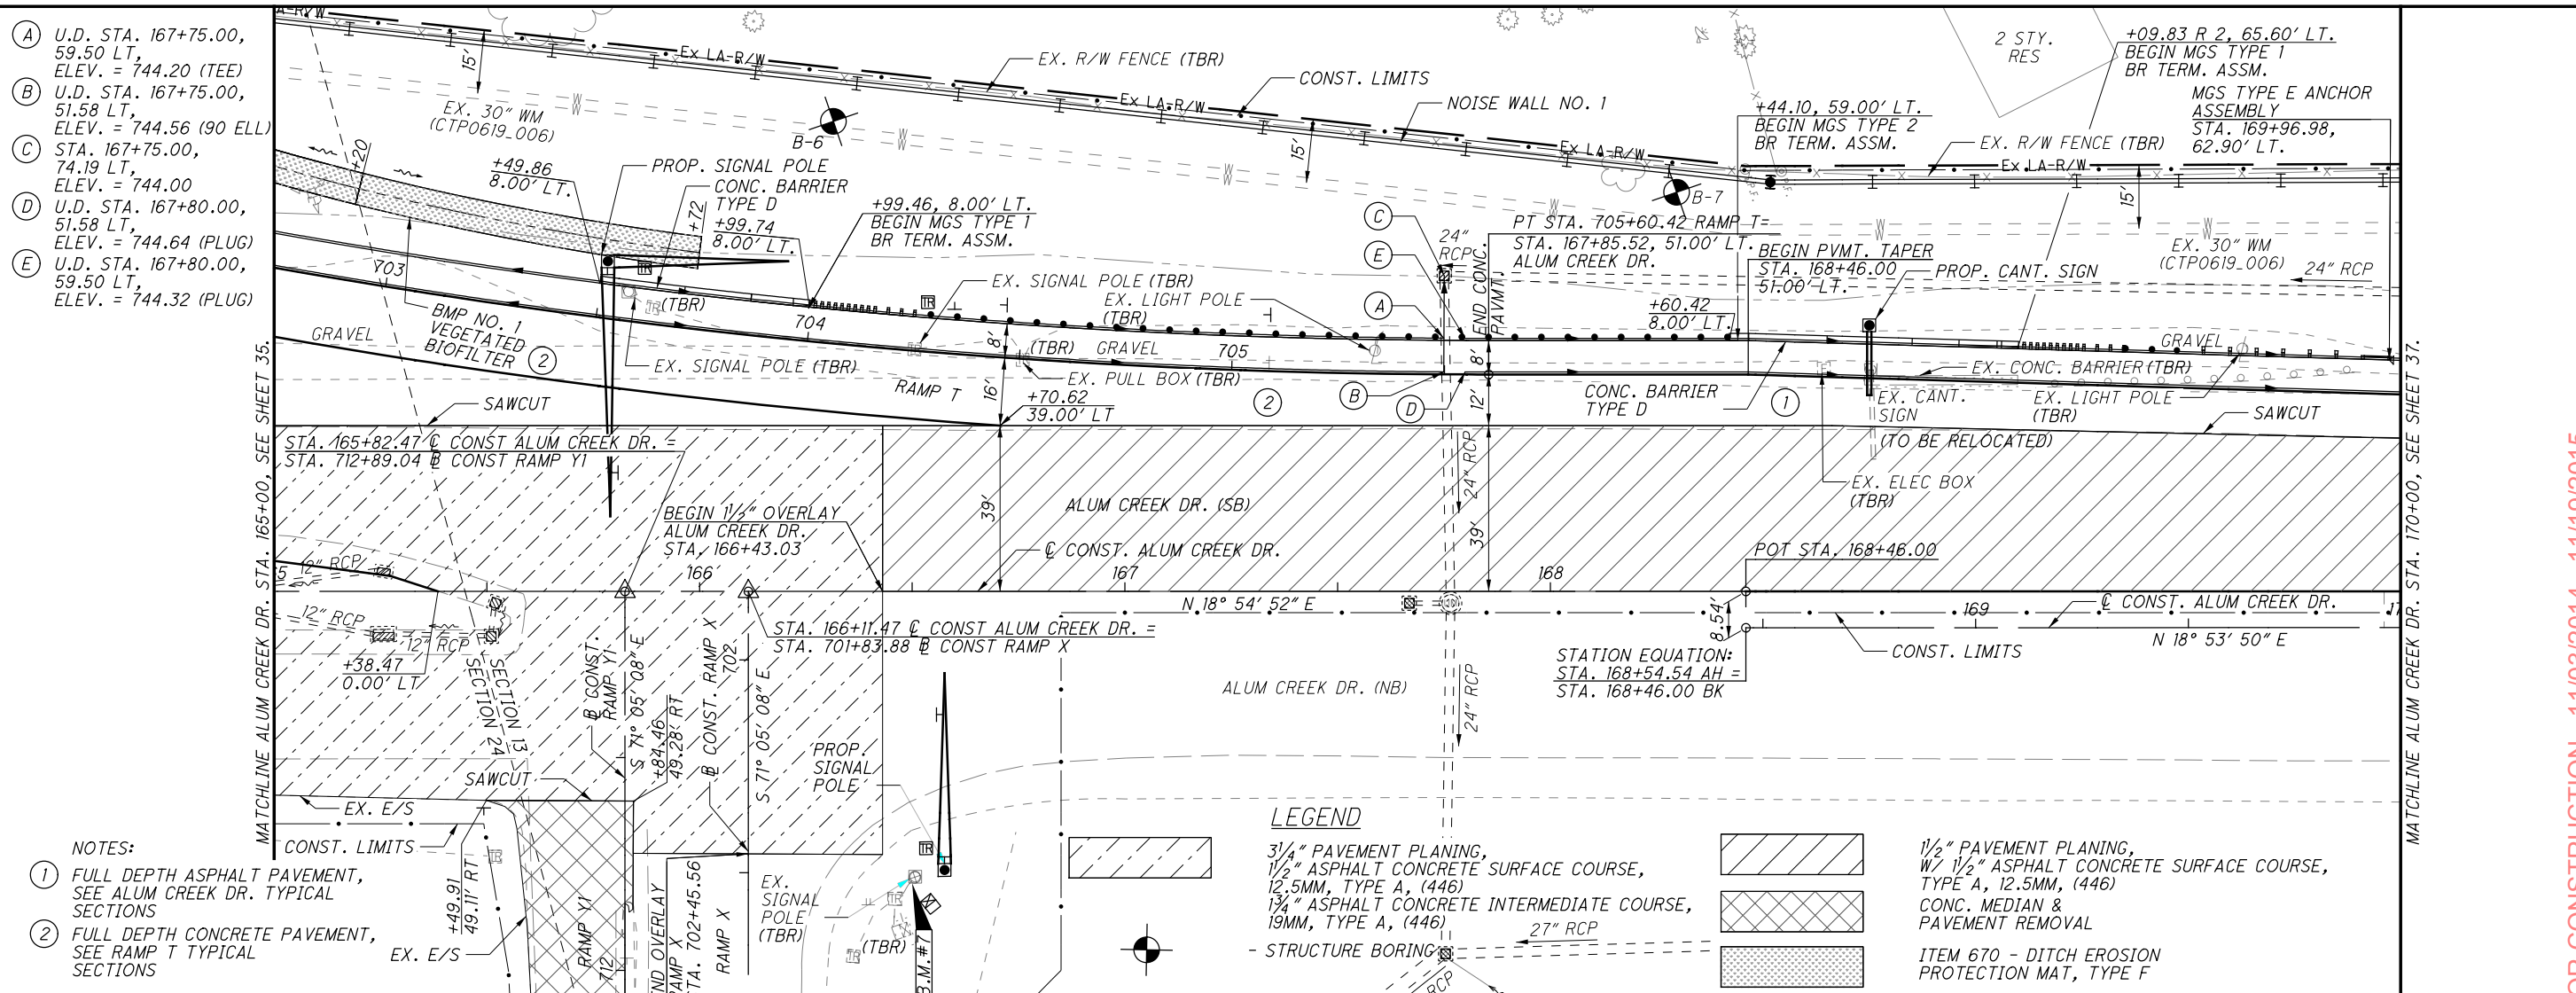

RELEASED FOR CONSTRUCTION - 11/03/2014 - 11/19/2015

PLAN AND PROFILE ALUM CREEK DR.
STA. 165+00 TO STA. 170+00


FRA - 270 - 49.00

36
182


AS BUILT - 4/22/2016

6/8/2016 12:19:55 PM colnr

G:\projects\2014\W-14-039_FRA-270-49.00\83988\roadway\sheets\83988FP005_Rev.dgn

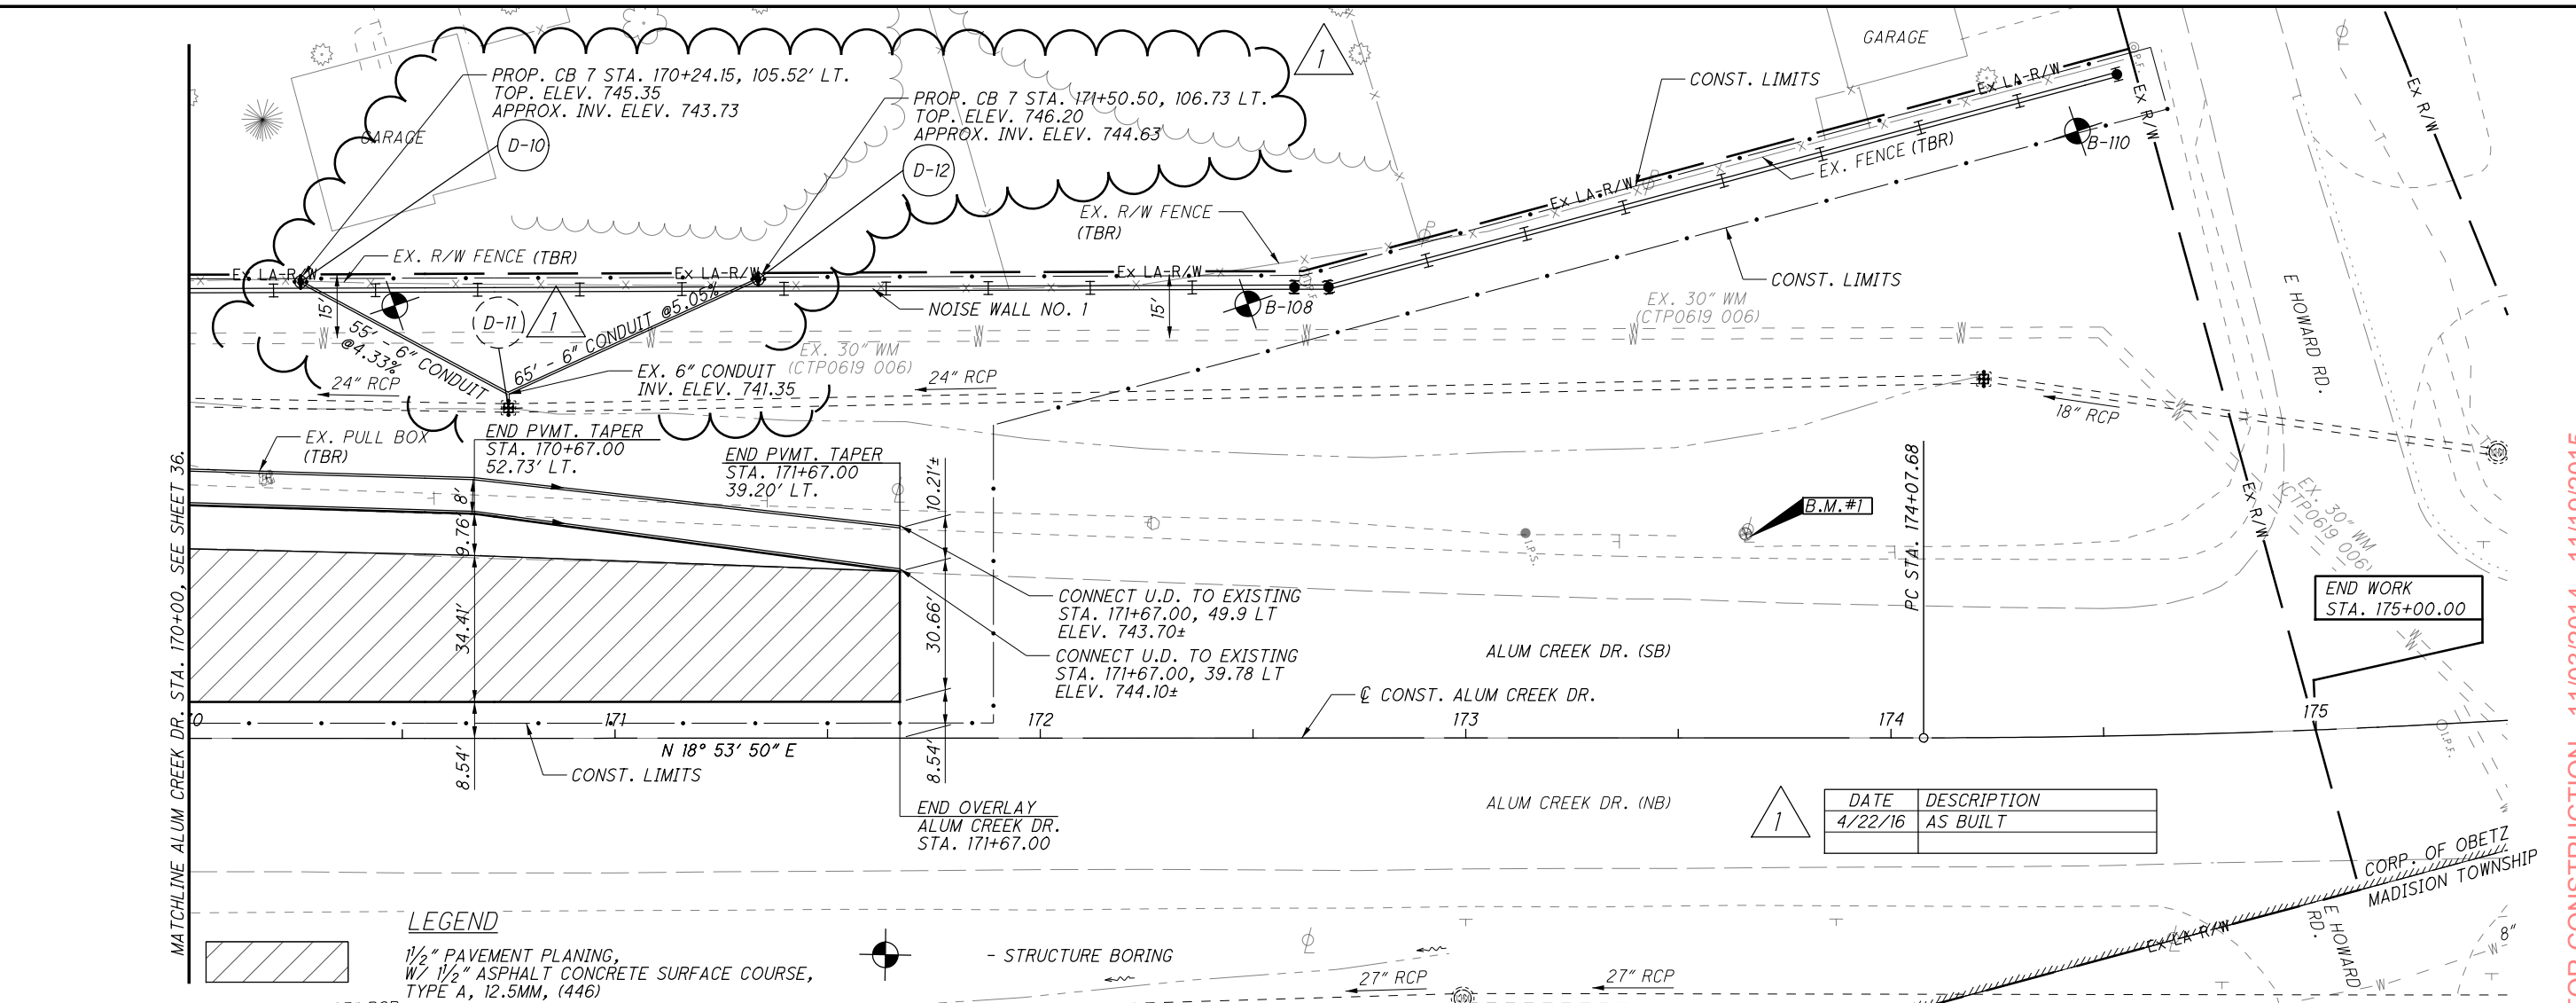

LEGEND
 1/2" PAVEMENT PLANING,
 W/ 1/2" ASPHALT CONCRETE SURFACE COURSE,
 TYPE A, 12.5MM, (446)

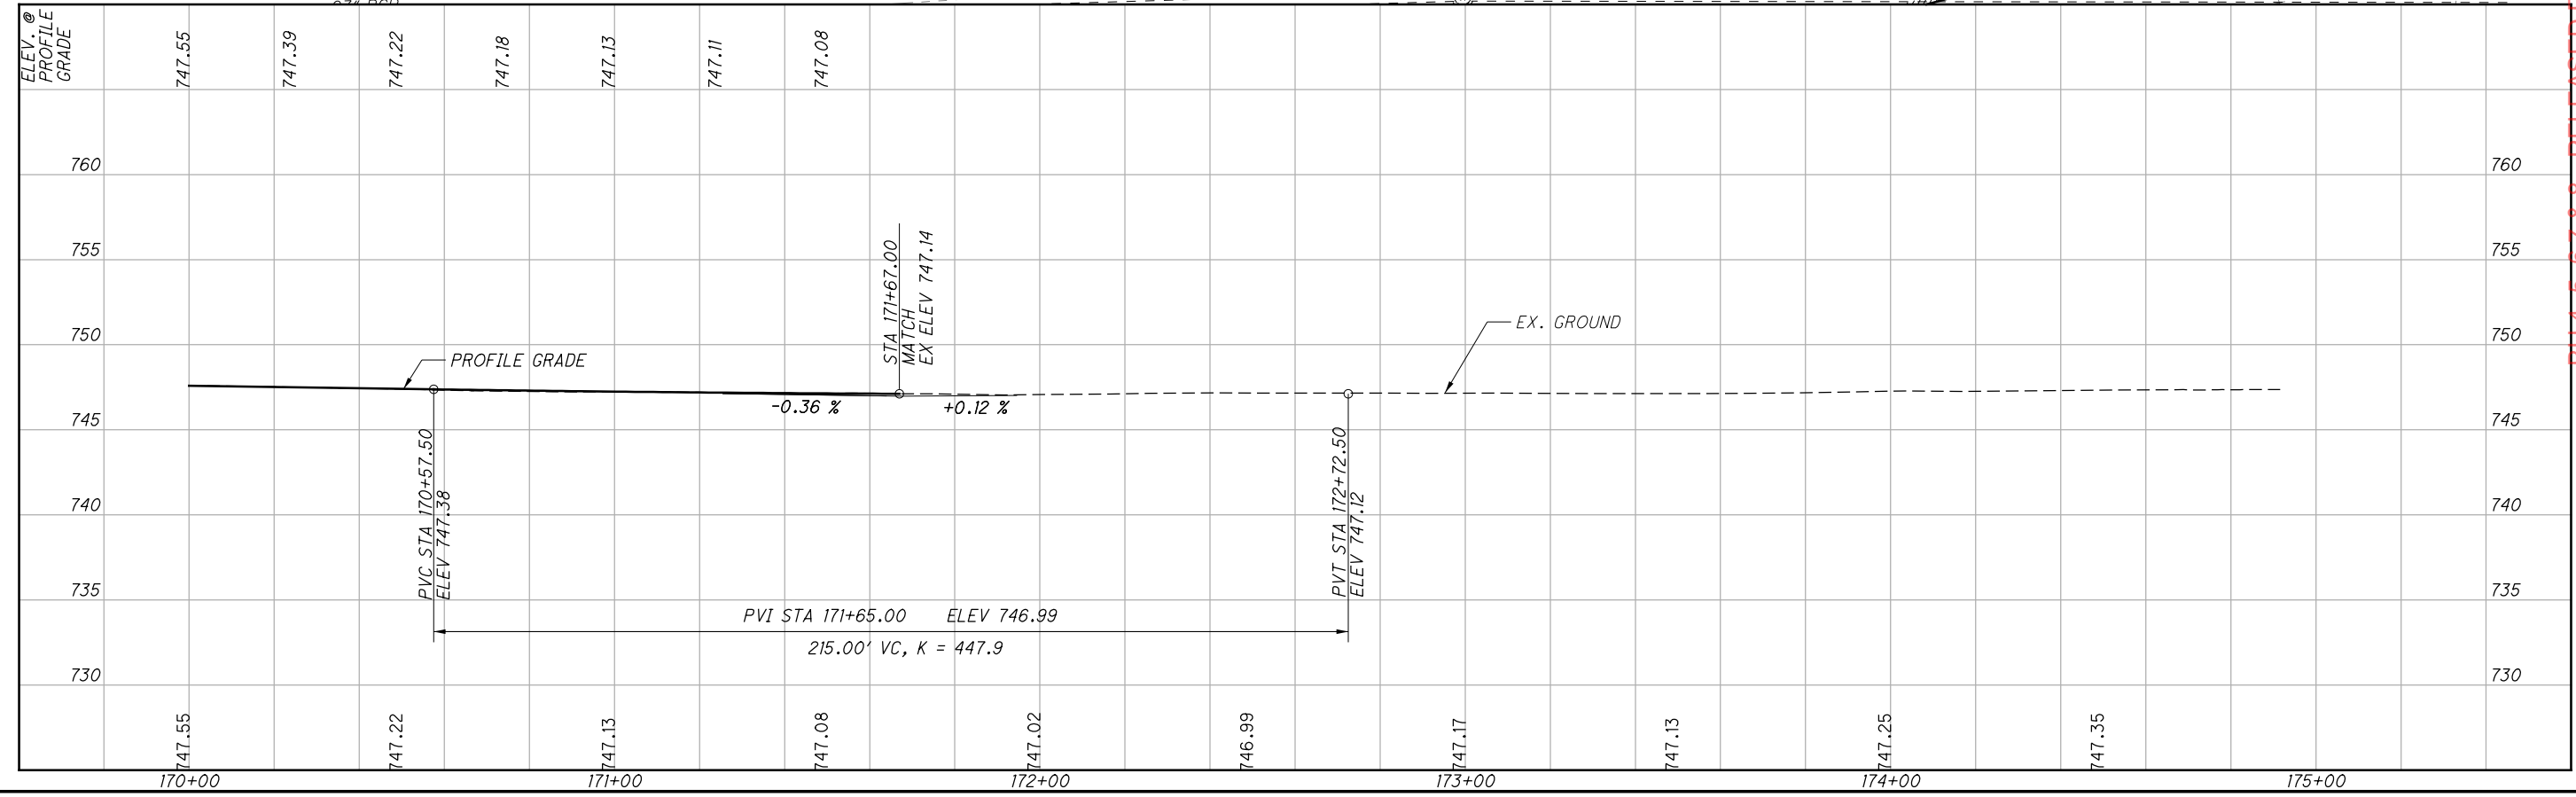

CALCULATED
 CFR
 CHECKED
 SSK


PLAN AND PROFILE ALUM CREEK DR.
 STA. 170+00 TO STA. 175+00

FRA - 270-49.00
 37
 182

BU 4, 5, 6, 7, & 8 - RELEASED FOR CONSTRUCTION - 11/03/2014 - 11/19/2015

AS BUILT - 4/22/2016

C:\projects\2014\W-14-039_FRA-270-49.00\83988\roadway\sheets\83988X5007.dgn 5/23/2016 7:30:52 AM kevinj

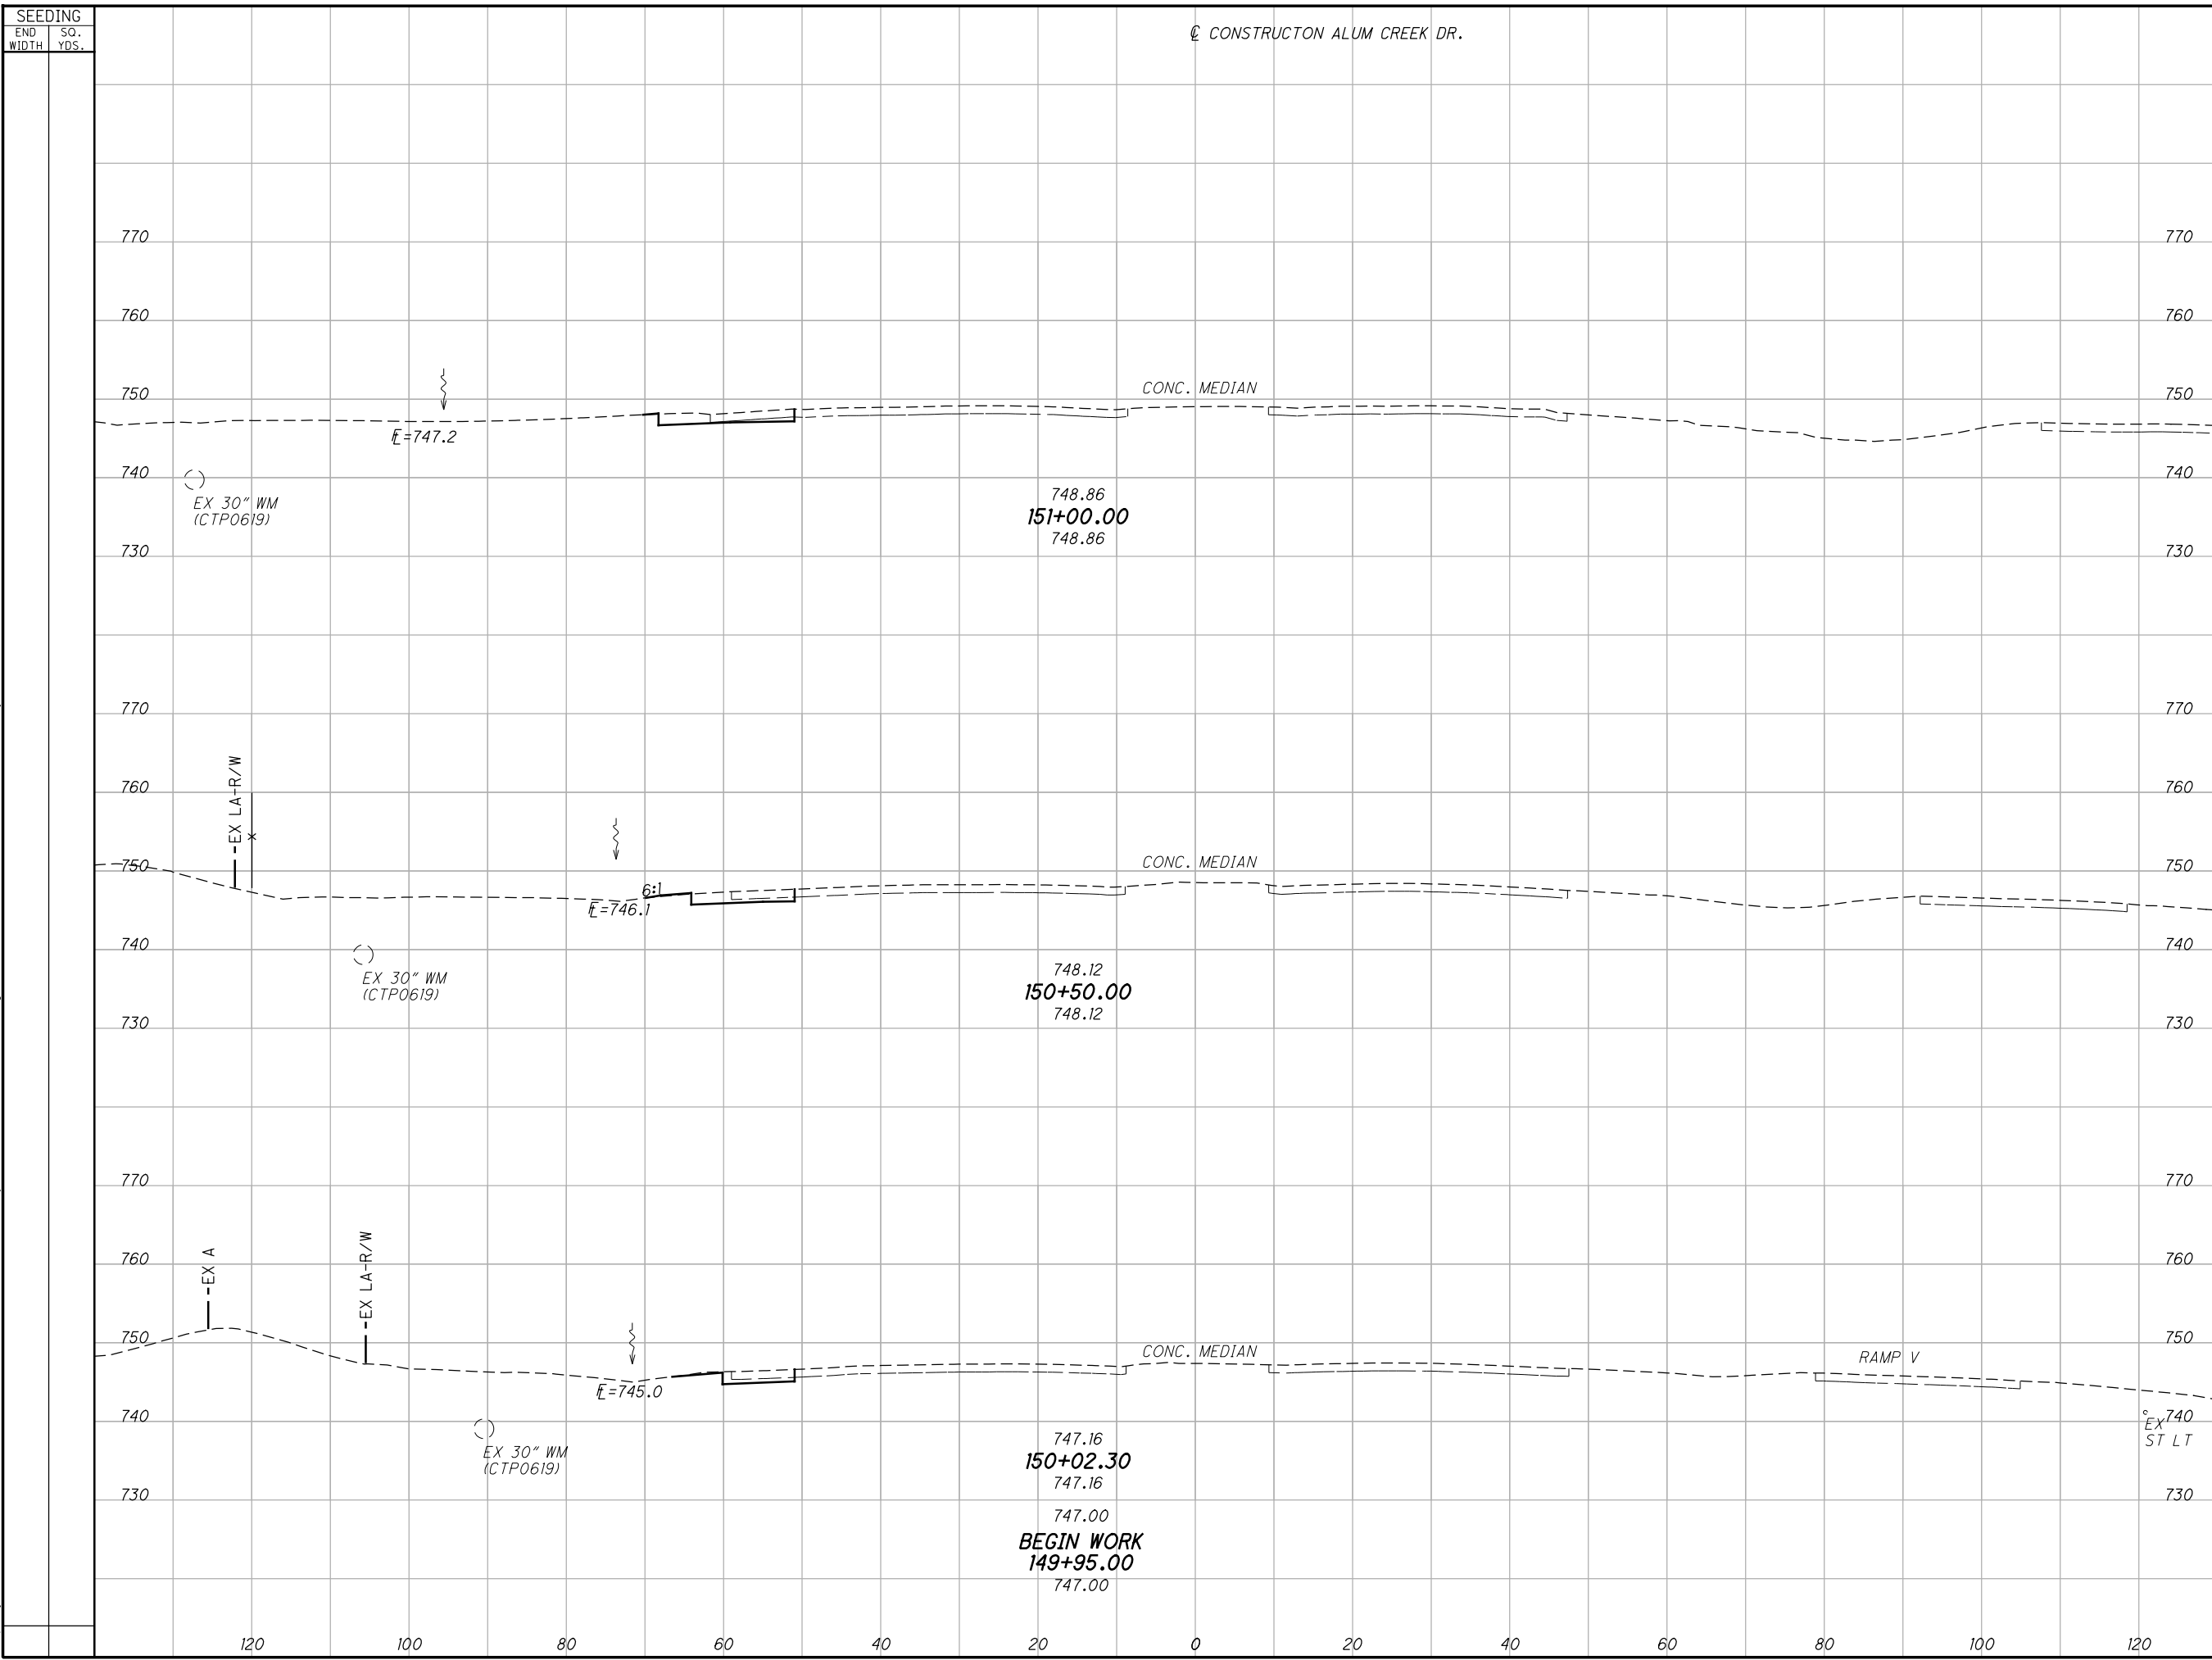

SEEDING		END AREA		VOLUME		CALCULATED	
END WIDTH	SO. YDS.	CUT	FILL	CUT	FILL	CFR	SSK

BU 4, 5, 6, 7, & 8 - RELEASED FOR CONSTRUCTION - 11/03/2014 - 11/19/2015

CROSS SECTIONS ALUM CREEK DR.
STA. 150+02.30 TO STA. 151+00.00

FRA - 270 - 49.00


38
182

CONSTRUCTON ALUM CREEK DR.

AS BUILT - 4/22/2016

C:\projects\2014\W-14-039_FRA-270-49.00\83988\roadway\sheets\83988X5007.dgn 5/23/2016 7:30:52 AM kevinj

SEEDING	
END WIDTH	SO. YDS.

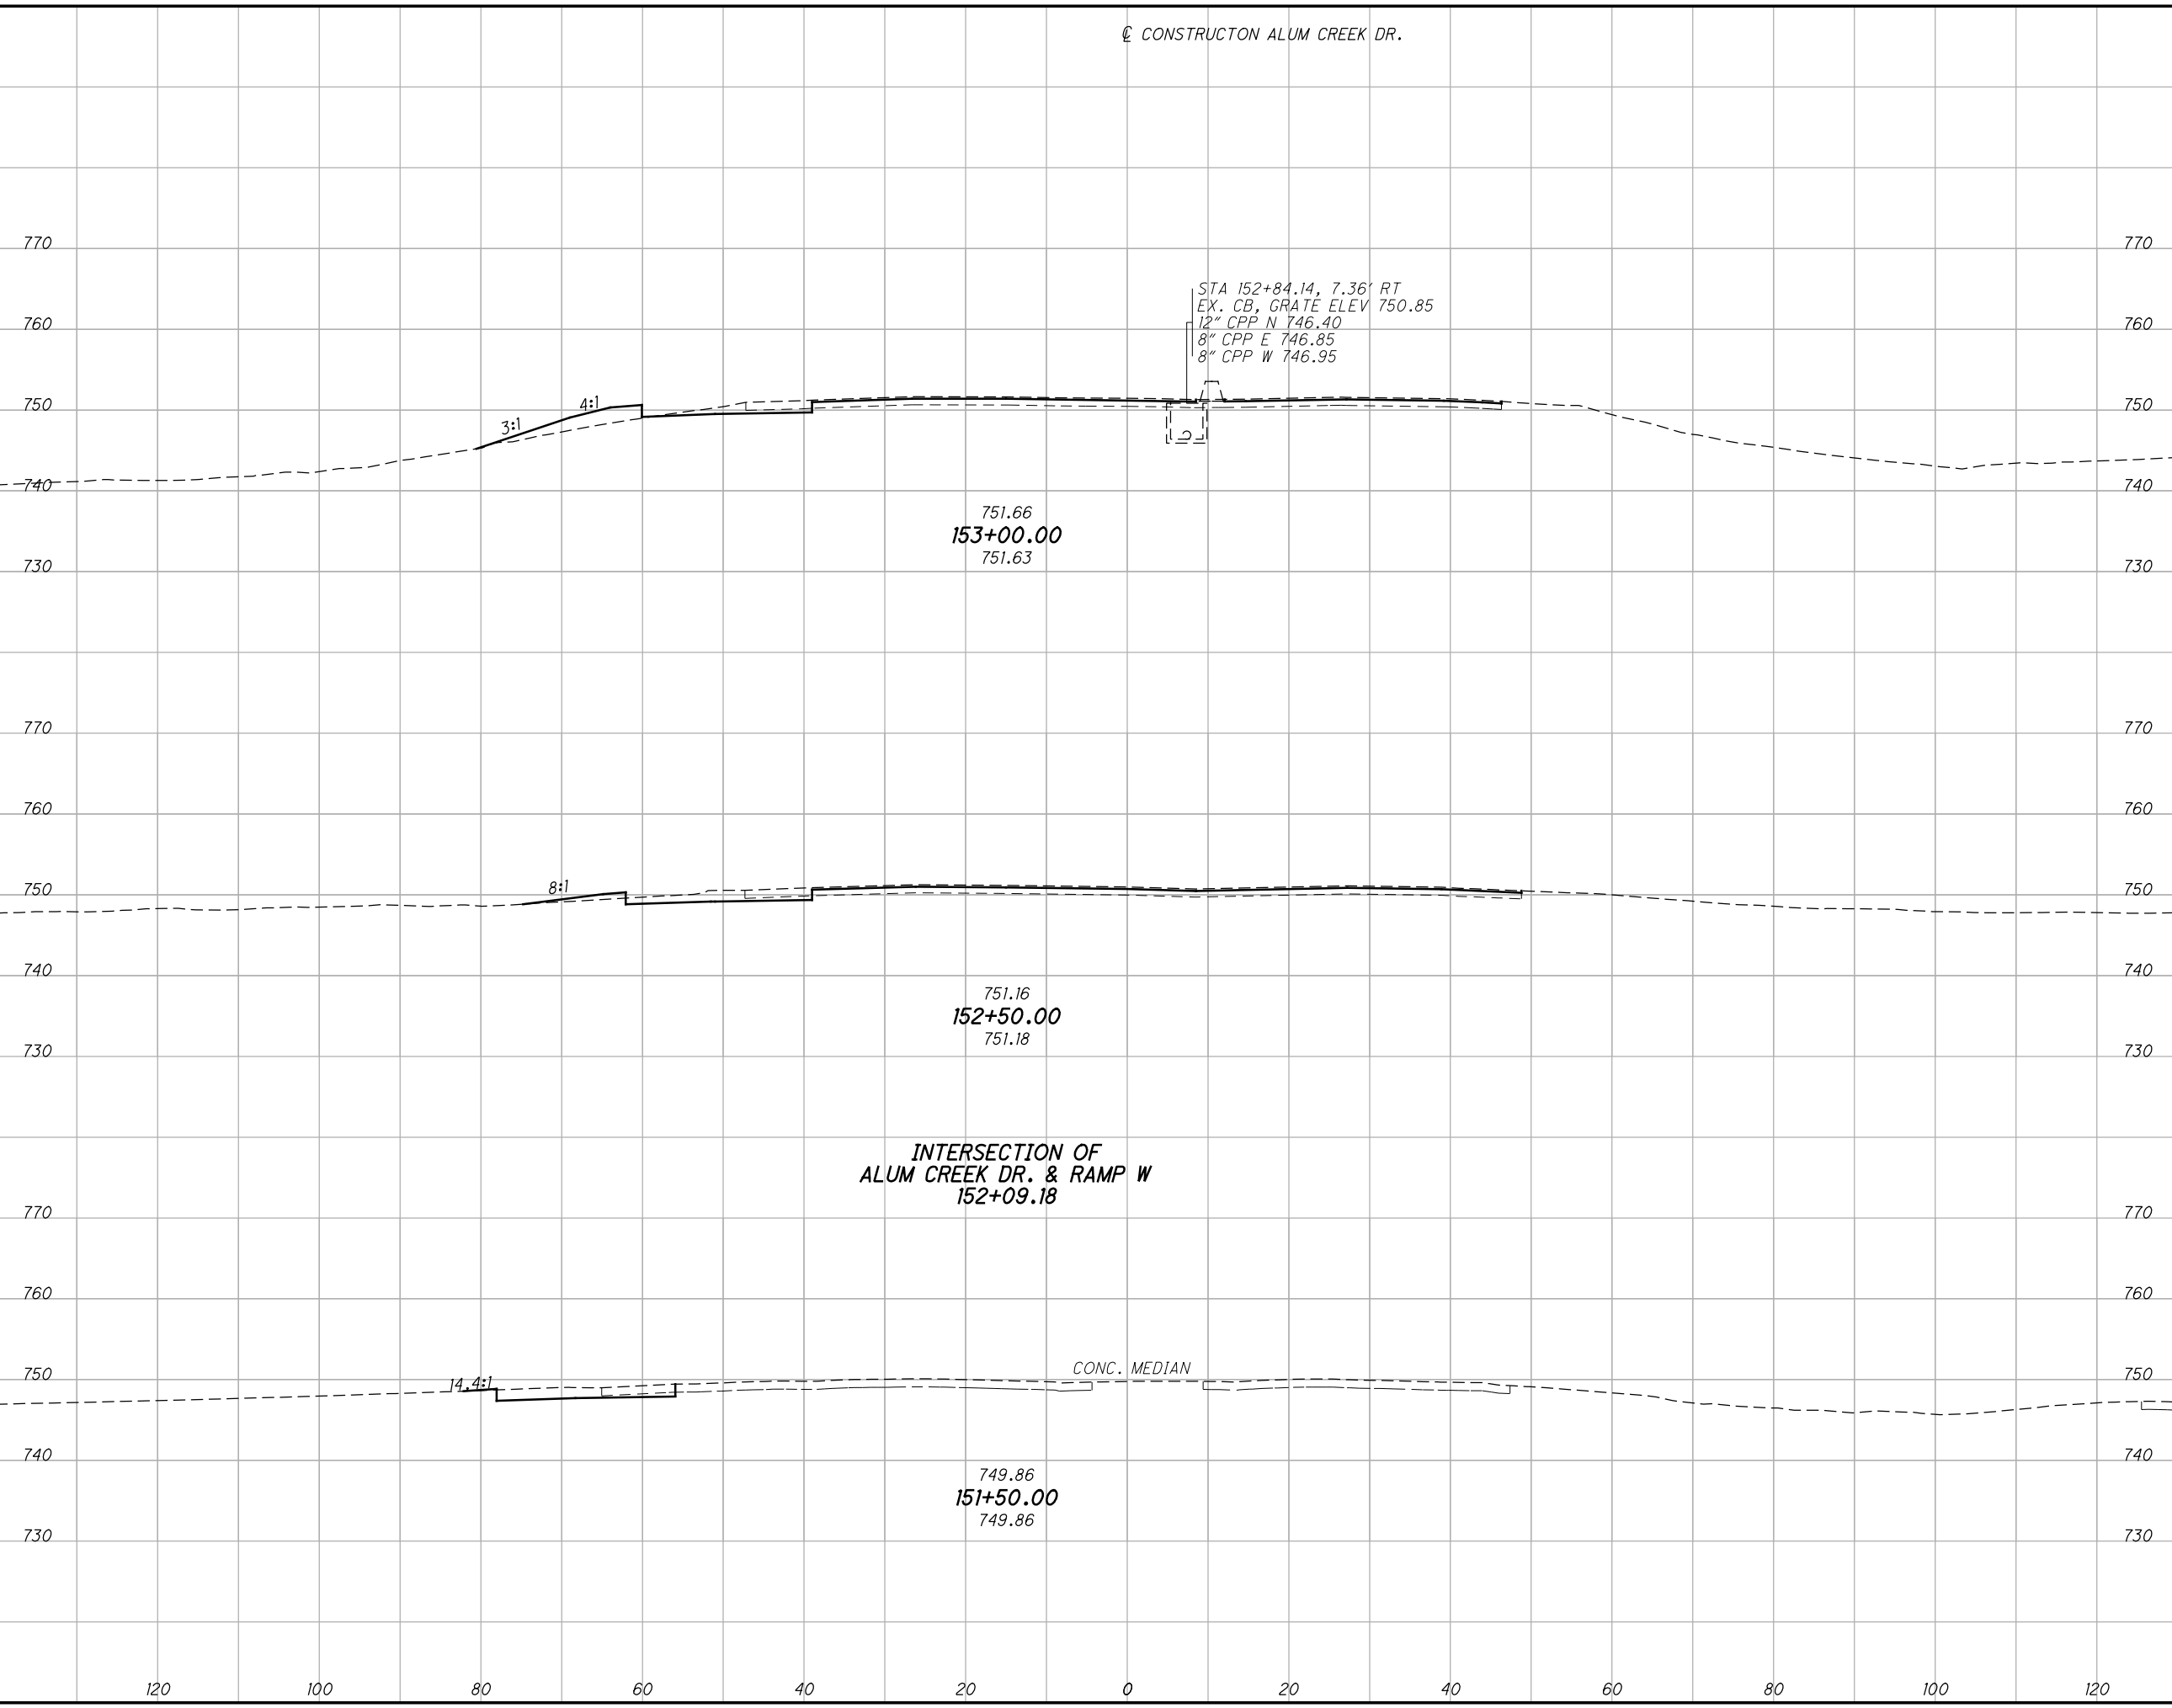

END AREA		VOLUME		CALCULATED	CFR	CHECKED	SSK
CUT	FILL	CUT	FILL				

BU 4, 5, 6, 7, & 8 - RELEASED FOR CONSTRUCTION - 11/03/2014 - 11/19/2015


**CROSS SECTIONS ALUM CREEK DR.
STA. 151+50.00 TO STA. 153+00.00**

FRA - 270 - 49.00

AS BUILT - 4/22/2016

C:\projects\2014\W-14-039 FRA-270-49.00\83988\roadway\sheets\83988X5007.dgn 5/23/2016 7:30:53 AM kevinj

SEEDING	
END WIDTH	SO. YDS.

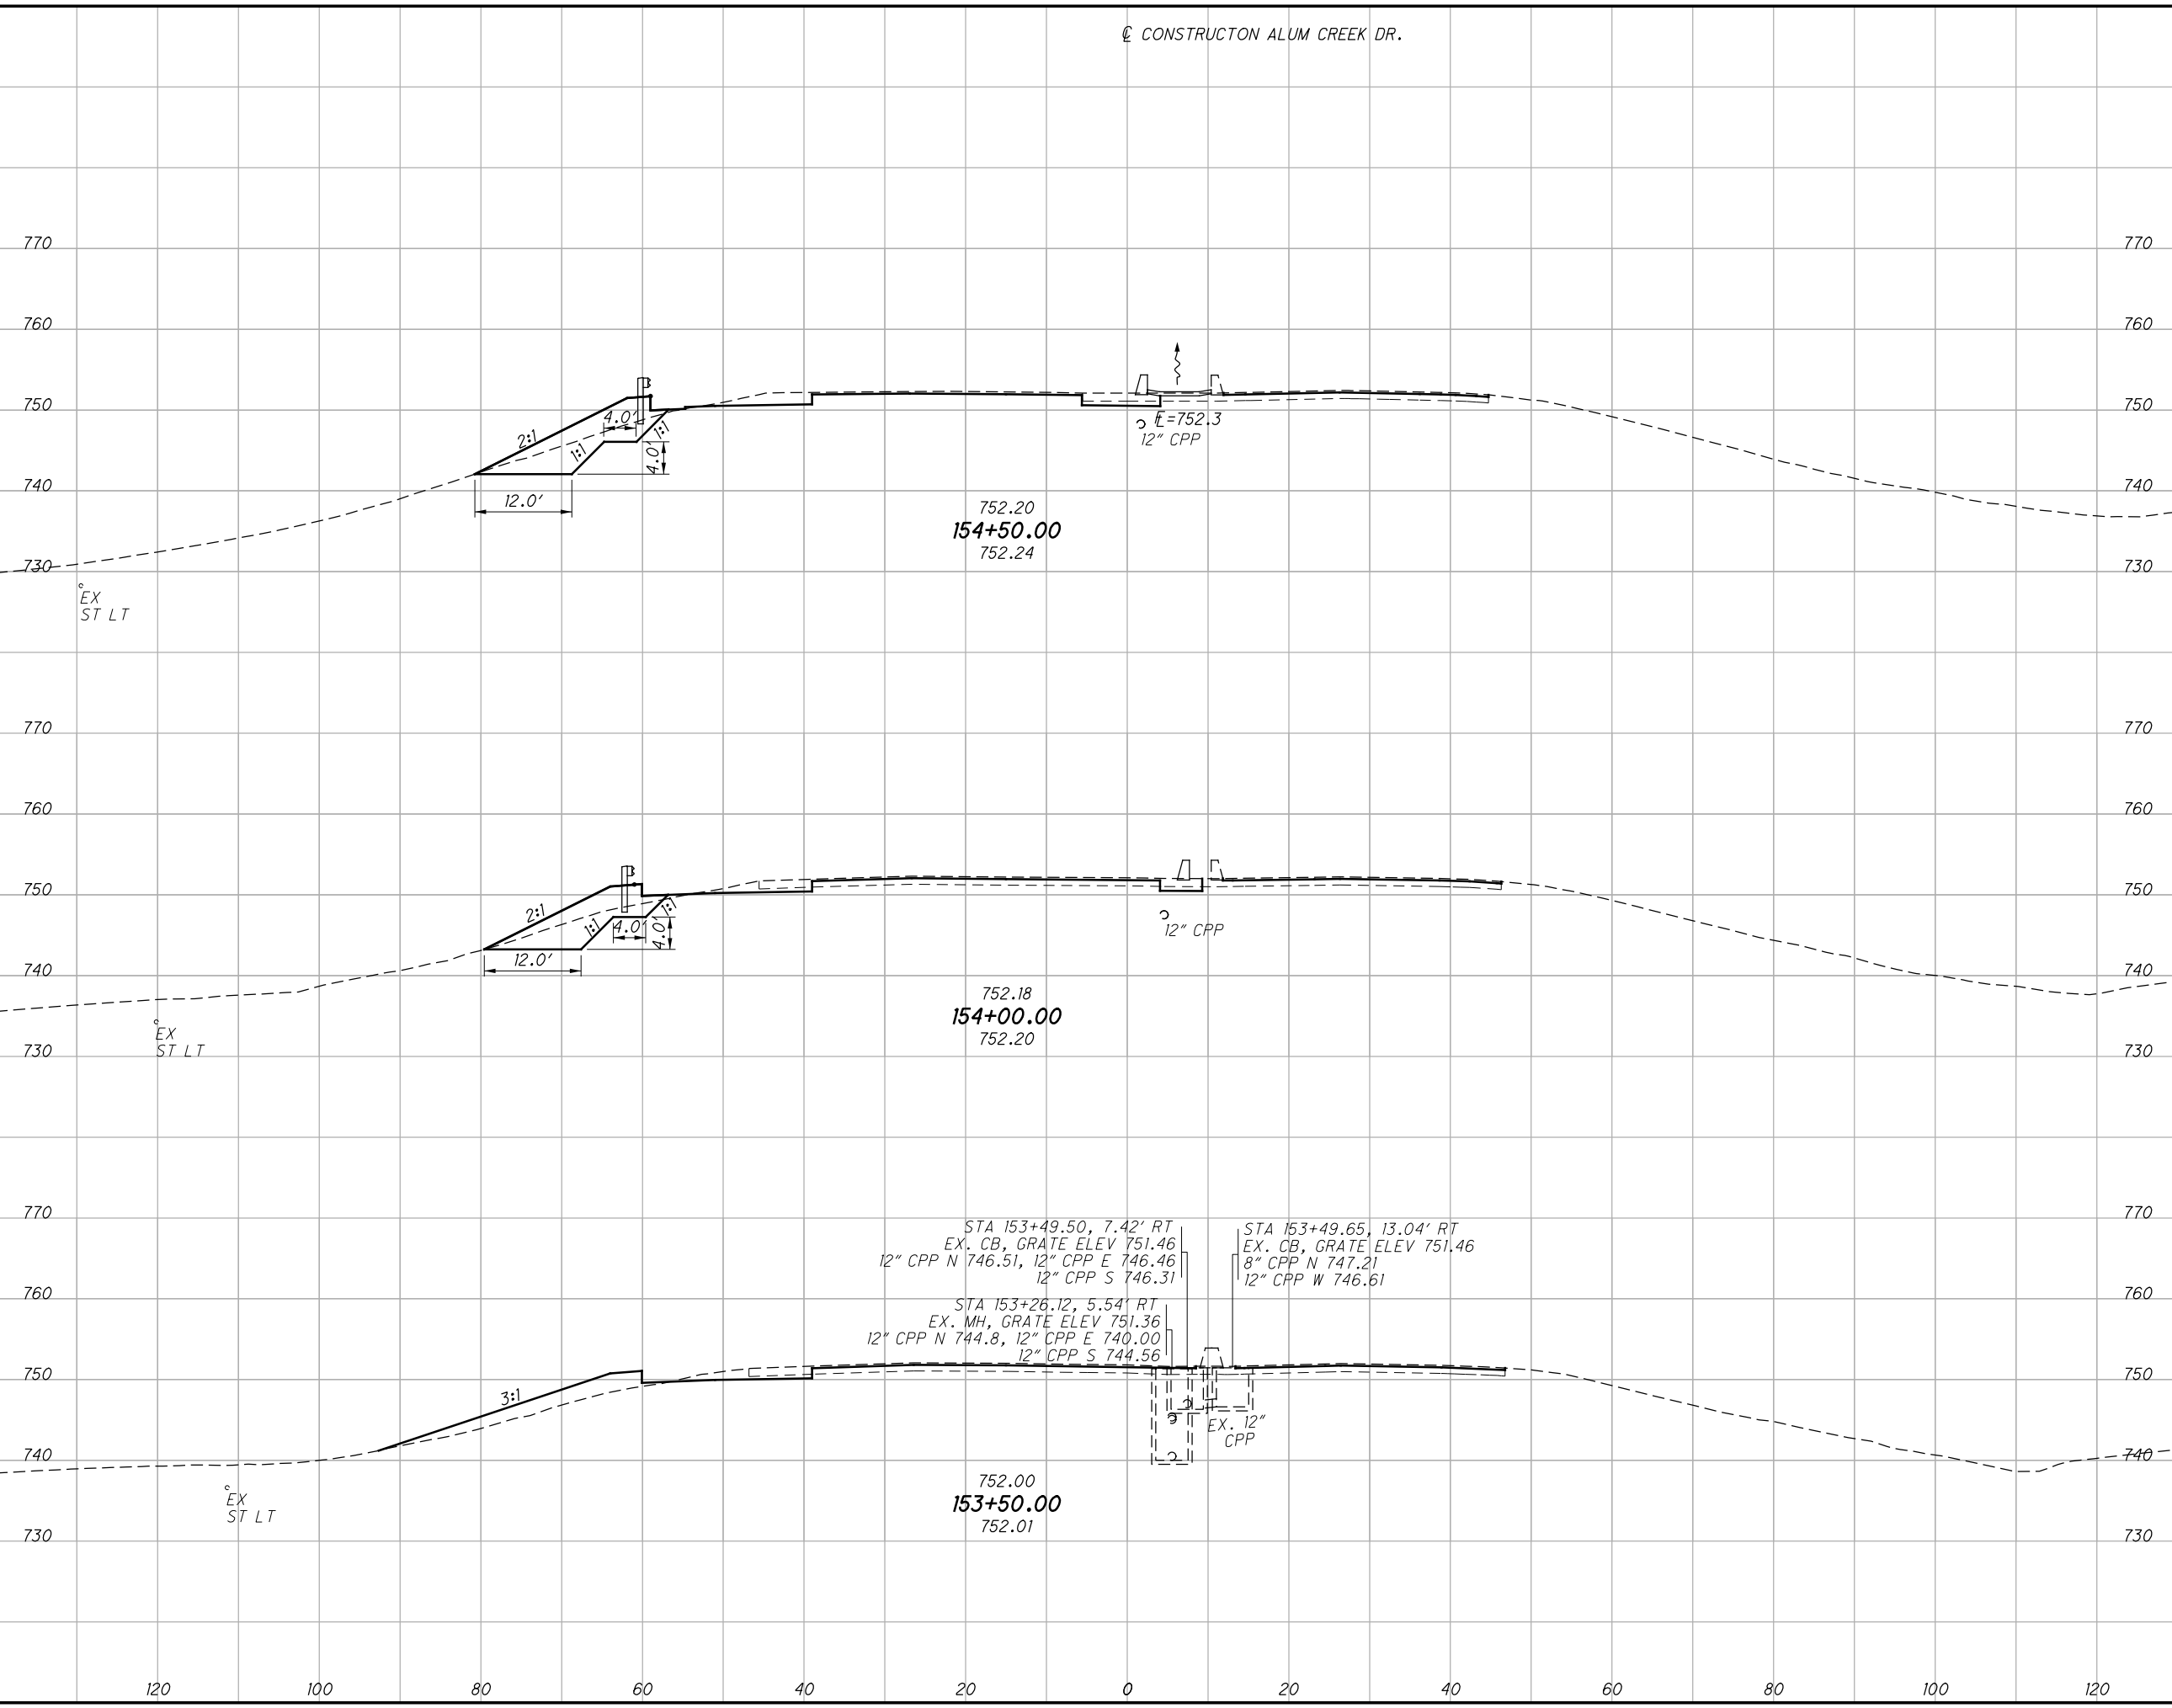

END AREA		VOLUME		CALCULATED	CFR	CHECKED	SSK
CUT	FILL	CUT	FILL				

BU 4, 5, 6, 7, & 8 - RELEASED FOR CONSTRUCTION - 11/03/2014 - 11/19/2015

CROSS SECTIONS ALUM CREEK DR.
STA. 153+50.00 TO STA. 154+50.00


FRA - 270-49.00

40
182

AS BUILT - 4/22/2016

G:\projects\2014\W-14-039 FRA-270-49.00\83988\roadway\sheets\83988X5007.dgn 5/23/2016 7:30:53 AM kevinj

SEEDING	
END WIDTH	SO. YDS.

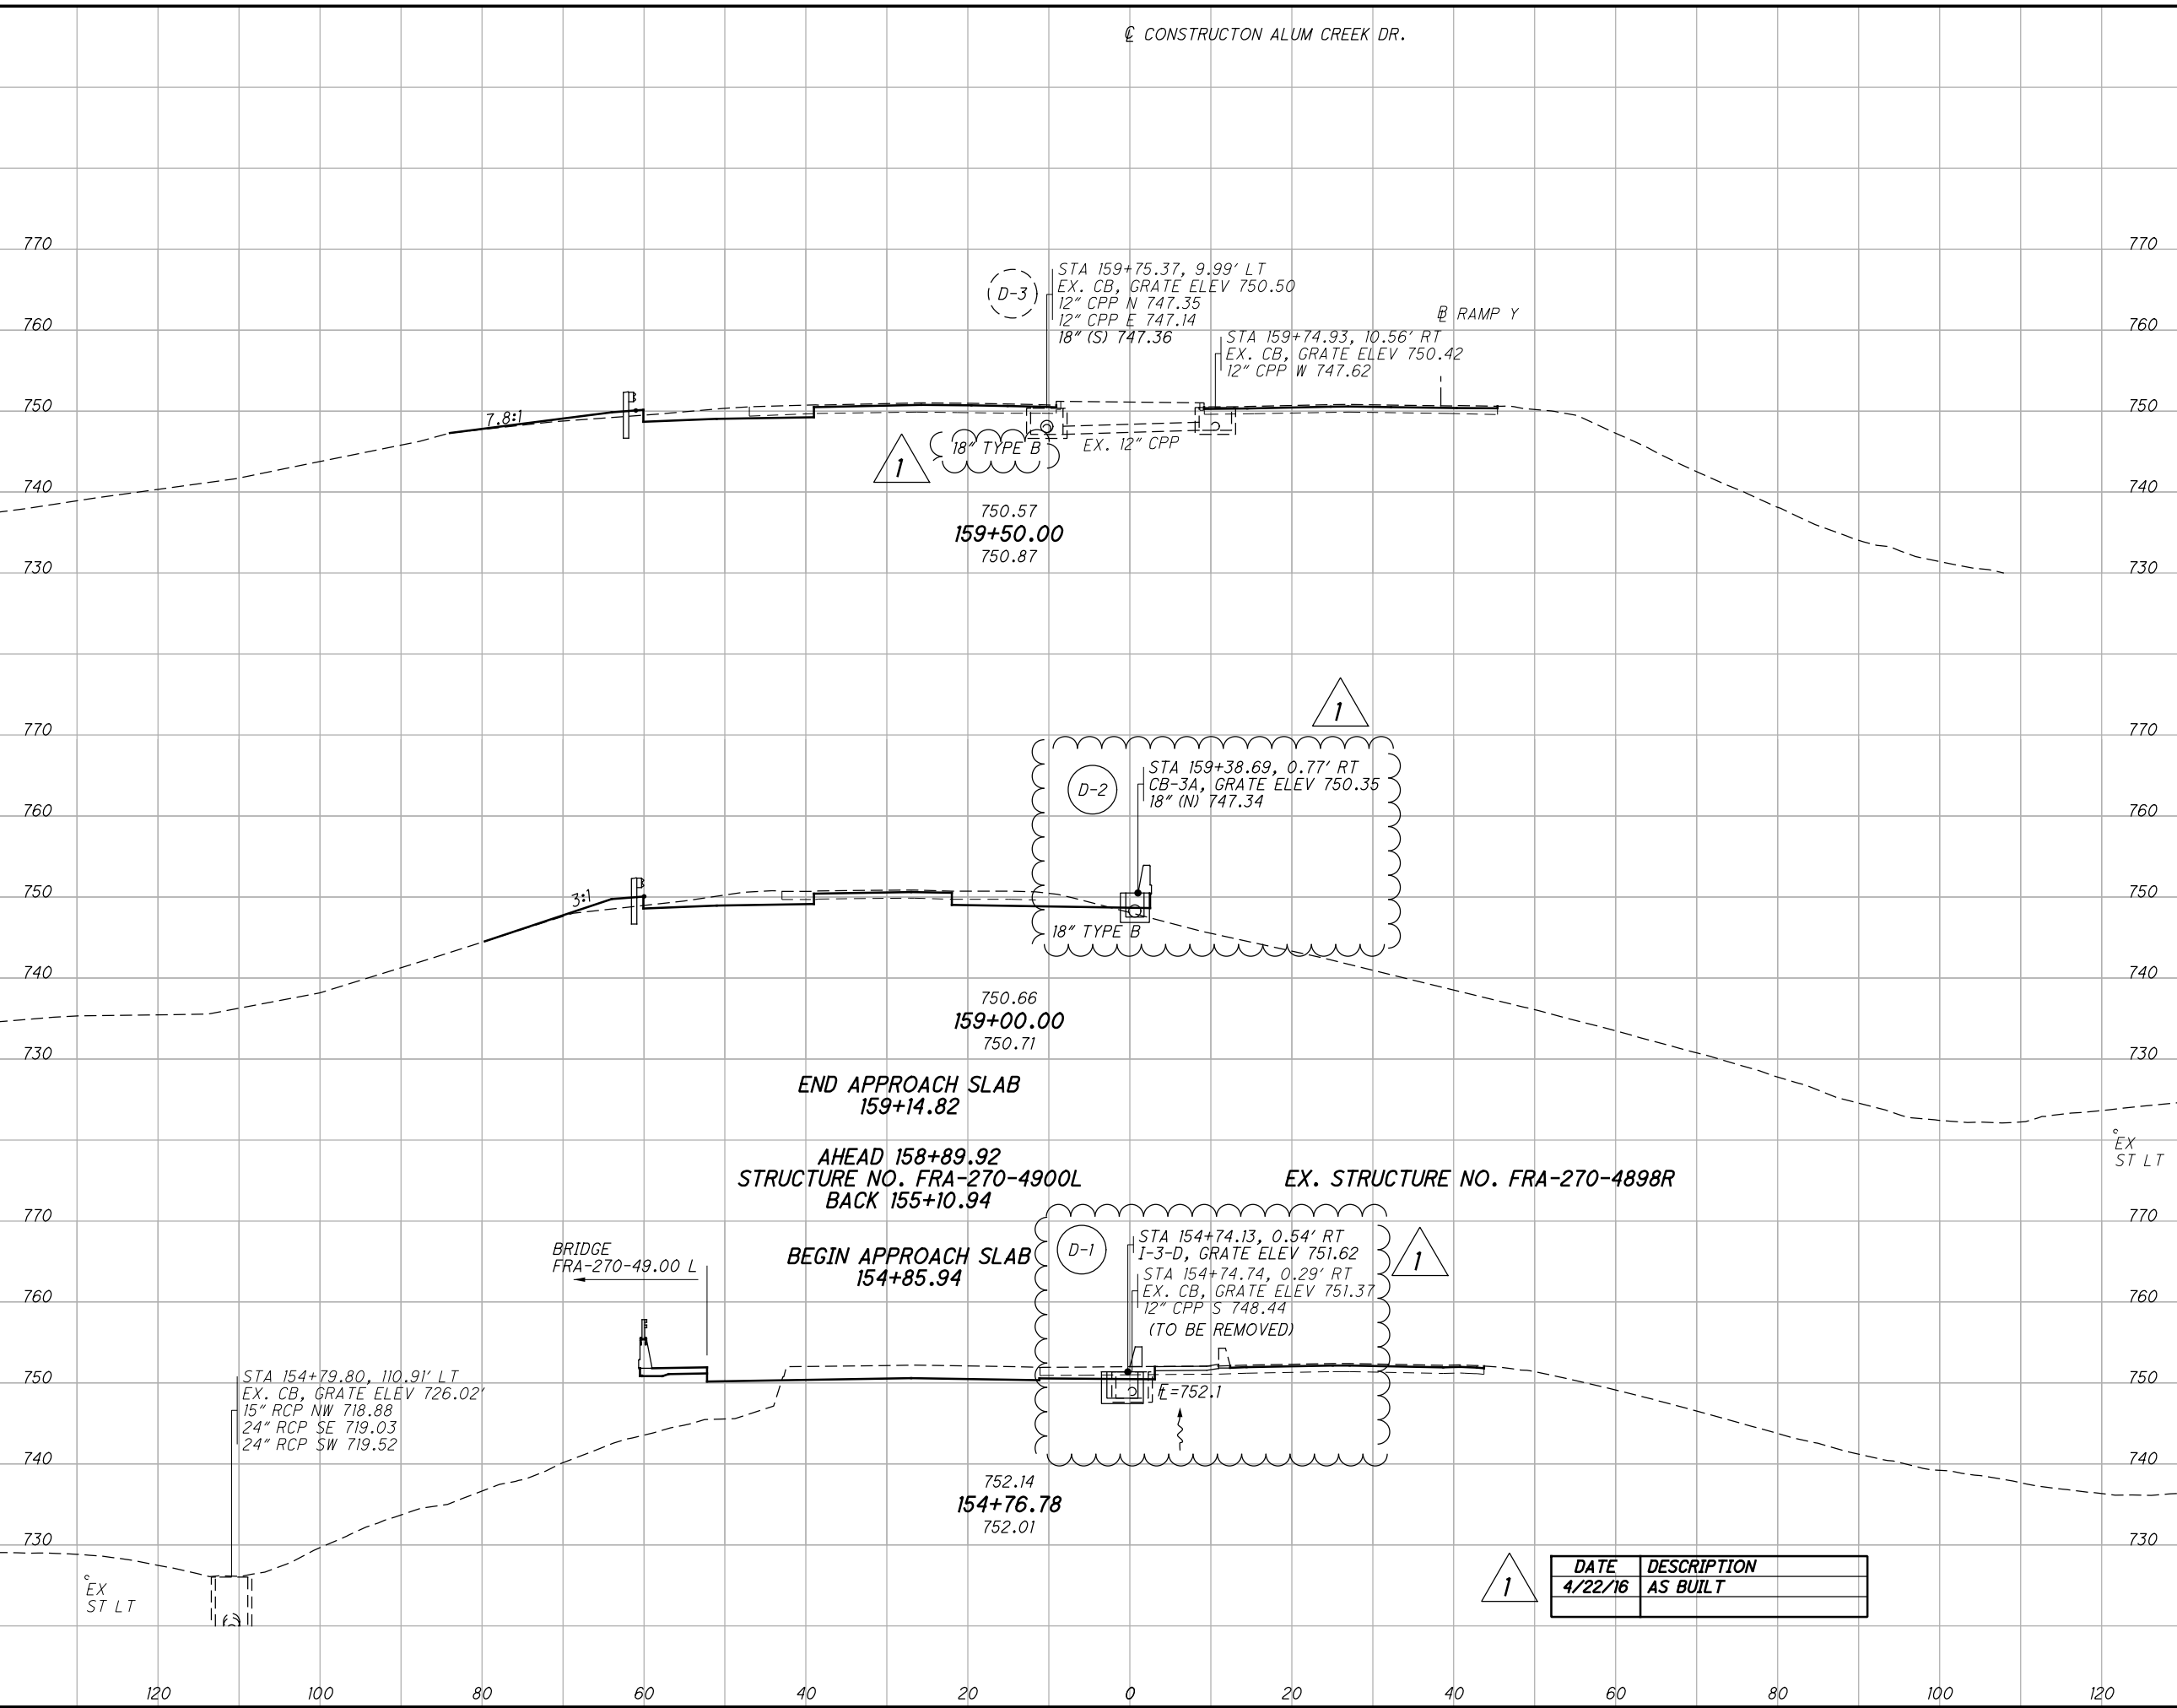

END AREA		VOLUME		CALCULATED	CFR	CHECKED	SSK
CUT	FILL	CUT	FILL				

BU 4, 5, 6, 7, & 8 - RELEASED FOR CONSTRUCTION - 11/03/2014 - 11/19/2015
CROSS SECTIONS ALUM CREEK DR.
STA. 154+76.78 TO STA. 159+50.00
FRA - 270 - 49.00


AS BUILT - 4/22/2016

G:\projects\2014\W-14-039 FRA-270-49.00\83988\roadway\sheets\83988X5007.dgn 5/23/2016 7:30:53 AM kevinj

CONSTRUCTON ALUM CREEK DR.

SEEDING	
END WIDTH	SO. YDS.

END AREA		VOLUME		CALCULATED	
CUT	FILL	CUT	FILL	CFR	SSK

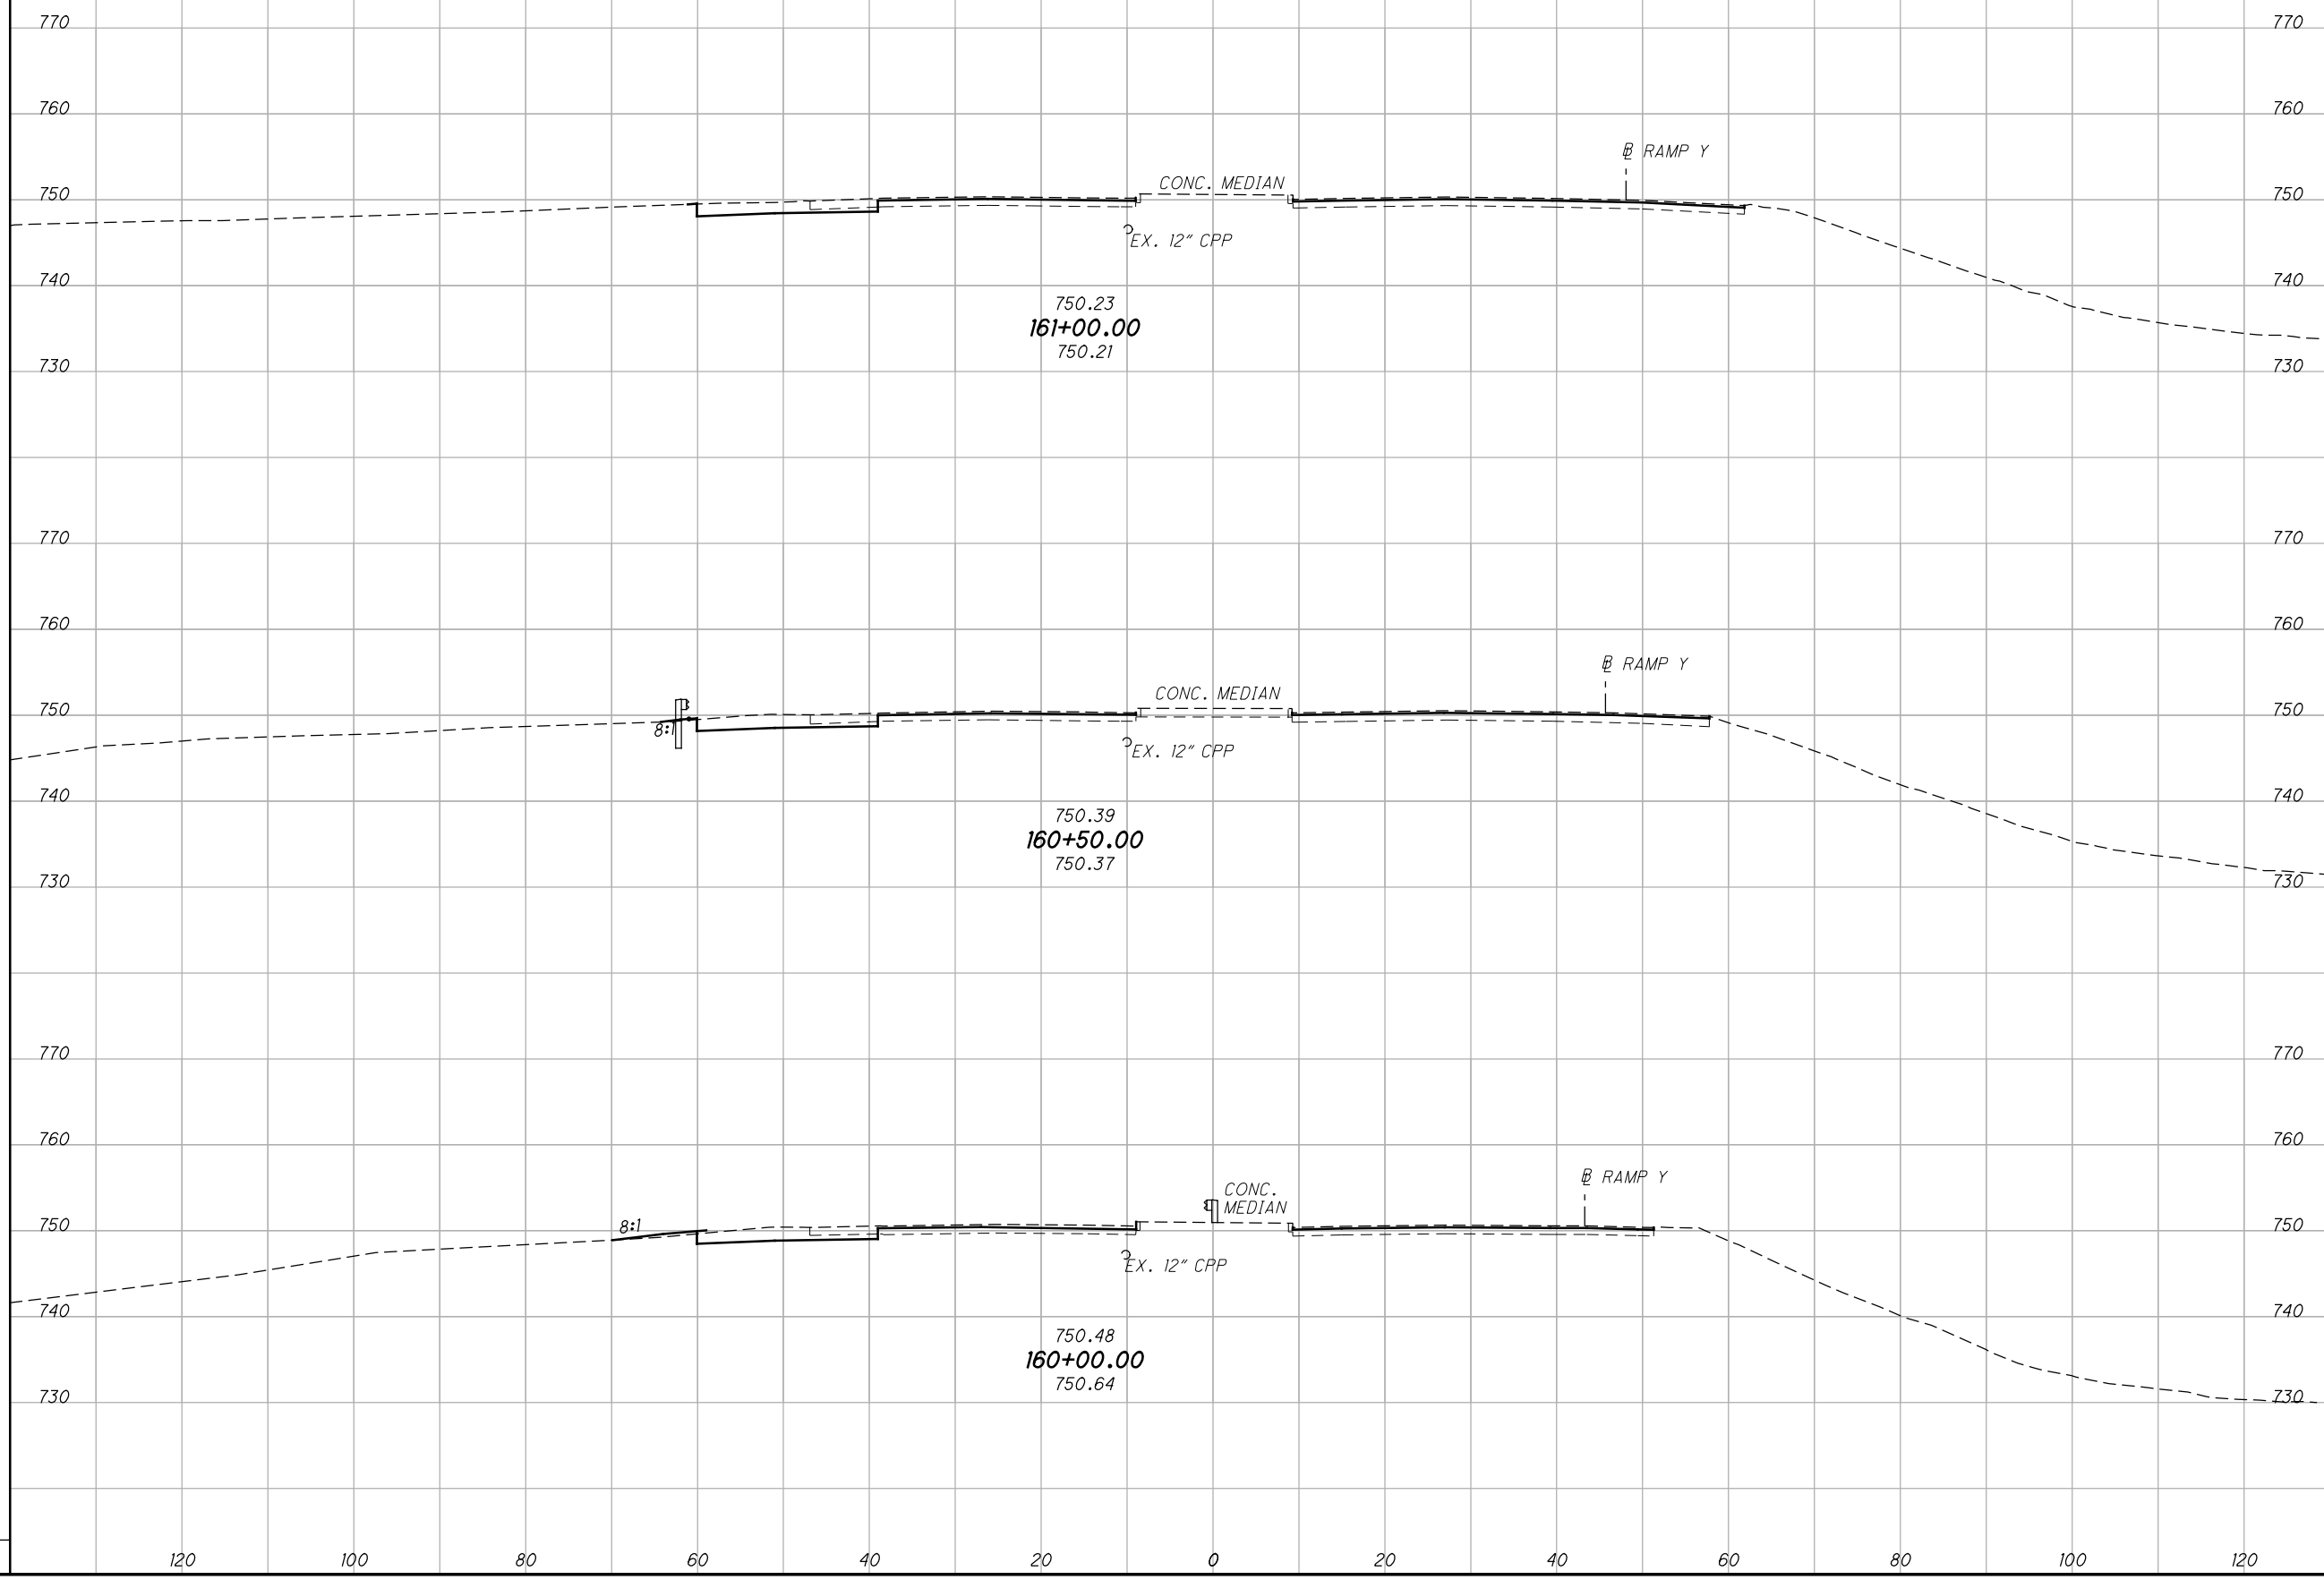

BU 4, 5, 6, 7, & 8 - RELEASED FOR CONSTRUCTION - 11/03/2014 - 11/19/2015

CROSS SECTIONS ALUM CREEK DR.
STA. 160+00.00 TO STA. 161+00.00


FRA - 270 - 49.00

42
182

AS BUILT - 4/22/2016

C:\projects\2014\W-14-039_FRA-270-49.00\83988\roadway\sheets\83988X5007.dgn 5/23/2016 7:30:54 AM kevinj

SEEDING	
END WIDTH	SO. YDS.

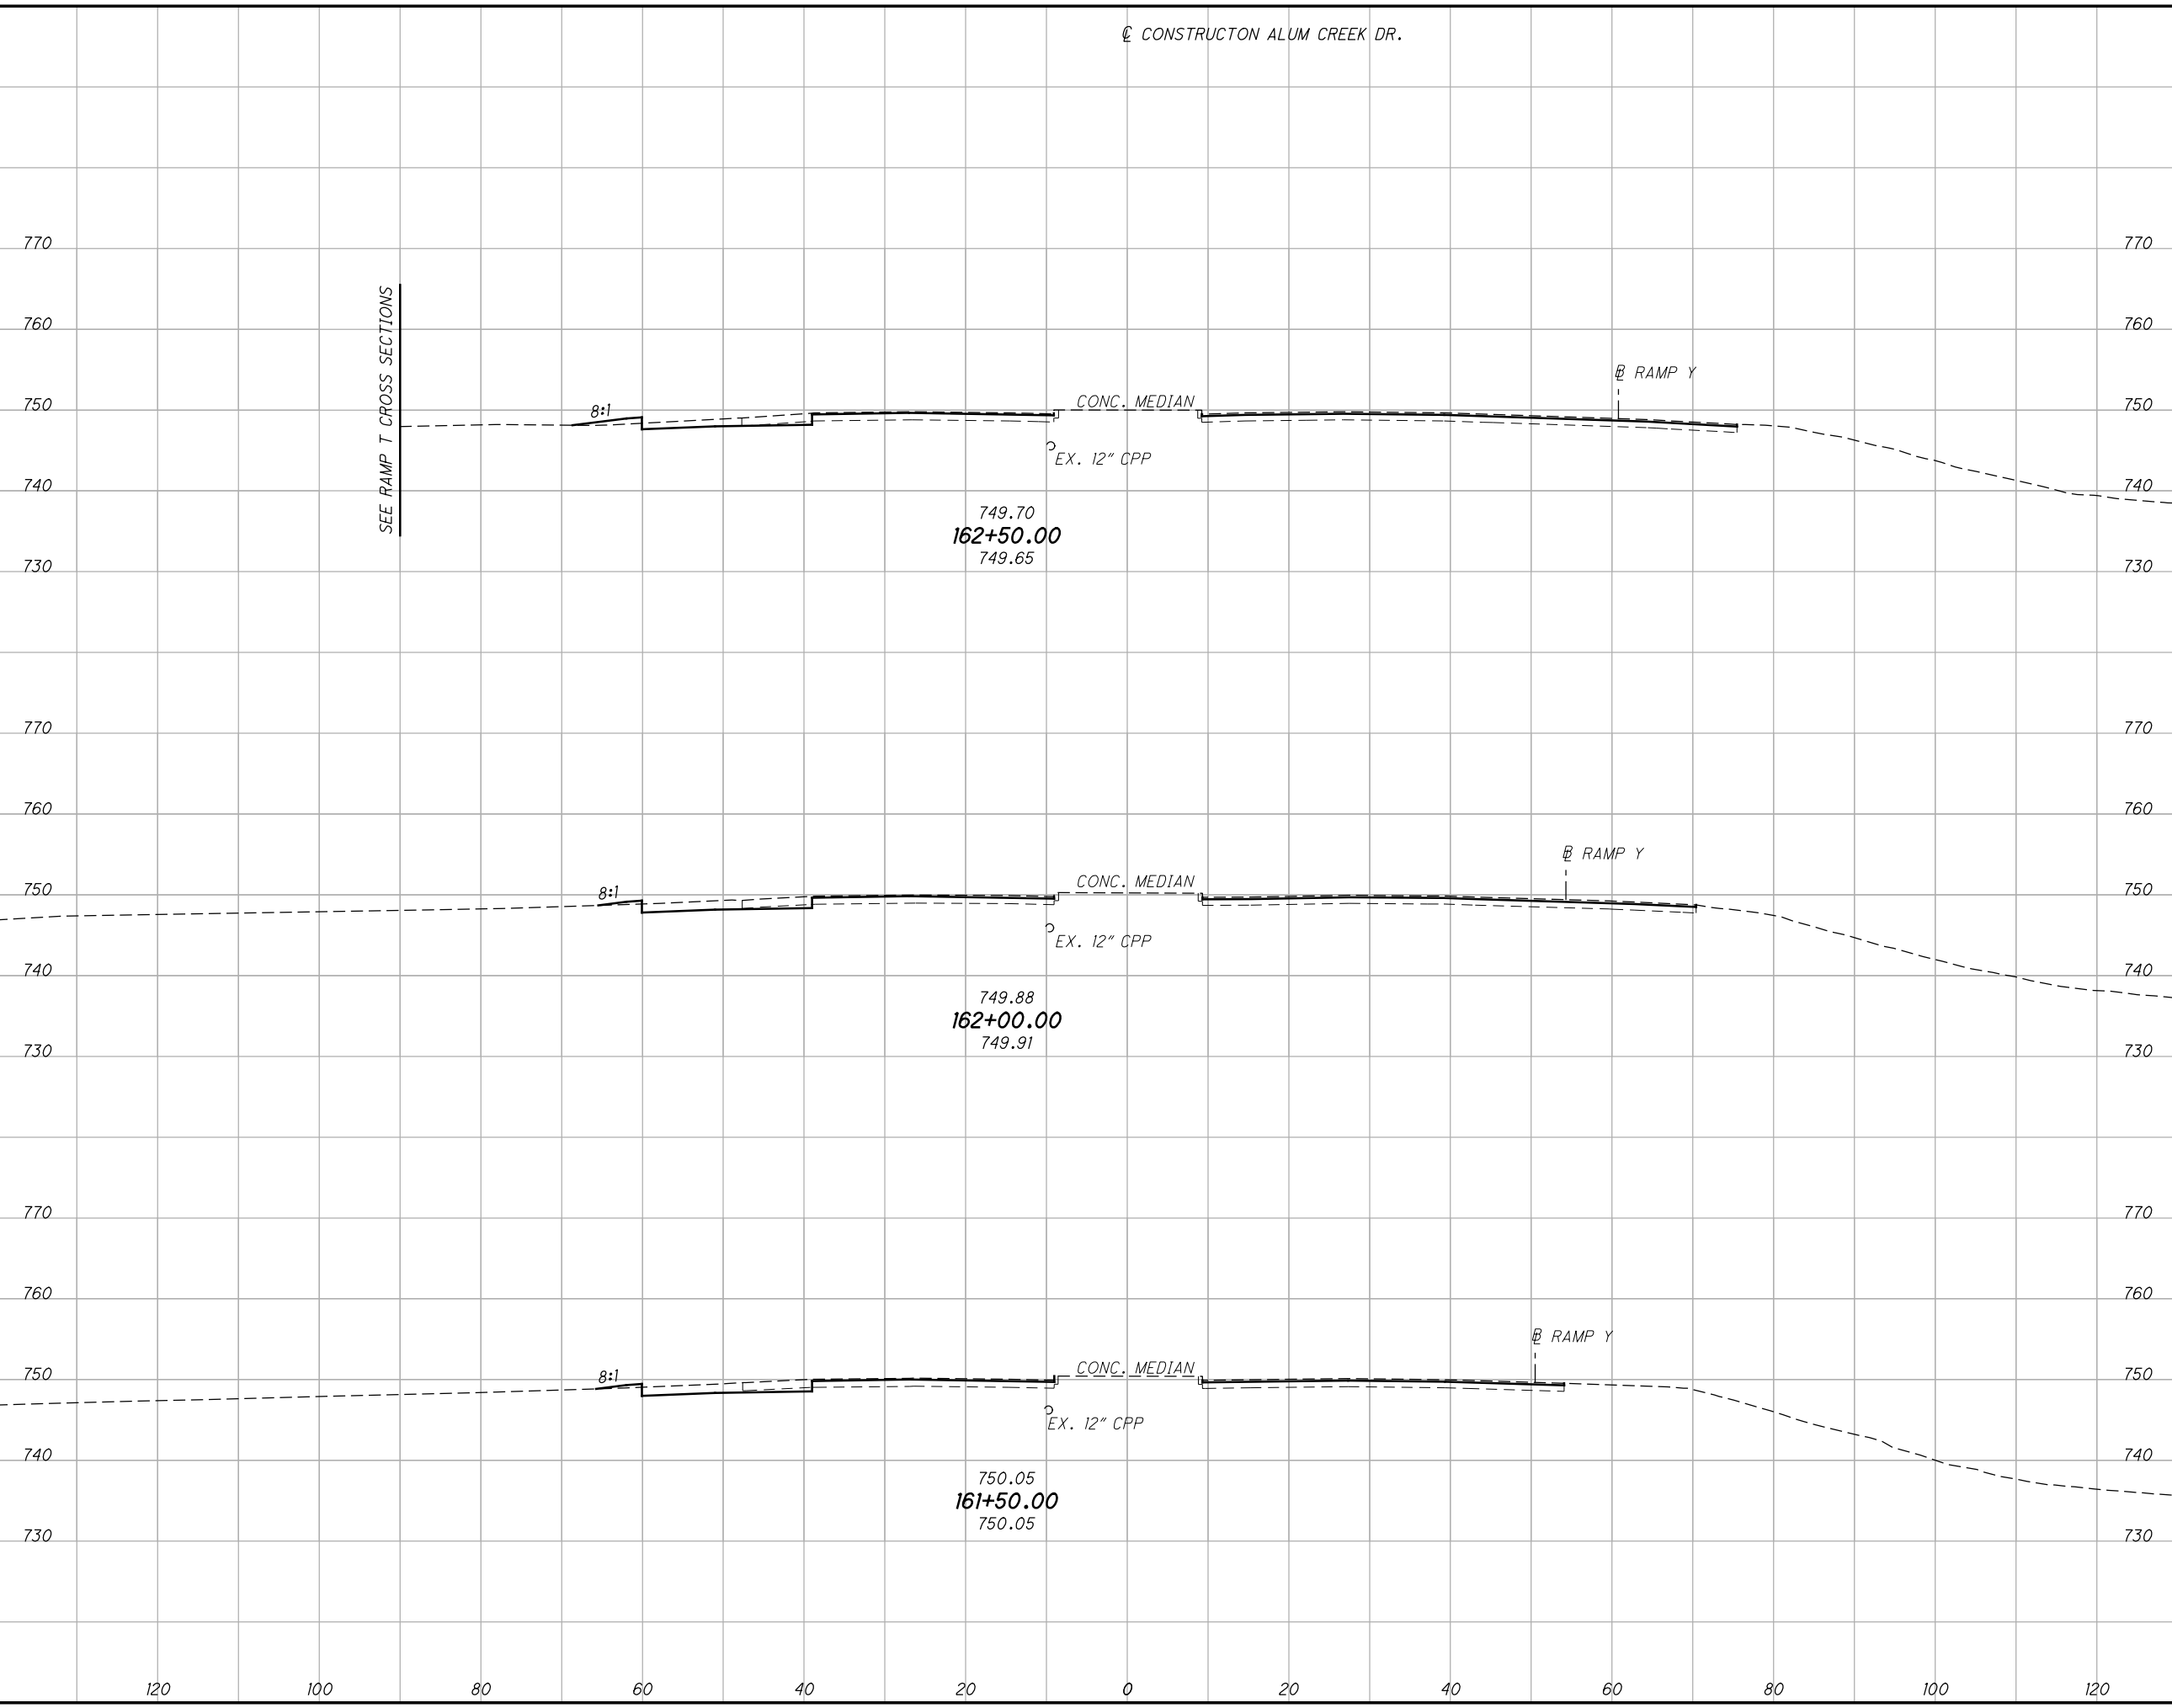

END AREA		VOLUME	
CUT	FILL	CUT	FILL

BU 4, 5, 6, 7, & 8 - RELEASED FOR CONSTRUCTION - 11/03/2014 - 11/19/2015


CROSS SECTIONS ALUM CREEK DR.
STA. 161+50.00 TO STA. 162+50.00

FRA - 270 - 49.00

CALCULATED	
CFR	
CHECKED	
SSK	

AS BUILT - 4/22/2016

C:\projects\2014\W-14-039_FRA-270-49.00\83988\roadway\sheets\83988X5007.dgn 5/23/2016 7:30:54 AM kevinj

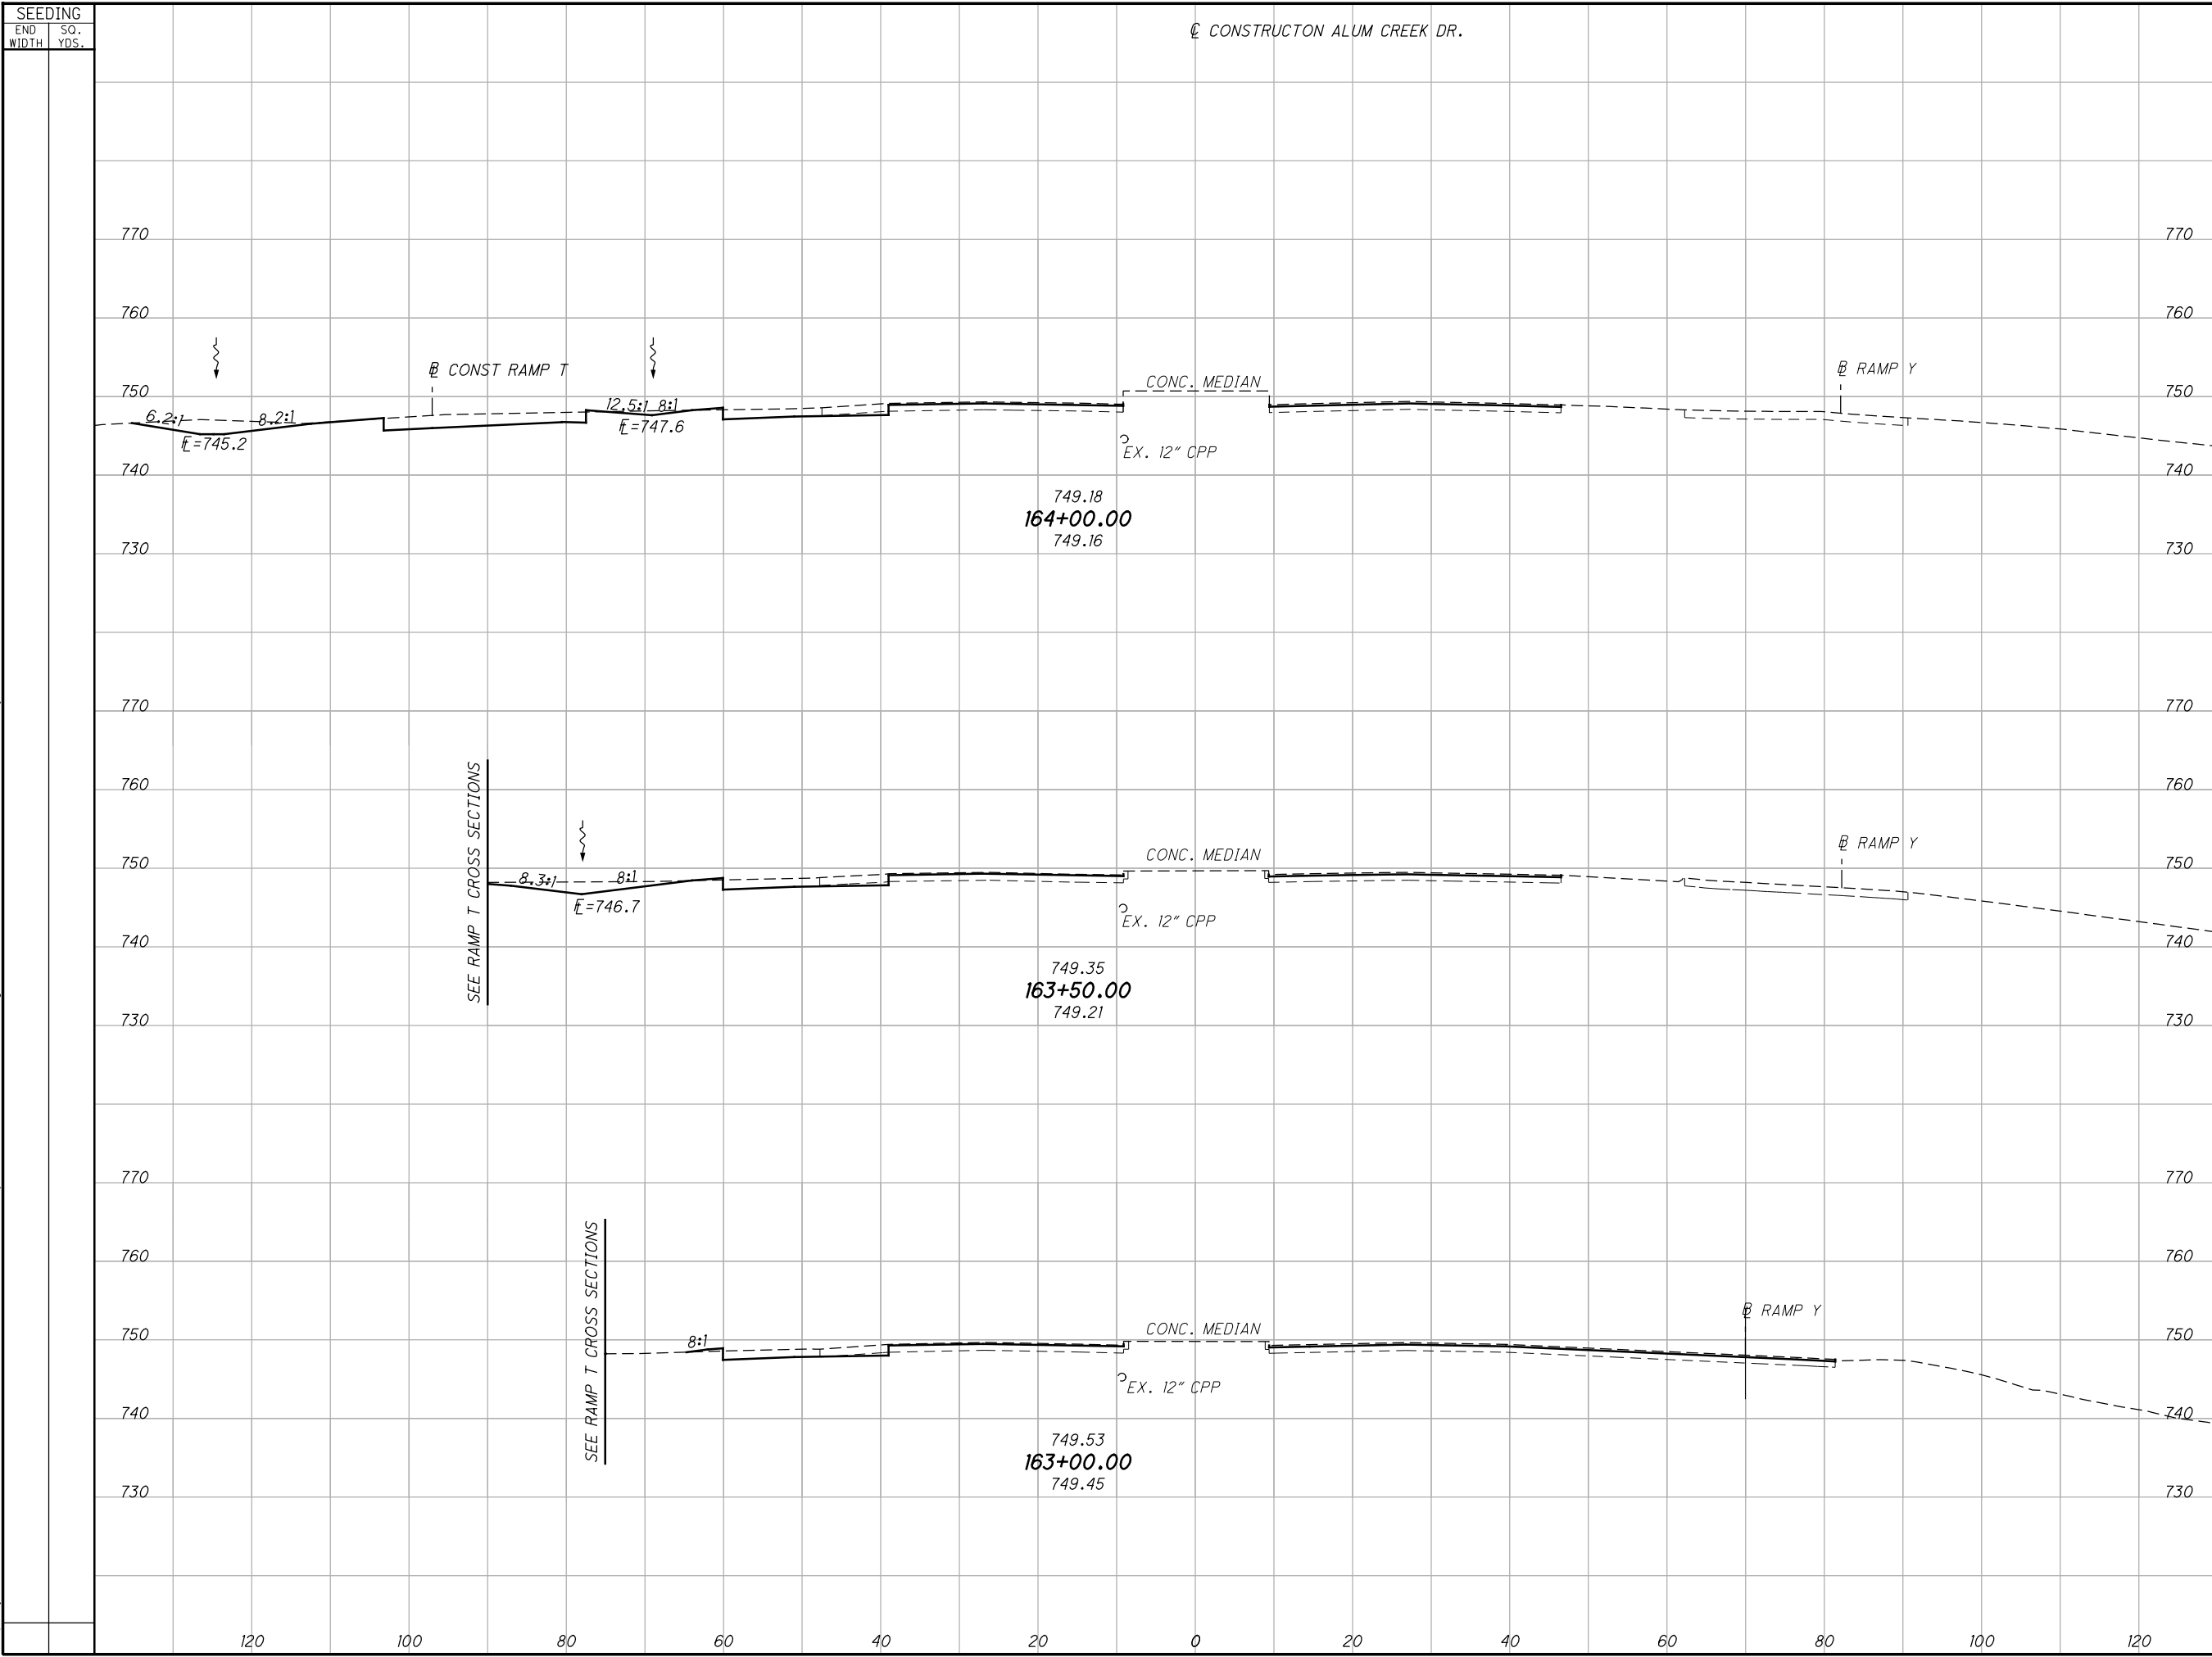


SEEDING		END AREA		VOLUME		CALCULATED	
END WIDTH	SO. YDS.	CUT	FILL	CUT	FILL	CFR	SSK

FRA - 270 - 49.00	
BU 4, 5, 6, 7, & 8 - RELEASED FOR CONSTRUCTION - 11/03/2014 - 11/19/2015 CROSS SECTIONS ALUM CREEK DR. STA. 163+00.00 TO STA. 164+00.00	
44 182	

AS BUILT - 4/22/2016

G:\projects\2014\W-14-039_FRA-270-49.00\83988\roadway\sheets\83988X5007.dgn 5/23/2016 7:30:55 AM kevinj

SEEDING	
END WIDTH	SO. YDS.

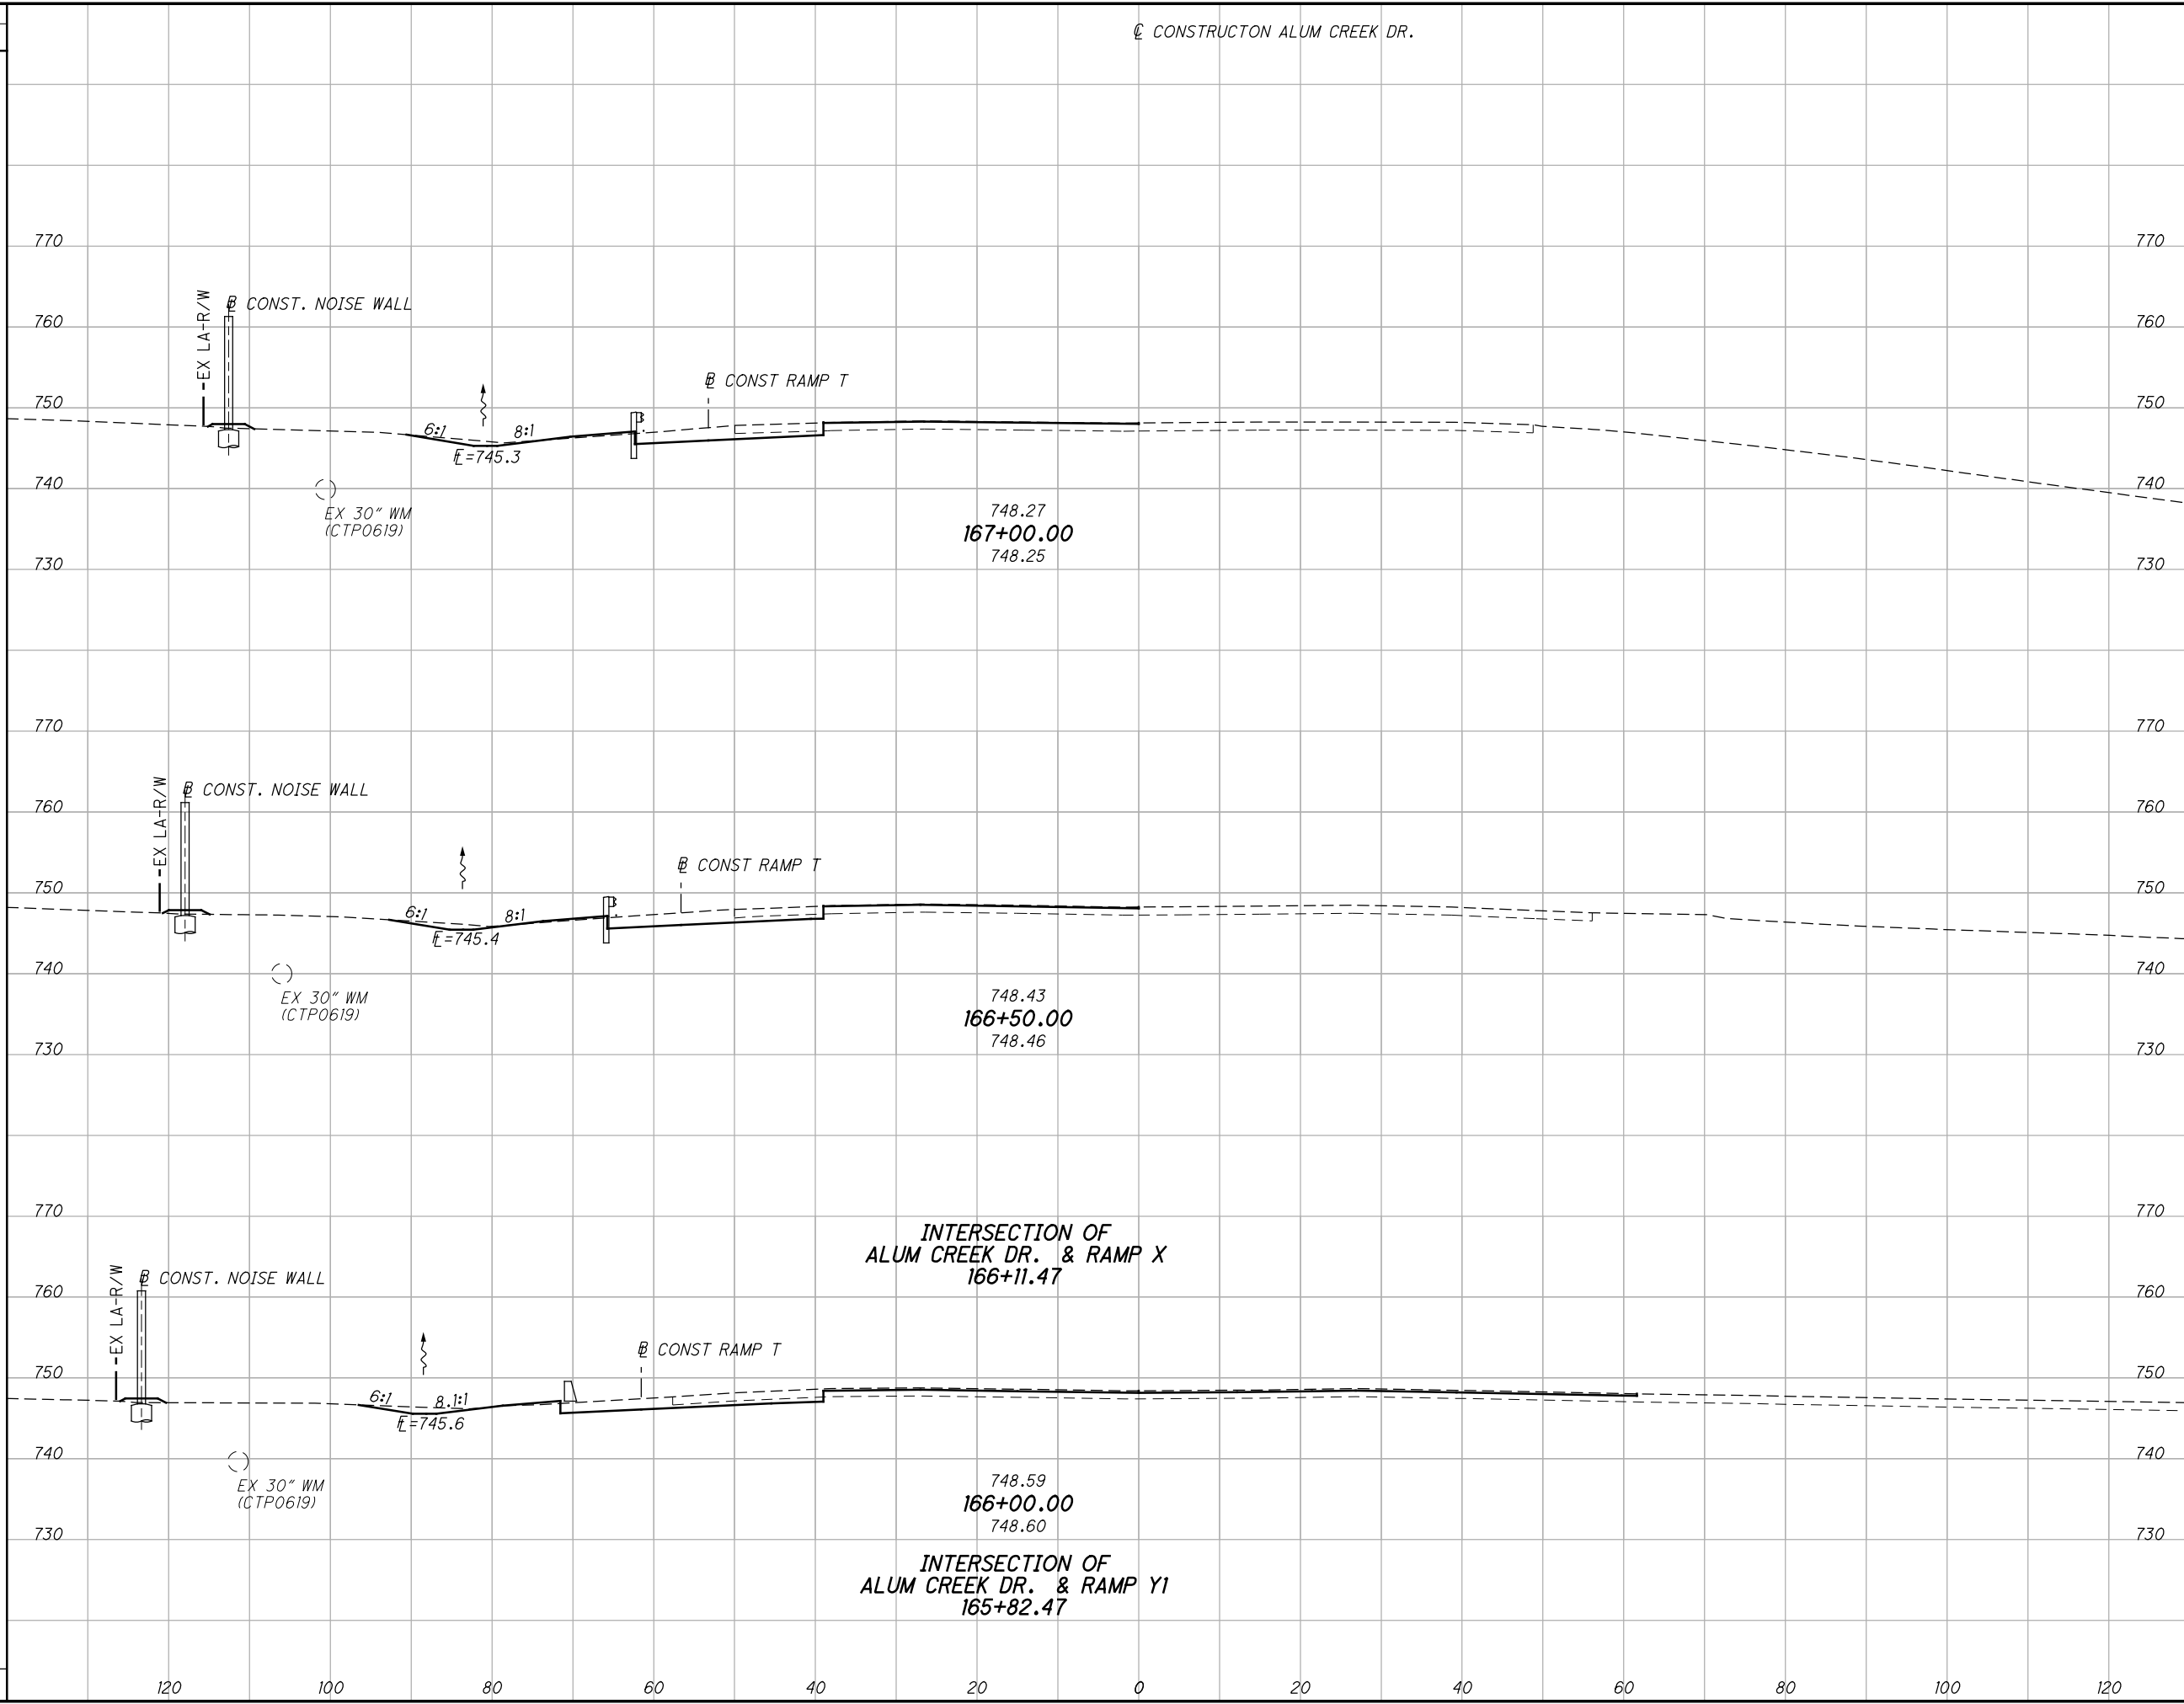

END AREA		VOLUME		CALCULATED	CFR	CHECKED	SSK
CUT	FILL	CUT	FILL				

BU 4, 5, 6, 7, & 8 - RELEASED FOR CONSTRUCTION - 11/03/2014 - 11/19/2015

CROSS SECTIONS ALUM CREEK DR.
STA. 166+00.00 TO STA. 167+00.00


FRA - 270 - 49.00

46
182

AS BUILT - 4/22/2016

G:\projects\2014\W-14-039 FRA-270-49.00\83988\roadway\sheets\83988X5007.dgn 5/23/2016 7:30:55 AM kevinj

SEEDING	
END WIDTH	SO. YDS.

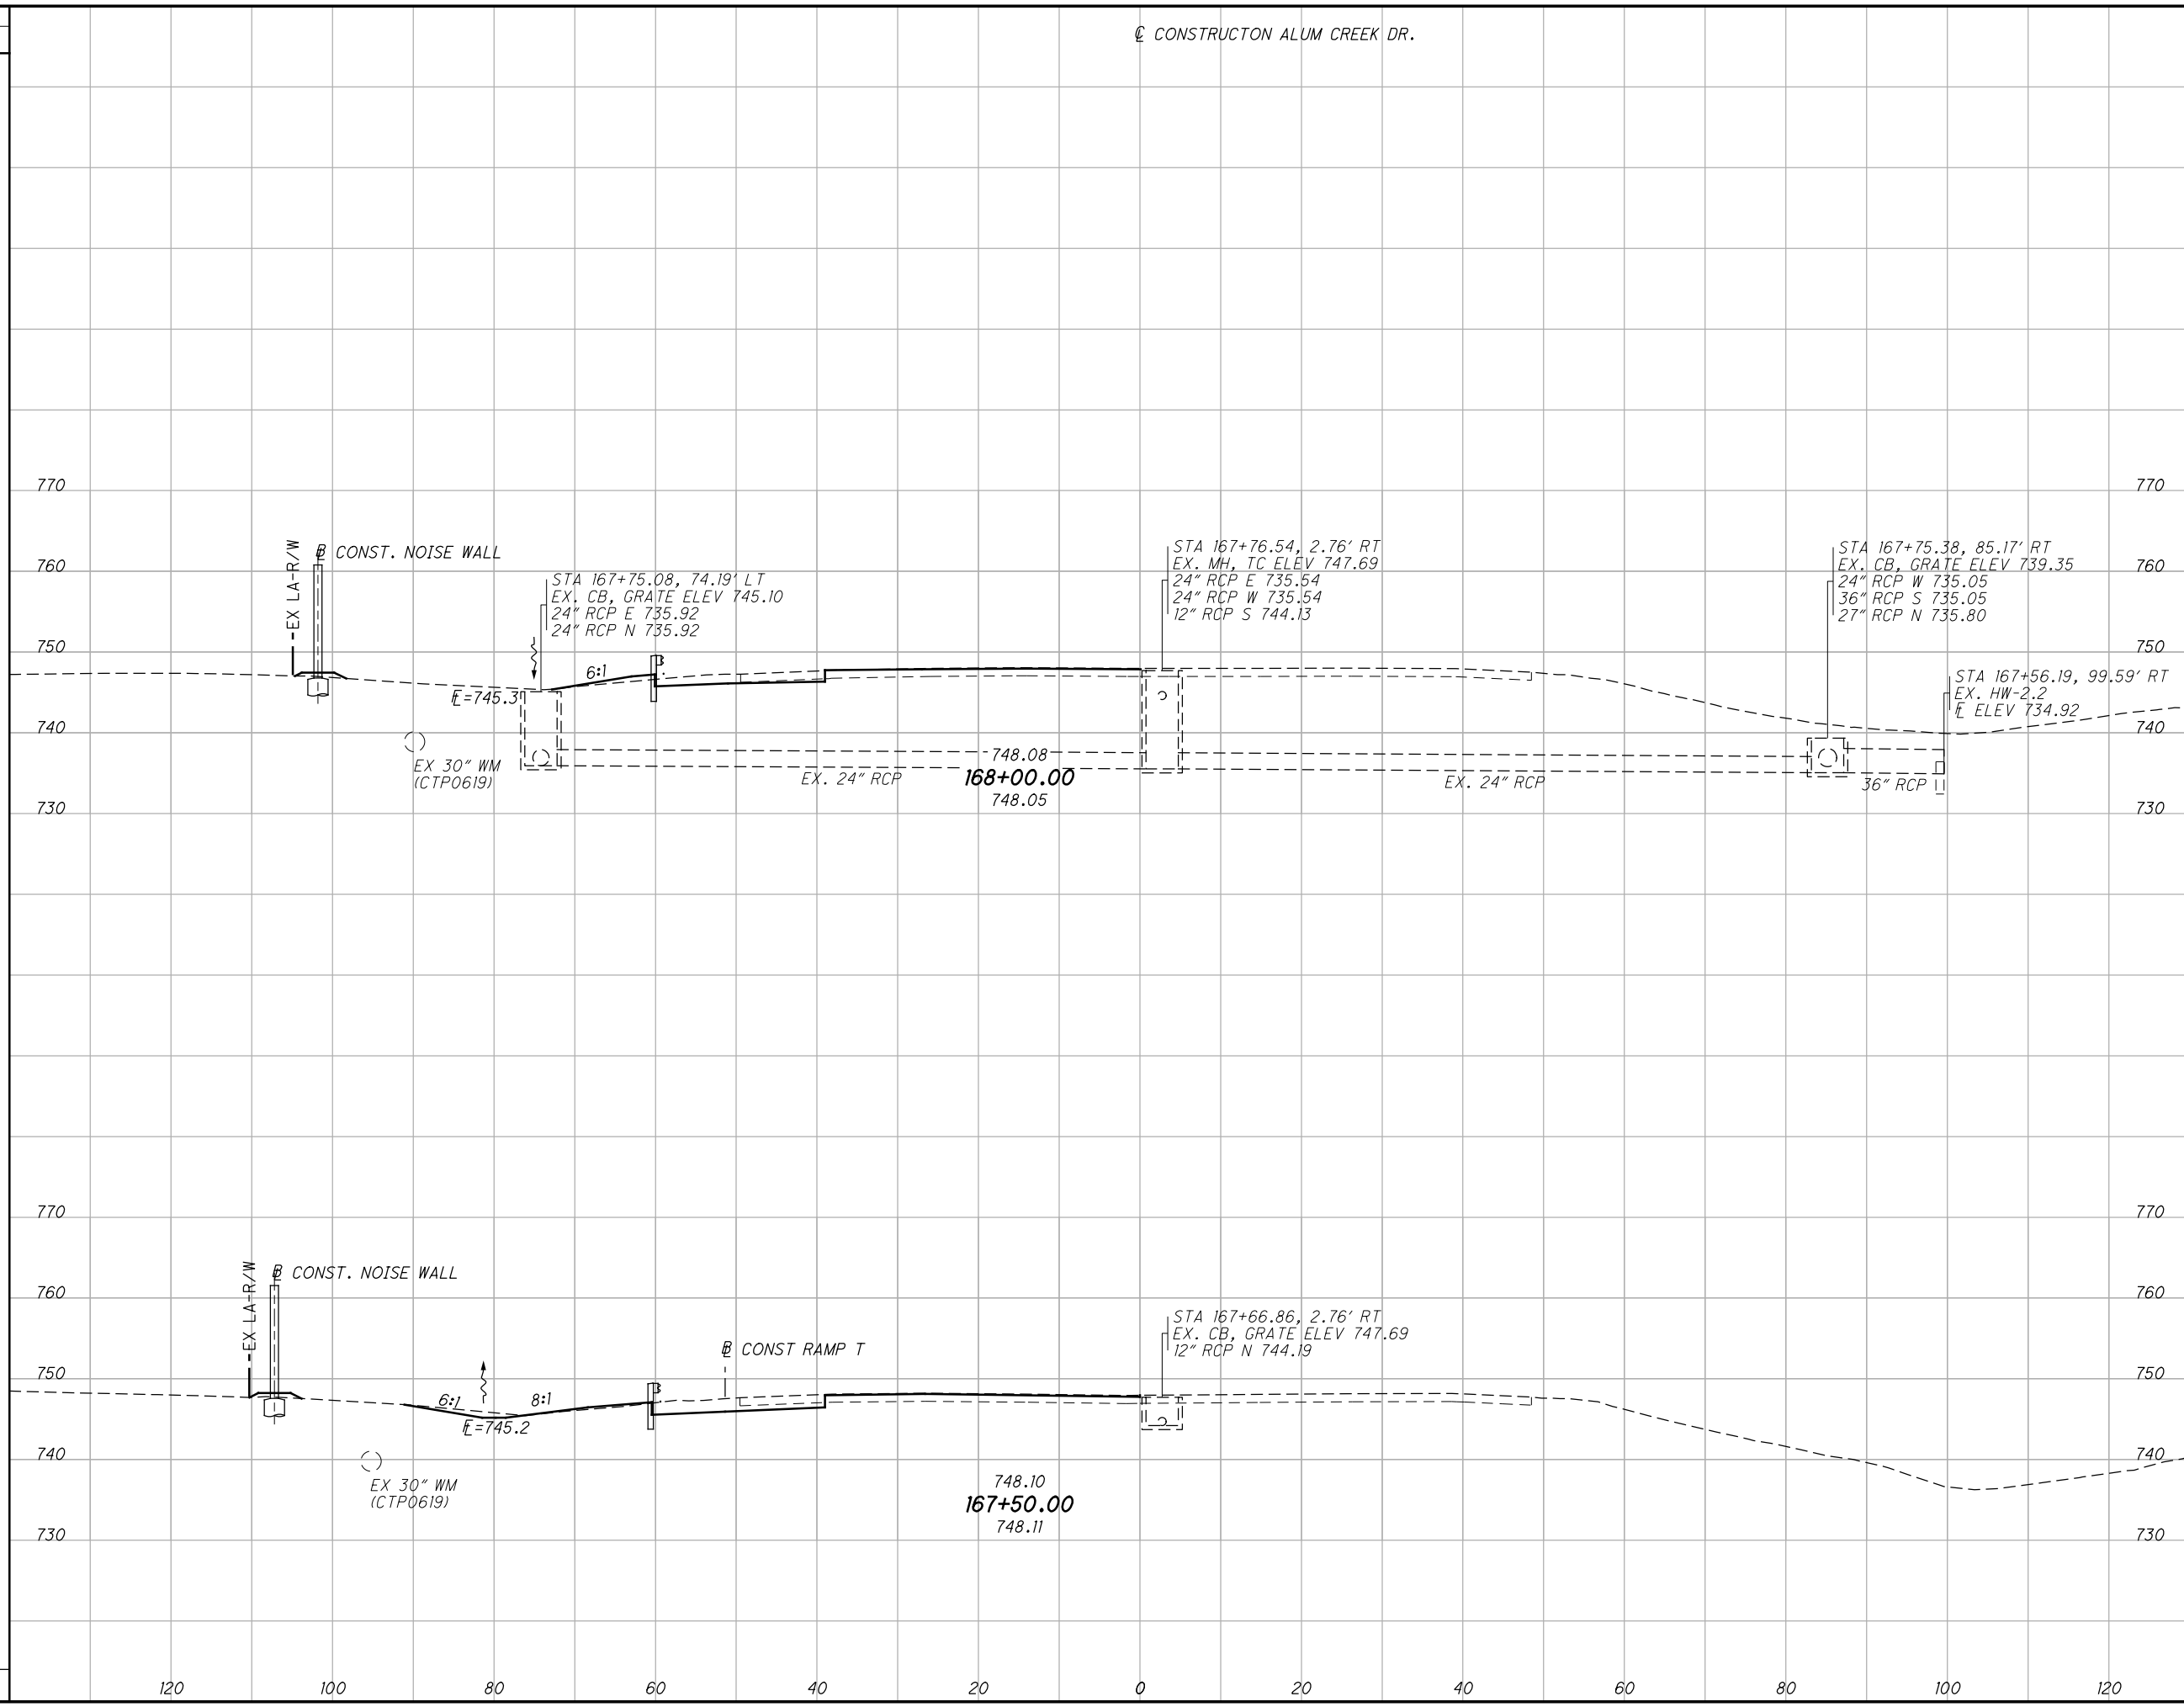

END AREA	VOLUME	CALCULATED	CFR	CHECKED	SSK

**CROSS SECTIONS ALUM CREEK DR.
STA. 167+50.00 TO STA. 168+00.00**

FRA - 270 - 49.00


47
182

BU 4, 5, 6, 7, & 8 - RELEASED FOR CONSTRUCTION - 11/03/2014 - 11/19/2015

CONSTRUCTON ALUM CREEK DR.

AS BUILT - 4/22/2016

G:\projects\2014\W-14-039_FRA-270-49.00\83988\roadway\sheets\83988X5007.dgn 6/8/2016 12:27:10 PM colnr

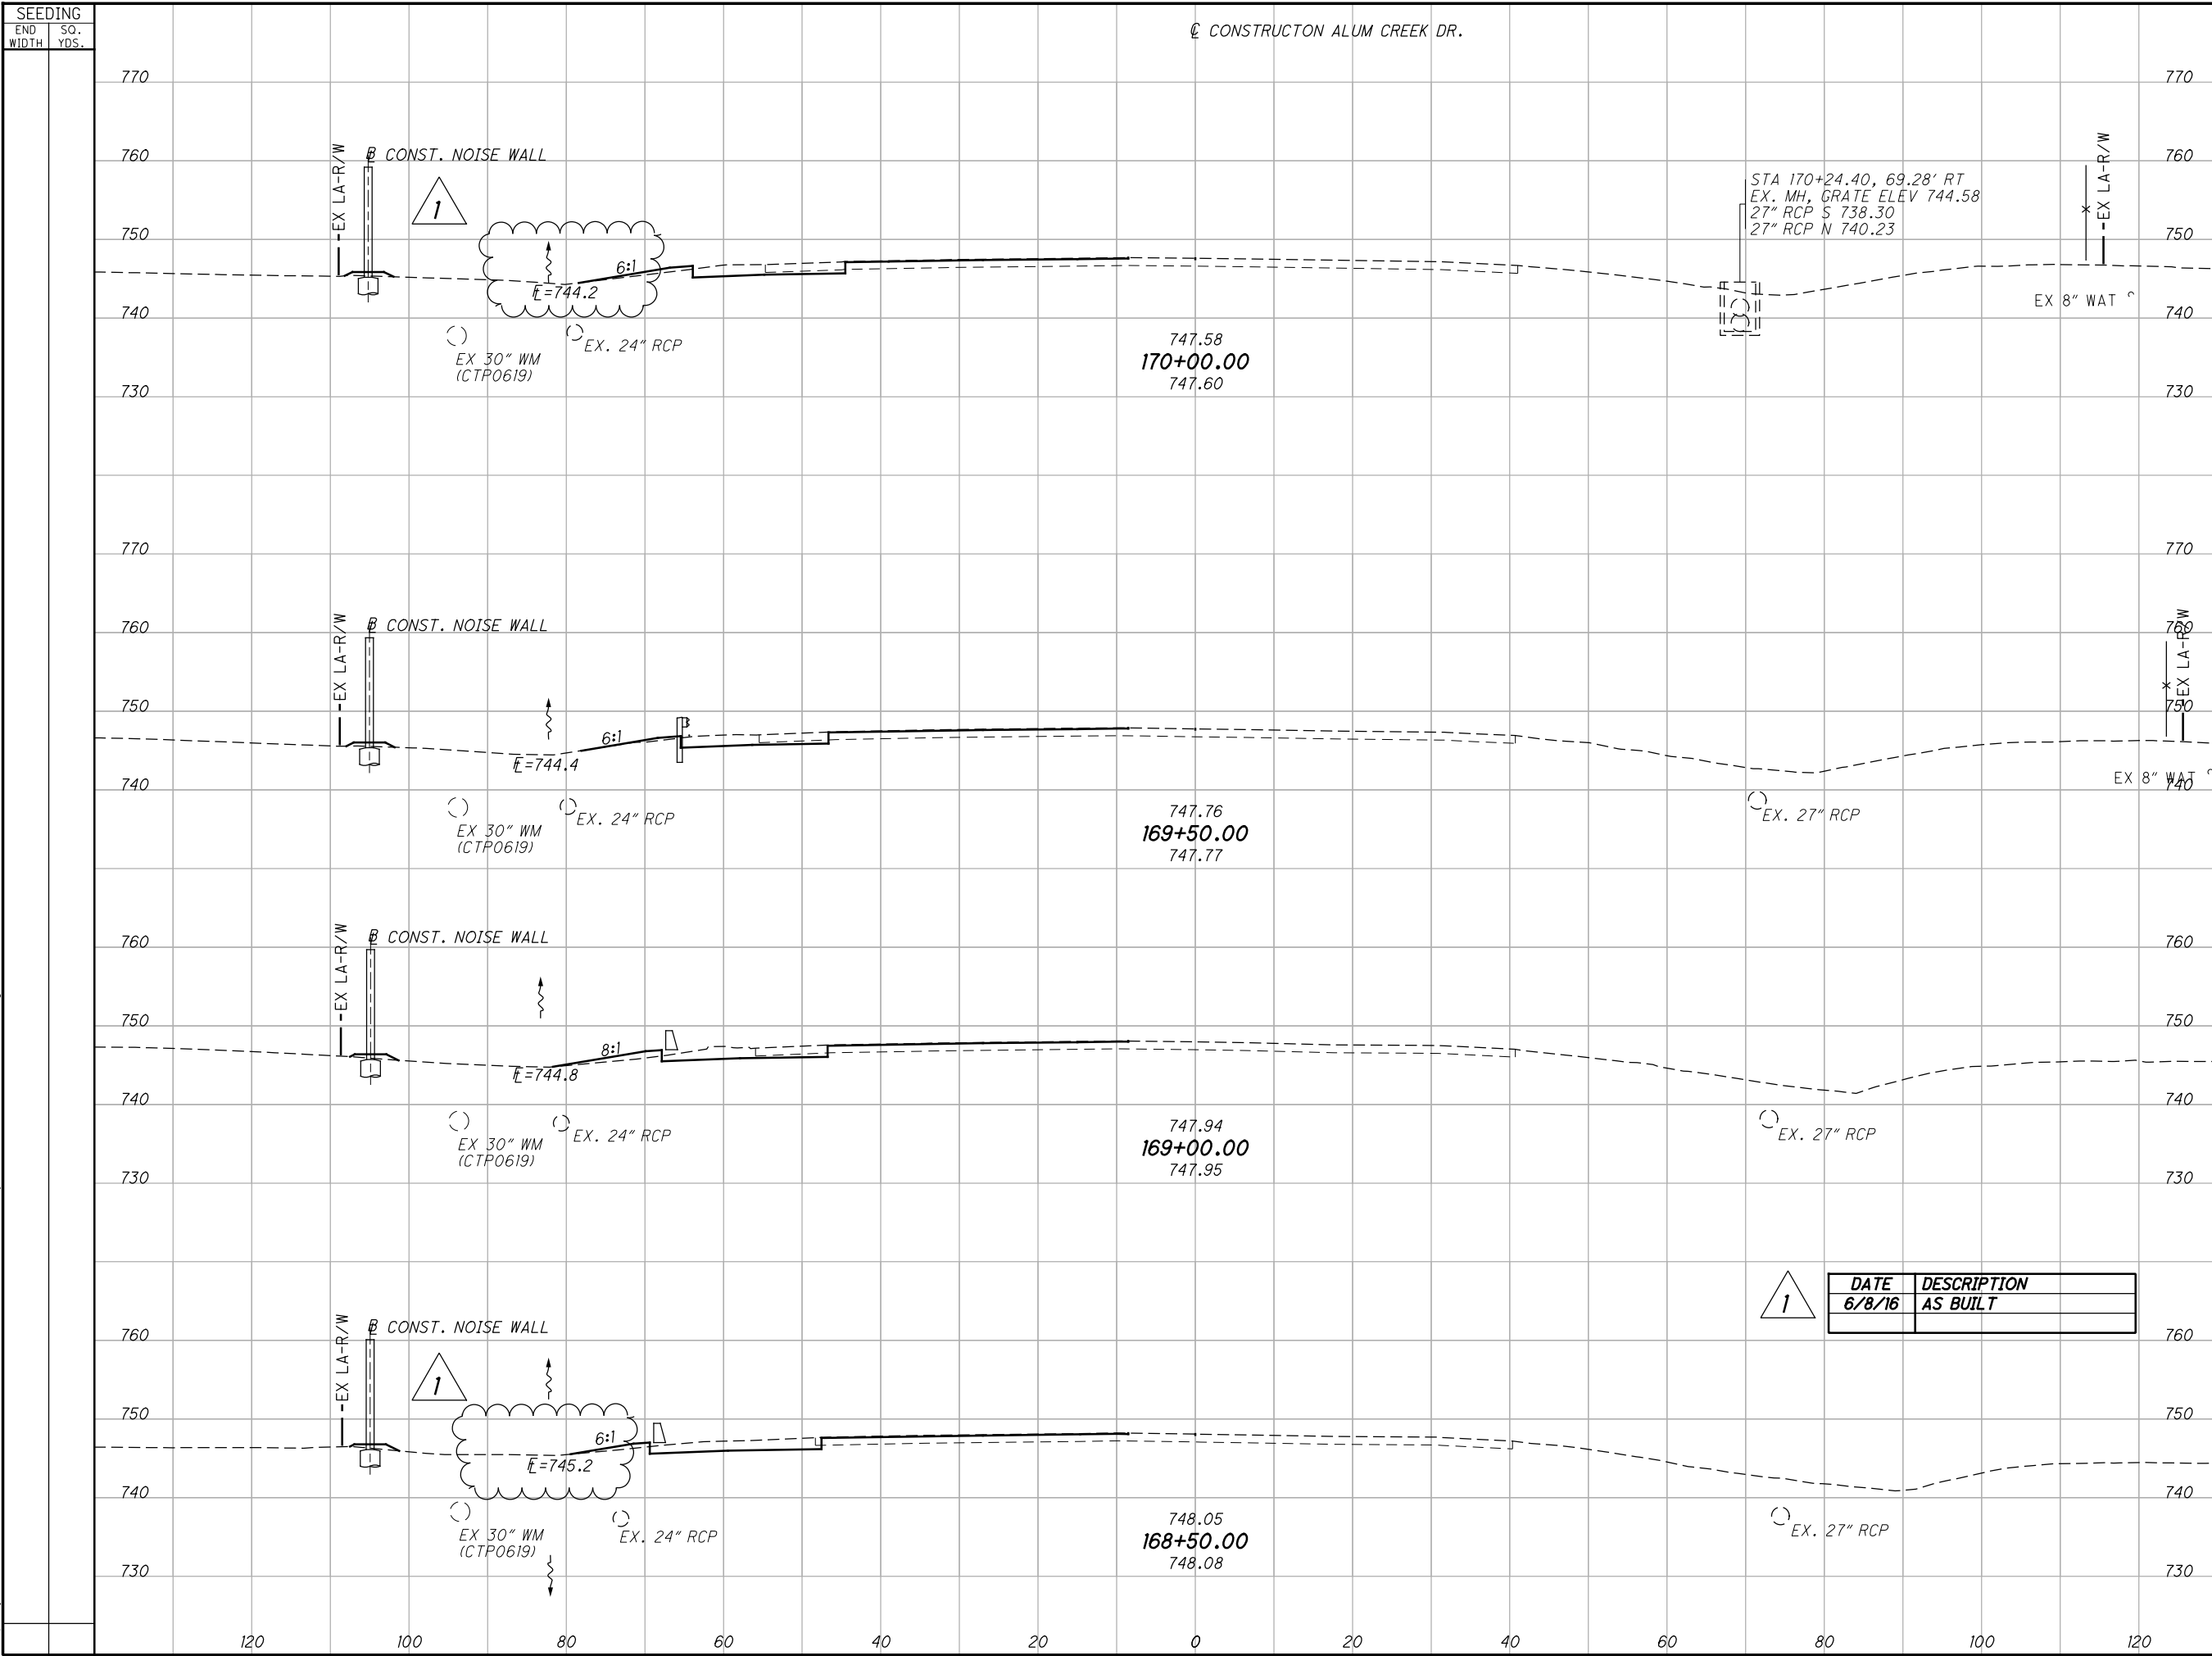

BU 4, 5, 6, 7, & 8 - RELEASED FOR CONSTRUCTION - 11/03/2014 - 11/19/2015

CROSS SECTIONS ALUM CREEK DR.
STA. 168+50.00 TO STA. 170+00.00

FRA - 270 - 49.00


AS BUILT - 4/22/2016

C:\projects\2014\W-14-039_FRA-270-49.00\83988\roadway\sheets\83988X5007.dgn 6/8/2016 12:31:39 PM colnr

SEEDING
END SO.
WIDTH YDS.

CONSTRUCTON ALUM CREEK DR.

END AREA VOLUME
CUT FILL CUT FILL
CALCULATED
CFR
CHECKED
SSK

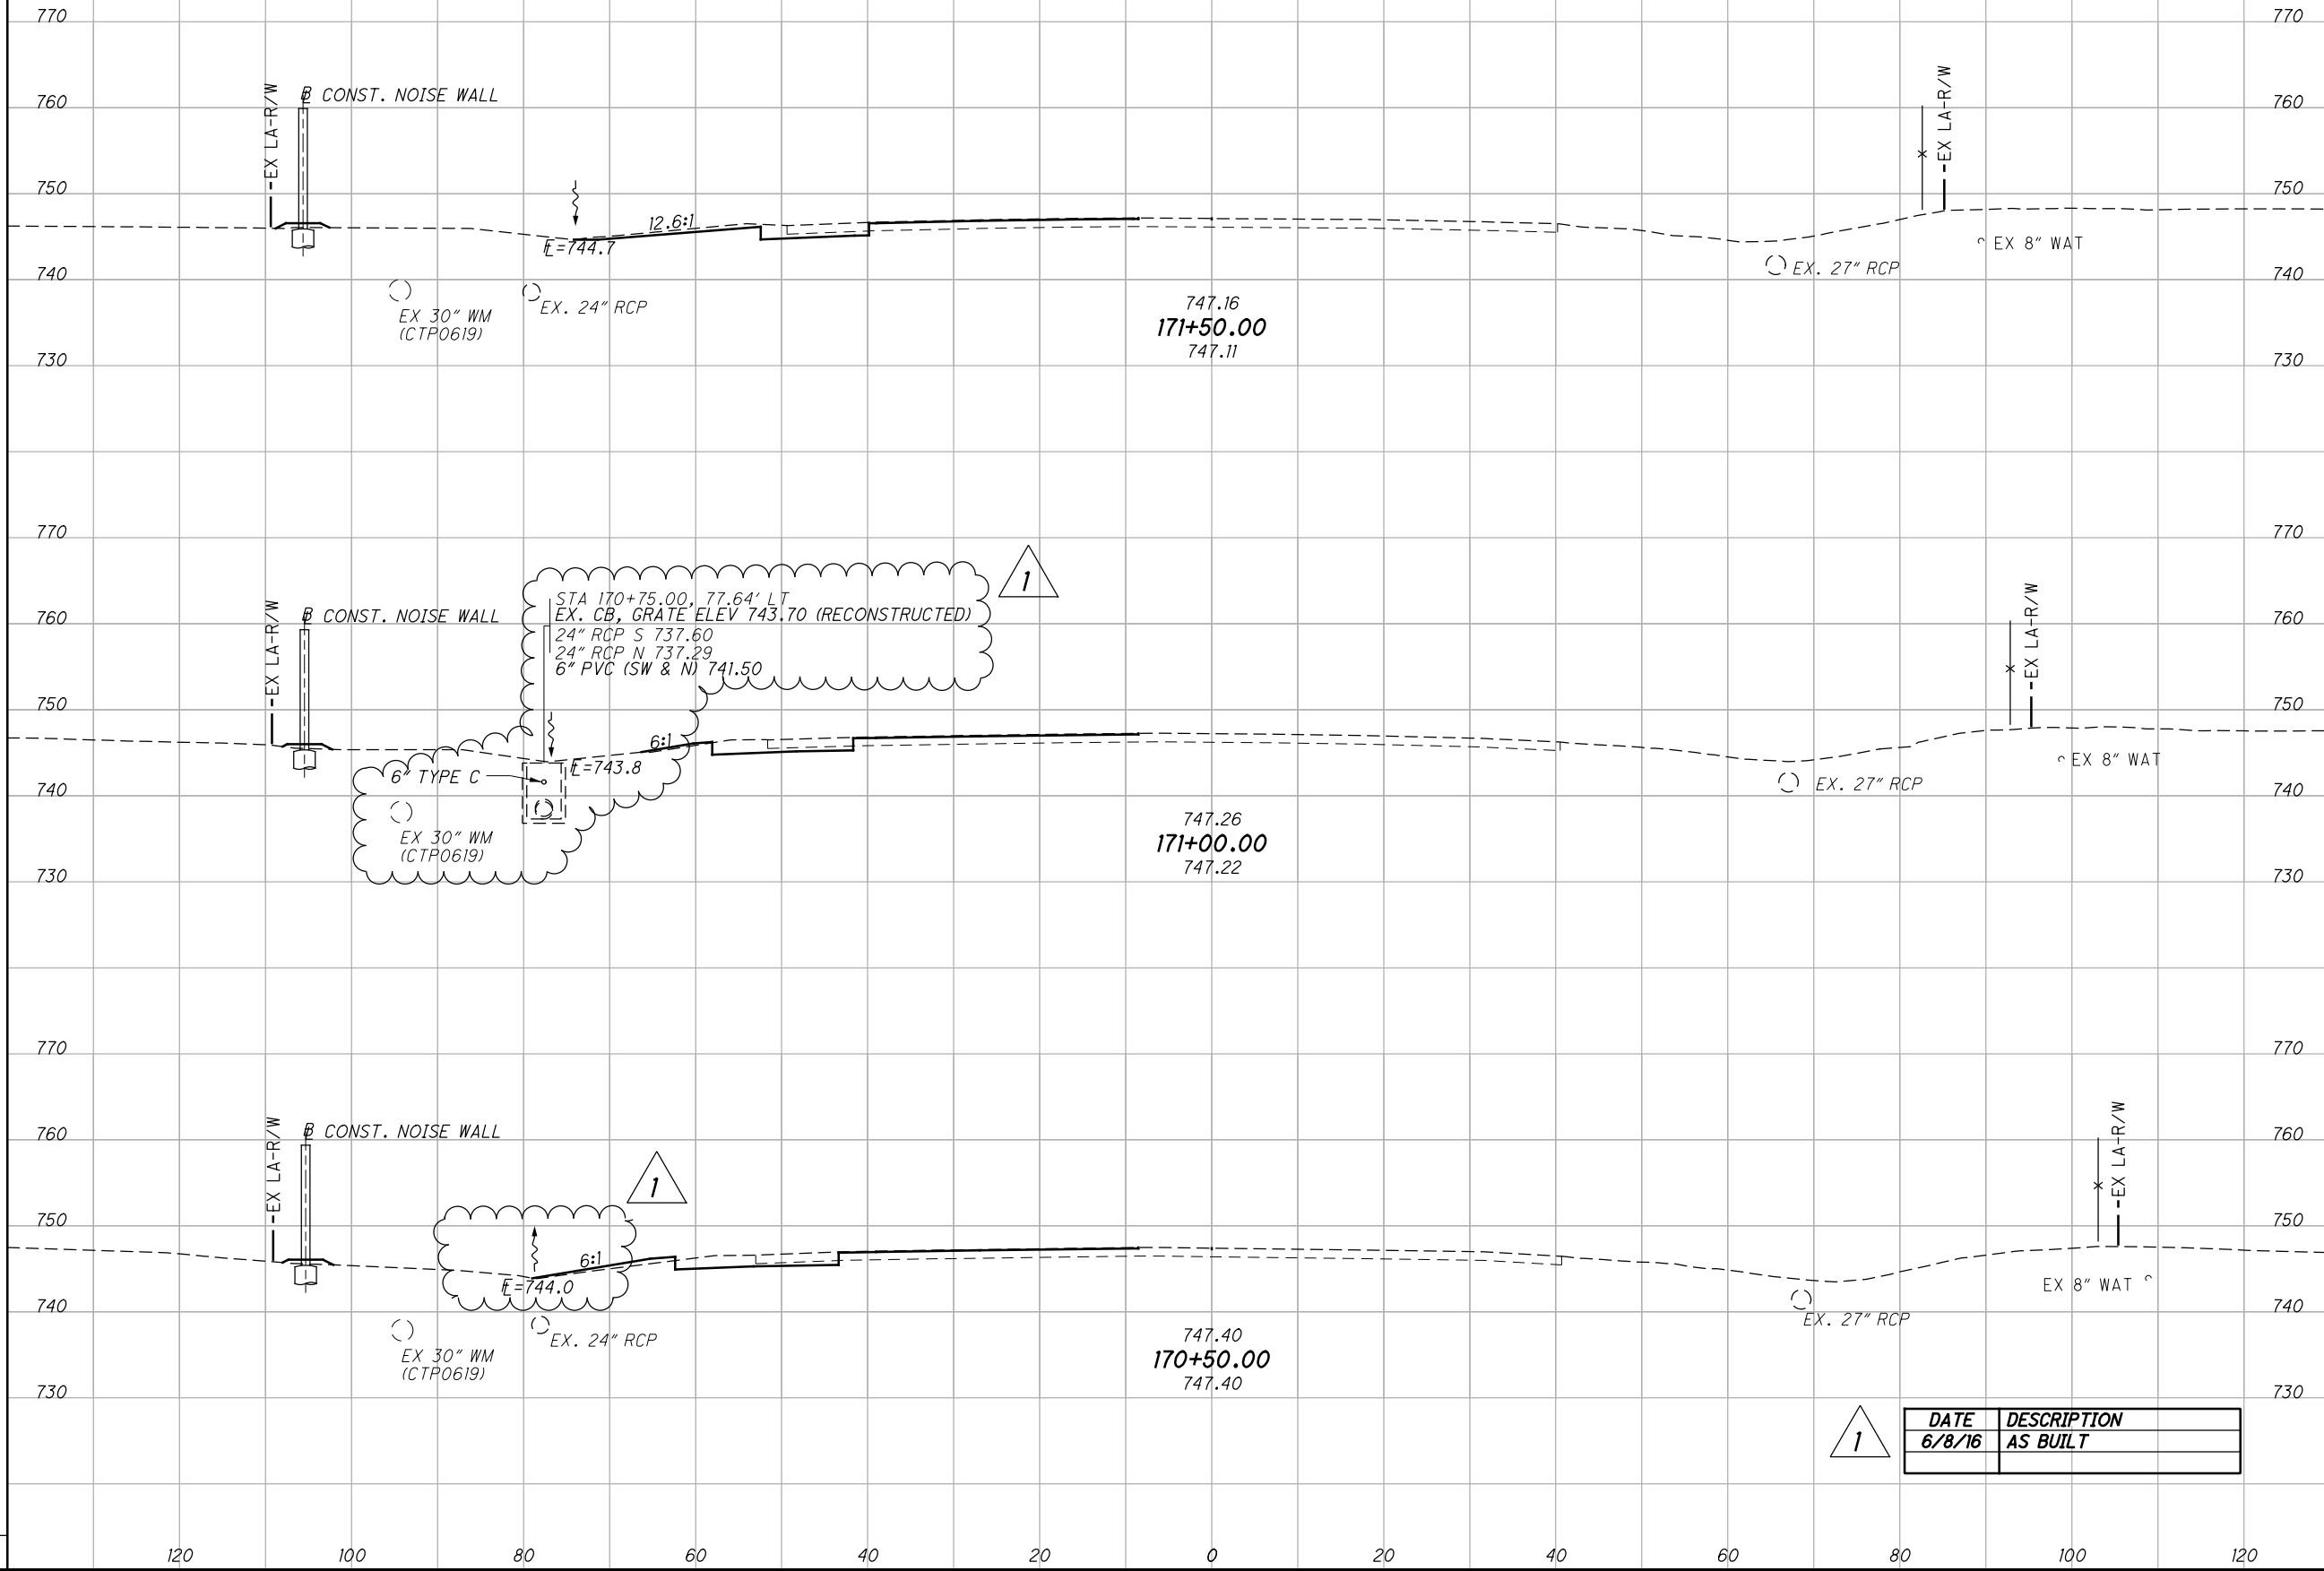

1

STA 170+75.00, 77.64' LT
EX. CB, GRATE ELEV 743.70 (RECONSTRUCTED)
24" RCP S 737.60
24" RCP N 737.29
6" PVC (SW & N) 741.50

1	DATE	DESCRIPTION
	6/8/16	AS BUILT

BU 4, 5, 6, 7, & 8 - RELEASED FOR CONSTRUCTION - 11/03/2014 - 11/19/2015

CROSS SECTIONS ALUM CREEK DR.
STA. 170+50.00 TO STA. 171+50.00


FRA - 270 - 49.00

49
182

AS BUILT - 4/22/2016

C:\projects\2014\W-14-039_FRA-270-49.00\83988\roadway\sheets\83988X5007.dgn 5/23/2016 7:30:56 AM kevinj

SEEDING	
END WIDTH	SO. YDS.

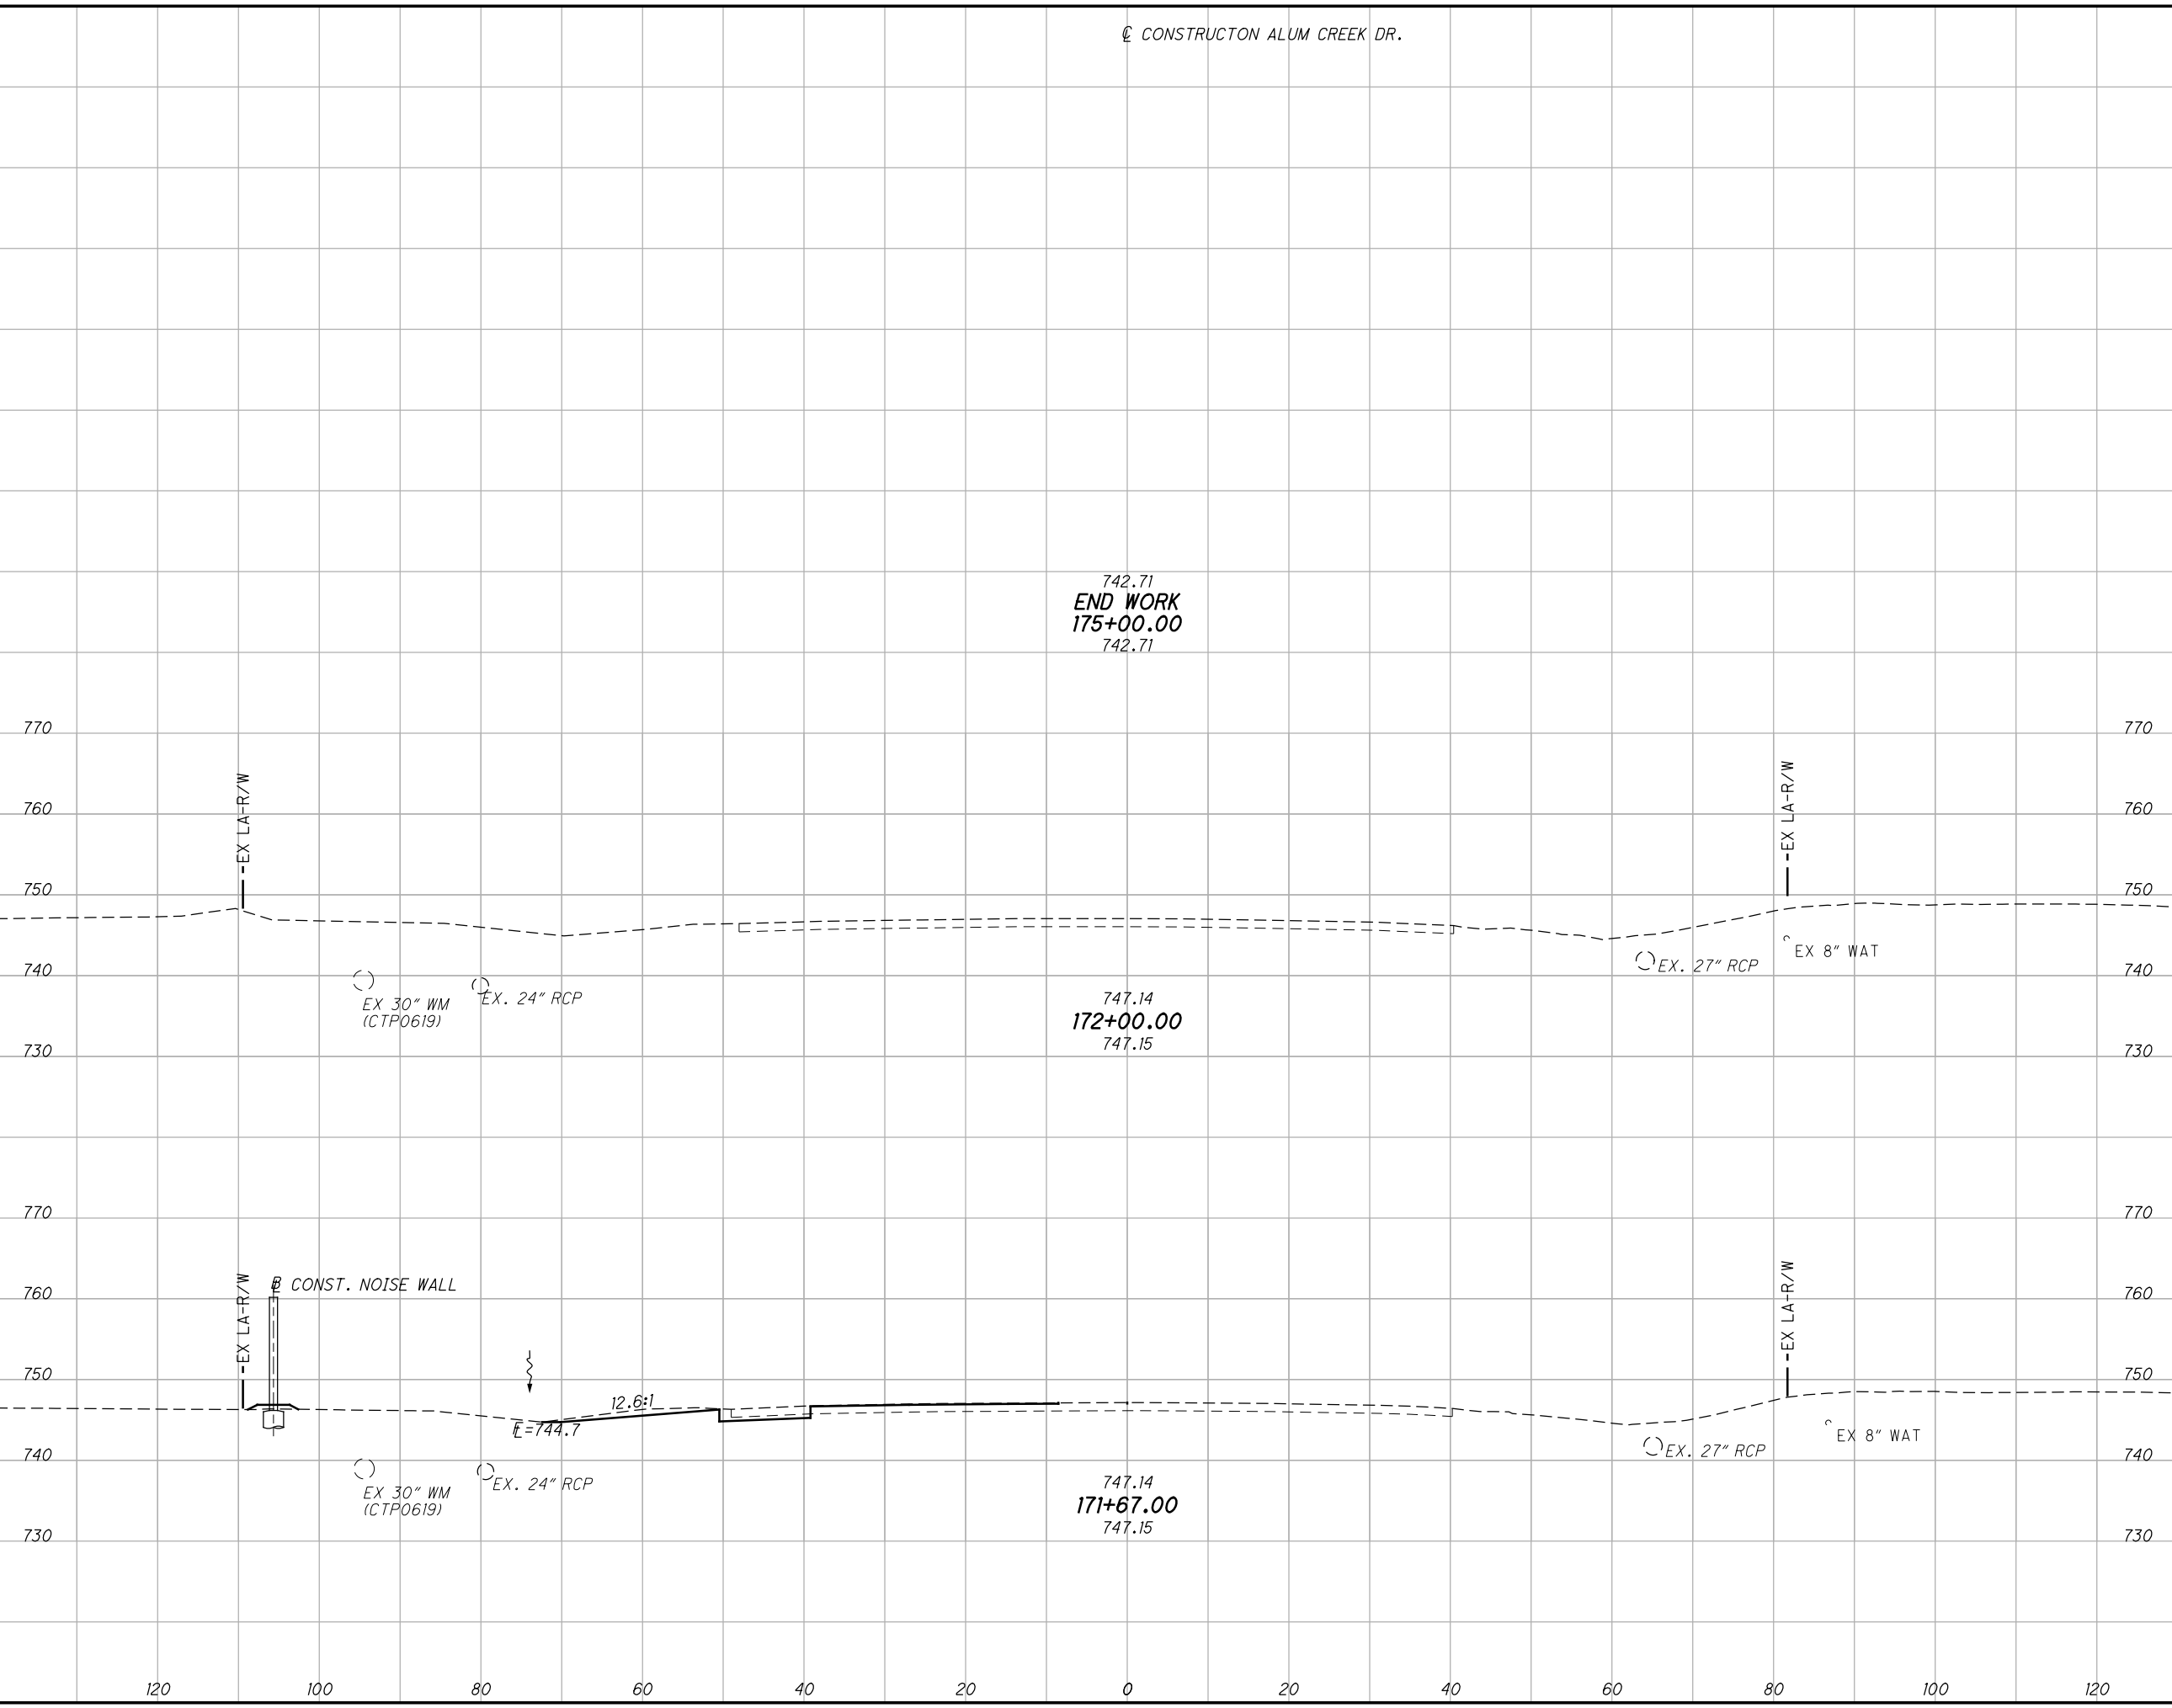

CONSTRUCTON ALUM CREEK DR.

END AREA		VOLUME		CALCULATED CFR	CHECKED SSK
CUT	FILL	CUT	FILL		

BU 4, 5, 6, 7, & 8 - RELEASED FOR CONSTRUCTION - 11/03/2014 - 11/19/2015


CROSS SECTIONS ALUM CREEK DR.
STA. 171+67.00 TO STA. 172+00.00

FRA - 270 - 49.00

50
182

AS BUILT - 4/22/2016

G:\projects\2014\W-14-039 FRA-270-49.00\83988\roadway\sheets\83988GP014_Rev.dgn 5/23/2016 7:30:58 AM kevinj

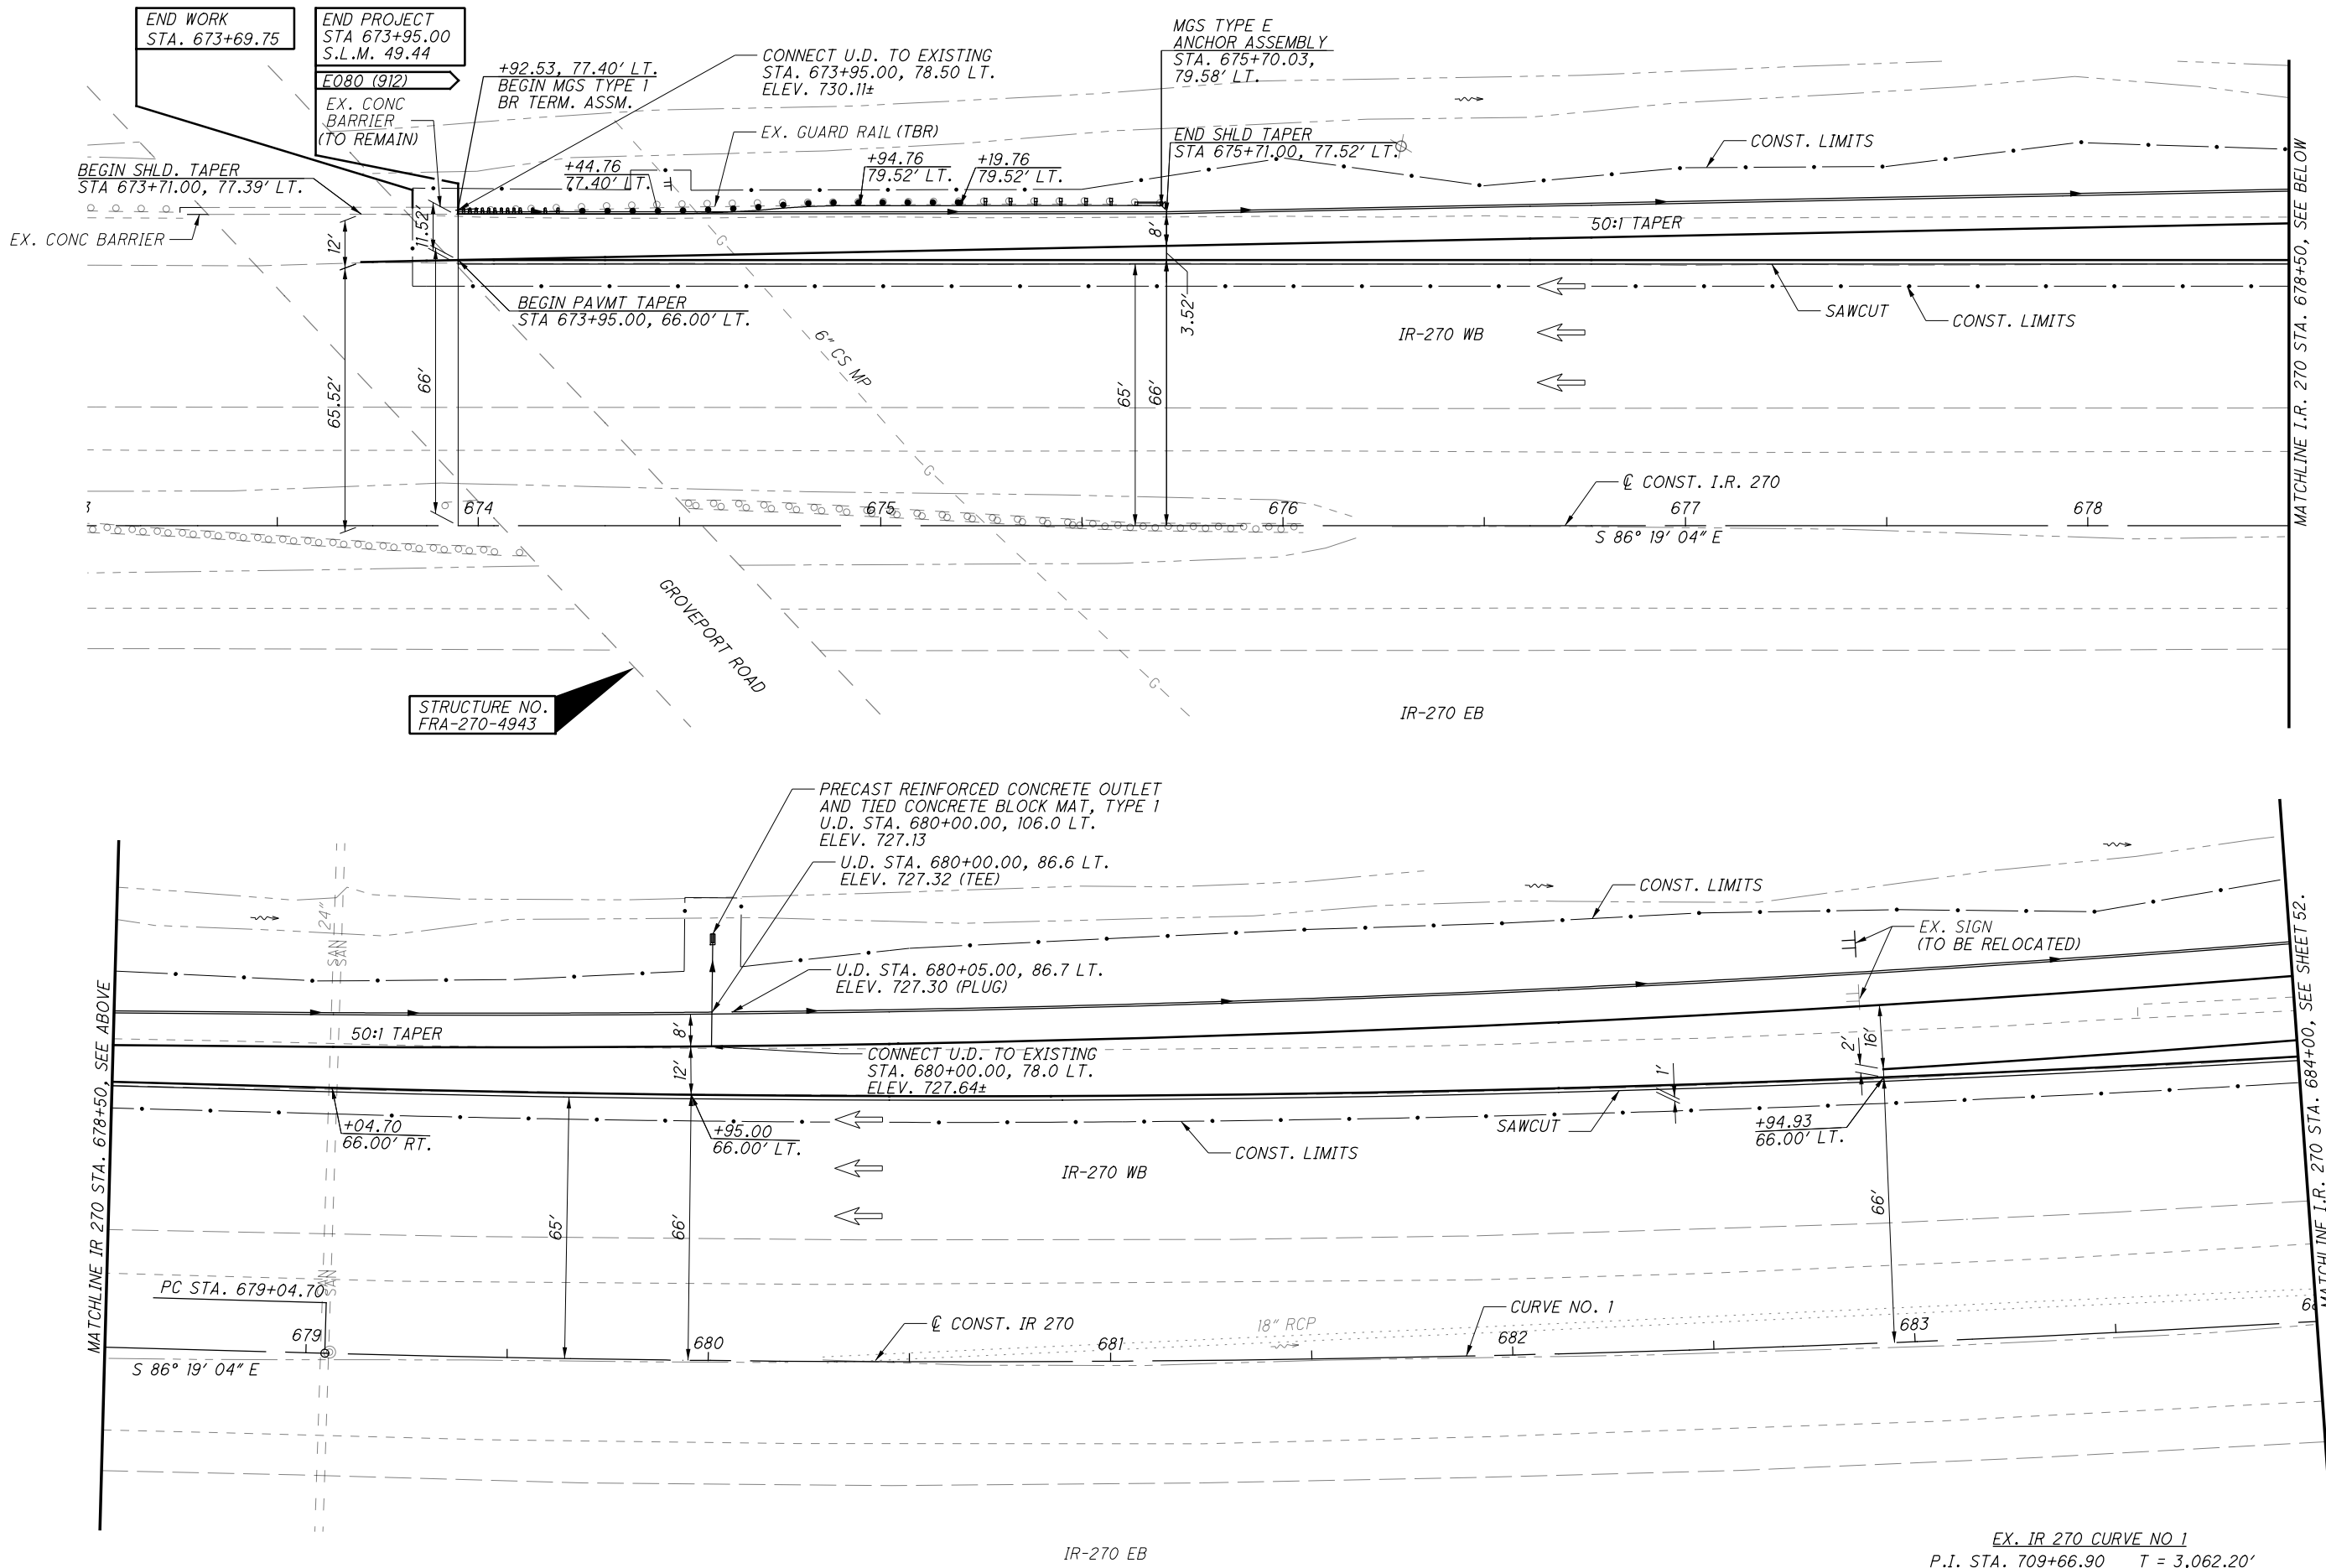

MATCHLINE IR 270 STA. 678+50, SEE ABOVE

MATCHLINE I.R. 270 STA. 678+50, SEE BELOW

MATCHLINE I.R. 270 STA. 684+00, SEE SHEET 52.

STRUCTURE NO.
FRA-270-4943

EX. IR 270 CURVE NO 1
 P.I. STA. 709+66.90 T = 3,062.20'
 $\Delta = 56^\circ 14' 42''$ (LT) L = 5,624.50'
 Dc = 1° 00' 00" E = 766.97'
 R = 5,729.58' $e_{max} = 0.032$



CALCULATED
CFR
CHECKED
SSK

BU 4, 5, 6, 7, & 8 - RELEASED FOR CONSTRUCTION - 11/03/2014 - 11/19/2015

IR 270 PLAN


STA. 673+50.00 TO STA. 684+00.00

FRA - 270 - 49.00


AS BUILT - 4/22/2016

5/23/2016 7:30:58 AM kevinj

G:\projects\2014\W-14-039_FRA-270-49.00\83988\roadway\sheets\83988\F015_Rev.dgn

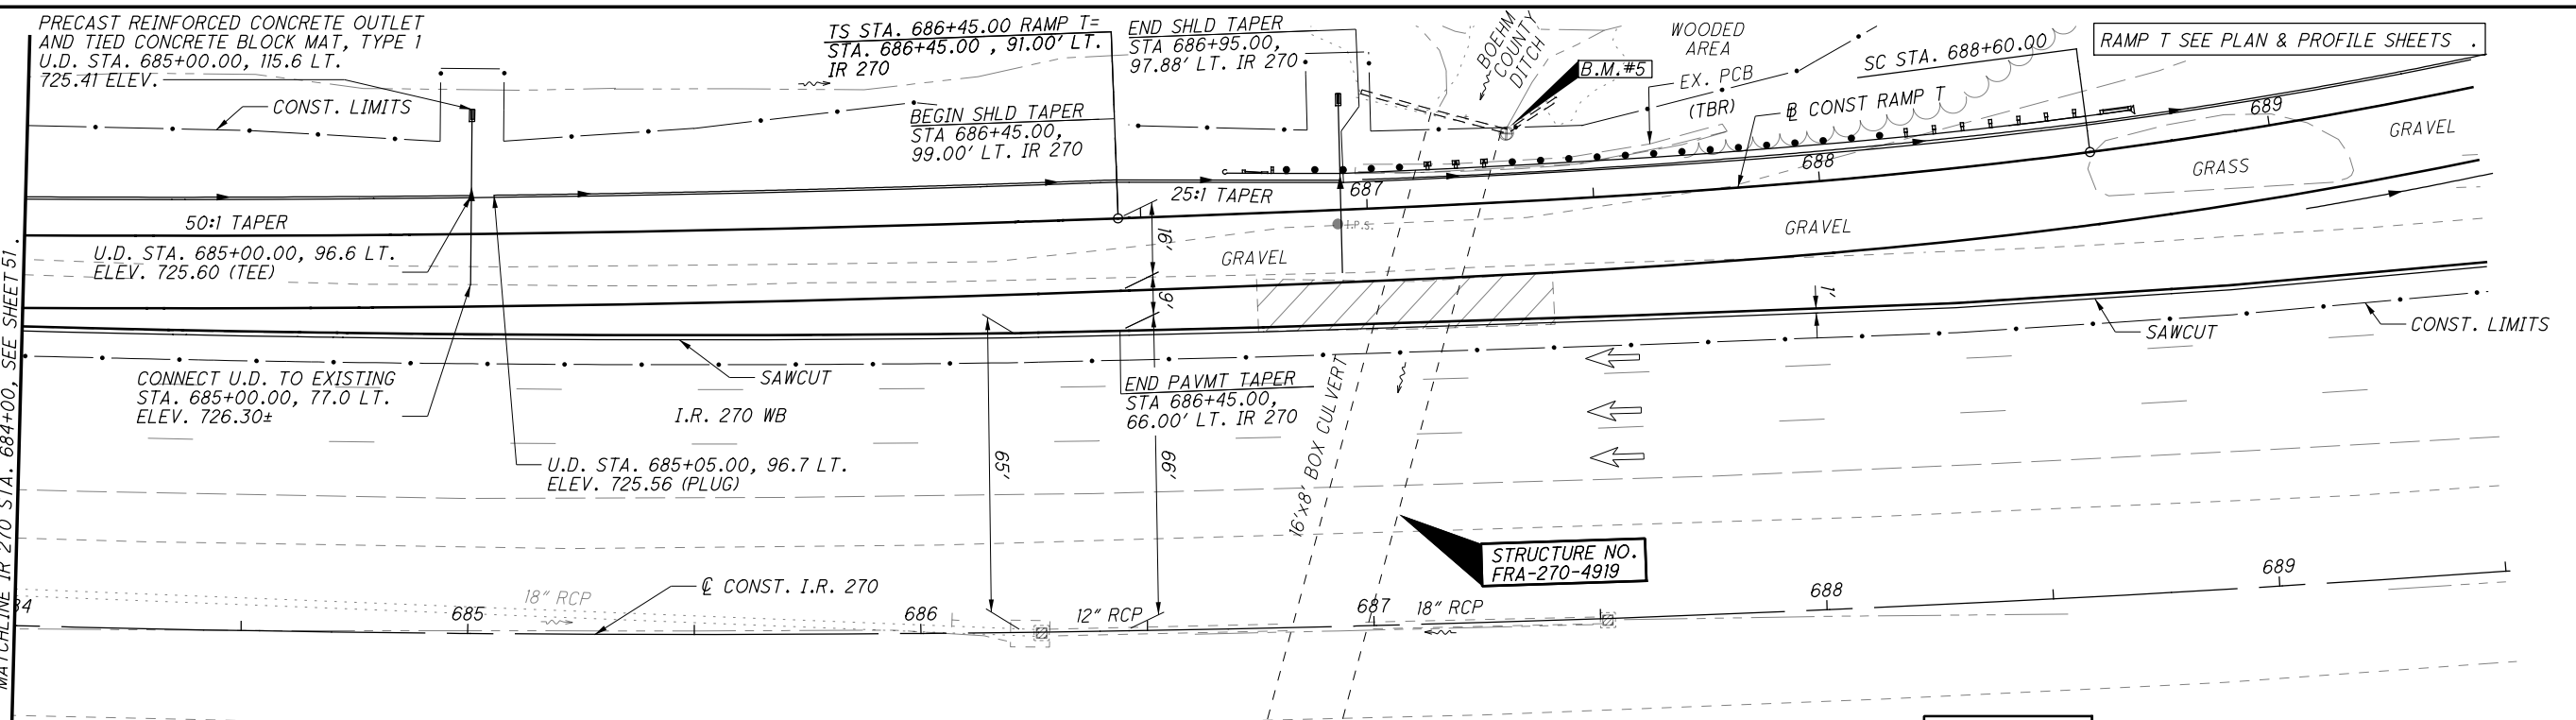

LEGEND
 [Hatched Box] EX. CONCRETE SLAB TO REMAIN

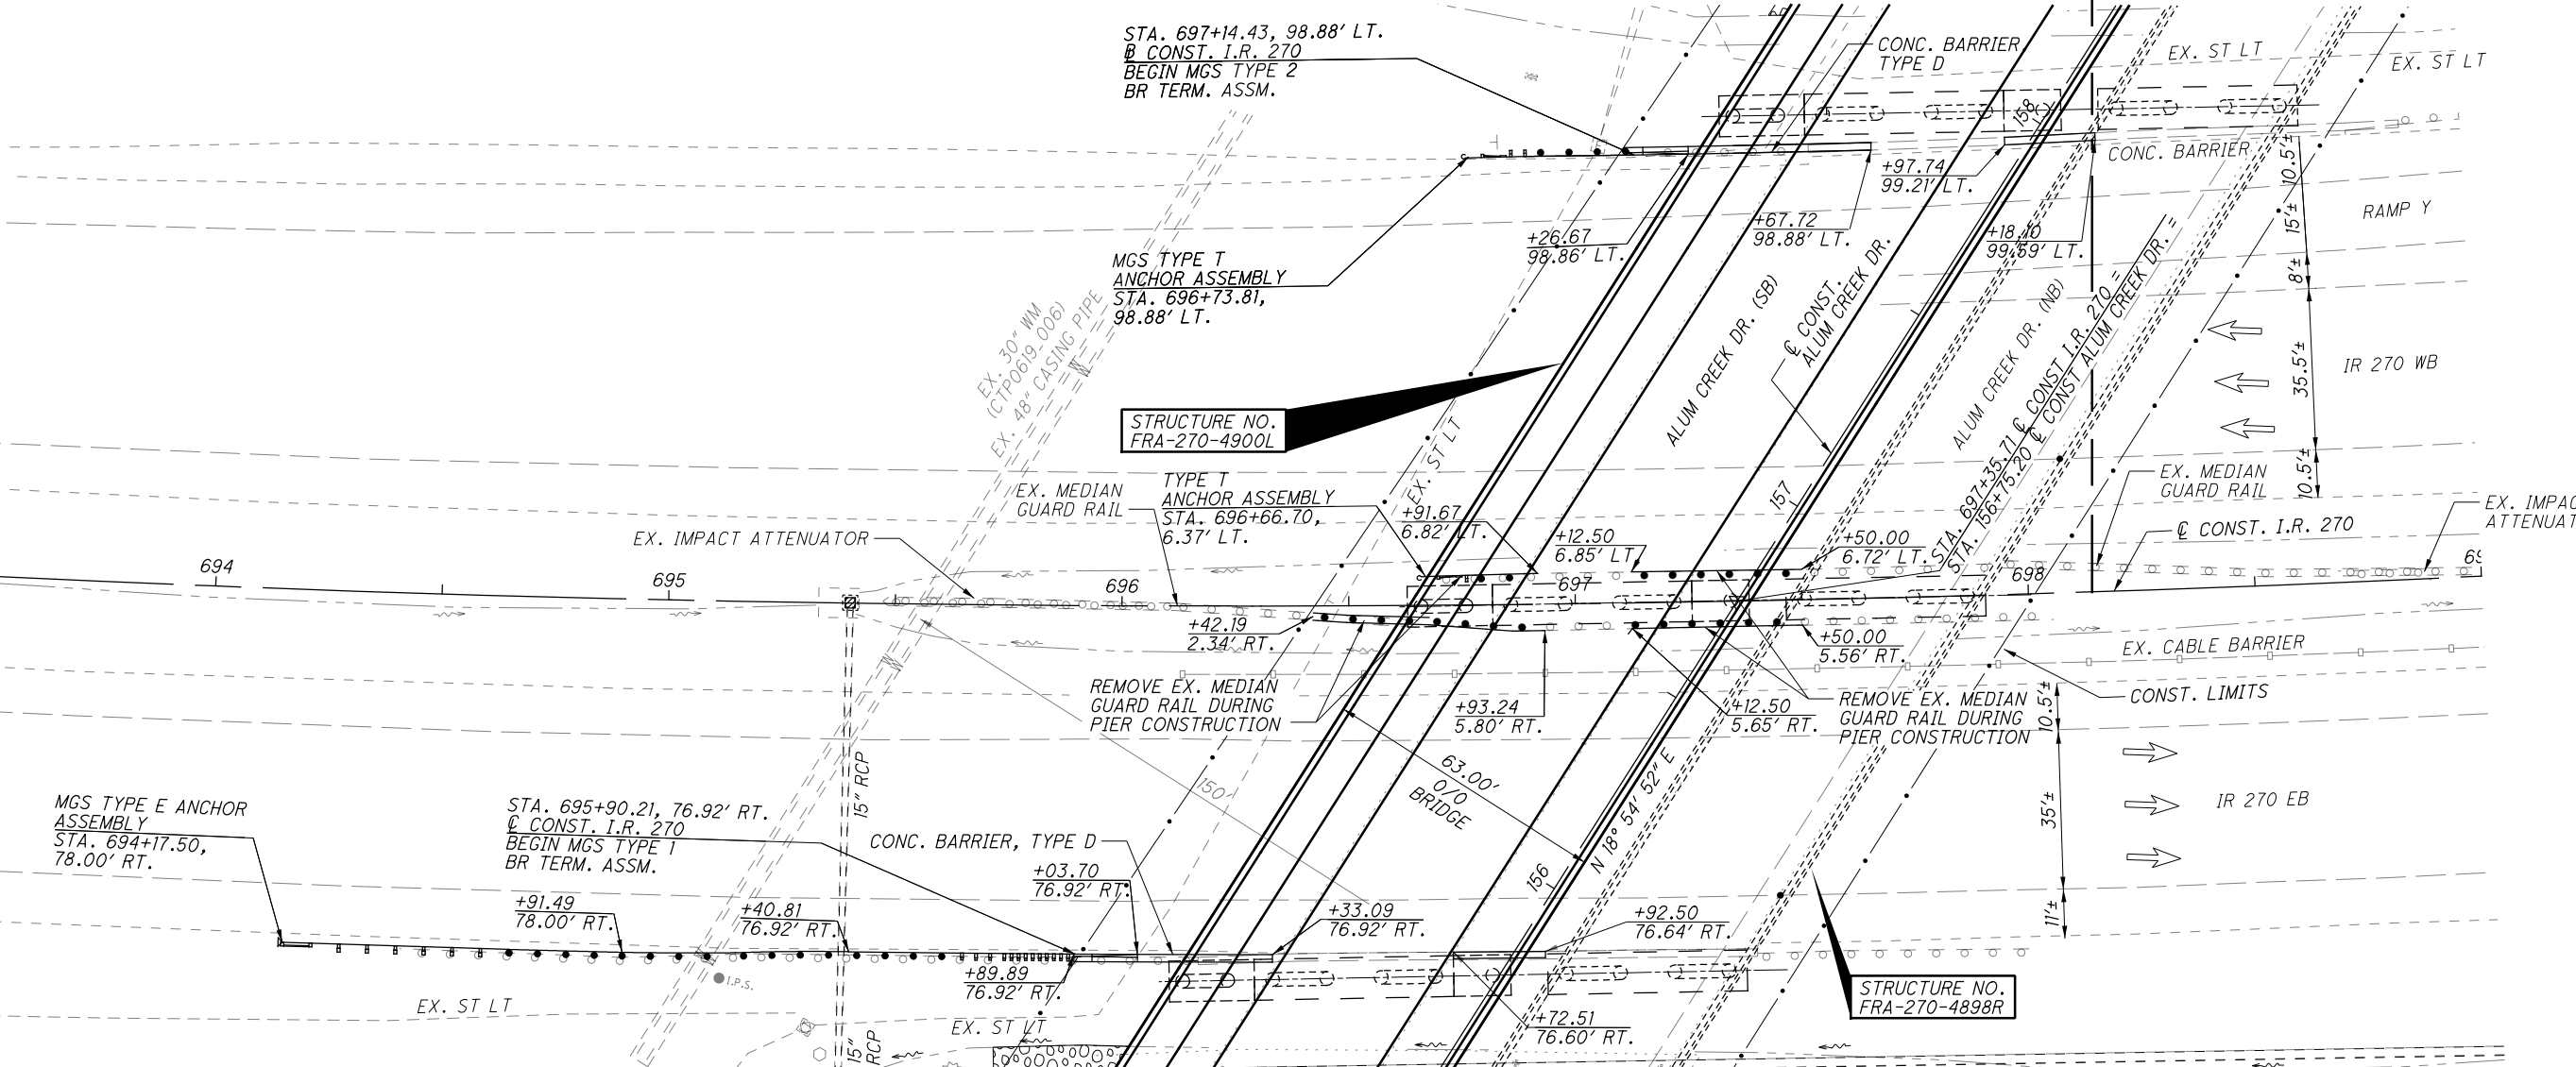

BU 4.5, 6.7, & 8 - RELEASED FOR CONSTRUCTION - 11/03/2014 - 11/19/2015

IR 270 PLAN
STA. 684+00.00 TO STA. 699+00.00


FRA-270-49.00

52
182

AS BUILT - 4/22/2016

G:\projects\2014\W-14-039_FRA-270-49.00\83988\roadway\sheets\83988X5005.dgn 5/23/2016 7:31:00 AM kevinj

SEEDING	
END WIDTH	SO. YDS.

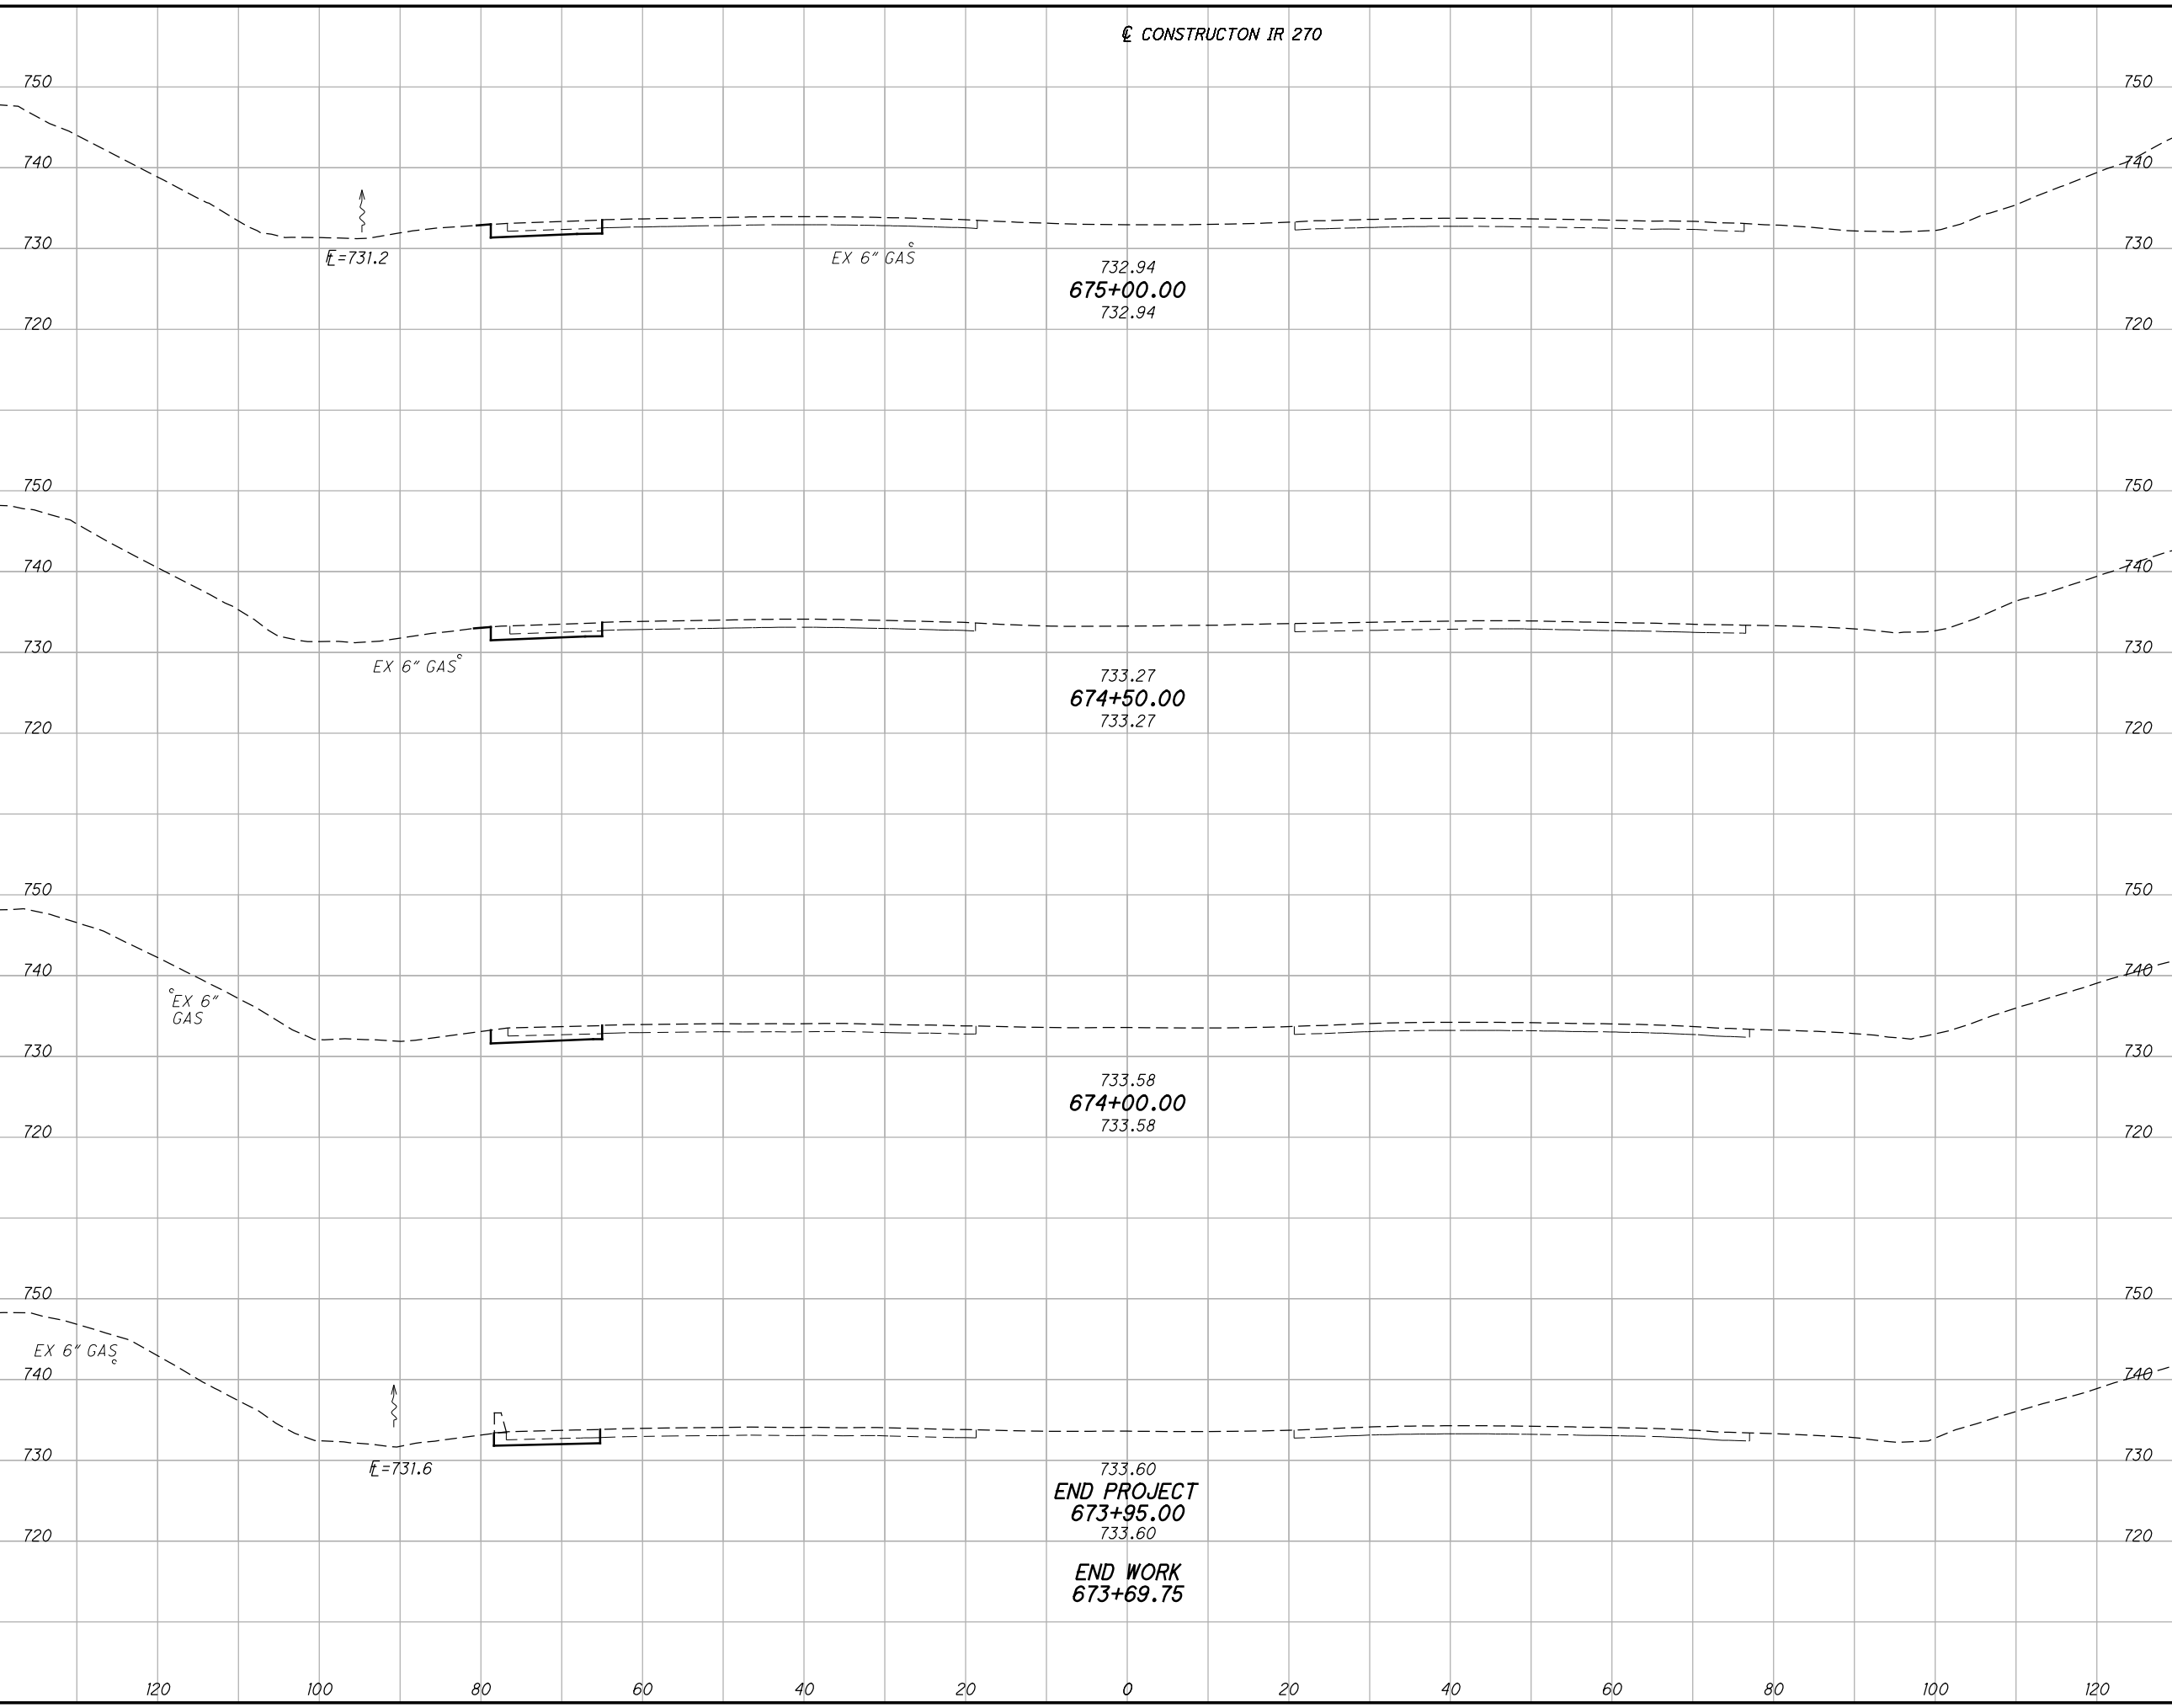

END AREA		VOLUME	
CUT	FILL	CUT	FILL

BU 4, 5, 6, 7, & 8 - RELEASED FOR CONSTRUCTION - 11/03/2014 - 11/19/2015

CROSS SECTIONS IR 270

STA. 673+50.00 TO STA. 675+00.00

FRA - 270 - 49.00

53
182

CONSTRUCTON IR 270

732.94
675+00.00
732.94

733.27
674+50.00
733.27

733.58
674+00.00
733.58

733.60
END PROJECT
673+95.00
733.60
END WORK
673+69.75

E=731.2

EX 6" GAS

EX 6" GAS

E=731.6


EX 6" GAS

120 100 80 60 40 20 0 20 40 60 80 100 120

AS BUILT - 4/22/2016

G:\projects\2014\W-14-039_FRA-270-49.00\83988\roadway\sheets\83988X5005.dgn 5/23/2016 7:31:00 AM kevinj

SEEDING	
END WIDTH	SO. YDS.

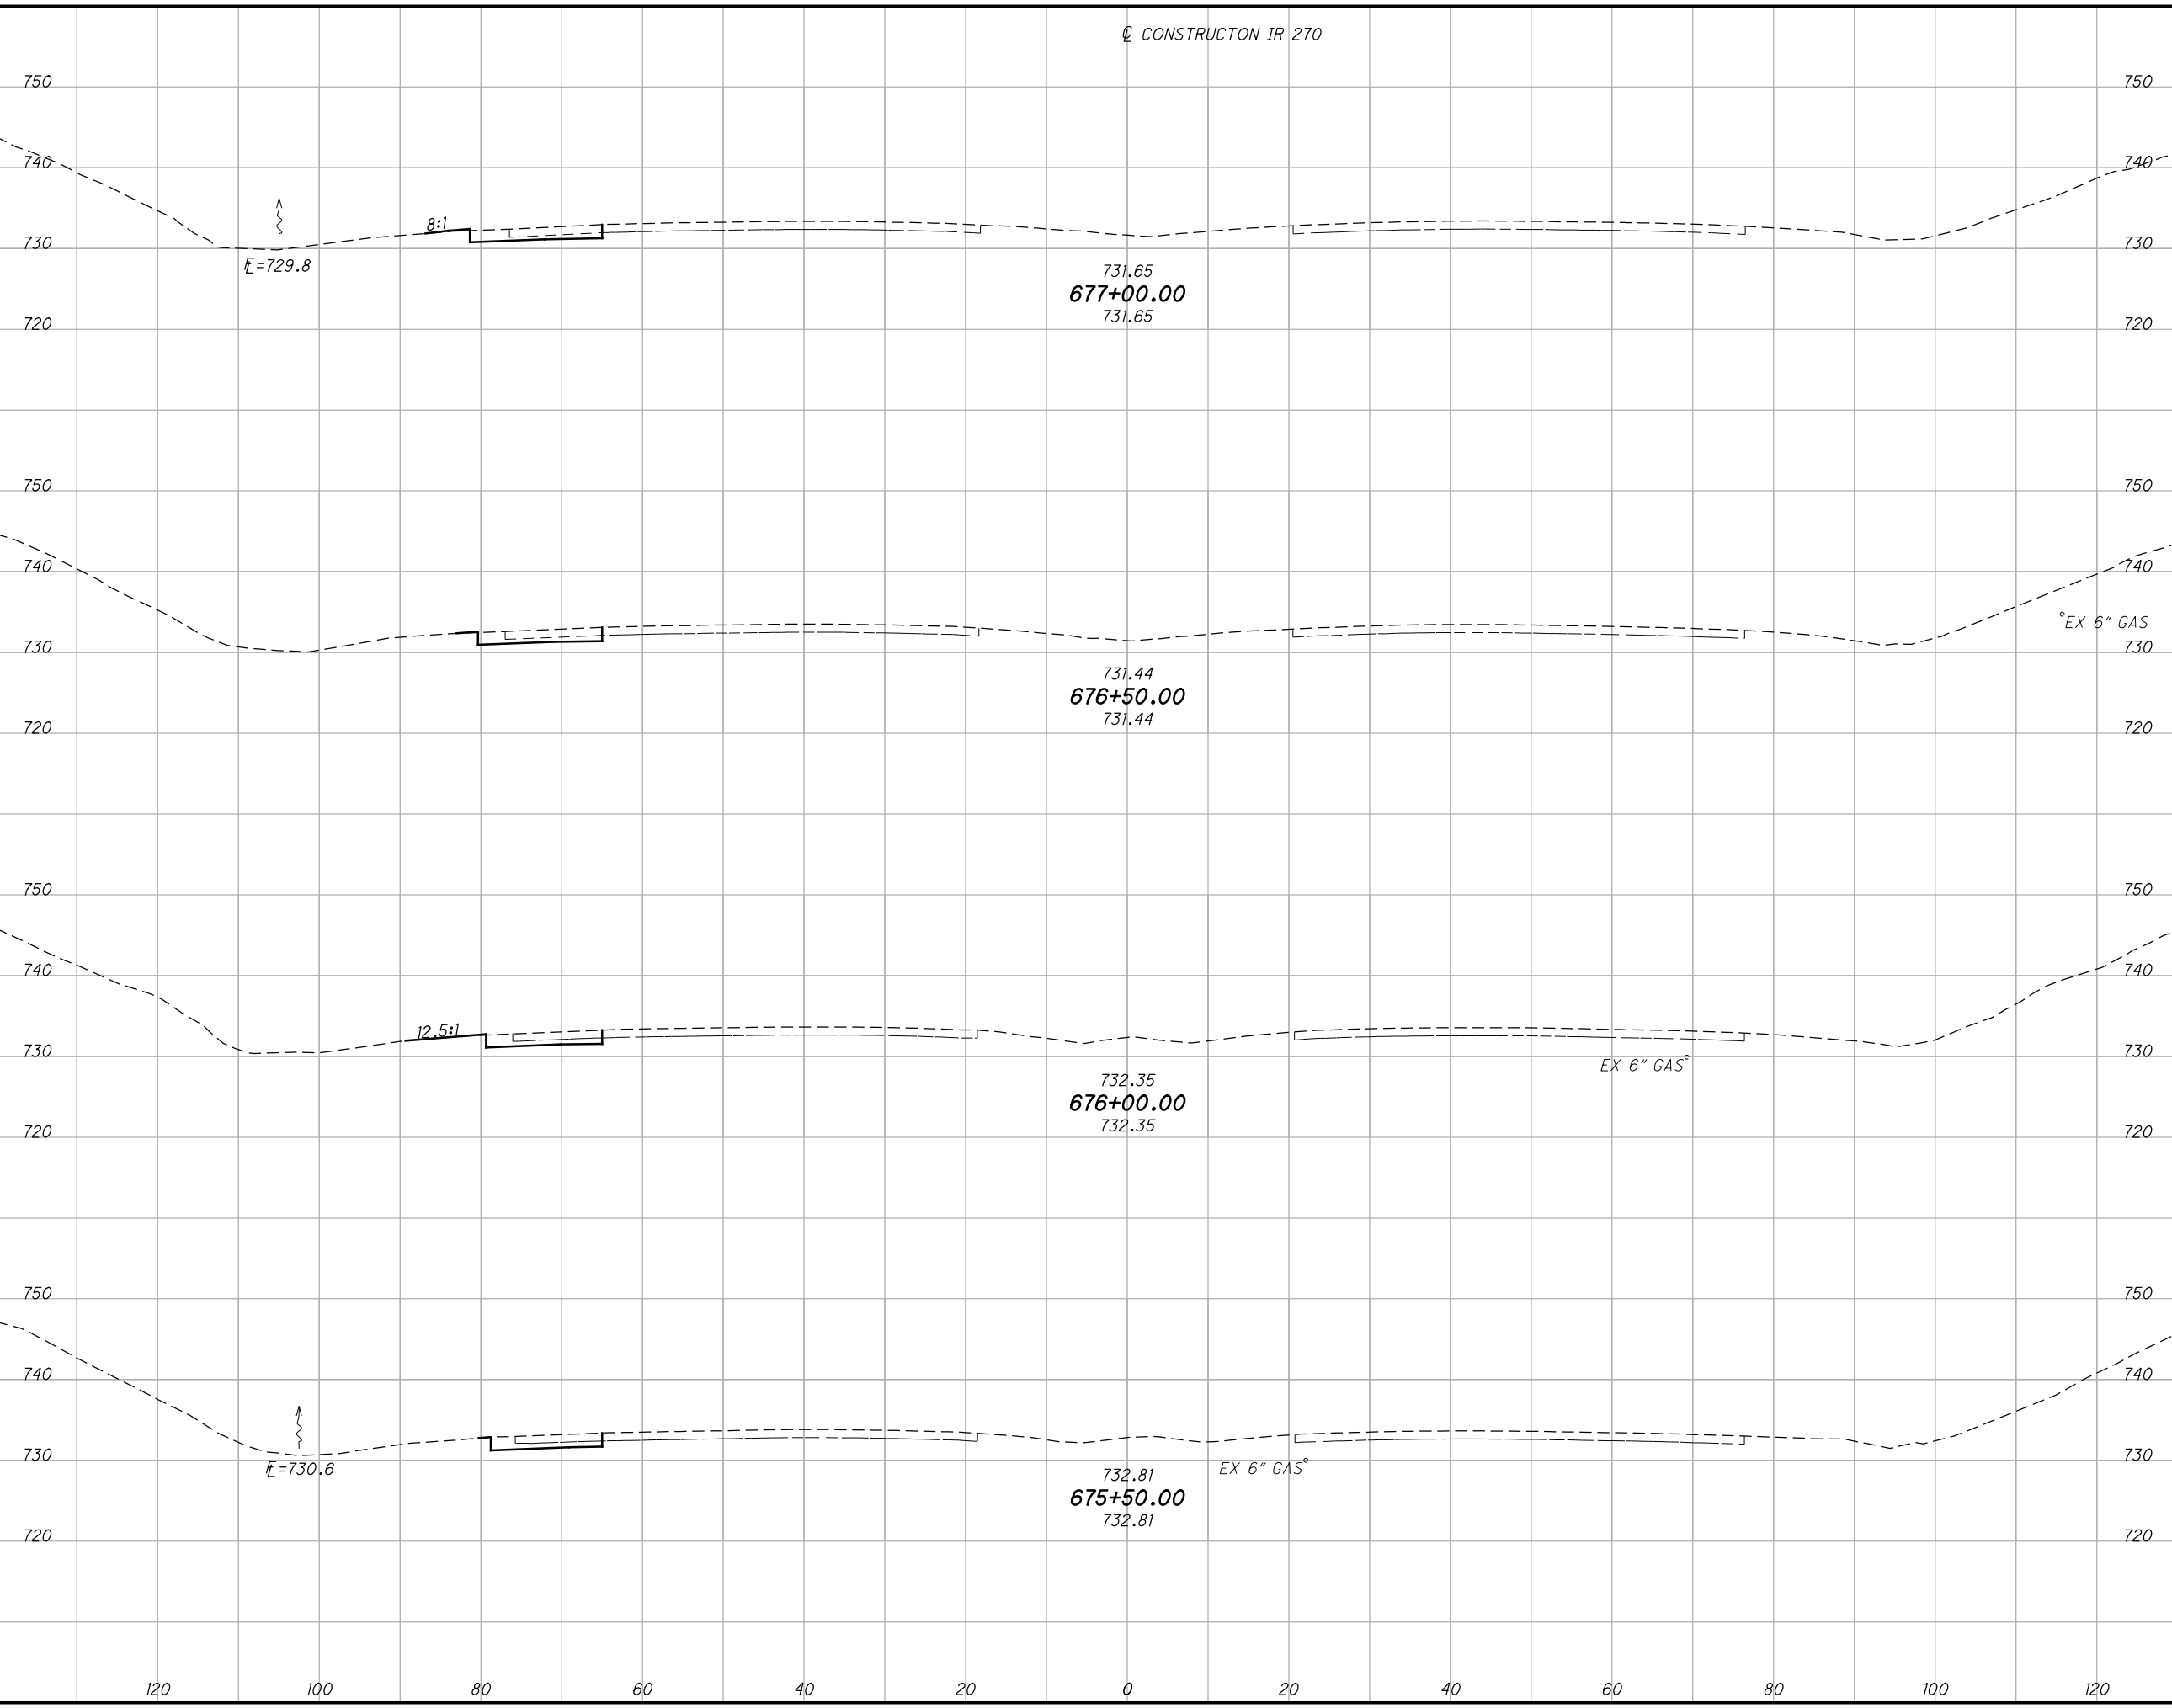

END AREA		VOLUME	
CUT	FILL	CUT	FILL

BU 4, 5, 6, 7, & 8 - RELEASED FOR CONSTRUCTION - 11/03/2014 - 11/19/2015

CROSS SECTIONS IR 270

STA. 675+50.00 TO STA. 677+00.00


FRA - 270 - 49.00

54
182

AS BUILT - 4/22/2016

C:\projects\2014\W-14-039_FRA-270-49.00\83988\roadway\sheets\83988X5005.dgn 5/23/2016 7:31:00 AM kevinj

SEEDING	
END WIDTH	SO. YDS.

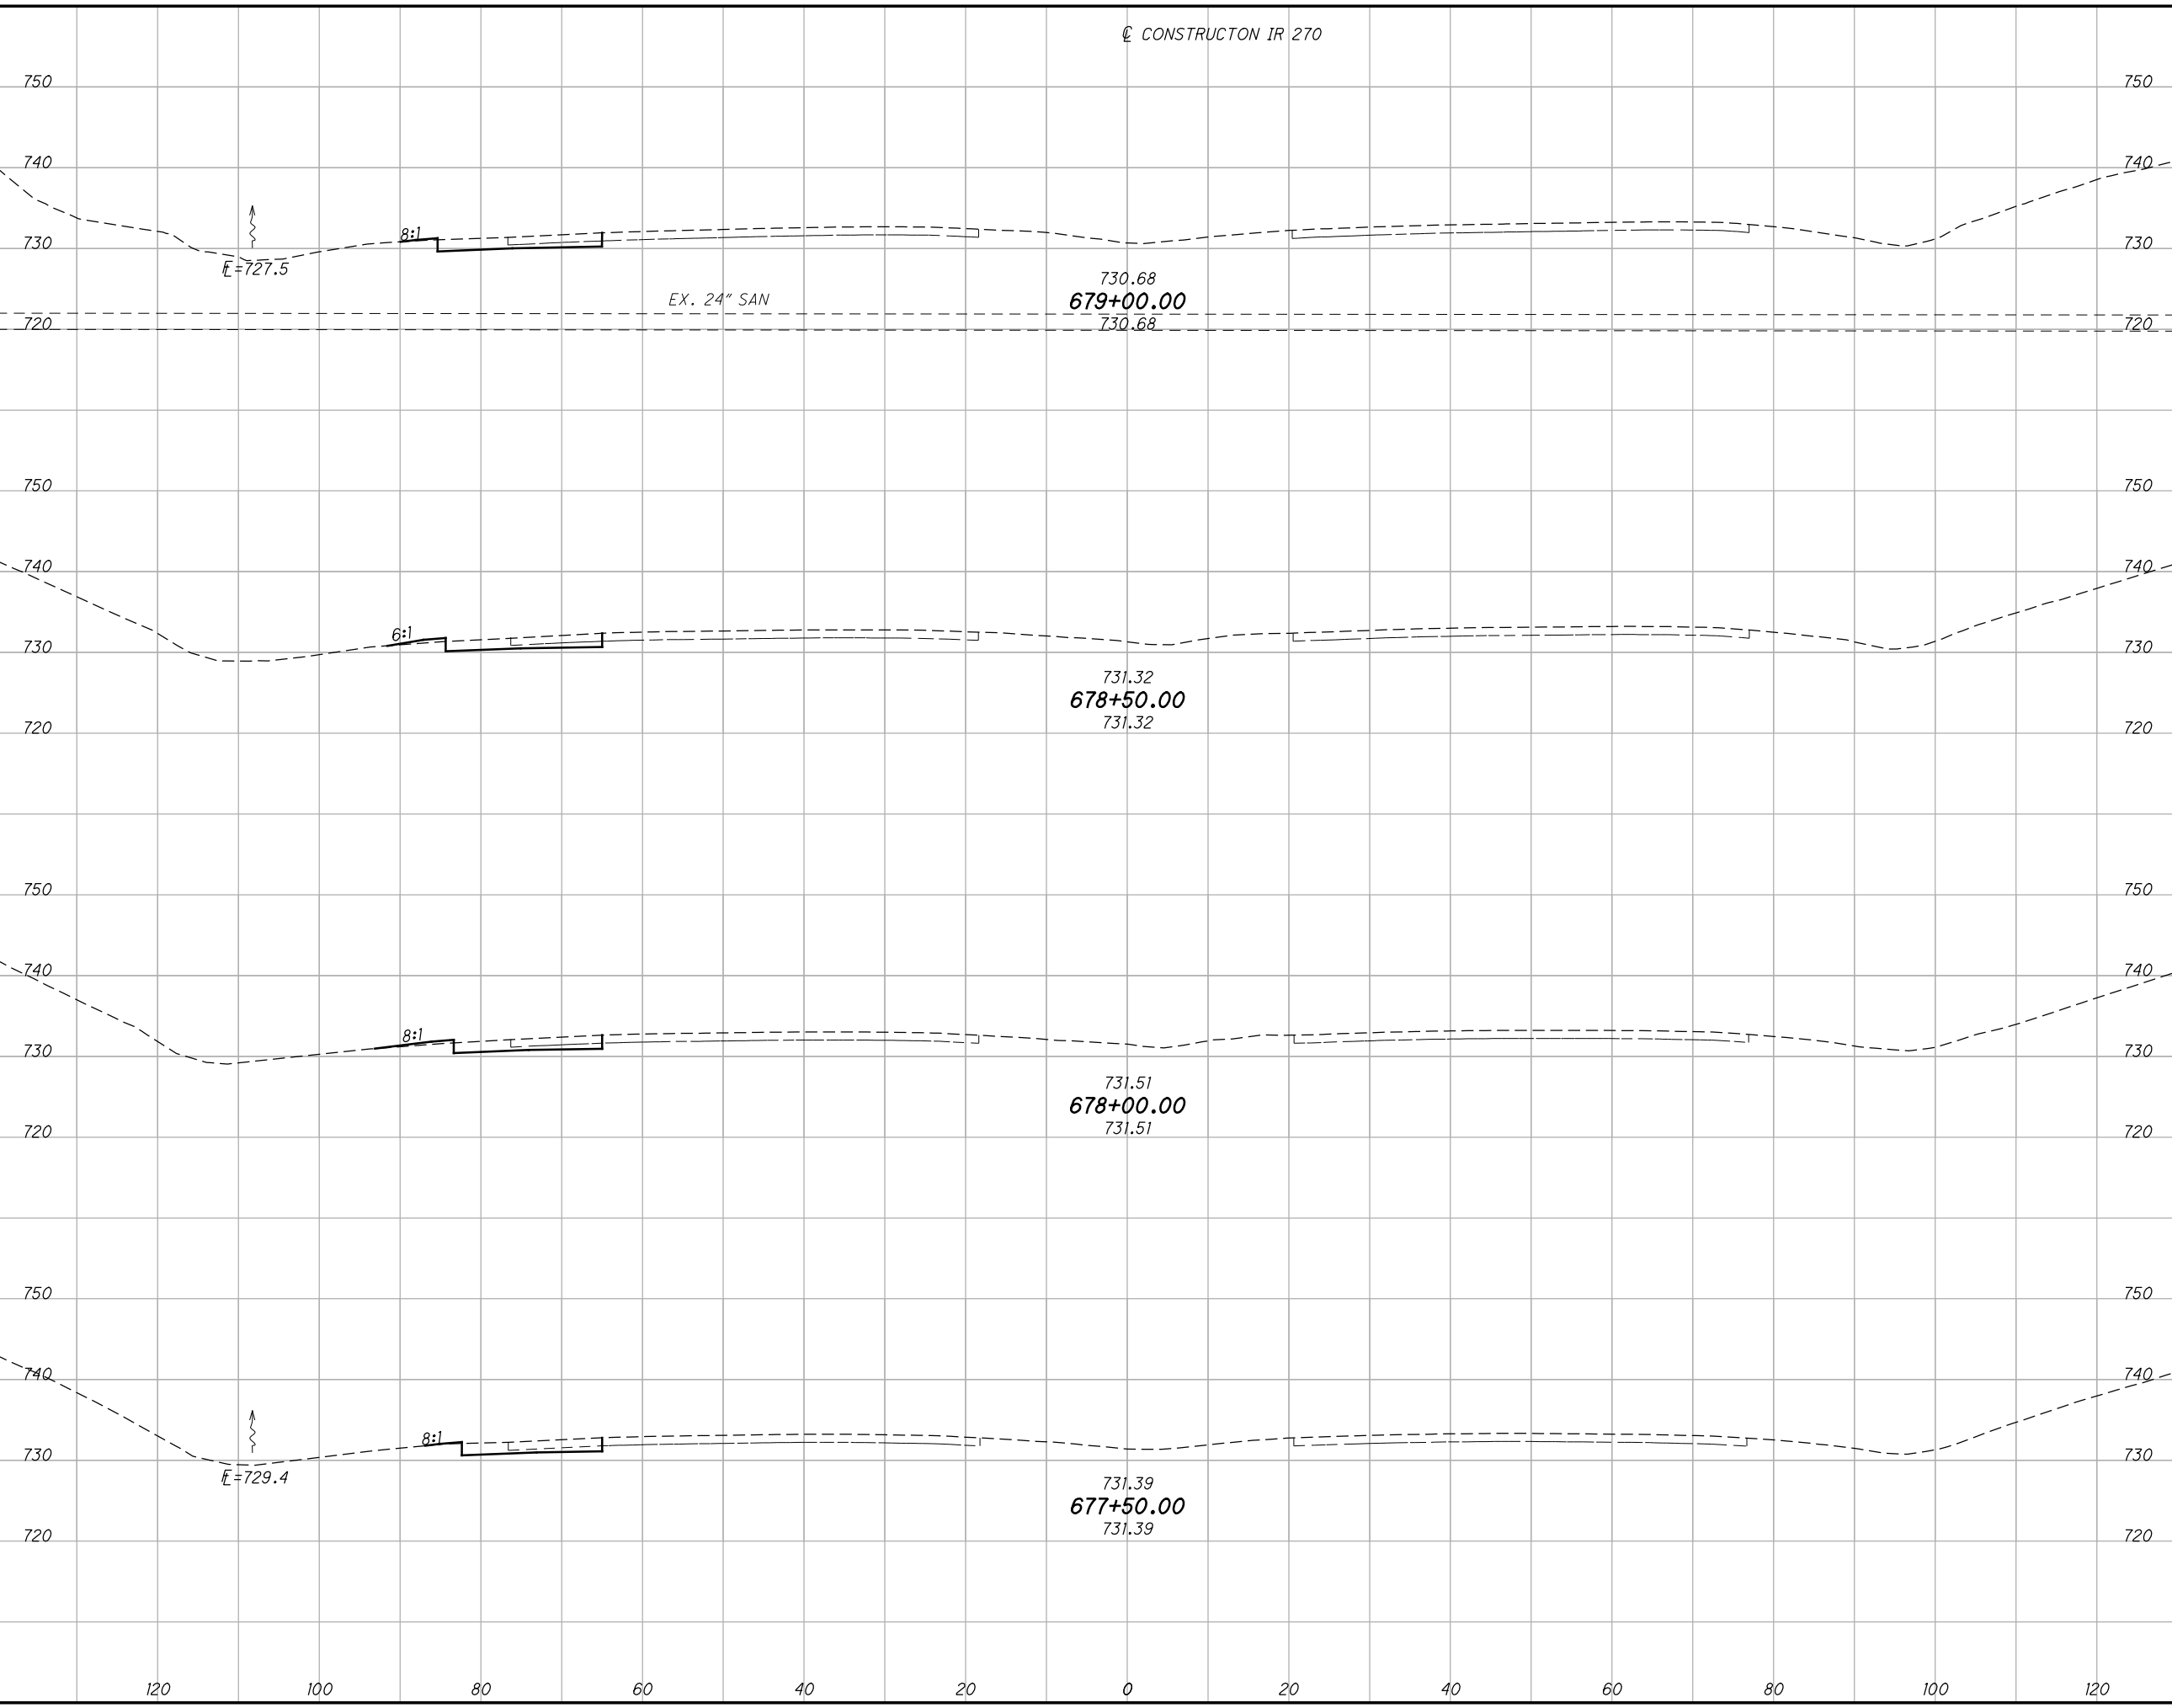

END AREA		VOLUME	
CUT	FILL	CUT	FILL

BU 4, 5, 6, 7, & 8 - RELEASED FOR CONSTRUCTION - 11/03/2014 - 11/19/2015

CROSS SECTIONS IR 270
STA. 677+50.00 TO STA. 679+00.00

FRA - 270 - 49.00


AS BUILT - 4/22/2016

G:\projects\2014\W-14-039_FRA-270-49.00\83988\roadway\sheets\83988X5005.dgn 5/23/2016 7:31:01 AM kevinj

SEEDING	
END WIDTH	SO. YDS.

CONSTRUCTON IR 270

END AREA		VOLUME		CALCULATED	
CUT	FILL	CUT	FILL	CFR	SSK

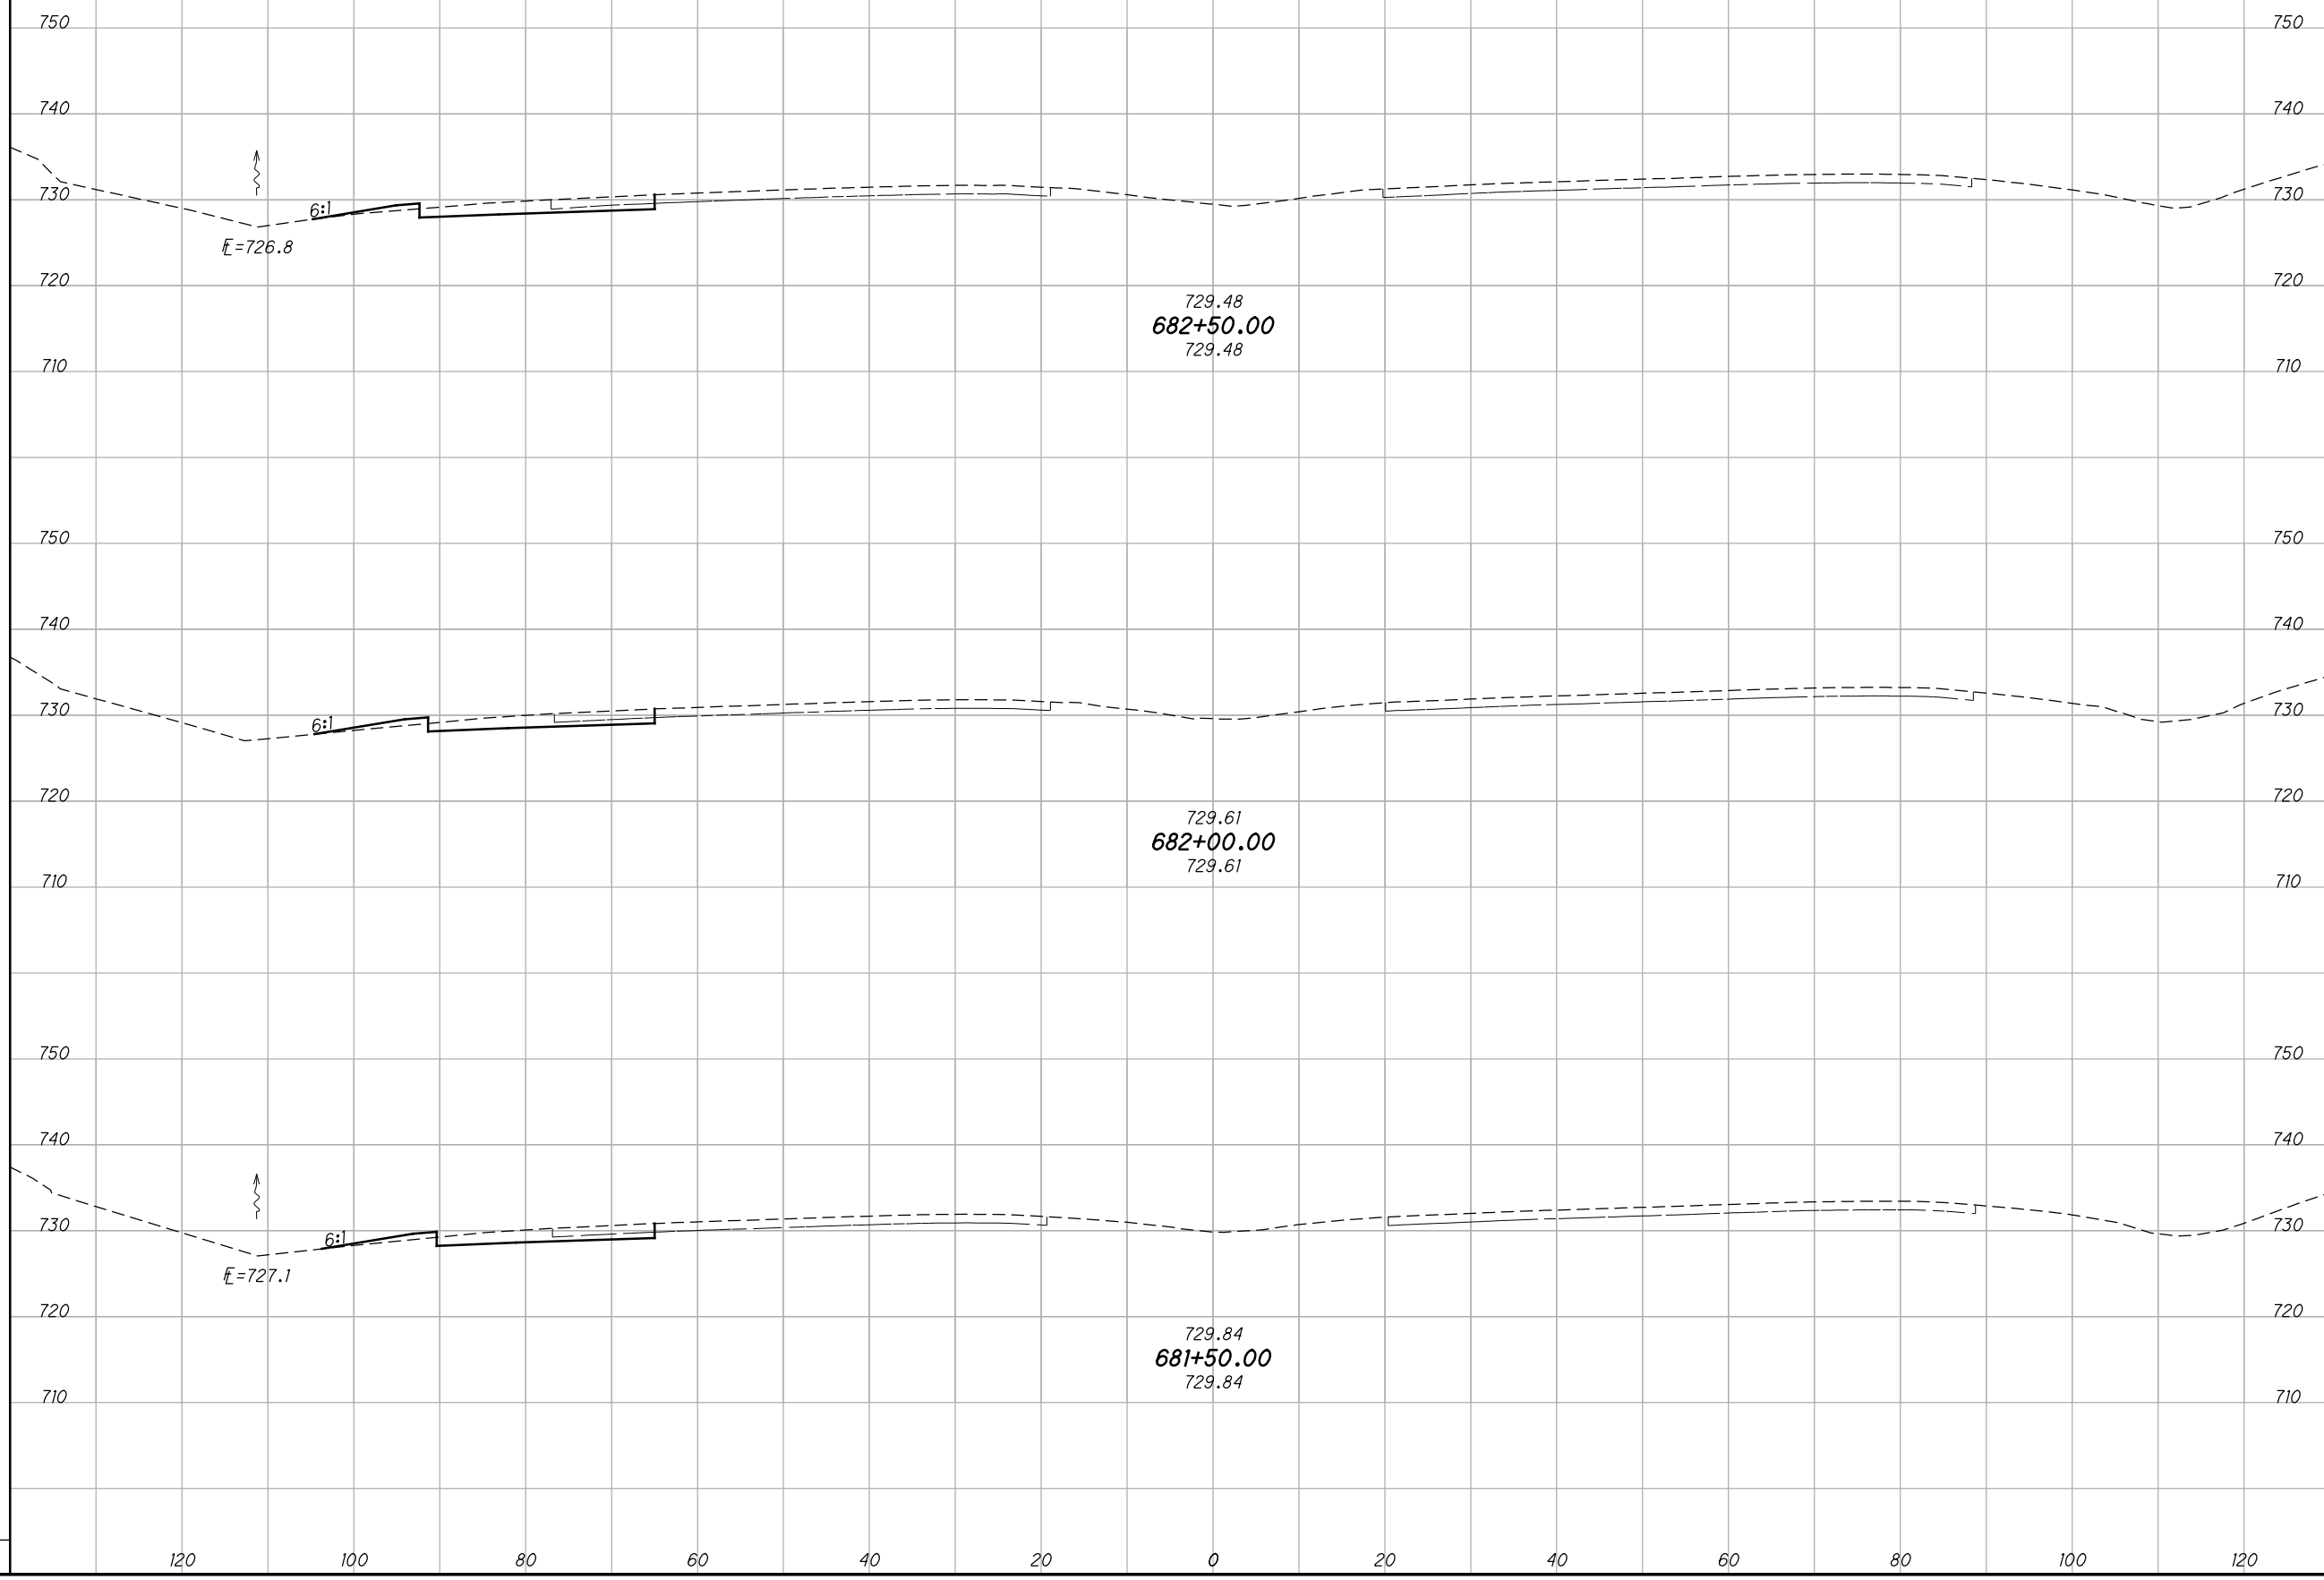

BU 4, 5, 6, 7, & 8 - RELEASED FOR CONSTRUCTION - 11/03/2014 - 11/19/2015


CROSS SECTIONS IR 270
STA. 681+50.00 TO STA. 682+50.00

FRA - 270 - 49.00

AS BUILT - 4/22/2016

C:\projects\2014\W-14-039_FRA-270-49.00\83988\roadway\sheets\83988X5005.dgn 5/23/2016 7:31:01 AM kevinj

SEEDING	
END WIDTH	SO. YDS.

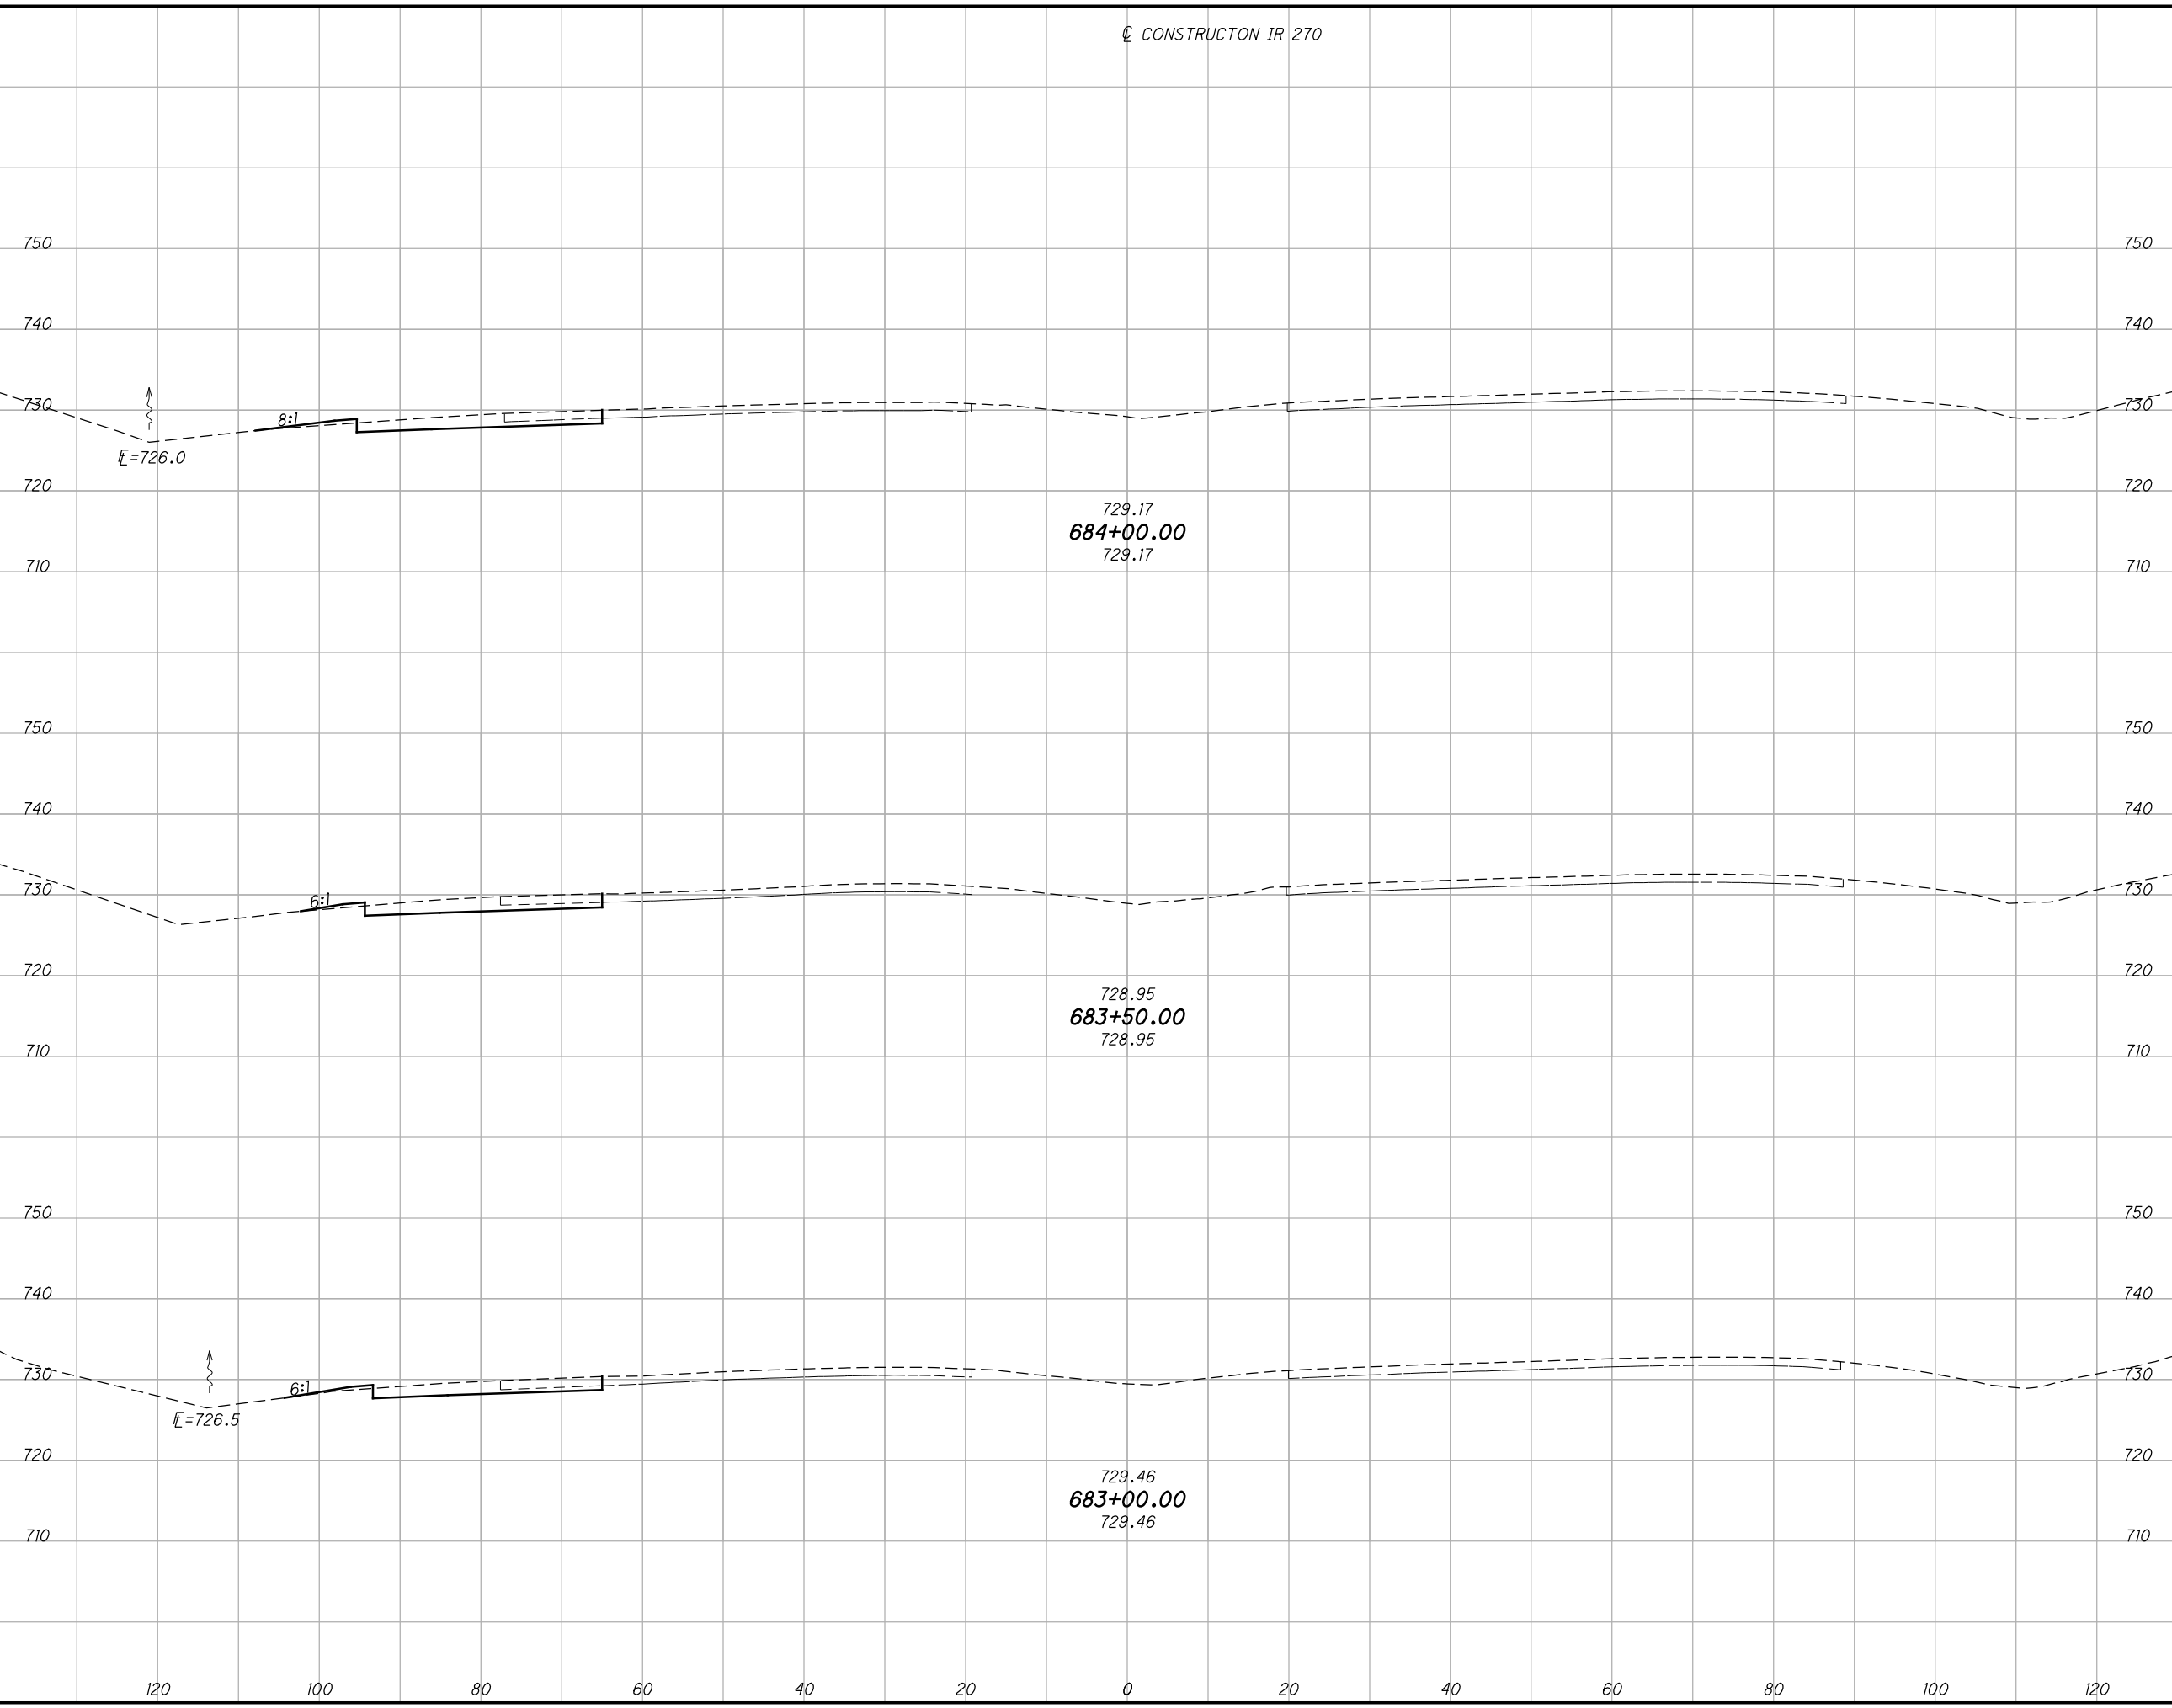

END AREA		VOLUME	
CUT	FILL	CUT	FILL

BU 4, 5, 6, 7, & 8 - RELEASED FOR CONSTRUCTION - 11/03/2014 - 11/19/2015

CROSS SECTIONS IR 270


STA. 683+00.00 TO STA. 684+00.00

FRA - 270 - 49.00

AS BUILT - 4/22/2016

C:\projects\2014\W-14-039_FRA-270-49.00\83988\roadway\sheets\83988X5005.dgn 5/23/2016 7:31:02 AM kevinj

SEEDING	
END WIDTH	SO. YDS.

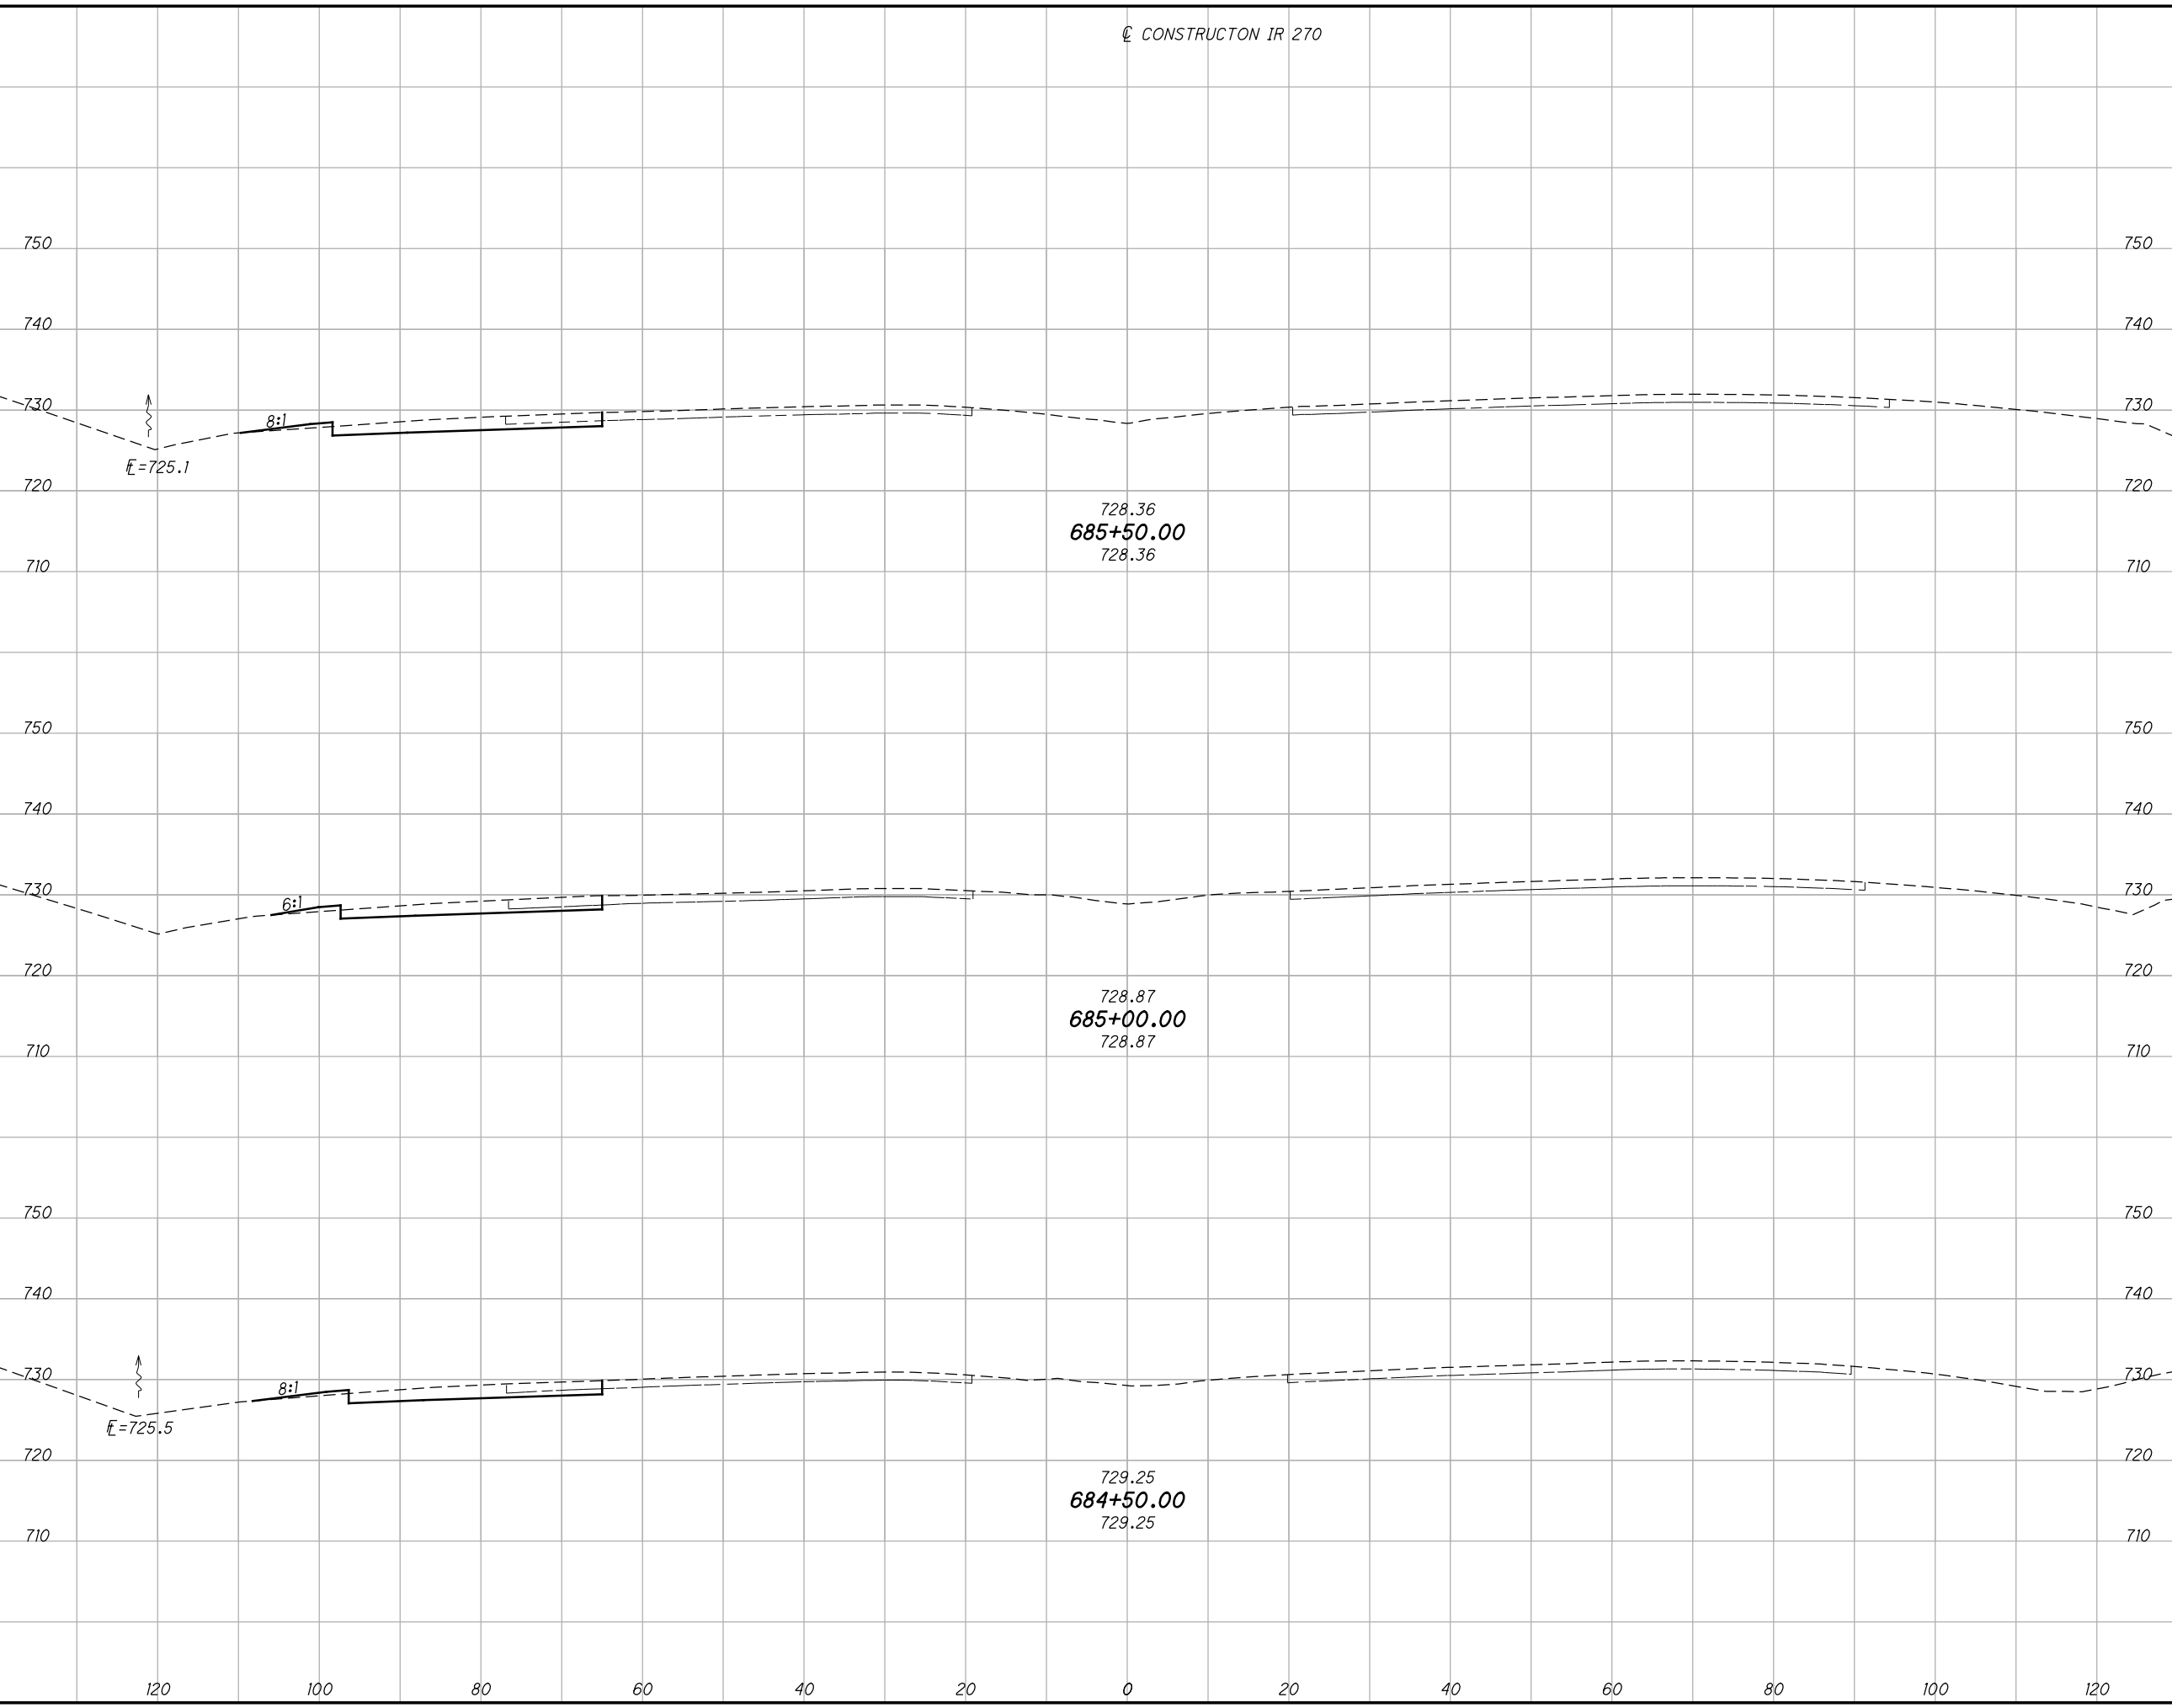

END AREA		VOLUME	
CUT	FILL	CUT	FILL

BU 4, 5, 6, 7, & 8 - RELEASED FOR CONSTRUCTION - 11/03/2014 - 11/19/2015

CROSS SECTIONS IR 270

STA. 684+50.00 TO STA. 685+50.00

FRA - 270 - 49.00

59
182

© CONSTRUCTON IR 270


AS BUILT - 4/22/2016

G:\projects\2014\W-14-039_FRA-270-49.00\83988\roadway\sheets\83988X5005.dgn 5/23/2016 7:31:02 AM kevinj

SEEDING	
END WIDTH	SO. YDS.

CONSTRUCTON IR 270

END AREA		VOLUME		CALCULATED	
CUT	FILL	CUT	FILL	CFR	SSK

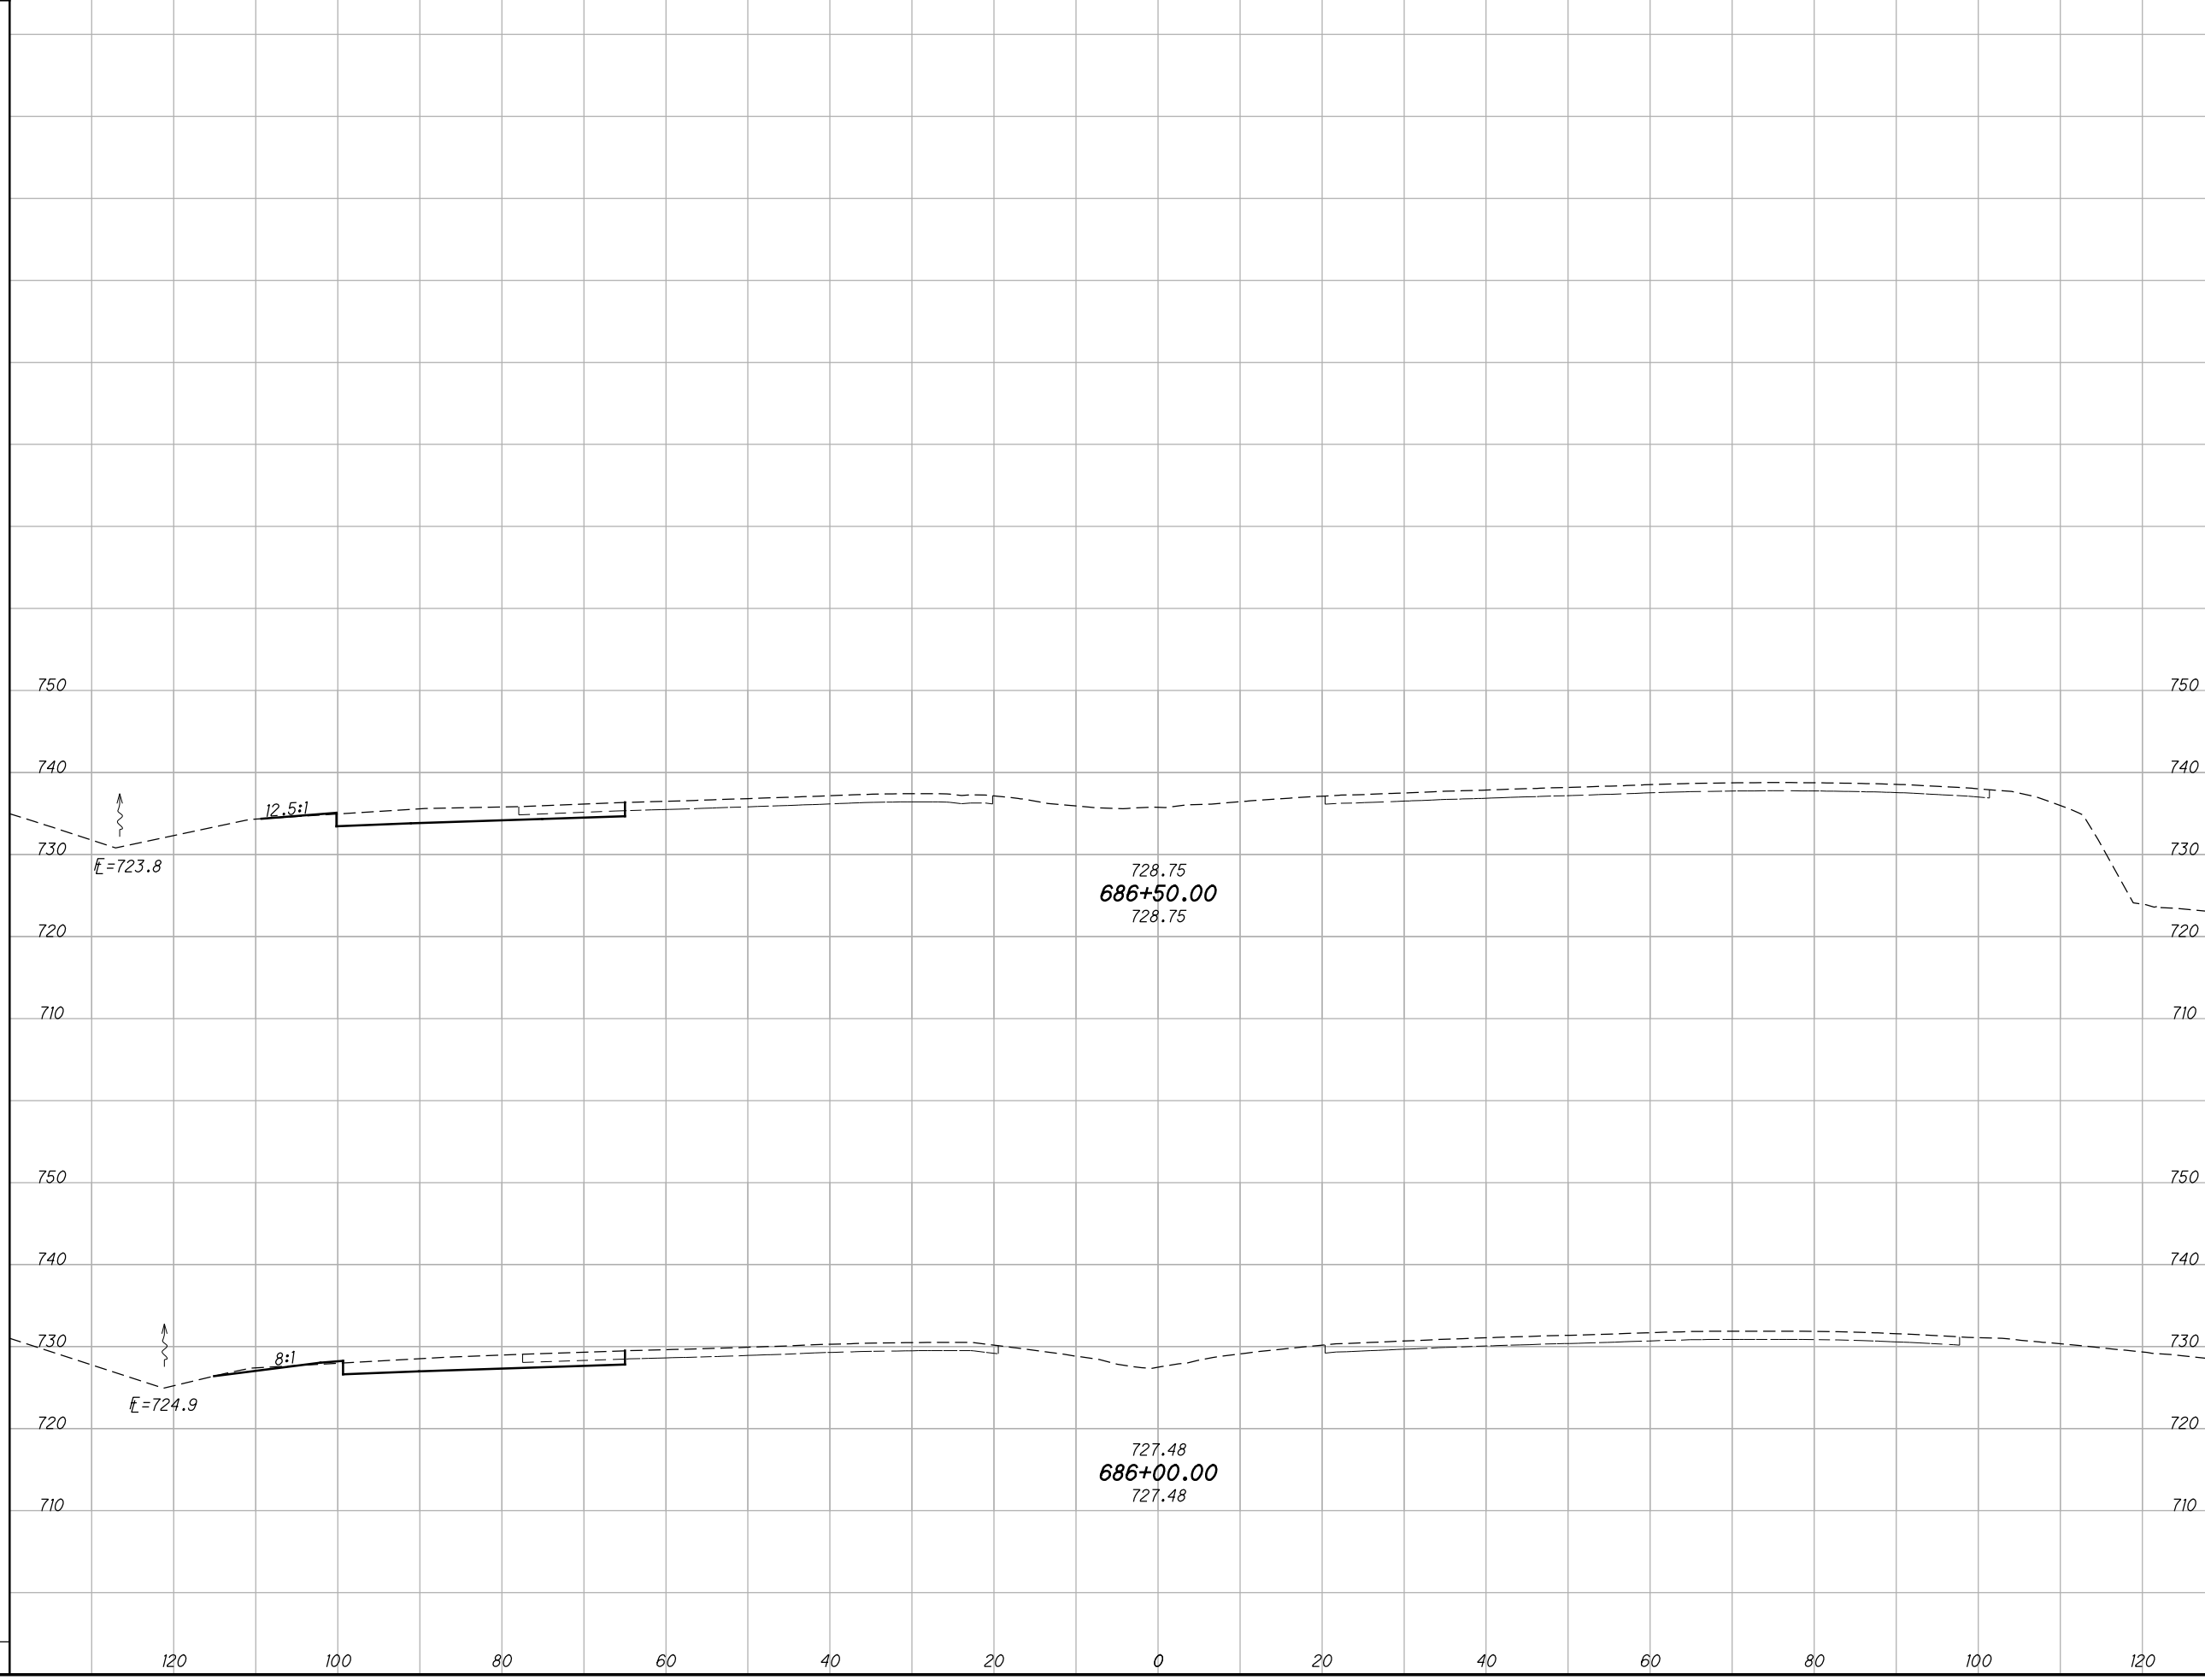

BU 4, 5, 6, 7, & 8 - RELEASED FOR CONSTRUCTION - 11/03/2014 - 11/19/2015

CROSS SECTIONS IR 270
STA. 686+00.00 TO STA. 686+50.00

FRA - 270 - 49.00

60
182


AS BUILT - 4/22/2016

G:\projects\2014\W-14-039_FRA-270-49.00\83988\roadway\sheets\83988X5008.dgn 5/23/2016 7:31:03 AM kevinj

SEEDING	
END WIDTH	SO. YDS.

© CONSTRUCTON IR 270

END AREA		VOLUME		CALCULATED	CFR	CHECKED	SSK
CUT	FILL	CUT	FILL				

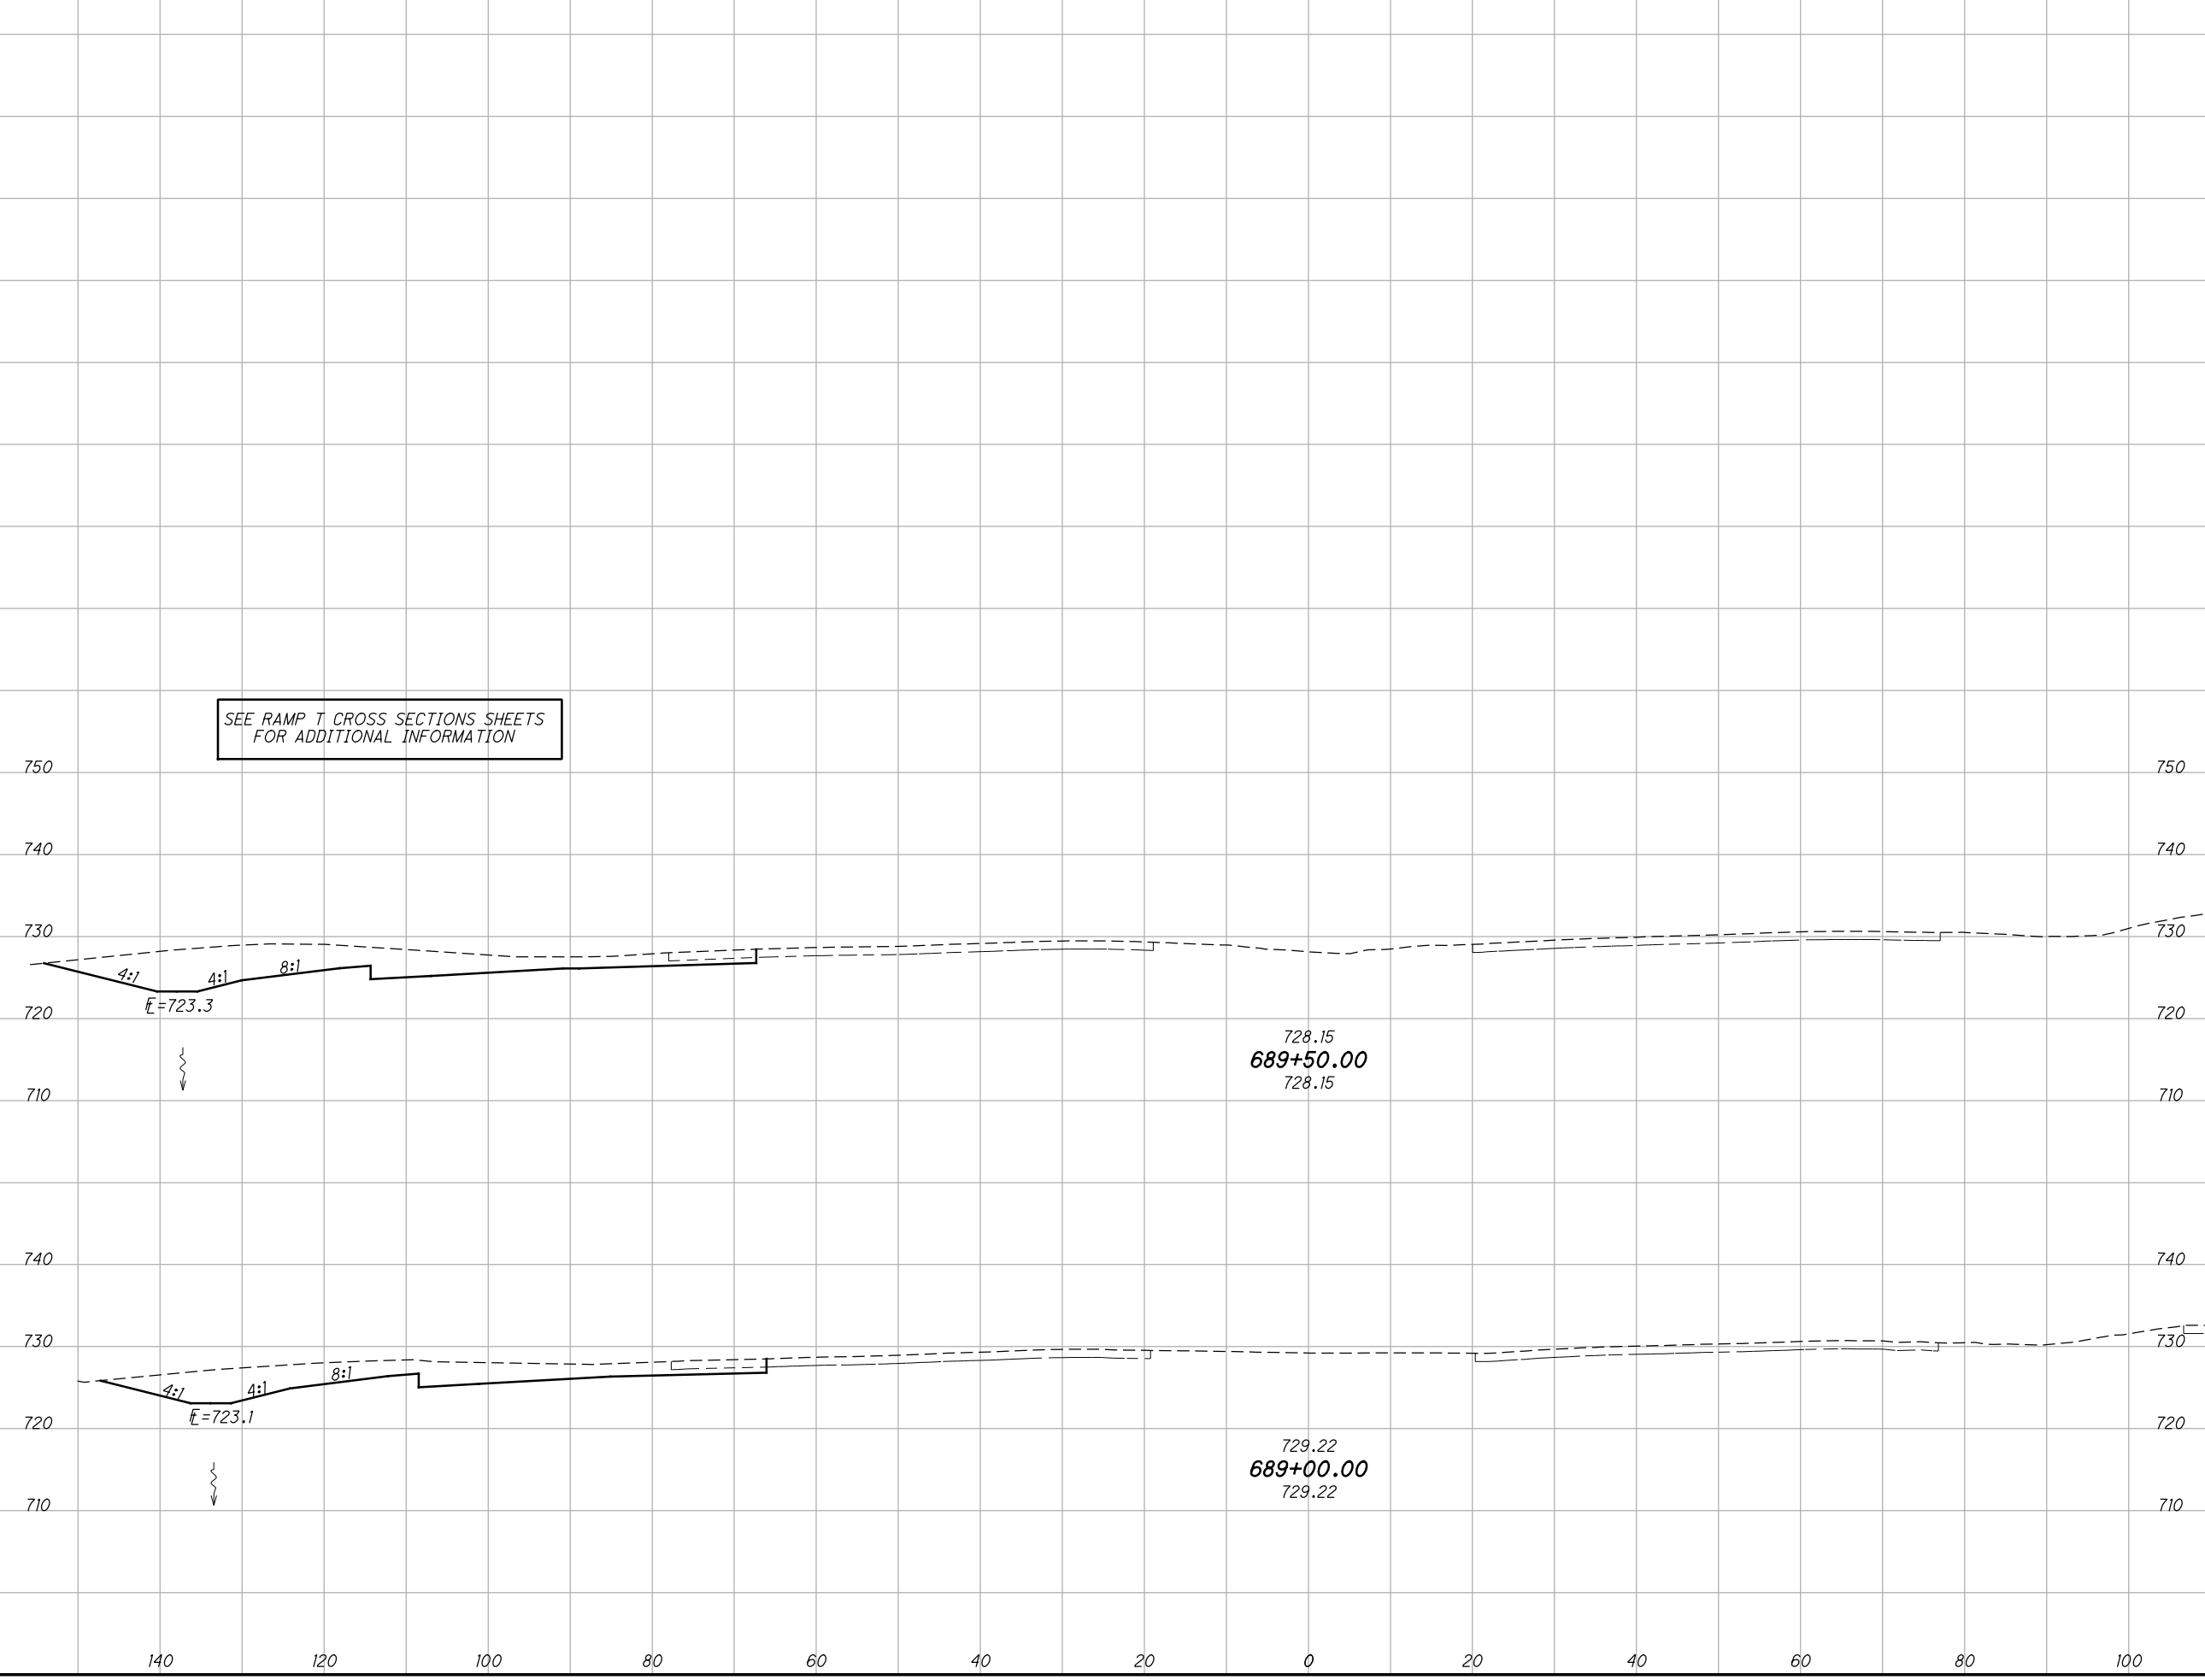

BU 4, 5, 6, 7, & 8 - RELEASED FOR CONSTRUCTION - 11/03/2014 - 11/19/2015

CROSS SECTIONS IR 270
STA. 689+00.00 TO STA. 689+50.00


FRA - 270 - 49.00

62
182

AS BUILT - 4/22/2016

5/23/2016 7:31:05 AM kevinj

G:\projects\2014\W-14-039_FRA-270-49.00\83988\roadway\sheets\83988GF007_Rev.dgn

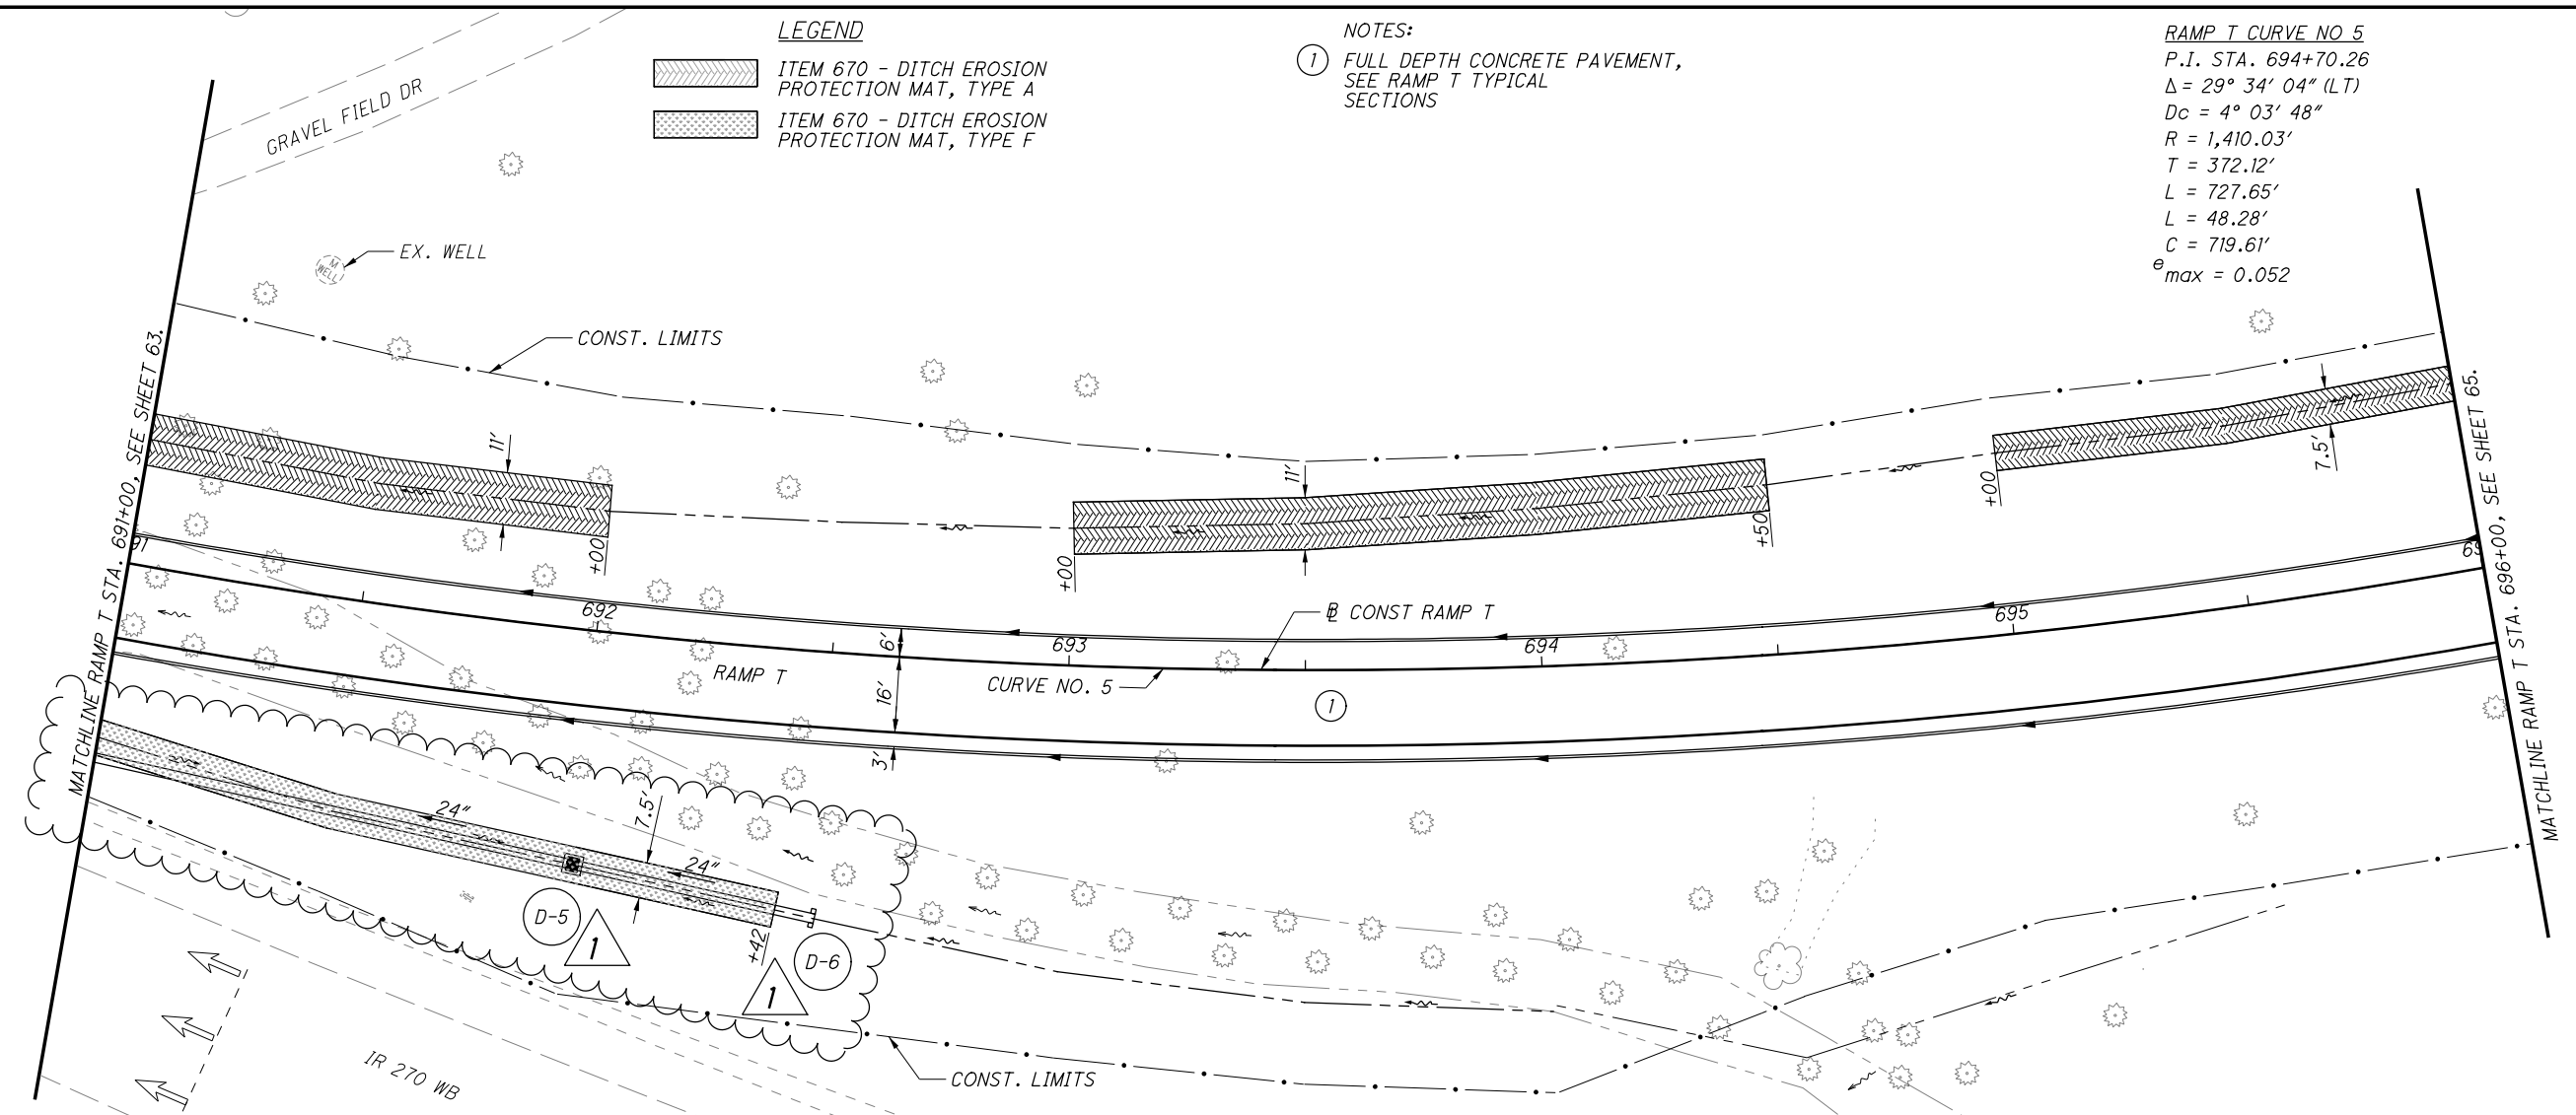

- LEGEND**
- ITEM 670 - DITCH EROSION PROTECTION MAT, TYPE A
 - ITEM 670 - DITCH EROSION PROTECTION MAT, TYPE F


NOTES:

① FULL DEPTH CONCRETE PAVEMENT, SEE RAMP T TYPICAL SECTIONS

RAMP T CURVE NO 5
 P.I. STA. 694+70.26
 $\Delta = 29^\circ 34' 04''$ (LT)
 $D_c = 4^\circ 03' 48''$
 $R = 1,410.03'$
 $T = 372.12'$
 $L = 727.65'$
 $C = 48.28'$
 $C = 719.61'$
 $e_{max} = 0.052$

CALCULATED
 CFR
 CHECKED
 SSK

0 20 40
 HORIZONTAL SCALE IN FEET

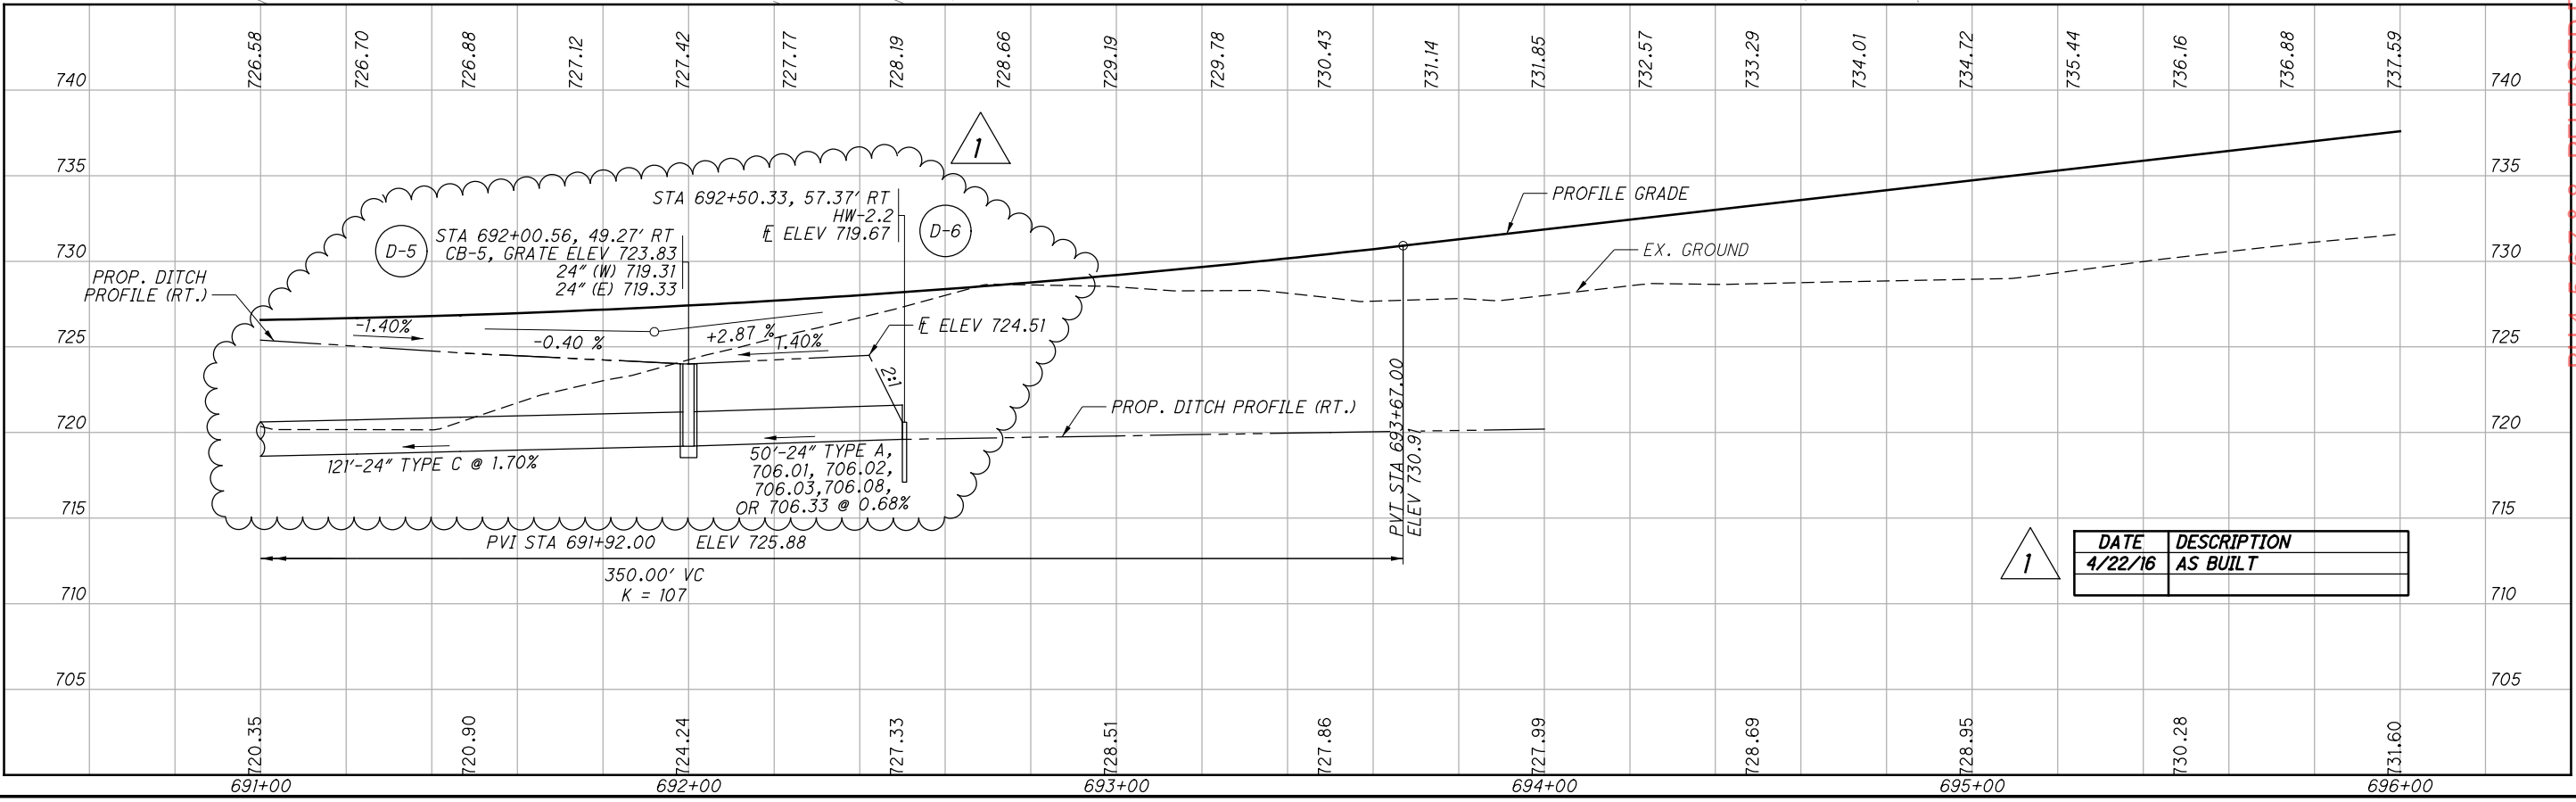

PROP. DITCH PROFILE (RT.)

STA 692+00.56, 49.27' RT
 CB-5, GRATE ELEV 723.83
 24" (W) 719.31
 24" (E) 719.33

STA 692+50.33, 57.37' RT
 HW-2.2
 E ELEV 719.67

PROP. DITCH PROFILE (RT.)

121'-24" TYPE C @ 1.70%

50'-24" TYPE A,
 706.01, 706.02,
 706.03, 706.08,
 OR 706.33 @ 0.68%

PVI STA 691+92.00 ELEV 725.88

350.00' VC
 K = 107

E ELEV 724.51

PVI STA 693+67.00
 ELEV 730.91

DATE	DESCRIPTION
4/22/16	AS BUILT

BU 4, 5, 6, 7, & 8 - RELEASED FOR CONSTRUCTION - 11/03/2014 - 11/19/2015

PLAN AND PROFILE - RAMP T
STA. 691+00 TO STA. 696+00

FRA - 270-49.00

64
 182



LEGEND

- ITEM 670 - DITCH EROSION PROTECTION MAT, TYPE A
- ITEM 670 - DITCH EROSION PROTECTION MAT, TYPE F
- STRUCTURE BORING

RAMP T CURVE NO 5
 P.I. STA. 694+70.26
 $\Delta = 29^\circ 34' 04''$ (LT)
 $D_c = 4^\circ 03' 48''$
 $R = 1,410.03'$
 $T = 372.12'$
 $L = 727.65'$
 $E = 48.28'$
 $e_{max} = 0.052$

RAMP T CURVE NO 6
 P.I. STA. 702+86.60
 $\Delta = 19^\circ 21' 14''$ (LT)
 $D_c = 3^\circ 30' 00''$
 $R = 1,637.02'$
 $T = 279.14'$
 $L = 552.97'$
 $E = 23.63'$
 $e_{max} = 0.048$

NOTES:
 ① FULL DEPTH CONCRETE PAVEMENT, SEE RAMP T TYPICAL SECTIONS

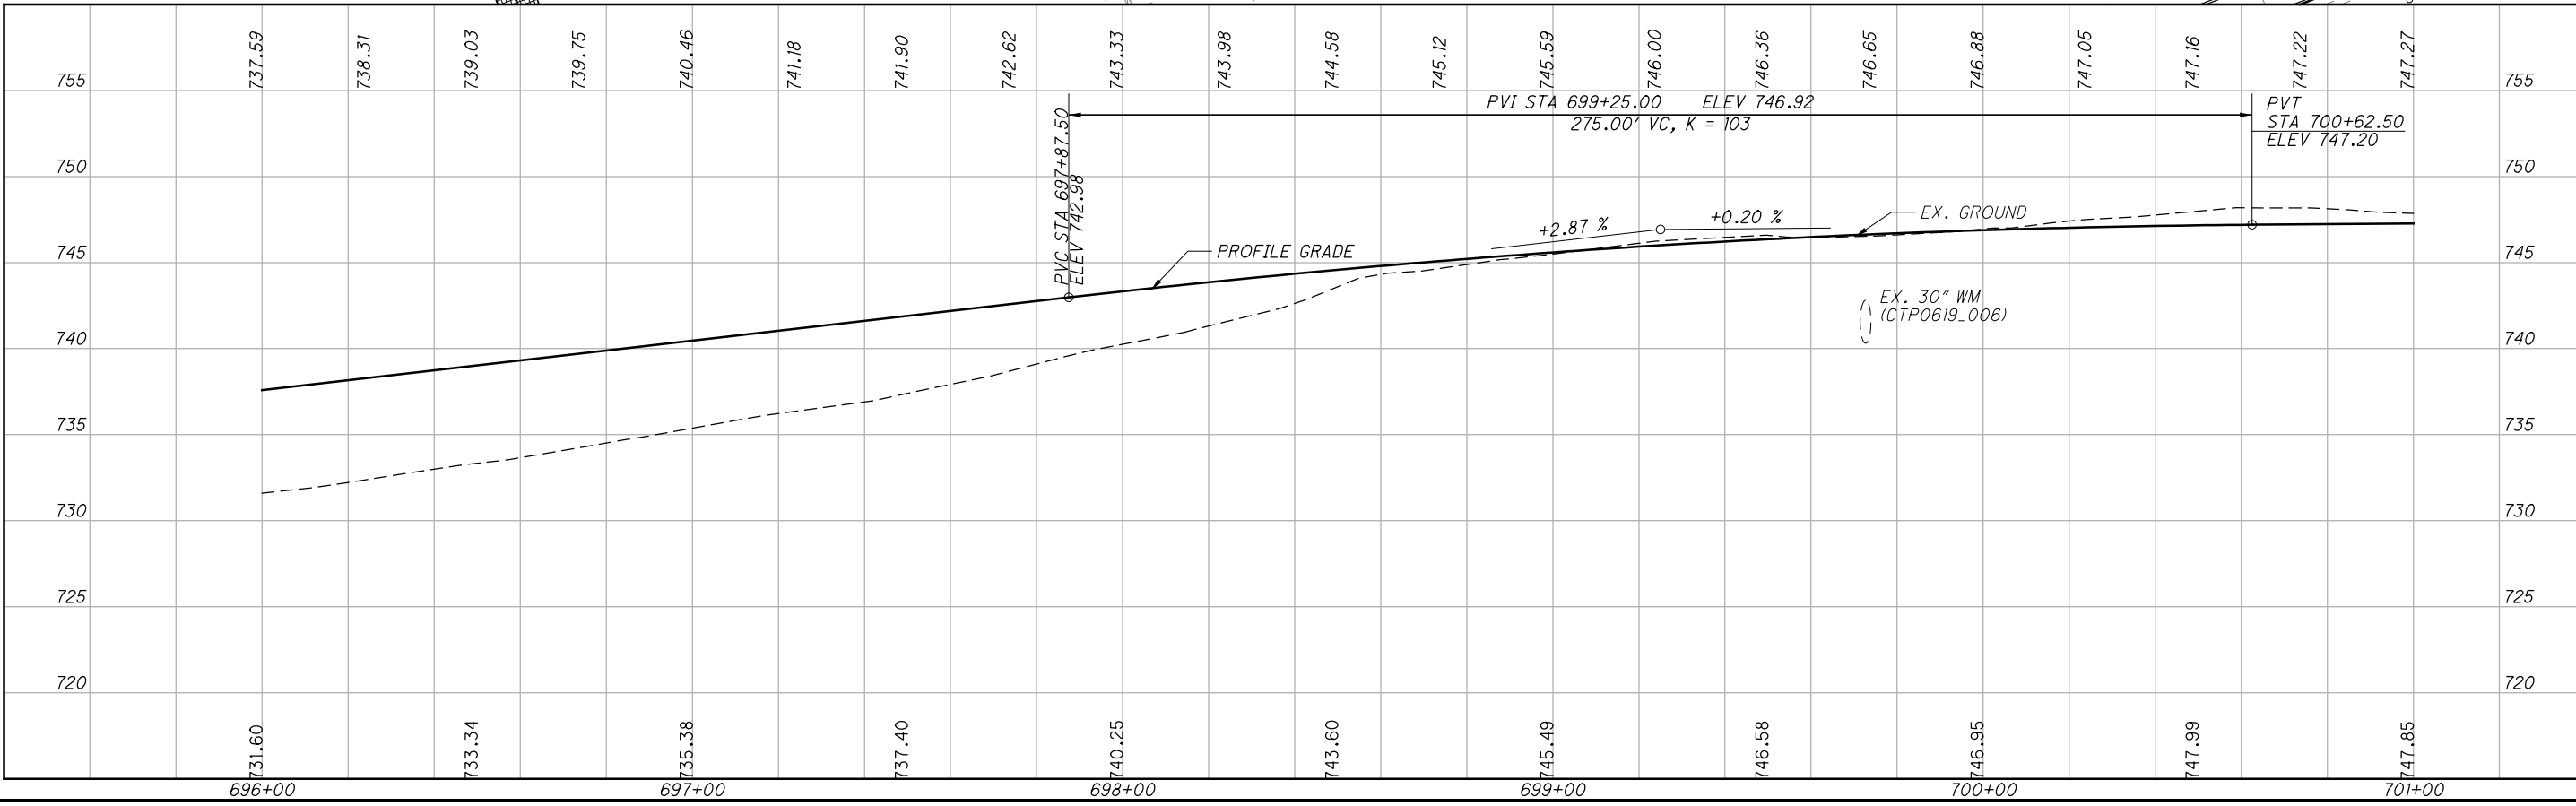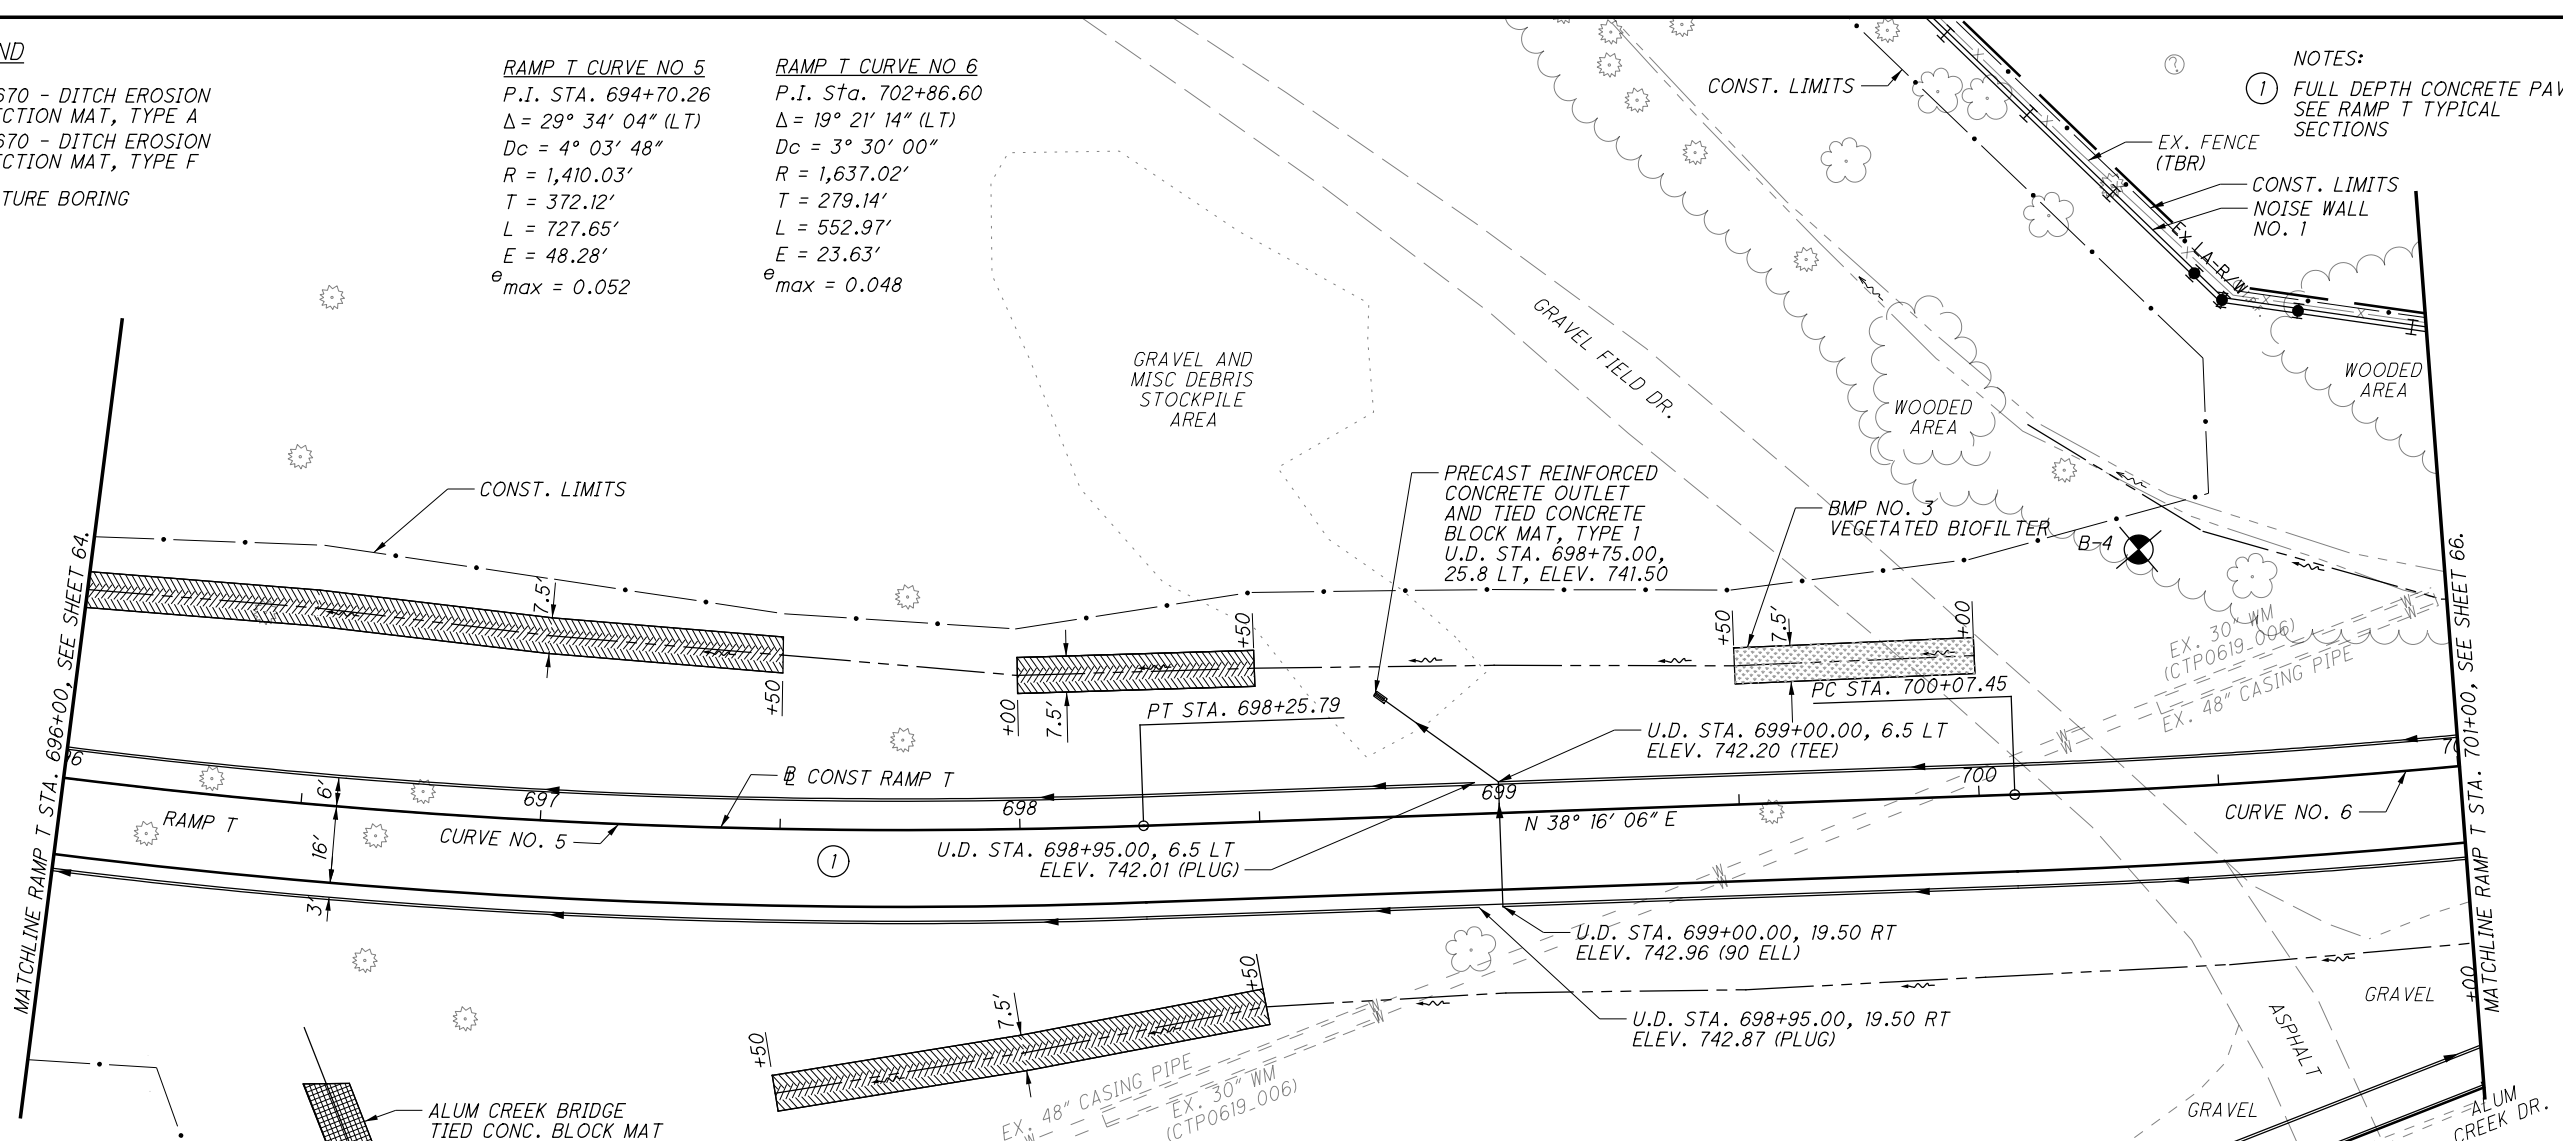

BU 4, 5, 6, 7, & 8 - RELEASED FOR CONSTRUCTION - 11/03/2014 - 11/19/2015

CALCULATED
CFR
CHECKED
SSK


0 20 40
HORIZONTAL SCALE IN FEET

PLAN AND PROFILE - RAMP T
STA. 696+00 TO STA. 701+00

FRA - 270 - 49.00

AS BUILT - 4/22/2016

RAMP T CURVE NO 6
P.I. STA. 702+86.60
 $\Delta = 19^\circ 21' 14''$ (LT)
 $D_c = 3^\circ 30' 00''$
 $R = 1,637.02$
 $T = 279.14'$
 $L = 552.97'$
 $E = 23.63'$
 $e_{max} = 0.048$

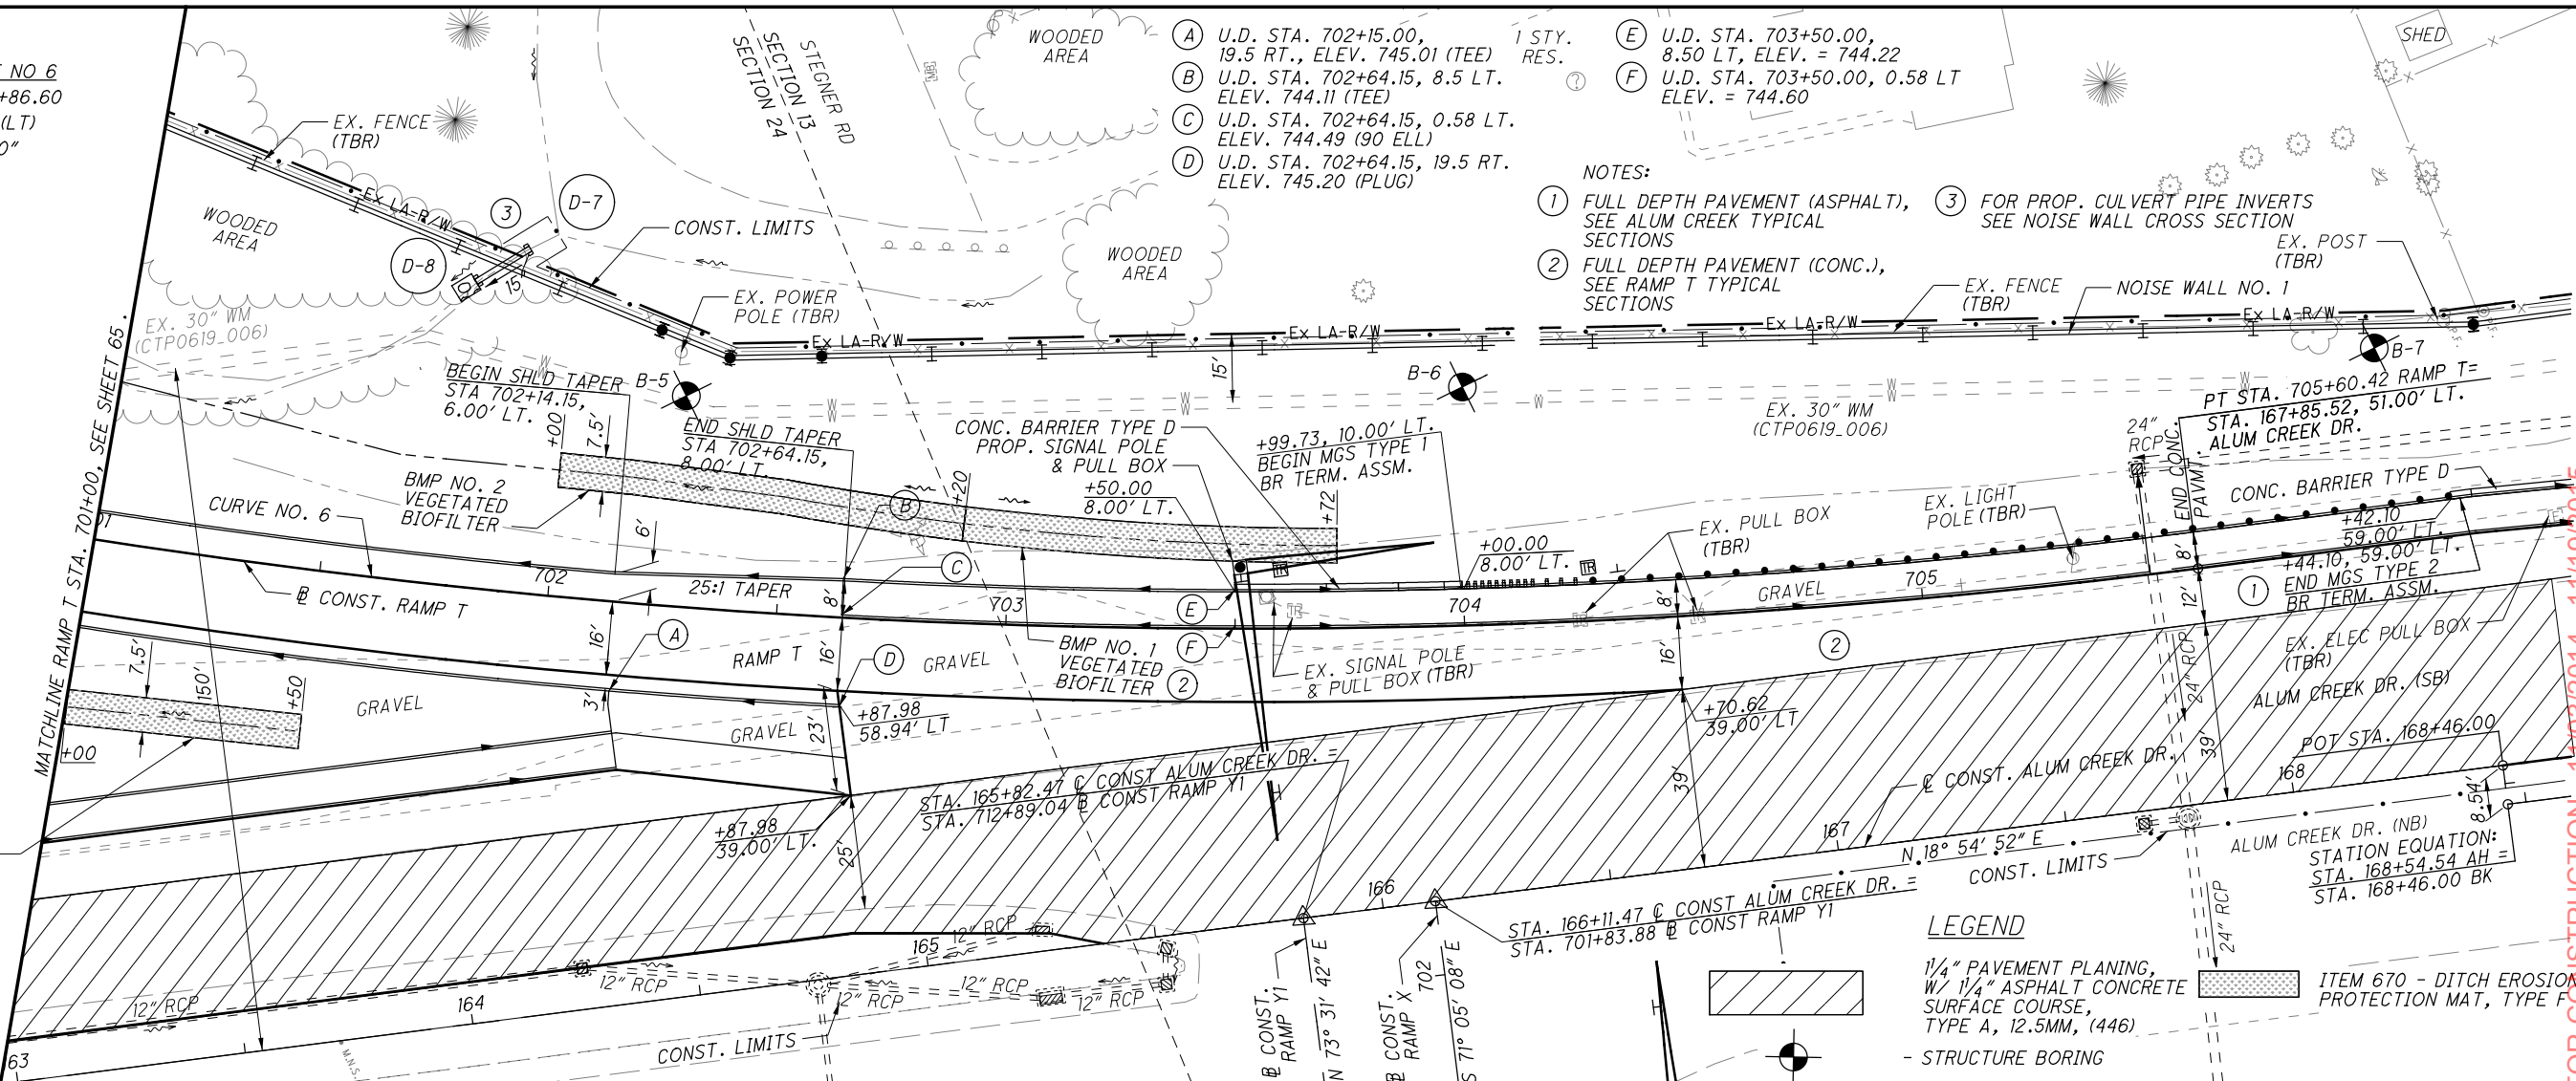


- (A) U.D. STA. 702+15.00, 19.5 RT., ELEV. 745.01 (TEE)
- (B) U.D. STA. 702+64.15, 8.5 LT. ELEV. 744.11 (TEE)
- (C) U.D. STA. 702+64.15, 0.58 LT. ELEV. 744.49 (90 ELL)
- (D) U.D. STA. 702+64.15, 19.5 RT. ELEV. 745.20 (PLUG)
- (E) U.D. STA. 703+50.00, 8.50 LT, ELEV. = 744.22
- (F) U.D. STA. 703+50.00, 0.58 LT ELEV. = 744.60

- NOTES:
- (1) FULL DEPTH PAVEMENT (ASPHALT), SEE ALUM CREEK TYPICAL SECTIONS
 - (2) FULL DEPTH PAVEMENT (CONC.), SEE RAMP T TYPICAL SECTIONS
 - (3) FOR PROP. CULVERT PIPE INVERTS SEE NOISE WALL CROSS SECTION

LEGEND

- 1/4" PAVEMENT PLANING, W/ 1/4" ASPHALT CONCRETE SURFACE COURSE, TYPE A, 12.5MM, (446)
- ITEM 670 - DITCH EROSION PROTECTION MAT, TYPE F
- STRUCTURE BORING

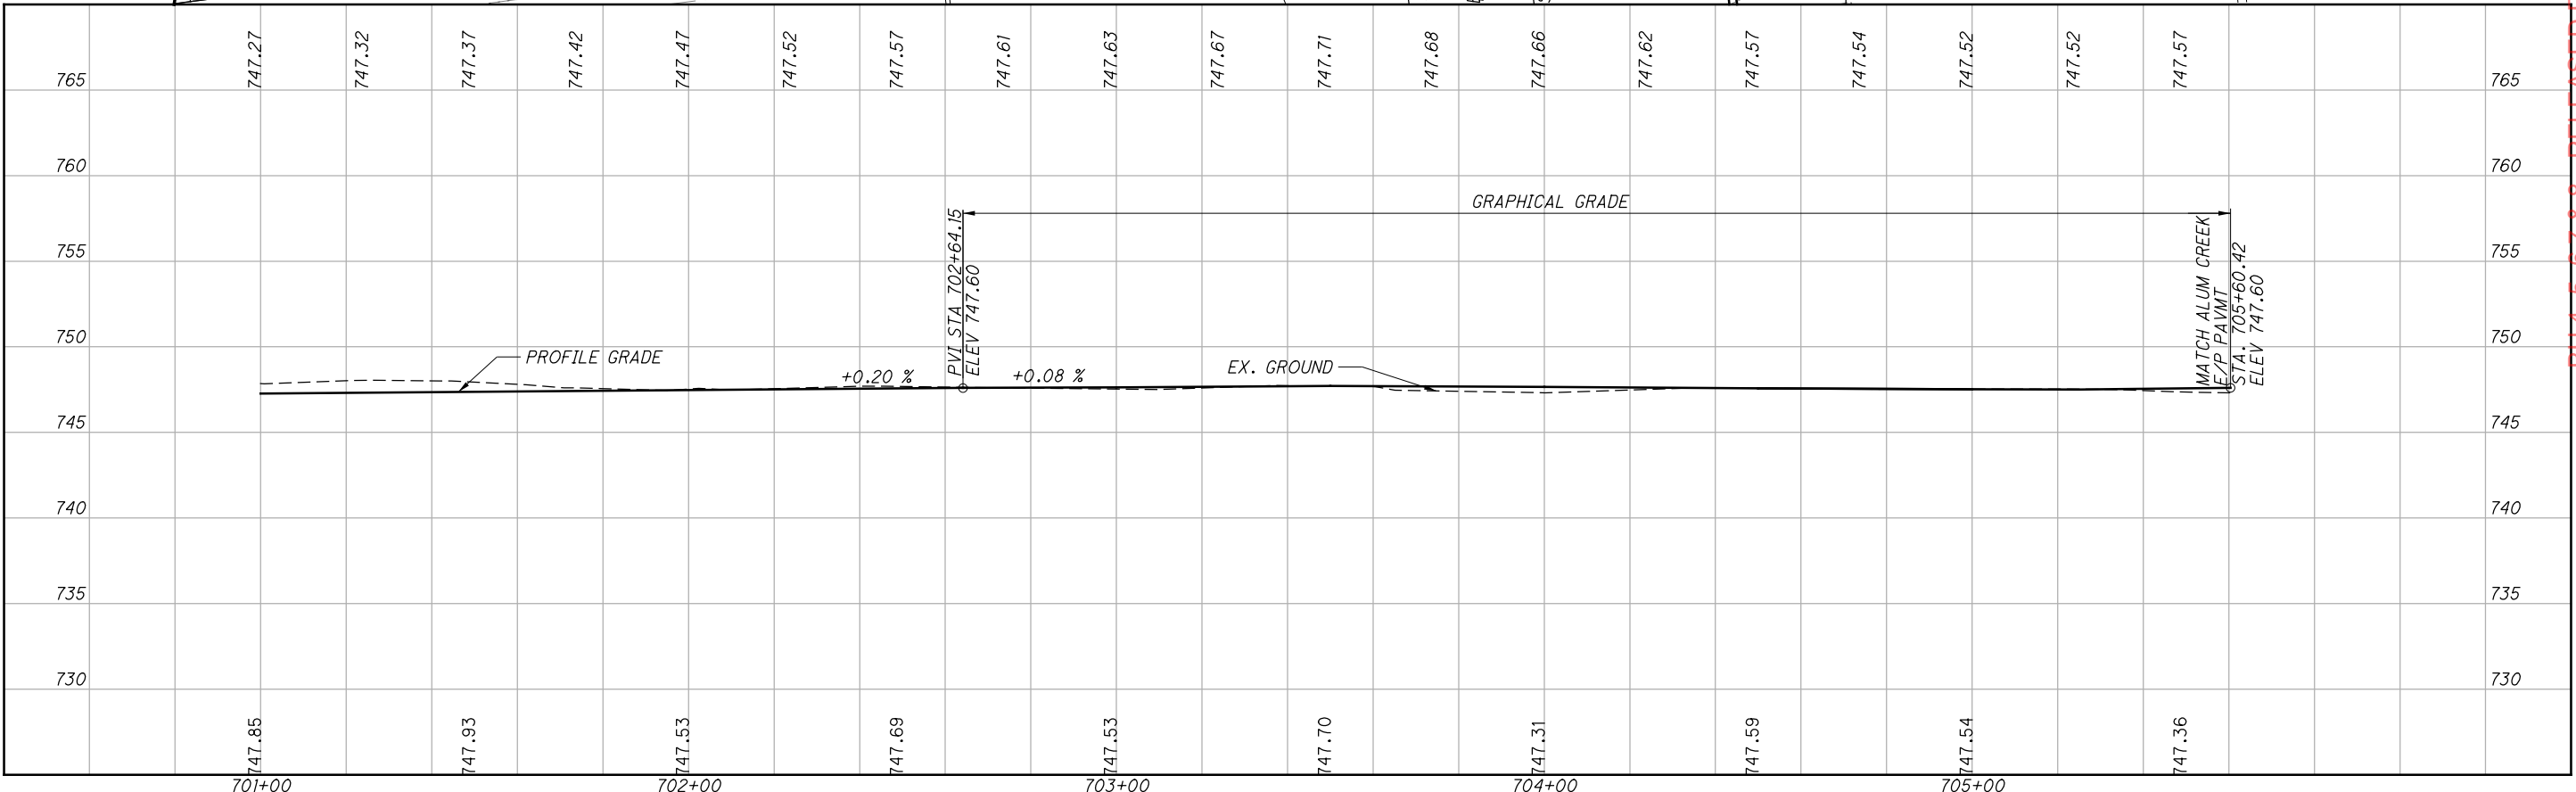

CALCULATED
CFR
CHECKED
SSK

0 20 40
HORIZONTAL SCALE IN FEET

PLAN AND PROFILE - RAMP T
STA. 701+00 TO STA. 705+25.82

FRA - 270-49.00

66
182


G:\projects\2014\W-14-039_FRA-270-49.00\83988\roadway_sheets\83988GF009_Rev.dgn 5/23/2016 7:31:06 AM kevinj

BU 4, 5, 6, 7, & 8 - RELEASED FOR CONSTRUCTION - 11/19/2015

AS BUILT - 4/22/2016

G:\projects\2014\W-14-039_FRA-270-49.00\83988\roadway\sheets\83988X5004.dgn 5/23/2016 7:31:08 AM kevinj

SEEDING	
END WIDTH	SO. YDS.

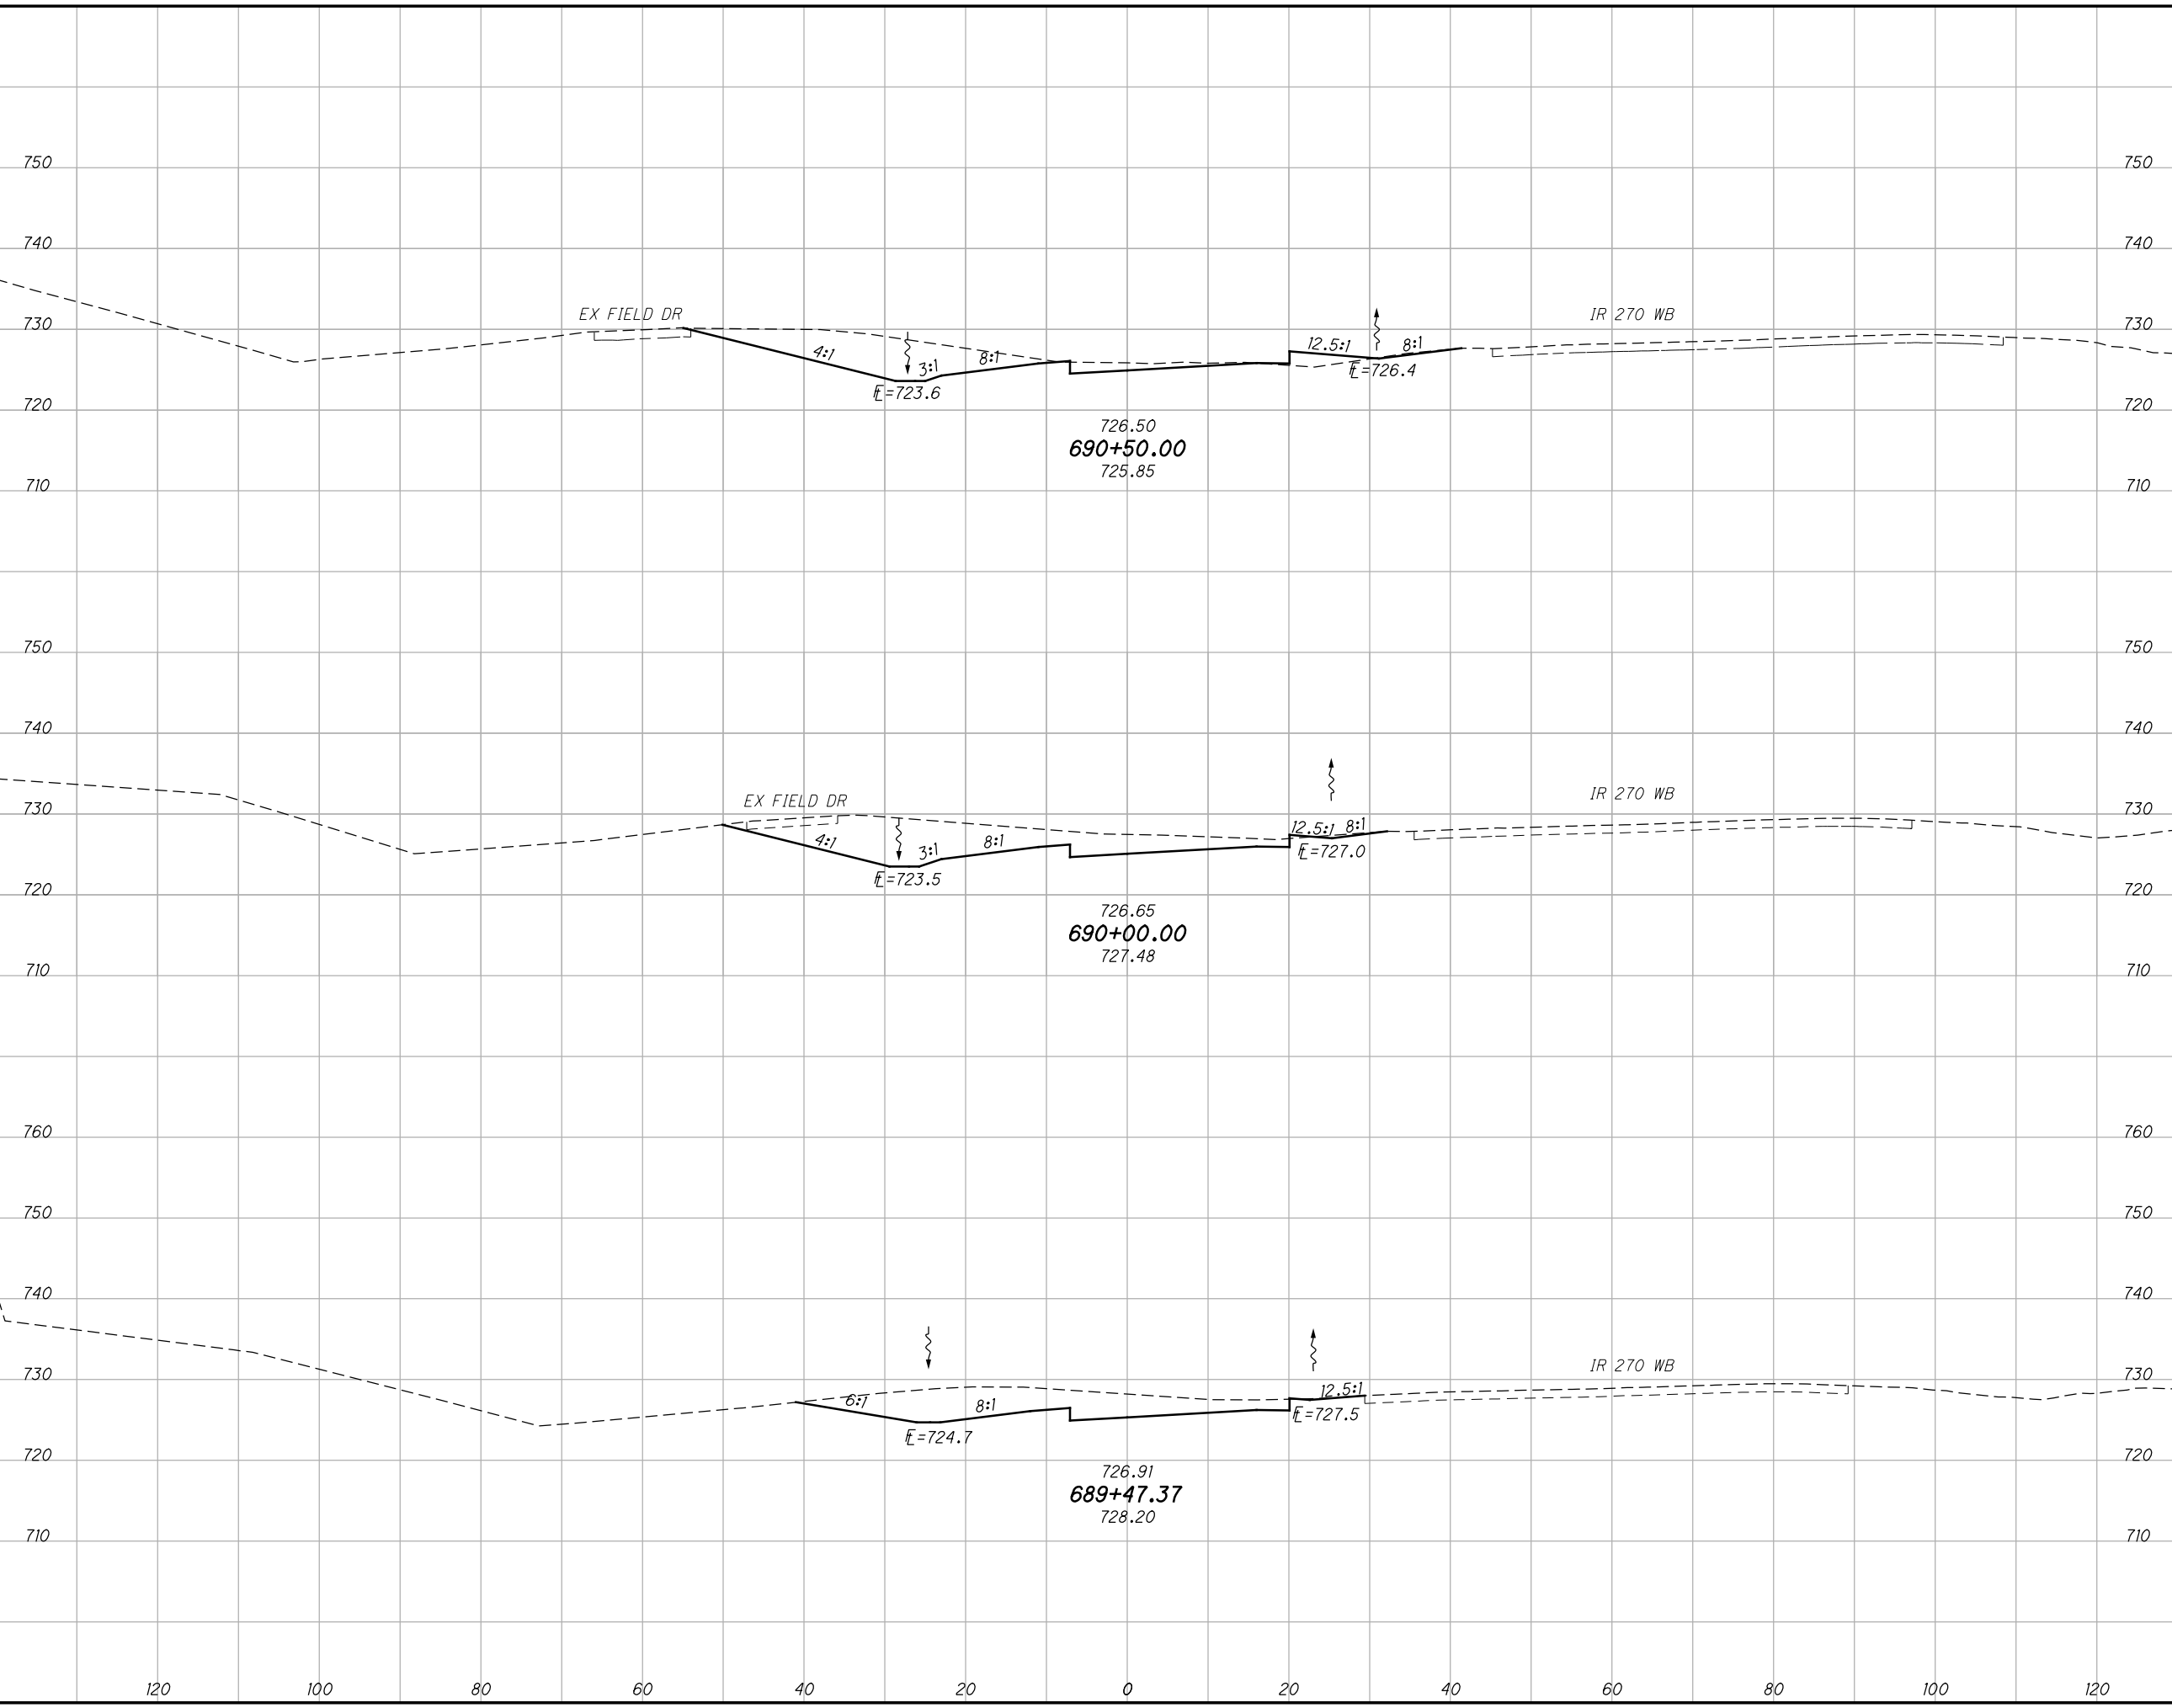

END AREA		VOLUME		CALCULATED CFR	CHECKED SSK
CUT	FILL	CUT	FILL		

BU 4, 5, 6, 7, & 8 - RELEASED FOR CONSTRUCTION - 11/03/2014 - 11/19/2015


CROSS SECTIONS RAMP T
STA. 689+47.37 TO STA. 690+50.00

FRA - 270 - 49.00

AS BUILT - 4/22/2016

C:\projects\2014\W-14-039_FRA-270-49.00\83988\roadway\sheets\83988X5004.dgn 5/23/2016 7:31:09 AM kevinj

SEEDING	
END WIDTH	SO. YDS.

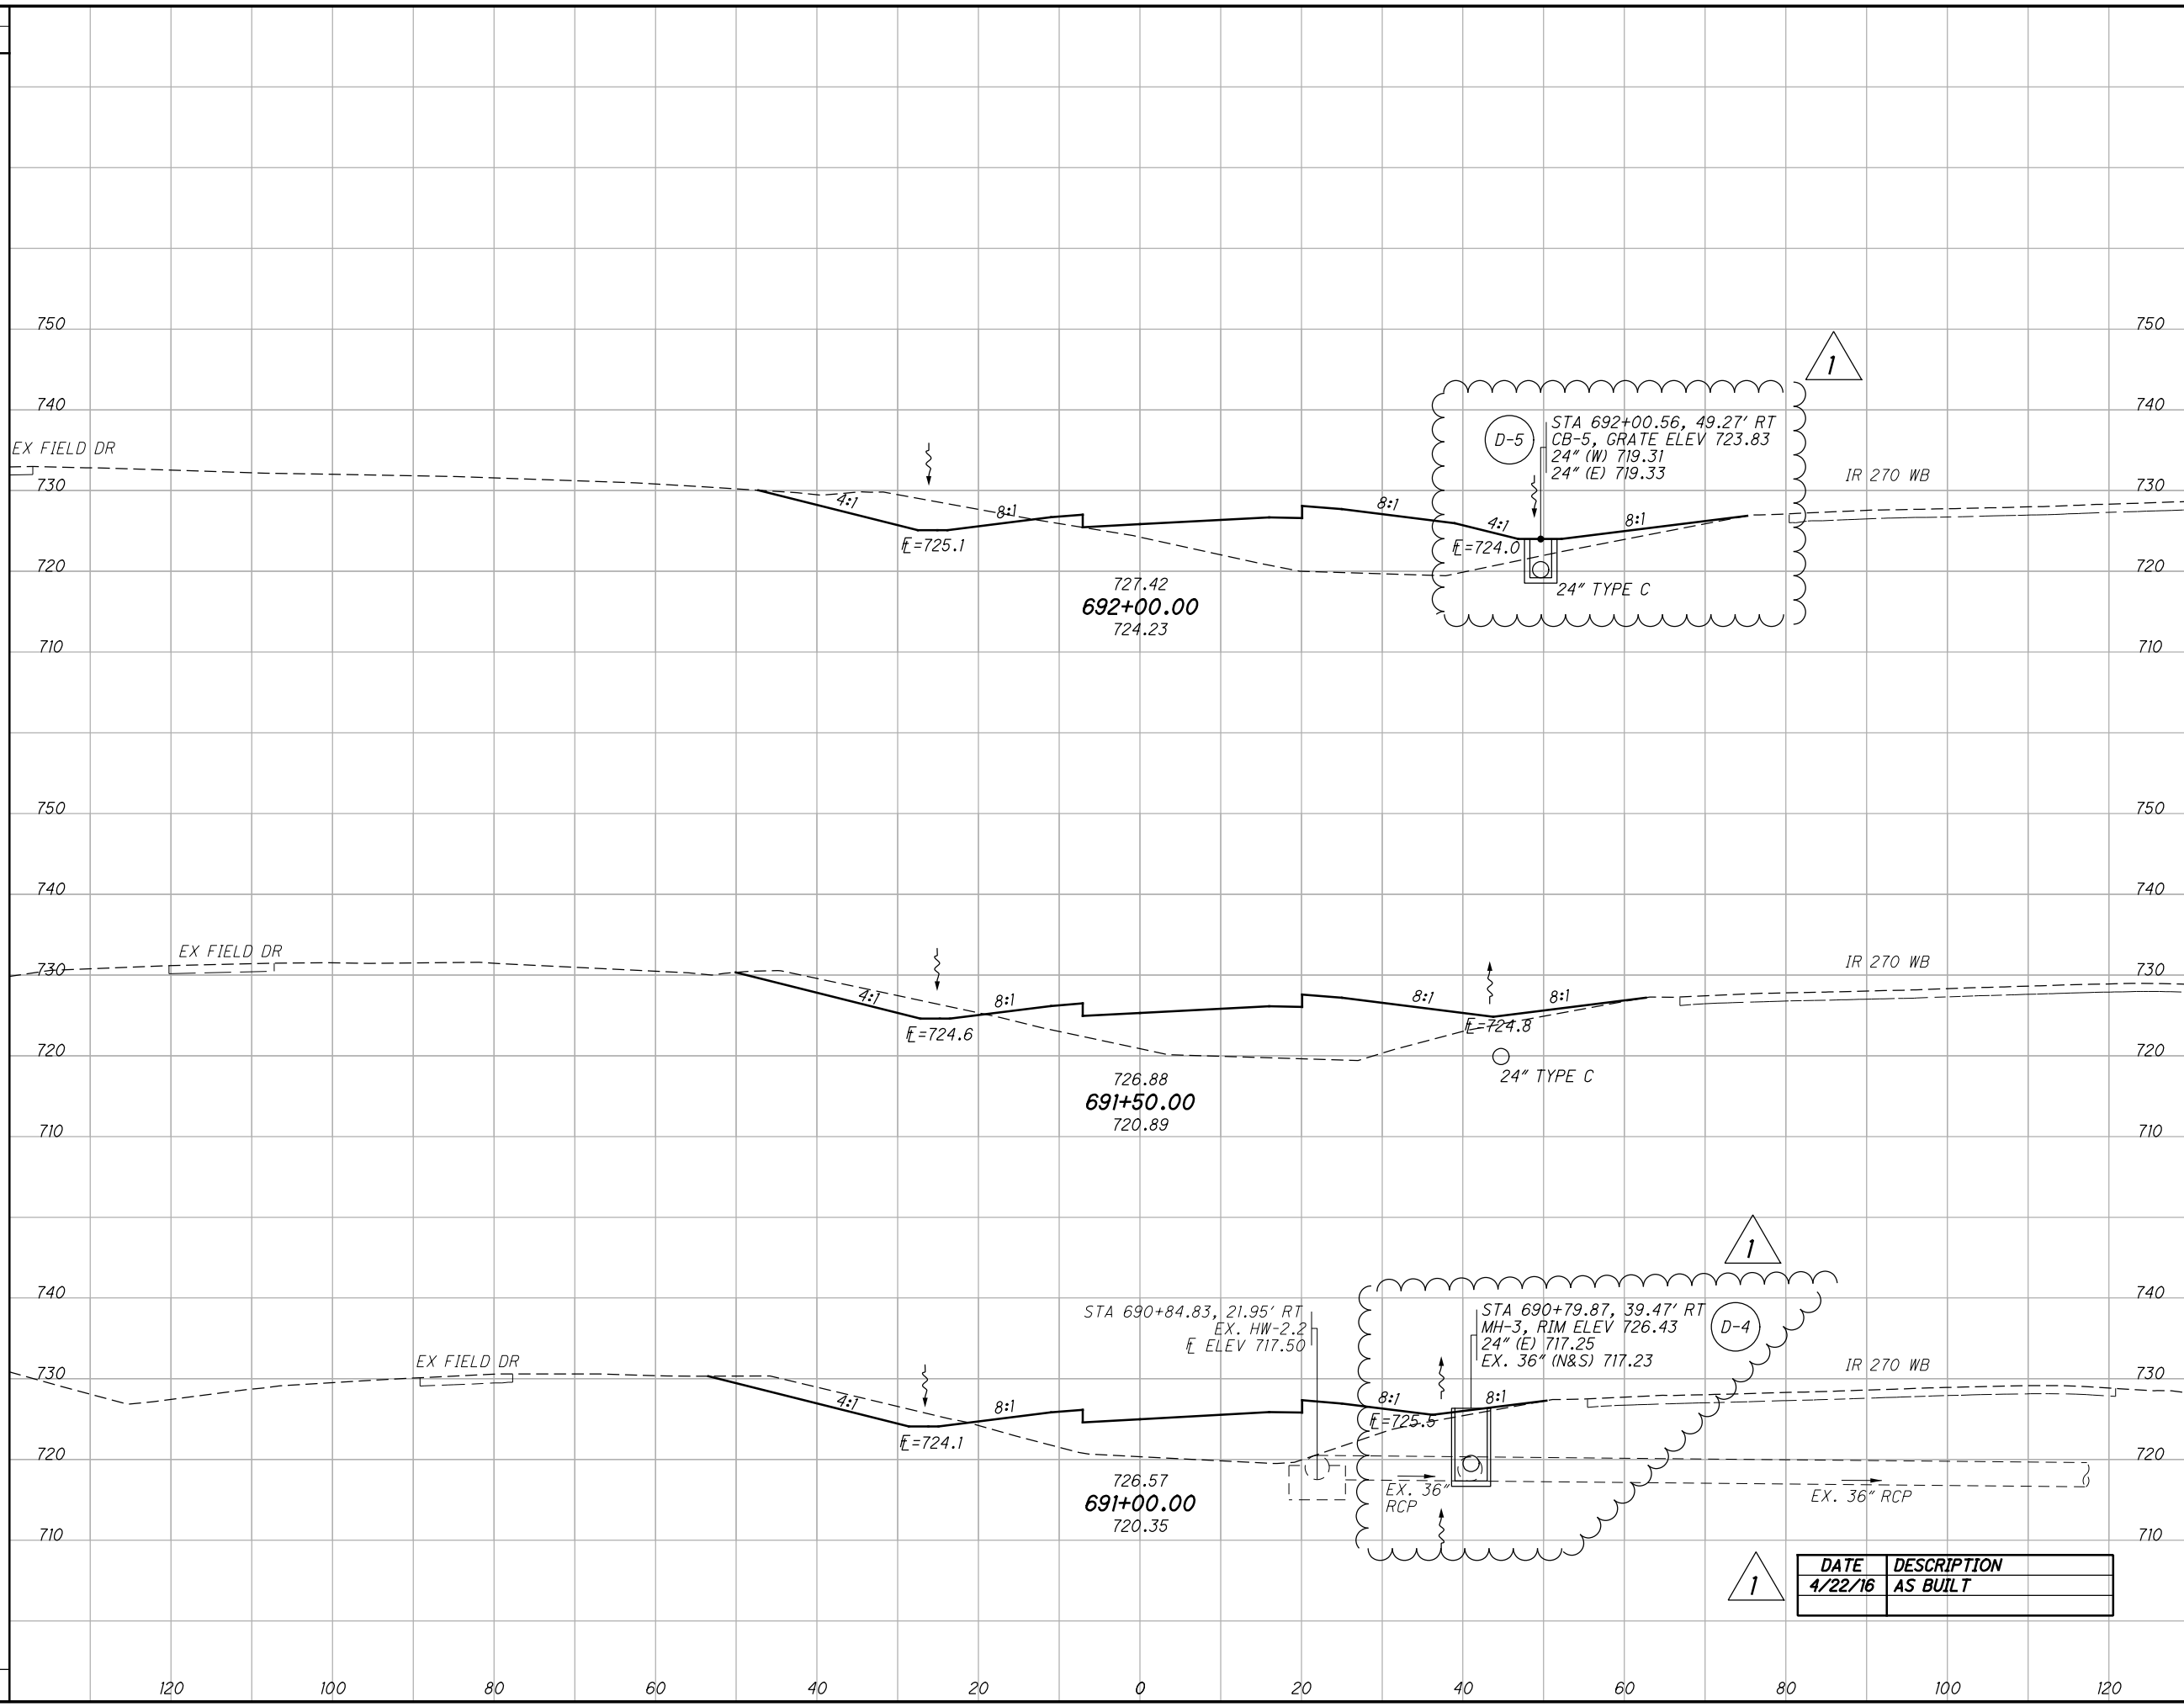

END AREA		VOLUME		CALCULATED	CFR	CHECKED	SSK
CUT	FILL	CUT	FILL				

FRA - 270 - 49.00	
CROSS SECTIONS RAMP T	
STA. 691+00.00 TO STA. 692+00.00	

68
182


BU 4, 5, 6, 7, & 8 - RELEASED FOR CONSTRUCTION - 11/03/2014 - 11/19/2015

DATE	DESCRIPTION
4/22/16	AS BUILT

AS BUILT - 4/22/2016

C:\projects\2014\W-14-039_FRA-270-49.00\83988\roadway\sheets\83988X5004.dgn 5/23/2016 7:31:09 AM kevinj

SEEDING	
END WIDTH	SO. YDS.

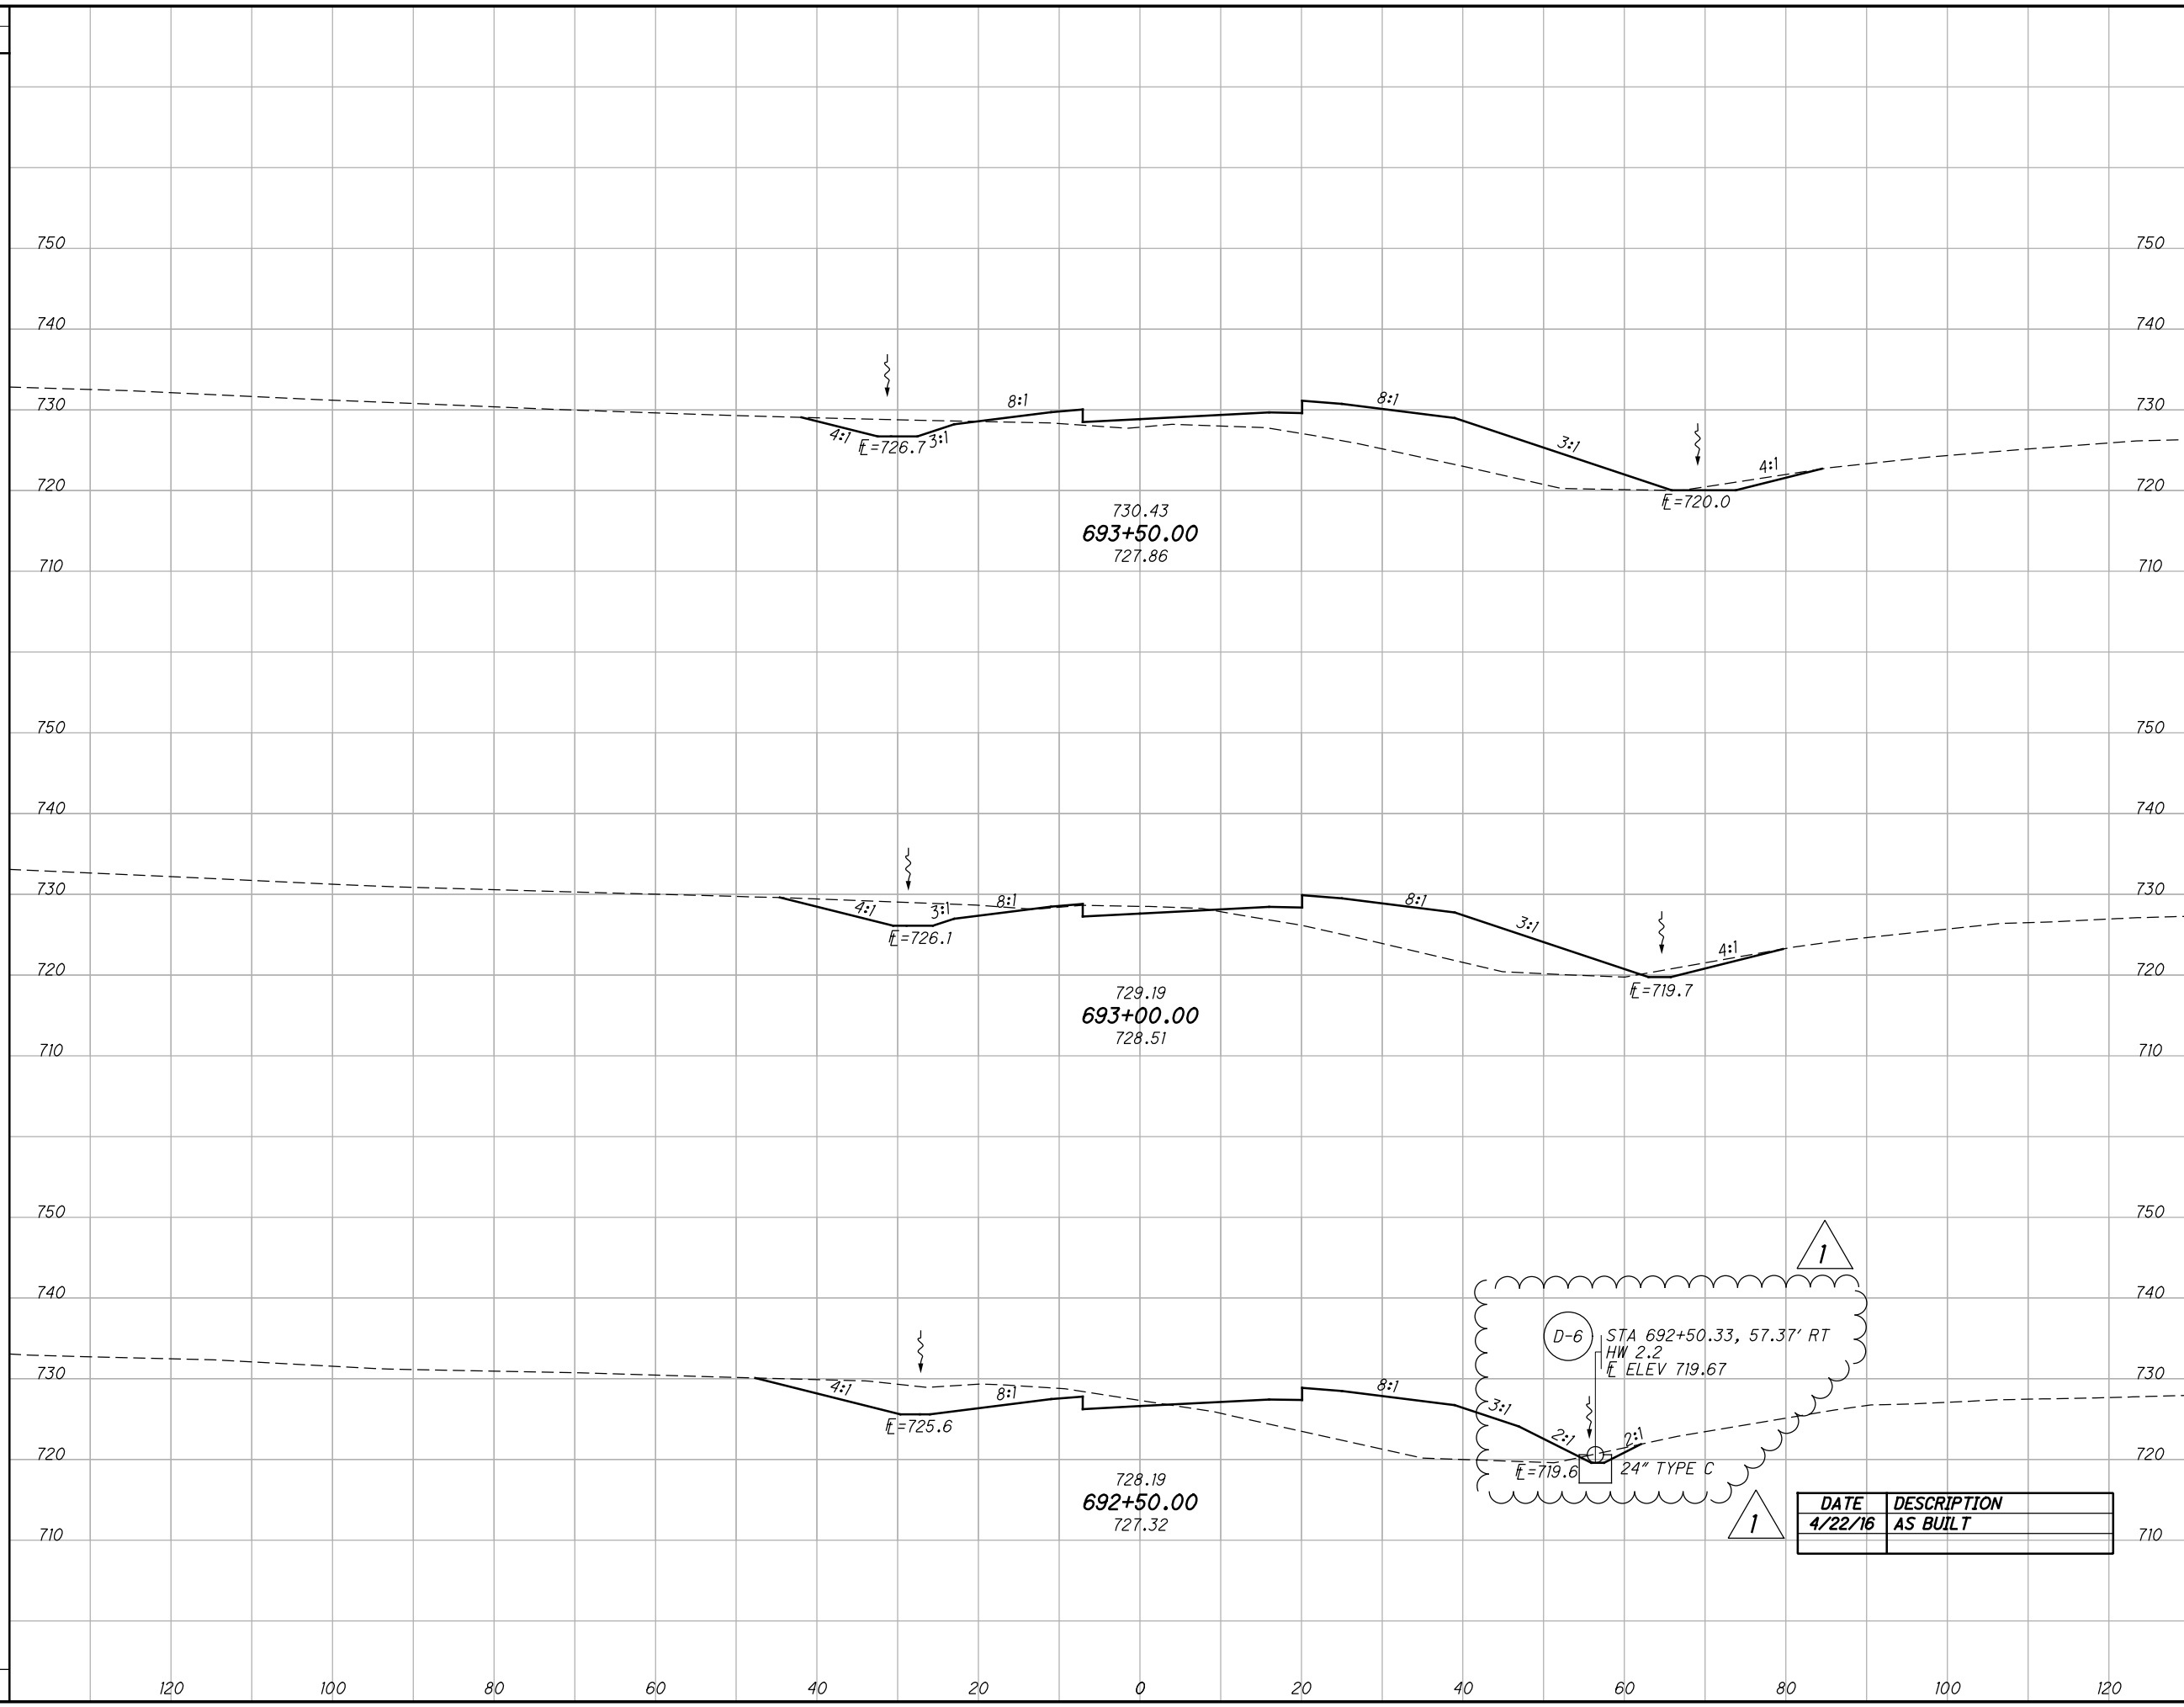

END AREA		VOLUME		CALCULATED	CFR	CHECKED	SSK
CUT	FILL	CUT	FILL				

BU 4, 5, 6, 7, & 8 - RELEASED FOR CONSTRUCTION - 11/03/2014 - 11/19/2015

CROSS SECTIONS RAMP T
STA. 692+50.00 TO STA. 693+50.00

FRA - 270 - 49.00


DATE	DESCRIPTION
4/22/16	AS BUILT

69
182

AS BUILT - 4/22/2016

G:\projects\2014\W-14-039_FRA-270-49.00\83988\roadway\sheets\83988X5004.dgn 5/23/2016 7:31:09 AM kevinj

SEEDING	
END WIDTH	SO. YDS.

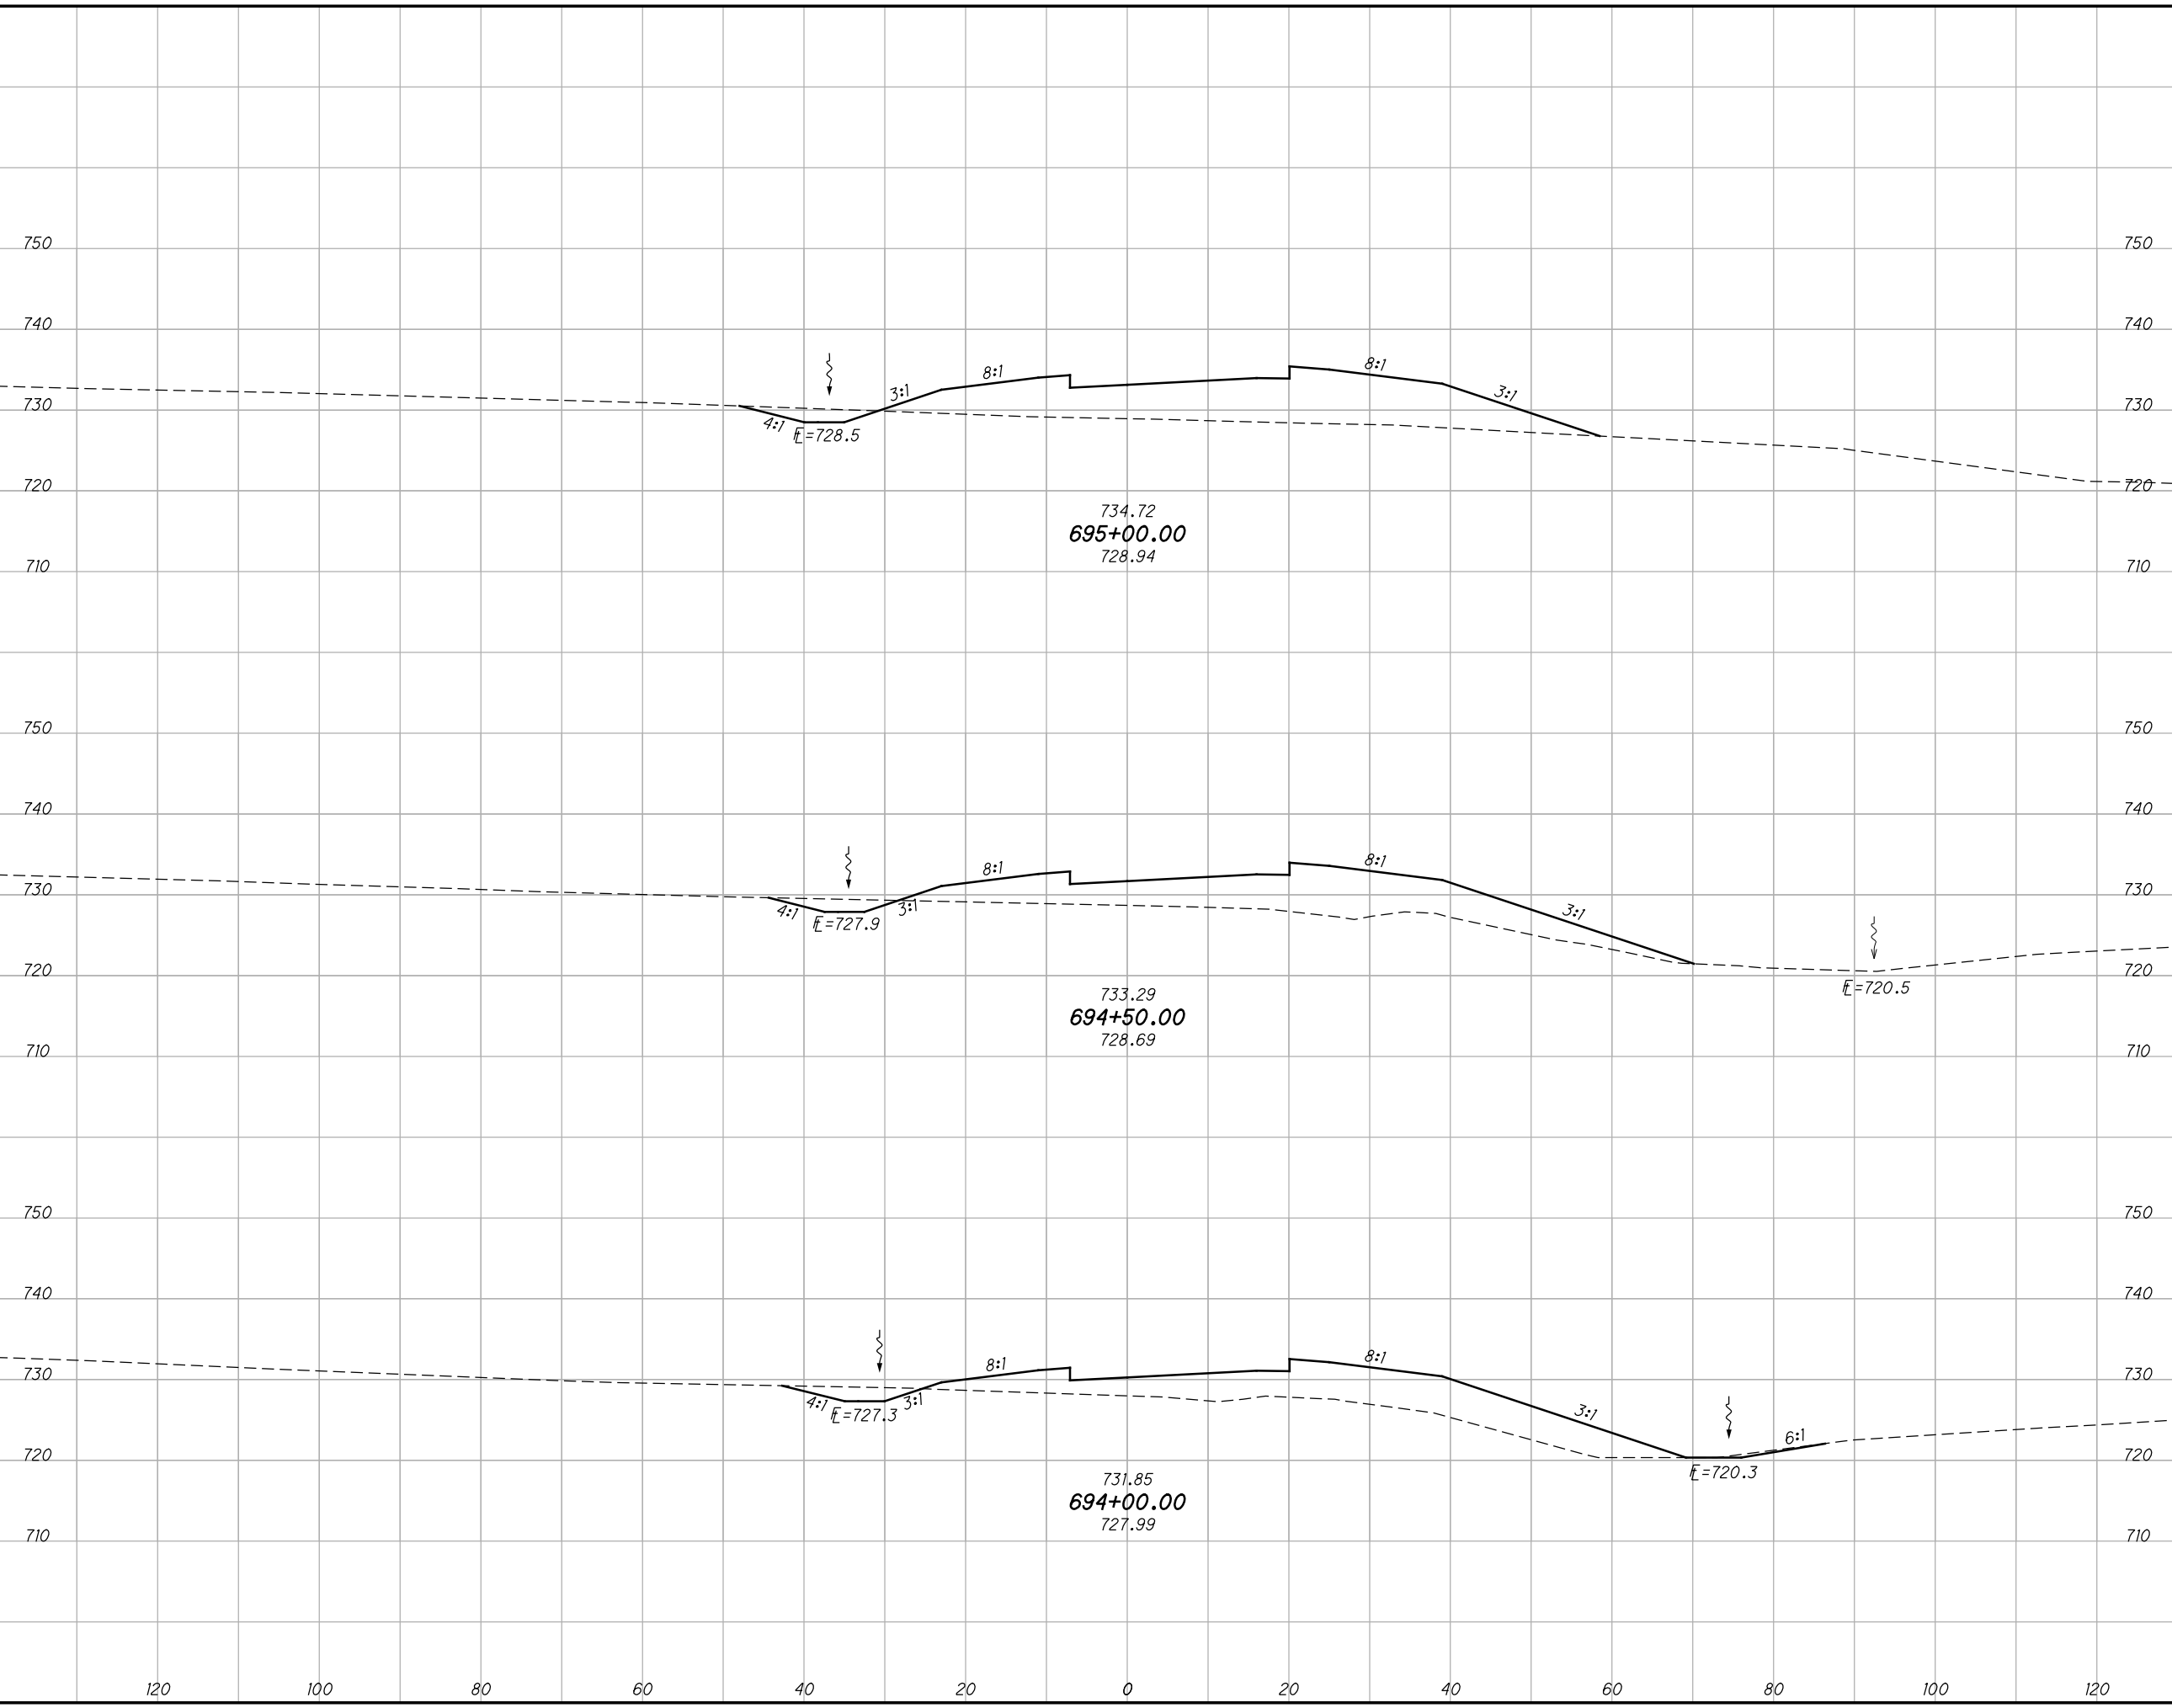

END AREA		VOLUME	
CUT	FILL	CUT	FILL

BU 4, 5, 6, 7, & 8 - RELEASED FOR CONSTRUCTION - 11/03/2014 - 11/19/2015

CROSS SECTIONS RAMP T
STA. 694+00.00 TO STA. 695+00.00

FRA - 270 - 49.00


70
182

AS BUILT - 4/22/2016

G:\projects\2014\W-14-039_FRA-270-49.00\83988\roadway\sheets\83988X5004.dgn 5/23/2016 7:31:09 AM kevinj

SEEDING
END SO.
WIDTH YDS.

END AREA
CUT FILL
VOLUME
CUT FILL
CALCULATED
CFR
CHECKED
SSK

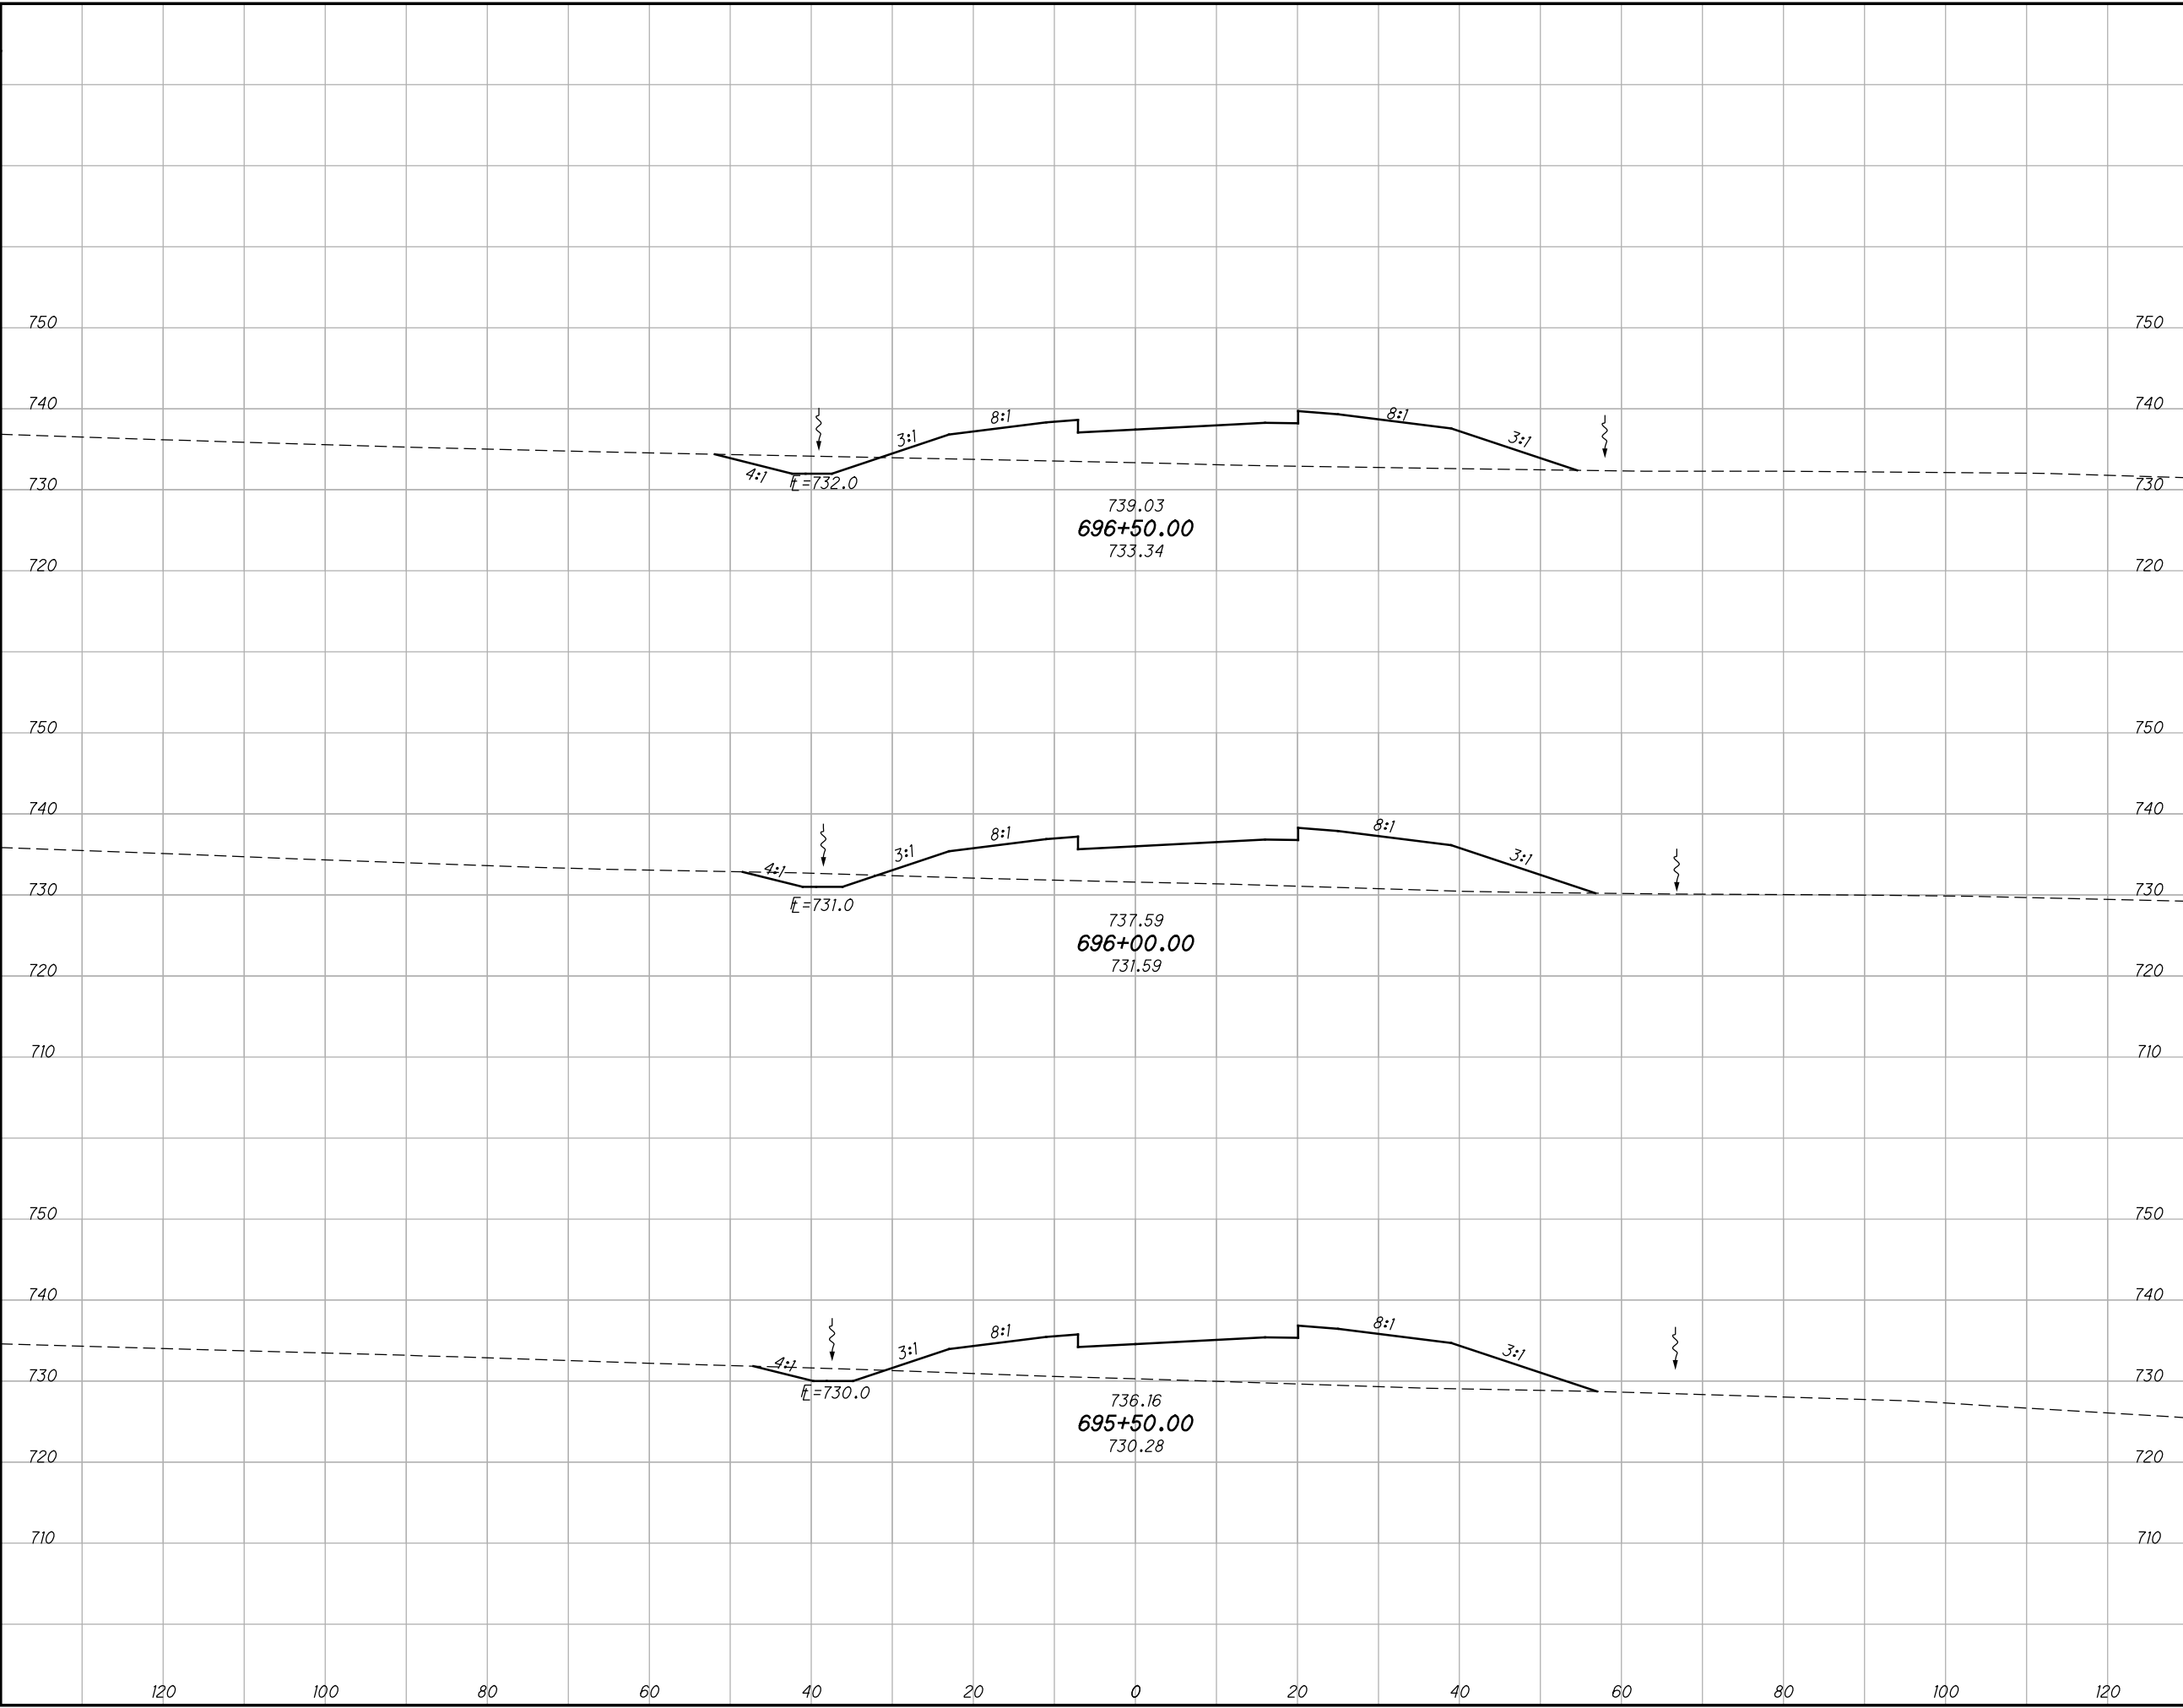

BU 4, 5, 6, 7, & 8 - RELEASED FOR CONSTRUCTION - 11/03/2014 - 11/19/2015

CROSS SECTIONS RAMP T
STA. 695+50.00 TO STA. 696+50.00


FRA - 270 - 49.00

71
182

AS BUILT - 4/22/2016

G:\projects\2014\W-14-039_FRA-270-49.00\83988\roadway\sheets\83988X5004.dgn 5/23/2016 7:31:10 AM kevinj

SEEDING	
END WIDTH	SO. YDS.

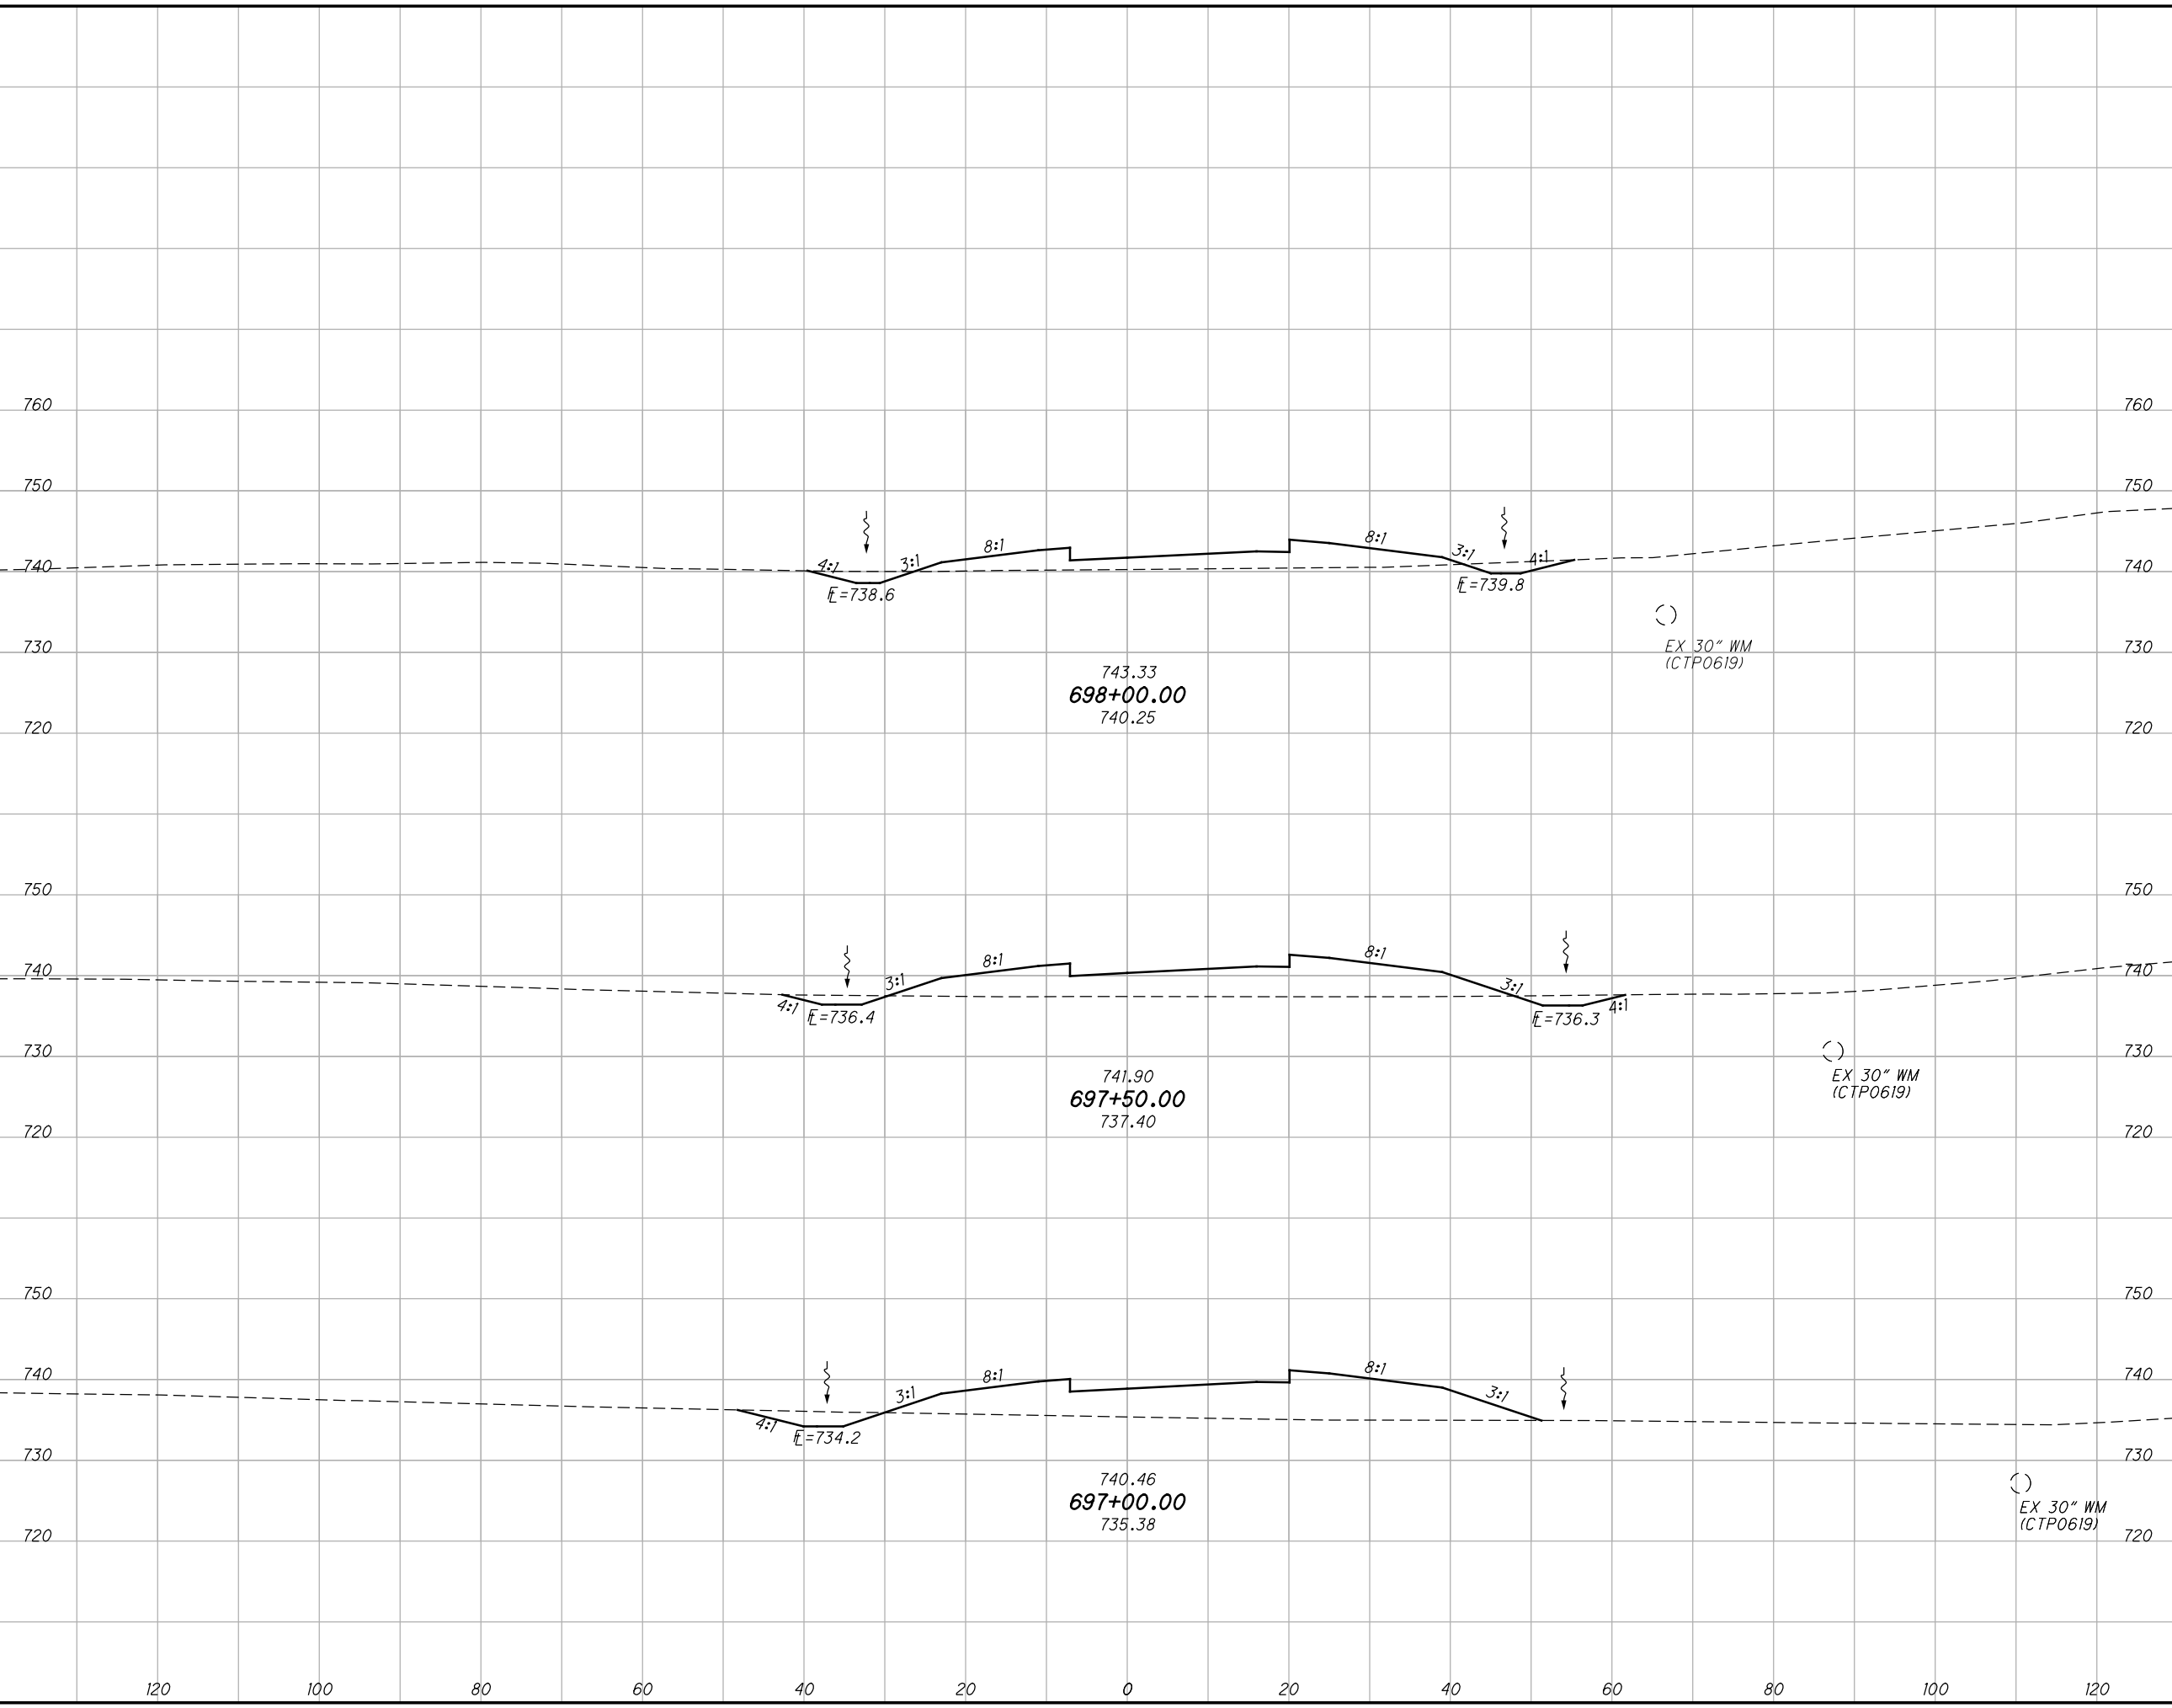

END AREA		VOLUME		CALCULATED	
CUT	FILL	CUT	FILL	CFR	SSK

BU 4, 5, 6, 7, & 8 - RELEASED FOR CONSTRUCTION - 11/03/2014 - 11/19/2015

CROSS SECTIONS RAMP T
STA. 697+00.00 TO STA. 698+00.00


FRA - 270 - 49.00

72
182

AS BUILT - 4/22/2016

G:\projects\2014\W-14-039 FRA-270-49.00\83988\roadway\sheets\83988X5004.dgn 5/23/2016 7:31:10 AM kevinj

SEEDING	
END WIDTH	SO. YDS.

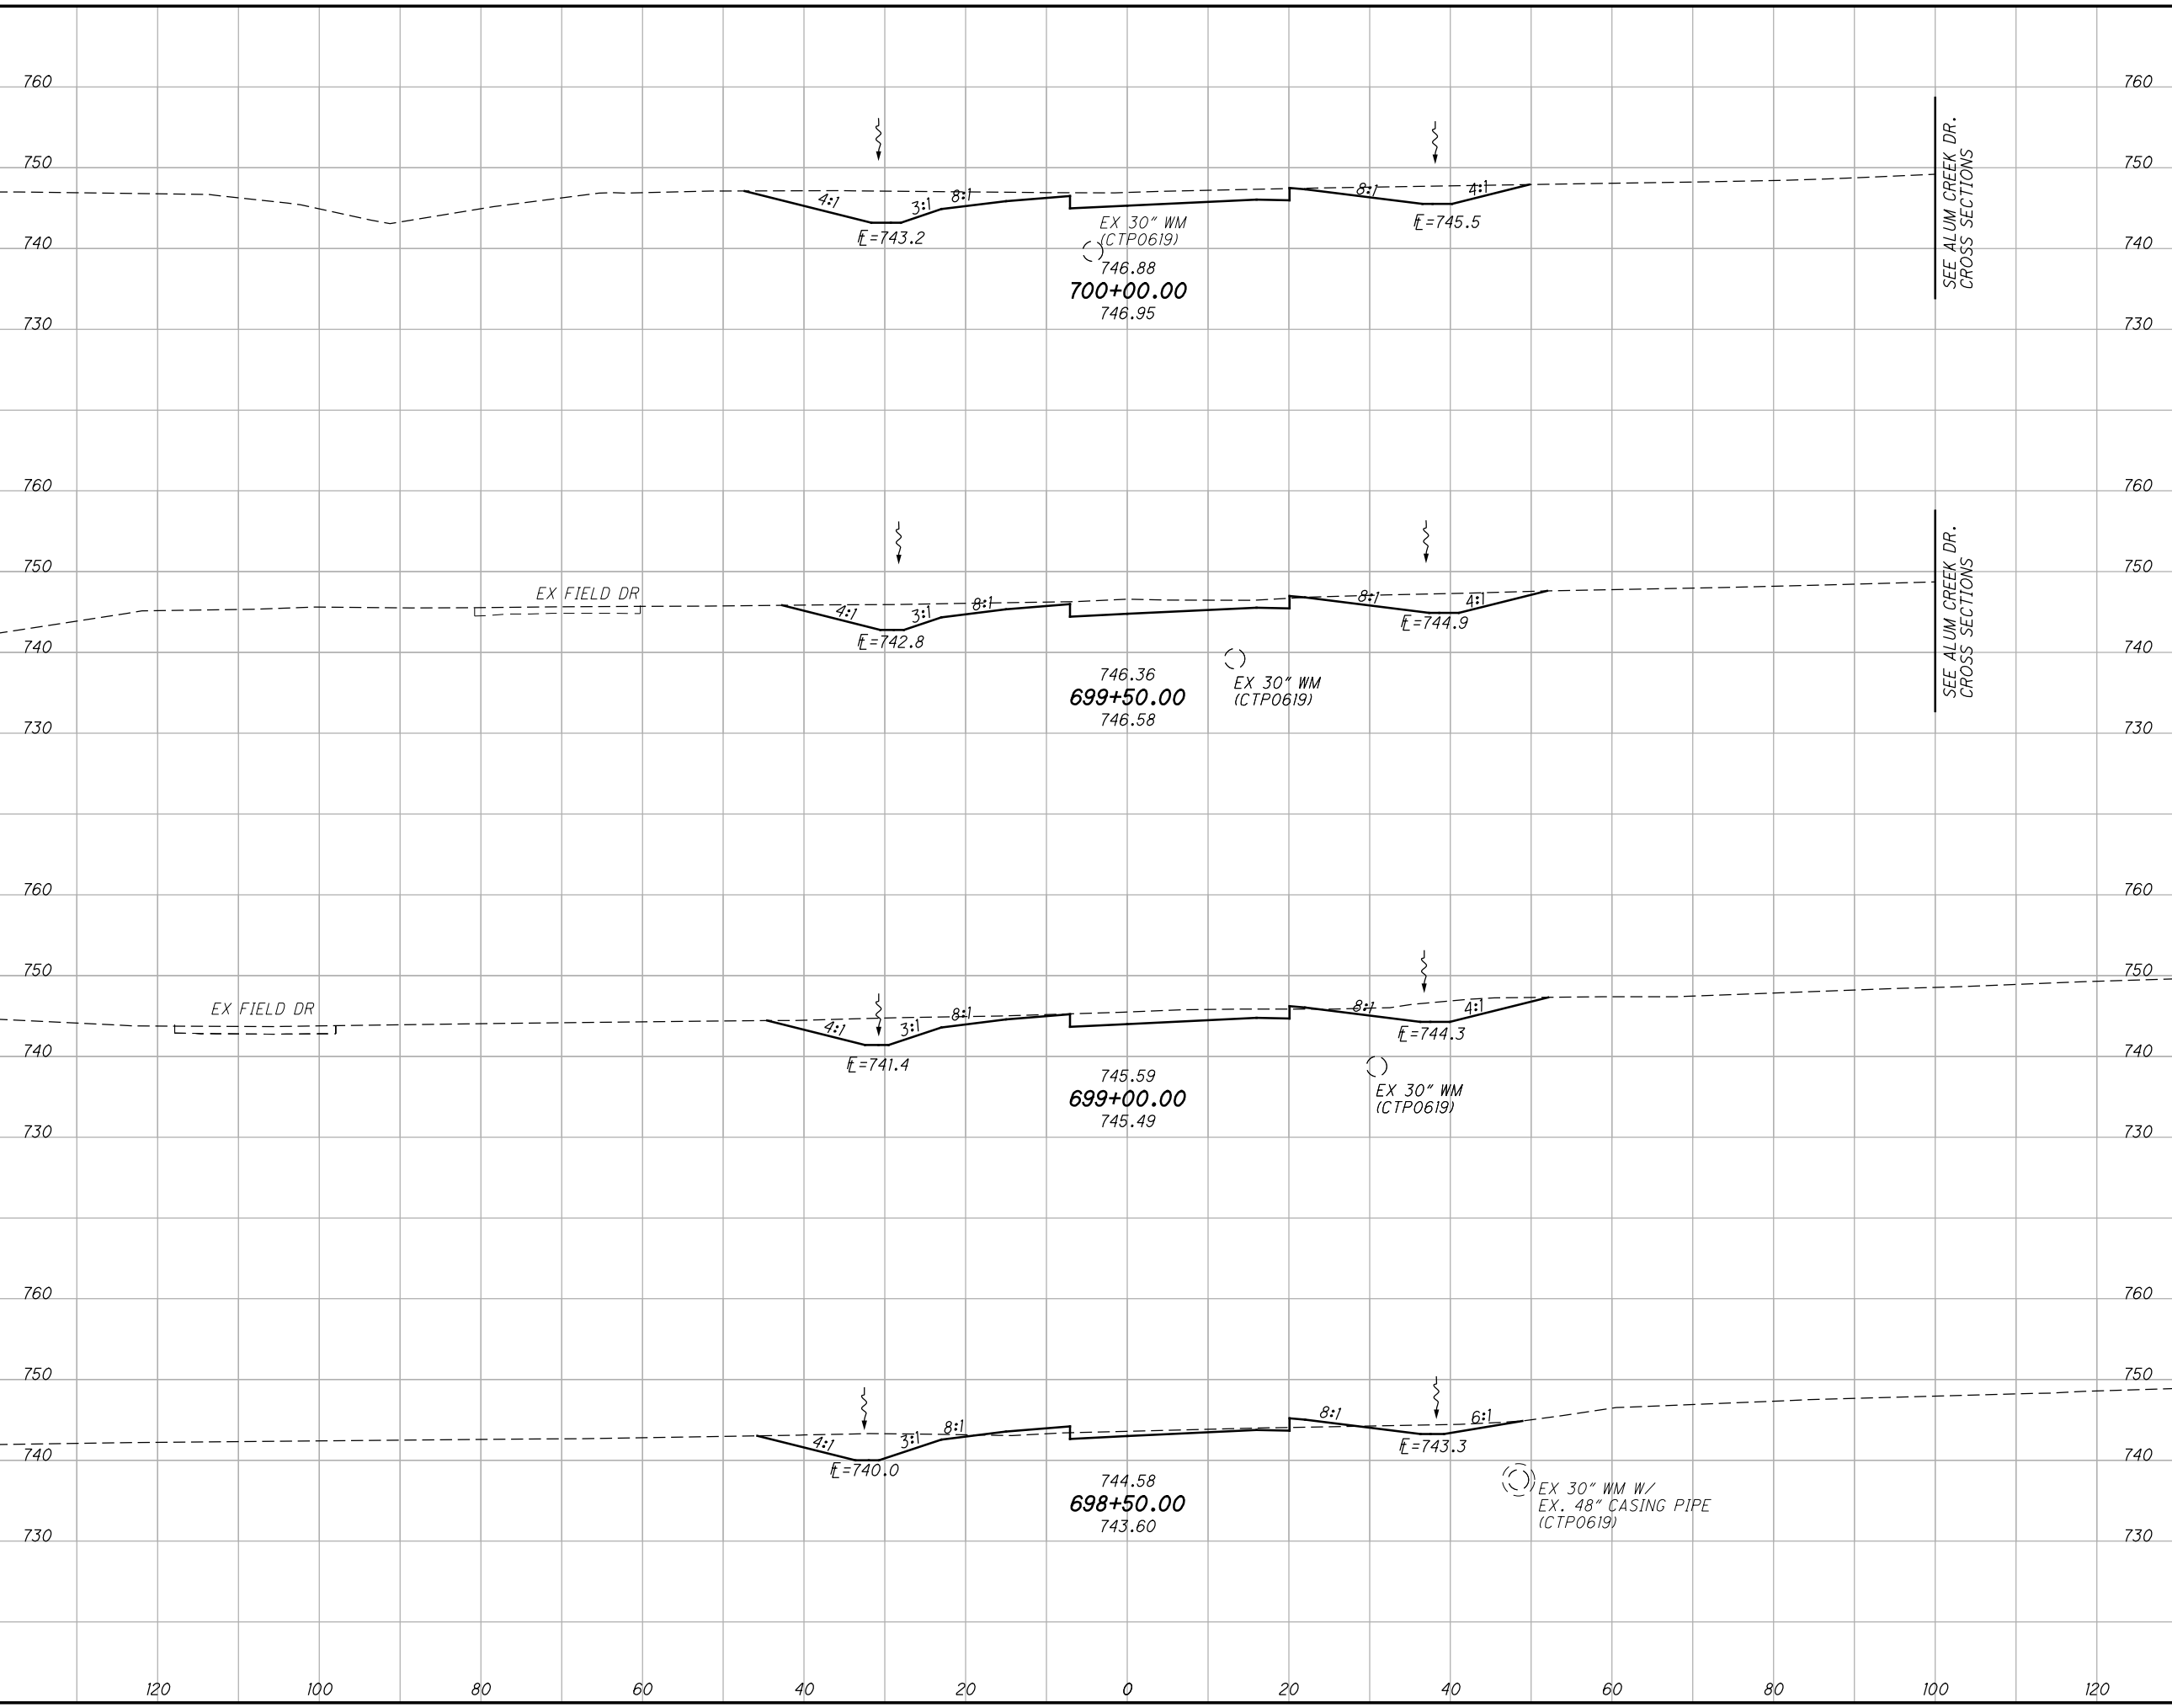

END	AREA		VOLUME		CALCULATED	CFR	CHECKED	SSK
	CUT	FILL	CUT	FILL				

BU 4, 5, 6, 7, & 8 - RELEASED FOR CONSTRUCTION - 11/03/2014 - 11/19/2015


CROSS SECTIONS RAMP T
STA. 698+50.00 TO STA. 700+00.00

FRA - 270 - 49.00

AS BUILT - 4/22/2016

G:\projects\2014\W-14-039_FRA-270-49.00\83988\roadway\sheets\83988X5004.dgn 5/23/2016 7:31:10 AM kevinj

SEEDING	
END WIDTH	SO. YDS.

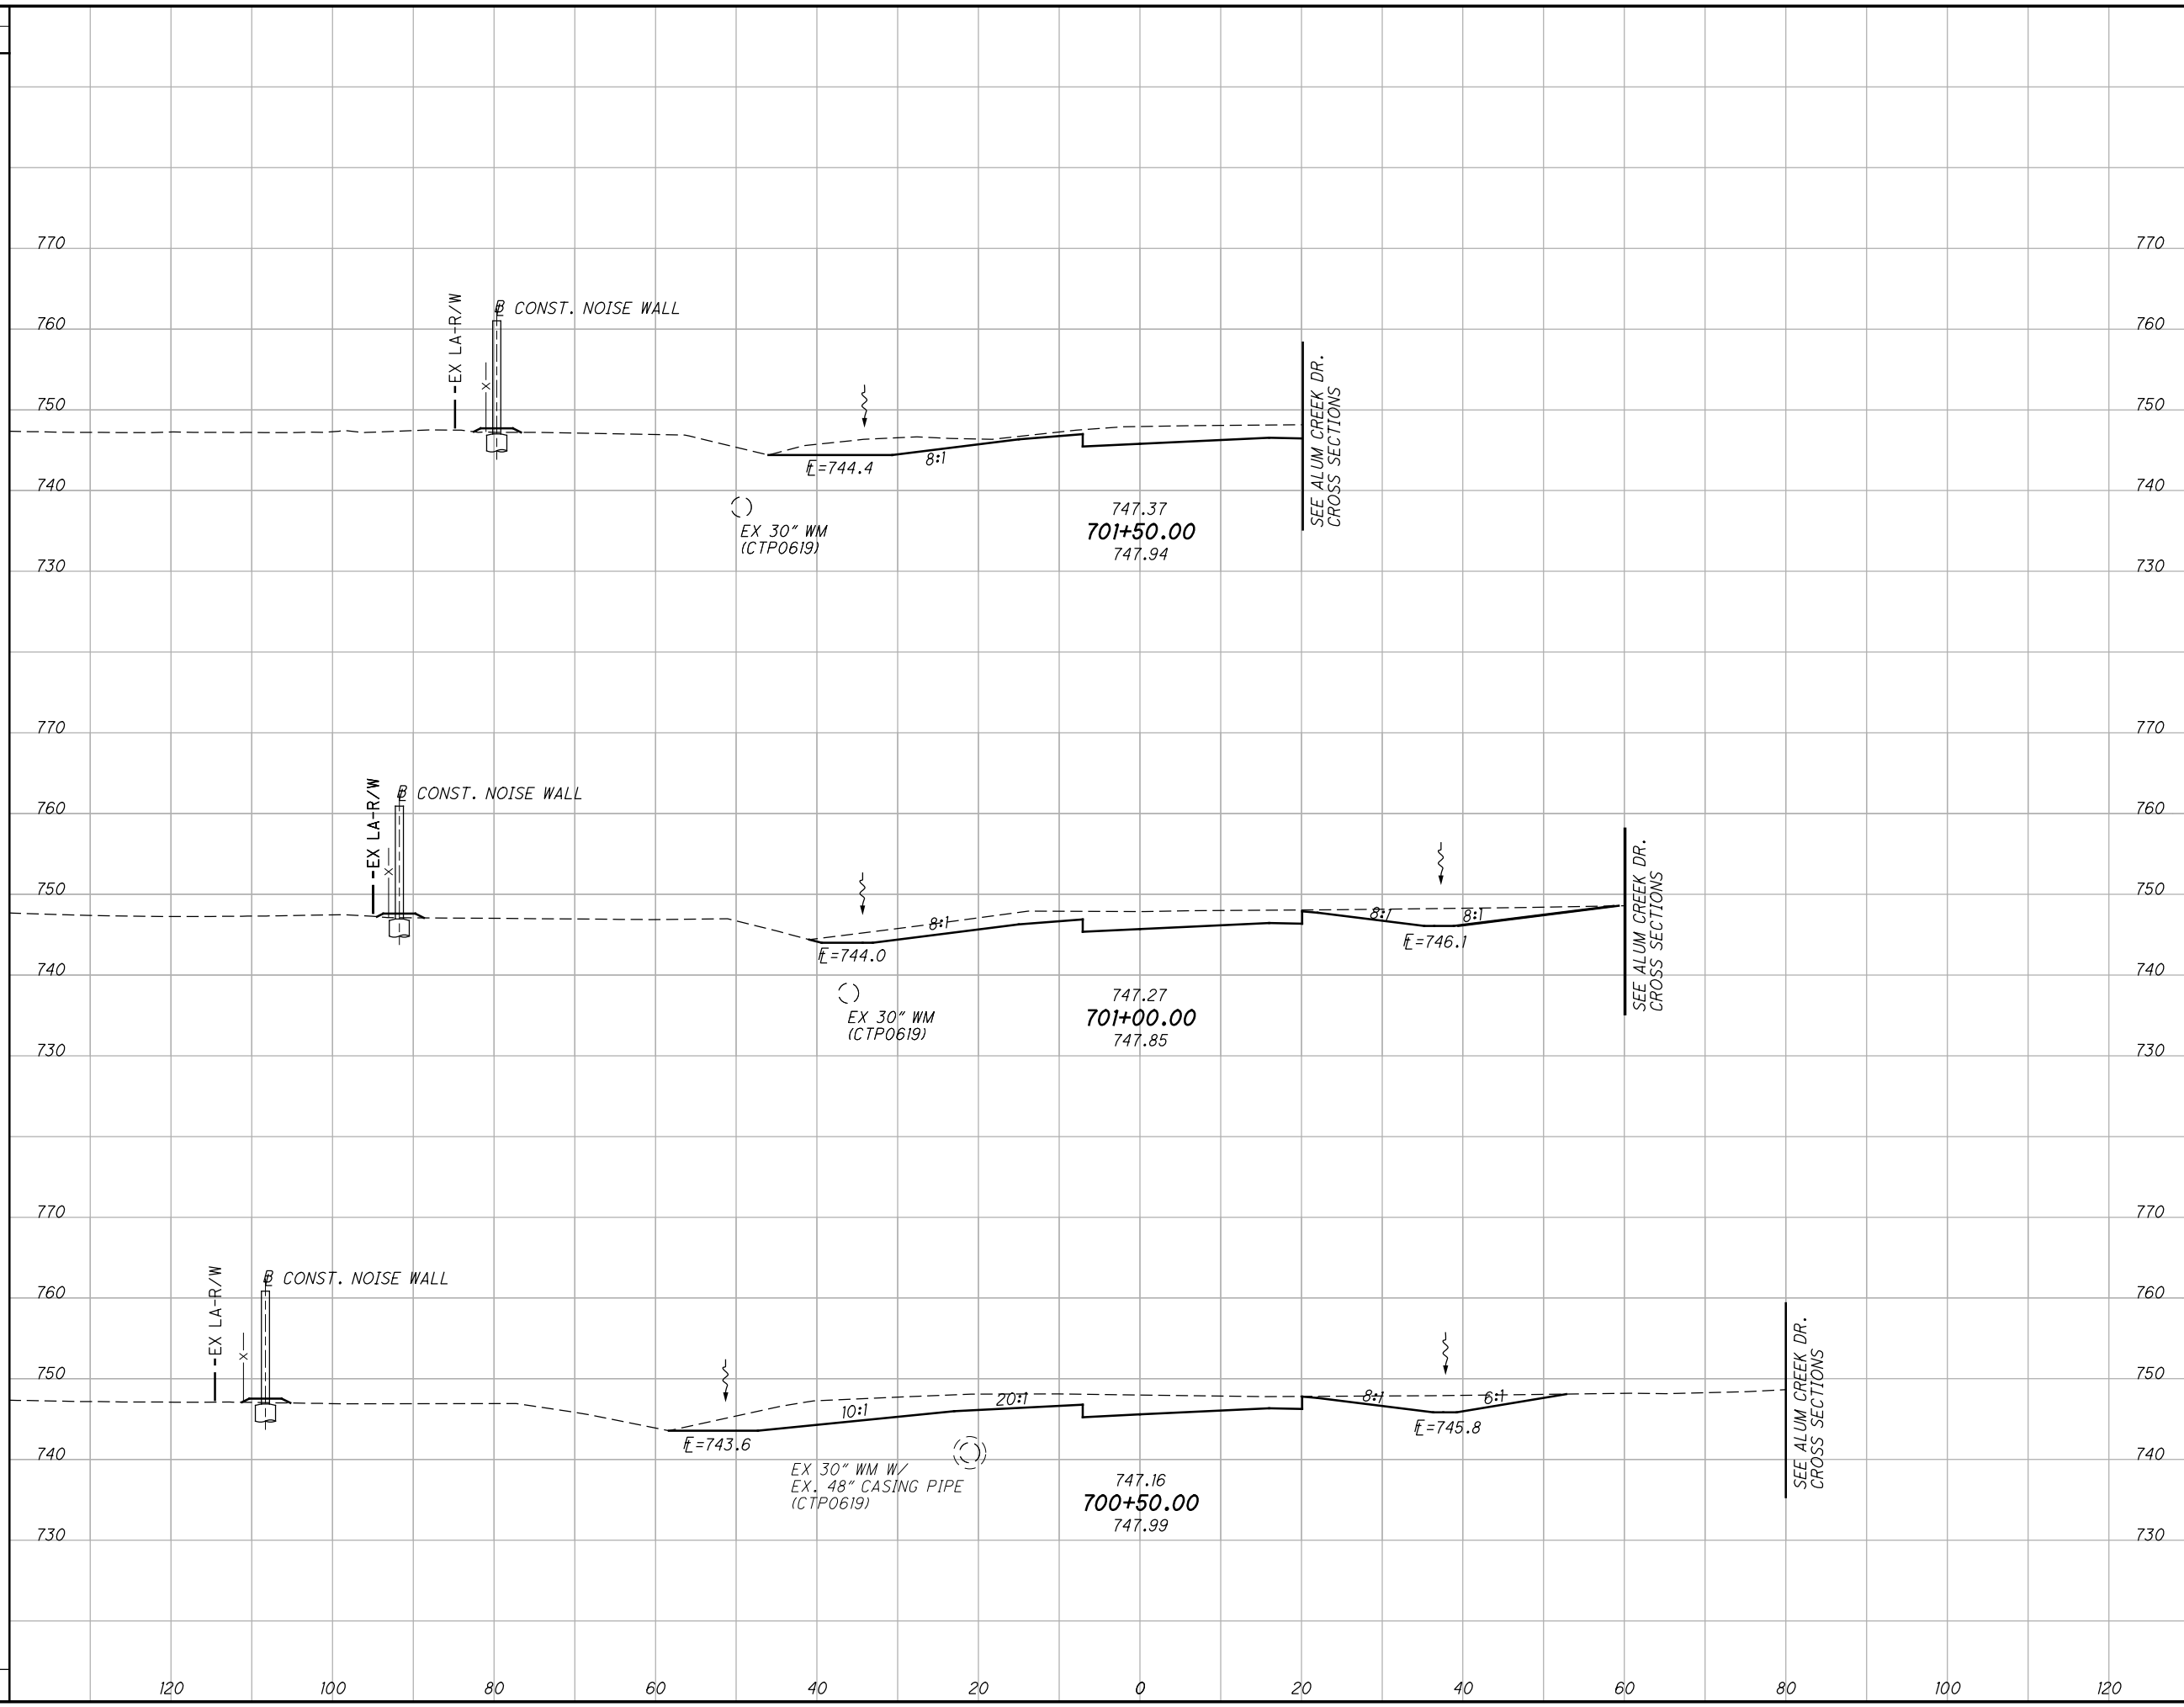

END AREA		VOLUME	
CUT	FILL	CUT	FILL

CALCULATED	CHECKED
CFR	SSK

BU 4, 5, 6, 7, & 8 - RELEASED FOR CONSTRUCTION - 11/03/2014 - 11/19/2015



CROSS SECTIONS RAMP T
STA. 700+50.00 TO STA. 701+50.00

FRA - 270 - 49.00

AS BUILT - 4/22/2016

5/23/2016 7:31:11 AM kevinj

G:\projects\2014\W-14-039_FRA-270-49\roadway\sheet\83988\83988FP10_Rev.dgn

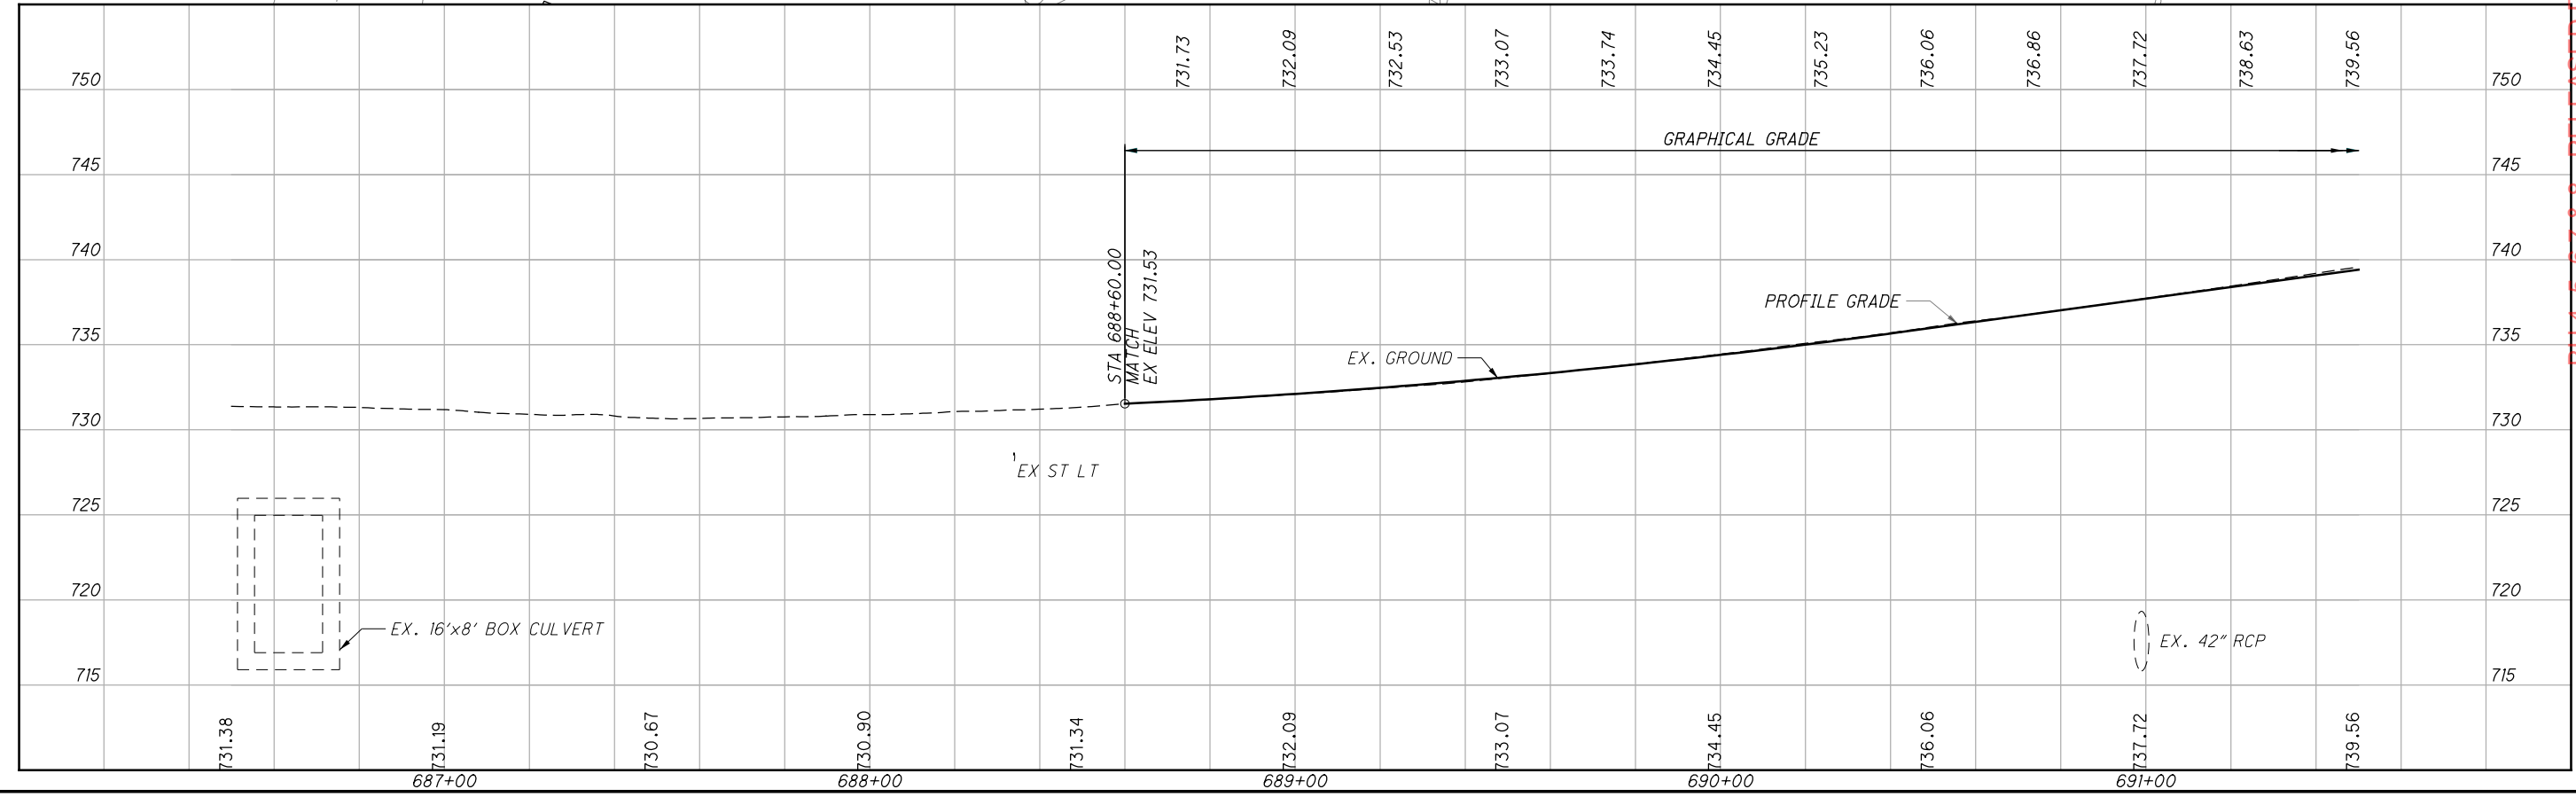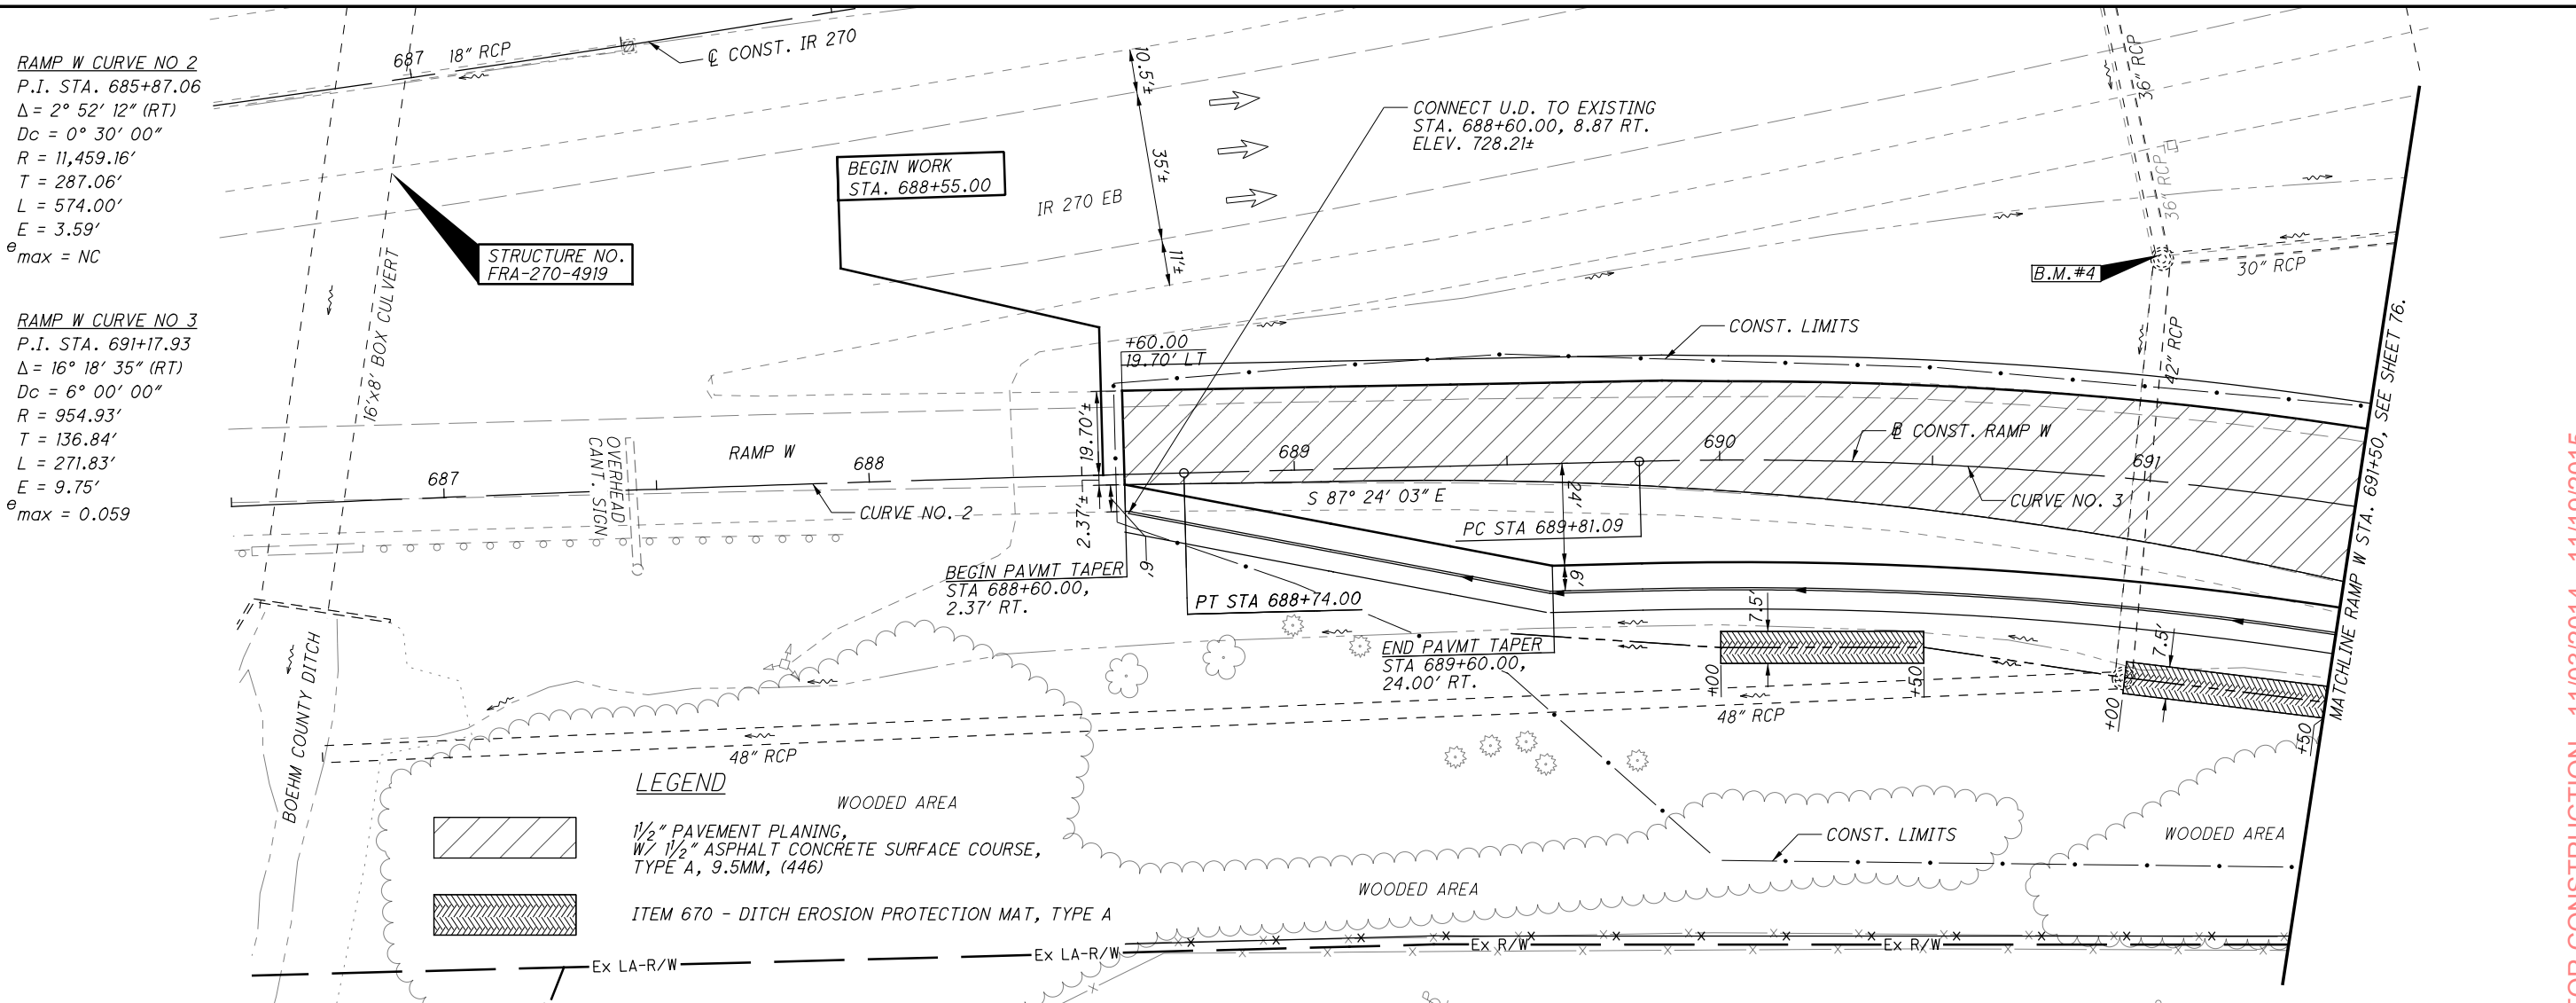

CALCULATED
CFR
CHECKED
SSK

0 20 40
HORIZONTAL
SCALE IN FEET

BU 4, 5, 6, 7, & 8 - RELEASED FOR CONSTRUCTION - 11/03/2014 - 11/19/2015

PLAN AND PROFILE - RAMP W
STA. 686+50 TO STA. 691+50



FRA - 270 - 49.00

75
182

AS BUILT - 4/22/2016

5/23/2016 7:31:12 AM kevinj

G:\projects\2014\W-14-039_FRA-270-49.00\83988\roadway\sheets\83988GF011_Rev.dgn

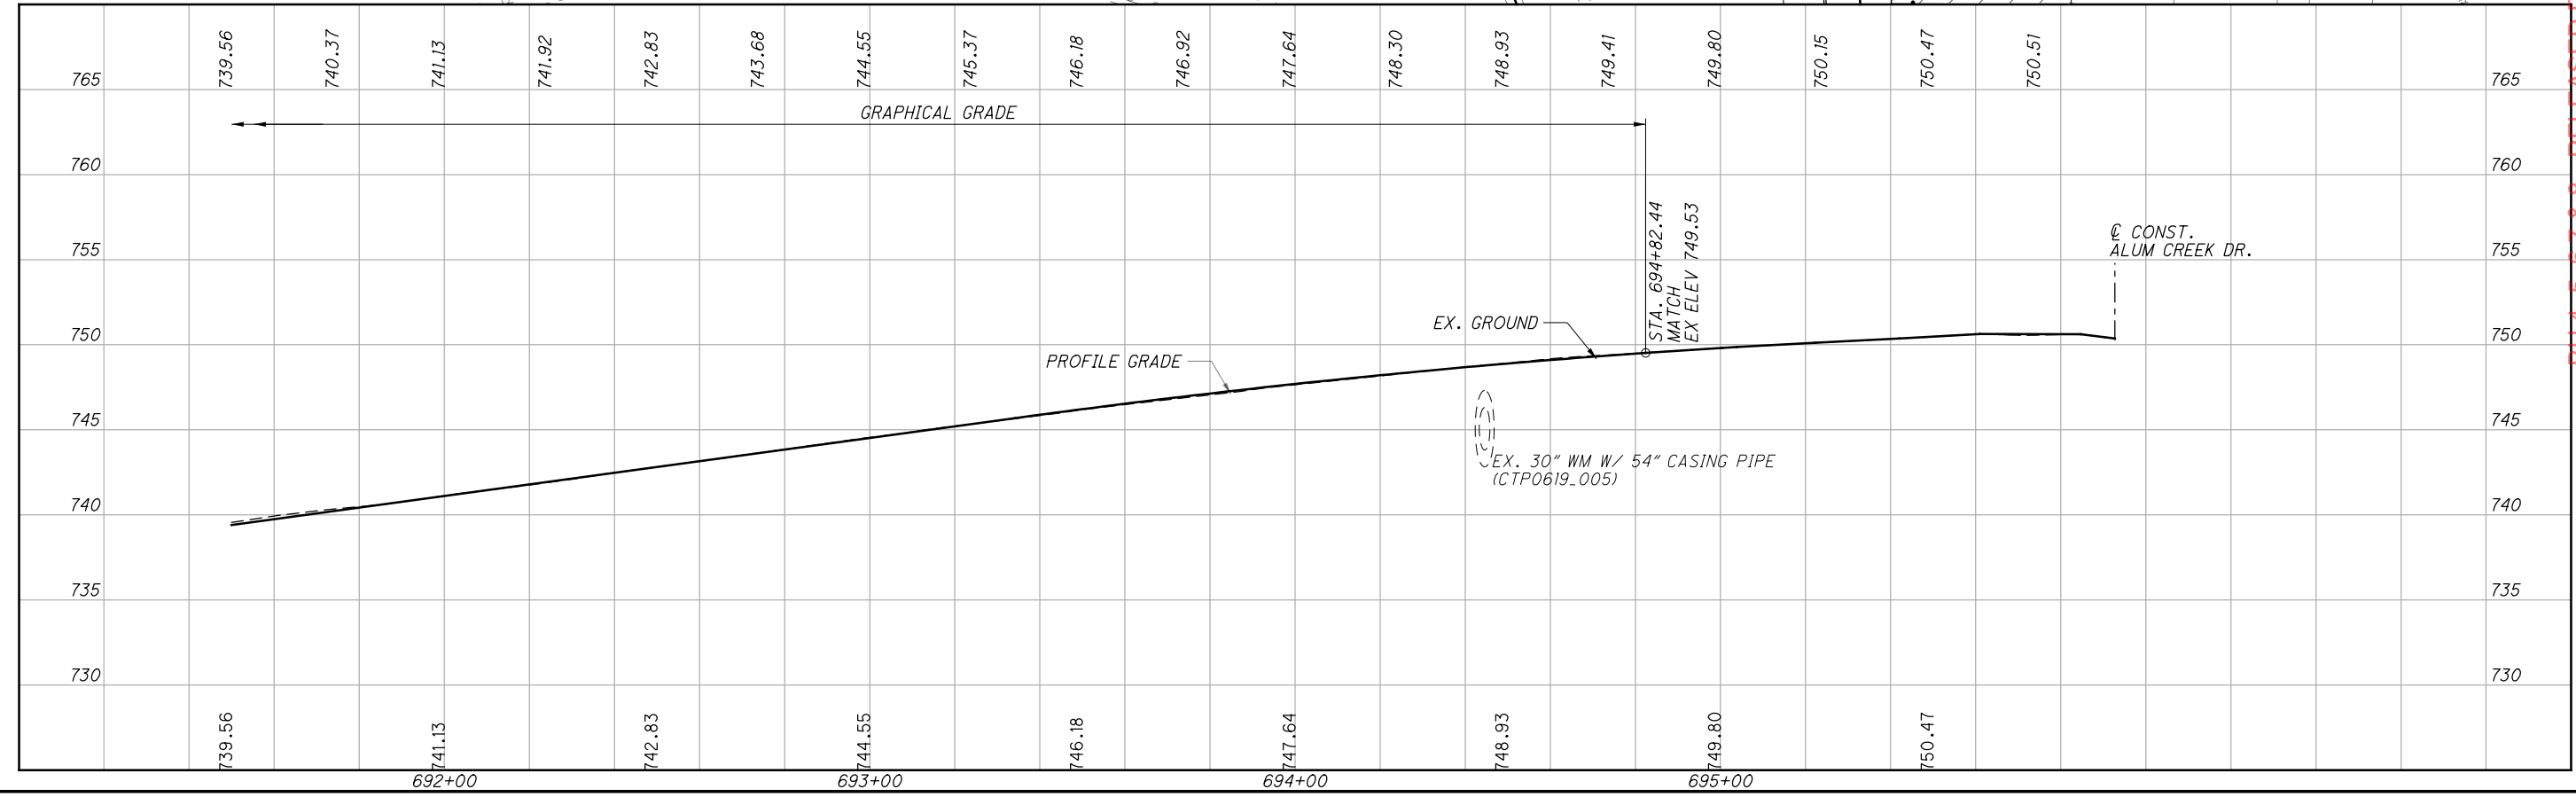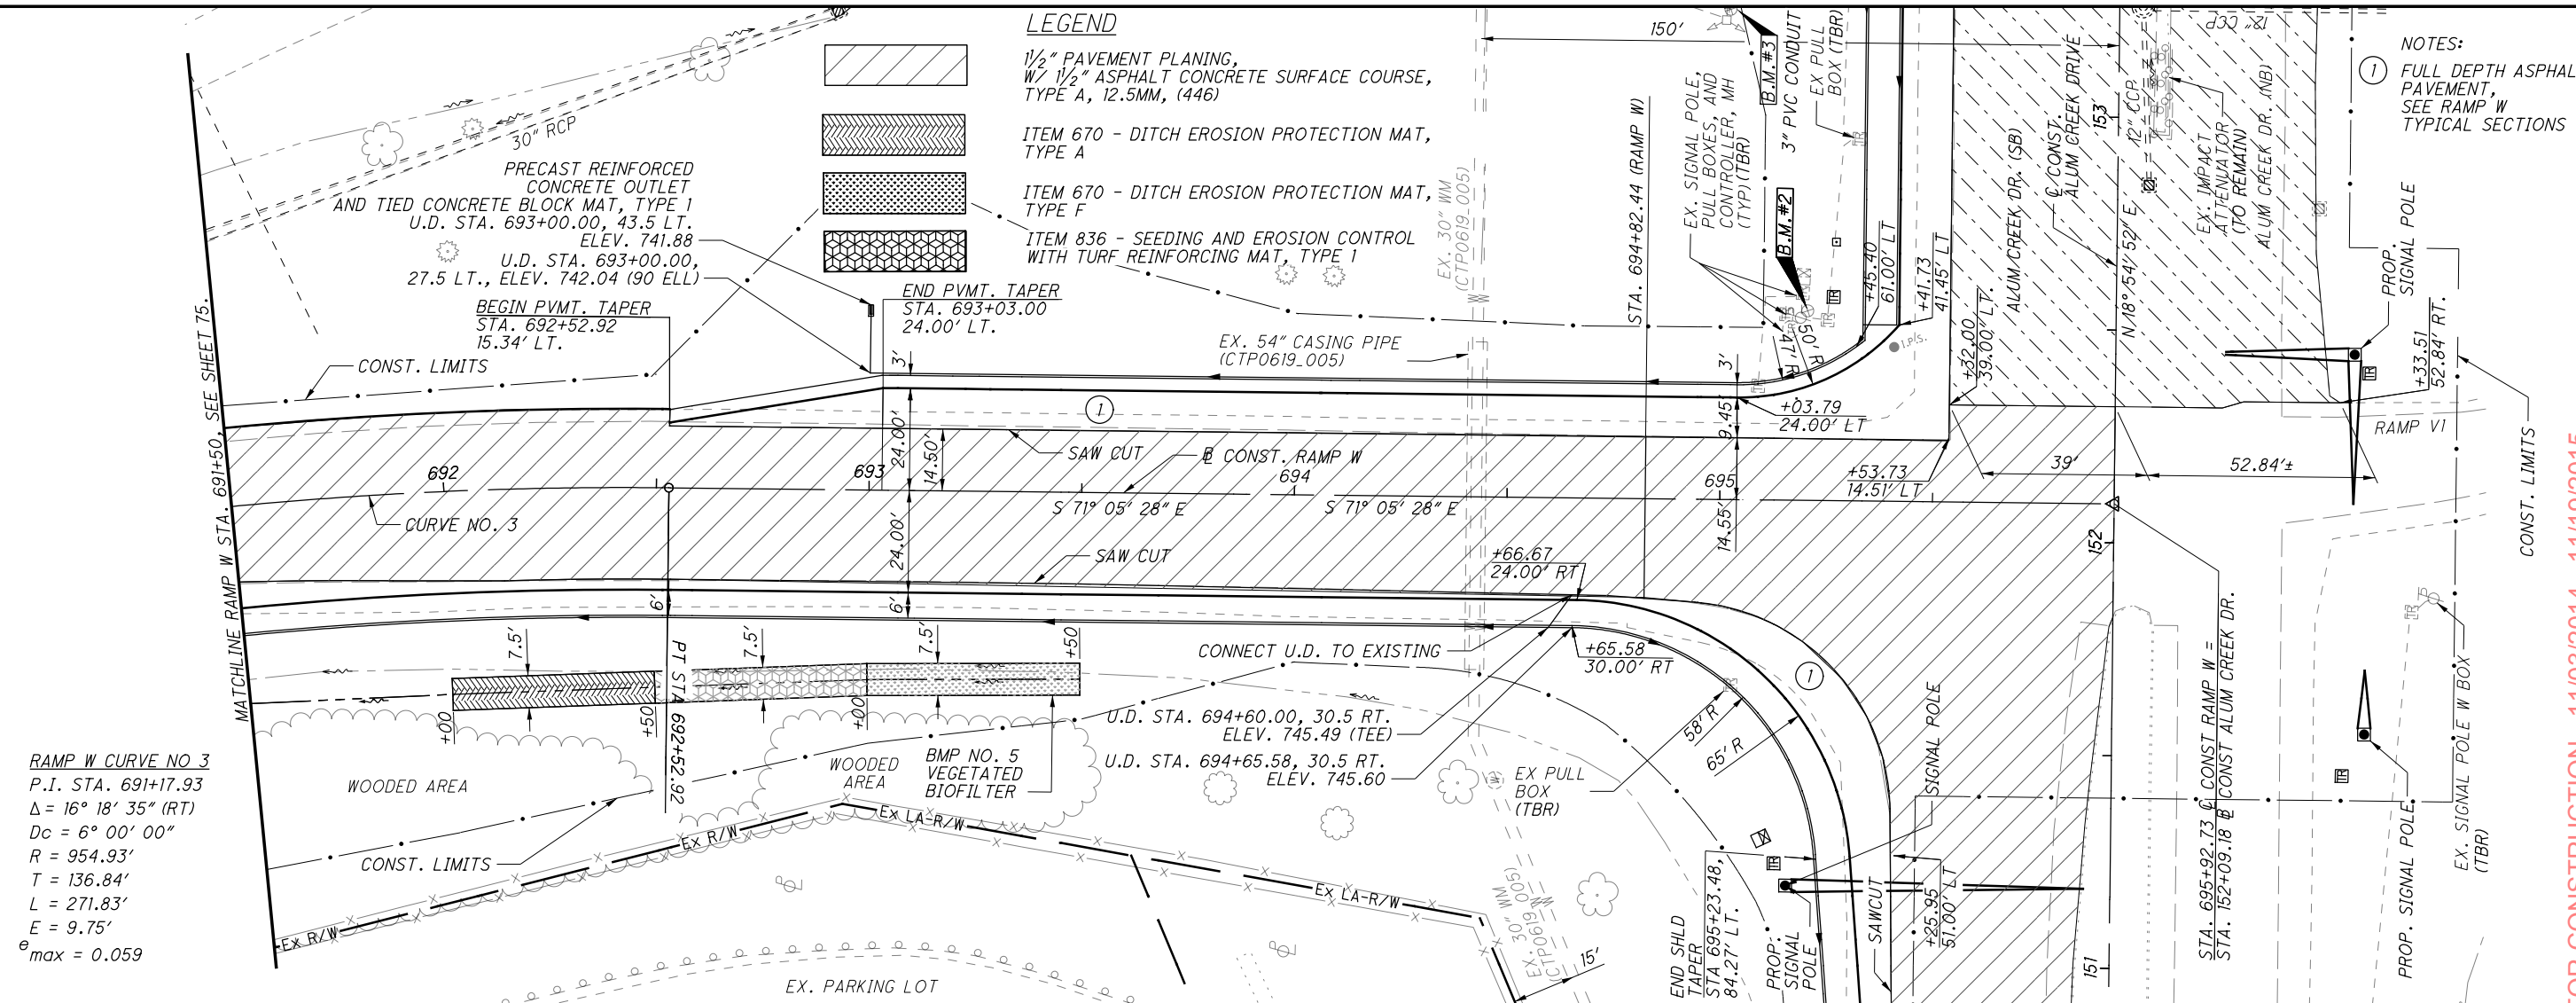

- LEGEND**
- 1/2" PAVEMENT PLANING, W/ 1/2" ASPHALT CONCRETE SURFACE COURSE, TYPE A, 12.5MM, (446)
 - ITEM 670 - DITCH EROSION PROTECTION MAT, TYPE A
 - ITEM 670 - DITCH EROSION PROTECTION MAT, TYPE F
 - ITEM 836 - SEEDING AND EROSION CONTROL WITH TURF REINFORCING MAT, TYPE 1

NOTES:
 (1) FULL DEPTH ASPHALT PAVEMENT, SEE RAMP W TYPICAL SECTIONS



BU 4, 5, 6, 7, & 8 - RELEASED FOR CONSTRUCTION - 11/03/2014 - 11/19/2015


**PLAN AND PROFILE - RAMP W
 STA. 691+50 TO STA. 695+92.73**

FRA - 270-49.00

AS BUILT - 4/22/2016

G:\projects\2014\W-14-039 FRA-270-49.00\83988\roadway\sheets\83988X5001.dgn 5/23/2016 7:31:13 AM kevinj

SEEDING	
END WIDTH	SO. YDS.

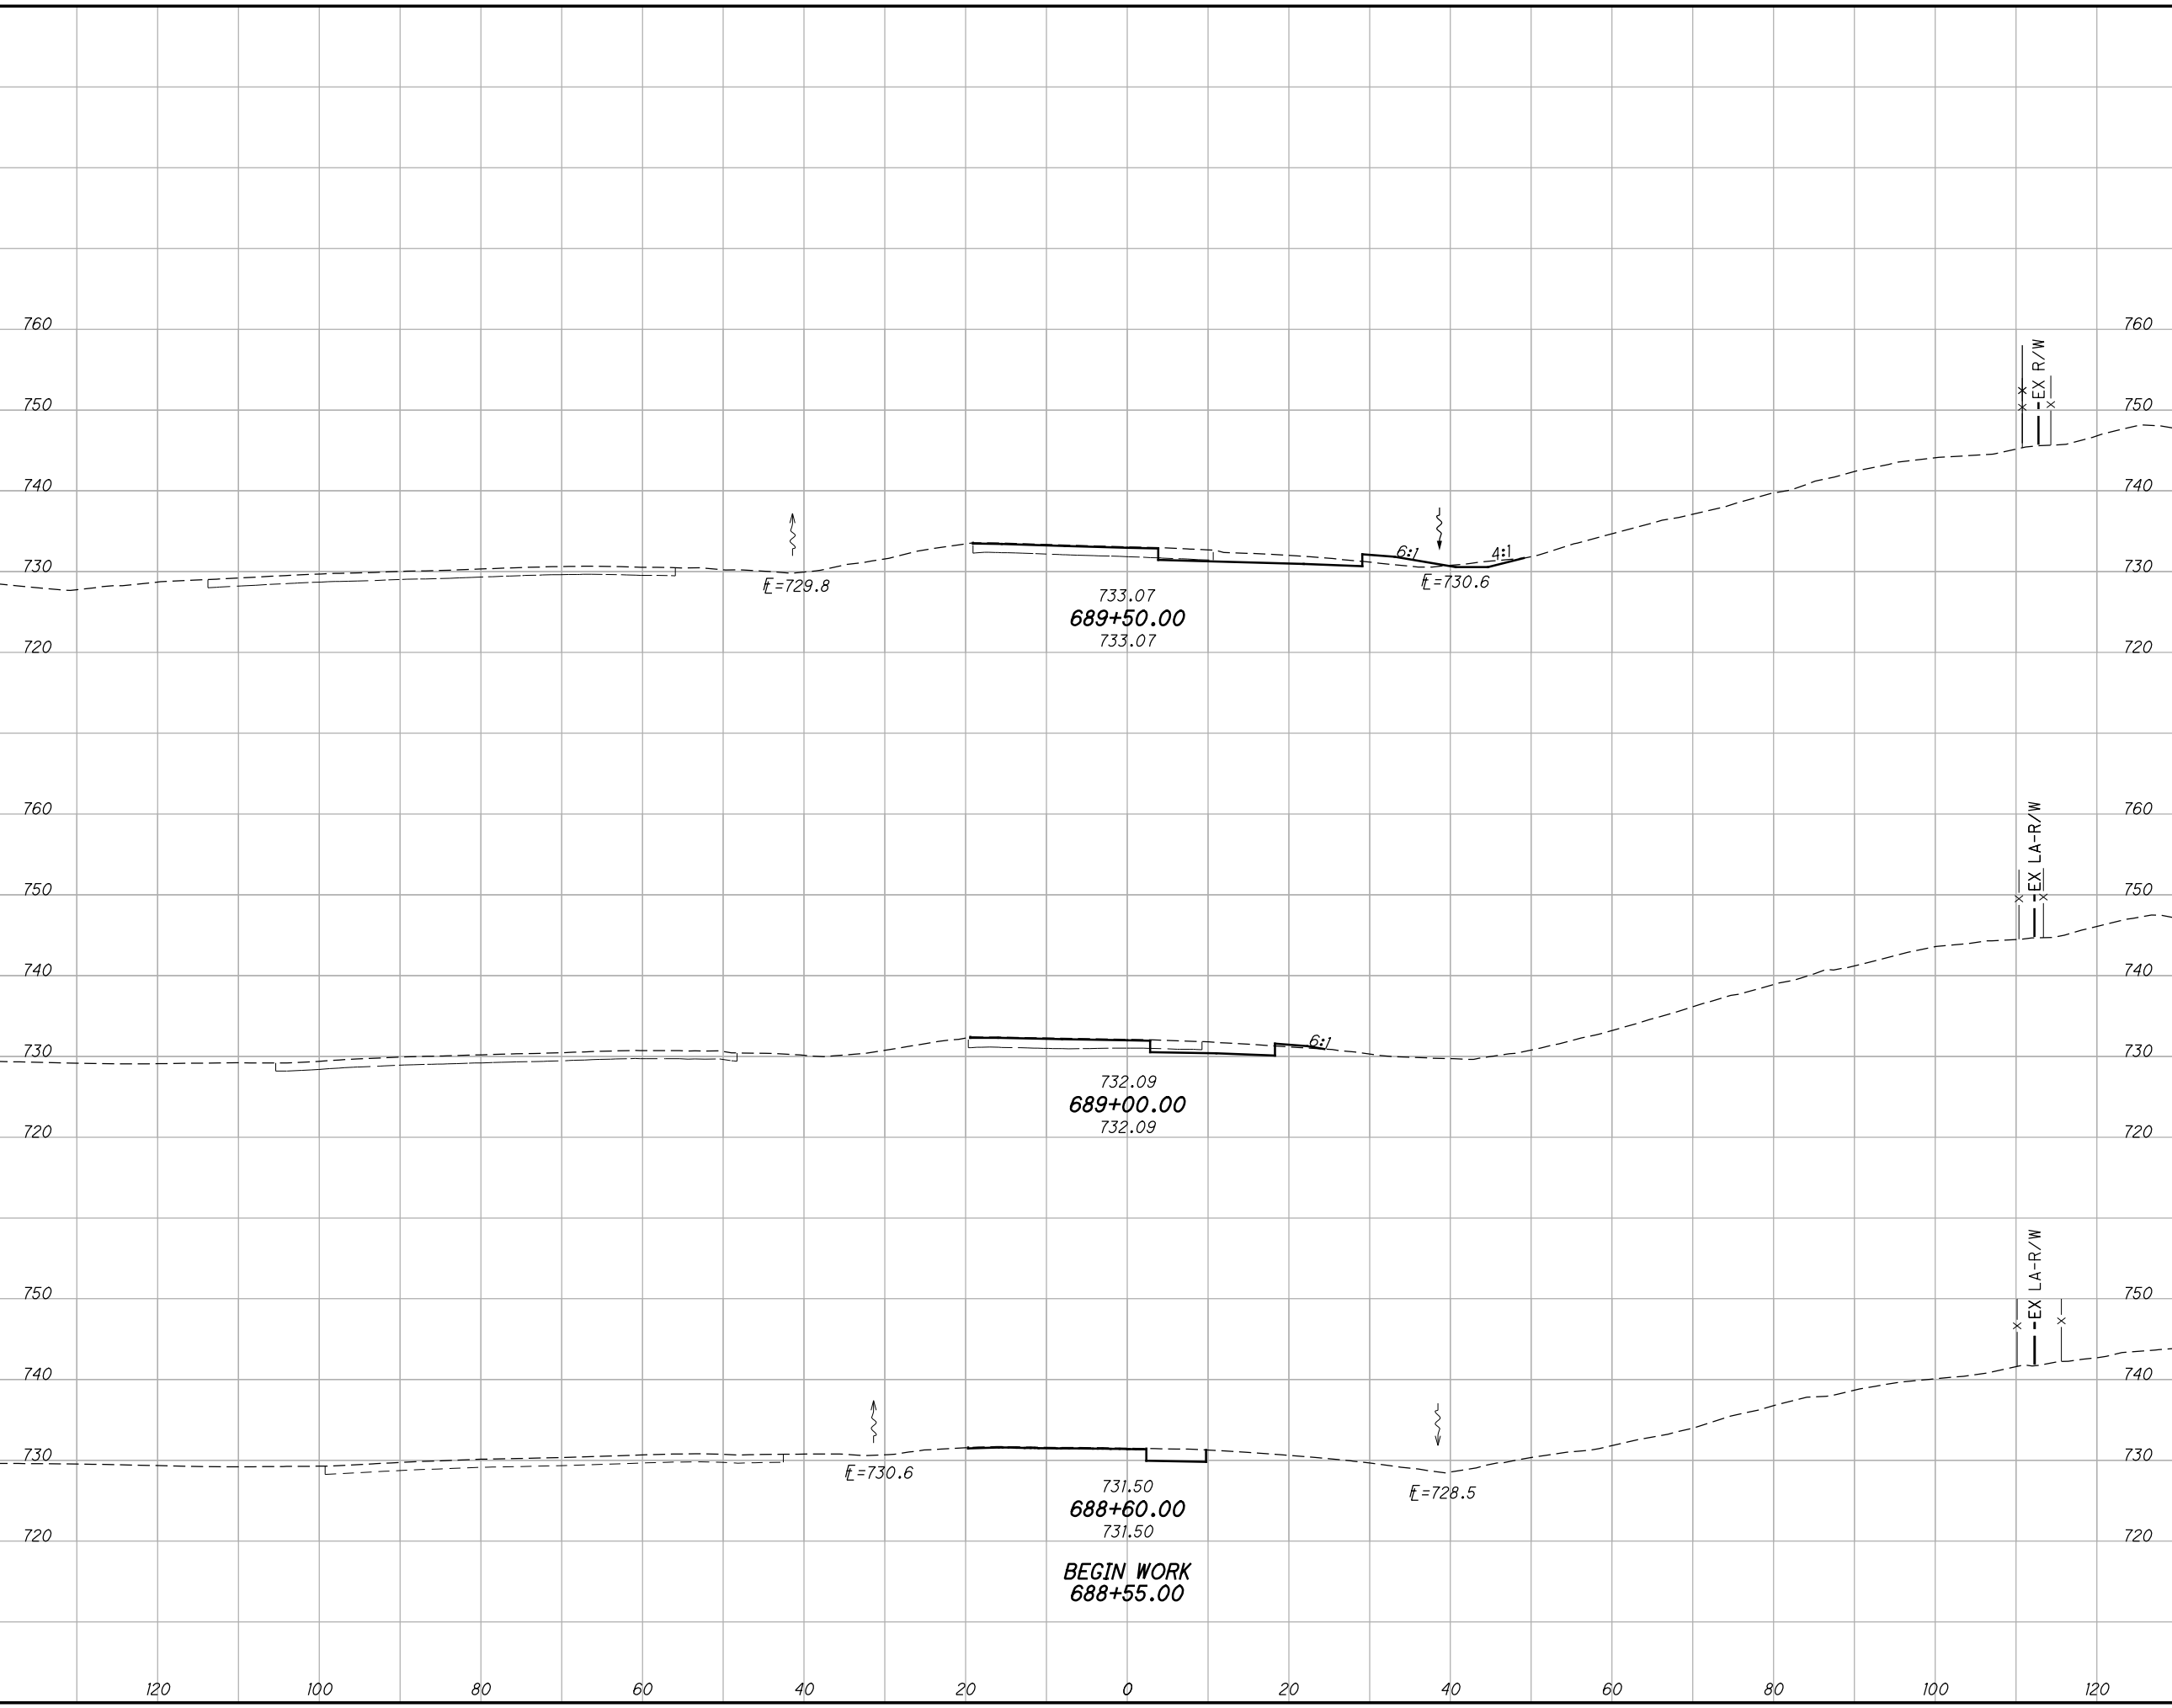

END AREA		VOLUME		CALCULATED	CFR	CHECKED	SSK
CUT	FILL	CUT	FILL				

BU 4, 5, 6, 7, & 8 - RELEASED FOR CONSTRUCTION - 11/03/2014 - 11/19/2015


CROSS SECTIONS RAMP W
STA. 688+60.00 TO STA. 689+50.00

FRA - 270-49.00

77
182

AS BUILT - 4/22/2016

G:\projects\2014\W-14-039_FRA-270-49.00\83988\roadway\sheets\83988X5001.dgn 5/23/2016 7:31:13 AM kevinj

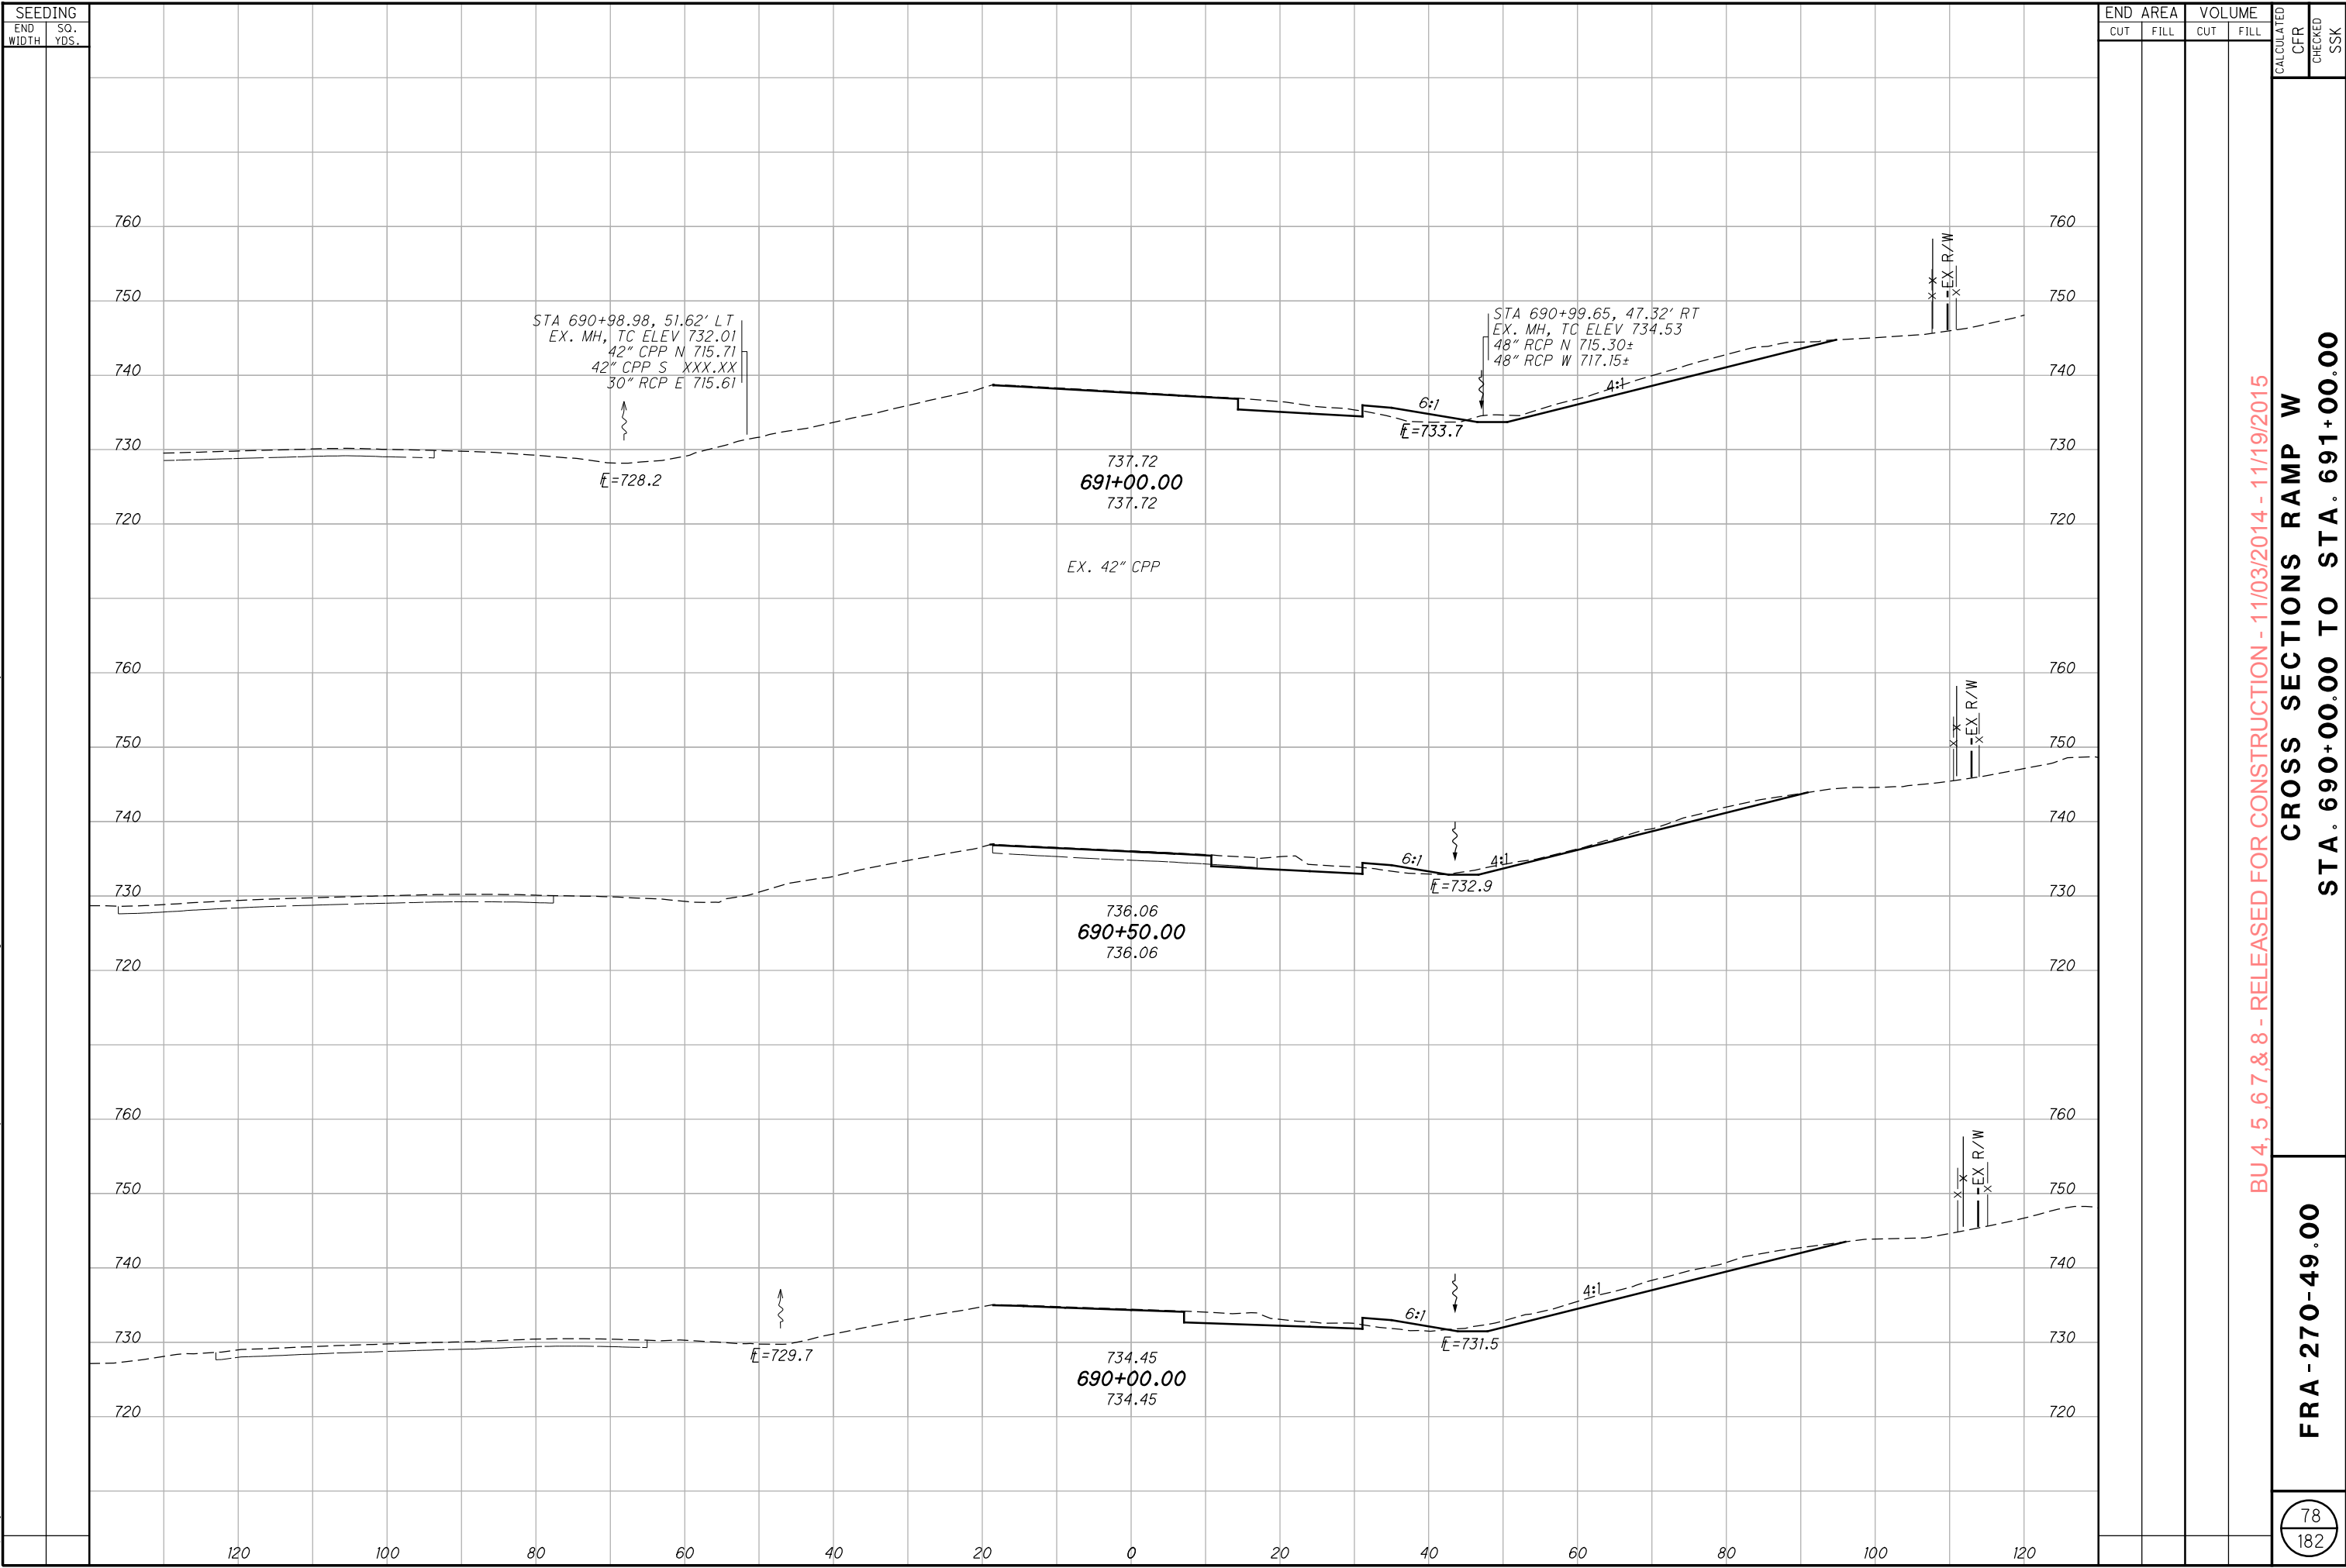

SEEDING		END AREA		VOLUME		CALCULATED	
END WIDTH	SO. YDS.	CUT	FILL	CUT	FILL	CFR	SSK

BU 4, 5, 6, 7, & 8 - RELEASED FOR CONSTRUCTION - 11/03/2014 - 11/19/2015

CROSS SECTIONS RAMP W

STA. 690+00.00 TO STA. 691+00.00


FRA - 270 - 49.00

78
182

AS BUILT - 4/22/2016

G:\projects\2014\W-14-039 FRA-270-49.00\83988\roadway\sheet\83988X5001.dgn 5/23/2016 7:31:14 AM kevinj

SEEDING	
END WIDTH	SO. YDS.

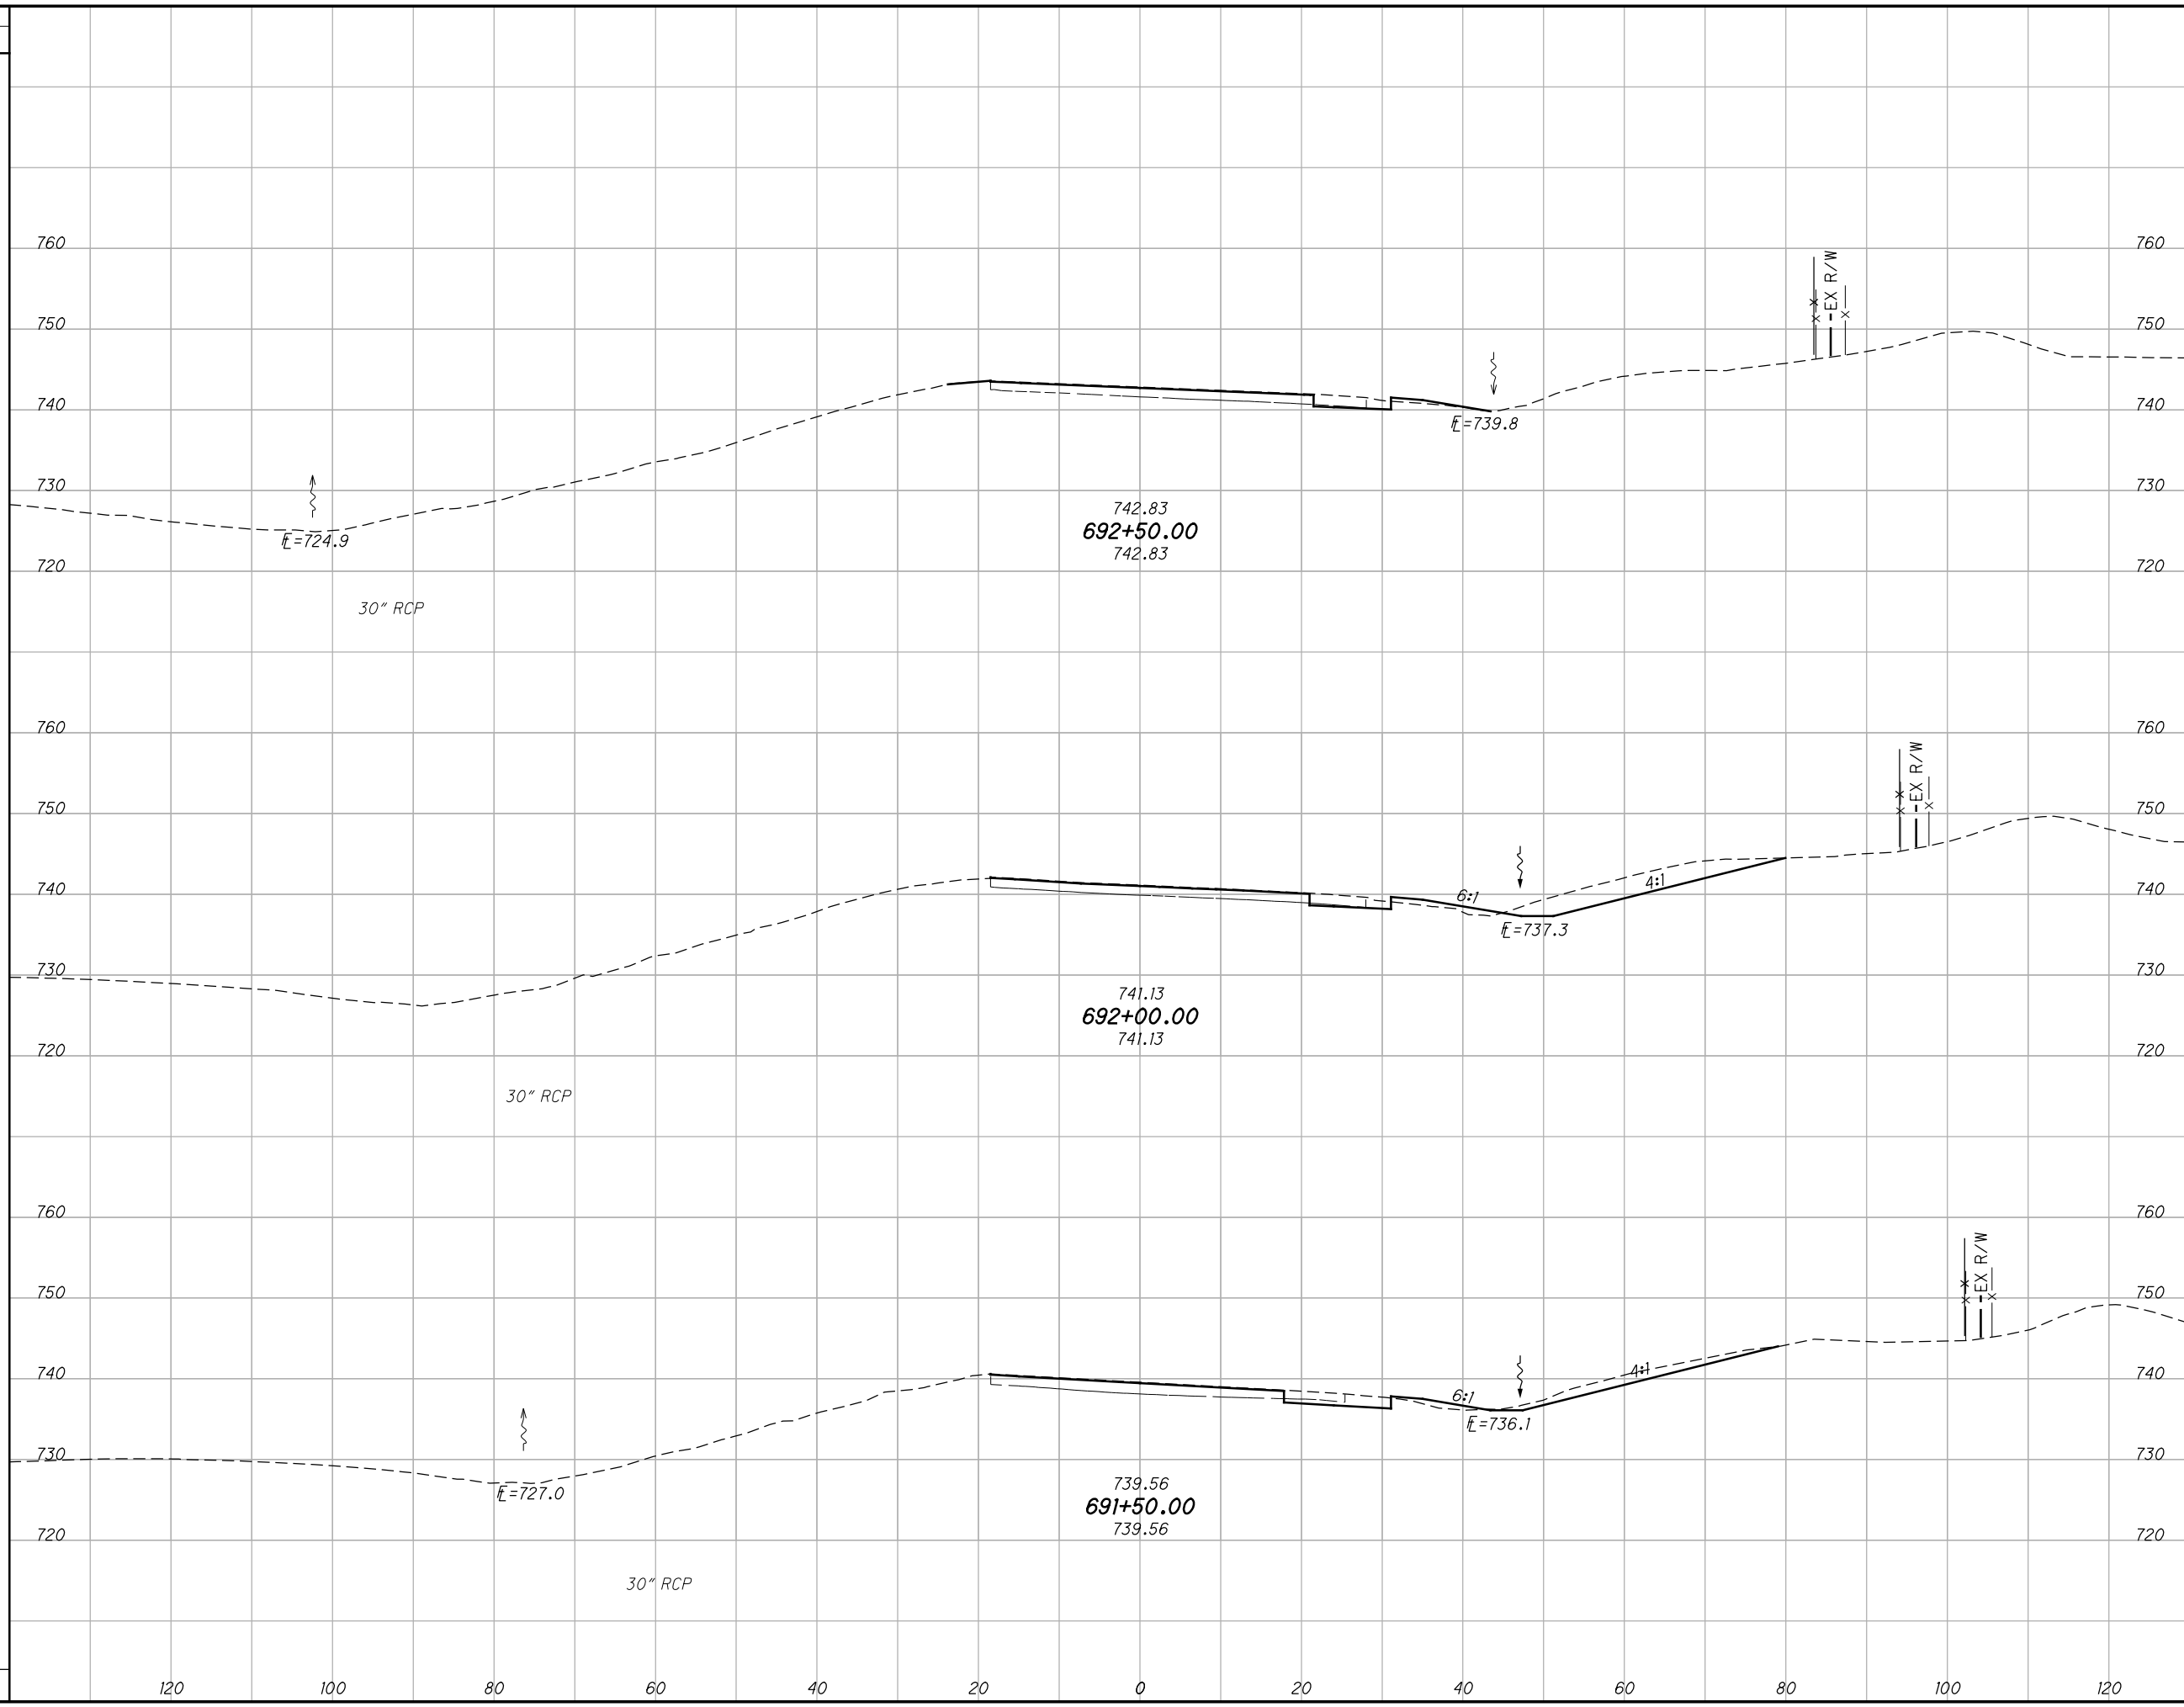

END AREA		VOLUME		CALCULATED	
CUT	FILL	CUT	FILL	CFR	SSK

BU 4, 5, 6, 7, & 8 - RELEASED FOR CONSTRUCTION - 11/03/2014 - 11/19/2015

CROSS SECTIONS RAMP W
STA. 691+50.00 TO STA. 692+50.00


FRA - 270 - 49.00

79
182

AS BUILT - 4/22/2016

G:\projects\2014\W-14-039 FRA-270-49.00\83988\roadway\sheets\83988X5001.dgn 5/23/2016 7:31:14 AM kevinj

SEEDING	
END WIDTH	SO. YDS.

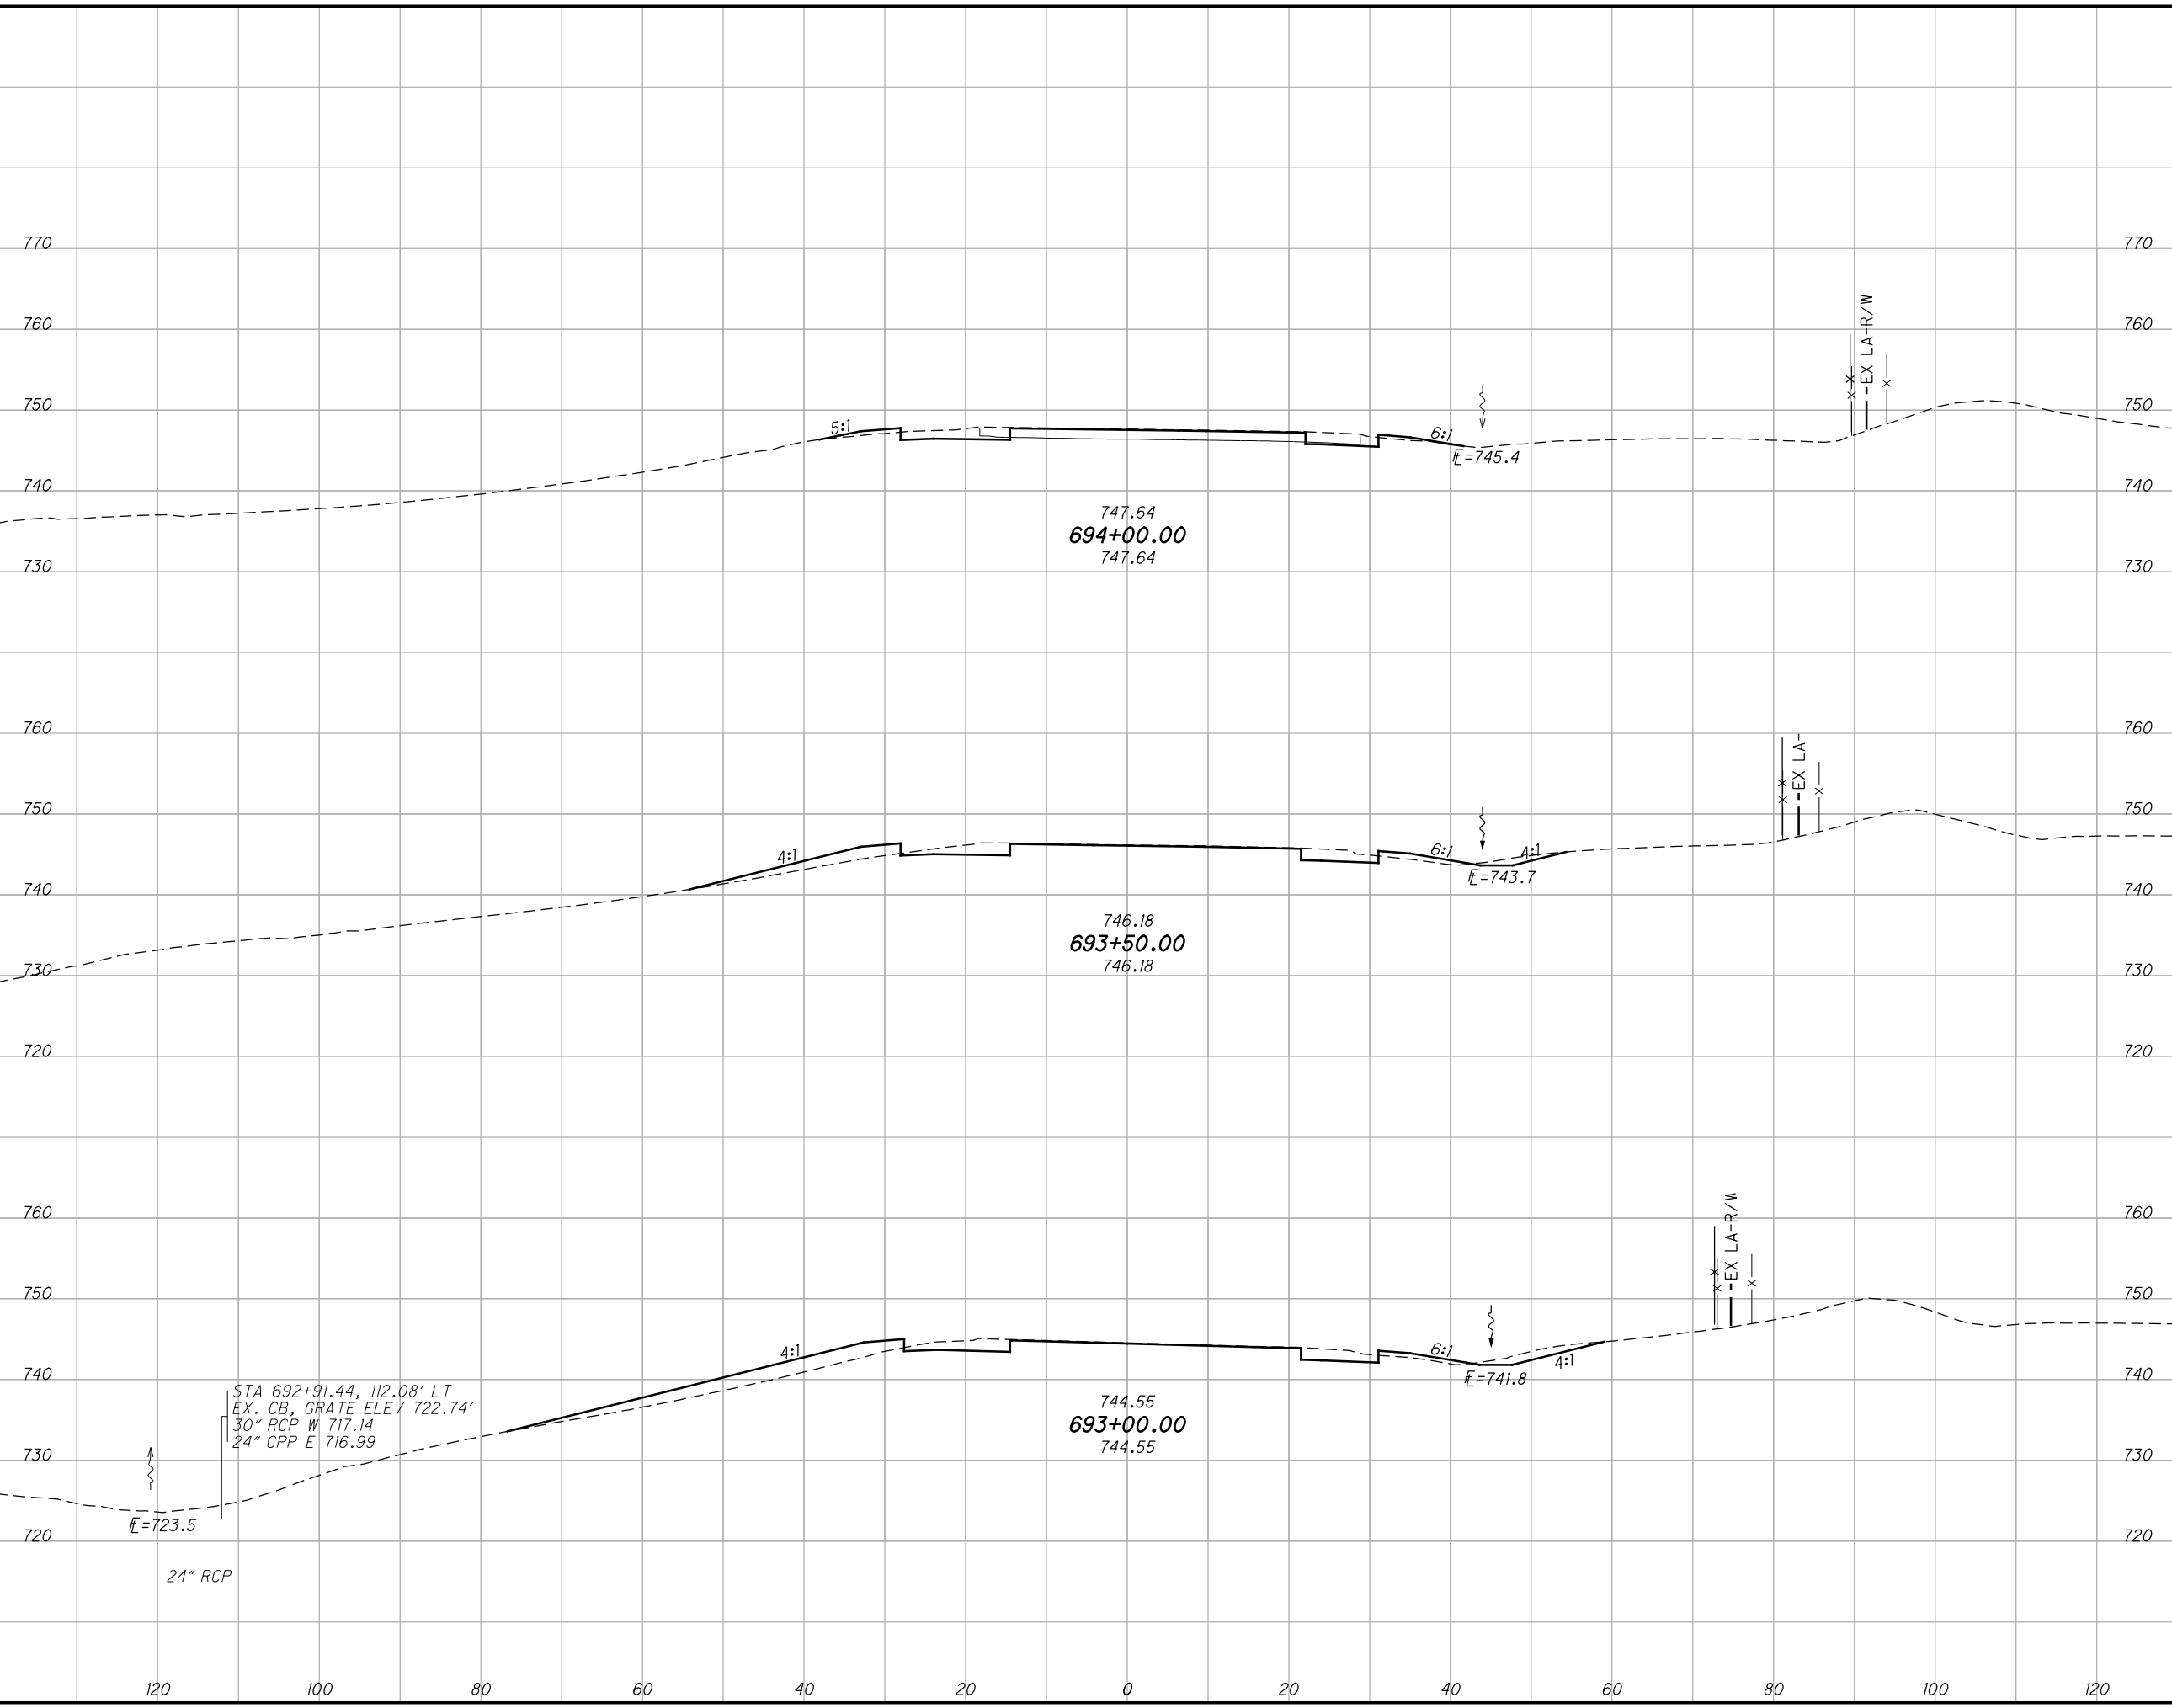

END AREA		VOLUME	
CUT	FILL	CUT	FILL

BU 4, 5, 6, 7, & 8 - RELEASED FOR CONSTRUCTION - 11/03/2014 - 11/19/2015

CROSS SECTIONS RAMP W

STA. 693+00.00 TO STA. 694+00.00


FRA - 270 - 49.00

80
182

AS BUILT - 4/22/2016

G:\projects\2014\W-14-039-FRA-270-49.00\83988\roadway\sheets\83988X5001.dgn 5/23/2016 7:31:14 AM kevinj

SEEDING	
END WIDTH	SO. YDS.

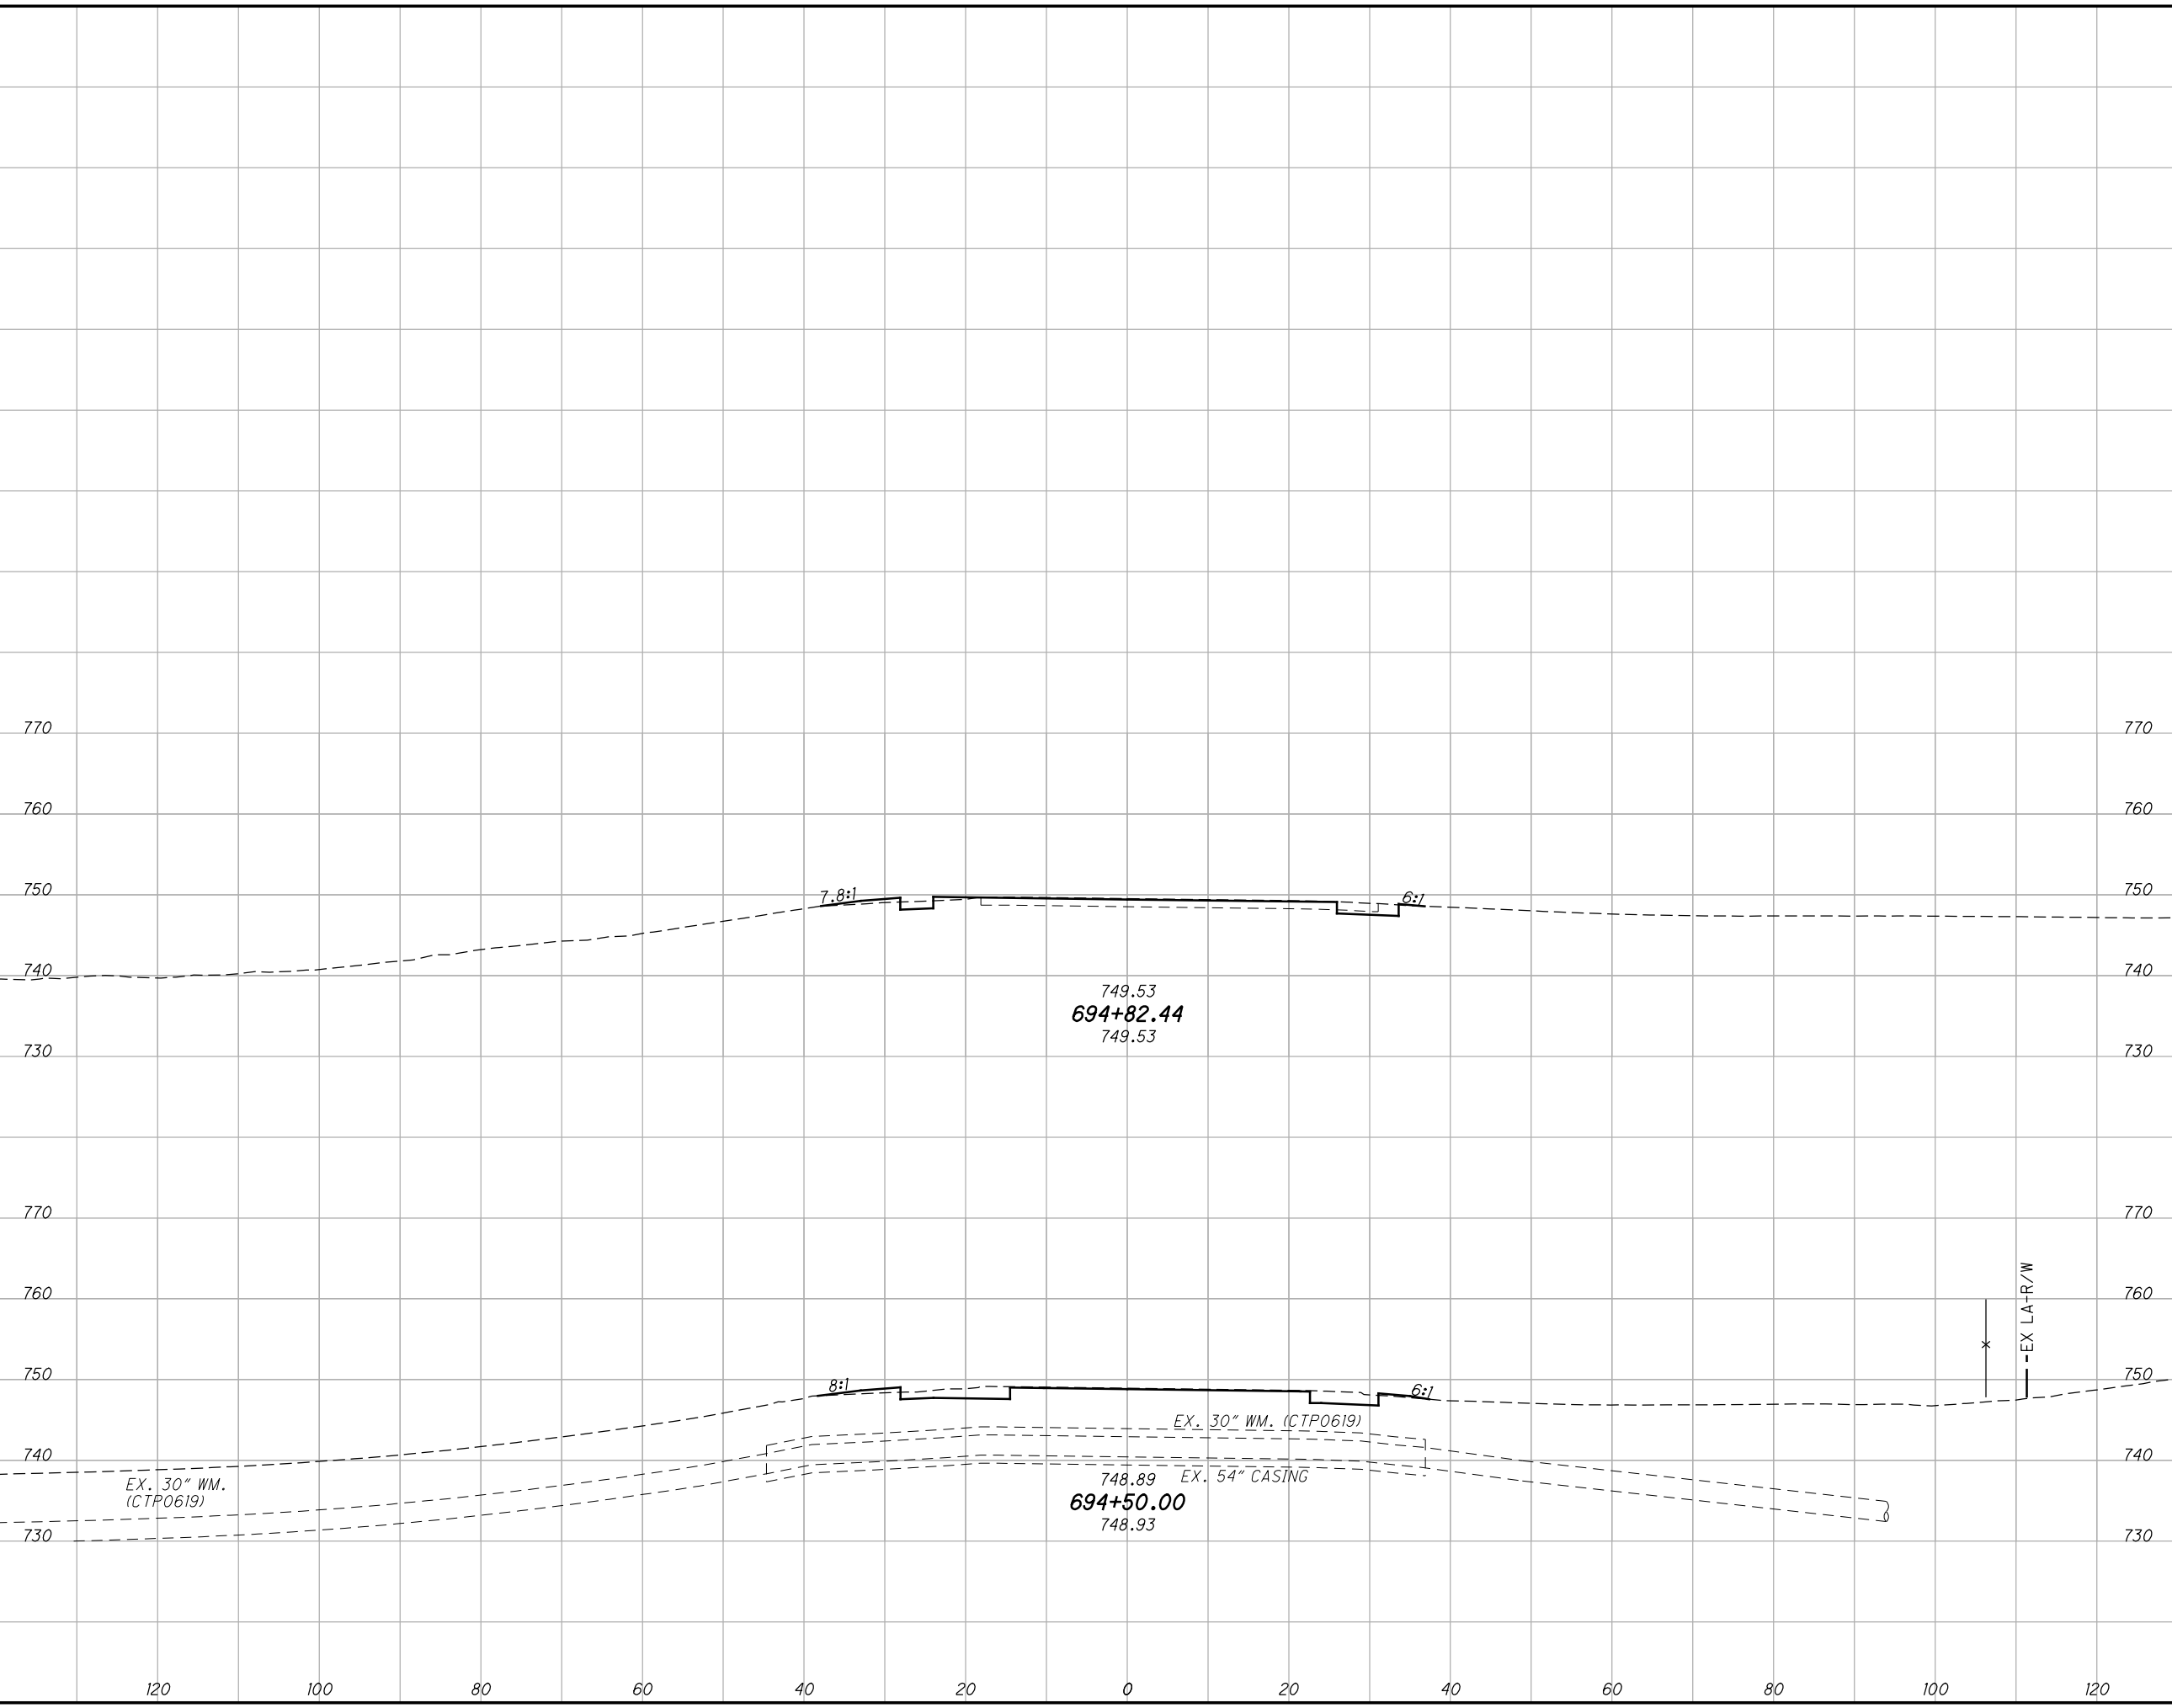

END AREA		VOLUME	
CUT	FILL	CUT	FILL

CALCULATED	CHECKED
CFR	SSK

BU 4, 5, 6, 7, & 8 - RELEASED FOR CONSTRUCTION - 11/03/2014 - 11/19/2015



CROSS SECTIONS RAMP W
STA. 694+50.00 TO STA. 694+82.44

FRA - 270 - 49.00

AS BUILT - 4/22/2016

5/23/2016 7:31:15 AM kevinj

G:\projects\2014\W-14-039_FRA-270-49.00\83988\roadway\sheets\83988GF012_Rev.dgn

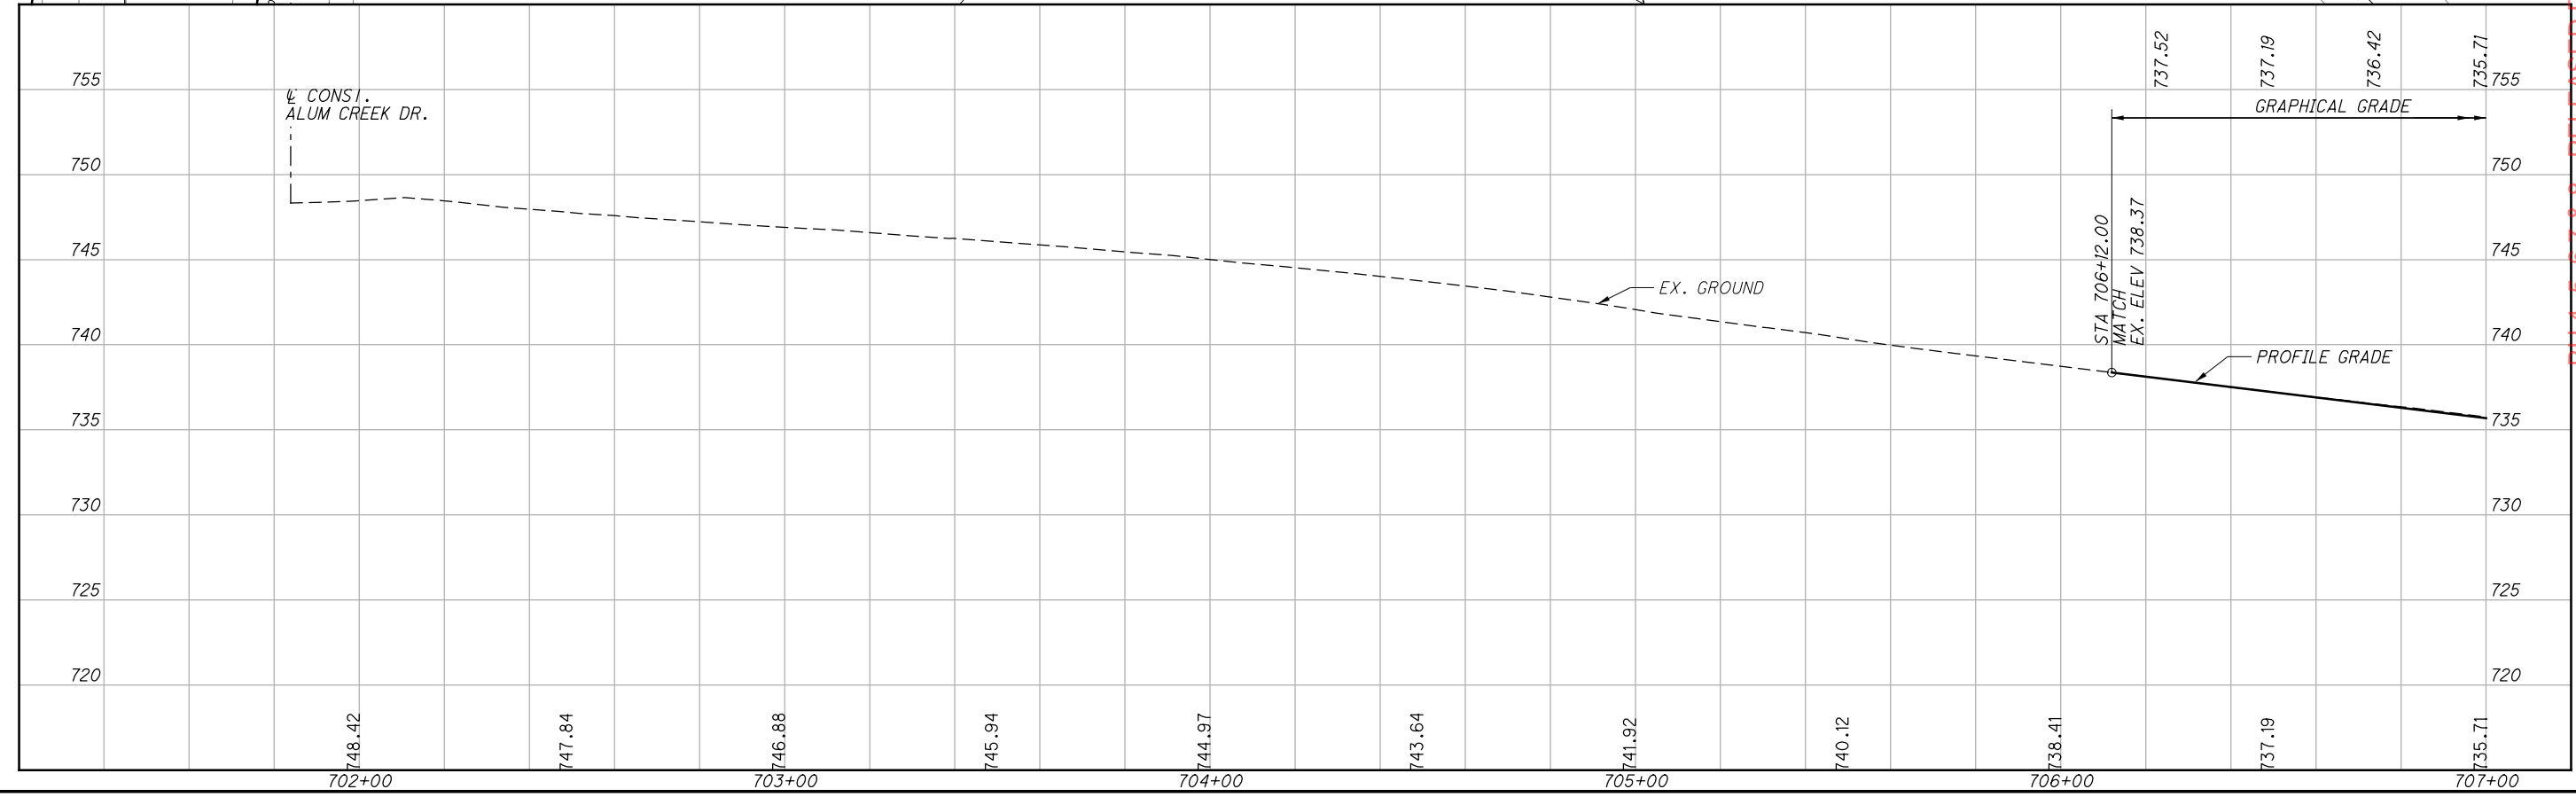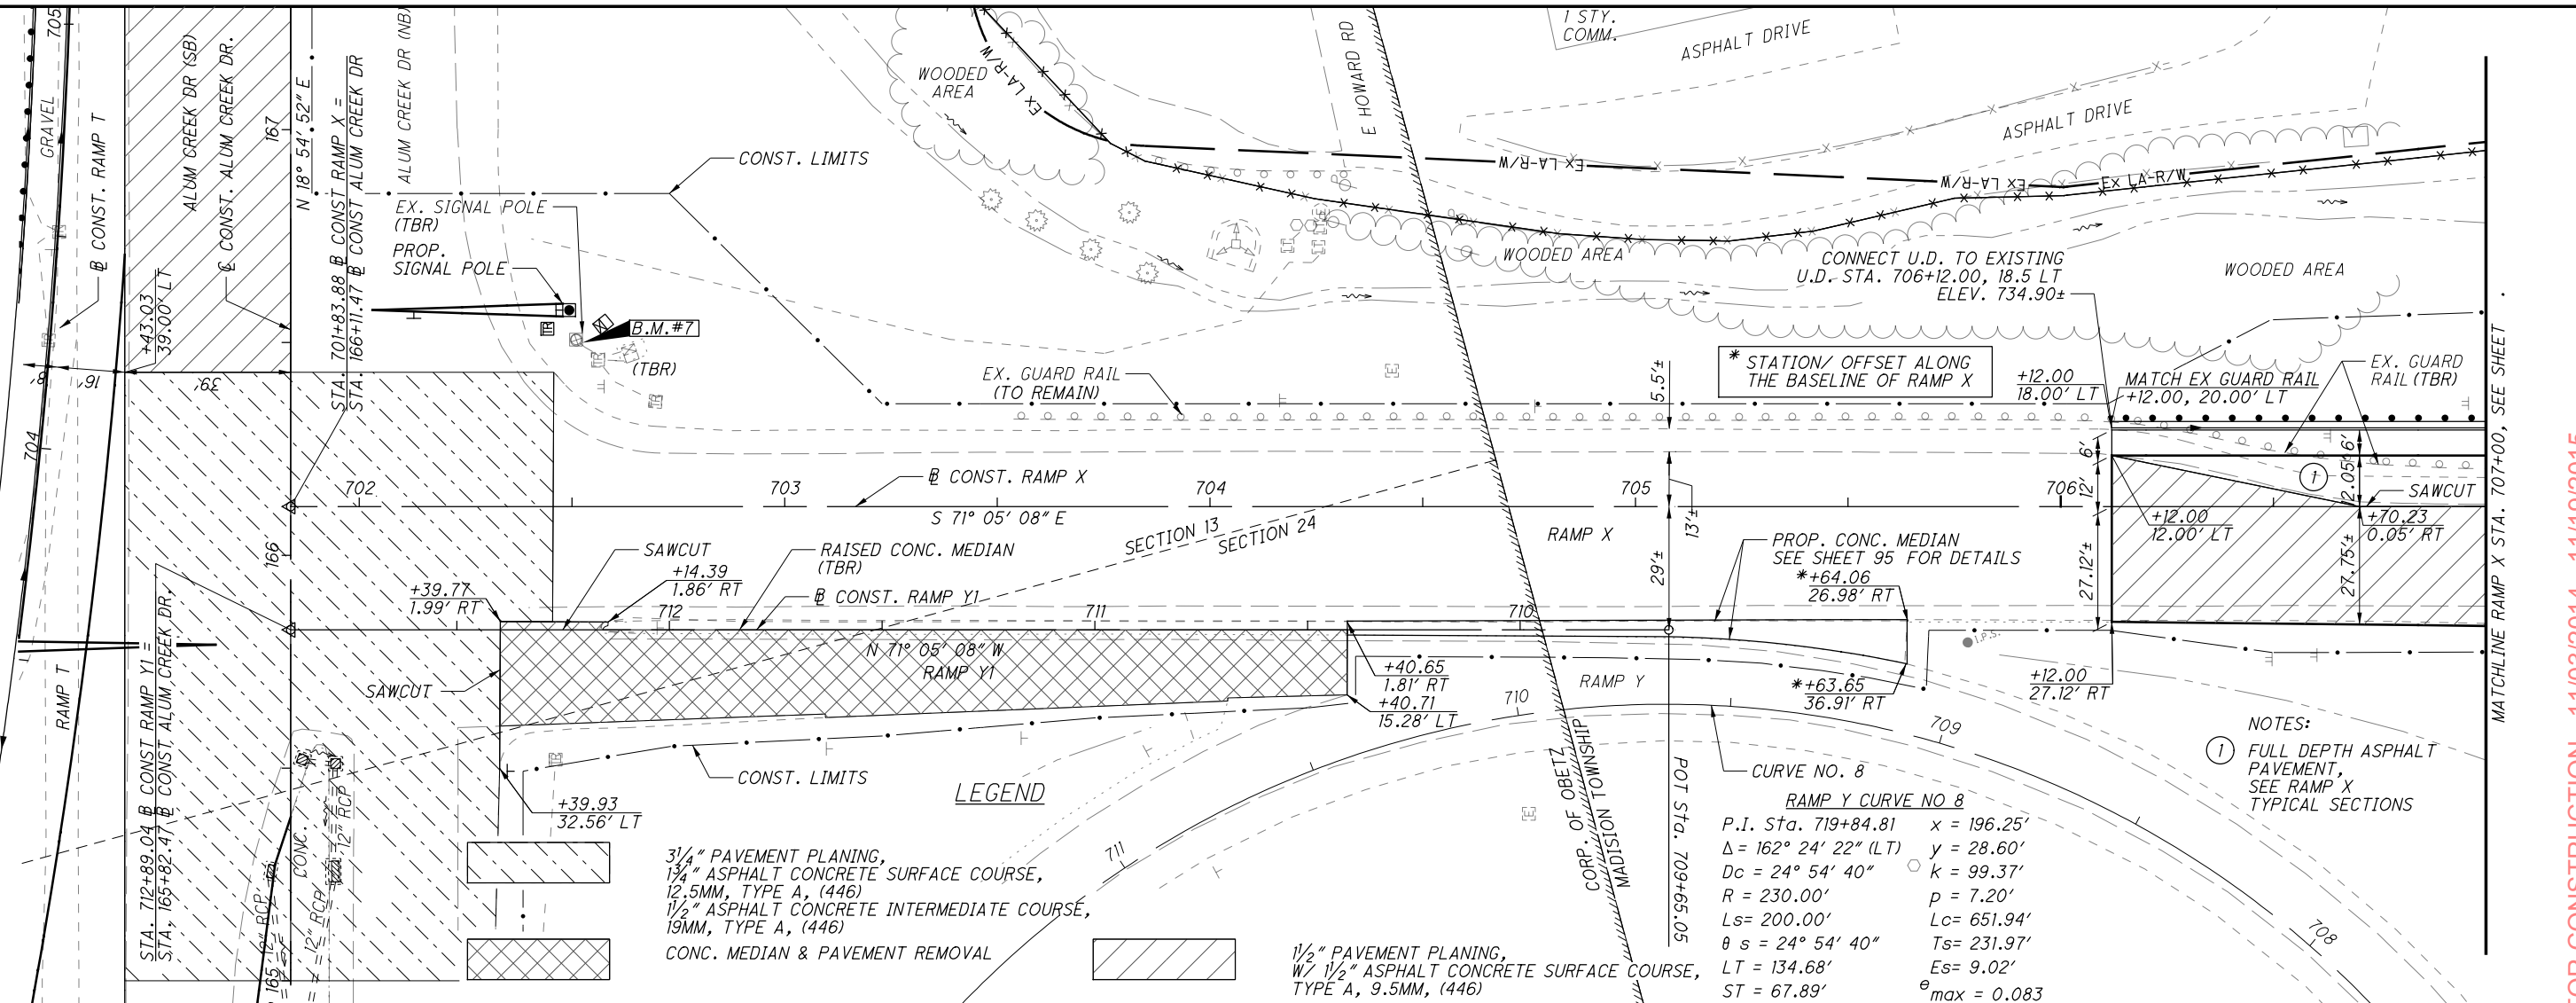


CALCULATED
 CFR
 CHECKED
 SSK

PLAN AND PROFILE - RAMP X & Y1
STA. 701+83.88 TO STA. 707+00

FRA - 270-49.00


82
 182

BU 4, 5, 6, 7, & 8 - RELEASED FOR CONSTRUCTION - 11/03/2014 - 11/19/2015

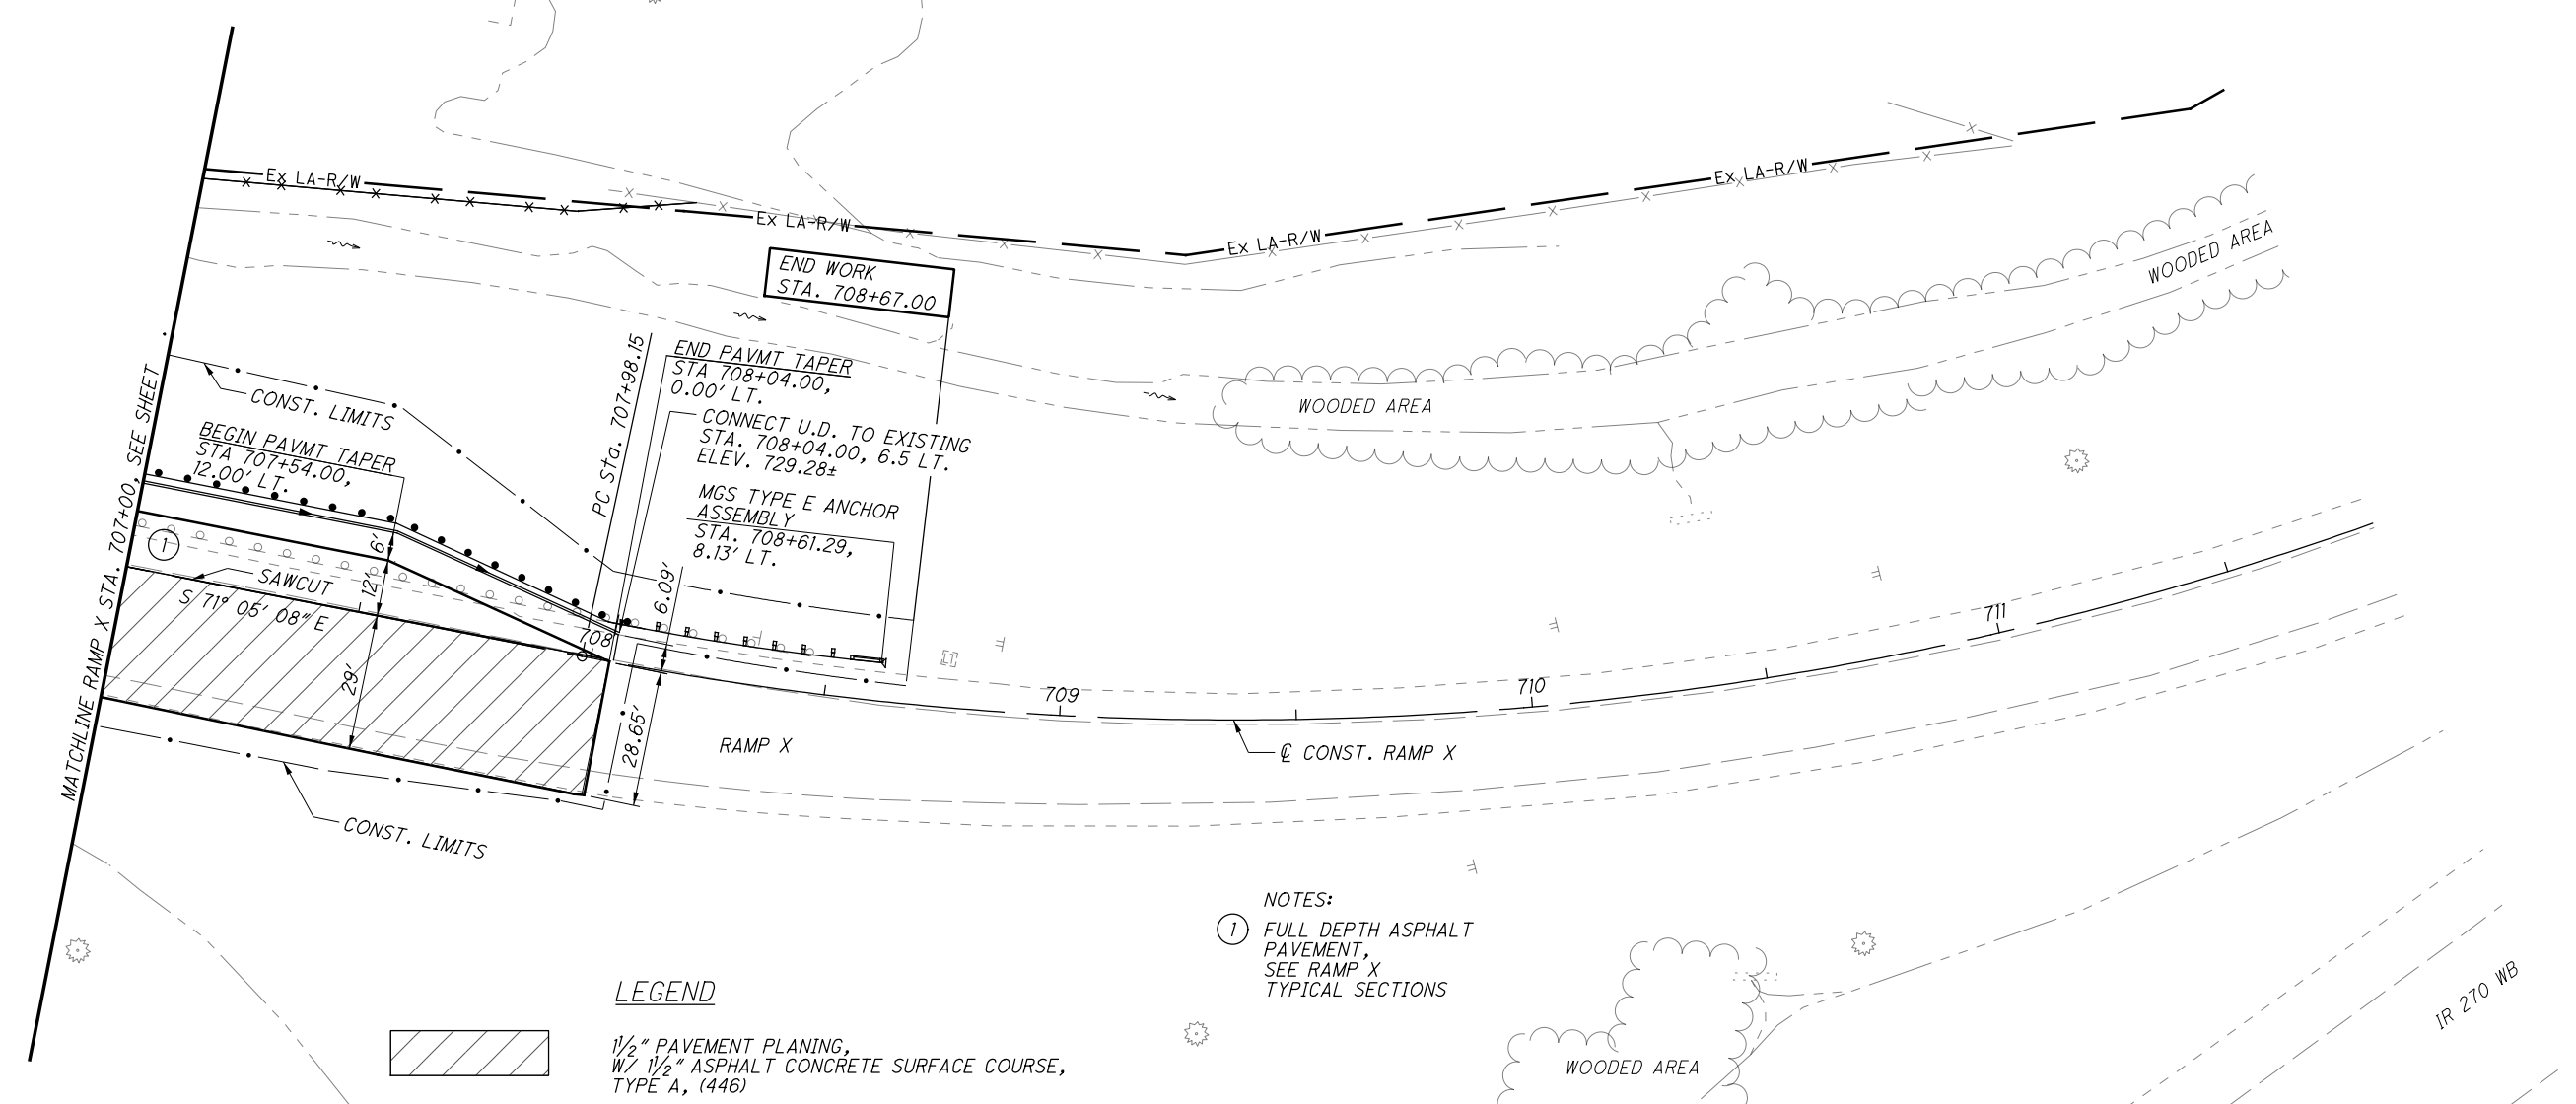

LEGEND
 1/2" PAVEMENT PLANING, W/ 1/2" ASPHALT CONCRETE SURFACE COURSE, TYPE A, (446)

NOTES:
 ① FULL DEPTH ASPHALT PAVEMENT, SEE RAMP X TYPICAL SECTIONS

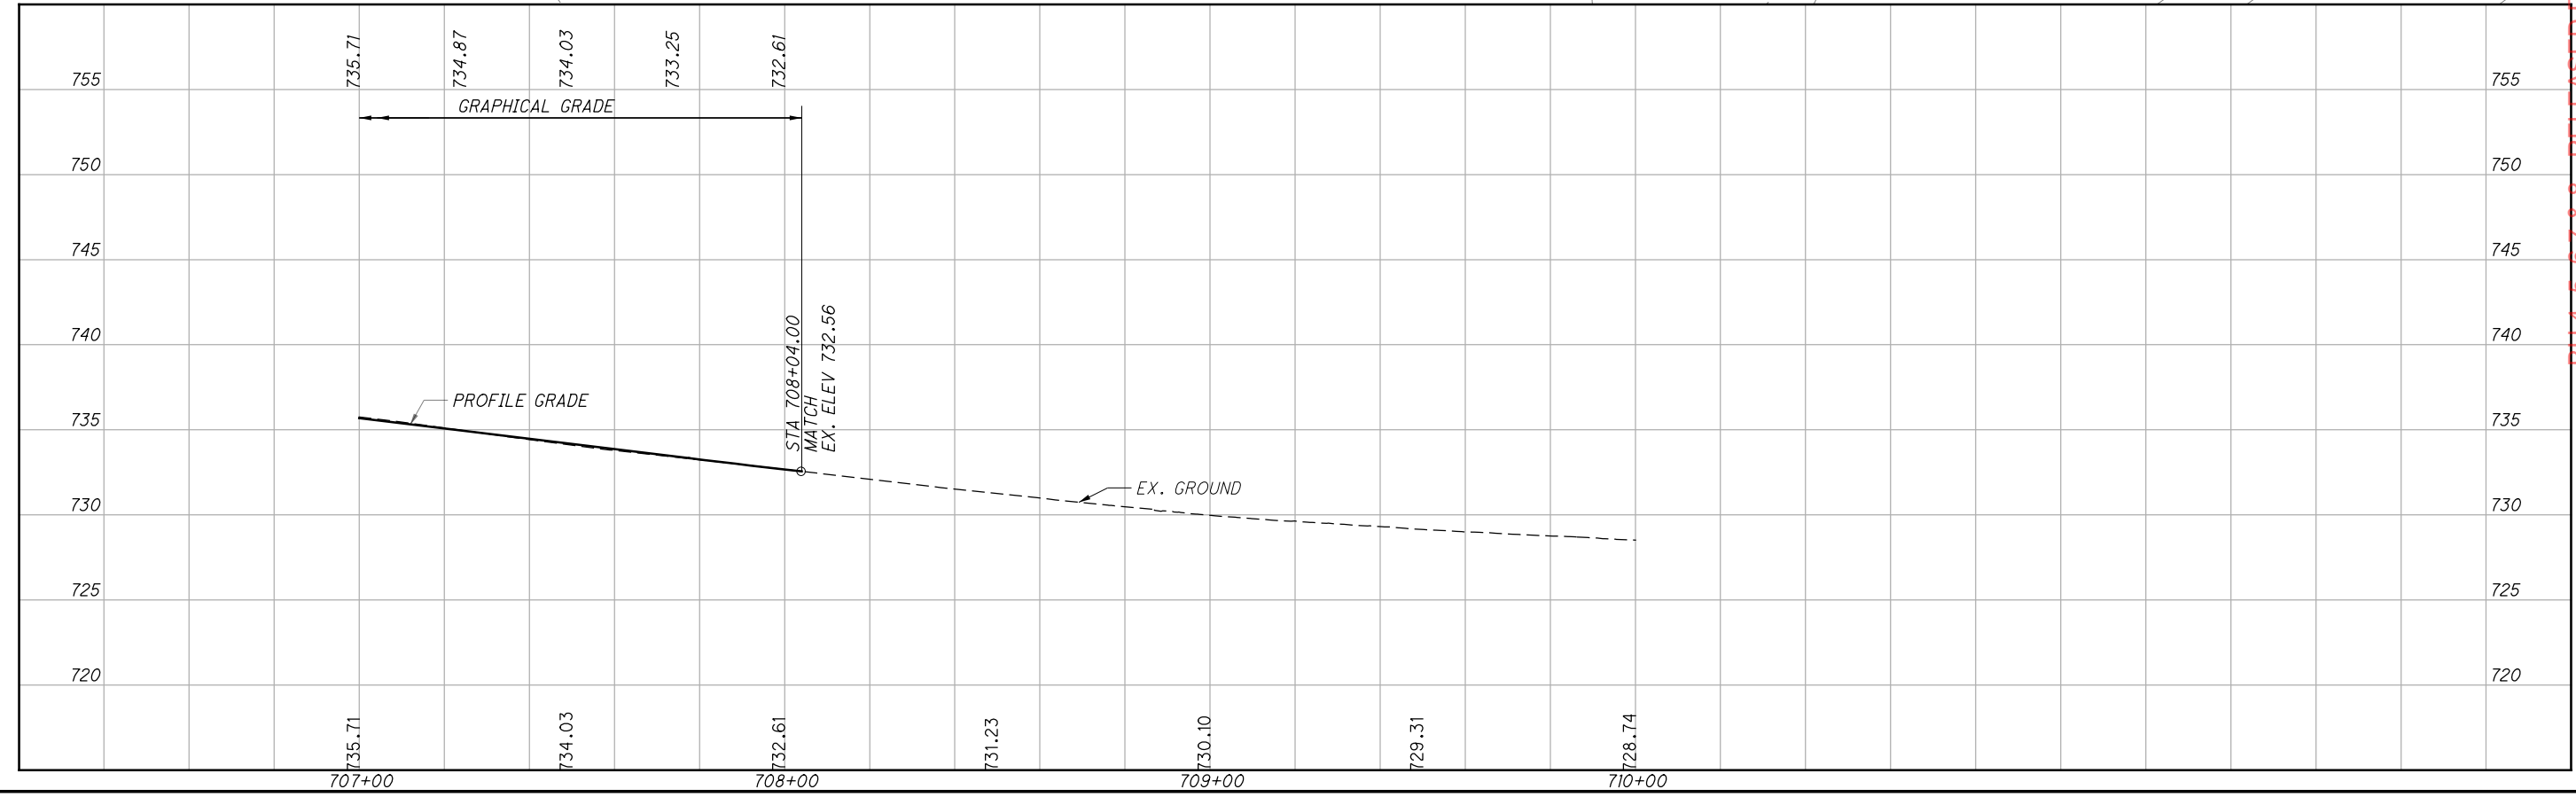

CALCULATED
 CFR
 CHECKED
 SSK

BU 4, 5, 6, 7, & 8 - RELEASED FOR CONSTRUCTION - 11/03/2014 - 11/19/2015

**PLAN AND PROFILE - RAMP X
 STA. 707+00 TO STA. 710+00**


FRA - 270-49.00

AS BUILT - 4/22/2016

G:\projects\2014\W-14-039_FRA-270-49.00\83988\roadway\sheets\83988X5002.dgn 5/23/2016 7:31:17 AM kevinj

SEEDING
END SO.
WIDTH YDS.

END AREA
CUT FILL
VOLUME
CUT FILL
CALCULATED
CFR
CHECKED
SSK

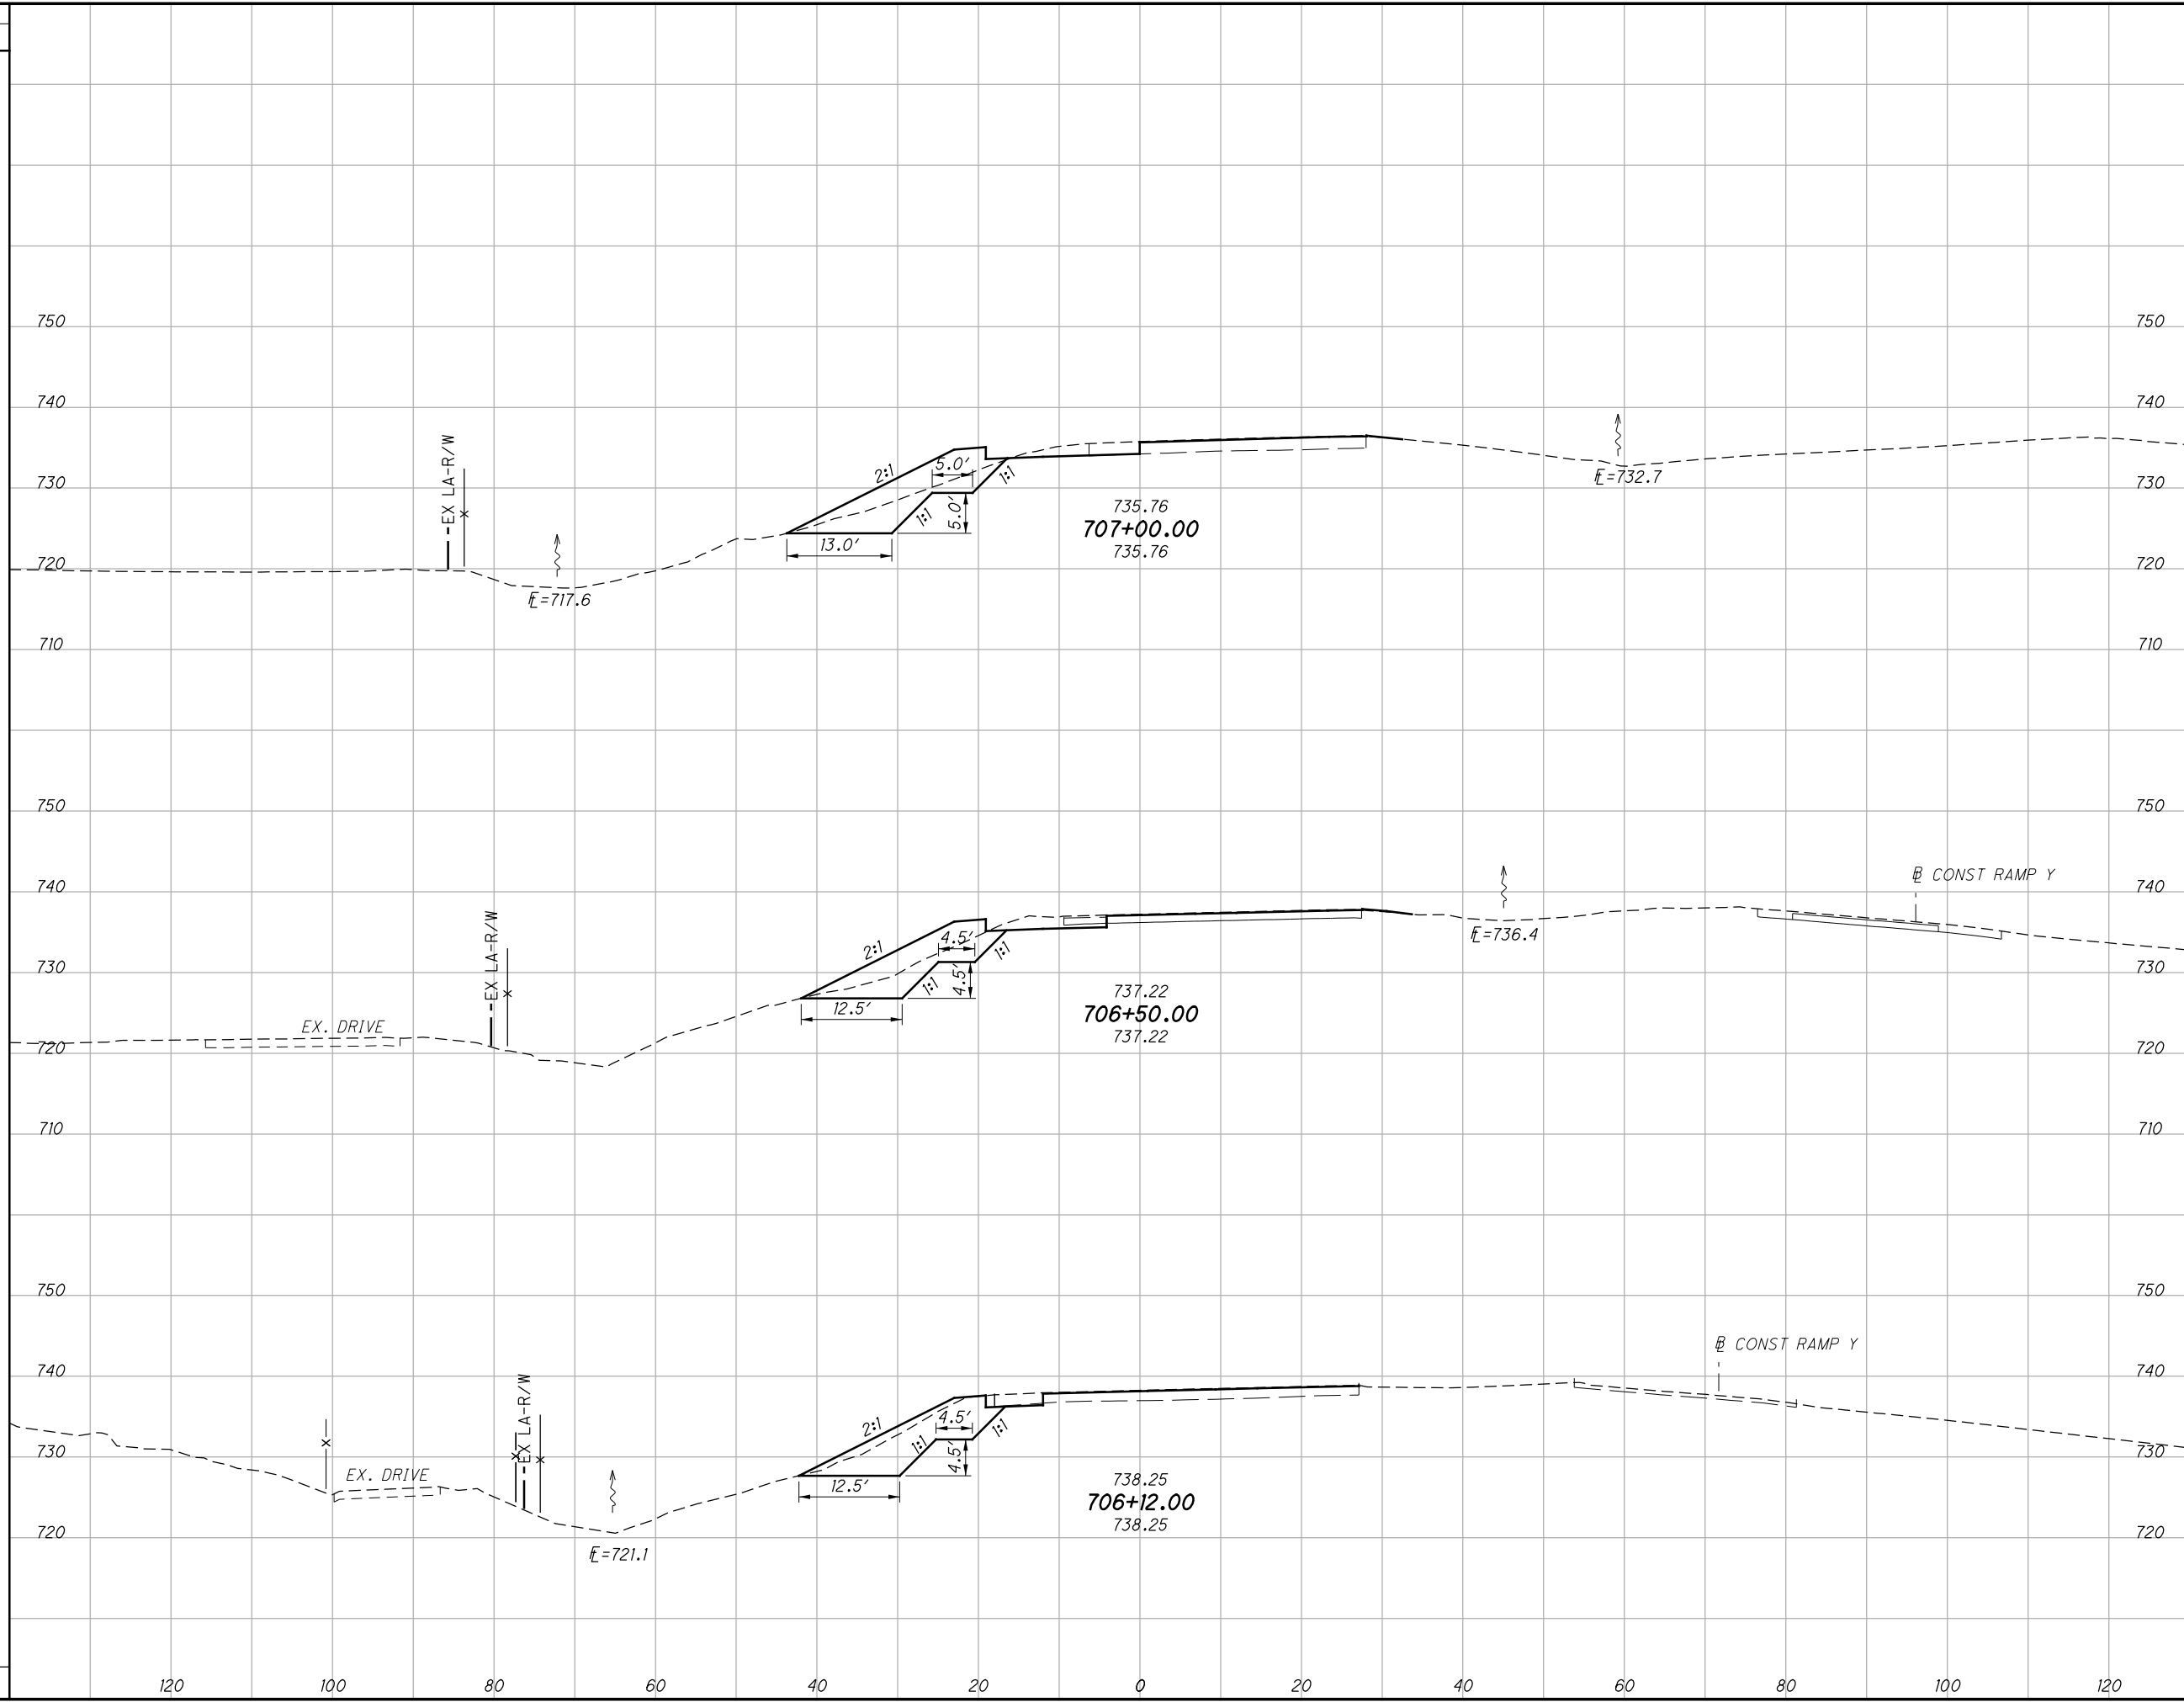

BU 4, 5, 6, 7, & 8 - RELEASED FOR CONSTRUCTION - 11/03/2014 - 11/19/2015

CROSS SECTIONS RAMP X
STA. 706+12.00 TO STA. 707+00.00


FRA - 270 - 49.00

84
182

AS BUILT - 4/22/2016

G:\projects\2014\W-14-039 FRA-270-49.00\83988\roadway\sheets\83988X5002.dgn 5/23/2016 7:31:17 AM kevinj

SEEDING	
END WIDTH	SO. YDS.

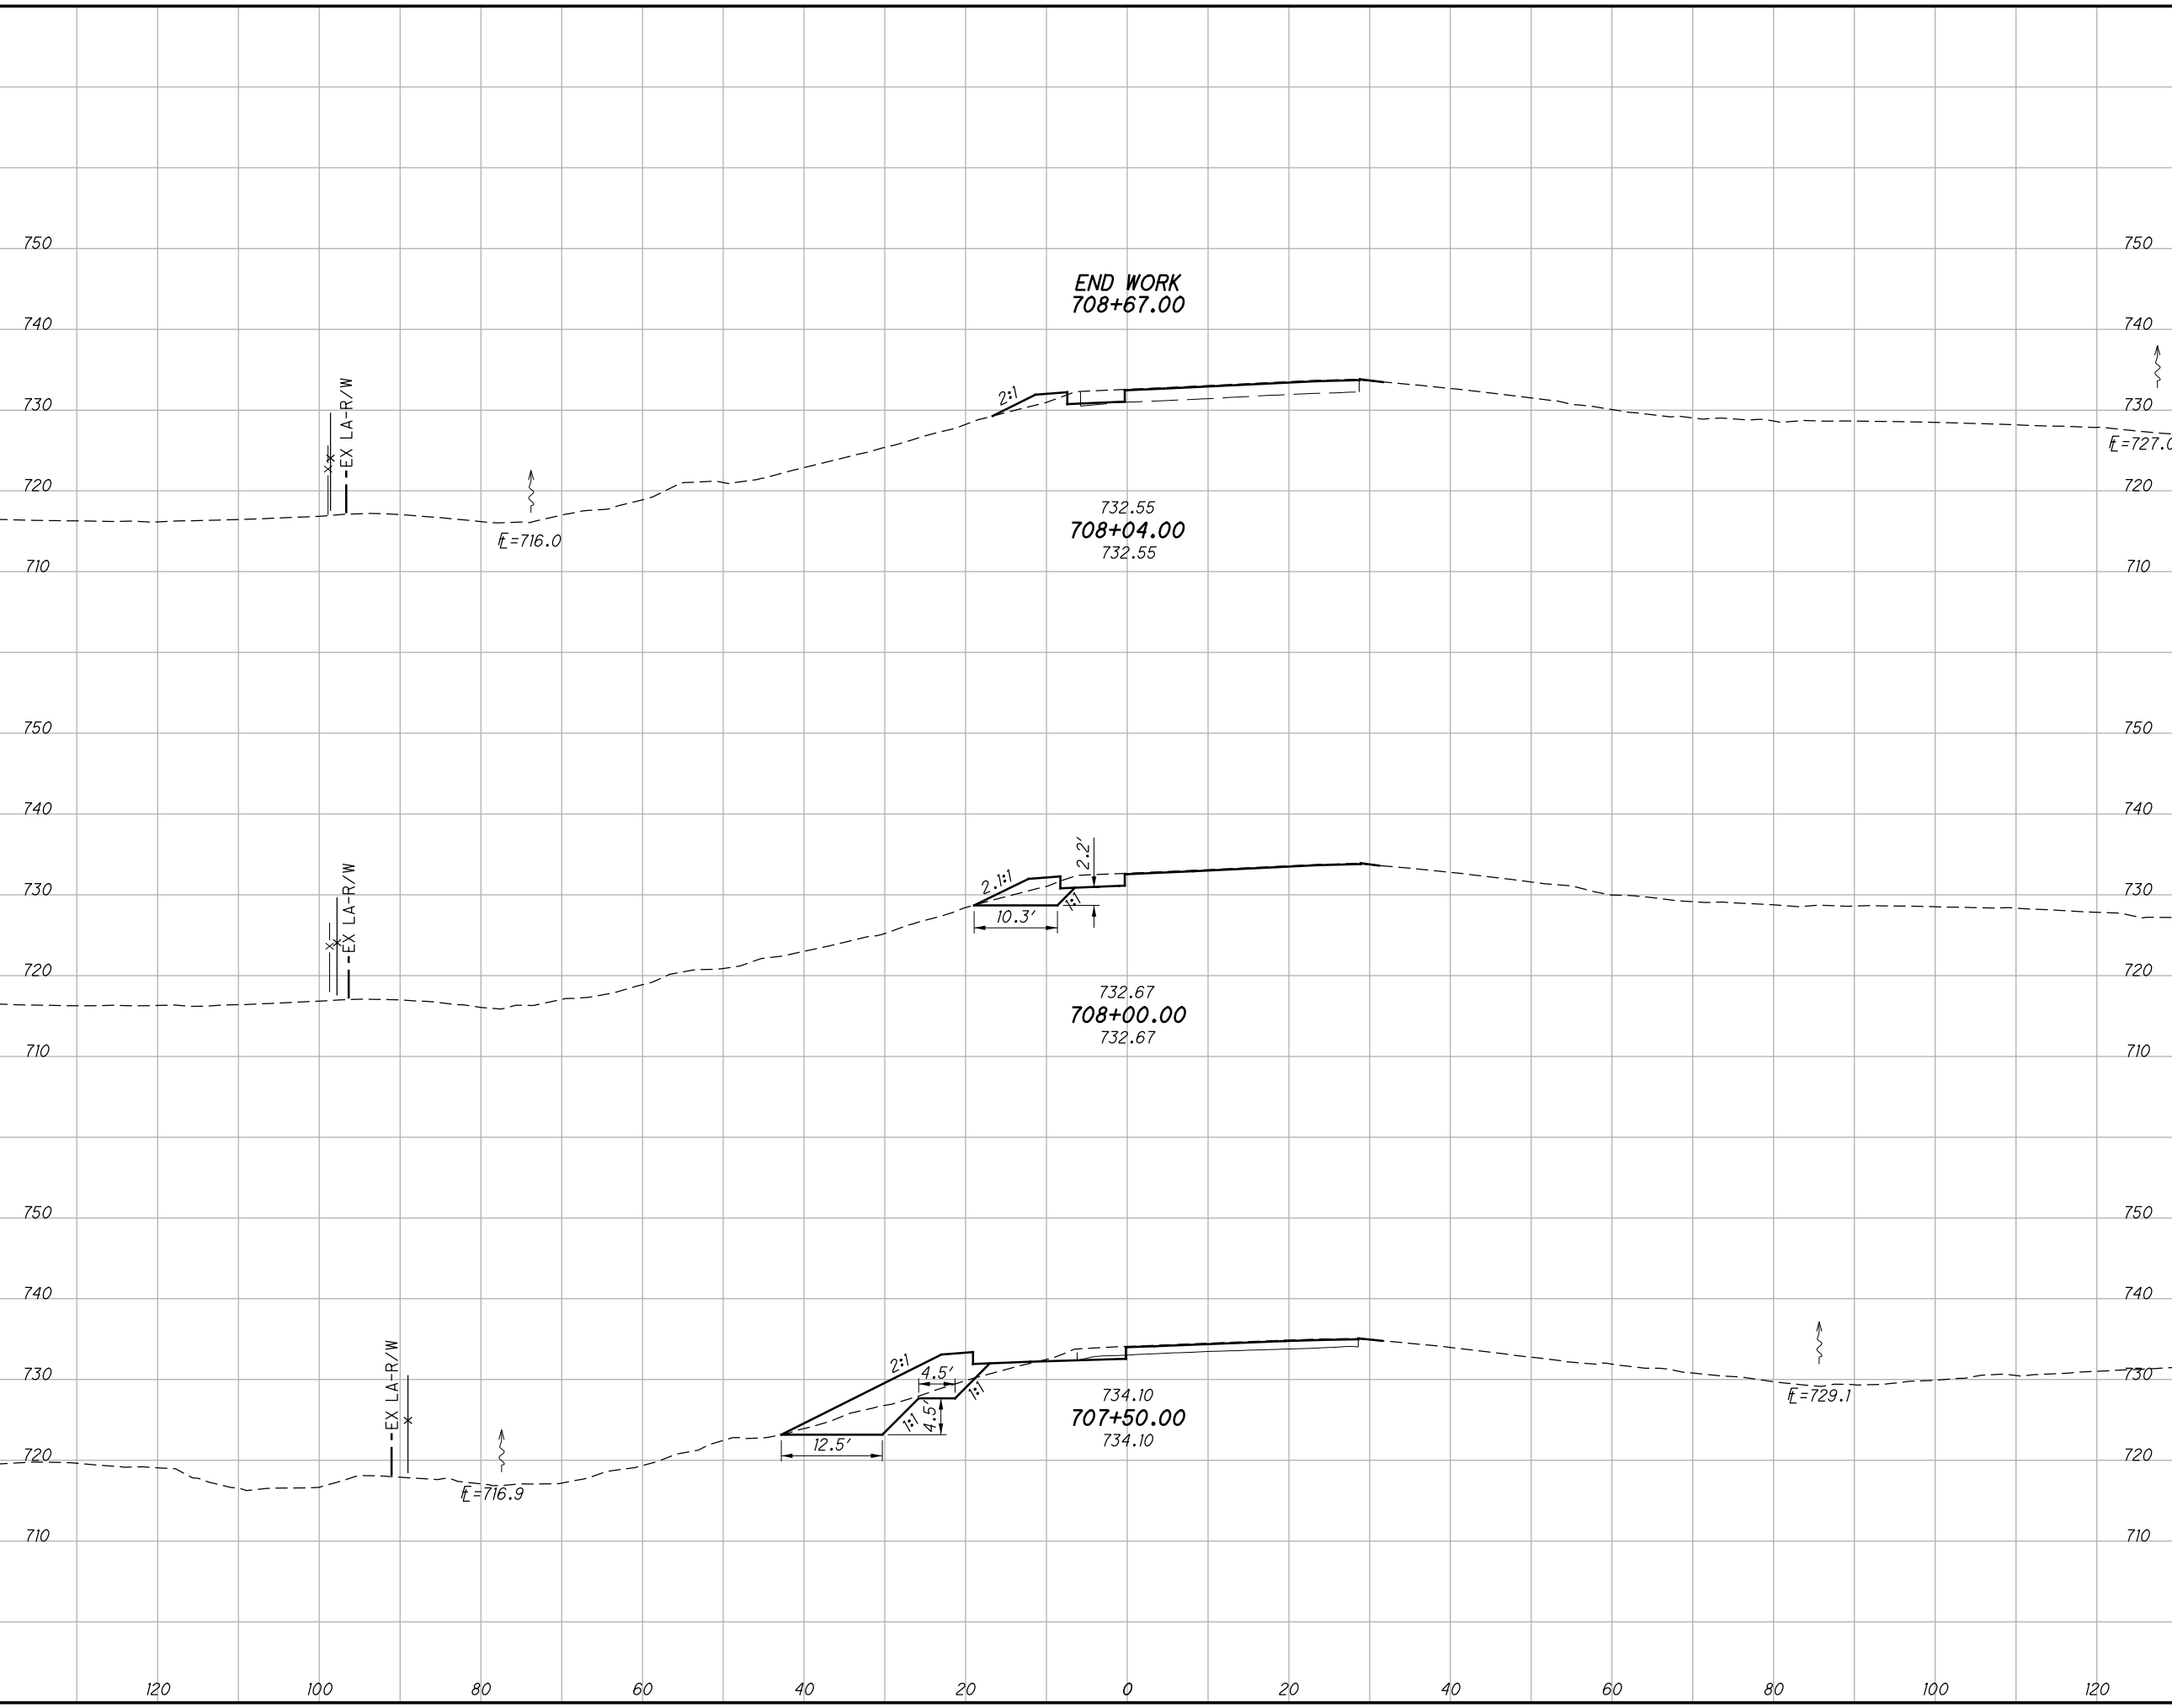

END AREA		VOLUME	
CUT	FILL	CUT	FILL

BU 4, 5, 6, 7, & 8 - RELEASED FOR CONSTRUCTION - 11/03/2014 - 11/19/2015

CROSS SECTIONS RAMP X


STA. 707+50.00 TO STA. 708+04.00

FRA - 270 - 49.00

85
182

AS BUILT - 4/22/2016

G:\projects\2014\W-14-039 FRA-270-49.00\83988\roadway\sheets\83988X5003.dgn 5/23/2016 7:31:17 AM kevinj

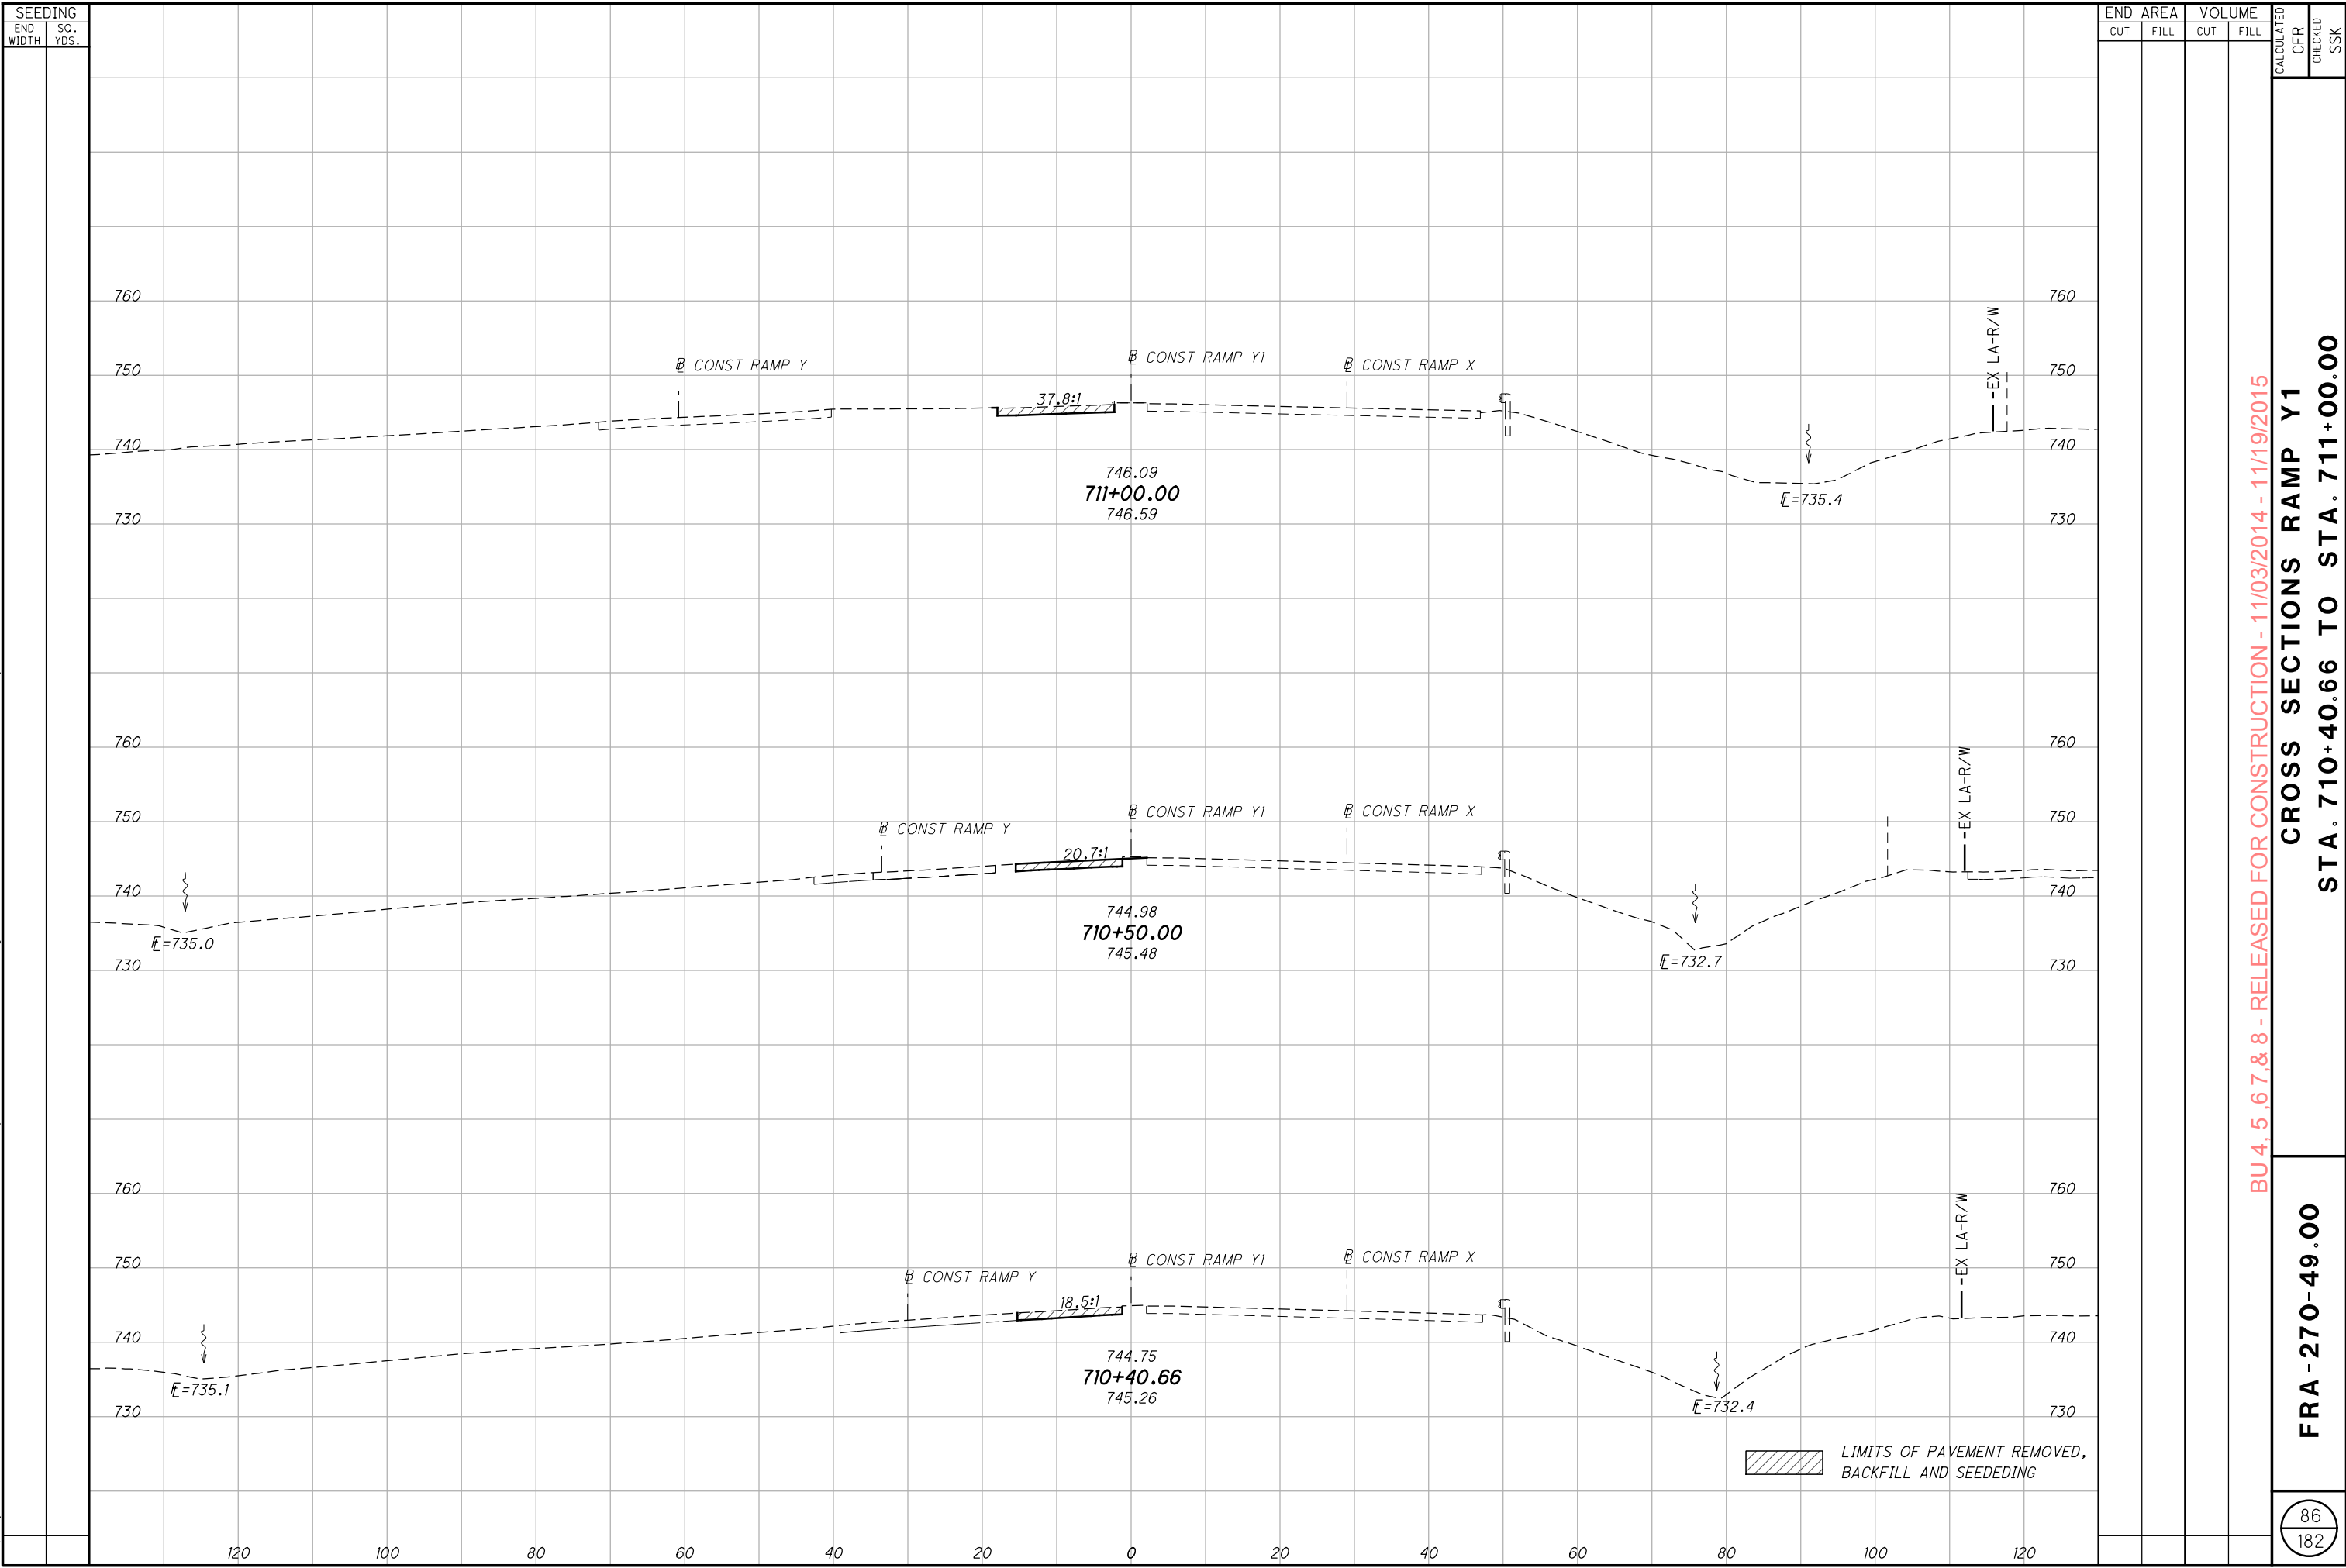

BU 4, 5, 6, 7, & 8 - RELEASED FOR CONSTRUCTION - 11/03/2014 - 11/19/2015

CROSS SECTIONS RAMP Y1
STA. 710+40.66 TO STA. 711+00.00


FRA - 270 - 49.00

86

182

AS BUILT - 4/22/2016

G:\projects\2014\W-14-039 FRA-270-49.00\83988\roadway\sheets\83988X5003.dgn 5/23/2016 7:31:18 AM kevinj

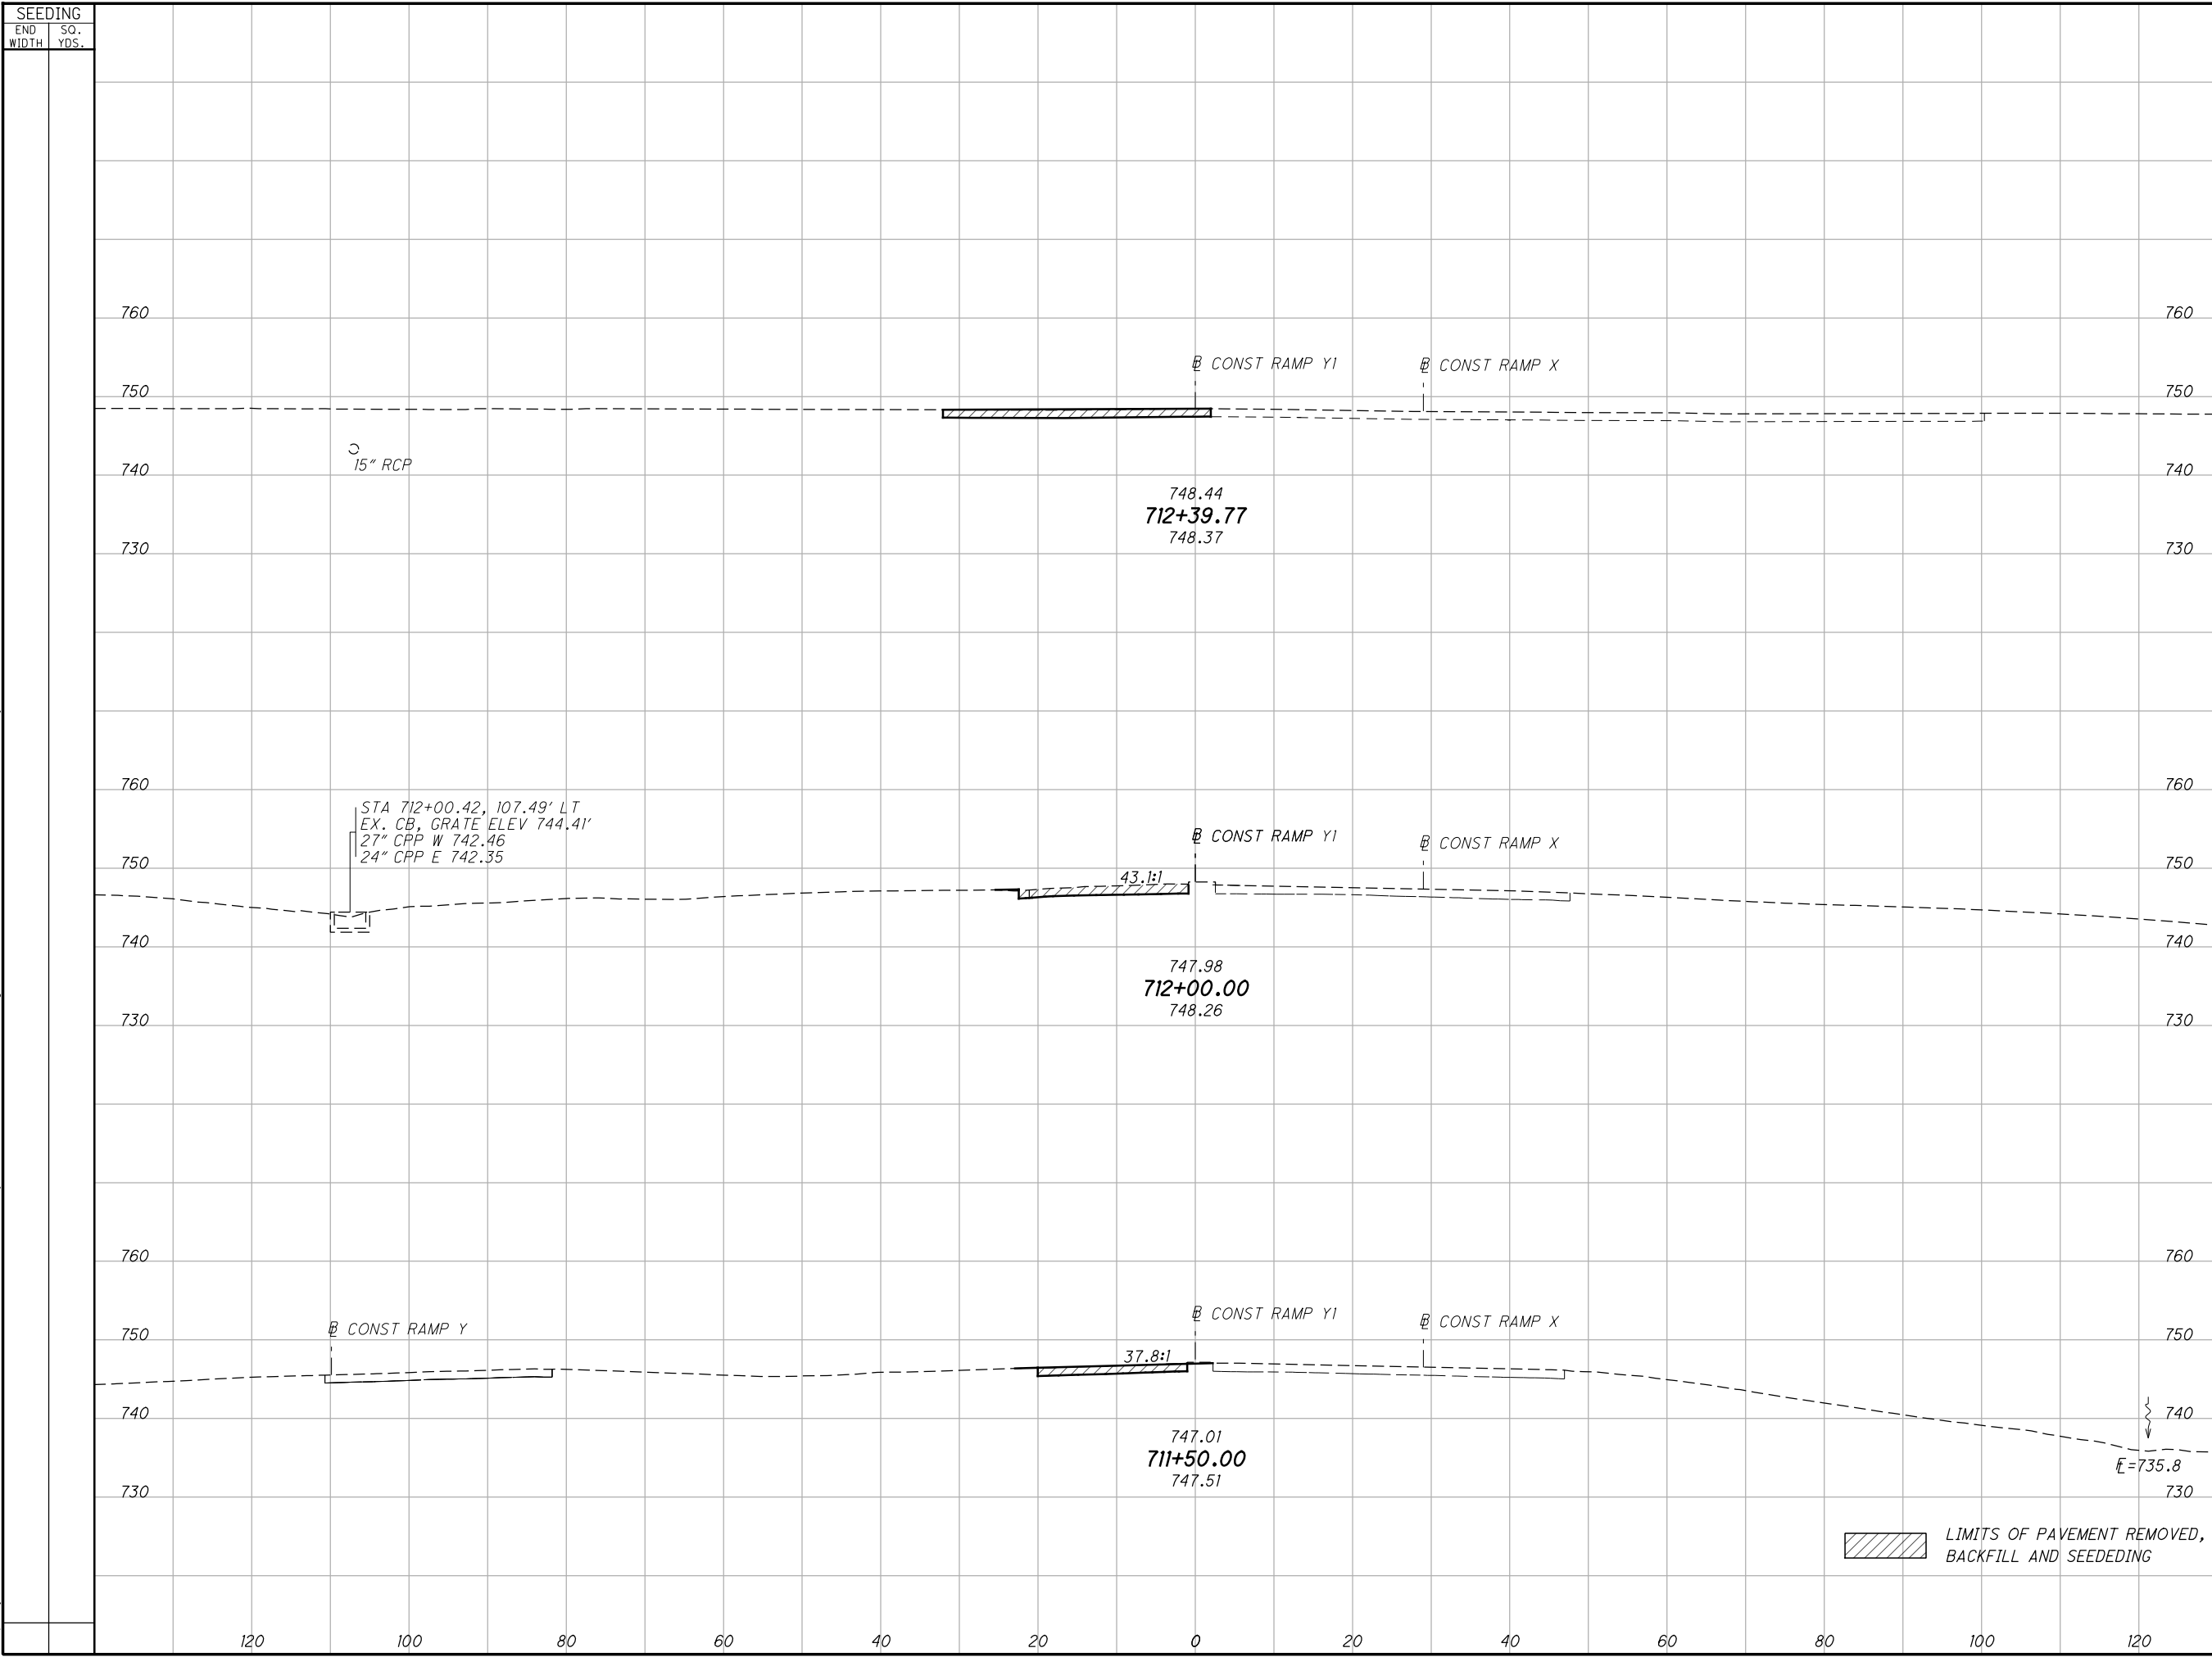

SEEDING		END AREA		VOLUME		CALCULATED	
END WIDTH	SO. YDS.	CUT	FILL	CUT	FILL	CFR	SSK

BU 4, 5, 6, 7, & 8 - RELEASED FOR CONSTRUCTION - 11/03/2014 - 11/19/2015

CROSS SECTIONS RAMP Y1
STA. 711+50.00 TO STA. 712+39.77


FRA - 270 - 49.00

87
182

SUPERELEVATION TABLE - I.R. 270 RAMP T

CURVE 4	P.I. STA. 689+79.50	Dc = 5° 00' 00"
CURVE 5	P.I. STA. 694+70.26	Dc = 4° 03' 48.36"
CURVE 6	P.I. STA. 702+86.60	Dc = 3° 30' 00"

SHOULDER					STATION	INSIDE EDGE (PROFILE GRADE)		RIGHT SIDE					SHOULDER					REMARKS
ELEVATION	ELEVATION CORRECTION	CROSS SLOPE	TRANSITION RATE	WIDTH		OFFSET	ELEVATION	WIDTH	TRANSITION RATE	CROSS SLOPE	ELEVATION CORRECTION	ELEVATION	WIDTH	TRANSITION RATE	CROSS SLOPE	ELEVATION CORRECTION	ELEVATION	
747.08	-0.29	-0.0480		6.0	701+50.00		747.37	16		0.0480	0.77	748.14	3		-0.0220	-0.07	748.07	
747.13	-0.29	-0.0480		6.0	701+75.00		747.42	16		0.0480	0.77	748.19	3		-0.0220	-0.07	748.12	
747.18	-0.29	-0.0480		6.0	702+00.00		747.47	16		0.0480	0.77	748.24	3		-0.0220	-0.07	748.17	
747.21	-0.32	-0.0480		6.6	702+25.00		747.52	16		0.0480	0.77	748.29	3		-0.0220	-0.07	748.22	
747.20	-0.34	-0.0480		7.1	702+36.95		747.55	16		0.0480	0.77	748.31	3	200:1	-0.0220	-0.07	748.25	
747.21	-0.36	-0.0480		7.6	702+50.00		747.57	16		0.0480	0.77	748.34	3	200:1	-0.0003	0.00	748.34	
747.22	-0.38	-0.0480		8.0	702+64.15		747.60	16		0.0480	0.77	748.37	3	200:1	0.0233	0.07	748.44	

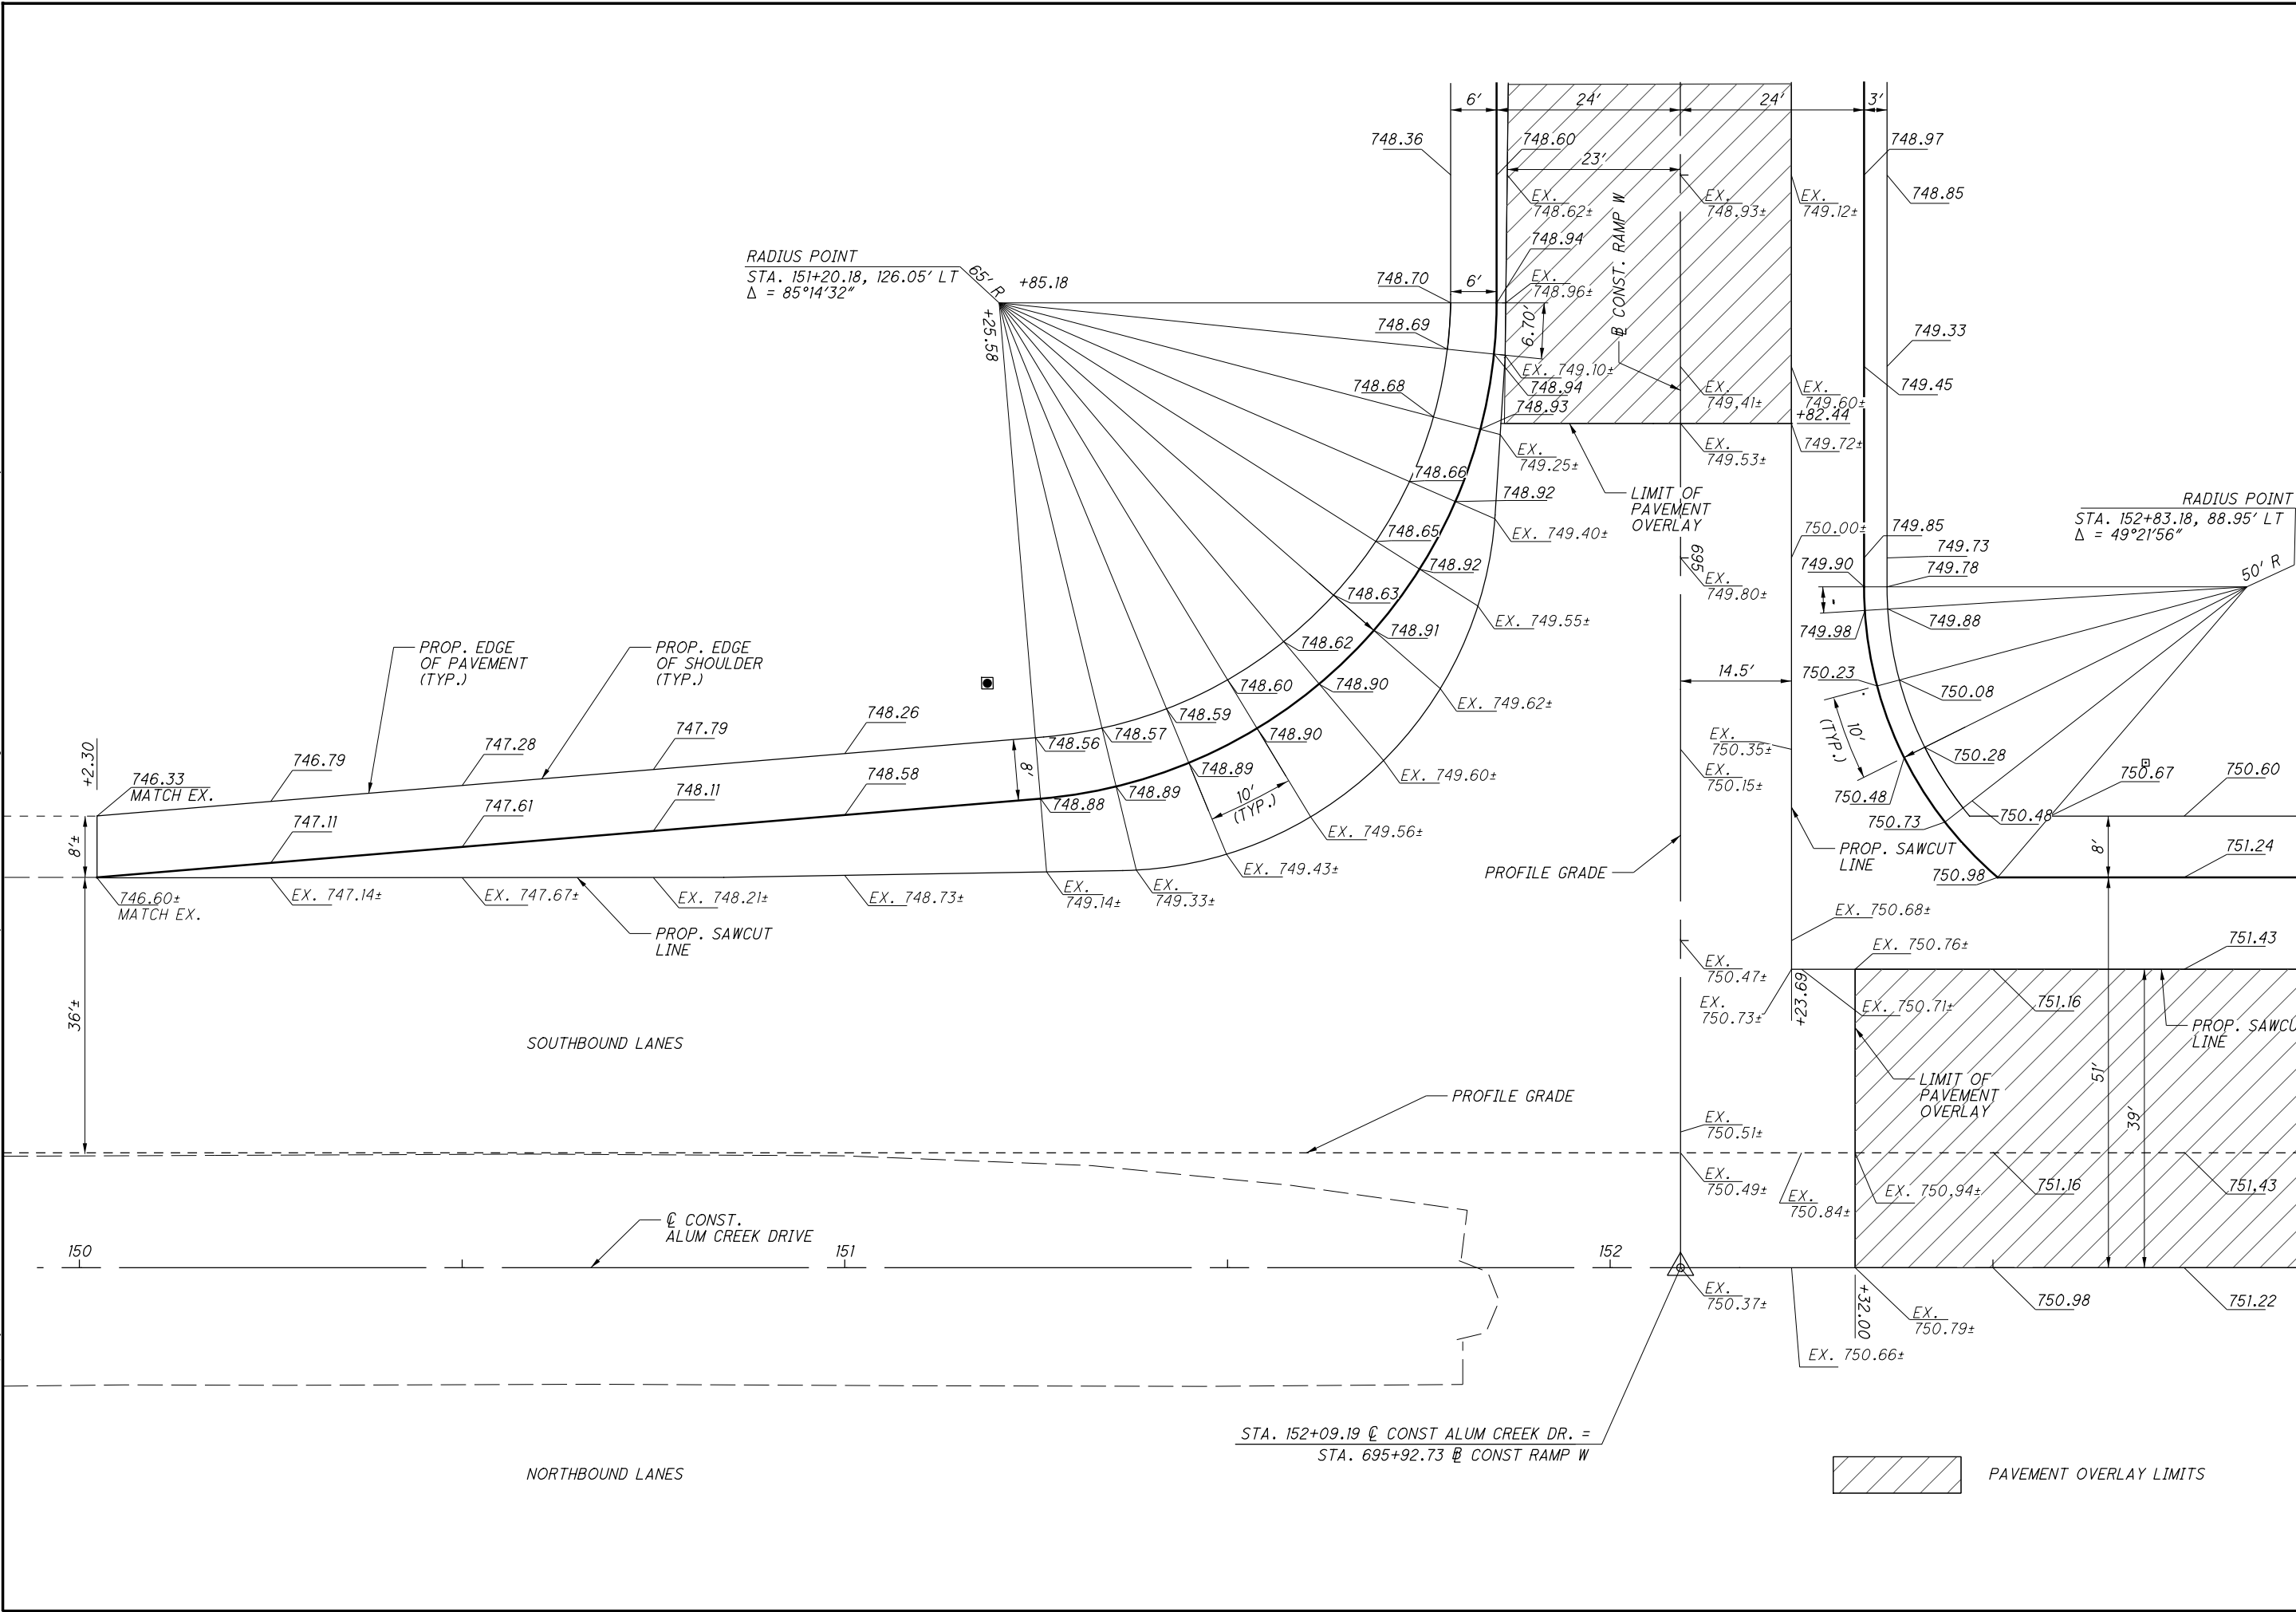

BU 4, 5, 6, 7, & 8 - RELEASED FOR CONSTRUCTION - 11/03/2014 - 11/19/2015

CALCULATED JLM
CHECKED SSK


0 5 10 20
HORIZONTAL SCALE IN FEET

INTERSECTION DETAIL
RAMP W AT ALUM CREEK DRIVE

FRA - 270-49.00

AS BUILT - 4/22/2016

G:\projects\2014\W-14-039 FRA-270-49\83988\roadway\sheets\83988G1003.dgn 5/23/2016 7:51:21 AM kevinj

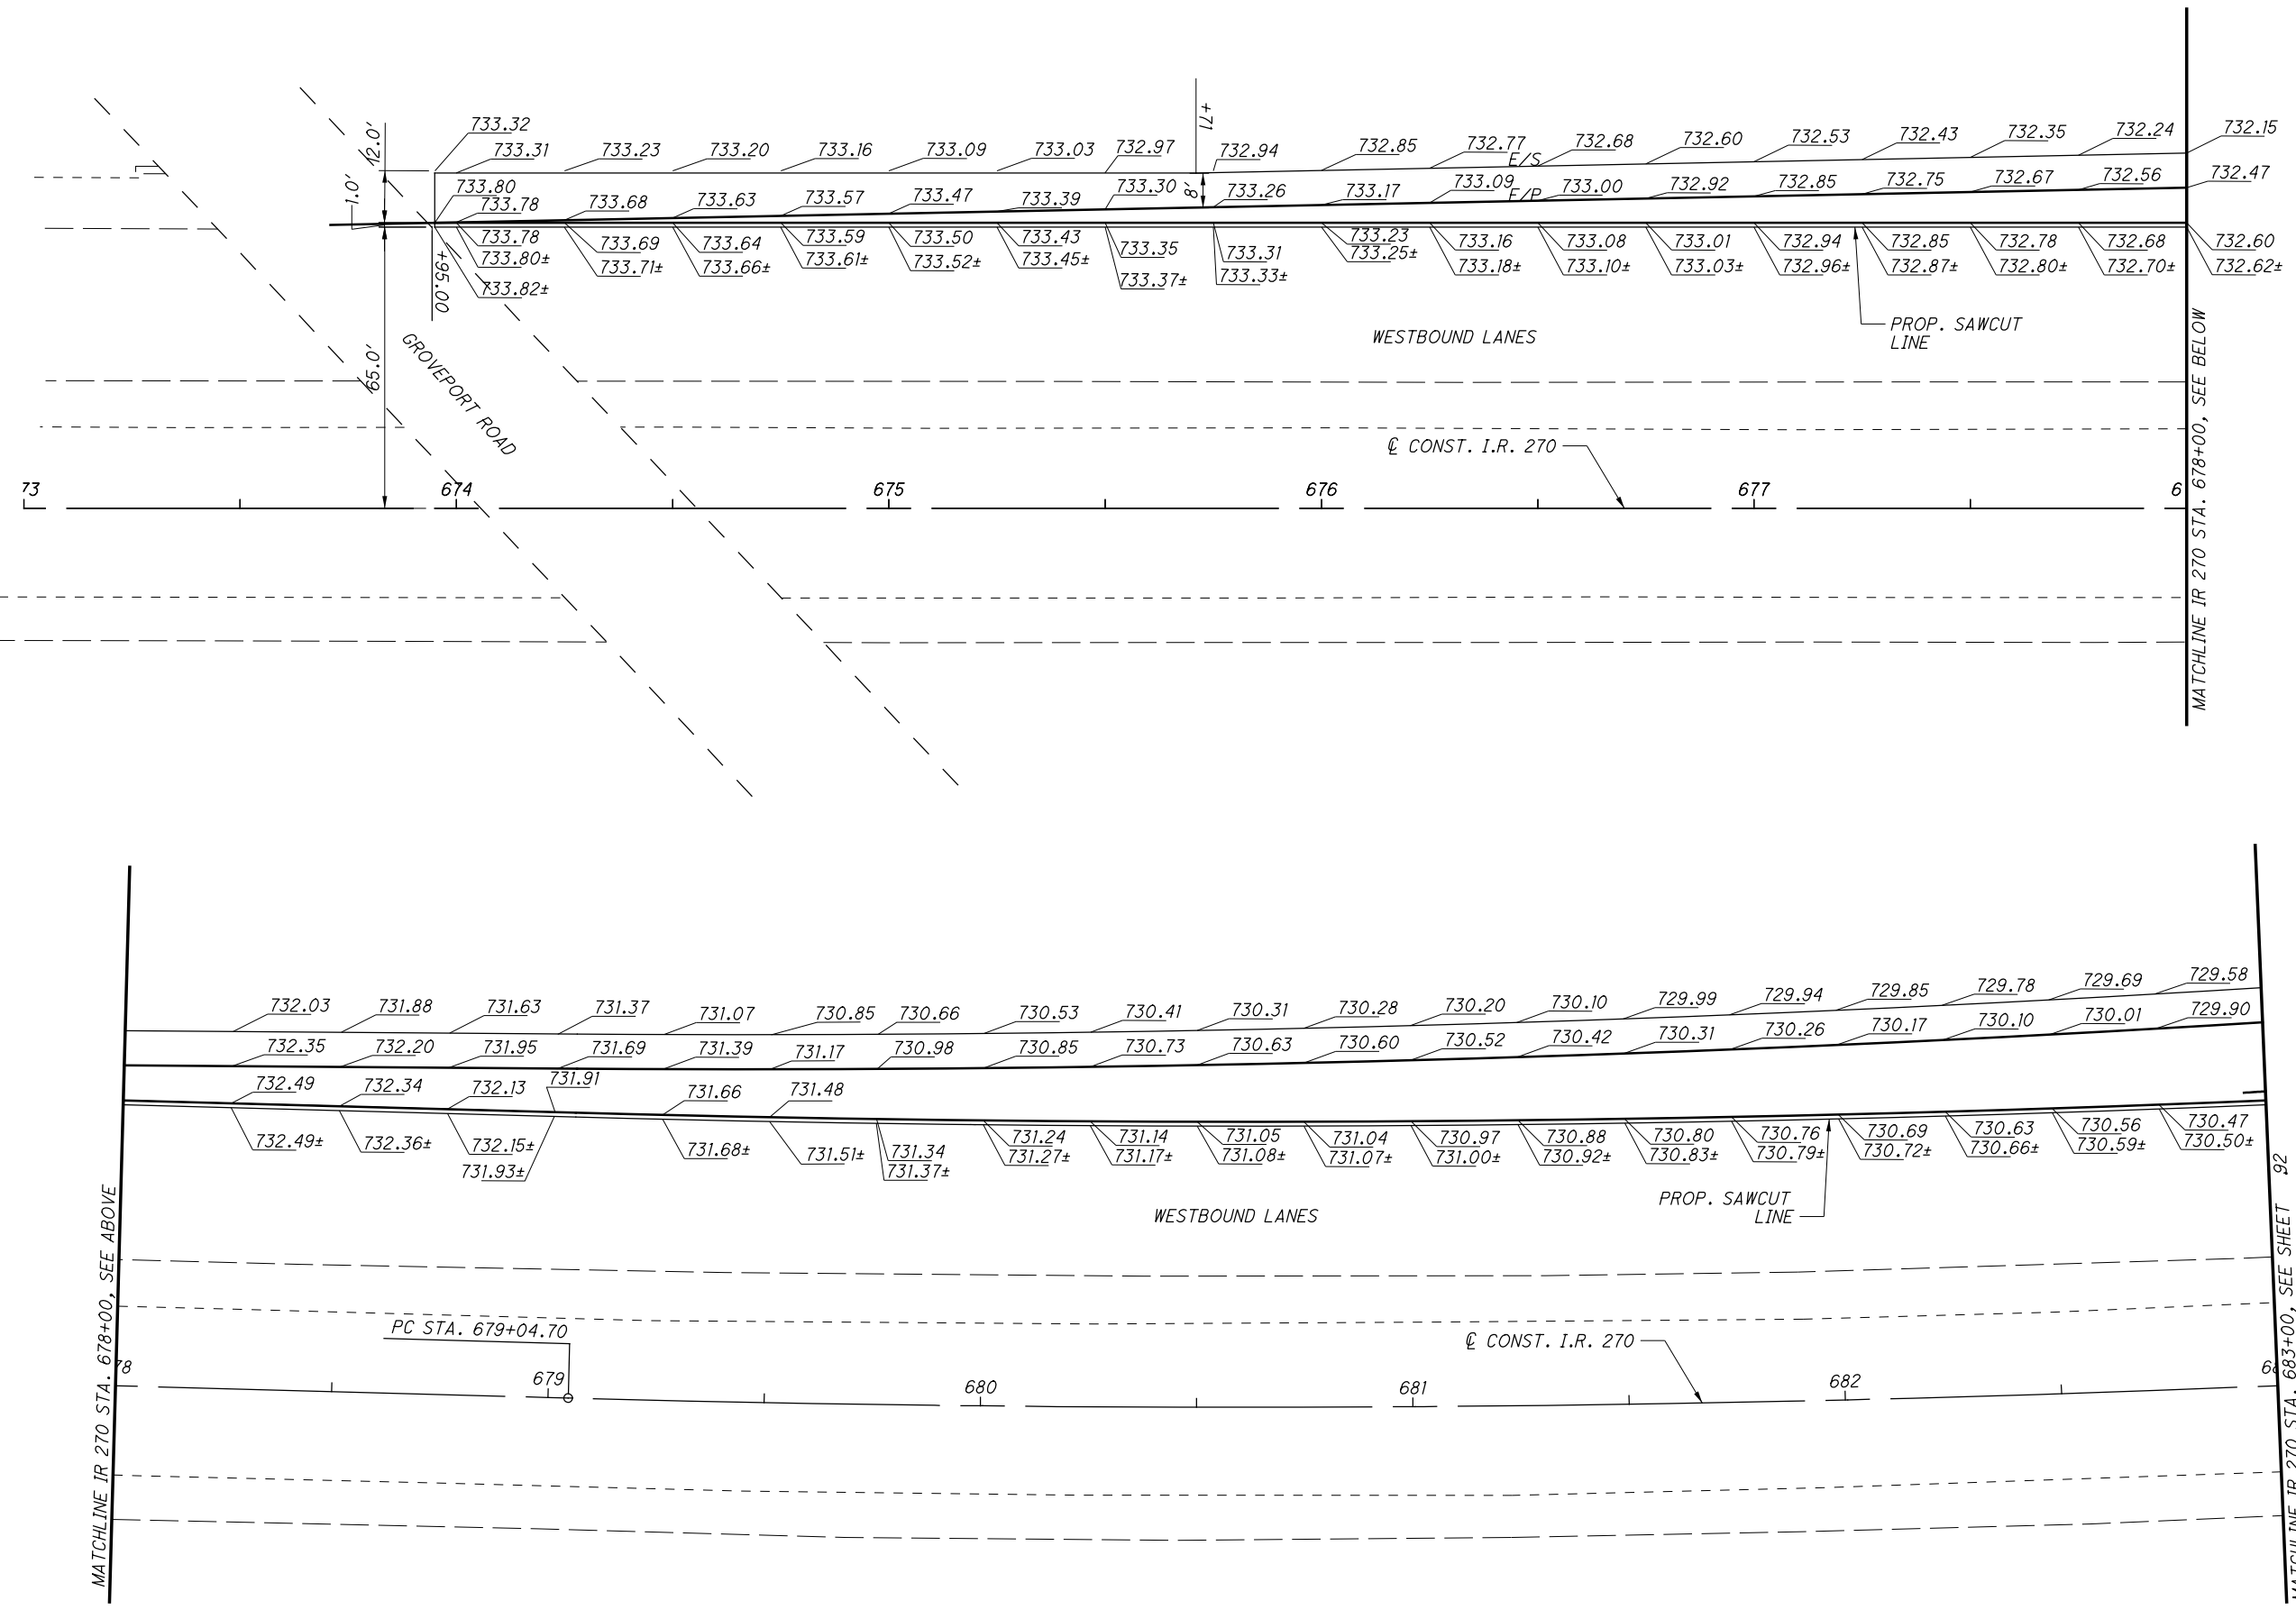

CALCULATED
JLM
CHECKED
SSK

0 20 40
HORIZONTAL
SCALE IN FEET



BU 4, 5, 6, 7, & 8 - RELEASED FOR CONSTRUCTION - 11/03/2014 - 11/19/2015

FRA - 270-49.00

RAMP TERMINAL DETAILS
STA. 673+00.00 TO STA. 683+00.00

AS BUILT - 4/22/2016

G:\projects\2014\W-14-039_FRA-270-49.00\83988\roadway\sheets\83988GI004.dgn 5/23/2016 7:31:21 AM kevinj

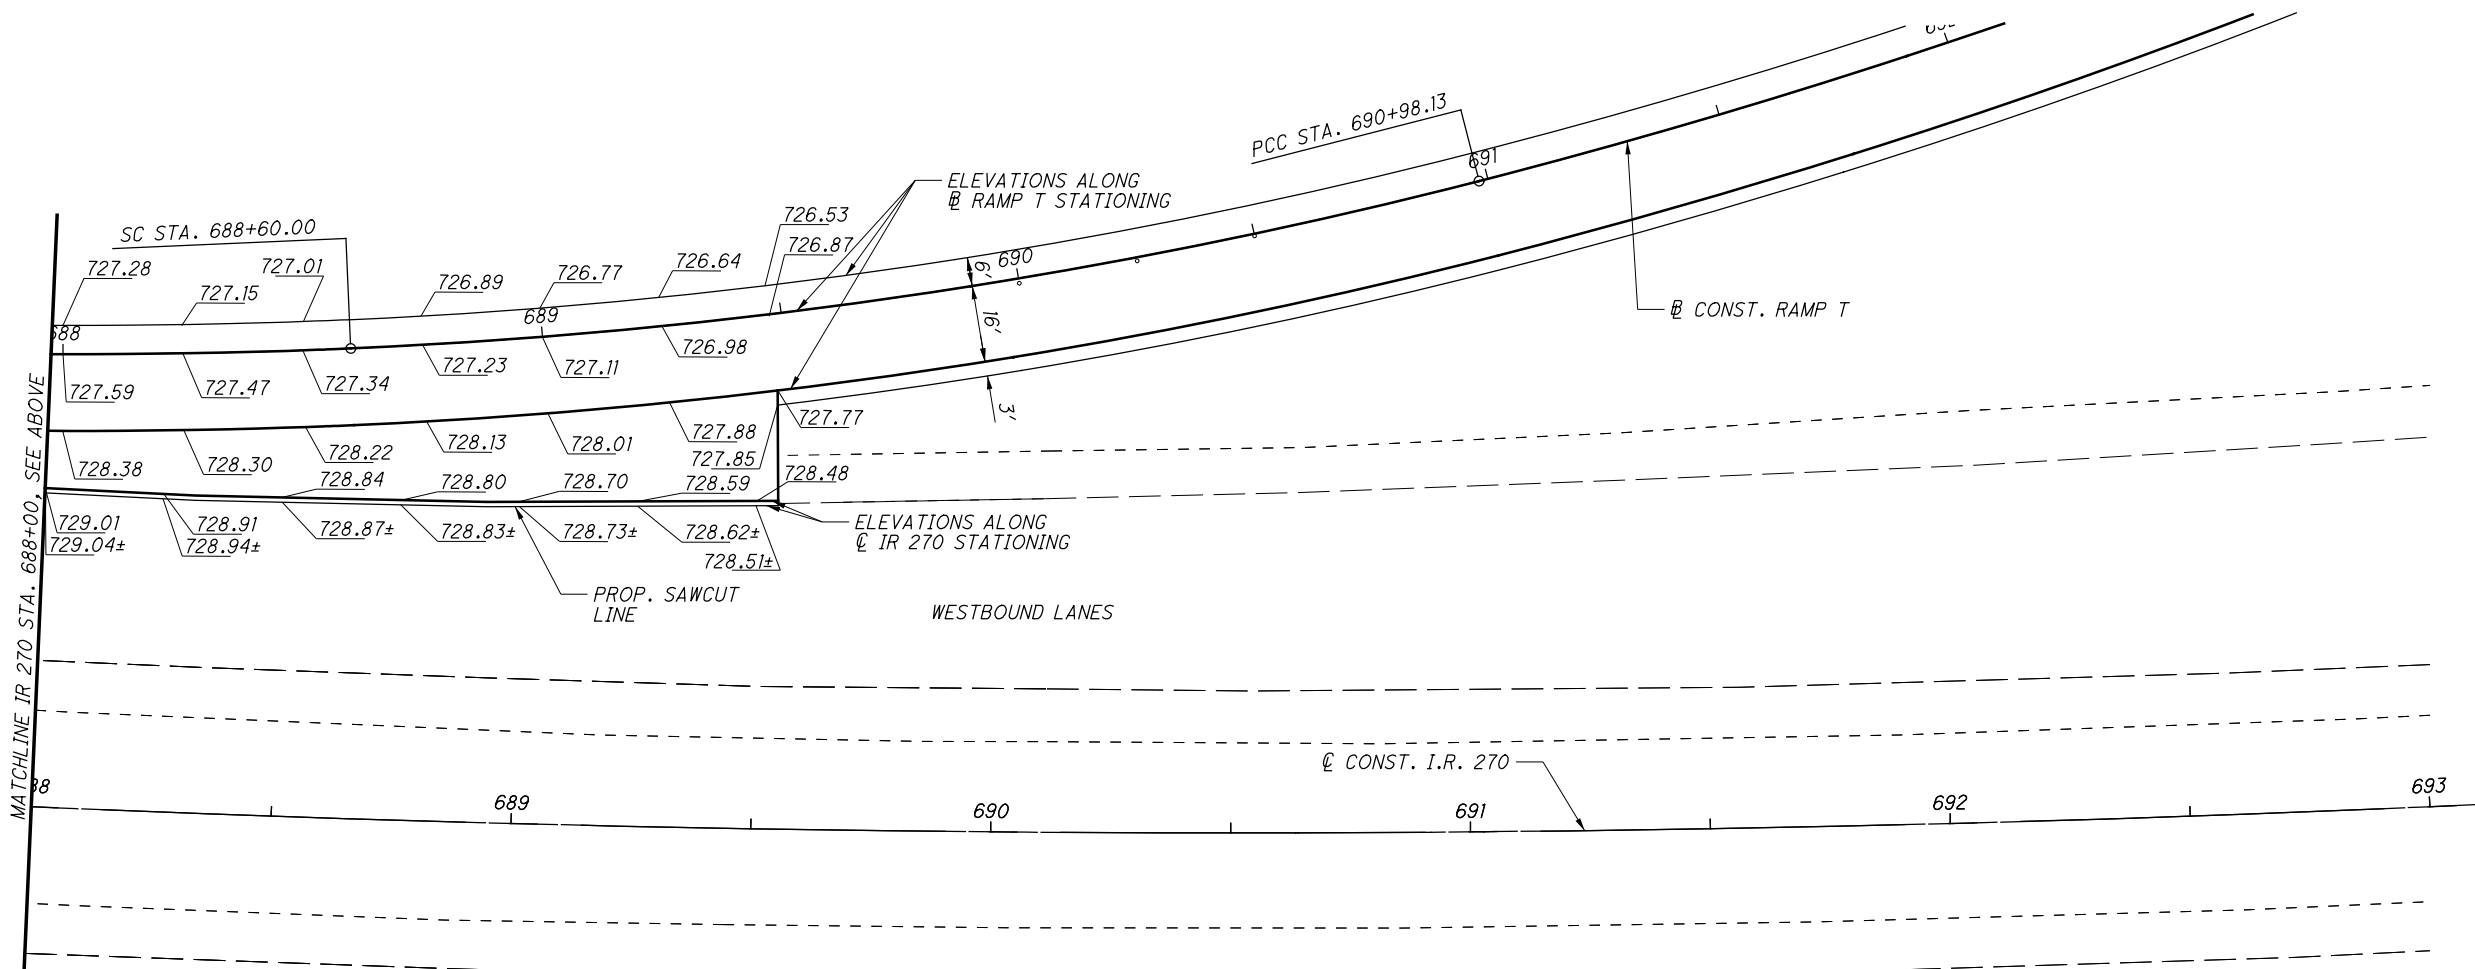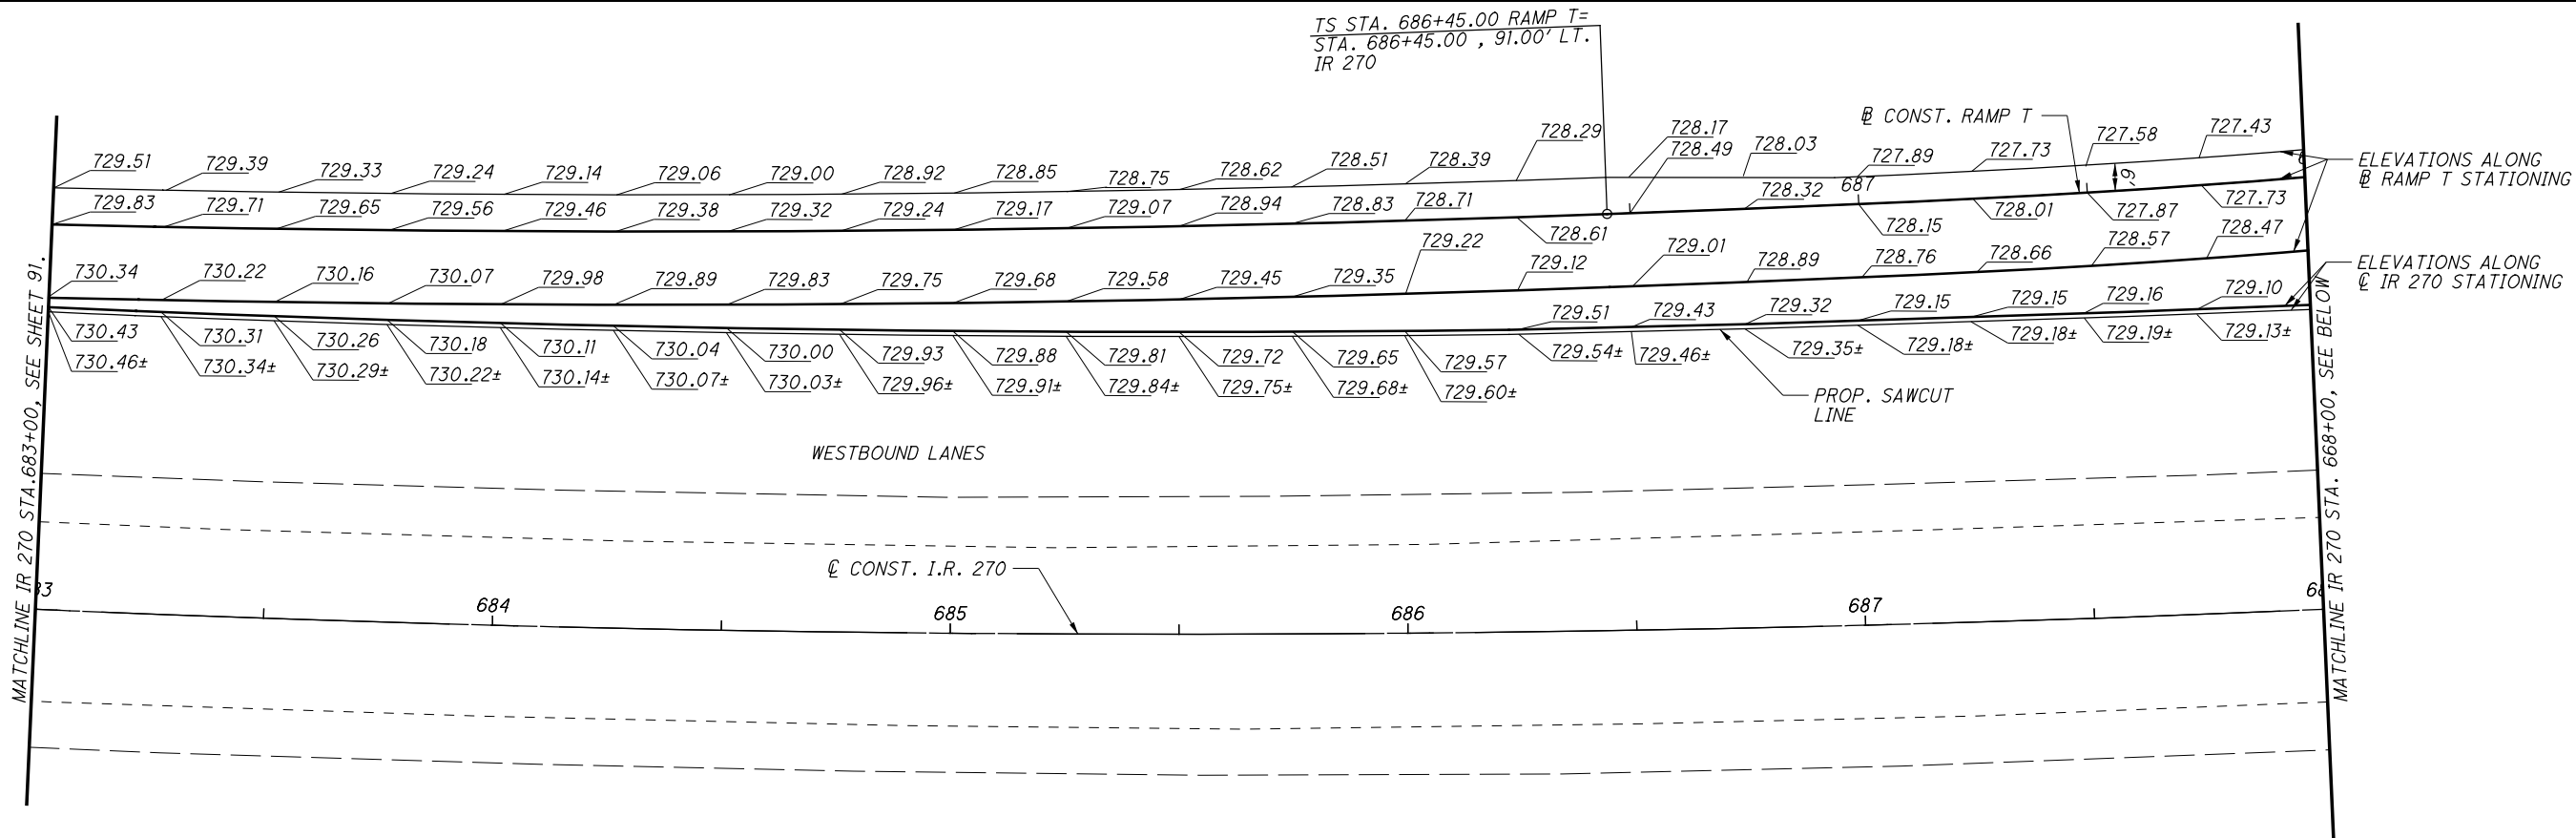

CALCULATED
 JLM

CHECKED
 SSK


0 20 40
 HORIZONTAL
 SCALE IN FEET

BU 4, 5, 6, 7, & 8 - RELEASED FOR CONSTRUCTION - 11/03/2014 - 11/19/2015

FRA - 270-49.00

92
182

RAMP TERMINAL DETAILS
 STA. 683+00.00 TO STA. 693+00.00

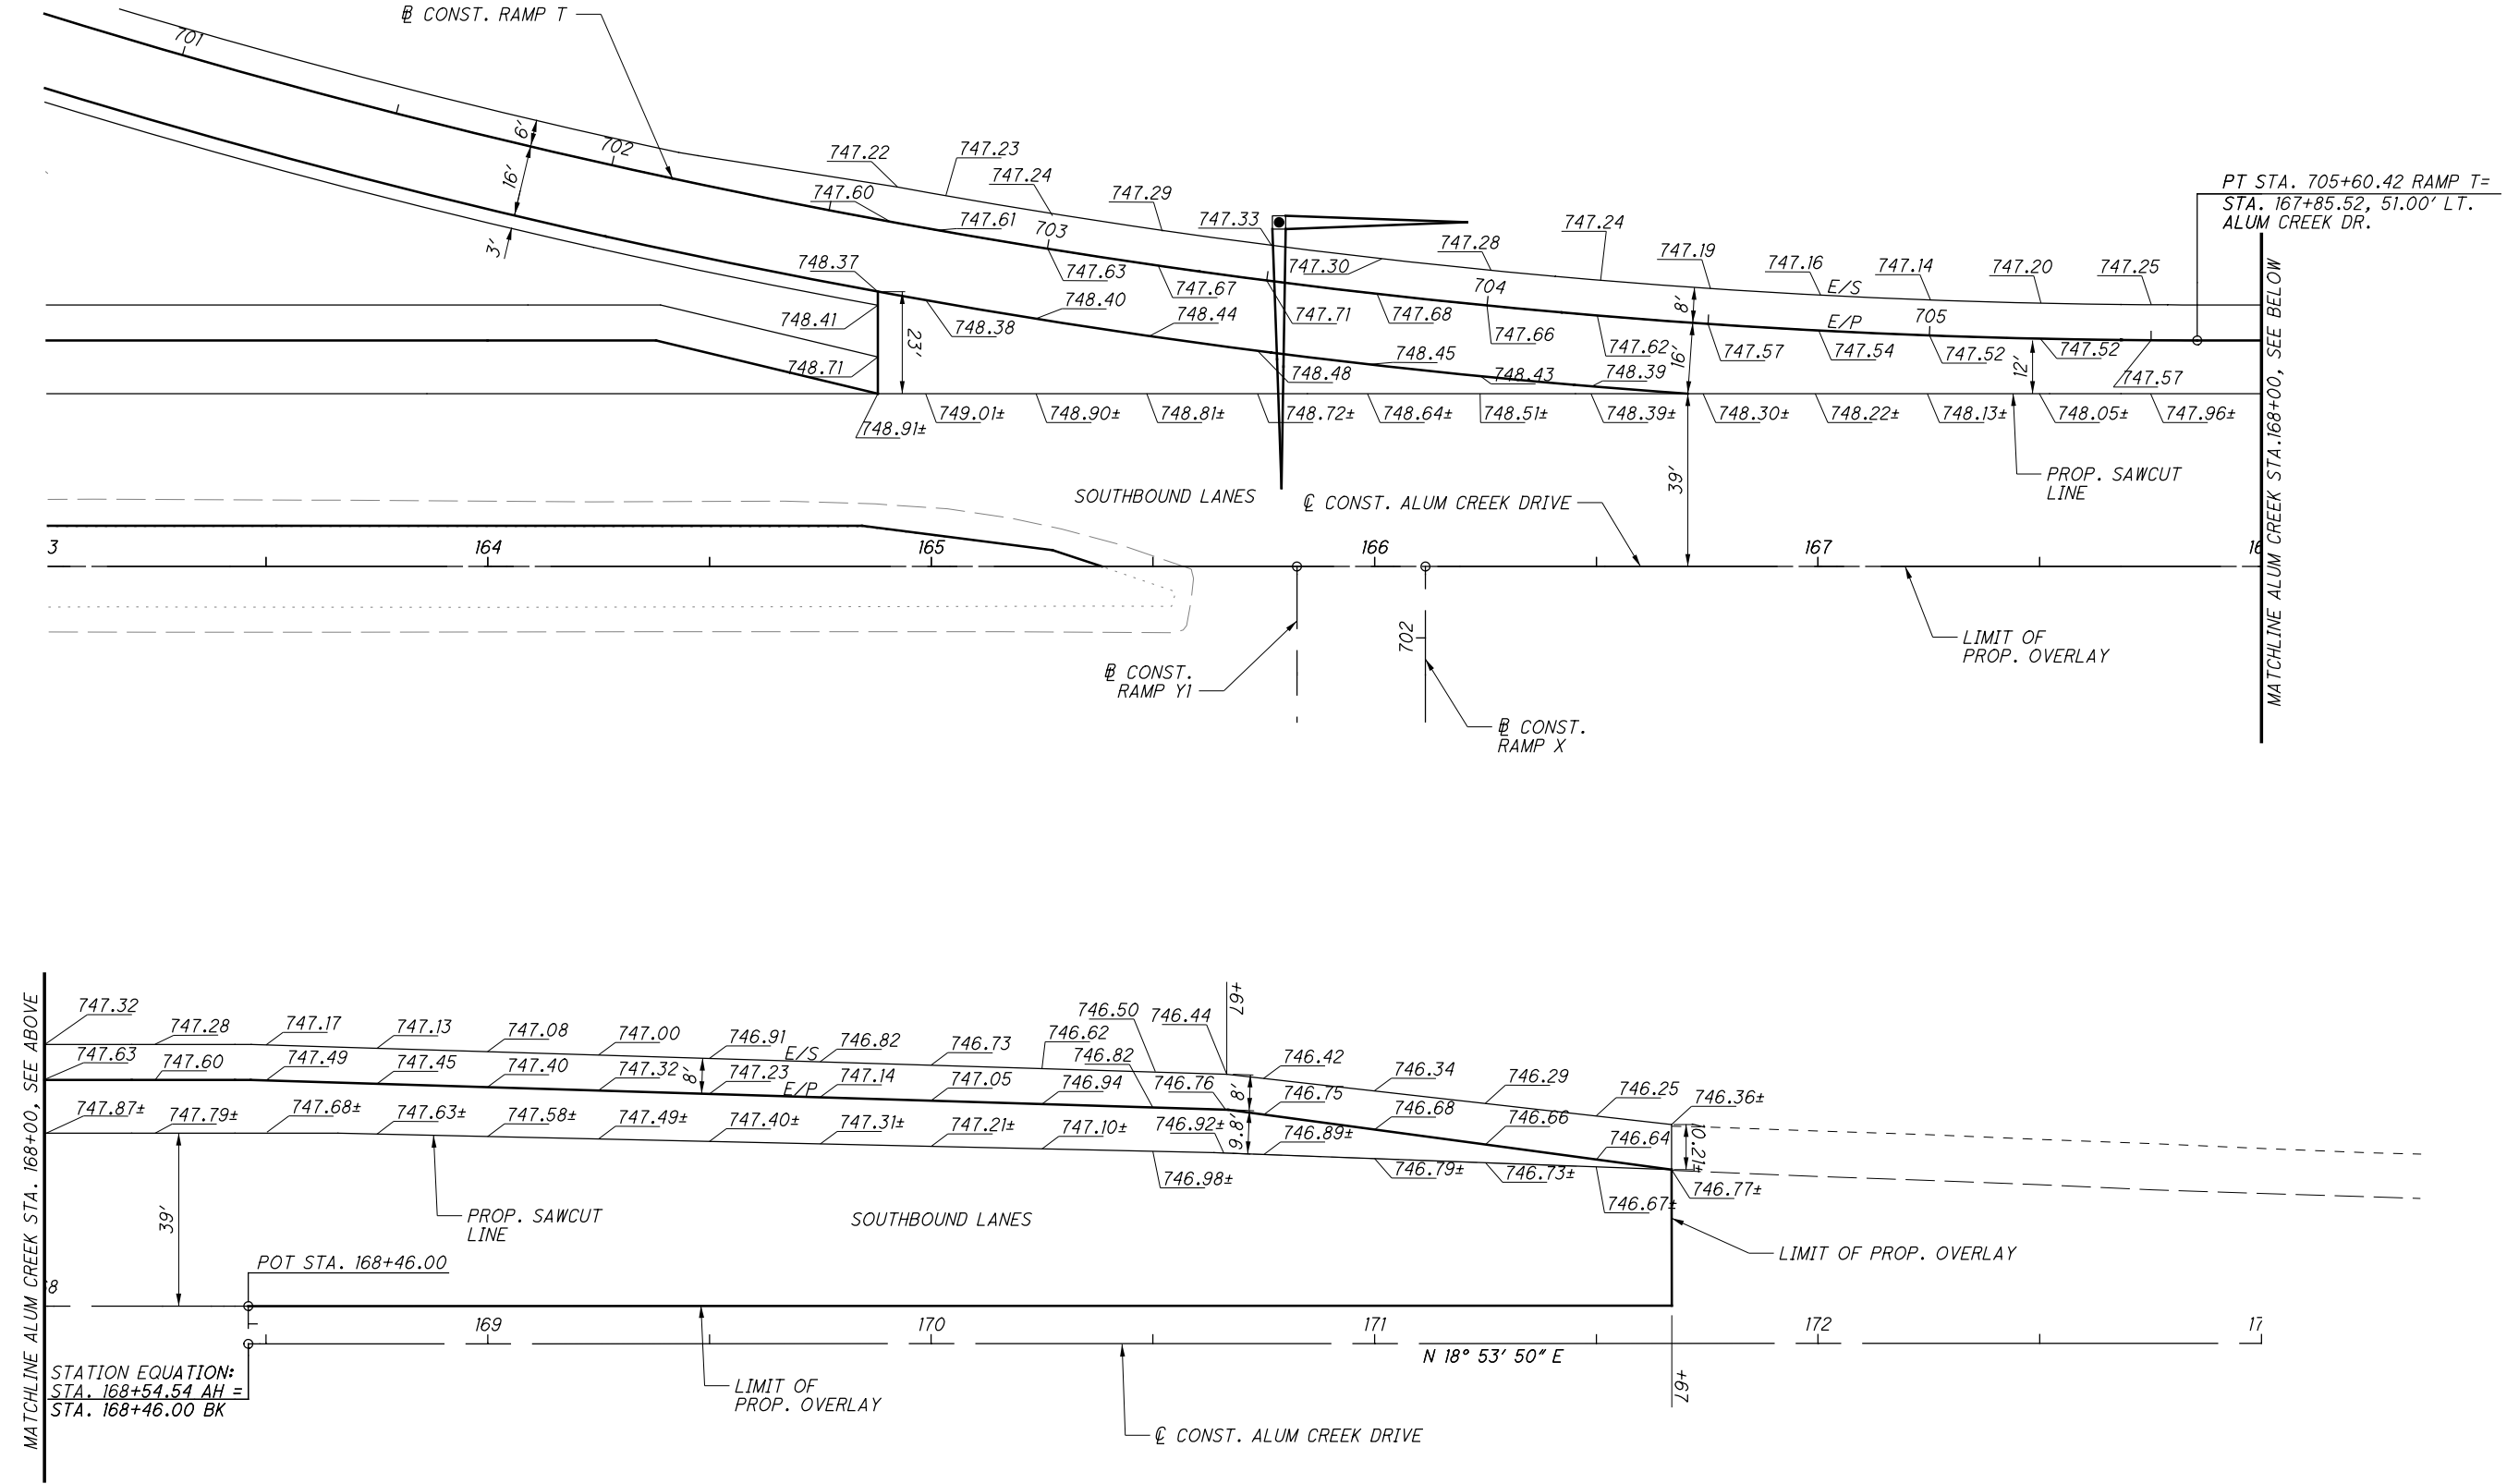

CALCULATED	JLM
CHECKED	SSK

BU 4, 5, 6, 7, & 8 - RELEASED FOR CONSTRUCTION - 11/03/2014 - 11/19/2015


RAMP TERMINAL DETAILS
STA. 163+00.00 TO STA. 173+00.00

FRA - 270-49.00


AS BUILT - 4/22/2016

5/23/2016 7:31:23 AM kevinj


G:\projects\2014\W-14-039 FRA-270-49.00\83988\roadway\sheets\83988GM001.dgn

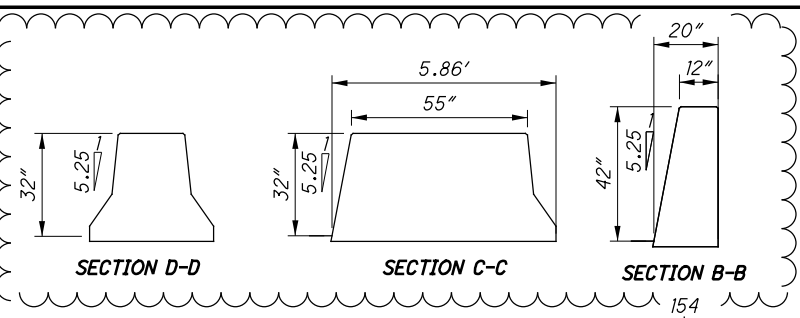


N 18° 54' 52" E

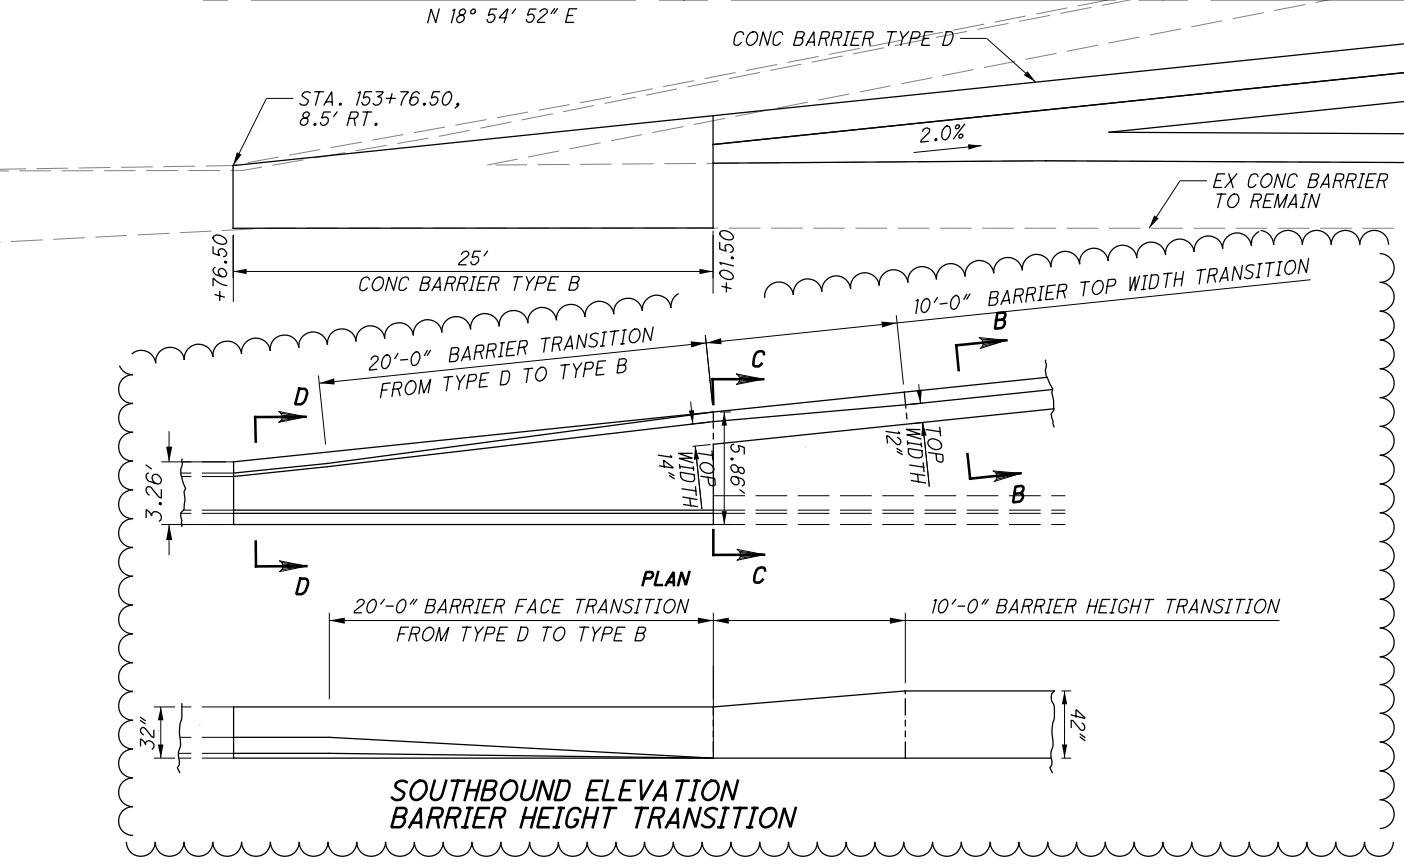

SOUTHBOUND ELEVATION BARRIER HEIGHT TRANSITION

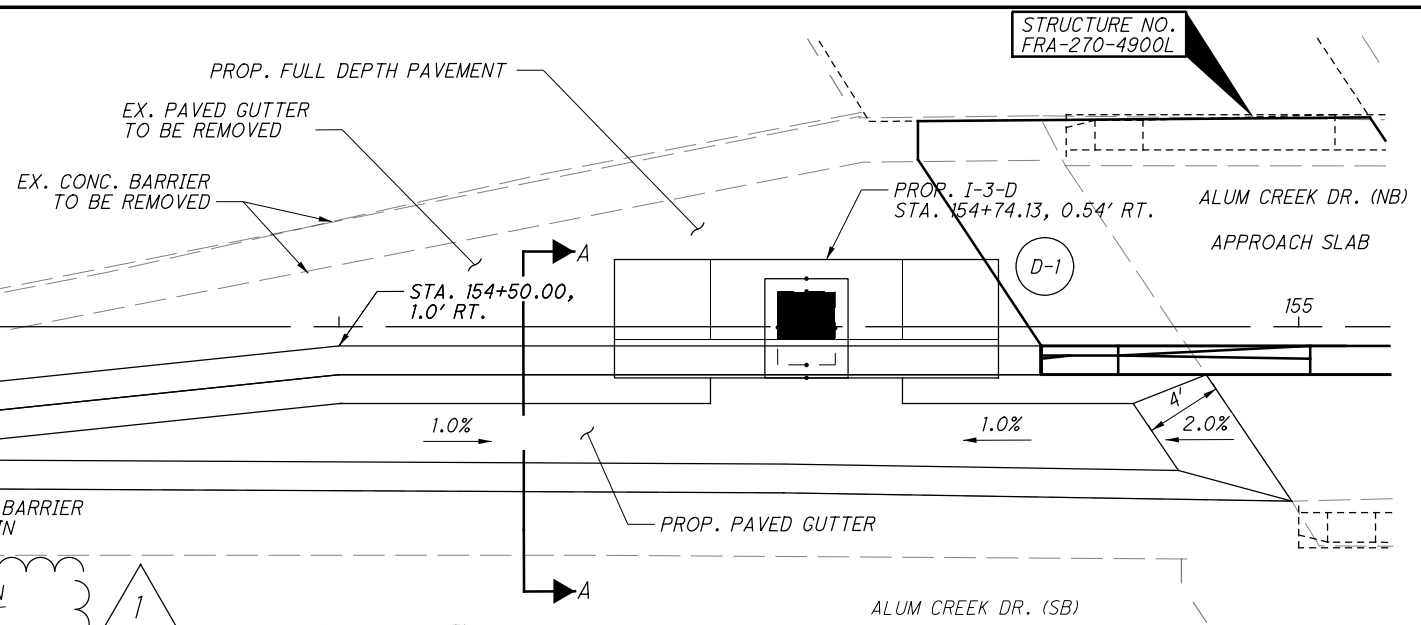


MEDIAN DETAIL

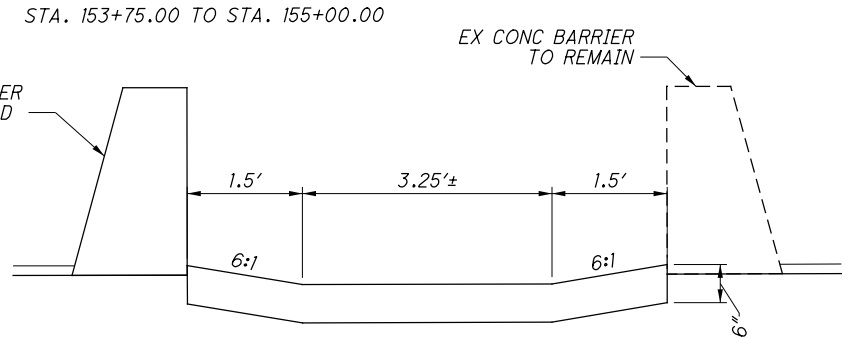


SECTION A-A PAVED GUTTER

DATE	DESCRIPTION
4/22/16	AS BUILT

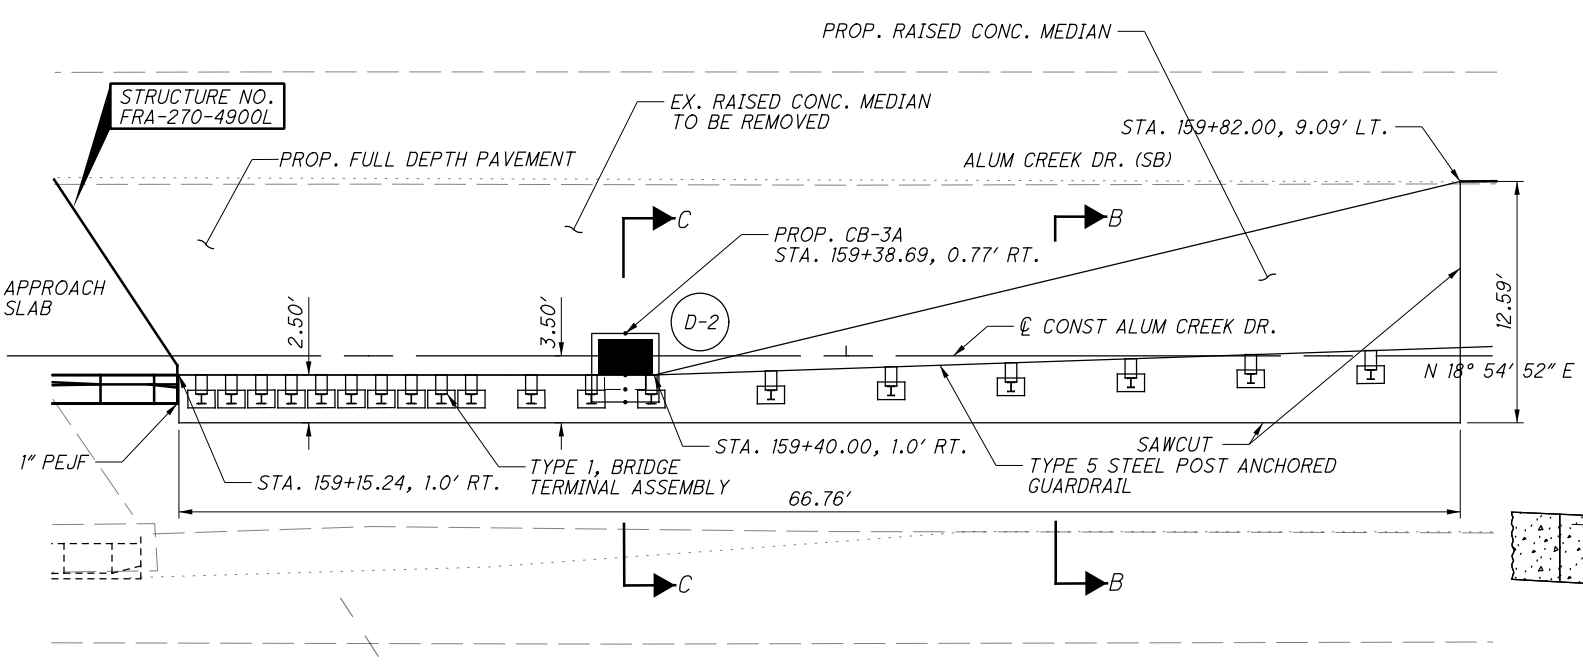


MEDIAN DETAIL

STA. 159+15.00 TO STA. 159+82.00

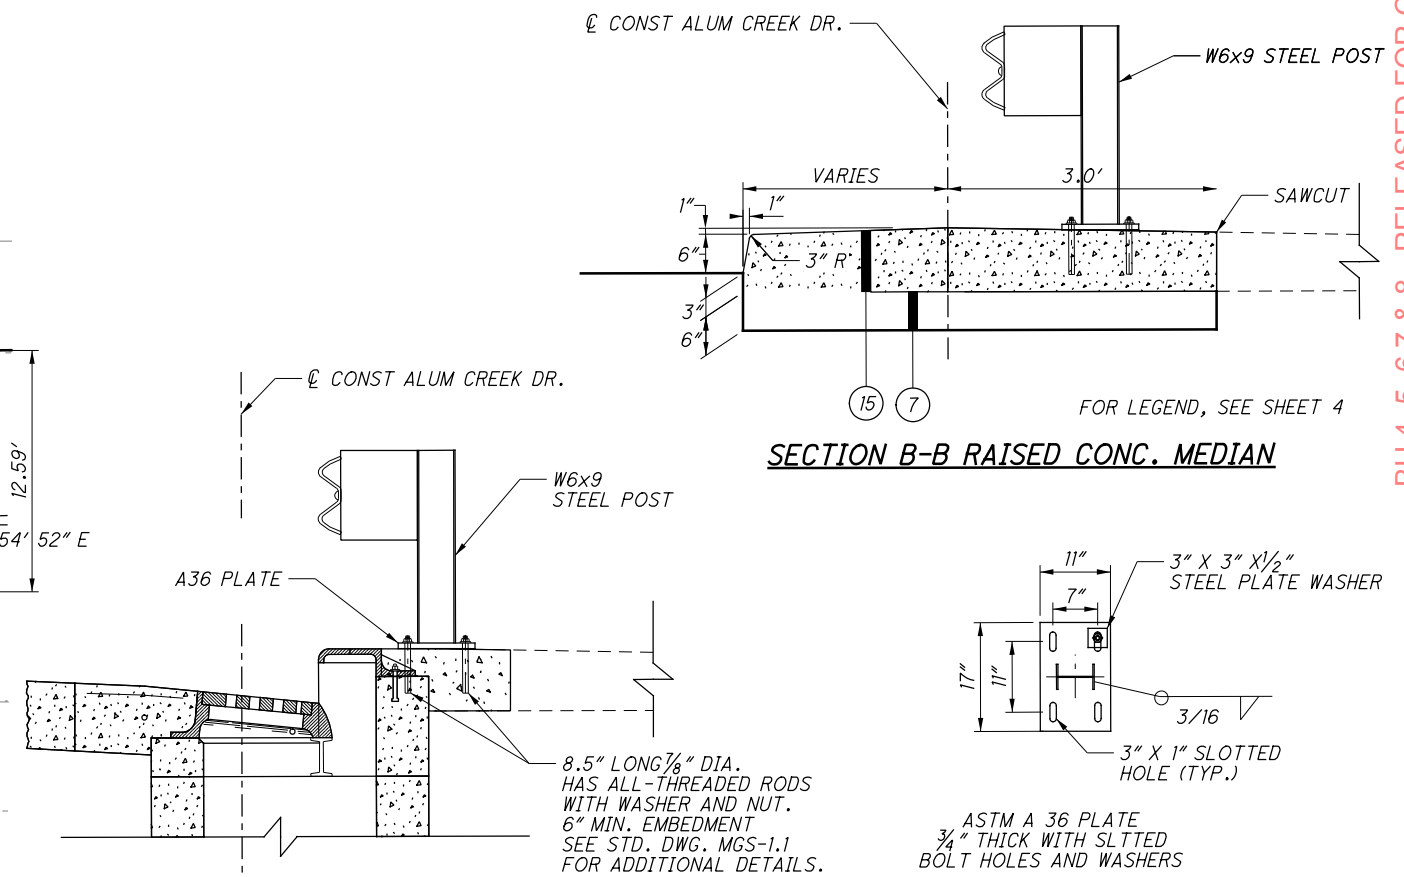

SECTION B-B RAISED CONC. MEDIAN


SECTION C-C RAISED CONC. MEDIAN

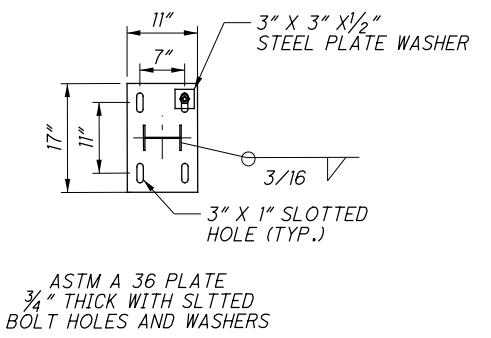


BU 4, 5, 6, 7, & 8 - RELEASED FOR CONSTRUCTION - 11/03/2014 - 11/19/2015

MEDIAN DETAILS ALUM CREEK DRIVE

FRA - 270 - 49.00

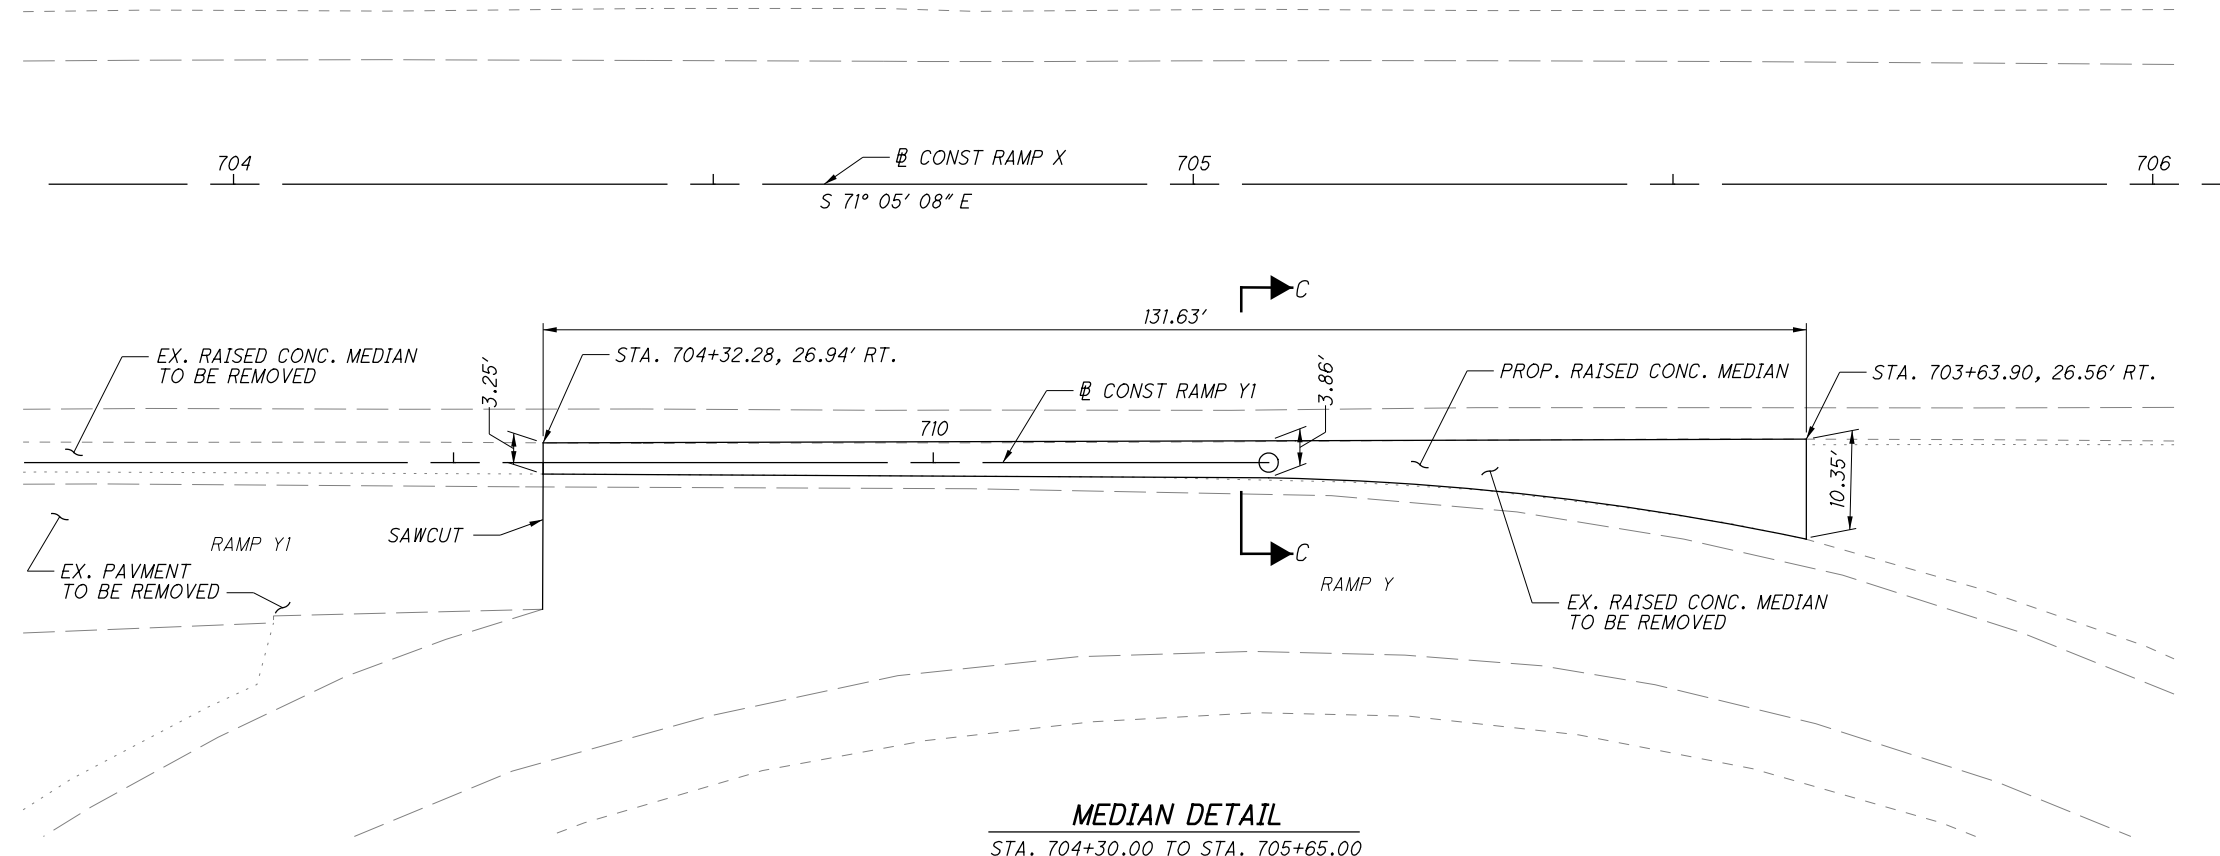

MEDIAN DETAIL
 STA. 704+30.00 TO STA. 705+65.00

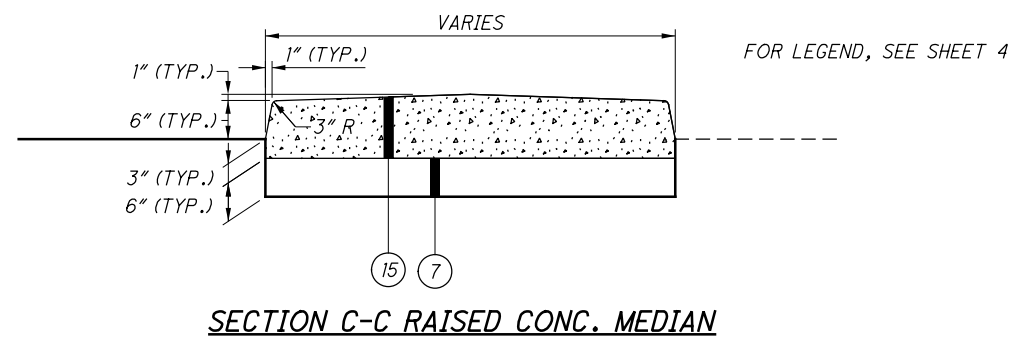


SECTION C-C RAISED CONC. MEDIAN

CALCULATED
 JLM
 CHECKED
 SSK

MEDIAN DETAILS
RAMP X

AS BUILT - 4/22/2016

G:\projects\2014\W-14-039 FRA-270-49.00\83988\structures\WALL_001\sheets\83988_00\WB001.dgn 5/23/2016 7:31:25 AM kevinj

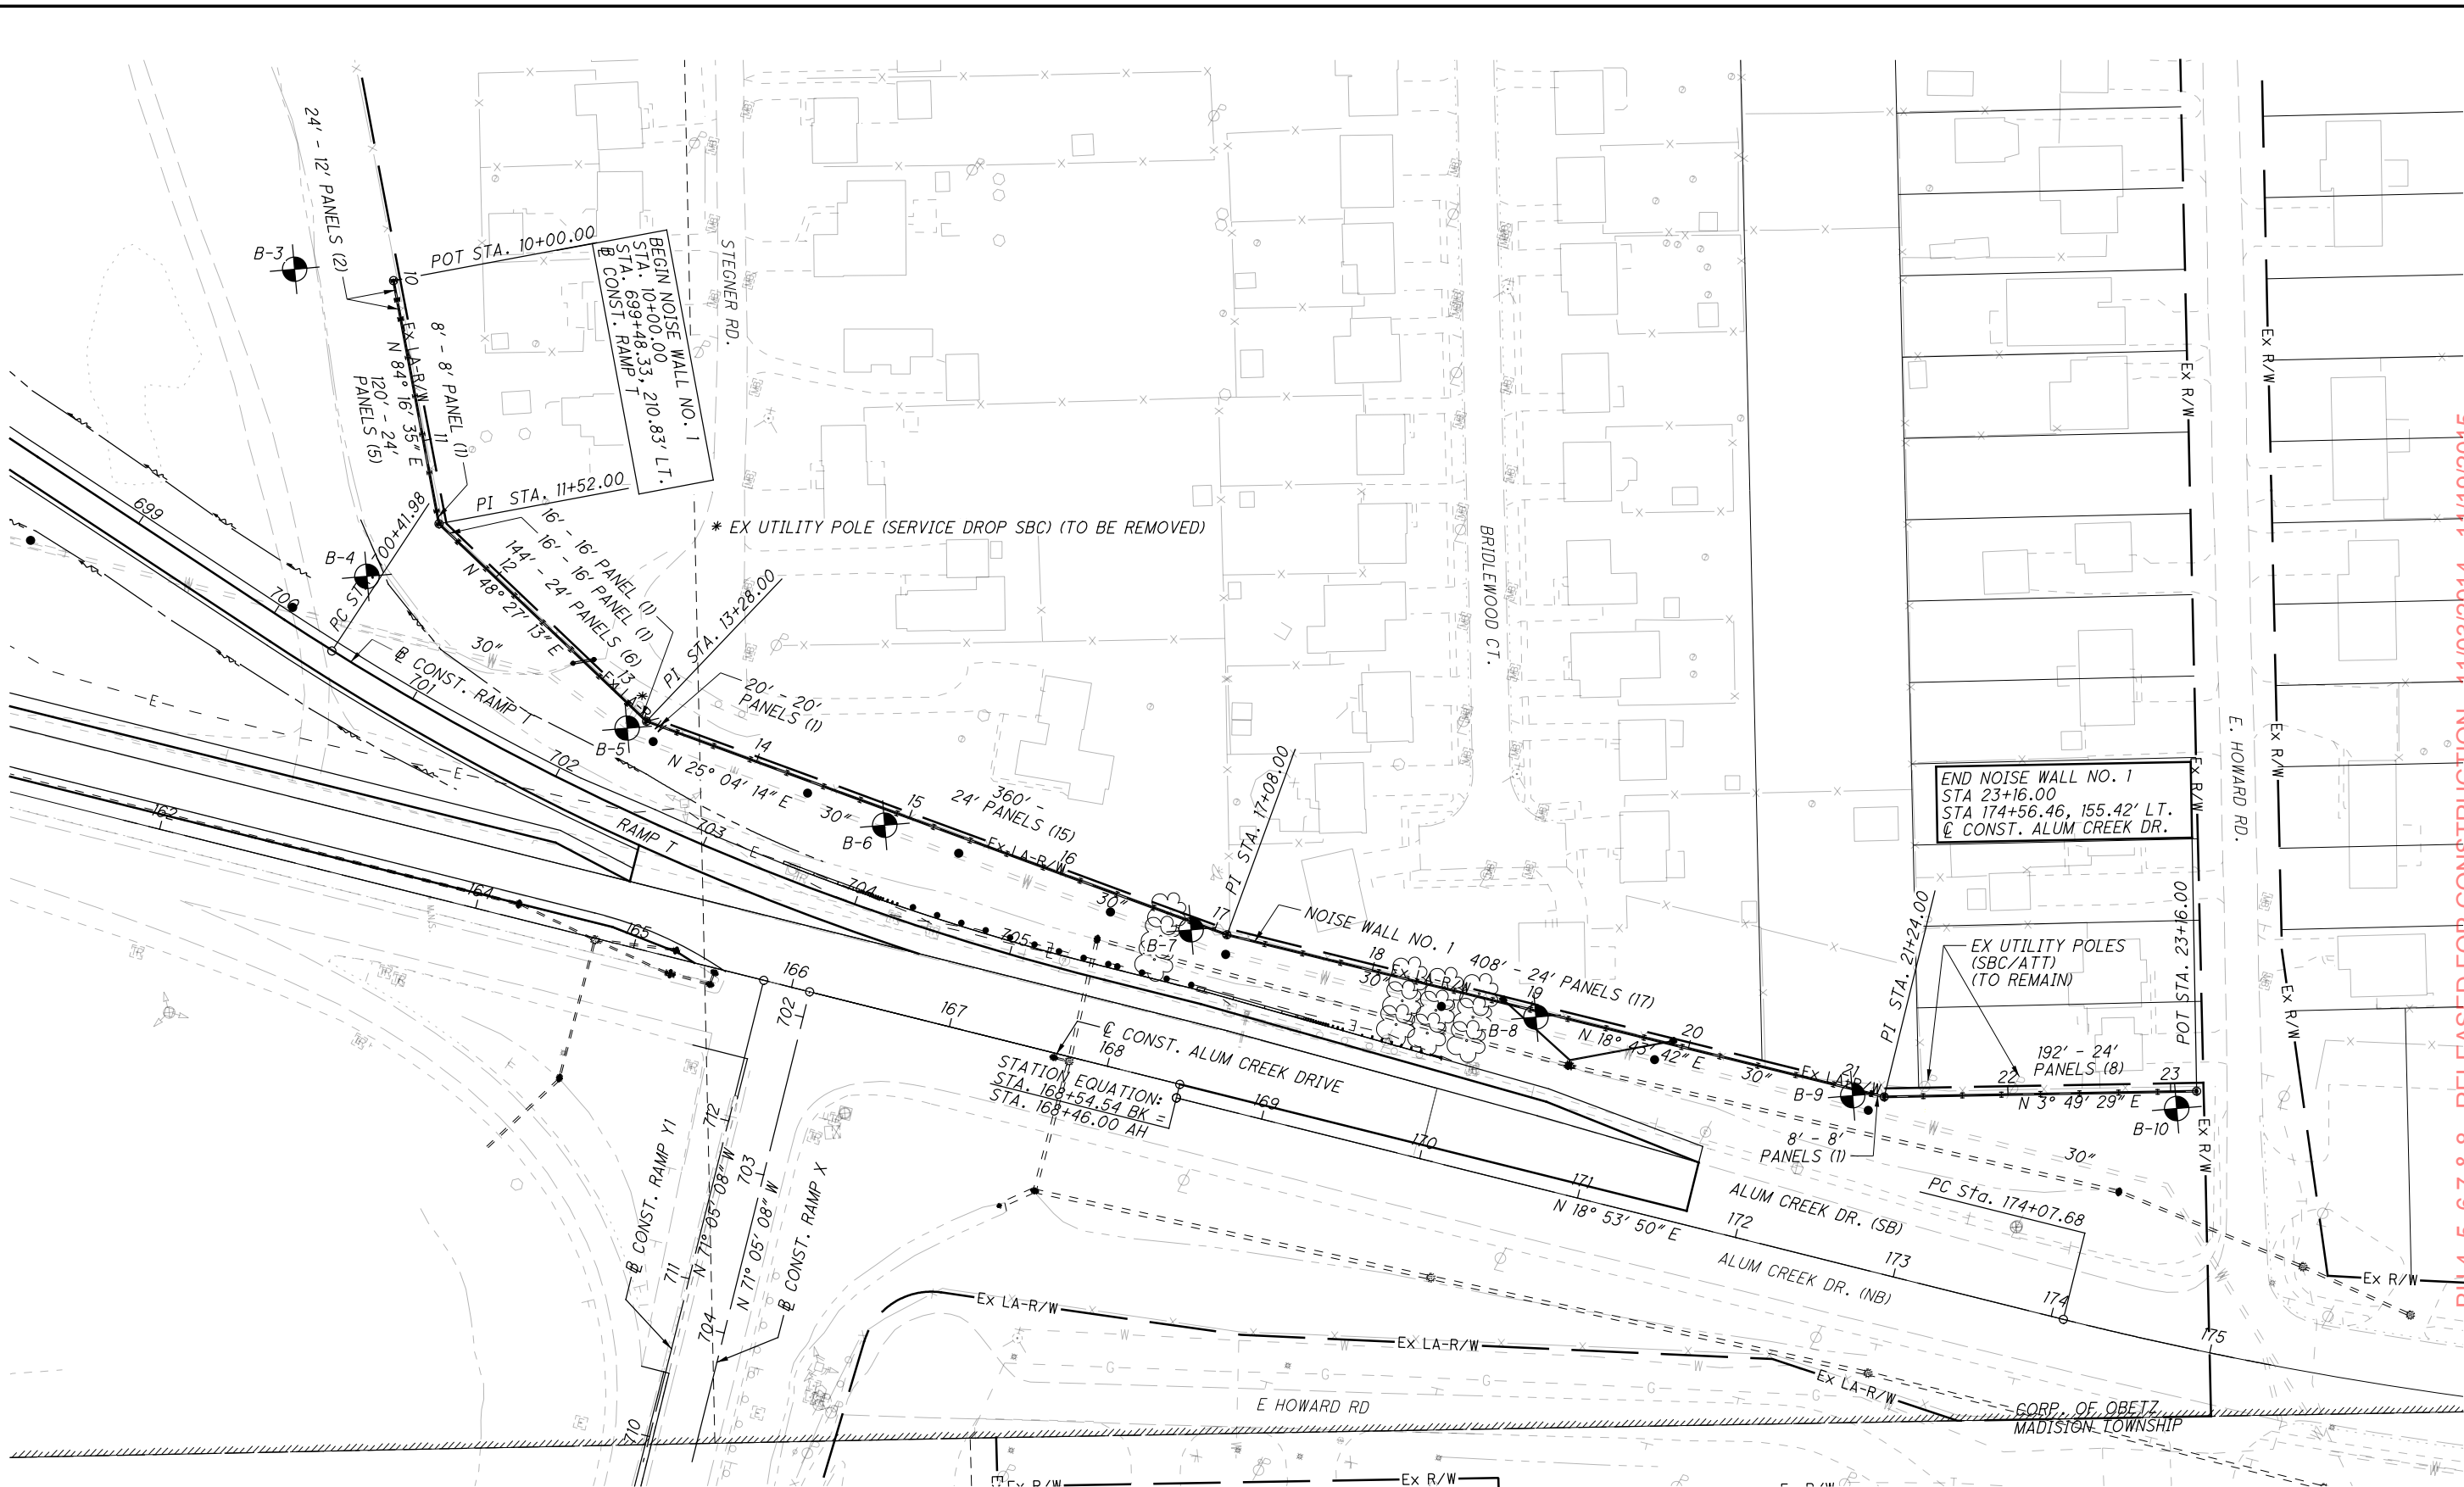

NOISE WALL NO. 1 - BASELINE GEOMETRY

P.I. NO.	NOISE BARRIER STATION	CL/BL	STATION	OFFSET	NORTHING	EASTING	BEARING
1	10+00.00	RAMP T	699+48.70	-210.83	682,780.49	1,846,788.45	N 84D 16' 35" E
2	11+52.00	RAMP T	700+57.35	-100.76	682,795.65	1,846,939.69	N 48D 27' 13" E
3	13+28.00	RAMP T	720+35.89	-54.98	682,912.37	1,847,071.41	N 25D 04' 14" E
4	17+08.00	ALUM CREEK DR.	168+46.00	-96.38	683,256.57	1,847,232.43	N 18D 43' 42" E
5	21+24.00	ALUM CREEK DR.	172+67.78	-105.98	683,650.55	1,847,366.00	N 3D 49' 29" E
6	23+16.00	ALUM CREEK DR.	174+56.46	-155.42	683,842.12	1,847,378.81	-



BU 4, 5, 6, 7, & 8 - RELEASED FOR CONSTRUCTION - 11/03/2014 - 11/19/2015


FRA - 270 - 49.00

1 / 10

96
182

SCHEMATIC PLAN - NOISE WALL NO. 1


CALCULATED SMJ
CHECKED NCK

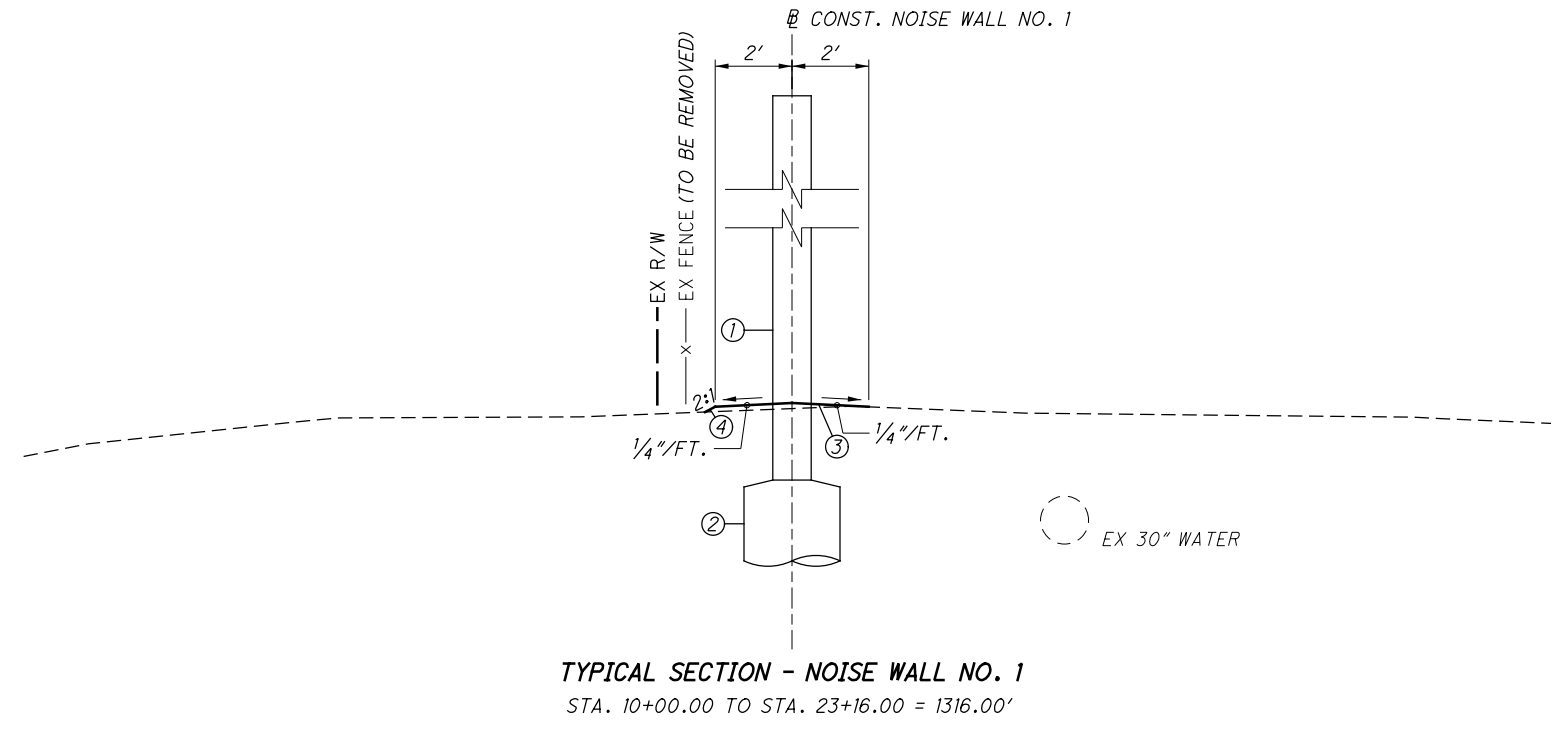

- LEGEND**
- ① ITEM SPECIAL - NOISE BARRIER
 - ② ITEM 524 - DRILLED SHAFTS
 - ③ ITEM 203 - EMBANKMENT
 - ④ ITEM 659 - SEEDING AND MULCHING

AS BUILT - 4/22/2016

G:\projects\2014\W-14-039_FRA-270-49.00\83988\structures\WALL_001\sheets\83988_00\WP001.dgn 5/23/2016 7:31:26 AM kevinj

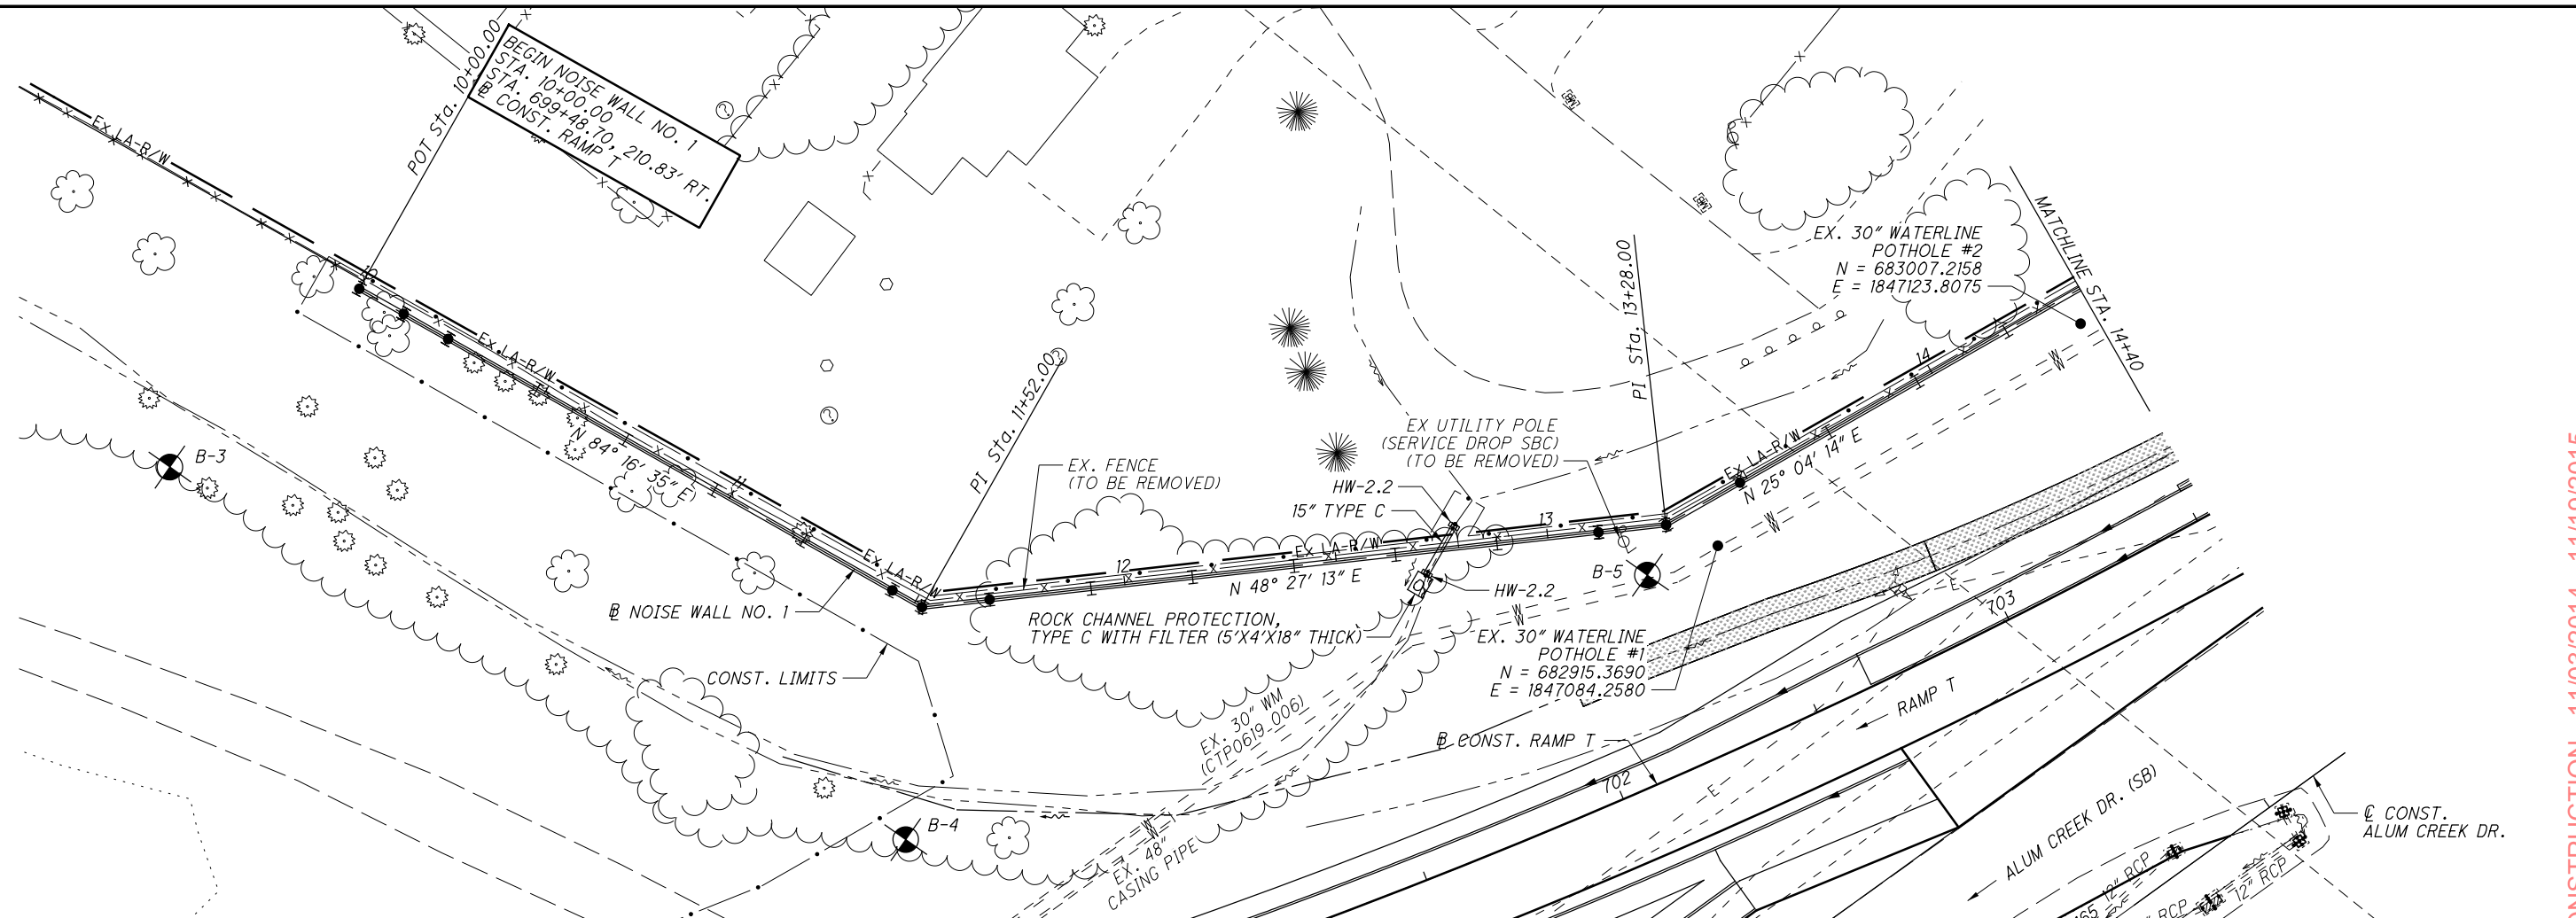

TOP OF WALL ELEV.	ACOUSTIC PROFILE ELEV.	BOTTOM OF WALL ELEV.	PANEL NO.	PROPOSED GRADE ELEV.	EX. GROUND ELEV.
751.50		746.50	1	705	700
755.50	759.22	746.50	2	747.33	747.16
759.50		746.50	3	747.31	747.22
759.50	759.15	746.50	4	747.29	747.14
759.50	759.07	746.50	5	747.31	747.06
759.50	759.23	746.50	6	747.33	747.23
759.50	759.16	746.50	7	747.22	747.15
759.50	758.99	746.50	8	747.12	746.99
759.50	759.05	746.50	9	747.20	747.05
759.50	759.13	746.50	10	747.29	747.13
759.50	759.21	746.50	11	747.32	747.20
759.50	759.20	746.50	12	747.35	747.20
759.50	759.26	746.50	13	747.41	744.32
759.50	759.41	746.50	14	747.46	747.39
759.50	759.34	746.50	15	747.31	747.34
759.50	759.45	746.50	16	747.16	747.03
759.50	758.68	746.00	17	747.02	746.66
759.50	758.77	746.00	18	746.88	746.77
759.50	758.85	746.00	19	747.02	746.85
759.50			20		
759.50			21		

BU 4, 5, 6, 7, & 8 - RELEASED FOR CONSTRUCTION - 11/03/2014 - 11/19/2015

PLAN AND PROFILE - NOISE WALL NO. 1
STA. 10+00 TO STA. 14+40

3 / 10

98
182


FRA - 270-49.00

SCALE IN FEET
 0 20 40
 HORIZONTAL

CALCULATED SMJ
 CHECKED NCK

AS BUILT - 4/22/2016

G:\projects\2014\W-14-039_FRA-270-49.00\83988\structures\WALL_001\sheet\83988_00\WP002.dgn 5/23/2016 7:31:27 AM kevinj

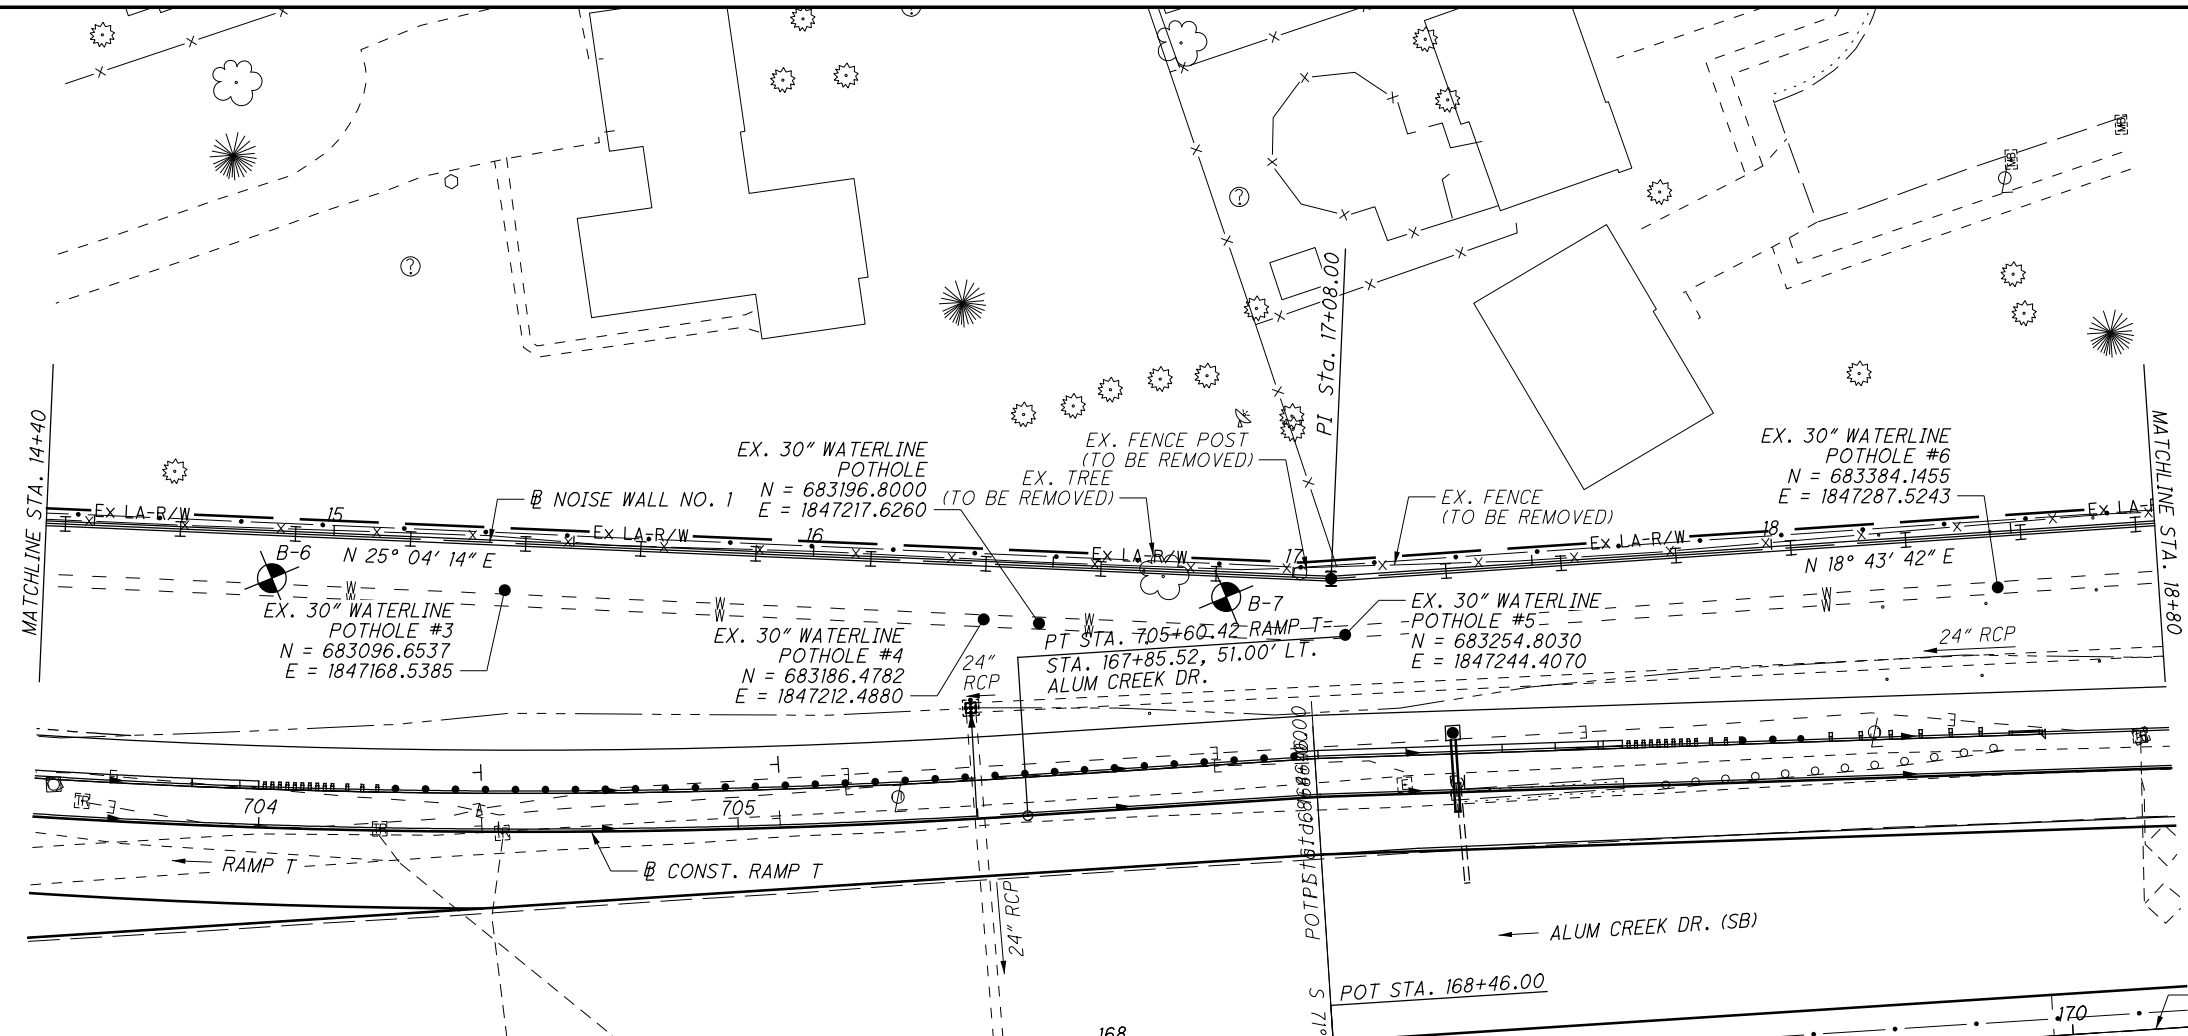

TOP OF WALL ELEV.	ACOUSTIC PROFILE ELEV.	BOTTOM OF WALL ELEV.	PANEL NO.	PROPOSED GRADE ELEV.	EX. GROUND ELEV.
759.50	758.93	746.50	22	747.17	746.93
759.50	759.07	746.50	23	747.33	747.06
759.50	759.32	746.50	24	747.50	747.32
759.50	759.58	747.00	25	747.60	747.57
759.50	759.66	747.00	26	747.70	747.50
759.50	759.61	747.00	27	747.81	747.60
759.50	759.81	747.00	28	747.92	747.80
759.50	759.45	746.50	29	747.58	747.42
759.50	759.04	746.50	30	747.25	747.03
759.50	758.77	746.00	31	746.96	746.76
759.50	758.42	746.00	32	746.67	746.39
758.50	758.15	745.50	33	746.43	746.15
758.50	758.01	745.50	34	746.19	745.97
758.50	757.62	745.00	35	745.96	745.60
758.50	757.55	745.00	36	745.72	745.55
758.50	757.47	745.00	37	745.64	745.47
758.50	757.39	745.00	38	745.55	745.39
758.50	757.34	745.00	39	745.66	745.33

XX = DRILLED SHAFT NUMBERS



PLAN AND PROFILE - NOISE WALL NO. 1
STA. 14+40 TO STA. 18+80


FRA-270-49.00
4/10
99/182

BU 4, 5, 6, 7, & 8 - RELEASED FOR CONSTRUCTION - 11/03/2014 - 11/19/2015


AS BUILT - 4/22/2016

5/23/2016 7:31:28 AM kevinj

G:\projects\2014\W-14-039_FRA-270-49.00\B3988\structures\WALL_001\sheet\B3988_00\WPO03.dgn

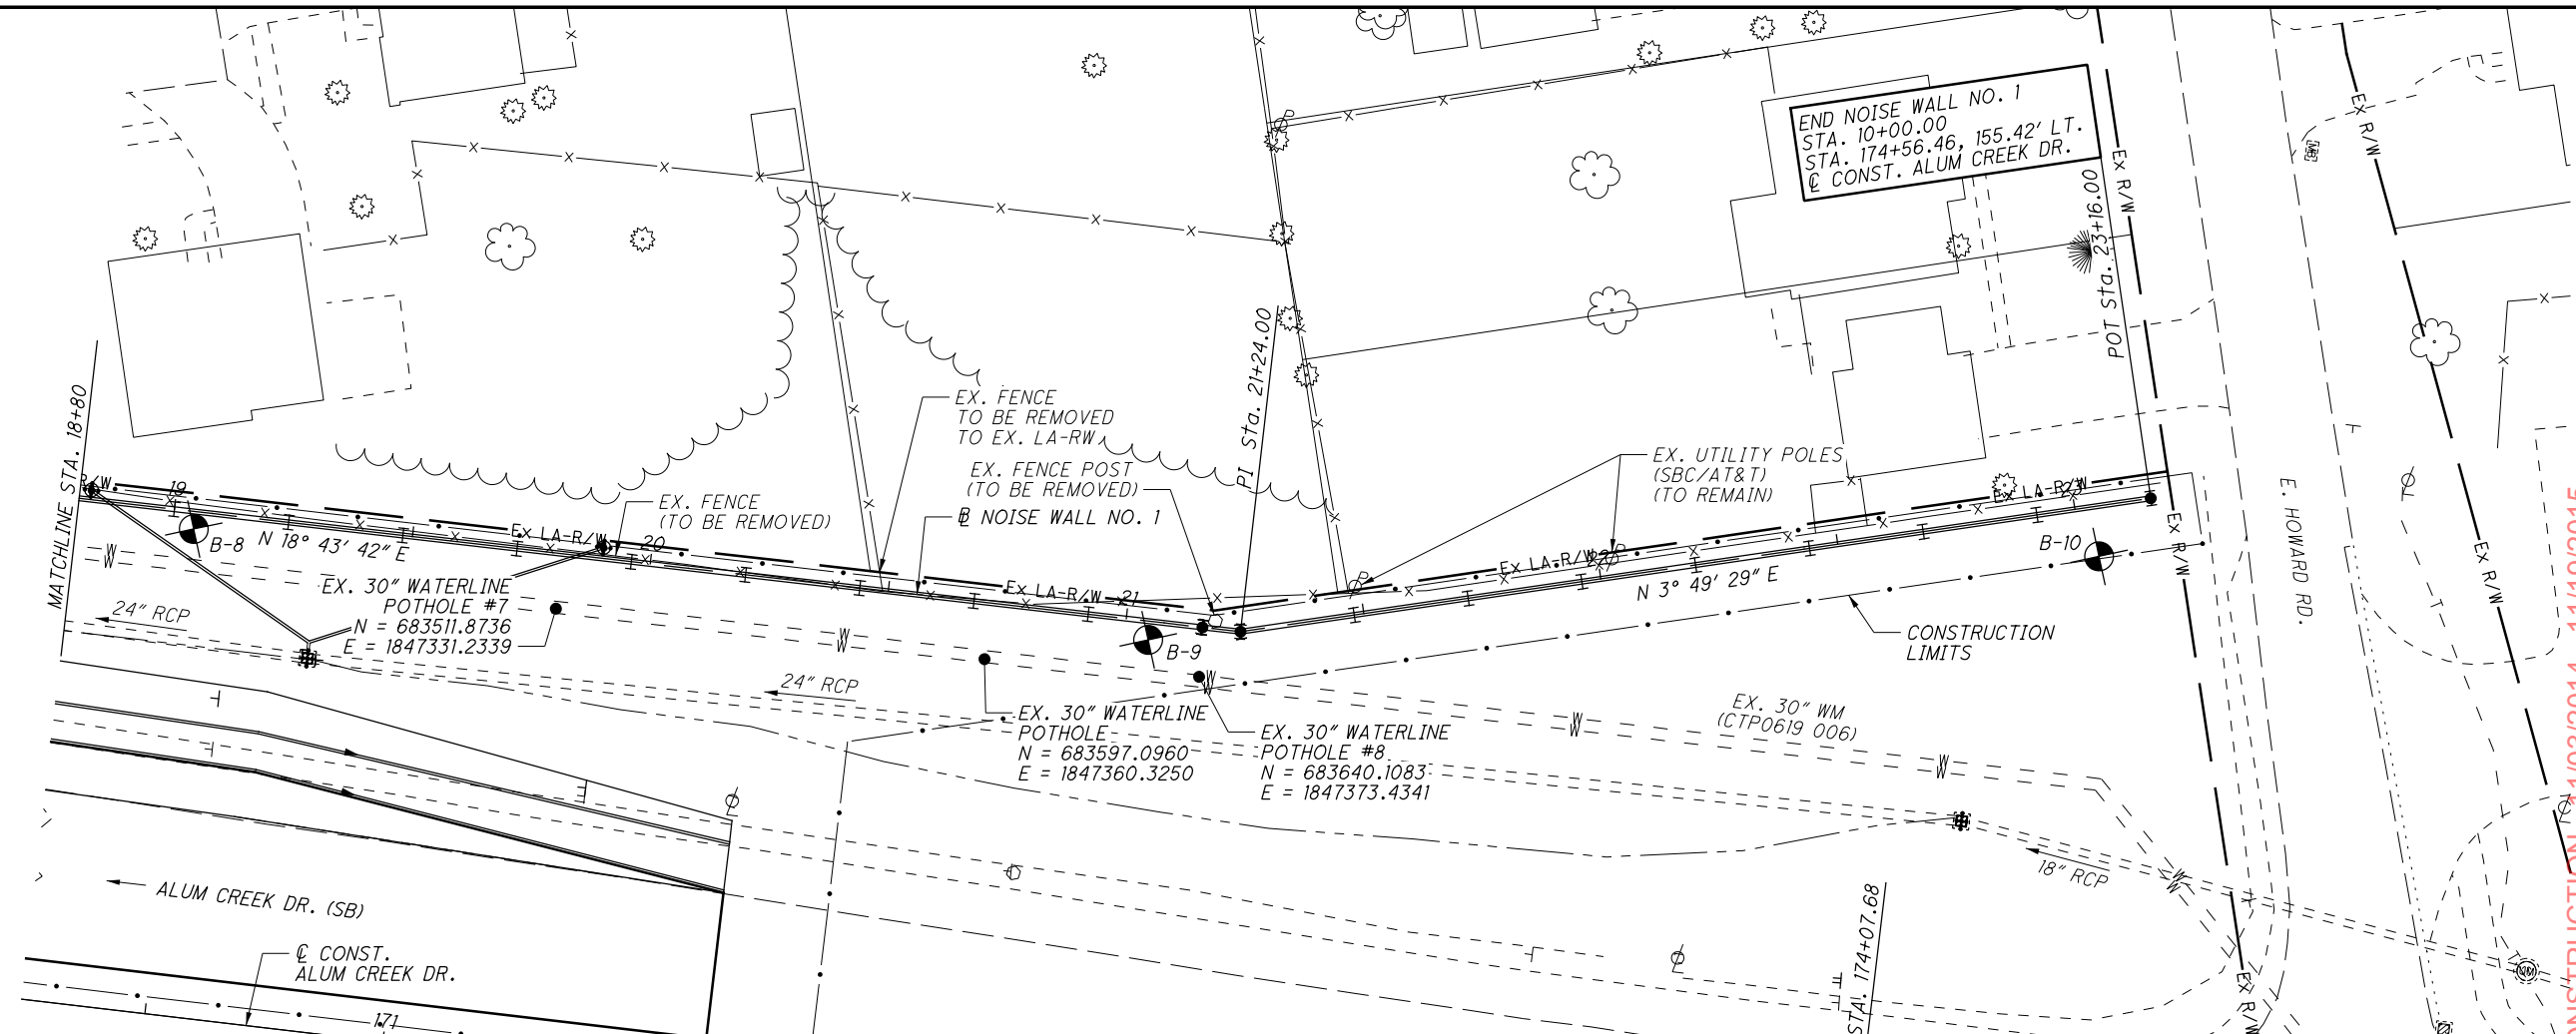

TOP OF WALL ELEV.	ACOUSTIC PROFILE ELEV.	BOTTOM OF WALL ELEV.	PANEL NO.	PROPOSED GRADE ELEV.	EX. GROUND ELEV.
758.50		745.00	40	745.77	745.55
758.50	757.56	745.00	41	745.79	745.59
758.50	757.59	745.00	42	745.82	745.52
758.50	757.52	745.00	43	745.96	745.63
758.50	757.65	745.00	44	746.09	745.99
759.00	758.01	745.50	45	746.76	746.39
759.50	758.41	746.00	46	747.42	746.81
759.50	759.71	746.50	47	747.41	747.14
759.50	759.32	746.50	48	747.39	747.23
759.50	759.24	746.50	49	747.51	747.28
759.50	759.28	746.50	50	747.64	747.49
759.50	759.49	747.00	51	747.65	747.57
760.00	759.57	747.00	52	747.67	747.51
760.00	759.51	747.00	53	747.59	747.51
760.00	759.51	747.00	54	747.52	747.40
760.00	759.41	747.00	55	747.70	747.40
760.00	759.42	747.00	56	747.88	747.40
760.00	759.78	747.00	57	748.11	747.76
760.00	759.78	747.00	58		747.98

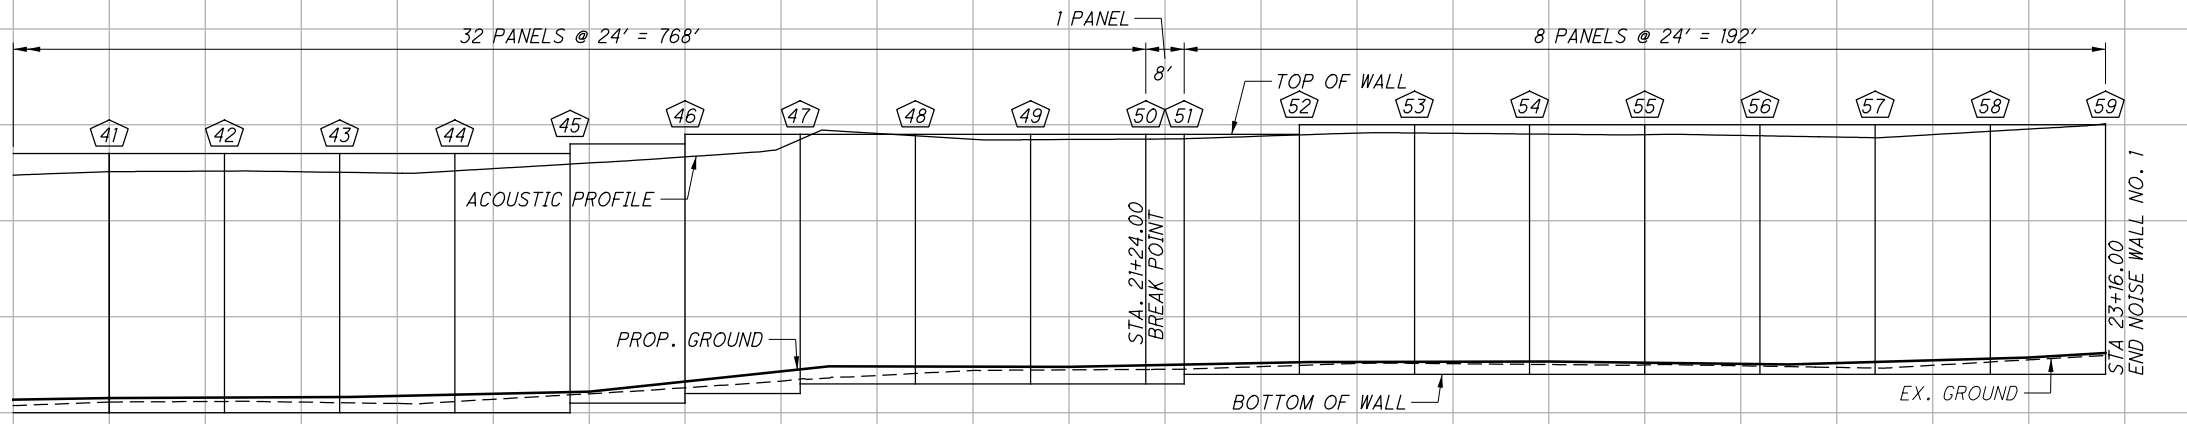

CALCULATED SMJ
CHECKED NCK

PLAN AND PROFILE - NOISE WALL NO. 1
STA. 18+80 TO STA. 23+16

FRA-270-49.00

5 / 10


100
182

BU 4, 5, 6, 7, & 8 - RELEASED FOR CONSTRUCTION - 11/03/2014 - 11/19/2015

AS BUILT - 4/22/2016

C:\projects\2014\W-14-039_FRA-270-49.00\83988\structures\WALL_001\sheets\83988_001X5001.dgn 5/23/2016 7:31:35 AM kevinj

SEEDING	
END WIDTH	SO. YDS.

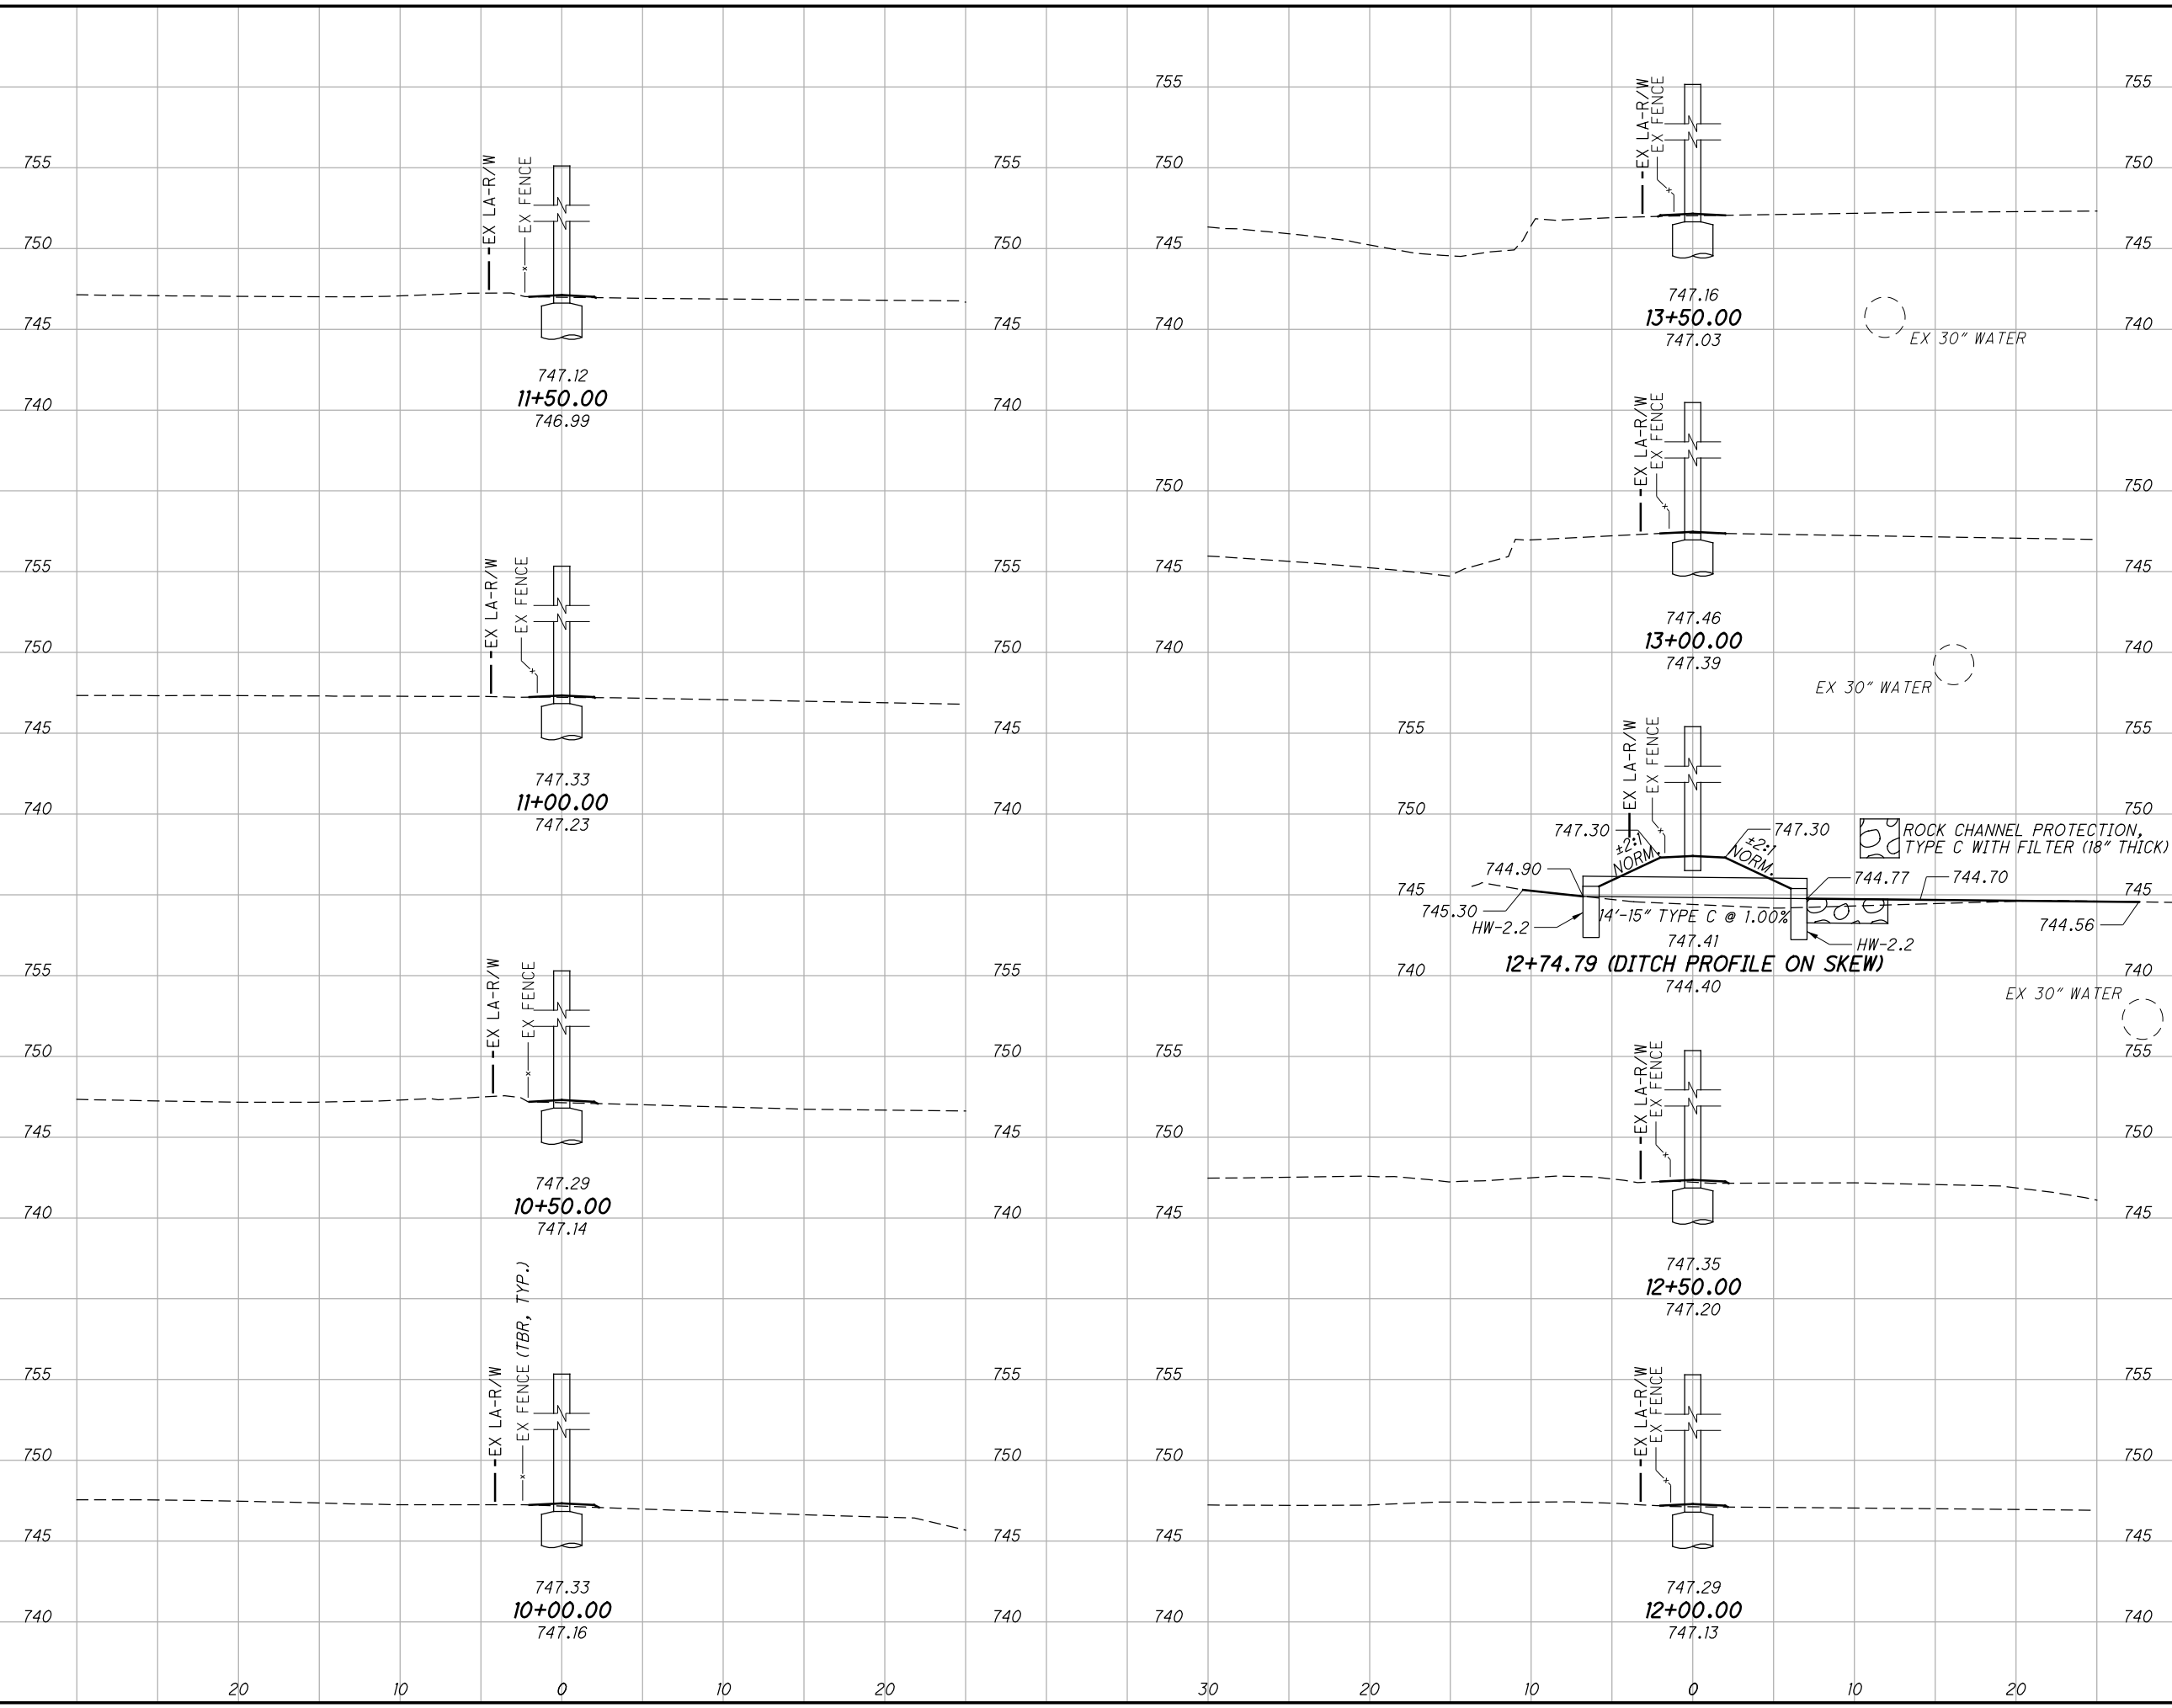

END AREA		VOLUME		CALCULATED	SMJ	CHECKED	NCK
CUT	FILL	CUT	FILL				

BU 4, 5, 6, 7, & 8 - RELEASED FOR CONSTRUCTION - 11/03/2014 - 11/19/2015

CROSS SECTIONS NOISE WALL NO. 1

STA. 10+00.00 TO STA. 13+50.00

FRA - 270 - 49.00


6 / 10

101 / 182

AS BUILT - 4/22/2016

G:\projects\2014\W-14-039_FRA-270-49.00\83988\structures\WALL_001\sheets\83988_001X5001.dgn 5/23/2016 7:31:36 AM kevinj

SEEDING	
END WIDTH	SO. YDS.

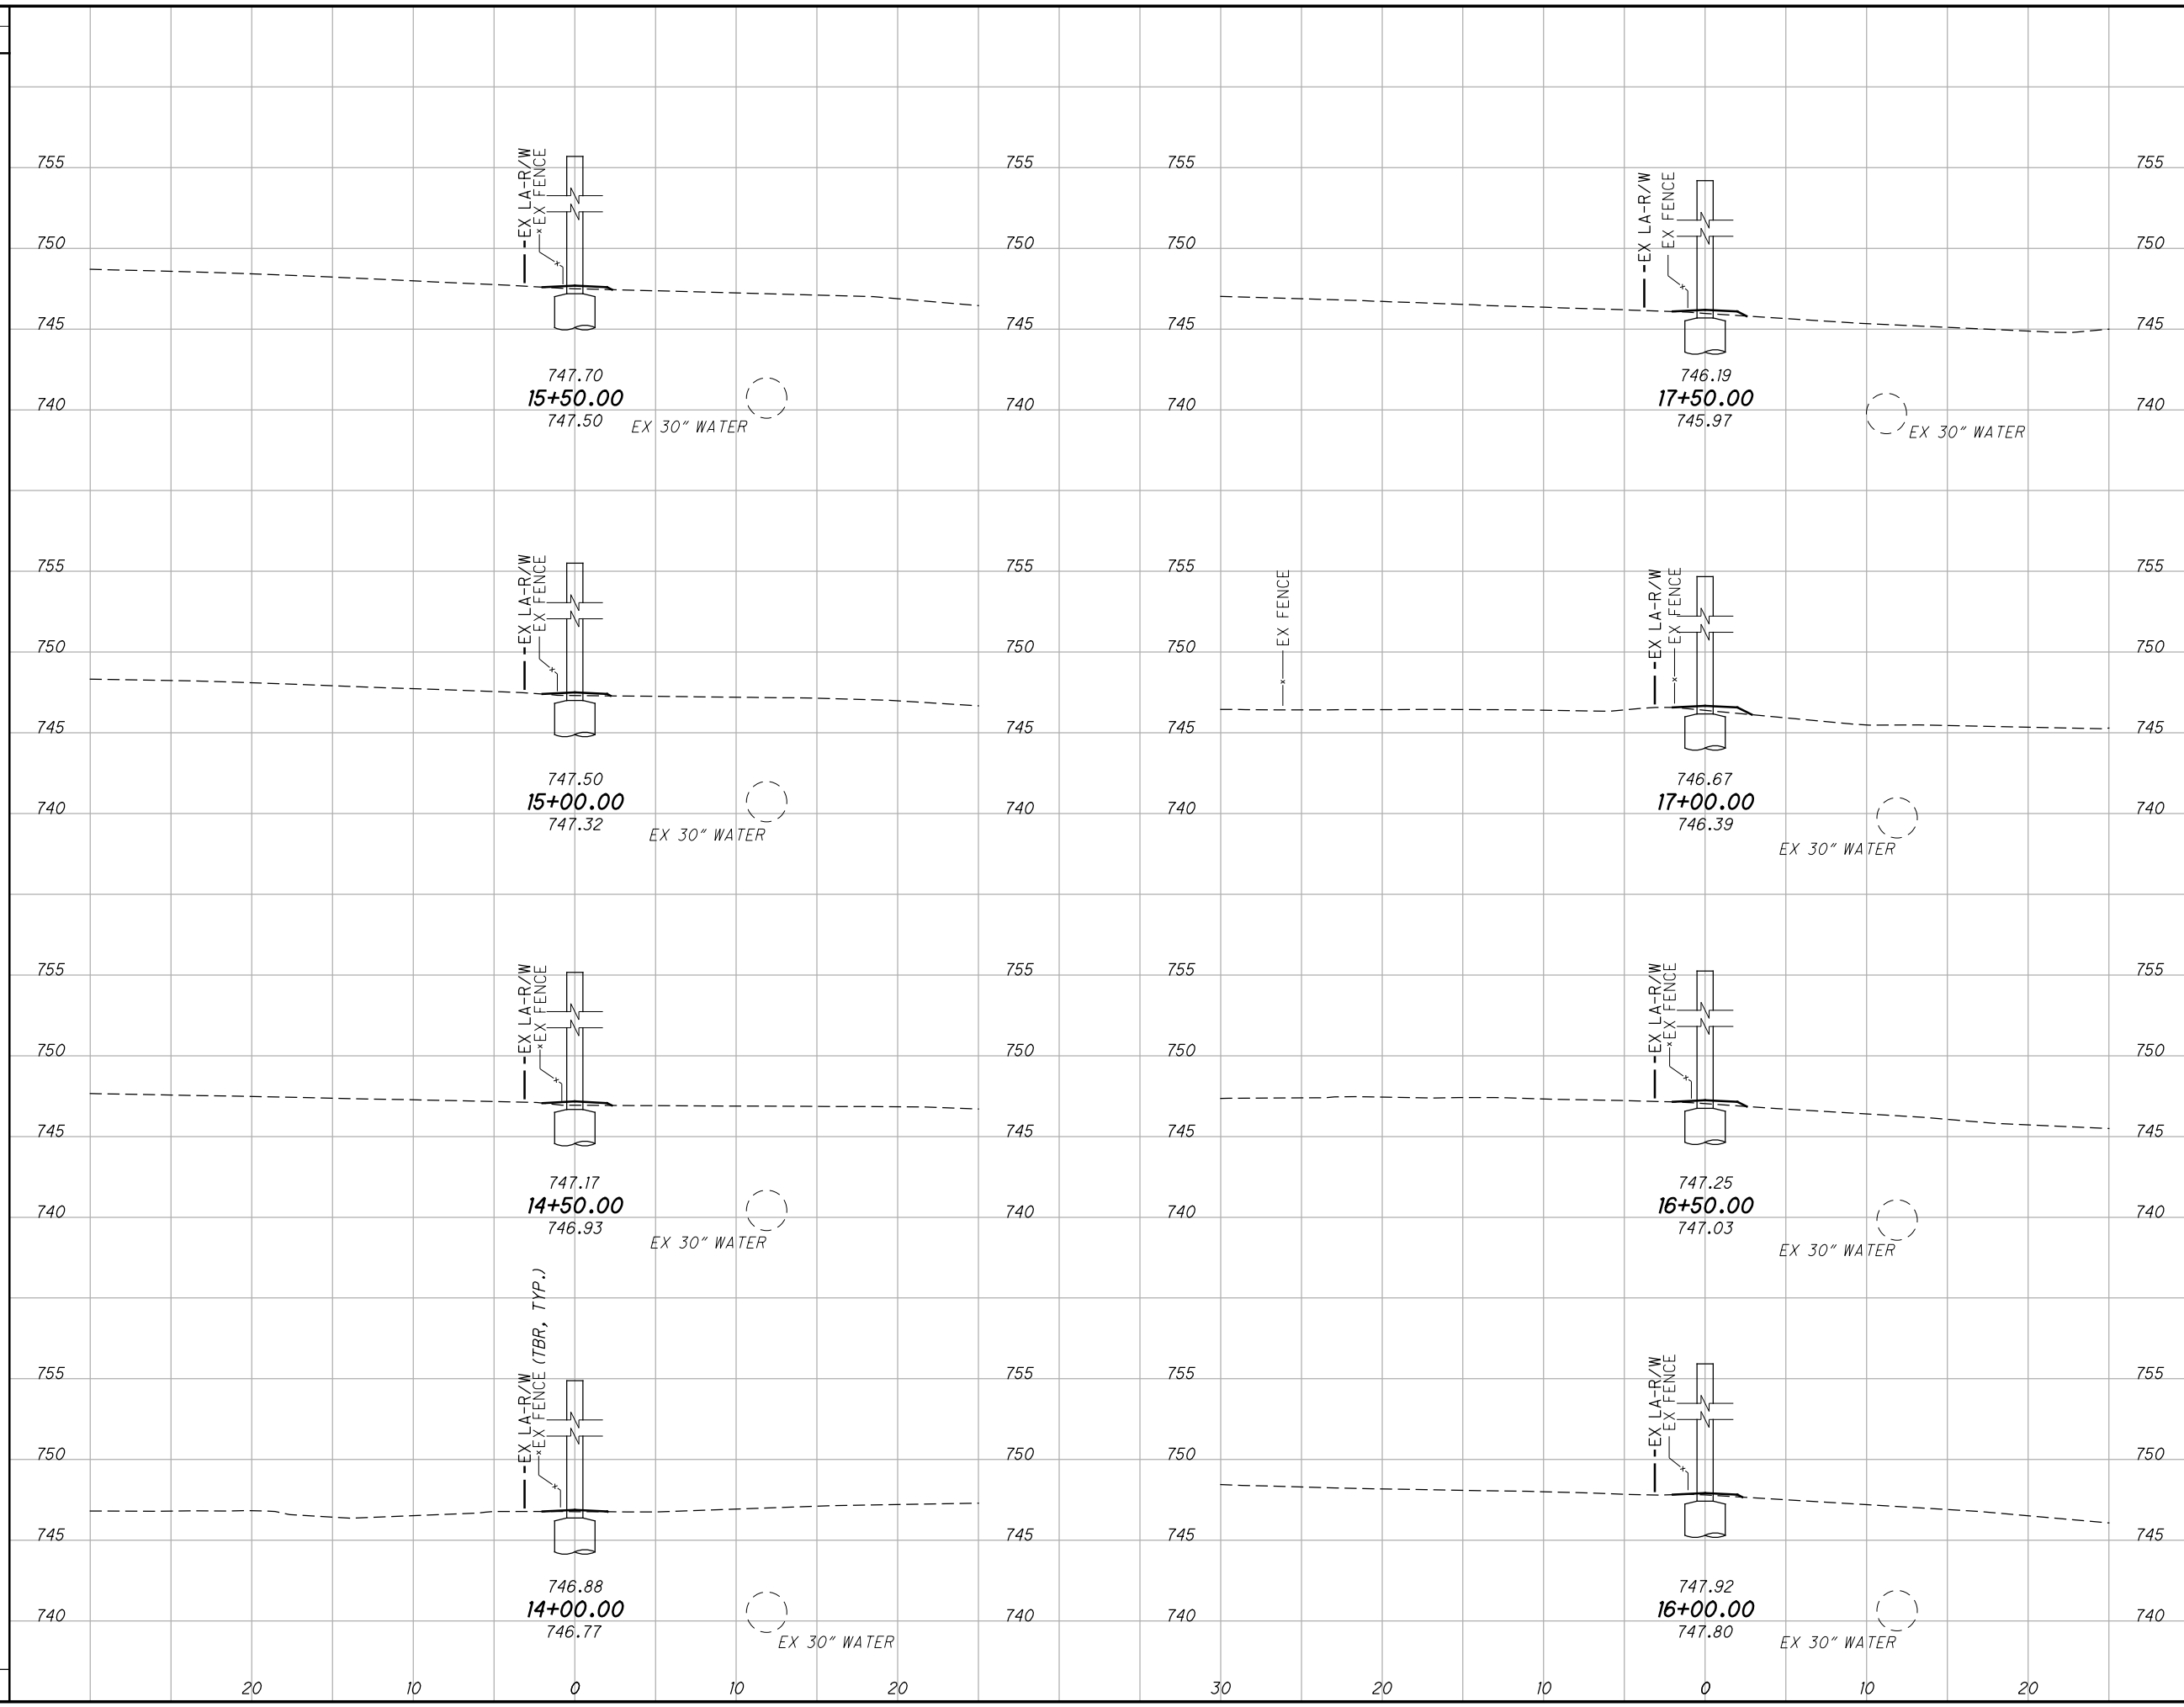

END AREA		VOLUME		CALCULATED	SMJ	CHECKED	NCK
CUT	FILL	CUT	FILL				

BU 4, 5, 6, 7, & 8 - RELEASED FOR CONSTRUCTION - 11/03/2014 - 11/19/2015
CROSS SECTIONS NOISE WALL NO. 1
STA. 14+00.00 TO STA. 17+50.00


FRA - 270 - 49.00

7 / 10
 102
 182

AS BUILT - 4/22/2016

C:\projects\2014\W-14-039_FRA-270-49.00\83988\structures\WALL_001\sheets\83988_001X5001.dgn 5/23/2016 7:31:36 AM kevinj

SEEDING	
END WIDTH	SO. YDS.

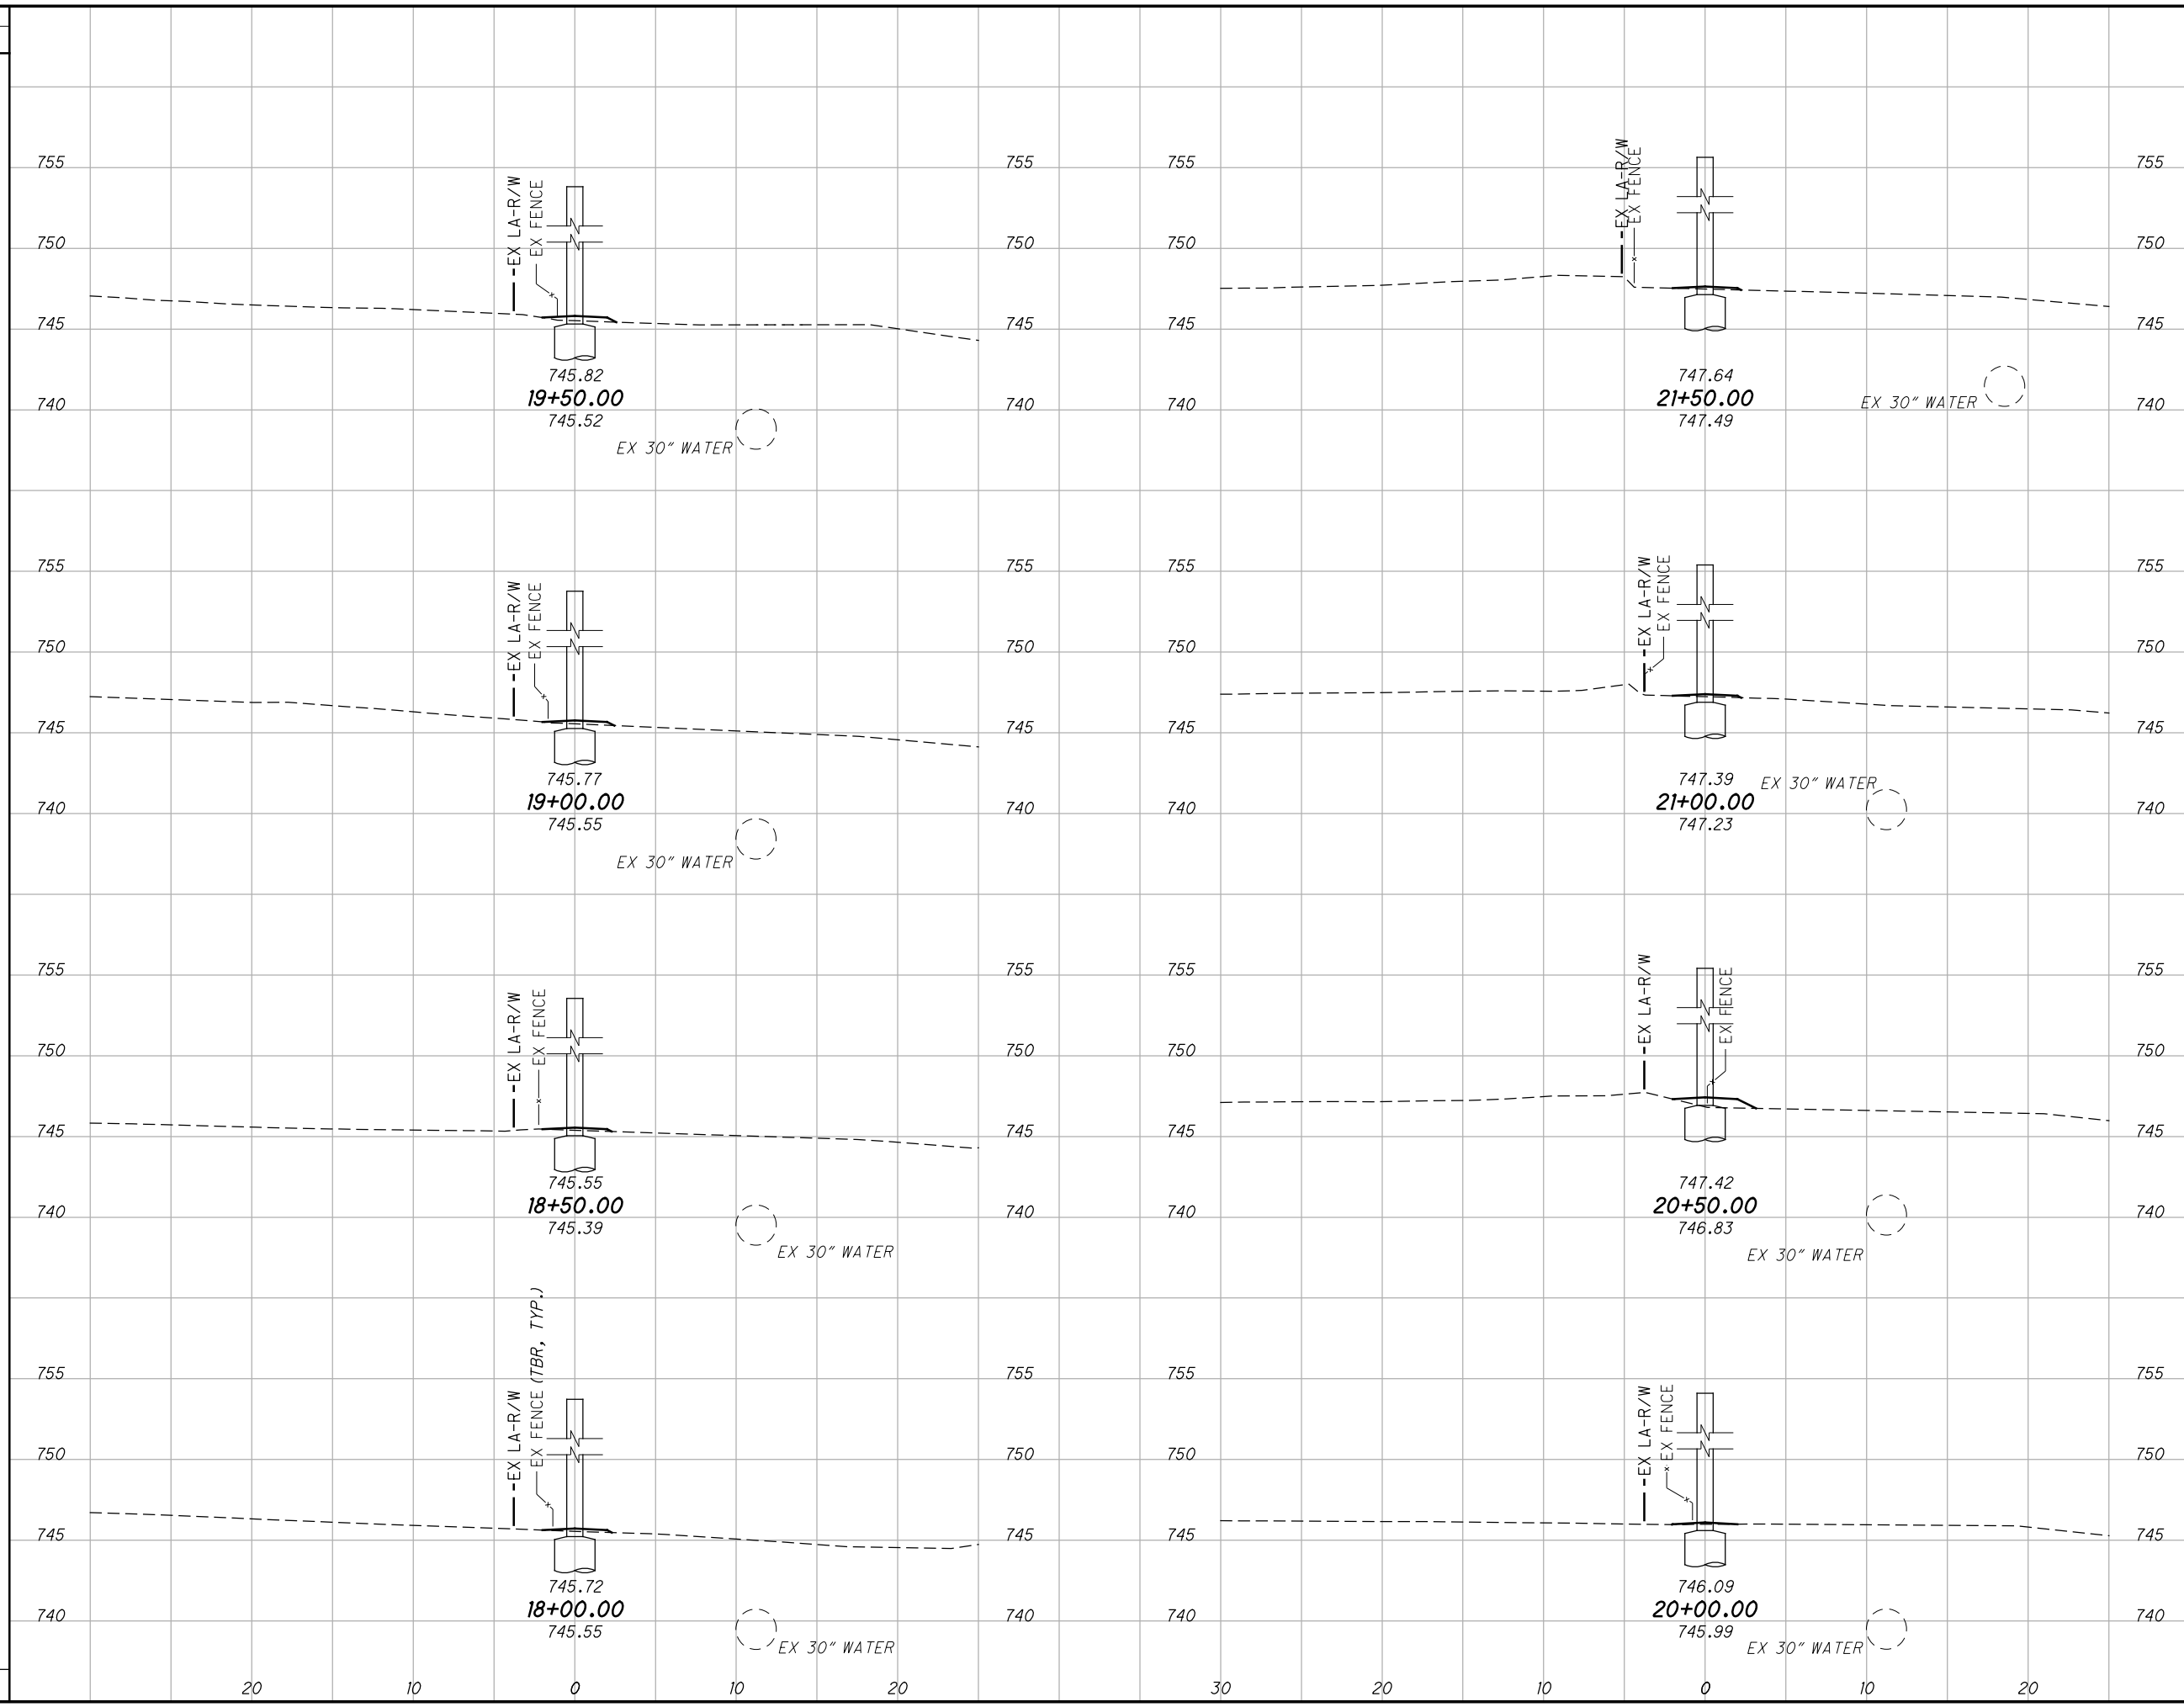

END AREA		VOLUME	
CUT	FILL	CUT	FILL

BU 4, 5, 6, 7, & 8 - RELEASED FOR CONSTRUCTION - 11/03/2014 - 11/19/2015

CROSS SECTIONS NOISE WALL NO. 1
STA. 18+00.00 TO STA. 21+50.00

FRA - 270 - 49.00

8 / 10

103
182


CALCULATED	CHECKED	NCK
SMJ		

AS BUILT - 4/22/2016

5/23/2016 7:31:37 AM kevinj

C:\projects\2014\W-14-039_FRA-270-49.00\83988\structures\WALL_001\sheets\83988_001X5001.dgn

SEEDING	
END WIDTH	SO. YDS.

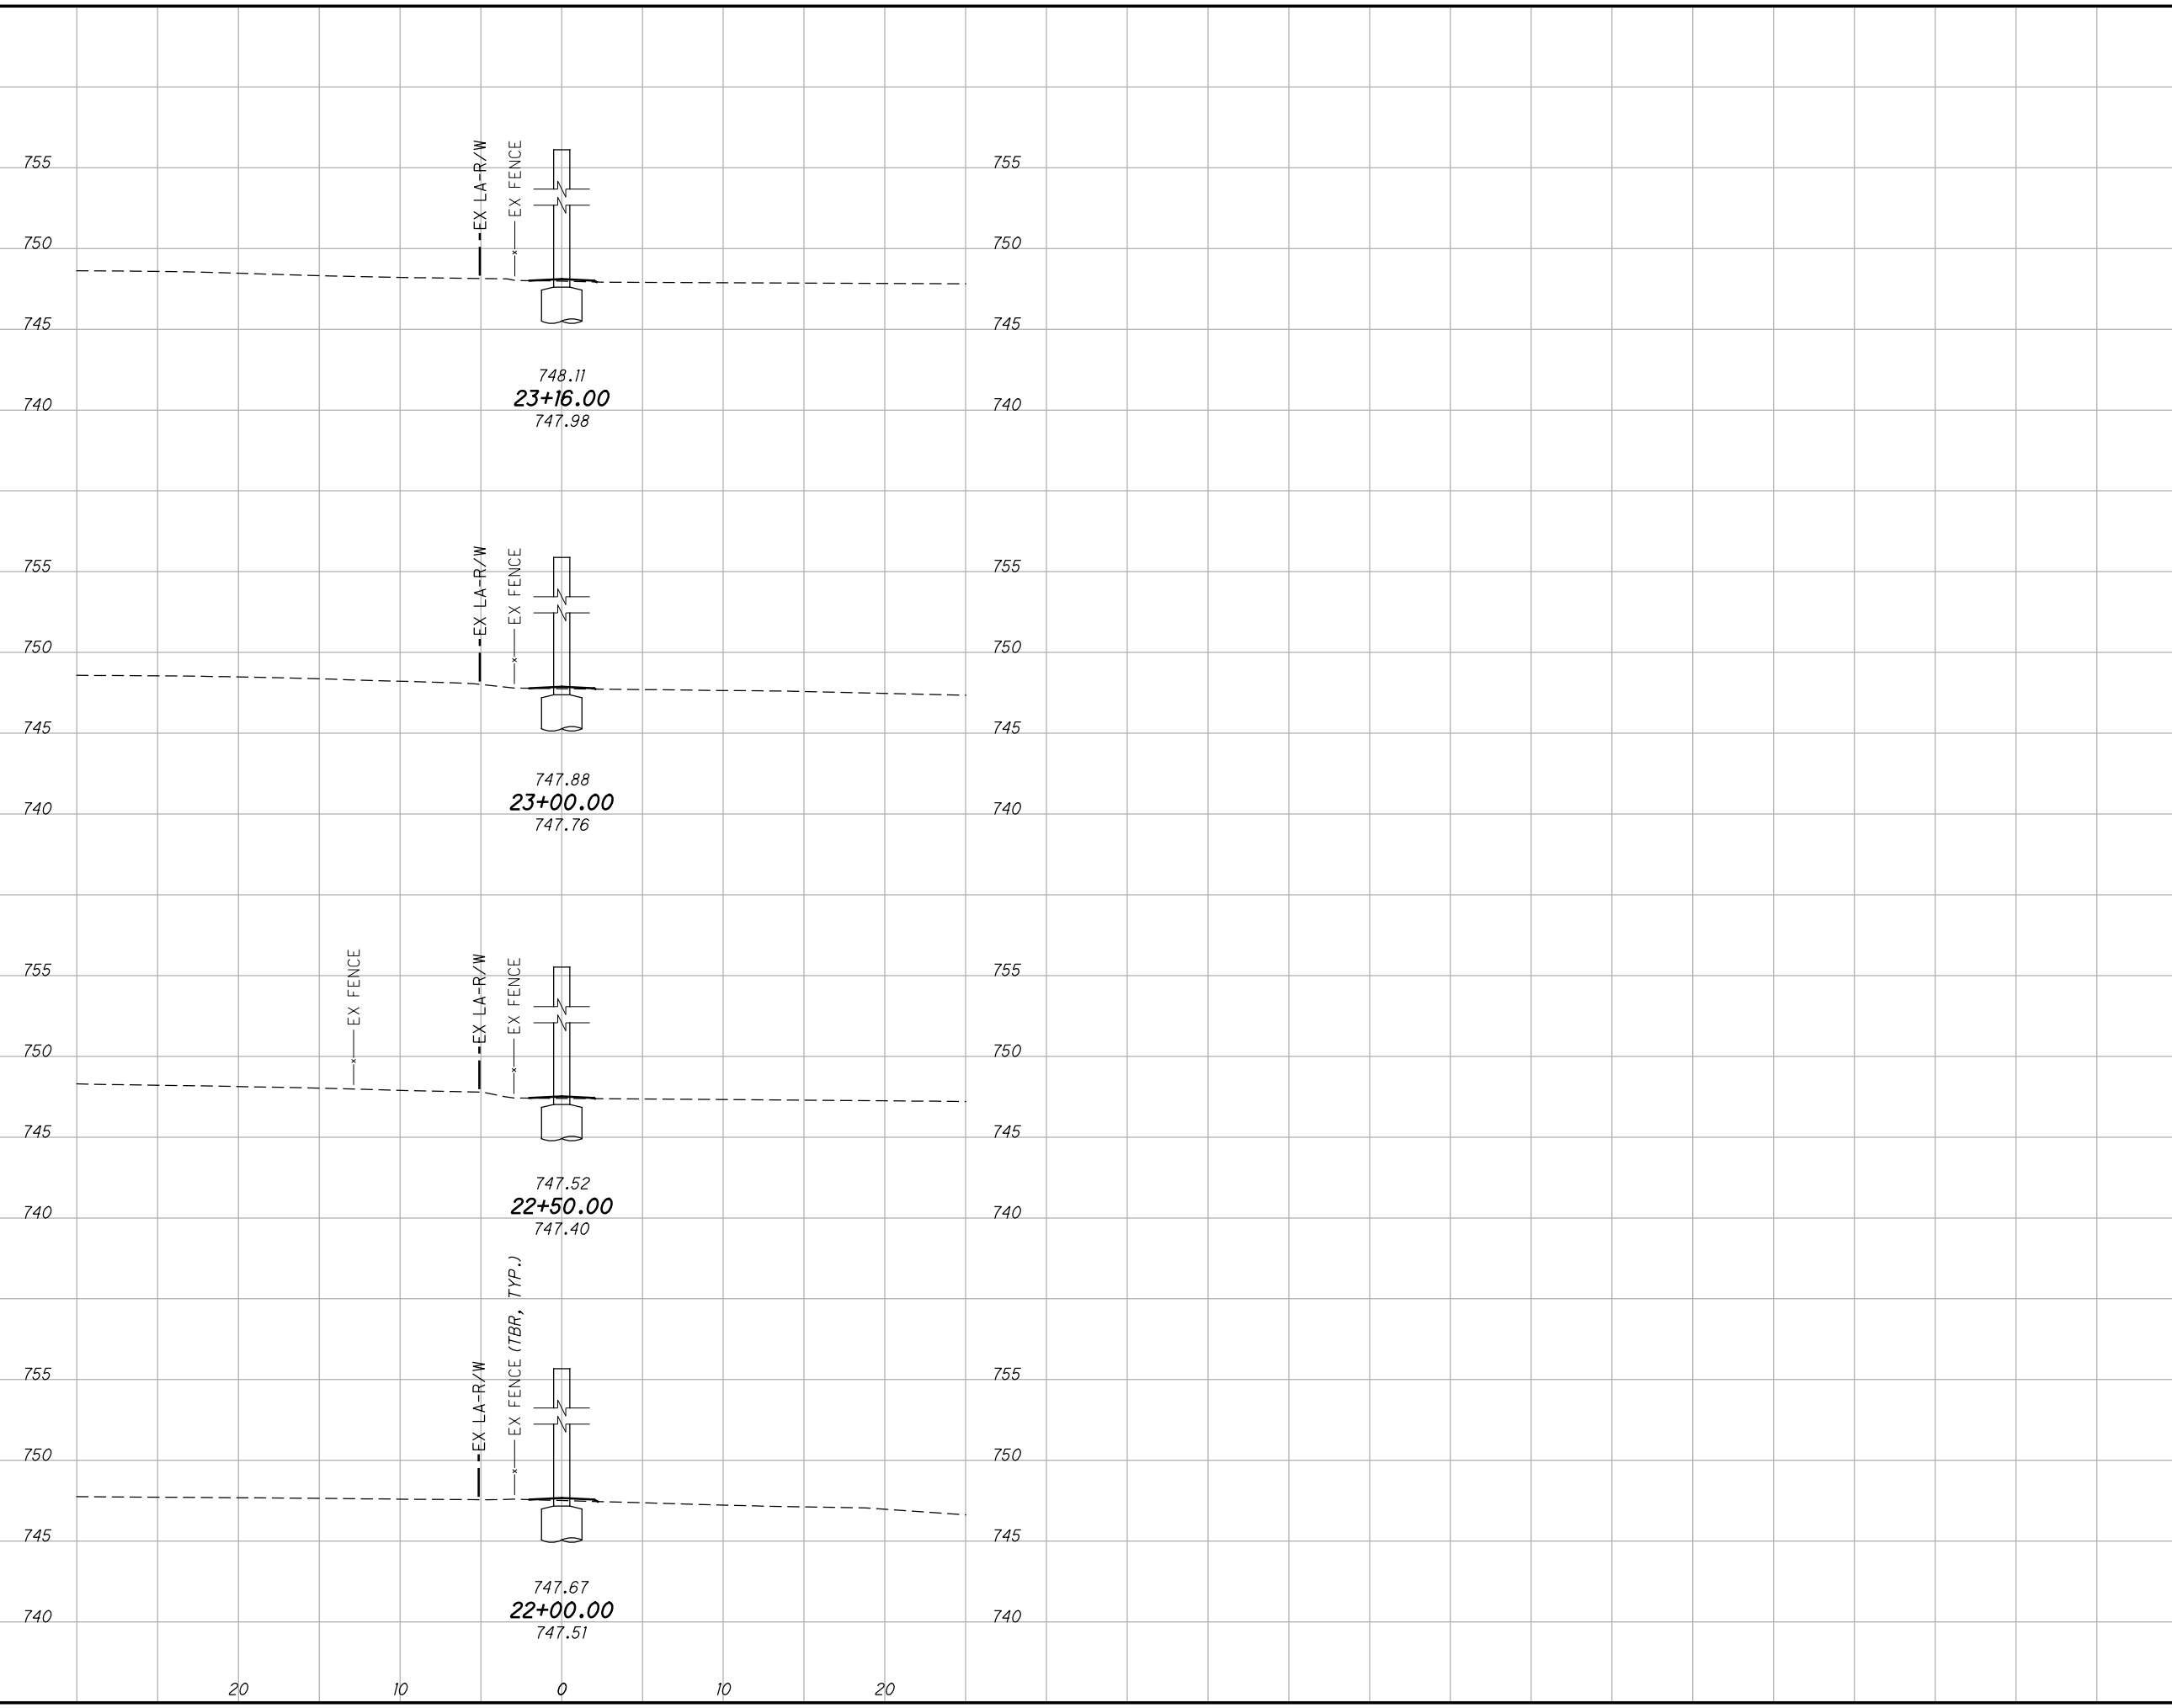


END AREA		VOLUME	
CUT	FILL	CUT	FILL

BU 4, 5, 6, 7, & 8 - RELEASED FOR CONSTRUCTION - 11/03/2014 - 11/19/2015
CROSS SECTIONS NOISE WALL NO. 1
STA. 22+00.00 TO STA. 23+16.00

FRA - 270 - 49.00

NOISE WALL NO. 1			
DRILLED SHAFT NO.	WORKPOINT STATION	TOP OF DRILLED SHAFT ELEVATION	SHAFT LENGTH (FEET)
1	10+00.00	746.26	7.00
2	10+12.00	746.19	7.00
3	10+24.00	746.19	7.00
4	10+48.00	746.19	7.00
5	10+72.00	746.19	7.00
6	10+96.00	746.19	7.00
7	11+20.00	746.19	7.00
8	11+44.00	746.19	7.00
9	11+52.00	746.19	7.00
10	11+68.00	746.19	7.00
11	11+92.00	746.19	7.00
12	12+16.00	746.19	7.00
13	12+40.00	746.19	7.00
14	12+64.00	746.19	10.00
15	12+88.00	746.19	10.00
16	13+12.00	746.19	10.00
17	13+28.00	746.19	10.00
18	13+48.00	746.19	10.00
19	13+72.00	745.69	10.00
20	13+96.00	745.69	10.00
21	14+20.00	745.69	10.00
22	14+44.00	745.69	9.50
23	14+68.00	746.19	9.50
24	14+92.00	746.19	9.50
25	15+16.00	746.19	9.50
26	15+40.00	746.69	9.50
27	15+64.00	746.69	9.50
28	15+88.00	746.69	9.50
29	16+12.00	746.19	9.50
30	16+36.00	746.19	9.50
31	16+60.00	745.69	9.50
32	16+84.00	745.69	9.50
33	17+08.00	745.19	9.50
34	17+32.00	745.19	9.50
35	17+56.00	744.69	9.50
36	17+80.00	744.69	9.50
37	18+04.00	744.69	9.50
38	18+28.00	744.69	9.50
39	18+52.00	744.69	9.50
40	18+76.00	744.69	9.50
41	19+00.00	744.69	9.50
42	19+24.00	744.69	9.50
43	19+48.00	744.69	9.50
44	19+72.00	744.69	9.50
45	19+96.00	744.69	9.50
46	20+20.00	745.19	9.50
47	20+44.00	745.69	9.50
48	20+68.00	745.69	9.50
49	20+92.00	745.69	9.50
50	21+16.00	745.69	9.50
51	21+24.00	746.19	9.50
52	21+48.00	746.69	9.50
53	21+72.00	746.69	9.50
54	21+96.00	746.69	9.50
55	22+20.00	746.69	9.50
56	22+44.00	746.69	9.50
57	22+68.00	746.69	9.50
58	22+92.00	746.69	9.50
59	23+16.00	746.76	9.50


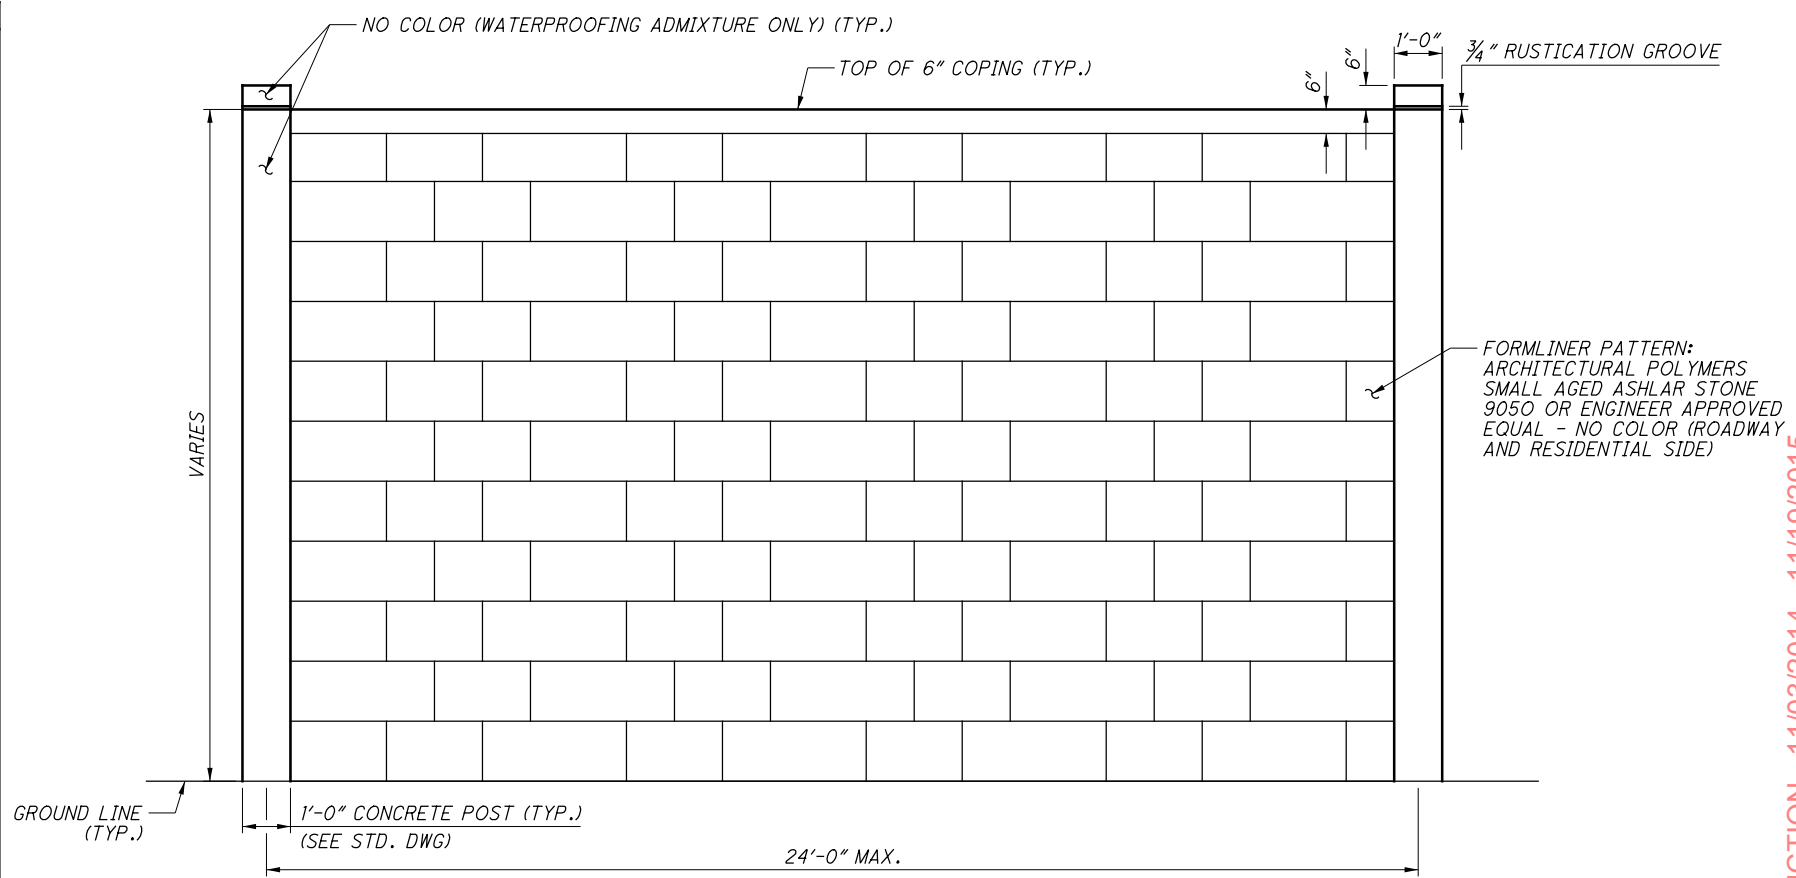


NOISE BARRIER ELEVATION
(ROADWAY AND RESIDENTIAL SIDE)

- NOTES:
1. SEE STANDARDS DRAWING NBS-1-09 FOR ADDITIONAL DETAILS.
 2. THE NOISE WALL SHALL BE REFLECTIVE CONCRETE.
 3. THE POST RUSTICATION GROOVE SHALL MEET THE TOP OF THE HIGHEST ADJACENT PANEL (TOP OF THE PANEL COPING).
 4. THE PANEL CAP SHALL HAVE A 2" OVERHANG AND THE POST CAP SHALL HAVE NO OVERHANG.

ITEM	ITEM EXT.	QUANTITY	UNIT	DESCRIPTION
606	10200	169	S.F.	SPECIAL - NOISE BARRIER (REFLECTIVE), 10' HEIGHT AND UNDER
606	10210	16940	S.F.	SPECIAL - NOISE BARRIER (REFLECTIVE), OVER 10' TO 14' HEIGHT

<p>RAMP T CURVE NO 5 P.I. STA. 694+70.26 $\Delta = 29^\circ 34' 04''$ (LT) $D_c = 4^\circ 03' 48''$ $R = 1,410.03'$ $T = 372.12'$ $L = 727.65'$ $E = 48.28'$ $e_{max} = 0.052$</p>	<p>RAMP T CURVE NO 6 P.I. Sta. 702+86.60 $\Delta = 19^\circ 21' 14''$ (LT) $D_c = 3^\circ 30' 00''$ $R = 1,637.02'$ $T = 279.14'$ $L = 552.97'$ $E = 23.63'$ $e_{max} = 0.048$</p>
--	--

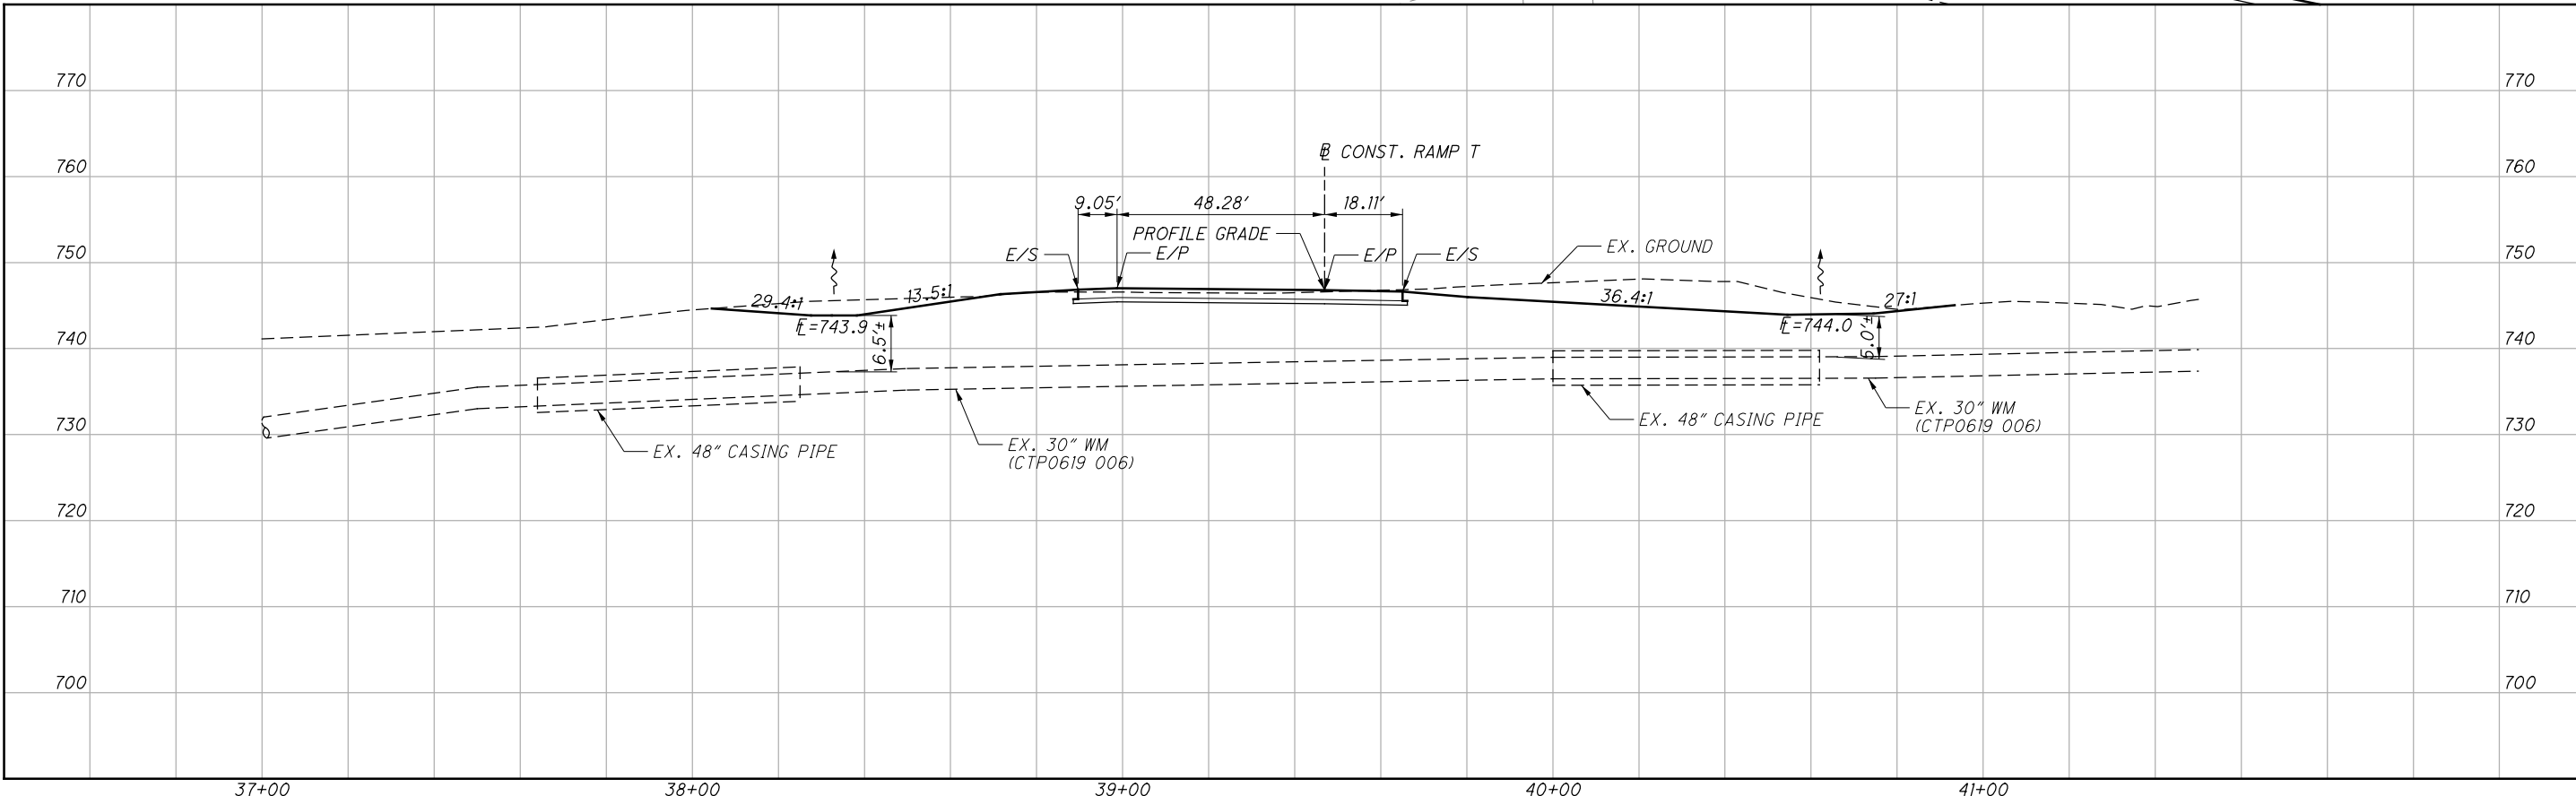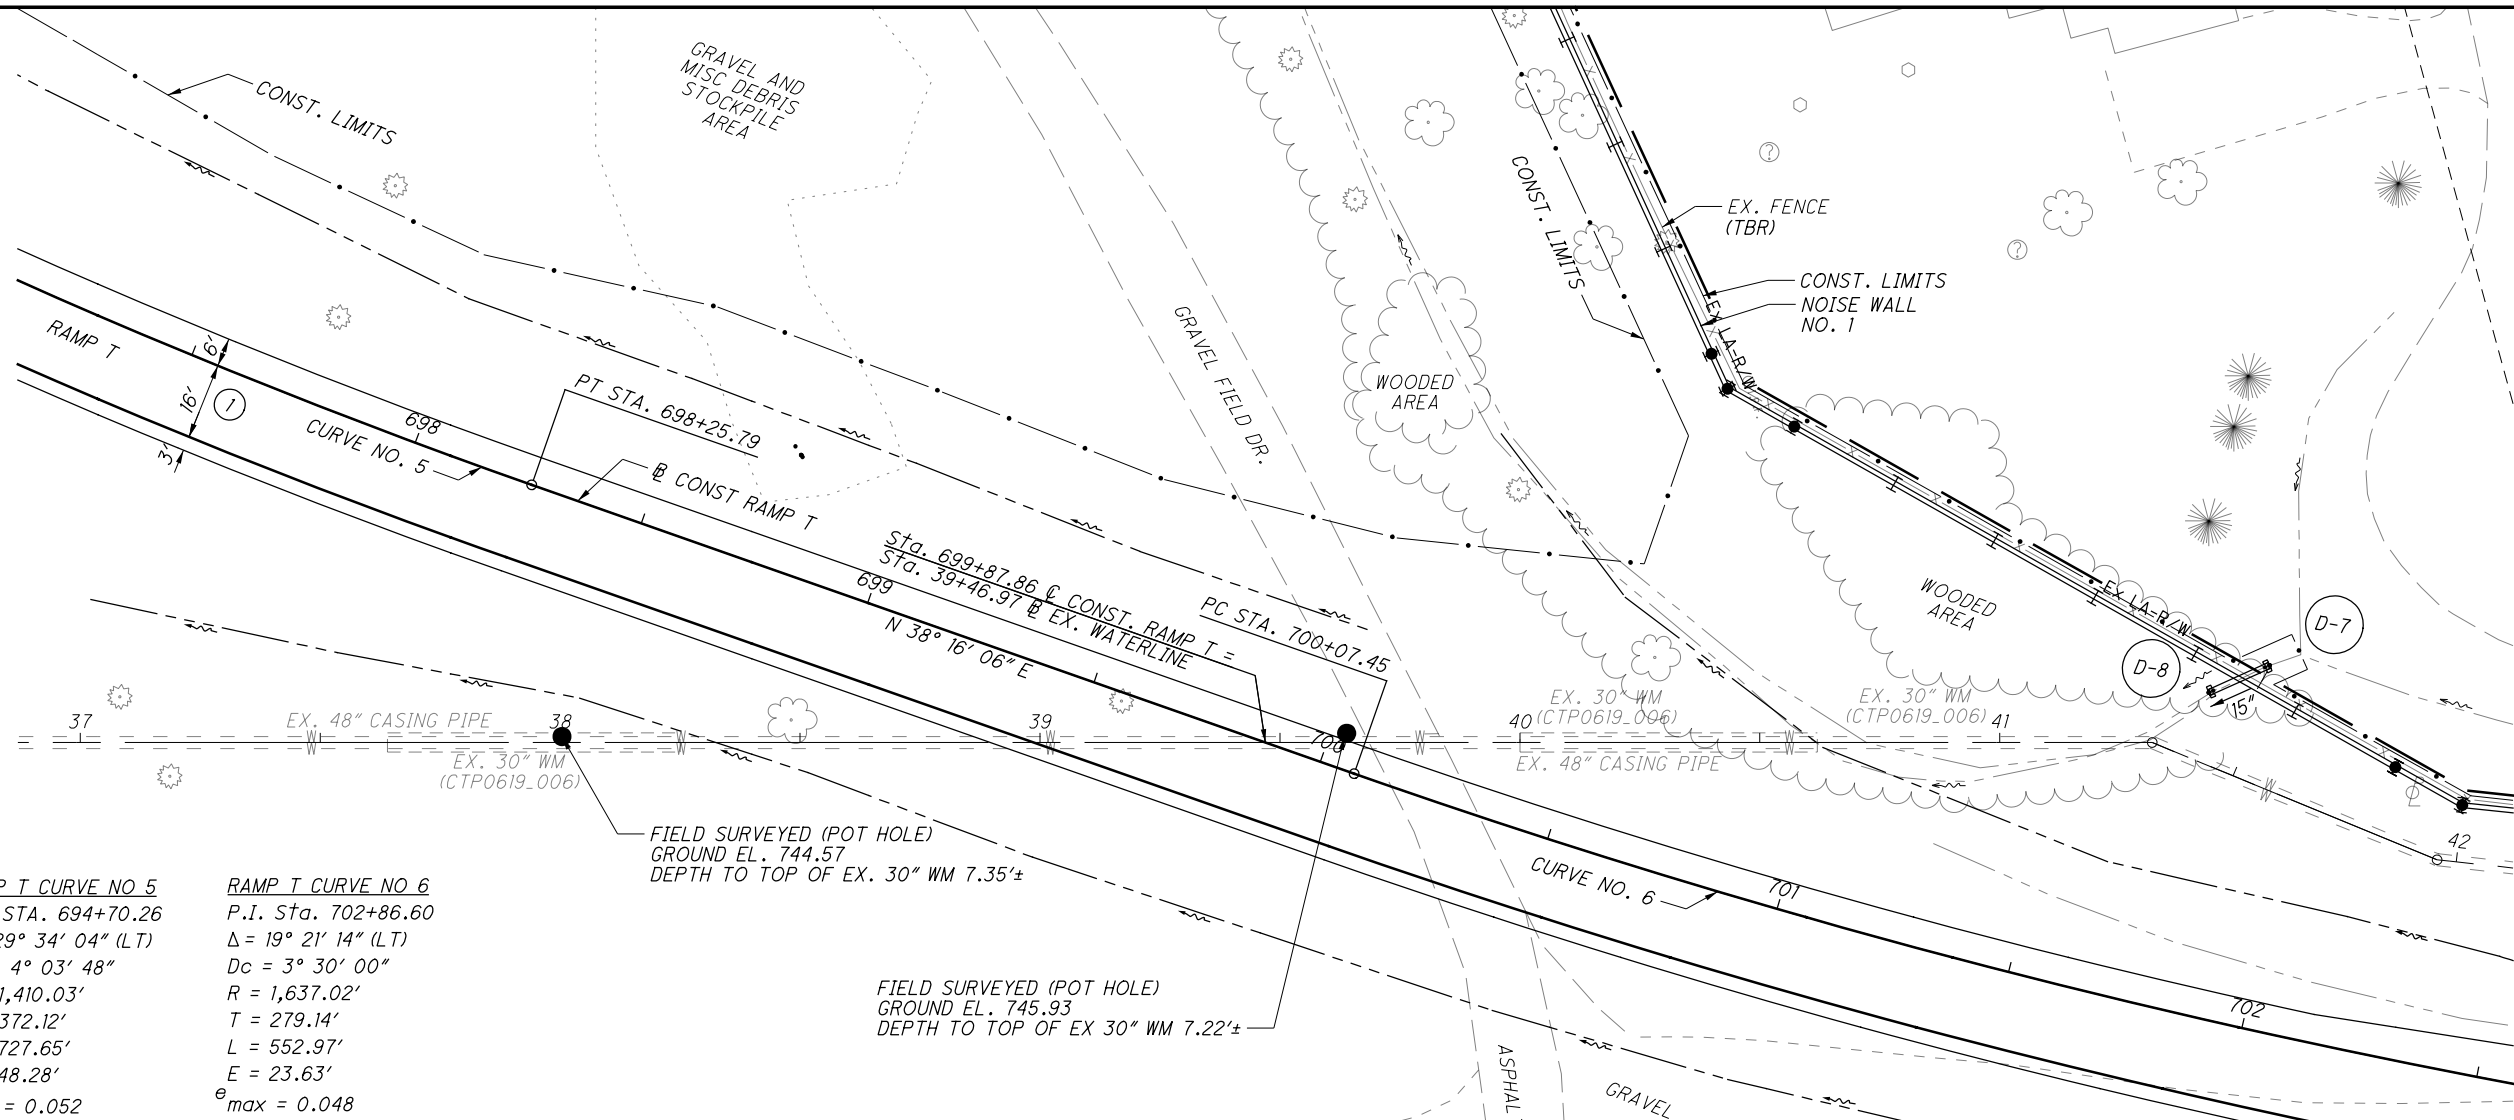

BU 4, 5, 6, 7, & 8 - RELEASED FOR CONSTRUCTION - 11/03/2014 - 11/19/2015



CALCULATED: CFR
 CHECKED: SSK
EX. WATER MAIN PLAN AND PROFILE - RAMP T
STA. 37+00 TO STA. 41+31.78

FRA - 270 - 49.00
 106
 182

AS BUILT - 4/22/2016

G:\projects\2014\W-14-039 FRA-270-49.00\83988\traffic control\sheets\83988T5003.dgn 5/23/2016 7:31:40 AM key:nj

LOCATION	STATION TO STATION		620		621		644													646				
			DELINEATOR POST MOUNTED, AS PER PLAN	RAISED PAVEMENT MARKERS	LANE LINE, 6"	LANE LINE, 4"	EDGE LINE, 6"	EDGE LINE, 4"	CENTERLINE, 4" DOUBLE SOLID	DOTTED LINE, 6"	STOP LINE, 24"	STOP LINE, 12"	CHANNELIZING LINE, 12"	CHANNELIZING LINE, 8"	TRANSVERSE LINE, 24"	TRANSVERSE LINE, 12"	LANE ARROW	LANE LINE, 4"	EDGE LINE, 4"	CHANNELIZING LINE, 8"	LANE ARROW			
			EACH	EACH	MILE	MILE	MILE	MILE	MILE	FT	FT	FT	FT	FT	FT	FT	FT	EACH	MILE	MILE	FT	EACH		
ALUM CREEK DRIVE	149+02	151+81																						
ALUM CREEK DRIVE	149+02	151+12					0.05																	
ALUM CREEK DRIVE	149+02	151+12				0.04																		
ALUM CREEK DRIVE	151+12	151+81				0.04						75												
ALUM CREEK DRIVE	152+21	152+87										102												
ALUM CREEK DRIVE	152+89														48									
ALUM CREEK DRIVE	152+89	154+52					0.03																	
ALUM CREEK DRIVE	152+89	154+60				0.03																		
ALUM CREEK DRIVE	152+89	154+67				0.03																		
ALUM CREEK DRIVE	152+89	154+84					0.04																	
ALUM CREEK DRIVE	152+89	154+75											186		2									
ALUM CREEK DRIVE	154+52	158+81															0.08							
ALUM CREEK DRIVE	154+60	158+89															0.08							
ALUM CREEK DRIVE	154+67	158+97															0.08							
ALUM CREEK DRIVE	154+75	159+05																430	3					
ALUM CREEK DRIVE	154+84	159+13															0.08							
ALUM CREEK DRIVE	158+81	164+88					0.11																	
ALUM CREEK DRIVE	158+89	164+88					0.11																	
ALUM CREEK DRIVE	158+97	165+34				0.11																		
ALUM CREEK DRIVE	158+97	165+34				0.12																		
ALUM CREEK DRIVE	159+05	159+22												17										
ALUM CREEK DRIVE	159+13	165+59					0.12																	
ALUM CREEK DRIVE	164+88	166+70												182	87									
ALUM CREEK DRIVE	164+88	168+46	12										358											
ALUM CREEK DRIVE	165+34	166+00										102												
ALUM CREEK DRIVE	166+36	172+90						0.12							277									
ALUM CREEK DRIVE	166+36	172+90				0.12																		
ALUM CREEK DRIVE	166+43													26										
ALUM CREEK DRIVE	168+46	171+67										102												
IR 270	667+26	709+25					0.80																	
IR 270	667+26	712+25		38	0.85																			
IR 270	667+26	712+25		38	0.85																			
IR 270	667+26	686+45					0.36																	
IR 270	673+95	682+95										102												
IR 270	682+95	686+45																						
IR 270	682+95	687+48												350										
IR 270	682+95	687+48												453										
IR 270	687+48	700+01					0.24																	
IR 270	687+48	700+01										1253												
IR 270	700+01	704+43																						
IR 270	704+43	709+25					0.09																	
RAMP T	686+45	687+48																						
RAMP T	686+45	705+60					0.36							103										
RAMP T	686+45	702+65					0.31																	
RAMP W	688+60	695+18					0.12																	
RAMP W	688+60	695+18					0.12																	
RAMP W	689+60	695+18																						
RAMP W	689+60	695+18												558										
RAMP W	689+60	695+18												558										
RAMP W	693+03	695+18												215	28	8								
RAMP W	695+18											75												
RAMP X	702+50	708+02					0.10																	
RAMP X	702+50																							
RAMP X	702+50	707+53																						
RAMP X	702+50	707+53												503		12								
RAMP X	702+50	706+12					0.07							503										
RAMP Y	700+01	704+34																						
RAMP Y	700+01	707+12												433										
RAMP Y	709+38	710+53					0.13																	
RAMP Y							0.02																	
TOTALS CARRIED TO GENERAL SUMMARY			12	77	2	1	3	0.36	0.12	1736	118	74	4118	743	28	364	22	0.16	0.16	430	3			

BU 4, 5, 6, 7, & 8 - RELEASED FOR CONSTRUCTION - 11/03/2014 - 11/19/2015

CALCULATED JLM CHECKED SSK

PAVEMENT MARKING SUBSUMMARY

FRA - 270 - 49.00

107 182

AS BUILT - 4/22/2016


G:\projects\2014\W-14-039_FRA-270-49.00\83988\traffic control\sheets\83988TS001.dgn 6/9/2016 12:47:44 PM colnr

REF. NO.	STATION	SIDE	SHEET NO.	SIGN FLATSHEET																		EXTRUSHEET						625	630						
				D1-H1-48	I5-30	I-H25a	M1-3-24	M1-3-36	M3-1-24	M3-4-36	M6-1-21	R2-1-30	R2-1-48	R3-H8cb	R3-H8cc	R3-H8dp AS PER PLAN	R5-1-48	R5-1a-42	R7-1	W3-3-48	D3-H3a	D3-H5	E "8' X 5"	E "12' X 6"	E "11.5' X 6"	GROUND ROD	SIGN, FLAT SHEET	SIGN GROUND MOUNTED EXTRUSHEET	SIGN, OVERHEAD EXTRUSHEET	REMOVAL OF GROUND MOUNTED SIGNS AND DISPOSAL	REMOVAL OF GROUND MOUNTED POST SUPPORT AND DISPOSAL	REMOVAL OF GROUND MOUNTED STRUCTURAL BEAM SUPPORT AND DISPOSAL	REMOVAL OF OVERHEAD MOUNTED SIGN AND DISPOSAL	REMOVAL OF OVERHEAD SIGN SUPPORT AND DISPOSAL	REMOVAL OF GROUND MOUNTED MAJOR SIGN AND DISPOSAL
S-1	150+51	LT	110																					EACH	SQ FT	SQ FT	SQ FT	EACH	EACH	EACH	EACH	EACH	EACH		
S-2	158+65	LT	110			1																			SQ FT	SQ FT	SQ FT								
S-3	159+19	LT	110																			1				SQ FT	SQ FT	SQ FT							
S-4	160+11	LT	110																							SQ FT	SQ FT	SQ FT							
S-5	162+29	LT	110																							SQ FT	SQ FT	SQ FT							
S-6	704+47	LT	110																							SQ FT	SQ FT	SQ FT							
S-7	705+09	LT	110																							SQ FT	SQ FT	SQ FT							
S-8	168+75	LT	110																							SQ FT	SQ FT	SQ FT							
S-9	170+57	LT	111																							SQ FT	SQ FT	SQ FT							
S-10	171+36	LT	111																							SQ FT	SQ FT	SQ FT							
S-11	674+48	LT	112																							SQ FT	SQ FT	SQ FT							
S-12	682+90	LT	112																							SQ FT	SQ FT	SQ FT							
S-13	693+46	LT.	115																							SQ FT	SQ FT	SQ FT							
S-14	695+22	LT.	115																							SQ FT	SQ FT	SQ FT							
S-14A	151+85	RT	115																							SQ FT	SQ FT	SQ FT							
S-15	689+12	RT.	115																							SQ FT	SQ FT	SQ FT							
S-16	689+19	RT.	115																							SQ FT	SQ FT	SQ FT							
S-17	690+42	RT.	115																							SQ FT	SQ FT	SQ FT							
S-18	691+80	RT.	115																							SQ FT	SQ FT	SQ FT							
S-19	691+80	LT.	115																							SQ FT	SQ FT	SQ FT							
S-20	693+35	RT.	115																							SQ FT	SQ FT	SQ FT							
S-21	693+43	RT.	115																							SQ FT	SQ FT	SQ FT							
S-22	706+63	LT.	115																							SQ FT	SQ FT	SQ FT							
S-23	706+96	LT.	115																							SQ FT	SQ FT	SQ FT							
S-24	702+30	RT.	115																							SQ FT	SQ FT	SQ FT							
S-25	702+40	LT.	115																							SQ FT	SQ FT	SQ FT							
S-26	703+00	RT.	115																							SQ FT	SQ FT	SQ FT							
S-27	710+80	LT	115																							SQ FT	SQ FT	SQ FT							
S-28	710+83	RT	115																							SQ FT	SQ FT	SQ FT							
S-29	174+00	LT	111																							SQ FT	SQ FT	SQ FT							
S-30	702+67	RT	113																							SQ FT	SQ FT	SQ FT							
TOTAL				1	2	1	1	1	1	1	2	2	1	2	1	3	2	5	3	1	4	2	1	1	1	1	221	252	69	30	34	7	1	1	5

BU 4, 5, 6, 7, & 8 - RELEASED FOR CONSTRUCTION - 1/03/2014 + 11/19/2015

1	DATE	DESCRIPTION
	6/8/16	AS BUILT

CALCULATED	JLM
CHECKED	SSK
SIGNING SUBSUMMARY	
FRA - 270-49.00	
108	182

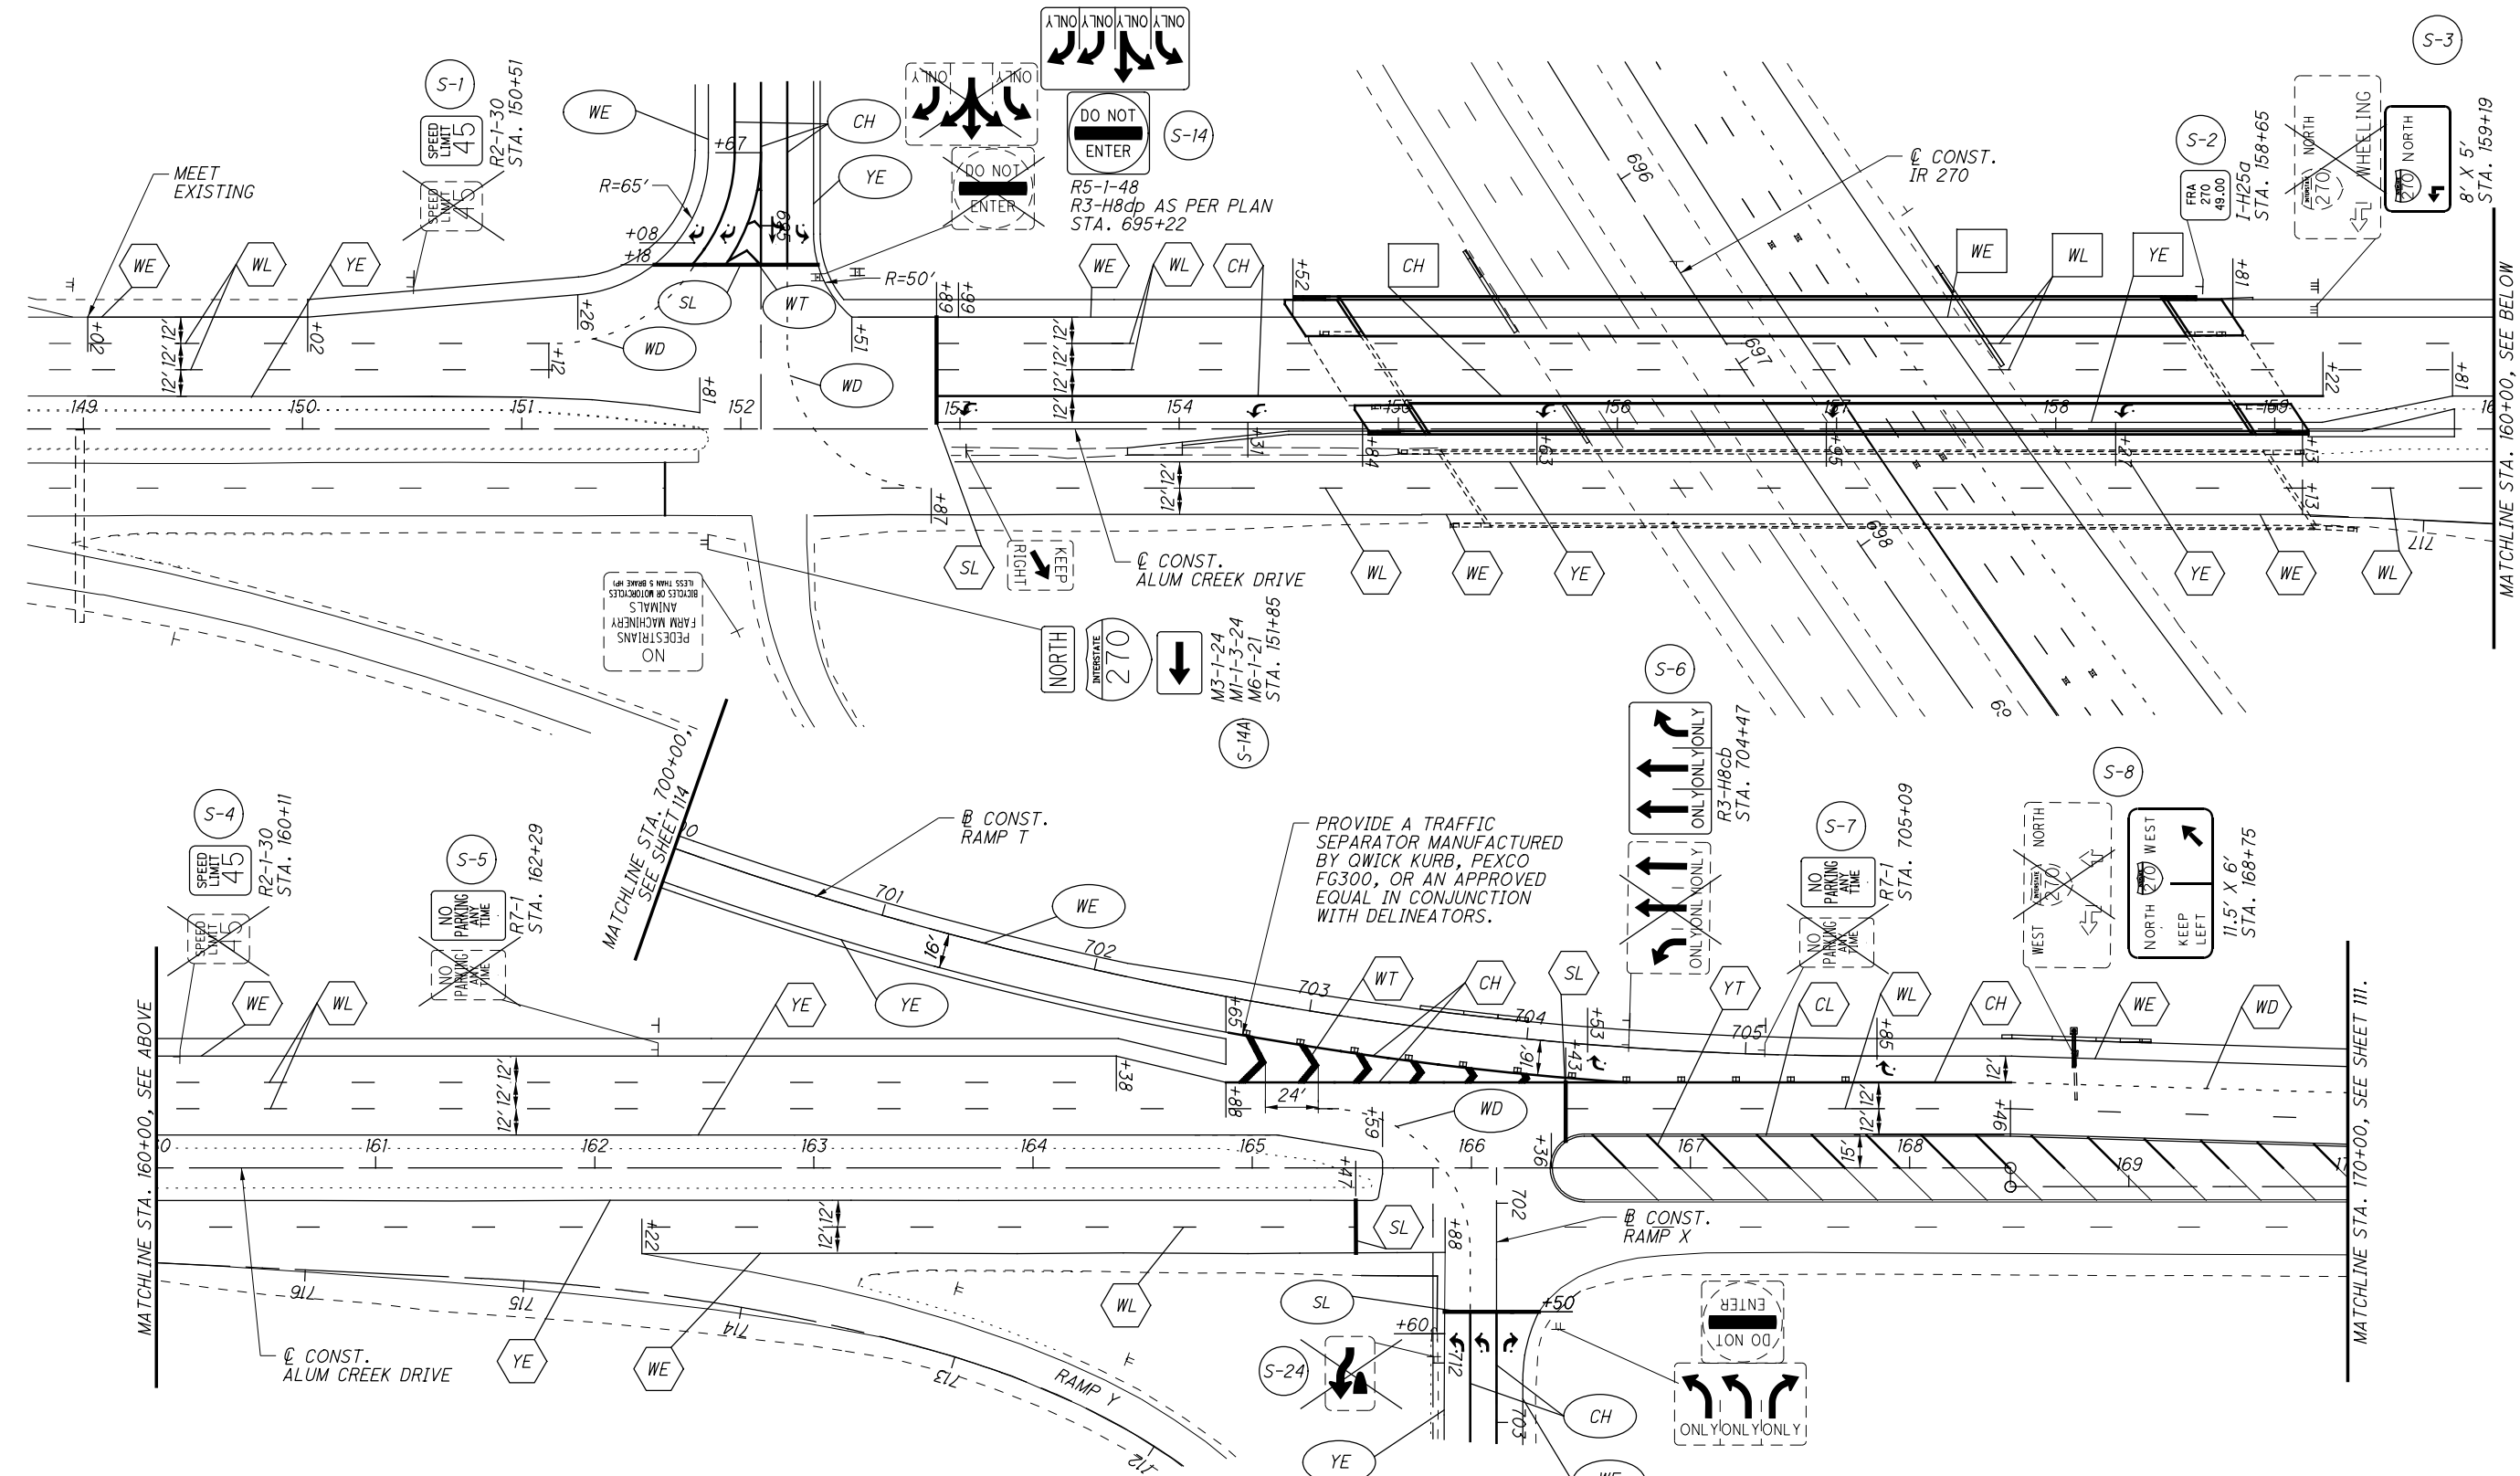

PAVEMENT MARKING LEGEND

- | | | | |
|----|---|----|--|
| CH | ITEM 644 - CHANNELIZING LINE, 12" WHITE | SL | ITEM 644 - STOP LINE, 24" WHITE |
| WL | ITEM 644 - LANE LINE, 6" WHITE | WL | ITEM 644 - LANE LINE, 4" WHITE |
| WE | ITEM 644 - EDGE LINE, 6" WHITE | YE | ITEM 644 - EDGE LINE, 4" YELLOW |
| YE | ITEM 644 - EDGE LINE, 6" YELLOW | WE | ITEM 644 - EDGE LINE, 4" WHITE |
| WT | ITEM 644 - TRANSVERSE LINE, 24" WHITE | CH | ITEM 644 - CHANNELIZING LINE, 8" WHITE |
| WD | ITEM 644 - DOTTED LINE, 6" WHITE | WD | ITEM 644 - DOTTED LINE, 4" WHITE |

- | | |
|----|--|
| CL | ITEM 644 - CENTERLINE, 4" DOUBLE SOLID |
| WT | ITEM 644 - TRANSVERSE LINE, 12" WHITE |
| YT | ITEM 644 - TRANSVERSE LINE, 12" YELLOW |
| SL | ITEM 644 - STOP LINE, 12" WHITE |

- | | |
|----|--|
| WL | ITEM 646 - LANE LINE, 4" WHITE |
| WE | ITEM 646 - EDGE LINE, 4" WHITE |
| YE | ITEM 646 - EDGE LINE, 4" YELLOW |
| CH | ITEM 646 - CHANNELIZING LINE, 8" WHITE |
| ■ | RAISED PAVEMENT MARKER |
| □ | TYPE C DELINEATOR, WHITE |

SIGNING LEGEND

- | | |
|--|-----------------------------|
| | PROPOSED SIGN |
| | EXISTING SIGN TO REMAIN |
| | EXISTING SIGN TO BE REMOVED |

BU 4.5, 6, 7, & 8 - RELEASED FOR CONSTRUCTION - 11/03/2014 - 11/19/2015

TRAFFIC CONTROL PLAN


ALUM CREEK DRIVE STATION 148+75 TO STATION 170+00

FRA - 270-49.00

CALCULATED JLM
CHECKED SSK

HORIZONTAL SCALE IN FEET

110
182

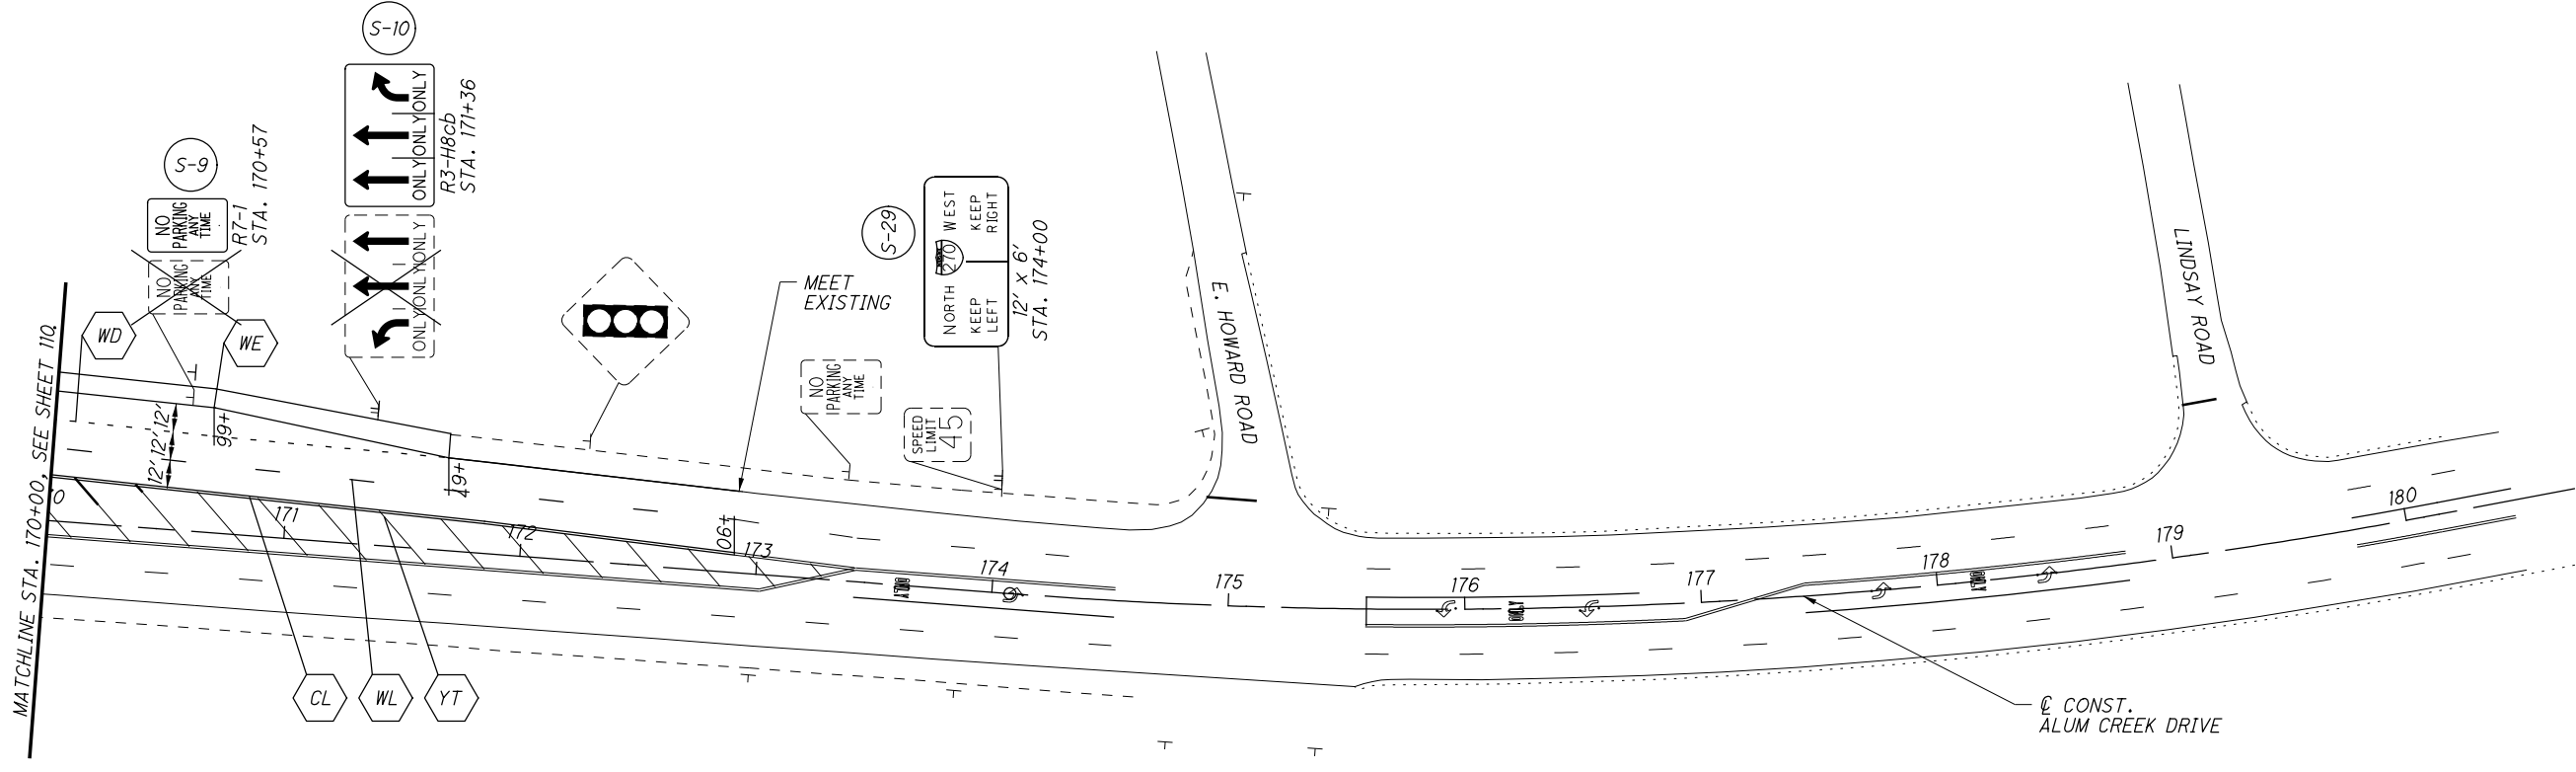

FOR LEGEND
SEE SHEET 110.

BU 4, 5, 6, 7, & 8 - RELEASED FOR CONSTRUCTION - 11/03/2014 - 11/19/2015


FRA - 270-49.00

TRAFFIC CONTROL PLAN
ALUM CREEK DRIVE STATION 170+00 TO STATION 180+00

CALCULATED
JLM
CHECKED
SSK

0 40 80
20
HORIZONTAL
SCALE IN FEET

111
182

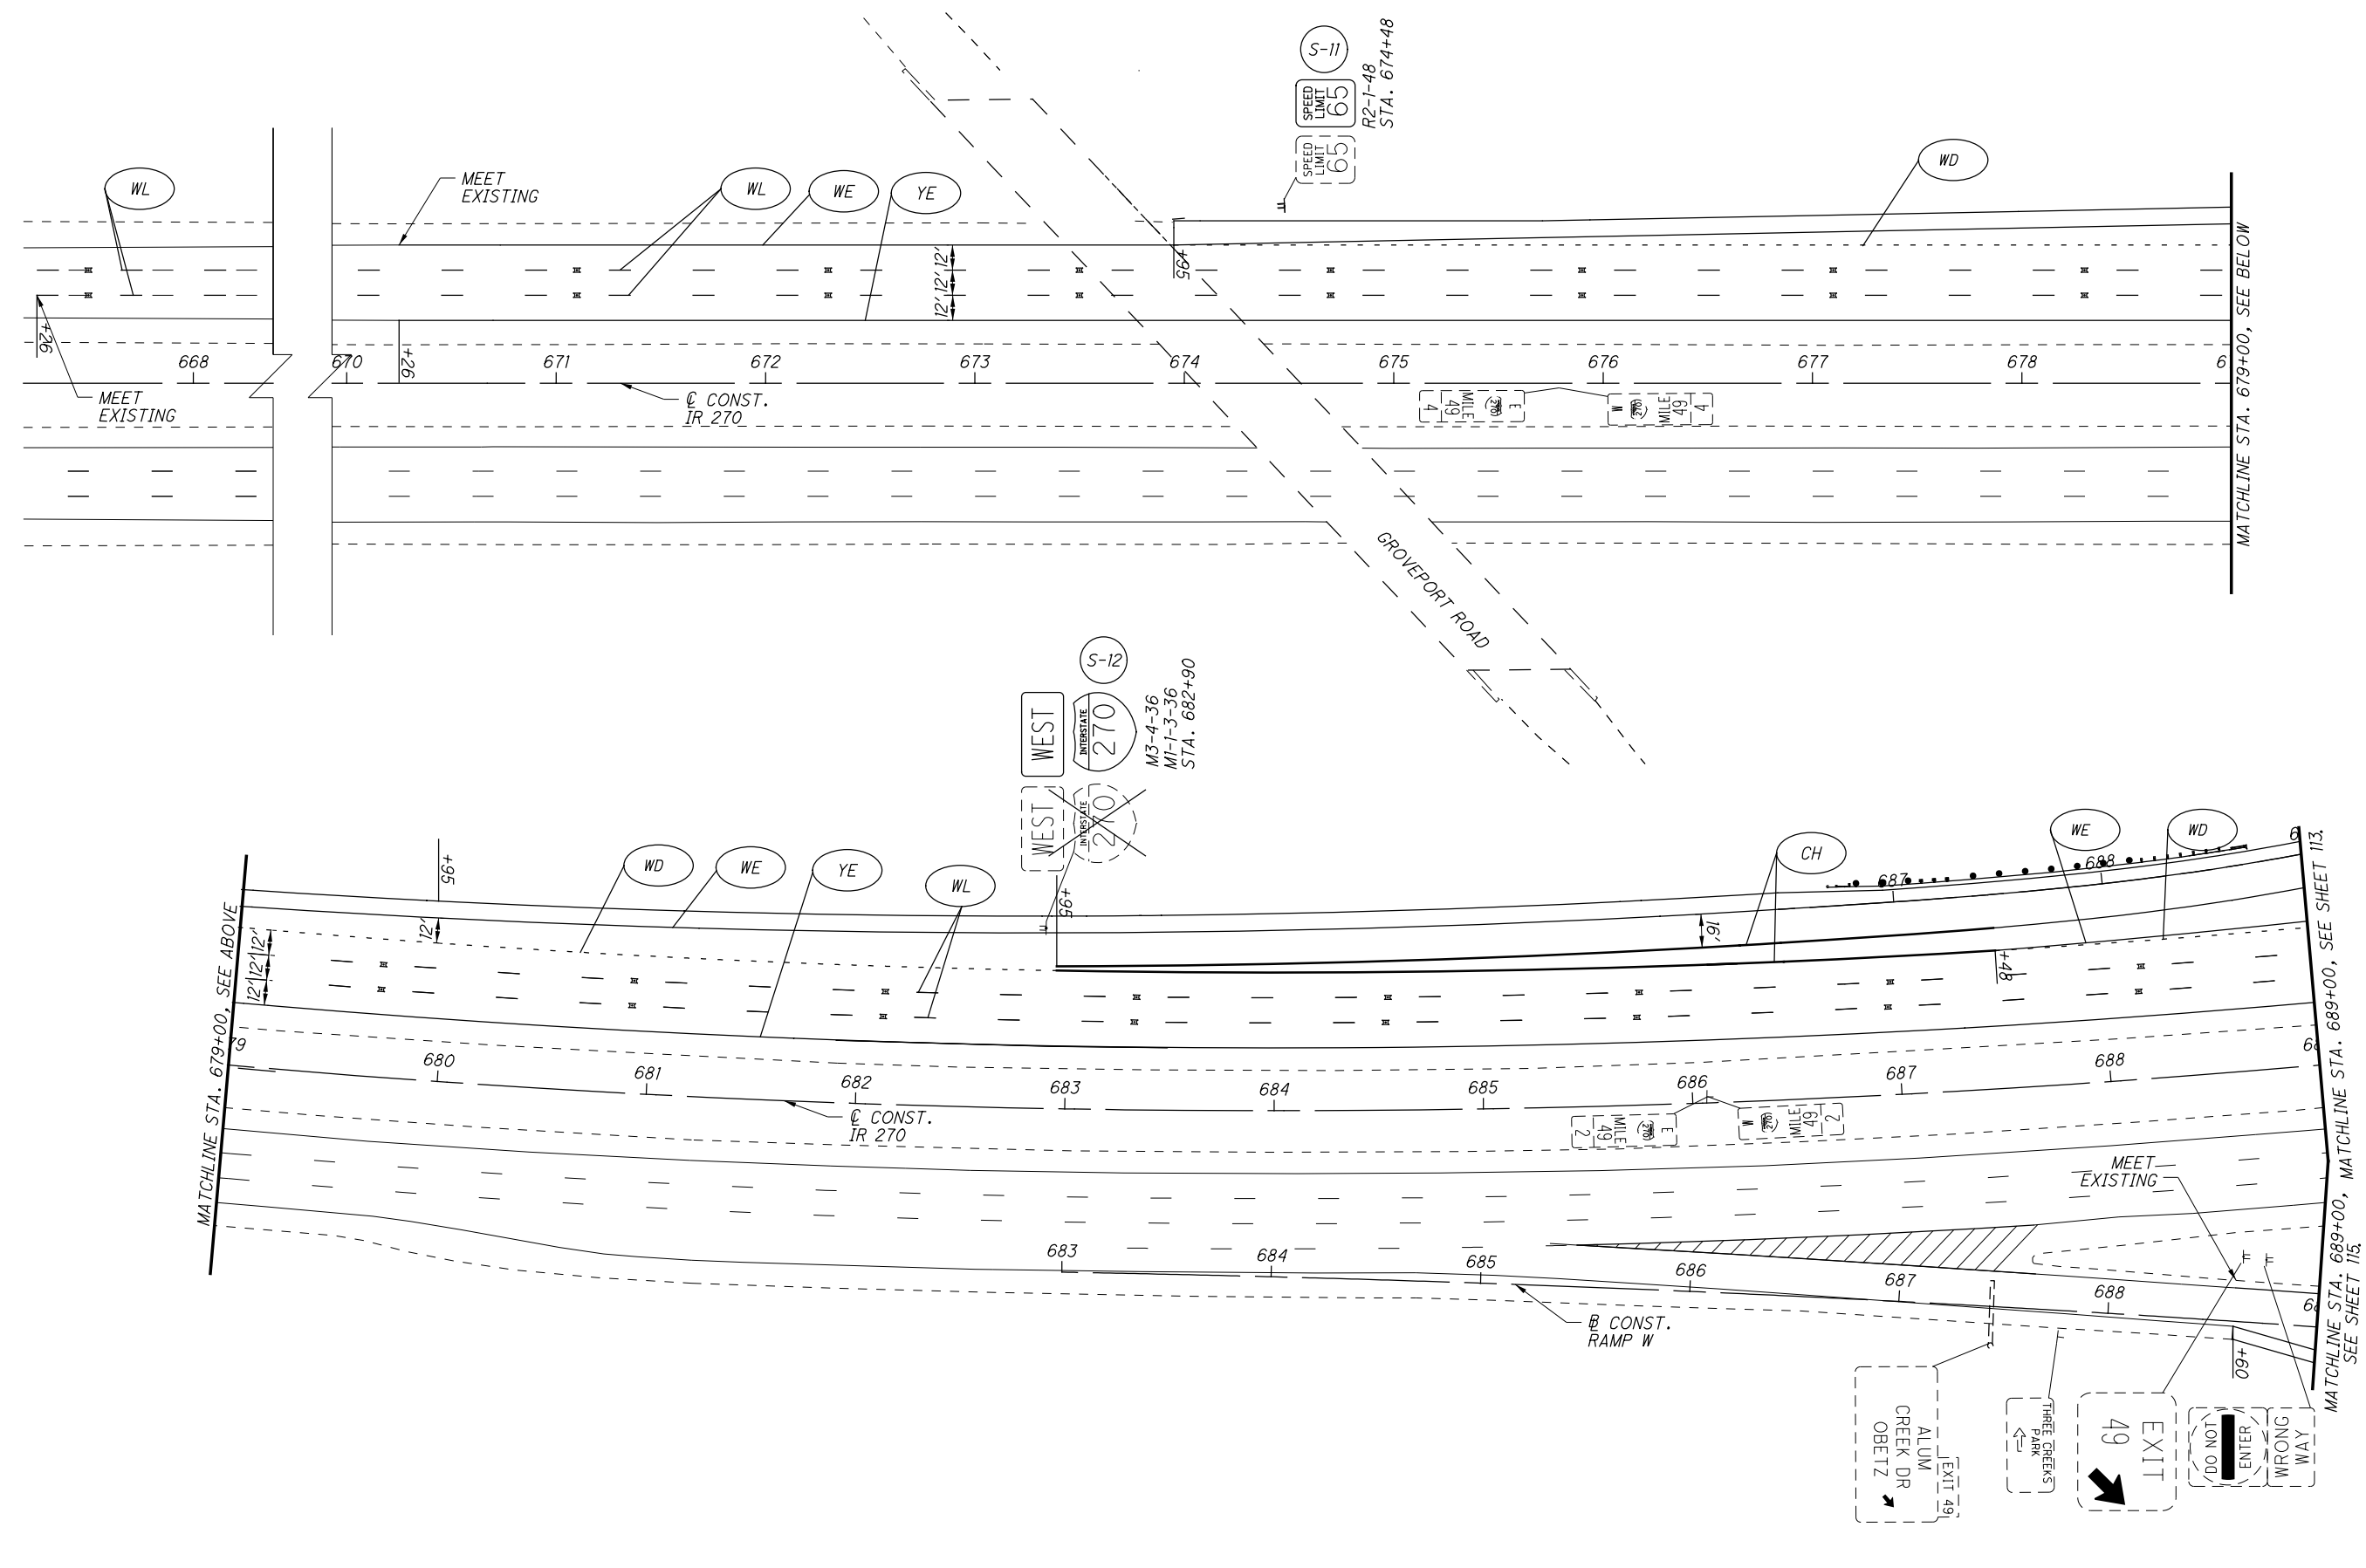

FOR LEGEND SEE SHEET 110.

CALCULATED JLM
CHECKED SSK


0 20 40 80
HORIZONTAL SCALE IN FEET

TRAFFIC CONTROL PLAN
I.R. 270 STATION 667+75 TO STATION 689+00

AS BUILT - 4/22/2016

G:\projects\2014\W-14-039_FRA-270-49.00\83988\traffic_control\sheets\83988TP004_RV.dgn 6/9/2016 12:27:25 PM colnr

DATE	DESCRIPTION
6/8/16	AS BUILT

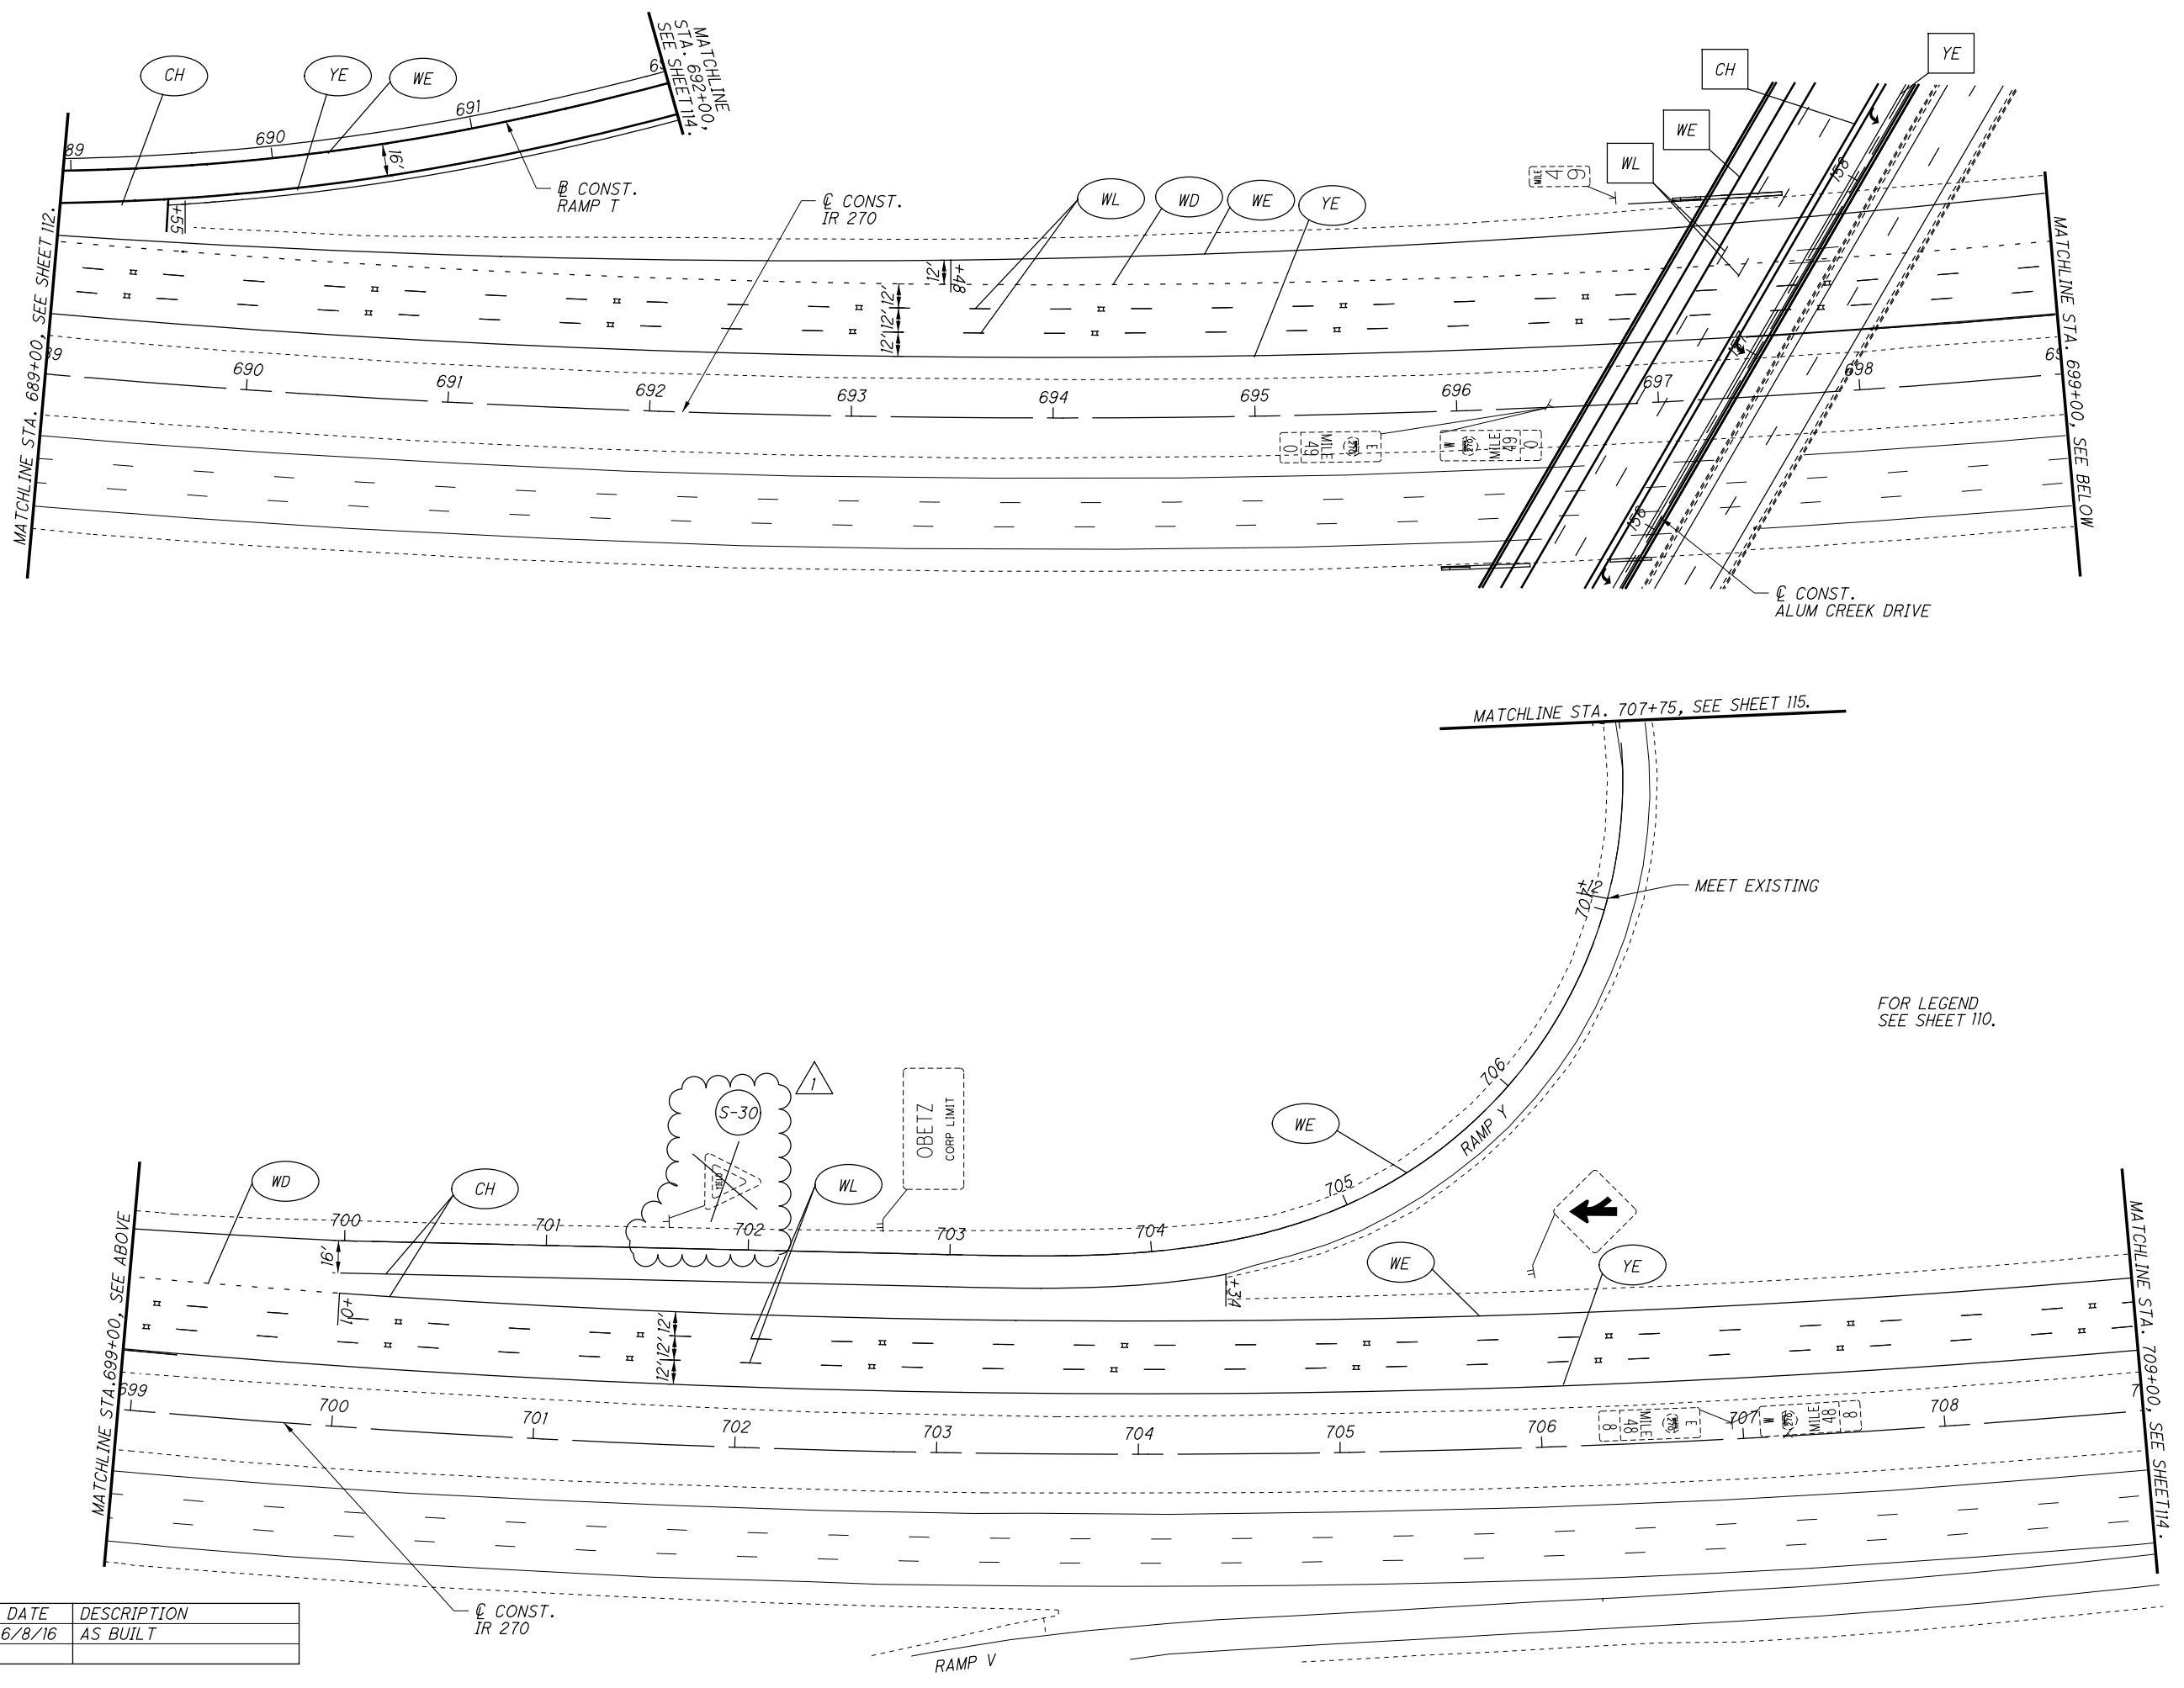

CALCULATED JLM
CHECKED SSK

HORIZONTAL SCALE IN FEET


BU 4, 5, 6, 7, & 8 - RELEASED FOR CONSTRUCTION - 11/03/2014 - 11/19/2015

TRAFFIC CONTROL PLAN

I.R. 270 STATION 689+00 TO STATION 709+00

FRA - 270 - 49.00

113
182

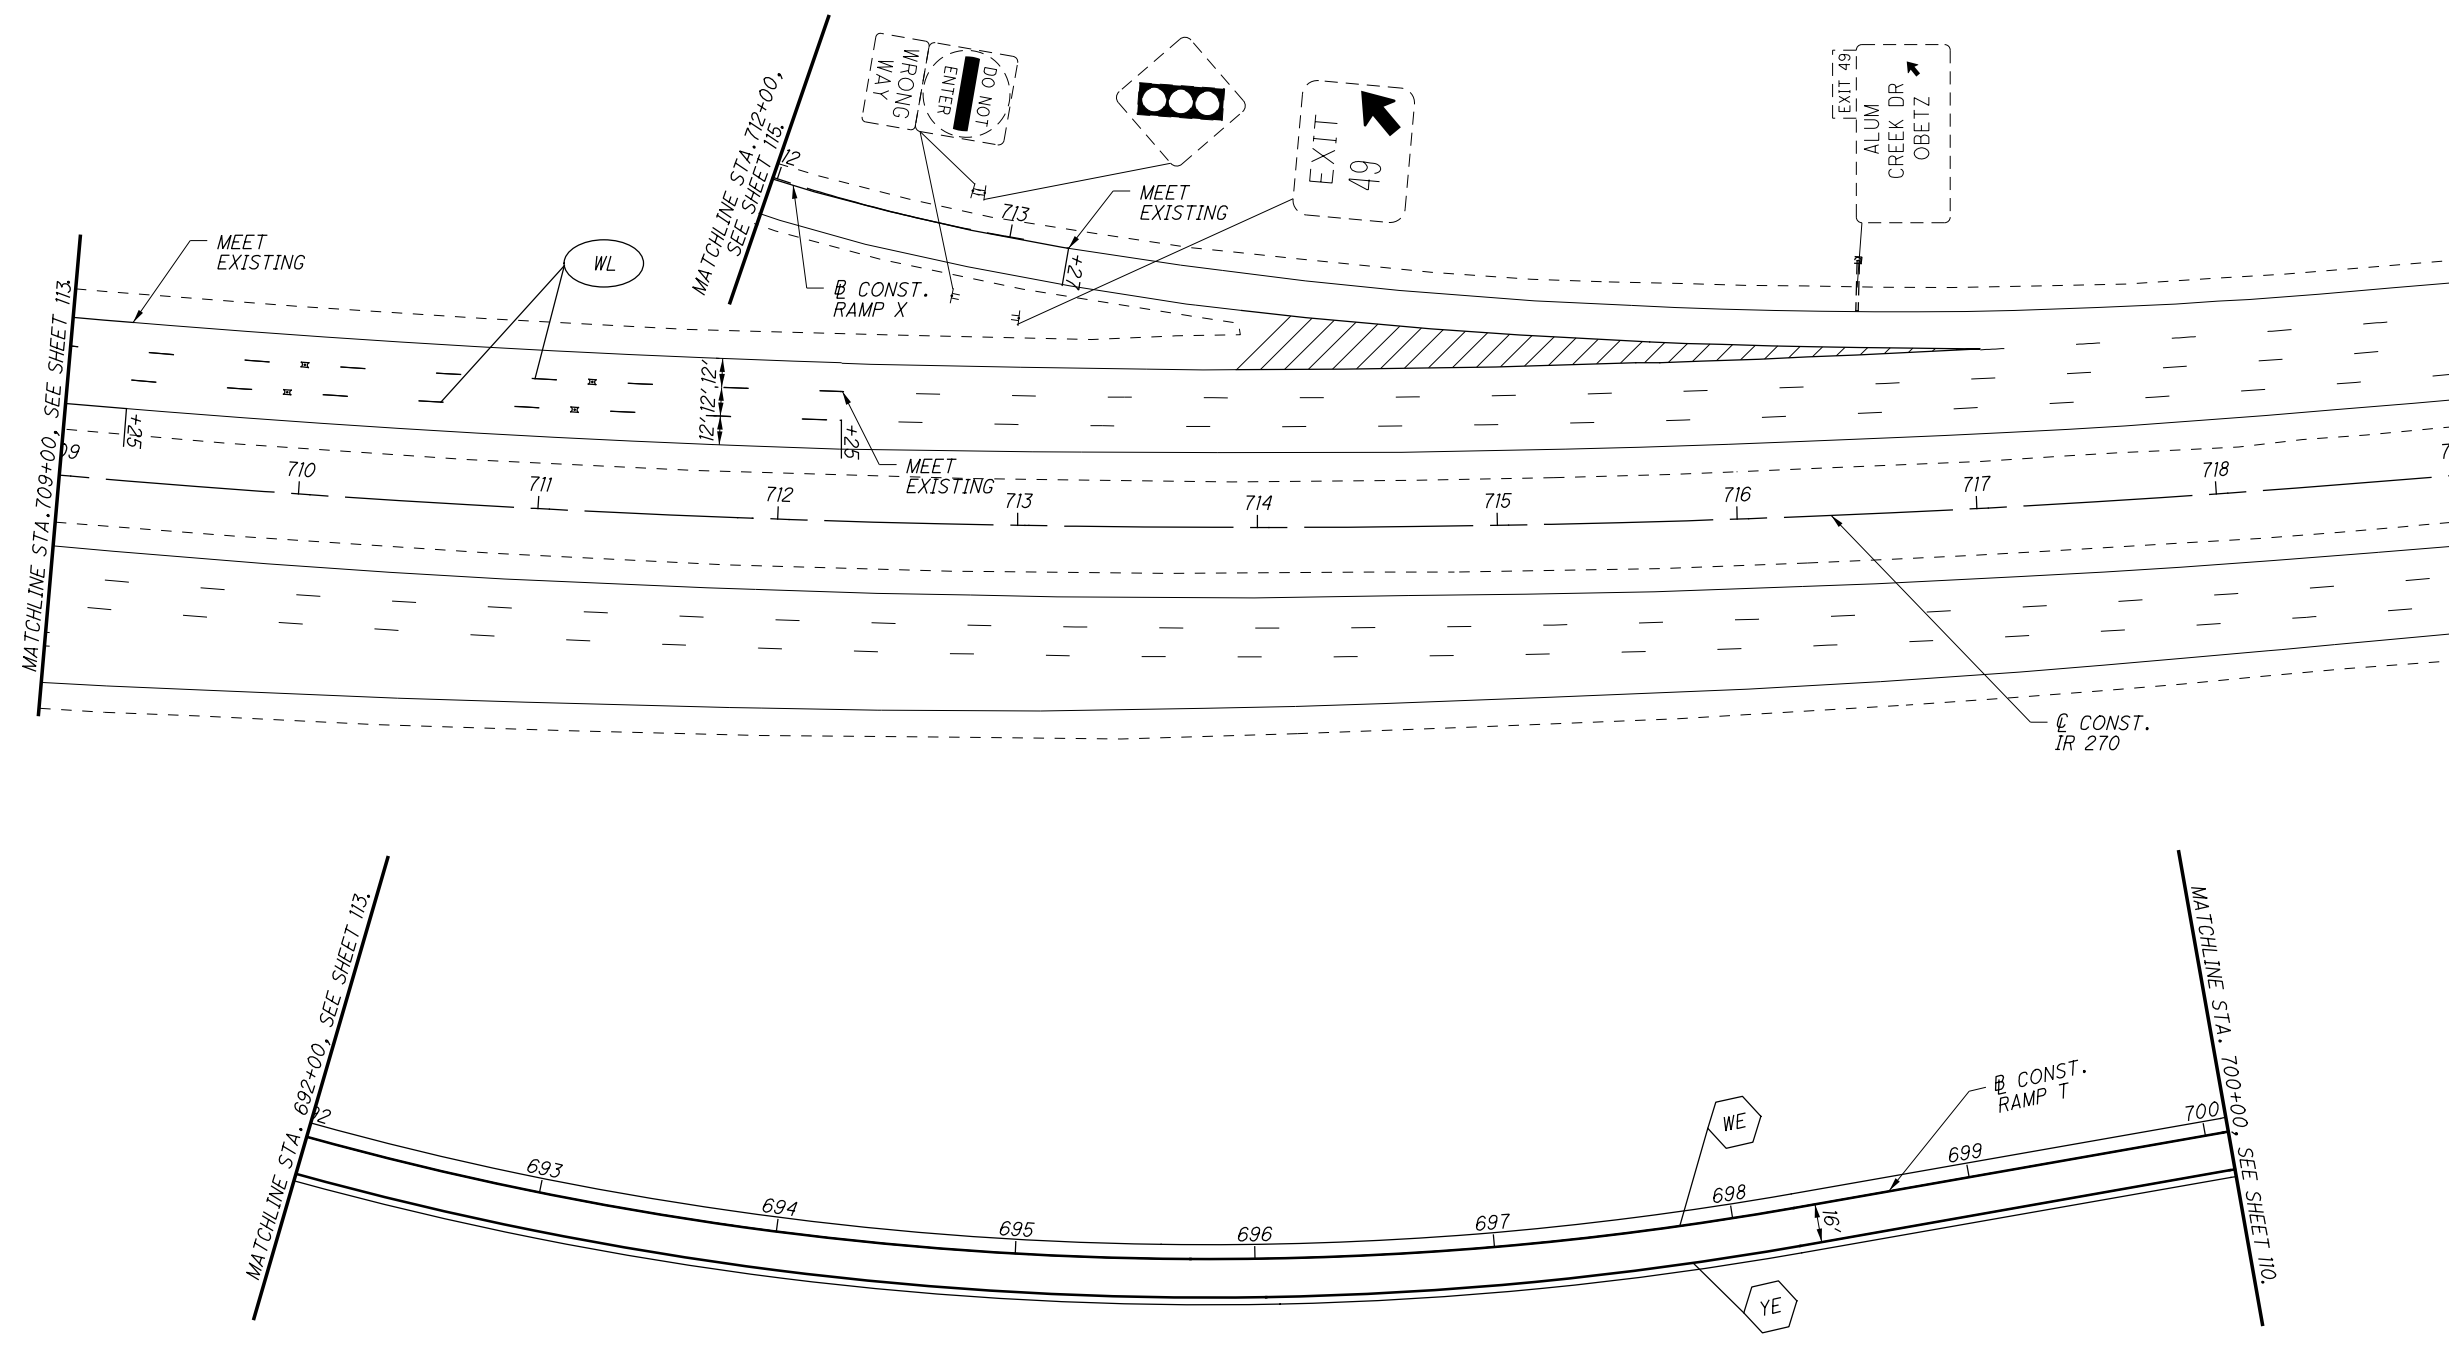

FOR LEGEND SEE SHEET 110.

BU 4, 5, 6, 7, & 8 - RELEASED FOR CONSTRUCTION - 11/03/2014 - 11/19/2015


FRA - 270 - 49.00

TRAFFIC CONTROL PLAN

I.R. 270 AND RAMP T STATION 709+00 TO STATION 700+00

CALCULATED JLM
CHECKED SSK



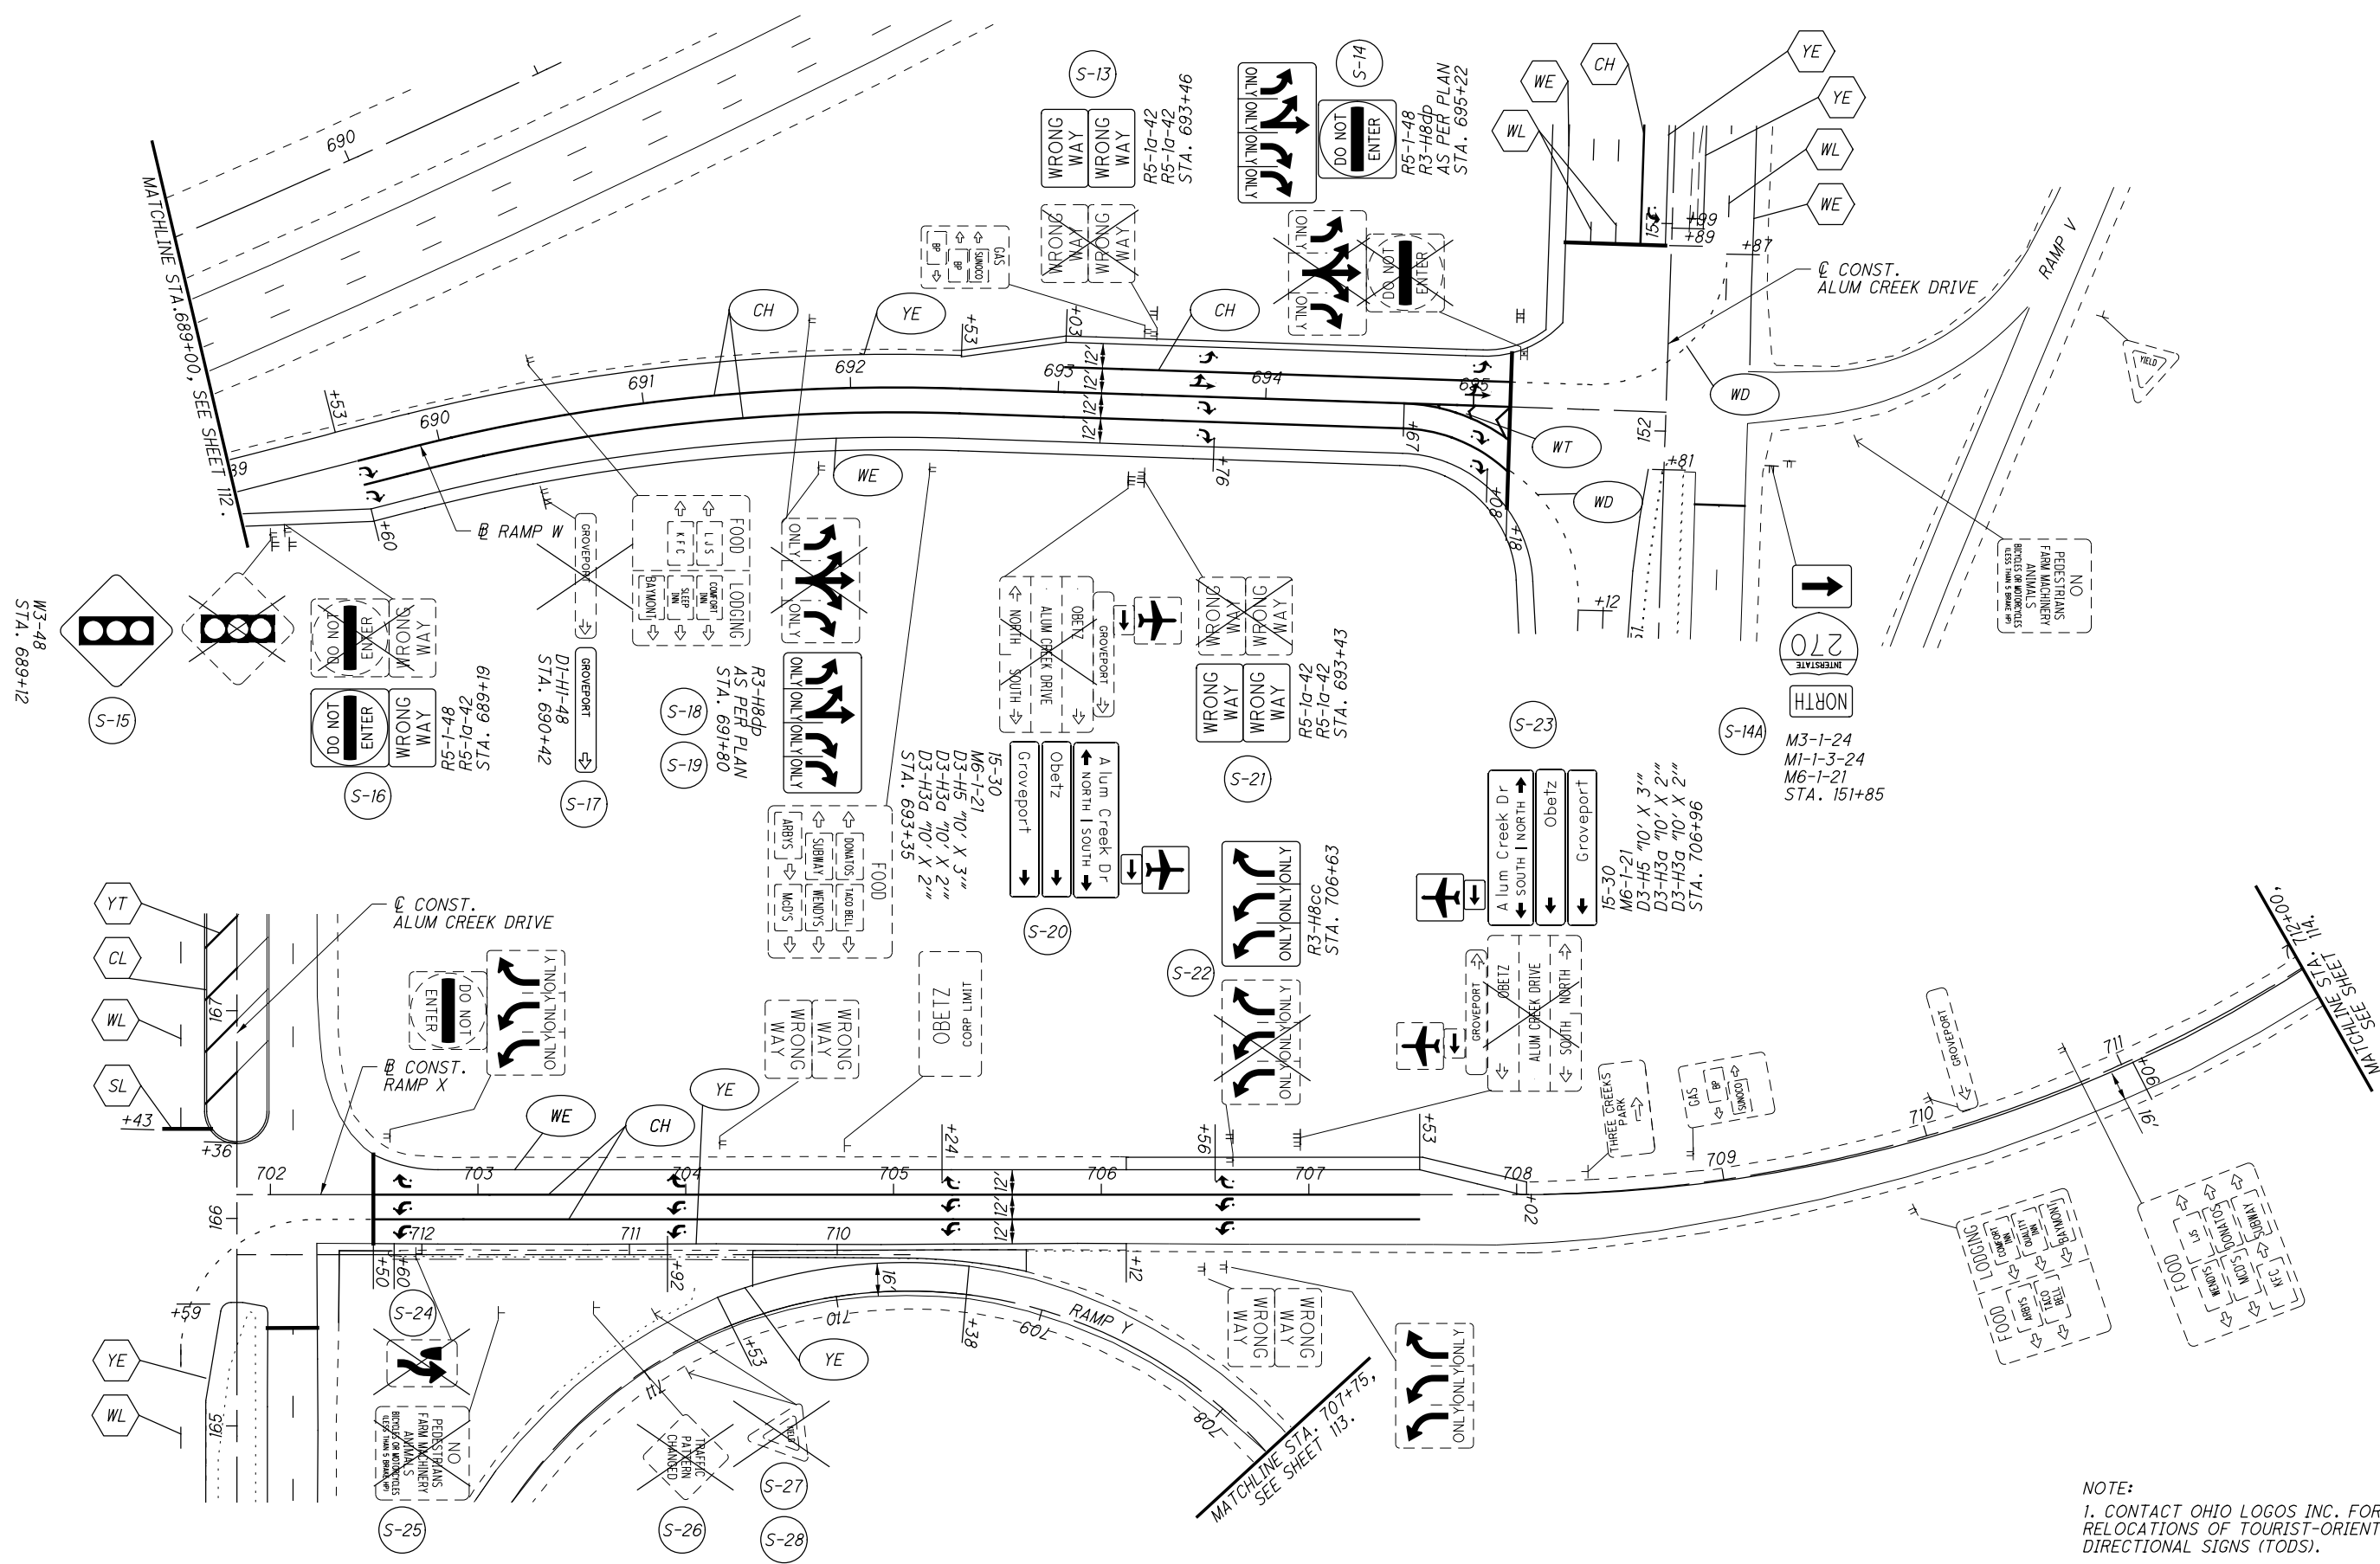

NOTE:
 1. CONTACT OHIO LOGOS INC. FOR RELOCATIONS OF TOURIST-ORIENTED DIRECTIONAL SIGNS (TODS).

FOR LEGEND SEE SHEET 110.

BU 4.5, 6, 7, & 8 - RELEASED FOR CONSTRUCTION - 11/03/2014 - 11/19/2015

FRA - 270-49.00



TRAFFIC CONTROL PLAN


RAMP W AND RAMP X STATION 690+00 TO STATION 712+00

115
182


CALCULATED JLM
 CHECKED SSK

0 20 40 80
 HORIZONTAL SCALE IN FEET

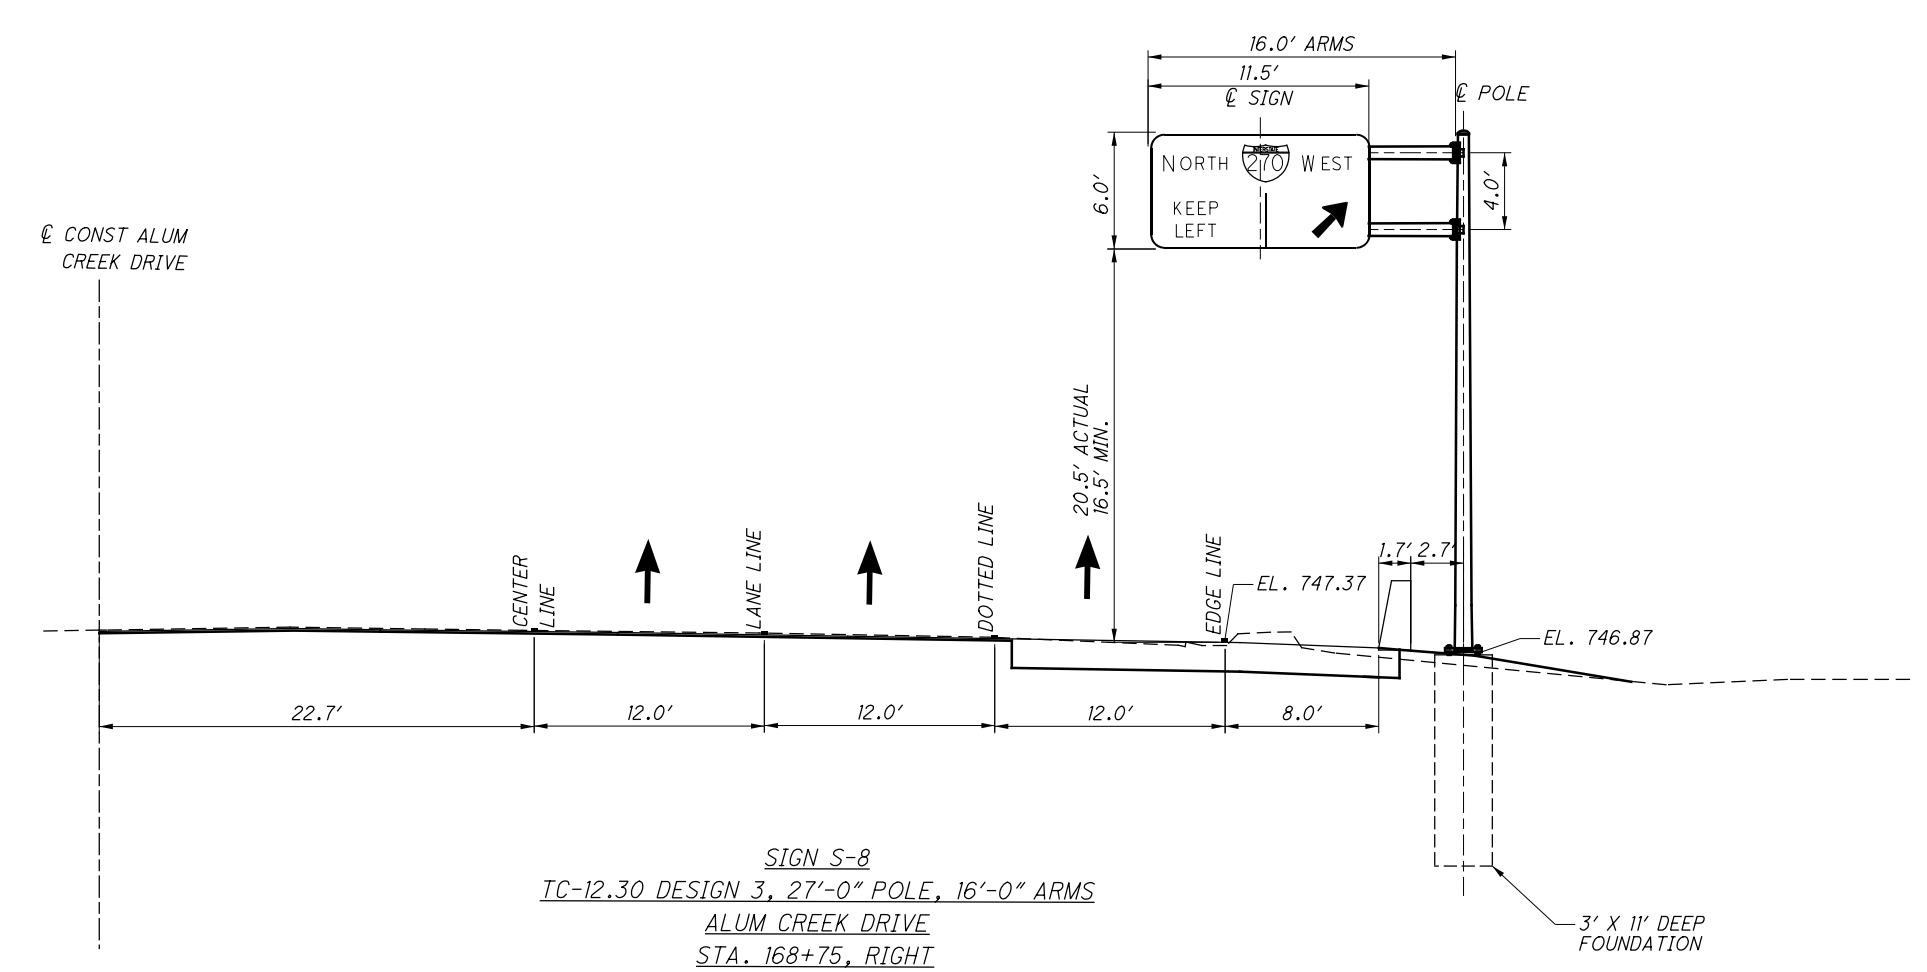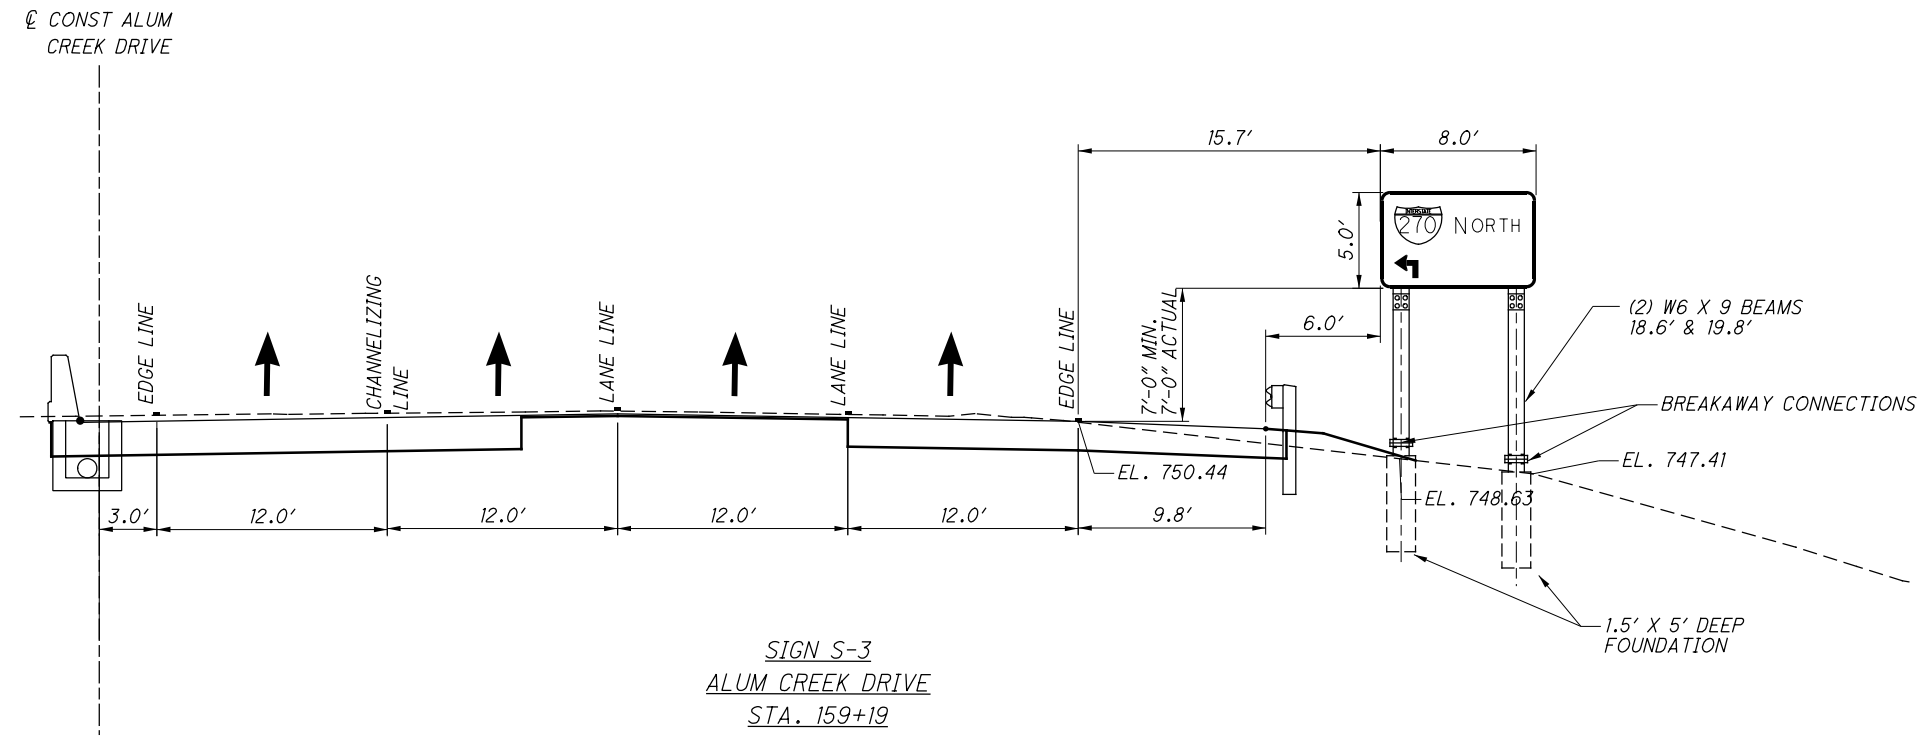

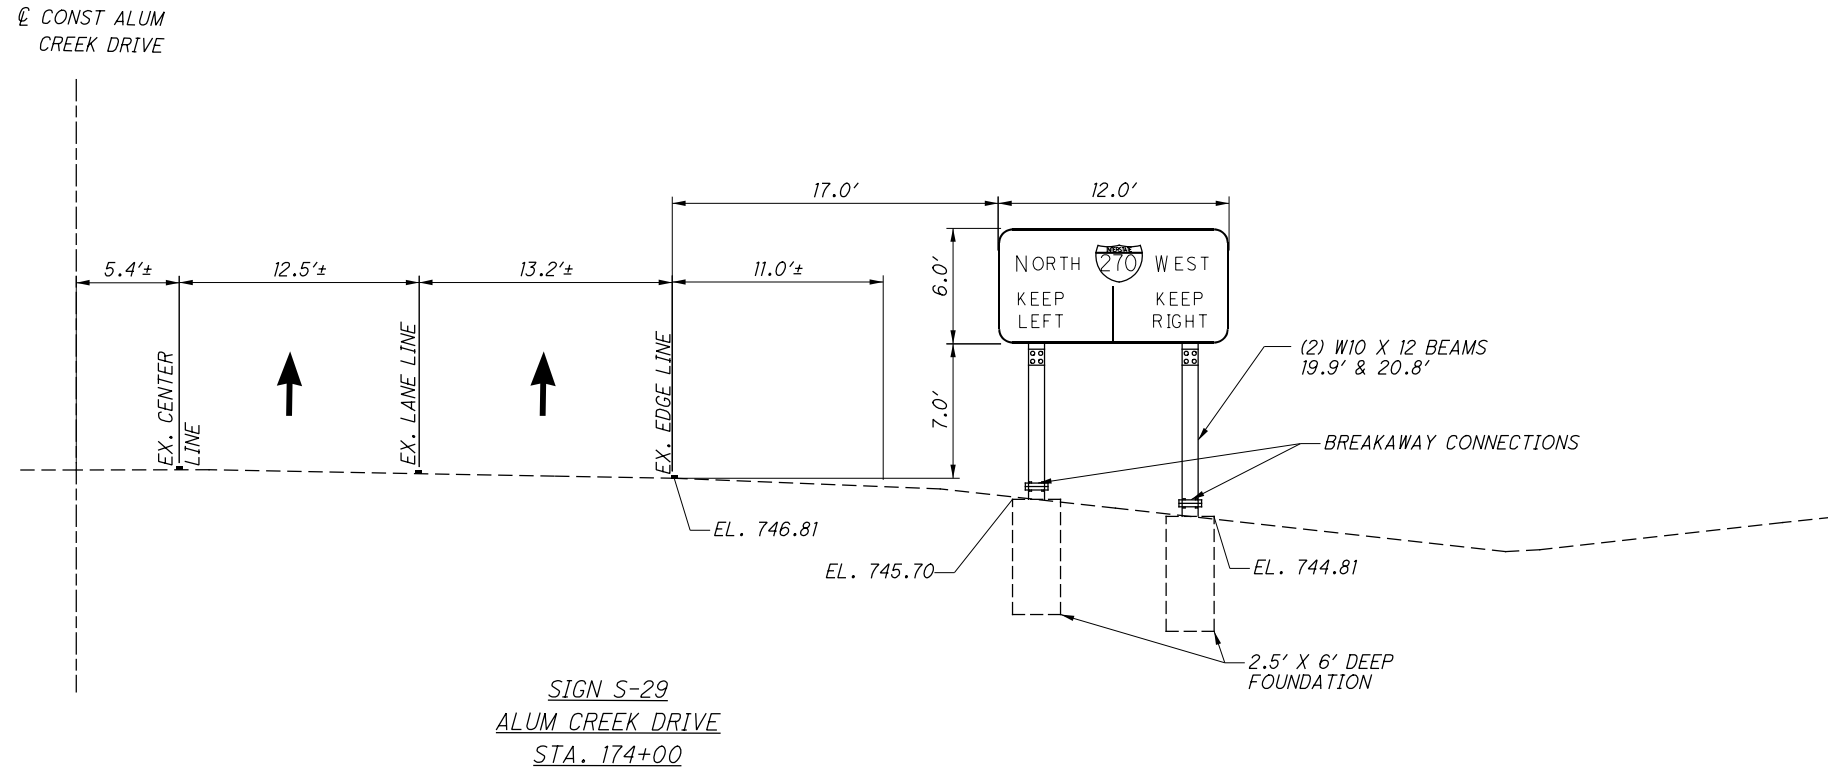

CALCULATED	JLM
CHECKED	SSK


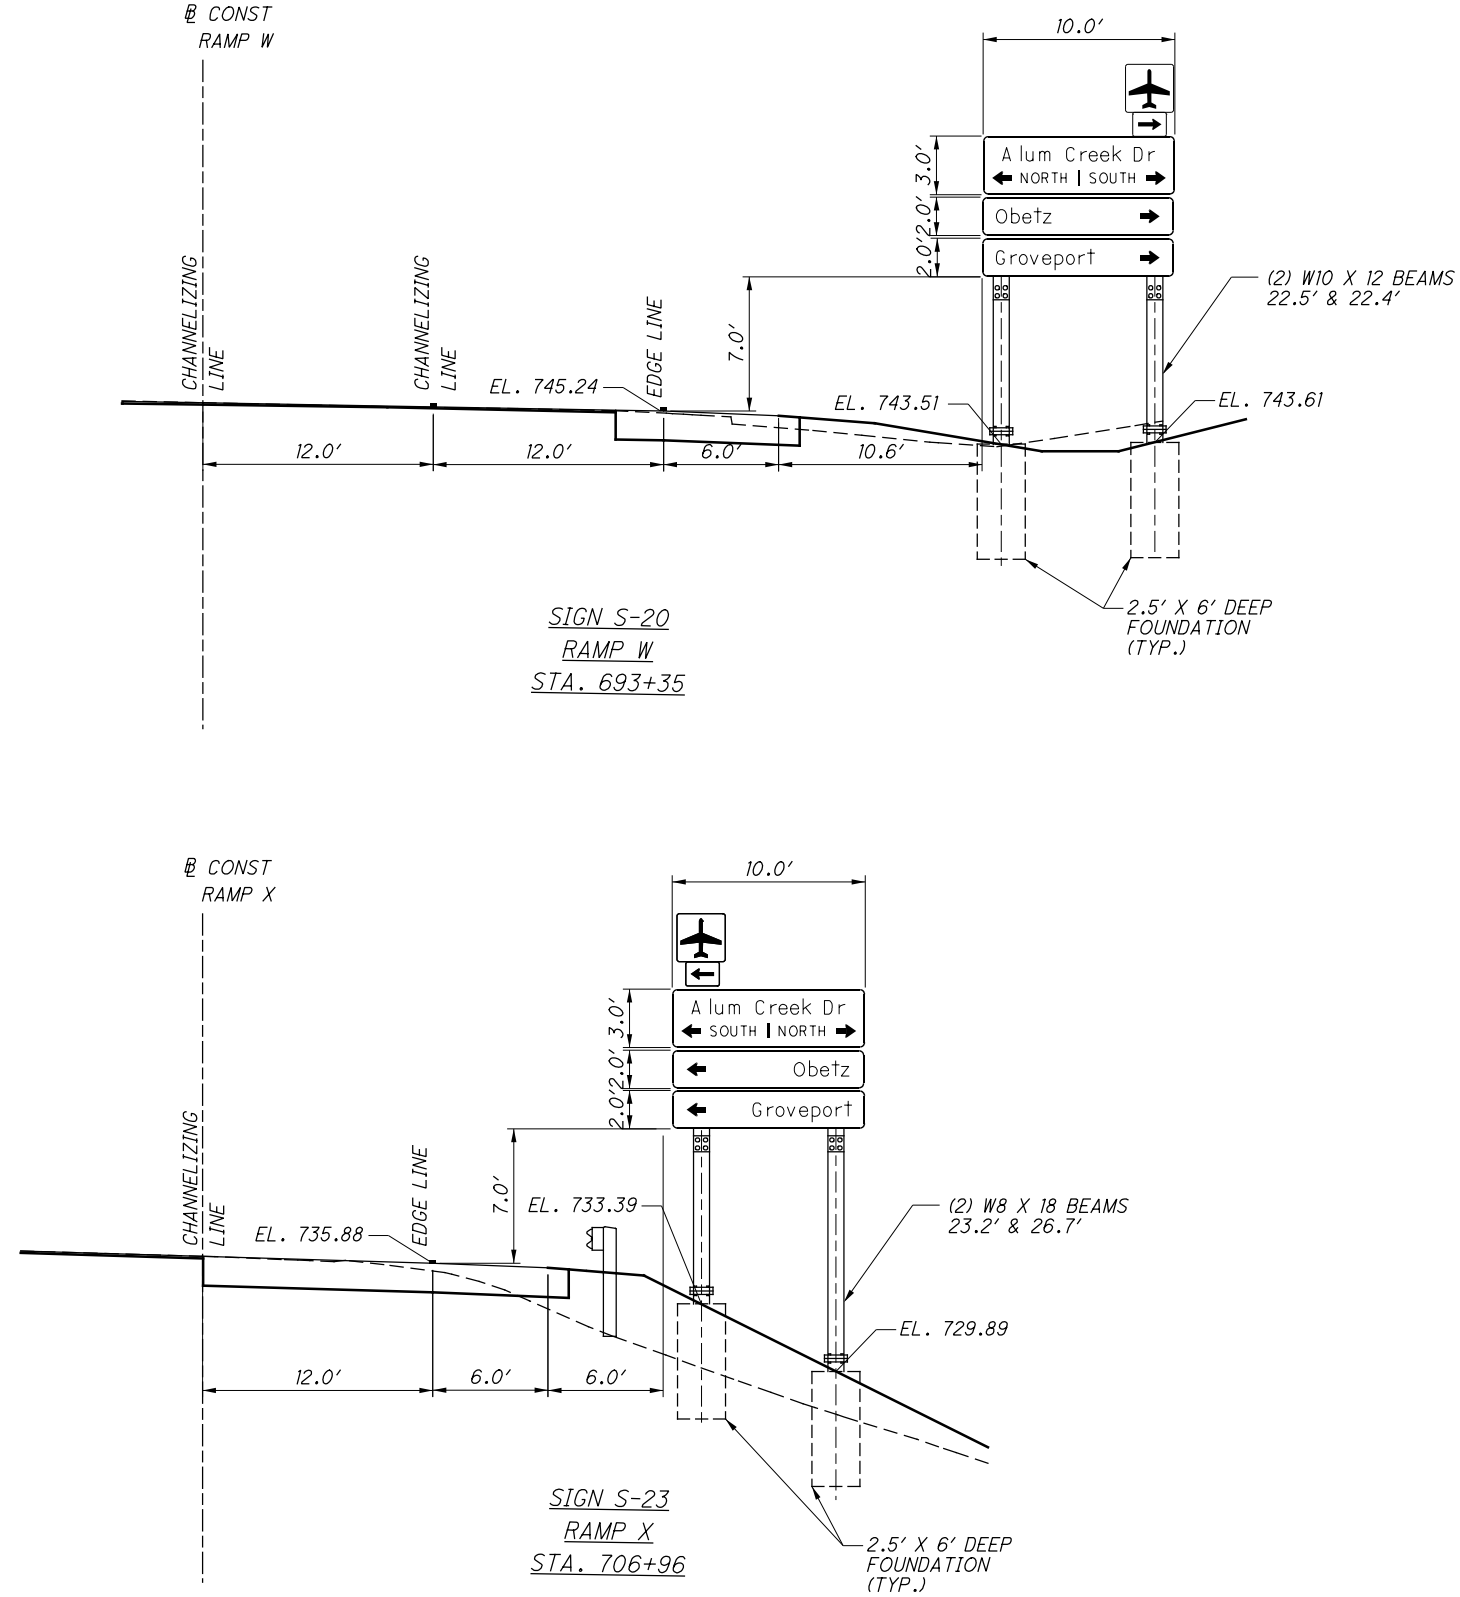


CALCULATED	JLM
CHECKED	SSK

SIGN ELEVATIONS

FRA - 270 - 49.00

LIGHTING SCHEMATIC AND SHEET INDEX

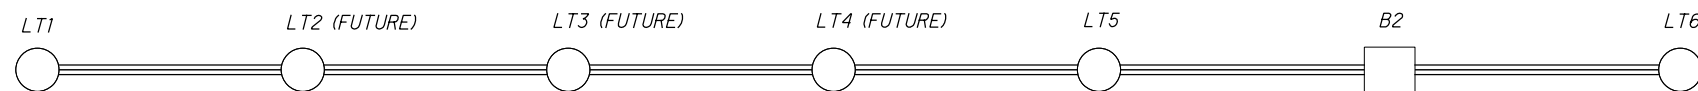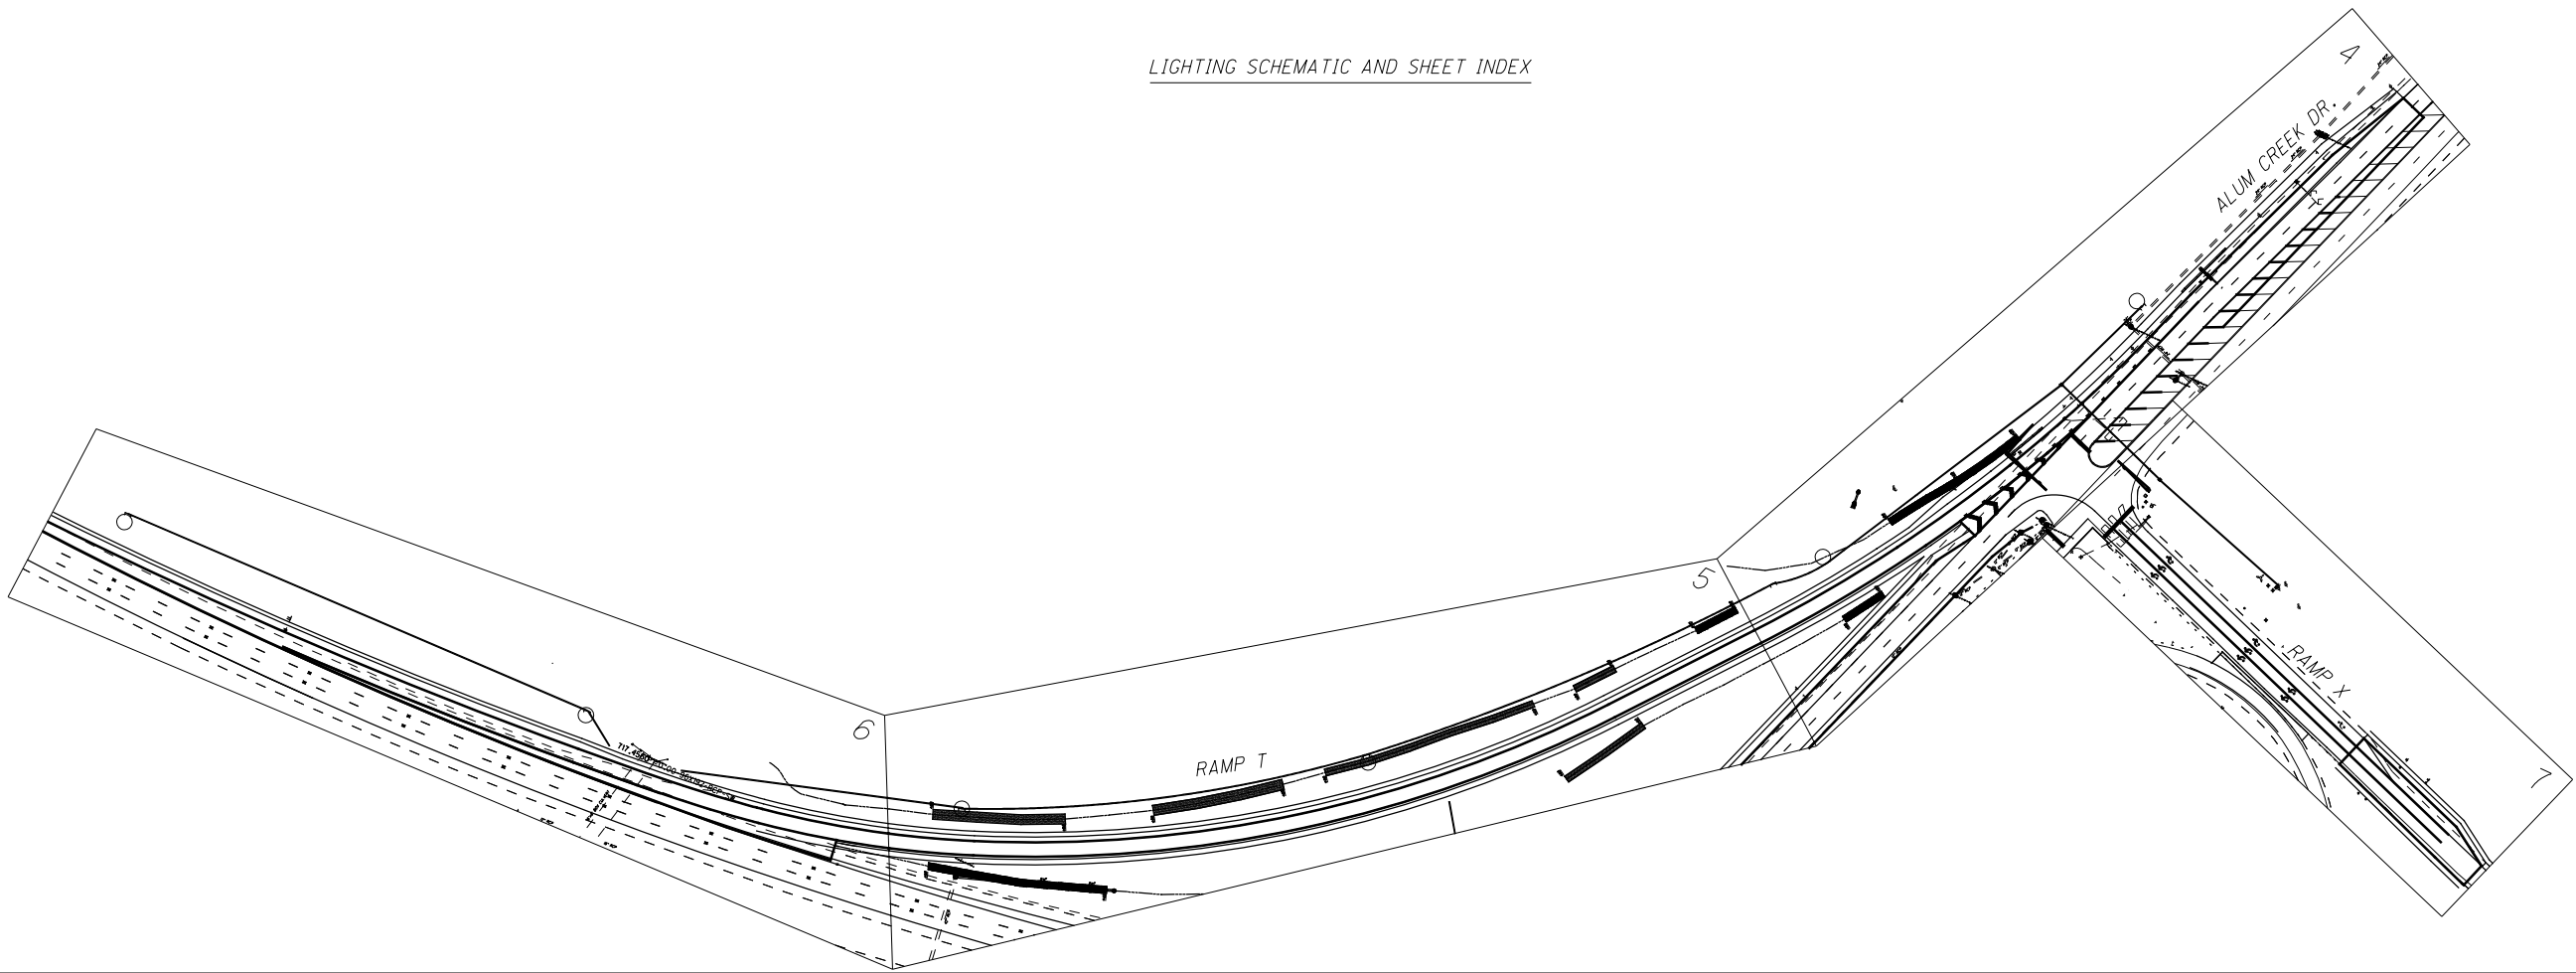

LIGHTING CONTROLLER SCHEDULE											
POWER SERVICE	LINE VOLTAGE (VOLTS)	CONNECTED LOAD (KVA)	SERVICE ENTRANCE CABLE (AWG)	ENCLOSURE RATING	CIRCUIT	BRANCH NO.	BRANCH LOAD (AMPS)	BRANCH LOAD (AMPS)	CIRCUIT FUSE SIZE (AMPS)	BRANCH CABLE SIZE (AWG)	MAINTAINING AGENCY
LCC	480	9.6	#4	120A	D	1	16.0	20	30	#4	ODOT
						2	4.0				ODOT
						A*	-	27	40	#4	ODOT
						B*	-	32	40	#4	ODOT

* PER LIGHTING PLANS, FRA-270-(42.82), (46.13), (48.98)

LIGHTING CIRCUIT DIAGRAM

POWER SERVICE ADDRESS:
4590 ALUM CREEK DR.
COLUMBUS, OH 43207

LIGHTING OVERVIEW

THE LIGHTING PORTION OF THIS PROJECT CONSISTS OF PROVISION AND INSTALLATION OF NEW HIGH-MAST LIGHTING, COMPLETE WITH ALL ASSOCIATED WIRING, CONDUIT, FOUNDATIONS, HARDWARE, ETC., AND CONNECTION TO EXISTING LIGHTING CONTROLLER, WITH REVISIONS TO THAT CONTROLLER. IN ADDITION, ONE HIGH-MAST TOWER IS TO BE RELOCATED, AND SOME EXISTING LIGHTING IS TO BE REMOVED.

NOTE THAT THERE IS SOME PROVISION FOR MORE LIGHTING TO BE ADDED IN THE FUTURE, BUT NO FOUNDATIONS ARE INCLUDED FOR THE FUTURE LIGHTING.

625. LUMINAIRE, HIGH MAST, AS PER PLAN

THE LUMINAIRE ARRAYS AND ASSOCIATED ILLUMINATION TEST AREAS SPECIFIED IN CMS 725.11 ARE HEREBY WAIVED. INSTEAD, THE LUMINAIRES FOR HIGH MAST LIGHTING SHALL MEET THE FOLLOWING REQUIREMENTS:

LUMINAIRES FOR HIGH-MAST LIGHTING UNITS WITH SYMMETRIC DISTRIBUTION SHALL BE HOLOPHANE "HMST" WITH PHOTOMETRIC DISTRIBUTION 36383, GENERAL ELECTRIC "HM" WITH PHOTOMETRIC DISTRIBUTION 6312, OR COOPER "HMX" WITH PHOTOMETRIC DISTRIBUTION HMX4SDW. OR EQUAL AS APPROVED BY THE ENGINEER.

LUMINAIRES FOR HIGH-MAST LIGHTING UNITS WITH ASYMMETRIC DISTRIBUTION SHALL BE HOLOPHANE "HMST" WITH PHOTOMETRIC DISTRIBUTION 46973, GENERAL ELECTRIC "HM" WITH PHOTOMETRIC DISTRIBUTION 7349, OR COOPER "HMC" WITH PHOTOMETRIC DISTRIBUTION HMC4S3D. OR EQUAL AS APPROVED BY THE ENGINEER.

LUMINAIRES FOR HIGH-MAST LIGHTING UNITS WITH LONG NARROW DISTRIBUTION SHALL BE HOLOPHANE "HMST" WITH PHOTOMETRIC DISTRIBUTION 36801, GENERAL ELECTRIC "HM" WITH PHOTOMETRIC DISTRIBUTION 8946, OR COOPER "HMC" WITH PHOTOMETRIC DISTRIBUTION HMC4SIDL. OR EQUAL AS APPROVED BY THE ENGINEER.

IN ADDITION, OTHER LUMINAIRES WILL BE CONSIDERED IF THE DESIGNED INTENSITY AND UNIFORMITY ARE PROVIDED USING THE POLE LOCATIONS AND THE DESIGNED NUMBER AND TYPE OF FIXTURES PER POLE.

PADLOCKS AND KEYS

PADLOCKS FURNISHED SHALL BE EITHER BRASS OR BRONZE, EQUAL TO MASTER NO. 4BKA OR WILSON BOHANNAN 660A, AND SHALL BE KEYED IN ACCORDANCE WITH CMS 631.06. PAYMENT SHALL BE INCLUDED IN THE BID FOR ITEM(S) BEING LOCKED.

625. RELOCATION OF EXISTING LIGHT TOWER

THE EXISTING LIGHT TOWER AND LUMINAIRES LOCATED AT STA: 702+80.0 @ RAMP T ARE TO BE REMOVED, AND REINSTALLED ON A NEW FOUNDATION AT STA: 701+13.5 @ RAMP T

625. LIGHT TOWER FOUNDATION, AS PER PLAN

THE PROPOSED LIGHT TOWER FOUNDATION LOCATED AT STA: 701+13.5 @ RAMP T SHALL MEET ALL REQUIREMENTS OF THE CMS AS WELL AS HAVE IDENTICAL ANCHOR BOLT ARRANGEMENT IN RELATION TO BOLT SIZE AND LOCATION AS THE EXISTING FOUNDATION LOCATED AT STA:STA: 704+79.6 @ RAMP T

625. PORTION OF LIGHT POLE FOUNDATION REMOVED, AS PER PLAN

THIS ITEM INCLUDES ALL REQUIREMENTS OF CMS 625 "PORTION OF LIGHT POLE REMOVED" WITH THE EXCEPTION OF IT PERTAINING TO THE EXISTING LIGHT TOWER FOUNDATION LOCATED AT STA. 702+80.0 @ RAMP T.

625. LIGHT POLE REMOVED FOR REERECTION, AS PER PLAN

THIS ITEM INCLUDES ALL REQUIREMENTS OF CMS 625 "LIGHT POLE REMOVED FOR REERECTION" WITH THE EXCEPTION OF IT PERTAINING TO THE EXISTING LIGHT TOWER LOCATED AT STA. 702+80.0 @ RAMP T.

625. LIGHTING MISCELLANEOUS: 3" RMC (725.04) IN TRENCH

THE PROPOSED RMC SHALL MEET ALL OF THE REQUIREMENTS OF CMS 725.04 AND SHALL BE PLACED IN A TRENCH. THE TRENCH SHALL CONFORM TO ODOT STANDARD CONSTRUCTION DRAWING HL-20.11, WITH THE EXCEPTION THAT, WHERE A TRENCH DEPTH OF 24 INCHES IS NOT POSSIBLE DUE TO THE CULVERT, THE TRENCH SHALL EXTEND TO THE TOP OF THE CULVERT.

625. LIGHTING MISCELLANEOUS, REVISE LIGHTING CONTROL CENTER

THE EXISTING LIGHTING CENTER ALONG RAMP X AT STA: 704+26.0 OFFSET: 69.3 IS 2-WIRE, 480 VOLT, 60 AMPERES WITH 2-40 AMP FUSES. EACH FUSE CURRENTLY SERVES ONE CIRCUIT WITH LOADS OF 27.0 AMPS AND 32.0 AMPS RESPECTIVELY. UPGRADE EXISTING CONTROL CENTER TO AN ENCLOSURE RATING OF 120 AMPS INCLUDING THE 2 EXISTING 40-AMP FUSES AND ONE NEW 30 AMP FUSE. THIS ITEM SHALL BE PAID AT A LUMP SUM BID PRICE AND INCLUDES ALL LABOR, PARTS, AND INCIDENTALS NECESSARY TO ACCOMODATE A 2-WIRE, 480 VOLT, 120 AMP SERVICE. THIS ITEM ALSO INCLUDES NEW SERVICE CABLE AND CONNECTIONS.

THIS WORK SHALL CONSIST OF CONVERTING THE EXISTING FLAT RATE POWER SERVICE AT SPECIFIED LOCATION(S) OVER TO METERED POWER SERVICE. REMOVAL OF EXISTING POWER SERVICE MAY INCLUDE BUT NOT LIMITED TO THE MATERIALS AND HARDWARE NORMALLY COMPRISING OF A POWER SERVICE. ALSO, THE AREA SHALL BE CLEARED OF GROWTH AND DEBRIS AT THE LOCATION(S). ANY RESULTANT OPENINGS SHALL BE BACKFILLED TO GRADE WITH SUITABLE COMPACTED SOIL AND RESTORED TO MATCH THE SURROUNDING AREA. ALL MATERIAL REMOVED SHALL BE DISPOSED OF BEYOND THE PROJECT SITE. THE CONTRACTOR SHALL BE RESPONSIBLE FOR ALL COORDINATION WITH THE POWER COMPANY FOR THE REMOVAL AND CONVERSION OF T HE POWER SERVICE. A UNIQUE POWER SERVICE ADDRESS WILL NEED TO BE ASSIGNED TO EACH LOCATION. THE ADDRESS FOR THIS POWER SERVICE SHALL BE:

4590 ALUM CREEK DRIVE
OBETZ, OH 43207

THE CONTACT PERSON FOR THE OHIO DEPARTMENT OF TRANSPORTATION IS LISTED BELOW:

CHARLIE FISHER
ODOT DISTRICT 6 TRAFFIC ENGINEER
740-833-8267




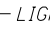


THE NEW METERS WILL BE PROVIDED BY THE POWER COMPANY AND SHALL BE INSTALLED BY THE CONTRACTOR AT THE LOCATIONS WHERE EXISTING SERVICE IS BEING REMOVED. CHANGEOVER SHALL BE PERFORMED IN A TIMELY FASHION SO THAT LIGHTING WILL BE PRESENT NIGHTLY. THE CONTRACTOR SHALL ASSURE THAT ALL CIRCUITS ARE IN OPERATION.



LOCATION	STATION	SIDE	ITEM 625																						
			LUMINAIRE, HIGH MAST, ASYMMETRIC, 400W HPS, 480 VOLT	LIGHT TOWER, BBBBB100	LIGHT TOWER FOUNDATION, 36"X20' DEEP	LIGHT TOWER FOUNDATION, 36"X20' DEEP, AS PER PLAN	NO. 4 AWG 2400 VOLT DISTRIBUTION CABLE	CONNECTION, UNFUSED PERMANENT	3" CONDUIT JACKED OR DRILLED UNDER PAVEMENT	TRENCH, 24" DEEP	PLASTIC CAUTION TAPE	PULLBOX, 725.08, 18"	GROUND ROD	LIGHTING MISC., 3" RMC (725.04) IN TRENCH	1 1/2" DUCT CABLE WITH TWO NO. 4 AWG 5000 VOLT CABLES	LIGHTING MISC.: REVISE LIGHTING CONTROL CENTER	PORTION OF LIGHT POLE FOUNDATION REMOVED, AS PER PLAN	LIGHT POLE REMOVED FOR REERECTION, AS PER PLAN	RE-ERECT EXISTING LIGHT TOWER	PORTION OF LIGHT POLE FOUNDATION REMOVED	LUMINAIRE REMOVED	LIGHT POLE REMOVED			
			EACH	EACH	EACH	EACH	FT	EACH	FT	FT	FT	EACH	EACH	FT	FT	LUMP	EACH	EACH	EACH	EACH	EACH	EACH			
IR 270	680+72.6	LT	4	1	1								2												
IR 270	680+72.6 686+78.0 (RAMP T)	RT							600	600					620										
RAMP T	686+78.0	LT						2				1													
RAMP T	686+78.0 687+60.0	LT							80	80				80	90										
RAMP T	687+60.0	LT						2				1													
RAMP T	687+60.0 700+50.0	LT							1255	1255					1265										
RAMP T	700+50.0	LT	4	1	1								2												
RAMP T	700+50.0 166+75.4 (ALUM CREEK)	LT							390	390					400										
ALUM CREEK DRIVE	166+75.4	RT						2				1	1					1	1						
ALUM CREEK DRIVE	166+75.4 168+00.0	LT								125	125				135										
ALUM CREEK DRIVE	168+00.0	LT				1							2							1					
ALUM CREEK DRIVE	166+75.4 166+75.4	RT/LT									320														
ALUM CREEK DRIVE	166+75.4	RT						2																	
ALUM CREEK DRIVE	166+75.4 704+25.8 (RAMP X)	RT											1	1											
RAMP X	704+26.0	LT																	1						
ALUM CREEK DRIVE	167+58.8	LT																				1	1		
ALUM CREEK DRIVE	169+62.7	LT																				1	1		
TOTALS CARRIED TO GENERAL SUMMARY			8	2	2	1		8	150	2625	2775		4	8	80	2695		1		1	1	1	2	2	

BU 4, 5, 6, 7, & 8 - RELEASED FOR CONSTRUCTION - 11/03/2014 - 11/19/2015

CALCULATED	SGB
	CHECKED
ERW	
LIGHTING SUBSUMMARY	
FRA - 270 - 49.00	
121	182

LEGEND



-  LUMINAIRE, HIGH MAST, ASYMMETRIC LUMINAIRE, BBBB100
-  LIGHT TOWER LOCATION TO BE INSTALLED AT A FUTURE DATE IF INTERCHANGE IS UPGRADED TO CONTINUOUS LIGHTING
-  LIGHT TOWER LTX (FUTURE)
-  LIGHT TOWER NUMBER
-  ELECTRICAL PULL BOX
-  PROPOSED DUCT CABLE, UNLESS OTHERWISE NOTED

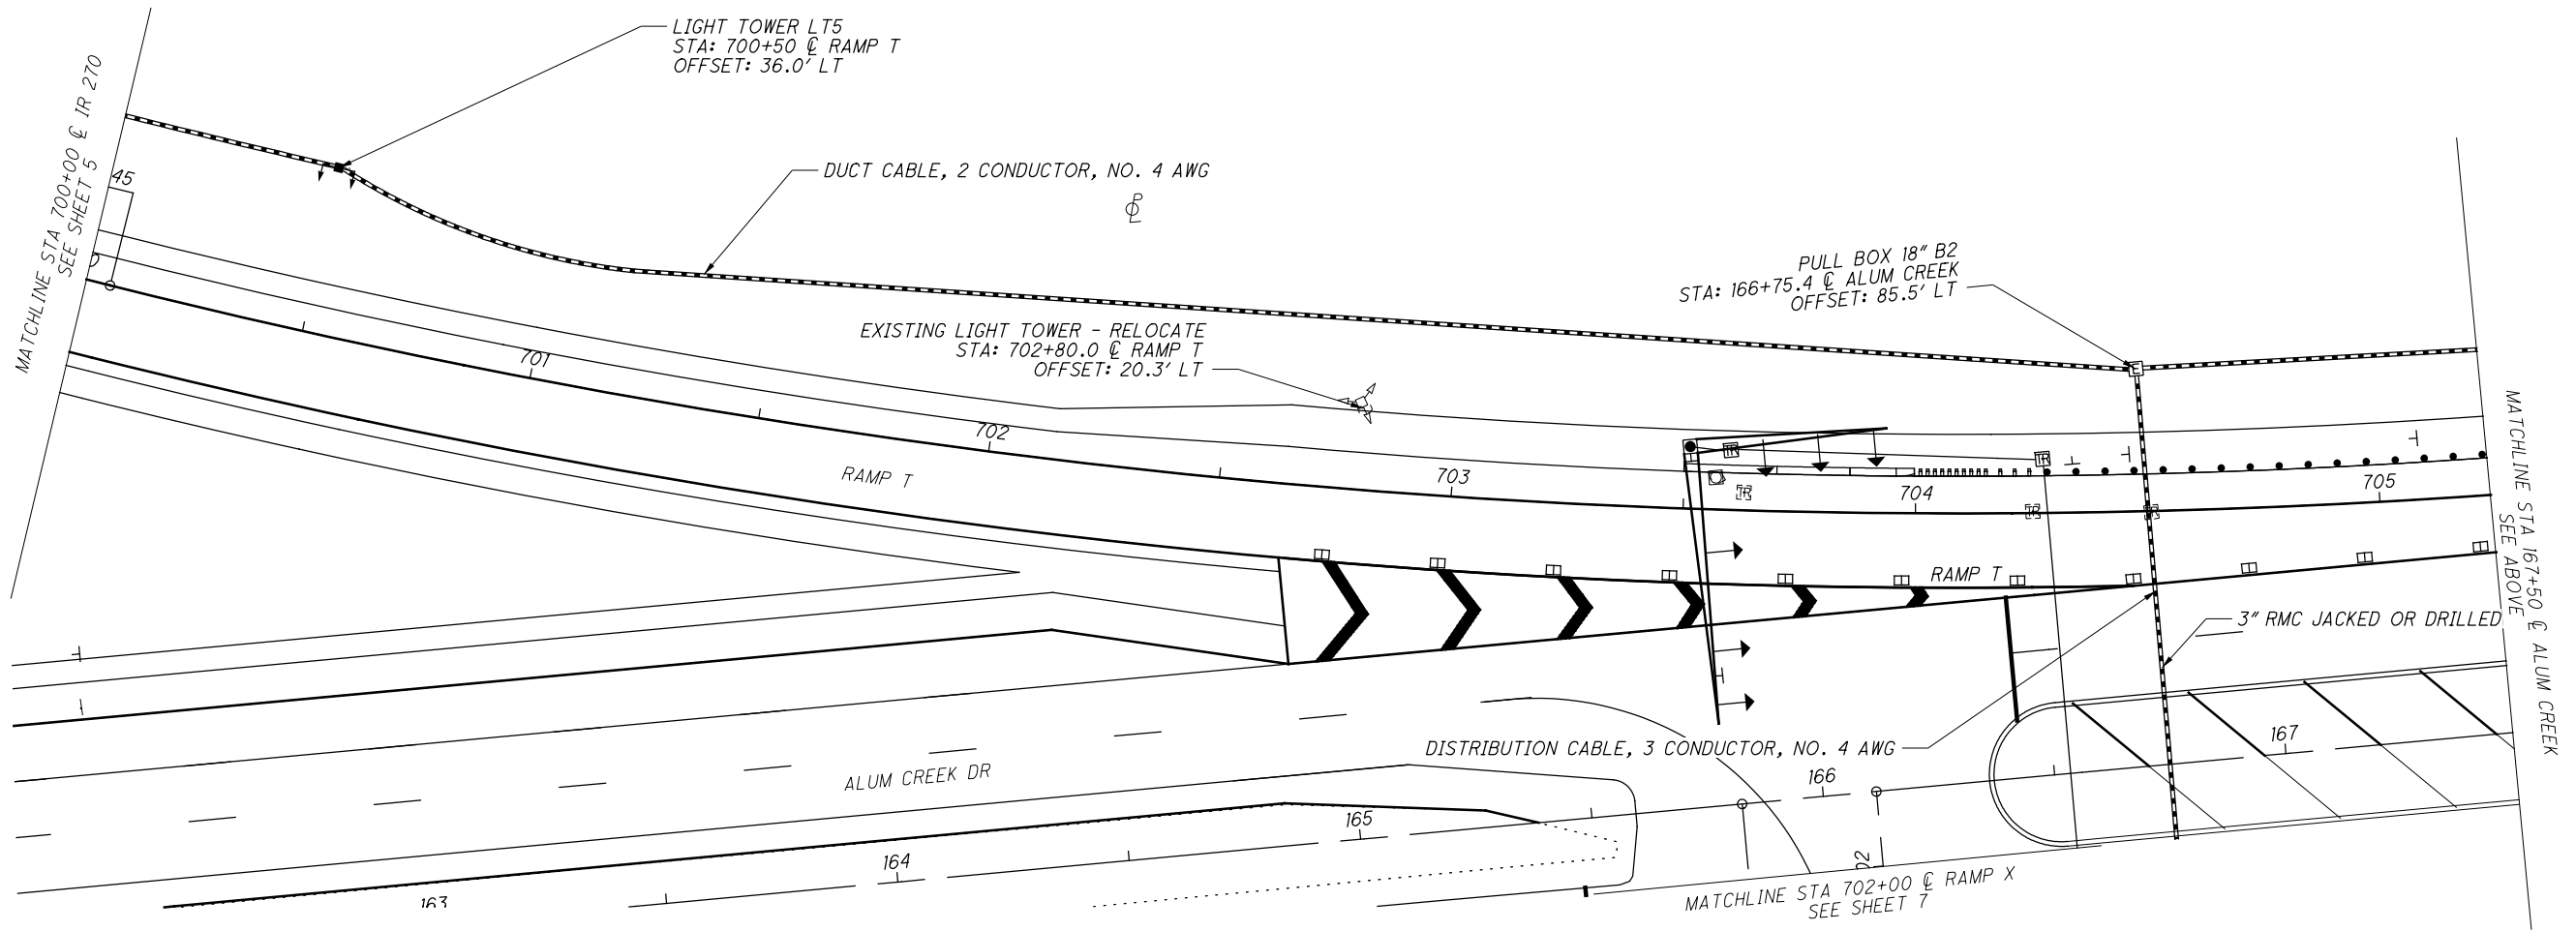
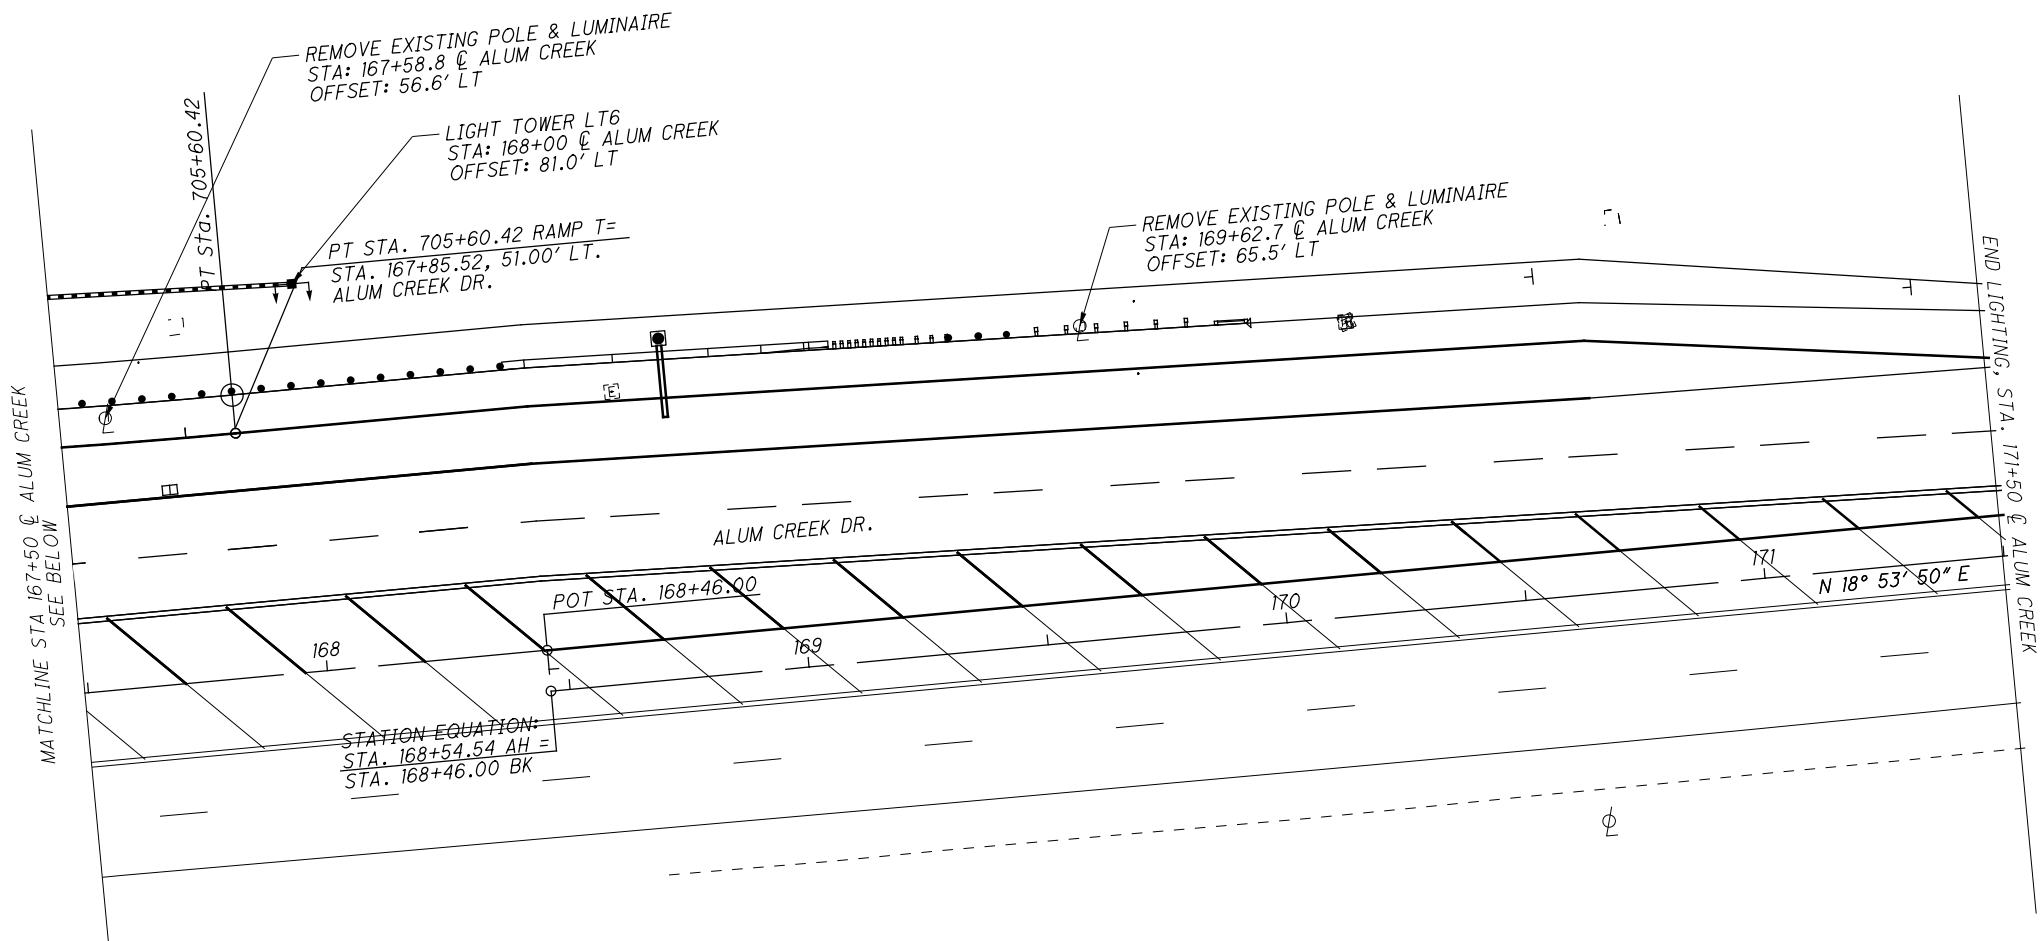


BU 4, 5, 6, 7, & 8 - RELEASED FOR CONSTRUCTION - 11/03/2014 - 11/19/2015

LIGHTING PLAN ALUM CREEK DR.

FRA - 270 - 49.00

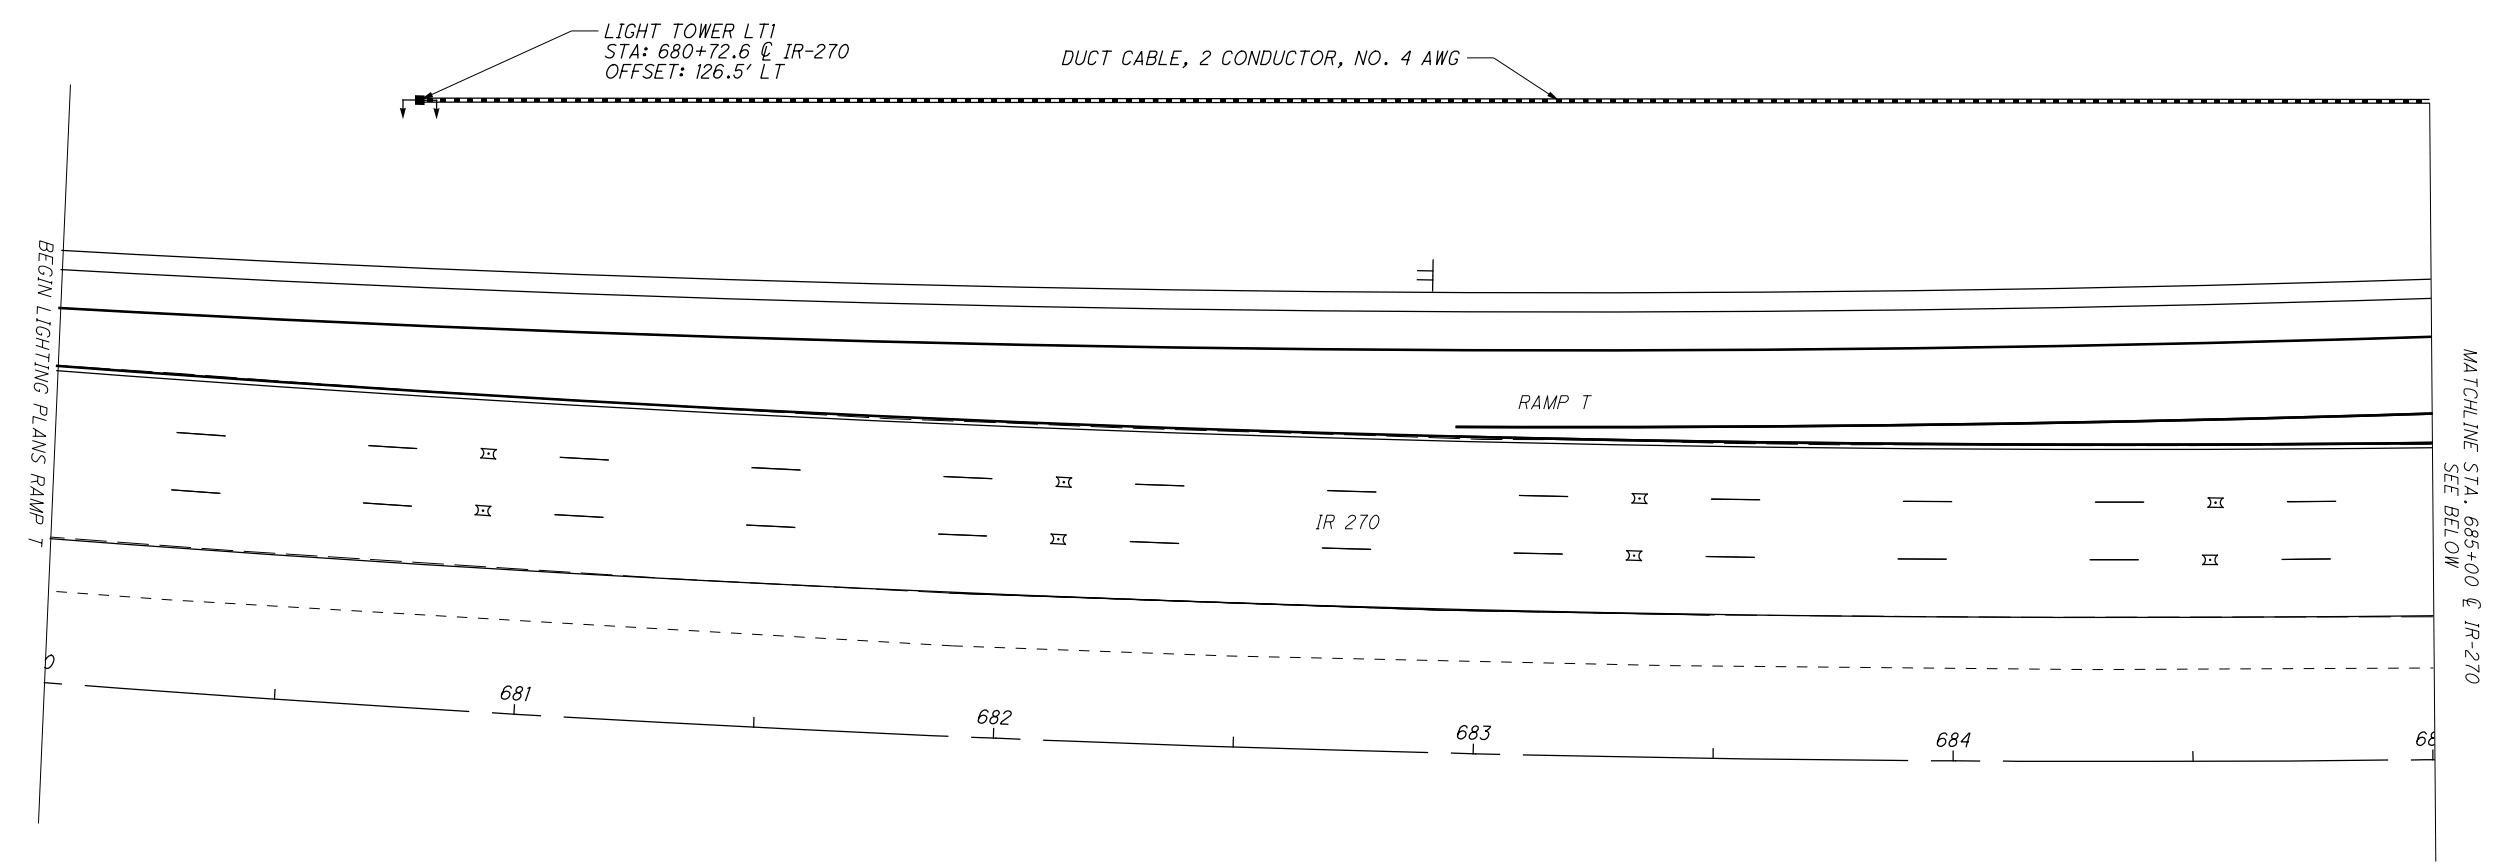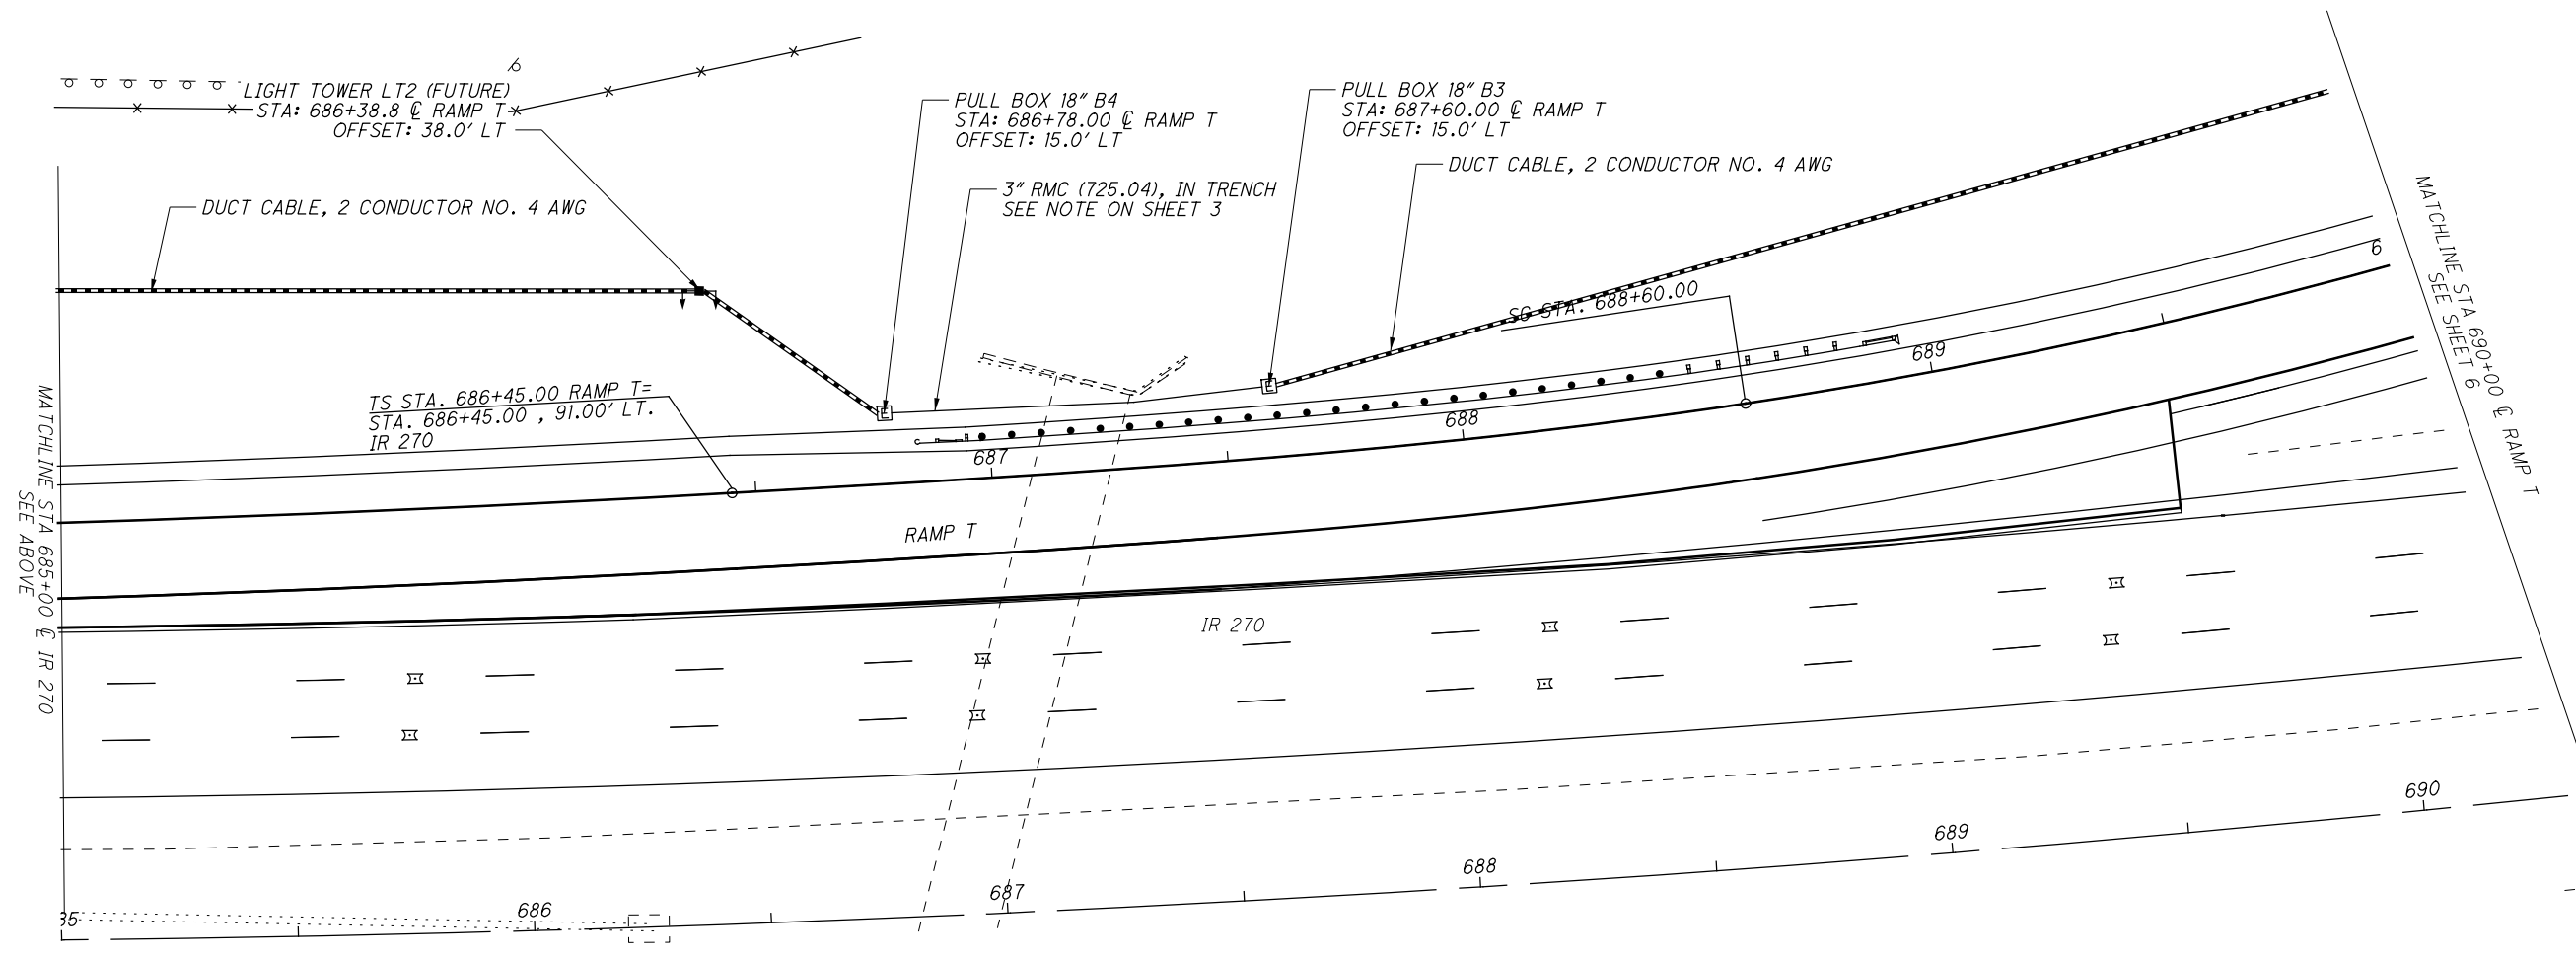

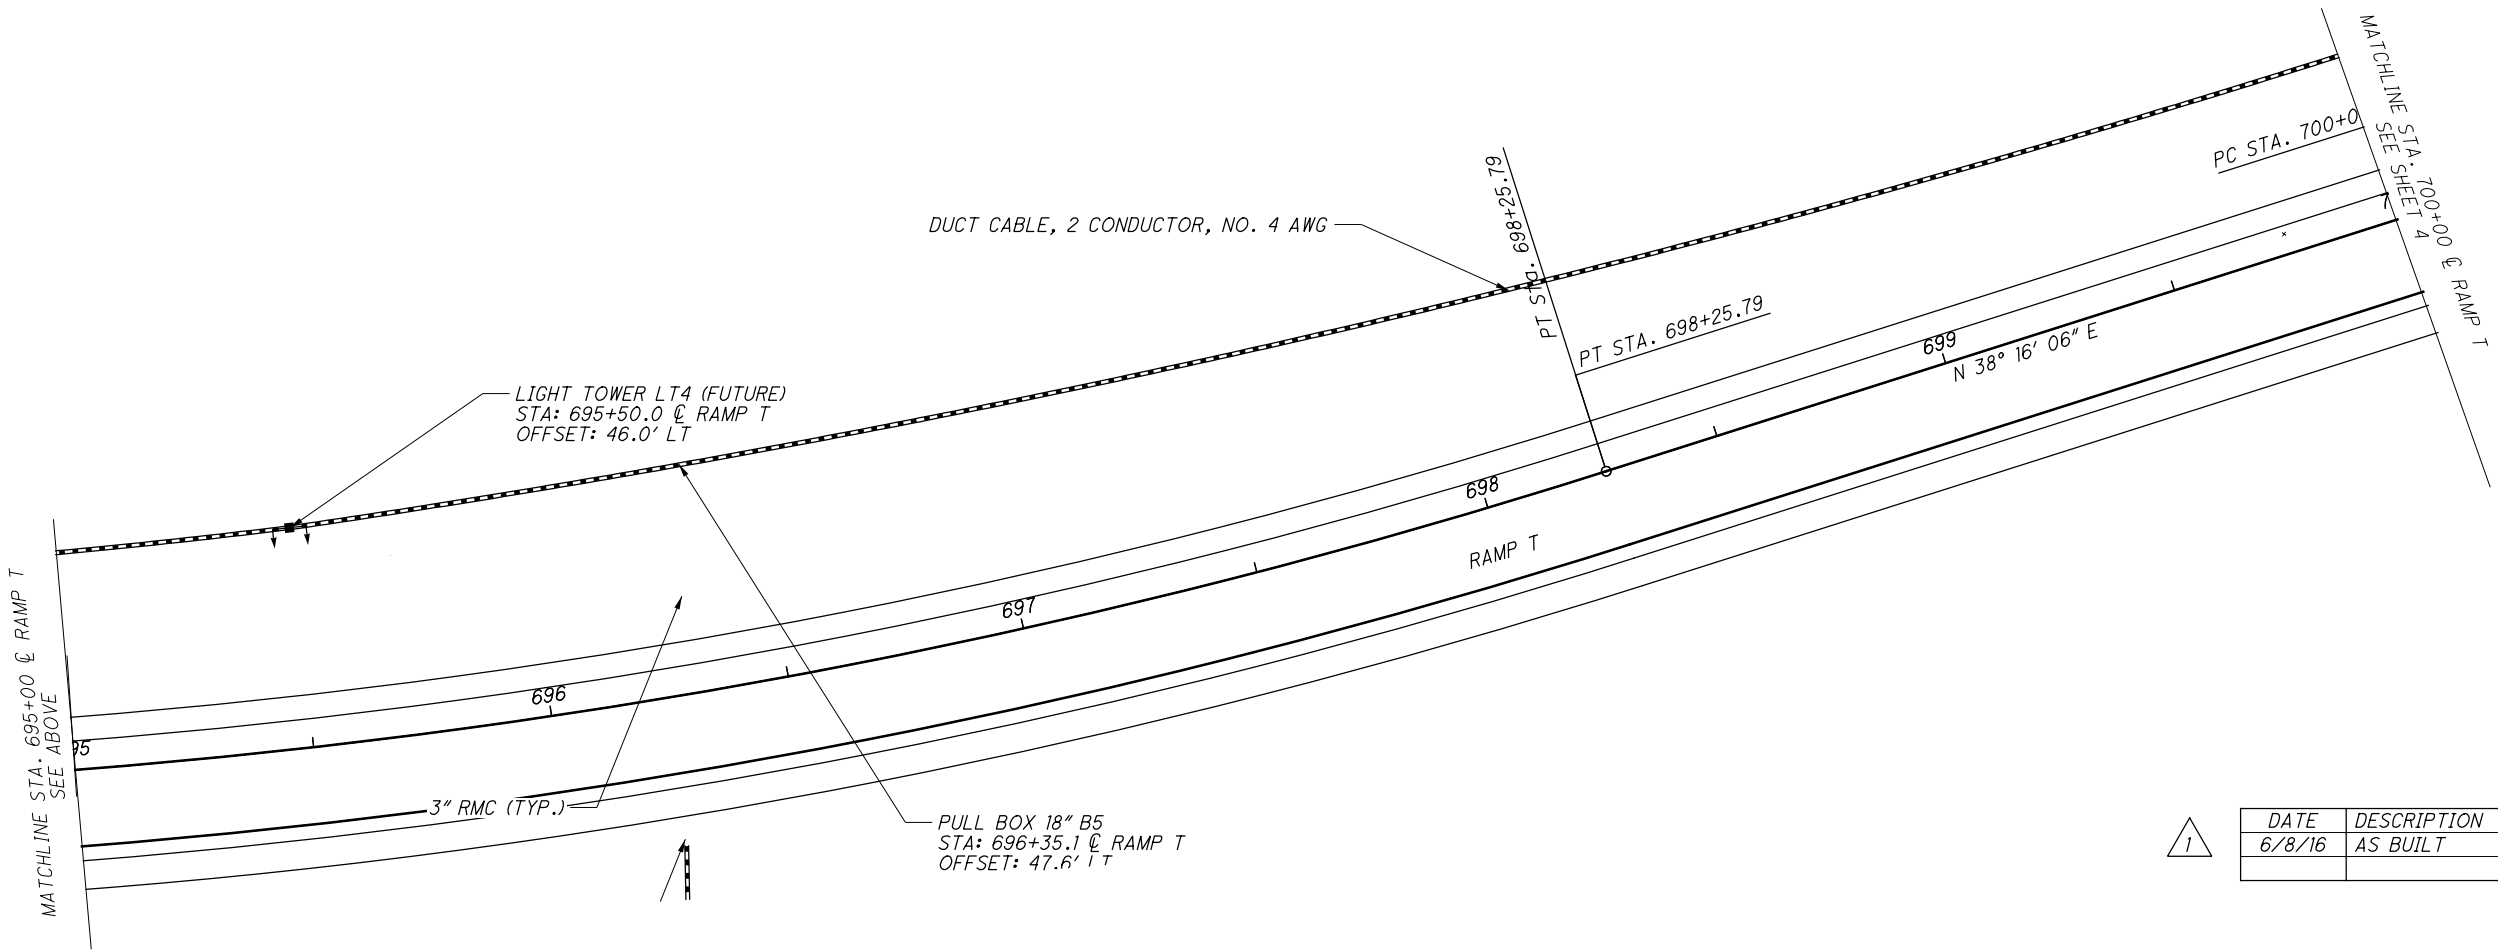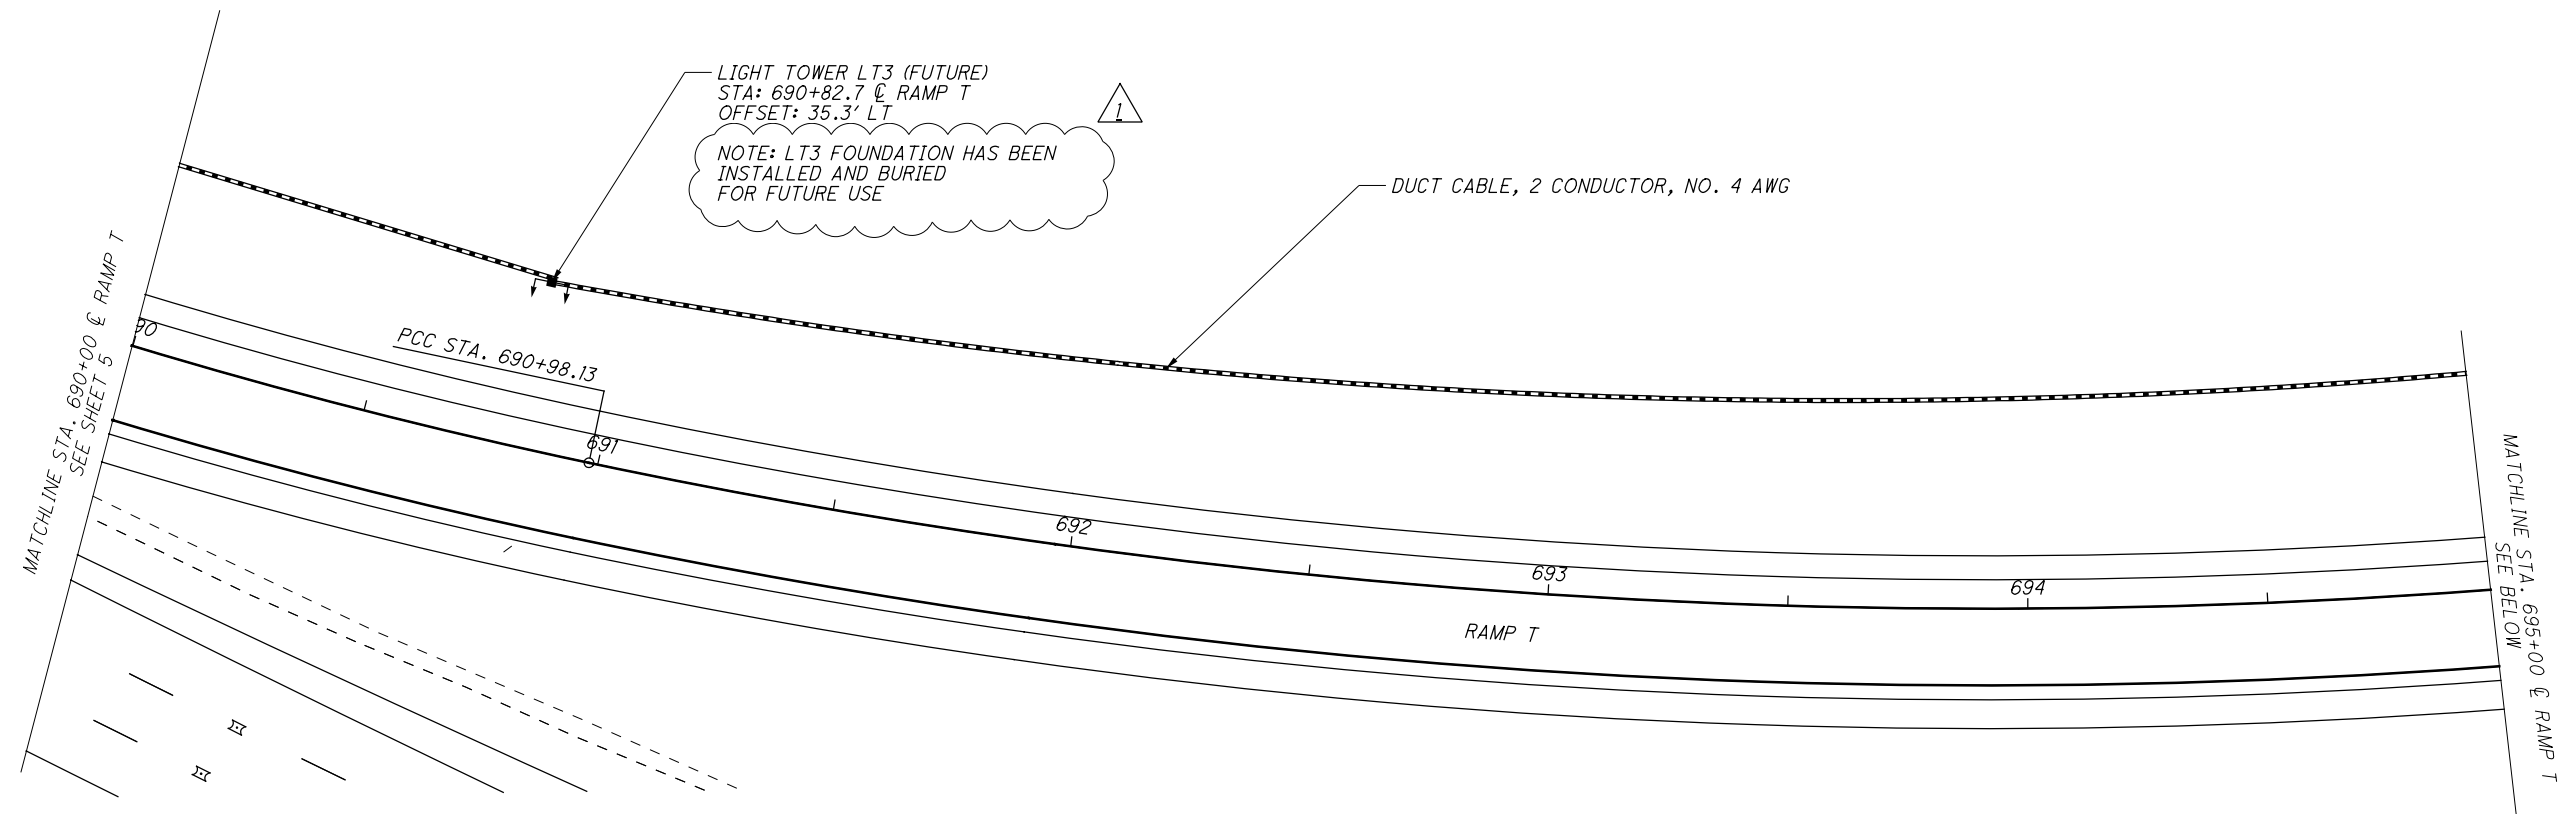

DATE	DESCRIPTION
6/8/16	AS BUILT

CALCULATED
SGB
CHECKED
ERW

0 20 40
HORIZONTAL
SCALE IN FEET

BU 4, 5, 6, 7, & 8 - RELEASED FOR CONSTRUCTION - 11/03/2014 - 11/19/2015

LIGHTING PLAN: RAMP T
STA. 690+00 TO STA. 700+00


FRA - 270 - 49.00

AS BUILT - 4/22/2016

6/15/2016 10:41:51 AM synchro

K:\2014 Projects\14115 Resource International\003 FRA IR 270 49.00\As Bults\Obsolete Sources\83988L\PO04.dgn

MATCHLINE STA 702+00 @ RAMP X
SEE SHEET 4

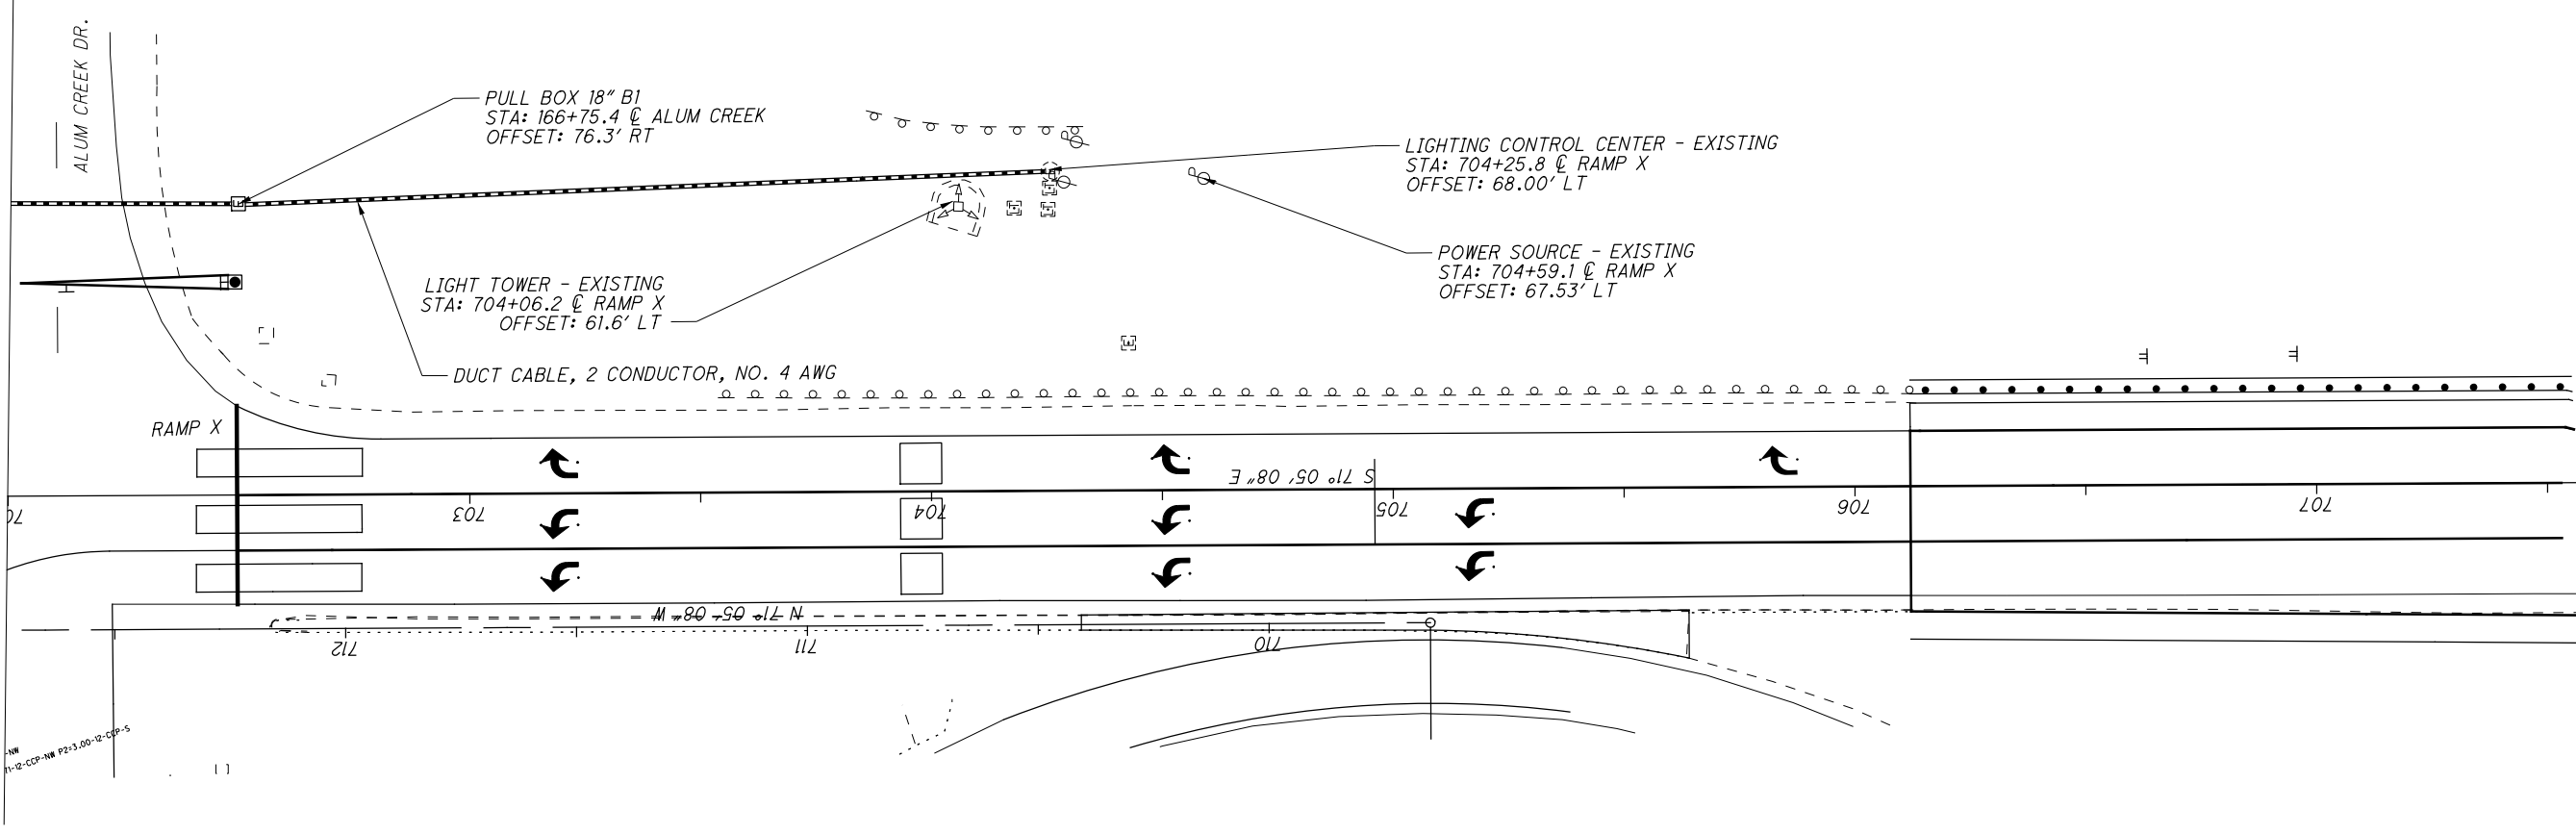

BU 4, 5, 6, 7, & 8 - RELEASED FOR CONSTRUCTION - 11/03/2014 - 11/19/2015

FRA - 270 - 49.00

LIGHTING PLAN: RAMP X
BEGIN CONSTRUCTION TO END OF RAMP X

CALCULATED
SGB
CHECKED
ERW



125
182

NEW TRAFFIC SIGNAL INSTALLATION

THIS WORK CONSISTS OF FURNISHING AND INSTALLING TRAFFIC SIGNAL EQUIPMENT, COMPLETE AND READY FOR SERVICE. THIS WORK ALSO INCLUDES NECESSARY EXCAVATION AND BACKFILL, DISPOSAL OF DISCARDED MATERIALS, RESTORATION OF DISTURBED FACILITIES AND SURFACES TO A CONDITION EQUAL TO THAT EXISTING BEFORE THE WORK STARTED, AND ELECTRICAL TESTING AS SPECIFIED.

PULL BOXES, CONDUITS, GROUND RODS, AND CABLE SPLICING KITS REQUIRED FOR TRAFFIC SIGNAL EQUIPMENT INSTALLATIONS ARE SPECIFIED IN ITEM 625. BEFORE ANY WORK IS STARTED ON THE TRAFFIC SIGNAL, THE DISTRICT SIX TRAFFIC ENGINEER (740-833-8198) AND THE CONTRACTORS REPRESENTATIVE SHALL REVIEW AND RESOLVE ANY POTENTIAL PROBLEMS AT THE LOCATION WHERE THE NEW SIGNAL WILL BE CONSTRUCTED.

ALL OF THE REQUIRED PERMANENT SIGNS SHALL BE ERECTED AND THE REQUIRED PAVEMENT MARKINGS SHALL BE IN PLACE PRIOR TO THE FINAL ACCEPTANCE OF THE TRAFFIC SIGNAL.

PRIOR TO THE FINAL ACCEPTANCE OF THE COMPLETED SIGNAL, THE DISTRICT SIX ROADWAY SERVICES REPRESENTATIVE AND THE CONTRACTORS REPRESENTATIVE, SHALL INSPECT AND RESOLVE ANY EXISTING PROBLEMS PRIOR TO THE ACCEPTANCE OF EACH NEW SIGNAL BY THE OHIO DEPARTMENT OF TRANSPORTATION.

MAINTENANCE OF TRAFFIC SIGNAL INSTALLATIONS

THE CONTRACTOR SHALL BE RESPONSIBLE FOR MAINTAINING TRAFFIC SIGNAL INSTALLATIONS WITHIN THE PROJECT UNDER THE FOLLOWING CIRCUMSTANCES:

- EXISTING SIGNAL INSTALLATION WHICH THE PLANS REQUIRE THE CONTRACTOR TO ADJUST, MODIFY, ADD ONTO OR REMOVE OR WHICH THE CONTRACTOR ACTUALLY ADJUSTS, MODIFIES, OR OTHERWISE DISTURBS: THE CONTRACTOR SHALL BE RESPONSIBLE FOR THE ENTIRE INSTALLATION (AT AN INTERSECTION) FROM THE TIME THE CONTRACTOR'S OPERATIONS FIRST DISTURB THE INSTALLATION UNTIL THE INSTALLATION HAS BEEN SUBSEQUENTLY REMOVED OR MODIFIED AND THE WORK IS ACCEPTED.
 - NEW SIGNAL INSTALLATION OR DEVICE, INSTALLED BY THE CONTRACTOR: THE CONTRACTOR SHALL BE RESPONSIBLE FOR MAINTENANCE OF THIS FROM THE TIME OF INSTALLATION UNTIL THE WORK IS ACCEPTED.
- THE CONTRACTOR SHALL CORRECT AS QUICKLY AS POSSIBLE ALL OUTAGES OR MALFUNCTIONS AND PROVIDE THE MAINTAINING AGENCY AND THE ENGINEER SUCH WITH THE NAME(S) AND THE PHONE NUMBER(S) OF THE CONTRACTORS REPRESENTATIVE(S) TO RECEIVE ALL CALLS AND DISPATCH THE NECESSARY MAINTENANCE FORCES TO CORRECT OUTAGES. SUCH A PERSON OR PERSONS MUST GIVE PROMPT ATTENTION TO THESE CALLS AND BE READILY AVAILABLE CONTINUOUSLY 24 HOURS A DAY, 7 DAYS A WEEK. ALL LAMP OUTAGES, CABLE OUTAGES, ELECTRICAL FAILURES, EQUIPMENT MALFUNCTIONS AND MISALIGNED SIGNAL HEADS SHALL BE CORRECTED TO THE SATISFACTION OF THE ENGINEER WITH THE SIGNAL BACK IN SERVICE WITHIN FOUR HOURS AFTER THE CONTRACTOR HAS BEEN NOTIFIED OF AN OUTAGE.
- IN THE EVENT NEW SIGNALS ARE DAMAGED PRIOR TO ACCEPTANCE, ALL DAMAGED EQUIPMENT EXCEPT POLES AND CONTROL EQUIPMENT SHALL BE REPLACED BY THE CONTRACTOR TO THE SATISFACTION OF THE ENGINEER WITH THE NEW SIGNAL BACK IN SERVICE WITHIN 8 HOURS AFTER THE CONTRACTOR HAS BEEN NOTIFIED OF THE OUTAGE. THE CONTRACTOR SHALL ARRANGE FOR FULL TRAFFIC CONTROL UNTIL THE SIGNAL IS BACK IN OPERATION.
- IF POLES AND/OR CONTROLLERS ARE DAMAGED AND MUST BE REPLACED, THE CONTRACTOR SHALL MAKE TEMPORARY REPAIRS AS NECESSARY TO BRING THE SIGNAL BACK INTO OPERATION WITHIN THE ALLOWED 8 HOUR TIME PERIOD, AND SHALL MAKE PERMANENT REPAIRS OR REPLACEMENT AS SOON THEREAFTER AS POSSIBLE. NONE OF THE ABOVE SHALL BE CONSTRUED AS COLLECTIVE OR CONSECUTIVE OUTAGE TIME PERIODS AT ANY ONE LOCATION. THAT IS, WHERE MORE THAN ONE OUTAGE OCCURS AT ANY ONE LOCATION THEN THE ALLOTTED TIME LIMIT SHALL BE FOR THE WORST SINGLE OUTAGE.
- WHERE OUTAGES ARE THE DIRECT RESULT OF A VEHICLE ACCIDENT THE RESPONSE OF THE CONTRACTOR SHALL BE AS OUTLINE ABOVE. THE CONTRACTOR SHALL BE RESPONSIBLE FOR THE COLLECTION OF ANY COMPENSATION FOR THIS WORK FROM THOSE PARTIES RESPONSIBLE FOR THE DAMAGE.
- WHERE THE CONTRACTOR HAS FAILED OR CANNOT RESPOND TO AN OUTAGE OR SIGNAL EQUIPMENT MALFUNCTION, AT THESE LOCATIONS WITHIN HIS RESPONSIBILITY, WITHIN PERIODS AS SPECIFIED ABOVE, THE ENGINEER MAY INVOKE THE PROVISIONS OF SECTION 105.15 AND ANY SUBSEQUENT BILLINGS TO THE STATE FOR POLICE SERVICES AND MAINTENANCE SERVICES BY THE PROVIDING AGENCY FORCES SHALL BE DEDUCTED FROM MONIES DUE OR TO BECOME DUE THE CONTRACTOR IN ACCORDANCE WITH PROVISIONS OF SECTION 105.15. ANY VEHICULAR TRAFFIC SIGNAL HEAD EITHER NEW OR EXISTING THAT WILL BE OUT OF OPERATION SHALL BE COVERED IN THE MANNER DESCRIBED IN 632.25. THE CONTRACTOR SHALL MAINTAIN COMPLETE RECORDS OF MALFUNCTIONS INCLUDING:
- TIME OF NOTIFICATION OF MALFUNCTION;
 - TIME OF WORK CREWS ARRIVAL TO CORRECT MALFUNCTION;
 - ACTIONS TAKEN TO CORRECT THE MALFUNCTION, INCLUDING A LIST OF PARTS REPAIRED AND REPLACED;
 - A DIAGNOSIS OR REASON FOR THE MALFUNCTION AND PROBABILITY OF REOCCURENCE;
 - TIME OF COMPLETION OF THE REPAIR AND SYSTEM RESTORED TO FULL SERVICE; A COPY OF THESE RECORDS SHALL BE PROVIDED TO THE ENGINEER WITHIN THREE (3) WORKING DAYS FOLLOWING COMPLETION OF EACH REPAIR.
- ALL COSTS RESULTING FROM THE ABOVE REQUIREMENTS SHALL BE CONSIDERED TO BE INCLUDING IN THE LUMP SUM PRICE BID FOR ITEM 614, MAINTAINING TRAFFIC.

TRAFFIC SIGNAL NOTES

GROUNDING AND BONDING

THE REQUIREMENTS OF THE CONSTRUCTION AND MATERIAL SPECIFICATIONS (CMS) AND THE TC SERIES OF STANDARD CONSTRUCTION DRAWINGS ARE MODIFIED AS FOLLOWS:

- ALL METALLIC PARTS CONTAINING ELECTRICAL CONDUCTORS SHALL BE PERMANENTLY JOINED TO FORM AN EFFECTIVE GROUND FAULT CURRENT PATH BACK TO THE GROUNDED CONDUCTOR IN THE POWER SERVICE DISCONNECT SWITCH.
 - PROVIDE AN EQUIPMENT GROUNDING CONDUCTOR IN METALLIC CONDUITS (725.04) IN ADDITION TO THE CONDUCTORS SPECIFIED AND BOND THE CONDUIT TO THIS GROUNDING CONDUCTOR.
 - WHEN AN EQUIPMENT GROUNDING CONDUCTOR IS REQUIRED IN PLASTIC CONDUIT (725.05), THE INSTALLATION SHALL INCLUDE A SEPARATE EQUIPMENT GROUNDING CONDUCTOR IN ADDITION TO THE CONDUCTORS SPECIFIED.
 - METALLIC CONDUIT CARRYING THE LOOP WIRES FROM IN THE PAVEMENT TO THE PULL BOX SPLICE LOCATION WILL ONLY BE BONDED AT THE PULL BOX END, AND WILL NOT CONTAIN AN EQUIPMENT GROUNDING CONDUCTOR.
 - IF MULTIPLE CONDUIT RUNS BEGIN AND END AT THE SAME POINTS, ONLY ONE EQUIPMENT GROUNDING CONDUCTOR IS REQUIRED.
 - IF AN EQUIPMENT GROUNDING CONDUCTOR IS NEEDED IN CONDUIT BETWEEN SIGNALIZED INTERSECTIONS FOR UNDERGROUND INTERCONNECT CABLE, THE GROUNDING SYSTEM FOR EACH SIGNALIZED INTERSECTION WILL BE SEPARATED ABOUT MIDWAY BETWEEN THE INTERSECTIONS.
 - THE MESSENGER WIRE AT SIGNALIZED INTERSECTIONS WILL BE USED AS THE CONDUCTIVE PATH FROM CORNER TO CORNER IF CONDUIT IS NOT PROVIDED UNDER THE ROADWAY. WHEN CONDUIT CONNECTS THE CORNERS OF AN INTERSECTION, AN EQUIPMENT GROUNDING CONDUCTOR SHALL BE USED IN THE CONDUIT.
- CONDUITS.
 - THE 725.04 CONDUIT SHALL HAVE GROUNDING BUSHINGS INSTALLED AT ALL TERMINATION POINTS. THE BUSHING MATERIAL SHALL BE COMPATIBLE WITH GALVANIZED STEEL CONDUIT AND THE GROUNDING LUG MATERIAL SHALL BE COMPATIBLE FOR USE WITH COPPER WIRE. THREADED OR COMPRESSION TYPE BUSHINGS MAY BE USED.
 - THE 725.05 CONDUIT SHALL HAVE THE INSIDE AND OUTSIDE DIAMETERS OF THE CONDUIT DEBURRED AT ALL TERMINATION POINTS.
 - BOTH ENDS OF METALLIC CONDUIT SHALL BE BONDED TO THE EQUIPMENT GROUNDING CONDUCTOR.
 - METALLIC CONDUIT MAY BE BONDED TO METALLIC BOXES THROUGH THE USE OF CONDUIT FITTINGS UL APPROVED FOR THIS TYPE OF CONNECTION, WITH THE BOX BONDED TO THE EQUIPMENT GROUNDING CONDUCTOR.
- WIRE FOR GROUNDING AND BONDING.
 - USE INSULATED, COPPER WIRE FOR THE EQUIPMENT GROUNDING CONDUCTOR. BONDING JUMPERS IN BOXES AND ENCLOSURES MAY BE BARE OR INSULATED COPPER WIRE. WIRE SIZE SHALL BE AS FOLLOWS:
 - USE 4 AWG BETWEEN THE POWER SERVICE AND SUPPORTS, POLES, PEDESTALS, CONTROLLER OR FLASHER CABINETS.
 - USE A MINIM UM 8 AWG BETWEEN LOOP DETECTOR PULL BOXES AND THE FIRST CONDUIT THAT REQUIRES A LARGER SIZE AS SPECIFIED IN 3.A.I ABOVE.
 - USE A MINIMUM 8 AWG BETWEEN THE "PREPARE TO STOP WHEN FLASHING" INSTALLATION (INCLUDING SUPPORT) AND THE FIRST CONDUIT THAT REQUIRES A LARGER SIZE AS SPECIFIED IN 3.A.I ABOVE.
 - THE INSULATION SHALL BE GREEN OR GREEN WITH YELLOW STRIPE(S). FOR 4 AWG OR LARGER, INSULATION MAY ALSO BE BLACK WITH GREEN TAPE/LABELS INSTALLED AT ALL ACCESS POINTS.
 - IN A HIGHWAY LIGHTING SYSTEM, THE EQUIPMENT GROUNDING CONDUCTOR SHALL BE THE SAME WIRE SIZE AS THE DUCT CABLE OR DISTRIBUTION CABLE CIRCUIT CONDUCTORS, WITH THE MINIMUM CONDUCTOR SIZE OF 4 AWG. BONDING JUMPERS WILL BE MINIMUM SIZE 4 AWG.
- GROUND ROD.
 - A 3/4 INCH SCHEDULE 40 PVC CONDUIT WILL BE USED IN FOUNDATIONS AND CONCRETE WALLS FOR THE GROUNDING CONDUCTOR (GROUND WIRE) RACEWAY TO THE GROUND ROD. SHOULD METALLIC CONDUIT BE USED, BOTH ENDS OF THE CONDUIT SHALL BE BONDED TO THE GROUNDING CONDUCTOR.
 - THE TYPICAL GROUNDING CONDUCTOR (GROUND WIRE) SHALL BE 4 AWG INSULATED, COPPER.
- THE GREEN CONDUCTOR IN SIGNAL CABLES (CONDUCTOR #4) SHALL NOT BE USED TO SUPPLY POWER TO A SIGNAL INDICATION. IT WILL BE CONNECTED TO THE SIGNAL BODY AS AN EQUIPMENT GROUND IN ALUMINUM HEADS AND IT WILL BE UNUSED IN PLASTIC HEADS. UNUSED CONDUCTORS SHALL BE GROUNDED IN THE CABINET. TYPICAL USE OF CONDUCTORS IS AS FOLLOWS:

COND. NO.	COLOR	VEHICLE SIGNAL	PEDESTRIAN SIGNAL
1	BLACK	GREEN BALL	#1 WALK
2	WHITE	AC NEUTRAL	AC NEUTRAL
3	RED	RED BALL	#1 DW/FDW
4	GREEN	EQUIPMENT GROUND	QUIPMENT GROUND
5	ORANGE	YELLOW BALL	#2 DW/FDW
6	BLUE	GREEN ARROW	#2 WALK
7	WHITE/BLACK STRIPE	YELLOW ARROW	NOT USED
- POWER SERVICE AND DISCONNECT SWITCH.
 - AT THE POWER SERVICE LOCATION, THE GROUNDING CONDUCTOR (GROUND WIRE) FROM THE DISCONNECT SWITCH NEUTRAL (AC-) BAR TO THE GROUND ROD SHALL BE A CONTINUOUS, UNSPLICED CONDUCTOR. IF SPLICED, IT SHALL BE AN EXOTHERMIC WELD BUTT SPICE.

- THE SERVICE NEUTRAL (AC-) SHALL ONLY BE CONNECTED TO GROUND AT THE PRIMARY POWER SERVICE DISCONNECT SWITCH.
 - NEMA CONTROLLER CABINETS: IF A POWER SERVICE DISCONNECT SWITCH IS LOCATED BEFORE THE CONTROLLER CABINET, THE NEUTRAL (AC-) AND THE GROUNDING BARS IN THE CONTROLLER CABINET SHALL NOT BE CONNECTED TOGETHER AS SHOWN IN NEMA TS-2, FIGURE 5-4.
 - IF SECONDARY DISCONNECT SWITCHES ARE CONNECTED AFTER THE PRIMARY DISCONNECT SWITCH, THE NEUTRAL (AC-) SHALL ONLY BE GROUNDED AT THE PRIMARY SWITCH. EQUIPMENT GROUNDING CONDUCTORS SHALL BE BROUGHT TO THE PRIMARY SWITCH, BUT SHALL BE GROUNDED AT BOTH SECONDARY AND PRIMARY SWITCHES.

614 MAINTAINING TRAFFIC, MISC.: TEMPORARY SIGNAL DETECTION

THE CONTRACTOR SHALL PROVIDE TEMPORARY DETECTION FOR THE EXISTING TRAFFIC SIGNALS WITHIN THE PROJECT AREA AS NEEDED TO MAINTAIN PROPER SIGNAL OPERATION THROUFHOUT ALL PHASES OF CONSTRUCTION.

DETECTION CAN BE ACCOMPLISHED THROUGH THE USE OF LOOP, VIDEO, OR RADAR DETECTION OR ANY COMBINATION OF THESE. THIS ITEM INCLUDES ALL MATERIALS AND LABOR FOR THE INSTALLATION OF THE TEMPORARY DETECTION AND ANY MODIFICATION REQUIRED TO PROVIDE PROPER SIGNAL OPERATION FOR EACH PHASE OF CONSTRUCTION.

632 REMOVAL OF TRAFFIC SIGNAL INSTALLATION, AS PER PLAN

TRAFFIC SIGNAL INSTALLATIONS, INCLUDING SIGNAL HEADS, CABLE, MESSENGER WIRE, STRAIN POLES, CABINET, CONTROLLER, ETC., SHALL BE REMOVED IN ACCORDANCE WITH CMS 632.26 AND AS INDICATED ON THE PLANS.

THE CONTRACTOR SHALL CONTACT CHARLES FISHER 740.833.8267 WHEN THE FOLLOWING ITEMS LISTED BELOW ARE READY FOR PICK UP. THESE ITEMS SHALL BE STORED SAFELY UNTIL THEY ARE PICKED UP BY ODOT DISTRICT 6.

- CONTROLLER CABINETS AND ALL CONTENTS
- VIDEO DETECTION UNITS AND ALL ASSOCIATED EQUIPMENT
- UPS CAPINETS ADN ALL CONTENTS
- VEHICULAR SIGNAL HEADS (EB RAMP ONLY)

IN THE EVENT THE ITEMS ARE NOT SALVAGED BY THE ENGINEERS OFFICE THE CONTRACTOR SHALL, WHEN DIRECTED BY THE ENGINEER IN WRITING, REMOVE AND DISPOSE OF THE ITEMS AT NO ADDITIONAL COST TO THE PROJECT.

632 SIGNAL SUPPORT. (BY TYPE), BY DESIGN, AS PER PLAN

POLE LOCATIONS HAVE BEEN INDICATED AS ACCURATELY AS POSSIBLE. IN NO CASE SHALL THE CLEARANCE FROM THE FACE OF CURB TO THE POLE, PEDESTRIAN SIGNAL, SIGN OR OTHER PROPOSED ITEMS BE LESS THAN 2 FT.

SIGNAL MAST ARM POLES SHALL MEET THE REQUIREMENT OF 732.11. POLES AND MAST ARMS SHALL BE PAINTED BLACK AND SHALL BE GALVANIZED PER ITEM 711.02.

632 VEHICULAR SIGNAL HEAD, LED, BLACK, (BY TYPE), WITH BACK PLATE, AS PER PLAN:

- IN ADDITION TO THE REQUIREMENTS OF CMS 632 AND 732, THE FOLLOWING SHALL APPLY:
- SIGNAL HEADS AND VISORS SHALL BE CONSTRUCTED OF BLACK POLYCARBONATE PLASTIC WITH VISORS AS SPECIFIED AND MEET ITE SPECIFICATIONS.
 - PROPER EXTERIOR COLORS SHALL BE OBTAINED BY USE OF COLORED PLASTIC MATERIAL RATHER THAN PAINTING.
 - ALL UPPER SIGNAL SUPPORT HARDWARE AND PIPING UP TO AND INCLUDING THE WIRE INLET FITTING SHALL BE FERROUS METAL.
 - THE ENTRANCE FITTING SHALL BE OF THE TRI-STUD DESIGN WITH SERRATED RINGS IN ORDER TO ACHIEVE POSITIVE LOCKING.
 - ALUMINUM BACKPLATES SHALL BE IN ACCORDANCE WITH CMS 732.22 AND INCLUDE A FLOURESCENT YELLOW REFLECTIVE BORDER.
 - THE LIGHT EMITTING DIODE (LED) SIGNAL LAMP UNITS SHALL MEET THE REQUIREMENTS OF CMS 732.04-C. THE CONTRACTOR SHALL PROVIDE ODOT, IN WRITING, WITH THE LED MANUFACTURER NAME, SERIAL NUMBER, PART NUMBER, DESCRIPTION OF LAMP, AND DATE OF MANUFACTURE FOR ALL LED UNITS THAT ARE TO BE USED IN THE SIGNAL HEAD PRIOR TO INSTALLATION, FOR ACCEPTANCE AND WARRANTY PURPOSES.
 - SIGNAL HEADS SHALL HAVE A MINIMUM WALL THICKNESS OF 0.117 INCHES.
 - SIGNAL HEADS SHALL INCLUDE CUTAWAY TYPE VISORS
 - APPLY A BEAD OF SILICONE TO THE SIGNAL HEAD, WASHER, AND ENTRANCE ADAPTER SERRATIONS TO PREVENT WATER INTRUSION. ALSO, FILL THE SPACE BETWEEN CONCENTRIC SERRATION RINGS ON THE TOP OF THE SIGNAL HEAD TO COMPLETELY EXCLUDE WATER FROM THE SPACE BETWEEN THE CONCENTRIC RINGS.

TRAFFIC SIGNAL NOTES

632 SIGNALIZATION, MISC.: CDMA MODEM, FURNISH ONLY

FURNISH A CDMA MODEM, TWO ANTENNAS WITH A 10-FOOT CABLE, AND A 10-FOOT ETHERNET CABLE FOR REMOTE WIRELESS CELLULAR COMMUNICATION. FOR NETWORK CONSISTENCY CDMA MODEMS SHALL BE THE SIERRA WIRELESS AIRLINK GX440 ETHERNET MODEL.

THIS ITEM SHALL INCLUDE THE FURNISHING OF A CONTROL ROCKETLINX ES8105 ETHERNET SWITCH WITH ALL POWER SUPPLIES NECESSARY TO FUNCTION.

THIS ITEM SHALL INCLUDE THE FURNISHING AND INSTALLATION OF A MOUNTING BRACKET FOR THE ANTENNA WITH ALL NECESSARY HARDWARE INCLUDING BUT NOT LIMITED TO SPRING NUTS, WASHERS, AND BOLTS THAT INSTALLS TO THE MOUNTING CHANNEL ON THE SIDE OF THE SIGNAL CABINET.

THE CDMA MODEM EQUIPMENT AND ETHERNET SWITCH SHALL BE DELIVERED TO ODOT DISTRICT 6 TRAFFIC FOR PROGRAMMING AND INSTALLATION.

ODOT DISTRICT 6 TRAFFIC
ATTN: KRAIG SHREWSBERRY
400 E. WILLIAM ST.
DELAWARE, OH 43015

THE CONTRACTOR SHALL PROVIDE THE MODEM SERIAL NUMBERS AND NECESSARY ESN NUMBERS FOR ODOT TO ESTABLISH WIRELESS SERVICE.

ITEM - 632 POWER SERVICE

THE CONTRACTOR SHALL CONTACT THE METER SECTION OF AMERICAN ELECTRIC POWER FOR INFORMATION REGARDING THE METER BASE INSTALLATION PRIOR TO ORDERING POLES. THE CONTRACTOR WILL BE RESPONSIBLE FOR REQUESTING AND SCHEDULING ANY INSPECTIONS THE POWER COMPANY MAY REQUIRE FOR THE POWER SERVICE HOOP UP. THE CONTRACTOR SHALL BE RESPONSIBLE TO CONTACT THE POWER COMPANY FOR THE ELECTRICAL SERVICE CONNECTION. UNDER NO CIRCUMSTANCES SHALL THE CONTRACTOR SPLICE POWER CABLE TO THE POWER COMPANY'S CIRCUITS. THE VOLTAGE SUPPLIED SHALL BE NOMINALLY 120 VOLTS. THE CONTRACTOR IS RESPONSIBLE FOR OBTAINING ANY NECESSARY PERMITS AND THE PAYING OF ALL FEES WITH THE EXCEPTION OF NORMAL MONTHLY ENERGY CHARGES. THE CONTRACTOR SHALL COORDINATE WITH THE POWER COMPANY TO CONTINUE BILLING ON THE EXISTING DISTRICT 6 ACCOUNT.

THE EXISTING SIGNAL ADDRESS ARE TO BE MAINTAINED:

- FRA-270 WB RAMPS & ALUM CREEK DR.
4600 ALUM CREEK DR.
COLUMBUS, OH 43207
- FRA-270 EB RAMPS ALUM CREEK DR.
4701 ALUM CREEK DR.
COLUMBUS, OH 43207

ITEM 633 - UNINTERRUPTIBLE POWER SUPPLY (UPS), 1000 WATT, AS PER PLAN:

IN ADDITION TO THE REQUIREMENTS OF CMS 633 AND 733, A 12-INCH CABINET RISER AND ANCHOR BOLTS SHALL BE PROVIDED WITH THE BASE MOUNTED CABINET. THE UPS CABINET SHALL INCLUDE AN AUXILIARY POWER PANEL WITH A HEAVY DUTY POWER RELAY VERSUS THE LINE VOLTAGE GENERATOR SWITCH. THE GENERATOR INLET SHALL BE A RECESSED PANEL WITH A DOOR THAT IS FLUSH WITH THE EXTERNAL SIDE OF THE UPS CABINET. IT SHALL INCLUDE A RECESSED PLUG, MANUAL TRANSFER SWITCH, A DOOR THAT SECURELY CLOSES OVER THE POWER CORD, AND AN LED LIGHT THAT INDICATES LINE POWER IS AVAILABLE. EACH BATTERY SHALL BE 12VDC AND BE RATED AT 105 AHRS TO ACHIEVE THE 2.5 HOUR RUN TIME REQUIREMENT. FURNISH BATTERIES EASILY REPLACED AND COMMERCIALY AVAILABLE OFF THE SHELF. FURNISH DEEP CYCLE, SEALED PRISMATIC LEAD-CALCIUM BASED AGM/VRLA (ABSORBED GLASS MAT/VALVE REGULATED LEAD ACID) BATTERIES. FURNISH BATTERIES CERTIFIED BY THE MANUFACTURER TO OPERATE OVER A TEMPERATURE RANGE OF -13°F TO +165°F. PLACE ALL BATTERIES ON BATTERY HEATER MATS IN THE ENCLOSURE. BATTERIES SHALL BE WARRANTED FOR FULL REPLACEMENT FOR TWO (2) YEARS FROM DATE OF ACCEPTANCE.

THE UPS OUTPUT NOTIFICATIONS FOR ON BATTERY, BATTERY 2 HOUR TIMER, AND LOW BATTERY SHALL BE WIRED INTO THE TRAFFIC SIGNAL CABINET BACK PANEL TO PROVIDE SPECIAL STATUS ALARMS FOR EACH OUTPUT INTO THE SIGNAL CONTROLLER. SPECIAL STATUS ALARMS SHALL BE PROGRAMMED INTO THE CONTROLLER.

THIS ITEM SHALL INCLUDE A RED LED STATUS INDICATOR LAMP TO ALLOW MAINTENANCE PERSONNEL AND LAW ENFORCEMENT TO QUICKLY ASSESS WHETHER A TRAFFIC SIGNAL CABINET IS BEING POWERED BY A UPS. THE LED HOUSING SHALL BE NEMA 4X, IP65 OR IP66, RATED FOR OUTDOOR USE AND BE TAMPER/SHATTER RESISTANT. IT SHALL BE A DOMED ENCLOSURE CONTAINING A RED LENS WITH LED THAT IS VISIBLE FROM 100 FEET MINIMUM. THE ENCLOSURE AND LED LAMP UNIT SHALL BE PLACED ON THE STREET-SIDE OF THE CABINET OR CENTERED ON THE TOP SURFACE OF THE UPS CABINET AND SEALED FROM WATER INTRUSION. IT SHOULD BE WIRED USING MINIMUM 20GA STRANDED, INSULATED HOOKUP WIRE TO THE STATUS RELAY OUTPUTS OF THE UPS. THE WIRES SHALL BE TERMINATED BY LUGS AT THE DISPLAY END AND PERMANENTLY LABELED "BACKUP POWER STATUS DISPLAY," WITH WIRE POLARITY INDICATED. THE RED LED SHALL ONLY ILLUMINATE TO INDICATE THE CABINET IS OPERATING UNDER UPS BACKUP POWER (THE "BACKUP" OPERATING CONDITION). THIS ITEM ALSO INCLUDES PROGRAMMING THE UPS STATUS RELAY OUTPUTS TO PRODUCE THE LAMP STATUS DISPLAYS. THESE STATUS DISPLAYS WILL BE SOLID 100% DUTY CYCLE (NOT FLASHING) DISPLAYS.

ITEM 632 - CONTROLLER UNIT, TYPE TS2/A2, WITH CABINET, TYPE TS2, AS PER PLAN

THE ELECTRICAL TRAFFIC CONTROL EQUIPMENT PROVIDED SHALL MEET THE FOLLOWING SPECIFICATIONS AND BE MANUFACTURED BY EAGLE TRAFFIC CONTROL SYSTEMS. THE EQUIPMENT PROVIDED AS PART OF THIS CONTRACT SHALL BE THE LATEST MODEL, CURRENTLY UNDER PRODUCTION AND NEW. THE CONTROLLER CABINET AND ACCESSORIES SHALL MEET THE NEMA TS-2, 1992 STANDARD FOR ACTUATED CONTROLLER UNITS. THE CATALOG NUMBER FOR THE GROUND MOUNTED P CABINET SHALL BE EL 712 OR NEWER. THE CABINET SHALL BE ALUMINUM WITH THE NATURAL ALUMINUM FINISH INSIDE AND OUTSIDE. THE LOAD BAY SHALL BE THE TF5016 OR NEWER, WITH 16 LOAD SWITCH POSITIONS. PROVIDE ONLY THE EXACT NUMBER OF LOAD SWITCHES REQUIRED. EACH LOAD SWITCH SHALL HAVE LIGHT EMITTING DIODES (LEDS) FOR THE CONTROLLER OUTPUT AND LOAD SWITCH OUTPUT. ALSO PROVIDE 8 FLASH RELAY POSITIONS (BUT ONLY SUPPLY THE EXACT NUMBER OF RELAYS NEEDED FOR EACH SPECIFIC INTERSECTION), 1 NEMA 2-CIRCUIT FLASHER, AND AN MMU MONITOR. EACH CABINET SHALL COME EQUIPPED WITH TWO 16-CHANNEL CABINET DETECTOR RACKS (CDR) INCLUDING BUS INTERFACE UNITS (BIU). THE LOOP DETECTOR TERMINATION PANEL FOR THE SECOND DETECTOR RACK SHALL BE OMITTED. WHERE LOOP DETECTORS ARE SPECIFIED, THE CABINET SHALL INCLUDE THE EXACT NUMBER OF FOUR CHANNEL DETECTOR CARDS WITH SOFTWARE REQUIRED FOR EACH INTERSECTION. THE CABINET SHALL BE EQUIPPED WITH A CABINET POWER SUPPLY (CPS). THE POLICE PANEL ON THE OUTSIDE OF THE CABINET DOOR SHALL HAVE A FLASH SWITCH, A SWITCH FOR AUTOMATIC/MANUAL OPERATION, SIGNAL ON/OFF SWITCH AND A MANUAL PUSHBUTTON WITH A MINIMUM CORD LENGTH OF 10 FEET. THE TECHNICIAN PANEL ON THE INSIDE OF THE CABINET DOOR SHALL INCLUDE A FLASH SWITCH, A STOP TIME SWITCH, AND AN EQUIPMENT ON/OFF SWITCH. A CABINET DOOR OPEN SWITCH AND A CABINET LIGHT ON / OFF SWITCH SHALL ALSO BE SUPPLIED.

THE CONTROLLER CABINET SHALL ALSO INCLUDE:
A SLIDE-OUT LAPTOP SHELF INTERIOR, UNDERSHELF LED CABINET LIGHTING, INCLUDING A MINIMUM OF 2 PANELS OF 6 HIGH-INTENSITY LED'S EACH AND A DOOR-ACTIVATED SWITCH. THE LED PANELS SHALL BE MOUNTED IN LOCATIONS TO MAXIMIZE LIGHT ON THE CABINET EQUIPMENT.
A GOOSENECK/ADJUSTABLE LIGHT FIXTURE WITH AN LED LAMP. THE ADJUSTABLE LIGHT FIXTURE SHALL BE MOUNTED ON THE LOWER RIGHT SIDE OF THE CONTROLLER CABINET.
A MINIMUM OF TWO (2) GFCI PROTECTED RECEPTACLES
A MINIMUM OF SIX (6) SURGE PROTECTED (NON-GFCI) RECEPTACLES

CONTROLLER CABINET LABELING TO IDENTIFY THE WIRING AND FUNCTION

DETECTOR LEAD-IN CABLE
PHASE NUMBER SERVICE, DIRECTION, MOVEMENT TYPE, AND LOOP PLAN NUMBER.
SIGNAL HEAD FIELD WIRING
PHASE NUMBER, DIRECTION, MOVEMENT TYPE, AND COLOR (RED, YELLOW, GREEN, YELLOW ARROW, GREEN ARROW) OR PEDESTRIAN MOVEMENT.

THE CONTROLLER TIMER SHALL BE THE GENESIS, EPAC3***M52 (OR MOST CURRENT MODEL) NEMA TS-2 TYPE 2 AND COME EQUIPPED WITH ALL INTERNAL COMPONENTS TO MAKE IT FULLY SYSTEM READY FOR THE ACTRA (OR LATEST) SYSTEM, INCLUDING THE INTERNAL MODEM. EACH CONTROLLER TIMER SHALL HAVE 6 MODES OF COORDINATION, ADAPTIVE TRAFFIC CONTROL, REPORTS, PREEMPTION / PRIORITY, DIAGNOSTICS AND INTERNAL TIME BASE CONTROL. THE CONTROLLER SHALL INCLUDE A "PORT 3 MODULE" AND AN ETHERNET PORT.

EACH CONDUIT ENTRANCE TO THE CABINET SHALL BE SEALED WITH A RUBBER PIPE/CONDUIT SEAL GASKET. THE SEAL SHALL BE OF A MATERIAL AND TYPE TIGHTLY FITTING AND ABLE TO SEAL OUT WATER, INSECTS, RODENTS, AND DIRT. THE SEAL SHALL BE EASILY REMOVED FOR SERVICE INSTALLATIONS OR CABLE REPLACEMENTS.

THE CONTRACTOR SHALL PROVIDE THE CABINET WIRING DIAGRAM/PLANS IN .PDF FORMAT TO ODOT DISTRICT 6 TRAFFIC.

ITEM 633 - DILEMMA ZONE DETECTION SYSTEM

THIS ITEM OF WORK SHALL CONSIST OF FURNISHING AND INSTALLING A WAVETRONIX SMARTSENSOR ADVANCE DETECTION UNIT (MODEL SS-200E). THE DETECTION UNIT SHALL INCLUDE THE FOLLOWING:
- POWER SHALL BE PROVIDED FROM THE TRAFFIC CABINET.
- ALL REQUIRED INPUTS CARDS SHALL BE INCLUDED IN THE TRAFFIC CABINET AND SHALL BE COMPATIBLE WITH CALTRANS, NEMA TS1 AND NEMA TS2 DETECTOR RACKS. THE CARDS SHALL PROVIDE TRUE PRESENCE DETECTOR CALLS OR CONTACT CLOSURE TO THE TRAFFIC CONTROLLER.
- THE UNIT SHALL BE MOUNTED DIRECTLY TO A POLE OR MAST ARM, AS RECOMMENDED BY THE MANUFACTURER. CABLE(S) SHALL BE PROVIDED AS REQUIRED AND RECOMMENDED BY THE MANUFACTURER.
- SURGE PROTECTION DEVICES, AS RECOMMENDED BY THE MANUFACTURER SHALL BE INCLUDED BOTH AT THE POLE WHERE THE UNIT IS LOCATED TO PROTECT THE UNIT AND IN THE TRAFFIC CABINET TO PROTECT THE CABINET ELECTRONICS.
- THE MANUFACTURER'S REPRESENTATIVE SHALL BE ON SITE DURING INSTALLATION AND TESTING AND SHALL PROVIDE ONSITE TRAINING ON THE SETUP, OPERATION AND MAINTENANCE OF THE UNIT.
- A SERIAL TO ETHERNET COMMUNICATIONS MODULE AND ETHERNET CABLE (MIN. 7 FEET)
- THE POWER SUPPLY AND COMMUNICATION MODULES SHALL BE SECURED TO A SINGLE PANEL THAT CAN BE MOUNTED INTERIOR TO THE TRAFFIC CABINET. THE PANEL SHALL INCLUDE MODULAR-PLUG STYLE CONNECTIONS FOR A UP TO FOUR (4) SENSOR CABLES. ADDITIONAL SENSORS MAY BE HARD-WIRED TO THE COMMUNICATION MODULES, AS NECESSARY.
- PRIOR TO PROGRAMMING, THE CONTRACTOR SHALL CONTACT THE ODOT DISTRICT 6 DISTRICT TRAFFIC ENGINEER AT 740-833-8198. A DISTRICT 6 TRAFFIC DEPARTMENT REPRESENTATIVE SHALL BE PRESENT DURING THE PROGRAMMING OF THE SYSTEM.

ITEM 633 - STOP BAR DETECTION RADAR UNIT

ITEM 633 STOP BAR DETECTION RADAR UNIT:
THIS ITEM OF WORK SHALL CONSIST OF FURNISHING AND INSTALLING A WAVETRONIX SMARTSENSOR MATRIX DETECTION UNIT. THE DETECTION UNIT SHALL INCLUDE THE FOLLOWING:
- POWER SHALL BE PROVIDED FROM THE TRAFFIC CABINET.
- ALL REQUIRED INPUTS CARDS SHALL BE INCLUDED IN THE TRAFFIC CABINET AND SHALL BE COMPATIBLE WITH CALTRANS, NEMA TS1 AND NEMA TS2 DETECTOR RACKS. THE CARDS SHALL PROVIDE TRUE PRESENCE DETECTOR CALLS OR CONTACT CLOSURE TO THE TRAFFIC CONTROLLER.
- THE UNIT SHALL BE MOUNTED DIRECTLY TO A POLE OR MAST ARM, AS RECOMMENDED BY THE MANUFACTURER. CABLE(S) SHALL BE PROVIDED AS REQUIRED AND RECOMMENDED BY THE MANUFACTURER.
- SURGE PROTECTION DEVICES, AS RECOMMENDED BY THE MANUFACTURER SHALL BE INCLUDED BOTH AT THE POLE WHERE THE UNIT IS LOCATED TO PROTECT THE UNIT AND IN THE TRAFFIC CABINET TO PROTECT THE CABINET ELECTRONICS.
- THE MANUFACTURER'S REPRESENTATIVE SHALL BE ON SITE DURING INSTALLATION AND TESTING AND SHALL PROVIDE ONSITE TRAINING ON THE SETUP, OPERATION AND MAINTENANCE OF THE UNIT.
- A SERIAL TO ETHERNET COMMUNICATIONS MODULE AND ETHERNET CABLE (MIN. 7 FEET)
- THE POWER SUPPLY AND COMMUNICATION MODULES SHALL BE SECURED TO A SINGLE PANEL THAT CAN BE MOUNTED INTERIOR TO THE TRAFFIC CABINET.
THE PANEL SHALL INCLUDE MODULAR-PLUG STYLE CONNECTIONS FOR A UP TO FOUR (4) SENSOR CABLES. ADDITIONAL SENSORS MAY BE HARD-WIRED TO THE COMMUNICATION MODULES, AS NECESSARY.
- PRIOR TO PROGRAMMING, THE CONTRACTOR SHALL CONTACT THE ODOT DISTRICT 6 DISTRICT TRAFFIC ENGINEER AT 740-833-8198. A DISTRICT 6 TRAFFIC DEPARTMENT REPRESENTATIVE SHALL BE PRESENT DURING THE PROGRAMMING OF THE SYSTEM.

AS BUILT - 4/22/2016

K:\2014 Projects\14115 Resource International\003 FRA IR 270 49.00\As BUILT\Obsolete Sources\83988CN003.dgn 6/15/2016 10:35:28 AM synchro

TRAFFIC SIGNAL NOTES

ITEM 633 SPREAD SPECTRUM RADIO

THE CONTRACTOR SHALL FURNISH AND INSTALL THE SPREAD SPECTRUM RADIO INTERCONNECT SYSTEM AND ALL NECESSARY ACCESSORIES THAT ARE REQUIRED TO MAKE THE CLOSED LOOP SYSTEM FUNCTIONAL AND OPERATIONAL. ITEMS TO BE INCLUDED ARE YAGI ANTENNA AT ALL LOCAL CONTROLLERS.

ALL LOCATIONS SHALL INCLUDE, BUT NOT LIMITED TO, GROUND STRAP FOR COAX SHIELD, POLY PHASER, SPREAD SPECTRUM RADIO (MDS TRANSNET 900 PRE-APPROVED EQUAL), COAX CABLE WITH MANUFACTURER RECOMMENDED CONNECTORS. SOFTWARE AND CONNECTORS TO PROGRAM THE RADIOS.

THE CONTRACTOR SHALL PERFORM A SITE SURVEY AT EACH RADIO LOCATION AND EVALUATE THE ANTENNA LOCATIONS FOR THE PURPOSE OF RELIABLE COMMUNICATIONS. IF THE CONTRACTOR DETERMINES A PROBLEM TO EXIST IT SHOULD BE BROUGHT TO THE ATTENTION OF THE PROJECT ENGINEER/COORDINATOR.

632 SIGNAL SUPPORT, MECHANICAL DAMPER FOR TC-81.21 MAST ARM (GREATER THAN 59' IN LENGTH), AS PER PLAN

THIS ITEM SHALL CONSIST OF THE CONTRACTOR INSTALLING A TUNED MECHANICAL STOCKBRIDGE OR MASS-SPRING TYPE DAMPER ON A TC-81.21 MAST ARM SIGNAL SUPPORT TO REDUCE THE POSSIBILITY OF HARMONIC VIBRATIONS CAUSED BY WIND LOADS. A MECHANICAL DAMPER SHALL BE APPLIED TO ALL MAST ARMS OVER 59 FEET IN LENGTH. THE INSTALLED DAMPER SHALL BE CAPABLE OF REDUCING THE LOADED MAXIMUM VERTICAL MOVEMENT AT THE TIP OF THE ARM TO 8 INCHES MEASURED FROM THE HIGHEST TO THE LOWEST POINT OF DEFLECTION AT WIND SPEEDS OF 5-20 MPH.

ALL ATTACHMENT HARDWARE CONNECTIONS SHALL BE STAINLESS STEEL. STOCKBRIDGE-TYPE DAMPERS SHALL HAVE A STAINLESS STEEL SAFETY CHAIN ANCHORED TO THE MAST ARM TO PREVENT WEIGHTS FROM FALLING SHOULD THEY BECOME SEPARATED FROM THE REST OF THE ASSEMBLY. THE DAMPER SHALL BE ATTACHED TO THE ARM WITHIN 8 FEET OF MAST ARM TIP. INSTALLATION SHALL BE PER THE MANUFACTURER'S GUIDELINES. STATIC DAMPERS SUCH AS HORIZONTAL FLAT SIGN MOUNTINGS SHALL NOT BE USED. ACCEPTABLE DEVICES INCLUDE THE FOLLOWING OR

- APPROVED EQUAL:
1. UNION METAL ALCOA DAMPER DEVICE DWG. NO. 2G-1817-C1
 2. VALMONT STRUCTURES ALCOA DEVICE DWG. NO. OH104242 P1
 3. FLORIDA DOT SPRING-MASS DAMPER DRAWING INDEX NO. 17749


CALCULATED
SGB
CHECKED
ERW

BU 4, 5, 6, 7, & 8 - RELEASED FOR CONSTRUCTION - 11/03/2014 - 11/19/2015

FRA - 270 - 49.00


TRAFFIC SIGNAL NOTES

- LEGEND**
- ↑ SIGNAL HEAD
 - ! PEDESTRIAN PUSHBUTTON
 - ☒ CONTROLLER CABINET
 - ☒ PULLBOX
 - SIGNAL SUPPORT
 - PEDESTAL
 - ▭ DETECTION ZONE

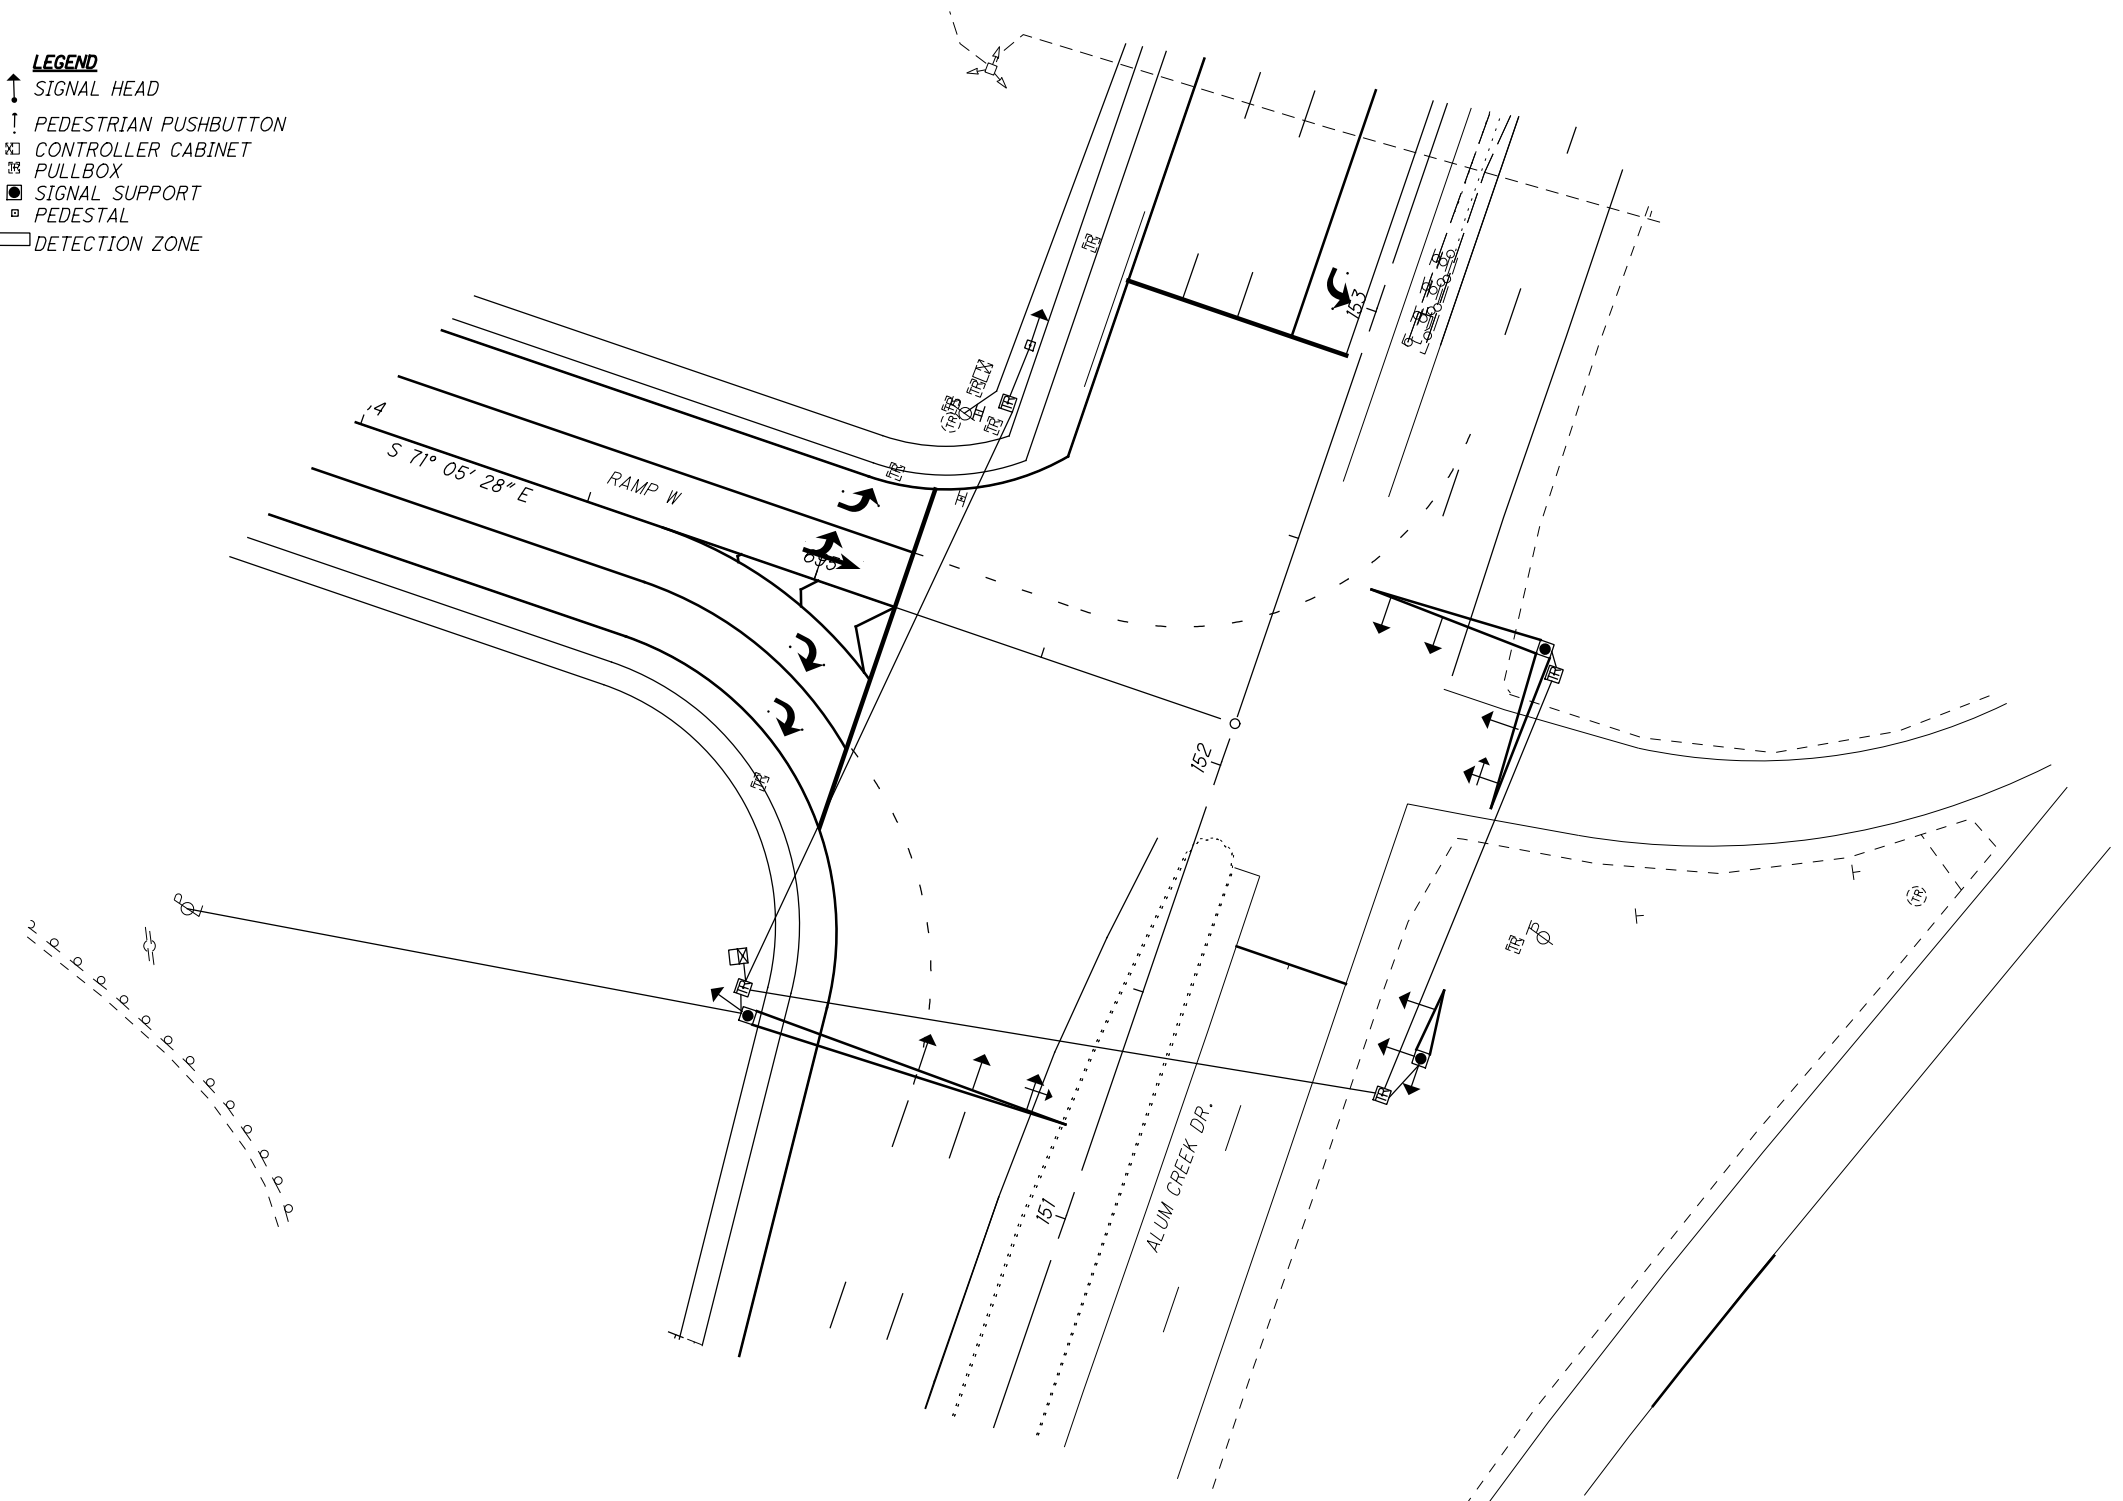


PROPOSED SIGNALS

PROPOSED 12 in. POLYCARBONATE (1FD) BLACK SIGNAL HEADS WITH BACKPLATES

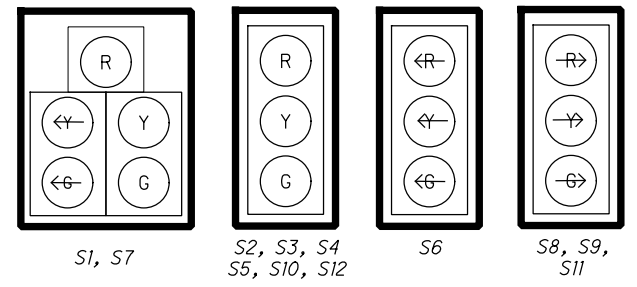

PROPOSED FLAT SHEET SIGNS

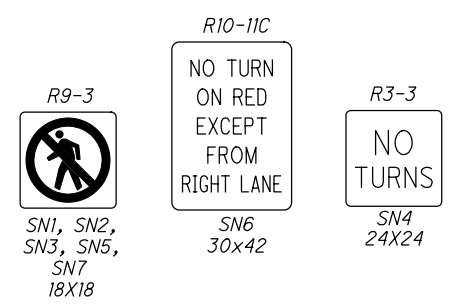


NOTES

1. ALL SIGNAL HEADS AND SIGNS SHALL BE FIELD ADJUSTED BY THE CONTRACTOR AS DIRECTED BY THE ENGINEER TO ENSURE CORRECT PLACEMENT
2. ALL PULLBOXES ARE 24" EXCEPT PULLBOX B2 & B3
3. POLE LOCATIONS HAVE BEEN INDICATED AS ACCURATELY AS POSSIBLE. IN NO CASE SHALL THE CLEARANCE FROM FACE OF CURB TO FACE OF POLE, PEDESTRIAN SIGNAL, SIGN OR OTHER PROPOSED ITEMS BE LESS THAN 2 FT. TOP OF POLE FOUNDATIONS SHALL BE FLUSH WITH ADJACENT WALK WAYS.


FIELD WIRING HOOK-UP CHART

SIGNAL HEAD	INDICATION	FIELD TERMINAL	FLASH
S1 (SBL)	R	φ 6 R	R
	Y	φ 6 Y	
	G	φ 6 G	
	←Y	φ 1 Y	
	←G	φ 1 G	
S2,S3 (SB)	R	φ 6 R	R
	Y	φ 6 Y	
	G	φ 6 G	
S4,S5,S10 (NB)	R	φ 2 R	R
	Y	φ 2 Y	
	G	φ 2 G	
S6 (EBL)	←R	φ 4 R	R
	←Y	φ 4 Y	
	←G	φ 4 G	
S7 (EBL)	R	φ 4 R	R
	Y	φ 4 Y	
	G	φ 4 G	
	←Y	φ 4 Y	
S8,S9,S11 (EBR)	←R	OLA	R
	←Y	OLA	
	←G	OLA	

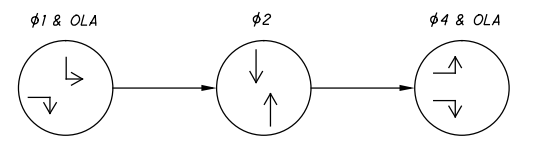

PROPOSED PHASE DIAGRAM



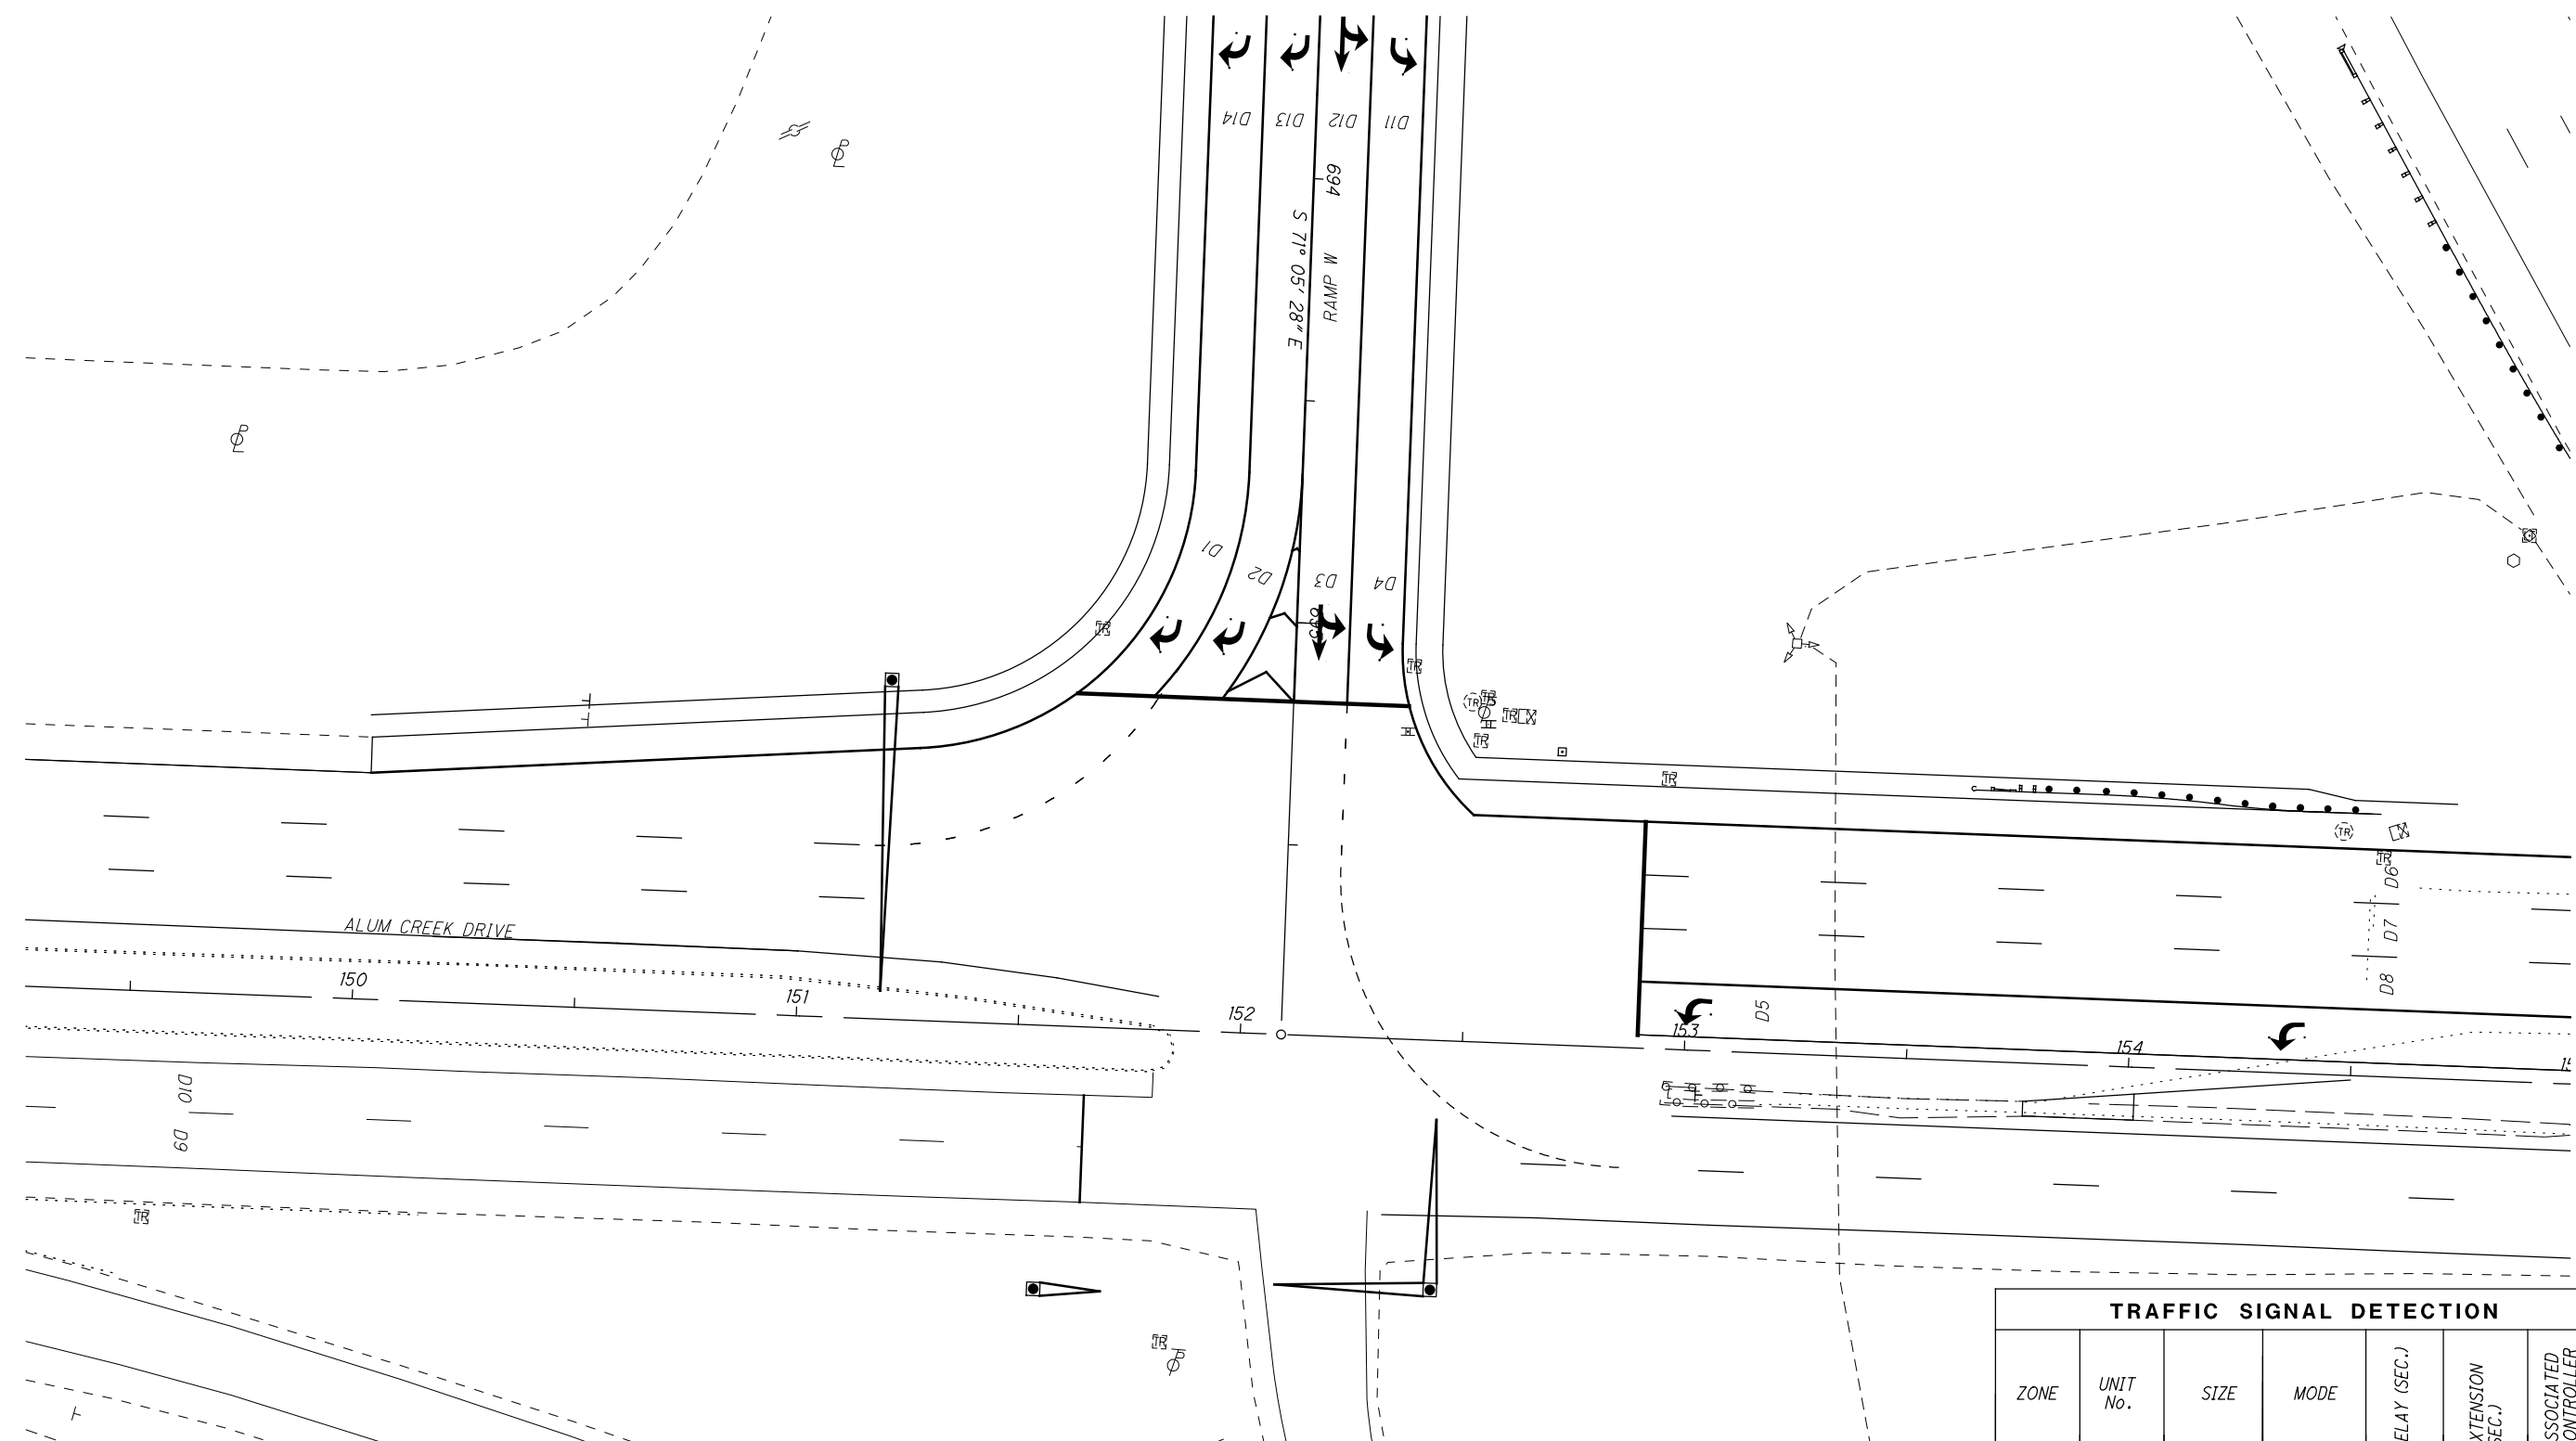

PROPOSED VEHICLE DETECTION PLAN

TRAFFIC SIGNAL DETECTION						
ZONE	UNIT No.	SIZE	MODE	DELAY (SEC.)	EXTENSION (SEC.)	ASSOCIATED CONTROLLER PHASE
D1	SB1	RADAR	PRESENCE	10	-	4
D2	SB1	RADAR	PRESENCE	5	-	4
D3	SB1	RADAR	PRESENCE	5	-	4
D4	SB1	RADAR	PRESENCE	5	-	4
D5	SB2	RADAR	PRESENCE	5	-	1
D6	AR2	RADAR	PULSE	-	-	6
D7	AR2	RADAR	PULSE	-	-	6
D8	AR2	RADAR	PULSE	-	-	6
D9	AR1	RADAR	PULSE	-	-	2
D10	AR1	RADAR	PULSE	-	-	2
D11	AR3	RADAR	PULSE	-	-	4
D12	AR3	RADAR	PULSE	-	-	4
D13	AR3	RADAR	PULSE	-	-	4
D14	AR3	RADAR	PULSE	-	-	4

BU 4.5.6.7 & 8 - RELEASED FOR CONSTRUCTION - 11/03/2014 - 11/19/2015

CALCULATED
SGB
CHECKED
ERW

0 20 40
HORIZONTAL SCALE IN FEET


TRAFFIC SIGNAL PLAN
ALUM CREEK DRIVE AND RAMP W

FRA - 270 49.00


ITEM	QTY	UNIT	ITEM DESCRIPTION
625	250	FT.	CONDUIT, JACKED OR DRILLED, 3"
625	270	FT.	CONDUIT, 3", 725.04
625	2	EACH	PULL BOX, 725.08, 18"
625	2	EACH	PULL BOX, 725.08, 24"
625	5	EACH	GROUND ROD
625	270	FT.	TRENCH
625	270	FT.	PLASTIC CAUTION TAPE
630	2	EACH	SIGN HANGER ASSEMBLY, MAST ARM
630	4	EACH	SIGN SUPPORT ASSEMBLY, POLE MOUNTED
630	24	S.F.	SIGN, FLAT SHEET
630	15	FT.	GROUND MOUNTED SUPPORT, NO. 2 POST
632	10	EACH	VEHICULAR SIGNAL HEAD, (LED), BLACK, 3 SECTION, 12" LENS 1-WAY WITH BACKPLATE, AS PER PLAN
632	2	EACH	VEHICULAR SIGNAL HEAD, (LED), BLACK, 5 SECTION, 12" LENS 1-WAY WITH BACKPLATE, AS PER PLAN
632	12	EACH	COVERING OF VEHICULAR SIGNAL HEAD
632	1825	FT.	SIGNAL CABLE, 7 CONDUCTOR, NO. 14 AWG
632	3	EACH	SIGNAL SUPPORT FOUNDATION
632	1	EACH	PEDESTAL FOUNDATION
632	210	FT.	POWER CABLE, 3 CONDUCTOR, NO. 4 AWG
632	1	EACH	POWER SERVICE, AS PER PLAN
632	1	EACH	SIGNAL SUPPORT, MECHANICAL DAMPER FOR TC-8121 MAST ARM (GREATER THAN 59' IN LENGTH), AS PER PLAN
632	1	EACH	SIGNAL SUPPORT, TYPE TC-81.21, DESIGN 14, AS PER PLAN
632	1	EACH	SIGNAL SUPPORT, TYPE TC-81.21, DESIGN 4, WITH MAST ARMS DESIGN 2 AND 3, AS PER PLAN
632	1	EACH	SIGNAL SUPPORT, TYPE TC-81.21, DESIGN 1, AS PER PLAN
632	1	EACH	PEDESTAL, 8', TRANSFORMER BASE, AS PER PLAN
632	1	EACH	SIGNALIZATION MISC.: CDMA MODEM, FURNISH ONLY
632	1	EACH	REMOVAL OF TRAFFIC SIGNAL INSTALLATION, AS PER PLAN
633	1	EACH	CONTROLLER UNIT, TYPE TS2/A2, WITH CABINET TYPE TSI, AS PER PLAN
633	1	EACH	CABINET RISER
633	1	EACH	CABINET FOUNDATION
633	1	EACH	CONTROLLER WORK PAD
633	3	EACH	ADVANCE/DILEMMA ZONE DETECTION RADAR
633	2	EACH	STOP BAR DETECTION RADAR
633	1	EACH	UNINTERRUPTIBLE POWER SUPPLY (UPS), 1000 WATT

SUPPORT NO.	LOCATION	STATION AND OFFSET		POLE TYPE	FOUNDATION ELEVATION	POLE HEIGHT	POLE DESIGN	MAST ARM "A" (FT)	MAST ARM "B" (FT)	L1 (FT)	L2 (FT)	L3 (FT)	L4 (FT)	L5 (FT)	L6 (FT)	ELEV.		INDEX ANGLE (DEG.)	ANGLES (DEG.) FROM INDEX LINE							
																A	B		MAST ARM B	PED SIGNAL	PUSHBUTTON	SIGN	LUMINAIRE	DISCONNECT	HANDHOLE	VEH SIGNAL
P1**	SW	151+18.6,	76.4' LT	TC-81.21	-	23'	14	70	-	44	54	68	-	-	-	-	-	0	-	-	-	0	-	180	180	196
P2	NE	152+44.8,	56.2' RT	TC-81.21	-	23'	4	36	-	22	28	34	-	-	-	-	-	0	-	-	-	0	-	-	180	-
P3	SE	151+55.6,	59.3' RT	TC-81.21	-	23'	1	15	-	5	11	-	-	-	-	-	-	90	-	-	-	0	-	180	0	270
TP1*	SW	151+38.2	79.7' LT	PED	-	17'	-	-	-	-	-	-	-	-	-	-	-	-	-	-	-	0	-	-	180	270

*POLE ITEMS ON PEDESTALS ARE MEASURED FROM PERPENDICULAR LINE TO C OF ALUM CREEK DR.
 **MECHANICAL DAMPER TO BE INSTALLED PER MANUFACTURER RECOMMENDED POSITION AND ORIENTATION
 ***RADAR DETECTION UNITS ARE NOT SHOWN IN CHART, TO BE ADDED TO THE SUPPORT/MASTARM PER MANUFACTURER RECOMMENDED POSITION AND ORIENTATION

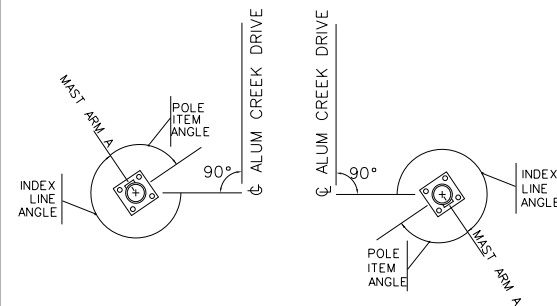

PROPOSED SIGNAL SUPPORT ORIENTATION DETAIL

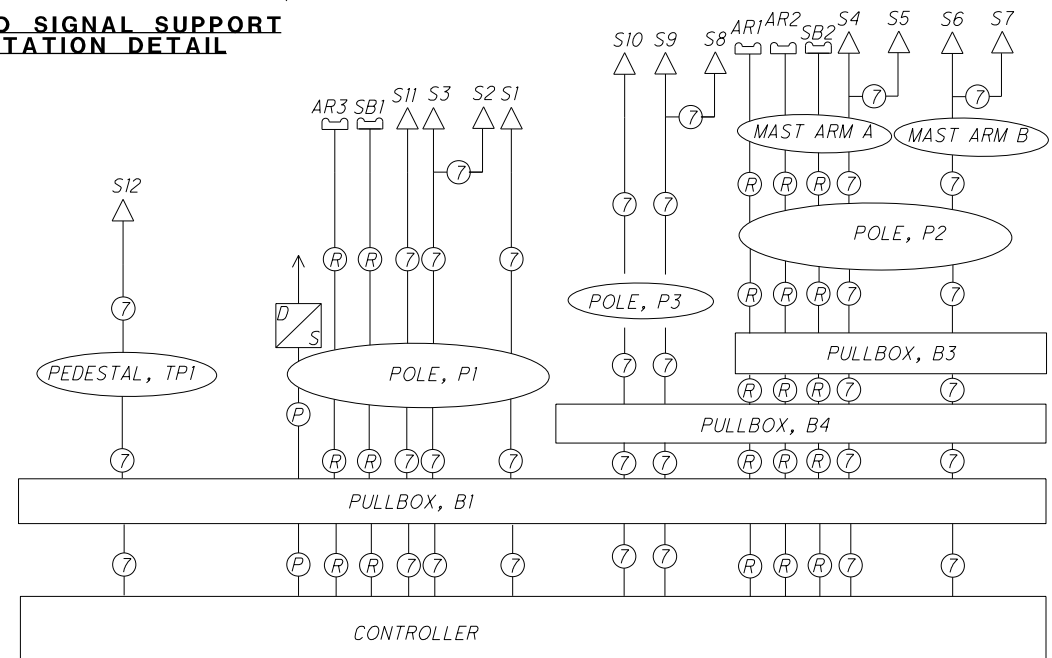



SIGNAL WIRING DIAGRAM LEGEND

- VEHICULAR SIGNAL HEAD
- ⑦ 7 CONDUCTOR, #14 AWG SIGNAL CABLE
- Ⓟ POWER CABLE
- Ⓡ RADAR CABLE
- SB1 STOP BAR RADAR
- AR1 ADVANCED DETECTION RADAR
- Ⓧ DISCONNECT SWITCH

SIGNAL WIRING DIAGRAM

TRAFFIC SIGNAL CONTROLLER TIMING CHART							
ALUM CREEK DRIVE & EB IR-270 RAMP MAINTAINING AGENCY: ODOT							
START UP				DUAL ENTRY ⊗ 2+6 REST IN RED: R1 ⊗ R2 ⊙			
START IN: Y/R FLASH ⊙; ALL RED ⊗ TIME FOR FLASH OR ALL RED: 10 SEC				OVERLAP			
FIRST PHASE: 2+6				PHASES			
COLOR DISPLAYED: GREEN ⊗; YELLOW ⊙							
INTERVAL OR FEATURE	CONTROLLER MOVEMENT No.						
	1	2	3	4	5	6	7
INTERSECTION MOVEMENT	↘	↑	↙	↓			
MINIMUM GREEN (INITIAL) (SEC.)	10	20	-	12	-	20	-
ADDED INITIAL (SEC./ACTUATION)	-	-	-	-	-	-	-
PASSAGE TIME (PRESET GAP)	3.0	5.0	-	4.0	-	5.0	-
MINIMUM GAP (SEC.)	-	-	-	-	-	-	-
TIME TO REDUCE (SEC.)	-	-	-	-	-	-	-
MAXIMUM GREEN I (SEC.)	20	50	-	40	-	50	-
MAXIMUM GREEN II (SEC.)	-	-	-	-	-	-	-
YELLOW CHANGE (SEC.)	4.5	4.5	-	4	-	4.5	-
ALL RED CLEARANCE (SEC.)	2.0	2.0	-	2.5	-	2.0	-
WALK (SEC.)	-	-	-	-	-	-	-
PEDESTRIAN CLEARANCE (SEC.)	-	-	-	-	-	-	-
RECALL	MAXIMUM (ON/OFF)	OFF	OFF	OFF	OFF	OFF	OFF
	MINIMUM (ON/OFF)	OFF	ON	OFF	OFF	ON	OFF
	PEDESTRIAN (ON/OFF)	OFF	OFF	OFF	OFF	OFF	OFF
MEMORY (ON/OFF)	-	-	OFF	-	-	OFF	-
CALL TO NON-ACTUATED	No. 1	ON			ON		
	No. 2						

NOTE: OMIT CALLS TO Φ1 DURING Φ6 GREEN.

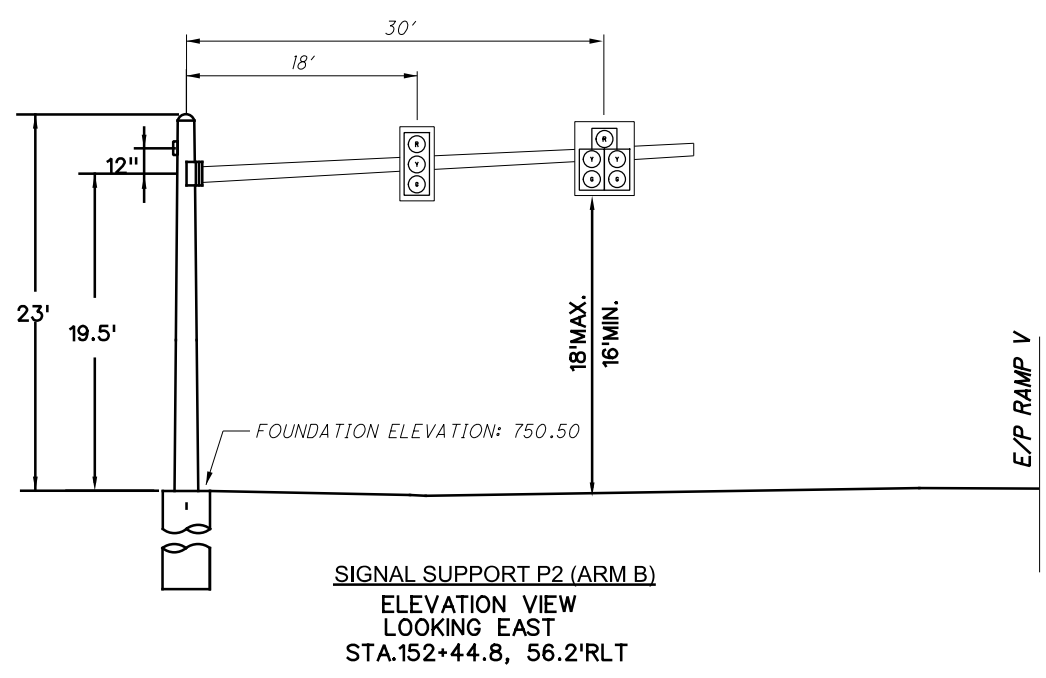
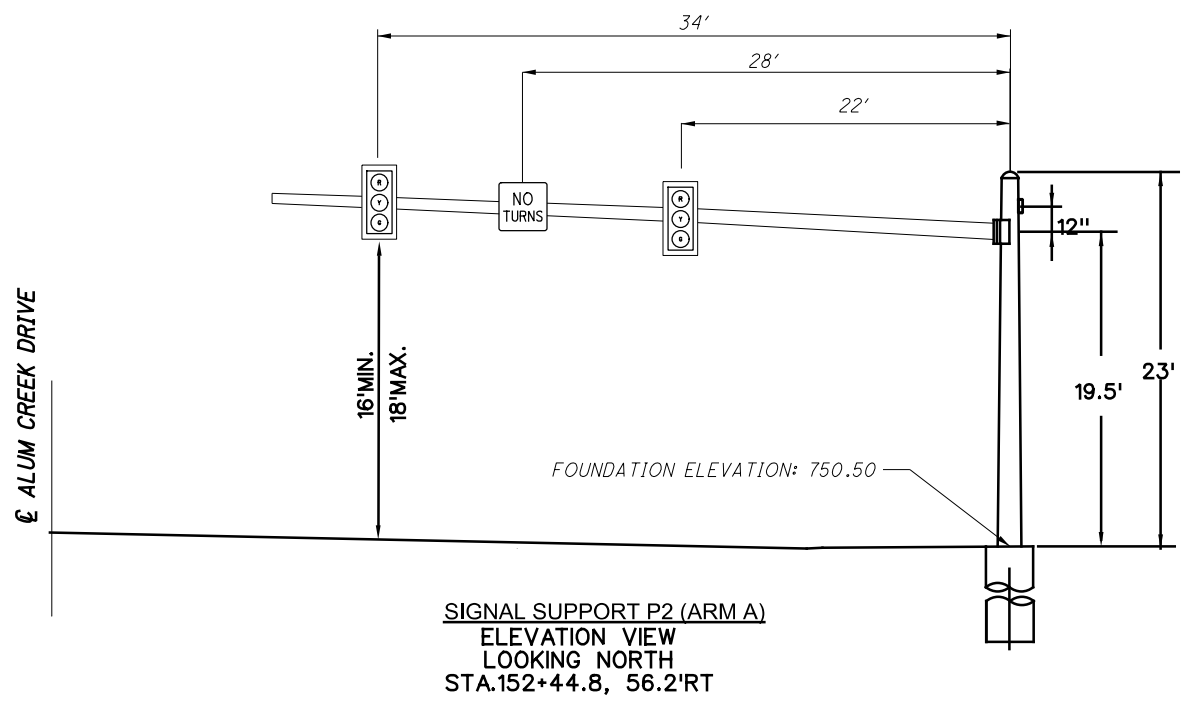


*RADAR UNITS NOT SHOWN

LEGEND


- ↑ SIGNAL HEAD
- ! PEDESTRIAN PUSHBUTTON
- ☐ CONTROLLER CABINET
- ☐ PULLBOX
- SIGNAL SUPPORT
- PEDESTAL
- ▭ DETECTION ZONE

FIELD	WIRING	HOOK-UP	CHART
SIGNAL HEAD	INDICATION	FIELD TERMINAL	FLASH
S1, S2 (NB)	R	φ 2 R	R
	Y	φ 2 Y	
	G	φ 2 G	
S3, S9 (WB)	→	φ 8 R	R
	←	φ 8 Y	
	↻	φ 8 G	
S4, S5 (WB)	→	φ 8 R	R
	←	φ 8 Y	
	↻	φ 8 G	
S6 (SB)	↑	OLA G	-
S7, S8 (SB)	R	φ 6 R	R
	Y	φ 6 Y	
	G	φ 6 G	

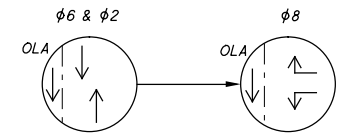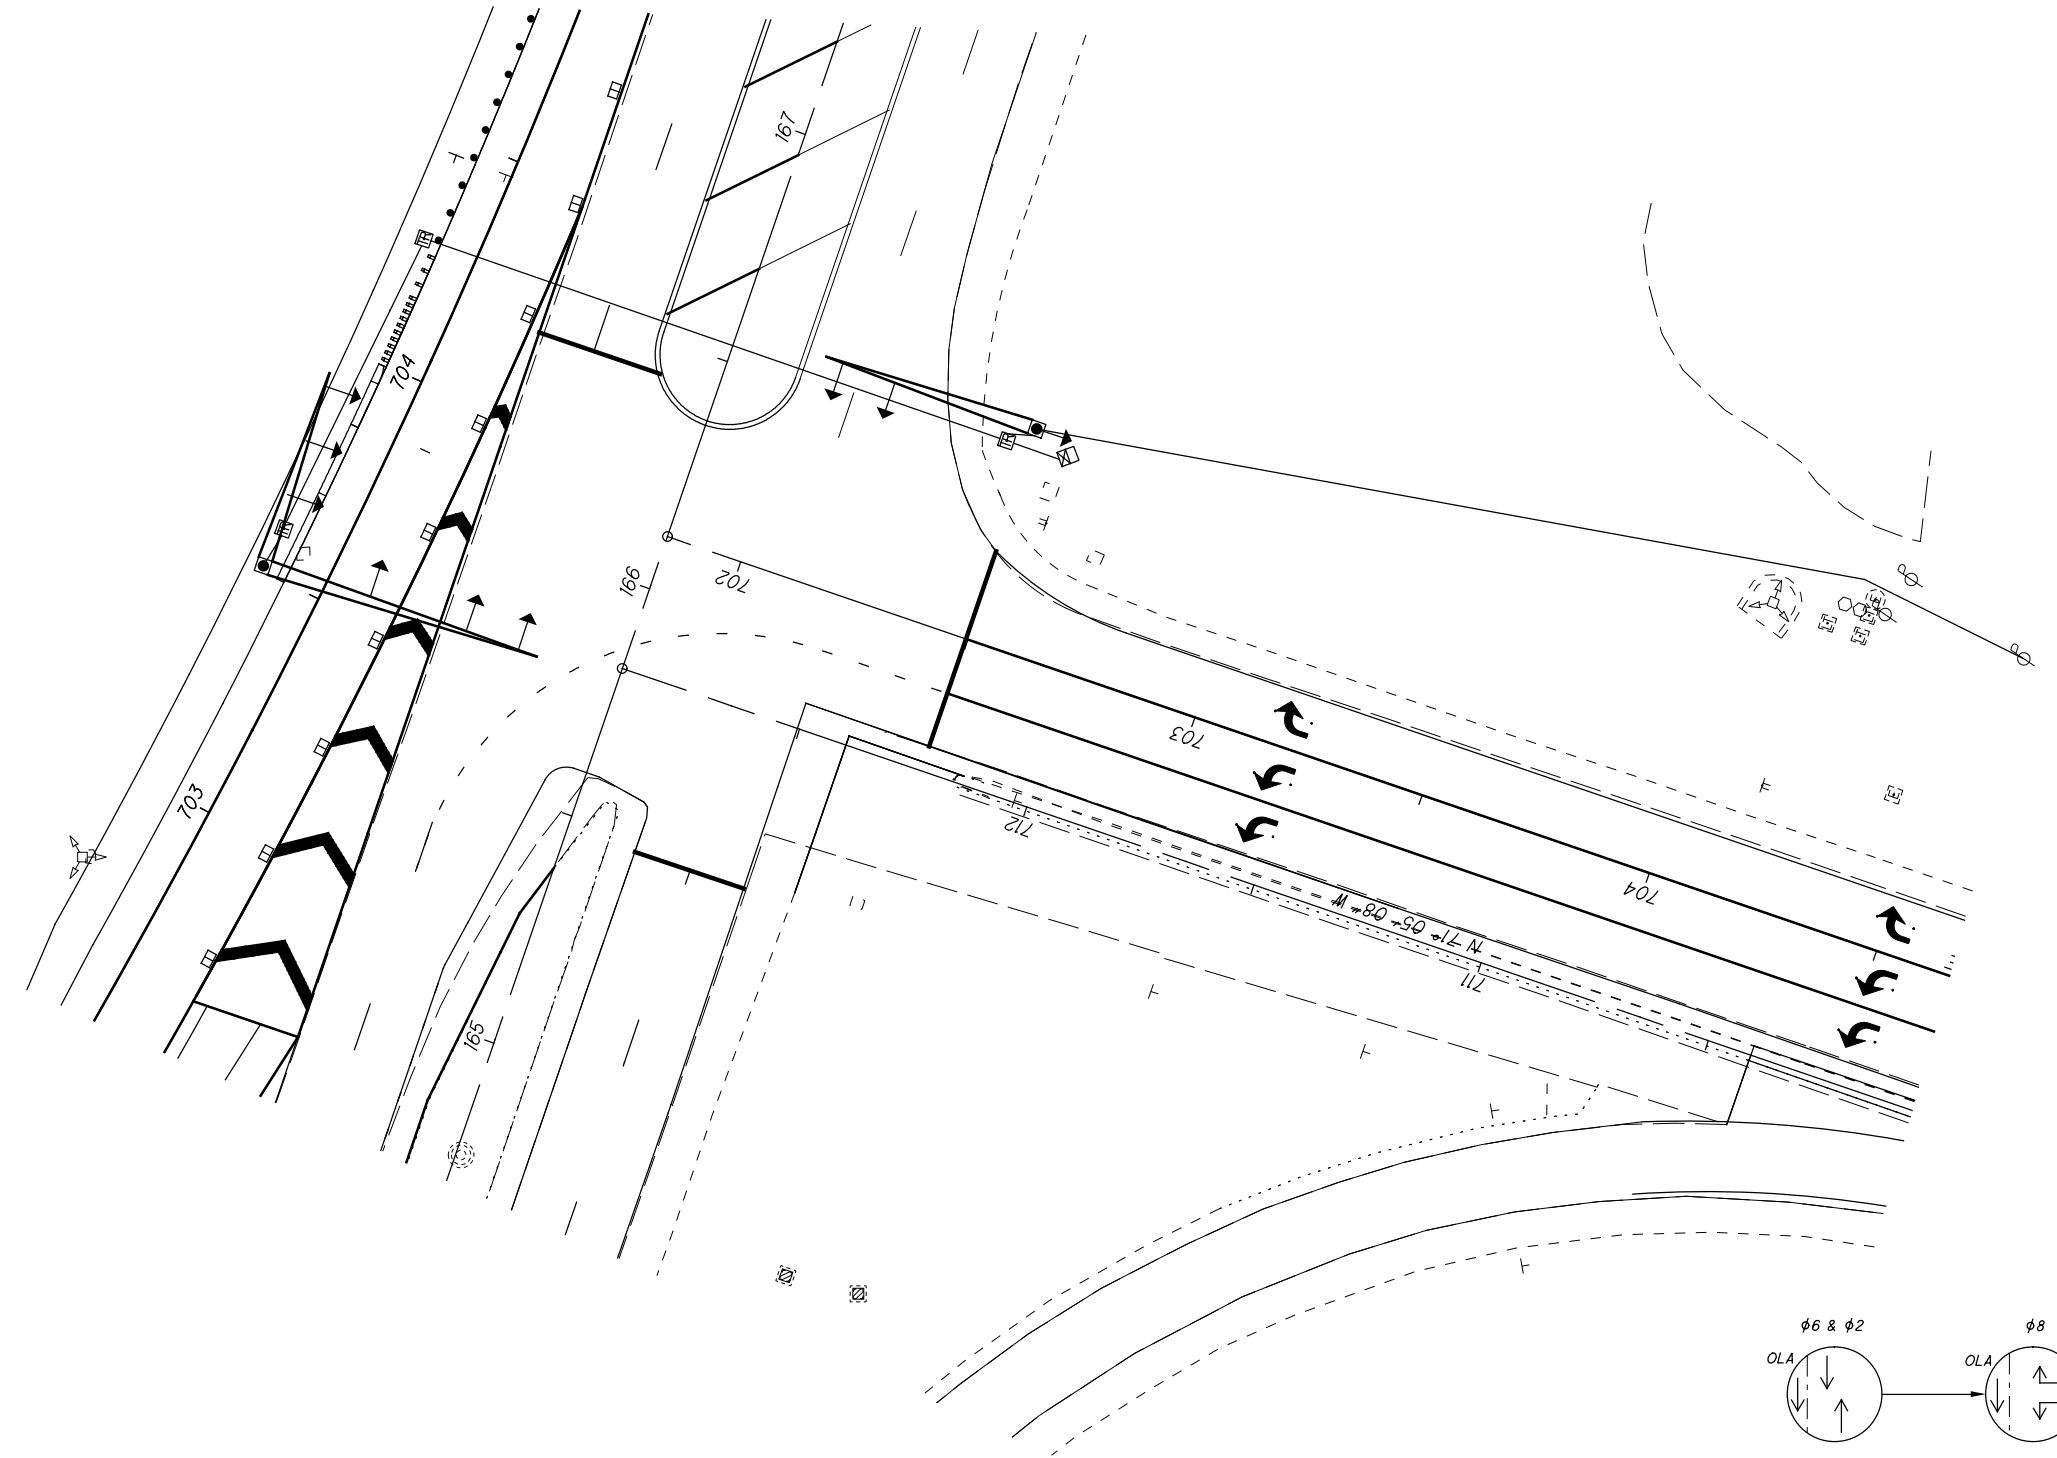


PROPOSED PHASE DIAGRAM

PROPOSED FLAT SHEET SIGNS

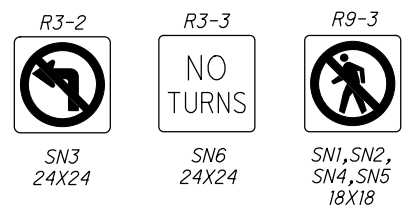


PROPOSED SIGNALS

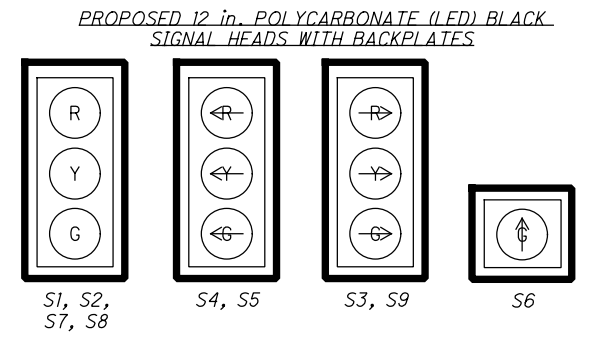



NOTES

- ALL SIGNAL HEADS AND SIGNS SHALL BE FIELD ADJUSTED BY THE CONTRACTOR AS DIRECTED BY THE ENGINEER TO ENSURE CORRECT PLACEMENT
- ALL PULLBOXES ARE 24" EXCEPT PULLBOX B3
- POLE LOCATIONS HAVE BEEN INDICATED AS ACCURATELY AS POSSIBLE. IN NO CASE SHALL THE CLEARANCE FROM FACE OF CURB TO FACE OF POLE, PEDESTRIAN SIGNAL, SIGN OR OTHER PROPOSED ITEMS BE LESS THAN 2 FT. TOP OF POLE FOUNDATIONS SHALL BE FLUSH WITH ADJACENT WALK WAYS.



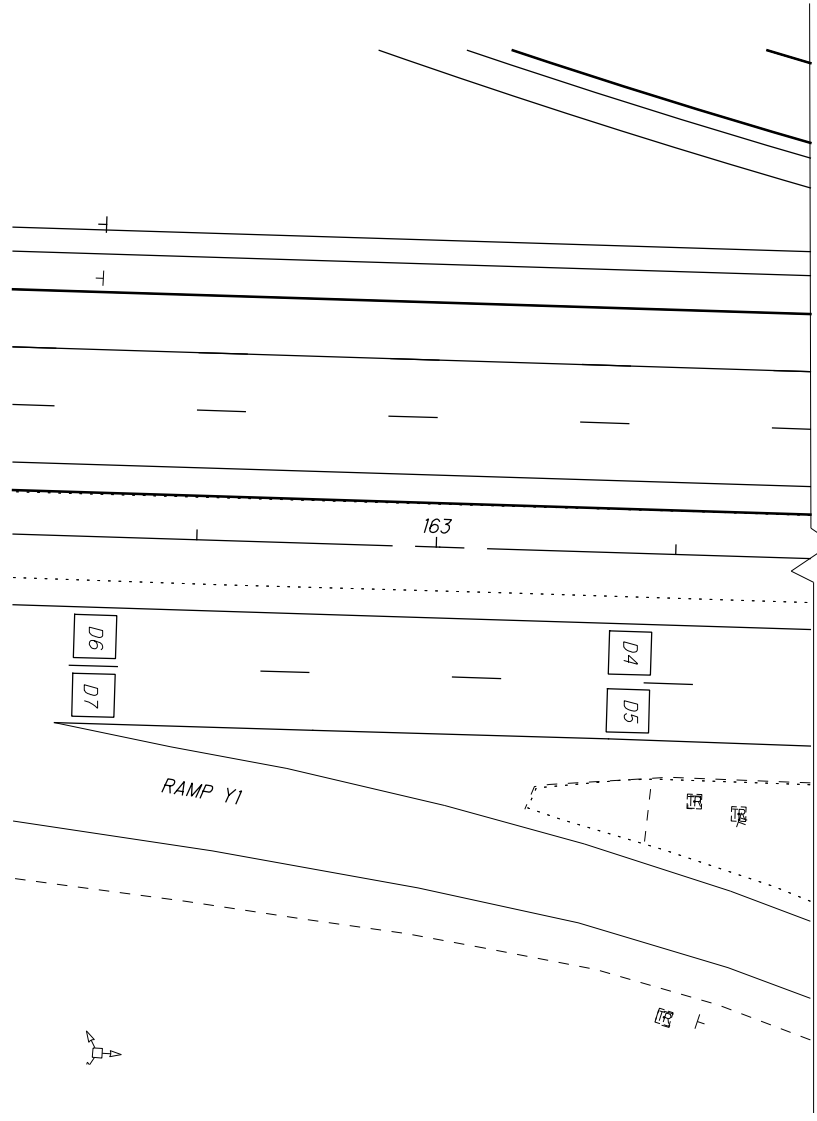

TRAFFIC SIGNAL DETECTION						
ZONE	UNIT No.	SIZE	MODE	DELAY (SEC.)	EXTENSION (SEC.)	ASSOCIATED CONTROLLER PHASE
D1	SB1	RADAR	PRESENCE	10	-	4
D2	SB1	RADAR	PRESENCE	5	-	4
D3	SB1	RADAR	PRESENCE	5	-	4
D4	AR1	RADAR	PULSE	-	-	2
D5	AR1	RADAR	PULSE	-	-	2
D6	AR1	RADAR	PULSE	-	-	2
D7	AR1	RADAR	PULSE	-	-	2
D8	AR2	RADAR	PULSE	-	-	6
D9	AR2	RADAR	PULSE	-	-	6
D10	AR3	RADAR	PULSE	-	-	6
D11	AR3	RADAR	PULSE	-	-	6
D12	AR3	RADAR	PULSE	-	-	6

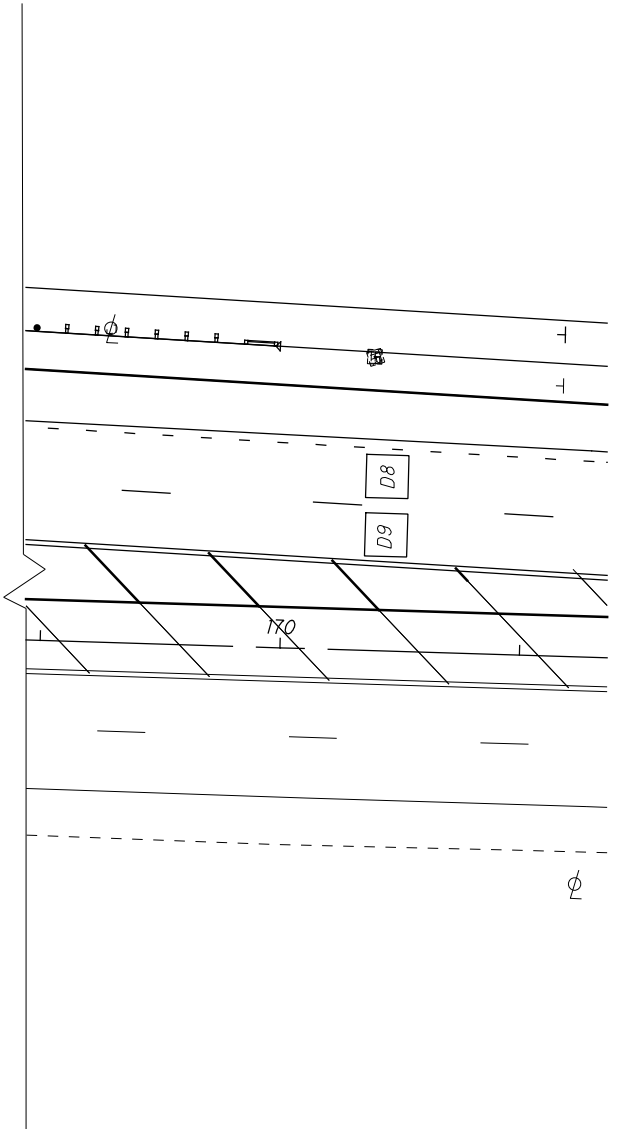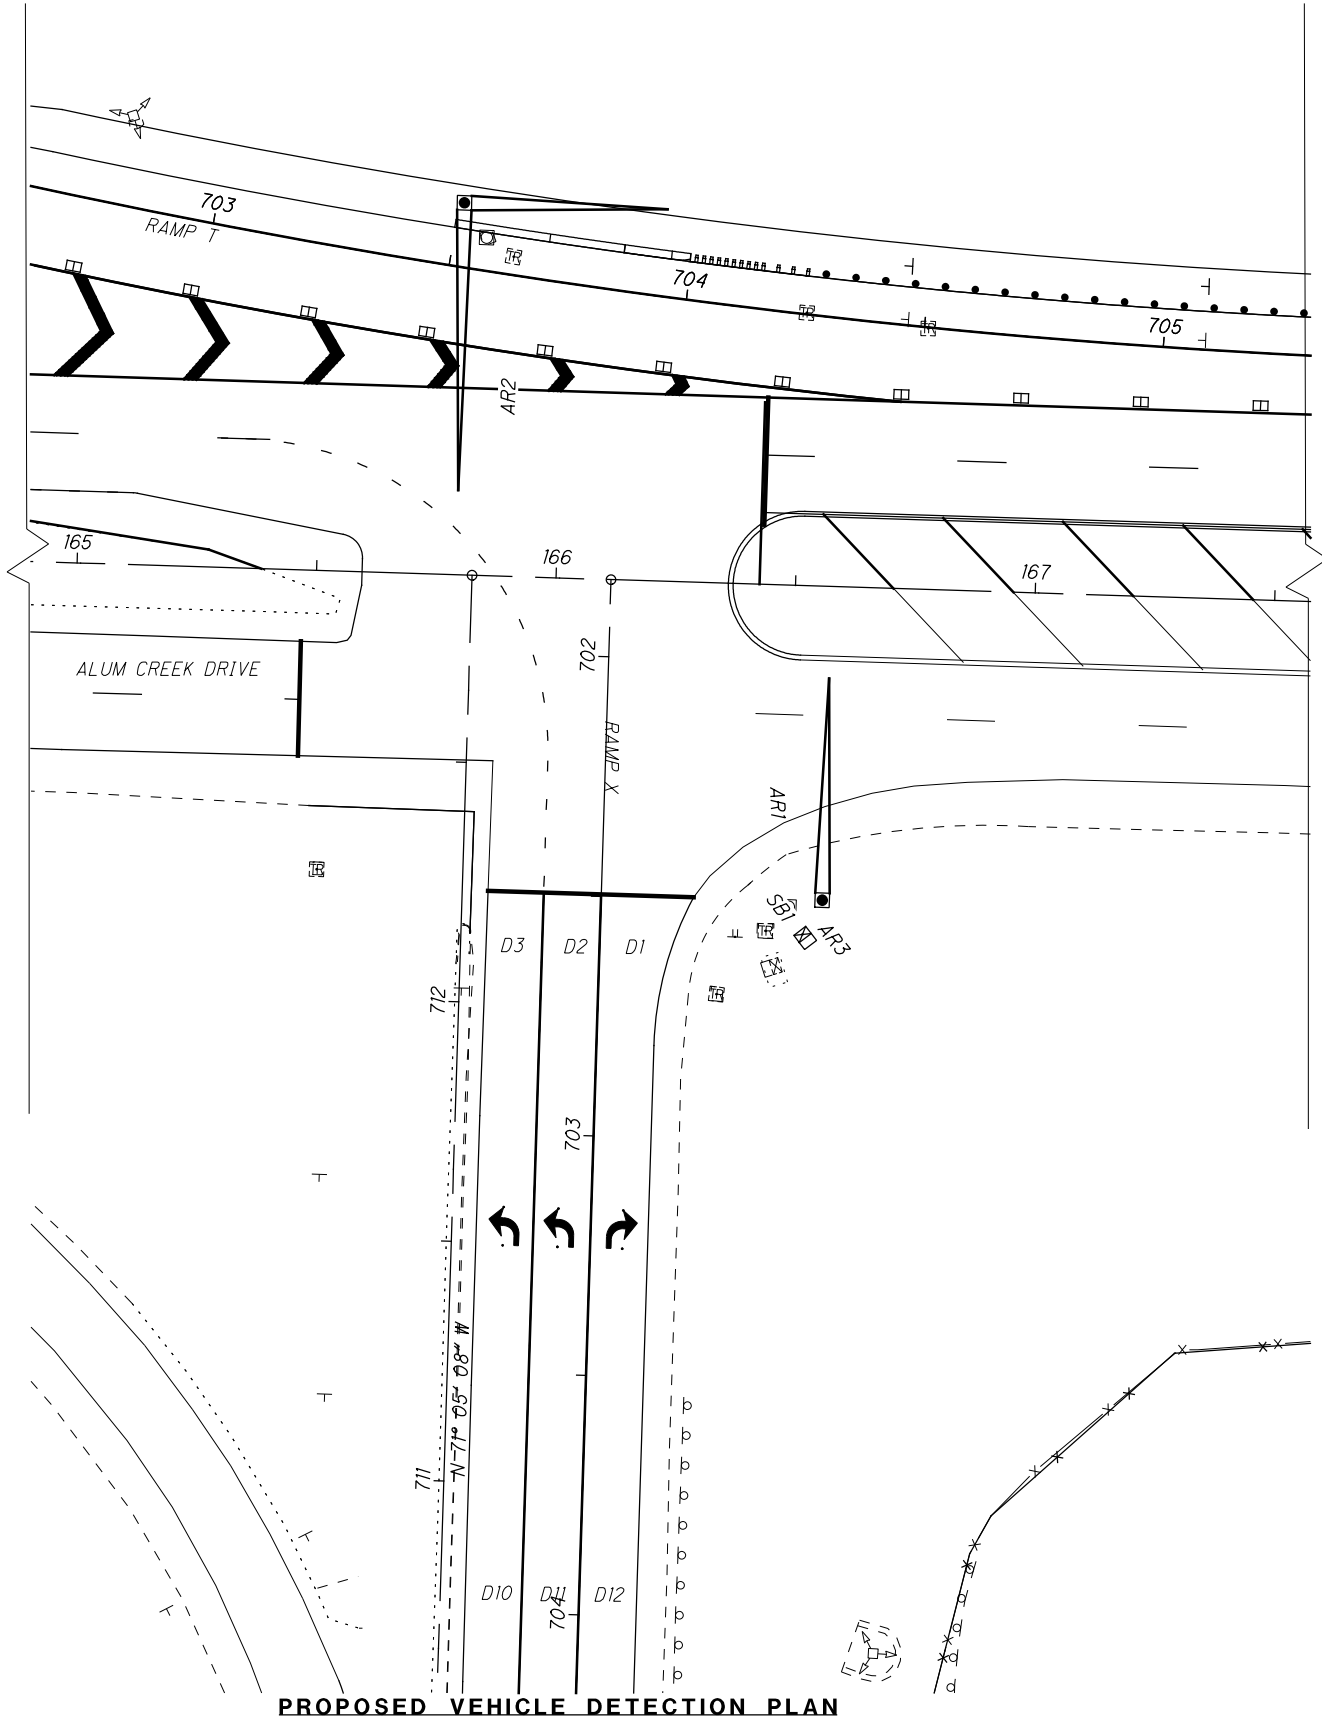

BU 4.5, 6.7, & 8 - RELEASED FOR CONSTRUCTION - 11/03/2014 - 11/19/2015

CALCULATED
SGB
CHECKED
ERW


0 20 40
HORIZONTAL
SCALE IN FEET

TRAFFIC SIGNAL PLAN
ALUM CREEK DRIVE AND RAMP X

FRA - 270 49.00

ITEM	QTY	UNIT	TRAFFIC SIGNAL
625	330	FT.	CONDUIT, 3", 725.051
625	130	FT.	CONDUIT, JACKED OR DRILLED 3"
625	330	FT.	TRENCH
625	330	FT.	PLASTIC CAUTION TAPE
625	1	EACH	PULL BOX, 725.08, 18"
625	2	EACH	PULL BOX, 725.08, 24"
625	3	EACH	GROUND ROD
630	2	EACH	SIGN SUPPORT ASSEMBLY, POLE MOUNTED
630	13	S.F.	SIGN, FLAT SHEET
630	30	FT.	STREET NAME SIGN SUPPORT, NO. 2 POST
632	1	EACH	VEHICULAR SIGNAL HEAD, (LED), 1 SECTION, 12" LENS, 1-WAY, POLYCARBONATE, AS PER PLAN
632	8	EACH	VEHICULAR SIGNAL HEAD, (LED) BLACK, 3-SECTION, 12" LENS, 1-WAY, WITH BACKPLATE, AS PER PLAN
632	9	EACH	COVERING OF VEHICULAR SIGNAL HEAD
632	1405	FT.	SIGNAL CABLE, 7 CONDUCTOR, NO. 14 AWG
632	300	FT.	POWER CABLE, 3 CONDUCTOR, NO. 4 AWG
632	1	EACH	POWER SERVICE, AS PER PLAN
632	1	EACH	SIGNAL SUPPORT, TYPE TC-81.21, DESIGN 14, AS PER PLAN
632	1	EACH	SIGNAL SUPPORT, TYPE TC-12.30, DESIGN 8 WITH MAST ARMS DESIGN 11 AND 13, AS PER PLAN
632	2	EACH	SIGNAL SUPPORT FOUNDATION
632	1	EACH	REMOVAL OF TRAFFIC SIGNAL INSTALLATION, AS PER PLAN
632	1	EACH	SIGNALIZATION MISC.: CDMA MODEM, FURNISH ONLY
633	1	EACH	CONTROLLER UNIT, TYPE TS2/A2, WITH CABINET TYPE TS1, AS PER PLAN
633	1	EACH	CABINET RISER
633	1	EACH	CABINET FOUNDATION
633	1	EACH	CONTROLLER WORK PAD
633	2	EACH	ADVANCE/DILEMMA ZONE DETECTION RADAR
633	1	EACH	STOP BAR DETECTION RADAR
633	1	EACH	UNINTERRUPTIBLE POWER SUPPLY (UPS), 1000 WATT

TRAFFIC SIGNAL CONTROLLER TIMING CHART								
ALUM CREEK DRIVE & WB IR-270 RAMP								
MAINTAINING AGENCY: ODOT								
START UP				DUAL ENTRY @ 2+6				
START IN: Y/R FLASH @ ALL RED @				REST IN RED: R1 @ R2 @				
TIME FOR FLASH OR ALL RED: 10 SEC				OVERLAP OL A				
FIRST PHASE: 2+6				PHASES 4&6				
COLOR DISPLAYED: GREEN @ :YELLOW @								
INTERVAL OR FEATURE	CONTROLLER MOVEMENT No.							
INTERSECTION MOVEMENT	1	2	3	4	5	6	7	8
MINIMUM GREEN (INITIAL) (SEC.)	-	20	-	20	-	20	-	-
ADDED INITIAL (SEC./ACTUATION)	-	-	-	-	-	-	-	-
PASSAGE TIME (PRESET GAP) (SEC.)	-	5.0	-	5.0	-	5.0	-	-
MINIMUM GAP (SEC.)	-	-	-	-	-	-	-	-
TIME TO REDUCE (SEC.)	-	-	-	-	-	-	-	-
MAXIMUM GREEN I (SEC.)	-	60	-	45	-	60	-	-
MAXIMUM GREEN II (SEC.)	-	60	-	45	-	60	-	-
YELLOW CHANGE (SEC.)	-	4.5	-	4.0	-	4.5	-	-
ALL RED CLEARANCE (SEC.)	-	2.0	-	2.5	-	2.0	-	-
WALK (SEC.)	-	-	-	-	-	-	-	-
PEDESTRIAN CLEARANCE (SEC.)	-	-	-	-	-	-	-	-
RECALL	MAXIMUM (ON/OFF)	OFF	OFF	OFF	OFF	OFF	OFF	OFF
	MINIMUM (ON/OFF)	OFF	ON	OFF	OFF	OFF	ON	OFF
MEMORY	PEDESTRIAN (ON/OFF)	OFF	OFF	OFF	OFF	OFF	OFF	OFF
	(ON/OFF)	-	-	OFF	-	-	-	OFF
CALL TO NON-ACTUATED	No. 1	ON					ON	
	No. 2							

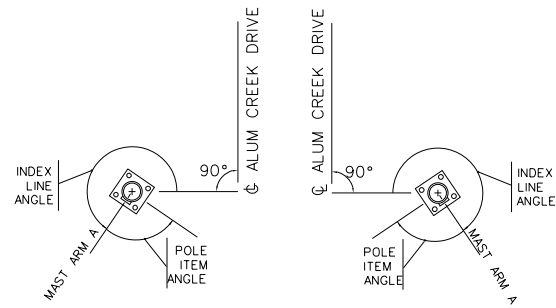


PROPOSED SIGNAL SUPPORT ORIENTATION DETAIL

SIGNAL WIRING DIAGRAM LEGEND

- VEHICULAR SIGNAL HEAD
- ⑦ 7 CONDUCTOR, #14 AWG SIGNAL CABLE
- Ⓟ POWER CABLE, 3 CONDUCTOR, #6 AWG
- Ⓡ RADAR CABLE
- SB1 STOP BAR RADAR
- AR1 ADVANCED DETECTION RADAR
- Ⓧ DISCONNECT SWITCH



SIGNAL WIRING DIAGRAM

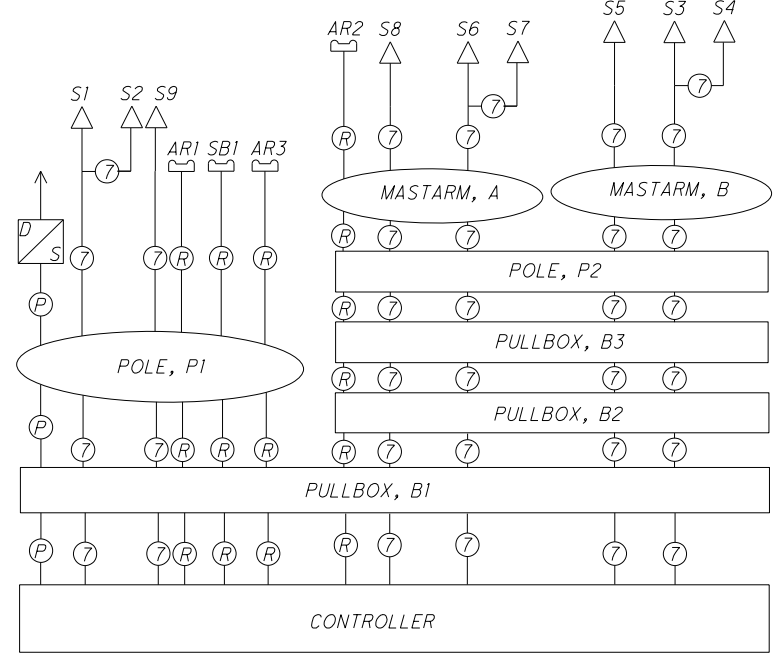

*DETECTION CABLE NOT SHOWN

SUPPORT NO.	LOCATION	STATION AND OFFSET	POLE TYPE	FOUNDATION ELEVATION	POLE HEIGHT	POLE DESIGN	MAST ARM "A" (FT)	MAST ARM "B" (FT)	L1 (FT)	L2 (FT)	L3 (FT)	L4 (FT)	L5 (FT)	L6 (FT)	ELEV.		INDEX ANGLE (DEG.)	ANGLES (DEG.) FROM INDEX LINE									
															A	B		MAST ARM B	PED SIGNAL	PUSHBUTTON	SIGN	LUMINAIRE	DISCONNECT	HANDHOLE	VEH SIGNAL		
P1	NE	166+57.6, 65.5' RT	TC-81.21	-	23'	14	46	-	31	37	43	-	-	-	-	-	0	-	-	-	0	-	-	-	180	180	180
P2	SW	165+78.5, 77.6' LT	TC-12.30	-	23'	8	58	-	23	44	50	56	-	-	-	-	0	-	-	-	0	-	-	-	180	-	-
							41	16	27	39	-	-	-	-	-	-	90	-	-	-	-	-	-	-	-	-	-

***RADAR DETECTION UNITS ARE NOT SHOWN IN CHART, TO BE ADDED TO THE SUPPORT/MASTARM PER MANUFACTURER RECOMENDED POSITION AND ORIENTATION

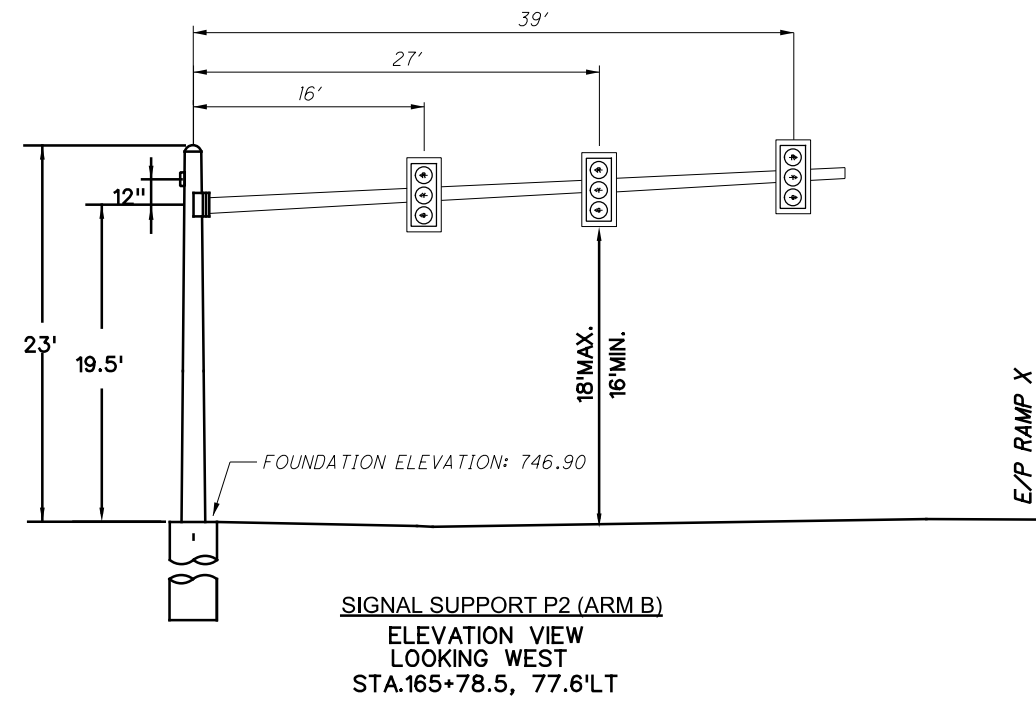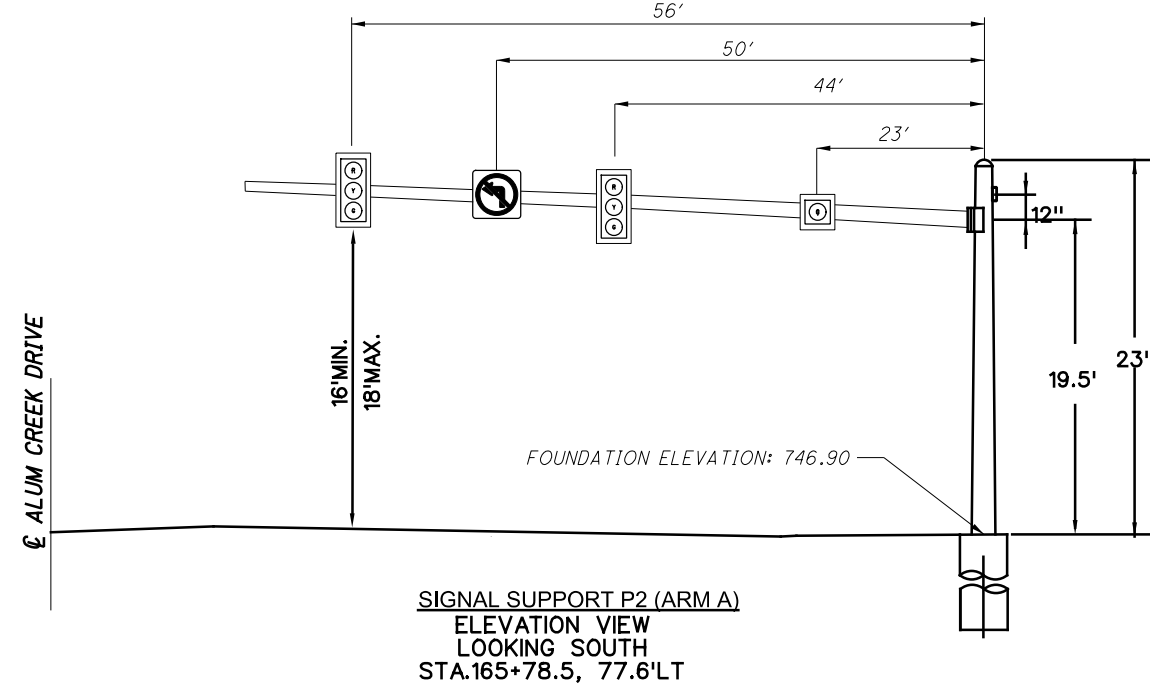

*RADAR UNITS NOT SHOWN

FRA - 270 49.00	TRAFFIC SIGNAL DETAILS		CALCULATED
	ALUM CREEK DRIVE AND RAMP X		SGB
136 182			CHECKED
			ERW

ITS NOTES

ITEM 632 - SIGNALIZATION MISC.: CCTV IP-CAMERA SYSTEM, DOME -TYPE

1300.1 GENERAL DESCRIPTION

CLOSED CIRCUIT TELEVISION (CCTV) POLE CAMERA ASSEMBLY THE CCTV POLE CAMERA ASSEMBLY SHALL INCLUDE THE CAMERA, UNPRESSURIZED DOME/HOUSING, PTZ UNIT, CAMERA CONTROLLER, LOCAL CAMERA CONTROL UNIT, ITS CABINET, WORK PAD, AND ALL MATERIALS, LABOR, WORKMANSHIP, EQUIPMENT, TESTING, DOCUMENTATION, AND INCIDENTAL ITEMS REQUIRED TO DELIVER A FULLY OPERATIONAL CCTV POLE CAMERA. ASSEMBLY IN ACCORDANCE WITH THESE SPECIAL PROVISIONS AND THE PLANS

THE CCTV IP-CAMERA SYSTEM WILL BE PLACED AT ROADSIDE LOCATIONS AND WILL MEET NEMA TYPE 4X AND IP66 ENVIRONMENTAL STANDARDS AND WILL BE SUITABLE FOR OUTDOOR INSTALLATION ATOP POLES UP TO 80 FEET. THE CCTV IP-CAMERA SYSTEM INCLUDES IP-CAMERA, UNPRESSURIZED DOME/HOUSING, PTZ UNIT, CAMERA CONTROLLER, AND ALL NECESSARY CONNECTORS AND CABLES.

THE CCTV IP-CAMERA SYSTEM SHALL BE ONE OF THE FOLLOWING TYPES:
PELCO SPECTRA IV IP H.264
COHU 3920 (VIA ONVIF DRIVER)
OPTELECOM HSD626

THE OHIO DEPARTMENT OF TRANSPORTATION WILL BE RESPONSIBLE FOR ALL COMMUNICATIONS WITH THE TMC; ALL CONTRARY REQUIREMENTS IN THIS PROVISION WILL BE EXCLUDED

THE IP-CAMERA ASSEMBLY WILL BE CAPABLE OF INDIVIDUAL, OR LOCAL, CAMERA SITE CONTROL BY WAY OF A LAPTOP COMPUTER. COMMUNICATIONS TO THE IP-CAMERA WILL BE ETHERNET I/O PROTOCOL. THE LOCAL CAMERA CONTROL UNIT SHALL BE A UNIT CAPABLE OF PROVIDING PTZ CONTROL AND VIDEO LOCALLY AT THE CAMERA POLE ONLY. THIS UNIT SHALL NOT BE USED IN ANY MANNER TO PORT VIDEO AND/OR PTZ CONTROL FOR REMOTE VIEWING AND/OR CONTROL. A SEPARATE MONITOR SHALL NOT BE NEEDED TO VIEW VIDEO FROM THIS UNIT. THE UNIT SHALL INCLUDE LOCAL ACCESS CONTROL SUCH AS PASSWORD PROTECTION OR REQUIRE USB KEY TO LOG IN.

THE CCTV WILL BE CAPABLE OF DISPLAYING THE COMPASS HEADING OF THE CAMERA DIRECTION (E; N, E, S, ETC.) AND ALLOW FOR TITLE OVERLAYS OF THE LOCATION OF THE CAMERA.

ALL CAMERA CONTROL, VIDEO COMPRESSION, AND RELATED CCTV FUNCTIONALITY SHALL BE CONTAINED IN THE IP CCTV HOUSING UNIT. NO SEPARATE UNIT WILL BE REQUIRE OR ACCEPTED BY ODOT IN THE ITS CABINET.

THE CCTV IP-CAMERA SYSTEM WILL BE CAPABLE OF USER SELECTABLE VIDEO COMPRESSION RATES OF H.264, MPEG-4 OR MJPEG.

THE CONTRACTOR SHALL SUPPLY THE FOLLOWING SOFTWARE OPTIONS FOR THE MILESTONE CAMERA MANAGEMENT SOFTWARE WITH EACH CAMERA PROVIDED AND SHALL PROVIDE ALL LICENSING DOCUMENTATION TO THE ODOT TRAFFIC OPERATIONS ITS/SIGNALS SECTION (2 HARD-COPIES AND 1 ELECTRONIC COPY):

- ONE MILESTONE XPROTECT CORPORATE DEVICE CHANNEL PER CAMERA
- ONE MILESTONE FIVE YEAR PMA FOR XPROTECT CORPORATE DEVICE CHANNEL LICENSE PER CAMERA

THE CONTRACTOR SHALL SUBMIT A DEMO CAMERA AND DRIVER FOR MATERIALS ACCEPTANCE TESTING PRIOR TO ODOT PROVIDING AUTHORIZATION TO THE CONTRACTOR TO MOVE FORWARD WITH CAMERA PURCHASING FOR THE ENTIRE PROJECT.

THE IP-CAMERA ASSEMBLY SHALL BE CAPABLE OF TRANSMITTING SIMULTANEOUS VIDEO VIA THE ENCODER LOCATED IN THE CAMERA HOUSING AND VIA A COAXIAL CABLE CONNECTED TO THE CAMERA AND RUN INTO THE ITS CABINET.

THIS COAXIAL CABLE SHALL BE FITTED WITH COMPRESSION BNC-TYPE CONNECTORS AND SHALL NOT BE USED FOR THE SOLE TEST OF THE CAMERA. THE SOLE PURPOSE OF THIS COAXIAL CONNECTION SHALL BE FOR VERIFYING CAMERA VIDEO FOR MAINTENANCE OPERATIONS. ALL MAIN TESTING OF THE CAMERA OPERATION SHALL BE PERFORMED THROUGH COMMUNICATIONS WITH THE CAMERA ENCODER.

1300.2 CLOSED CIRCUIT-TELEVISION (CCTV) IP CAMERA EQUIPMENT

THE CCTV COMMUNICATIONS SUBSYSTEM WILL PROVIDE FOR TWO BASIC FUNCTIONS:
(1) THE EXCHANGE OF CONTROL AND STATUS DATA FROM THE LOCAL CONTROL TO THE IP-CAMERA AND THE PAN TILT ZOOM (PTZ) UNIT ON WHICH THE IP-CAMERA IS MOUNTED, AND (2) THE TRANSMISSION OF IMAGES FROM THE VIDEO IP-CAMERA TO THE LOCAL CONTROL.

VIDEO IMAGES WILL BE GENERATED AT THE CCTV SITE AT THE RATE OF NO LESS THAN THIRTY FRAMES PER SECOND ACCORDING TO THE APPLICABLE MULTI-STREAM H.264, MPEG-4 AND MOTION JPEG. IMAGES CAPTURED BY THE IP CAMERA WILL BE CONTINUALLY TRANSMITTED VIA HARDWIRED COMMUNICATION TO THE IP-CAMERA CONTROL UNIT.

1300.3 FUNCTIONAL PROVISIONS

THE CCTV ASSEMBLY COMPONENTS WILL BE COMPATIBLE WITH EACH OTHER. ALL CCTV ASSEMBLY COMPONENTS WILL BE PROVIDED AND WARRANTED BY A SINGLE VENDOR, TO PROVIDE AN END-TO-END MANUFACTURER RESPONSIBILITY.

A MINIMUM OF SIXTY-FOUR PRESETS WILL BE PROVIDED ON BOTH THE ZOOM LENS AND THE PAN/TILT MECHANISM TO ALLOW SETTING THE LENS AND THE PAN/TILT TO PREDEFINED LOCATIONS IN ACCORDANCE WITH THE PROJECT REQUIREMENTS. THE PAN, TILT, ZOOM, PRESET SELECTION, POWER ON/OFF AND OTHER FUNCTIONS OF EACH CCTV FIELD IP-CAMERA WILL BE CONTROLLED FROM THE CENTRAL SITE, BOTH MANUALLY WITH A CONTROL PANEL AND BY USING A HTTP BROWSER BASED APPLICATION WITH A GRAPHICAL USER INTERFACE. THE CCTV WILL INCLUDE, BUT NOT BE LIMITED TO, THE FOLLOWING COMPONENTS AND FEATURES:

- PASSWORD PROTECTION: PROGRAMMABLE SETTINGS WITH OPTIONAL PASSWORD PROTECTION
- OPEN API FOR SOFTWARE INTEGRATION
- A CCTV IP CAMERA WITH AUTO FOCUS ZOOM LENS IN AN OUTDOOR DOME ATTACHED TO THE IP-CAMERA-LOWERING DEVICE.
- A DOMED, WATERTIGHT, ENVIRONMENTAL HOUSING WITH AN INTEGRATED POSITIONED FOR PAN AND TILT UNIT AND CCTV IP-CAMERA, AS DETERMINED, PER IP-CAMERA SITE BY THE DEPARTMENT AND AS DETAILED HEREIN, WITHIN THE PLAN SET, AND/OR IN THE CONTRACT; (ALL CAMERA CIRCUITRY SHALL BE LOCATED WITHIN THE DOME HOUSING)
- DOMED MOUNTING HARDWARE OF THE VERTICAL OR ADAPTED WALL MOUNTING TYPE WITH NO EXPOSED CAMERA CONTROL WIRING:
- IP-CAMERA SITE EXTERIOR ETHERNET CAT-6 STP OR EQUAL COMPOSITE CABLING.
- JUNCTION BOXES AS REQUIRED HEREIN, WITHIN THE PLAN SET, AND/OR IN THE CONTRACT;
- IP-CAMERA CONTROL ELECTRONICS AND EQUIPMENT (I.E HARDWARE AND SOFTWARE):
- A IP-CCTV ASSEMBLY WITH AZIMUTH POSITIONING CAPABILITIES;
- EXTERIOR ETHERNET STP CAT-6 OR EQUAL COMPOSITE; POWER, AND DATA/VIDEO CABLES FOR POWER SUPPLY, IMAGES, AND CAMERA CONTROLS;
- TRANSFER VOLTAGE SUPPRESSION AND PROTECTION;
- IP-CAMERA CONTROLLER

1300.4 IP-CAMERA ASSEMBLY ELECTRICAL PROVISIONS

THE IP-CAMERA ASSEMBLY WILL BE FURNISHED WITH ANY AND ALL EQUIPMENT REQUIRED FOR A FULLY FUNCTIONAL SYSTEM, INCLUDING ALL APPROPRIATE POWER AND COMMUNICATION CABLES AS DEFINED BY THE MANUFACTURER. THE POWER CABLES WILL BE SIZED TO MEET THE APPLICABLE NATIONAL ELECTRICAL CODE (NEC) REQUIREMENTS THE COMMUNICATION CABLES FROM THE IP-CAMERA ASSEMBLY TO THE NETWORK COMMUNICATION DEVICES WILL BE APPROPRIATE FOR THE TECHNOLOGY EMPLOYED (E.G., FIBER OPTIC, TWISTED PAIR,) AND WILL MEET THE MINIMUM SIZE AND/OR BANDWIDTH REQUIREMENTS DEFINED BY THE MANUFACTURER. THE EXTERIOR CAMERA CAT-6 STP OR EQUAL COMPOSITE CABLE WILL BE OUTDOOR NEC RATED.

ALL DEVICES SUPPLIED AS SYSTEM COMPONENTS WILL ACCEPT, AS A PRIMARY POWER SOURCE, OF 120 VOLTS ALTERNATING CURRENT (VAC)/60 HERTZ (HZ) INPUT, EXCLUDING CAMERAS. ANY DEVICE THAT REQUIRES SOURCE INPUT OTHER THAN 120 VAC/60 HZ, SUCH AS CAMERAS, PTUS, AND DOME HEATERS/BLOWERS THAT OPERATE AT 24 VOLTS, WILL BE FURNISHED WITH THE APPROPRIATE MEANS OF CONVERSION.

THE LENGTH OF THE CABLES WILL BE BASED UPON THE CCTV POLE LENGTH (70 AND 80 FEET) AND NECESSARY CABLE TO BE ROUTED INTO THE ITS CABINET

1300.5 NETWORK COMMUNICATION PROVISION
ODOT WILL FURNISH THE NETWORK SWITCHES, INSTALL, CONFIGURE AND TEST THE VIDEO AND NETWORK EQUIPMENT.

1300.6 PROTOCOL

AT A MINIMUM, THE FOLLOWING SUPPORTED PROTOCOLS WILL BE PROVIDED FOR THE IP CAMERA:

- IP, HTTP, UPNP, SNMP, RTSP, RTP, TCP, UDP, IGMP, DHC, H 264, MPEG-4, MJPEG

1300.7 IP-CAMERA ASSEMBLY PERFORMANCE PROVISIONS

1300.7.1 IP-CAMERA IMAGE SENSOR PROVISIONS

THE CCTV IP-CAMERA IMAGE SENSOR WILL BE A DAY/NIGHT CAMERA THAT PROVIDES COLOR IMAGES DURING DAYTIME AND BLACK AND WHITE (MONOCHROME) IMAGES DURING NIGHTTIME BOTH WITH MANUAL OR AUTOMATIC CONTROL CAPABILITIES. THE IP-CAMERA VIDEO OUTPUT WILL BE COMPLIANT WITH ITU-T VIDEO CODING EXPERTS GROUP (VCEG) AND ISO/IEC MOVING PICTURE EXPERTS GROUP (MPEG) STANDARDS. THE IP-CAMERA SENSOR WILL BE A CHARGE-COUPLED DEVICE (CCD) WITH 1/4 INCH PROGRESSIVE SCAN.

THE MINIMUM RESOLUTION SUPPORTED WILL BE NTSC: 700X480 TO 176X120. THE CCTV ASSEMBLY WILL PROVIDE VIDEO IMAGES WITH MINIMAL QUALITY/BANDWIDTH DEGRADATION IN VARIOUS ENVIRONMENTAL CONDITIONS. THE CCTV ASSEMBLY WILL PROVIDE LOW LIGHT-LEVEL SENSITIVITY TO ACHIEVE DESIRED LEVELS OF OPERATION AT NIGHT.

THE IP-CAMERA WILL SUPPORT THE FOLLOWING IMAGE SETTINGS

- WIDE DYNAMIC RANGE (WDR),
- ELECTRONIC IMAGE STABILIZATION (EIS),
- MANUAL SHUTTER TIME COLOR, BRIGHTNESS, CONTRAST, SHARPNESS
- TEXT AND IMAGE OVERLAY AND PRIVACY MASK

THE IP-CAMERA WILL SUPPORT AUTOMATIC SHUTTER TIME/SPEED THAT IS SELECTABLE ALLOW SETTING TO YIELD OPTIMAL RESULTS UNDER LOW LIGHTING CONDITIONS WITHOUT BLOOMING OR SMEARING.

THE IP-CAMERA SENSOR WILL SUPPORT AUTOMATIC AND MANUAL IRIS ADJUSTMENT. THE IP-CAMERA WILL SUPPORT AUTOMATIC GAIN CONTROL (AGC). THE IP-CAMERA ASSEMBLY WILL BE CAPABLE OF GENERATING AND OVERLAYING LINES OF ENGLISH LANGUAGE TEXT ON THE VIDEO IMAGE. A MINIMUM OF TWENTY ALPHANUMERIC CHARACTERS PER LINE WILL BE SUPPORTED. CONTROL (ENABLE, DISABLE, AND EDIT) OF THIS FEATURE WILL BE AVAILABLE REMOTELY

AND AT THE SITE USING A LAPTOP COMPUTER. THE TEXT MESSAGES WILL BE STORED IN NON-VOLATILE MEMORY. THE IP-CAMERA ID TEXT WILL CONSIST OF ONE LINE OF TEXT. SECTOR TEXT WILL CONSIST OF TEXT MESSAGES THAT CHANGE BASED ON THE POSITION OF THE IP-CAMERA WITHIN A SECTOR. A MINIMUM OF EIGHT UNIFORM SECTORS WILL BE PROVIDED.

THE IP-CAMERA WILL INCLUDE PRIVACY ZONES SO THAT THE OPERATOR CANNOT VIEW SCENES AT PREPROGRAMMED CAMERA POSITIONS. THIS PREVENTS VIEWING THE WINDOWS OF PRIVATE HOMES, HOTELS, OR OTHER BUILDINGS IN THE VICINITY OF THE CAMERA. THE PRIVACY ZONES WILL BE USER DEFINABLE. THERE WILL BE A MINIMUM OF EIGHT PRIVACY ZONES. PROVIDE A IP-CAMERA INTERFACE COMPATIBLE WITH THE COMMUNICATION EQUIPMENT.

1300.7.2 IP-CAMERA LENS PROVISIONS

THE IP-CAMERA LENS WILL BE MOTORIZED, AND BE MECHANICALLY OR ELECTRICALLY PROTECTED FROM OVERRUNNING IN EXTREME POSITIONS. INTEGRATED CAMERA/LENS COMBINATION MAY BE SUBSTITUTED

OPTICAL ZOOM RANGE WILL BE 35X. DIGITAL ZOOM RANGE WILL BE 1X THROUGH 12X WITH A SMOOTH TRANSITION FROM OPTICAL TO DIGITAL ZOOM.

THE LENS WILL HAVE AN AUTOMATIC IRIS CAPABILITY WITH MANUAL OVERRIDE.

THE ZOOM LENS WILL BE SELECTED AUTOMATICALLY OR MANUALLY TO PROVIDE A MINIMUM FOCAL LENGTH OF 0.14 TO 3.2 INCHES (3.5 TO 81 MM) THAT PROVIDES THE FULL COVERAGE OF THE CORRIDOR MAINLINES AND SHOULDERS

THE MINIMUM FOCUSING DISTANCE WILL BE A DISTANCE OF 4 FEET (1.2 M). THE LENS WILL ALSO HAVE A MINIMUM APERTURE OF F/1.2 AND A 1/4 INCH [0.6 CM] WITH 10 PRESET POSITION POINTS. THE IRIS, ZOOM AND FOCUS WILL BE CONTROLLED FROM THE CENTRAL LOCATION VIA HTTP PROTOCOL. THE MOTORS CONTROLLING THE IRIS, ZOOM AND FOCUS WILL NOT BE DAMAGED DUE TO OVERLOAD AT TRAVEL LIMITS. THE IP-CAMERA LENS WILL SUPPORT

OPTICAL ZOOMING RANGING FROM 2.5°TELEPHOTO (MAX) TO 25°WIDE ANGLE (MIN). THE IP-CAMERA WILL SUPPORT AUTOMATIC FOCUS ADJUSTMENTS, WITH MANUAL OVERRIDE. VIBRATION OR AMBIENT TEMPERATURE CHANGES WILL NOT AFFECT THE AUTOMATIC IRIS FUNCTION, FOCUS MECHANISM, AND ZOOM MECHANISM.

THE IP-CAMERA/LENS COMBINATION WILL SUPPORT AUTOMATIC RECOVERY FROM OVER AND UNDER VOLTAGE CONDITIONS, WHEN POWER IS RETURNED TO NORMAL VALUES. THE LENS WILL RETURN TO THE LAST POSITION PRIOR TO THE OVER/UNDER VOLTAGE CONDITION

THE IP-CAMERA/LENS COMBINATION WILL SUPPORT AUTOMATIC RECOVERY FROM OVER AND UNDER VOLTAGE CONDITIONS, WHEN POWER IS RETURNED TO NORMAL VALUES. THE LENS WILL RETURN TO THE LAST POSITION PRIOR TO THE OVER/UNDER VOLTAGE CONDITION

1300.7.3 IP-CAMERA PAN/TILT UNIT (PTU)/POSITIONER PROVISIONS
THE PTU WILL BE A DOOM INTEGRATED MOTORIZED, REMOTELY CONTROLLED DEVICE THAT ALLOWS THE OPERATOR TO POINT THE IP-CAMERA INTO A PAN (HORIZONTAL VECTORING) RANGE WITH THE FOLLOWING REQUIREMENTS

- 360° CONTINUOUS ROTATION CAPABILITY IN EITHER DIRECTION. SOFTWARE LIMITS PROVIDED FOR PAN MODE.
- 90° OF TILT MOVEMENT, VIDEO ROTATION AT 90° DOWN WITH AUTO-FLIP.
- PAN SPEED (OPERATOR CONTROL): VARIABLE FROM 0.1°/S TO 80 °/S
- PAN SPEED (PRESET CONTROL): MINIMUM 200°/S
- TILT SPEED (OPERATOR CONTROL): VARIABLE FROM 0.1°/S TO 40 °/S
- TILT SPEED (PRESET CONTROL): 60°/S
- MINIMUM SIXTY-FOUR PRESET POSITIONS WITH REPUTABILITY WITHIN *0.1°

1300.7.4 IP-CAMERA CONTROLLER
THE IP-CAMERA CONTROLLER WILL PROVIDE A SINGLE POINT INTERFACE FOR CONTROL AND VIDEO COMMUNICATIONS. IT WILL ALSO PROVIDE A SINGLE POINT INTERFACE FOR PRIME POWER THAT PROVIDES POWER PROTECTION, CONVERSION, AND DISTRIBUTION TO THE IP-CAMERA ASSEMBLY. THE IP-CAMERA CONTROLLER WILL HAVE 10/100 BASE-T RJ-45 ETHERNET OUTPUT FOR LOCAL VIDEO MONITORING AND COMMUNICATIONS TO A LAPTOP. THE IP-CAMERA CONTROLLER WILL RECEIVE PROCESS AND CONTROL CAMERA, ZOOM LENS, AND PTU CENTRAL COMMANDS. THESE COMMANDS WILL BE PROCESSED AND DISTRIBUTED TO THE APPROPRIATE DEVICES. THE CAMERA CONTROLLER WILL USE NON-VOLATILE MEMORY TO STORE THE REQUIRED INFORMATION FOR PRESETS, CAMERA ID, AND SECTOR TEXT. A MINIMUM OF SIXTY-FOUR PRESETS WILL BE SUPPORTED. EACH PRESET WILL CONSIST OF PAN, TILT, ZOOM, AND FOCUS POSITIONS.

THE USE OF A SEPARATE CONTROL BOX FOR POWER SURGES, TESTING, VIDEO PROCESSING AND CAMERA CONTROL WILL NOT BE REQUIRED OR ACCEPTED BY ODOT.

ITS NOTES

1300.8 IP-CAMERA ENVIRONMENTAL ENCLOSURE PROVISIONS

THE CCTV IP-CAMERA ASSEMBLY WILL MEET NEMA TYPE 4X AND IP66 ENVIRONMENTAL STANDARDS AND INCLUDE AN UNPRESSURIZED DOME-TYPE HOUSING ENCLOSURE WITH AN MINIMUM AMBIENT OPERATING TEMPERATURE OF -40 TO 140 *F (-40 TO 60 *C) WITH 100 PERCENT RELATIVE HUMIDITY THAT PROVIDES COMPLETE PROTECTION FOR THE CAMERA AND ZOOM LENS ASSEMBLY FROM MOISTURE AND AIRBORNE CONTAMINANTS. THE ENCLOSURE WILL PROTECT THE CAMERA ELECTRONICS AND ZOOM LENSES FROM BLOWING RAIN AT STORM RATES, BLOWING SAND, BLOWING DUST, TEMPERATURE, AND SOLAR LOADING, WITH AN INTERNAL HEATER AND BLOWER. THE ENCLOSURE WILL BE CORROSION RESISTANT, AND MOUNTABLE IN A MANNER, WHICH LEAVES NO EXPOSED CABLING. THE MAXIMUM OUTSIDE DIAMETER OF THE DOME WILL BE A MINIMUM OF 11.1 INCHES (280 MM), WITH A MAXIMUM OVERALL DIMENSION OF 15 X 15 IN (380 X 380 MM).

THE DOME-TYPE HOUSING'S LOWER SECTION WILL BE SITE-COATED WITH RAIN-X OR AN EQUIVALENT PRODUCT PRIOR TO FINAL ACCEPTANCE;

1300.9 IP-CAMERA CABLES

FURNISH ALL CABLES FOR THE IP-CAMERA, PTZ DOME, AND CONTROLLER. THE MOUNTING HEIGHT WILL BE 80 FEET MAXIMUM. THE CABLE SHOULD BE COMPOSITE SINGLE JACKET AND FULLY COMPATIBLE WITH THE CAMERA LOWERING UNIT.

1300.10 IP-CAMERA CONSTRUCTION PROVISIONS

FURNISH ALL TOOLS, EQUIPMENT, MATERIALS, SUPPLIES, AND MANUFACTURED ARTICLES, AND PERFORM ALL OPERATIONS AND EQUIPMENT INTEGRATION NECESSARY TO PROVIDE A COMPLETE, FULLY OPERATIONAL IP-CAMERA SITE AS DEPICTED HEREIN, WITHIN THE PLAN SET, AND/OR IN THE CONTRACT.

PROVIDE THE DEPARTMENT WITH A WRITTEN INVENTORY BY LOCATION INCLUDING SERIAL NUMBERS OF ITEMS RECEIVED AND THE CONDITION IN WHICH THEY WERE RECEIVED. ONCE RECEIVED, THE EQUIPMENT BECOMES THE CONTRACTOR'S RESPONSIBILITY. PROVIDE ALL LABOR AND EQUIPMENT NECESSARY TO MOVE INVENTORY OUT OF THE DESIGNATED STORAGE FACILITY AND TO TRANSPORT IT TO THE INSTALLATION LOCATION. ALL ITEMS WILL BE INSTALLED IN ACCORDANCE WITH THE MANUFACTURER'S INSTRUCTIONS OR AS DIRECTED BY THE DEPARTMENT.

MESSANGER WIRE (IF REQUIRED) WILL BE USED FOR ALL OVERHEAD WIRING OF IP-CAMERA CABLE. CABLES WILL BE ATTACHED TO MESSANGER WIRE AS PER PLAN SHEET TC-24.81.

IF IT IS DETERMINED THAT RADIO FREQUENCY INTERFERENCE (RFI) IS INDUCING NOISE AND DEGRADING THE QUALITY OF THE VIDEO IMAGES BEING TRANSMITTED BY THE IP-CAMERA ASSEMBLY OR ITS COMPONENTS, IF REQUIRED BY THE DEPARTMENT, FURNISH AND INSTALL FERRITE COILS OR OTHER RADIO FREQUENCY (RF) SUPPRESSION DEVICES FOR RFI DAMPENING. THIS INSTALLATION AND THE PLACEMENT OF THESE RF SUPPRESSION DEVICES WILL BE AS RECOMMENDED BY THE MANUFACTURER. THE FURNISHING AND INSTALLATION OF THESE DEVICES WILL BE AN ANCILLARY COST TO THE IP-CAMERA ASSEMBLY PAY ITEM.

1300.11 IP-CAMERA TESTING PROVISIONS

THE CONTRACTOR WILL PROVIDE ONE (1) COMPLETE IP-CCTV UNIT INCLUDING SOFTWARE TO ODOT FOR TESTING IN ADVANCE OF INSTALLATION. THE CONTRACTOR WILL NOT ORDER ADDITIONAL IP-CAMERA UNITS UNTIL ODOT HAS TESTED THE FIRST UNIT AND DETERMINED IT ACCEPTABILITY. IF APPROVED, THIS UNIT SHALL BECOME THE PROPERTY OF ODOT AND SHALL NOT BE INCLUDED IN THE QUANTITY FOR THE TOTAL NUMBER OF CAMERAS TO BE PROVIDED ON THE PROJECT.

TESTING PROCESS WILL INCLUDE IP-CAMERA CABLE TESTING AND IP-CAMERA LOCAL CONTROL TESTING

THE DEPARTMENT WILL BE NOTIFIED AT LEAST FOURTEEN WORKING DAYS PRIOR TO INSTALLATION OF THE IP-CAMERA ASSEMBLY SO THAT THE DEPARTMENT, OR HIS REPRESENTATIVE(S), CAN BE PRESENT TO ESTABLISH THE APPROPRIATE SETTINGS FOR THE PAN-AND-TILT STOPS.

THE DEPARTMENT WILL BE NOTIFIED AT LEAST FOURTEEN WORKING DAYS IN ADVANCE OF THE PROPOSED DATE FOR THE IP-CAMERA CABLE TEST AND THE LOCAL FIELD OPERATIONAL TEST. THE DEPARTMENT HAS THE RIGHT TO WITNESS SUCH TESTS OR TO DESIGNATE A REPRESENTATIVE OR ENTITY TO WITNESS SUCH TESTS ON THE ODOT'S BEHALF.

1300.11.1 IP-CAMERA CABLE TESTING PROVISIONS

FURNISH ALL EQUIPMENT, APPLIANCES, AND LABOR NECESSARY TO TEST THE INSTALLED IP-CAMERA CABLE BETWEEN THE IP-CAMERA ASSEMBLY AND THE NETWORK COMMUNICATION DEVICE. BEFORE ANY CONNECTIONS ARE MADE.

- VERIFY EXTERIOR IP-CAMERA CAT-6 STP CABLE IS OUTDOOR NEC RATED AND IS COMPLIANT TO TELECOMMUNICATIONS INDUSTRY ASSOCIATION (TIA). INTERNATIONAL ORGANIZATION FOR STANDARDS (ISO/ IEC) CREATES AND MAINTAINS STANDARDS FOR TELECOMMUNICATION CABLING.
- PERFORM A CABLE ANALYSIS TO ANSI/TIA-568-C.2 STANDARDS OF CATEGORY 6 CABLING AND CONTINUITY TEST ON THE IP-CAMERA CABLE, WHICH MUST NOT EXHIBIT ANY DISCONTINUITIES, SUCH AS OPENING, SHORTS, CRIMPS, OR DEFECTS;
- REPLACE ANY CABLE THAT FAILS TO MEET THE PARAMETERS, OR IF ANY TESTING REVEALS DEFECTS IN THE CABLE, AND RETEST NEW CABLE AS SPECIFIED ABOVE; AND
- FURNISH ALL TEST EQUIPMENT.

1300.11.2 IP-CAMERA LOCAL CONTROL TESTING

THE FOLLOWING LOCAL FIELD OPERATIONAL TESTS WILL BE PERFORMED AT THE IP-CAMERA ASSEMBLY FIELD SITE IN ACCORDANCE WITH THE TEST PLANS. A PDA OR LAPTOP COMPUTER WILL PROVIDE IP-CAMERA CONTROL AND POSITIONING. AFTER THE IP-CAMERA ASSEMBLY, INCLUDING THE CAMERA HARDWARE, POWER SUPPLY, AND CONNECTING CABLES, HAS BEEN INSTALLED.

- VERIFY THAT PHYSICAL CONSTRUCTION HAS BEEN COMPLETED AS DETAILED HEREIN, WITHIN THE PLAN SET, AND/OR IN THE CONTRACT;
- INSPECT THE QUALITY AND TIGHTNESS OF GROUND AND SURGE PROTECTOR CONNECTIONS;
- CHECK THE POWER SUPPLY VOLTAGES AND OUTPUT;
- CONNECT DEVICES TO THE POWER SOURCE;
- VERIFY TINSTALLATION OF SPECIFIED CABLES AND CONNECTIONS BETWEEN THE IP-CAMERA, PTU, AND IP-CAMERA CONTROL RECEIVER;
- CONNECT TO IP-CAMERA THROUGH A LAPTOP ETHERNET CONNECTION AND ESTABLISH COMMUNICATION WITH IP-CAMERA VIA TCP/IP-HTTP PROTOCOLS.
- SET THE IP-CAMERA ADDRESS;
- VERIFY THE PRESENCE OF INDUSTRY COMPLIANT VIDEO IMAGE I.E. H.264 WITH LOCAL OR REMOTE LAPTOP/COMPUTER. EXERCISE THE PAN, TILT, ZOOM, FOCUS, IRIS OPENING, AND MANUAL IRIS CONTROL SELECTION, AND THE OPERATION, LOW PRESSURE ALARM (IF PRESENT), PRESENT POSITIONING, AND POWER ON/OFF FUNCTIONS;
- OBSERVE THE VIDEO PICTURE ON A LAPTOP/COMPUER; DEMONSTRATE IP-CAMERA SENSITIVITY AT LOWLIGHT LEVELS TO MEET THE PROVISIONS;
- DEMONSTRATE THE PAN/TILT SPEED AND EXTENT OF MOVEMENT TO MEET THE PROVISIONS;
- VERIFY PROPER VOLTAGE OF ALL THE POWER SUPPLIES.

1300.12 VENDOR AND MANUAL PROVISIONS

PROVIDE A TRAINING AND MAINTENANCE MANUAL FOR THE IP-CAMERA ASSEMBLY AND THE CCTV NETWORKS, INCLUDING DETAILED PROVISIONS AND INFORMATION REGARDING THE FOLLOWING CCTV SYSTEM COMPONENTS.

WEIGHT AND DIMENSIONS;RESOLUTION;
SENSITIVITY;
POWER CONSUMPTION;
OPTICAL ZOOM RANGE;
DIGITAL ZOOM RANGE;
ZOOM AND FOCUS PRESETS;
PAN/TILT PRESETS;
ETHERNET CONNECTION;
SECURITY;
SUPPORTED NETWORK PROTOCOLS;
VIDEO COMPRESSION;
FRAME RATE;
NUMBER OF VIDEO STREAMS AND STREAM OUTPUTS;
IP-CAMERA CONTROL INTERFACE AS REQUIRED BY RECOMMENDED STANDARD 10/100 BASE-T RJ-45 ETHERNET, ETC.;;
OPERATING TEMPERATURE AND RELATIVE HUMIDITY; AND GENERAL MAINTENANCE PROCEDURES

PROVIDE DOCUMENTATION DETAILING THE TECHNICAL AND OPERATIONAL ASPECTS OF THE COMPLETED SYSTEM. THIS WILL INCLUDE DEVICE MANUALS, SYSTEM DIAGRAMS, CABLING DIAGRAMS, ANY AND ALL FIELD ENGINEERING NOTES SPECIFIC TO EACH INSTALLED IP-CAMERA ASSEMBLY, AND ANY OTHER DOCUMENTATION AS REQUIRED BY THE DEPARTMENT.SUPPLY A MINIMUM OF TWO DAYS OF TRAINING FOR OPERATIONS AND MAINTENANCE PERSONNEL REGARDING ALL FUNCTIONAL, OPERATIONAL, AND MECHANICAL ASPECTS OF THE IP-CAMERA ASSEMBLY AND THE SUPPORTING NETWORK COMMUNICATION DEVICES.

THE VENDOR SHALL SUPPLY TO ODOT COPIES OF THE COMPUTER SOFTWARE FOR SETUP, TESTING, AND CONTROL OF THE CCTV LOCALLY

1300.13 WARRANTY

EQUIPMENT FURNISHED UNDER THIS SPECIFICATION WILL BE GUARANTEED TO PERFORM ACCORDING TO THESE SPECIFICATIONS AND TO THE MANUFACTURER'S PUBLISHED SPECIFICATIONS. EQUIPMENT WILL BE WARRANTED FOR A MINIMUM OF FIVE (5) YEARS FROM TIME OF ACCEPTANCE AGAINST MANUFACTURER'S DEFECTS AND/OR FAILURE IN DESIGN, MATERIALS OR WORKMANSHIP. THE CONTRACTOR SHALL BE RESPONSIBLE FOR THE LABOR TO TROUBLESHOOT/RESOLVE ISSUES DURING THIS 5 YEAR WARRANTY. UNLESS OTHERWISE SPECIFIED IN THE INVITATION FOR BIDS, WARRANTY COVERAGE WILL BECOME EFFECTIVE ON THE DATE OF FINAL ACCEPTANCE OF THE SYSTEM BY THE DEPARTMENT. THE CCTV IP-CAMERA SYSTEM MANUFACTURER(S) WILL ASSIGN TO THE DEPARTMENT ALL MANUFACTURER'S NORMAL WARRANTIES OR GUARANTEES, ON ALL SUCH ELECTRONIC, ELECTRICAL AND MECHANICAL EQUIPMENT, MATERIALS, TECHNICAL DATA, AND PRODUCTS FURNISHED FOR AND INSTALLED ON THE PROJECT. DEFECTIVE EQUIPMENT WILL BE REPAIRED OR REPLACED, AT THE MANUFACTURER'S OPTION, DURING THE WARRANTY PERIOD AT NO COST TO THE DEPARTMENT. THE CONTRACTOR SHALL HAVE PERSONNEL ON SITE TO TROUBLESHOOT WITHIN TEN (10) BUSINESS DAYS UPON NOTIFICATION FROM ODOT. IF PARTS ARE REQUIRED, THE CONTRACTOR MAY BE GIVEN AN ADDITIONAL TEN (10) BUSINESS DAYS TO RECEIVE THE PARTS AND COMPLETELY RESOLVE THE ISSUE. IF THE PROBLEM IS NOT RESOLVED DUE TO NEGLIGENCE IN RESPONSE FROM THE CONTRACTOR AFTER THIRTY (30) DAYS, ODOT RESERVES THE RIGHT TO BACK-CHARGE THE CONTRACTOR IN ORDER TO INTERNALLY FIX OR HIRE A 3RD PARTY CONTRACTOR TO MAKE NECESSARY REPAIRS. THIS WARRANTY RESPONSIBILITY TO ODOT MAY BE TRANSFERRED FROM THE CONTRACTOR'S RESPONSIBILITY TO THE MANUFACTURER IF WRITTEN DOCUMENTATION IS PROVIDED AND ACCEPTED BY ODOT.

ITS NOTES

ITEM 633 - CONTROLLER ITEM, MISC.: ITS CABINET, GROUND MOUNTED (CONTINUED)

1800.3.11 POWER UNIT

A RACK MOUNTED POWER UNIT SHALL BE MOUNTED IN THE BOTTOM FRONT OF THE CABINET. THE POWER UNIT SHALL CONTAIN THE FOLLOWING REQUIREMENTS:

- MAXIMUM DIMENSIONS: 17 INCHES (W) X 7 INCHES (H) X 8 INCHES (D)
- EQUIPMENT RECEPTACLE:

1. SHALL BE MOUNTED ON THE REAR OF THE POWER UNIT
2. EQUIPMENT RECEPTACLES SHALL BE DUPLEX, 3-PRONG, NEMA TYPE 5-20R GROUNDING TYPE OUTLET AND SHALL CONFORM TO THE REQUIREMENTS IN UL STANDARD 943.

- FIELD PERSONNEL TESTING OUTLET

1. ONE GFCI RECEPTACLE OUTLET ON RIGHT FRONT

- SURGE SUPPRESSION:

1. SHALL BE INSTALLED SO THAT ANY LED INDICATORS CAN BE EASILY SEEN AND THE UNIT CAN BE EASILY REPLACED.
2. MOUNTED ON RIGHT FRONT OF UNIT WITH THE FOLLOWING SPECIFICATIONS
3. 100 KA PER PHASE RATING 120 SINGLE PHASE
4. UL 1449 LISTED
5. < 1 NANOSECOND RESPONSE TIME
6. NORMAL OPERATING TEMPERATURE: -40 TO +55 CELSIUS
7. PEAK OPERATING TEMPERATURE: 80 CELSIUS
8. MAXIMUM DIMENSIONS: 8 INCHES (W) X 4 INCHES (H) X 4 INCHES (D)

- 3 CIRCUIT BREAKERS MOUNTED ON LEFT FRONT OF UNIT (1-60 AMP & 2-20 AMP)

1. CIRCUIT BREAKERS SHALL HAVE A MINIMUM INTERRUPTING CAPACITY OF 5000 A, ROOT MEAN SQUARE (RMS).
2. THE 60 AMP BREAKER (CB1) SHALL BE THE MAIN BREAKER OF THE CABINET. INCOMING POWER SHALL BE WIRED THROUGH THE FOLLOWING PATH:
3. ONE 20 AMP BREAKER (CB2) SHALL BE UTILIZED FOR ALL CABINET EQUIPMENT.
4. ONE 20 AMP BREAKER (CB3) SHALL BE UTILIZED FOR THE GFCI, LED LIGHTING, AND CABINET FANS.
5. THE SURGE SUPPRESSION SHALL BE WIRED TO ENCOMPASS BOTH 20 AMP BREAKERS.
6. THE NOISE FILTER SHALL BE WIRED TO ONLY ENCOMPASS THE EQUIPMENT OUTLET.

- POWER DISTRIBUTION BLOCKS

A POWER DISTRIBUTION BLOCK SHALL BE PROVIDED FOR THE MAIN POWER ENTERING THE CABINET. THE POWER DISTRIBUTION BLOCK SHALL HAVE THE FOLLOWING MINIMUM REQUIREMENTS:

1. CURRENT RATING 175 AMPS
2. VOLTAGE RATING 600 VOLTS
3. 3 POLE
4. PRIMARY WIRE RANGE 14 2/0 AWG COPPER
5. SECONDARY WIRE RANGE 14 4 AWG COPPER
6. SHALL BE EQUIPPED WITH A TOUCH SAFE COVER

A SEPARATE UNIT SHALL ALSO BE INCIDENTAL TO THE PRICE OF THE CABINET FOR THE PURPOSE OF REMOTE MANAGEMENT OF 12VDC AND 24VDC POWER OUTPUTS. THIS UNIT SHALL BE 19 INCH RACK-MOUNTABLE AND SHALL ALLOW FOR REMOTE MANAGEMENT OF A MINIMUM OF 5 SEPARATE DC POWER SOURCES. THERE SHALL BE A MINIMUM OF 3 ALARM CONTACT CLOSURE INPUTS, THAT WHEN TRIGGERED WILL SEND AN EMAIL TO A USER DEFINED ADDRESS. THE UNIT SHALL ALSO MONITOR THE OUTPUT STATES OF ALL THE POWER OUTPUTS.

1800.3.12 TERMINAL BLOCKS

TERMINAL BLOCKS SHALL BE RATED 600 VAC, MINIMUM, AND SHALL BE PROVIDED WITH NICKEL, SILVER OR CADMIUM PLATED BRASS BINDER HEAD SCREW TERMINALS. HEAVY DUTY TERMINAL BLOCKS SHALL BE RATED AT 20 A AND SHALL BE PROVIDED WITH TWELVE POLES WITH NUMBER 10 X 5/16 IN (250 X 7.9 MM) NICKEL PLATED BRASS BINDER HEAD SCREWS AND NICKEL PLATED BRASS INSERTS. EACH POLE POSITION SHALL BE PROVIDED WITH TWO TERMINAL POSITIONS. THE TERMINAL BLOCKS SHALL BE THE BARRIER TYPE, WITH SHORTING BARS IN EACH OF THE TWELVE POSITIONS, AND SHALL BE PROVIDED WITH INTEGRAL TYPE MARKING STRIPS. LIGHT DUTY TERMINAL BLOCKS SHALL BE RATED AT 5 A AND SHALL BE PROVIDED WITH TWELVE POLES WITH NUMBER 6 X 1/8 IN (150 X 3.2 MM) BINDER HEAD SCREWS. EACH POLE POSITION SHALL BE PROVIDED WITH ONE TERMINAL POSITION. ALL TERMINAL BLOCKS SHALL BE FITTED WITH ASSOCIATED CLEAR SAFETY COVERS TO PROTECT AGAINST ACCIDENT CONTACT.

1800.3.13 PULLOUT DRAWER ASSEMBLY

A PULLOUT DRAWER SHALL BE INSTALLED IN THE CABINET CAGE. THE DRAWER SHALL BE 16.92 INCHES (430 MM) LONG BY 16.92 INCHES (430 MM) WIDE BY 1.73 INCHES (44 MM) DEEP. IT SHALL HAVE A HINGED TOP THAT COVERS THE STORAGE BOX AREA AND ALSO PROVIDES A SMOOTH SURFACE TO WRITE ON. THE TOP OF THE STORAGE COMPARTMENT SHALL BE ALUMINUM. THE DRAWER SHALL BE GENERAL DEVICES D4080-19W (OR EQUAL). THE COMPARTMENT SHALL HAVE BALL BEARING TELESCOPING DRAWER GUIDES TO ALLOW FULL EXTENSION FROM THE RACK ASSEMBLY. WHEN EXTENDED, THE STORAGE COMPARTMENT SHALL OPEN TO PROVIDE STORAGE SPACE FOR CABINET DOCUMENTATION AND OTHER MISCELLANEOUS ITEMS. THE STORAGE COMPARTMENT SHALL BE OF ADEQUATE CONSTRUCTION TO SUPPORT A WEIGHT OF 20 POUNDS (9 KG) WHEN EXTENDED WITHOUT SAGGING. A PLASTIC ENVELOPE WITH RE-SEALABLE OPENING SHALL BE IN EACH DRAWER TO PROVIDE PROTECTION FOR CABINET AND SITE DETAILED DRAWINGS. THE SIZE OF THE ENVELOPES SHALL BE BIG ENOUGH TO ACCOMMODATE THE ABOVE DRAWINGS.

1800.3.14 CABINET MONITOR

ALL CABINETS SHALL HAVE DOOR-ACTIVATED SWITCHES THAT PROVIDE A CONTACT CLOSURE FOR ALARMS WHEN THE DOOR(S) ARE OPENED TO A CABINET MONITORING UNIT. THE GAUGE OF THE WIRE CONNECTED TO THE SWITCHES SHALL BE 16 AWG. THE MONITORING UNIT SHALL HAVE THE FOLLOWING REQUIREMENTS:

- MINIMUM 4 DRY CONTACTS FOR VARIOUS CABINET ALARMS
- NOTIFICATION OF ALARMS VIA MULTIPLE EMAIL / SMS USERS
- WEB-INTERFACE TCP/IP ADDRESSABLE

1800.3.15 CARTRIDGE FUSES

CARTRIDGE FUSES SHALL BE INSTALLED IN PANEL MOUNTED FUSE HOLDERS. FUSE TYPE AND RATING SHALL BE AS RECOMMENDED BY THE FUSE MANUFACTURER FOR THE TYPE OF LOAD BEING PROTECTED.

1800.3.16 AC POWER DISTRIBUTION UNIT

THE CABINET SHALL INCLUDE A MANAGED POWER DISTRIBUTION UNIT WITH THE FOLLOWING REQUIREMENTS:

- SHALL BE CAPABLE OF REMOTELY CONTROL INDIVIDUAL OUTLETS TO REBOOT EQUIPMENT REMOTELY.
- SHALL HAVE A MINIMUM OF 8 120 VAC, 15 AMP OUTLETS
- SHALL HAVE A CURRENT (A) MONITORING DIGITAL DISPLAY.
- THE OUTLETS SHALL BE LOCATED IN THE REAR OF THE UNIT.

1800.3.17 DC POWER DISTRIBUTION UNIT

THE CABINET SHALL INCLUDE A MANAGED POWER DISTRIBUTION UNIT WITH THE FOLLOWING REQUIREMENTS:

- SHALL INCLUDE ONE 12 VDC (3- 1.0 AMP OUTPUTS)
- SHALL INCLUDE ONE 24 VDC MINIMUM (2 1.0 AMP OUTPUTS AND 1- 2.0 AMP OUTPUT)
- SHALL INCLUDE ONE 48 VDC (2 2.0 AMP OUTPUTS)
- SHALL BE CAPABLE OF REMOTELY CONTROLLING INDIVIDUAL 12VDC, 24 VDC, AND 48 VDC POWER SUPPLIES.
- THE 2 2.0 AMP OUTPUTS SHALL BE LABELED AND WIRED TO SEPARATE TERMINAL STRIPS ON THE NETWORK DEVICE DIN RAIL.
- THE MAXIMUM DIMENSIONS OF THIS UNIT ARE 17 INCHES (W) X 7 INCHES (H) X 8 INCHES (D)

1800.3.18 NETWORK DEVICE DIN RAIL

THE CABINET SHALL INCLUDE A RACK MOUNT DIN RAIL UNIT FOR MOUNTING A CISCO IE3000-8TC NETWORK SWITCH WITH CISCO IEM-3000-4SM EXPANSION MODULE. THE DIN RAIL SHALL BE RECESSED AND SHALL HAVE ACCESS HOLES FOR NETWORK CABLING ON EACH SIDE OF THE PANEL AS WELL AS CABLE MANAGEMENT PANELS AT THE TOP OF THE CABINET FRONT AND BACK. THE ACCESS HOLES SHALL HAVE GROMMETS INSTALLED TO PROTECT THE CABLES FROM WEARING ON BARE METAL. THE DIMENSIONS SHALL BE APPROXIMATELY 17 INCHES (W) X 8 INCHES (H) X 10 INCHES (D) AND SHALL HAVE A LOUVERED BOTTOM TO ACT AS A SHELF WHEN IE3000 SWITCHES ARE NOT UTILIZED.

1800.3.19 GENERATOR POWER PANEL

THE CABINET SHALL INCLUDE A GENERATOR POWER PANEL PER ODOT PLAN INSERT SHEET (PIS #203011).

1800.3.20 CONNECTORS

CONNECTORS USED FOR INTERCONNECTING VARIOUS PORTIONS OF CIRCUITS TOGETHER SHALL BE DESIGNED AND CONSTRUCTED FOR THE APPLICATION INVOLVED. CONNECTORS SHALL BE DESIGNED TO PROVIDE POSITIVE CONNECTION OF ALL CIRCUITS, AND EASY INSERTION AND REMOVAL OF MATING CONTACTS. CONNECTORS SHALL BE PERMANENTLY KEYS TO PREVENT IMPROPER CONNECTION OF CIRCUITS. CONNECTORS, OR DEVICES PLUGGING INTO CONNECTORS, SHALL BE PROVIDED WITH POSITIVE MEANS TO PREVENT ANY INDIVIDUAL CIRCUIT FROM BEING BROKEN DUE TO VIBRATION, PULL ON CONNECTING CABLE OR SIMILAR DISRUPTIVE FORCE.

1800.3.21 CONDUITS ENTERING FOUNDATION

THERE SHALL BE A TOTAL OF 4 CONDUITS ENTERING THE FOUNDATION. THIS INCLUDES TWO 4-INCH SCHEDULE 40 MULTI-CELL CONDUITS TO BE CONNECTED TO 36-INCH COMMUNICATIONS "TRAFFIC9" PULLBOX, ONE 2-INCH SCHEDULE 40 CONDUIT TO BE CONNECTED TO THE 18-INCH POWER "ELECTRIC" PULLBOX, AND ONE 3/4-INCH GALVANIZED STEEL CONDUIT TO BE CONNECTED TO THE GROUND ROD. THE COST OF THESE CONDUITS SHALL BE INCIDENTAL TO THE COST OF THE ITS CABINET. IT SHALL BE THE CONTRACTOR'S RESPONSIBILITY TO PLACE BOTH THE "ELECTRIC" AND "TRAFFIC" PULL BOXES IN LOCATIONS AS IDENTIFIED IN THE PLANS SO AS TO GET AN ACCURATE QUANTITY OF CONDUIT TO PROVIDE ON A PER SITE BASIS.

1800.3.22 WORKPADS

WORK PADS SHALL BE INSTALLED PER ODOT CMS 633.11 AND SHALL BE INCIDENTAL TO THE PRICE OF THE CABINET.

1800.4 ENVIRONMENTAL

THE COMPONENTS SUCH AS SURGE SUPPRESSORS AND POWER DISTRIBUTION SHALL OPERATE PROPERLY WITHIN THE AMBIENT TEMPERATURE LIMITS OF 0 °F (-17.8 °C) TO 120 °F (48.9 °C) AND MEET THE AMBIENT TEMPERATURE RANGE, RELATIVE HUMIDITY, APPLIED POWER, SHOCK AND VIBRATION RANGE OF NEMA TS-2.

1800.5 TESTING

GENERAL: SUBJECT THE EQUIPMENT COVERED BY THESE PROVISIONS TO DESIGN APPROVAL TEST (DAT) AND FACTORY APPROVAL TESTS (FAT'S). THE DEPARTMENT RESERVES THE RIGHT TO WITNESS ALL FAT'S. COMPLETE THE TESTS WITHIN FIVE CALENDAR DAYS. ENSURE THAT THE TEST PLANS DEMONSTRATE EACH AND EVERY FEATURE AVAILABLE IN THE DEVICE OR SYSTEM UNDER TEST AND INCLUDES THE TESTS DISCUSSED BELOW. THE DEPARTMENT WILL EVALUATE MATERIAL AND DEVICES PURCHASED UNDER THIS CONTRACT TO VERIFY COMPLIANCE WITH PROVISIONS AND DETERMINE SUITABILITY FOR USE. SAMPLE MATERIAL AND DEVICES MUST BE SUBMITTED AT NO ADDITIONAL COST TO THE DEPARTMENT FOR EVALUATION AND WILL BE RETAINED FOR OPERATIONAL TESTING AS LONG AS THE MATERIAL OR DEVICE IS APPROVED FOR USE.

DAT AND FAT: DEVELOP AND SUBMIT A TEST PLAN FOR DAT'S AND FAT'S TO THE DEPARTMENT FOR CONSIDERATION AND APPROVAL. THE DEPARTMENT MAY ACCEPT CERTIFICATION BY AN INDEPENDENT TESTING LABORATORY IN LIEU OF THE DAT'S TO SATISFY THE REQUIREMENT THAT CERTAIN FEATURES AND FUNCTIONS HAVE BEEN WITNESSED AND DOCUMENTED AS PERFORMING SATISFACTORILY. ARRANGE FOR AND CONDUCT THE TESTS AND IS RESPONSIBLE FOR SATISFYING ALL INSPECTION REQUIREMENTS PRIOR TO SUBMISSION FOR THE DEPARTMENT'S INSPECTION AND ACCEPTANCE. THE DEPARTMENT RESERVES THE RIGHT TO WITNESS ALL DAT'S AND FAT'S. COMPLETE THE TESTS WITHIN FIVE CALENDAR DAYS.

TRANSIENT, TEMPERATURE, VOLTAGE, AND HUMIDITY TESTING: THE SELECTED MANUFACTURER WILL PROVIDE ONE CABINET OF EACH TYPE FOR TESTING AND EVALUATION PURPOSES AT NO COST TO THE DEPARTMENT. THE UNITS SHALL BE TESTED AND EVALUATED AS INDICATED BELOW. THE TRAFFIC OPERATIONS RESEARCH LABORATORY (TERL) WILL REVIEW THE PROPOSED PRODUCTS FOR COMPLIANCE OF THE TEST PROCEDURES AS NOTED WITHIN SECTION 2.2.7 OF THE NEMA TS 2-1998 STANDARD AND SHALL INCLUDE THE FOLLOWING TESTS:

- TEST A: (DAT) PLACEMENT IN ENVIRONMENTAL CHAMBER AND CHECK-OUT OF HOOK-UP.
- TEST B: (DAT) TEMPERATURE CYCLING AND APPLIED TRANSIENT TESTS (POWER SERVICE).
- TEST C: (DAT AND PRODUCTION TESTING) LOW-TEMPERATURE LOW-VOLTAGE TESTS.
- TEST D: (DAT AND PRODUCTION TESTING) LOW-TEMPERATURE HIGH-VOLTAGE TESTS.
- TEST E: (DAT AND PRODUCTION TESTING) HIGH-TEMPERATURE HIGH-VOLTAGE TESTS.
- TEST F: (DAT AND PRODUCTION TESTING) HIGH-TEMPERATURE LOW-VOLTAGE TESTS.
- TEST G: TEST TERMINATION (ALL TESTS).
- TEST H: APPRAISAL OF EQUIPMENT UNDER TEST.

ITEM 633 - CONTROLLER ITEM, MISC.: RELOCATE POWER SUPPLY

THIS ITEM INCLUDES ALL LABOR, MATERIAL, AND INCIDENTALS, INCLUDING BUT NOT LIMITED TO NEW CABLE OR CABLE EXTENSION, TO RELOCATE THE EXISTING ITS POWER SUPPLY FROM THE EXISTING ITS CABINET TO THE PROPOSED ITS CABINET.

ITEM 633 - CONTROLLER ITEM, MISC.: RELOCATE ITS COMMUNICATION

THIS ITEM INCLUDES ALL LABOR, MATERIAL, AND INCIDENTALS, INCLUDING BUT NOT LIMITED TO NEW CABLE OR CABLE EXTENSION, TO RELOCATE THE EXISTING ITS COMMUNICATIONS FROM THE EXISTING ITS CABINET TO THE PROPOSED ITS CABINET. THIS ITEM INCLUDES COMPLETE CONNECTION OF COMMUNICATIONS TO THE PROPOSED ITS CAMERA USING THE SAME PARAMETERS AND PROTOCOLS OF THE EXISTING CAMERA INSTALLATION. THIS ITEM SHALL BE PAID AT THE LUMP SUM PRICE UPON ACCEPTANCE OF COMPLETED COMMUNICATIONS RELOCATION.

AS BUILT - 4/22/2016

synchro

6/15/2016 8:15:37 AM

Sources\83988CN007.dgn

Buils\Obsolete

FRA IR 270

Resource International\003

CALCULATED
SGB
CHECKED
ERW

BU 4, 5, 6, 7, & 8 - RELEASED FOR CONSTRUCTION - 11/03/2014 - 11/19/2015

ITS NOTES

FRA - 270 - 49.00

140
182

ITS NOTES

AS BUILT - 4/22/2016

synchro

6/15/2016 8:16:43 AM

Sources\83988CN009.dgn

6/15/2016 8:16:43 AM

6/15/2016 8:16:43 AM

ITEM 632 - SIGNALIZATION, MISC.: CCTV POLE, CONCRETE, 70', WITH LOWERING UNIT (CONTINUED)

ALL ELECTRICAL AND VIDEO CONNECTIONS BETWEEN THE FIXED AND LOWER-ABLE PORTION OF THE OUTDOOR-RATED CONTACT BLOCK WILL BE PROTECTED FROM EXPOSURE TO THE WEATHER BY A WATERPROOF SEAL TO PREVENT DEGRADATION OF THE ELECTRICAL CONTACTS. THE ELECTRICAL CONNECTIONS BETWEEN THE FIXED AND MOVABLE LOWERING DEVICE COMPONENTS WILL BE DESIGNED TO CONDUCT HIGH FREQUENCY DATA BITS AND ONE (1) VOLT PEAK-TO-PEAK VIDEO SIGNALS AS WELL AS THE POWER REQUIREMENTS FOR OPERATION OF DOME ENVIRONMENTAL CONTROLS.

THE INTERFACE AND LOCKING COMPONENTS WILL BE MADE OF STAINLESS STEEL OR ALUMINUM. ALL EXTERNAL COMPONENTS OF THE LOWERING DEVICE WILL BE MADE OF CORROSION RESISTANT MATERIALS, POWDER COATED, GALVANIZED, OR OTHERWISE PROTECTED FROM THE ENVIRONMENT BY INDUSTRY-ACCEPTED COATINGS TO WITHSTAND EXPOSURE TO A CORROSIVE ENVIRONMENT.

THE CAMERA MANUFACTURER, IF NEEDED, WILL PROVIDE EITHER WEIGHTS OR COUNTERWEIGHTS AS NECESSARY TO ASSURE THAT THE ALIGNMENT OF PINS AND CONNECTORS ARE PROPER FOR THE CAMERA SUPPORT TO BE RAISED INTO POSITION WITHOUT BINDING. THE LOWERING UNIT WILL HAVE SUFFICIENT WEIGHT TO DISENGAGE THE CAMERA AND ITS CONTROL COMPONENTS IN ORDER THAT IT CAN BE LOWERED PROPERLY.

THE CAMERA MANUFACTURER, IF NEEDED, WILL PROVIDE THE APPROPRIATE LENGTH, TYPE OF POWER AND SIGNAL CABLE TO THE LOWERING SYSTEM MANUFACTURER SO THAT SAME CAN BE PRE-WIRED TO THE FEMALE CONNECTOR AND STRAIN-RELIEVED AT THE LOWERING DEVICE FACTORY PRIOR TO SHIPMENT.

THE CAMERA MANUFACTURER WILL PROVIDE A MOUNTING FLANGE SUFFICIENT FOR MOUNTING THEIR RESPECTIVE CAMERA ASSEMBLY TO THE BOTTOM OF THE CAMERA CONNECTION BOX.

ITEM 632 - INTERCONNECT CABLE MISC.: CATEGORY 5E CABLE, OUTDOOR RATED

2400.1 GENERAL DESCRIPTION

THE CONTRACTOR SHALL FURNISH AND INSTALL A CATEGORY 5E OUTSIDE PLANT ETHERNET CABLE THAT MEETS THE

FOLLOWING MINIMUM SPECIFICATIONS:

- FOOTAGE MARKINGS: EVERY 3 FEET
- ARMOR: HELICALLY APPLIED 12MM ALUMINUM WITH INNER JACKET
- CONDUCTOR INSULATION: POLYOLEFIN
- JACKET: UV AND ABRASION RESISTANT POLYETHYLENE
- CONDUCTORS: 24 AWG SOLID BARE ANNEALED COPPER
- CABLE DIAMETER: MAXIMUM 0.35 INCHES
- FLOODING COMPOUND: WATERPROOF GEL
- MINIMUM BEND RADIUS: 1.0 INCH
- MAXIMUM PULLING FORCE: 25 POUNDS
- TEMPERATURE RATING
- INSTALLATION: -30 TO +60 C
- OPERATION: -45 TO +80 C
- COLOR CODE
- PAIR 1: BLUE-WHITE/BLUE
- PAIR 2: ORANGE-WHITE/ORANGE
- PAIR 3: GREEN-WHITE/GREEN
- PAIR 4: BROWN-WHITE/BROWN

THE CONTRACTOR SHALL INSTALL CABLE AS SHOWN IN PLANS, OR AS DIRECTED BY ENGINEER, LEAVING 10 FEET OF SLACK IN EACH PULL BOX. THE CABLE SHALL BE TERMINATE WITH RJ-45 CONNECTORS AND WIRED PER TIA/EIA 568-B.


CALCULATED
SGB
CHECKED
ERW

BU 4, 5, 6, 7, & 8 - RELEASED FOR CONSTRUCTION - 11/03/2014 - 11/19/2015

FRA - 270 - 49.00


ITS NOTES

142
182

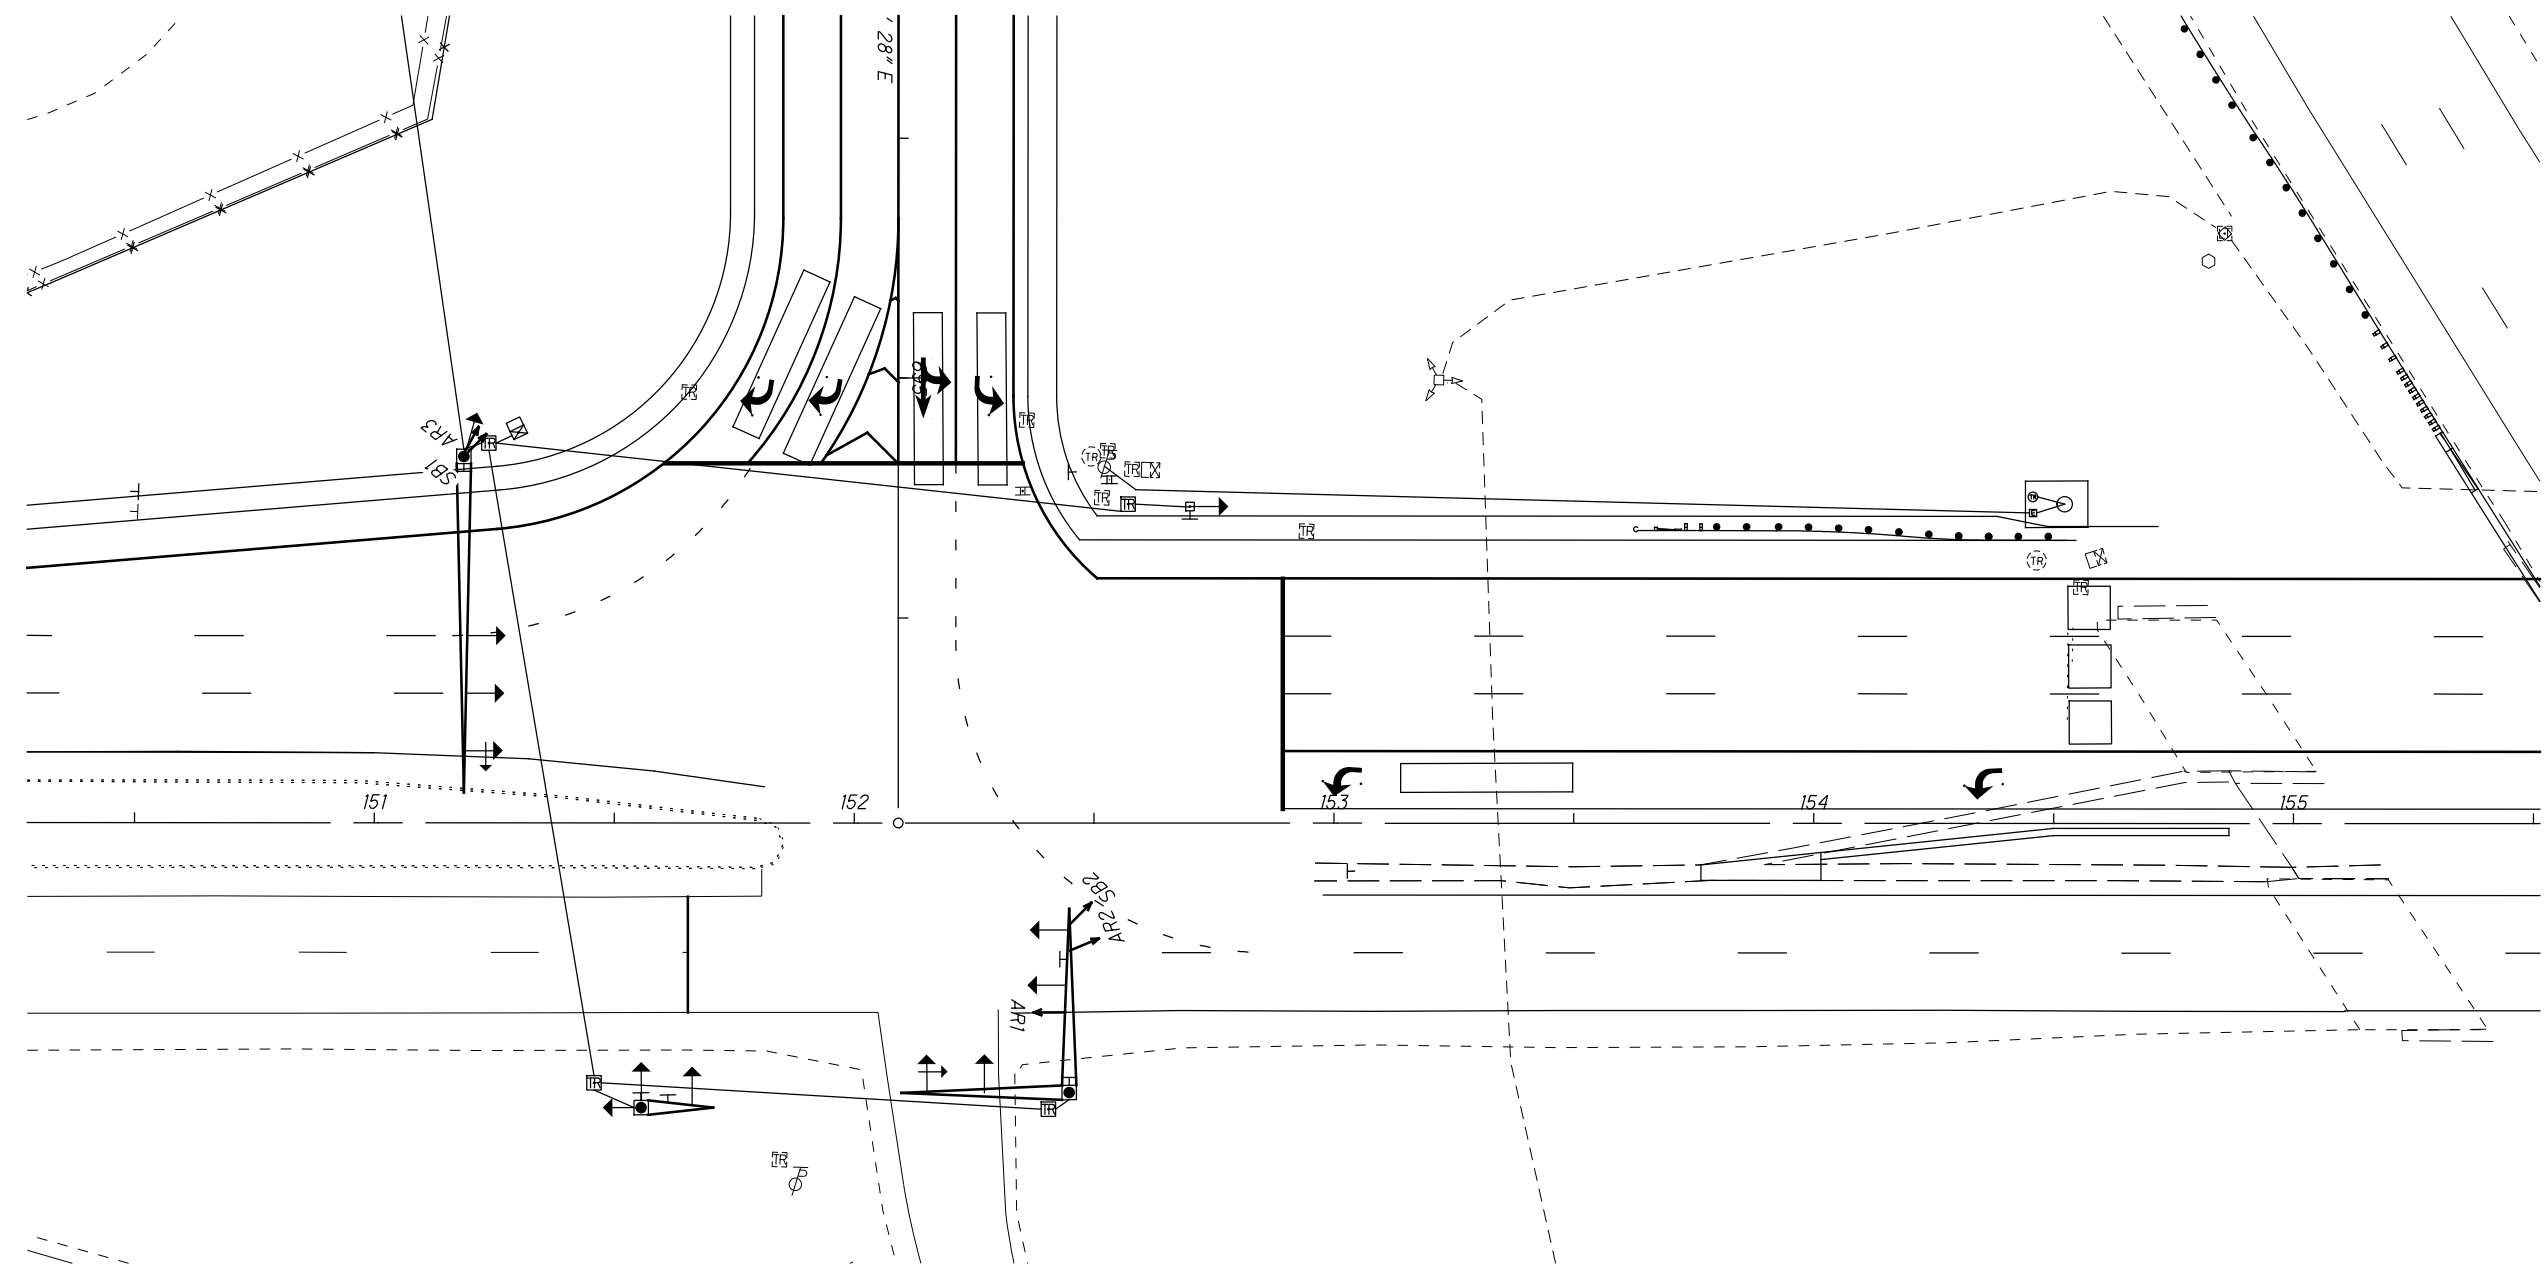


ITEM	UNIT	DESCRIPTION	Total
		ITS	
625	FT	CONDUIT, 3", 725.05	200
625	FT	PULLBOX, 725.08, 18"	1
632	EACH	SIGNALIZATION, MISC.: CCTV IP-CAMERA SYSTEM, DOME TYPE	1
632	EACH	SIGNALIZATION, MISC.: CCTV POLE, CONCRETE, 70', WITH LOWERING UNIT	1
632	EACH	SIGNALIZATION, MISC.: 32" ROUND CONCRETE PULLBOX	1
633	EACH	CONTROLLER ITEM, MISC.: ITS CABINET, GROUND MOUNTED	1
633	FT	INTERCONNECT CABLE MISC.: CATEGORY 5E CABLE, OUTDOOR RATED	135
633	EACH	CONTROLLER MISC.: ITS WORK PAD	1



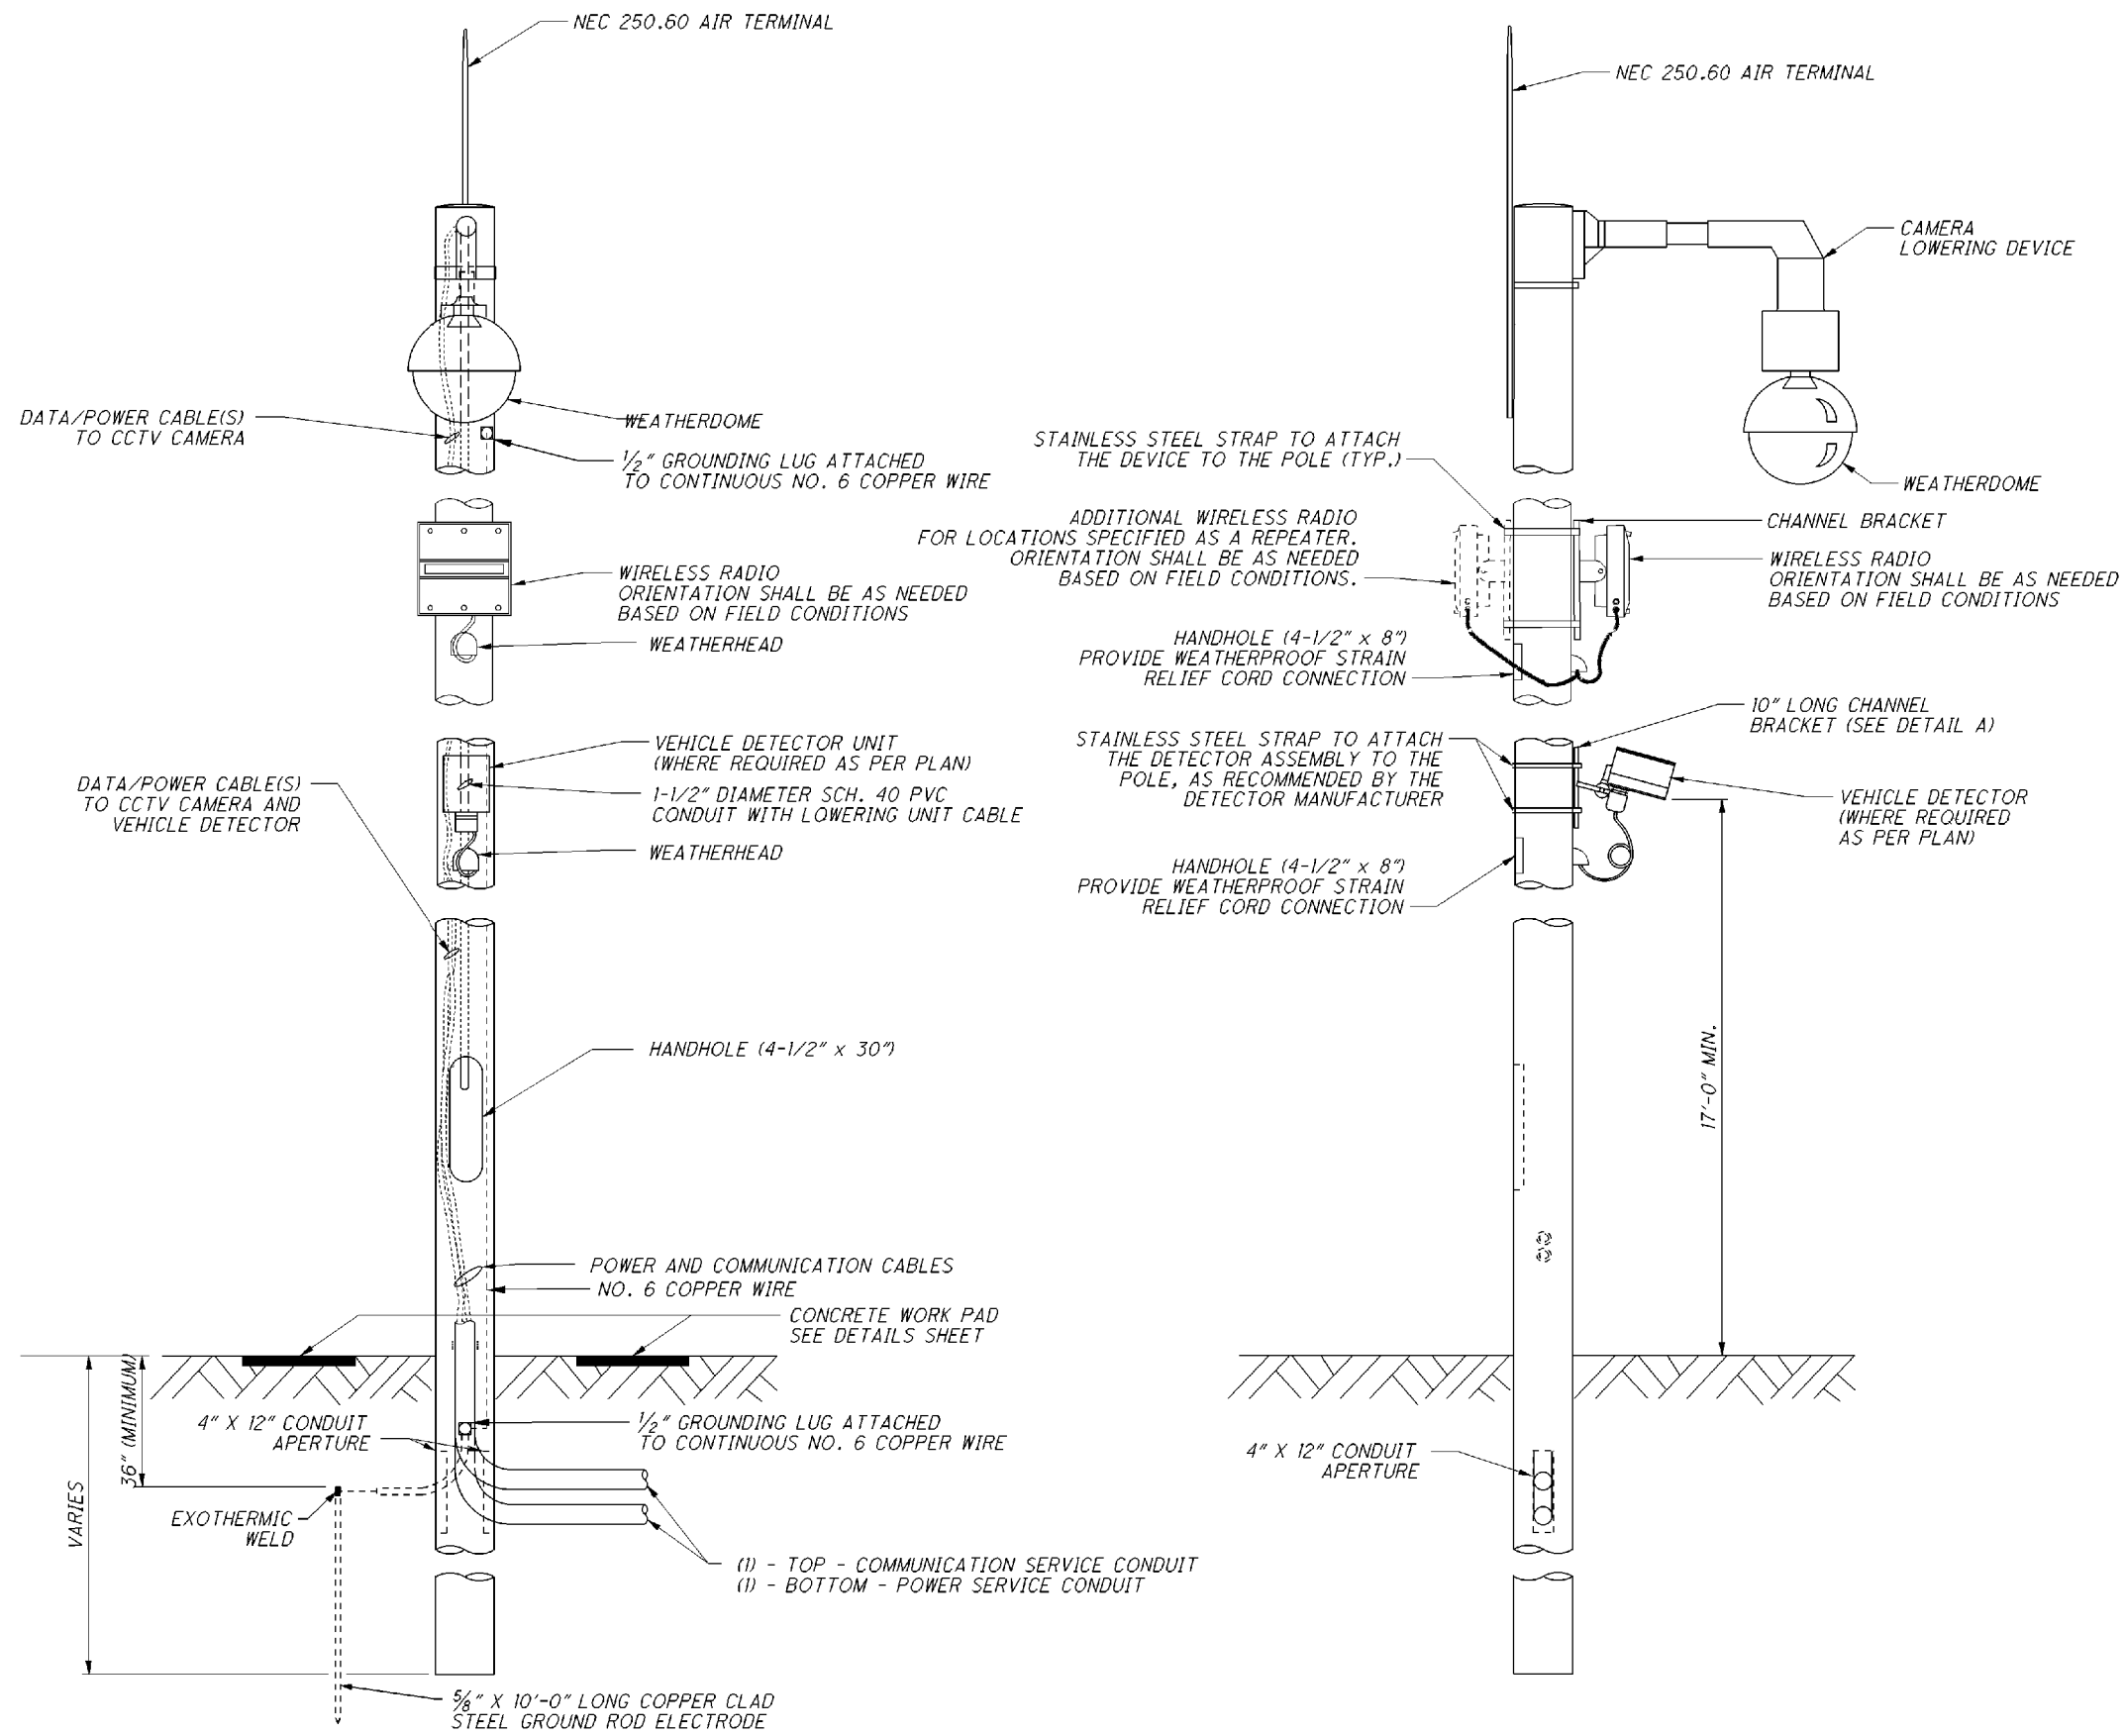


CCTV CAMERA ASSEMBLY (TYPICAL)
NOT TO SCALE

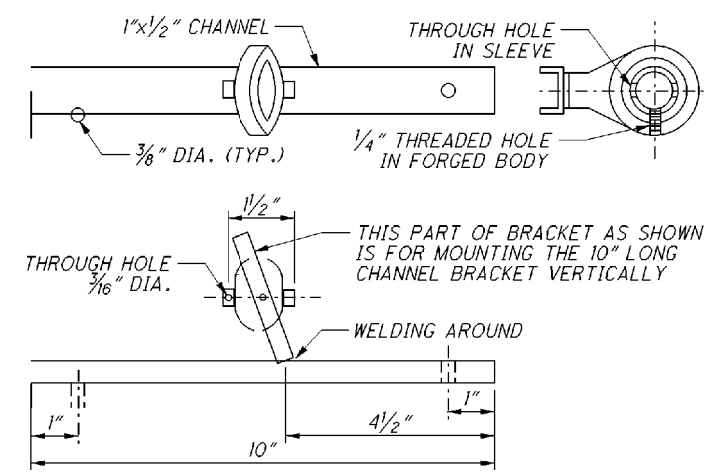


DETAIL 'A', CHANNEL BRACKET
(SUPPLIED BY DETECTOR MANUFACTURER)
NOT TO SCALE

- NOTES:**
1. MOUNT VEHICLE DETECTOR UNIT SO THAT THE DETECTOR IS MOUNTED ON THE ROADWAY SIDE OF POLE AT A HEIGHT RECOMMENDED BY THE MANUFACTURER.
 2. SUPPORT HOOKS SHOULD BE APPROPRIATELY SIZED FOR THE NUMBER AND SIZE OF CONDUCTORS TO BE SUPPORTED. SUPPORT ELECTRICAL AND COMMUNICATION CABLES WITH SEPARATE HOOKS.
 3. RUN ALL WIRING INSIDE THE POLE AND PROVIDE STRAIN RELIEF AND SUPPORT FOR ALL CONTROL CABLES.
 4. SEE PLAN SHEETS FOR VEHICLE DETECTOR LOCATIONS.
 5. WHEN INSTALLING THE MOUNTING BRACKETS FOR VEHICLE DETECTORS, ALIGN AND ANGLE THE DETECTORS TO COVER THE DETECTION ZONE(S) PER MANUFACTURER'S SPECIFICATIONS.

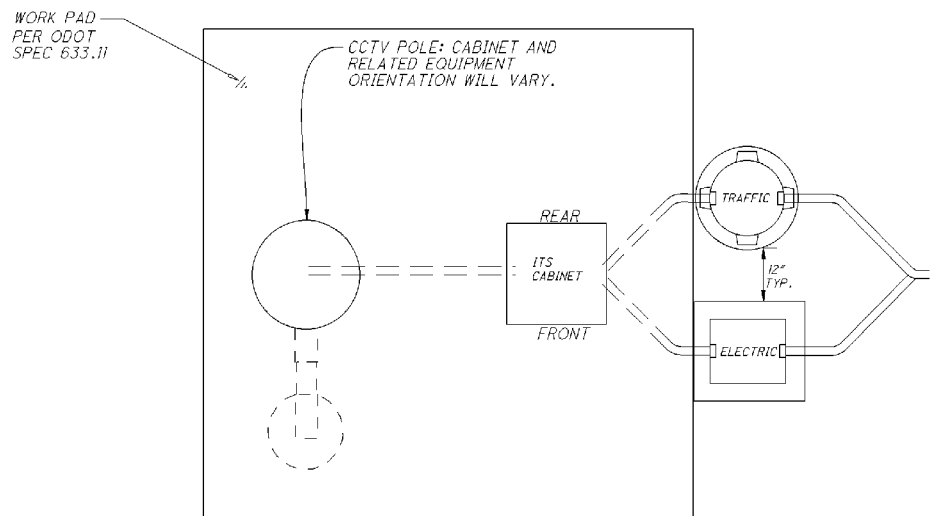


**TYPICAL CCTV CAMERA POLE
DEVICE WORK PAD DETAIL (116"x116"x6")
PLAN VIEW
NOT TO SCALE**

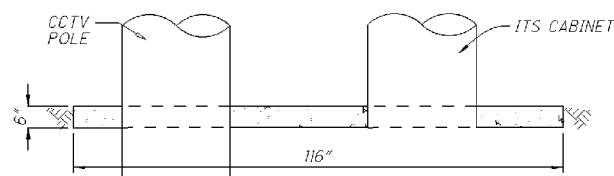






**CROSS-SECTION
DEVICE WORK PAD
(116"x116"x6")
ELEVATION VIEW
NOT TO SCALE**

NOTES:

1. 1/2" PREFORMED JOINT FILLER AS PER 705.03 SHALL BE USED BETWEEN CONCRETE POLE AND ADJACENT PAVED AREAS.
2. A 6" THICK WORK PAD WITH DIMENSIONS SHOWN ON DETAILS SHALL BE PROVIDED UNLESS IN AN OTHERWISE PAVED AREA. IN LEVEL AREAS, THE TOP OF THE PAD SHALL BE 1" ABOVE THE GROUND LINE. IN STEEPLY SLOPED AREAS, THE PAD'S DESIGN SHALL BE ADJUSTED TO PROVIDE ACCESS, DRAINAGE, AND SAFETY, AS APPROVED BY THE PROJECT ENGINEER. SEE TYPICAL DRAWING FOR SLOPED AREA DEVICE WORK PAD DESIGN DETAILS IF PROVIDED.

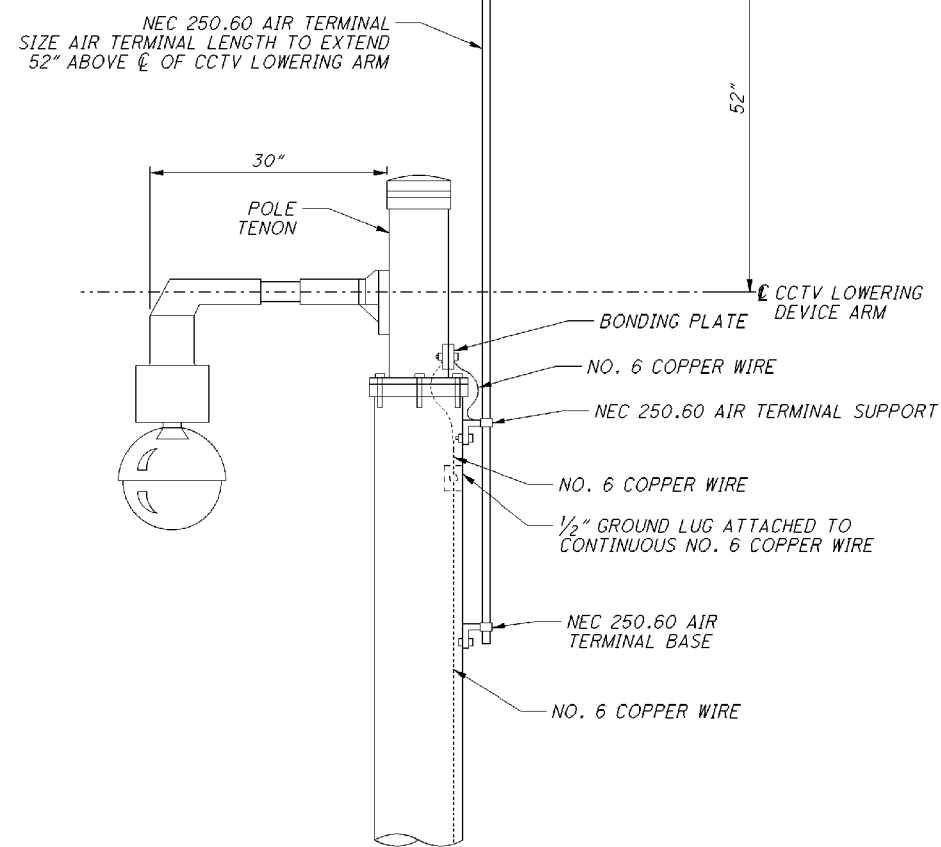

**DETAIL
AIR TERMINAL
NOT TO SCALE**

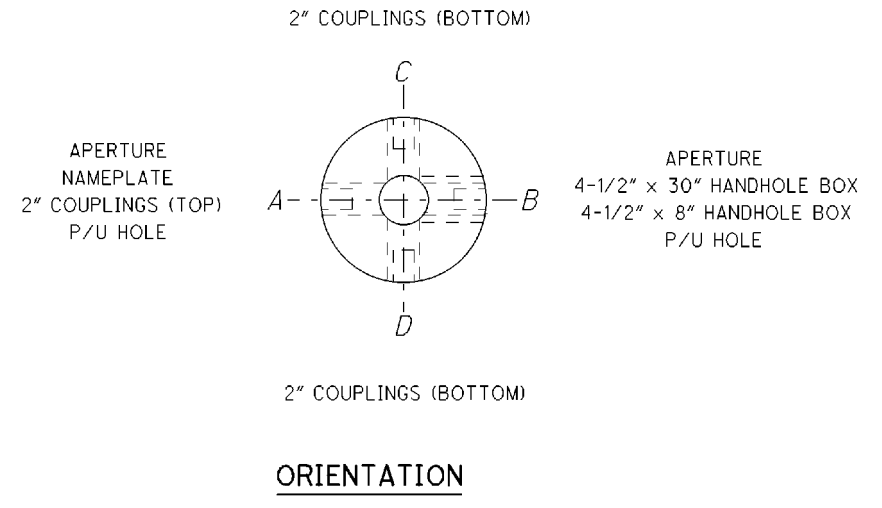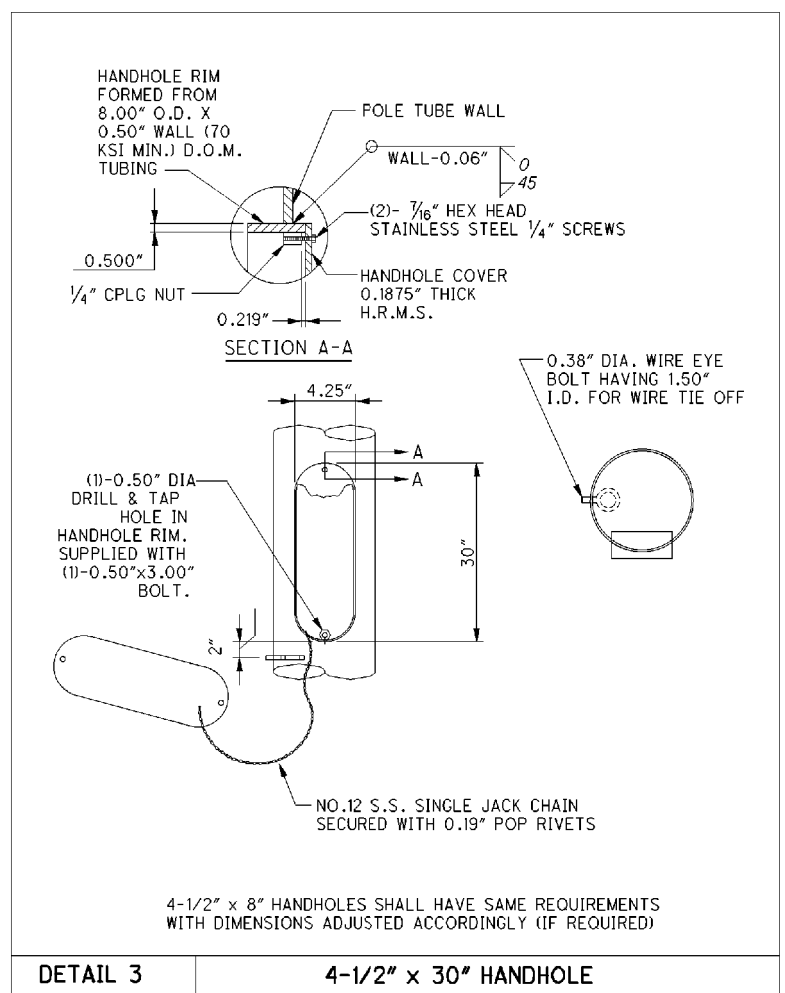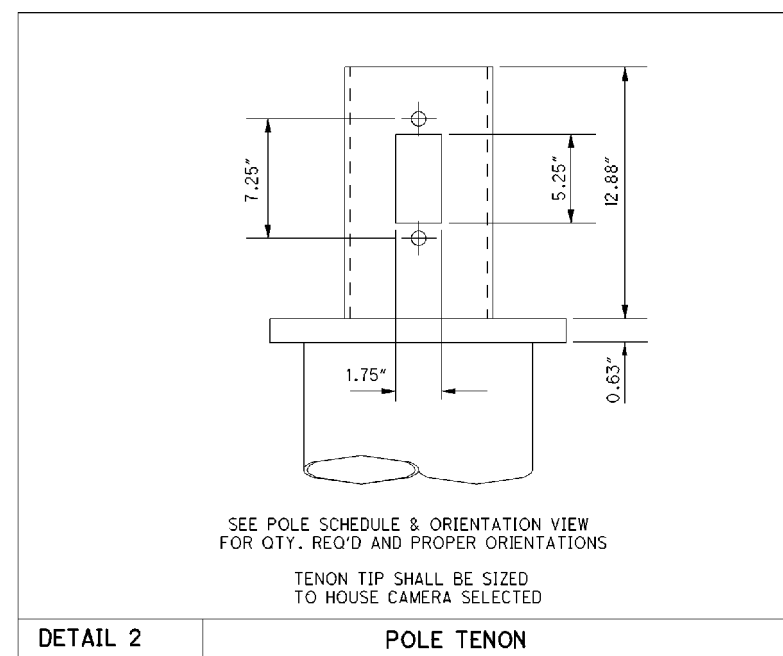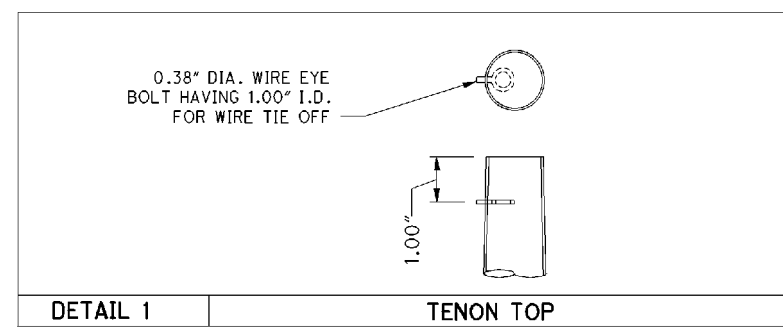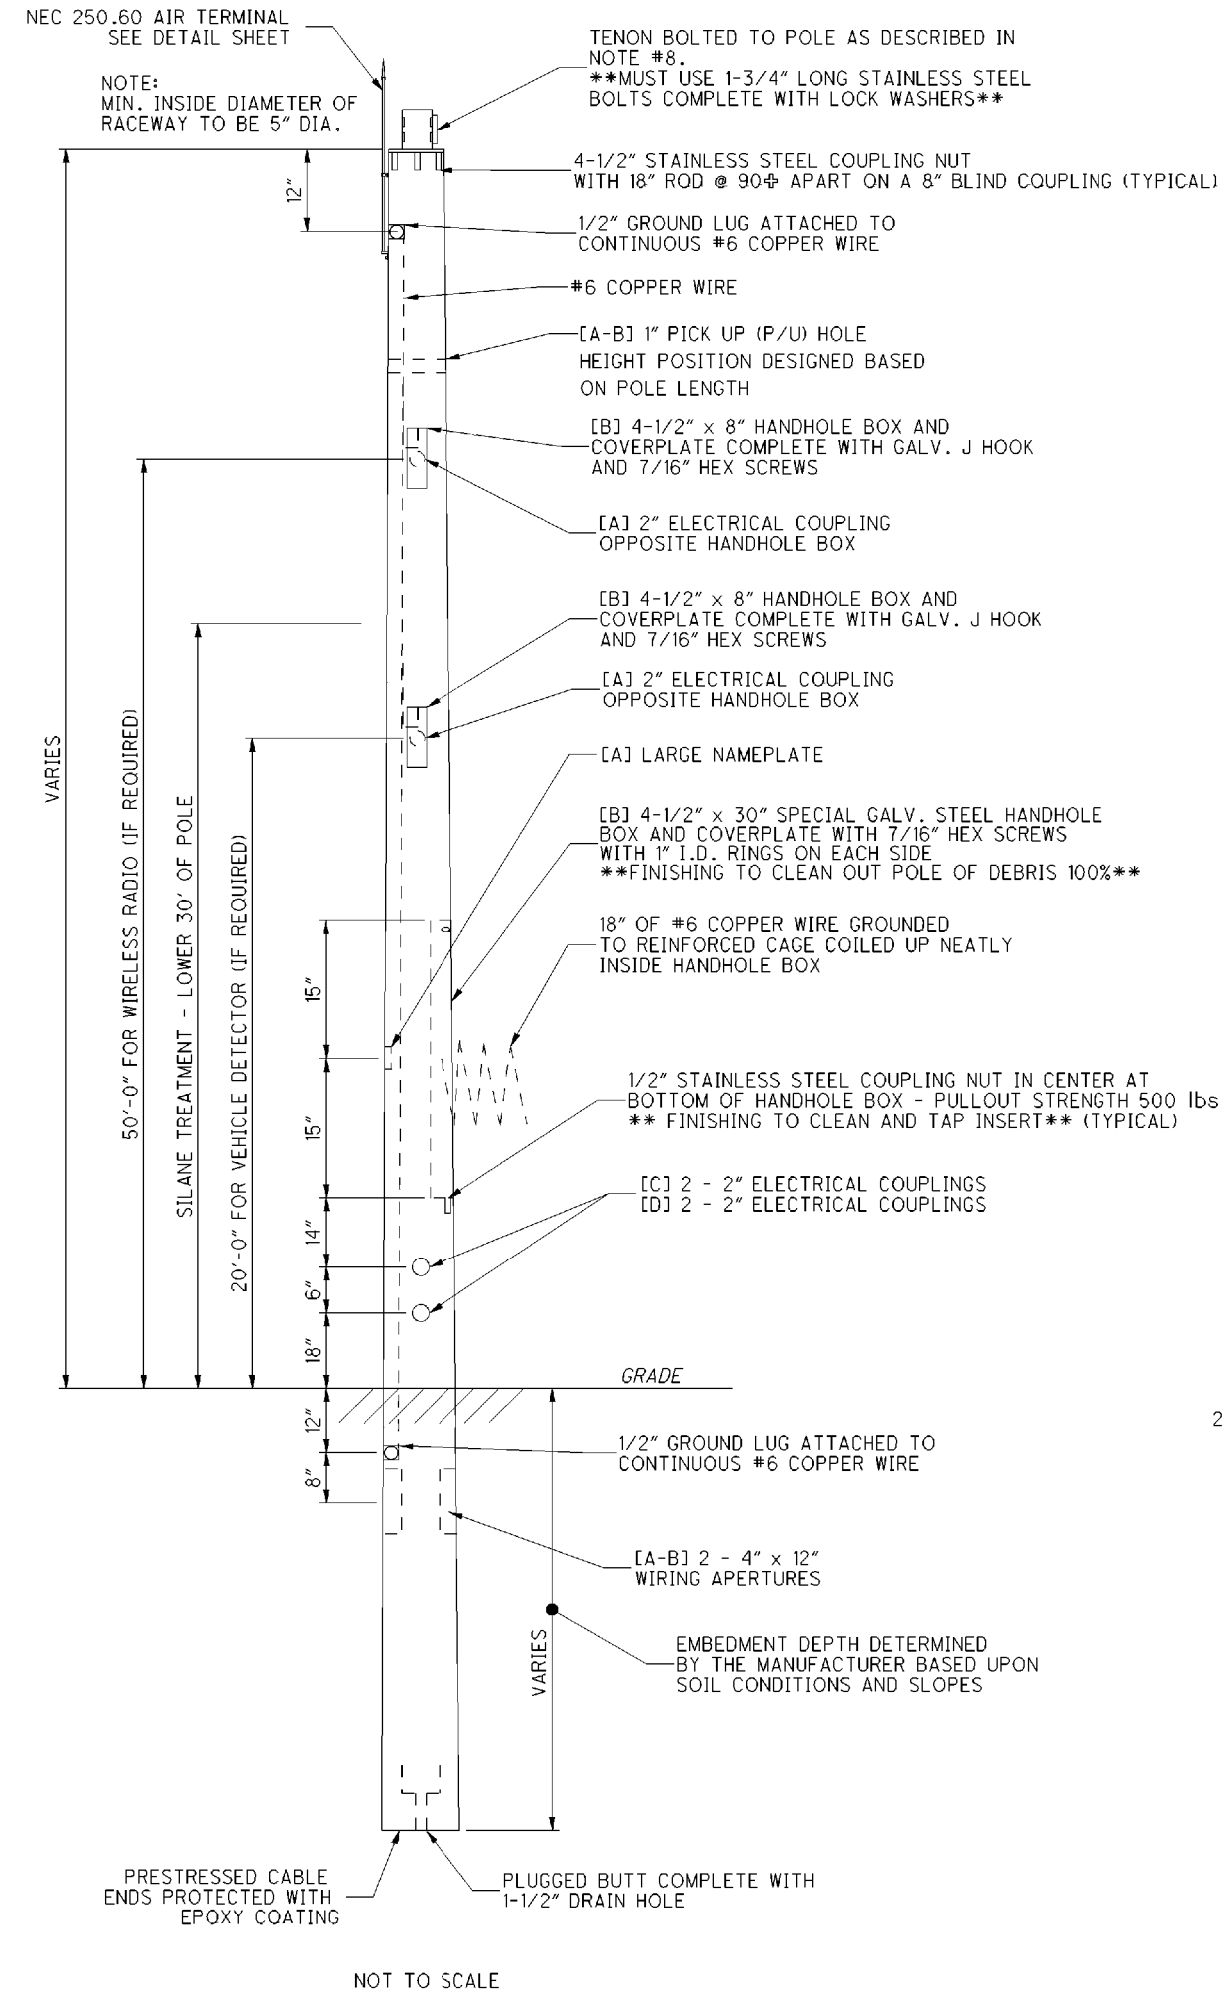


- NOTES:**
- IF ITS CABINET IS POLE-MOUNTED, IT SHALL BE ORIENTED ON SIDE [C] OF POLE, ABOVE 2" COUPLINGS.
 - IF COMM CABINET IS POLE-MOUNTED, IT SHALL BE ORIENTED ON SIDE [D] OF POLE, ABOVE 2" COUPLINGS (IF REQUIRED).
 - LOWERING DEVICE WITH CAMERA ARM SHALL BE ORIENTED ON SIDE [A] OF POLE OR OFFSET ANGLE ALLOWABLE UP TO 45 DEGREES TOWARD SIDE [C] OR [D], TO AVOID LOWERING CAMERA INTO THE POLE-MOUNTED CABINETS, APPROVED BY ENGINEER.
 - THE GROUNDING SYSTEM/LUGS SHALL BE INTEGRATED NEARBY THE 4-1/2" X 30" HANDHOLE OPENING TO ALLOW FOR EASY INSPECTION AND ATTACHMENT OF GROUNDING WIRE TO LUG. THE GROUNDING LUG SHALL IN NO WAY INTERFERE WITH THE PLACEMENT/OPERATION OF THE CAMERA LOWERING DEVICE OR WINCH.
 - MAXIMUM HORIZONTAL DEFLECTION IS 1 (ONE) INCH FOR A SUSTAINED 30 MPH WIND VELOCITY WITH NO GUST.
 - LOADING AND ALLOWING STRESS CRITERIA: 1994 AASHTO "STANDARD SPECIFICATIONS FOR STRUCTURAL SUPPORTS FOR HIGHWAY SIGNS, LUMINAIRES AND TRAFFIC SIGNALS."
 - ALL UNUSED COUPLING HOLES SHALL BE PLUGGED TO PREVENT ANY KIND OF WEATHER/RODENT INTRUSION.
 - TENON BOLTED TO POLE SO THE RECTANGULAR OPENING FOR THE CAMERA ARM IS ORIENTED IN THE RANGE OF 130 TO 230 DEGREES FROM THE LARGE HANDHOLE BOX. THE CAMERA ARM SHALL BE ORIENTED TO BE CAPABLE OF VIEWING IN ALL ROADWAY DIRECTIONS. THEREFORE, THE POLE SHALL BLOCK AS LITTLE AMOUNT OF ROADWAY AS POSSIBLE. THE CAMERA SHALL ALSO BE ORIENTED SO THAT UPON LOWERING THE CAMERA WILL NOT HIT ANY POLE MOUNTED CABINETS OR OTHER EQUIPMENT.


AS BUILT - 4/22/2016

5/23/2016 7:31:54 AM kevinj

G:\projects\2014\W-14-039_FRA-270-49.00\83988\structures\FRA270_4900L\sheets\270_4900L_SPO01.dgn

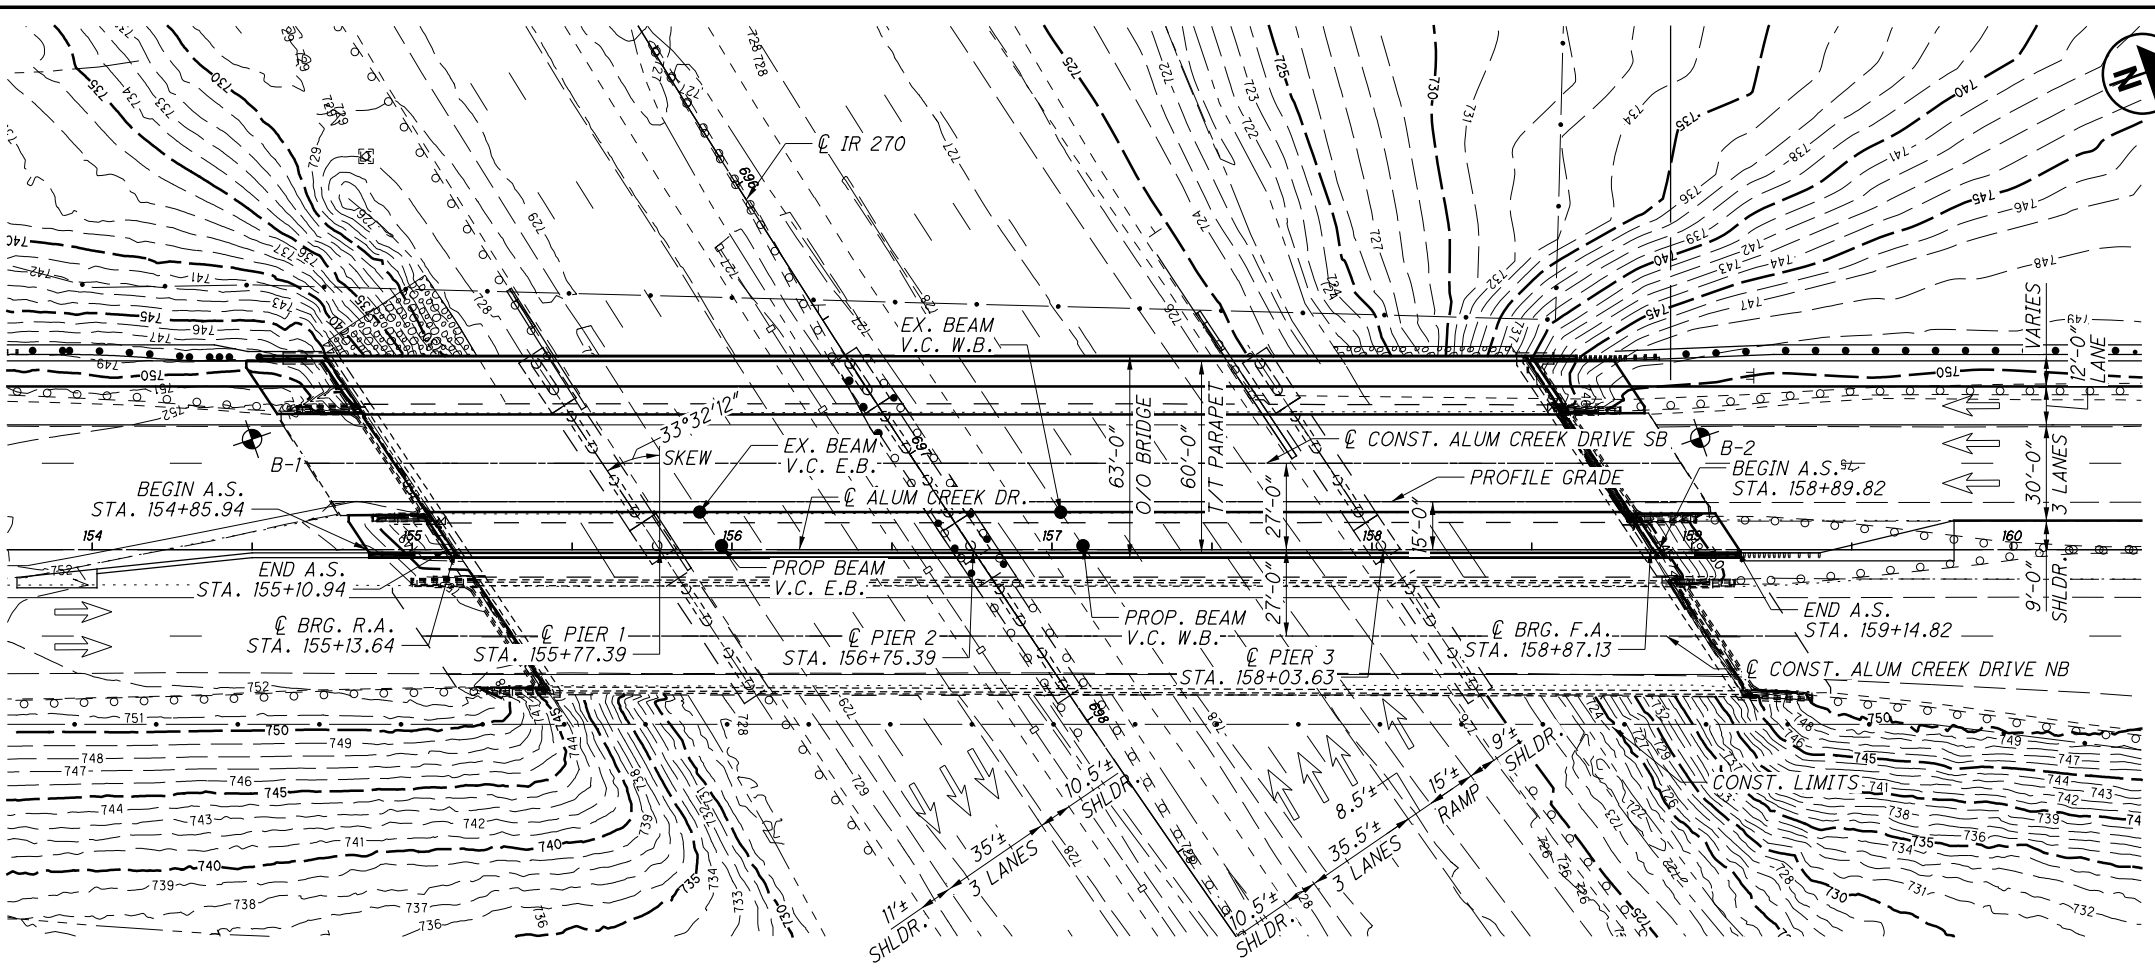

PLAN

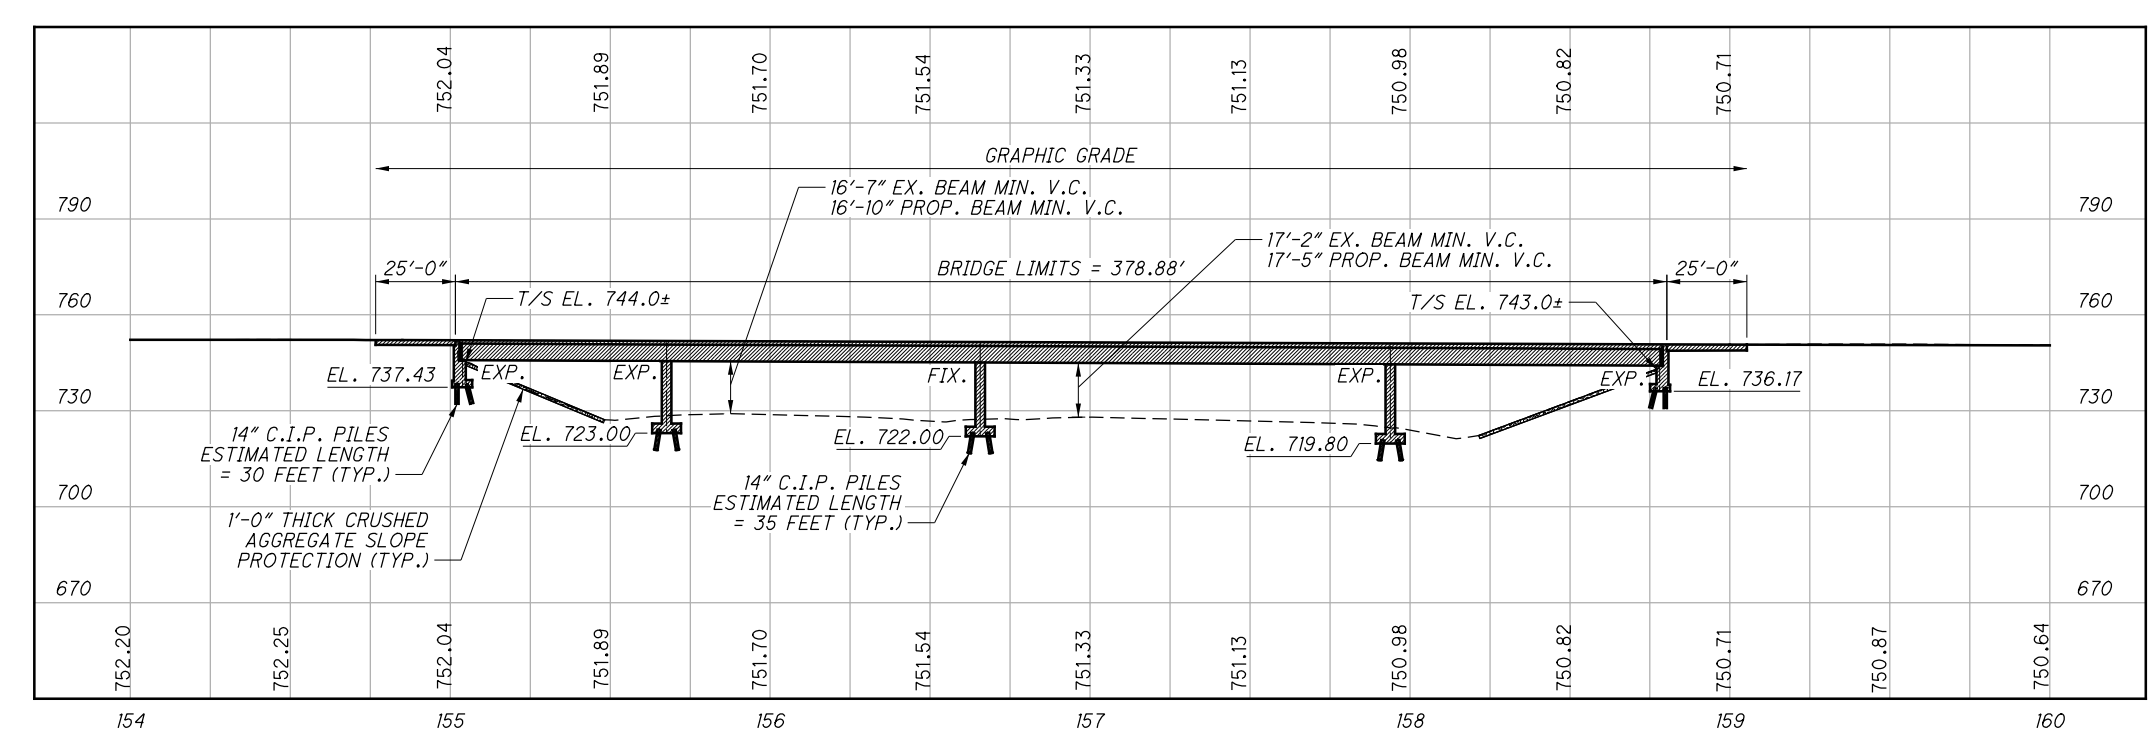

PROFILE - ALONG PROFILE GRADE

BENCHMARK DATA

BM #1 STA. 173+65.92, ELEV. 746.07, OFFSET 47.83', LT.
 BM #2 STA. 152+53.72, ELEV. 749.35, OFFSET 72.54', LT.
 BM #3 STA. 153+24.40, ELEV. 742.92, OFFSET 91.38', LT.

FOR ADDITIONAL BENCHMARK INFORMATION, SEE BU 6 - ROADWAY PLAN, SHEET 3/88

NOTES

EARTHWORK LIMITS SHOWN ARE APPROXIMATE. ACTUAL SLOPES SHALL CONFORM TO PLAN CROSS SECTIONS.

DESIGN TRAFFIC:
 2016 ADT = 27,490 2016 ADTT = 4,674
 2036 ADT = 43,970 2036 ADTT = 7,475
 DIRECTIONAL DISTRIBUTION = 55%

LEGEND

- ⊕ BORING LOCATION
- 16'-0" REQUIRED MINIMUM VERTICAL CLEARANCE
- 16'-7" ACTUAL MINIMUM VERTICAL CLEARANCE

EXISTING STRUCTURE

TYPE: 4 SPAN CONTINUOUS NON-COMPOSITE STEEL GIRDERS WITH REINFORCED CONCRETE DECK & SUBSTRUCTURE.
 SPANS: 63.75', 98.0', 128.25', 83.5' C/C BRGS.
 ROADWAY: 30'-8±" T/T CURB
 LOADING: CF - 2000 (57)
 SKEW: 33° 32' 12" R.F.
 APPROACH SLABS: SPECIAL (25' LONG)
 WEARING SURFACE: 1/4" MICROSILICA MODIFIED CONCRETE OVERLAY
 ALIGNMENT: TANGENT
 CROWN: 3/16" / FT.
 STRUCTURAL FILE NUMBER: 2513862
 DATE BUILT: 1966
 DISPOSITION: TO BE REHABILITATED

PROPOSED STRUCTURE

TYPE: 4 SPAN CONTINUOUS NON-COMPOSITE STEEL GIRDERS WITH REINFORCED CONCRETE DECK & SUBSTRUCTURE.
 SPANS: 63.75', 98.0', 128.25', 83.5' C/C BRGS.
 ROADWAY: 60'-0" T/T PARAPET
 LOADING: HS20 CASE II AND ALTERNATE MILITARY
 FUTURE WEARING SURFACE LOADING: 60 PSF
 WEARING SURFACE: 1" MONOLITHIC CONCRETE
 SKEW: 33° 32' 12" R.F.
 APPROACH SLABS: 25'-0" LONG (AS-1-81)
 ALIGNMENT: TANGENT
 CROWN: 0.016
 COORDINATES: LATITUDE 39° 52' 19"
 LONGITUDE 82° 56' 01"

RESOURCE INTERNATIONAL INC.
 6350 PRESIDENTIAL GATEWAY
 COLUMBUS, OHIO 43231
 (614) 823-4848

Rii

DATE: 12/01/2015
 REVIEWED: NCK
 DRAWN: JGM
 DESIGNED: JGM
 CHECKED: JLM
 STRUCTURE FILE NUMBER: 2513862


FRANKLIN COUNTY
 STA. 155+10.94
 STA. 158+89.82

SITE PLAN
 BRIDGE NO. FRA-270-4900
 OVER IR 270

FRA-270-49.00
 PID No. 83988

1/32
 147
 182

BU 4, 5, 6, 7 & 8 - RELEASED FOR CONSTRUCTION - 11/03/2014 - 11/19/2015

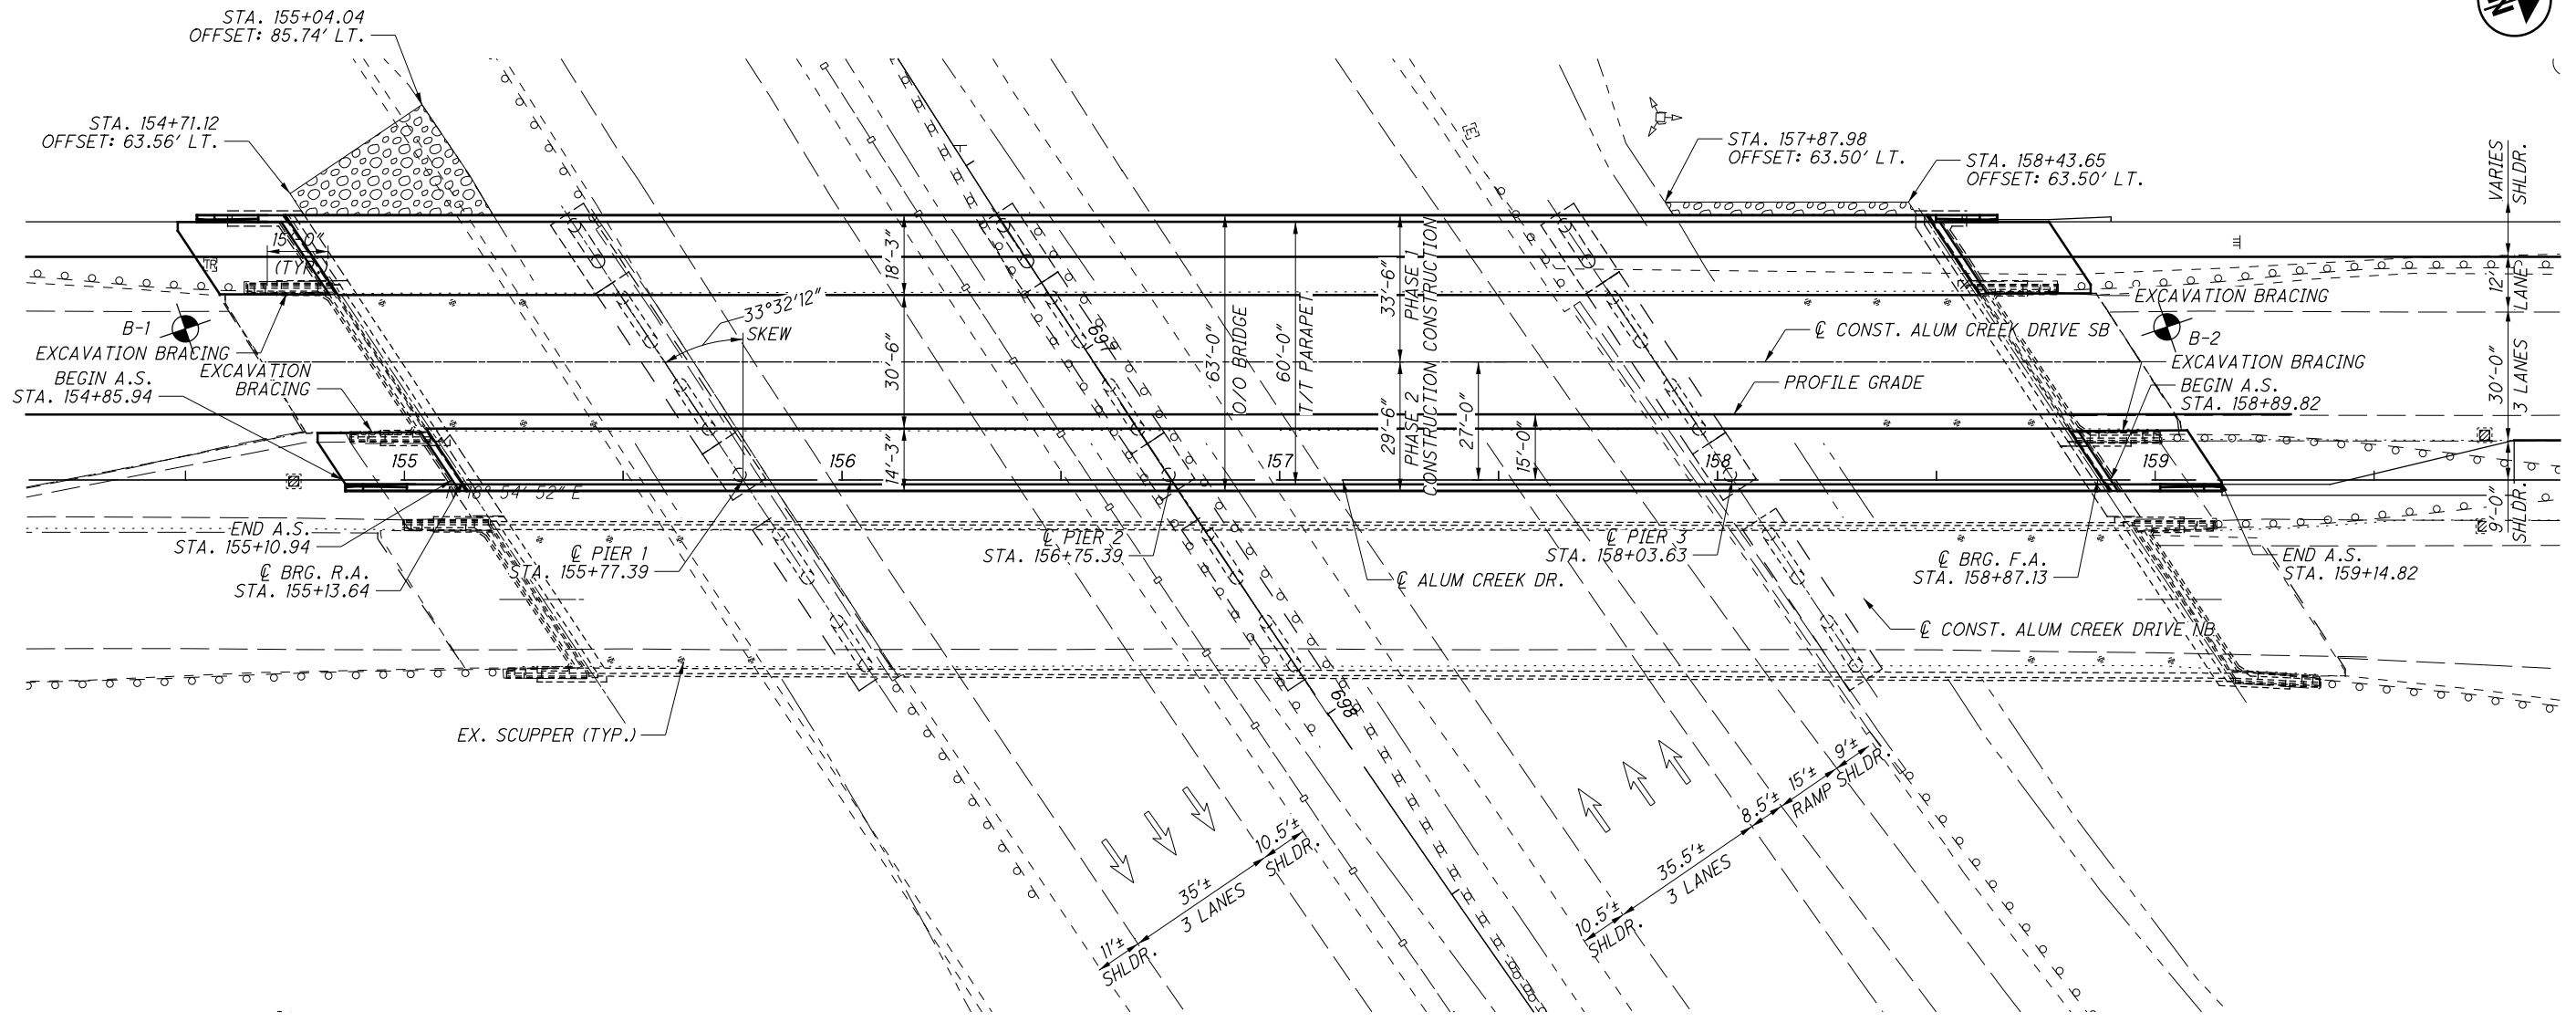

GENERAL PLAN

PROPOSED WORK:

1. CONSTRUCT PIERS AS SHOWN ON SHEET 13/32
2. PLUG SCUPPERS
3. REMOVE PORTION OF SLAB AND PARAPET AS SHOWN ON SHEET 5/32
4. REMOVE PORTION OF ABUTMENTS AS SHOWN ON SHEET 6/32 & 7/32
5. CONSTRUCT ABUTMENTS AS SHOWN ON SHEETS 9/32 10/32 12/32
6. CONSTRUCT PROPOSED GIRDERS, PG1, PG2 & PG3. INSTALL CROSSFRAMES.
7. CONSTRUCT DECK AND PARAPETS.
8. SEAL PHASE C.J. WITH 2'-0" HMWM RESIN.
9. SEAL PARAPETS, PIERS AND ABUTMENTS WITH A NON-EPOXY SEALER.
10. PAINT FASCIA BEAMS, LEFT FASCIA BEAM (PROPOSED) ON THE LEFT BRIDGE AND RIGHT FASCIA BEAM (EXISTING) ON THE RIGHT BRIDGE.
11. INSTALL ORNAMENTAL RAILING.



DESIGNED	JGM	CHECKED	JLM
DRAWN	JGM	REVISED	
REVIEWED	NCK	DATE	12/01/2015
STRUCTURE FILE NUMBER	2513862		

GENERAL PLAN
BRIDGE NO. FRA-270-4900
OVER IR 270

BU 4, 5, 6, 7, & 8 - RELEASED FOR CONSTRUCTION - 11/03/2014 - 11/19/2015

FRA - 270-49.00
PID No. 83988

REFER TO THE FOLLOWING STANDARD BRIDGE DRAWING(S):

A-1-69 REVISED 07-19-02
 AS-1-81 REVISED 01-18-13
 EXJ-4-87 REVISED 07-19-02
 GSD-1-96 REVISED 07-19-02
 PCB-91 REVISED 01-18-13
 SBR-1-99 REVISED 07-19-02

DESIGN SPECIFICATIONS:

THIS STRUCTURE CONFORMS TO "STANDARD SPECIFICATIONS FOR HIGHWAY BRIDGES" ADOPTED BY THE AMERICAN ASSOCIATION OF STATE HIGHWAY AND TRANSPORTATION OFFICIALS, 2002, AND THE ODOT BRIDGE DESIGN MANUAL.

DESIGN LOADING:

HS-20-44 CASE II AND ALTERNATE MILITARY LOADING
 FUTURE WEARING SURFACE (FWS) OF 60 PSF

DESIGN DATA:

CONCRETE CLASS QC2 - COMPRESSIVE STRENGTH 4500 PSI (SUPERSTRUCTURE)

CONCRETE CLASS QC1 - COMPRESSIVE STRENGTH 4000 PSI (SUBSTRUCTURE)

REINFORCING STEEL - ASTM A615 OR A996 GRADE 60 MINIMUM YIELD STRENGTH 60,000 PSI

STRUCTURAL STEEL - ASTM A709 GRADE 50W - YIELD STRENGTH 50 KSI

DECK PROTECTION METHOD:

EPOXY COATED REINFORCING STEEL
 2 1/2" CONCRETE COVER

MONOLITHIC WEARING SURFACE:

MONOLITHIC WEARING SURFACE IS ASSUMED, FOR DESIGN PURPOSES, TO BE 1 INCH THICK.

EXISTING STRUCTURE REMOVAL NOTES:

SUBSTRUCTURE CONCRETE REMOVAL:

REMOVE CONCRETE BY MEANS OF APPROVED PNEUMATIC HAMMERS EMPLOYING POINTED AND BLUNT CHISEL TOOLS. HYDRAULIC HOE-RAM TYPE HAMMERS WILL NOT BE PERMITTED. THE WEIGHT OF THE HAMMER SHALL NOT BE MORE THAN 35 POUNDS FOR REMOVAL WITHIN 18 INCHES OF PORTIONS TO BE PRESERVED. OUTSIDE THE 18 INCH LIMIT, THE CONTRACTOR MAY USE HAMMERS NOT EXCEEDING 90 POUNDS UPON THE APPROVAL OF THE ENGINEER. DO NOT PLACE PNEUMATIC HAMMERS IN DIRECT CONTACT WITH REINFORCING STEEL THAT IS TO BE RETAINED IN REBUILT STRUCTURE.

CONCRETE DECK REMOVAL PROJECTS:

THIS WORK CONSISTS OF THE REMOVAL OF CONCRETE DECKS INCLUDING, PARAPETS, DECK JOINTS AND OTHER APPURTENANCES FROM STEEL SUPPORTING SYSTEMS (GIRDERS, CROSS FRAMES, ETC.). THE PROVISIONS OF ITEM 202 APPLY EXCEPT AS SPECIFIED BY THE FOLLOWING NOTES. PERFORM WORK CAREFULLY DURING DECK REMOVALS TO PROTECT PORTIONS OF SUCH SYSTEMS THAT ARE TO BE SALVAGED AND INCORPORATED INTO THE PROPOSED STRUCTURE. THE USE OF EXPLOSIVES, HEADACHE BALLS AND/OR HOE RAM TYPE OF EQUIPMENT IS PROHIBITED. SUBMIT CONSTRUCTION PLANS ACCORDING TO CMS 501.05.

PROTECTION OF STEEL SUPPORT SYSTEMS:

BEFORE DECK SLAB CUTTING IS PERMITTED, DRAW THE OUTLINE OF PRIMARY STEEL MEMBERS IN CONTACT WITH THE BOTTOM OF THE DECK ON THE SURFACE OF DECK. DRILL SMALL DIAMETER PILOT HOLES 2 INCHES OUTSIDE THESE LINES TO CONFIRM THE LOCATION OF FLANGE EDGES. DECK CUTS OVER OR WITHIN 2 INCHES OF FLANGE EDGES SHALL NOT EXTEND LOWER THAN BOTTOM LAYER DECK SLAB REINFORCING STEEL. CUTS MADE OUTSIDE 2 INCHES OF FLANGE EDGES MAY EXTEND THE FULL DEPTH OF THE DECK. PERFORM WORK CAREFULLY DURING CUTTING OF THE DECK SLAB TO AVOID DAMAGING STEEL MEMBERS THAT ARE TO BE INCORPORATED INTO THE PROPOSED STRUCTURE. REPLACE OR REPAIR STEEL MEMBERS DAMAGED BY THE DECK SLAB CUTTING OPERATIONS AT NO COST TO THE PROJECT. AT LEAST 7 DAYS BEFORE PERFORMING REPAIR WORK, SUBMIT A PROPOSED REPAIR PLAN, DEVELOPED BY AN OHIO REGISTERED PROFESSIONAL ENGINEER TO THE DIRECTOR. OBTAIN THE DIRECTOR'S APPROVAL BEFORE PERFORMING REPAIR.

REMOVAL METHODS:

THE CONTRACTOR MAY REMOVE CONCRETE BY CUTTING AND BY MEANS OF HAND OPERATED PNEUMATIC HAMMERS POINTED OR BLUNTED CHISEL TOOLS. FOR REMOVALS OVER STRUCTURAL MEMBERS (STEEL GIRDER), THE CONTRACTOR MAY USE A HAMMER HEAVIER THAN 35 POUNDS BUT NOT TO EXCEED 90 POUNDS UNLESS APPROVED BY THE ENGINEER. REMOVAL METHODS OVER STRUCTURAL MEMBERS SHALL ENSURE ADEQUATE DEPTH CONTROL AND PREVENT NICKING OR GOUGING THE PRIMARY STRUCTURAL MEMBERS. DUE TO THE POSSIBLE PRESENCE OF ATTACHMENTS (EG., FINISHING MACHINE, SCUPPER AND FORM SUPPORTS, ETC.) TO EXISTING STRUCTURAL MEMBERS, PERFORM WORK CAREFULLY DURING DECK REMOVAL TO AVOID DAMAGING STRUCTURAL MEMBERS THAT ARE REMAIN. REPLACE OR REPAIR STRUCTURAL MEMBERS DAMAGED BY THE REMOVAL OPERATIONS AT NO COST TO THE PROJECT. AT LEAST 7 DAYS BEFORE PERFORMING REPAIR WORK, SUBMIT A PROPOSED REPAIR PLAN, DEVELOPED BY AN OHIO REGISTERED PROFESSIONAL ENGINEER TO THE DIRECTOR. OBTAIN THE DIRECTOR'S APPROVAL BEFORE PERFORMING REPAIR.

EXISTING WELDED ATTACHMENTS:

REMOVE EXISTING WELDED ATTACHMENTS (E.G., FINISHING MACHINE AND FORM SUPPORTS; AND SUPPORTS FOR SCUPPERS AND BULB ANGLES WHICH ARE TO BE REMOVED) LOCATED IN THE DESIGNATED TENSION PORTIONS OF THE TOP FLANGES OF EXISTING STEEL MEMBERS AND GRIND THE FLANGE SURFACES SMOOTH. CAREFULLY GRIND PARALLEL TO THE FLANGES.

CUT LINE CONSTRUCTION JOINT PREPARATION:

SAW CUT BOUNDARIES OF PROPOSED CONCRETE REMOVALS 1 INCH DEEP. REMOVE CONCRETE TO A ROUGH SURFACE. LEAVE THE EXISTING REINFORCING STEEL, IF REQUIRED IN THE PLANS, IN PLACE. INSTALL DOWEL BARS IF SPECIFIED. PRIOR TO CONCRETE PLACEMENT ABRASIVELY CLEAN JOINT SURFACES AND EXISTING EXPOSED REINFORCEMENT TO REMOVE LOOSE AND DISINTEGRATED CONCRETE AND LOOSE RUST. THOROUGHLY CLEAN THE JOINT SURFACE AND EXPOSED REINFORCEMENT OF ALL DIRT, DUST, RUST OR OTHER FOREIGN MATERIAL BY THE USE OF WATER, AIR UNDER PRESSURE, OR OTHER METHODS THAT PRODUCE SATISFACTORY RESULTS. EXISTING REINFORCING STEEL DOES NOT HAVE TO HAVE A BRIGHT STEEL FINISH, BUT REMOVE ALL PACK AND LOOSE RUST. THOROUGHLY DRENCH EXISTING CONCRETE SURFACES WITH CLEAN WATER AND ALLOW TO DRY TO A DAMP CONDITION BEFORE PLACING CONCRETE.

REHABILITATION OF EXISTING STRUCTURES:

EXISTING STRUCTURE VERIFICATION:

DETAILS AND DIMENSIONS SHOWN ON THESE PLANS PERTAINING TO THE EXISTING STRUCTURE HAVE BEEN OBTAINED FROM PLANS OF THE EXISTING STRUCTURE AND FROM FIELD OBSERVATIONS AND MEASUREMENTS. CONSEQUENTLY, THEY ARE INDICATIVE OF THE EXISTING STRUCTURE AND THE PROPOSED WORK BUT THEY SHALL BE CONSIDERED TENTATIVE AND APPROXIMATE. THE CONTRACTOR IS REFERRED TO CMS SECTIONS 102.05,105.02 AND 513.04.

REINFORCING STEEL REPLACEMENT:

ITEM 509 REINFORCING STEEL, REPLACEMENT OF EXISTING REINFORCING STEEL, AS PER PLAN:

REPLACE ALL EXISTING REINFORCING BARS DEEMED BY THE ENGINEER TO BE UNUSABLE BECAUSE OF CORROSION. THE DEPARTMENT WILL MEASURE THE REPLACEMENT REINFORCING STEEL BY THE NUMBER OF POUNDS ACCEPTED IN PLACE.

REPLACE ALL EXISTING REINFORCING STEEL BARS WHICH ARE TO BE INCORPORATED INTO THE NEW WORK AND ARE DEEMED BY THE ENGINEER TO BE MADE UNUSABLE BY CONCRETE REMOVAL OPERATIONS WITH NEW EPOXY COATED REINFORCING STEEL OF THE SAME SIZE AT NO COST TO THE DEPARTMENT.

ITEM 514 - FIELD PAINTING STRUCTURAL STEEL, FINISH COAT:

THE FINISH COAT OF PAINT ON THE STRUCTURAL STEEL IS TO BE FEDERAL COLOR - BLUE (#15526). PAINT FASCIA BEAMS ONLY SEE SHEET [5/32] FOR PAINTING LIMITS.

DECK PLACEMENT DESIGN ASSUMPTIONS:

THE FOLLOWING ASSUMPTIONS OF CONSTRUCTION MEANS AND METHODS WERE MADE FOR THE ANALYSIS AND DESIGN OF THE SUPERSTRUCTURE. THE CONTRACTOR IS RESPONSIBLE FOR THE DESIGN OF THE FALSEWORK SUPPORT SYSTEM WITHIN THESE PARAMETERS AND WILL ASSUME RESPONSIBILITY FOR SUPERSTRUCTURE ANALYSIS FOR DEVIATION FROM THESE DESIGN ASSUMPTIONS.

AN EIGHT WHEEL FINISHING MACHINE WITH A MAXIMUM LOAD OF 1.75 KIPS FOR A TOTAL MACHINE LOAD OF 14 KIPS.

A MINIMUM OUT-TO-OUT WHEEL SPACING AT EACH END OF THE MACHINE OF 103".

A MAXIMUM SPACING OF OVERHANG FALSEWORK BRACKETS OF 48 IN.

A MAXIMUM DISTANCE FROM THE CENTERLINE OF THE FASCIA GIRDER TO THE FACE OF THE SAFETY HANDRAIL OF 65".

PILE DESIGN LOADS (ULTIMATE BEARING VALUE):

THE ULTIMATE BEARING VALUE IS 65 TONS PER PILE FOR THE ABUTMENT PILES. THE ULTIMATE BEARING VALUE IS 112.50 TONS PER PILE FOR THE PIER PILES.

ABUTMENT PILES:

14" DIAMETER C.I.P. PILES 35 FEET LONG, ORDER LENGTH 1 DYNAMIC LOAD TESTING ITEM


PIER PILES:

14" DIAMETER C.I.P. PILES 40 FEET LONG, ORDER LENGTH 1 DYNAMIC LOAD TESTING ITEM

ABBREVIATIONS:

- ABUT. - ABUTMENT
- ADT - AVERAGE DAILY TRAFFIC
- ADTT - AVERAGE DAILY TRUCK TRAFFIC
- A.S. - APPROACH SLAB
- B - BASELINE
- BRG. - BEARING
- C/C - CENTER TO CENTER
- C.J. - CONSTRUCTION JOINT
- C.I.P. - CAST-IN-PLACE
- CL - CENTERLINE
- CLR. - CLEAR
- CONC. - CONCRETE
- CONST. - CONSTRUCTION
- DIA. - DIAMETER
- EL. - ELEVATION
- EQ. - EQUAL
- EX. - EXISTING
- EXP. - EXPANSION
- F.A. - FORWARD ABUTMENT
- F/F - FACE TO FACE
- FWD. - FORWARD
- IN. - INCH
- IN-BET. - IN-BETWEEN
- INCR. - INCREMENT
- JNT. - JOINT
- L.F. - LEFT FORWARD
- LT. - LEFT
- MID. - MIDDLE
- MIN. - MINIMUM
- NB - NORTHBOUND
- NO. - NUMBER
- NPCPP - NON-PERFORATED CORRUGATED PLASTIC PIPE
- O/O - OUT TO OUT
- PCB - PORTABLE CONCRETE BARRIER
- PCPP - PERFORATED CORRUGATED PLASTIC PIPE
- PEJF - PREFORMED EXPANSION JOINT FILLER
- P - PLATE
- PRESS. - PRESSURE
- PROP. - PROPOSED
- PVI - POINT OF VERTICAL INTERSECTION
- R.A. - REAR ABUTMENT
- RAD. - RADIUS
- RD. - ROAD
- REQ'D - REQUIRED
- RT. - RIGHT
- SB - SOUTHBOUND
- SER. - SERIES
- SHLDR. - SHOULDER
- SPA. - SPACES
- STA. - STATION
- STR. - STRAIGHT
- SUPER. - SUPERSTRUCTURE
- TEMP. - TEMPORARY
- T/T - TOE TO TOE
- TYP. - TYPICAL
- VAR. - VARYING
- VERT. - VERTICAL
- W/ - WITH

BU 4, 5, 6, 7, & 8 - RELEASED FOR CONSTRUCTION - 11/03/2014 - 11/19/2015

	RESOURCE INTERNATIONAL INC. 6350 PRESIDENTIAL GATEWAY COLUMBUS, OHIO 43231 (614) 823-4849
DATE 12/01/2015	REVIEWED NCK
DRAIN JCM	REVISION REVISED
DESIGNED JCM	CHECKED JLM
GENERAL NOTES BRIDGE NO. FRA-270-4900 OVER IIR 270	
FRA - 270-49-00	PID No. 83988
3 / 32	149 182

ESTIMATED QUANTITIES

ITEM	EXTENSION	TOTAL	UNIT	DESCRIPTION	ABUT.	PIERS	SUPER.	GEN.	SHEET NO.
202	11203	LUMP		PORTIONS OF STRUCTURE REMOVED, OVER 20 FOOT SPAN, AS PER PLAN				LUMP	3
503	11100	LUMP		COFFERDAMS AND EXCAVATION BRACING			LUMP		
503	21300	LUMP		UNCLASSIFIED EXCAVATION				LUMP	
505	11100	LUMP		PILE DRIVING EQUIPMENT MOBILIZATION				LUMP	
507	600	1650	FT	14" CAST-IN-PLACE REINFORCED CONCRETE PILES, DRIVEN	600	1050			
507	650	1900	FT	14" CAST-IN-PLACE REINFORCED CONCRETE PILES, FURNISHED	700	1200			
509	10000	168599	POUND	EPOXY COATED REINFORCING STEEL	11882	29321	127396		
509	20000	119	POUND	REINFORCING STEEL, REPLACEMENT OF EXISTING REINFORCING STEEL	119				
510	10000	180	EACH	DOWEL HOLES WITH NONSHRINK, NONMETALLIC GROUT	180				
511	34446	435	CU YD	CLASS QC2 CONCRETE WITH QC/QA, BRIDGE DECK			435		
511	34450	133	CU YD	CLASS QC2 CONCRETE WITH QC/QA, BRIDGE DECK (PARAPET)			133		
511	50212	304	CU YD	CLASS QC1 CONCRETE WITH QC/QA, SUBSTRUCTURE	153	151			
512	10100	1364	SQ YD	SEALING OF CONCRETE SURFACES (NON-EPOXY)	109	201	1054		
512	33000	17	SQ YD	TYPE 2 WATERPROOFING	17				
513	10280	218810	LB	STRUCTURAL STEEL MEMBERS, LEVEL 4			218810		
514	00050	3284	SQ FT	SURFACE PREPARATION OF EXISTING STRUCTURAL STEEL			3284		
514	00056	3284	SQ FT	FIELD PAINTING OF EXISTING STRUCTURAL STEEL, PRIME COAT			3284		
514	00060	6172	SQ FT	FIELD PAINTING STRUCTURAL STEEL, INTERMEDIATE COAT			6172		
514	00066	6172	SQ FT	FIELD PAINTING STRUCTURAL STEEL, FINISH COAT			6172		
514	00504	6	MAN HOUR	GRINDING FINS, TEARS, SLIVERS ON EXISTING STRUCTURAL STEEL			6		
514	10000	5	EACH	FINAL INSPECTION REPAIR			5		
516	11210	73	FT	STRUCTURAL EXPANSION JOINT INCLUDING ELASTOMERIC STRIP SEAL				73	
516	13900	85	SF	2" PREFORMED EXPANSION JOINT FILLER	85				
516	44200	6	EACH	ELASTOMERIC BEARING WITH INTERNAL LAMINATES AND LOAD PLATE (NEOPRENE) 12" X 18" X 3.32" WITH 19" X 13" X 1 1/2" LOAD PLATE	6				
516	44200	3	EACH	ELASTOMERIC BEARING WITH INTERNAL LAMINATES AND LOAD PLATE (NEOPRENE) 15" X 24" X 3.61" WITH 25" X 16" X 2" LOAD PLATE	3				
516	44200	2	EACH	ELASTOMERIC BEARING WITH INTERNAL LAMINATES AND LOAD PLATE (NEOPRENE) 18" X 23" X 3.61" WITH 29" X 19" X 2 1/2" LOAD PLATE	2				
516	44200	2	EACH	ELASTOMERIC BEARING WITH INTERNAL LAMINATES AND LOAD PLATE (NEOPRENE) 18" X 23" X 3.61" WITH 24" X 19" X 2 1/2" LOAD PLATE	2				
516	44200	1	EACH	ELASTOMERIC BEARING WITH INTERNAL LAMINATES AND LOAD PLATE (NEOPRENE) 18" X 25" X 3.61" WITH 31" X 19" X 2 1/2" LOAD PLATE	1				
516	44200	1	EACH	ELASTOMERIC BEARING WITH INTERNAL LAMINATES AND LOAD PLATE (NEOPRENE) 18" X 25" X 3.61" WITH 26" X 19" X 2 1/2" LOAD PLATE	1				
518	12500	24	EACH	SCUPPER, MISC.: PLUG SCUPPER				24	
518	21200	62	CU YD	POROUS BACKFILL WITH FILTER FABRIC	62				
518	40000	72	FT	6" PERFORATED CORRUGATED PLASTIC PIPE				72	
518	40010	46	FT	6" NON-PERFORATED CORRUGATED PLASTIC PIPE, INCLUDING SPECIALS				46	
526	25000	167	SQ YD	REINFORCED CONCRETE APPROACH SLABS (T=15")			167		
601	20010	88	CU YD	CRUSHED AGGREGATE SLOPE PROTECTION				88	
848	50000	42	SQ YD	HAND CHIPPING			42		

BU 4, 5, 6, 7, & 8 - RELEASED FOR CONSTRUCTION - 11/03/2014 - 11/19/2015


ESTIMATED QUANTITIES
BRIDGE NO. FRA-270-4900
OVER I.R. 270

FRA-270-49.00
PID No. 83988




AS BUILT - 4/22/2016


G:\projects\2014\W-14-039 FRA-270-49-00\83988\structures\FRA270_4900L\PC001.dgn 5/23/2016 7:31:57 AM kevinj

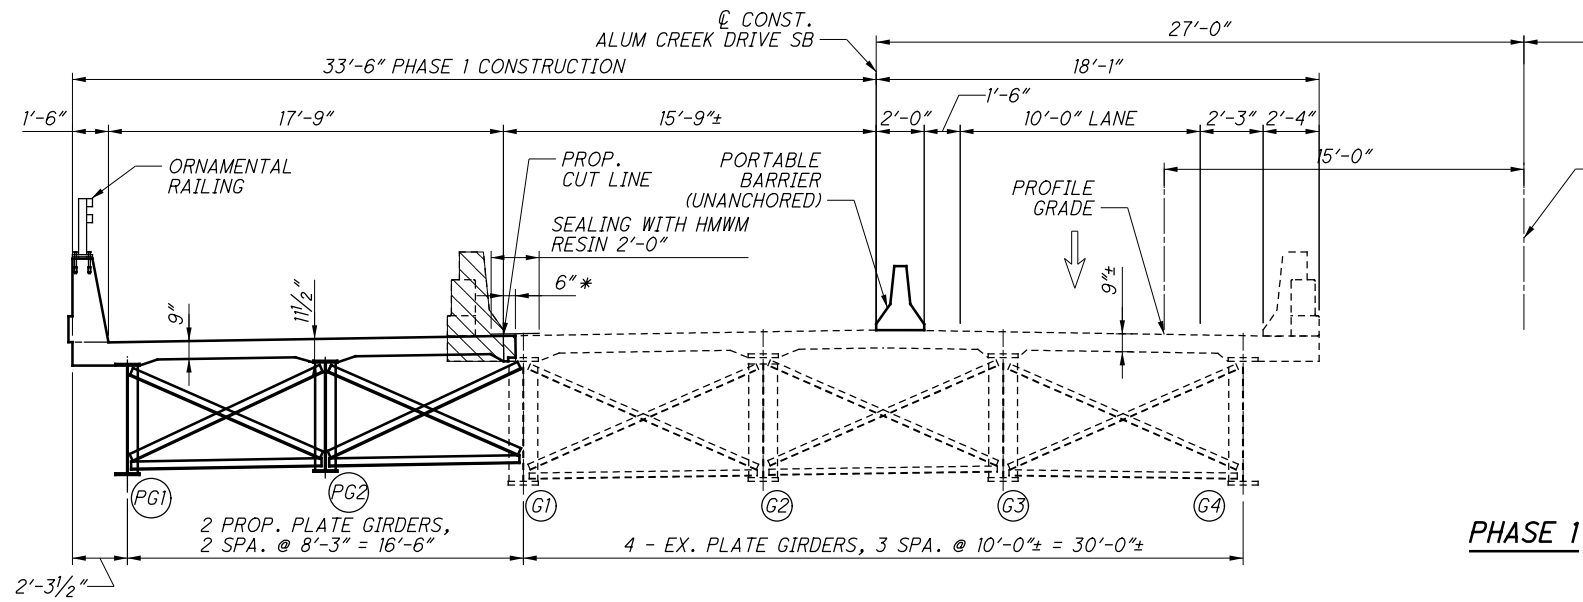


PHASE 1

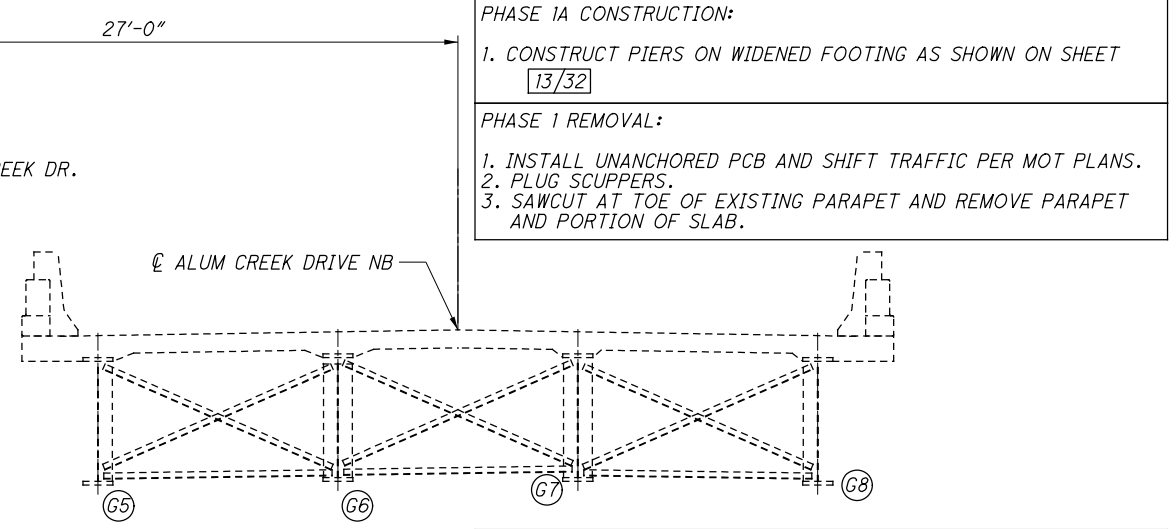


- PHASE 1A CONSTRUCTION:**
1. CONSTRUCT PIERS ON WIDENED FOOTING AS SHOWN ON SHEET 13/32
- PHASE 1 REMOVAL:**
1. INSTALL UNANCHORED PCB AND SHIFT TRAFFIC PER MOT PLANS.
 2. PLUG SCUPPERS.
 3. SAWCUT AT TOE OF EXISTING PARAPET AND REMOVE PARAPET AND PORTION OF SLAB.

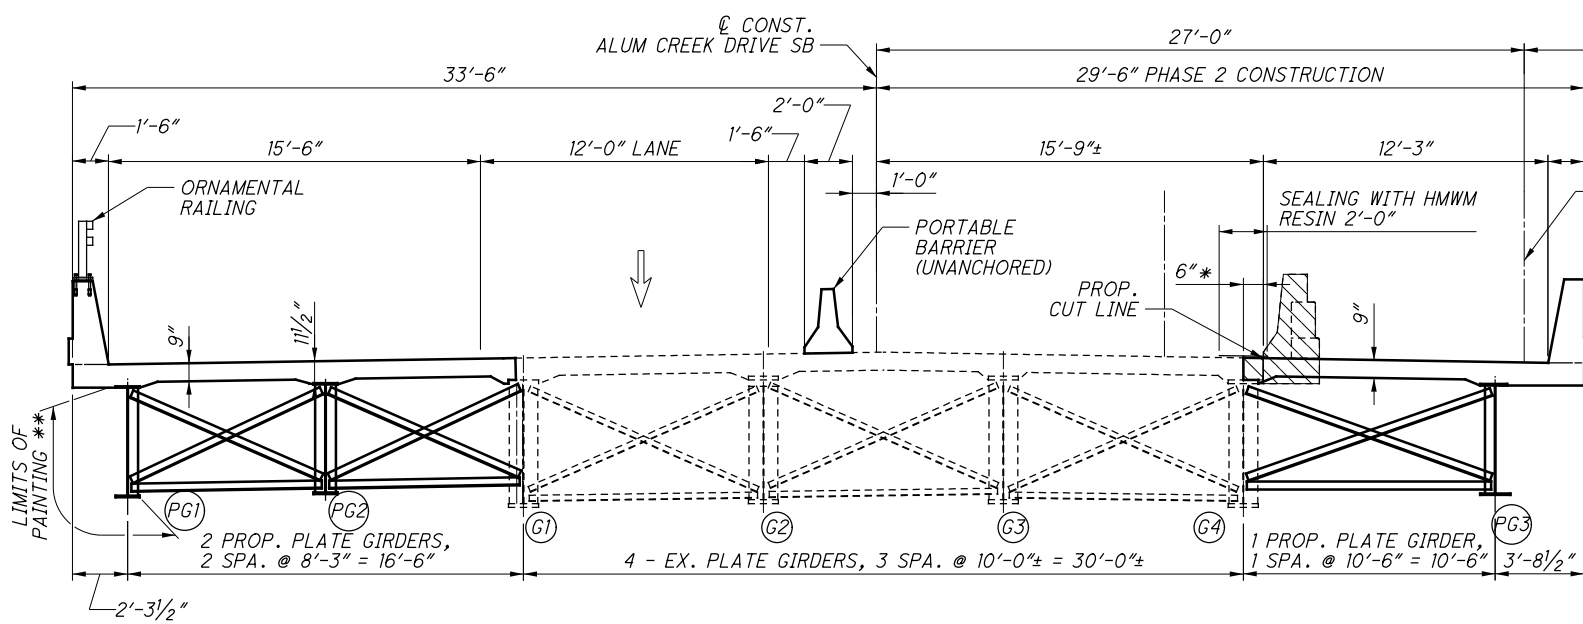


PHASE 2

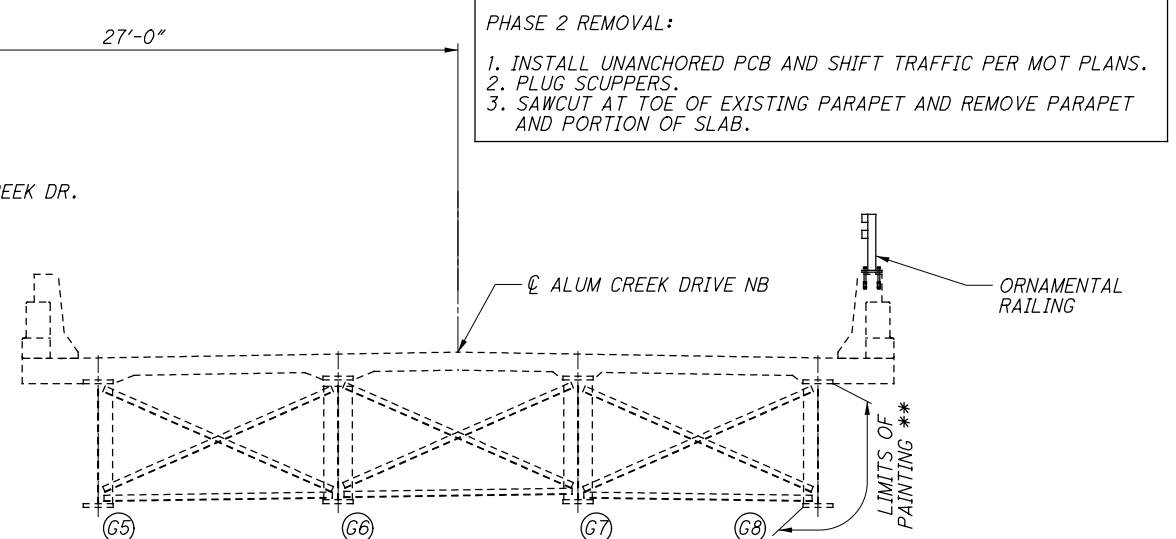

- PHASE 2 REMOVAL:**
1. INSTALL UNANCHORED PCB AND SHIFT TRAFFIC PER MOT PLANS.
 2. PLUG SCUPPERS.
 3. SAWCUT AT TOE OF EXISTING PARAPET AND REMOVE PARAPET AND PORTION OF SLAB.

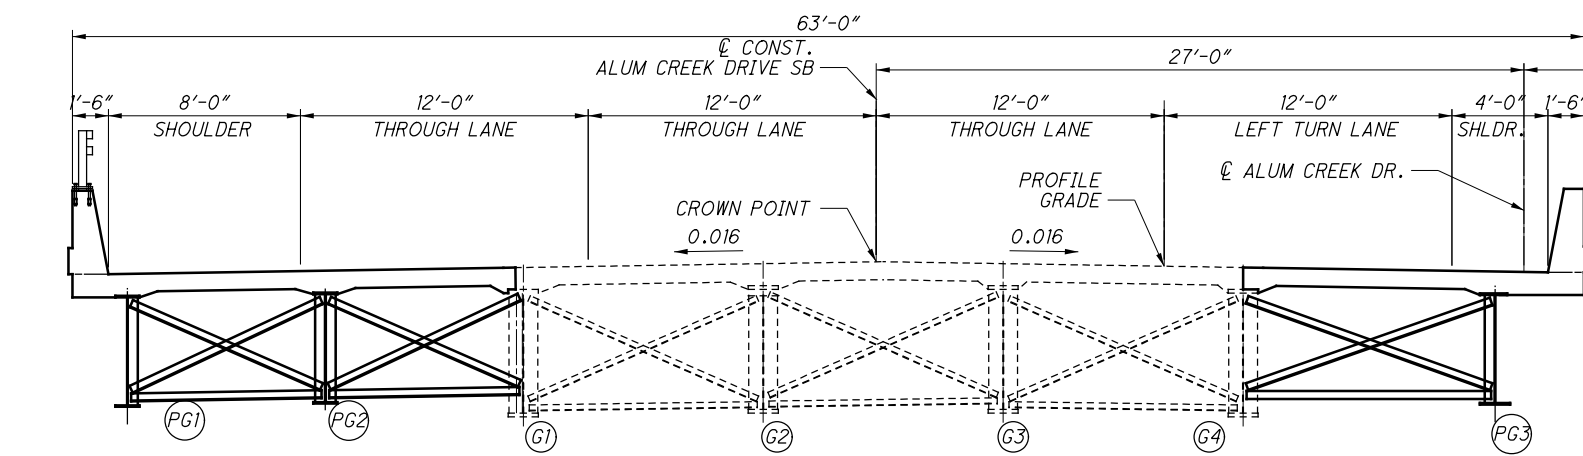

FINAL CONFIGURATION

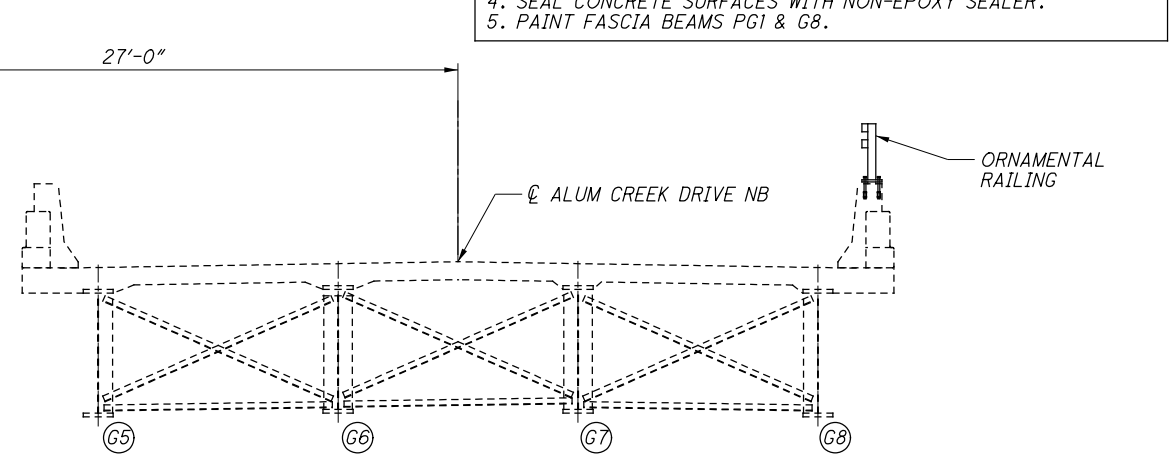

- PHASE 2 CONSTRUCTION:**
1. WIDEN SUBSTRUCTURE AS SHOWN IN ABUTMENT SHEET 9/32 & 10/32
 2. INSTALL PG3, CROSSFRAMES, DECK AND PROPOSED RAILING.
 3. SEAL PHASE C.J. WITH 2'-0" HMWM RESIN
 4. SEAL CONCRETE SURFACES WITH NON-EPOXY SEALER.
 5. PAINT FASCIA BEAMS PG1 & G8.

LEGEND:

- ITEM 202 PORTIONS OF STRUCTURE REMOVED

** PAINT ALL EXPOSED SURFACES OF THE BEAM FOR THE LAST 10 FEET, INCLUDING CROSS FRAMES.

* HAND CHIP AND REMOVE 6" ± OF EXISTING DECK. CARE SHOULD BE TAKEN TO NOT REMOVE PORTION OF THE DECK BEYOND THE CENTER OF FLANGE IN ORDER TO PROVIDE SUFFICIENT BEARING FOR EXISTING DECK SLAB. PRESERVE EXISTING TRANSVERSE REINFORCEMENT. PROVIDE MECHANICAL CONNECTORS TO CONNECT EXISTING TRANSVERSE REBARS TO PROPOSED TRANSVERSE REBARS.

RESOURCE INTERNATIONAL INC.
 6350 PRESIDENTIAL GATEWAY
 COLUMBUS, OHIO 43231
 (614) 823-4848

DATE: 12/01/2015
 REVIEWED: NCK
 DRAWN: JLM
 CHECKED: JGM
 DESIGNED: JLM
 REVISIONS: JGM

STRUCTURE FILE NUMBER: 2513862

PHASE CONSTRUCTION DETAILS
 BRIDGE NO. FRA-270-4900
 OVER IR 270


FRA-270-49-00
 PID No. 83988

BU 4.5, 6.7, & 8 - RELEASED FOR CONSTRUCTION - 11/03/2014 - 11/19/2015


5 / 32
 151
 182

AS BUILT - 4/22/2016

G:\projects\2014\W-14-039 FRA-270-49.00\83988\structures\FRA270_4900L\sheets\270_4900L\RE001.dgn 5/23/2016 7:31:58 AM kevinj

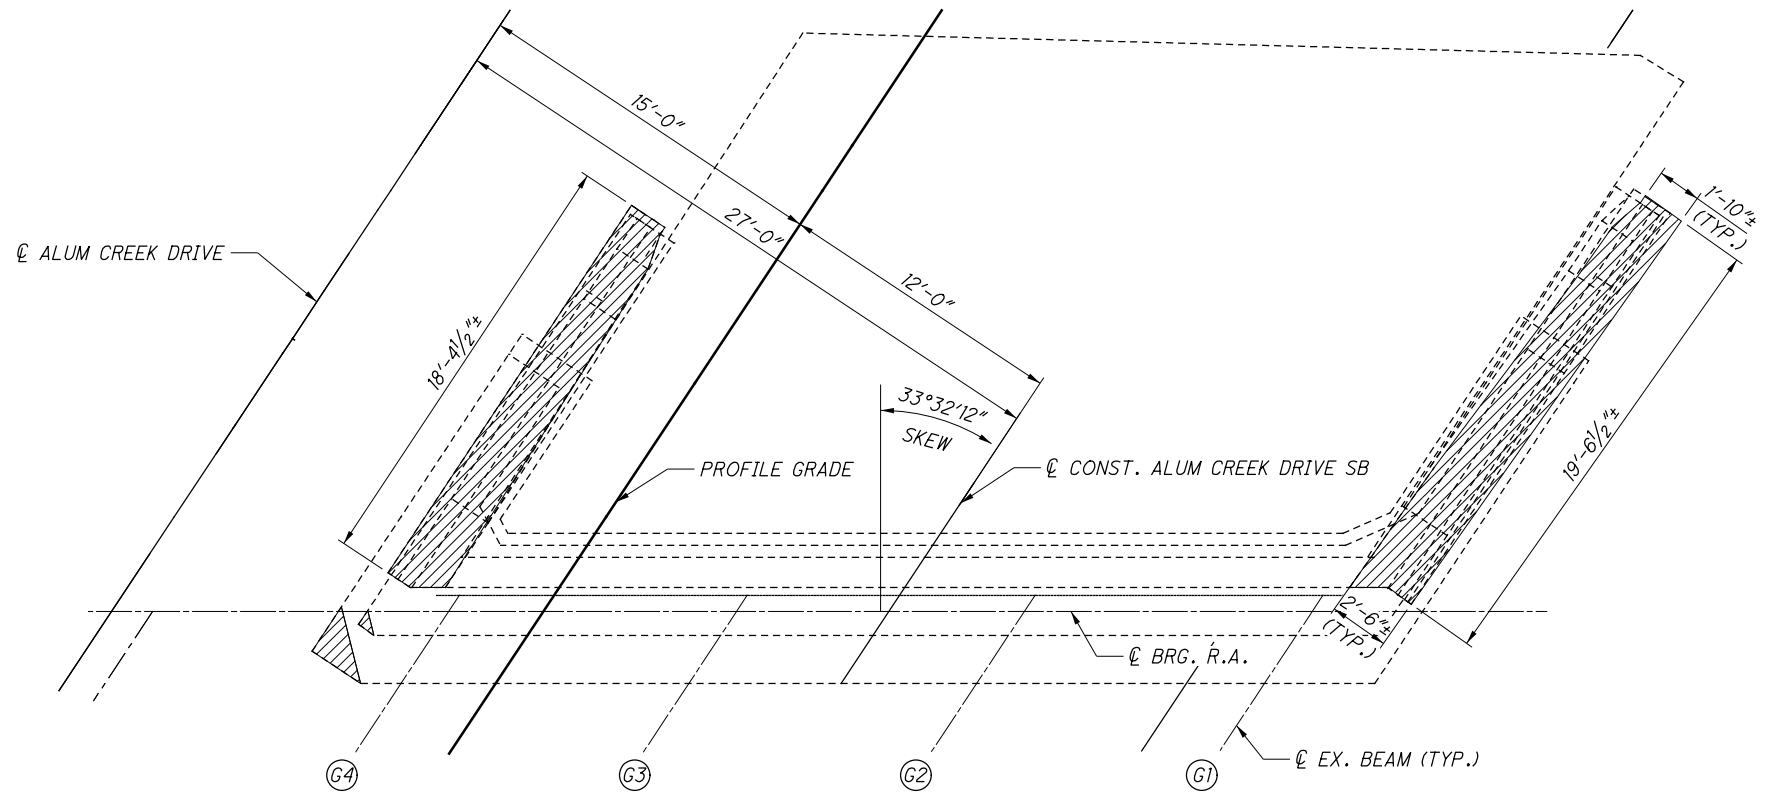

PLAN

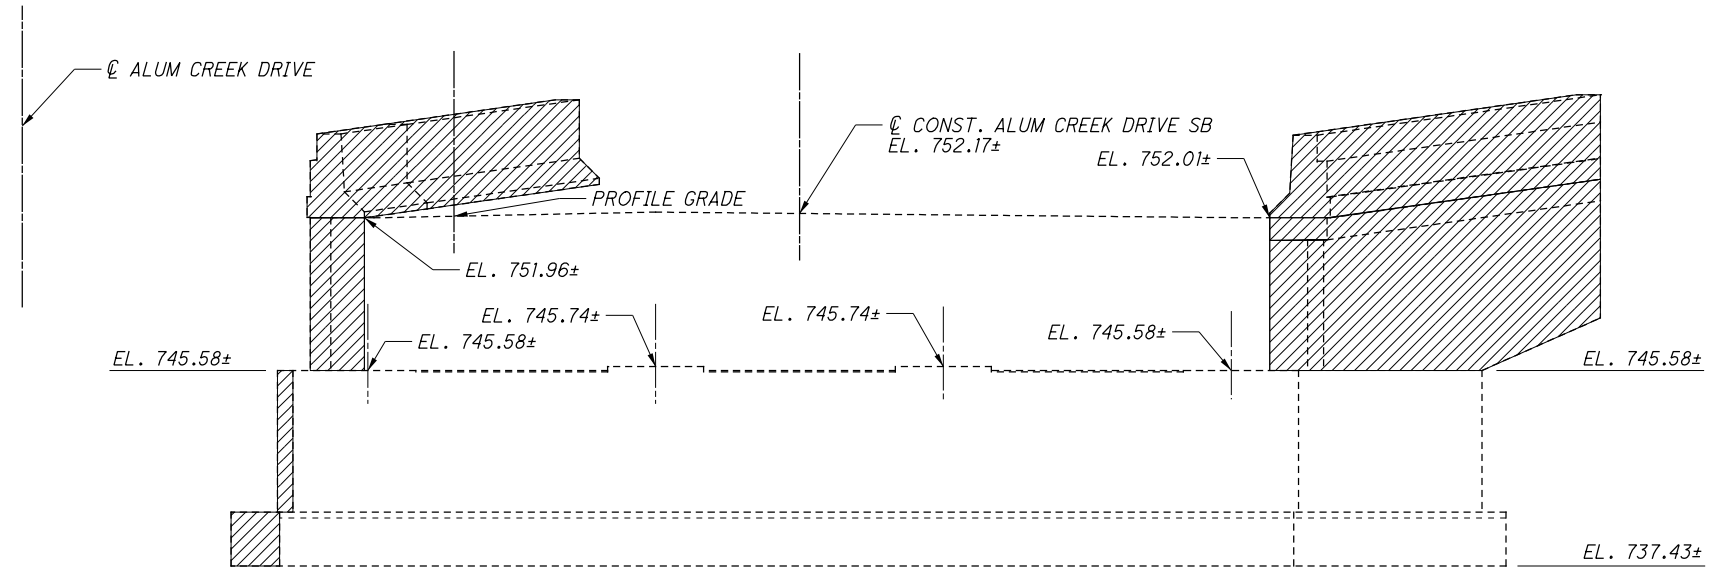

ELEVATION



LEGEND:

- ITEM 202 PORTIONS OF STRUCTURE REMOVED

NOTE:

CONTRACTOR TO DETERMINE ACTUAL REMOVAL LIMITS IN THE FIELD AS APPROVED BY THE ENGINEER.

BU 4, 5, 6, 7 & 8 - RELEASED FOR CONSTRUCTION - 11/03/2014 - 11/19/2015

REAR ABUTMENT REMOVAL DETAILS

BRIDGE NO. FRA-270-4900
OVER IR 270

FRA - 270-49.00
PID No. 83988

6 / 32

152
182

RESOURCE INTERNATIONAL INC.
6350 PRESIDENTIAL GATEWAY
COLUMBUS, OHIO 43231
(614) 823-4848



REVIEWED DATE
NCK 12/01/2015


DRAWN
JGM

DESIGNED
JGM


CHECKED
JLM

STRUCTURE FILE NUMBER
2513862

REVISER
REVISED

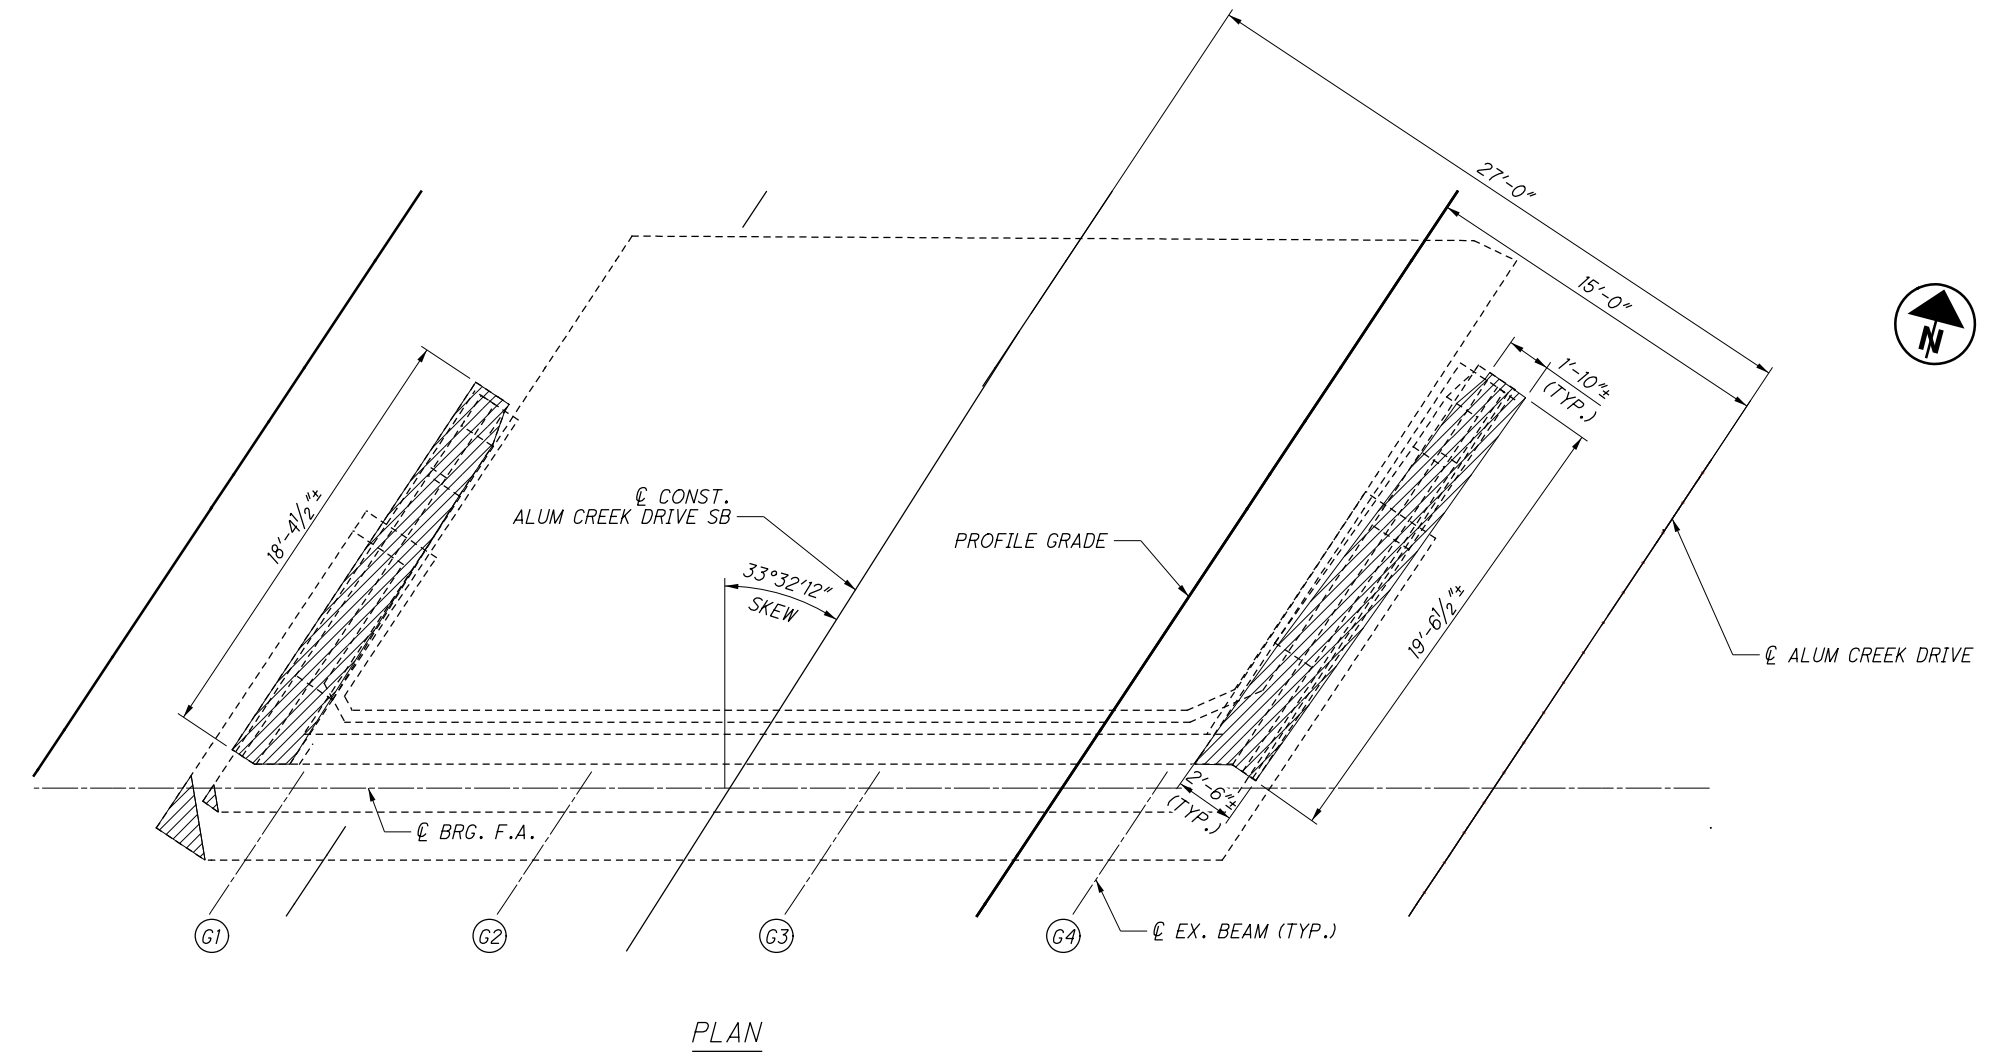

PLAN

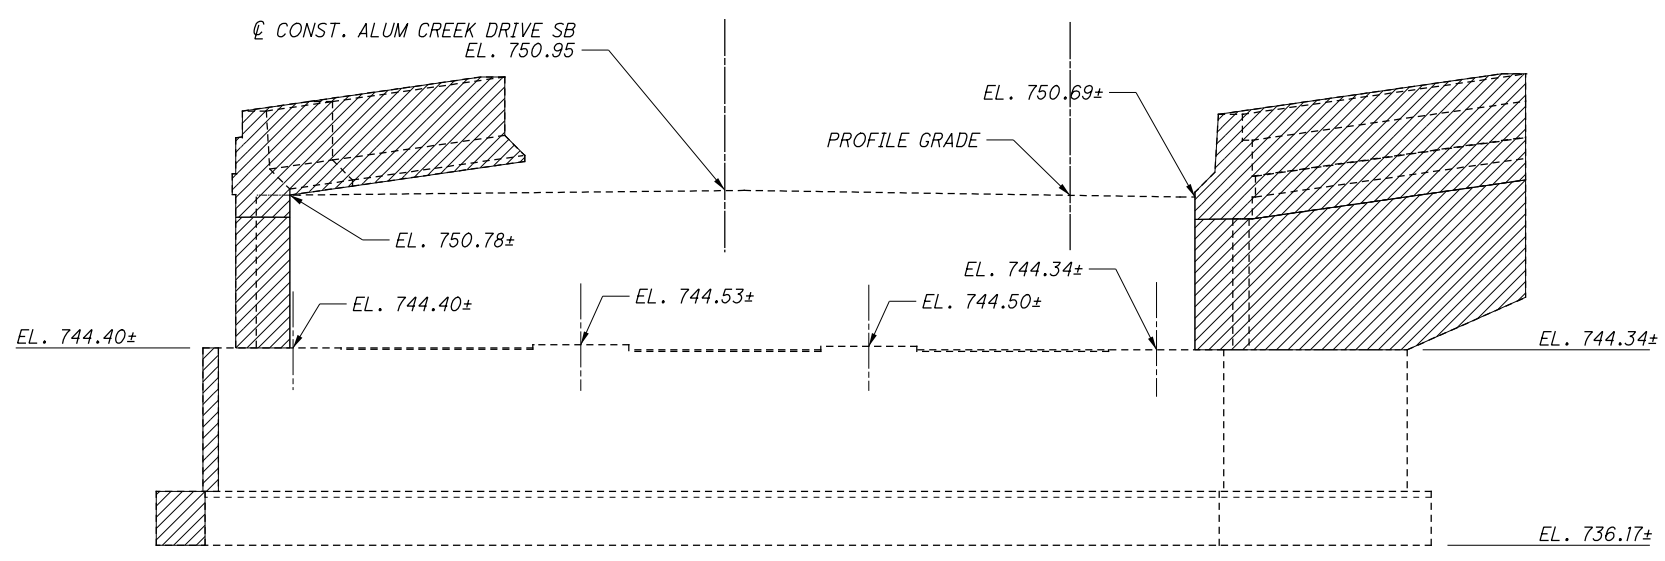

ELEVATION

LEGEND:

 - ITEM 202 PORTIONS OF STRUCTURE REMOVED

NOTE:

CONTRACTOR TO DETERMINE ACUTAL REMOVAL LIMITS IN THE FIELD AS APPROVED BY THE ENGINEER.


BU 4, 5, 6, 7 & 8 - RELEASED FOR CONSTRUCTION - 11/03/2014 - 11/19/2015
 FORWARD ABUTMENT REMOVAL DETAILS
 BRIDGE NO. FRA-270-4900
 OVER IR 270

DESIGNED	JGM	CHECKED	JLM
DRAWN	JGM	REVISED	
REVIEWED	NCK	DATE	12/01/2015
STRUCTURE FILE NUMBER	2513862		

RESOURCE INTERNATIONAL INC.
 6350 PRESIDENTIAL GATEWAY
 COLUMBUS, OHIO 43231
 (614) 823-4848

FRA - 270-49.00
PID No. 83988

7 / 32
 153
 182

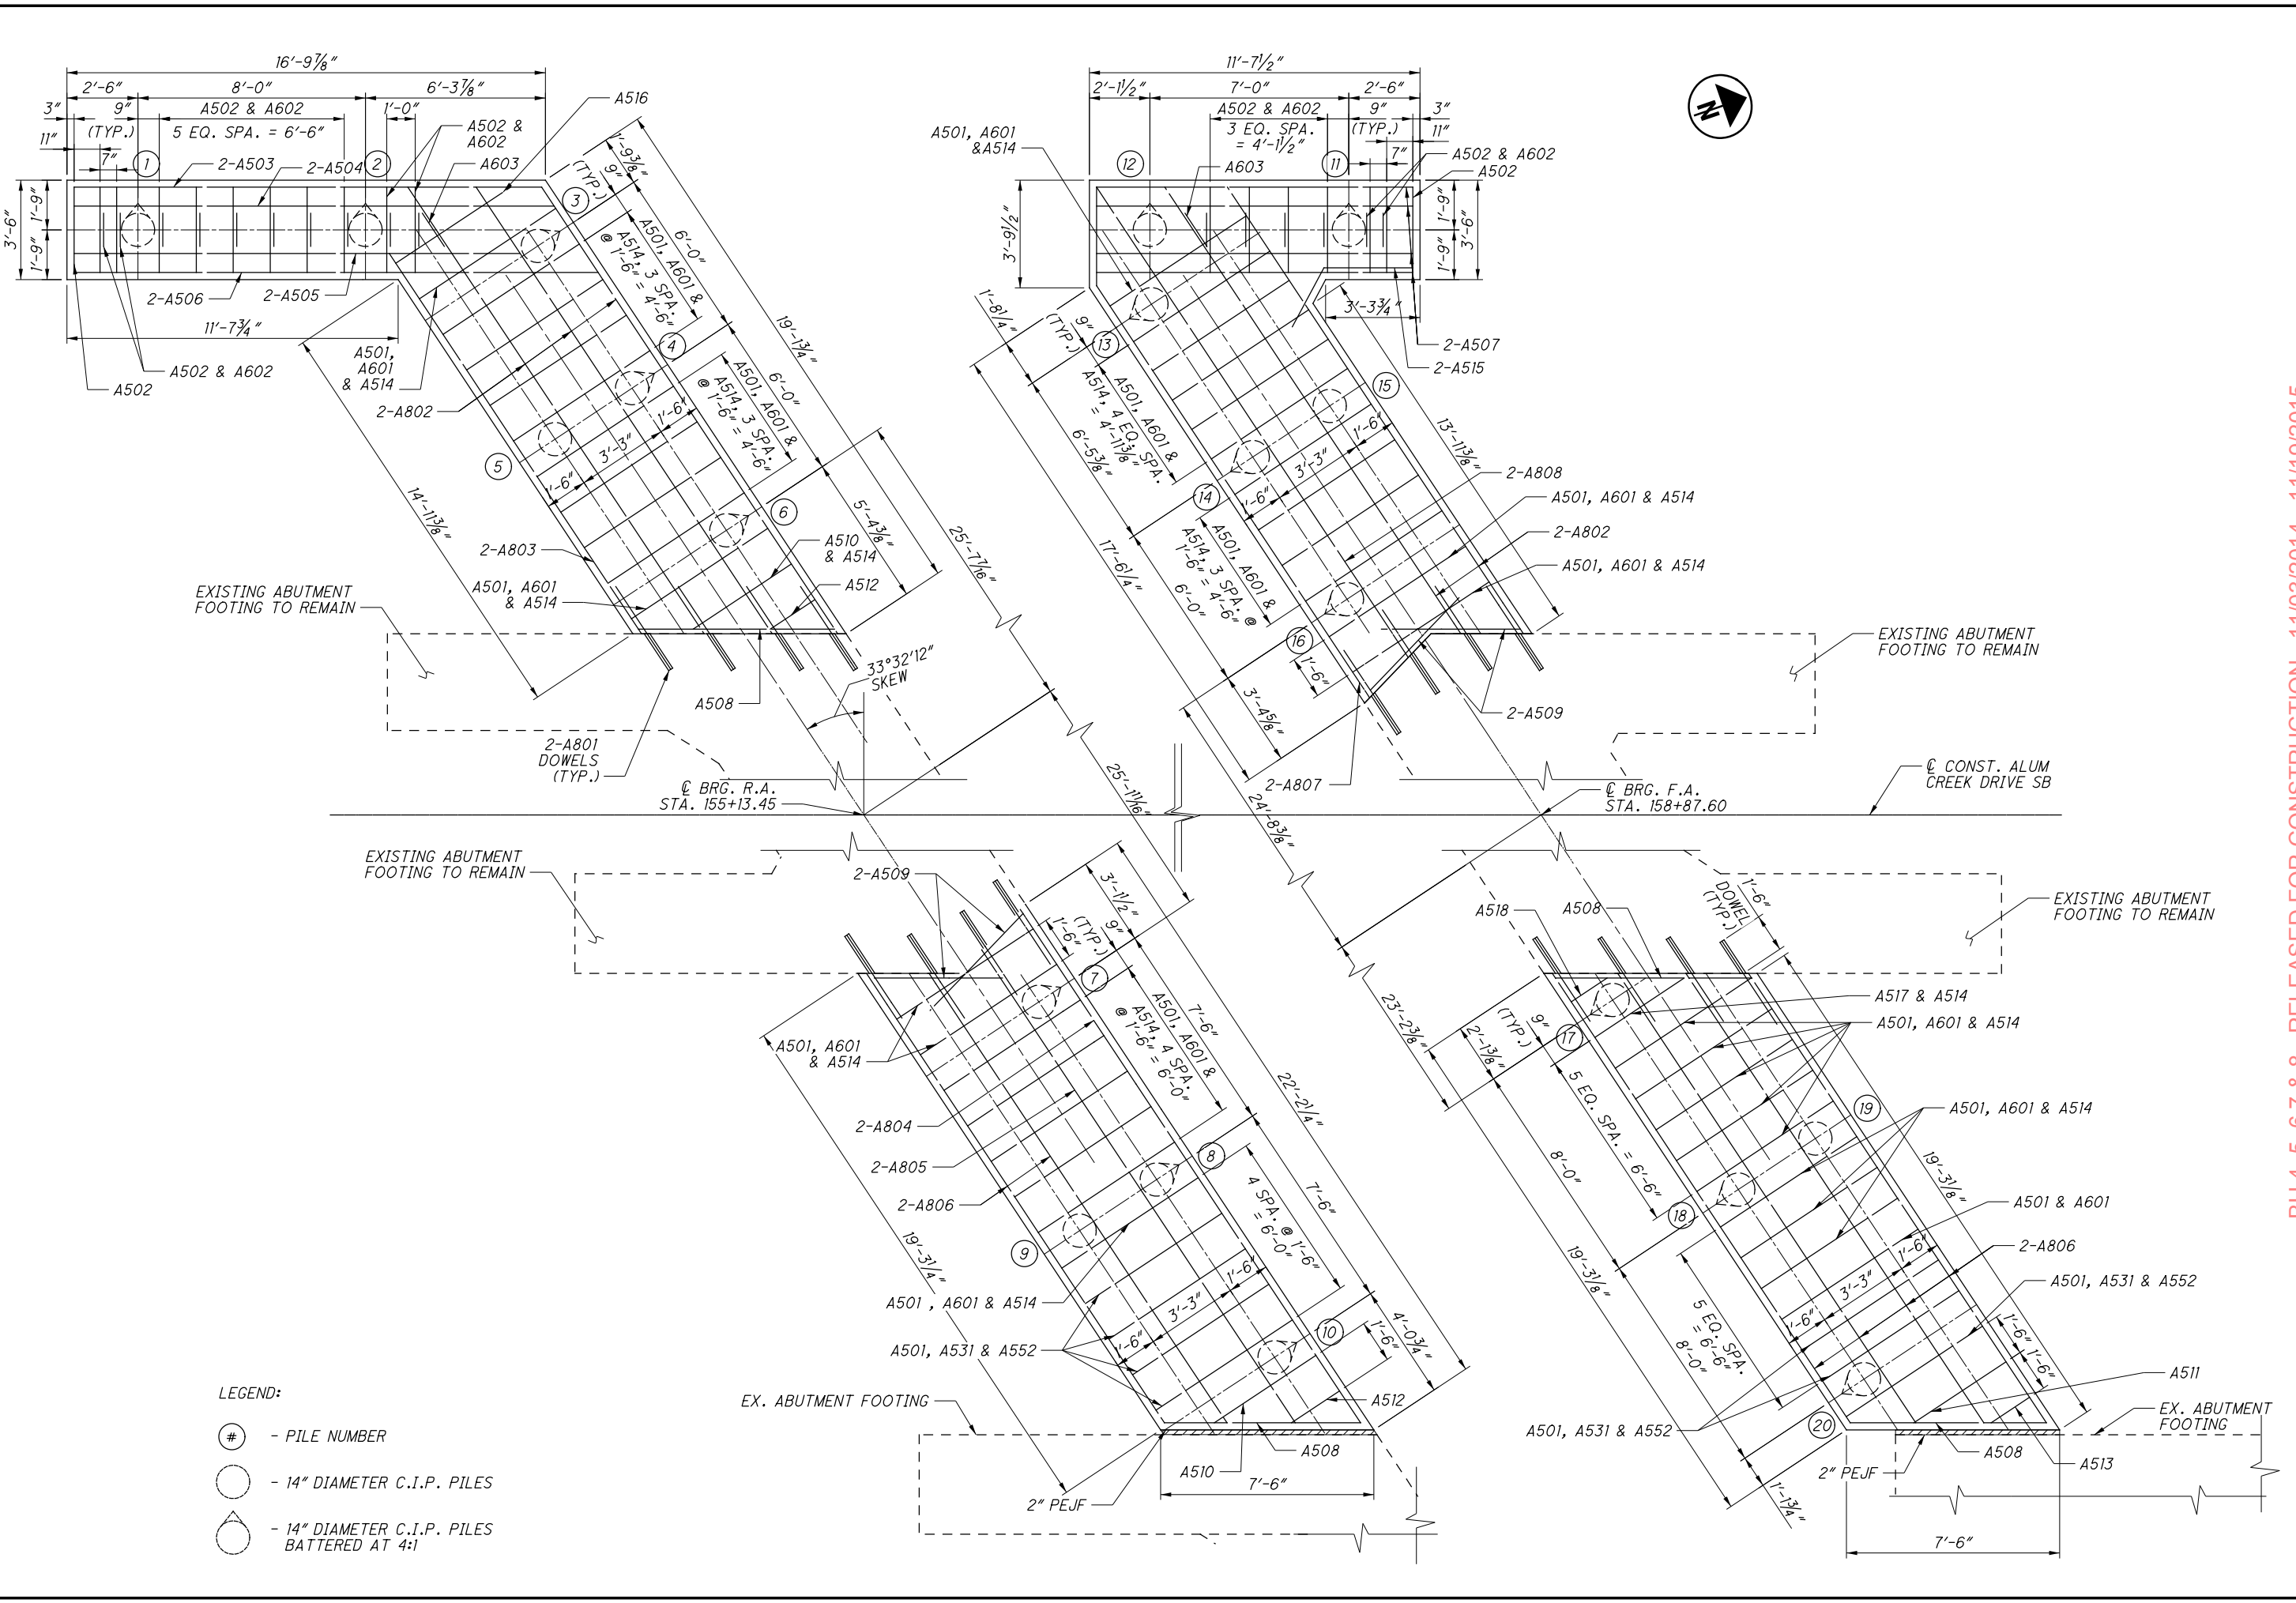

- LEGEND:
- ① - PILE NUMBER
 - - 14" DIAMETER C.I.P. PILES
 - ◐ - 14" DIAMETER C.I.P. PILES BATTERED AT 4:1




BU 4, 5, 6, 7, & 8 - RELEASED FOR CONSTRUCTION - 11/03/2014 - 11/19/2015
 ABUTMENT FOOTING DETAILS
 BRIDGE NO. FRA-270-4900
 OVER IR 270

DESIGNED	JGM	CHECKED	JLM
DRAWN	JGM	REVIEWED	JLM
DATE	NCK	STRUCTURE FILE NUMBER	2513862
REVIEWED	12/01/2015		


RESOURCE INTERNATIONAL INC.
 6350 PRESIDENTIAL GATEWAY
 COLUMBUS, OHIO 43231
 (614) 823-4848

FRA - 270-36.94
 PID No. 83988

8 / 32
 154
 182

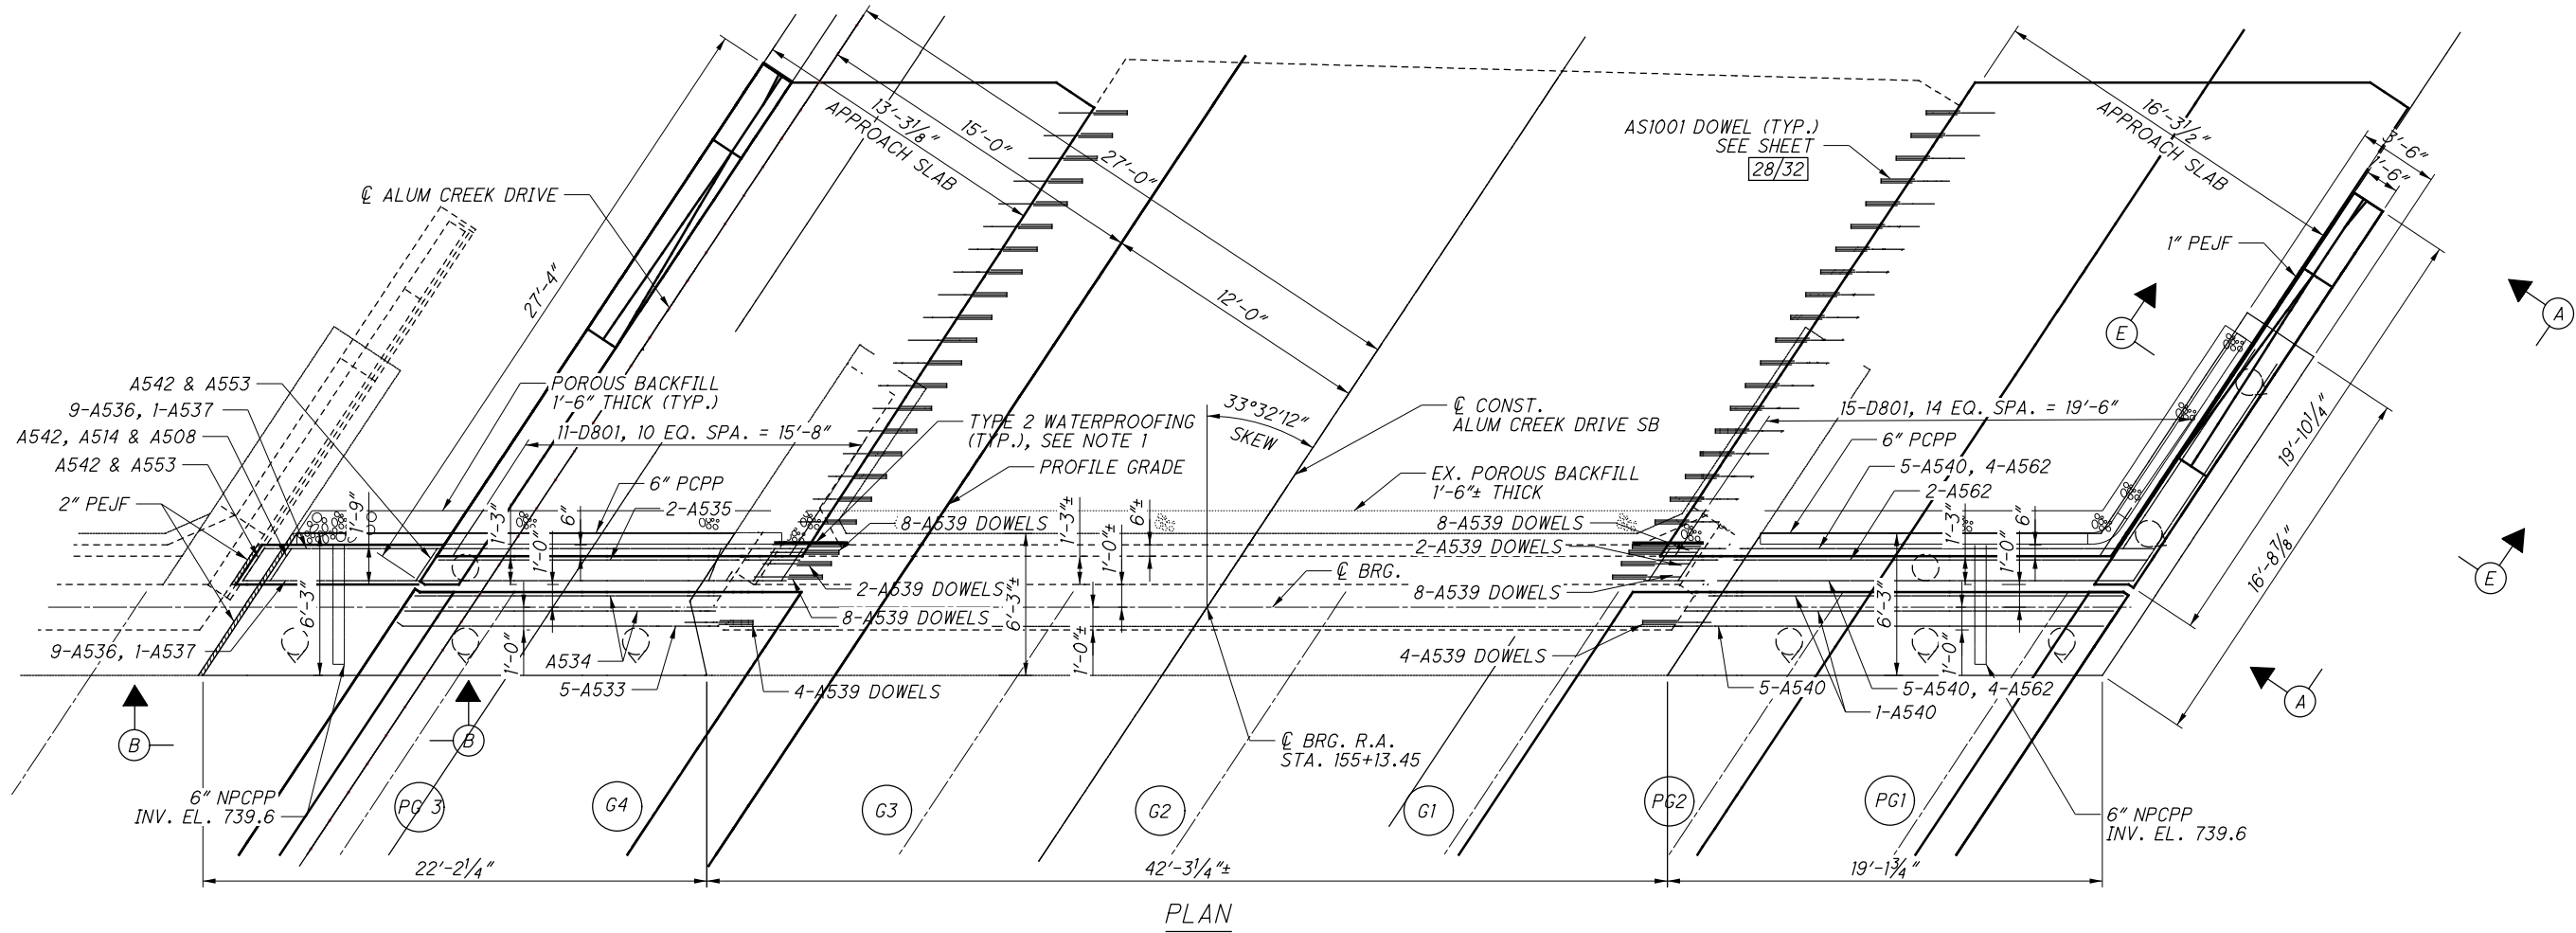

PLAN

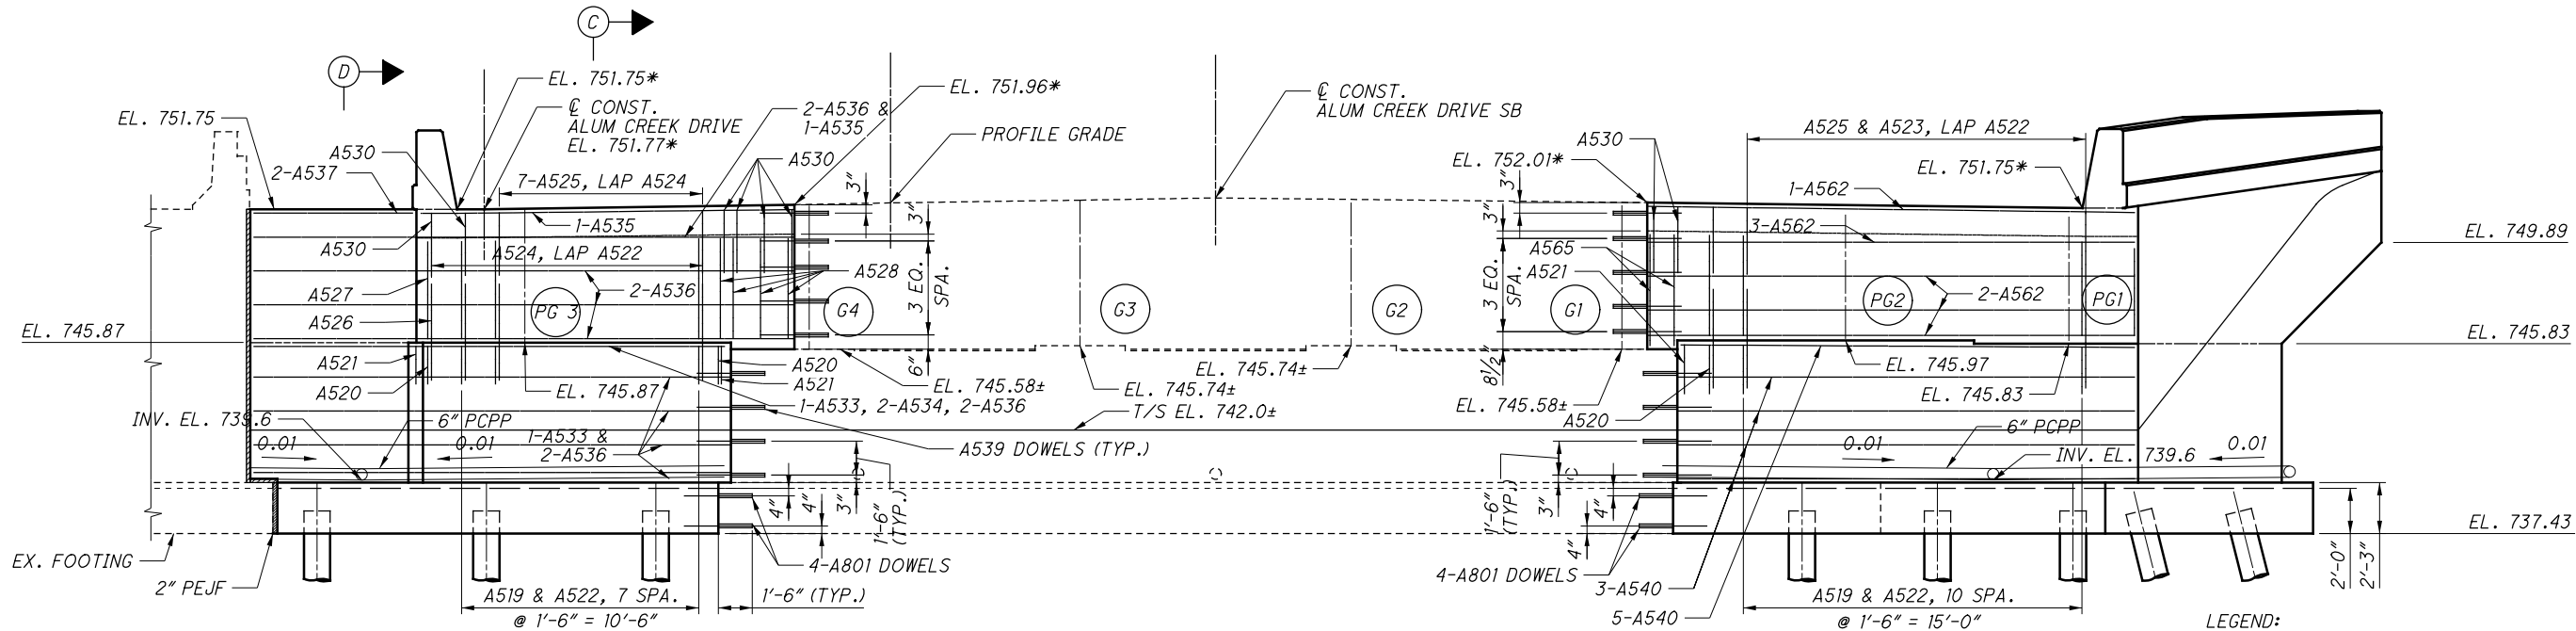

ELEVATION

NOTE:

- 1. APPLY TYPE 2 WATERPROOFING, 3'-0" WIDE, CENTERED ON THE VERTICAL JOINT BETWEEN EXISTING AND PROPOSED CONCRETE.


LEGEND:

- * - PROPOSED ELEVATION AT FACE OF BACKWALL
- (GX) - EXISTING GIRDER NUMBER
- (PG X) - PROPOSED GIRDER NUMBER




AS BUILT - 4/22/2016

G:\projects\2014\W-14-039_FRA-270-49\00\83988\structures\FRA270_4900L\sheets\270_4900L_AF001.dgn 5/23/2016 7:32:04 AM kevinj

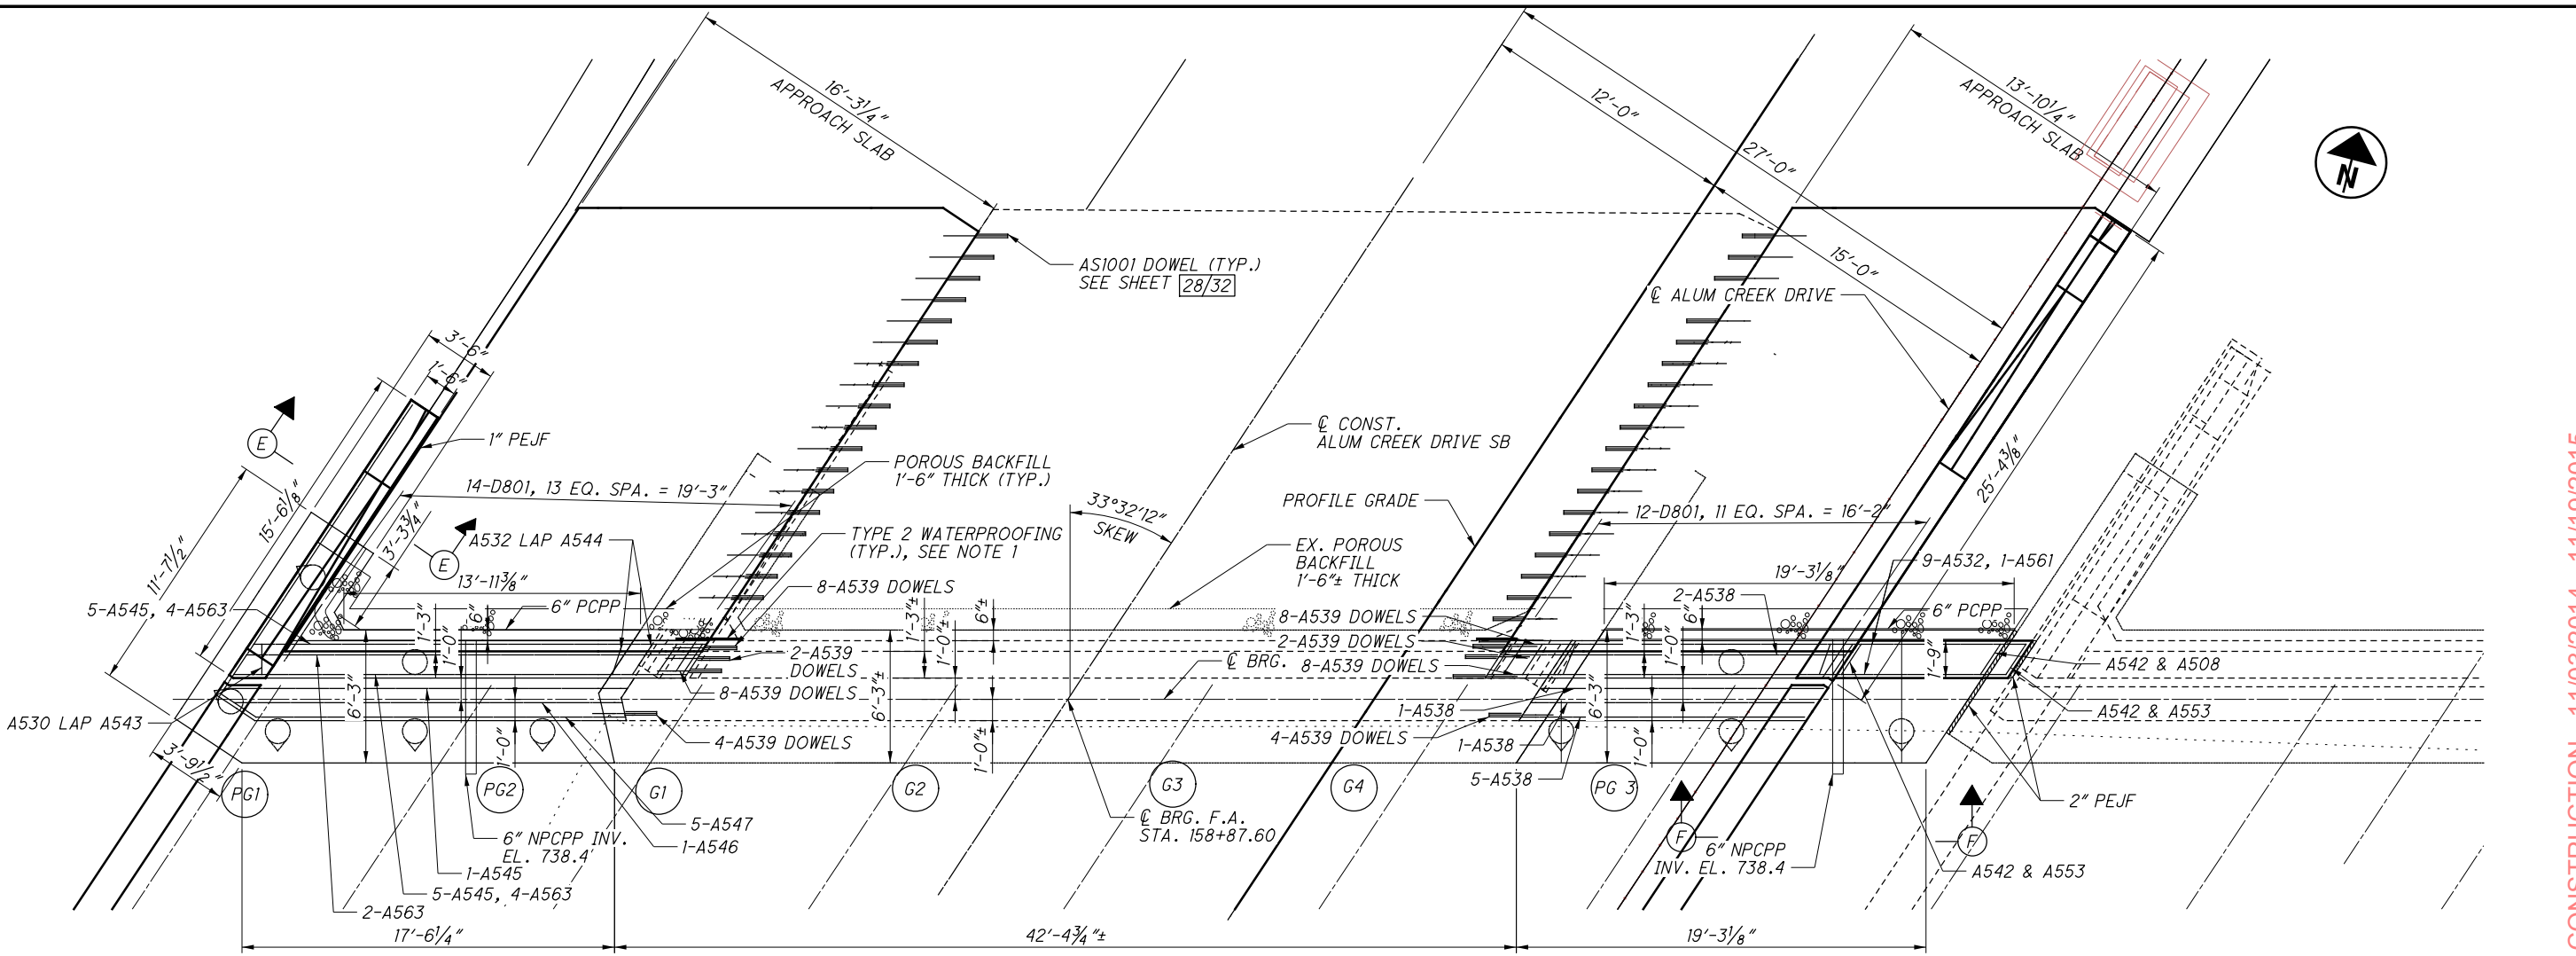

PLAN

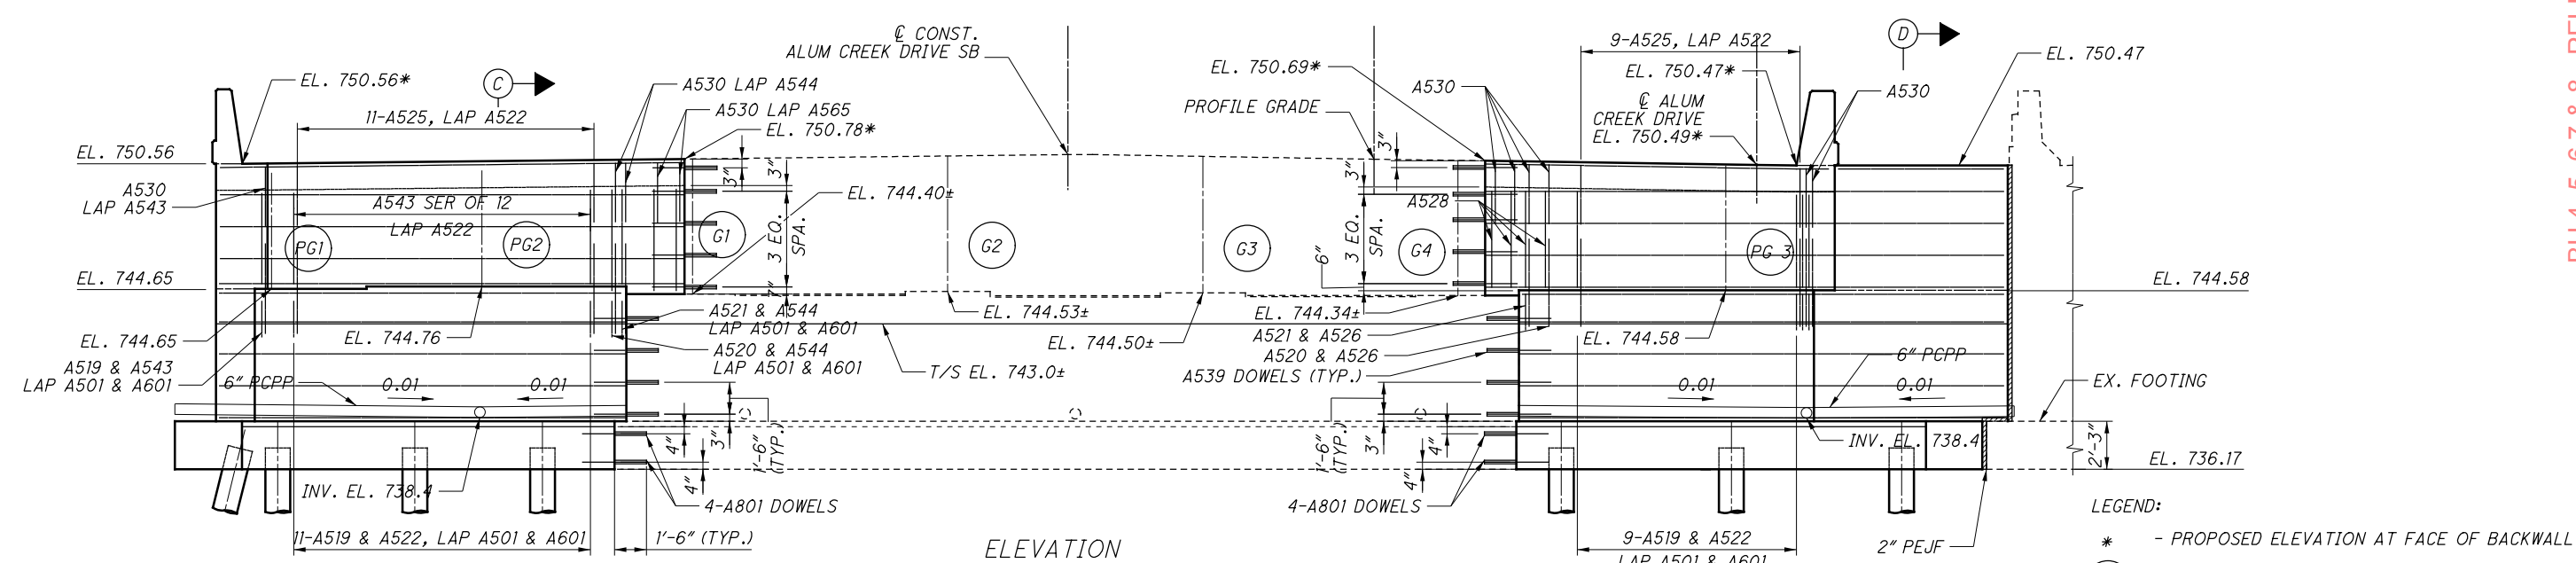

ELEVATION

NOTE:

1. APPLY TYPE 2 WATERPROOFING, 3'-0" WIDE, CENTERED ON THE VERTICAL JOINT BETWEEN EXISTING AND PROPOSED CONCRETE.

LEGEND:

- * - PROPOSED ELEVATION AT FACE OF BACKWALL
- GX - EXISTING GIRDER NUMBER
- PG X - PROPOSED GIRDER NUMBER

RESOURCE INTERNATIONAL INC.
 6350 PRESIDENTIAL GATEWAY
 COLUMBUS, OHIO 43231
 (614) 823-4848

Rii
 DATE: 12/01/2015
 REVIEWED: NCK
 DRAWN: JGM
 CHECKED: JLM
 STRUCTURE FILE NUMBER: 2513862

BU 4, 5, 6, 7, & 8 - RELEASED FOR CONSTRUCTION - 11/03/2014 - 11/19/2015
FORWARD ABUTMENT DETAILS
 BRIDGE NO. FRA-270-4900
 OVER IR 270


FRA - 270-49.00
 PID No. 83988

10 / 32
 156 / 182


AS BUILT - 4/22/2016

5/23/2016 7:32:05 AM kevinj


G:\projects\2014\W-14-039 FRA-270-49.00\83988\structures\FRA270_4900L\sheets\270_4900L\AR004.dgn

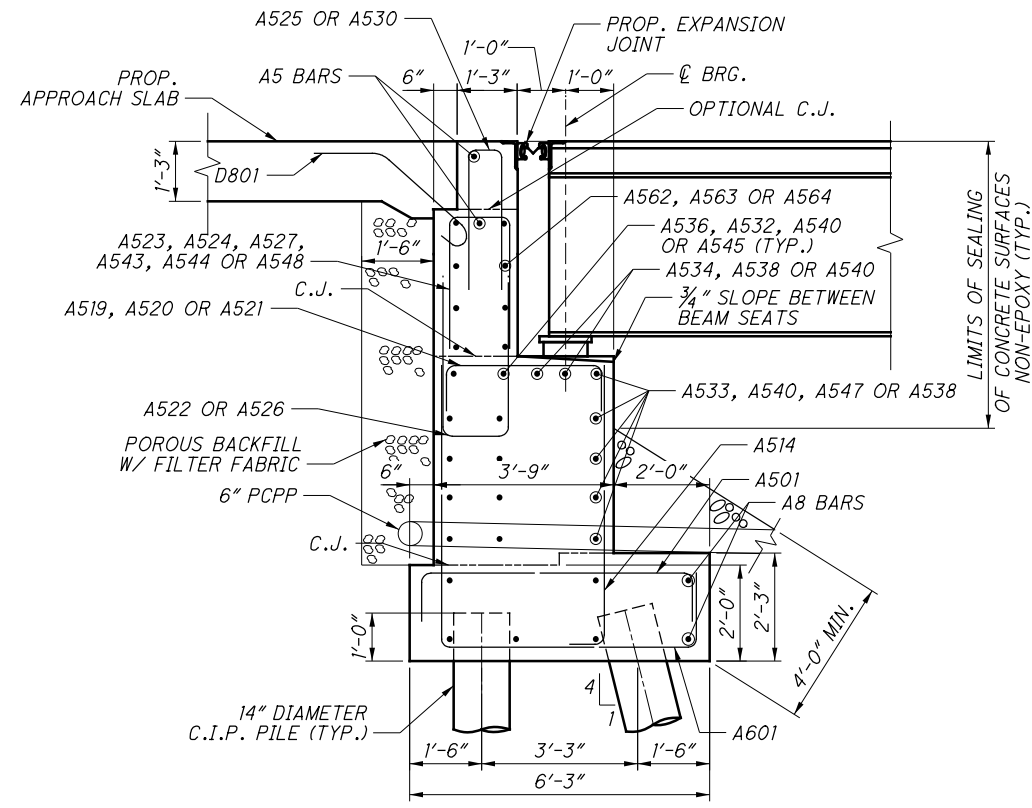


SECTION C-C

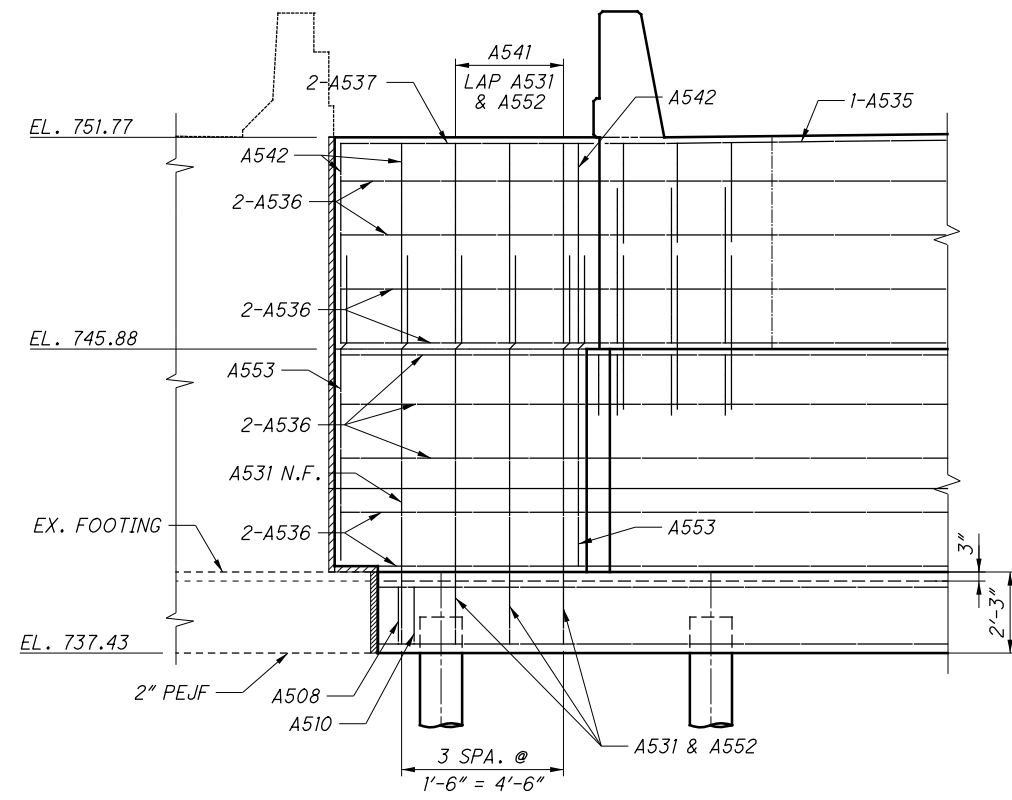

VIEW B-B
(REAR ABUTMENT)

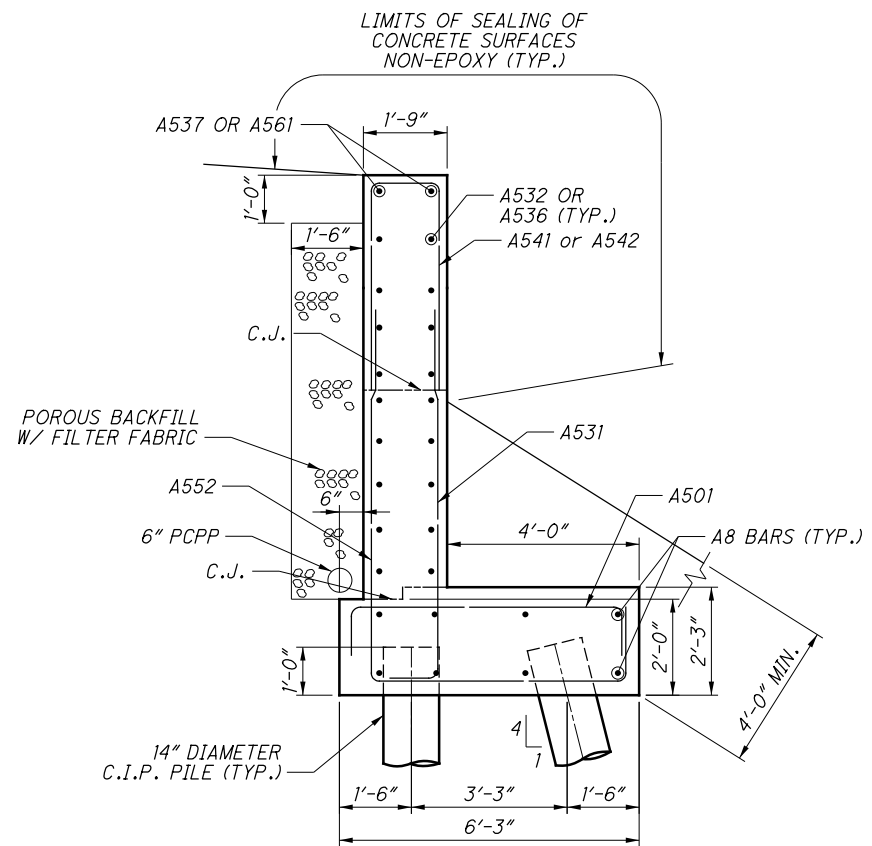

SECTION D-D

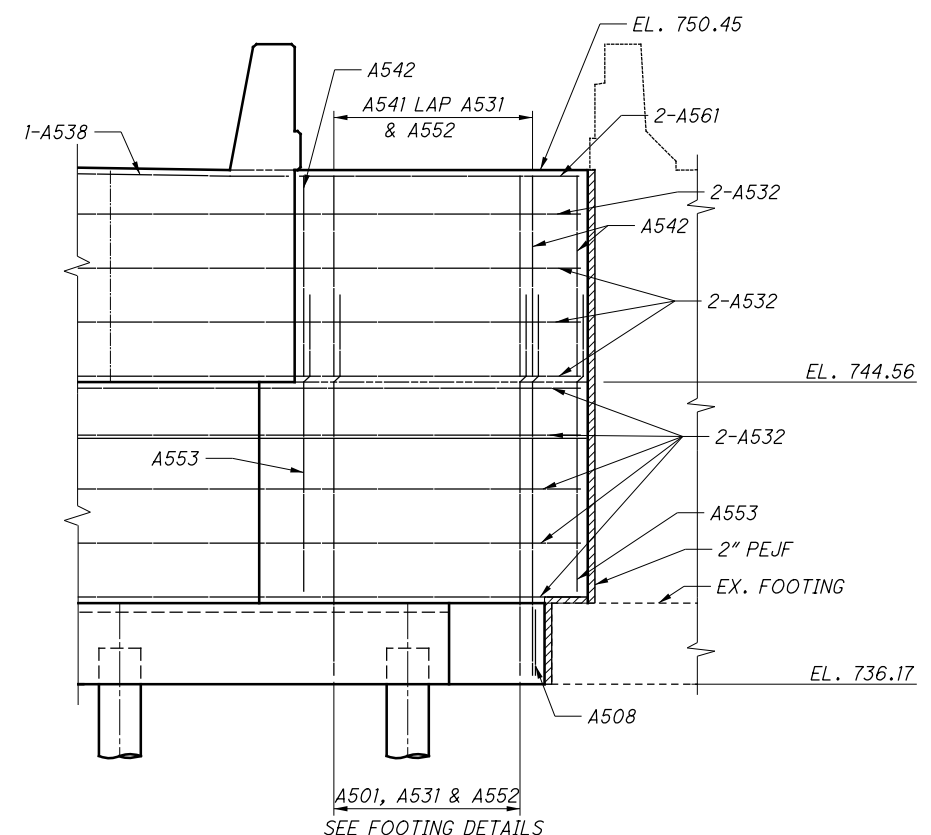

VIEW F-F
(FORWARD ABUTMENT)

RESOURCE INTERNATIONAL INC.
6350 PRESIDENTIAL GATEWAY
COLUMBUS, OHIO 43231
(614) 823-4848



DESIGNED	JGM	CHECKED	JLM
DRAWN	JGM	REVISED	
REVIEWED	NCK	DATE	12/01/2015
STRUCTURE FILE NUMBER	2513862		


BU 4, 5, 6, 7, & 8 - RELEASED FOR CONSTRUCTION - 11/03/2014 - 11/19/2015

ABUTMENT DETAILS
BRIDGE NO. FRA-270-4900
OVER I-70


FRA-270-49.00
PID No. 86088

11/32


157
182

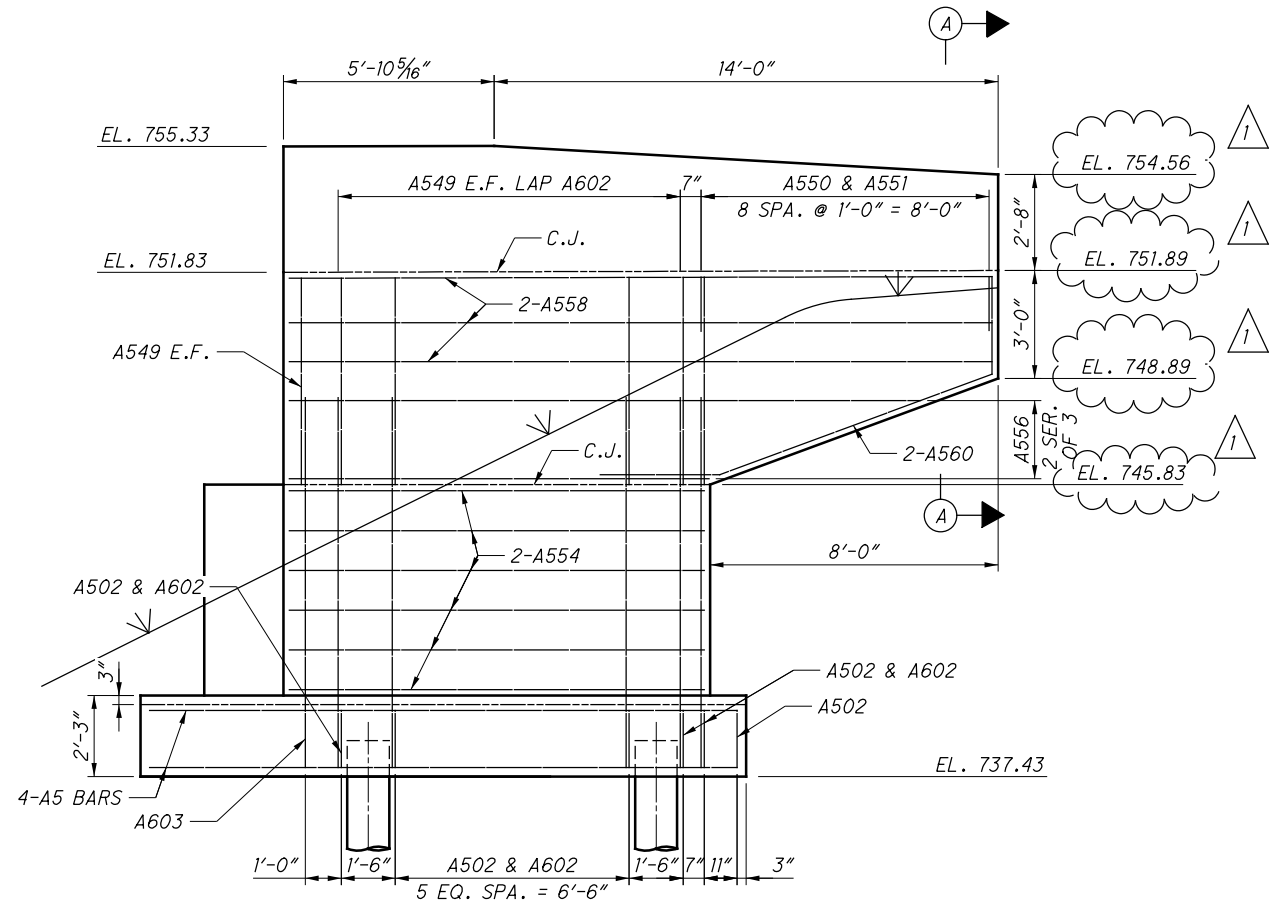


VIEW A-A

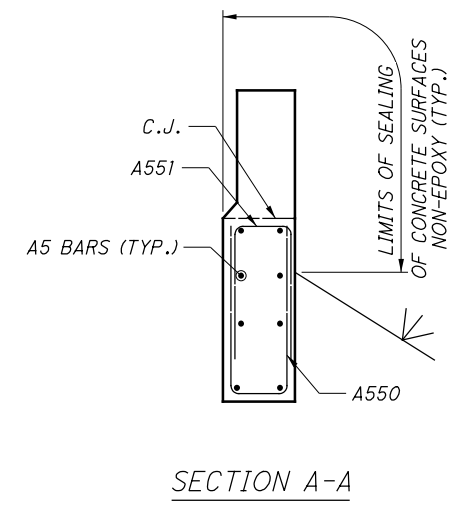

SECTION A-A

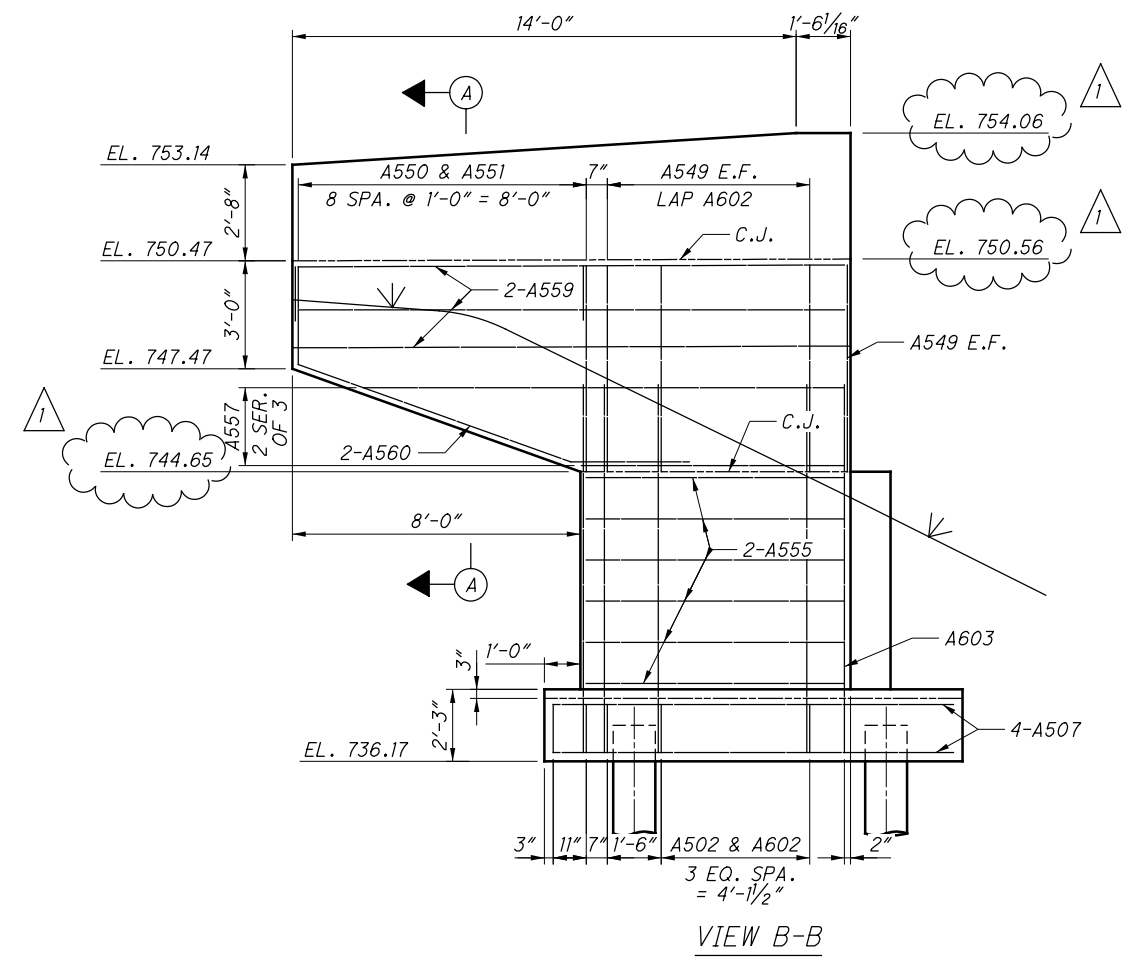

VIEW B-B

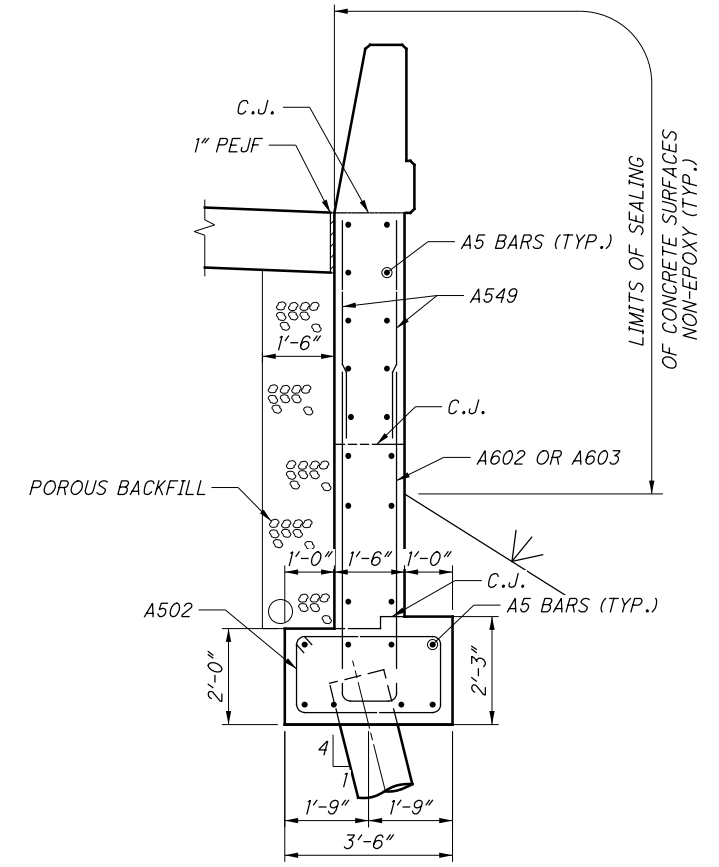

SECTION E-E


REVISED 4/24/2015
BU 4, 5, 6, 7, & 8 - RELEASED FOR CONSTRUCTION - 11/03/2014 - 11/19/2015

		RESOURCE INTERNATIONAL INC. 6350 PRESIDENTIAL GATEWAY COLUMBUS, OHIO 43231 (614) 823-4848	
DESIGNED	JGM	CHECKED	JLM
DRAWN	JGM	REVIEWED	NCK
ABUTMENT DETAILS BRIDGE NO. FRA-270-4900 OVER IR 270		DATE	12/01/2015
		STRUCTURE FILE NUMBER	2513862
FRA - 270-49.00 PID No. 83988			
12 / 32 158 182			

AS BUILT - 4/22/2016


5/23/2016 7:32:08 AM kevinj

G:\projects\2014\W-14-039 FRA-270-49.00.83988\structures\FRA270_4900L\P1001.dgn

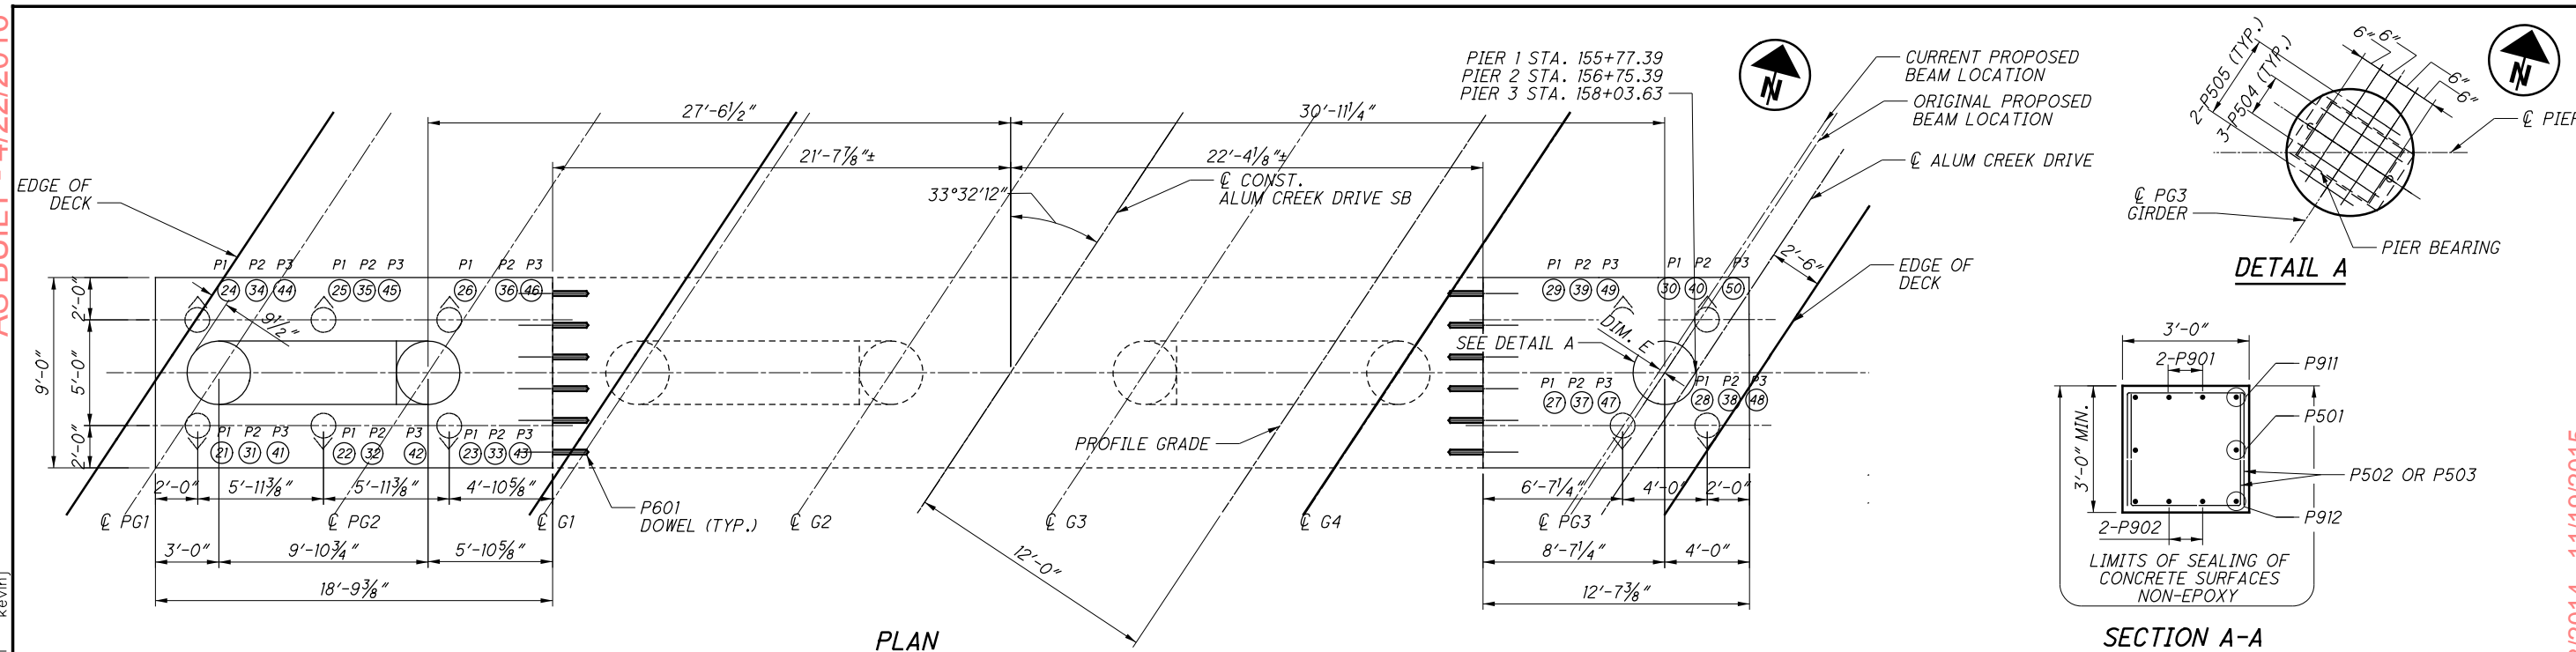


PLAN


LOCATION	DIMENSION E
PIER 1	2 ³ / ₁₆ "
PIER 2	3 ³ / ₁₆ "
PIER 3	3 ⁵ / ₁₆ "

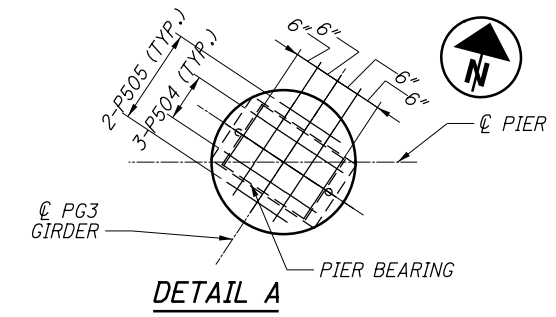


DETAIL A

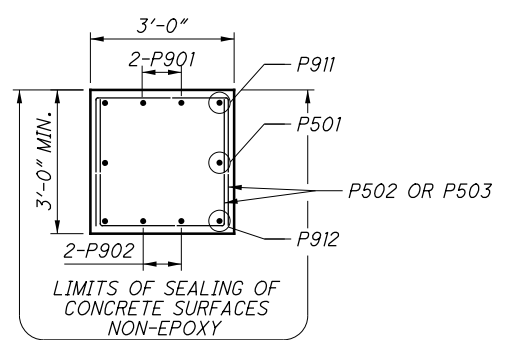


SECTION A-A

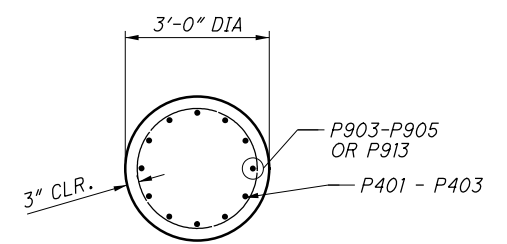


SECTION B-B (PIER 1)

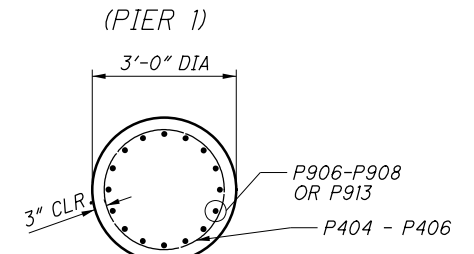

SECTION C-C (PIER 2 PIER 3)

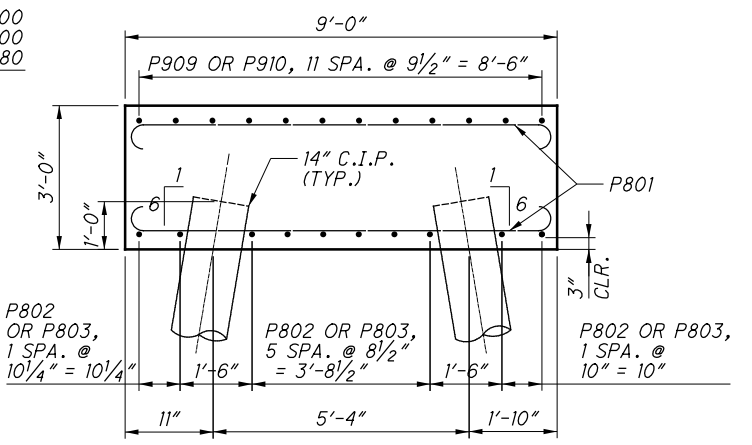

SECTION D-D

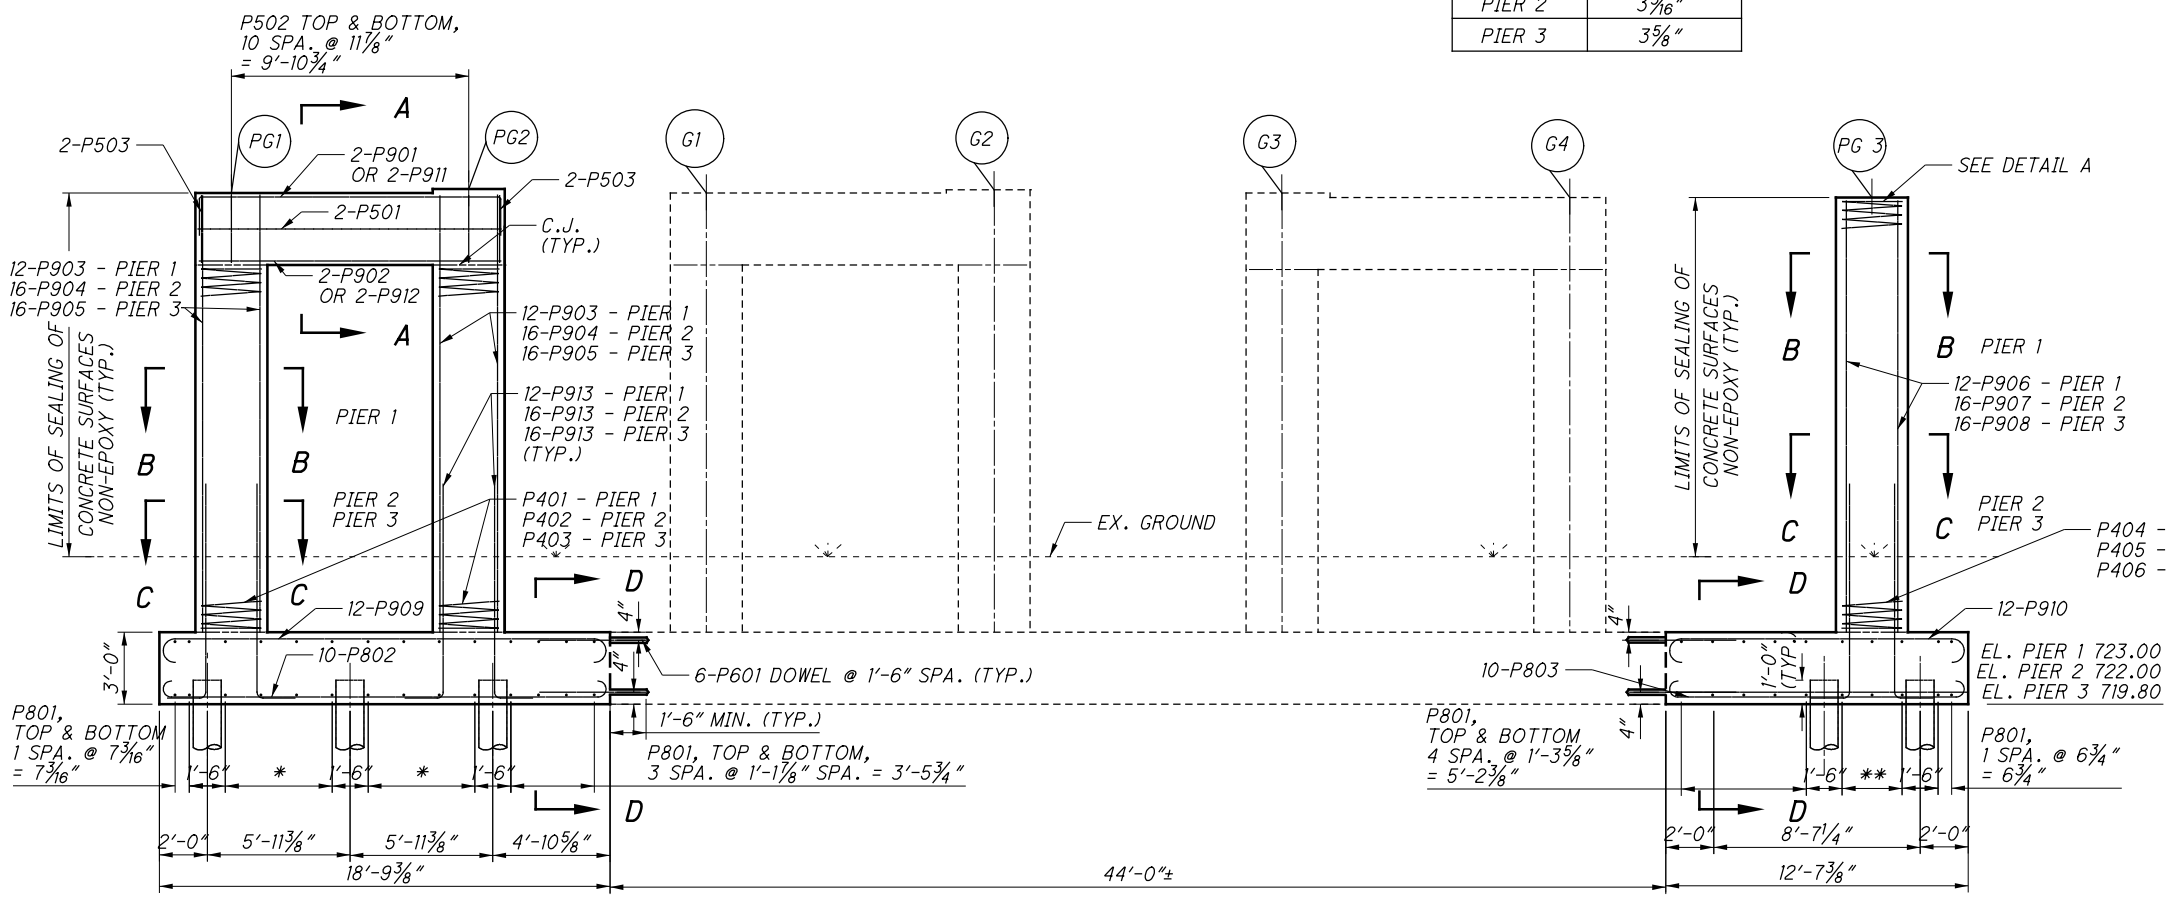

ELEVATION

* P801 TOP & BOTTOM, 3 SPA. @ 1'-5³/₄" = 4'-5³/₄"
 ** P801 TOP & BOTTOM, 2 SPA. @ 1'-3" = 2'-6"

LAP NO. 9 BAR - 6'-2" MIN.

	PG1	PG2	G1	G2	G3	G4	PG3
PIER 1	745.67	745.77	744.29	744.45	744.38	744.25	745.60
PIER 2	745.19	745.31	744.60	744.73	744.70	744.55	745.12
PIER 3	744.68	744.80	743.31	743.46	743.43	743.24	744.66

LEGEND
 14" DIA. CAST IN PLACE PILE BATTERED AT 6:1
 * PILE NUMBER

NOTE
 1. ACCURATELY PLACE REINFORCING STEEL IN THE VICINITY OF THE BRIDGE SEAT TO AVOID INTERFERENCE WITH THE DRILING OF BEARING ANCHOR HOLES OR THE PRE-SETTING OF BEARING ANCHORS.

RESOURCE INTERNATIONAL INC.
 6350 PRESIDENTIAL GATEWAY
 COLUMBUS, OHIO 43231
 (614) 823-4848

Rii

DESIGNED BY: JLM
 CHECKED BY: JGM

DRAWN BY: JGM
 REVISED BY:

REVIEWED BY: NCK
 DATE: 12/01/2015

STRUCTURE FILE NUMBER: 2513862



BRIDGE NO. FRA-270-4900
 OVER IR 270

PIER DETAILS

FRA - 270-49.00
 PID No. 83988

13 / 32

159
 182

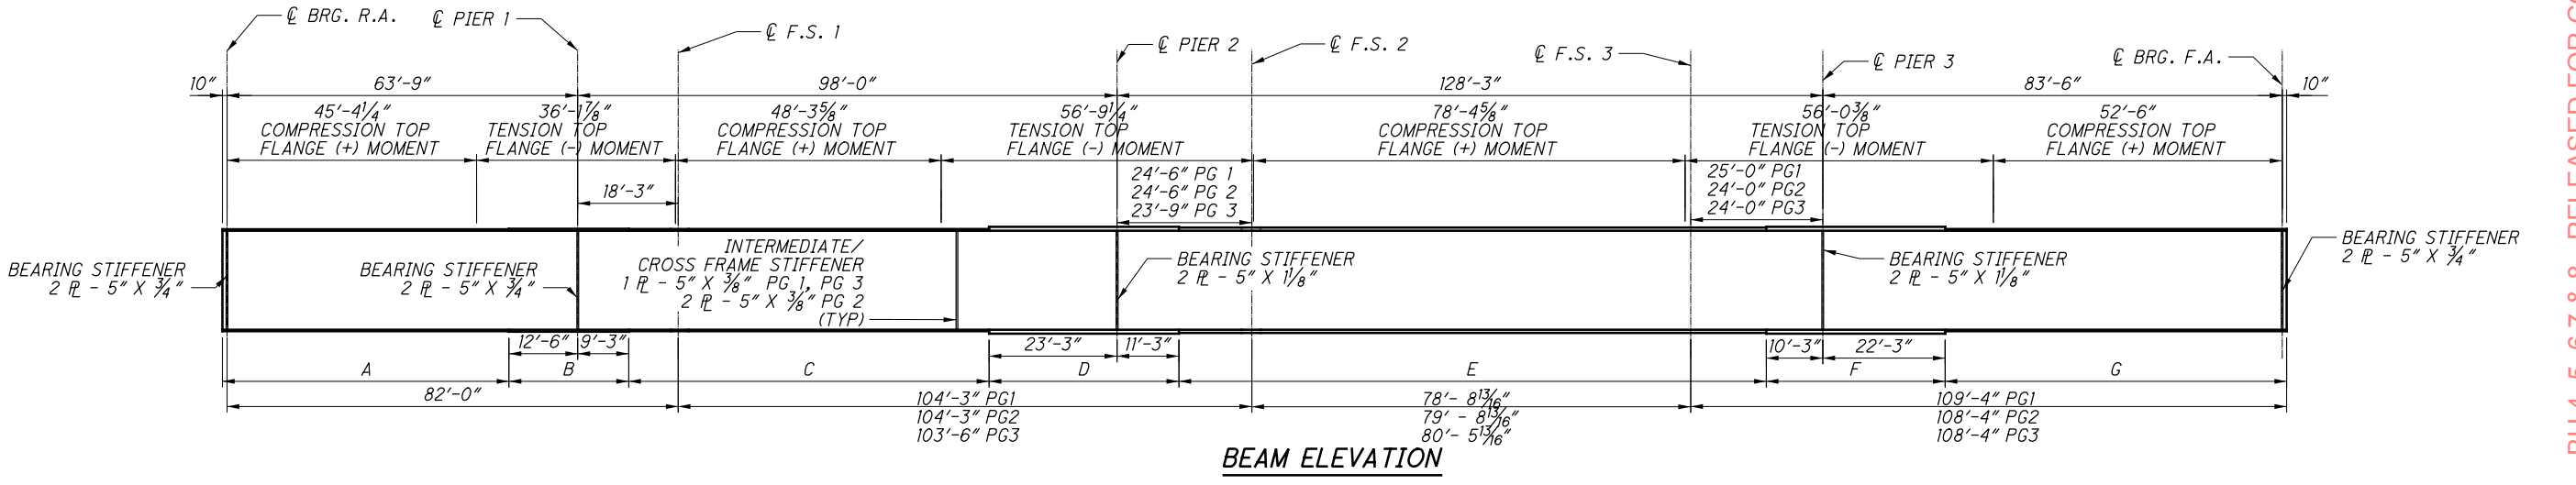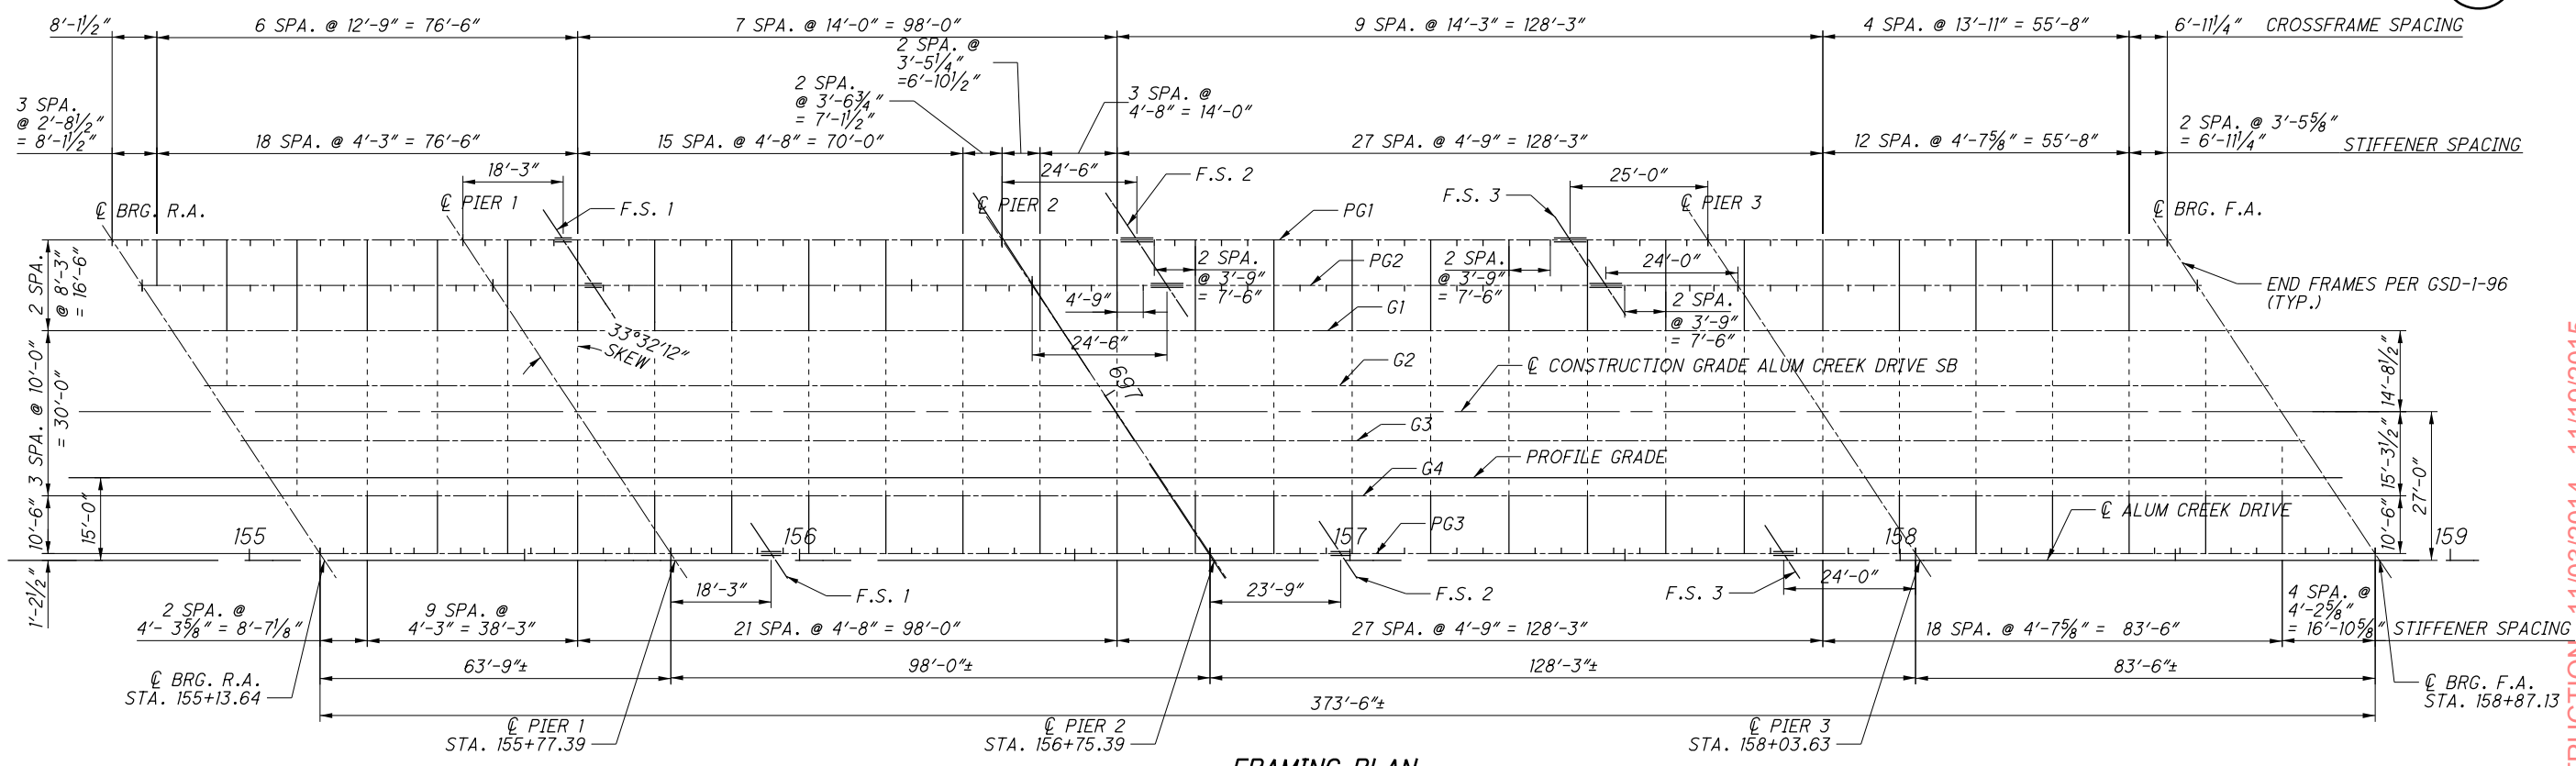

DIMENSION	LENGTH	WEB PLATE	PG1 & PG2 TOP & BOTTOM FLANGE PLATES	PG3 TOP & BOTTOM FLANGE PLATES
A	52'-1"	54" X 3/8"	12" X 3/4"	15" X 3/4"
B	21'-9"	54" X 3/8"	12" X 1 1/8"	15" X 1 1/8"
C	65'-6"	54" X 3/8"	12" X 0 7/8"	15" X 0 7/8"
D	34'-6"	54" X 3/8"	12" X 2 1/8"	15" X 2"
E	106'-9"	54" X 3/8"	12" X 1 3/4"	15" X 1 3/4"
F	32'-6"	54" X 3/8"	12" X 2 1/8"	15" X 2"
G	62'-1"	54" X 3/8"	12" X 0 7/8"	15" X 0 7/8"

NOTES:

- INTERMEDIATE STIFFENERS SHALL BE PLACED AT APPROXIMATELY EQUAL SPACING BETWEEN INTERMEDIATE CROSSFRAMES AND BEARING STIFFENERS AS SHOWN IN THE FRAMING PLAN. IN NO CASE SHALL THE CLEAR SPACING BETWEEN STIFFENERS EXCEED 60 INCHES EXCEPT AS SHOWN ON THE FRAMING PLAN NEAR FIELD SPLICES.
- STIFFENERS FOR INTERMEDIATE CROSS FRAMES SHALL BE PLACED IN LINE WITH EXISTING CROSSFRAMES ON EXISTING BEAMS. LOCATIONS OF EXISTING CROSSFRAME STIFFENERS SHALL BE FIELD VERIFIED PRIOR TO FABRICATION.
- THE DIMENSIONS LOCATING THE BOLTED FIELD SPLICES MAY BE VARIED ± 18" MAX. TO AVOID INTERFERENCE OF INTERMEDIATE STIFFENERS OR CROSSFRAME ANGLES WITH THE WEB SPLICE PLATES.
- WELD ATTACHMENT OF SUPPORTS FOR CONCRETE DECK FINISHING MACHINE TO AREAS OF THE FASCIA GIRDER FLANGES DESIGNATED "COMPRESSION". DO NOT WELD ATTACHMENTS TO AREAS DESIGNATED "TENSION". FILLET WELDS TO COMPRESSION FLANGES SHALL BE AT LEAST 1" FROM EDGE OF FLANGE, BE NO MORE THAN 2" LONG, AND BE AT LEAST 1/4" FOR THICKNESSES UP TO 3/4" OR 5/16" FOR GREATER THAN 3/4" THICK.
- PAINT FASCIA BEAMS SEE SHEET 3/32 AND 5/32 FOR NOTES AND LIMITS.
- WELD ATTACHMENT OF SUPPORTS FOR CONCRETE DECK FINISHING MACHINE TO AREAS OF THE FASCIA STRINGER FLANGES DESIGNATED "COMPRESSION". DO NOT WELD ATTACHMENTS TO AREAS DESIGNATED "TENSION". FILLET WELDS TO COMPRESSION FLANGES SHALL BE AT LEAST 1" FROM EDGE OF FLANGE, BE NO MORE THAN 2" LONG, AND BE AT LEAST 1/4" FOR THICKNESS UP TO 3/4" OR 5/16" FOR GREATER THAN 3/4" THICK.

BU 4, 5, 6, 7, & 8 - RELEASED FOR CONSTRUCTION - 11/03/2014 - 11/19/2015




RESOURCE INTERNATIONAL INC.
6350 PRESIDENTIAL GATEWAY
COLUMBUS, OHIO 43231
(614) 823-4848



DESIGNED: NCK
CHECKED: JLM
DRAWN: JGM
REVISED:
REVIEWED: SSK
DATE: 12/01/2015
STRUCTURE FILE NUMBER: 2513862



SUPERSTRUCTURE DETAILS
BRIDGE NO. FRA-270-4900
OVER IR 270

FRA - 270-49.00
PID No. 83988

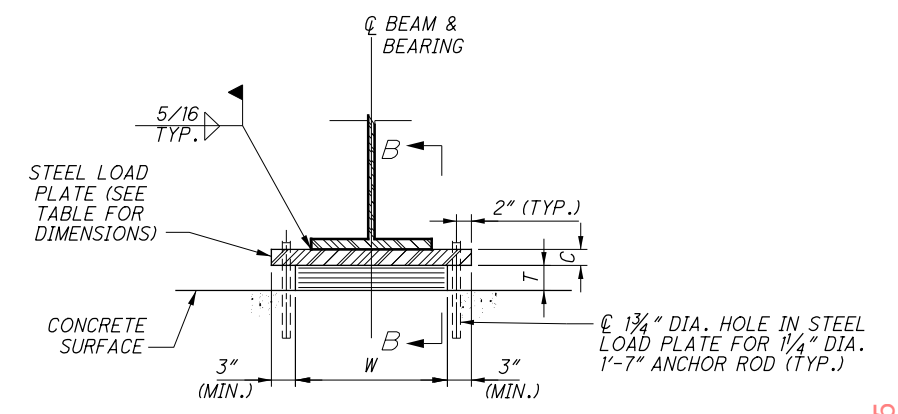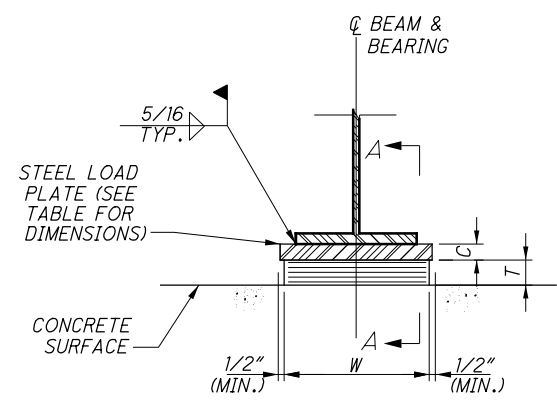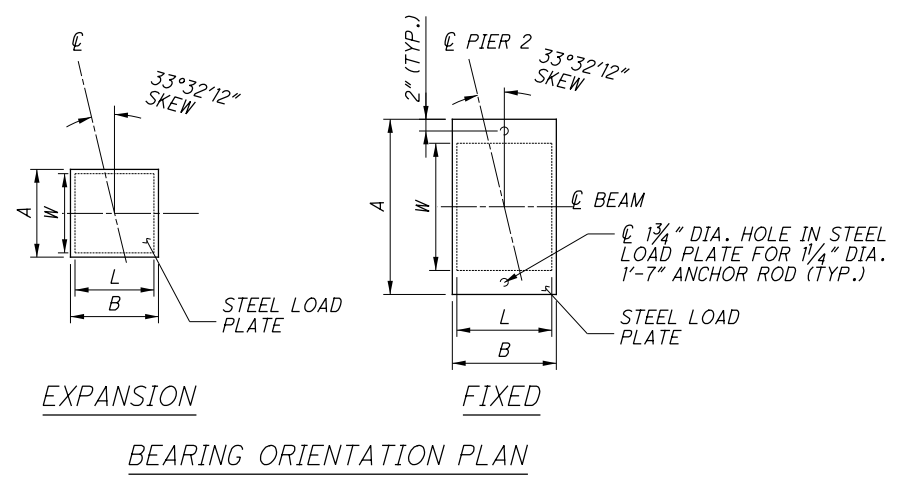

LAMINATED ELASTOMERIC BEARING
EXPANSION AT ABUTMENTS, PIER 1, AND PIER 3

LAMINATED ELASTOMERIC BEARING
FIXED AT PIER 2

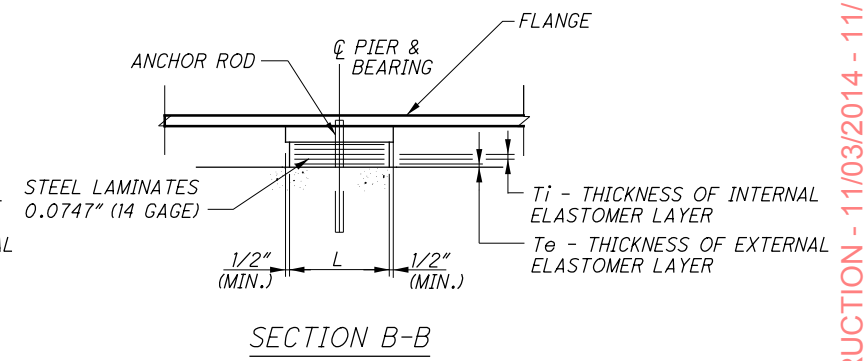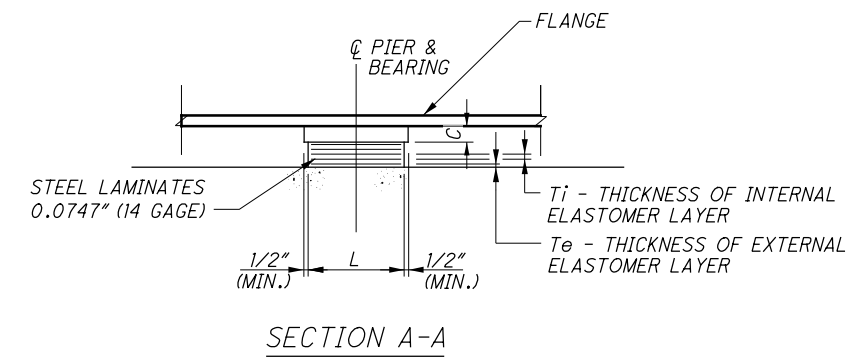

NOTES

1. STEEL LOAD PLATE AND PEDESTAL SHALL MEET THE REQUIREMENTS OF ASTM-A709, GRADE 50W STEEL.
2. THE ELASTOMER SHALL HAVE A HARDNESS OF 50 DUROMETER. THE BEARINGS WERE DESIGNED UNDER DIVISION I, SECTION 14.6.6 (METHOD A) OF THE AASHTO STANDARD SPECIFICATIONS FOR HIGHWAY BRIDGES.

TABLE OF ELASTOMERIC BEARING DATA

BEARING TYPE	GIRDER NUMBER	LOCATION	BEARING TYPE	NO. REQ.	L (INCHES)	W (INCHES)	T (INCHES)	Te (INCHES)	TI (INCHES)	NUMBER OF INTERNAL LAYERS	NUMBER OF STEEL LAMINATES	LOAD PLATE SIZE (INCHES)			MAX. DEAD LOAD (KIPS)	MAX. LIVE LOAD (KIPS)	DESIGN LOAD (KIPS)
												A	B	C			
1	PG1	REAR ABUTMENT	EXPANSION	1	12	18	3.32	0.48	0.6875	3	4	19	13	1.5	38.5	40.2	78.7
1	PG1	FORWARD ABUTMENT	EXPANSION	1	12	18	3.32	0.48	0.6875	3	4	19	13	1.5	44.9	41.8	86.7
1	PG2	REAR ABUTMENT	EXPANSION	1	12	18	3.32	0.48	0.6875	3	4	19	13	1.5	43.9	48.9	92.8
1	PG2	FORWARD ABUTMENT	EXPANSION	1	12	18	3.32	0.48	0.6875	3	4	19	13	1.5	51.2	50.7	101.9
1	PG3	REAR ABUTMENT	EXPANSION	1	12	18	3.32	0.48	0.6875	3	4	19	13	1.5	51.6	46.8	98.4
1	PG3	FORWARD ABUTMENT	EXPANSION	1	12	18	3.32	0.48	0.6875	3	4	19	13	1.5	60.8	48.7	109.5
2	PG1	PIER 1	EXPANSION	1	15	24	3.61	0.53	0.75	3	4	25	16	2	141.4	60.9	202.3
2	PG2	PIER 1	EXPANSION	1	15	24	3.61	0.53	0.75	3	4	25	16	2	161.2	67.1	228.3
2	PG3	PIER 1	EXPANSION	1	15	24	3.61	0.53	0.75	3	4	25	16	2	190.0	70.9	260.9
3	PG1	PIER 2	FIXED	1	18	23	3.61	0.53	0.75	3	4	29	19	2.5	213.2	75.1	288.3
3	PG1	PIER 3	EXPANSION	1	18	23	3.61	0.53	0.75	3	4	24	19	2.5	215.4	74.2	289.5
3	PG2	PIER 2	FIXED	1	18	23	3.61	0.53	0.75	3	4	29	19	2.5	241.9	82.8	324.7
3	PG2	PIER 3	EXPANSION	1	18	23	3.61	0.53	0.75	3	4	24	19	2.5	244.4	81.7	326.1
4	PG3	PIER 2	FIXED	1	18	25	3.61	0.53	0.75	3	4	31	19	2.5	285.2	87.5	372.7
4	PG3	PIER 3	EXPANSION	1	18	25	3.61	0.53	0.75	3	4	26	19	2.5	286.4	86.0	372.4

RESOURCE INTERNATIONAL INC.
 6350 PRESIDENTIAL GATEWAY
 COLUMBUS, OHIO 43231
 (614) 823-4848





DATE: 12/01/2015
 REVIEWED: NCK
 STRUCTURE FILE NUMBER: 2513862
 DRAWN: JGM
 CHECKED: JGM
 DESIGNED: JLM
 REVISIONS:

SUPERSTRUCTURE DETAILS
 BRIDGE NO. FRA-270-4900
 OVER IR 270

FRA-270-49.00
 PID No. 83988

16 / 32

BU 4, 5, 6, 7, & 8 - RELEASED FOR CONSTRUCTION - 11/03/2014 - 11/19/2015

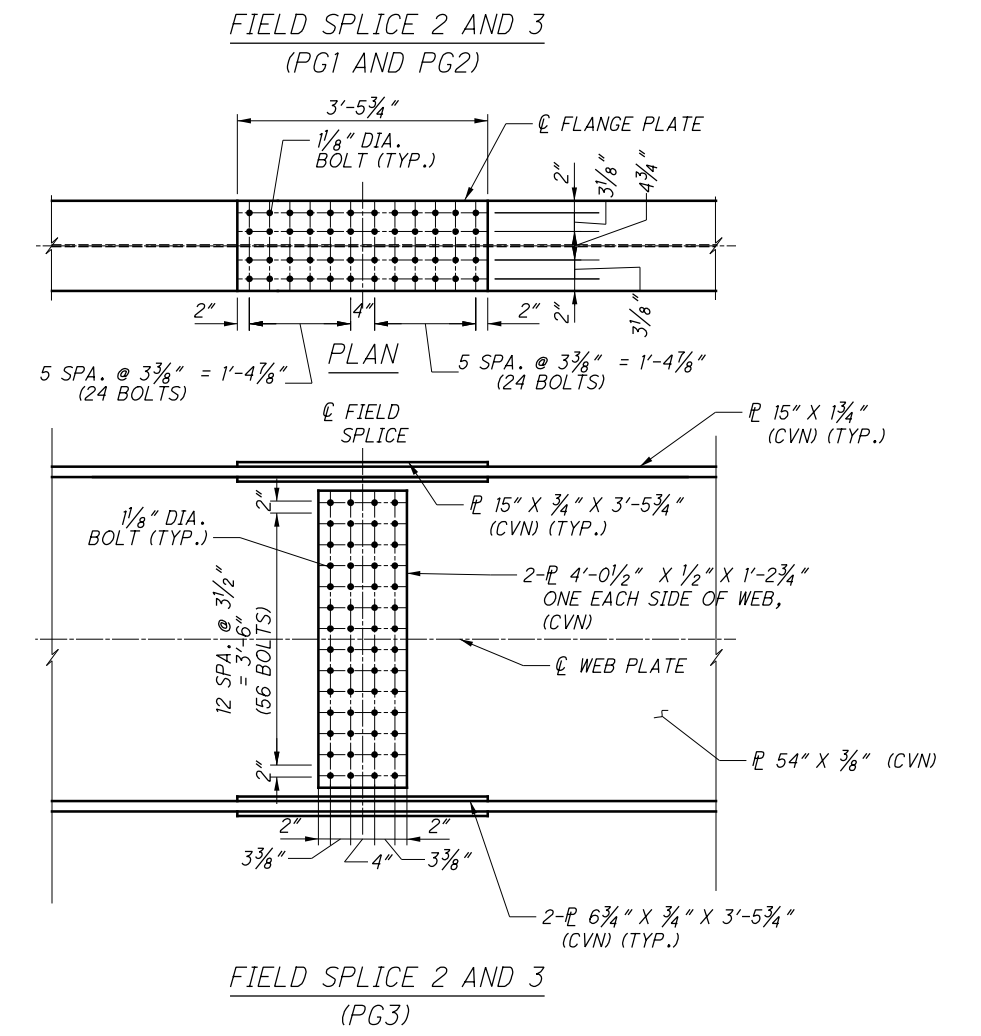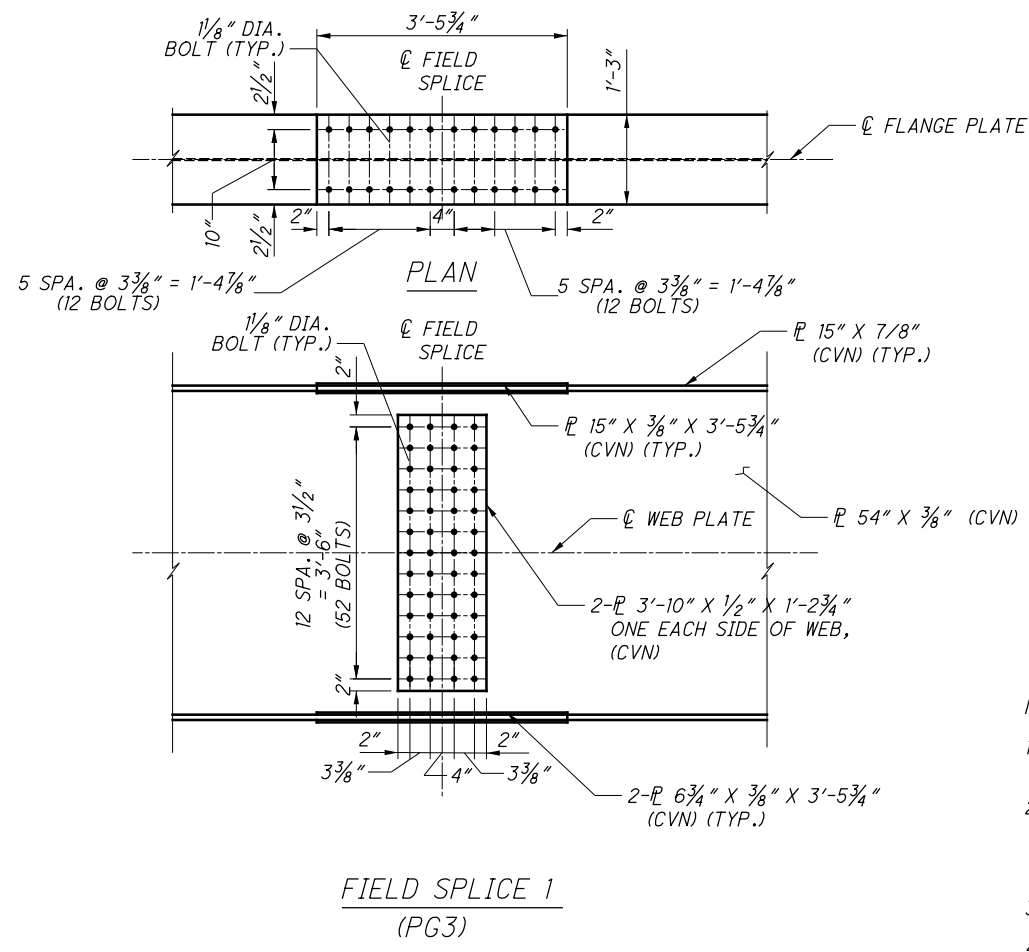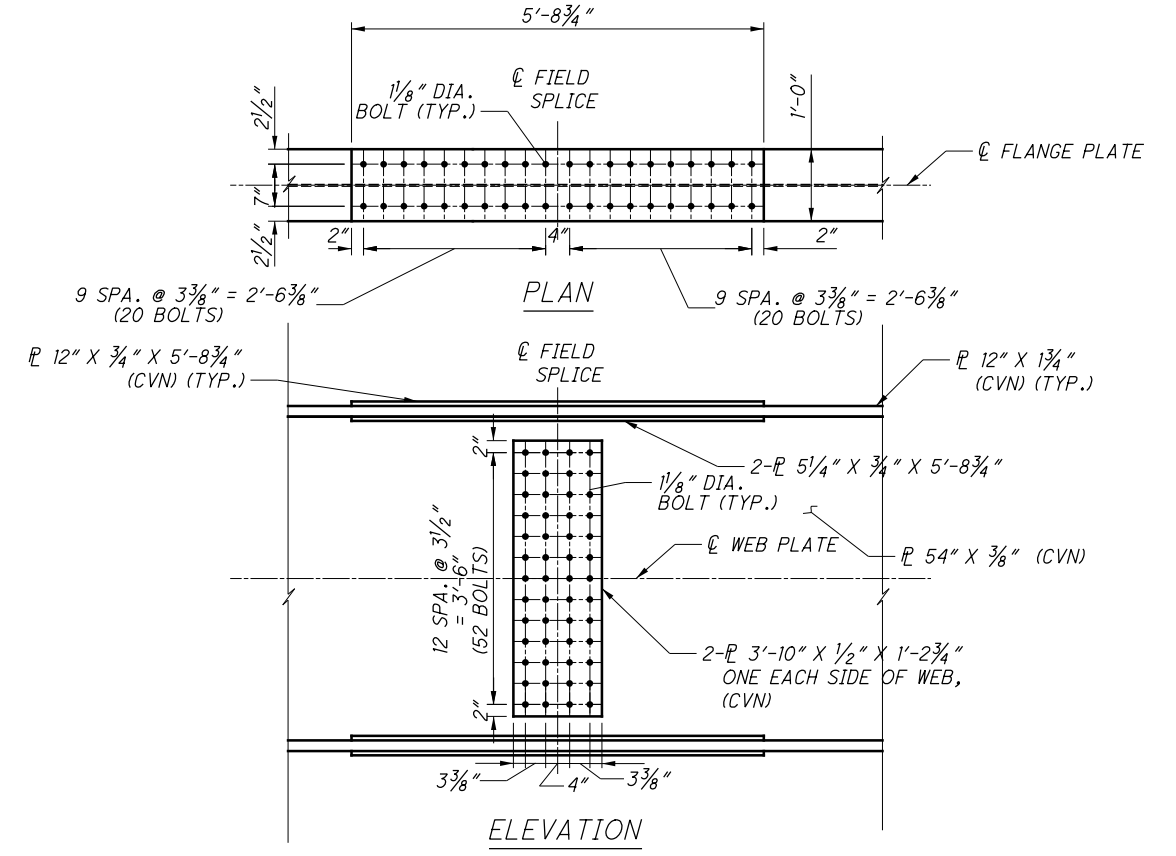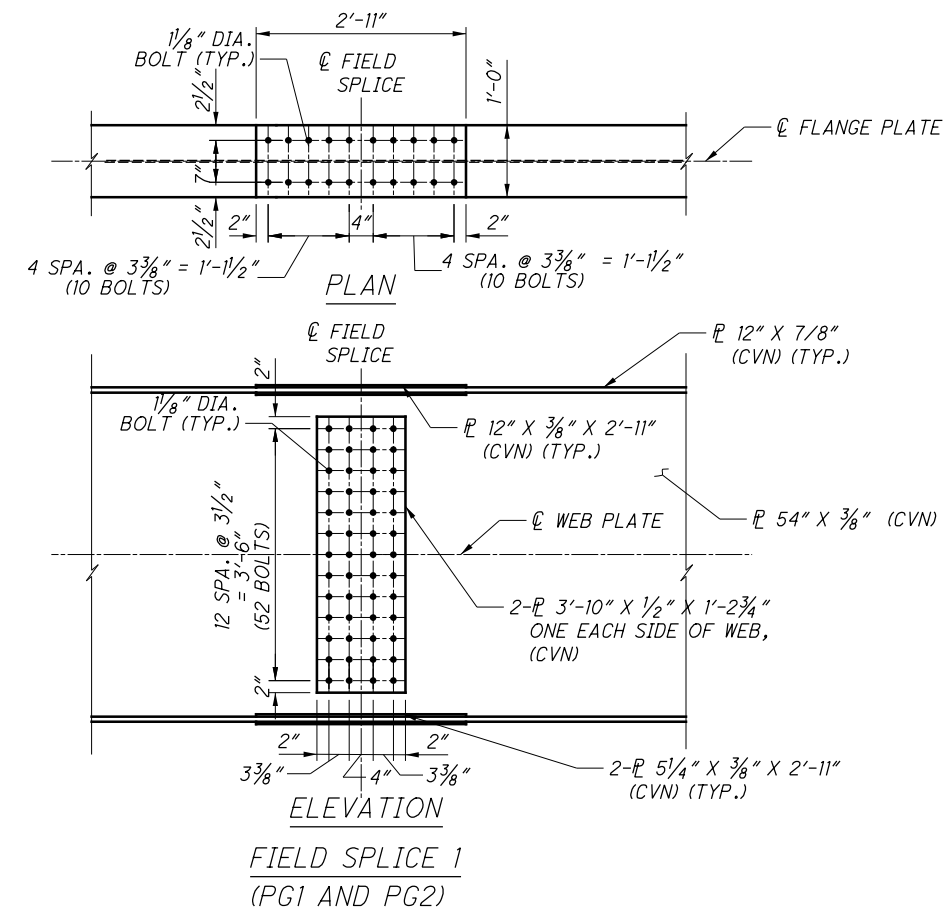

- NOTES:**
1. ALL BOLTED SPLICE FASTENERS ARE 1/8" DIAMETER, TYPE 3 HIGH STRENGTH BOLTS, ASTM - A325.
 2. CHARPY-V-NOTCH TOUGHNESS: WHERE A SHAPE OR PLATE IS DESIGNATED (CVN) THE MATERIAL SHALL MEET SPECIFIED MINIMUM NOTCH TOUGHNESS REQUIREMENTS AS SPECIFIED IN 711.01.
 3. PLACE BOLT HEAD ON EXPOSED SIDE OF FASCIA GIRDER.
 4. FOR FIELD SPLICE LOCATIONS, SEE FRAMING PLAN SHEET 14/32

RESOURCE INTERNATIONAL INC.
6350 PRESIDENTIAL GATEWAY
COLUMBUS, OHIO 43231
(614) 823-4848

Rii

DESIGNED	JLM	CHECKED	JJM
DRAWN	JJM	REVIEWED	JJM
DATE	12/01/2015	STRUCTURE FILE NUMBER	2513862
REVIEWED	NCK		


BU 4, 5, 6, 7, & 8 - RELEASED FOR CONSTRUCTION - 11/03/2014 - 11/19/2015

SUPERSTRUCTURE DETAILS
BRIDGE NO. FRA-270-4900
OVER IR 270


FRA-270-49.00
PID No. 83988

17/32


163
182

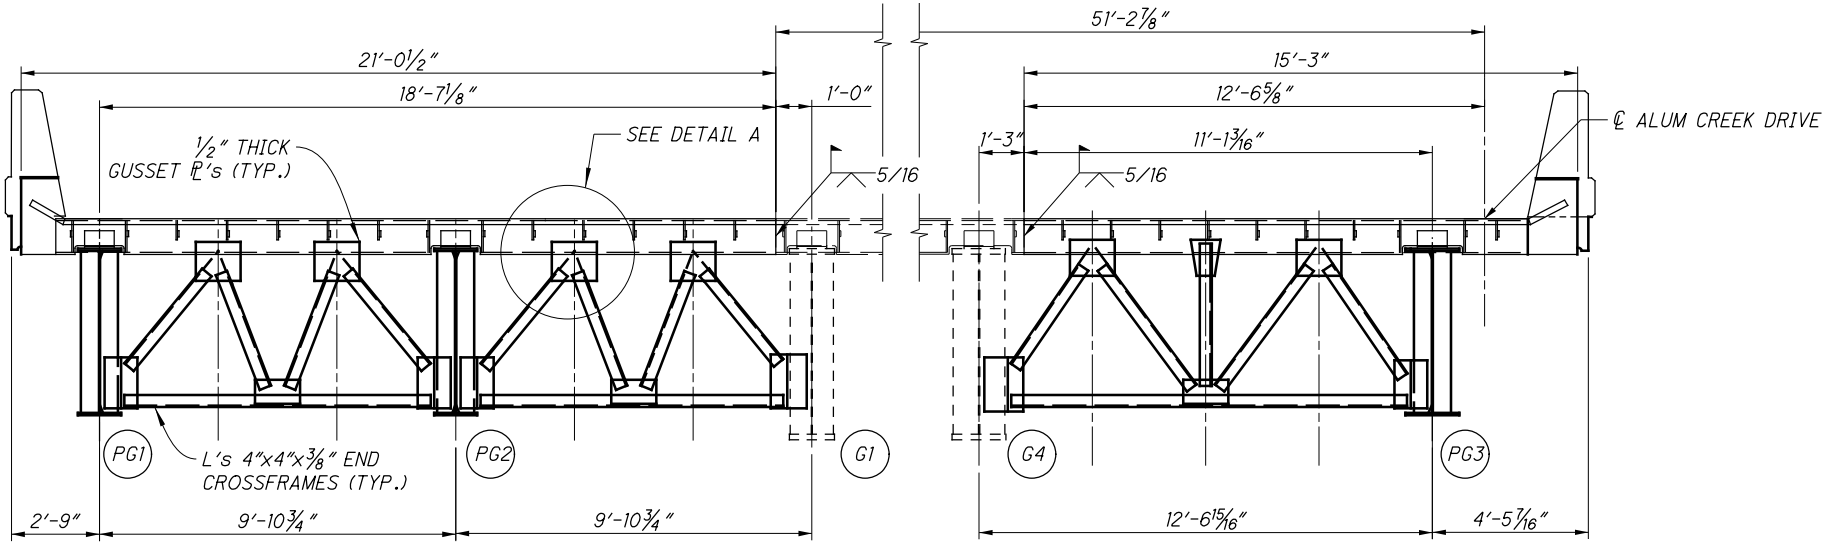

TRANSVERSE SECTION AT ABUTMENT (ALONG SKEW)

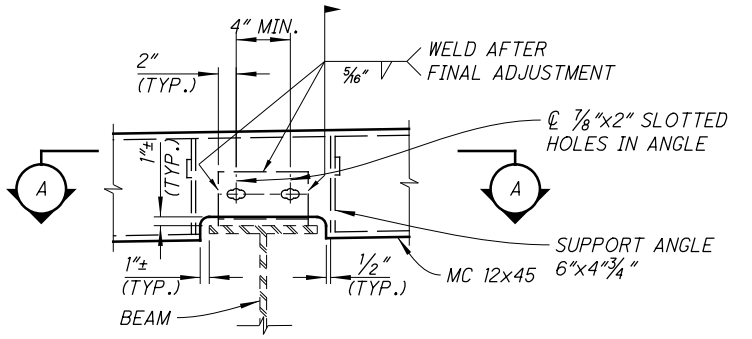


DETAIL A

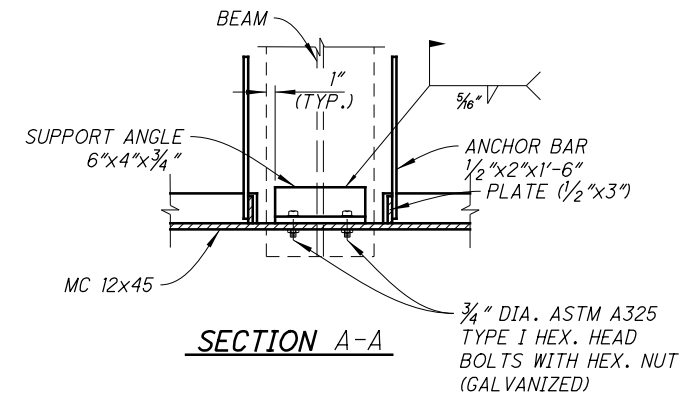


SECTION A-A

TEMPERATURE (°F)	REAR ABUTMENT DIMENSION "A" INCHES	FORWARD ABUTMENT DIMENSION "A" INCHES
30	2 1/2"	2 1/2"
40	2 5/16"	2 5/16"
50	2 3/16"	2 3/16"
60	2"	2"
70	1 13/16"	1 13/16"
80	1 5/8"	1 5/8"
90	1 1/16"	1 1/16"


NOTES:
1. SEE EXJ-4-87 FOR ADDITIONAL STRIP SEAL EXPANSION JOINT DETAILS.

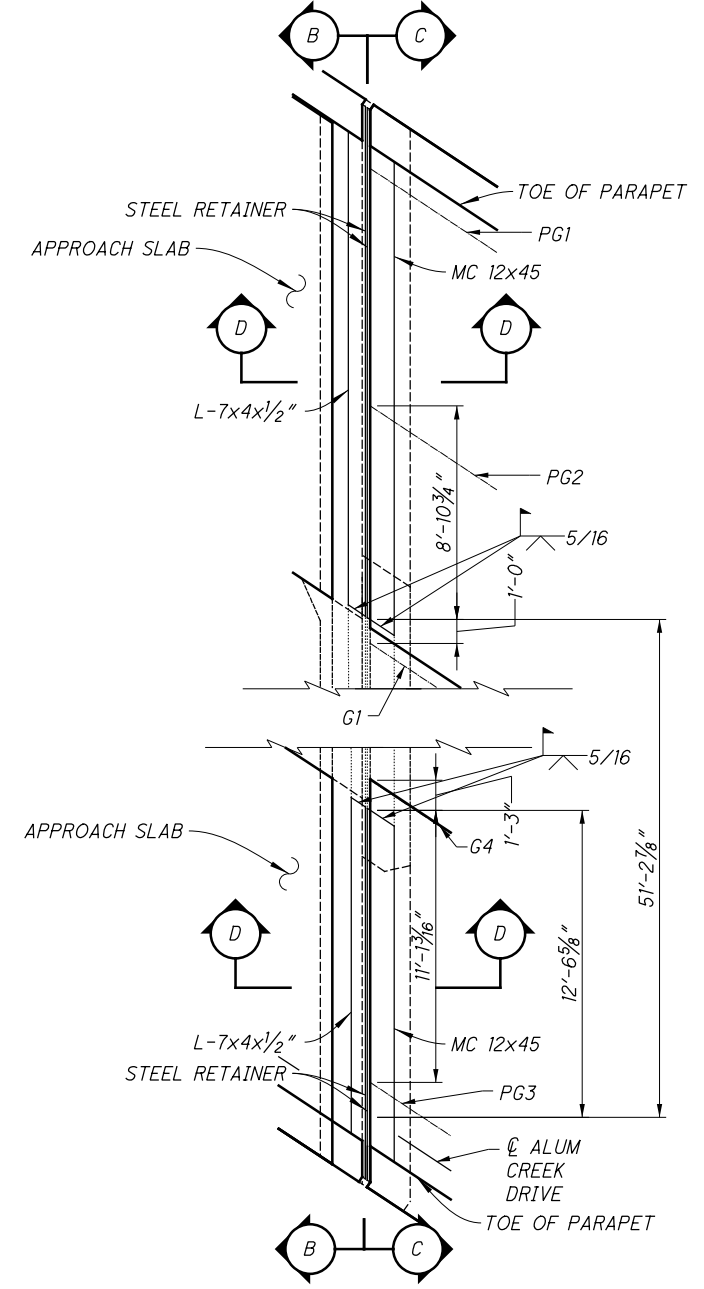


PART PLAN AT ABUTMENT

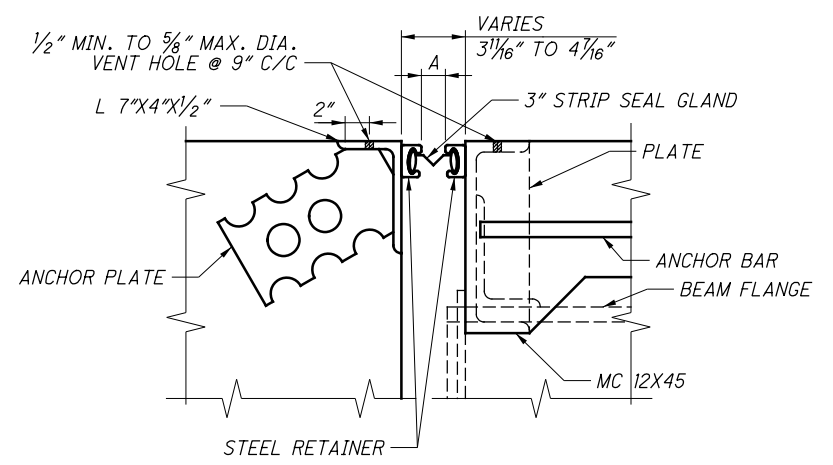

SECTION D-D

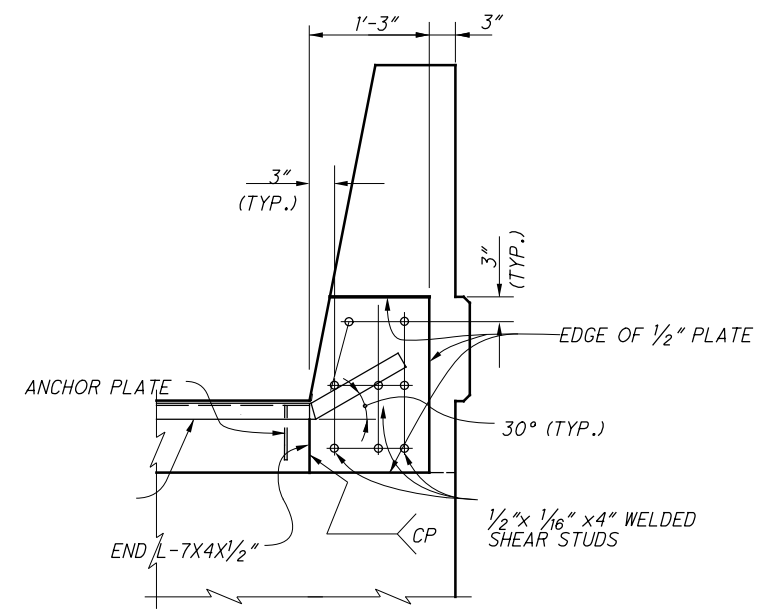

SECTION B-B

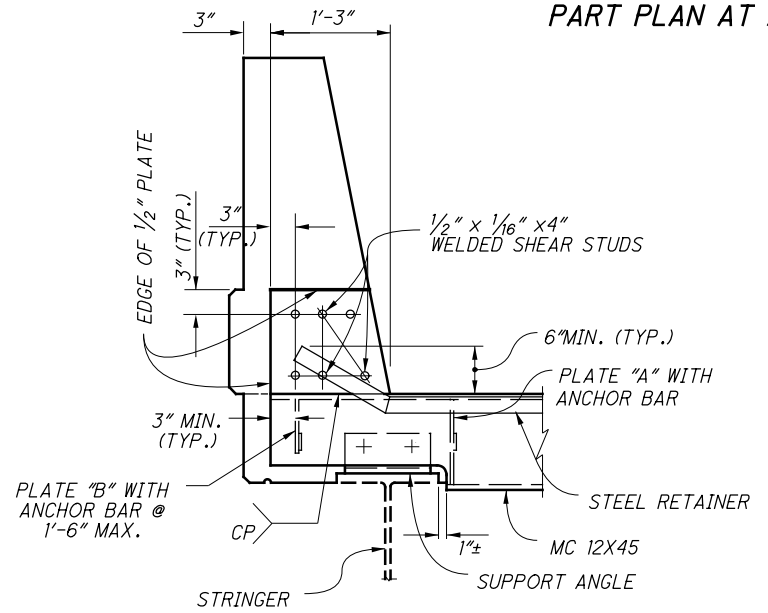

SECTION C-C

RESOURCE INTERNATIONAL INC.
 6350 PRESIDENTIAL GATEWAY
 COLUMBUS, OHIO 43231
 (614) 823-4848
Rii
 DATE: 12/01/2015
 REVISION: NCK
 DRAWN: JLM
 CHECKED: JCM
 STRUCTURE FILE NUMBER: 2513862
 DESIGNED: JLM
 OVER IR 270
EXPANSION JOINT DETAILS
 BRIDGE NO. FRA-270-4900
 FRA - 270-49.00
 PID No. 83988
 18 / 32
 164
 182

AS BUILT - 4/22/2016

5/23/2016 7:32:13 AM kevinj

G:\projects\2014\W-14-039_FRA-270-49.00\83988\structures\FRA270_4900L\sheets\270_4900L\SD014.dgn

FINAL DECK ELEVATIONS

LOCATION	SPAN 1										SPAN 2									
	BRG. R.A.		1/4 SPAN		1/2 SPAN		3/4 SPAN		BRG. PIER 1		F.S. 1		1/4 SPAN		1/2 SPAN		3/4 SPAN		BRG. PIER 2	
	STATION	ELEV.	STATION	ELEV.	STATION	ELEV.	STATION	ELEV.	STATION	ELEV.	STATION	ELEV.	STATION	ELEV.	STATION	ELEV.	STATION	ELEV.	STATION	ELEV.
TOE OF PARAPET	154+74.53	751.75	154+90.47	751.75	155+06.41	751.76	155+22.34	751.70	155+38.28	751.68	155+56.53	751.59	155+62.78	751.55	155+87.28	751.46	156+11.78	751.38	156+36.28	751.32
PG1	154+75.06	751.76	154+90.99	751.76	155+06.93	751.77	155+22.87	751.71	155+38.81	751.69	155+57.06	751.60	155+63.31	751.56	155+87.81	751.47	156+12.31	751.40	156+36.81	751.34
PG2	154+80.52	751.89	154+96.46	751.90	155+12.40	751.88	155+28.34	751.84	155+44.27	751.79	155+62.52	751.70	155+68.77	751.66	155+93.27	751.57	156+17.77	751.51	156+42.27	751.45
C.J.	154+85.63	752.01	155+01.57	752.02	155+17.51	751.99	155+33.45	751.98	155+49.38	751.88	155+67.63	751.79	155+73.88	751.75	155+98.38	751.67	156+22.88	751.61	156+47.38	751.56
C.J. & G4	155+05.88	751.97	155+21.81	751.94	155+37.75	751.91	155+53.69	751.87	155+69.63	751.82	155+87.88	751.75	155+94.13	751.73	156+18.63	751.63	156+43.13	751.53	156+67.63	751.48
PG3	155+12.84	751.79	155+28.77	751.76	155+44.71	751.71	155+60.65	751.70	155+76.59	751.62	155+94.84	751.56	156+01.09	751.54	156+25.59	751.44	156+50.09	751.34	156+74.59	751.26
C/L ALUM CREEK DR.	155+13.64	751.77	155+29.57	751.74	155+45.51	751.69	155+61.45	751.67	155+77.39	751.60	155+95.64	751.54	156+01.89	751.51	156+26.39	751.42	156+50.89	751.32	156+75.39	751.23
TOE OF PARAPET	155+14.30	751.75	155+30.24	751.73	155+46.18	751.67	155+62.11	751.65	155+78.05	751.58	155+96.30	751.52	156+02.55	751.49	156+27.05	751.40	156+51.55	751.31	156+76.05	751.21

LOCATION	SPAN 3										SPAN 4									
	F.S. 2		1/4 SPAN		1/2 SPAN		3/4 SPAN		F.S. 3		BRG. PIER 3		1/4 SPAN		1/2 SPAN		3/4 SPAN		BRG. F.A.	
	STATION	ELEV.	STATION	ELEV.	STATION	ELEV.	STATION	ELEV.	STATION	ELEV.	STATION	ELEV.	STATION	ELEV.	STATION	ELEV.	STATION	ELEV.	STATION	ELEV.
TOE OF PARAPET	156+61.28	751.25	156+68.34	751.23	157+00.40	751.09	157+32.46	750.92	157+39.02	750.89	157+64.52	750.82	157+85.40	750.74	158+06.27	750.68	158+27.15	750.63	158+48.02	750.57
PG1	156+61.81	751.26	156+68.87	751.25	157+00.93	751.10	157+32.99	750.93	157+39.55	750.90	157+65.05	750.83	157+85.92	750.75	158+06.80	750.69	158+27.67	750.64	158+48.55	750.58
PG2	156+66.77	751.38	156+74.33	751.37	157+06.39	751.21	157+38.45	751.04	157+47.51	751.01	157+70.51	750.95	157+91.39	750.87	158+12.26	750.81	158+33.14	750.76	158+54.01	750.69
C.J.	156+71.88	751.50	156+79.44	751.47	157+11.50	751.30	157+43.56	751.14	157+52.62	751.11	157+75.62	751.06	157+96.50	750.97	158+17.37	750.92	158+38.25	750.87	158+59.12	750.80
C.J. & G4	156+92.13	751.37	156+99.69	751.31	157+31.75	751.20	157+63.81	751.10	157+72.87	751.02	157+95.87	750.99	158+16.74	750.91	158+37.62	750.85	158+58.49	750.78	158+79.37	750.69
PG3	156+97.59	751.16	157+06.65	751.14	157+38.71	751.00	157+70.77	750.87	157+78.83	750.83	158+02.83	750.79	158+23.70	750.72	158+44.58	750.66	158+65.45	750.59	158+86.33	750.51
C/L ALUM CREEK DR.	156+98.39	751.13	157+07.45	751.12	157+39.51	750.98	157+71.57	750.84	157+79.63	750.82	158+03.63	750.77	158+24.50	750.69	158+45.38	750.63	158+66.25	750.57	158+87.13	750.49
TOE OF PARAPET	156+99.05	751.11	157+08.11	751.10	157+40.17	750.96	157+72.23	750.82	157+80.29	750.80	158+04.29	750.75	158+25.17	750.68	158+46.04	750.61	158+66.92	750.55	158+87.79	750.47

FINAL DECK SURFACE ELEVATIONS


FINAL DECK SURFACE ELEVATIONS SHOWN REPRESENT THE DECK SURFACE LOCATION AFTER ALL ANTICIPATED DEAD LOAD DEFLECTIONS HAVE OCCURRED.

CAMBER TABLE

	SPAN 1				BRG. PIER 1	SPAN 2				BRG. PIER 2	SPAN 3					BRG. PIER 3	SPAN 4			
	BRG. R.A.	1/4 SPAN	1/2 SPAN	3/4 SPAN		F.S. 1	1/4 SPAN	1/2 SPAN	3/4 SPAN		F.S. 2	1/4 SPAN	1/2 SPAN	3/4 SPAN	F.S. 3		1/4 SPAN	1/2 SPAN	3/4 SPAN	BRG. F.A.
PG1																				
DEFLECTION DUE TO WEIGHT OF STEEL	0	1/16	1/16	0	0	0	1/16	0	- 1/16	0	3/16	5/16	7/16	5/16	3/16	0	- 1/16	0	1/16	0
DEFLECTION DUE TO REMAINING DEAD LOAD	0	1/8	3/16	1/16	0	1/8	3/16	1/4	1/16	0	7/16	5/8	1	5/8	7/16	0	0	1/4	1/4	0
ADJUSTMENT REQUIRED FOR VERTICAL CURVE	0	0	0	0	0	0	0	0	0	0	0	0	0	0	0	0	0	0	0	0
REQUIRED SHOP CAMBER (IN)=	0	3/16	3/16	1/16	0	1/8	3/16	1/4	0	0	5/8	7/8	1 1/2	7/8	5/8	0	0	1/4	1/4	0
PG2																				
DEFLECTION DUE TO WEIGHT OF STEEL	0	1/16	1/16	0	0	0	1/16	0	- 1/16	0	3/16	5/16	7/16	5/16	3/16	0	- 1/16	0	1/16	0
DEFLECTION DUE TO REMAINING DEAD LOAD	0	3/16	3/16	1/16	0	1/8	1/4	5/16	1/16	0	9/16	3/4	1 1/4	3/4	1/2	0	1/16	1/4	5/16	0
ADJUSTMENT REQUIRED FOR VERTICAL CURVE	0	0	0	0	0	0	0	0	0	0	0	0	0	0	0	0	0	0	0	0
REQUIRED SHOP CAMBER (IN)=	0	3/16	1/4	1/8	0	3/16	1/4	5/16	0	0	3/4	1 1/16	1 11/16	1	3/4	0	0	1/4	5/16	0
PG3																				
DEFLECTION DUE TO WEIGHT OF STEEL	0	1/16	1/16	0	0	0	0	0	- 1/16	0	3/16	5/16	7/16	5/16	3/16	0	- 1/16	0	0	0
DEFLECTION DUE TO REMAINING DEAD LOAD	0	3/16	3/16	1/16	0	1/8	3/16	5/16	1/16	0	1/2	3/4	1 3/16	3/4	1/2	0	1/16	1/4	5/16	0
ADJUSTMENT REQUIRED FOR VERTICAL CURVE	0	0	0	0	0	0	0	0	0	0	0	0	0	0	0	0	0	0	0	0
REQUIRED SHOP CAMBER (IN)=	0	3/16	1/4	1/16	0	3/16	1/4	5/16	0	0	3/4	1	1 5/8	1	3/4	0	0	1/4	5/16	0

VERTICAL OFFSETS

	BRG. R.A.	BRG. PIER 1	BRG. PIER 2	BRG. PIER 3	BRG. F.A.
PG1	0	0	0	0	0
PG1	0	0	0	0	0
PG1	0	0	0	0	0

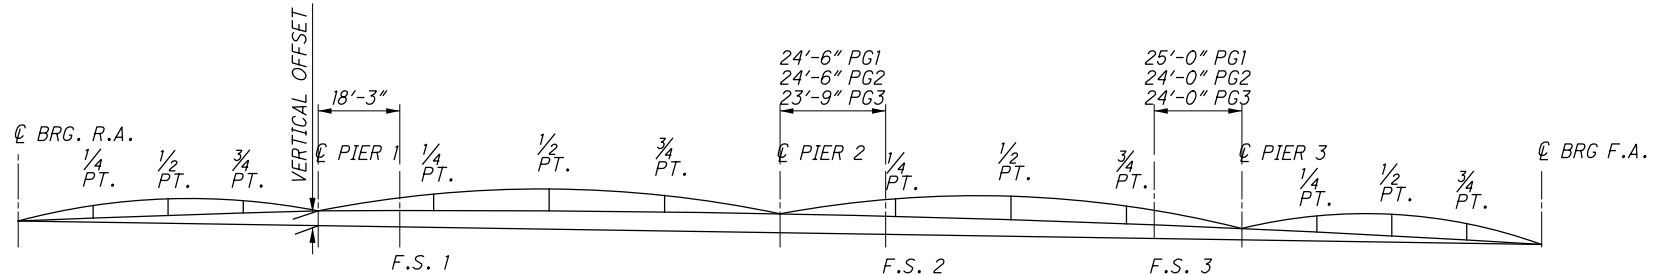

RESOURCE INTERNATIONAL INC.
6350 PRESIDENTIAL GATEWAY
COLUMBUS, OHIO 43231
(614) 823-8649



DATE
12/01/2015
REVIEWED
NCK
STRUCTURE FILE NUMBER
2513862

DRAWN
JCM
DESIGNED
JCM
CHECKED
JLM

BU 4, 5, 6, 7, & 8 - RELEASED FOR CONSTRUCTION - 11/03/2014 - 11/19/2015

SUPERSTRUCTURE DETAILS
BRIDGE NO. FRA-270-4900
OVER IR 270

FRA - 270-49.00
PID No. 83988

SCREED ELEVATIONS


LOCATION	SPAN 1										SPAN 2									
	BRG. R.A.		1/4 SPAN		1/2 SPAN		3/4 SPAN		BRG. PIER 1		F.S. 1		1/4 SPAN		1/2 SPAN		3/4 SPAN		BRG. PIER 2	
	STATION	ELEV.	STATION	ELEV.	STATION	ELEV.	STATION	ELEV.	STATION	ELEV.	STATION	ELEV.	STATION	ELEV.	STATION	ELEV.	STATION	ELEV.	STATION	ELEV.
TOE OF PARAPET	154+74.53	751.75	154+90.47	751.76	155+06.41	751.77	155+22.34	751.71	155+38.28	751.68	155+56.53	751.60	155+62.78	751.57	155+87.28	751.48	156+11.78	751.39	156+36.28	751.32
C.J.	154+85.63	752.01	155+01.57	752.04	155+17.51	752.00	155+33.45	751.71	155+49.38	751.88	155+67.63	751.80	155+73.88	751.77	155+98.38	751.69	156+22.88	751.61	156+47.38	751.56
C.J.	155+05.88	751.97	155+21.81	751.95	155+37.75	751.93	155+53.69	751.88	155+69.63	751.82	155+87.88	751.76	155+94.13	751.75	156+18.63	751.65	156+43.13	751.54	156+67.63	751.48
TOE OF PARAPET	155+14.30	751.75	155+30.24	751.74	155+46.18	751.69	155+62.11	751.66	155+78.05	751.58	155+96.30	751.53	156+02.55	751.51	156+27.05	751.42	156+51.55	751.31	156+76.05	751.21

LOCATION	SPAN 3										SPAN 4									
	F.S. 2		1/4 SPAN		1/2 SPAN		3/4 SPAN		F.S. 3		BRG. PIER 3		1/4 SPAN		1/2 SPAN		3/4 SPAN		BRG. F.A.	
	STATION	ELEV.	STATION	ELEV.	STATION	ELEV.	STATION	ELEV.	STATION	ELEV.	STATION	ELEV.	STATION	ELEV.	STATION	ELEV.	STATION	ELEV.	STATION	ELEV.
TOE OF PARAPET	156+61.28	751.29	156+68.34	751.29	157+00.40	751.18	157+32.46	750.97	157+39.02	750.92	157+64.52	750.82	157+85.40	750.74	158+06.27	750.70	158+27.15	750.65	158+48.02	750.57
C.J.	156+71.88	751.54	156+79.44	751.54	157+11.50	751.41	157+43.56	751.20	157+52.62	751.16	157+75.62	751.06	157+96.50	750.98	158+17.37	750.94	158+38.25	750.89	158+59.12	750.80
C.J.	156+92.13	751.41	156+99.69	751.37	157+31.75	751.30	157+63.81	751.16	157+72.87	751.06	157+95.87	750.99	158+16.74	750.92	158+37.62	750.88	158+58.49	750.80	158+79.37	750.69
TOE OF PARAPET	156+99.05	751.16	157+08.11	751.16	157+40.17	751.06	157+72.23	750.88	157+80.29	750.84	158+04.29	750.75	158+25.17	750.68	158+46.04	750.64	158+66.92	750.58	158+87.79	750.47


TOP OF HAUNCH ELEVATIONS

LOCATION	SPAN 1										SPAN 2									
	BRG. R.A.		1/4 SPAN		1/2 SPAN		3/4 SPAN		BRG. PIER 1		F.S. 1		1/4 SPAN		1/2 SPAN		3/4 SPAN		BRG. PIER 2	
	STATION	ELEV.	STATION	ELEV.	STATION	ELEV.	STATION	ELEV.	STATION	ELEV.	STATION	ELEV.	STATION	ELEV.	STATION	ELEV.	STATION	ELEV.	STATION	ELEV.
PG1	154+75.06	751.01	154+90.99	751.02	155+06.93	751.04	155+22.87	750.97	155+38.81	750.94	155+57.06	750.86	155+63.31	750.82	155+87.81	750.74	156+12.31	750.65	156+36.81	750.59
PG2	154+80.52	751.14	154+96.46	751.16	155+12.40	751.15	155+28.34	751.10	155+44.27	751.04	155+62.52	750.96	155+68.77	750.92	155+93.27	750.85	156+17.77	750.76	156+42.27	750.70
PG3	155+12.84	751.04	155+28.77	751.03	155+44.71	750.98	155+60.65	750.95	155+76.59	750.87	155+94.84	750.82	156+01.09	750.80	156+25.59	750.71	156+50.09	750.60	156+74.59	750.51

LOCATION	SPAN 3										SPAN 4									
	F.S. 2		1/4 SPAN		1/2 SPAN		3/4 SPAN		F.S. 3		BRG. PIER 3		1/4 SPAN		1/2 SPAN		3/4 SPAN		BRG. F.A.	
	STATION	ELEV.	STATION	ELEV.	STATION	ELEV.	STATION	ELEV.	STATION	ELEV.	STATION	ELEV.	STATION	ELEV.	STATION	ELEV.	STATION	ELEV.	STATION	ELEV.
PG1	156+61.81	750.55	156+68.87	750.55	157+00.93	750.44	157+32.99	750.23	157+39.55	750.19	157+65.05	750.08	157+85.92	750.00	158+06.80	749.96	158+27.67	749.91	158+48.55	749.83
PG2	156+66.77	750.68	156+74.33	750.68	157+06.39	750.56	157+38.45	750.35	157+47.51	750.30	157+70.51	750.20	157+91.39	750.12	158+12.26	750.08	158+33.14	750.03	158+54.01	749.94
PG3	156+97.59	750.45	157+06.65	750.45	157+38.71	750.35	157+70.77	750.18	157+78.83	750.13	158+02.83	750.04	158+23.70	749.97	158+44.58	749.93	158+65.45	749.87	158+86.33	749.76

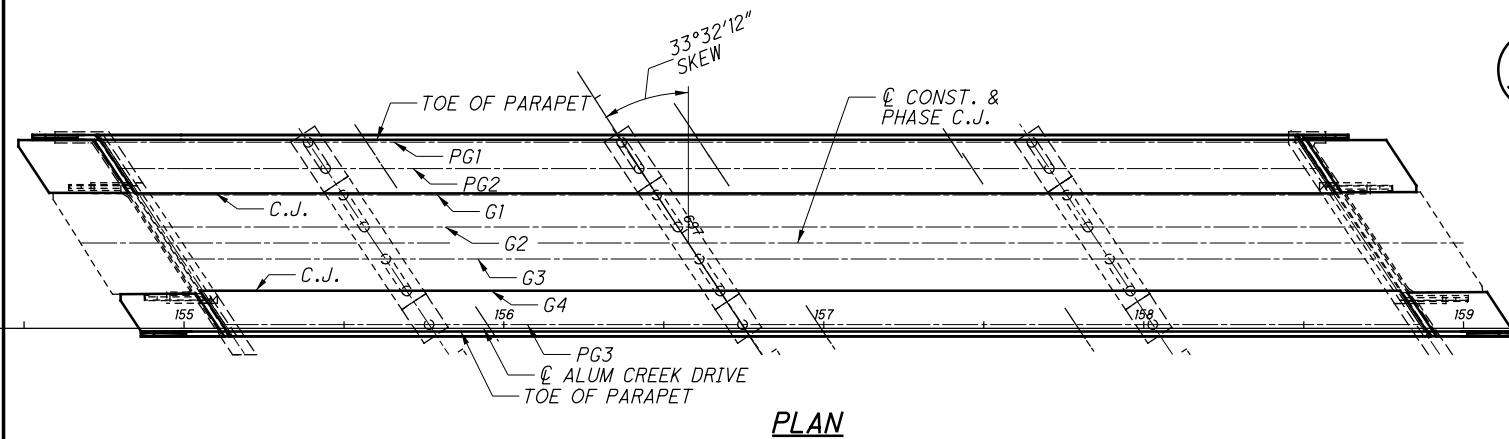

PLAN

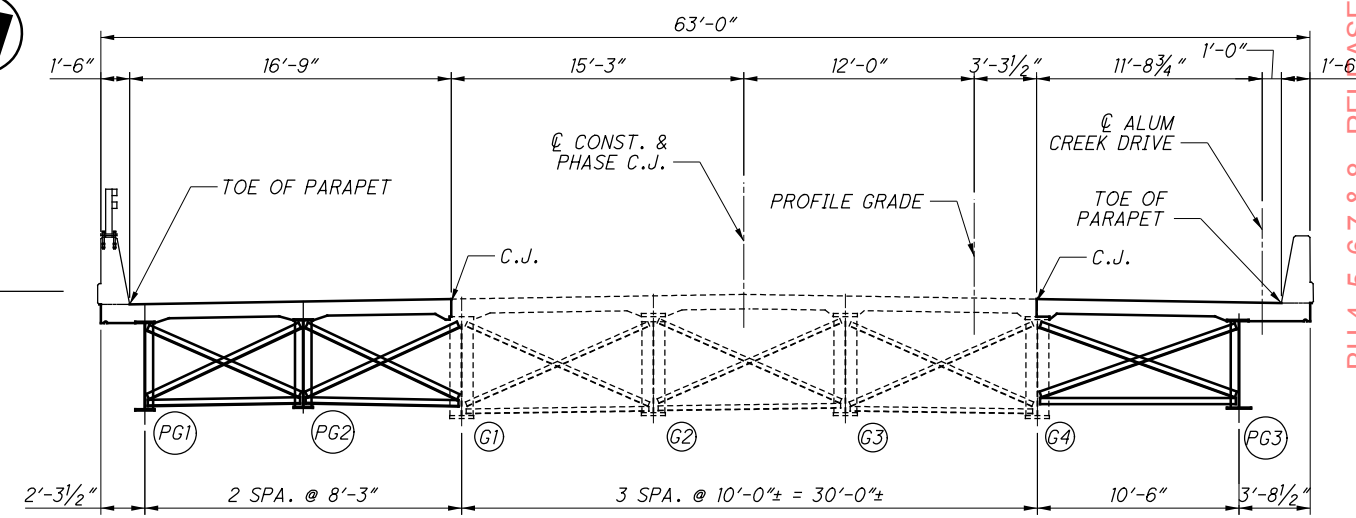

TRANSVERSE SECTION

SCREED ELEVATION

SCREED ELEVATIONS SHOWN REPRESENT THE THEORETICAL DECK SURFACE LOCATION PRIOR TO DEFLECTIONS CAUSED BY DECK PLACEMENT AND OTHER ANTICIPATED DEAD LOADS.

TOP OF HAUNCH ELEVATIONS

TOP OF HAUNCH ELEVATIONS SHOWN REPRESENT THE THEORETICAL LOCATION OF THE BOTTOM OF THE DECK ABOVE THE BEAM/GIRDER HAUNCH PRIOR TO DEFLECTIONS CAUSED BY DECK PLACEMENT AND OTHER ANTICIPATED DEAD LOADS.


G:\projects\2014\W-14-039_FRA-270-49\83988\structures\FRA270_4900L\sheets\270_4900L\SD013.dgn 5/23/2016 7:32:14 AM kevinj

AS BUILT - 4/22/2016


RESOURCE INTERNATIONAL INC.
 6350 PRESIDENTIAL GATEWAY
 COLUMBUS, OHIO 43231
 (614) 823-4849

 DATE: 12/01/2015
 NCK: 2513862
 STRUCTURE FILE NUMBER: 2513862
 DESIGNED: JLM
 CHECKED: JGM
 DRAWN: JGM
 REVISED:
 SUPERSTRUCTURE DETAILS
 BRIDGE NO. FRA-270-4900
 OVER IR 270
 FRA-270-49.00
 PID No. 83988
 20/32



BU 4.5, 6.7 & 8 - RELEASED FOR CONSTRUCTION - 11/03/2014 - 11/19/2015

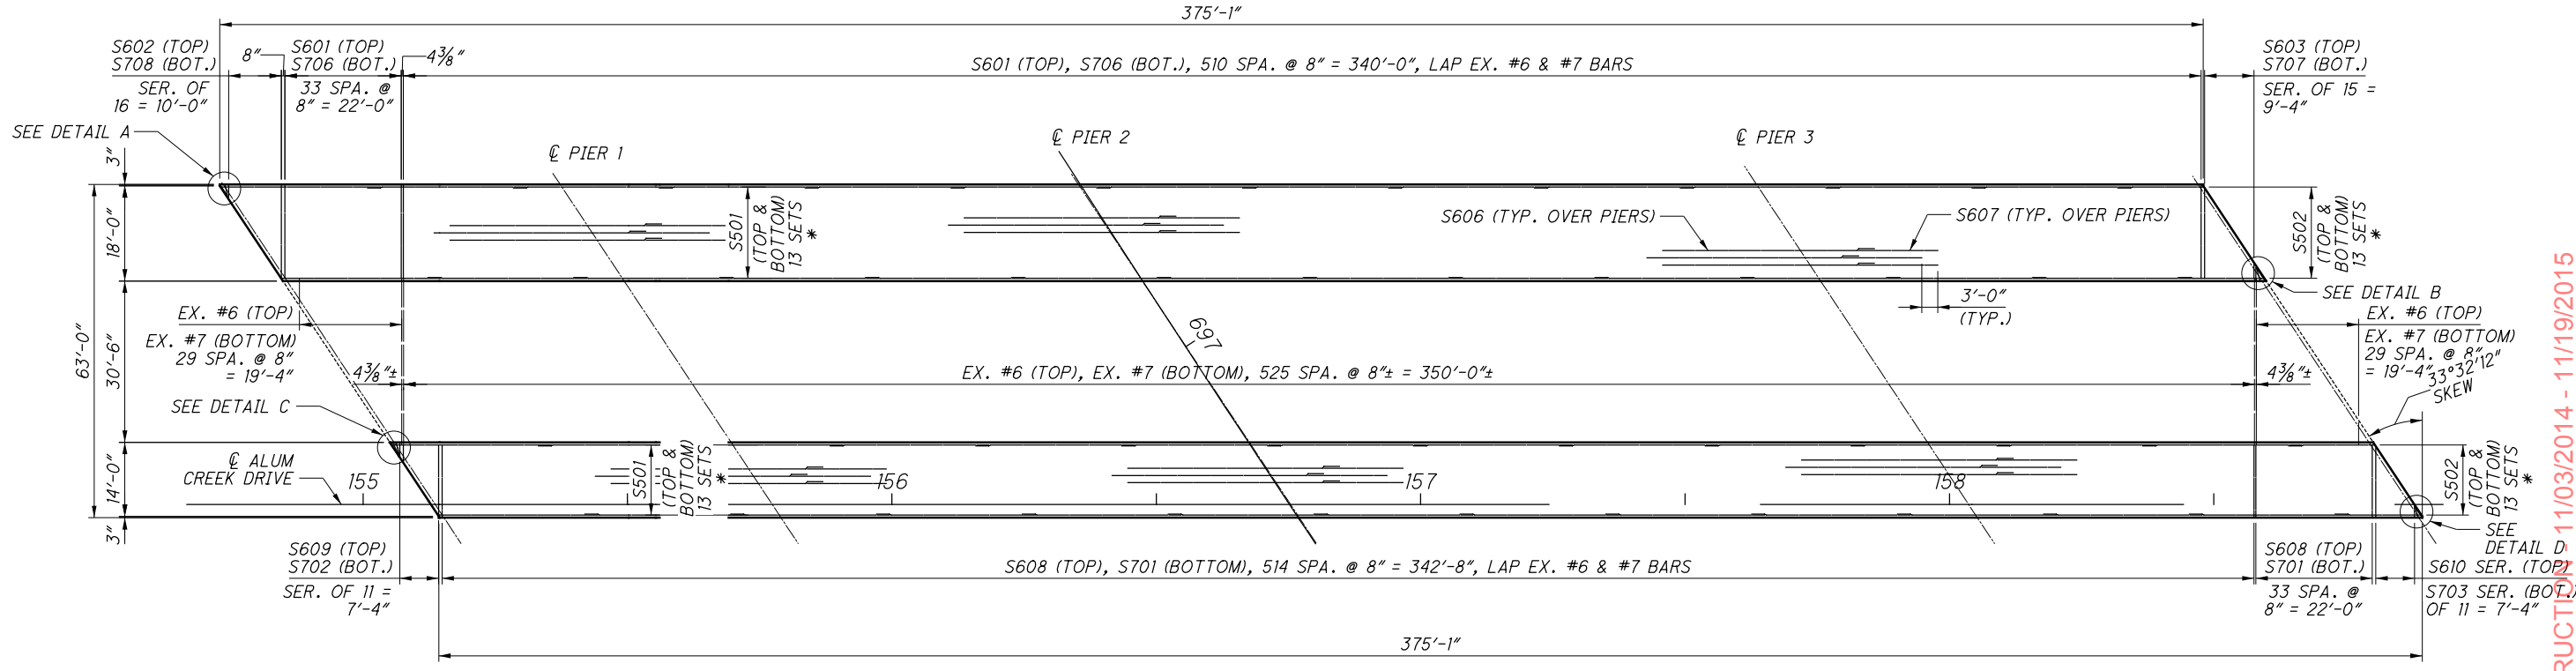


DECK PLAN

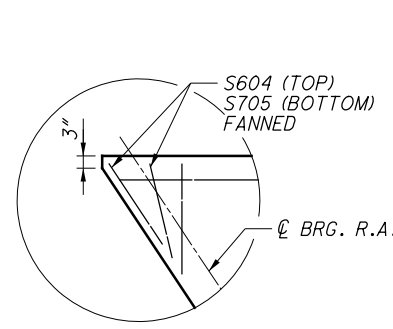


DETAIL A

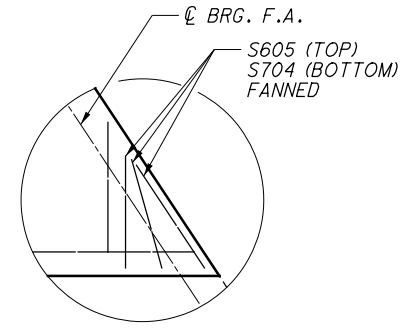

DETAIL B

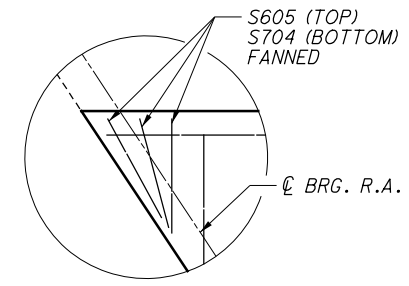

DETAIL C

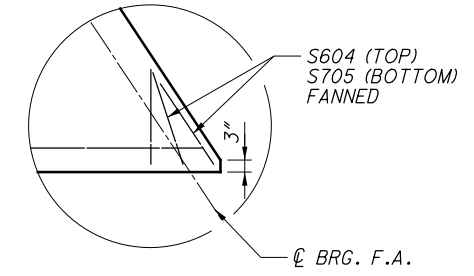

DETAIL D

LEGEND:

* - SEE SHEET 22/32 FOR SPACING

NOTES:

LAP NO. 5 BAR - 2'-5" MIN.



DESIGNED	JGM	CHECKED	JLM
DRAWN	JGM	REVISED	
REVIEWED	NCK	DATE	12/01/2015
STRUCTURE FILE NUMBER	2513862		

DECK SLAB DETAILS
BRIDGE NO. FRA-270-4900
OVER IR 270

BU 4, 5, 6, 7, & 8 - RELEASED FOR CONSTRUCTION 11/03/2014 - 11/19/2015







FRA - 270-49.00
PID No. 83988

21/32

AS BUILT - 4/22/2016

5/23/2016 7:32:16 AM kevinj

G:\projects\2014\W-14-039 FRA-270-49.00\83988\structures\FRA270_4900L\sheets\270_4900L\TS001.dgn

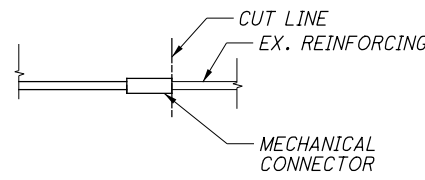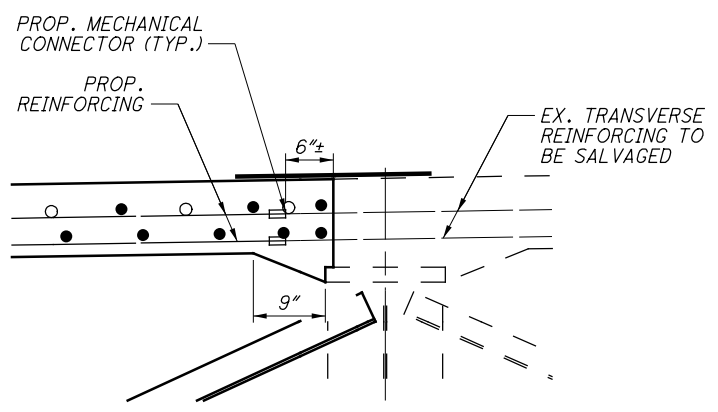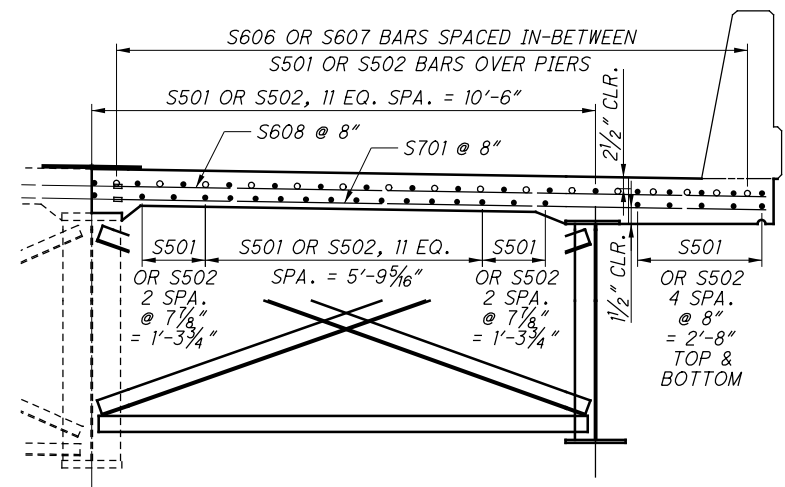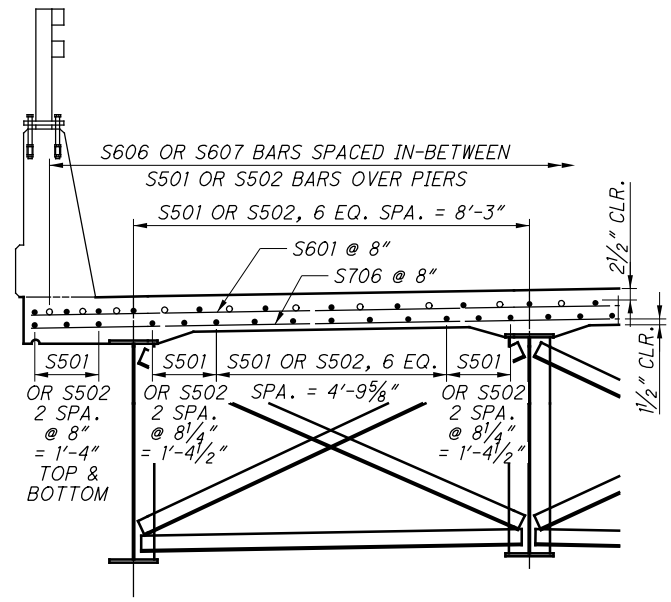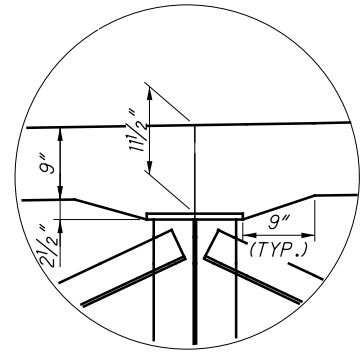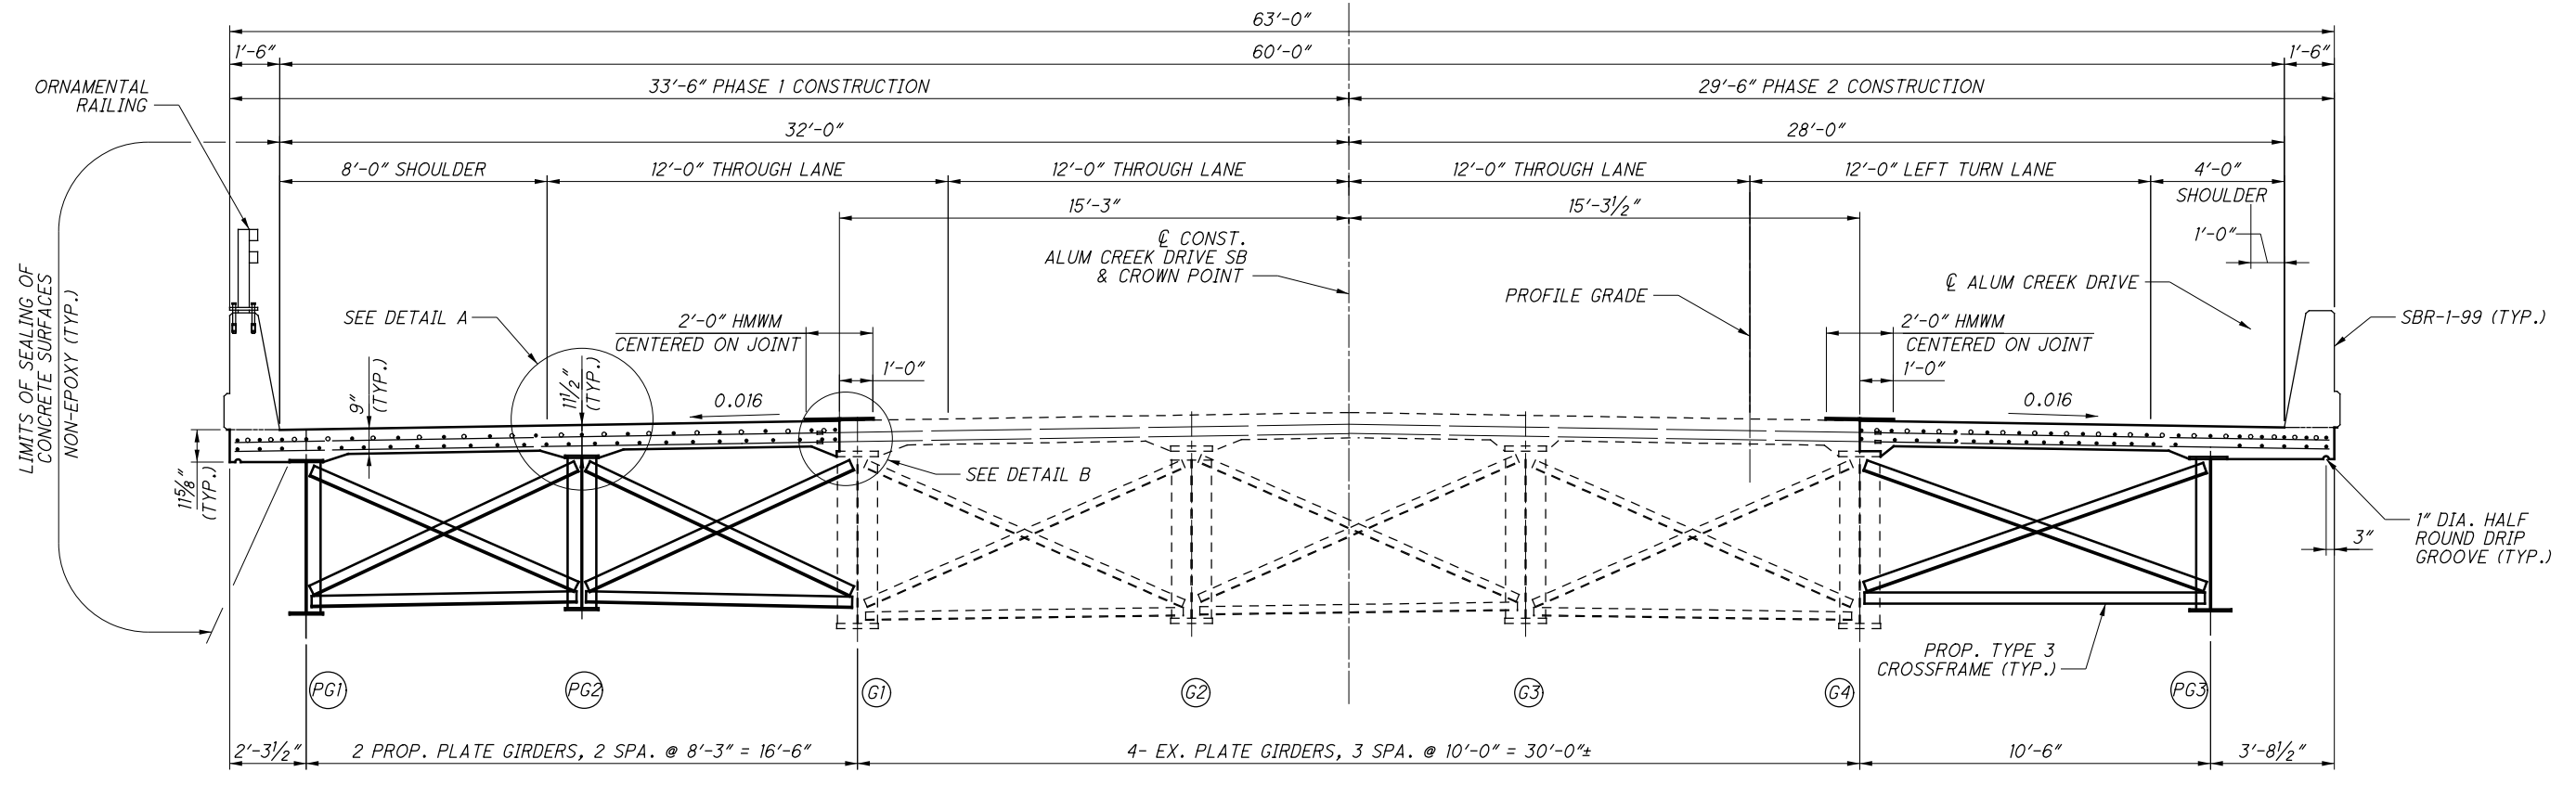

NOTES:
 LAP NO. 5 BAR 2'-5" MIN.
 LAP NO. 6 BAR 2'-11" MIN.
 LAP NO. 7 BAR 3'-8" MIN.

RESOURCE INTERNATIONAL INC.
 6350 PRESIDENTIAL GATEWAY
 COLUMBUS, OHIO 43231
 (614) 823-4848

Rii

REVIEWED DATE 12/01/2015
 DRAWN JGM
 CHECKED JLM
 DESIGNED JGM
 STRUCTURE FILE NUMBER 2513862


BU 4, 5, 6, 7, & 8 - RELEASED FOR CONSTRUCTION - 11/03/2014 - 11/19/2015

TRANSVERSE SECTION
 BRIDGE NO. FRA-270-4900
 OVER IR 270


FRA - 270-49.00
 PID No. 83988

22 / 32


168
 182

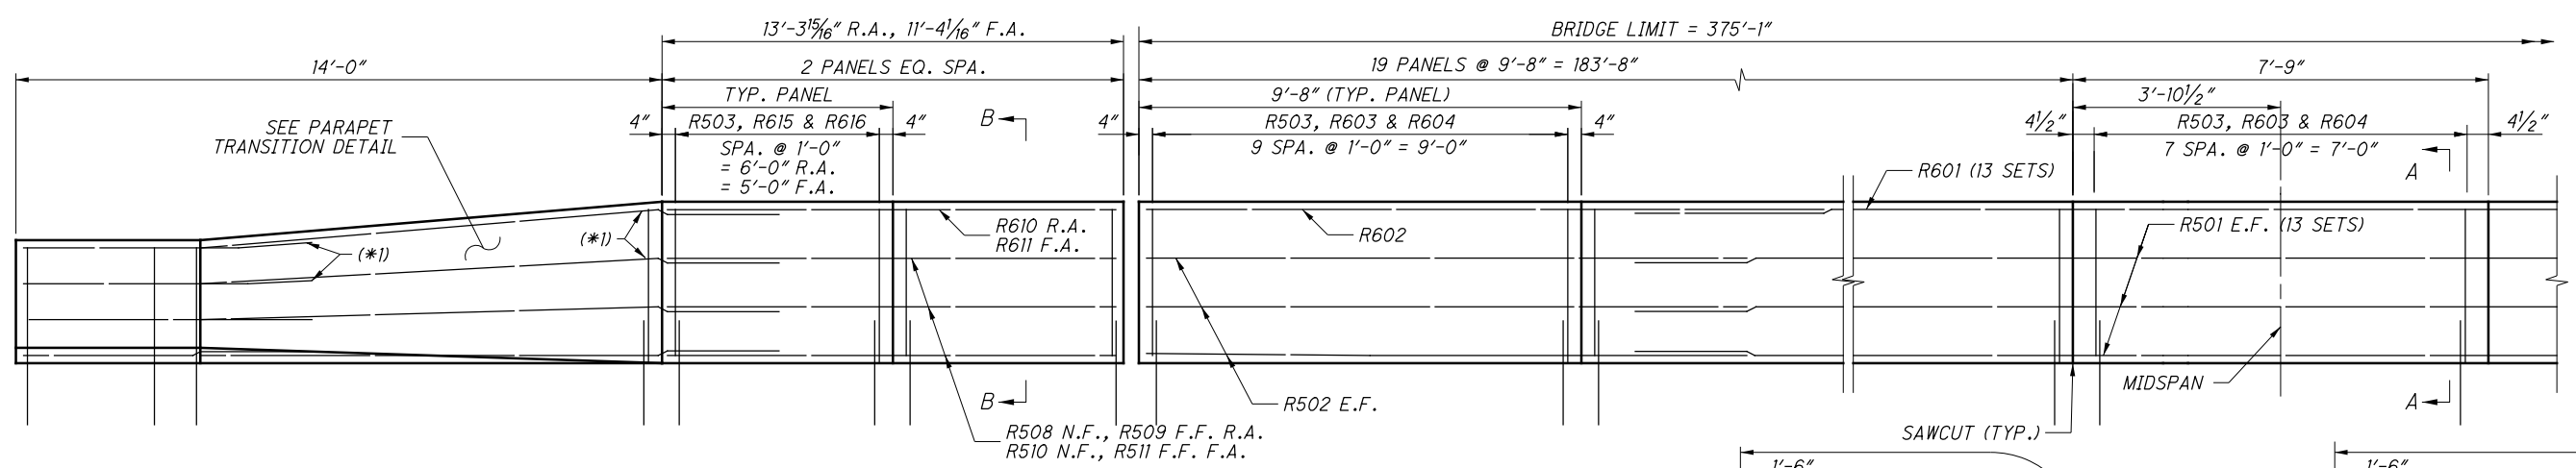


HALF PARAPET REINFORCING DETAIL
(SYMMETRICAL ABOUT MIDSPAN)

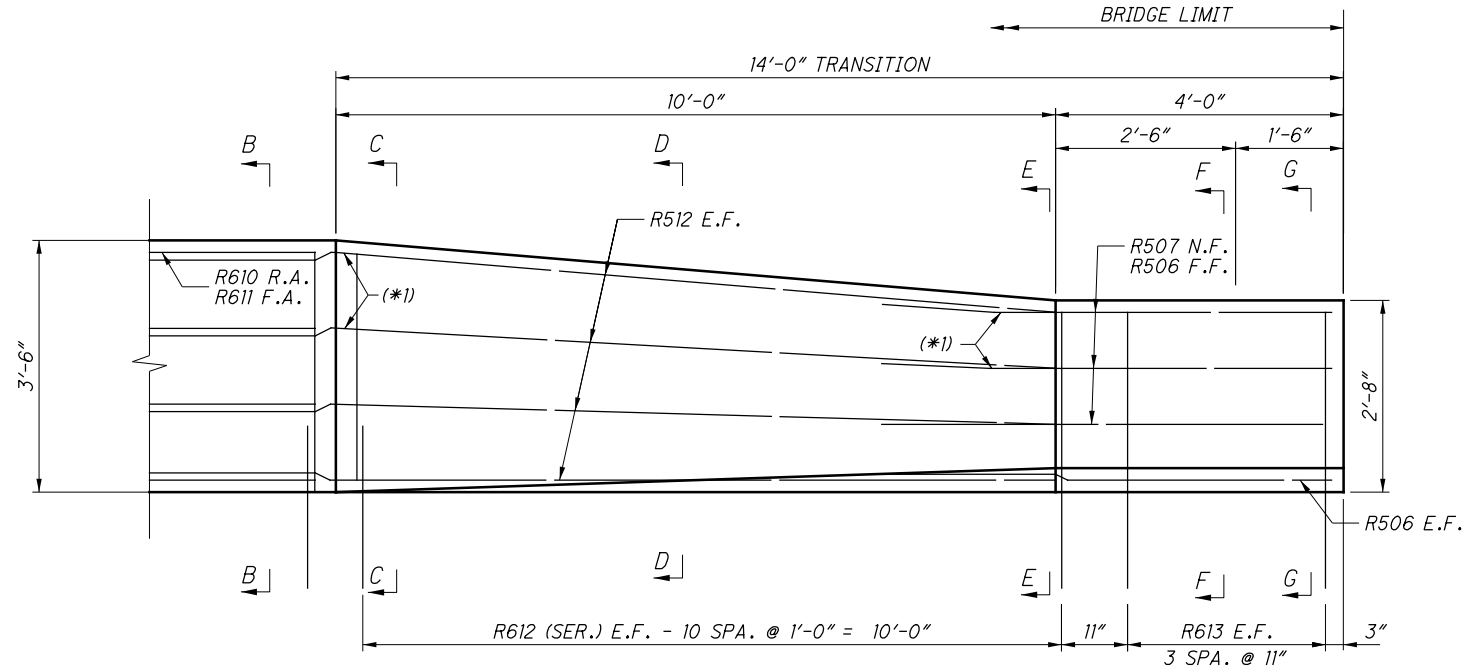

PARAPET TRANSITION DETAIL

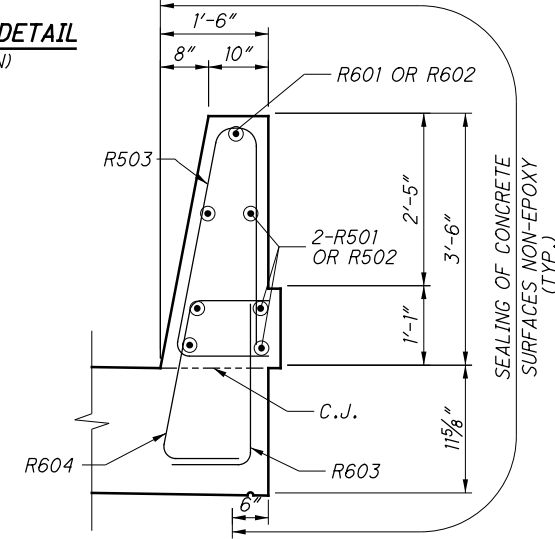


SECTION A-A

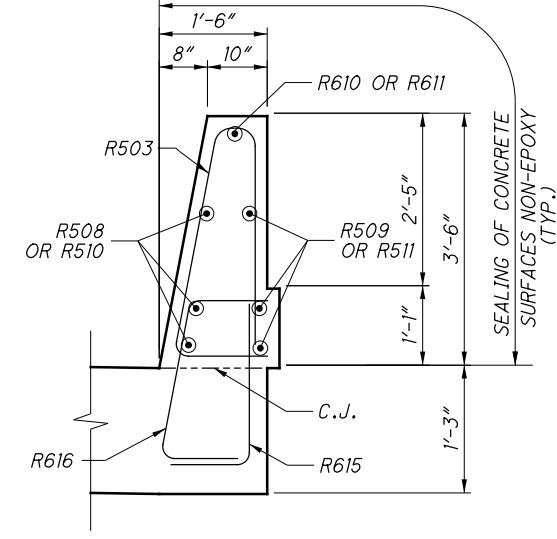


SECTION B-B

LEGEND:
(*1) FIELD BEND AS NECESSARY


- NOTES:**
- FOR NOTES AND ADDITIONAL DETAILS OF THE CONCRETE PARAPET, REFERENCE STANDARD DRAWING SBR-1-99.
 - MINIMUM LAP LENGTHS:
#5 BARS 2'-5"
#6 BARS 2'-11"
TOP #6 BARS 4'-1"

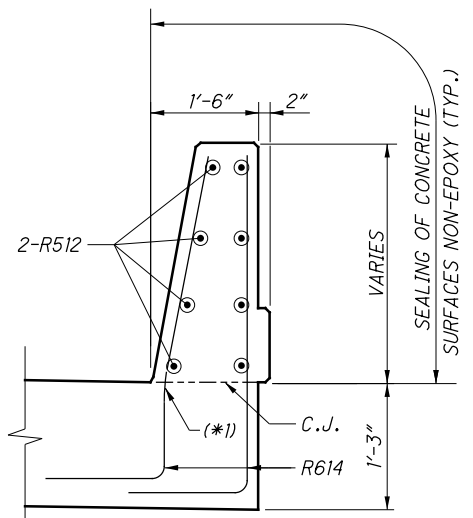


SECTION C-C

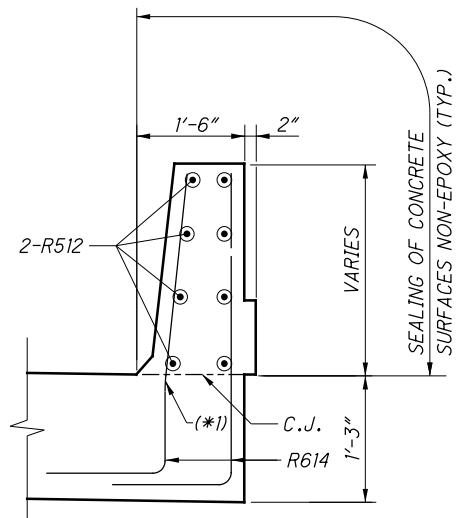


SECTION D-D

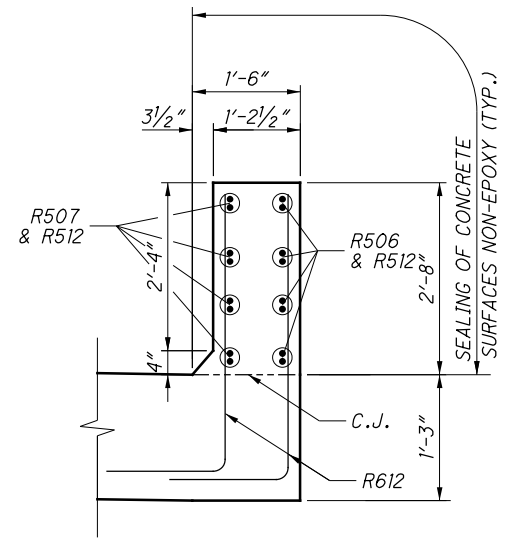

SECTION E-E

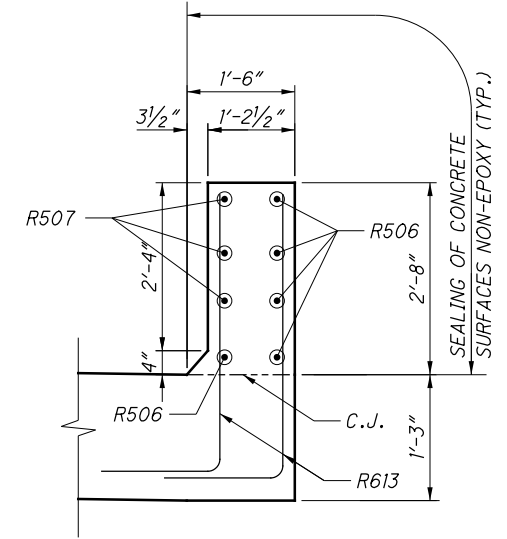

SECTION F-F

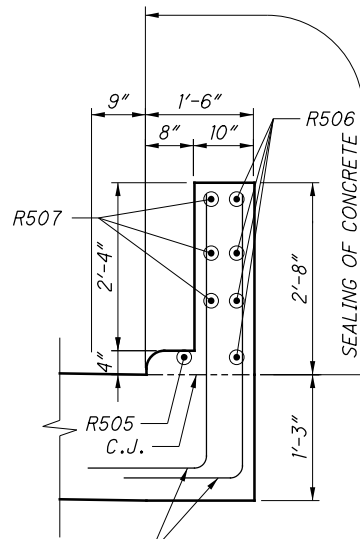

SECTION G-G

RESOURCE INTERNATIONAL INC.
6350 PRESIDENTIAL GATEWAY
COLUMBUS, OHIO 43231
(614) 823-4848

Rii

DATE	12/01/2015
REVIEWED	NCK
DESIGNED	JGM
CHECKED	JLM
DRAWN	JGM
REVISED	JLM
STRUCTURE FILE NUMBER	2513862

FRA - 270-49-00
PID No. 83988




BRIDGE NO. FRA-270-4900
OVER IR 270

RIGHT PARAPET & TRANSITION DETAILS

RELEASED FOR CONSTRUCTION - 11/03/2014 - 11/19/2015






23 / 32

169
182


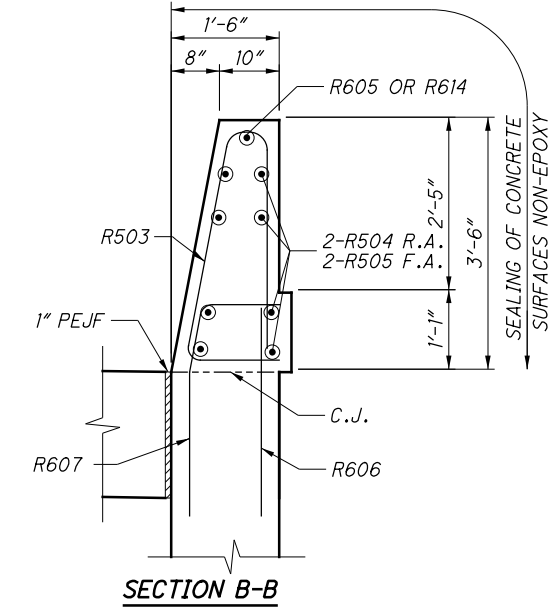
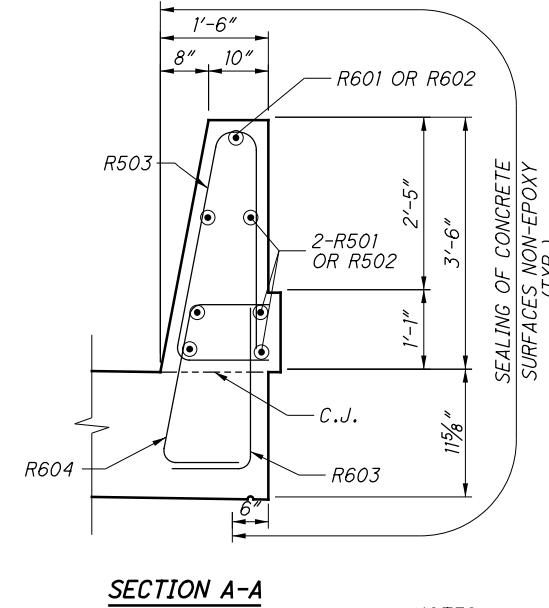
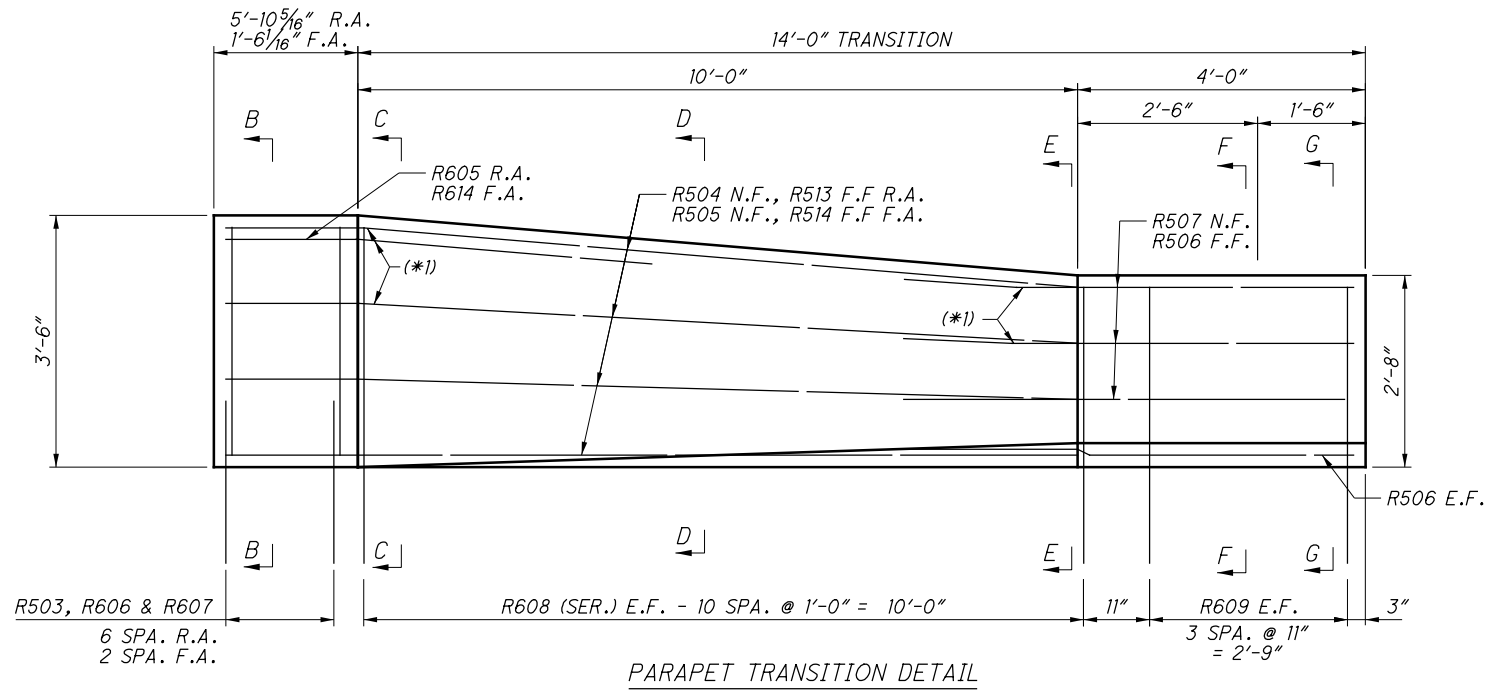


LEGEND:
 (*1) FIELD BEND AS NECESSARY


- NOTES:**
- FOR NOTES AND ADDITIONAL DETAILS OF THE CONCRETE PARAPET, REFERENCE STANDARD DRAWING SBR-1-99.
 - MINIMUM LAP LENGTHS:
 #5 BARS 2'-5"
 #6 BARS 2'-11"
 - PARAPET DIMENSIONS ARE MEASURED ALONG THE INSIDE FACE OF PARAPET

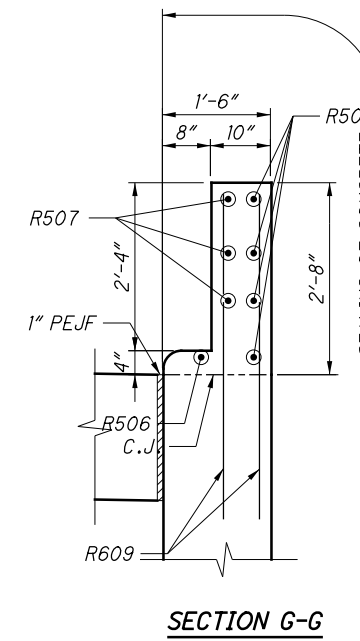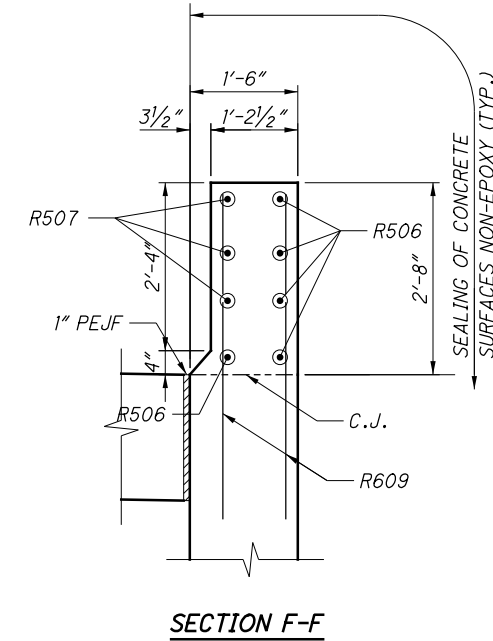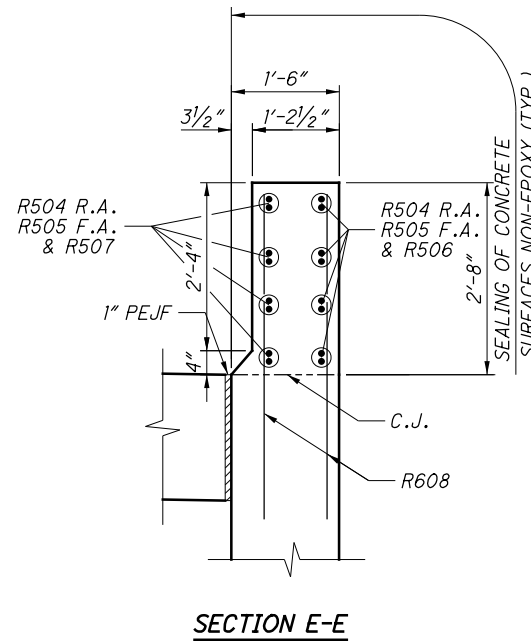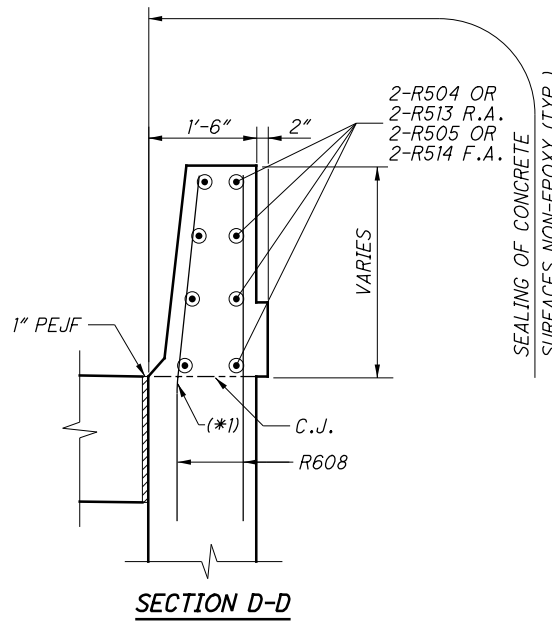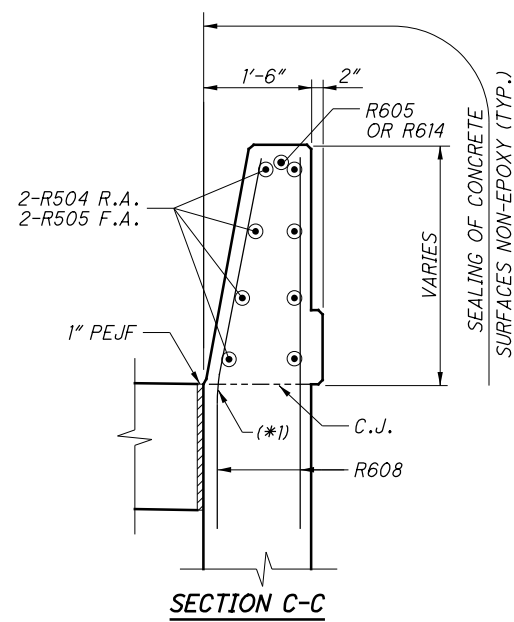


		RESOURCE INTERNATIONAL INC. 6350 PRESIDENTIAL GATEWAY COLUMBUS, OHIO 43231 (614) 823-4849	
DATE 12/01/2015	REVIEWED NCK	DRAWN JGM	DESIGNED JGM
STRUCTURE FILE NUMBER 2513862	CHECKED JLM	REVISIONS	OVER IR 270
FRA - 270-49.00 PID No. 83988			
LEFT PARAPET & TRANSITION DETAILS BRIDGE NO. FRA-270-4900			
7 & 8 - RELEASED FOR CONSTRUCTION - 11/03/2014 - 11/19/2015			
24 / 32			
170 182			

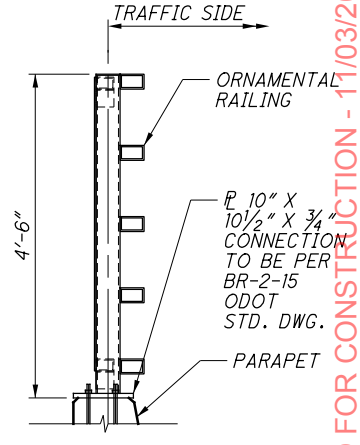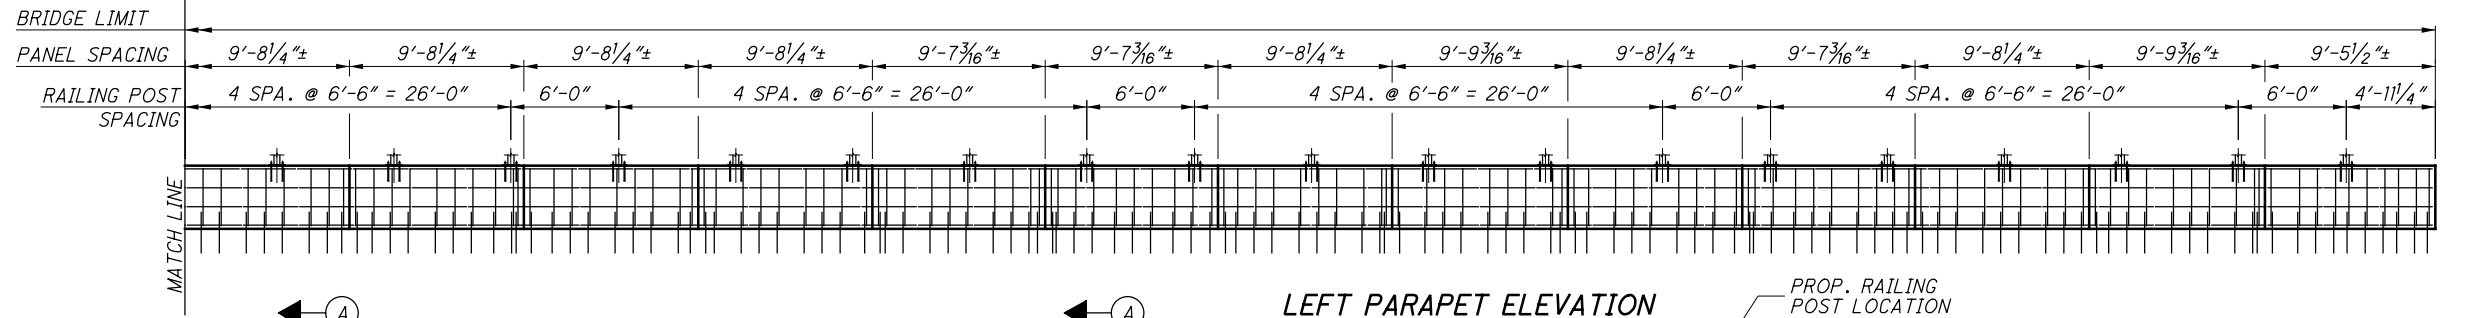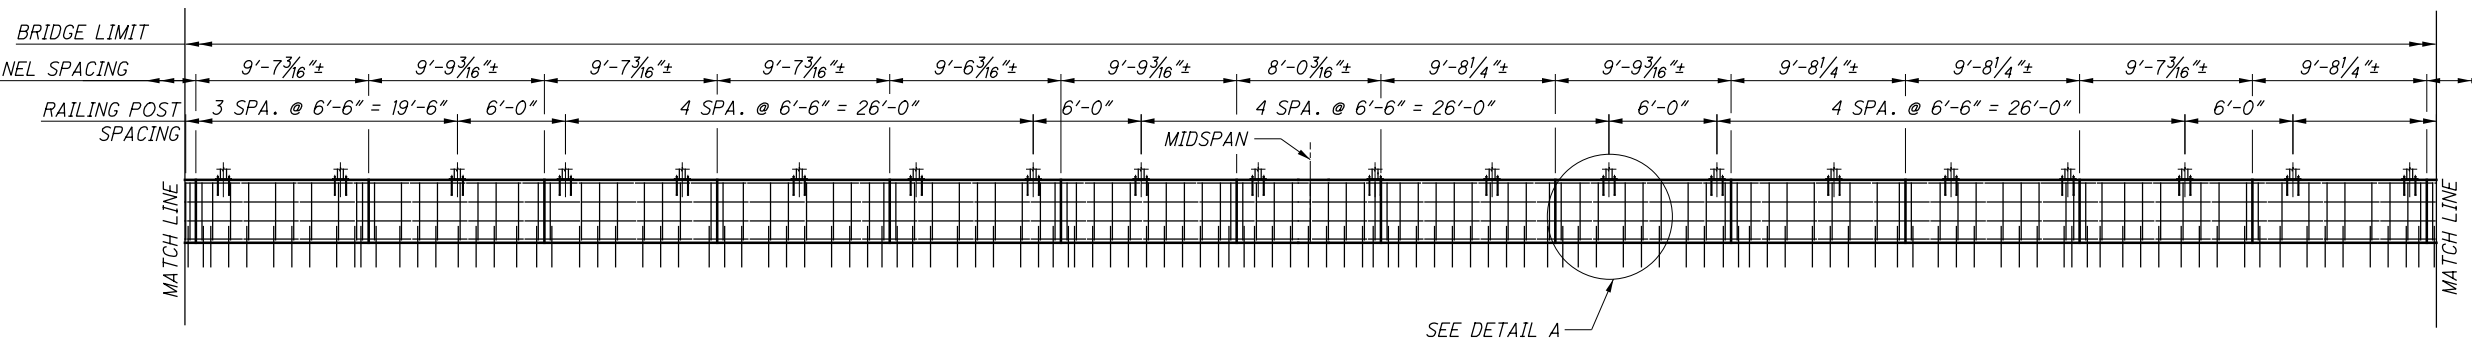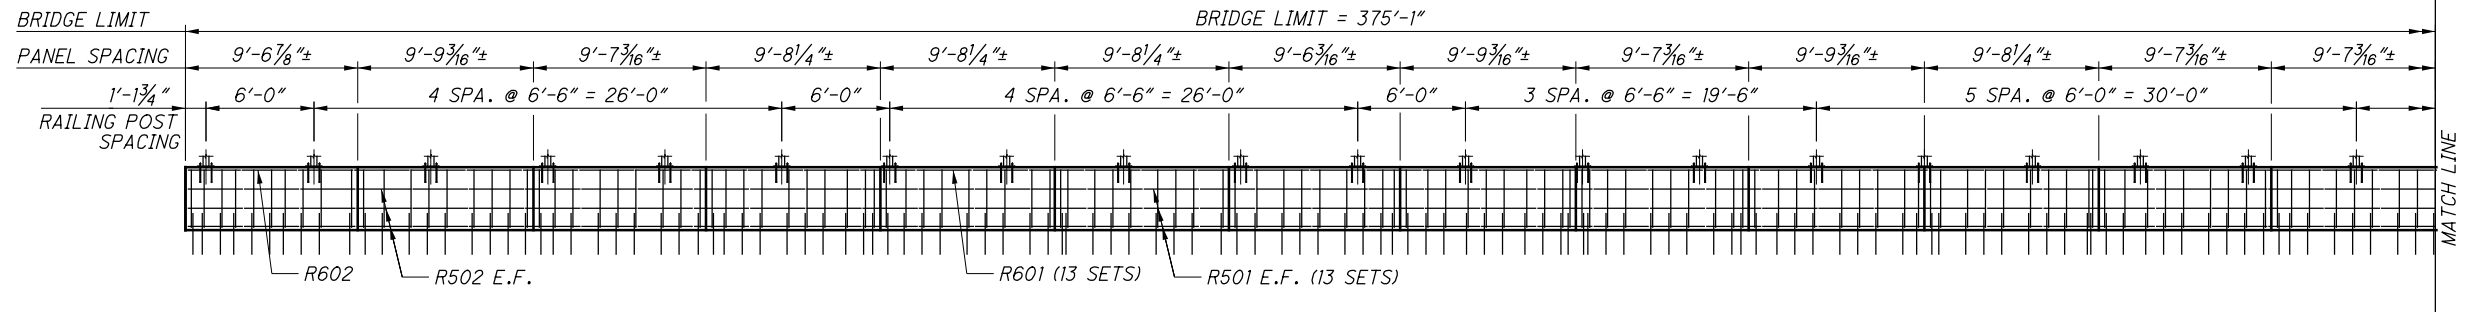


ORNAMENTAL RAILING

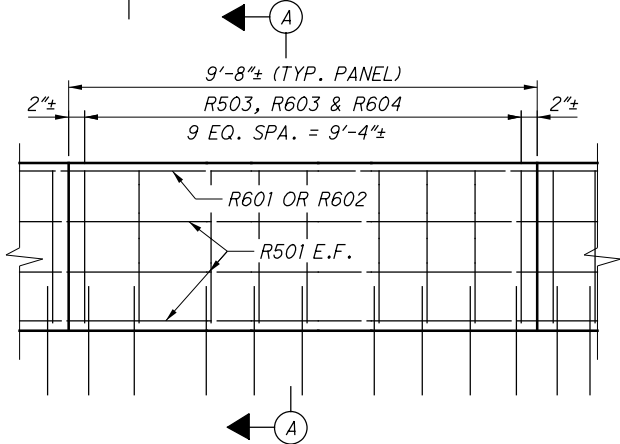

9'-8"± TYPICAL PANEL

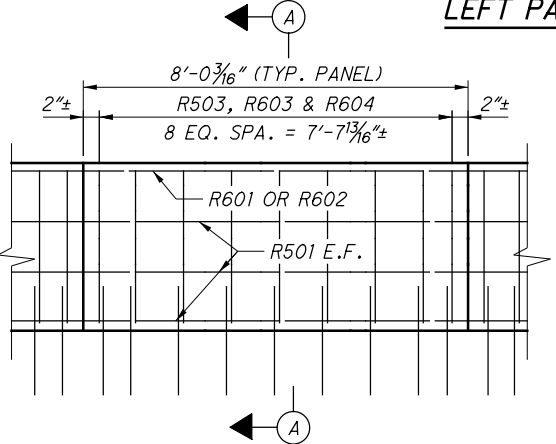


8'-0 3/16"± PANEL

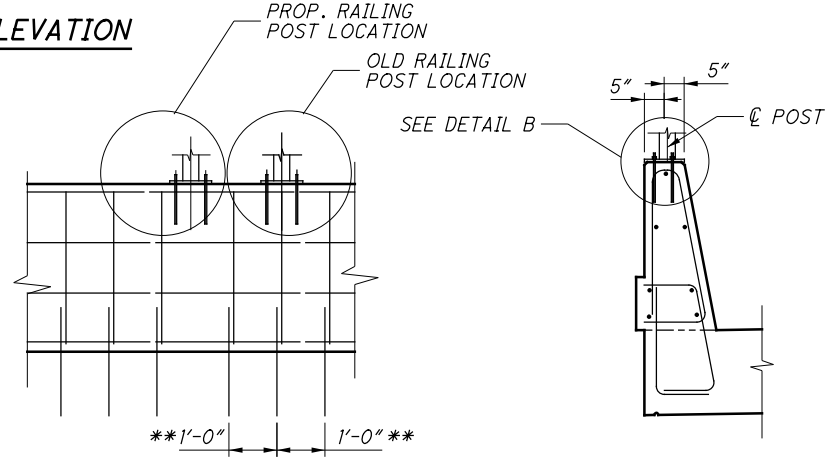


DETAIL A


SECTION A-A

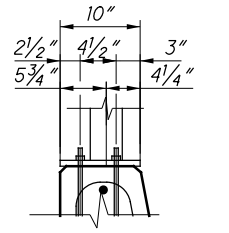

DETAIL B

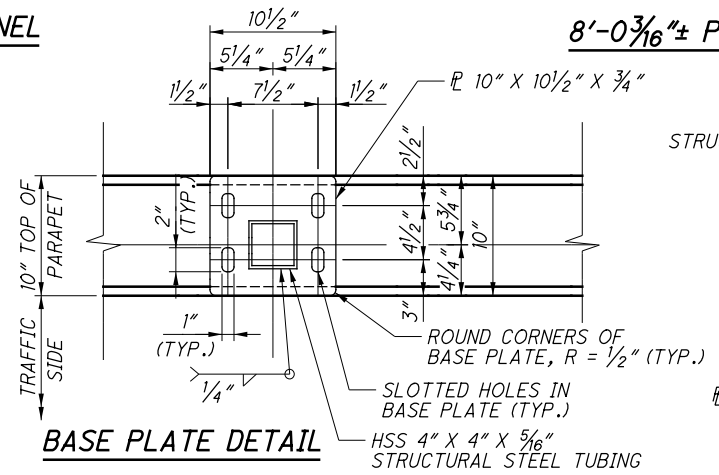

BASE PLATE DETAIL

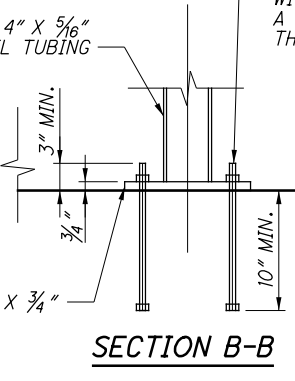

SECTION B-B

LEFT PARAPET ELEVATION

LEGEND:

** - ADDITIONAL R503, R603 & R604 BARS CENTERED AT EACH OLD RAILING POST LOCATION. STAGGERED WITH STANDARD PARAPET REINFORCEMENT. (RAILING POST LOCATIONS HAVE BEEN MODIFIED SINCE CONSTRUCTION. LOCATIONS OF REBAR AT OLD POST LOCATIONS ARE SHOWN IN ELEVATION VIEW.)

DRILL HOLES FOR 7/8" DIA. X 1'-1" LONG, ASTM A449 ANCHOR BOLTS, WITH HEX NUT AND WASHER WITH A MINIMUM OF 10" EMBEDMENT IN THE CONCRETE BARRIER (TYP.)

NOTES:


1. SEE SHEET [26/32] FOR ADDITIONAL RAILING NOTES.
2. DIMENSIONS ARE MEASURED ALONG BACK FACE OF PARAPET.
3. FASTENERS: THE 7/8 INCH DIA. HIGH STRENGTH BOLTS, NUTS AND WASHERS SHALL BE IN ACCORDANCE WITH C&MS 711.09 (ASTM A 325) GALVANIZED.

USE POWERS PE1000+ EPOXY ADHESIVE ANCHOR SYSTEM (ICCES REPORT ESR-2583) ANCHOR ADHESIVE EVALUATED ACCORDING TO ICCES REPORT AC308, "ACCEPTANCE CRITERIA FOR POST-INSTALLED ADHESIVE ANCHORS IN CONCRETE ELEMENTS", FOR CRACKED AND UNCRACKED CONCRETE APPLICATIONS.

INSTALL ADHESIVE ANCHORS ACCORDING TO THE MANUFACTURER'S INSTALLATION INSTRUCTIONS PUBLISHED IN SECTION 4.3 OF THE ICCES REPORTS LISTED ABOVE. THE MINIMUM EMBEDMENT DEPTH (H_{EV}) FOR ANCHORS SHALL BE 10".


4. BASE PLATES SHALL CLEAR PARAPET DEFLECTION CONTROL JOINTS BY 2" MINIMUM. IF REQUIRED, CONTRACTOR MAY SAW CUT ADDITIONAL DEFLECTION CONTROL JOINTS IF THERE IS A POST/JOINT CONFLICT.

5. AVOID INTERFERENCE WITH EXISTING AND PROPOSED REBAR WHEN INSTALLING PROPOSED THREADED ANCHORS.

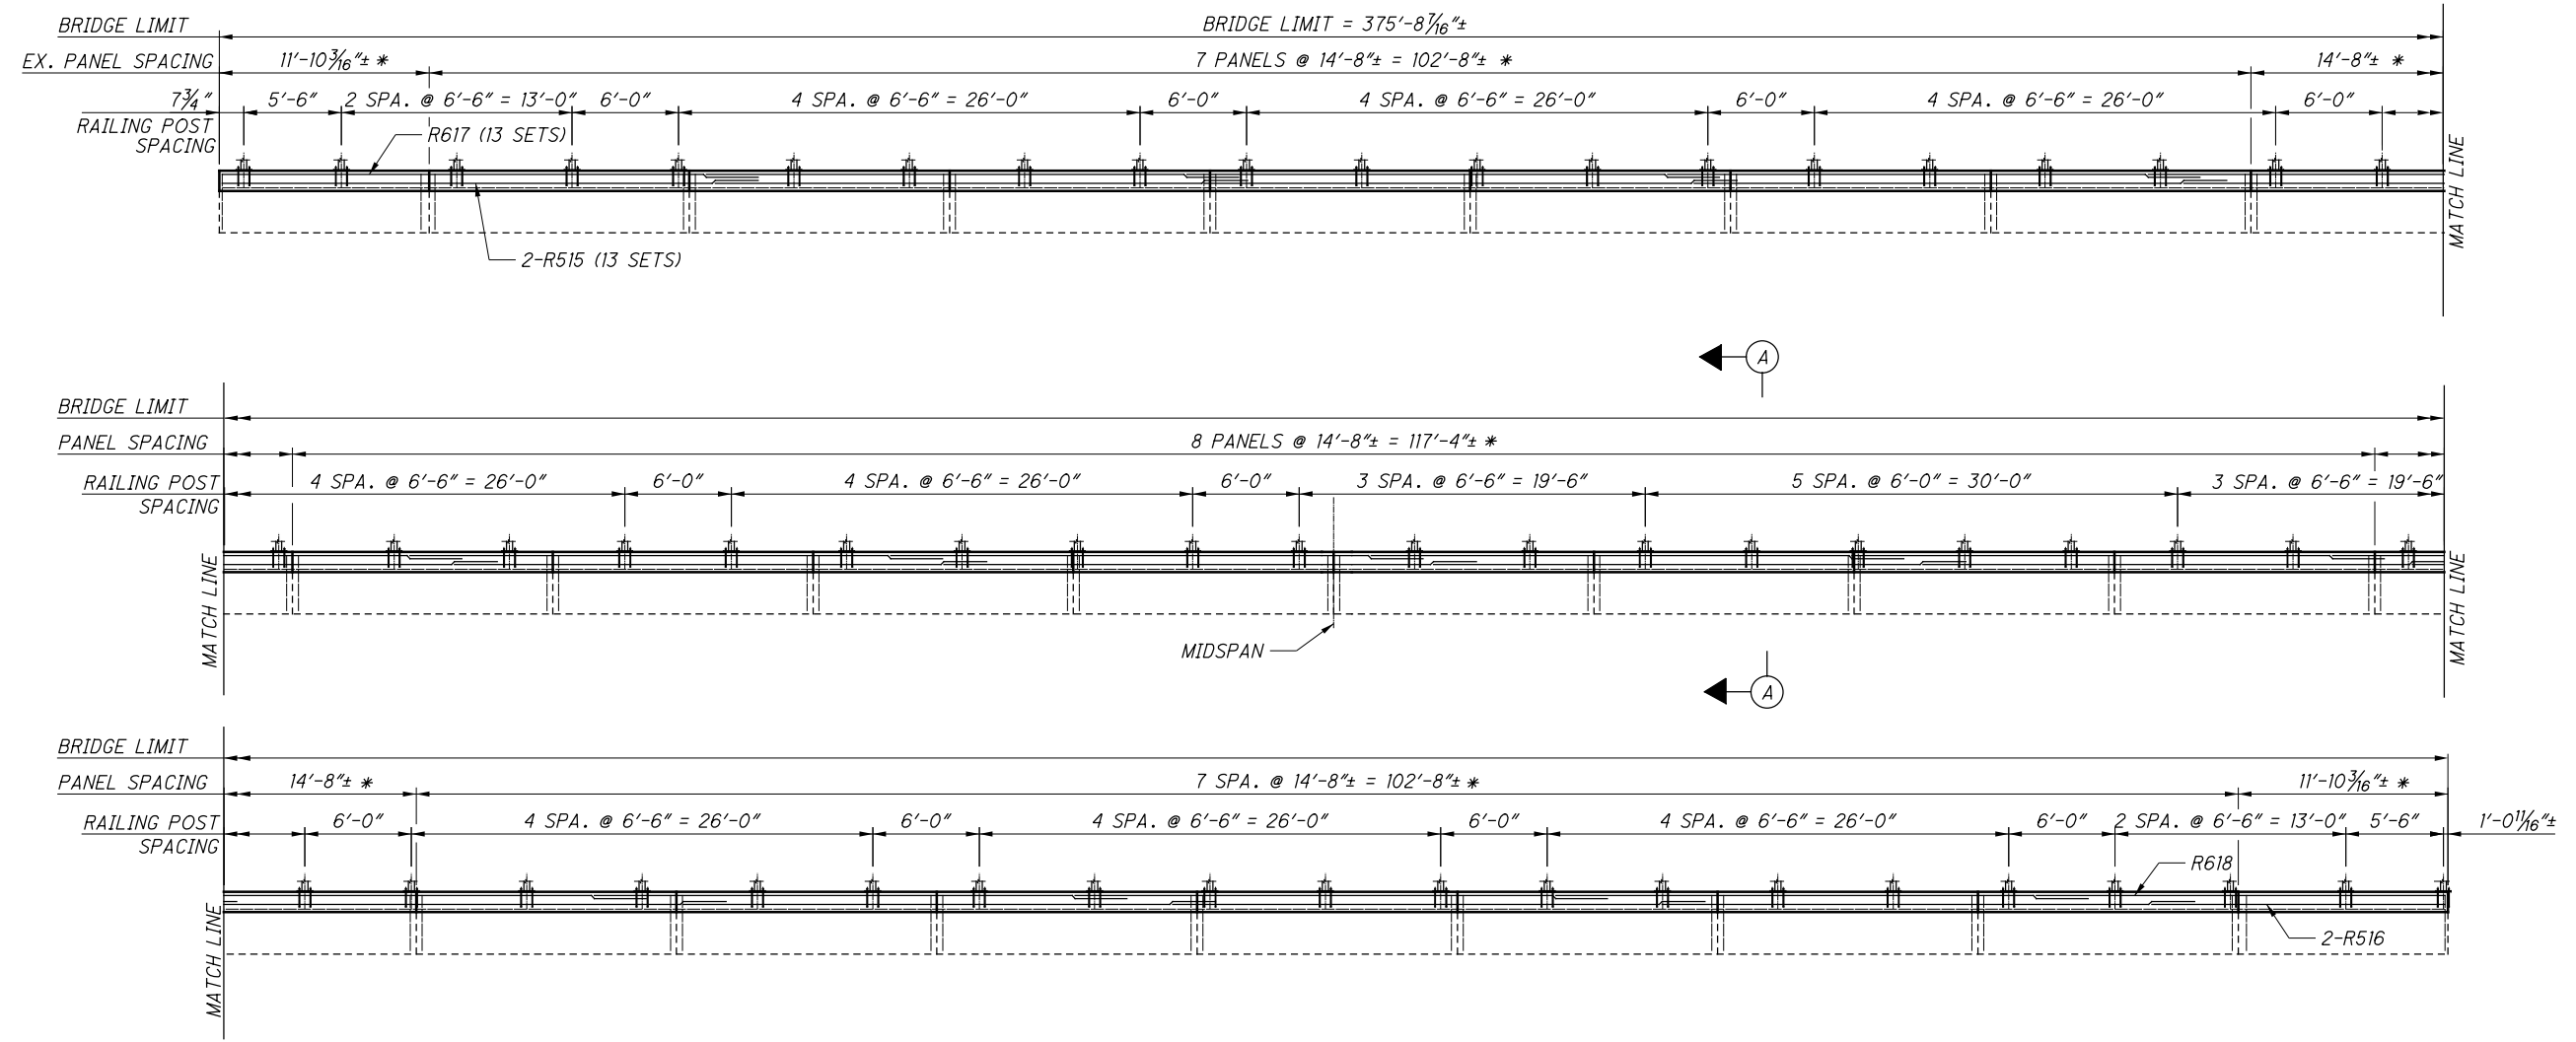


RIGHT PARAPET ELEVATION

MARK	TOTAL	LENGTH	WEIGHT (LBS.)	TYPE	DIMENSIONS					
					A	B	C	D	E	R
PARAPET										
R515	26	30'-0"	814	ST						
R516	2	17'-6"	37	ST						
R617	13	30'-0"	586	ST						
R618	1	24'-0"	36	ST						
TOTAL			1472							

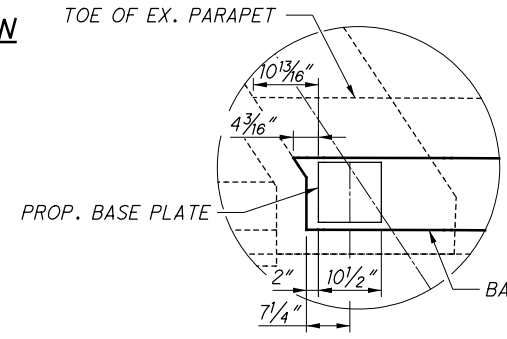

PLAN

(BASE PLATE AT REAR ABUTMENT)

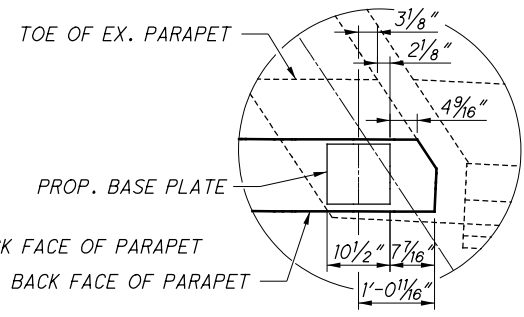

PLAN


(BASE PLATE AT FORWARD ABUTMENT)

NOTES:


- BASE PLATES SHALL BE ASTM A709 GRADE 50 STEEL GALVANIZED ACCORDING TO 711.02.
- FURNISH FASTENERS AS FOLLOWS:
THE ANCHOR BOLTS SHALL BE HEAVY HEX ASTM A449 WITH HARDENED STEEL WASHERS AND HEAVY HEX NUTS.
THE HEX CAP SCREWS (BOLTS), HEX NUTS, AND WASHERS AT RAILING INTERNAL SPLICE, SHALL CONFORM TO ASTM A449.
- GALVANIZE ALL STRUCTURAL STEEL PLATES, HARDWARE AND ACCESSORIES ACCORDING TO CMS 711.02.
- REFER TO ODOT STANDARD DRAWING BR-2-15 FOR ADDITIONAL DETAILS.
- THE ANCHORS SHALL BE CAST-IN-PLACE WITH A MINIMUM 10" EMBEDMENT LENGTH.
- PROPOSED RAILING IS PER MANUFACTURE'S SPECIFICATIONS.
- BASE PLATES SHALL CLEAR PARAPET DEFLECTION CONTROL JOINTS BY 2" MINIMUM. IF REQUIRED, CONTRACTOR MAY SAW CUT ADDITIONAL DEFLECTION CONTROL JOINTS IF THERE IS A POST/JOINT CONFLICT.
- AVOID INTERFERENCE WITH EXISTING AND PROPOSED REBAR WHEN INSTALLING PROPOSED THREADED ANCHORS.
- DIMENSIONS MEASURED ALONG THE BACK FACE OF PARAPET.
- MIN. LAP LENGTHS
NO. 5 BAR: 2'-5"
NO. 6 BAR: 2'-11"
- PROPOSED CONTROL JOINTS FOR CONCRETE PARAPETS: SAWCUT 1/4" DEEP CONTROL JOINTS ALONG THE PERIMETER OF THE PARAPET AS SOON AS THE SAW CAN BE OPERATED WITHOUT DAMAGING THE CONCRETE.
- USE AN EDGE GUIDE, FENCE OR JIG TO ENSURE THAT THE CUT JOINT IS STRAIGHT, TRUE AND ALIGNED ON ALL FACES OF THE PARAPET. THE JOINT WIDTH SHALL BE THE WIDTH OF THE SAW BLADE, A NOMINAL WIDTH OF 1/4 INCH.
- PLACE CONTROL JOINTS TO LINE UP WITH EXISTING JOINTS.
- SEAL THE PERIMETER OF THE CONTROL JOINT TO A MINIMUM DEPTH OF ONE INCH WITH POLYURETHANE OR POLYMETRIC MATERIAL CONFORMING TO ASTM C920, TYPE S.

LEGEND:

* - PROPOSED PANEL JOINTS SHALL LINE UP WITH EXISTING JOINTS.

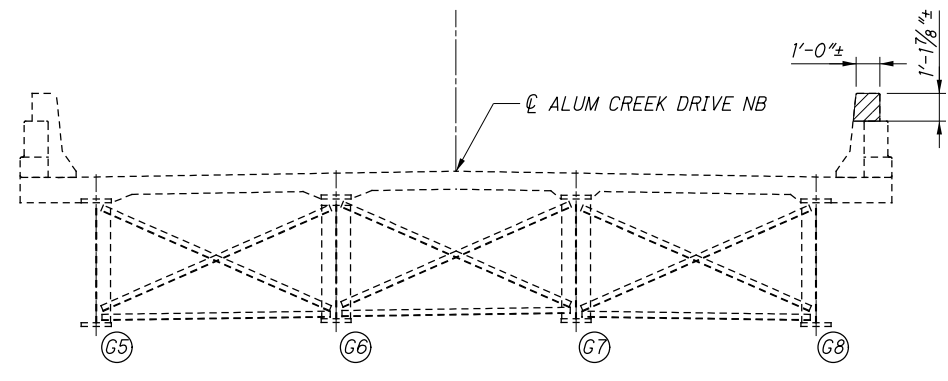


PARAPET REMOVAL

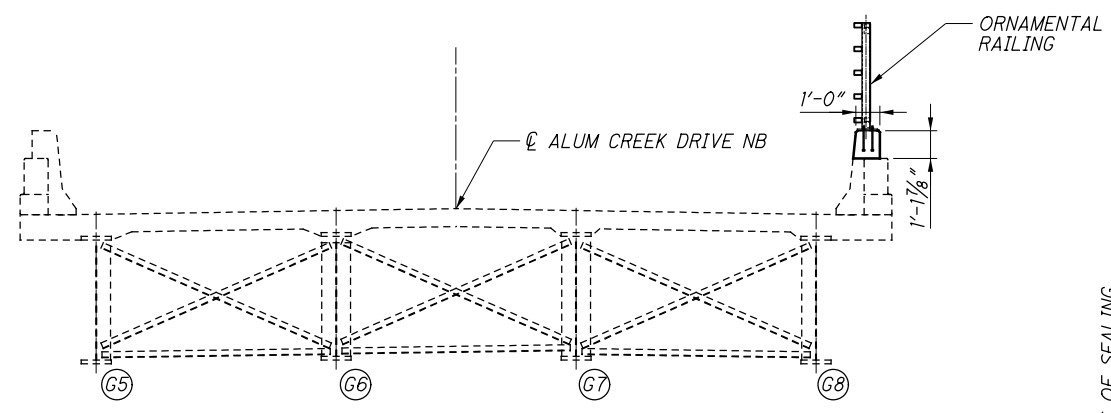


PARAPET CONSTRUCTION


- RAILING REMOVAL:**
1. REMOVE PORTION OF EXISTING PARAPET AS SHOWN.
 2. SALVAGE EXISTING REBARS AS SHOWN IN DETAIL A.
- RAILING CONSTRUCTION:**
1. CONSTRUCT PORTION OF PARAPET AS SHOWN IN DETAIL A.
 2. INSTALL ORNAMENTAL RAILING.

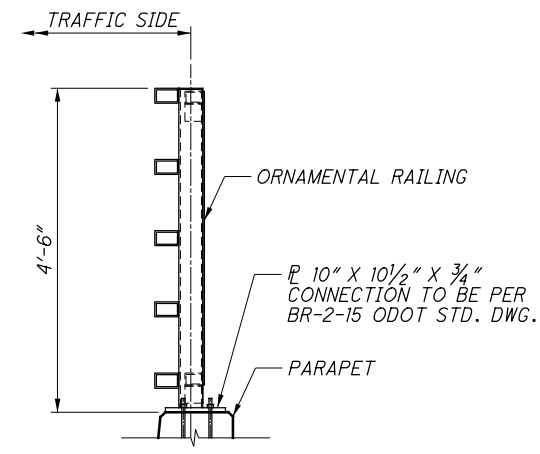


ORNAMENTAL RAILING

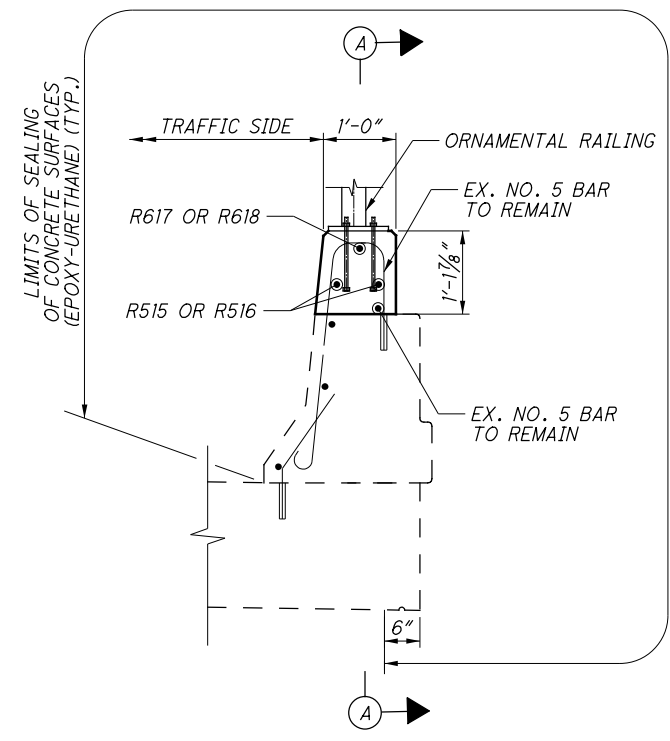

DETAIL A

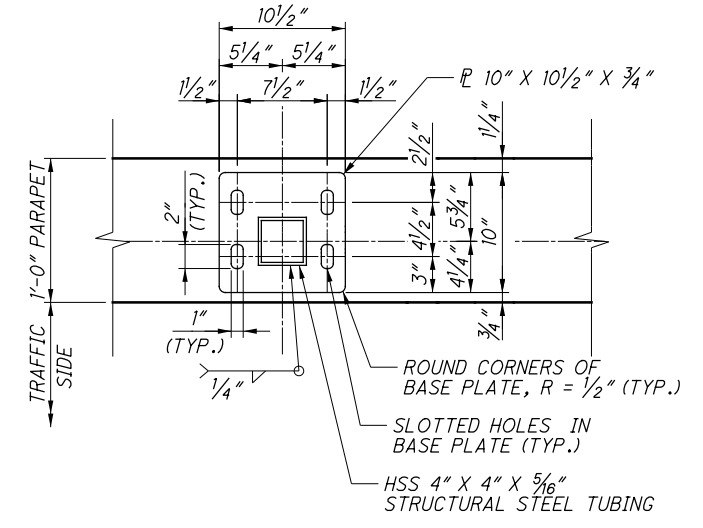

BASE PLATE DETAIL

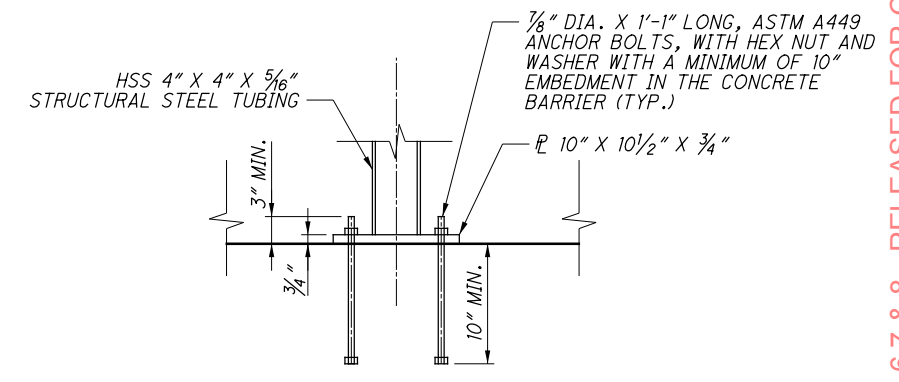

SECTION A-A

- NOTES:**
1. REFER TO ODOT STANDARD DRAWING BR-2-15 FOR ADDITIONAL DETAILS.
 2. SEE SHEET 26/32 FOR RAILING NOTES.

- LEGEND:**
- ITEM 202 PORTIONS OF STRUCTURE REMOVED

RESOURCE INTERNATIONAL INC.
6350 PRESIDENTIAL GATEWAY
COLUMBUS, OHIO 43231
(614) 823-4848

Rii

DESIGNED	JGM	CHECKED	NCK
DRAWN	JGM	REVISED	
REVIEWED	SSK	STRUCTURE FILE NUMBER	2513862
DATE	12/01/2015		

RIGHT RAILING DETAILS ON EXISTING PARAPET



BRIDGE NO. FRA-270-4900
OVER IR 270

FRA - 270-49.00
PID No. 83988

27 / 32


173
182

BU 4, 5, 6, 7 & 8 - RELEASED FOR CONSTRUCTION - 11/03/2014 - 11/19/2015

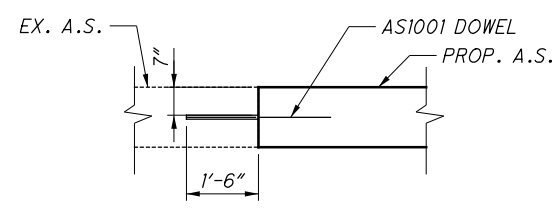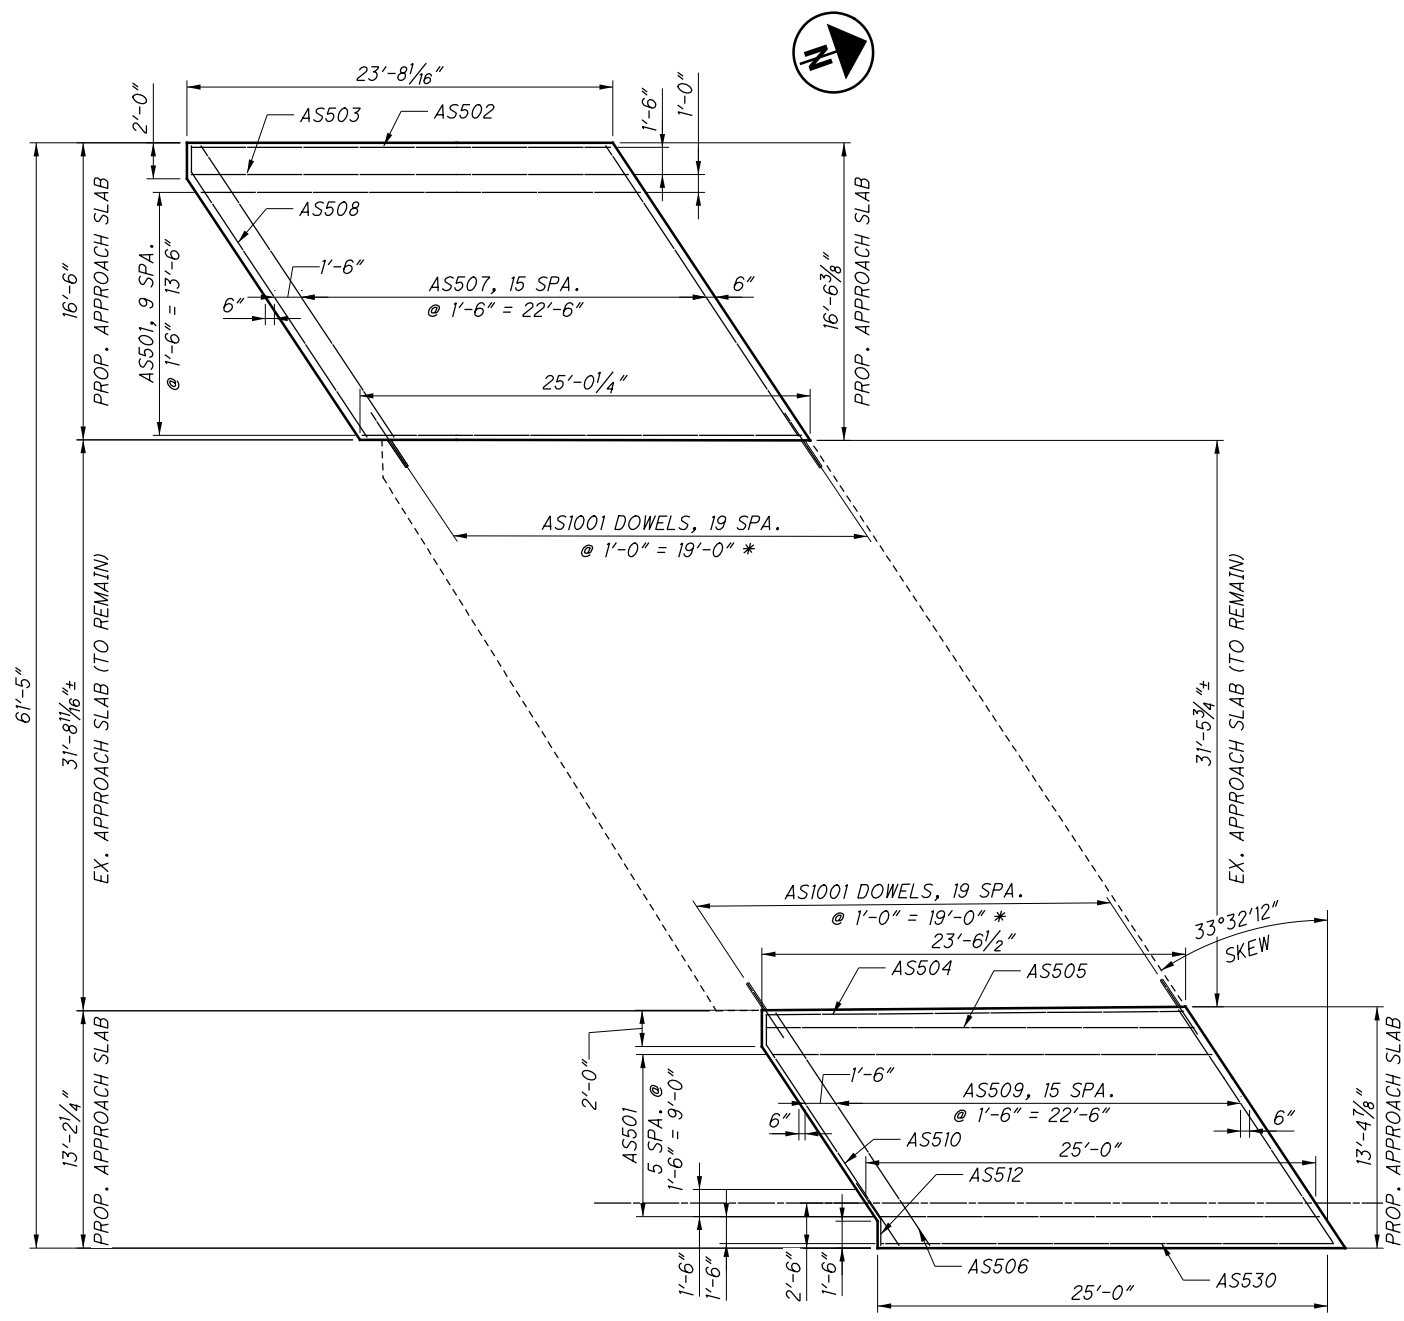

DETAIL A

REAR APPROACH SLAB TOP REINFORCING

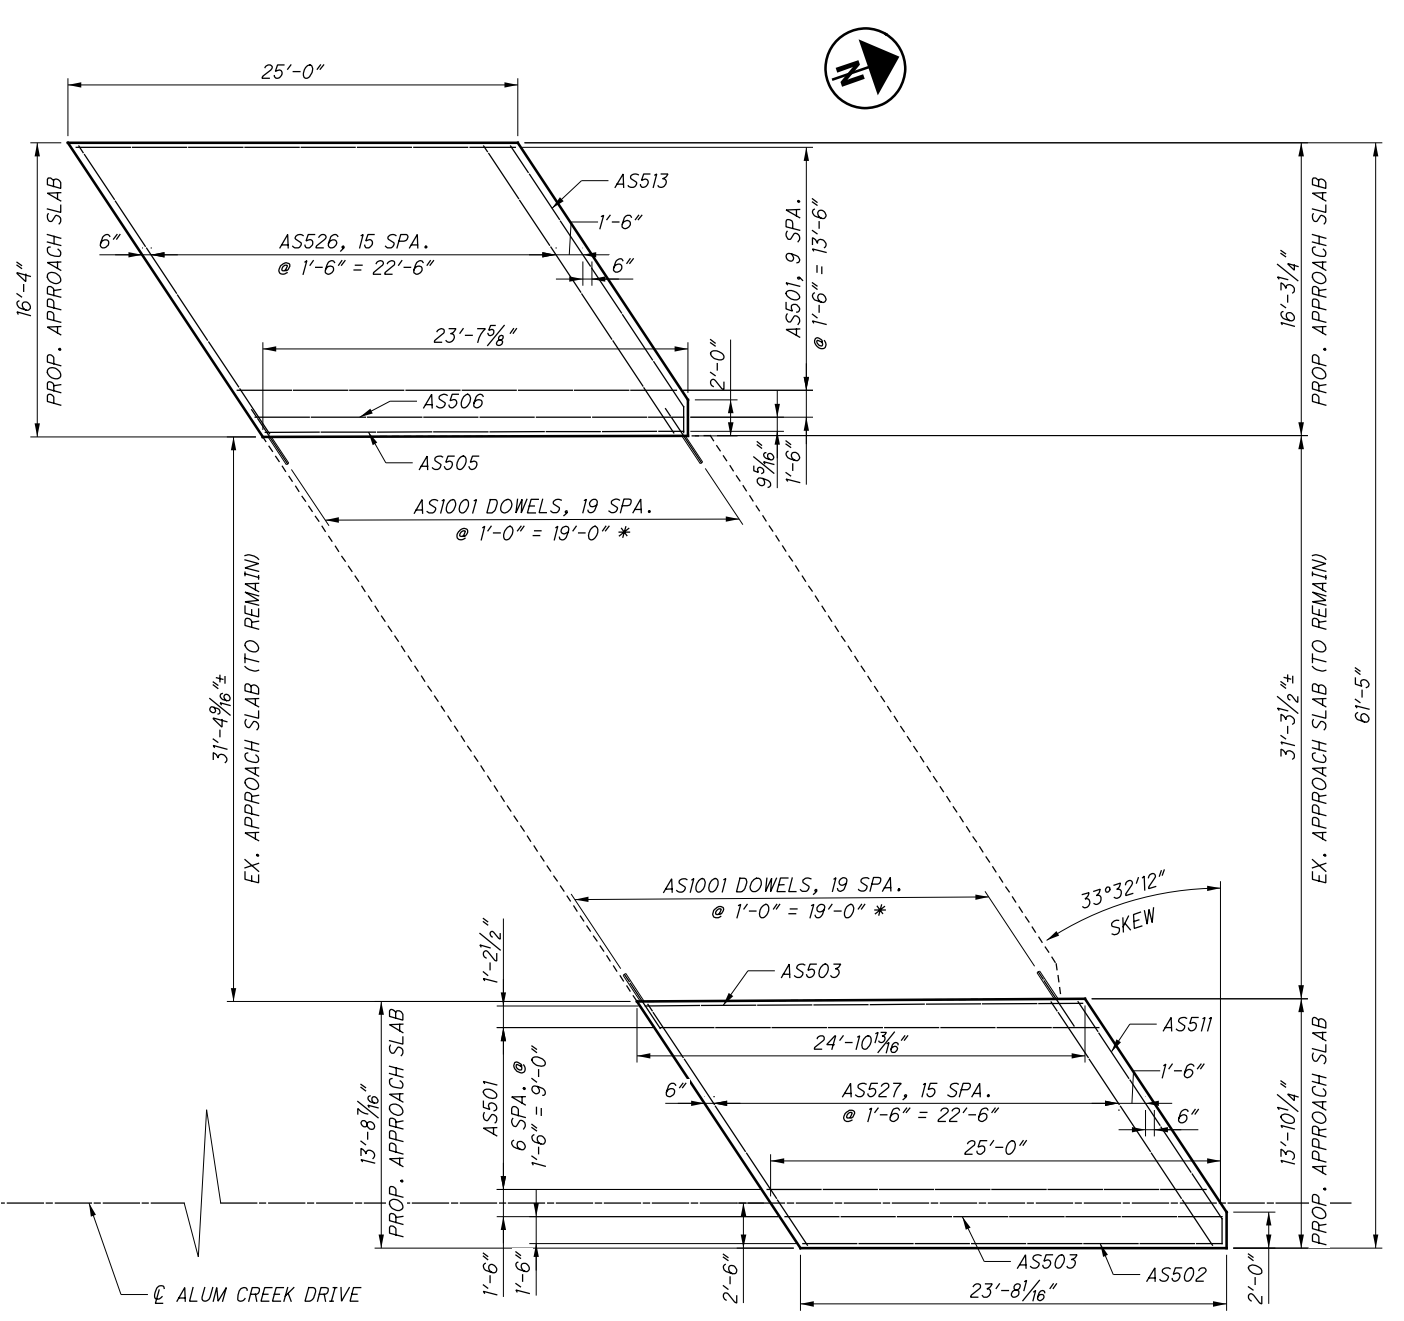

FORWARD APPROACH SLAB TOP REINFORCING

NOTES:
 1. SEE ODOT STANDARD DRAWING AS-1-81 FOR REINFORCING DETAILS.

LEGEND:
 * - MEASURED PERPENDICULAR TO APPROACH SLAB. DOWELS ARE LOCATED IN THE CENTER OF THE CONCRETE. SEE DETAIL A.

BU 4, 5, 6, 7, & 8 - RELEASED FOR CONSTRUCTION - 11/03/2014 - 11/19/2015


APPROACH SLAB DETAILS

BRIDGE NO. FRA-270-4900 OVER IR 270


FRA - 270-49.00 PID No. 83988



DESIGNED	JGM	CHECKED	JLM
DRAWN	JGM	REVISED	
REVIEWED	NCK	DATE	12/01/2015
STRUCTURE FILE NUMBER	2513862		

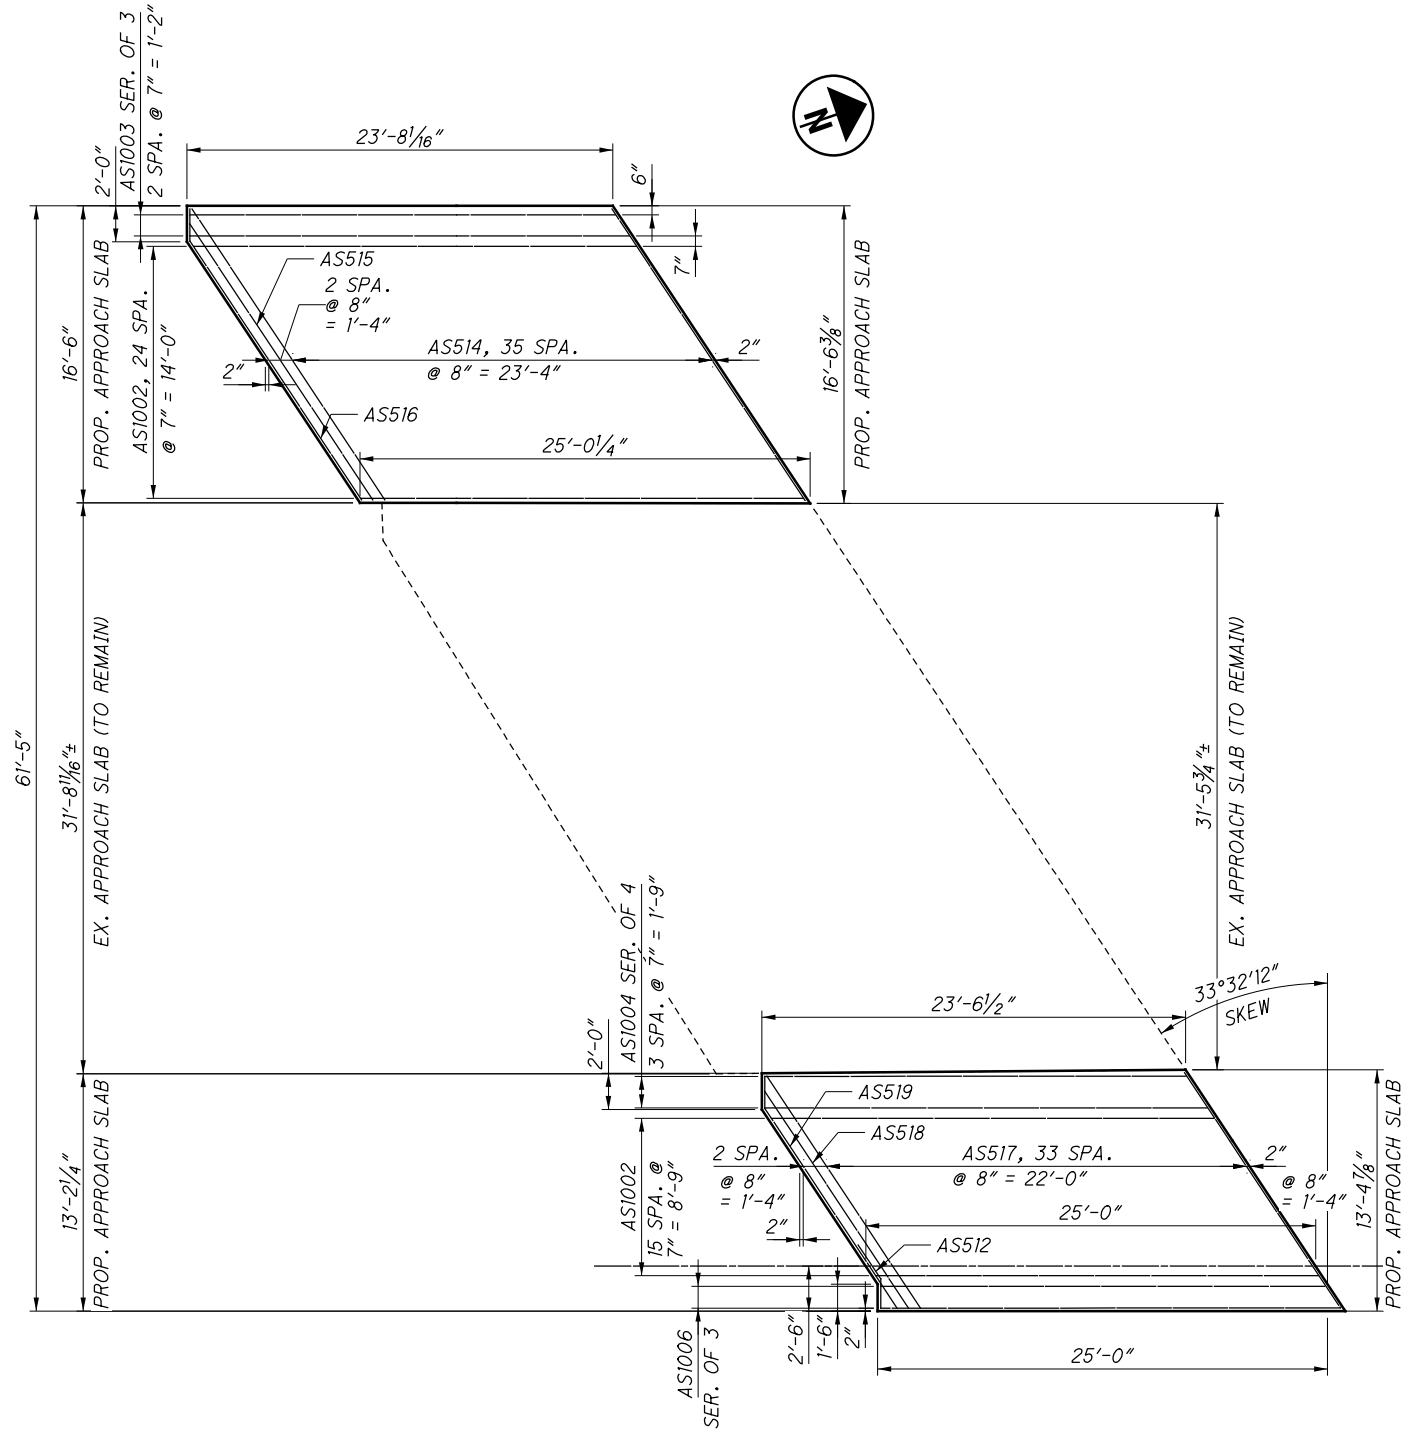

REAR APPROACH SLAB
BOTTOM REINFORCING

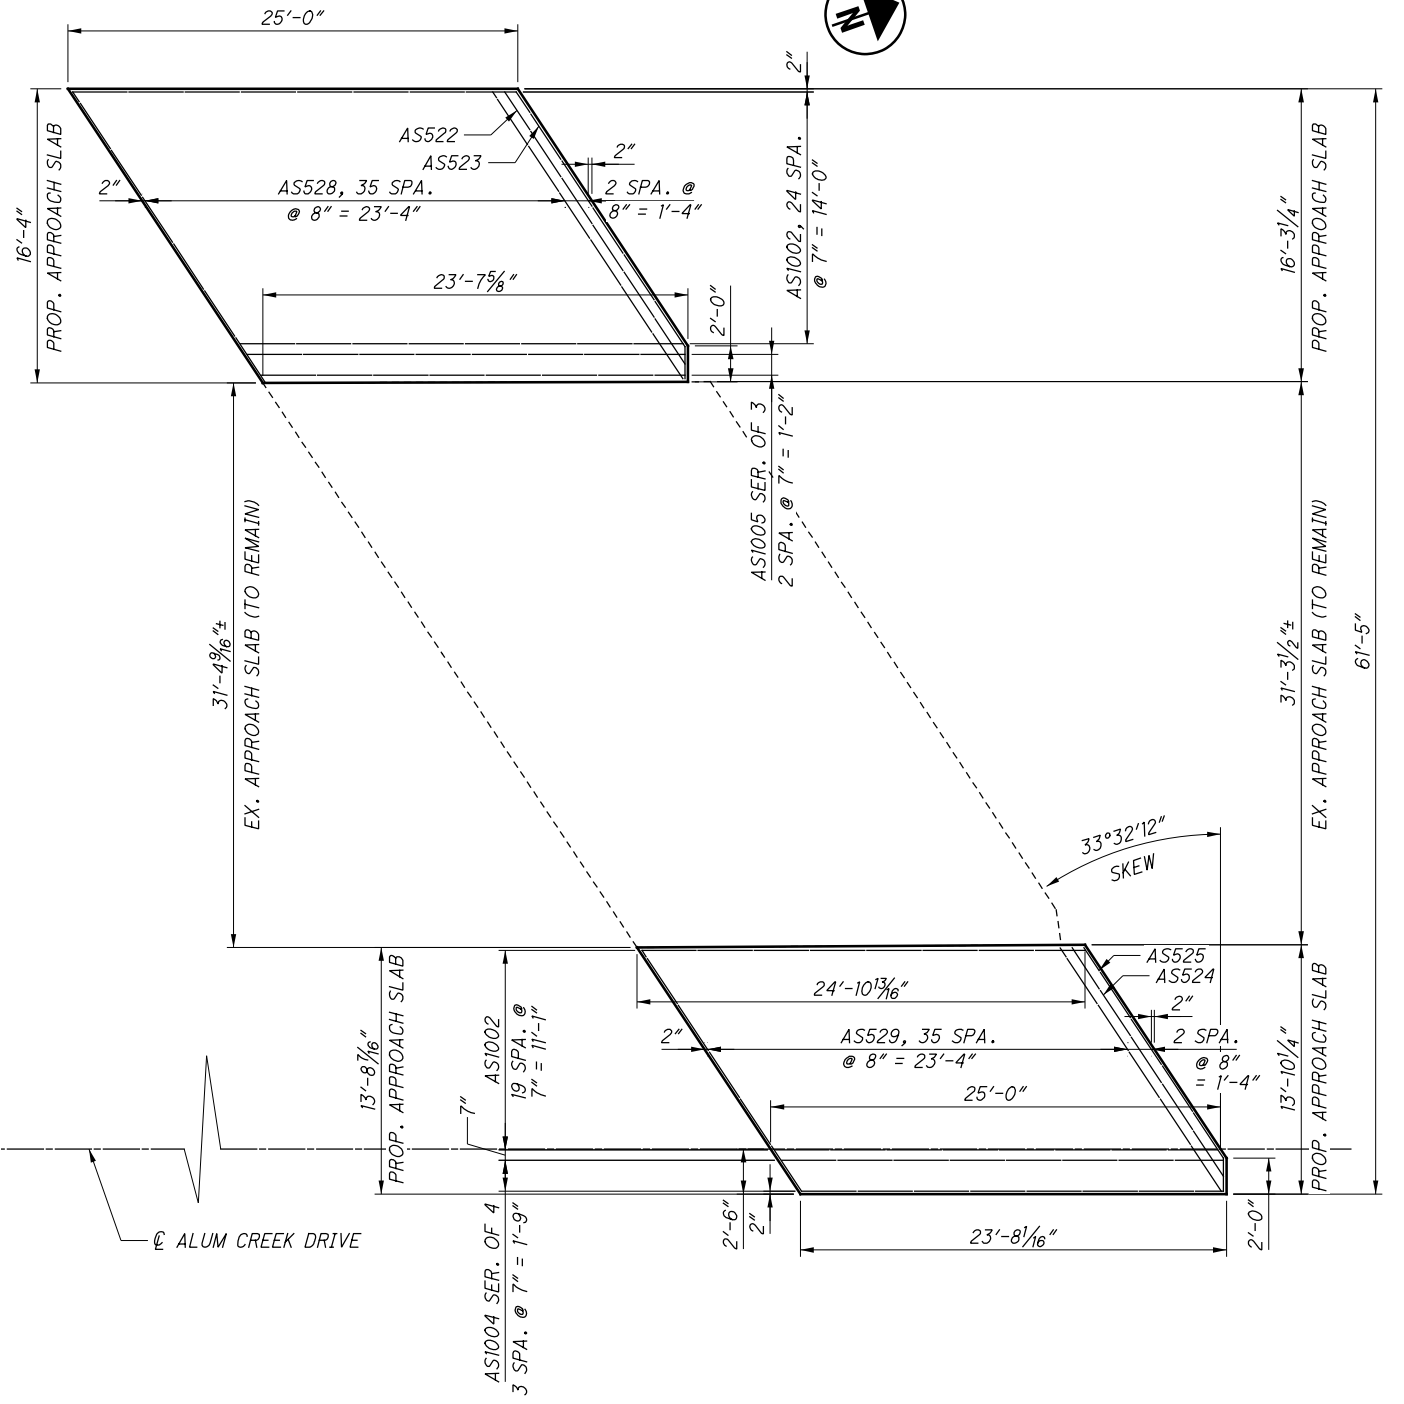

FORWARD APPROACH SLAB
BOTTOM REINFORCING

NOTES:
 1. SEE ODOT STANDARD DRAWING AS-1-81 FOR REINFORCING DETAILS.

LEGEND:
 * - MEASURED PERPENDICULAR TO APPROACH SLAB

BU 4, 5, 6, 7, & 8 - RELEASED FOR CONSTRUCTION - 11/03/2014 - 11/19/2015

APPROACH SLAB DETAILS
 BRIDGE NO. FRA-270-4900
 OVER IR 270

DESIGNED	JGM	CHECKED	JLM
DRAWN	JGM	REVISED	
REVIEWED	NCK	DATE	12/01/2015
STRUCTURE FILE NUMBER	2513862		

FRA - 270-49.00
 PID No. 83988

29 / 32

175
182

RESOURCE INTERNATIONAL INC.
 6350 PRESIDENTIAL GATEWAY
 COLUMBUS, OHIO 43231
 (614) 823-4848

AS BUILT - 4/22/2016


5/23/2016 7:32:24 AM kevinj

G:\projects\2014-W-14-039 FRA-270-49.00\83988\structures\FRA270_4900L.RL001.dgn

MARK	NUMBER			LENGTH	WEIGHT (LBS.)	TYPE	DIMENSIONS						
	R.A	F.A	TOTAL				A	B	C	D	E	R	INC
ABUTMENTS													
A501	22	23	45	8'-10"	415	2	1'-7"	5'-11"	1'-7"				
A502	11	7	18	9'-7"	180	3	3'-0"	1'-7"					
A503	2		2	16'-5"	34	ST							
A504	2		2	16'-10"	35	ST							
A505	2		2	15'-8"	33	ST							
A506	2		2	18'-5"	38	ST							
A507		8	8	11'-1"	92	ST							
A508	2	2	4	17'-3"	72	3	6'-10"	1'-7"					
A509	4	4	8	4'-9"	40	ST							
A510	2		2	11'-11"	25	3	4'-2"	1'-7"					
A511		1	1	11'-3"	12	3	3'-10"	1'-7"					
A512	2		2	7'-1"	15	3	1'-9"	1'-7"					
A513		1	1	6'-9"	7	3	1'-7"	1'-7"					
A514	18	21	39	9'-1"	369	1	1'-0"	8'-2"					
A515		2	2	5'-4"	11	19	3'-0"	1'-2"	2'-1"				
A516			1	13'-3"	14	3	4'-10"	1'-7"					
A517		1	1	11'-1"	12	3	3'-9"	1'-7"					
A518		1	1	6'-7"	7	3	1'-6"	1'-7"					
A519	19	21	40	7'-2"	299	2	2'-0"	3'-5"	2'-0"				
A520	3	3	6	7'-4"	46	2	2'-0"	3'-8"	2'-0"				
A521	3	3	6	7'-6"	47	2	2'-0"	3'-10"	2'-0"				
A522	16	21	37	10'-4"	399	2	4'-7"	1'-5"	4'-7"				
A523	1 SER. OF 11		1 SER. OF 11	9'-3" TO 10'-0"	110	2	4'-0 5/8" TO 4'-5"	1'-5"				7/16"	
A524	1 SER. OF 8		1 SER. OF 8	9'-9" TO 10'-0"	82	2	4'-3 1/2" TO 4'-5"	1'-5"				3/16"	
A525	18	20	38	6'-2"	244	2	2'-9"	11"	2'-9"				
A526	2	5	7	10'-7"	77	2	4'-7"	1'-8"	4'-7"				
A527	3	2	5	9'-11"	52	2	4'-3"	1'-8"	4'-3"				
A528	4	4	8	10'-3"	86	2	4'-5"	1'-8"	4'-5"				
A529	1		1	10'-7"	11	2	4'-7"	1'-8"	4'-7"				
A530	8		8	6'-4"	119	2	2'-9"	1'-1"	2'-9"				
A531	4	4	8	12'-8"	106	1	1'-6"	11'-3"					
A532		18	18	24'-4"	457	ST							
A533	5		5	14'-1"	73	19	13'-10"	2 1/2"	1 3/4"				
A534	2		2	13'-5"	28	ST							
A535	2		2	15'-10"	33	ST							
A536	18		18	23'-10"	447	ST							
A537	2		2	7'-8"	16	ST							
A538		7	7	13'-4"	97	ST							
* A539	44	44	88	3'-11"	359	ST							
A540	17		17	18'-10"	334	ST							
A541	3	6	9	12'-6"	117	2	5'-8"	1'-5"	5'-8"				
A542	3	3	6	12'-9"	80	2	5'-8"	1'-8"	5'-8"				
A543		1 SER. OF 12	1 SER. OF 12	9'-8" TO 10'-0"	123	2	4'-3" TO 4'-5"	1'-5"				3/16"	
A544		2	2	10'-3"	21	2	4'-5"	1'-8"	4'-5"				
A545		11	11	18'-11"	217	ST							
A546		1	1	18'-3"	19	ST							
A547		5	5	19'-4"	101	19	17'-4"	1'-8"	1'-1"				
A548		1 SER. OF 8	1 SER. OF 8	9'-10" TO 10'-1 1/2"	83	2	4'-4" TO 4'-5 3/4"	1'-5"				1/4"	
A549	18	12	30	5'-9"	180	ST							
A550	1 SER. OF 9	1 SER. OF 9	2 SER. OF 9	6'-5" TO 12'-8"	179	2	2'-9" TO 5'-9"	1'-2"	2'-9" TO 5'-9"			4 1/2"	
A551	9	9	18	4'-3"	80	2	1'-8"	1'-2"	1'-8"				
A552	3	4	7	17'-11"	82	2	11'-3"	5'-4"	1'-7"				
A553	2	2	4	19'-11"	83	2	9'-3"	1'-8"	9'-3"				
A554	12		12	11'-6"	144	ST							
A555		12	12	7'-2"	90	ST							

MARK	NUMBER			LENGTH	WEIGHT (LBS.)	TYPE	DIMENSIONS						
	R.A	F.A	TOTAL				A	B	C	D	E	R	INC
ABUTMENTS													
A556	2 SER. OF 3		2 SER. OF 3	11'-8" TO 17'-6"	91	ST						2'-11"	
A557		2 SER. OF 3	2 SER. OF 3	7'-4" TO 13'-4"	65	ST						3'-0"	
A558	6		6	19'-6"	122	ST							
A559		6	6	15'-2"	95	ST							
A560	2	2	4	11'-4"	47	19	8'-4"	2'-10"	1'-0"				
A561		2	2	7'-8"	16	ST							
A562	10		10	21'-6"	224	ST							
A563		10	10	21'-3"	222	ST							
A564		4	4	23'-2"	97	ST							
A565	2	2	4	13'-7"	57	3	1'-8"	4'-11"					
A601	18	21	39	17'-10"	1045	2	1'-7"	5'-4"	11'-3"				
A602	11	6	17	23'-2"	592	2	11'-2"	1'-2"	11'-2"				
A603	1	1	2	23'-4"	70	3	11'-2"	1'-4"	11'-2"				
D801	26	26	52	5'-2"	717	18	2'-9"	1'-0"	1'-0"				
* A801	16	16	32	3'-0"	256	ST							
A802	6	4	10	18'-10"	503	ST							
A803	2		2	16'-0"	85	ST							
A804	2		2	21'-8"	116	ST							
A805	2		2	19'-11"	106	ST							
A806	4	8	12	18'-11"	606	ST							
A807		2	2	20'-9"	111	19	17'-4"	2'-10"	1'-11"				
A808		2	2	19'-10"	106	ST							
				SUB TOTAL	11882								

BENDING DIAGRAMS

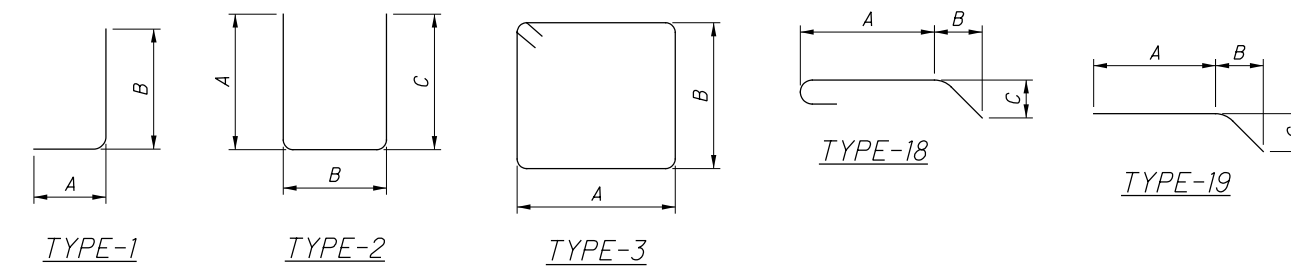

LEGEND:

* - DOWEL BAR

NOTES:

1. THE BAR SIZE NUMBER IS SPECIFIED ON THE PLANS IN THE BAR MARK COLUMN. THE FIRST DIGIT WHERE 3 DIGITS ARE USED, AND THE FIRST 2 DIGITS WHERE FOUR DIGITS ARE USED, INDICATES THE BAR SIZE NUMBER. FOR EXAMPLE, P601 IS A NO. 6 BAR. BAR DIMENSIONS SHOWN ARE OUT TO OUT UNLESS OTHERWISE INDICATED. "R" INDICATES INSIDE RADIUS, UNLESS OTHERWISE NOTED. "STD." WRITTEN IN PLACE OF A DIMENSION INDICATES A STANDARD BEND AT THE END OF THE BAR.

2. ALL REINFORCING STEEL TO BE EPOXY COATED, UNLESS NOTED OTHERWISE.

RESOURCE INTERNATIONAL INC.
 6350 PRESIDENTIAL GATEWAY
 COLUMBUS, OHIO 43231
 (614) 823-4849

DATE: 12/01/2015
 NCK: 2513862
 STRUCTURE FILE NUMBER: 2513862

DESIGNED: JGM
 CHECKED: JLM

DRAWN: JGM
 REVISED:

REVIEWED:

BU 4, 5, 6, 7, & 8 - RELEASED FOR CONSTRUCTION - 11/03/2014 - 11/19/2015

REINFORCING STEEL LIST
 BRIDGE NO. FRA-270-4900
 OVER IR 270

FRA - 270 - 49.00

PID No. 83988

30 / 32

176
182

AS BUILT - 4/22/2016


5/23/2016 7:32:24 AM kevinj

G:\projects\2014-W-14-039 FRA-270-49.00\83988\structures\FRA270_4900L\sheets\270_4900L.R.002.dgn

MARK	PIER 1	PIER 2	PIER 3	TOTAL	LENGTH	WEIGHT (LBS.)	TYPE	DIMENSIONS								
								A	B	C	D	E	R	INC		
PIERS																
P401	2			2	16'-5"	482	27	4 1/2"	2'-6"	16'-5"						
P402		2		2	17'-0"	498	27	4 1/2"	2'-6"	17'-0"						
P403			2	2	18'-9"	546	27	4 1/2"	2'-6"	18'-9"						
P404	1			1	19'-4"	282	27	4 1/2"	2'-6"	19'-4"						
P405		1		1	19'-11"	290	27	4 1/2"	2'-6"	19'-11"						
P406			1	1	21'-8"	314	27	4 1/2"	2'-6"	21'-8"						
P501	2	2	2	6	9'-10"	62	ST.									
P502	22	22	22	66	7'-3"	499	2	2'-6"	2'-6"	2'-6"						
P503	4	4	4	12	6'-1"	76	2	2'-6"	1'-4"	2'-6"						
P504	6	6	6	18	2'-3"	42	ST.									
P505	4	4	4	12	1'-6"	19	ST.									
P601	24	24	24	72	4'-5"	478	ST.									
P801	48	48	48	144	10'-2"	3909	17	8'-6"								
P802	10	10	10	30	20'-1"	1609	17	18'-5"								
P803	10	10	10	30	13'-11"	1115	17	12'-3"								
P901	2	2	2	6	15'-1"	308	2	12'-5"	1'-7"							
P902	2	2	2	6	12'-5"	253	ST.									
P903	24			24	19'-2"	1564	ST.									
P904		32		32	19'-10"	2158	ST.									
P905			32	32	21'-7"	2348	ST.									
P906	12			12	19'-4"	789	ST.									
P907		16		16	19'-11"	1083	ST.									
P908			16	16	21'-8"	1179	ST.									
P909	12	12	12	36	20'-11"	2560	17	18'-5"								
P910	12	12	12	36	14'-9"	1805	17	12'-3"								
P911	2	2	2	6	12'-5"	253	2	9'-10"	1'-7"							
P912	2	2	2	6	9'-10"	201	ST.									
P913	36	48	48	132	10'-3"	4600	1	8'-11"	1'-7"							
SUB-TOTAL					29321											

MARK	TOTAL	LENGTH	WEIGHT (LBS.)	TYPE	DIMENSIONS						
					A	B	C	D	E	R	INC
SUPERSTRUCTURE											
S501	1053	30'-0"	32948	ST							
S502	81	16'-6"	1394	ST							
S601	545	17'-7"	14394	ST							
S602	1 SER. OF 16	2'-3" TO 17'-3"	234	ST							1'-0"
S603	1 SER. OF 15	2'-8" TO 16'-9"	219	ST							11 1/4"
S604	4	2'-0"	12	ST							
S605	6	2'-4"	21	ST							
S606	93	40'-0"	5587	ST							
S607	93	14'-11"	2084	ST							
S608	549	13'-7"	11201	ST							
S609	1 SER. OF 11	3'-0" TO 13'-0"	132	ST							1'-0"
S610	1 SER. OF 11	2'-0" TO 12'-10"	123	ST							1'-1"
S701	549	13'-7"	15243	ST							
S702	1 SER. OF 11	3'-0" TO 13'-0"	180	ST							1'-0"
S703	1 SER. OF 11	2'-0" TO 12'-10"	167	ST							1'-1"
S704	6	2'-4"	29	ST							
S705	4	2'-0"	16	ST							
S706	545	17'-7"	19587	ST							
S707	1 SER. OF 15	2'-8" TO 16'-9"	298	ST							11 1/4"
S708	1 SER. OF 16	2'-3" TO 17'-3"	319	ST							1'-0"
SUB-TOTAL					104187						

BENDING DIAGRAMS

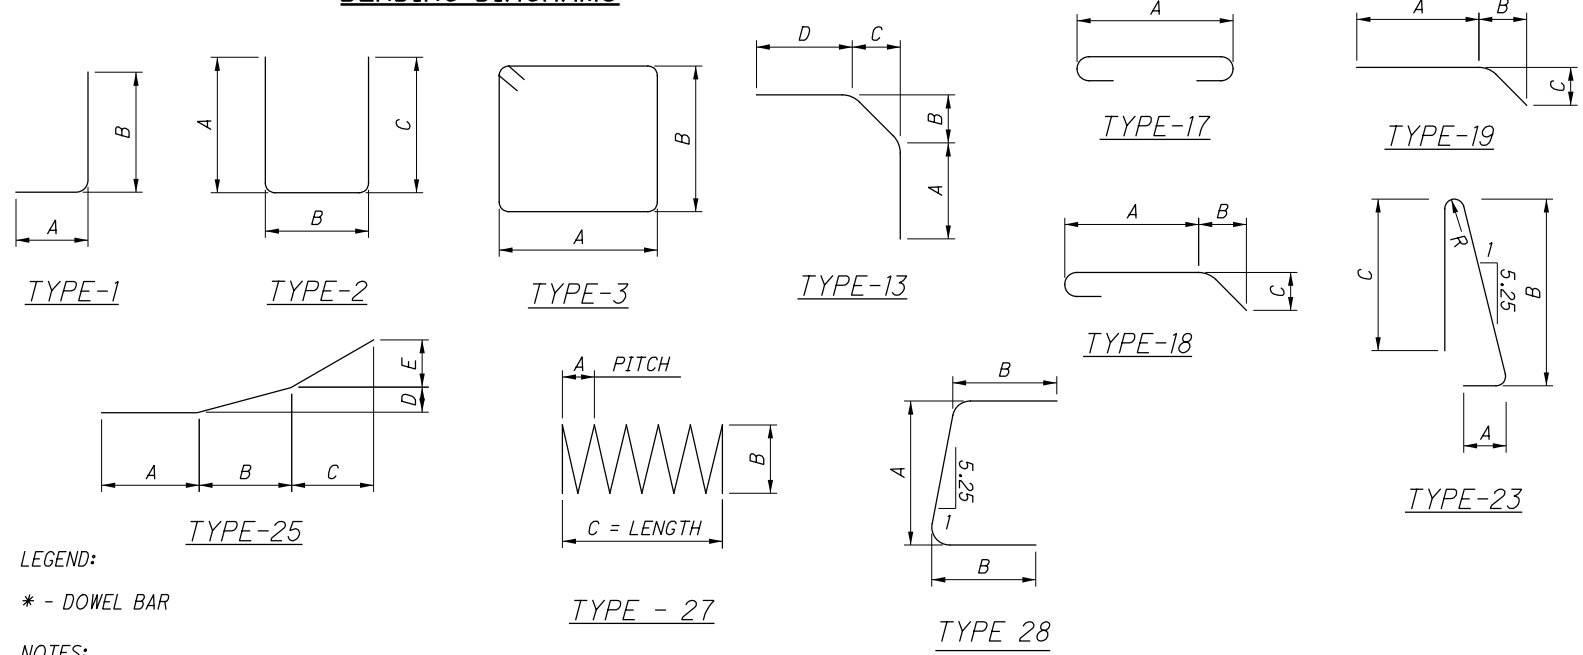

LEGEND:
* - DOWEL BAR

NOTES:

1. THE BAR SIZE NUMBER IS SPECIFIED ON THE PLANS IN THE BAR MARK COLUMN. THE FIRST DIGIT WHERE 3 DIGITS ARE USED, AND THE FIRST 2 DIGITS WHERE FOUR DIGITS ARE USED, INDICATES THE BAR SIZE NUMBER. FOR EXAMPLE, P601 IS A NO. 6 BAR. BAR DIMENSIONS SHOWN ARE OUT TO OUT UNLESS OTHERWISE INDICATED. "R" INDICATES INSIDE RADIUS, UNLESS OTHERWISE NOTED. "STD." WRITTEN IN PLACE OF A DIMENSION INDICATES A STANDARD BEND AT THE END OF THE BAR.

2. ALL REINFORCING STEEL TO BE EPOXY COATED, UNLESS NOTED OTHERWISE.

RESOURCE INTERNATIONAL INC.
6350 PRESIDENTIAL GATEWAY
COLUMBUS, OHIO 43231
(614) 823-4849



DATE: 12/01/2015
REVIEWED: NCK
STRUCTURE FILE NUMBER: 2513862

DRAWN: JGM
CHECKED: JLM

DESIGNED: JGM
CHECKED: JLM

BU 4, 5, 6, 7, & 8 - RELEASED FOR CONSTRUCTION - 11/03/2014 - 11/19/2015

REINFORCING STEEL LIST
BRIDGE NO. FRA-270-4900
OVER IR 270

FRA - 270 - 49.00
PID No. 83988


AS BUILT - 4/22/2016

5/23/2016 7:32:25 AM kevinj

G:\projects\2014\W-14-039 FRA-270-49.00\83988\structures\FRA270_4900L\sheets\270_4900L\003.dgn

MARK	TOTAL	LENGTH	WEIGHT (LBS.)	TYPE	DIMENSIONS						
					A	B	C	D	E	R	INC
PARAPET											
R501	156	30'-0"	4881	ST							
R502	24	9'-4"	234	ST							
R503	831	7'-5"	6428	23	1'-1"	3'-2"	3'-0"				2 3/4"
R504	4	16'-4"	68	ST							
R505	4	10'-7"	44	ST							
R506	20	5'-6"	115	ST							
R507	12	5'-6"	69	25	1'-8"	2'-5"	1'-4 1/4"	1 1/2"	5"		
R508	3	13'-2"	41	ST							
R509	3	12'-5"	39	ST							
R510	3	11'-1"	35	ST							
R511	3	11'-10"	37	ST							
R512	16	12'-5"	207	ST							
R513	4	15'-6"	65	ST							
R514	4	11'-4"	47	ST							
R601	26	30'-0"	1172	ST							
R602	4	12'-10"	77	ST							
R603	791	2'-8"	3167	1	1'-1"	1'-8 1/2"					
R604	791	3'-7"	4257	28	1'-8 1/2"	1'-1"					
R605	1	8'-11"	13	ST							
R606	10	2'-11"	44	ST							
R607	10	3'-11"	59	13	2'-0"	11"	2 1/8"	1'-1"			
R608	8 SER. OF 11	5'-6" TO 6'-4"	782	ST							1"
R609	8	5'-4"	64	ST							
R610	1	12'-9"	19	ST							
R611	1	11'-5"	17	ST							
* R612	8 SER. OF 11	6'-5" TO 7'-3"	903	1	1'-1"	5'-6" TO 6'-4"					1"
R613	8	4'-6"	54	1	1'-1"	3'-7"					
R614	1	4'-3"	6	ST							
R615	26	2'-11"	114	1	1'-1"	2'-0"					
R616	26	3'-10"	150	28	1'-1"	2'-0"					
SUB-TOTAL			23209								
TOTAL			168599								

BENDING DIAGRAMS

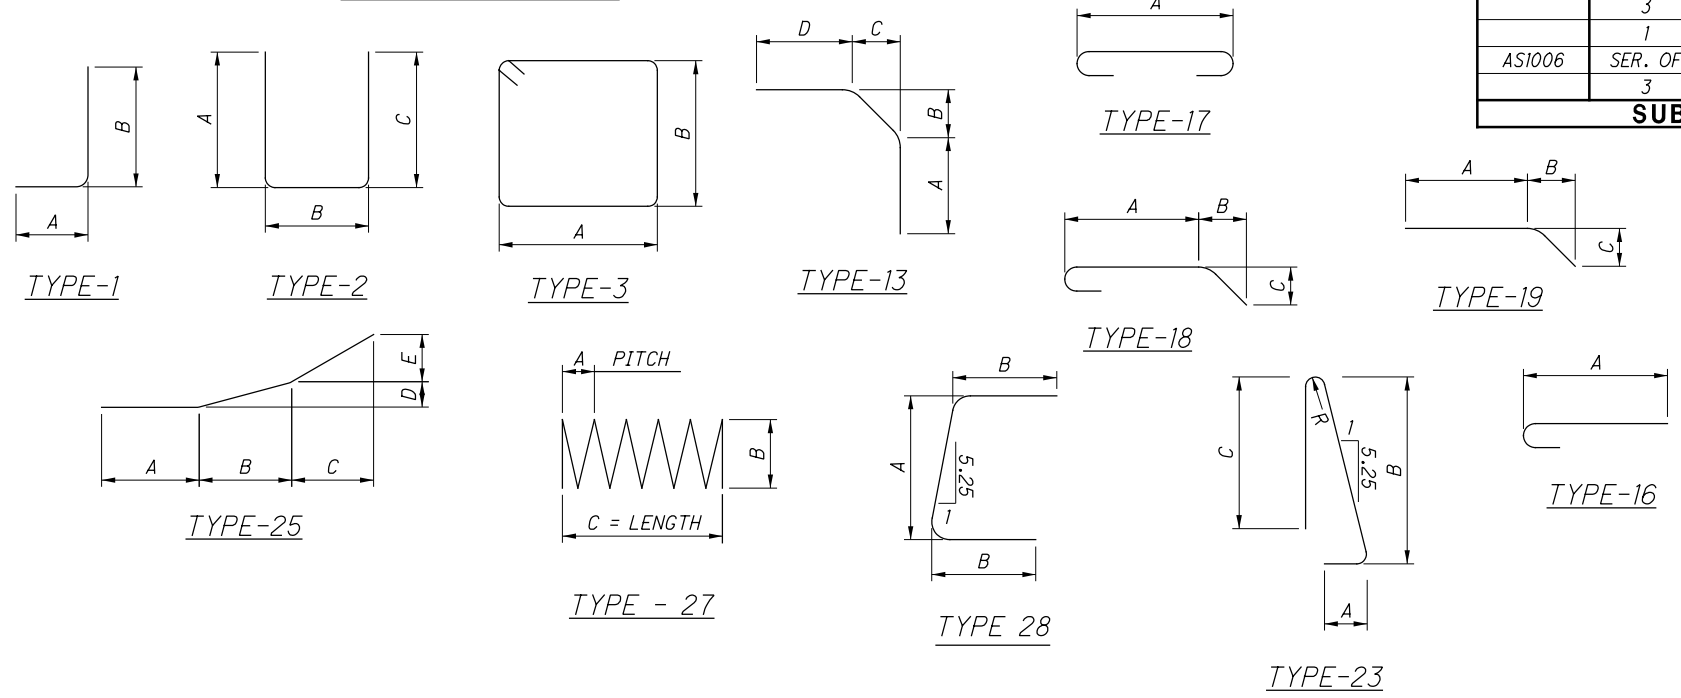

LEGEND:

* - DOWEL BAR

NOTES:

1. THE BAR SIZE NUMBER IS SPECIFIED ON THE PLANS IN THE BAR MARK COLUMN. THE FIRST DIGIT WHERE 3 DIGITS ARE USED, AND THE FIRST 2 DIGITS WHERE FOUR DIGITS ARE USED, INDICATES THE BAR SIZE NUMBER. FOR EXAMPLE, P601 IS A NO. 6 BAR. BAR DIMENSIONS SHOWN ARE OUT TO OUT UNLESS OTHERWISE INDICATED. "R" INDICATES INSIDE RADIUS, UNLESS OTHERWISE NOTED. "STD." WRITTEN IN PLACE OF A DIMENSION INDICATES A STANDARD BEND AT THE END OF THE BAR.

2. ALL REINFORCING STEEL TO BE EPOXY COATED, UNLESS NOTED OTHERWISE.

MARK	TOTAL	LENGTH	WEIGHT (LBS.)	TYPE	DIMENSIONS						
					A	B	C	D	E	R	INC
APPROACH SLABS - INFO ONLY											
AS501	33	24'-6"	847	ST							
AS502	2	23'-3"	49	ST							
AS503	3	24'-3"	76	ST							
AS504	1	23'-2"	25	ST							
AS505	2	23'-9"	50	ST							
AS506	2	24'-4"	51	ST							
AS507	16	19'-2"	320	ST							
AS508	1	19'-0"	20	19	17'-7"	1'-2 1/2"	9 11/16"				
AS509	16	15'-6"	259	ST							
AS510	1	15'-0"	16	19	13'-4"	1'-4 3/4"	11 1/8"				
AS511	1	15'-5"	17	19	14'-6"	9 1/2"	6 1/4"				
AS512	2	3'-10"	8	19	2'-5"	1'-2"	9 3/8"				
AS513	1	18'-9"	20	19	17'-4"	1'-2 1/2"	9 5/8"				
AS514	72	19'-4"	1452	ST							
AS515	1	18'-4"	20	ST							
AS516	1	19'-0"	20	19	17'-3"	1'-5 3/4"	11 7/8"				
AS517	36	15'-8"	589	ST							
AS518	1	14'-5"	16	ST							
AS519	1	15'-0"	16	19	13'-3"	1'-5 3/4"	11 7/8"				
AS520	NOT	USED									
AS521	NOT	USED									
AS522	1	18'-1"	19	ST							
AS523	1	18'-10"	20	19	17'-0"	1'-5 3/4"	11 7/8"				
AS524	1	15'-2"	16	ST							
AS525	1	15'-10"	17	19	14'-0"	1'-5 3/4"	11 7/8"				
AS526	16	19'-2"	320	ST							
AS527	15	16'-1"	252	ST							
AS528	36	19'-2"	720	ST							
AS529	36	16'-1"	604	ST							
AS530	1	25'-0"	27	ST							
ASI001	60	3'-0"	775	ST							
ASI002	86	25'-11"	9592	16	24'-6"						
	1	25'-1"			23'-8"						
ASI003	SER. OF 3	TO 25'-10"	329	16	TO						4 1/2"
	2	24'-10"			23'-5"						
ASI004	SER. OF 4	TO 25'-11"	874	16	TO						4 1/2"
	1	24'-11"			24'-6 1/2"						
ASI005	SER. OF 3	TO 25'-8"	327	16	TO						4 1/2"
	1	26'-1"			24'-3"						
	3	26'-11"			24'-8"						
ASI006	SER. OF 3	TO 26'-11"	342	16	TO						5"
SUB-TOTAL			18104								

RESOURCE INTERNATIONAL INC.
 6350 PRESIDENTIAL GATEWAY
 COLUMBUS, OHIO 43231
 (614) 823-4849

Ri

DATE: 12/01/2015
 REVISED: NCK
 DRAWN: JGM
 CHECKED: JLM
 STRUCTURE FILE NUMBER: 2513862

DESIGNED: JGM
 REINFORCING STEEL LIST
 BRIDGE NO.: FRA-270-4900
 OVER IR 270

BU 4, 5, 6, 7, & 8 - RELEASED FOR CONSTRUCTION - 11/03/2014 - 11/19/2015


FRA - 270 - 49 . 00
 PID No. 83988

32 / 32
 178
 182

AS BUILT - 4/22/2016

R/W FENCE SYMBOLS

- ⓔ END POST ASSEMBLY
- ⓐ CORNER POST ASSEMBLY
- ⓓ INTERMEDIATE ANCHOR POST
LINK BRACE POST ASSEMBLY

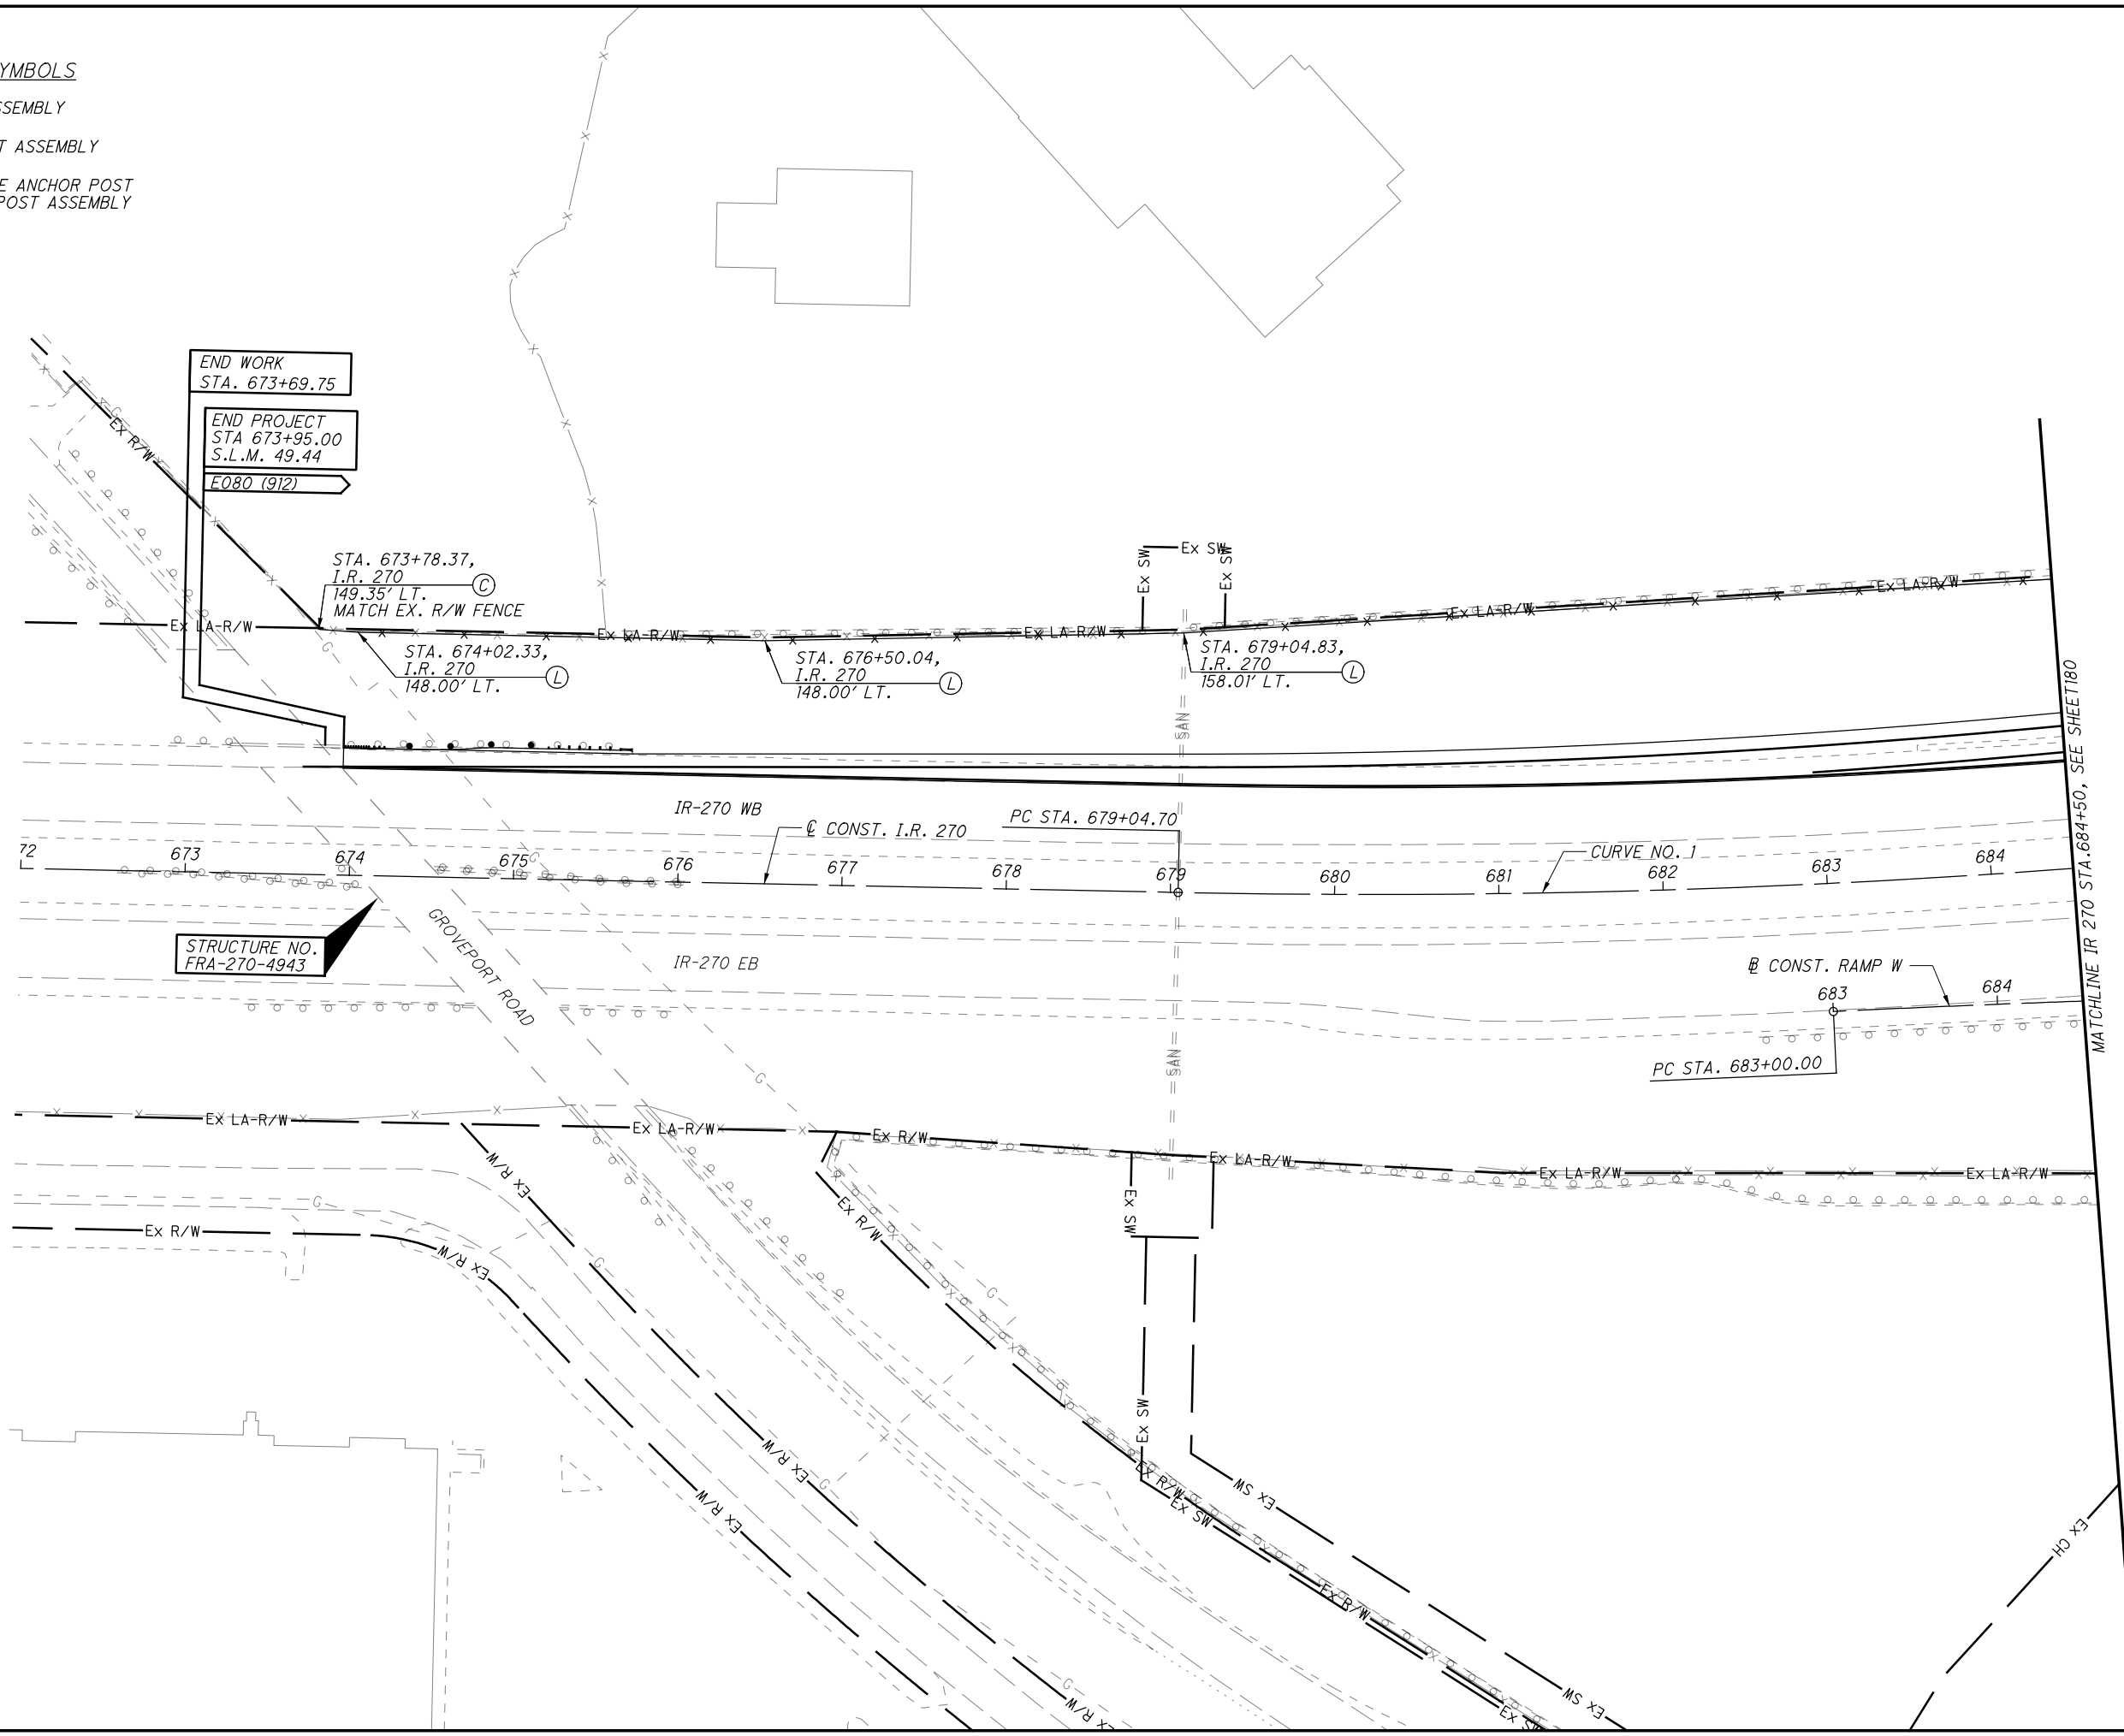

CALCULATED
CFR
CHECKED
SSK

0 50 100
HORIZONTAL
SCALE IN FEET

179
182

BU 4, 5, 6, 7, & 8 - RELEASED FOR CONSTRUCTION - 11/03/2014 - 11/19/2015


FENCE PLAN
STA. 672+00.00 TO STA. 684+50.00

G:\projects\2014\W-14-039 FRA-270-49.00\83988\roadway\sheets\83988GX001.dgn 5/23/2016 7:32:26 AM kevinj

- R/W FENCE SYMBOLS
- (E) END POST ASSEMBLY
 - (C) CORNER POST ASSEMBLY
 - (I) INTERMEDIATE ANCHOR POST
LINK BRACE POST ASSEMBLY

CALCULATED
CFR
CHECKED
SSK

HORIZONTAL SCALE IN FEET

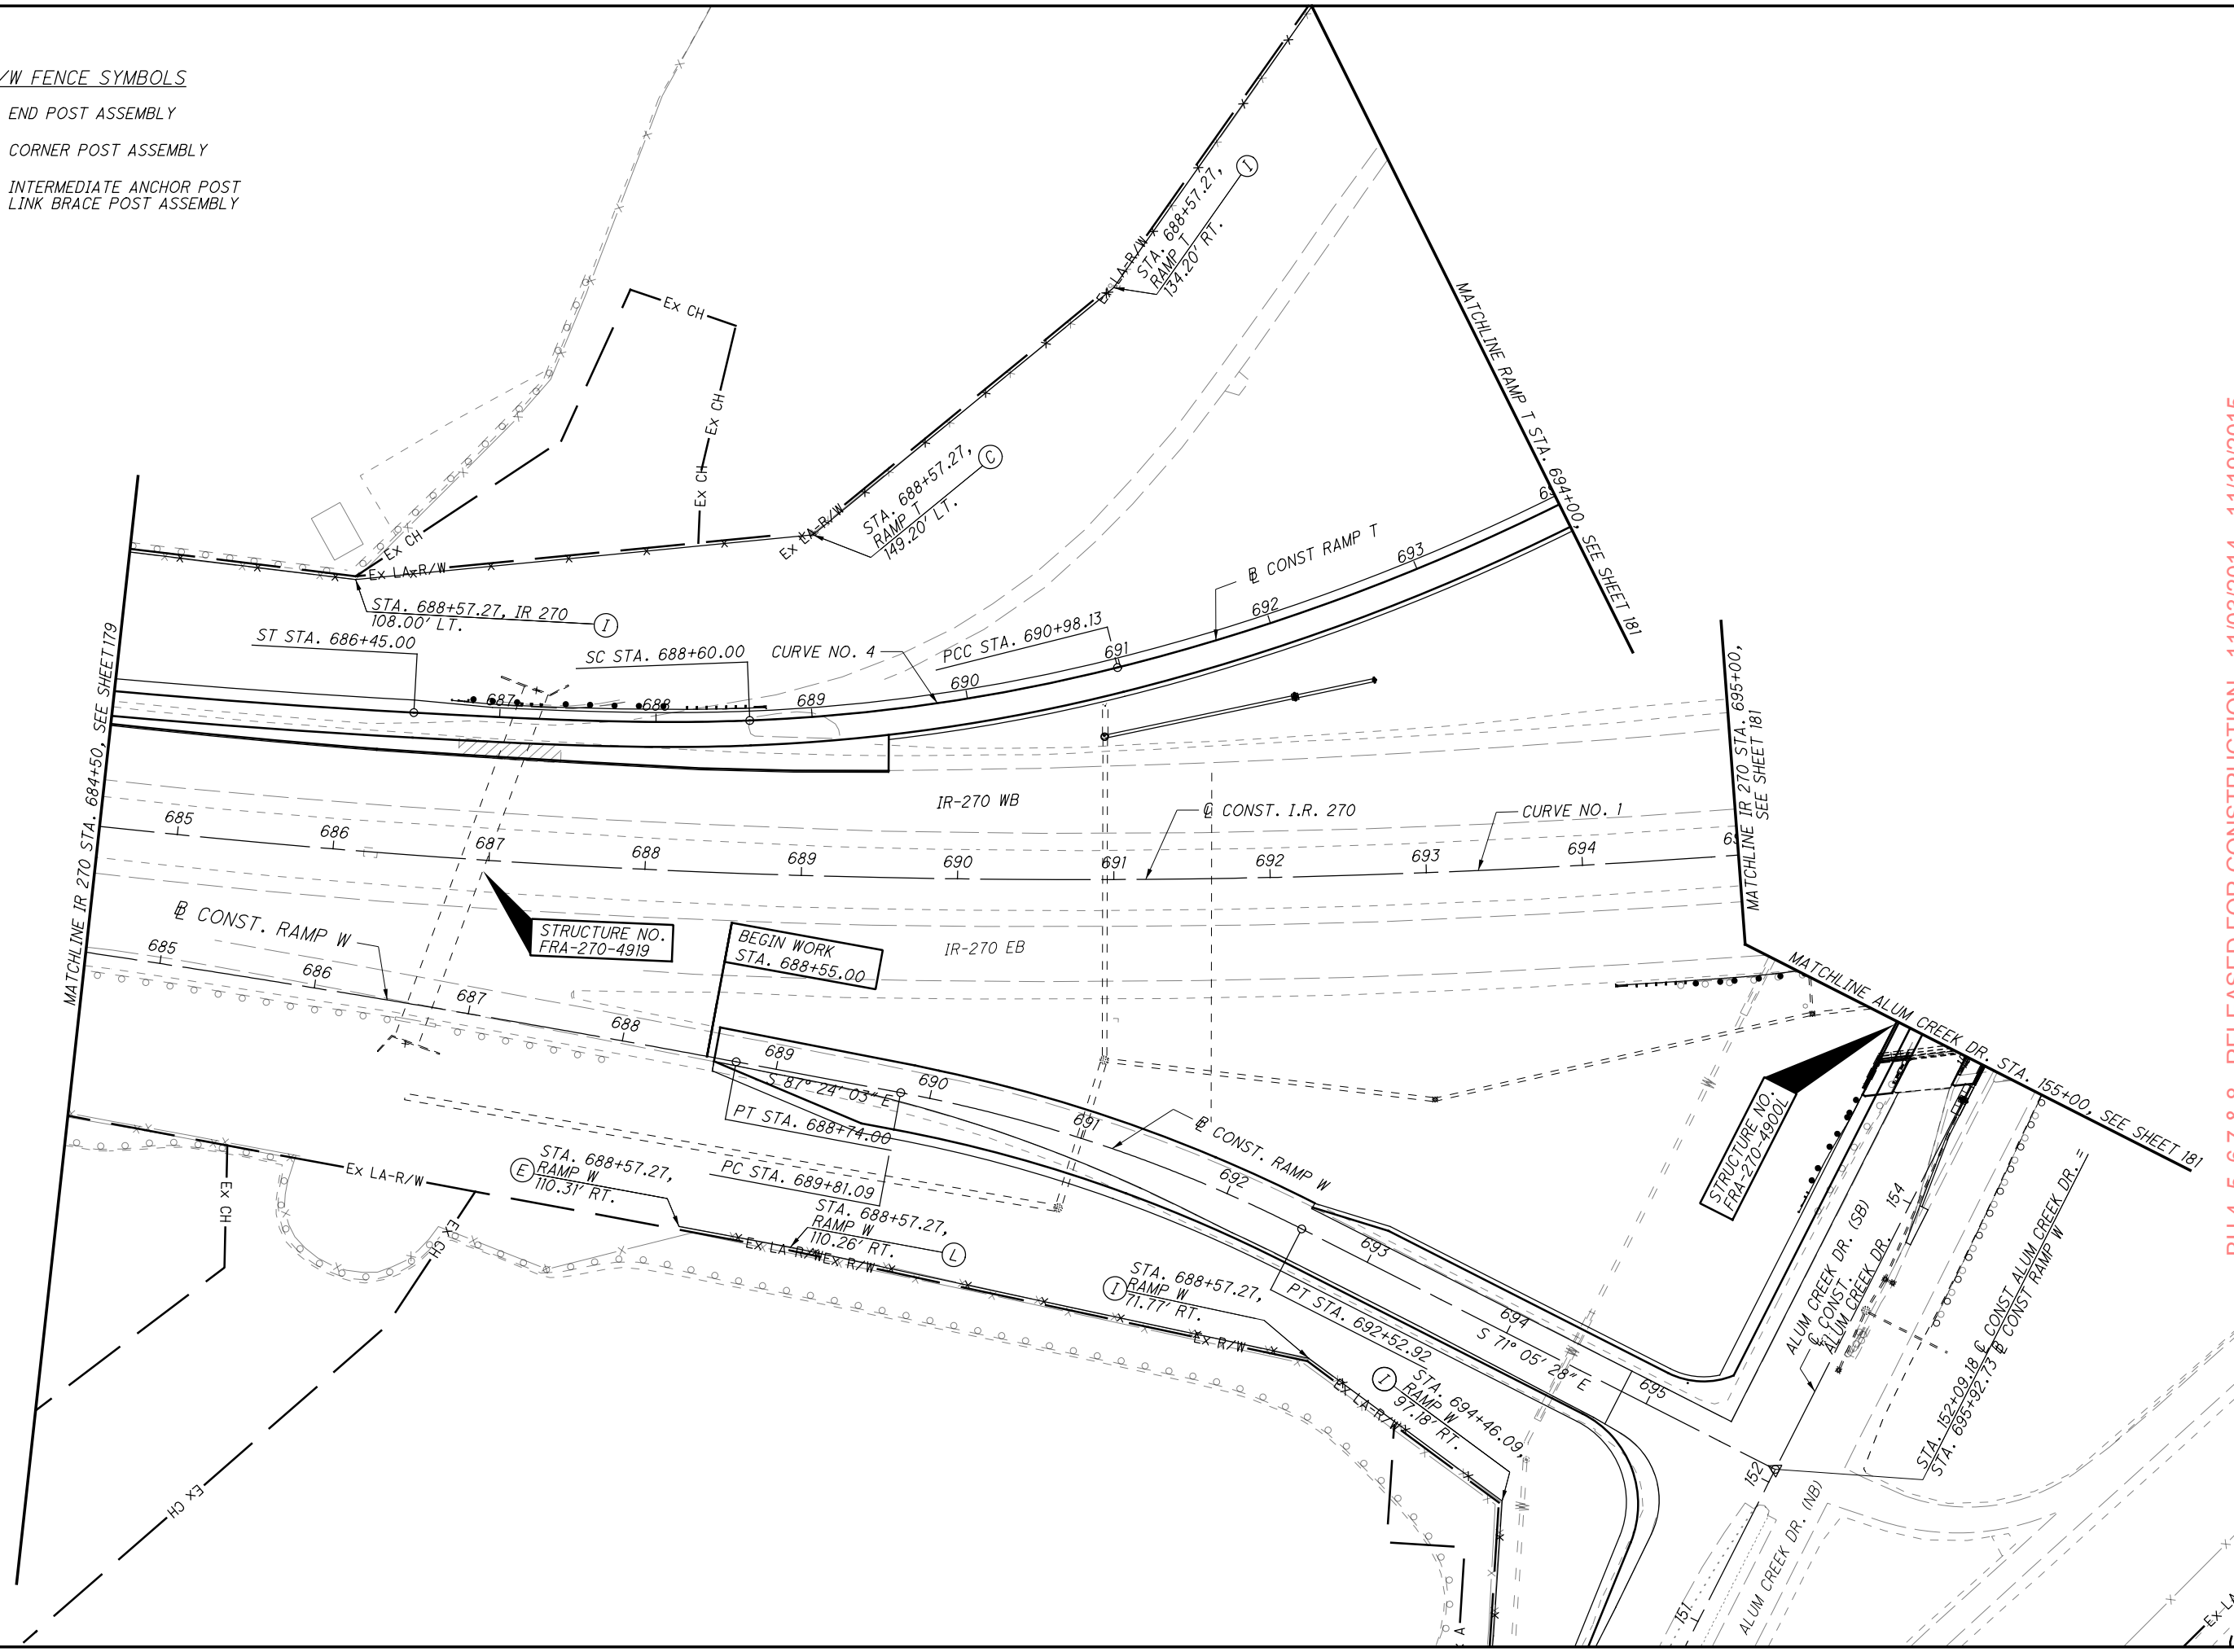


BU 4.5, 6.7, & 8 - RELEASED FOR CONSTRUCTION - 11/03/2014 - 11/19/2015

FENCE PLAN
STA 684+50.00 TO STA. 695+00.00

FRA - 270 - 49.00

180
182

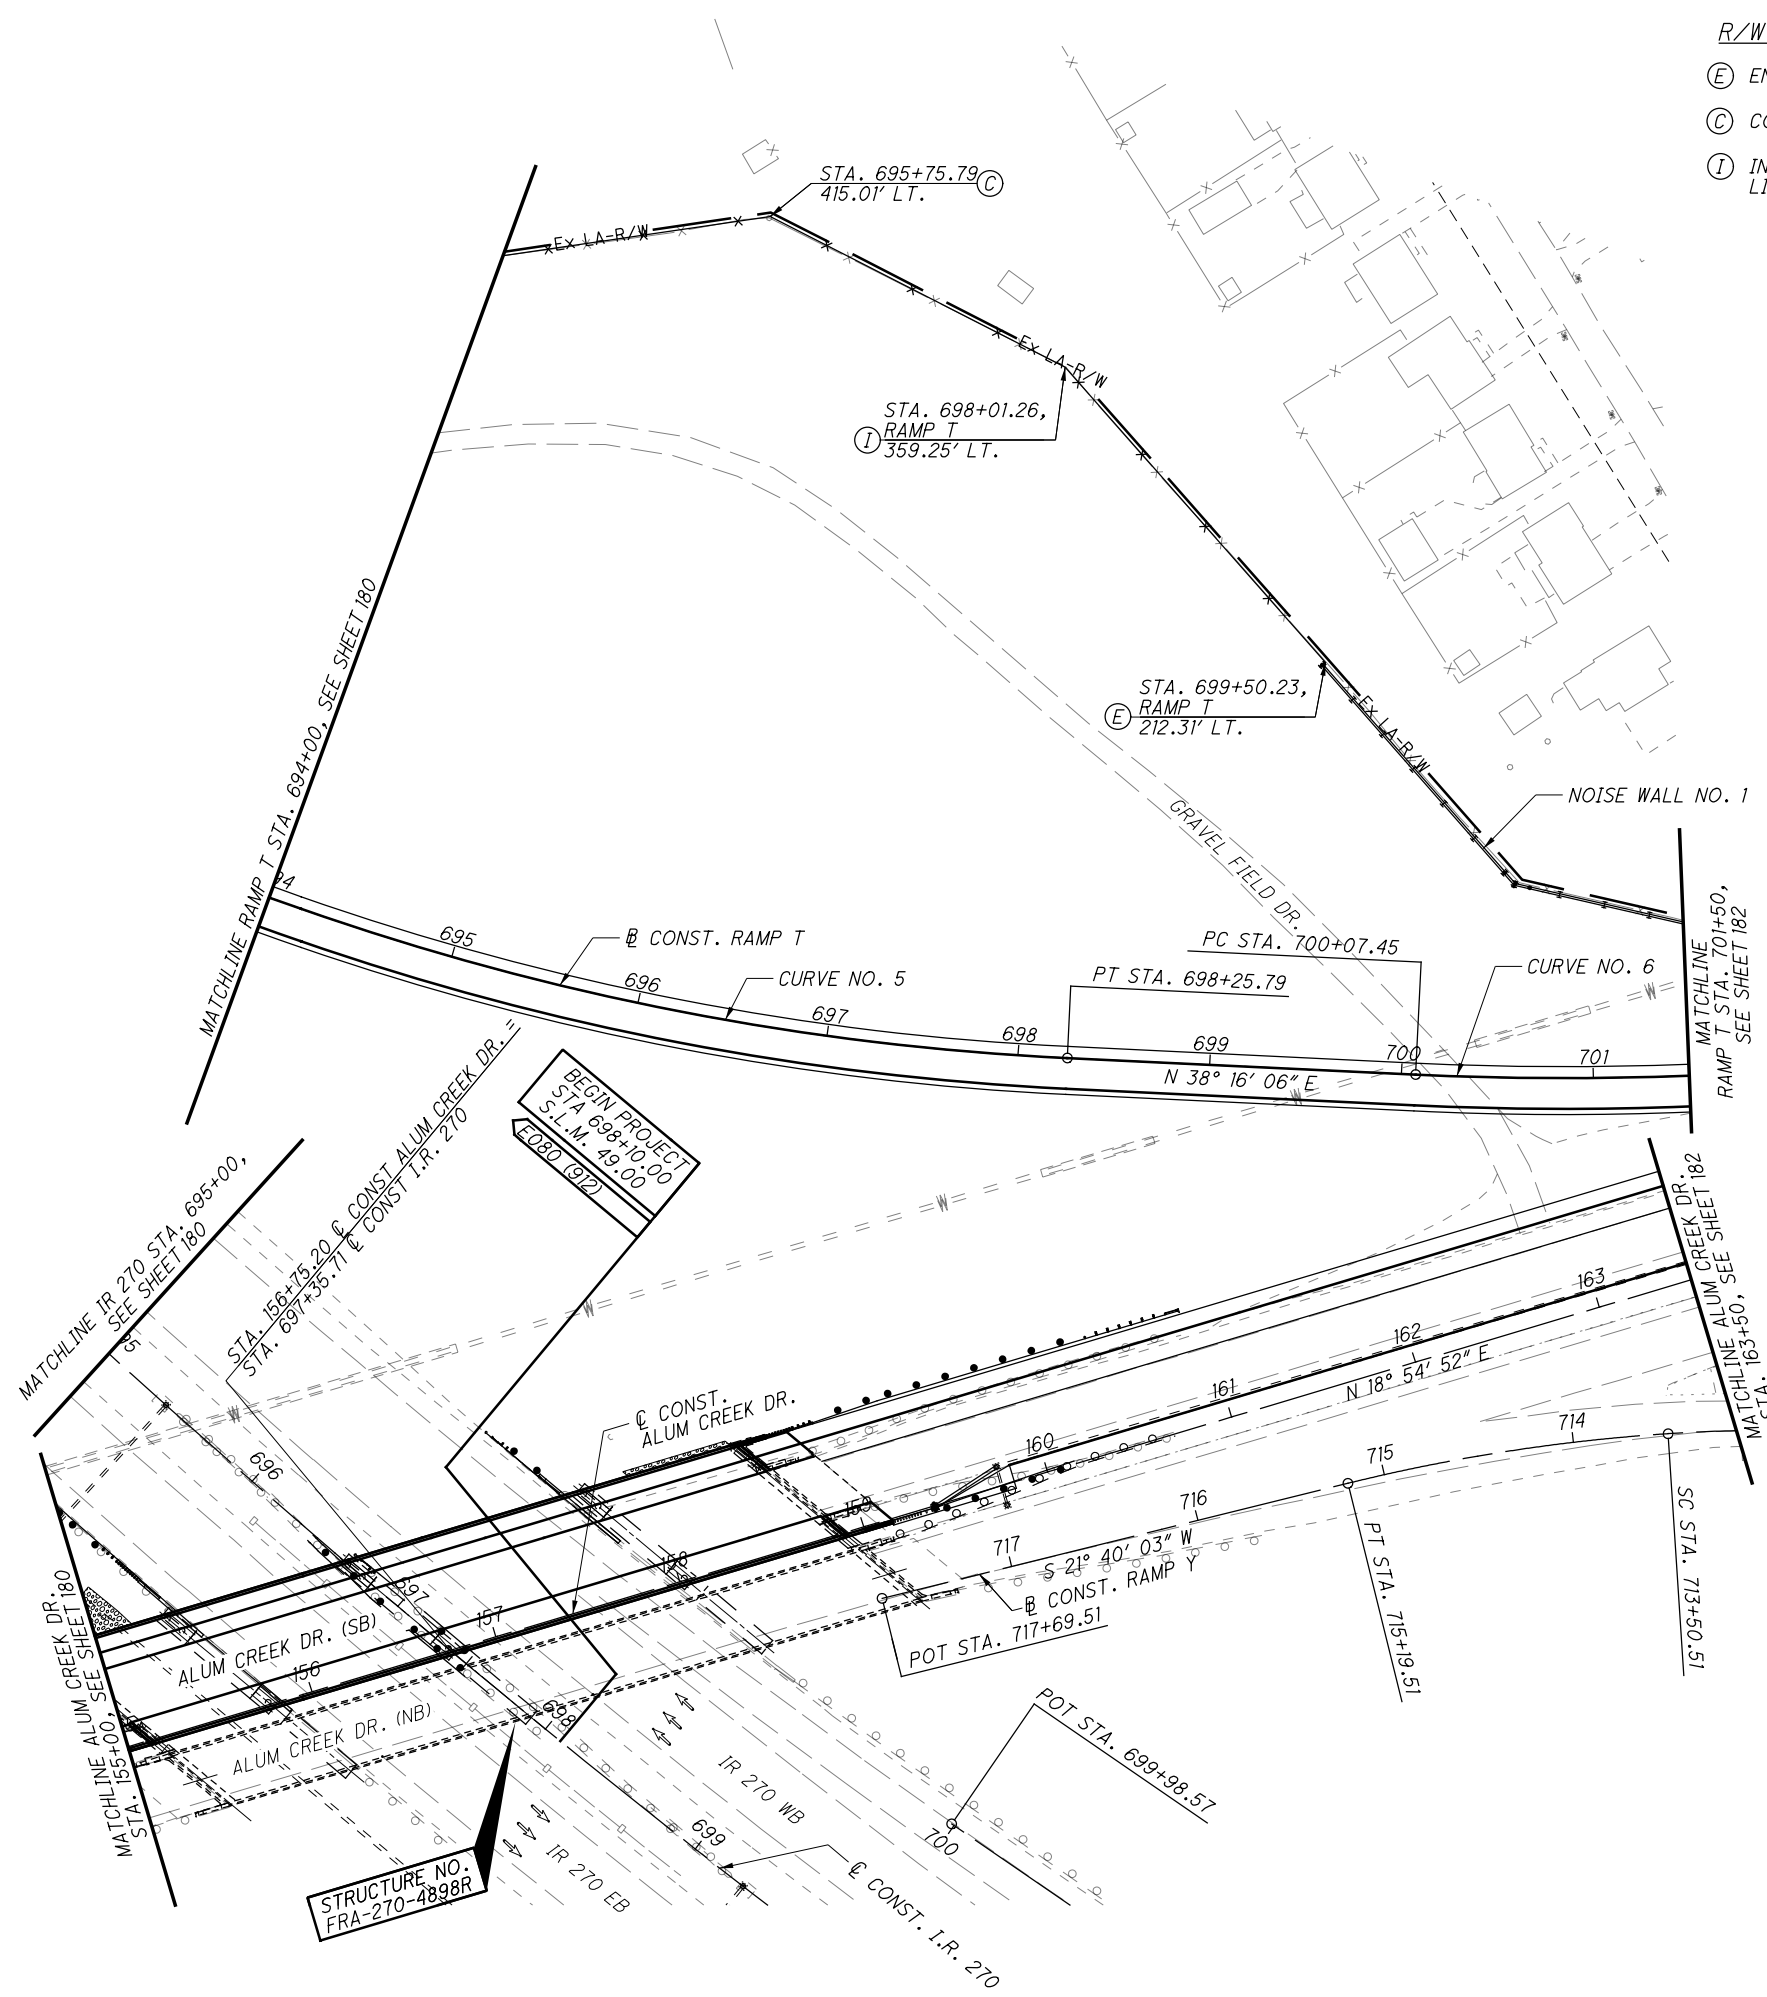

R/W FENCE SYMBOLS


- (E) END POST ASSEMBLY
- (C) CORNER POST ASSEMBLY
- (I) INTERMEDIATE ANCHOR POST LINK BRACE POST ASSEMBLY

CALCULATED
CFR
CHECKED
SSK

0 50 100
HORIZONTAL
SCALE IN FEET

AS BUILT - 4/22/2016

G:\projects\2014\W-14-039 FRA-270-49.00\83988\roadway\sheets\83988GX004.dgn 5/23/2016 7:32:28 AM kevinj

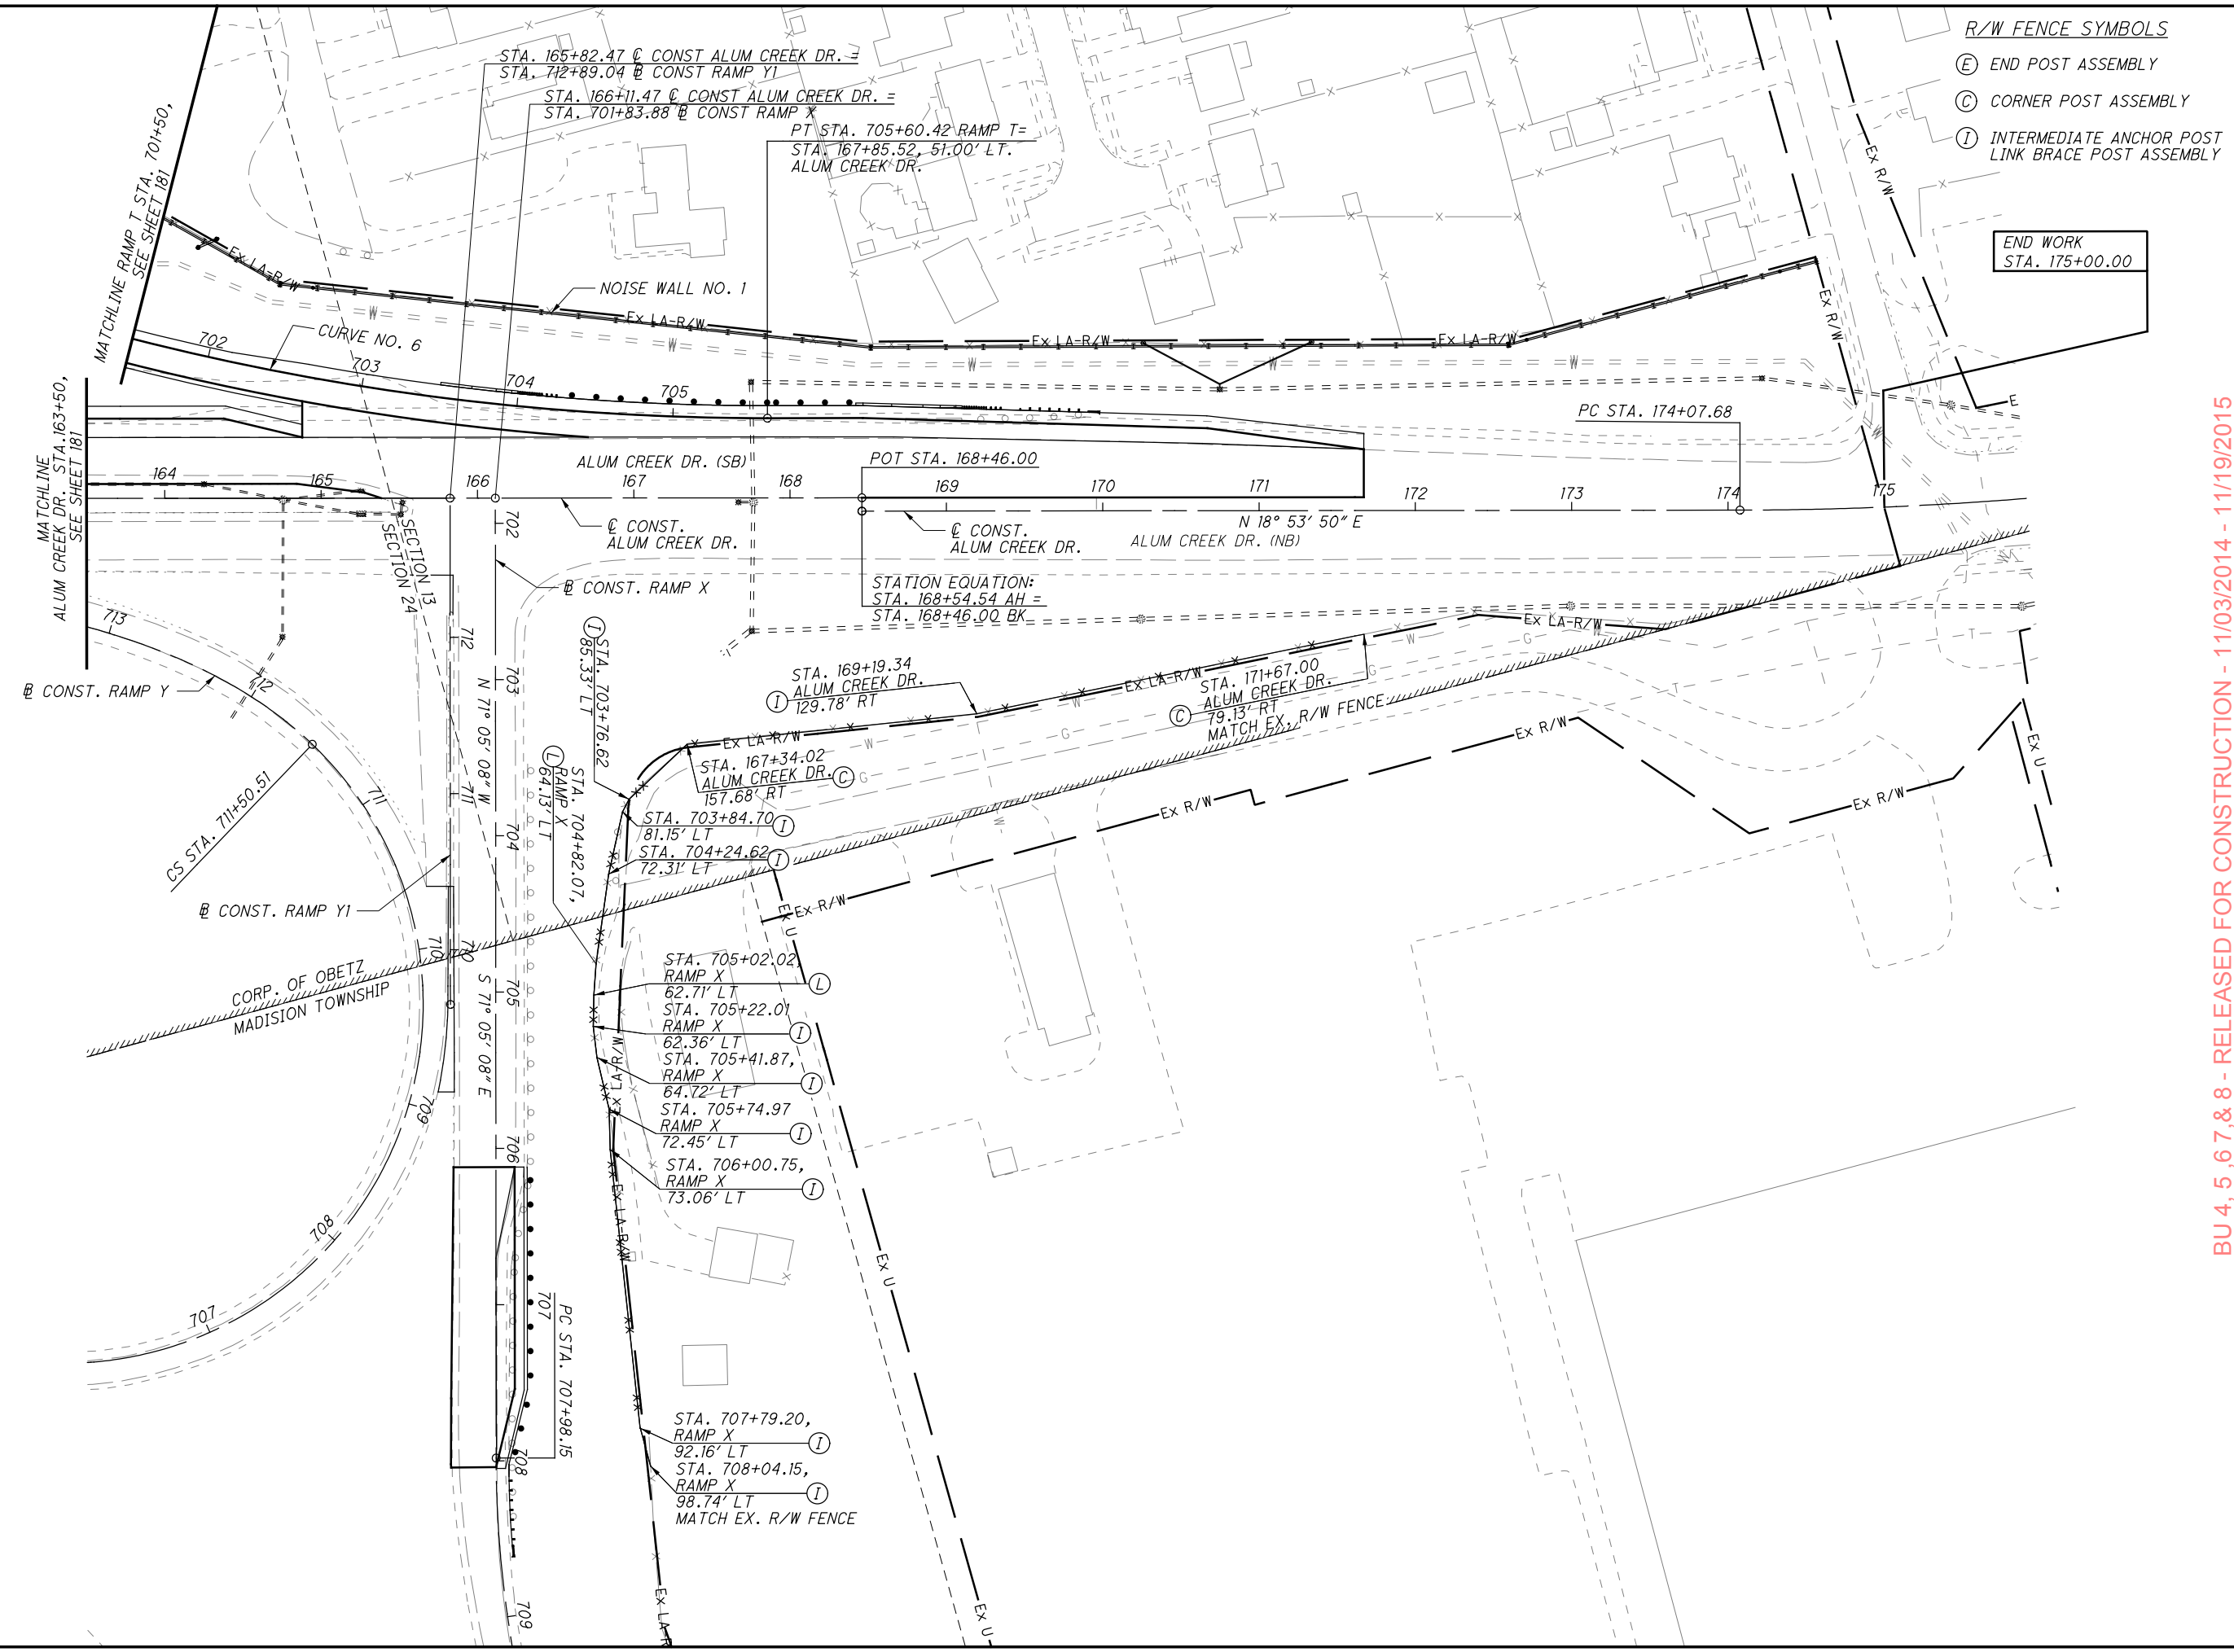

- R/W FENCE SYMBOLS
- (E) END POST ASSEMBLY
 - (C) CORNER POST ASSEMBLY
 - (I) INTERMEDIATE ANCHOR POST LINK BRACE POST ASSEMBLY

CALCULATED
CFR
CHECKED
SSK

0 50 100
25
HORIZONTAL
SCALE IN FEET

BU 4, 5, 6, 7, & 8 - RELEASED FOR CONSTRUCTION - 11/03/2014 - 11/19/2015

FENCE PLAN

STA. 163+50.00 TO 176+00.00

FRA - 270-49.00