

STATE OF OHIO  
DEPARTMENT OF TRANSPORTATION


# FRA - 270 - 51.50 PART 1

CITY OF COLUMBUS  
HAMILTON TOWNSHIP  
FRANKLIN COUNTY


FOR PART 2, SEE FRA-23-4.19 (PID 110380)

INDEX OF SHEETS:

TITLE SHEET	1	PLAN AND PROFILE - RAMP P2	257 - 258
TRAFFIC DATA	2	CROSS SECTIONS - RAMP P2	259 - 264
SCHEMATIC PLAN	3 - 4	PLAN - RAMP Q	265 - 266
CONTROL POINTS	5 - 6	PLAN AND PROFILE - RAMP R	267 - 272
STANDARD ABBREVIATIONS	7	CROSS SECTIONS - RAMP R	273 - 300
TYPICAL SECTIONS	8 - 14	PLAN AND PROFILE - RAMP S	301 - 304
GENERAL NOTES	15 - 19	CROSS SECTIONS RAMP S	305 - 319
MAINTENANCE OF TRAFFIC	20 - 76	PLAN AND PROFILE - ACCESS ROAD	320
GENERAL SUMMARY	77 - 84	EARTHWORK AND SEEDING SUBSUMMARY	321 - 324
SUBSUMMARIES	85 - 100	SUPERELEVATION TABLE	325 - 332
PROJECT SITE PLAN	101	INTERSECTION DETAILS	333 - 334
PLAN - IR 270 EASTBOUND	102 - 104	PAVEMENT DETAILS	335 - 348
PLAN - IR 270 WESTBOUND	105 - 108	DRIVEWAY PROFILES	349 - 350
CROSS SECTIONS - IR 270 WESTBOUND	109 - 137	CONCRETE JOINT DETAILS	351 - 359
PLAN AND PROFILE - IR 270 EASTBOUND MERGE	138 - 143	STORM SEWER PROFILES	360 - 366
CROSS SECTIONS - IR 270 EASTBOUND MERGE	144 - 171	CULVERT DETAILS	367 - 376
PLAN AND PROFILE - IR 270 CD LANE	172 - 173	DRIVE PIPE DETAILS	377
PLAN - US 23	174 - 175	FLAP GATE DETAILS	378
PLAN AND PROFILE - US 23 ACCEL. LANE	176 - 178	SIGNING AND PAVEMENT MARKINGS	379 - 391
CROSS SECTIONS - US 23 ACCEL. LANE	179 - 188	SIGNING ELEVATION DETAILS	392 - 398
PLAN AND PROFILE - US 23 DECEL. LANE	189 - 191	TRAFFIC SIGNAL PLANS	399 - 414
CROSS SECTIONS - US 23 DECEL. LANE	192 - 201	TRAFFIC SIGNAL INTERCONNECT PLANS	415 - 428
PLAN AND PROFILE - RAMP L	202 - 207	LIGHTING PLANS	429 - 455
CROSS SECTIONS - RAMP L	208 - 219	LIGHTING CIRCUIT DIAGRAMS	456 - 469
PLAN AND PROFILE - RAMP M	220 - 222	OVERHEAD POWER	470 - 482
PLAN - RAMP N	223 - 224	STRUCTURES OVER 20' (FRA-023-0517)	483 - 504
PLAN AND PROFILE - RAMP O	225 - 227	STRUCTURES OVER 20' (FRA-270-5264)	505 - 545
PLAN AND PROFILE - RAMP P1	228 - 233	RIGHT OF WAY PLANS	546 - 554
CROSS SECTIONS - RAMP P1	234 - 256	SOIL PROFILES	

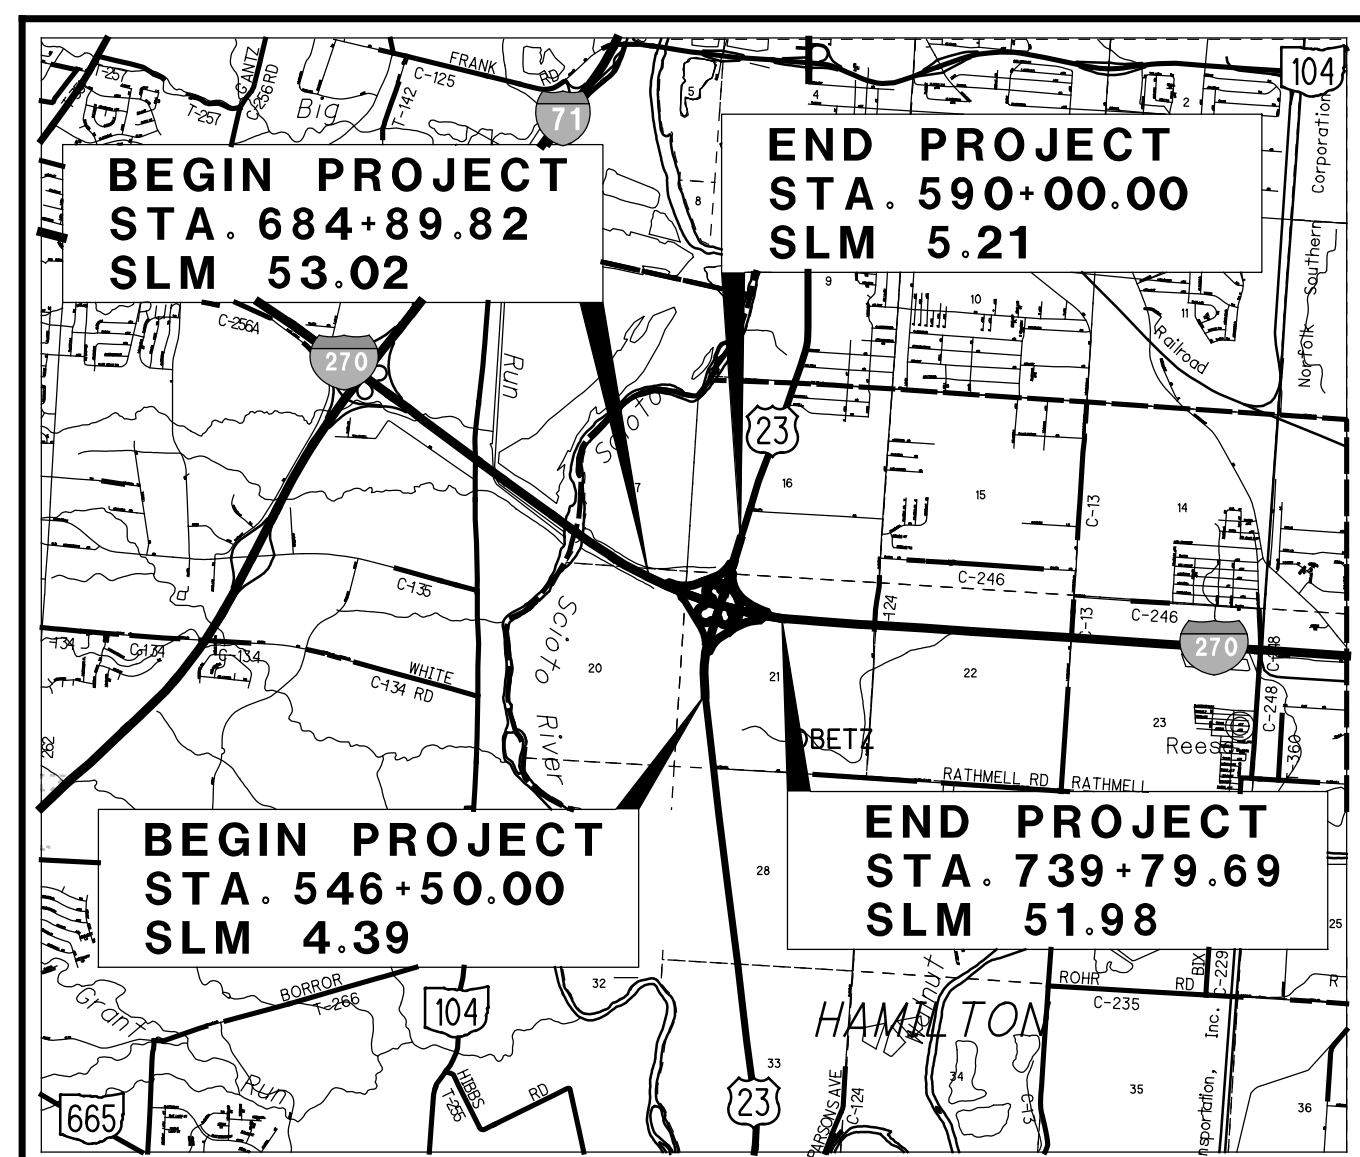

LOCATION MAP  
LATITUDE: 39° 52' 30" LONGITUDE: 83° 00' 14"  
SCALE IN MILES

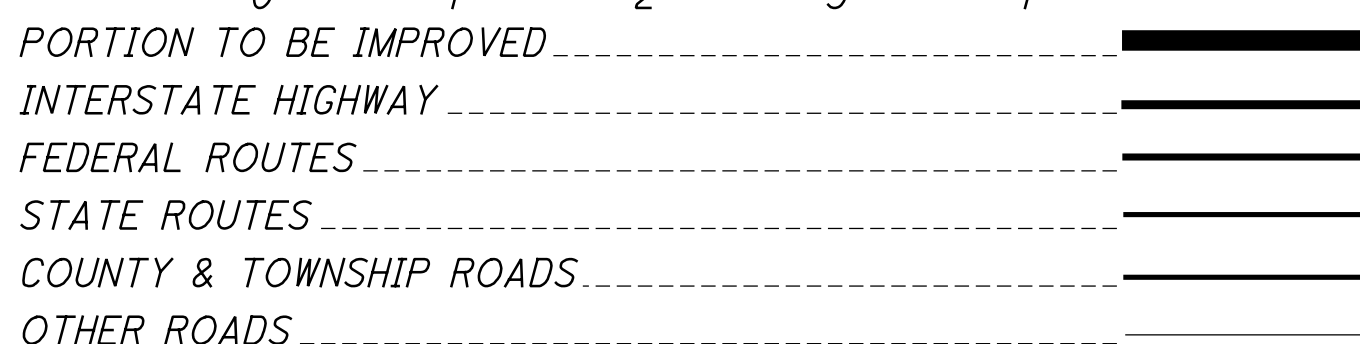

DESIGN DESIGNATION - SEE SHEET 2

ENGINEERS SEAL:  
  
SIGNED:  
DATE:  
SHEETS: 429-482

**UNDERGROUND UTILITIES**  
CONTACT BOTH SERVICES  
CALL TWO WORKING DAYS  
**BEFORE YOU DIG**  
CALL  
**1-800-362-2764**  
(TOLL FREE)  
OHIO UTILITIES PROTECTION SERVICE  
NON-MEMBERS  
MUST BE CALLED DIRECTLY  
OIL & GAS PRODUCERS UNDERGROUND  
PROTECTION SERVICE CALL: **1-800-925-0988**

ENGINEERS SEAL:  
  
SIGNED:  
DATE:  
SHEETS: 483-545

ENGINEERS SEAL:  
  
SIGNED:  
DATE:  
SHEETS: 1 - 428

PARTS 1 AND 2

ODOT STANDARD CONSTRUCTION DRAWINGS										COC STANDARD CONSTRUCTION DRAWINGS										SUPPLEMENTAL SPECIFICATIONS	
BP-2.1	1/21/22	DM-4.4	1/15/16	ITS-14.10	1/21/22	MT-95.41	1/17/20	MT-105.10	1/17/20	TC-51.12	1/15/16	1500	9/15/15	4170	7/1/21	MIS-1	1/1/18	SS800	SEE PROPOSAL		
BP-2.2	1/15/21	F-1.1	7/19/13	ITS-15.10	1/15/21	MT-95.45	1/17/20	MT-120.00	7/15/22	TC-52.10	10/18/13	1510	9/15/15	4200	8/1/15	MIS-2	1/1/18	SS804	7/15/22		
BP-2.3	7/18/14	F-3.1	7/19/13	ITS-15.11	1/15/21	MT-95.50	7/21/17	RM-1.1	1/15/21	TC-52.20	1/15/21	1520	9/15/15	4202	8/10/17	MIS-3	1/1/18	SS809	7/15/22		
BP-2.5	1/21/22	F-3.2	7/18/14	ITS-18.10	7/16/21	MT-95.82	7/19/13	RM-4.2	4/17/20	TC-65.10	1/17/14	1540	9/15/15	4205	5/1/14	MIS-4	1/1/18	SS813	10/19/18		
BP-3.1	1/21/22	F-3.3	7/19/13	ITS-30.11	4/16/21	MT-96.11	4/16/21	RM-4.3	1/21/22	TC-65.11	7/15/22	1550	9/15/15	4253	5/1/14	MIS-5A	1/1/18	SS825	1/17/20		
BP-4.1	7/19/13	F-3.4	7/19/13	ITS-30.12	4/16/21	MT-96.26	1/18/19	RM-4.4	7/19/19	TC-71.10	7/15/22	4000	8/10/17	4330	8/10/17	MIS-5AAPP	1/1/18	SS832	7/15/22		
BP-5.1	7/15/22	HL-10.11	7/15/22	ITS-30.13	4/16/21	MT-97.12	1/20/17	TC-12.31	1/21/22	TC-72.20	7/20/18	4001	8/1/15	4331	5/1/14	MIS-56	1/1/18	SS833	1/21/22		
BP-6.1	7/19/13	HL-10.12	1/20/17	ITS-30.14	1/15/21	MT-97.11	1/20/17	TC-15.116	7/16/21	TC-73.20	1/17/20	4002	5/1/14	4600	7/1/20	MIS-57	1/1/18	SS839	7/16/21		
BP-9.1	1/18/19	HL-10.13	4/17/20	ITS-50.10	1/15/21	MT-98.10	1/17/20	TC-16.22	7/16/21	TC-81.11	7/16/21	4020	5/1/14	4602	7/1/20	MIS-58	1/1/18	SS844	4/20/18		
BP-9.2	1/15/21	HL-10.31	7/15/22	MGS-1.1	7/16/21	MT-98.11	1/17/20	TC-21.11	7/16/21	TC-83.10	1/17/20	4021	7/1/20	4603	7/1/20	MIS-202	1/1/18	SS861	1/15/21		
CB-1.1	7/16/21	HL-20.11	1/15/21	MGS-2.1	1/19/18	MT-98.21	1/17/20	TC-21.21	7/15/22	TC-83.20	7/15/22	4022	7/1/20	4650	7/1/20	MIS-301	1/1/18	SS878	1/21/22		
CB-2-2B	7/15/22	HL-20.21	1/15/21	MGS-3.2	1/18/13	MT-99.20	4/19/19	TC-22.10	4/17/20	TC-84.20	10/18/13	4023	7/1/20			MIS-302	1/1/18	SS904	7/15/22		
CB-5A,8A	7/16/21	HL-30.11	1/15/21	MGS-4.2	7/19/13	MT-99.30	1/17/20	TC-22.20	1/17/14	TC-84.21	10/18/13	4051	5/1/14			MIS-402	1/1/18	SS909	10/21/22		
CB-5	7/16/21	HL-30.21	4/17/20	MGS-4.3	1/18/13	MT-99.60	7/15/16	TC-41.10	7/19/13	TC-85.10	7/15/16	4104	8/10/17			MIS-403	1/1/18	SS913	4/16/21		
CB-6	1/21/22	HL-30.22	1/15/21	MGS-5.2	7/15/16	MT-101.60	1/17/20	TC-41.20	10/18/13	TC-85.21	7/16/21	4105	8/10/17	L-6309B	9/1/22	MIS-404	1/1/18	COC1611	2/1/13		
CB-8	7/16/21	HL-40.20	7/15/22	MGS-5.3	7/15/16	MT-101.70	1/17/20	TC-41.30	10/18/13	TC-85.22	1/19/18	4110	10/1/18	L-6310	1/26/18	MIS-501	1/1/18	COC1620	9/10/18		
DM-1.1	7/17/20	HL-60.11	7/21/17	MGS-6.1	1/19/18	MT-101.75	1/17/20	TC-41.40	10/18/13			4122	10/1/18	L-6311	1/26/18	MIS-603	1/1/18				
DM-1.2	7/16/21	HL-60.31	1/17/20	MH-3	7/16/21	MT-101.80	1/17/20	TC-41.41	7/19/19			4160	10/1/18	L-6316B	1/26/18	MIS-700	1/1/18				
DM-1.3	7/18/14	HW-2.1	7/20/18	MT-95.30	7/19/19	MT-101.90	7/17/20	TC-41.50	10/18/13			4161	8/1/15	L-8508B	9/21/22	MIS-702	1/1/18				
DM-4.1	7/17/20	HW-2.2	7/20/18	MT-95.31	7/19/19	MT-102.10	1/17/20	TC-42.10	10/18/13			4162	7/1/20			MIS-800	1/1/18				
DM-4.2	7/20/12	ITS-10.11	7/18/15	MT-95.32	4/19/19	MT-102.20	4/19/19	TC-42.20	10/18/13			4163	7/1/21								
DM-4.3	1/15/16	ITS-14.11	1/21/22	MT-95.40	1/17/20	MT-103.10	1/21/22	TC-51.11	1/15/16			4164	10/1/20								

**PROJECT DESCRIPTION**  
THIS PROJECT CONSISTS OF THE REMOVAL OF RAMP N (IR 270 WEST TO US 23 SOUTH) AND RAMP Q (IR 270 EAST TO US 23 NORTH). WORK INCLUDES THE RECONFIGURATION OF RAMP P1 (IR 270 EAST) AND RAMP S (IR 270 WEST), THE CONSTRUCTION OF A SINGLE LEFT TURN LANE AT RAMP S AND US 23, AND THE CONSTRUCTION OF TWO SIGNALIZED INTERSECTIONS TO PROVIDE ACCESS TO US 23 NORTH AND SOUTH. WORK ALSO INCLUDES FULL DEPTH PAVEMENT AND PAVEMENT OVERLAY ON RAMPS L, M, O, P1, AND S.

**EARTH DISTURBED AREAS**  
PROJECT EARTH DISTURBED AREA: 78.0 ACRES  
ESTIMATED CONTRACTOR EARTH DISTURBED AREA: 9.22 ACRES  
NOTICE OF INTENT EARTH DISTURBED AREA: 87.2 ACRES  
**LIMITED ACCESS**

THIS IMPROVEMENT IS ESPECIALLY DESIGNED FOR THROUGH TRAFFIC AND HAS BEEN DECLARED A LIMITED ACCESS HIGHWAY OR FREEWAY BY ACTION OF THE DIRECTOR IN ACCORDANCE WITH THE PROVISIONS OF SECTION 5511.02 OF THE OHIO REVISED CODE.

**2019 SPECIFICATIONS**  
THE STANDARD SPECIFICATIONS OF THE STATE OF OHIO, DEPARTMENT OF TRANSPORTATION, INCLUDING SUPPLEMENTAL SPECIFICATIONS LISTED IN THE PLANS AND CHANGES LISTED IN THE PROPOSAL SHALL GOVERN THIS IMPROVEMENT.

I HEREBY APPROVE THESE PLANS AND DECLARE THAT THE MAKING OF THIS IMPROVEMENT WILL NOT REQUIRE THE CLOSING TO TRAFFIC OF THE HIGHWAY EXCEPT AS NOTED ON SHEET 20, AND THAT DETOURS WILL BE PROVIDED AS INDICATED ON THE PLANS.

APPROVED \_\_\_\_\_  
DATE \_\_\_\_\_ DISTRICT DEPUTY DIRECTOR

APPROVED \_\_\_\_\_  
DATE \_\_\_\_\_ DIRECTOR, DEPARTMENT OF TRANSPORTATION

PLAN CERTIFIED AS TO COMPLETENESS AND QUALITY

SIGNATURE \_\_\_\_\_ DATE \_\_\_\_\_  
FIRM \_\_\_\_\_ TITLE \_\_\_\_\_

FIRM # 39049C0319K

PLAN PREPARED BY:  
**LDLZ**  
ARCHITECTURE • ENGINEERING • PLANNING  
SURVEYING • CONSTRUCTION SERVICES  
INNOVATIVE IDEAS  
EXCEPTIONAL DESIGN  
UNMATCHED CLIENT SERVICE

DLZ OHIO, INC.  
6121 HUNTLEY RD.  
COLUMBUS, OH 43229


ADDENDUM #1  
04/21/2023

FEDERAL PROJECT NO. **E131 (486)**  
CONSTRUCTION PROJECT NO. **92616**  
RAILROAD INVOLVEMENT **NONE**  
**FRA - 270 - 51.50**  
1  
554  
**3196 - E**

X:\Projects\2013\1321\1010\FRA\92616\roadway\sheet\92616GT001.dgn 4/25/2023 6:01:38 AM c.wong



X:\Projects\2013\1010\FRA\92616\roadway\sheet\92616GB001A.dgn 4/18/2023 1:44:09 PM cwong

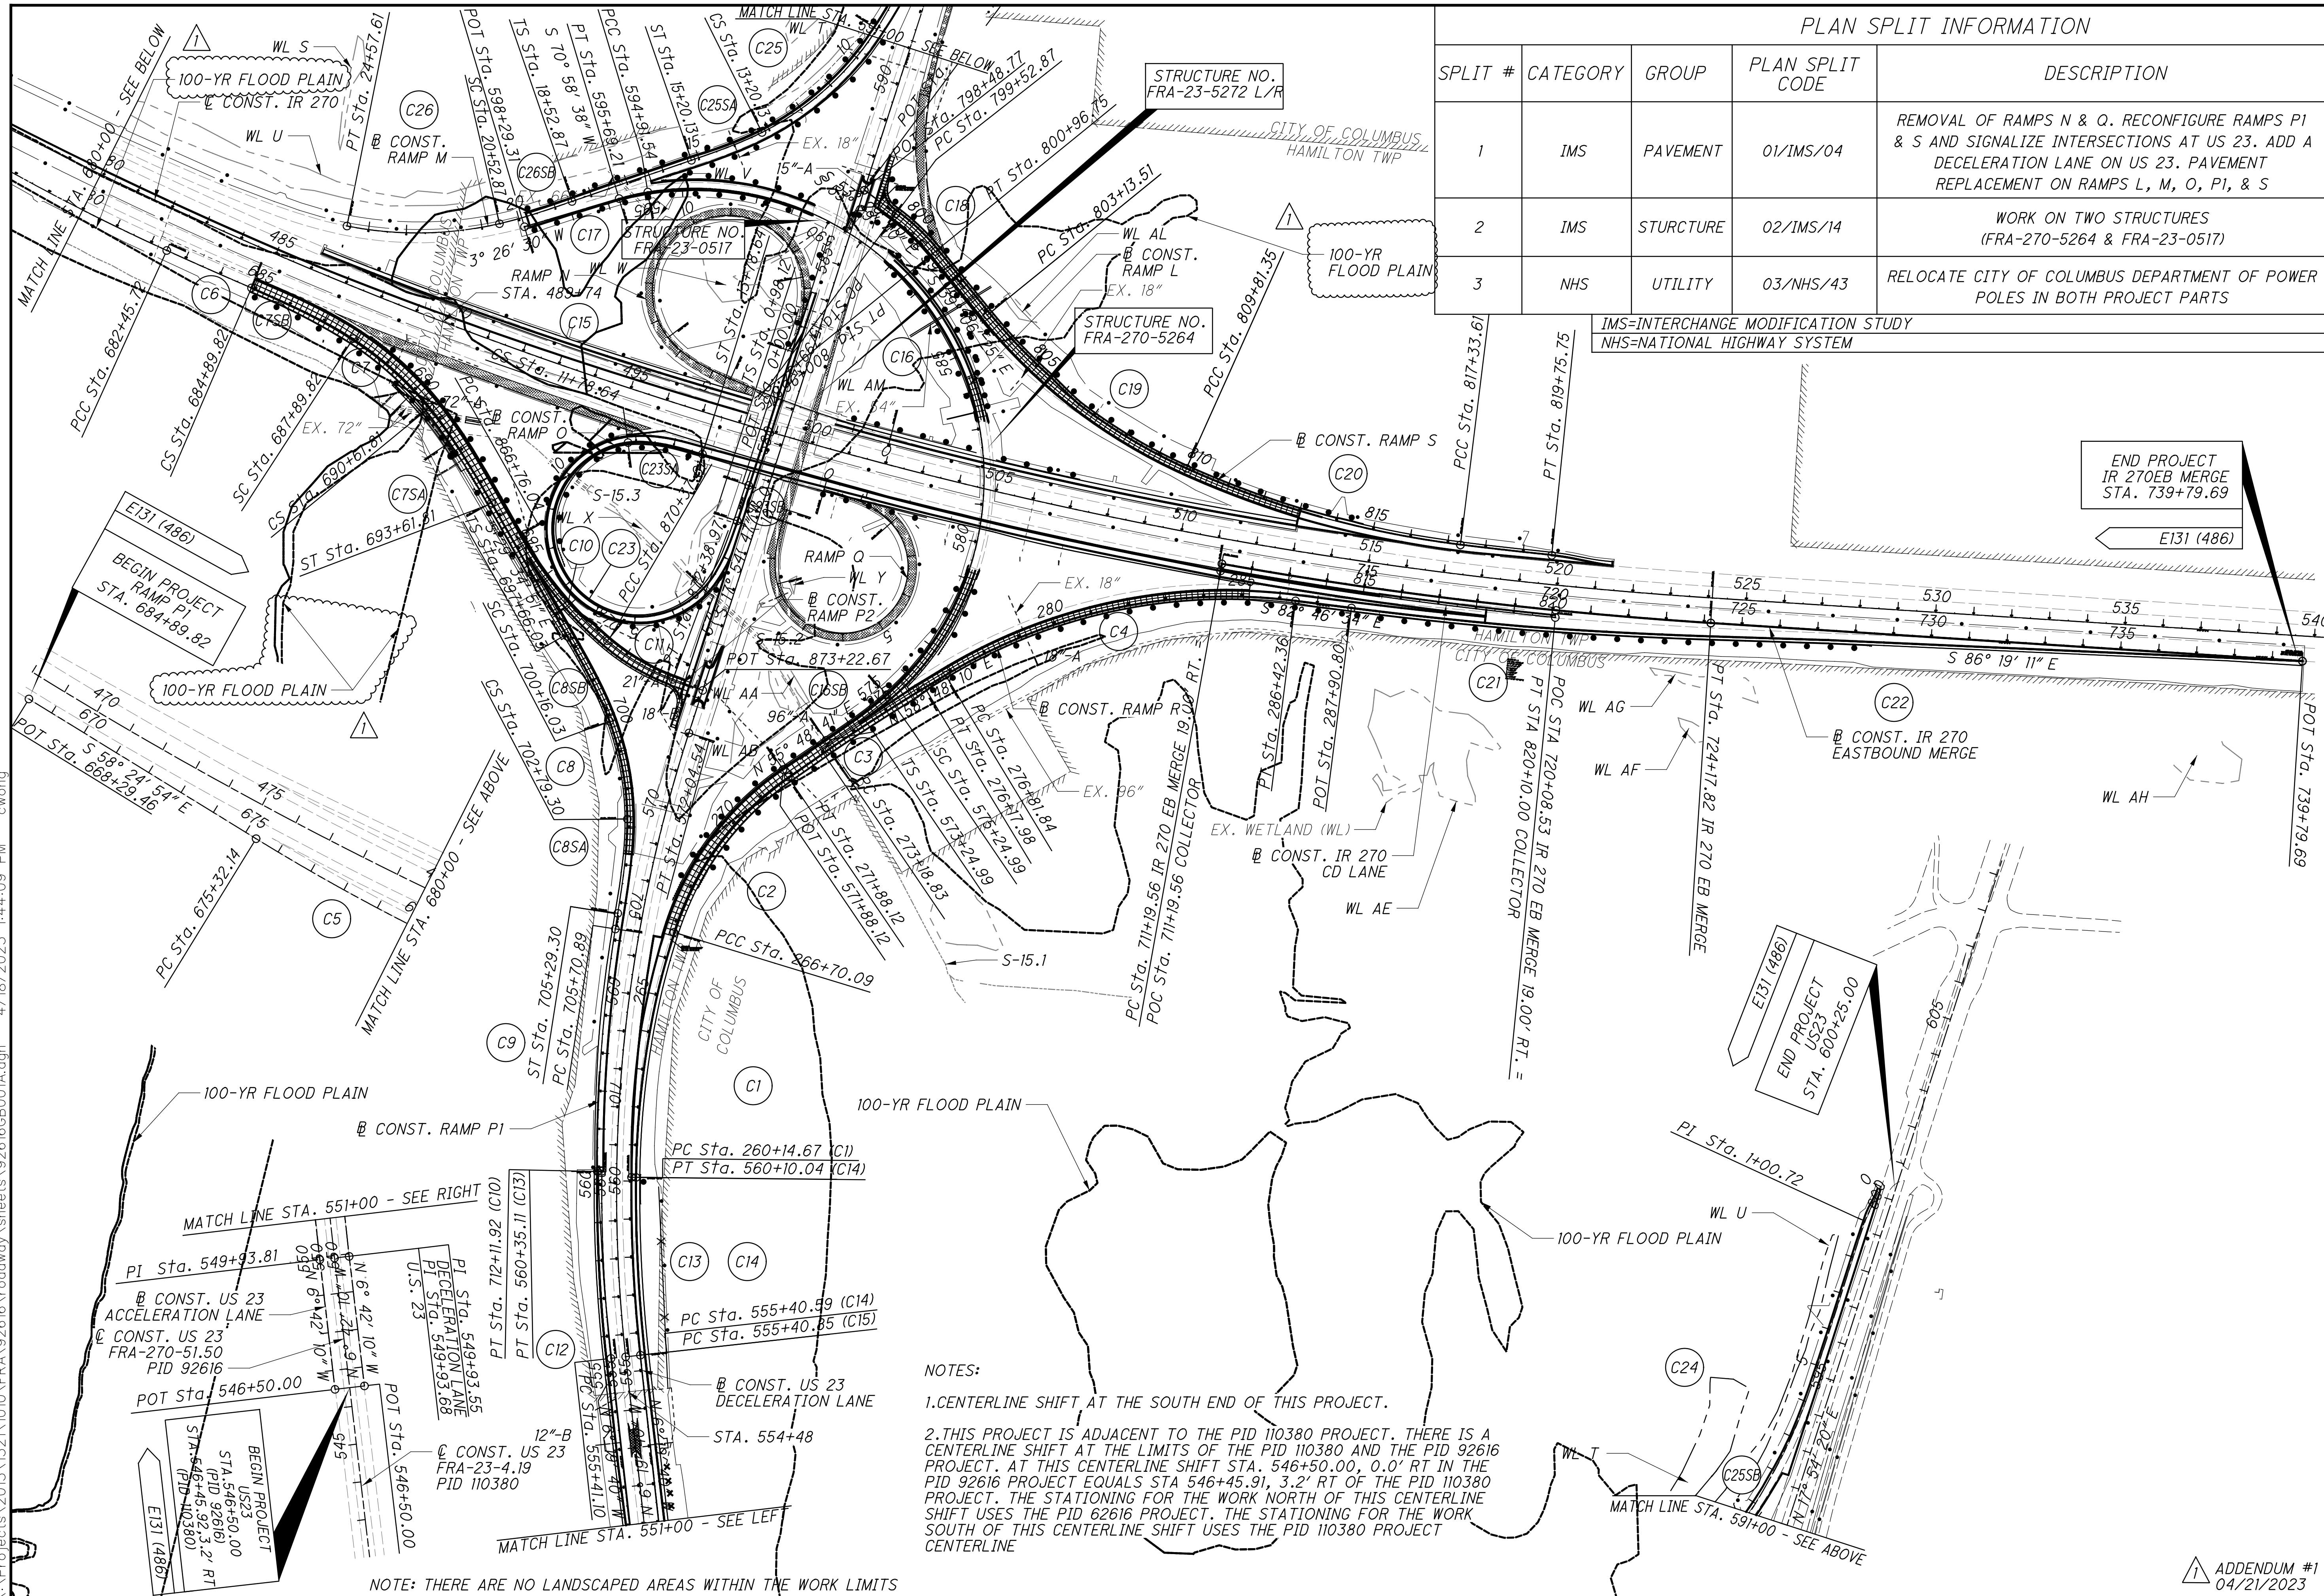

PLAN SPLIT INFORMATION				
SPLIT #	CATEGORY	GROUP	PLAN SPLIT CODE	DESCRIPTION
1	IMS	PAVEMENT	01/IMS/04	REMOVAL OF RAMPS N & Q. RECONFIGURE RAMPS P1 & S AND SIGNALIZE INTERSECTIONS AT US 23. ADD A DECELERATION LANE ON US 23. PAVEMENT REPLACEMENT ON RAMPS L, M, O, P1, & S
2	IMS	STURCTURE	02/IMS/14	WORK ON TWO STRUCTURES (FRA-270-5264 & FRA-23-0517)
3	NHS	UTILITY	03/NHS/43	RELOCATE CITY OF COLUMBUS DEPARTMENT OF POWER POLES IN BOTH PROJECT PARTS

IMS=INTERCHANGE MODIFICATION STUDY  
NHS=NATIONAL HIGHWAY SYSTEM

END PROJECT  
IR 270EB MERGE  
STA. 739+79.69



SCHEMATIC PLAN

FRA - 270-51.50


3  
554

NOTES:  
1. CENTERLINE SHIFT AT THE SOUTH END OF THIS PROJECT.  
2. THIS PROJECT IS ADJACENT TO THE PID 110380 PROJECT. THERE IS A CENTERLINE SHIFT AT THE LIMITS OF THE PID 110380 AND THE PID 92616 PROJECT. AT THIS CENTERLINE SHIFT STA. 546+50.00, 0.0' RT IN THE PID 92616 PROJECT EQUALS STA 546+45.91, 3.2' RT OF THE PID 110380 PROJECT. THE STATIONING FOR THE WORK NORTH OF THIS CENTERLINE SHIFT USES THE PID 92616 PROJECT. THE STATIONING FOR THE WORK SOUTH OF THIS CENTERLINE SHIFT USES THE PID 110380 PROJECT CENTERLINE

NOTE: THERE ARE NO LANDSCAPED AREAS WITHIN THE WORK LIMITS


ADDENDUM #1  
04/21/2023



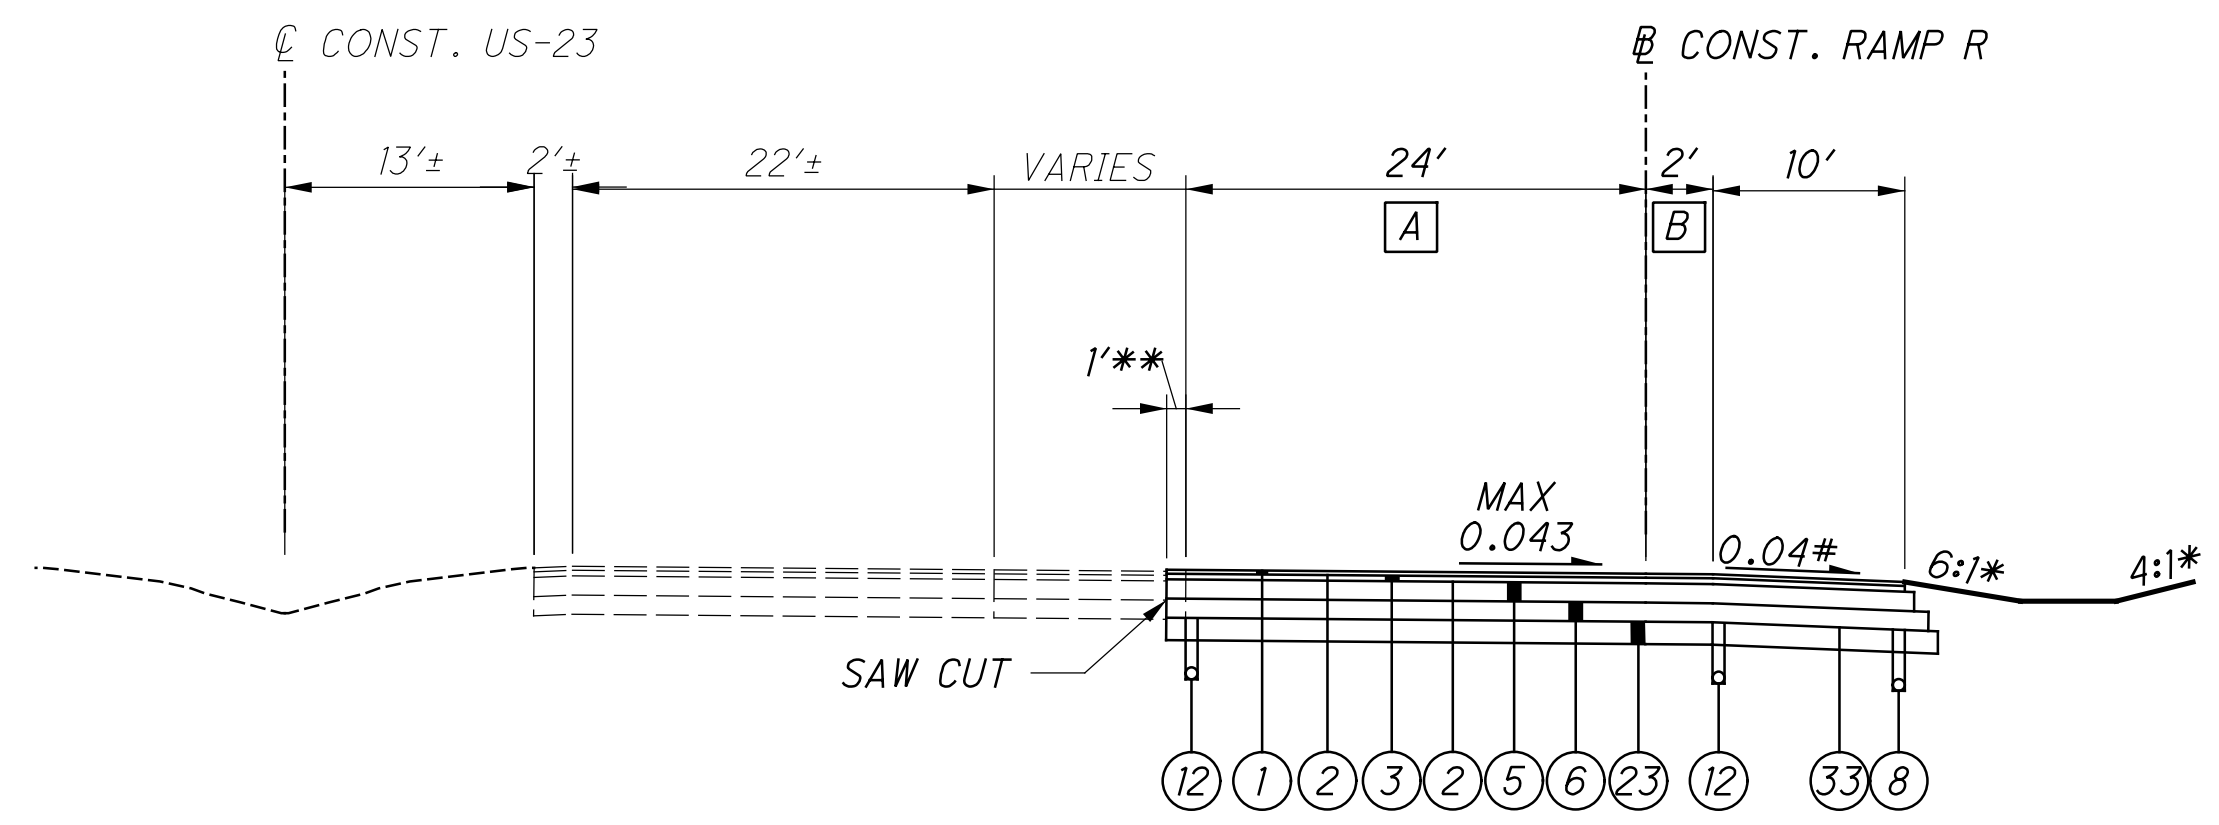


PROPOSED SUPERELEVATED SECTION RAMP R  
STA 260+14.67 TO STA 266+48.50

- [A] VARIES FROM 12.0' AT STA. 260+14.67 TO 24.0' AT STA. 264+09.72  
24.0' FROM STA. 264+09.72 TO STA. 266+48.50
- [B] 0.0' FROM STA. 260+14.67 TO 265+21.48  
VARIES FROM 0.0' AT STA. 265+21.48 TO 2.0' AT STA. 266+48.50

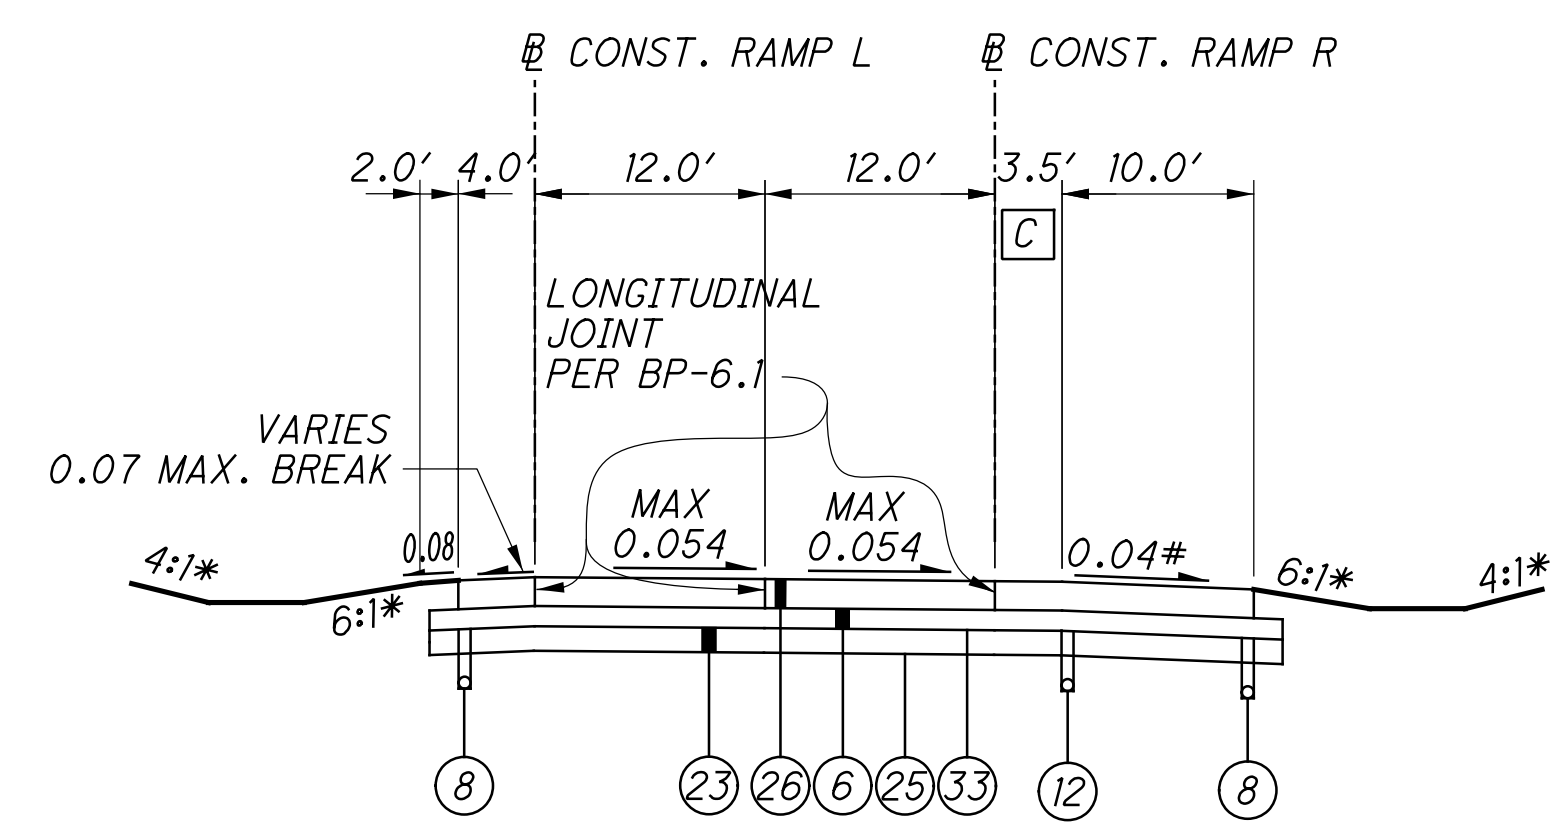


PROPOSED SUPERELEVATED SECTION RAMP R  
STA 266+48.50 TO STA 272+70.68

- [C] VARIES FROM 2.0' AT STA. 266+48.50 TO 3.5' AT STA. 267+44.39  
3.5' FROM STA. 267+44.39 TO STA. 271+13.82  
VARIES FROM 3.5' AT STA. 271+13.82 TO 1.0' AT STA. 272+70.68

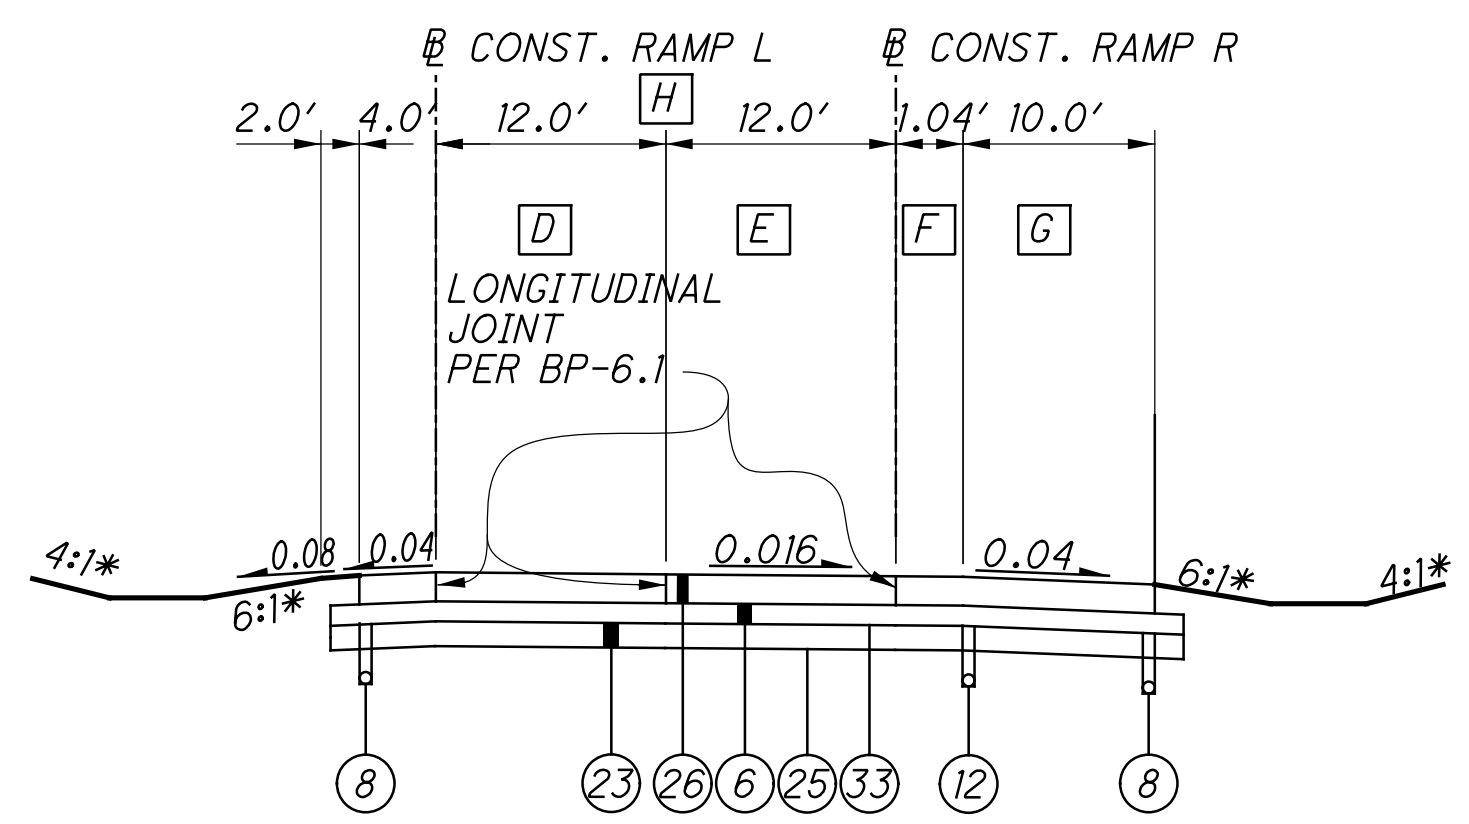


PROPOSED NORMAL SECTION RAMP R  
STA 272+70.68 TO STA 276+30.51

- [D] 12.0' SEE RAMP L
- [E] 12.0' FROM STA. 272+70.68 TO STA. 274+23.44  
VARIES FROM 12.0' AT STA. 274+23.44 TO 16.0' AT STA. 275+79.94  
16.0' FROM STA. 275+79.94 TO STA. 276+30.51
- [F] VARIES FROM 1.0' AT STA. 272+70.68 TO 0.0' AT STA. 273+36.73
- [G] VARIES FROM 10.0' AT STA. 275+79.94 TO 6.0' AT STA. 276+29.94.  
6.0' FROM STA. 276+29.94 TO STA. 276+30.51.
- [H] SEE PAVEMENT DETAIL

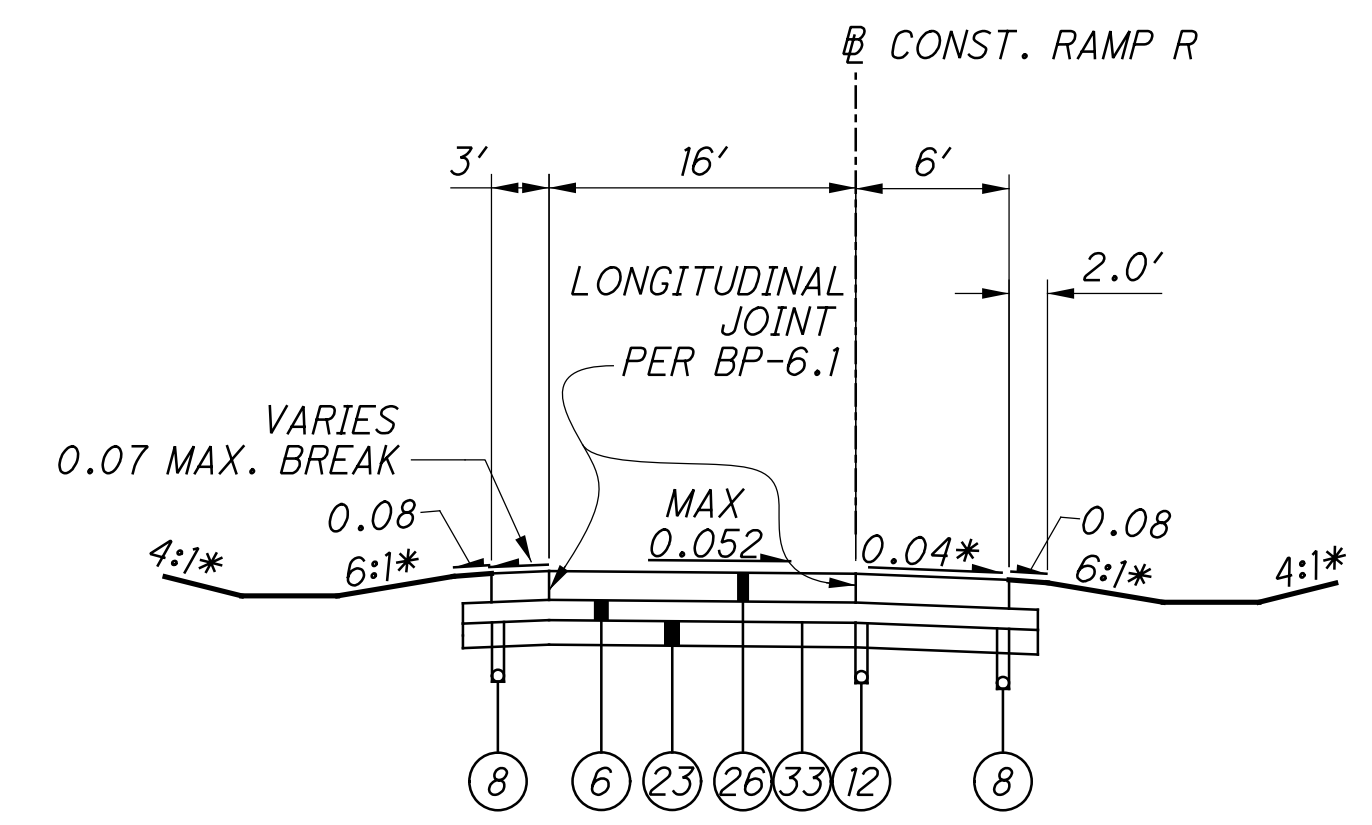


PROPOSED SUPERELEVATED SECTION RAMP R  
STA 276+30.51 TO STA 285+19.83

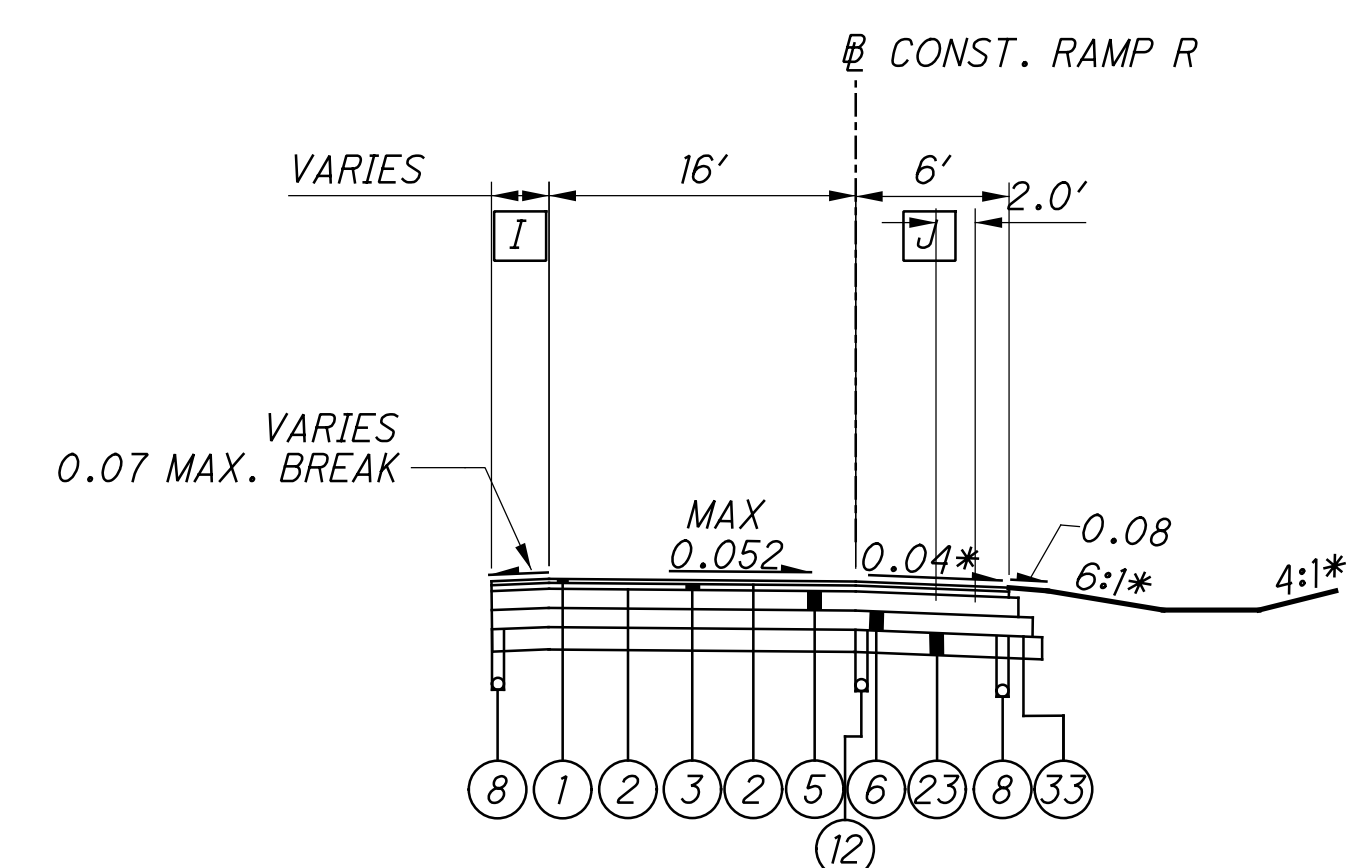


PROPOSED SUPERELEVATED SECTION RAMP R  
STA STA 285+19.83 TO STA. 287+02.09

- [I] SEE IR 270 CD LANE SECTION
- [J] VARIES FROM 6.0' AT STA. 286+42.36 TO 8.0' AT STA. 286+92.92  
8.0' FROM STA. 286+92.92 TO STA. 287+02.09

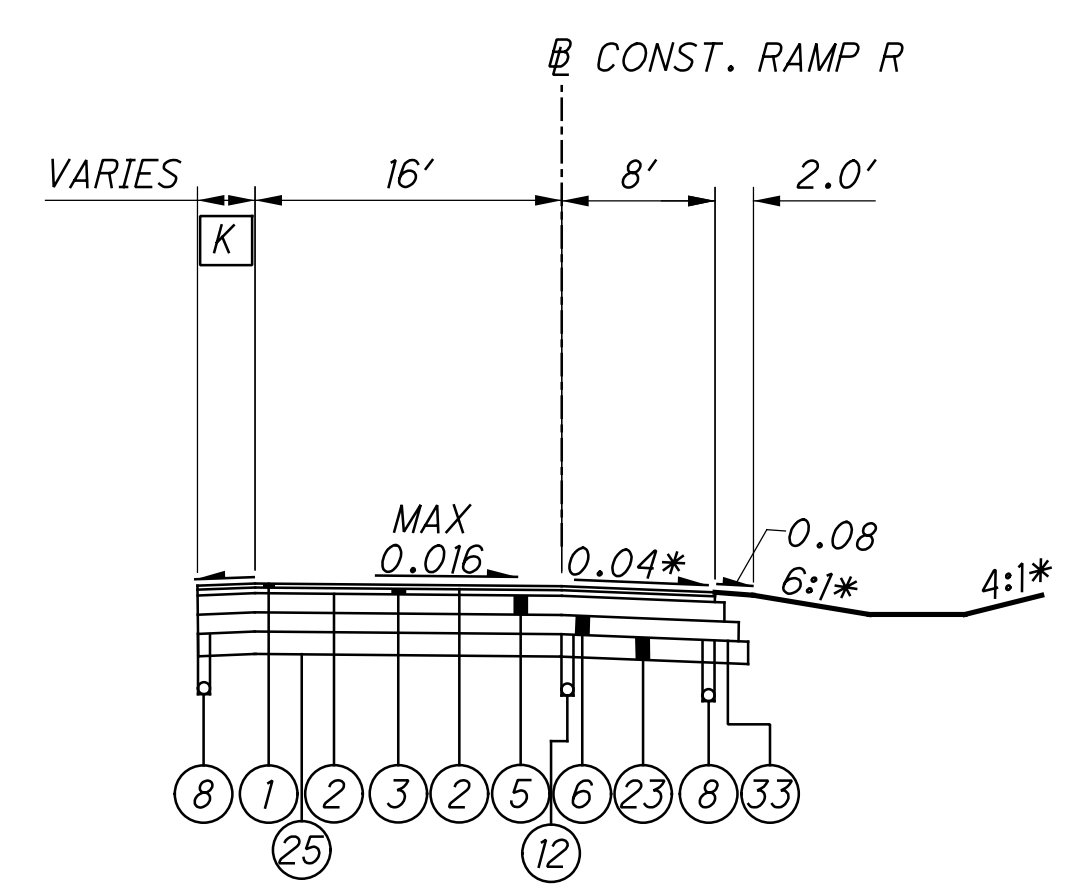


PROPOSED NORMAL SECTION RAMP R  
STA. 287+02.09 TO STA. 287+90.80

- [K] SEE IR 270 CD LANE SECTION

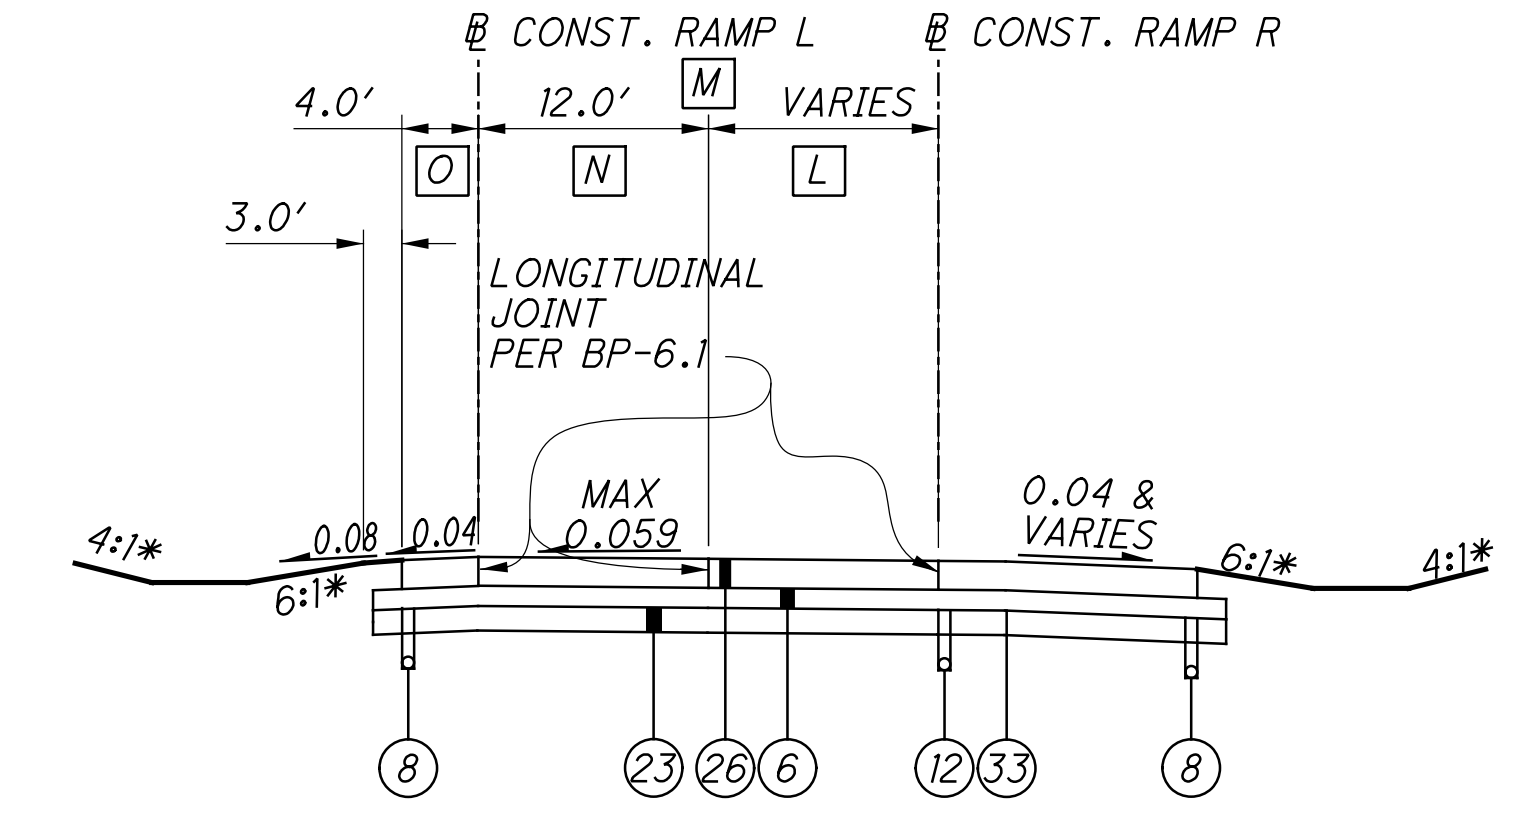

PROPOSED SUPERELEVATED SECTION RAMP L  
STA 571+88.12 TO STA 578+67.54


- [L] 12.0' SEE RAMP R
- [M] SEE PAVEMENT DETAIL
- [N] VARIES FROM 12.0' AT STA. 574+23.32 TO 16.0' AT STA. 575+79.41  
16.0' FROM STA. 575+79.41 TO STA. 578+67.54
- [O] VARIES FROM 4.0' AT STA. 575+86.90 TO 3.0' AT STA. 576+36.90  
3.0' FROM 576+36.90 TO STA. 578+67.54

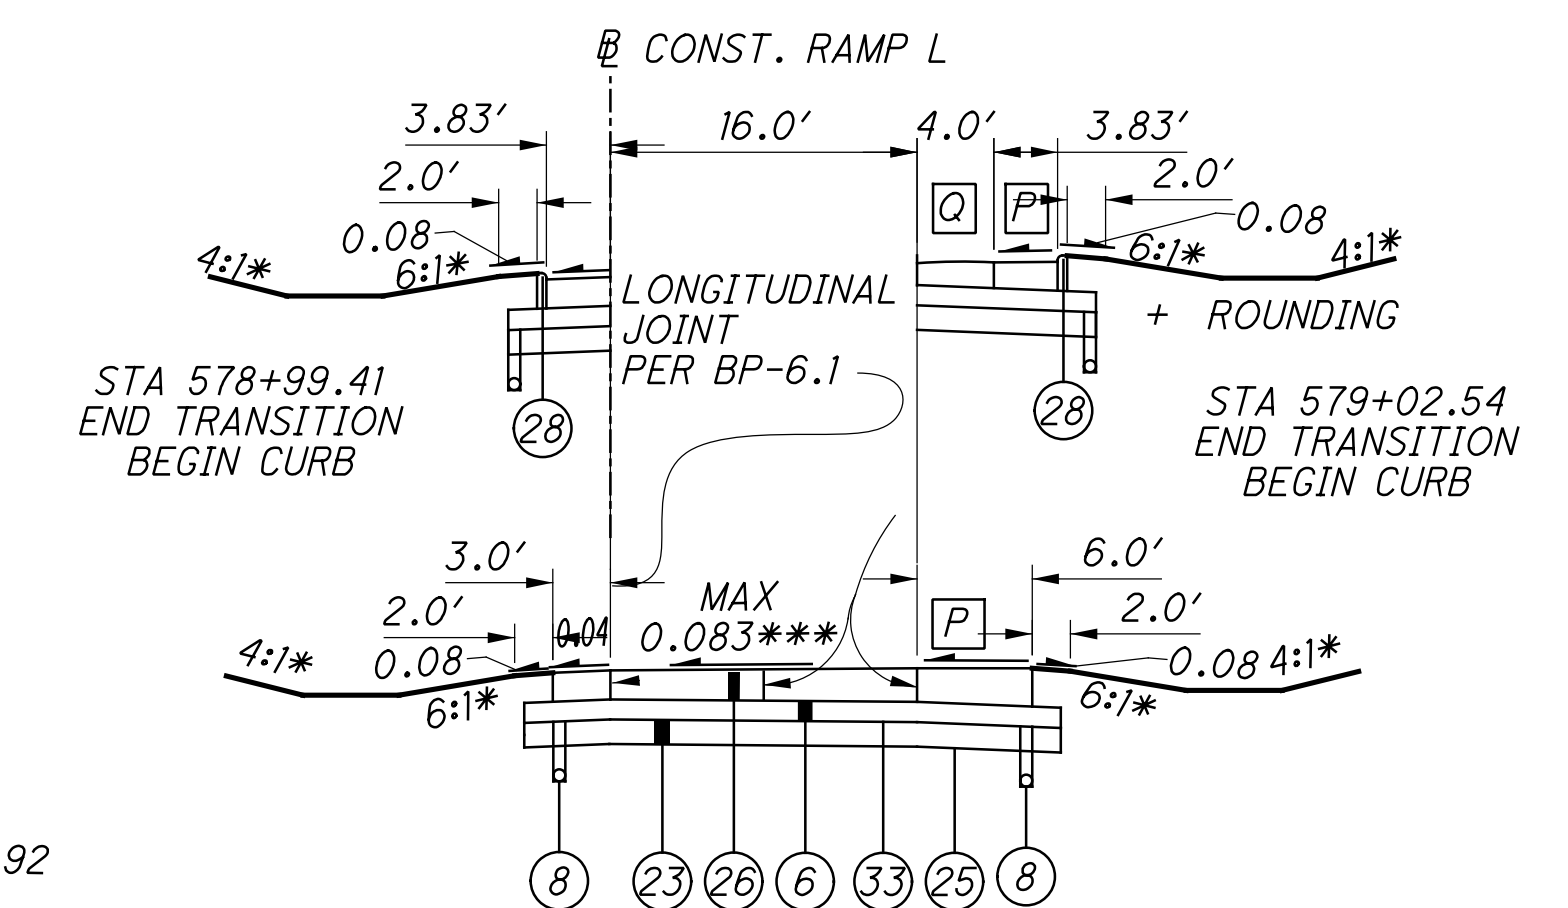

PROPOSED SUPERELEVATED SECTION RAMP L  
STA 578+67.54 TO STA. 579+24.81

- [P] VARIES FROM 0.011 FT./FT. AT STA. 578+67.54 TO 0.083 FT./FT. AT STA. 579+02.54.
- [Q] MAINTAIN 4.0' OF ROUNDING AS NEEDED

\*\*\* 50' SLOPE TRANSITION FROM 0.059 TO 0.083 TO MATCH THE PROPOSED APPROACH SLAB SLOPE. ALSO A 35' MINIMUM SHOULDER TAPER SHALL BE USED FROM THE ROADWAY TO THE APPROACH SLAB.

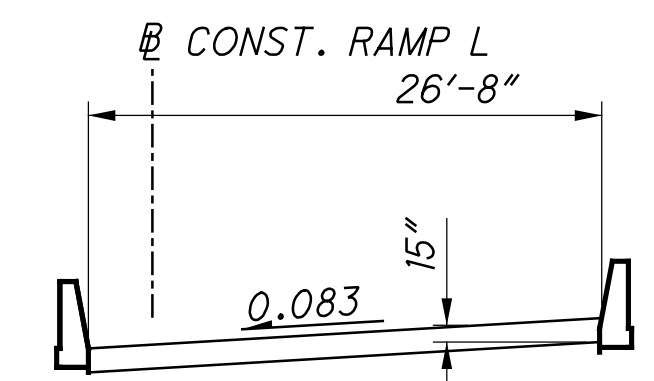

PROPOSED SUPERELEVATED RAMP L FORWARD AND REAR APPROACH SLAB (T=15")  
STA 579+24.81 TO STA. 579+49.81  
STA. 583+01.24 TO STA. 583+26.24

ADDENDUM #1  
04/21/2023

# MATCH LANE CROSS SLOPE WHEN LANE CROSS SLOPE IS GREATER THAN 0.04  
\* OR AS NOTED IN CROSS SECTIONS  
\*\* OUTSIDE EDGE OF PAVEMENT

X:\Projects\2013\1321\1010\FRA\92616\roadway\sheets\92616GY001.dgn 4/18/2023 1:37:18 PM cwong



CROSSINGS AND CONNECTIONS TO EXISTING PIPES AND UTILITIES

WHERE PLANS PROVIDE FOR A PROPOSED CONDUIT TO BE CONNECTED TO, OR CROSS OVER OR UNDER AN EXISTING SEWER OR UNDERGROUND UTILITY, THE CONTRACTOR SHALL LOCATE THE EXISTING PIPES OR UTILITIES BOTH AS TO LINE AND GRADE BEFORE STARTING TO LAY THE PROPOSED CONDUIT.

IF IT IS DETERMINED THAT THE ELEVATION OF THE EXISTING CONDUIT, OR EXISTING APPURTENANCE TO BE CONNECTED, DIFFERS FROM THE PLAN ELEVATION OR RESULTS IN A CHANGE IN THE PLAN CONDUIT SLOPE, THE ENGINEER SHALL BE NOTIFIED BEFORE STARTING CONSTRUCTION OF ANY PORTION OF THE PROPOSED CONDUIT WHICH WILL BE AFFECTED BY THE VARIANCE IN THE EXISTING ELEVATIONS.

IF IT IS DETERMINED THAT THE PROPOSED CONDUIT WILL INTERSECT AN EXISTING SEWER OR UNDERGROUND UTILITY IF CONSTRUCTED AS SHOWN ON THE PLAN, THE ENGINEER SHALL BE NOTIFIED BEFORE STARTING CONSTRUCTION OF ANY PORTION OF THE PROPOSED CONDUIT WHICH WOULD BE AFFECTED BY THE INTERFERENCE WITH AN EXISTING FACILITY. PAYMENT FOR ALL THE OPERATIONS DESCRIBED ABOVE SHALL BE INCLUDED IN THE CONTRACT PRICE FOR THE PERTINENT 611 CONDUIT ITEM.

PIPE CONNECTIONS TO CORRUGATED METAL STRUCTURES

CONNECTIONS OF PROPOSED LONGITUDINAL DRAINAGE TO CORRUGATED METAL STRUCTURES SHALL BE MADE BY MEANS OF A SHOP FABRICATED OR FIELD WELDED STUB ON THE STRUCTURE. THE STUB SHALL MEET THE REQUIREMENTS OF 707 AND HAVE A MINIMUM LENGTH OF 2 FEET AND A MINIMUM WALL THICKNESS OF 0.064 INCHES.

THE LOCATION AND ELEVATION OF THE STUB ARE TO BE CONSIDERED APPROXIMATE AND MAY BE ADJUSTED BY THE ENGINEER TO AVOID CUTTING THROUGH JOINTS IN THE STRUCTURE.

THE FIELD WELDED JOINT, IF USED, SHALL BE THOROUGHLY CLEANED AND REGALVANIZED OR OTHERWISE SUITABLY REPAIRED. WELDING SHALL MEET THE REQUIREMENTS OF 513.21.

A MASONRY COLLAR, AS PER STANDARD DRAWING DM-1.1, WILL BE REQUIRED TO CONNECT THE LONGITUDINAL DRAINAGE TO THE STUB, WHEN PIPE OTHER THAN CORRUGATED METAL IS PROVIDED FOR THE LONGITUDINAL DRAINAGE. PAYMENT FOR CUTTING INTO THE STRUCTURE AND PROVIDING THE CONNECTION DESCRIBED, SHALL BE INCLUDED IN THE CONTRACT PRICE FOR ITEM 611 OR 522.

FARM DRAINS

ALL FARM DRAINS, WHICH ARE ENCOUNTERED DURING CONSTRUCTION, SHALL BE PROVIDED WITH UNOBSTRUCTED OUTLETS. EXISTING COLLECTORS WHICH ARE LOCATED BELOW THE ROADWAY DITCH ELEVATIONS, AND WHICH CROSS THE ROADWAY, SHALL BE REPLACED WITHIN THE CONSTRUCTION LIMITS BY ITEM 611 CONDUIT, TYPE B, ONE COMMERCIAL SIZE LARGER THAN THE EXISTING CONDUIT.

EXISTING COLLECTORS AND ISOLATED FARM DRAINS, WHICH ARE ENCOUNTERED ABOVE THE ELEVATION OF ROADWAY DITCHES, SHALL BE OUTLETTED INTO THE ROADWAY DITCH BY 611 TYPE F CONDUIT. THE OPTIMUM OUTLET ELEVATION SHALL BE ONE FOOT ABOVE THE FLOWLINE ELEVATION OF THE DITCH. LATERAL FIELD TILES WHICH CROSS THE ROADWAY SHALL BE INTERCEPTED BY 611, TYPE E CONDUIT, AND CARRIED IN A LONGITUDINAL DIRECTION TO AN ADEQUATE OUTLET OR ROADWAY CROSSING.

THE LOCATION, TYPE, SIZE AND GRADE OF REPLACEMENTS SHALL BE DETERMINED BY THE ENGINEER AND PAYMENT SHALL BE MADE ON FINAL MEASUREMENTS.

EROSION CONTROL PADS AND ANIMAL GUARDS SHALL BE PROVIDED AT THE OUTLET END OF ALL FARM DRAINS AS PER STANDARD CONSTRUCTION DRAWING DM-1.1, EXCEPT WHEN THEY OUTLET INTO A DRAINAGE STRUCTURE. PAYMENT FOR THE EROSION CONTROL PADS AND ANIMAL GUARDS AND ANY NECESSARY BENDS OR BRANCHES SHALL BE INCLUDED FOR PAYMENT IN THE PERTINENT CONDUIT ITEMS. THE FOLLOWING ESTIMATED QUANTITIES HAVE BEEN INCLUDED IN THE GENERAL SUMMARY FOR THE WORK NOTED ABOVE:

611 6" CONDUIT, TYPE B	100 FT
611 6" CONDUIT, TYPE E	100 FT
611 6" CONDUIT, TYPE F	100 FT
601 ROCK CHANNEL PROTECTION TYPE C WITH FILTER	10 CU. YD

REVIEW OF DRAINAGE FACILITIES

BEFORE ANY WORK IS STARTED ON THE PROJECT AND AGAIN BEFORE FINAL ACCEPTANCE BY THE STATE, REPRESENTATIVES OF THE STATE AND THE CONTRACTOR, ALONG WITH LOCAL REPRESENTATIVES, SHALL MAKE AN INSPECTION OF ALL EXISTING SEWERS WHICH ARE TO REMAIN IN SERVICE AND WHICH MAY BE AFFECTED BY THE WORK. THE CONDITION OF THE EXISTING CONDUITS AND THEIR APPURTENANCE SHALL BE DETERMINED FROM FIELD OBSERVATIONS. RECORDS OF THE INSPECTION SHALL BE KEPT IN WRITING BY THE STATE.

ALL NEW CONDUITS, INLETS, CATCH BASINS, AND MANHOLES CONSTRUCTED AS A PART OF THE PROJECT SHALL BE FREE OF ALL FOREIGN MATTER AND IN A CLEAN CONDITION BEFORE THE PROJECT WILL BE ACCEPTED BY THE STATE.

ALL EXISTING SEWERS INSPECTED INITIALLY BY THE ABOVE MENTIONED PARTIES SHALL BE MAINTAINED AND LEFT IN A CONDITION REASONABLY COMPARABLE TO THAT DETERMINED BY THE ORIGINAL INSPECTION. ANY CHANGE IN THE CONDITION RESULTING FROM THE CONTRACTOR'S OPERATIONS SHALL BE CORRECTED BY THE CONTRACTOR TO THE SATISFACTION OF THE ENGINEER.

PAYMENT FOR ALL OPERATIONS DESCRIBED ABOVE SHALL BE INCLUDED IN THE CONTRACT PRICE FOR THE PERTINENT 611 CONDUIT ITEMS.

UNRECORDED STORM WATER DRAINAGE

FURNISH A CONTINUANCE FOR ALL UNRECORDED STORM WATER DRAINAGE, SUCH AS ROOF DRAINS, FOOTER DRAINS, OR YARD DRAINS, DISTURBED BY THE WORK. FURNISH EITHER AN OPEN CONTINUANCE OR AN UNOBSTRUCTED CONTINUANCE BY CONNECTING A CONDUIT THROUGH THE CURB OR INTO A DRAINAGE STRUCTURE. THE LOCATION, TYPE, SIZE AND GRADE OF THE NEEDED CONDUIT TO REPLACE OR EXTEND AN EXISTING DRAIN WILL BE DETERMINED BY THE ENGINEER. ALL SUCH CONTINUANCE REQUIRES A RIGHT OF WAY USE PERMIT.

THE FOLLOWING ESTIMATED QUANTITIES HAVE BEEN INCLUDED IN THE GENERAL SUMMARY FOR USE AS DIRECTED BY THE ENGINEER FOR THE WORK NOTED ABOVE:

611, 6" CONDUIT, TYPE B, FOR DRAINAGE CONNECTION	100 FT.
611, 6" CONDUIT, TYPE C, FOR DRAINAGE CONNECTION	100 FT.
611, 6" CONDUIT, TYPE E, FOR DRAINAGE CONNECTION	100 FT.
611, 6" CONDUIT, TYPE F, FOR DRAINAGE CONNECTION	100 FT.

MANHOLES, CATCH BASINS AND INLETS REMOVED OR ABANDONED

PAYMENT FOR ALL OF THE ABOVE SHALL BE INCLUDED IN THE CONTRACT PRICE FOR THE PERTINENT 202 ITEM.

ITEM SPECIAL - PIPE CLEANOUT

THIS WORK SHALL CONSIST OF REMOVING SEDIMENT AND DEBRIS FROM THE EXISTING DRAINAGE CONDUITS SPECIFIED IN THE PLANS. ALL MATERIAL REMOVED SHALL BE DISPOSED OF AS PER 105.16 AND 105.17. ALL SEWERS SHALL BE CLEANED OUT TO THE SATISFACTION OF THE ENGINEER.

CLEANOUT OF THE PIPE SHALL BE PAID FOR AT THE UNIT PRICE BID FOR ITEM SPECIAL - PIPE CLEANOUT. THIS PRICE SHALL INCLUDE THE COST FOR MATERIAL, EQUIPMENT, LABOR, AND ALL INCIDENTALS REQUIRED TO COMPLETE THE CLEANOUT.

THE FOLLOWING ESTIMATED QUANTITIES HAVE BEEN INCLUDED IN THE GENERAL SUMMARY FOR THE ABOVE NOTED WORK:

SPECIAL, PIPE CLEANOUT, 24" AND UNDER	2600 FT.
SPECIAL, PIPE CLEANOUT, 27" TO 48"	250 FT.
SPECIAL, PIPE CLEANOUT, OVER 48"	1500 FT.

THE CONTRACTOR SHALL PROVIDE A VIDEO OF THE INSIDE OF THE PIPE AFTER CLEANING TO VERIFY PIPE HAS BEEN COMPLETELY CLEANED.

THE PIPES LABELED ON SHEETS 174, 175, 202, 206, 221, 224, 225, 226, 227, 229, 230, 257, 258, 269, 270, AND 302 SHALL BE CLEANED OUT PER ITEM SPECIAL - PIPE CLEANOUT.

EXISTING SUBSURFACE DRAINAGE

PROVIDE UNOBSTRUCTED OUTLETS FOR ALL EXISTING UNDERDRAINS OR AGGREGATE DRAINS ENCOUNTERED DURING CONSTRUCTION.

PROVIDE AN OUTLET PER STANDARD CONSTRUCTION DRAWING DM-1.1 FOR ALL UNDERDRAINS THAT OUTLET TO A SLOPE.

UNDERDRAINS THAT CAN BE CONNECTED TO THE NEW OR EXISTING UNDERDRAINS AT THE END OF THE PROJECT LIMITS AS WELL AS ALL NECESSARY BENDS OR BRANCHES REQUIRED FOR CONNECTION ARE INCLUDED IN THE BASIS OF PAYMENT FOR UNCLASSIFIED PIPE UNDERDRAINS.

THE FOLLOWING ESTIMATED QUANTITIES HAVE BEEN INCLUDED IN THE GENERAL SUMMARY FOR THE WORK NOTED ABOVE:

601, TIED CONCRETE BLOCK MAT, TYPE 1	10 SQ. YD.
605, AGGREGATE DRAINS	50 FT.
611 6" CONDUIT, TYPE F	100 FT.
611, PRECAST REINFORCED CONCRETE OUTLET	10 EACH
605 6" UNCLASSIFIED PIPE UNDERDRAINS	200 FT.

SEEDING AND MULCHING

THE FOLLOWING QUANTITIES ARE PROVIDED TO PROMOTE GROWTH AND CARE OF PERMANENT SEEDED AREAS:

659, SOIL ANALYSIS TEST	2 EACH
659, TOPSOIL	5574 CU. YD.
659, SEEDING AND MULCHING	50209 SQ. YD.
659, REPAIR SEEDING AND MULCHING	2511 SQ. YD.
659, INTER-SEEDING	2511 SQ. YD.
659, COMMERCIAL FERTILIZER	7.79 TON
659, LIME	10.38 ACRES
659, WATER	407 M. GAL.
659, MOWING	113 M. SQ. FT.

SEEDING AND MULCHING SHALL BE APPLIED TO ALL AREAS OF EXPOSED SOIL BETWEEN THE RIGHT-OF-WAY LINES, AND WITHIN THE CONSTRUCTION LIMITS FOR AREAS OUTSIDE THE RIGHT-OF-WAY LINES COVERED BY WORK AGREEMENT OR SLOPE EASEMENT. QUANTITY CALCULATIONS FOR SEEDING AND MULCHING ARE BASED ON THESE LIMITS.

CULVERT AND STORM SEWER EXTENSIONS

THE EXISTING CULVERT OR STORM SEWER SHOULD BE REMOVED BACK TO THE FIRST JOINT AT THE OUTLET END AND THE SECOND JOINT AT THE INLET END OF THE CULVERT, MEASURED IN THE FIELD AND PROVIDE A MASONRY COLLAR PER DM-1.1 AT CONNECTION. MATCH EXISTING MATERIAL FOR CULVERT EXTENSION. THE CONTRACTOR SHALL INSPECT EACH PIPE TO ENSURE PIPE IS IN GOOD CONDITION AND SHALL PROMPTLY INFORM THE ENGINEER IF ADDITIONAL PIPE REMOVAL AND REPLACEMENT IS REQUIRED.

PERMITS, WATERWAY PERMITS

A WATERWAYS PERMIT SHALL BE OBTAINED FOR THE PROJECT PRIOR TO PROJECT CONSTRUCTION. ONCE RECEIVED, THE SPECIAL PROVISIONS FOR THE PROJECT SHALL BE ATTACHED TO THE CONSTRUCTION PLANS. ALL CONDITIONS SHALL BE ADHERED TO DURING CONSTRUCTION. ALSO, A COPY OF THE PERMIT IS TO BE KEPT AT THE WORK SITE AT ALL TIMES.

ANTI-SEGREGATION

PROVIDE ANTI-SEGREGATION EQUIPMENT FOR ALL COURSES OF UNIFORM THICKNESS IN ACCORDANCE WITH C&MS 401.12

NON-RUBBER TIRE VEHICLES

NO NON-RUBBER TIRE VEHICLE SHALL BE MOVED ON STATE OR COUNTY ROADS. EXCEPTIONS MAY BE GRANTED BY AN AUTHORIZED STATE OR COUNTY OFFICIAL WHERE SHORT DISTANCES AND SPECIAL CIRCUMSTANCES ARE INVOLVED. GRANTING OF EXCEPTIONS MUST BE IN WRITING AND ANY RESULTING DAMAGE MUST BE REPAIRED FOR THE SATISFACTION OF THE STATE OR COUNTY

PAVEMENT REPAIRS

THE CONTRACTOR IS RESPONSIBLE FOR ALL PAVEMENT REPAIRS THAT ARE NEEDED FROM THE START OF CONSTRUCTION THRU COMPLETION OF THE PROJECT. ANY PAVEMENT REPAIRS SHALL BE INCLUDED IN THE BID COST FOR ITEM 614 MAINTENANCE OF TRAFFIC.

PAVEMENT FOR MAINTAINING TRAFFIC

A QUANTITY OF 50 CY OF ASPHALT FOR MAINTAIN TRAFFIC HAS BEEN TO BE USED AS DIRECTED BY THE ENGINEER TO LEVEL OUT ANY SETTLEMENT IN THE TEMPORARY PAVEMENT DURING CONSTRUCTION OPERATIONS.

ITEM 202 - PAVEMENT REMOVED AS PER PLAN

ALL EXISTING PAVEMENT TO BE REMOVED CONTAINING LAYERS OF CONCRETE, INCLUDING COMPOSITE ASPHALT OVER CONCRETE PAVEMENT, SHALL BE REMOVED UNDER ITEM 202 PAVEMENT REMOVED, AS PER PLAN. EXISTING PAVEMENT NOT CONTAINING CONCRETE SHALL BE REMOVED UNDER ITEM 202 PAVEMENT REMOVED, ASPHALT. SEE THE EXISTING TYPICAL SECTIONS FOR PAVEMENT BUILDUP. PAYMENT FOR THE OPERATION DESCRIBED ABOVE SHALL BE INCLUDED IN THE CONTRACT PRICE FOR THE PERTINENT 202 ITEMS.

DRAINAGE AND UTILITY SETTLEMENT

PIPES, DRAINAGE STRUCTURES, OR UTILITIES LOCATED IN FILL ALONG THE TOE OF EMBANKMENTS SHALL NOT BE CONSTRUCTED UNTIL AT LEAST 30 DAYS AFTER COMPLETION OF EMBANKMENT.

ITEM 203 EMBANKMENT, AS PER PLAN

AS SPECIFIED IN THE GEOTECHNICAL REPORT, DRAINAGE LAYERS SHOULD BE COMPOSED OF FINE AGGREGATE THAT MEETS THE GRADATION CRITERIA OF C&MS 703.02 OR 703.03, SHOULD BE GRADED TO DRAIN, AND SHOULD HAVE A MINIMUM OF 2 FEET COVER. SEE PLAN SHEET NO 324 FOR ADDITIONAL INFORMATION.

ITEM 203 GRANULAR MATERIAL, TYPE E, AS PER PLAN

IN THE AREA ALONG TEMPORARY RAMP L BETWEEN STA. 91+00 AND 93+00, GRANULAR MATERIAL, TYPE E, SIZES NO. 1 AND NO. 2 STONE MAY BE PLACED BY THE METHOD OF END DUMPING IF SOFT/WET FOUNDATION SOILS ARE PRESENT AT THE TIME OF CONSTRUCTION. END DUMPING METHODS MAY BE USED UP TO AN ELEVATION 12 INCHES ABOVE THE FOUNDATION SUBGRADE. ABOVE THIS ELEVATION, EMBANKMENT CONSTRUCTION METHODS WILL BE IN ACCORDANCE WITH 203.05 TO 203.07 INCLUSIVE. DURING NORMAL CLEARING AND GRUBBING WHERE END DUMPING IS PERMITTED, THE REQUIREMENTS OF 201.04 FOR SCALPING SHALL BE WAIVED.

TEST PITS CONSTRUCTED FOR TEMPORARY RAMP L SHALL BE PAID FOR AS PART OF THIS PAY ITEM

BENCHING OF FOUNDATION SLOPES

ALTHOUGH CROSS-SECTIONS INDICATE SPECIFIC DIMENSIONS FOR PROPOSED BENCHING OF THE EMBANKMENT FOUNDATIONS IN CERTAIN AREAS, NO WAIVER OF THE SPECIFICATIONS IS INTENDED. BENCH ALL OTHER SLOPED EMBANKMENT AREAS AS SET FORTH IN 203.05. NO ADDITIONAL PAYMENT WILL BE MADE FOR BENCHING REQUIRED UNDER THE PROVISIONS OF 203.05

TEMPORARY DRAINAGE ITEMS

TEMPORARY DRAINAGE ITEMS LABELED ON THE MAINTENANCE OF TRAFFIC PLAN ARE ITEMIZED ON THE MOT PLANS. PAYMENT FOR THE TEMPORARY DRAINAGE ITEMS ARE ITEMIZED AND CARRIED TO THE GENERAL SUMMARY.

ADDENDUM #1  
04/21/2023

X:\Projects\2013\1321\1010\FRA\92616\roadway\sheets\92616GN001.dgn 4/18/2023 1:56:21 PM cwong



TEMPORARY RAMP L

CONTRACTOR SHALL MAINTAIN TRAFFIC ALONG RAMP L DURING THE RECONSTRUCTION OF THE BRIDGES BY CONSTRUCTING A TEMPORARY RAMP AS SHOWN ON SHEETS 36-43. DUE TO THE POTENTIAL PRESENCE OF PEAT SOILS IN THIS AREA, THE CONTRACTOR SHALL DIG TEST PITS TO DETERMINE THE PRESENCE AND DEPTH EXTENT OF THE PEAT. TEST PITS SHALL BE LOCATED AT 50' ON-CENTER ALONG THE ALIGNMENT AND EXTEND TO A MINIMUM DEPTH OF 4.0' EACH. TEST PITS SHALL BE PAID FOR AS PART OF THE PAY ITEM, ITEM 203 - GRANULAR MATERIAL, TYPE E, AS PER PLAN.

CONDITION 1: WHERE PEAT IS NOT ENCOUNTERED WITHIN 4.0' BELOW THE SUBGRADE, A 2.0' THICK GEOGRID AND STONE WORK PLATFORM SHALL BE CONSTRUCTED AT THE FOUNDATION SUBGRADE. THE FOUNDATION SUBGRADE SHALL BE SCALPED IN ACCORDANCE WITH C&MS ITEM 201 PRIOR TO CONSTRUCTION OF THE WORK PLATFORM. THE WORK PLATFORM SHALL BE CONSTRUCTED USING ITEM 203 GRANULAR MATERIAL, TYPE E, SIZES NO. 1 AND NO. 2 STONE. TWO LAYERS OF GEOGRID SHALL BE INCORPORATED IN THE WORK PLATFORM. THE STONE MAY BE END DUMPED TO A DEPTH OF 12 INCHES.

CONDITION 2: PEAT WITH DEPTHS LESS THAN 4.0. REMOVE PEAT IN ITS ENTIRETY. CONSTRUCT 2.0' THICK GEOGRID AND STONE WORK PLATFORM AT BOTTOM OF EXCAVATION. THE WORK PLATFORM SHALL BE CONSTRUCTED USING ITEM 203 GRANULAR MATERIAL, TYPE E, AS PER PLAN, SIZES NO. 1 AND NO. 2 STONE WITH TWO LAYERS OF GEOGRID ONE AT THE BASE AND ANOTHER PLACED MID-HEIGHT. THE STONE MAY BE END DUMPED TO A DEPTH OF 12 INCHES.

CONDITION 3: PEAT IN EXCESS OF 4.0' SHALL BE REMOVED TO A DEPTH OF 4.0' AND REPLACED WITH ITEM 203 GRANULAR MATERIAL, TYPE E, AS PER PLAN SIZES NO.1 AND NO. 2 STONE WITH GEOGRID AT THE BASE AND ANOTHER LAYER OF GEOGRID PLACED MID-HEIGHT WITHIN THE BACKFILL.

THE FOLLOWING CONTINGENCY QUANTITIES HAVE BEEN CARRIED TO THE GENERAL SUMMARY FOR THE STABILIZATION OF TEMPORARY RAMP L.

ITEM 203 EXCAVATION,	504 CY
ITEM 203 GRANULAR MATERIAL,	
TYPE E, AS PER PLAN	504 CY
ITEM 204 GEOTEXTILE	2276 SY
ITEM 861 GEOGRID	756 SY

WATER

THE CITY OF COLUMBUS, CONSTRUCTION AND MATERIAL SPECIFICATIONS, 2018 EDITION AND ALL REVISIONS, INCLUDING ALL SUPPLEMENTS THERETO, SHALL GOVERN ALL CONSTRUCTION ITEMS THAT ARE A PART OF THIS PLAN, UNLESS OTHERWISE NOTED.

ALL WATER MAIN MATERIALS AND INSTALLATIONS SHALL BE IN ACCORDANCE WITH THE CURRENT RULES AND REGULATIONS OF THE CITY OF COLUMBUS, DIVISION OF WATER. ALL CITY OF COLUMBUS, DIVISION OF WATER STANDARD DRAWINGS SHALL APPLY TO THE PROJECT, UNLESS OTHERWISE NOTED.

FOR ANY EMERGENCIES INVOLVING THE WATER DISTRIBUTION SYSTEM, PLEASE CONTACT THE DIVISION OF WATER DISTRIBUTION MAINTENANCE OFFICE AT 614-645-7788.

ALL BRASS FITTINGS ASSOCIATED WITH WATER WORK, INCLUDING REPAIRS TO THE EXISTING SYSTEM, SHALL CONFORM TO THE REVISED ALLOWABLE LEAD EXTRACTION LIMIT PER THE UPDATED NSF/ANSI 61 STANDARD. THE DIVISION OF WATER'S APPROVED MATERIALS LIST HAS BEEN UPDATED TO REFLECT THIS REQUIREMENT.

NO PERSON SHALL BEGIN CONSTRUCTION OR INSTALLATION OF A PUBLIC WATER MAIN UNTIL PLANS HAVE BEEN APPROVED BY THE STATE OF OHIO ENVIRONMENTAL PROTECTION AGENCY (OEPA).

ALL WATER MAINS SHALL BE CLEANED AND FLUSHED, AND ANY WATER MAIN 12-INCH AND LARGER MUST BE PROPERLY PIGGED, IN ACCORDANCE WITH SECTION 801.15 OF THE CITY OF COLUMBUS, CONSTRUCTION AND MATERIAL SPECIFICATIONS.

IT SHALL BE UNLAWFUL FOR ANY PERSON TO PERFORM ANY WORK ON CITY OF COLUMBUS WATER MAIN SYSTEMS WITHOUT FIRST SECURING LICENSE TO ENGAGE IN SUCH WORK, AS INDICATED IN COLUMBUS CITY CODE SECTION 1103.02 AND 1103.06. THIS WORK INCLUDES ANY ATTACHMENTS, ADDITIONS TO OR ALTERATIONS IN ANY CITY SERVICE PIPE OR APPURTENANCES (INCLUDING WATER SERVICE LINES AND TAPS). THIS REQUIREMENT MAY BE MET BY UTILIZATION OF A SUBCONTRACTOR WHO HOLDS A CITY OF COLUMBUS WATER CONTRACTOR LICENSE OR A COMBINED WATER/SEWER CONTRACTOR LICENSE TO PERFORM THIS WORK. UTILIZATION OF A SUBCONTRACTOR MUST MEET THE LICENSING REQUIREMENTS OF CITY OF COLUMBUS BUILDING CODE, IN PARTICULAR SECTION 4114.119 AND 4114.529.

THE CONTRACTOR SHALL OBTAIN THE PROPER HYDRANT PERMIT(S), AND PAY ANY APPLICABLE FEES, FOR ANY APPROVED HYDRANT USAGE DEEMED NECESSARY FOR WORK UNDER THIS IMPROVEMENT. PERMITS MAY BE OBTAINED THROUGH THE DIVISION OF WATER PERMIT OFFICE (645-7330). THE CONTRACTOR SHALL ADHERE TO ALL RULES & REGULATIONS GOVERNING SAID PERMIT AND MUST HAVE THE ORIGINAL PERMIT ON SITE ANYTIME IN WHICH THE HYDRANT IS IN USE. PERMITS MAY BE OBTAINED BY ACCESSING [HTTP://PORTAL.COLUMBUS.GOV/PERMITS/](http://portal.columbus.gov/permits/). COST TO BE INCLUDED IN THE VARIOUS BID ITEMS.

ALL WATER MAINS SHALL BE PRESSURE TESTED IN ACCORDANCE WITH SECTION 801.16 OF THE CITY OF COLUMBUS, CONSTRUCTION AND MATERIAL SPECIFICATIONS. THE CITY MAY NOT APPROVE ANY TEST LASTING LESS THAN TWO HOURS, REGARDLESS OF THE AMOUNT OF LEAKAGE.

ANY SECTION OF WATER MAIN THAT IS LONGER THAN 20 FEET IN LENGTH SHALL BE CHLORINATED. HAND SWABBING METHODS WILL ONLY BE PERMITTED FOR SECTIONS LESS THAN OR EQUAL TO 20 FEET IN LENGTH. USE UNSCENTED HOUSEHOLD BLEACH FOR HAND SWABBING OF PIPE AND FITTINGS. PLEASE NOTE THAT CUT-IN-TEES, SLEEVES, AND ANY OTHER REQUIRED FITTINGS OR PIPING SHALL BE TAKEN INTO ACCOUNT AND ARE INCLUDED IN THE TOTAL LENGTH OF THE SECTION (CUT TO CUT).

ONLY ONE CONNECTION TO AN EXISTING WATER MAIN IS PERMITTED BEFORE DISINFECTION OF A NEW WATER MAIN HAS BEEN COMPLETED. ALL OTHER CONNECTIONS MUST BE MADE AFTER THE MAIN HAS BEEN DISINFECTED.

ALL FIRE HYDRANTS TO BE INSTALLED IN THE CITY OF COLUMBUS SHALL BE PAINTED WITH THE COLOR "SAFETY ORANGE". THE FIRE HYDRANTS SHALL BE PROVIDED WITH TWO COATS IN A GLOSS ENAMEL OF THE "SAFETY ORANGE" COLOR FOR THE ENTIRE HYDRANT. THE TOPS OF THE FIRE HYDRANTS ARE NO LONGER REQUIRED TO BE PAINTED BLACK. AFTER INSTALLATION OF FIRE HYDRANTS, THE CONTRACTOR IS RESPONSIBLE TO APPLY TOUCH UP PAINT TO ANY DAMAGE TO THE FACTORY APPLIED HYDRANT PAINT. HYDRANTS WILL NOT BE ACCEPTED UNTIL ANY PAINT DAMAGE FROM SHIPPING OR INSTALLATION HAS BEEN REPAIRED. USE HYDRANT TOUCH UP PAINT IN ACCORDANCE WITH THE APPROVED MATERIALS LIST.

MAINTAIN EIGHTEEN (18) INCHES VERTICAL AND TEN (10) FEET HORIZONTAL SEPARATION BETWEEN ANY SANITARY OR STORM SEWER PIPING AND ALL PROPOSED WATER MAINS.

WHEN CROSSING THE EXISTING WATER MAIN, AND LOW STRENGTH MORTAR (ITEM 613) IS TO BE USED AS BACKFILL, THE CONTRACTOR SHALL PROVIDE SIZE NO. 57 CRUSHED CARBONATE STONE (CCS) 1 FOOT BELOW TO 1 FOOT ABOVE THE EXISTING WATER MAIN.

IF DURING EXCAVATION, THE POLYETHYLENE ENCASEMENT ON THE EXISTING WATER MAIN BECOMES DAMAGED, THE CONTRACTOR SHALL REPAIR THE POLYETHYLENE ENCASEMENT PER MANUFACTURER'S SPECIFICATIONS AND DOW STANDARD DRAWINGS L-1003 AND L-1004, AT THEIR OWN EXPENSE. ENSURE THAT THE ENTIRE EXPOSED AREA IS COVERED WITH NEW POLYETHYLENE ENCASEMENT AND SECURELY TAPED, PRIOR TO BACKFILLING.

CONTRACTOR SHALL ADHERE TO THE REQUIREMENTS OF THE OHIO ADMINISTRATIVE CODE CHAPTER 3745-83-02 WATER DISRUPTION OF SERVICE RULE. EXCAVATE PITS SUFFICIENTLY BELOW THE AREA TO BE CONNECTED TO IN ORDER TO MAINTAIN WATER LEVELS BELOW THE WATER MAIN. IF WATER FROM THE PIT ENTERS THE EXISTING MAIN, CONTACT DIVISION OF WATER IMMEDIATELY. ENSURE THAT SUFFICIENTLY SIZED PUMPS ARE UTILIZED TO REMOVE WATER FROM THE TRENCH AND BACKUP PUMPS ARE KEPT ON SITE FOR REDUNDANCY.

"ITEM SPECIAL SURVEY COORDINATES" SHALL INCLUDE ALL MATERIAL, EQUIPMENT, AND LABOR NECESSARY TO OBTAIN HORIZONTAL AND VERTICAL (NORTHING, EASTING, AND CENTERLINE OF PIPE ELEVATION) SURVEY COORDINATES FOR THE WATER MAIN IMPROVEMENTS. THE SURVEY COORDINATES SHALL BE OBTAINED FOR THE COMPLETED WATER MAIN CONSTRUCTION AND SHALL INCLUDE ALL VALVES, TEES, CROSSES, BENDS, HORIZONTAL DEFLECTIONS, PLUGS, REDUCERS, TAPPING SLEEVES, FIRE HYDRANTS, AIR RELEASES, CURB STOPS, TRACER WIRE BOXES, AND CASING PIPE TERMINI. ADDITIONAL SURVEY COORDINATES ARE REQUIRED ON THE WATER MAIN EVERY 200 FEET WHERE NO FITTING OR OTHER WATER MAIN STRUCTURE IS BEING INSTALLED WITHIN THAT LENGTH OF THE IMPROVEMENT.

ALL SURVEY COORDINATES SHALL BE REFERENCED TO THE APPLICABLE COUNTY ENGINEER'S MONUMENTS, AND SHALL BE BASED ON THE NORTH AMERICAN DATUM OF 1983 (NAD 83) WITH THE (NSRS2007) ADJUSTMENT, WITH FURTHER REFERENCE MADE TO THE OHIO STATE PLANE SOUTH COORDINATE SYSTEM, SOUTH ZONE, WITH ELEVATIONS BASED ON NAVD 88 DATUM. ALL COORDINATES (NORTHING, EASTING, CENTERLINE ELEVATION) SHALL BE REFERENCED TO THE NEAREST HUNDREDTH (N XXXXXX.XX, E XXXXXX.XX, C/L ELEV. XXX.XX). ALL SURVEY COORDINATES SHALL BE ACCURATE TO WITHIN 1.0 FOOT HORIZONTAL AND A TENTH OF A FOOT (0.10) OR LESS VERTICAL.

THE COORDINATES SHALL BE DOCUMENTED TO THE ENGINEER IN DIGITAL SPREADSHEET FORM AND SHALL INCLUDE THE APPLICABLE ITEM, STATION, NORTHING, EASTING, AND CENTERLINE ELEVATION. COORDINATES SHALL BE SUBMITTED TO THE ENGINEER ON A BI-WEEKLY BASIS. COORDINATES SHALL ALSO BE REQUIRED TO BE SUBMITTED TO THE DIVISION OF WATER AS PART OF THE REQUEST FOR CHLORINATION.

LUMP SUM PAYMENT IS FULL COMPENSATION FOR ALL WORK INVOLVED IN OBTAINING AND DOCUMENTING THE SURVEY COORDINATES AS DESCRIBED IN THIS SPECIFICATION.



ALL WATER MAIN VALVE BOXES, WATER TAP BOXES, TEST STATIONS, PITOMETER TAP STRUCTURES, METER PIT COVERS, AND OTHER SURFACE UTILITY STRUCTURES WITHIN THE DISTURBED AREA SHALL BE ADJUSTED TO GRADE. ANY OF THESE STRUCTURES LOCATED WITHIN PAVEMENT, DRIVEWAYS, OR OTHER TRAVELED AREAS, WHETHER EXISTING OR PROPOSED, SHALL BE EQUIPPED WITH A TRAFFIC RATED, HEAVY DUTY VALVE BOX AND/OR COVER IN ACCORDANCE WITH THE STANDARD DRAWINGS. EXISTING WATER TAP BOXES TO REMAIN THAT ARE ENCOUNTERED WITHIN THE PROJECT LIMITS SHALL BE CLEANED OUT, CENTERED OVER THE CURB STOP, AND ADJUSTED TO THE PROPOSED GRADE.

WHERE NEW CONDUIT IS PROPOSED TO CROSS AN EXISTING OR PROPOSED WATER MAIN OR WATER TAP/SERVICE LINE, A MINIMUM OF 12-INCHES OF VERTICAL CLEARANCE SHALL BE MAINTAINED BETWEEN THE CONDUIT AND THE WATER MAIN OR TAP/SERVICE LINE. A MINIMUM OF 3-FEET OF HORIZONTAL CLEARANCE (OUT TO OUT) IS REQUIRED AT LOCATIONS WHERE THE CONDUIT IS PARALLEL TO THE WATER MAIN AND AT LOCATIONS OF WATER MAIN THRUST BLOCKS.

A MINIMUM OF 3 FEET OF HORIZONTAL CLEARANCE (OUT TO OUT) SHALL BE MAINTAINED BETWEEN ALL EXISTING WATER MAINS AND FOUNDATIONS FOR POLES, PULL BOXES, PUSH BUTTON PEDESTALS, AND ANY OTHER MISCELLANEOUS ELECTRICAL STRUCTURE.

DURING CONSTRUCTION, THE CONTRACTOR SHALL USE EXTREME CAUTION NOT TO DAMAGE THE EXISTING WATER MAINS DUE TO MINIMAL COVER.

FIRE HYDRANT RELOCATIONS SHALL CONFORM TO APPLICABLE SECTIONS OF ITEM 809 OF THE CITY OF COLUMBUS CONSTRUCTION AND MATERIAL SPECIFICATIONS. WORK SHALL CONSIST OF REMOVING THE EXISTING HYDRANT, INSTALLING NEW 6" PIPE AND FITTING AS REQUIRED TO LOCATE THE FIRE HYDRANT 2 FEET FROM BACK OF PROPOSED CURB OR 8 FEET OFF EDGE OF PAVEMENT, RESETTING HYDRANT AND BLOCKING AS REQUIRED. ALL 6" PIPE SHALL BE INSTALLED AT 4"-0" MINIMUM COVER. HYDRANT EXTENSIONS SHALL BE PROVIDED PER ITEM 810, AS REQUIRED. RELOCATED FIRE HYDRANTS SHALL BE ADJUSTED TO PROPER GRADE AND FACED IN THE PROPER DIRECTION. WHEN A HYDRANT IS RELOCATED FIFTEEN (15) FEET OR MORE FROM THE "TYPICAL HYDRANT SETTING" VALVE LOCATION (SEE L-6409 & L-6637), AN ADDITIONAL VALVE SHALL BE INSTALLED, AND RESTRAINED, WITHIN TWO (2) FEET OF THE RELOCATED HYDRANT. PAYMENT IS TO BE INCLUDED UNDER ITEM 809, FIRE HYDRANT RELOCATED.

RELOCATED FIRE HYDRANTS SHALL BE PUT BACK IN SERVICE AS SOON AS POSSIBLE. THE CONTRACTOR SHALL NOTIFY THE DIVISION OF FIRE ALARM OFFICE, 221-3132, WHENEVER FIRE HYDRANTS ARE TAKEN OUT OF SERVICE AND PLACED BACK IN SERVICE. NO TWO (2) ADJACENT FIRE HYDRANTS SHALL BE TAKEN OUT OF SERVICE CONCURRENTLY.

THE CONTRACTOR SHALL COORDINATE HIS WORK SUCH THAT NO WATER CUSTOMER WILL HAVE THEIR SERVICE DISRUPTED MORE THAN TWO (2) TIMES THROUGHOUT THE DURATION OF THIS PROJECT.

IF A LEAD WATER TAP IS ENCOUNTERED AND IS NEITHER DAMAGED NOR PART OF A PLANNED RELOCATION/REPLACEMENT, THE CONTRACTOR SHALL REPORT THE PRESENCE OF THE LEAD TAP TO THE DIVISION OF WATER DISTRIBUTION MAINTENANCE GROUP AT 614-645-7788.

ADDENDUM #1  
04/21/2023

X:\Projects\2013\1321\1010\FRA\92616\Roadway\sheet\92616GN001.dgn 4/18/2023 1:57:53 PM c.wong



WATER (CONTINUED)

IF A LEAD TAP IS EITHER DAMAGED DURING CONSTRUCTION OR IS PART OF A PLANNED WATER TAP RELOCATION/REPLACEMENT, THE CONTRACTOR SHALL TAKE THE FOLLOWING STEPS:

1. IF DAMAGED, IMMEDIATELY CONTACT LEW FLEMISTER, DIVISION OF WATER, (614-645-7028), TO REQUEST THE SHUT OFF OF THE EXISTING CURB STOP. IF LEW CANNOT BE REACHED, CONTACT THE DIVISION OF WATER DISTRIBUTION ENGINEERING OFFICE AT 614-645-7677 TO REQUEST THE SHUT OFF.

2. CONTRACTOR SHALL EXPOSE THE OWNER'S SIDE OF THE WATER SERVICE TO CONFIRM THE MATERIAL. THE INSPECTOR SHALL BE PRESENT FOR THIS.

3. IF THE CUSTOMER'S PRIVATE SERVICE MATERIAL IS LEAD, STOP WORK AND NOTIFY THE DIVISION OF WATER DISTRIBUTION ENGINEERING OFFICE (614-645-7677) IMMEDIATELY. IF THE MATERIAL IS NOT LEAD, THE CONTRACTOR SHALL REPLACE THE LEAD TAP (FROM EXISTING CORPORATION STOP TO CURB STOP) AND REINSTATE SERVICE TO THE CUSTOMER. PARTIAL REPAIRS OF THE LEAD TAP ARE NOT PERMITTED.

4. REFER TO DIVISION OF WATER STANDARD DRAWINGS L-7102C AND L-9901 FOR INFORMATION ON WATER TAP RELOCATIONS, PLACING NEW CURB STOPS, AND RELOCATING CURB BOXES.

ITEM SPECIAL - FILL AND PLUG EXISTING CONDUIT

THIS ITEM CONSISTS OF THE CONSTRUCTION OF BULKHEADS IN AN EXISTING 15 INCH DIAMETER CONDUIT AND FILLING THE AREA SEALED OFF WITH ITEM 613, SAND OR OTHER MATERIAL APPROVED BY THE ENGINEER.

LOCATE THE BULKHEADS AT THE LIMITS OF THE AREA TO BE FILLED, AS INDICATED ON THE PLANS. THE BULKHEADS CONSIST OF BRICK OR CONCRETE MASONRY WITH A MINIMUM THICKNESS OF 12 INCHES.

PUMP THE FILL MATERIAL INTO PLACE OR BY OTHER MEANS APPROVED BY THE ENGINEER, SO THAT AFTER SETTLEMENT, AT LEAST 90 PERCENT OF THE CROSS- SECTIONAL AREA OF THE CONDUIT, FOR ITS ENTIRE LENGTH IS FILLED. THE LENGTH OF FILLED AND PLUGGED CONDUIT TO BE PAID FOR IS THE ACTUAL NUMBER OF FEET (MEASURED ALONG THE CENTERLINE OF EACH CONDUIT FROM OUTER FACE TO OUTER FACE OF BULKHEADS) FILLED AND PLUGGED AS DESCRIBED ABOVE.

IN LIEU OF FILLING AND PLUGGING THE EXISTING CONDUIT, THE PIPE MAY BE CRUSHED AND BACKFILLED PER 203, OR IT MAY BE REMOVED. THE LENGTH, MEASURED AS PROVIDED ABOVE, WILL BE PAID FOR AT THE CONTRACT PRICE PER FOOT FOR, ITEM SPECIAL, FILL AND PLUG EXISTING CONDUIT.



ITEM 618 - RUMBLE STRIPS, SHOULDER (ASPHALT CONCRETE), AS PER PLAN

THE CONTRACTOR SHALL MILL 2 INCHES BY 2 FEET WIDE OF THE EXISTING ASPHALT SHOULDER IN ORDER TO REMOVE THE EXISTING RUMBLE STRIPS WITHIN THE PROJECT LIMITS IN THE AREA WHERE TRAFFIC IS SHIFTED. THE CONTRACTOR SHALL THEN COAT ALL MILLED SURFACES HORIZONTAL AND VERTICAL WITH APPROVED AC LIQUID. NEXT THE CONTRACTOR SHALL PLACE 2 INCHES OF ITEM 448 ASPHALT CONCRETE SURFACE COURSE, TYPE 1, PG 64-28.

ONCE THE PROJECT IS COMPLETE, THE CONTRACTOR SHALL INSTALL NEW RUMBLE STRIPS AS PER THE CONSTRUCTION AND MATERIAL SPECIFICATIONS SECTION 618.

ALL COST ASSOCIATED WITH THE REMOVAL OF THE EXISTING PAVEMENT, PLACEMENT OF THE SURFACE COURSE AND INSTALLATION OF THE RUMBLE STRIPS SHALL BE INCLUDED IN UNIT PRICE BID PER FOOT OF ITEM 618 - RUMBLE STRIPS, SHOULDER (ASPHALT CONCRETE), AS PER PLAN.

AN ESTIMATED QUANTITY OF 9190 FEET HAS BEEN CARRIED TO THE MAINTENANCE OF TRAFFIC SUBSUMMARY.

COORDINATION BETWEEN CONTRACTORS

THE CONTRACTOR SHALL COORDINATE WORK ON THIS PROJECT WITH ADJACENT CONSTRUCTION PROJECTS, INCLUDING PID 105839 SPOT PAVE WORK, WHILE THIS PROJECT IS UNDER CONSTRUCTION.

PAVEMENT CUTTING, SAWING, AND EXCAVATION OPERATIONS NOTE:

ALL PUBLIC AGENCIES AND PRIVATE CONTRACTORS PERFORMING PAVEMENT-CUTTING OPERATIONS ON CITY OF COLUMBUS STREETS AND ROADWAYS SHALL PROTECT THE ENVIRONMENT FROM DISCHARGES CREATED BY THEIR PAVEMENT CUTTING OPERATIONS. NOTE THAT COLUMBUS CITY CODE 1145 PROHIBITS NON-STORM WATER DISCHARGE INTO THE CITY OF COLUMBUS SEWER SYSTEM, CURB INLETS AND ANY PART OF ITS MS4 (MUNICIPAL SEPARATE STORM SEWER SYSTEM).

THE REQUIREMENT INCLUDES BUT IS NOT LIMITED TO WET OR DRY SAW-CUTTING, JACK HAMMERING, EXCAVATION EQUIPMENT USE, ETC. THE PUBLIC AGENCY AND/OR PRIVATE CONTRACTOR WORK CREWS SHALL RECOVER AND DISPOSE OF DETRITUS, POLLUTED WATERS, OR OTHER SUCH DISCHARGES RESULTING FROM THEIR PAVEMENT CUTTING OPERATIONS AND PROTECT ALL STORM SEWER INLETS FROM RECEIVING ANY DISCHARGES FROM THE CONSTRUCTION OPERATIONS. THE AGENCY OR CONTRACTOR RESPONSIBLE FOR EACH PAVEMENT CUTTING ACTIVITY SHALL BE SOLELY LIABLE FOR NOTICE OF VIOLATIONS (NOV/S) AND FINES ISSUED BY CITY OF COLUMBUS AND/OR STATE OF OHIO AUTHORITIES.

EQUIPMENT, MATERIALS AND METHODS SHALL BE PROVIDED BY THE RESPONSIBLE PUBLIC AGENCY AND/OR PRIVATE CONTRACTOR TO WORK CREWS PERFORMING THE PAVEMENT CUTTING ACTIVITY AND MADE AVAILABLE TO WORK CREWS FOR USE IN CLEANING UP DISCHARGES RESULTING FROM SUCH CUTTING ACTIVITIES AND PREVENTING RUNOFF. ALL WORK CREWS SHALL BE TRAINED TO EXERCISE AND EMPLOY EQUIPMENT, MATERIALS, AND ENVIRONMENTAL PROTECTIVE MEASURES TO PREVENT POLLUTED DISCHARGES FROM ENTERING THE CITY OF COLUMBUS STORM SEWER SYSTEM AND WATERS OF THE STATE OF OHIO.

THE PUBLIC AGENCY AND/OR PRIVATE CONTRACTOR IS SOLELY RESPONSIBLE FOR ENSURING THAT THE INLET PROTECTION IS ADEQUATE. THE MOST STRINGENT PROJECT PLANS, NOTES AND/OR DRAWINGS INCLUDING STORMWATER POLLUTION PREVENTION PLAN (SWP3) OR SPILL PREVENTION/REMEDICATION PLAN SHALL APPLY TO ALL PAVEMENT CUTTING, SAWING OR EXCAVATION OPERATIONS.

NOTE TO SPECIFICATION WRITERS: IF SWP3 OR SPILL PREVENTION/REMEDICATION PLANS ARE INCLUDED IN CONTRACT DOCUMENTS, THEY SHOULD BE CITED IN THE LAST PARAGRAPH ABOVE BY VOLUME, PAGE OR SHEET NUMBERS; SO DIRECTING THE READER TO SUCH PLAN.

DELINEATION OF PORTABLE AND PERMANENT BARRIER

BARRIER REFLECTORS AND OBJECT MARKERS SHALL BE INSTALLED ON ALL PORTABLE BARRIER (PB) USED FOR TRAFFIC CONTROL AND ON PERMANENT CONCRETE BARRIER (INCLUDING BRIDGE PARAPETS) LOCATED WITHIN 5 FEET OF THE EDGE OF THE ADJACENT TRAVEL LANE.

BARRIER REFLECTORS SHALL CONFORM TO C&MS 626, EXCEPT THAT THE SPACING SHALL BE AS PER TRAFFIC SCD MT-101.70. OBJECT MARKERS AND THEIR INSTALLATION SHALL CONFORM TO C&MS 614.03 AND SCD MT-101.70. WHEN THE PB CONTAINS GLARE SCREEN, ONE SET OF THREE VERTICAL STRIPES OF SHEETING SHALL BE CONSIDERED EQUIVALENT TO AN OBJECT MARKER, ONE-WAY.

INCREASED BARRIER DELINEATION, AS SPECIFIED HEREIN, SHALL BE INSTALLED ON ALL PB AND CONCRETE PERMANENT BARRIER LOCATED WITHIN 5 FEET OF THE EDGE OF THE TRAVELED LANE.

THE INCREASED BARRIER DELINEATION SHALL CONSIST OF THE TRIPLE STACKING OF WORK ZONE BARRIER REFLECTORS.

TRIPLE-STACKED BARRIER REFLECTORS SHALL CONSIST OF ALIGNING THREE BARRIER REFLECTORS VERTICALLY, AT LOCATIONS WHERE A SINGLE BARRIER REFLECTOR WOULD BE OTHERWISE ATTACHED. THERE SHALL BE NO OPEN SPACE BETWEEN THE ADJACENT BARRIER REFLECTORS. THE TRIPLE-STACKED BARRIER REFLECTORS SHALL CONFORM TO C&MS 626, EXCEPT THAT THEY SHALL BE SPACED AND ALIGNED PER TRAFFIC SCD MT-101.70.

THE FOLLOWING ESTIMATED QUANTITIES HAVE BEEN INCLUDED IN THE PLANS AND CARRIED TO THE GENERAL SUMMARY:

ITEM 614, BARRIER REFLECTOR, TYPE B	739 EACH
ITEM 614, OBJECT MARKER, 1-WAY	329 EACH

PAYMENT SHALL BE FULL COMPENSATION FOR ALL MATERIAL, LABOR, INCIDENTALS AND EQUIPMENT NECESSARY FOR FURNISHING, INSTALLING, MAINTAINING AND REMOVING EACH OF THE ABOVE ITEMS

COORDINATION WITH ADJACENT PROJECTS

THE CONTRACTOR SHALL COORDINATE WORK WITH ODOT AND THE CONTRACTORS ON THE ADJACENT PROJECTS INCLUDING PID 110696. COORDINATION SHALL BE MADE TO PREVENT CONFLICTING ADVANCE WARNING SIGNS, CONFLICTING DETOUR ROUTES, OVERLAPING/CONFLICTING LANE CLOSURES, AND TO ENSURE THAT A MINIMUM DISTANCE OF 2 MILES BETWEEN ADJACENT LANE CLOSURES IS MAINTAINED. THIS IS NOT AN EXHAUSTIVE LIST OF COORDINATION ITEMS THAT MAY NEED TO BE RESOLVED BETWEEN PROJECTS. THE DEPARTMENT RESERVES THE RIGHT TO DECIDE WHICH PROJECT'S ACTIVITIES TAKE PRECEDENCE. PROJECTS THAT HAVE ACTIVITIES DELAYED DUE TO CONFLICTS WILL CONSIDER THIS AN EXCUSABLE, NON-COMPENSABLE DELAY PER 108.06.B. ON PROJECTS THAT HAVE ACTIVITIES DELAYED DUE TO CONFLICTS WHERE THE CONTRACTOR FAILED TO MEET THE NOTIFICATION REQUIREMENTS, THE DELAYS SHALL NOT BE CONSIDERED EXCUSABLE OR COMPENSABLE. ATTENDANCE AT DEPARTMENT ORDERED TRAFFIC COORDINATION MEETINGS BETWEEN ADJACENT PROJECTS SHALL BE CONSIDERED MANDATORY FOR EACH PROJECT'S SUPERINTENDENT AND WORKSITE TRAFFIC SUPERVISOR (WTS)\*, AND INCIDENTAL TO THE LUMP SUM MAINTENANCE OF TRAFFIC PAYMENT ITEM

\*IF REQUIRED BY THE PROJECT



CALCULATED  
ACF  
CHECKED  
CSR

GENERAL NOTES

FRA - 270-51.50

18  
554



**SEQUENCE OF CONSTRUCTION**

**PHASE 1**

CONSTRUCT THE EARTHWORK, DRAINAGE AND PAVEMENT FOR TEMPORARY RAMP (TO BE USED IN PHASE 2 BY DETOURED RAMP L TRAFFIC) FROM US 23 TO RAMP M. CONSTRUCT TEMPORARY SIGNAL AT TEMPORARY RAMP. THIS WORK MAY CONTINUE THROUGH PHASE 1A. RAMP M MAY BE DETOURED FOR UP TO TWO WEEKS TO CONSTRUCT THE TIE IN TO TEMPORARY RAMP L.

MAINTAIN TRAFFIC ON RIGHT SIDE OF RAMP P1 WHILE CONSTRUCTING THE EARTHWORK, DRAINAGE AND FULL DEPTH PAVEMENT FOR RAMP P2 AND WIDENING LEFT ON RAMP P1. CONSTRUCT THE EARTHWORK AND PAVEMENT FOR MAINTAINING TRAFFIC FOR THE CONNECTION OF RAMP P2 TO RAMP O (TO BE USED IN PHASE 2 BY DIVERTED RAMP R TRAFFIC) FROM US 23 TO RAMP O. CONSTRUCT PERMANENT SIGNAL AT RAMP P2 AND MODIFY FOR USE IN PHASE 1A. THE CONTRACTOR CAN CLOSE RAMP O FOR UP TO TWO WEEKS TO CONSTRUCT THE PROPOSED STORM SEWER BETWEEN RAMP O AND RAMP P2.

USING PERMISSIBLE LANE CLOSURES, CONSTRUCT EARTHWORK, DRAINAGE, PERMANENT PAVEMENT AND PAVEMENT FOR MAINTAINING TRAFFIC IN US 23 MEDIAN TO ACCOMMODATE LEFT TURN LANES.

ON I-270 EB, SHIFT LANES LEFT AND CONSTRUCT EARTHWORK, DRAINAGE, AND PERMANENT PAVEMENT ON RIGHT SIDE OF I-270 EB FROM STA. 534+00 TO STA. 539+00.

**PHASE 1A**

PLACE WORKZONE CONTROL MARKINGS ON US 23 AND ACTIVATE SIGNAL.

MAINTAIN TRAFFIC (270 EB TO 23 SB) ON THE LEFT SIDE OF RAMP P1 AND RAMP P2 TO THE MODIFIED SIGNAL. CONSTRUCT THE EARTHWORK AND PAVEMENT FOR THE RIGHT SIDE OF RAMP P1. CONSTRUCT THE EARTHWORK AND PAVEMENT FOR THE ACCELERATION LANE FOR RAMP P1 TO US 23 SOUTH USING PERMISSIBLE LANE CLOSURES AND ADHERING TO THE DROP OFF REQUIREMENTS OF SCD MT-101.90.

CONSTRUCT PERMANENT SIGNAL AT INTERSECTION OF RAMP P2 AND US 23 AND MODIFY FOR USE WITH ADDITIONAL US23 NB LEFT TURNING TRAFFIC REROUTED FROM RAMP R. (TO BE USED IN PHASE 2 BY DETOURED RAMP R TRAFFIC.)

**PHASE 2**

PLACE WORK ZONE CONTROL MARKINGS ON US 23 AND ACTIVATE SIGNAL TO MAINTAIN TRAFFIC (I 270 WB TO US 23 SB & NB AND US 23 NB TO I 270 EB) VIA RAMP P1, RAMP P2 AND RAMP O. CLOSE RAMP L AND RAMP R ROUTING TRAFFIC TO TEMPORARY RAMPS.

CONSTRUCT THE SUBSTRUCTURE REPAIRS ON RAMP L STRUCTURE OVER IR 270 AND THE SUBSTRUCTURE RAMP L STRUCTURE OVER US 23 USING PERMITTED LANE CLOSURES.

REMOVE THE EXISTING SUPERSTRUCTURE FOR RAMP L STRUCTURE OVER IR 270 USING PERMITTED LANE CLOSURES AND SHORT DURATION CLOSURES AT NIGHT FOR REMOVING EXISTING BEAMS.

CONSTRUCT RAMP L OVER IR 270 STRUCTURE WORK (ABUTMENT REHABILITATION, BEARINGS, BEAMS, DECK AND APPROACH SLAB REPLACEMENT) USING PERMITTED LANE CLOSURES AND SHORT DURATION CLOSURES AT NIGHT FOR PLACING BEAMS.\*

CONSTRUCT THE SUPERSTRUCTURE REPAIRS AND OVERLAY ON RAMP L STRUCTURE OVER US 23.

**PHASE 2 (CONT.)**

CONSTRUCT THE EARTHWORK, DRAINAGE AND PAVEMENT FOR RAMP L. \*

CONSTRUCT FULL DEPTH PAVEMENT ON RAMP P1 FROM STA. 684+89 TO STA. 688+00 DURING NON-PEAK HOURS USING LANE CLOSURES. THIS WORK SHOULD OCCUR DURING WEEKENDS BEGINNING NO EARLIER THAN 9 PM ON FRIDAY AND COMPLETED BY 6 AM ON MONDAY. (SEE SHEET 52.)

CONSTRUCT THE EARTHWORK, DRAINAGE AND PAVEMENT FOR RAMP R.

PLACE THE WORK ZONE CONTROL MARKINGS, DRUMS, AND TEMPORARY BARRIER TO MAINTAIN CD ROAD MERGE WITH I-270 AND CONSTRUCT THE EARTHWORK AND FULL DEPTH PAVEMENT ON THE CD ROAD/RAMP R ACCELERATION LANE TO THE RIGHT OF EXISTING PAVEMENT.

CONSTRUCT TEMPORARY PAVEMENT IN THE GORE AREA OF RAMP R AND THE CD ROAD.

DETOUR RAMP S AND CONSTRUCT EARTHWORK, DRAINAGE, FULL DEPTH PAVEMENT AND SIGNAL ON RAMP S.\*

\*THIS WORK MAY CONTINUE THROUGH PHASE 2A.

**PHASE 2A**

PLACE THE WORK ZONE CONTROL MARKINGS, DRUMS, AND TEMPORARY BARRIER TO MAINTAIN CD ROAD MERGE WITH I-270 VIA TEMPORARY PAVEMENT AND THE NEW PAVEMENT ON THE FAR RIGHT. CONSTRUCT THE EARTHWORK, DRAINAGE AND FULL DEPTH PAVEMENT ON THE CD ROAD/RAMP R ACCELERATION LANE BETWEEN I-270 EB AND THE NEW PAVEMENT WIDENING.

**PHASE 3**

MAINTAIN TRAFFIC ON I 270 WB BY SHIFTING 2 LANES LEFT AND MAKING RIGHT LANE EXIT ONLY TO US 23 ON RAMP S. CONSTRUCT THE EARTHWORK, DRAINAGE AND FULL DEPTH PAVEMENT ON THE RIGHT SIDE OF I 270 WB.

REMOVE PAVEMENT FOR MAINTAINING TRAFFIC BETWEEN RAMP P1 AND RAMP O AND PLACE REMAINING PAVEMENT ON RAMP P2 AT STA 867+00 TO 870+00.

MAINTAIN TRAFFIC USING BARRELS AND/OR FLAGGERS TO PLACE FINAL OVERLAY AND PAVEMENT MARKINGS, INCLUDING OVERLAY ON RAMP M AND RAMP O.

REMOVE TEMPORARY RAMP L, RAMP N, AND RAMP Q.

**EARTHWORK FOR MAINTAINING TRAFFIC**

WHEN UNDERCUTS ARE NECESSARY FOR PAVEMENT FOR MAINTAINING TRAFFIC OR EMBANKMENT CONSTRUCTION, EVALUATE THE NEED FOR TEMPORARY ROAD UNDERCUTS IF WITHIN A CLOSE PROXIMITY TO THE MAINLINE UNDERCUTS. A GEOTECHNICAL EVALUATION SHOULD BE CONSIDERED TO DETERMINE IF THE EXISTING SOIL CONDITIONS ARE ADEQUATE TO SUPPORT THE TEMPORARY ROAD. ADDITIONAL SOIL BORINGS ALONG THE TEMPORARY ROAD ARE NOT NORMALLY REQUIRED.

**ITEM 614, MAINTAINING TRAFFIC (LANES OPEN DURING HOLIDAYS AND SPECIAL EVENTS)**

NO WORK SHALL BE PERFORMED AND THE SAME NUMBER OF LANES AS WERE AVAILABLE AT THE START OF THE PROJECT SHALL BE OPEN TO TRAFFIC DURING THE FOLLOWING DESIGNATED HOLIDAYS OR SPECIAL EVENTS:

NEW YEAR'S (OBSERVED)	LABOR DAY
TOTAL SOLAR ECLIPSE (4/8/24)	GENERAL/REGULAR ELECTION DAY (NOV)
MEMORIAL DAY	THANKSGIVING
FOURTH OF JULY (OBSERVED)	CHRISTMAS (OBSERVED)

THE PERIOD OF TIME THAT THE LANES ARE TO BE OPEN DEPENDS ON THE DAY OF THE WEEK ON WHICH THE HOLIDAY OR SPECIAL EVENT FALLS. THE FOLLOWING SCHEDULE SHALL BE USED TO DETERMINE THIS PERIOD:

DAY OF HOLIDAY OR SPECIAL EVENT	TIME ALL LANES MUST BE OPEN TO TRAFFIC
SUNDAY	12:00N FRIDAY THROUGH 6:00 AM MONDAY
MONDAY	12:00N FRIDAY THROUGH 6:00 AM TUESDAY
MONDAY	12:00N FRIDAY THROUGH 6:00 AM TUESDAY (TOTAL SOLAR ECLIPSE)
TUESDAY	12:00N MONDAY THROUGH 6:00 AM WEDNESDAY
TUESDAY	5:00 AM TUESDAY THROUGH 12:00 AM WEDNESDAY (GEN./REG. ELECTION)
WEDNESDAY	12:00N TUESDAY THROUGH 6:00 AM THURSDAY
THURSDAY	12:00N WEDNESDAY THROUGH 6:00 AM FRIDAY
THURSDAY (THANKSGIVING ONLY)	6:00 AM WEDNESDAY THROUGH 6:00 AM MONDAY
FRIDAY	12:00N THURSDAY THROUGH 6:00 AM MONDAY
SATURDAY	12:00N FRIDAY THROUGH 6:00 AM MONDAY

**SPECIAL EVENTS**

DURING THE SAME PERIODS, MAINTAIN PEDESTRIAN ACCESS IF PEDESTRIAN ACCESS WAS PRESENT PRIOR TO CONSTRUCTION.

NO EXTENSIONS OF TIME SHALL BE GRANTED FOR DELAYS IN MATERIAL DELIVERIES, UNLESS SUCH DELAYS ARE INDUSTRY WIDE, OR FOR LABOR STRIKES, UNLESS SUCH STRIKES ARE AREA WIDE.

SHOULD THE CONTRACTOR FAIL TO MEET ANY OF THESE REQUIREMENTS, THE CONTRACTOR SHALL BE ASSESSED A DISINCENTIVE PER THE LANE VALUE CONTRACT (PN 127).

**TRENCH FOR WIDENING**

TRENCH EXCAVATION FOR BASE WIDENING SHALL BE ONLY ON ONE SIDE OF THE PAVEMENT AT A TIME. THE OPEN TRENCH SHALL BE ADEQUATELY MAINTAINED AND PROTECTED WITH DRUMS OR BARRICADES AT ALL TIMES. PLACEMENT OF PROPOSED SUBBASE AND BASE MATERIAL SHALL FOLLOW AS CLOSELY AS POSSIBLE BEHIND EXCAVATION OPERATIONS. THE LENGTH OF WIDENING TRENCH WHICH IS OPEN AT ANY ONE TIME SHALL BE HELD TO A MINIMUM AND SHALL AT ALL TIMES BE SUBJECT TO APPROVAL OF THE ENGINEER.

**MAINTAINING TRAFFIC (TIME LIMITATION ON A DETOUR)**

RAMP R AND L SHALL BE FULLY OPEN AND MAINTAINED FOR ONE WAY TRAFFIC AT ALL TIMES, EXCEPT FOR A PERIOD NOT TO EXCEED 180 CONSECUTIVE CALENDAR DAYS, WHEN THROUGH TRAFFIC MAY BE DETOURED AS SHOWN ON SHEET 24. A DISINCENTIVE SHALL BE ASSESSED IN THE AMOUNT OF \$12,000 PER DAY FOR EACH CALENDAR DAY THE ROADWAY REMAINS CLOSED TO TRAFFIC BEYOND THE SPECIFIED LIMIT.

X:\Projects\2013\1321\1010\FRA\92616\mot\sheets\92616\MN001.dgn 4/25/2023 7:01:55 AM cwong

CALCULATED  
MBE  
CHECKED  
RCH

MAINTENANCE OF TRAFFIC GENERAL NOTES

FRA - 270-51.50

**ITEM 614, PORTABLE CHANGEABLE MESSAGE SIGNS, AS PER PLAN**

THE CONTRACTOR SHALL FURNISH, INSTALL, MAINTAIN AND REMOVE, WHEN NO LONGER NEEDED, A CHANGEABLE MESSAGE SIGN. THE SIGN SHALL BE OF A TYPE SHOWN ON A LIST OF APPROVED PCMS UNITS AVAILABLE ON THE OFFICE OF MATERIALS MANAGEMENT WEB PAGE. THE LIST CONTAINS CLASS A AND B UNITS WITH MINIMUM LEGIBILITY DISTANCES OF 800 FEET AND 650 FEET, RESPECTIVELY.

EACH SIGN SHALL BE TRAILER-MOUNTED AND EQUIPPED WITH A FUNCTIONAL DIMMING MECHANISM, TO DIM THE SIGN DURING DARKNESS, AND A TAMPER AND VANDAL PROOF ENCLOSURE. EACH SIGN SHALL BE PROVIDED WITH APPROPRIATE TRAINING AND OPERATION INSTRUCTIONS TO ENABLE ON-SITE PERSONNEL TO OPERATE AND TROUBLESHOOT THE UNIT. THE SIGN SHALL ALSO BE CAPABLE OF BEING POWERED BY AN ELECTRICAL SERVICE DROP FROM A LOCAL UTILITY COMPANY. THE PCMS SHALL BE DELINEATED IN ACCORDANCE WITH C&MS 614.03.

THE PROBABLE PCMS LOCATIONS AND WORK LIMITS FOR THOSE LOCATIONS ARE SHOWN ON SHEET(S) OF THE PLAN. PLACEMENT, OPERATION, MAINTENANCE AND ALL ACTIVATION OF THE SIGNS BY THE CONTRACTOR SHALL BE AS DIRECTED BY THE ENGINEER. THE PCMS SHALL BE LOCATED IN A HIGHLY VISIBLE POSITION YET PROTECTED FROM TRAFFIC. THE CONTRACTOR SHALL, AT THE DIRECTION OF THE ENGINEER, RELOCATE THE PCMS TO IMPROVE VISIBILITY OR ACCOMMODATE CHANGED CONDITIONS. WHEN NOT IN USE, THE PCMS SHALL BE TURNED OFF. ADDITIONALLY, WHEN NOT IN USE FOR EXTENDED PERIODS OF TIME, THE PCMS SHALL BE TURNED AWAY FROM ALL TRAFFIC.

THE ENGINEER SHALL BE PROVIDED ACCESS TO EACH SIGN UNIT AND SHALL BE PROVIDED WITH APPROPRIATE TRAINING AND OPERATION INSTRUCTIONS TO ENABLE ODOT PERSONNEL TO OPERATE AND TROUBLESHOOT THE UNIT, AND TO REVISE SIGN MESSAGES, IF NECESSARY.

(THE CONTRACTOR SHALL IMPLEMENT A SYSTEM WHEREBY CHANGEABLE MESSAGES WILL BE IMPLEMENTED WITHIN HOURS FOLLOWING TELEPHONE NOTIFICATION FROM THE PROJECT ENGINEER TO A DESIGNATED PHONE.)

ALL MESSAGES TO BE DISPLAYED ON THE SIGN WILL BE PROVIDED BY THE ENGINEER. A LIST OF ALL REQUIRED PRE-PROGRAMMED MESSAGES WILL BE GIVEN TO THE CONTRACTOR AT THE PROJECT PRECONSTRUCTION CONFERENCE. THE SIGN SHALL HAVE THE CAPABILITY TO STORE UP TO 99 MESSAGES. MESSAGE MEMORY OR PRE-PROGRAMMED DISPLAYS SHALL NOT BE LOST AS A RESULT OF POWER FAILURES TO THE ON-BOARD COMPUTER. THE SIGN LEGEND SHALL BE CAPABLE OF BEING CHANGED IN THE FIELD. THREE-LINE PRESENTATION FORMATS WITH UP TO SIX MESSAGE PHASES SHALL BE SUPPORTED. PCMS FORMAT SHALL PERMIT THE COMPLETE MESSAGE FOR EACH PHASE TO BE READ AT LEAST TWICE.


THE PCMS SHALL CONTAIN AN ACCURATE CLOCK AND PROGRAMMING LOGIC WHICH WILL ALLOW THE SIGN TO BE ACTIVATED, DEACTIVATED OR MESSAGES CHANGED AUTOMATICALLY AT DIFFERENT TIMES OF THE DAY FOR DIFFERENT DAYS OF THE WEEK.

**ITEM 614, PORTABLE CHANGEABLE MESSAGE SIGNS, AS PER PLAN (CONTINUED)**

(THE PCMS SHALL CONTAIN A CELLULAR TELEPHONE DATA LINK WHICH WILL (IN ACTIVE CELLULAR PHONE AREAS) ALLOW REMOTE SIGN ACTIVATION, MESSAGE CHANGES, MESSAGE ADDITIONS AND REVISIONS TO TIME OF DAY PROGRAMS. THE SYSTEM SHALL ALSO PERMIT VERIFICATION OF CURRENT AND PROGRAMMED MESSAGES. ONE REMOTE DATA INPUT DEVICE (LAPTOP COMPUTER PLUS MODEM OR EQUIVALENT) SHALL BE FURNISHED FOR USE BY THE DISTRICT TRAFFIC ENGINEER, OR EQUIVALENT, AND SHALL BE INSURED AGAINST THEFT.)THE PCMS UNIT SHALL BE MAINTAINED IN GOOD WORKING ORDER BY THE CONTRACTOR IN ACCORDANCE WITH THE PROVISIONS OF C&MS 614.07. THE CONTRACTOR SHALL, PRIOR TO ACTIVATING THE UNIT, MAKE ARRANGEMENTS, WITH AN AUTHORIZED SERVICE AGENT FOR THE PCMS, TO ASSURE PROMPT SERVICE IN THE EVENT OF FAILURE. ANY FAILURE SHALL NOT RESULT IN THE SIGN BEING OUT OF SERVICE FOR MORE THAN 12 HOURS, INCLUDING WEEKENDS. FAILURE TO COMPLY MAY RESULT IN AN ORDER TO STOP WORK AND OPEN ALL TRAFFIC LANES AND/OR IN THE DEPARTMENT TAKING APPROPRIATE ACTION TO SAFELY CONTROL TRAFFIC. THE ENTIRE COST TO CONTROL TRAFFIC, ACCRUED BY THE DEPARTMENT DUE TO THE CONTRACTOR'S NONCOMPLIANCE, WILL BE DEDUCTED FROM MONEYS DUE, OR TO BECOME DUE THE CONTRACTOR ON HIS CONTRACT.

THE CONTRACTOR SHALL BE RESPONSIBLE FOR 24-HOUR-PER-DAY OPERATION AND MAINTENANCE OF THESE SIGNS ON THE PROJECT FOR THE DURATION OF THE PHASES WHEN THE PLAN REQUIRES THEIR USE.

PAYMENT FOR THE ABOVE DESCRIBED ITEM SHALL BE AT THE CONTRACT UNIT PRICE. PAYMENT SHALL INCLUDE ALL LABOR, MATERIALS, EQUIPMENT, FUELS, LUBRICATING OILS, SOFTWARE, HARDWARE AND INCIDENTALS TO PERFORM THE ABOVE DESCRIBED WORK.

ITEM 614, PORTABLE CHANGEABLE MESSAGE SIGN, AS PER PLAN ASSUMING 3 PCMS SIGN(S) FOR 24 MONTH(S) 

NOTIFICATION OF CONSTRUCTION INITIATION


AT LEAST FOURTEEN DAYS PRIOR TO STARTING INITIAL CONSTRUCTION ACTIVITIES, THE CONTRACTOR SHALL ADVISE THE DISTRICT OFFICE OF COMMUNICATIONS VIA EMAIL AT D06.PIO@DOT.OHIO.GOV, THE DISTRICT WORK ZONE TRAFFIC MANAGER VIA EMAIL AT D06.MOT@DOT.OHIO.GOV AND THE CENTRAL OFFICE SPECIAL HAUL PERMITS SECTION VIA EMAIL AT HAULING.PERMITS@DOT.OHIO.GOV OF THE ANTICIPATED START DATE OF ANY CONSTRUCTION ACTIVITIES INCLUDING BUT NOT LIMITED TO THE PLACING OF WORK ZONE SIGNS. THE NOTIFICATION SHALL ALSO INCLUDE THE PROJECT NUMBER, PID, NAME AND PHONE NUMBER OF THE CONTRACTOR, A POINT OF CONTACT AND THE ANTICIPATED IMPACT ON TRAFFIC. THE CONTRACTOR WILL IMMEDIATELY INFORM THE DISTRICT OFFICE OF COMMUNICATIONS AND THE DISTRICT WORK ZONE TRAFFIC MANAGER OF ANY AND ALL DELAYS AND/OR CHANGES REGARDING THE CONSTRUCTION INITIATION DATE.

INGRESS/EGRESS

WORKSITE INGRESS AND EGRESS MEETING THE DESCRIPTIONS BELOW SHALL NOT OCCUR DURING PEAK HOURS. PEAK HOURS ARE CONSIDERED TO BE 5AM-9AM AND 3PM-6PM MONDAY-FRIDAY.

- ENTERING THE WORKSITE FROM RAMPS, INTERSTATE SHOULDERS OR INTERSTATE LANES

- EXITING THE WORKSITE ONTO OR ALONGSIDE RAMPS, INTERSTATE SHOULDERS OR INTERSTATE LANES

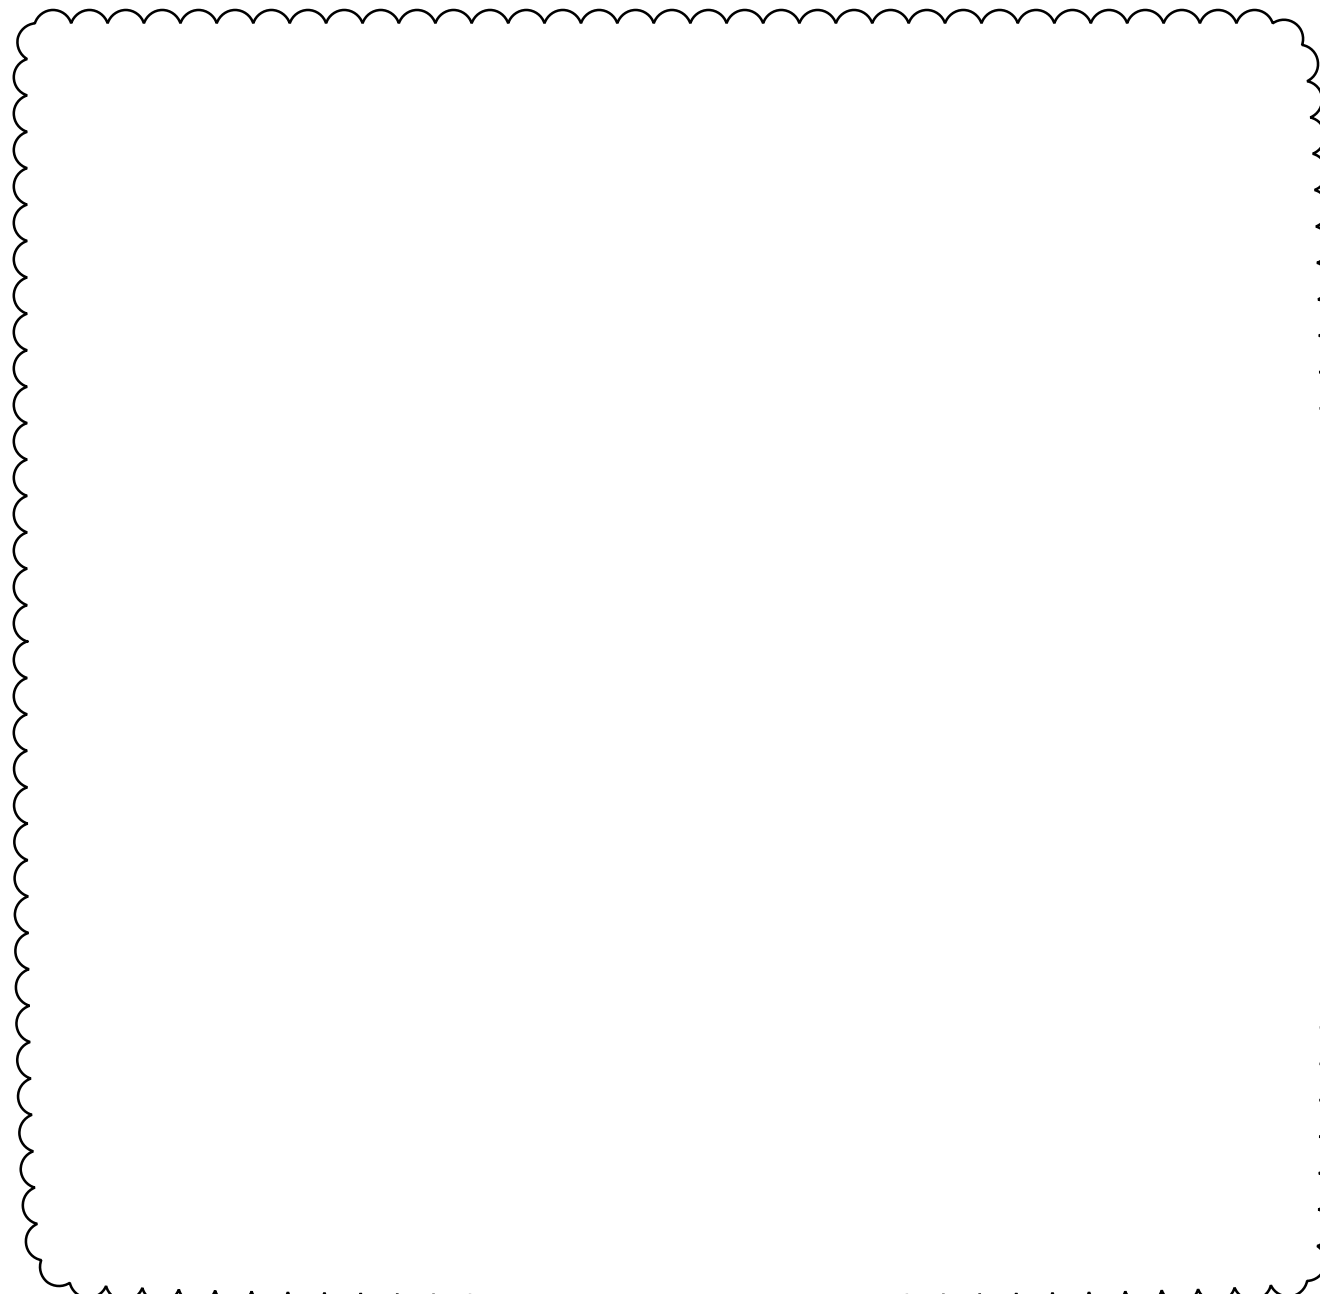

PUBLIC OUTREACH AND NOTIFICATION (ROAD CLOSURE)

THE CONTRACTOR SHALL BE RESPONSIBLE FOR CONTACTING THE DISTRICT 6 PUBLIC INFORMATION OFFICE VIA EMAIL AT D06.PIO@DOT.OHIO.GOV TO COORDINATE EFFORTS TO NOTIFY ALL LOCAL COUNTY, STATE AND FEDERAL EMERGENCY SERVICES, SCHOOL DISTRICTS AND ADJACENT RESIDENTS AND BUSINESSES OF THE UPCOMING CLOSURE. ADVANCE NOTIFICATION SHALL OCCUR NO LATER THAN FOURTEEN (14) DAYS PRIOR TO CLOSING THE ROAD. IF, SUBSEQUENT TO THE ADVANCE NOTIFICATION, THE START DATE IS CHANGED, THEN A NEW SEVEN (7) DAY NOTIFICATION WILL BE REQUIRED. THE ROAD CANNOT BE CLOSED UNLESS PRIOR NOTIFICATION HAS BEEN ACCOMPLISHED. THE SAME PARTIES SHALL BE NOTIFIED WHEN THE CLOSURE HAS CONCLUDED AND THE ROAD IS BACK OPEN TO TRAFFIC. ALL NOTIFICATIONS SHALL BE MADE UTILIZING THE TEMPLATE PROVIDED BY THE DISTRICT 6 PUBLIC INFORMATION OFFICE.

PERMITTED LANE CLOSURES

THE EXISTING NUMBER OF LANES IN EACH DIRECTION SHALL BE MAINTAINED AT ALL TIMES EXCEPT DURING PERIODS OF WORK AT WHICH TIME LANES MAY BE CLOSED IN ACCORDANCE WITH THE UNAUTHORIZED LANE USE TABLE FOR EACH LOCATION UNLESS OTHERWISE SHOWN IN THE PLANS.

LENGTH AND DURATION OF LANE CLOSURES AND RESTRICTIONS SHALL BE AT THE APPROVAL OF THE ENGINEER. IT IS THE INTENT TO MINIMIZE THE IMPACT TO THE TRAVELING PUBLIC. LANE CLOSURES OR RESTRICTIONS OVER SEGMENTS OF THE PROJECT IN WHICH NO WORK IS ANTICIPATED WITHIN A REASONABLE TIME FRAME, AS DETERMINED BY THE ENGINEER, SHALL NOT BE PERMITTED. THE LEVEL OF UTILIZATION OF MAINTENANCE OF TRAFFIC DEVICES SHALL BE COMMENSURATE WITH THE WORK IN PROGRESS.

ALL WORK AND TRAFFIC CONTROL DEVICES SHALL BE IN ACCORDANCE WITH C&MS 614 AND OTHER APPLICABLE PORTIONS OF THE SPECIFICATIONS, AS WELL AS THE OHIO MANUAL OF UNIFORM TRAFFIC CONTROL DEVICES.

PAYMENT FOR ALL LABOR, EQUIPMENT AND MATERIALS SHALL BE INCLUDED IN THE LUMP SUM CONTRACT PRICE FOR ITEM 614, MAINTAINING TRAFFIC, UNLESS SEPARATELY ITEMIZED IN THE PLAN.

**FLOODLIGHTING**

FLOODLIGHTING OF THE WORK SITE FOR OPERATIONS CONDUCTED DURING NIGHTTIME PERIODS SHALL BE ACCOMPLISHED SO THAT THE LIGHTS DO NOT CAUSE GLARE TO THE DRIVERS ON THE ROADWAY. TO ENSURE THE ADEQUACY OF THE FLOODLIGHT PLACEMENT, THE CONTRACTOR AND THE ENGINEER SHALL DRIVE THROUGH THE WORK SITE EACH NIGHT WHEN THE LIGHTING IS IN PLACE AND OPERATIVE PRIOR TO COMMENCING ANY WORK. IF GLARE IS DETECTED, THE LIGHT PLACEMENT AND SHIELDING SHALL BE ADJUSTED TO THE SATISFACTION OF THE ENGINEER BEFORE WORK PROCEEDS.

PAYMENT FOR ALL LABOR, EQUIPMENT AND MATERIALS SHALL BE INCLUDED IN THE LUMP SUM CONTRACT PRICE FOR ITEM 614, MAINTAINING TRAFFIC.

**ITEM 614, REPLACEMENT SIGN**

FLATSHEET SIGNS FURNISHED BY THE CONTRACTOR IN ACCORDANCE WITH THE REQUIREMENTS OF THE PLANS, SPECIFICATIONS AND PROPOSAL WHICH BECOME DAMAGED BY TRAFFIC FOR REASONS BEYOND THE CONTROL OF THE CONTRACTOR SHALL BE REPLACED IN KIND WHEN ORDERED BY THE ENGINEER. REPLACEMENT SIGNS SHALL BE NEW. OTHER MATERIALS MAY BE IN USED, BUT GOOD, CONDITION SUBJECT TO APPROVAL BY THE ENGINEER.

PAYMENT FOR THE NEW SIGNS SHALL BE MADE AT THE CONTRACT PRICE PER EACH FOR ITEM 614, REPLACEMENT SIGN, AND SHALL INCLUDE THE COST OF REMOVING AND DISPOSING OF DAMAGED SIGNS, HARDWARE AND SUPPORTS, AND PROVIDING THE NECESSARY REPLACEMENT HARDWARE, SUPPORTS, ETC.

AN ESTIMATED QUANTITY OF 10 EACH HAS BEEN PROVIDED IN THE GENERAL SUMMARY.

**ITEM 614, REPLACEMENT DRUM**

DRUMS FURNISHED BY THE CONTRACTOR IN ACCORDANCE WITH THE REQUIREMENTS OF THE PLANS, SPECIFICATIONS AND PROPOSAL WHICH BECOME DAMAGED BY TRAFFIC FOR REASONS BEYOND THE CONTROL OF THE CONTRACTOR SHALL BE REPLACED IN KIND WHEN ORDERED BY THE ENGINEER. REPLACEMENT DRUMS SHALL BE NEW.



PAYMENT FOR THE NEW DRUMS SHALL BE MADE AT THE CONTRACT PRICE PER EACH FOR ITEM 614, REPLACEMENT DRUM, AND SHALL INCLUDE THE COST OF REMOVING AND DISPOSING OF THE DAMAGED DRUM, AND PROVIDING AND MAINTAINING THE REPLACEMENT DRUM IN ACCORDANCE WITH THE CONTRACT REQUIREMENTS FOR THE ORIGINAL DRUM.

AN ESTIMATED QUANTITY OF 100 EACH HAS BEEN PROVIDED IN THE GENERAL SUMMARY.

**DETOUR SIGNING**

THIS ITEM SHALL BE IN ACCORDANCE WITH CM&S 614.06 B. CONTRACTOR DETOUR SIGNING PAYMENT IN FULL FOR ALL DETOURS AND DIVERSIONS WITHIN THESE PLANS OR AS NECESSARY FOR MAINTAINING TRAFFIC THROUGHOUT THE CONSTRUCTION PERIOD. THE FOLLOWING PAY ITEM SHALL BE PAYMENT IN FULL FOR THE ABOVE DESCRIBED WORK AND INCLUDE ALL MATERIALS, SUPPORTS, HARDWARE AND INCIDENTALS NECESSARY FOR THIS WORK.

ITEM 614 DETOUR SIGNING LUMP SUM

 ADDENDUM #1  
04/21/2023  
 ADDENDUM #2  
05/05/2023

X:\Projects\2013\1321\1010\FRA\92616\mot\sheets\92616MNO02.dgn 5/17/2023 5:51:15 AM cwong

CALCULATED  
MBE  
CHECKED  
RCH

MAINTENANCE OF TRAFFIC GENERAL NOTES

FRA - 270-51.50



WEEKLY MAINTENANCE OF TRAFFIC MEETING

AFTER THE INITIAL PRE-MAINTENANCE OF TRAFFIC MEETING, THE CONTRACTOR SHALL MEET WITH THE PROJECT ENGINEER ON A WEEKLY BASIS TO GO OVER A DETAILED MAINTENANCE OF TRAFFIC REPORT OF AT LEAST 7 CALENDAR DAYS. THIS MEETING SHOULD BE HELD ON THE SAME DAY AND TIME OF EACH WEEK.

THE CONTRACTOR WILL PROVIDE TO THE PROJECT ENGINEER A WRITTEN DETAIL OF THE INFORMATION REQUIRED BY THE NOTIFICATION OF TRAFFIC RESTRICTIONS NOTE PRIOR TO THE MEETING.

IN ADDITION TO THE DETAILED MAINTENANCE OF TRAFFIC REPORT THE CONTRACTOR SHALL GIVE A GENERAL LOOK AHEAD OF AN ADDITIONAL 2 WEEKS OF UPCOMING WORK ACTIVITIES. THIS WILL INCLUDE ANY NOTIFICATION REQUIREMENTS FOR RESTRICTIONS THAT HAVE A DURATION GREATER THAN 12 HOURS.

PRE-MAINTENANCE OF TRAFFIC MEETING

A PRE-MAINTENANCE OF TRAFFIC MEETING SHALL BE HELD (MINIMUM 14 WORK DAYS) PRIOR TO WORK BEGINNING OR ANY CHANGE OF PHASING. THIS MEETING SHALL INCLUDE THE DISTRICT WORK ZONE TRAFFIC MANAGER (DO6.MOT@DOT.OHIO.GOV) AS WELL AS THE CONTRACTOR AND ANY OF HIS SUB-CONTRACTORS INVOLVED WITH TEMPORARY TRAFFIC CONTROL. FOR COLUMBUS SECTIONS OF ROADWAY, ALSO INCLUDE THE TEMPORARY CONTROL COORDINATOR (614-645-6269 OR 614-645-5845) FROM THE CITY OF COLUMBUS TRANSPORTATION DIVISION.

DUST CONTROL

THE CONTRACTOR SHALL FURNISH AND APPLY WATER FOR DUST CONTROL AS DIRECTED BY THE ENGINEER. THE FOLLOWING ESTIMATED QUANTITIES HAVE BEEN INCLUDED FOR DUST CONTROL PURPOSES:

ITEM 616, WATER M. GAL.

ITEM 614, WORK ZONE RAISED PAVEMENT MARKER, AS PER PLAN

WORK ZONE RAISED PAVEMENT MARKERS, AS PER PLAN, AND THEIR INSTALLATION SHALL CONFORM TO C&MS 614 OR C&MS 621 AS SPECIFIED HEREIN.

RAISED PAVEMENT MARKERS IN USE DURING THE SNOW-PLOWING SEASON SHALL CONFORM TO 621. RAISED PAVEMENT MARKERS IN USE DURING THE NON-SNOW-PLOW SEASON SHALL CONFORM TO EITHER 614 OR TO 621.

THE SNOW-PLOWING SEASON SHALL RUN FROM THROUGH

IF PROJECT DELAYS, NOT THE FAULT OF ODOT, CAUSE THE WORK TO EXTEND INTO THE SNOW-PLOWING SEASON, THE CONTRACTOR SHALL BE RESPONSIBLE FOR REPLACING WORK ZONE RAISED PAVEMENT MARKERS (WZRPMS) CONFORMING TO C&MS 614, WITH RAISED PAVEMENT MARKERS CONFORMING TO 621, AS DETERMINED BY THE ENGINEER, AT THE CONTRACTOR'S EXPENSE.

THIS ITEM SHALL INCLUDE PURCHASE, INSTALLATION AND REMOVAL OF ITEM 614 WORK ZONE RAISED PAVEMENT MARKER, AS PER PLAN, INCLUDING FILLING OF ANY DEPRESSIONS CREATED IN THE PAVEMENT AS PER C&MS 621.08.

RESURFACING OF THE TRANSITION AREAS SHALL BE PERFORMED AT THE TIME THAT THE SURFACE COURSE IS BEING APPLIED TO THE ENTIRE PROJECT. PRIOR TO APPLICATION OF THE SURFACE COURSE ON THE PROJECT, THE EXISTING PAVEMENT WITHIN THE TRANSITION AREA SHALL BE REMOVED TO A DEPTH NECESSARY TO REACH THE LEVEL OF THE INTERMEDIATE COURSE OF THE PAVEMENT, AS DETERMINED BY THE ENGINEER.

THE FOLLOWING BID ITEMS SHOULD BE INCLUDED IN THE PLANS:

ITEM 254 PAVEMENT PLANING, ASPHALT CONCRETE SY

ITEM 614 WORK ZONE RAISED PAVEMENT MARKER, AS PER PLAN EACH

PAYMENT FOR RESURFACING WITHIN THE TRANSITION AREA SHALL BE PAID FOR UNDER THE APPROPRIATE BID ITEMS FOR THE WORK REQUIRED, AS PROVIDED FOR IN THE PLANS.

ITEM 614, WORK ZONE IMPACT ATTENUATOR FOR 24" WIDE HAZARDS (BIDIRECTIONAL)

THIS ITEM SHALL CONSIST OF FURNISHING AND INSTALLING A NON-GATING IMPACT ATTENUATOR. FURNISH AN IMPACT ATTENUATOR FROM THE OFFICE OF ROADWAY ENGINEERING'S APPROVED LIST FOR WORK ZONE IMPACT ATTENUATORS, FROM THE ROADWAY STANDARDS APPROVED PRODUCTS WEB PAGE.

INSTALLATION SHALL BE AT THE LOCATIONS SPECIFIED IN THE PLANS IN ACCORDANCE WITH THE MANUFACTURER'S SPECIFICATIONS.

THE CONTRACTOR SHALL REPAIR OR REPLACE A DAMAGED UNIT WITHIN 24 HOURS OF A DAMAGING IMPACT.

WHEN BIDIRECTIONAL DESIGNS ARE SPECIFIED, THE CONTRACTOR SHALL SUPPLY APPROPRIATE TRANSITIONS.

WHEN GATING IMPACT ATTENUATORS ARE DESIRED, THE CONTRACTOR SHALL SUBMIT DOCUMENTATION TO THE ENGINEER FOR ACCEPTANCE.

THE COST FOR THE ADDITIONAL BARRIER REQUIRED FOR A GATING IMPACT ATTENUATOR SHALL BE INCLUDED IN THE COST OF THE GATING IMPACT ATTENUATOR.

PAYMENT FOR THE ABOVE WORK SHALL BE MADE AT THE UNIT PRICE BID AND SHALL INCLUDE ALL LABOR, TOOLS, EQUIPMENT AND MATERIALS NECESSARY TO CONSTRUCT AND MAINTAIN A COMPLETE AND FUNCTIONAL IMPACT ATTENUATOR SYSTEM, INCLUDING ALL RELATED BACKUPS, TRANSITIONS, LEVELING PADS, HARDWARE AND GRADING, NOT SEPARATELY SPECIFIED, AS REQUIRED BY THE MANUFACTURER.

TRANSVERSE DRAINAGE CROSSINGS OF IR 270 AND US 23

BEFORE ANY ROADWAY CONSTRUCTION BEGINS THE CONTRACTOR SHALL CONSTRUCT THE TRANSVERSE DRAINAGE CROSSINGS. IT SHALL BE THE CONTRACTOR'S RESPONSIBILITY TO MAINTAIN ADEQUATE DRAINAGE THROUGHOUT ALL PHASES OF CONSTRUCTION. THIS MAY REQUIRE CONSTRUCTION OF TEMPORARY CONDUITS AND/OR TEMPORARY DITCHING. TRAFFIC CONTROL DURING THIS OPERATION SHALL BE AS PER STANDARD DRAWING MT-97.10. ANY LANE RESTRICTIONS CAUSED BY THE TRANSVERSE DRAINAGE CROSSING WORK SHALL BE LIMITED TO BETWEEN THE HOURS OF 9:30 AM TO 3:30 PM TO MINIMIZE THE IMPACT ON TRAFFIC.

ALL LABOR, MATERIALS, AND EQUIPMENT NECESSARY TO COMPLETE THE ABOVE WORK SHALL BE INCLUDED IN THE LUMP SUM BID FOR ITEM 614 UNLESS OTHERWISE NOTED IN THE PLANS.

PAVEMENT RESTORATION FOR PIPE INSTALLATIONS

THE FOLLOWING QUANTITY HAS BEEN PROVIDED FOR PAVEMENT RESTORATION FOLLOWING REMOVAL AND INSTALLATION OF PIPES UNDER ITEMS 203 AND 603.

ITEM 301 ASPHALT CONCRETE BASE, PG64-22

THE ABOVE QUANTITY IS BASED ON A 301 THICKNESS OF 9 INCHES AND A PAVEMENT RESTORATION WIDTH THAT INCLUDES THE TRENCH WIDTH PLUS TWO FEET ON EACH SIDE OF THE TRENCH. THE TRENCH WIDTH IS ASSUMED TO EQUAL THE SPAN TIMES 1.25 PLUS ONE FOOT.

PROVIDE ANY MATERIALS USED OUTSIDE THE LIMITED STATED ABOVE AT NO ADDITIONAL COST.

TRAFFIC INCIDENT MANAGEMENT (TIM) DURING MOT

OHIO TIM IS OHIO'S TRAFFIC INCIDENT MANAGEMENT PROGRAM WHICH IS COMMITTED TO MAINTAINING THE SAFE AND EFFECTIVE FLOW OF TRAFFIC DURING EMERGENCIES AS TO PREVENT FURTHER DAMAGE, INJURY OR UNDUE DELAY OF THE MOTORING PUBLIC. IN ADDITION TO COMPLYING WITH THE PROVISION OF OMUTCD CHAPTER 6I, CONTROL OF TRAFFIC THROUGH TRAFFIC INCIDENT MANAGEMENT AREAS, THE CONTRACTOR SHALL ACTIVELY PARTICIPATE IN TIM PLANNING AND IMPLEMENTATION AS OUTLINED BELOW.

1. SUPERINTENDENT SHALL IDENTIFY THE INDIVIDUAL PERSONS ON THE PROJECT WHO WILL, OR MAY NEED TO, PERFORM THE DUTIES HEREIN. AT A MINIMUM, INCLUDE THE SUPERINTENDENT, FOREMEN AND SUPERVISORS (OR EQUIVALENT) AS WELL AS THE WORKSITE TRAFFIC SUPERVISOR (WTS; IF APPLICABLE TO THE PROJECT). THESE INDIVIDUALLY IDENTIFIED PERSONS SHALL COLLECTIVELY BE KNOWN AS CONTRACTOR TRAFFIC INCIDENT MANAGEMENT (TIM) CONTACTS. NOTIFY THE PROJECT ENGINEER OF THE CONTRACTOR TIM CONTACTS (ALONG WITH CONTACT INFORMATION FOR EACH) AT OR BEFORE THE PRECONSTRUCTION MEETING.

2. SUPERINTENDENT SHALL NOTIFY THE ENGINEER IMMEDIATELY IF ANY CONTRACTOR TIM CONTACT IS ADDED, REMOVED OR THE CONTACT INFORMATION CHANGES OVER THE COURSE OF THE PROJECT.

3. PRIOR THE FIRST DAY OF WORK IN THE FIELD, EACH CONTRACTOR TIM CONTACT ON THE PROJECT SHALL HAVE ATTENDED AND SUCCESSFULLY COMPLETED OHIO TIM TRAINING PROVIDED BY THE DEPARTMENT OR DESIGNEE. TRAINING INFORMATION CAN BE FOUND ONLINE.

4. SUPERINTENDENT, AT A MINIMUM, SHALL ATTEND AND ACTIVELY PARTICIPATE IN A DEPARTMENT SCHEDULED TIM MEETING BEFORE CONSTRUCTION WORK BEGINS AND BEFORE EACH PHASE CHANGE. THESE MEETINGS WILL RESULT IN A DEPARTMENT ISSUED PROJECT SPECIFIC TRAFFIC INCIDENT MANAGEMENT PLAN (TIMP). AT THE TIM MEETINGS THE ATTENDING CONTRACTOR TIM CONTACTS SHALL:

- A. COLLABORATE WITH ODOT AND SAFETY FORCES;
- B. SHARE PROJECT SPECIFIC DETAILS THAT IMPACT TIM RESPONDERS; AND

C. RECOMMEND WAYS TO INCORPORATE NECESSARY EMERGENCY ACCESS AND OTHER TIM ELEMENTS FOR TIM RESPONDERS GIVEN PROJECT SPECIFIC WORK BEING COMPLETED AND PROJECT SPECIFIC PHASING.

5. CONTRACTOR TIM CONTACTS SHALL IMPLEMENT COMPONENTS OF THE RESULTING TIMP (SUCH AS APPROVED EMERGENCY INGRESS/EGRESS POINTS, ETC), AS DIRECTED BY THE ENGINEER IN ACCORDANCE WITH 109.05.

6. CONTRACTOR TIM CONTACTS SHALL PERFORM, AT A MINIMUM, THE FOLLOWING FUNCTIONS WHEN AN INCIDENT/CRASH OCCURS:

A. IF OBSERVED OR PRESENT WHEN OCCURS, CALL 911 AND THEN NOTIFY THE TRAFFIC MANAGEMENT CENTER (TMC) TO PROVIDE THE FOLLOWING:

- I. LOCATION, INCLUDING MILEPOST NUMBER AND DIRECTION OF TRAVEL
- II. NUMBER AND TYPE OF VEHICLES INVOLVED, IF KNOWN
- III. ESTIMATED EXTENT OF DAMAGE OR INJURY, IF KNOWN
- IV. ESTIMATED NUMBER OF PATIENTS INVOLVED, IF KNOWN
- V. ANY POTENTIAL HAZARDOUS CONDITIONS, IF KNOWN
- VI. THE PLACARD NUMBER ON ANY HAZARDOUS MATERIALS PLACARD FROM A SAFE DISTANCE, IF APPLICABLE AND VISIBLE

B. FOLLOWING AN INCIDENT/CRASH:

- I. INITIATE TRAFFIC MANAGEMENT/PROVIDE TEMPORARY TRAFFIC CONTROL AS INDICATED IN THE TIMP, AS DIRECTED BY THE ENGINEER IN ACCORDANCE WITH 109.05.
- II. RECOMMEND ROADWAY REPAIR NEEDS.
- III. PROVIDE REPAIR RESOURCES AND INITIATE REPAIRS, AS DIRECTED BY THE ENGINEER IN ACCORDANCE WITH 109.05.
- IV. ATTEND AND PARTICIPATE IN AN AFTER ACTION REVIEW (AAR).

ALL COSTS, UNLESS OTHERWISE SPECIFIED, RESULTING FROM THE ABOVE REQUIREMENTS SHALL BE CONSIDERED TO BE INCLUDED IN THE LUMP SUM PRICE FOR ITEM 614, MAINTAINING TRAFFIC. FAILURE TO PERFORM THE REQUIREMENTS OF THIS PLAN NOTE WILL RESULT IN A DAILY FINE OF 2% OF ITEM 614, MAINTAINING TRAFFIC AND MAY RESULT IN ONE OR MORE CONTRACTOR TIM CONTACTS BEING REMOVED FROM THE LIST OF OHIO TIM TRAINED INDIVIDUALS (AT THE SOLE DISCRETION OF THE OHIO TIM EXECUTIVE COMMITTEE). IN THE EVENT AN INDIVIDUAL IS REMOVED FROM THE OHIO TIM TRAINED LIST, THE INDIVIDUAL WILL BE REMOVED FROM CONTRACTOR TIM CONTACT RESPONSIBILITIES ON ALL PROJECTS.

DELINEATION OF TEMPORARY AND PERMANENT GUARDRAIL

BARRIER REFLECTORS SHALL BE INSTALLED ON ALL TEMPORARY GUARDRAIL USED FOR TRAFFIC CONTROL; AND, ON ALL PERMANENT GUARDRAIL LOCATED WITHIN 5 FEET OF THE EDGE OF THE ADJACENT TRAVEL LANE. BARRIER REFLECTORS SHALL CONFORM TO C&MS 626 AND THE SPACING SHALL BE APPROXIMATELY 50 FEET.

THE FOLLOWING ESTIMATED QUANTITIES HAVE BEEN INCLUDED IN THE PLANS AND CARRIED TO THE GENERAL SUMMARY:

ITEM 614, BARRIER REFLECTOR, TYPE (2, 3, 4, OR 5) (ONE-WAY OR BI-DIRECTIONAL) 1 EACH

PAYMENT SHALL BE FULL COMPENSATION FOR ALL MATERIAL, LABOR, INCIDENTALS AND EQUIPMENT NECESSARY FOR FURNISHING, INSTALLING, MAINTAINING AND REMOVING THE ABOVE ITEMS).





RAMP CLOSURE RESTRICTIONS					
INTERSTATE ROUTE 270 IN FRANKLIN COUNTY					
SECONDARY ROUTE: US ROUTE 23		SLM ALONG 270: 52.64		(SOUTH SIDE)	
RAMP	MOVEMENT	NO CLOSURES ALLOWED		DETOUR ROUTES	
		MON TO FRI	SAT TO SUN	PRIMARY ROUTE	SECONDARY ROUTE
L	US 23 NB TO I-270 WB	5AM-10PM	8AM-8PM	RAMP R (23N TO 270 E) TO ALUM CREEK DRIVE N TO 270 W	23 N TO U-TURN* TO RAMP M (23 S TO 270 W)
M	US 23 SB TO I-270 WB	5AM-7PM	NO RESTRICTION	RAMP O (23S TO 270 E) TO ALUM CREEK DRIVE N TO 270 W	NONE
N	I-270 WB TO US 23 SB	6AM-7PM	NO RESTRICTION	270 W TO 71 S TO STRINGTOWN RD E TO 71 N TO 270 E TO RAMP P (270 E TO 23 S)	270 W TO 62 S TO 270 E TO RAMP P (270 E TO 23 S)
O	US 23 SB TO I-270 EB	3PM-6PM	NO RESTRICTION	270 W TO 71 S TO STRINGTOWN RD E TO 71 N TO 270 E	270 W TO 62 S TO 270 E
P	I-270 EB TO US 23 SB	5AM-10PM	8AM-8PM	270 E TO ALUM CREEK DR E TO 270 W TO RAMP N (270 W TO 23 S)	NONE
Q	I-270 EB TO US 23 NB	6AM-7PM	NO RESTRICTION	270 E TO ALUM CREEK DR E TO 270 W TO RAMP S (270 W TO 23 N)	NONE
R	US 23 NB TO I-270 EB	6AM-6PM	NO RESTRICTION	RAMP L (23 N TO 270 W) TO 62 S TO 270 E	23 N TO U-TURN* TO RAMP O (23 S TO 270 E)
S	I-270 WB TO US 23 NB	6AM-6PM	NO RESTRICTION	RAMP N (270 W TO 23 S) TO RAMP O (23 S TO 270 E) TO RAMP Q (270 E TO 23 N)	270 W TO 62 S TO 270 E TO RAMP Q (270 E TO 23 N)

LANE VALUE CONTRACT TABLE						
SECTION (SLM)	EXISTING NUMBER OF LANES PER DIRECTION	LANE CLOSURES ARE NOT PERMITTED				DISINCENTIVE AMOUNTS PER MINUTE PER LANE
		LANE REDUCTION	MON TO FRI	SAT	SUN	
FRA-23						
PICKAWAY COUNTY LINE (0.00) TO RATHMELL ROAD (4.18) NORTHBOUND	2	2 TO 1	5AM-10AM	NO RESTRICTION	NO RESTRICTION	\$175
PICKAWAY COUNTY LINE (0.00) TO RATHMELL ROAD (4.18) SOUTHBOUND	2	2 TO 1	3PM-7PM	NO RESTRICTION	NO RESTRICTION	\$175
RATHMELL ROAD (4.18) TO GREENLAWN AVENUE (9.60)	2	2 TO 1	6AM-9AM & 3PM-7PM	NO RESTRICTION	NO RESTRICTION	\$185
SHORT TERM SHOULDER CLOSURES ARE NOT PERMITTED 6AM-9AM AND 3PM-6PM MONDAY-FRIDAY						

LANE VALUE CONTRACT TABLE						
SECTION (SLM)	EXISTING NUMBER OF LANES PER DIRECTION	LANE CLOSURES ARE NOT PERMITTED				DISINCENTIVE AMOUNTS PER MINUTE PER LANE
		LANE REDUCTION	MON TO FRI	SAT	SUN	
FRA-270						
I-71 SOUTHBOUND (0.00) TO 1/2 MILE WEST OF I-71 (0.60)	2	2 TO 1	5AM-9PM	6AM-7PM	6AM-7PM	\$ 310.00
1/2 MILE WEST OF I-71 (0.60) TO US 40 - BROAD STREET (7.04)	3	3 TO 2	5AM-9PM & 3PM-6PM	NO RESTRICTION	NO RESTRICTION	\$ 205.00
		3 TO 1	5AM-9PM	6AM-7PM	6AM-7PM	\$ 205.00
WILLIAMS ROAD (47.42) TO US 23 INTERCHANGE (52.30)	3	3 TO 2	5AM-9PM & 3PM-7PM	NO RESTRICTION	NO RESTRICTION	\$ 205.00
		3 TO 1	5AM-8PM	6AM-7PM	6AM-7PM	\$ 205.00
THRU US 23 INTERCHANGE EASTBOUND (52.30) TO (53.20)	3	3 TO 2	5AM-9PM & 3PM-7PM	NO RESTRICTION	NO RESTRICTION	\$ 205.00
		3 TO 1	5AM-8PM	6AM-7PM	6AM-7PM	\$ 205.00
THRU US 23 INTERCHANGE WESTBOUND (52.30) TO (53.20)	2	2 TO 1	5AM-8PM	6AM-7PM	6AM-7PM	\$ 310.00
		3 TO 2	5AM-9PM & 3PM-7PM	NO RESTRICTION	NO RESTRICTION	\$ 255.00
US 23 INTERCHANGE (53.20) TO I-71 INTERCHANGE (54.44) MAINLINE EASTBOUND	3	3 TO 1	5AM-8PM	6AM-7PM	6AM-7PM	\$ 255.00
		MON TO FRI: 5A-9A & 3P-7P, SAT & SUN NO RESTRICTION WHEN MAINTAINING 3 LANES MAINLINE. MON TO FRI: 5A-10P, SAT & SUN 8A-8P WHEN CLOSING ADJACENT MAINLINE LANE				\$ 255.00
US 23 INTERCHANGE (53.20) TO I-71 INTERCHANGE (54.44) MAINLINE WESTBOUND	2	2 TO 1	5AM-9PM & 3PM-7PM	6AM-7PM	6AM-7PM	\$ 310.00
US 23 INTERCHANGE (53.20) TO I-71 INTERCHANGE (54.44) AUXILLARY LANES WESTBOUND	2	2 TO 1	5AM-9PM & 3PM-7PM	NO RESTRICTION	NO RESTRICTION	\$ 310.00
		2 TO 0	MON TO FRI: 5A-10P, SAT & SUN 8A-8P WHEN CLOSING ADJACENT MAINLINE LANE			
THRU I-71 INTERCHANGE SOUTH SIDE (54.44) TO (0.00)	2	2 TO 1	5AM-9PM	6AM-7PM	6AM-7PM	\$ 310.00
I-71 SOUTHBOUND (0.00) TO 1/2 MILE WEST OF I-71 (0.60)	2	2 TO 1	5AM-9PM	6AM-7PM	6AM-7PM	\$ 310.00
SHORT TERM SHOULDER CLOSURES ARE NOT PERMITTED 5AM-9AM AND 3PM-7PM MONDAY-FRIDAY						

X:\Projects\2013\1010\FRA\92616\mot\sheets\92616MNO05.dgn 4/18/2023 2:48:18 PM cwong





X:\Projects\2013\1321\1010\FRA\92616\mot\sheets\92616MS001.dgn 4/28/2023 11:39:35 AM c.wong

SHEET NO.	PHASE	202	411	606	606	606	611	611	614	614	614	614	614	614	614	614	614	614	614	614	614	615	622		
		GUARDRAIL REMOVED FT	STABILIZED CRUSHED AGGREGATE CY	GUARDRAIL, TYPE MGS FT	ANCHOR ASSEMBLY, TYPE E EACH	ANCHOR ASSEMBLY, TYPE T EACH	CATCH BASIN, NO. 2-2B EACH	12" CONDUIT, TYPE B FT	WORK ZONE IMPACT ATTENUATOR, 24" WIDE HAZARDS, (BIDIRECTIONAL) EACH	WORK ZONE RAISED PAVEMENT MARKER(YELLOW) EACH	WORK ZONE RAISED PAVEMENT MARKER(YELLOW) EACH	WORK ZONE RAISED PAVEMENT MARKER(WHITE) EACH	BARRIER REFLECTOR, TYPE I, ONE WAY EACH	OBJECT MARKER, ONE WAY EACH	WORK ZONE LANE LINE, CLASS I MILE	WORK ZONE EDGE LINE, CLASS I (YELLOW) MILE	WORK ZONE EDGE LINE, CLASS (WHITE) MILE	WORK ZONE CHANNELIZING LINE, CLASS I FT	WORK ZONE DOTTED LINE, CLASS I FT	WORK ZONE TRANSVERSE/DIAGONAL LINE, CLASS I FT	WORK ZONE STOP LINE, CLASS I FT	WORK ZONE ARROW, CLASS I EACH	WORK ZONE WORD ON PAVEMENT, 96", CLASS I EACH	PAVEMENT FOR MAINTAINING TRAFFIC, CLASS A SY	PORTABLE BARRIER, UNANCHORED EACH
IR 270	1	25		25	1	1			1		330	665	47	22		1.25	1.5	13300				287	1010		
US 23	1						2	122														6884			
TEMP L	1																					13567			
RAMP O	1									34		64	13		0.13							957	640		
RAMP P1	1								1	150	150	68	47		0.6	0.6	3220						2360		
US23	1A		98						3	42	5	44	15		0.16	0.25	100						730		
RAMP P1	1A								1	48	11				0.18	0.25	210								
RAMP P2	1A									32					0.12	0.12									
IR 270	2								1	330	665	165	44		1.25	1.5	13300						2220		
US 23	2		49						5	240	265	58	41	0.06	0.91	0.82	5304	700	189	82	12	7	2050		
TEMP L	2								2	32		58	12	0.02	0.12	0.11		579					580		
RAMP O	2								1	34		61	12		0.13			524					610		
RAMP P2	2									24	24	28	6		0.09	0.16		57	65	30	2	1	280		
IR 270	2A								1	494	665	71	51		1.87	1.96	13300	680					2550		
IR 270	3								1	206	317	75	58		0.78	0.68	6348						2900		
<b>TOTALS CARRIED TO GENERAL SUMMARY</b>		25	148	25	1	1	2	122	17	24	1996	2743	739	321	0.08	7.59	7.95	55082	2540	254	112	14	8	21695	15930

**MAINTENANCE OF TRAFFIC SUBSUMMARY**

**FRA - 270-51.50**

CALCULATED  
MBE  
CHECKED  
RCH

ADDENDUM #1  
04/21/2023

23  
554



X:\Projects\2013\1321\1010\FRA\92616\mot\sheets\92616MD301.dgn 4/18/2023 2:50:10 PM cwong

▲ ADDENDUM #1  
04/21/2023

**FRA - 270-51.50**

**MAINTENANCE OF TRAFFIC DETOUR MAP - RAMP M**

CALCULATED
MBE
CHECKED
RCH


25  
554

X:\Projects\2013\1010\FRA\92616\mot\sheets\92616MD401.dgn 4/25/2023 5:47:31 AM cwong

### DETOUR PLAN NOTES

SEE NOTES 1-4 SHEET 27

- 5. AT ANY POINT DURING CONSTRUCTION, ANY EXISTING, TEMPORARY OR PROPOSED SIGNING IN PLACE WHICH CONFLICTS WITH PRESENT TRAFFIC SHALL BE REMOVED FROM VIEW BY REMOVAL, OVERLAY, OR OTHER APPROVED METHOD.
- 6. AN "EXIT CLOSED" PLAQUE (W20-H15), 108 X 18 INCHES, SHALL BE PLACED HORIZONTALLY ACROSS ALL EXTRUSHEET GUIDE SIGNS PERTAINING TO THE CLOSED EXIT UNTIL THE EXIT IS READY TO BE RE-OPENED.
- 7. RAMP O SHALL NOT BE OPENED TO TRAFFIC UNTIL FINAL SIGNING AND PAVEMENT MARKINGS ARE INSTALLED. RAMP O AND RAMP M SHALL NOT BE CLOSED AT THE SAME TIME.
- 8. SIGN 4 SHALL BE MOUNTED ON TYPE 3 BARRICADES AND SHALL HAVE FLASHING BARRICADE WARNING LIGHTS PLACED ABOVE IT AS PER SCD MT-101.60.
- 9. SIGNS 1 AND 2 SHALL BE GROUND MOUNTED WITH TYPE A WARNING LIGHTS PLACED ABOVE THEM AS PER SCD MT-98.29.
- 10. SIGN 5 & 6 SHALL HAVE A BLACK LEGEND ON A REFLECTIVE ORANGE BACKGROUND.
- 11. SEE SHEET 20 FOR MAINTENANCE OF TRAFFIC NOTES.

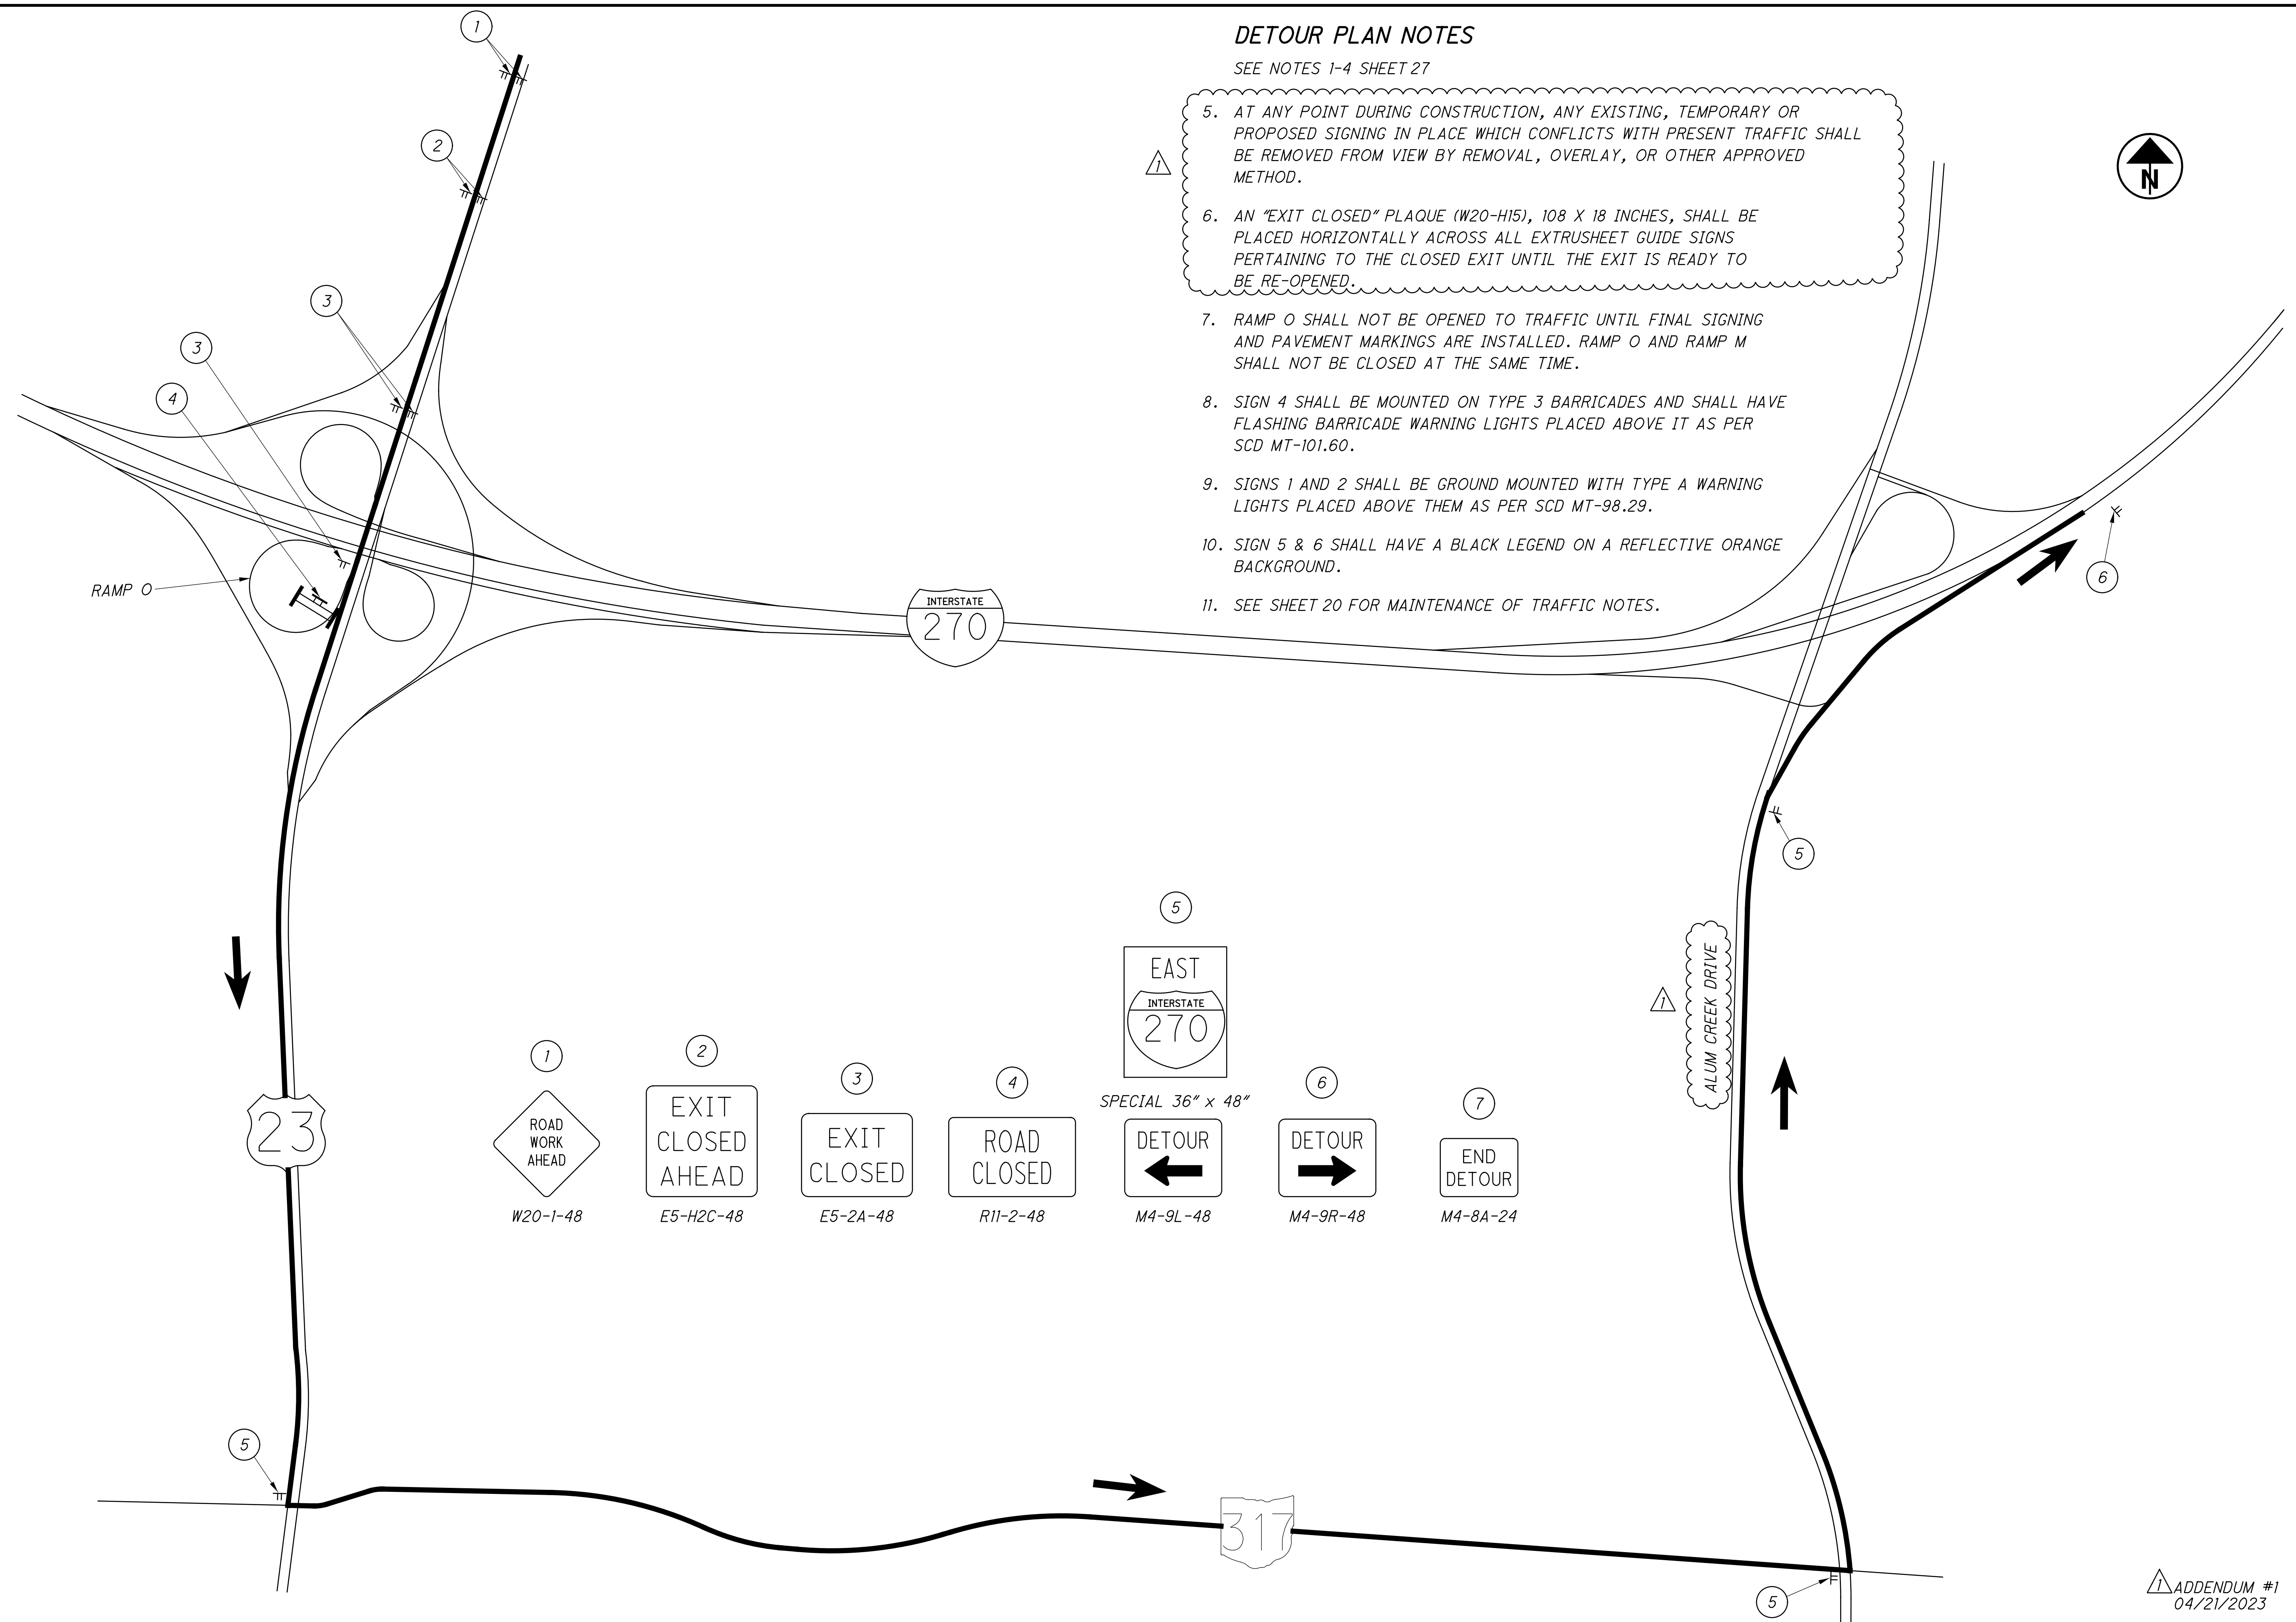

CALCULATED
MBE
CHECKED
RCH

MAINTENANCE OF TRAFFIC DETOUR MAP - RAMP O

FRA - 270-51.50

ADDENDUM #1  
04/21/2023


26
554



DETOUR PLAN NOTES

1. IT IS THE INTENTION TO PERFORM ALL REQUIRED WORK WITH THE LEAST INCONVENIENCE TO AND THE MAXIMUM SAFETY OF THE CONTRACTOR AND TRAVELING PUBLIC. ANY VARIANCES FROM THE MAINTENANCE OF TRAFFIC NOTES NEED TO BE APPROVED BY ODOT.
2. ALL WORK AND TRAFFIC CONTROL DEVICES SHALL BE IN ACCORDANCE WITH ITEM 614 OF THE 2019 ODOT CONSTRUCTION AND MATERIAL SPECIFICATIONS, OTHER APPLICABLE PORTIONS OF THE 2019 ODOT SPECIFICATIONS, AND THE OHIO MANUAL OF UNIFORM TRAFFIC CONTROL DEVICES. PAYMENT FOR ALL LABOR, EQUIPMENT AND MATERIALS SHALL BE INCLUDED IN THE LUMP SUM CONTRACT PRICE FOR ITEM 614, MAINTAINING TRAFFIC, UNLESS ITEMIZED SEPARATELY IN THE PLAN.
3. BEFORE WORK BEGINS, THE CONTRACTOR SHALL PROVIDE THE ENGINEER THE NAME(S) AND TELEPHONE NUMBER(S) OF RESPONSIBLE PERSON(S) WHO CAN BE CONTACTED AT ANY TIME, 24 HOURS A DAY, BY THE ENGINEER. THESE PERSON(S) SHALL BE RESPONSIBLE FOR PLACING OR REPLACING NECESSARY TRAFFIC CONTROL DEVICES TO MAINTAIN TRAFFIC.
4. THE WORK LIMITS SHOWN ARE FOR PHYSICAL CONSTRUCTION ONLY. THE INSTALLATION AND OPERATION OF ALL TRAFFIC CONTROL DEVICES REQUIRED BY THE OHIO MANUAL OF UNIFORM TRAFFIC CONTROL DEVICES SHALL BE PROVIDED BY THE CONTRACTOR WHETHER INSIDE OR OUTSIDE THESE LIMITS. ALL TRAFFIC CONTROL ITEMS OR DEVICES SHALL BE INSTALLED OR LOCATED WITHIN THE EXISTING RIGHT-OF-WAY.

5. AT ANY POINT DURING CONSTRUCTION, ANY EXISTING, TEMPORARY OR PROPOSED SIGNING IN PLACE WHICH CONFLICTS WITH PRESENT TRAFFIC SHALL BE REMOVED FROM VIEW BY REMOVAL, OVERLAY, OR OTHER APPROVED METHOD.
6. AN "EXIT CLOSED" PLAQUE (W20-H15), 108 X 18 INCHES, SHALL BE PLACED HORIZONTALLY ACROSS ALL EXTRUSHEET GUIDE SIGNS PERTAINING TO THE CLOSED EXIT UNTIL THE EXIT IS READY TO BE RE-OPENED.
7. RAMP S SHALL NOT BE OPENED TO TRAFFIC UNTIL FINAL SIGNING AND PAVEMENT MARKINGS ARE INSTALLED.
8. SIGN 4 SHALL BE MOUNTED ON TYPE 3 BARRICADES AND SHALL HAVE FLASHING BARRICADE WARNING LIGHTS PLACED ABOVE IT AS PER SCD MT-101.60.
9. SIGNS 1 AND 2 SHALL BE GROUND MOUNTED WITH TYPE A WARNING LIGHTS PLACED ABOVE THEM AS PER SCD MT-98.29.
10. SIGN 5 & 6 SHALL HAVE A BLACK LEGEND ON A REFLECTIVE ORANGE BACKGROUND.
11. SEE SHEET 20 FOR MAINTENANCE OF TRAFFIC NOTES.

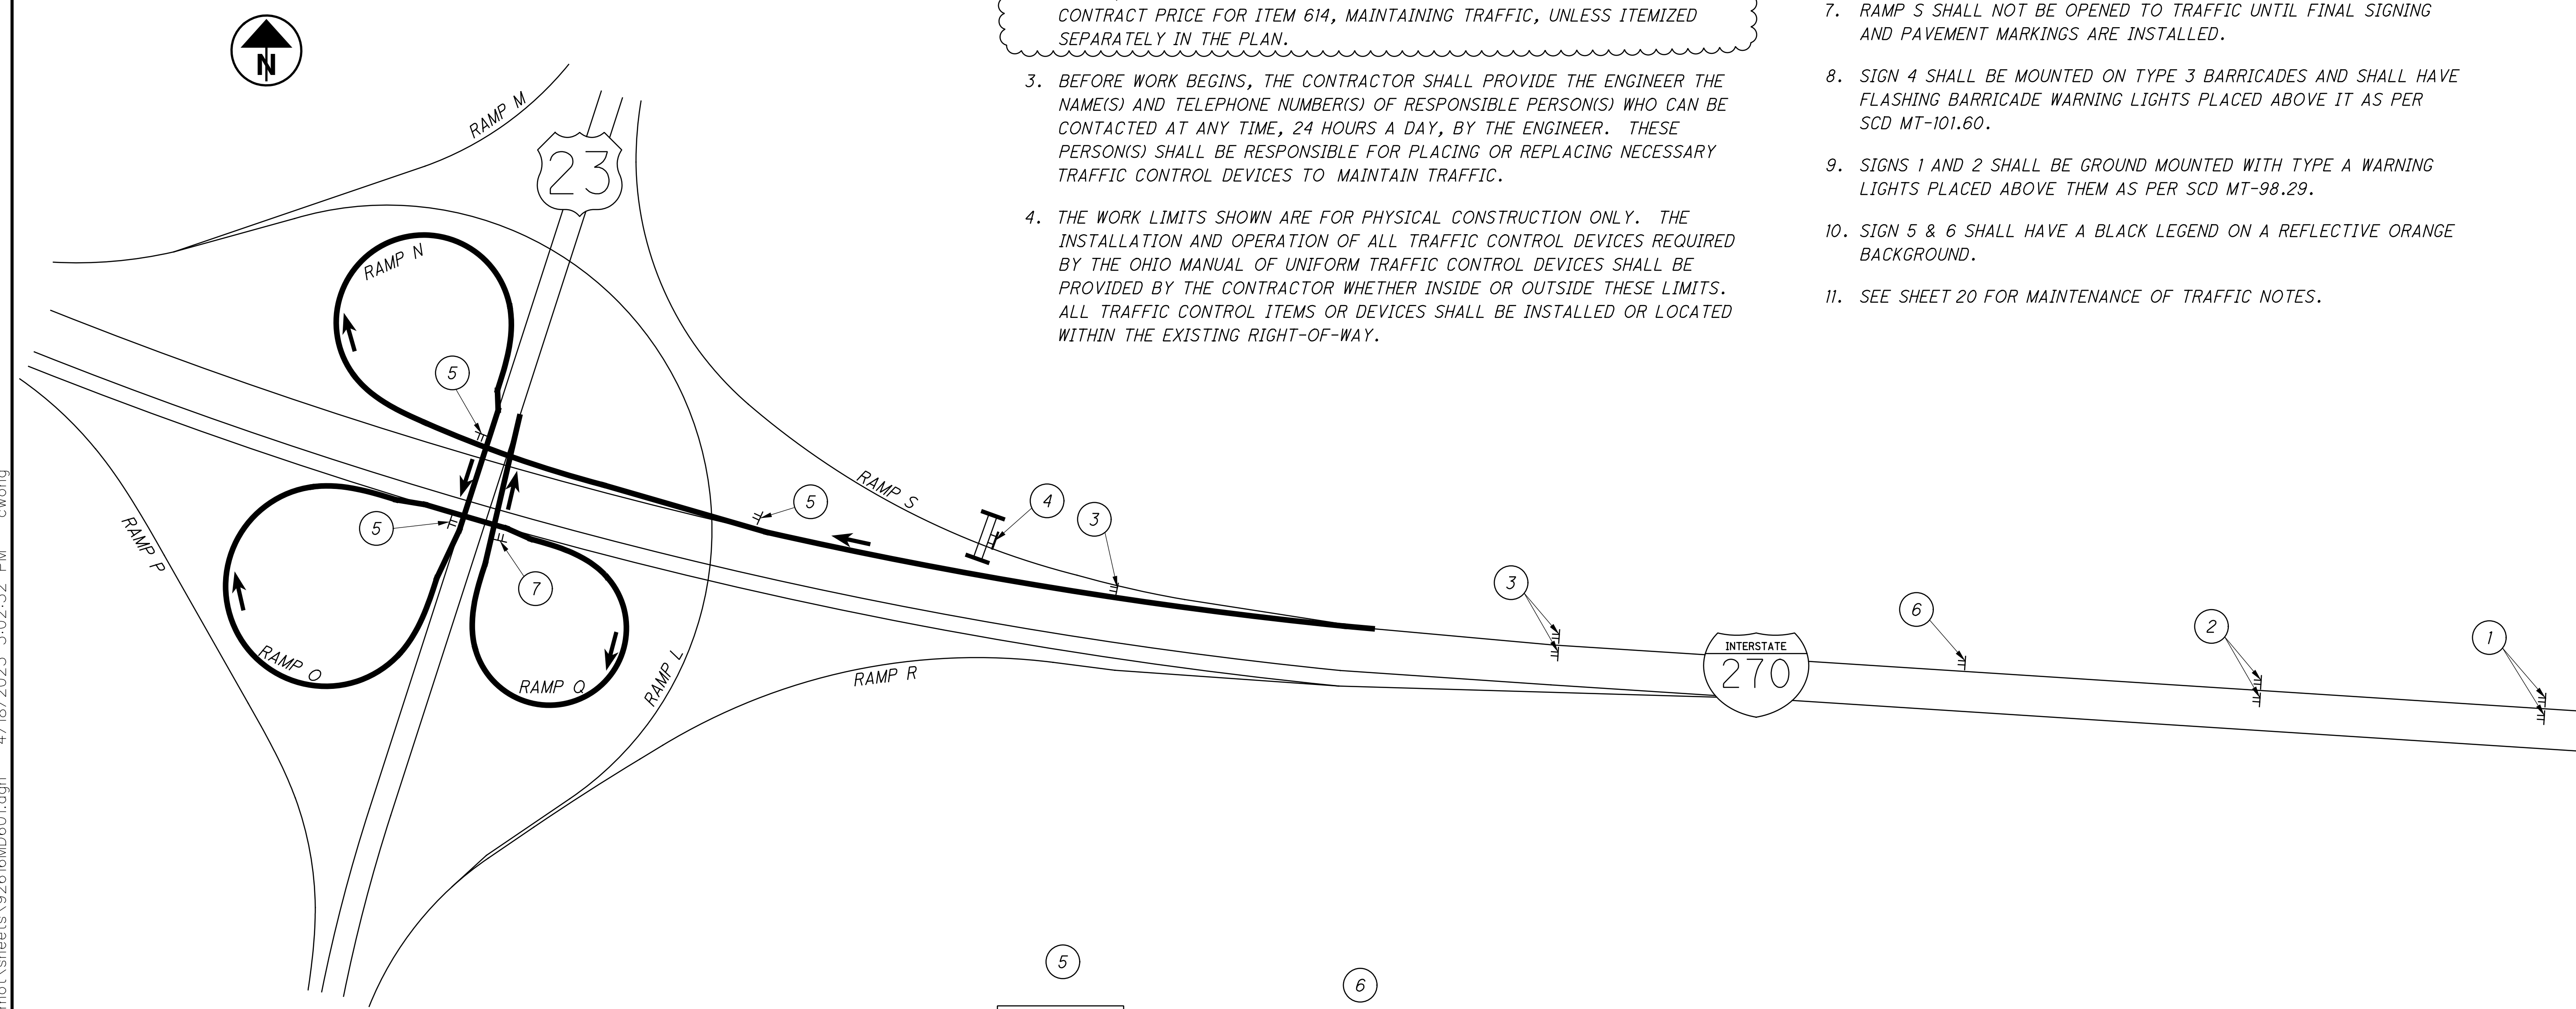





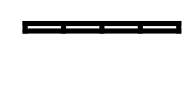
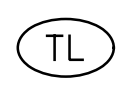

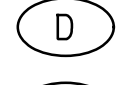





 

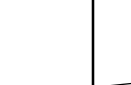
① ROAD WORK AHEAD W20-1-48	② EXIT CLOSED AHEAD E5-H2C-48	③ EXIT CLOSED E5-2A-48	④ ROAD CLOSED R11-2-48	⑤ NORTH 23 SPECIAL 36" x 48" M6-2-30	⑥ 23 NORTH High St USE EXIT 52B SPECIAL 192" X 144"	⑦ END DETOUR M4-8A-24
----------------------------------	-------------------------------------	------------------------------	------------------------------	--	---	-----------------------------




ADDENDUM #1  
04/21/2023

X:\Projects\2013\1321\1010\FRA\92616\mot\sheet\92616MD601.dgn 4/18/2023 3:02:32 PM cwong

X:\Projects\2013\1010\FRA\92616\mot\sheet\92616MP011.dgn 4/18/2023 3:07:09 PM cwong

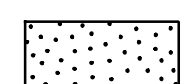**LEGEND**

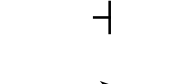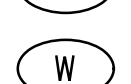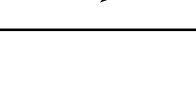 WORK ZONE	 EL EDGE LINE
 PAVEMENT FOR MAINTAINING TRAFFIC	 LL LANE LINE
 32" PORTABLE BARRIER	 CH CHANNELIZING LINE
 DRUMS	 TL TRANSVERSE LINE
 IMPACT ATTENUATOR	 D DOTTED LINE
 TYPE 3 BARRICADE	 S STOP LINE
 SIGN	 A LANE ARROW
 DIRECTION OF TRAFFIC	 W WORD ON PAVEMENT

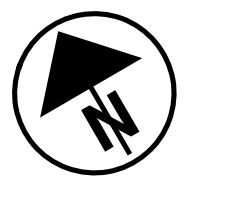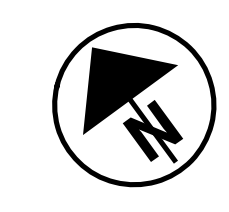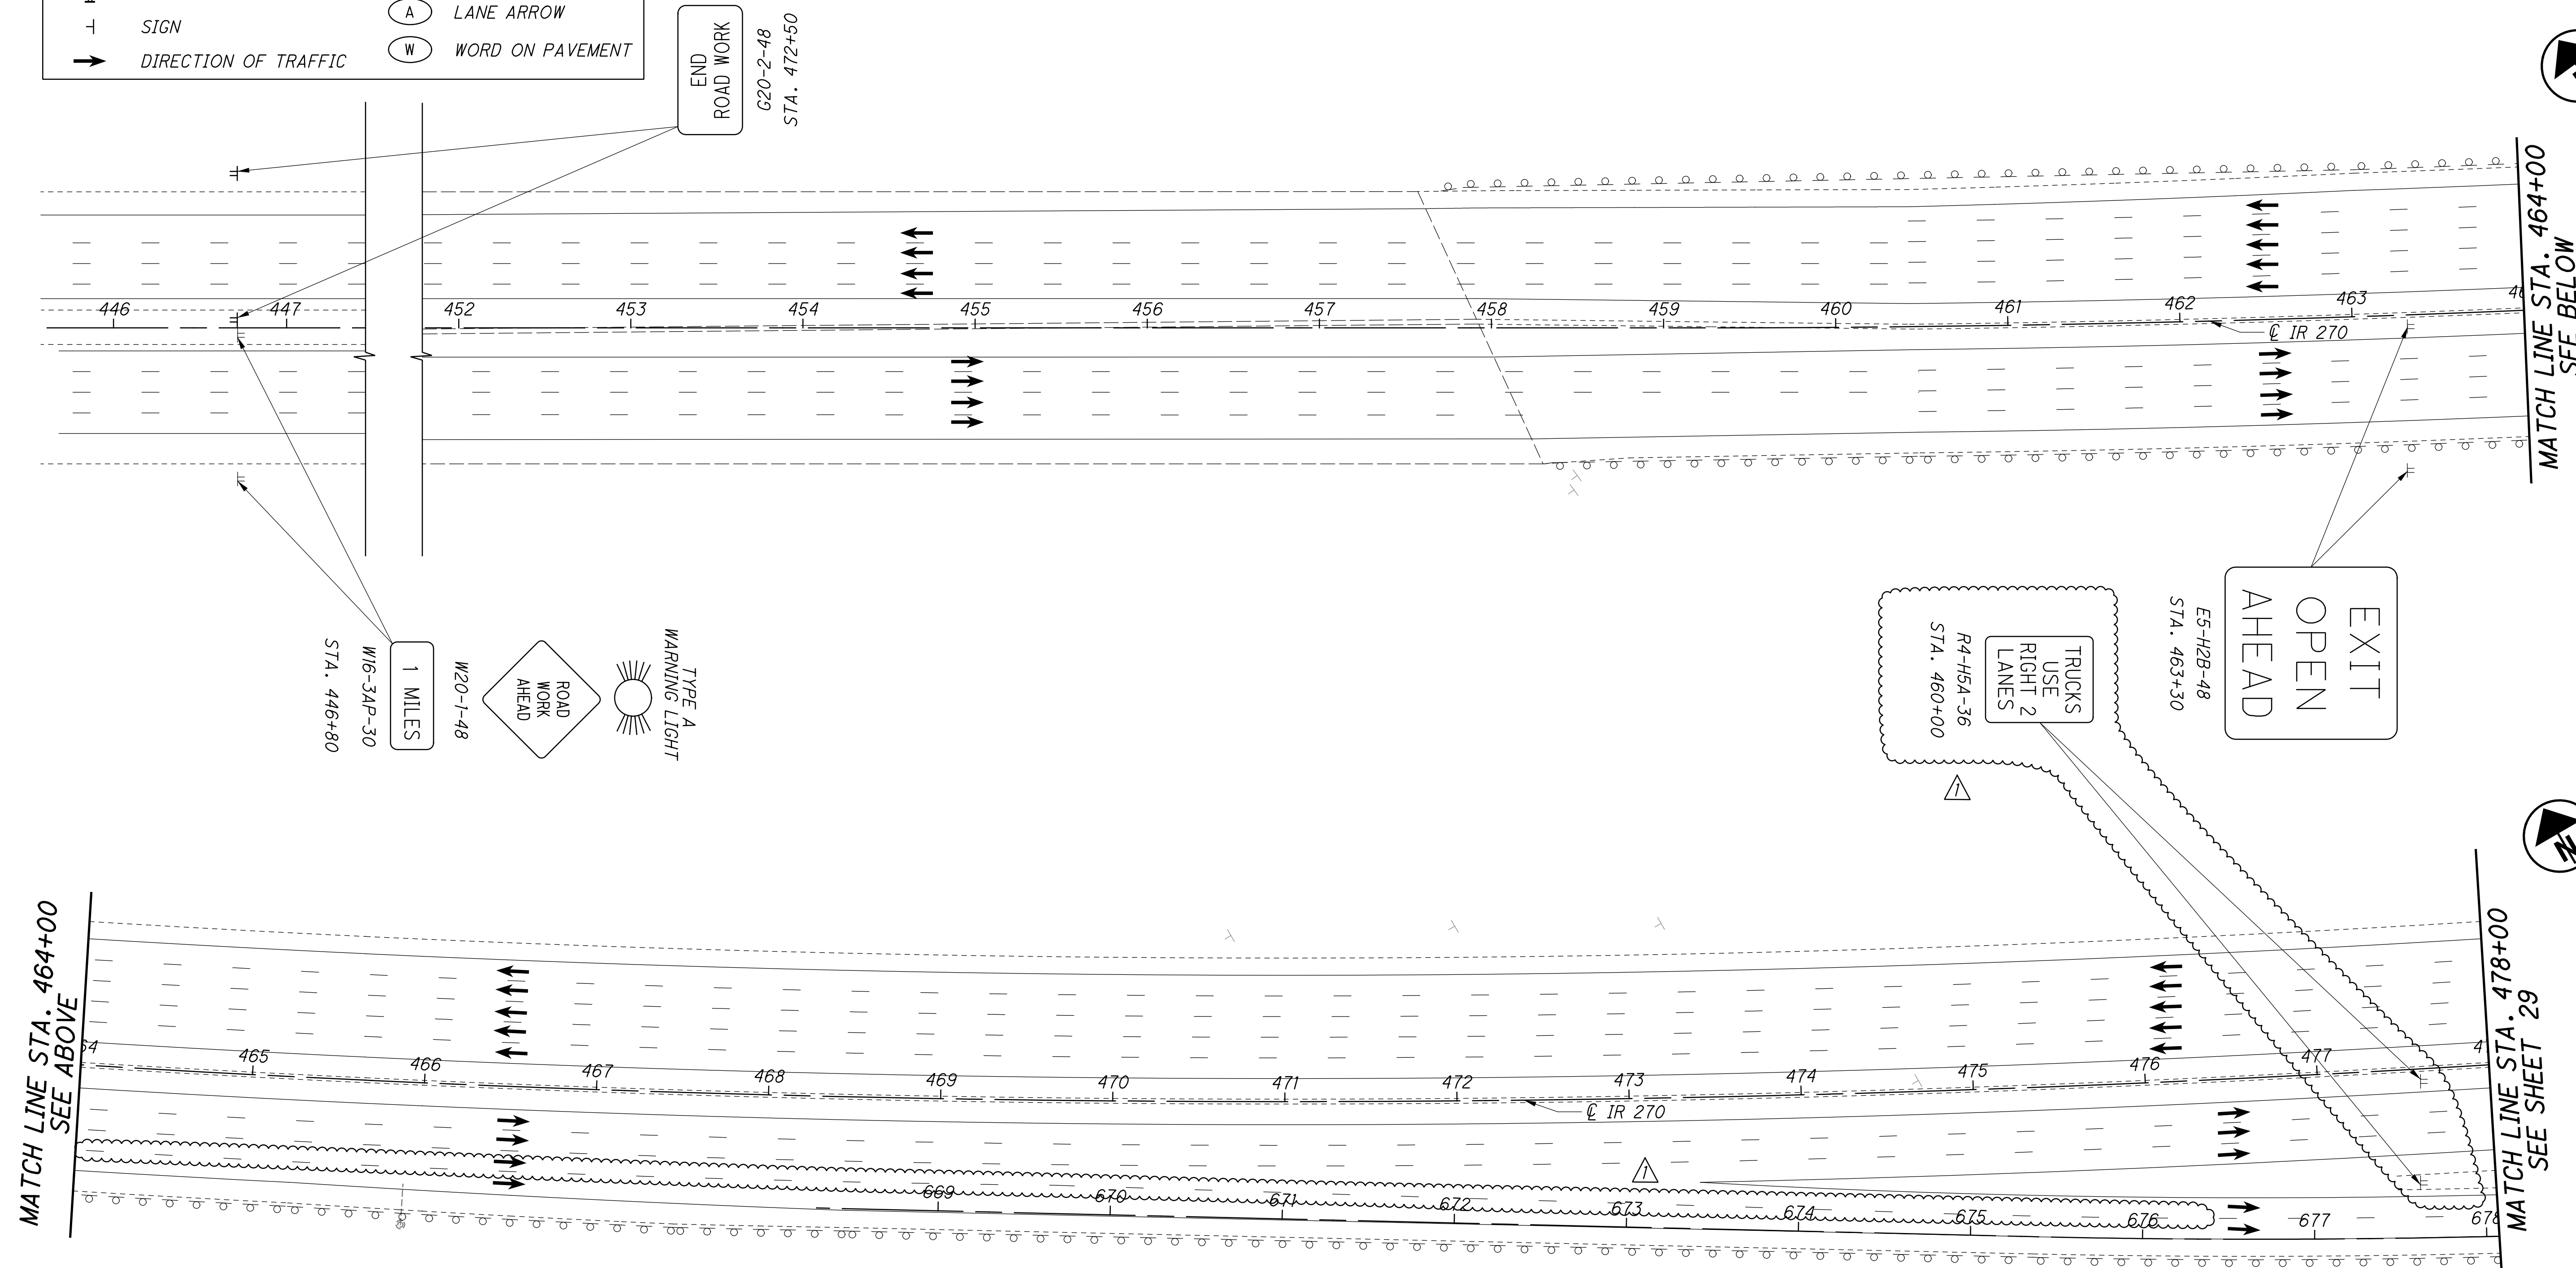

CALCULATED DJR  
CHECKED RCH

0 50 100  
25  
HORIZONTAL SCALE IN FEET



**MAINTENANCE OF TRAFFIC - PHASE 1**  
**I-270 STA. 450+00 TO STA. 478+00**

**FRA - 270-51.50**



X:\Projects\2013\1321\1010\FRA\92616\mot\sheets\92616MP012.dgn 4/18/2023 3:08:13 PM cwong

LEGEND			
	WORK ZONE		EDGE LINE
	PAVEMENT FOR MAINTAINING TRAFFIC		LANE LINE
	32" PORTABLE BARRIER		CHANNELIZING LINE
	DRUMS		TRANSVERSE LINE
	IMPACT ATTENUATOR		DOTTED LINE
	TYPE 3 BARRICADE		STOP LINE
	SIGN		LANE ARROW
	DIRECTION OF TRAFFIC		WORD ON PAVEMENT

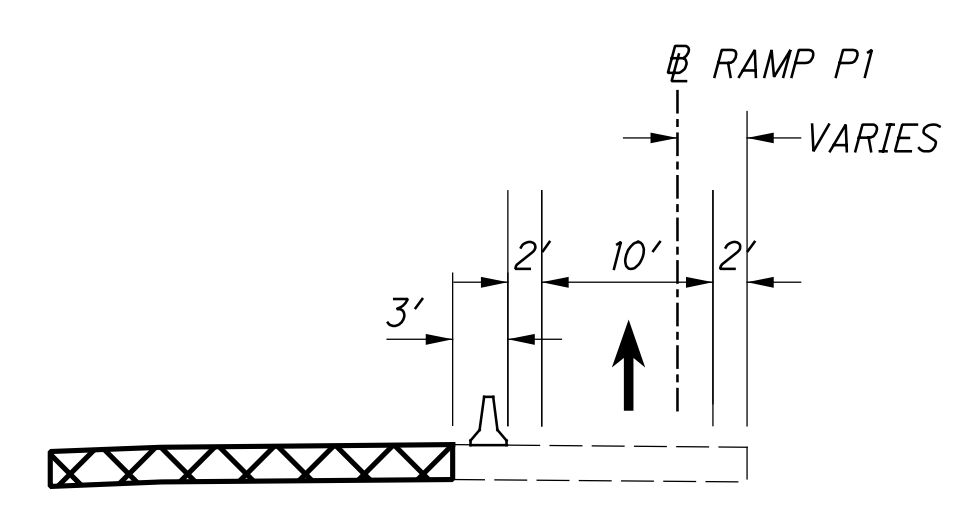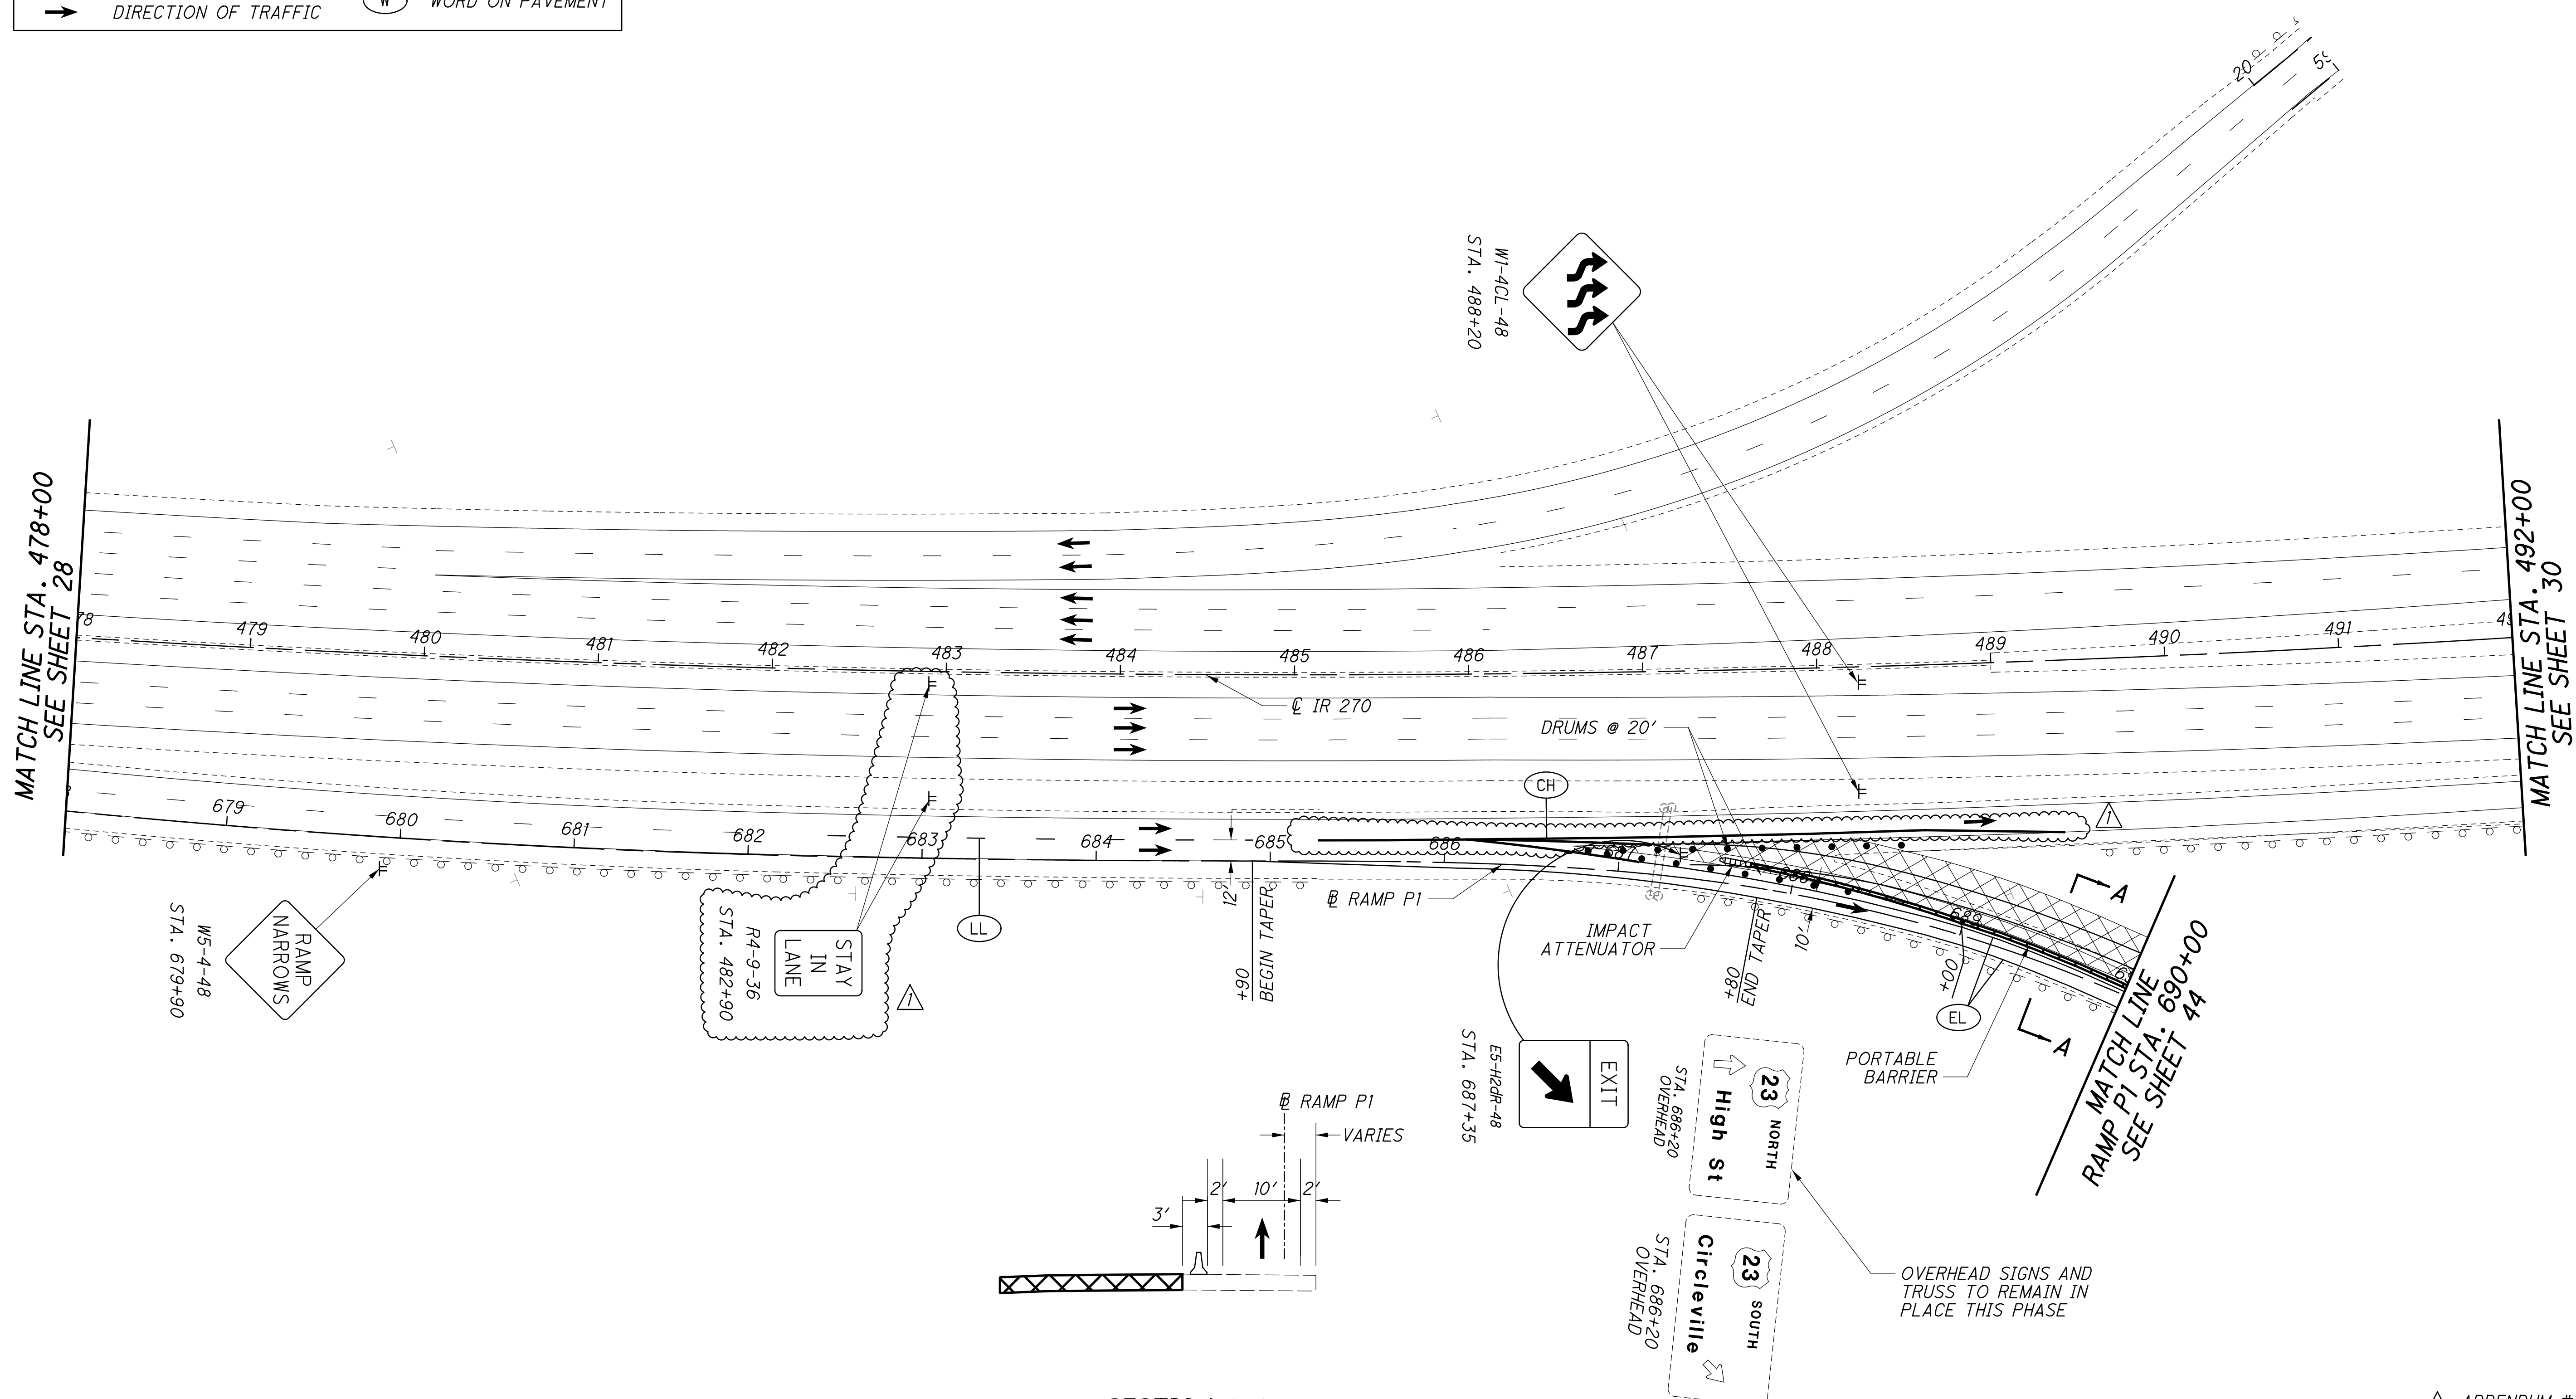

SECTION A-A

CALCULATED  
DJR  
CHECKED  
RCH

0 50 100  
25  
HORIZONTAL  
SCALE IN FEET

**MAINTENANCE OF TRAFFIC - PHASE 1**  
**I-270 STA. 478+00 TO STA. 492+00**

**FRA-270-51.50**

ADDENDUM #1  
04/21/2023

OVERHEAD SIGNS AND TRUSS TO REMAIN IN PLACE THIS PHASE







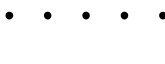

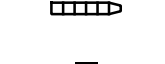

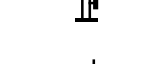



 

MATCH LINE STA. 690+00  
RAMP P1 STA. 690+00  
SEE SHEET 44





MATCH LINE STA. 492+00  
SEE SHEET 30

MATCH LINE STA. 478+00  
SEE SHEET 28

X:\Projects\2013\1321\1010\FRA\92616\mot\sheets\92616MPO13.dgn 4/21/2023 4:33:04 PM cwong

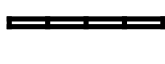**LEGEND**

 WORK ZONE	 EL EDGE LINE
 PAVEMENT FOR MAINTAINING TRAFFIC	 LL LANE LINE
 32" PORTABLE BARRIER	 CH CHANNELIZING LINE
 DRUMS	 TL TRANSVERSE LINE
 IMPACT ATTENUATOR	 D DOTTED LINE
 TYPE 3 BARRICADE	 S STOP LINE
 SIGN	 A LANE ARROW
 DIRECTION OF TRAFFIC	 W WORD ON PAVEMENT

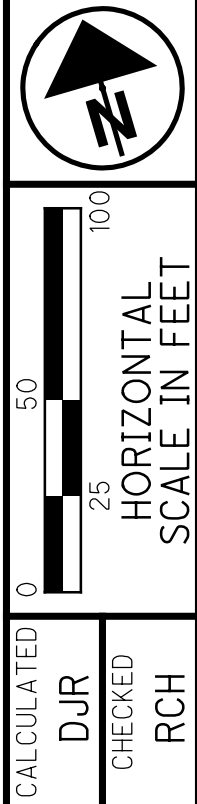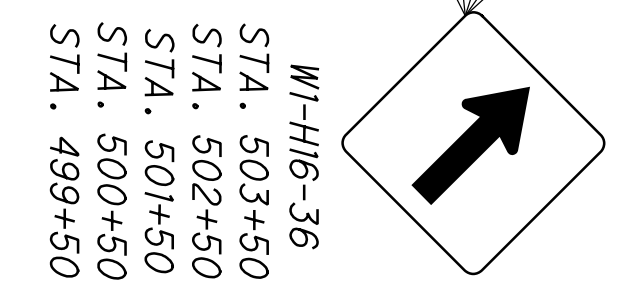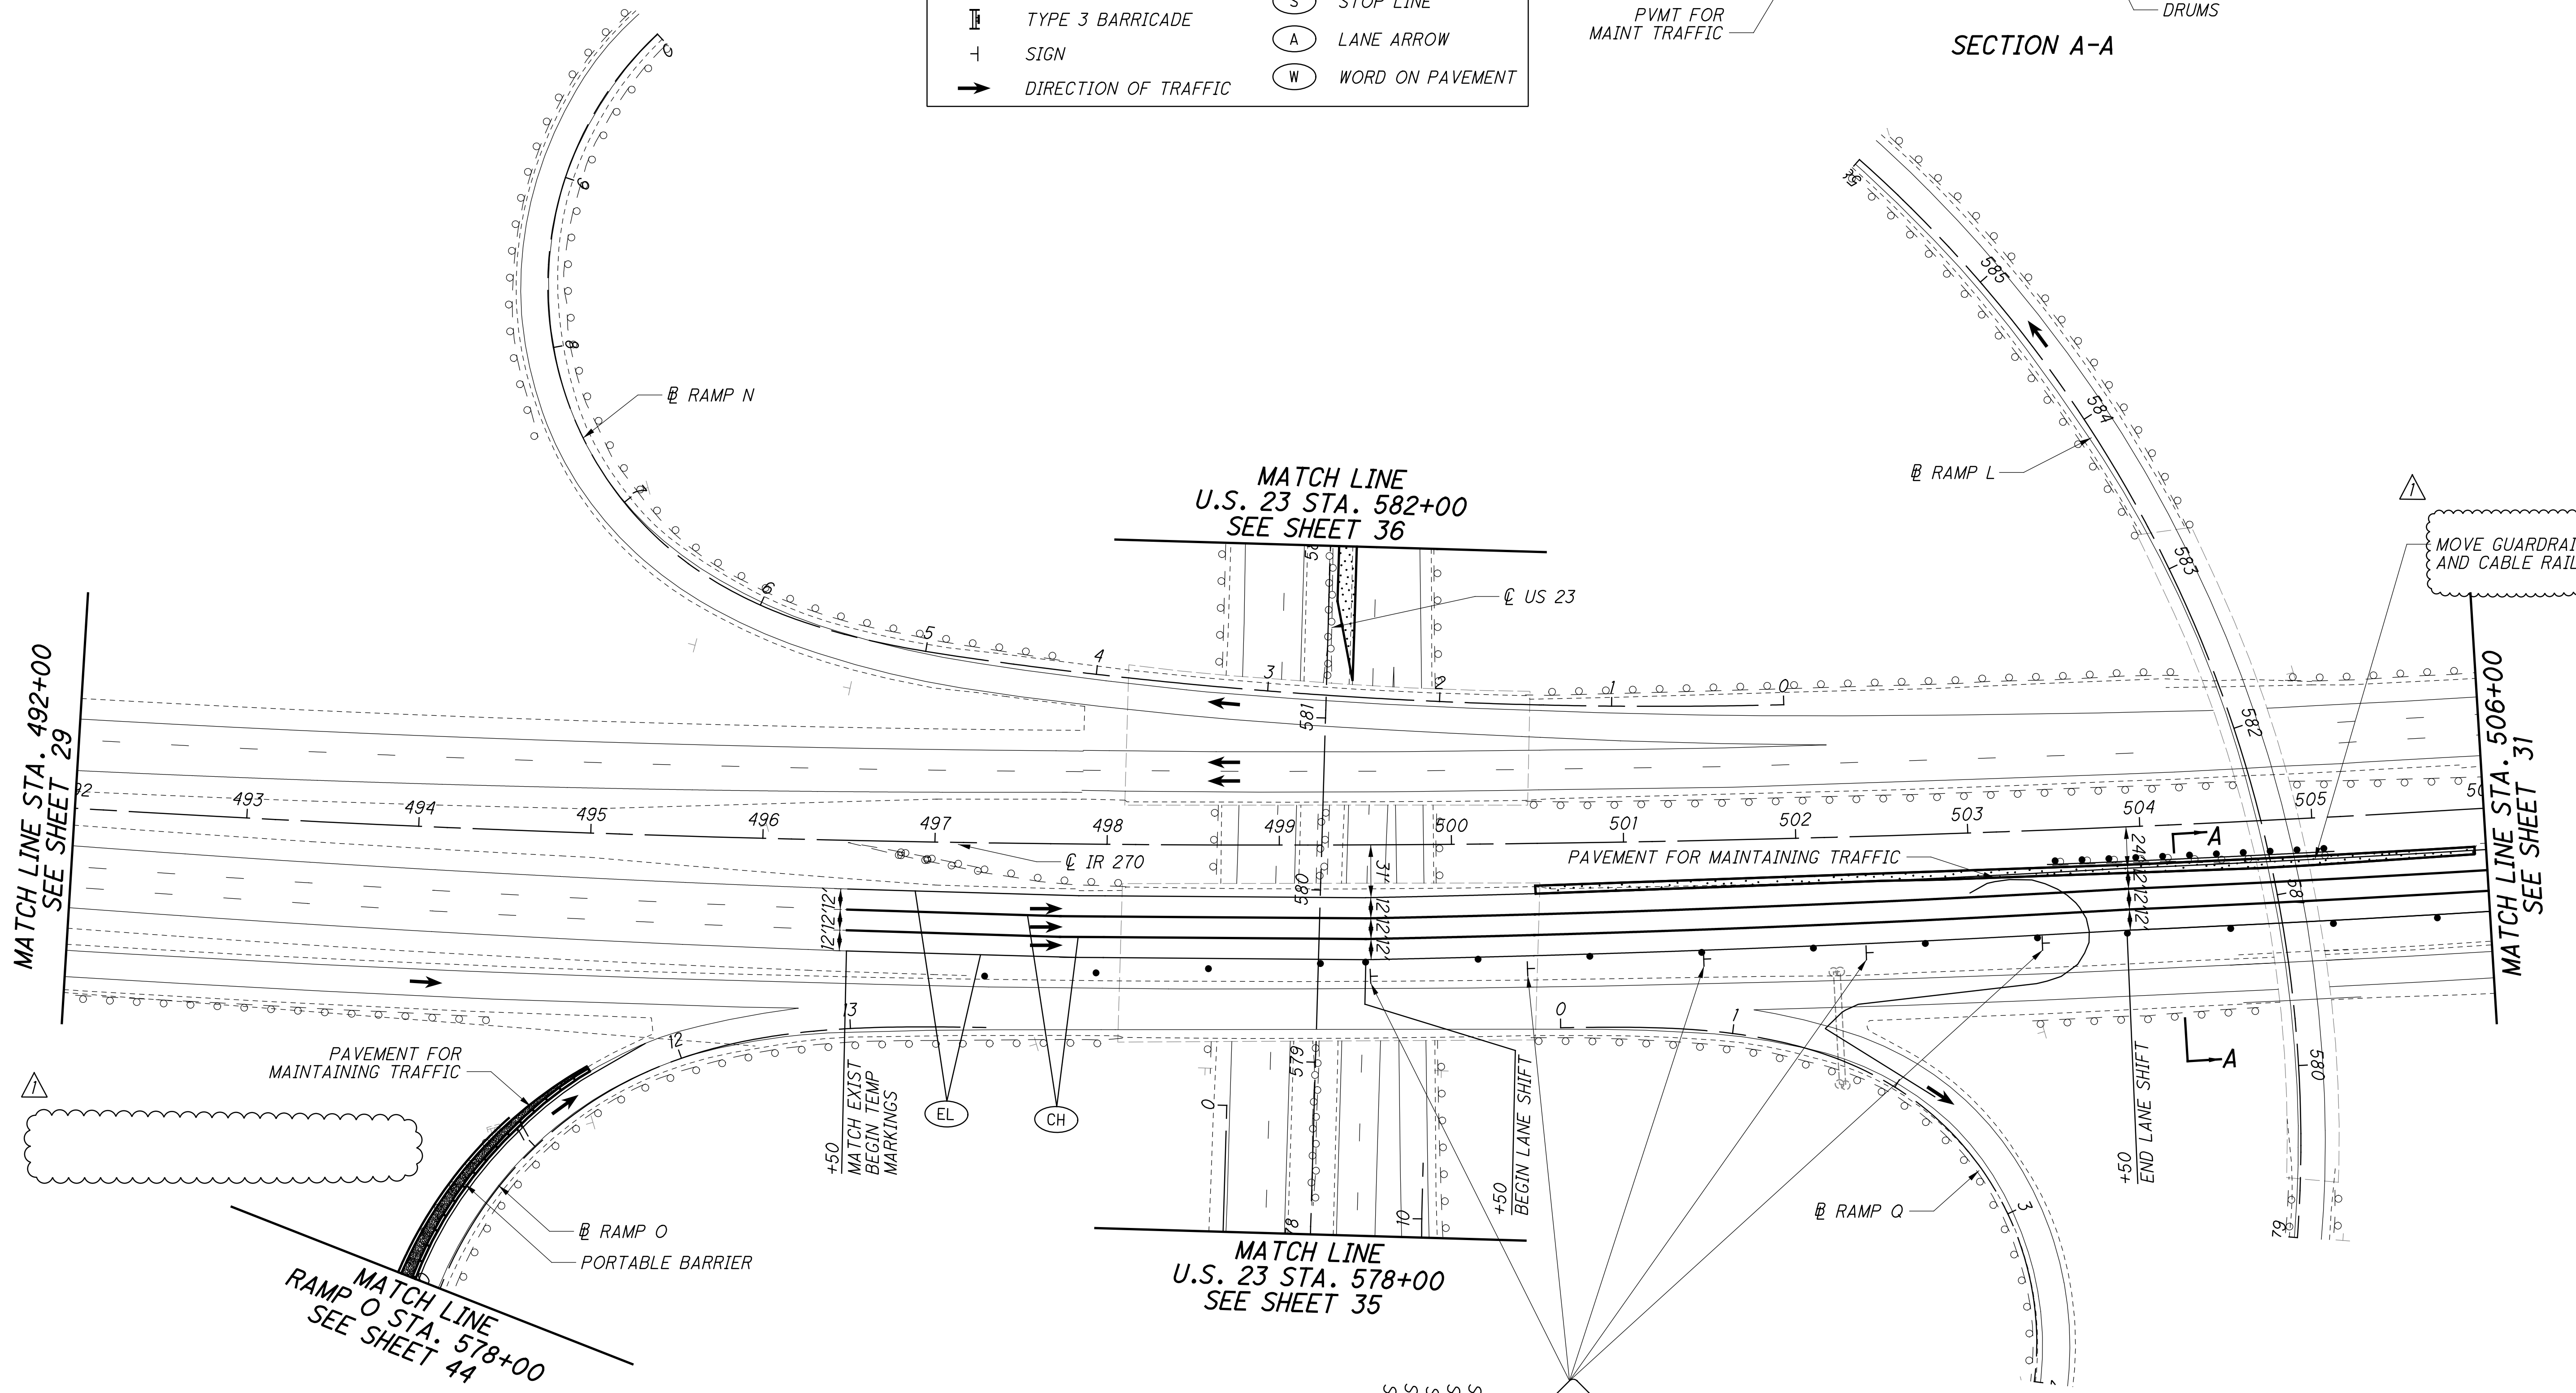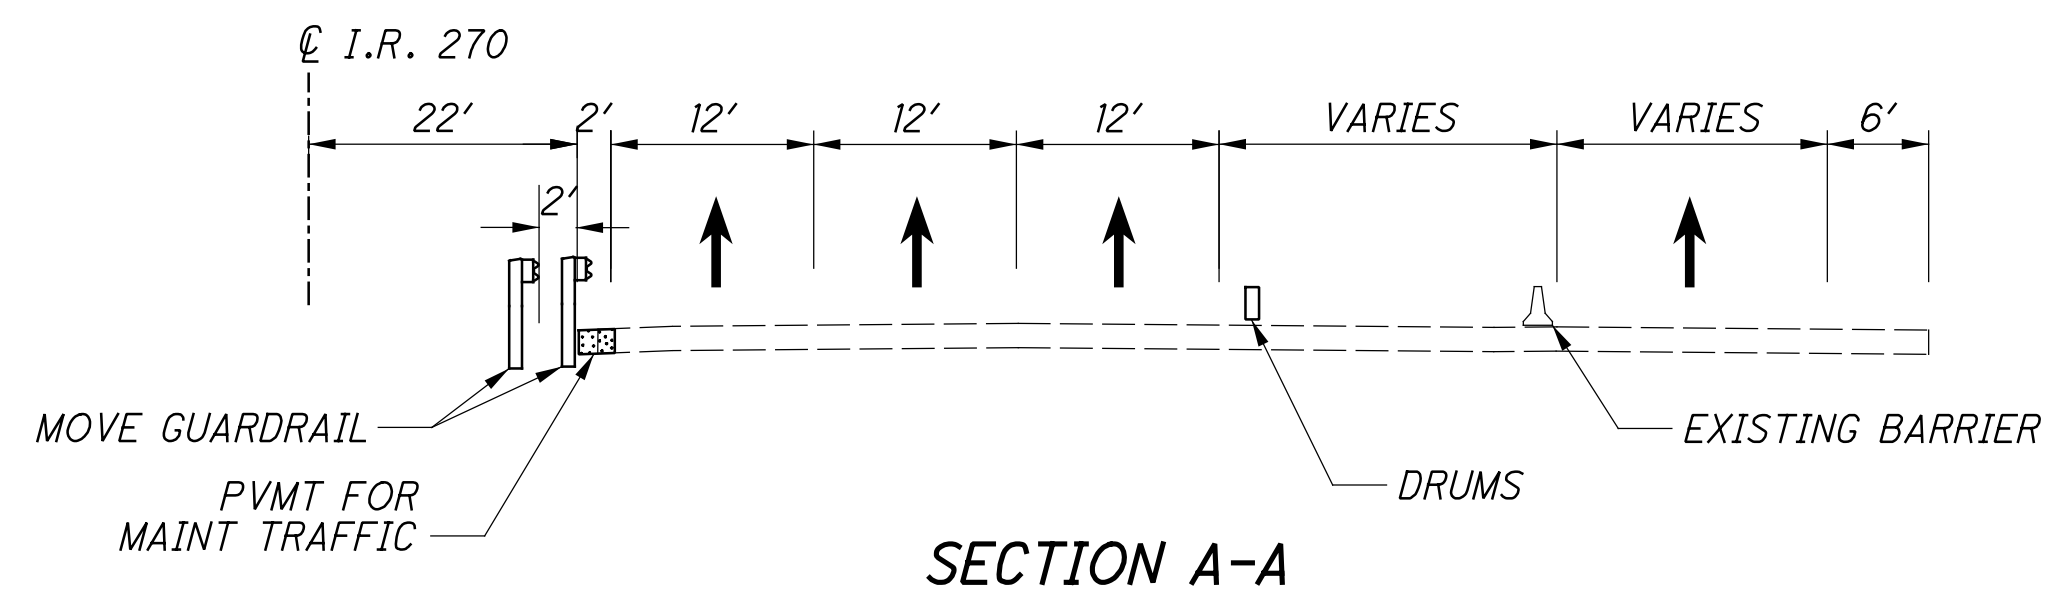

**MAINTENANCE OF TRAFFIC - PHASE 1**  
I-270 STA. 492+00 TO STA. 506+00


**FRA-270-51.50**

30  
554

ADDENDUM #1  
04/21/2023




X:\Projects\2013\1321\1010\FRA\92616\mot\sheets\92616MP015.dgn 4/18/2023 3:11:58 PM c.wong

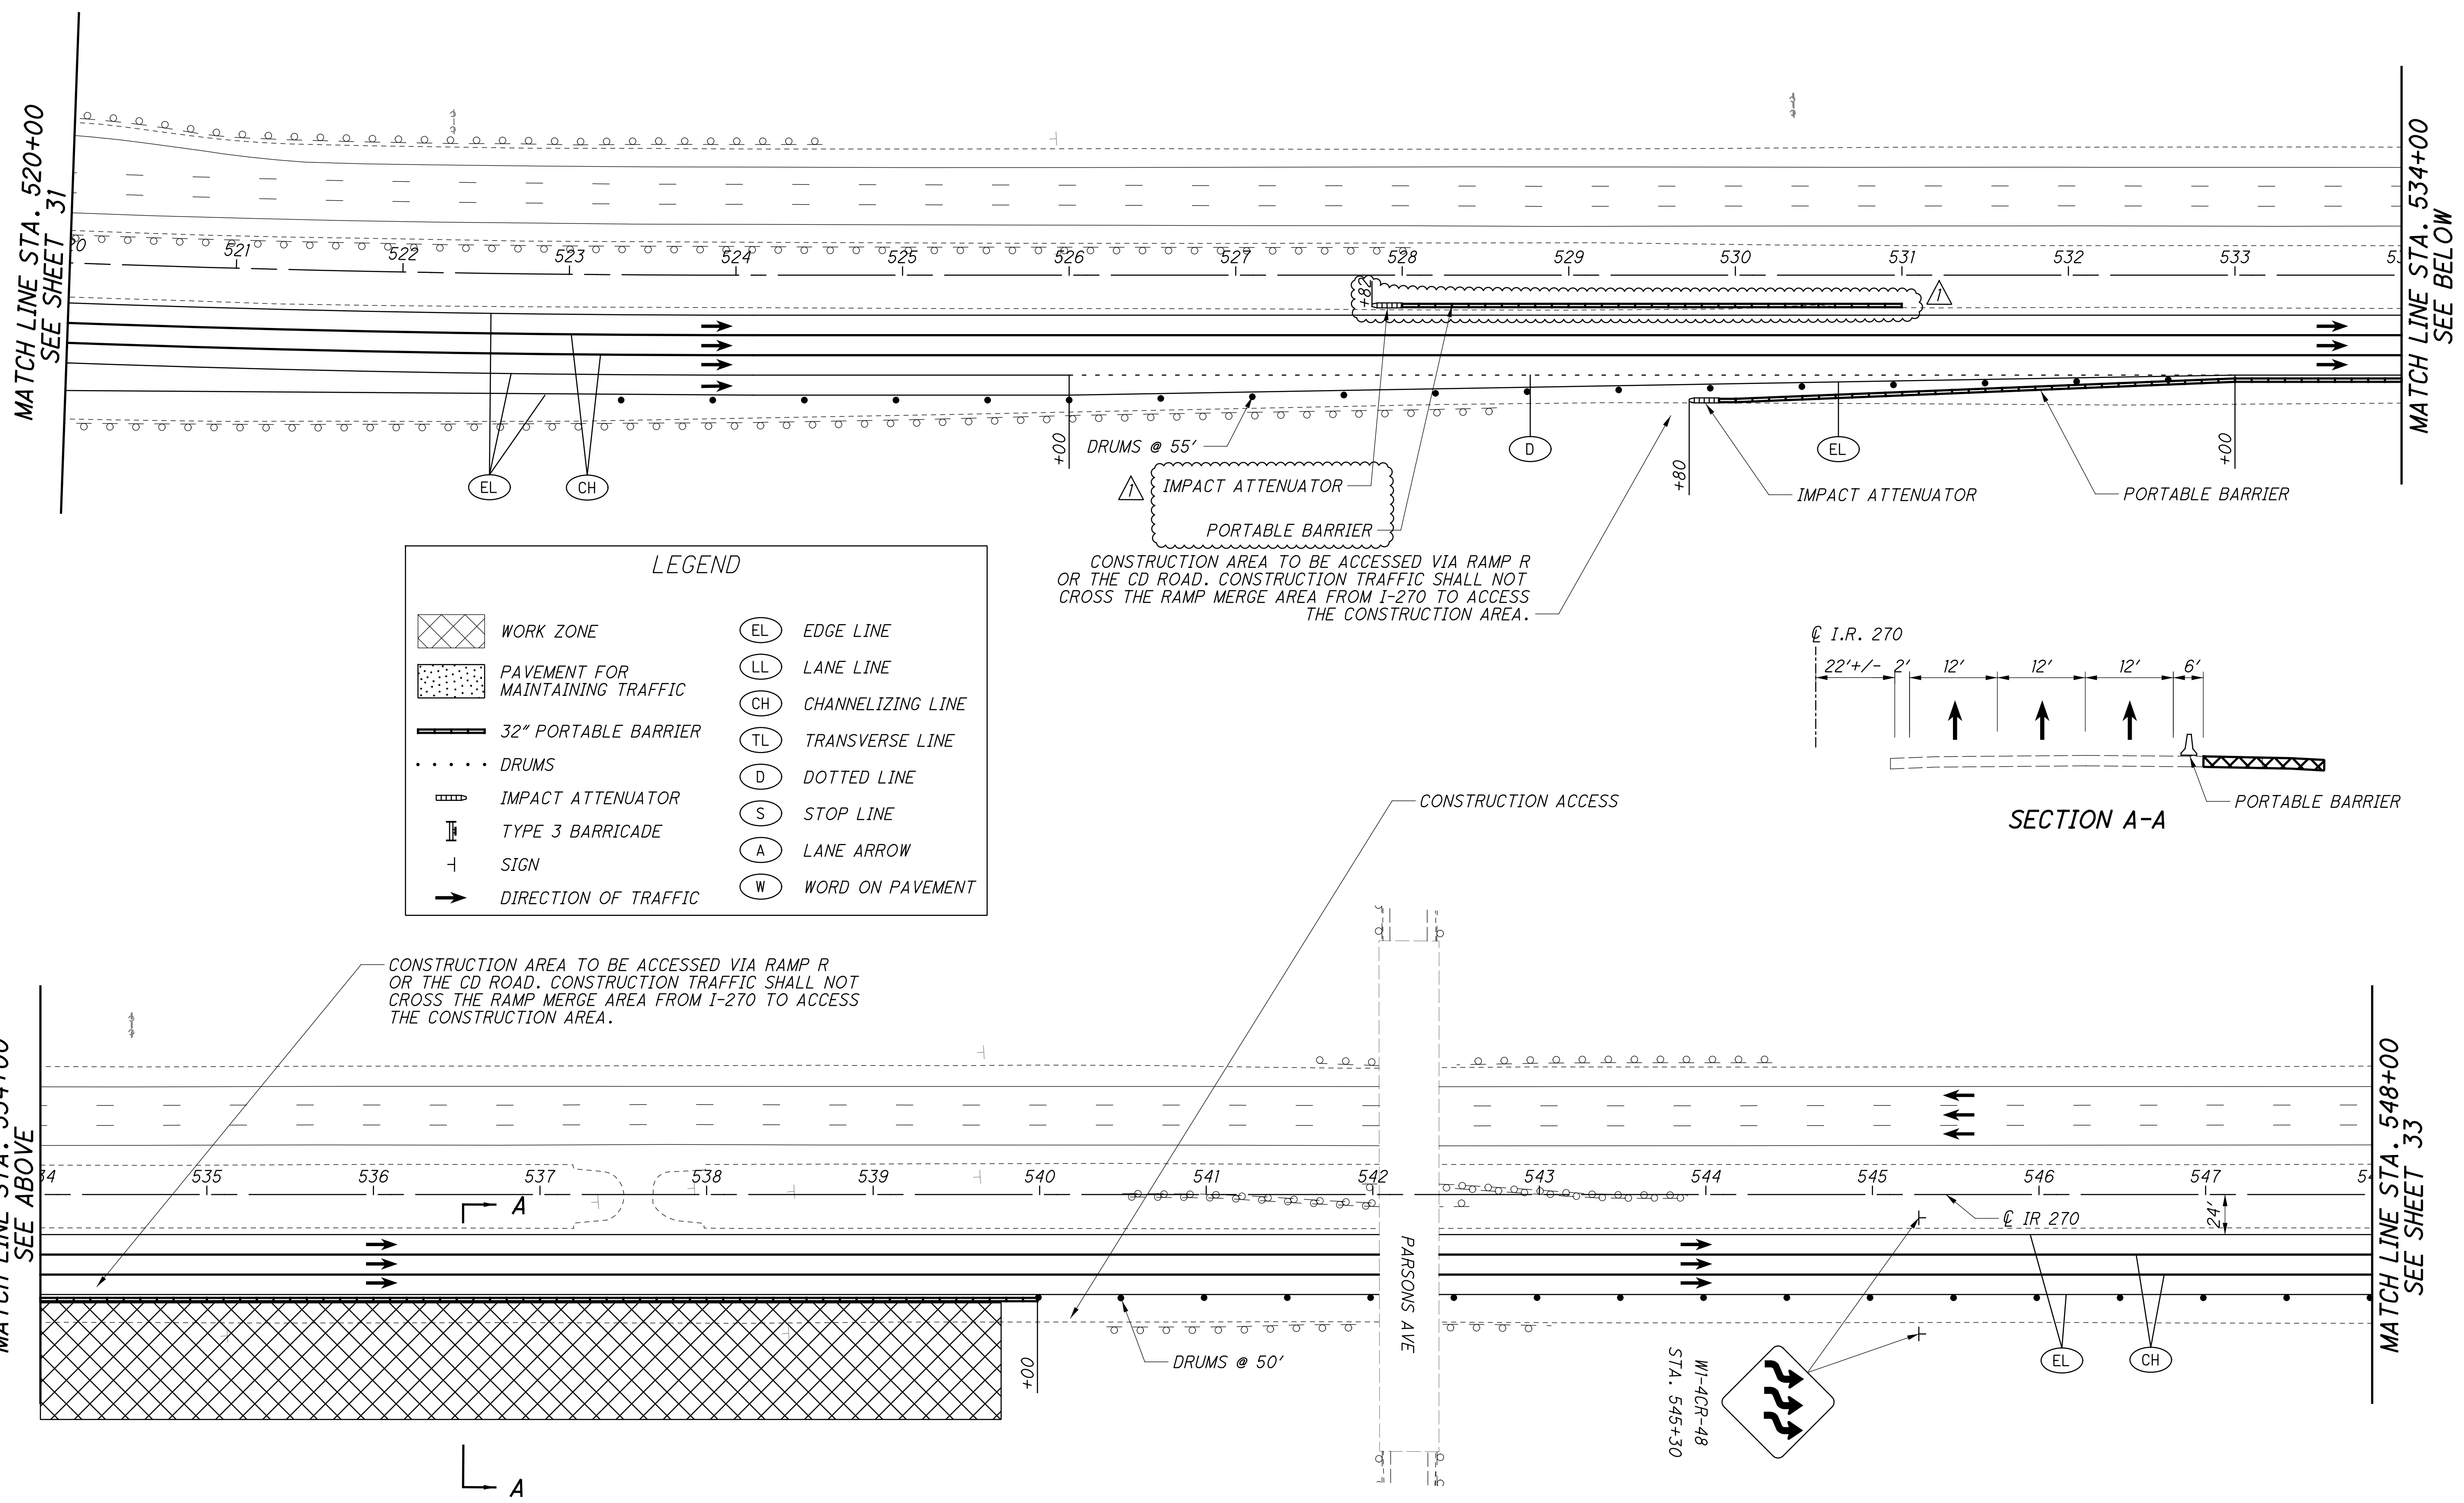

**LEGEND**

	WORK ZONE		EDGE LINE
	PAVEMENT FOR MAINTAINING TRAFFIC		LANE LINE
	32" PORTABLE BARRIER		CHANNELIZING LINE
	DRUMS		TRANSVERSE LINE
	IMPACT ATTENUATOR		DOTTED LINE
	TYPE 3 BARRICADE		STOP LINE
	SIGN		LANE ARROW
	DIRECTION OF TRAFFIC		WORD ON PAVEMENT

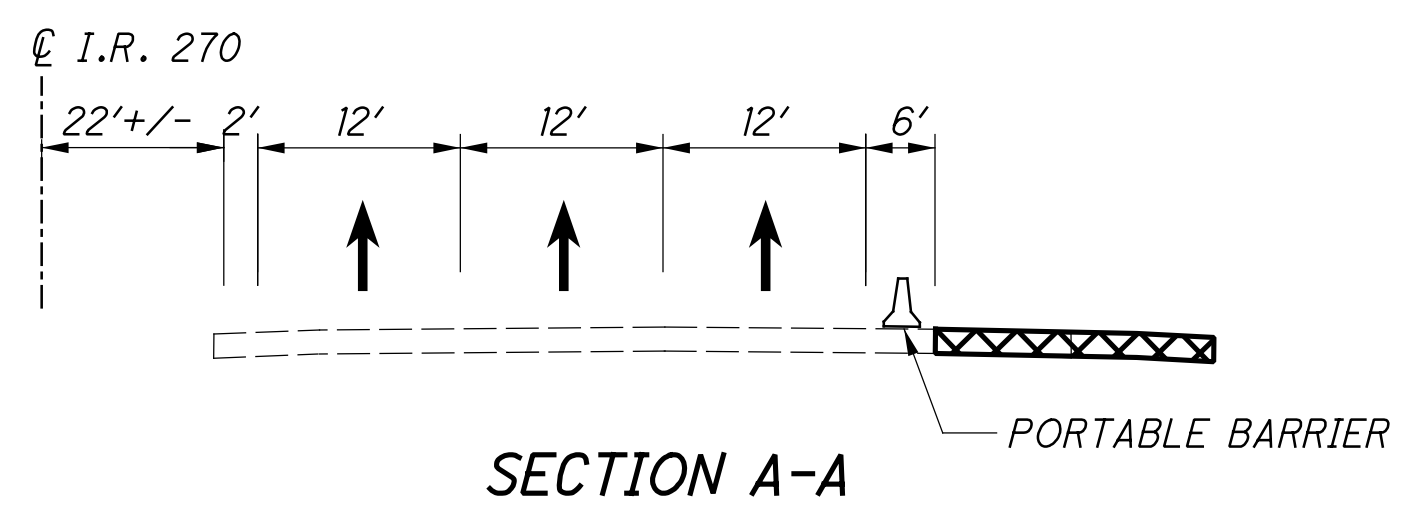


CALCULATED  
DJR  
CHECKED  
RCH

0 50 100  
25  
HORIZONTAL  
SCALE IN FEET

**MAINTENANCE OF TRAFFIC - PHASE 1**  
**I-270 STA. 520+00 TO STA. 548+00**

**FRA-270-51.50**


ADDENDUM #1  
04/21/2023

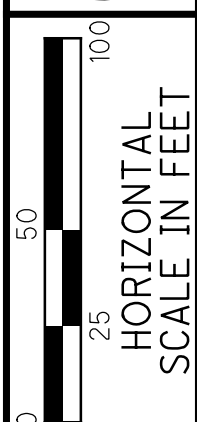


CALCULATED  
DJR  
CHECKED  
RCH

**MAINTENANCE OF TRAFFIC - PHASE 1**  
**U.S. 23 STA. 564+00 TO STA. 582+00**

**FRA-270-51.50**

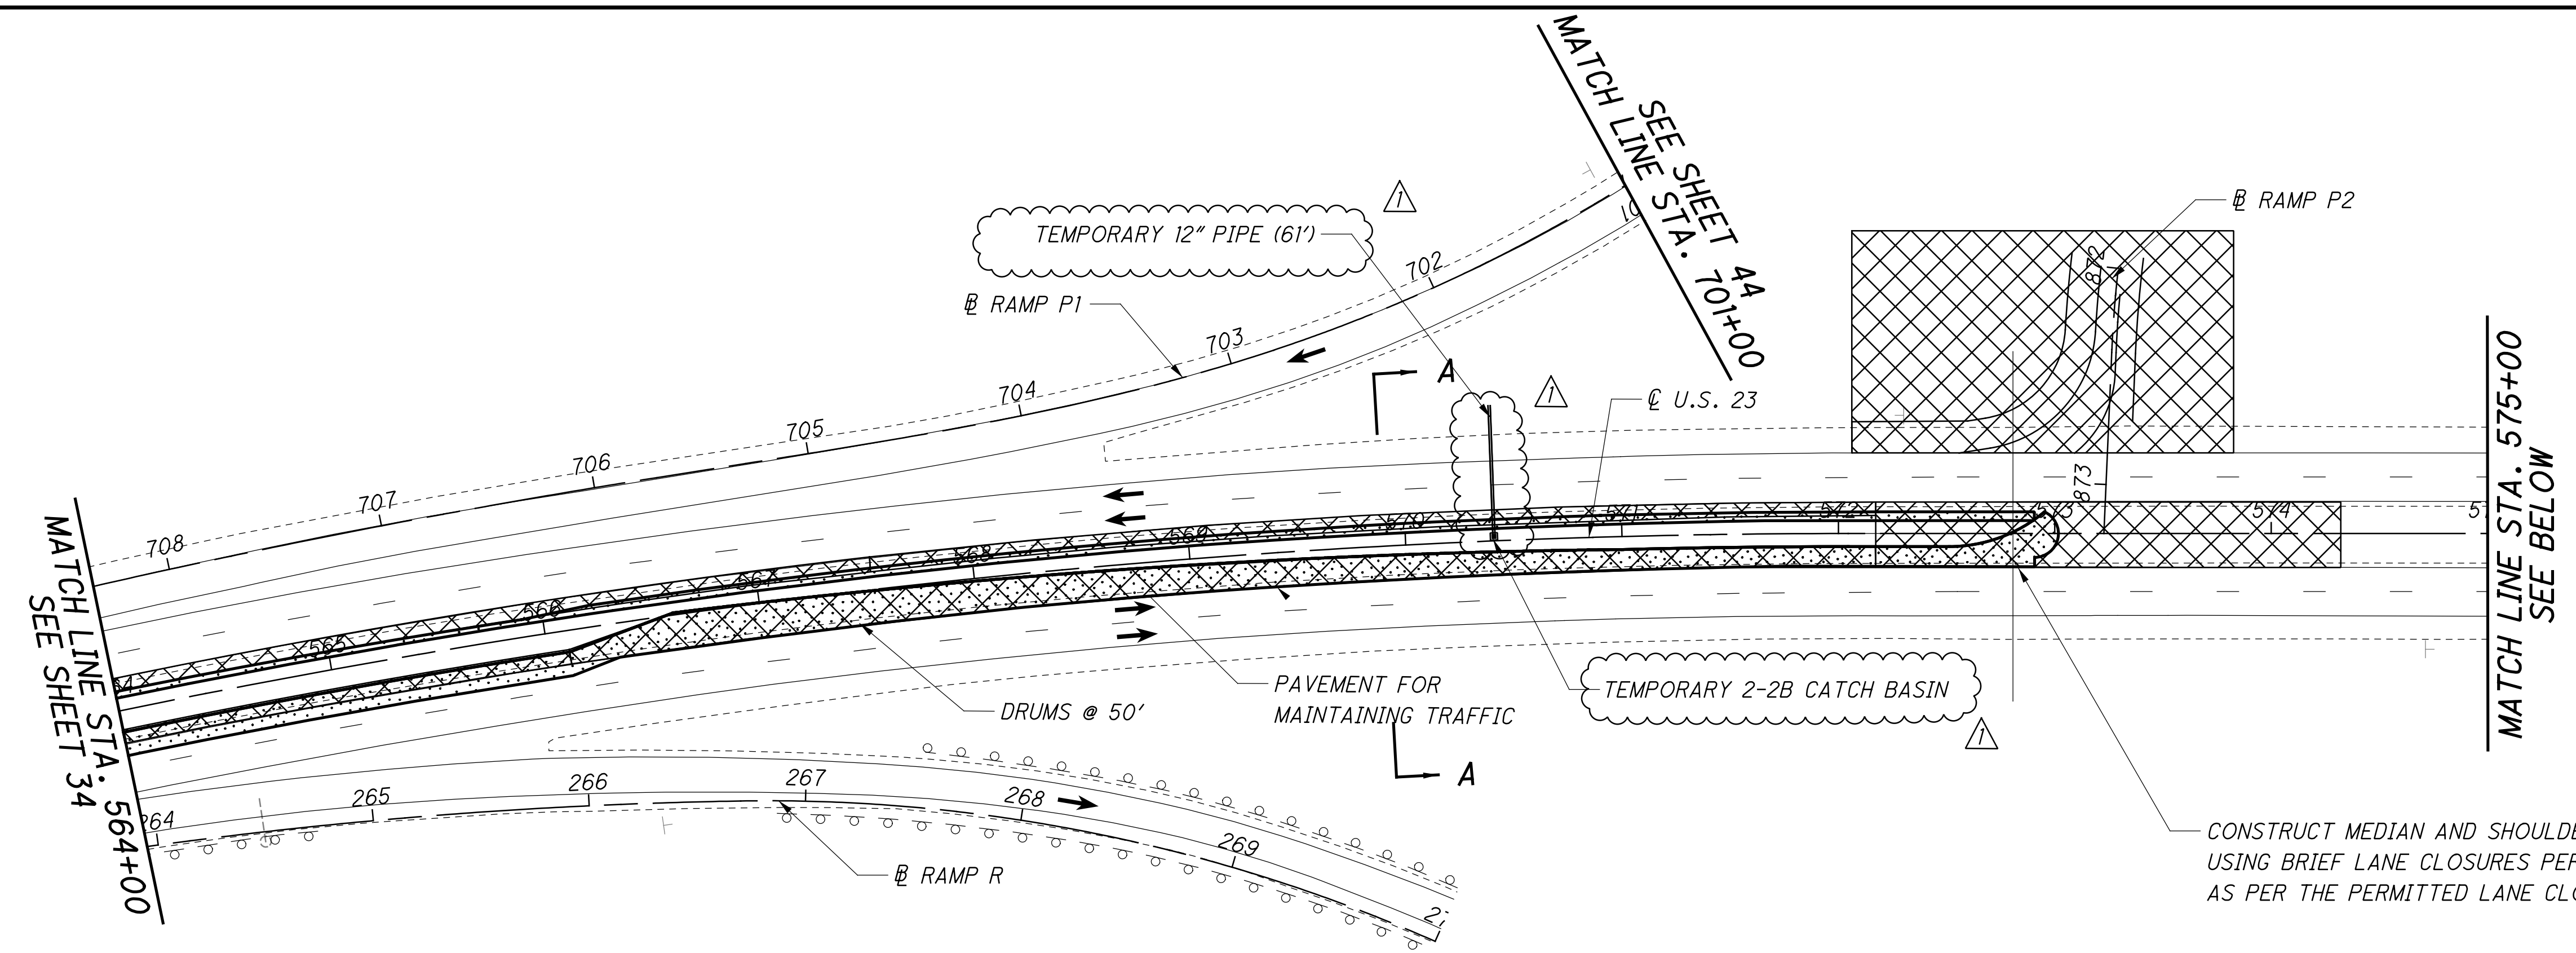


CONSTRUCT MEDIAN AND SHOULDER PAVEMENT USING BRIEF LANE CLOSURES PER SCD MT-95.30 AS PER THE PERMITTED LANE CLOSURE SCHEDULE.

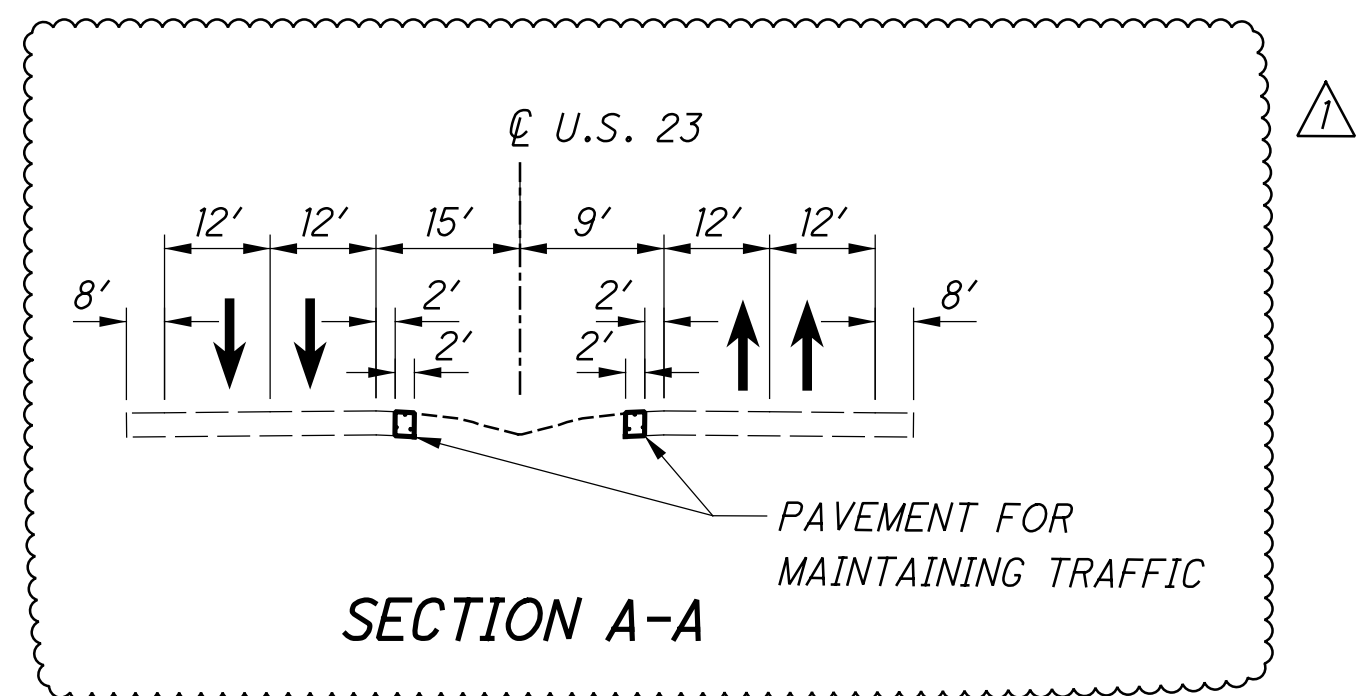

**LEGEND**

WORK ZONE	EDGE LINE
PAVEMENT FOR MAINTAINING TRAFFIC	LANE LINE
32" PORTABLE BARRIER	CHANNELIZING LINE
DRUMS	TRANSVERSE LINE
IMPACT ATTENUATOR	DOTTED LINE
TYPE 3 BARRICADE	STOP LINE
SIGN	LANE ARROW
DIRECTION OF TRAFFIC	WORD ON PAVEMENT

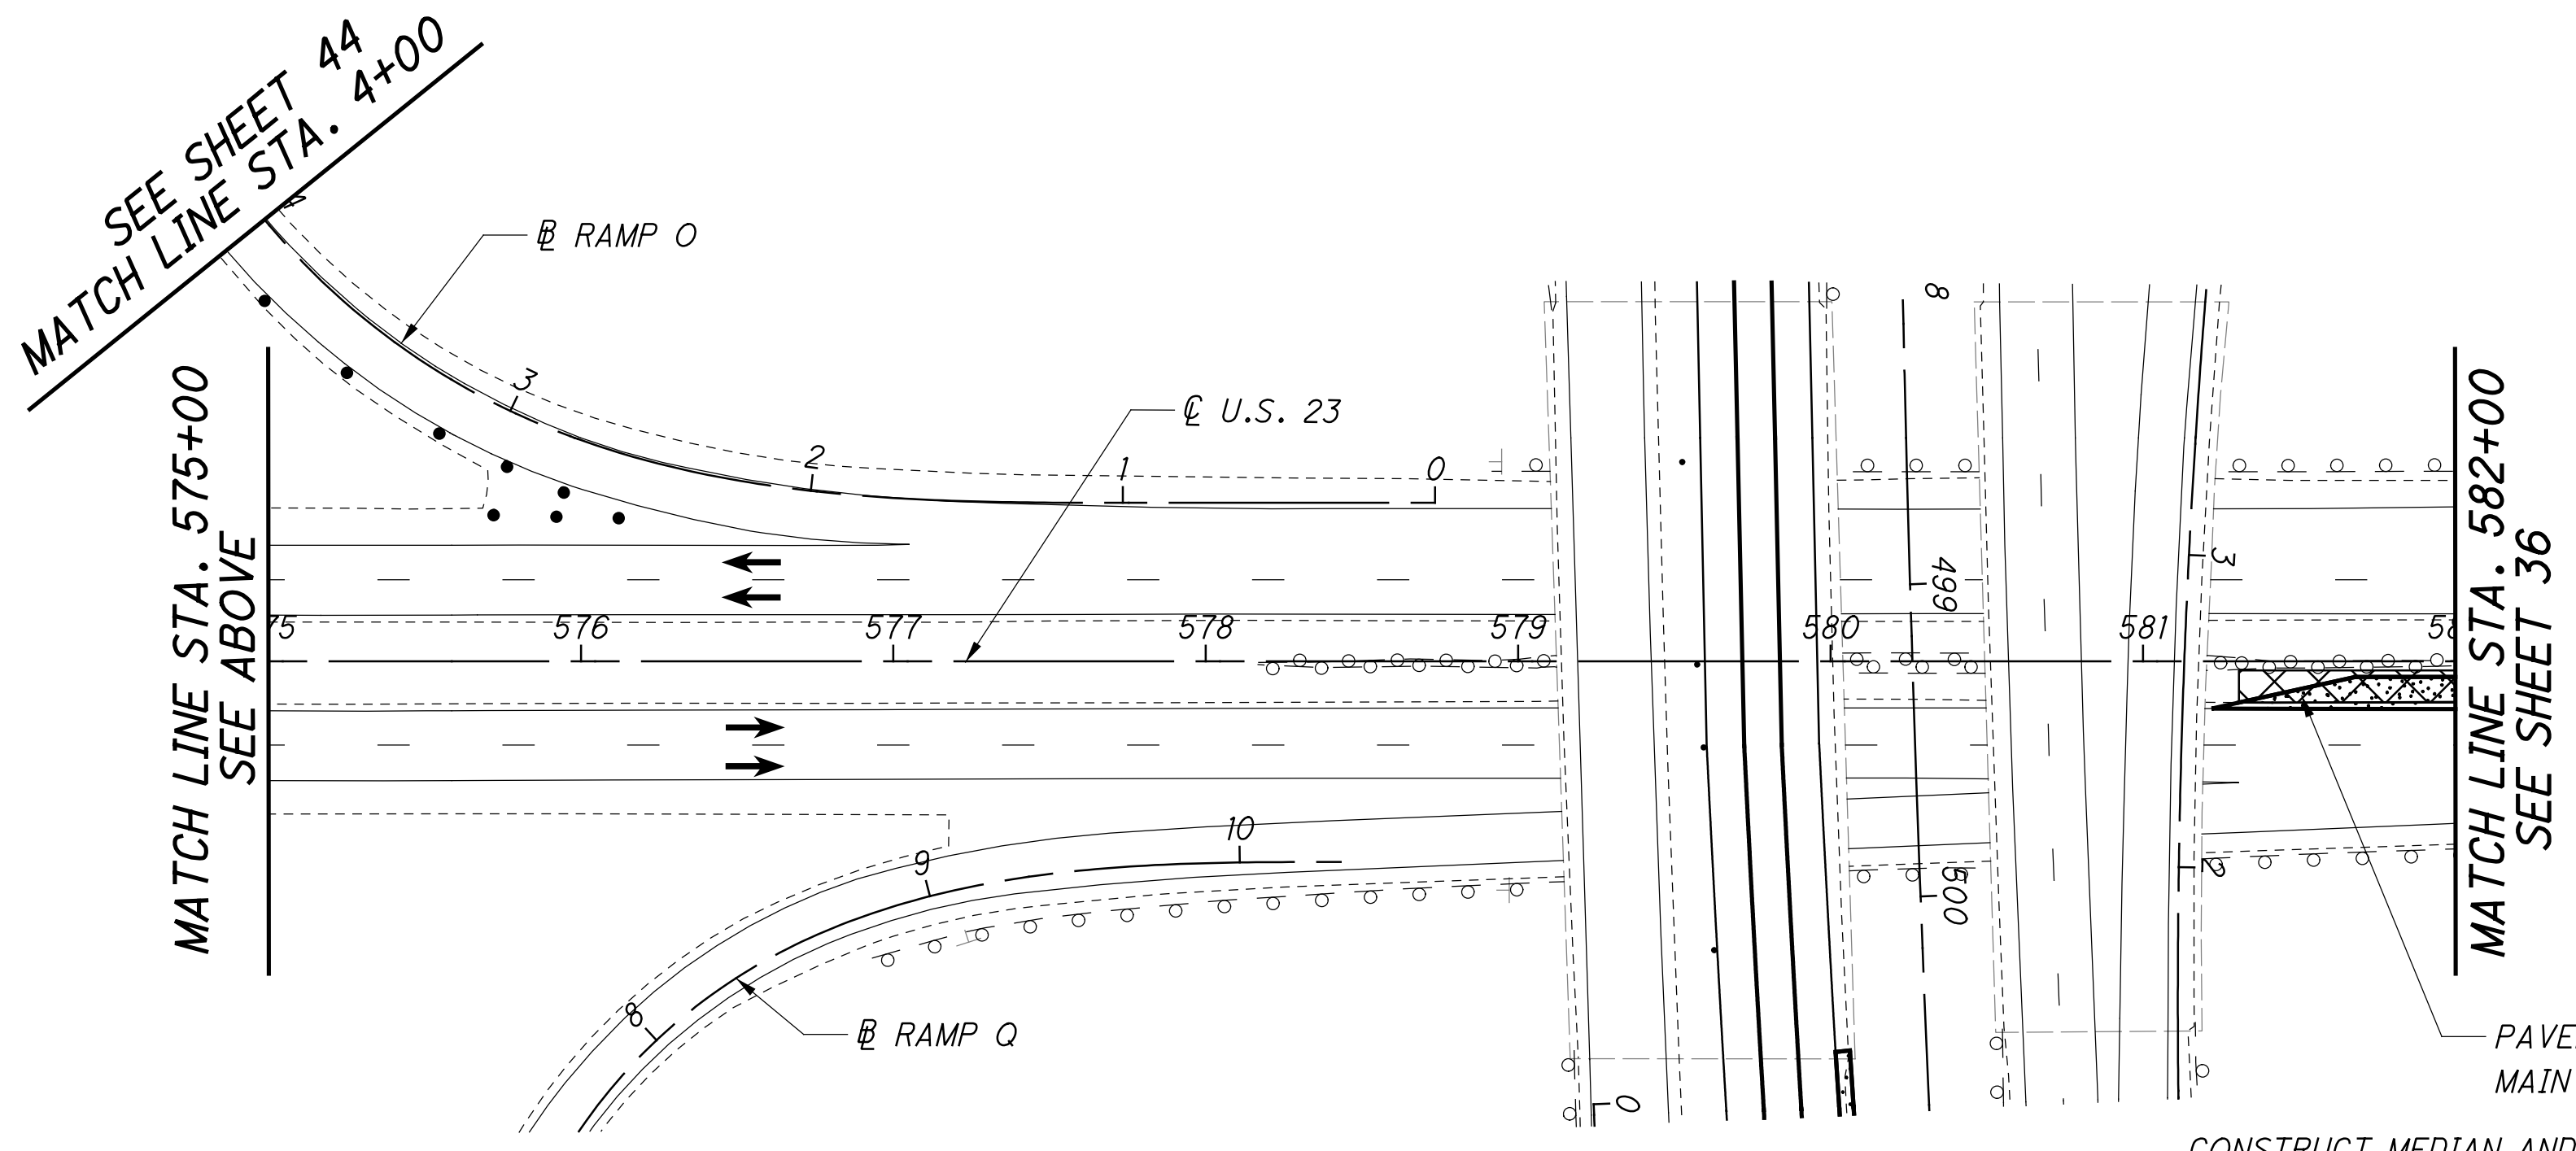



CONSTRUCT MEDIAN AND SHOULDER PAVEMENT USING BRIEF LANE CLOSURES PER SCD MT-95.30 AS PER THE PERMITTED LANE CLOSURE SCHEDULE.

ADDENDUM #1  
04/21/2023

X:\Projects\2013\1321\1010\FRA\92616\mot\sheets\92616MP152.dgn 4/21/2023 6:59:29 PM cwong



X:\Projects\2013\1010\FRA\92616\mot\sheet\92616MP15.3.dgn 4/24/2023 6:29:23 AM cwong

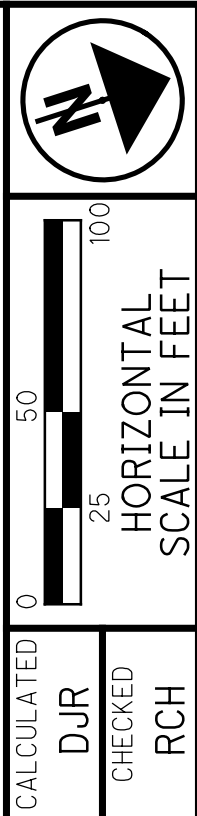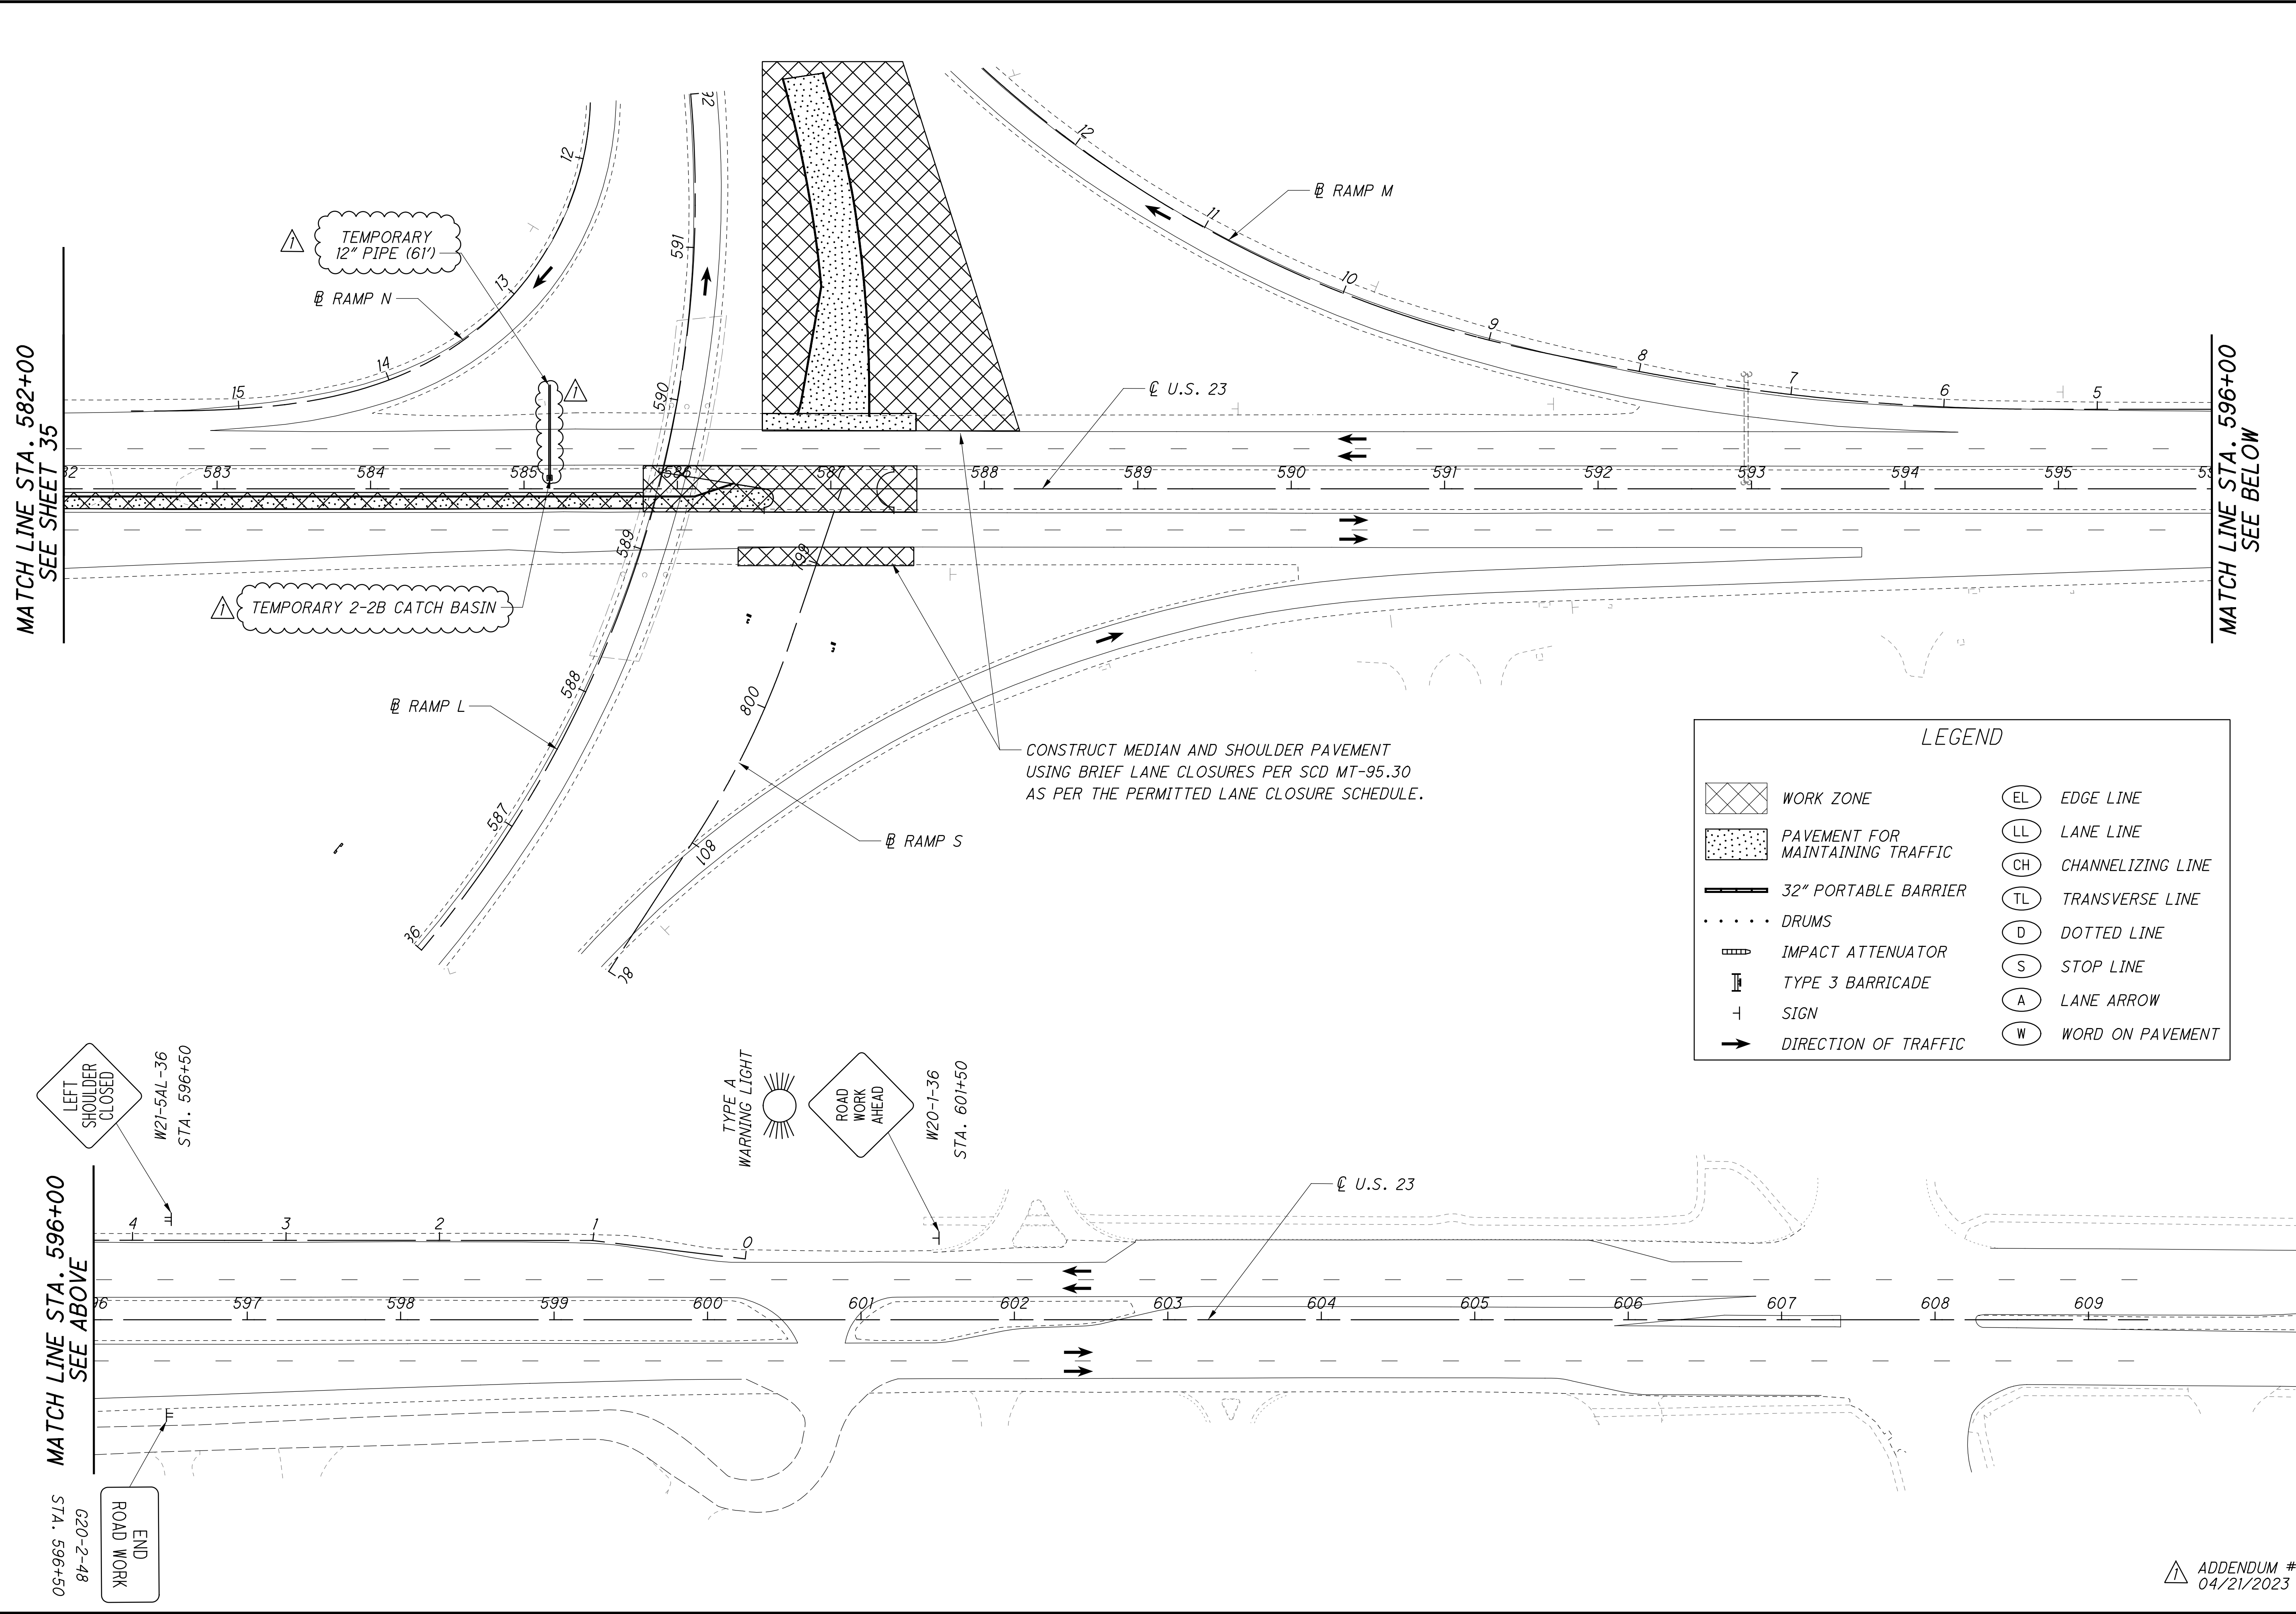

**MAINTENANCE OF TRAFFIC - PHASE 1**  
**U.S. 23 STA. 582+00 TO STA. 609+00**

**FRA-270-51.50**


36  
554

ADDENDUM #1  
04/21/2023

X:\Projects\2013\1010\FRA\92616\mot\sheet\92616MY201.dgn 4/28/2023 11:35:41 AM cwong


SUPERELEVATION TABLE

LEFT EDGE OF SHOULDER				LEFT EDGE OF PAVEMENT				BASELINE CONTROL		RIGHT EDGE OF PAVEMENT				RIGHT EDGE OF SHOULDER				
EDGE ELEVATION	CORRECTION FACTOR	CROSS SLOPE	WIDTH	EDGE ELEVATION	CORRECTION FACTOR	CROSS SLOPE	WIDTH	STATION	PGL ELEVATION	WIDTH	CROSS SLOPE	CORRECTION FACTOR	EDGE ELEVATION	WIDTH	CROSS SLOPE	CORRECTION FACTOR	EDGE ELEVATION	
						EXIST.		89+53.58	700.23		EXIST.							
699.85	-0.04	-0.013	3.00	699.89	-0.20	-0.013	15.80	89+75.00	700.09	22.00	0.013	0.28	700.37	3.00	-0.057	-0.17	700.20	
699.74	-0.06	-0.021	3.00	699.80	-0.23	-0.021	11.15	90+00.00	700.03	22.00	0.021	0.45	700.48	3.00	-0.049	-0.15	700.34	
699.85	-0.09	-0.029	3.00	699.94	-0.16	-0.029	5.63	90+25.00	700.10	22.00	0.029	0.63	700.73	3.00	-0.042	-0.12	700.60	
700.18	-0.11	-0.036	3.00	700.29	0.00	-0.036	0.00	90+50.00	700.29	22.00	0.036	0.80	701.09	3.00	-0.034	-0.10	700.99	
700.48	-0.13	-0.044	3.00	700.61	0.00	-0.044	0.00	90+75.00	700.61	22.00	0.044	0.97	701.58	3.00	-0.026	-0.08	701.51	
700.89	-0.16	-0.052	3.00	701.05	0.00	-0.052	0.00	91+00.00	701.05	22.00	0.052	1.15	702.20	3.00	-0.018	-0.05	702.15	
701.36	-0.18	-0.059	3.00	701.54	0.00	-0.059	0.00	91+21.58	701.54	21.53	0.059	1.27	702.81	3.00	-0.011	-0.03	702.78	
701.45	-0.18	-0.059	3.00	701.63	0.00	-0.059	0.00	91+25.00	701.63	21.45	0.059	1.27	702.90	3.00	-0.011	-0.03	702.86	
702.14	-0.18	-0.059	3.00	702.32	0.00	-0.059	0.00	91+50.00	702.32	20.90	0.059	1.23	703.55	3.00	-0.011	-0.03	703.52	
702.87	-0.18	-0.059	3.00	703.05	0.00	-0.059	0.00	91+75.00	703.05	20.35	0.059	1.20	704.25	3.00	-0.011	-0.03	704.22	
703.59	-0.18	-0.059	3.00	703.77	0.00	-0.059	0.00	92+00.00	703.77	19.80	0.059	1.17	704.94	3.00	-0.011	-0.03	704.91	
704.32	-0.18	-0.059	3.00	704.50	0.00	-0.059	0.00	92+25.00	704.50	19.25	0.059	1.14	705.64	3.00	-0.011	-0.03	705.60	
705.04	-0.18	-0.059	3.00	705.22	0.00	-0.059	0.00	92+50.00	705.22	18.70	0.059	1.10	706.32	3.00	-0.011	-0.03	706.29	
705.77	-0.18	-0.059	3.00	705.95	0.00	-0.059	0.00	92+75.00	705.95	18.15	0.059	1.07	707.02	3.00	-0.011	-0.03	706.99	
706.39	-0.18	-0.059	3.00	706.57	0.00	-0.059	0.00	93+00.00	706.57	17.60	0.059	1.04	707.61	3.00	-0.011	-0.03	707.58	
706.82	-0.18	-0.059	3.00	707.00	0.00	-0.059	0.00	93+25.00	707.00	17.05	0.059	1.01	708.01	3.00	-0.011	-0.03	707.97	
707.04	-0.18	-0.059	3.00	707.22	0.00	-0.059	0.00	93+50.00	707.22	16.50	0.059	0.97	708.19	3.00	-0.011	-0.03	708.16	
707.08	-0.18	-0.059	3.00	707.26	0.00	-0.059	0.00	93+60.00	707.26	16.28	0.059	0.96	708.22	3.00	-0.011	-0.03	708.19	
707.08	-0.17	-0.057	3.00	707.25	0.00	-0.057	0.00	93+75.00	707.25	15.95	0.057	0.91	708.16	3.00	-0.013	-0.04	708.12	
706.91	-0.16	-0.054	3.00	707.07	0.00	-0.054	0.00	94+00.00	707.07	15.40	0.054	0.83	707.90	3.00	-0.016	-0.05	707.85	
706.53	-0.17	-0.057	3.00	706.70	0.00	-0.057	0.00	94+25.00	706.70	14.85	0.057	0.85	707.55	3.00	-0.013	-0.04	707.51	
						EXIST.		94+50.00	706.07	14.30	0.048	0.68	706.75	3.00	-0.023	-0.07	706.68	
						EXIST.		94+80.60	705.59		EXIST.							

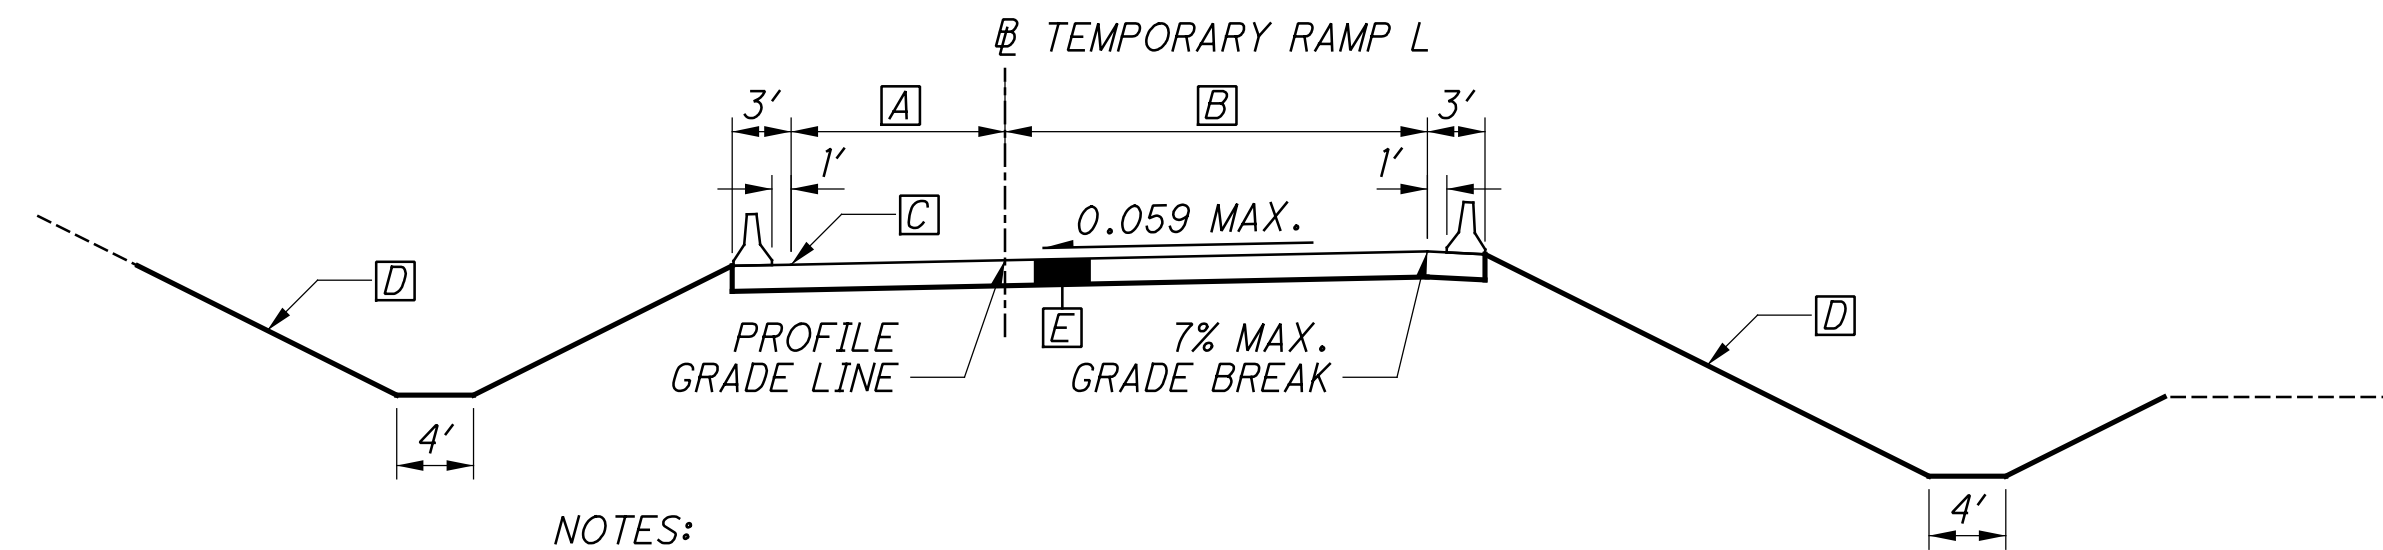


- NOTES:
- [A] VARIES 22.59' - 0' FROM STA. 89+53.58 TO STA. 90+47.11.  
0' FROM STA. 90+47.11 TO STA. 94+80.60.
  - [B] 22' FROM STA. 89+53.58 TO STA. 91+00.00.  
VARIES 22' - 13.69' FROM STA. 91+00.00 TO STA. 94+80.60.
  - [C] LEFT SHOULDER CROSS SLOPE EQUALS PAVEMENT SLOPE.
  - [D] SEE SHEETS 39 - 42 FOR FORESLOPE AND BACKSLOPE GRADES.
  - [E] ITEM 615 - PAVEMENT FOR MAINTAINING TRAFFIC, CLASS A - QUANTITIES FOR THIS ITEM ARE INCLUDED IN THE SUBSUMMARY ON SHEET 23.

TYPICAL SECTION  
TEMPORARY RAMP L  
STA. 89+53.58 TO STA. 94+80.60

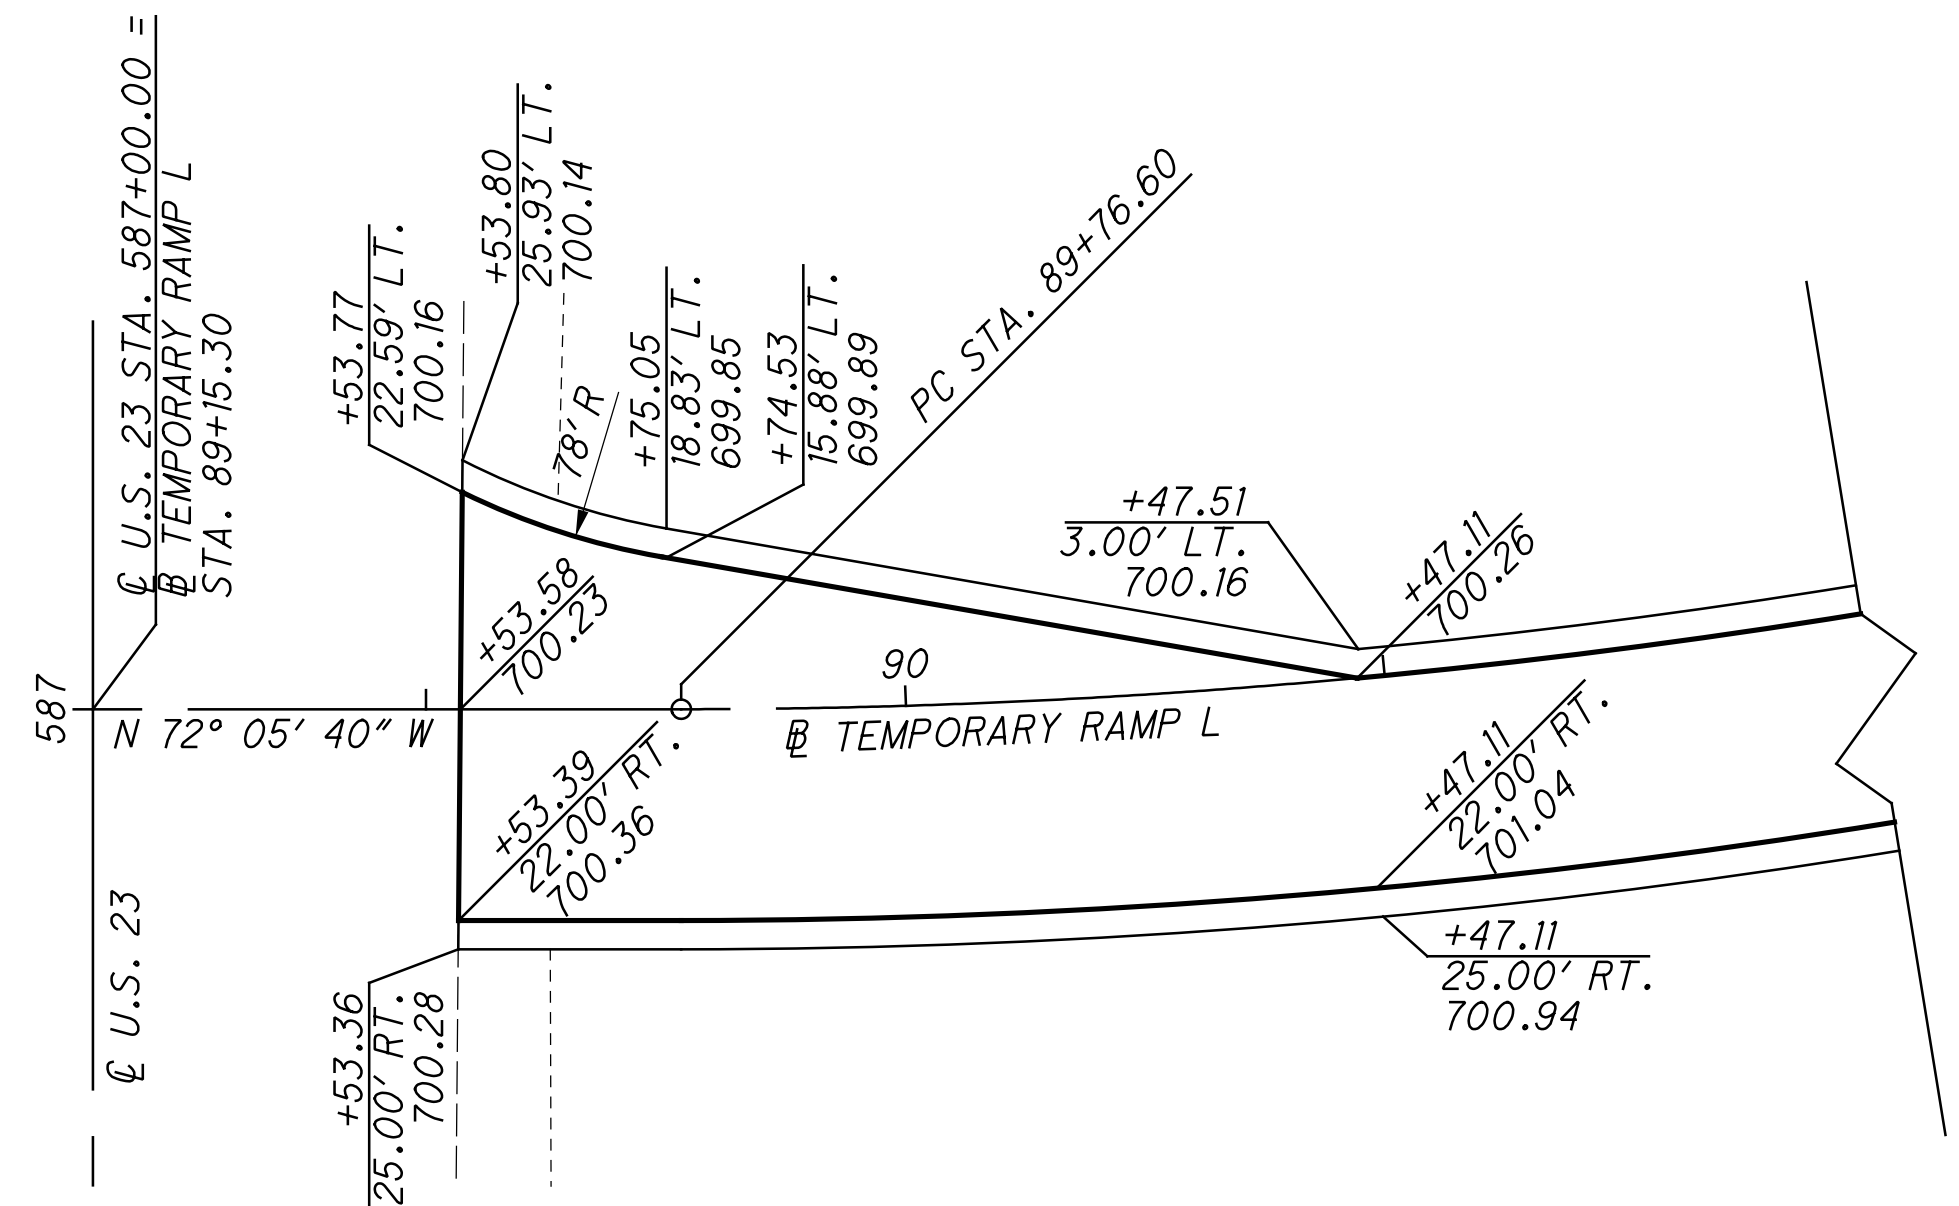

INTERSECTION DETAIL  
TEMPORARY RAMP L AT U.S. 23

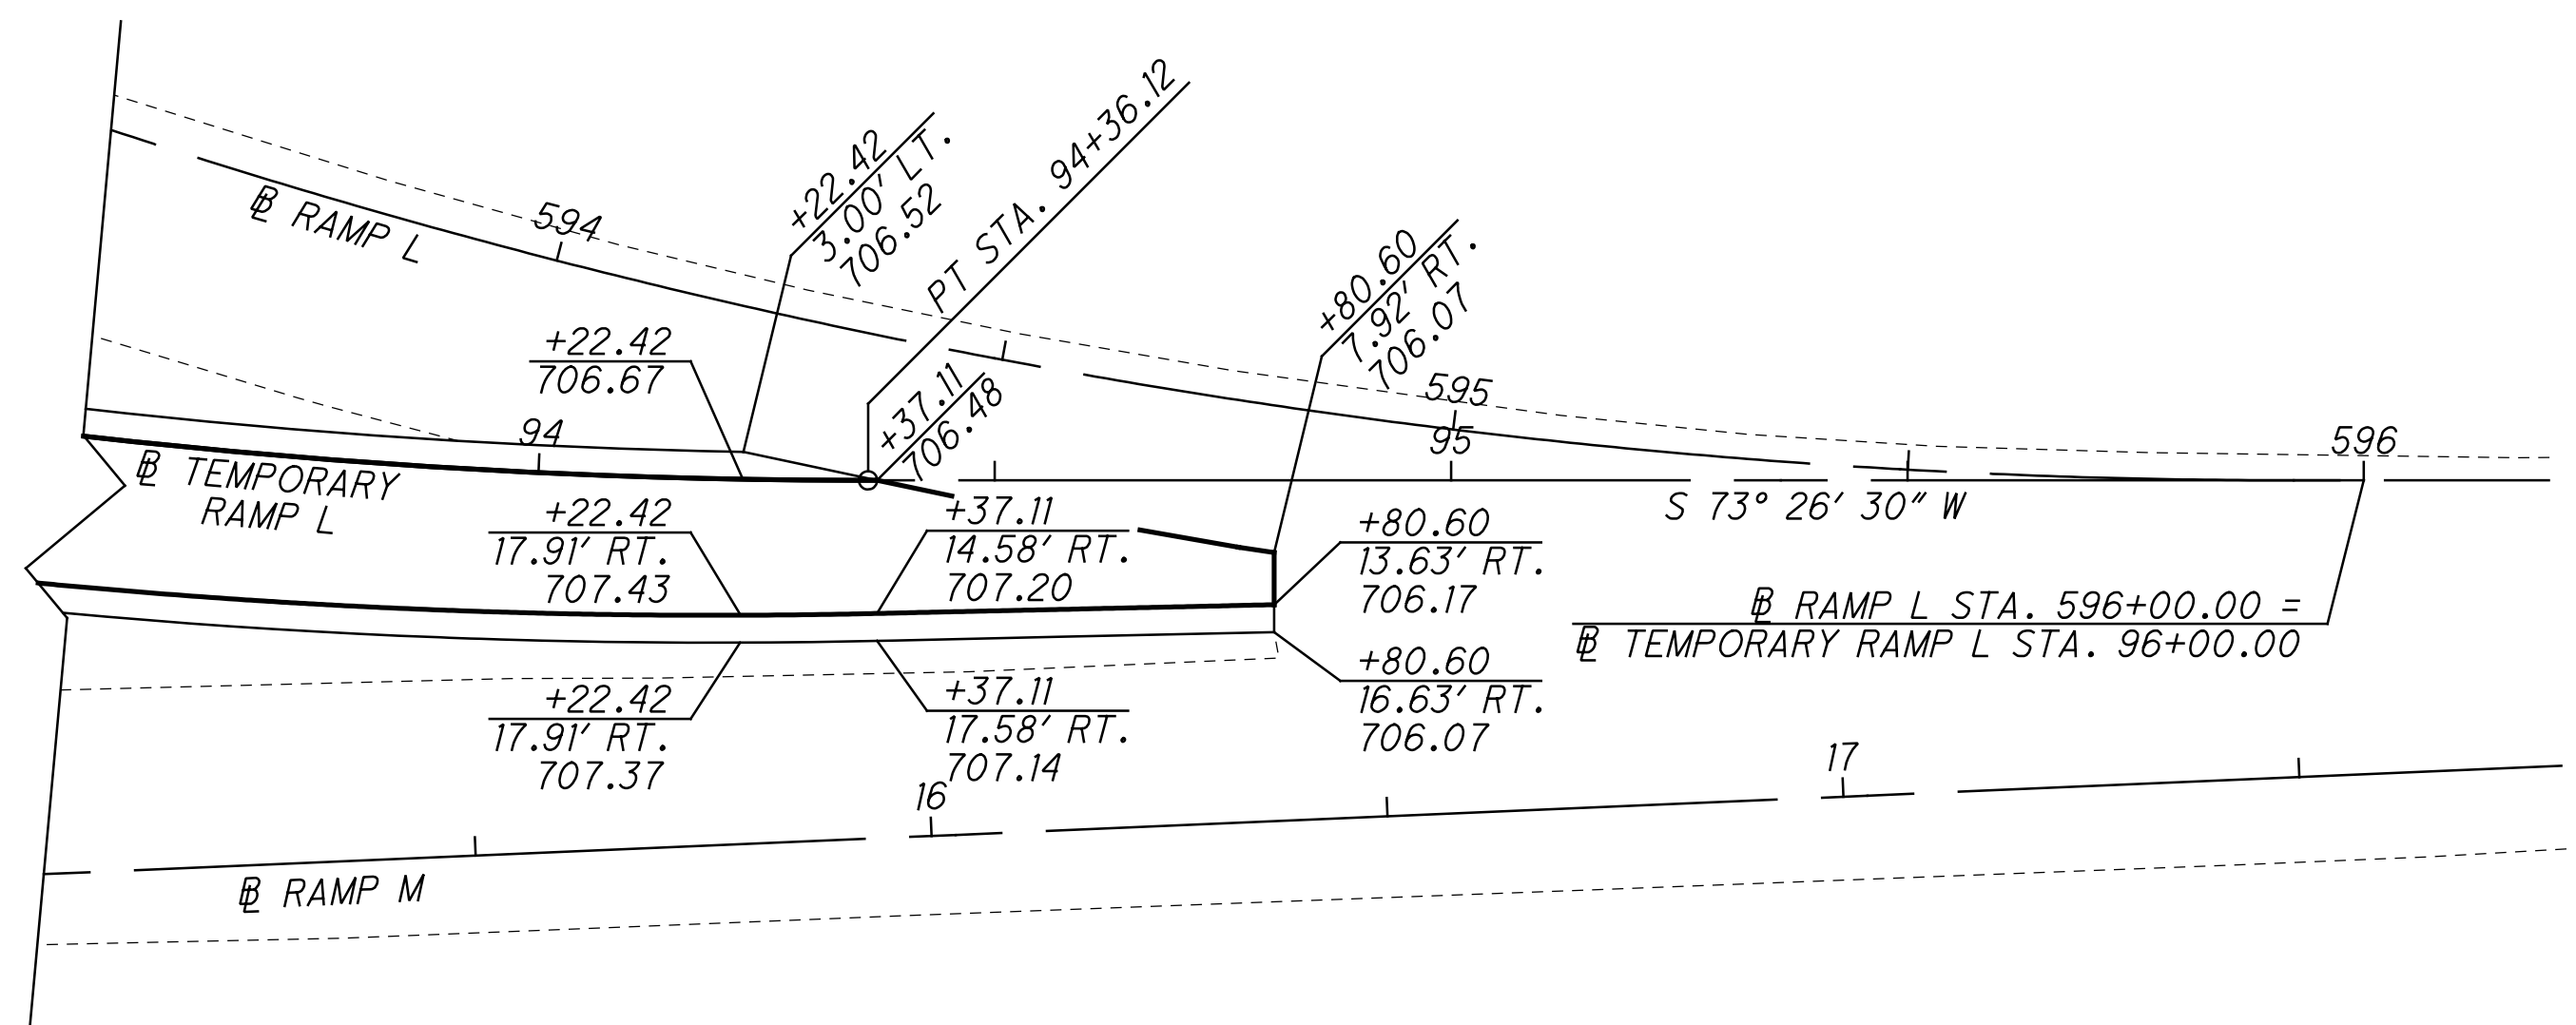

INTERSECTION DETAIL  
TEMPORARY RAMP L AT RAMP L

TYPICAL SECTIONS AND ELEVATIONS TEMPORARY RAMP L

FRA - 270-51.50



TEMPORARY RAMP L  
 CURVE DATA  
 P.I. STA. 92+13.55  
 $\Delta = 34^\circ 27' 50''$  (LT)  
 $D_c = 7^\circ 30' 00''$   
 $R = 763.94'$   
 $T = 236.95'$   
 $L = 459.52'$   
 $E = 35.90'$   
 $C = 452.62'$   
 C.B. = N 89° 19' 35" W



REMOVE 50 LF OF EXISTING  
 GUARDRAIL FROM RAMP M  
 STA. 15+50.00 TO STA. 15+96.00  
 AND SPLICE PROPOSED TEMPORARY  
 GUARDRAIL INTO EXISTING GUARDRAIL

REMOVE 150 LF OF EXISTING  
 GUARDRAIL FROM RAMP L  
 STA. 593+00.00 TO STA. 594+47.00

QUANTITIES ARE FOR INFORMATION ONLY.  
 THE FOLLOWING ITEMS ARE TO BE INCLUDED  
 IN THE BID PRICE FOR ITEM 615 - ROADS  
 FOR MAINTAINING TRAFFIC

ESTIMATED QUANTITIES	
PIPE REMOVED	20 FT
SEEDING AND MULCHING	2267 SY
ROCK CHANNEL PROTECTION, TYPE C WITH FILTER	18 CY
CONCRETE MASONRY	0.86 CY
15" CONDUIT, TYPE B	60 FT
18" CONDUIT, TYPE A	62 FT
18" CONDUIT, TYPE C	104 FT
CATCH BASIN, NO. 2-3	1 EACH
MANHOLE, NO. 3	1 EACH
EXCAVATION	140 CY
EMBANKMENT	4676 CY
GUARDRAIL, TYPE MGS	582 FT
ANCHOR ASSEMBLY, TYPE E	2 EACH
ANCHOR ASSEMBLY, TYPE T	1 EACH

ADDENDUM #1  
 04/21/2023

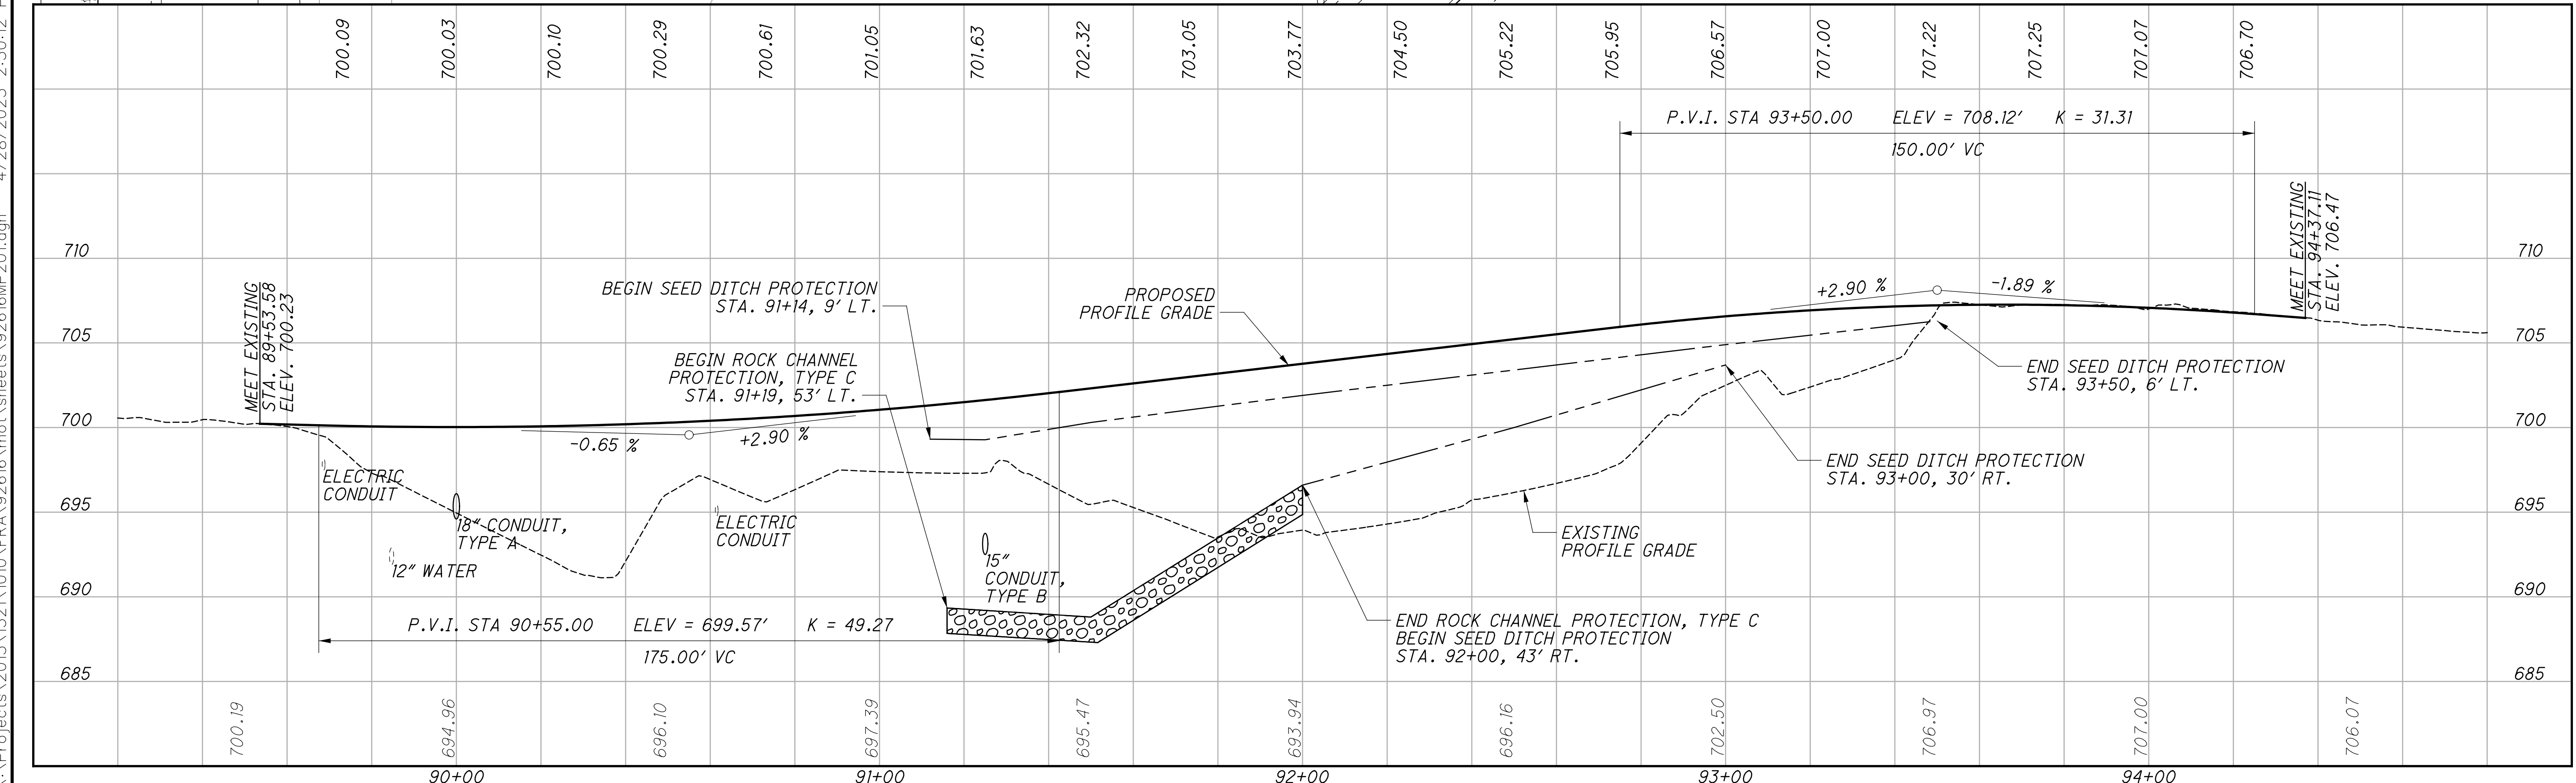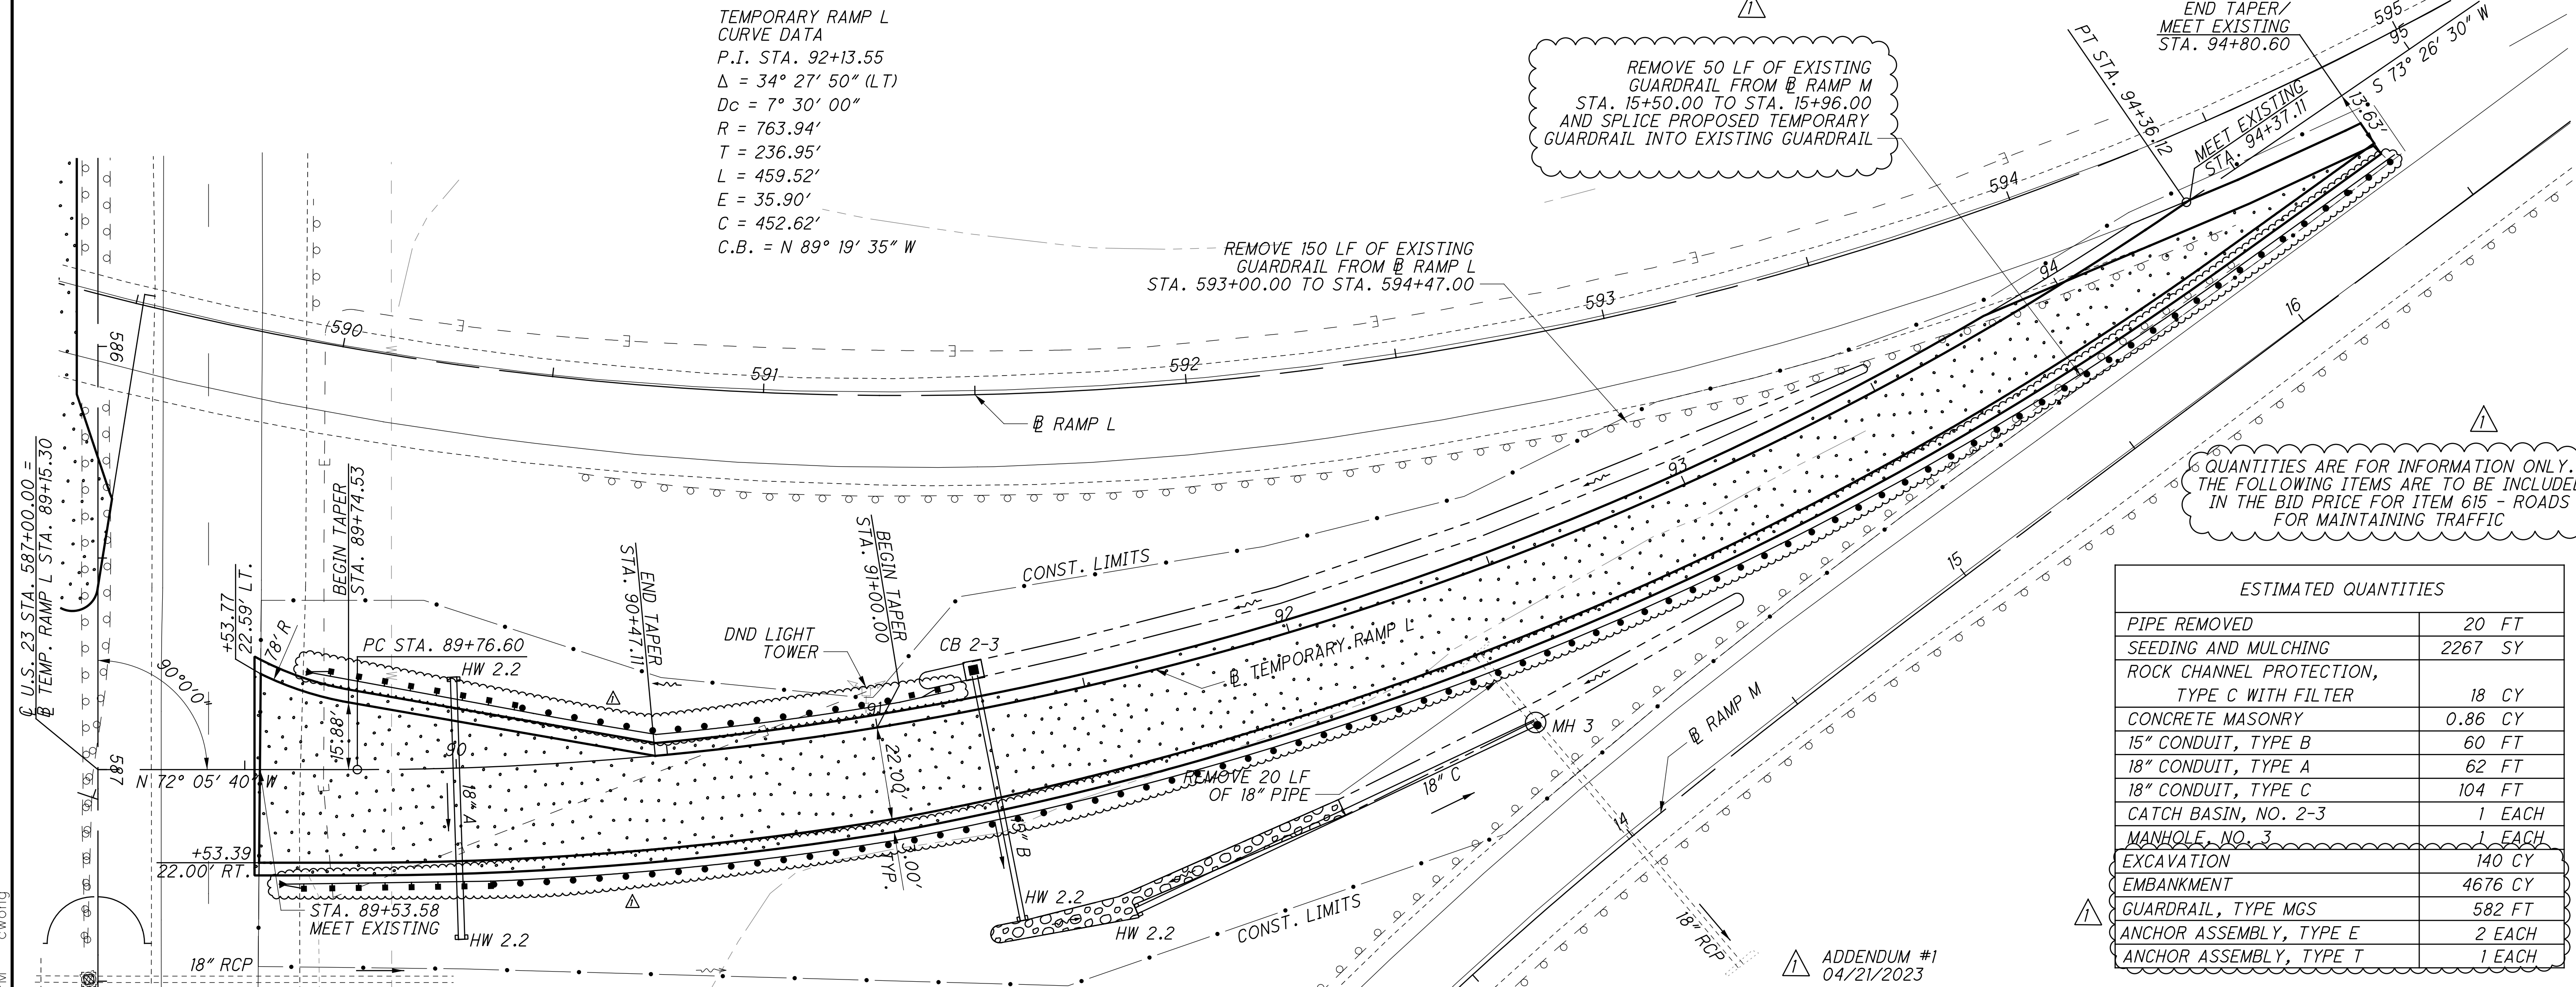


PLAN AND PROFILE TEMPORARY RAMP L  
 STA. 89+15.30 TO STA. 95+00.00  
 FRA - 270-51.50  
 38  
 554

X:\Projects\2013\1010\FRA\2616\MP201.dgn 4/28/2023 2:50:12 PM cwong

x:\Projects\2013\1321\1010\FRA\92616\mot\sheet\92616XM201.dgn 4/18/2023 3:26:34 PM cwong

SEEDING  
END SQ.  
WIDTH YDS.

END AREA VOLUME  
CUT FILL CUT FILL  
CALCULATED  
D.J.R. CHECKED  
R.C.H.

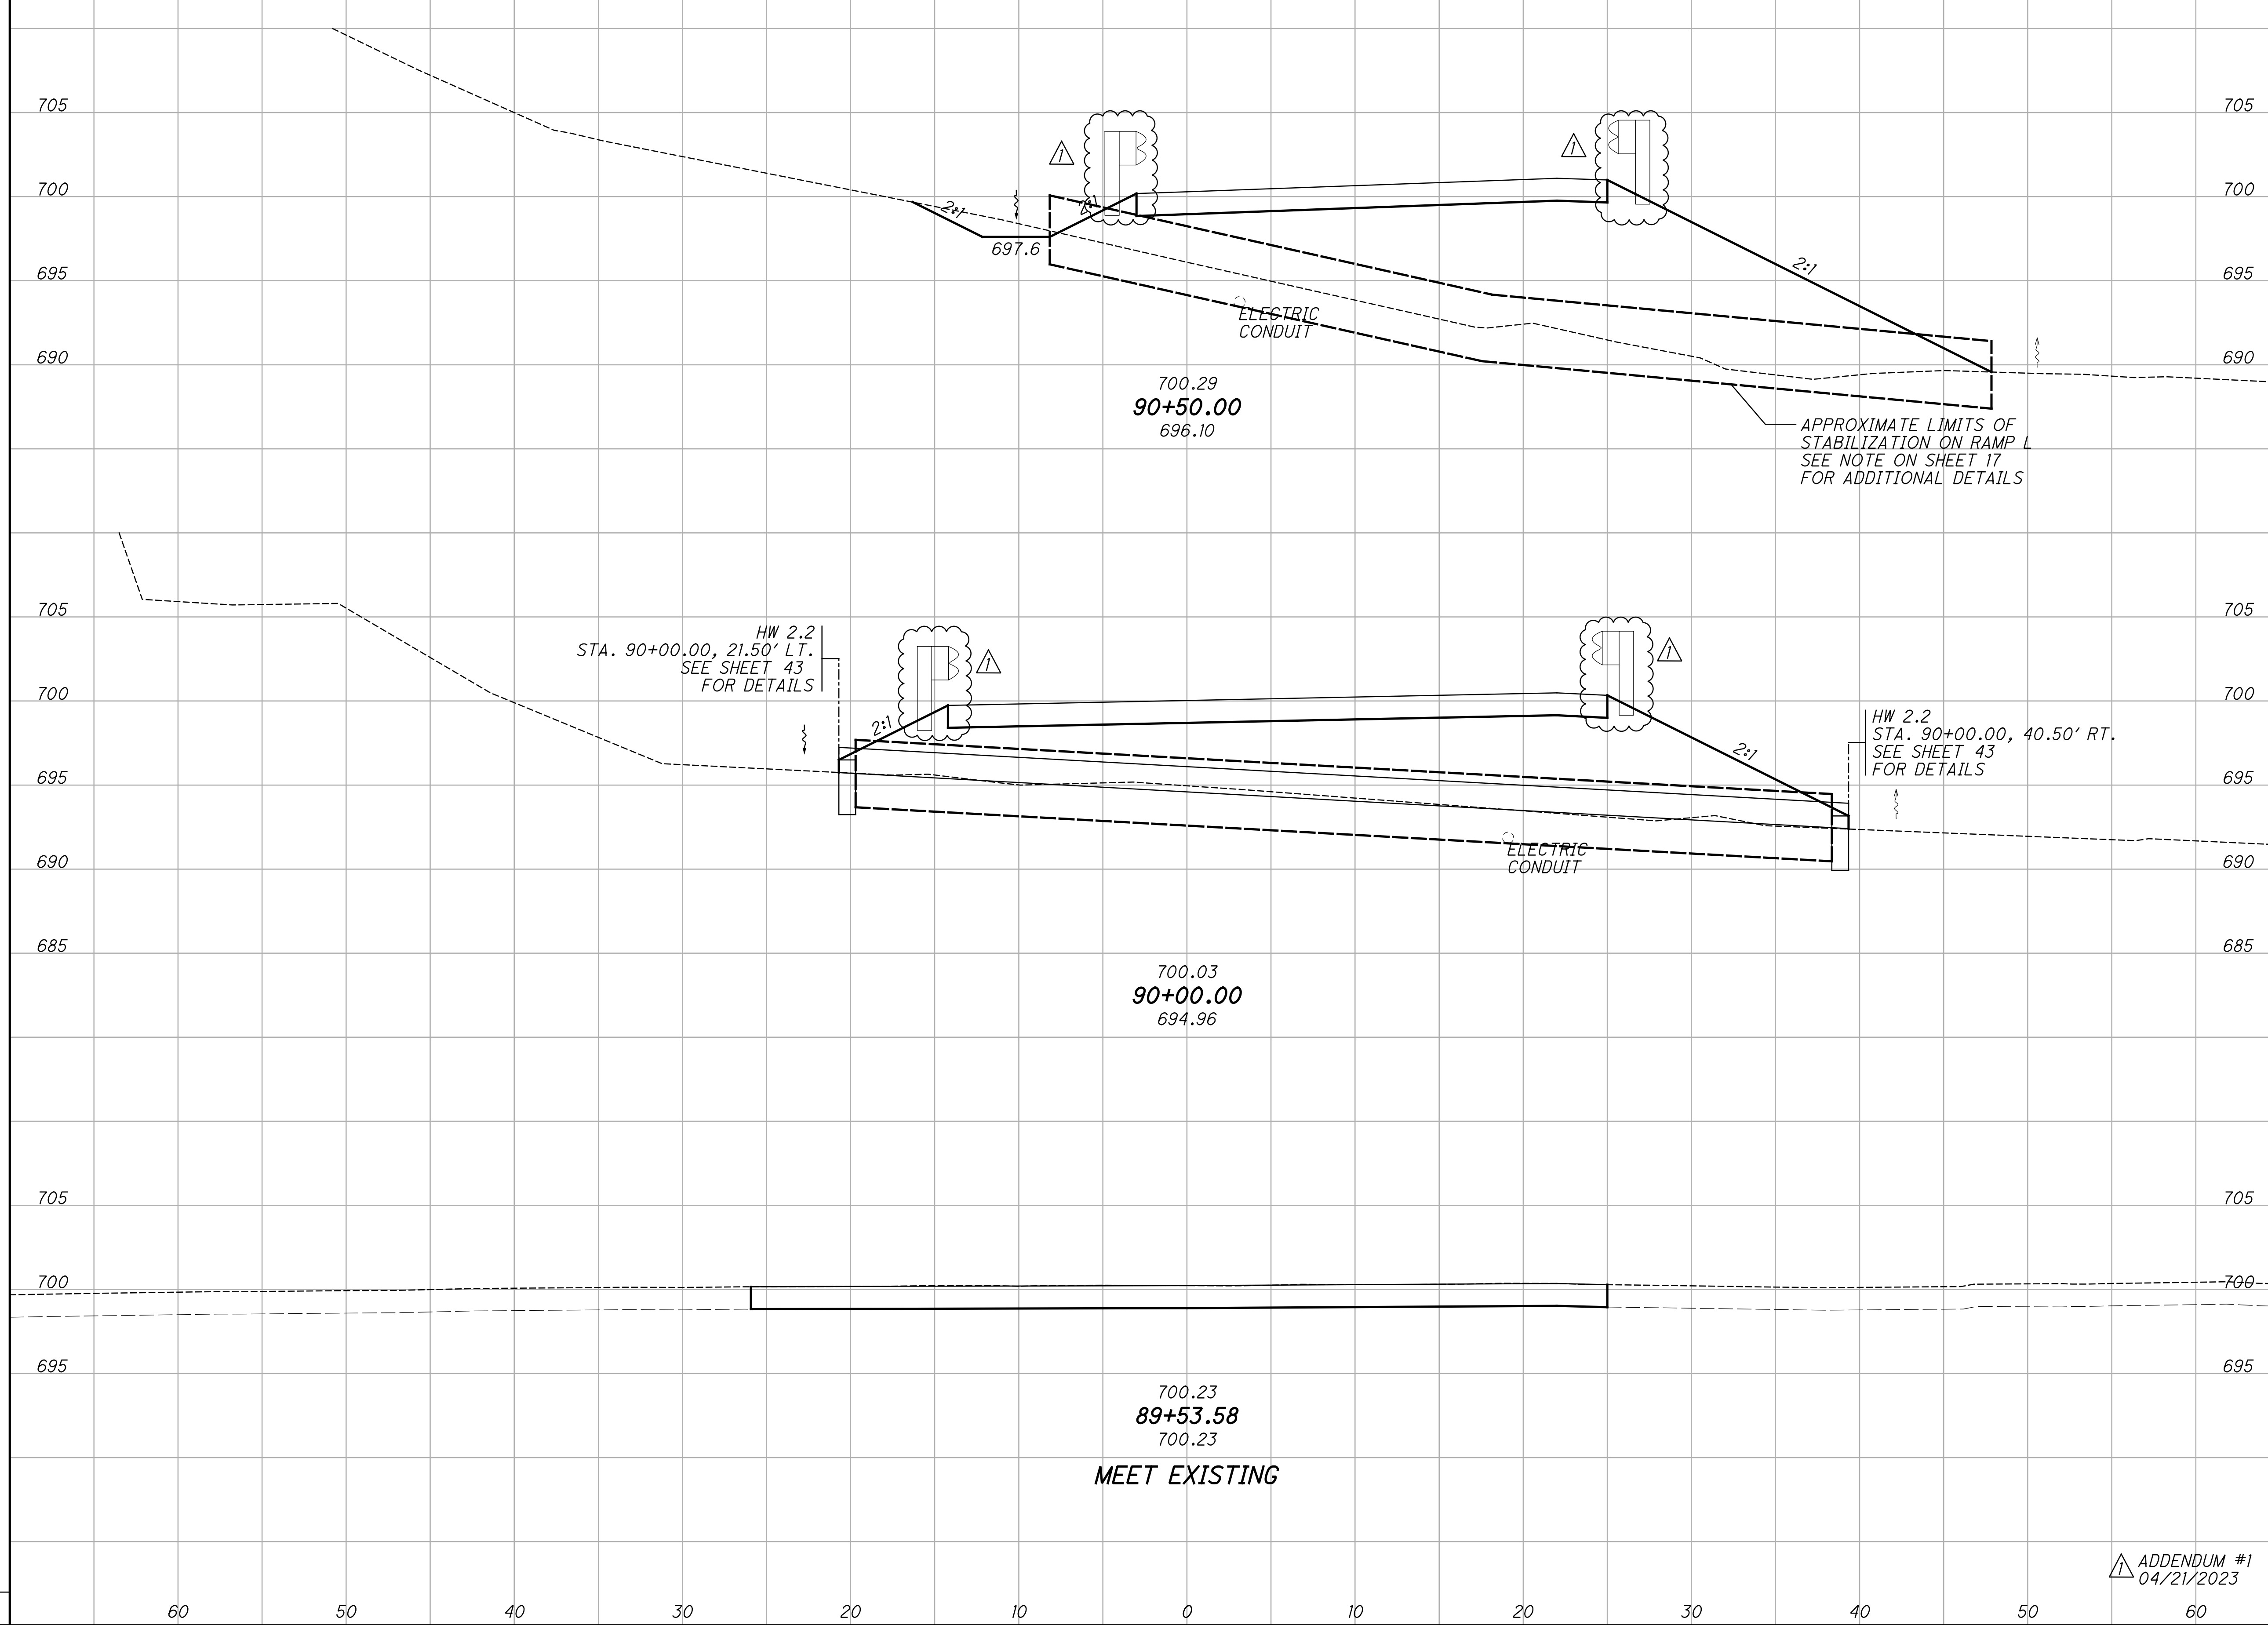

END AREA	VOLUME		CALCULATED	D.J.R. CHECKED	R.C.H.
	CUT	FILL			
6	286				
6	490				
0	243				
6	490				

CROSS SECTIONS TEMPORARY RAMP L  
STA. 89+53.58 TO STA. 90+50.00

FRA - 270 - 51.50

ADDENDUM #1  
04/21/2023


39  
554



X:\Projects\2013\1321\1010\FRA\92616\mot\sheets\92616XM201.dgn 4/18/2023 3:30:35 PM cwong

SEEDING	
END WIDTH	SO. YDS.

END AREA		VOLUME		CALCULATED		CHECKED	
CUT	FILL	CUT	FILL	DJR	RCH	DJR	RCH
0	645	17	1044				
18	482	17	785				
0	365	6	603				
		40	2432				

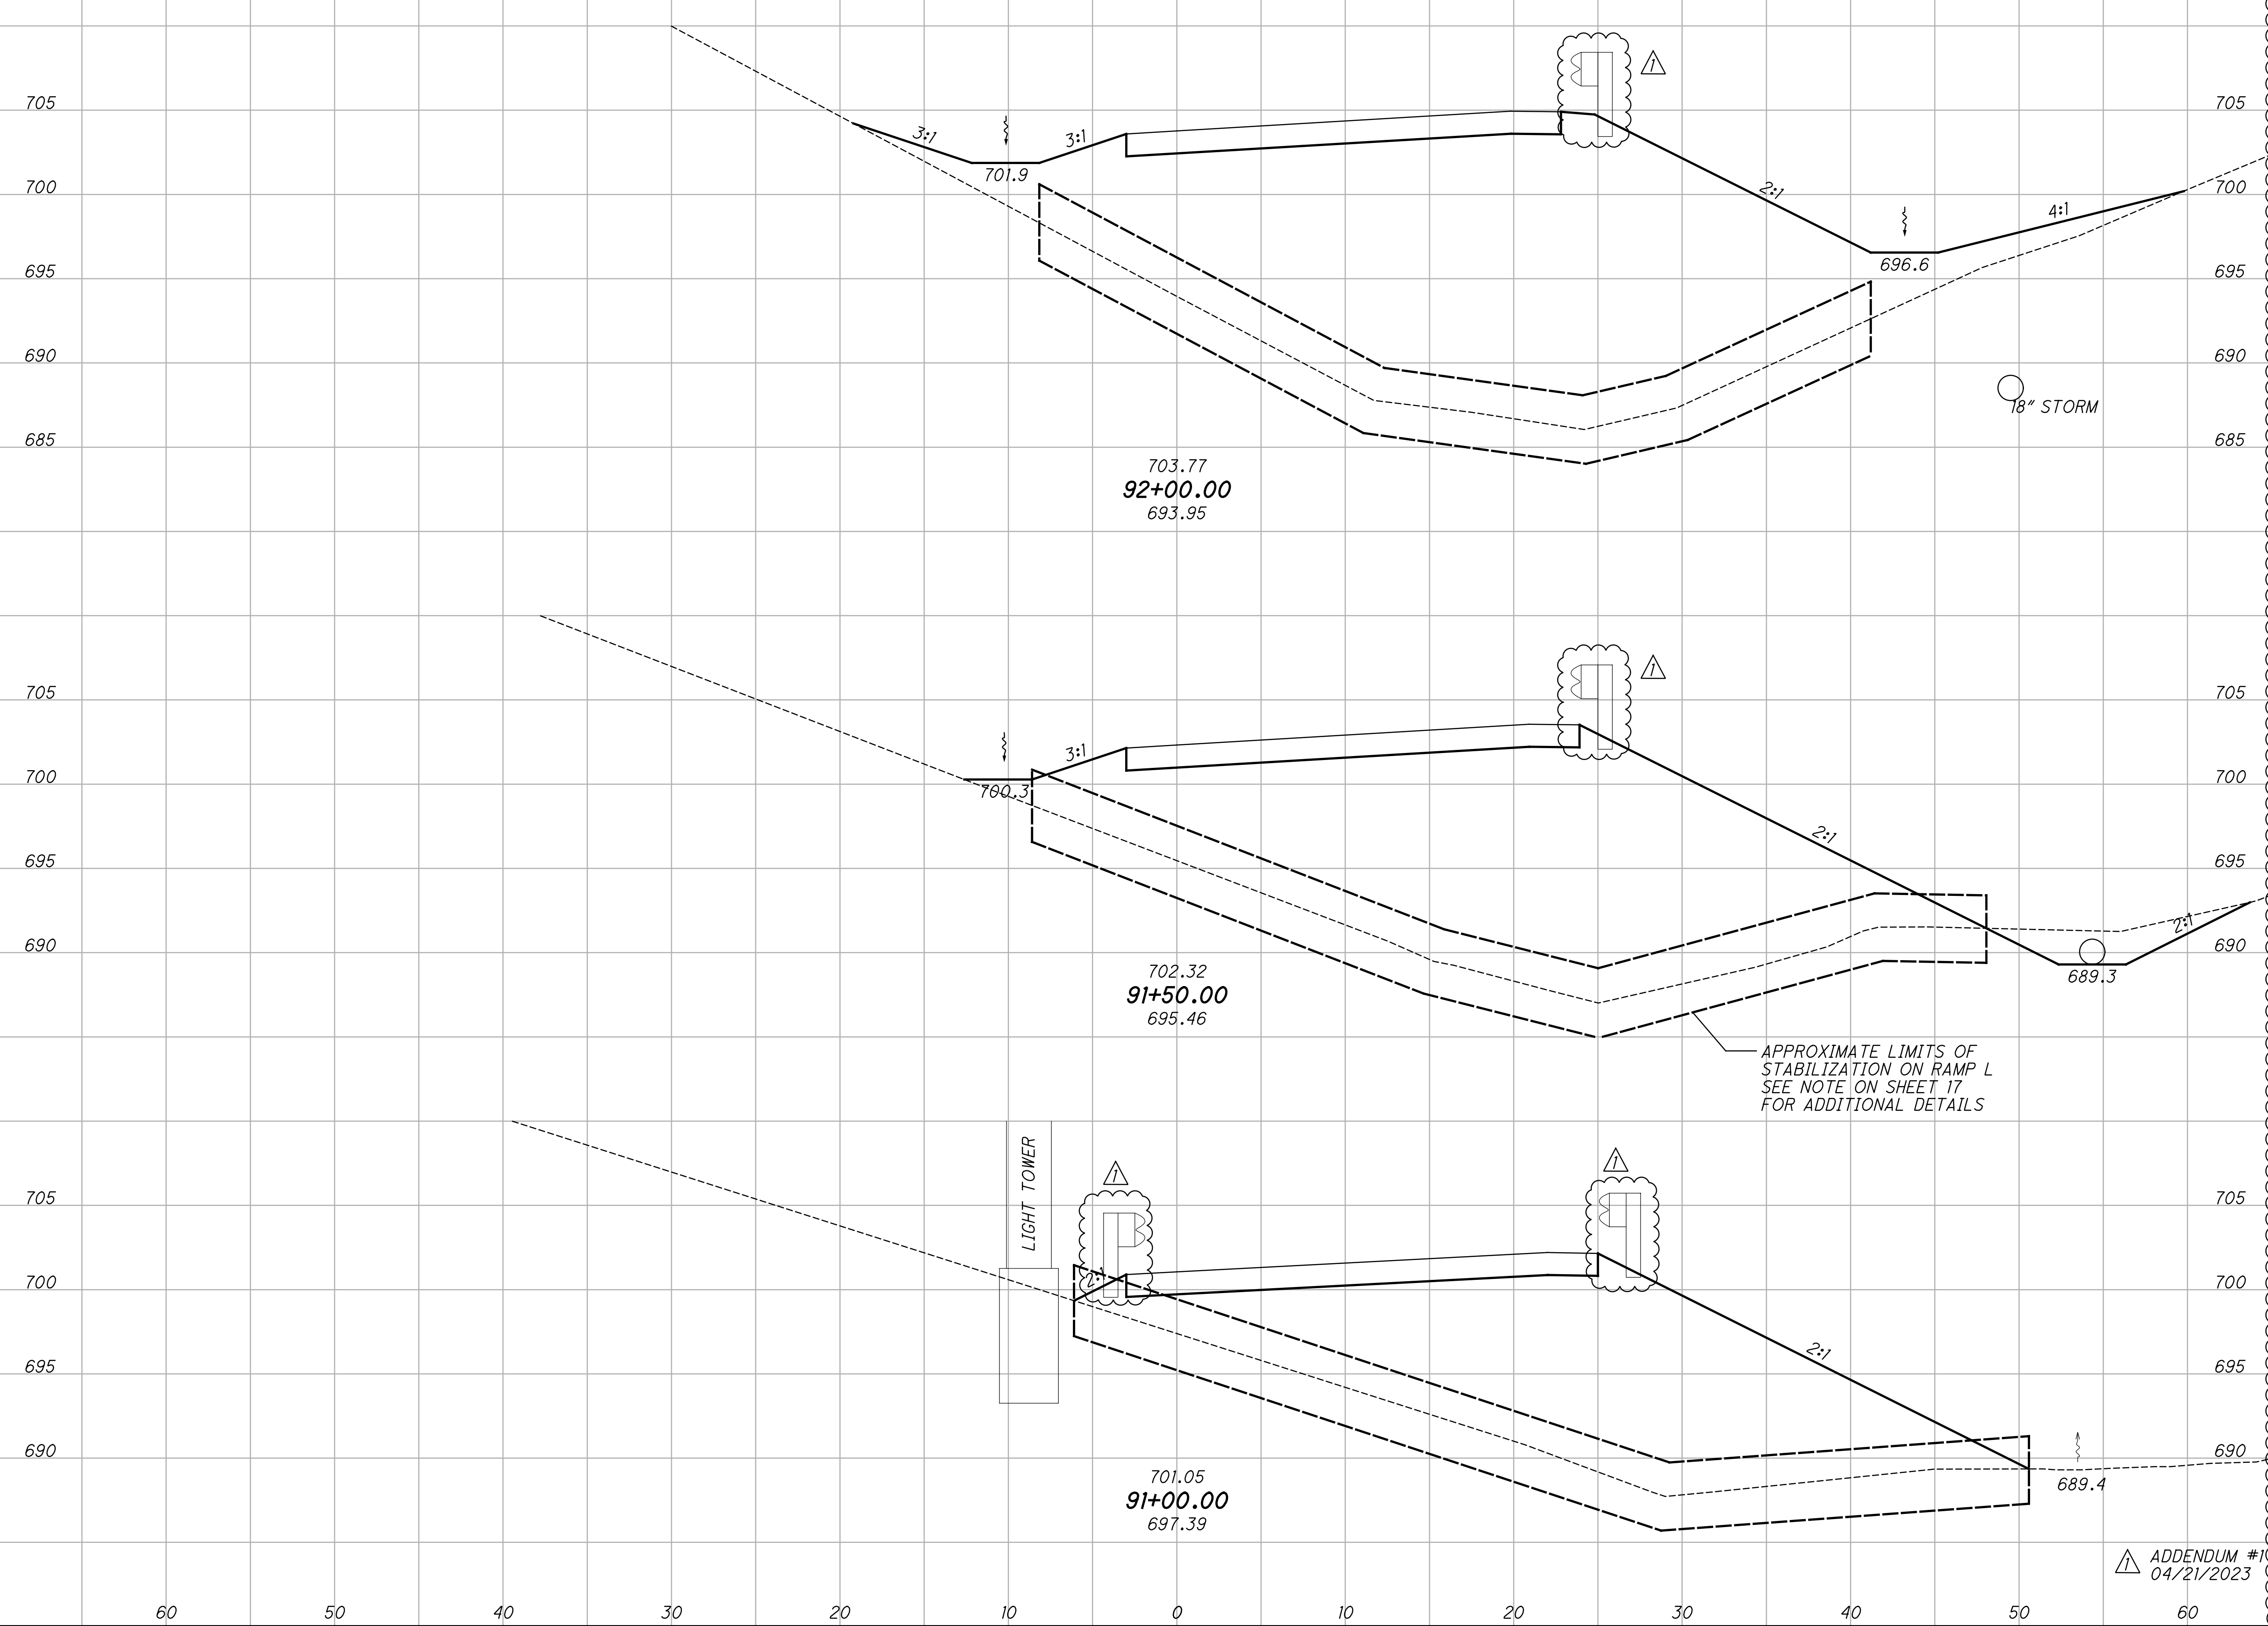

APPROXIMATE LIMITS OF STABILIZATION ON RAMP L  
SEE NOTE ON SHEET 17  
FOR ADDITIONAL DETAILS

ADDENDUM #1  
04/21/2023


**CROSS SECTIONS TEMPORARY RAMP L**  
**STA. 91+00.00 TO STA. 92+00.00**

**FRA - 270-51.50**

40  
554

X:\Projects\2013\1321\1010\FRA\92616\mot\sheet\92616XM201.dgn 4/18/2023 3:31:42 PM cwong

SEEDING  
END SQ.  
WIDTH YDS.

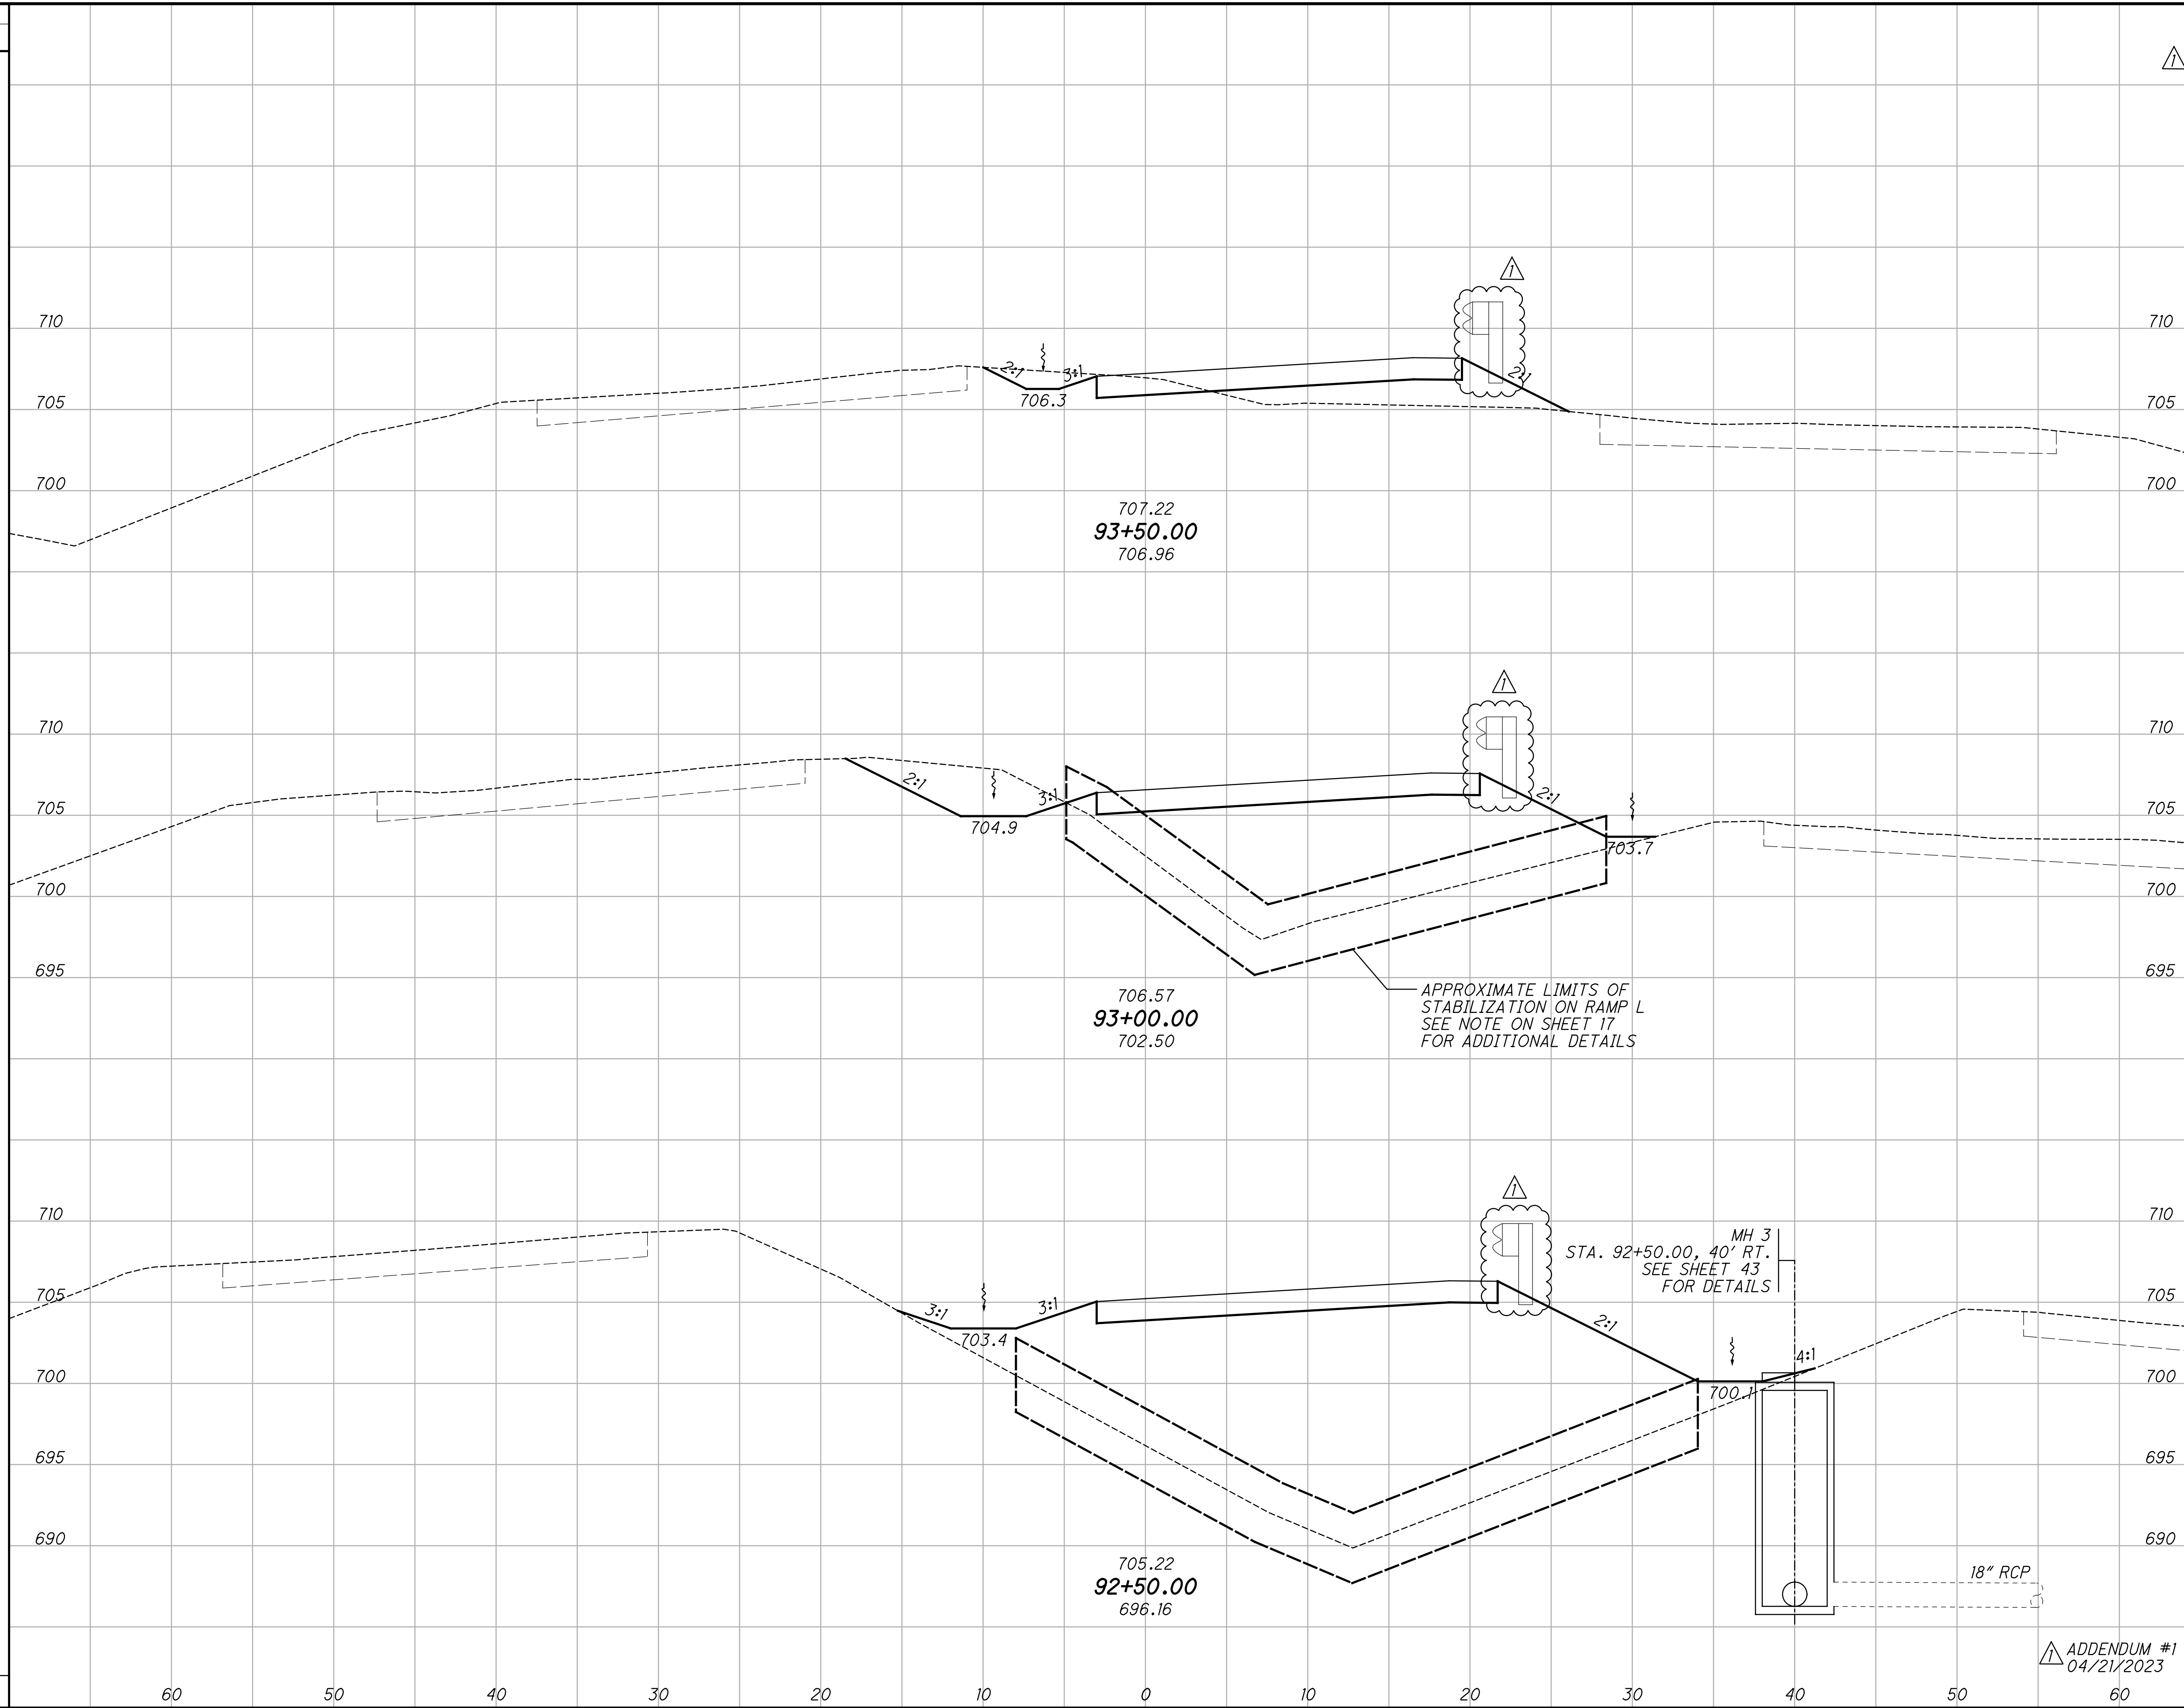

END AREA	VOLUME	
	CUT	FILL
11	28	
25	167	
0	418	
58	1708	

CROSS SECTIONS TEMPORARY RAMP L  
 STA. 92+50.00 TO STA. 93+50.00

FRA-270-51.50


41  
554

ADDENDUM #1  
04/21/2023

X:\Projects\2013\1321\1010\FRA\92616\mot\sheets\92616XM201.dgn 4/18/2023 3:32:35 PM cwong

SEEDING	
END WIDTH	SO. YDS.

END AREA		VOLUME		CALCULATED		CHECKED	
CUT	FILL	CUT	FILL	DUR	RCH	DUR	RCH

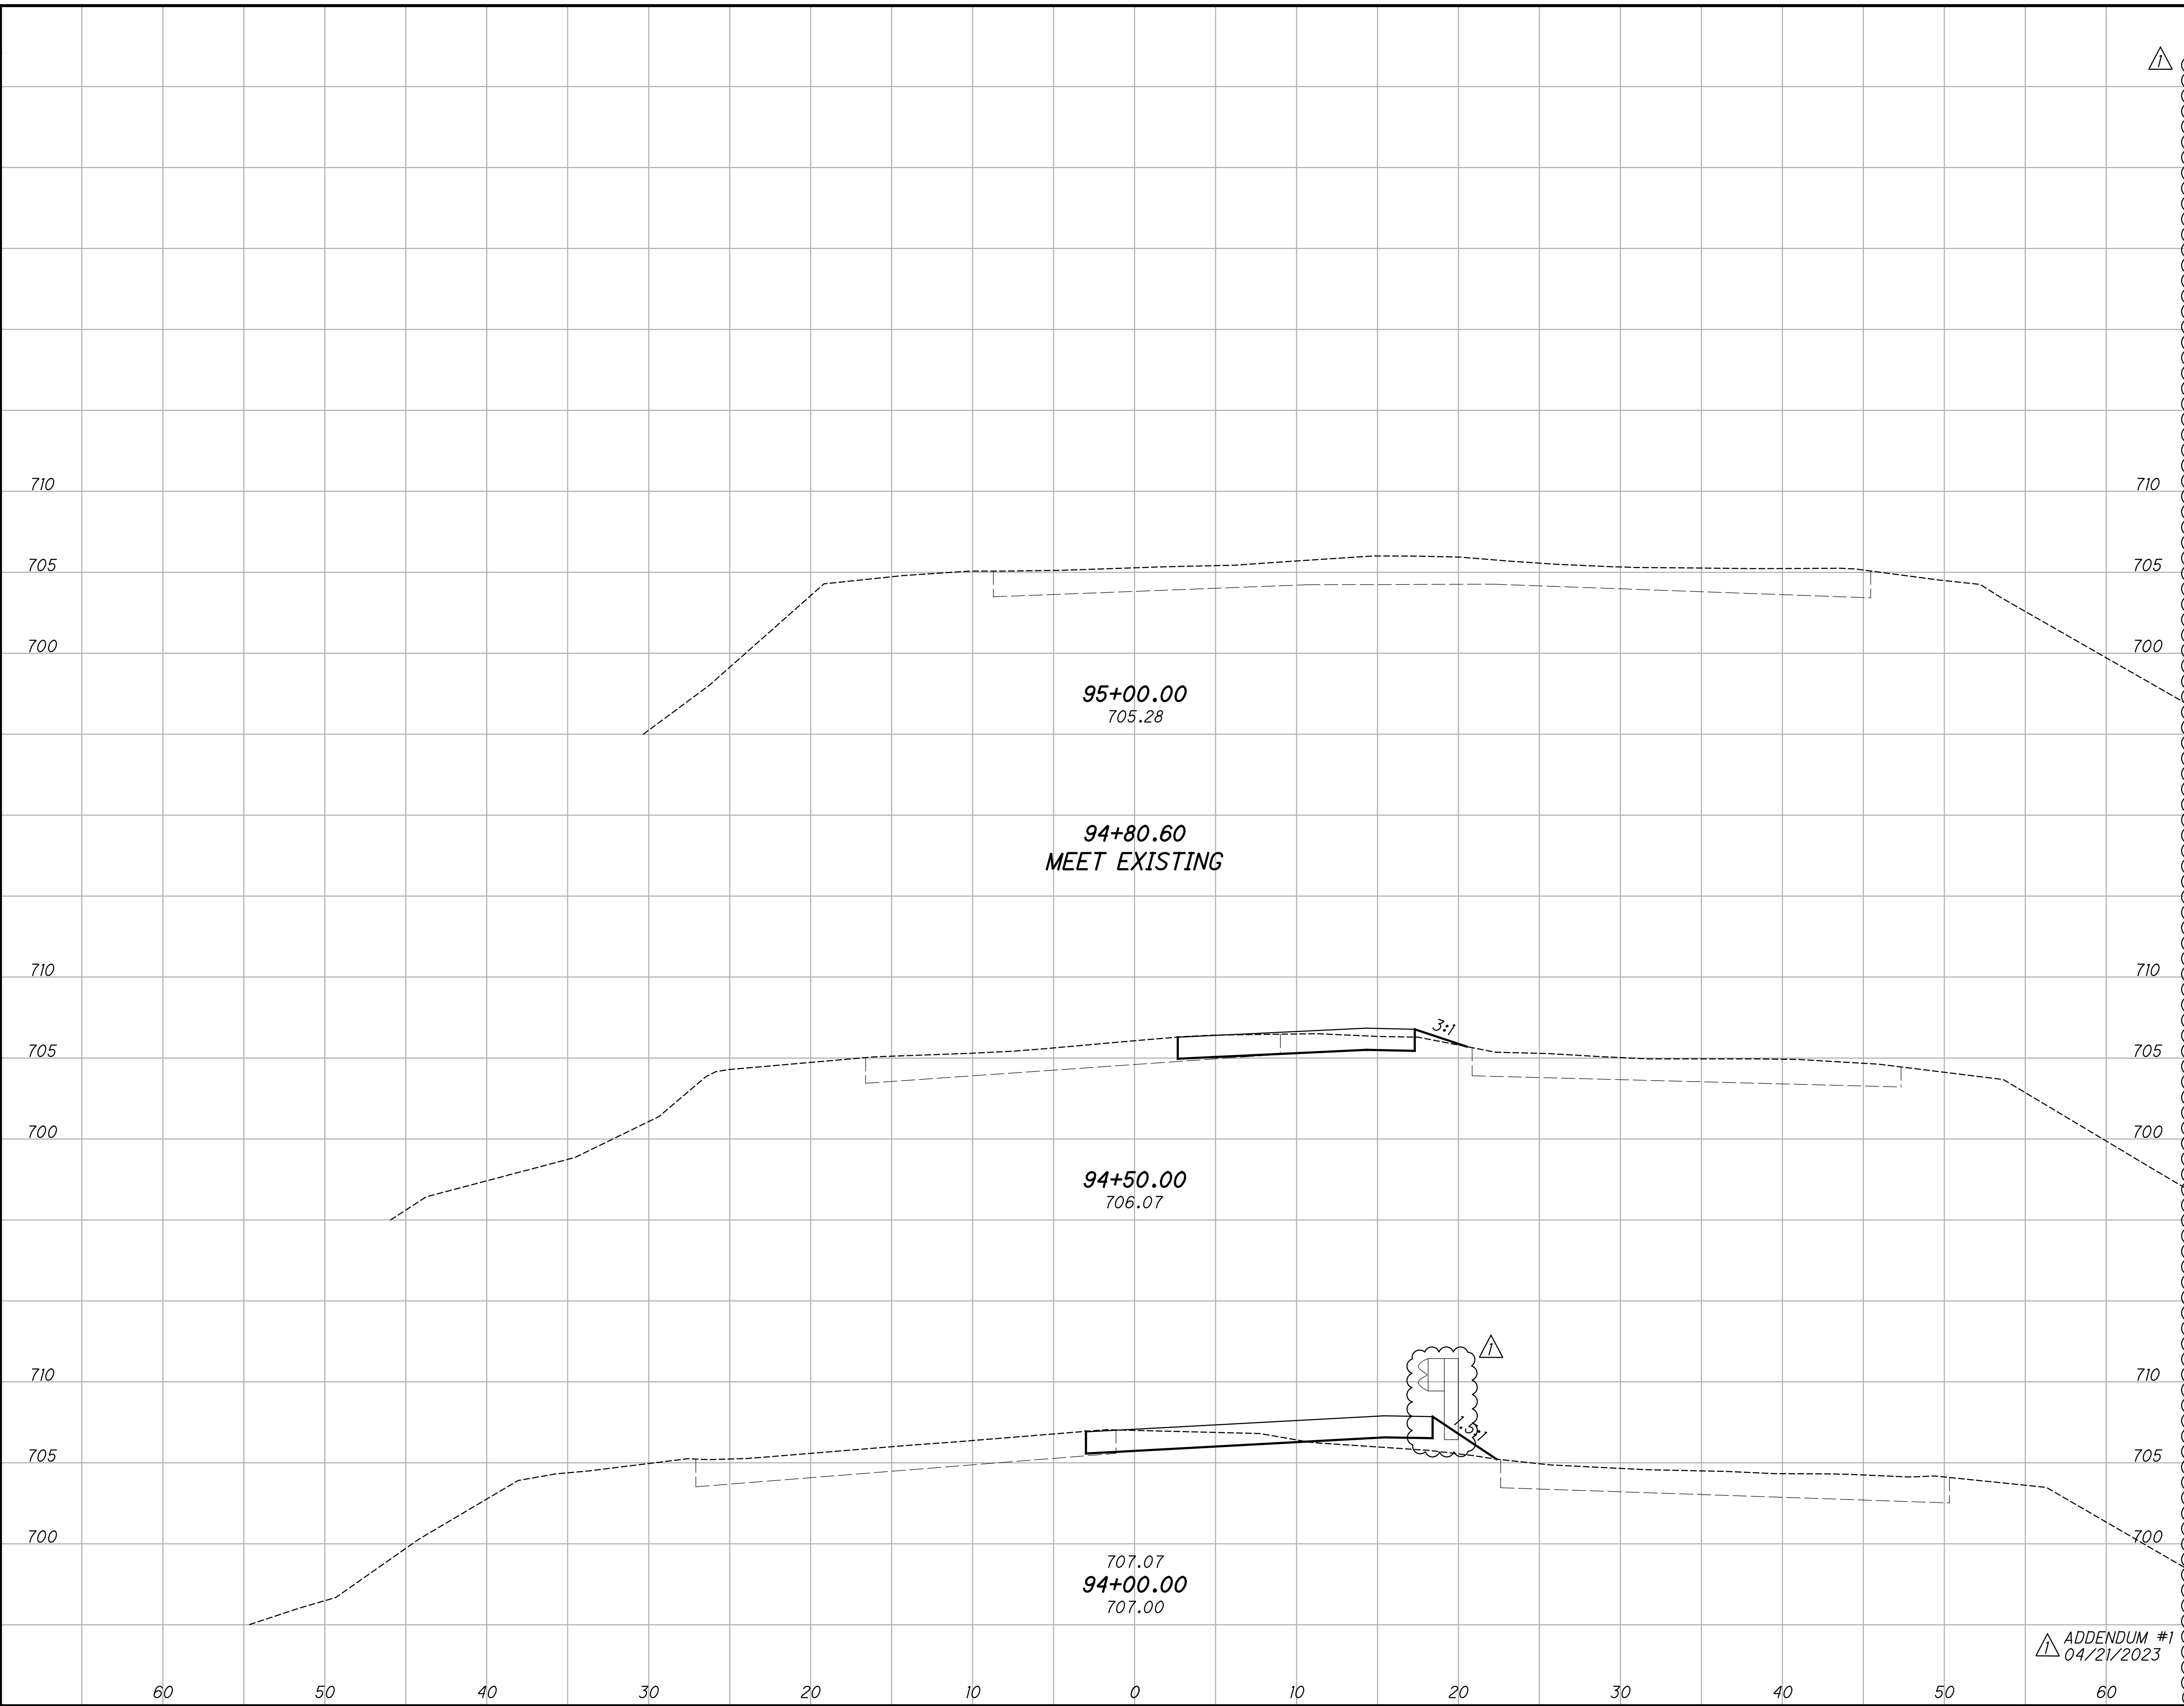

**CROSS SECTIONS TEMPORARY RAMP L**  
**STA. 94+00.00 TO STA. 95+00.00**

**FRA-270-51.50**


ADDENDUM #1  
 04/21/2023

42  
 554

0	4
13	12
13	8
23	34
36	46




X:\Projects\2013\132\1010\FRA\92616\mot\sheets\92616MP401.dgn 4/21/2023 4:35:09 PM cwong



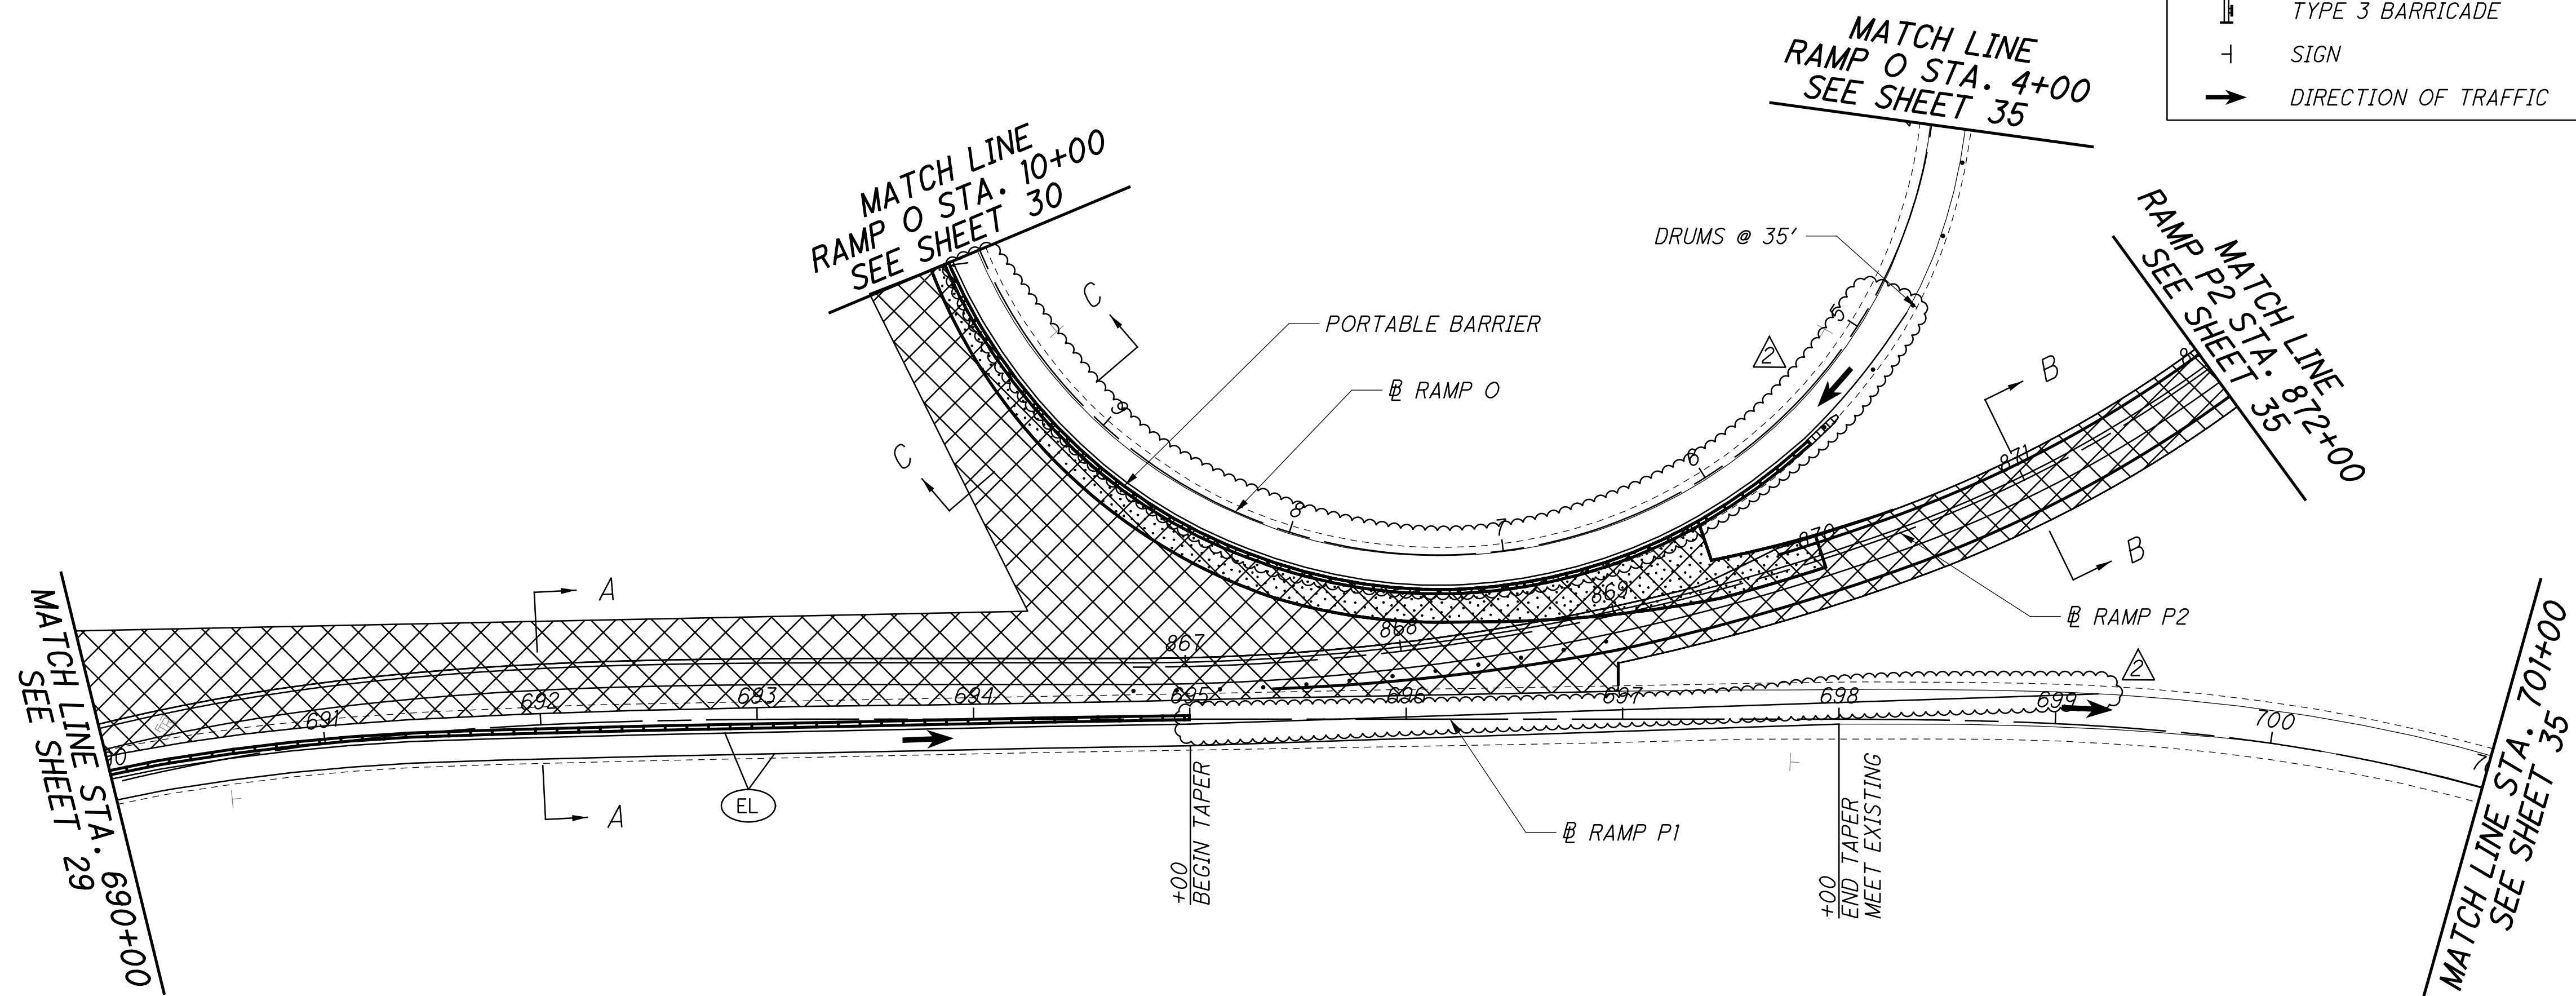


**LEGEND**

WORK ZONE	EDGE LINE
PAVEMENT FOR MAINTAINING TRAFFIC	LANE LINE
32" PORTABLE BARRIER	CHANNELIZING LINE
DRUMS	TRANSVERSE LINE
IMPACT ATTENUATOR	DOTTED LINE
TYPE 3 BARRICADE	STOP LINE
SIGN	LANE ARROW
DIRECTION OF TRAFFIC	WORD ON PAVEMENT

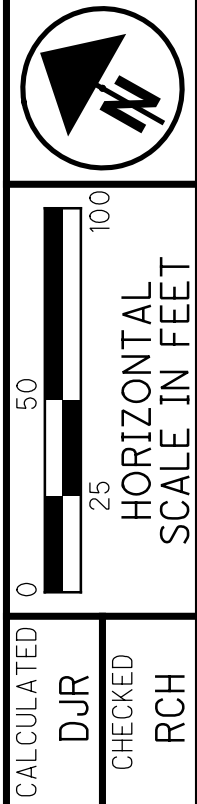

**MAINTENANCE OF TRAFFIC - PHASE 1**  
**RAMP P1 STA. 690+00 TO STA. 701+00**

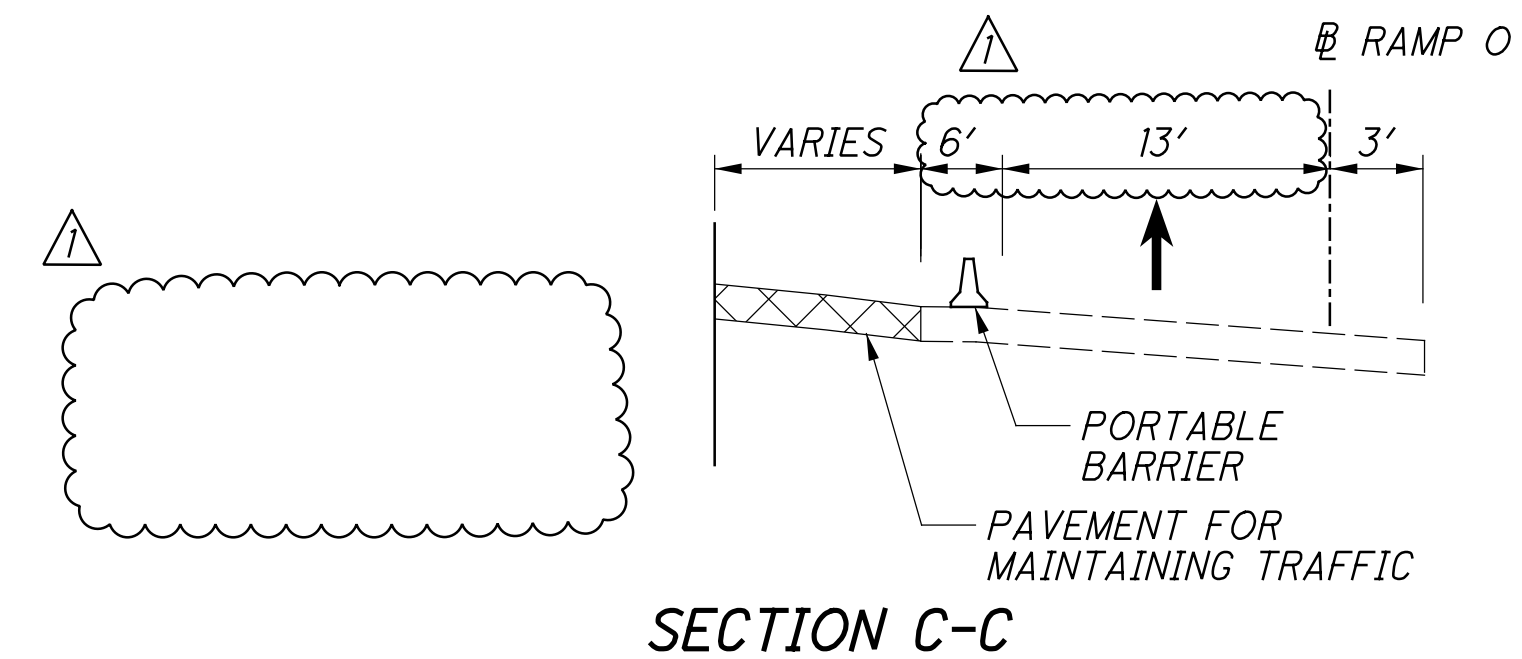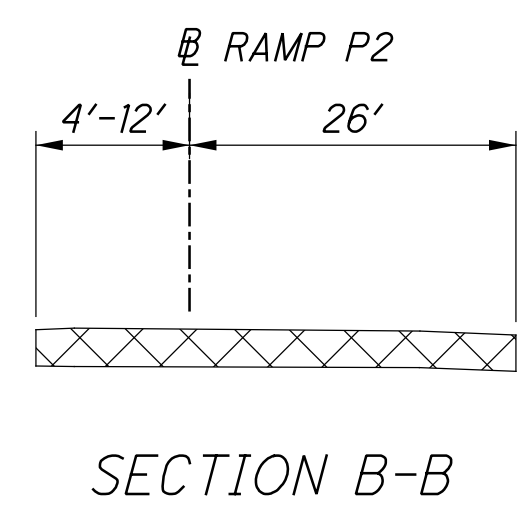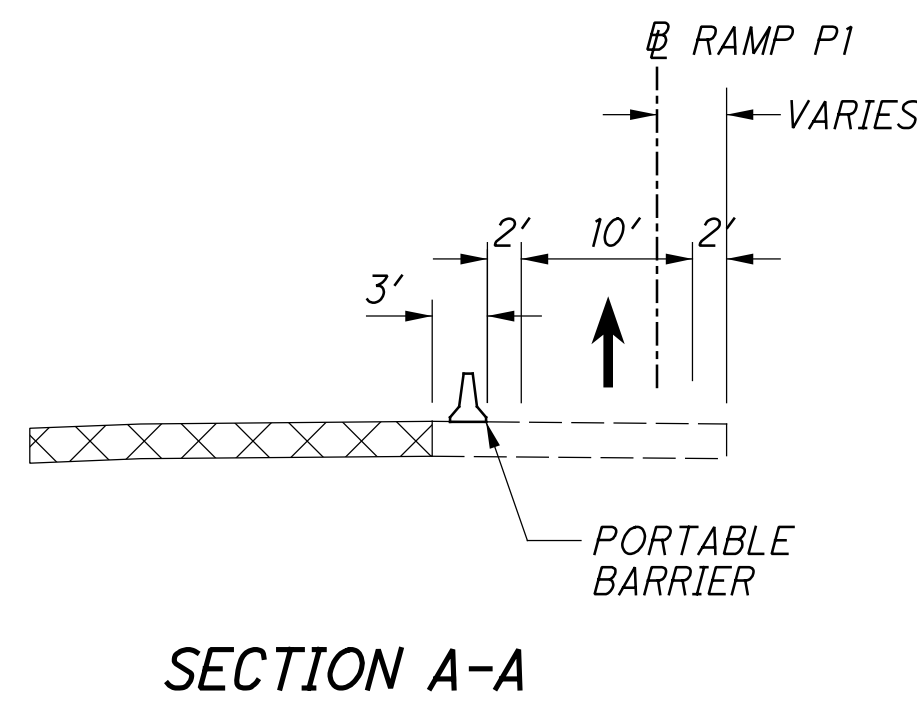


ADDENDUM #1  
04/21/2023

**FRA - 270-51.50**

X:\Projects\2013\1010\FRA\92616\mot\sheets\92616MPO25.dgn 4/19/2023 6:18:30 AM cwong

LEGEND			
	WORK ZONE		EDGE LINE
	PAVEMENT FOR MAINTAINING TRAFFIC		LANE LINE
	32" PORTABLE BARRIER		CHANNELIZING LINE
	DRUMS		TRANSVERSE LINE
	IMPACT ATTENUATOR		DOTTED LINE
	TYPE 3 BARRICADE		STOP LINE
	SIGN		LANE ARROW
	DIRECTION OF TRAFFIC		WORD ON PAVEMENT

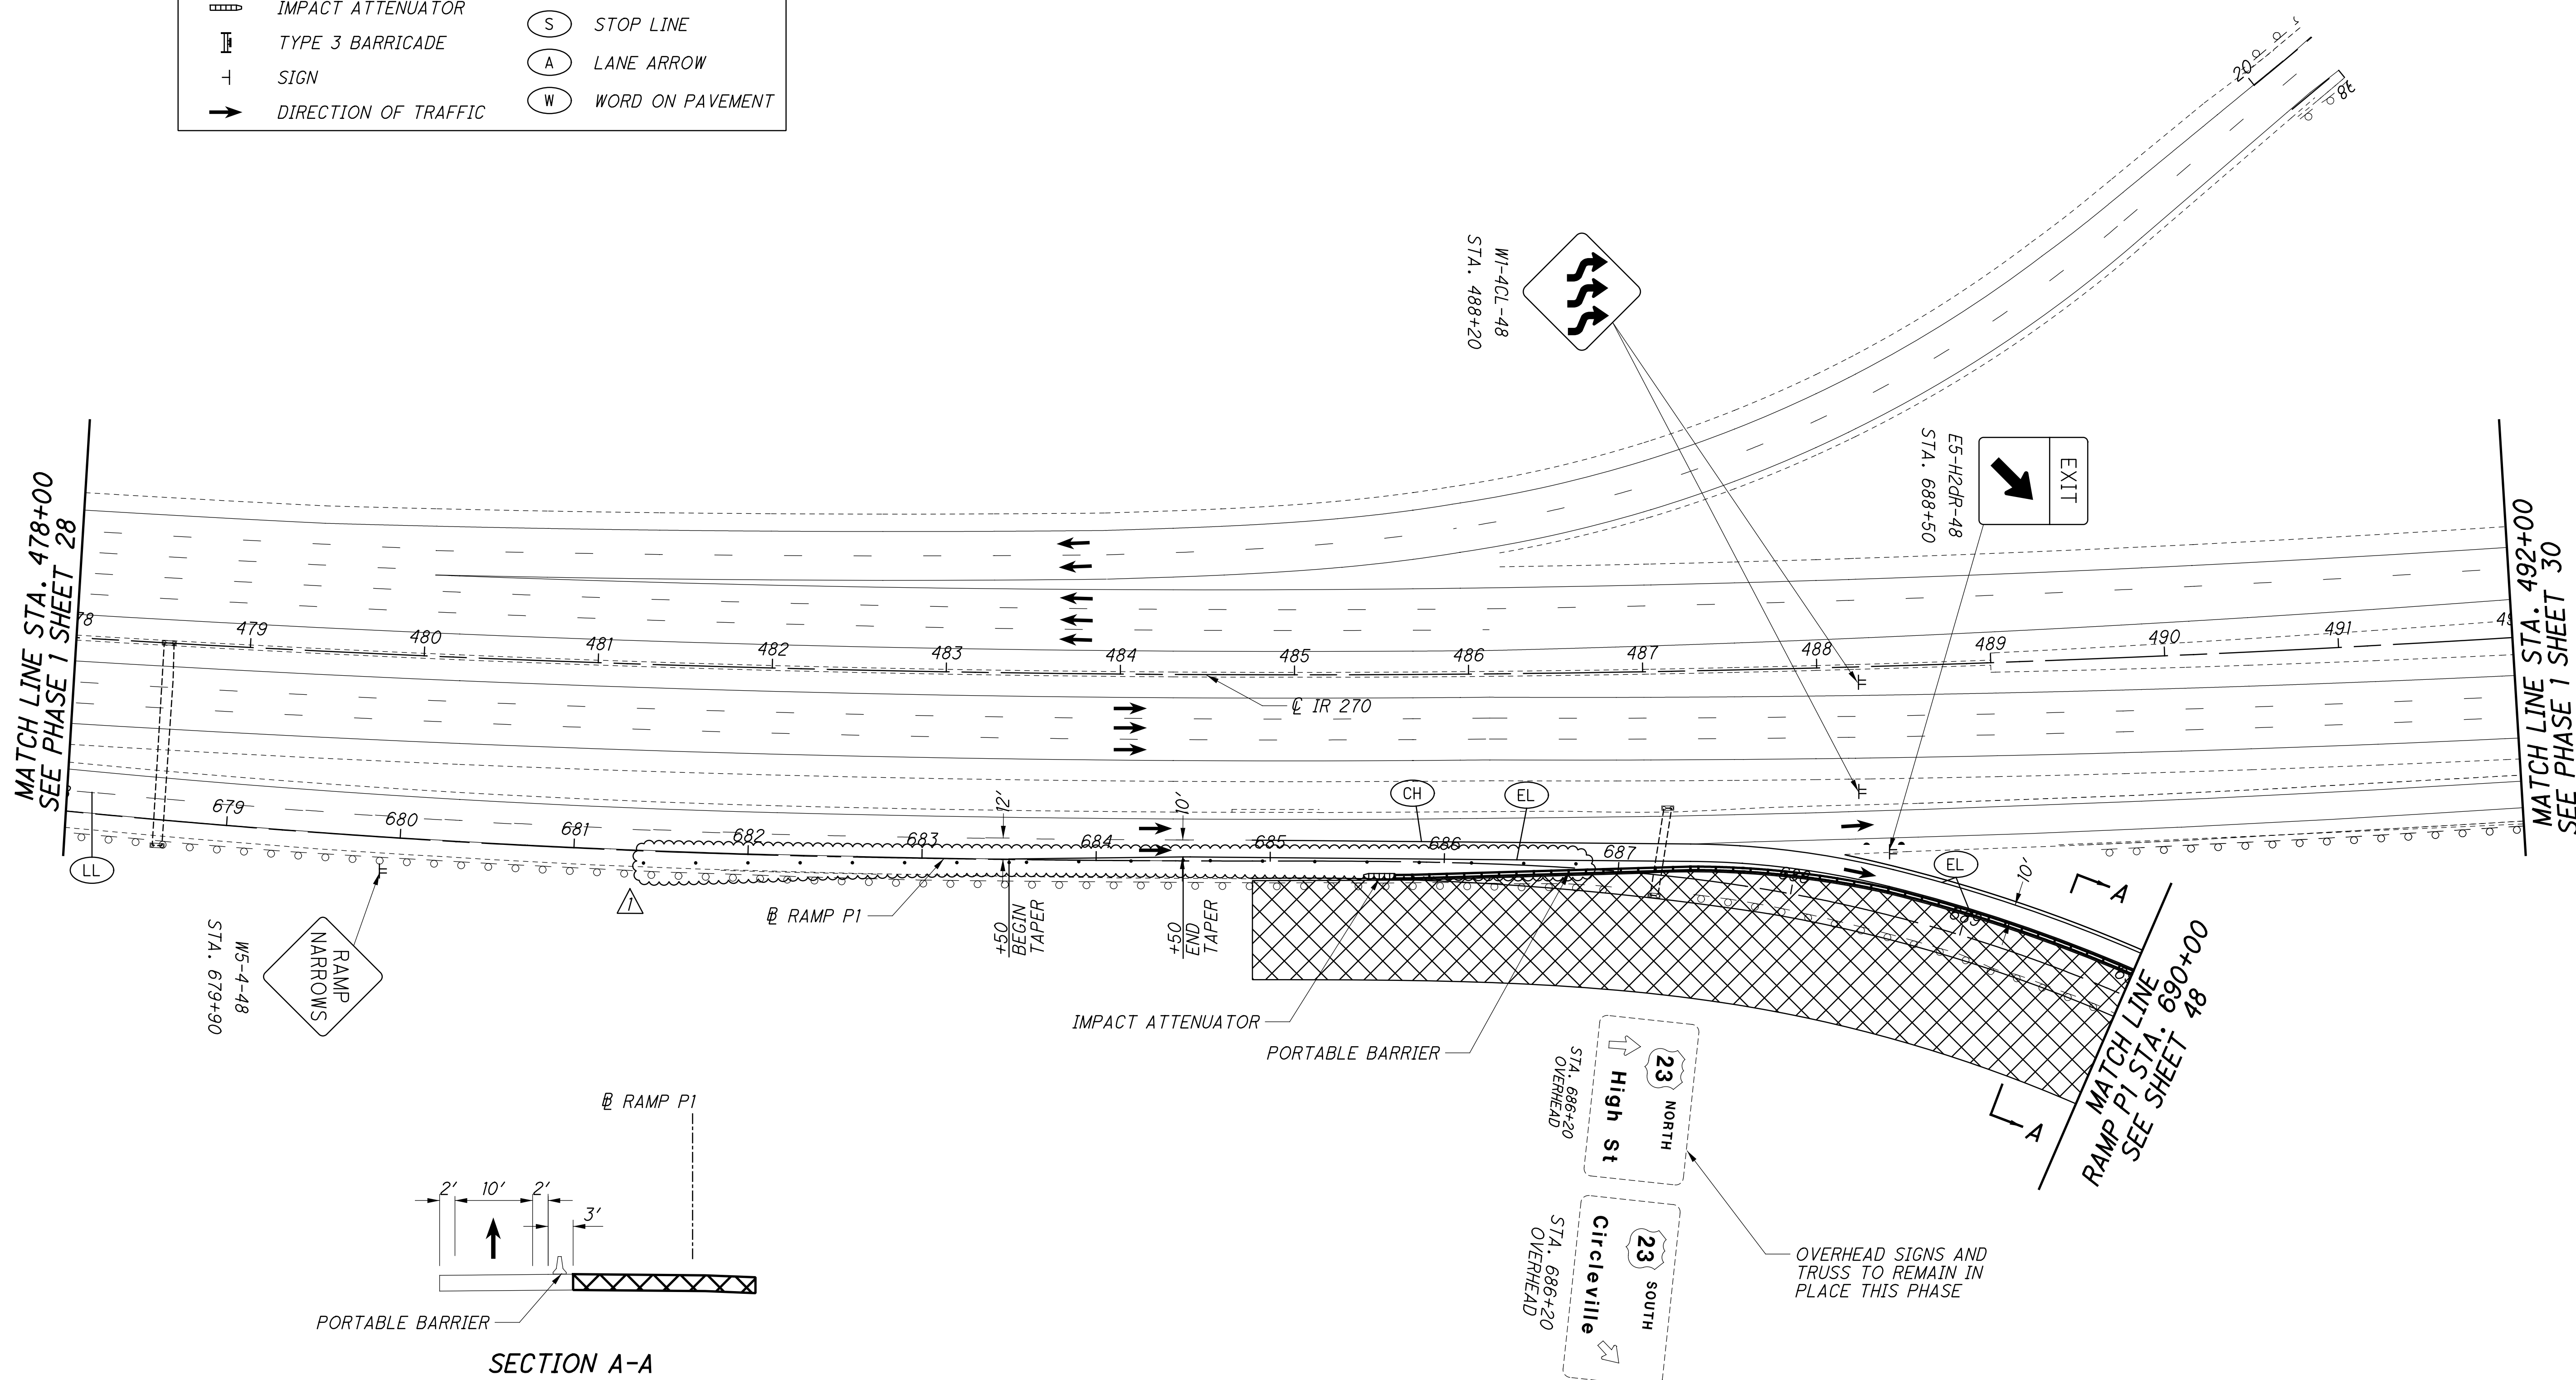

CALCULATED DJR  
CHECKED RCH

0 50 100  
25  
HORIZONTAL SCALE IN FEET

**MAINTENANCE OF TRAFFIC - PHASE 1A**  
I-270 STA. 478+00 TO STA. 492+00

**FRA-270-51.50**



ADDENDUM #1  
04/21/2023

OVERHEAD SIGNS AND TRUSS TO REMAIN IN PLACE THIS PHASE

RAMP P1 STA. 690+00  
SEE SHEET 48


MATCH LINE STA. 492+00  
SEE PHASE 1 SHEET 30

MATCH LINE STA. 478+00  
SEE PHASE 1 SHEET 28

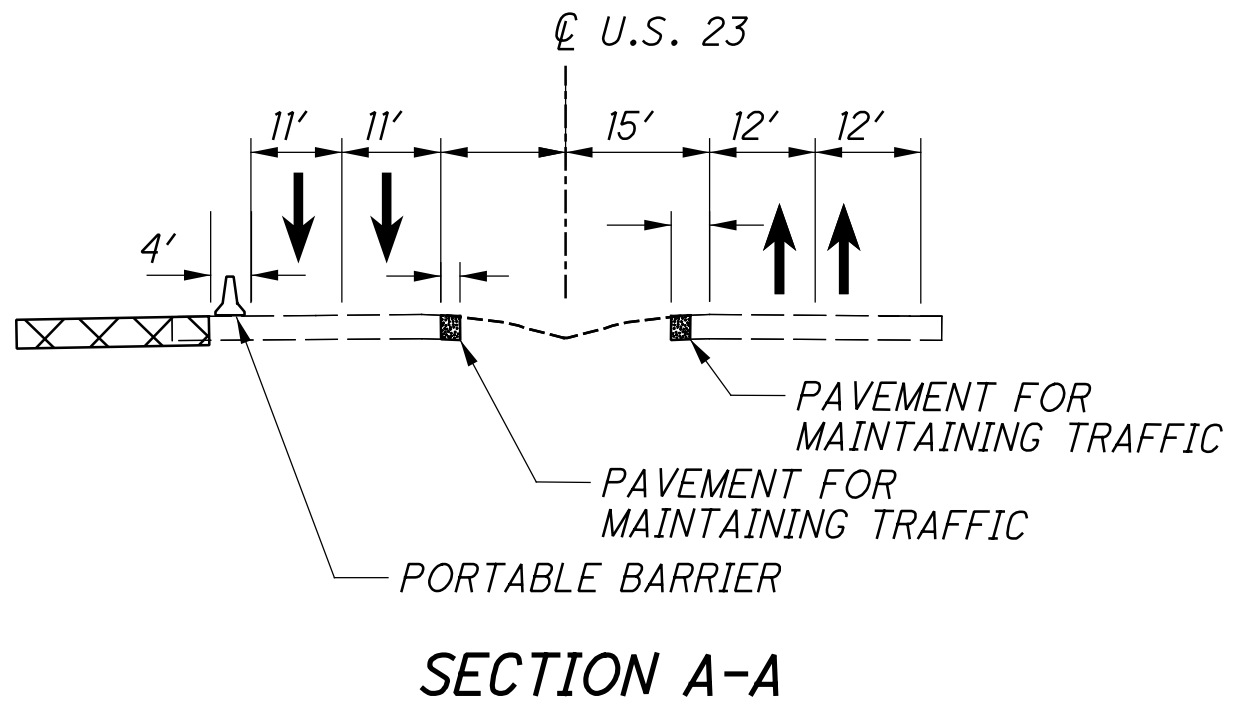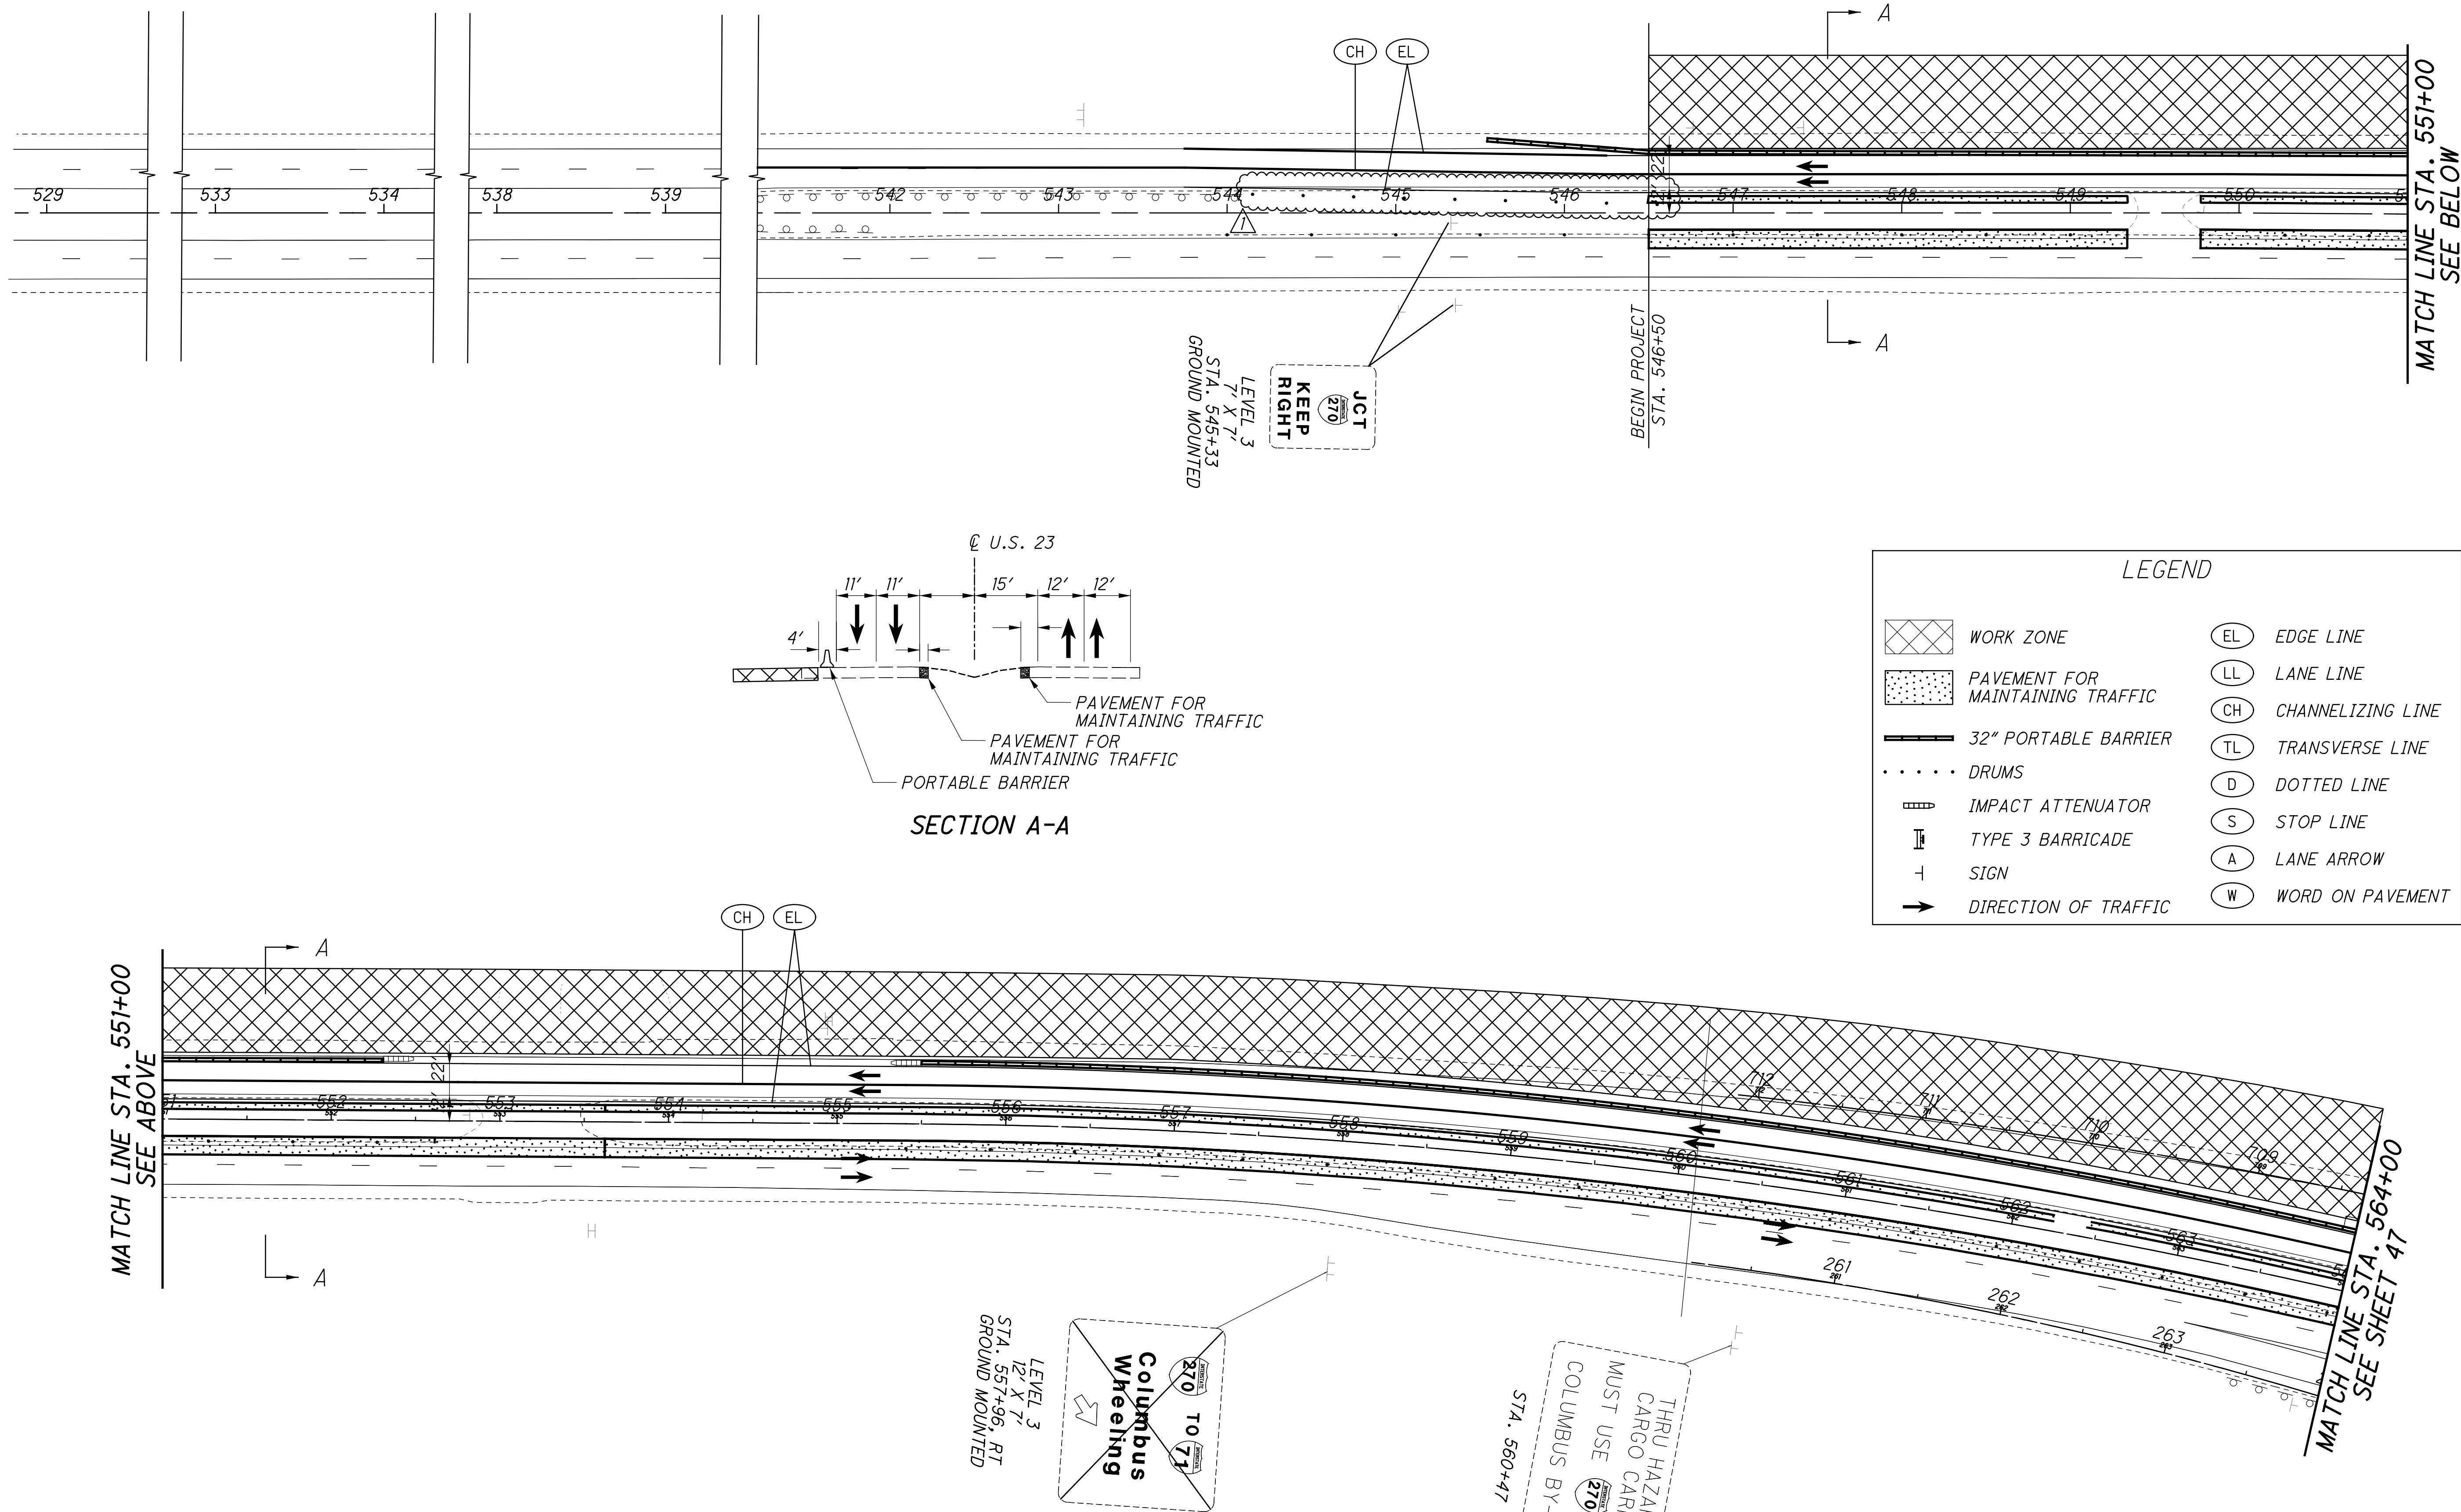

LEGEND

	WORK ZONE		EDGE LINE
	PAVEMENT FOR MAINTAINING TRAFFIC		LANE LINE
	32" PORTABLE BARRIER		CHANNELIZING LINE
	DRUMS		TRANSVERSE LINE
	IMPACT ATTENUATOR		DOTTED LINE
	TYPE 3 BARRICADE		STOP LINE
	SIGN		LANE ARROW
	DIRECTION OF TRAFFIC		WORD ON PAVEMENT

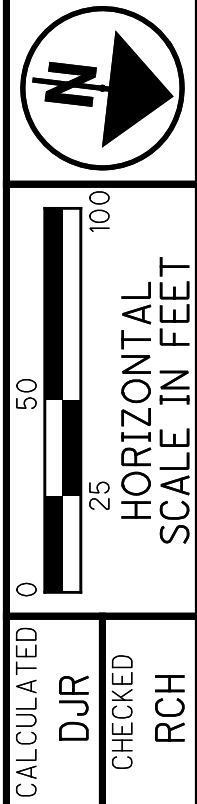

MAINTENANCE OF TRAFFIC - PHASE 1A  
 U.S. 23 STA. 537+00 TO STA. 564+00





FRA - 270-51.50

ADDENDUM #1  
04/21/2023



X:\Projects\2013\1321\1010\FRA\92616\mot\sheets\92616MP402.dgn 4/19/2023 6:26:03 AM cwong

LEGEND			
	WORK ZONE		EDGE LINE
	PAVEMENT FOR MAINTAINING TRAFFIC		LANE LINE
	32" PORTABLE BARRIER		CHANNELIZING LINE
	DRUMS		TRANSVERSE LINE
	IMPACT ATTENUATOR		DOTTED LINE
	TYPE 3 BARRICADE		STOP LINE
	SIGN		LANE ARROW
	DIRECTION OF TRAFFIC		WORD ON PAVEMENT

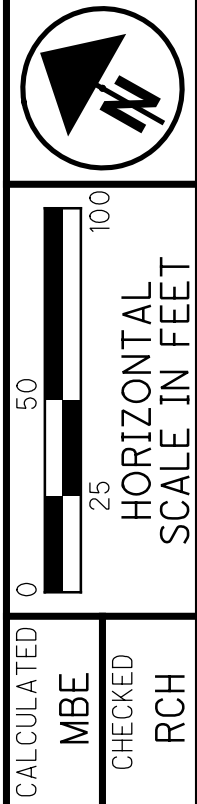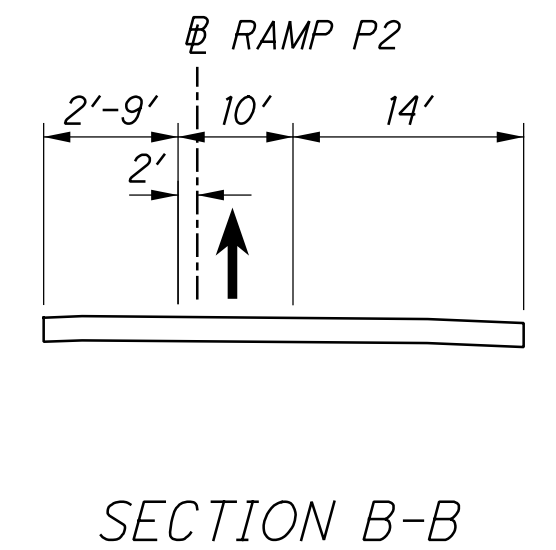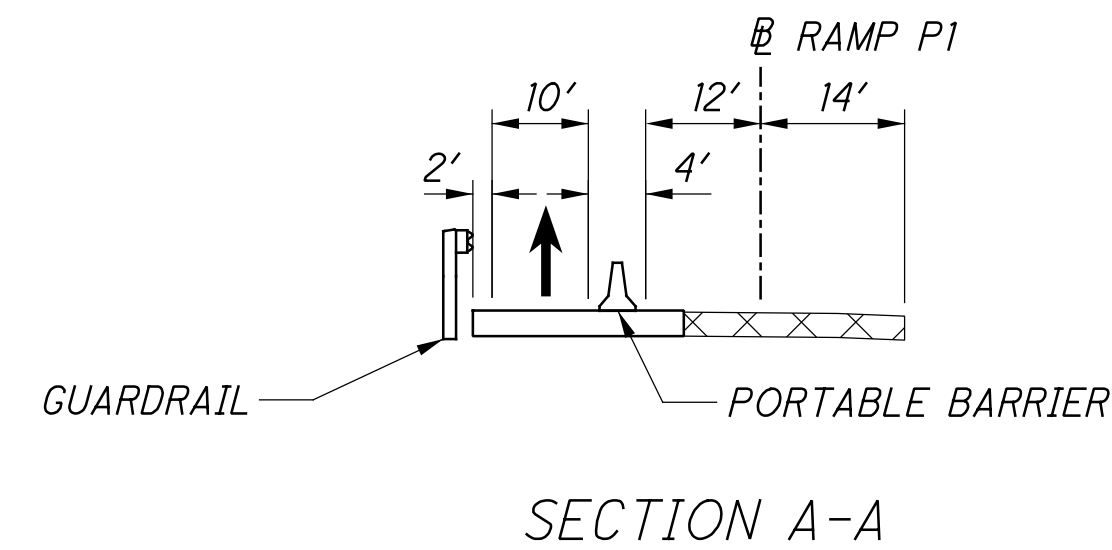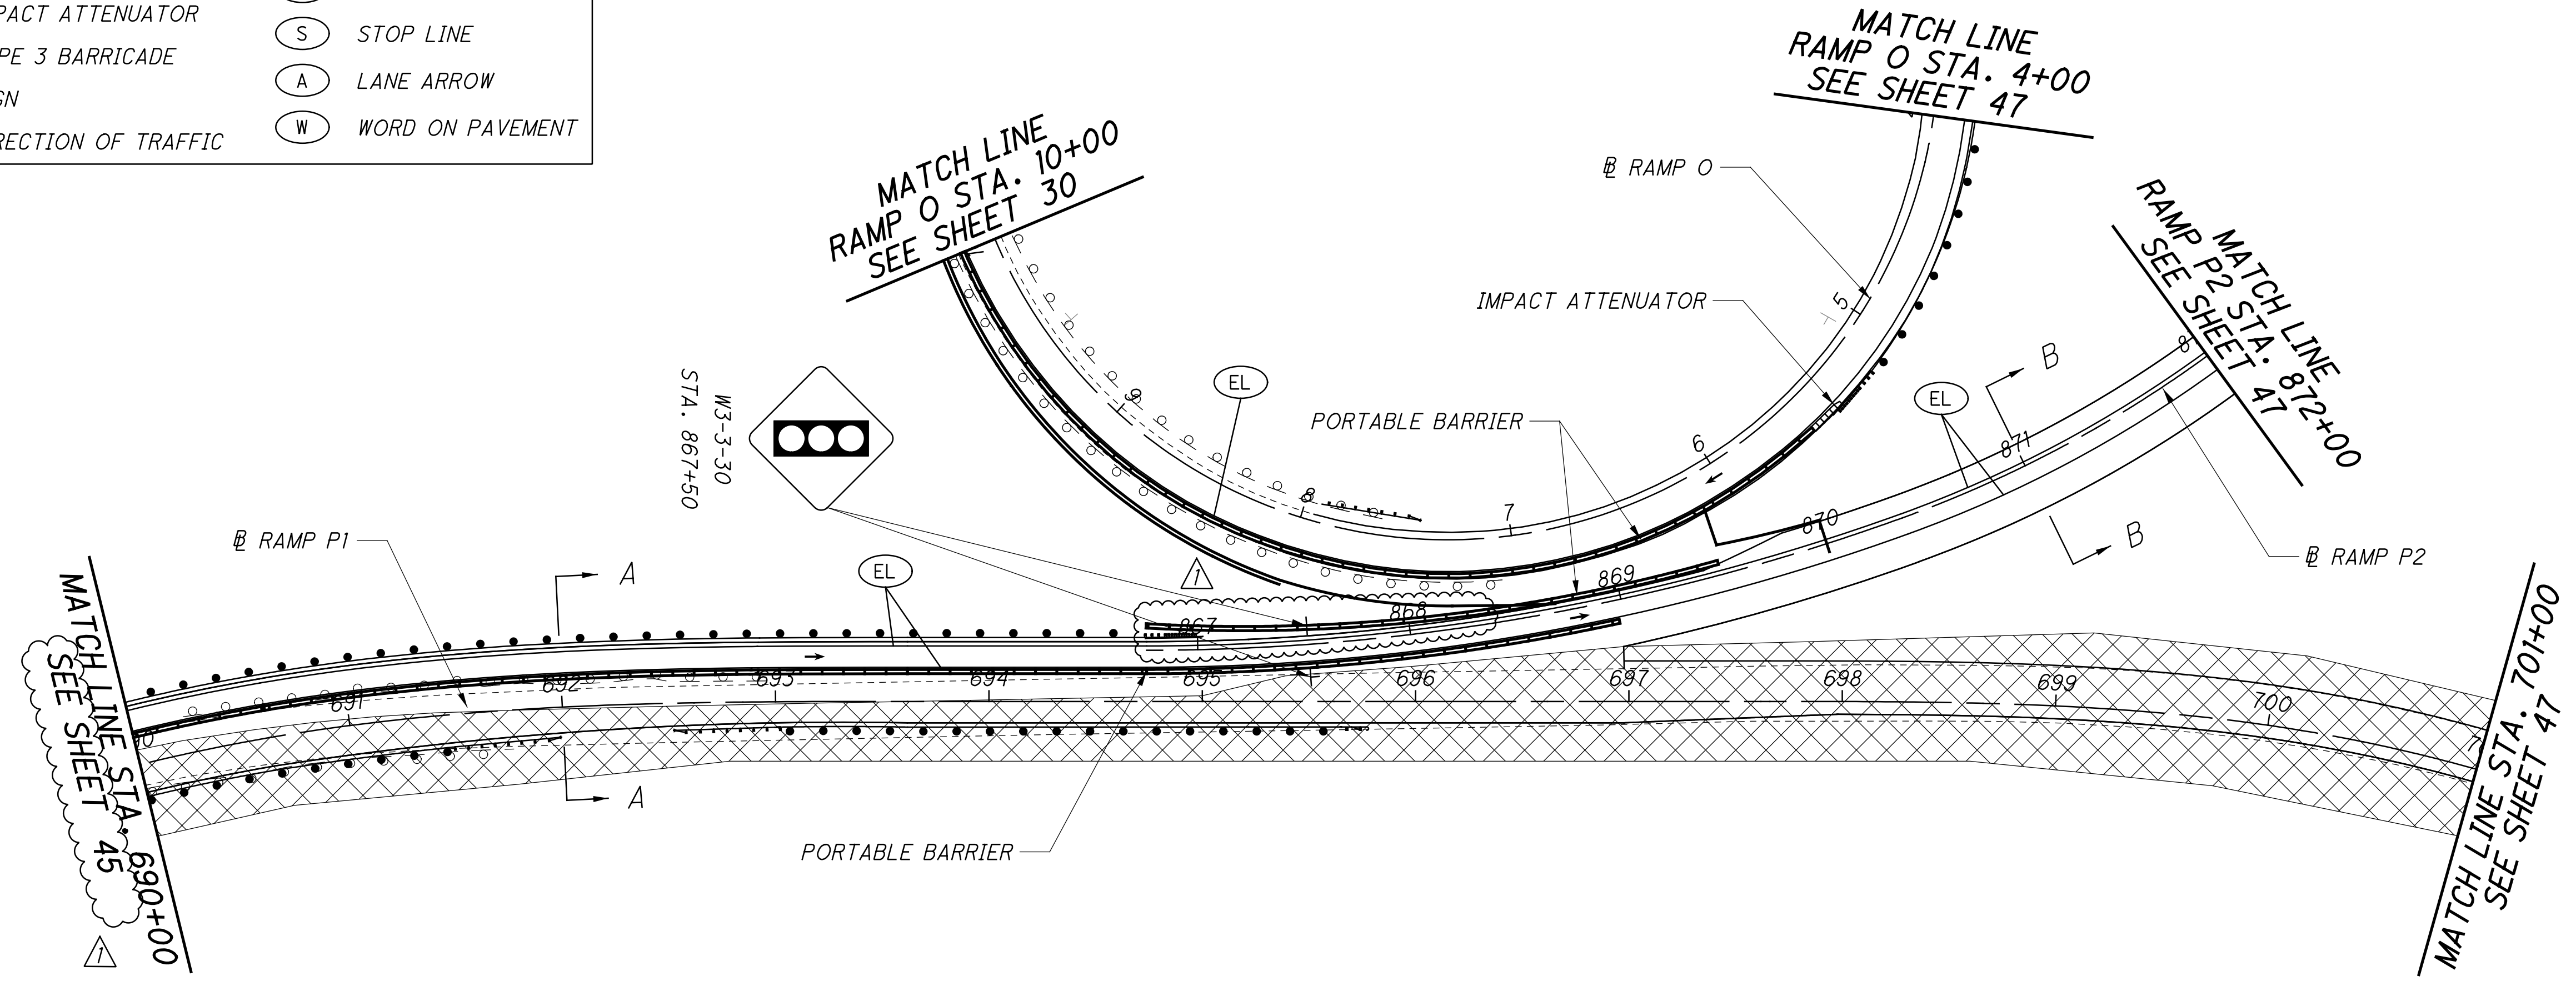

CALCULATED MBE CHECKED RCH


RAMP P1 STA. 690+00 TO STA. 701+00  
 RAMP P2 STA. 867+00 TO STA. 872+00  
 RAMP O STA. 4+00 TO STA. 10+00

MAINTENANCE OF TRAFFIC - PHASE 1A  
 RAMPS P1, P2 & O


FRA-270-51.50

NOTES:

- [A] 15' FROM STA. 7+00 TO STA. 8+00  
VARIES 15' TO 3' FROM STA. 8+00 TO STA. 11+50
- [B] VARIES: FROM .02 FT/FT AT STA. 7+00  
TO .06 FT/FT AT STA. 7+50  
MATCH EXISTING .08± FT/FT STA. 8+00 TO 11+50
- [C] PAVEMENT FOR MAINTAINING TRAFFIC, CLASS A


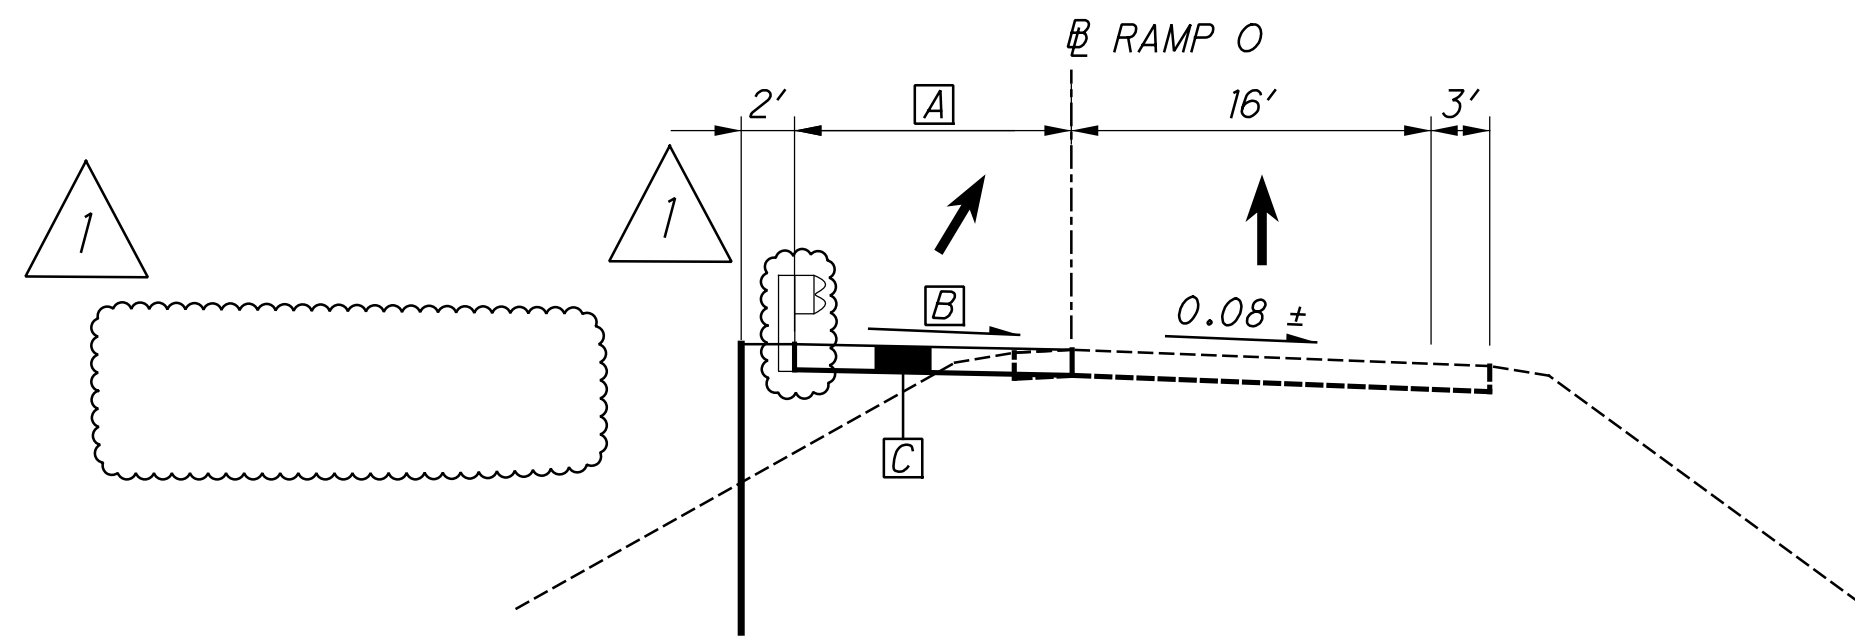


PHASE 2

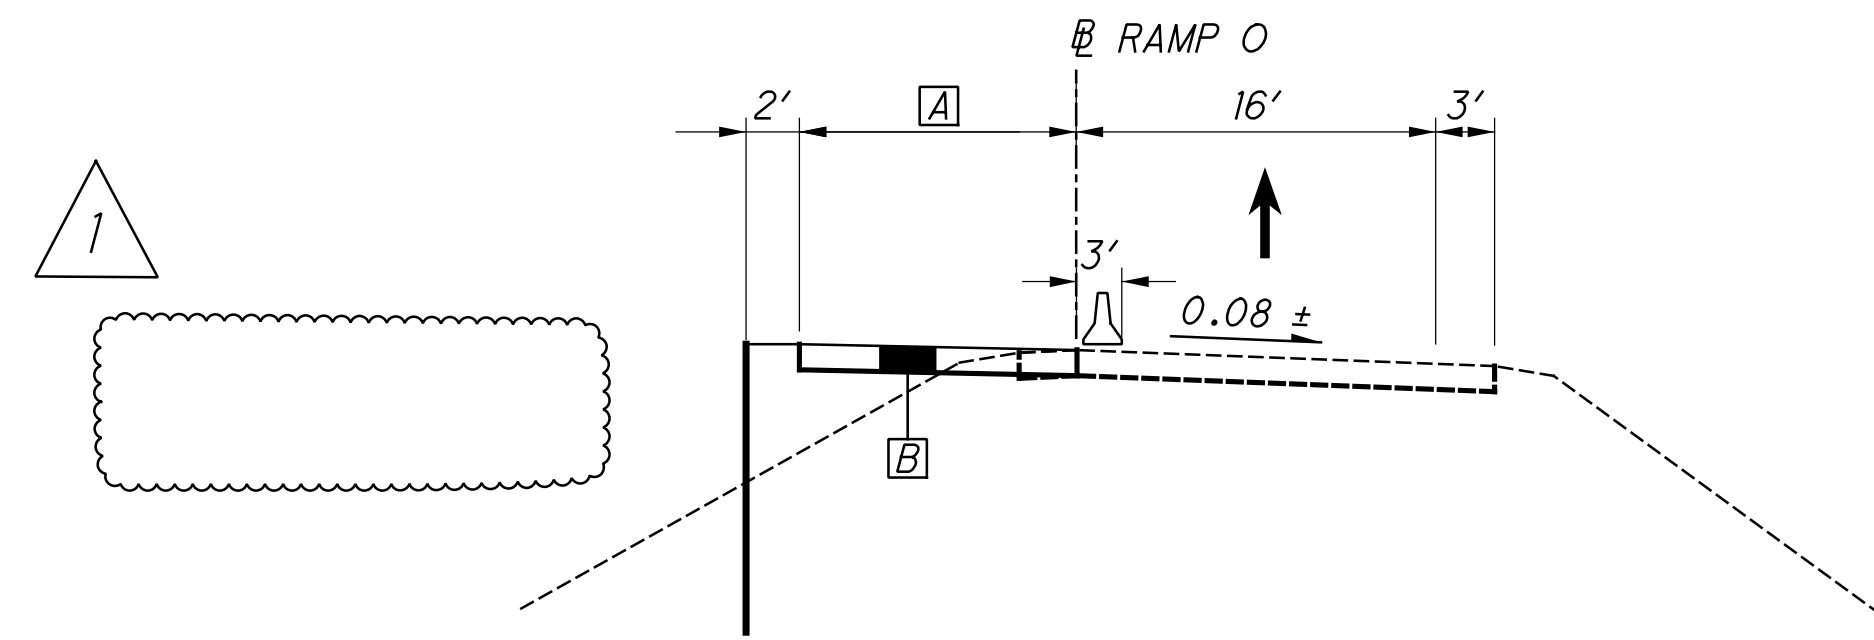

PHASE 1

TYPICAL SECTION TEMPORARY WIDENING RAMP O

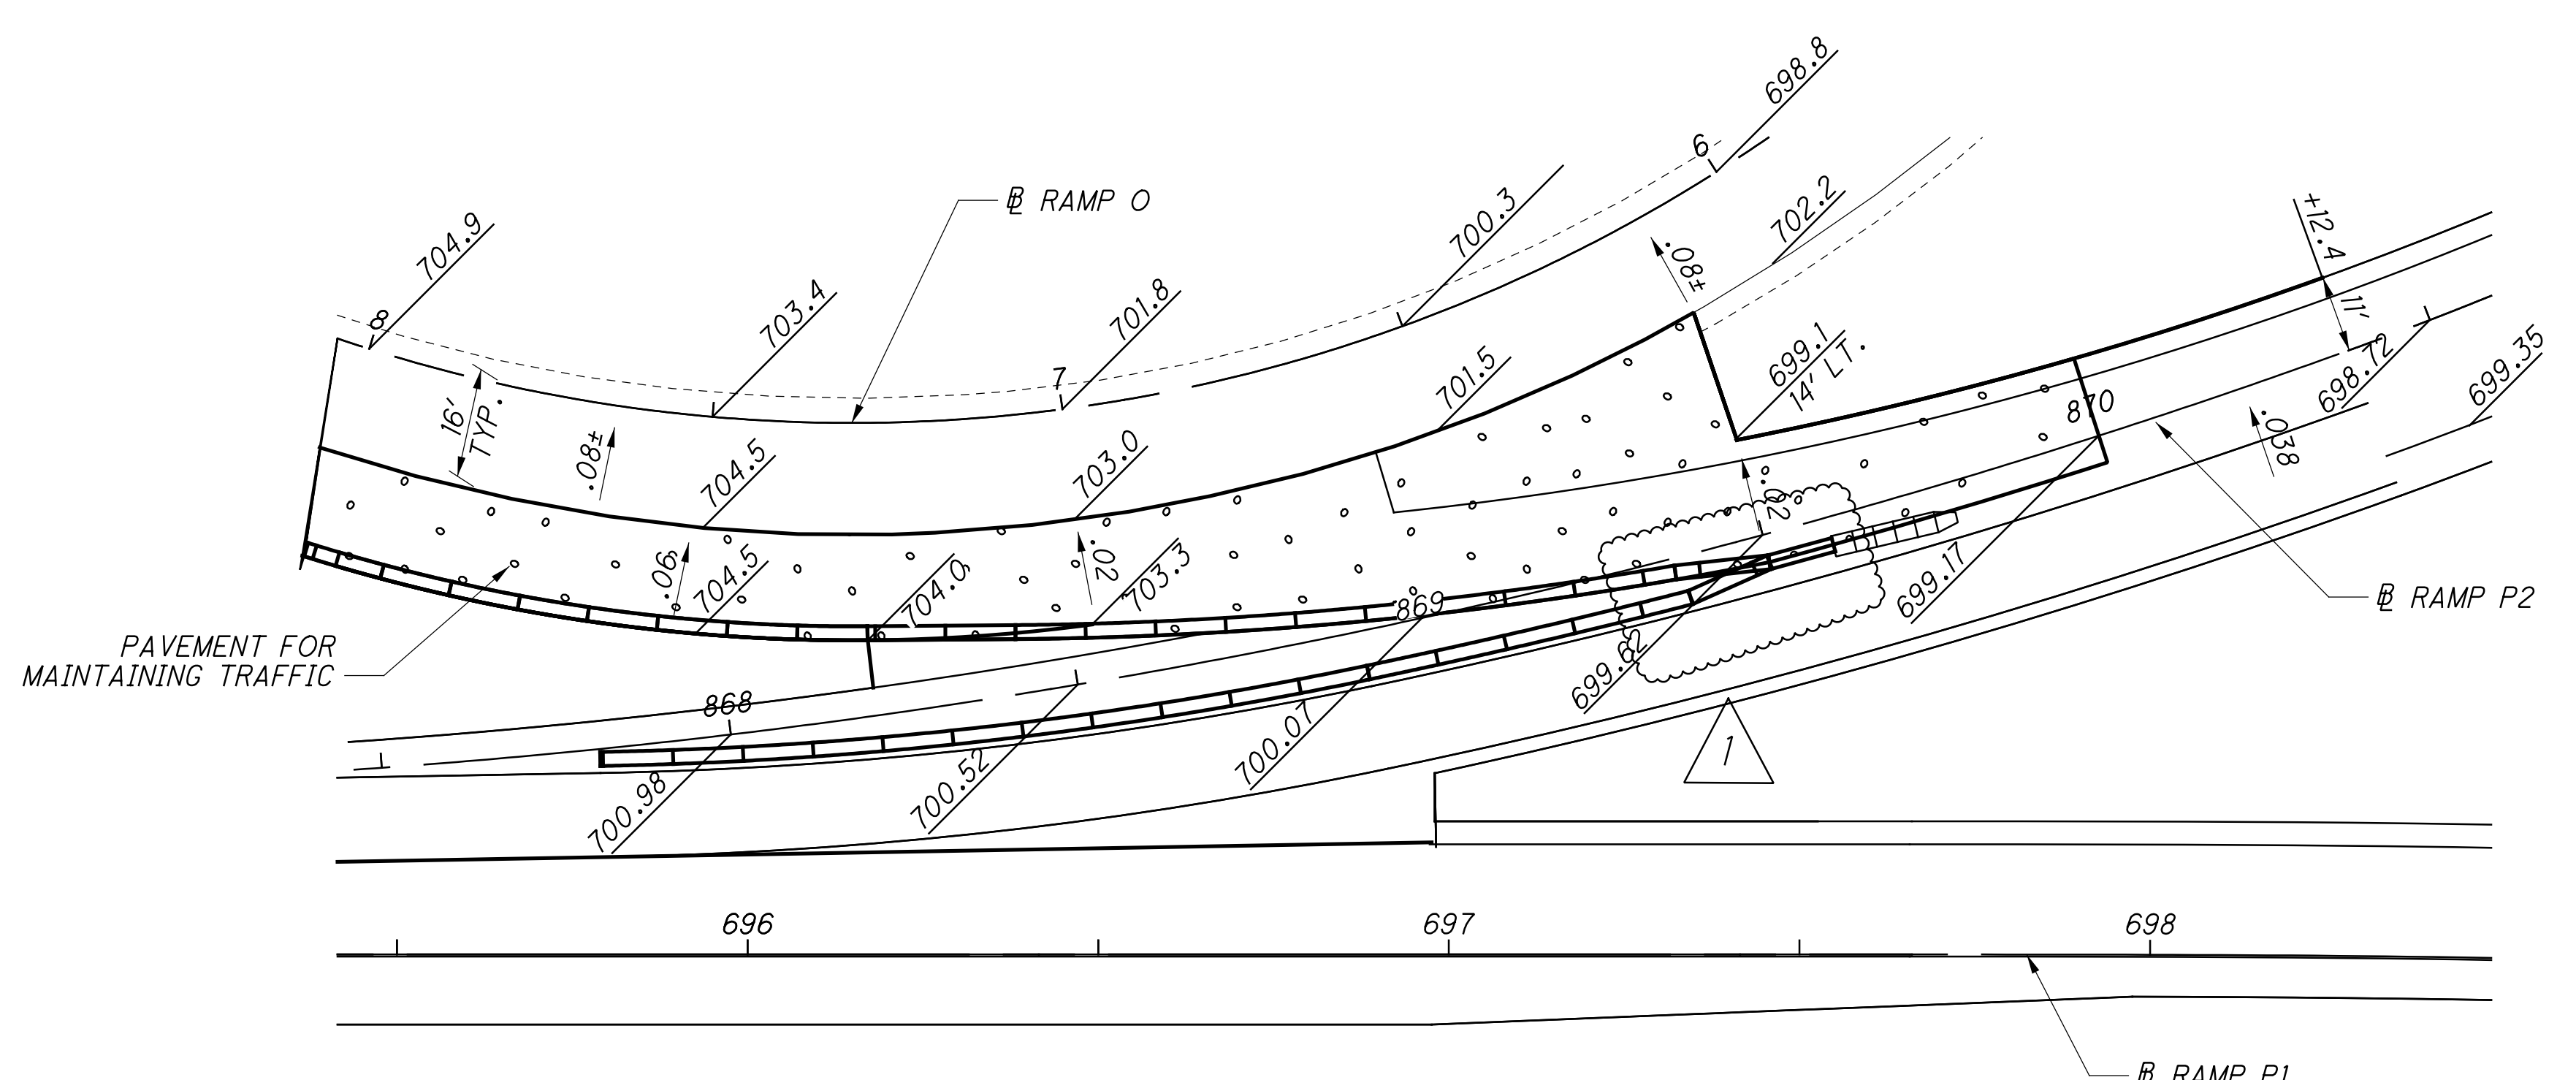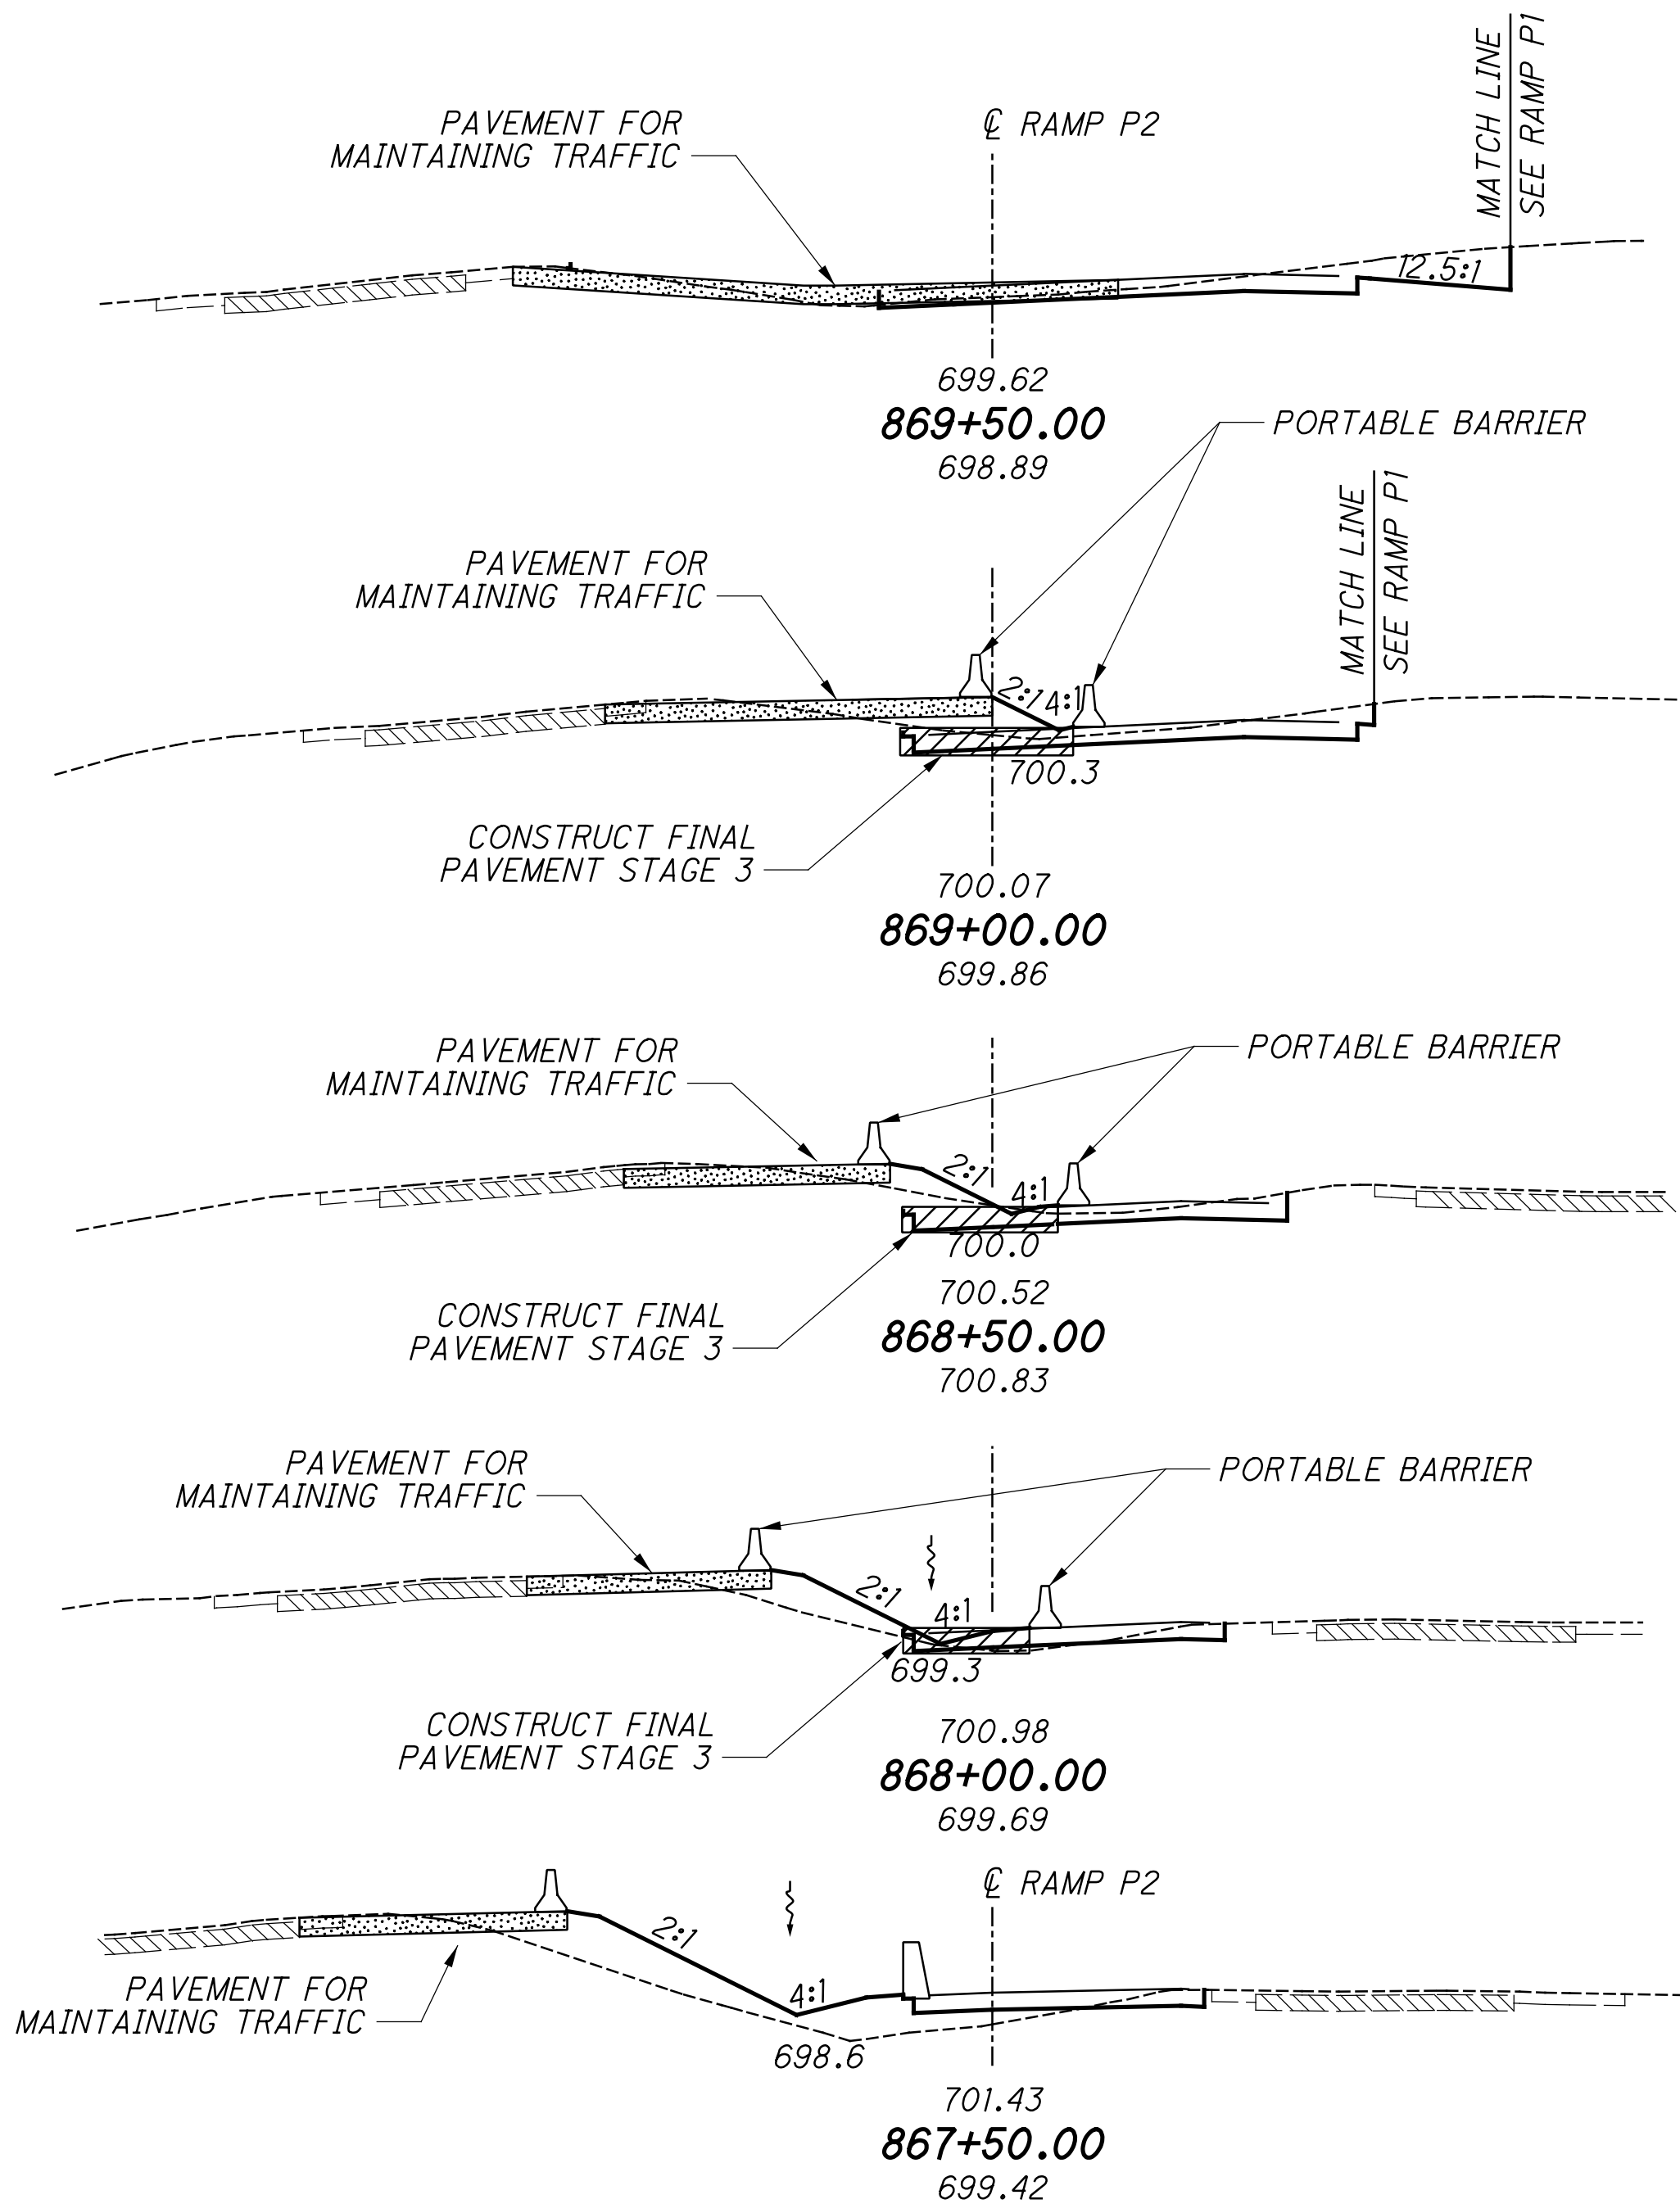

PAVEMENT FOR MAINTAINING TRAFFIC DETAILS  
TEMPORARY CONNECTION RAMP P2 TO RAMP O

X:\Projects\2013\1321\1010\FRA\92616\mot\sheet\92616MY202.dgn 4/21/2023 7:21:47 PM cwong

RAMP O TEMPORARY CONNECTION & TYPICAL SECTION

FRA - 270-51.50

ADDENDUM #1  
04/21/2023

50  
554

X:\Projects\2013\1010\FRA\92616\mot\sheet\92616MPO03.dgn 4/21/2023 4:40:43 PM c.wong





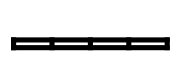







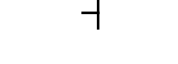



CALCULATED  
DJR  
CHECKED  
RCH


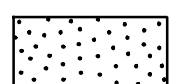
0 50 100  
25  
HORIZONTAL  
SCALE IN FEET

**MAINTENANCE OF TRAFFIC - PHASE 2**  
**I-270 STA. 492+00 TO STA. 506+00**

**FRA-270-51.50**

**LEGEND**


 WORK ZONE	 EDGE LINE
 PAVEMENT FOR MAINTAINING TRAFFIC	 LANE LINE
 32" PORTABLE BARRIER	 CHANNELIZING LINE
 DRUMS	 TRANSVERSE LINE
 IMPACT ATTENUATOR	 DOTTED LINE
 TYPE 3 BARRICADE	 STOP LINE
 SIGN	 LANE ARROW
 DIRECTION OF TRAFFIC	 WORD ON PAVEMENT

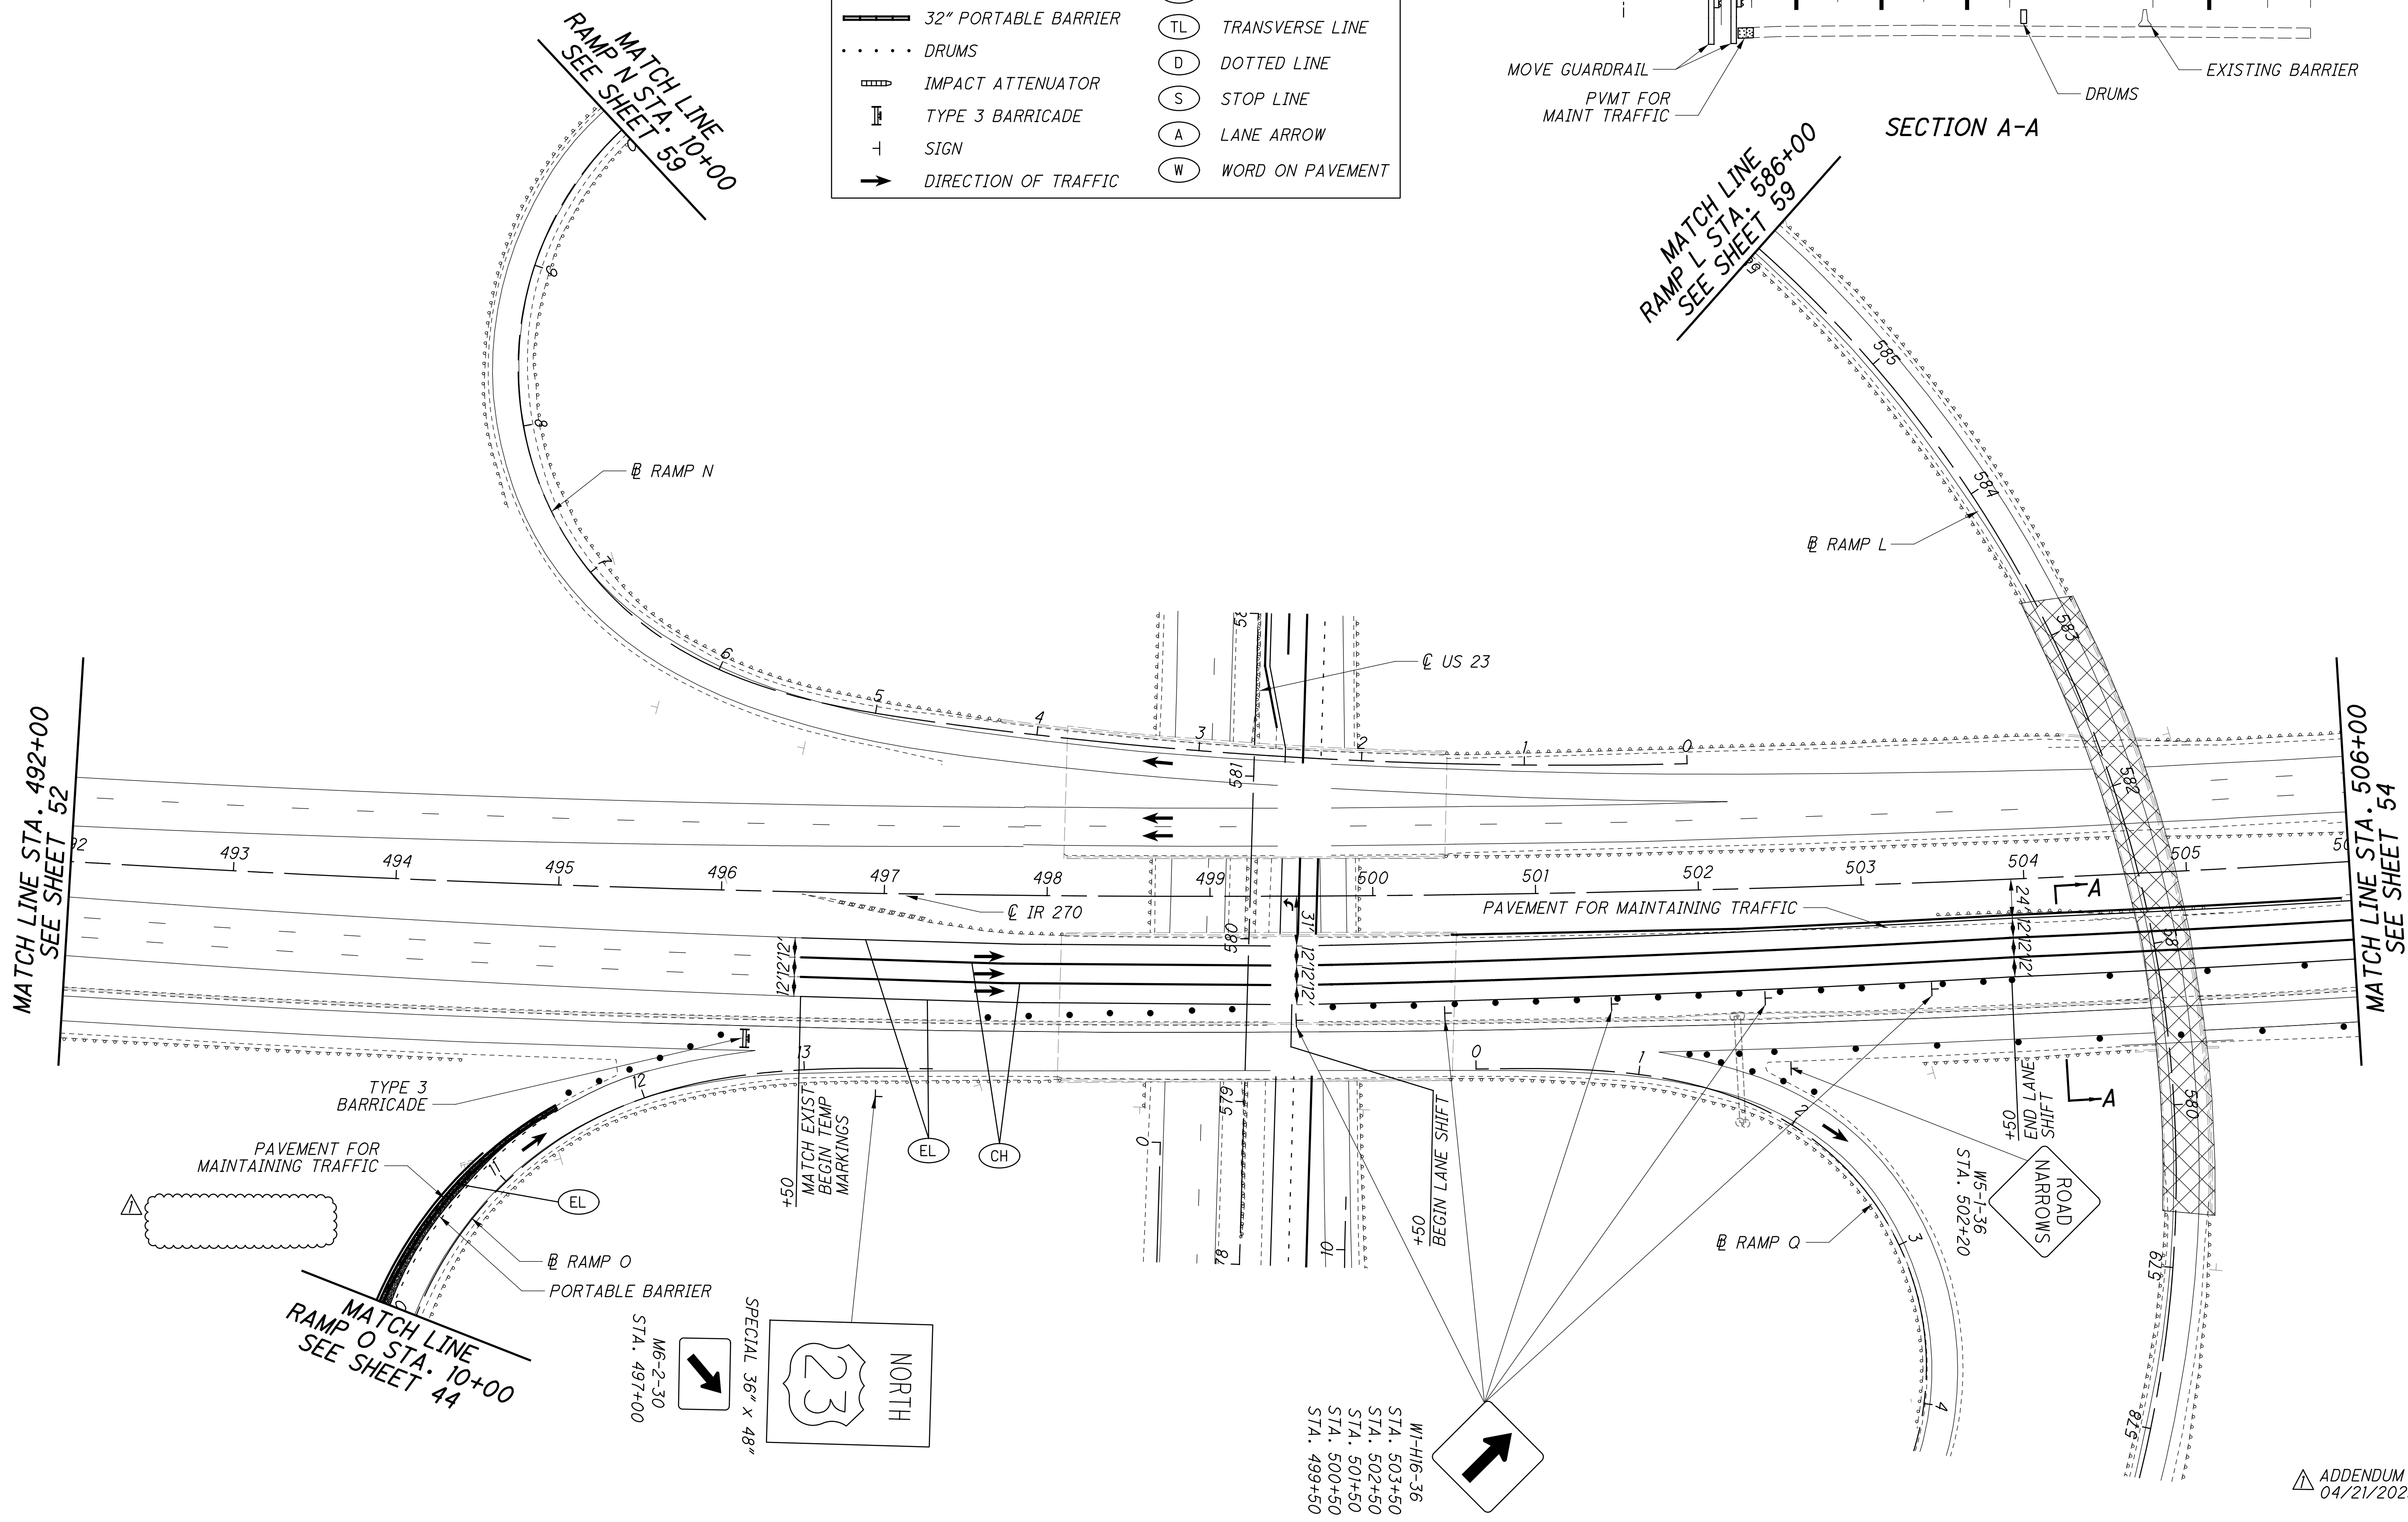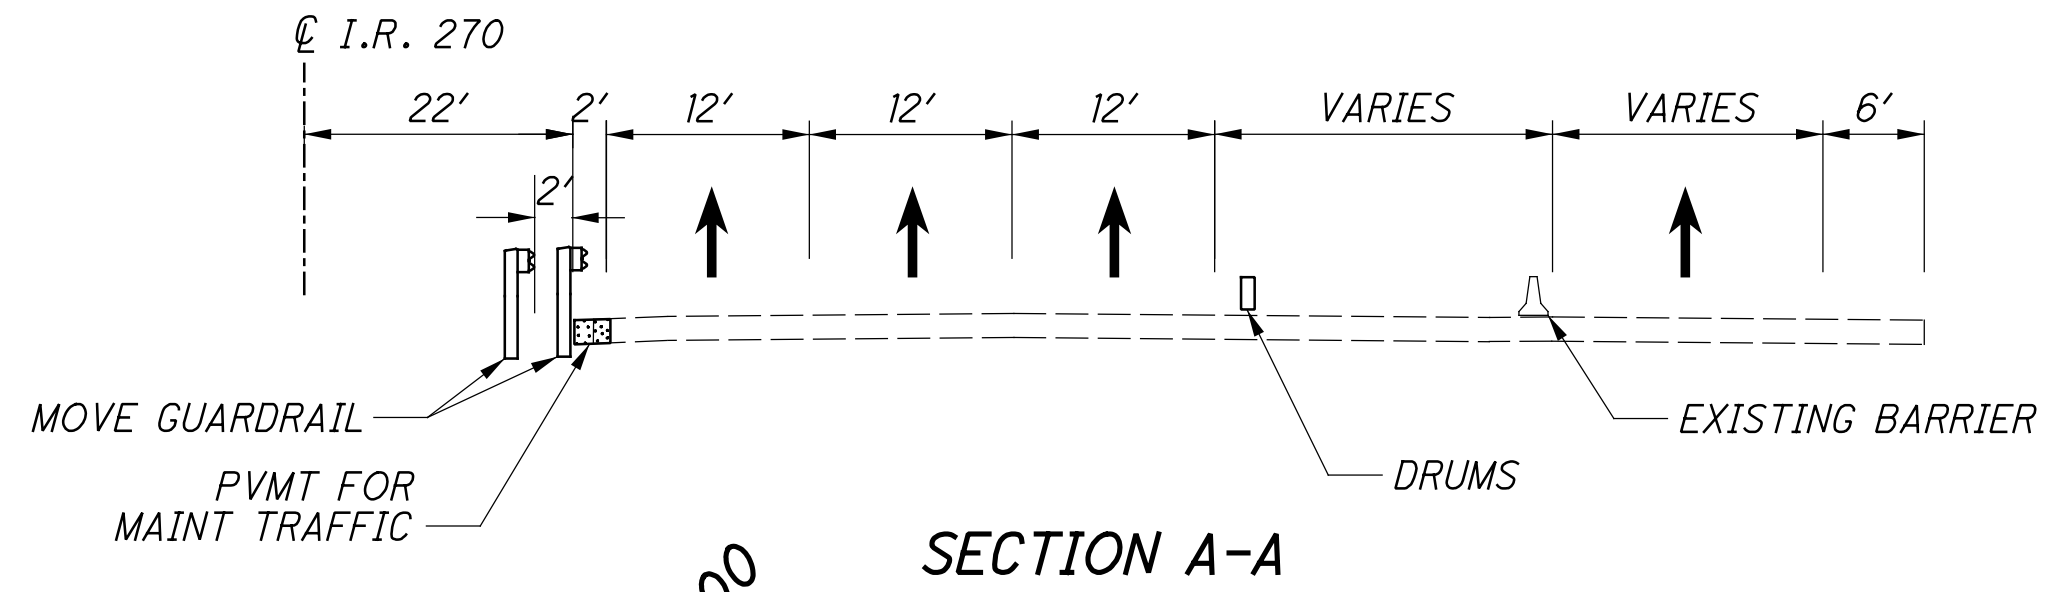

ADDENDUM #1  
04/21/2023



X:\Projects\2013\1010\FRA\92616\mot\sheet\92616MP005.dgn 4/19/2023 6:39:31 AM cwong

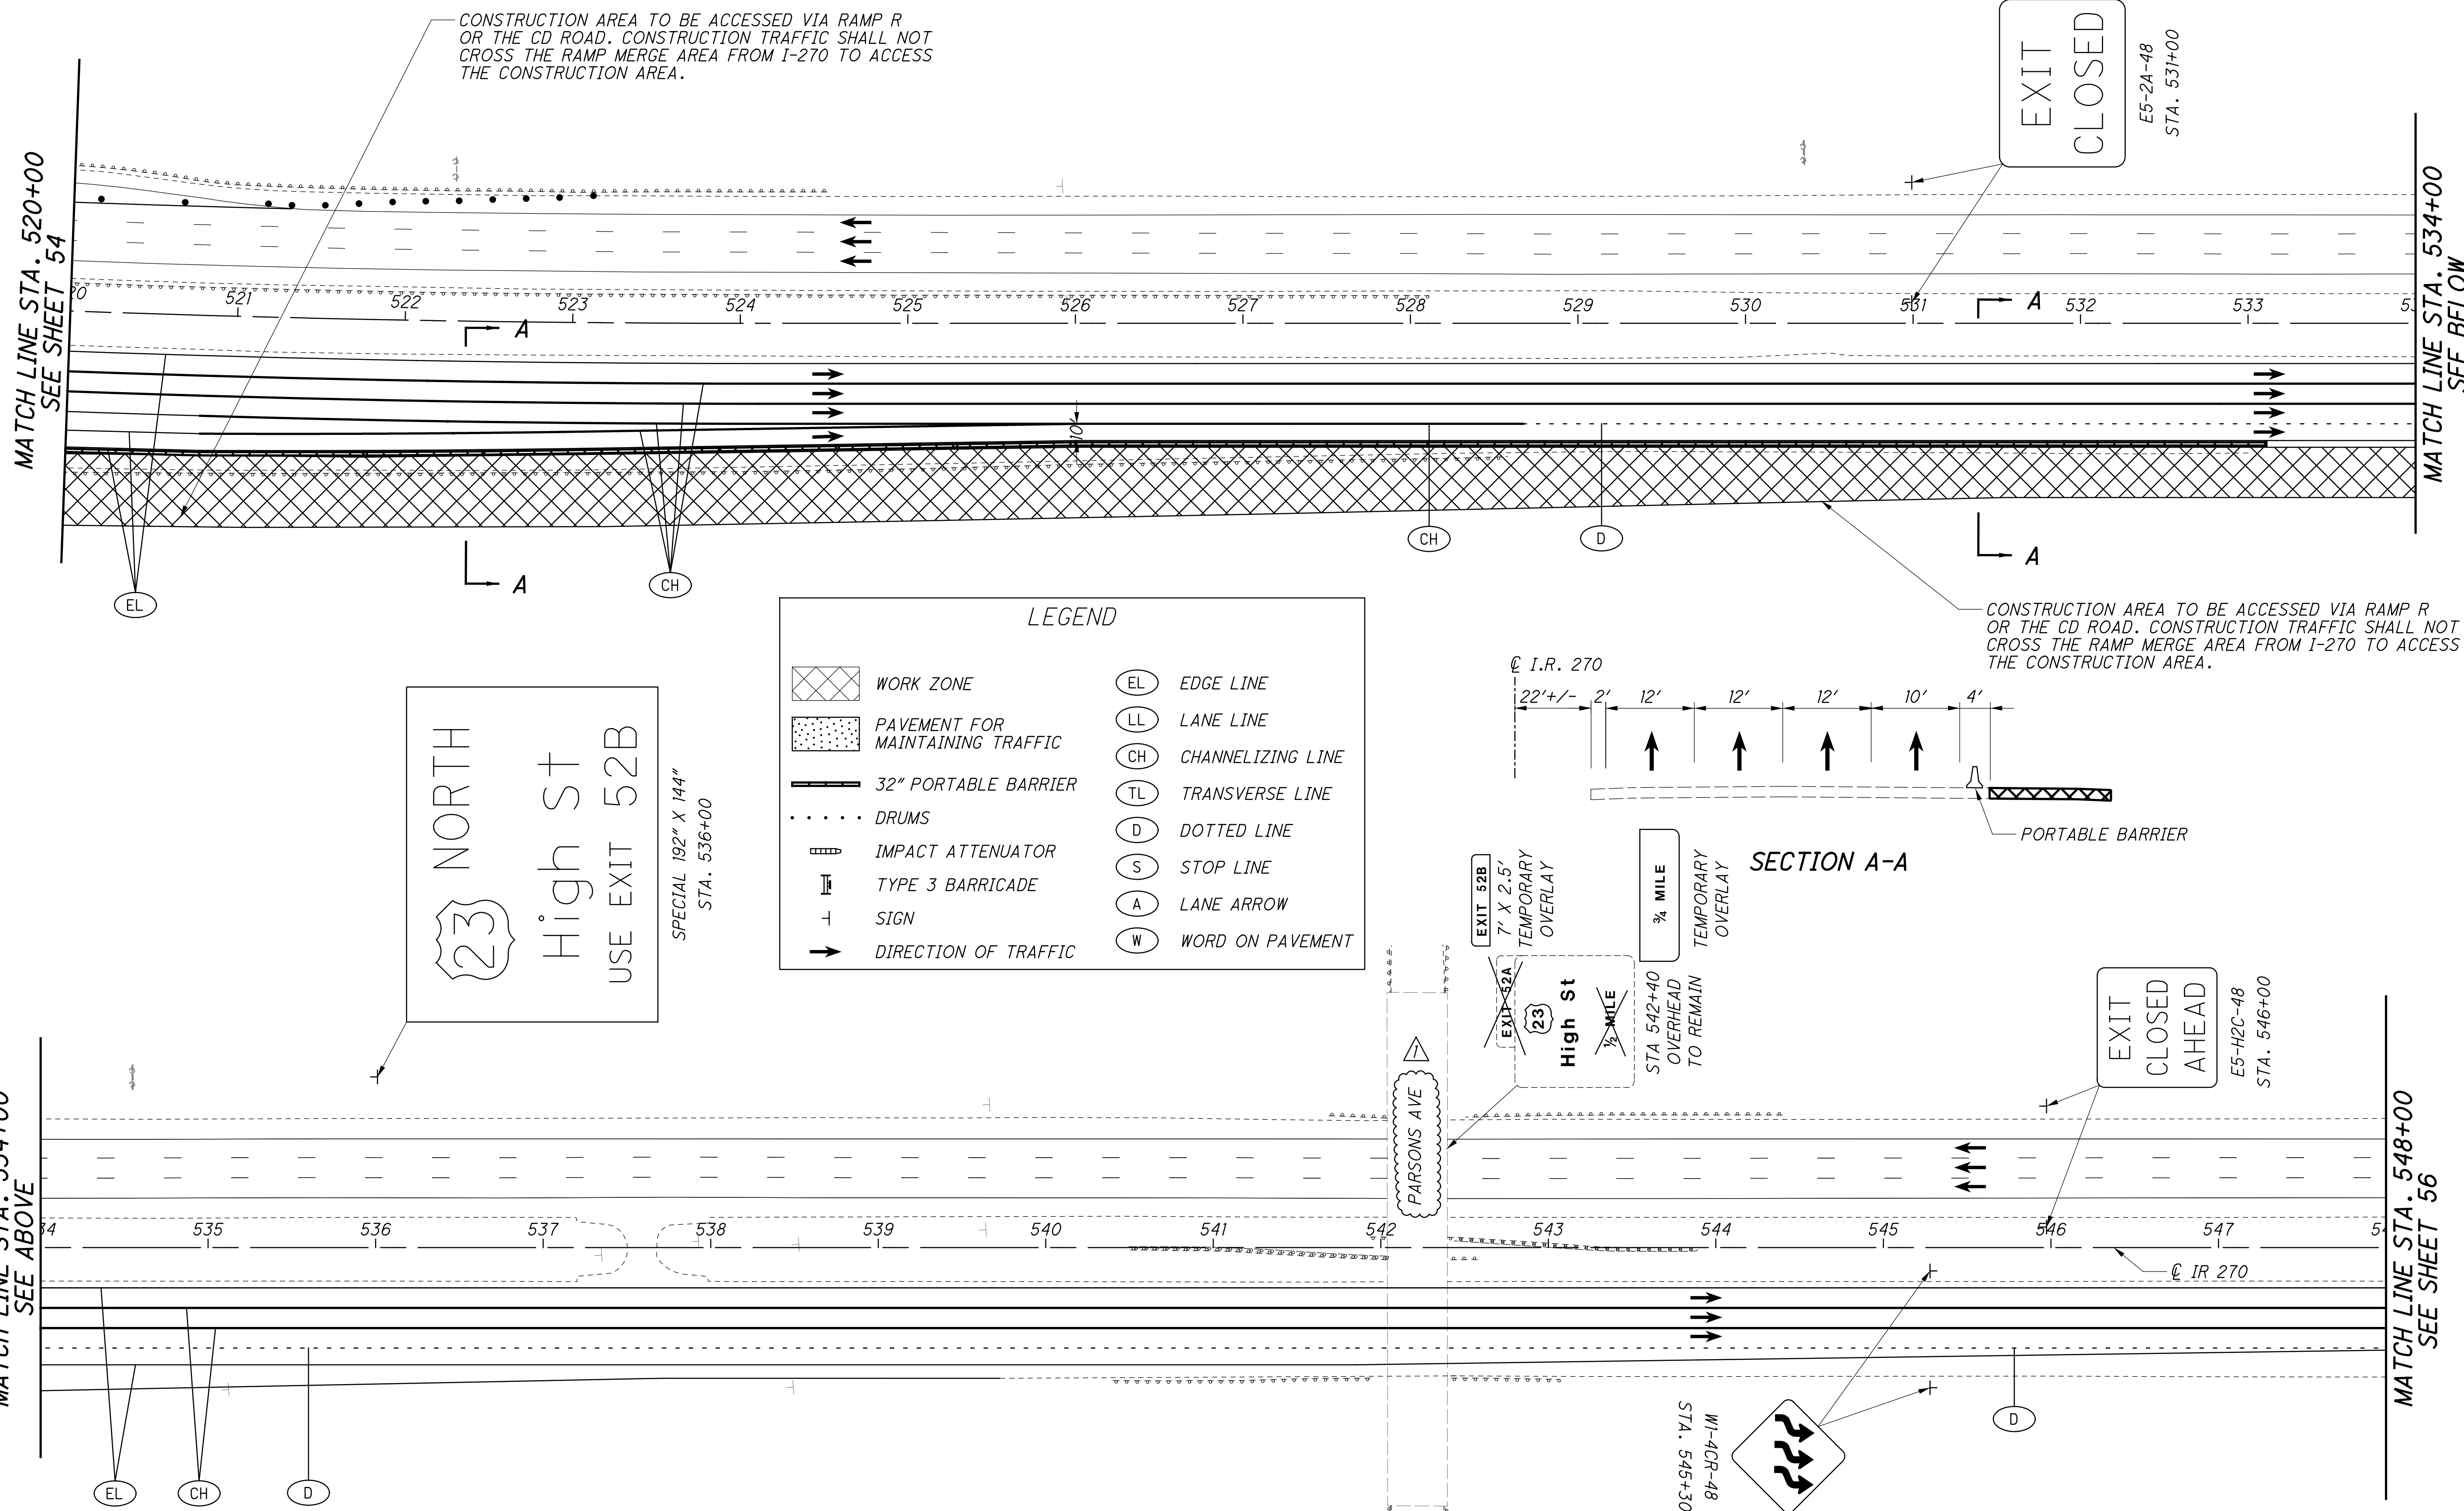

CONSTRUCTION AREA TO BE ACCESSED VIA RAMP R OR THE CD ROAD. CONSTRUCTION TRAFFIC SHALL NOT CROSS THE RAMP MERGE AREA FROM I-270 TO ACCESS THE CONSTRUCTION AREA.


EXIT CLOSED  
E5-2A-48  
STA. 531+00

CONSTRUCTION AREA TO BE ACCESSED VIA RAMP R OR THE CD ROAD. CONSTRUCTION TRAFFIC SHALL NOT CROSS THE RAMP MERGE AREA FROM I-270 TO ACCESS THE CONSTRUCTION AREA.

LEGEND

WORK ZONE	EDGE LINE
PAVEMENT FOR MAINTAINING TRAFFIC	LANE LINE
32" PORTABLE BARRIER	CHANNELIZING LINE
DRUMS	TRANSVERSE LINE
IMPACT ATTENUATOR	DOTTED LINE
TYPE 3 BARRICADE	STOP LINE
SIGN	LANE ARROW
DIRECTION OF TRAFFIC	WORD ON PAVEMENT

NORTH  
High St  
USE EXIT 52B  
SPECIAL 192" X 144"  
STA. 536+00

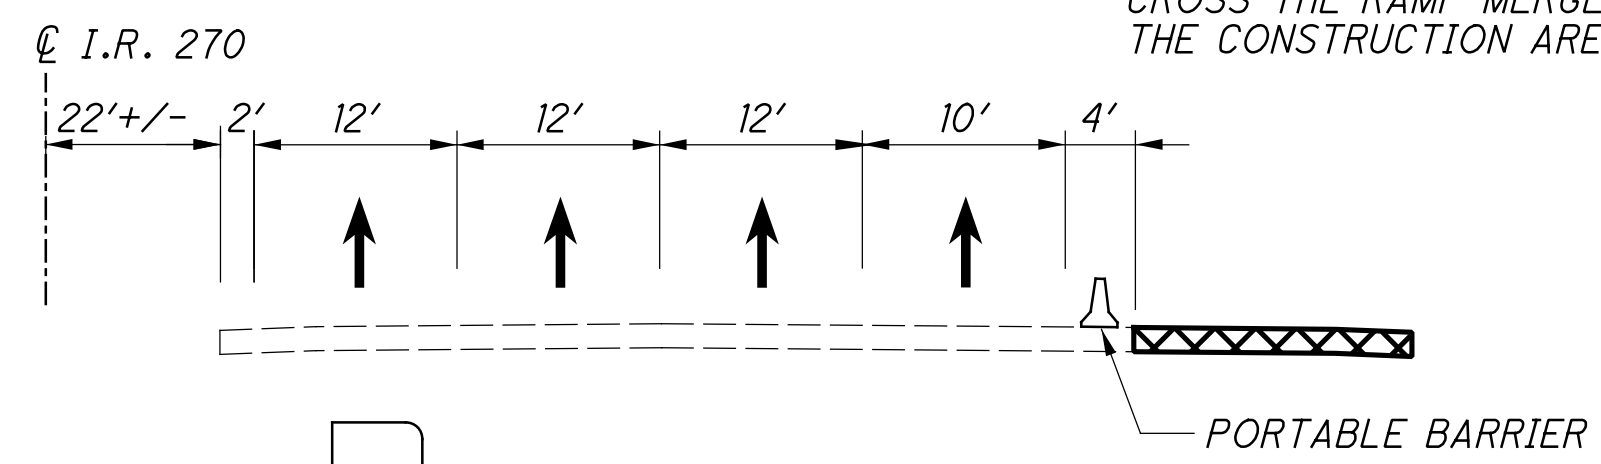

EXIT CLOSED AHEAD  
E5-H2C-48  
STA. 546+00


W1-4CR-48  
STA. 545+30

MATCH LINE STA. 520+00  
SEE SHEET 54

MATCH LINE STA. 534+00  
SEE BELOW

MATCH LINE STA. 534+00  
SEE ABOVE


MATCH LINE STA. 548+00  
SEE SHEET 56

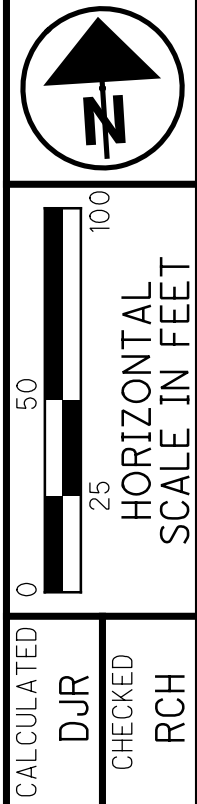


MAINTENANCE OF TRAFFIC - PHASE 2  
I-270 STA. 520+00 TO STA. 548+00

FRA - 270-51.50

X:\Projects\2013\1321\1010\FRA\92616\mot\sheets\92616MP154.dgn 4/19/2023 6:47:52 AM cwong

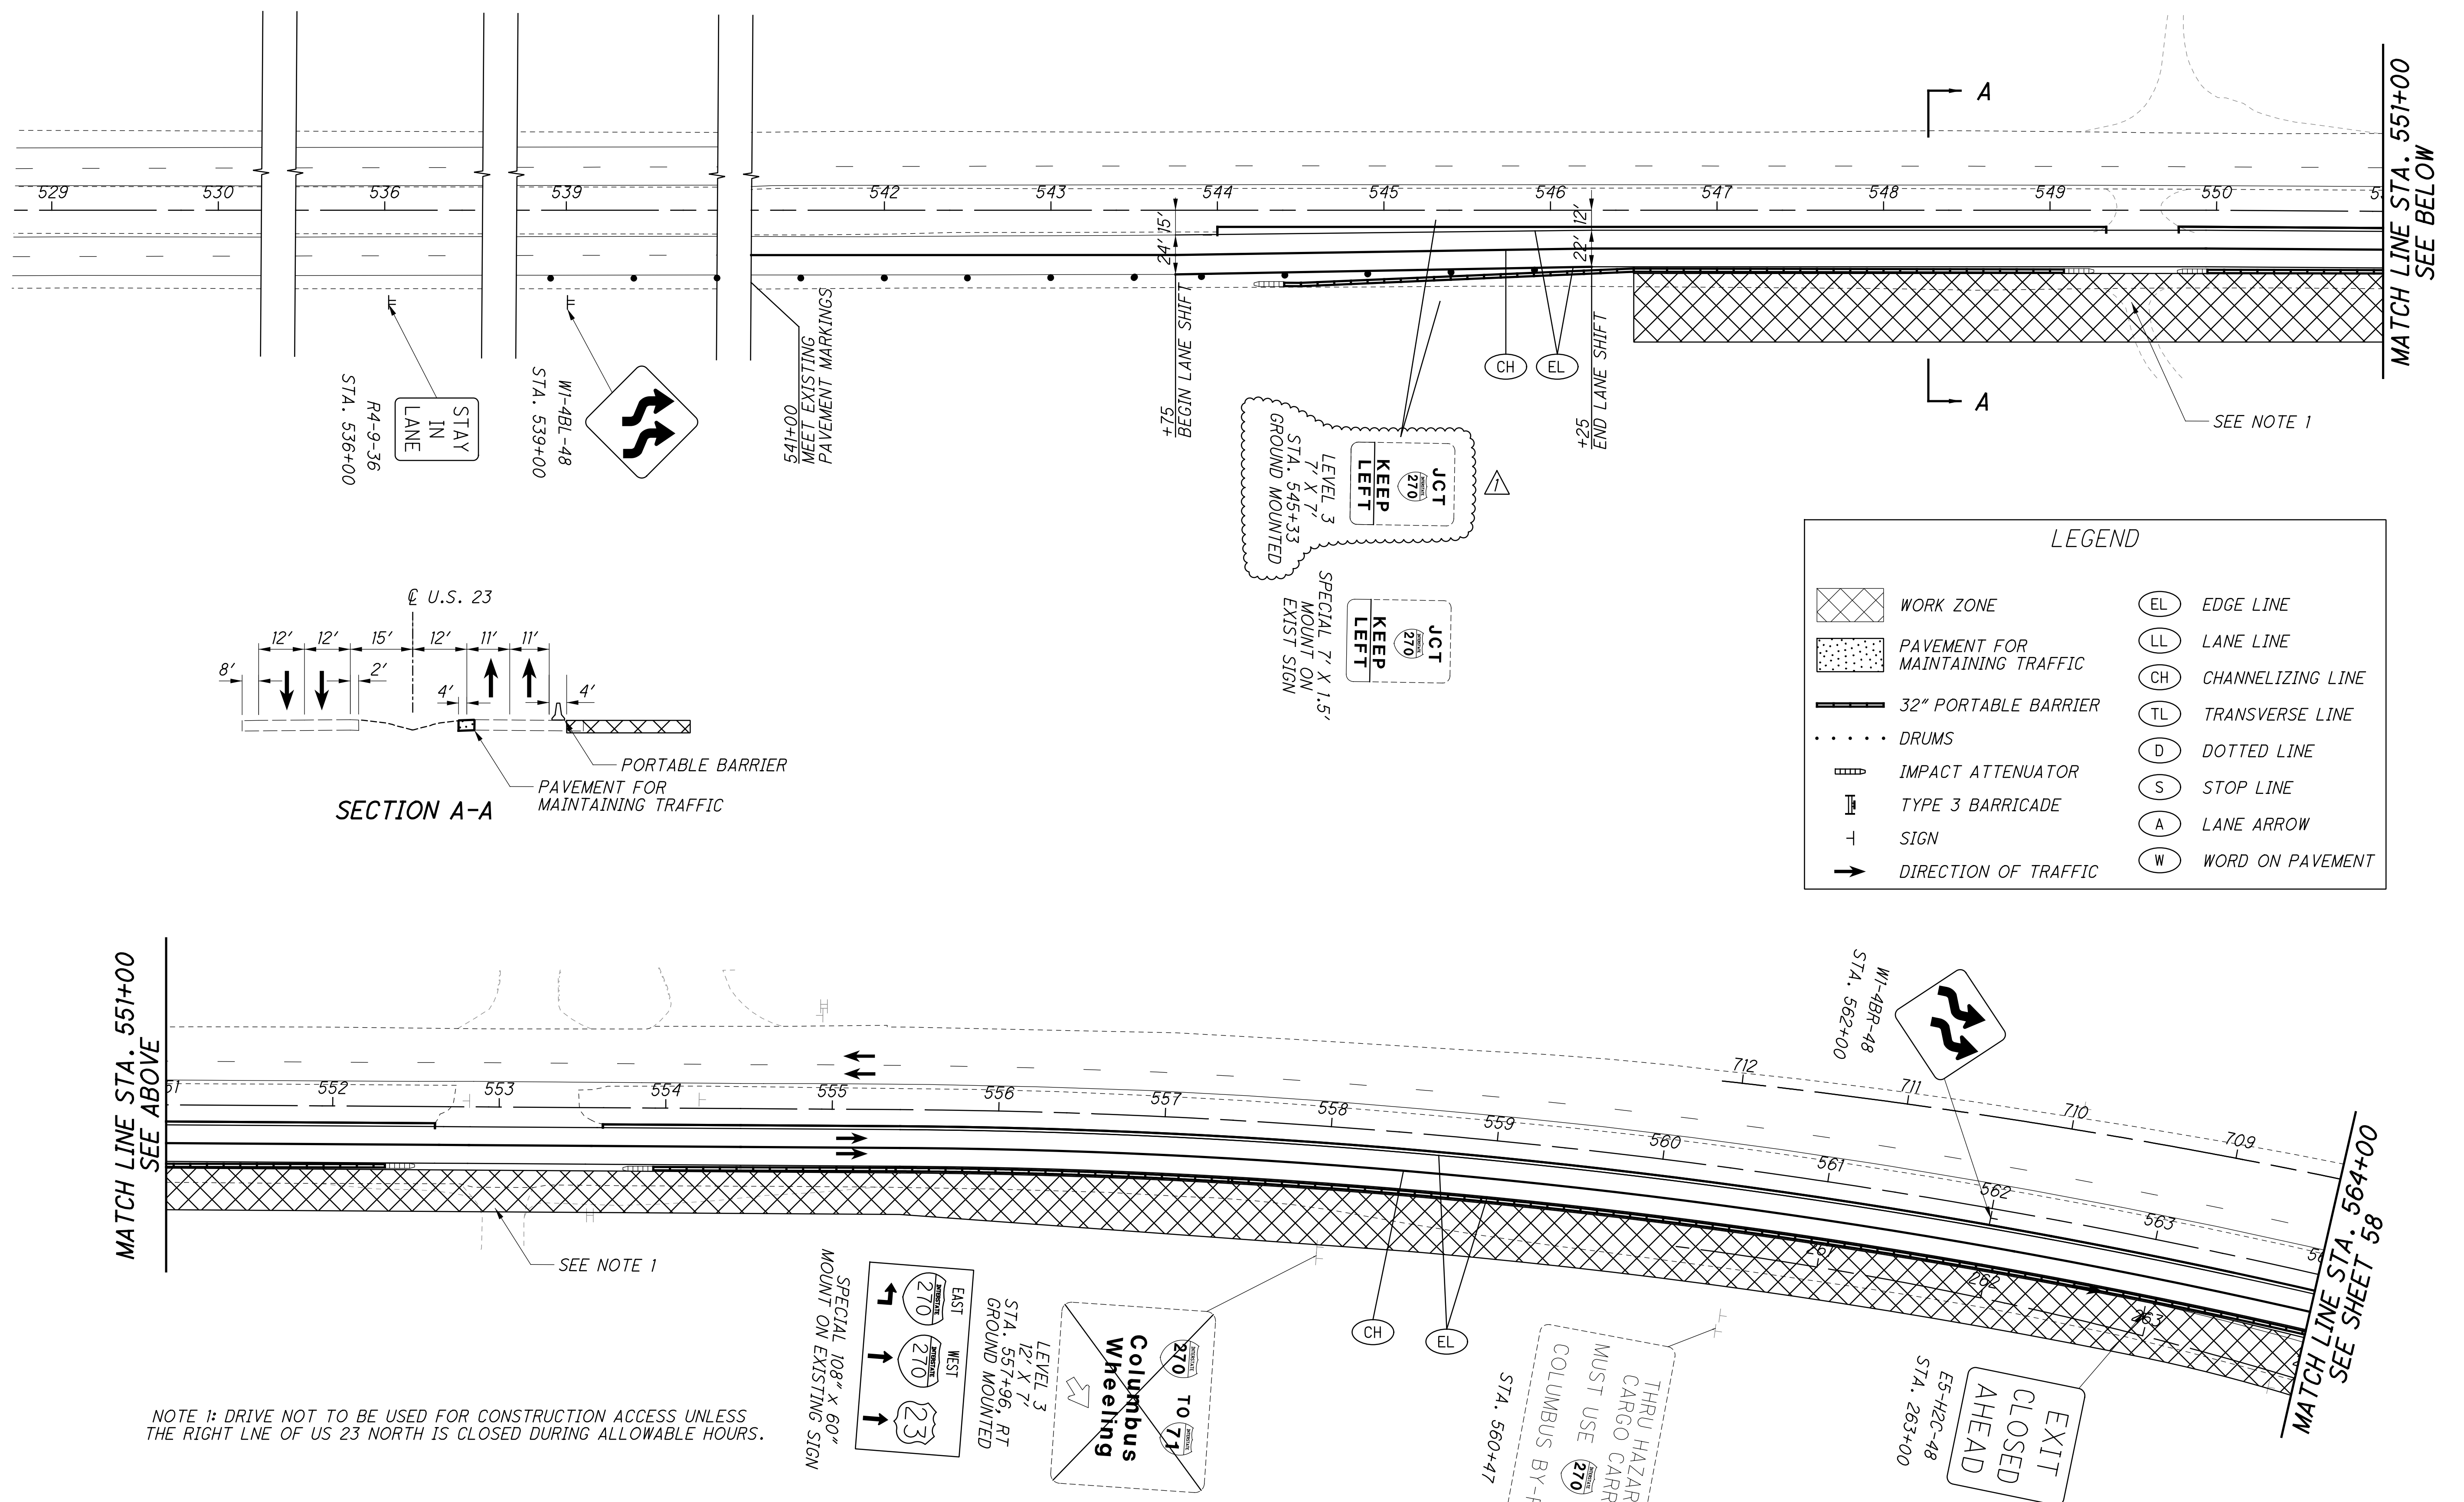

NOTE 1: DRIVE NOT TO BE USED FOR CONSTRUCTION ACCESS UNLESS THE RIGHT LINE OF US 23 NORTH IS CLOSED DURING ALLOWABLE HOURS.

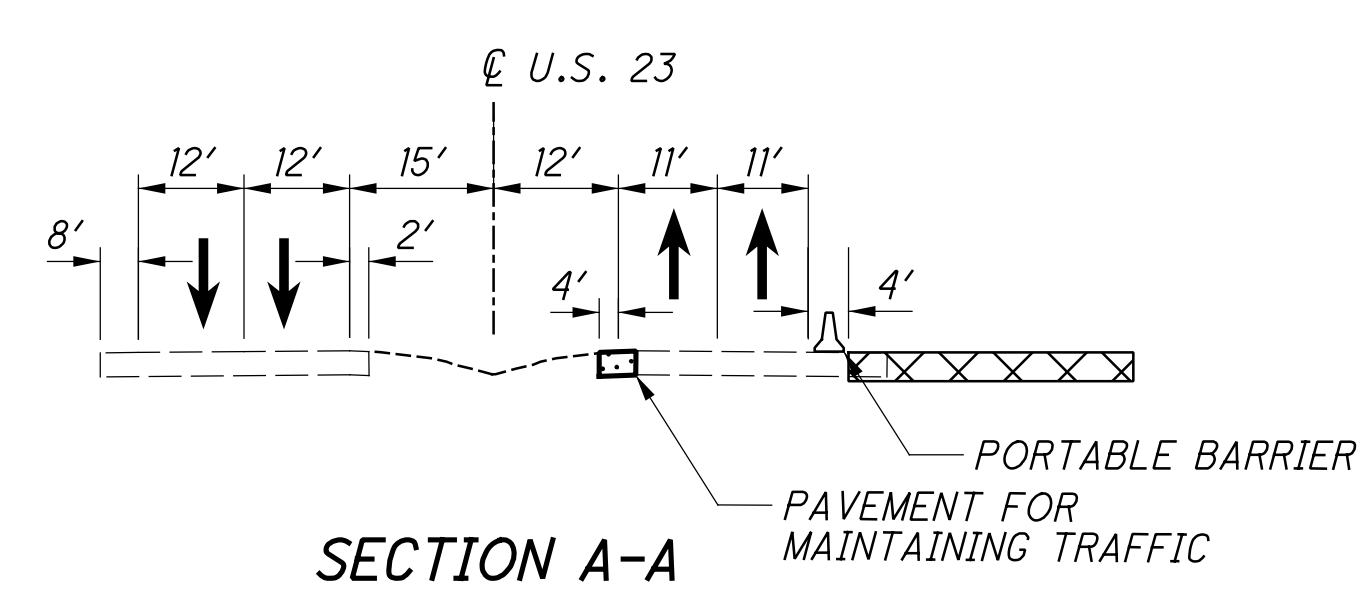

LEGEND

WORK ZONE	EDGE LINE
PAVEMENT FOR MAINTAINING TRAFFIC	LANE LINE
32" PORTABLE BARRIER	CHANNELIZING LINE
DRUMS	TRANSVERSE LINE
IMPACT ATTENUATOR	DOTTED LINE
TYPE 3 BARRICADE	STOP LINE
SIGN	LANE ARROW
DIRECTION OF TRAFFIC	WORD ON PAVEMENT

CALCULATED DJR CHECKED RCH

0 50 100  
25  
HORIZONTAL SCALE IN FEET


**MAINTENANCE OF TRAFFIC - PHASE 2**  
**U.S. 23 STA. 529+00 TO STA. 564+00**

**FRA-270-51.50**

ADDENDUM #1  
04/21/2023

NOTE:  
SEE SHEET 60 FOR ADDITIONAL SIGNAGE.



LEGEND			
	WORK ZONE		EDGE LINE
	PAVEMENT FOR MAINTAINING TRAFFIC		LANE LINE
	32" PORTABLE BARRIER		CHANNELIZING LINE
	DRUMS		TRANSVERSE LINE
	IMPACT ATTENUATOR		DOTTED LINE
	TYPE 3 BARRICADE		STOP LINE
	SIGN		LANE ARROW
	DIRECTION OF TRAFFIC		WORD ON PAVEMENT

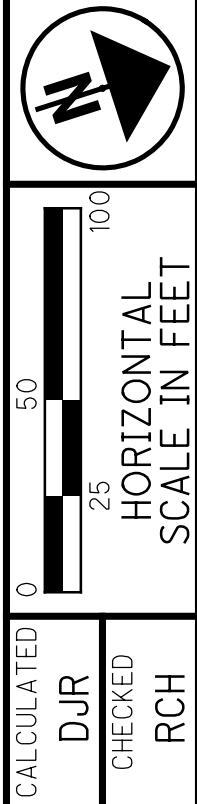

MAINTENANCE OF TRAFFIC - PHASE 2  
U.S. 23 STA. 582+00 TO STA. 609+00


FRA - 270-51.50

X:\Projects\2013\1321\1010\FRA\92616\mot\sheet\92616MP156.dgn 4/19/2023 6:52:32 AM cwong

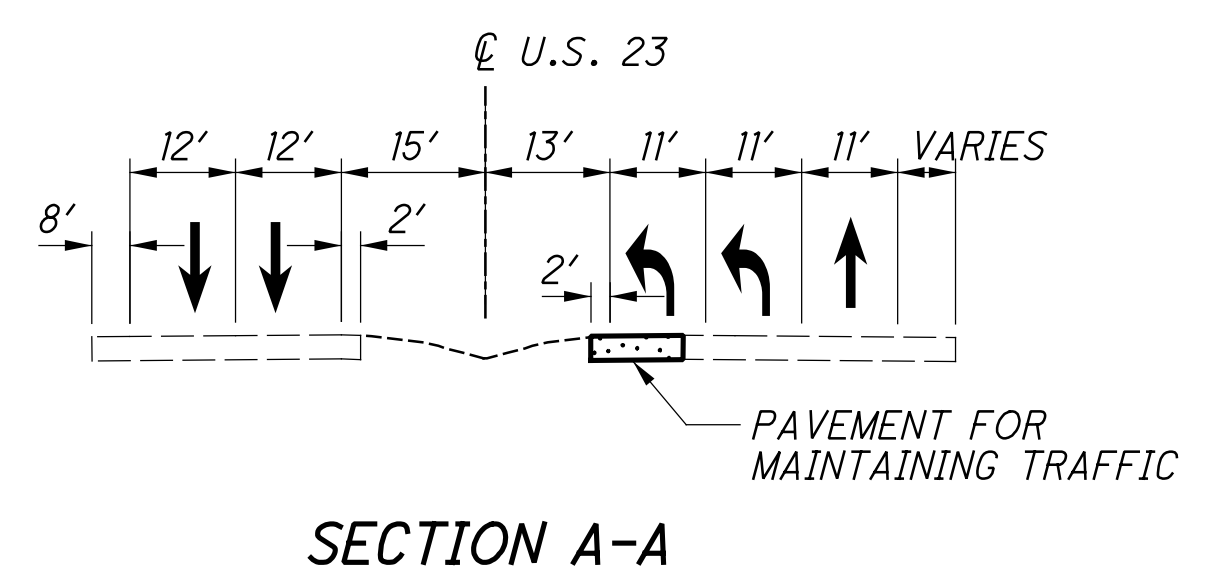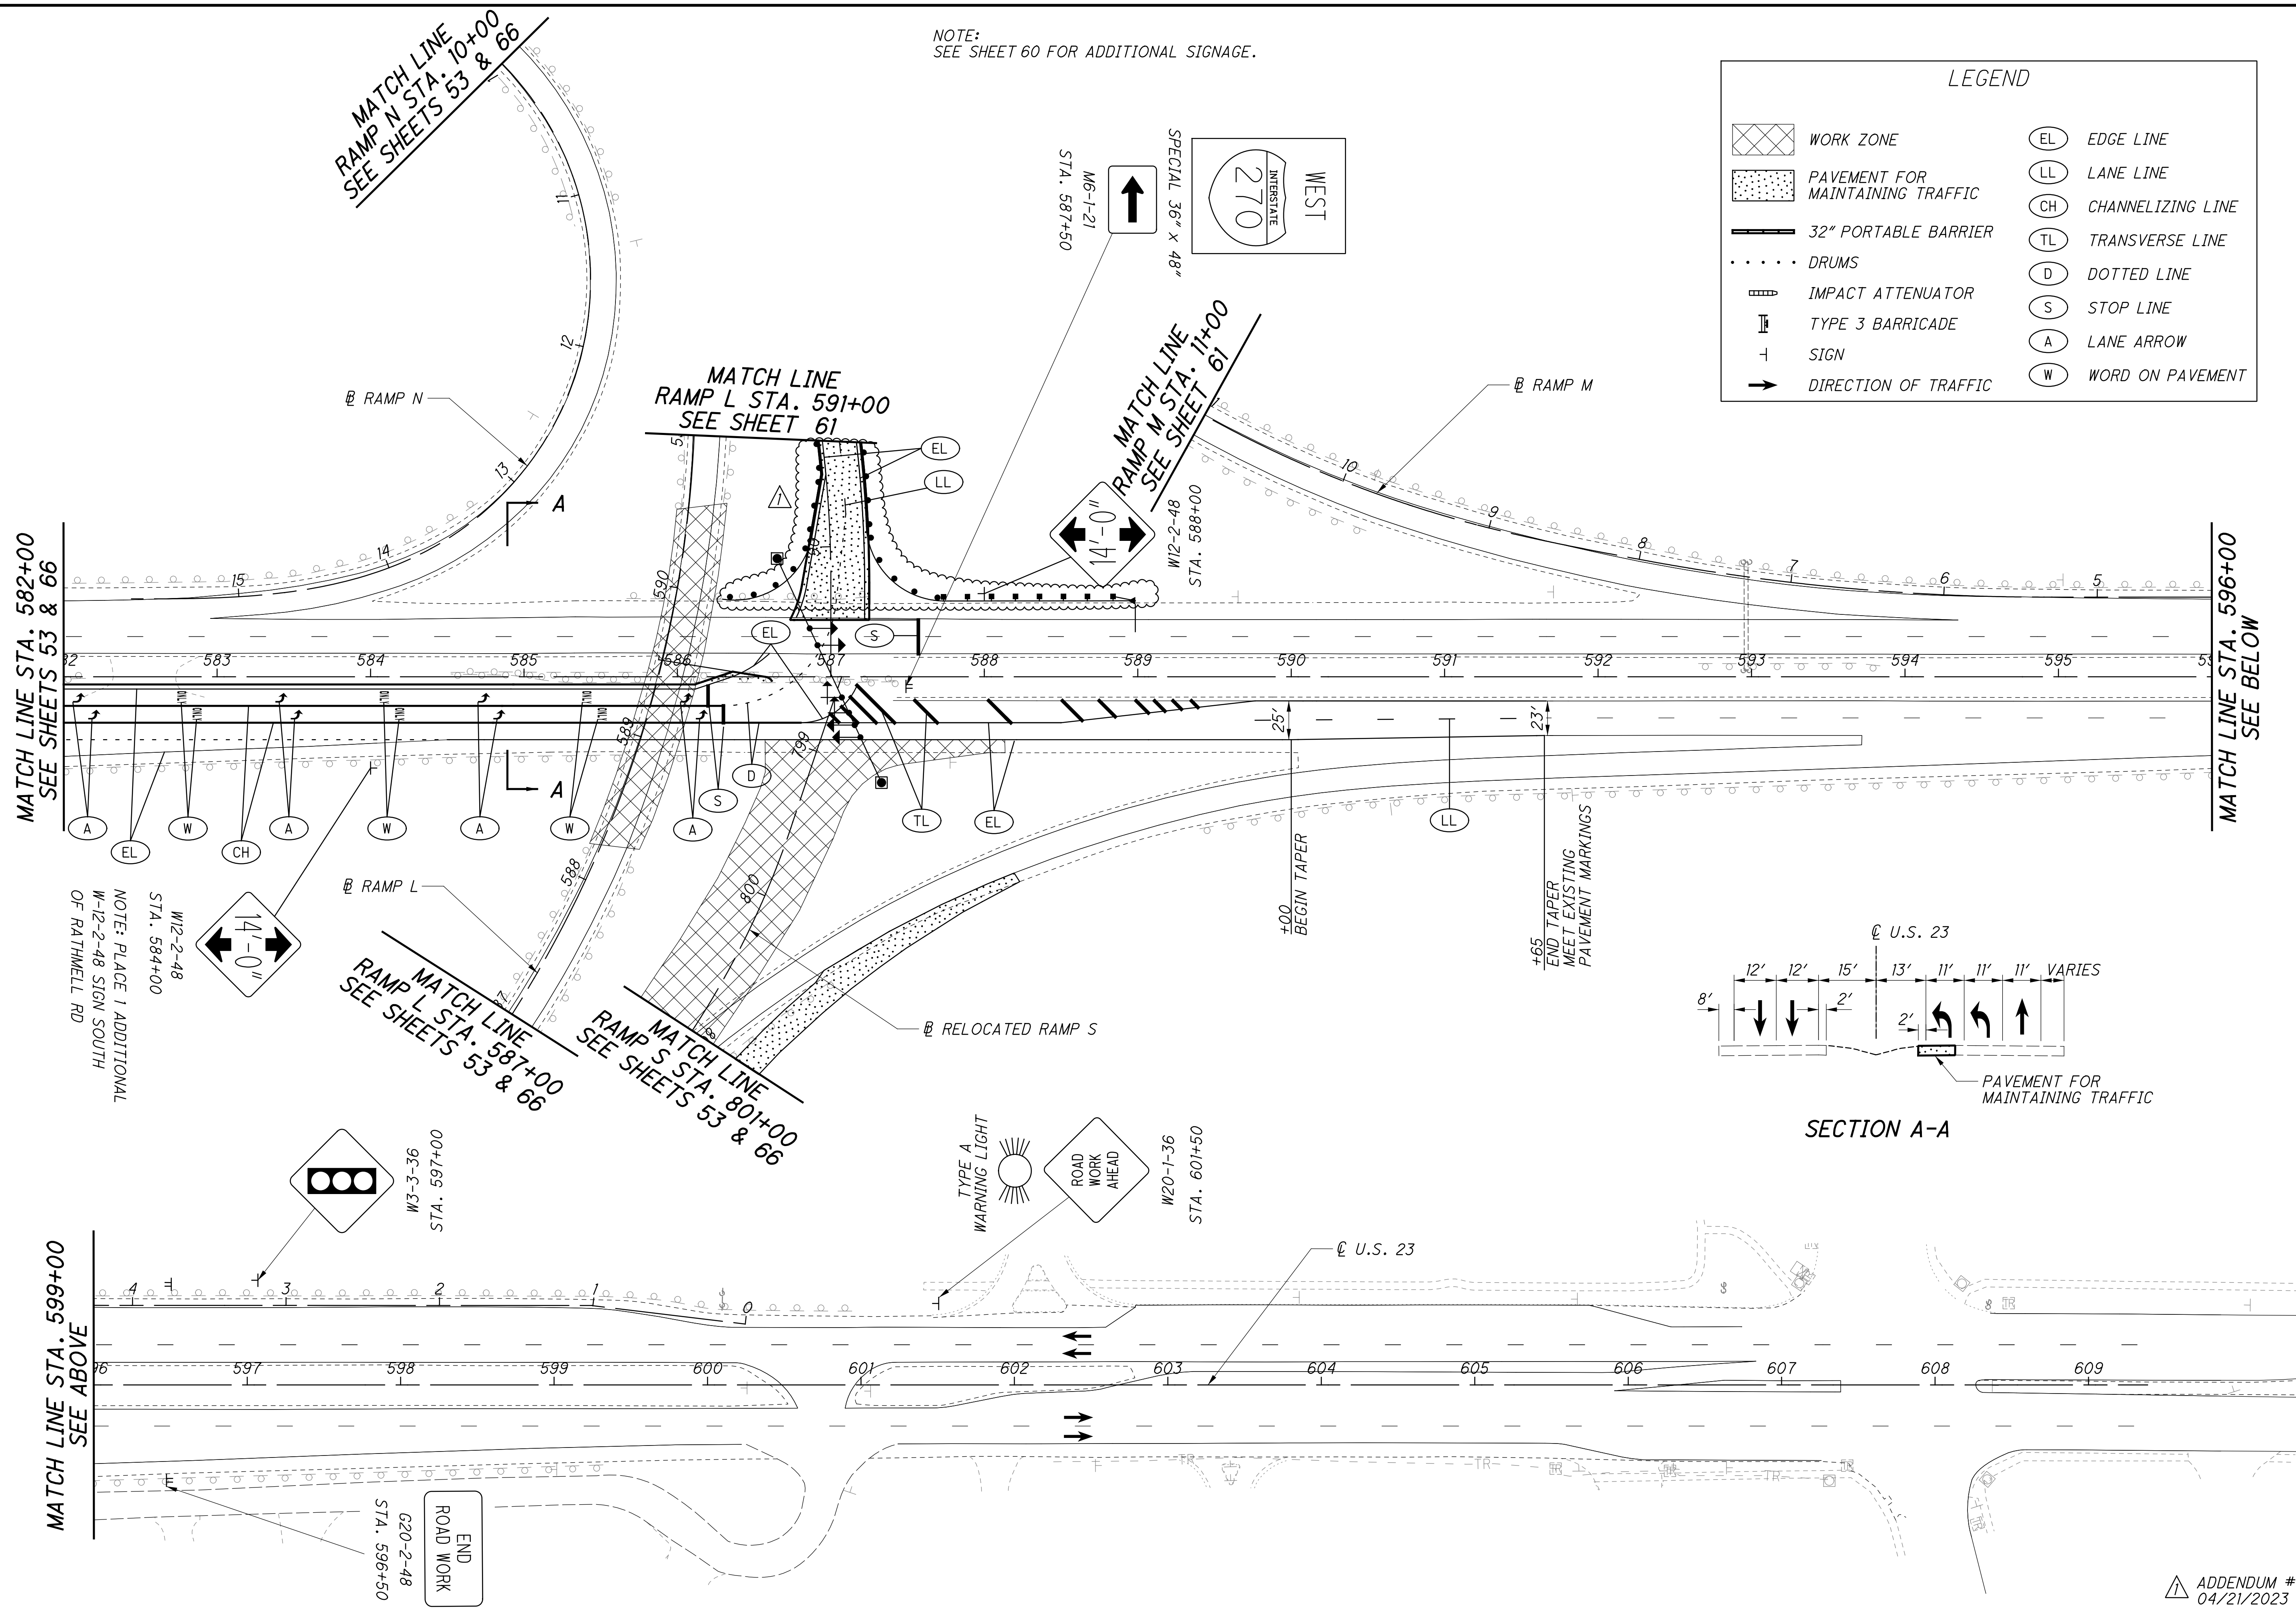

ADDENDUM #1  
04/21/2023



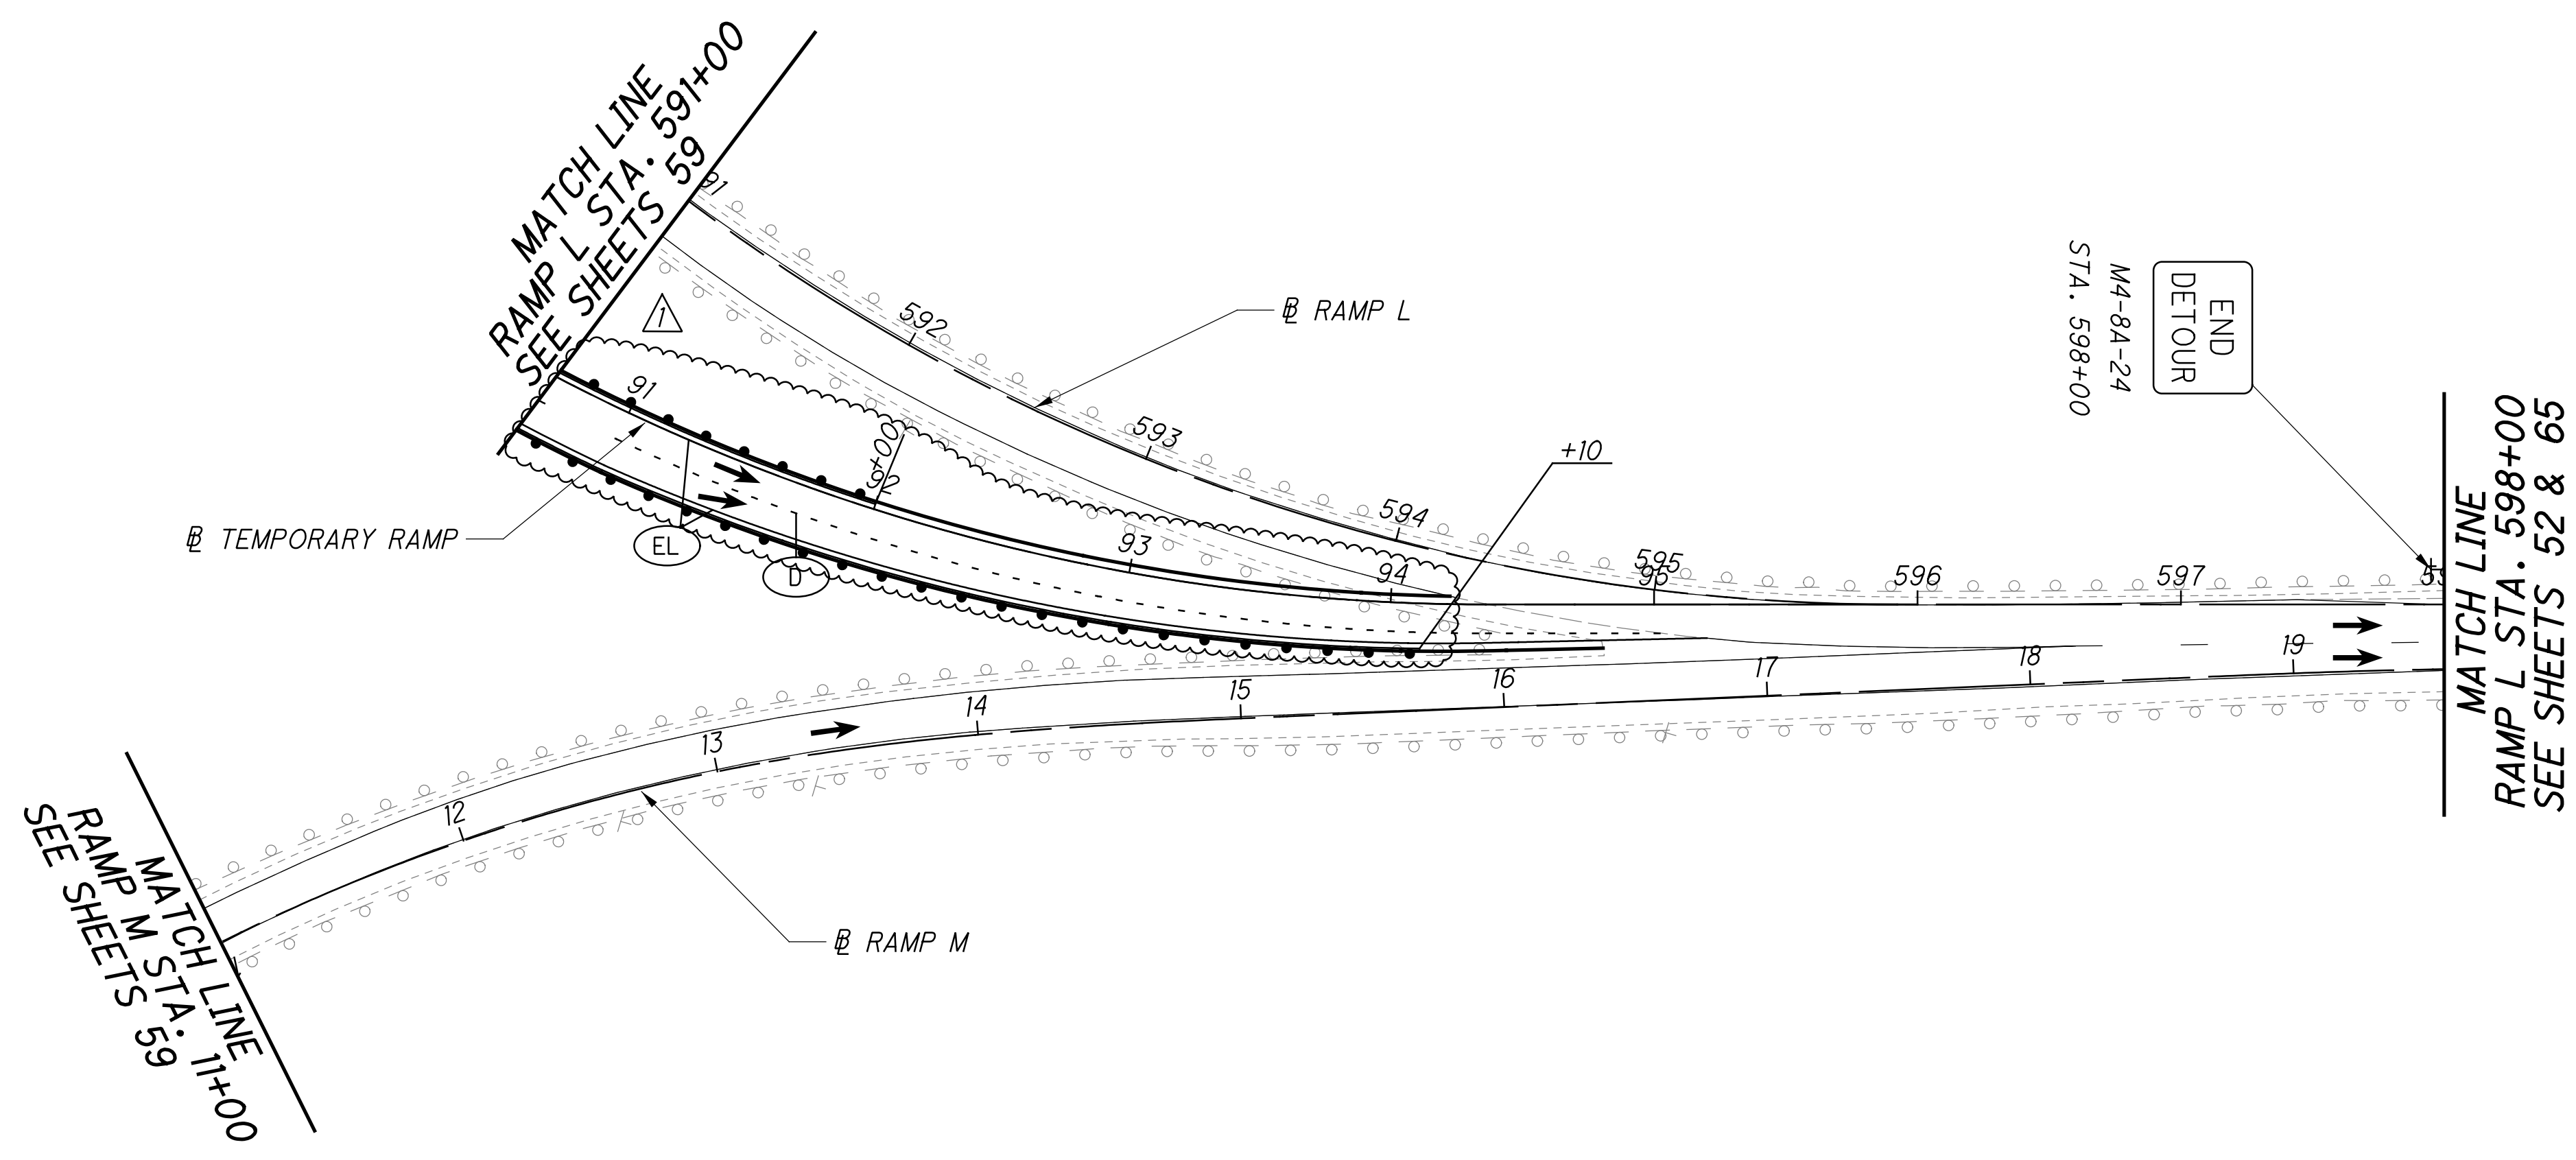

**LEGEND**

WORK ZONE	EDGE LINE
PAVEMENT FOR MAINTAINING TRAFFIC	LANE LINE
32" PORTABLE BARRIER	CHANNELIZING LINE
DRUMS	TRANSVERSE LINE
IMPACT ATTENUATOR	DOTTED LINE
TYPE 3 BARRICADE	STOP LINE
SIGN	LANE ARROW
DIRECTION OF TRAFFIC	WORD ON PAVEMENT


CALCULATED  
DJR  
CHECKED  
RCH

0 50 100  
HORIZONTAL  
SCALE IN FEET

**MAINTENANCE OF TRAFFIC - PHASES 2  
RAMP L STA. 591+00 TO STA. 598+00**




**FRA - 270-51.50**

X:\Projects\2013\1010\FRA\92616\mot\sheets\92616MP403.dgn 4/21/2023 4:44:01 PM cwong

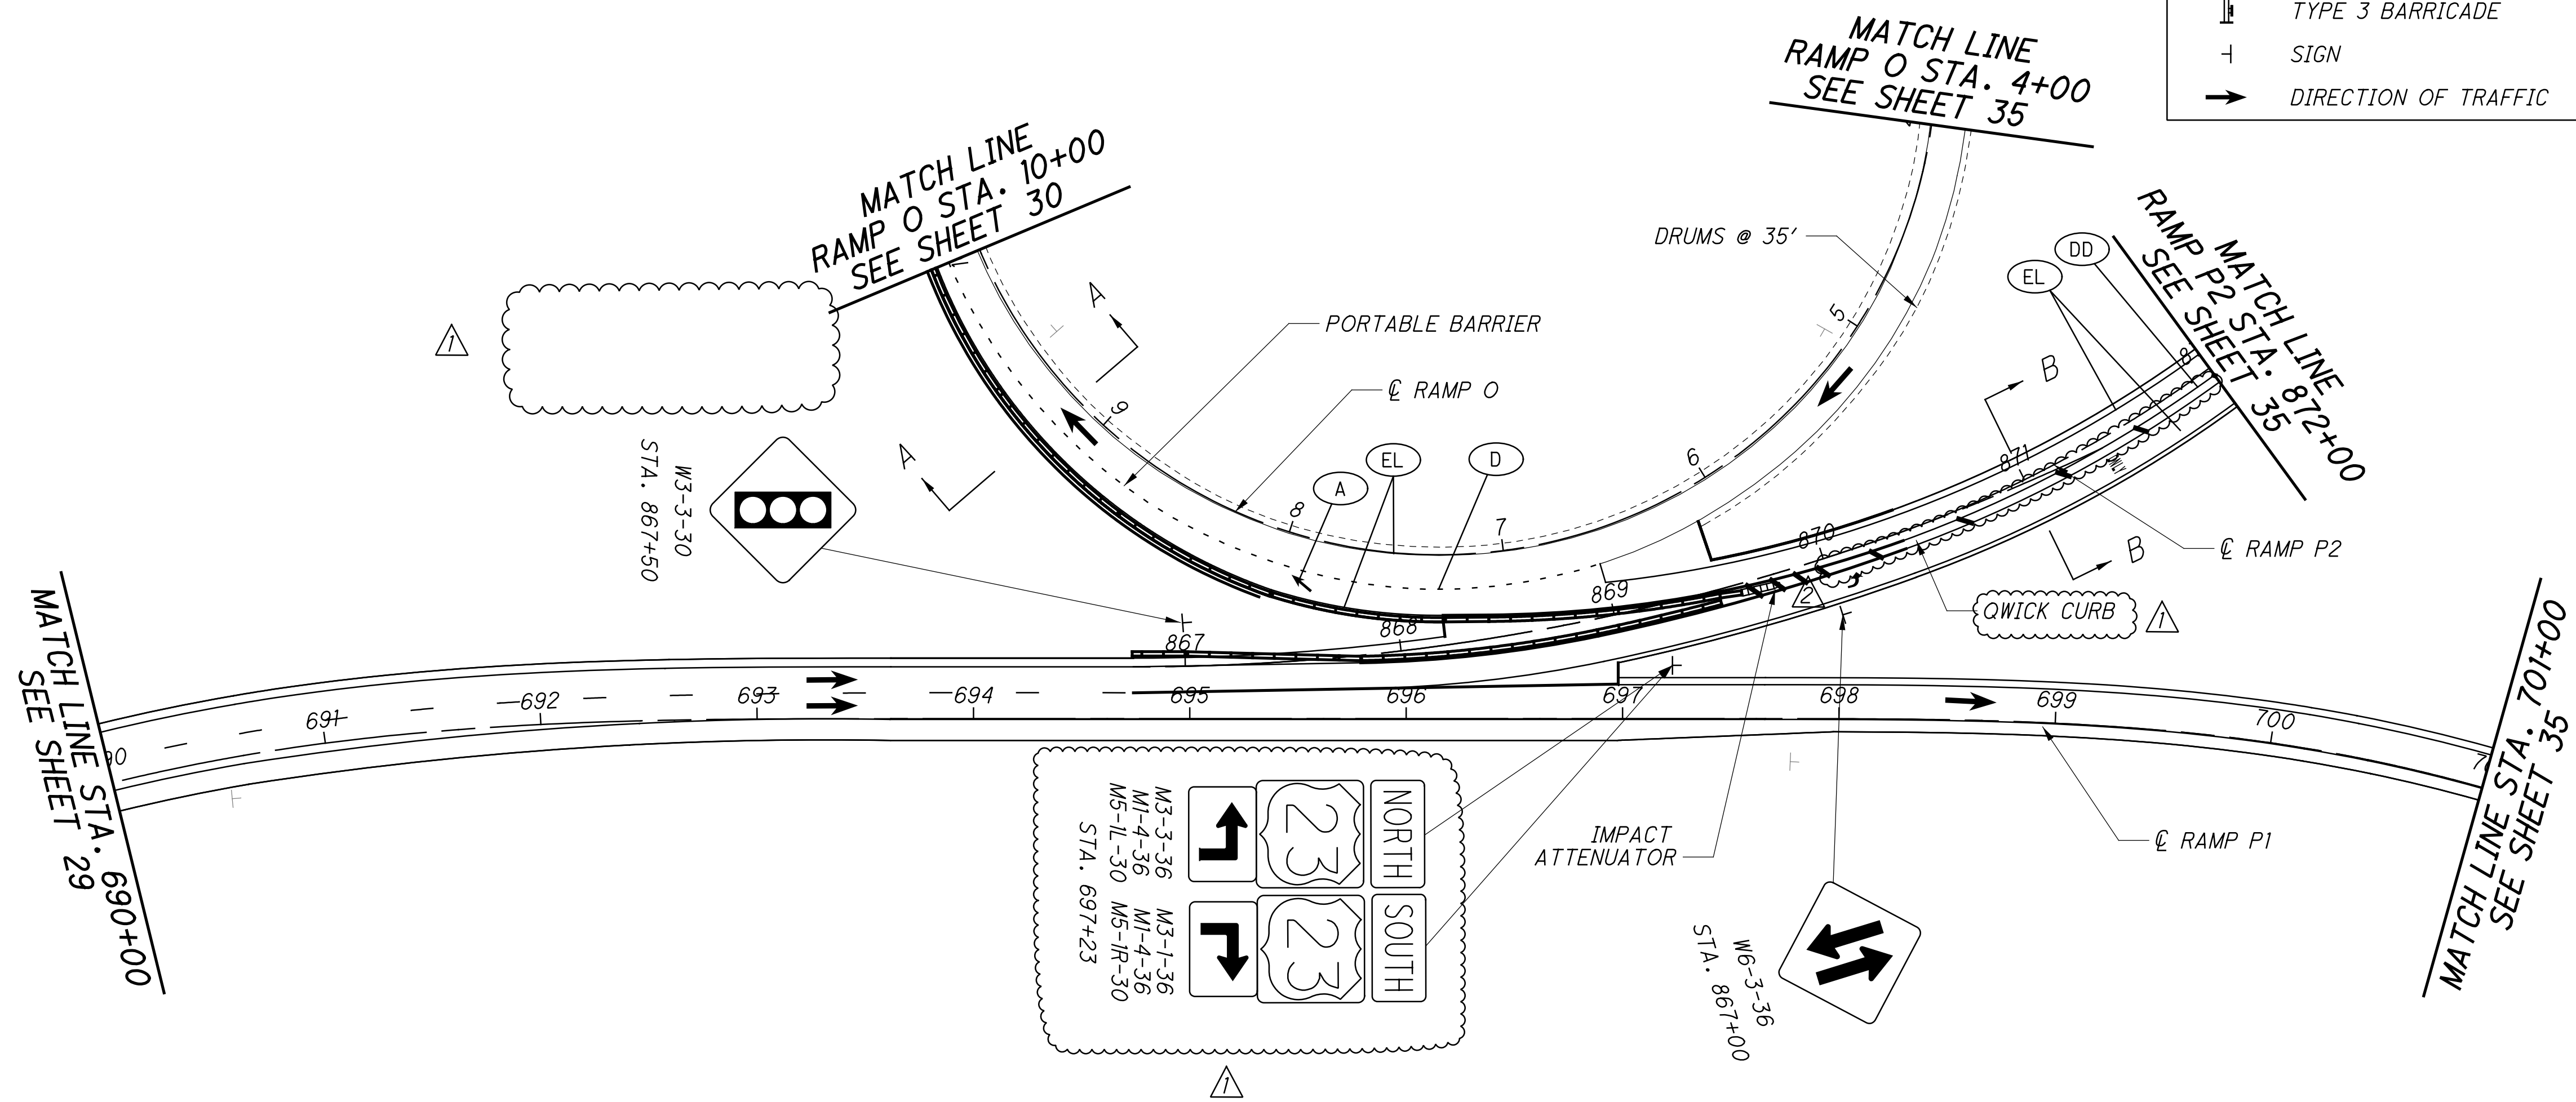

**LEGEND**

	WORK ZONE		DOUBLE YELLOW $\mathcal{C}$
	PAVEMENT FOR MAINTAINING TRAFFIC		EDGE LINE
	32" PORTABLE BARRIER		LANE LINE
	DRUMS		CHANNELIZING LINE
	IMPACT ATTENUATOR		TRANSVERSE LINE
	TYPE 3 BARRICADE		DOTTED LINE
	SIGN		STOP LINE
	DIRECTION OF TRAFFIC		LANE ARROW
			WORD ON PAVEMENT

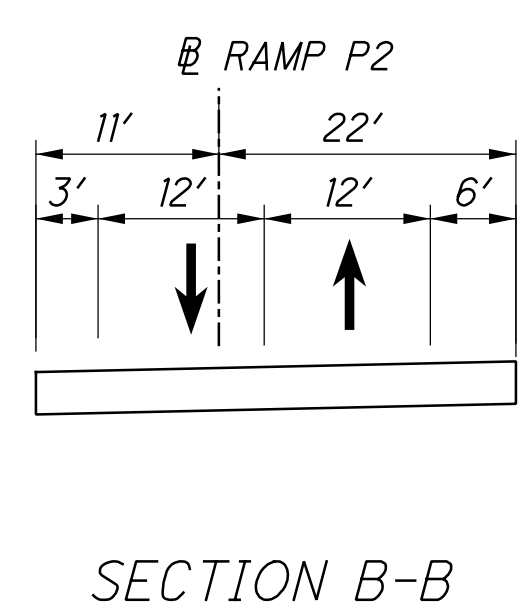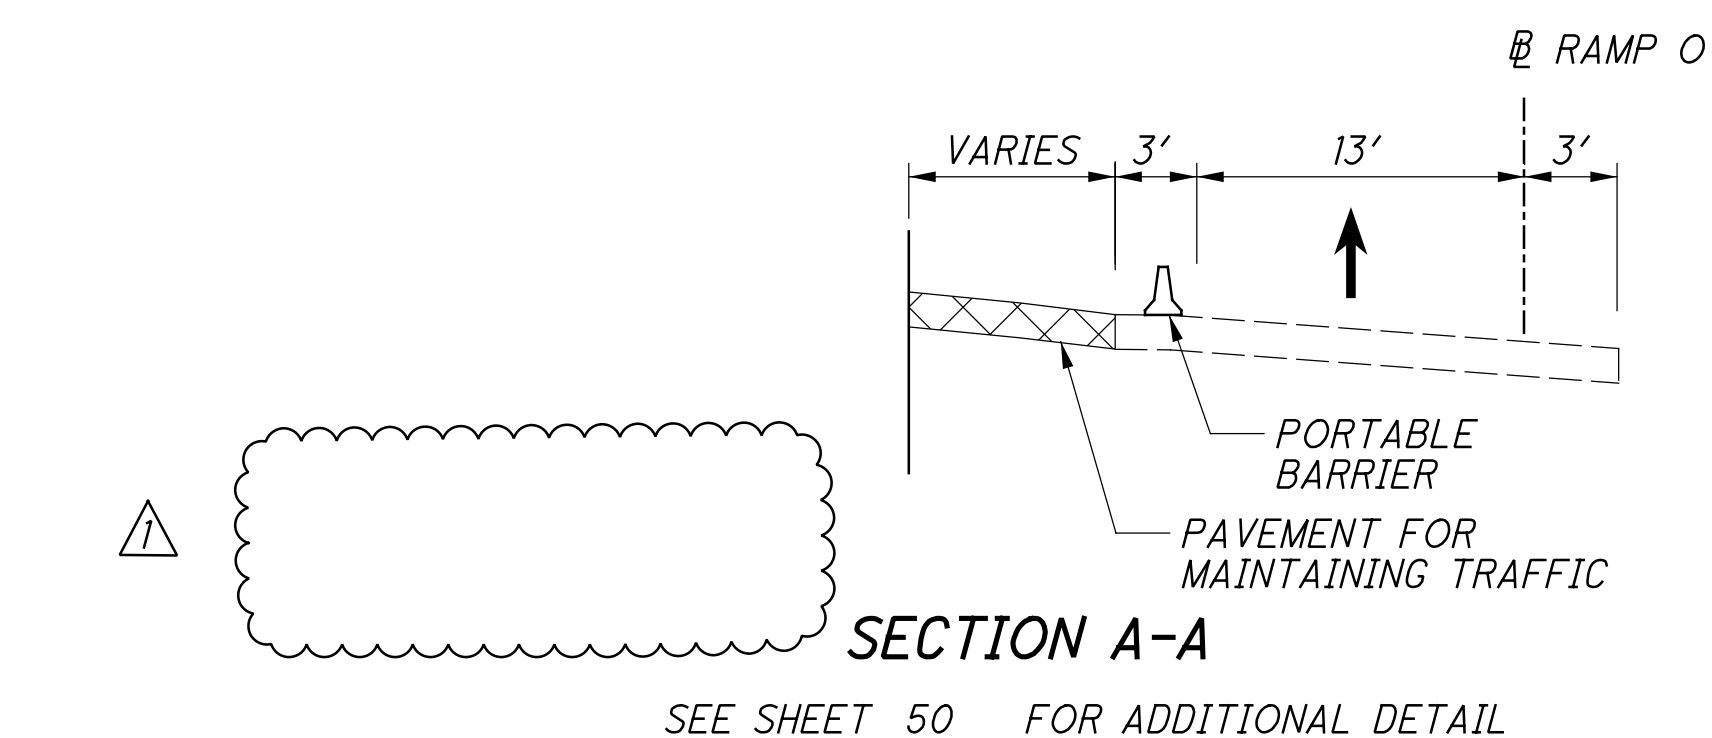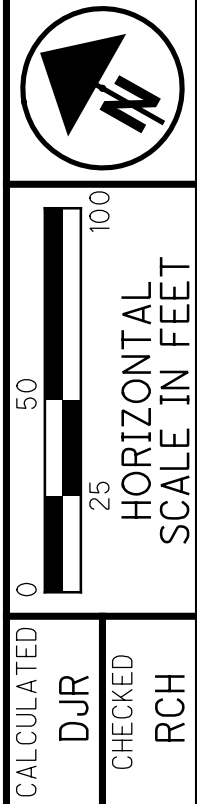


**RAMP P1 STA. 690+00 TO STA. 701+00**  
**RAMP P2 STA. 867+00 TO STA. 872+00**  
**RAMP O STA. 4+00 TO STA. 10+00**

**MAINTENANCE OF TRAFFIC - PHASE 2**  
**RAMPS P1, P2, & O**

**FRA - 270-51.50**

ADDENDUM #1  
04/21/2023

X:\Projects\2013\1321\1010\FRA\92616\mot\sheets\92616MP007.dgn 4/19/2023 6:59:02 AM cwong

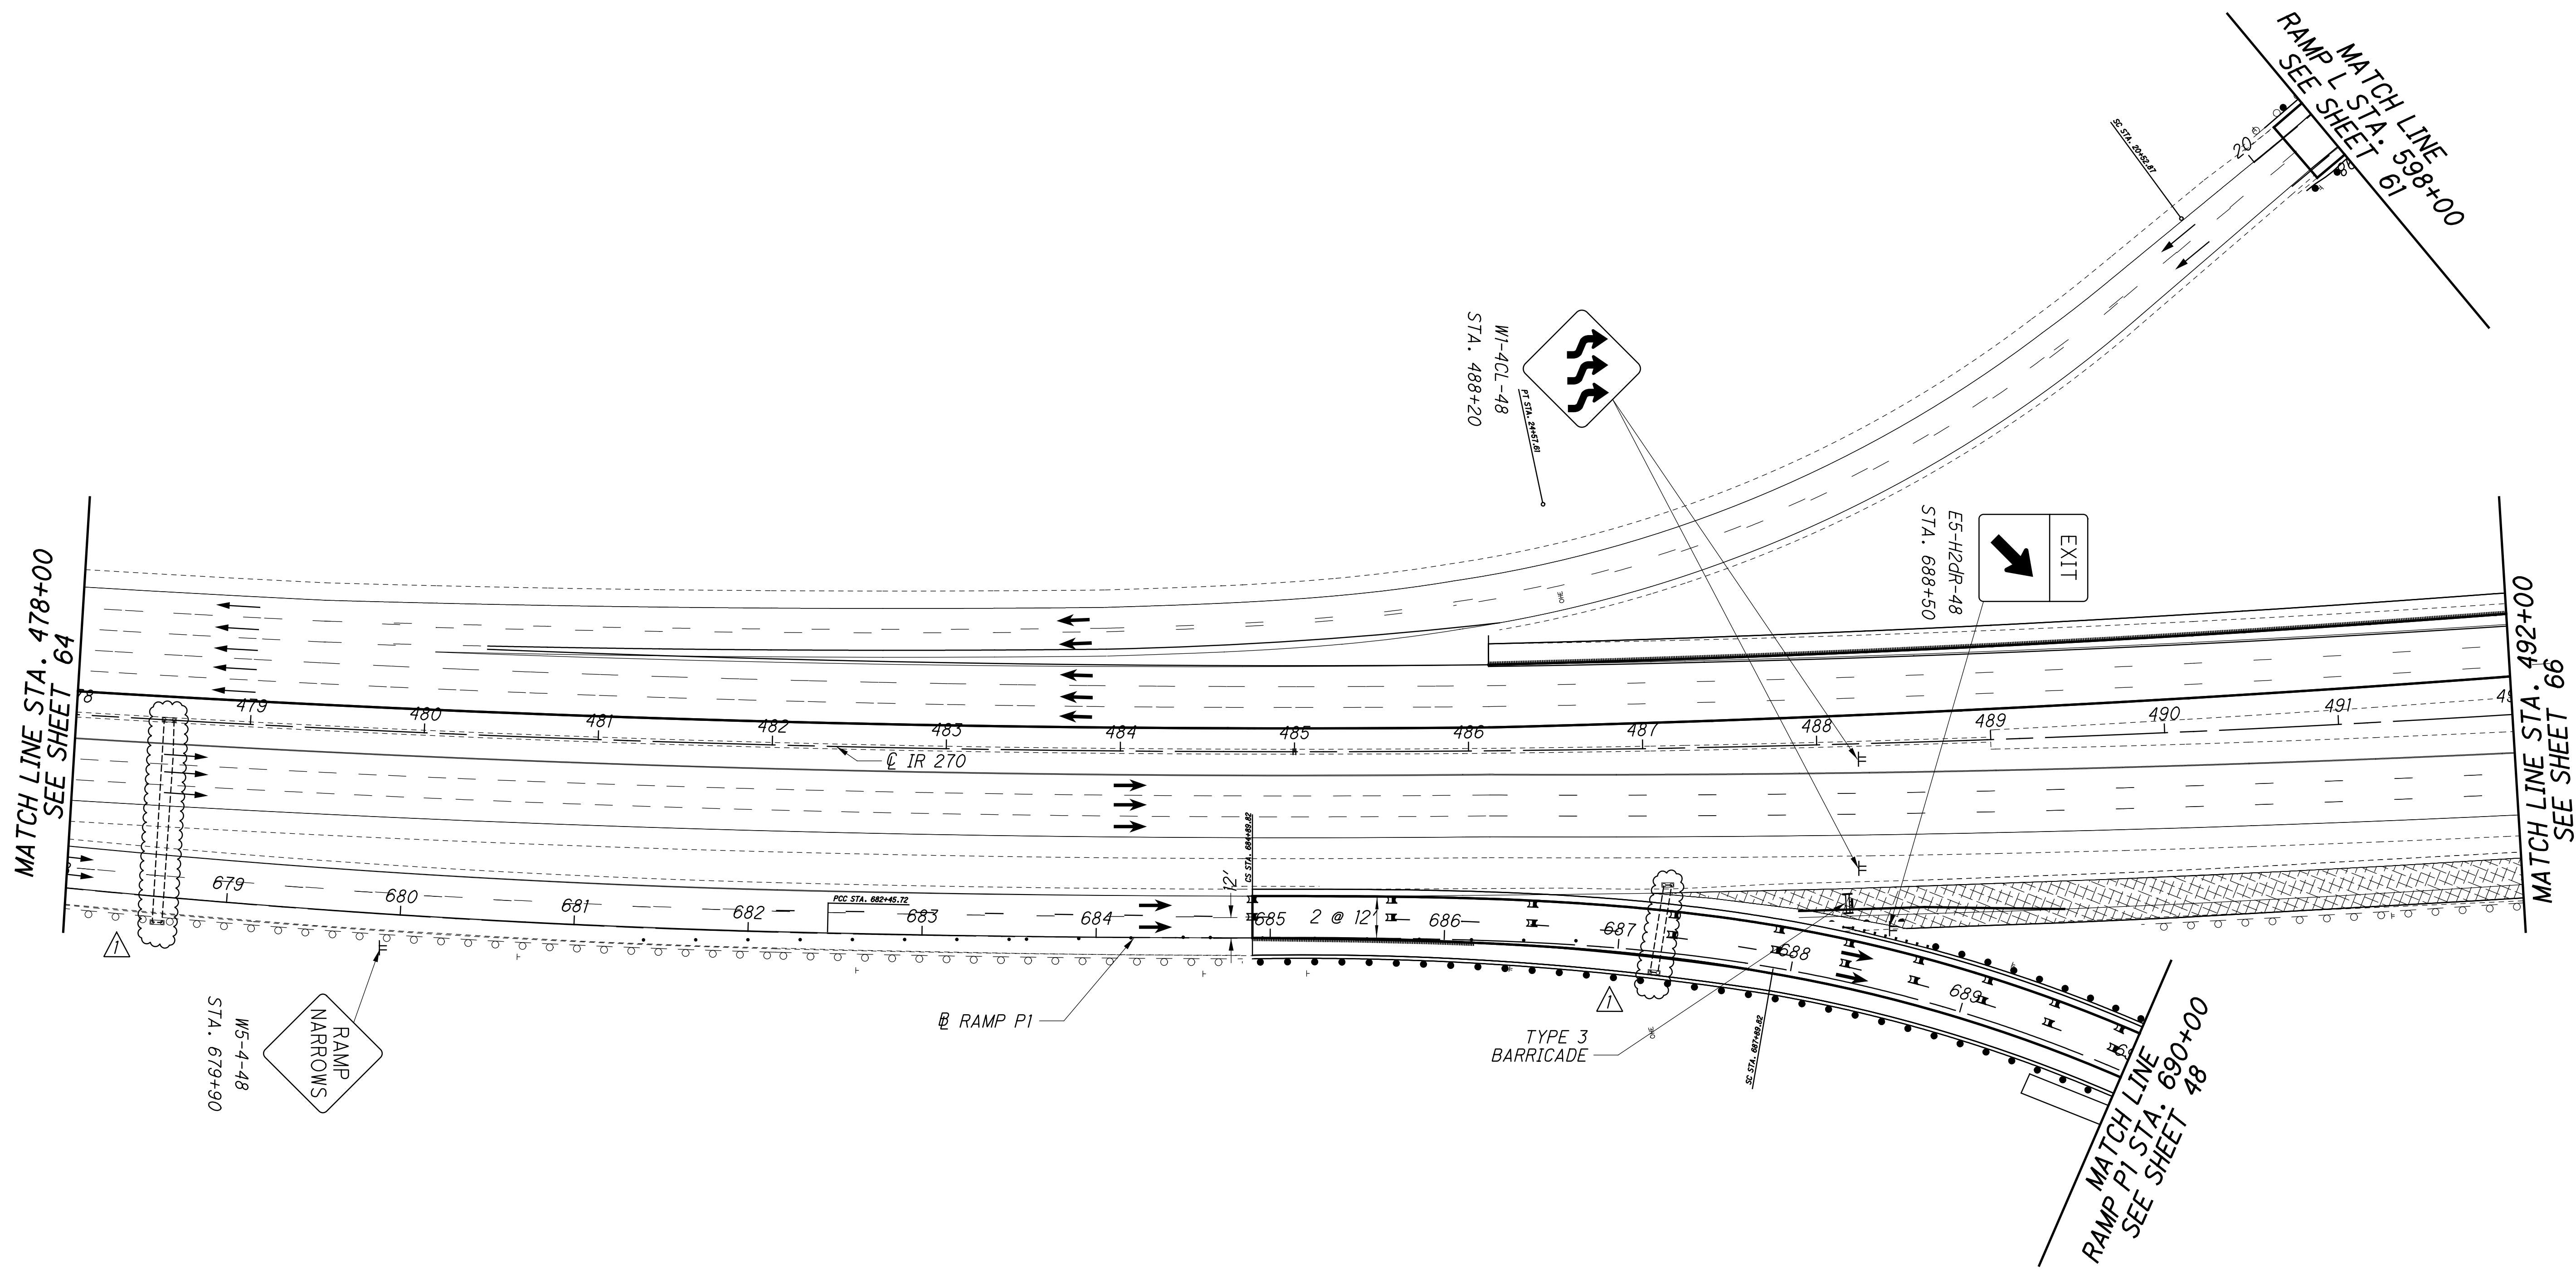

CALCULATED  
DJR  
CHECKED  
RCH

0 50 100  
HORIZONTAL  
SCALE IN FEET















 

**MAINTENANCE OF TRAFFIC - PHASE 2A**  
**I-270 STA. 478+00 TO STA. 492+00**



**FRA - 270-51.50**

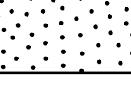

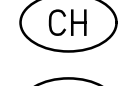X:\Projects\2013\1010\FRA\92616\mot\sheets\92616MPO08.dgn 4/21/2023 4:45:37 PM c.wong

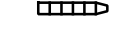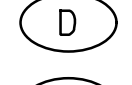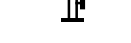**LEGEND**

	WORK ZONE		EDGE LINE
	PAVEMENT FOR MAINTAINING TRAFFIC		LANE LINE
	32" PORTABLE BARRIER		CHANNELIZING LINE
	DRUMS		TRANSVERSE LINE
	IMPACT ATTENUATOR		DOTTED LINE
	TYPE 3 BARRICADE		STOP LINE
	SIGN		LANE ARROW
	DIRECTION OF TRAFFIC		WORD ON PAVEMENT

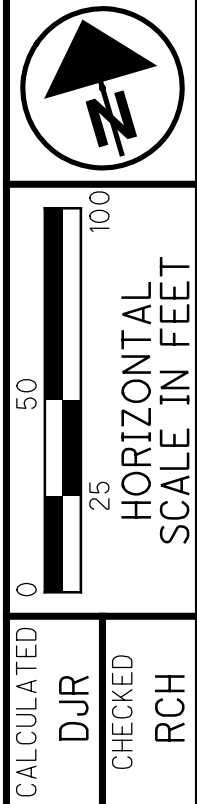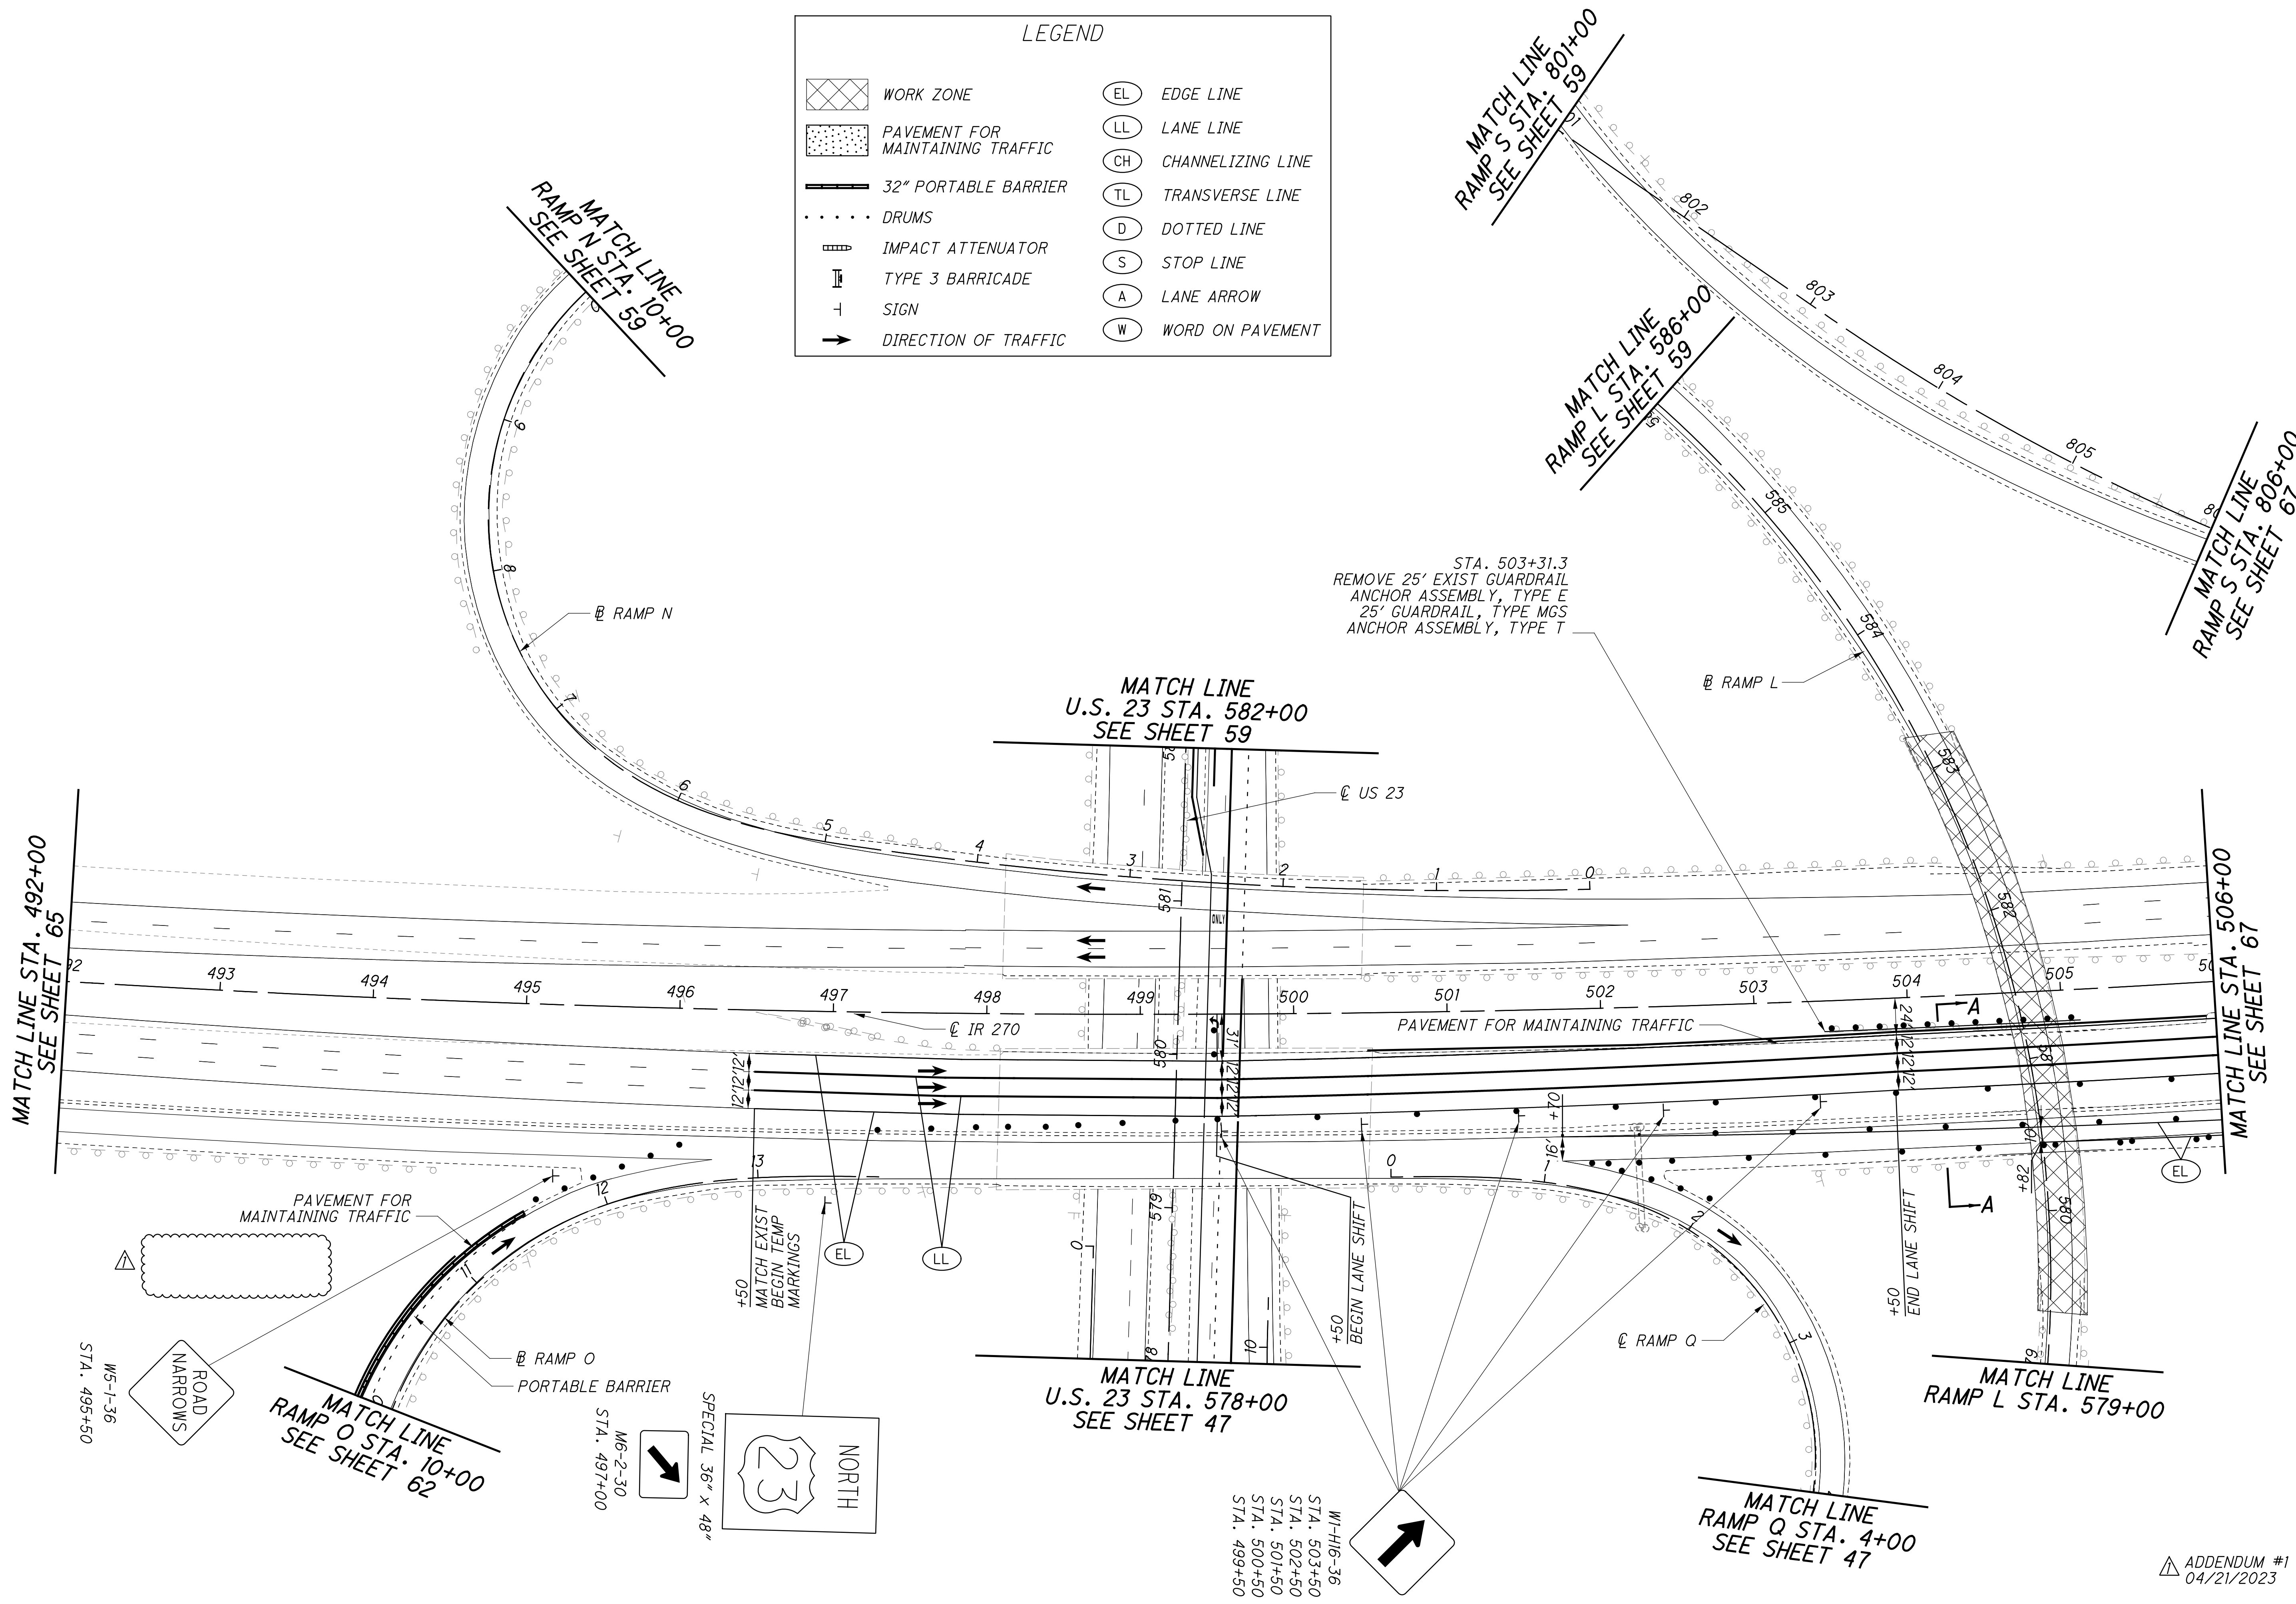


**MAINTENANCE OF TRAFFIC - PHASE 2A**  
**I-270 STA. 492+00 TO STA. 506+00**

**FRA-270-51.50**

ADDENDUM #1  
04/21/2023

X:\Projects\2013\1321\1010\FRA\92616\mot\sheets\92616MP009.dgn 4/19/2023 7:00:18 AM cwong

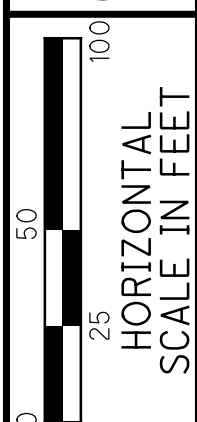



CALCULATED  
DJR  
CHECKED  
RCH

**MAINTENANCE OF TRAFFIC - PHASE 2A**  
**I-270 STA. 506+00 TO STA. 520+00**

**FRA - 270-51.50**


**LEGEND**

	WORK ZONE		EDGE LINE
	PAVEMENT FOR MAINTAINING TRAFFIC		LANE LINE
	32" PORTABLE BARRIER		CHANNELIZING LINE
	DRUMS		TRANSVERSE LINE
	IMPACT ATTENUATOR		DOTTED LINE
	TYPE 3 BARRICADE		STOP LINE
	SIGN		LANE ARROW
	DIRECTION OF TRAFFIC		WORD ON PAVEMENT

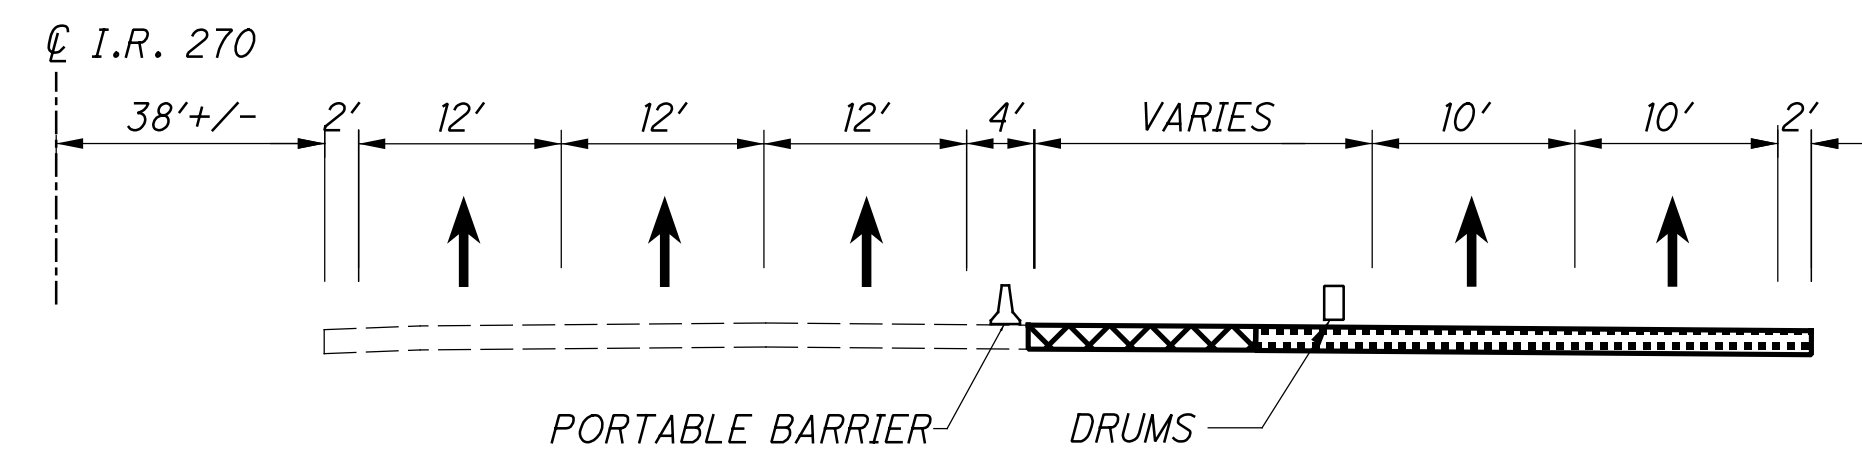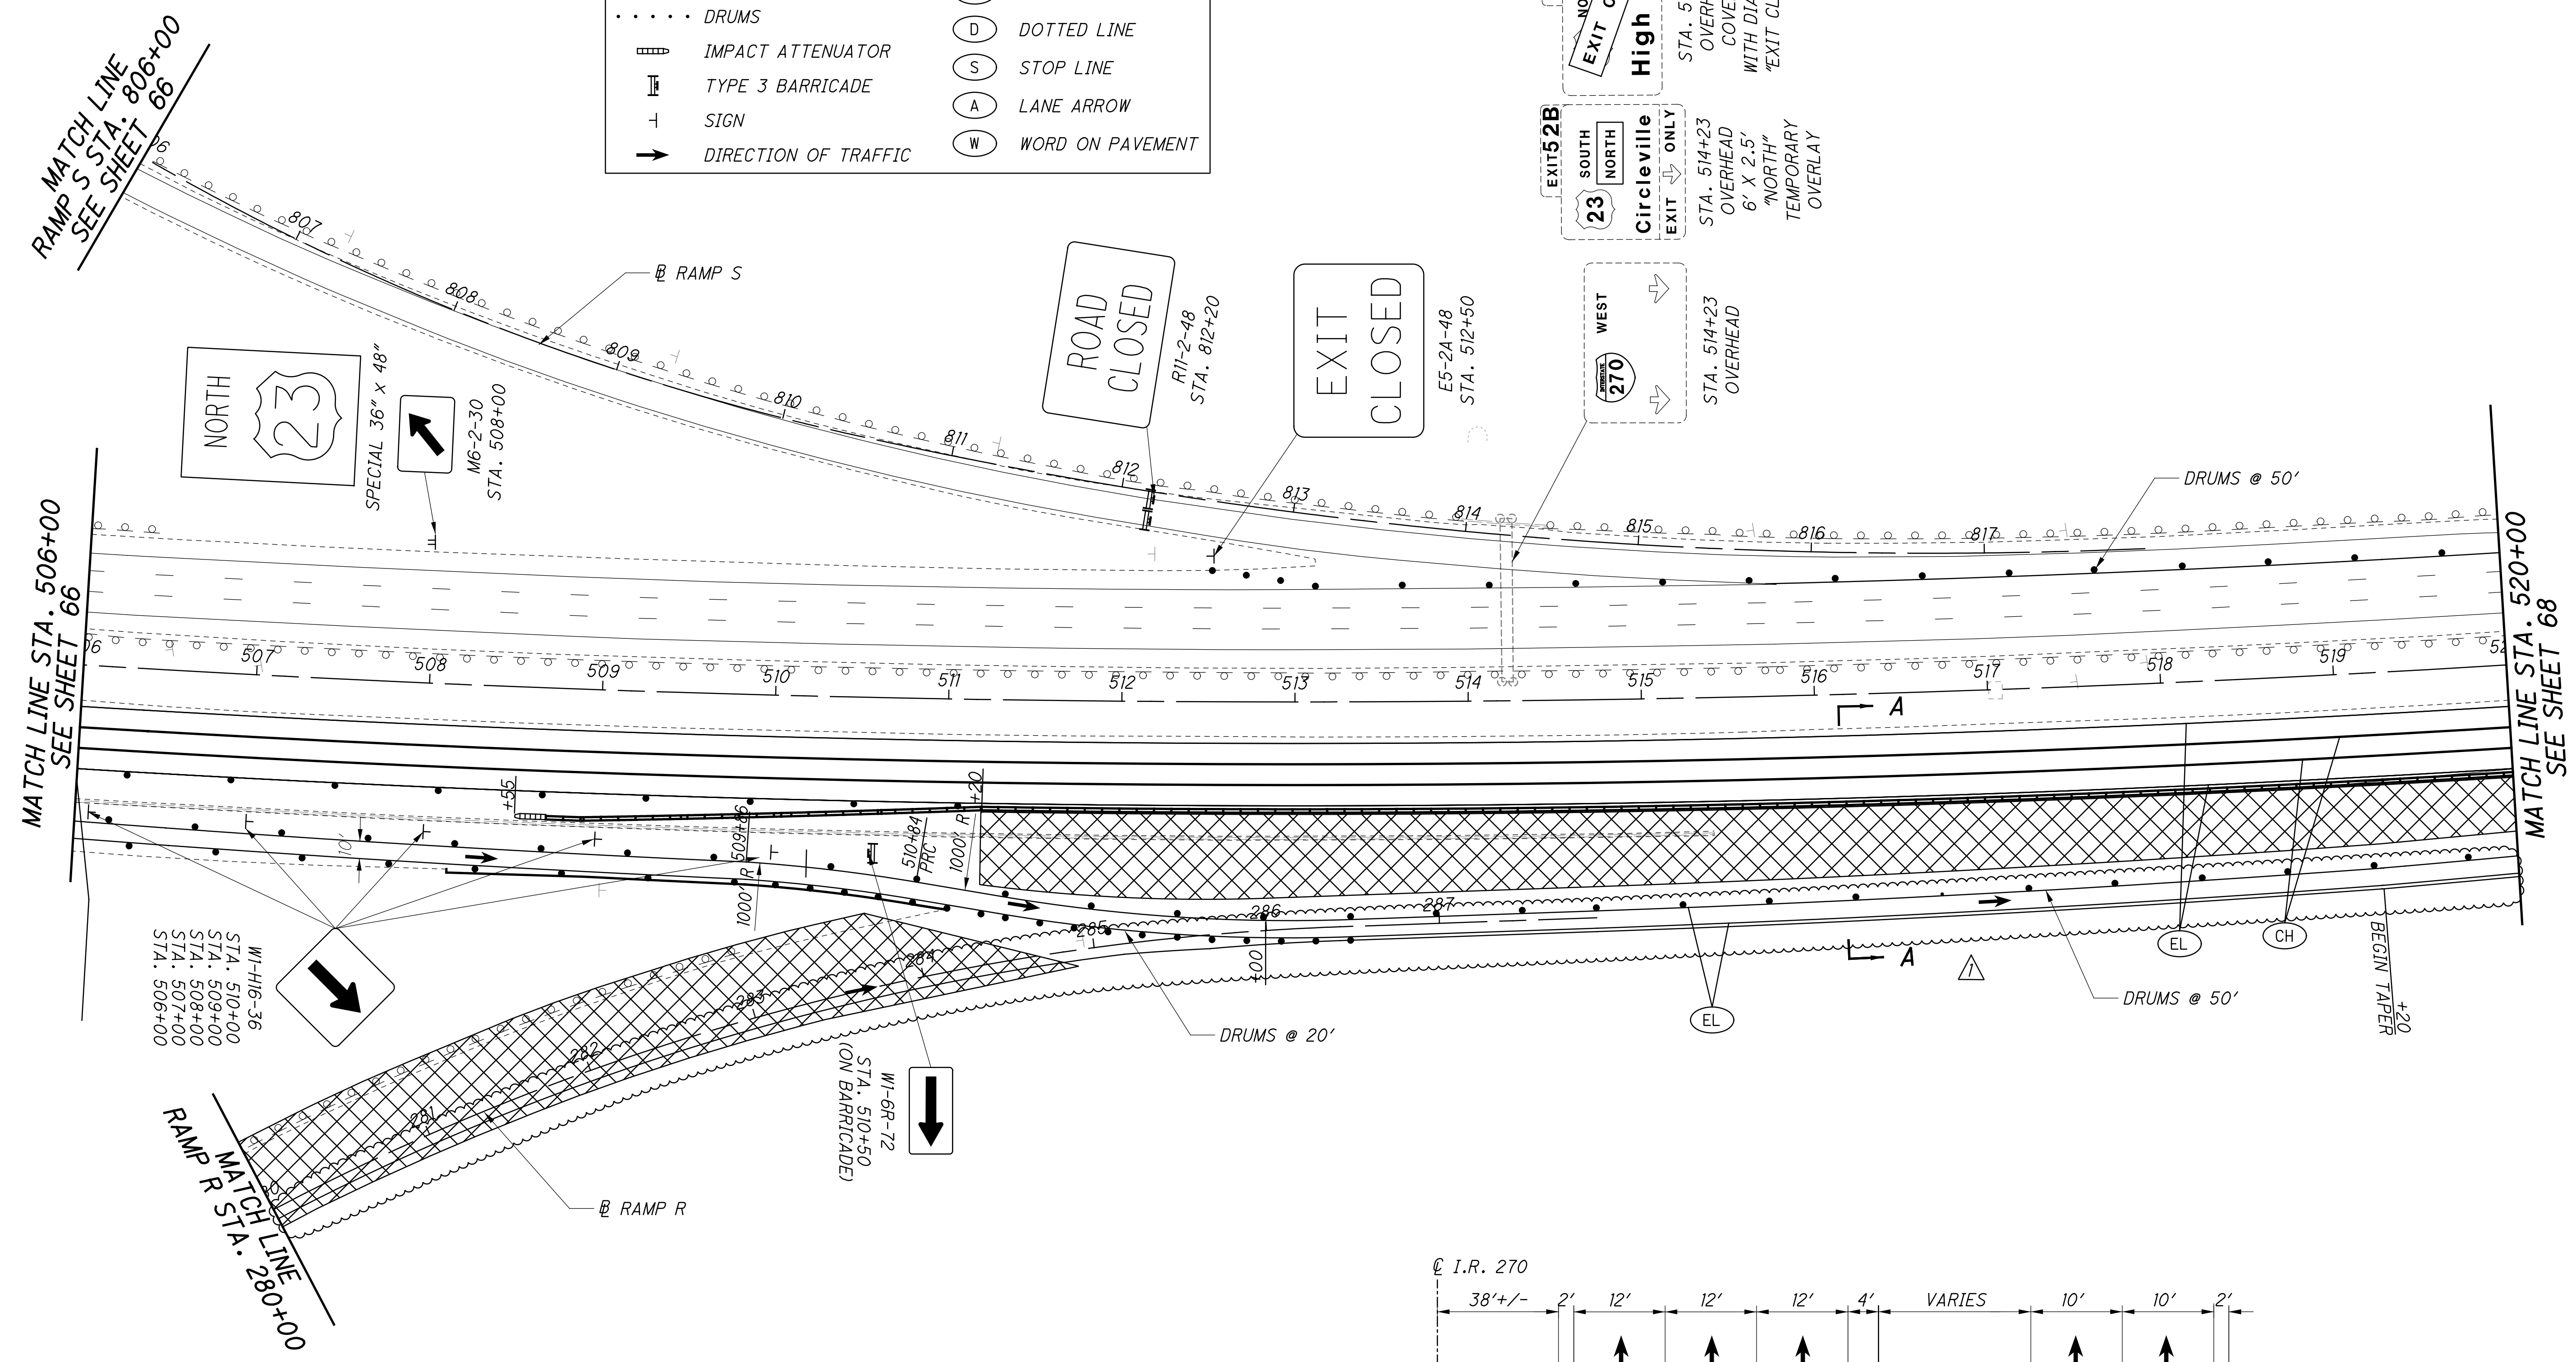


**SECTION A-A**

X:\Projects\2013\1010\FRA\92616\mot\sheet\92616MPO19.dgn 4/19/2023 7:01:54 AM cwong

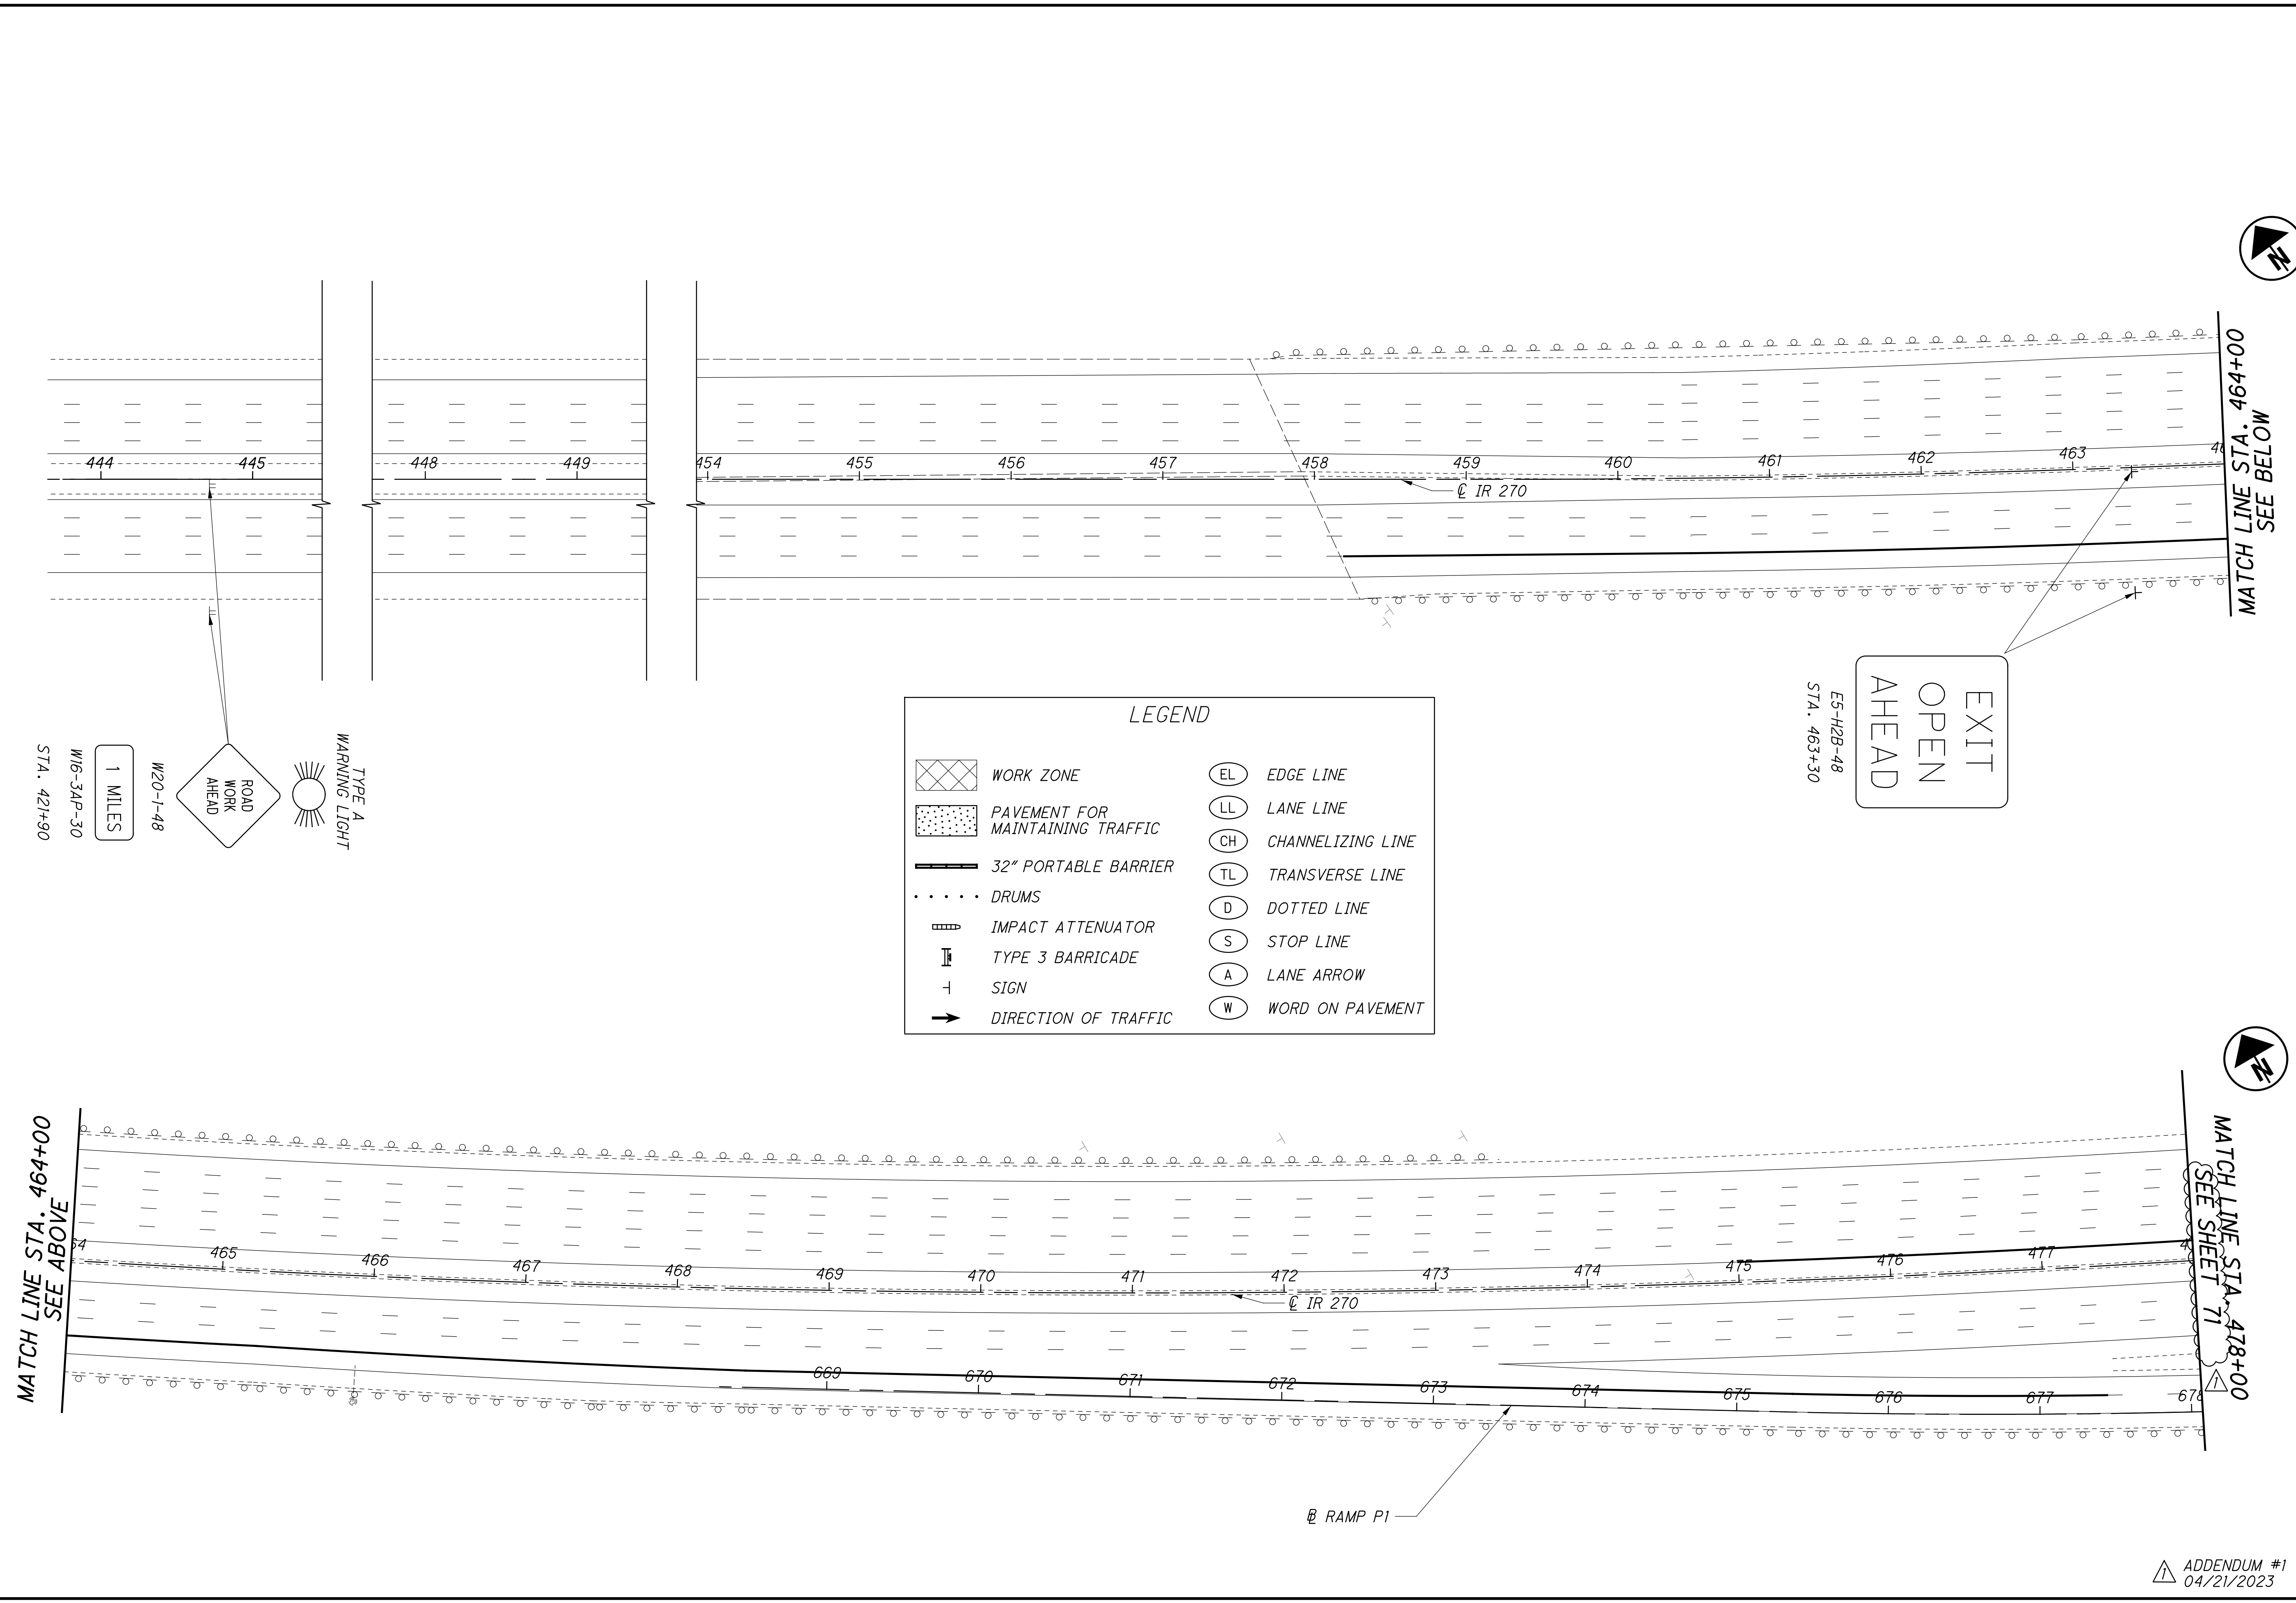

**LEGEND**

WORK ZONE	EDGE LINE
PAVEMENT FOR MAINTAINING TRAFFIC	LANE LINE
32" PORTABLE BARRIER	CHANNELIZING LINE
DRUMS	TRANSVERSE LINE
IMPACT ATTENUATOR	DOTTED LINE
TYPE 3 BARRICADE	STOP LINE
SIGN	LANE ARROW
DIRECTION OF TRAFFIC	WORD ON PAVEMENT

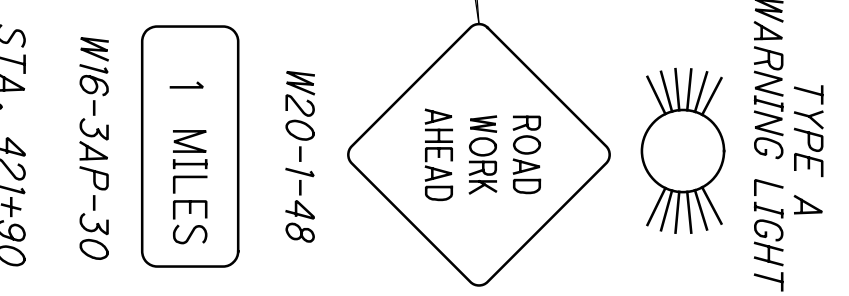

EXIT  
 OPEN  
 AHEAD

ES-H2B-48  
 STA. 463+30



**MAINTENANCE OF TRAFFIC - PHASE 3**  
**I-270 STA. 450+00 TO STA. 478+00**

MATCH LINE STA. 464+00 SEE ABOVE


MATCH LINE STA. 478+00 SEE SHEET 71

ADDENDUM #1  
 04/21/2023

**FRA - 270-51.50**

70  
554



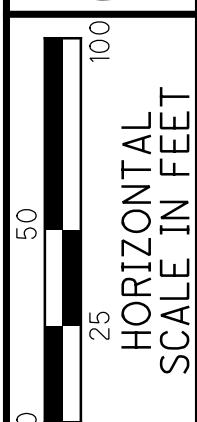




CALCULATED MBE CHECKED RCH

**MAINTENANCE OF TRAFFIC - PHASE 3**  
**I-270 STA. 478+00 TO STA. 492+00**

**FRA-270-51.50**

**LEGEND**


WORK ZONE	EDGE LINE
PAVEMENT FOR MAINTAINING TRAFFIC	LANE LINE
32" PORTABLE BARRIER	CHANNELIZING LINE
DRUMS	TRANSVERSE LINE
IMPACT ATTENUATOR	DOTTED LINE
TYPE 3 BARRICADE	STOP LINE
SIGN	LANE ARROW
DIRECTION OF TRAFFIC	WORD ON PAVEMENT

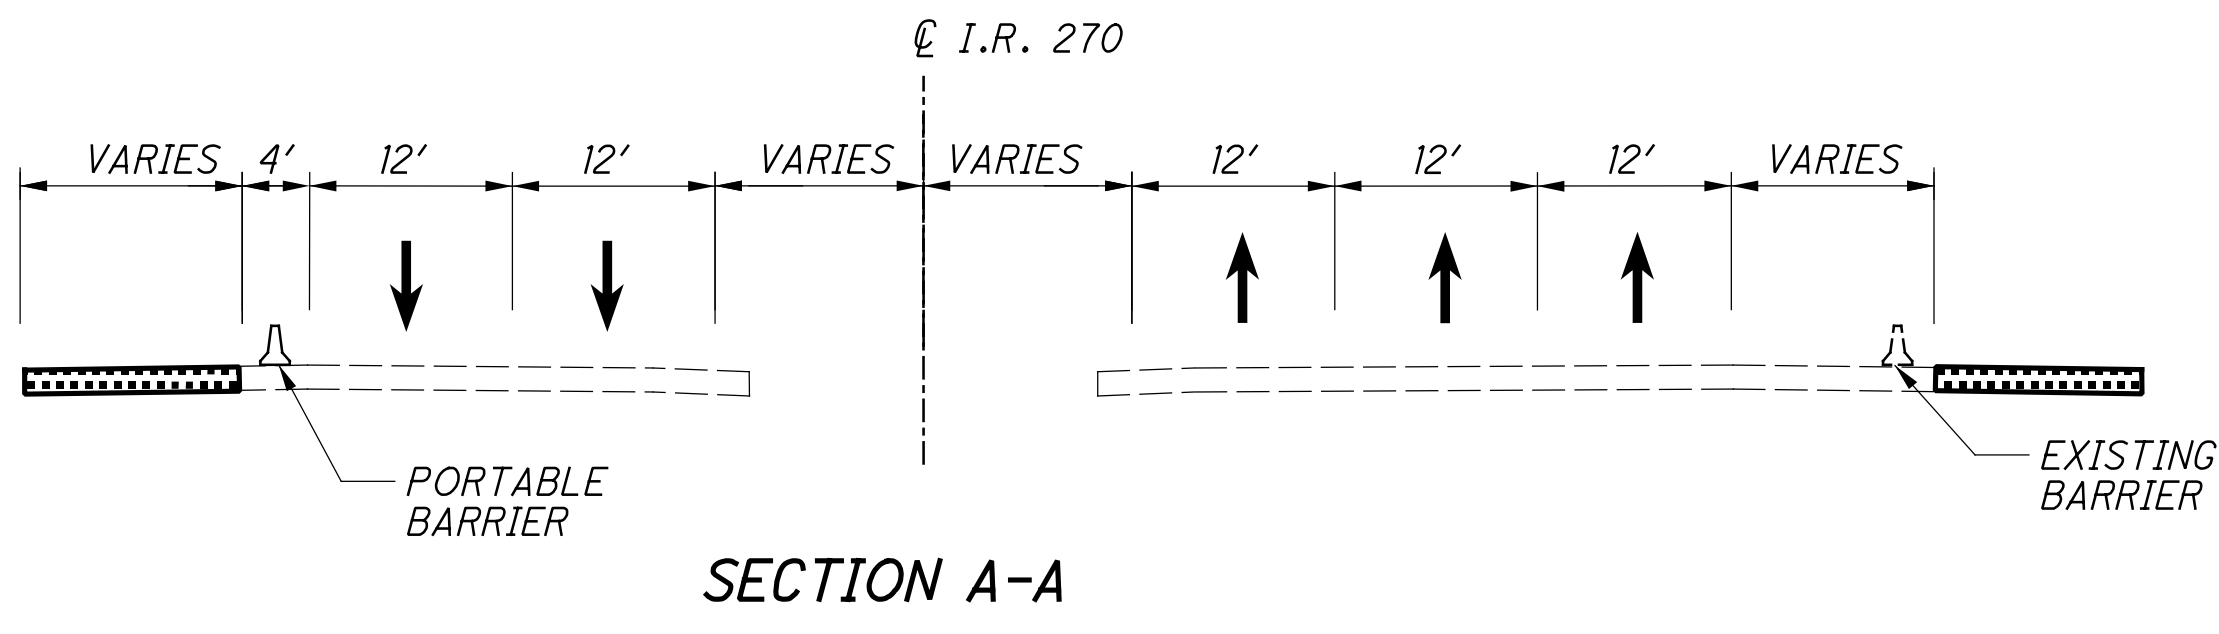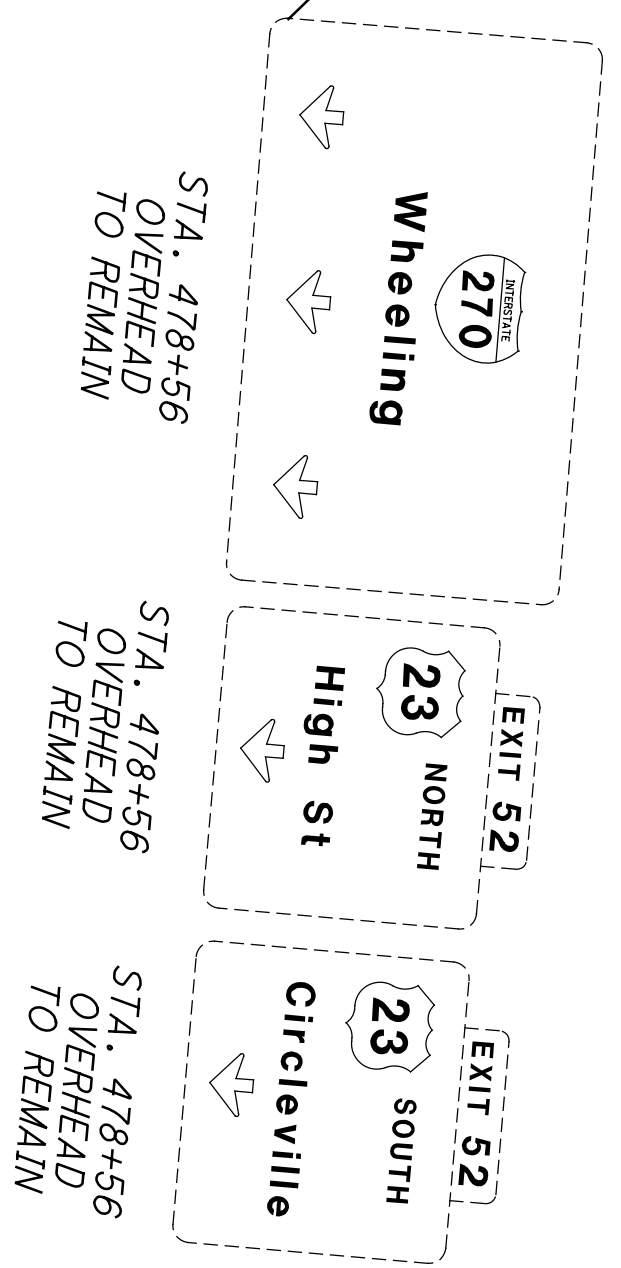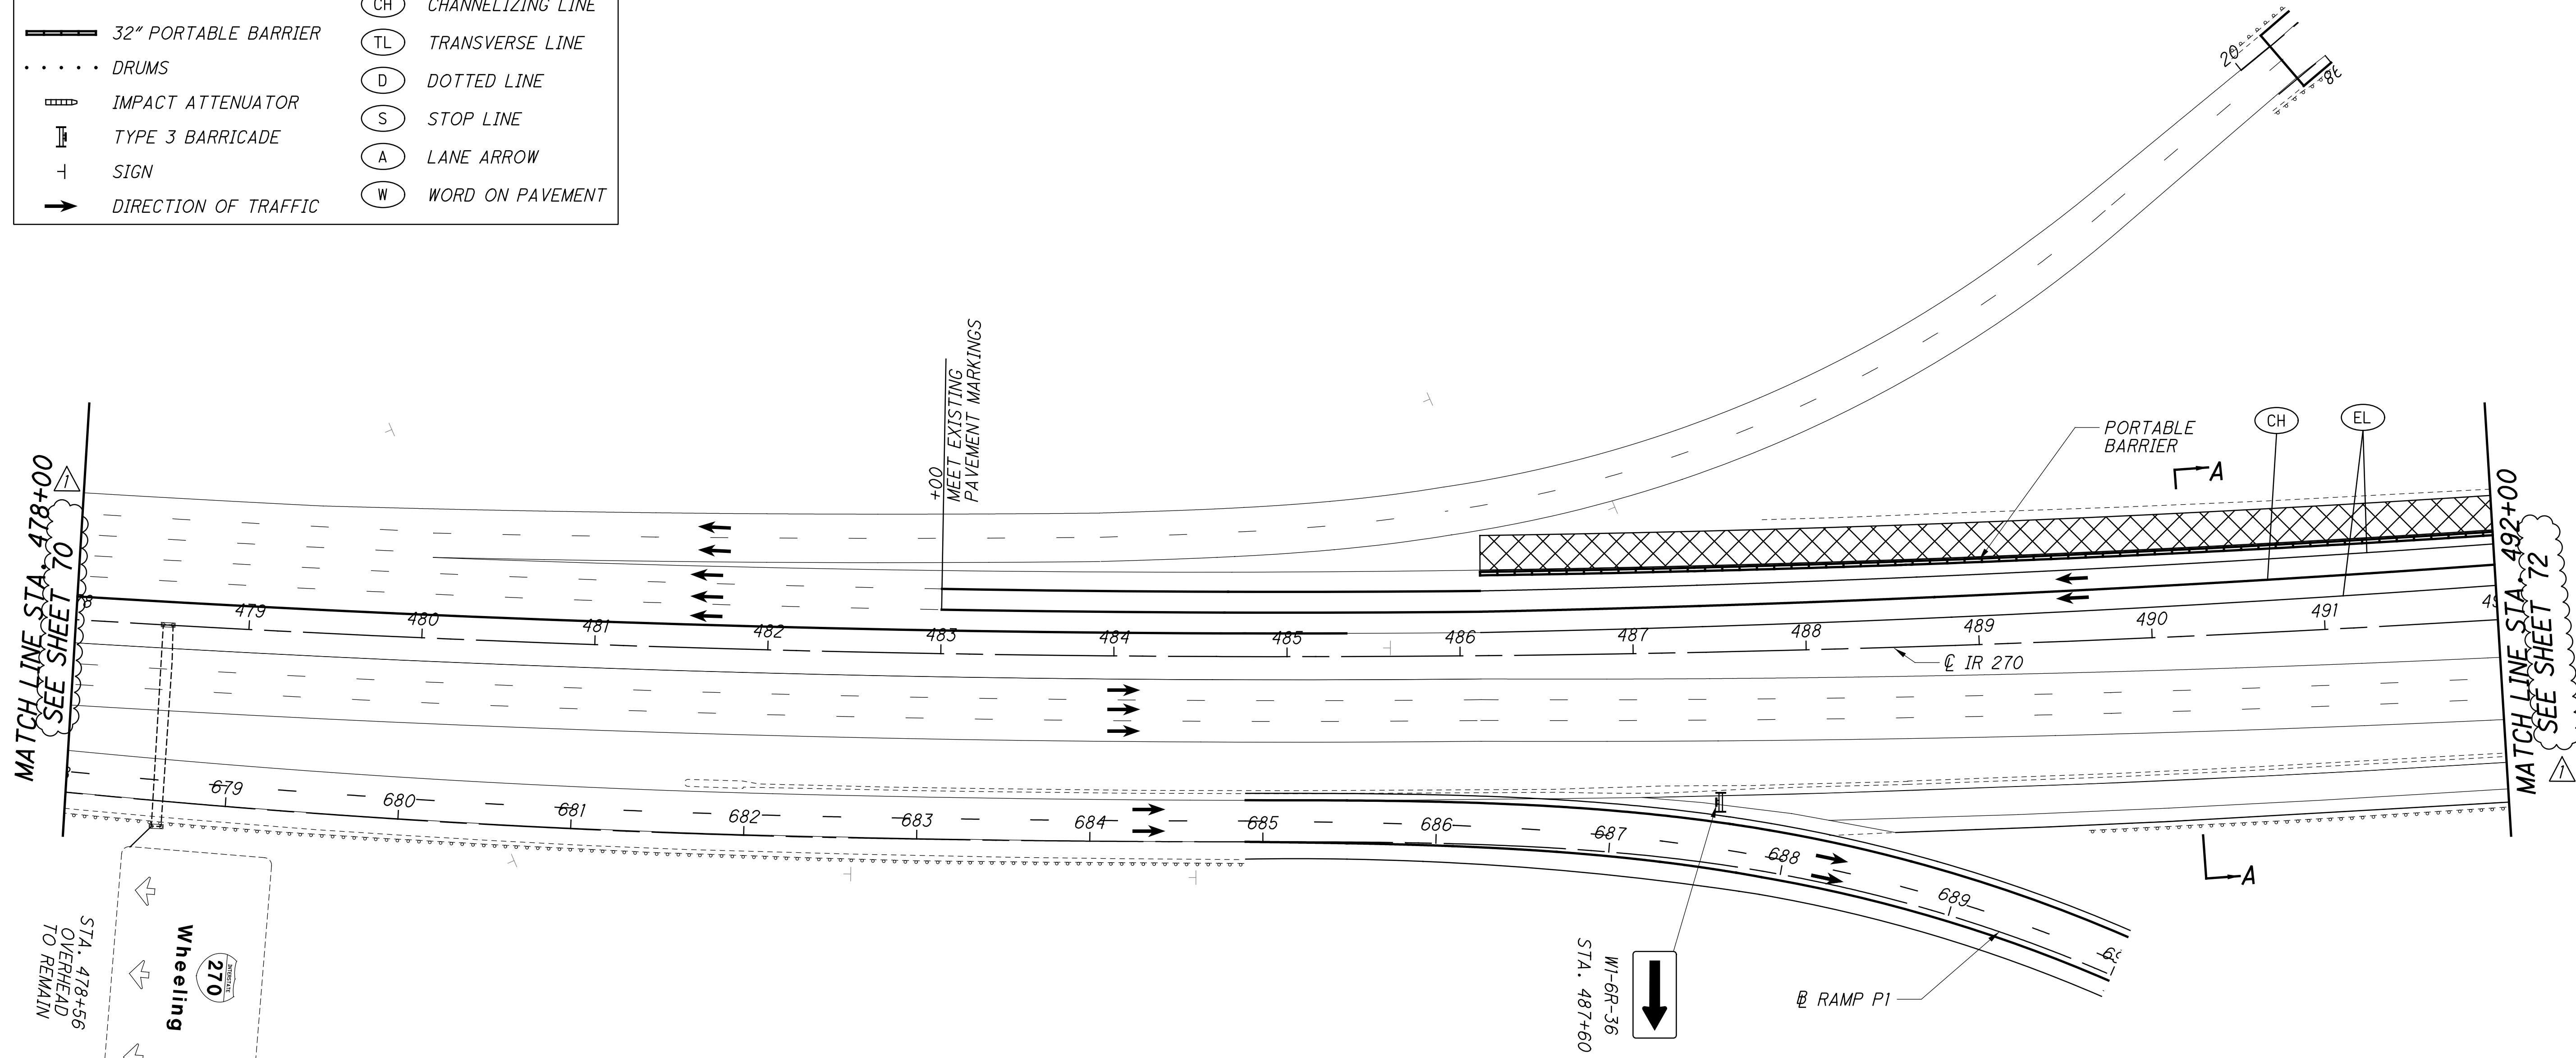

X:\Projects\2013\1321\1010\FRA\92616\mot\sheets\92616MPO20.dgn 4/19/2023 7:03:33 AM cwong

MATCH LINE STA. 520+00  
SEE SHEET 73

MATCH LINE STA. 534+00  
SEE ABOVE

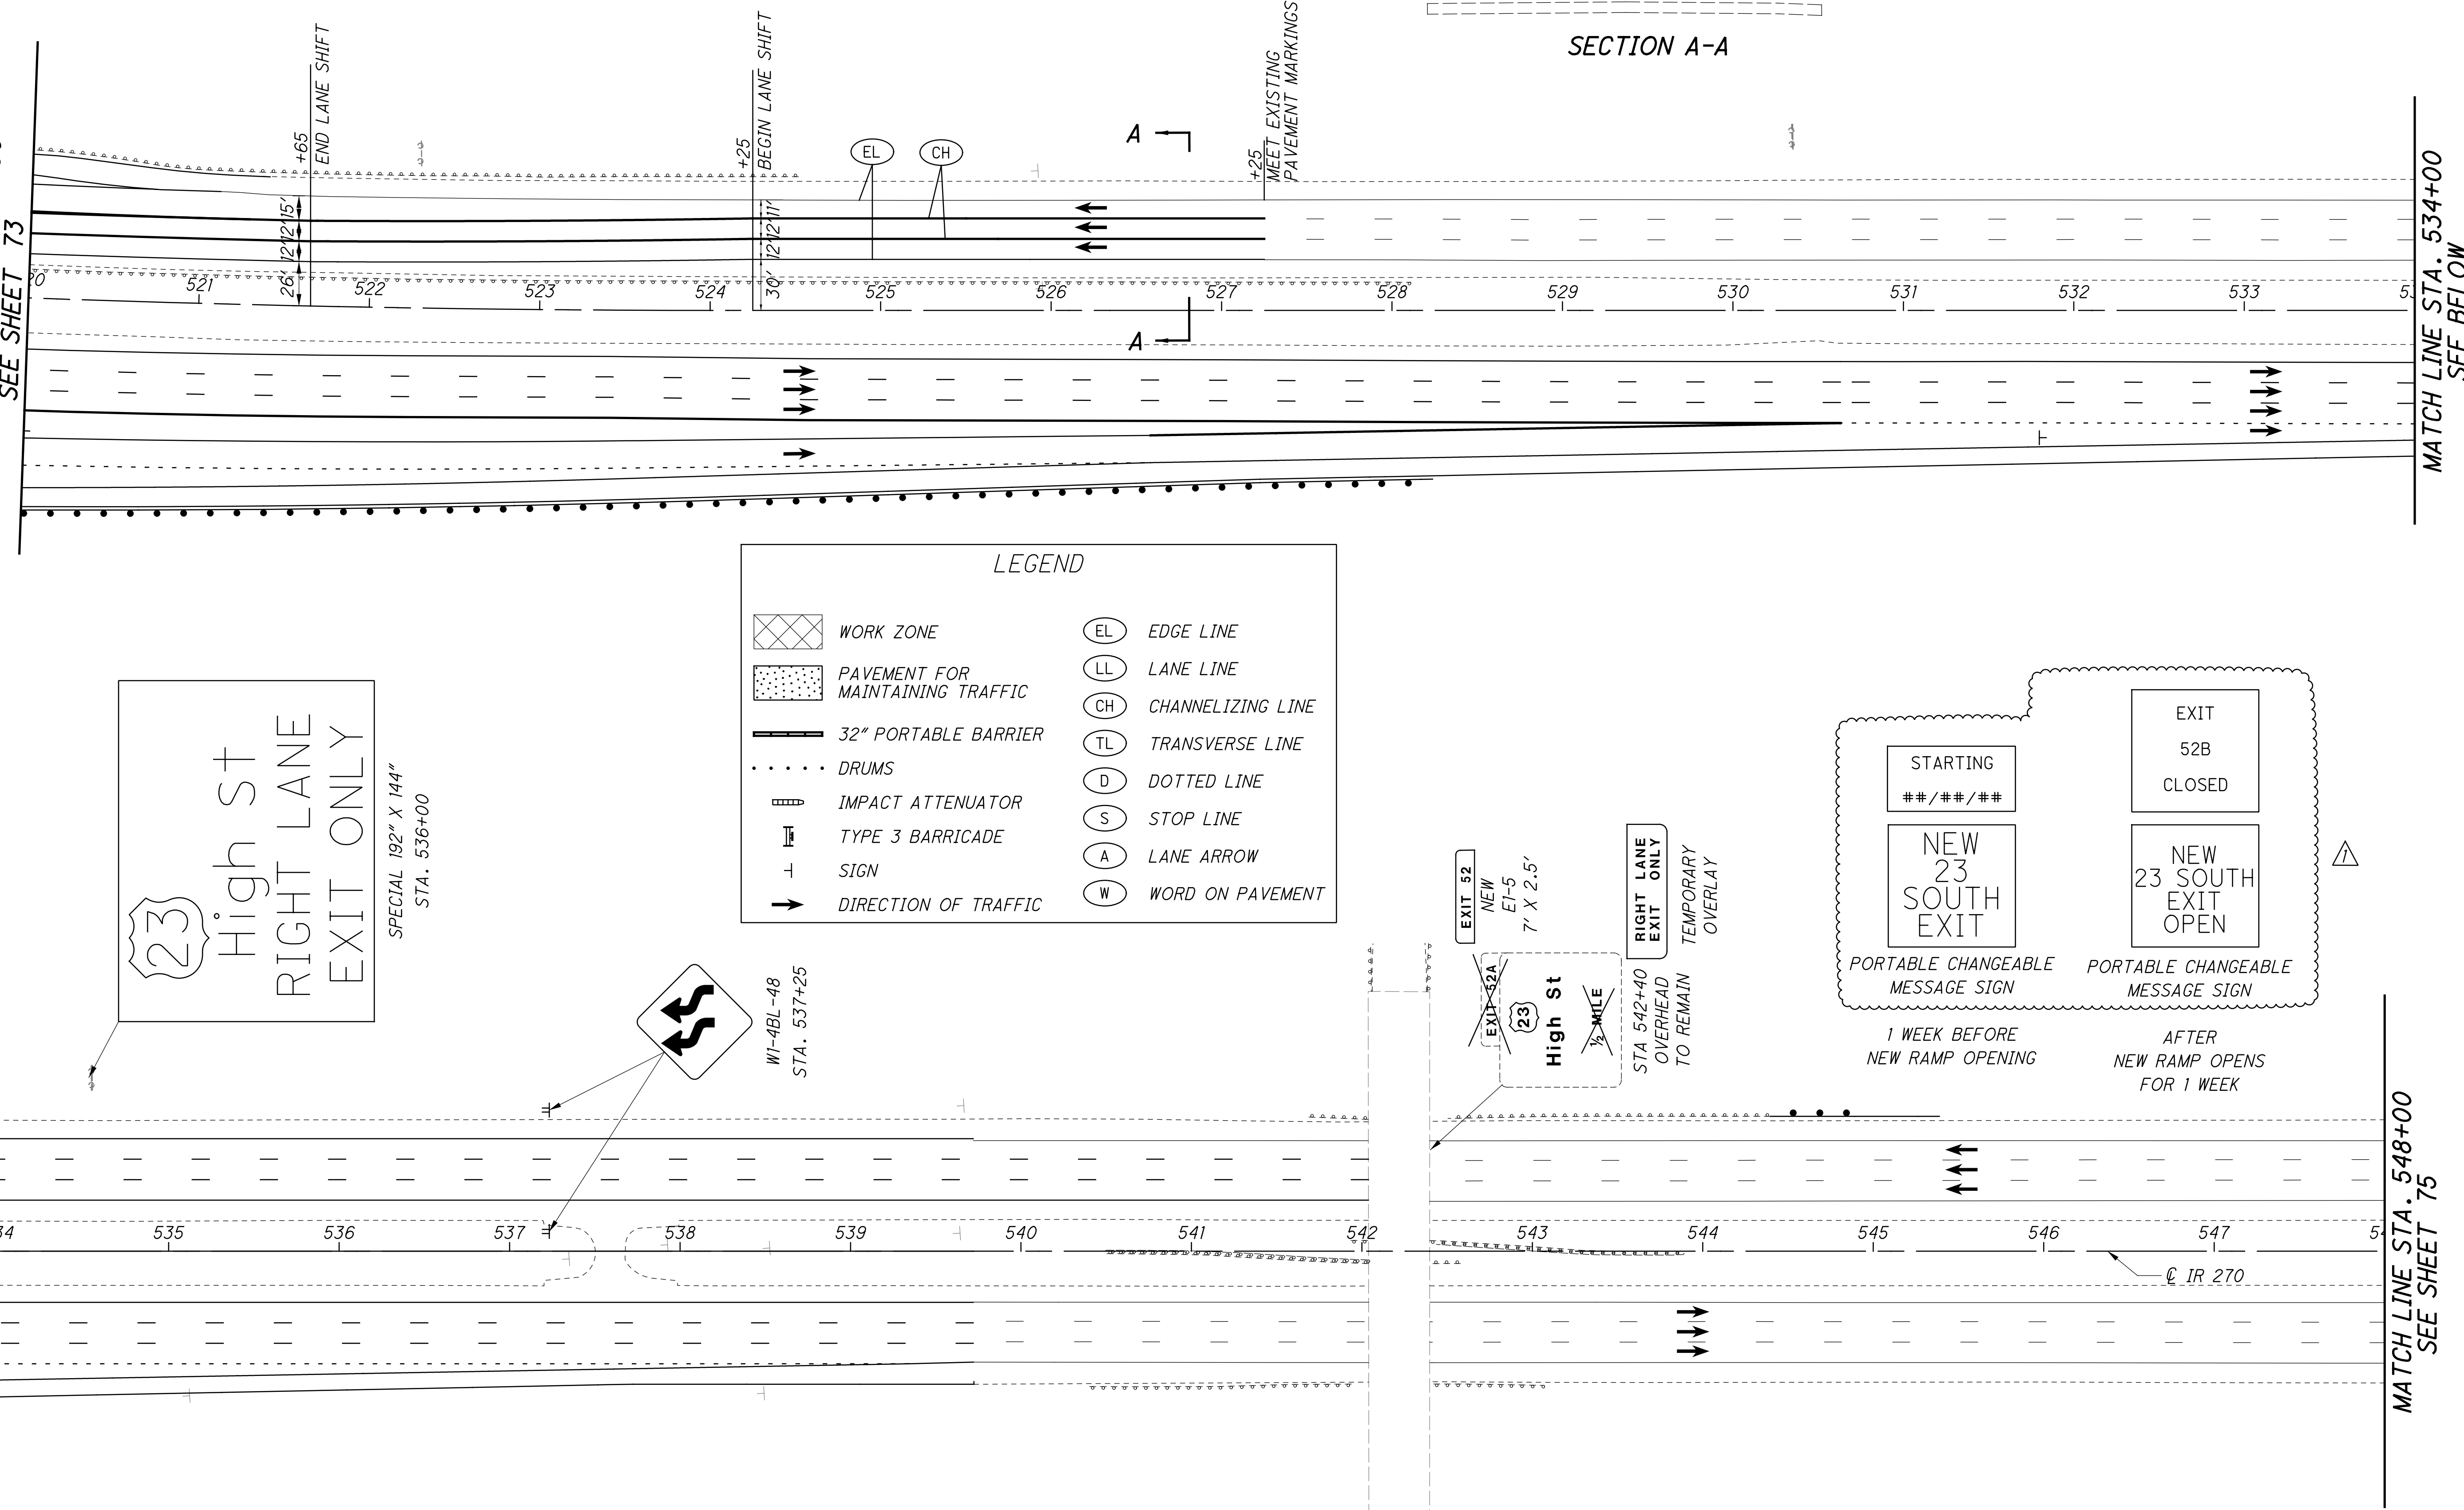

23  
High St  
RIGHT LANE  
EXIT ONLY  
SPECIAL 192" X 144"  
STA. 536+00

**LEGEND**

WORK ZONE	EDGE LINE
PAVEMENT FOR MAINTAINING TRAFFIC	LANE LINE
32" PORTABLE BARRIER	CHANNELIZING LINE
DRUMS	TRANSVERSE LINE
IMPACT ATTENUATOR	DOTTED LINE
TYPE 3 BARRICADE	STOP LINE
SIGN	LANE ARROW
DIRECTION OF TRAFFIC	WORD ON PAVEMENT

EXIT 52  
NEW  
EI-5  
7' X 2.5'  
High St  
1/2 MILE  
STA 542+40  
RIGHT LANE  
EXIT ONLY  
OVERHEAD  
TEMPORARY  
TO REMAIN

STARTING  
##/##/##

NEW  
23  
SOUTH  
EXIT

PORTABLE CHANGEABLE  
MESSAGE SIGN

1 WEEK BEFORE  
NEW RAMP OPENING


EXIT  
52B  
CLOSED

NEW  
23 SOUTH  
EXIT  
OPEN

PORTABLE CHANGEABLE  
MESSAGE SIGN

AFTER  
NEW RAMP OPENS  
FOR 1 WEEK

MATCH LINE STA. 548+00  
SEE SHEET 75

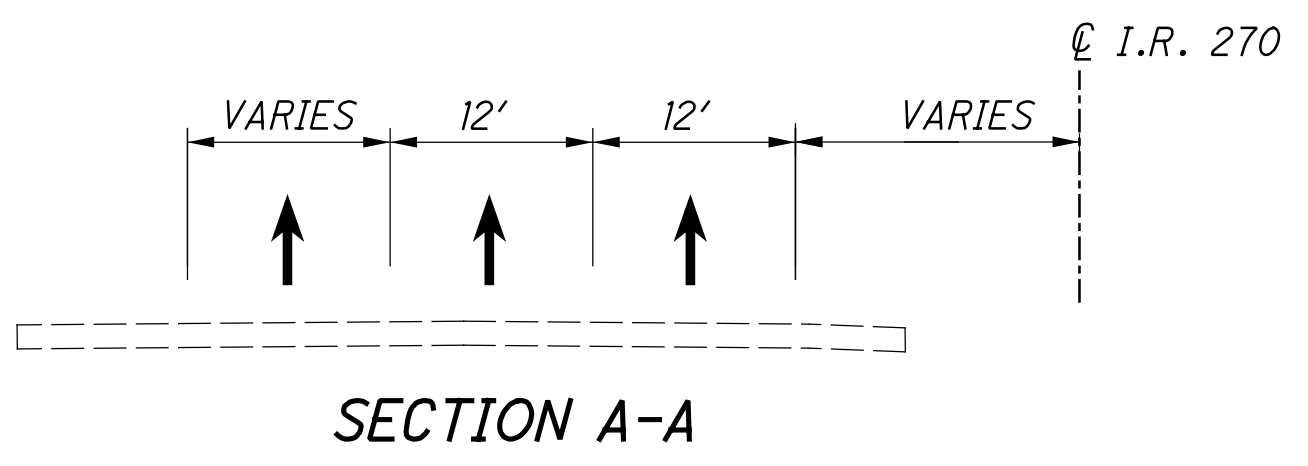

CALCULATED  
MBE  
CHECKED  
RCH

0 50 100  
25  
HORIZONTAL  
SCALE IN FEET

**MAINTENANCE OF TRAFFIC - PHASE 3**  
**I-270 STA. 520+00 TO STA. 548+00**

**FRA - 270-51.50**









X:\Projects\2013\1321\1010\FRA\92616\roadway\sheet\92616GG001.dgn 4/26/2023 3:23:10 PM cwong

SHEET NUM.										PART.			ITEM	ITEM EXT	GRAND TOTAL	UNIT	DESCRIPTION	SEE SHEET NO.
379	95	96	97	98	99	100	406	409	415	01/IMS/04	02/IMS/14	03/NHS/43						
					390	399	43	43		875			630	80100	875	SF	TRAFFIC CONTROL	
					125	376				501			630	80200	501	SF	SIGN, GROUND MOUNTED EXTRUSHEET	
					890	161				1,051			630	80224	1,051	SF	SIGN, OVERHEAD EXTRUSHEET	
					2.5					2.5			630	80400	2.5	SF	SIGN, PERMANENT OVERLAY	
					6	4				10			630	84500	10	EACH	GROUND MOUNTED STRUCTURAL BEAM SUPPORT FOUNDATION	
					6	6				12			630	84510	12	EACH	RIGID OVERHEAD SIGN SUPPORT FOUNDATION	
				62						62			630	84900	62	EACH	REMOVAL OF GROUND MOUNTED SIGN AND DISPOSAL	
				5						5			630	85100	5	EACH	REMOVAL OF GROUND MOUNTED SIGN AND REERECTION	
				4						4			630	85400	4	EACH	REMOVAL OF GROUND MOUNTED MAJOR SIGN AND DISPOSAL	
				68						68			630	86002	68	EACH	REMOVAL OF GROUND MOUNTED POST SUPPORT AND DISPOSAL	
				5						5			630	86102	5	EACH	REMOVAL OF GROUND MOUNTED STRUCTURAL BEAM SUPPORT AND DISPOSAL	
				1						1			630	86274	1	EACH	REMOVAL OF GROUND MOUNTED PIPE SUPPORT AND REERECTION	
				3						3			630	86310	3	EACH	REMOVAL OF STRUCTURE MOUNTED SIGN AND DISPOSAL	
				6						6			630	87100	6	EACH	REMOVAL OF OVERHEAD MOUNTED SIGN AND REERECTION	
				15						15			630	87400	15	EACH	REMOVAL OF OVERHEAD MOUNTED SIGN AND DISPOSAL	
				2						2			630	89706	2	EACH	REMOVAL OF OVERHEAD SIGN SUPPORT AND DISPOSAL, TYPE TC-12.30	
				5						5			630	89802	5	EACH	REMOVAL OF OVERHEAD SIGN SUPPORT AND DISPOSAL, TYPE TC-7.65	
				10						10			631	94250	10	EACH	REMOVAL OF LUMINAIRE	
				2						2			631	94350	2	EACH	REMOVAL OF DISCONNECT SWITCH	
				3						3			631	94450	3	EACH	REMOVAL OF BALLAST	
				5						5			631	94470	5	EACH	REMOVAL OF SIGN SERVICE	
				3						3			631	94490	3	EACH	REMOVAL, MISC.: REMOVAL OF LOOP WARNING SIGN AND FLASHERS	
1	4.21	3.69	1.56							10.46			644	00104	10.46	MILE	EDGE LINE, 6"	
2	1.56	1.77	0.54							5.87			644	00204	5.87	MILE	LANE LINE, 6"	
			0.02							0.02			644	00300	0.02	MILE	CENTER LINE	
	430	5,081	4,276							9,787			644	00404	9,787	FT	CHANNELIZING LINE, 12"	
			177							177			644	00500	177	FT	STOP LINE	
		43	201							244			644	00720	244	FT	CHEVRON MARKING	
			8							8			644	01300	8	EACH	LANE ARROW	
			4							4			644	01360	4	EACH	WRONG WAY ARROW	
	614	2,118	899							3,631			644	01510	3,631	FT	DOTTED LINE, 6"	
		900								900			644	01511	900	FT	DOTTED LINE, 6", AS PER PLAN	379
		3,327	1,268							4,595			644	30000	4,595	FT	REMOVAL OF PAVEMENT MARKING	
	3.21	3.63	0.82							7.66			644	30030	7.66	MILE	REMOVAL OF PAVEMENT MARKING	
	0.32		0.08							0.4			646	10010	0.4	MILE	EDGE LINE, 6"	
	0.08									0.08			646	10110	0.08	MILE	LANE LINE, 6"	
	0.22		0.08							0.3			646	50300	0.3	MILE	REMOVAL OF PAVEMENT MARKING	
																	TRAFFIC SIGNALS	
						100	54			154			625	25400	154	FT	CONDUIT, 2", 725.04	
						32	11			43			625	25600	43	FT	CONDUIT, 4", 725.04	
								401		401			625	25600	401	FT	CONDUIT, 4", 725.04 JACK OR DRILLED	
								161		161			625	25602	161	FT	CONDUIT, 4", 725.05 4" MULTICELL, SCHEDULE 80, 725.20	
								124		124			625	25920	124	FT	CONDUIT, MISC.:CONDUIT, 4", MULTICELL, 725.20, EPC-80, CITY OF COLUMBUS	411
								382		382			625	25920	382	FT	CONDUIT, MISC.:CONDUIT, 4" MULTICELL, SCHEDULE 80, 725.20, JACK OR DRILLED	413
								6,023		6,023			625	25920	6,023	FT	CONDUIT, MISC.:ENCASED INTERCONNECT CONDUIT BANK, TC2, SCH 40, (4)-3" & (1)-1.5", CITY OF COLUMBUS	411
						132	65			197			625	29000	197	FT	TRENCH	
								6,911		6,911			625	29001	6,911	FT	TRENCH, AS PER PLAN	411
								407		407			625	29401	407	FT	TRENCH IN PAVED AREAS, AS PER PLAN	411
						1	1			2			625	30706	2	EACH	PULL BOX, 725.08, 24"	
								2		2			625	30711	2	EACH	PULL BOX, 725.08, 32", AS PER PLAN	414
								14		14			625	31600	14	EACH	PULL BOX, MISC.: PULL BOX, CONCRETE 32" (725.08) CITY OF COLUMBUS	411
								3		3			625	31600	3	EACH	PULL BOX, MISC.: PULL BOX, CONCRETE 48" (725.08) CITY OF COLUMBUS	411
						6	6			12			625	32000	12	EACH	GROUND ROD	
						4	4			8			625	76000	8	EACH	ARC FLASH CALCULATIONS AND LABEL, POLES P1-P4 ON EB OFF RAMP AND WB OFF RAMP	

GENERAL SUMMARY

FRA - 270-51.50

CALCULATED  
ACF  
CHECKED  
CSR



X:\Projects\2013\1321\1010\FRA\92616\roadway\sheet\92616GG001.dgn 4/26/2023 3:25:32 PM cwong

SHEET NUM.					PART.			ITEM	ITEM EXT	GRAND TOTAL	UNIT	DESCRIPTION	SEE SHEET NO.	
406	409	415	487	509	01/IMS/04	02/IMS/14	03/NHS/43							
TRAFFIC SIGNALS														
2	2							4	630	79000	4	EACH	SIGN HANGER ASSEMBLY, SPAN WIRE	
7	7							14	632	04910	14	EACH	VEHICULAR SIGNAL HEAD, (LED), 3-SECTION, 12" LENS, 1-WAY, ALUMINUM, WITH BACK PLATE	
2	2							4	632	05060	4	EACH	VEHICULAR SIGNAL HEAD, (LED), 4-SECTION, 12" LENS, 1-WAY, ALUMINUM, WITH BACK PLATE	
9	9							18	632	25000	18	EACH	COVERING OF VEHICULAR SIGNAL HEAD	
402	561	27						990	632	30400	990	FT	MESSENGER WIRE, 7 STRAND, 1/2" DIAMETER WITH ACCESSORIES	
402	561							963	632	30600	963	FT	TETHER WIRE, WITH ACCESSORIES	
1,279	1,389							2,668	632	40700	2,668	FT	SIGNAL CABLE, 7 CONDUCTOR, NO. 14 AWG	
		6,217						6,217	632	62810	6,217	FT	INTERCONNECT CABLE, MISC., FIBER OPTIC CABLE, 144 STRAND (COC SSI620)	412
		3						3	632	62820	3	EACH	INTERCONNECT, MISC.:FIBER OPTIC SPLICE ENCLOSURE, CLAMSHELL, 288 SPLICE (COC SSI620)	412
		240						240	632	62820	240	EACH	INTERCONNECT, MISC.: FIBER OPTIC FUSION SPLICE (COC SSI620)	412
		3						3	632	62820	3	EACH	INTERCONNECT, MISC.: TERMINATION PANEL, 24 FIBER, WITH 200 FT DROP CABLE	412
4	4							8	632	64000	8	EACH	STRAIN POLE FOUNDATION	
525	387							912	632	68100	912	FT	POWER CABLE, 1 CONDUCTOR, NO. 6 AWG	
		1,000						1,000	632	69300	1,000	FT	POWER CABLE, 3 CONDUCTOR, NO. 4 AWG	
								2	632	70000	2	EACH	POWER SERVICE	
								3	632	70400	3	EACH	CONDUIT RISER, 2" DIAMETER	
4	4							8	632	83000	8	EACH	STRAIN POLE, TYPE TC-81.10, DESIGN 10	
		1						1	632	89300	1	EACH	WOOD POLE	
1	1							2	633	65511	2	EACH	CABINET, TYPE TS-2, AS PER PLAN	400
1	1							2	633	67101	2	EACH	CABINET FOUNDATION, AS PER PLAN	400
1	1							2	633	67201	2	EACH	CONTROLLER WORK PAD, AS PER PLAN	400
1	1							2	633	75001	2	EACH	UNINTERRUPTIBLE POWER SUPPLY (UPS), 1000 WATT, AS PER PLAN	400
		6						6	633	99000	6	EACH	CONTROLLER ITEM, MISC.: FIBER OPTIC ETHERNET TRANSCEIVER, SHORT RANGE	413
		3						3	633	99000	3	EACH	CONTROLLER ITEM, MISC.: LAYER 2 ETHERNET SWITCH	413
		2						2	633	99000	2	EACH	CONTROLLER ITEM, MISC.: TERMINAL PORT SERVER	412
1	1							2	633	99000	2	EACH	CONTROLLER ITEM, MISC.:UNMANAGED ETHERNET SWITCH	400
		3						3	804	30010	3	EACH	FAN-OUT KIT, 12 FIBER	
		3						3	804	34012	3	EACH	FIBER TERMINATION PANEL, 12 FIBER	
		2						2	804	37000	2	EACH	SPLICE ENCLOSURE, BUTT STYLE	
3	3							6	809	69001	6	EACH	ADVANCE RADAR DETECTION, AS PER PLAN	400
1	1							2	809	69101	2	EACH	STOP LINE RADAR DETECTION, AS PER PLAN	400
1	1							2	809	69122	2	EACH	ATC V6.24 CONTROLLER, AS PER PLAN	
STRUCTURE REPAIR (FRA-023-0517 SFN 2513447)														
								LUMP	202	11203	LS		PORTIONS OF STRUCTURE REMOVED, OVER 20 FOOT SPAN, AS PER PLAN	485
		166						166	202	22900	166	SY	APPROACH SLAB REMOVED	
		143						143	202	23500	143	SY	WEARING COURSE REMOVED	
		436						436	503	21100	436	CY	UNCLASSIFIED EXCAVATION	
		40,400						40,400	509	10000	40,400	LB	EPOXY COATED REINFORCING STEEL	
		110						110	509	30020	110	FT	NO. 4 DEFORMED GFRP REINFORCEMENT	
		208						208	510	10000	208	EACH	DOWEL HOLES WITH NONSHRINK, NONMETALLIC GROUT	
		88						88	511	34447	88	CY	CLASS QC2 CONCRETE WITH QC/QA, BRIDGE DECK, AS PER PLAN	485
		63						63	511	34451	63	CY	CLASS QC2 CONCRETE WITH QC/QA, BRIDGE DECK (PARAPET), AS PER PLAN	485
		41						41	511	45711	41	CY	CLASS QC1 CONCRETE, ABUTMENT, AS PER PLAN	
		172						172	511	81300	172	EACH	CONCRETE, MISC.: EMBEDDED GALVANIC ANODE (EGA)	485

CALCULATED	ACF	CHECKED	CSR
GENERAL SUMMARY			
FRA - 270-51.50			
82			
554			



X:\Projects\2013\1321\1010\FRA\92616\roadway\sheet\92616GS001.dgn 4/19/2023 7:19:53 AM cwong

REF NO.	SHEET NO.	STATION TO STATION				202	202	202	202	202	SPECIAL	202	252	611	618	618										
																	HEADWALL REMOVED	PAVEMENT REMOVED	CONCRETE BARRIER REMOVED	PIPE REMOVED, 24" AND UNDER	PIPE REMOVED, OVER 24"	FILL AND PLUG EXISTING CONDUIT	GUARDRAIL REMOVED	FULL DEPTH PAVEMENT SAWING	DRAINAGE STRUCTURE, MISC.: FLAP GATE REMOVED	RUMBLE STRIPS, SHOULDER (ASPHALT CONCRETE), AS PER PLAN
		TO				EACH	SY	FT	FT	FT	FT	FT	FT	EACH	FT	FT										
I-270 EASTBOUND																										
R1	102	489+59.30		494+44.96	RT						488															
P1	102	487+03.75		495+81.90	RT		2038					16														
P1	103	501+73.26		501+73.26	RT							16														
I-270 WESTBOUND																										
P1	105	486+12.07		496+00.00	LT							1001														
P2	105	486+12.07		496+00.00	LT									988												
P1	106	496+00.00		498+10.74	LT							210														
P2	106	500+45.63		506+00.00	LT							552														
P3	106	496+00.00		498+11.00	LT									209												
P4	106	500+49.05		506+00.00	LT									551												
P1	107	506+00.00		512+96.84	LT							718														
P2	107	506+00.00		512+96.84	LT									693												
P1	108	516+00.00		521+40.00	LT									537												
US-23																										
P1	174	578+43.19		584+77.90	RT		747																			
R1	175	586+12.71		587+41.96	LT&RT						130															
R2	175	586+11.09		587+41.98	RT						131															
RAMP L																										
R1	202	571+88.12		576+00.00	LT						410															
R1	203	576+00.00		579+10.18	LT						286															
R2	203	577+37.74		579+08.33	RT			48			201															
R1	204	583+25.93		586+00.00	LT						271															
R2	204	583+13.10		586+00.00	RT						295															
R1	205	586+00.00		587+98.26	LT						220															
R2	205	586+00.00		588+07.52	RT						238															
R3	205	590+76.08		591+00.00	LT						49															
R4	205	590+81.17		591+00.00	RT						43															
R1	206	591+00.00		596+00.00	LT						496															
R2	206	591+00.00		594+46.57	RT						358															
R1	207	596+00.00		598+24.65	LT						225															
RAMP M																										
R1	221	10+00.00		15+97.14	LT						608															
R2	221	10+00.00		19+78.39	RT						973															
RAMP N																										
P1	223	03+81.21		06+13.41	LT&RT		2938																			
R1	223	04+22.19		10+00.00	RT						558															
R2	223	07+55.20		10+00.00	LT						270															
R3	223	09+38.36		09+37.76	LT&RT	2				88																
R1	224	10+00.00		11+11.35	LT						123															
R2	224	10+00.00		11+19.77	RT						115															
R3	224	12+88.98		12+89.68	LT&RT	2		94																		
R4	224	13+27.11		15+70.02	RT						236															
RAMP O																										
R1	226	07+06.18		10+00.00	LT						319															
R1	227	10+00.00		10+86.77	LT						94															
R2	227	10+00.00		498+09.95	RT						450															
RAMP P1																										
P1	228	684+89.82		684+89.82	LT&RT							39														
P2	228	684+89.82		686+17.29	RT									128												
R1	228	684+89.82		688+00.00	RT			48			264															
R1	229	688+00.00		691+75.98	RT					130	371															
R2	229	690+20.45		692+95.59	LT						279															
R3	229	689+90.71		690+23.11	RT									2												
R4	229	691+40.54		691+68.26	LT																					
P1	232	703+70.79		703+70.79	LT&RT	1						26														
P1	233	709+50.00		712+11.92	RT									262												
TOTALS CARRIED TO GENERAL SUMMARY						5	5723	96	94	88	130	8501	2578	2	3240	128										

CALCULATED ACF CHECKED CSR	ROADWAY ESTIMATED QUANTITIES	FRA - 270-51.50
-------------------------------------	------------------------------	-----------------

ADDENDUM #1  
04/21/2023



X:\Projects\2013\1321\1010\FRA\92616\roadway\sheet\92616GS001.dgn 4/19/2023 7:21:09 AM cwong

REF NO.	SHEET NO.	STATION TO STATION				202	202	202	202	202	202	202	202	252	607	618	618	625	625	638	638	638	638	638	SPECIAL
						HEADWALL REMOVED	PAVEMENT REMOVED	CONCRETE BARRIER REMOVED	PIPE REMOVED, 24" AND UNDER	PIPE REMOVED, OVER 24"	GUARDRAIL REMOVED	CATCH BASIN REMOVED	FENCE REMOVED	VALVE BOX REMOVED	FULL DEPTH PAVEMENT SAWING	FENCE, TYPE CLT	RUMBLE STRIPS, SHOULDER (ASPHALT CONCRETE), AS PER PLAN	RUMBLE STRIPS, SHOULDER (CONCRETE)	LIGHT POLE REMOVED	PULL BOX REMOVED	6" WATER MAIN DUCTILE IRON PIPE ANSI CLASS 52, PUSH-ON JOINTS AND FITTINGS	6" GATE VALVE AND VALVE BOX	FIRE HYDRANT REMOVED AND DISPOSED OF	6" FIRE HYDRANT	VALVE BOX ADJUSTED TO GRADE
					EACH	SY	FT	FT	FT	FT	EACH	FT	FT	FT	FT	EACH	EACH	FT	EACH	EACH	EACH	EACH	FT		
RAMP Q																									
P1	265	00+00.00		10+32.31	LT&RT		2446																		
R1	265	500+44.77		04+15.80	RT					422															
R2	265	07+99.35		08+01.24	LT&RT	2			82																
R1	267	263+39.81		264+80.45	RT					141															
RAMP R																									
P1	267	260+14.67		265+00.00	LT							490													
P2	267	260+14.67		265+00.00	RT										486										
P1	268	265+00.00		266+46.89	LT						160														
P2	268	265+00.00		265+52.69	RT										53										
P3	268	265+49.00		266+45.96	LT										100										
R1	268	267+53.16		270+00.00	RT					254															
R2	268	266+86.94		270+00.00	LT					311															
R1	269	270+00.00		275+00.00	RT					499															
R2	269	270+00.00		271+88.12	LT					195															
R3	269	273+11.96		273+27.87	RT	1			31																
R1	270	277+27.38		280+00.00	LT					280															
R2	270	275+00.00		280+00.00	RT			47		458															
R3	270	279+13.15		279+22.12	RT	1																			
R1	271	280+00.00		283+01.54	LT					310															
R2	271	280+00.00		285+00.00	RT					503															
P1	272	286+18.48		287+90.80	RT										172										
R1	272	285+00.00		287+90.80	LT					292															
RAMP S																									
R1	301	800+29.29		803+00.00	LT					288															
R2	301	802+45.09		802+70.17	RT	1																			
R1	302	803+00.00		808+00.00	LT&RT					501															
R2	302	804+85.58		804+98.77	LT	1																			
R1	303	808+00.00		813+00.00	LT					498															
P1	304	813+02.09		813+02.09	LT&RT							25													
P2	304	813+99.05		816+00.00	LT										19	182									
R1	304	813+00.00		815+80.00	LT			50		234															
US-23 ACCELERATION LANE																									
F1	176	546+50.00		546+46.49	LT									302											
P1	176	546+50.00		551+00.00	RT							460													
P2	176	546+50.00		551+00.00	LT																				
R1	176	546+50.00		549+21.47	LT																				
R2	176	549+42.78		549+44.60	LT																				
W1	176	546+68.85		546+68.85	LT																				
W2	176	550+68.75		550+68.75	LT																				
P1	177	551+00.00		556+00.00	RT							500			348										
P2	177	551+00.00		556+00.00	LT																				
R1	177	553+43.05		553+93.88	LT																				
R2	177	554+58.70		556+00.00	LT				51																
R3	177	552+97.99		552+97.99	LT																				
R4	177	553+92.60		553+92.60	LT																				
R5	177	554+37.64		554+37.64	LT																				
W1	177	554+69.46		554+69.46	LT																				
W2	177	552+52.85		552+52.85	LT																				
W3	177	552+89.30		552+89.30	LT																				
P1	178	556+00.00		560+35.52	LT&RT							444													
P2	178	556+00.00		560+35.11	LT																				
R1	178	556+00.00		557+28.47	LT					42					435										
W1	178	558+47.01		558+47.01	LT																				
TOTALS CARRIED TO GENERAL SUMMARY					6	2446	97	133	31	5186	1	489	2079	302	1952	182	3	1	134	1	2	2	4	1	18

ROADWAY ESTIMATED QUANTITIES

FRA - 270-51.50

CALCULATED  
ACF  
CHECKED  
CSR

86  
554

ADDENDUM #1  
04/21/2023

X:\Projects\2013\1321\1010\FRA\92616\roadway\sheet\92616GS003.dgn 4/25/2023 9:30:46 AM cwong

REF NO.	SHEET NO.	STATION TO STATION				MATERIALS																				CALCULATED ACF CHECKED CSR	
						601	601	601	601	602	605	605	611	611	611	611	611	611	611	611	611	611	611	611	611		
					SY	SY	CY	CY	CY	FT	FT	FT	FT	FT	FT	FT	FT	FT	EACH	EACH	EACH	EACH	EACH	EACH			
I-270 WESTBOUND																											
U1	105	486+11.99		496+00.00	LT																						
U2	105	486+11.99		496+00.00	LT																						
U1	106	496+00.00		498+11.27	LT																						
U2	106	496+00.00		498+11.27	LT																						
U3	106	500+46.49		506+00.00	LT																						
U4	106	500+46.49		506+00.00	LT																						
U1	107	506+00.00		512+96.84	LT																						
U2	107	506+00.00		512+96.84	LT																						
US-23																											
D1	174	572+88.00		573+44.15	LT&RT																						
D2	174	573+78.19		573+78.19	LT																						
RAMP L																											
U1	202	571+88.12		574+27.40	LT																						
D1	203	578+91.37		579+00.41	LT																						
D2	203	578+94.78		579+03.51	RT																						
D1	204	583+45.00		583+45.00	LT																						
D2	204	583+51.95		583+61.00	LT																						
D3	204	583+38.79		583+47.52	RT																						
RAMP P1																											
U1	228	684+89.82		687+75.75	LT																						
U2	228	684+89.82		687+74.90	LT&RT																						
U3	228	684+89.82		687+74.62	RT																						
U1	229	688+00.00		693+00.00	RT																						
U2	229	688+00.00		693+00.00	RT																						
U3	229	688+00.00		693+00.00	LT																						
D1	229	689+68.39		691+77.29	LT&RT																						
D2	229	689+99.56		689+48.63	LT&RT																						
U1	230	693+00.00		698+00.00	RT																						
U2	230	693+00.00		698+00.00	LT&RT																						
U3	230	693+00.00		694+73.94	LT																						
U4	230	697+00.00		698+00.00	LT																						
D1	230	694+36.09		694+36.09	RT																						
D2	230	866+76.04		866+82.28	LT																						
D3	230	866+82.28		868+67.15	LT																						
D4	230	869+75.62		869+83.78	LT																						
U1	231	698+00.00		700+16.50	LT																						
U2	231	698+00.00		700+16.50	LT&RT																						
U3	231	698+00.00		700+16.50	RT																						
U1	232	703+00.00		703+70.79	LT																						
U2	232	703+00.00		703+70.79	LT&RT																						
U3	232	703+00.00		703+70.79	RT																						
RAMP P2																											
U1	257	866+76.04		871+00.00	LT																						
U2	257	868+96.68		871+00.00	RT																						
D1	257	867+48.52		867+48.52	RT																						
D2	257	869+10.95		869+10.95	RT																						
U1	258	871+00.00		872+72.48	LT																						
U2	258	871+00.00		872+70.98	RT																						
D1	258	872+16.23		872+29.91	LT&RT																						
TOTALS CARRIED TO GENERAL SUMMARY					18	322	78	6	73	300	11235	90	243	36	95	146	81	303	95	70	1	1	1	3	3	15	2

DRAINAGE ESTIMATED QUANTITIES

FRA - 270-51.50

ADDENDUM #1  
04/21/2023

X:\Projects\2013\1321\1010\FRA\92616\roadway\sheet\92616GS003.dgn 4/19/2023 7:24:06 AM cwong

REF NO.	SHEET NO.	STATION TO STATION	TO	203	601	601	601	602	605	611	611	611	611	611	611	611	611	611	613	
				CY	SY	CY	CY	CY	FT	FT	FT	FT	FT	FT	FT	FT	FT	FT	EACH	CY
RAMP R																				
U1	267	260+14.67				265+00.00	LT		489	24										
U2	267	260+14.67				265+00.00	LT&RT		500	9										
U3	267	260+14.67				265+00.00	RT		495		16							1		
U1	268	265+00.00				270+00.00	LT		514		20							2		
U2	268	265+00.00				270+00.00	LT&RT		499	11										
U3	268	265+00.00				270+00.00	RT		493		16							1		
U1	269	270+00.00				275+00.00	LT&RT		499	11										
U2	269	270+00.00				275+00.00	RT		496		9							1		
U3	269	270+00.00				271+88.12	LT		195											
D1	269	273+20.11				273+18.42	LT&RT	146		12									146	
U1	270	275+00.00				280+00.00	LT&RT				71									
U2	270	275+00.00				280+00.00	RT													
U3	270	275+89.89				280+00.00	LT													
D1	270	279+16.51				279+20.62	RT	66			2	0.3								
U1	271	280+00.00				285+00.00	LT&RT													
U2	271	280+00.00				284+50.00	LT													
U3	271	280+00.00				285+00.00	RT													
U1	272	285+00.00				287+90.80	LT&RT		291											
U2	272	285+00.00				287+90.80	RT		290											
RAMP S																				
U1	301	799+27.09				803+00.00	LT		414		10								1	
U2	301	799+27.80				803+00.00	RT		384		10								1	
D1	301	799+20.43				799+26.23	LT&RT				2	0.5				60				
D2	301	802+57.57				802+61.26	LT				5	2.2								
U1	302	803+00.00				808+00.00	RT		507										1	
U2	302	803+00.00				808+00.00	LT		496										1	
D1	302	804+88.56				804+89.92	LT													
U1	303	808+00.00				813+00.00	LT		505											
U2	303	808+00.00				813+00.00	RT		499											
TOTALS CARRIED TO GENERAL SUMMARY																				
				212	19	71	6	12	7566	55	2995	34	56	18	60	64	250	31	13	212



CALCULATED	ACF		
	CHECKED		
CSR			
<b>DRAINAGE ESTIMATED QUANTITIES</b>			
<b>FRA - 270-51.50</b>			
<table border="1"> <tr> <td>90</td> </tr> <tr> <td>554</td> </tr> </table>		90	554
90			
554			













LEGEND

- CATCH BASIN 2-2B
- INLET, NO. 3 FOR SINGLE SLOPE BARRIER, TYPE B
- MANHOLE, NO. 1

VEGETATED FILTER STRIP								
ROUTE	STATION		SIDE	TREATED AREA (AC.)	FROM		TO	
	FROM	TO			NORTHING	EASTING	NORTHING	EASTING
IR 270	463+99	471+93	CT	2	684411.009	1824687.46	1824095.8	684798.703
IR 270	471+93	481+88	CT	3.03	683954.668	1825571.32	684402.84	1824704.11
IR 270	505+75	510+48	CT	1.45	683100.64	1828308.15	683190.68	1827872.37
IR 270	510+48	516+80	CT	1.56	683002.05	1828928.92	683100.64	1828308.15
IR 270	520+22	527+40	CT	1.59	682911.76	1829975.07	682964.64	1829272.34
IR 270	527+39	537+41	CT	1.77	682845.29	1830970.30	682909.86	1830004.62
US 23	546+50	549+45	LT	0.42	680041.06	1826825.73	680366.65	1826779.45
US 23	549+00	548+86	RT	0.32	680109.75	1826981.89	680295.68	1826963.51
US 23	548+87	552+70	RT	0.68	680295.68	1826963.51	680656.11	1826922.28
US 23	550+00	552+80	LT	0.46	680858.68	1826720.73	681256.28	1826690.42
US 23	554+50	558+70	LT	0.38	680366.65	1826779.45	680660.66	1826742.11
US 23	553+95	560+12	RT	1.12	680754.66	1826903.30	681407.48	1826859.06
US 23	558+70	560+35	LT	0.17	681256.28	1826690.42	681423.16	1826689.23
RAMP R	260+42	265+74	RT	1.04	681407.48	1826859.06	681942.58	1826932.47

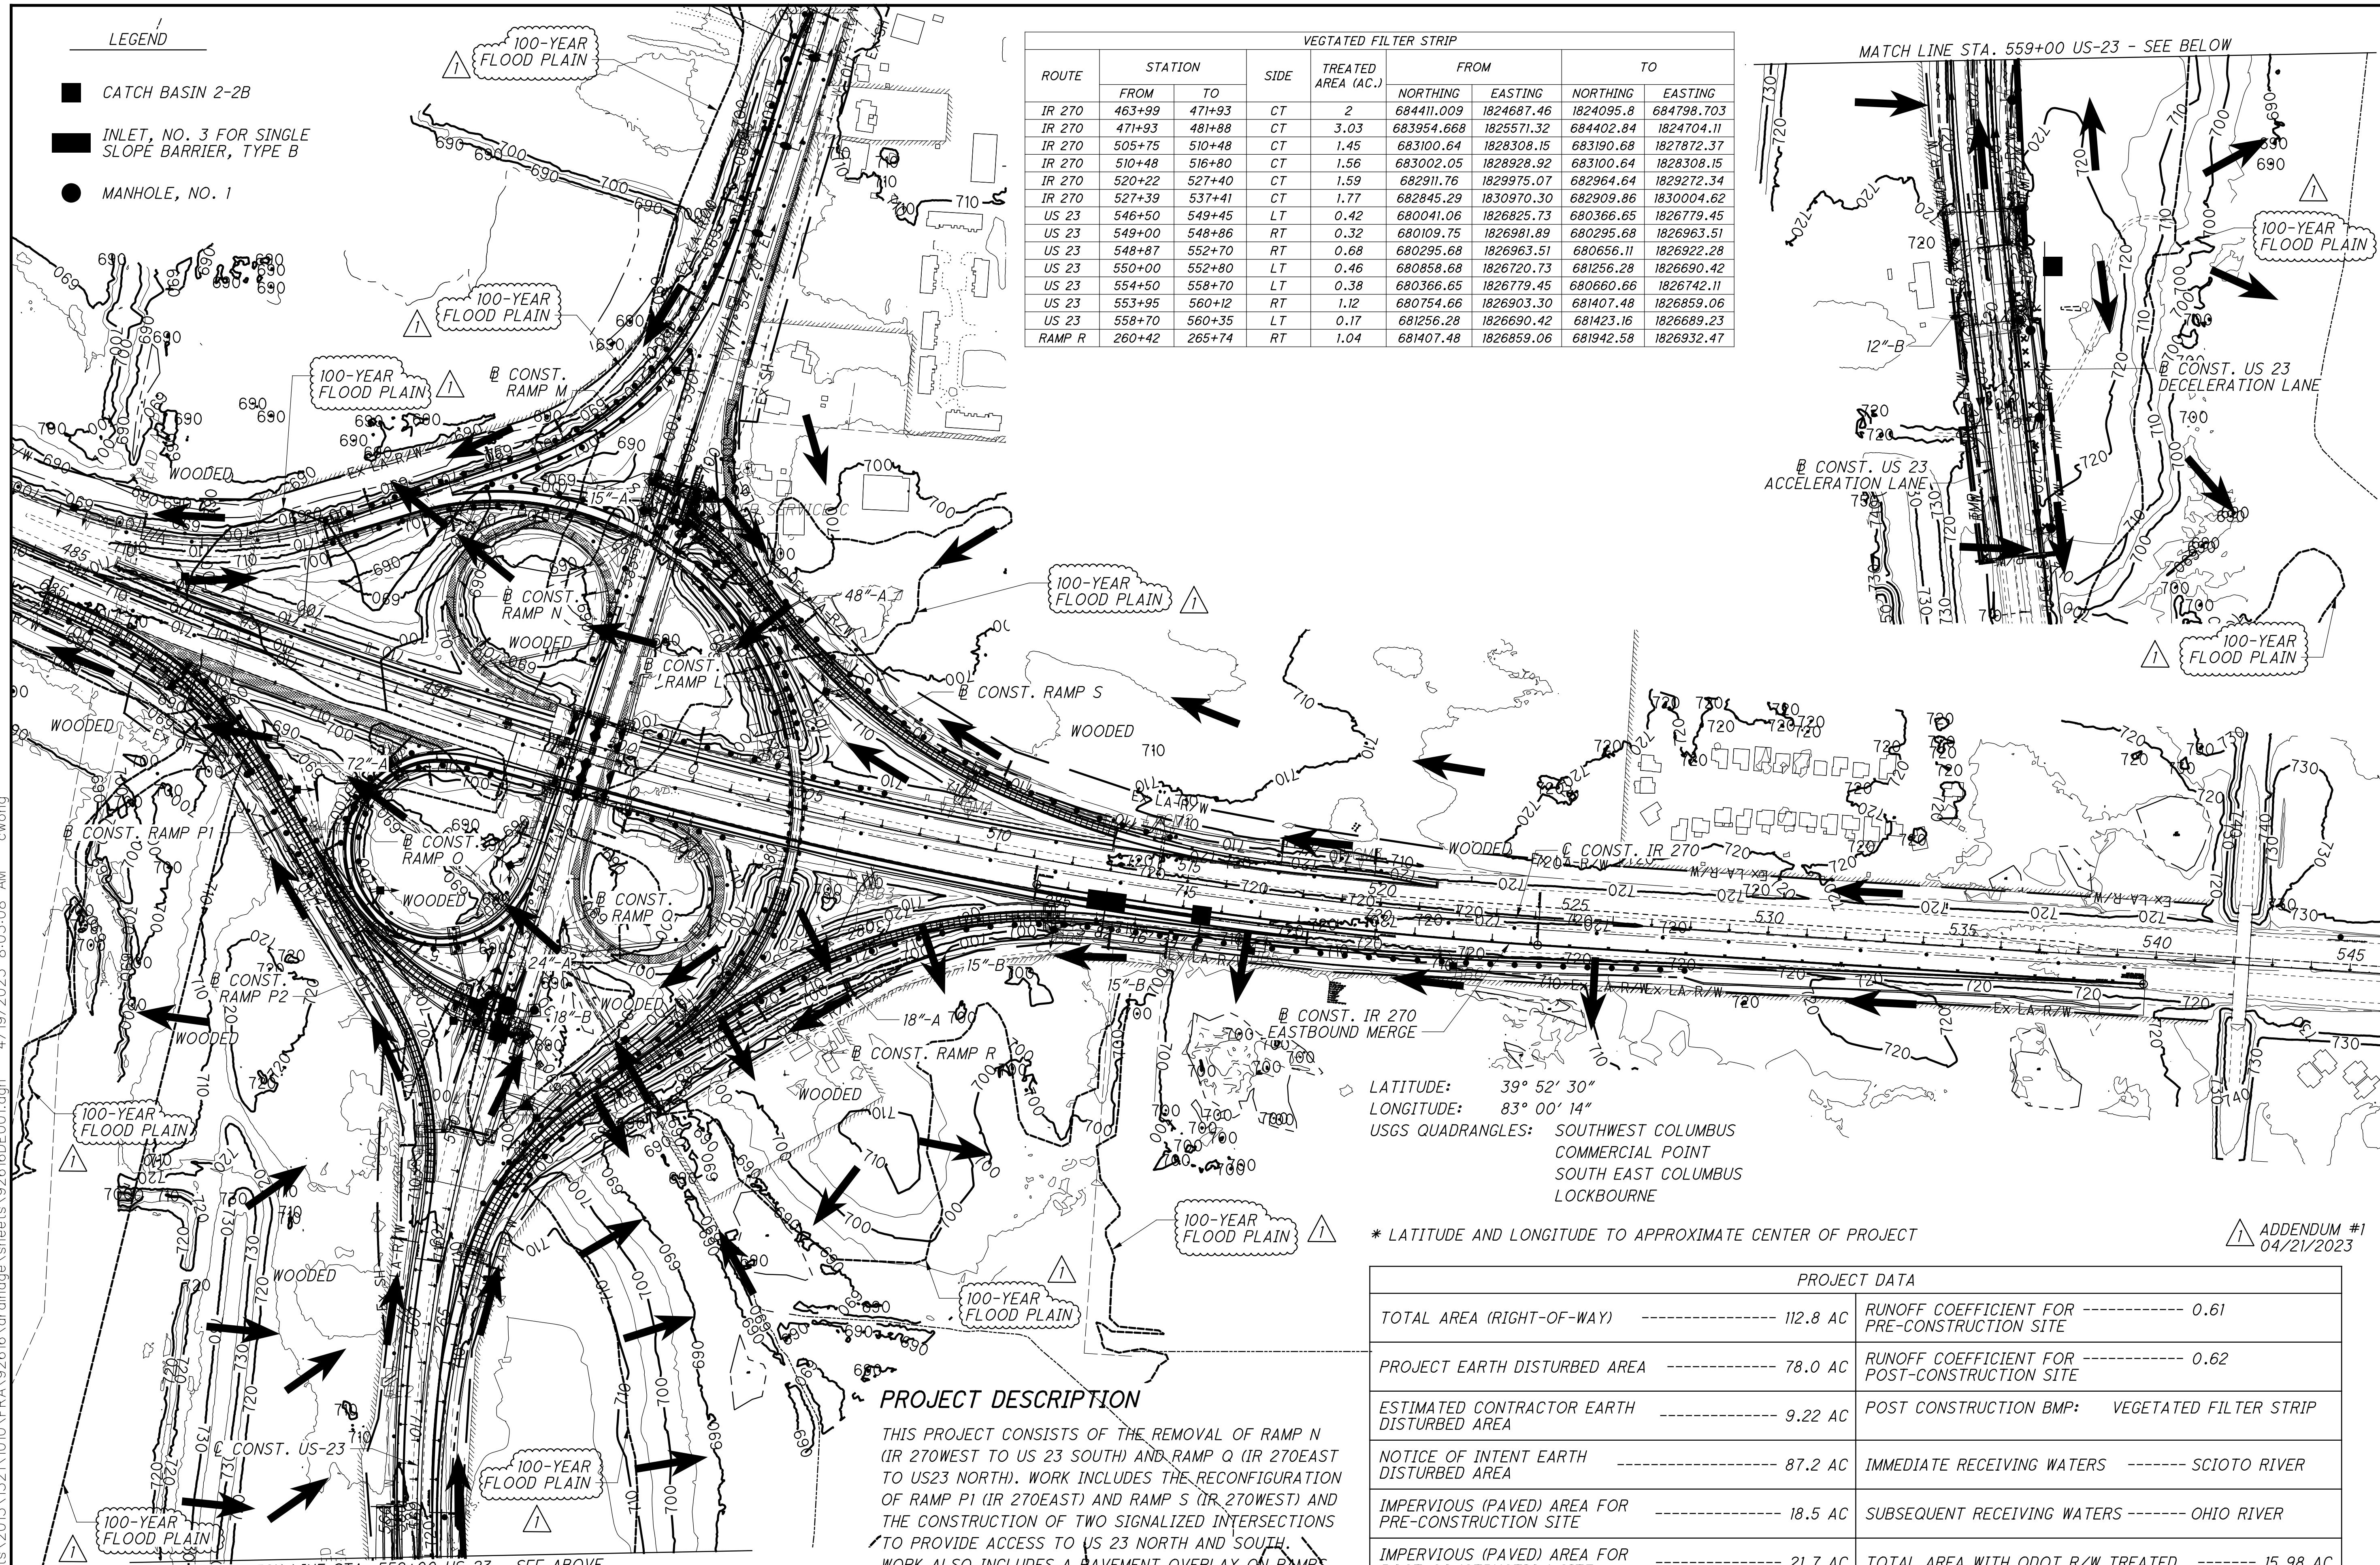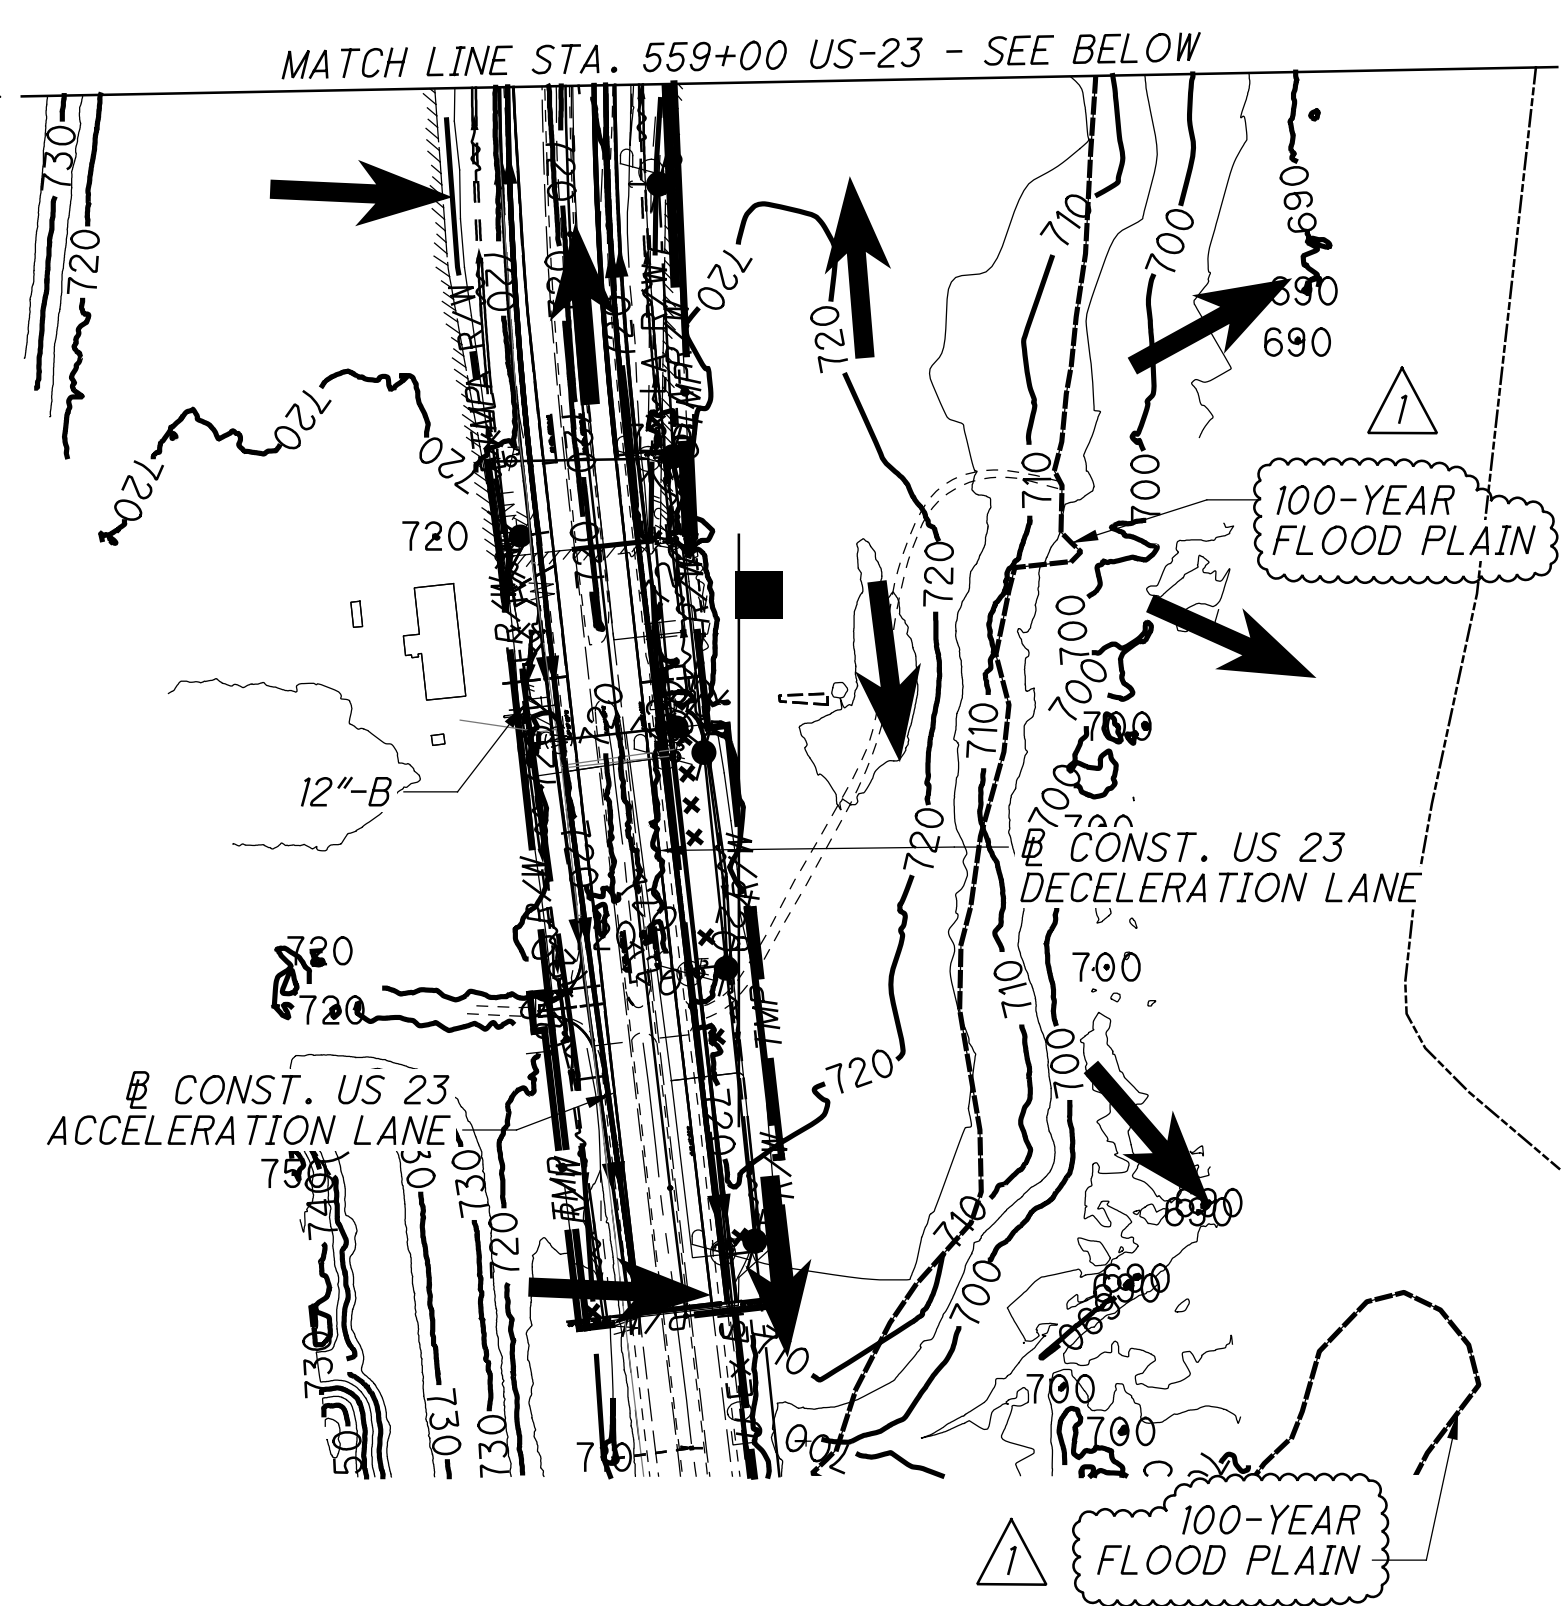

LATITUDE: 39° 52' 30"  
 LONGITUDE: 83° 00' 14"  
 USGS QUADRANGLES: SOUTHWEST COLUMBUS  
 COMMERCIAL POINT  
 SOUTH EAST COLUMBUS  
 LOCKBOURNE

\* LATITUDE AND LONGITUDE TO APPROXIMATE CENTER OF PROJECT

ADDENDUM #1  
 04/21/2023

**PROJECT DESCRIPTION**

THIS PROJECT CONSISTS OF THE REMOVAL OF RAMP N (IR 270 WEST TO US 23 SOUTH) AND RAMP Q (IR 270 EAST TO US 23 NORTH). WORK INCLUDES THE RECONFIGURATION OF RAMP P1 (IR 270 EAST) AND RAMP S (IR 270 WEST) AND THE CONSTRUCTION OF TWO SIGNALIZED INTERSECTIONS TO PROVIDE ACCESS TO US 23 NORTH AND SOUTH. WORK ALSO INCLUDES A PAVEMENT OVERLAY ON RAMPS L, M, P, AND S

PROJECT DATA			
TOTAL AREA (RIGHT-OF-WAY)	112.8 AC	RUNOFF COEFFICIENT FOR PRE-CONSTRUCTION SITE	0.61
PROJECT EARTH DISTURBED AREA	78.0 AC	RUNOFF COEFFICIENT FOR POST-CONSTRUCTION SITE	0.62
ESTIMATED CONTRACTOR EARTH DISTURBED AREA	9.22 AC	POST CONSTRUCTION BMP:	VEGETATED FILTER STRIP
NOTICE OF INTENT EARTH DISTURBED AREA	87.2 AC	IMMEDIATE RECEIVING WATERS	SCIOTO RIVER
IMPERVIOUS (PAVED) AREA FOR PRE-CONSTRUCTION SITE	18.5 AC	SUBSEQUENT RECEIVING WATERS	OHIO RIVER
IMPERVIOUS (PAVED) AREA FOR POST-CONSTRUCTION SITE	21.7 AC	TOTAL AREA WITH ODOT R/W TREATED	15.98 AC
		TREATMENT REQUIREMENTS	15.77 AC

PROJECT SITE PLAN  
 FRA - 270-51.50  
 101  
 554


CALCULATED: ACF  
 CHECKED: CSR

HORIZONTAL SCALE IN FEET  
 0 200 400


X:\Projects\2013\1321\1010\FRA\92616\drainage\sheets\92616DE001.dgn 4/19/2023 8:05:08 AM c.wong




X:\Projects\2013\1010\_FRA\92616\roadway\sheets\92616GP051.dgn 4/19/2023 8:29:54 AM c.wong

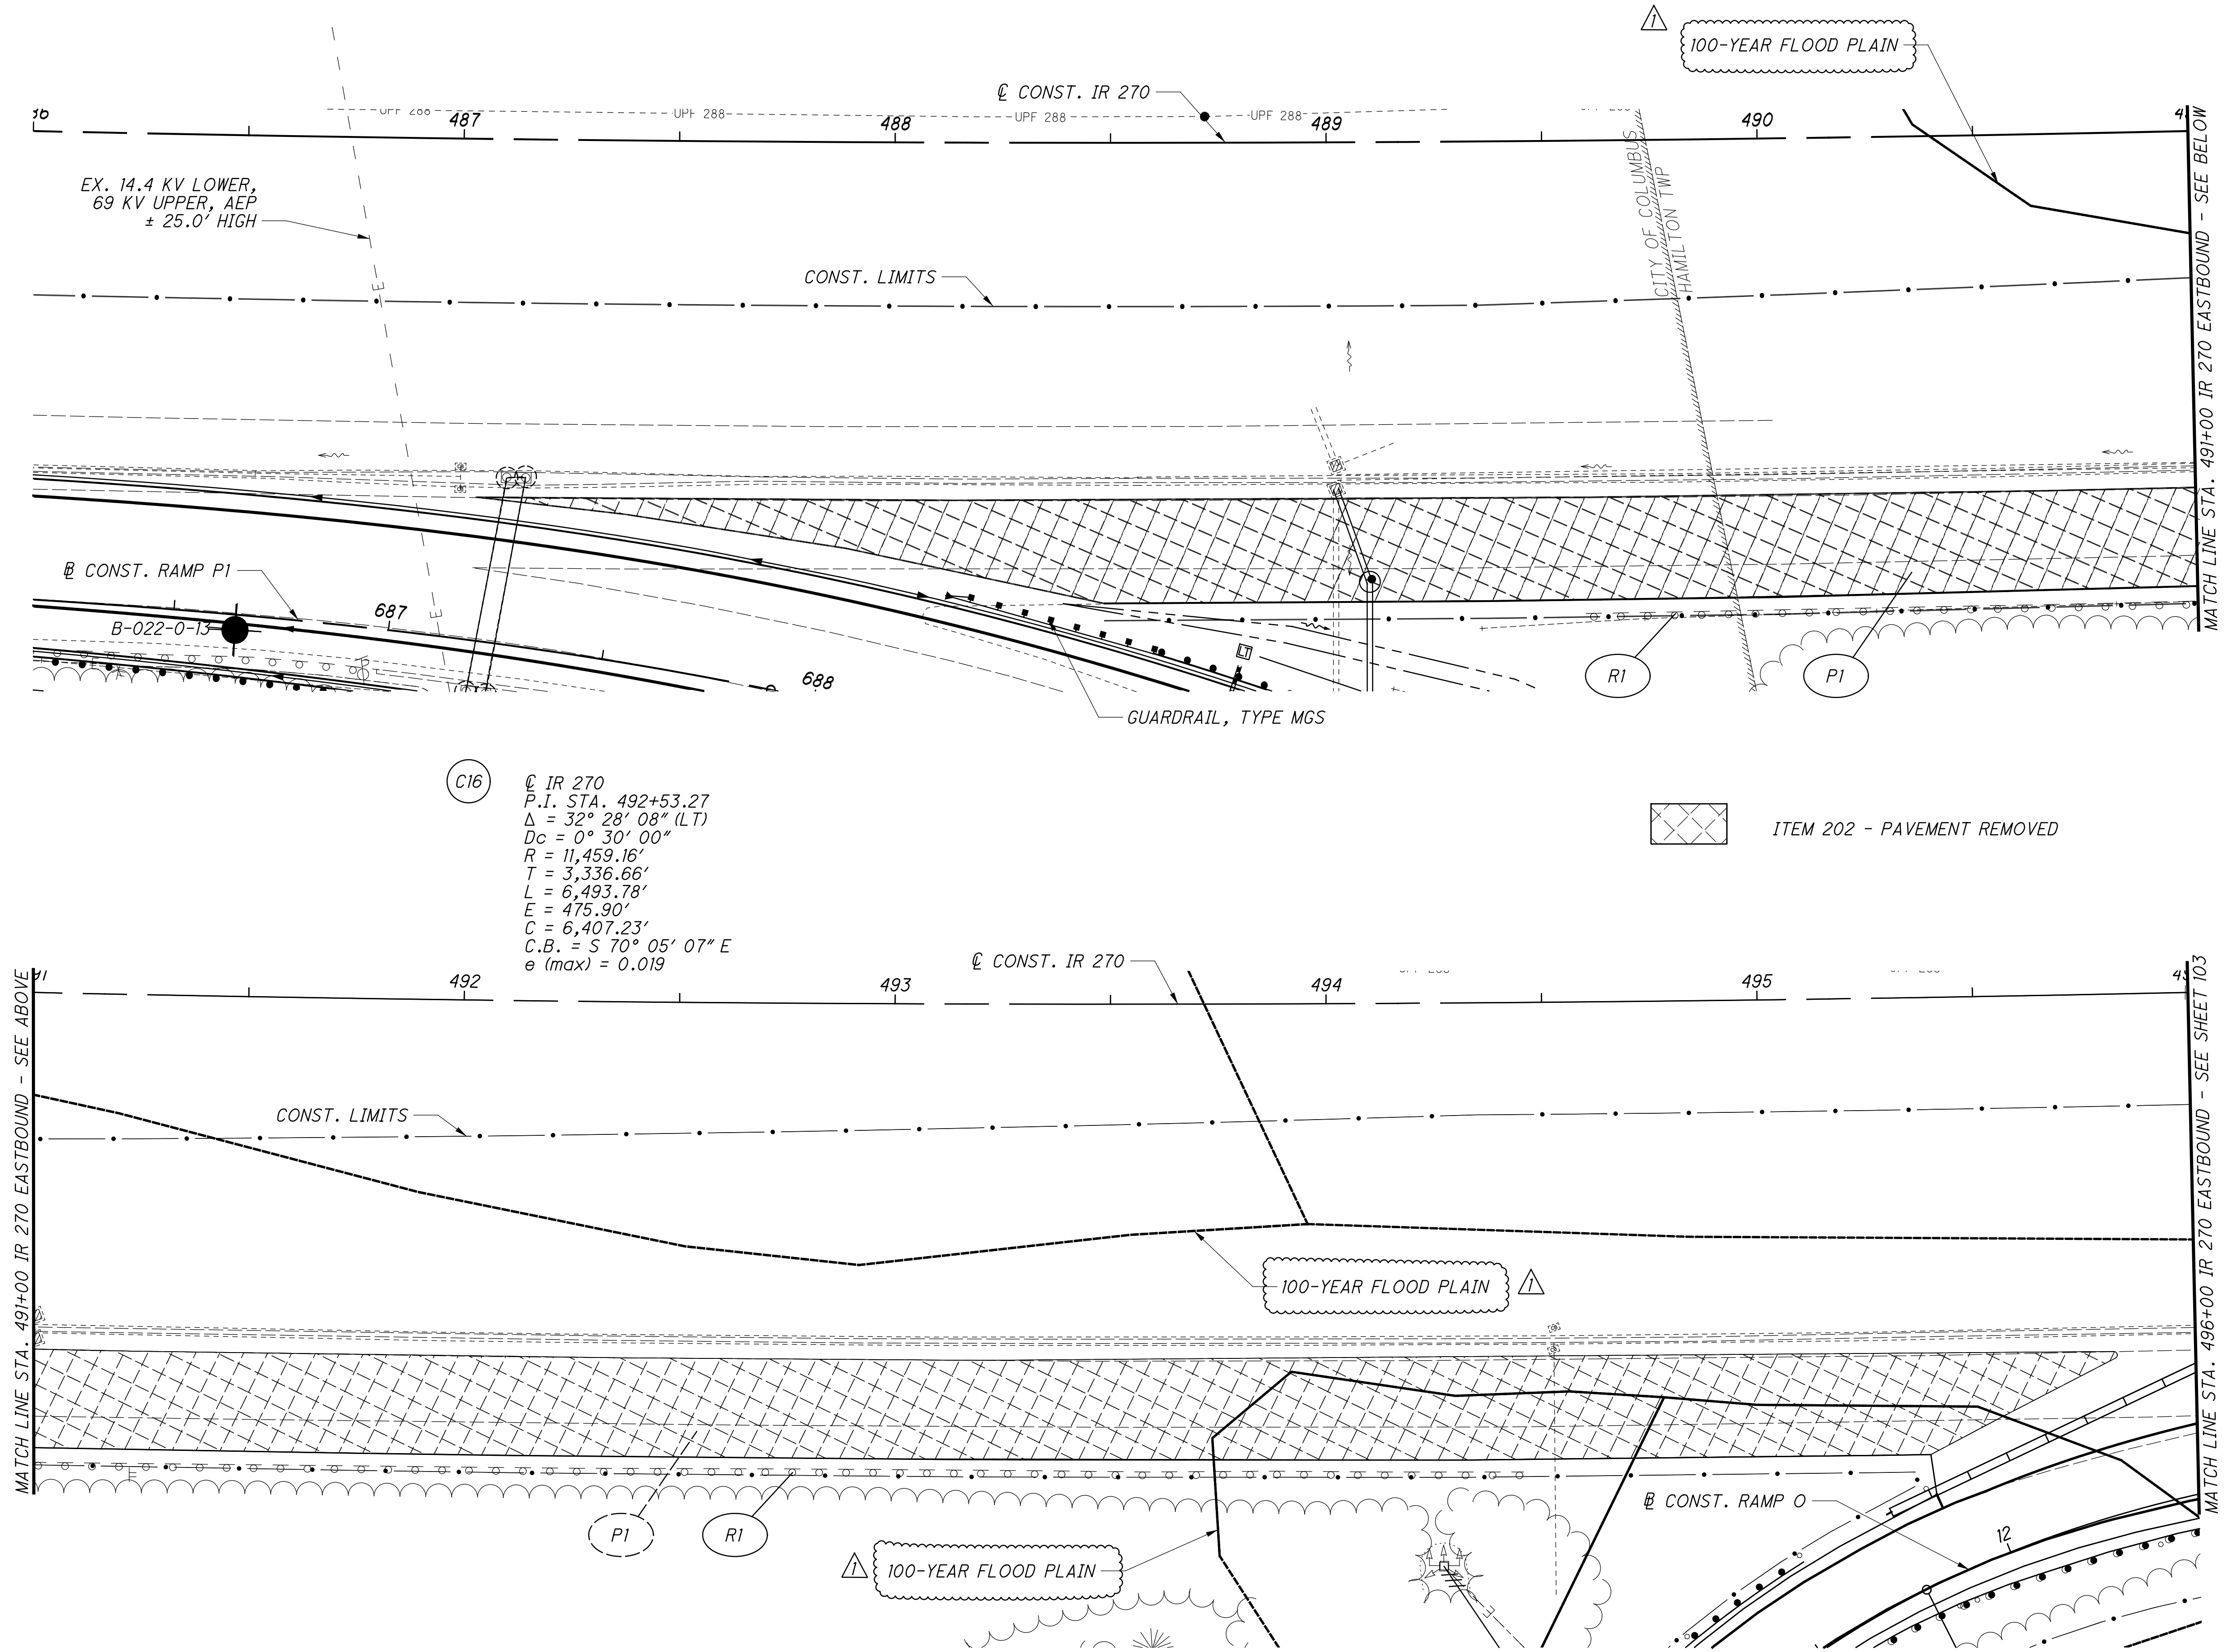

(C16) @ IR 270  
 P.I. STA. 492+53.27  
 $\Delta = 32^\circ 28' 08''$  (LT)  
 $Dc = 0^\circ 30' 00''$   
 $R = 11,459.16'$   
 $T = 3,336.66'$   
 $L = 6,493.78'$   
 $E = 475.90'$   
 $C = 6,407.23'$   
 C.B. = S  $70^\circ 05' 07''$  E  
 $e$  (max) = 0.019

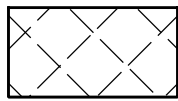 ITEM 202 - PAVEMENT REMOVED

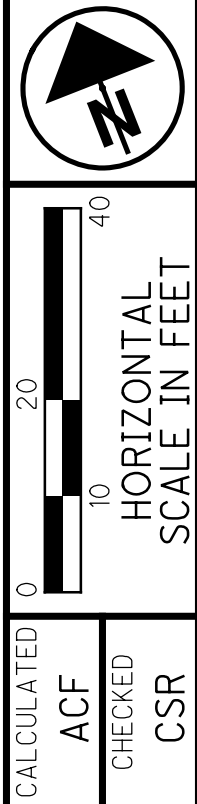

CALCULATED	ACF	CHECKED	CSR
------------	-----	---------	-----

**PLAN - IR 270 EASTBOUND**  
**STA. 486+00 TO STA. 496+00**




**FRA - 270-51.50**

102  
554

ADDENDUM #1  
04/21/2023



X:\Projects\2013\1321\1010\FRA\92616\roadway\sheets\92616GP052.dgn 4/19/2023 8:44:18 AM cwong

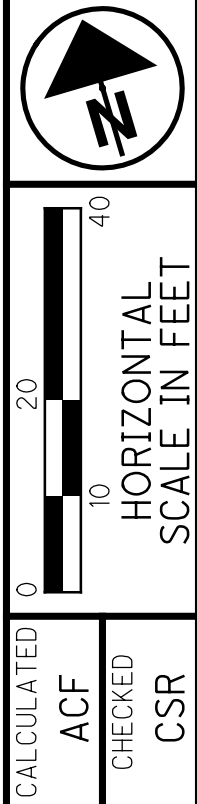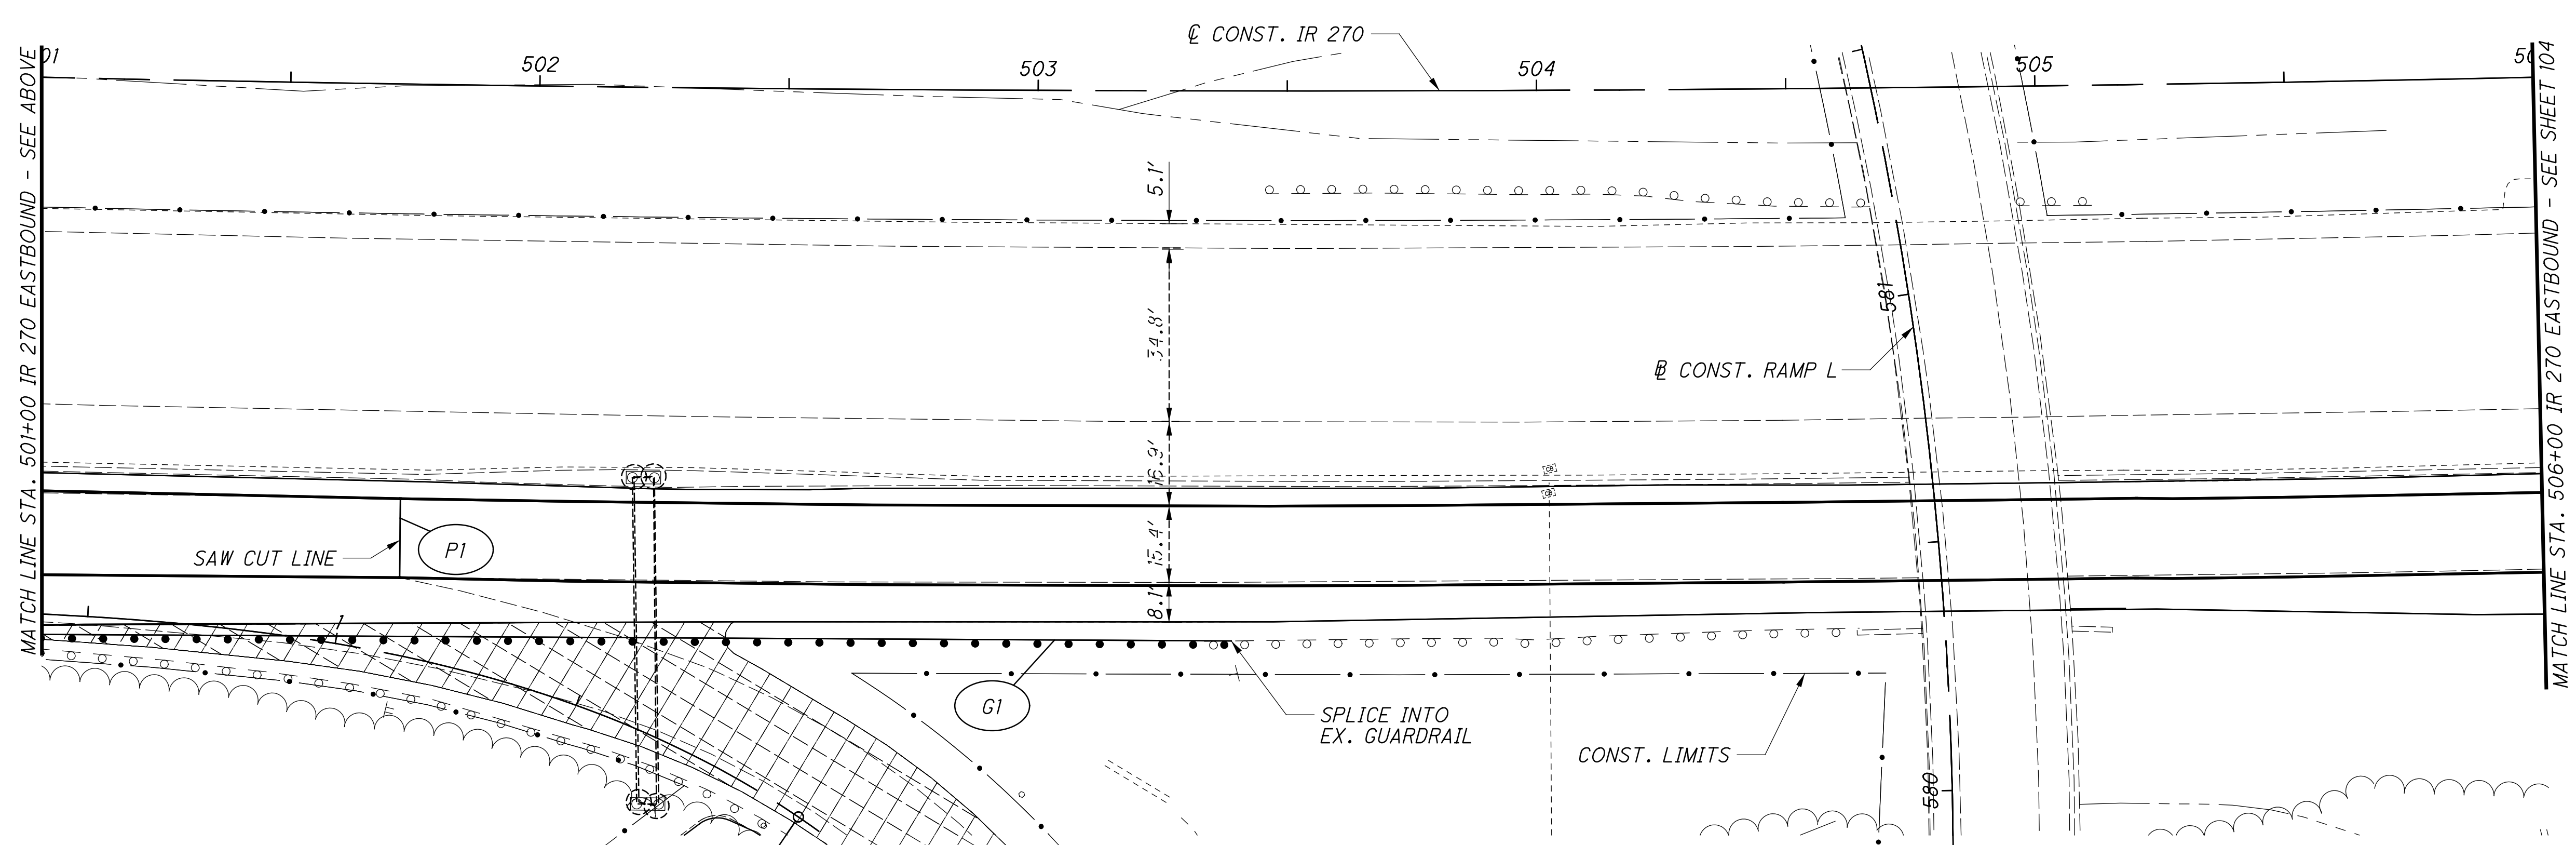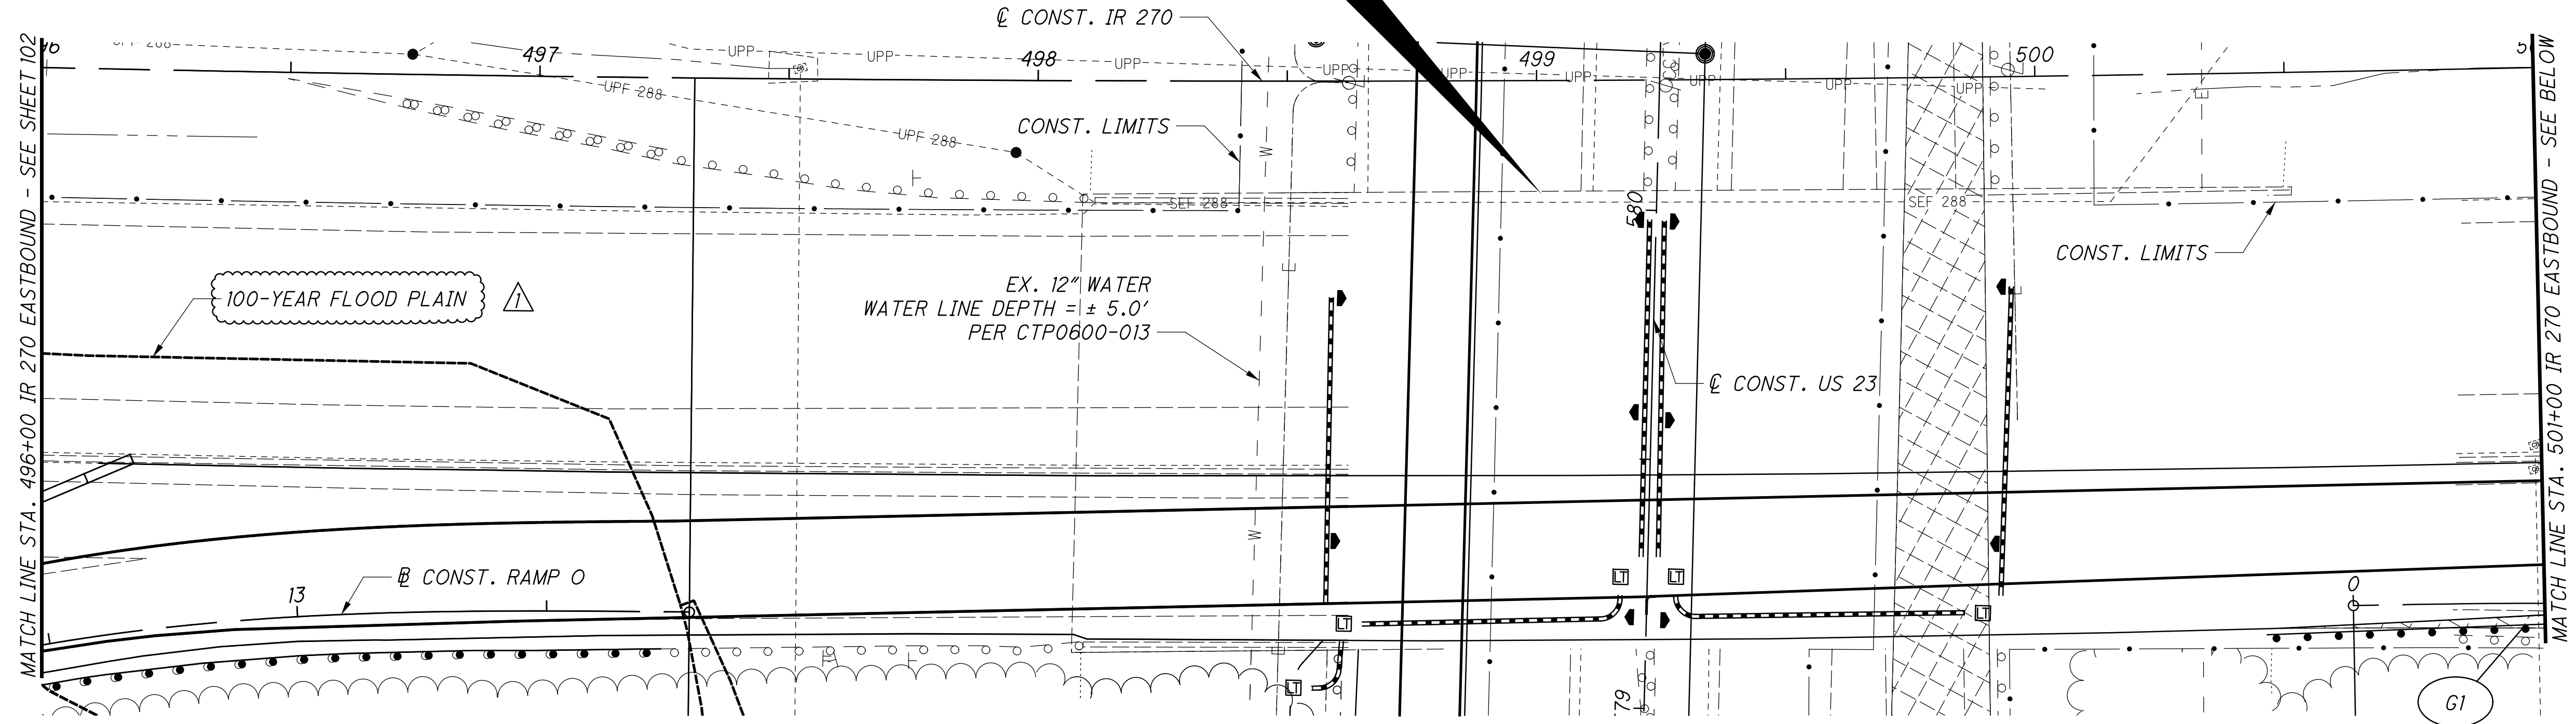

CALCULATED	ACF	CHECKED	CSR

**PLAN - IR 270 EASTBOUND**  
**STA. 496+00 TO STA. 506+00**

**FRA-270-51.50**

103  
554

ADDENDUM #1  
04/21/2023


X:\Projects\2013\1010\FRA\92616\roadway\sheets\92616GP101.dgn 4/19/2023 9:00:30 AM cwong

CALCULATED  
ACF  
CHECKED  
CSR

0 10 20 40  
HORIZONTAL  
SCALE IN FEET

PLAN - IR 270 WESTBOUND  
STA. 486+00 TO STA. 496+00

FRA - 270-51.50

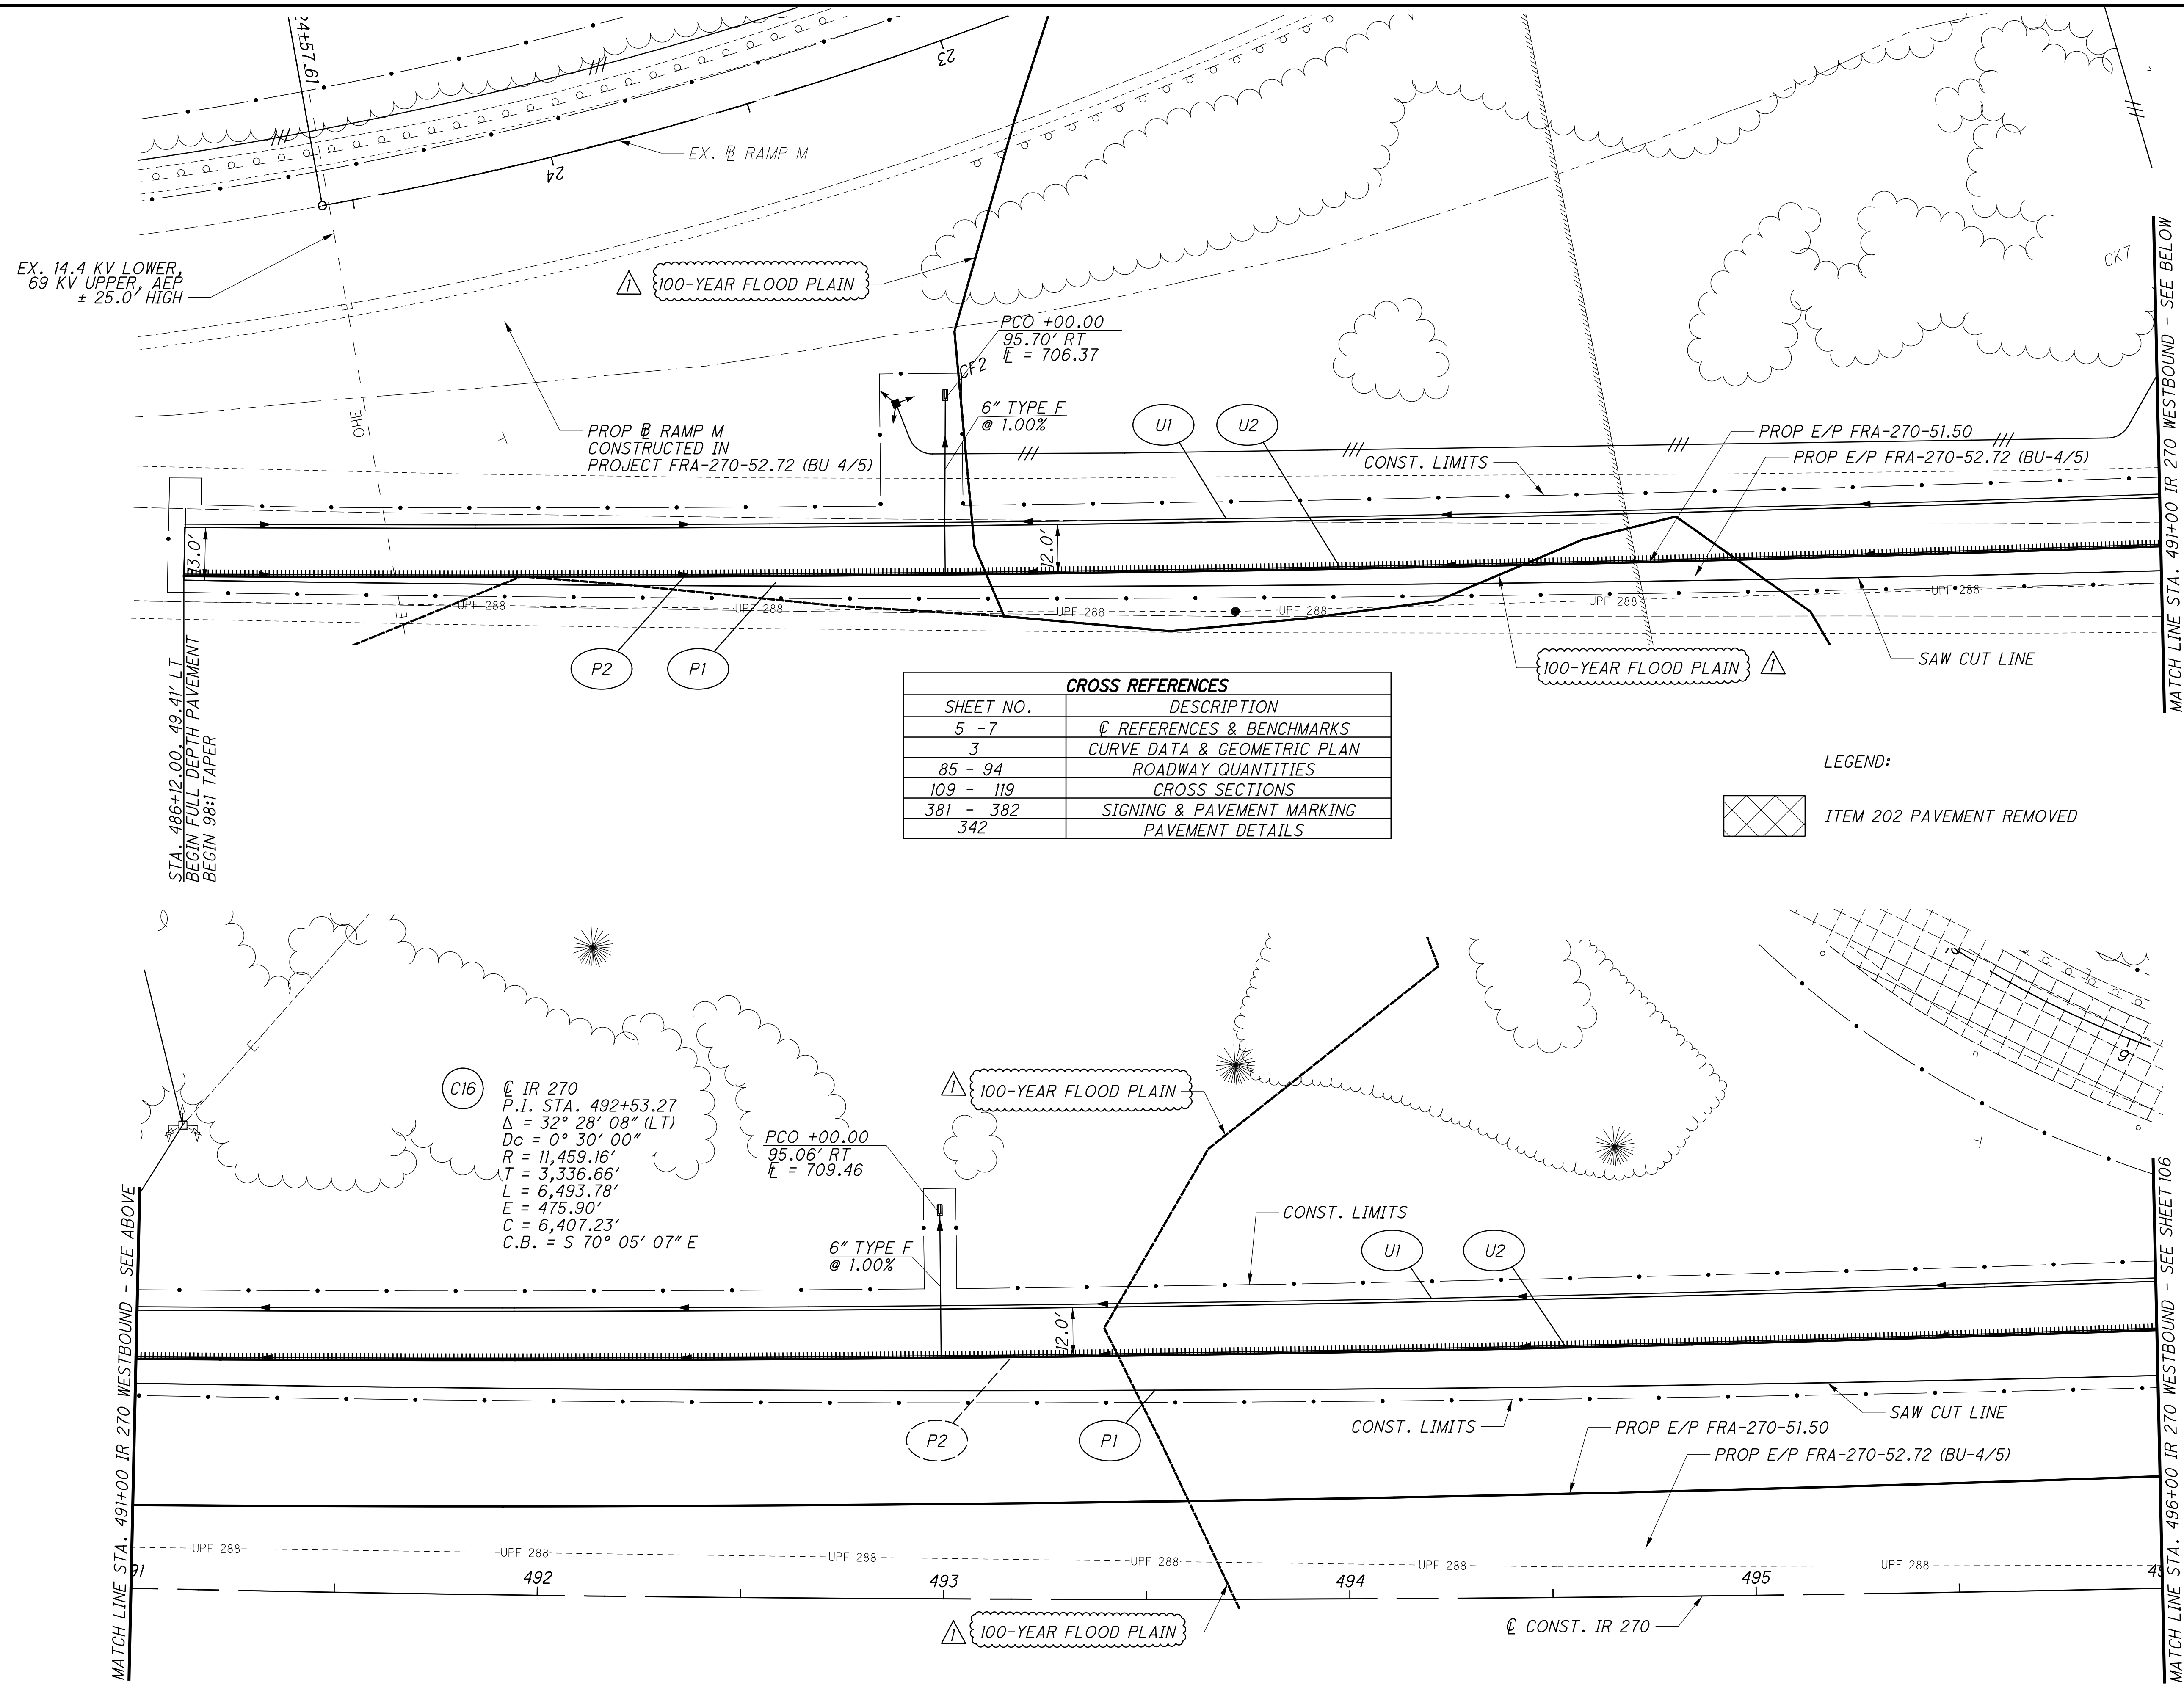

CROSS REFERENCES	
SHEET NO.	DESCRIPTION
5 - 7	REFERENCES & BENCHMARKS
3	CURVE DATA & GEOMETRIC PLAN
85 - 94	ROADWAY QUANTITIES
109 - 119	CROSS SECTIONS
381 - 382	SIGNING & PAVEMENT MARKING
342	PAVEMENT DETAILS

LEGEND:  
 ITEM 202 PAVEMENT REMOVED


C16  
 C IR 270  
 P.I. STA. 492+53.27  
 $\Delta = 32^\circ 28' 08''$  (LT)  
 $Dc = 0^\circ 30' 00''$   
 $R = 11,459.16'$   
 $T = 3,336.66'$   
 $L = 6,493.78'$   
 $E = 475.90'$   
 $C = 6,407.23'$   
 $C.B. = S 70^\circ 05' 07'' E$

PCO +00.00  
 95.06' RT  
 $L = 709.46$

6" TYPE F  
 @ 1.00%



ADDENDUM #1  
 04/21/2023

X:\Projects\2013\1010\FRA\92616\roadway\sheets\92616GP102.dgn 4/19/2023 9:01:46 AM cwong

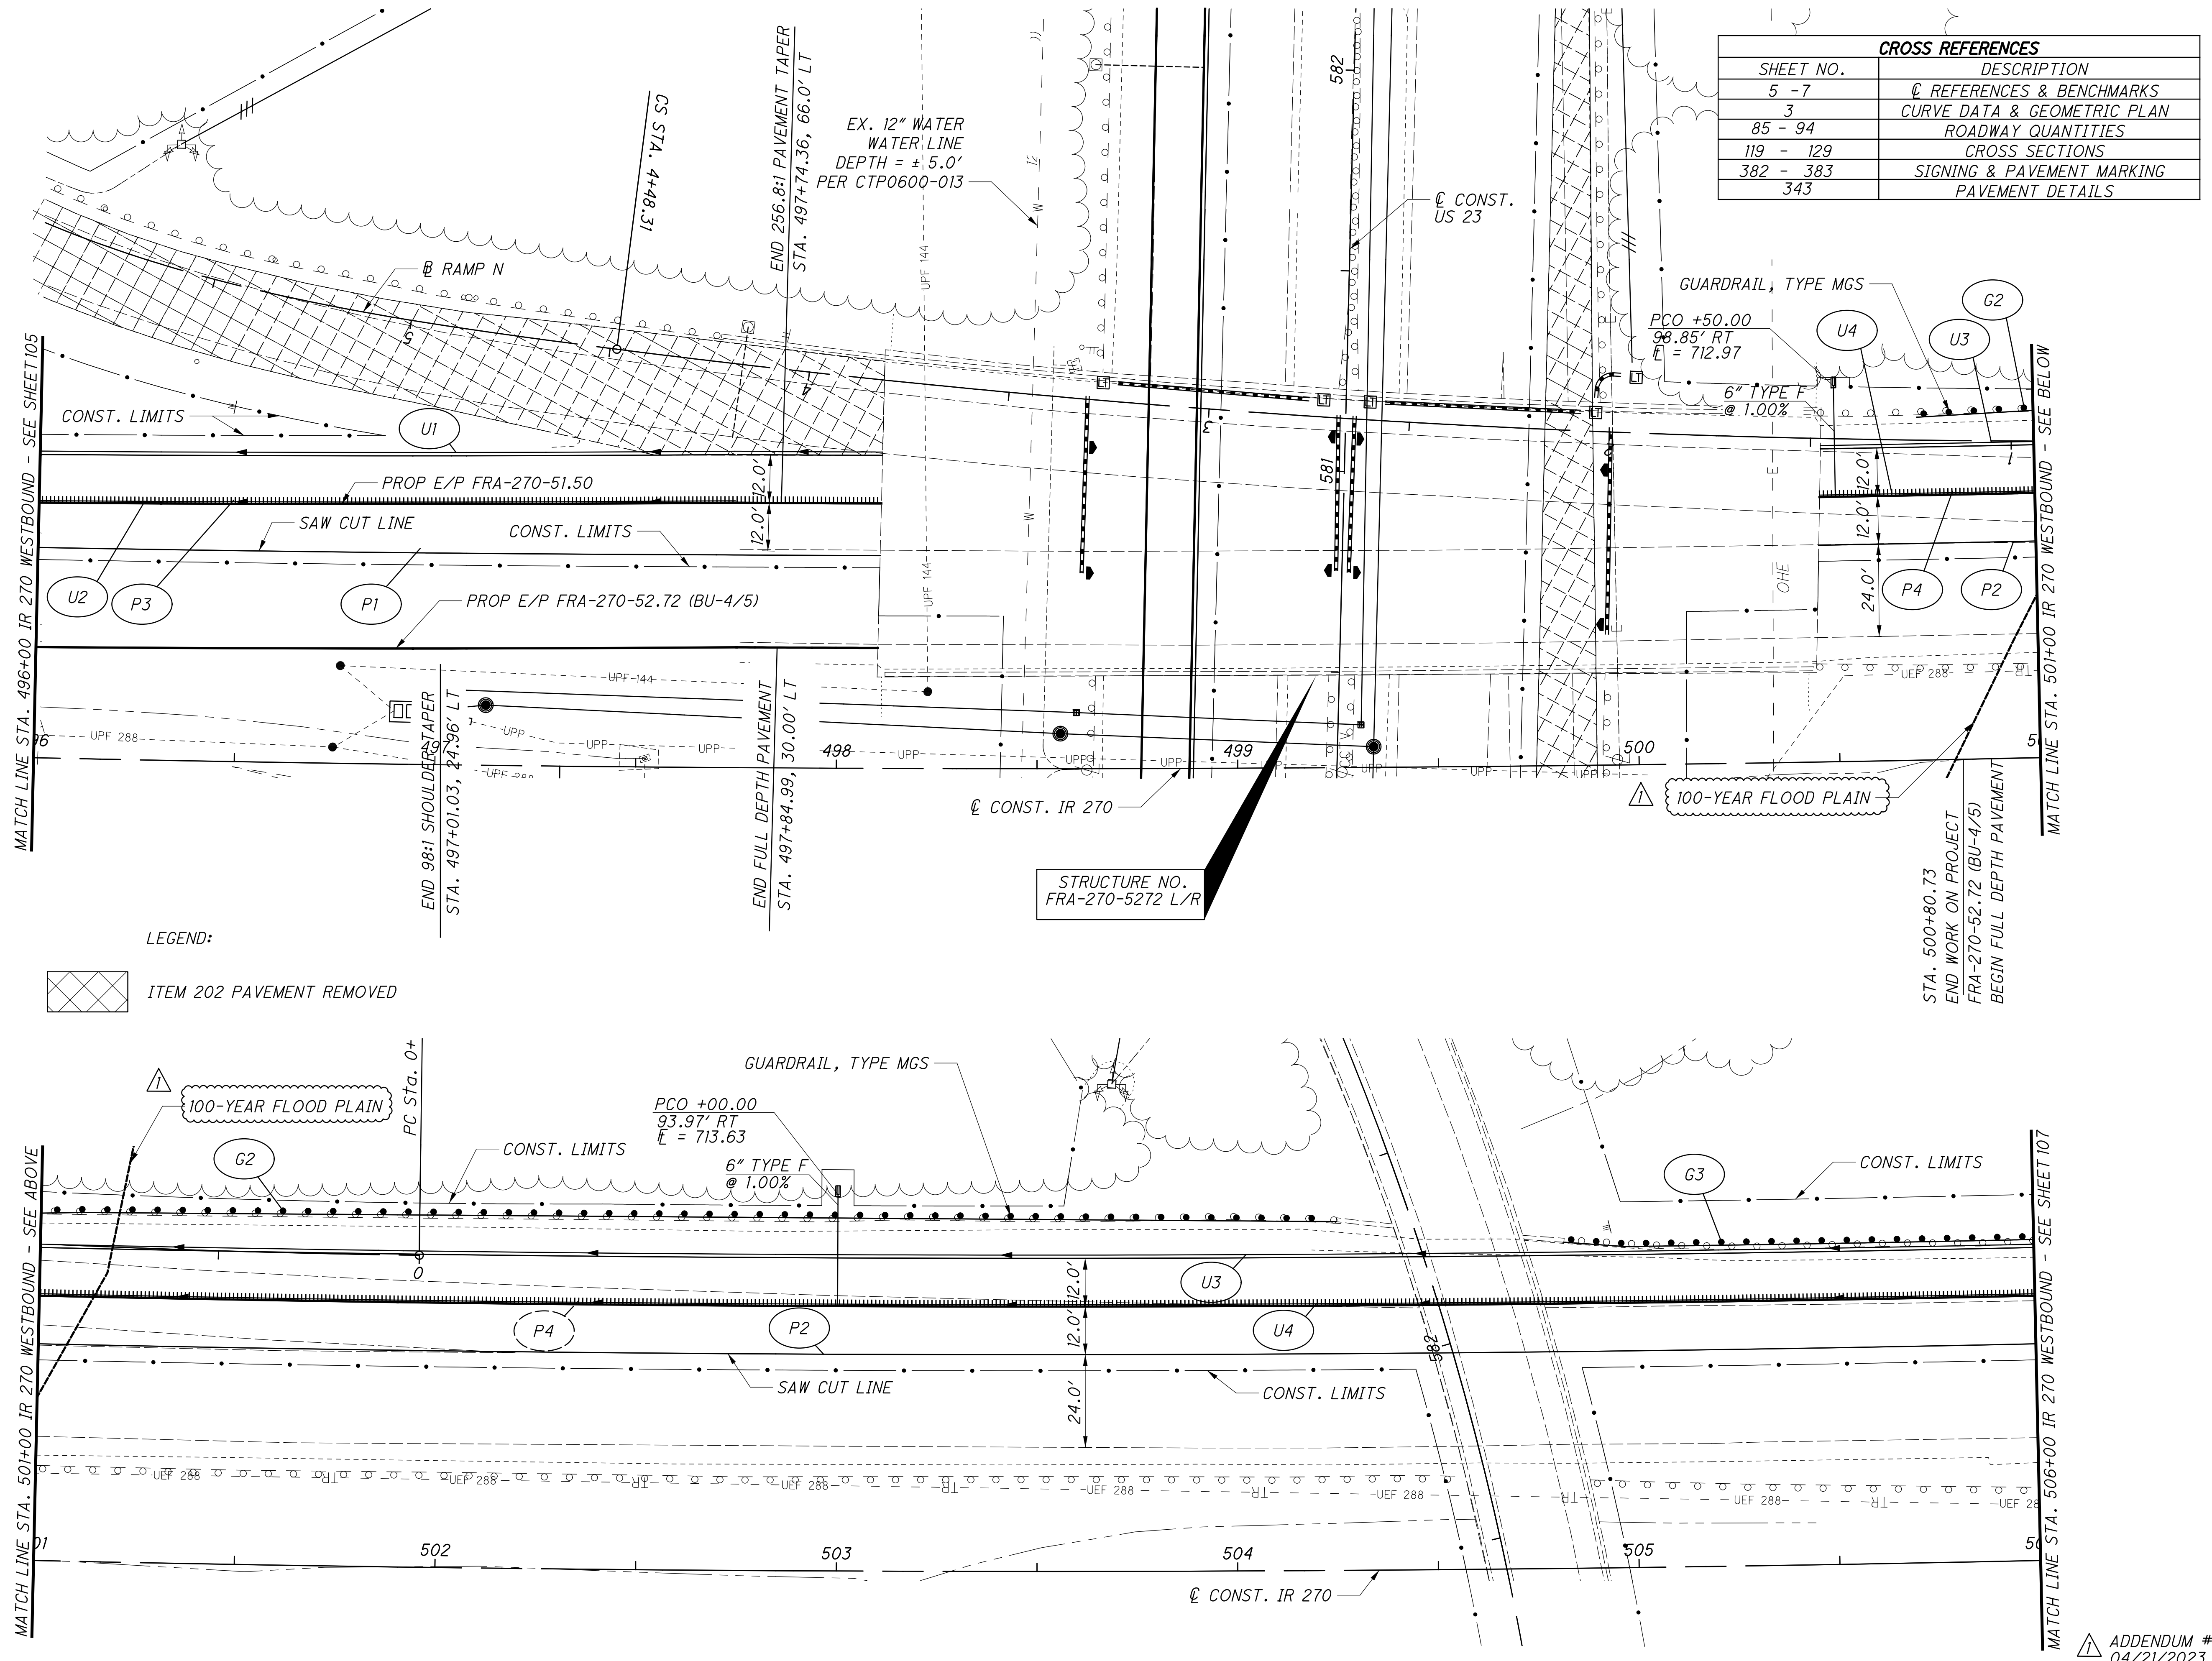

CROSS REFERENCES	
SHEET NO.	DESCRIPTION
5 - 7	☉ REFERENCES & BENCHMARKS
3	☉ CURVE DATA & GEOMETRIC PLAN
85 - 94	☉ ROADWAY QUANTITIES
119 - 129	☉ CROSS SECTIONS
382 - 383	☉ SIGNING & PAVEMENT MARKING
343	☉ PAVEMENT DETAILS

LEGEND:

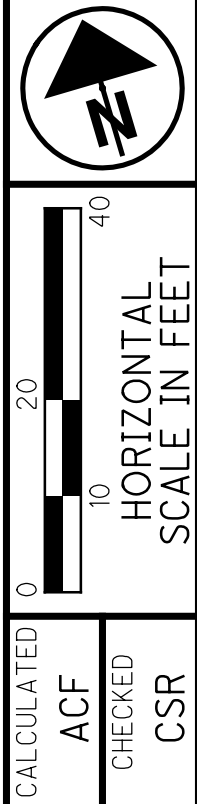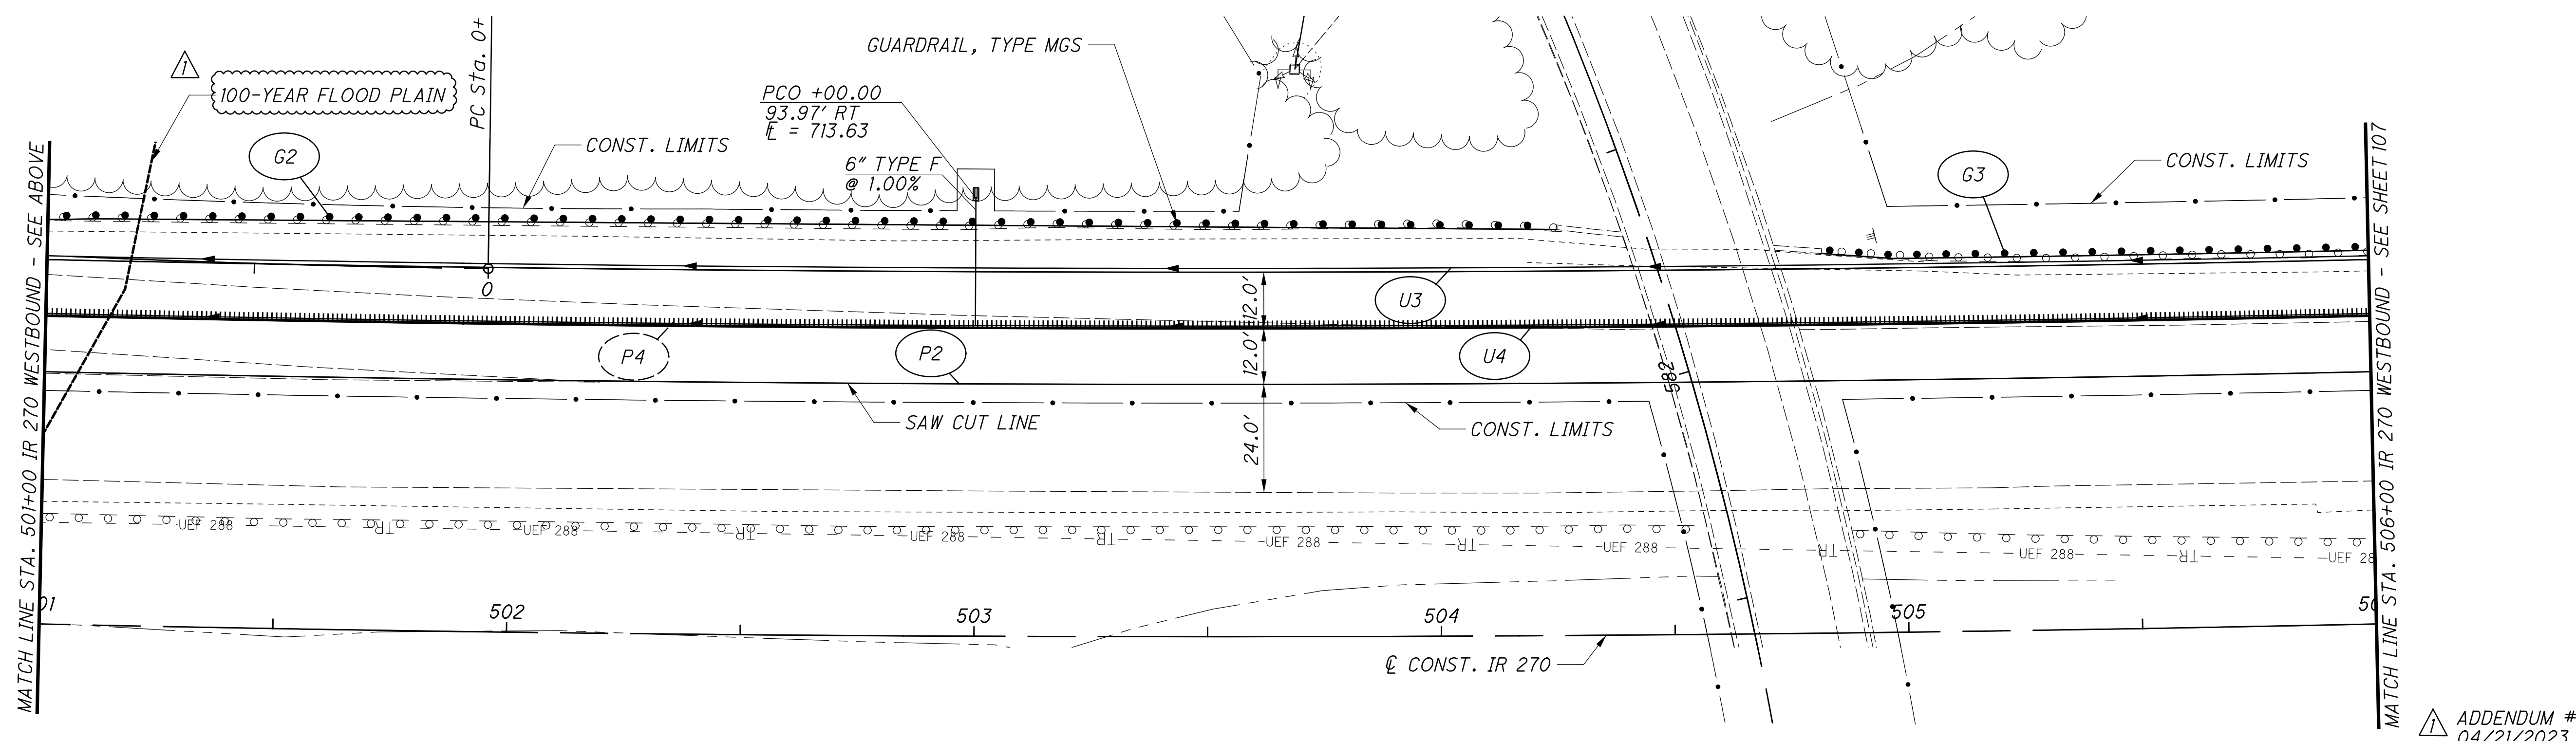

CALCULATED ACF CHECKED CSR

PLAN - IR 270 WESTBOUND  
STA. 496+00 TO STA. 506+00

FRA-270-51.50

106  
554



ADDENDUM #1  
04/21/2023



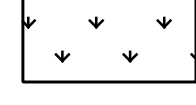



C21 IR 270EB MERGE  
 P.I. STA. 717+69.38  
 $\Delta = 6^\circ 27' 15''$  (LT)  
 $D_c = 0^\circ 29' 50''$   
 $R = 111,525.16'$   
 $T = 649.82'$   
 $L = 1,298.26'$   
 $E = 18.30'$   
 $C = 1,297.57'$   
 $C.B. = S 83^\circ 05' 33'' E$   
 $e$  (max) = 0.016

C22 IR 270GD MERGE  
 P.I. STA. 817+70.45  
 $\Delta = 6^\circ 27' 15''$  (LT)  
 $D_c = 0^\circ 29' 50''$   
 $R = 111,544.16'$   
 $T = 650.89'$   
 $L = 1,300.40'$   
 $E = 18.31'$   
 $C = 1,299.71'$   
 $C.B. = S 83^\circ 05' 33'' E$   
 $e$  (max) = 0.016

CROSS REFERENCES	
SHEET NO.	DESCRIPTION
5 - 7	REFERENCES & BENCHMARKS
3	CURVE DATA & GEOMETRIC PLAN
85 - 94	ROADWAY QUANTITIES
148 - 152	CROSS SECTIONS
383 - 384	SIGNING & PAVEMENT MARKING
339	PAVEMENT DETAILS

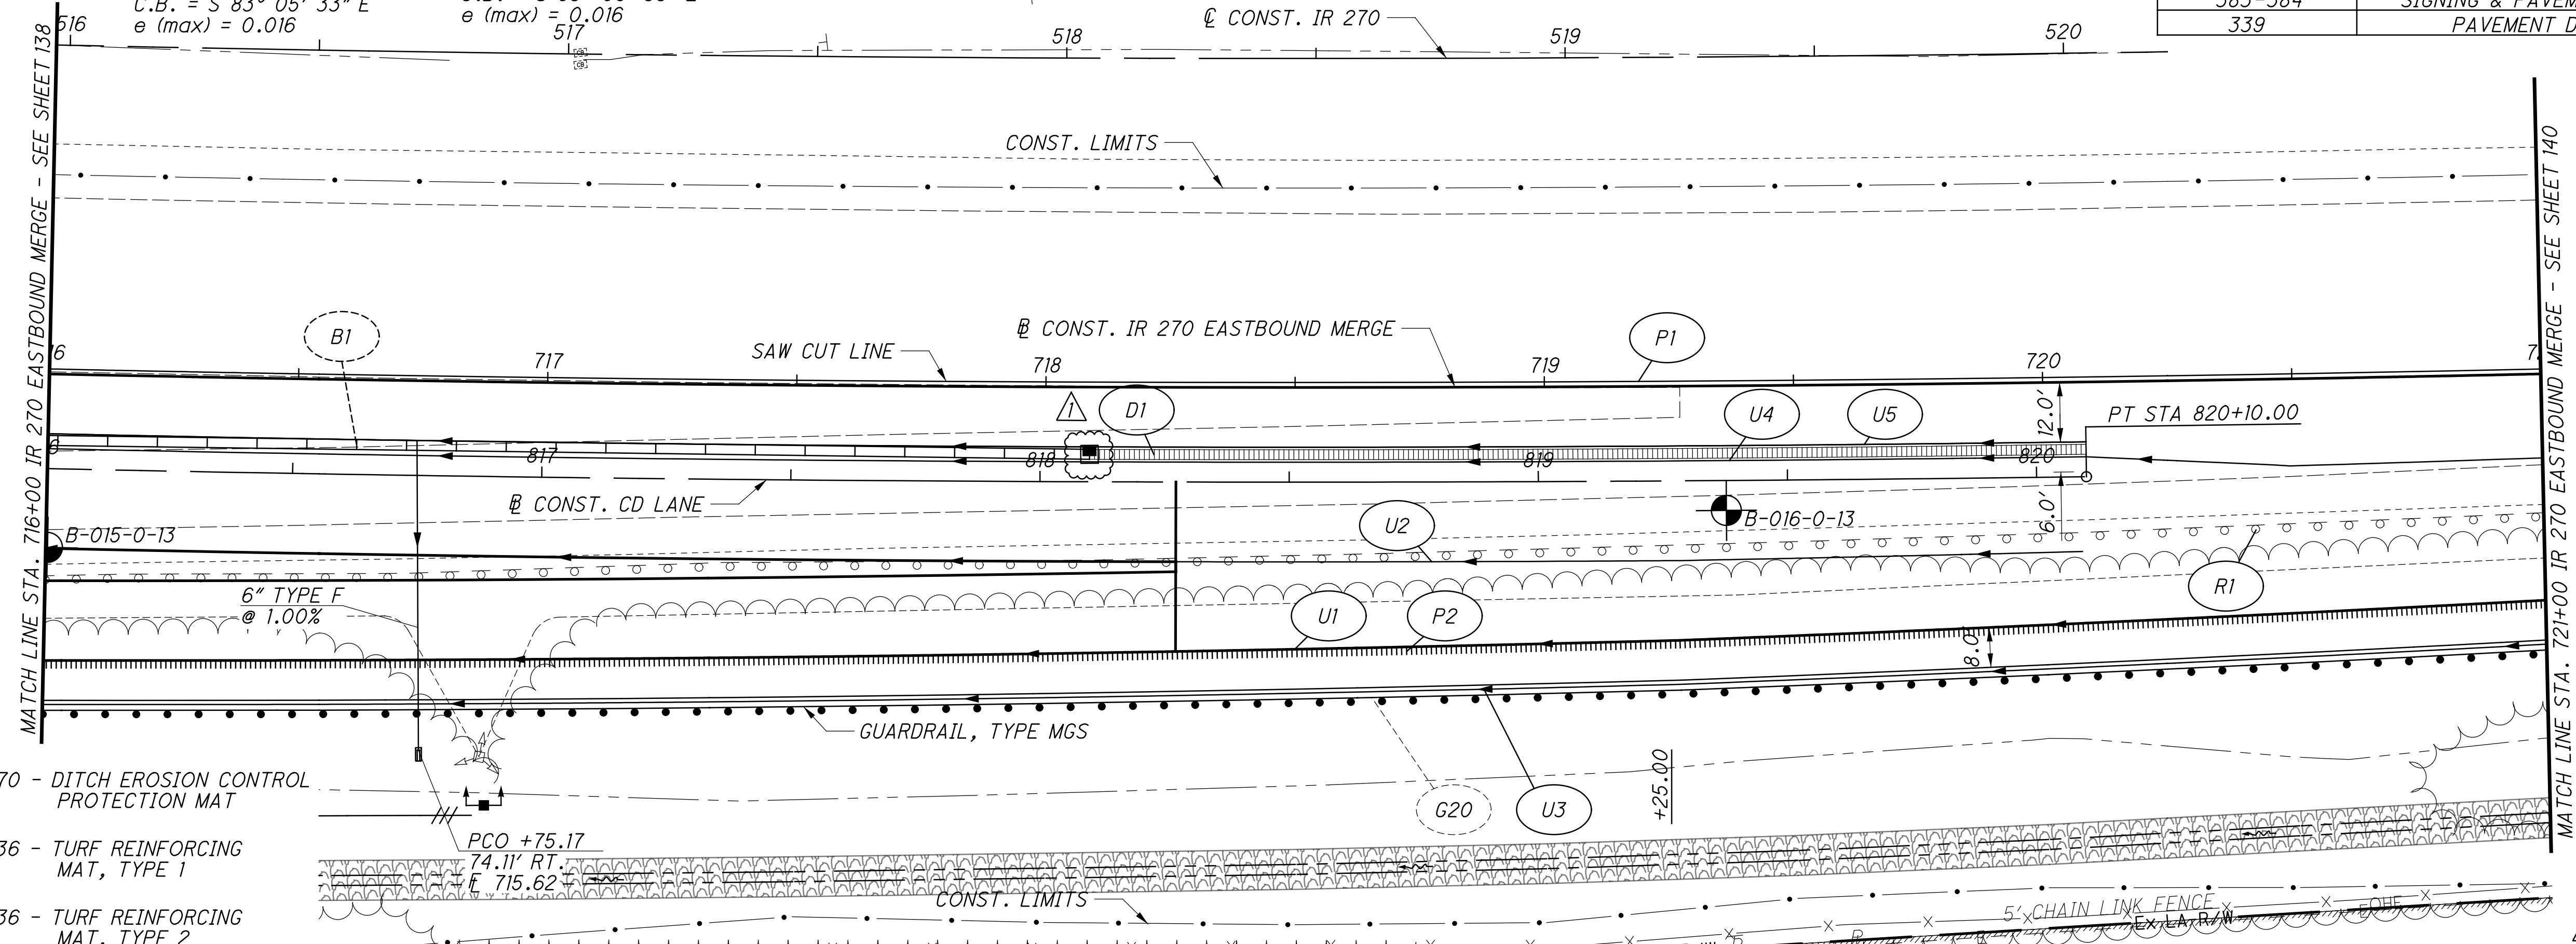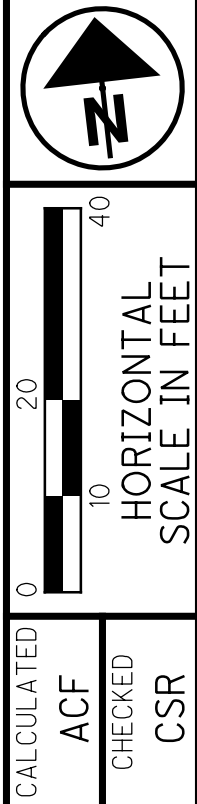

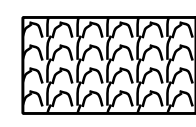-  ITEM 670 - DITCH EROSION CONTROL PROTECTION MAT
-  ITEM 836 - TURF REINFORCING MAT, TYPE 1
-  ITEM 836 - TURF REINFORCING MAT, TYPE 2

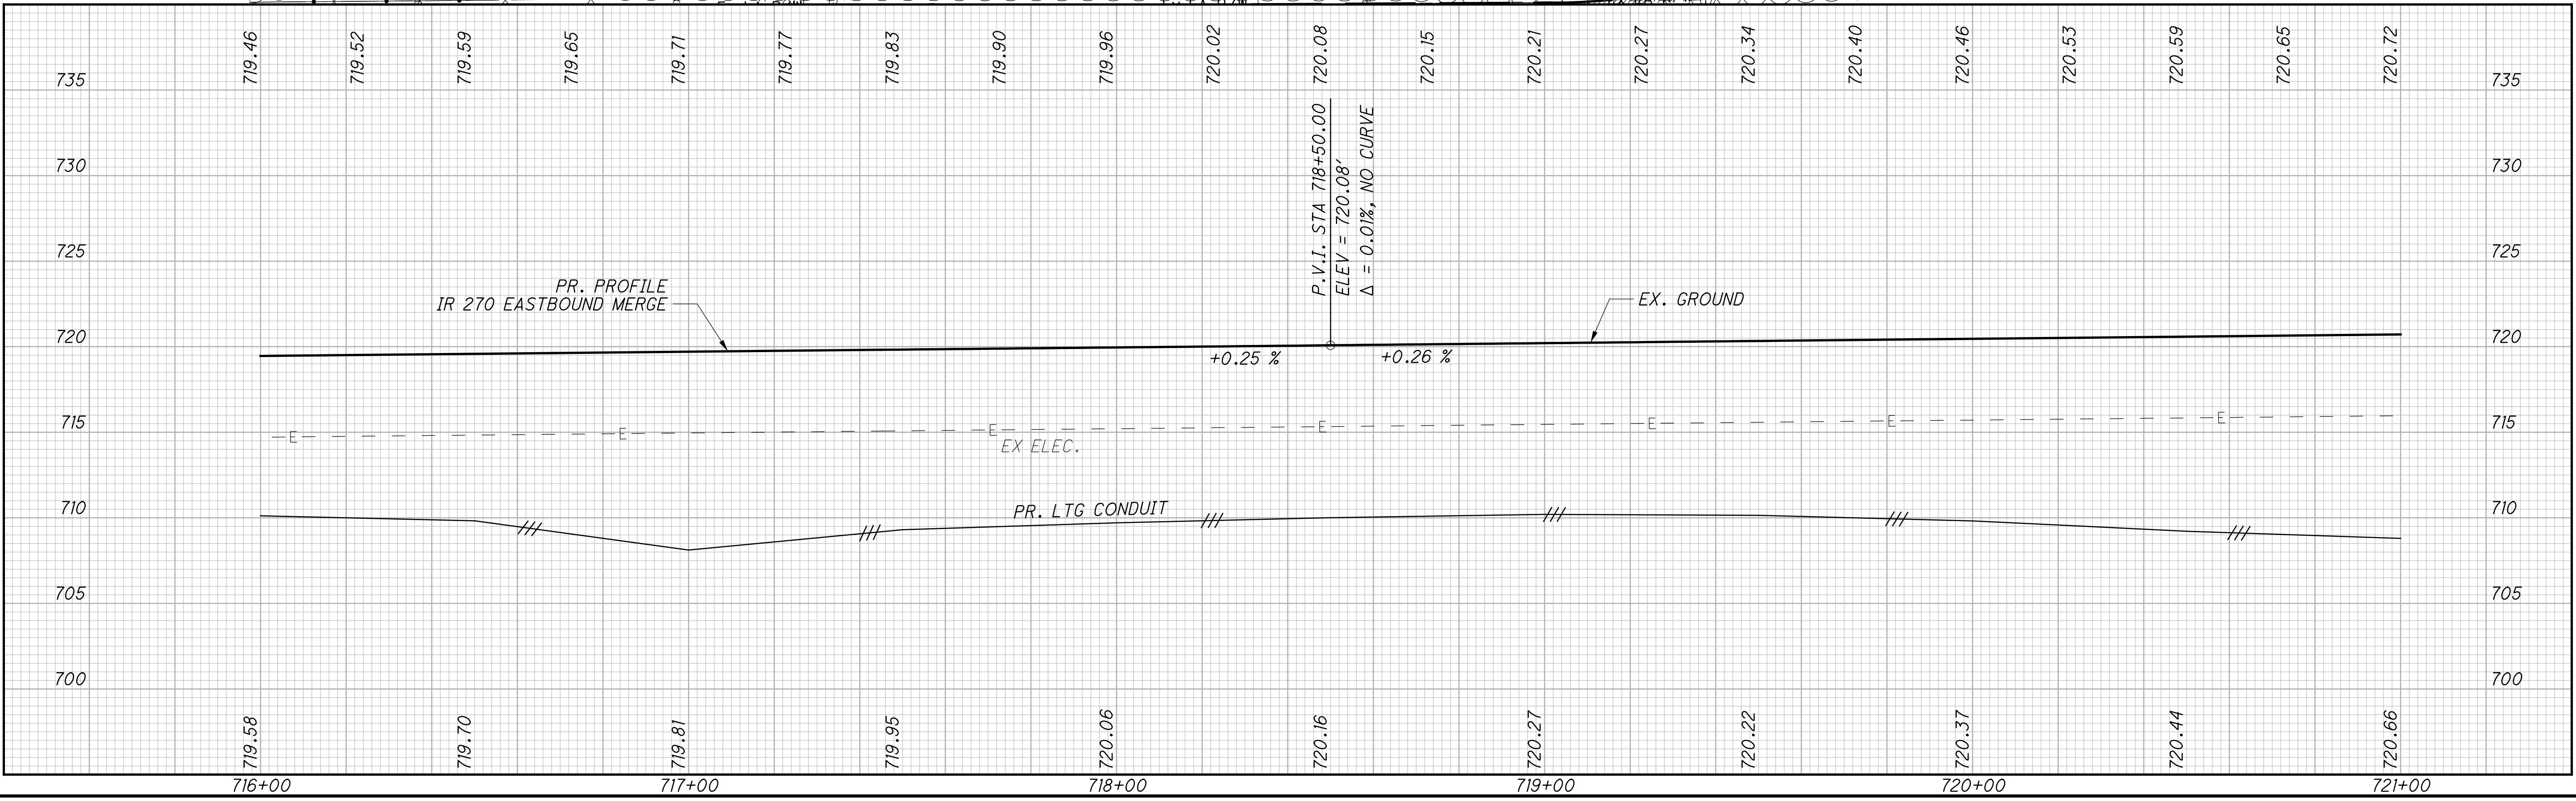

ADDENDUM #1  
 04/21/2023


X:\Projects\2013\132\1010\FRA\92616\roadway\sheet\92616GP752.dgn 4/19/2023 9:05:31 AM c.wong

PLAN AND PROFILE IR 270 EASTBOUND MERGE  
 STA. 716+00 TO STA. 721+00



FRA - 270-51.50

139  
 554

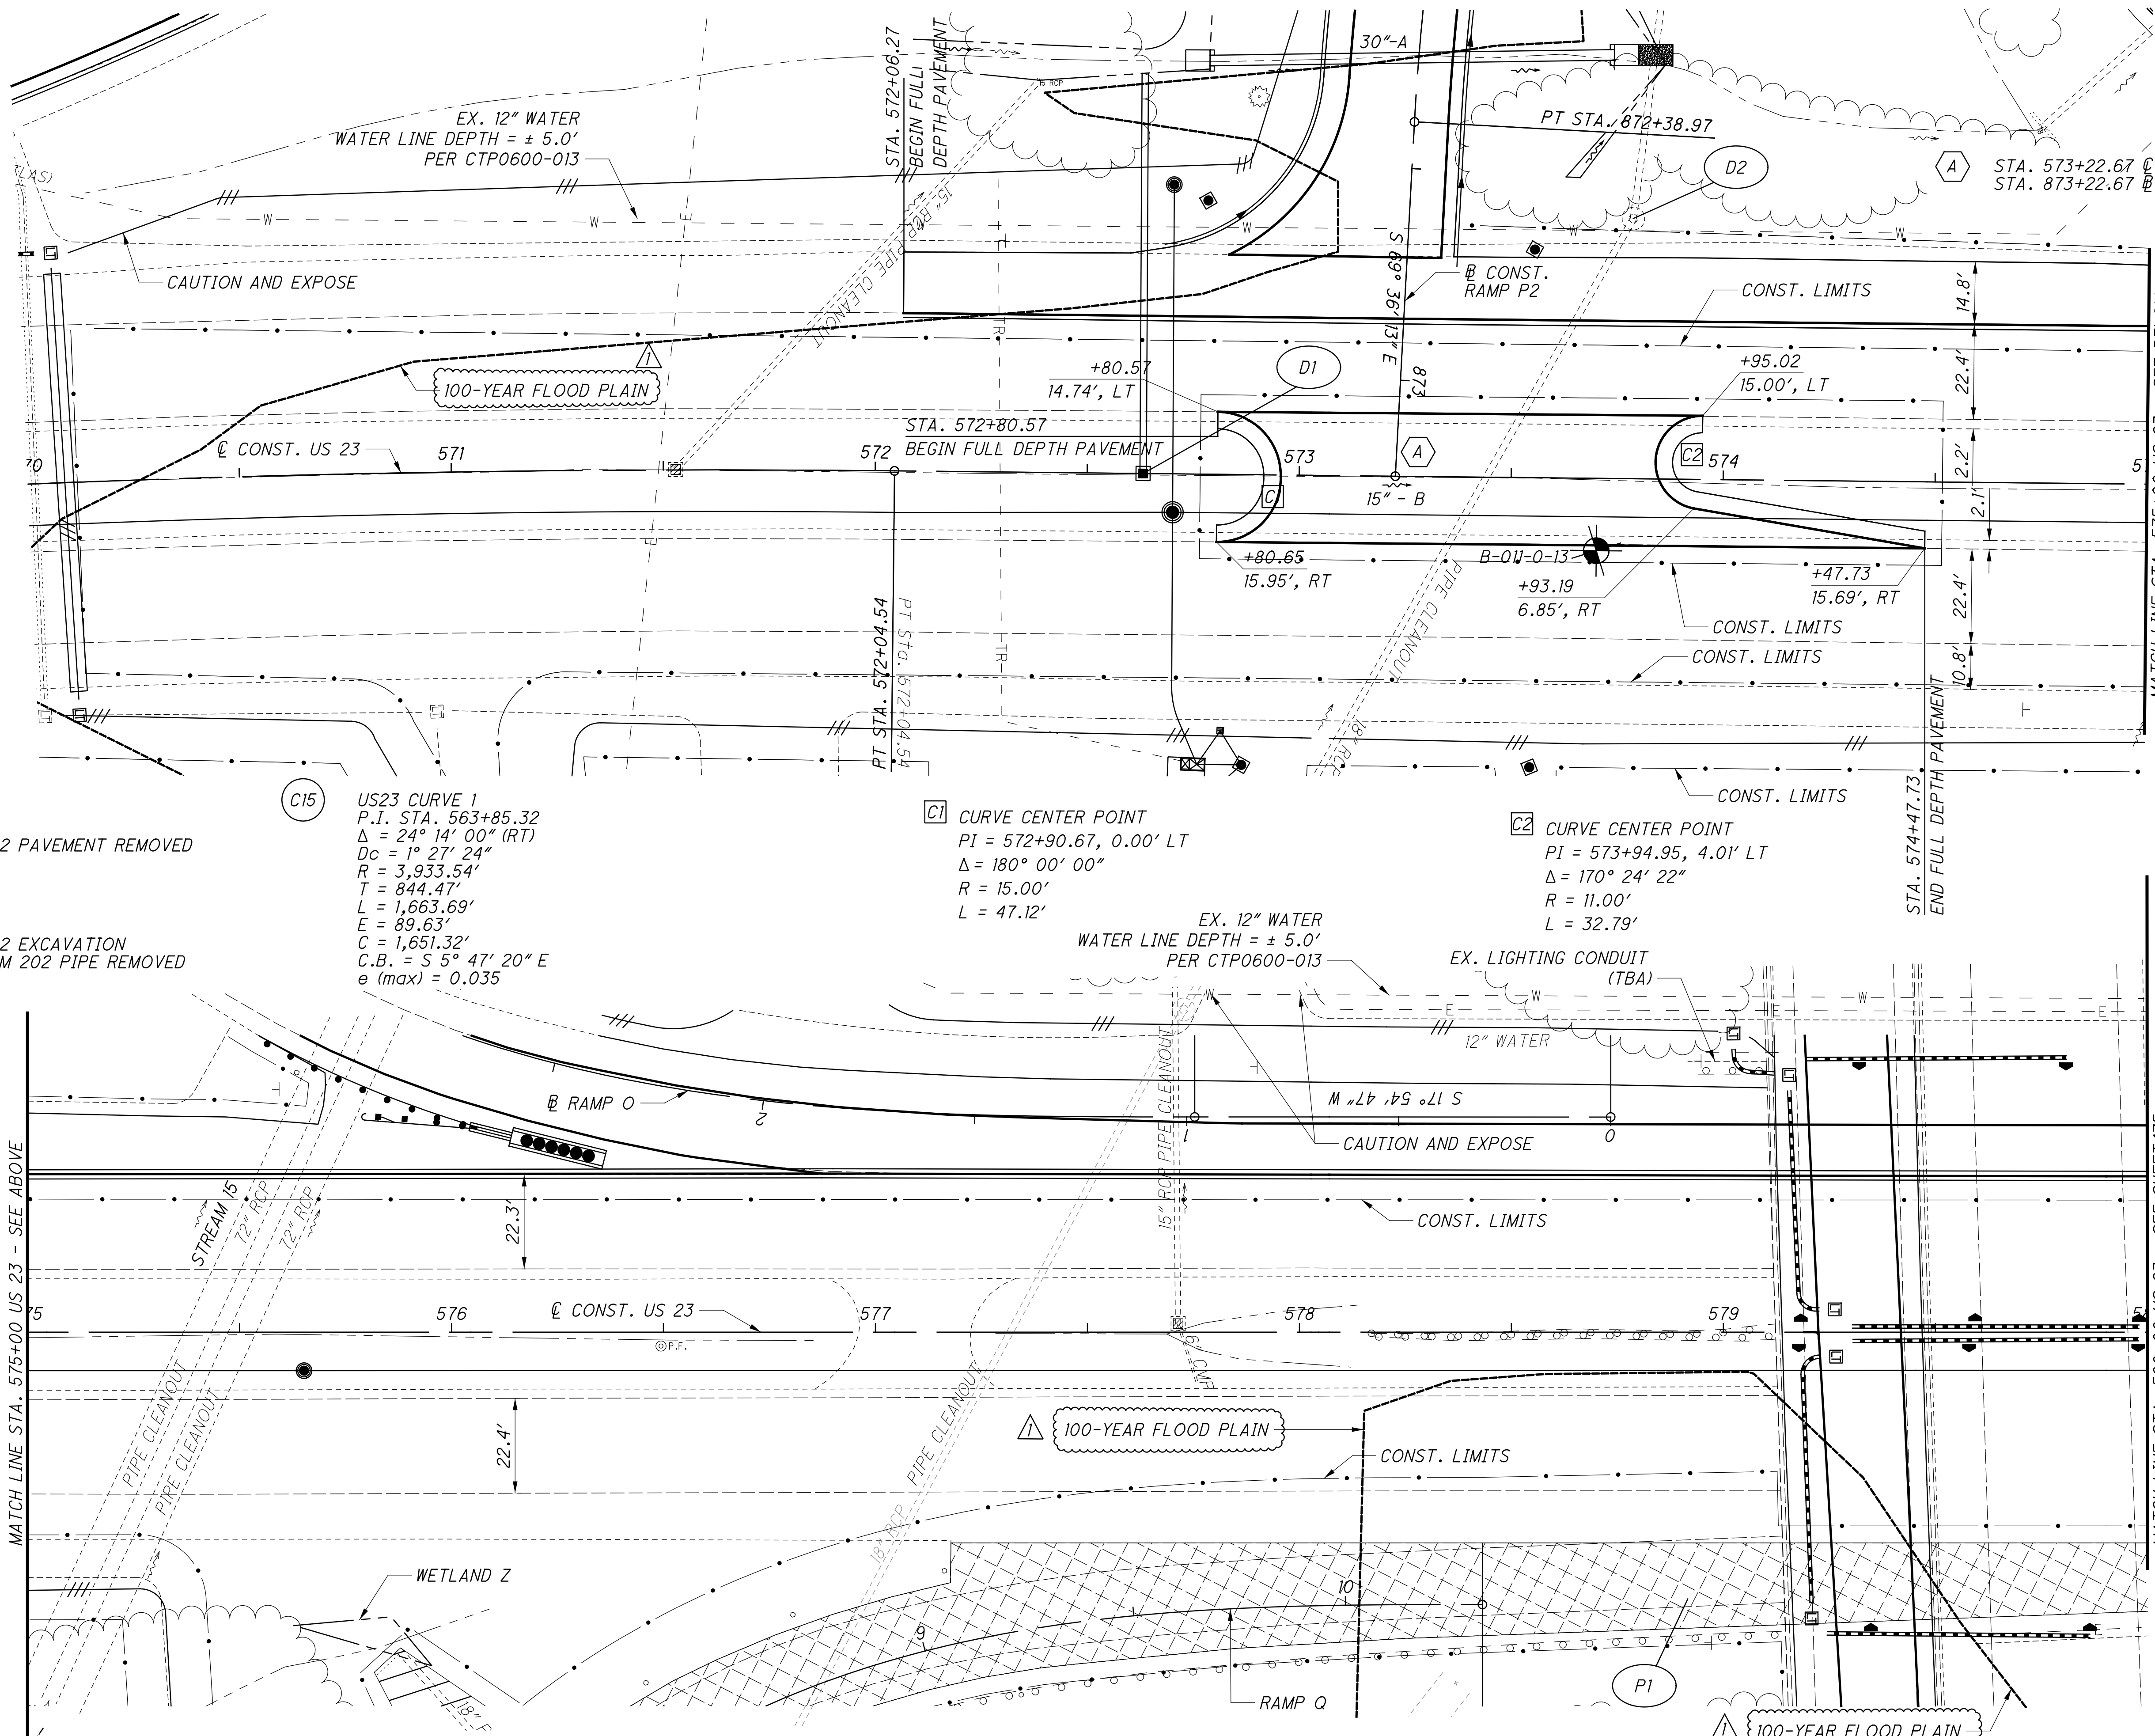X:\Projects\2013\1010\_FRA\92616\roadway\sheet\92616GP151.dgn 4/19/2023 9:07:18 AM cwong



LEGEND:

-  ITEM 202 PAVEMENT REMOVED
-  ITEM 202 EXCAVATION AND ITEM 202 PIPE REMOVED

**C15** US23 CURVE 1  
 P.I. STA. 563+85.32  
 $\Delta = 24^\circ 14' 00''$  (RT)  
 $D_c = 1^\circ 27' 24''$   
 $R = 3,933.54'$   
 $T = 844.47'$   
 $L = 1,663.69'$   
 $E = 89.63'$   
 $C = 1,651.32'$   
 $C.B. = S 5^\circ 47' 20'' E$   
 $e$  (max) = 0.035

**C1** CURVE CENTER POINT  
 PI = 572+90.67, 0.00' LT  
 $\Delta = 180^\circ 00' 00''$   
 $R = 15.00'$   
 $L = 47.12'$

**C2** CURVE CENTER POINT  
 PI = 573+94.95, 4.01' LT  
 $\Delta = 170^\circ 24' 22''$   
 $R = 11.00'$   
 $L = 32.79'$

CALCULATED  
 ACF  
 CHECKED  
 CSR

0 10 20 40  
 HORIZONTAL  
 SCALE IN FEET

PLAN - US 23  
 STA. 570+00 TO STA. 580+00

FRA - 270-51.50

ADDENDUM #1  
 04/21/2023




0 10 20 40  
HORIZONTAL SCALE IN FEET

CALCULATED  
ACF  
CHECKED  
CSR


PLAN - US 23  
STA. 580+00 TO STA. 590+00

FRA - 270-51.50

175  
554

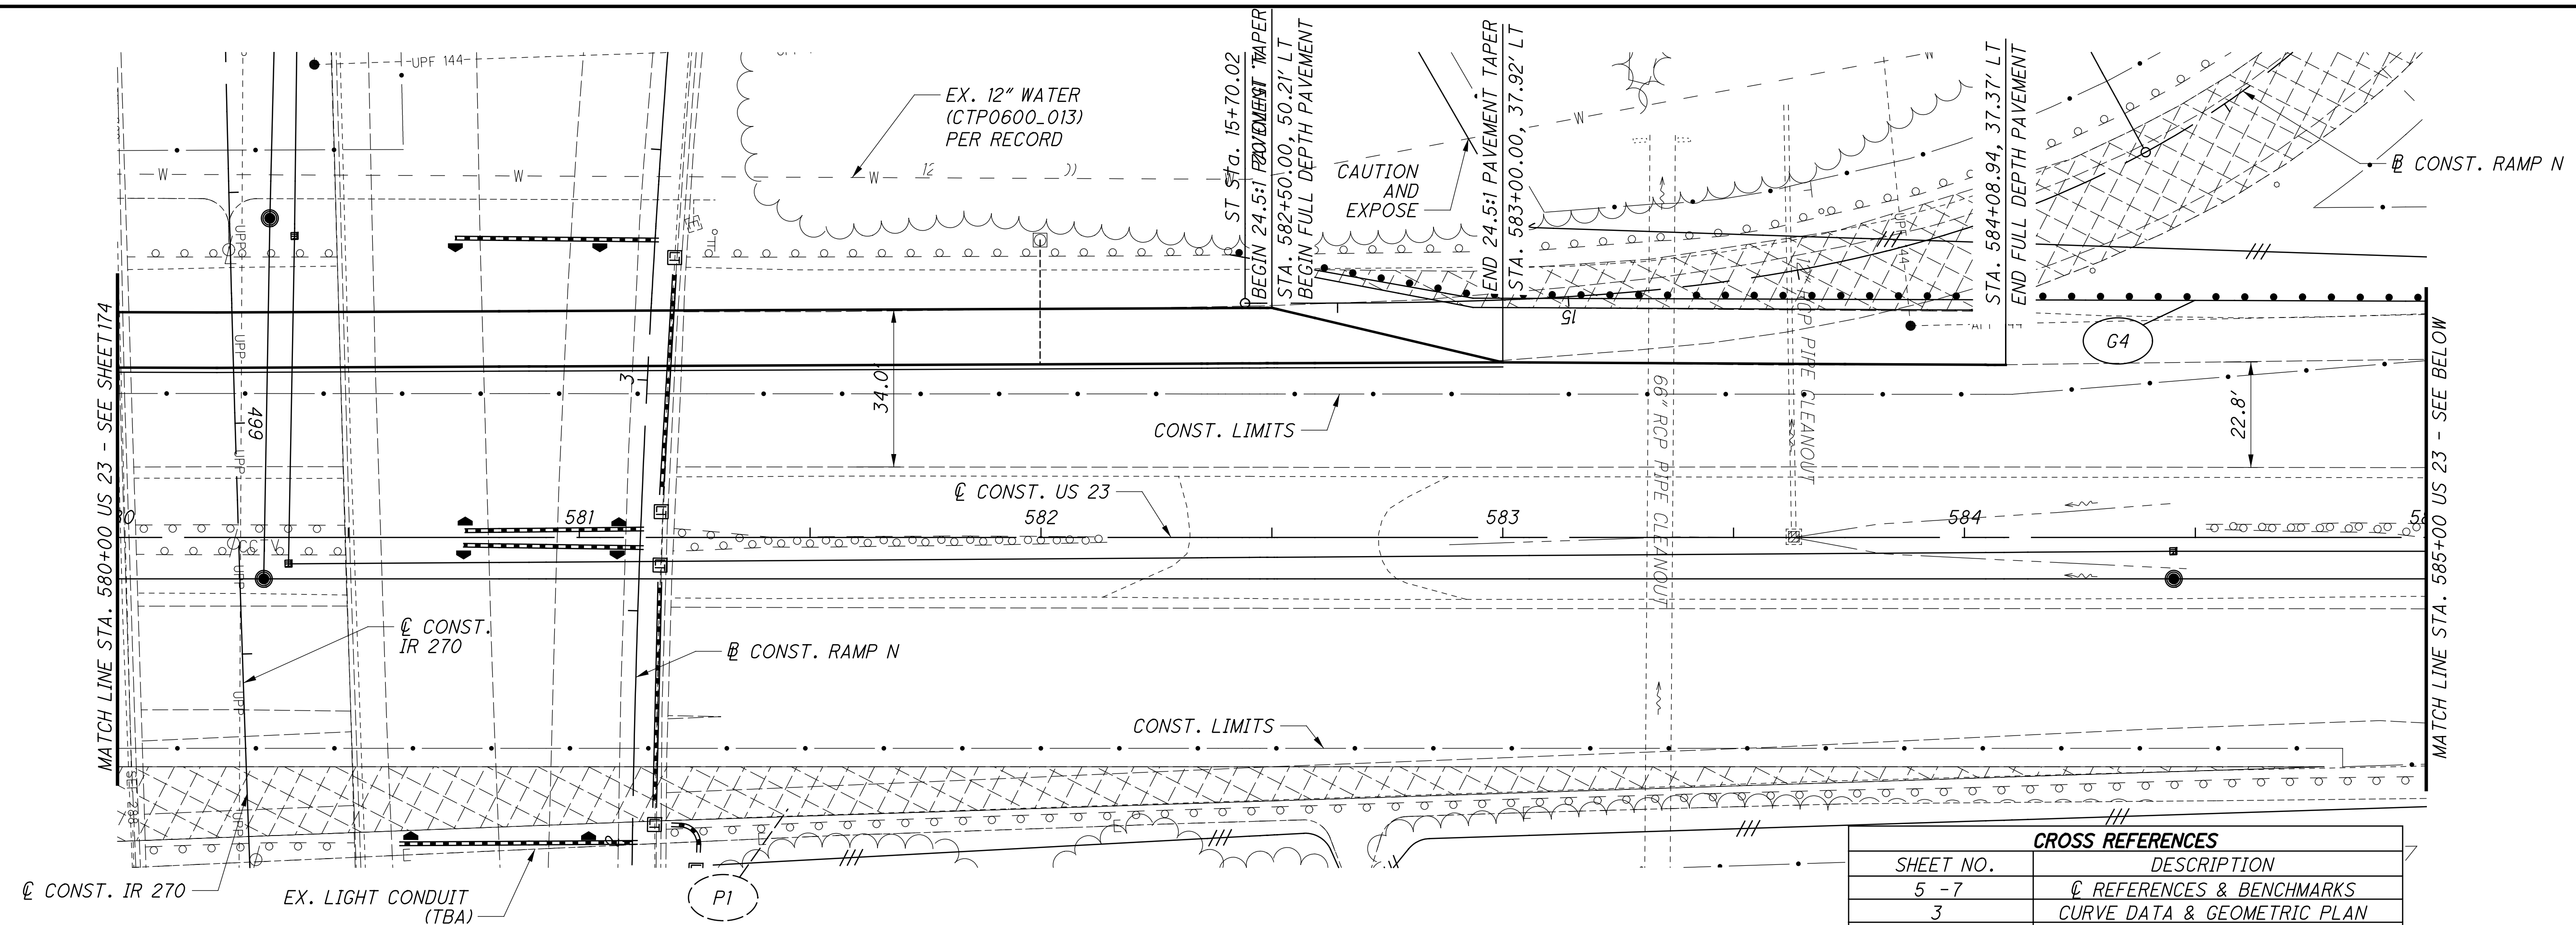

LEGEND:  
 ITEM 202 PAVEMENT REMOVED

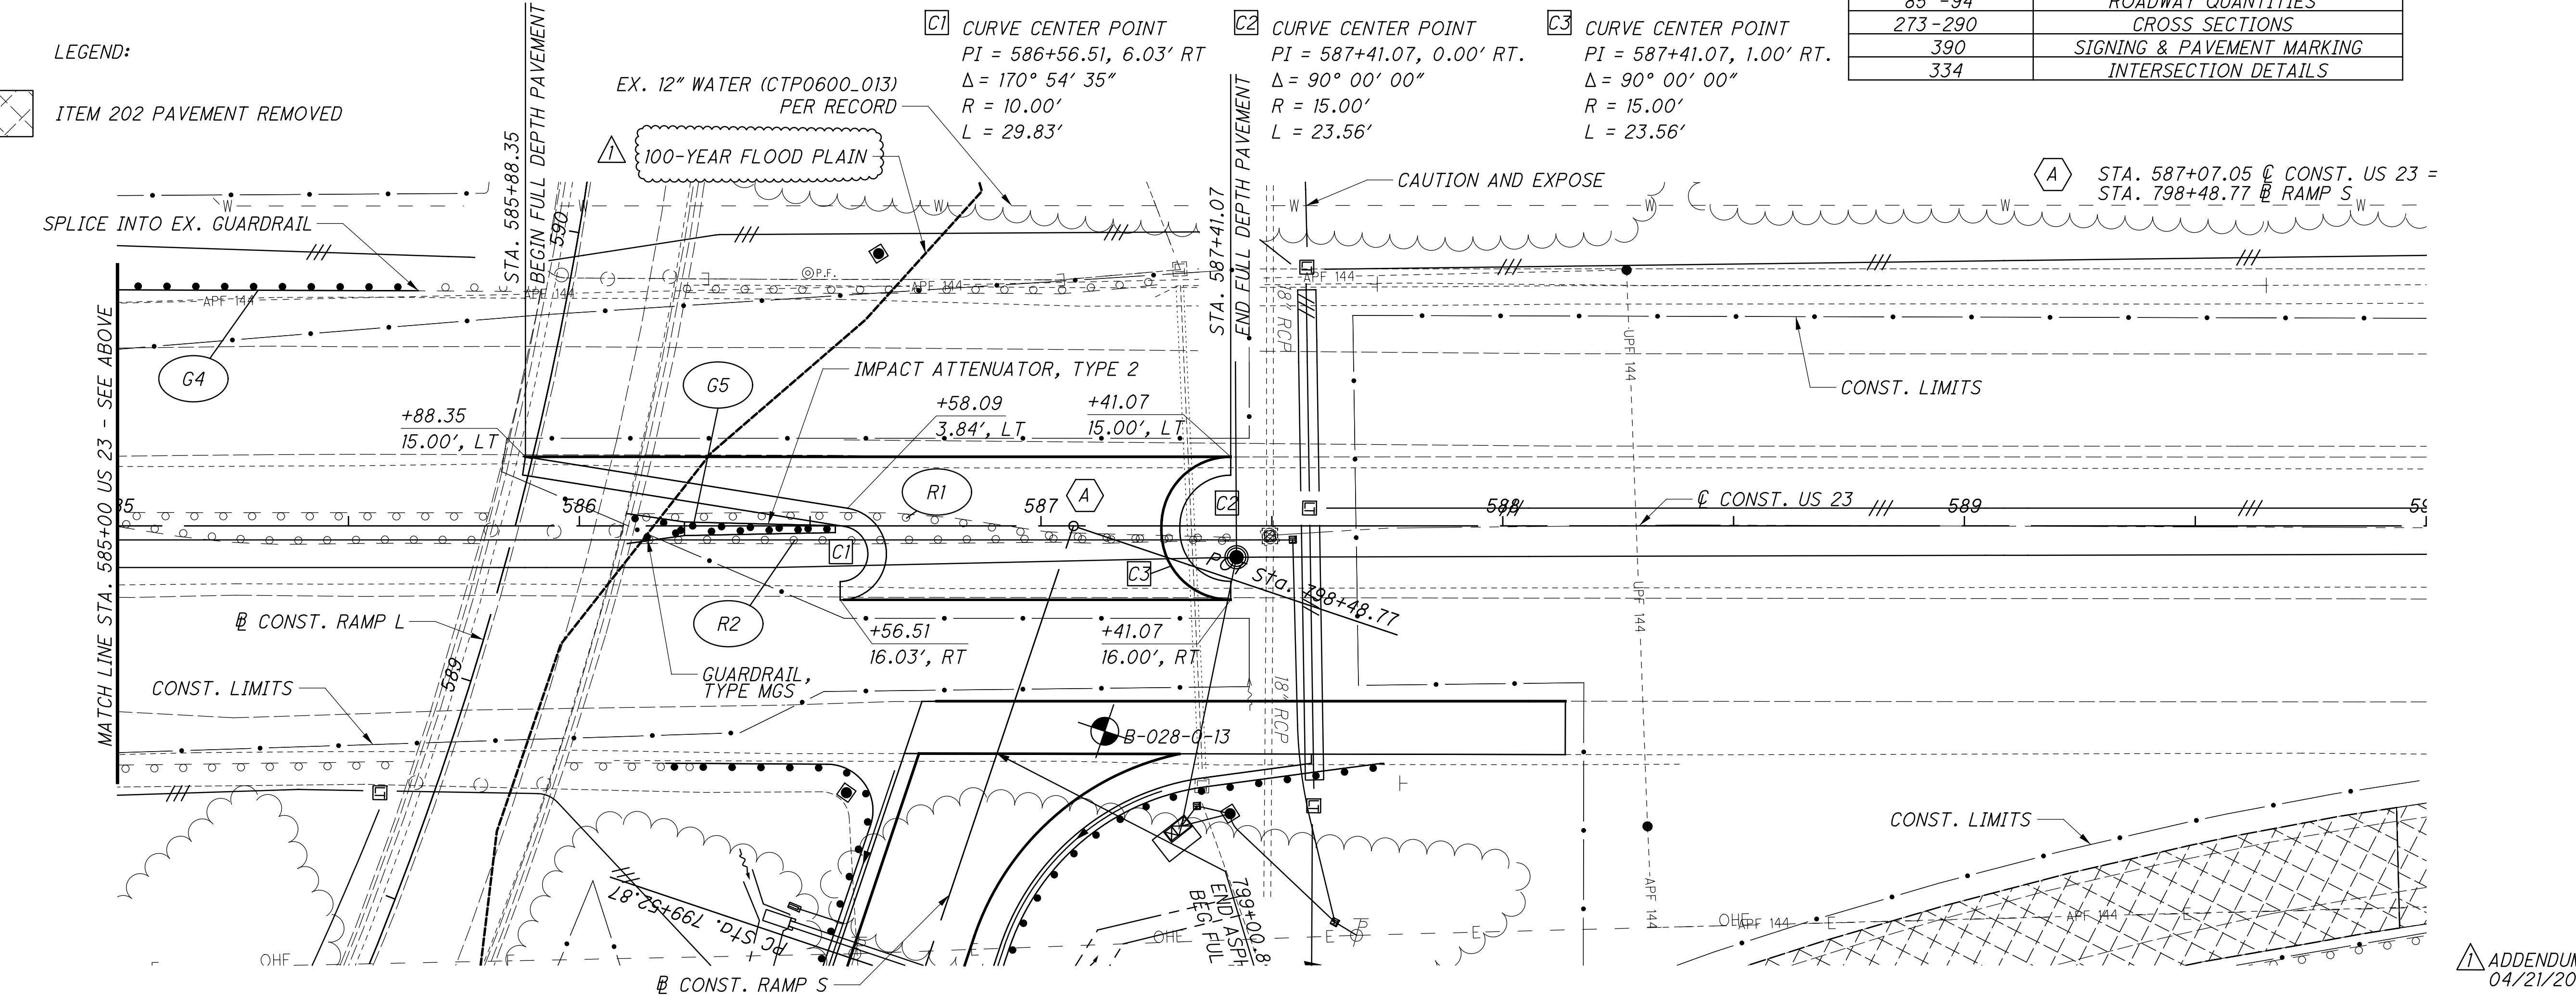

CROSS REFERENCES	
SHEET NO.	DESCRIPTION
5 - 7	☉ REFERENCES & BENCHMARKS
3	☉ CURVE DATA & GEOMETRIC PLAN
85 - 94	☉ ROADWAY QUANTITIES
273 - 290	☉ CROSS SECTIONS
390	☉ SIGNING & PAVEMENT MARKING
334	☉ INTERSECTION DETAILS


- ☐1 CURVE CENTER POINT  
PI = 586+56.51, 6.03' RT  
Δ = 170° 54' 35"  
R = 10.00'  
L = 29.83'
- ☐2 CURVE CENTER POINT  
PI = 587+41.07, 0.00' RT.  
Δ = 90° 00' 00"  
R = 15.00'  
L = 23.56'
- ☐3 CURVE CENTER POINT  
PI = 587+41.07, 1.00' RT.  
Δ = 90° 00' 00"  
R = 15.00'  
L = 23.56'

☉A STA. 587+07.05 ☉ CONST. US 23 =  
STA. 798+48.77 ☉ RAMP S

X:\Projects\2013\1321\1010\FRA\92616\roadway\sheets\92616GP152.dgn 4/19/2023 9:09:38 AM cwong

ADDENDUM #1  
04/21/2023



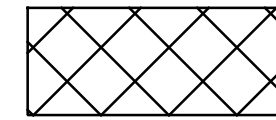


MEDIAN ACCESS REMOVED

PFK COMPANY I, LLC AND  
TAMARACK ENTERPRISES I, L.P.  
510-181564  
4755 S HIGH ST

EVIDENCE OF BURIED  
TELEPHONE IN AREA  
(NOT MARKED)

CROSS REFERENCES

SHEET NO.	DESCRIPTION
5 - 7	☉ REFERENCES & BENCHMARKS
3	☉ CURVE DATA & GEOMETRIC PLAN
85-94	ROADWAY QUANTITIES
377	CULVERT DETAILS
179-188	CROSS SECTIONS
387-388	SIGNING & PAVEMENT MARKING
345-346	PAVEMENT DETAILS

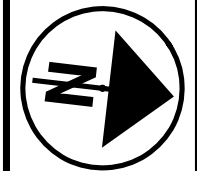

0 10 20 40  
HORIZONTAL  
SCALE IN FEET



CALCULATED  
ACF  
CHECKED  
CSR

US 23

PLAN AND PROFILE ACCELERATION LANE US 23  
STA. 546+50 TO STA. 551+00

FRA - 270-51.50


176  
554

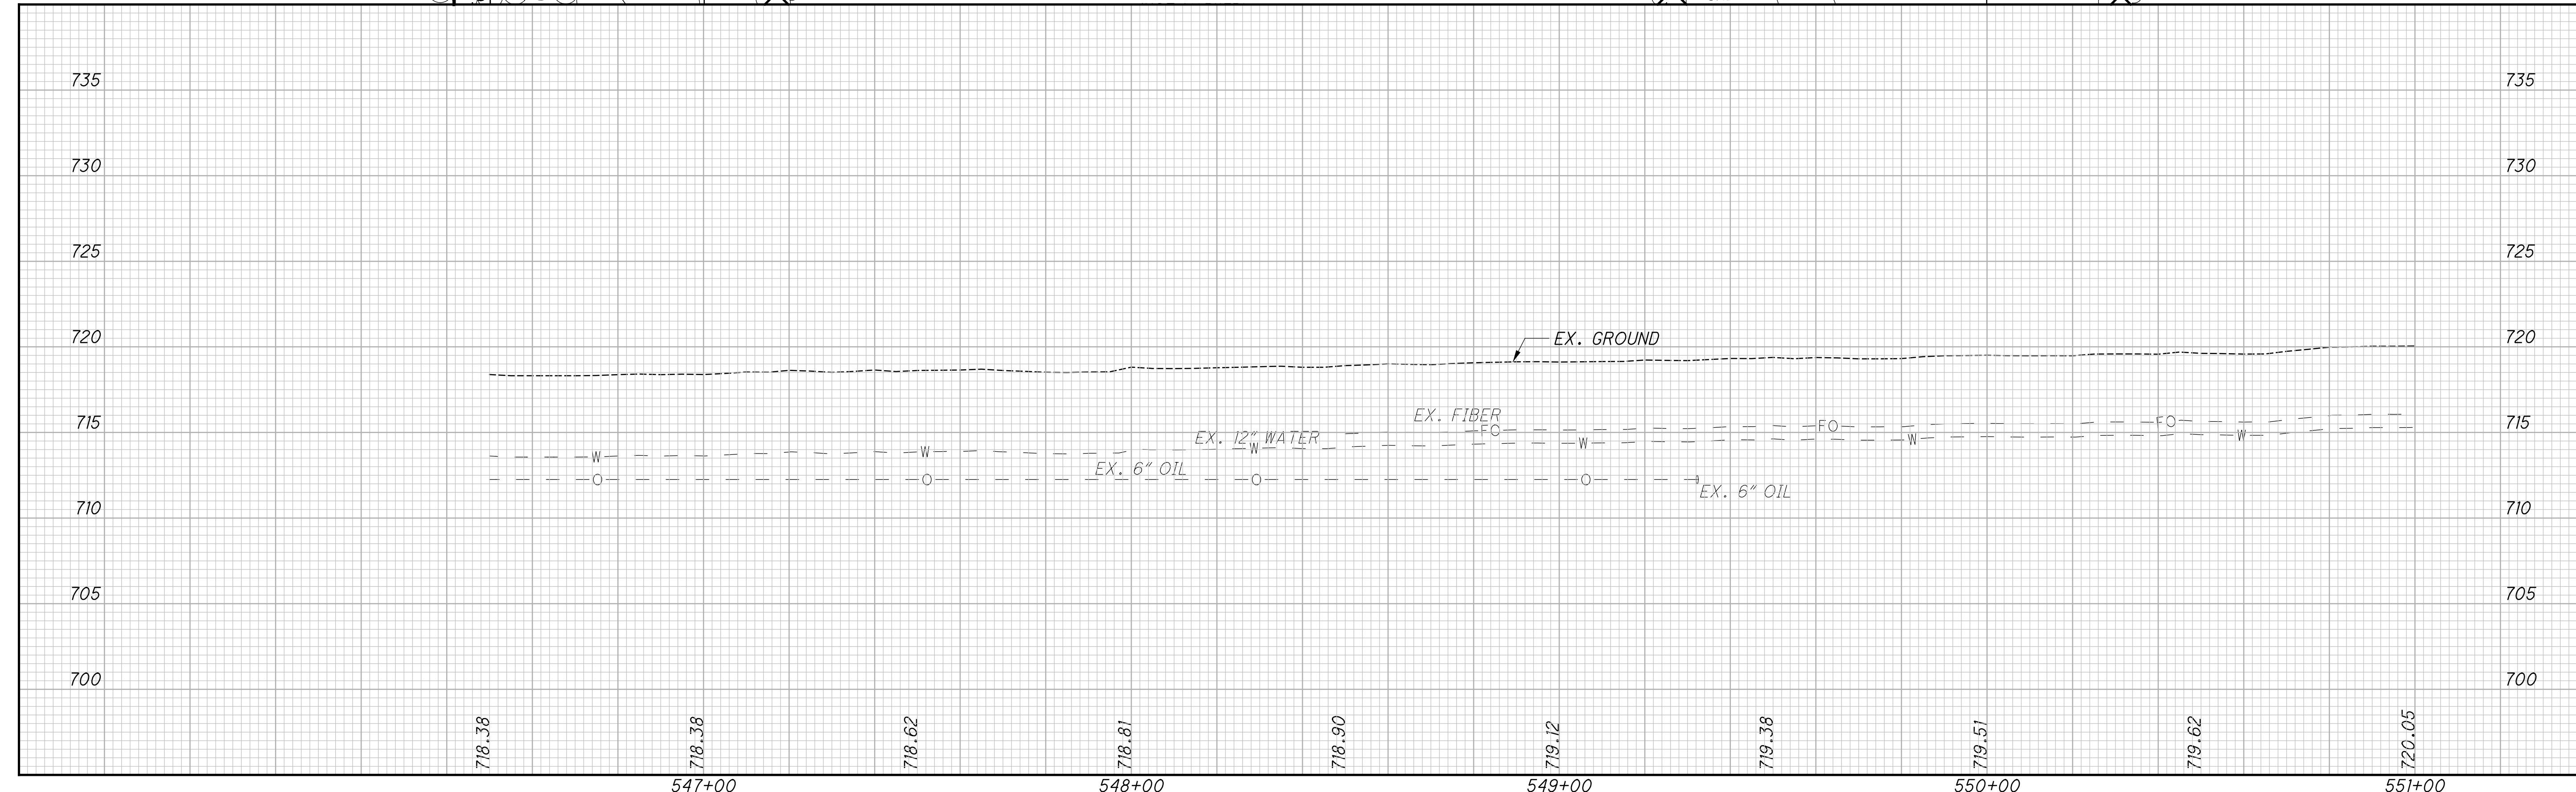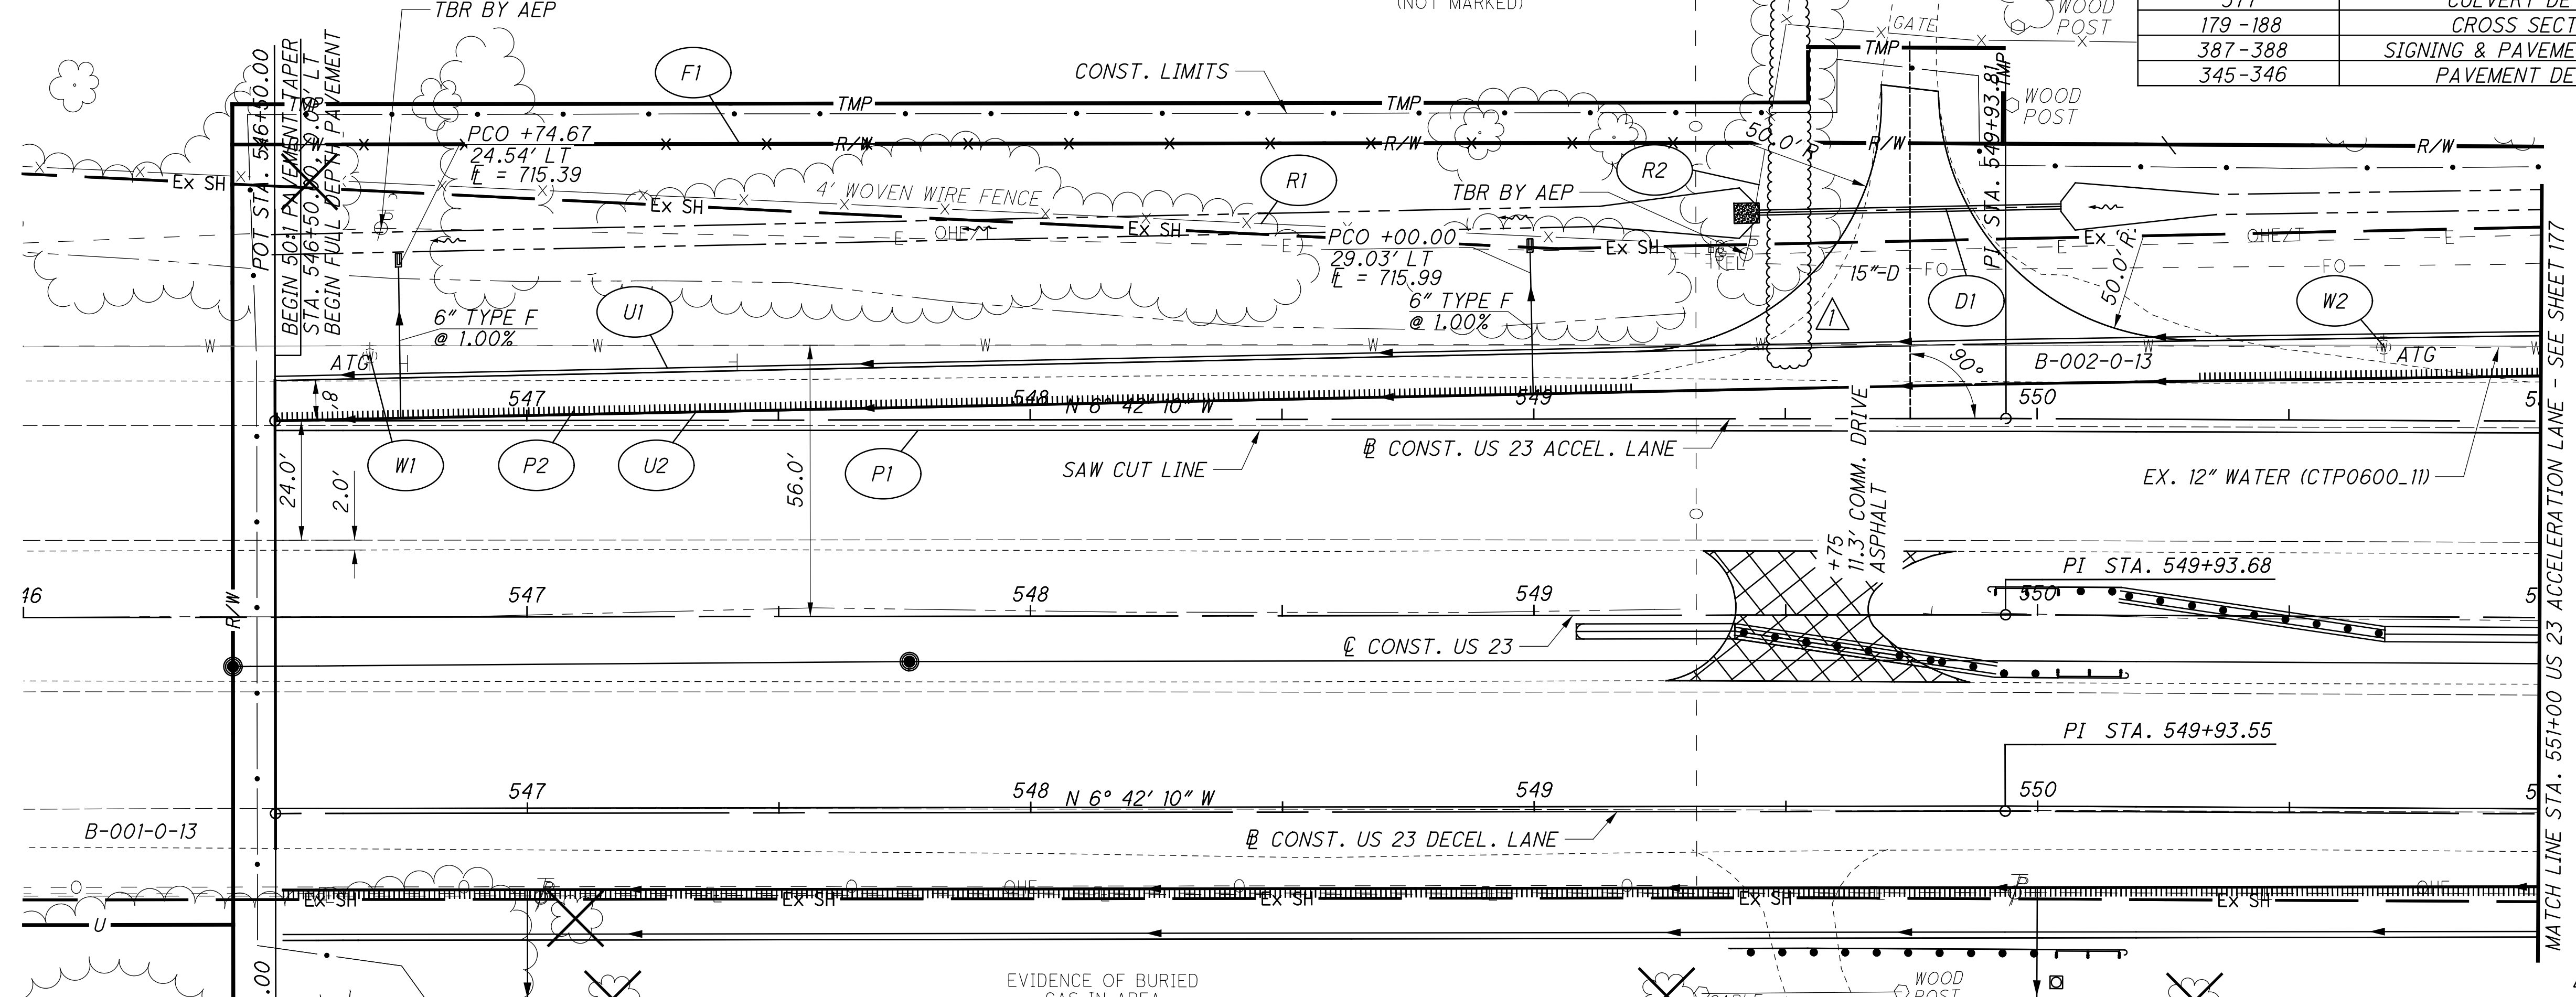

EVIDENCE OF BURIED  
GAS IN AREA

ADDENDUM #1  
04/21/2023

X:\Projects\2013\1010\FRA\92616\roadway\sheets\92616GP651.dgn 4/19/2023 9:10:59 AM cwong

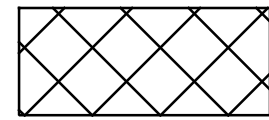


MEDIAN ACCESS REMOVED

PFK COMPANY I, LLC AND  
TAMARACK ENTERPRISES I, L.P.  
510-181564  
4755 S HIGH ST

F.W. ENGLEFIELD IV  
AND BENJAMIN B. ENGLEFIELD  
510-180714 CANOPY

PFK COMPANY I, LLC AND  
TAMARACK ENTERPRISES I, L.P.  
510-181564  
4755 S HIGH ST

CROSS REFERENCES	
SHEET NO.	DESCRIPTION
5 - 7	☉ REFERENCES & BENCHMARKS
3	☉ CURVE DATA & GEOMETRIC PLAN
85-94	ROADWAY QUANTITIES
363	CULVERT DETAILS
179-188	CROSS SECTIONS
388	SIGNING & PAVEMENT MARKING
345	PAVEMENT DETAILS

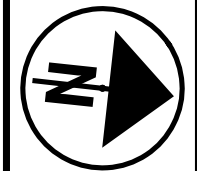



0 20 40  
HORIZONTAL  
SCALE IN FEET

CALCULATED  
ACF  
CHECKED  
CSR

PLAN AND PROFILE US 23 ACCELERATION LANE  
STA. 551+00 TO STA. 556+00

FRA - 270-51.50


177  
554

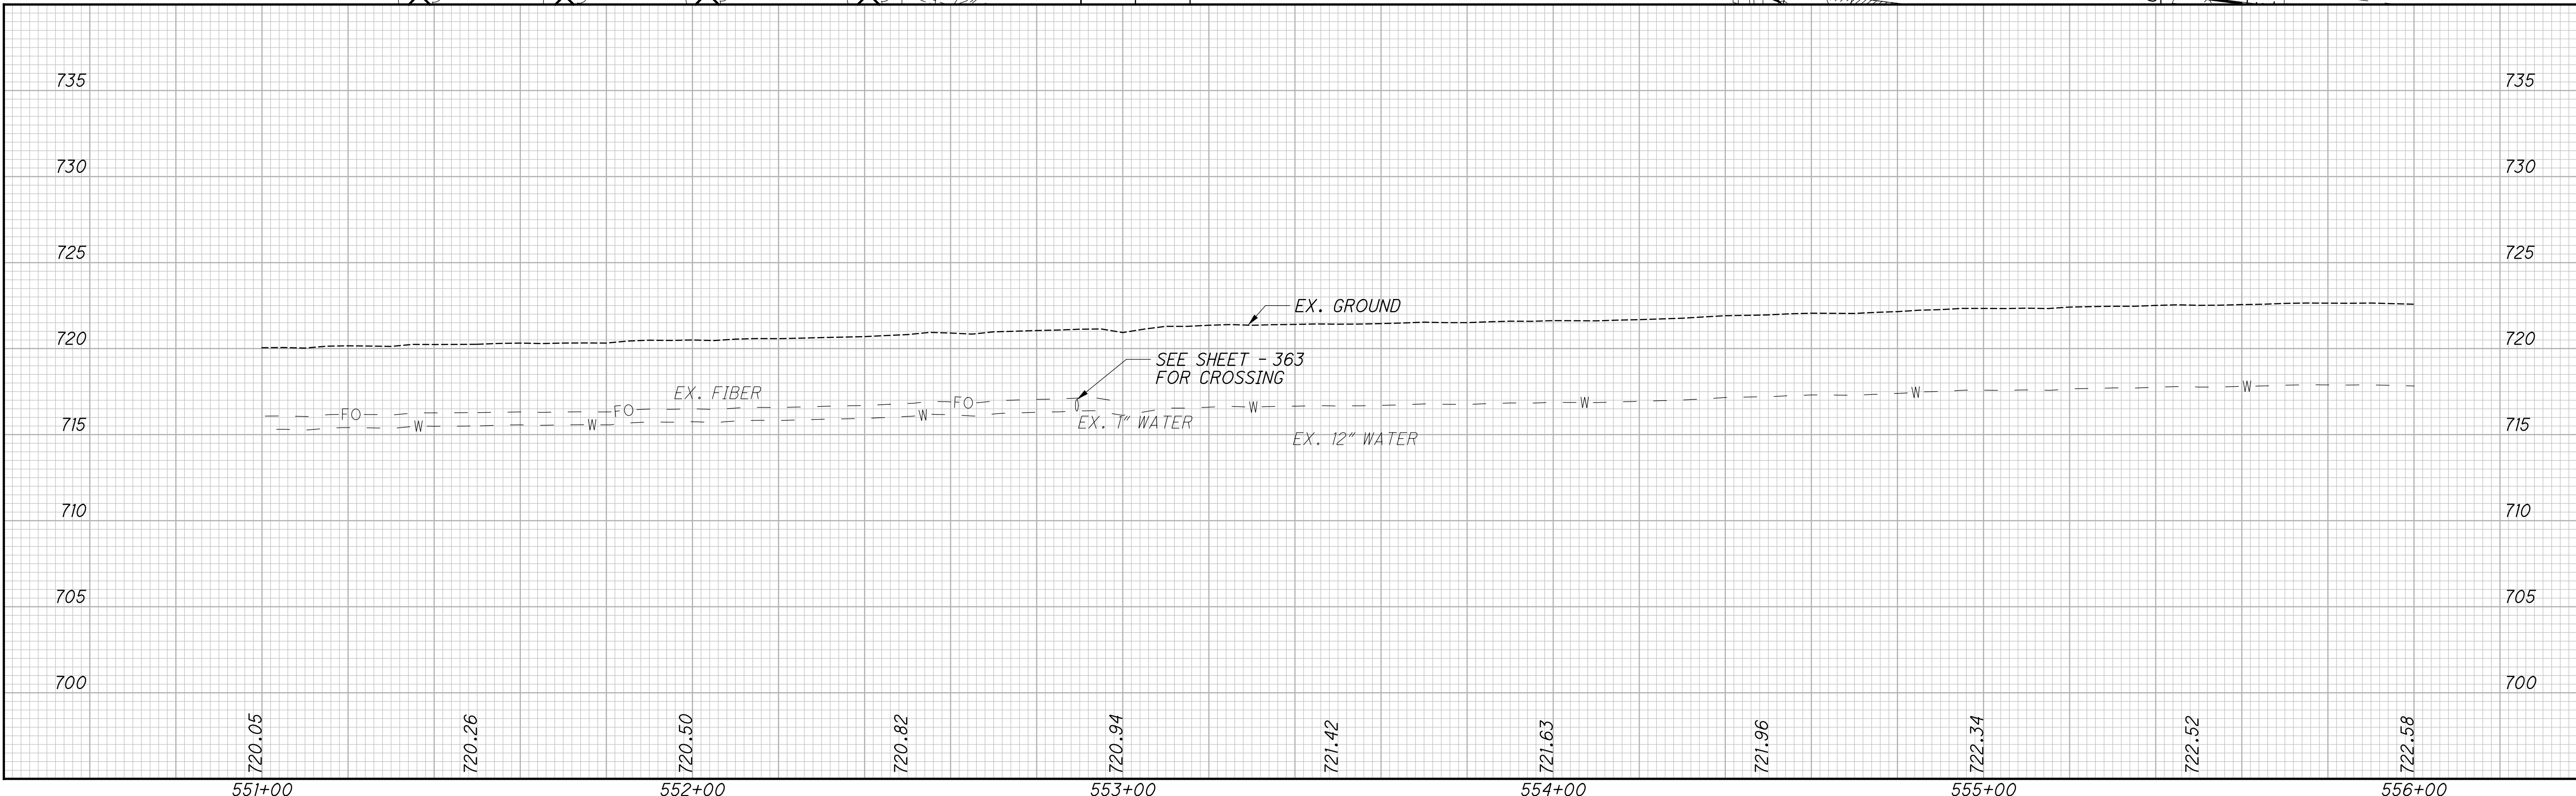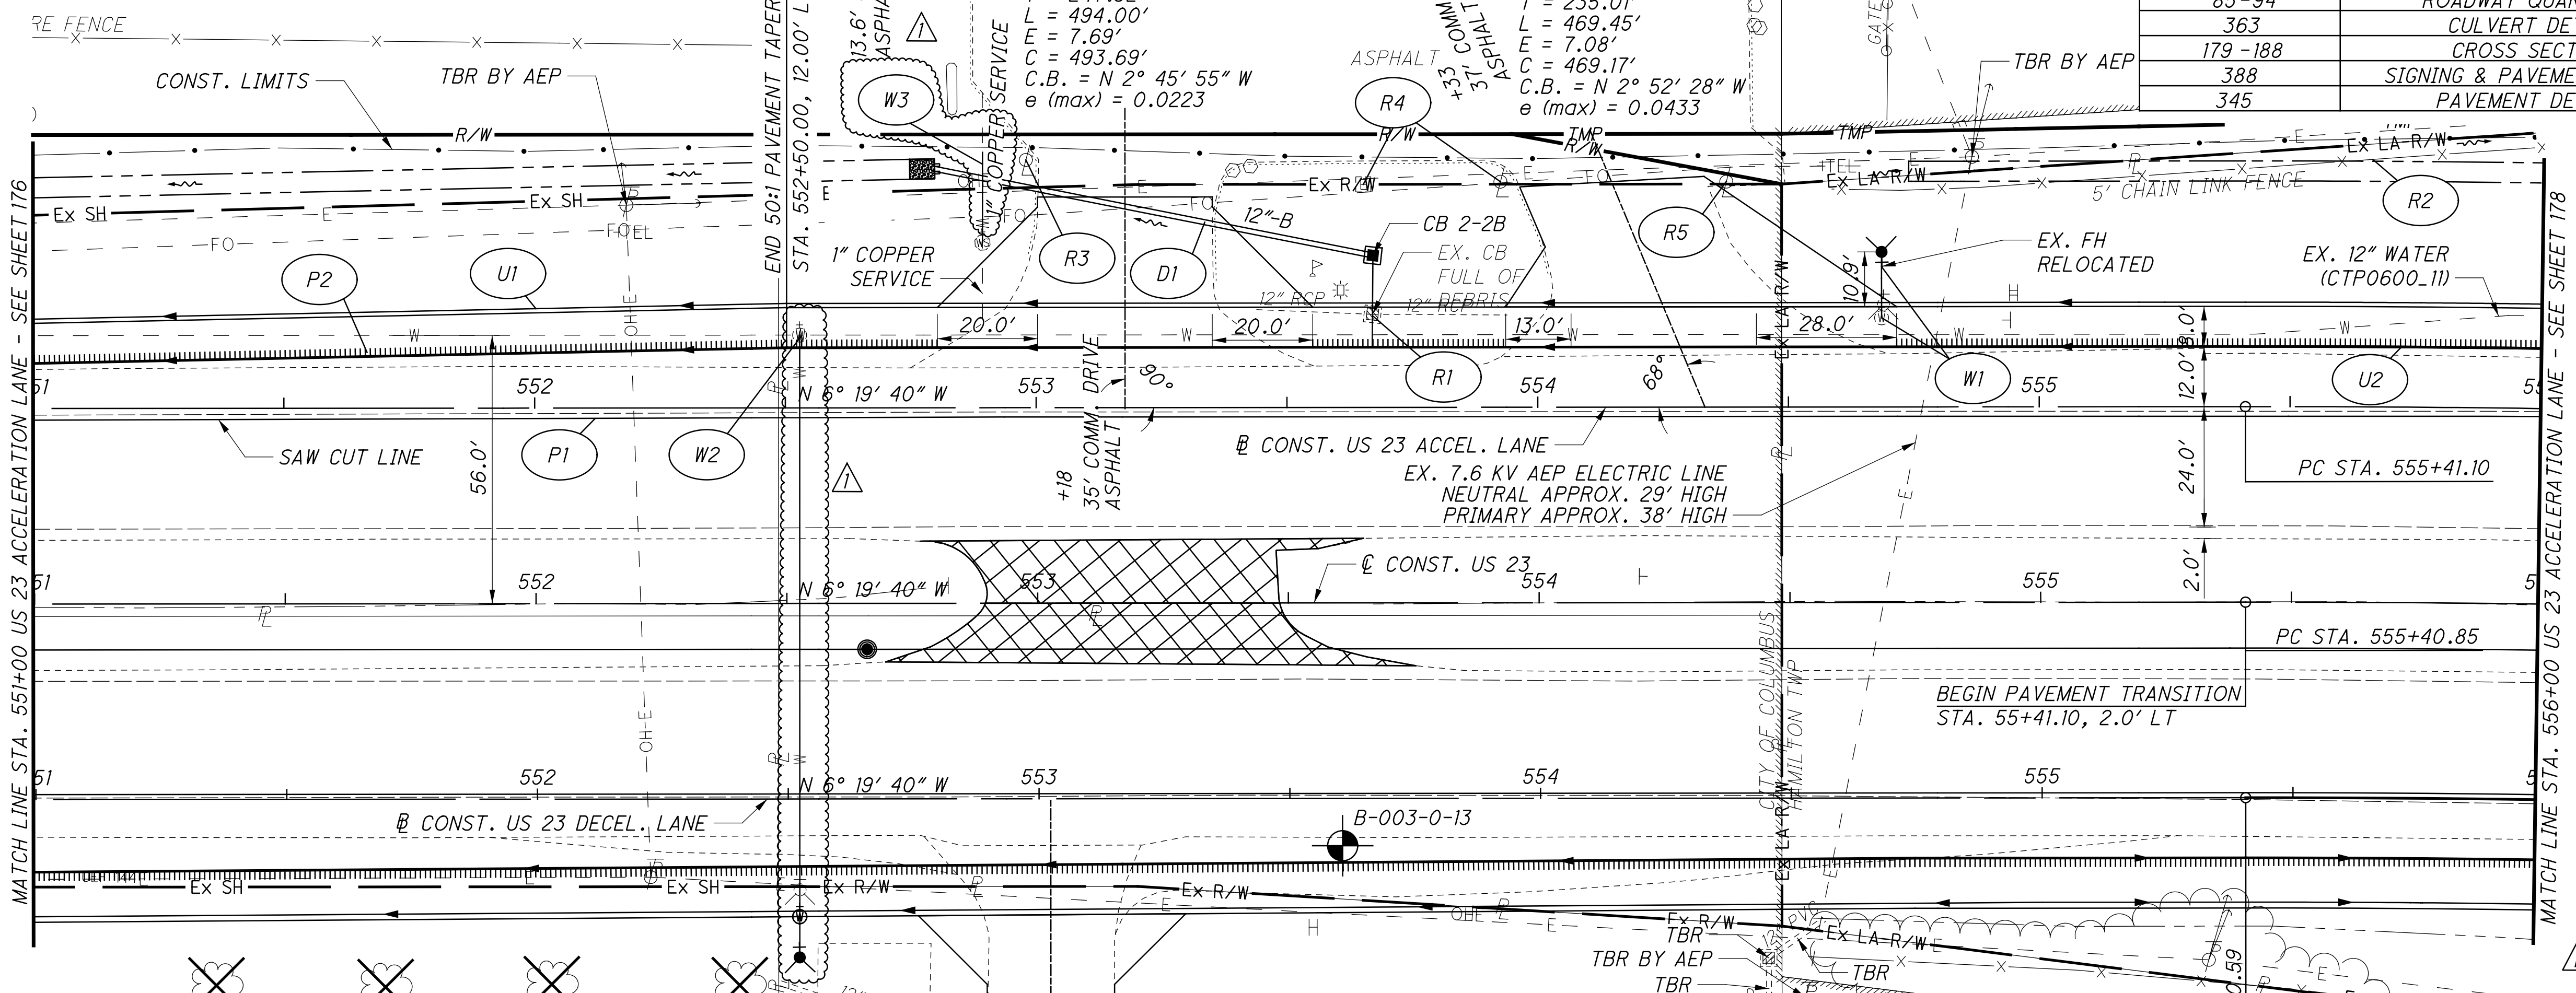

X:\Projects\2013\1010\FRA\92616\roadway\sheet\92616GP652.dgn 4/19/2023 9:16:50 AM cwrong

ADDENDUM #1  
04/21/2023

X:\Projects\2013\1010\FRA\92616\roadway\sheet\92616GP701.dgn 4/19/2023 9:18:42 AM cwong

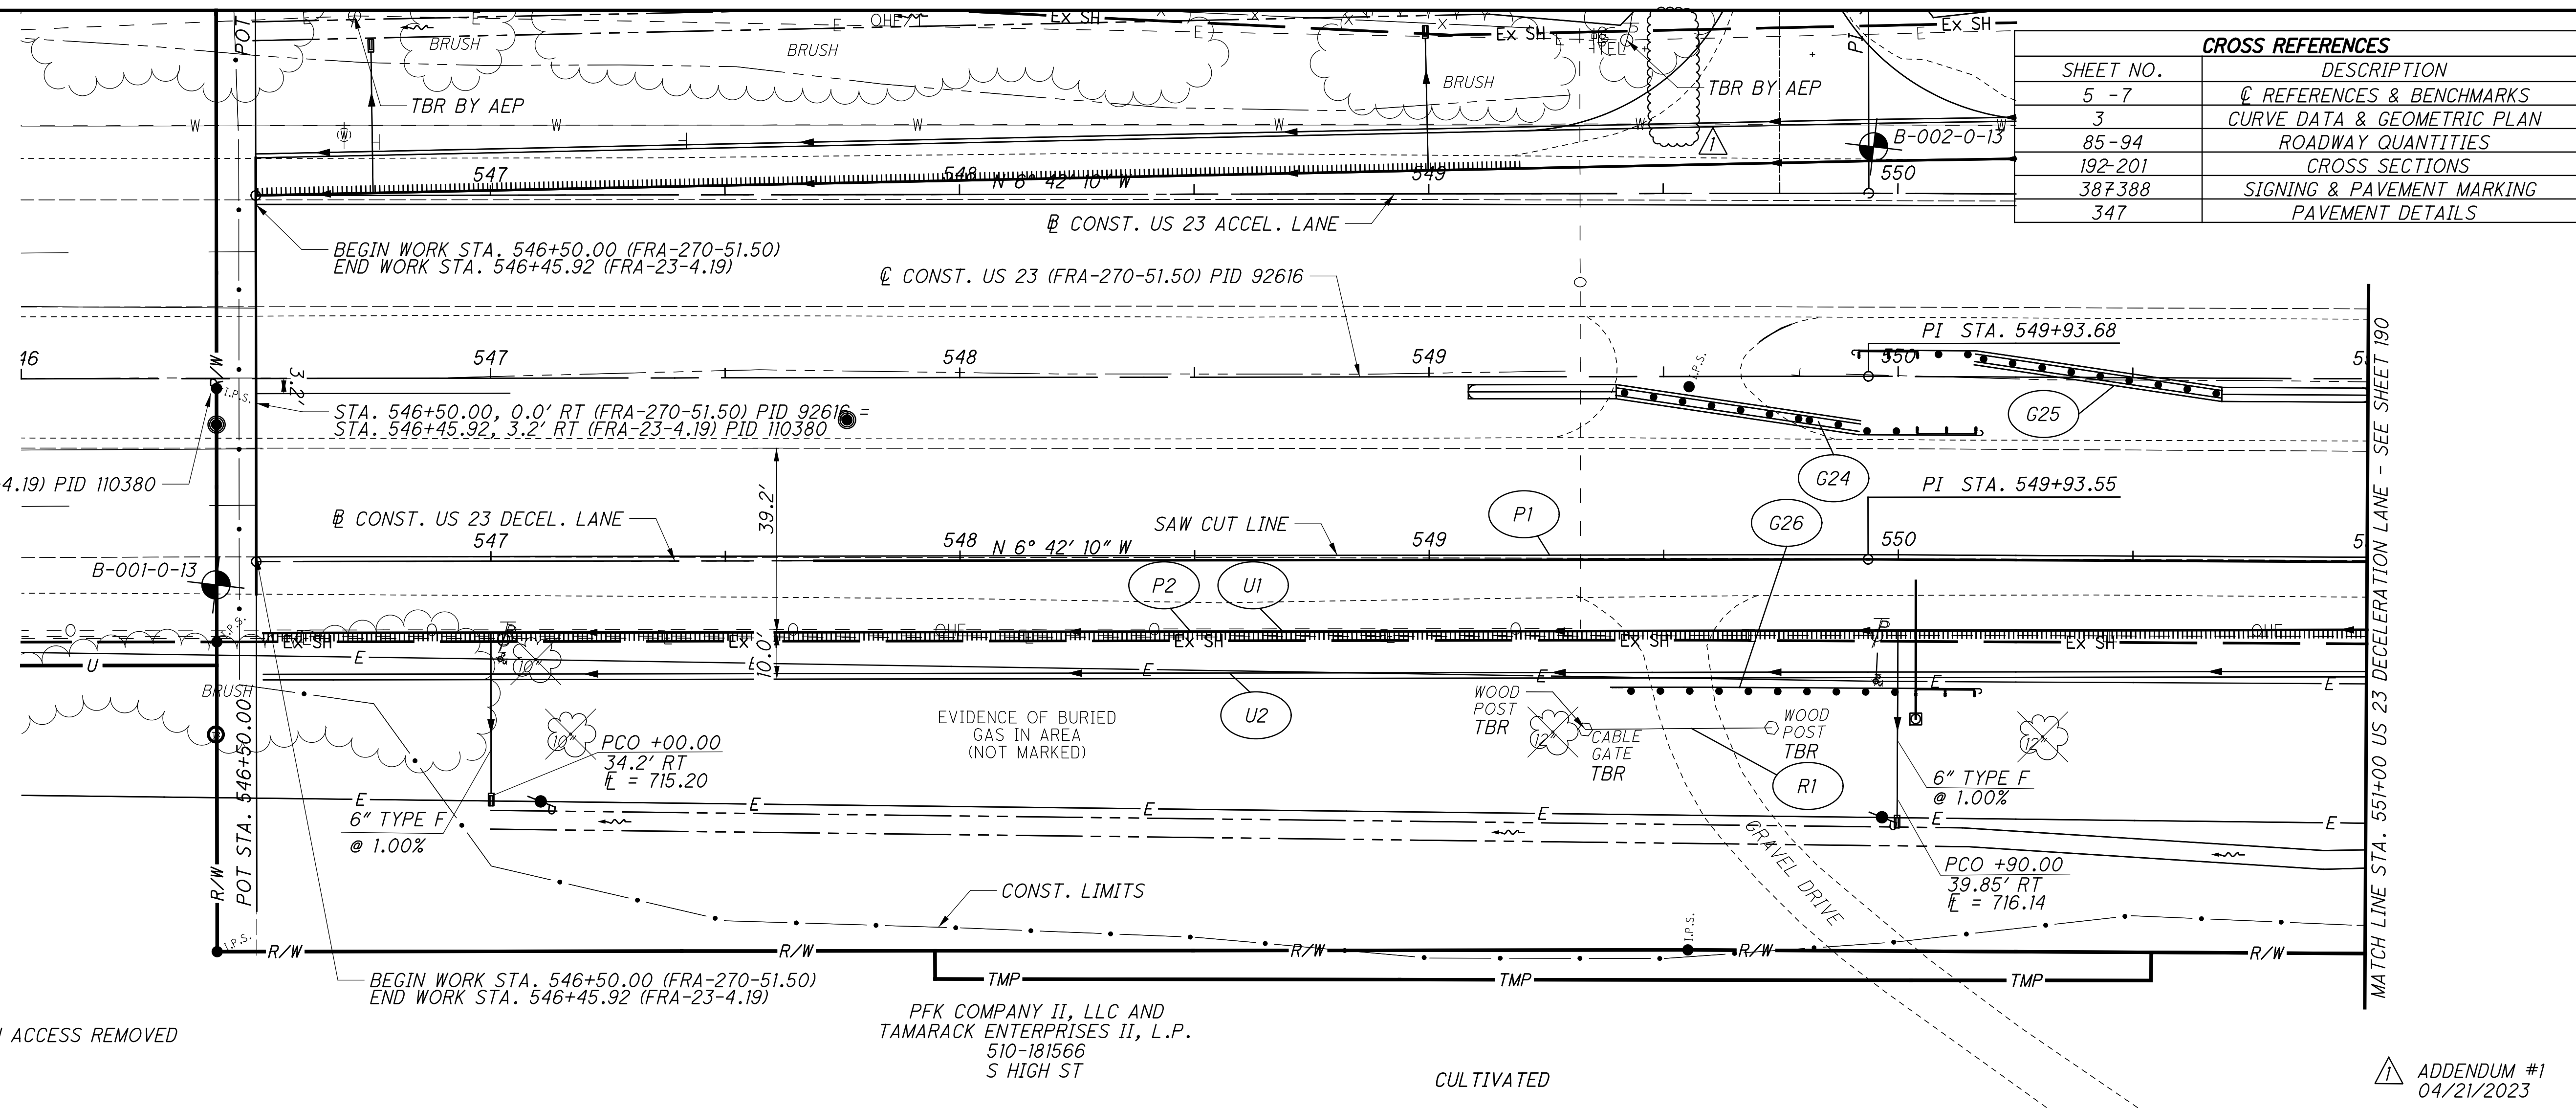


CROSS REFERENCES	
SHEET NO.	DESCRIPTION
5 - 7	REFERENCES & BENCHMARKS
3	CURVE DATA & GEOMETRIC PLAN
85 - 94	ROADWAY QUANTITIES
192 - 201	CROSS SECTIONS
387 - 388	SIGNING & PAVEMENT MARKING
347	PAVEMENT DETAILS



PFK COMPANY II, LLC AND  
TAMARACK ENTERPRISES II, L.P.  
510-181566  
S HIGH ST

ADDENDUM #1  
04/21/2023

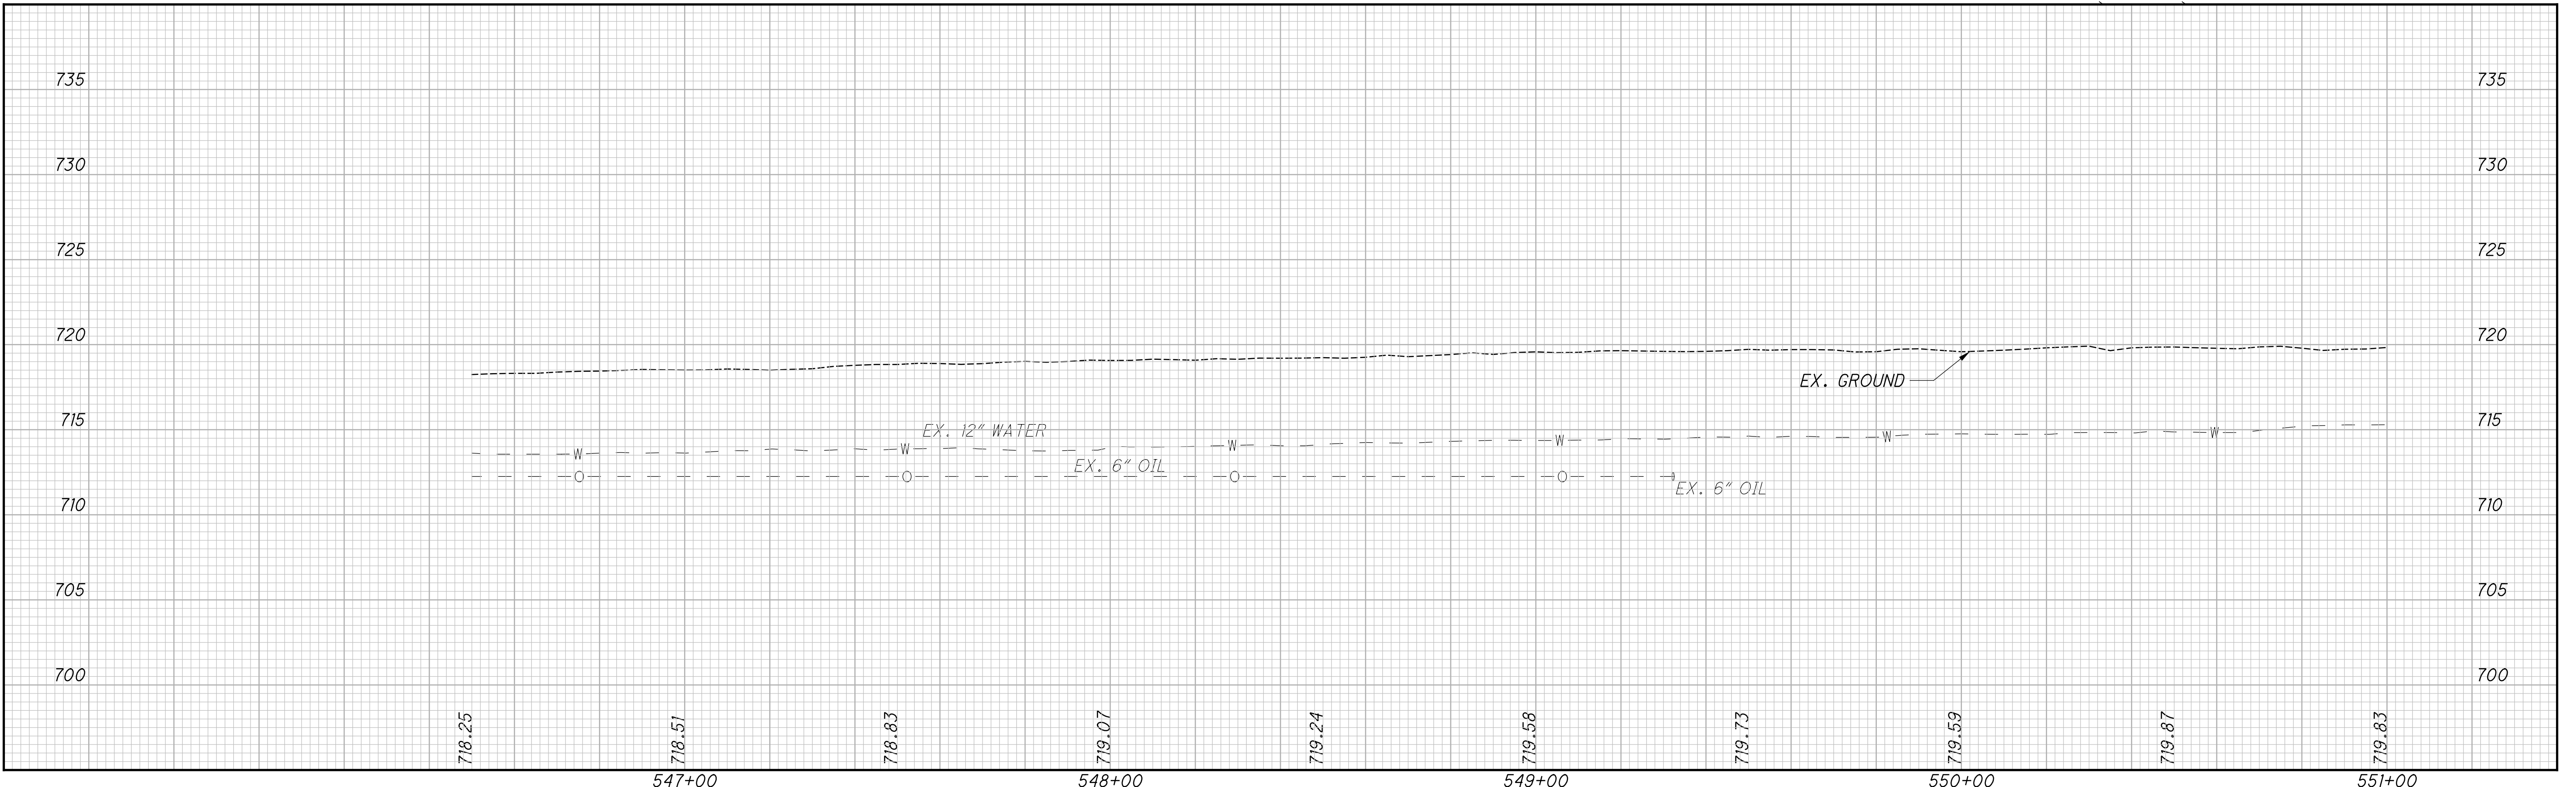

PLAN AND PROFILE US 23 DECELERATION LANE  
STA. 546+50 TO STA. 551+00


FRA - 270 - 51.50

189  
554




 MEDIAN ACCESS REMOVED

CROSS REFERENCES	
SHEET NO.	DESCRIPTION
5 - 7	☑ REFERENCES & BENCHMARKS
3	☑ CURVE DATA & GEOMETRIC PLAN
85 - 94	ROADWAY QUANTITIES
192 - 201	CROSS SECTIONS
388	SIGNING & PAVEMENT MARKING
347	PAVEMENT DETAILS

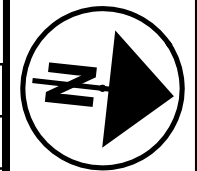

CALCULATED ACV  
CHECKED CSR

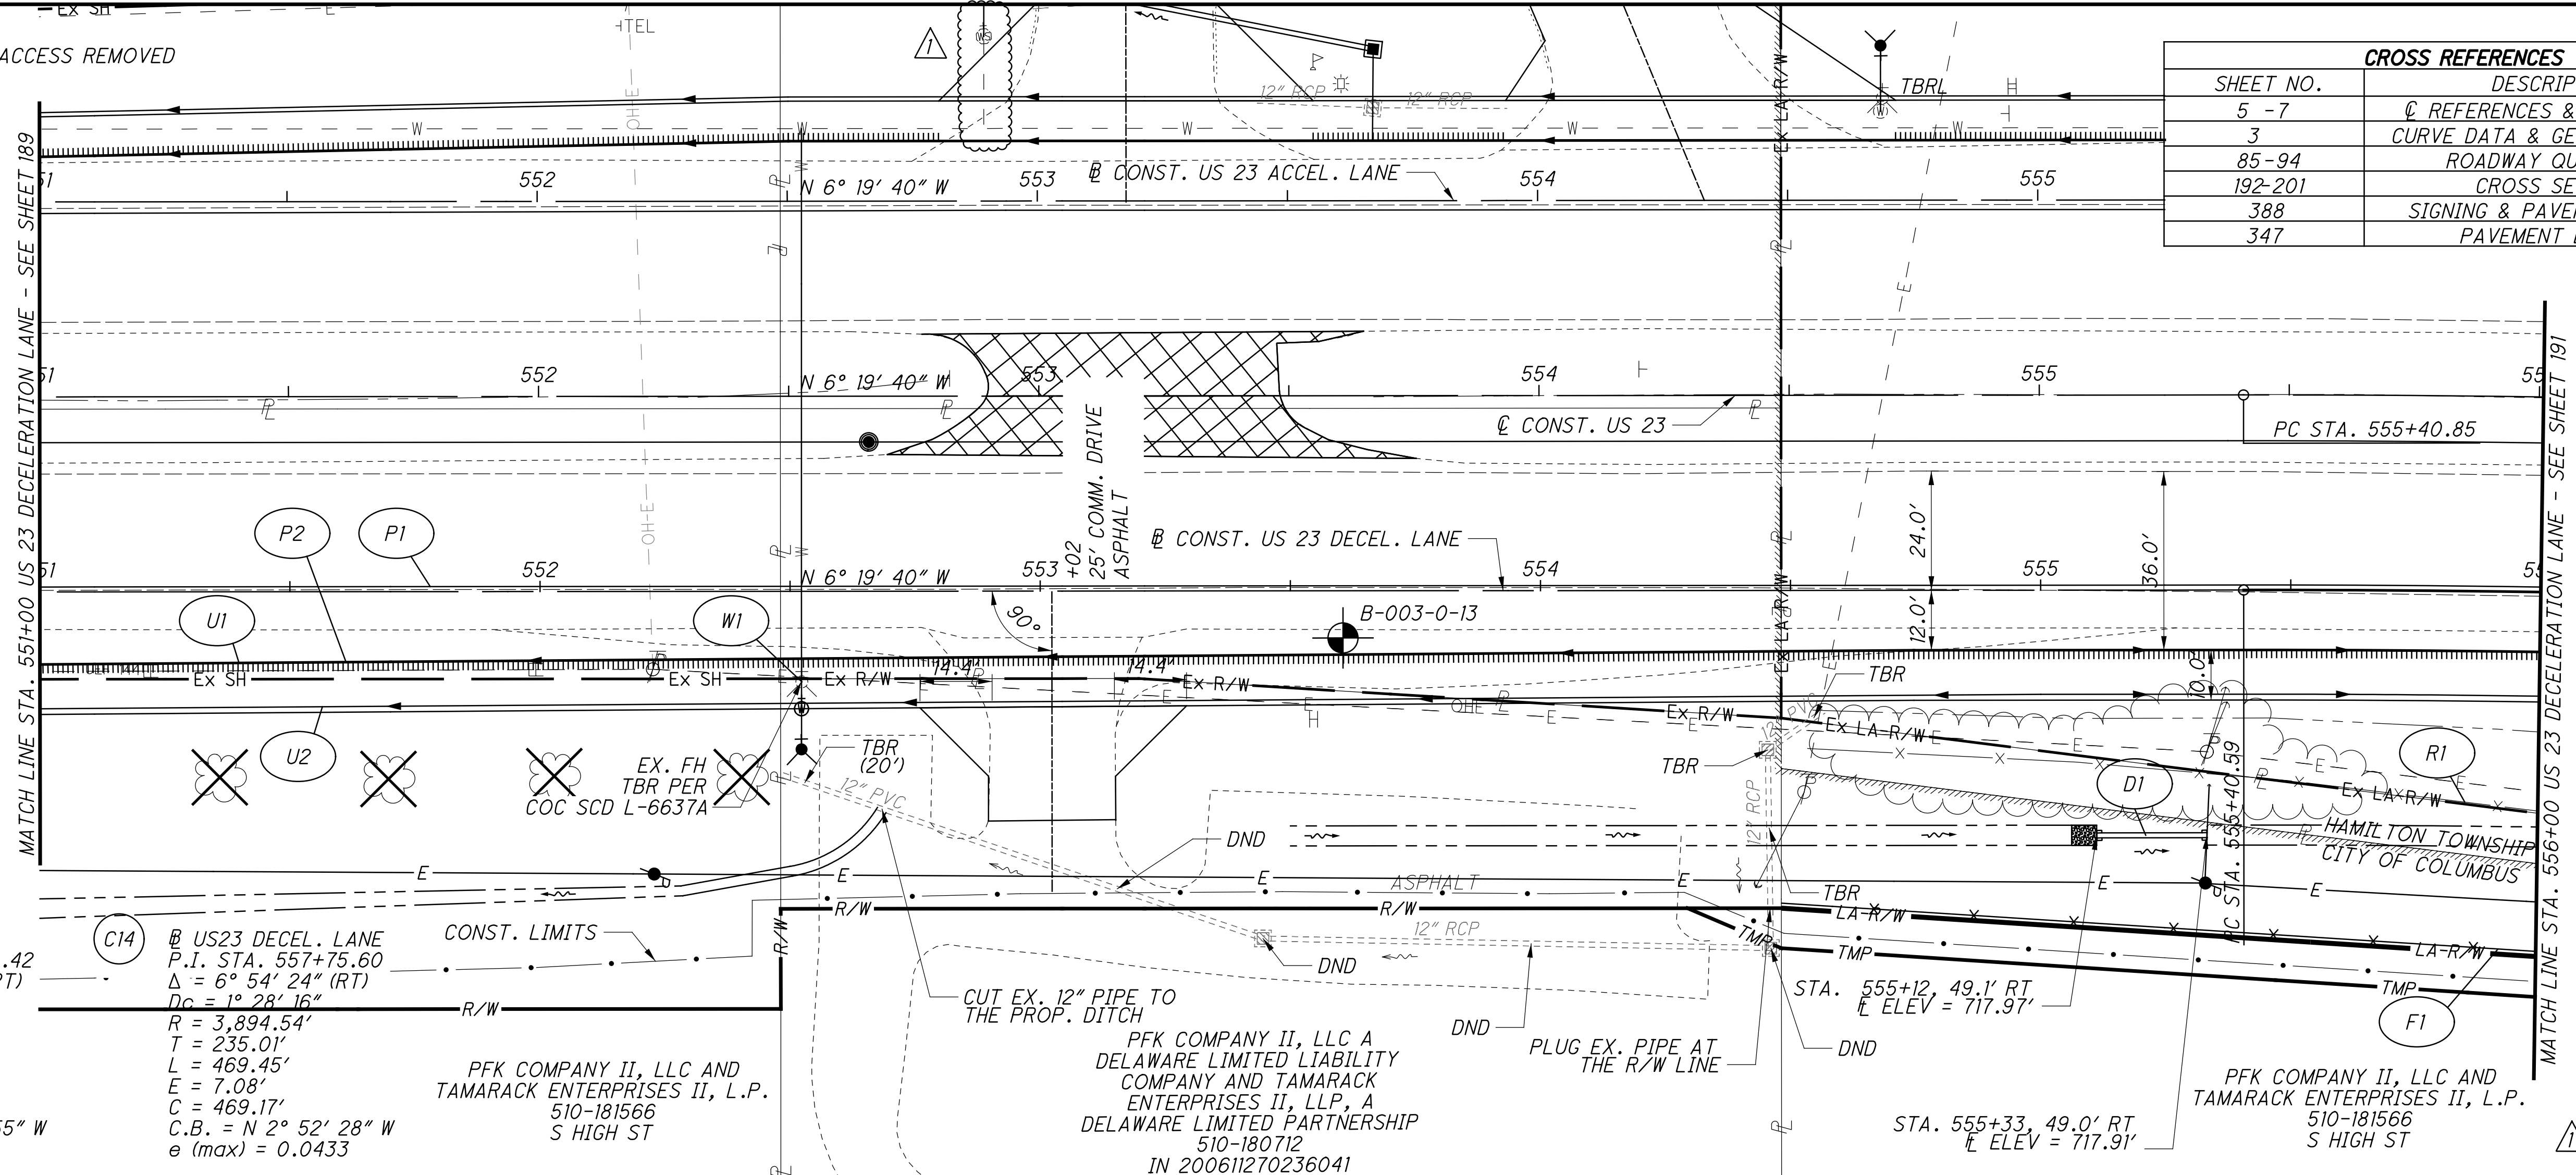

**C13** US 23 ACCEL.  
P.I. STA. 557+88.42  
 $\Delta = 7^\circ 07' 30''$  (RT)  
 $D_c = 1^\circ 26' 32''$   
 $R = 3,972.54'$   
 $T = 247.32'$   
 $L = 494.00'$   
 $E = 7.69'$   
 $C = 493.69'$   
C.B. =  $N 2^\circ 45' 55'' W$   
 $e$  (max) = 0.0223


**C14** US23 DECEL. LANE  
P.I. STA. 557+75.60  
 $\Delta = 6^\circ 54' 24''$  (RT)  
 $D_c = 1^\circ 28' 16''$   
 $R = 3,894.54'$   
 $T = 235.01'$   
 $L = 469.45'$   
 $E = 7.08'$   
 $C = 469.17'$   
C.B. =  $N 2^\circ 52' 28'' W$   
 $e$  (max) = 0.0433

PFK COMPANY II, LLC AND  
TAMARACK ENTERPRISES II, L.P.  
510-181566  
S HIGH ST

PFK COMPANY II, LLC A  
DELAWARE LIMITED LIABILITY  
COMPANY AND TAMARACK  
ENTERPRISES II, LLP, A  
DELAWARE LIMITED PARTNERSHIP  
510-180712  
IN 200611270236041

PFK COMPANY II, LLC AND  
TAMARACK ENTERPRISES II, L.P.  
510-181566  
S HIGH ST

ADDENDUM #1  
04/21/2023

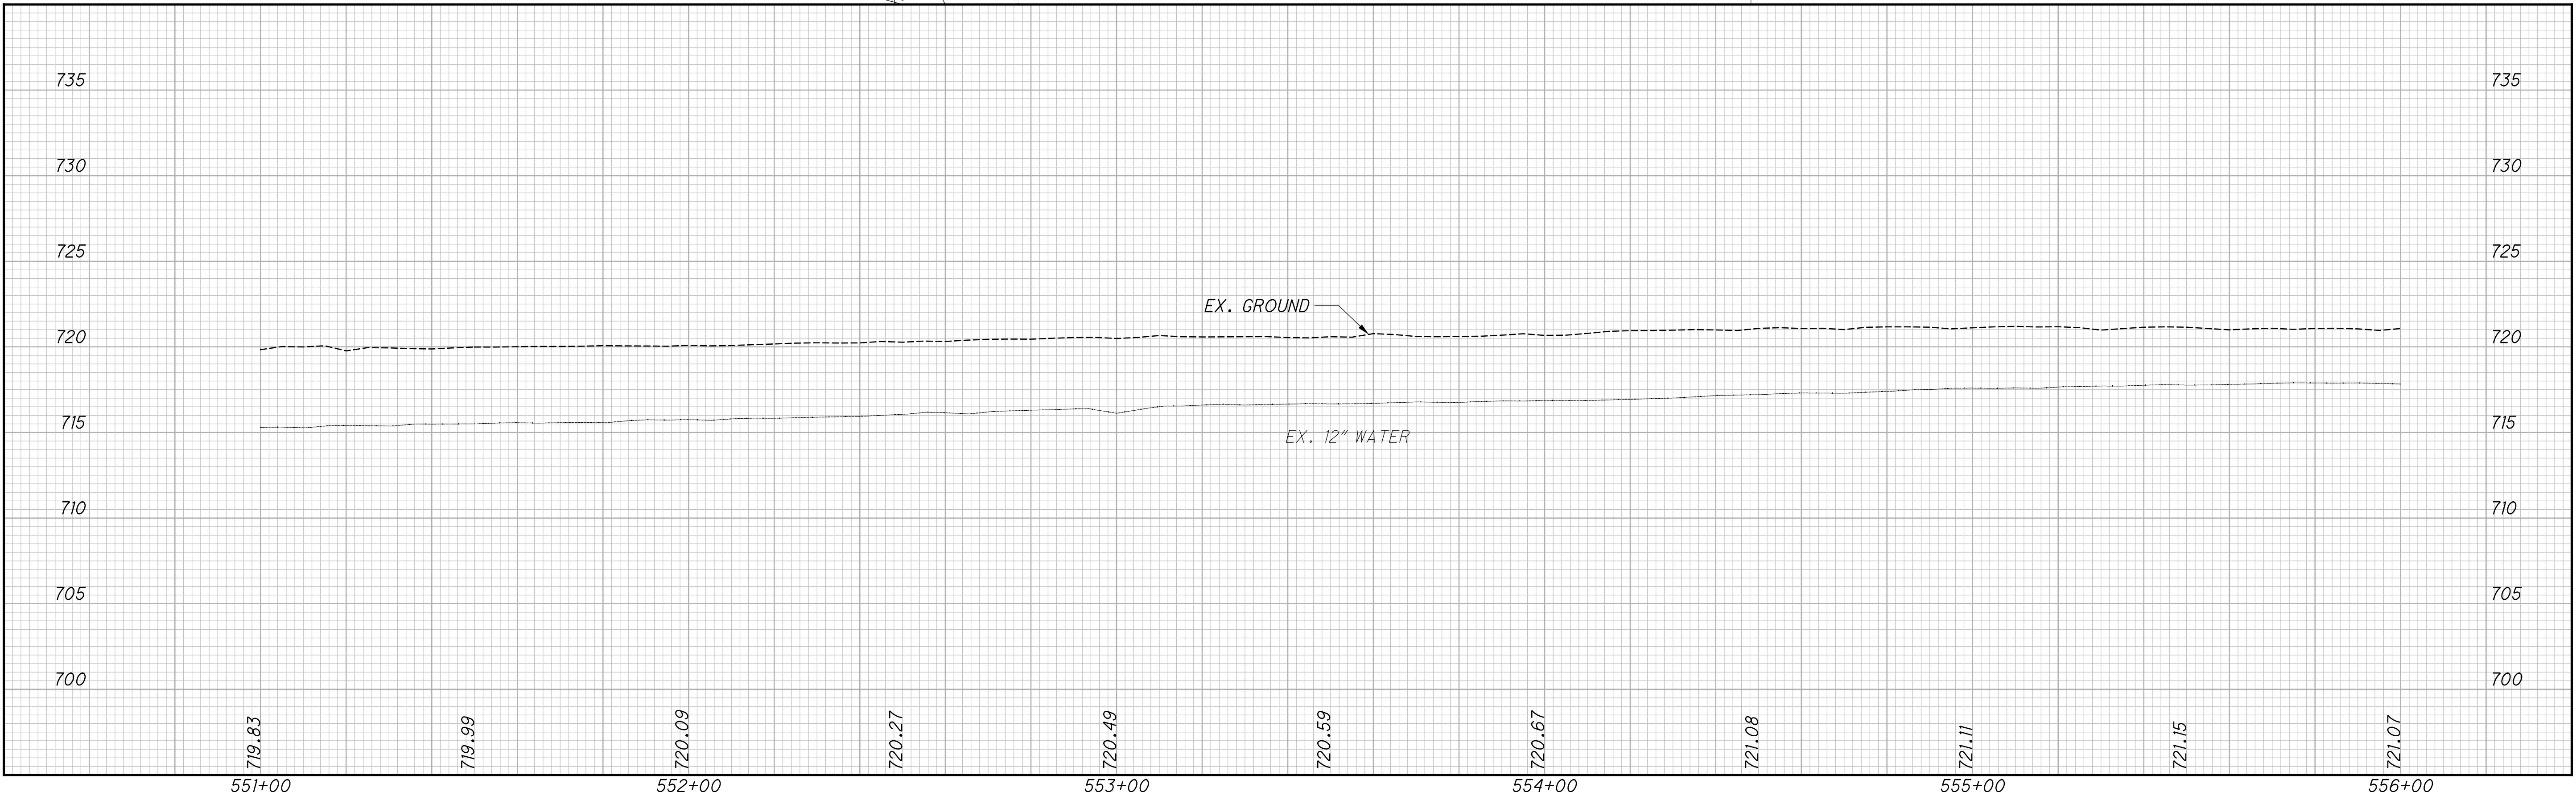


PLAN AND PROFILE US 23 DECELERATION LANE  
STA. 551+00 TO STA. 556+00

FRA - 270-51.50


190  
554

X:\Projects\2013\1010\FRA\92616\roadway\sheet\92616GP702.dgn 4/19/2023 9:22:34 AM cwong

X:\Projects\2013\1010\FRA\92616\roadway\sheets\92616GP201.dgn 4/19/2023 9:24:35 AM c.wong

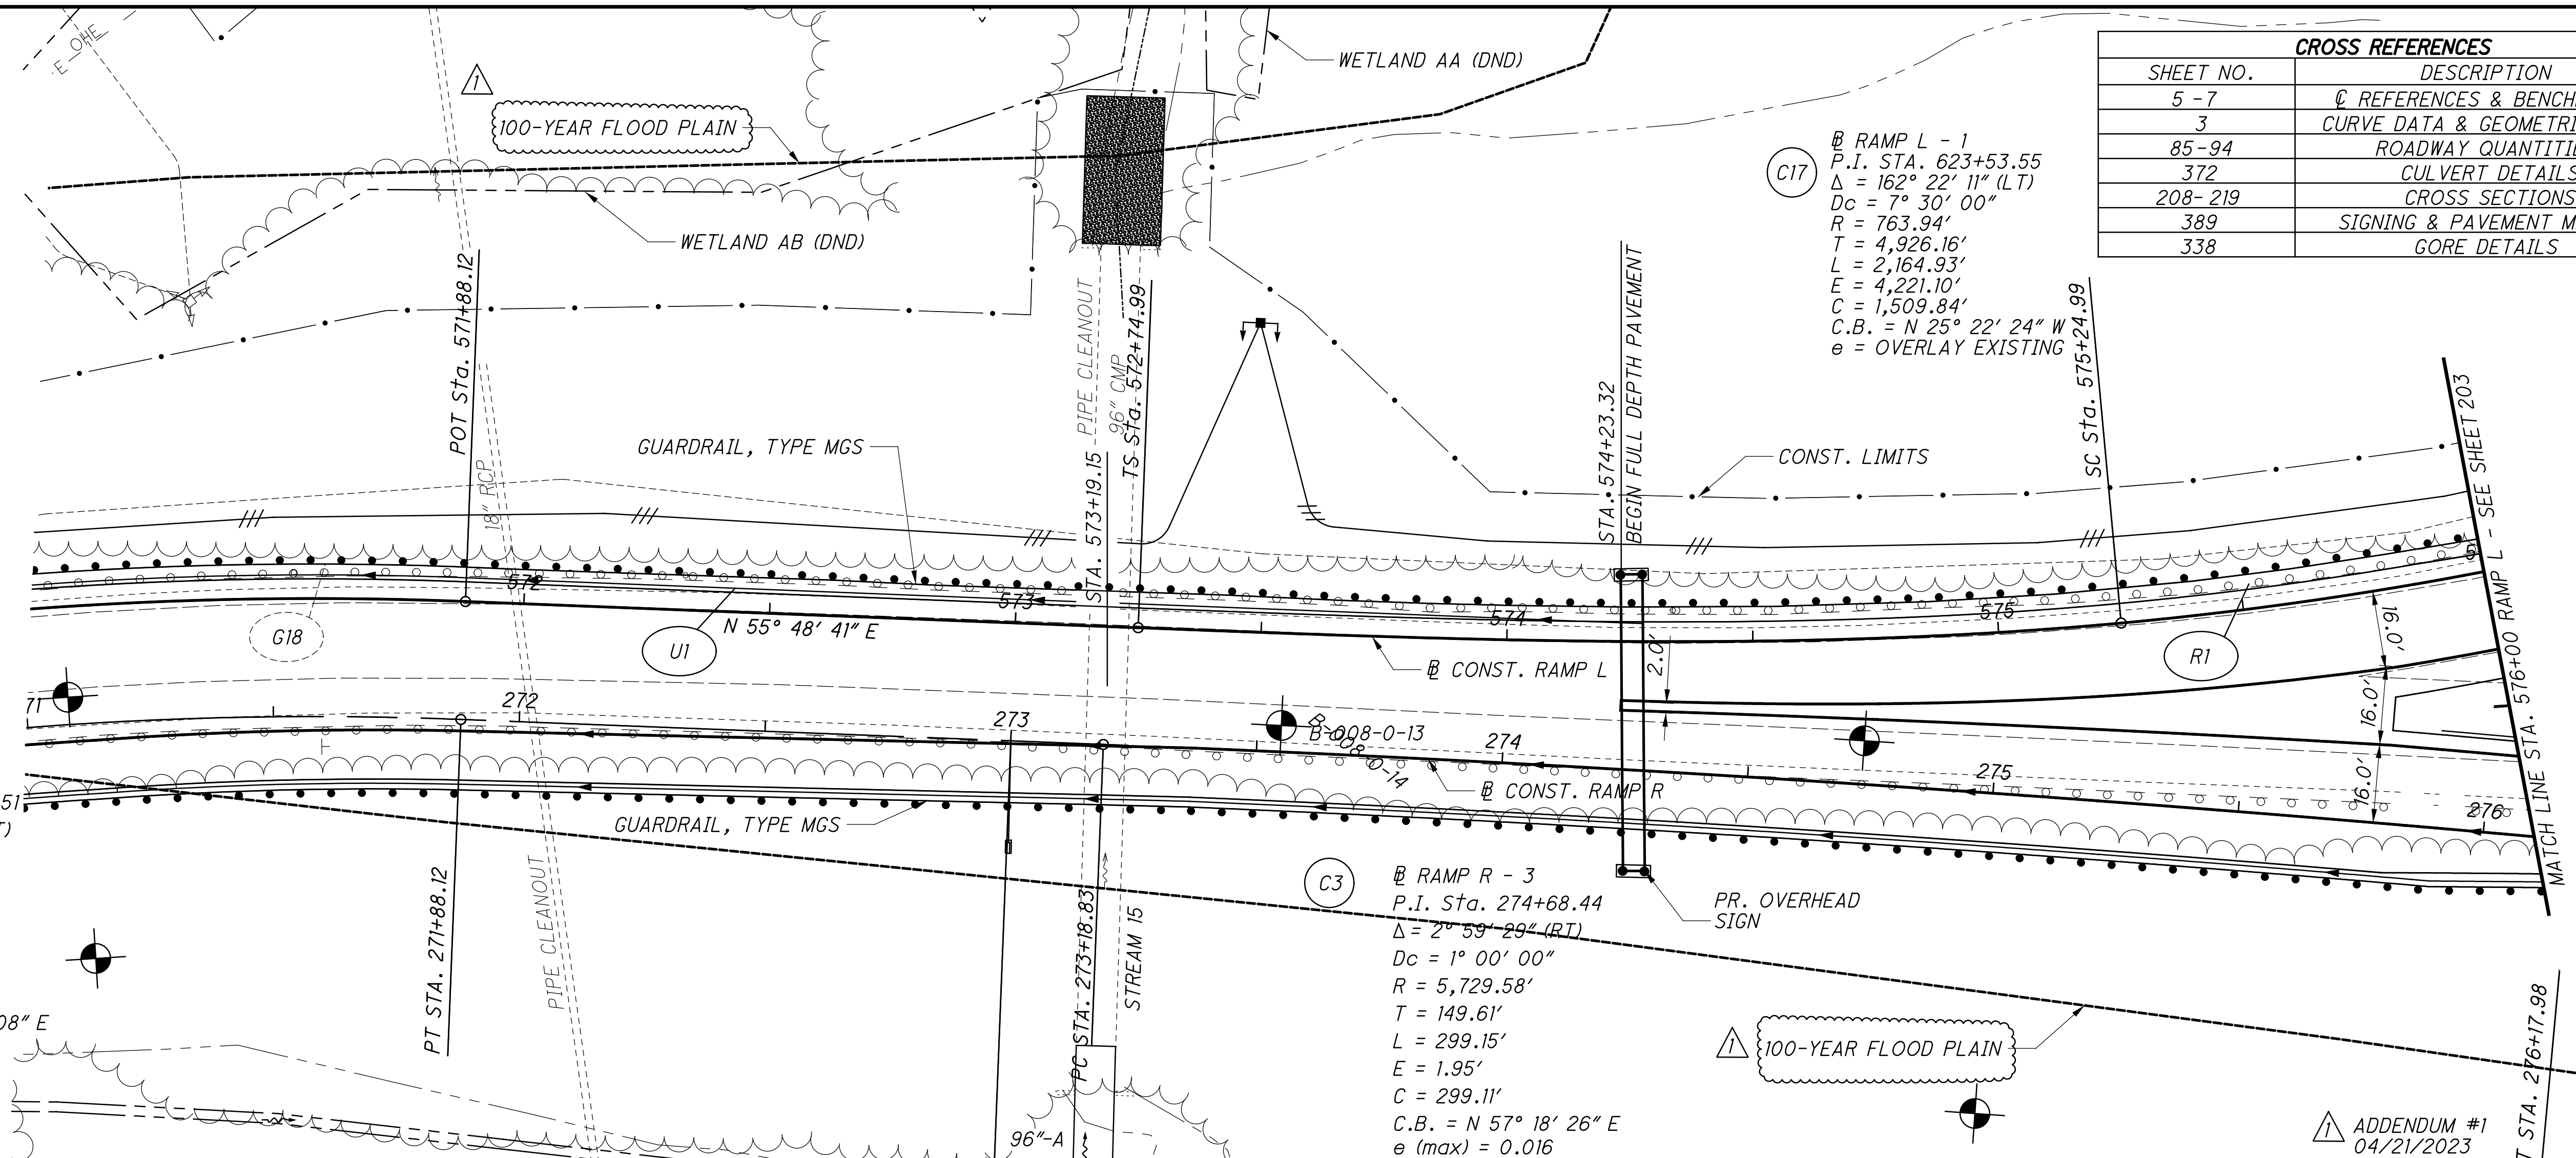

CROSS REFERENCES	
SHEET NO.	DESCRIPTION
5-7	REFERENCES & BENCHMARKS
3	CURVE DATA & GEOMETRIC PLAN
85-94	ROADWAY QUANTITIES
372	CULVERT DETAILS
208-219	CROSS SECTIONS
389	SIGNING & PAVEMENT MARKING
338	GORE DETAILS

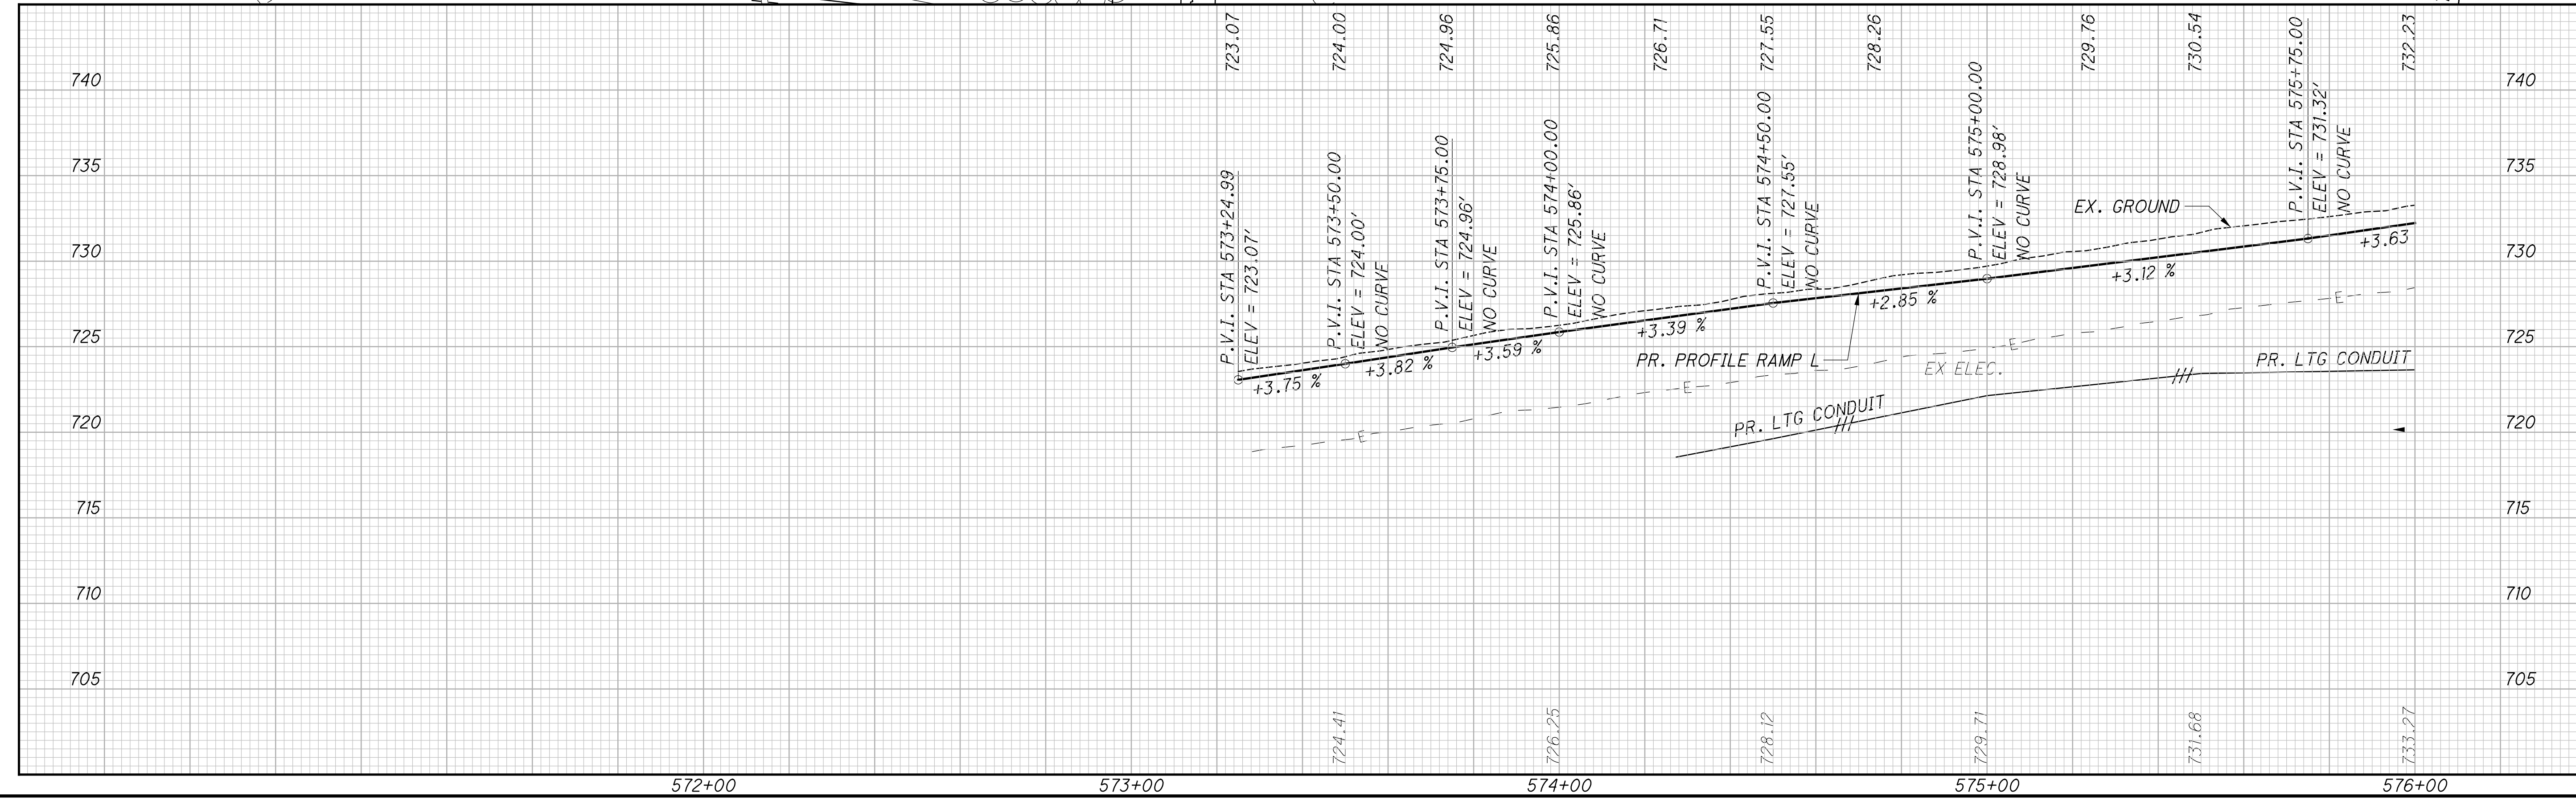


PLAN AND PROFILE - RAMP L  
STA. 571+88.12 TO STA. 576+00

FRA - 270-51.50

202  
554

LEGEND:

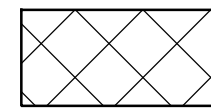

ITEM 202 PAVEMENT REMOVED

CROSS REFERENCES	
SHEET NO.	DESCRIPTION
5-7	☉ REFERENCES & BENCHMARKS
3	⤵ CURVE DATA & GEOMETRIC PLAN
85-94	ROADWAY QUANTITIES
208-219	CROSS SECTIONS
390	SIGNING & PAVEMENT MARKING
505-545	BRIDGE PLANS



0 10 20 30 40  
HORIZONTAL SCALE IN FEET


CALCULATED ACF CHECKED CSR

DESIGN EXCEPTION  
HSSD = 264' (260' MIN)  
ACTUAL DESIGN SPEED = 36 MPH

C17  
RAMP L - 1  
P.I. STA. 623+53.55  
 $\Delta = 162^\circ 22' 11''$  (LT)  
 $D_c = 7^\circ 30' 00''$   
 $R = 763.94'$   
 $T = 4,926.16'$   
 $L = 2,164.93'$   
 $E = 4,221.10'$   
 $C = 1,509.84'$   
C.B. = N 25° 22' 24" W  
e = OVERLAY EXISTING

STRUCTURE NO.  
FRA-270-52.64

ADDENDUM #1  
04/21/2023

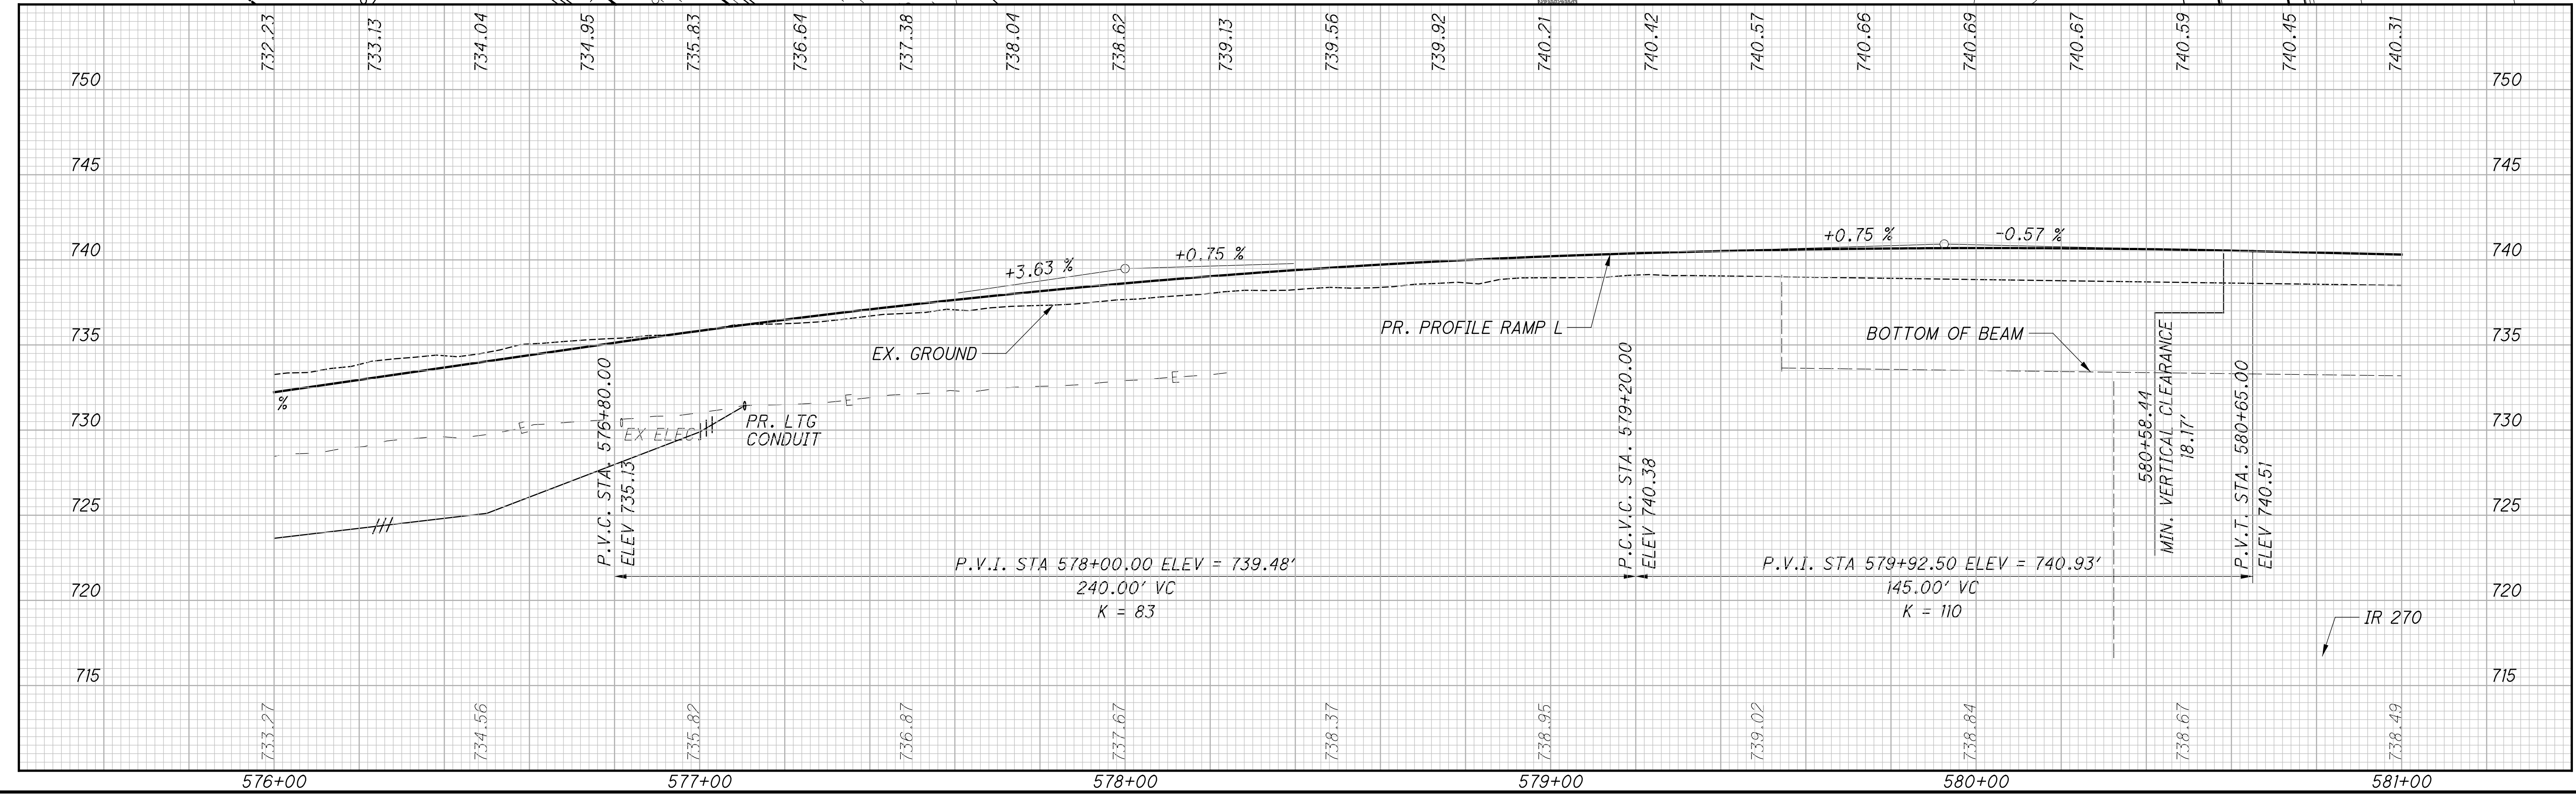


PLAN AND PROFILE - RAMP L  
STA. 576+00 TO STA. 581+00

FRA - 270 - 51.50


203  
554

X:\Projects\2013\1010\FRA\92616\roadway\sheets\92616GP202.dgn 4/19/2023 9:26:05 AM cwong



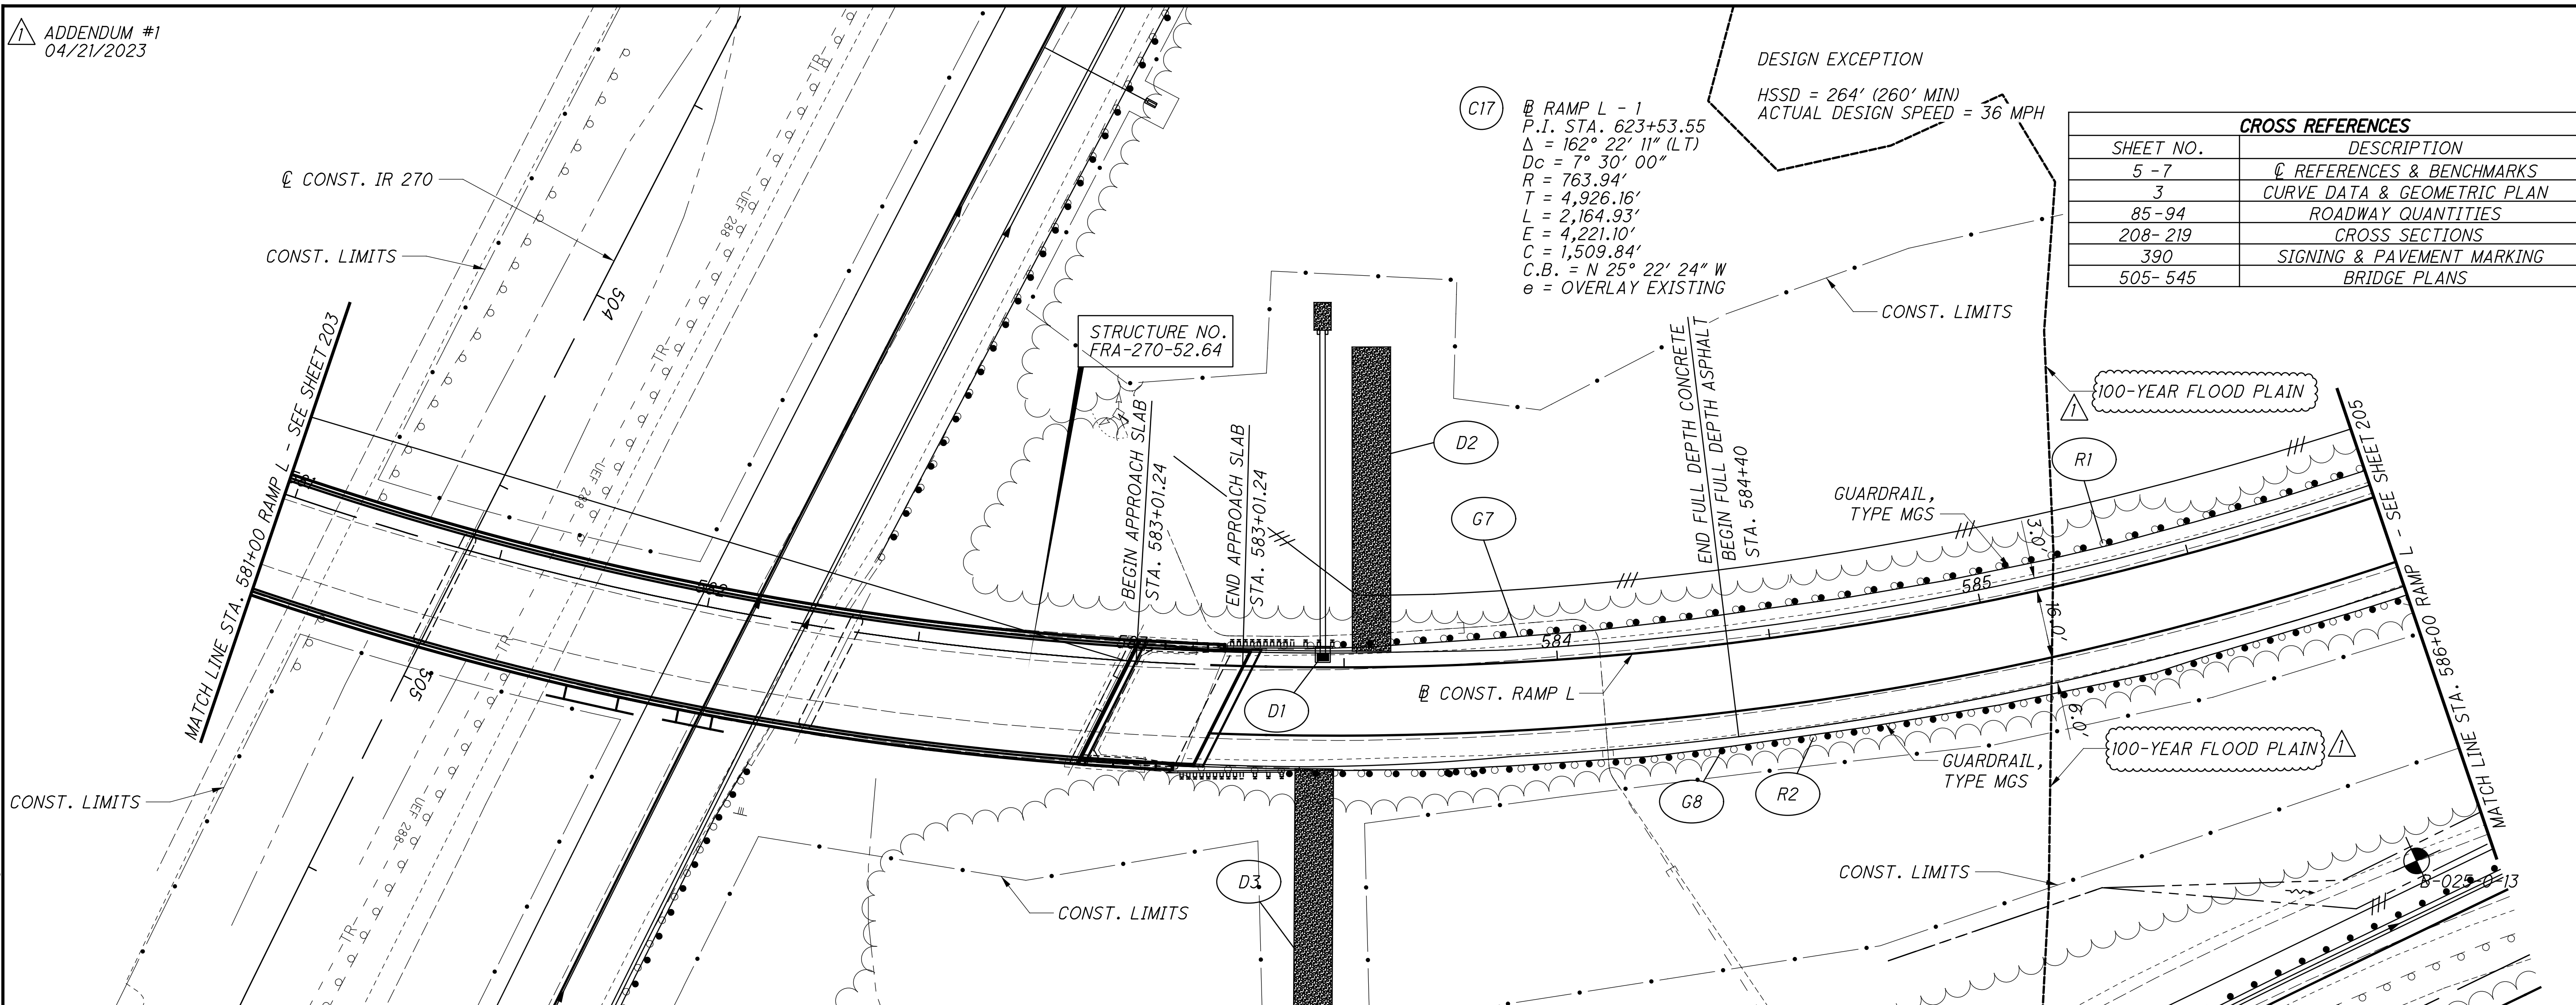

CROSS REFERENCES	
SHEET NO.	DESCRIPTION
5-7	REFERENCES & BENCHMARKS
3	CURVE DATA & GEOMETRIC PLAN
85-94	ROADWAY QUANTITIES
208-219	CROSS SECTIONS
390	SIGNING & PAVEMENT MARKING
505-545	BRIDGE PLANS

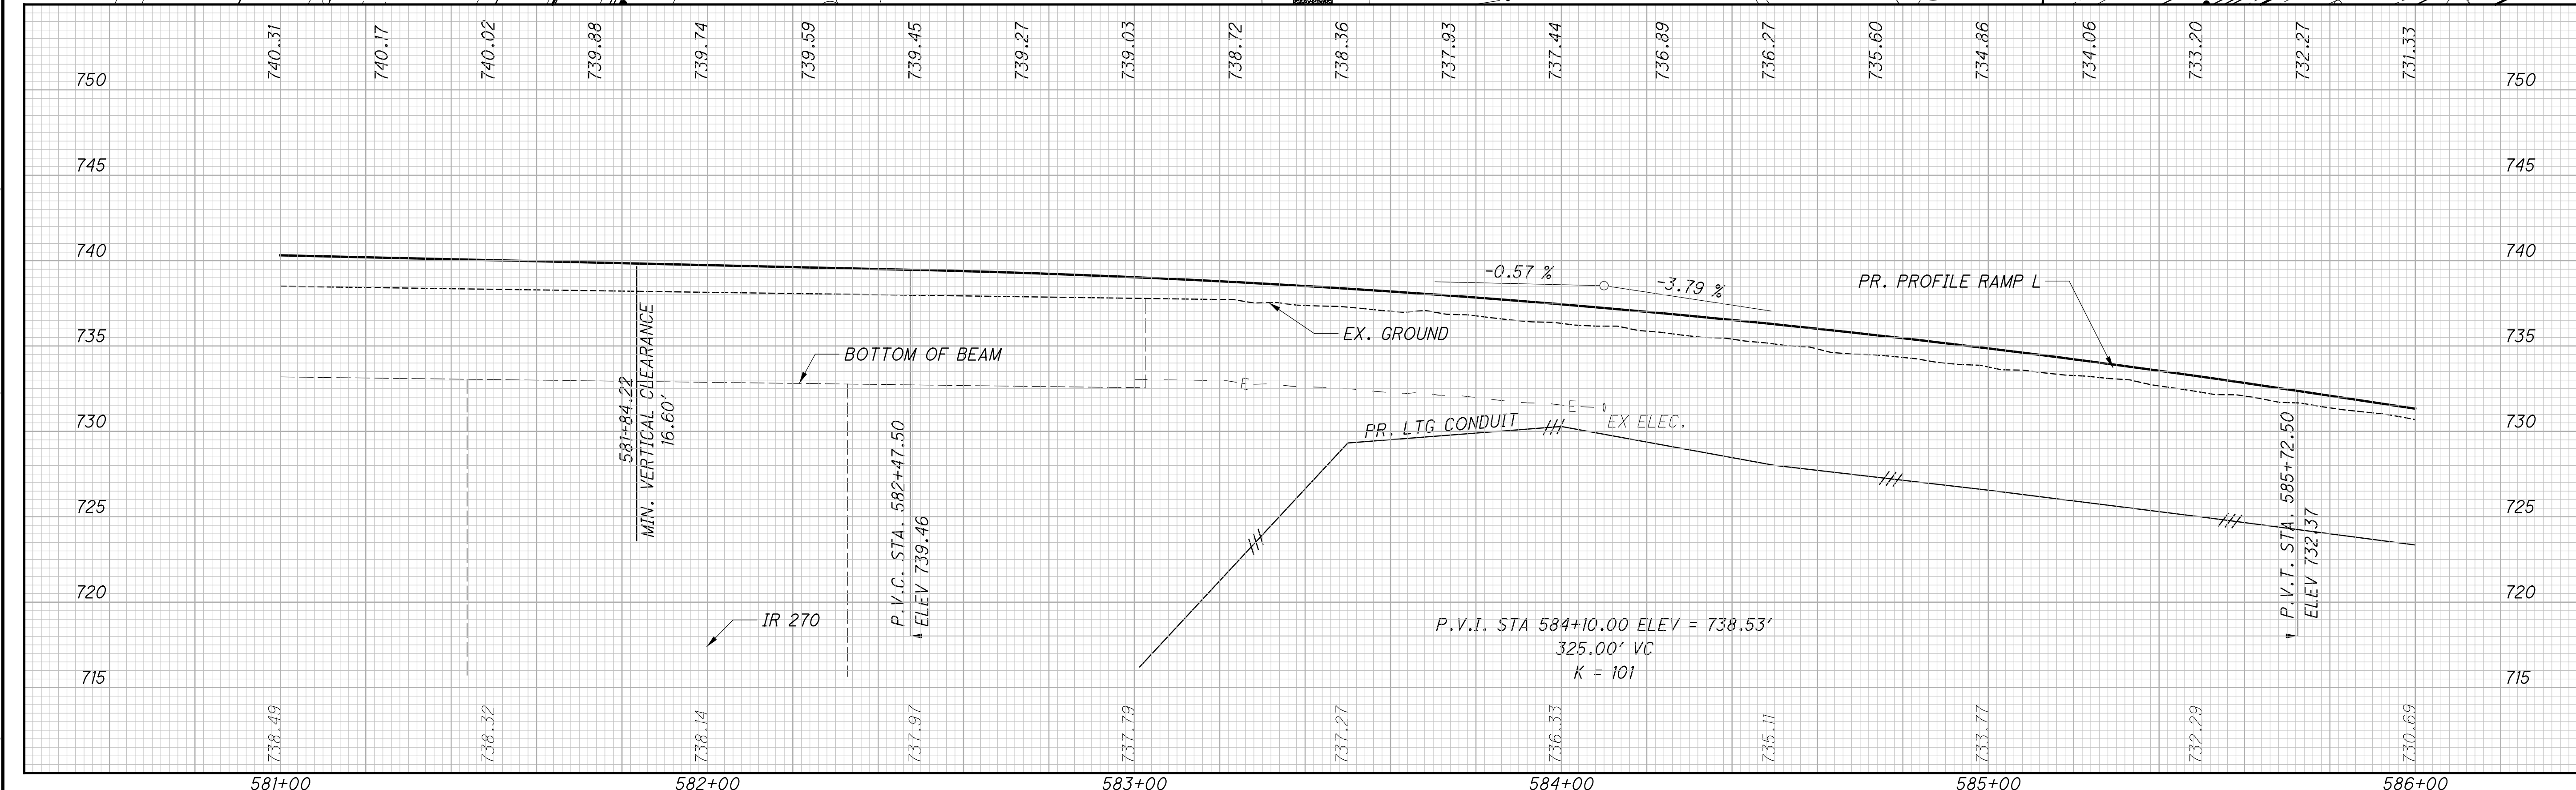

X:\Projects\2013\1010\FRA\roadway\sheet\92616GP203.dgn 4/19/2023 9:27:29 AM cwong

C17  
 @ RAMP L - 1  
 P.I. STA. 623+53.55  
 $\Delta = 162^\circ 22' 11''$  (LT)  
 $D_c = 7^\circ 30' 00''$   
 $R = 763.94'$   
 $T = 4,926.16'$   
 $L = 2,164.93'$   
 $E = 4,221.10'$   
 $C = 1,509.84'$   
 $C.B. = N 25^\circ 22' 24'' W$   
 $e =$  OVERLAY EXISTING

CROSS REFERENCES	
SHEET NO.	DESCRIPTION
5-7	☉ REFERENCES & BENCHMARKS
3	☉ CURVE DATA & GEOMETRIC PLAN
85-94	☉ ROADWAY QUANTITIES
208-219	☉ CROSS SECTIONS
390	☉ SIGNING & PAVEMENT MARKING
483-504	☉ BRIDGE PLANS



ADDENDUM #1  
 04/21/2023

CALCULATED  
 ACI  
 CHECKED  
 CSR  
 HORIZONTAL SCALE IN FEET  
 0 10 20 40

PLAN AND PROFILE - RAMP L  
 STA. 586+00 TO STA. 591+00

FRA - 270-51.50



205  
 554

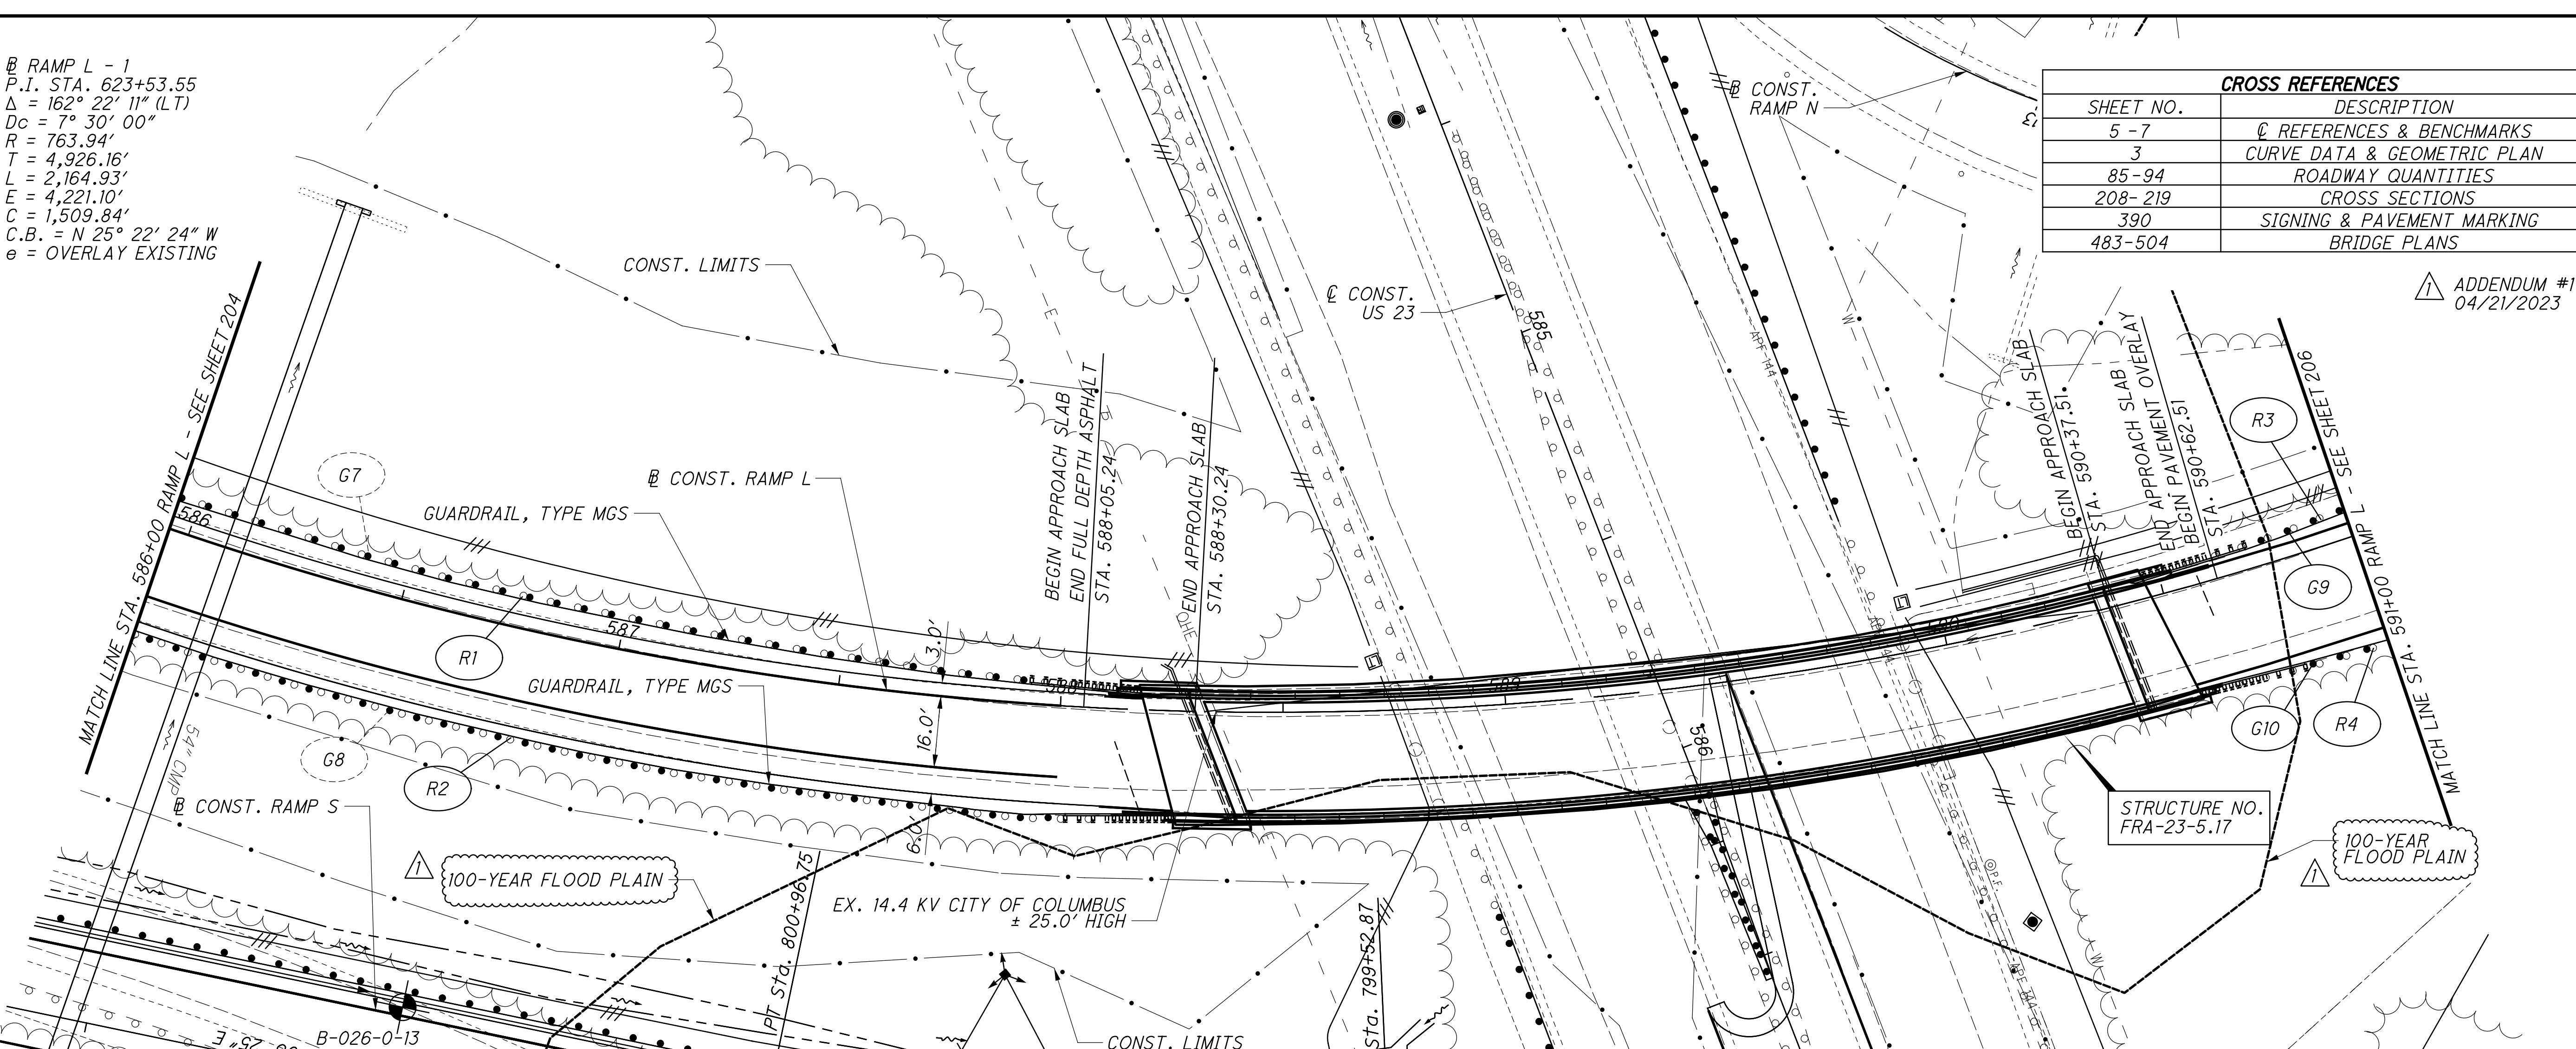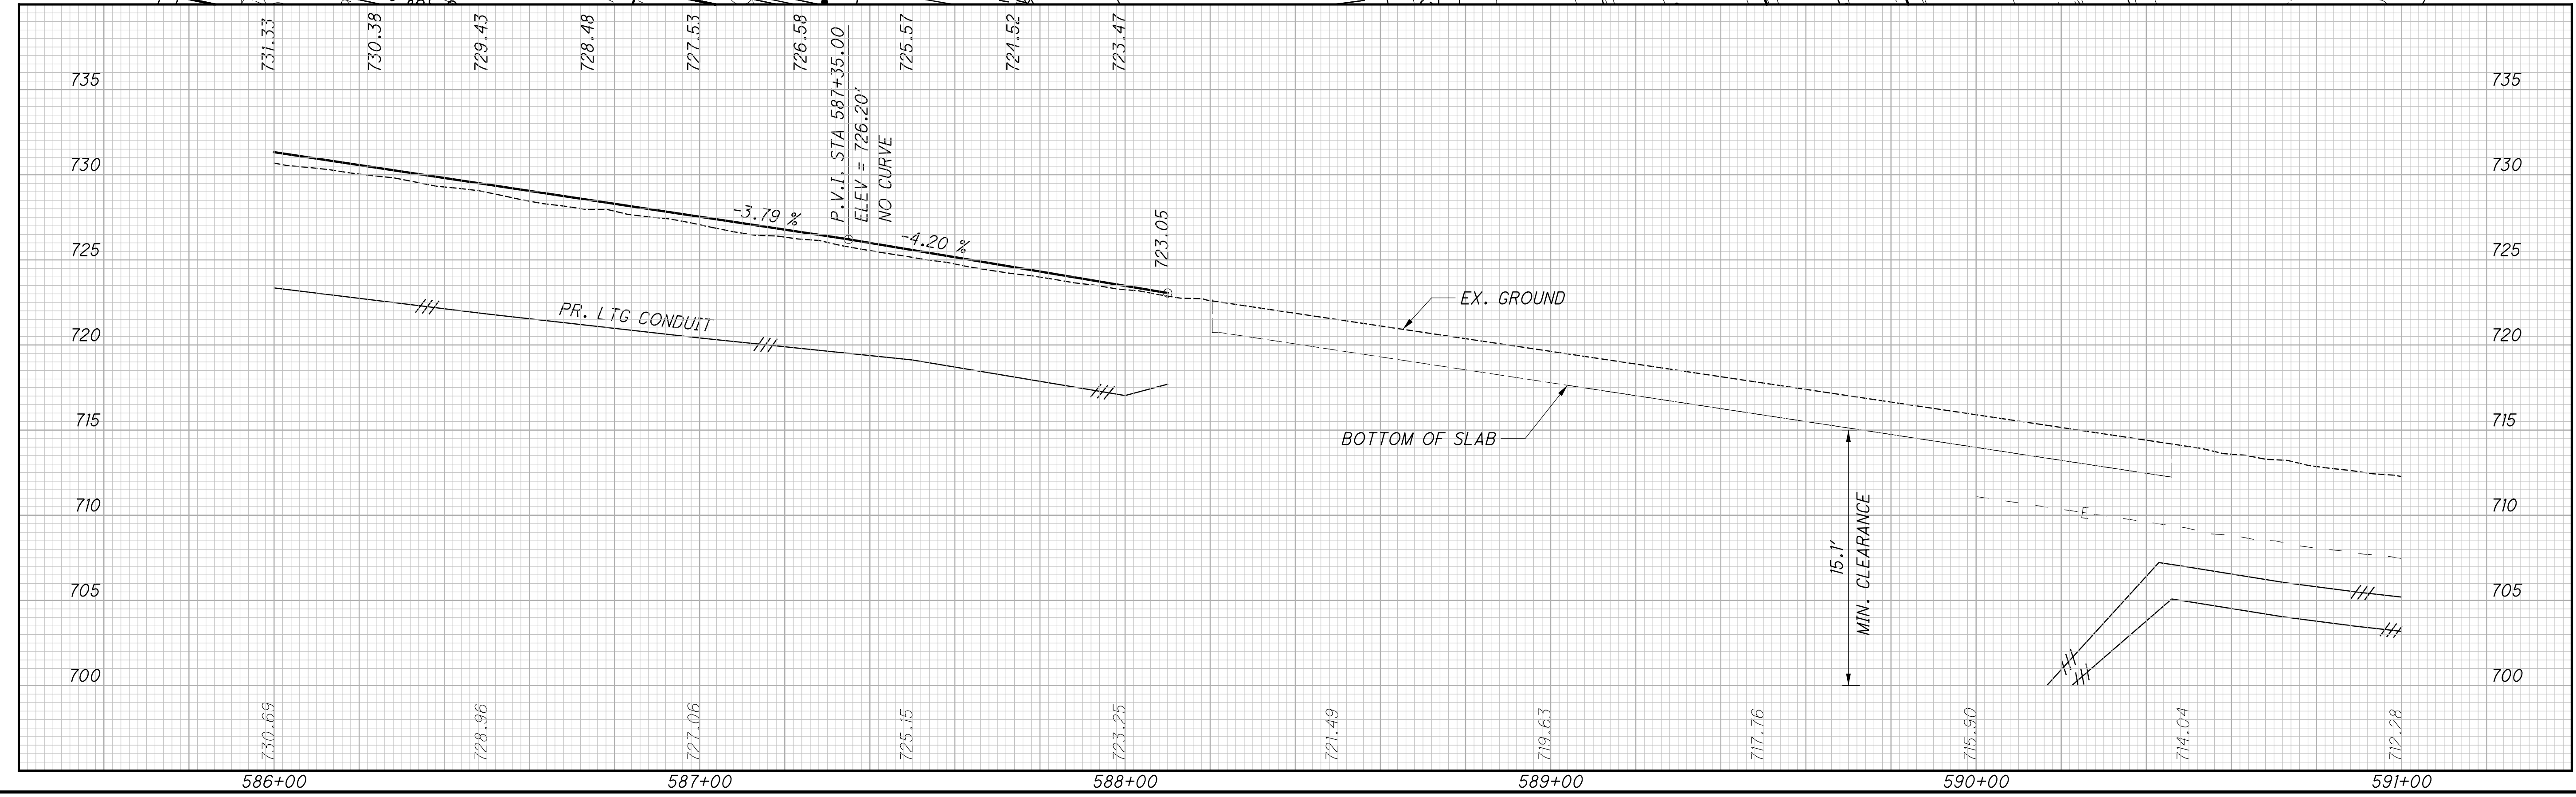

X:\Projects\2013\1010\FRA\92616\roadway\sheet\92616GP204.dgn 4/19/2023 9:28:43 AM cwong




LEGEND:

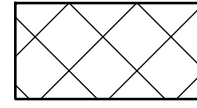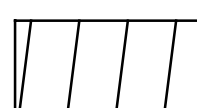-  ITEM 202 PAVEMENT REMOVED
-  ITEM 202 EXCAVATION AND ITEM 202 PIPE REMOVED

CROSS REFERENCES	
SHEET NO.	DESCRIPTION
3	CURVE DATA & GEOMETRIC PLAN
5 - 7	☉ REFERENCES & BENCHMARKS
221	PLAN - RAMP M
85-94	ROADWAY QUANTITIES
208-219	CROSS SECTIONS
391	SIGNING & PAVEMENT MARKING



N

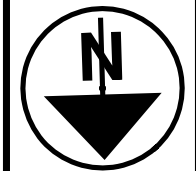

10  
HORIZONTAL  
SCALE IN FEET

CALCULATED ACF CHECKED CSR

C17  
 RAMP L - 1  
 P.I. STA. 623+53.55  
 $\Delta = 162^\circ 22' 11''$  (LT)  
 $\Delta c = 7^\circ 30' 00''$   
 $R = 763.94'$   
 $T = 4,926.16'$   
 $L = 2,164.93'$   
 $E = 4,221.10'$   
 $C = 1,509.84'$   
 $C.B. = N 25^\circ 22' 24'' W$   
 $e =$  OVERLAY EXISTING

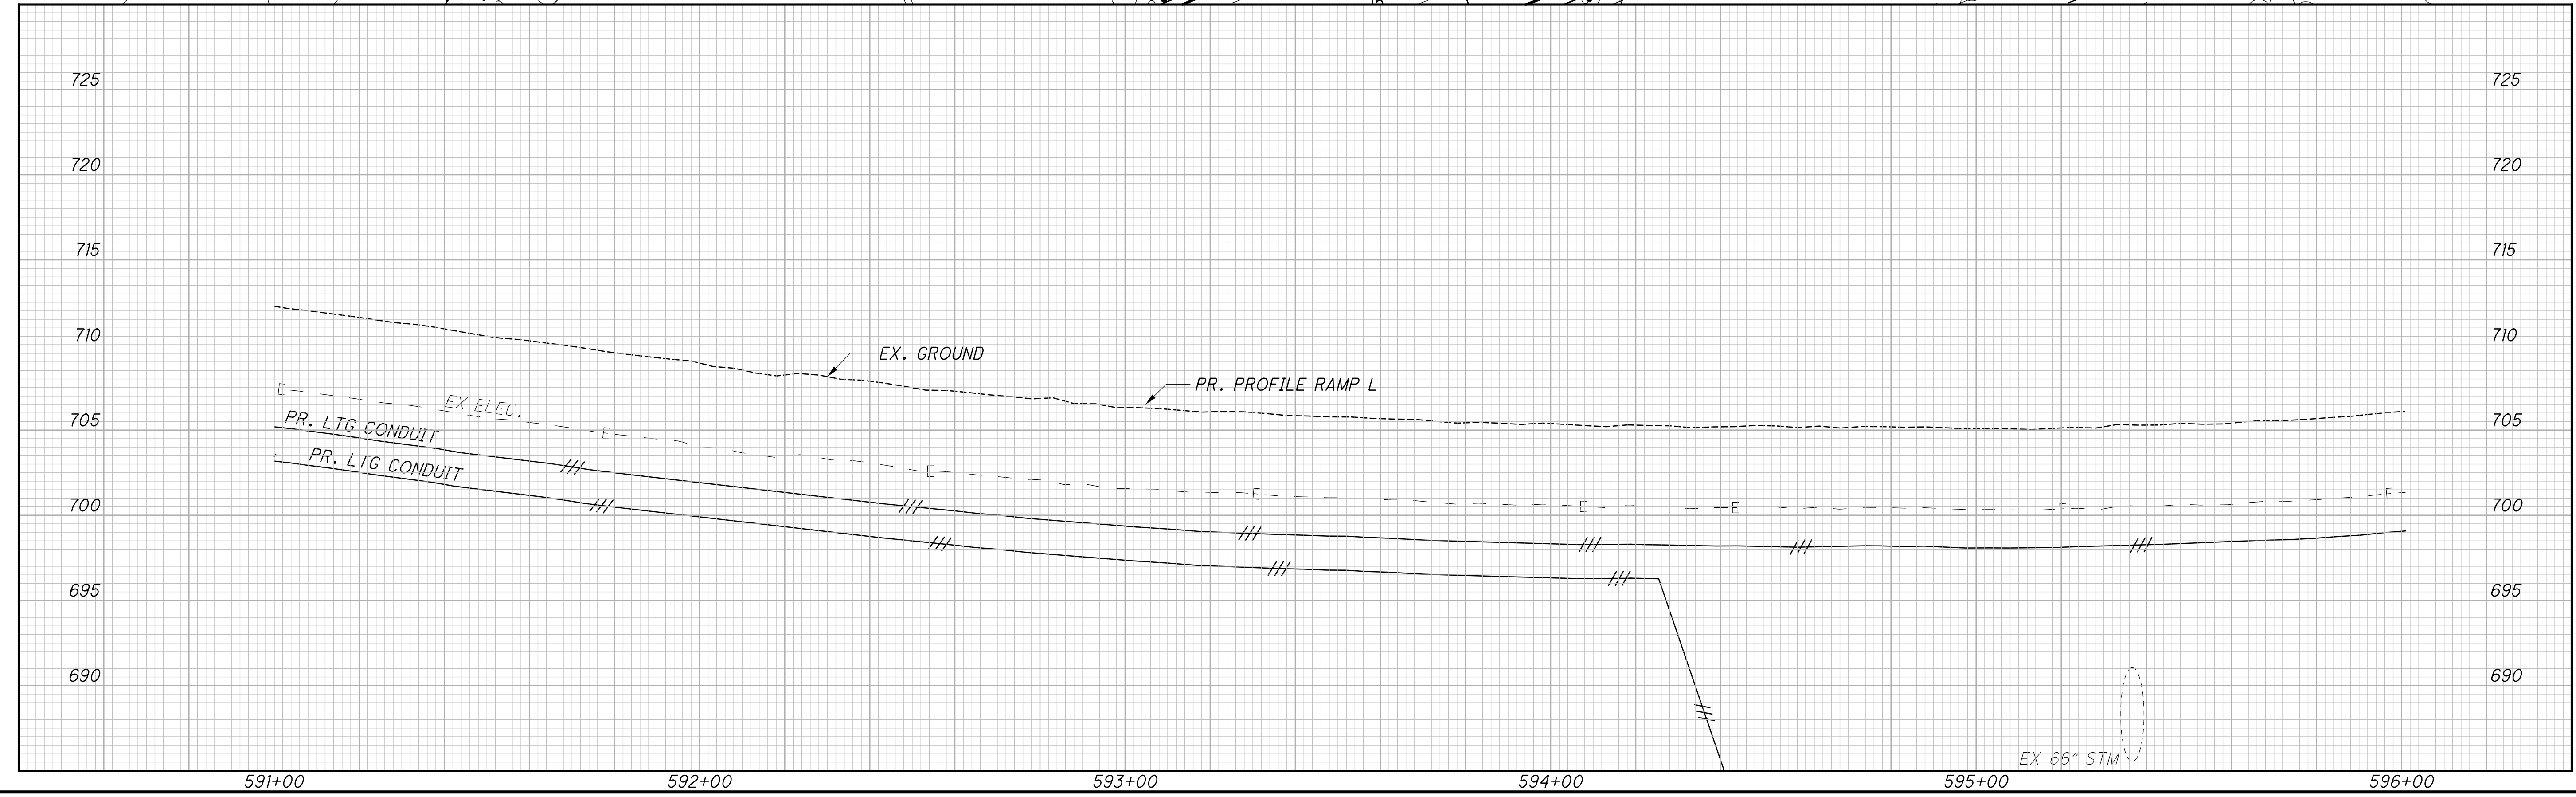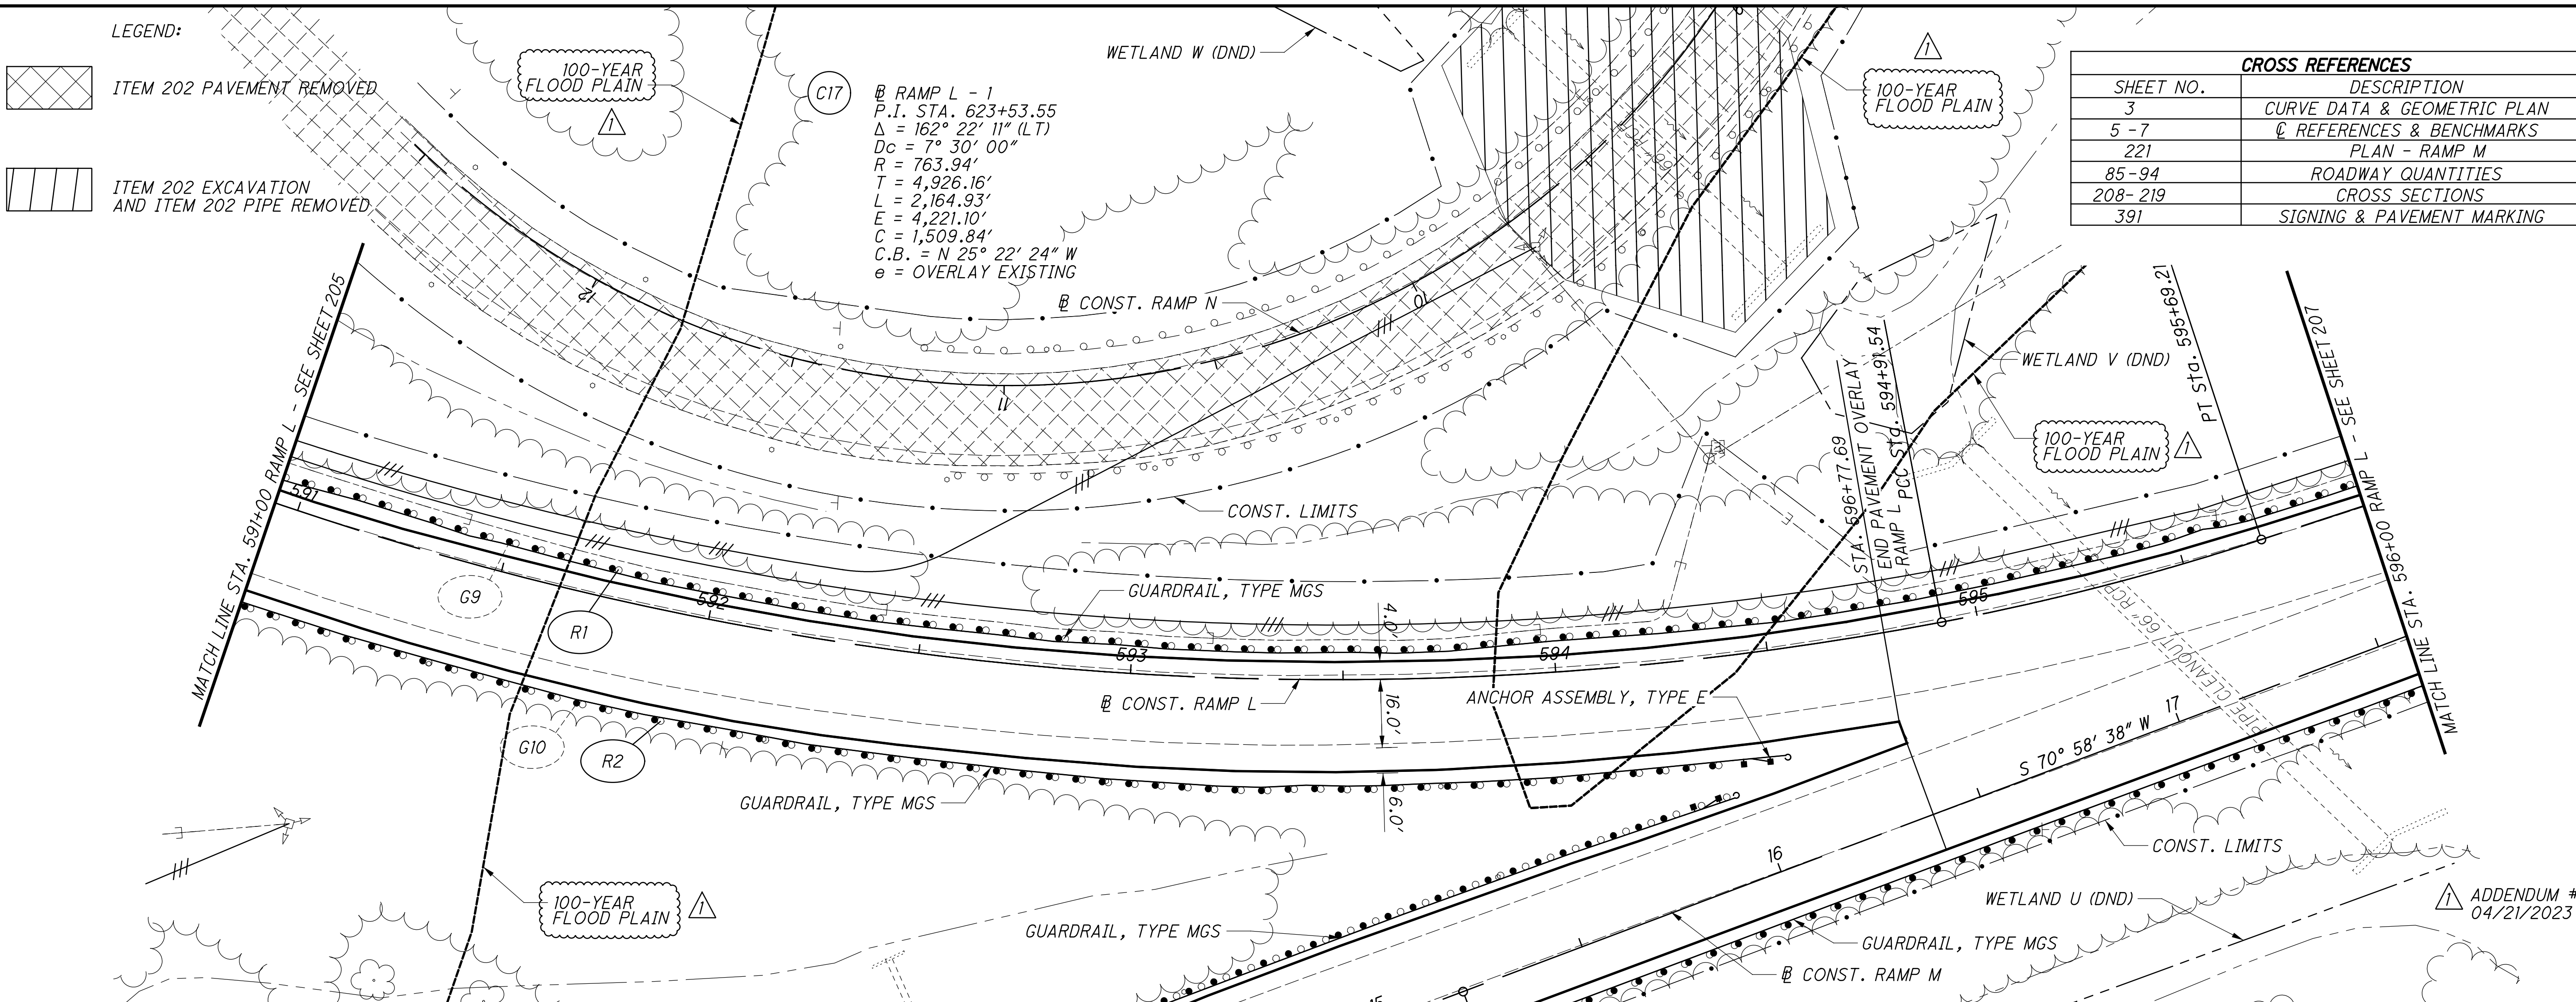

PLAN AND PROFILE - RAMP L  
STA. 591+00 TO STA. 596+00

FRA - 270-51.50


X:\Projects\2013\1010\_FRA\270-51.50\roadway\sheet\92616GP205.dgn 4/19/2023 9:30:45 AM cwong

ADDENDUM #1  
04/21/2023





CROSS REFERENCES	
SHEET NO.	DESCRIPTION
5 - 7	REFERENCES & BENCHMARKS
3	CURVE DATA & GEOMETRIC PLAN
85 - 94	ROADWAY QUANTITIES
208 - 219	CROSS SECTIONS
391	SIGNING & PAVEMENT MARKING
221 - 222	PLAN - RAMP M

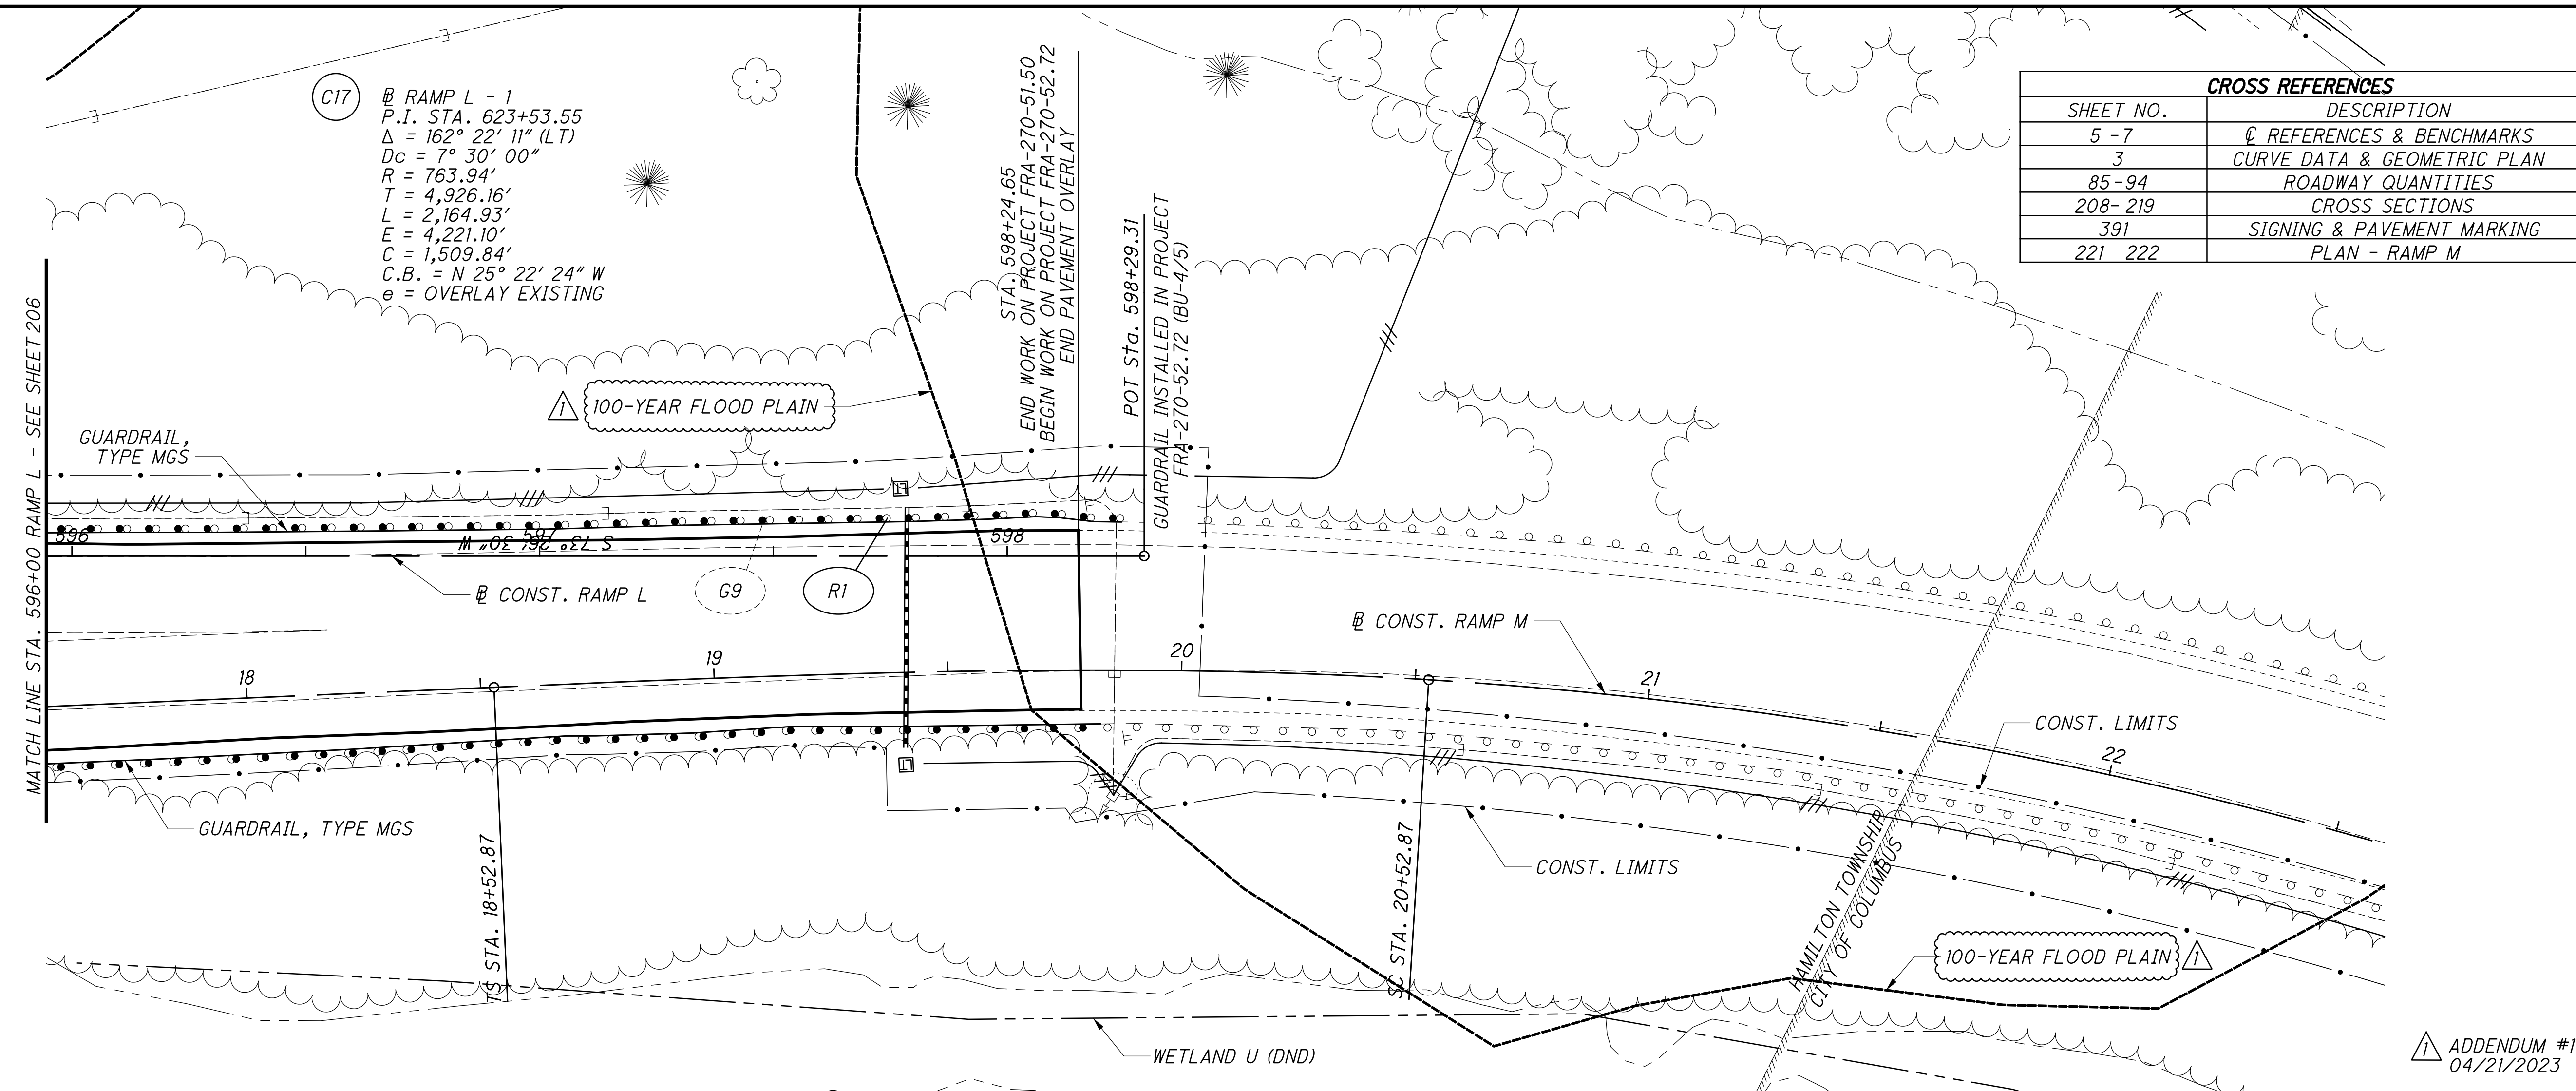

ADDENDUM #1  
04/21/2023



C17  
 RAMP L - 1  
 P.I. STA. 623+53.55  
 $\Delta = 162^\circ 22' 11''$  (LT)  
 $D_c = 7^\circ 30' 00''$   
 $R = 763.94'$   
 $T = 4,926.16'$   
 $L = 2,164.93'$   
 $E = 4,221.10'$   
 $C = 1,509.84'$   
 C.B. = N  $25^\circ 22' 24''$  W  
 $\theta =$  OVERLAY EXISTING

STA. 598+24.65  
 END WORK ON PROJECT FRA-270-51.50  
 BEGIN WORK ON PROJECT FRA-270-52.72  
 END PAVEMENT OVERLAY

POT Sta. 598+29.31  
 GUARDRAIL INSTALLED IN PROJECT  
 FRA-270-52.72 (BU-4/5)




X:\Projects\2013\132\1010\FRA\92616\roadway\sheet\92616GP206.dgn 4/19/2023 9:32:20 AM cwrong

PLAN AND PROFILE - RAMP L  
 STA. 596+00 TO STA. 598+34.78

FRA - 270-51.50

207  
554

X:\Projects\2013\1010\_FRA\92616\roadway\sheets\92616GP251.dgn 4/19/2023 9:37:17 AM cwong

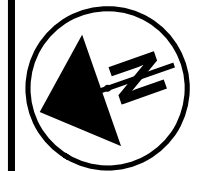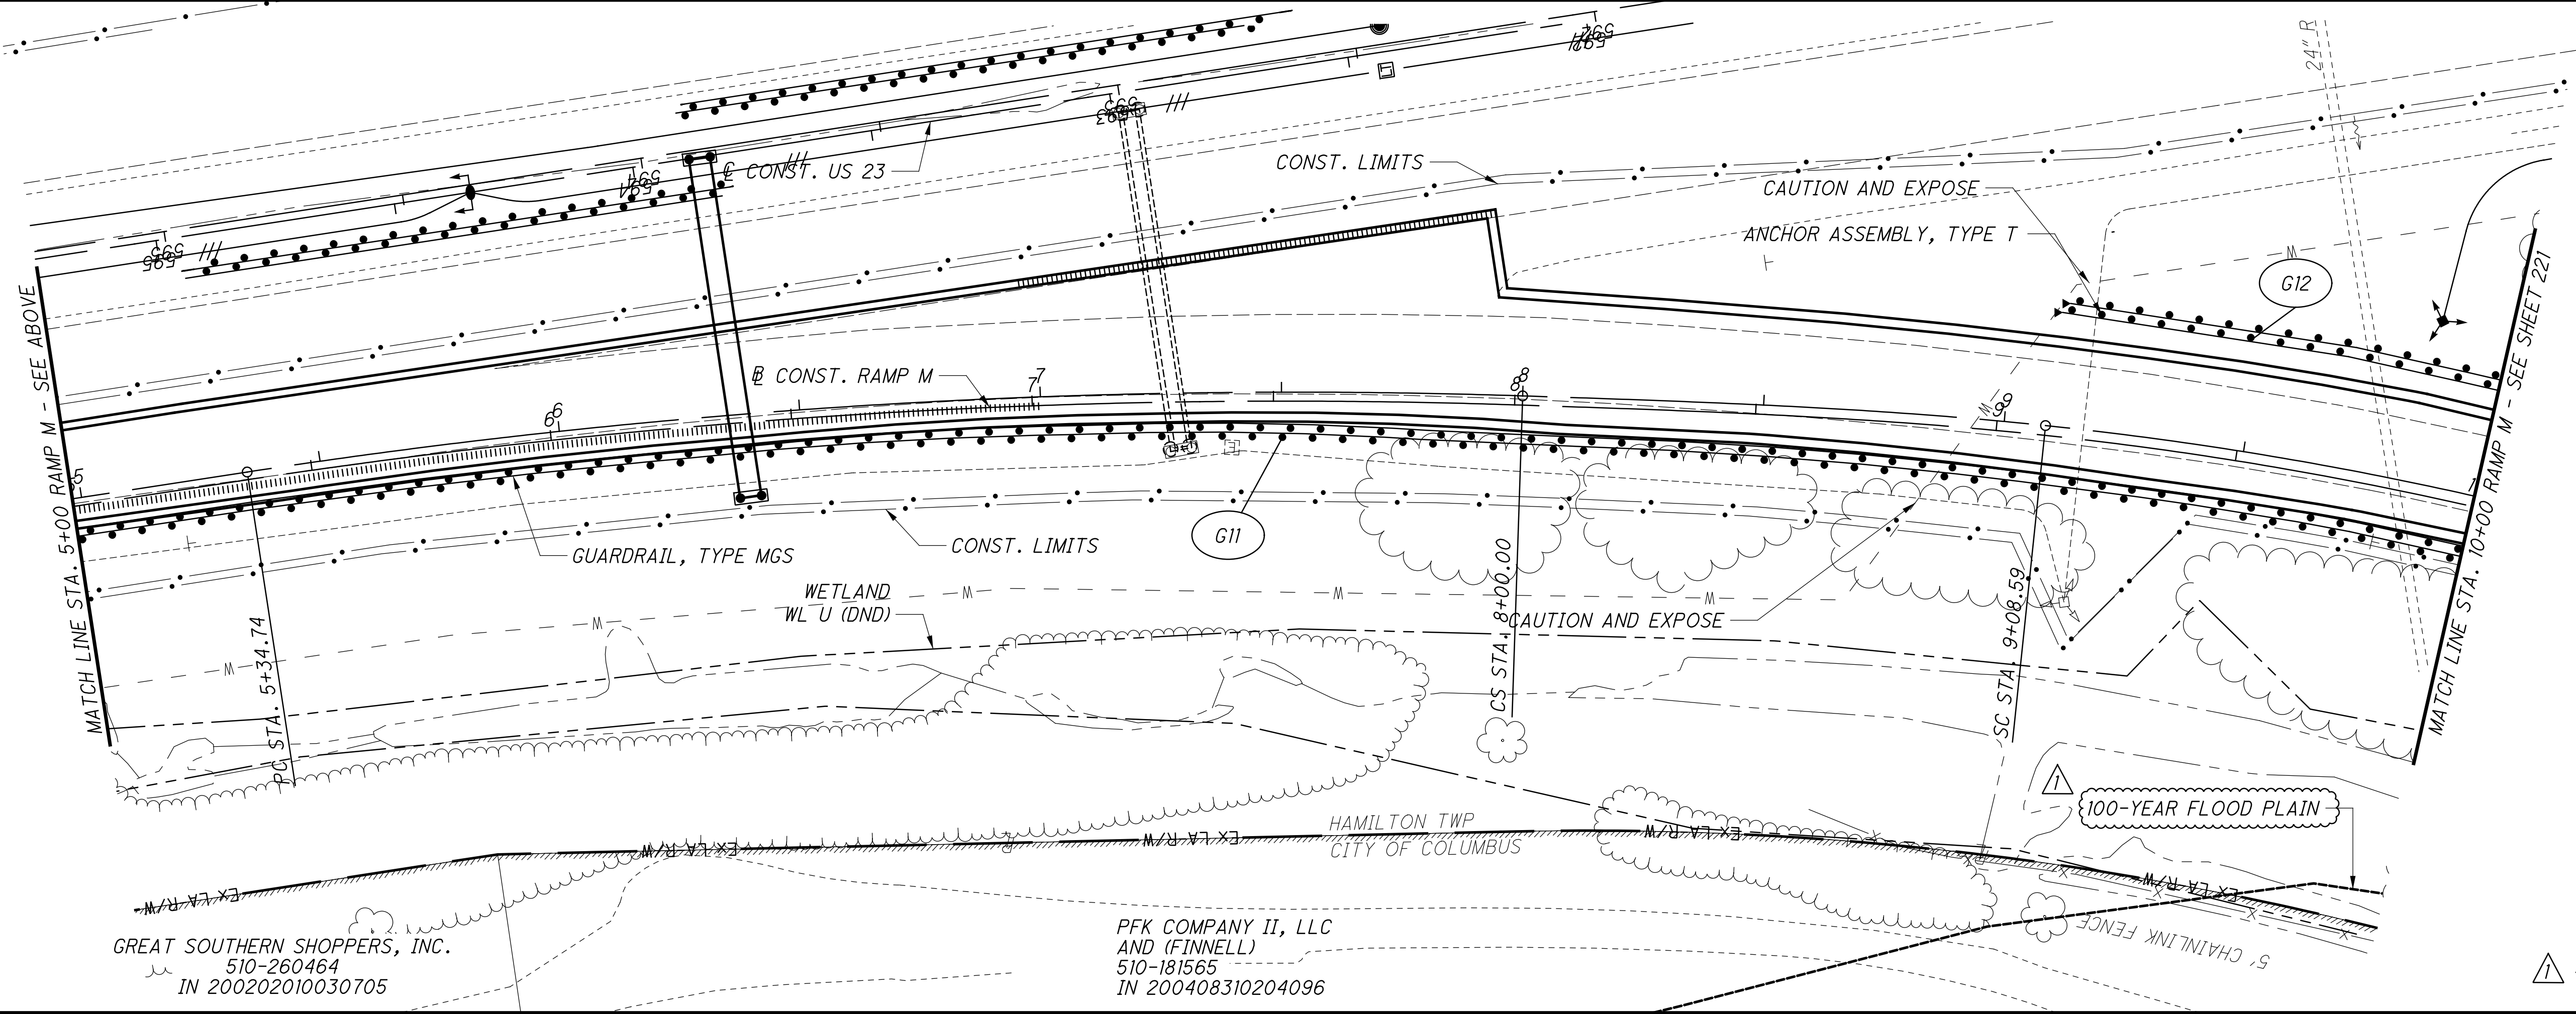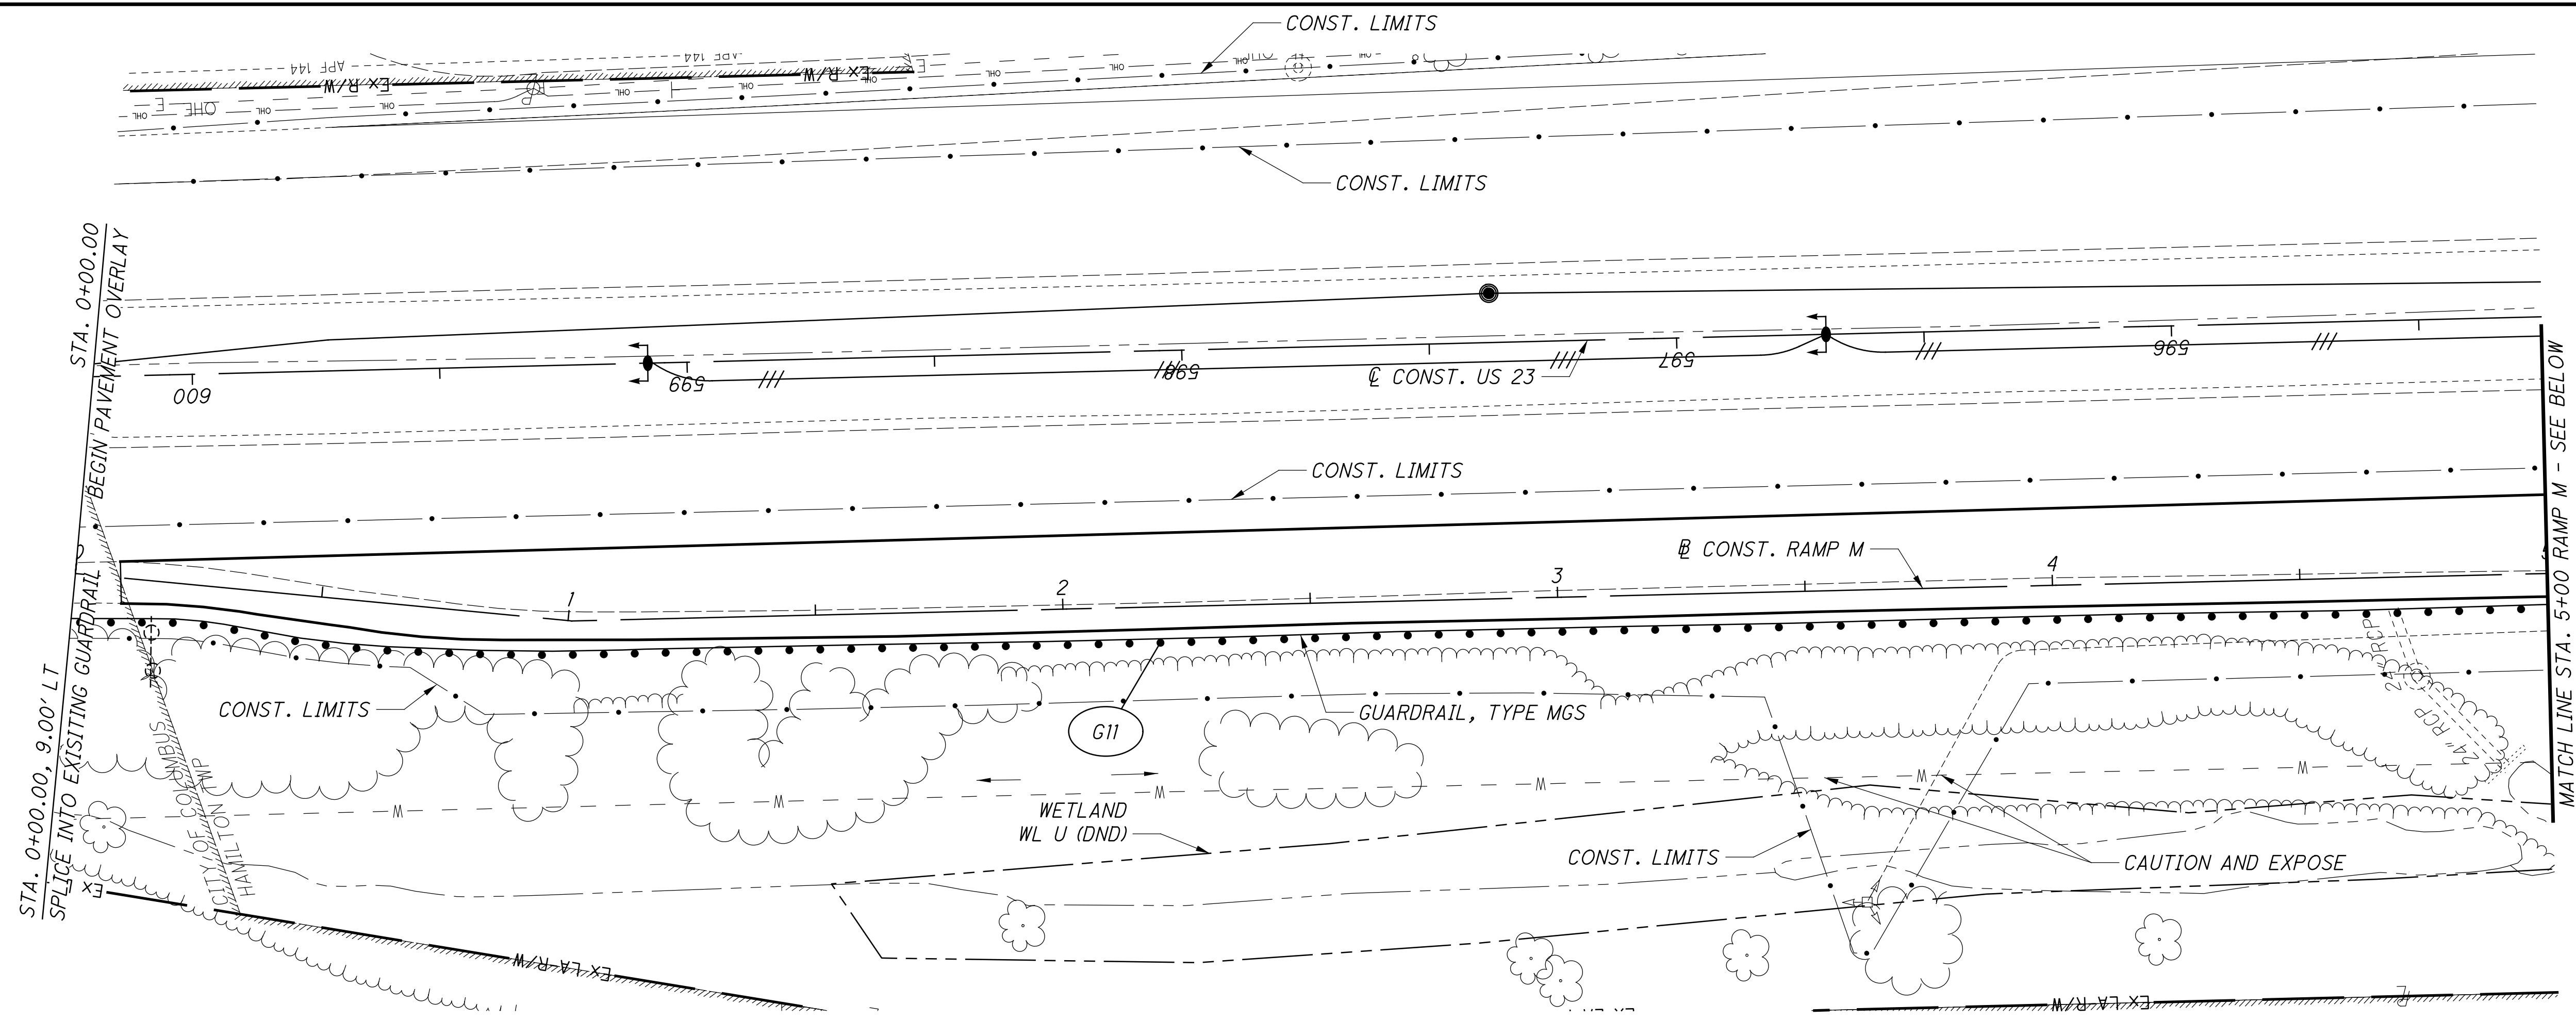

CALCULATED ACF  
 CHECKED CSR


**PLAN - RAMP M**  
**STA. 0+00.00 TO STA. 10+00.00**




**FRA - 270-51.50**

220  
 554

X:\Projects\2013\1010\FRA\92616\roadway\sheets\92616GP252.dgn 4/19/2023 9:39:15 AM cwong

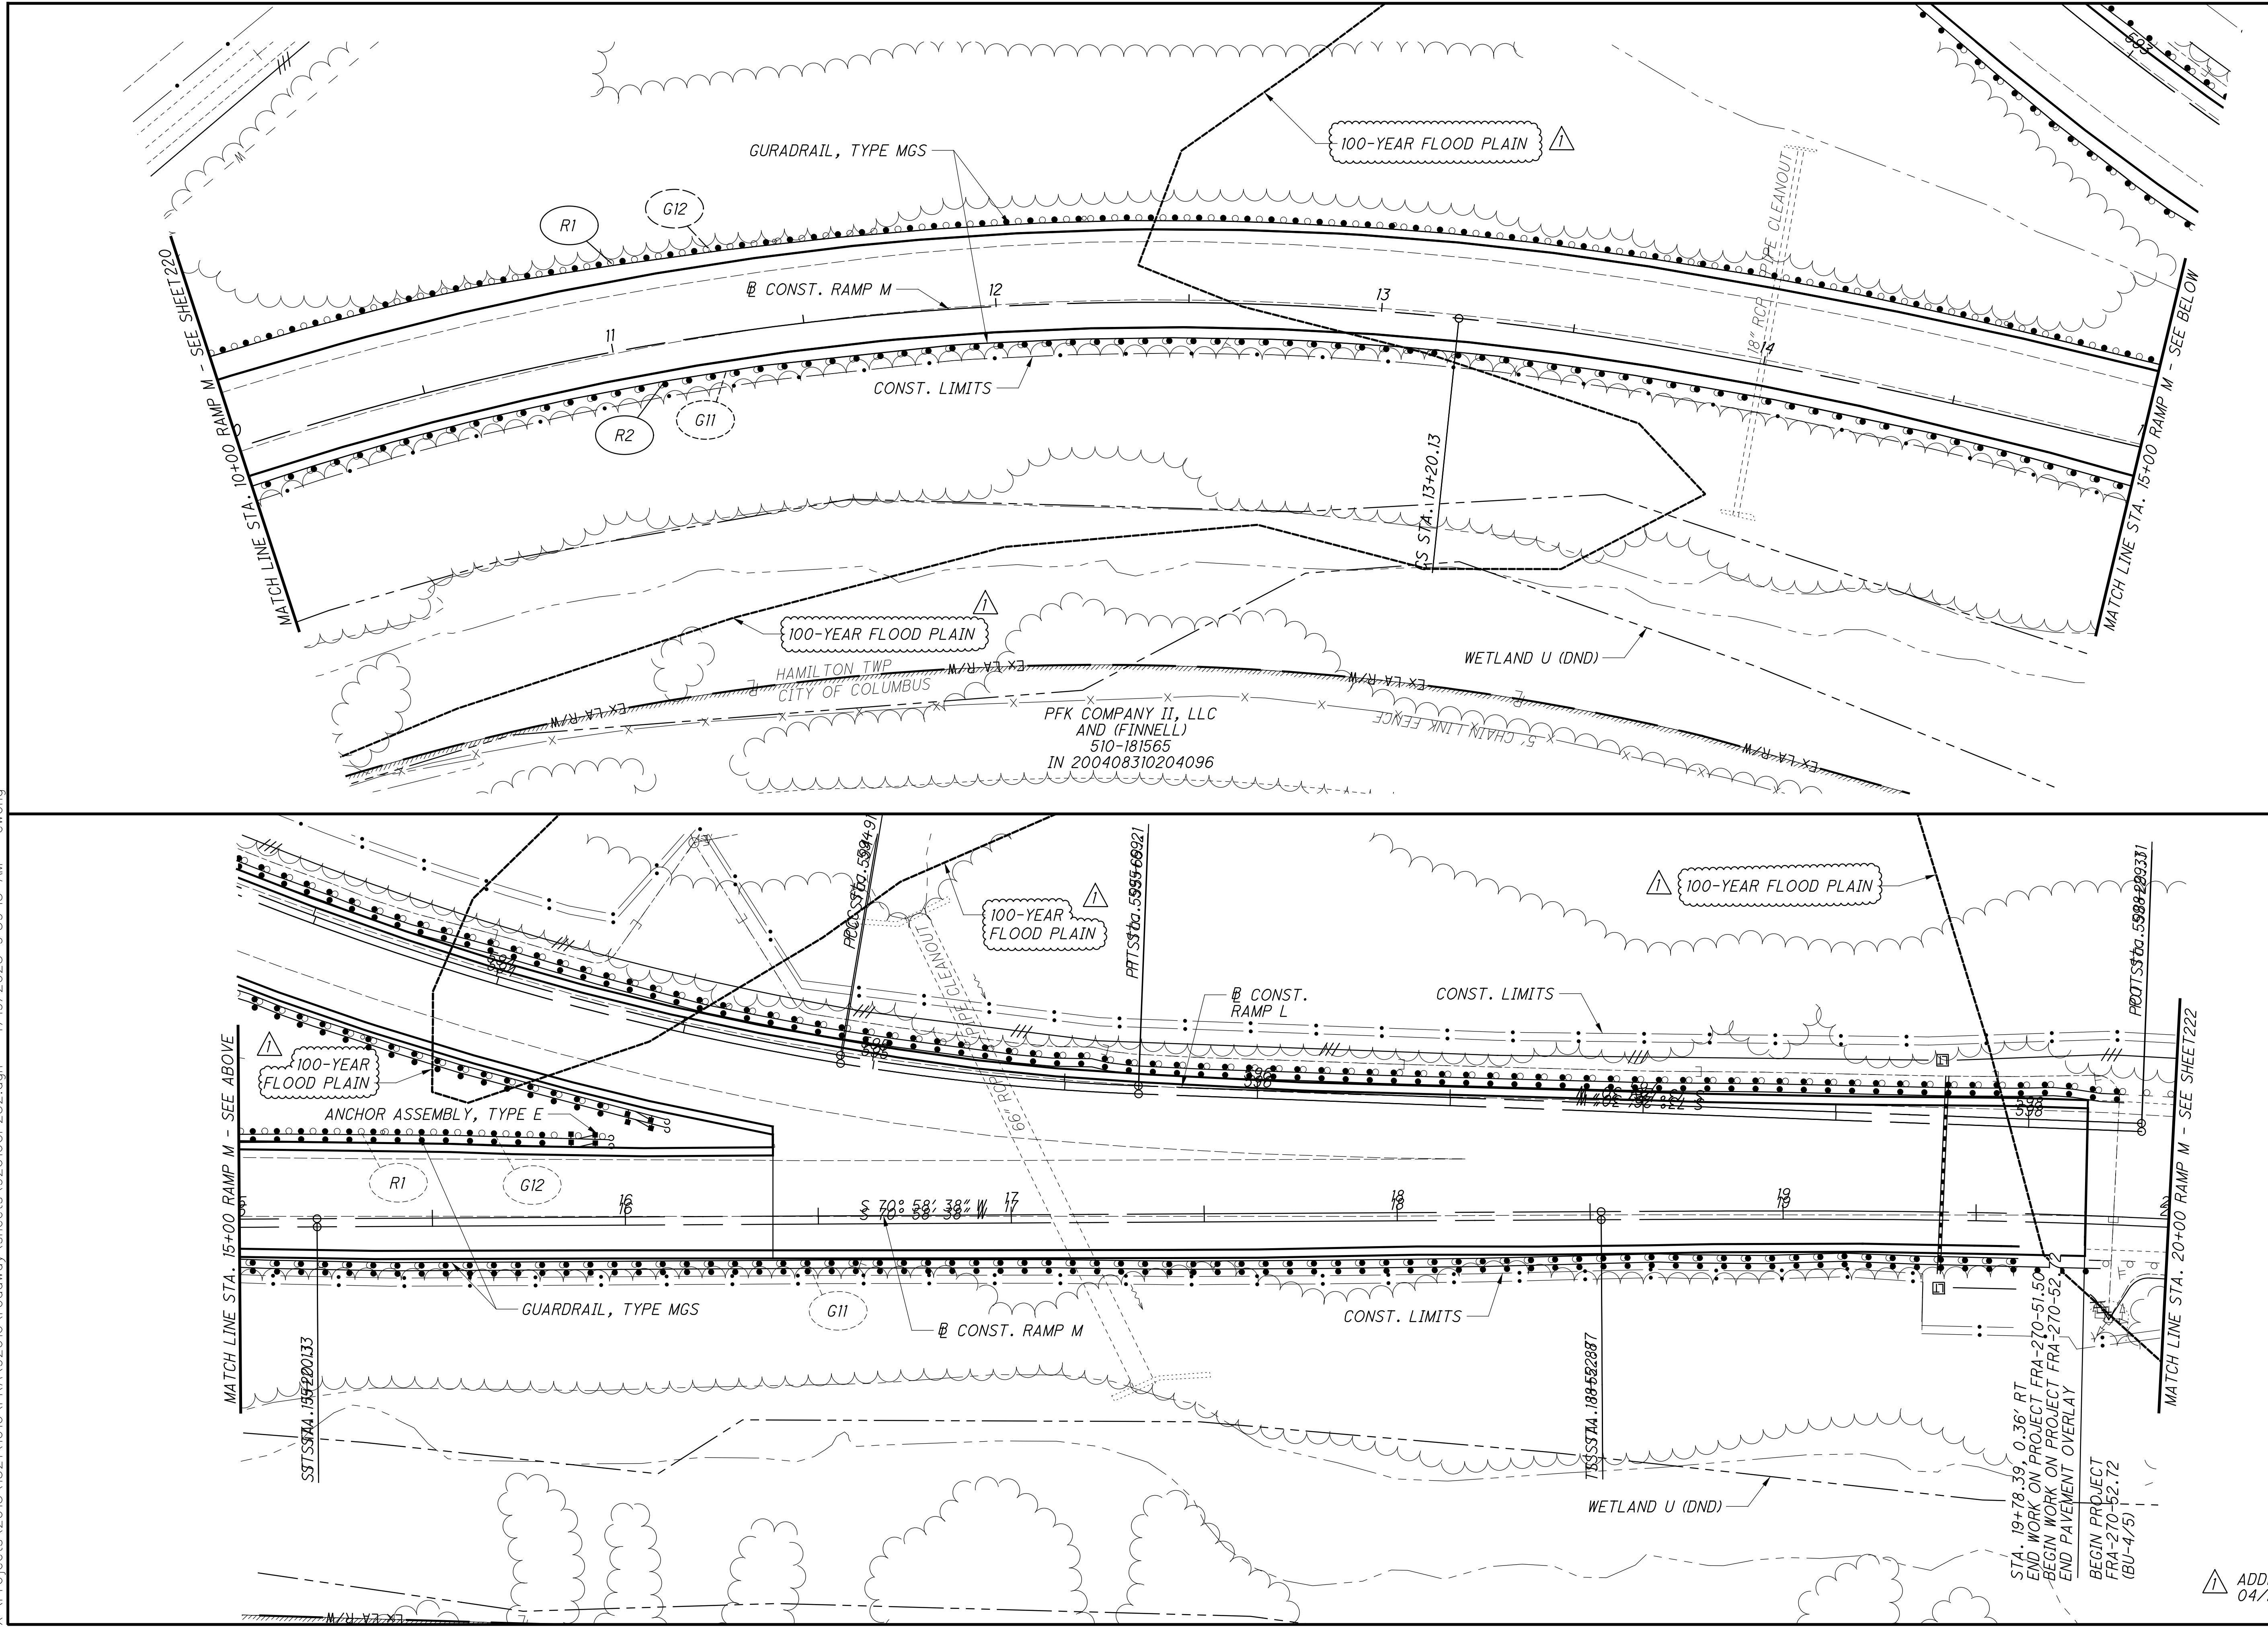

CALCULATED 20
   
 ACF
   
 CHECKED CSR
   
 HORIZONTAL SCALE IN FEET
   
 0 10 20 40

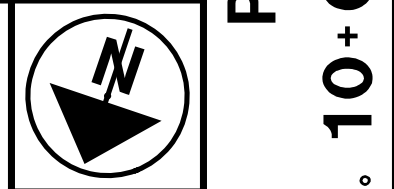


**PLAN - RAMP M**  
**STA. 10+00.00 TO STA. 20+00.00**

**FRA - 270 - 51.50**

ADDENDUM #1  
 04/21/2023



X:\Projects\2013\1321\1010\FRA\92616\roadway\sheets\92616GP253.dgn 4/19/2023 9:40:33 AM cwong

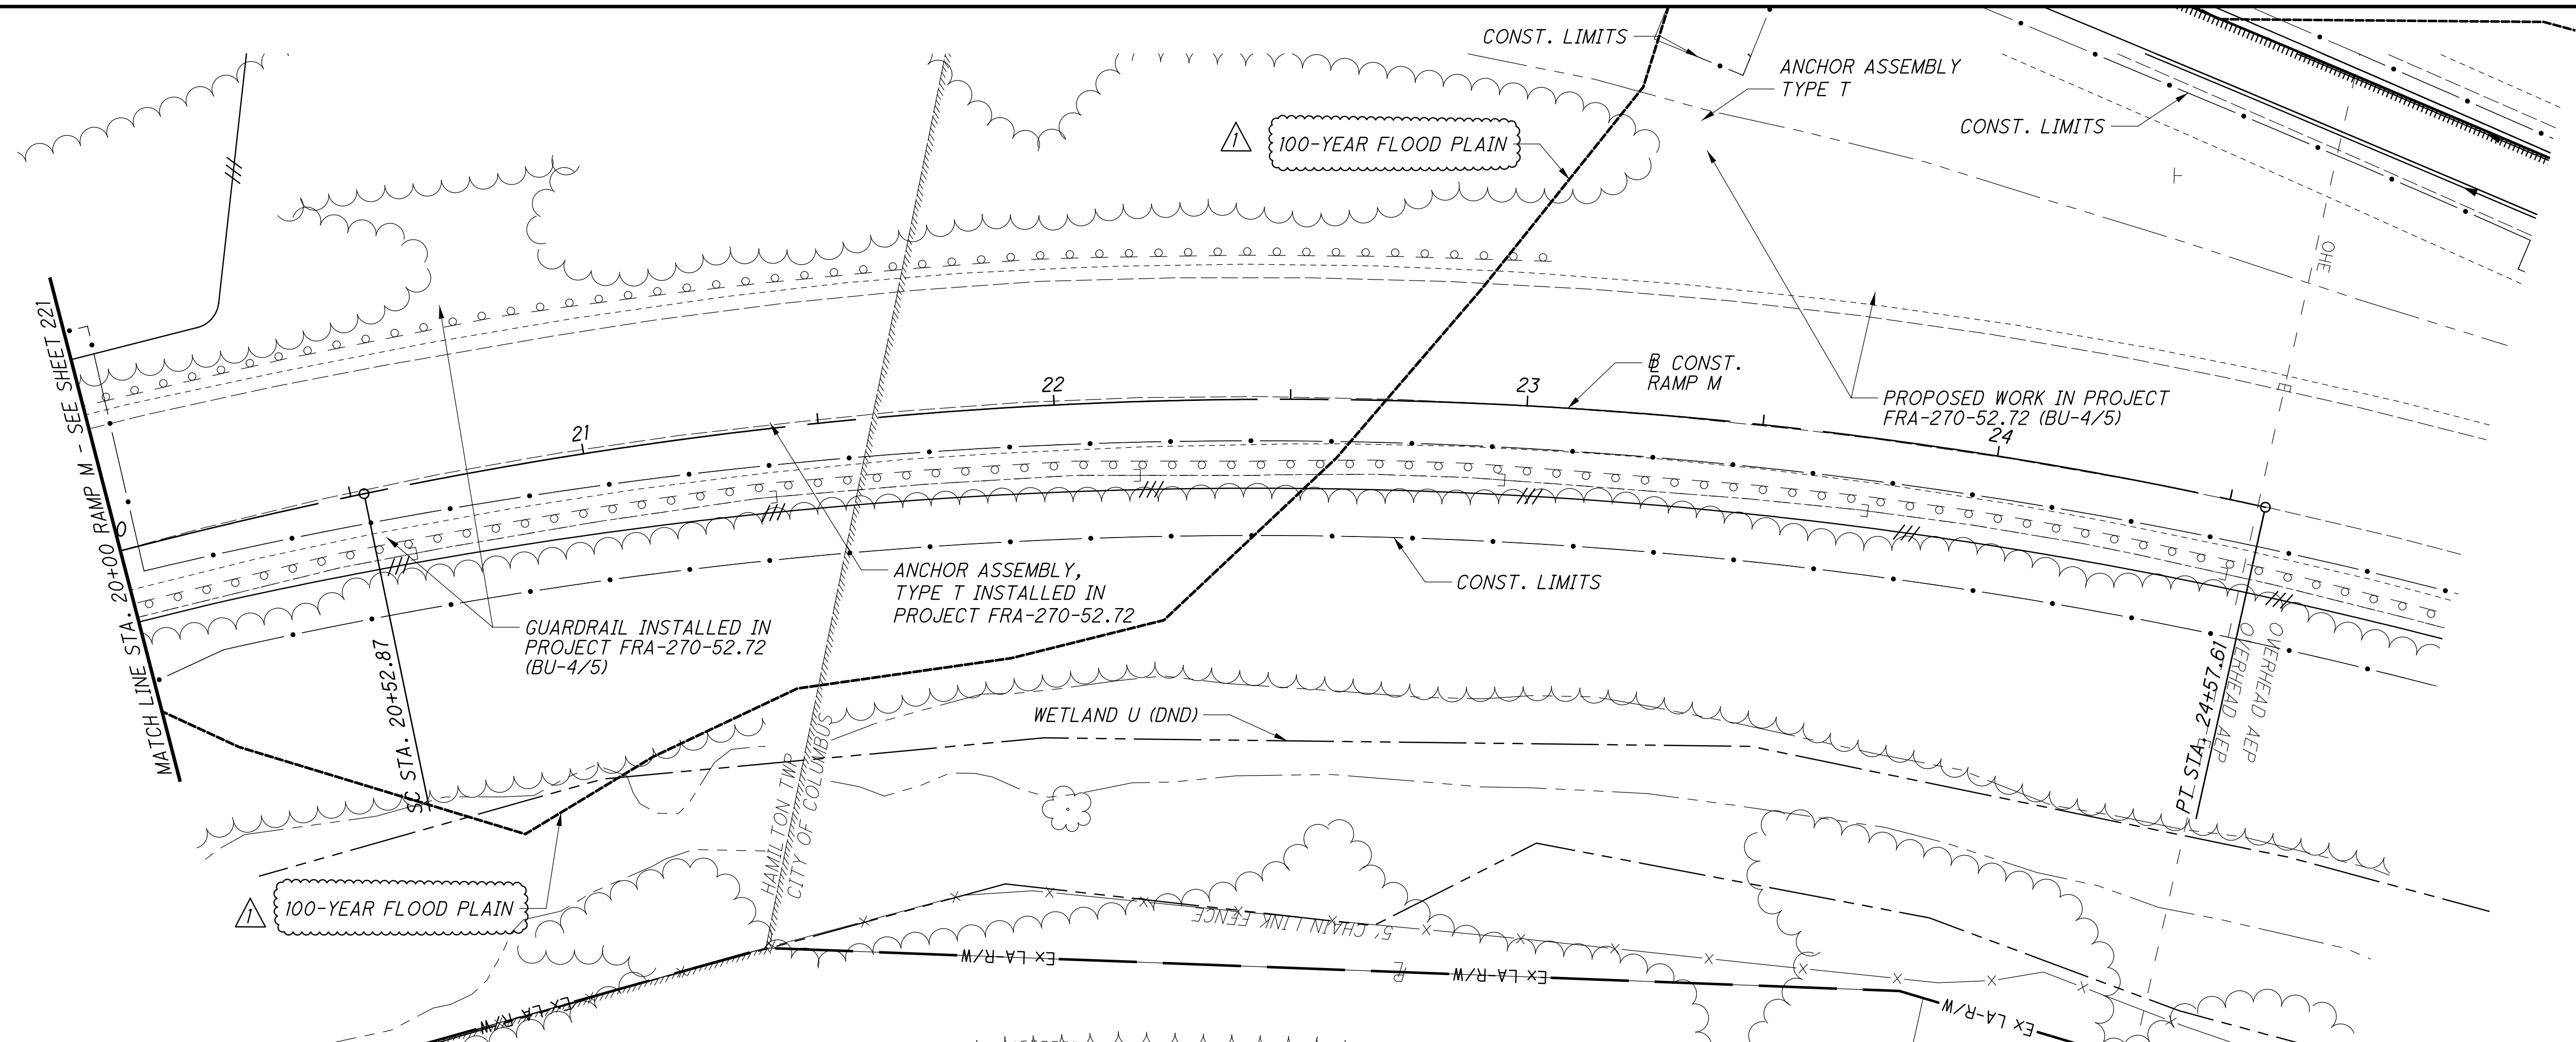

PFK COMPANY II, LLC  
 AND (FINNELL)  
 510-181565  
 IN 200408310204096



CALCULATED 0  
 ACF 10  
 CHECKED 40  
 CSR

HORIZONTAL SCALE IN FEET



**PLAN - RAMP M**  
**STA. 20+00.00 TO STA. 24+57.61**

**FRA - 270 - 51.50**

X:\Projects\2013\1321\1010\FRA\92616\roadway\sheets\92616GP301.dgn 4/19/2023 9:43:29 AM c.wong

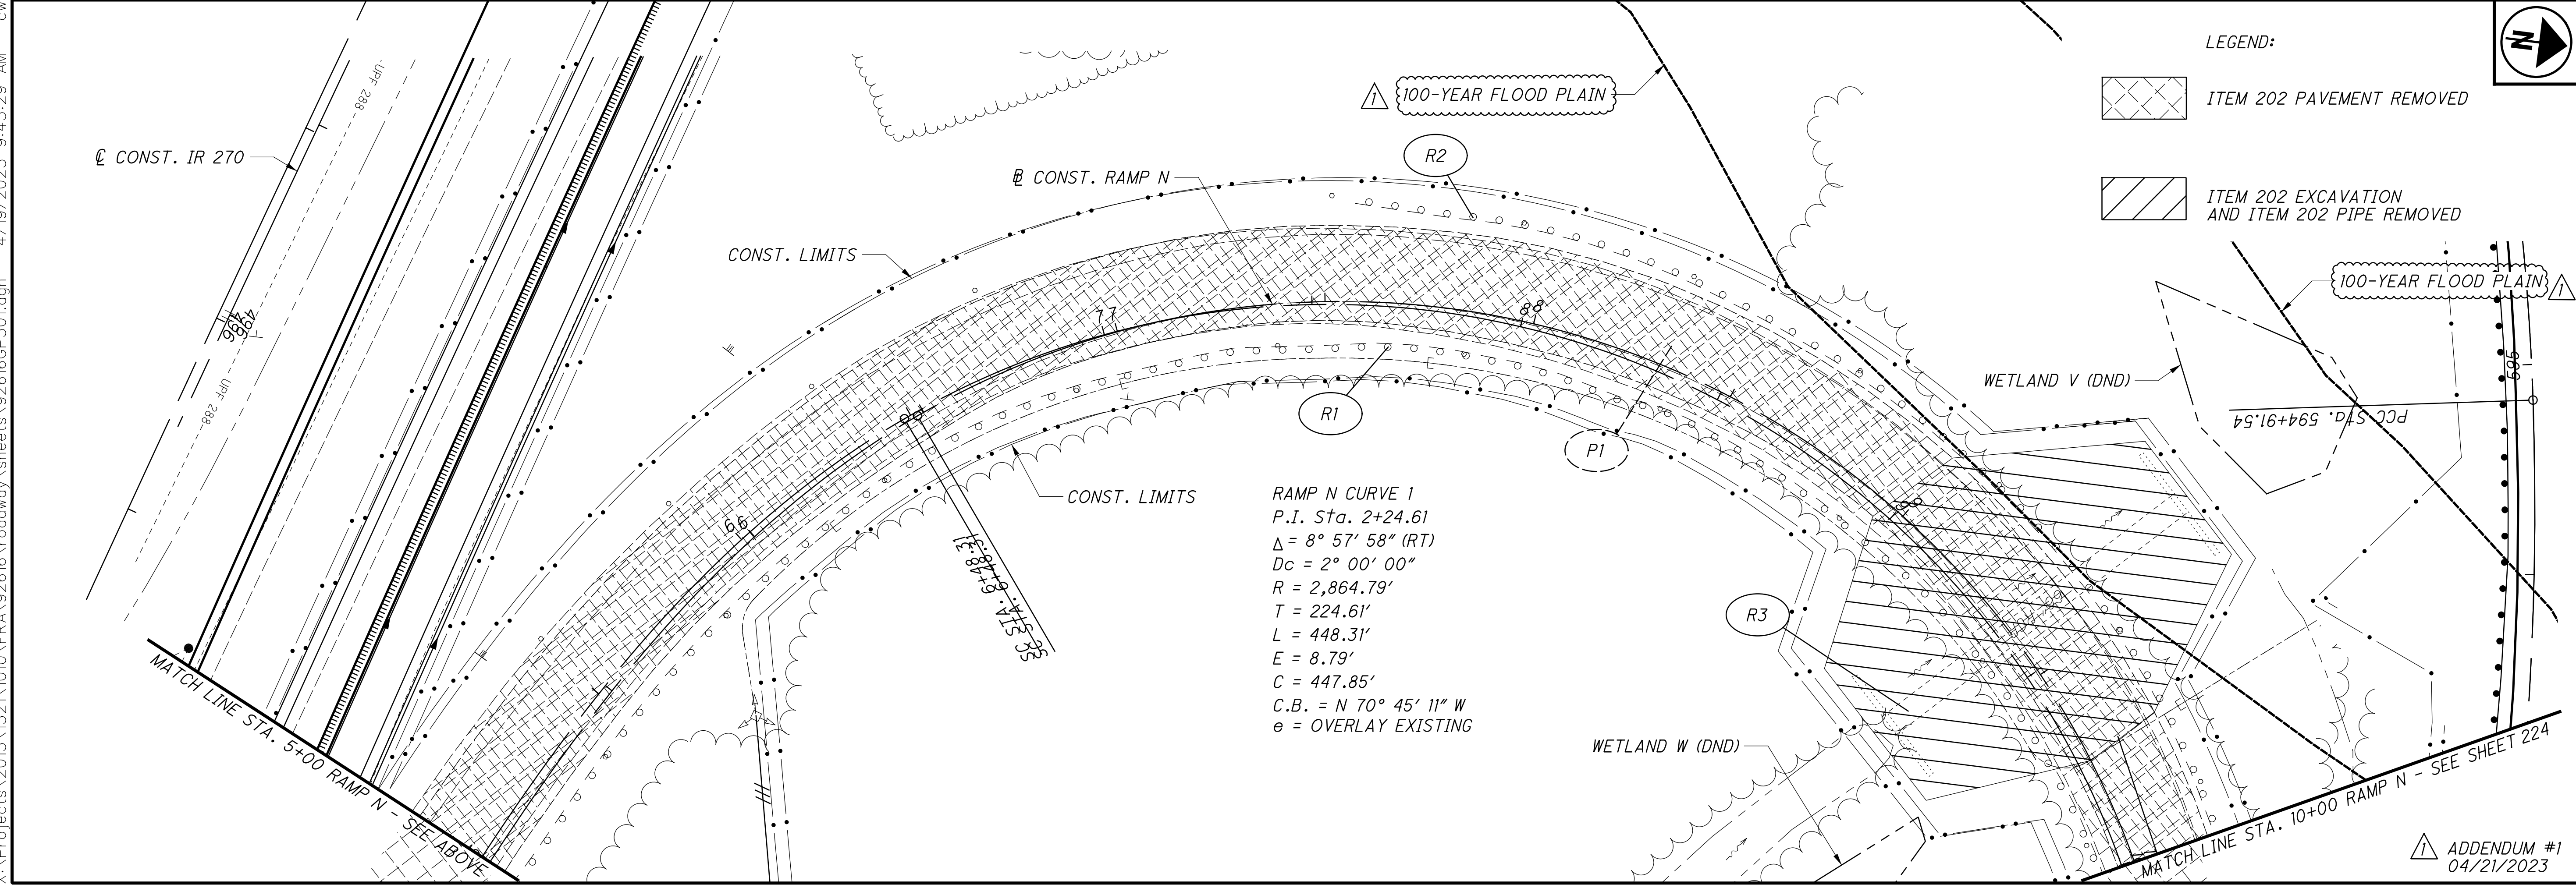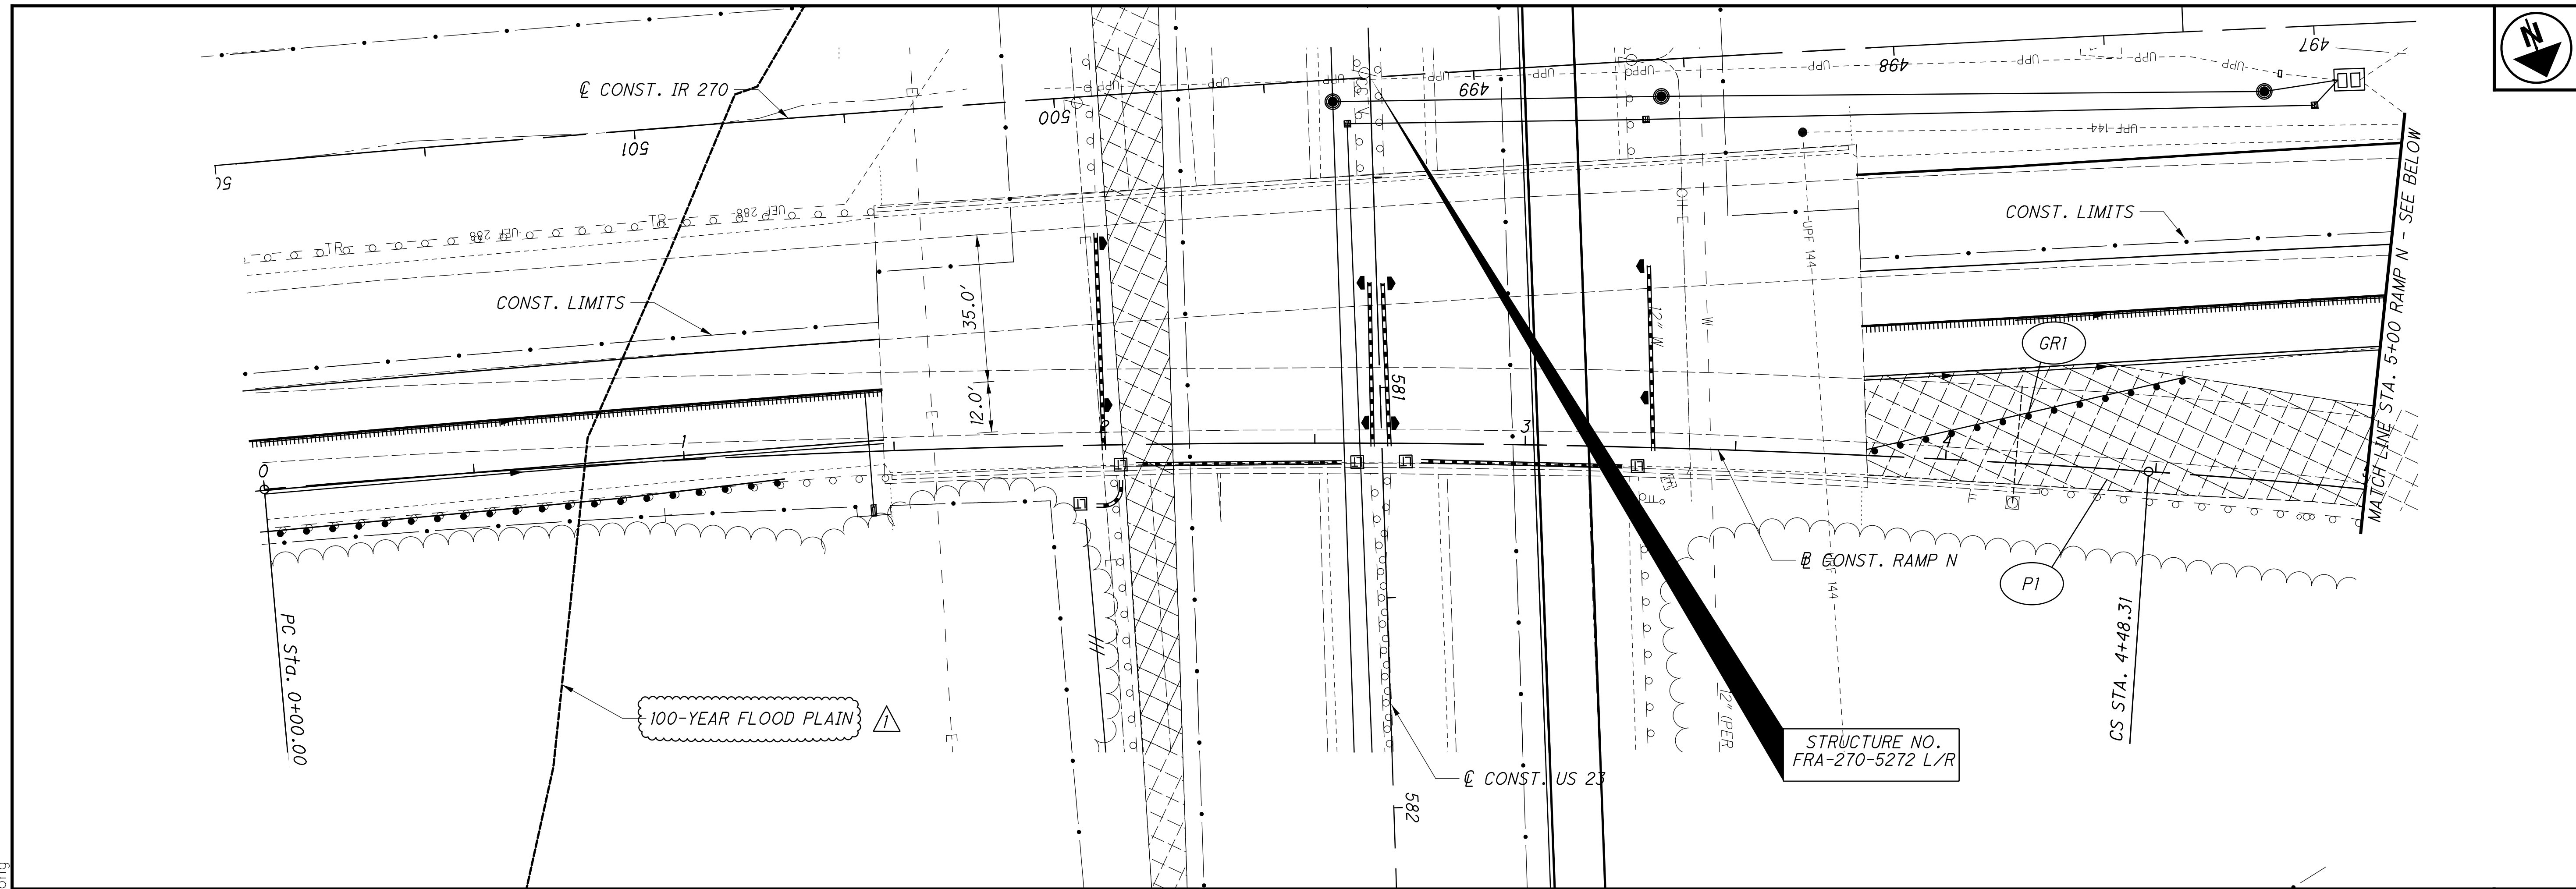


RAMP N CURVE 1  
 P.I. Sta. 2+24.61  
 $\Delta = 8^\circ 57' 58" (RT)$   
 $Dc = 2^\circ 00' 00"$   
 $R = 2,864.79'$   
 $T = 224.61'$   
 $L = 448.31'$   
 $E = 8.79'$   
 $C = 447.85'$   
 $C.B. = N 70^\circ 45' 11" W$   
 $e = \text{OVERLAY EXISTING}$

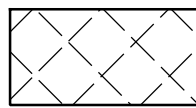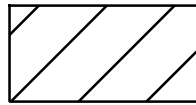- LEGEND:
-  ITEM 202 PAVEMENT REMOVED
  -  ITEM 202 EXCAVATION AND ITEM 202 PIPE REMOVED

CALCULATED 0  
 ACF 10  
 CHECKED 20  
 CSR 40

HORIZONTAL SCALE IN FEET

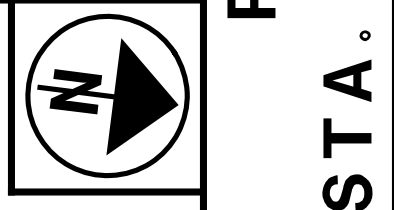

PLAN - RAMP N  
 STA. 0+00 TO STA. 10+00


FRA - 270-51.50

223  
 554

ADDENDUM #1  
 04/21/2023



X:\Projects\2013\1010\FRA\92616\roadway\sheets\92616GP302.dgn 4/19/2023 9:48:22 AM cwong

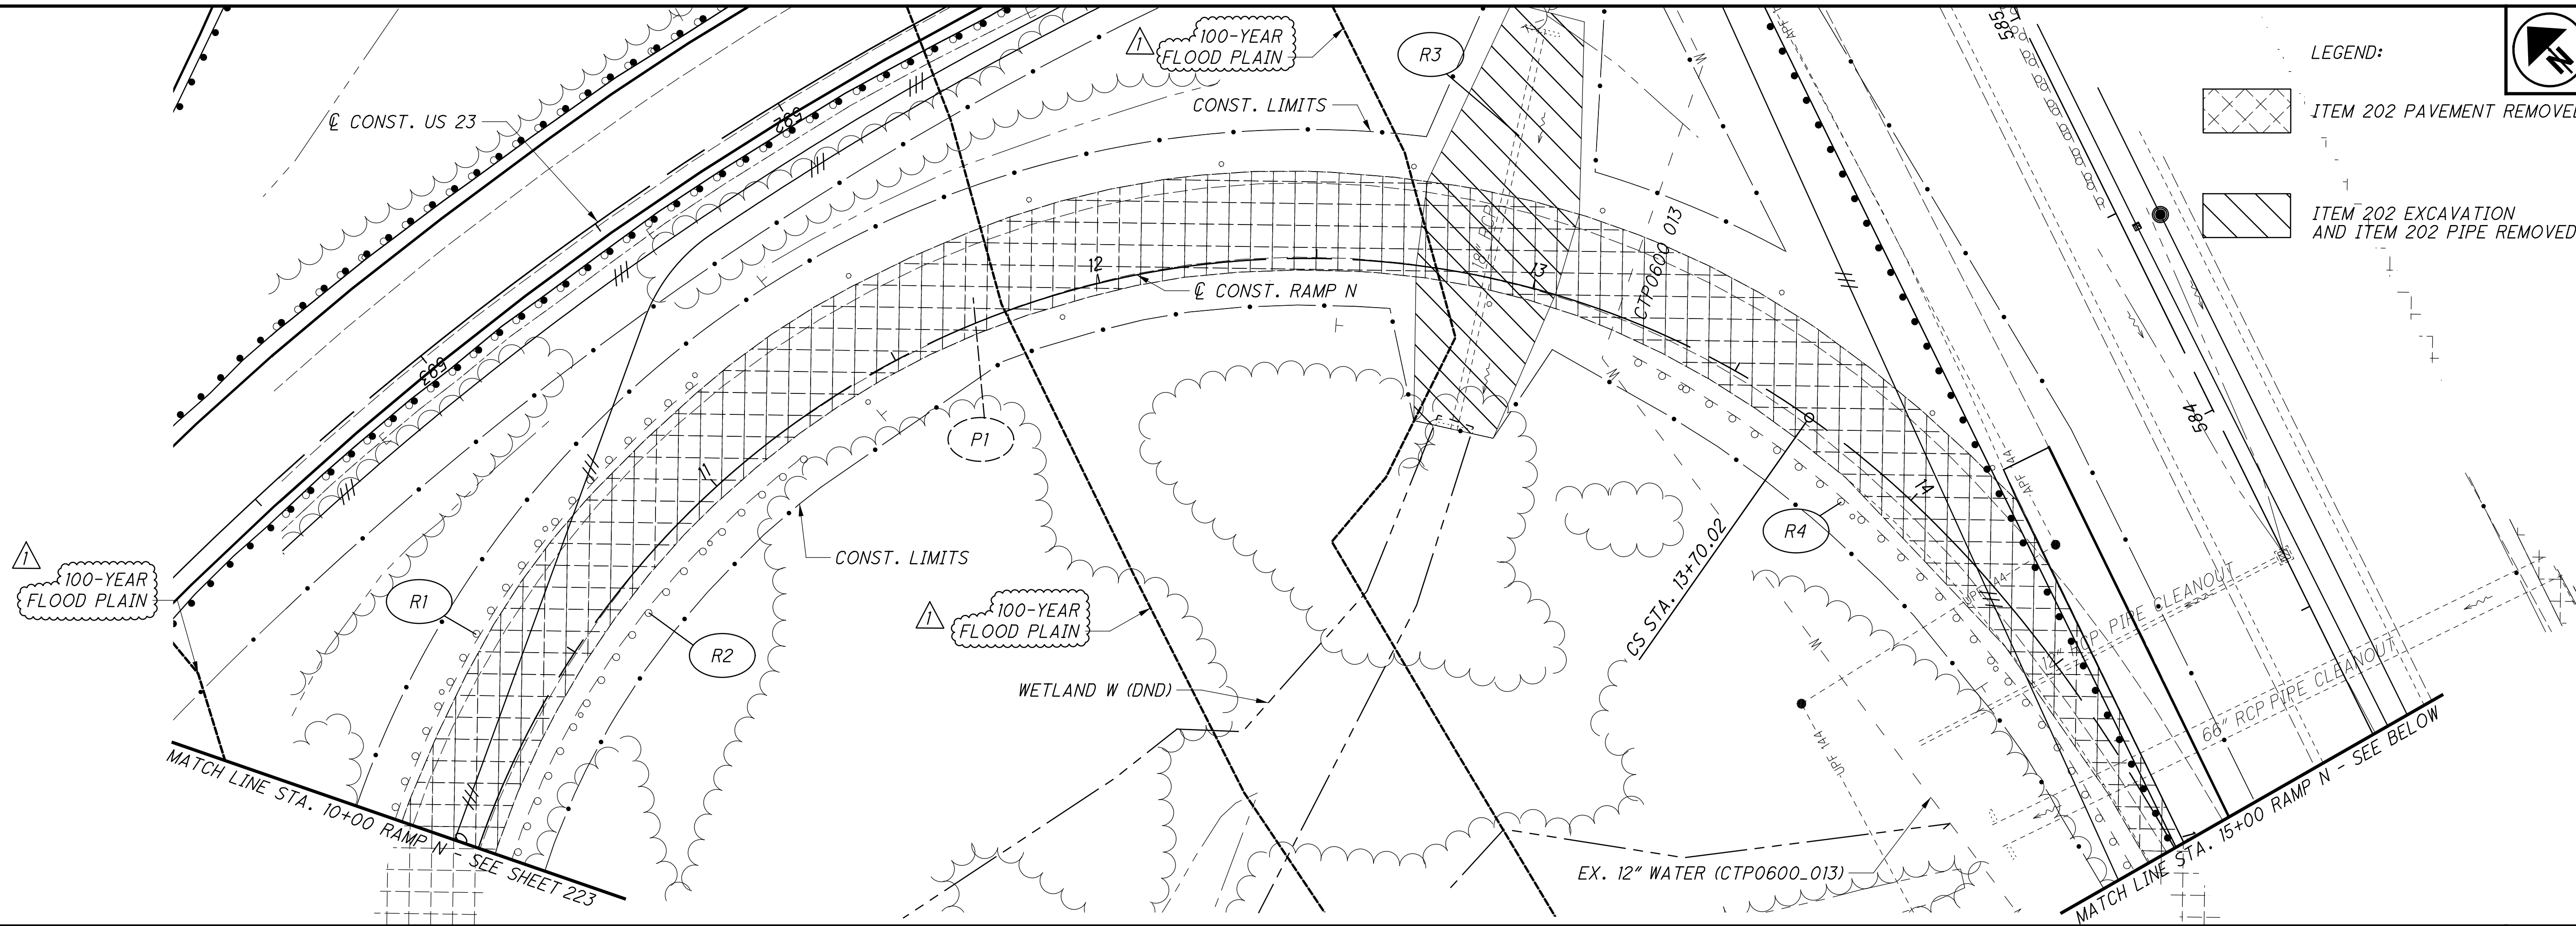

LEGEND:


- ITEM 202 PAVEMENT REMOVED
- ITEM 202 EXCAVATION AND ITEM 202 PIPE REMOVED

CALCULATED ACF CHECKED CSR

HORIZONTAL SCALE IN FEET

0 10 20 40

PLAN - RAMP N  
STA. 10+00 TO STA. 15+70.02

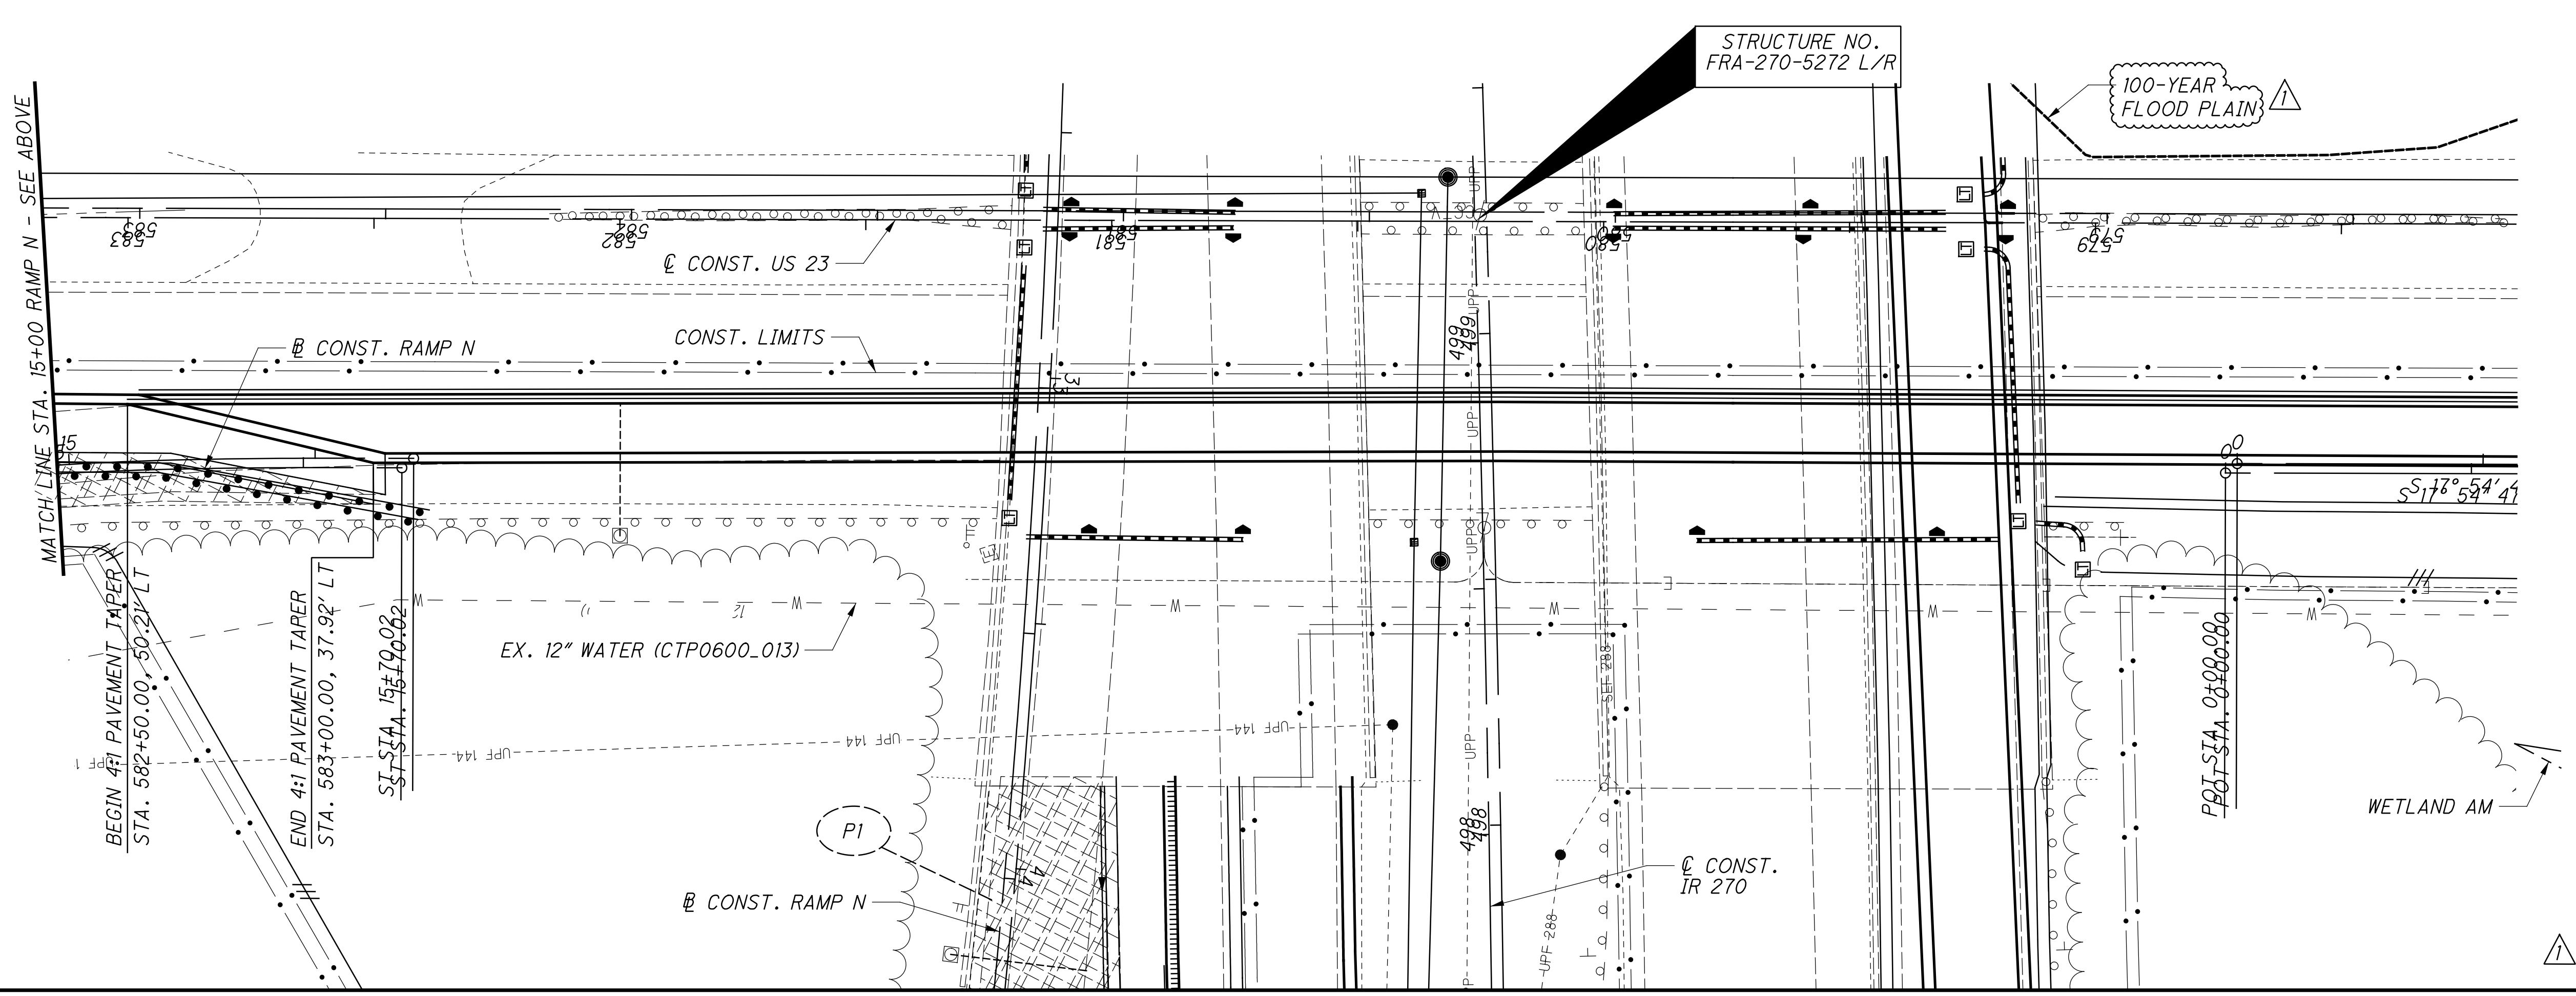

FRA - 270-51.50

224  
554

ADDENDUM #1  
04/21/2023




X:\Projects\2013\1010\FRA\92616\roadway\sheets\92616GP351.dgn 4/19/2023 9:52:23 AM c.wong

CROSS REFERENCES	
SHEET NO.	DESCRIPTION
5-7	REFERENCES & BENCHMARKS
3	CURVE DATA & GEOMETRIC PLAN
85-94	ROADWAY QUANTITIES



CALCULATED  
ACF  
CHECKED  
CSR

**PLAN AND PROFILE - RAMP 0**  
**STA. 0+00 TO STA. 5+00**

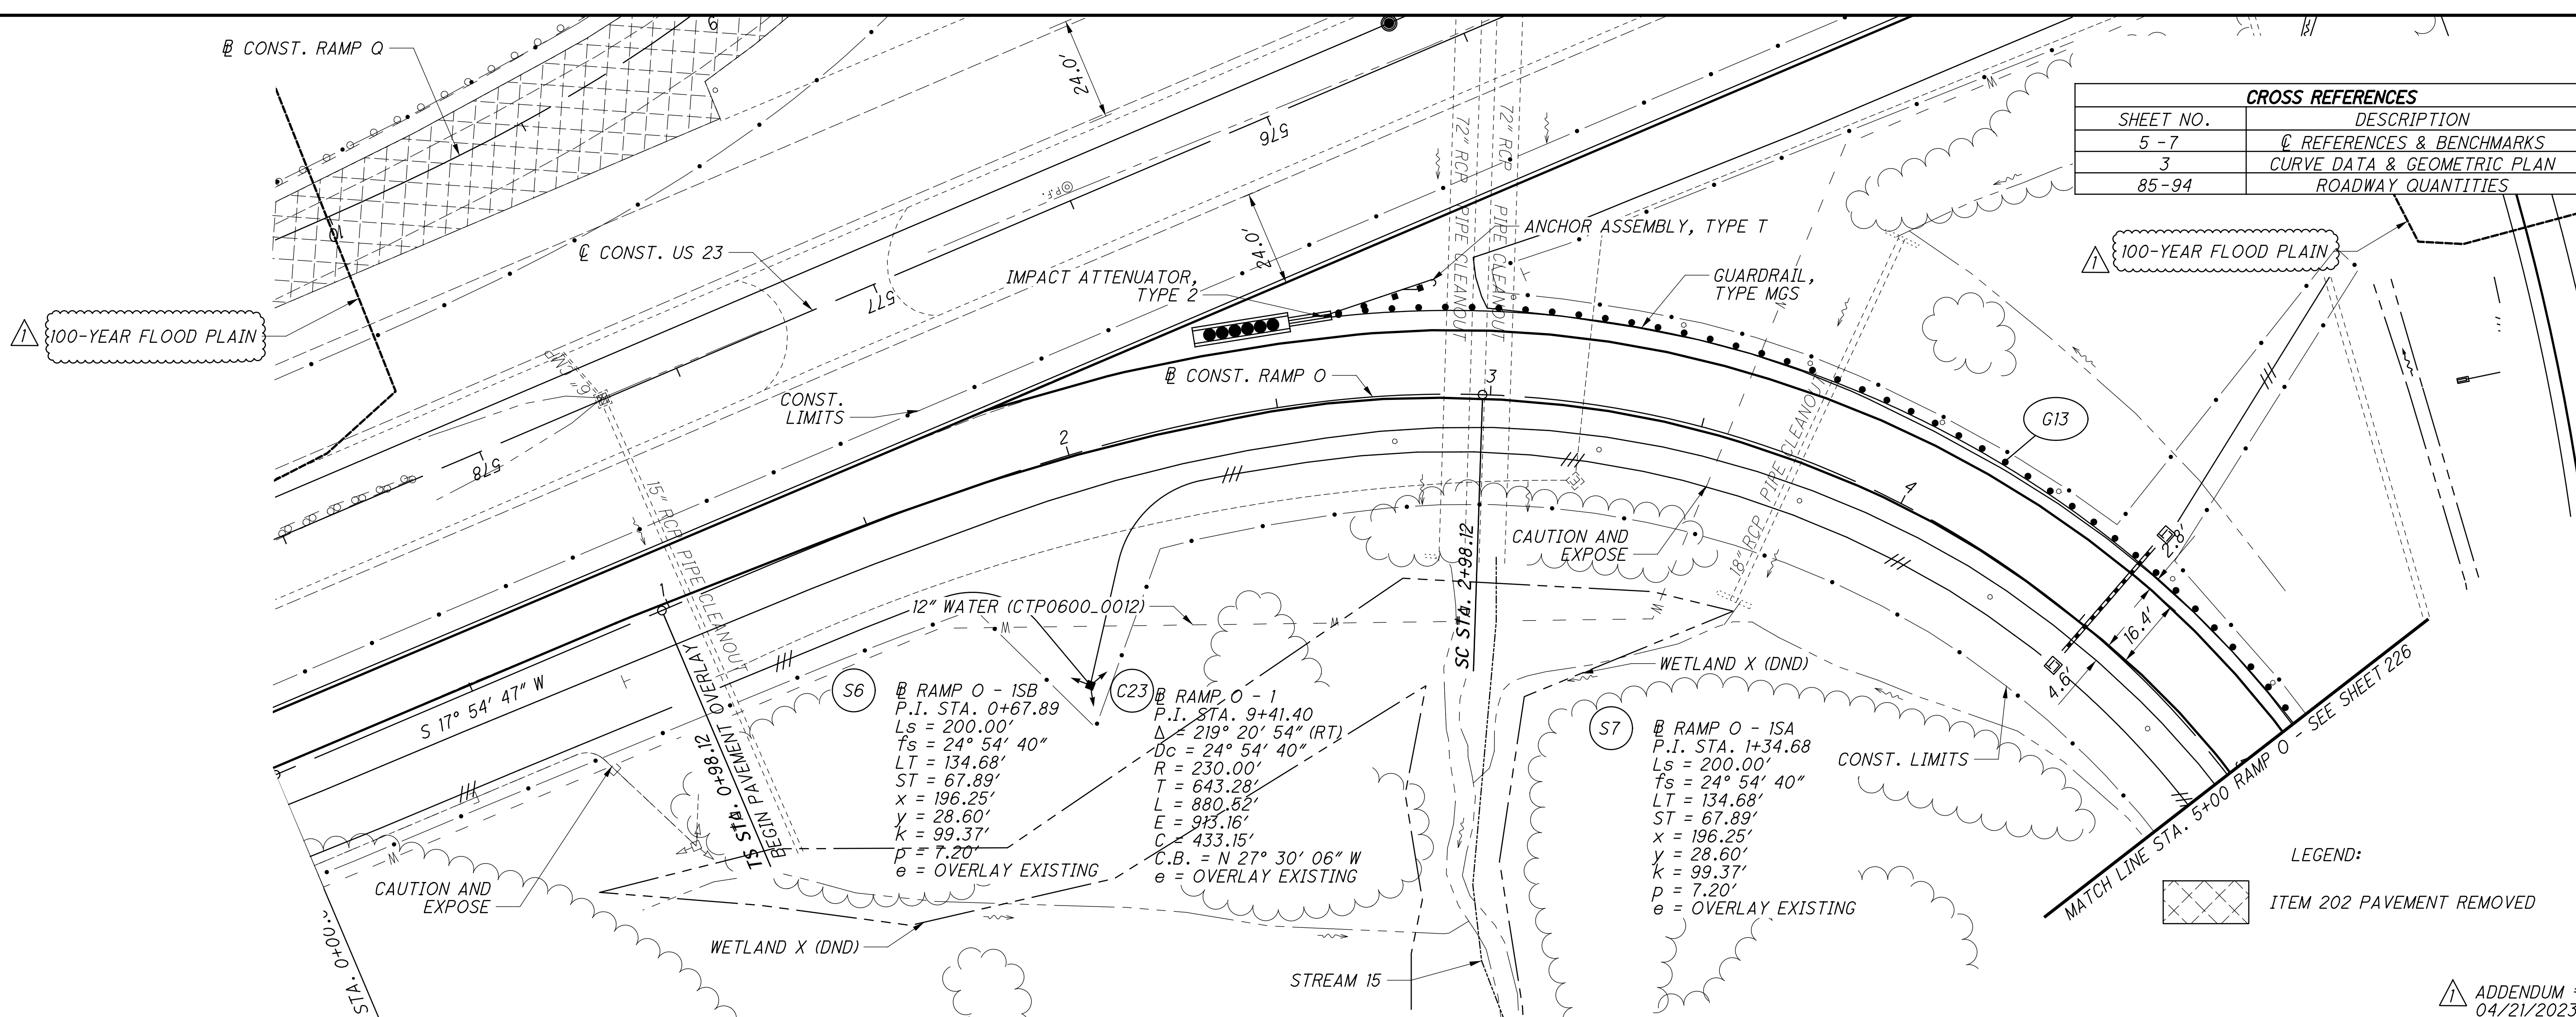


**S6**  
 RAMP 0 - 1SB  
 P.I. STA. 0+67.89  
 Ls = 200.00'  
 Ts = 24° 54' 40"  
 LT = 134.68'  
 ST = 67.89'  
 x = 196.25'  
 y = 28.60'  
 k = 99.37'  
 p = 7.20'  
 e = OVERLAY EXISTING

**C23**  
 RAMP 0 - 1  
 P.I. STA. 9+41.40  
 Δ = 219° 20' 54" (RT)  
 Dc = 24° 54' 40"  
 R = 230.00'  
 T = 643.28'  
 L = 880.52'  
 E = 933.16'  
 C = 433.15'  
 C.B. = N 27° 30' 06" W  
 e = OVERLAY EXISTING

**S7**  
 RAMP 0 - 1SA  
 P.I. STA. 1+34.68  
 Ls = 200.00'  
 Ts = 24° 54' 40"  
 LT = 134.68'  
 ST = 67.89'  
 x = 196.25'  
 y = 28.60'  
 k = 99.37'  
 p = 7.20'  
 e = OVERLAY EXISTING

**LEGEND:**  
 ITEM 202 PAVEMENT REMOVED

**ADDENDUM #1**  
04/21/2023

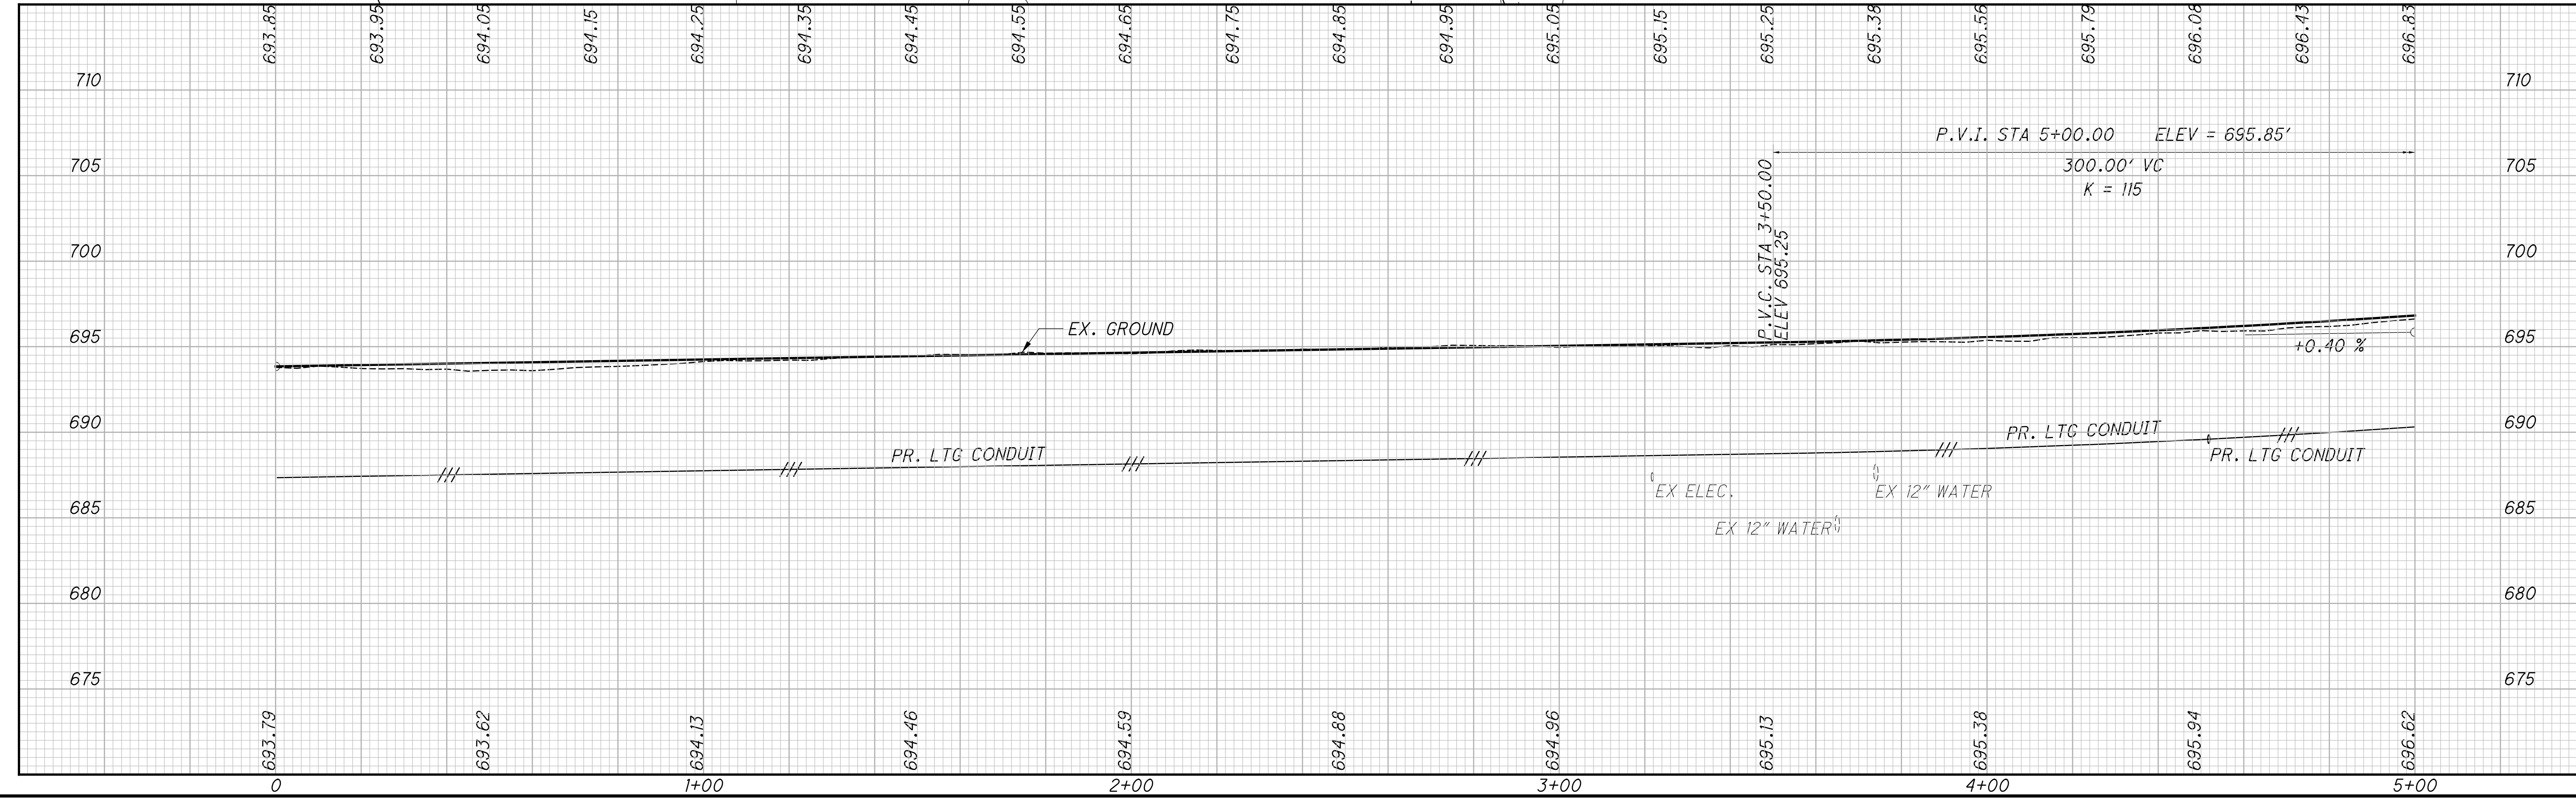



**FRA - 270-51.50**



CALCULATED  
ACF  
CHECKED  
CSR

0 10 20 40  
HORIZONTAL  
SCALE IN FEET

CROSS REFERENCES	
SHEET NO.	DESCRIPTION
5-7	REFERENCES & BENCHMARKS
3	CURVE DATA & GEOMETRIC PLAN
85-94	ROADWAY QUANTITIES

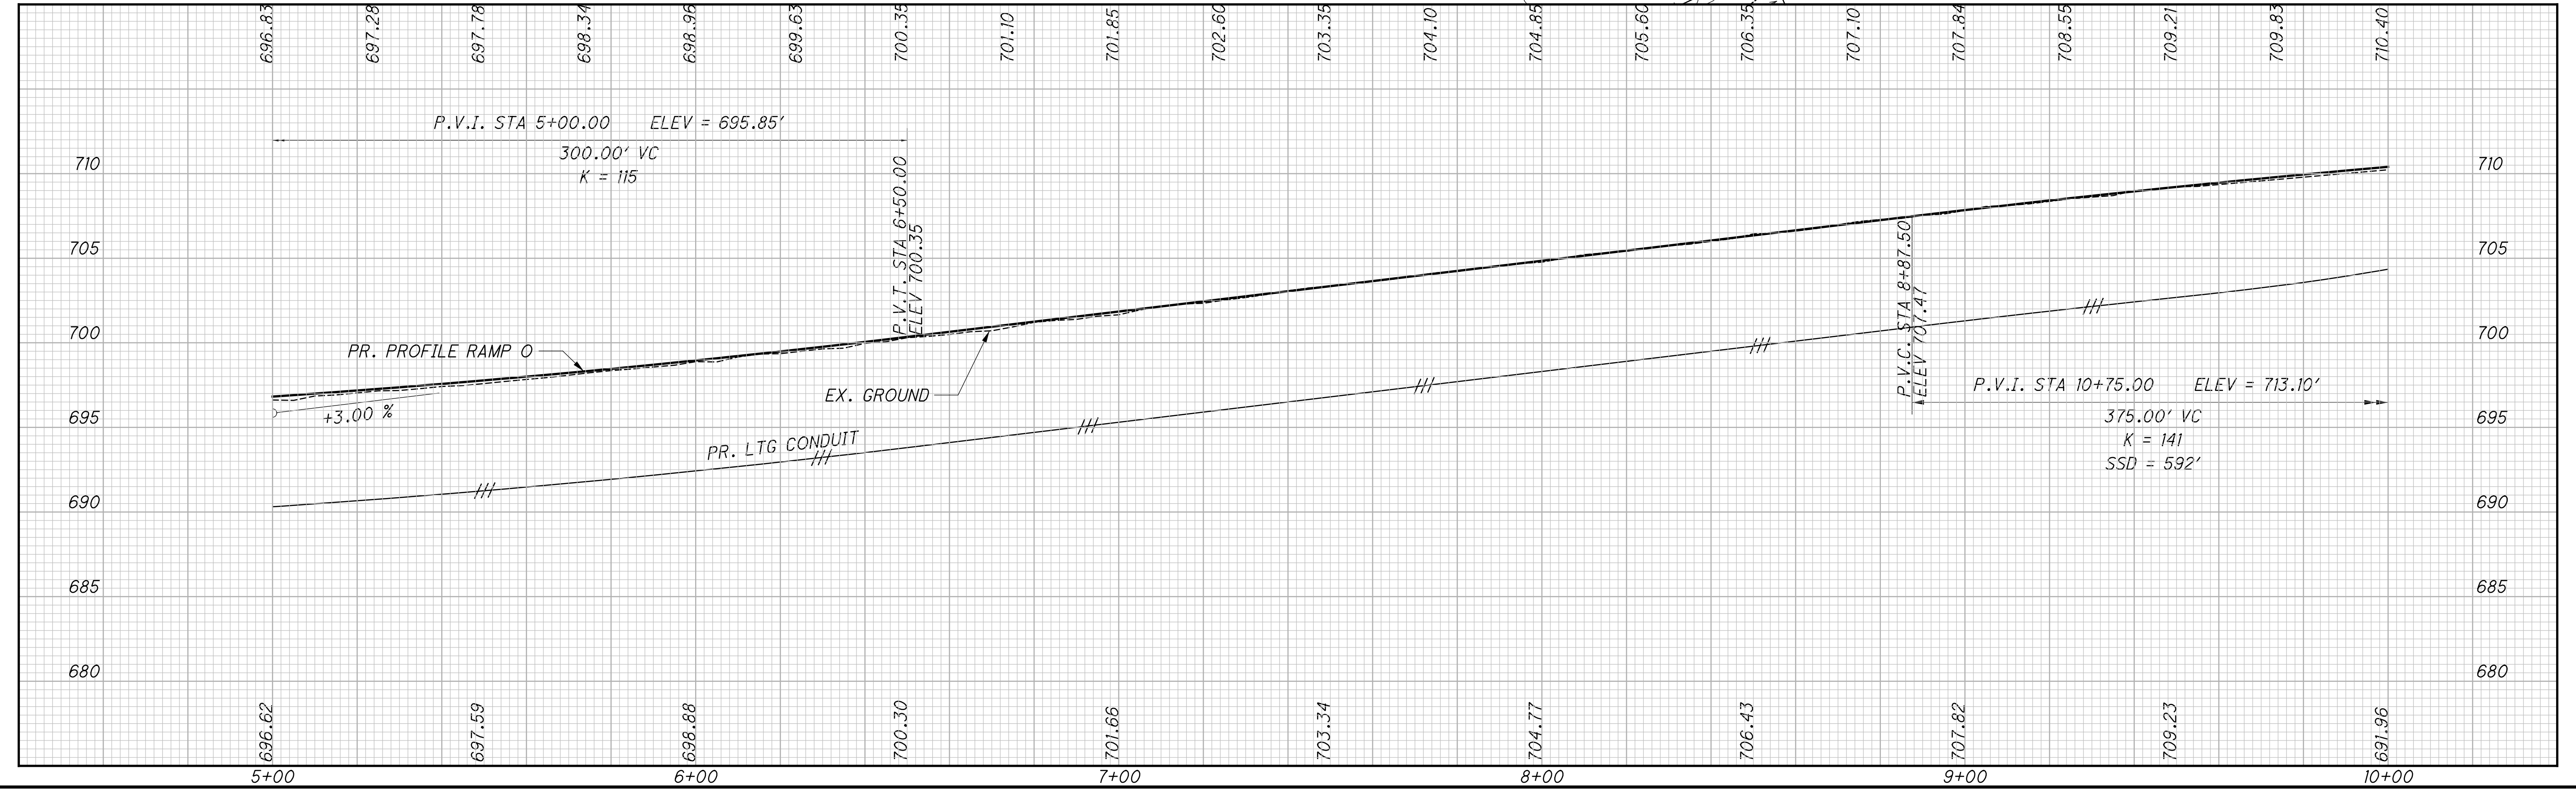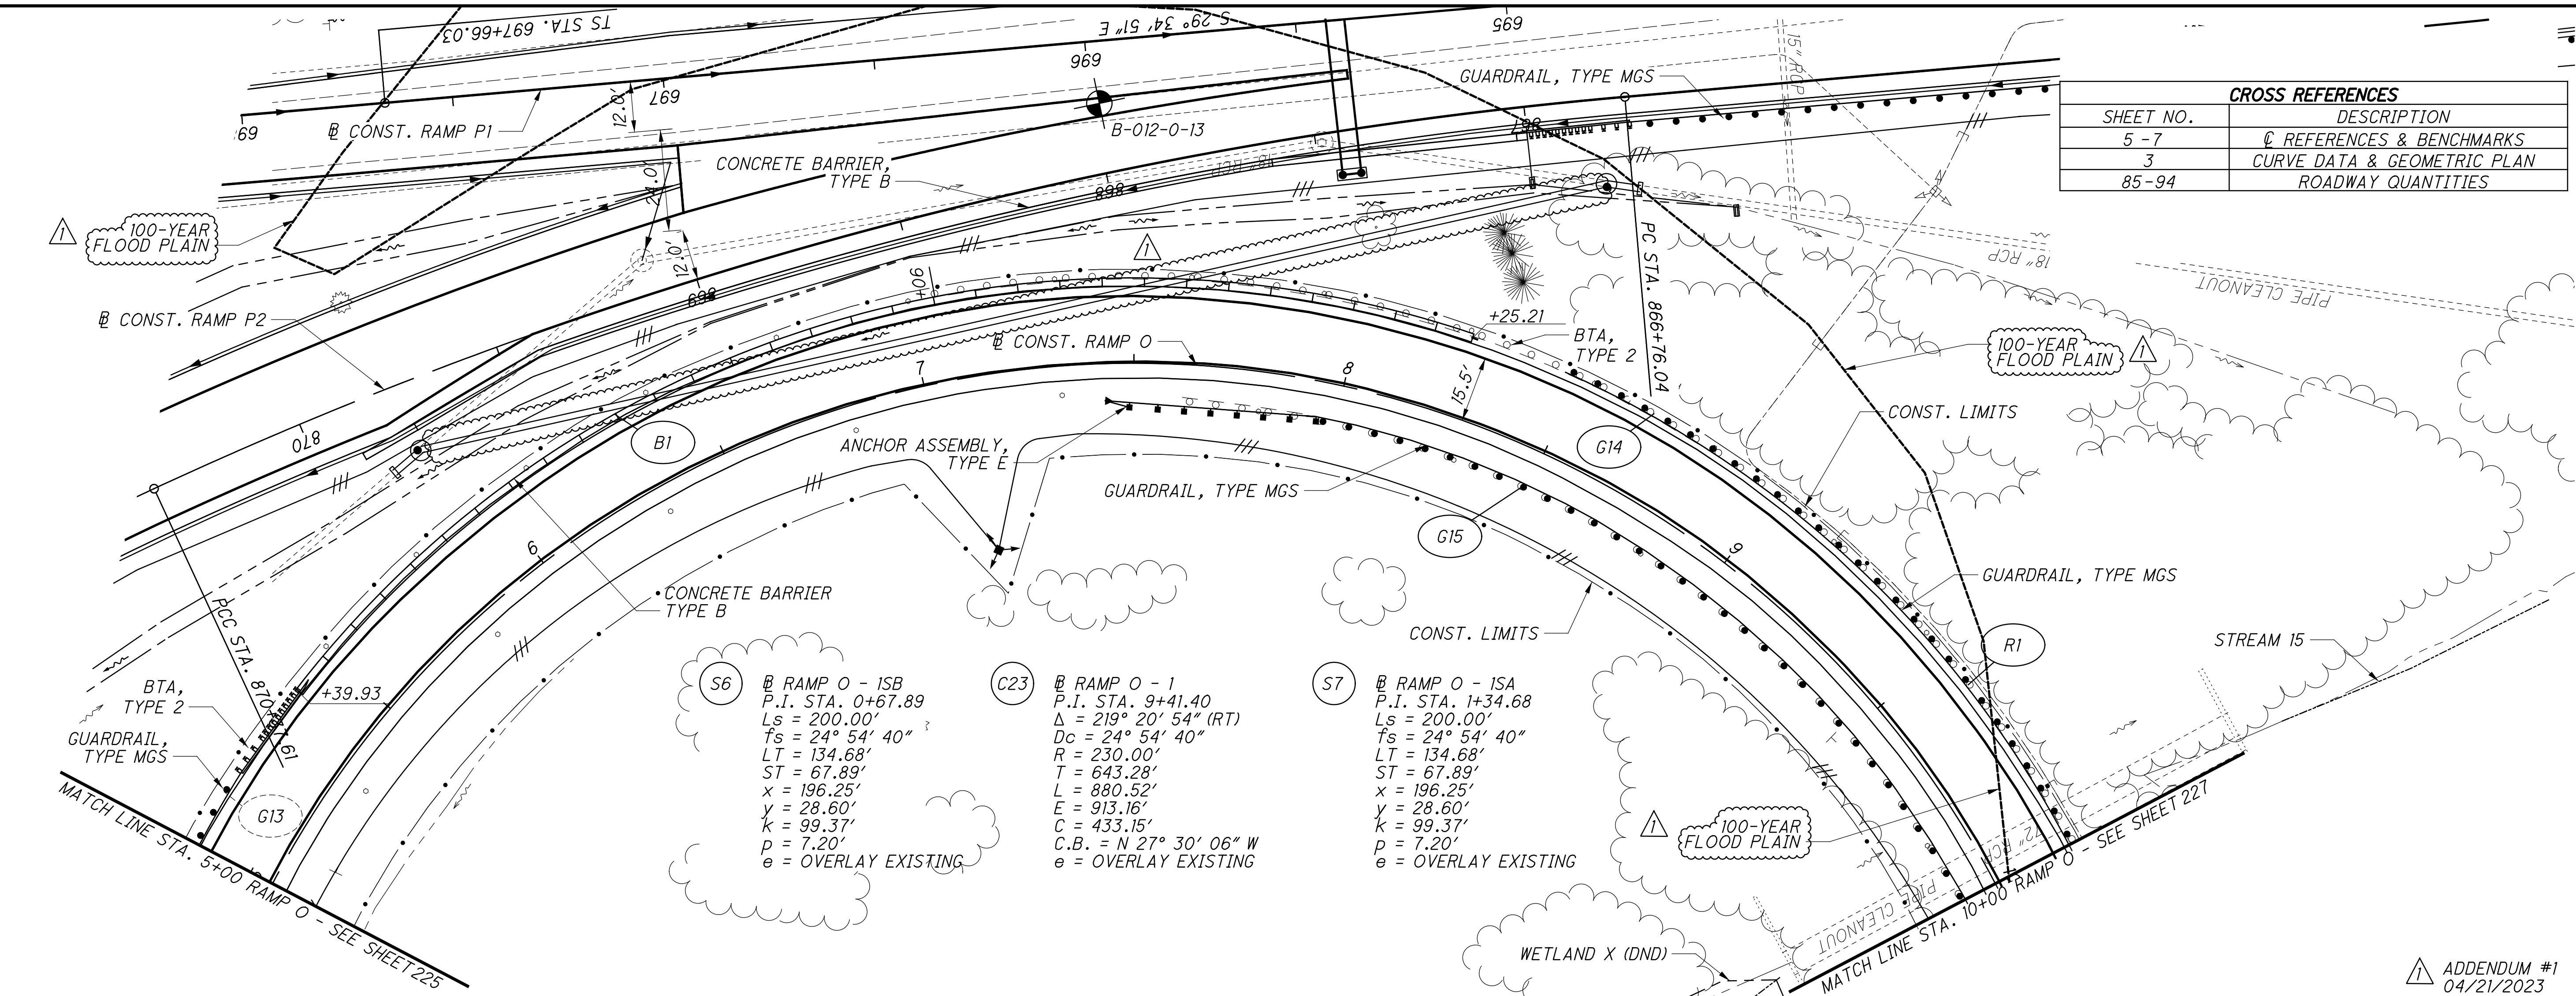

PLAN AND PROFILE - RAMP O  
STA. 5+00 TO STA. 10+00



FRA - 270-51.50

226  
554

X:\Projects\2013\132\1010\FRA\270-51.50\roadway\sheet\92616GP352.dgn 4/19/2023 9:54:42 AM cwong


ADDENDUM #1  
04/21/2023

X:\Projects\2013\1010\FRA\92616\roadway\sheet\92616GP353.dgn 4/19/2023 9:58:12 AM cwrong

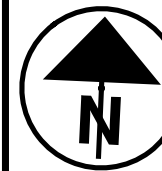
  

  
 HORIZONTAL SCALE IN FEET


CALCULATED ACF CHECKED CSR  
**PLAN AND PROFILE - RAMP O**  
**STA. 10+00 TO STA. 13+78.64**

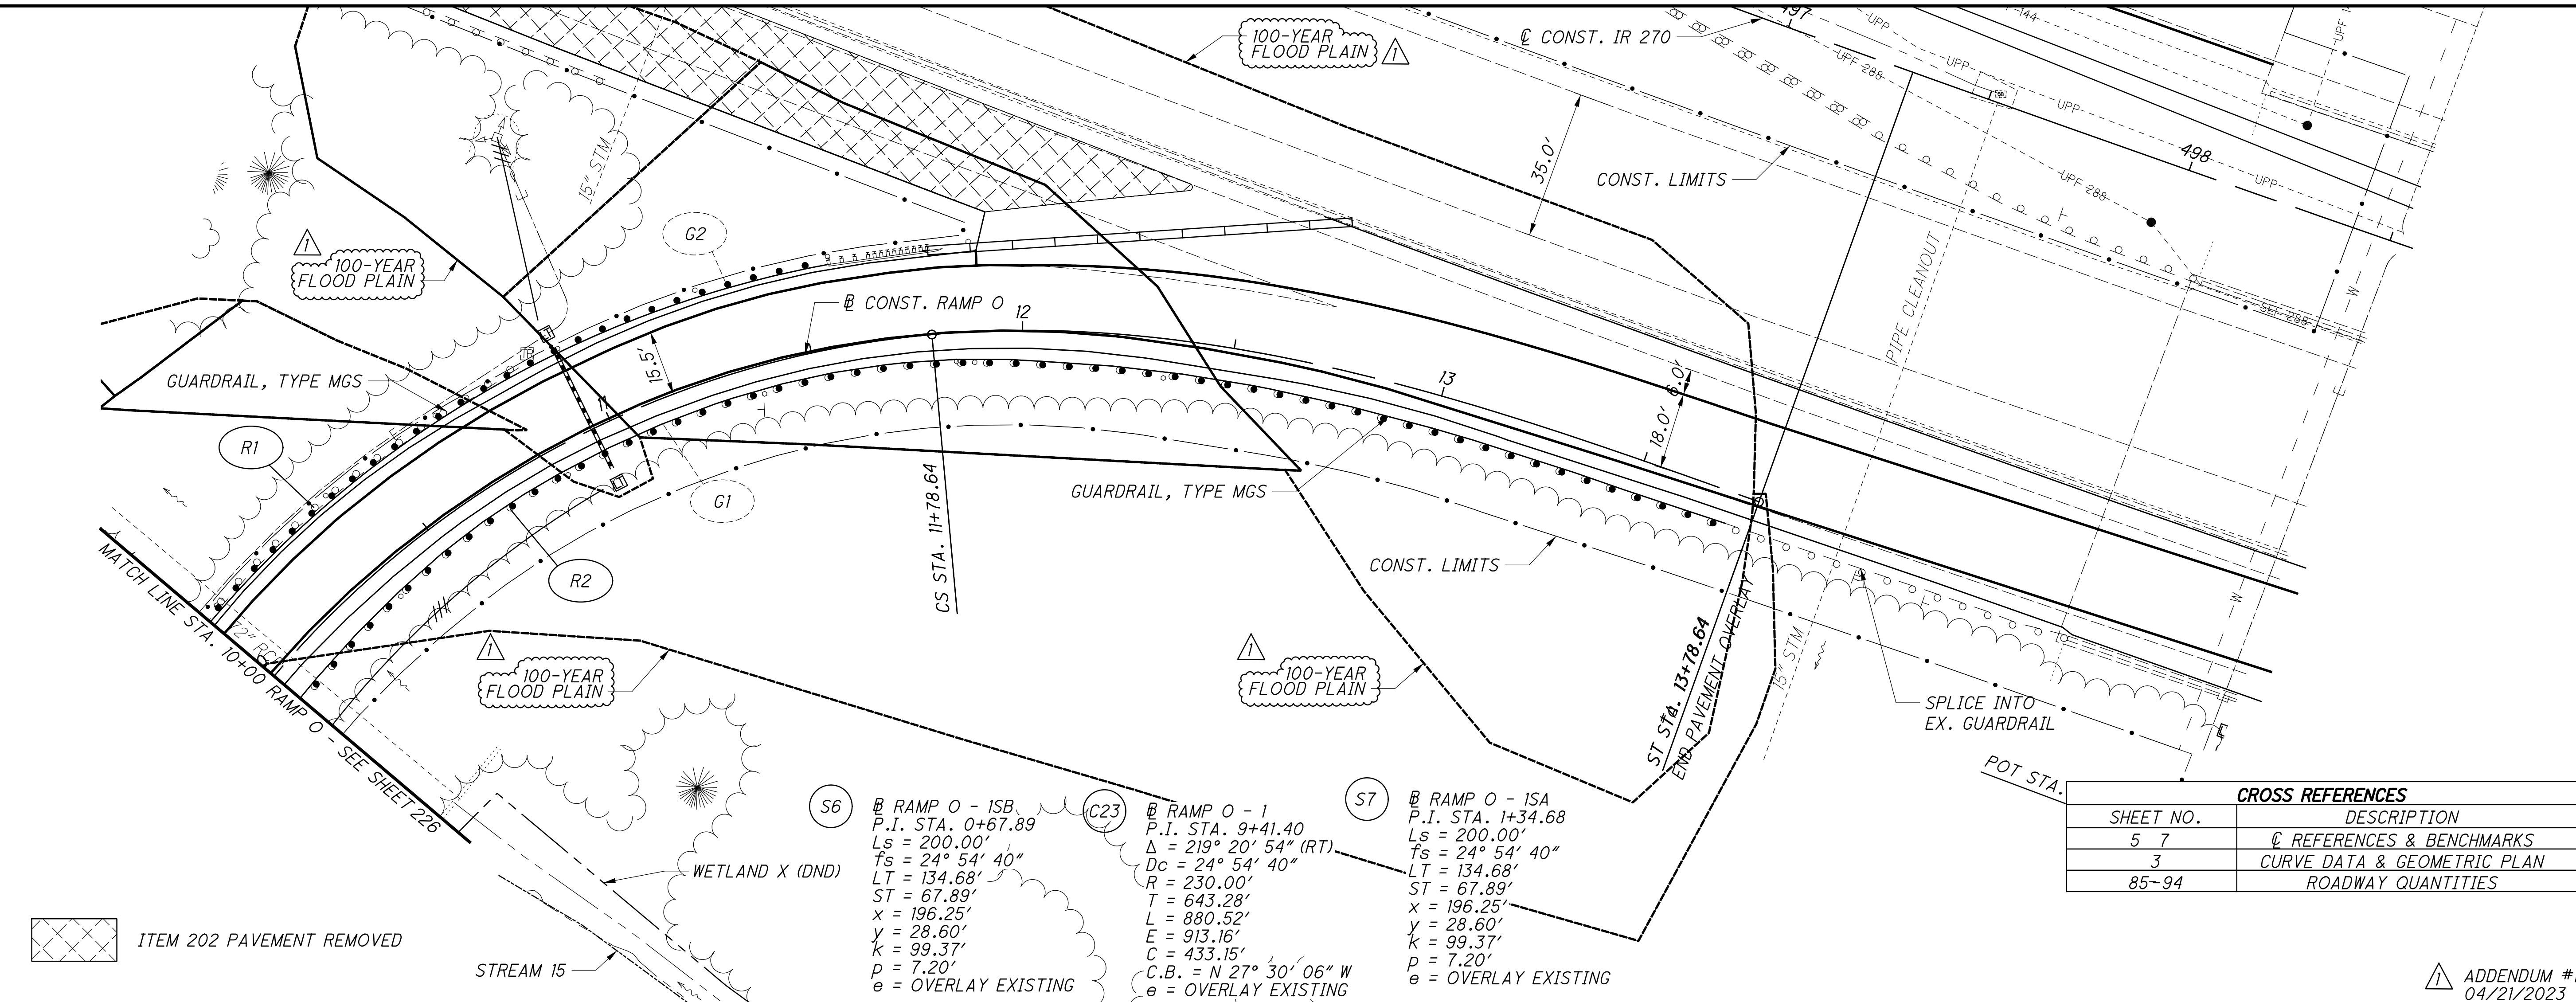**FRA - 270-51.50**  
 227  
 554



CROSS REFERENCES	
SHEET NO.	DESCRIPTION
5 7	REFERENCES & BENCHMARKS
3	CURVE DATA & GEOMETRIC PLAN
85-94	ROADWAY QUANTITIES


- S6** RAMP O - ISB  
 P.I. STA. 0+67.89  
 Ls = 200.00'  
 fs = 24° 54' 40"  
 LT = 134.68'  
 ST = 67.89'  
 x = 196.25'  
 y = 28.60'  
 k = 99.37'  
 p = 7.20'  
 e = OVERLAY EXISTING
- C23** RAMP O - 1  
 P.I. STA. 9+41.40  
 Δ = 219° 20' 54" (RT)  
 Dc = 24° 54' 40"  
 R = 230.00'  
 T = 643.28'  
 L = 880.52'  
 E = 913.16'  
 C = 433.15'  
 C.B. = N 27° 30' 06" W  
 e = OVERLAY EXISTING
- S7** RAMP O - ISA  
 P.I. STA. 1+34.68  
 Ls = 200.00'  
 fs = 24° 54' 40"  
 LT = 134.68'  
 ST = 67.89'  
 x = 196.25'  
 y = 28.60'  
 k = 99.37'  
 p = 7.20'  
 e = OVERLAY EXISTING

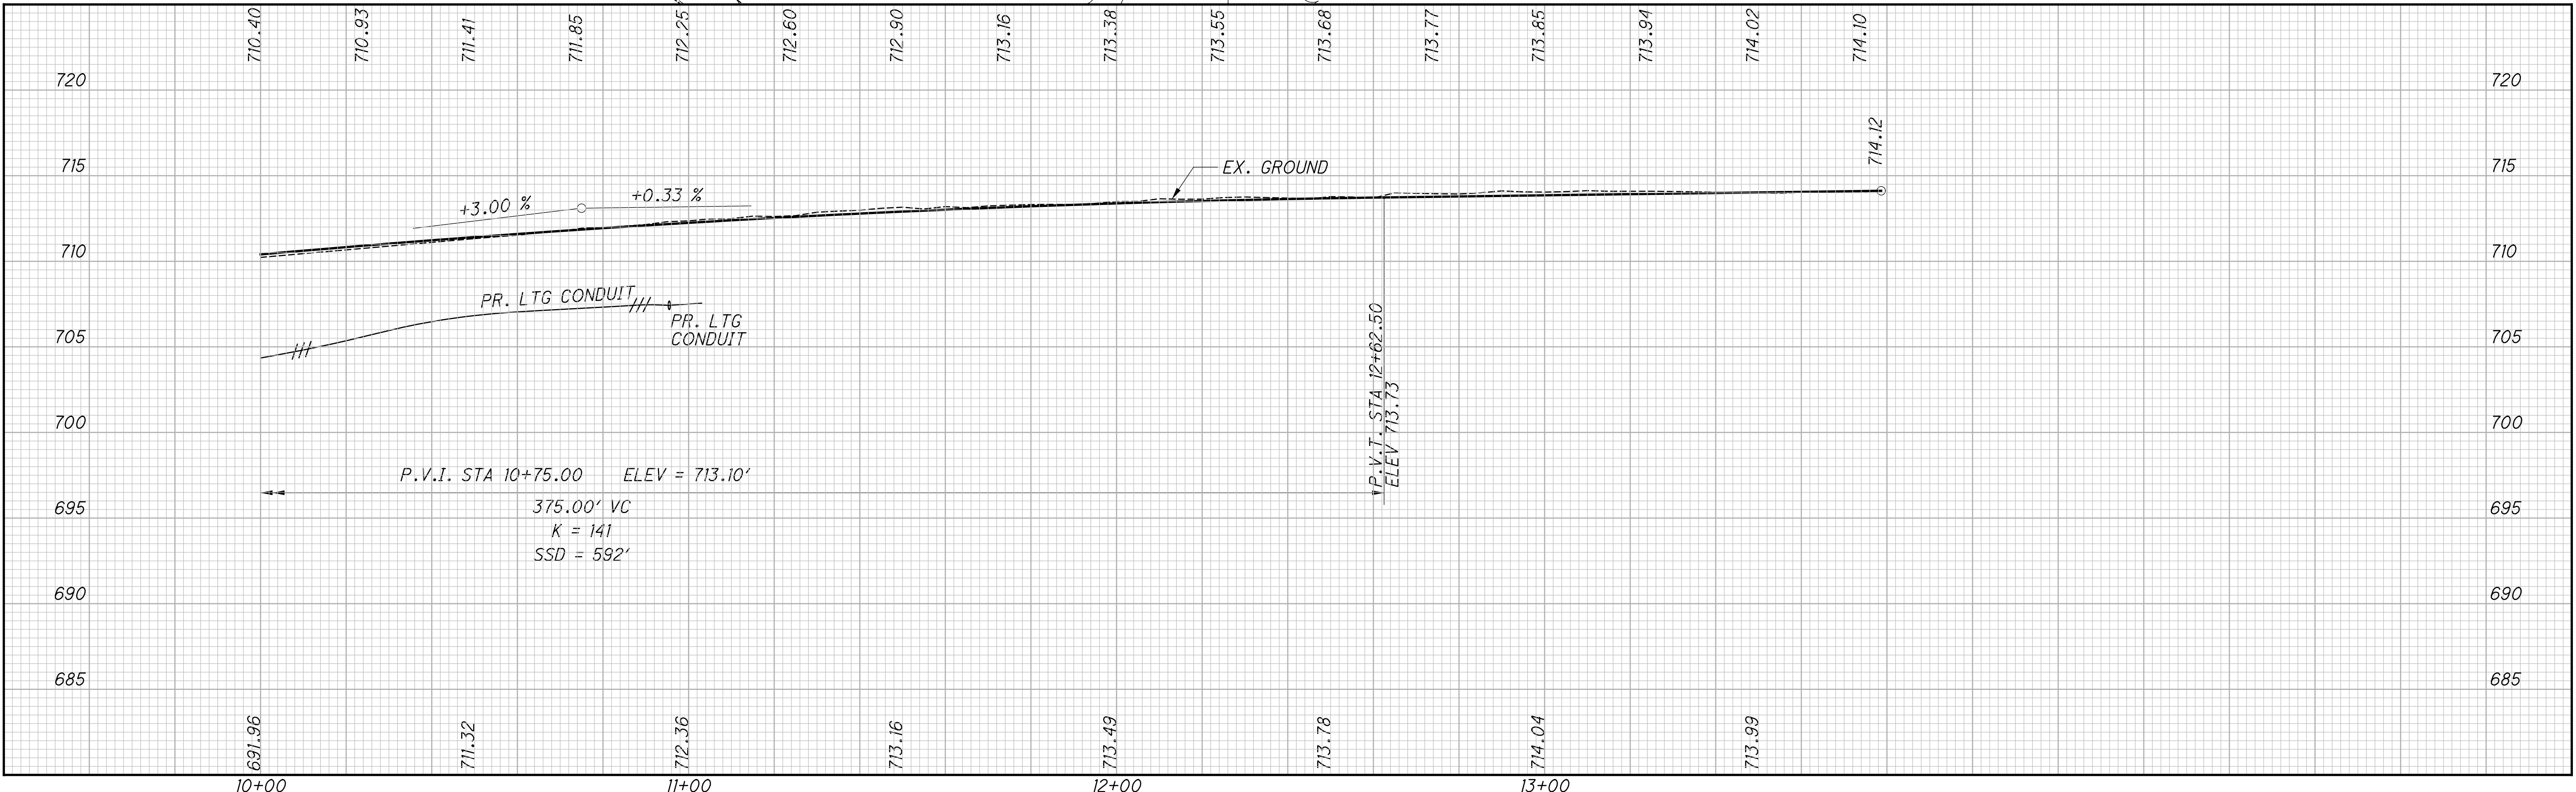


ADDENDUM #1  
 04/21/2023



X:\Projects\2013\132\1010\FRA\92616\roadway\sheets\92616GP404.dgn 4/19/2023 10:03:45 AM cwong

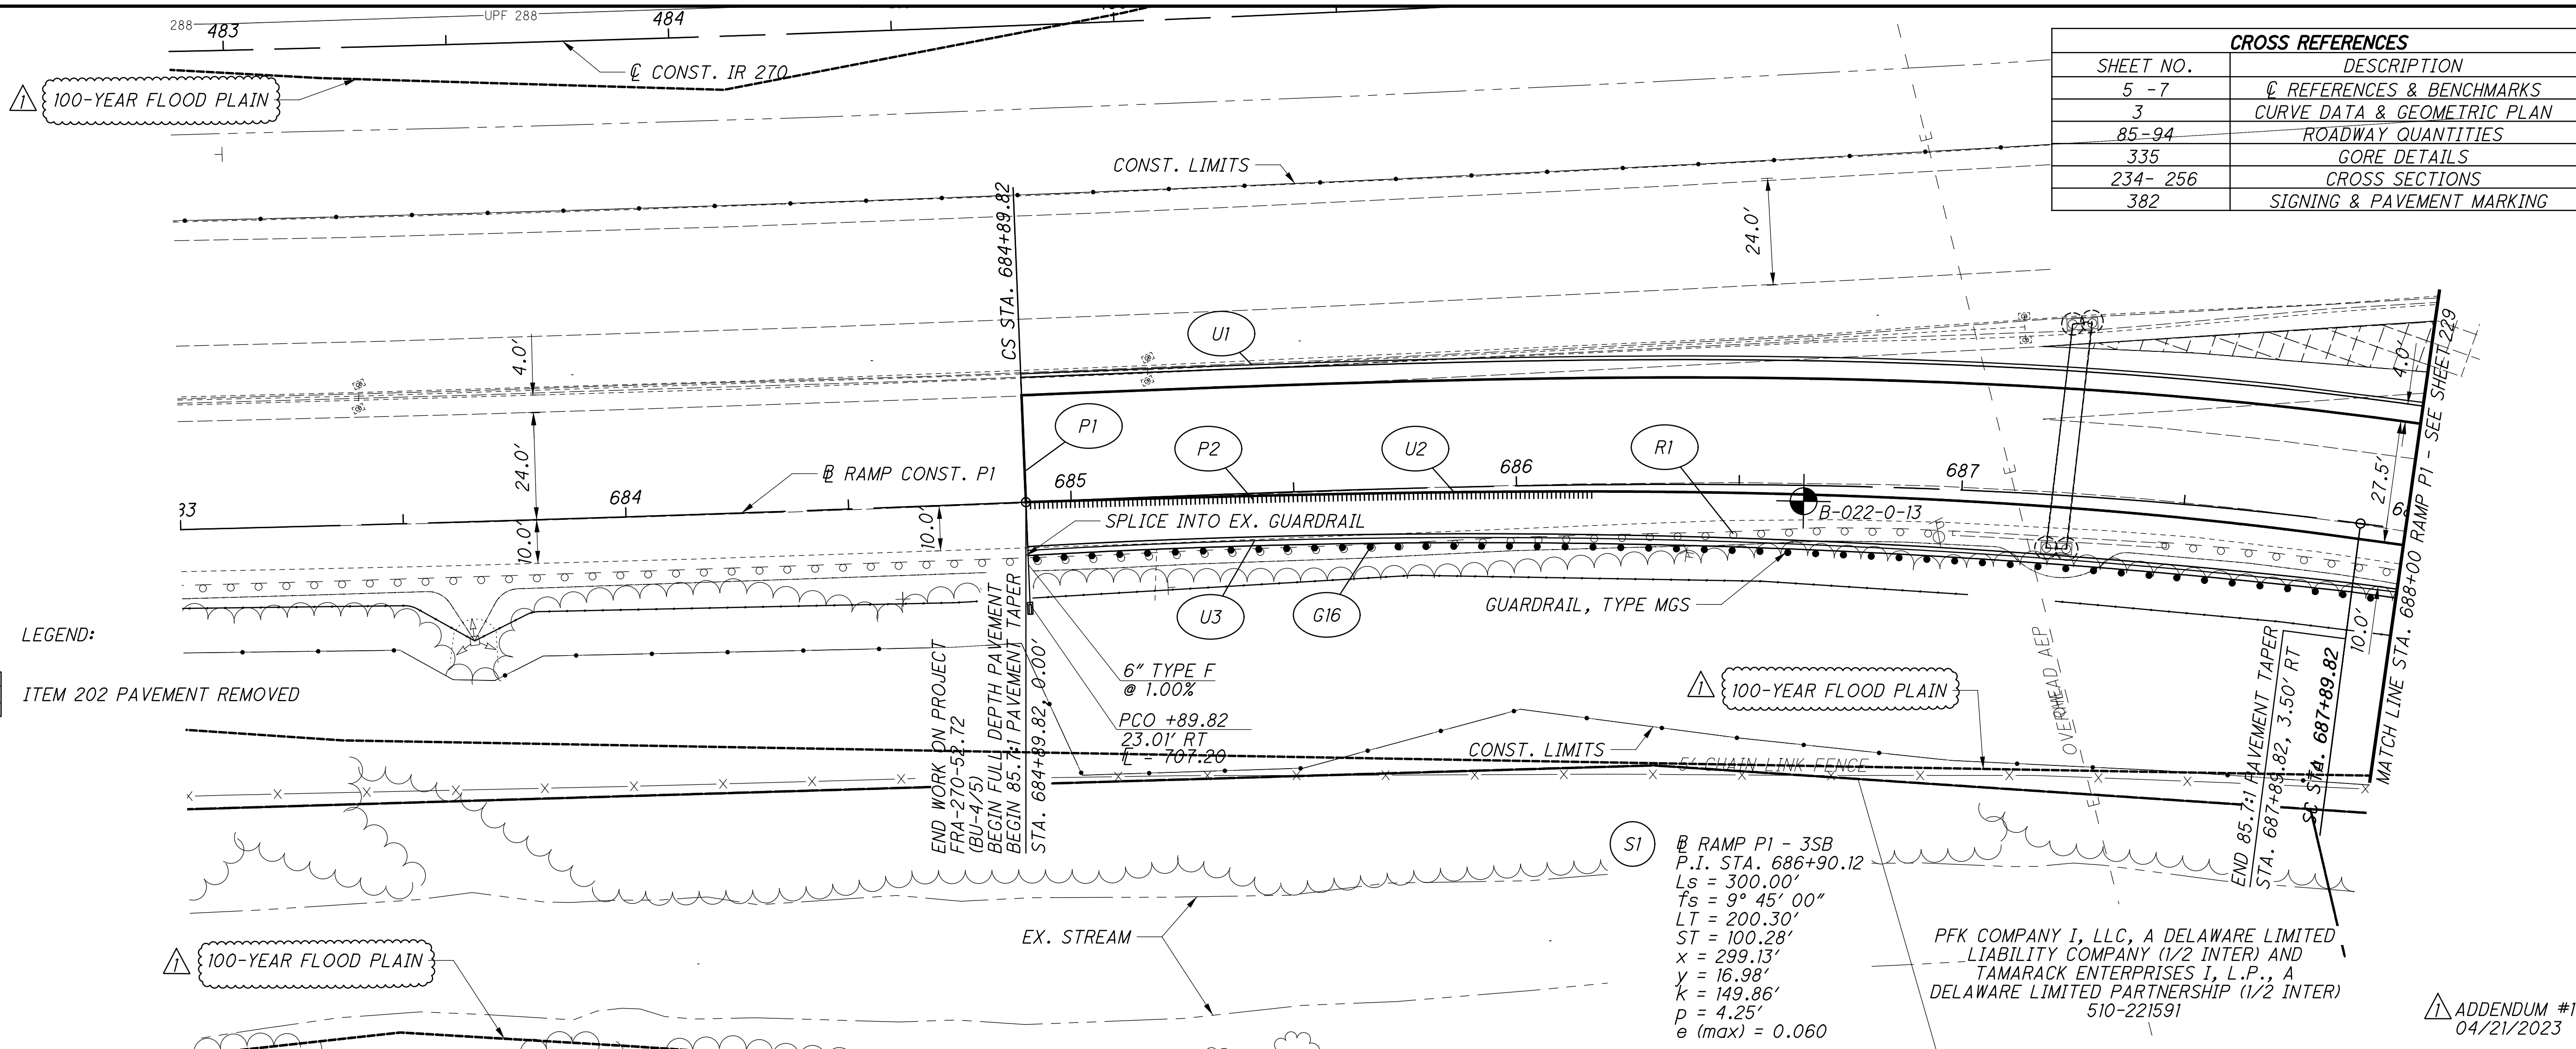

CROSS REFERENCES	
SHEET NO.	DESCRIPTION
5 - 7	☉ REFERENCES & BENCHMARKS
3	⤵ CURVE DATA & GEOMETRIC PLAN
85 - 94	ROADWAY QUANTITIES
335	GORE DETAILS
234 - 256	CROSS SECTIONS
382	SIGNING & PAVEMENT MARKING

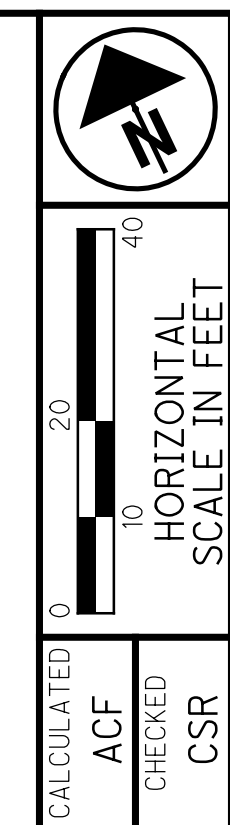


LEGEND:  
 ITEM 202 PAVEMENT REMOVED

S1  
 RAMP P1 - 3SB  
 P.I. STA. 686+90.12  
 $L_s = 300.00'$   
 $T_s = 9^\circ 45' 00''$   
 $LT = 200.30'$   
 $ST = 100.28'$   
 $x = 299.13'$   
 $y = 16.98'$   
 $K = 149.86'$   
 $p = 4.25'$   
 $e \text{ (max)} = 0.060$

PFK COMPANY I, LLC, A DELAWARE LIMITED LIABILITY COMPANY (1/2 INTER) AND TAMARACK ENTERPRISES I, L.P., A DELAWARE LIMITED PARTNERSHIP (1/2 INTER) 510-221591

ADDENDUM #1  
04/21/2023



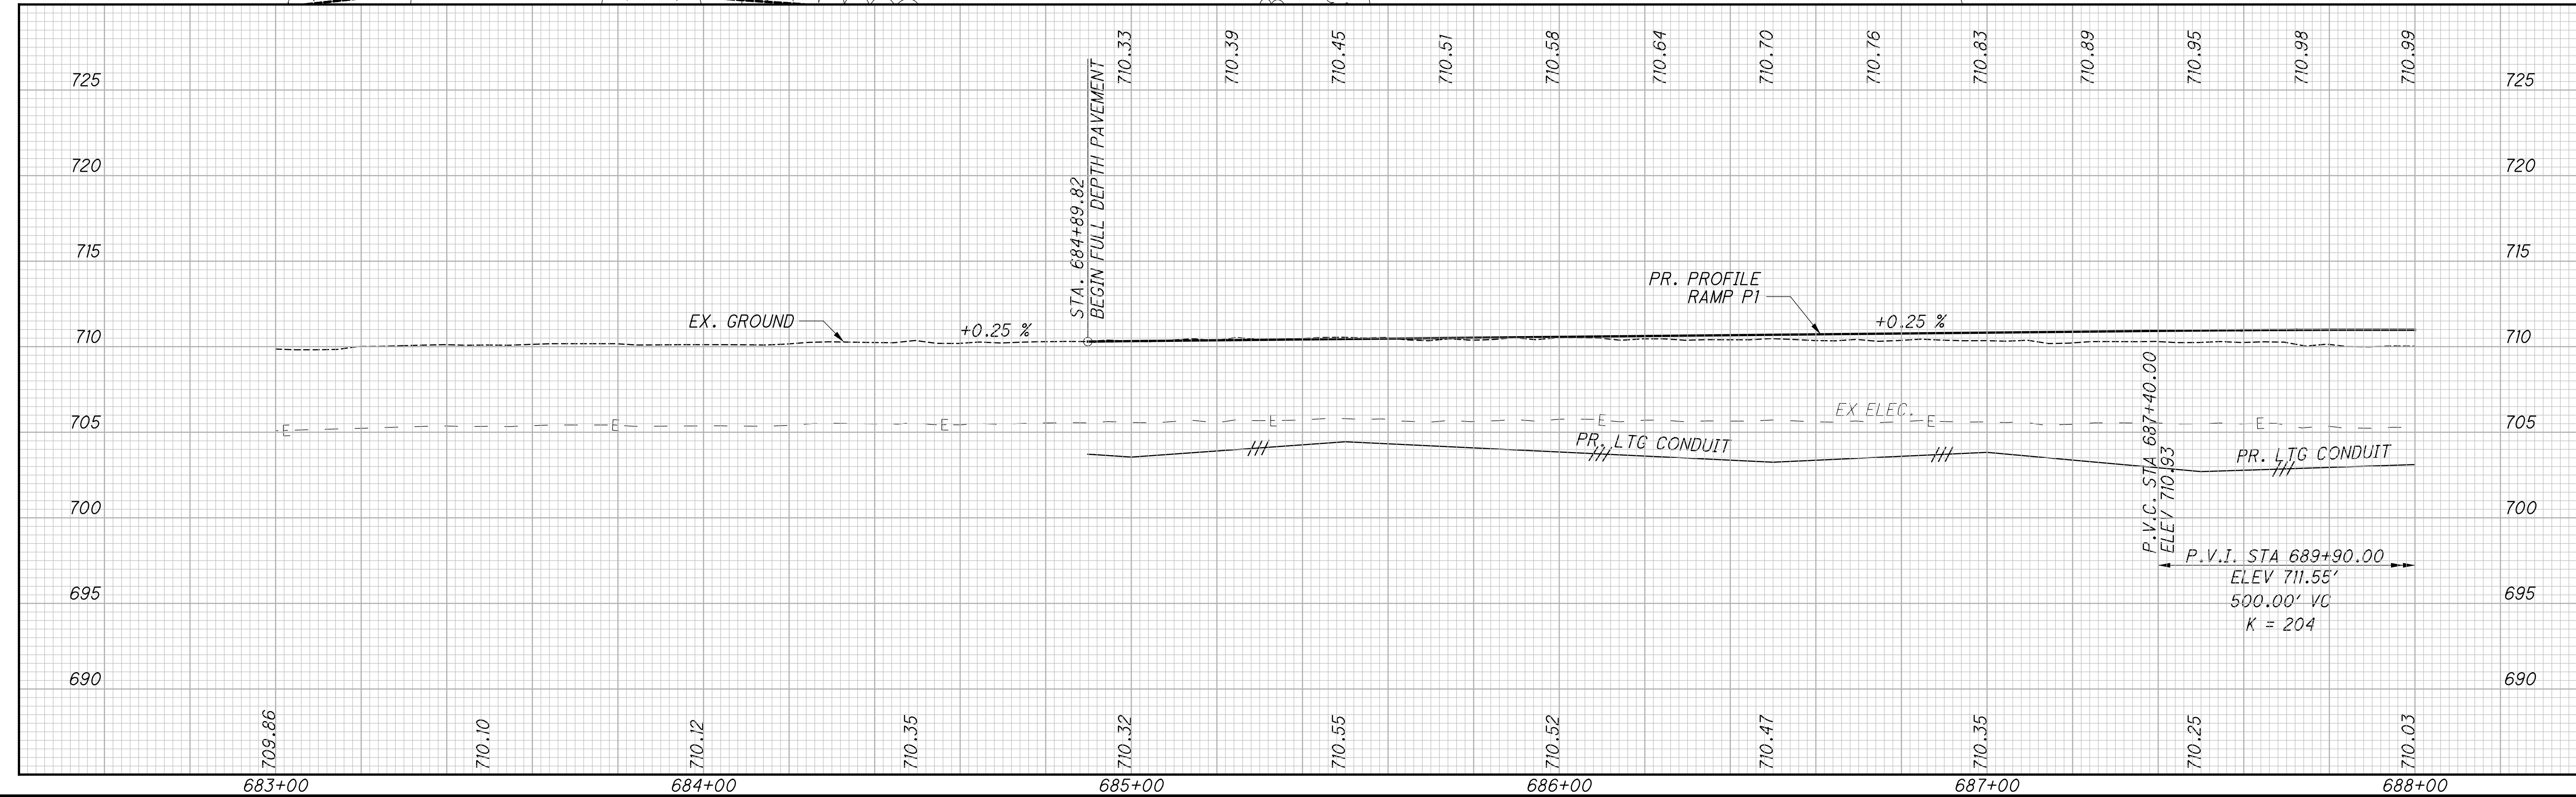


PLAN AND PROFILE - RAMP P1  
 STA. 683+00 TO STA. 688+00

FRA - 270 - 51.50

X:\Projects\2013\1010\FRA\92616\roadway\sheet\92616GP405.dgn 4/25/2023 9:27:27 AM cwong

CROSS REFERENCES	
SHEET NO.	DESCRIPTION
5 - 7	☉ REFERENCES & BENCHMARKS
3	☉ CURVE DATA & GEOMETRIC PLAN
85 - 94	ROADWAY QUANTITIES
369	CULVERT DETAILS
234 - 256	CROSS SECTIONS
335 - 336	GORE DETAILS
378	FLAP GATE DETAILS
320	ACCESS ROAD PLAN
364	STORM SEWER PROFILE

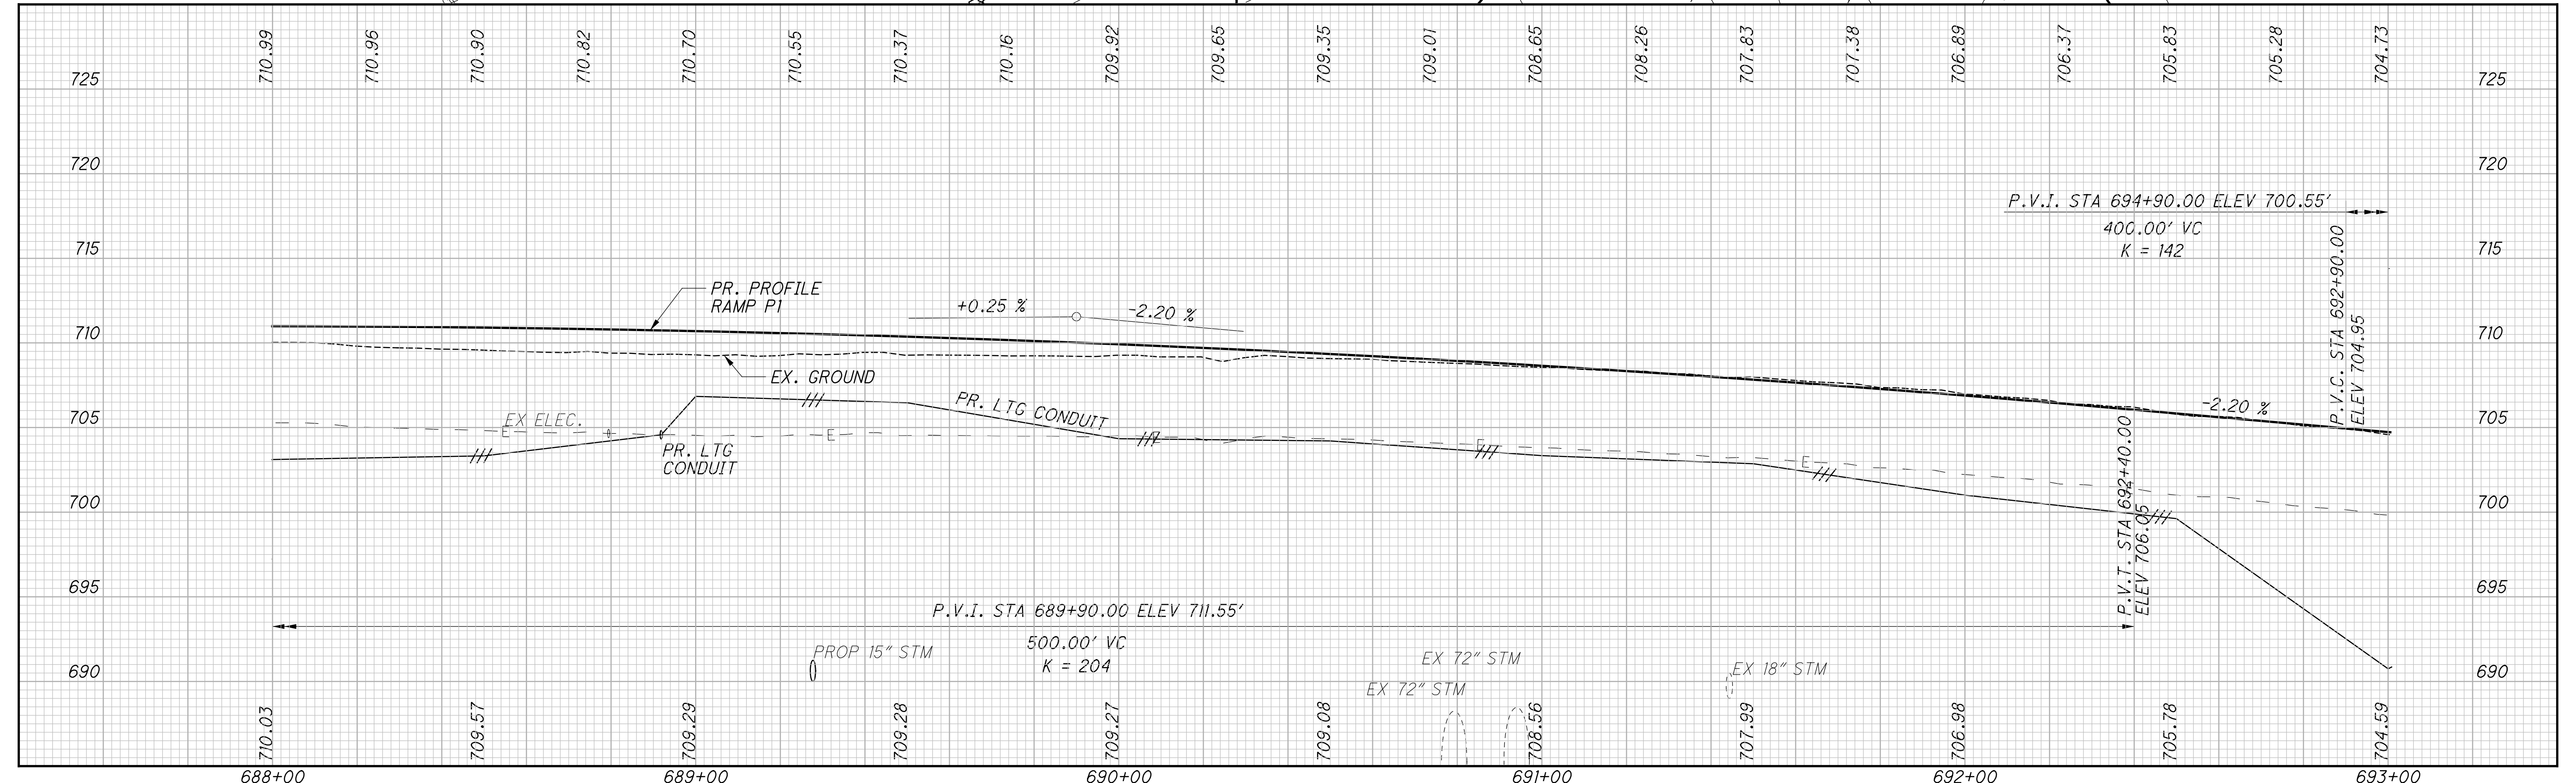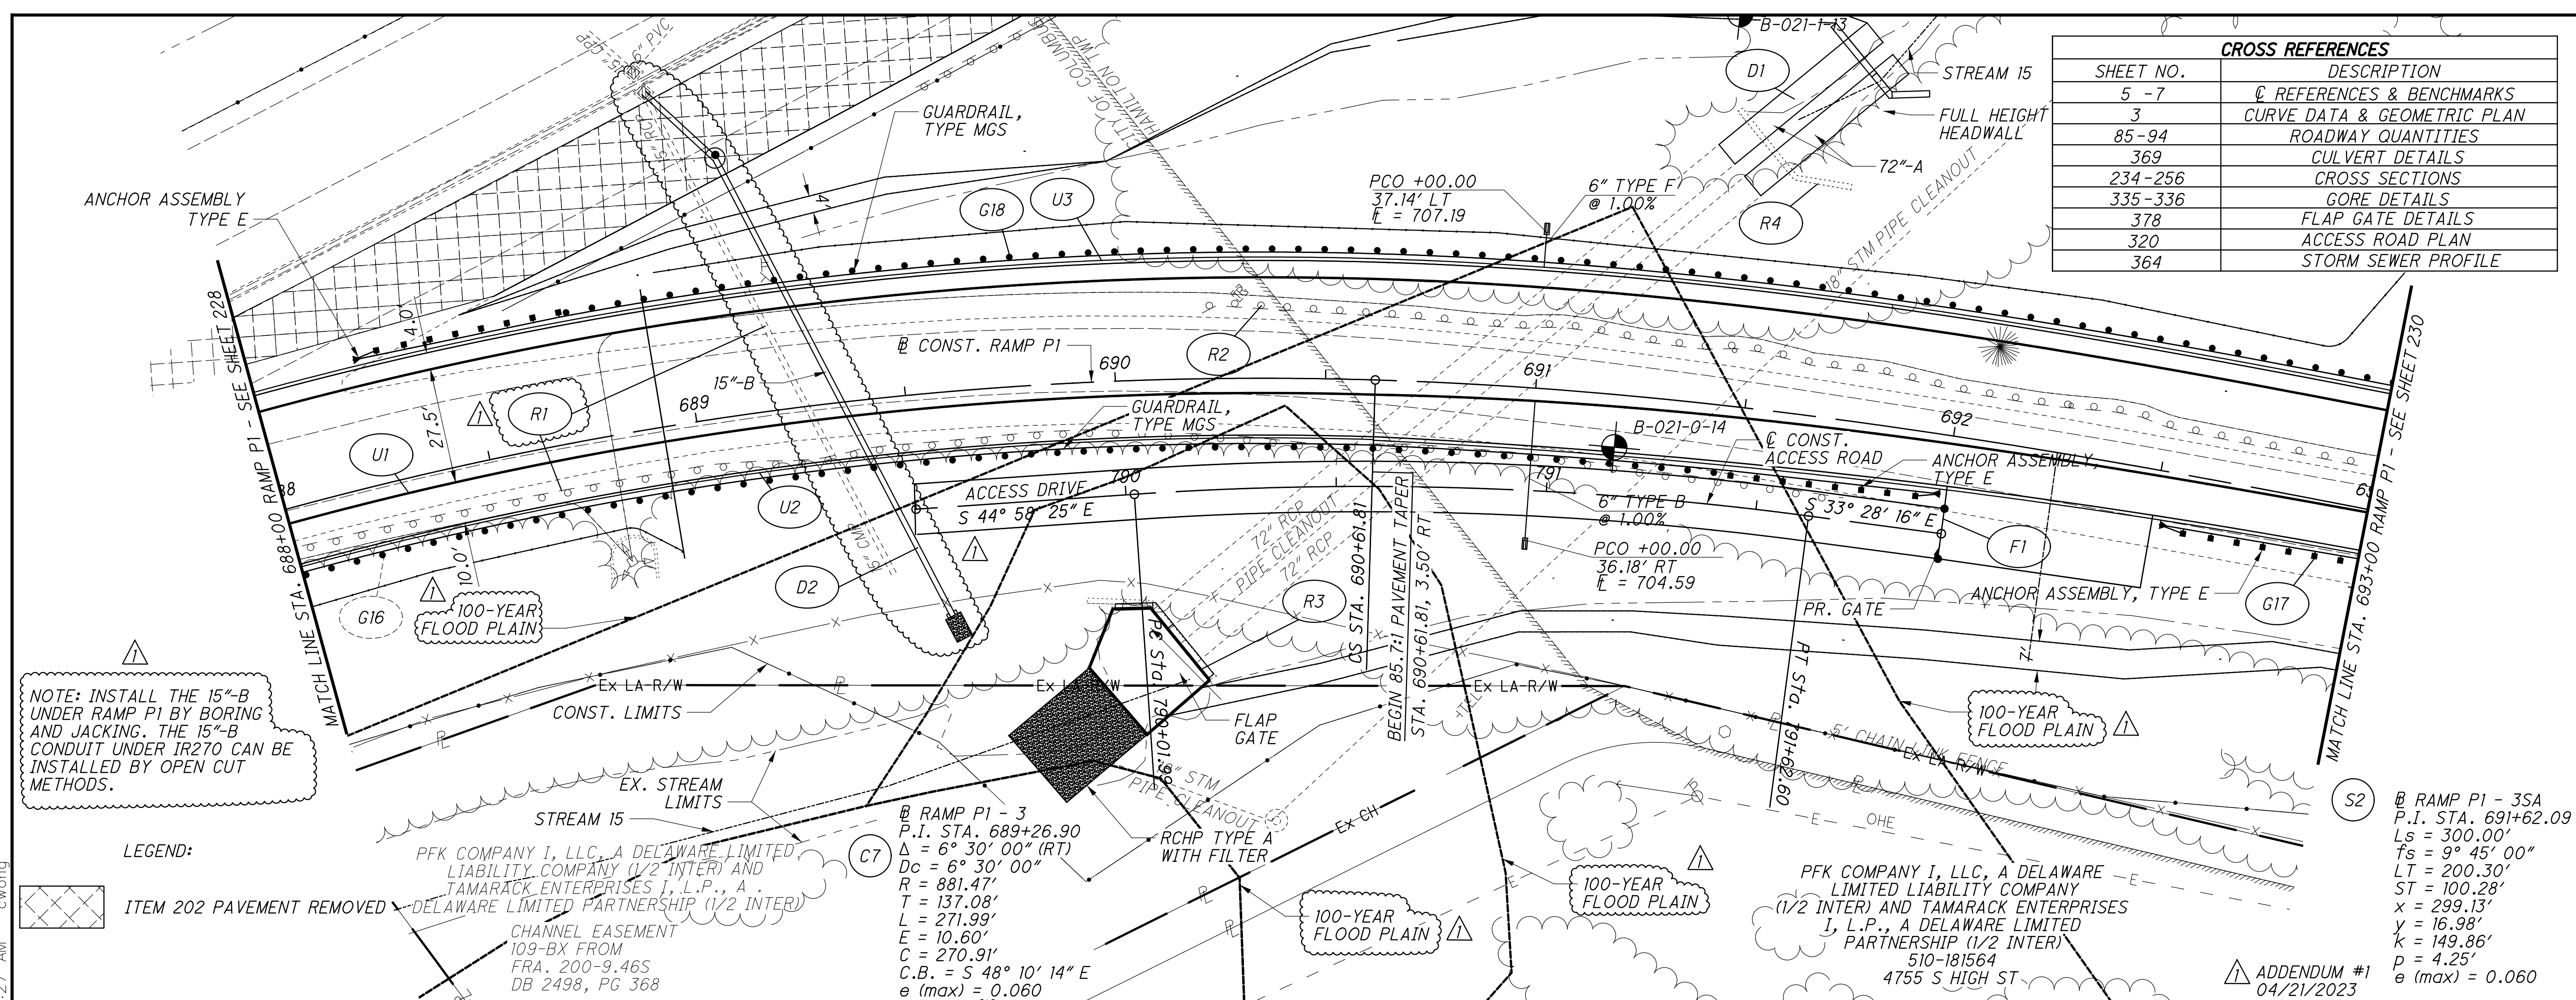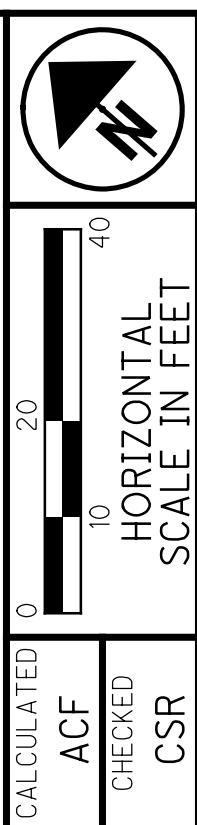


**PLAN AND PROFILE - RAMP P1**  
**STA. 688+00 TO STA. 693+00**

**FRA - 270-51.50**





X:\Projects\2013\1010\FRA\roadway\sheet\92616GP406.dgn 4/19/2023 10:25:00 AM cwong

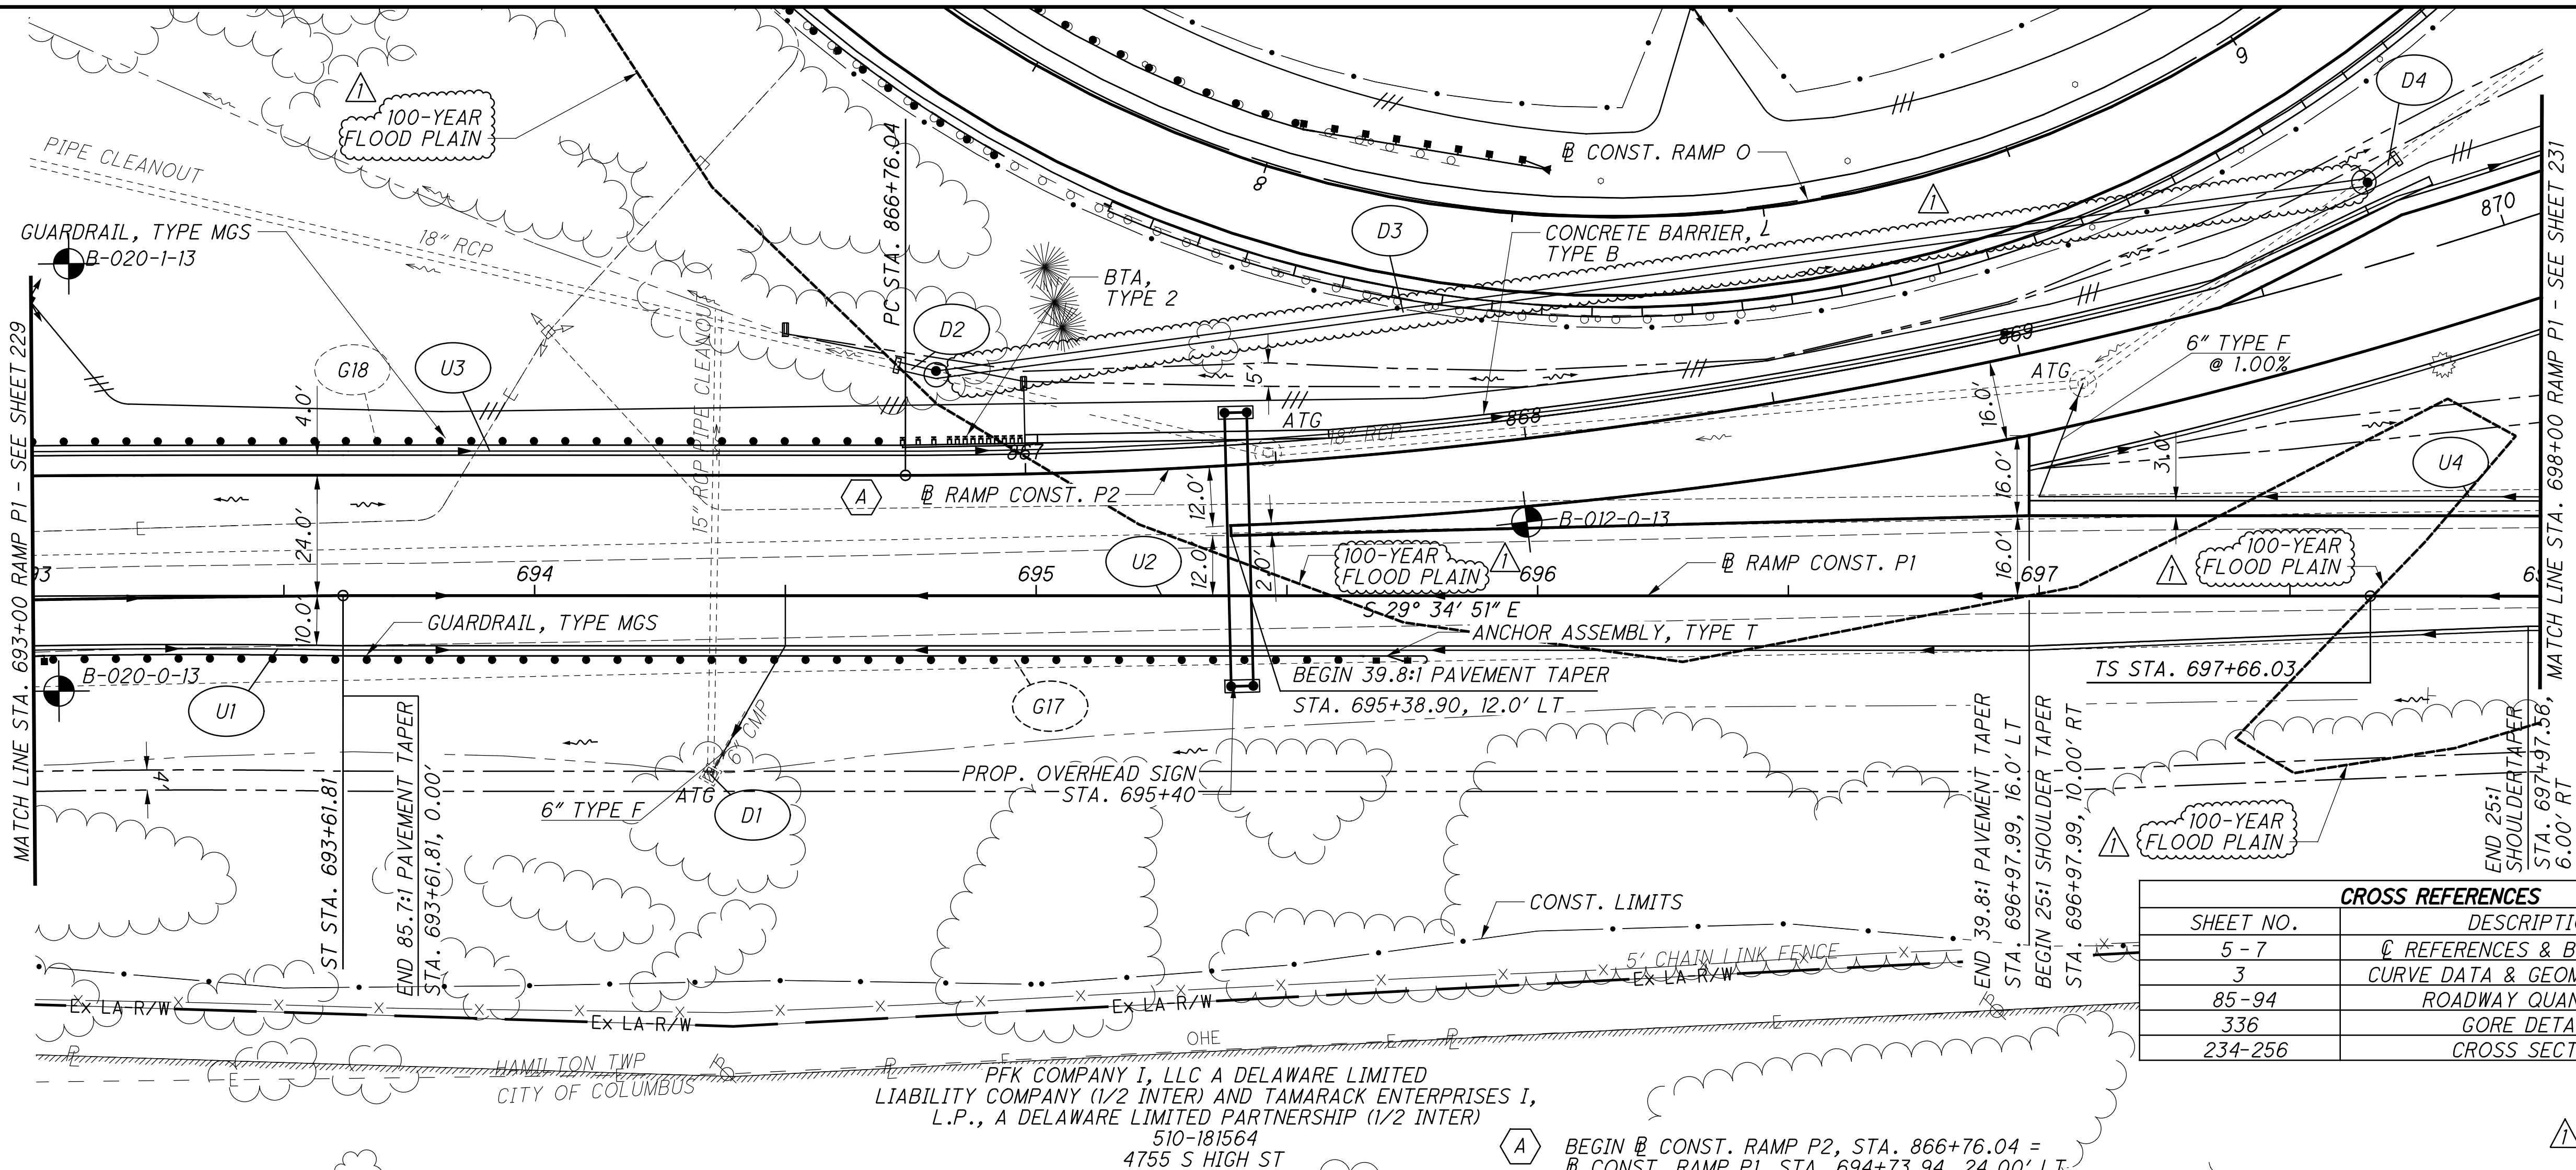

CROSS REFERENCES	
SHEET NO.	DESCRIPTION
5-7	REFERENCES & BENCHMARKS
3	CURVE DATA & GEOMETRIC PLAN
85-94	ROADWAY QUANTITIES
336	GORE DETAILS
234-256	CROSS SECTIONS

PFK COMPANY I, LLC A DELAWARE LIMITED LIABILITY COMPANY (1/2 INTER) AND TAMARACK ENTERPRISES I, L.P., A DELAWARE LIMITED PARTNERSHIP (1/2 INTER)  
510-181564  
4755 S HIGH ST

ADDENDUM #1  
04/21/2023

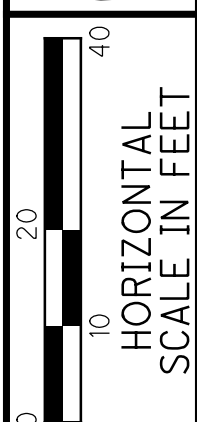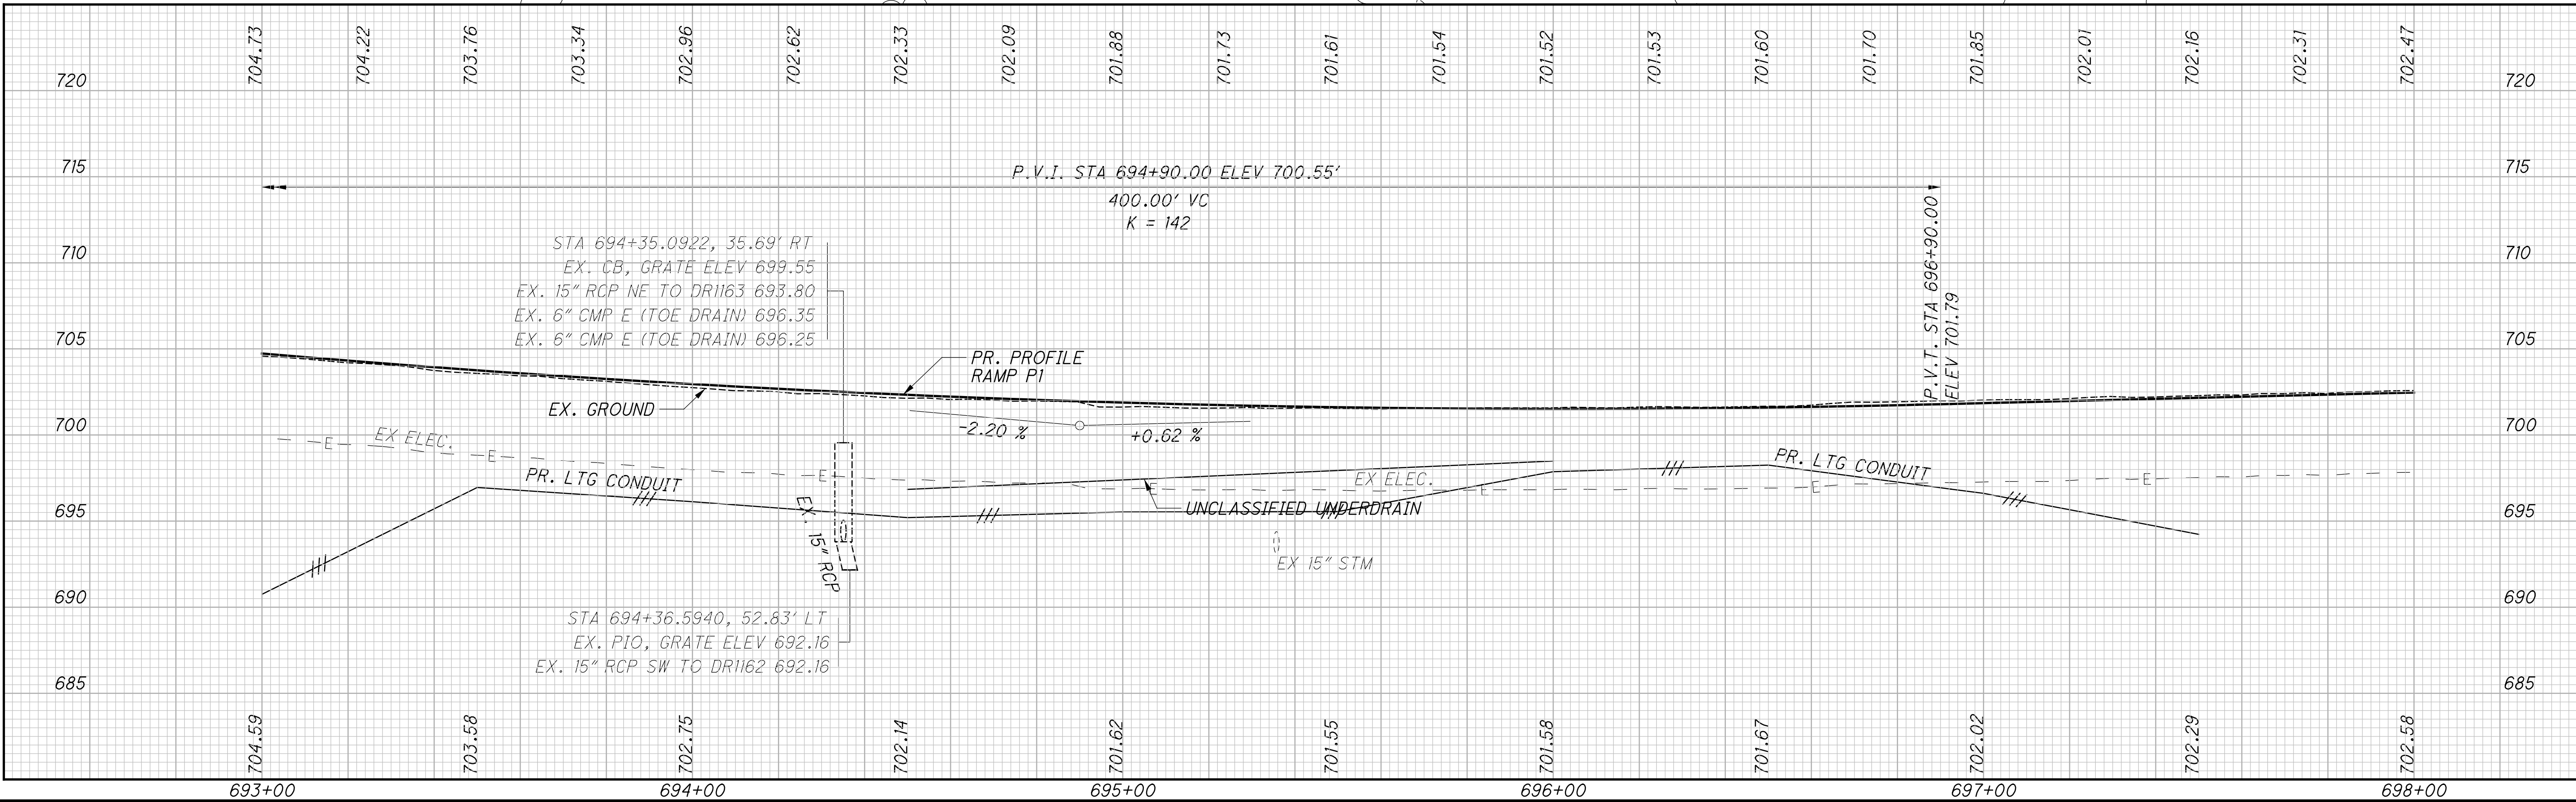


CALCULATED ACF CHECKED CSR

**PLAN AND PROFILE - RAMP P1  
STA. 693+00 TO STA. 698+00**

**FRA - 270-51.50**


230  
554



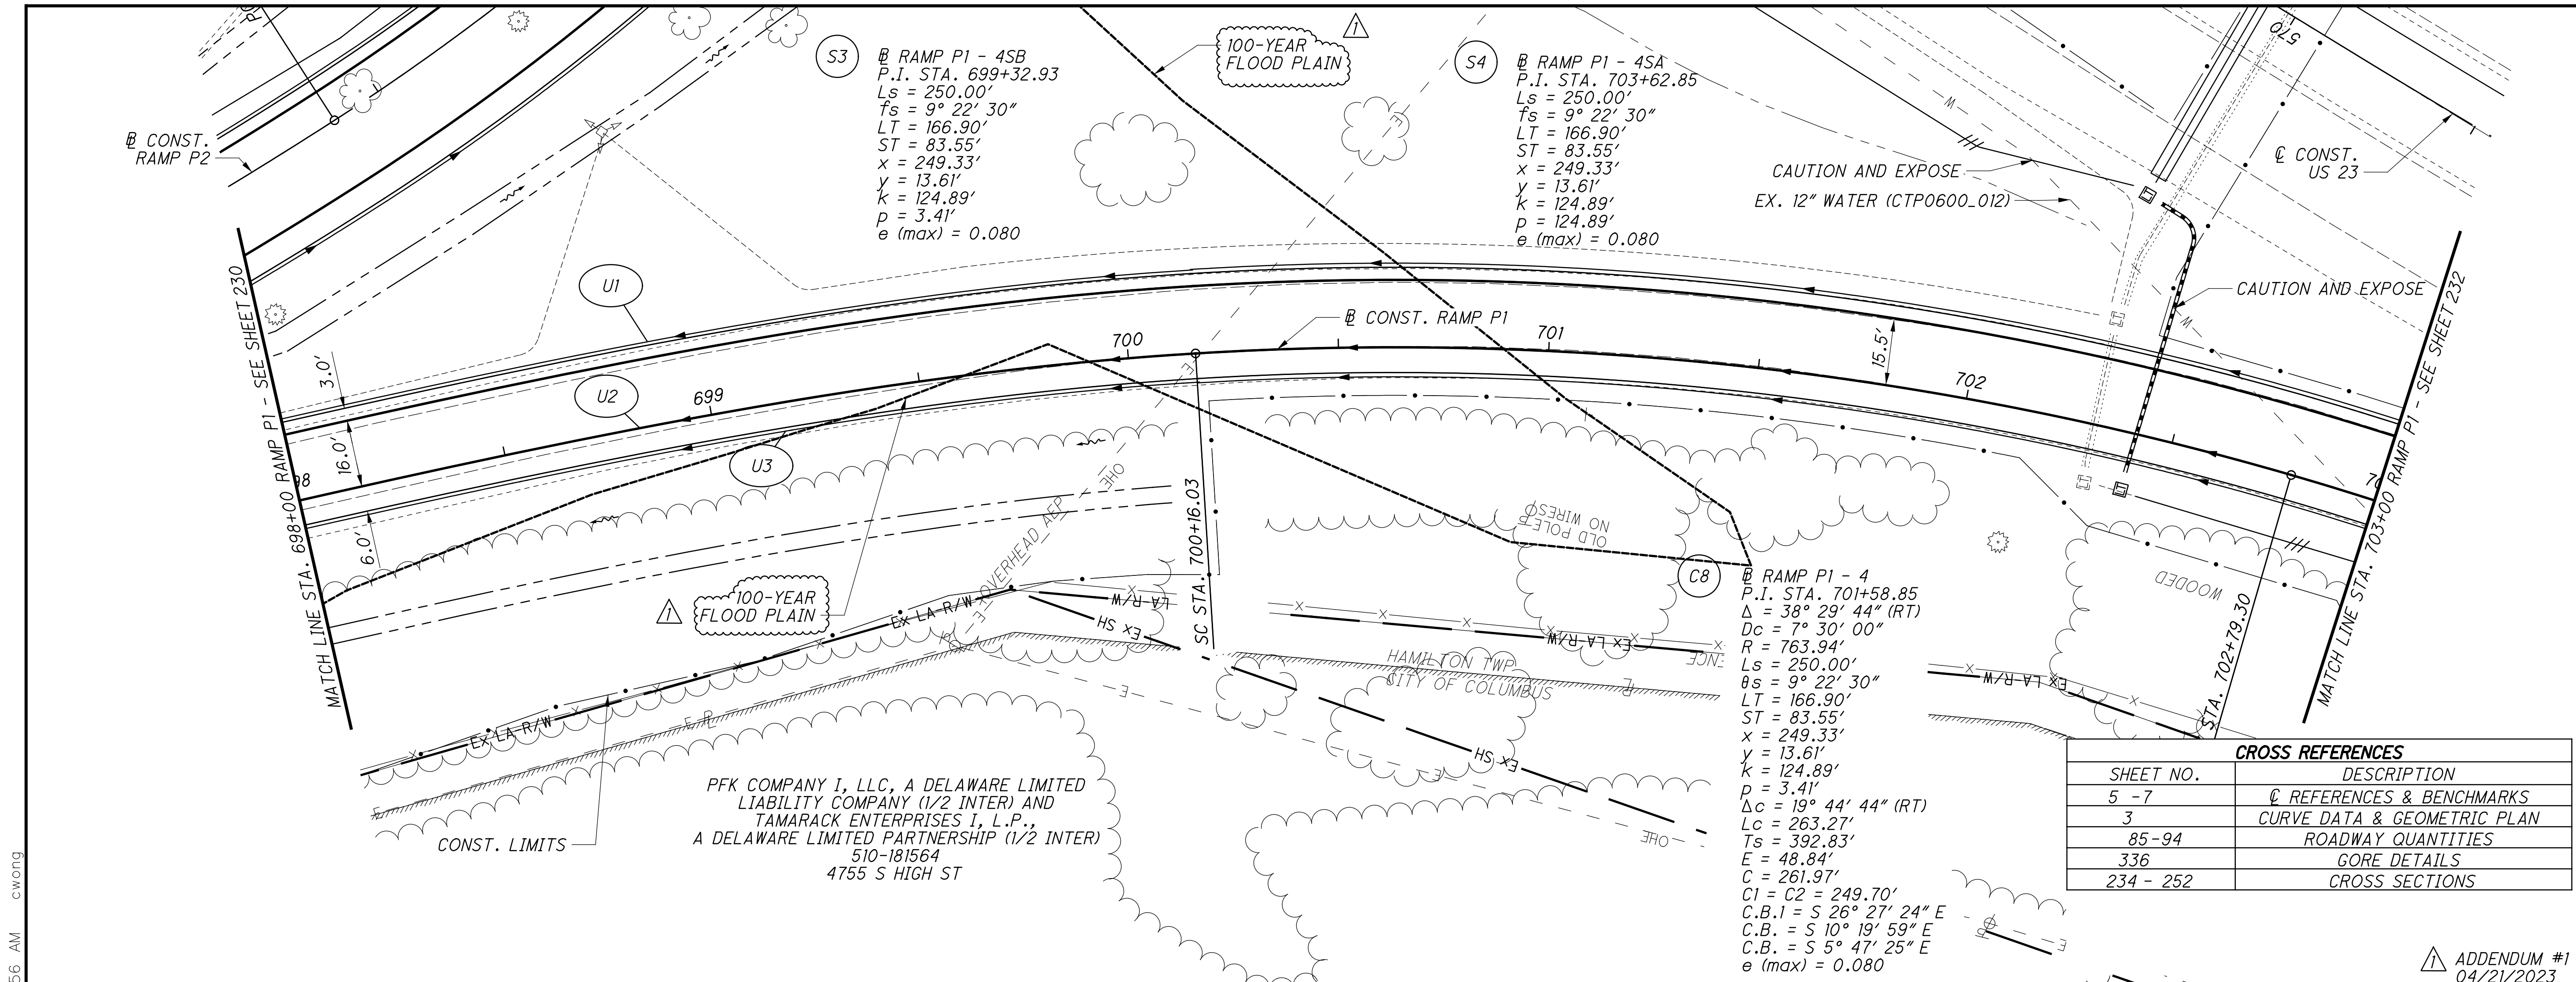

CROSS REFERENCES	
SHEET NO.	DESCRIPTION
5 - 7	☉ REFERENCES & BENCHMARKS
3	CURVE DATA & GEOMETRIC PLAN
85 - 94	ROADWAY QUANTITIES
336	GORE DETAILS
234 - 252	CROSS SECTIONS

ADDENDUM #1  
04/21/2023


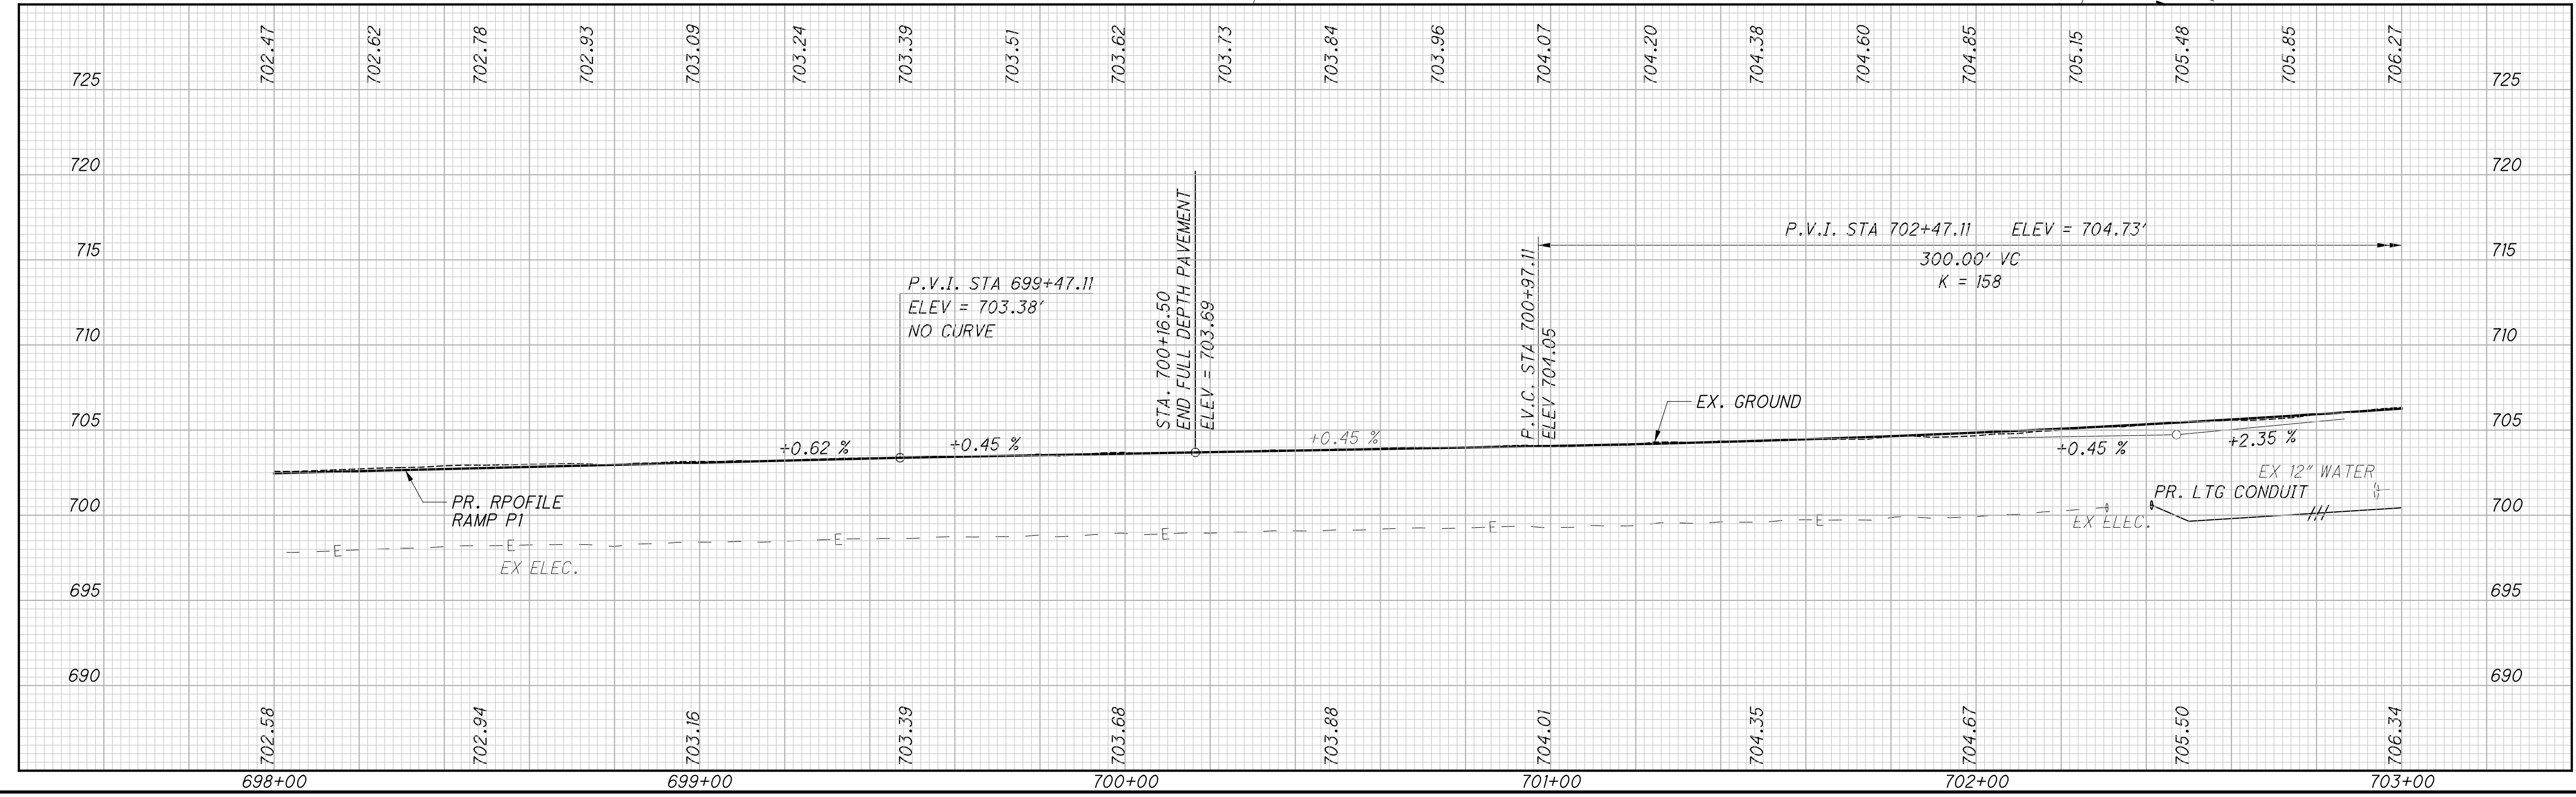


X:\Projects\2013\1010\FRA\92616\roadway\sheet\92616GP407.dgn 4/19/2023 10:28:56 AM cwong


100-YEAR FLOOD PLAIN

(C11) RAMP P2 - 1  
 P.I. STA. 868+58.66  
 $\Delta = 19^\circ 53' 11''$  (LT)  
 $D_c = 5^\circ 30' 00''$   
 $R = 1,041.74'$   
 $T = 182.62'$   
 $L = 361.57'$   
 $E = 15.89'$   
 $C = 359.76'$   
 $C.B. = S 39^\circ 31' 27'' E$   
 $e$  (max) = 0.047

CROSS REFERENCES	
SHEET NO.	DESCRIPTION
5 - 7	☉ REFERENCES & BENCHMARKS
3	☉ CURVE DATA & GEOMETRIC PLAN
85 - 94	ROADWAY QUANTITIES
230 - 231	PLAN AND PROFILE - RAMP P1
259 - 264	CROSS SECTIONS
336	GORE DETAILS

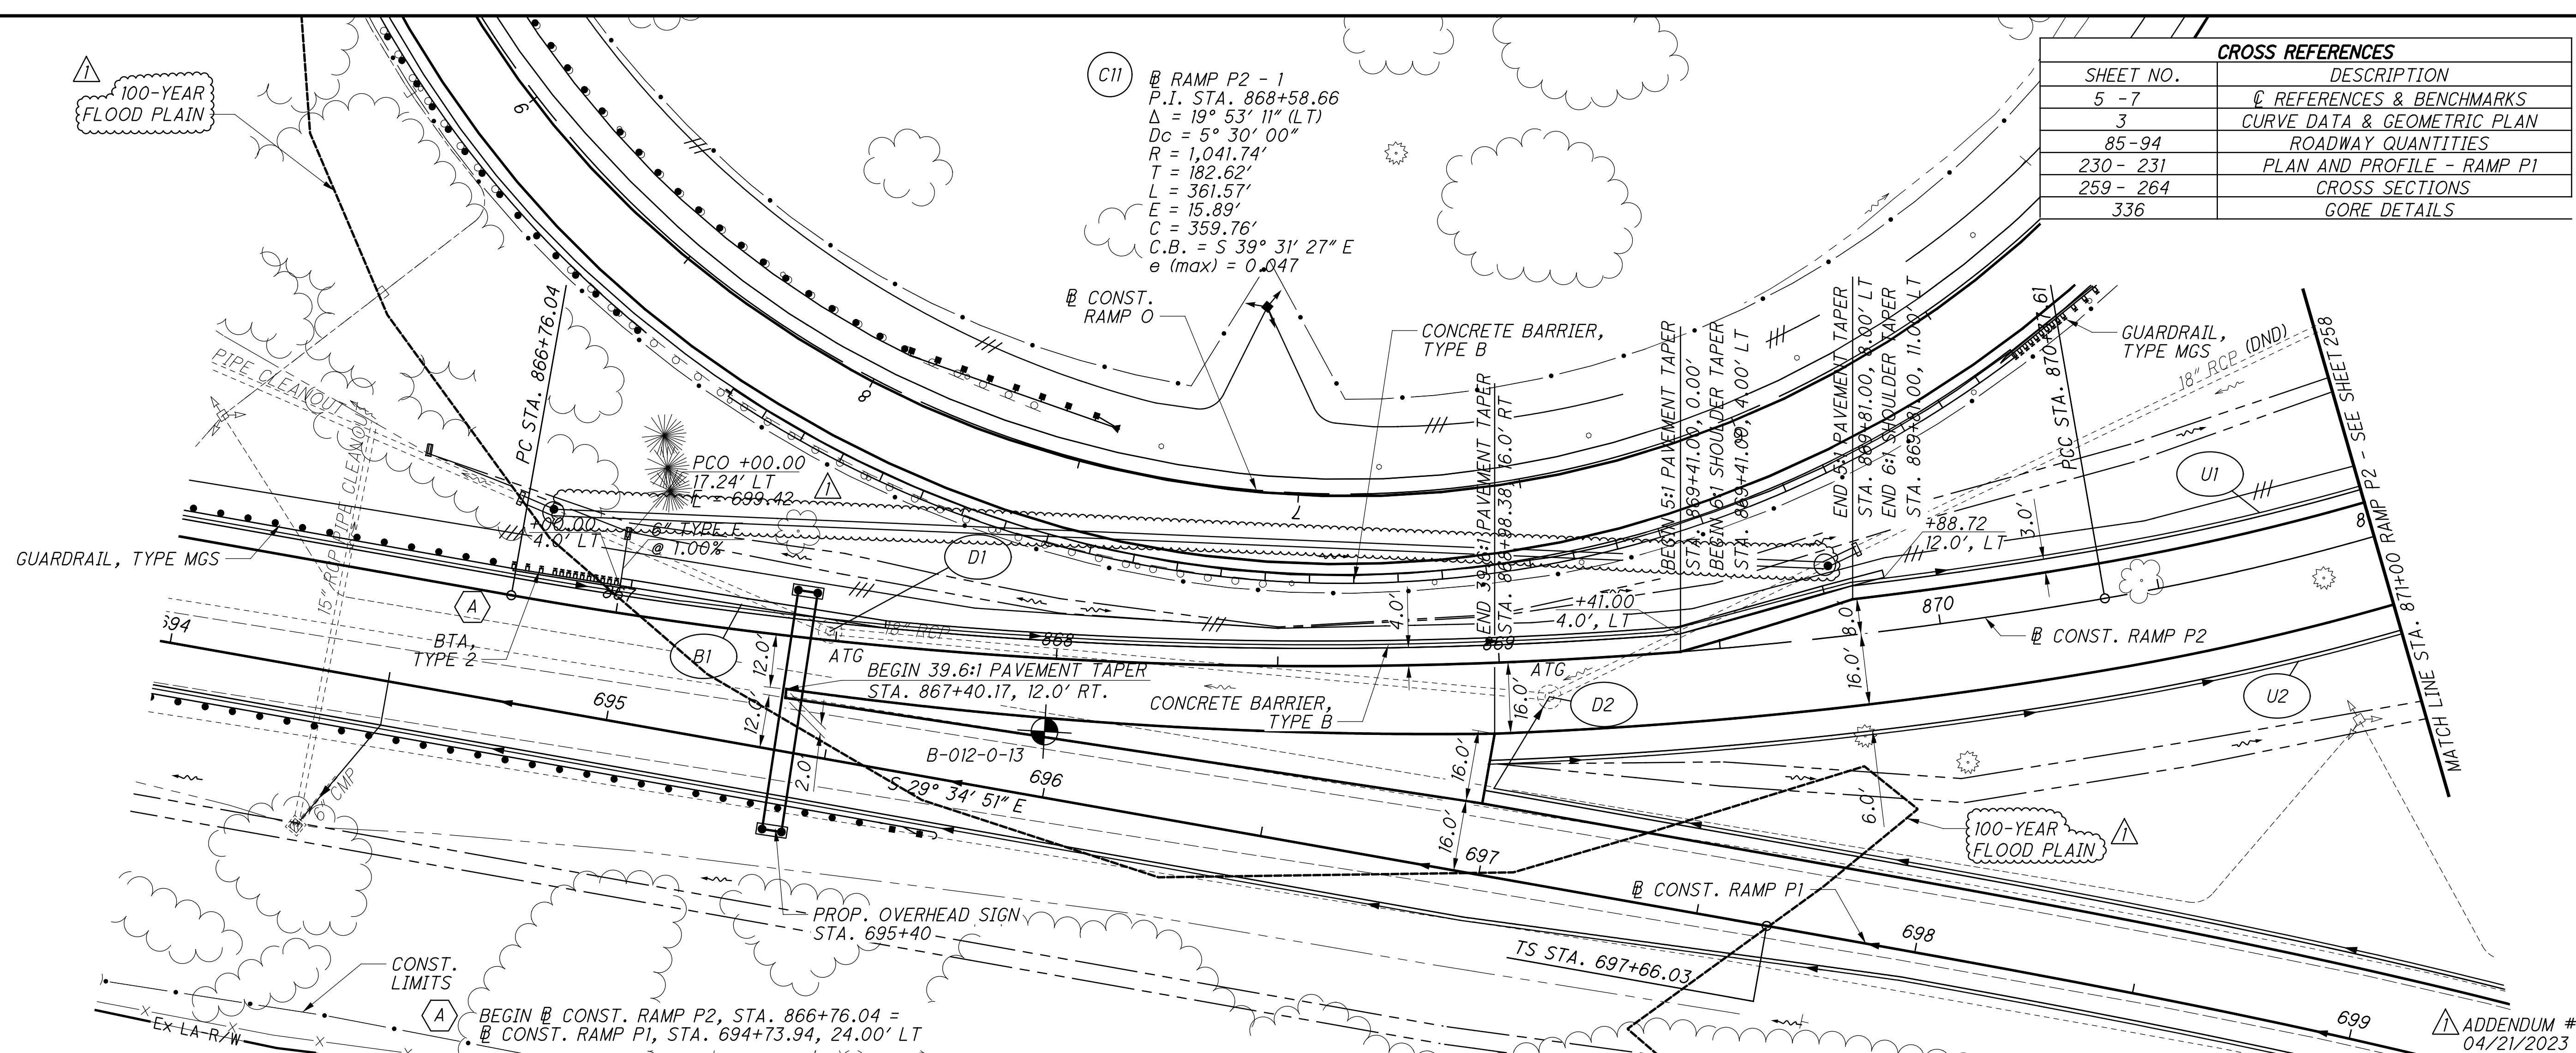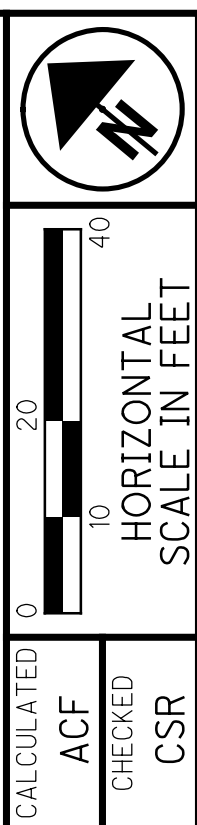

PLAN AND PROFILE - RAMP P2  
 STA. 866+76.04 TO STA. 871+00

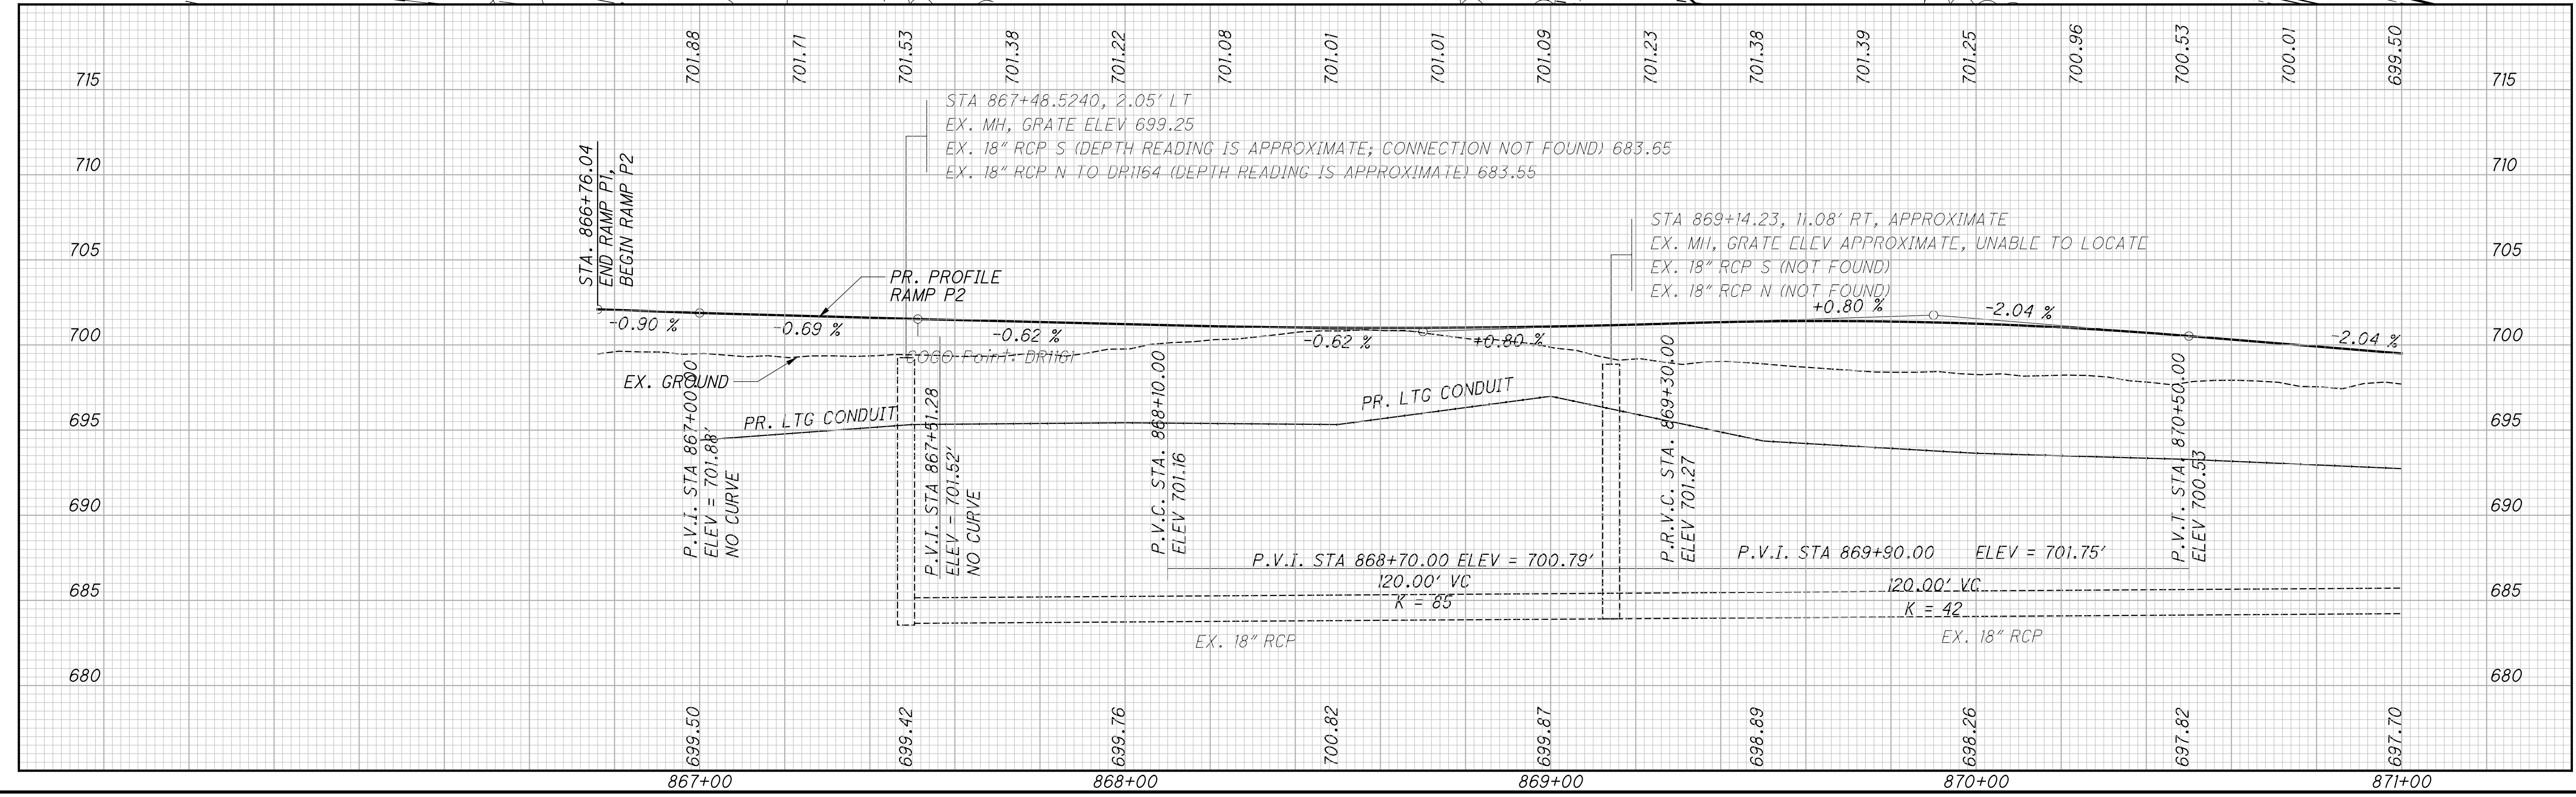

FRA - 270-51.50




X:\Projects\2013\1010\FRA\92616\roadway\sheet\92616GP451.dgn 4/19/2023 11:31:05 AM cwong

ADDENDUM #1  
04/21/2023



X:\Projects\2013\1010\FRA\roadway\sheet\92616\roadway\92616GP452.dgn 4/19/2023 11:33:16 AM c.wong

CROSS REFERENCES	
SHEET NO.	DESCRIPTION
5 - 7	☉ REFERENCES & BENCHMARKS
3	CURVE DATA & GEOMETRIC PLAN
85-94	ROADWAY QUANTITIES
370	CULVERT DETAILS
259-264	CROSS SECTIONS
333	INTERSECTION DETAILS
404	TRAFFIC SIGNAL PLANS

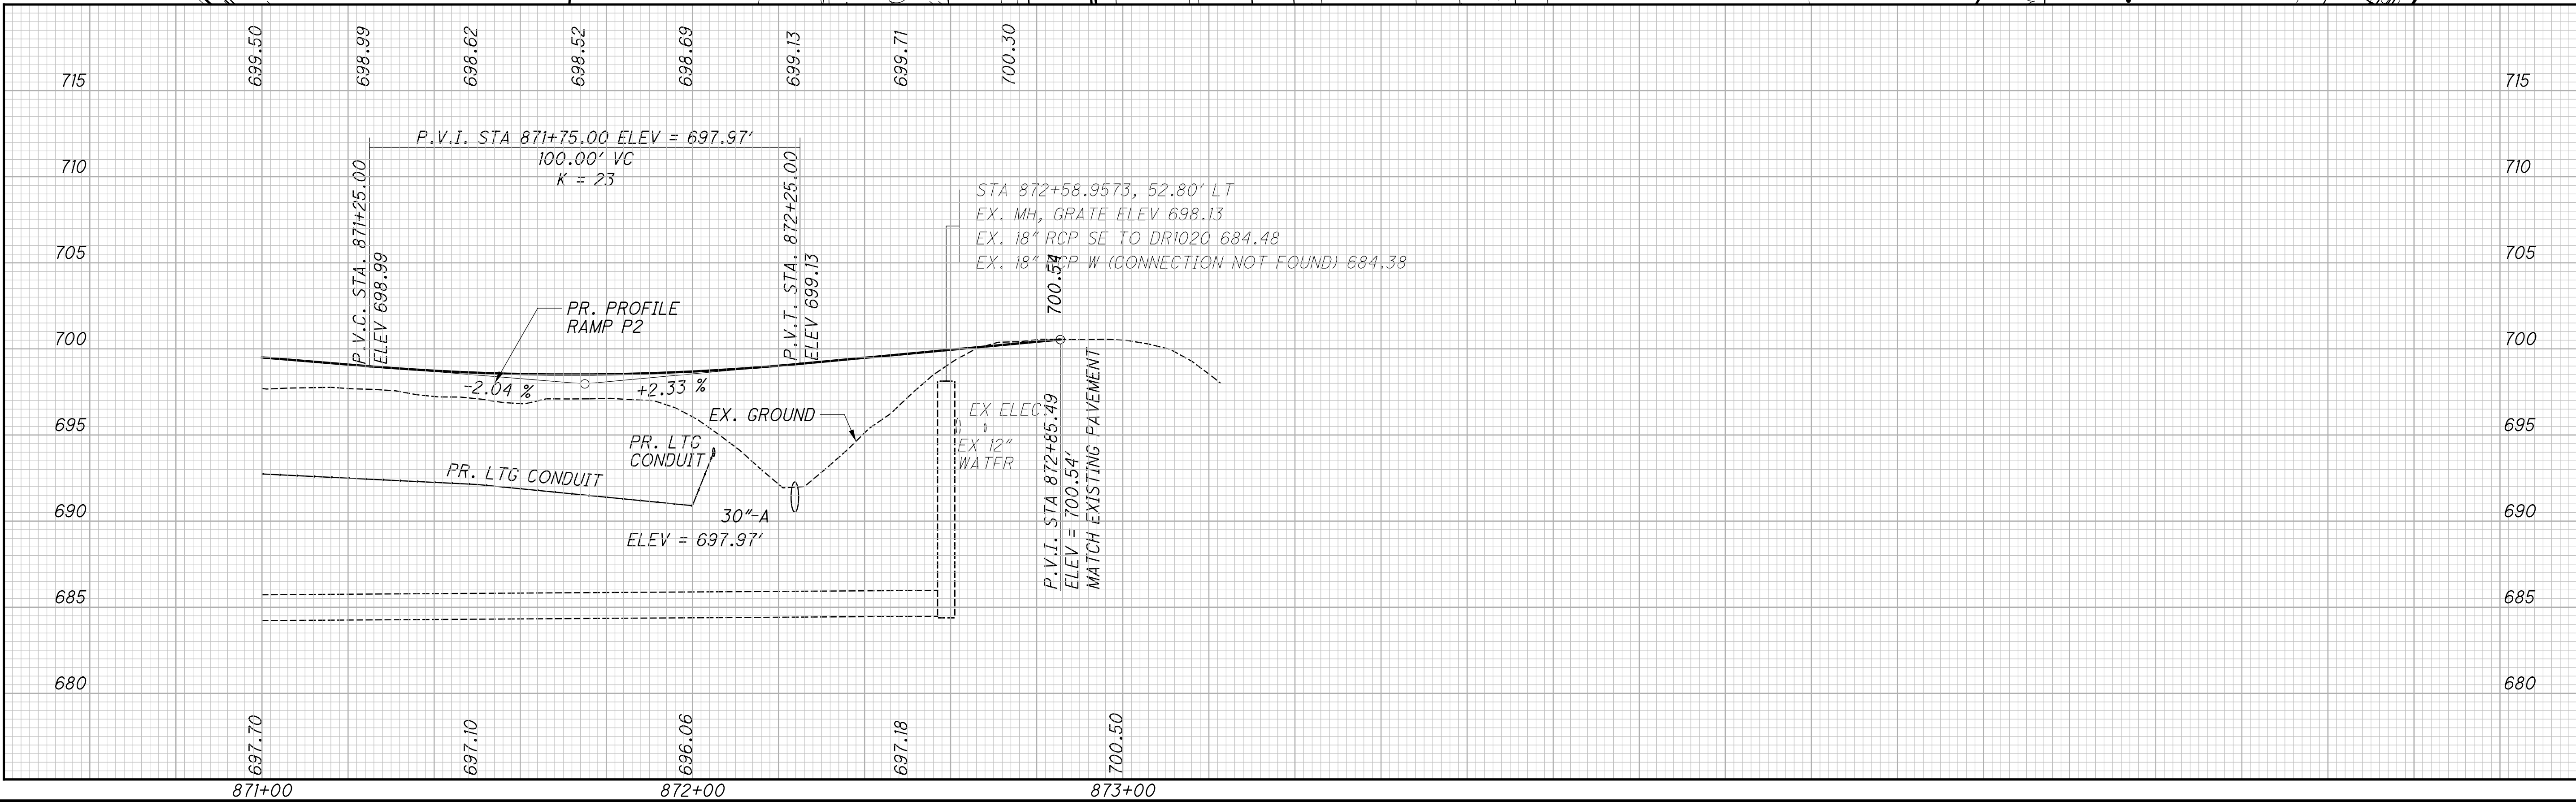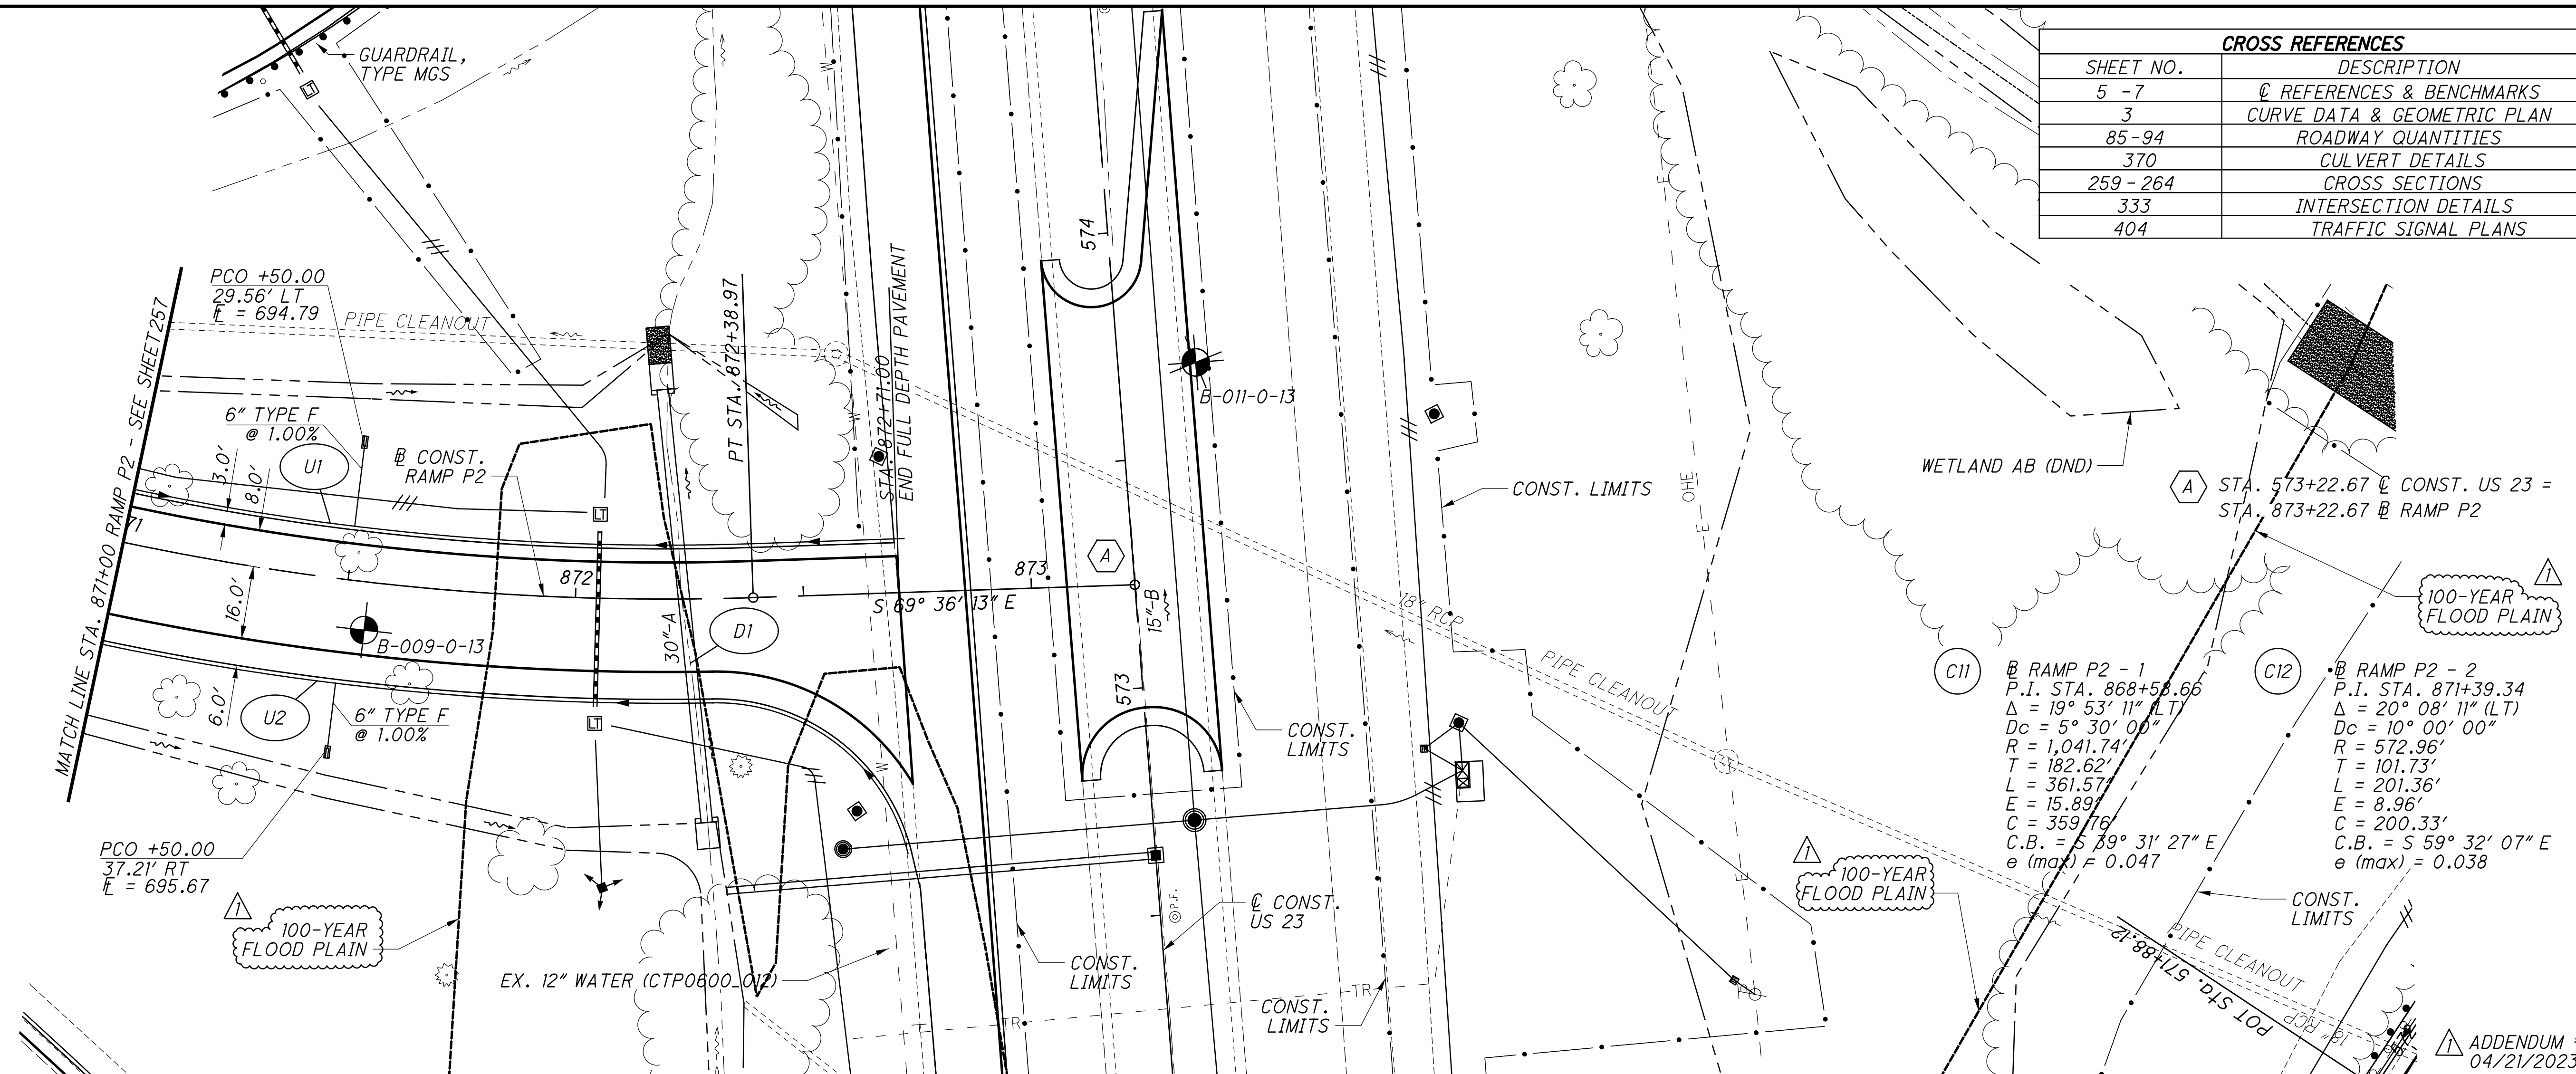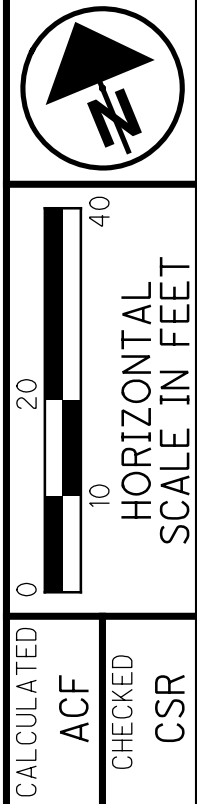

CALCULATED ACF CHECKED CSR


PLAN AND PROFILE - RAMP P2  
STA. 871+00 TO STA. 873+22.67

FRA - 270-51.50

258  
554


ADDENDUM #1  
04/21/2023



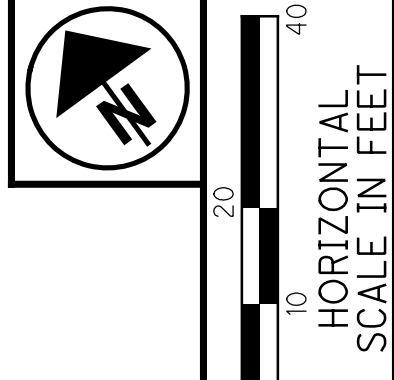

CALCULATED 20  
ACF  
CHECKED  
CSR

**PLAN - RAMP Q**  
**STA. 0+00 TO STA. 8+50**


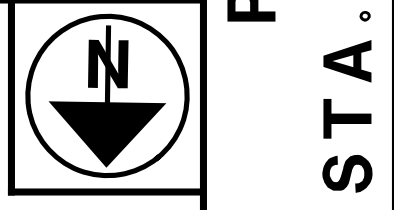


**FRA - 270-51.50**

265  
554


ADDENDUM #1  
04/21/2023

X:\Projects\2013\1321\1010\FRA\92616\roadway\sheet\92616GP501.dgn 4/19/2023 11:35:41 AM cwong

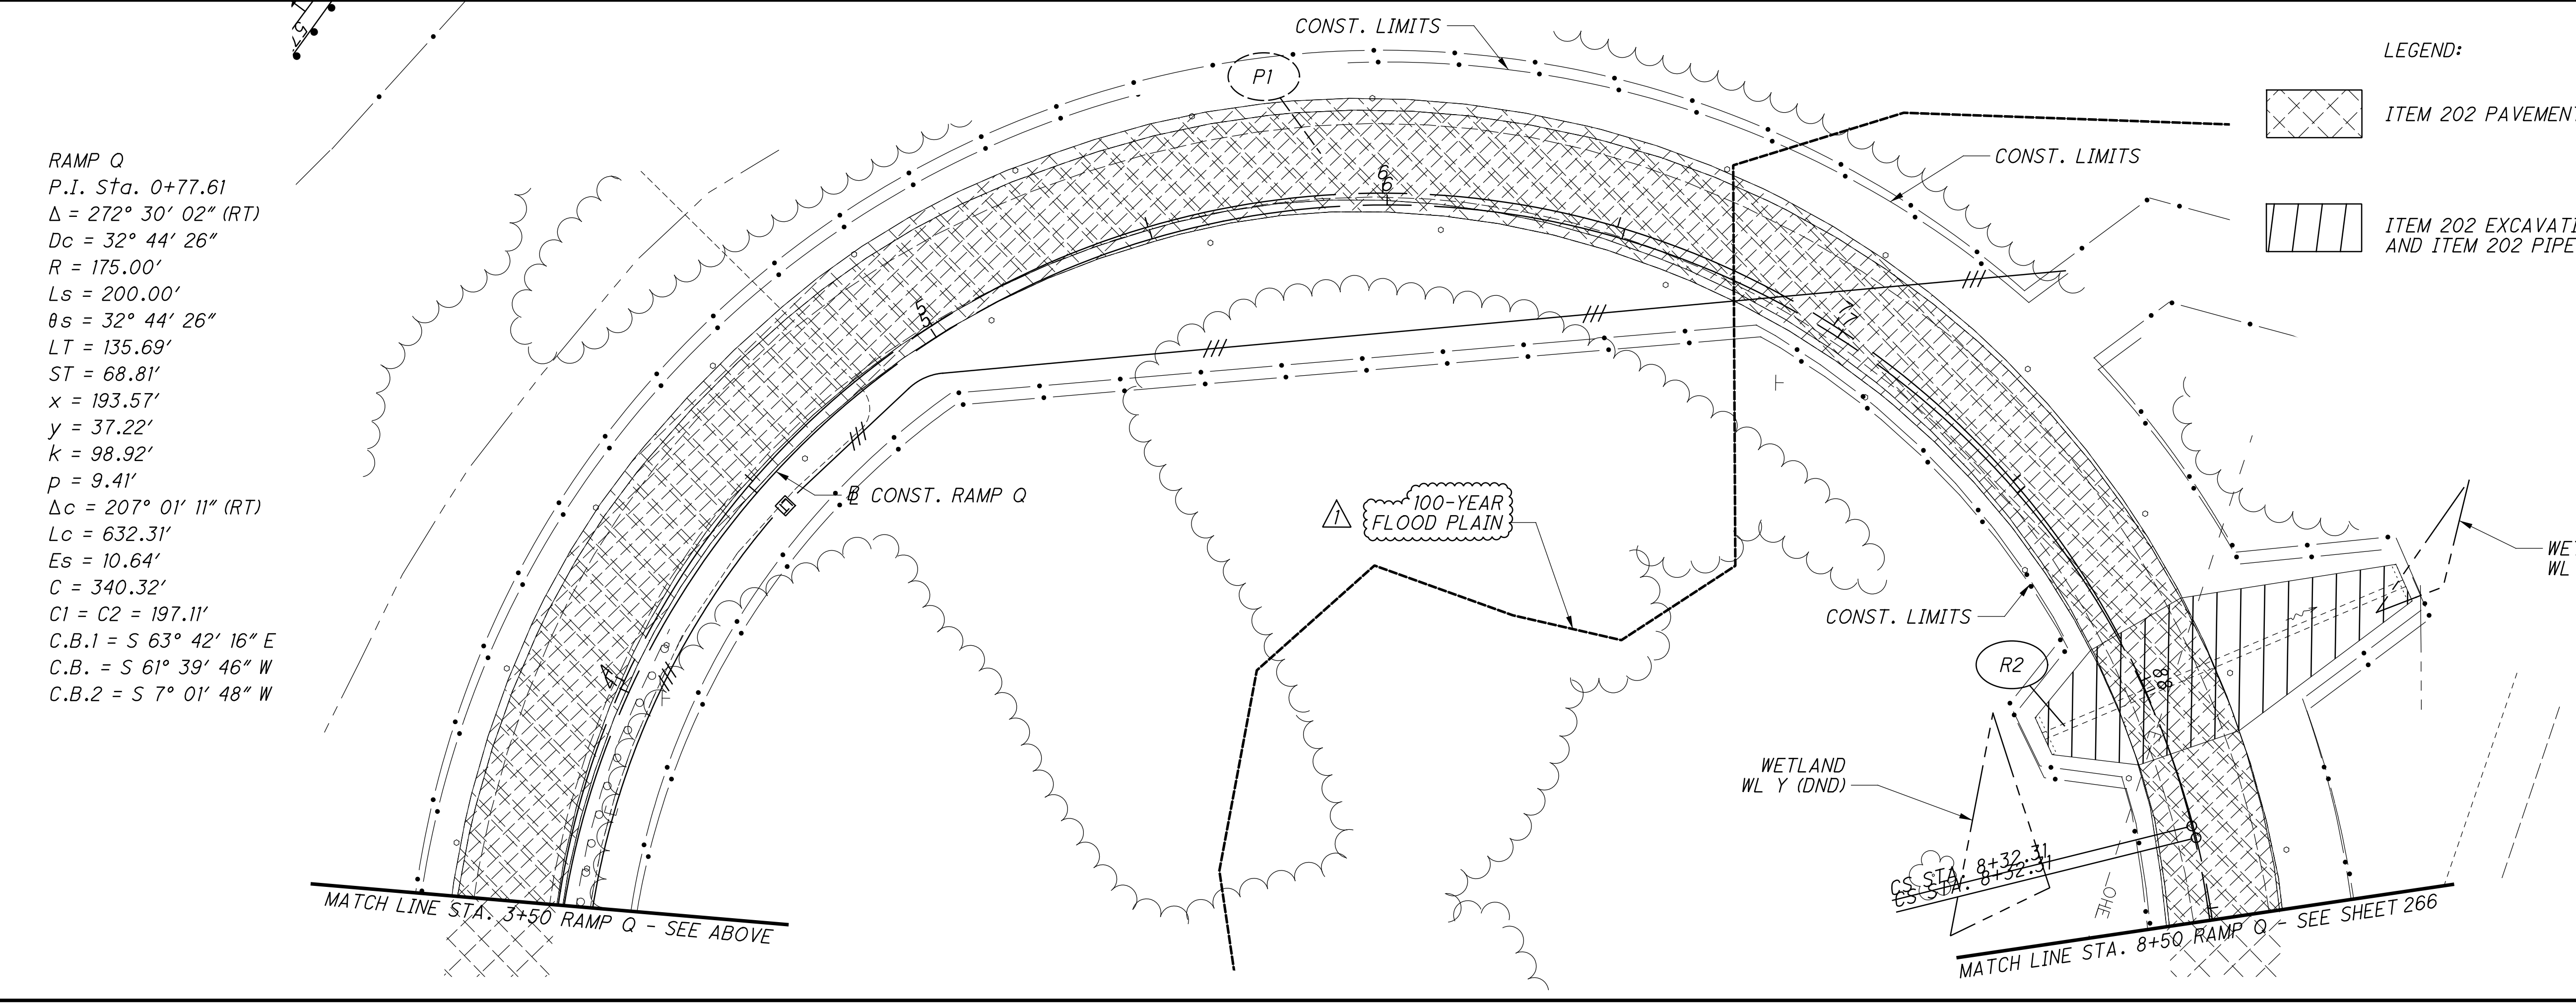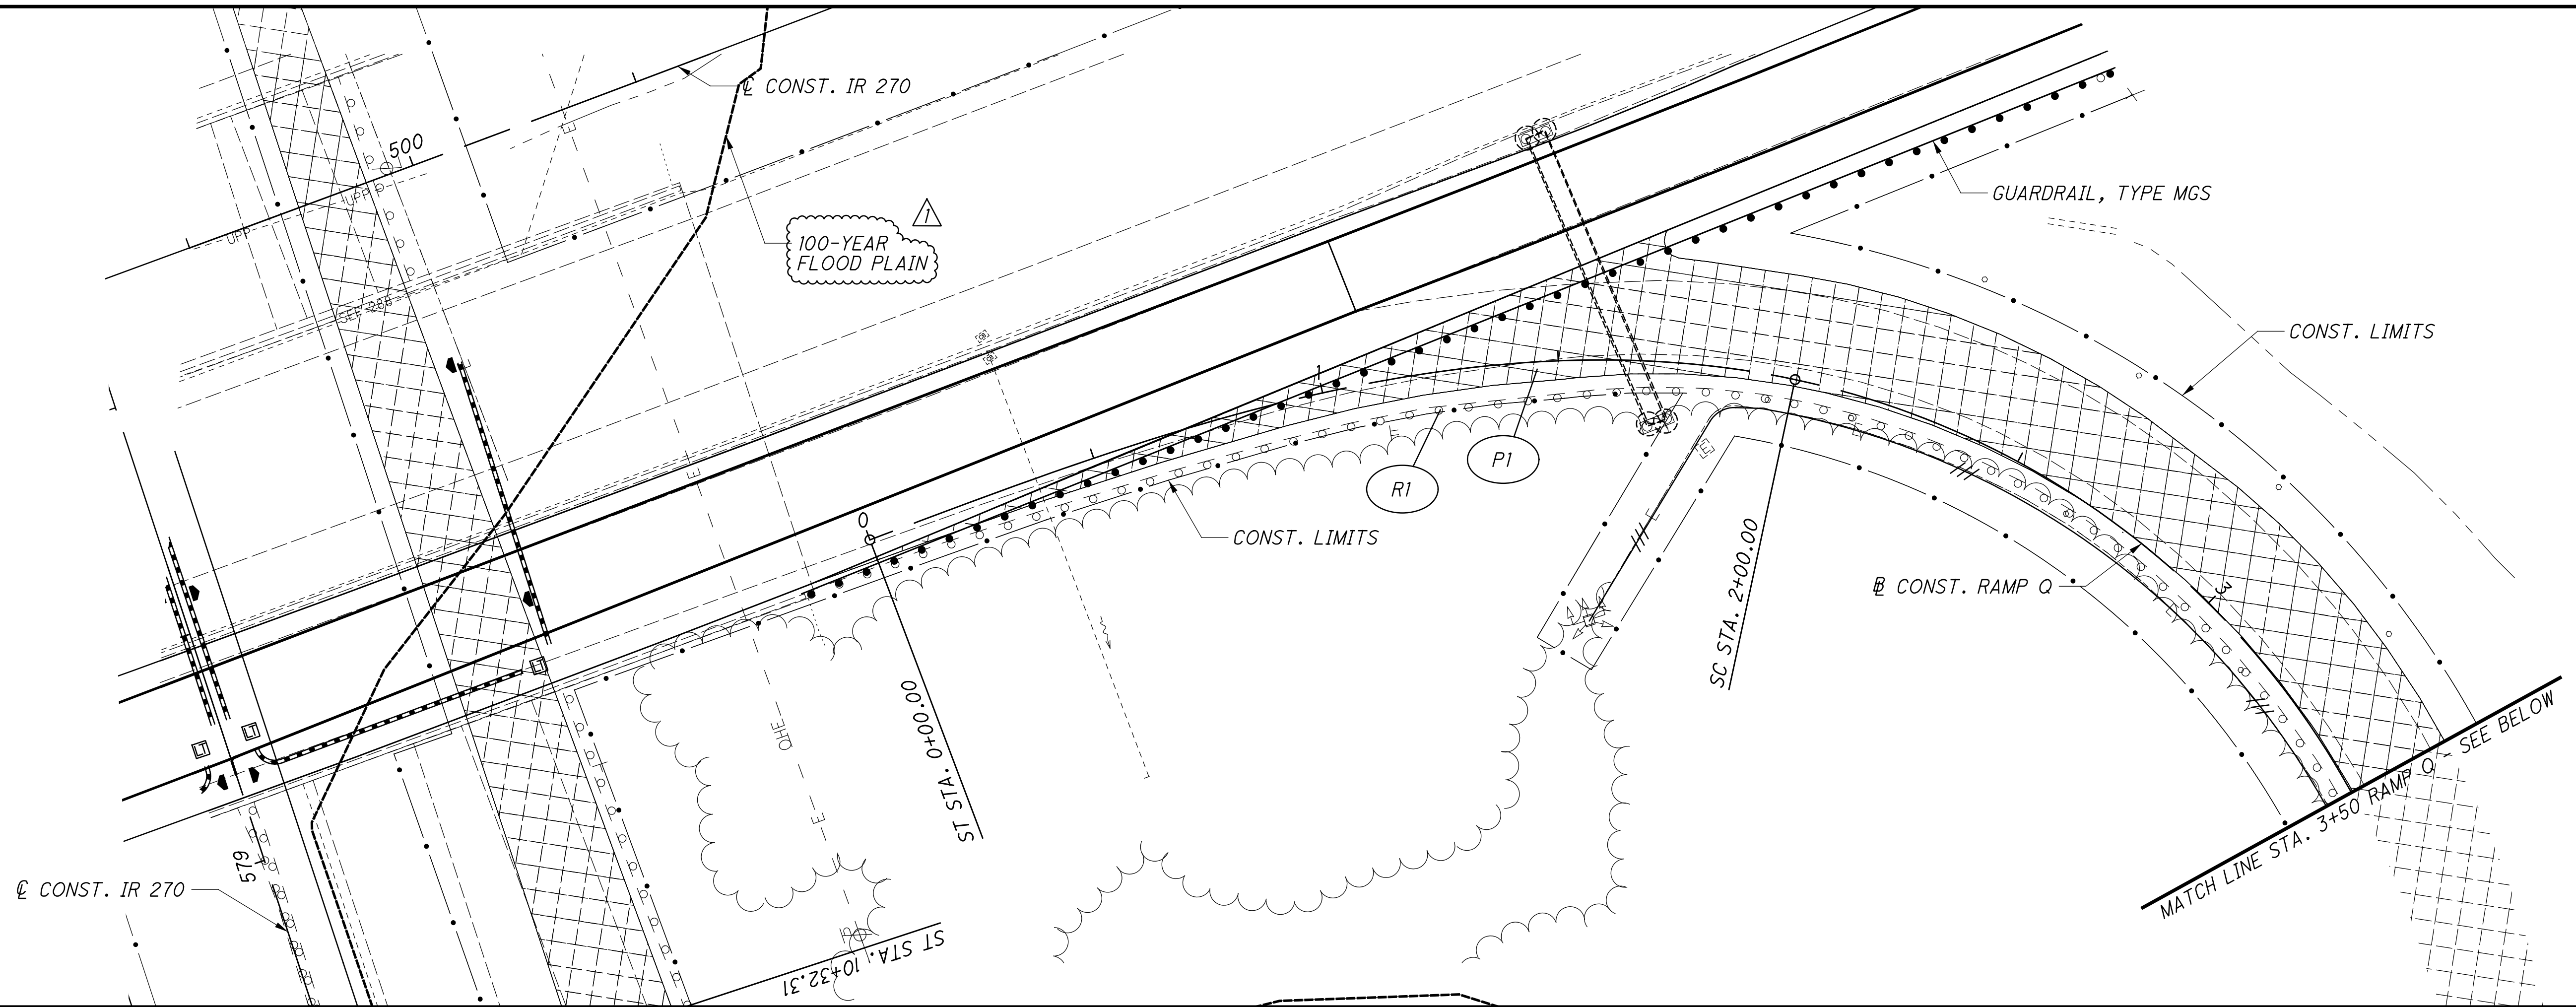


**RAMP Q**  
 P.I. Sta. 0+77.61  
 $\Delta = 272^\circ 30' 02''$  (RT)  
 $Dc = 32^\circ 44' 26''$   
 $R = 175.00'$   
 $Ls = 200.00'$   
 $\theta s = 32^\circ 44' 26''$   
 $LT = 135.69'$   
 $ST = 68.81'$   
 $x = 193.57'$   
 $y = 37.22'$   
 $k = 98.92'$   
 $p = 9.41'$   
 $\Delta c = 207^\circ 01' 11''$  (RT)  
 $Lc = 632.31'$   
 $Es = 10.64'$   
 $C = 340.32'$   
 $C1 = C2 = 197.11'$   
 $C.B.1 = S 63^\circ 42' 16'' E$   
 $C.B. = S 61^\circ 39' 46'' W$   
 $C.B.2 = S 7^\circ 01' 48'' W$

**LEGEND:**  
 ITEM 202 PAVEMENT REMOVED  
 ITEM 202 EXCAVATION AND ITEM 202 PIPE REMOVED

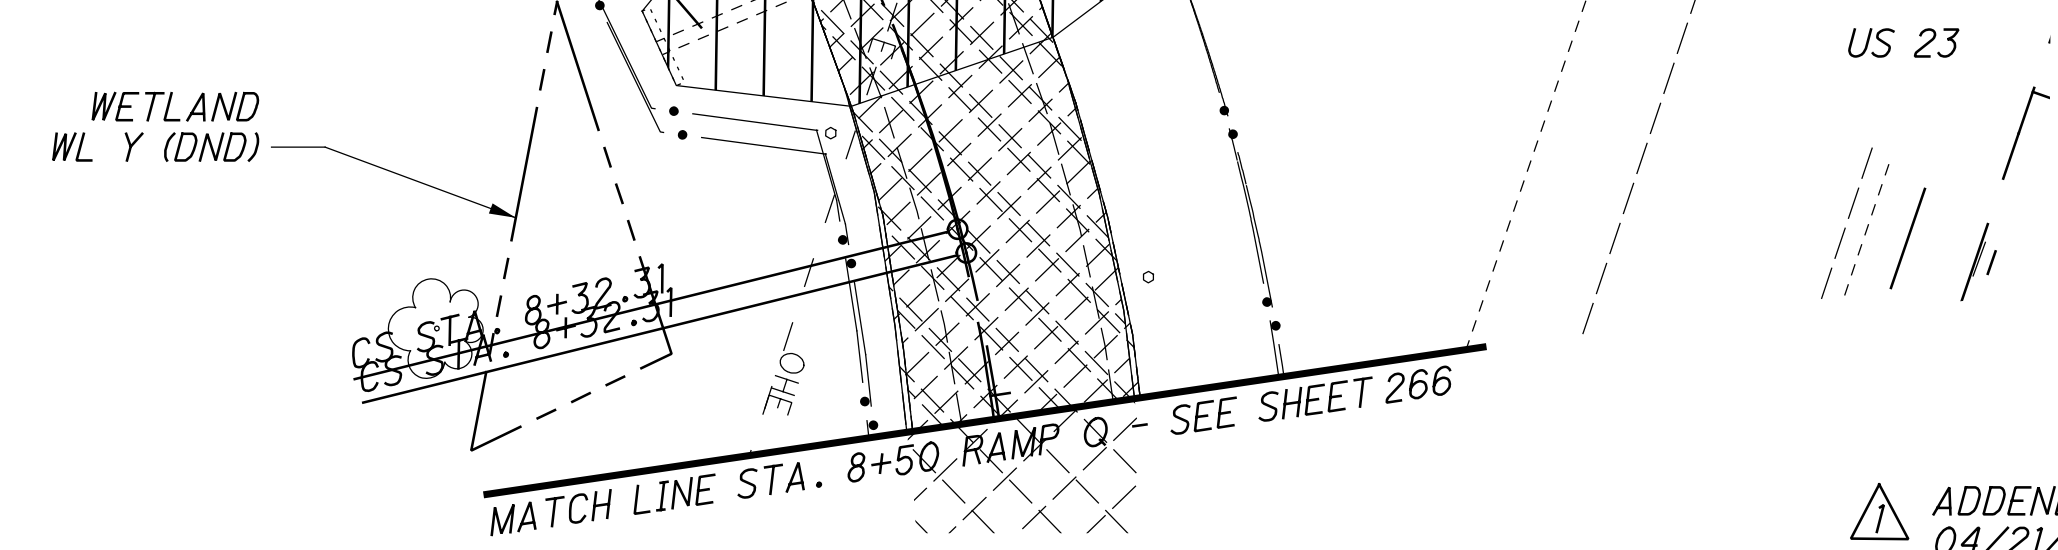


X:\Projects\2013\1321\1010\FRA\92616\roadway\sheets\92616GP502.dgn 4/19/2023 11:38:09 AM cwong

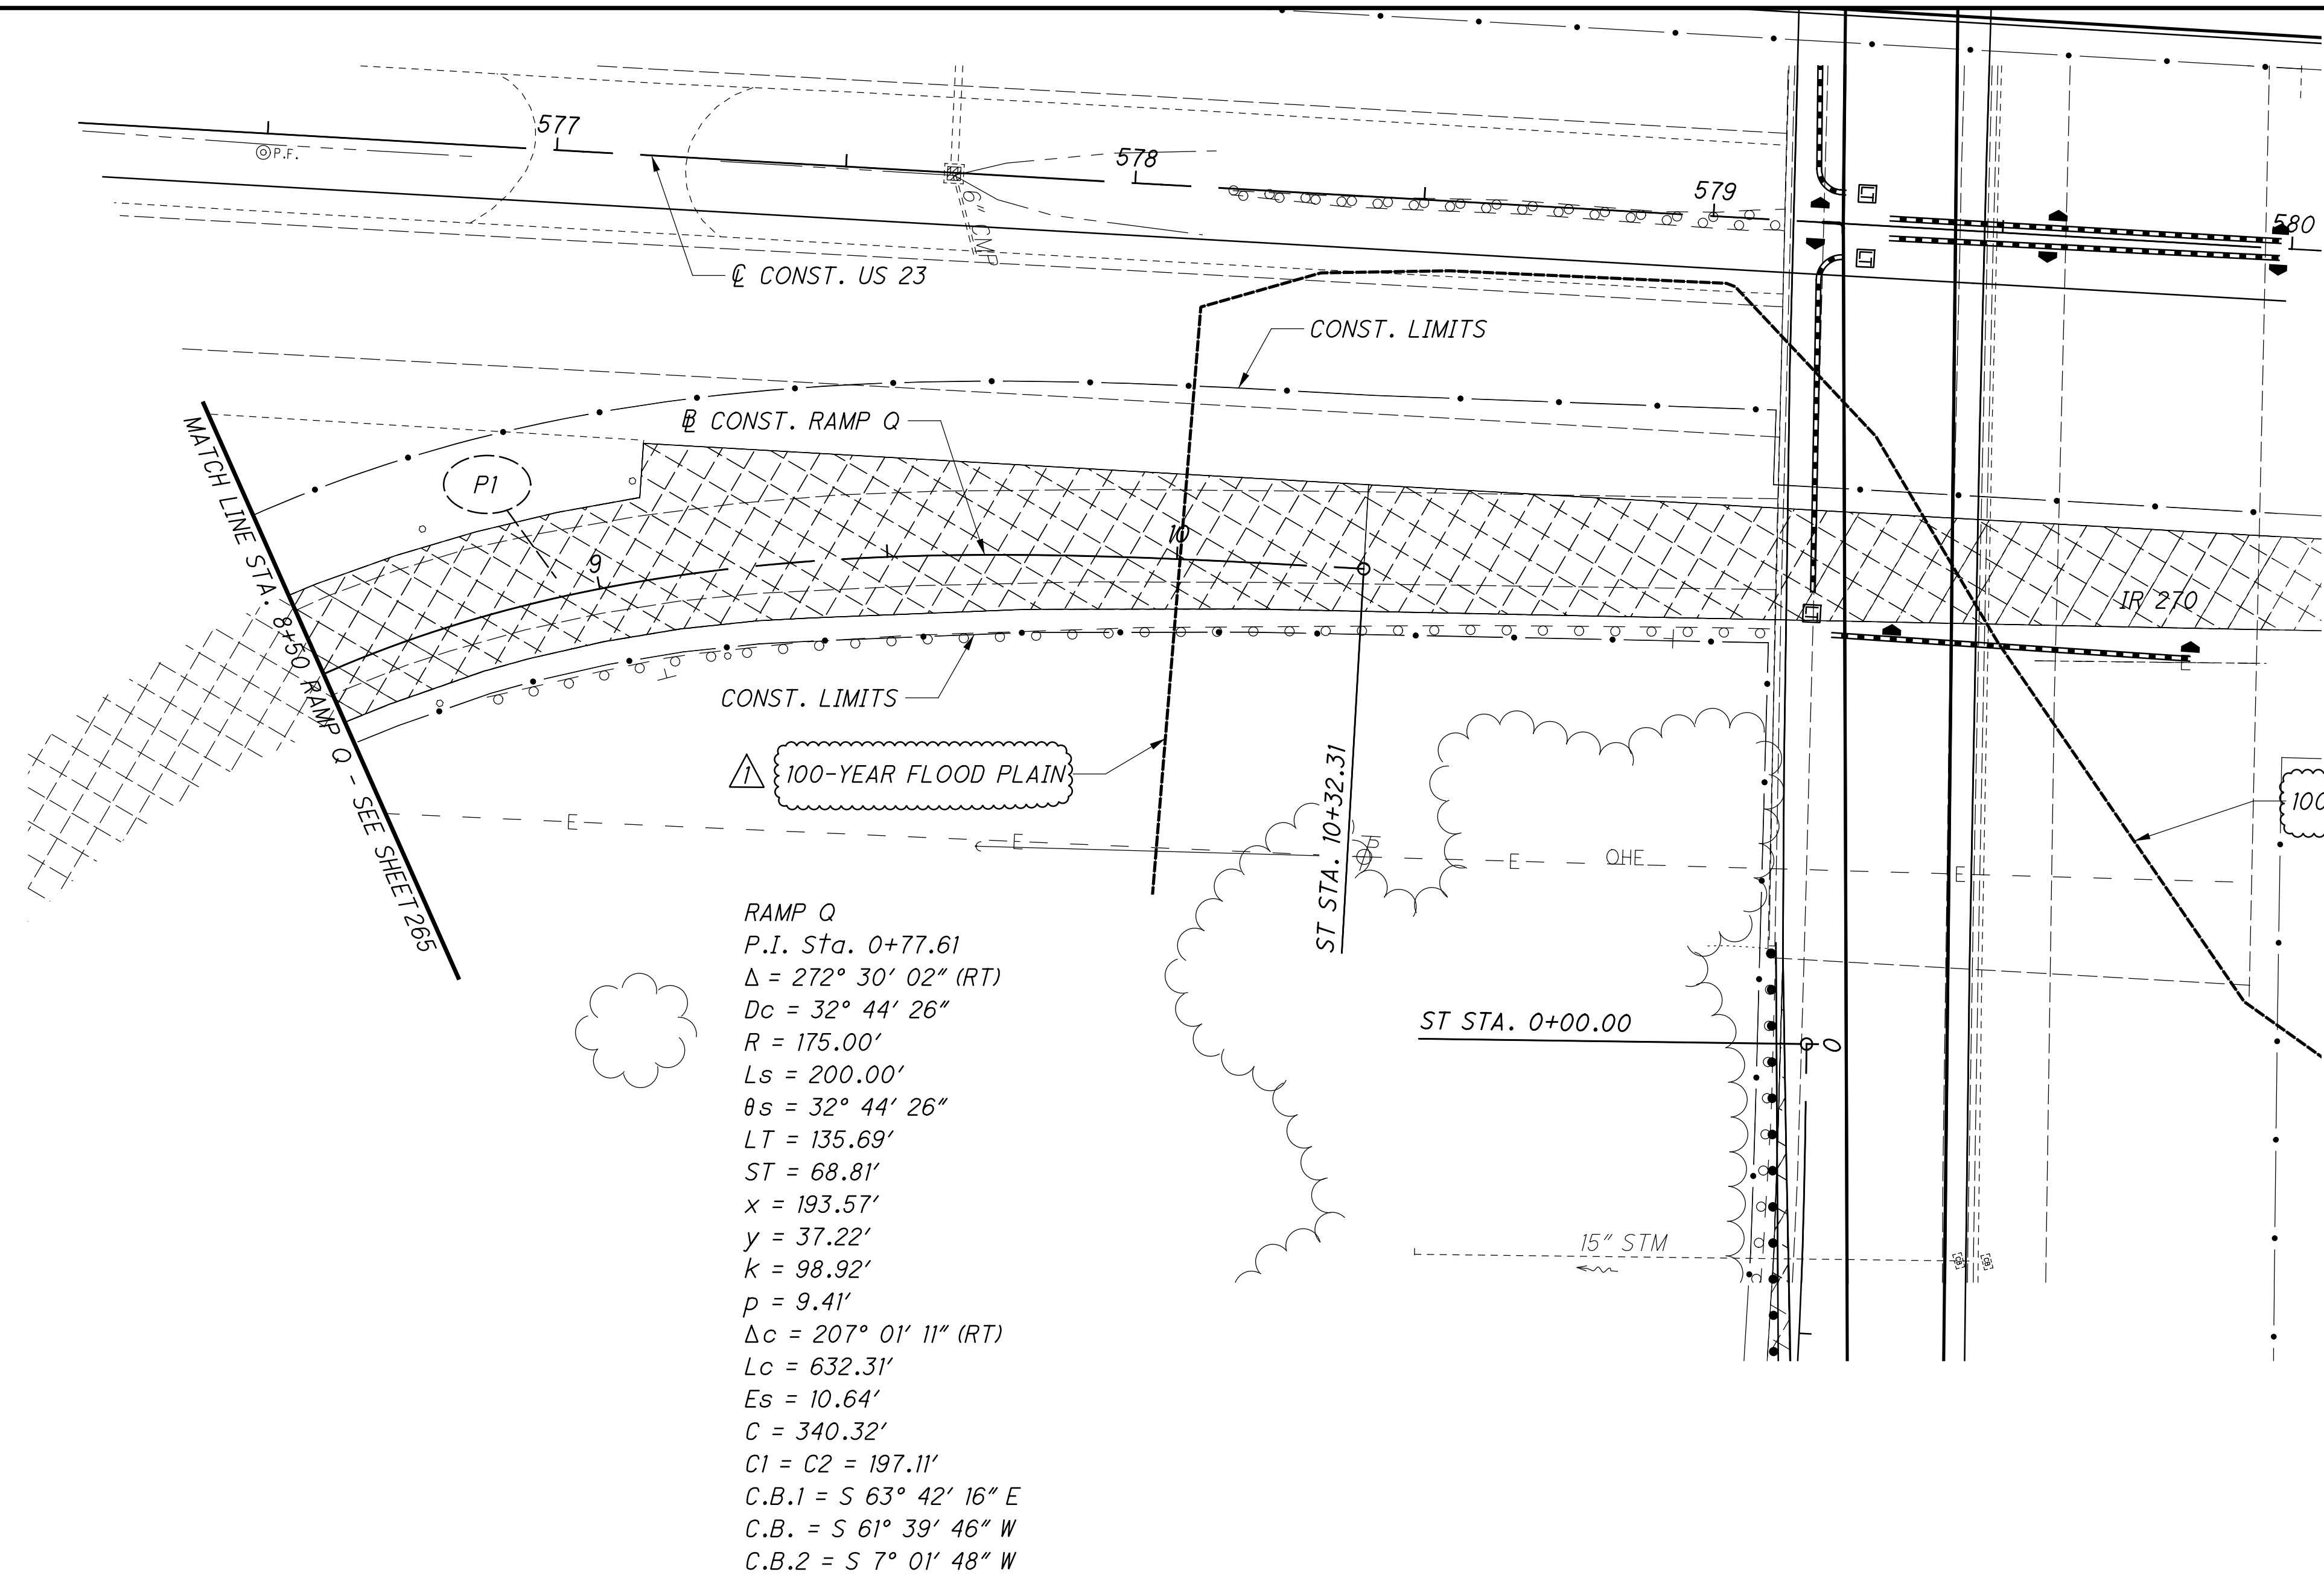

RAMP Q  
 P.I. Sta. 0+77.61  
 $\Delta = 272^\circ 30' 02''$  (RT)  
 $Dc = 32^\circ 44' 26''$   
 $R = 175.00'$   
 $Ls = 200.00'$   
 $\theta s = 32^\circ 44' 26''$   
 $LT = 135.69'$   
 $ST = 68.81'$   
 $x = 193.57'$   
 $y = 37.22'$   
 $k = 98.92'$   
 $p = 9.41'$   
 $\Delta c = 207^\circ 01' 11''$  (RT)  
 $Lc = 632.31'$   
 $Es = 10.64'$   
 $C = 340.32'$   
 $C1 = C2 = 197.11'$   
 $C.B.1 = S 63^\circ 42' 16'' E$   
 $C.B. = S 61^\circ 39' 46'' W$   
 $C.B.2 = S 7^\circ 01' 48'' W$

LEGEND:

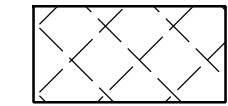 ITEM 202 PAVEMENT REMOVED

CROSS REFERENCES	
SHEET NO.	DESCRIPTION
174	PLAN - US 23

CALCULATED ACF CHECKED CSR

0 10 20 40  
 HORIZONTAL SCALE IN FEET




PLAN - RAMP Q  
 STA. 8+50 TO STA. 10+32.31




FRA - 270-51.50

266  
554

ADDENDUM #1  
04/21/2023

X:\Projects\2013\1010\FRA\92616\roadway\sheet\92616GP552.dgn 4/19/2023 11:42:57 AM cwong

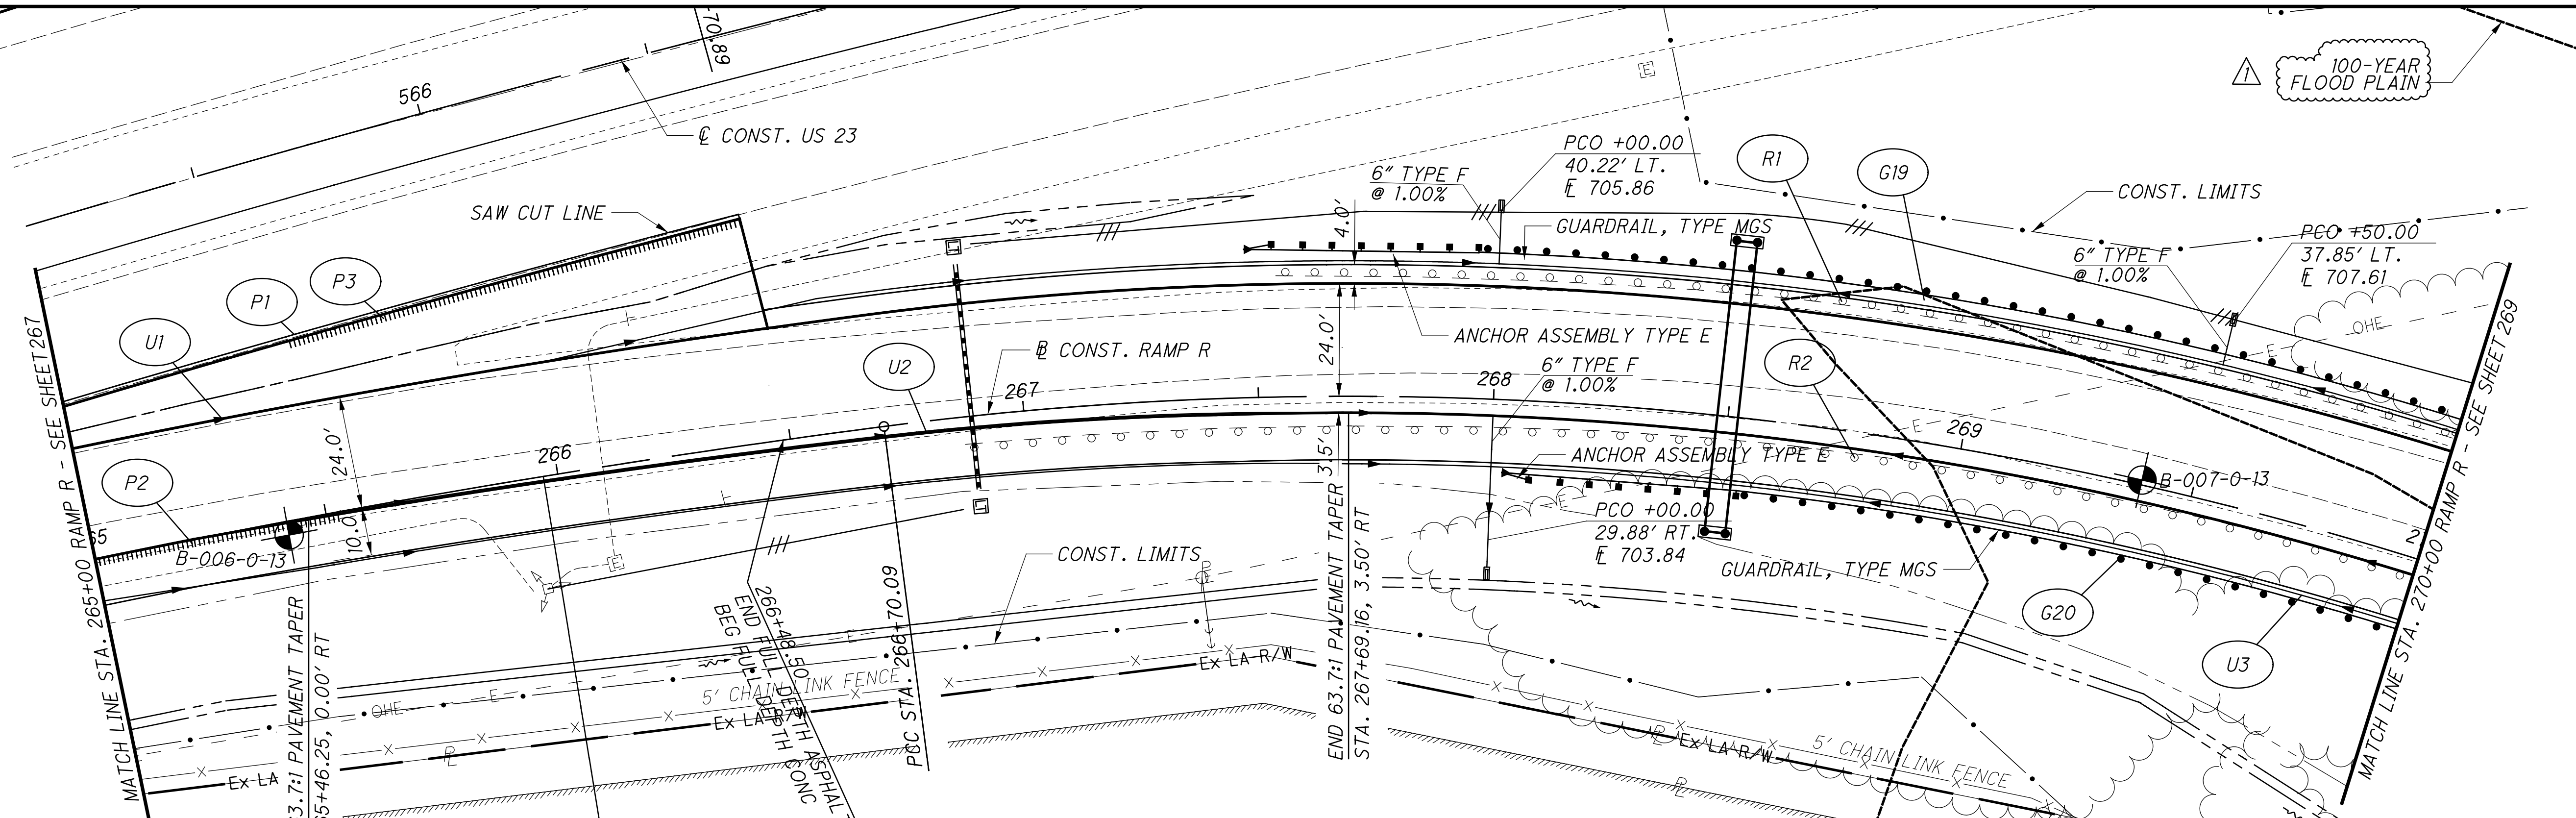

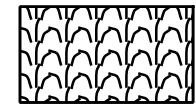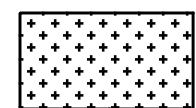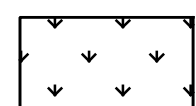
-  ITEM 670 - DITCH EROSION CONTROL PROTECTION MAT
-  ITEM 836 - TURF REINFORCING MAT, TYPE 1
-  ITEM 836 - TURF REINFORCING MAT, TYPE 2

- (C1) **RAMP R1 - 1**  
 P.I. STA. 263+44.63  
 $\Delta = 16^\circ 23' 08''$  (RT)  
 $D_c = 2^\circ 30' 00''$   
 $R = 2,291.83'$   
 $T = 329.97'$   
 $L = 655.43'$   
 $E = 23.63'$   
 $C = 653.20'$   
 C.B. =  $N 8^\circ 46' 00'' E$   
 $e$  (max) = 0.035
- (C2) **RAMP R - 2**  
 P.I. STA. 269+39.51  
 $\Delta = 38^\circ 51' 07''$  (RT)  
 $D_c = 7^\circ 30' 00''$   
 $R = 763.94'$   
 $T = 329.97'$   
 $L = 269.42'$   
 $E = 46.11'$   
 $C = 508.16'$   
 C.B. =  $N 36^\circ 23' 08'' E$   
 $e$  (max) = 0.054


PFK COMPANY II, LLC, A DELAWARE LIMITED LIABILITY COMPANY (1/2 INTER) AND TAMARACK ENTERPRISES II, L.P., A DELAWARE LIMITED PARTNERSHIP (1/2 INTER)  
 510-181566  
 S HIGH ST

CROSS REFERENCES	
SHEET NO.	DESCRIPTION
5 - 7	REFERENCES & BENCHMARKS
3	CURVE DATA & GEOMETRIC PLAN
85 - 94	ROADWAY QUANTITIES
273 - 300	CROSS SECTIONS
337 - 338	GORE DETAILS

ADDENDUM #1  
 04/21/2023



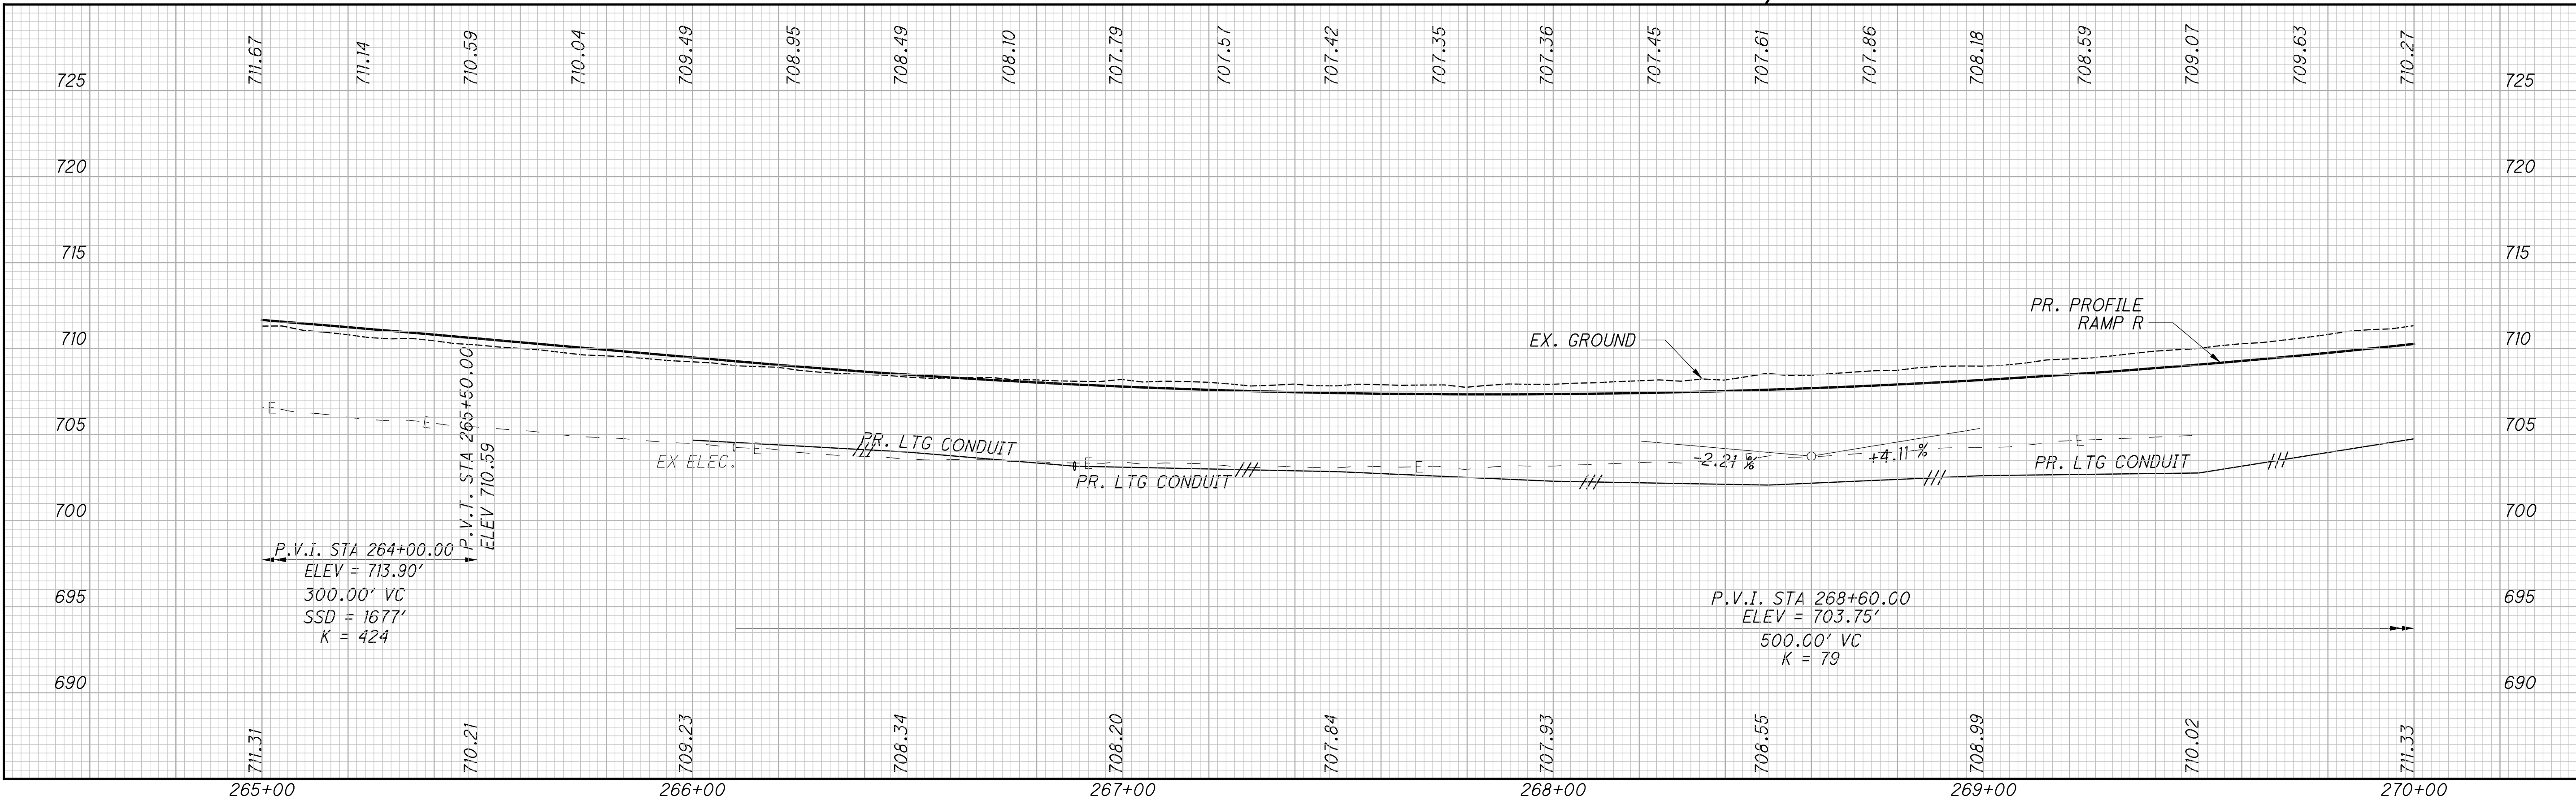


**PLAN AND PROFILE - RAMP R**  
**STA. 265+00 TO STA. 270+00**  
**FRA - 270-51.50**  
 268  
 554

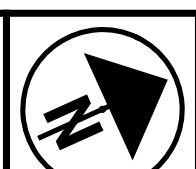CALCULATED: CSR  
 ACF: CSR  
 CHECKED: CSR  
 HORIZONTAL SCALE IN FEET: 1" = 40'  




CROSS REFERENCES	
SHEET NO.	DESCRIPTION
5 - 7	☑ REFERENCES & BENCHMARKS
3	CURVE DATA & GEOMETRIC PLAN
85 - 94	ROADWAY QUANTITIES
372	CULVERT DETAILS
273 - 300	CROSS SECTIONS
338	GORE DETAILS

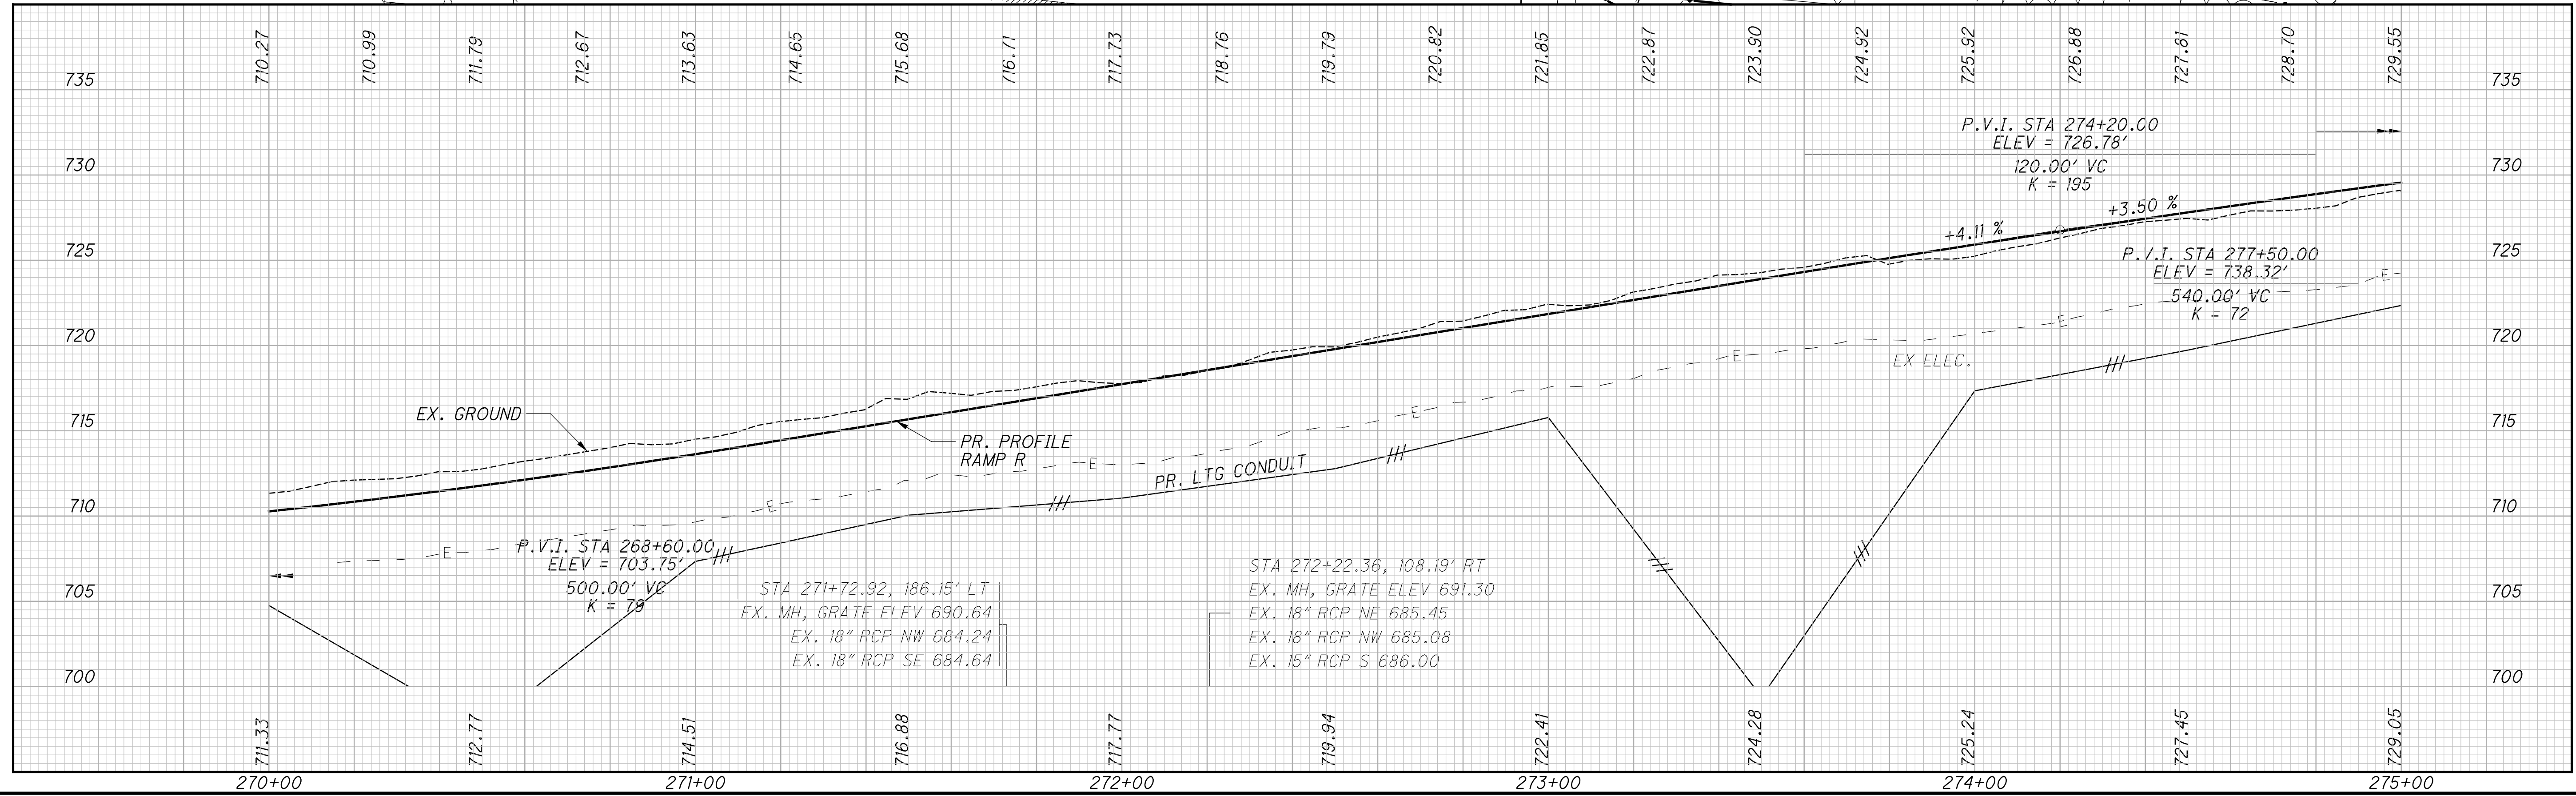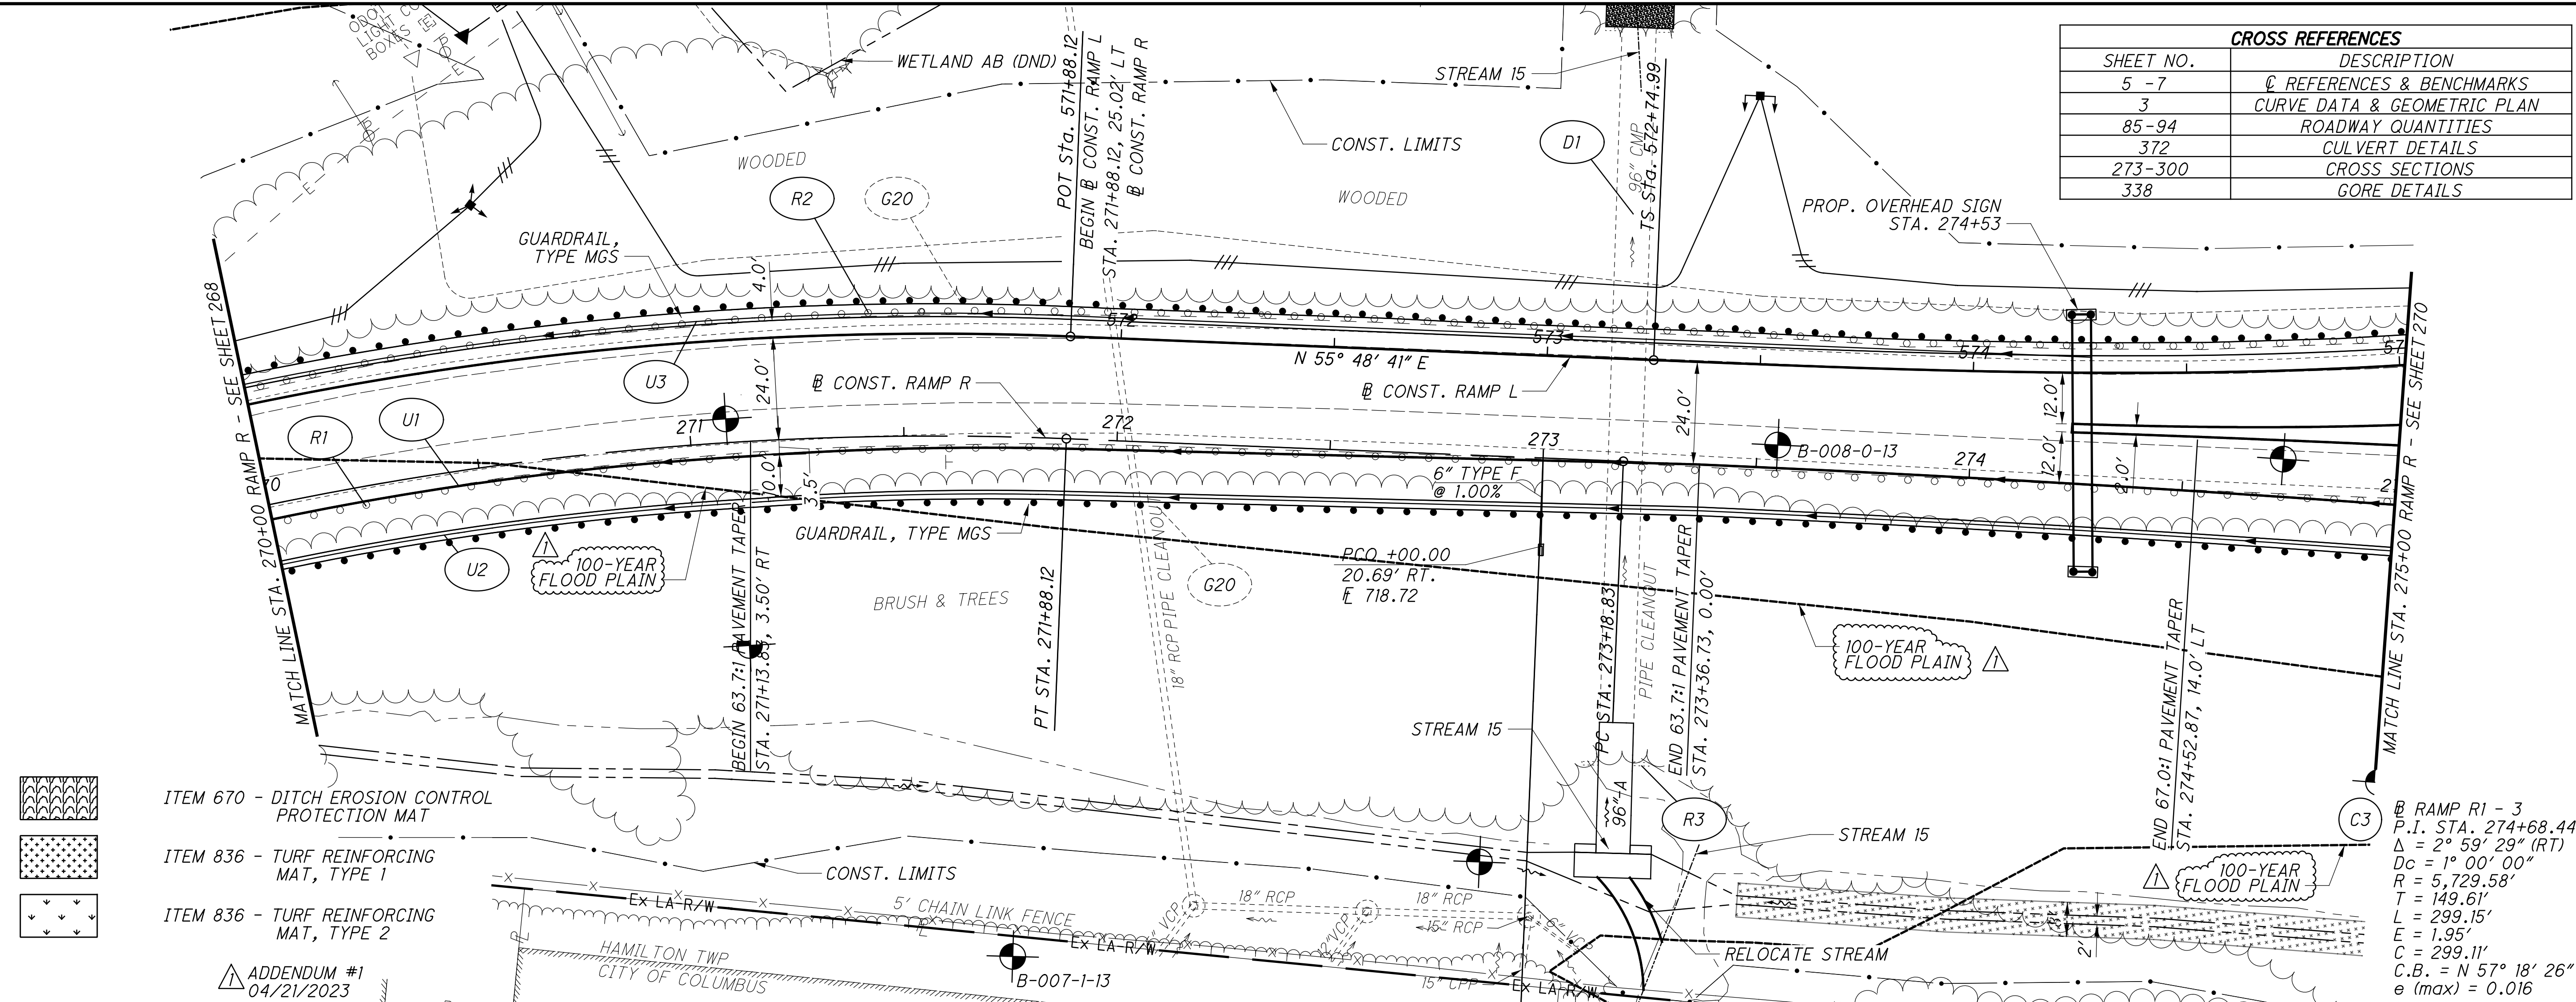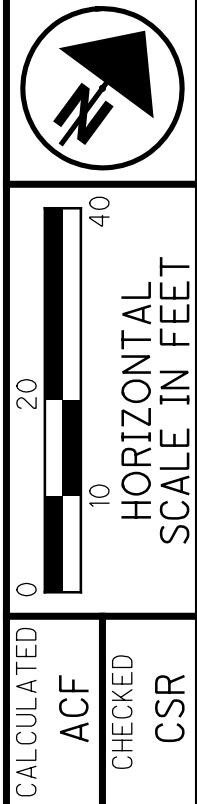

- ITEM 670 - DITCH EROSION CONTROL PROTECTION MAT
- ITEM 836 - TURF REINFORCING MAT, TYPE 1
- ITEM 836 - TURF REINFORCING MAT, TYPE 2
- ADDENDUM #1  
04/21/2023



B RAMP R1 - 3  
 P.I. STA. 274+68.44  
 $\Delta = 2^\circ 59' 29''$  (RT)  
 $D_c = 1^\circ 00' 00''$   
 $R = 5,729.58'$   
 $T = 149.61'$   
 $L = 299.15'$   
 $E = 1.95'$   
 $C = 299.11'$   
 $C.B. = N 57^\circ 18' 26''$   
 $e$  (max) = 0.016




**PLAN AND PROFILE - RAMP R**  
**STA. 270+00 TO STA. 275+00**


**FRA - 270-51.50**

X:\Projects\2013\1010\FRA\92616\roadway\sheet\92616GP554.dgn 4/19/2023 12:01:23 PM cwong

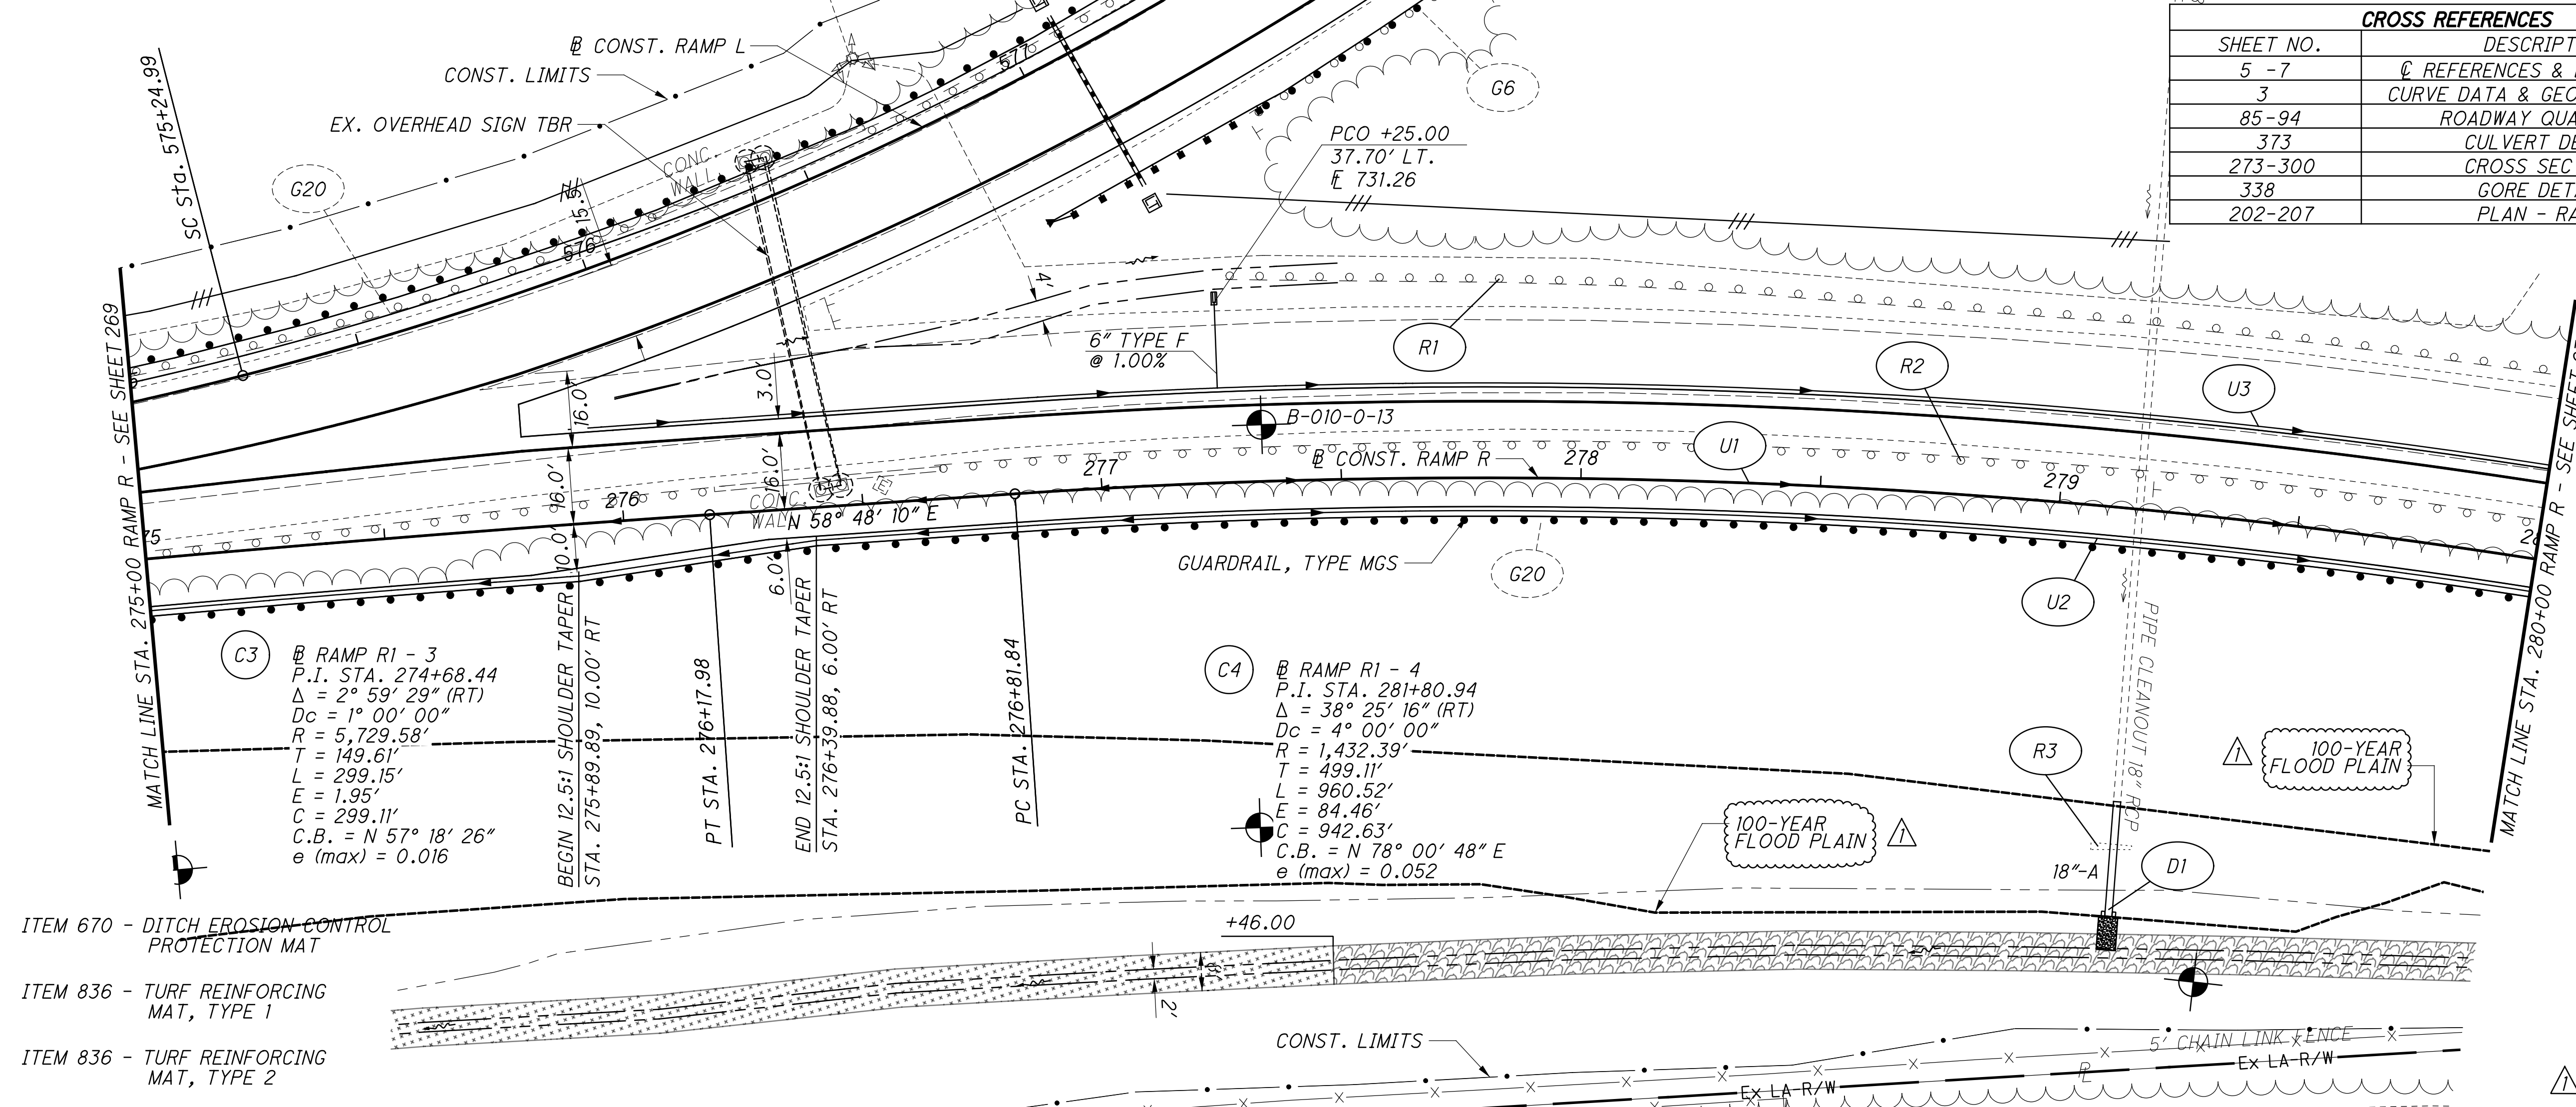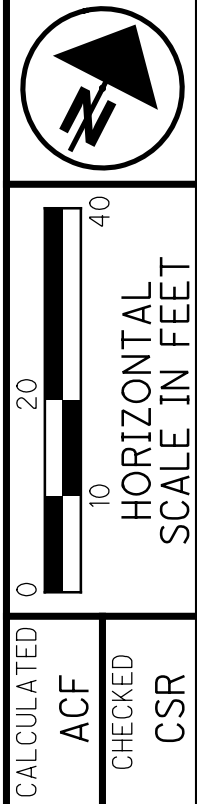CROSS REFERENCES	
SHEET NO.	DESCRIPTION
5 - 7	REFERENCES & BENCHMARKS
3	CURVE DATA & GEOMETRIC PLAN
85-94	ROADWAY QUANTITIES
373	CULVERT DETAILS
273-300	CROSS SECTIONS
338	GORE DETAILS
202-207	PLAN - RAMP L

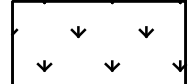

-  ITEM 670 - DITCH EROSION CONTROL PROTECTION MAT
-  ITEM 836 - TURF REINFORCING MAT, TYPE 1
-  ITEM 836 - TURF REINFORCING MAT, TYPE 2

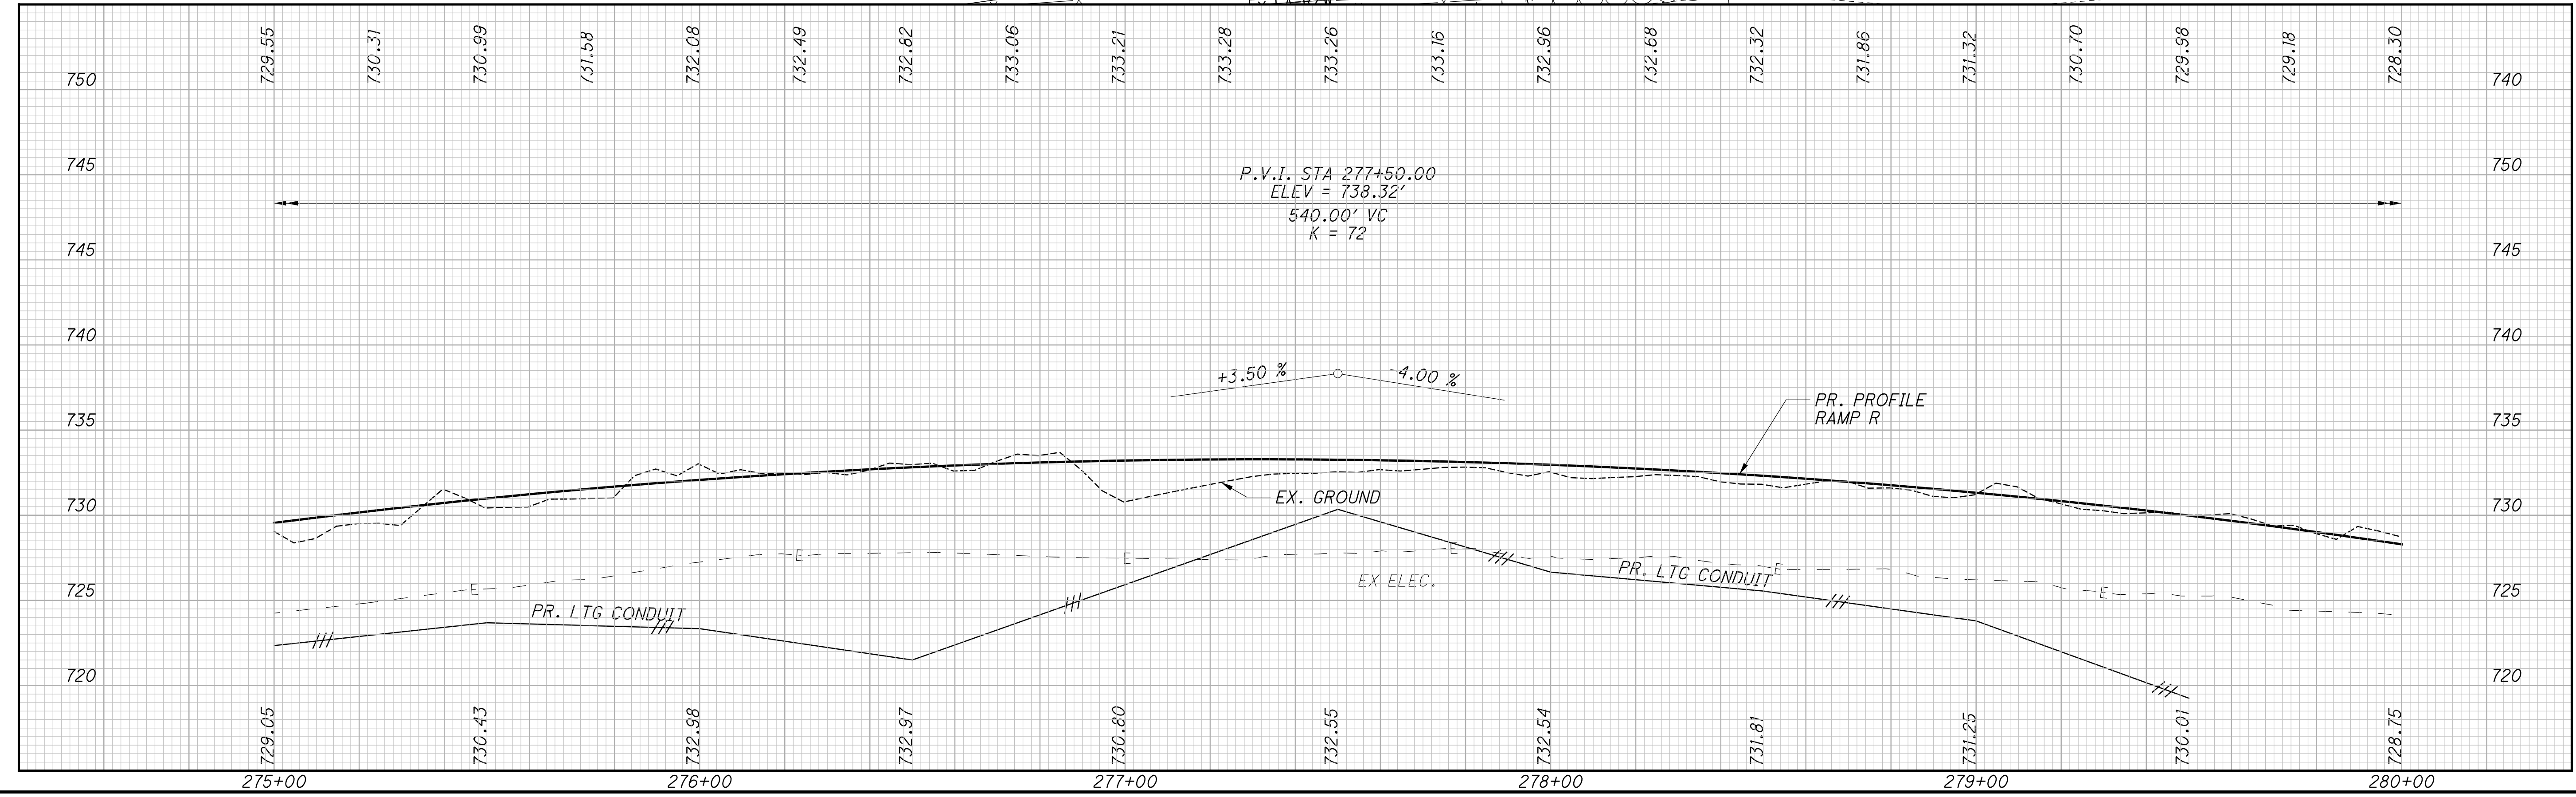

**PLAN AND PROFILE - RAMP R**  
**STA. 275+00 TO STA. 280+00**


**FRA - 270-51.50**

270  
554


ADDENDUM #1  
04/21/2023




CROSS REFERENCES	
SHEET NO.	DESCRIPTION
5-7	☐ REFERENCES & BENCHMARKS
3	☐ CURVE DATA & GEOMETRIC PLAN
85-94	☐ ROADWAY QUANTITIES
273-300	☐ CROSS SECTIONS

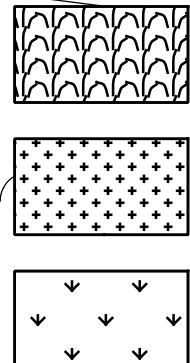

- ITEM 670 - DITCH EROSION CONTROL PROTECTION MAT
- ITEM 836 - TURF REINFORCING MAT, TYPE 1
- ITEM 836 - TURF REINFORCING MAT, TYPE 2

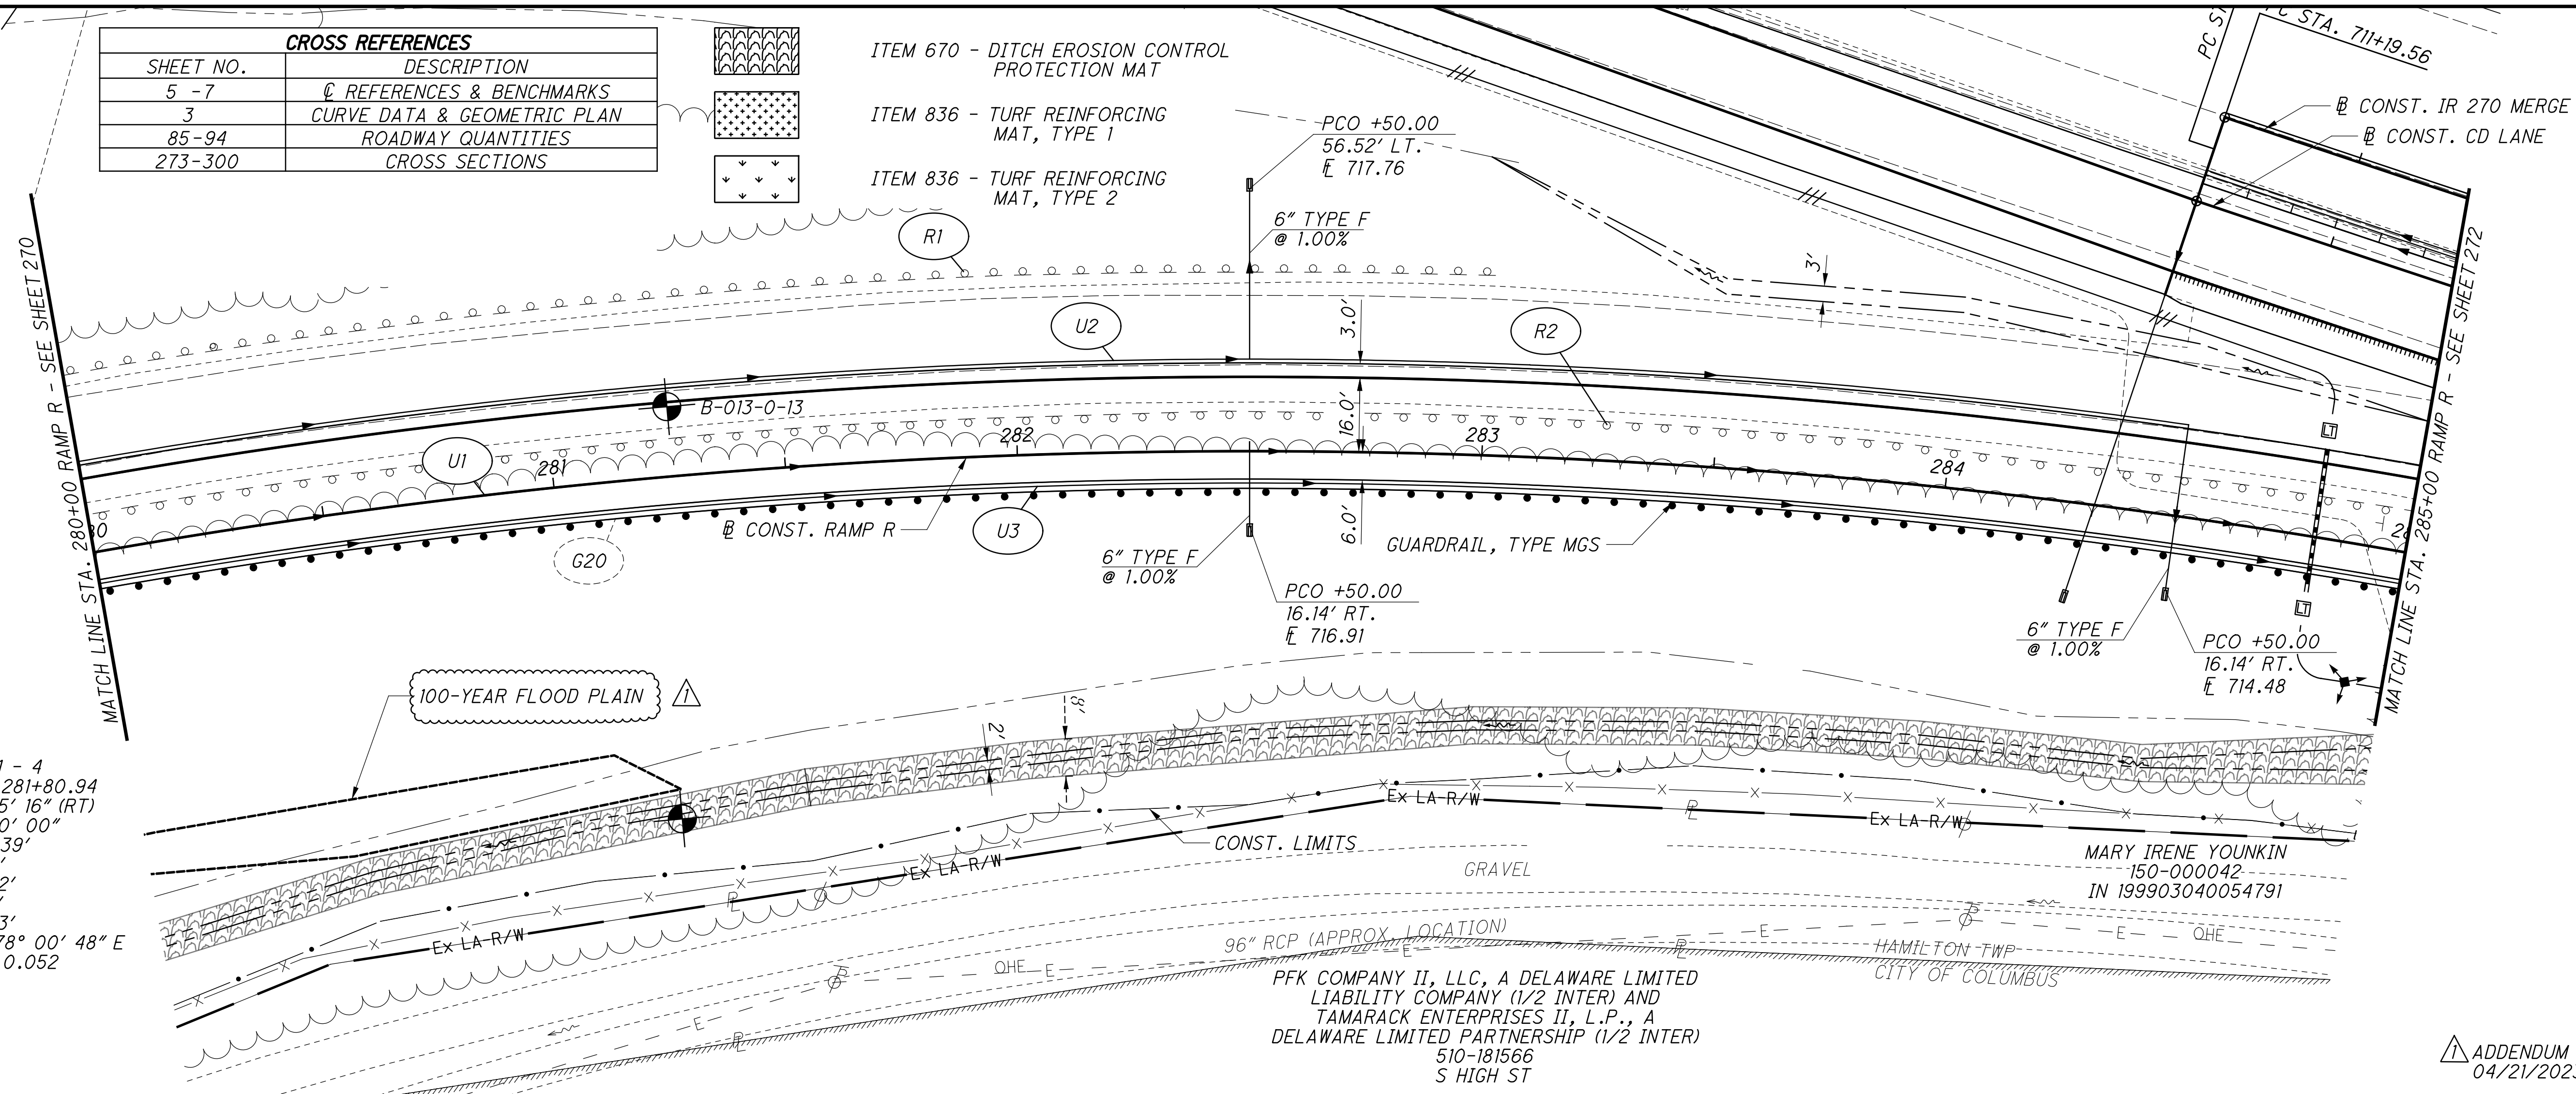

C4  
 B RAMP R1 - 4  
 P.I. STA. 281+80.94  
 $\Delta = 38^\circ 25' 16''$  (RT)  
 $D_c = 4^\circ 00' 00''$   
 $R = 1,432.39'$   
 $T = 499.11'$   
 $L = 960.52'$   
 $E = 84.46'$   
 $C = 942.63'$   
 $C.B. = N 78^\circ 00' 48'' E$   
 $e \text{ (max)} = 0.052$

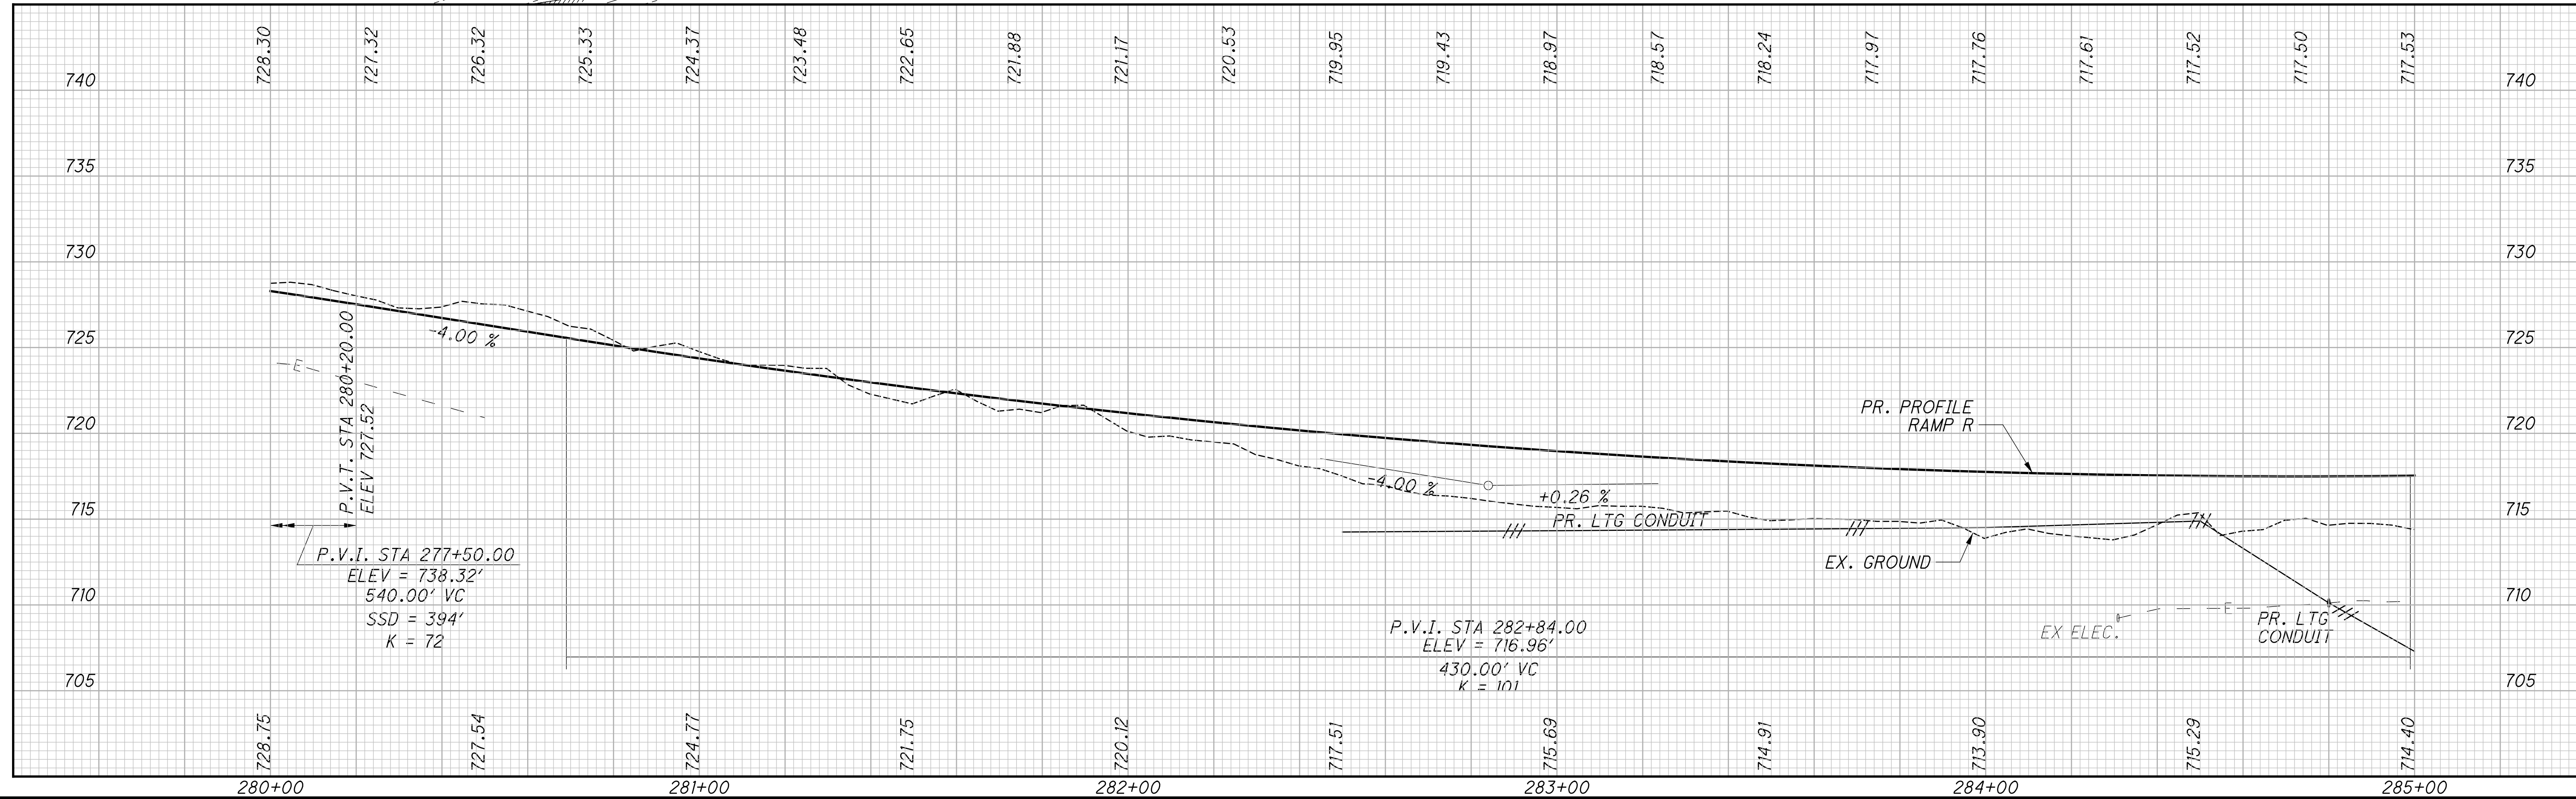

PLAN AND PROFILE - RAMP R  
 STA. 280+00 TO STA. 285+00

X:\Projects\2013\1321\1010\FRA\92616\roadway\sheets\92616GP555.dgn 4/19/2023 12:02:42 PM cwong





HORIZONTAL SCALE IN FEET


CALCULATED JGB CHECKED CSR

PLAN AND PROFILE RAMP S  
STA. 798+48.77 TO STA. 803+00.00





FRA - 270-51.50

301  
554

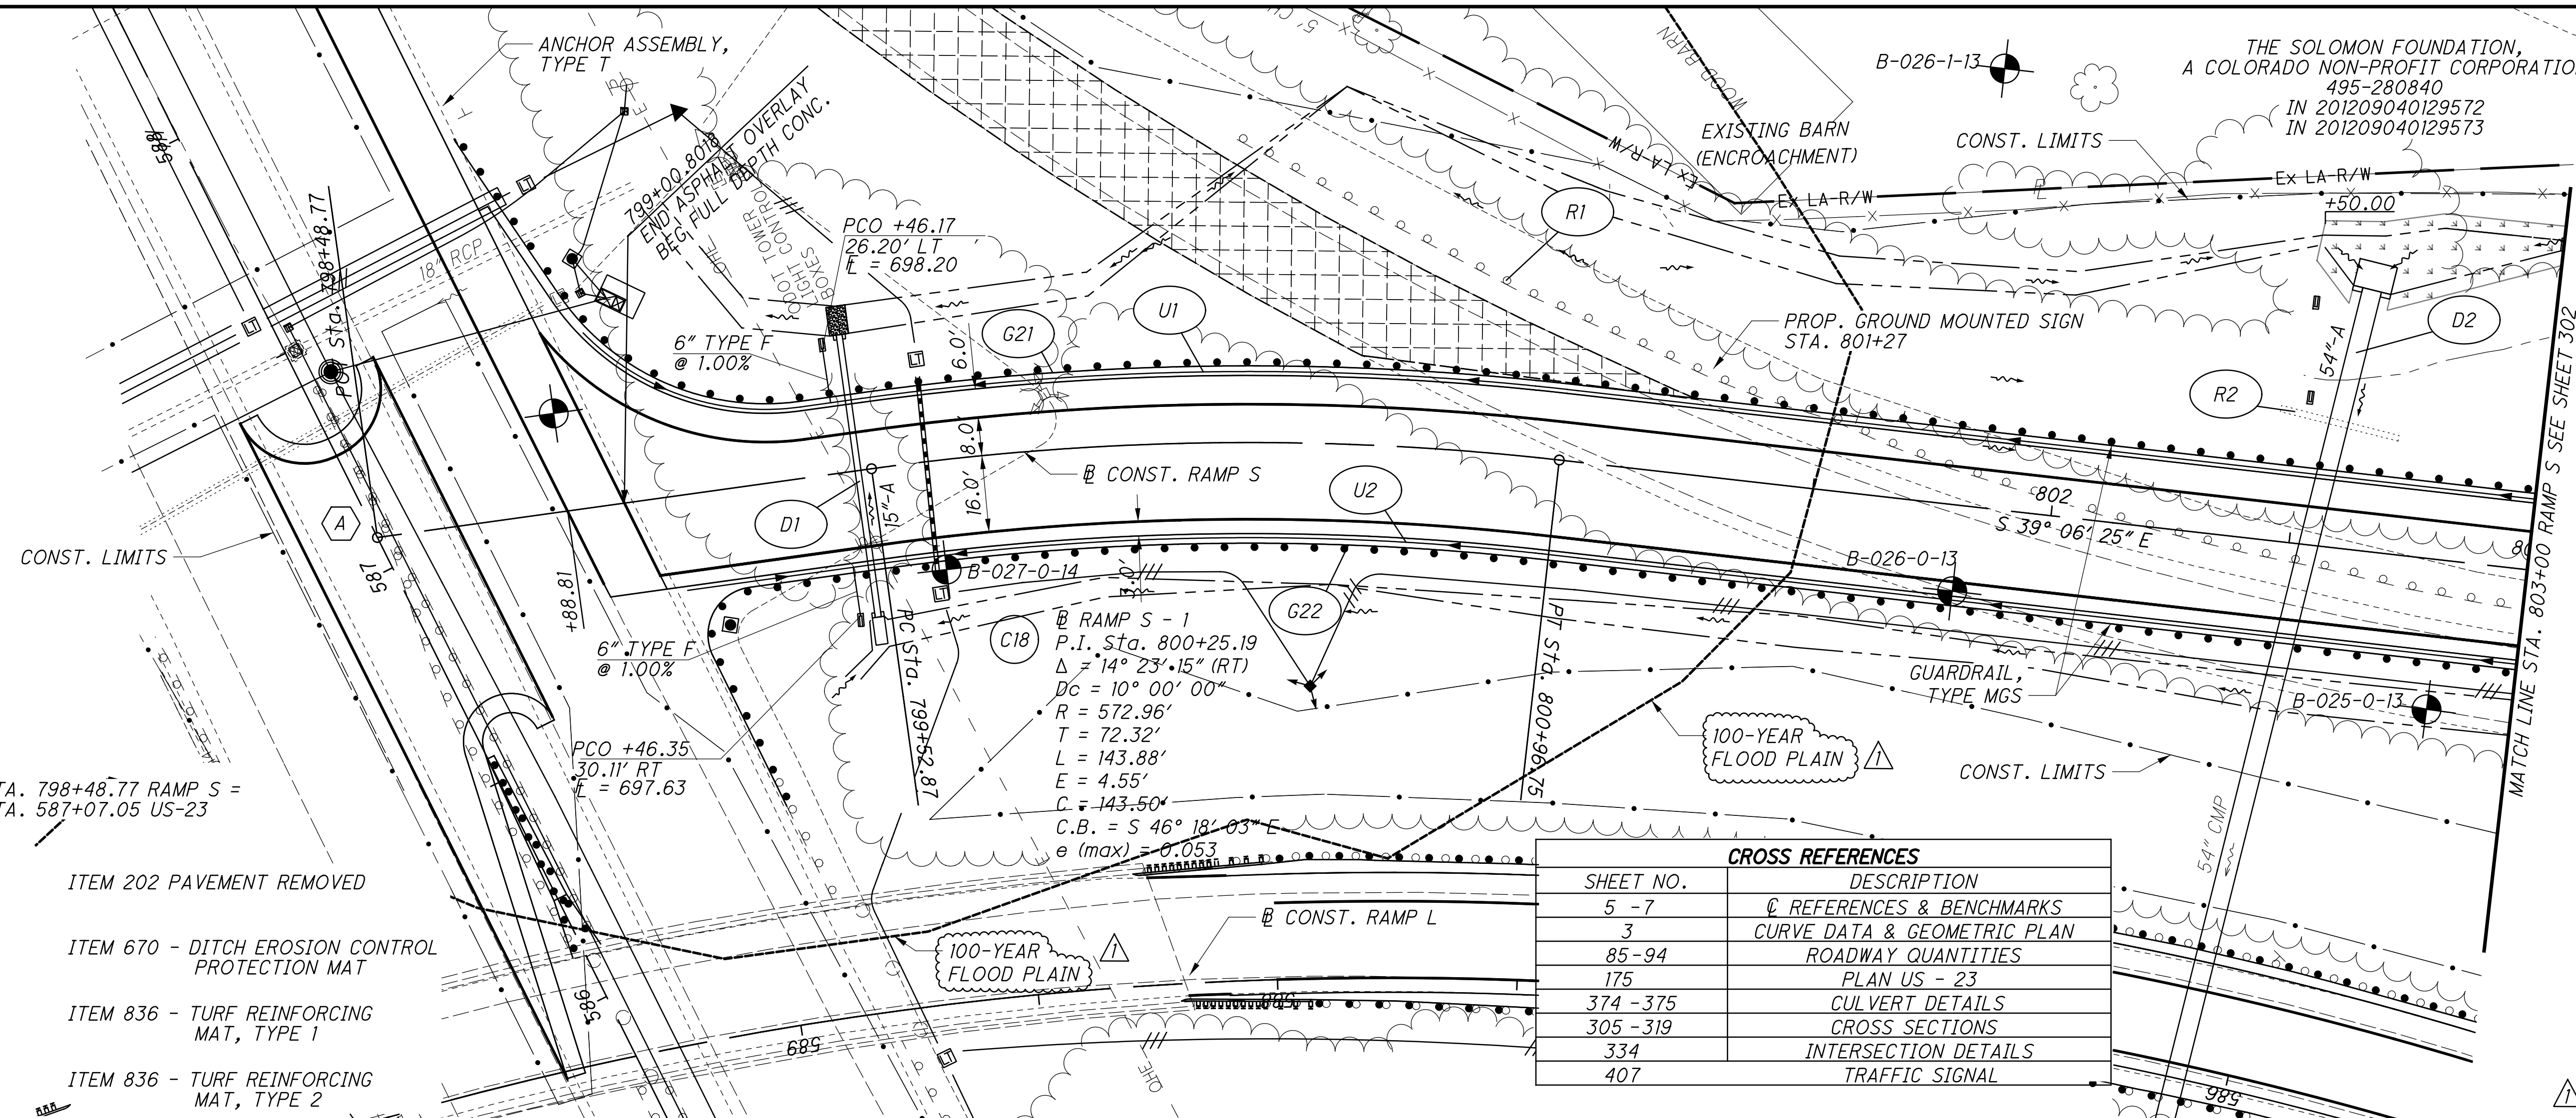THE SOLOMON FOUNDATION,  
A COLORADO NON-PROFIT CORPORATION  
495-280840  
IN 201209040129572  
IN 201209040129573




A B STA. 798+48.77 RAMP S =  
C STA. 587+07.05 US-23

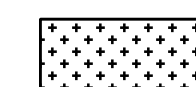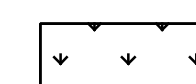-  ITEM 202 PAVEMENT REMOVED
-  ITEM 670 - DITCH EROSION CONTROL PROTECTION MAT
-  ITEM 836 - TURF REINFORCING MAT, TYPE 1
-  ITEM 836 - TURF REINFORCING MAT, TYPE 2

CROSS REFERENCES	
SHEET NO.	DESCRIPTION
5 - 7	REFERENCES & BENCHMARKS
3	CURVE DATA & GEOMETRIC PLAN
85 - 94	ROADWAY QUANTITIES
175	PLAN US - 23
374 - 375	CULVERT DETAILS
305 - 319	CROSS SECTIONS
334	INTERSECTION DETAILS
407	TRAFFIC SIGNAL

ADDENDUM #1  
04/21/2023

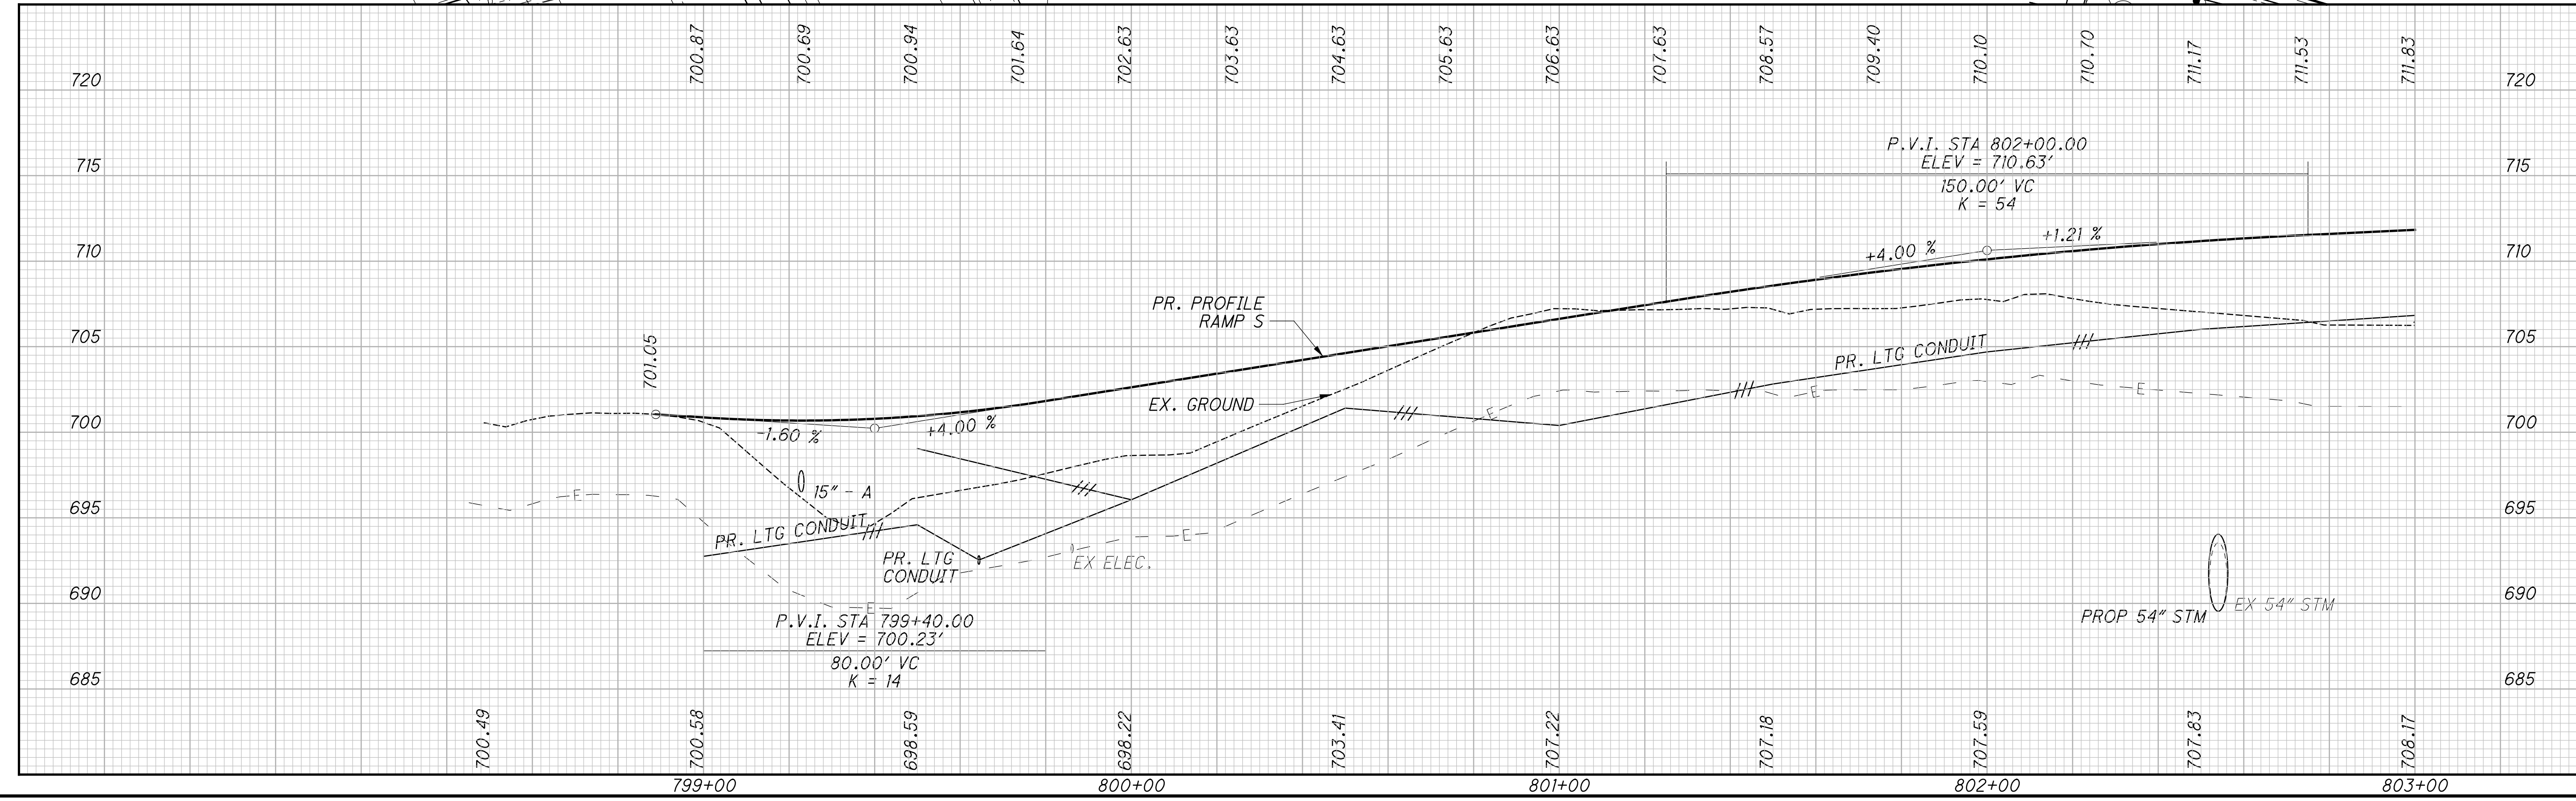


X:\Projects\2013\1010\FRA\92616\roadway\sheet\92616GP601.dgn 4/19/2023 12:08:31 PM c.wong

C-19 RAMP S - 2  
 P.I. Sta. 806+85.23  
 $\Delta = 29^\circ 05' 45''$  (LT)  
 $Dc = 4^\circ 00' 00''$   
 $R = 1,432.39'$   
 $T = 371.72'$   
 $L = 727.40'$   
 $E = 47.45'$   
 $C = 719.61'$   
 C.B. =  $S 53^\circ 39' 18'' E$   
 $e$  (max) = 0.040


THE SOLOMON FOUNDATION,  
 A COLORADO NON-PROFIT CORPORATION  
 495-280840  
 IN 201209040129572  
 IN 201209040129573

CROSS REFERENCES	
SHEET NO.	DESCRIPTION
5 - 7	REFERENCES & BENCHMARKS
3	CURVE DATA & GEOMETRIC PLAN
85 - 94	ROADWAY QUANTITIES
305 - 319	CROSS SECTIONS
335 - 336	GORE DETAILS

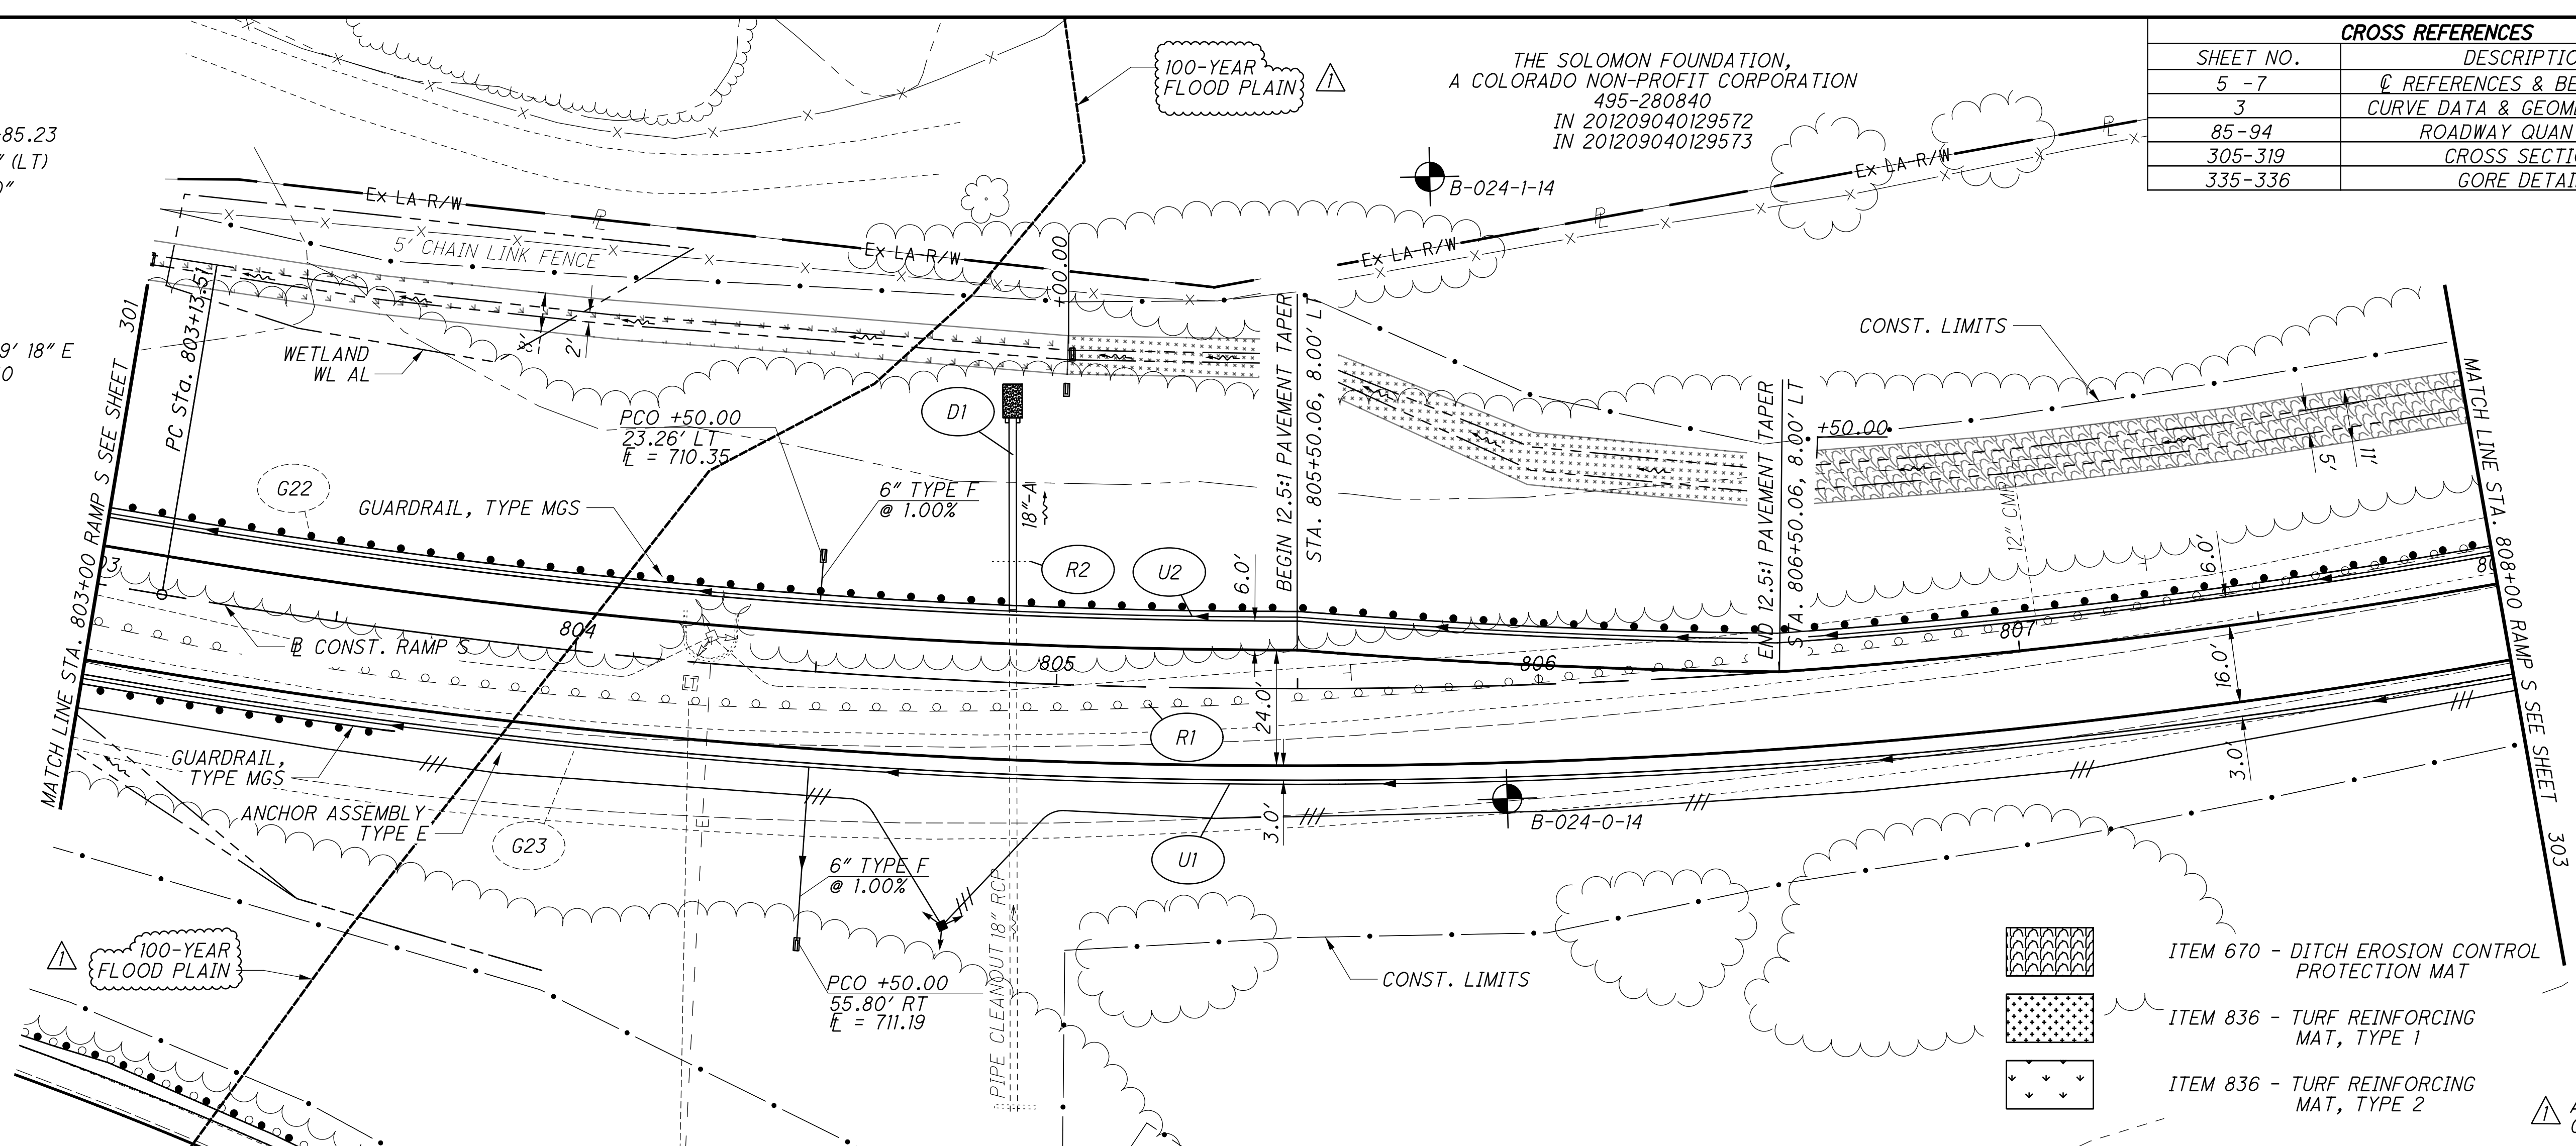

- ITEM 670 - DITCH EROSION CONTROL PROTECTION MAT
- ITEM 836 - TURF REINFORCING MAT, TYPE 1
- ITEM 836 - TURF REINFORCING MAT, TYPE 2

ADDENDUM #1  
 04/21/2023

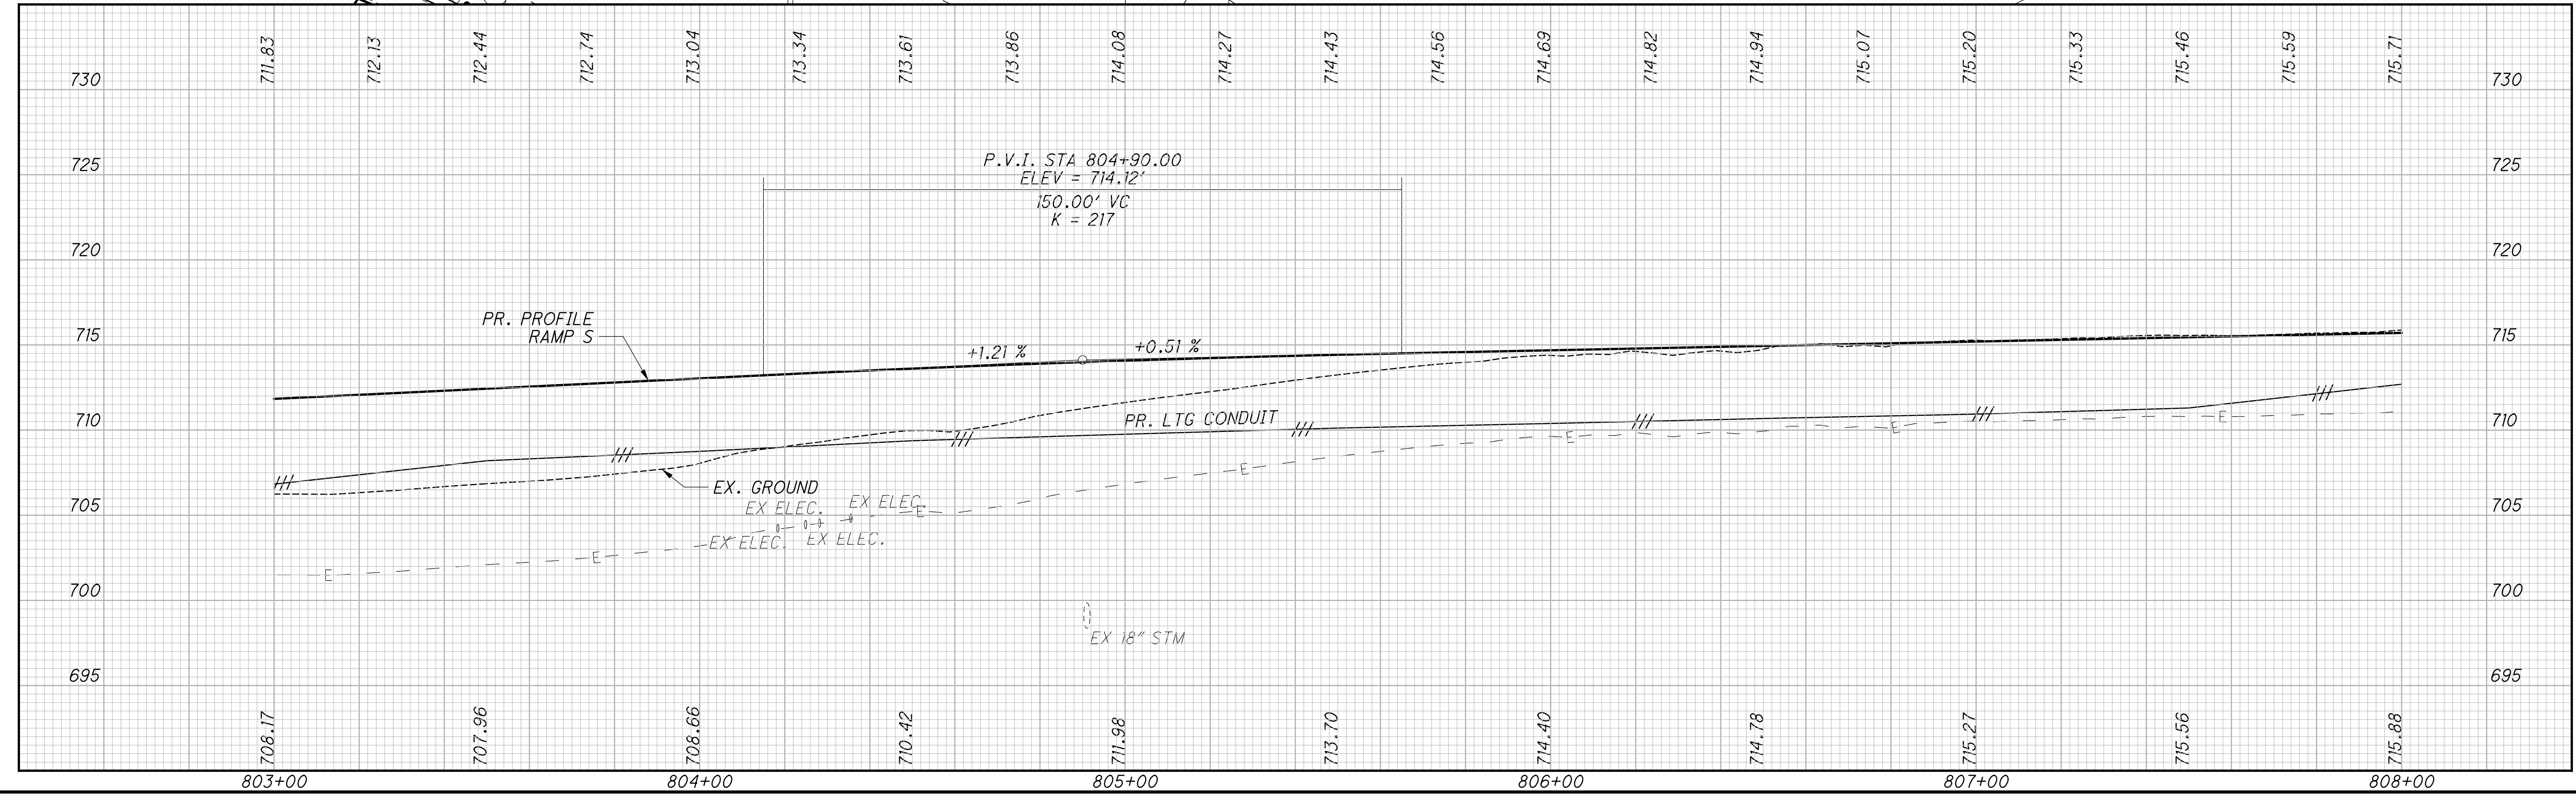



PLAN AND PROFILE RAMP S  
 STA. 803+00.00 TO STA. 808+00.00

FRA - 270-51.50

X:\Projects\2013\1010\FRA\92616\roadway\sheets\92616GP602.dgn 4/19/2023 12:12:37 PM cwong





X:\Projects\2013\1010\FRA\92616\roadway\sheets\92616GP901.dgn 4/19/2023 12:20:06 PM cwong

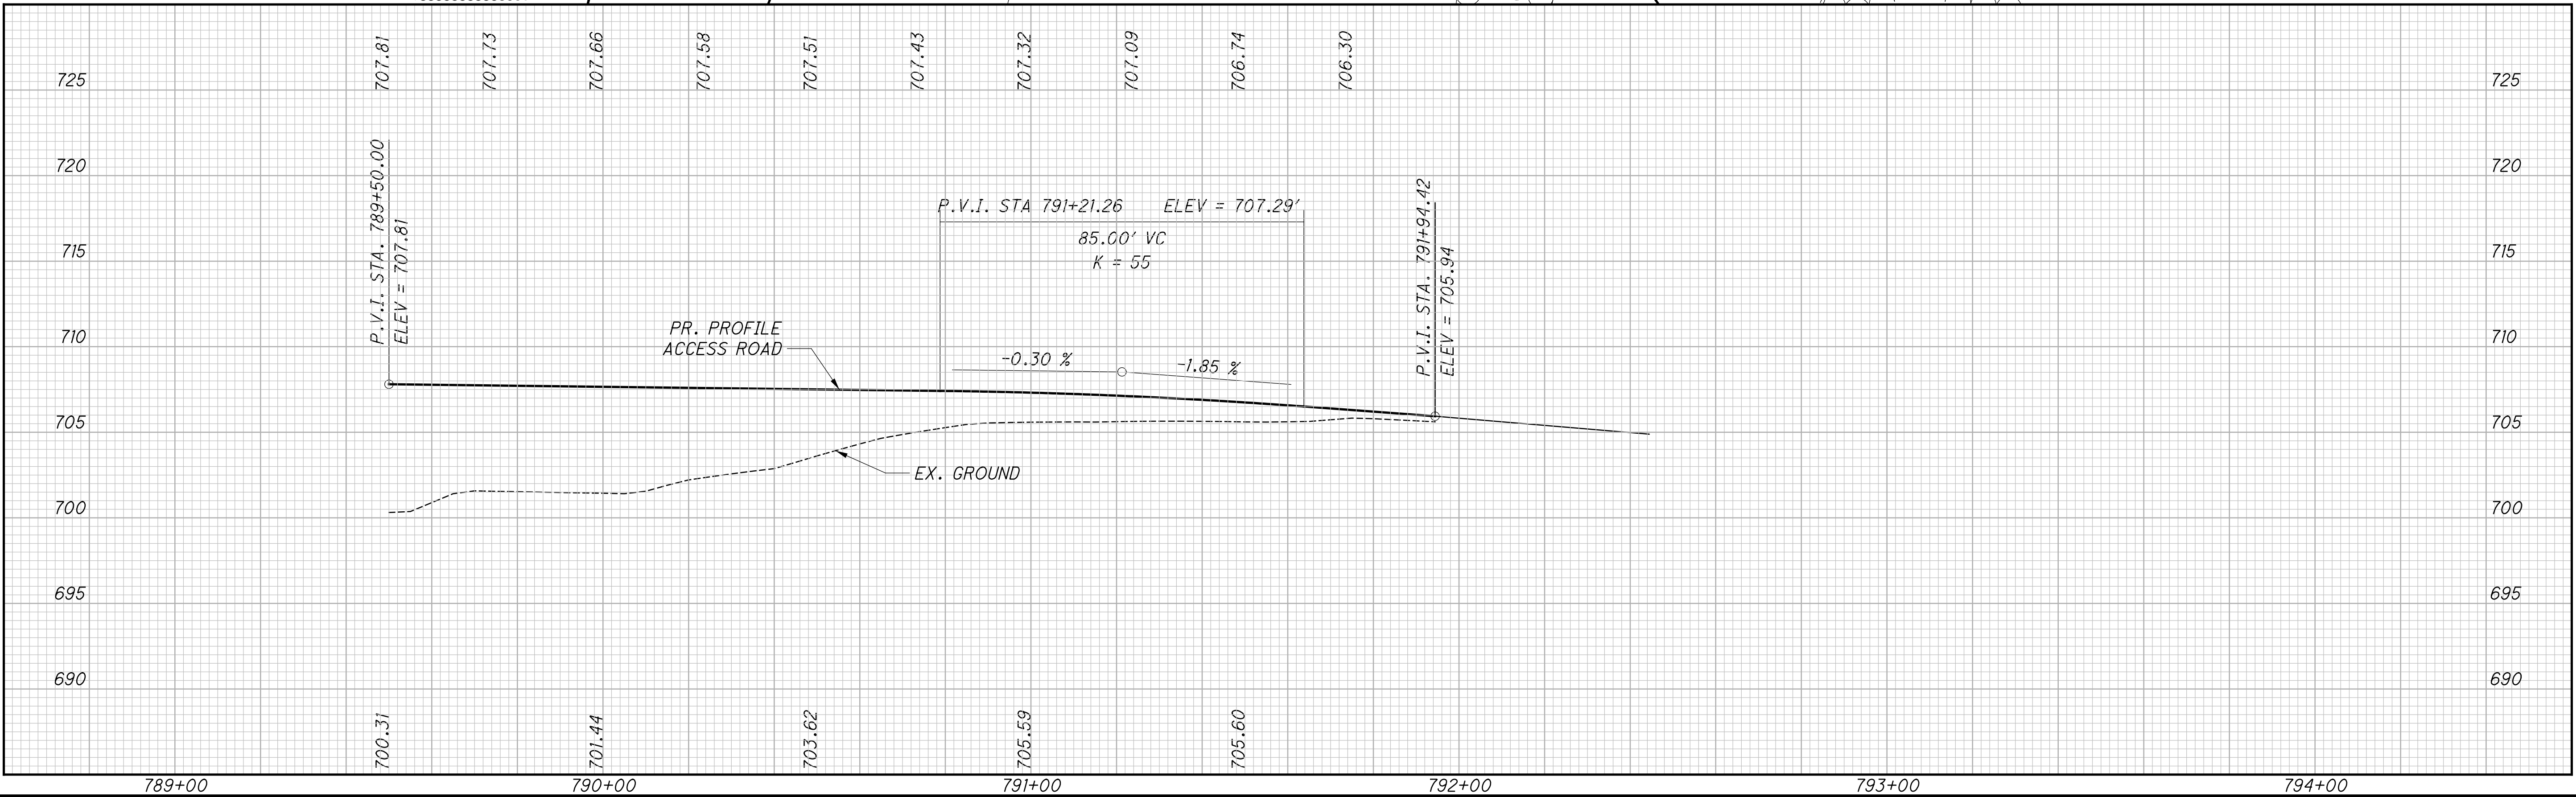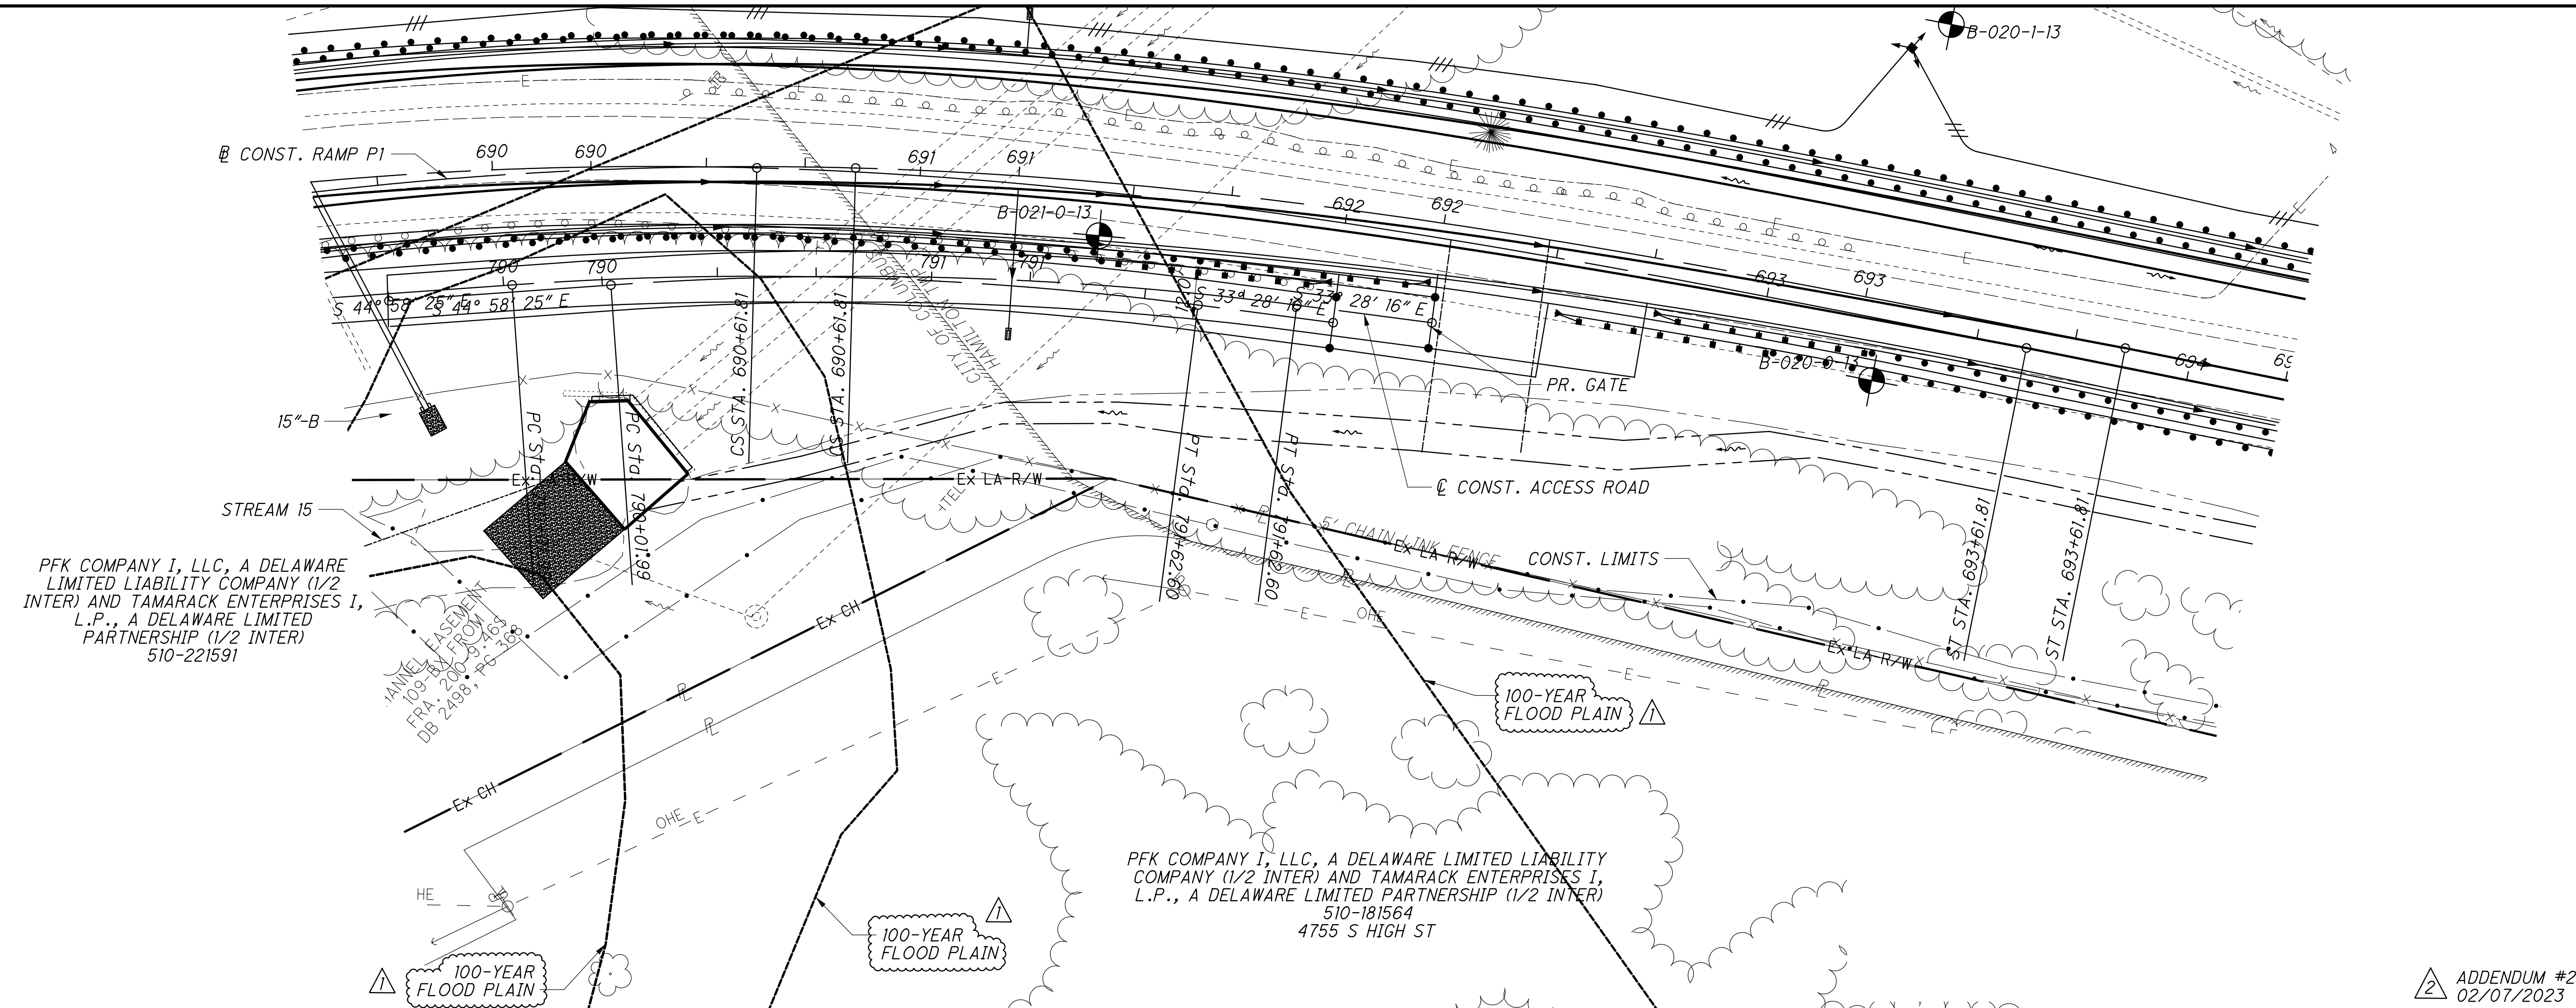

CALCULATED: ACF  
 CHECKED: CSR  
**PLAN AND PROFILE**  
**ACCESS ROAD**  
**FRA - 270-51.50**  
 320  
 554



X:\Projects\2013\1010\FRA\92616\drainage\sheet\92616DC006.dgn 4/19/2023 12:32:21 PM cswong

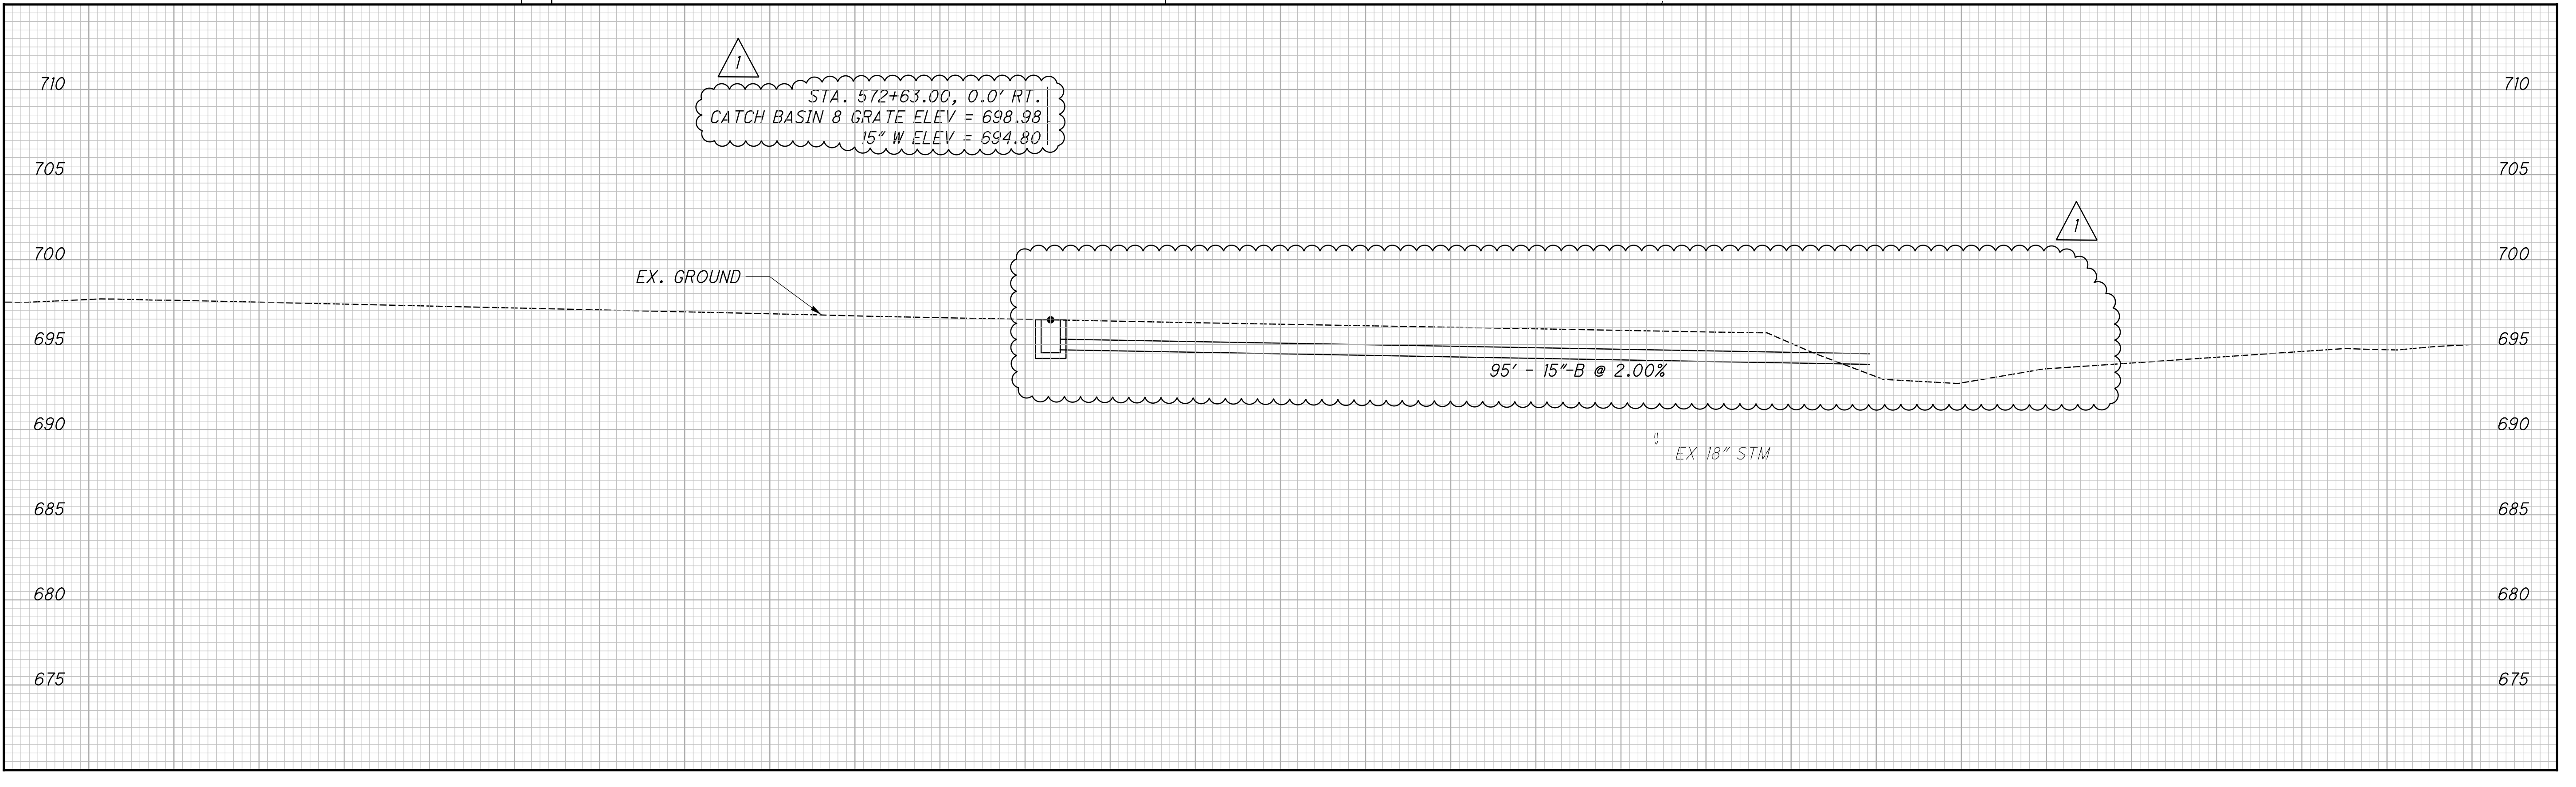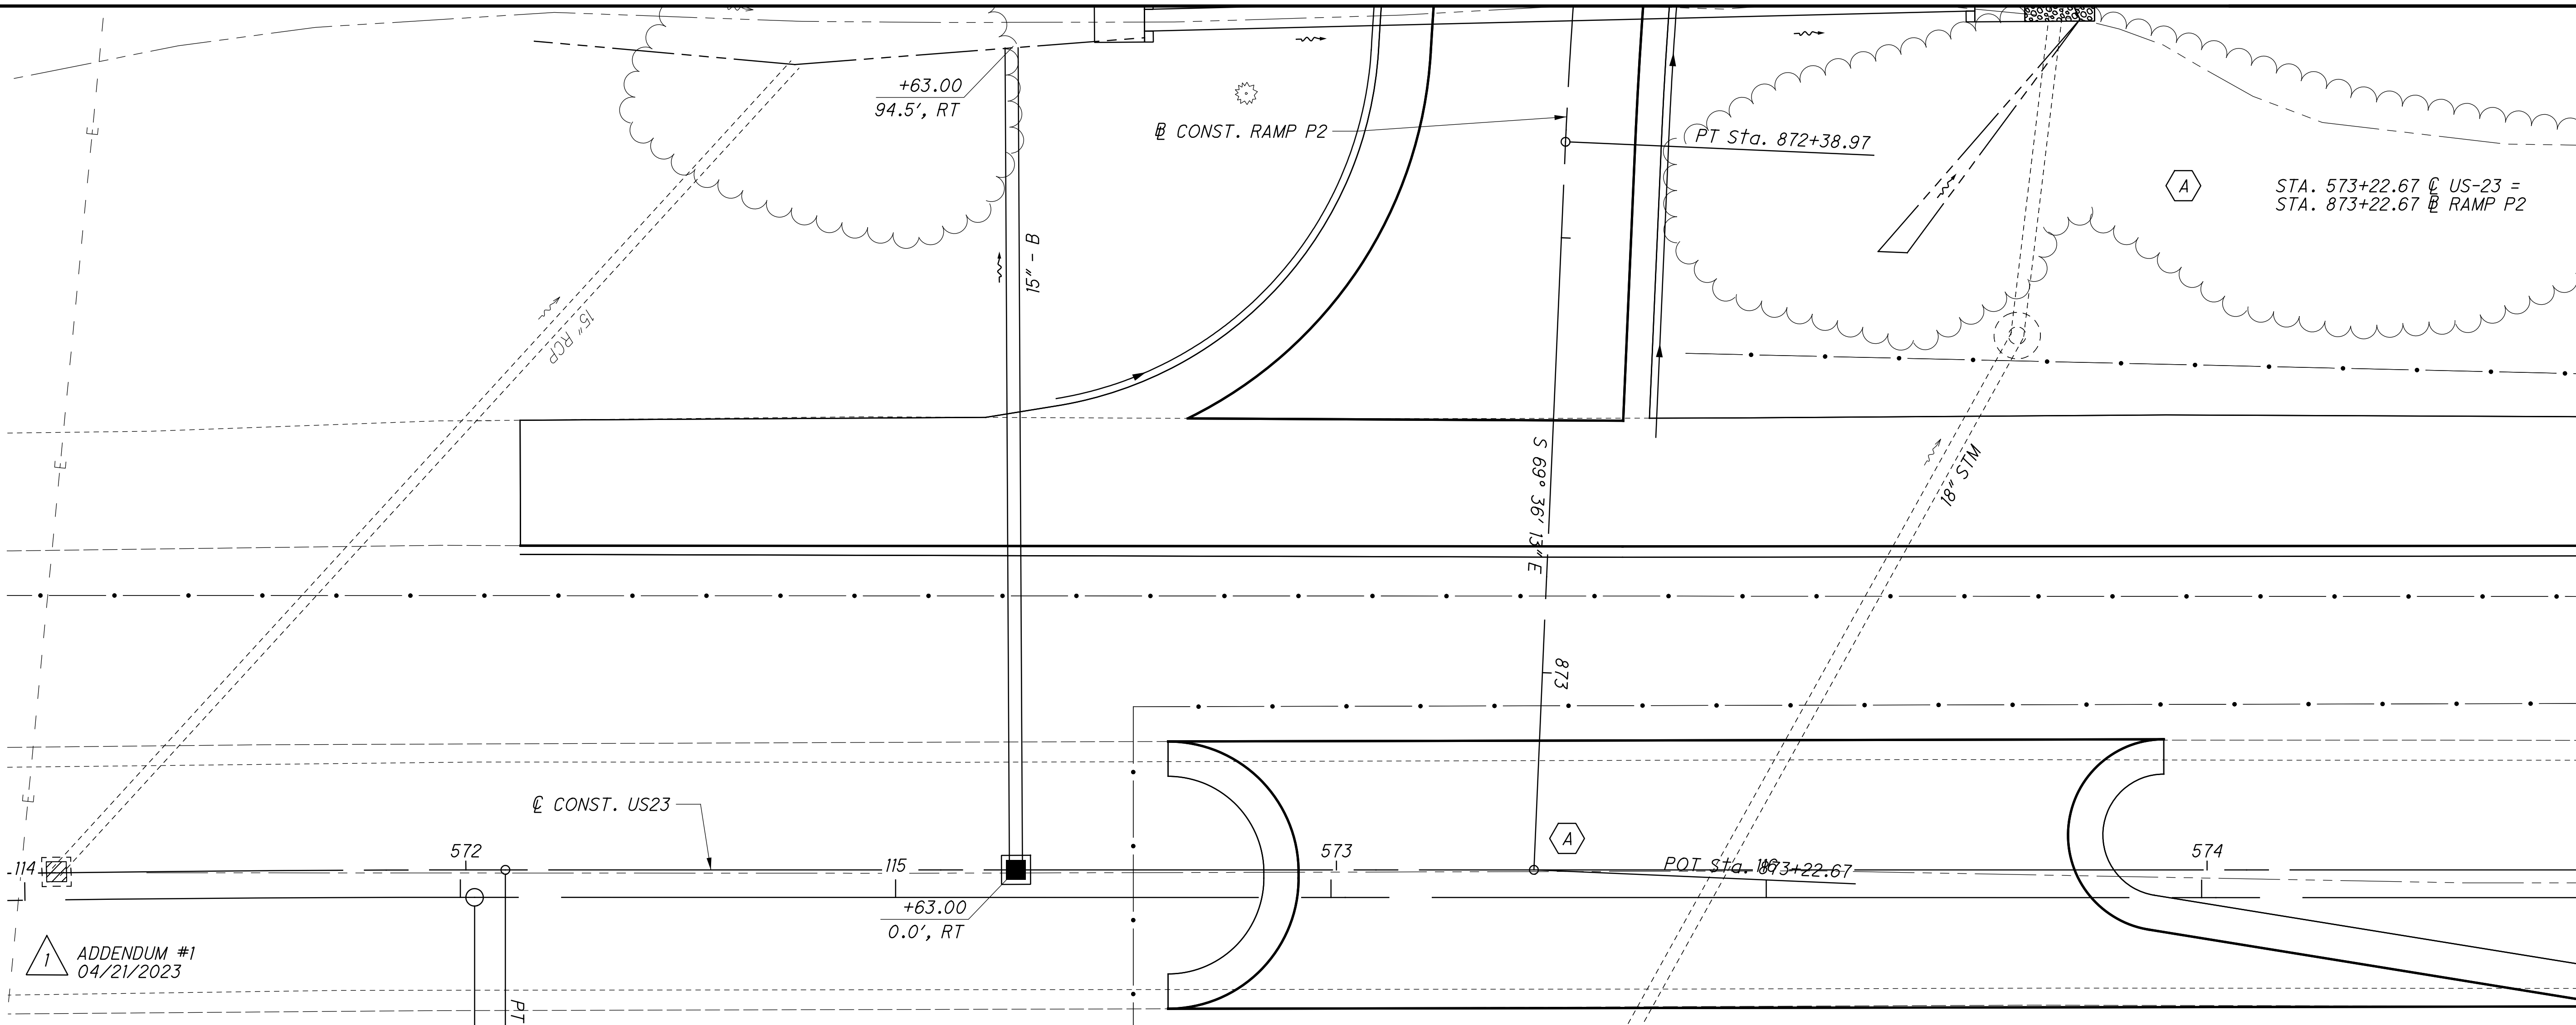

CALCULATED ACF CHECKED CSR



0 5 10 15 20  
HORIZONTAL SCALE IN FEET

STORM SEWER PROFILE - US 23  
STA. 572+63.00

FRA - 270-51.50



362  
554

X:\Projects\2013\132\1010\FRA\92616\drainage\sheets\92616DC012.dgn 4/19/2023 12:35:53 PM cwong

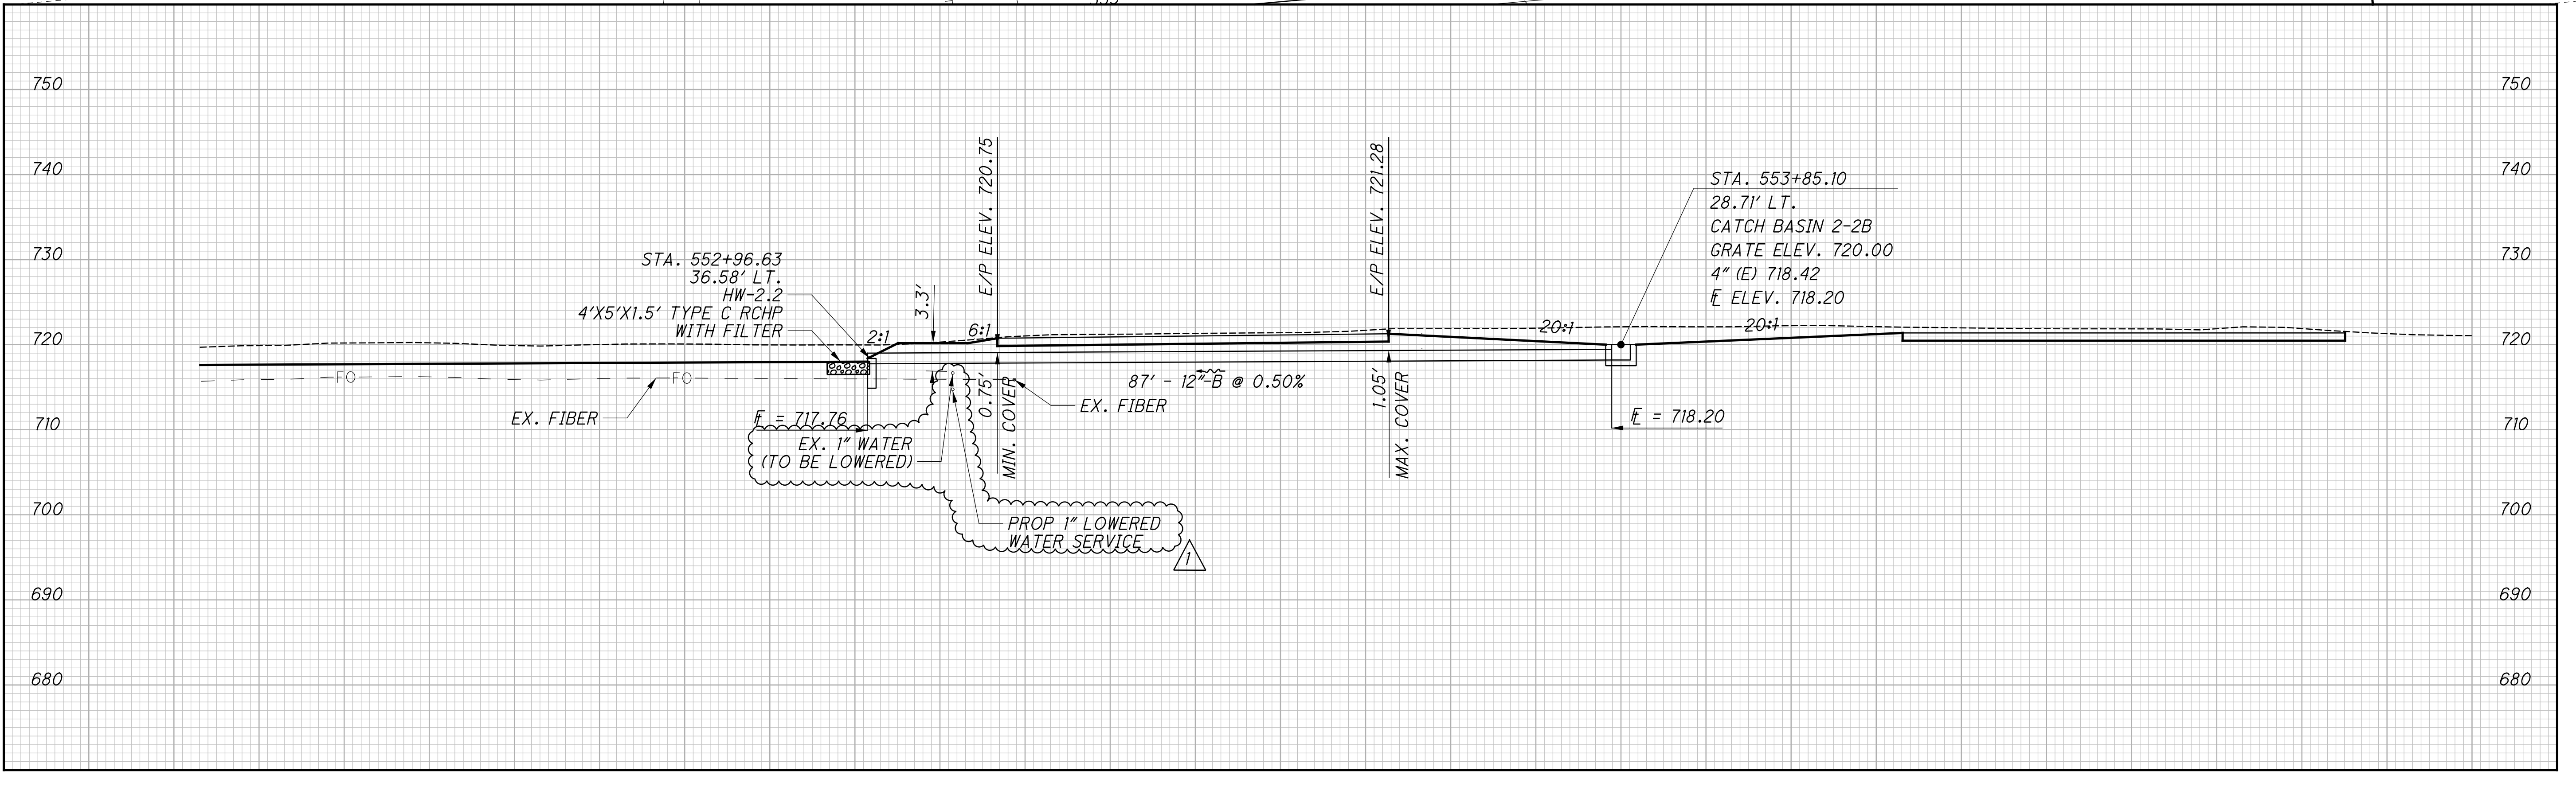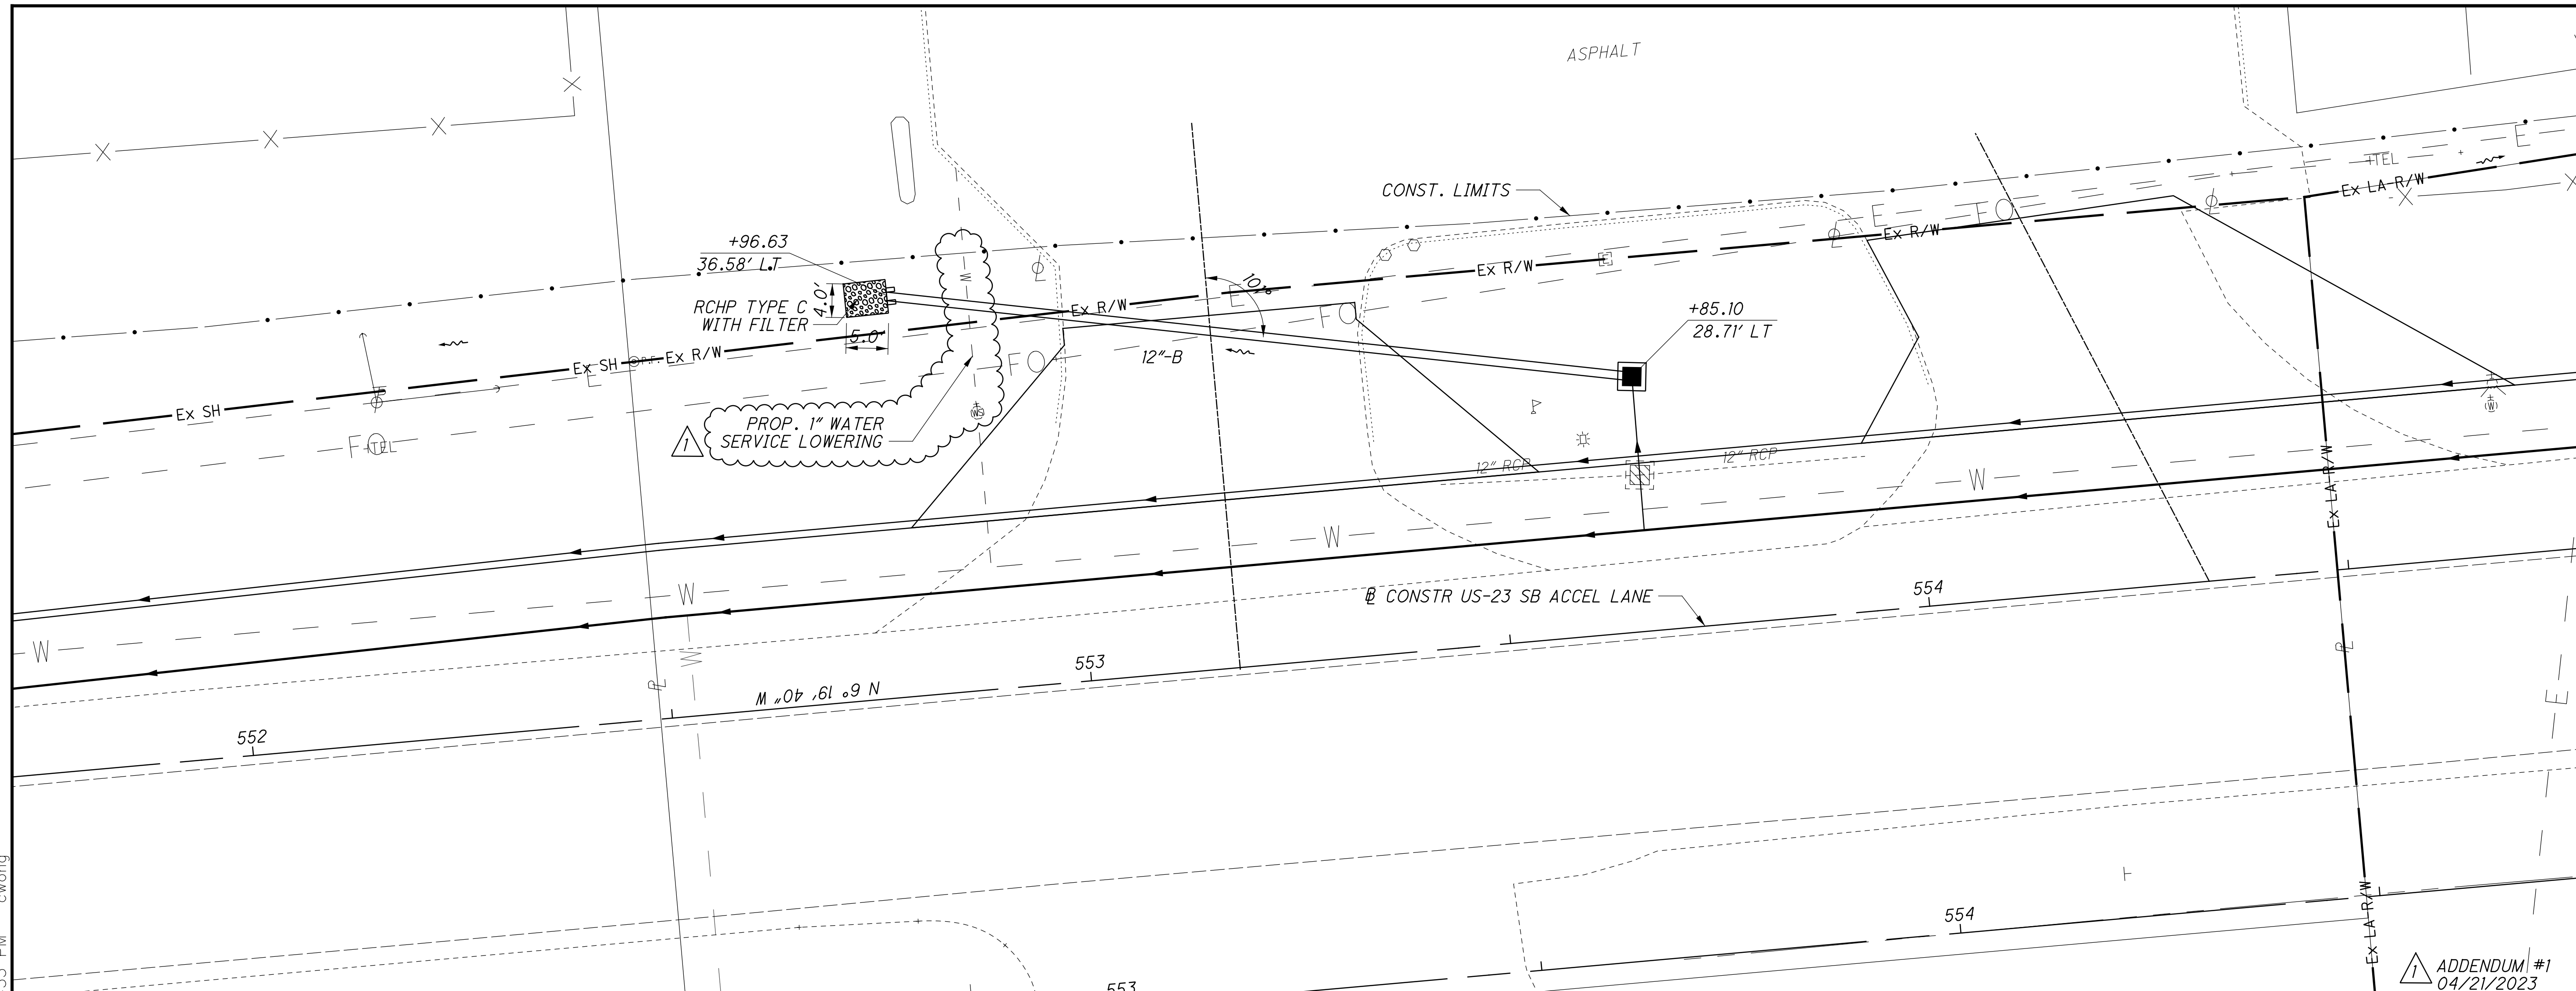

CALCULATED JGB  
 CHECKED CSR  
**STORM SEWER PROFILE US 23 ACCEL. LANE**  
**STA. 553+85**  
**FRA - 270-51.50**  
 363  
 554

X:\Projects\2013\132\1010\FRA\92616\drainage\sheet\92616DC018.dgn 4/19/2023 12:26:10 PM c.wong

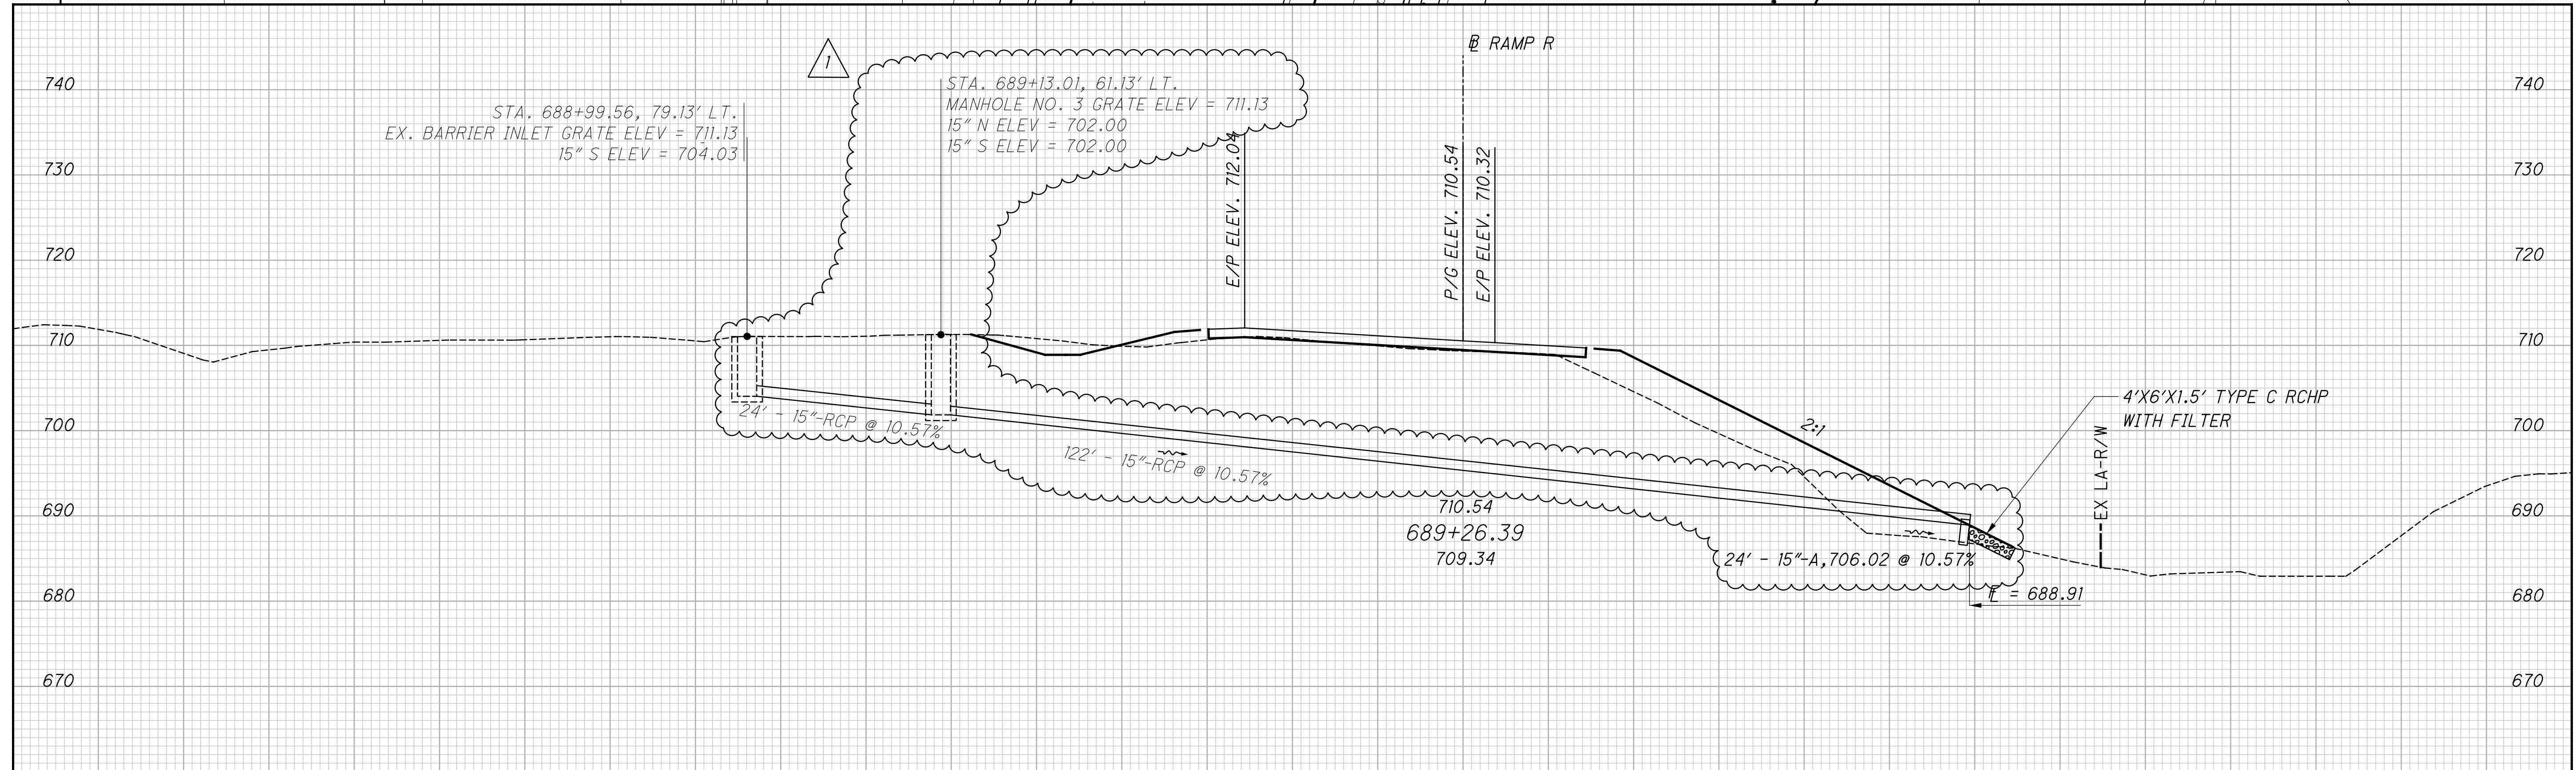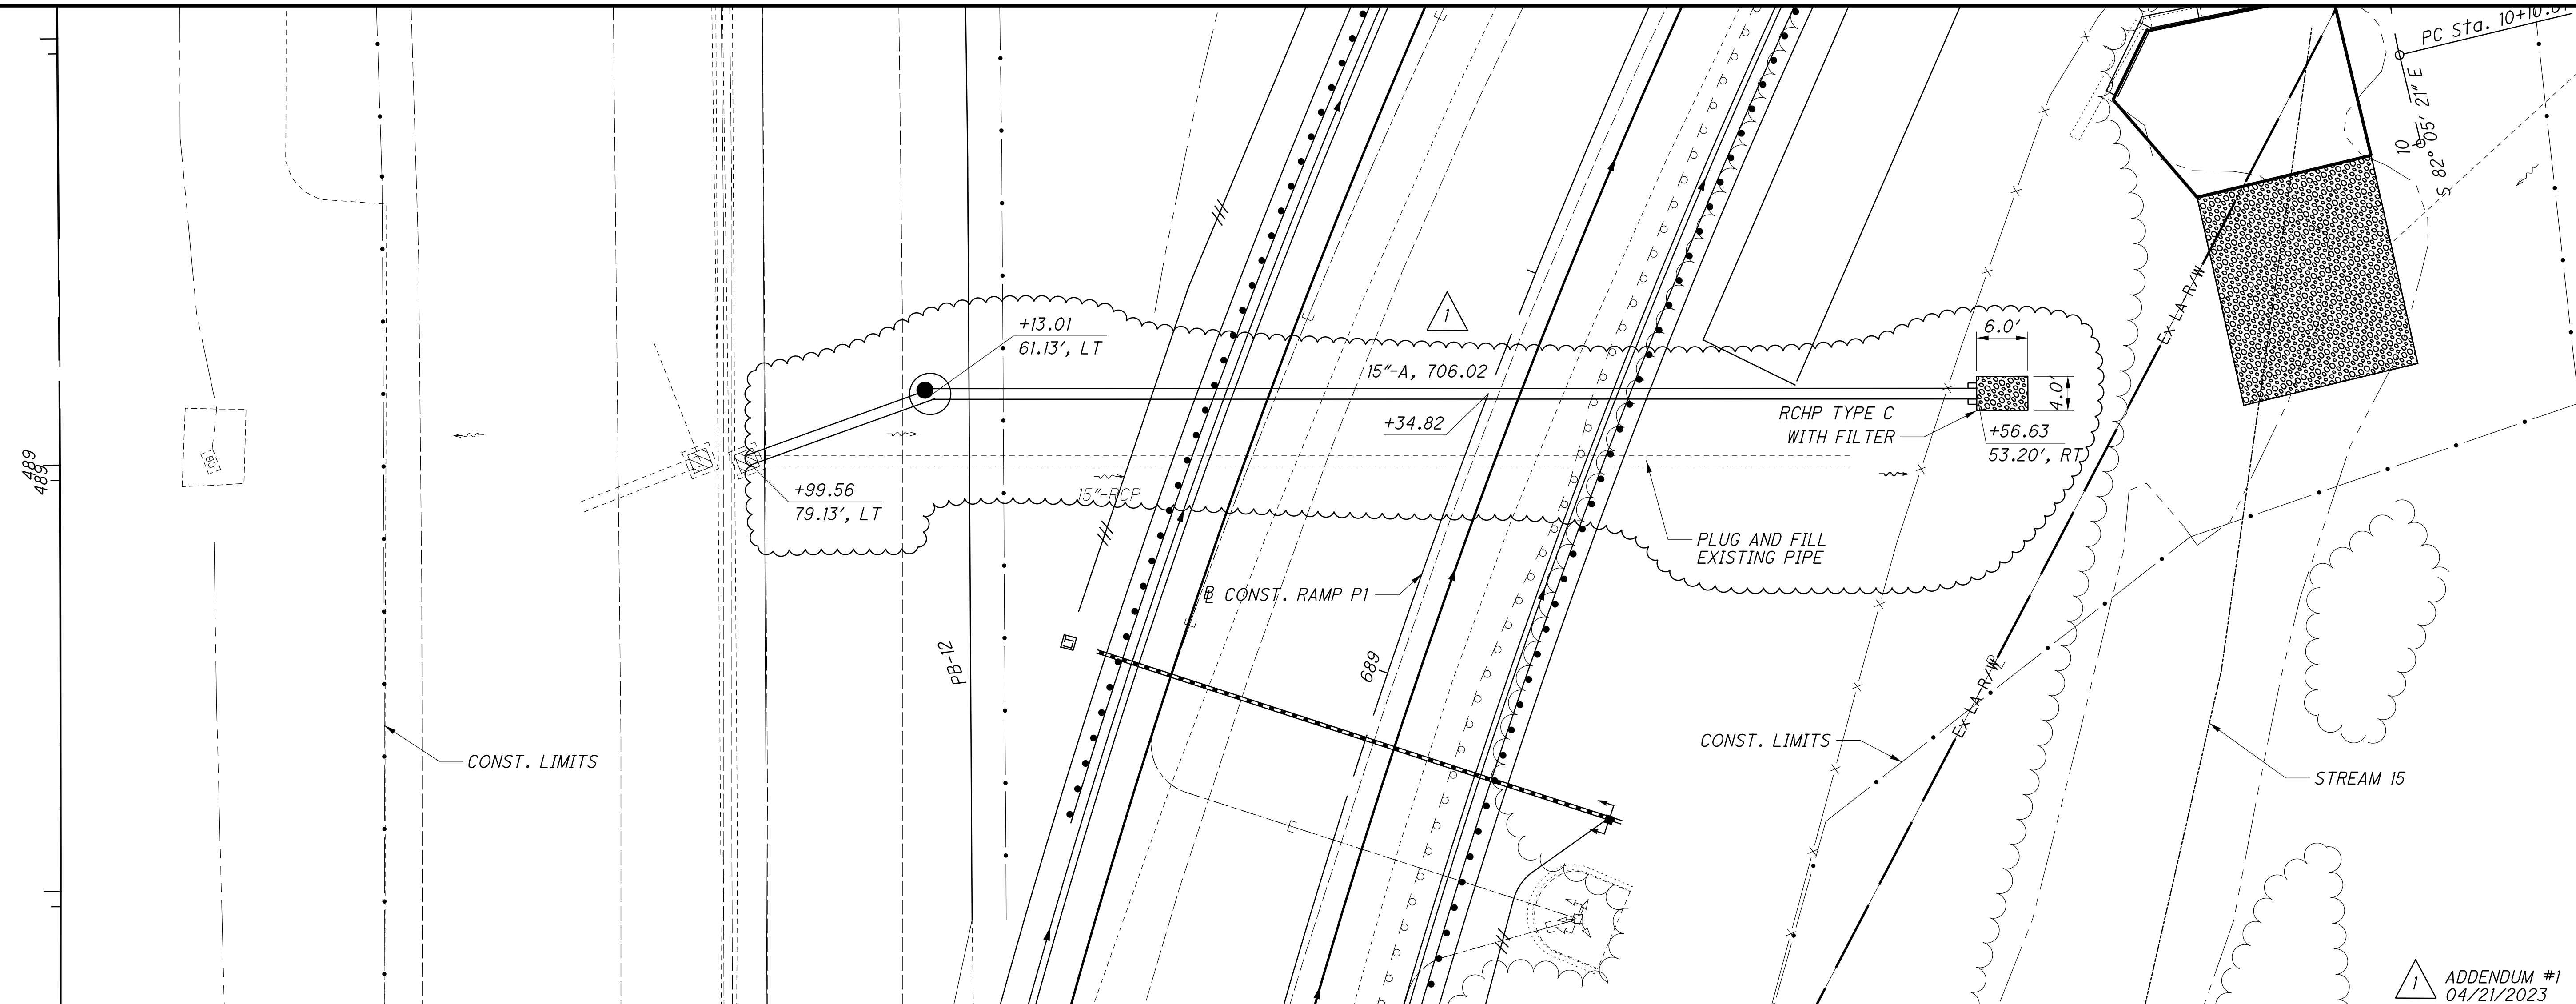

CALCULATED  
ACF  
CHECKED  
CSR

0 5 10 20  
HORIZONTAL  
SCALE IN FEET

**STORM SEWER PROFILE - RAMP P1**  
**STA. 689+26**

1 ADDENDUM #1  
04/21/2023


**FRA - 270-51.50**

364  
554




X:\Projects\2013\1010\FRA\92616\drainage\sheet\92616DF001.dgn 4/19/2023 12:28:06 PM cwong

STA. 866+82.28, 20.05' LT.  
MH-3 GRATE ELEV = 702.79  
18" NW ELEV = 678.88  
18" SE ELEV = 678.88

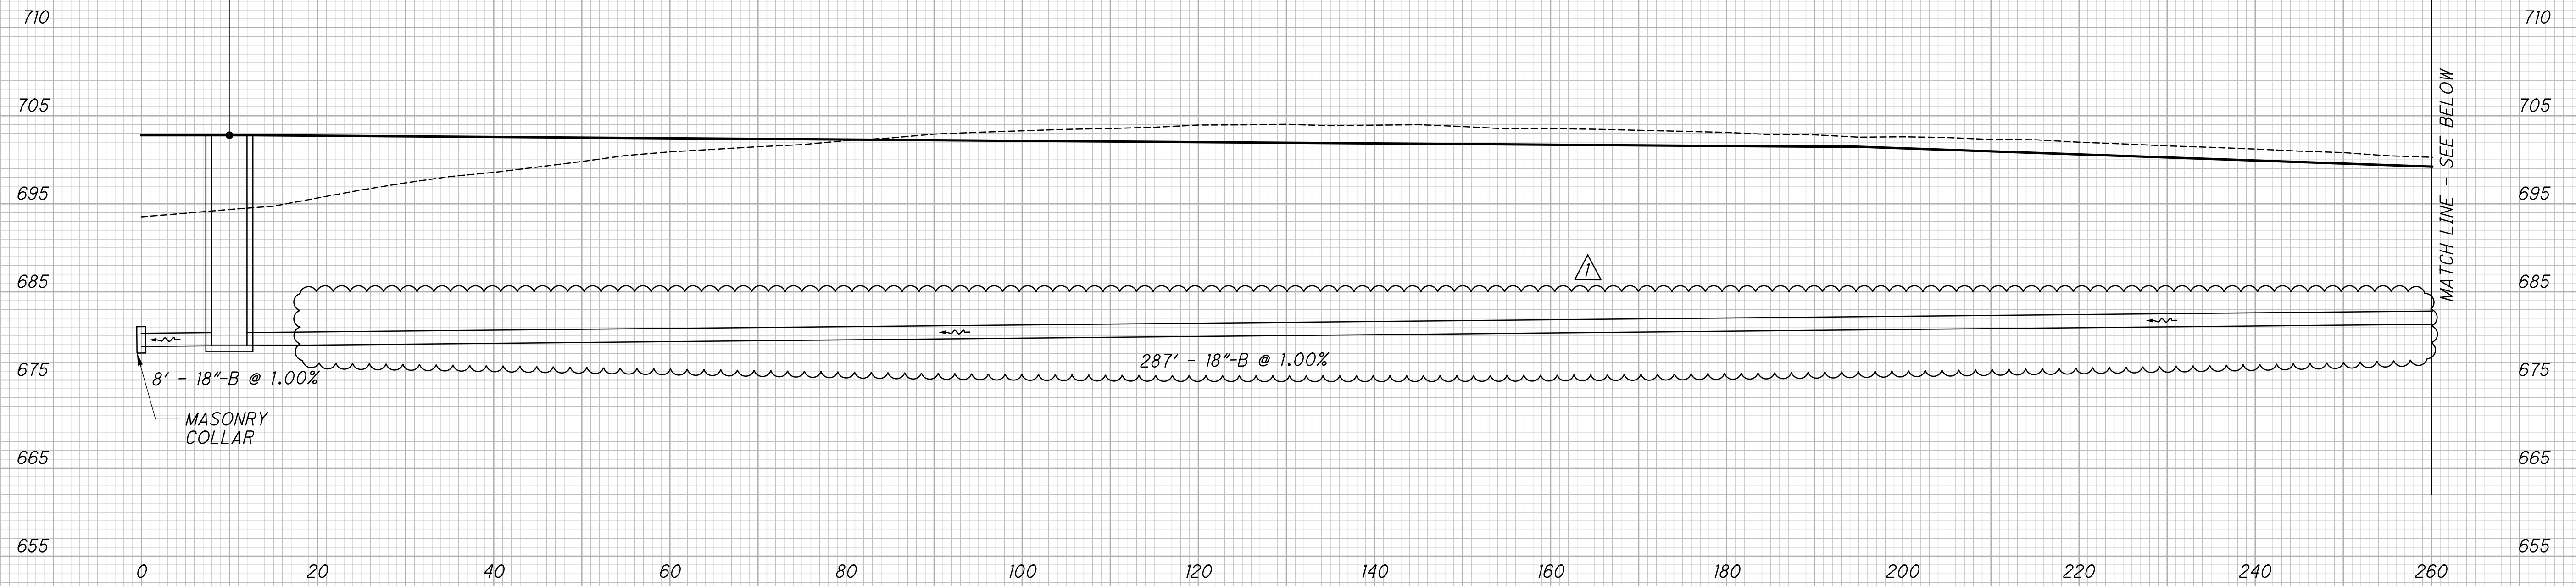

STA. 869+75.62, 16.47' LT.  
MH-3 GRATE ELEV = 697.96  
18" NW ELEV = 681.69  
18" SE ELEV = 681.69

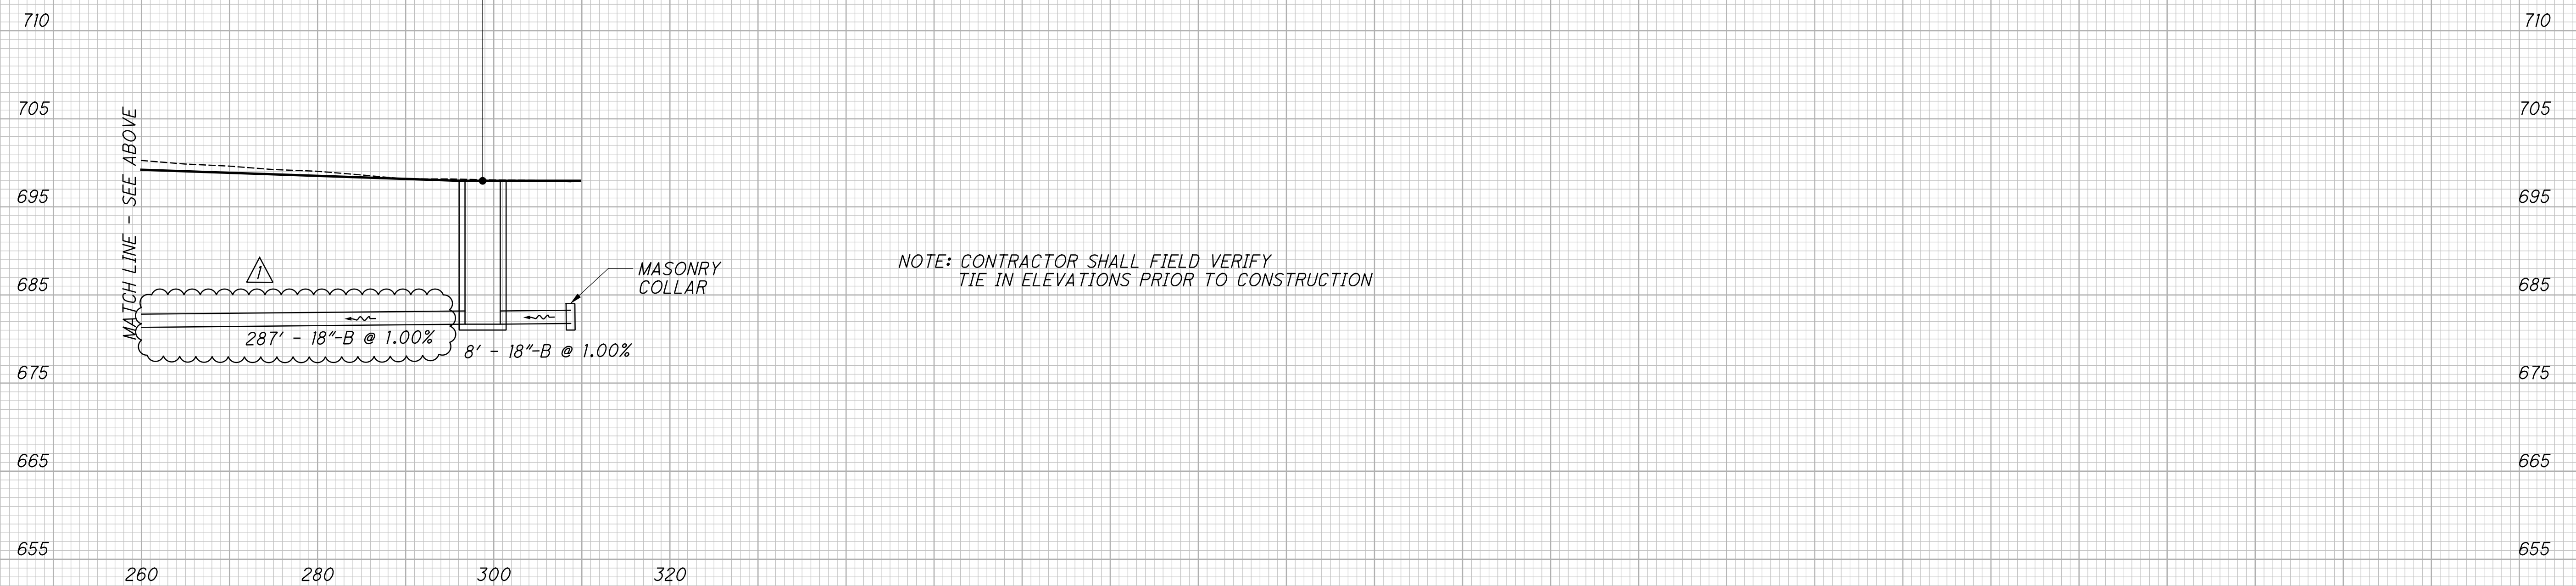

NOTE: CONTRACTOR SHALL FIELD VERIFY  
TIE IN ELEVATIONS PRIOR TO CONSTRUCTION

ADDENDUM #1  
04/21/2023


CALCULATED  
ACF  
CHECKED  
CSR

STORM SEWER PROFILE

FRA - 270-51.50

365  
554

X:\Projects\2013\1010\FRA\92616\drainage\sheet\92616DC019.dgn 4/19/2023 12:37:57 PM cwong

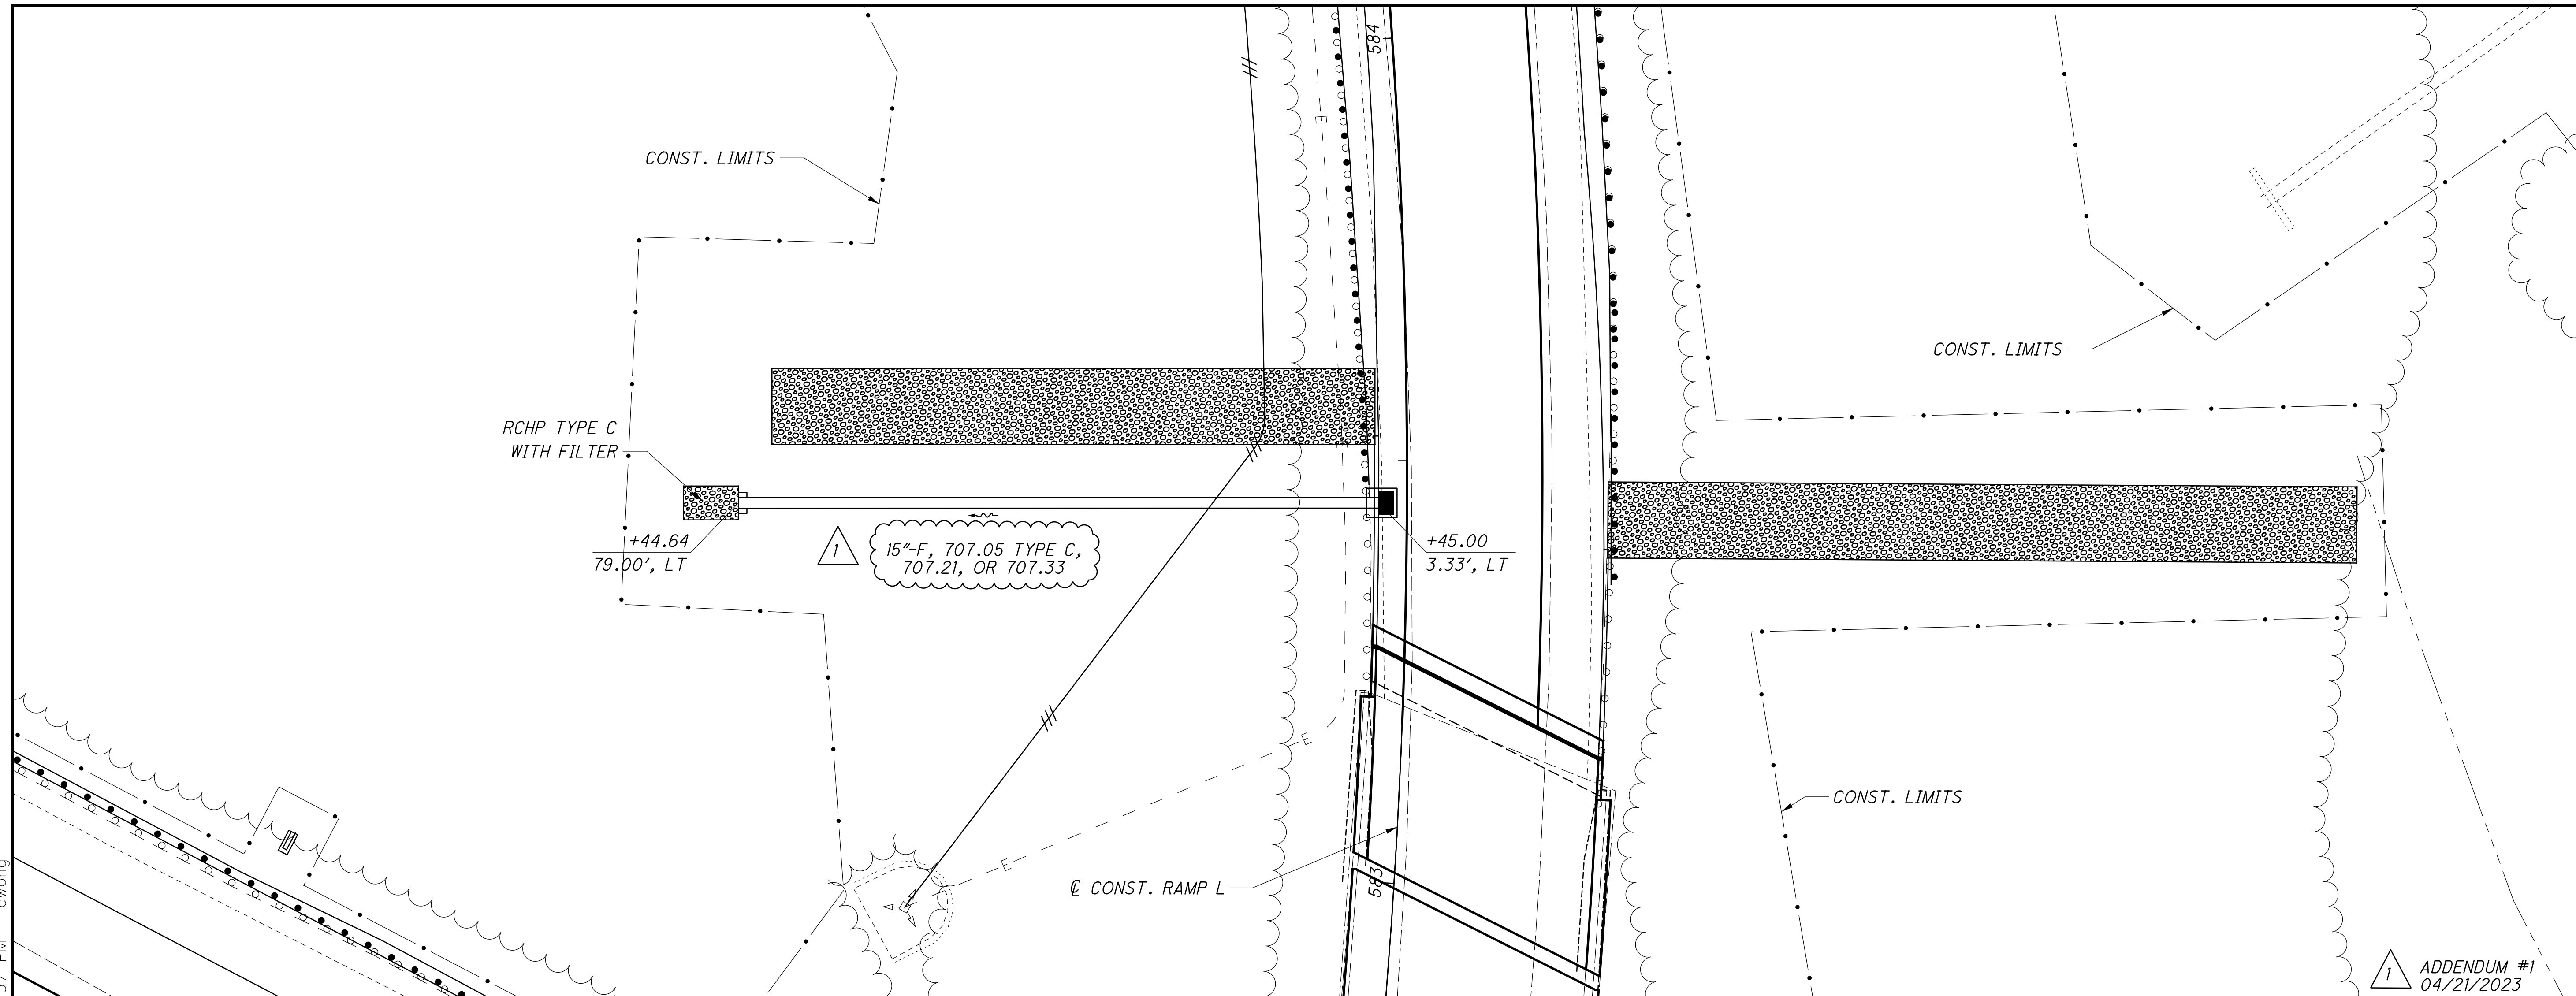


CALCULATED  
ACF

CHECKED  
CSR

0 5 10 20  
HORIZONTAL  
SCALE IN FEET



**STORM SEWER PROFILE - RAMP L**  
**STA. 583+45.00**

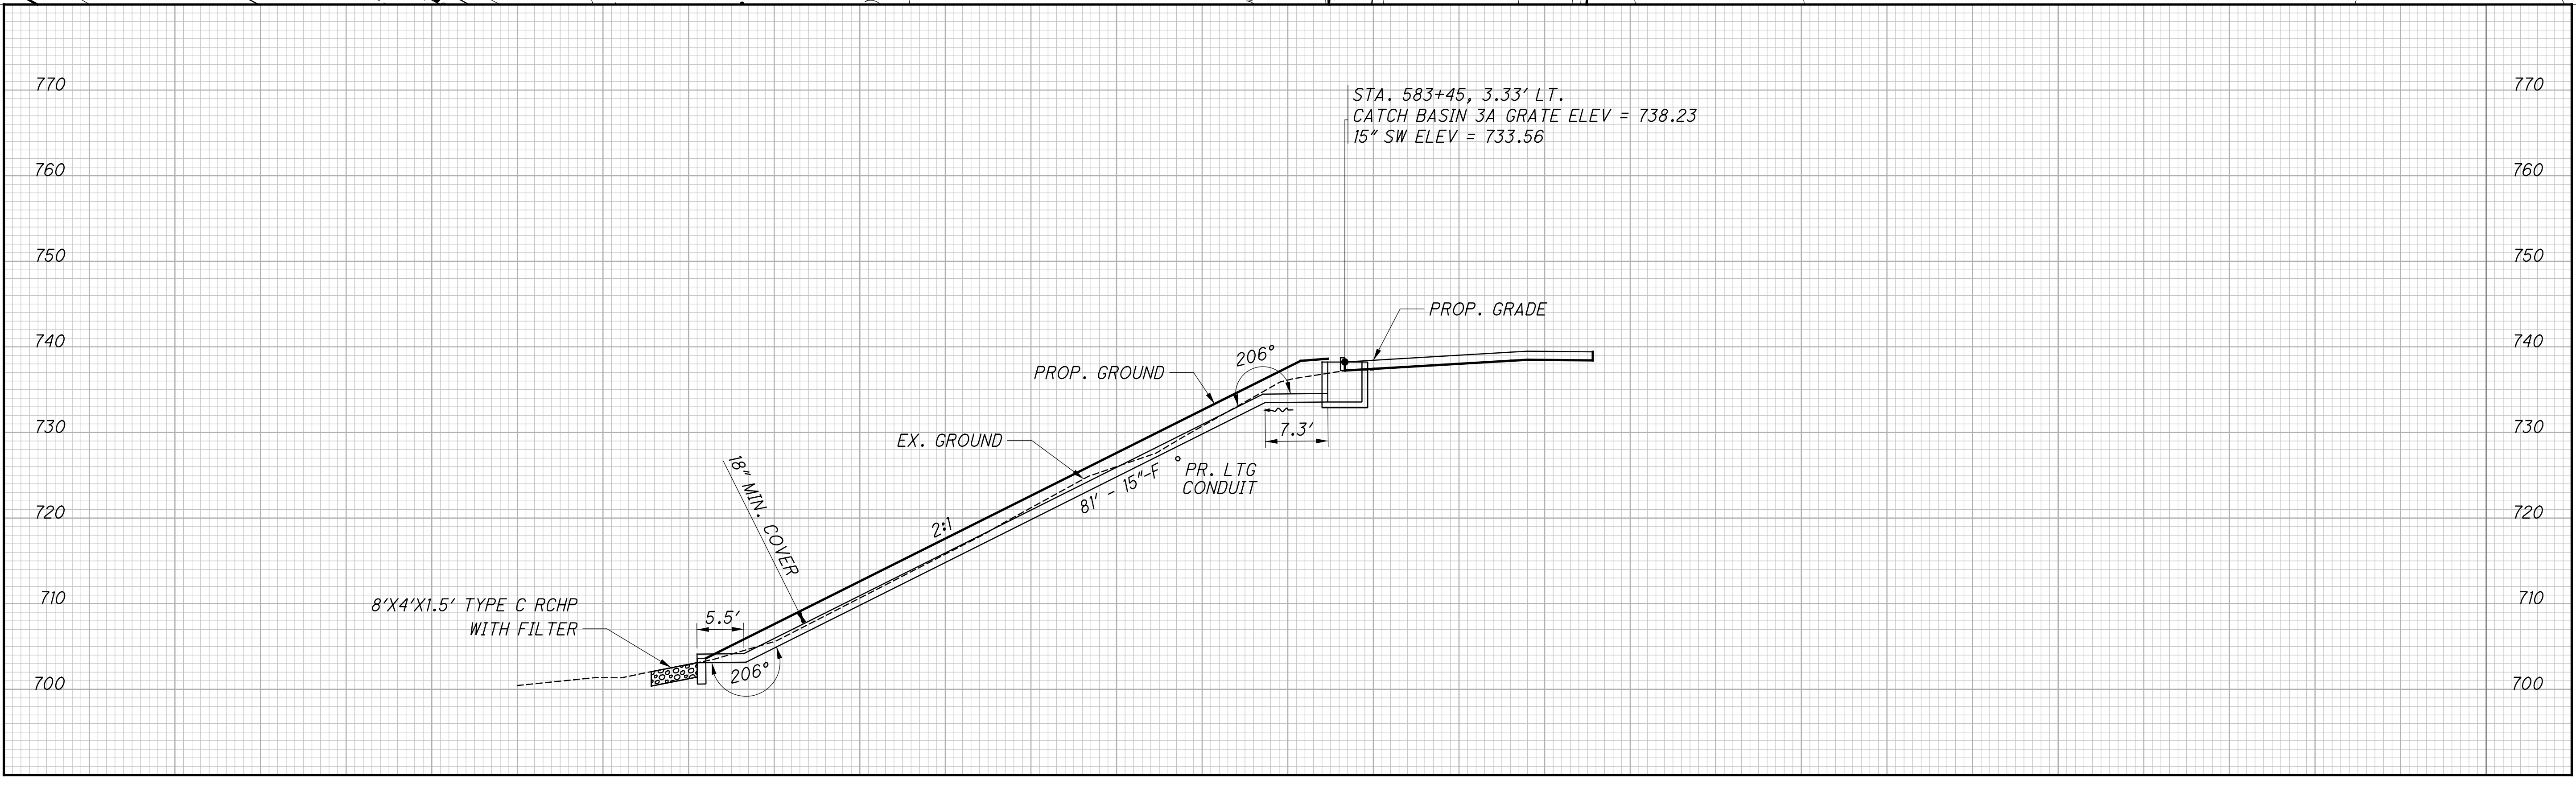


X:\Projects\2013\132\1010\FRA\92616\drainage\sheet\92616DC005.dgn 4/19/2023 12:49:24 PM cwong

EXISTING STRUCTURE DATA			
CFN:	1869019	DESIGN SERVICE LIFE:	75 YEARS
SIZE:	96"	STREAM pH:	7.0
TYPE:	CORRUGATED METAL	ABBRASSIVENESS:	N/A
LENGTH:	126'	HEADWALL:	HALF HEIGHT
DATE CONSTRUCTED:	1963		


HYDRAULIC DATA	
DRAINAGE AREA: 4.22 SQ. MI.	
$Q_{50} = 994$ CFS	$Q_{100} = 1140$ CFS
$V_{50} = 19.8$ FPS	$V_{100} = 22.7$ FPS
$HW_{50} = 703.36$	$HW_{100} = 706.89$

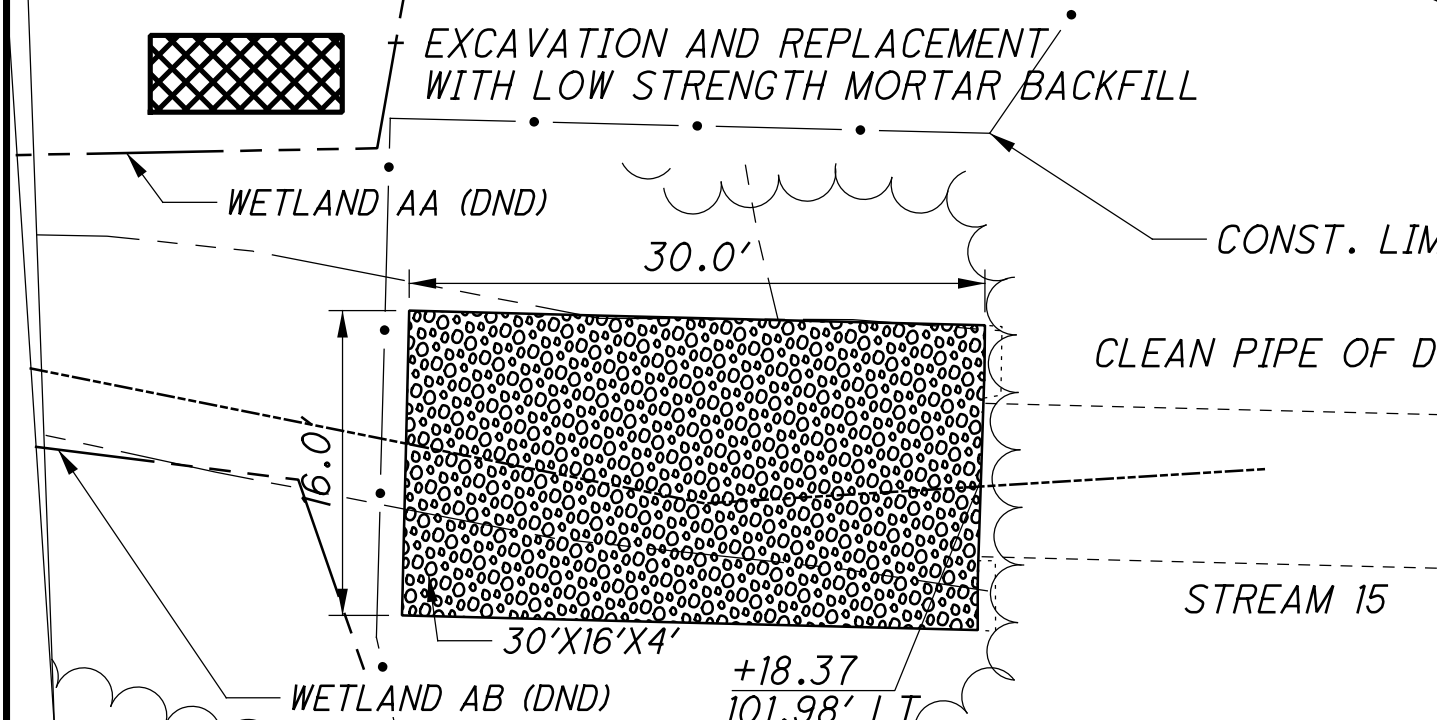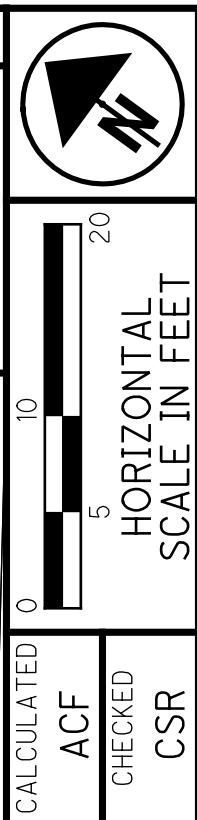

ESTIMATED QUANTITIES			
ITEM	QUANTITY	UNIT	DESCRIPTION
601	12	SY	RIPRAP, TYPE D
602	8	CY	CONCRETE MASONRY
611	31	FT	96" CONDUIT, TYPE A, AS PER PLAN, 707.02 (0.249)
203	146	CY	EXCAVATION
613	146	CY	LOW STRENGTH MORTAR BACKFILL
601	71	CY	ROCK CHANNEL PROTECTION, TYPE A WITH FILTER

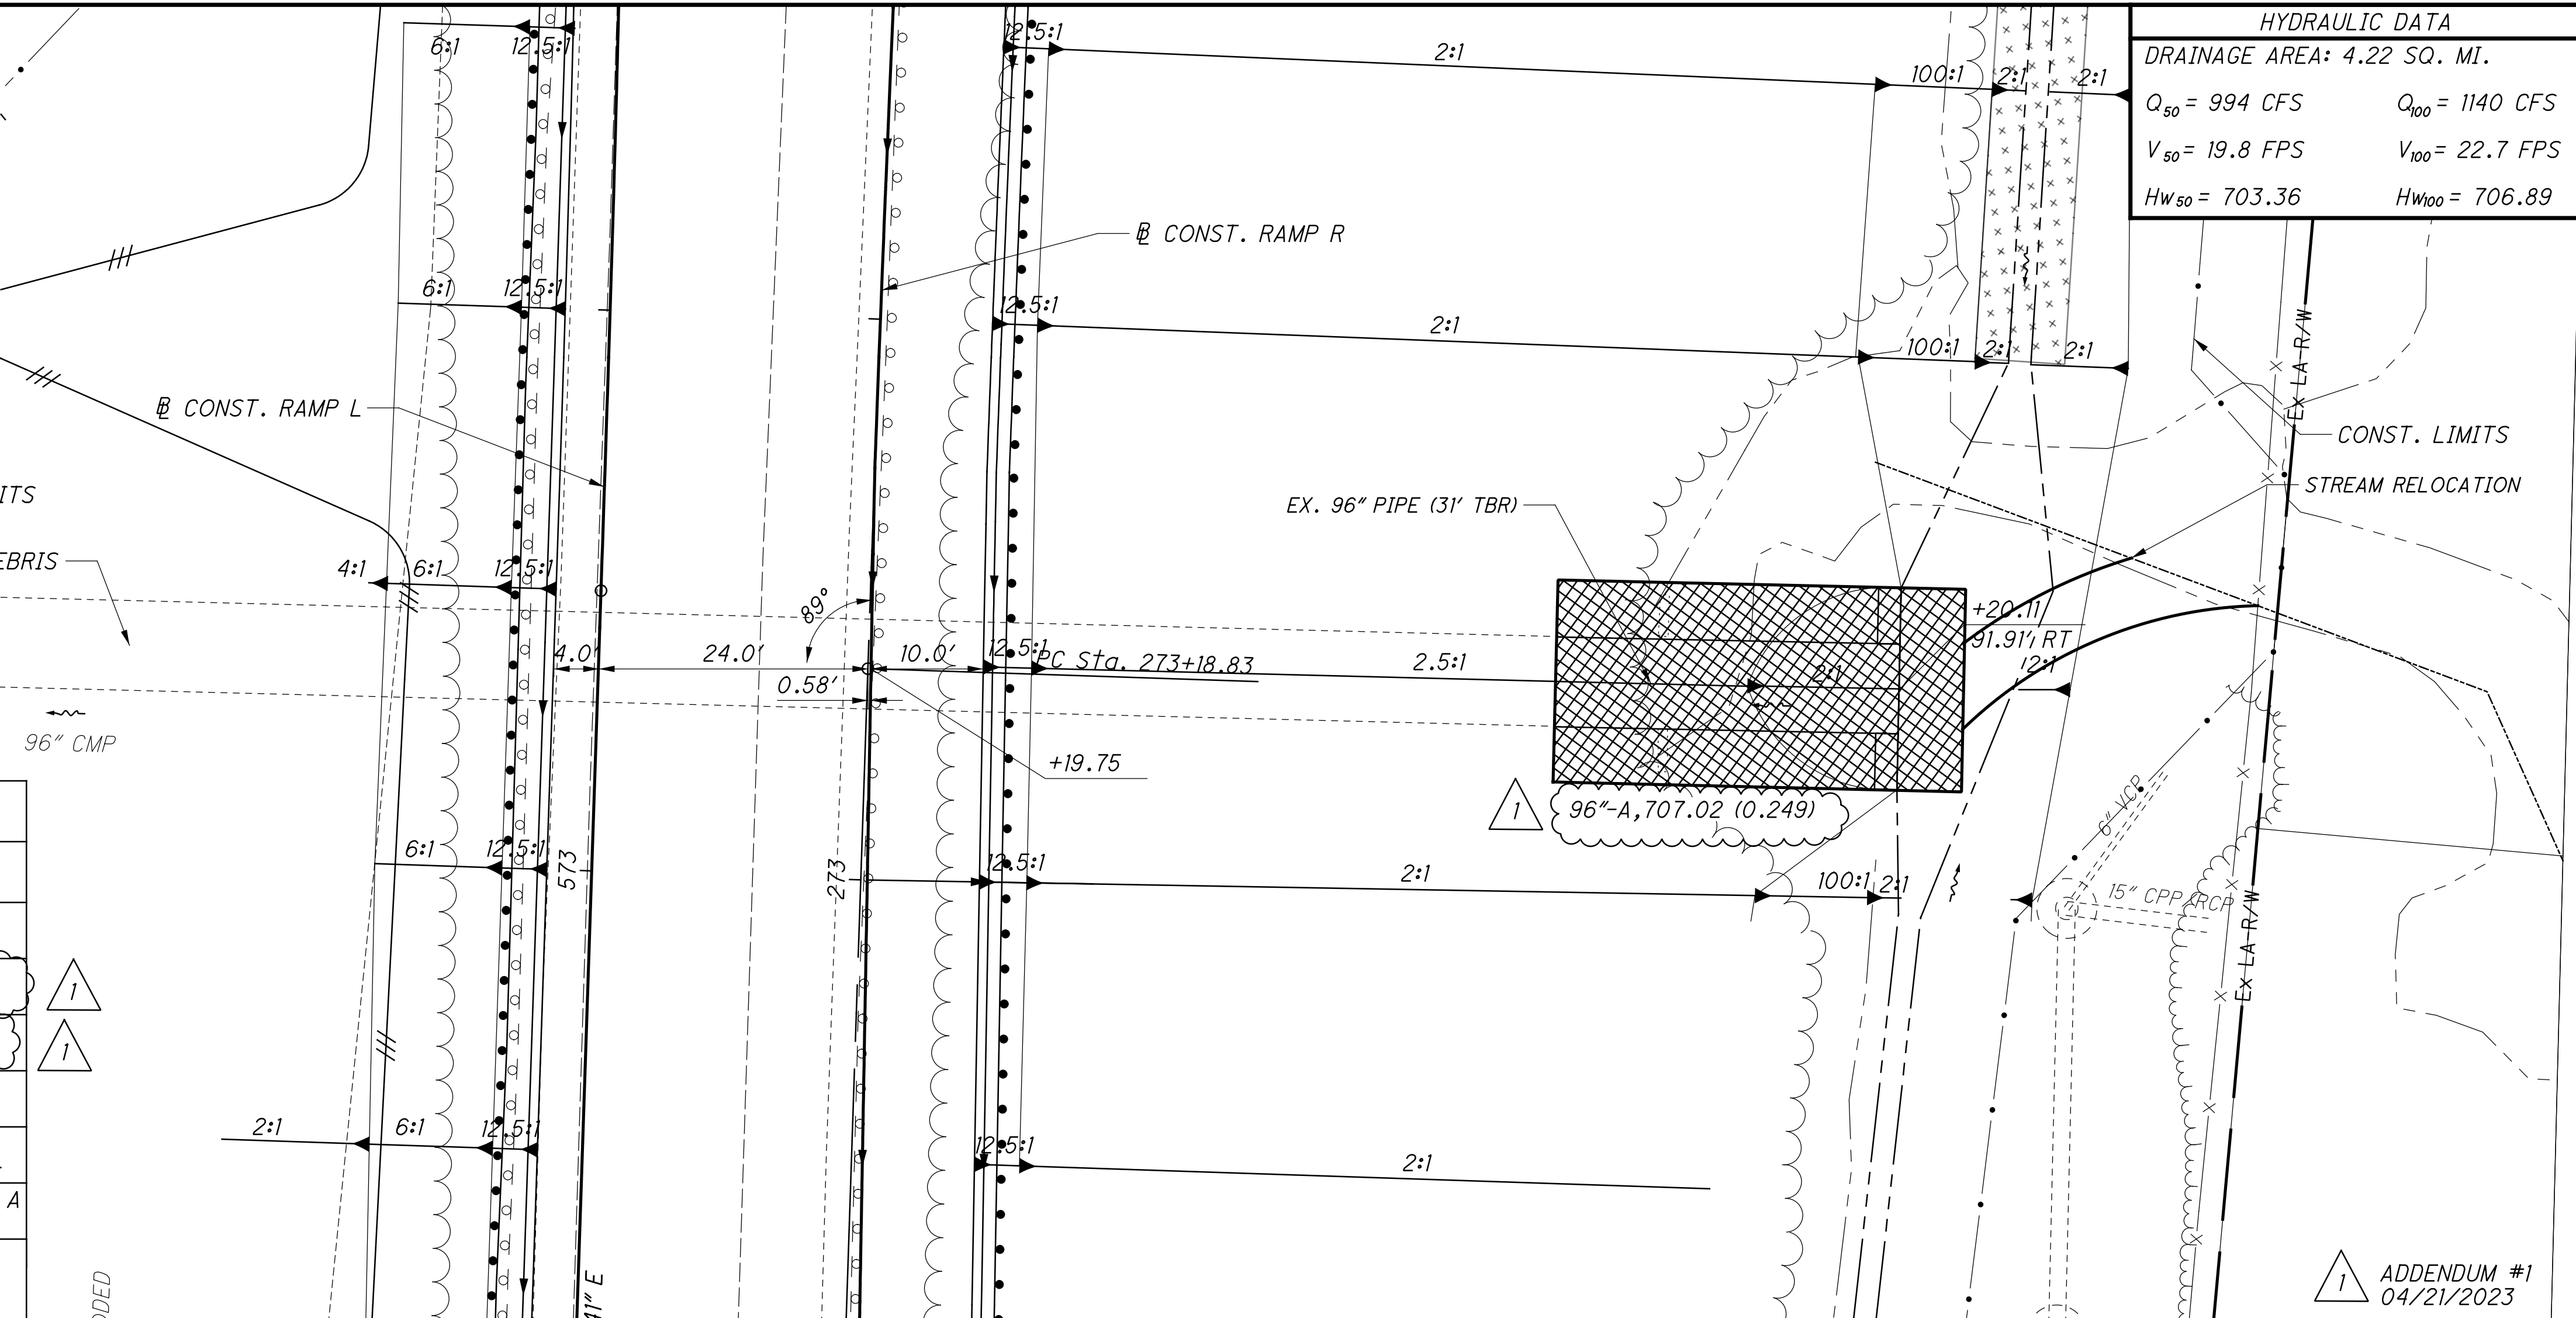

ADDENDUM #1  
04/21/2023

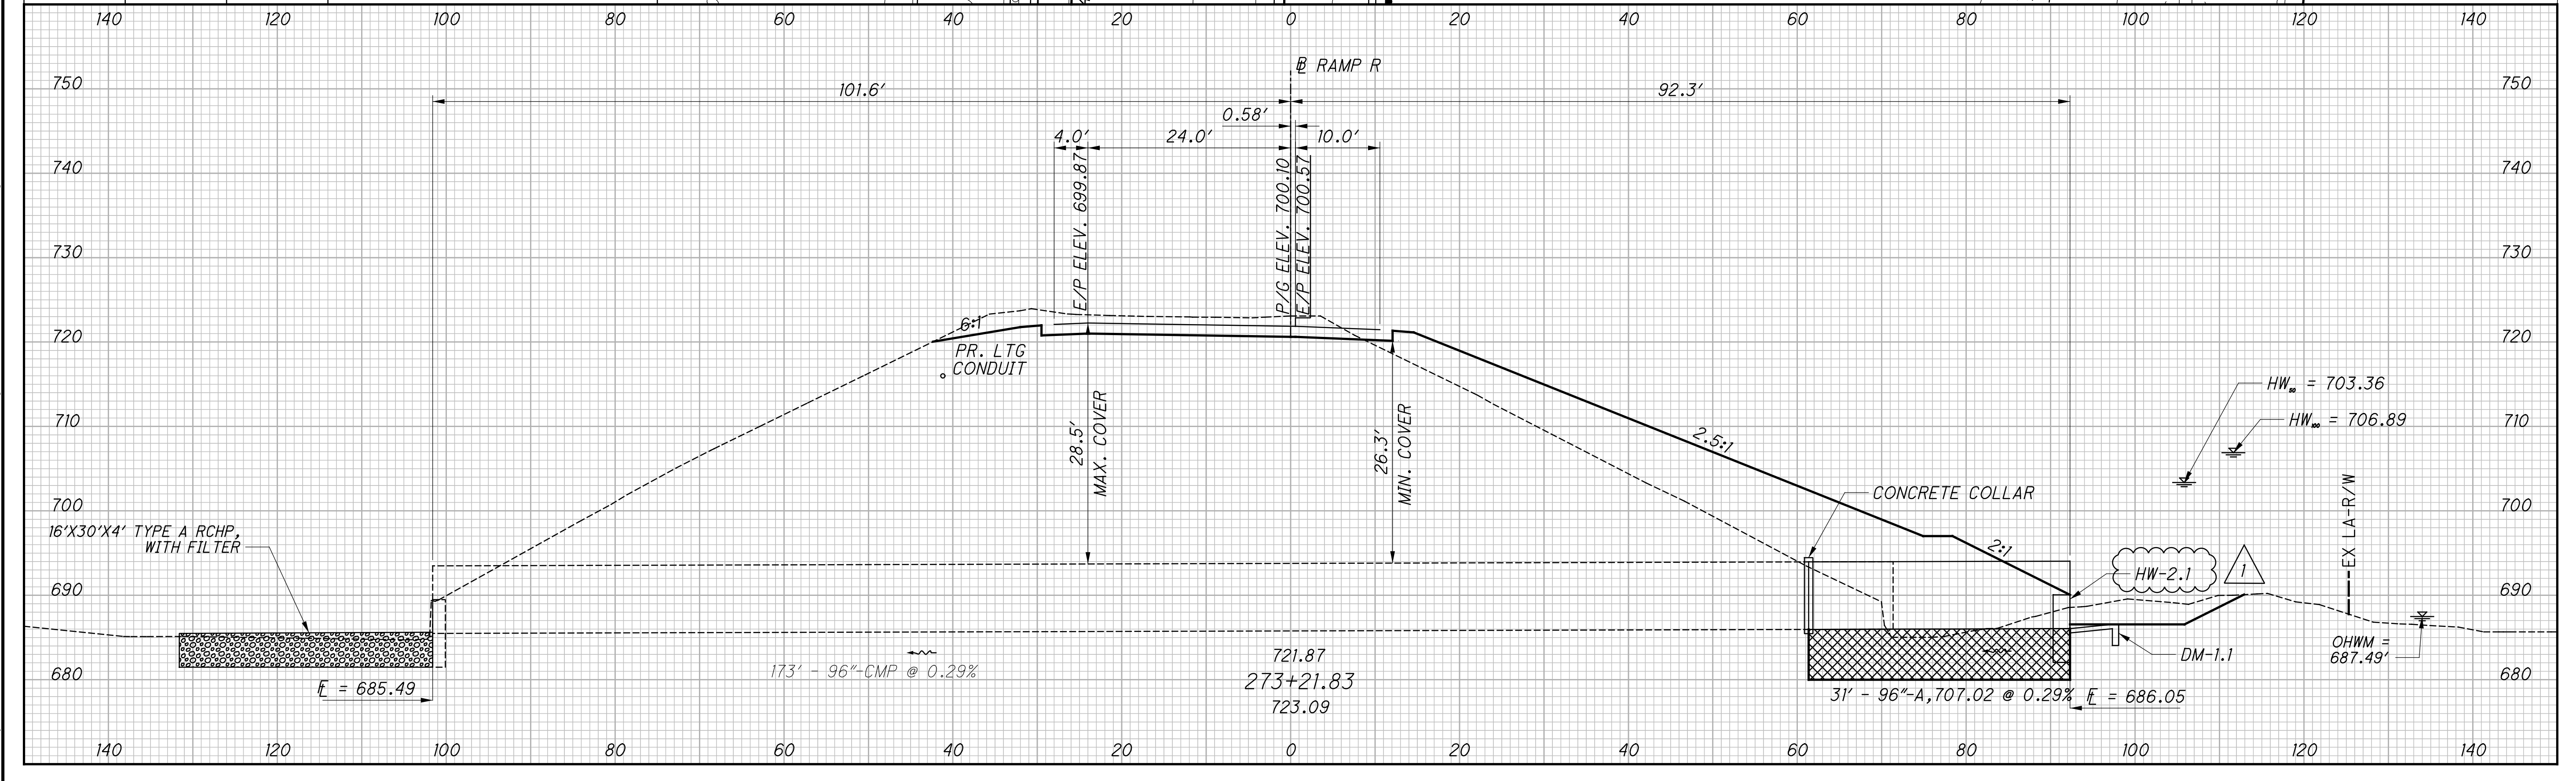

CALCULATED ACF CHECKED CSR

**CULVERT DETAIL - RAMP R**



**STA. 273+22.00**

**FRA - 270-51.50**

372  
554



X:\Projects\2013\1010\FRA\92616\drainage\sheet\92616DC009.dgn 4/19/2023 12:57:26 PM cwong

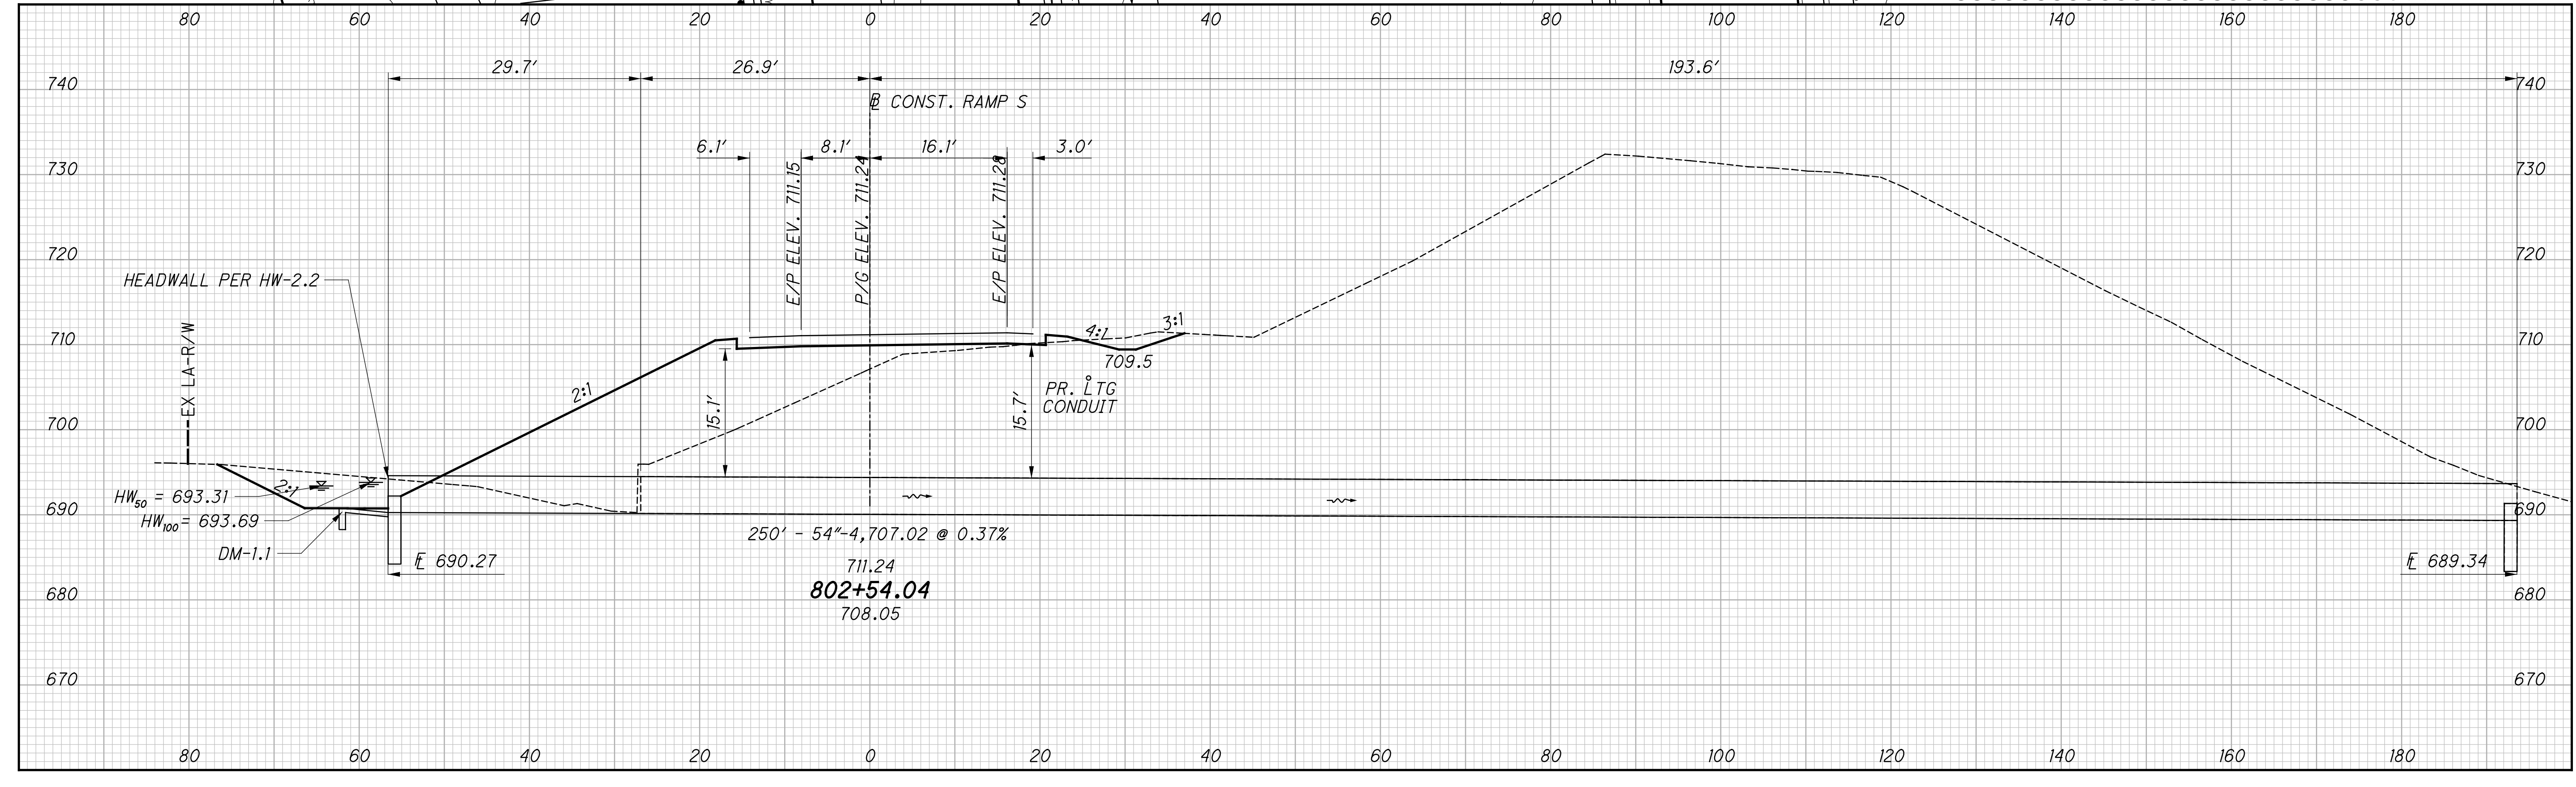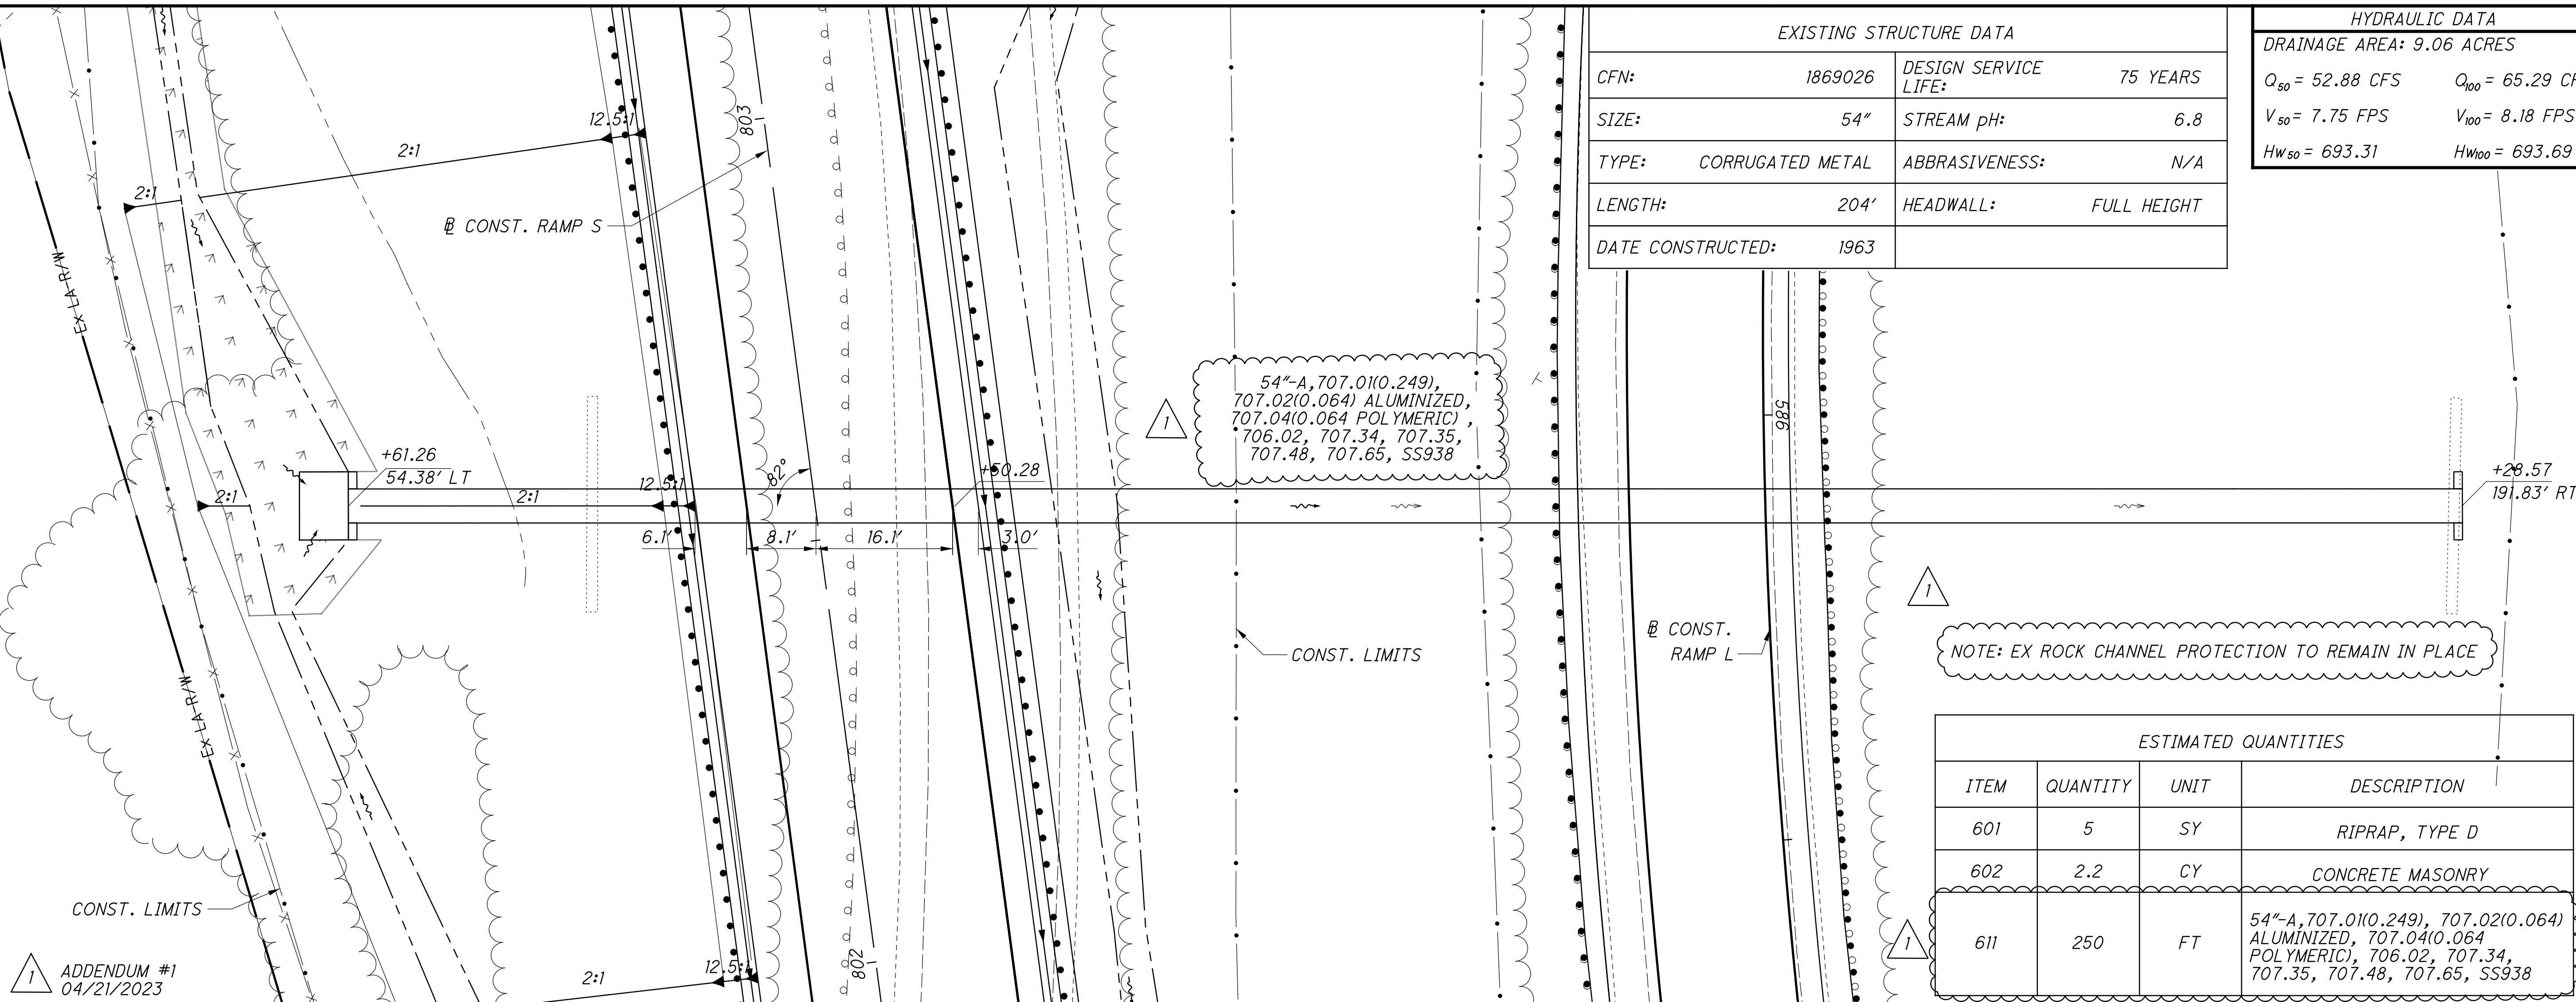

EXISTING STRUCTURE DATA			
CFN:	1869026	DESIGN SERVICE LIFE:	75 YEARS
SIZE:	54"	STREAM pH:	6.8
TYPE:	CORRUGATED METAL	ABRASIVENESS:	N/A
LENGTH:	204'	HEADWALL:	FULL HEIGHT
DATE CONSTRUCTED:	1963		

HYDRAULIC DATA			
DRAINAGE AREA: 9.06 ACRES			
Q <sub>50</sub> = 52.88 CFS	Q <sub>100</sub> = 65.29 CFS		
V <sub>50</sub> = 7.75 FPS	V <sub>100</sub> = 8.18 FPS		
HW <sub>50</sub> = 693.31	HW <sub>100</sub> = 693.69		



NOTE: EX ROCK CHANNEL PROTECTION TO REMAIN IN PLACE

ESTIMATED QUANTITIES			
ITEM	QUANTITY	UNIT	DESCRIPTION
601	5	SY	RIPRAP, TYPE D
602	2.2	CY	CONCRETE MASONRY
611	250	FT	54"-A, 707.01(0.249), 707.02(0.064) ALUMINIZED, 707.04(0.064 POLYMERIC), 706.02, 707.34, 707.35, 707.48, 707.65, SS938



ADDENDUM #1  
04/21/2023

CULVERT DETAIL - RAMP S  
STA. 802+54.00

FRA - 270-51.50

375  
554

X:\Projects\2013\1321\1010\FRA\92616\drainage\sheet\92616DC015.dgn 4/19/2023 1:05:42 PM cwong

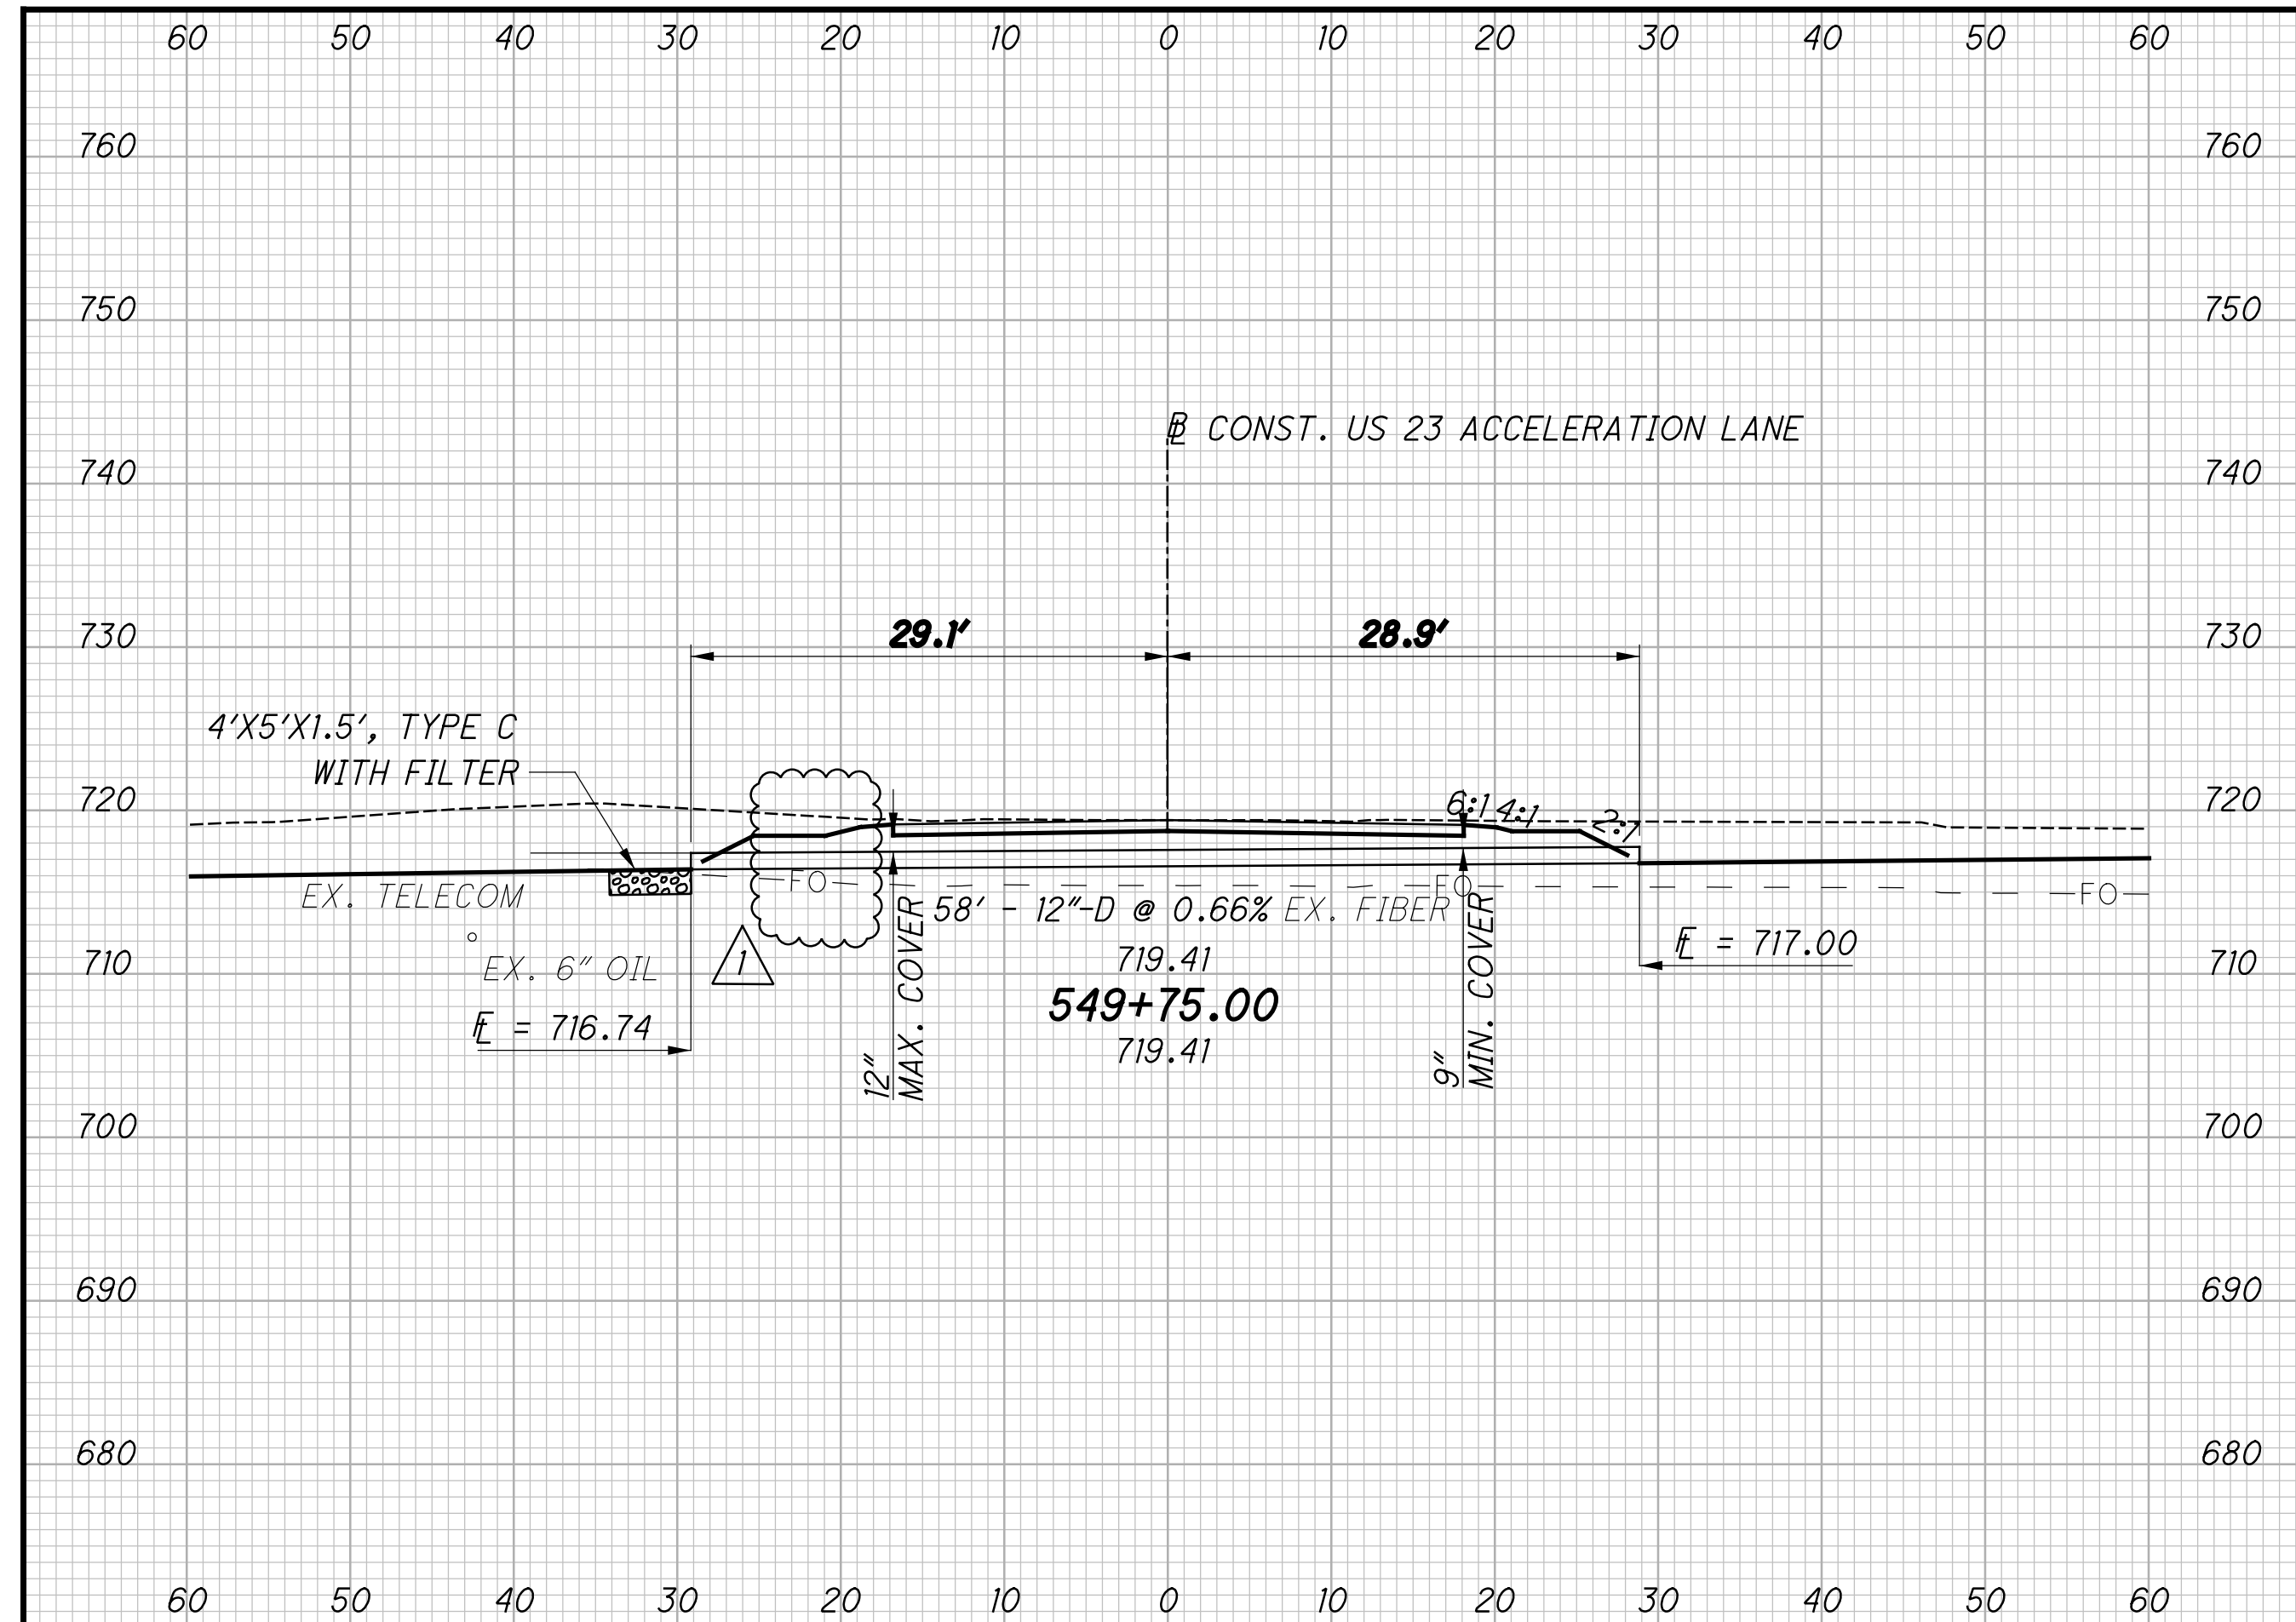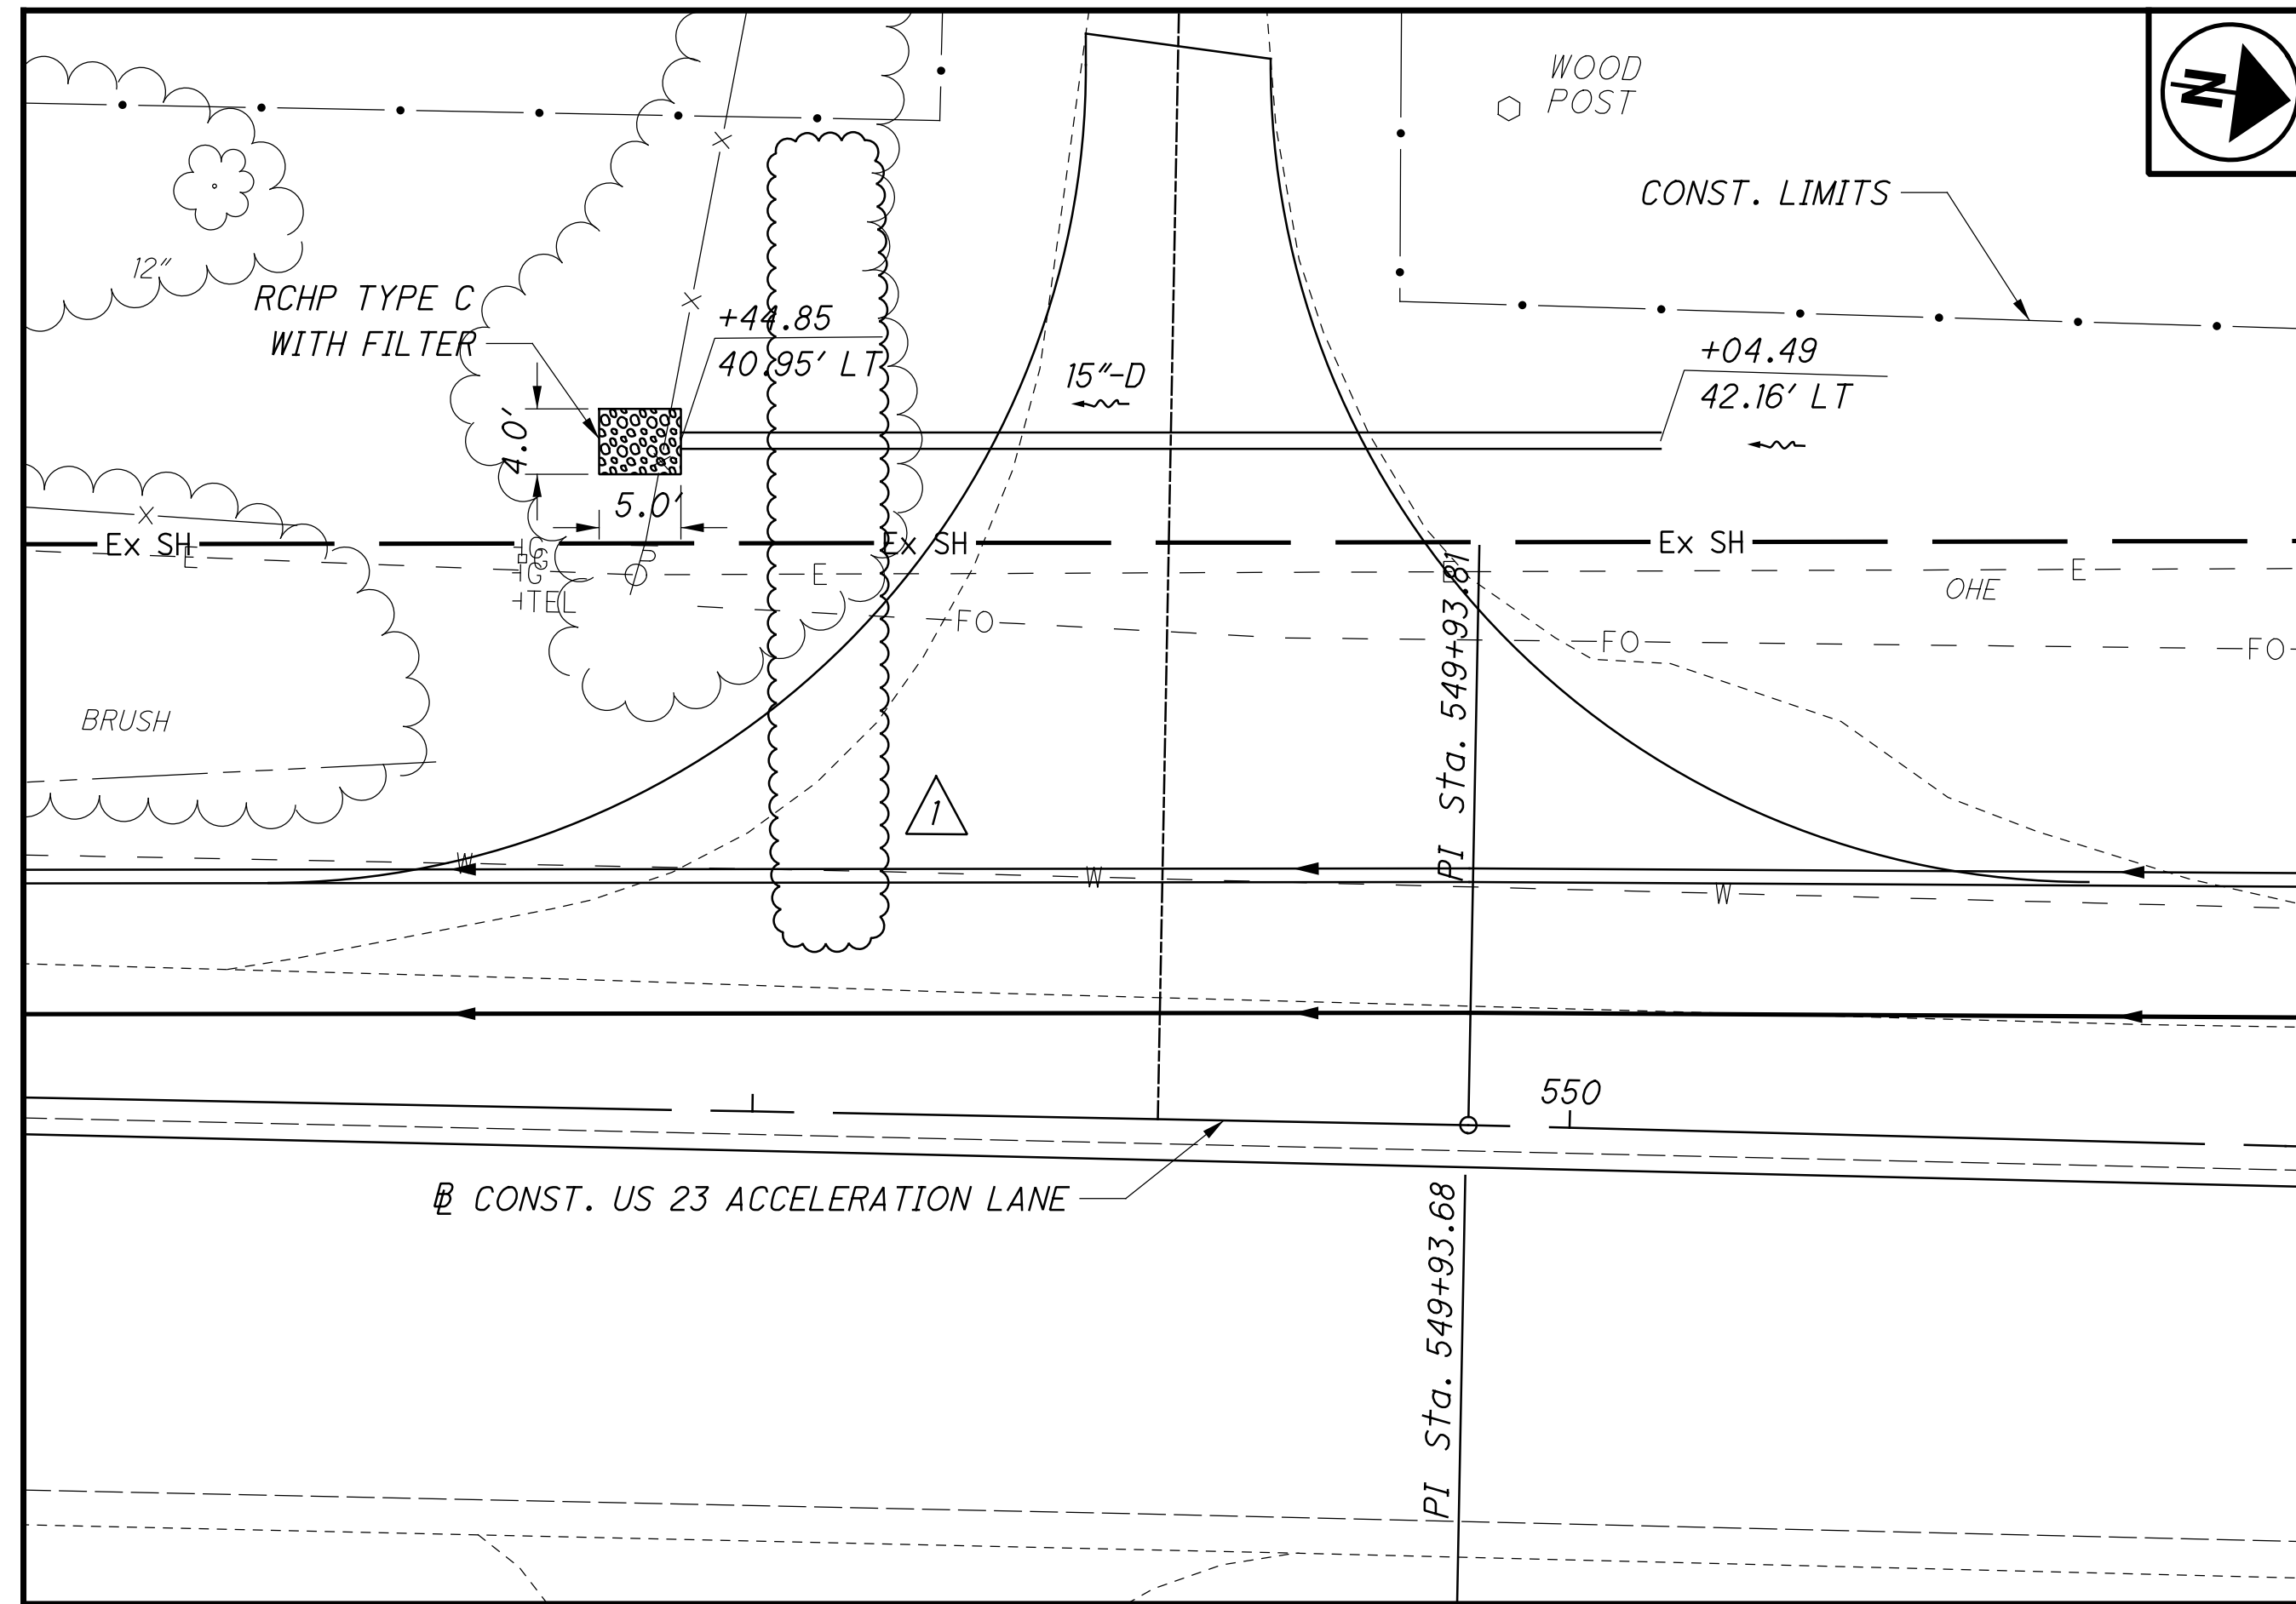

CALCULATED	ACF	CHECKED	CSR

**CULVERT DETAILS - US 23 ACCELERATION LANE  
STA. 549+75**


**FRA - 270-51.50**





FIELD WIRING HOOK-UP CHART

SIGNAL HEAD #	INDICATION	FIELD TERMINAL	FLASH
1-2, 4 (NB)	R	φ2 R	R
	Y	φ2 Y	
	G	φ2 G	
7 (WB)	R	φ8 R	R
	Y	φ8 Y	
	G	φ8 G	
3 & 8 (WB)	R	φ8 R	R
	Y	φ8 Y	
	G	φ8 G	
5-6, 9 (SB)	R	φ6 R	R
	Y	φ6 Y	
	G	φ6 G	

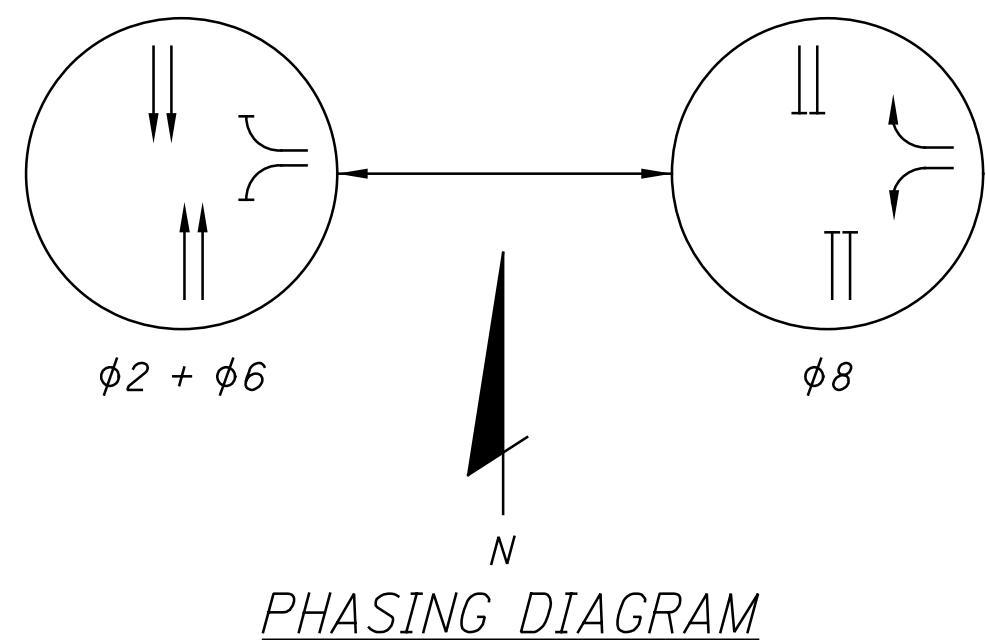


MAINTENANCE/OWNER:  
ODOT WILL OWN AND MAINTAIN THIS SIGNAL.

INTERSECTION TIMING								
	1	2	3	4	5	6	7	8
DIRECTION	-	NB	-	-	-	SB	-	WB
MIN GREEN	-	20	-	-	-	20	-	10
PASSAGE	-	1.0*	-	-	-	1.0*	-	3.0*
MAX 1	-	45	-	-	-	45	-	40
MAX 2	-	45	-	-	-	45	-	40
YELLOW	-	5.0	-	-	-	5.0	-	4.0
ALL RED	-	1.0	-	-	-	1.0	-	2.0
WALK	-	-	-	-	-	-	-	-
PED CLEAR	-	-	-	-	-	-	-	-
INITIALIZE	-	G	-	-	-	G	-	-
LOCKING MEMORY	OFF	ON	OFF	OFF	OFF	ON	OFF	OFF
VEH RECALL	OFF	ON	OFF	OFF	OFF	ON	OFF	OFF
PED RECALL	OFF	OFF	OFF	OFF	OFF	OFF	OFF	OFF

\* PROGRAM PER RADAR ADVANCED DETECTOR MANUFACTURER'S RECOMMENDATIONS


DETECTION CHART							
DETECTOR	DETECTOR TYPE	MOVEMENT	DETECTION ZONE	RADAR UNIT	MODE	DELAY	ASSOCIATED CONTROLLER PHASE
R1	RADAR	NB	-	ADVANCE	PRESENCE	-	φ2
R2	RADAR	WB	-	ADVANCE	PRESENCE	-	φ8
R3	RADAR	WB	DZ1	STOP BAR	PRESENCE	8	φ8
			DZ2	STOP BAR	PRESENCE	0	φ8
R4	RADAR	SB	-	ADVANCE	PRESENCE	-	φ6

WIRING DIAGRAM

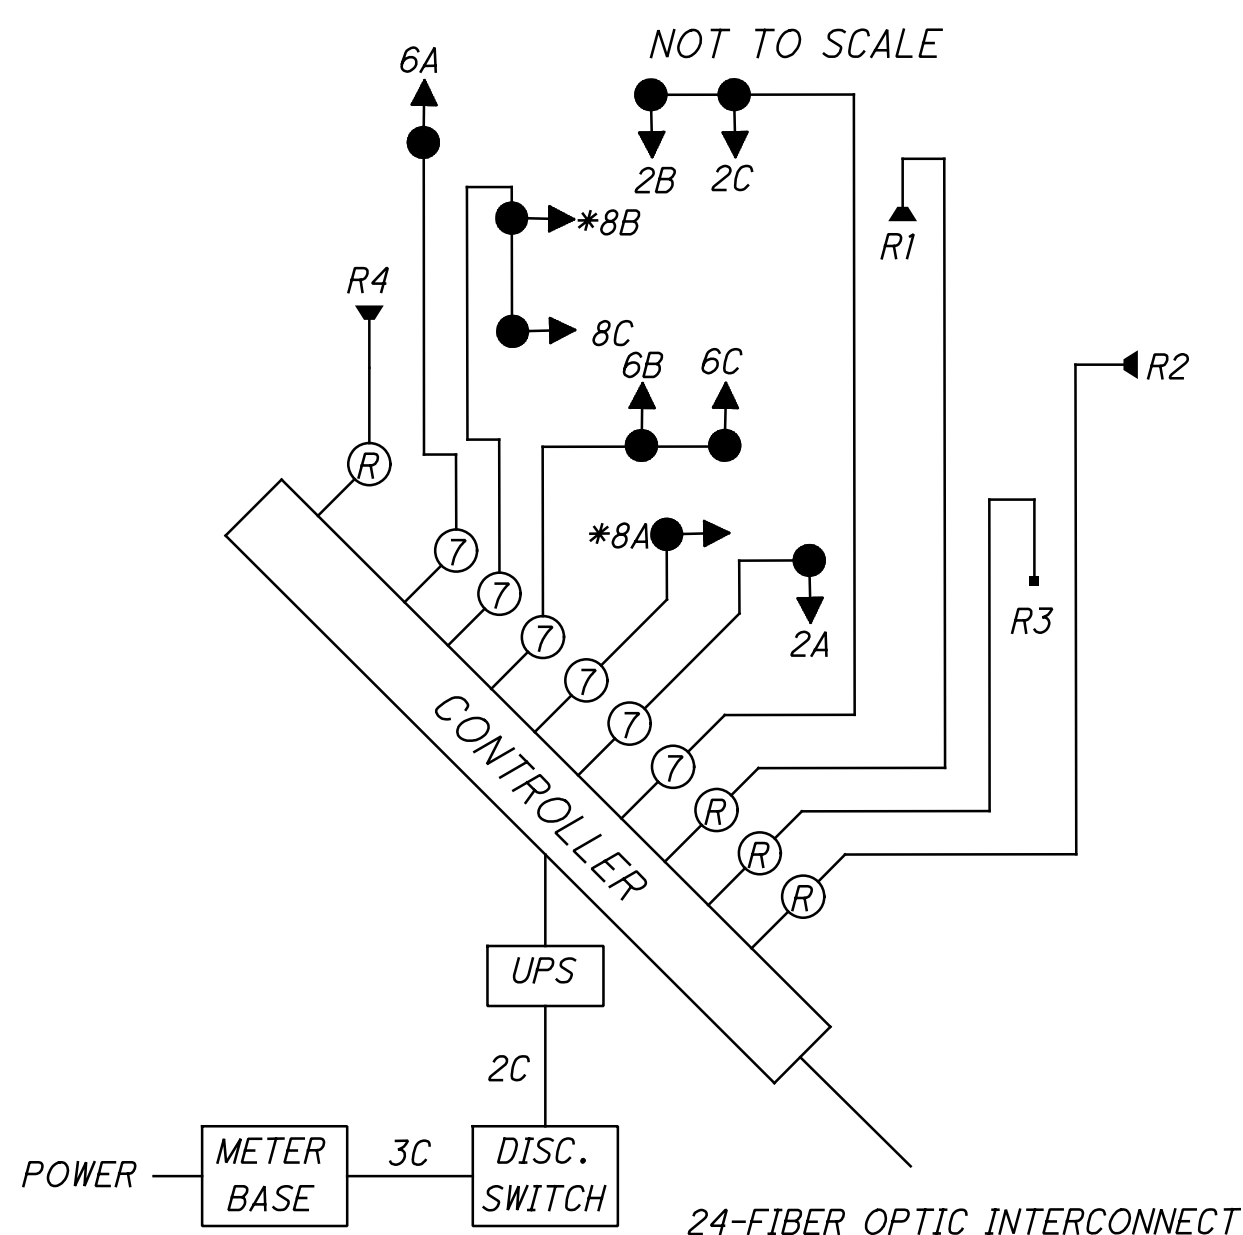


WIRING DIAGRAM LEGEND

- X 3-SECTION VEHICULAR SIGNAL HEAD
- \*X 4-SECTION VEHICULAR SIGNAL HEAD
- ⊗ SIGNAL CABLE, # OF CONDUCTORS
- ◄ PROPOSED RADAR ADVANCED DETECTOR
- PROPOSED RADAR STOP BAR DETECTOR
- ⊕ PROPOSED RADAR DETECTOR CABLE

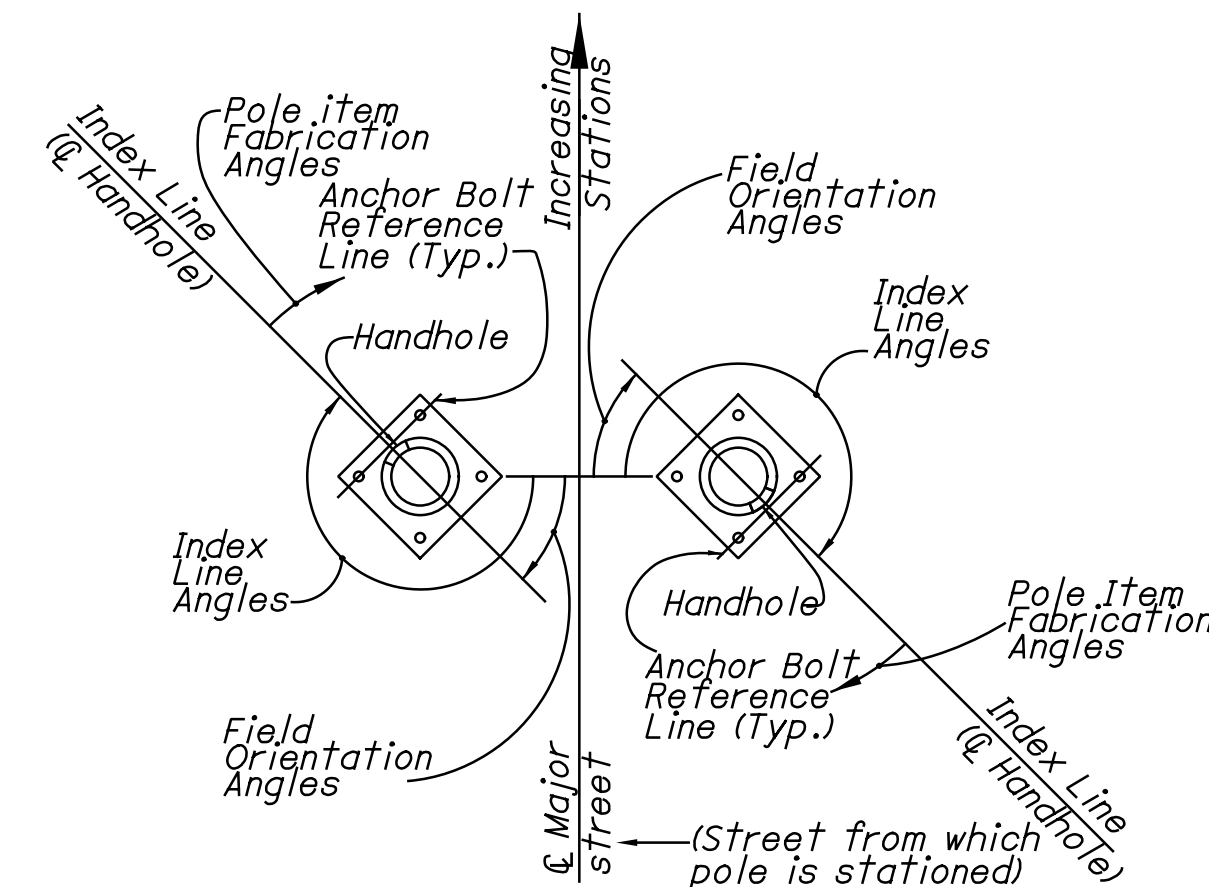

NOTES:  
All angles measured clockwise.  
Index line goes through the center of the handhole.

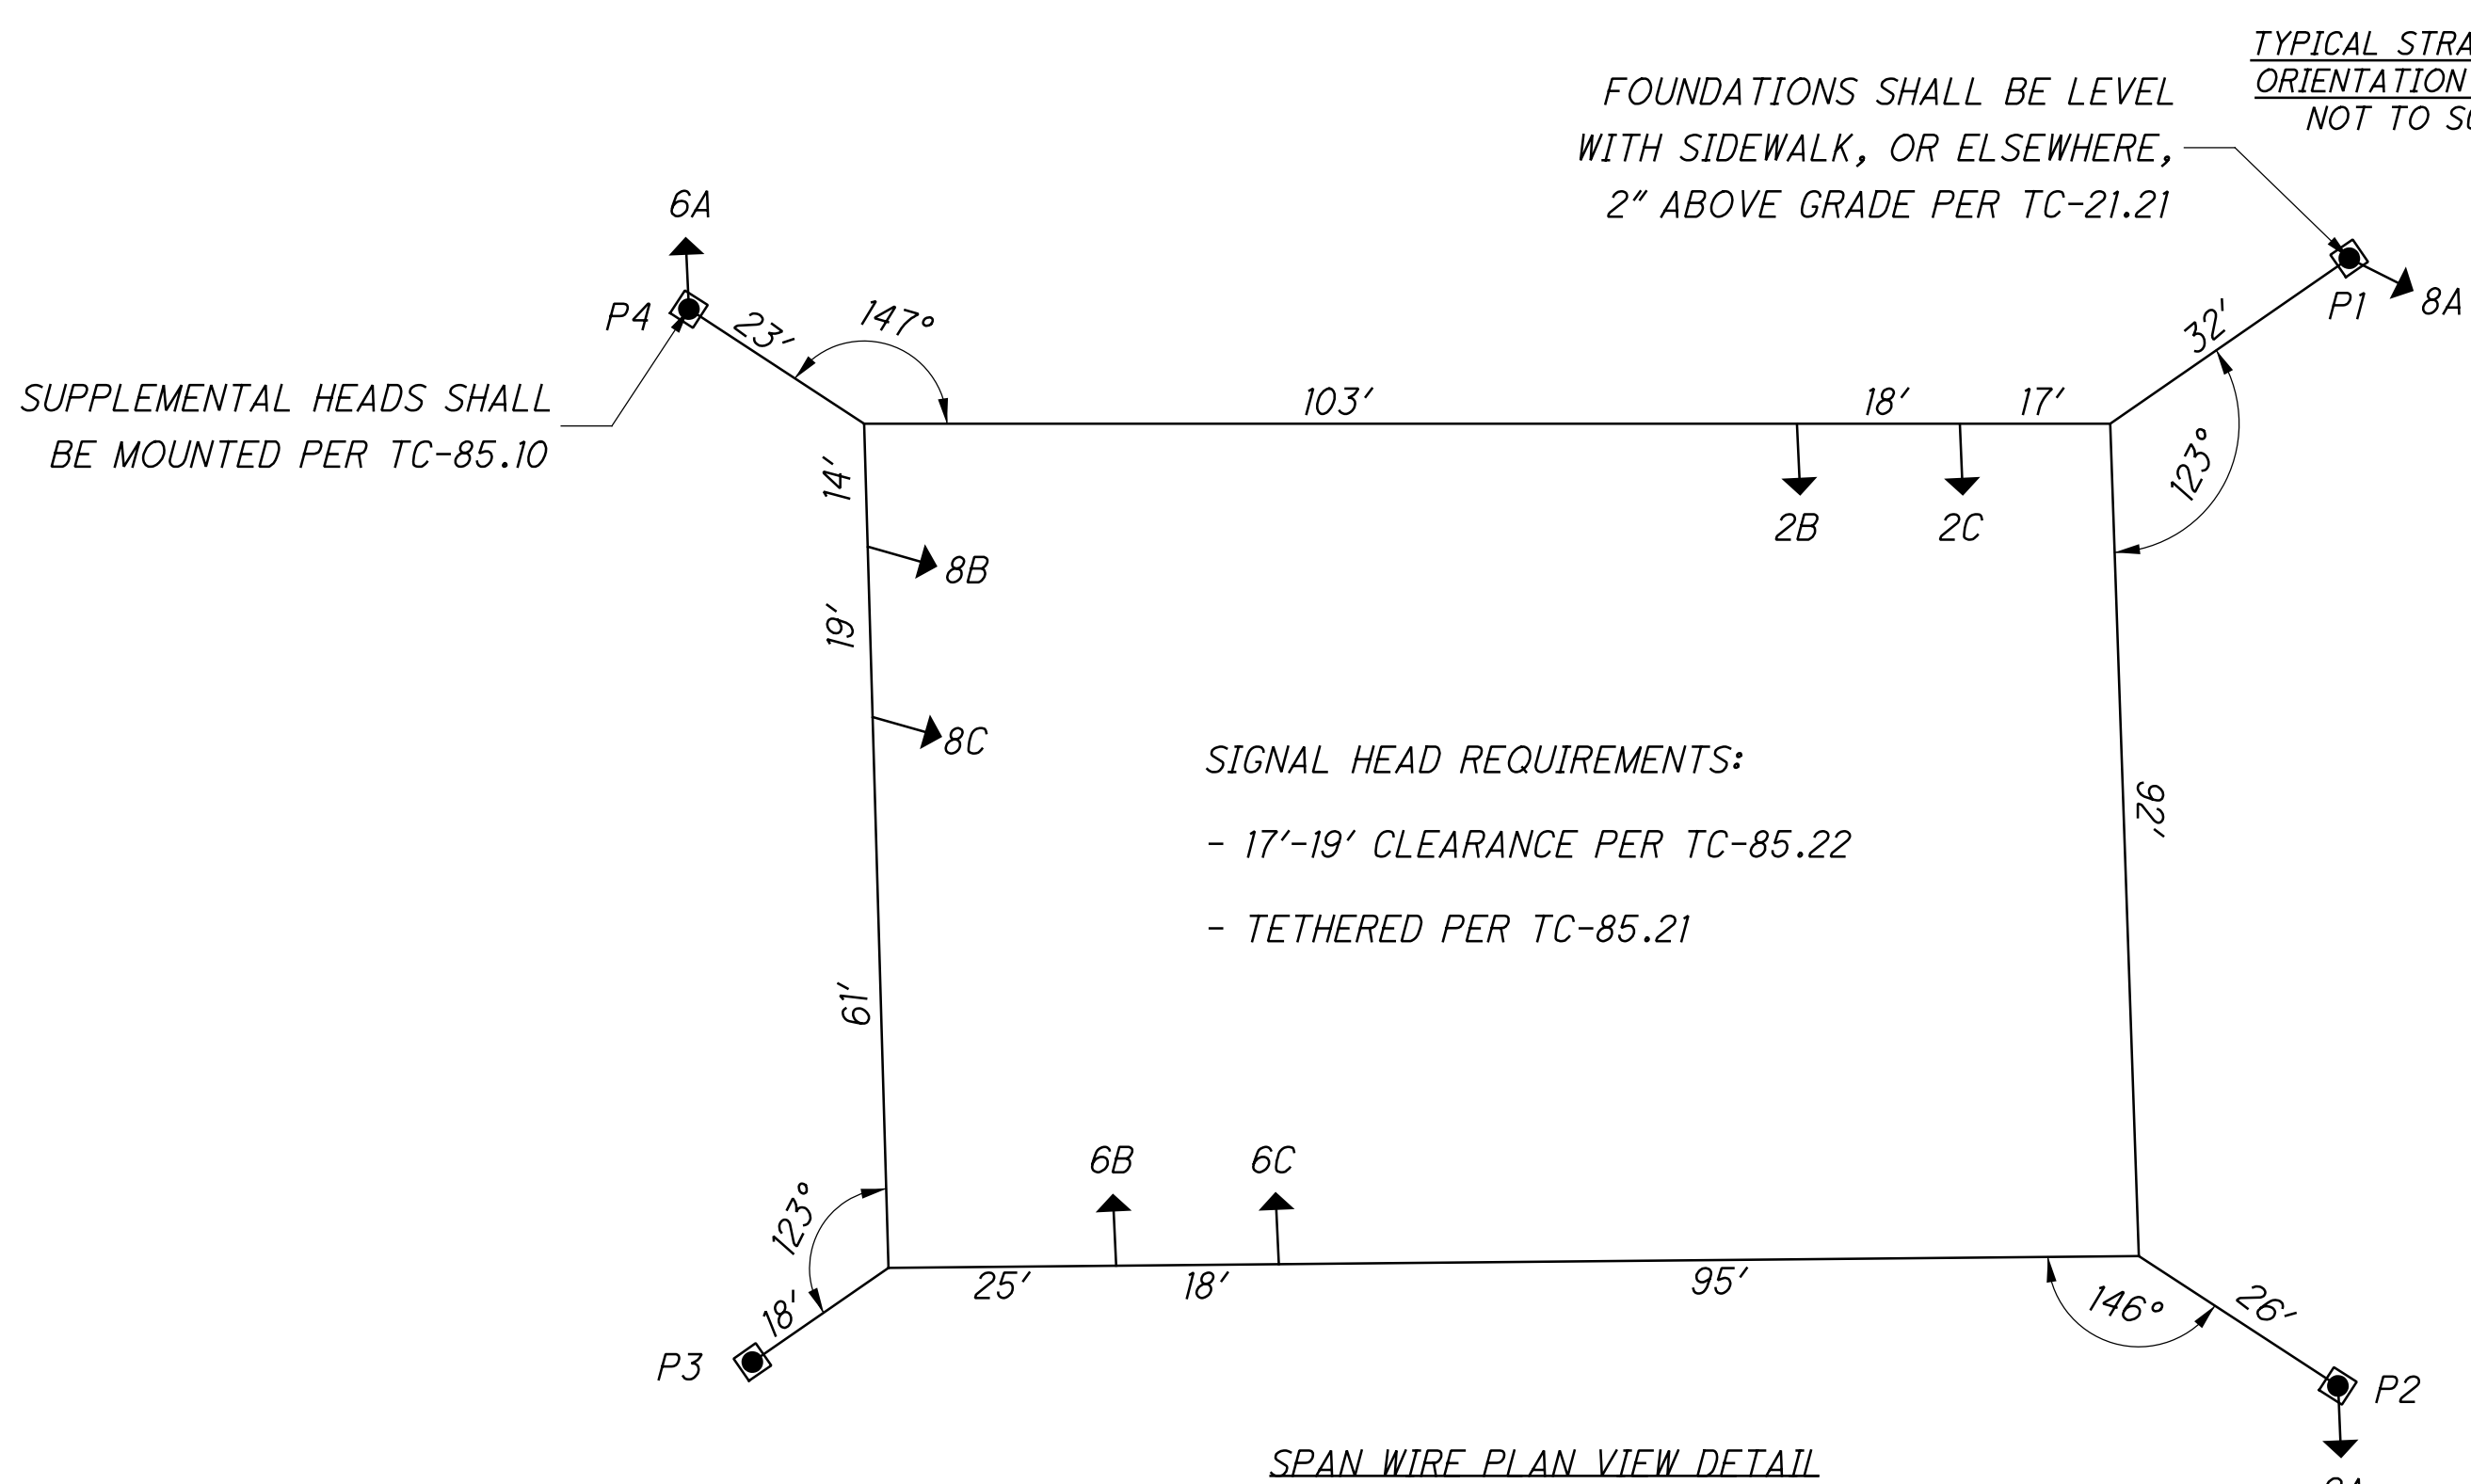

POLE NO.	DESIGN NO.	POLE HEIGHT (FT.)	FOUNDATION			SPAN ATTACHMENT HEIGHT	RADAR DETECTOR ATTACHMENT HEIGHT	ANGLES (DEG.) FROM INDEX LINE			
			STATION	OFFSET	ELEVATION			SUPPLEMENTAL SIGNAL HEAD	HANDHOLE	POWER SERVICE	SPARE 2" CONDUIT (CAPPED)
P1	10	33'	587+41.0	62.3' RT	698.48	30'	18'	61°	180°	90°	90°
P2	10	31'	586+57.8	57.8' RT	698.82	28'	18'	54°	180°	-	270°
P3	10	32'	586+64.8	59.0' LT	698.26	29'	-	-	180°	-	90°
P4	10	32'	587+41.8	60.1' LT	698.33	29'	-	54°	180°	-	180°

ADDENDUM #1  
04/21/2023

ODOT INTERCONNECT NOTES



ITEM 632 - INTERCONNECT, MISC.: FIBER OPTIC SPLICE ENCLOSURE, CLAMHELL, 288 SPLICE

FIBER OPTIC CABLE SPLICES SHALL BE PERFORMED IN SPLICE ENCLOSURES AS SHOWN ON THE PLANS. THE SPLICE ENCLOSURES SHALL BE CORROSION RESISTANT, RODENT PROOF, RE-ENTERABLE, AND MANUFACTURER CERTIFIED FOR UNDERGROUND INSTALLATION.

288 CLAMHELL SPLICE ENCLOSURES ARE TO BE INSTALLED IN 32", 36", OR 48" PULL BOXES OR MOUNTED AERIALLY AS DIRECTED IN THE PLANS. CONTRACTOR SHALL ADVISE THE ENGINEER IN THE EVENT THAT CABLES CANNOT ENTER SPLICE ENCLOSURE PERPENDICULARLY TO CABLE PORT ENTRY PLATE, OR IF CABLE BENDS EXCEED MINIMUM INSTALLATION BEND RADIUS RATING AT THE ENCLOSURE ENTRY DUE TO EXISTING FIELD CONDITIONS SUCH AS INADEQUATE SPACE IN PULL BOX OR OTHER OBSTRUCTIONS. ADDITIONALLY, CONTRACTOR SHALL ADVISE THE ENGINEER PRIOR TO BEGINNING SPLICING IF PLANNED NUMBER OF SPLICES CANNOT BE NEATLY AND SECURELY CONTAINED IN THE TYPE OF SPLICE ENCLOSURE CALLED OUT IN THE PLANS.

FOR UNDERGROUND INSTALLATION, SPLICE ENCLOSURE AND SLACK CABLE MUST FIT WITHIN PULL BOX TO AVOID DAMAGE TO THE ENCLOSURE OR CABLE UPON CLOSING THE PULL BOX LID.

FOR AERIAL INSTALLATION, EXTENDED STRENGTH BRACKET SHALL BE INSTALLED WITH THE SPLICE ENCLOSURE TO ENSURE CABLE ENTRIES REMAIN PERPENDICULAR AND SECURELY FASTENED TO THE PORT ENTRY PLATE. AERIAL MOUNTED SLACK STORAGE RACKS ARE TO BE USED FOR ALL INSTALLATIONS WHERE CABLES ARE LOOPED OR BENT 180°. THE COST OF THE STRAIN RELIEF HARDWARE, STRENGTH BRACKETS, TIES OR OTHER INSTALLATION HARDWARE IS CONSIDERED INCIDENTAL TO THIS PAY ITEM.

THE SPLICE ENCLOSURE SHALL BE WEATHERPROOF, WATERPROOF, CORROSION RESISTANT, RODENT PROOF, RE-ENTERABLE, AND CRUSH RESISTANT. CLAMHELL ENCLOSURES SHALL HAVE UPPER AND LOWER PIECES WITH CABLE ENTRY PLATE THAT ARE TIGHTENED DOWN AND SEALED USING SCREWS / BOLTS. DOME ENCLOSURES SHALL BE SINGLE TUBE WITH CABLE ENTRY PLATE. THE SPLICE ENCLOSURE SHALL EASILY FIT INTO PULL BOXES ALONG WITH LOOPS OF SLACK CABLE IN BOX (APPROX. 150 FT) THE SPLICE ENCLOSURE SHALL BE A COMPLETE KIT INCLUDING ALL COMPONENTS AND HARDWARE FOR INSTALLATION. THE SPLICE ENCLOSURE SHALL BE SUITABLE FOR APPLICATION IN THE TEMPERATURE RANGE OF -40 C TO +70 C. THE SPLICE ENCLOSURE SHALL PROVIDE SPACE, ALLOWING ENTRY OF FIBER OPTIC CABLE WITHOUT EXCEEDING THE MINIMUM BEND RADIUS OF THE CABLE. THE ENCLOSURE SHALL HAVE PROVISIONS FOR CABLE AND PIGTAIL STRAIN-RELIEF, AND SHALL BE EQUIPPED WITH STRAIN-RELIEF HARDWARE. THE SPLICE ENCLOSURE SHALL BE EQUIPPED WITH ELASTOMERIC SPLICE BLOCKS ENCLOSED WITHIN MANUFACTURER SPLICE TRAYS AND SHALL PERMIT SELECTIVE FIBER SPLICING (LOOPING A BACKBONE CABLE IN AND OUT WHILE ONLY CUTTING INTO THE DESIRED FIBERS ALL BUFFER TUBES NOT SHOWN AS BEING SPLICED IN THE PLANS ARE TO BE SECURELY COILED WITHIN THE SPLICE ENCLOSURE). THE SIZE OF THE CLOSURE SHALL ALLOW ALL THE FIBERS OF THE LARGEST OPTICAL FIBER TRUNK CABLE TO BE FUSION SPLICED TO A SECOND CABLE OF THE SAME SIZE, PLUS ADDITIONAL PIGTAILS. THE SPLICE ENCLOSURE SHALL ALLOW SPLICING OF ALL FIBERS UP TO THE MAXIMUM NUMBER SPECIFIED ON THE CONTRACT DRAWINGS.

FIBER OPTIC CABLE SPLICE ENCLOSURES SHALL HAVE A THREE-SECTION, 4, 6, OR 8 PORT END PLATE WITH 7/8" DIAMETER PORTS. PLUG KITS AND BRACKETS SHALL BE INCIDENTAL TO PAY ITEM. ANY PROPOSED EQUIVALENT MUST BE APPROVED BY THE ENGINEER PRIOR TO INSTALLATION. FIBER OPTIC CABLE SPLICE ENCLOSURES MUST MEET THE REQUIREMENTS LISTED UNDER BELL CORE TESTING REQUIREMENT GR-771-CORE AND UL 1863.

THE WORK AS DESCRIBED WILL BE MEASURED AS ONE UNIT FOR EACH OF THE INSTALLATIONS SPECIFIED, AND SHALL INCLUDE ALL MATERIALS, EQUIPMENT AND INCIDENTALS, COMPLETE IN PLACE. TERMINATIONS, CONNECTIONS, AND OTHER MISCELLANEOUS ITEMS AND MATERIALS SHALL BE INCIDENTAL TO THIS WORK AND NO SEPARATE PAYMENT WILL BE MADE. (12/2/15)

ITEM 632 - INTERCONNECT, MISC.: TERMINATION PANEL, 24 FIBER, WITH 200 FT DROP CABLE

THE TERMINATION PANEL SHALL BE FURNISHED AND INSTALLED IN THE TRAFFIC SIGNAL CONTROLLER CABINET AT LOCATIONS SHOWN ON THE PLANS. THE TERMINATION PANEL DROP CABLE SHALL BE FIBER CONNECTIONS "GATORPATCH" MODEL FCP6684-61-0 (200 FT).

THE OPTICAL TERMINATION PANEL SHALL HOUSE AND PROTECT THE LC CONNECTORS ON EACH TERMINATION PANEL DROP CABLE AND FIBER OPTIC TERMINATION CORD. THE FACTORY TERMINATED TERMINATION PANEL SHALL UTILIZE DUPLEX LC (UPC) CONNECTORS FOR THE EQUIPMENT SIDE TO THE PRE-CONNECTORIZED 24-STRAND OR 12-STRAND FIBER OPTIC TERMINATION PANEL DROP CABLE THAT LEADS TO THE SPLICE ENCLOSURE.

A PRE-TERMINATED 24-STRAND OR 12-STRAND FIBER OPTIC DROP CABLE SHALL BE INCLUDED AND SHALL BE CONSIDERED INCIDENTAL TO THE TERMINATION PANEL. THE CONTRACTOR SHALL PROVIDE SINGLE MODE FIBER OPTIC DROP CABLES WITH COLOR CODED BUFFER TUBES. FIBER OPTIC CABLE USED FOR TERMINATION PANEL DROP CABLES SHALL BE OF THE TIGHT BUFFERED TYPE PROTECTED BY ARAMID FIBERS. SINGLE-MODE DROP CABLES SHALL BE PROVIDED WITH FACTORY PRE-CONNECTORIZED SINGLE-MODE CONNECTORS. CONNECTORS SHALL HAVE A MAXIMUM LOSS OF 0.5 DB THROUGH EACH MATED PAIR OF SINGLE-MODE FIBERS. EACH CONNECTOR SHALL BE CAPABLE OF 100 REPEATED MATINGS WITH MAXIMUM INCREASE IN SPLICE LOSS LIMITED TO 0.2 DB. THE DROP CABLE SLACK SHALL BE NEATLY COILED AND SECURED IN A MANNER THAT DOES NOT EXCEED THE MINIMUM OPERATIONAL BENDING RADIUS OF THE DROP CABLE, AS SPECIFIED BY THE MANUFACTURER. SIX (6) FEET OF FIBER OPTIC CABLE SHALL BE NEATLY COILED INSIDE THE CONTROLLER CABINET.

ALL TERMINATION CORDS OF APPROPRIATE LENGTHS TO CONNECT TO THE ETHERNET SWITCH SHALL BE INCLUDED AND SHALL BE CONSIDERED INCIDENTAL TO THE TERMINATION PANEL. THE OPTICAL TERMINATION CORDS FURNISHED SHALL CONSIST OF A SECTION OF JACKETED, SINGLE-MODE FIBER CABLE EQUIPPED WITH FACTORY ASSEMBLED OPTICAL CONNECTORS AT BOTH ENDS. EACH TERMINATION CORD SHALL HAVE UNIQUE IDENTIFICATION LABELS ON EACH END.

THE SHEATH SHALL BE FLAME RETARDANT AND CODED NFR IN ACCORDANCE WITH THE NATIONAL ELECTRIC CODE. THE OPTICAL CONNECTORS ON THE ETHERNET SWITCH END OF THESE TERMINATION CORDS SHALL BE COMPATIBLE WITH THE CONNECTORS FURNISHED ON THE OPTICAL DEVICE TRANSMIT AND RECEIVE CARDS.

THIS ITEM INCLUDES ALL MATERIALS, EQUIPMENT AND INCIDENTALS COMPLETE IN PLACE. TERMINATIONS, CONNECTIONS, AND OTHER MISCELLANEOUS ITEMS AND MATERIALS SHALL BE INCIDENTAL TO THIS WORK AND NO SEPARATE PAYMENT WILL BE MADE.

CONTACT TRAFFIC MANAGEMENT AT 614-645-7393 FOURTEEN (14) DAYS IN ADVANCE OF FINAL TESTING. PRIOR TO FINAL TESTING OF A SEGMENT OF INSTALLED FIBER OPTIC CABLE USING THE TERMINATION PANEL AND DROP CABLE ASSEMBLY, THE PATCH PANEL MUST BE INSTALLED IN ITS FINAL POSITION WITHIN THE CONTROLLER CABINET AND/OR EQUIPMENT RACK AS INDICATED IN THE PLANS, AND THE DROP CABLE PATH MUST BE INSTALLED IN ITS FINAL POSITION FROM THE CONTROLLER CABINET TO THE SPLICE ENCLOSURE. FAILURE TO TEST THE CABLE SYSTEM AND ITS COMPONENTS IN THEIR FINAL INSTALLED PLACEMENT WILL RESULT IN NULLIFICATION OF TEST RESULTS AND WILL REQUIRE THE RETESTING OF THOSE CABLE SEGMENTS.

THE WORK AS DESCRIBED WILL BE MEASURED AS ONE UNIT FOR EACH INSTALLATION SPECIFIED, AND SHALL INCLUDE ALL MATERIALS, EQUIPMENT, TESTING, AND INCIDENTALS, COMPLETE IN PLACE. TERMINATIONS, CONNECTIONS, AND OTHER MISCELLANEOUS ITEMS AND MATERIALS SHALL BE INCIDENTAL TO THIS WORK AND NO SEPARATE PAYMENT WILL BE MADE.

ITEM 633 - CONTROLLER ITEM, MISC.: TERMINAL PORT SERVER

THIS WORK IS THE FURNISHING AND INSTALLATION OF A TERMINAL PORT SERVER TO PROVIDE COMMUNICATION BETWEEN SERIAL DEVICES AND ETHERNET SWITCH. THE TERMINAL PORT SERVER SHALL BE DIGI MODEL PORTSERVER TS 2 H MEI.

PROVIDE CONNECTOR CABLE FROM TERMINAL SERVER TO SIGNAL CONTROLLER. ALL D-SUB CONNECTORS SHALL BE OF HEAVY DUTY METAL CONSTRUCTION AND MANUFACTURED BY AMP, L-COM, OR EQUIVALENT. PROVIDE CAT 5E CABLE FROM PORT SERVER TO THE ETHERNET SWITCH.

TRAFFIC MAINTENANCE SHALL BE CONTACTED AT 645-7393 ONE (1) WEEK PRIOR TO INSTALLATION TO PROGRAM THE TERMINAL PORT SERVER. THE CONTRACTOR SHALL INSTALL THE TERMINAL PORT SERVER IN THE CABINET BUT SHALL NOT MAKE ANY CONNECTIONS TO THE TERMINAL PORT SERVER.

TESTING OF THE TERMINAL PORT SERVER WILL BE THE RESPONSIBILITY OF THE CONTRACTOR. THE CONTRACTOR SHALL BE RESPONSIBLE FOR PROVIDING A COMPLETE, FUNCTIONAL SYSTEM INCLUDING ALL NECESSARY CABLES AND CONNECTORS IN ACCORDANCE TO THE SPECIFICATIONS AND AS SPECIFIED ON THE PLANS.

CITY OF COLUMBUS INTERCONNECT NOTES



ITEM 1620 - INTERCONNECT, MISC.: FIBER OPTIC CABLE, 144 STRAND

IN ADDITION TO THE REQUIREMENTS OF SUPPLEMENTAL SPECIFICATION 1620, THE CONTRACTOR SHALL PROVIDE ALL MATERIALS REQUIRED FOR THE INSTALLATION, CONNECTORIZATION, AND SPLICING OF THE SPECIFIED COMMUNICATIONS CABLES. THE 144-STRAND CABLE SHALL BE CORNING PART NUMBER 144EU4-T4701D20. (4/22/19)

X:\Projects\2013\1010\FRA\92616\signals\sheets\92616cN004.dgn 4/19/2023 1:26:28 PM cwrong

CALCULATED  
DKA  
CHECKED  
SGJ

TRAFFIC SIGNAL INTERCONNECT NOTES

FRA - 270-51.50

CITY OF COLUMBUS INTERCONNECT NOTES

ITEM 633 - CONTROLLER ITEM, MISC.: TERMINAL PORT SERVER (CONTINUED)

ALL CABLES SHALL MEET THE PROPOSED EQUIPMENT SPECIFICATION REQUIREMENTS AND SHALL MEET EIA/TIA TELECOMMUNICATIONS STANDARDS.

THE WORK AS DESCRIBED WILL BE MEASURED AS ONE UNIT FOR EACH OF THE INSTALLATIONS SPECIFIED, AND SHALL INCLUDE ALL MATERIALS, EQUIPMENT AND INCIDENTALS, COMPLETE IN PLACE. TERMINATIONS, CABLES, CONNECTORS, AND OTHER MISCELLANEOUS ITEMS AND MATERIALS SHALL BE INCIDENTAL TO THIS WORK AND NO SEPARATE PAYMENT WILL BE MADE. (5/24/2016)

ITEM 633 - CONTROLLER ITEM, MISC.: FIBER OPTIC ETHERNET TRANSCEIVER, SHORT RANGE

THE CONTRACTOR SHALL FURNISH AND INSTALL SINGLE MODE FIBER (SMF), SMALL FORM FACTOR PLUGGABLE (SFP) GIGABIT INTERFACE CONNECTOR (GBIC) MODULES AT LOCATIONS AS SHOWN ON THE PLANS.

THE GBIC TRANSCEIVER SHALL BE 1000BASE LX/LH SFP-LC TRANSCEIVER (CISCO PART #GLC-LX-SM-RGD).

THE CONTRACTOR SHALL INSTALL THE SFP MODULE IN THE ETHERNET SWITCH SLOT AND CONFIGURE AS NECESSARY.

THE CONTRACTOR SHALL BE RESPONSIBLE FOR PROVIDING A COMPLETE, FUNCTIONAL SYSTEM INCLUDING ALL NECESSARY CABLES AND CONNECTORS IN ACCORDANCE TO THE SPECIFICATIONS AND AS SPECIFIED ON THE PLANS. ALL MISCELLANEOUS PATCH AND INTERCONNECT CABLES SHALL MEET THE PROPOSED EQUIPMENT SPECIFICATION REQUIREMENTS AND SHALL MEET EIA/TIA TELECOMMUNICATIONS STANDARDS. THE WORK AS DESCRIBED WILL BE MEASURED AS ONE UNIT FOR EACH OF THE INSTALLATIONS SPECIFIED, AND SHALL INCLUDE ALL MATERIALS, EQUIPMENT AND INCIDENTALS, COMPLETE IN PLACE. PATCH CABLES, TERMINATIONS, CONNECTIONS, AND OTHER MISCELLANEOUS ITEMS AND MATERIALS SHALL BE CONSIDERED INCIDENTAL TO THIS WORK AND NO SEPARATE PAYMENT WILL BE MADE. (12/2/2015)

ITEM 633 - CONTROLLER ITEM, MISC.: LAYER 2 ETHERNET SWITCH

THE CONTRACTOR SHALL PURCHASE AND INSTALL ENVIRONMENTALLY HARDENED LAYER 2 ETHERNET SWITCHES AS SHOWN ON THE PLANS. LAYER 2 ETHERNET SWITCHES SHALL BE COMNET MODEL CNGE1FX3TX8MS THIS WORK IS THE FURNISHING AND INSTALLATION OF A LAYER 2 SWITCH WITH THREE 100/1000BASE-FX SFP PORTS AND EIGHT SWITCHED 10/100/1000BASE-TX RJ45 PORTS.

ALL EQUIPMENT SHALL BE NEW AND IN STRICT ACCORDANCE WITH THE DETAILS SHOWN ON THE PLANS AND THE SPECIFICATIONS.

TRAFFIC MAINTENANCE SHALL BE CONTACTED AT 645-7393 14 CALENDAR DAYS PRIOR TO INSTALLATION TO PROGRAM THE SWITCH. THE CONTRACTOR SHALL INSTALL THE SWITCH IN THE CABINET BUT SHALL NOT MAKE ANY CONNECTIONS TO THE SWITCH.

THE TRAFFIC MAINTENANCE MANAGER SHALL INSPECT THE CONDITION OF ALL COMPONENTS UPON INSTALLATION. NO DAMAGED COMPONENT WILL BE ACCEPTED, AND NO COMPONENT SHALL BE CONSIDERED INSTALLED UNTIL THE TRAFFIC MAINTENANCE MANAGER APPROVES OF THE SWITCH INSTALLATION. LAYER 2 ETHERNET SWITCHES SHALL SUPPORT DIRECT CONNECTIVITY TO PROPOSED AND EXISTING NETWORKS CONFIGURED IN RING AND MESH FAULT TOLERANT TOPOLOGIES ENABLING APPLICATIONS TO OPERATE RELIABLY, AND WITH LOW LATENCY.

ALL EQUIPMENT SHALL INCLUDE LICENSES, WHERE REQUIRED, FOR ANY SOFTWARE OR HARDWARE IN THE SYSTEM.

LAYER 2 ETHERNET SWITCHES SHALL SUPPORT DIRECT CONNECTIVITY TO PROPOSED AND EXISTING NETWORKS CONFIGURED IN RING AND MESH FAULT TOLERANT TOPOLOGIES ENABLING APPLICATIONS TO OPERATE RELIABLY, AND WITH LOW LATENCY.

1. INSTALL POWER ADAPTER, POWER CABLES, CATEGORY 5E OR CATEGORY 6 PATCH CORDS, AND SINGLE MODE PATCH CABLES AS REQUIRED AND DEPICTED ON COMMUNICATIONS DIAGRAMS.

2. SECURELY MOUNT THE SWITCH AND POWER SUPPLY IN THE CABINET.

3. MAKE POWER CONNECTION TO AN AVAILABLE OUTLET ON THE INSTALLED SURGE SUPPRESSOR.

4. MAKE THE COMMUNICATION CONNECTIONS.


5. ESTABLISH AND VERIFY COMMUNICATIONS TO THE NETWORK PRIOR TO TRANSITIONING SIGNAL CONTROLLER TO NEW SYSTEM.

THE CONTRACTOR SHALL BE RESPONSIBLE FOR PROVIDING A COMPLETE, FUNCTIONAL SYSTEM INCLUDING ALL NECESSARY CABLES AND CONNECTORS IN ACCORDANCE TO THE SPECIFICATIONS AND AS SPECIFIED ON THE PLANS. ALL MISCELLANEOUS PATCH AND INTERCONNECT CABLES SHALL MEET THE PROPOSED EQUIPMENT SPECIFICATION REQUIREMENTS AND SHALL MEET EIA/TIA TELECOMMUNICATIONS STANDARDS. ADDITIONALLY, FIBER OPTIC PATCH CABLES SHALL CONFORM TO THE PLAN REQUIREMENTS FOR PATCH CABLES. (5/12/20)

ITEM 625 - CONDUIT, MISC.: 4", MULTICELL, 725.20, EPC-80, CITY OF COLUMBUS


THIS ITEM SHALL FOLLOW CITY OF COLUMBUS CMS 625 AND 725.20, AND SHALL BE DIRECTIONALLY BORED AS INDICATED IN THE PLANS.

CONDUIT MISC.: ENCASED INTERCONNECT CONDUIT BANK, TC2, SCH 40, (4)-3" & (1)-1.5", CITY OF COLUMBUS CROSS SECTION (TYPICAL)

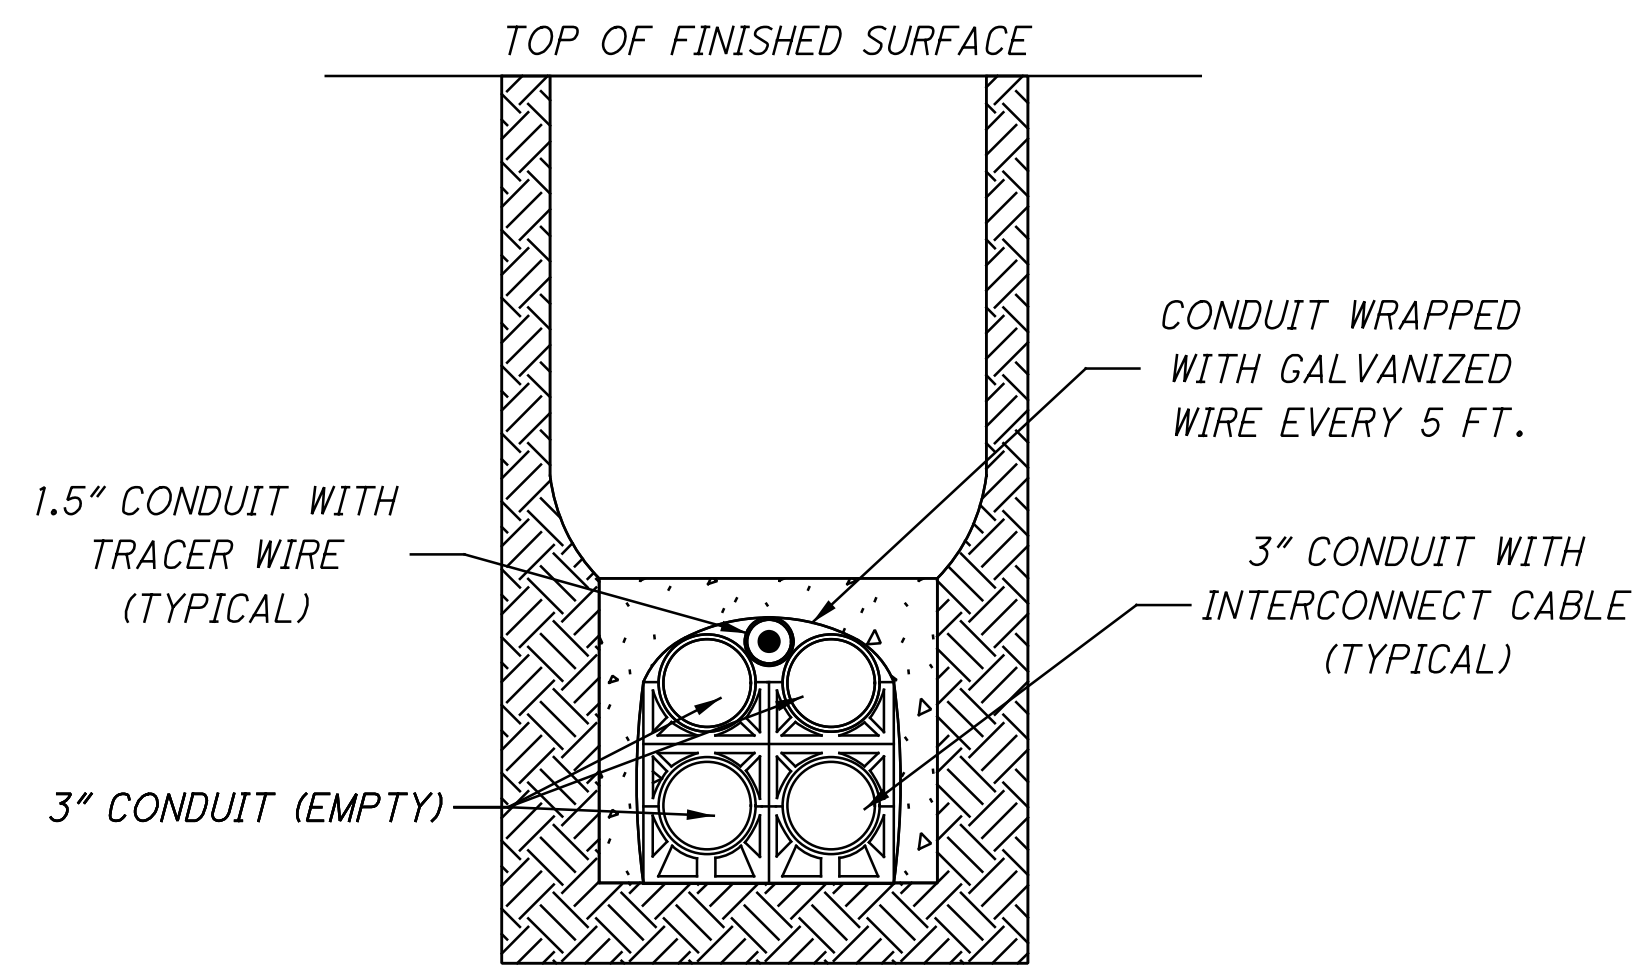

APPLIES TO:  
 STA. 546+50 TO STA. 580+32 LOOKING NORTH  
 STA. 546+50, 11.0' RT TO STA. 546+50, 75.7' RT LOOKING EAST  
 STA. 580+32 TO STA. 602+64 LOOKING NORTH  
 STA. 602+64, 9.0' LT TO STA. 602+64, 71.0' LT LOOKING WEST  
 STA. 602+64 TO STA. 606+90 LOOKING NORTH

CTSS D EXISTING CONDUIT AND PROPOSED CONDUIT CROSS SECTION

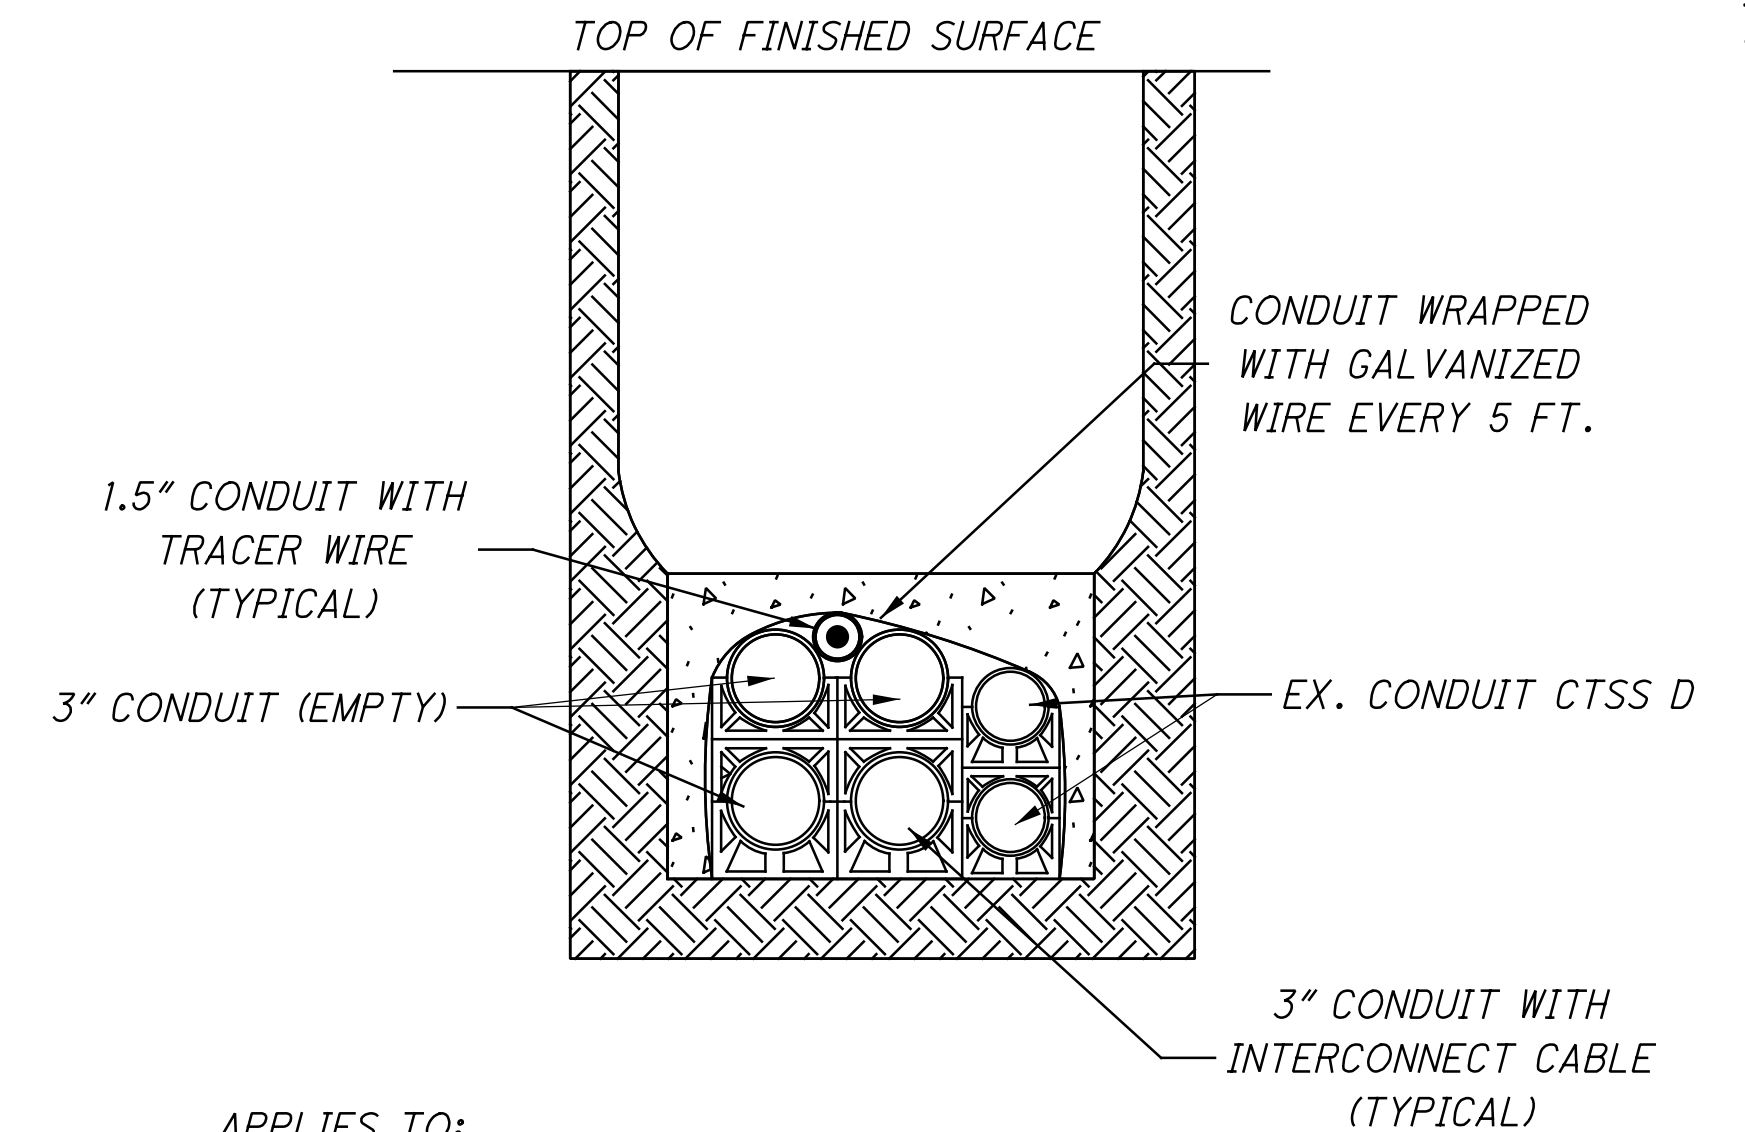

APPLIES TO:  
 STA. 496+75, 4' LT TO STA. 498+05, 19' RT LOOKING EAST

X:\Projects\2013\1010\FRA\92616\signals\sheets\92616CN005.dgn 4/26/2023 3:07:54 PM cwong

CALCULATED  
 DKA  
 CHECKED  
 SGJ


TRAFFIC SIGNAL INTERCONNECT NOTES

FRA - 270-51.50

413  
 554



X:\Projects\2013\1010\FRA\92616\signals\92616CP003-IC.dgn 4/26/2023 3:13:35 PM c.wong

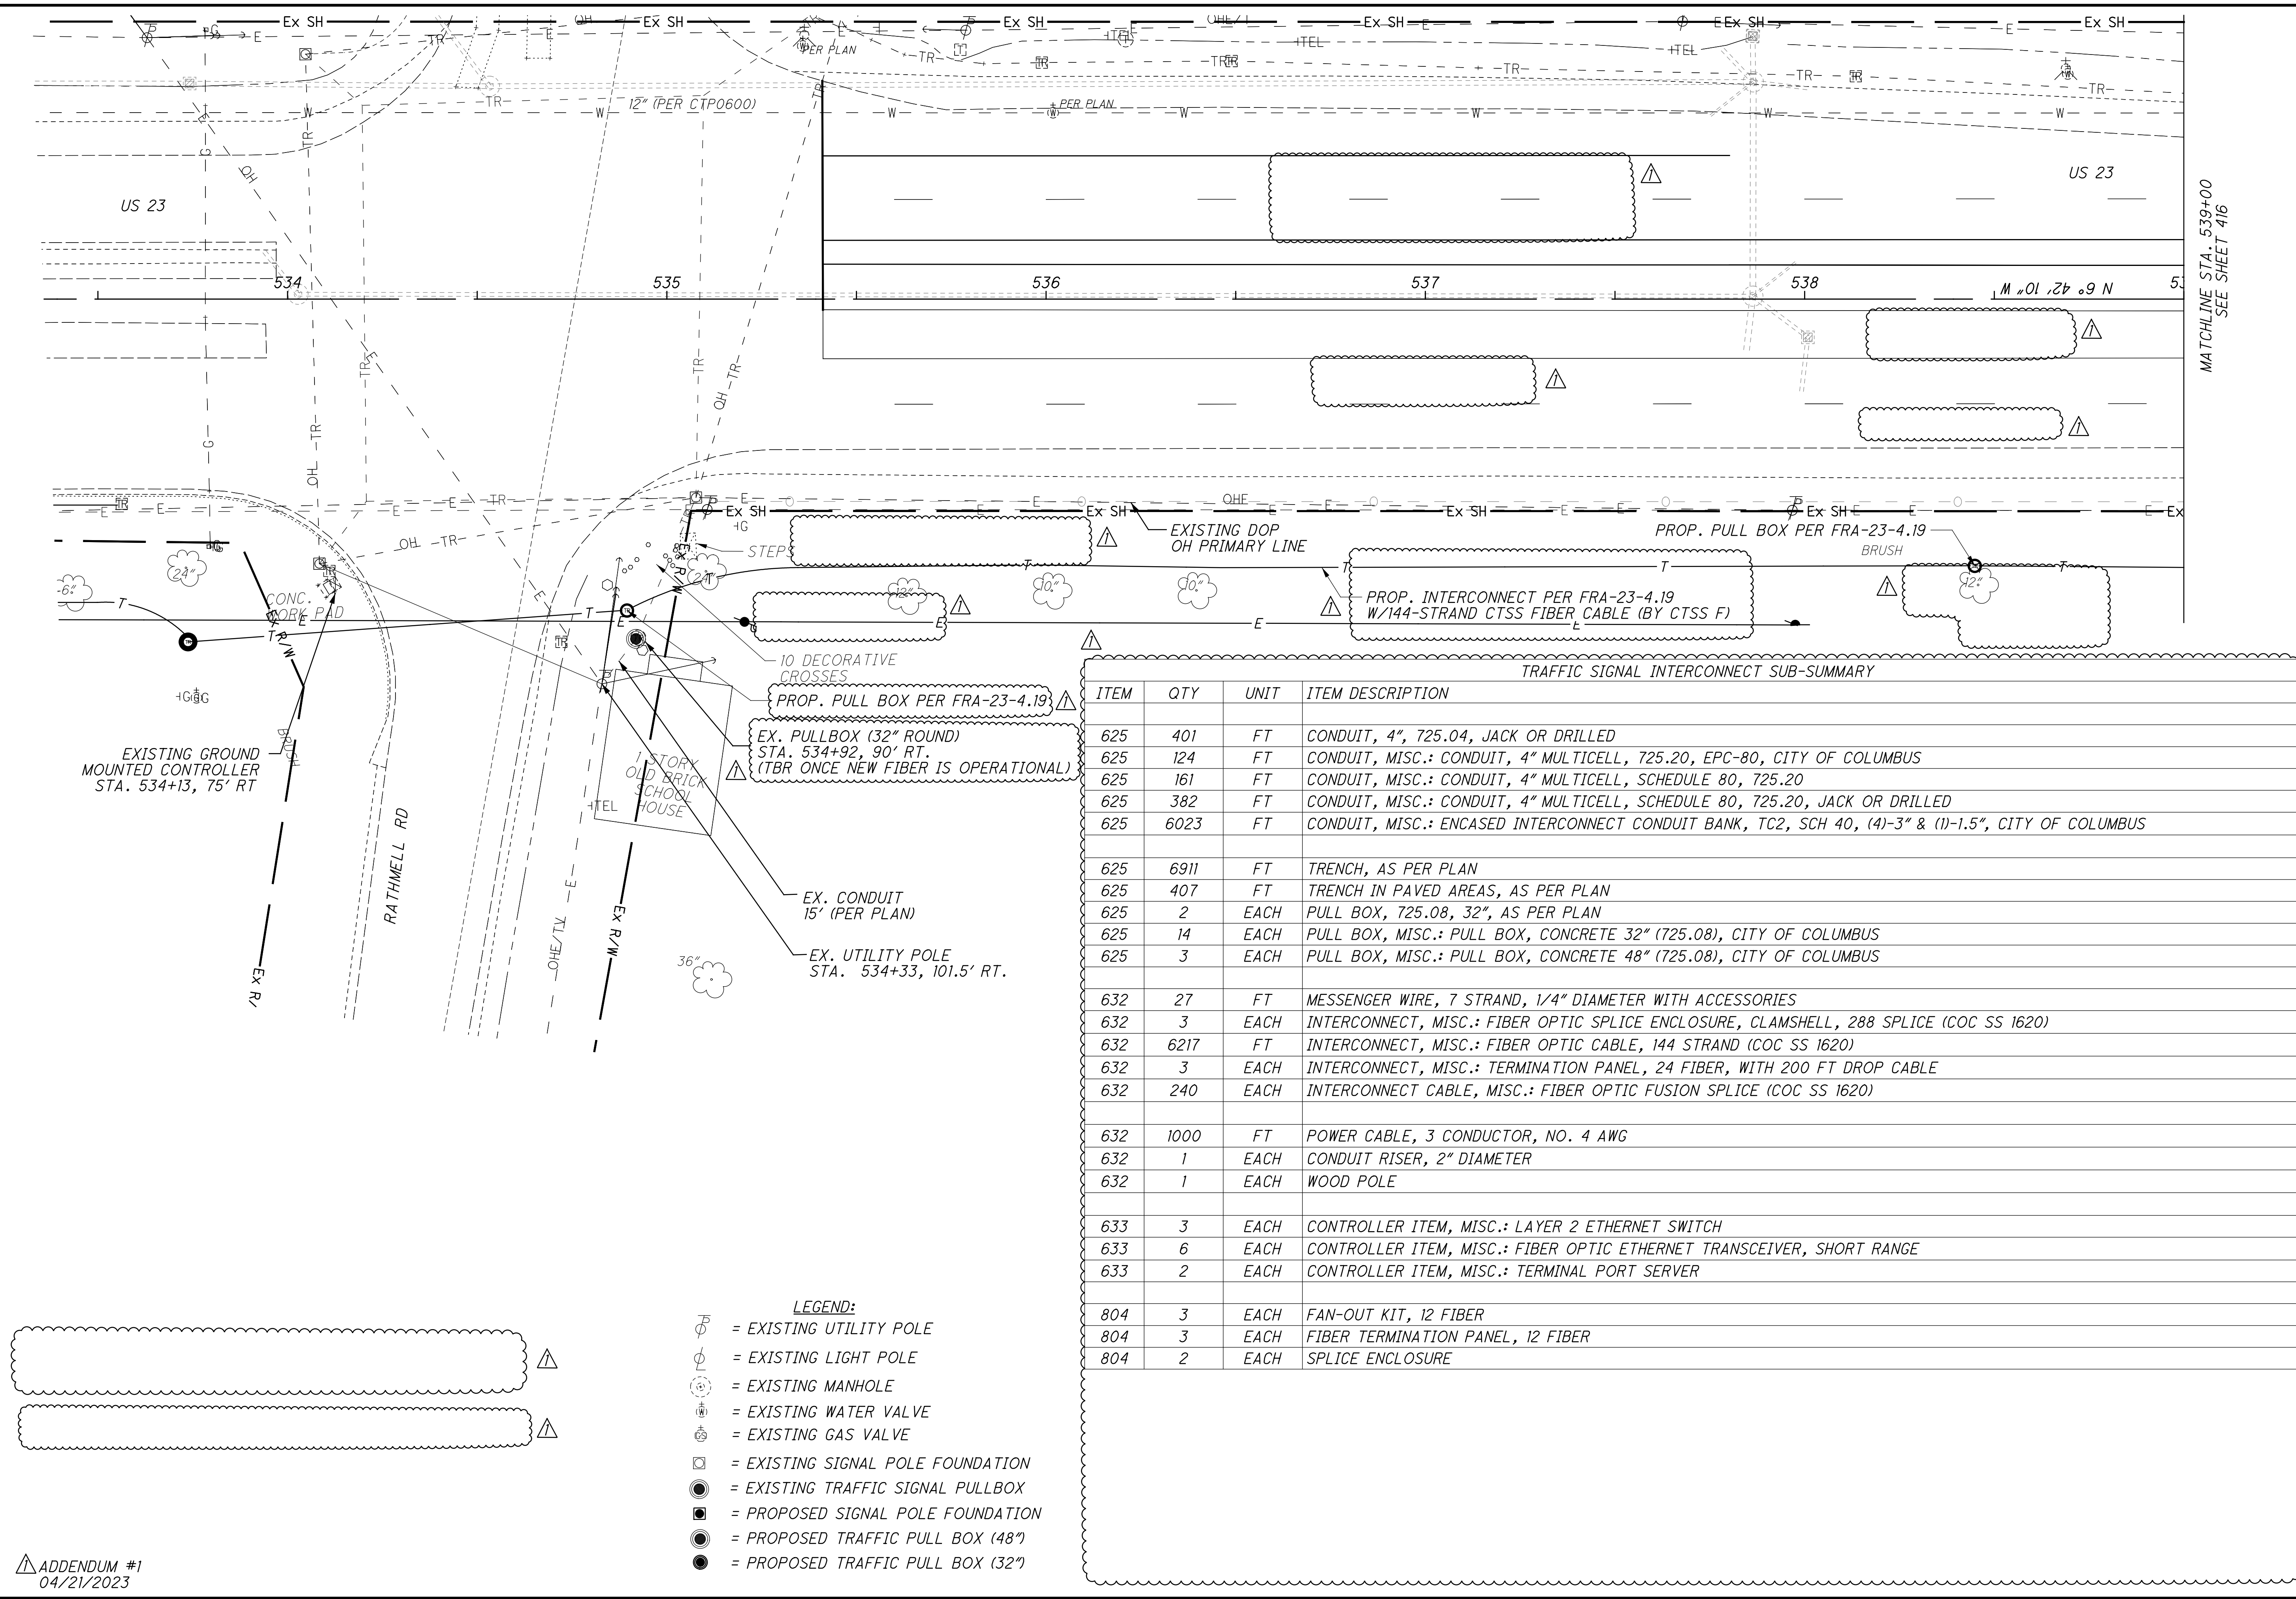


MATCHLINE STA. 539+00  
SEE SHEET 416



**TRAFFIC SIGNAL INTERCONNECT PLAN**  
**U.S. 23 STA. 533+50 TO STA. 539+00**

**FRA - 270-51.50**

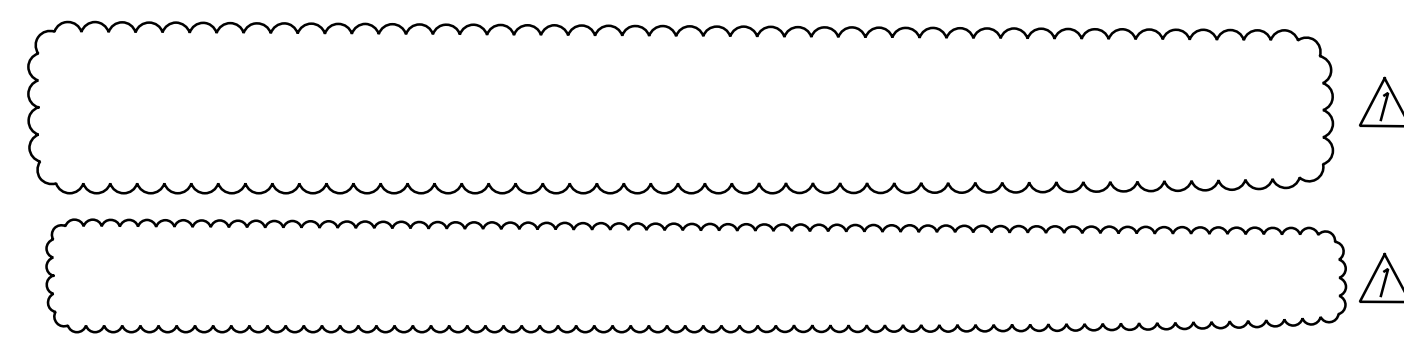


- LEGEND:**
- ⊕ = EXISTING UTILITY POLE
  - ⊙ = EXISTING LIGHT POLE
  - ⊙ = EXISTING MANHOLE
  - ⊕ = EXISTING WATER VALVE
  - ⊕ = EXISTING GAS VALVE
  - ⊠ = EXISTING SIGNAL POLE FOUNDATION
  - ⊙ = EXISTING TRAFFIC SIGNAL PULLBOX
  - ⊠ = PROPOSED SIGNAL POLE FOUNDATION
  - ⊙ = PROPOSED TRAFFIC PULL BOX (48")
  - ⊙ = PROPOSED TRAFFIC PULL BOX (32")

ADDENDUM #1  
04/21/2023

**TRAFFIC SIGNAL INTERCONNECT SUB-SUMMARY**

ITEM	QTY	UNIT	ITEM DESCRIPTION
625	401	FT	CONDUIT, 4", 725.04, JACK OR DRILLED
625	124	FT	CONDUIT, MISC.: CONDUIT, 4" MULTICELL, 725.20, EPC-80, CITY OF COLUMBUS
625	161	FT	CONDUIT, MISC.: CONDUIT, 4" MULTICELL, SCHEDULE 80, 725.20
625	382	FT	CONDUIT, MISC.: CONDUIT, 4" MULTICELL, SCHEDULE 80, 725.20, JACK OR DRILLED
625	6023	FT	CONDUIT, MISC.: ENCASED INTERCONNECT CONDUIT BANK, TC2, SCH 40, (4)-3" & (1)-1.5", CITY OF COLUMBUS
625	6911	FT	TRENCH, AS PER PLAN
625	407	FT	TRENCH IN PAVED AREAS, AS PER PLAN
625	2	EACH	PULL BOX, 725.08, 32", AS PER PLAN
625	14	EACH	PULL BOX, MISC.: PULL BOX, CONCRETE 32" (725.08), CITY OF COLUMBUS
625	3	EACH	PULL BOX, MISC.: PULL BOX, CONCRETE 48" (725.08), CITY OF COLUMBUS
632	27	FT	MESSENGER WIRE, 7 STRAND, 1/4" DIAMETER WITH ACCESSORIES
632	3	EACH	INTERCONNECT, MISC.: FIBER OPTIC SPLICE ENCLOSURE, CLAMSHELL, 288 SPLICE (COC SS 1620)
632	6217	FT	INTERCONNECT, MISC.: FIBER OPTIC CABLE, 144 STRAND (COC SS 1620)
632	3	EACH	INTERCONNECT, MISC.: TERMINATION PANEL, 24 FIBER, WITH 200 FT DROP CABLE
632	240	EACH	INTERCONNECT CABLE, MISC.: FIBER OPTIC FUSION SPLICE (COC SS 1620)
632	1000	FT	POWER CABLE, 3 CONDUCTOR, NO. 4 AWG
632	1	EACH	CONDUIT RISER, 2" DIAMETER
632	1	EACH	WOOD POLE
633	3	EACH	CONTROLLER ITEM, MISC.: LAYER 2 ETHERNET SWITCH
633	6	EACH	CONTROLLER ITEM, MISC.: FIBER OPTIC ETHERNET TRANSCEIVER, SHORT RANGE
633	2	EACH	CONTROLLER ITEM, MISC.: TERMINAL PORT SERVER
804	3	EACH	FAN-OUT KIT, 12 FIBER
804	3	EACH	FIBER TERMINATION PANEL, 12 FIBER
804	2	EACH	SPLICE ENCLOSURE

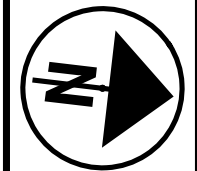


CALCULATED  
DKA  
CHECKED  
SGJ

# TRAFFIC SIGNAL INTERCONNECT PLAN

## U.S. 23 STA. 539+00 TO STA. 550+00

### FRA-270-51.50

416  
554


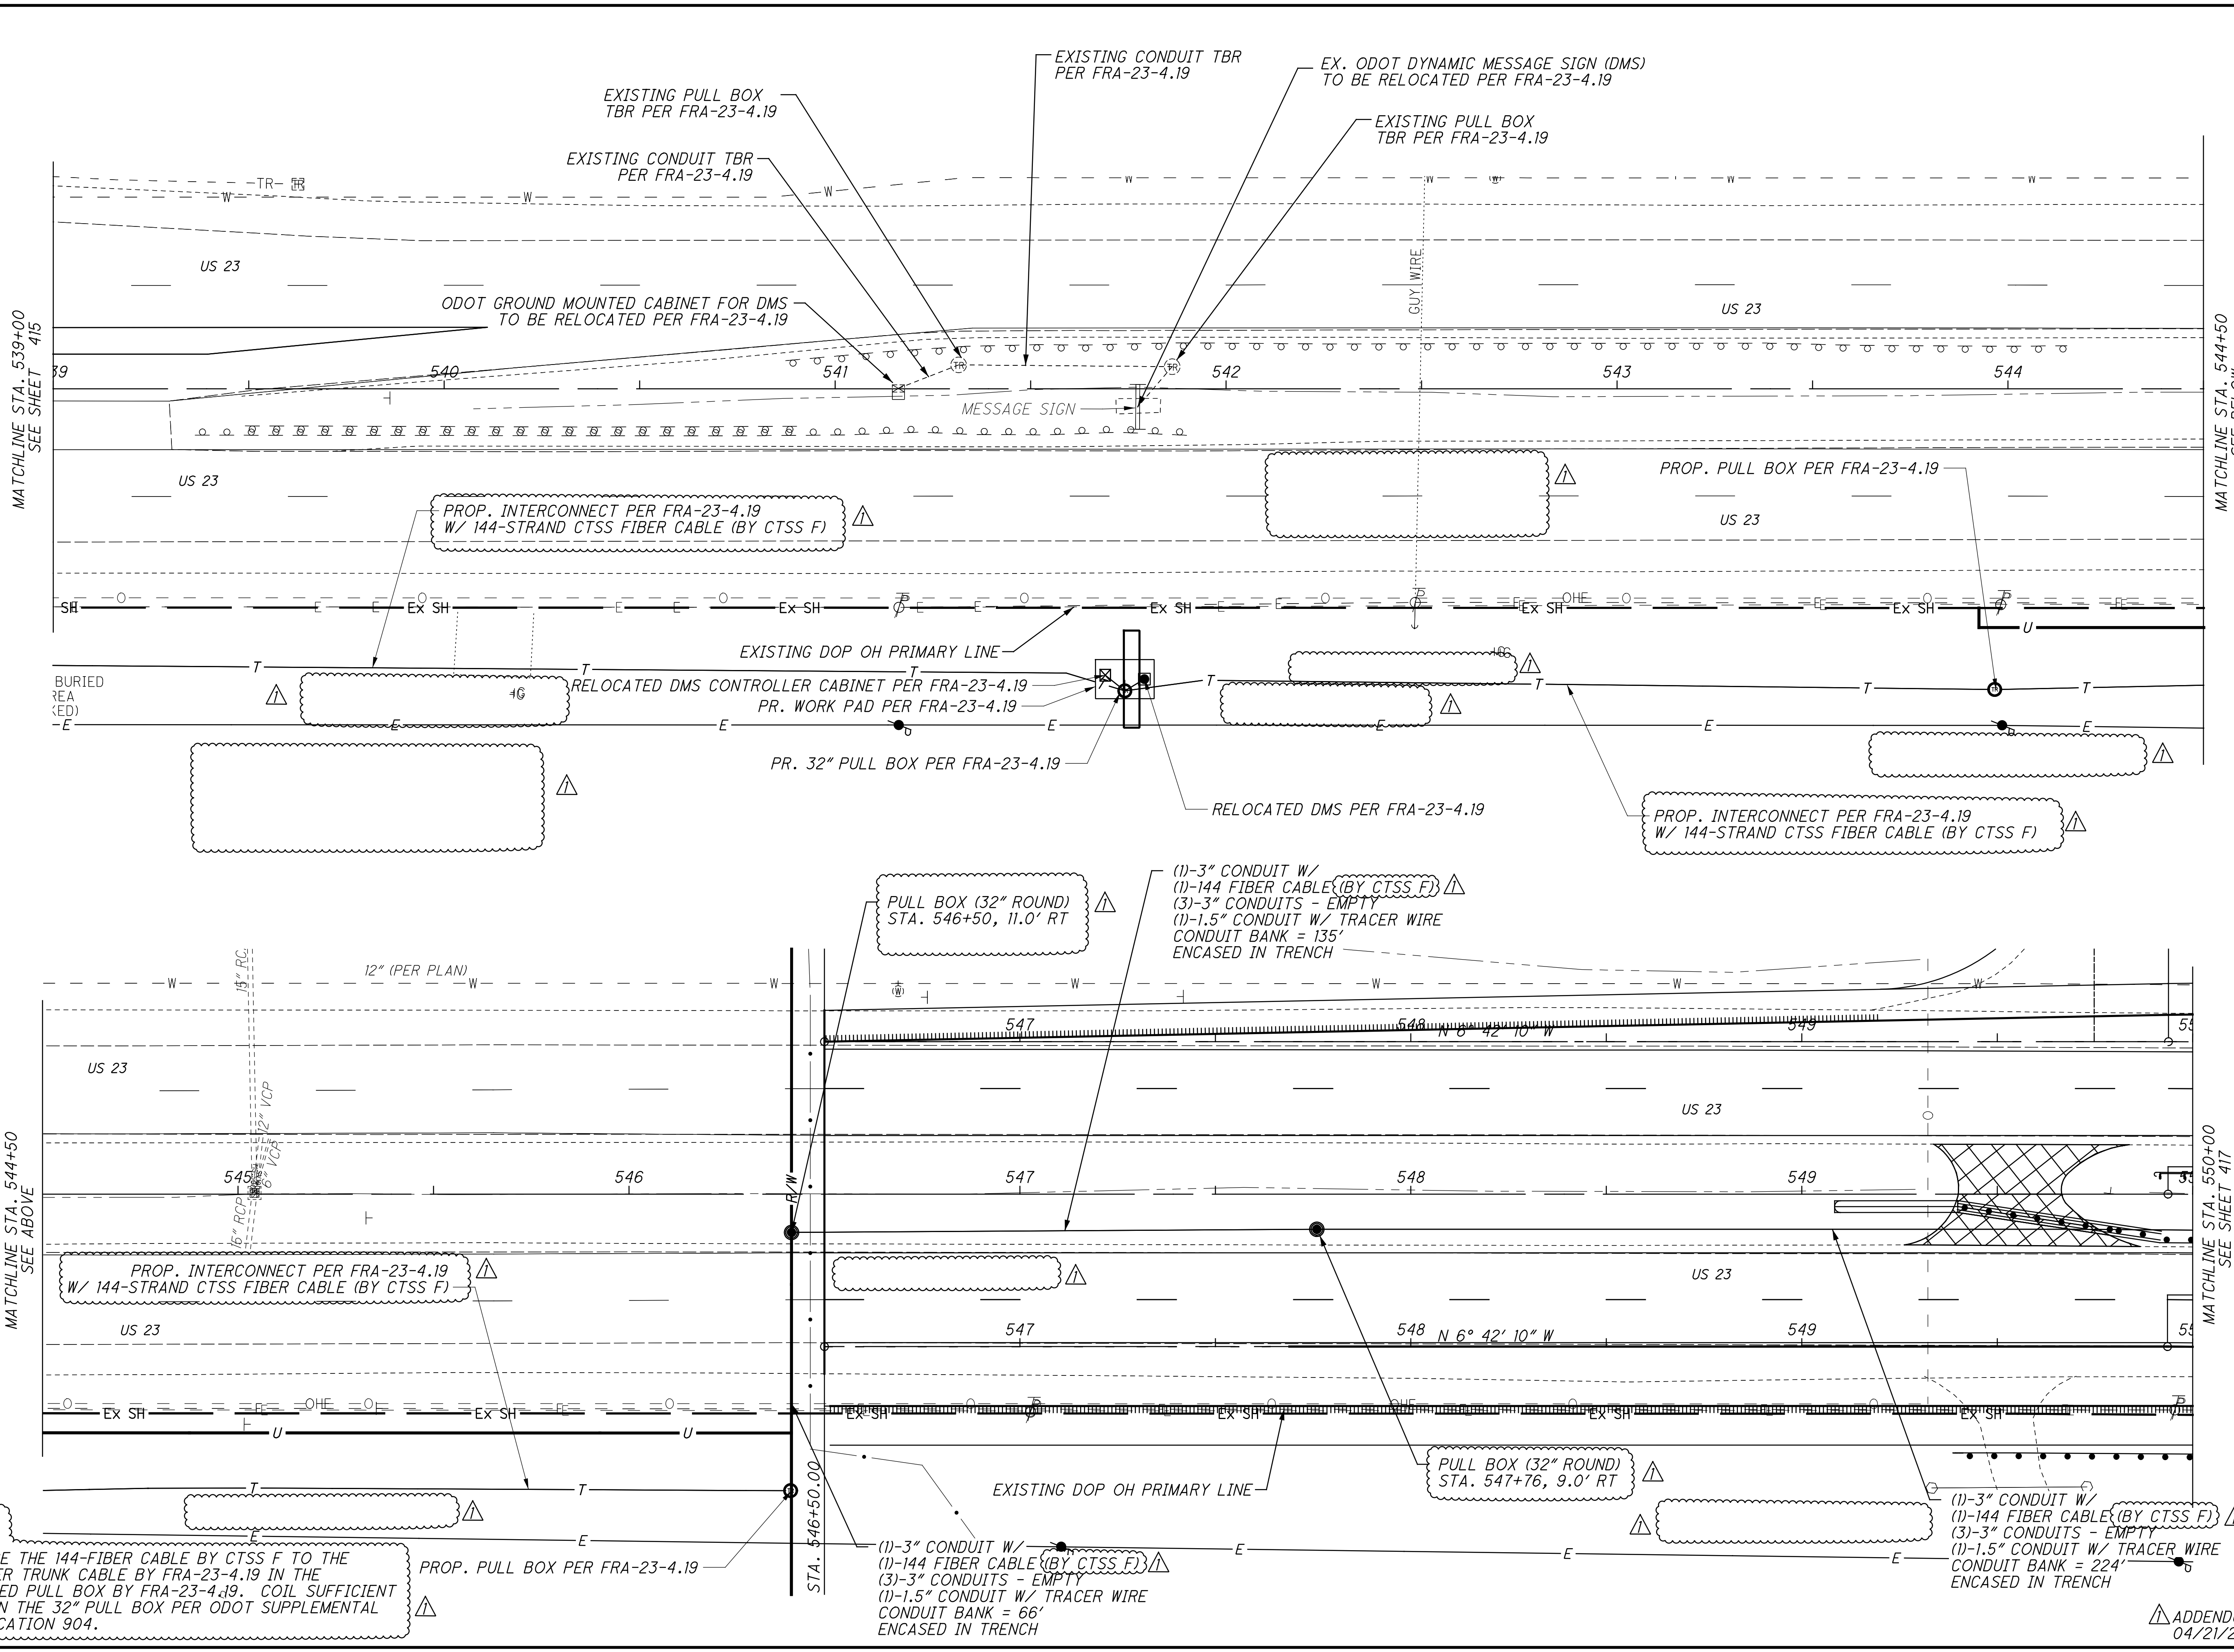


X:\Projects\2013\1321\1010\FRA\92616\signals\92616CP004-1C.dgn 4/26/2023 5:58:19 AM cwong

**NOTES:**

1. SPLICE THE 144-FIBER CABLE BY CTSS F TO THE 144-FIBER TRUNK CABLE BY FRA-23-4.19 IN THE PROPOSED PULL BOX BY FRA-23-4.19. COIL SUFFICIENT SLACK IN THE 32" PULL BOX PER ODOT SUPPLEMENTAL SPECIFICATION 904.

ADDENDUM #1  
04/21/2023

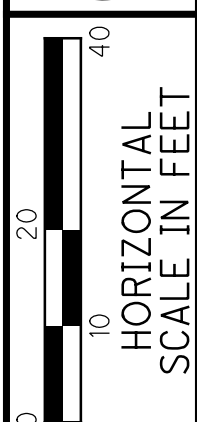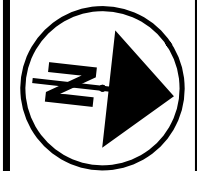


CALCULATED  
DKA  
CHECKED  
SGJ

**TRAFFIC SIGNAL INTERCONNECT PLAN**  
**U.S. 23 STA. 550+00 TO STA. 561+00**

**FRA-270-51.50**

417  
554

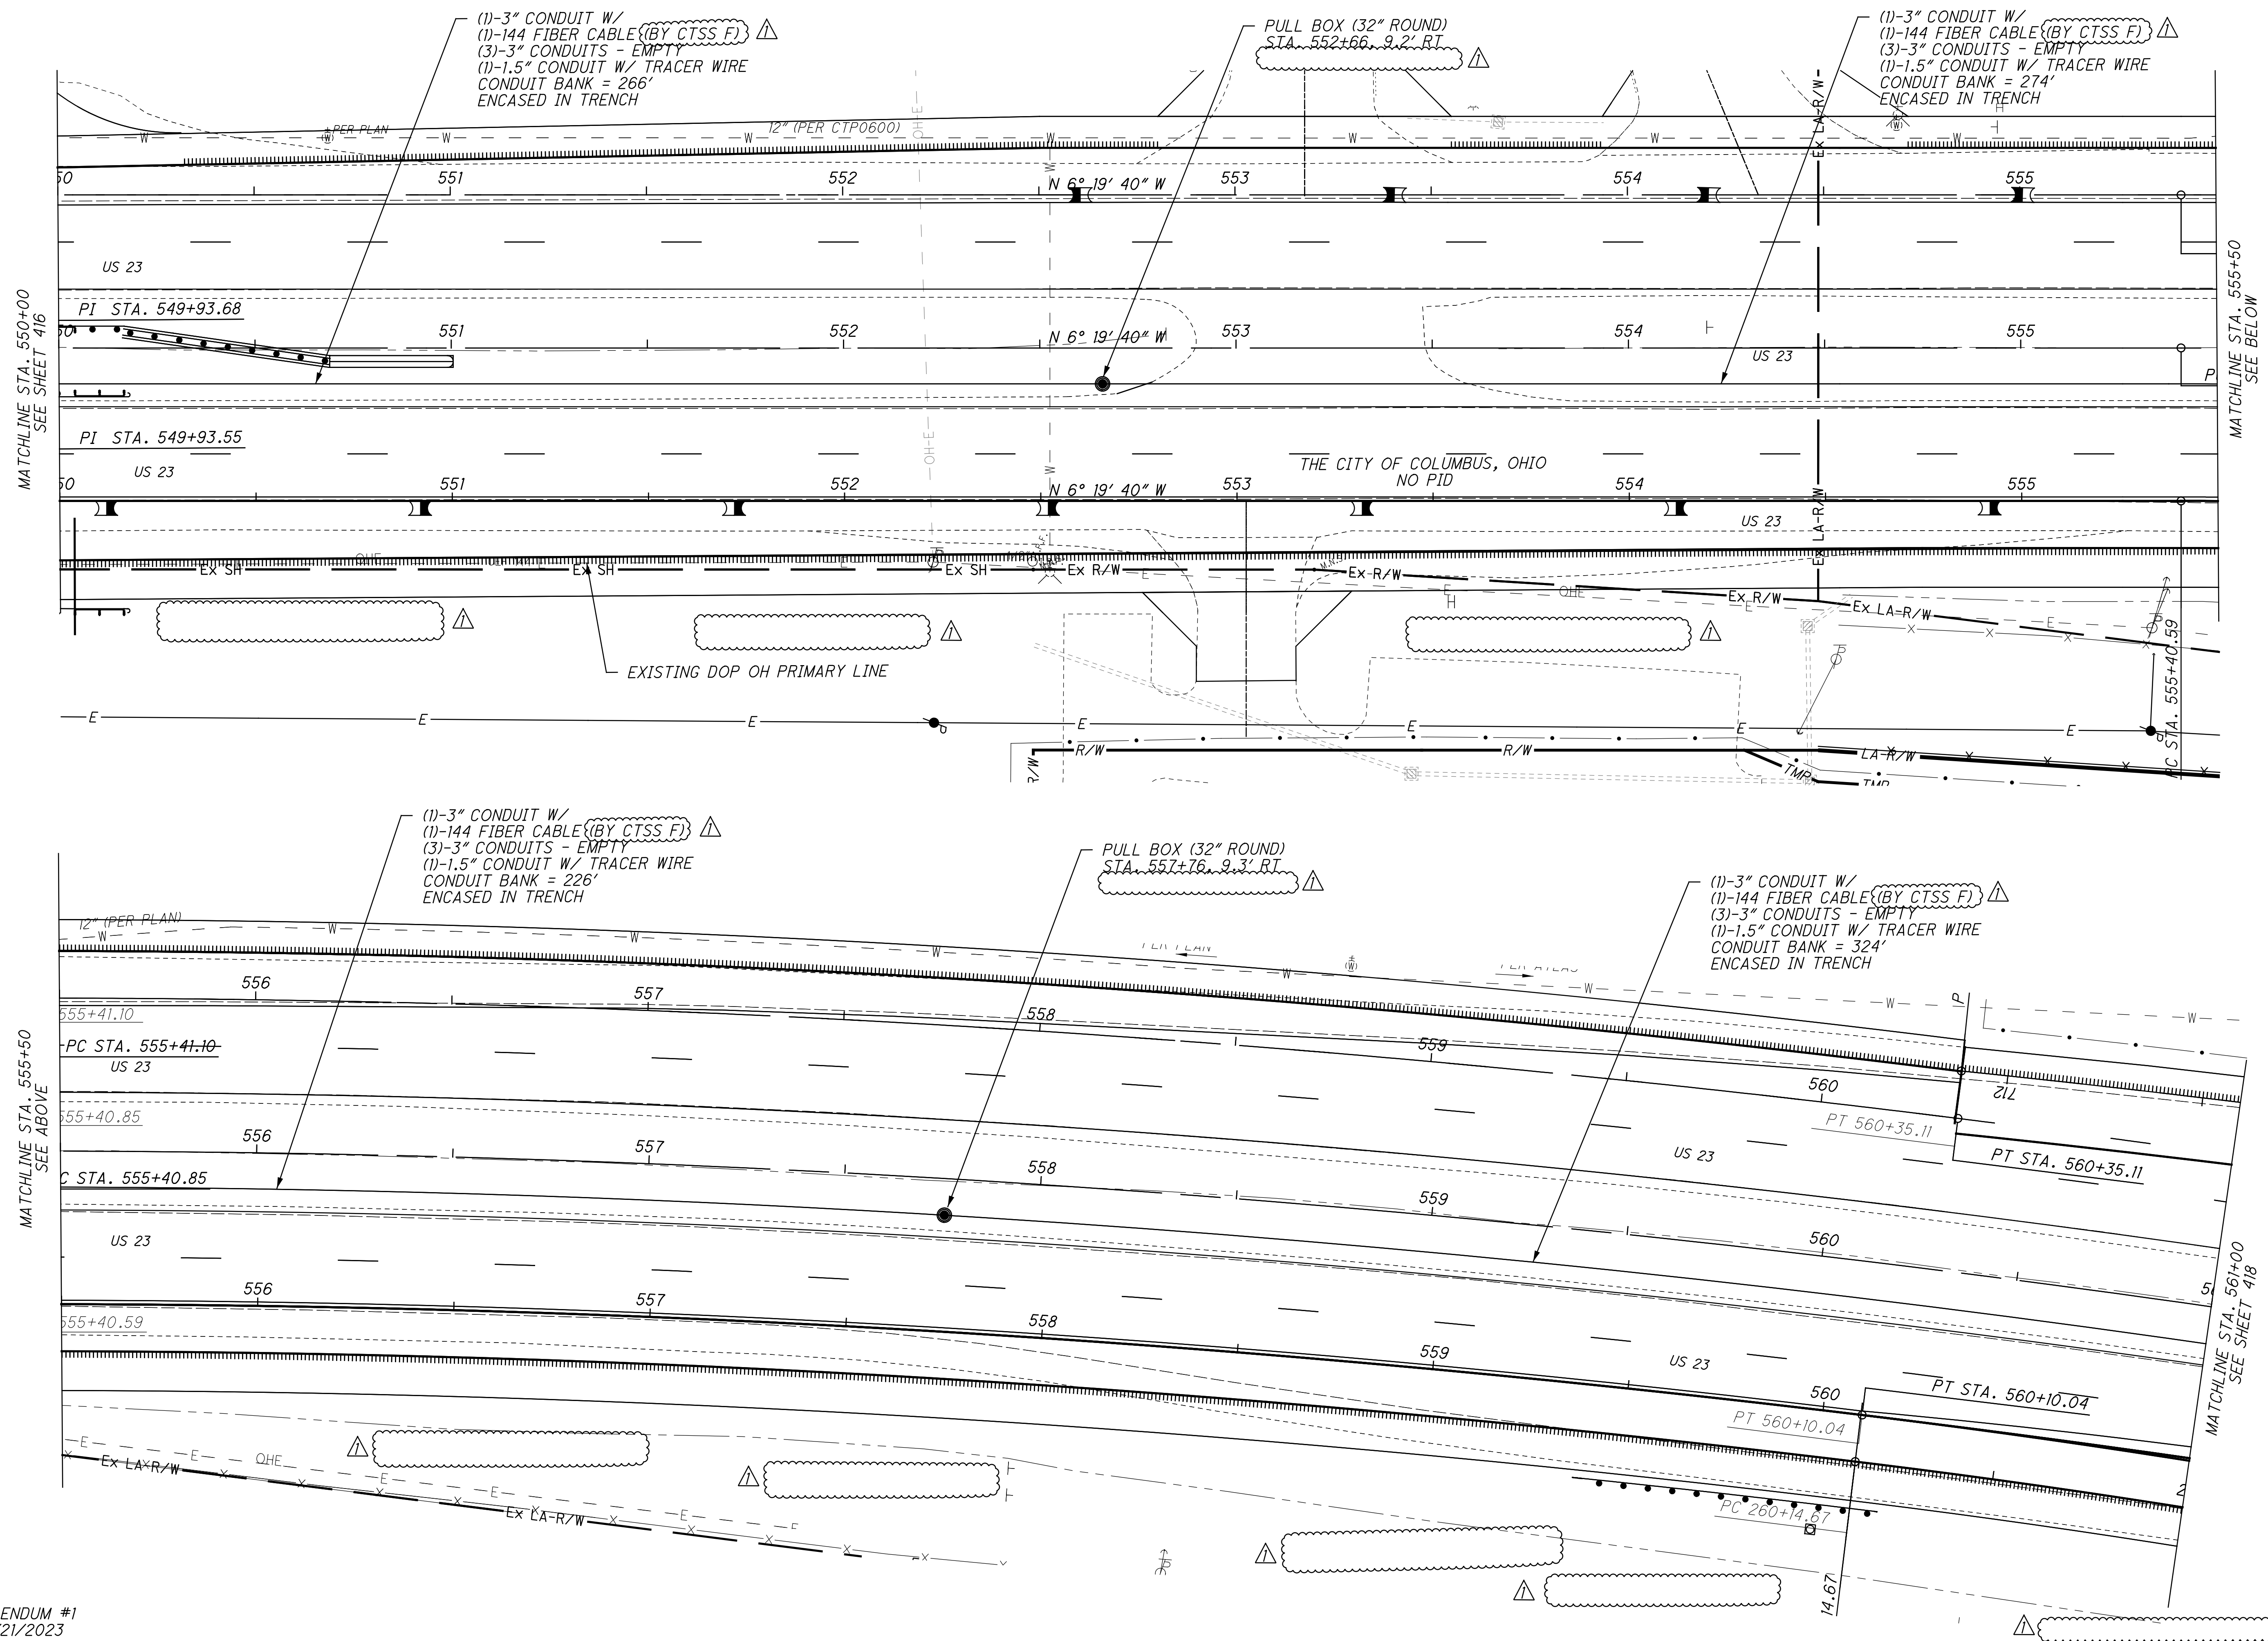


X:\Projects\2013\1321\1010\FRA\92616\signals\92616CP005-IC.dgn 4/19/2023 1:38:32 PM cwong

ADDENDUM #1  
04/21/2023



X:\Projects\2013\1010\FRA\92616\signals\92616CP006-IC.dgn 4/19/2023 1:40:24 PM cwong

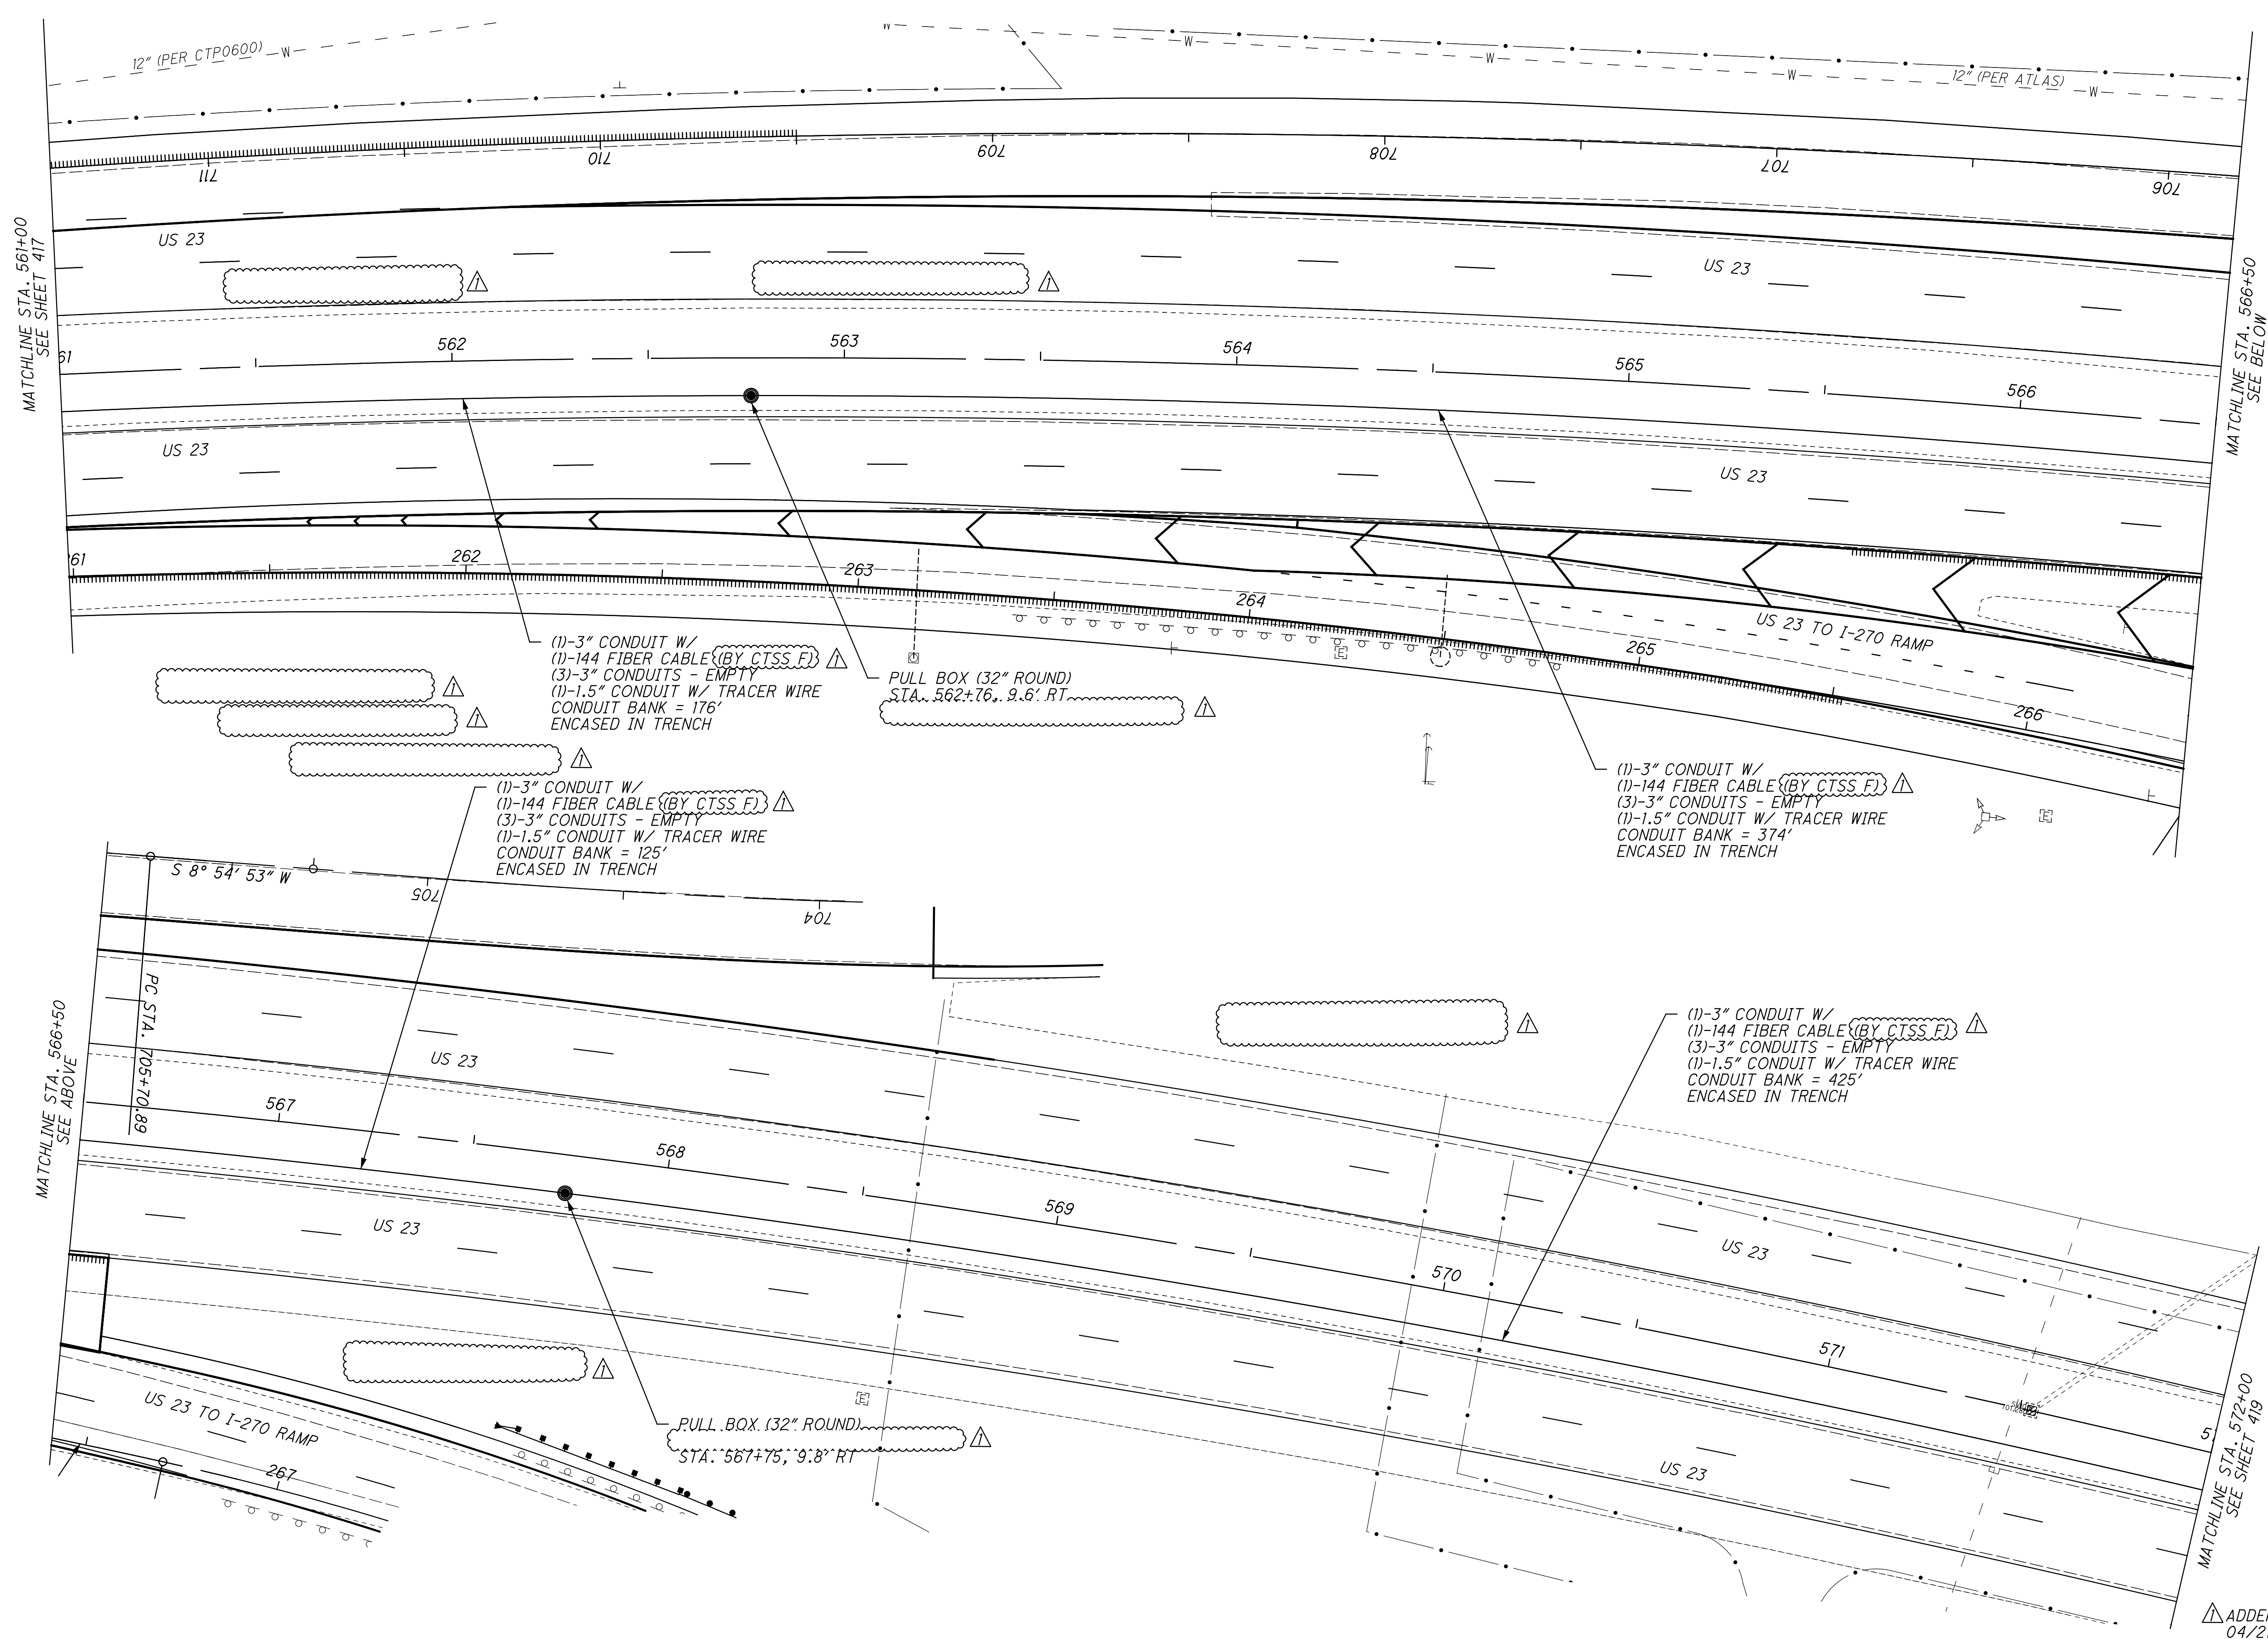

(1)-3" CONDUIT W/  
 (1)-144 FIBER CABLE (BY CTSS.F)  
 (3)-3" CONDUITS - EMPTY  
 (1)-1.5" CONDUIT W/ TRACER WIRE  
 CONDUIT BANK = 176'  
 ENCASED IN TRENCH

PULL BOX (32" ROUND)  
 STA. 562+76.9, 9.6' RT.

(1)-3" CONDUIT W/  
 (1)-144 FIBER CABLE (BY CTSS.F)  
 (3)-3" CONDUITS - EMPTY  
 (1)-1.5" CONDUIT W/ TRACER WIRE  
 CONDUIT BANK = 125'  
 ENCASED IN TRENCH

(1)-3" CONDUIT W/  
 (1)-144 FIBER CABLE (BY CTSS.F)  
 (3)-3" CONDUITS - EMPTY  
 (1)-1.5" CONDUIT W/ TRACER WIRE  
 CONDUIT BANK = 374'  
 ENCASED IN TRENCH

(1)-3" CONDUIT W/  
 (1)-144 FIBER CABLE (BY CTSS.F)  
 (3)-3" CONDUITS - EMPTY  
 (1)-1.5" CONDUIT W/ TRACER WIRE  
 CONDUIT BANK = 425'  
 ENCASED IN TRENCH

PULL BOX (32" ROUND)  
 STA. 567+75.9, 9.8' RT.

CALCULATED DKA CHECKED SGJ

HORIZONTAL SCALE IN FEET


**TRAFFIC SIGNAL INTERCONNECT PLAN**  
**U.S. 23 STA. 561+00 TO STA. 572+00**

**FRA - 270-51.50**

ADDENDUM #1  
04/21/2023

NOTE

COIL SUFFICIENT 24-FIBER DROP CABLE IN THE PROPOSED 48" PULL BOX (STATION 572+76) AND THE PROPOSED CONTROLLER CABINET (STATION 572+76.5) PER ODOT SUPPLEMENTAL SPECIFICATION 804.

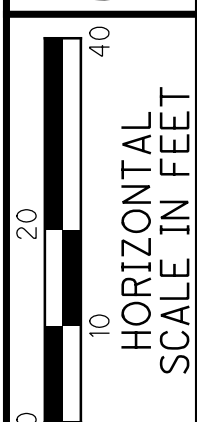

CALCULATED DKA CHECKED SGJ

TRAFFIC SIGNAL INTERCONNECT PLAN  
U.S. 23 STA. 572+00 TO STA. 577+50

FRA - 270-51.50

419  
554

(2) - 4" CONDUITS (MULTICELL) JACK OR DRILLED, 77' (EMPTY)

(1)-3" CONDUIT W/  
(1)-144 FIBER CABLE (BY CTSS F)  
(3)-3" CONDUITS - EMPTY  
(1)-1.5" CONDUIT W/ TRACER WIRE  
CONDUIT BANK = 76'  
ENCASED IN TRENCH

PULL BOX (32" ROUND)  
STA. 572+76, 77.0' LT

(1)-3" CONDUIT W/  
(1)-144 FIBER CABLE (BY CTSS F)  
(3)-3" CONDUITS - EMPTY  
(1)-1.5" CONDUIT W/ TRACER WIRE  
CONDUIT BANK = 185'  
ENCASED IN TRENCH

(1)-3" CONDUIT W/  
(1)-144 FIBER CABLE (BY CTSS F)  
(3)-3" CONDUITS - EMPTY  
(1)-1.5" CONDUIT W/ TRACER WIRE  
CONDUIT BANK = 295'  
ENCASED IN TRENCH

PULL BOX (48" ROUND) TYPE 1  
STA. 572+76, 9.0' RT  
W/ SPLICE ENCLOSURE  
(SPLICE 144-FIBER TO  
24-FIBER DROP CABLE)

(2)-4" CONDUITS (MULTICELL) W/  
(1) - 24-FIBER DROP CABLE,  
JACK OR DRILLED, 55'

PROPOSED GROUND  
MOUNTED CONTROLLER  
STA. 572+76.5, 61.4' RT  
INSTALL (2)-GBIC MODULES  
INSTALL (1)-LAYER 2 SWITCH

CONDUIT TO PROPOSED  
POWER LOCATION

PULL BOX (32" ROUND)  
STA. 575+65, 9.1' RT

PT STA. 872+38.97

EX. 12" WATER (CTP0600-013)

MATCHLINE STA. 572+00  
SEE SHEET 418

MATCHLINE STA. 577+50  
SEE SHEET 420

US 23

US 23

US 23

US 23

RAMP P2  
30°

573

574

575

576

577

9

X:\Projects\2013\1321\1010\FRA\92616\signals\92616CP007-IC.dgn 4/19/2023 1:42:17 PM cwong

NOTES

COIL SUFFICIENT 12-FIBER DROP CABLE IN THE PROPOSED PTZ CAMERA CONTROL BOX (STATION 580+17) AND THE PROPOSED 32" PULL BOX (STATION 580+17) PER ODOT SUPPLEMENTAL SPECIFICATION 804.

COIL SUFFICIENT 24-FIBER DROP CABLE IN THE PROPOSED CONTROLLER CABINET (STATION 587+29.7) AND THE PROPOSED 48" PULL BOX (STATION 587+37) PER ODOT SUPPLEMENTAL SPECIFICATION 804.


MATCHLINE STA. 577+50  
SEE SHEET 419

MATCHLINE STA. 583+00  
SEE ABOVE

MATCHLINE STA. 583+00  
SEE BELOW


MATCHLINE STA. 588+50  
SEE SHEET 421

X:\Projects\2013\1321\1010\FRA\92616\signals\92616CP008-IC.dgn 4/26/2023 12:34:22 PM cwong

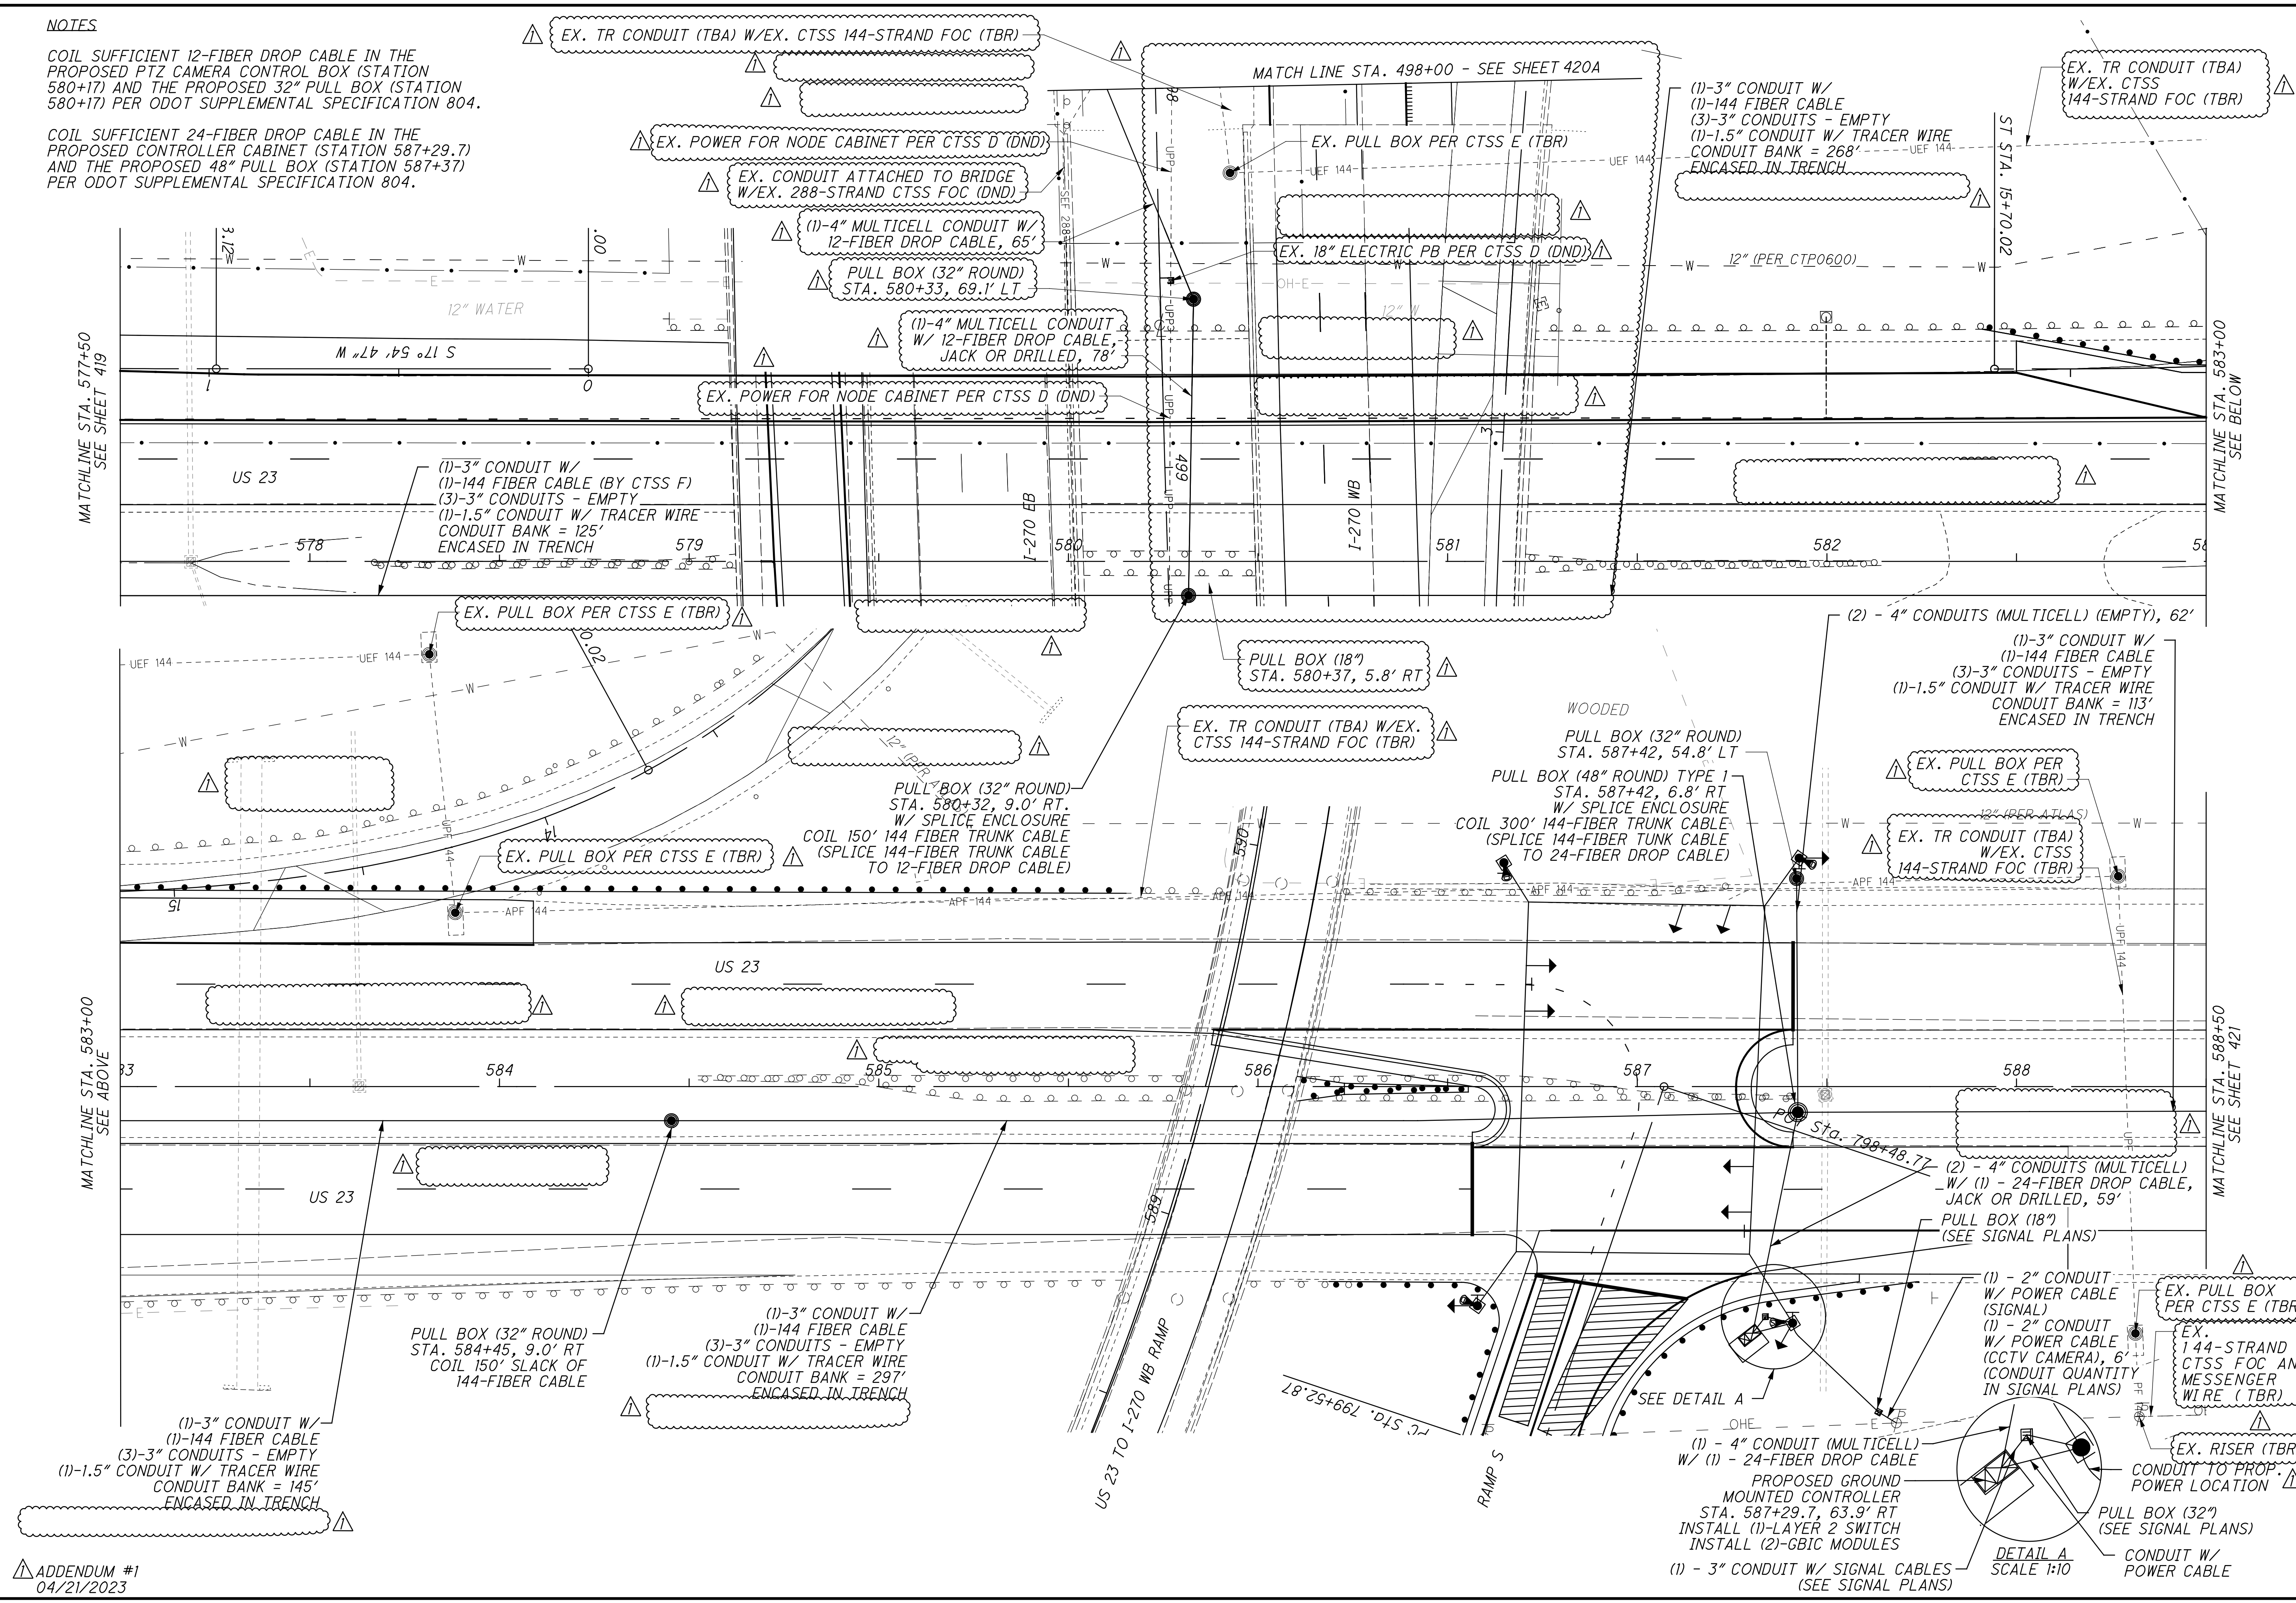

TRAFFIC SIGNAL INTERCONNECT PLAN  
U.S. 23 STA. 577+50 TO STA. 588+50



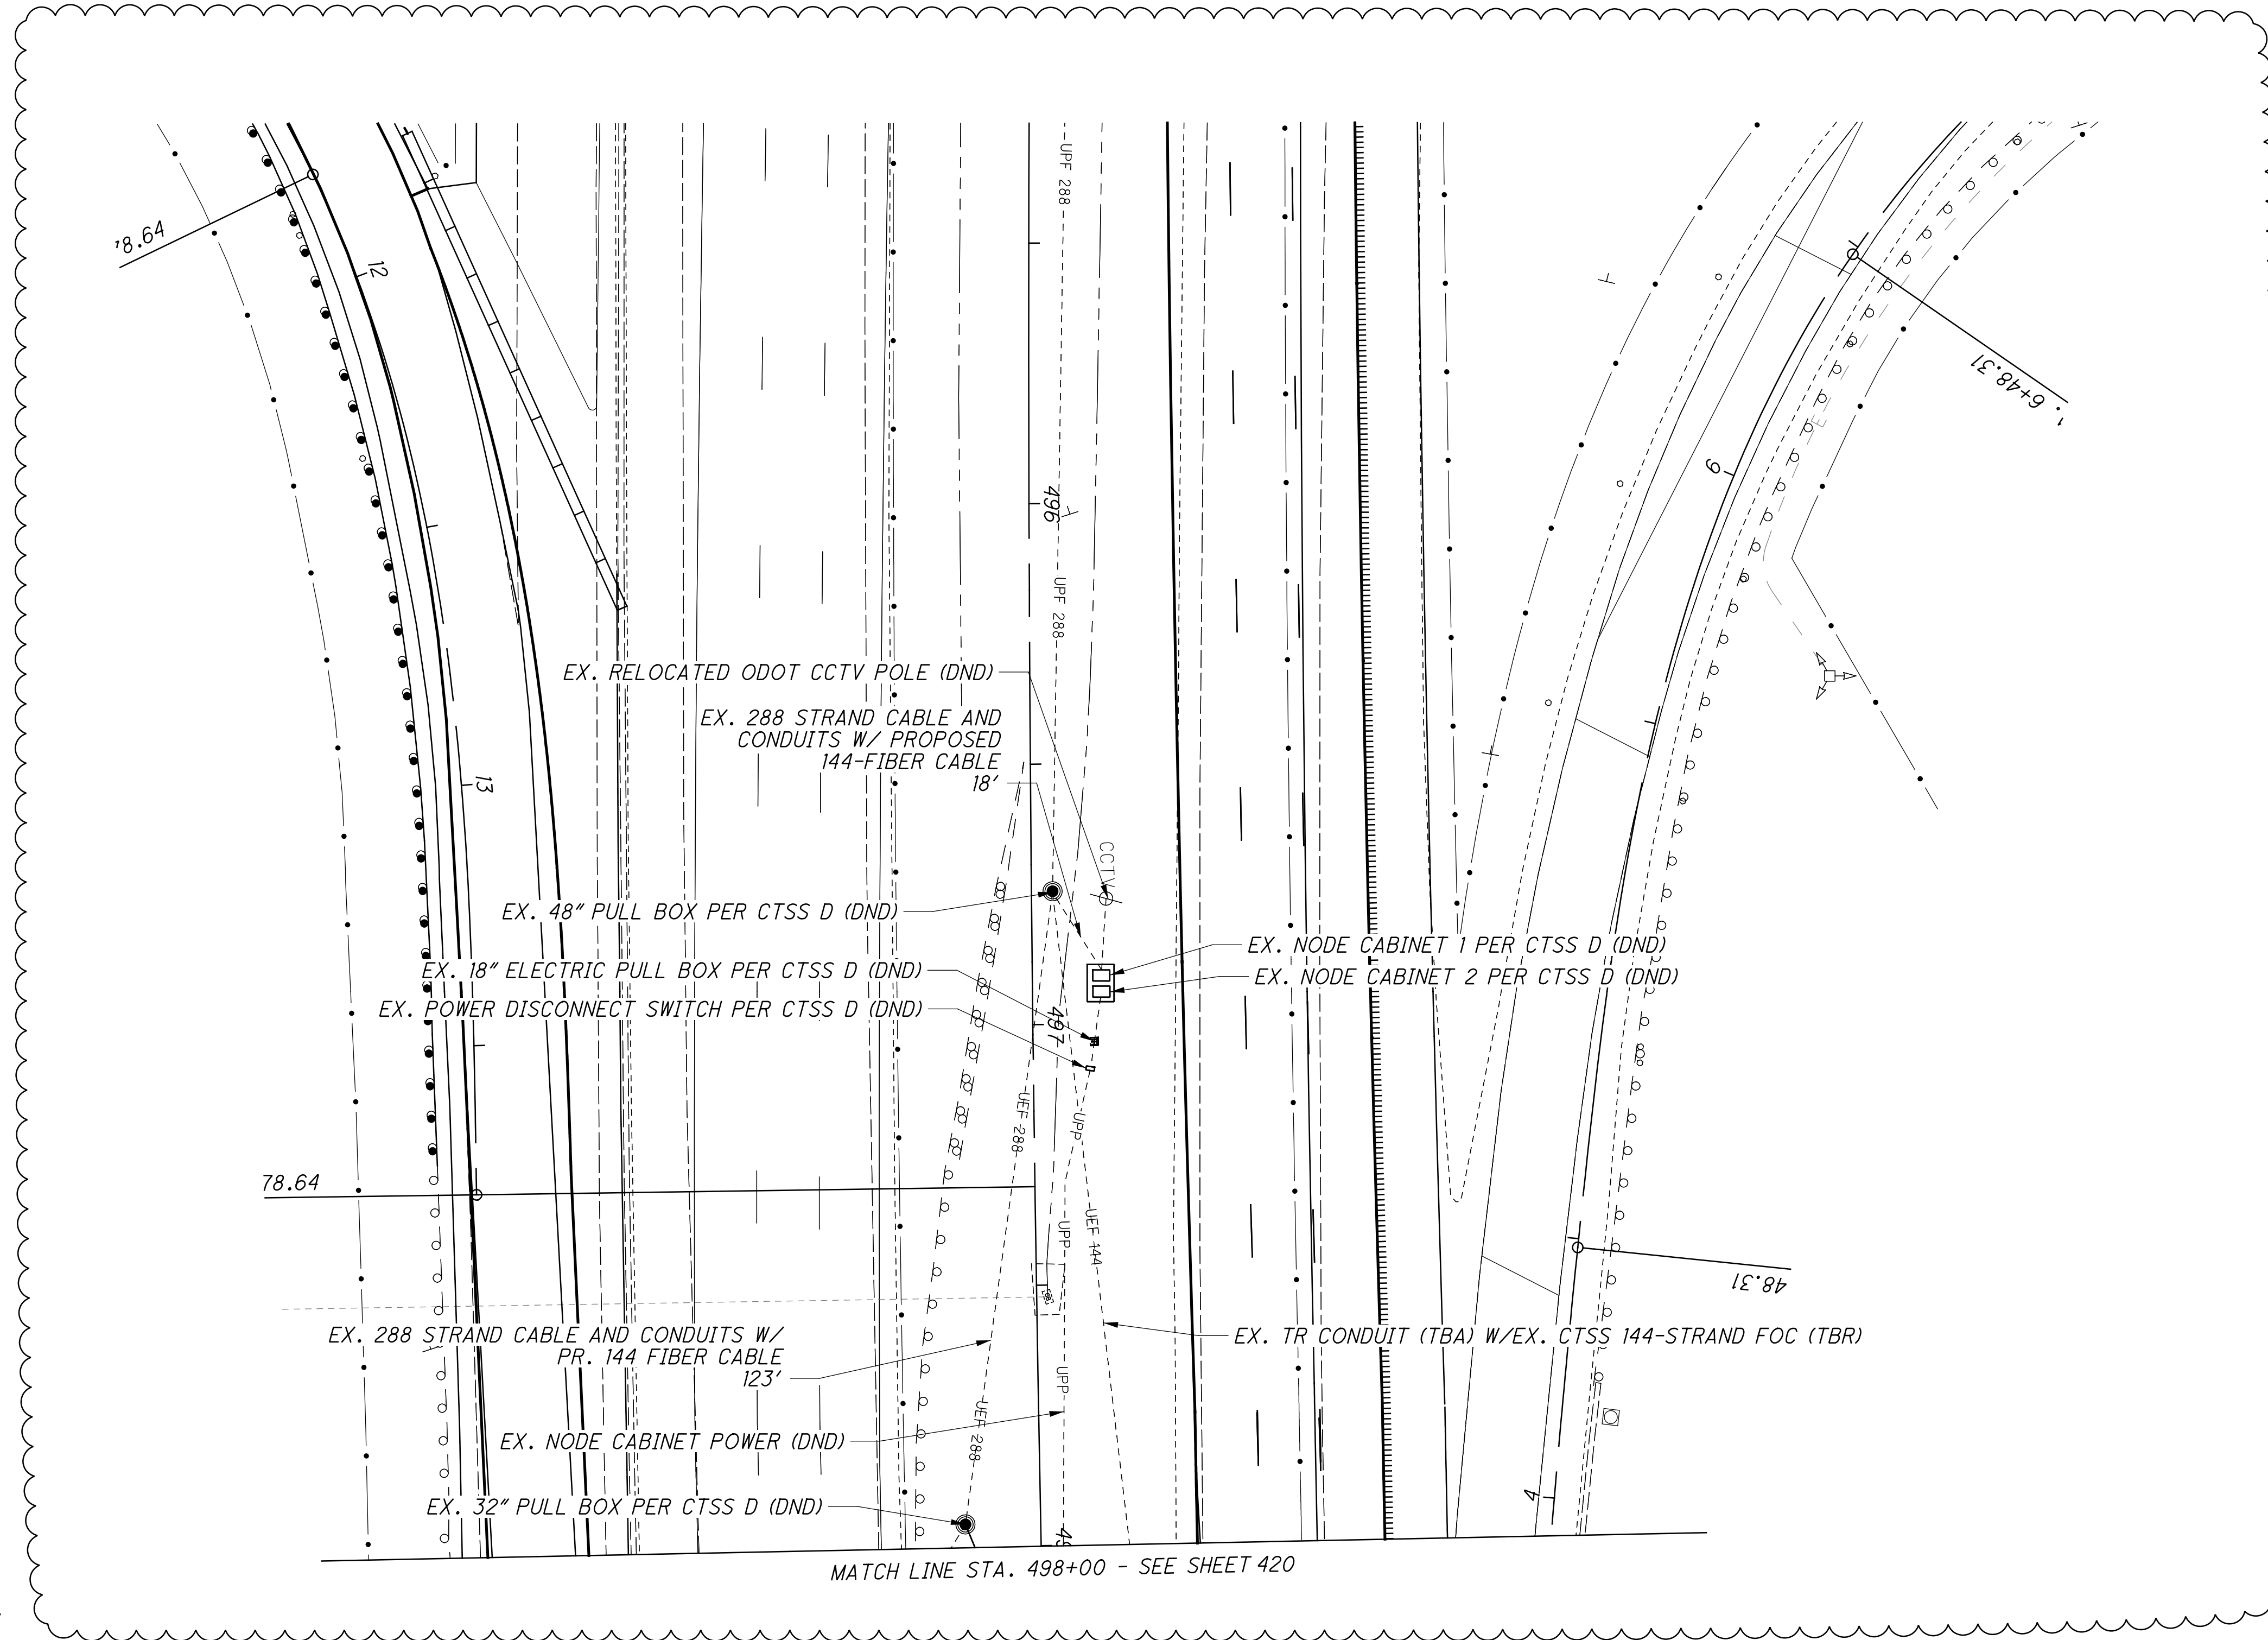


MATCH LINE STA. 498+00 - SEE SHEET 420

CALCULATED  
DKA  
CHECKED  
SGJ

0 10 20 40  
HORIZONTAL  
SCALE IN FEET

**TRAFFIC SIGNAL INTERCONNECT PLAN**  
**U.S. 23 STA. 577+50 TO STA. 588+50**

**FRA - 270-51.50**

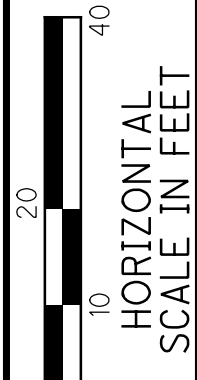


CALCULATED  
DKA  
CHECKED  
SGJ

# TRAFFIC SIGNAL INTERCONNECT PLAN U.S. 23 STA. 588+50 TO STA. 599+50

## FRA - 270-51.50

421  
554

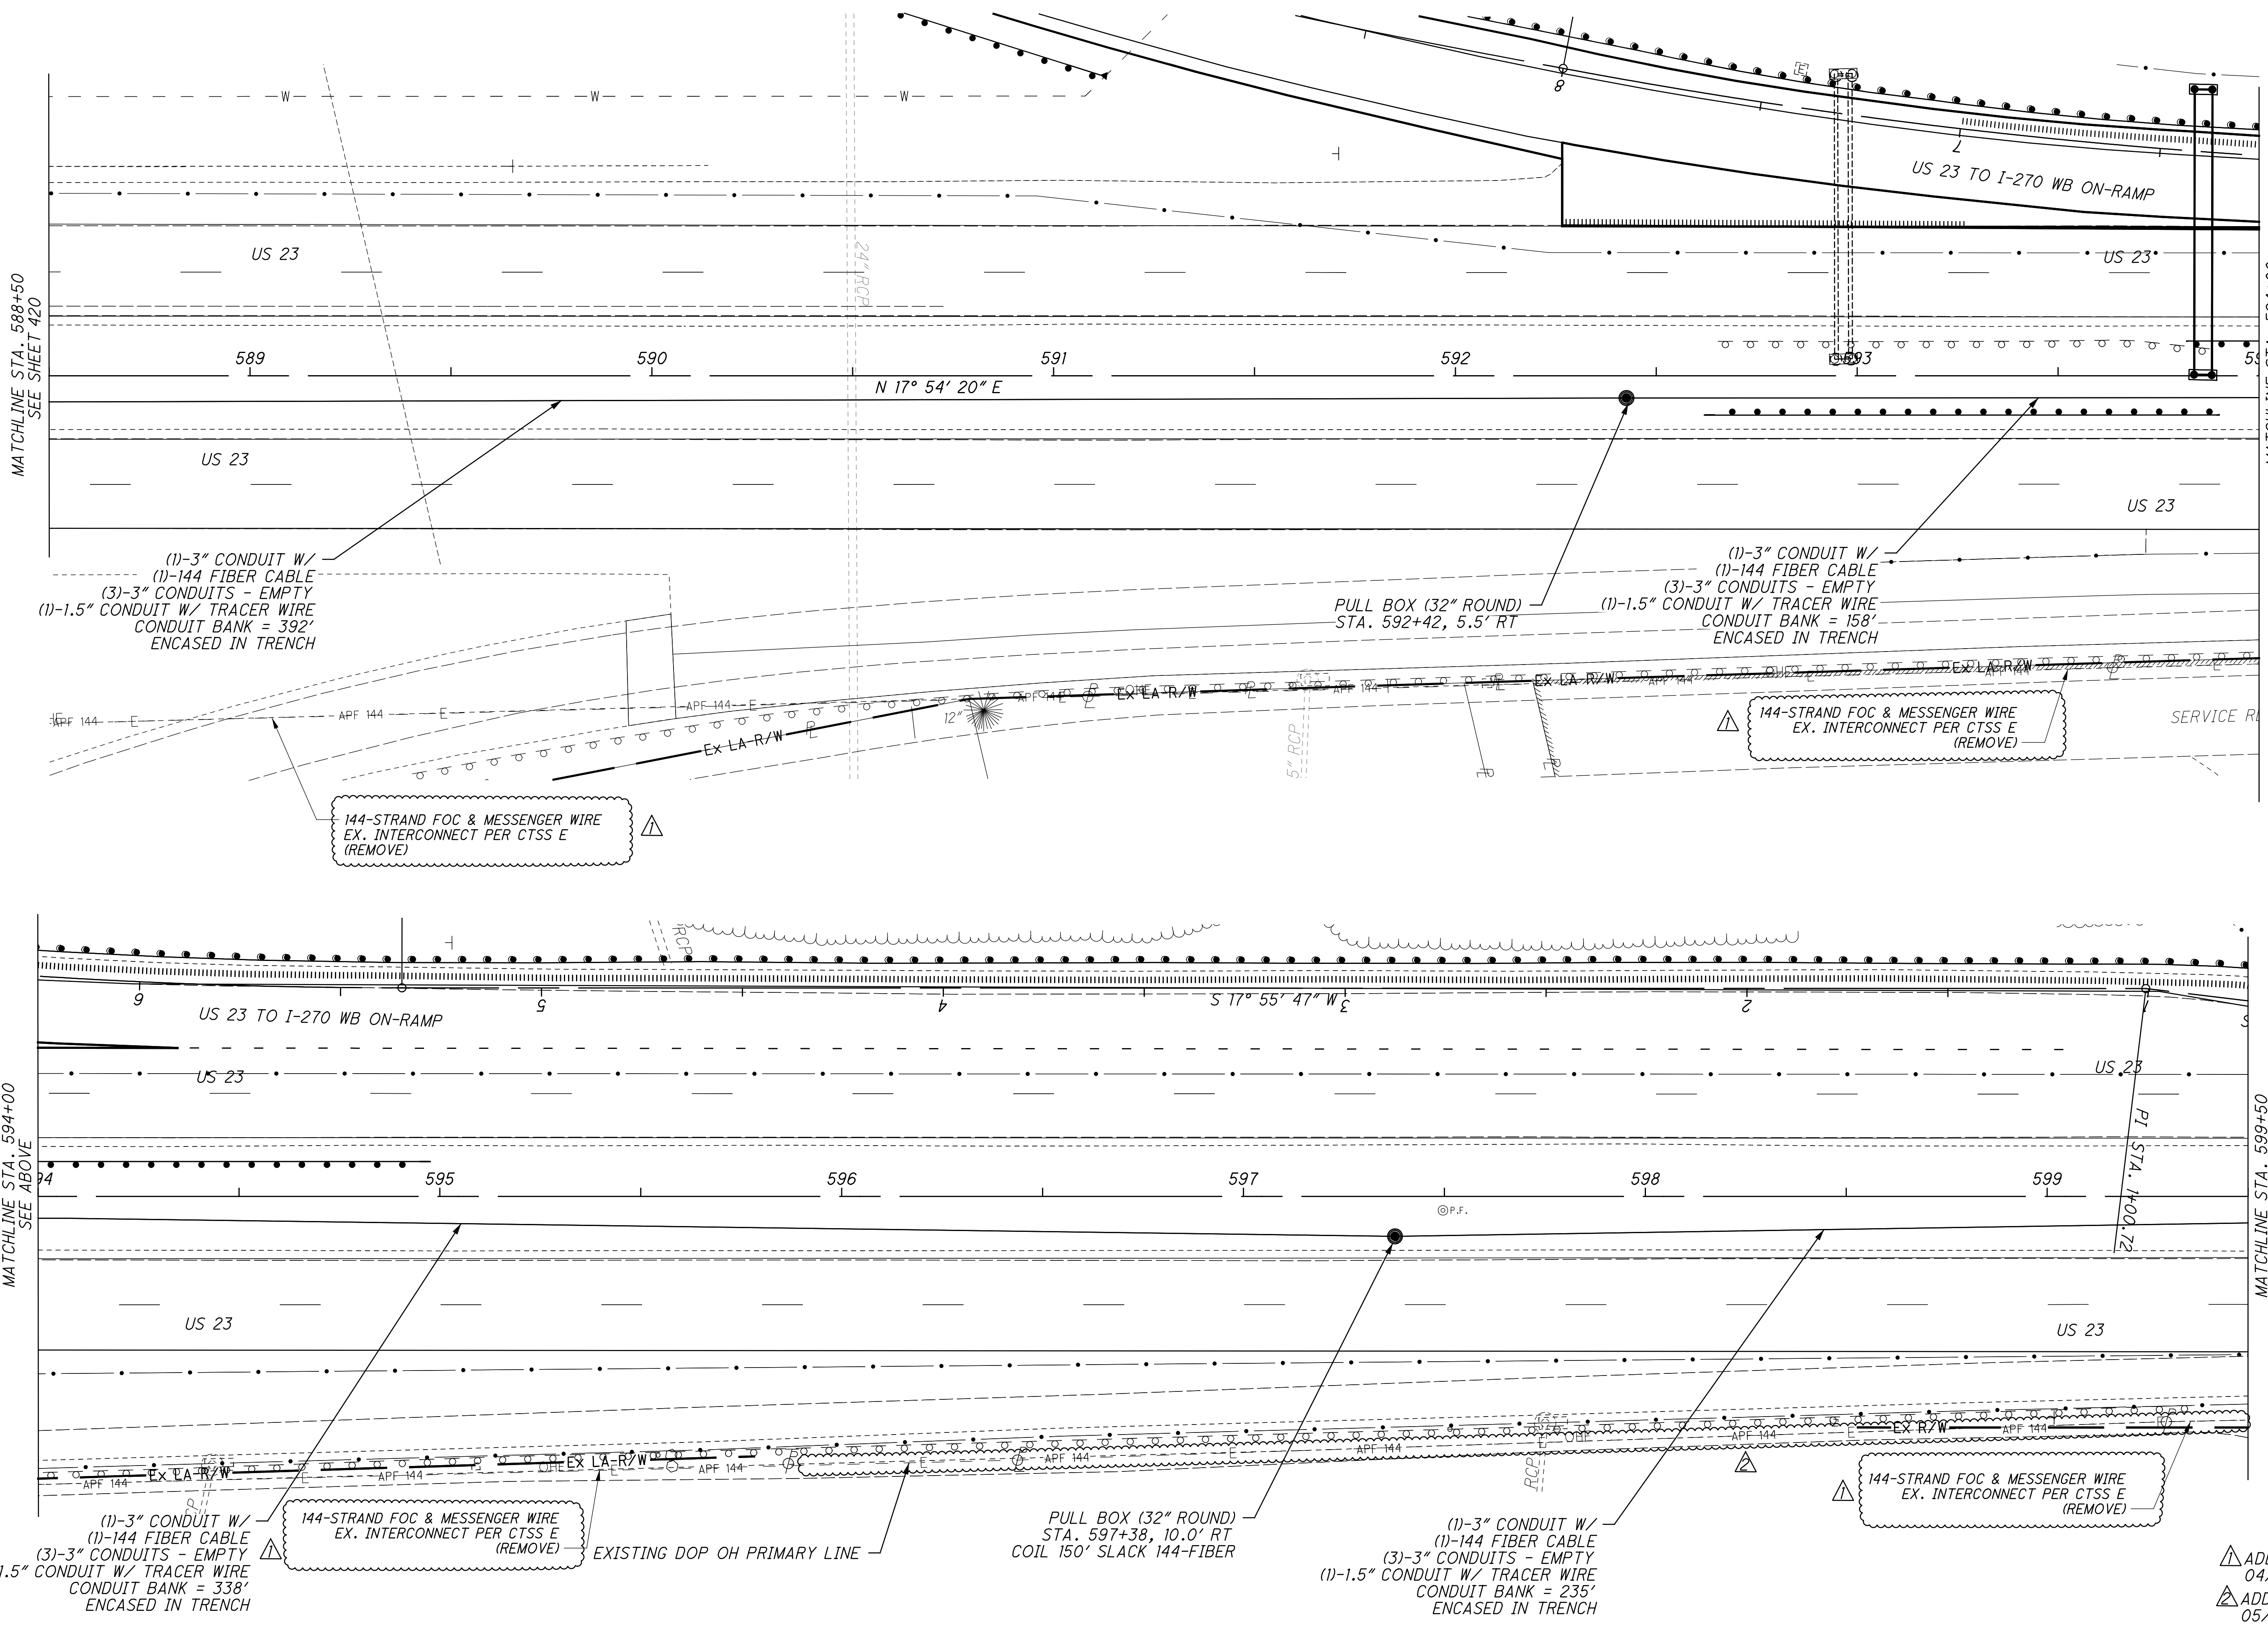

ADDENDUM #1  
04/21/2023  
ADDENDUM #2  
05/05/2023

X:\Projects\2013\1321\1010\FRA\92616\signals\92616CP009-IC.dgn 5/17/2023 6:37:02 AM cwong

X:\Projects\2013\1010\FRA\92616\signals\92616CP010-C.dgn 5/11/2023 6:51:01 AM cwong

MATCHLINE STA. 599+50  
SEE SHEET 421

MATCHLINE STA. 605+00  
SEE ABOVE


MATCHLINE STA. 605+00  
SEE BELOW



**TRAFFIC SIGNAL INTERCONNECT PLAN**  
**U.S. 23 STA. 599+50 TO STA. 608+81**

**FRA - 270-51.50**

422  
554

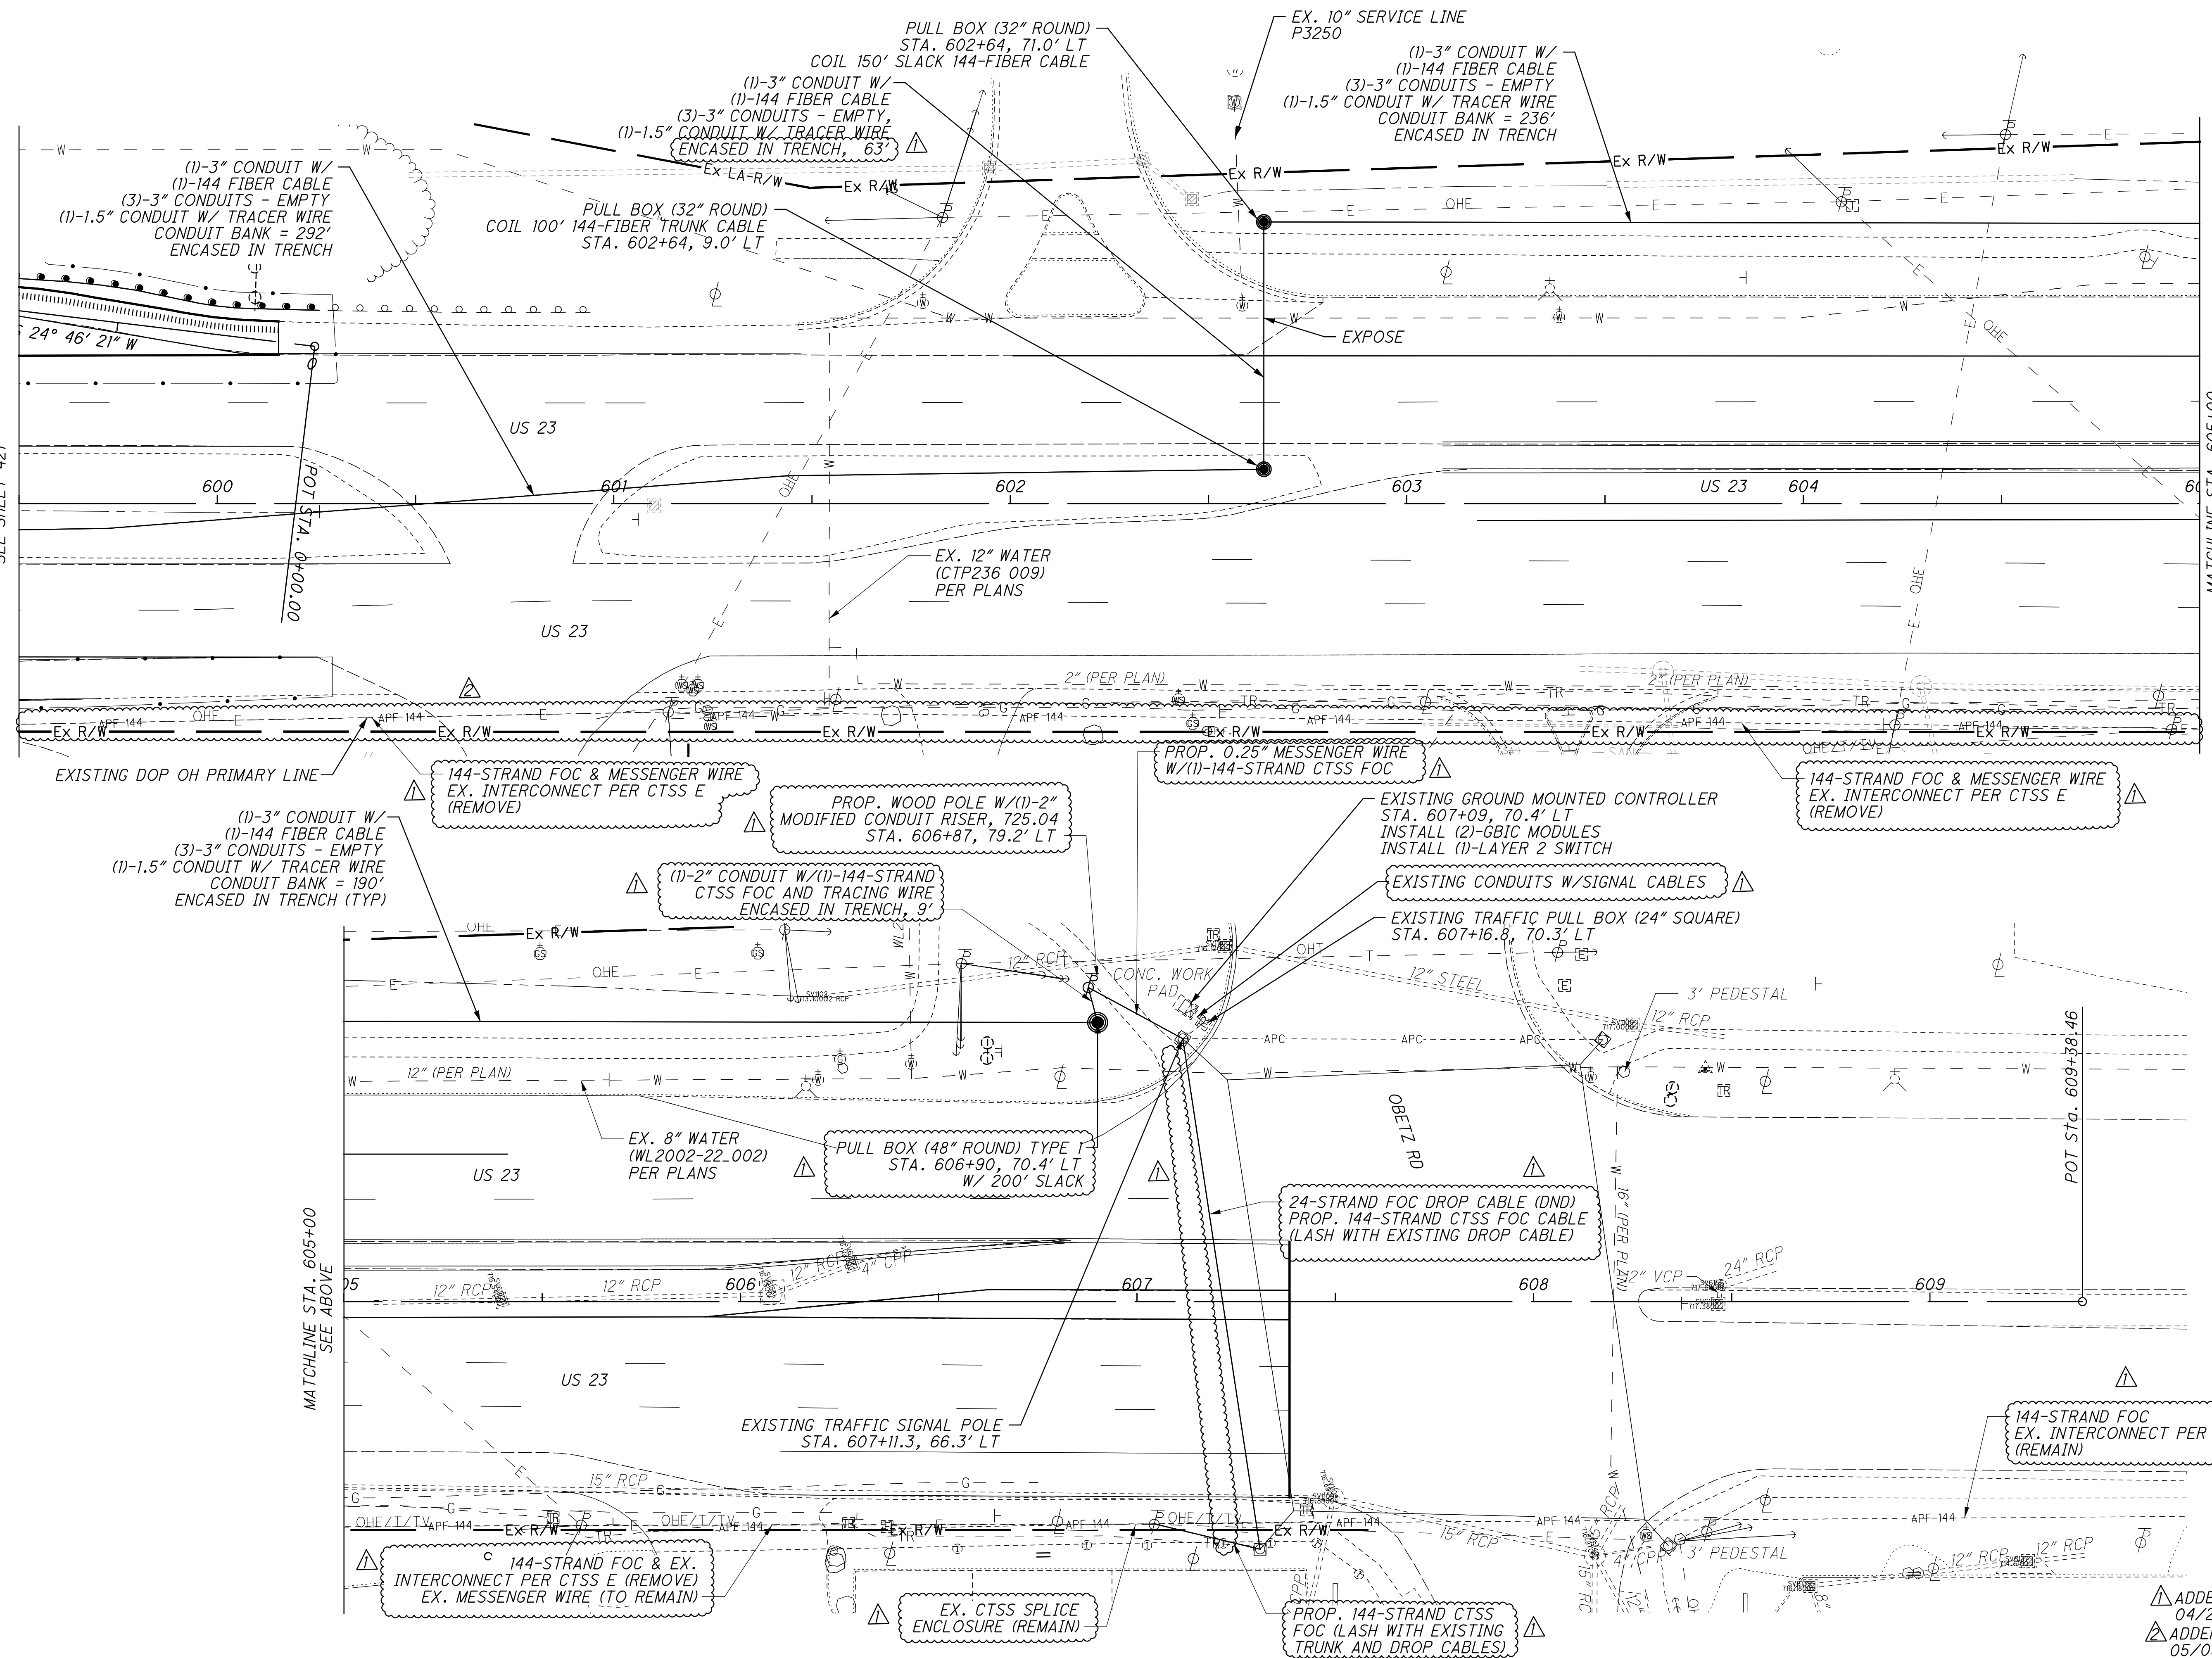


CALCULATED  
DKA  
CHECKED  
SGJ

ADDENDUM #1  
04/21/2023  
ADDENDUM #2  
05/05/2023



**LEGEND**

- 144-FIBER OPTIC TRUNK CABLE (UNDERGROUND)
- EX. 144-FIBER OPTIC TRUNK CABLE
- 24-FIBER OPTIC DROP CABLE (UNDERGROUND)
- 12-FIBER OPTIC DROP CABLE (UNDERGROUND)
- PROPOSED CONTROLLER CABINET
- EXISTING CONTROLLER CABINET
- 48" PULL BOX
- 32" PULL BOX
- EX. 48" PULL BOX
- EX. UTILITY POLE

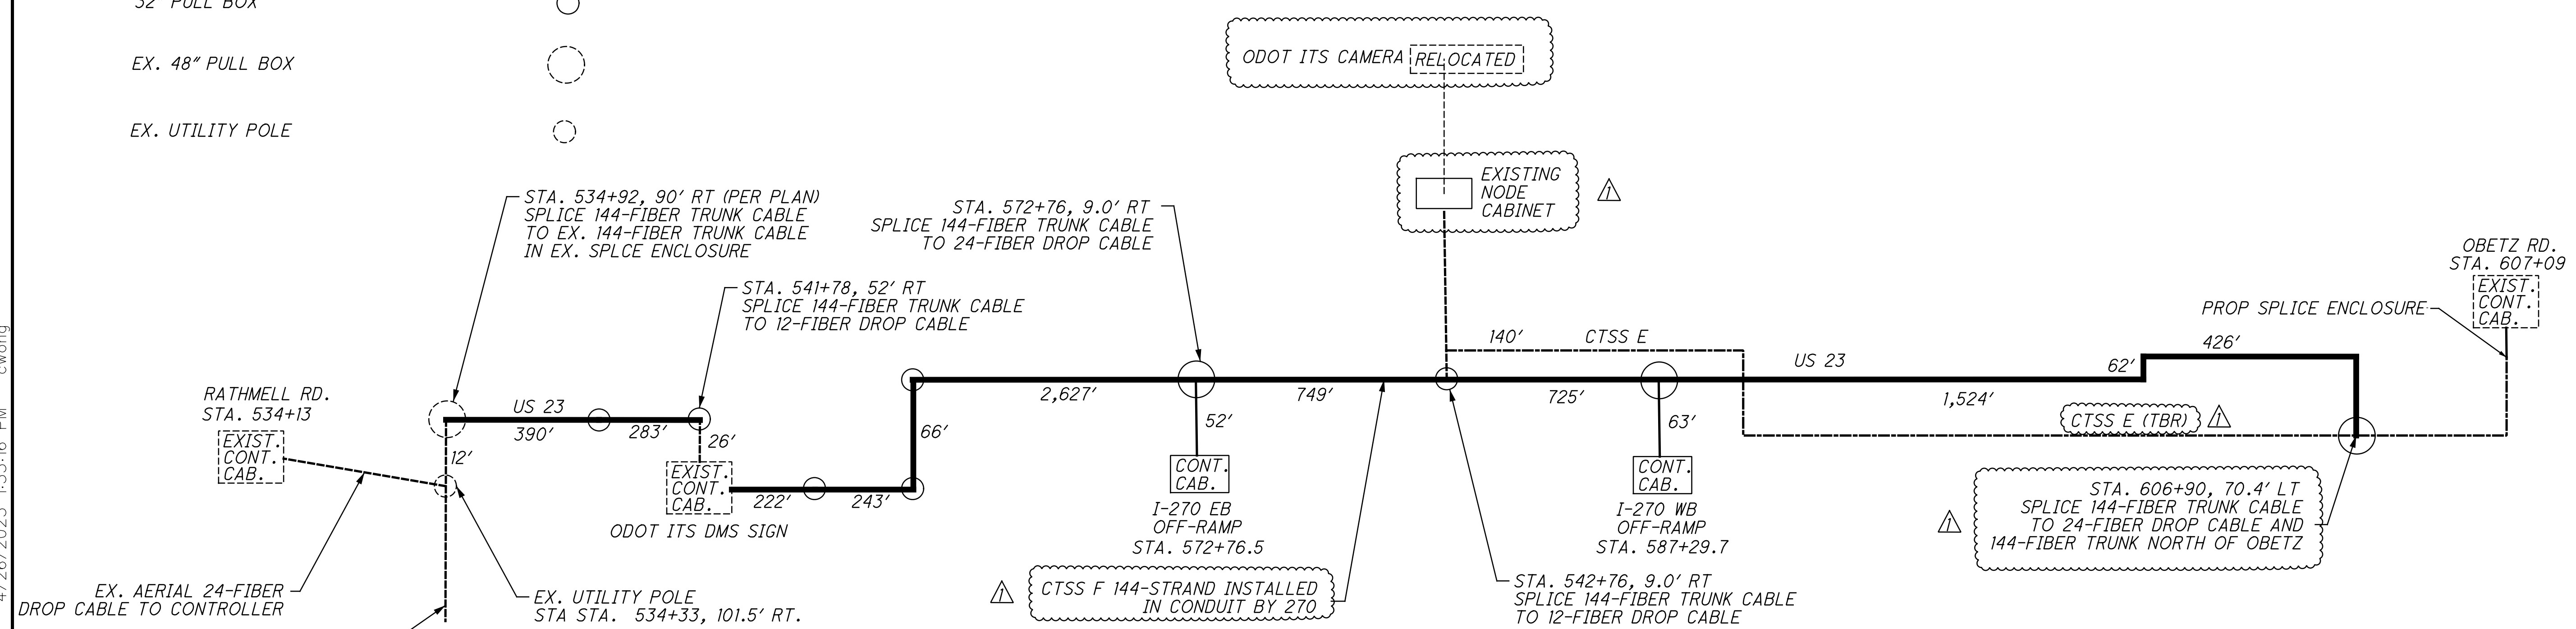

NOTE: FOR CROSS-SECTION OF CONDUIT BANK, SEE CITY OF COLUMBUS STANDARD DRAWING 4001 (TRAFFIC SIGNAL CONDUIT BANK STANDARDS).

X:\Projects\2013\1321\1010\FRA\92616\signals\sheets\92616CD006-1C.dgn 4/26/2023 1:53:16 PM cwong

X:\Projects\2013\13A\10\FA\92646\GIS\shp\92665D00X\GIS\92665D00X\92665D00X.dwg 4/21/2023 3:25:17 PM

ADDENDUM #1  
04/21/2023


FRA - 270-51.50

TRAFFIC SIGNAL INTERCONNECT  
COMMUNICATIONS PLAN

CALCULATED  
DKA  
CHECKED  
SGJ


424  
554

**TRAFFIC SIGNAL CABINET ASSEMBLY**

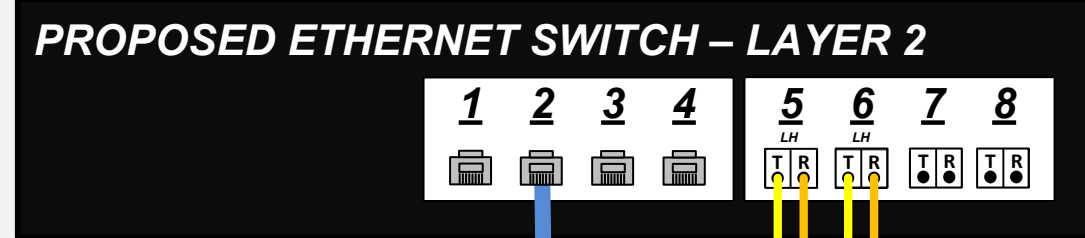


**ETHERNET SWITCH PORT DESTINATION**

PORT 5: INT. # 2069: HIGH ST AT OBETZ RD (SEE SHEET 427)  
 PORT 6: PARSONS AVE AT RATHMELL ROAD (END OF PROJECT)

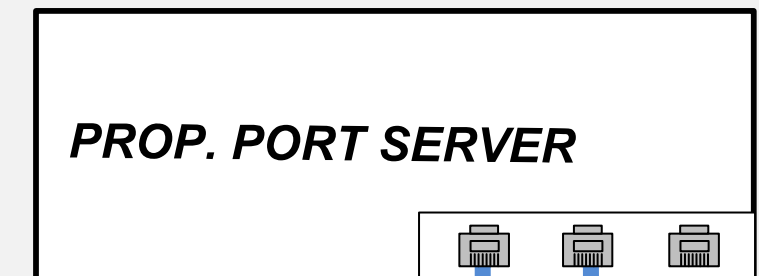

**PATCH PANEL ENCLOSURE – 24 TERMINATION**


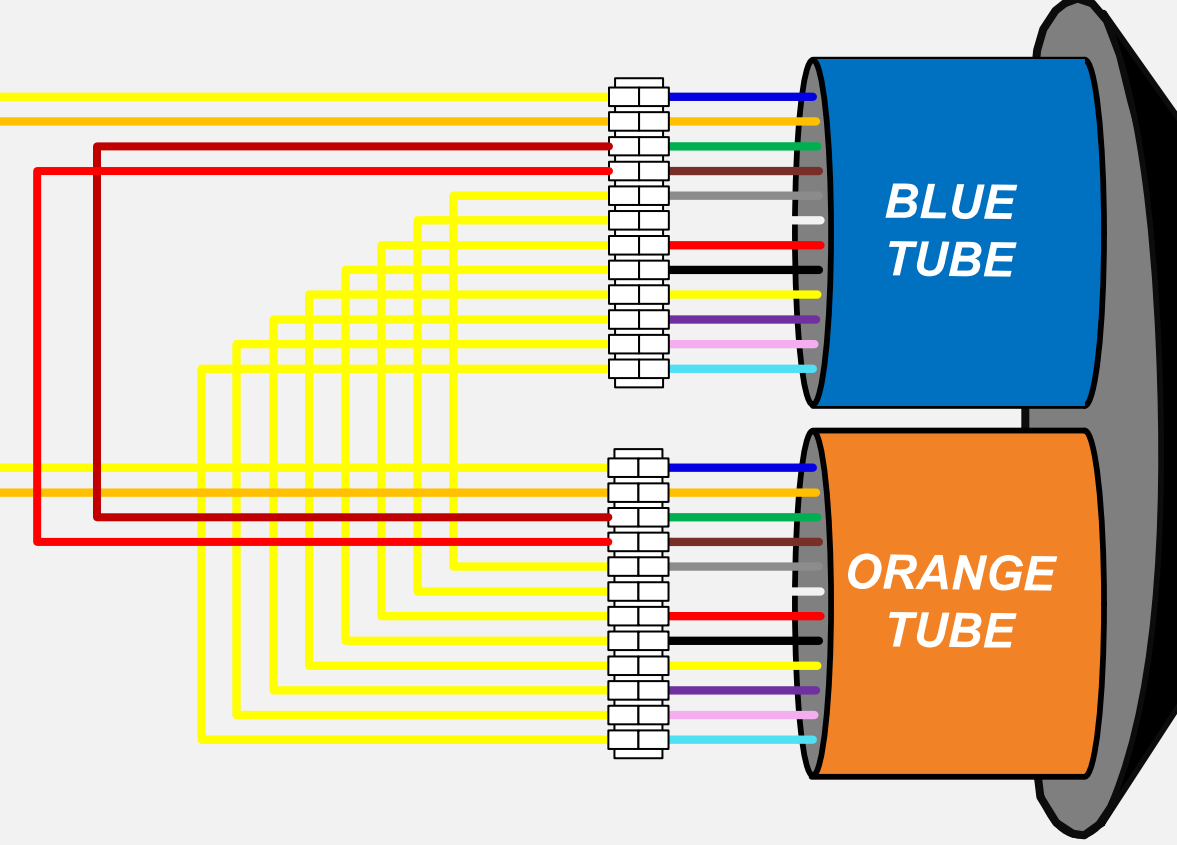


24 STRAND FOC

**LEGEND**

- FIBER PATCH CABLE TX/RX STANDARD
- FIBER PATCH CABLE RX/TX CROSSOVER
- CAT 5E CABLE
- PATCH PANEL
- EXISTING/PROPOSED FIBER OR BUFFER TUBE LEFT COILED IN SPLICE ENCLOSURE
- FUSION SPLICE – SINGLE FIBER
- FIBER BUFFER TUBE SPLICE PR / EX
- GBIC OPTICAL TRANSCEIVER  
LH – LED  
ZX – LASER
- 8P8C CONNECTOR
- COLUMBUS - CTSS

**LOCATION MAP**

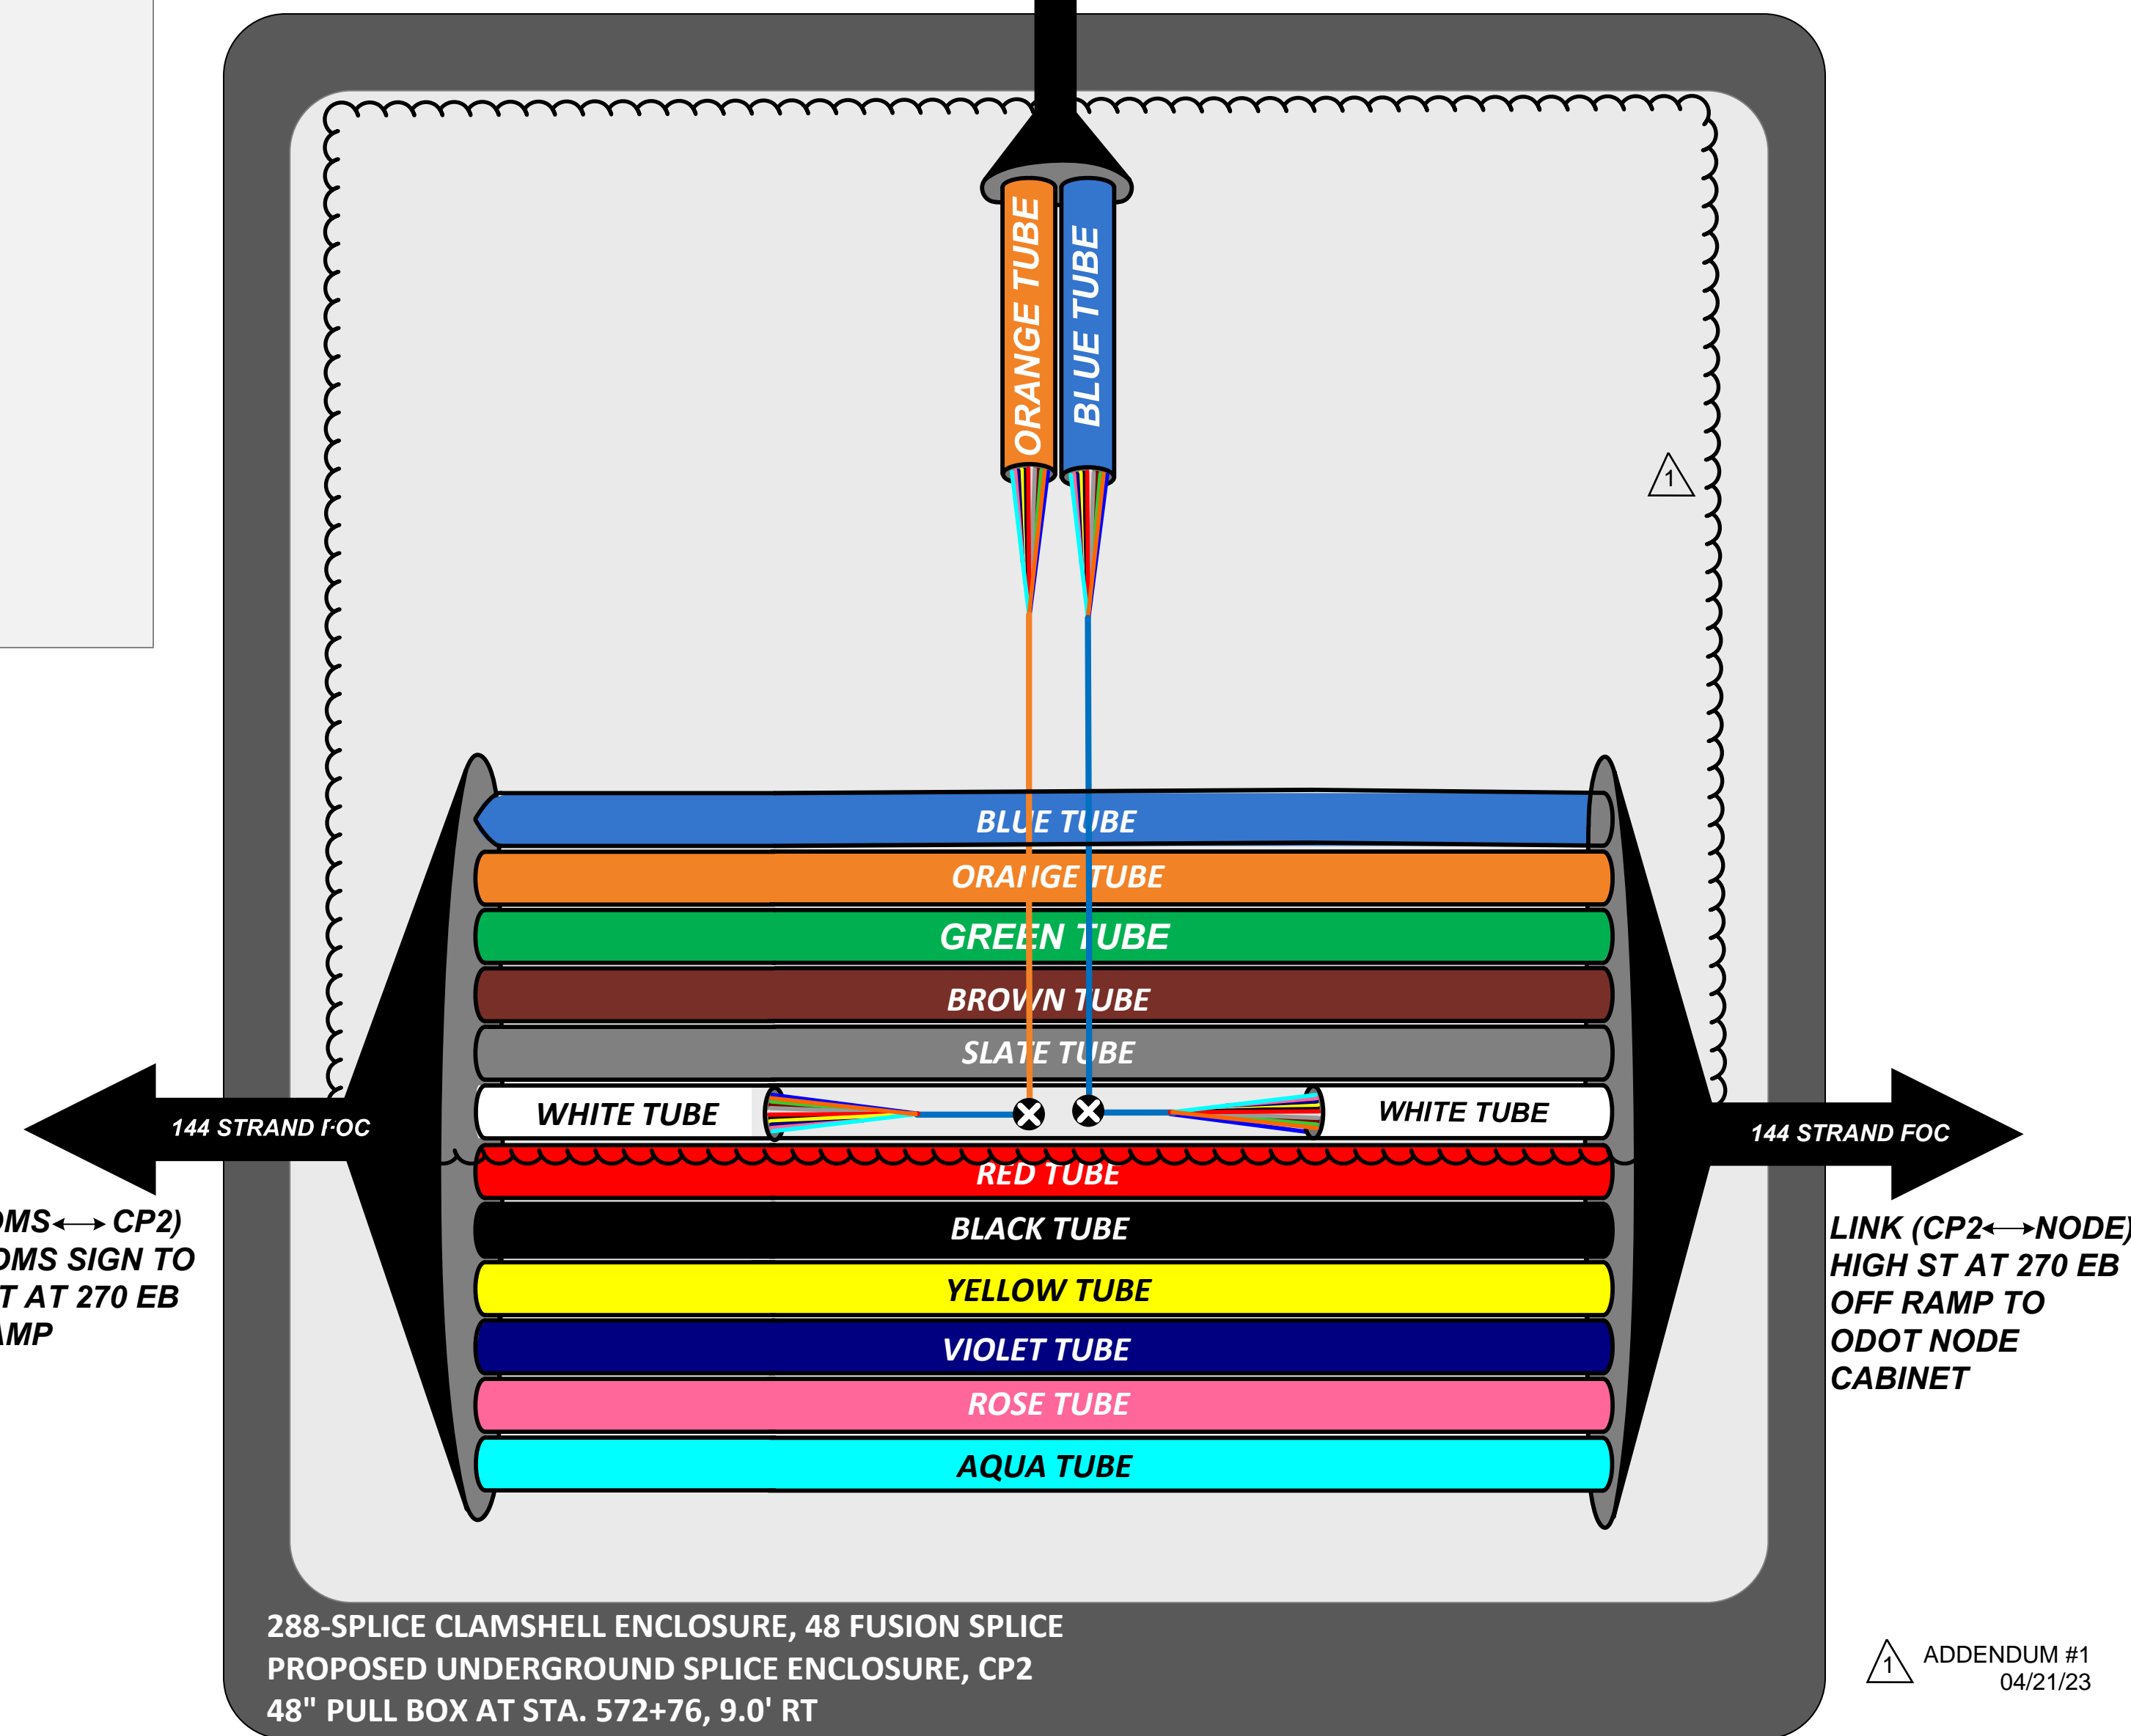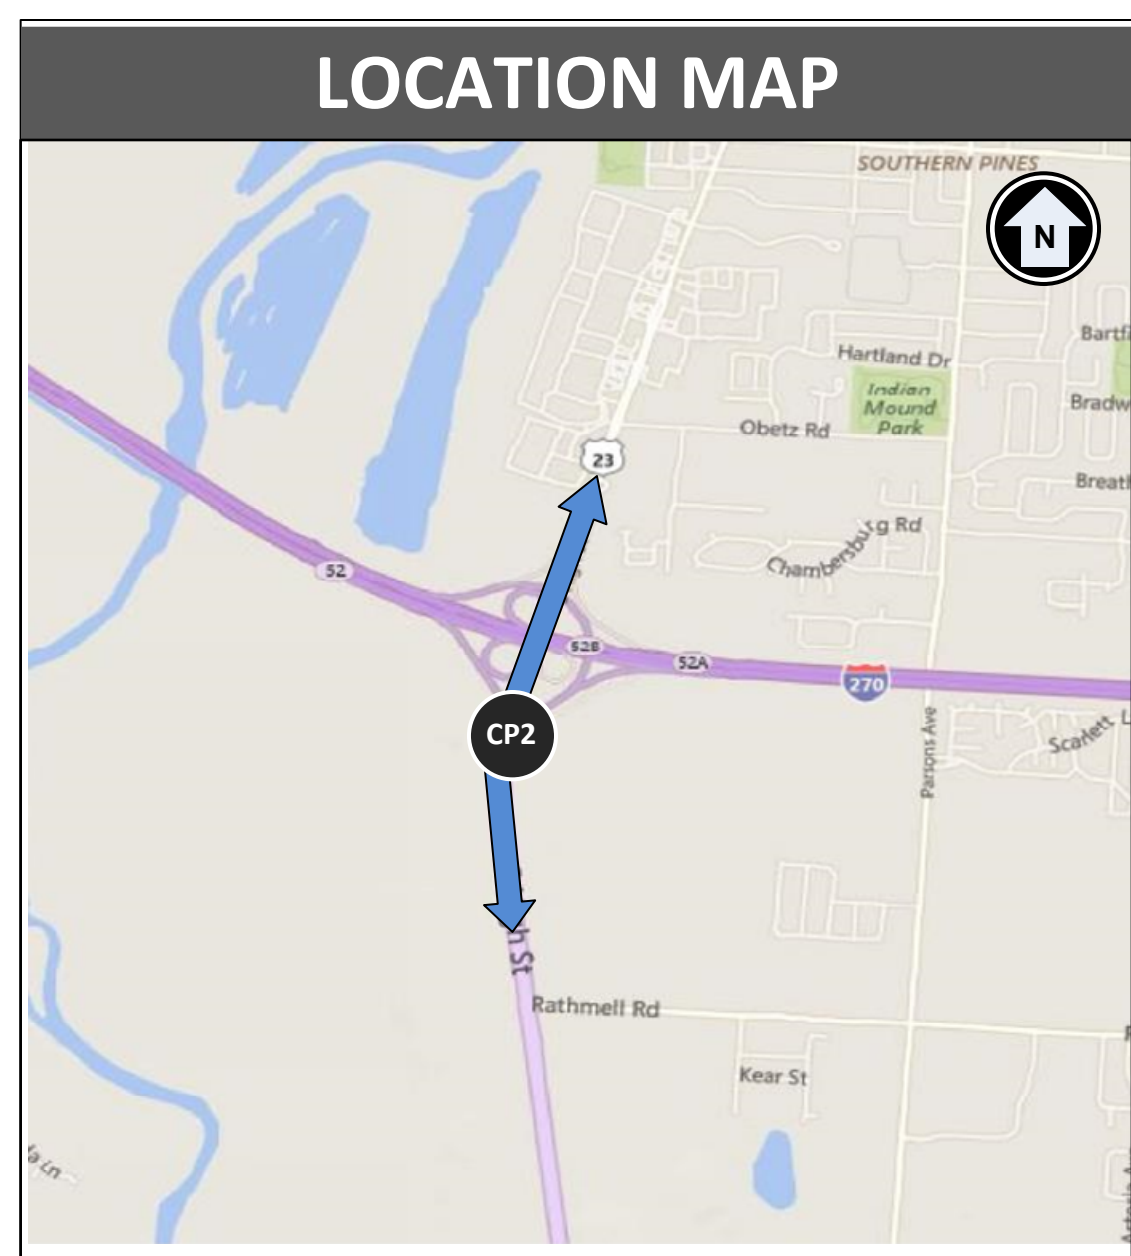

LINK (DMS ↔ CP2)  
 ODOT DMS SIGN TO  
 HIGH ST AT 270 EB  
 OFF RAMP


LINK (CP2 ↔ NODE)  
 HIGH ST AT 270 EB  
 OFF RAMP TO  
 ODOT NODE  
 CABINET

288-SPLICE CLAMSHELL ENCLOSURE, 48 FUSION SPLICE  
 PROPOSED UNDERGROUND SPLICE ENCLOSURE, CP2  
 48" PULL BOX AT STA. 572+76, 9.0' RT

ADDENDUM #1  
 04/21/23



**ITS CABINET**

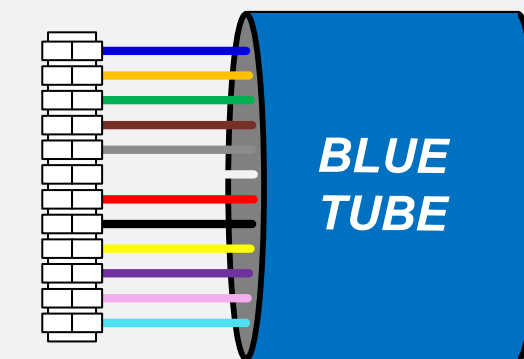



12 STRAND FOC

INSTALL 20 FEET OF SLACK IN CABINET CONNECTIONS TO PATCH PANEL ENCLOSURE TO BE COMPLETED BY OTHERS

**LEGEND**

- FIBER PATCH CABLE TX/RX STANDARD
- FIBER PATCH CABLE RX/TX CROSSOVER
- CAT 5E CABLE
- PATCH PANEL
- EXISTING/PROPOSED FIBER OR BUFFER TUBE LEFT COILED IN SPLICE ENCLOSURE
- FUSION SPLICE - SINGLE FIBER
- FIBER BUFFER TUBE SPLICE PR / EX
- GBIC OPTICAL TRANSCEIVER  
LH - LED  
ZX - LASER
- 8P8C CONNECTOR
- COLUMBUS - CTSS

**LOCATION MAP**

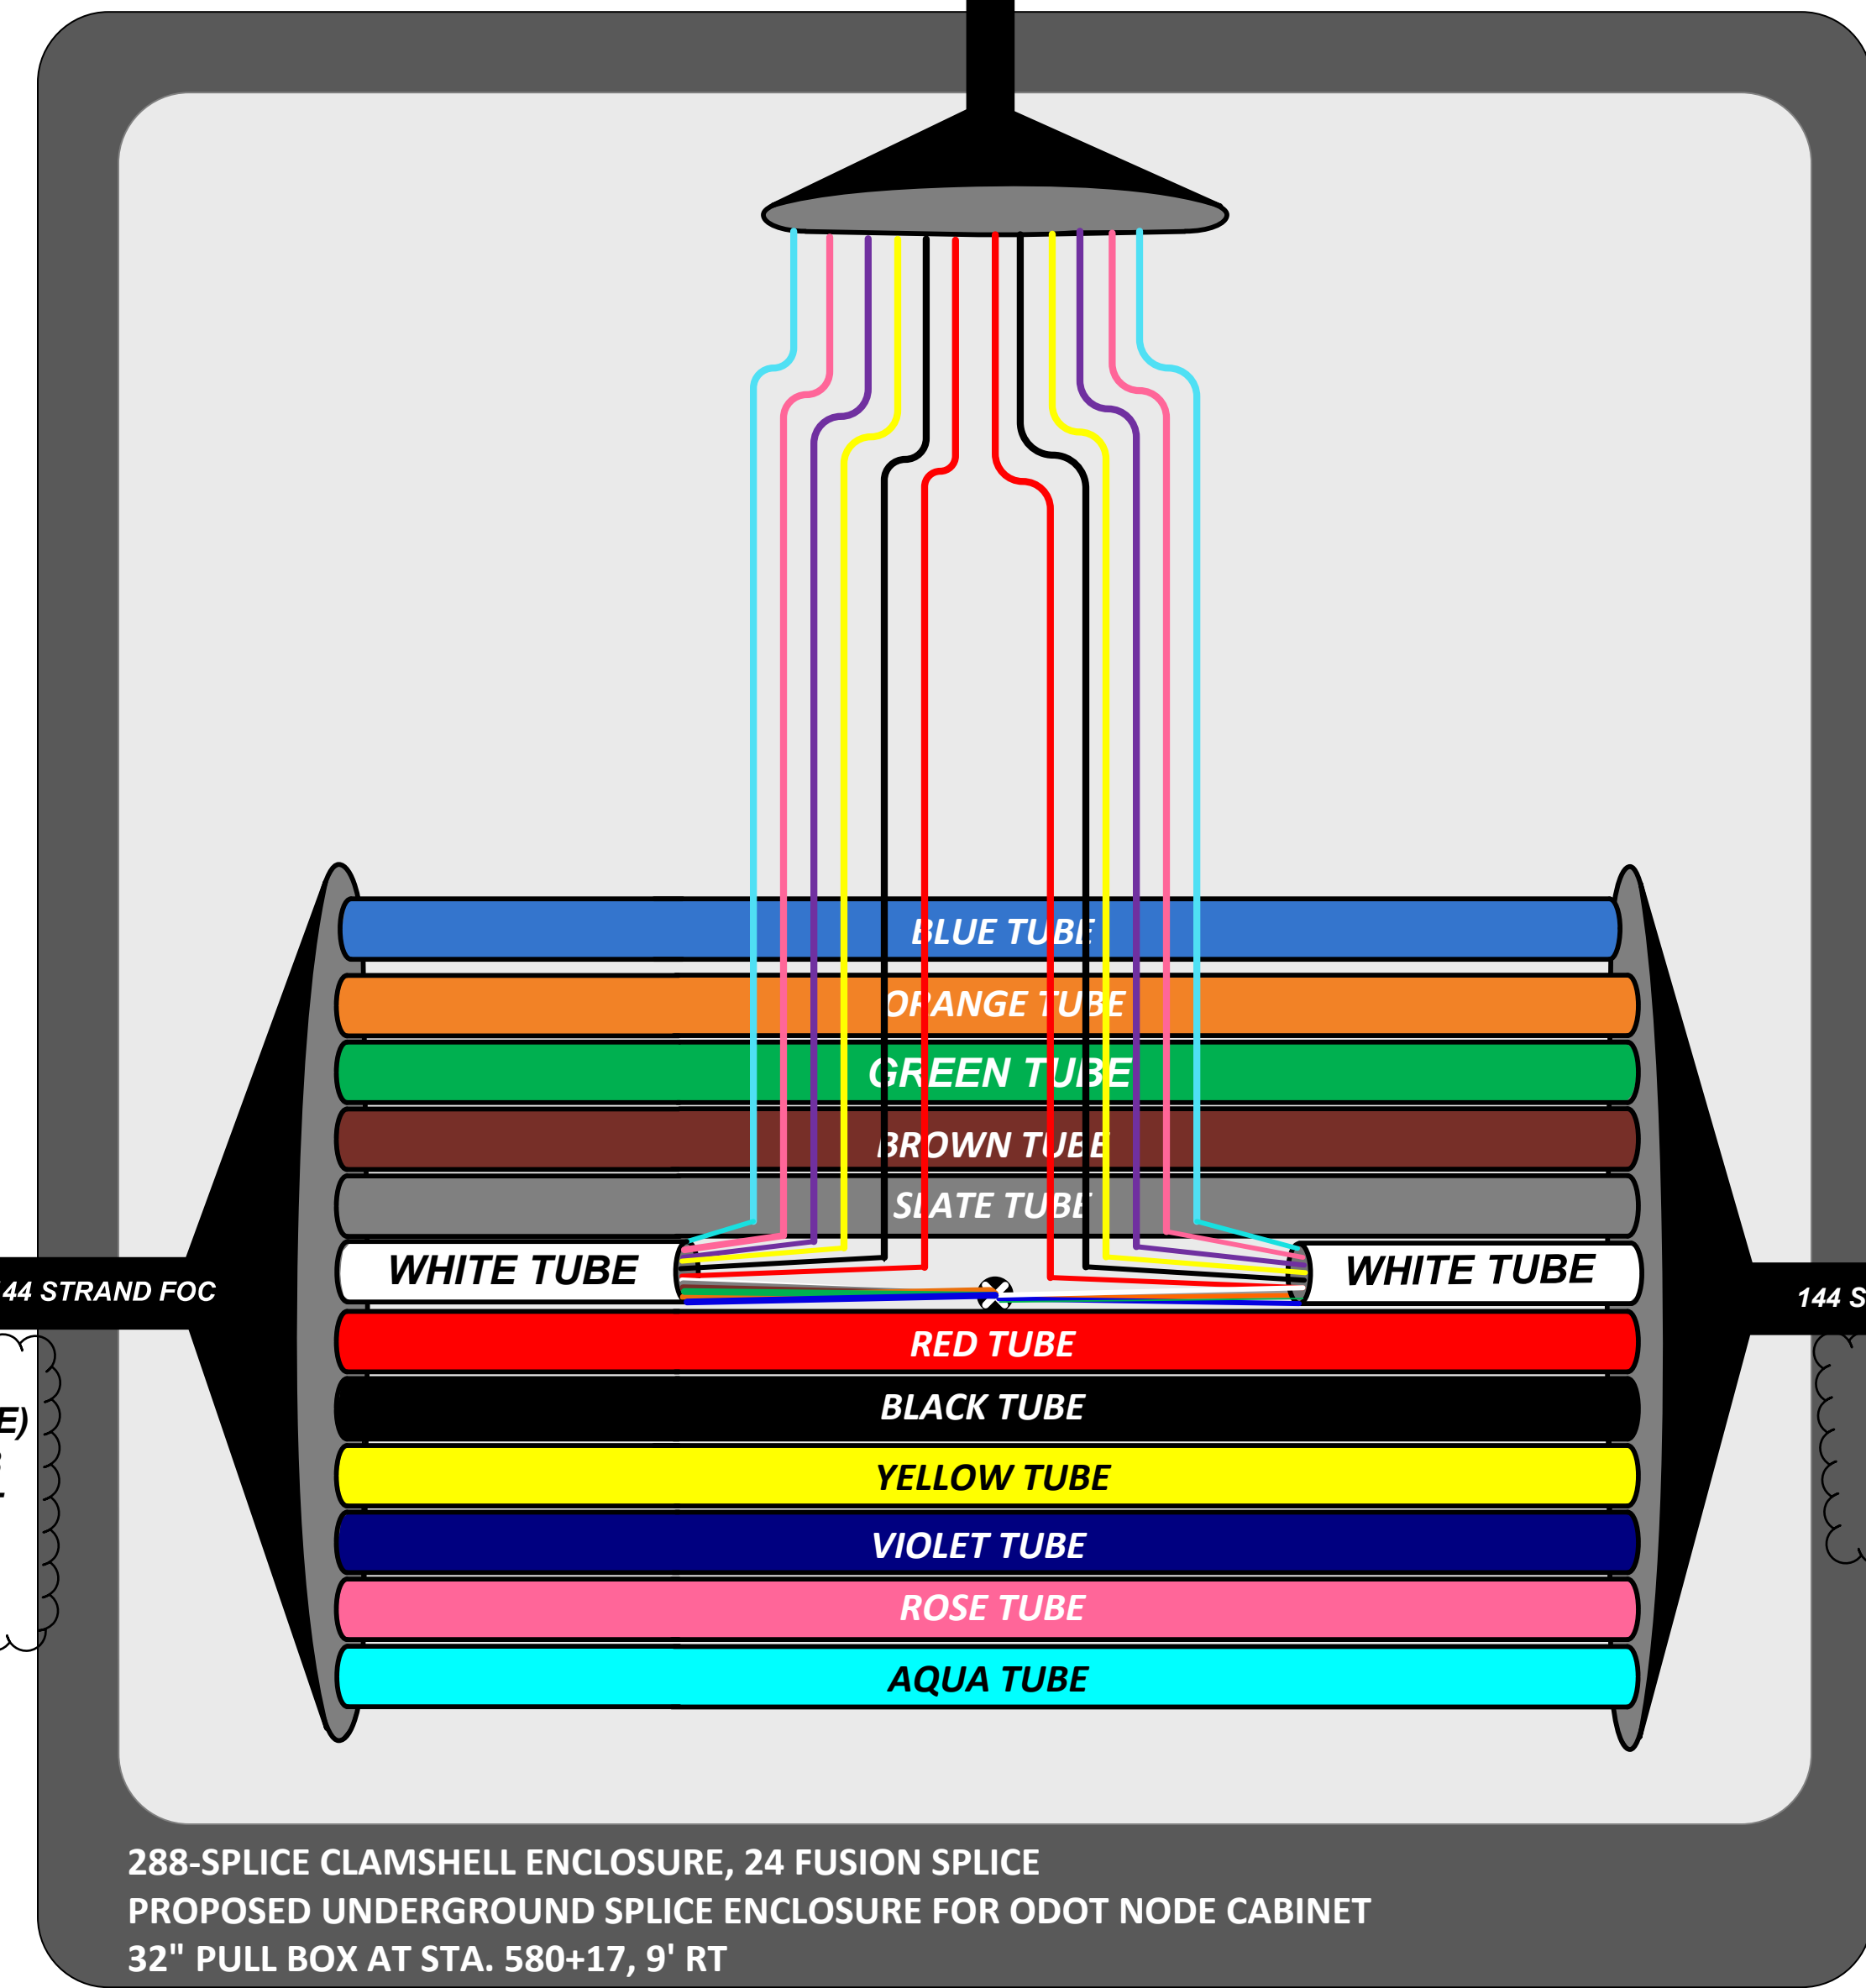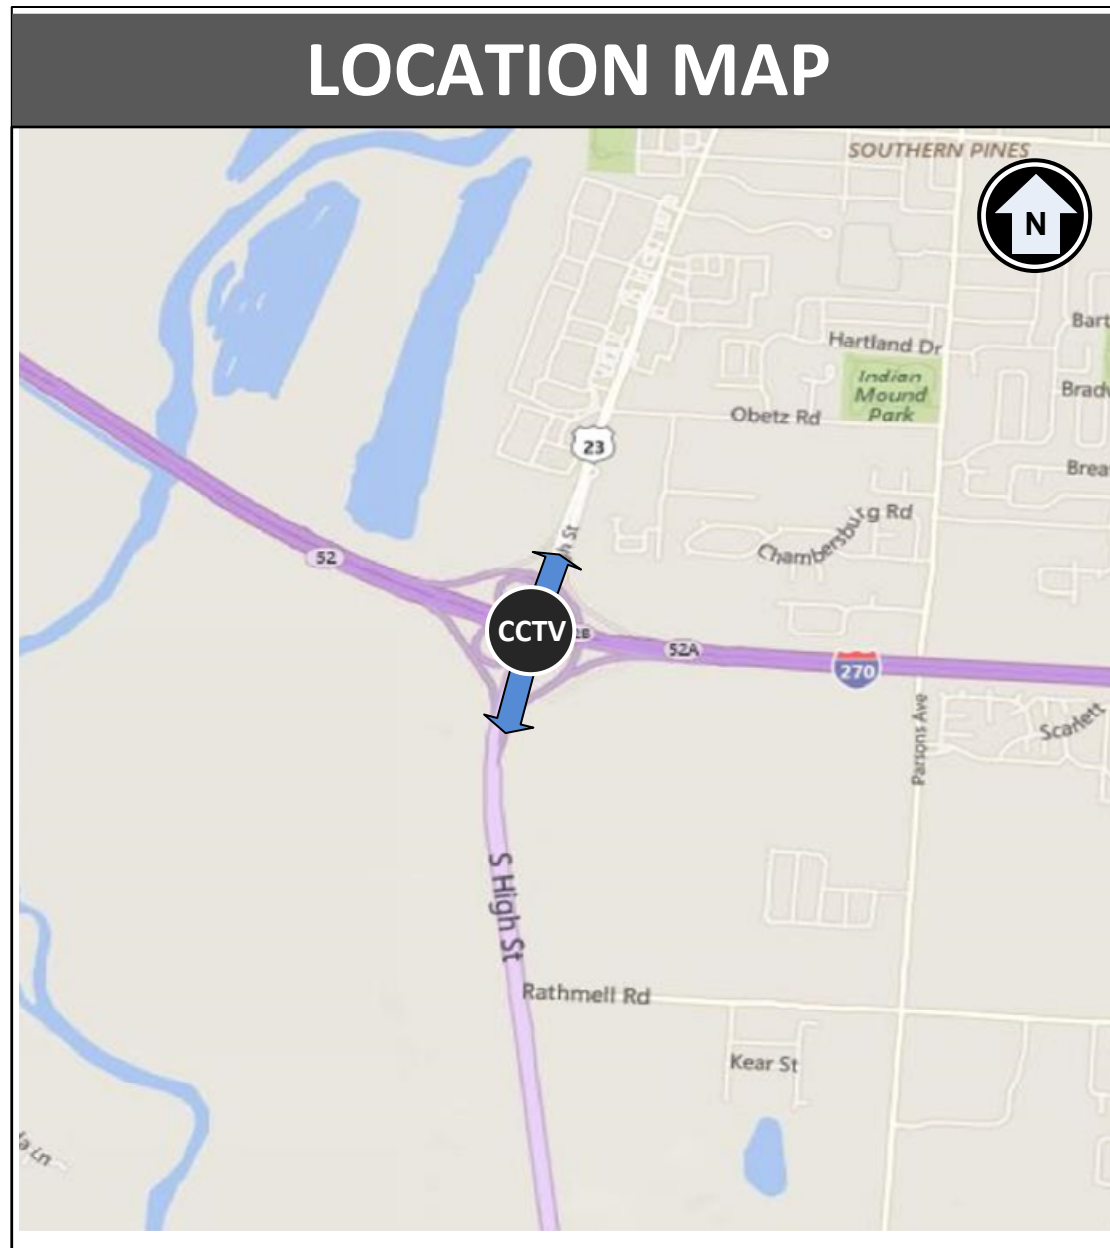

LINK (CP2 ↔ NODE)  
HIGH ST AT 270 EB  
FF RAMP TO ODOT  
NODE CABINET

LINK (NODE ↔ CP3)  
ODOT NODE  
CABINET TO 270  
WB OFF RAMP

288-SPLICE CLAMSHELL ENCLOSURE, 24 FUSION SPLICE  
PROPOSED UNDERGROUND SPLICE ENCLOSURE FOR ODOT NODE CABINET  
32" PULL BOX AT STA. 580+17, 9' RT

FIBER OPTIC SLICING DIAGRAM  
ODOT NODE CABINET: STA. 496+92

FRA-270-51.50


CREATED  
DKA  
CHECKED  
SGJ

ADDENDUM #1  
04/21/23

426  
554



**TRAFFIC SIGNAL CABINET ASSEMBLY**

**PROPOSED ETHERNET SWITCH – LAYER 2**

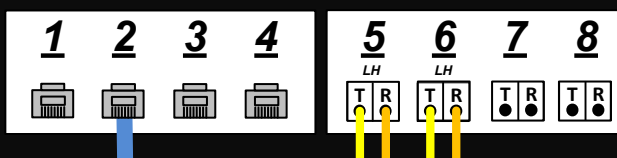


**ETHERNET SWITCH PORT DESTINATION**

PORT 5: INT. # 2182: HIGH ST AT RATHMELL RD (SEE SHEET 422)  
 PORT 6: INT # 2069: HIGH ST AT OBETZ RD (SEE SHEET 427)

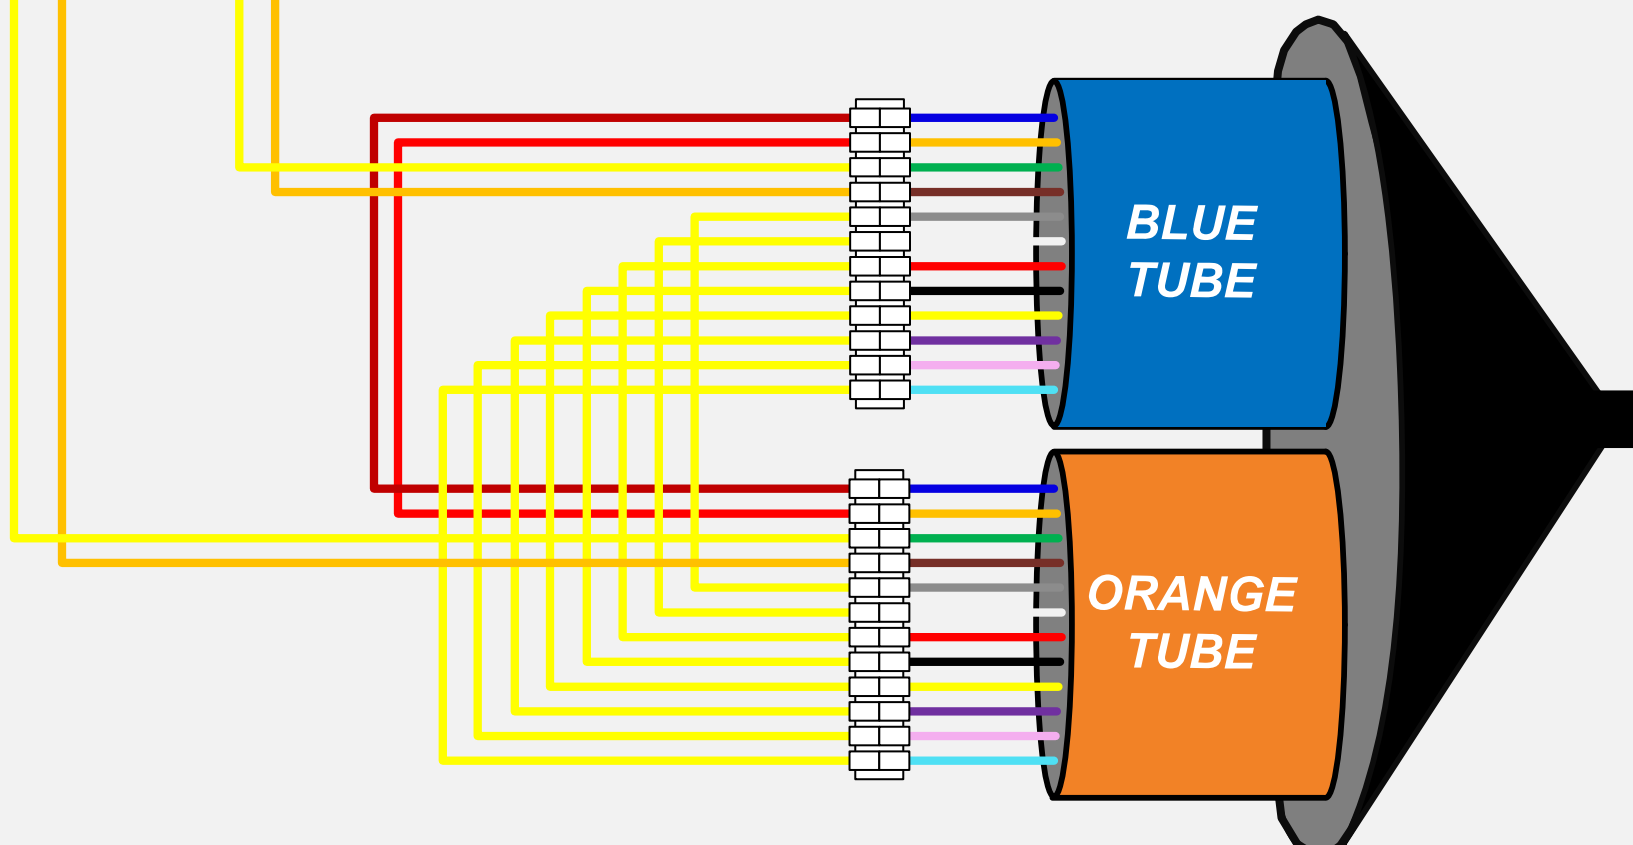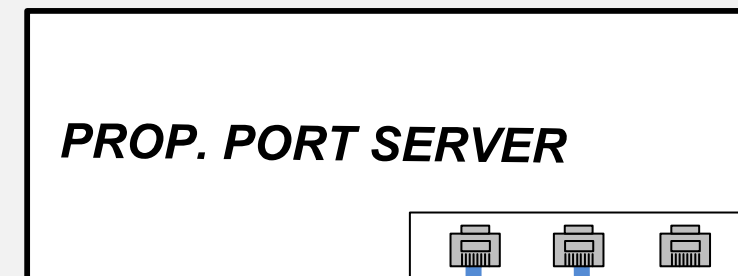

PATCH PANEL ENCLOSURE – 24 TERMINATION

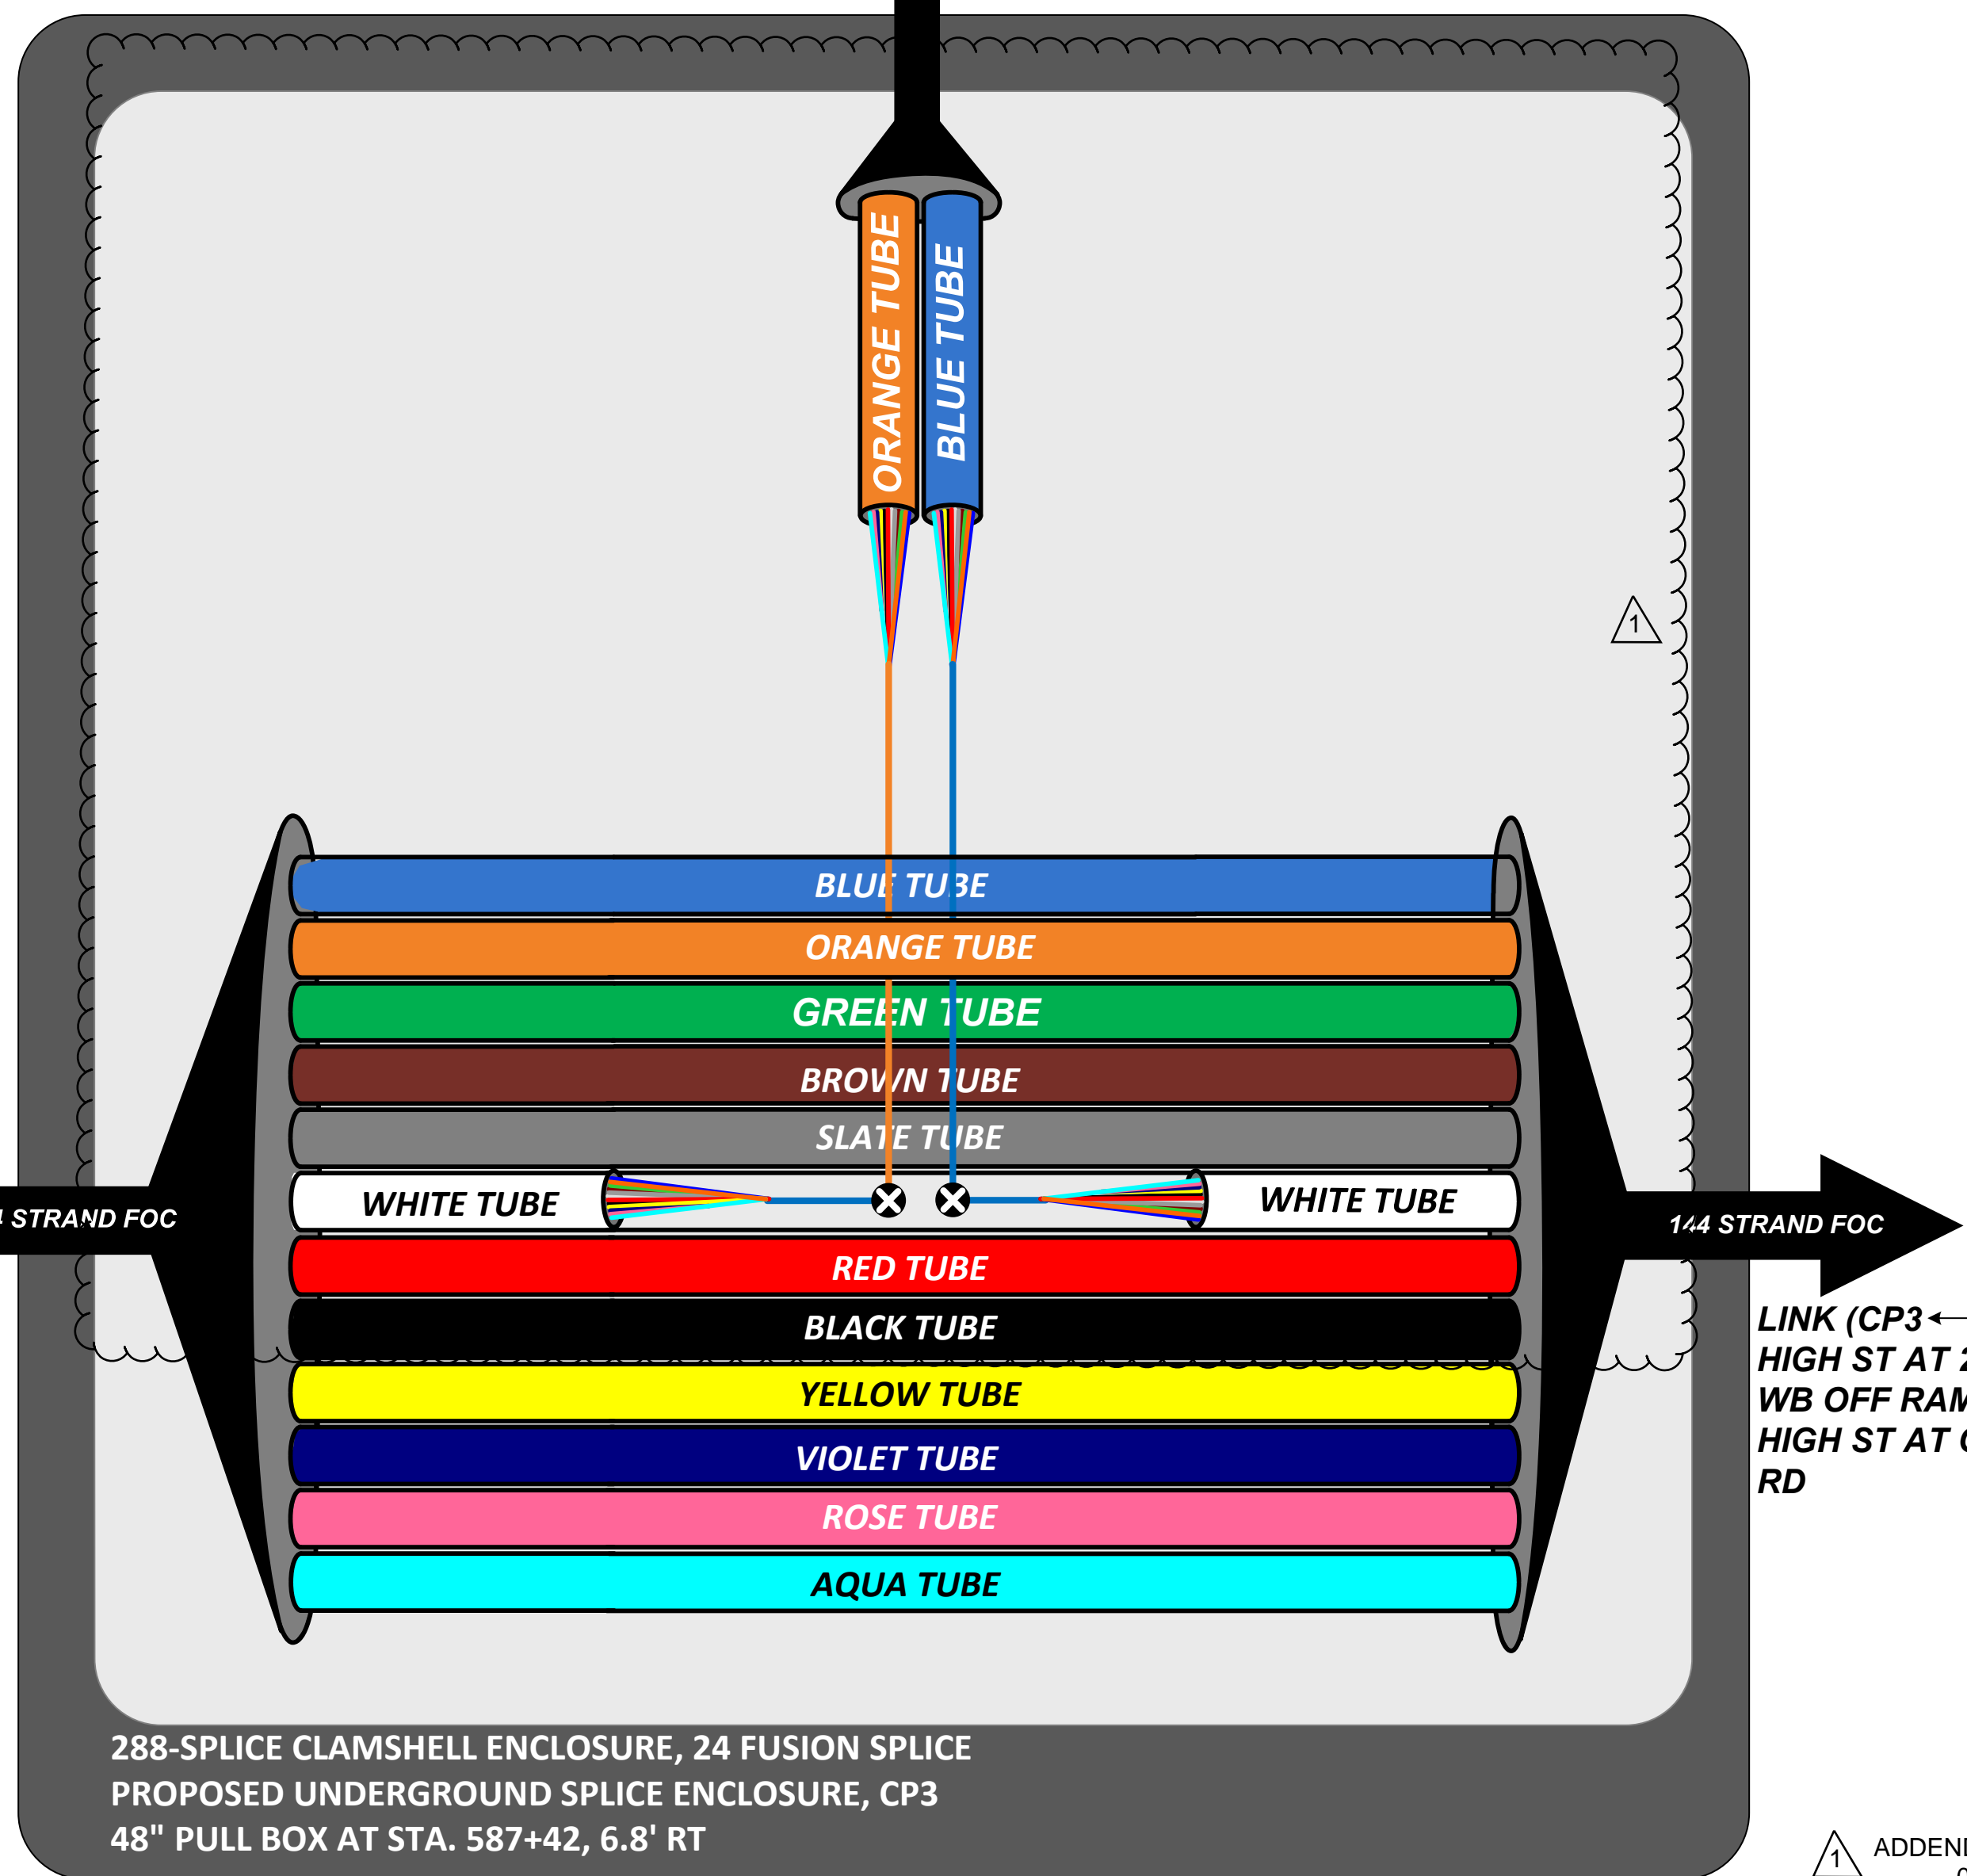

288-SPLICE CLAMSHELL ENCLOSURE, 24 FUSION SPLICE  
 PROPOSED UNDERGROUND SPLICE ENCLOSURE, CP3  
 48" PULL BOX AT STA. 587+42, 6.8' RT


LINK (NODE ← CP3)  
 ODOT NODE CABINET  
 TO HIGH ST AT 270 WB  
 OFF RAMP

LINK (CP3 ↔ CP4)  
 HIGH ST AT 270  
 WB OFF RAMP TO  
 HIGH ST AT OBETZ  
 RD

**LEGEND**

- FIBER PATCH CABLE TX/RX STANDARD
- FIBER PATCH CABLE RX/TX CROSSOVER
- CAT 5E CABLE
- PATCH PANEL
- EXISTING/PROPOSED FIBER OR BUFFER TUBE LEFT COILED IN SPLICE ENCLOSURE
- FUSION SPLICE – SINGLE FIBER
- FIBER BUFFER TUBE SPLICE PR / EX
- GBIC OPTICAL TRANSCEIVER  
LH – LED  
ZX – LASER
- 8P8C CONNECTOR
- COLUMBUS - CTSS

**LOCATION MAP**

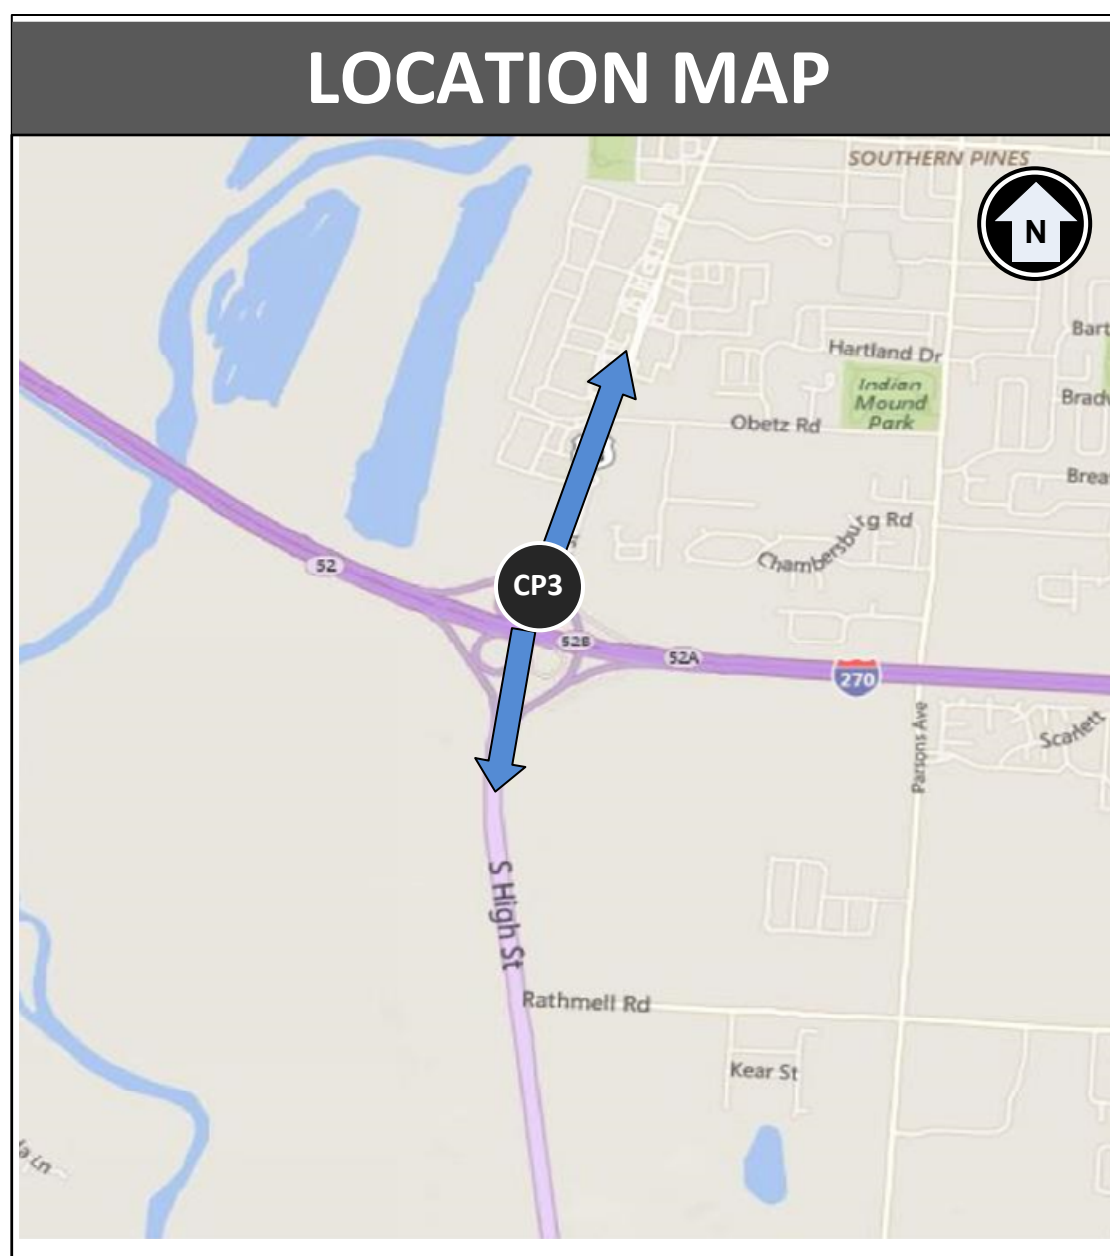

CREATED  
DKA

CHECKED  
SGJ

FIBER OPTIC SLICING DIAGRAM  
RAMP S (I-270 WB OFF-RAMP AT US 23)


FRA-270-51.50

427  
554


ADDENDUM #1  
04/21/23



TRAFFIC SIGNAL CABINET ASSEMBLY

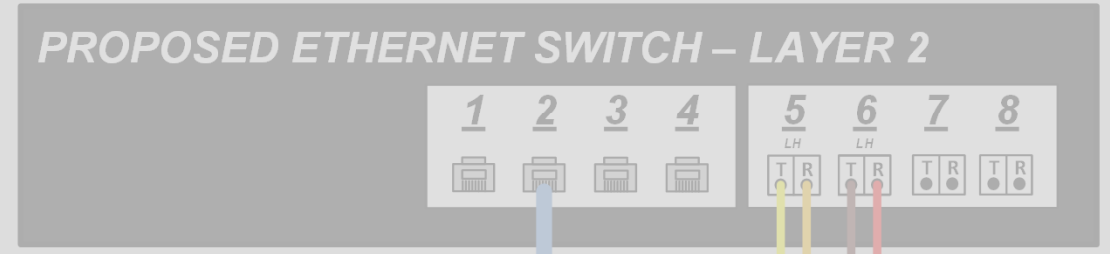

EXISTING CABINET - DND

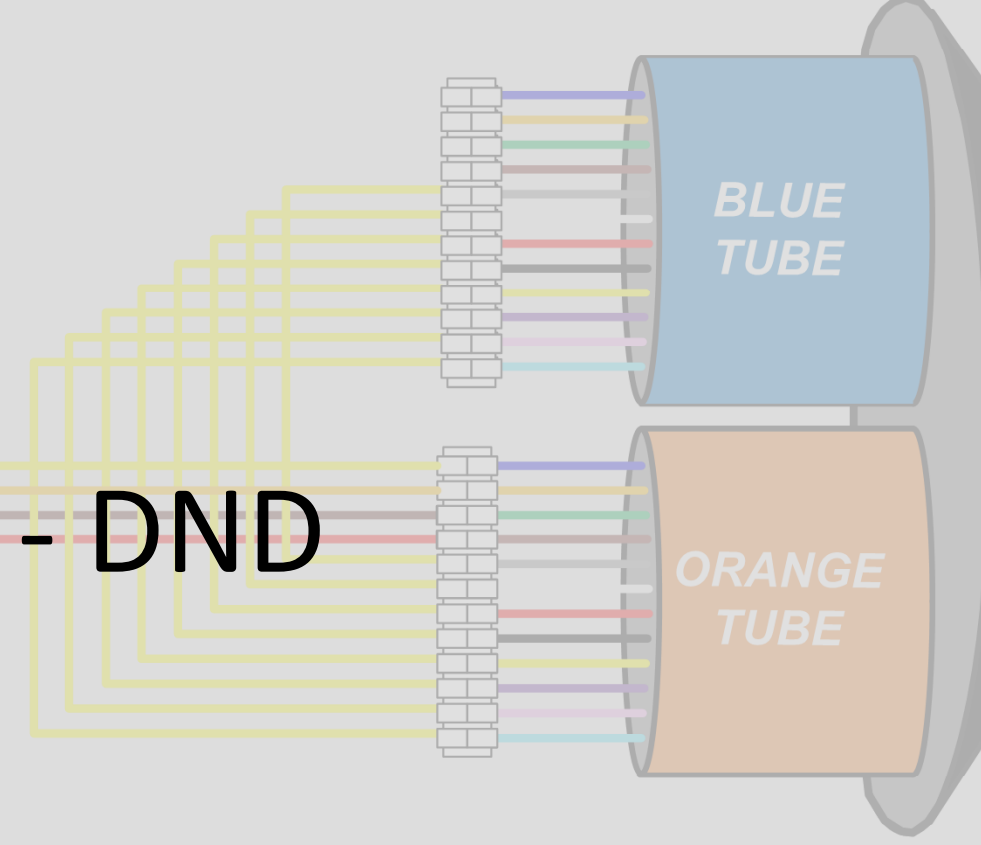


\* EXISTING CONTROLLER TO BE REPLACED BY CITY OF COLUMBUS FORCES

PATCH PANEL ENCLOSURE - 24 TERMINATION



LEGEND

- FIBER PATCH CABLE TX/RX STANDARD
- FIBER PATCH CABLE RX/TX CROSSOVER
- CAT 5E CABLE
- PATCH PANEL
- EXISTING/PROPOSED FIBER OR BUFFER TUBE LEFT COILED IN SPLICE ENCLOSURE
- FUSION SPLICE - SINGLE FIBER
- FIBER BUFFER TUBE SPLICE PR / EX
- GBIC OPTICAL TRANSCEIVER  
LH - LED  
ZX - LASER
- 8P8C CONNECTOR
- COLUMBUS - CTSS

LOCATION MAP

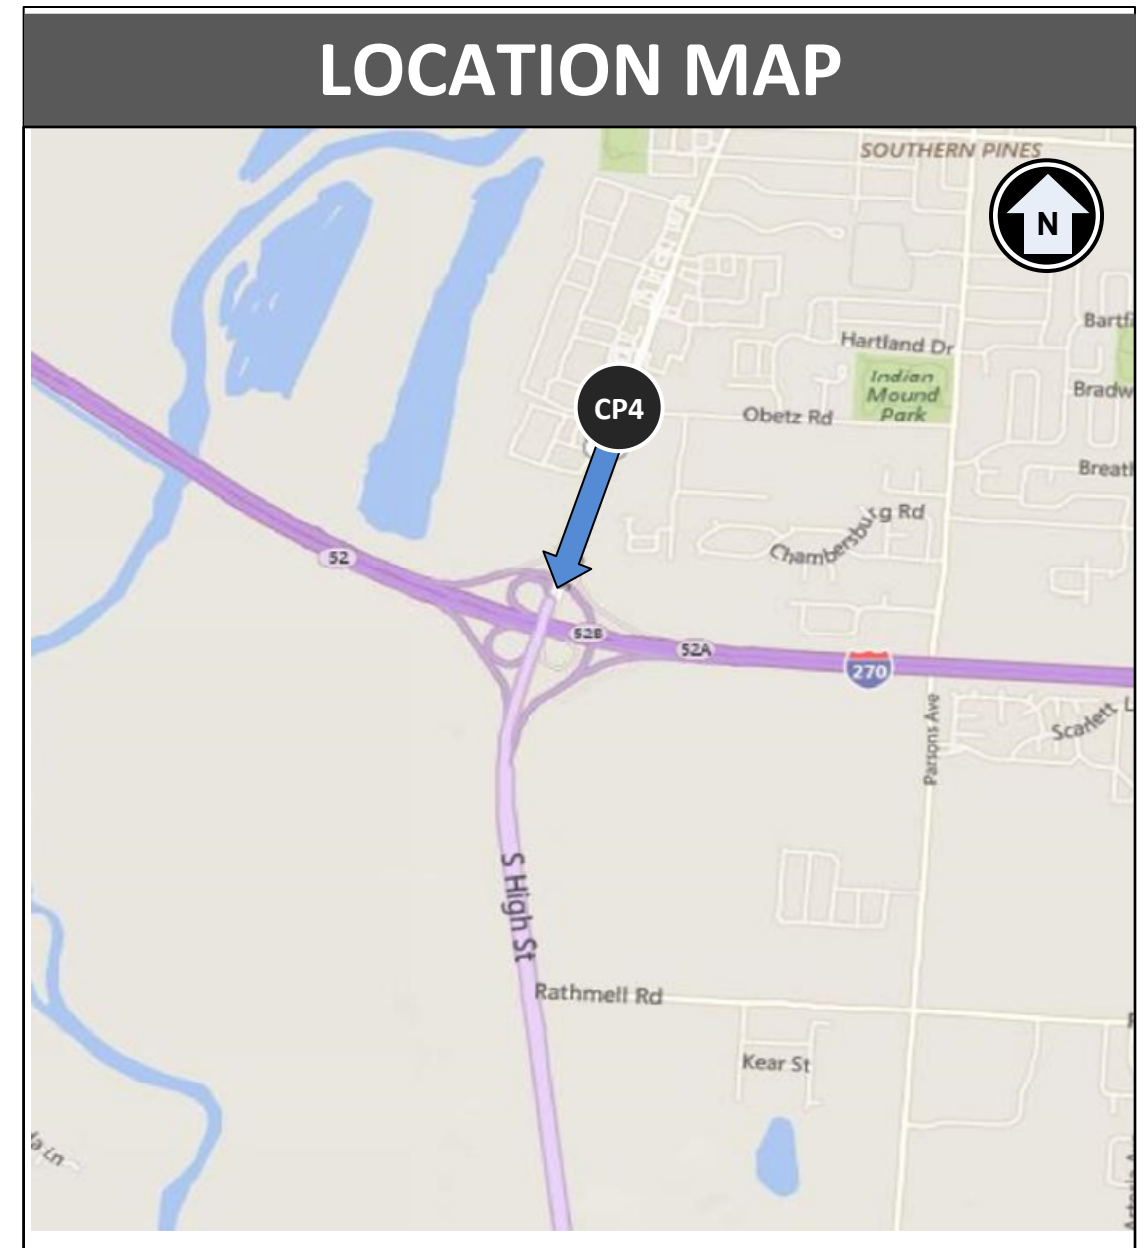

LINK (CP3 ↔ CP4)  
HIGH ST AT 270 WB  
OFF RAMP TO HIGH ST AT OBETZ RD

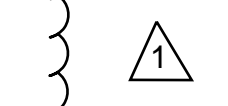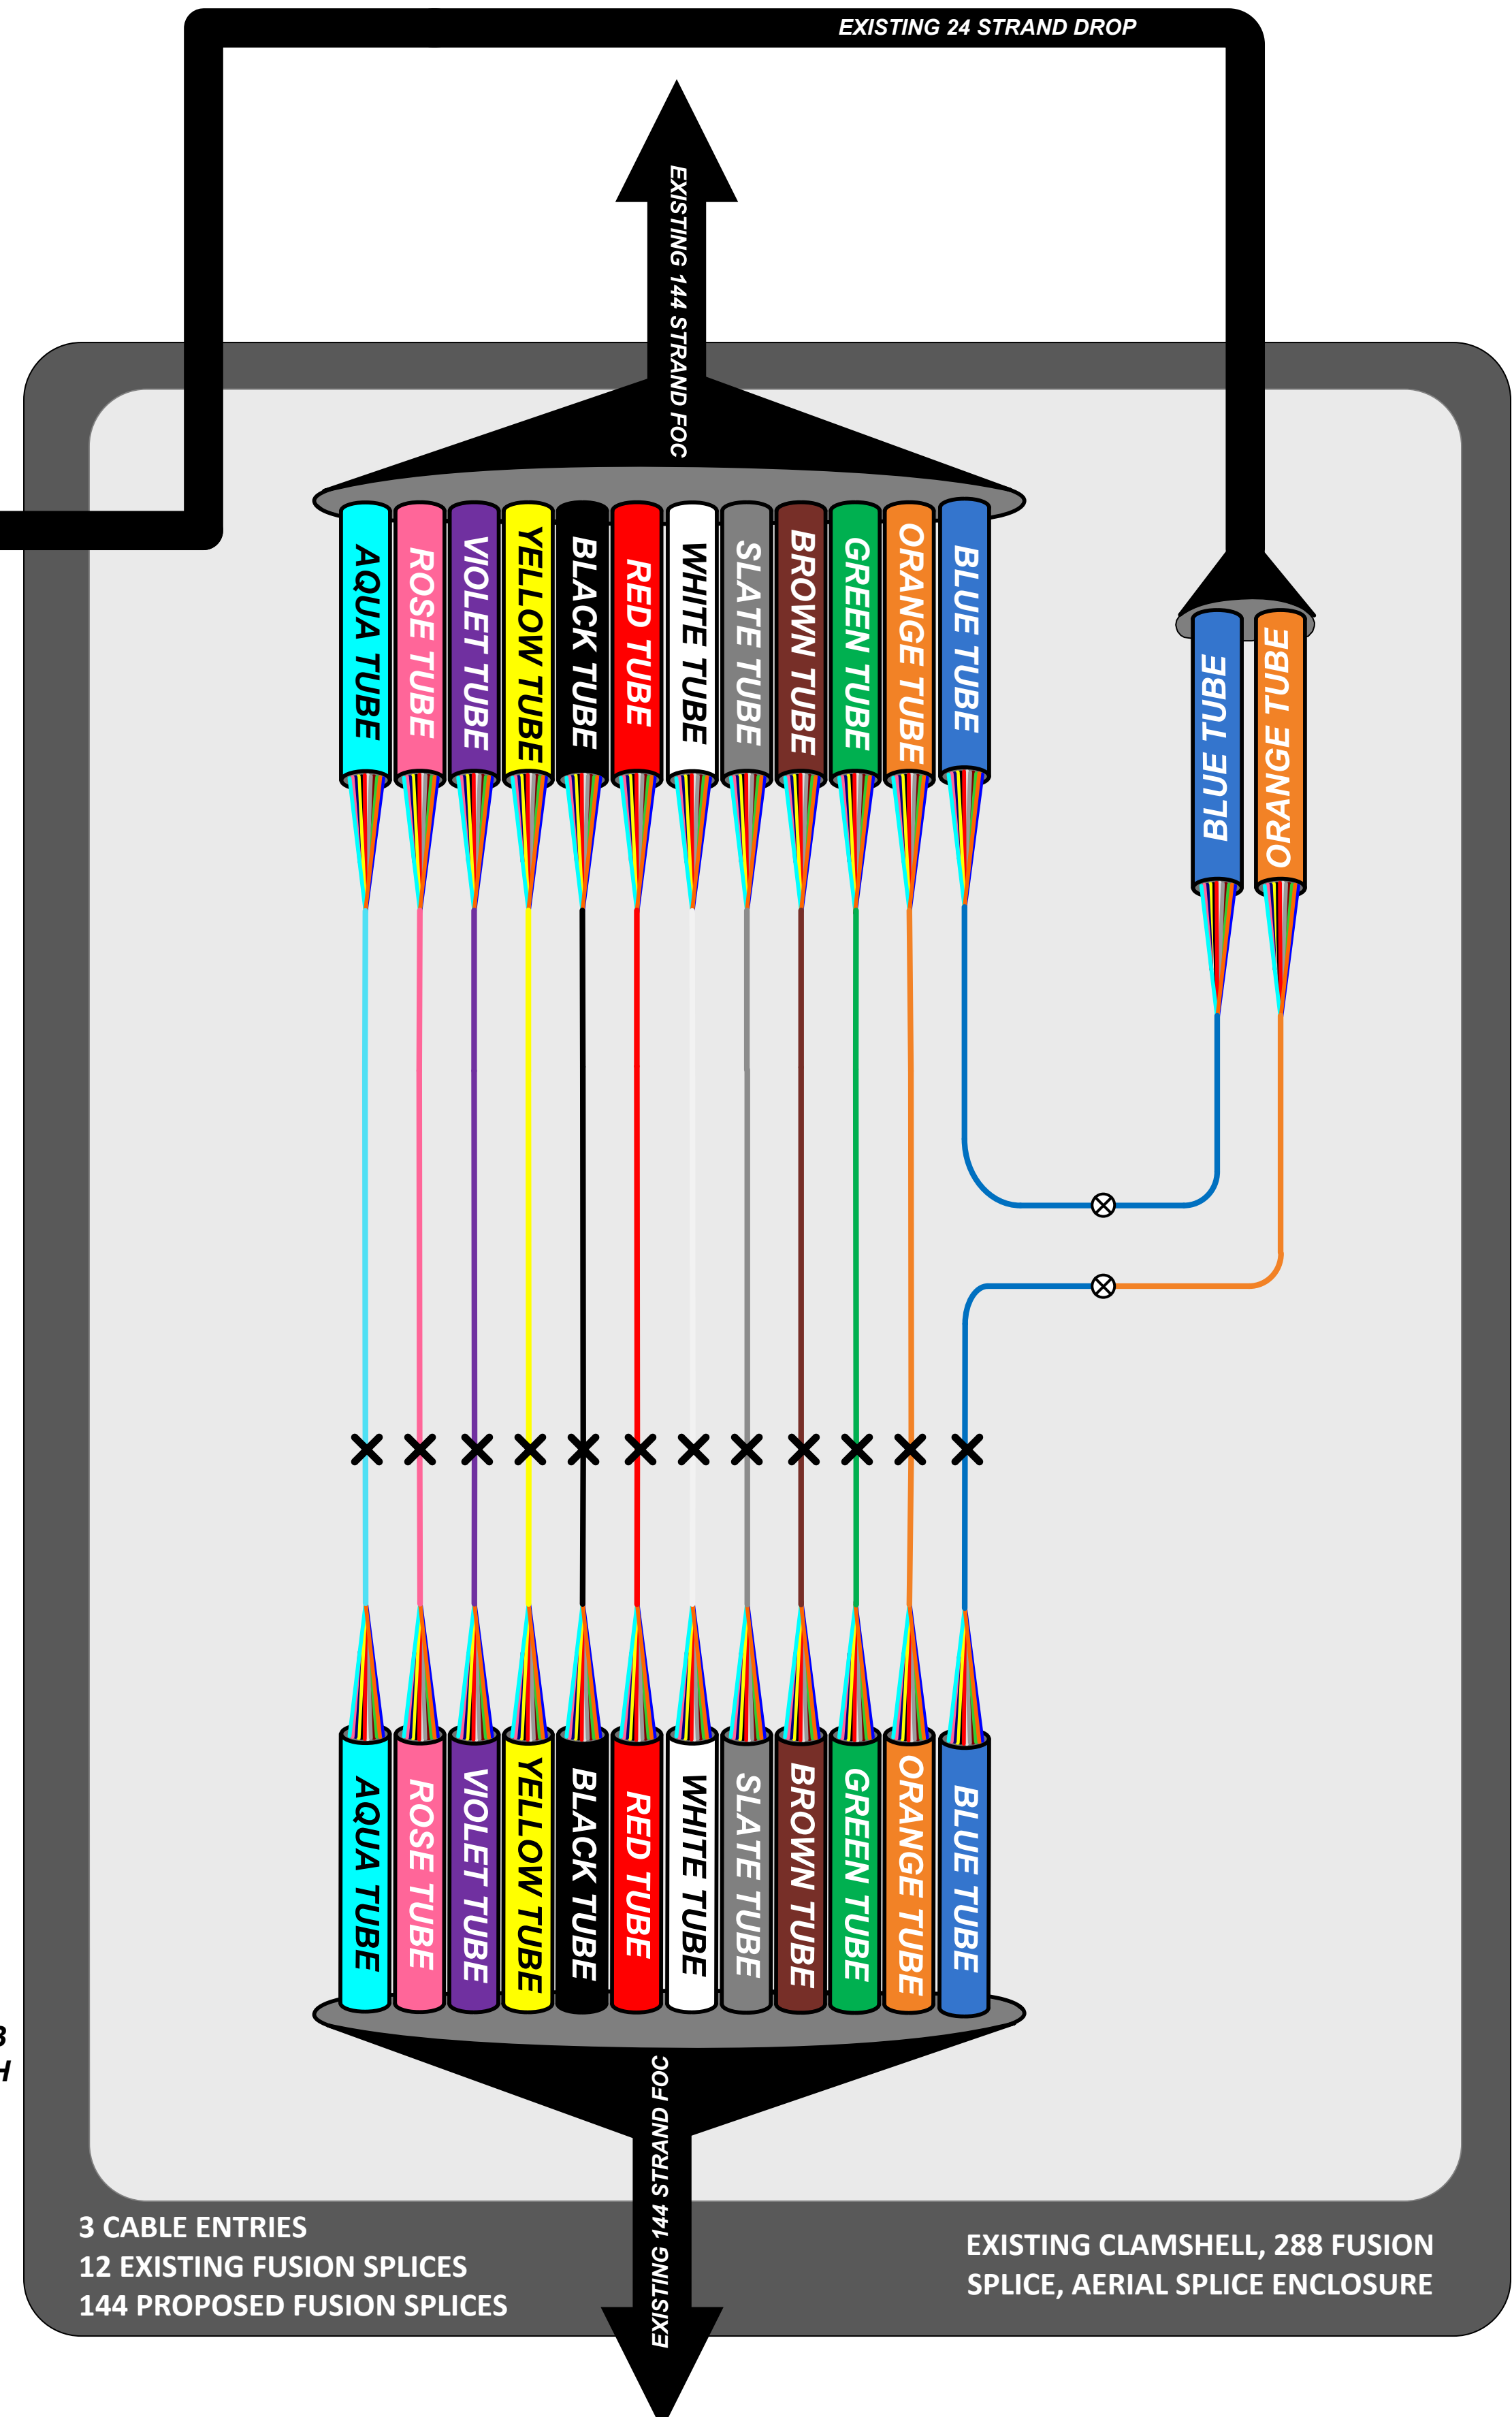




MODEL: Sheet PAPER: 17x11 (in.) DATE: 2023-04-07 TIME: 3:45:18 PM USER: william.croxton  
 \\10.120.112.5\share\122592\_Safety\Design\7.0\_Production\7.3\_Civil\Worksheets\110380\_FRA-23-4.19-Engineering\Roadway\Sheets\110380\_GY001.dgn

**EXISTING LEGEND: (SEE NOTE #2)**


- (A#) (20± WIDTH) NB TRAVELED WAY  
 A1-(8.5±) ASPHALT CONCRETE (2± ORIGINAL + 6.5± SHOWN PER 2013 PLANS)  
 A2-(1± ORIGINAL) ROAD MIX SURFACE COURSE±  
 A3-(3.5± ORIGINAL) BRICK  
 A4-(5.5± ORIGINAL) PLAIN CONCRETE  
 A5-(12±X4± ORIGINAL INTEGRAL CONCRETE CURB (WITH A1 ON TOP)
- (B#) (2± WIDTH) NB INSIDE/OUTSIDE SHOULDER  
 B1-(8.5±) ASPHALT CONCRETE (2± ORIGINAL + 6.5± SHOWN PER 2013 PLANS)  
 B2-(3± ORIGINAL) BITUMINOUS BASE COURSE  
 B3-(1.5± ORIGINAL) INSULATION COURSE
- (C#) (24± WIDTH) SB TRAVELED WAY  
 C1-(6± SHOWN PER 2013 PLANS) ASPHALT CONCRETE  
 C2-(9± PER 1954 PLANS) REINFORCED CONCRETE PAVEMENT  
 C3-(4± PER 1954 PLANS) SUBBASE
- (D#) (4± ORIGINAL WIDTH) SB OUTSIDE SHOULDER  
 D1-(6± SHOWN PER 2013 PLANS) ASPHALT CONCRETE  
 D2-(6± PER 1954 PLANS) STABILIZED CRUSHED AGGREGATE SHOULDER
- (E#) (2± WIDTH) NB INSIDE SHOULDER  
 (8± WIDTH) NB OUTSIDE SHOULDER  
 (2± WIDTH) SB INSIDE SHOULDER  
 (5± WIDTH) SB OUTSIDE SHOULDER  
 E1-(6± PER 1986 PLANS) ASPHALT CONCRETE  
 E2-(6± PER 1986 PLANS) AGGREGATE BASE
- (F#) F1-(1.25± PER 1989 PLANS) ASPHALT SURFACE COURSE  
 F2-(1.75± PER 1989 PLANS) ASPHALT INTERMEDIATE COURSE  
 F3-(8" PER 1989 PLANS) ASPHALT CONCRETE BASE  
 F4-(8" PER 1989 PLANS) AGGREGATE BASE
- (G) (2± WIDTH) ALONG SHOULDERS  
 (2± AVG. DEPTH) COMPACTED AGGREGATE (PER 2013 PLANS)
- (H) 6" DEEP UNDERDRAINS (50" TYP) (PER 1954 PLANS)  
 (STA 495+00 TO STA 545+00, STA 547+00 TO STA 570+50  
 NOTE: AGGREGATE DRAINS BETWEEN STA 545+00 TO STA 547+00
- (I) SPECIAL 8" COMBINED CURB AND GUTTER (2± WIDTH) (PER 1989 PLANS)
- (J) 4" BASE PIPE UNDERDRAINS (<18" TYP) (PER 1989 PLANS)
- (K) SHOULDER RUMBLE STRIPS (16" WIDE PER 2013 PLANS)
- (L) 8± TO 14± ASPHALT CONCRETE
- (M) 6± TO 8± AGGREGATE BASE
- (N) GUARDRAIL
- (O) UPDATED DMS LOCATION ON EX. DMS SUPPORT CONSTRUCTED PER  
 FRA-DMS REPLACEMENT FY20 PROJECT IN 2020 (PID 109467) (US-23 NB DMS)

**PROPOSED LEGEND:**


- 1 US-23 - (1.50") ITEM 442 - ASPHALT CONCRETE SURFACE COURSE,  
 12.5MM, TYPE A, (446), PG70-22M  
 CR-121 - (1.25") ITEM 441 - ASPHALT CONCRETE SURFACE COURSE,  
 TYPE 1, (446), PG70-22M
- 2A US-23 - (1.75") ITEM 442 - ASPHALT CONCRETE INTERMEDIATE COURSE,  
 12.5MM, TYPE A, (446)  
 CR-121 - (1.75") ITEM 441 - ASPHALT CONCRETE INTERMEDIATE COURSE,  
 TYPE 2, (446)
- 2B US-23 - (1.75") ITEM 442 - ASPHALT CONCRETE INTERMEDIATE COURSE,  
 12.5MM, TYPE A, (448), PG 64-28, AS PER PLAN
- 3 US-23 - (9") ITEM 301 - ASPHALT CONCRETE BASE, PG64-22, (449)  
 (PLACED IN TWO LIFTS)  
 CR-121 - (9") ITEM 301 - ASPHALT CONCRETE BASE, PG64-22, (449)  
 (PLACED IN TWO LIFTS)
- 4 (VAR., 6" MIN) ITEM 304 - AGGREGATE BASE  
 (SEE NOTE #4)
- 5 ITEM 407 - NON-TRACKING TACK COAT  
 (PLACED IN BETWEEN LIFT OF ASPHALT)  
 (APPLIED AT 0.055 GAL/SY AVG FOR NEW PAVEMENT  
 (APPLIED AT 0.085 GAL/SY AVG FOR PLANED ASPHALT SURFACE)
- 6 CHEMICALLY STABILIZED SUBGRADE: (SEE NOTE #4)  
 ITEM 204 - PROOF ROLLING  
 (APPLIED AT 1 HR/2000 SY FOR RECONSTRUCTION)  
 (APPLIED AT 1 HR/3000 SY FOR NEW CONSTRUCTION)  
 ITEM 206 - CEMENT  
 (APPLIED AT 5% PER 115 LB/CF SOIL)  
 ITEM 206 - CEMENT STABILIZED SUBGRADE, 12-INCHES DEEP  
 ITEM 206 - CURING COAT  
 ITEM 206 - MIXTURE DESIGN FOR CHEMICALLY STABILIZED SOILS  
 (SPECIFIED ON PROJECTS > 40,000 SY, SEE SUPPLEMENT 1120
- 7 ITEM 254 - PAVEMENT PLANING, ASPHALT CONCRETE (1" MIN, 3.25" MAX)
- 8 ITEM 202 - PAVEMENT REMOVED (SEE NOTE #3)
- 9 ITEM 605 - 4" SHALLOW PIPE UNDERDRAINS WITH GEOTEXTILE FABRIC  
 (VAR. 18" TO 30" DEPTH)
- 10 ITEM 605 - 4" BASE PIPE UNDERDRAINS WITH GEOTEXTILE FABRIC  
 (18" DEPTH)
- 11 ITEM 606 - GUARDRAIL, TYPE MGS
- 12 ITEM 606 - GUARDRAIL, BARRIER DESIGN, TYPE MGS
- 13 ITEM 609 - CURB, TYPE 4-C
- 14 ITEM 618 - RUMBLE STRIPS, TRANSVERSE (ASPHALT CONCRETE)  
 ITEM 618 - RUMBLE STRIPS, SHOULDER (ASPHALT CONCRETE)
- 15 ITEM 659 - SEEDING AND MULCHING, CLASS 2

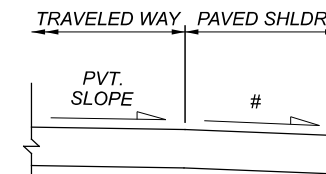


PAVED SHOULDER (ANY WIDTH) CROSS SLOPE DETAILS FOR LOW SIDE OF SUPERELEVATED SECTION  
 # = 0.040 OR SUPERELEVATION RATE, WHICHEVER IS GREATER

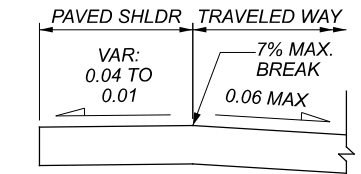

PAVED SHOULDER (4' TO 10' WIDTH) CROSS SLOPE DETAILS FOR HIGH SIDE OF SUPERELEVATED SECTION

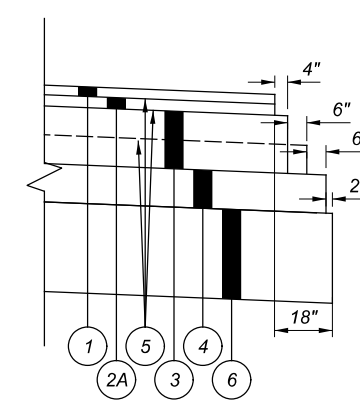

PAVED SHOULDER EDGE COURSE DETAIL FOR US-23 & CR-121

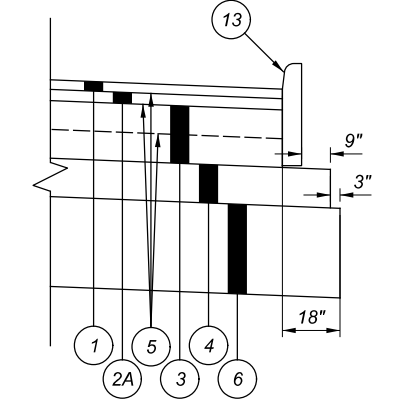

PAVED SHOULDER EDGE COURSE DETAIL WITH CURB, TYPE 4-C FOR CR-121

**TYPICAL SECTION NOTES:**

- SEE CROSS SECTIONS FOR DETAILED GRADING AND SIDESLOPE CONDITIONS, INCLUDING DITCH SECTIONS.
- THE EXISTING PAVEMENT BUILDUP (COMPOSITION AND DEPTHS) ARE BASED ON EXISTING PLAN INFORMATION AND AVERAGE RESULTS OF BORING LOCATIONS PER REPORT OF ROADWAY EXPLORATION DATED 11-18-2020 BY STANTEC.
- ALL SAWCUTS AND THE REMOVAL LIMITS AND THE REMOVAL OF ALL EXISTING PAVEMENT LAYERS, INCLUDING ASPHALT, CONCRETE, BRICK, FROM THE SURFACE TO THE BOTTOM OF PAVEMENT COURSES AT LOCATIONS SHOWN IN THE PLANS SHALL BE PAID UNDER ITEM 202 - PAVEMENT REMOVED. THE REMOVAL OF ANY UNBOUND AGGREGATE OR NATURAL SOIL MATERIAL IS NOT INCLUDED AND SHALL BE PAID UNDER ITEM 203 - EXCAVATION.
- FOR FULL DEPTH ASPHALT PAVEMENT WIDENING, THE EXISTING PAVEMENT EDGES SHALL BE SAW CUT PER ODOT C&MS 202.05 AT LOCATIONS SHOWN IN THE ROADWAY PLANS OR AT SOUND PAVEMENT, AS DIRECTED BY THE ENGINEER. THE EXISTING PAVEMENT AND FULL DEPTH ASPHALT WIDENING SECTION SHOULD MEET AT THE SAME SUBGRADE ELEVATION. THE BASE UNDER THE WIDENING SECTION SHOULD BE THICKENED TO MATCH THE ADJACENT SUBGRADE OF EXISTING MAINLINE PAVEMENT AND PROPOSED DRIVEWAY PAVEMENT.
- THE CONSTRUCTION LIMITS SHOWN IN ROADWAY PLANS ARE DEFINED BY 2' OFFSET FROM EDGE OF PROPOSED GRADING DUE TO ROUNDING.

**CROSS REFERENCES:**

- SEE SHEET P.4 FOR TYPICAL SECTION NOTES
- SEE SHEET P.4 FOR PAVED SHOULDER DETAILS
- SEE SHEET P.4 FOR GEOTECHNICAL BORING INFO
- SEE SHEET P.5-7 FOR US-23 TYPICAL SECTIONS
- SEE SHEET P.8 FOR CR-121 TYPICAL SECTIONS
- SEE SHEET P.9 FOR ROADSIDE GRADING DETAILS
- SEE SHEET P.10 FOR END CONDITIONS
- SEE SHEET P.95 FOR INTERSECTION DETAILS - US-23 & CR-121
- SEE SHEET P.96 FOR DRIVE DETAILS
- SEE SHEET P.97-106 FOR DRAINAGE DETAILS

**GEOTECHNICAL BORING INFORMATION**

BORING ID	STATION	OFFSET	ROADWAY	LOCATION	EXISTING PAVEMENT COMPOSITION
B-001-0-20	525+42.77	19.88' RT	US-23	NB INSIDE THRU LANE	13" ASPHALT, 3.5" BRICK
B-002-0-20	525+96.25	34.29' RT	US-23	SB OUTSIDE THRU LANE	6" ASPHALT, 8" CONCRETE
B-003-0-20	528+46.43	43.86' RT	US-23	NB OUTSIDE SHOULDER	9.5" ASPHALT
B-004-0-20	528+82.42	14.83' LT	US-23	SB INSIDE SHOULDER	3.25" ASPHALT
B-005-0-20	531+06.81	44.27' RT	US-23	NB OUTSIDE SHOULDER	7" ASPHALT
B-006-0-20	531+56.69	43.16' LT	US-23	SB OUTSIDE SHOULDER	6.75" ASPHALT
B-007-0-20	532+71.37	1.99' LT	US-23	NB LT. TURN LANE	13" ASPHALT
B-008-0-20	533+46.90	46.05' RT	US-23	NB RT. TURN LANE	12" ASPHALT
B-008-1-20	107+84.65	21.21' LT	CR-121	WB LANE	9.75" ASPHALT
B-008-2-20	0+95.94	22.28' RT	QUARRY DR.	WB LANE	15.5" ASPHALT
B-009-0-20	536+11.09	6.63' RT	US-23	SB LT. TURN LANE	13" ASPHALT
B-010-0-20	536+02.26	37.02' RT	US-23	NB OUTSIDE THRU LANE	12.25" ASPHALT, 4.5" CONCRETE
B-011-0-20	537+16.32	45.57' LT	US-23	SB RT. TURN LANE	13" ASPHALT
B-012-0-20	539+00.04	46.81' RT	US-23	NB OUTSIDE SHOULDER	6" ASPHALT
B-013-0-20	540+12.56	19.35' LT	US-23	SB INSIDE LANE	5.25" ASPHALT, 9.5" CONCRETE
B-014-0-20	542+05.06	19.97' RT	US-23	NB INSIDE LANE	13" ASPHALT, 3.5" BRICK
B-015-0-20	543+06.58	15.79' LT	US-23	SB INSIDE LANE	6" ASPHALT, 9" CONCRETE
B-016-0-20	545+13.97	43.34' RT	US-23	NB OUTSIDE SHOULDER	7" ASPHALT
B-017-0-20	546+23.77	41.51' LT	US-23	NB OUTSIDE SHOULDER	7" ASPHALT
B-018-0-20	550+89.29	43.86' RT	US-23	NB OUTSIDE SHOULDER	7" ASPHALT
B-019-0-20	554+09.68	18.74' RT	US-23	NB INSIDE LANE	18" ASPHALT
B-020-0-20	556+15.66	43.83' RT	US-23	NB OUTSIDE SHOULDER	N/A - SOIL

DESIGN AGENCY



DESIGNER

WLC

REVIEWER

KMK 12-01-22

PROJECT ID

92616

SHEET

P.4

TOTAL

170



SHEET NUM.										PART.		ITEM	ITEM EXT	GRAND TOTAL	UNIT	DESCRIPTION	SEE SHEET NO.
P.44	P.109	P.111	P.133	P.138	P.141					04/NHS/04	05/NHS/05						
<b>LIGHTING</b>																	
					4					4		625	98000	4	EACH	LIGHTING, MISC.: CMSC 1001 - 13 INCH X 24 INCH PULL BOX (MIS-54)	P.141
					3					3		625	98000	3	EACH	LIGHTING, MISC.: CMSC 1001 - 17 INCH X 30 INCH X 24 INCH (MIS-54-APP)	P.141
					1					1		625	98000	1	EACH	LIGHTING, MISC.: CMSC 1001 - STREETLIGHT CIRCUIT RISER (MIS-56)	P.141
					1					1		625	98000	1	EACH	LIGHTING, MISC.: CMSC 1001 - METER, SELF CONTAINED WITH METER SOCKET, 100 AMP (MIS-57)	P.141
					6					6		625	98000	6	EACH	LIGHTING, MISC.: CMSC 1001 - 8' STREET LIGHT FOUNDATION (MIS-202)	P.141
					2					2		625	98000	2	EACH	LIGHTING, MISC.: CMSC 1001 - POLE, ALUMINUM, 10' BRACKET, T-BASE, 40' MOUNTING HEIGHT (MIS-301)	P.141
					4					4		625	98000	4	EACH	LIGHTING, MISC.: CMSC 1001 - POLE, ALUMINUM, 15' BRACKET, T-BASE, 40' MOUNTING HEIGHT (MIS-302)	P.141
					6					6		625	98000	6	EACH	LIGHTING, MISC.: CMSC 1001 - 3-WIRE POLE TO BE WIRED (MIS-501)	P.141
					1					1		625	98000	1	EACH	LIGHTING, MISC.: CMSC 1001 - 3-WIRE, 480V PAD MOUNT CONTROLLER (MIS-603)	P.141
					6					6		625	98000	6	EACH	LIGHTING, MISC.: CMSC 1001 - COBRA HEAD LED LUMINAIRE (MIS-800)	P.141
					1					1		625	98000	1	EACH	LIGHTING, MISC.: CMSC 1001 - POWER SERVICE, AS PER PLAN	P.141
					190					190		625	98100	190	FT	LIGHTING, MISC.: CMSC 1001 - 2-WIRE #6 DUPLEX OVERHEAD CIRCUIT (MIS-402)	P.141
					10					10		625	98100	10	FT	LIGHTING, MISC.: CMSC 1001 - 2-WIRE UNDERGROUND CIRCUIT (MIS-403)	P.141
					725					725		625	98100	725	FT	LIGHTING, MISC.: CMSC 1001 - 3-WIRE UNDERGROUND CIRCUIT (MIS-404)	P.141
					275					275		625	98100	275	FT	LIGHTING, MISC.: CMSC 1001 - 2-INCH CONDUIT, CONCRETE ENCASED (MIS-700)	P.141
					410					410		625	98100	410	FT	LIGHTING, MISC.: CMSC 1001 - 3-INCH RIGID STEEL WITH 2-INCH CONDUIT INSERT (MIS-702)	P.141
<b>TRAFFIC SURVEILLANCE</b>																	
					2,200					2,200		625	23000	2,200	FT	NO. 4 AWG 600 VOLT DISTRIBUTION CABLE	
					345					345		625	25408	345	FT	CONDUIT, 2", 725.051	
					78					78		625	25803	78	FT	CONDUIT, CONCRETE ENCASED, 3", 725.051, AS PER PLAN	P.123
					1,904					1,904		625	25920	1,904	FT	CONDUIT, MISC.:ENCASED INTERCONNECT CONDUIT BANK, TC2, SCH 40, (4)-3" & (1)-1.5"	P.126
					103					103		625	25920	103	FT	CONDUIT, MISC.:ENCASED INTERCONNECT CONDUIT BANK, TC2, SCH 80, (4)-3" & (1)-1.5"	P.126
					120					120		625	25906	120	FT	CONDUIT, 2", JACKED OR DRILLED, 725.051	
					2,085					2,085		625	29001	2,085	FT	TRENCH, AS PER PLAN	P.123
					357					357		625	29011	357	FT	TRENCH, 30" DEEP, AS PER PLAN	P.137
					4					4		625	30700	4	EACH	PULL BOX, 725.08, 18"	
					1					1		625	30710	1	EACH	PULL BOX, 725.08, 32"	
					6					6		625	31600	6	EACH	PULL BOX, MISC.:PULLBOX, 32"	P.123
					2					2		625	32000	2	EACH	GROUND ROD	
					4					4		625	32001	4	EACH	GROUND ROD, AS PER PLAN	P.137
					1					1		625	34001	1	EACH	POWER SERVICE, AS PER PLAN	P.137
					477					477		625	36010	477	FT	UNDERGROUND WARNING/MARKING TAPE	
					1					1		630	70044	1	EACH	OVERHEAD SIGN SUPPORT, DMS PEDESTAL	
					1					1		630	70060	1	EACH	CATWALK, DMS PEDESTAL	
					1					1		630	70082	1	EACH	OVERHEAD SIGN SUPPORT FOUNDATION, DMS PEDESTAL	
					301					301		632	62810	301	FT	INTERCONNECT CABLE, MISC.: CMSC 1620 - FIBER OPTIC CABLE, 24 STRAND	P.126
					1					1		632	62820	1	EACH	INTERCONNECT, MISC.: CMSC 1620 - TERMINATION PANEL, 24 FIBER	P.126
					12					12		632	62820	12	EACH	INTERCONNECT, MISC.: FIBER OPTIC FUSION SPLICE	P.126
					1					1		632	70401	1	EACH	CONDUIT RISER, 2" DIAMETER, AS PER PLAN	P.126
					1					1		633	67101	1	EACH	CABINET FOUNDATION, AS PER PLAN	P.137
					1					1		633	67201	1	EACH	CONTROLLER WORK PAD, AS PER PLAN	P.137
					1					1		633	99000	1	EACH	CONTROLLER ITEM, MISC.: LAYER 2 ETHERNET SWITCH	P.126
					1					1		633	99000	1	EACH	CONTROLLER ITEM, MISC.:FIBER OPTIC ETHERNET TRANSCEIVER, SHORT RANGE	P.126
					463					463		804	15040	463	FT	FIBER OPTIC CABLE, 144 FIBER	
					26					26		809	24500	26	FT	CONDUIT, 4", MULTICELL, HDPE WITH 4 - 1" INNERDUCTS	
					146					146		809	64550	146	FT	ETHERNET CABLE, OUTDOOR-RATED	
					1					1		809	65990	1	EACH	ITS DEVICE, MISC.: REMOVE AND RELOCATE DMS CABINET	P.137
					1					1		809	65990	1	EACH	ITS DEVICE, MISC.: REMOVE AND RELOCATE DMS SIGN	P.137
					1					1		809	65990	1	EACH	ITS DEVICE, MISC.: REMOVAL OF DMS INSTALLATION	P.137
<b>TRAFFIC CONTROL</b>																	
					283					201	82	621	00100	283	EACH	RPM	
					3					3		625	32000	3	EACH	GROUND ROD	
25										25		626	00110	25	EACH	BARRIER REFLECTOR, TYPE 2 (ONE-WAY)	
3										3		626	00110	3	EACH	BARRIER REFLECTOR, TYPE 2 (BIDIRECTIONAL)	

DESIGN AGENCY



DESIGNER

WLC

REVIEWER

KMK 12-01-22

PROJECT ID


92616

SHEET TOTAL

P.40 170



NOTES:  
1. SEE SHEET P. 58 FOR CGO TEST HOLE INFORMATION FOR TH#1 AND TH#2  
2. SEE SHEET P.11 FOR CONTRACTOR'S USE OF PARCEL 2T.

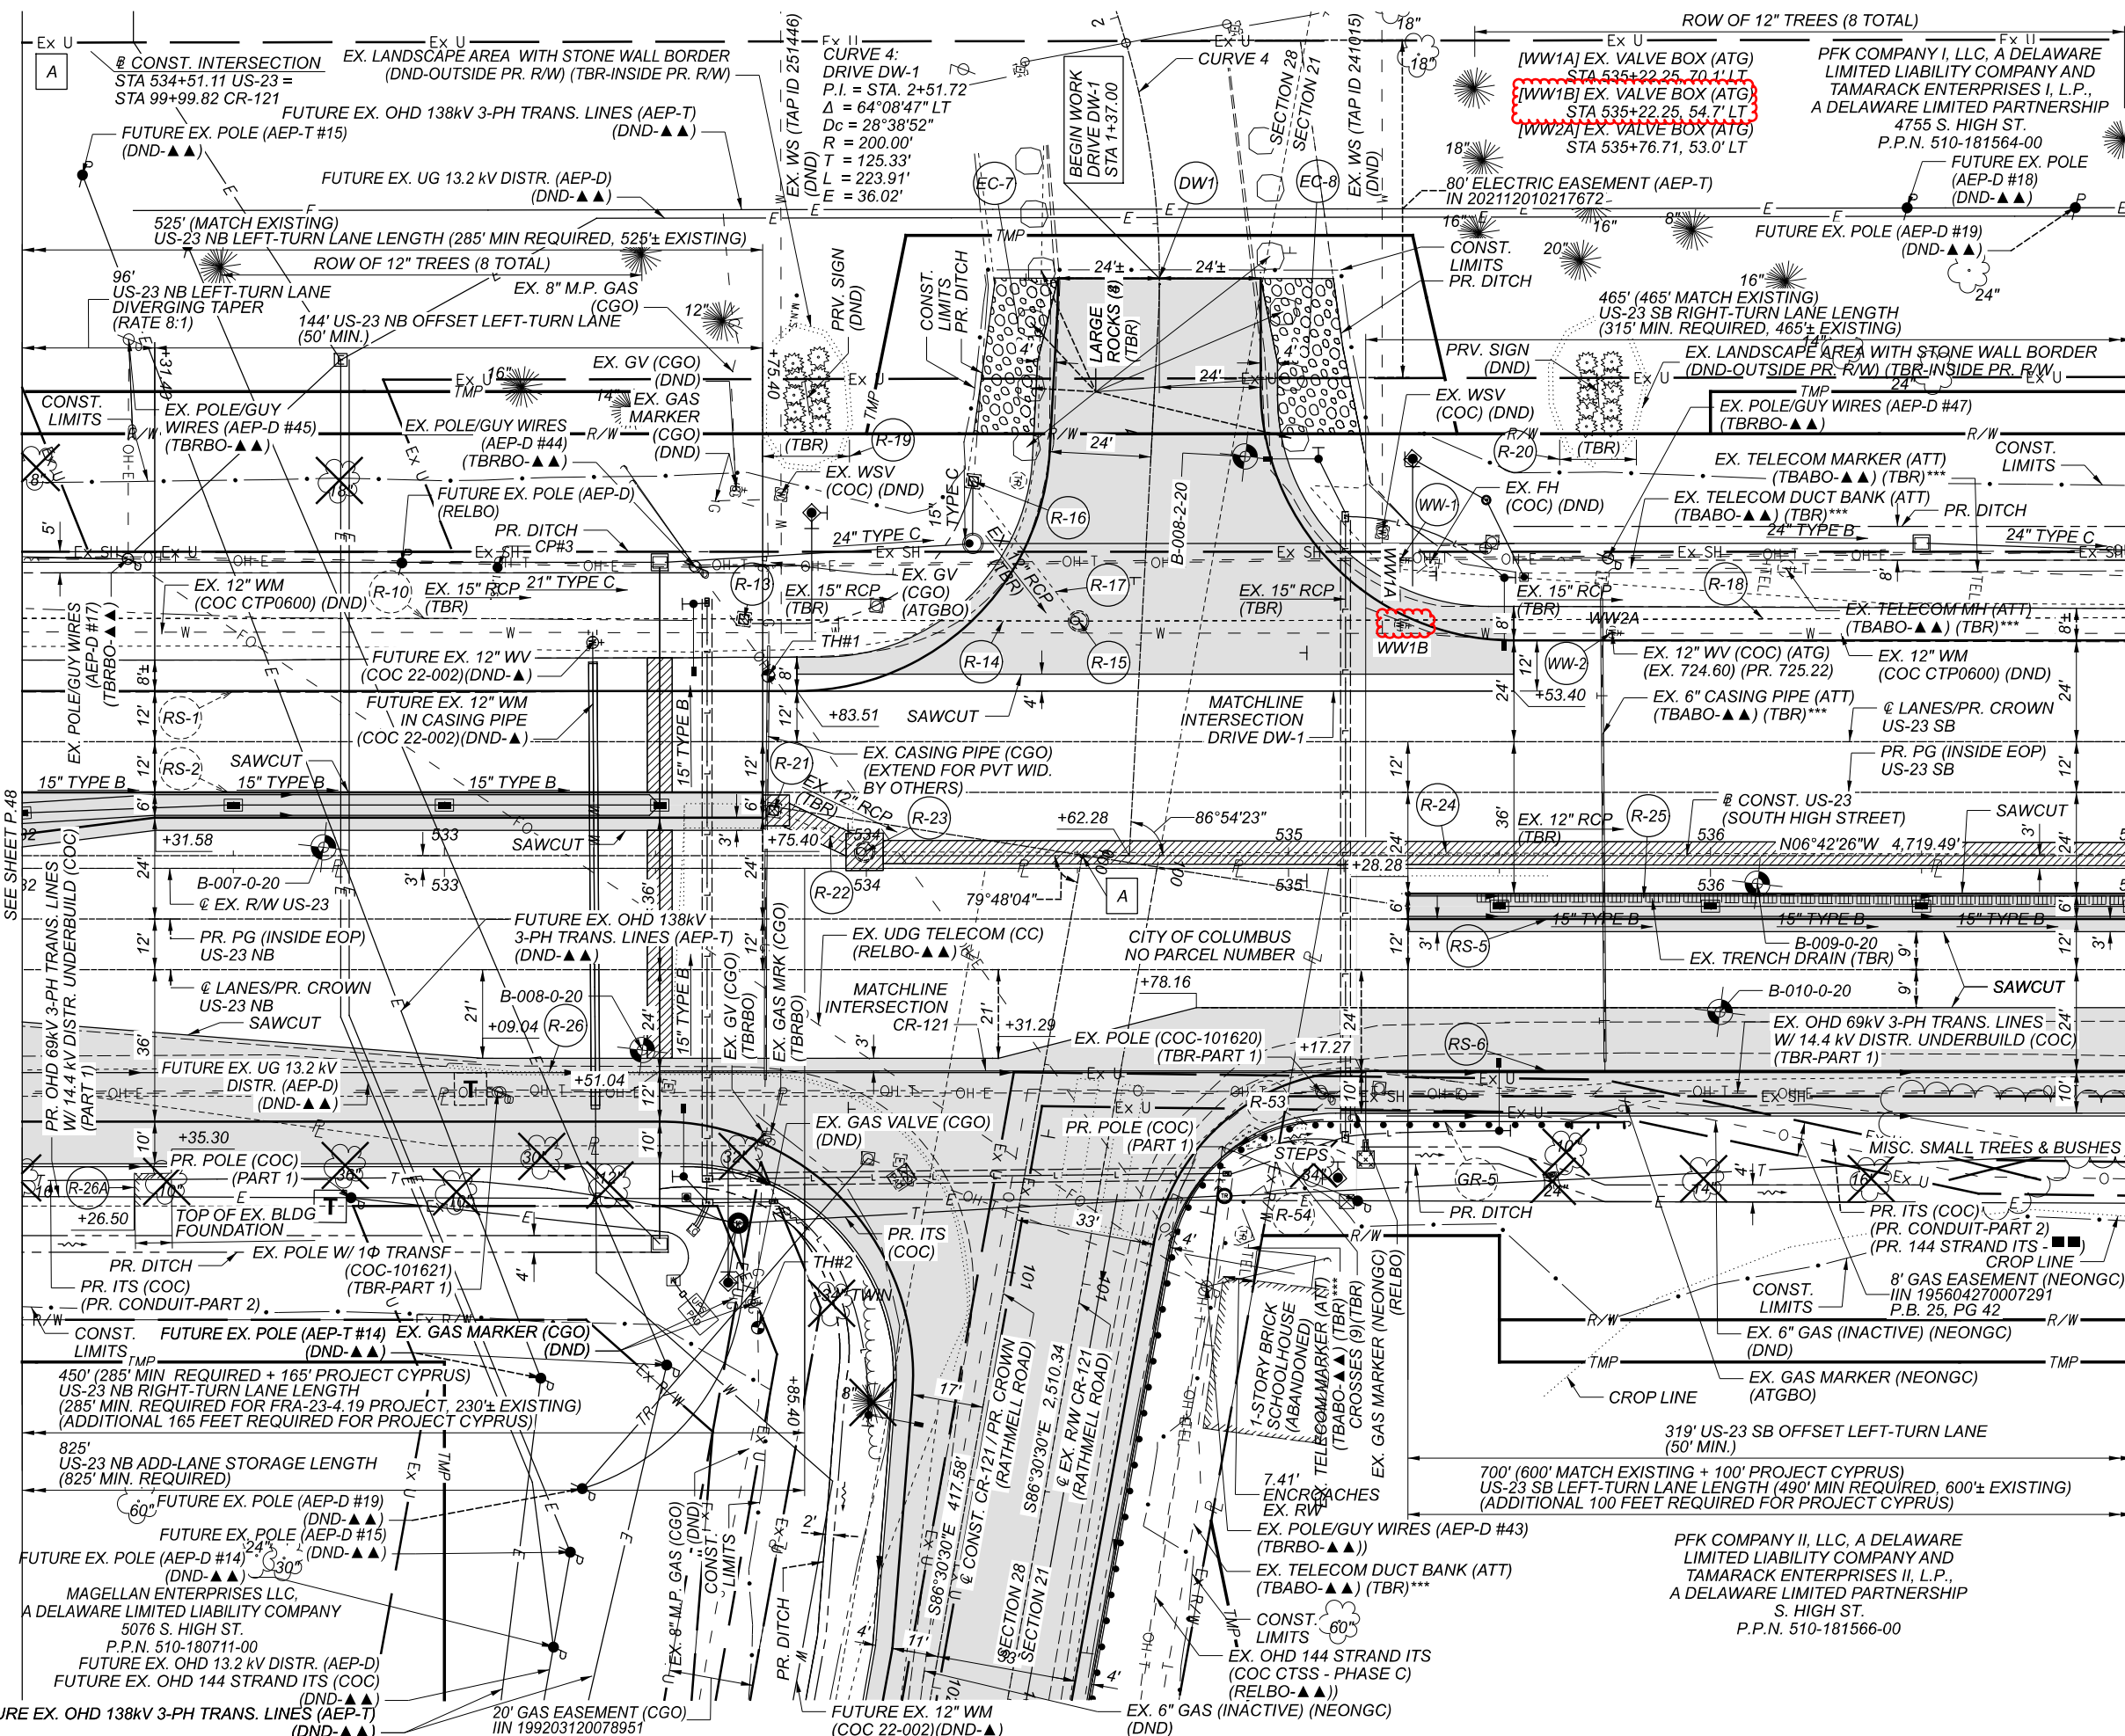


CROSS REFERENCES:  
SEE SHEET P.3 FOR PROJECT CONTROL, SEE SHEET P.47 FOR PLAN LEGENDS  
SEE SHEET P.43-P.45 FOR SUBSUMARIES  
SEE SHEET P.53 FOR PROFILE - US-23 SB - STA 532+00 TO STA 542+00  
SEE SHEET P.56 FOR PROFILE - US-23 NB - STA 532+00 TO STA 542+00  
SEE SHEET P.95 FOR INTERSECTION DETAILS - US-23 & CR-121 / SEE SHEET P.96 FOR DRIVE DETAILS  
SEE SHEET P.97-P.106 FOR DRAINAGE DETAILS  
SEE SHEET P.107-P.108 FOR WATER WORK  
SEE SHEET P.109-P.132 FOR TRAFFIC CONTROL, SEE SHEET P.133-140 FOR TRAFFIC SURVEILLANCE  
SEE SHEET P.141-P.144 FOR LIGHTING

MATCHLINE US-23 - STA 532+00  
SEE SHEET P.48

MATCHLINE US-23 - STA 537+00  
SEE SHEET P.50

SEE SHEET P. 11 FOR CGO, NEONGC, COC DPU GENERAL NOTE  
\*\*\* SEE SHEET P. 13 FOR ATT PAY ITEM NOTE (ITEM 202 - REMOVAL, MISC.: ABANDONED TELECOM FACILITIES)

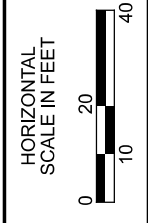


PLAN - US-23 (SOUTH HIGH STREET)  
STA 532+00 TO STA 537+00

DESIGN AGENCY	[BI]
DESIGNER	WLC
REVIEWER	KMK 12-01-22
PROJECT ID	92616
SHEET	P.49
TOTAL	170




MATCHLINE US-23 - STA 542+00  
 SEE SHEET P.50

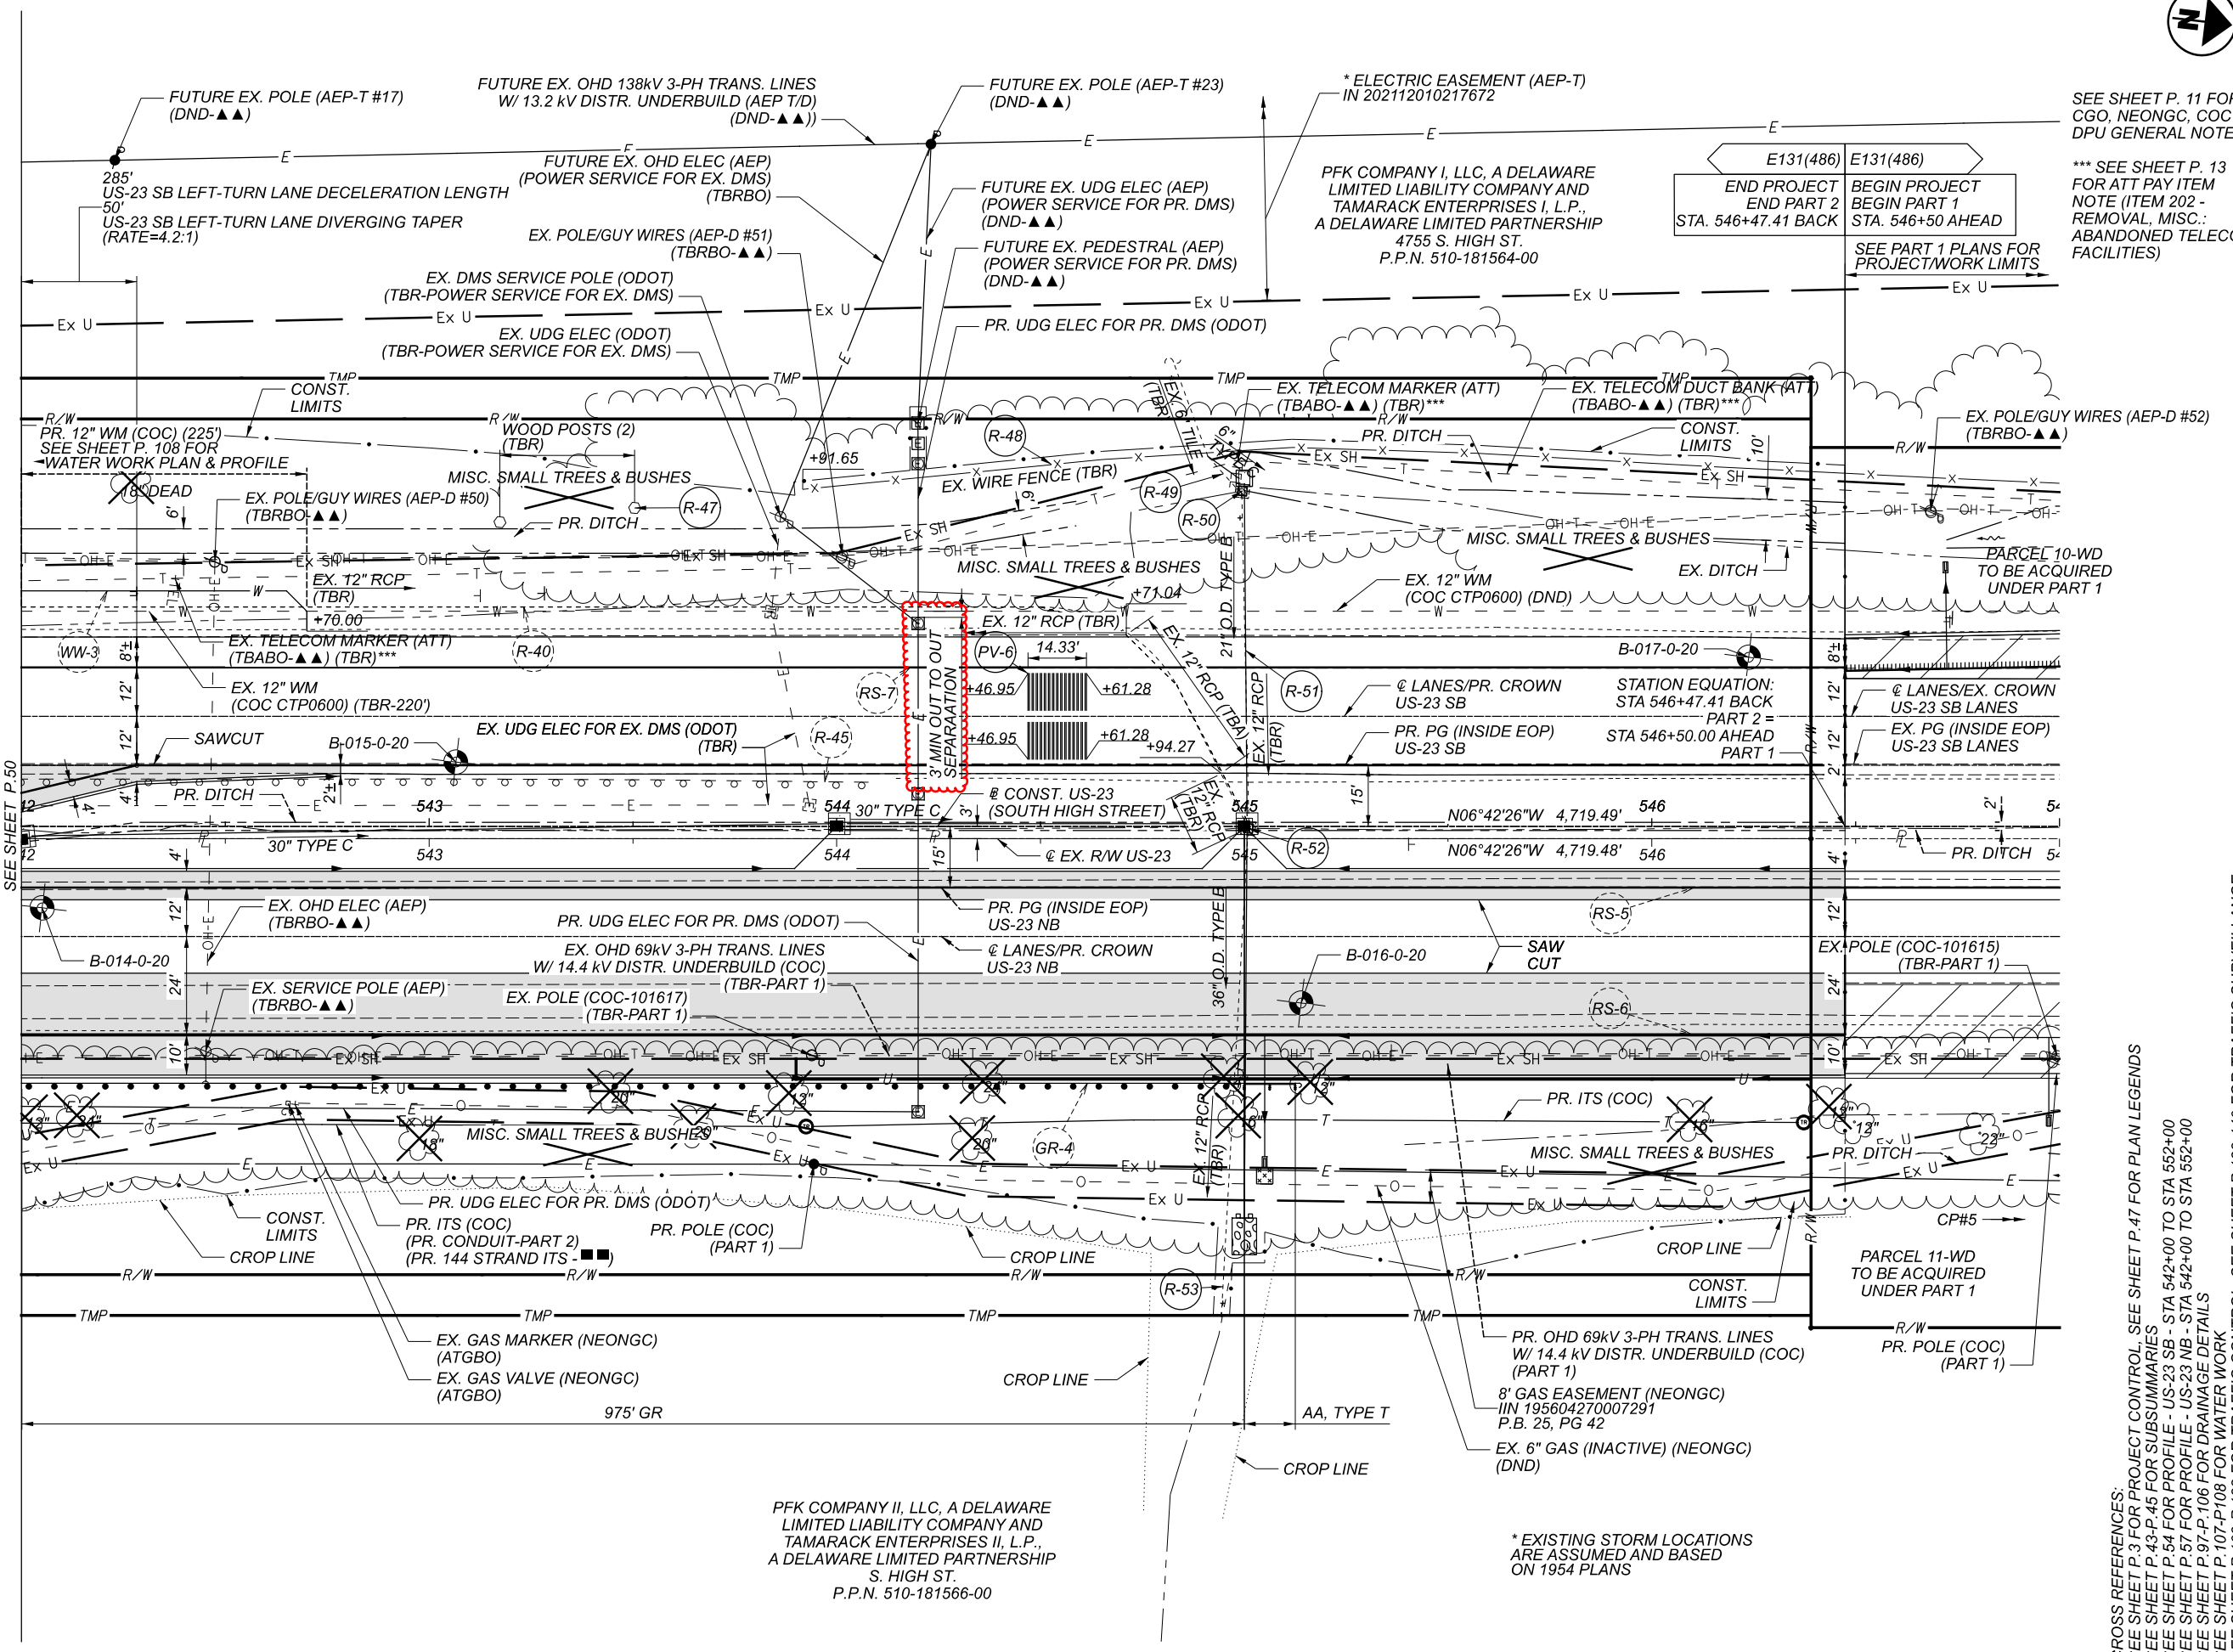

E131(486)	E131(486)
END PROJECT END PART 2 STA. 546+47.41 BACK	BEGIN PROJECT BEGIN PART 1 STA. 546+50 AHEAD

SEE SHEET P. 11 FOR  
 CGO, NEONGC, COC  
 DPU GENERAL NOTE

\*\*\* SEE SHEET P. 13  
 FOR ATT PAY ITEM  
 NOTE (ITEM 202 -  
 REMOVAL, MISC.:  
 ABANDONED TELECOM  
 FACILITIES)

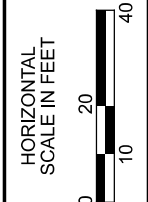

PLAN - US-23 (SOUTH HIGH STREET)  
 STA 542+00 TO STA 546+47.41

CROSS REFERENCES:  
 SEE SHEET P.3 FOR PROJECT CONTROL, SEE SHEET P.47 FOR PLAN LEGENDS  
 SEE SHEET P.43-P.45 FOR SUBSUMMARIES  
 SEE SHEET P.54 FOR PROFILE - US-23 SB - STA 542+00 TO STA 552+00  
 SEE SHEET P.57 FOR PROFILE - US-23 NB - STA 542+00 TO STA 552+00  
 SEE SHEET P.97-P.106 FOR DRAINAGE DETAILS  
 SEE SHEET P.107-P.108 FOR WATER WORK  
 SEE SHEET P.109-P.132 FOR TRAFFIC CONTROL, SEE SHEET P.133-140 FOR TRAFFIC SURVEILLANCE


PFK COMPANY II, LLC, A DELAWARE  
 LIMITED LIABILITY COMPANY AND  
 TAMARACK ENTERPRISES II, L.P.,  
 A DELAWARE LIMITED PARTNERSHIP  
 S. HIGH ST.  
 P.P.N. 510-181566-00

\* EXISTING STORM LOCATIONS  
 ARE ASSUMED AND BASED  
 ON 1954 PLANS

DESIGN AGENCY	[ B ]
DESIGNER	WLC
REVIEWER	KMK 12-01-22
PROJECT ID	92616
SHEET	P.51
TOTAL	170




NOTES:  
 1. SEE SHEET P. 58 FOR CGO TEST HOLE INFORMATION FOR TH#1 AND TH#2  
 2. SEE SHEET P.11 FOR CONTRACTOR'S USE OF PARCEL 2T.

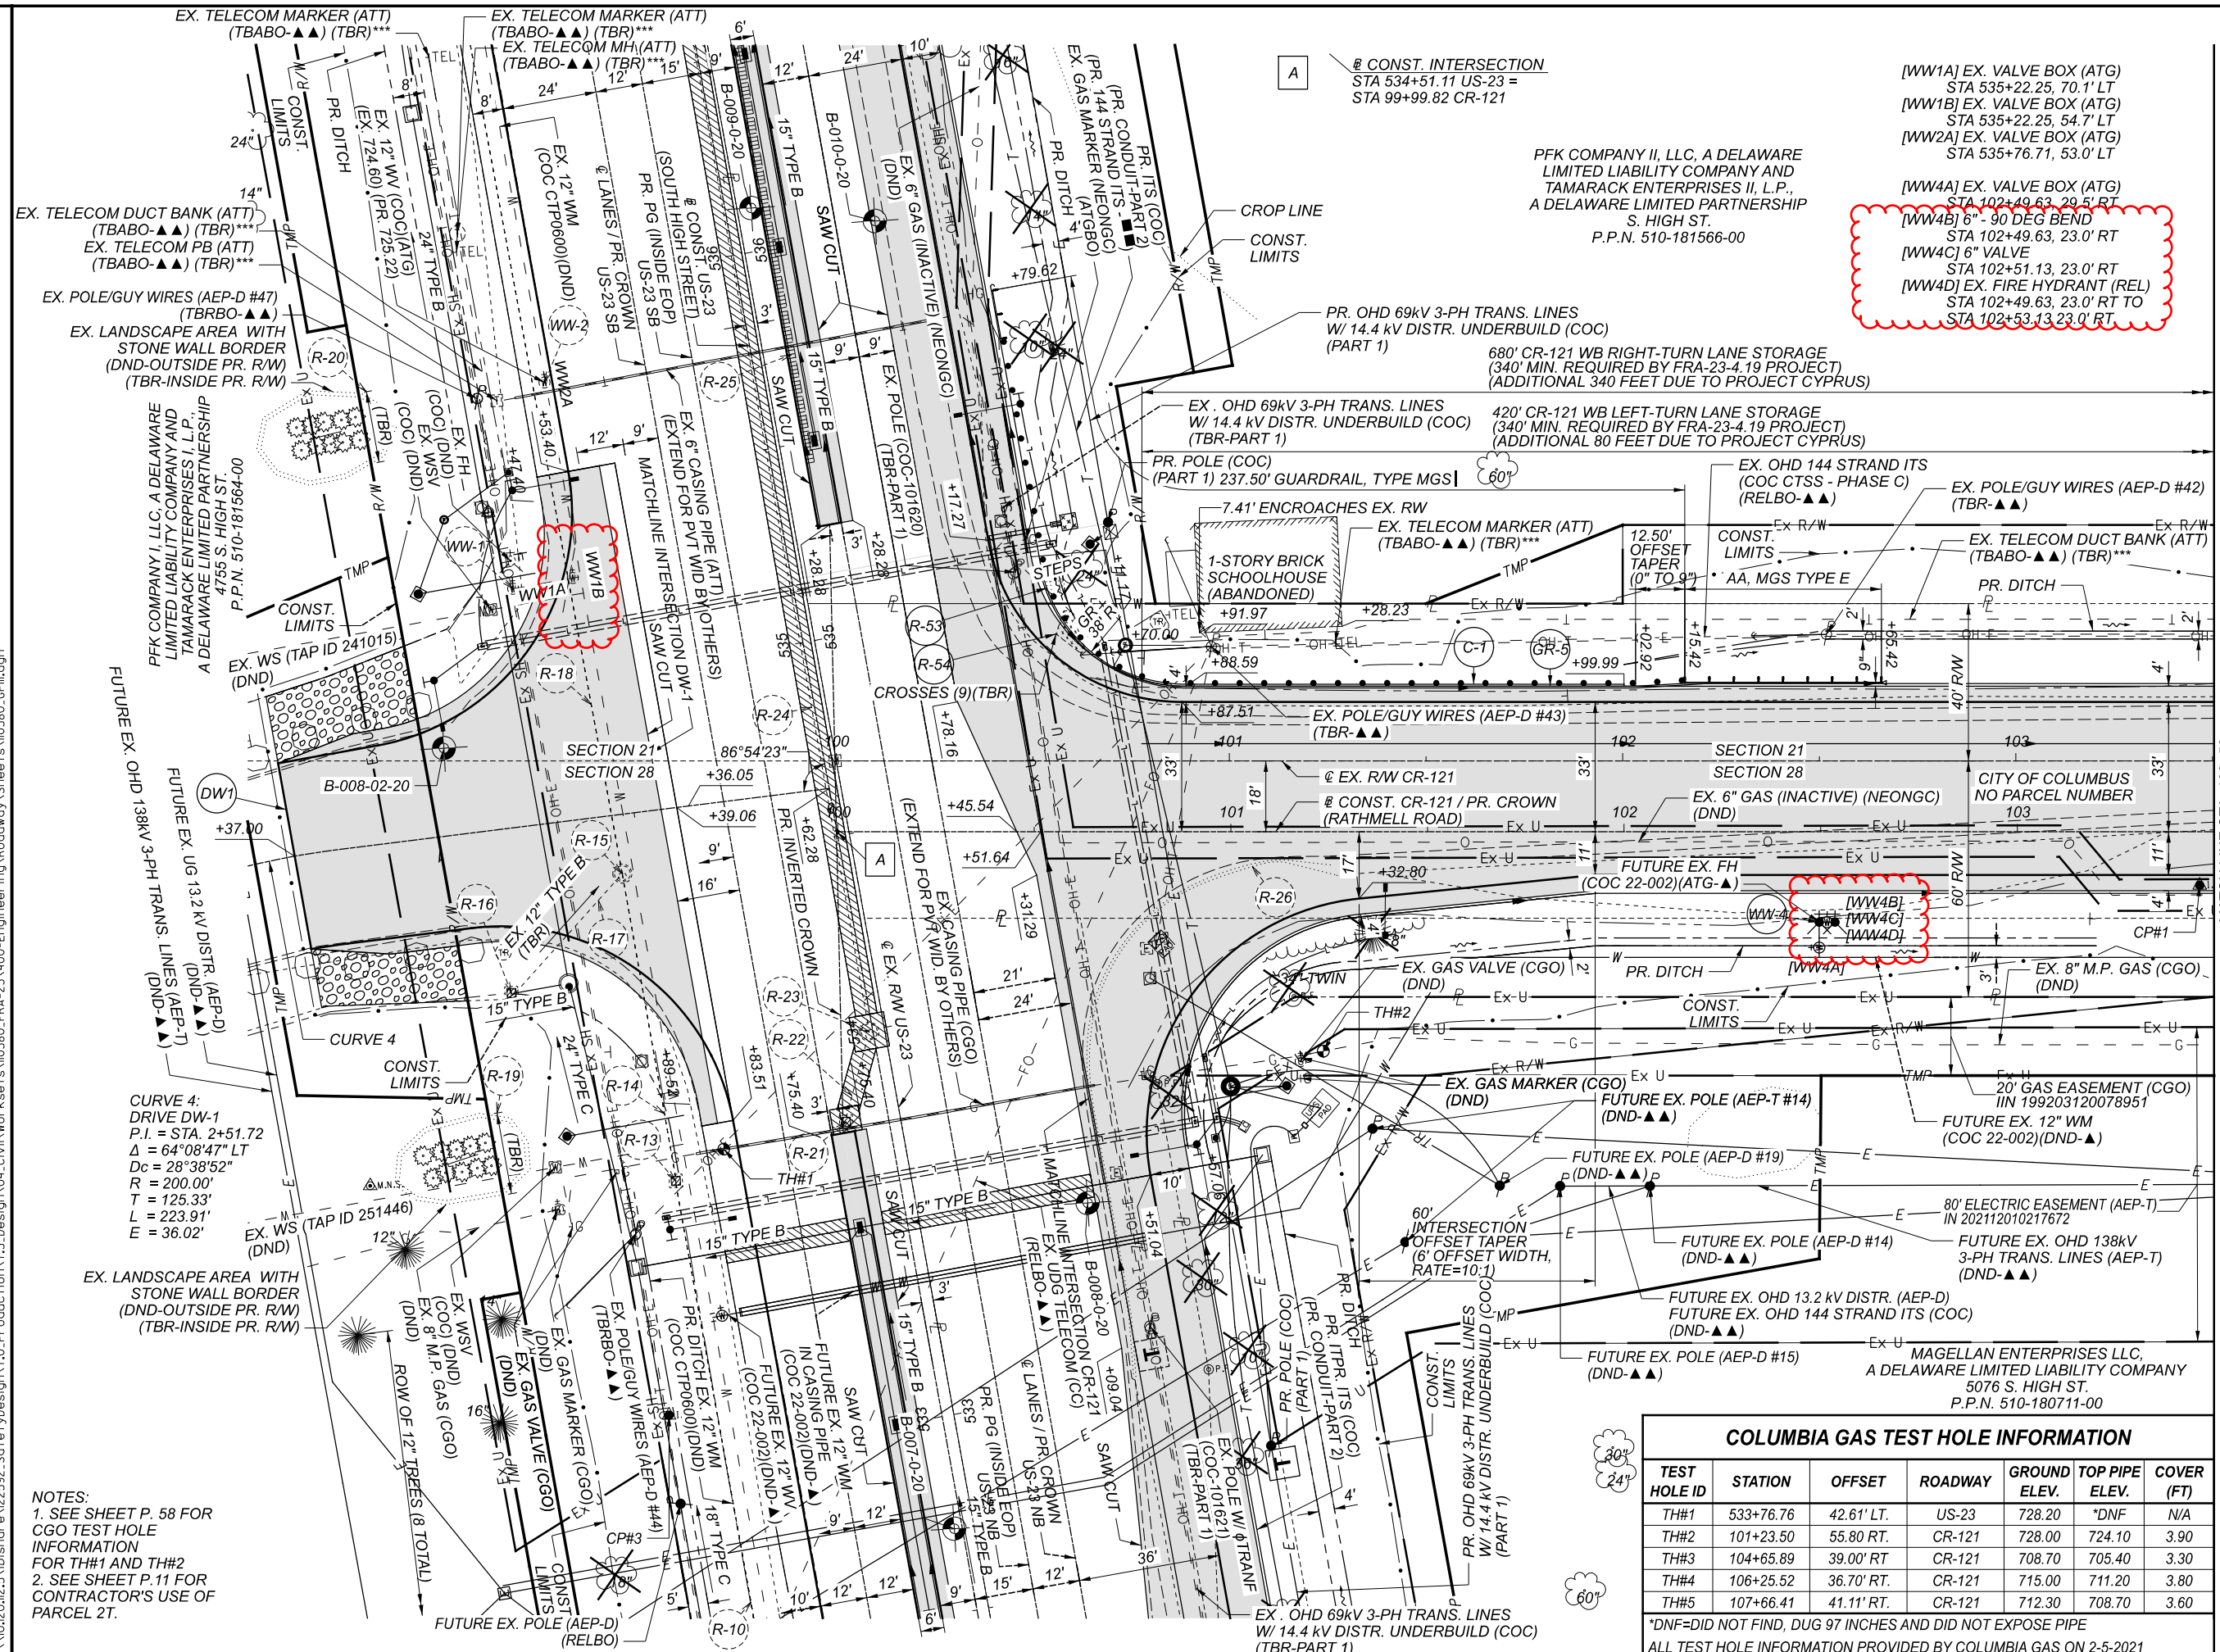

SEE SHEET P. 11 FOR CGO, NEONGC, COC DPU GENERAL NOTE

\*\*\* SEE SHEET P. 13 FOR ATT PAY ITEM NOTE (ITEM 202 - REMOVAL, MISC.: ABANDONED TELECOM FACILITIES)

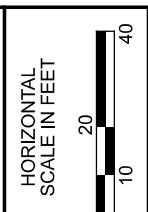

PLAN - CR-121 (RATHMELL ROAD)  
 STA 99+99.82 TO STA 103+50

PKF COMPANY II, LLC, A DELAWARE LIMITED LIABILITY COMPANY AND TAMARACK ENTERPRISES II, L.P., A DELAWARE LIMITED PARTNERSHIP  
 S. HIGH ST.  
 P.P.N. 510-181566-00

- [WW1A] EX. VALVE BOX (ATG) STA 535+22.25, 70.1' LT
- [WW1B] EX. VALVE BOX (ATG) STA 535+22.25, 54.7' LT
- [WW2A] EX. VALVE BOX (ATG) STA 535+76.71, 53.0' LT
- [WW4A] EX. VALVE BOX (ATG) STA 102+49.63, 29.5' RT
- [WW4B] 6" - 90 DEG BEND STA 102+49.63, 23.0' RT
- [WW4C] 6" VALVE STA 102+51.13, 23.0' RT
- [WW4D] EX. FIRE HYDRANT (REL) STA 102+49.63, 23.0' RT TO STA 102+53.13 23.0' RT

680' CR-121 WB RIGHT-TURN LANE STORAGE (340' MIN. REQUIRED BY FRA-23-4.19 PROJECT) (ADDITIONAL 340 FEET DUE TO PROJECT CYPRUS)

420' CR-121 WB LEFT-TURN LANE STORAGE (340' MIN. REQUIRED BY FRA-23-4.19 PROJECT) (ADDITIONAL 80 FEET DUE TO PROJECT CYPRUS)

CITY OF COLUMBUS NO PARCEL NUMBER 103

**COLUMBIA GAS TEST HOLE INFORMATION**

TEST HOLE ID	STATION	OFFSET	ROADWAY	GROUND ELEV.	TOP PIPE ELEV.	COVER (FT)
TH#1	533+76.76	42.61' LT.	US-23	728.20	*DNF	N/A
TH#2	101+23.50	55.80' RT.	CR-121	728.00	724.10	3.90
TH#3	104+65.89	39.00' RT.	CR-121	708.70	705.40	3.30
TH#4	106+25.52	36.70' RT.	CR-121	715.00	711.20	3.80
TH#5	107+66.41	41.11' RT.	CR-121	712.30	708.70	3.60

\*DNF= DID NOT FIND, DUG 97 INCHES AND DID NOT EXPOSE PIPE  
 ALL TEST HOLE INFORMATION PROVIDED BY COLUMBIA GAS ON 2-5-2021

CROSS REFERENCES:  
 SEE SHEET P.3 FOR PROJECT CONTROL, SEE SHEET P.47 FOR PLAN LEGENDS  
 SEE SHEET P.43-P.45 FOR SUBSUMMARIES  
 SEE SHEET P.62 FOR PROFILE - CR-121 - STA 99+99.82 TO STA 108+50  
 SEE SHEET P.95 FOR INTERSECTION DETAILS - US-23 & CR-121 / SEE SHEET P.96 FOR DRIVE DETAILS  
 SEE SHEET P.97-P.106 FOR DRAINAGE DETAILS  
 SEE SHEET P.107-P.108 FOR WATER WORK  
 SEE SHEET P.109-P.132 FOR TRAFFIC CONTROL, SEE SHEET P.133-140 FOR TRAFFIC SURVEILLANCE  
 SEE SHEET P.141-P.144 FOR LIGHTING

DESIGN AGENCY

DESIGNER  
WLC


REVIEWER  
KMK 12-01-22

PROJECT ID  
92616

SHEET TOTAL  
P.58 170



NOTES:  
 1. SEE SHEET P. 58 FOR CGO TEST HOLE INFORMATION FOR TH#1 AND TH#2  
 2. SEE SHEET P.11 FOR CONTRACTOR'S USE OF PARCEL 2T.

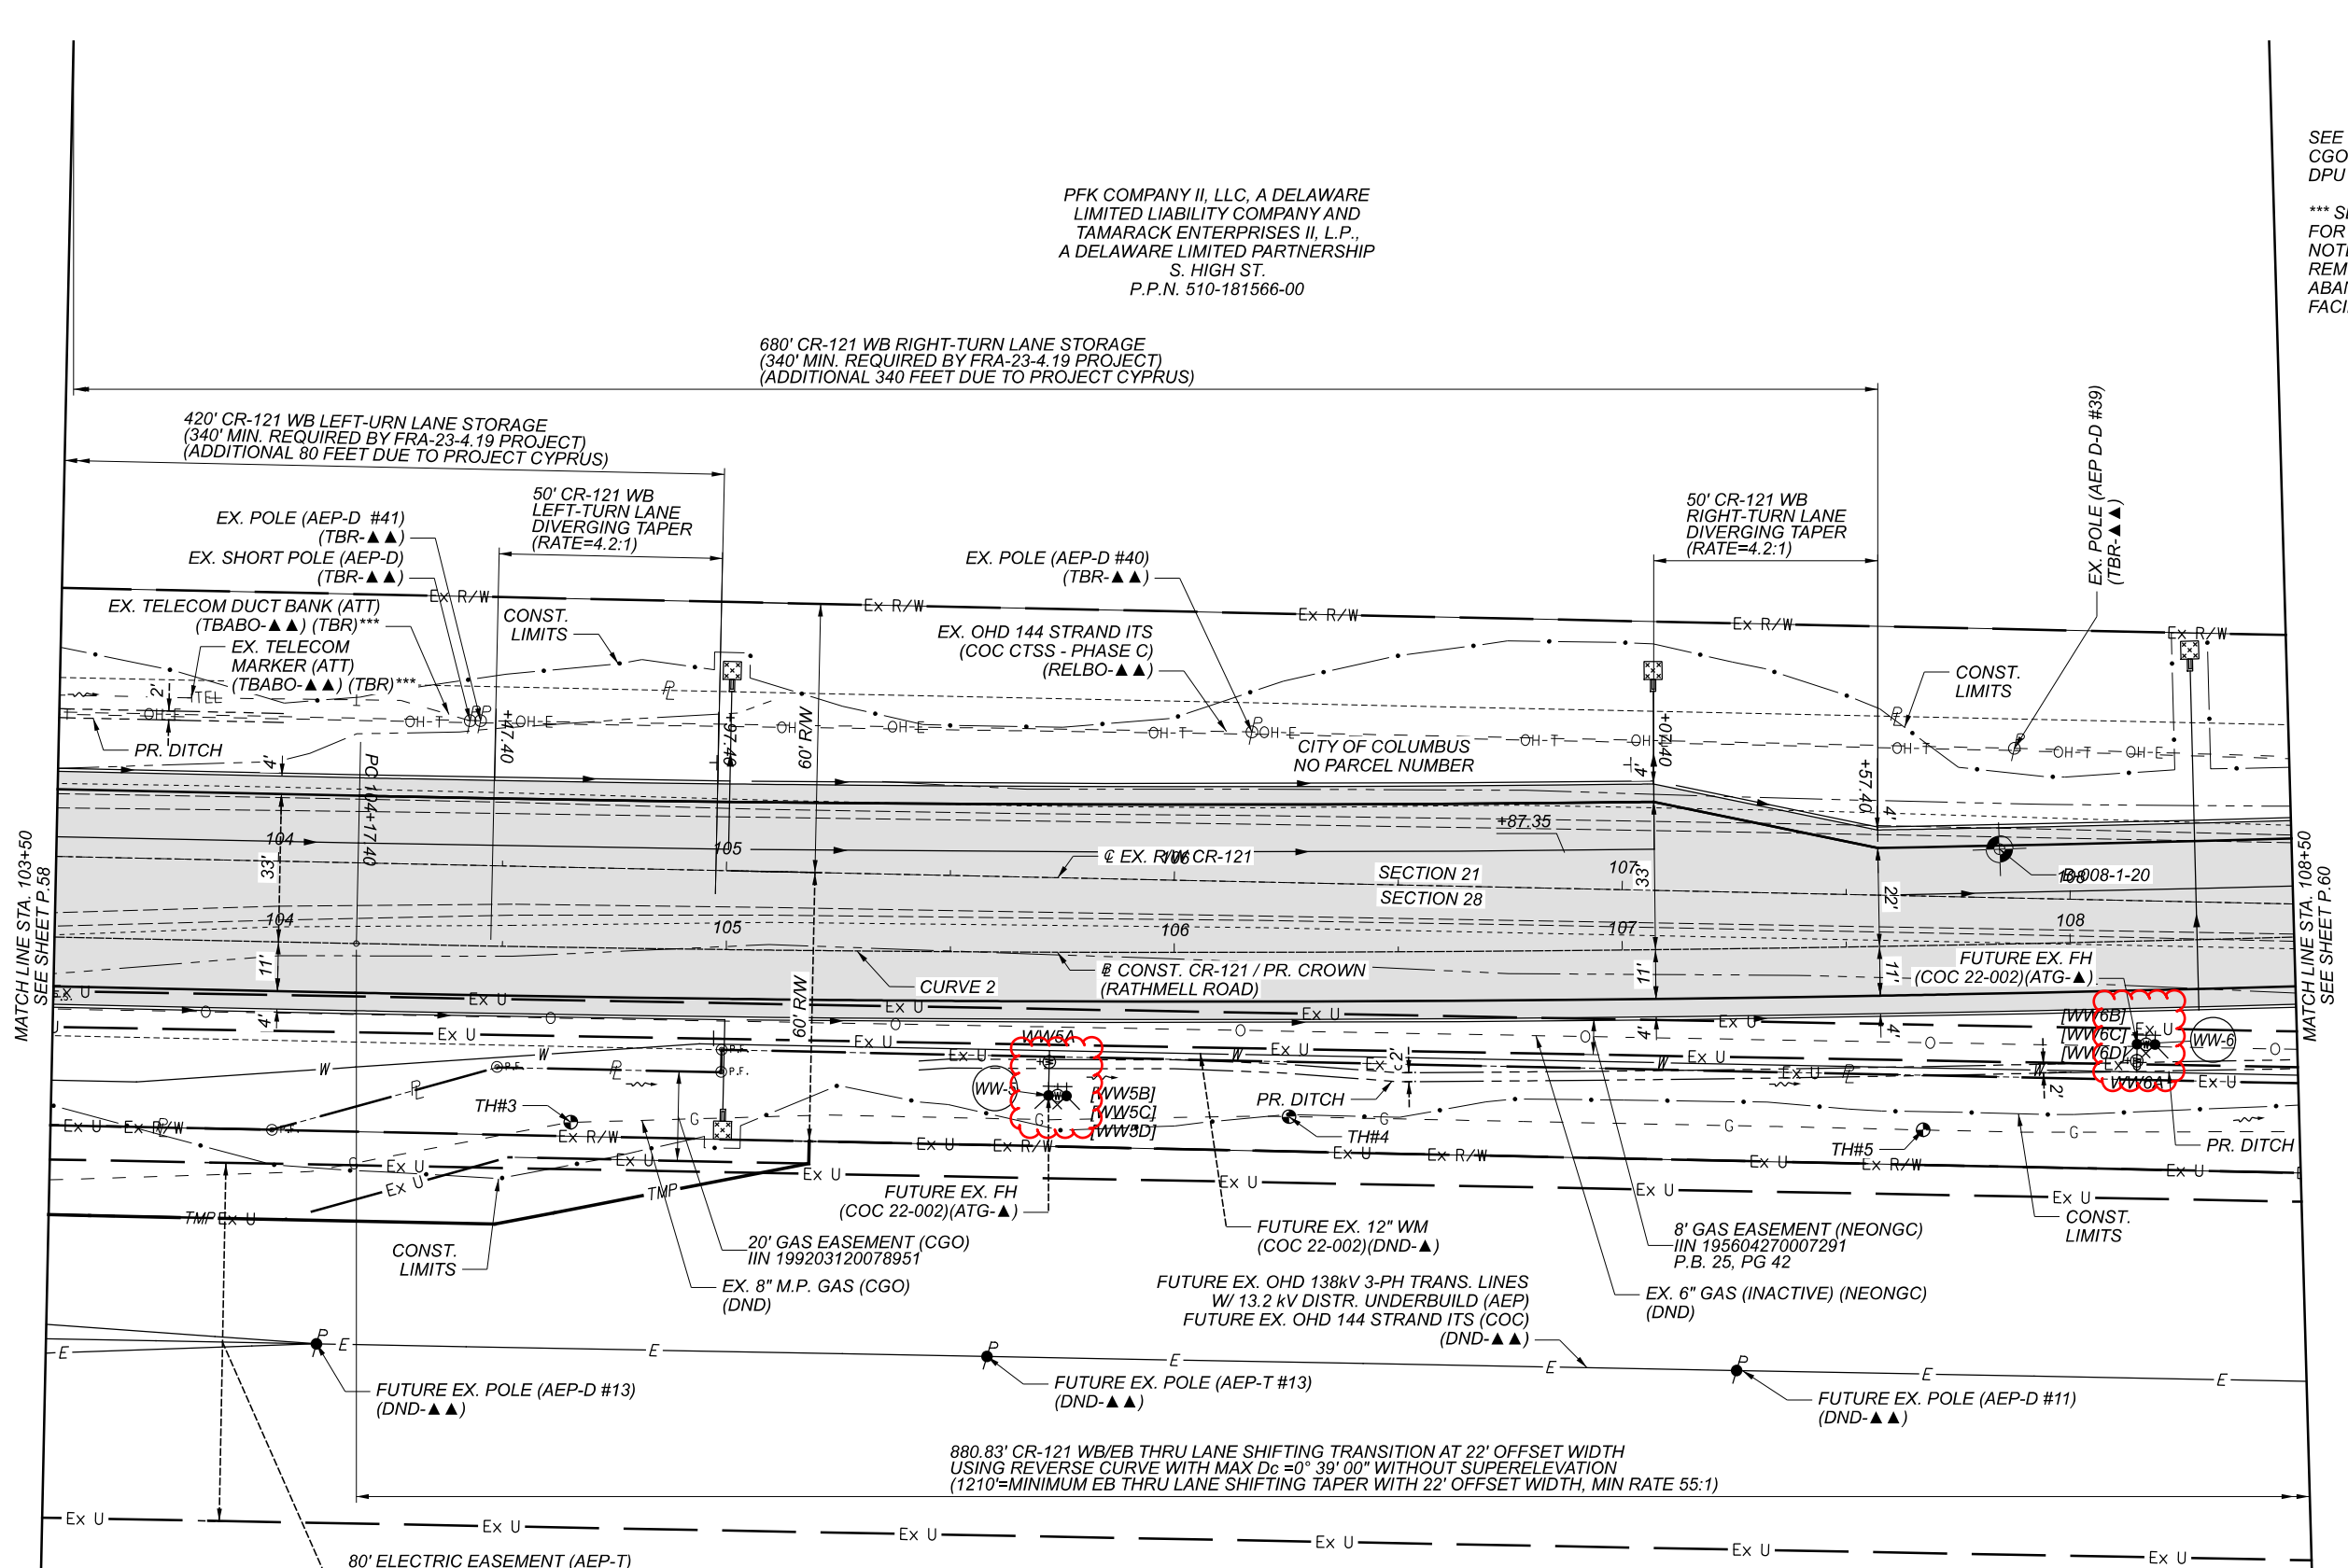


PFK COMPANY II, LLC, A DELAWARE LIMITED LIABILITY COMPANY AND TAMARACK ENTERPRISES II, L.P., A DELAWARE LIMITED PARTNERSHIP  
 S. HIGH ST.  
 P.P.N. 510-181566-00

MAGELLAN ENTERPRISES LLC, A DELAWARE LIMITED LIABILITY COMPANY  
 5076 S. HIGH ST.  
 P.P.N. 510-180711-00

- [WW5A] EX. VALVE BOX (ATG) STA 105+72.04 24.5' RT
- [WW5B] 6" - 90 DEG BEND STA 102+72.04, 23.0' RT
- [WW5C] 6" VALVE STA 102+74.54, 23.0' RT
- [WW5D] EX. FIRE HYDRANT (REL) STA 102+72.04, 23.0' RT TO STA 102+76.54 23.0' RT
- [WW6A] EX. VALVE BOX (ATG) STA 108+14.38 26.8' RT
- [WW6B] 6" - 90 DEG BEND STA 108+14.38, 23.0' RT
- [WW6C] 6" VALVE STA 108+16.88, 23.0' RT
- [WW6D] EX. FIRE HYDRANT (REL) STA 108+14.38., 23.0' RT TO STA 108+18.88 23.0' RT

SEE SHEET P. 11 FOR CGO, NEONGC, COC DPU GENERAL NOTE


\*\*\* SEE SHEET P. 13 FOR ATT PAY ITEM NOTE (ITEM 202 - REMOVAL, MISC.: ABANDONED TELECOM FACILITIES)

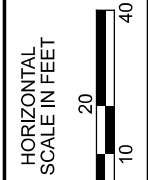

PLAN - CR-121 (RATHMELL ROAD)  
 STA 103+50 TO STA 108+50

CROSS REFERENCES:  
 SEE SHEET P.3 FOR PROJECT CONTROL. SEE SHEET P.47 FOR PLAN LEGENDS  
 SEE SHEET P.3 FOR PROJECT CONTROL. SEE SHEET P.47 FOR PLAN LEGENDS  
 SEE SHEET P.43-P.45 FOR SUBSUMMARIES  
 SEE SHEET P.62 FOR PROFILE - CR-121 - STA 99+99.82 TO STA 108+50  
 SEE SHEET P.97-P.106 FOR DRAINAGE DETAILS  
 SEE SHEET P.107-P.108 FOR WATER WORK  
 SEE SHEET P.109-P.132 FOR TRAFFIC CONTROL

DESIGN AGENCY	[B]
DESIGNER	WLC
REVIEWER	KMK 12-01-22
PROJECT ID	92616
SHEET	P.59
TOTAL	170

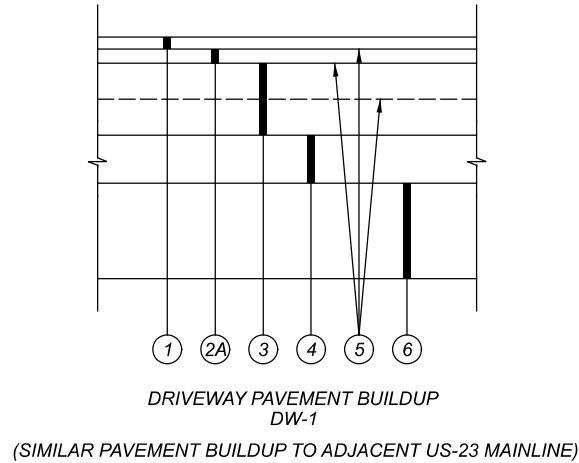

**PROPOSED LEGEND:**

- 1 (1.50") ITEM 442 - ASPHALT CONCRETE SURFACE COURSE, 12.5MM, TYPE A, (446), PG70-22M
- 2A (1.75") ITEM 442 - ASPHALT CONCRETE INTERMEDIATE COURSE, 12.5MM, TYPE A, (446)
- 3 (9") ITEM 301 - ASPHALT CONCRETE BASE, PG64-22, (449)  
(PLACED IN TWO LIFTS)
- 4 (6") ITEM 304 - AGGREGATE BASE
- 5 ITEM 407 - NON-TRACKING TACK COAT  
(PLACED IN BETWEEN LIFT OF ASPHALT)  
(APPLIED AT 0.055 GAL/SY AVG FOR NEW PAVEMENT)
- 6 CHEMICALLY STABILIZED SUBGRADE:  
ITEM 204 - PROOF ROLLING  
(APPLIED AT 1 HR/3000 SY FOR NEW CONSTRUCTION)  
ITEM 206 - CEMENT  
(APPLIED AT 5% PER 115 LB/CF SOIL)  
ITEM 206 - CEMENT STABILIZED SUBGRADE, 12-INCHES DEEP  
ITEM 206 - CURING COAT  
ITEM 206 - MIXTURE DESIGN FOR CHEMICALLY STABILIZED SOILS  
(SPECIFIED ON PROJECTS > 40,000 SY, SEE SUPPLEMENT 1120)

**PAVEMENT LEGEND:**



- PLANING (VAR. DEPTH) & RESURFACING (3.25") WITH PR. ASPHALT LEVELING COURSES (VAR. DEPTH)
- PR. ASPHALT PAVEMENT (FULL DEPTH)
- PAVEMENT RESTORATION FOR PIPE INSTALLATIONS AND/OR REMOVALS (SEE SHEET P.16)

**CROSS REFERENCES:**


SEE SHEET P.95 FOR INTERSECTION DETAILS - US-23 & CR-121 & DW-1

**NOTES:**

1. DUE TO SIMILAR FULL DEPTH PAVEMENT BUILDUP TO ADJACENT US-23 MAINLINE, THE DRIVEWAY PAVEMENT CALCULATIONS FOR DW-1 HAVE BEEN INCLUDED WITH GENERAL PAVEMENT CALCULATIONS. THE DRIVEWAY PAVEMENT ESTIMATED QUANTITIES HAVE BEEN CARRIED TO GENERAL SUMMARY AND LISTED UNDER OFFICE CALCS.

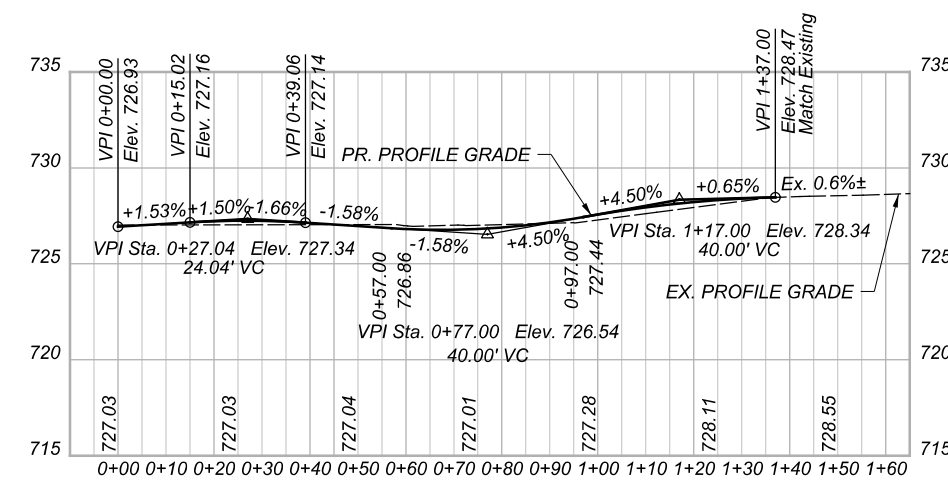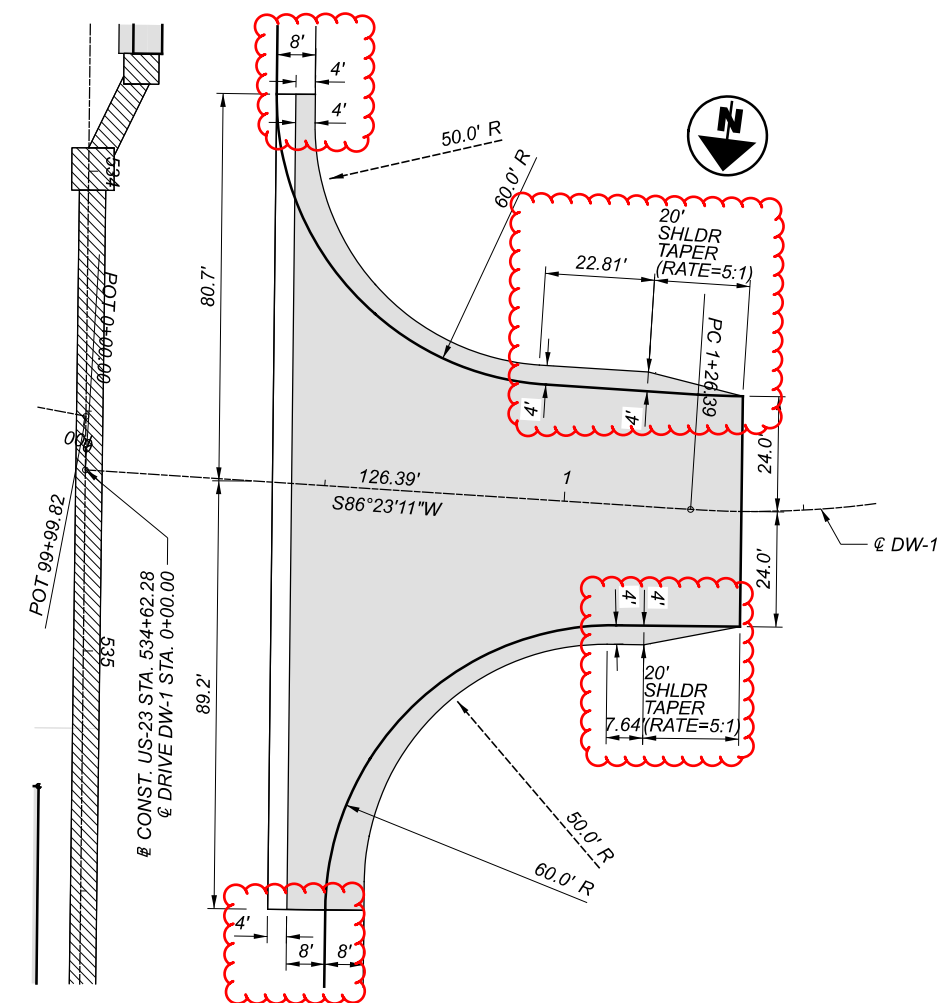

DRIVEWAY PLAN AND PROFILE  
DW-1  
STA. 534+62.28 (LT)

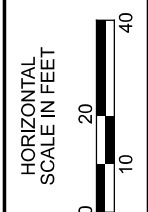

DRIVE DETAILS

DESIGN AGENCY	[B]
DESIGNER	WLC
REVIEWER	KMK 12-01-22
PROJECT ID	92616
SHEET TOTAL	P.96   170



**WATER WORK:**

**CITY OF COLUMBUS, DIVISION OF WATER GENERAL NOTES:**  
THE CITY OF COLUMBUS, CONSTRUCTION AND MATERIAL SPECIFICATIONS, 2018 EDITION AND ALL REVISIONS, INCLUDING ALL SUPPLEMENTS THERETO, SHALL GOVERN ALL CONSTRUCTION ITEMS THAT ARE A PART OF THIS PLAN, UNLESS OTHERWISE NOTED.

ALL WATER MAIN MATERIALS AND INSTALLATIONS SHALL BE IN ACCORDANCE WITH THE CURRENT RULES AND REGULATIONS OF THE CITY OF COLUMBUS, DIVISION OF WATER. ALL CITY OF COLUMBUS, DIVISION OF WATER STANDARD DRAWINGS SHALL APPLY TO THE PROJECT, UNLESS OTHERWISE NOTED.

FOR ANY EMERGENCIES INVOLVING THE WATER DISTRIBUTION SYSTEM, PLEASE CONTACT THE DIVISION OF WATER DISTRIBUTION MAINTENANCE OFFICE AT 614-645-7788.

ALL BRASS FITTINGS ASSOCIATED WITH WATER WORK, INCLUDING REPAIRS TO THE EXISTING SYSTEM, SHALL CONFORM TO THE REVISED ALLOWABLE LEAD EXTRACTION LIMIT PER THE UPDATED NSF/ANSI 61 STANDARD. THE DIVISION OF WATER'S APPROVED MATERIALS LIST HAS BEEN UPDATED TO REFLECT THIS REQUIREMENT.

IT SHALL BE UNLAWFUL FOR ANY PERSON TO PERFORM ANY WORK ON CITY OF COLUMBUS WATER MAIN SYSTEMS WITHOUT FIRST SECURING LICENSE TO ENGAGE IN SUCH WORK, AS INDICATED IN COLUMBUS CITY CODE SECTION 1103.02 AND 1103.06. THIS WORK INCLUDES ANY ATTACHMENTS, ADDITIONS TO OR ALTERATIONS IN ANY CITY SERVICE PIPE OR APPURTENANCES (INCLUDING WATER SERVICE LINES AND TAPS). THIS REQUIREMENT MAY BE MET BY UTILIZATION OF A SUBCONTRACTOR WHO HOLDS A CITY OF COLUMBUS WATER CONTRACTOR LICENSE OR A COMBINED WATER/SEWER CONTRACTOR LICENSE TO PERFORM THIS WORK. UTILIZATION OF A SUBCONTRACTOR MUST MEET THE LICENSING REQUIREMENTS OF CITY OF COLUMBUS BUILDING CODE, IN PARTICULAR SECTION 4114.119 AND 4114.529.

THE CONTRACTOR SHALL OBTAIN THE PROPER HYDRANT PERMIT(S), AND PAY ANY APPLICABLE FEES, FOR ANY APPROVED HYDRANT USAGE DEEMED NECESSARY FOR WORK UNDER THIS IMPROVEMENT. PERMITS MAY BE OBTAINED THROUGH THE DIVISION OF WATER PERMIT OFFICE (614-645-7330). THE CONTRACTOR SHALL ADHERE TO ALL RULES & REGULATIONS GOVERNING SAID PERMIT AND MUST HAVE THE ORIGINAL PERMIT ON SITE ANYTIME IN WHICH THE HYDRANT IS IN USE. PERMITS MAY BE OBTAINED BY ACCESSING [HTTP://PORTAL.COLUMBUS.GOV/PERMITS/](http://portal.columbus.gov/permits/). COST TO BE INCLUDED IN THE VARIOUS BID ITEMS.

THESE DESIGN PLANS HAVE ASSUMED DUCTILE IRON AS THE BASELINE PIPE MATERIAL FOR DESIGN. ALL FITTINGS, DEFLECTIONS, AND OTHER DESIGN ELEMENTS ARE BASED OFF OF THE DUCTILE IRON STANDARDS. **PVC WILL NOT BE PERMITTED SINCE THIS IS LOCATED IN A PRIORITY 1 STREET.**

ALL WATER MAINS SHALL BE CLEANED AND FLUSHED, AND ANY WATER MAIN 12-INCH AND LARGER MUST BE PROPERLY PIGGED, IN ACCORDANCE WITH SECTION 801.15 OF THE CITY OF COLUMBUS, CONSTRUCTION AND MATERIAL SPECIFICATIONS.

ALL WATER MAINS SHALL BE PRESSURE TESTED IN ACCORDANCE WITH SECTION 801.16 OF THE CITY OF COLUMBUS, CONSTRUCTION AND MATERIAL SPECIFICATIONS. THE CITY MAY NOT APPROVE ANY TEST LASTING LESS THAN TWO HOURS, REGARDLESS OF THE AMOUNT OF LEAKAGE.

ALL WATER MAINS SHALL BE DISINFECTED IN ACCORDANCE WITH SECTION 801.17 OF THE CITY OF COLUMBUS CONSTRUCTION AND MATERIAL SPECIFICATIONS. SPECIAL ATTENTION IS DIRECTED TO APPLICABLE SECTIONS OF A.W.W.A. C-651. WHEN THE WATER MAINS ARE READY FOR DISINFECTION, THE INSPECTOR SHALL SUBMIT A WRITTEN REQUEST FOR CHLORINATION OF THE MAINS THAT NEED DISINFECTED, THREE (3) SETS OF "AS-BUILT" PLANS (FULL SIZE SHEETS ONLY), THE AS-BUILT SURVEY COORDINATES, WATER SERVICE REPORTS AND A PRESSURE TEST TO THE CITY OF COLUMBUS, DIVISION OF WATER. THE CONTRACTOR SHALL BE RESPONSIBLE FOR ALL COSTS ASSOCIATED WITH THE DISINFECTION OF ALL WATER MAINS CONSTRUCTED UNDER THIS PLAN.

**CITY OF COLUMBUS, DIVISION OF WATER GENERAL NOTES: (CONT.)**  
THE CONTRACTOR SHALL PROVIDE CHLORINATION TAPS AND BLOWOFFS AS PER THE REQUIREMENTS OF SECTION 801.17 OF THE CITY OF COLUMBUS, CONSTRUCTION AND MATERIAL SPECIFICATIONS. IN ADDITIONS TO THE BLOWOFF LOCATIONS NOTED IN 801.17, THE CONTRACTOR SHALL ALSO INSTALL BLOWOFFS AT EVERY 1,100 LINEAR FEET OF THE WATER MAIN INSTALLED FOR SAMPLING.

ANY SECTION OF WATER MAIN THAT IS LONGER THAN 20 FEET IN LENGTH SHALL BE CHLORINATED. HAND SWABBING METHODS WILL ONLY BE PERMITTED FOR SECTIONS LESS THAN OR EQUAL TO 20 FEET IN LENGTH. USE UNSCENTED HOUSEHOLD BLEACH FOR HAND SWABBING OF PIPE AND FITTINGS. PLEASE NOTE THAT CUT-IN TEES, SLEEVES, AND ANY OTHER REQUIRED FITTINGS OR PIPING SHALL BE TAKEN INTO ACCOUNT AND ARE INCLUDED IN THE TOTAL LENGTH OF THE SECTION (CUT TO CUT).

ONLY ONE CONNECTION TO AN EXISTING WATER MAIN IS PERMITTED BEFORE DISINFECTION OF A NEW WATER MAIN HAS BEEN COMPLETED. ALL OTHER CONNECTIONS MUST BE MADE AFTER THE MAIN HAS BEEN DISINFECTED.

ALL FIRE HYDRANTS TO BE INSTALLED IN THE CITY OF COLUMBUS SHALL BE PAINTED WITH THE COLOR "SAFETY ORANGE." THE FIRE HYDRANTS SHALL BE PROVIDED WITH TWO COATS IN A GLOSS ENAMEL OF THE "SAFETY ORANGE" COLOR FOR THE ENTIRE HYDRANT. THE TOPS OF THE FIRE HYDRANTS ARE NO LONGER REQUIRED TO BE PAINTED PLACK. AFTER INSTALLATION OF FIRE HYDRANTS, THE CONTRACTOR IS RESPONSIBLE TO APPLY TOUCH UP PAINT TO ANY DAMAGE TO THE FACTORY APPLIED HYDRANT PAINT. HYDRANTS WILL NOT BE ACCEPTED UNTIL ANY PAINT DAMAGE FROM SHIPPING OR INSTALLATION HAS BEEN REPAIRED. USE HYDRANT TOUCH UP PAINT IN ACCORDANCE WITH THE APPROVED MATERIALS LIST.

ALL FIRE HYDRANTS, WHETHER NEW OR RELOCATED, SHALL BE INSPECTED AND APPROVED BY THE DIVISION OF FIRE PRIOR TO BEING PUT INTO SERVICE. THE CONTRACTOR SHALL CONTACT THE DIVISION OF FIRE AT 614-645-7642 EXT. 75658 TO SCHEDULE THE INSPECTION OF THE NEW OR RELOCATED FIRE HYDRANTS. THE CITY WILL PROVIDE THE CONTRACTOR "OUT OF SERVICE" RINGS THAT SHALL BE PLACED ON ALL NEW OR RELOCATED FIRE HYDRANTS TO CLEARLY IDENTIFY THEM AS INACTIVE. AFTER WRITTEN NOTIFICATION OF ACCEPTANCE HAS BEEN RECEIVED AND FINAL WATER MAIN CONNECTIONS HAVE OCCURRED, THE CONTRACTOR SHALL REMOVE THE "OUT OF SERVICE" RINGS FROM THE FIRE HYDRANTS. ALL "OUT OF SERVICE" RINGS SHALL BE RETURNED TO THE CITY. ALL COORDINATION AND WORK REQUIRED TO TEST AND ACCEPT THE FIRE HYDRANTS SHALL BE INCLUDED IN THE PRICE BID ITEM 809.

MAINTAIN EIGHTEEN (18) INCHES VERTICAL AND TEN (10) FEET HORIZONTAL SEPARATION BETWEEN ANY SANITARY OR STORM SEWER PIPING AND ALL PROPOSED WATER MAINS.

WHEN CROSSING THE EXISTING WATER MAIN, AND LOW STRENGTH MORTAR (ITEM 613) IS TO BE USED AS BACKFILL, THE CONTRACTOR SHALL PROVIDE SIZE NO. 57 CRUSHED CARBONATE STONE (CCS) 1 FOOT BELOW TO 1 FOOT ABOVE THE EXISTING WATER MAIN.

IF DURING EXCAVATION, THE POLYETHYLENE ENCASEMENT ON THE EXISTING WATER MAIN BECOMES DAMAGED, THE CONTRACTOR SHALL REPAIR THE POLYETHYLENE ENCASEMENT PER MANUFACTURER'S SPECIFICATIONS AND DOW STANDARD DRAWINGS L-1003 AND L-1004, AT THEIR OWN EXPENSE. ENSURE THAT THE ENTIRE EXPOSED AREA IS COVERED WITH NEW POLYETHYLENE ENCASEMENT AND SECURELY TAPED, PRIOR TO BACKFILLING.

CONTRACTOR SHALL ADHERE TO THE REQUIREMENTS OF THE OHIO ADMINISTRATIVE CODE CHAPTER 3745-83-02 WATER DISRUPTION OF SERVICE RULE. EXCAVATE PITS SUFFICIENTLY BELOW THE AREA TO BE CONNECTED TO IN ORDER TO MAINTAIN WATER LEVELS BELOW THE WATER MAIN. IF WATER FROM THE PIT ENTERS THE EXISTING MAIN, CONTACT DIVISION OF WATER IMMEDIATELY. ENSURE THAT SUFFICIENTLY SIZED PUMPS ARE UTILIZED TO REMOVE WATER FROM THE TRENCH AND BACKUP PUMPS ARE KEPT ON SITE FOR REDUNDANCY.

**CITY OF COLUMBUS, DIVISION OF WATER GENERAL NOTES: (CONT.)**  
"SURVEY COORDINATES" SHALL INCLUDE ALL MATERIAL, EQUIPMENT, AND LABOR NECESSARY TO OBTAIN HORIZONTAL AND VERTICAL (NORTHING, EASTING, AND CENTERLINE ELEVATION) SURVEY COORDINATES FOR THE WATER MAIN IMPROVEMENTS. THE SURVEY COORDINATES SHALL BE OBTAINED FOR THE COMPLETED WATER MAIN CONSTRUCTION AND SHALL INCLUDE ALL VALVES, TEES, CROSSES, BENDS, HORIZONTAL DEFLECTIONS, PLUGS, REDUCERS, TAPPING SLEEVES, FIRE HYDRANTS, AIR RELEASES, CURB STOPS, AND CASING PIPE TERMINI. ADDITIONAL SURVEY COORDINATES ARE REQUIRED ON THE WATER MAIN EVERY 200 FEET WHERE NO FITTING OR OTHER WATER MAIN STRUCTURE IS BEING INSTALLED WITHIN THAT LENGTH OF THE IMPROVEMENT.

ALL SURVEY COORDINATES SHALL BE REFERENCED TO THE APPLICABLE COUNTY ENGINEER'S MONUMENTS, AND SHALL BE BASED ON THE NORTH AMERICAN DATUM OF 1983 (NAD 83) WITH THE 2011 ADJUSTMENT, WITH FURTHER REFERENCE MADE TO THE OHIO STATE PLANE SOUTH COORDINATE SYSTEM, SOUTH ZONE, WITH ELEVATIONS BASED ON NAVD 88 DATUM. ALL COORDINATES (NORTHING, EASTING, CENTERLINE ELEVATION) SHALL BE REFERENCED TO THE NEAREST HUNDREDTH (N XXXXXX.XX, E XXXXXX.XX, C/L ELEV. XXX.XX). ALL SURVEY COORDINATES SHALL BE ACCURATE TO WITHIN 1.0 FOOT HORIZONTAL AND A TENTH OF A FOOT (0.10) OR LESS VERTICAL.

THE COORDINATES SHALL BE DOCUMENTED TO THE ENGINEER IN DIGITAL SPREADSHEET FORM AND SHALL INCLUDE THE APPLICABLE ITEM, STATION, NORTHING, EASTING, AND CENTERLINE ELEVATION. COORDINATES SHALL BE SUBMITTED TO THE ENGINEER ON A BI-WEEKLY BASIS. COORDINATES SHALL ALSO BE REQUIRED TO BE SUBMITTED TO THE DIVISION OF WATER AS PART OF THE REQUEST FOR CHLORINATION.

LUMP SUM PAYMENT IS FULL COMPENSATION FOR ALL WORK INVOLVED IN OBTAINING AND DOCUMENTING THE SURVEY COORDINATES AS DESCRIBED IN THIS SPECIFICATION.

ALL WATER MAIN VALVE BOXES, WATER TAP BOXES, TEST STATIONS, PITOMETER TAP STRUCTURES, METER PIT COVERS, AND OTHER SURFACE UTILITY STRUCTURES WITHIN THE DISTURBED AREA SHALL BE ADJUSTED TO GRADE. ANY OF THESE STRUCTURES LOCATED WITHIN PAVEMENT, DRIVEWAYS, OR OTHER TRAVELED AREAS, WHETHER EXISTING OR PROPOSED, SHALL BE EQUIPPED WITH A TRAFFIC RATED, HEAVY DUTY VALVE BOX AND/OR COVER IN ACCORDANCE WITH THE STANDARD DRAWINGS. EXISTING WATER TAP BOXES TO REMAIN THAT ARE ENCOUNTERED WITHIN THE PROJECT LIMITS SHALL BE CLEANED OUT, CENTERED OVER THE CURB STOP, AND ADJUSTED TO THE PROPOSED GRADE.

**RISER RINGS WILL NOT BE PERMITTED ON ANY NEWLY INSTALLED VALVE BOXES TO BRING VALVES TO FINAL GRADE. THE CONTRACTOR SHALL ENSURE THAT THE BOXES ARE INSTALLED AT THE CORRECT GRADE FOR FINAL PAVING OPERATIONS AND THAT THEIR PAVING CONTRACTOR INSTALLS PAVEMENT CORRECTLY AT LIDS DURING PAVING OPERATIONS. VALVE LIDS ARE NOT PERMITTED TO SET ABOVE FINAL GRADE AND SHALL BE A MAXIMUM OF 1/4" BELOW FINAL GRADE.**

WHERE NEW CONDUIT IS PROPOSED TO CROSS AN EXISTING OR PROPOSED WATER MAIN OR WATER TAP/SERVICE LINE, A MINIMUM OF 12-INCHES OF VERTICAL CLEARANCE SHALL BE MAINTAINED BETWEEN THE CONDUIT AND THE WATER MAIN OR TAP/SERVICE LINE. A MINIMUM OF 3- FEET OF HORIZONTAL CLEARANCE (OUT TO OUT) IS REQUIRED AT LOCATIONS WHERE THE CONDUIT IS PARALLEL TO THE WATER MAIN AND AT LOCATIONS OF WATER MAIN THRUST BLOCKS.

A MINIMUM OF 3 FEET OF HORIZONTAL CLEARANCE (OUT TO OUT) SHALL BE MAINTAINED BETWEEN ALL EXISTING WATER MAINS AND FOUNDATIONS FOR POLES, PULL BOXES, PUSH BUTTON PEDESTALS, AND ANY OTHER MISCELLANEOUS ELECTRICAL STRUCTURE.

**CITY OF COLUMBUS, DIVISION OF WATER GENERAL NOTES: (CONT.)**  
MINIMUM OF 4 FEET OF COVER IS REQUIRED PRIOR TO PRESSURE TESTING ANY WATER MAIN. A SUFFICIENT AMOUNT OF BACKFILL SHALL BE INSTALLED TO PROVIDE THE ADEQUATE RESTRAINT IN AREAS WHERE REQUIRED.

THE PROPOSED WATER MAIN SHALL BE LOCATED A MINIMUM DISTANCE OF TWENTY (20) FEET AWAY FROM ANY EXISTING OR PROPOSED STRUCTURE, OVERHANG OR FOOTER.

FIRE HYDRANT RELOCATIONS SHALL CONFORM TO APPLICABLE SECTIONS OF ITEM 809 OF THE CITY OF COLUMBUS CONSTRUCTION AND MATERIAL SPECIFICATIONS. WORK SHALL CONSIST OF REMOVING THE EXISTING HYDRANT, INSTALLING NEW 6" PIPE AND FITTING AS REQUIRED TO LOCATE THE FIRE HYDRANT 2 FEET FROM BACK OF PROPOSED CURB OR 8 FEET OFF EDGE OF PAVEMENT, RESETTING HYDRANT AND BLOCKING AS REQUIRED. ALL 6" PIPE SHALL BE INSTALLED AT 4'-0" MINIMUM COVER. HYDRANT EXTENSIONS SHALL BE PROVIDED PER ITEM 810, AS REQUIRED. RELOCATED FIRE HYDRANTS SHALL BE ADJUSTED TO PROPER GRADE AND FACED IN THE PROPER DIRECTION. WHEN A HYDRANT IS RELOCATED FIFTEEN (15) FEET OR MORE FROM THE "TYPICAL HYDRANT SETTING" VALVE LOCATION (SEE L-6409 & L-6637), AN ADDITIONAL VALVE SHALL BE INSTALLED, AND RESTRAINED, WITHIN TWO (2) FEET OF THE RELOCATED HYDRANT. PAYMENT IS TO BE INCLUDED UNDER ITEM 809, FIRE HYDRANT RELOCATED.

RELOCATED FIRE HYDRANTS SHALL BE PUT BACK IN SERVICE AS SOON AS POSSIBLE. THE CONTRACTOR SHALL NOTIFY THE DIVISION OF FIRE ALARM OFFICE, 221-3132, WHENEVER FIRE HYDRANTS ARE TAKEN OUT OF SERVICE AND PLACED BACK IN SERVICE. NO TWO (2) ADJACENT FIRE HYDRANTS SHALL BE TAKEN OUT OF SERVICE CONCURRENTLY.

THE CONTRACTOR SHALL COORDINATE HIS WORK SUCH THAT NO WATER CUSTOMER WILL HAVE THEIR SERVICE DISRUPTED MORE THAN TWO (2) TIMES THROUGHOUT THE DURATION OF THIS PROJECT.

IF A LEAD WATER TAP IS ENCOUNTERED AND IS NEITHER DAMAGED NOR PART OF A PLANNED RELOCATION/REPLACEMENT, THE CONTRACTOR SHALL REPORT THE PRESENCE OF THE LEAD TAP TO THE DIVISION OF WATER DISTRIBUTION MAINTENANCE GROUP AT 614-645-7788.

IF A LEAD TAP IS EITHER DAMAGED DURING CONSTRUCTION OR IS PART OF A PLANNED WATER TAP RELOCATION/REPLACEMENT, THE CONTRACTOR SHALL TAKE THE FOLLOWING STEPS:

1. IF DAMAGED, IMMEDIATELY CONTACT LEW FLEMISTER, DIVISION OF WATER, (614-645-7028), TO REQUEST THE SHUT OFF OF THE EXISTING CURB STOP. IF LEW CANNOT BE REACHED, CONTACT THE DIVISION OF WATER DISTRIBUTION ENGINEERING OFFICE AT 614-645-7677 TO REQUEST THE SHUT OFF.
2. CONTRACTOR SHALL EXPOSE THE OWNER'S SIDE OF THE WATER SERVICE TO CONFIRM THE MATERIAL. THE INSPECTOR SHALL BE PRESENT FOR THIS.
3. IF THE CUSTOMER'S PRIVATE SERVICE MATERIAL IS LEAD, STOP WORK AND NOTIFY THE DIVISION OF WATER DISTRIBUTION ENGINEERING OFFICE (614- 645- 7677) IMMEDIATELY. IF THE MATERIAL IS NOT LEAD, THE CONTRACTOR SHALL REPLACE THE LEAD TAP (FROM EXISTING CORPORATION STOP TO CURB STOP) AND REINSTATE SERVICE TO THE CUSTOMER. PARTIAL REPAIRS OF THE LEAD TAP ARE NOT PERMITTED.
4. REFER TO DIVISION OF WATER STANDARD DRAWINGS L-7102C AND L-9901 FOR INFORMATION ON WATER TAP RELOCATIONS, PLACING NEW CURB STOPS, AND RELOCATING CURB BOXES.

THE CONTRACTOR IS REQUIRED TO SUBMIT A SEQUENCE OF CONSTRUCTION TO THE CITY AT THE PRECONSTRUCTION CONFERENCE. THIS SEQUENCE OF CONSTRUCTION SHOULD ALSO DETAIL THE CONTRACTOR'S PLANS FOR TESTING AND CHLORINATION OF THE NEW MAINS, INCLUDING THE SOURCE OF THE WATER AND LOCATION OF TEMPORARY CHLORINATION AND BLOW-OFF TAPS. THE CITY SHALL HAVE THE RIGHT TO APPROVE, REJECT OR MODIFY THE CONSTRUCTION SEQUENCE TO ENSURE THAT THE INTERRUPTIONS ARE HELD TO A MINIMUM. NOTE: THE CITY MAY TAKE UP TO 10 WORKING DAYS TO RESPOND TO THIS SUBMITTAL.

DESIGN AGENCY



DESIGNER  
WLC/CJK

REVIEWER  
KMK 12-01-22

PROJECT ID  
92616

SHEET TOTAL  
P.107 170





SHEET NO.	LOCATION	LENGTH	625					632				633	
			CONDUIT, CONCRETE ENCASED, 3", 725.051, AS PER PLAN	CONDUIT, MISC.: ENCASED INTERCONNECT CONDUIT BANK, TC2, SCH 40, (4)-3" & (1)-1.5"	CONDUIT, MISC.: ENCASED INTERCONNECT CONDUIT BANK, TC2, SCH 80, (4)-3" & (1)-1.5"	TRENCH, AS PER PLAN	PULL BOX, MISC.: PULL BOX, 32"	INTERCONNECT CABLE, MISC.: CMSC 1620 - FIBER OPTIC CABLE, 24 STRAND	CONDUIT RISER, 2" DIAMETER, AS PER PLAN	INTERCONNECT, MISC.: CMSC 1620 - TERMINATION PANEL, 24 FIBER	INTERCONNECT, MISC.: FIBER OPTIC FUSION SPLICE	CONTROLLER ITEM, MISC.: LAYER 2 ETHERNET SWITCH	CONTROLLER ITEM, MISC.: FIBER OPTIC ETHERNET TRANSCEIVER, SHORT RANGE
			FT	FT	FT	FT	EACH	FT	EACH	EACH	EACH	EACH	EACH
	US 23 & RATHMELL ROAD												
134	PB1					1							
134	PB1 TO PB2	459		459		459							
134	PB2					1							
134	PB2 TO PB3	292		292		292							
134	UTILITY POLE (AERIAL SPLICE) TO PULL BOX	78	78			78		128	1		12		
134	PB3 (PULLBOX QUANTIFIED WITH SIGNAL)							150					
134	PB3 TO CABINET	23		23		23		23					
134	CABINET									1		1	1
134	PB3 TO PB4	114			103	103							
134	PB4						1						
134	PB4 TO PB5	356		356		356							
134	PB5						1						
135	PB5 TO PB6	329		329		329							
	PULL BOX 6 (SEE DMS SHEETS)												
135	PB6 TO PB7	202		202		202							
135	PB7						1						
135	PB7 TO PB8	243		243		243							
135	PB8						1						
TOTALS CARRIED TO GENERAL SUMMARY			78	1904	103	2085	6	301	1	1	12	1	1

TRAFFIC SIGNAL INTERCONNECT SUBSUMMARY  
 US-23 (SOUTH HIGH STREET) & CR-121 (RATHMELL ROAD)