


TYPICAL SECTION

Sta. 0+00.00 to Sta. 11+90.00
 Sta. 0+35.83 to Sta. 1+49.10 (Wilson Bridge Road Culvert & RCP)
 Sta. 8+16.41 to Sta. 9+53.29 (Worthington-Galena Culvert, RCP, and Vane)
 Sta. 10+85.20 to Sta. 11+67.23 (Private Drive Culvert & RCP)

Legend

- 1 Item 601 - Crushed Aggregate Slope Protection
- 2 Item 204 - Geotextile Fabric, As Per Plan
- 3 Item 601 - Channel Protection, Misc.: River Rock, As Per Plan
- 4 Item 661 - Live Stakes, 24" Ht., As Per Plan
- 5 Item 659 - Seeding and Mulching, Class 3B
- 6 Item 659 - Seeding and Mulching, Class 1
- 7 Item Special - High Performance Flexible Growth Medium

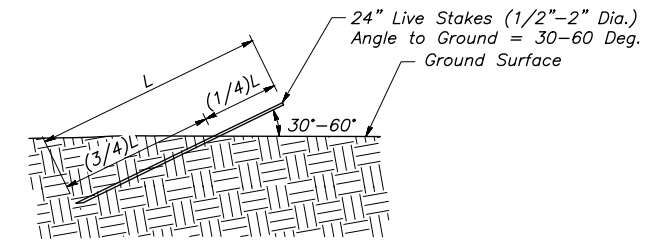

DETAIL A: LIVE STAKE DETAIL
 Not to Scale

RUSH RUN STREAM RESTORATION SUBSUMMARY OF QUANTITIES

ITEM NO.	EXTENSION	QUANTITY	UNIT	DESCRIPTION
203	10000	695	CY	EXCAVATION
* 204	13000	500	CY	EXCAVATION OF SUBGRADE
* 204	20000	500	CY	EMBANKMENT
204	50000	1,010	SY	GEOTEXTILE FABRIC, AS PER PLAN
601	20000	1,010	SY	CRUSHED AGGREGATE SLOPE PROTECTION
601	51000	35	CY	CHANNEL PROTECTION, MISC.: RIVER ROCK, AS PER PLAN
661	99910	4,800	EACH	PLANTING, MISC.: LIVE STAKE, 24 INCH HEIGHT, AS PER PLAN
SPECIAL	98000	1	EACH	ROCK VANE
SPECIAL	98300	5,000	SY	INVASIVE TREATMENT
SPECIAL	98300	1200	SY	HIGH PERFORMANCE FLEXIBLE GROWTH MEDIUM
SPECIAL	98400	LUMP	SUM	DEWATERING, AS PER PLAN
SPECIAL	98400	LUMP	SUM	PROOF SURVEY (RUSH RUN)

- A See Detail A: Live Stakes, this sheet
- B See Planting Zone Notes on sheet 183 for additional information

* CONTINGENCY QUANTITY TO BE USED AS DIRECTED BY THE ENGINEER.
 SEE NORTHEAST GATEWAY GENERAL NOTES FOR SEEDING QUANTITIES.

A:\2016\43\Proj\04\Sheets\Final\Plan\Plan\Restoration_Summary_Sheet.dwg, Last Saved By: emorris, 3/18/2020 8:10 AM, Last Printed By: Morris, Eric, 3/18/2020 8:10 AM (No Xrefs)