

ITEM 614 - MAINTAINING TRAFFIC

CONSTRUCTION OPERATIONS SHALL NOT BEGIN UNTIL ALL TRAFFIC CONTROL IS IN PLACE AND APPROVED BY ODOT PERSONNEL. THE PROJECT ENGINEER SHALL APPROVE ALL TEMPORARY TRAFFIC CONTROL DEVICES FOR CONDITION AND LOCATION BEFORE THE CONTRACTOR WILL BE ALLOWED TO BEGIN WORK. IF THE CONTRACTOR DOES NOT COMPLY WITH THE STANDARDS, HIS PERMIT SHALL BE REVOKED AND ALL WORK SHALL BE TERMINATED.


ALL SIGNS, BARRACADES, SIGN SUPPORTS, DRUMS, FLAGGERS, WORK ZONE TRAFFIC SIGNALS AND INCIDENTALS FOR TRAFFIC CONTROL SHALL BE FURNISHED, ERECTED, MAINTAINED AND REMOVED BY THE CONTRACTOR IN CONFORMANCE WITH THE MOST RECENT REVISIONS, CURRENT EDITION OF THE OHIO MANUAL OF UNIFORM TRAFFIC CONTROL DEVICES FOR STREETS AND HIGHWAYS (OMUTCD). ALL SIGNS USED FOR THE MAINTENANCE OF TRAFFIC SHALL BE NEW OR LIKE NEW CONDITION SUBJECT TO THE APPROVAL OF THE ENGINEER. DEVICES USED TO MAINTAIN TRAFFIC SHALL BE REMOVED IMMEDIATELY AFTER THE TERMINATION OF SAID WORK. PAYMENT SHALL BE INCLUDED IN THE LUMP SUM BID FOR ITEM 614 MAINTAINING TRAFFIC.

FOR WORK WHICH IS CONFINED TO THE SHOULDER, TRAFFIC CONTROL SHALL CONFORM TO FIGURES TA-1, TA-3, TA-4, AND TA-6 OF THE OMUTCD AND SCD MT-95.45. IF THE CONTRACTOR FAILS TO COMPLY WITH THE PROVISIONS FOR TRAFFIC CONTROL AS SET FORTH IN THESE PLANS AND PROVISIONS OF THE OMUTCD AND FAILURE RESULTS IN A CONDITION AT THE WORK SITE WHICH IS UNSAFE FOR TRAFFIC, THE ENGINEER HAS THE AUTHORITY TO SUSPEND WORK UNTIL THE CONTRACTOR COMPLIES WITH THE NECESSARY REQUIREMENTS.

ALL WORK AND TRAFFIC CONTROL DEVICES SHALL BE IN ACCORDANCE WITH CMS 614 AND OTHER APPLICABLE PORTIONS OF THE SPECIFICATIONS, AS WELL AS THE OHIO MANUAL OF UNIFORM TRAFFIC CONTROL DEVICES. PAYMENT FOR ALL LABOR, EQUIPMENT, AND MATERIALS SHALL BE INCLUDED IN THE LUMP SUM CONTRACT PRICE FOR ITEM 614 - MAINTAINING TRAFFIC, UNLESS SEPERATELY ITEMIZED IN THE PLAN.

NOTIFICATION OF CONSTRUCTION INITIATION

AT LEAST FOURTEEN DAYS PRIOR TO STARTING INITIAL CONSTRUCTION ACTIVITIES, THE CONTRACTOR SHALL ADVISE THE DISTRICT OFFICE OF COMMUNICATIONS VIA EMAIL AT D06.PIO@DOT.OHIO.GOV, THE DISTRICT WORK ZONE TRAFFIC MANAGER VIA EMAIL AT D06.MOT@DOT.OHIO.GOV AND THE CENTRAL OFFICE SPECIAL HAUL PERMITS SECTION VIA EMAIL AT HAULING.PERMITS@DOT.OHIO.GOV OF THE ANTICIPATED START DATE OF ANY CONSTRUCTION ACTIVITIES INCLUDING BUT NOT LIMITED TO THE PLACING OF WORK ZONE SIGNS. THE NOTIFICATION SHALL ALSO INCLUDE THE PROJECT NUMBER, PID, NAME AND PHONE NUMBER OF THE CONTRACTOR, A POINT OF CONTACT AND THE ANTICIPATED IMPACT ON TRAFFIC. THE CONTRACTOR WILL IMMEDIATELY INFORM THE DISTRICT OFFICE OF COMMUNICATIONS AND THE DISTRICT WORK ZONE TRAFFIC MANAGER OF ANY AND ALL DELAYS AND/OR CHANGES REGARDING THE CONSTRUCTION INITIATION DATE.

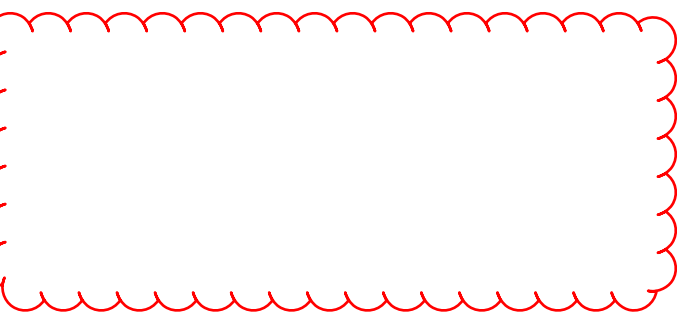

LANE CLOSURE/REDUCTION REQUIRED

LENGTH AND DURATION OF LANE CLOSURES AND RESTRICTIONS SHALL BE AT THE APPROVAL OF THE ENGINEER. IT IS THE INTENT TO MINIMIZE THE IMPACT TO THE TRAVELING PUBLIC. LANE CLOSURES OR RESTRICTIONS OVER SEGMENTS OF THE PROJECT IN WHICH NO WORK IS ANTICIPATED WITHIN A REASONABLE TIME FRAME, AS DETERMINED BY THE ENGINEER, SHALL NOT BE PERMITTED. THE LEVEL OF UTILIZATION OF MAINTENANCE OF TRAFFIC DEVICES SHALL BE COMMENSURATE WITH THE WORK IN PROGRESS.

PRE-MAINTENANCE OF TRAFFIC MEETING

A PRE-MAINTENANCE OF TRAFFIC MEETING SHALL BE HELD (MINIMUM OF 10 WORK DAYS) PRIOR TO WORK BEGINNING OR ANY CHANGE OF PHASING. THIS MEETING SHALL INCLUDE THE DISTRICT WORK ZONE TRAFFIC MANAGER (d06.mot@dot.ohio.gov) AS WELL AS THE CONTRACTOR AND ANY OF HIS SUB-CONTRACTORS INVOLVED WITH TEMPORARY TRAFFIC CONTROL. FOR COLUMBUS SECTIONS OF ROADWAY, ALSO INCLUDE THE TEMPORARY TRAFFIC CONTROL COORDINATOR (614-645-6269 OR 614-645-5845) FROM THE CITY OF COLUMBUS TRANSPORTATION DIVISION.

WEEKLY MAINTENANCE OF TRAFFIC MEETING

AFTER THE INITIAL PRE-MAINTENANCE OF TRAFFIC MEETING, THE CONTRACTOR SHALL MEET WITH THE PROJECT ENGINEER ON A WEEKLY BASIS TO GO OVER A DETAILED MAINTENANCE OF TRAFFIC REPORT OF AT LEAST 7 CALENDAR DAYS. THIS MEETING SHOULD BE HELD ON THE SAME DAY AND TIME OF EACH WEEK.

THE CONTRACTOR WILL PROVIDE TO THE PROJECT ENGINEER A WRITTEN DETAIL OF THE INFORMATION REQUIRED BY THE NOTIFICATION OF TRAFFIC RESTRICTIONS NOTE PRIOR TO THE MEETING.

IN ADDITION TO THE DETAILED MAINTENANCE OF TRAFFIC REPORT THE CONTRACTOR SHALL GIVE A GENERAL LOOK AHEAD OF AN ADDITIONAL 2 WEEKS OF UPCOMING WORK ACTIVITIES. THIS WILL INCLUDE ANY NOTIFICATION REQUIREMENTS FOR RESTRICTIONS THAT HAVE A DURATION GREATER THAN 12 HOURS.

NOTICE OF CLOSURE SIGN

NOTICE OF CLOSURE SIGNS (W20-H13) SHALL BE ERECTED BY THE CONTRACTOR PRIOR TO THE SCHEDULED ROAD OR RAMP CLOSURE IN ACCORDANCE WITH THE NOTICE OF CLOSURE TIME TABLE BELOW. AT THE APPROVAL OF THE ENGINEER, PORTABLE CHANGEABLE MESSAGE SIGNS MAY BE USED IN LIEU OF THE STANDARD FLATSHEET SIGN FOR CLOSURE DURATIONS OF LESS THAN 1 WEEK.

THE SIGNS SHALL BE ERECTED ON THE RIGHT-HAND SIDE OF THE ROAD/RAMP FACING TRAFFIC. THEY SHALL BE PLACED SO AS NOT TO INTERFERE WITH THE VISIBILITY OF ANY OTHER TRAFFIC CONTROL SIGNS. ON ROADWAYS, THEY SHOULD BE ERECTED AT OR NEAR THE POINT OF CLOSURE. THE SIGNS MAY BE ERECTED ANYWHERE ON RAMPS AS LONG AS THEY ARE VISIBLE TO THE MOTORISTS USING THE RAMP. ON ENTRANCE RAMPS, THE SIGN SHALL BE ERECTED WELL IN ADVANCE OF THE MERGE AREA TO AVOID DISTRACTING MOTORISTS.

NOTIFICATION OF CLOSURE SIGN TIME TABLE		
ITEM	DURATION OF CLOSURE	SIGN DISPLAYED TO PUBLIC
RAMP AND ROAD CLOSURES	>= 2 WEEKS	14 CALENDAR DAYS PRIOR TO CLOSURE
	> 12 HOURS AND < 2 WEEKS	7 CALENDAR DAYS PRIOR TO CLOSURE
	<= 12 HOURS	2 BUSINESS DAYS PRIOR TO CLOSURE

THE SIGN SHALL DISPLAY THE DATE OF THE CLOSURE IN MMM-DD FORMAT AND THE NUMBER OF DAYS OF THE CLOSURE. THE LAST LINE OF THE W20-H13 SIGN LISTS A PHONE NUMBER WHICH A MOTORIST MAY CALL FOR ADDITIONAL INFORMATION. THIS IS TO BE A SPECIFIC OFFICE WITHIN THE DISTRICT RATHER THAN THE GENERAL SWITCHBOARD NUMBER.

DUST CONTROL

THE CONTRACTOR SHALL FURNISH AND APPLY WATER FOR DUST CONTROL AS DIRECTED BY THE ENGINEER. THE FOLLOWING ESTIMATED QUANTITY HAS BEEN INCLUDED FOR DUST CONTROL PURPOSES:

ITEM 616 - WATER 1007 M. GAL.

ITEM 614 MAINTAINING TRAFFIC (LANES OPEN DURING HOLIDAYS OR SPECIAL EVENTS)

NO WORK SHALL BE PERFORMED AND THE SAME NUMBER OF LANES AS WERE AVAILABLE AT THE START OF THE PROJECT SHALL BE OPEN TO TRAFFIC DURING THE FOLLOWING DESIGNATED HOLIDAYS OR EVENTS:

CHRISTMAS	FOURTH OF JULY
NEW YEARS	LABOR DAY
MEMORIAL DAY	THANKSGIVING

THE PERIOD OF TIME THAT THE LANES ARE TO BE OPEN DEPENDS ON THE DAY OF THE WEEK ON WHICH THE HOLIDAY OR EVENT FALLS. THE FOLLOWING SCHEDULE SHALL BE USED TO DETERMINE THIS PERIOD:

DAY OF HOLIDAY OR EVENT	TIME ALL LANES MUST BE OPEN TO TRAFFIC
SUNDAY	12:00N FRIDAY THROUGH 6:00 AM MONDAY
MONDAY	12:00N FRIDAY THROUGH 6:00 AM TUESDAY
TUESDAY	12:00N MONDAY THROUGH 6:00 AM WEDNESDAY
WEDNESDAY	12:00N TUESDAY THROUGH 6:00 AM THURSDAY
THURSDAY	12:00N WEDNESDAY THROUGH 6:00 AM FRIDAY
THURSDAY (THANKSGIVING ONLY)	6:00AM WEDNESDAY THROUGH 6:00 AM MONDAY
FRIDAY	12:00N THURSDAY THROUGH 6:00 AM MONDAY
SATURDAY	12:00N FRIDAY THROUGH 6:00 AM MONDAY

SHOULD THE CONTRACTOR FAIL TO MEET ANY OF THESE REQUIREMENTS, THE CONTRACTOR SHALL BE ASSESSED A DISINCENTIVE PER THE LANE VALUE CONTRACT (PN 127).

NOTIFICATION OF TRAFFIC RESTRICTIONS

THROUGHOUT THE DURATION OF THE PROJECT, THE CONTRACTOR SHALL NOTIFY THE PROJECT ENGINEER IN WRITING OF ALL TRAFFIC RESTRICTIONS AND UPCOMING MAINTENANCE OF TRAFFIC CHANGES. THE CONTRACTOR SHALL ENSURE THE WRITTEN NOTIFICATION IS SUBMITTED IN A TIMELY MANNER TO ALLOW THE PROJECT ENGINEER TO MEET THE REQUIRED TIME FRAMES SET FORTH IN THE TABLE BELOW TO INFORM THE SPECIAL HAULING PERMITS SECTION (HAULING.PERMITS@DOT.OHIO.GOV) AND THE DISTRICT PUBLIC INFORMATION OFFICE (PIO). THIS NOTIFICATION SHALL BE RECEIVED BY THE PROJECT ENGINEER PRIOR TO THE PHYSICAL SETUP OF ANY APPLICABLE SIGNS OR MESSAGE BOARDS.

INFORMATION SHOULD INCLUDE, BUT IS NOT LIMITED TO, ALL CONSTRUCTION ACTIVITIES THAT IMPACT OR INTERFERE WITH TRAFFIC AND SHALL LIST THE SPECIFIC LOCATION, TYPE OF WORK, ROAD STATUS, DATE AND TIME OF RESTRICTION, DURATION OF RESTRICTION, NUMBER OF LANES MAINTAINED, NUMBER OF LANES CLOSED, MINIMUM VERTICAL CLEARANCE, MINIMUM WIDTH OF DRIVABLE PAVEMENT, DETOUR ROUTES, IF APPLICABLE, AND ANY OTHER INFORMATION REQUESTED BY THE PROJECT ENGINEER.

NOTIFICATION TIME TABLE		
ITEM	DURATION OF CLOSURE	NOTIFICATION DUE TO PERMITS AND PIO
RAMP AND ROAD CLOSURES	>= 2 WEEKS	21 CALENDAR DAYS PRIOR TO CLOSURE
	> 12 HOURS AND < 2 WEEKS	14 CALENDAR DAYS PRIOR TO CLOSURE
	<= 12 HOURS	4 BUSINESS DAYS PRIOR TO CLOSURE
LANE CLOSURES/RESTRICTIONS	>= 2 WEEKS	14 CALENDAR DAYS PRIOR TO CLOSURE
	< 2 WEEKS	5 BUSINESS DAYS PRIOR TO CLOSURE
START OF CONSTRUCTION & TRAFFIC PATTERN CHANGES	N/A	14 CALENDAR DAYS PRIOR TO IMPLEMENTATION

ANY UNFORSEEN CONDITIONS NOT SPECIFIED IN THE PLANS REQUIRING TRAFFIC RESTRICTIONS SHALL ALSO BE REPORTED TO THE PROJECT ENGINEER USING THE NOTIFICATION TIME TABLE.

DRUM REQUIREMENTS

IN ADDITION TO THE REQUIREMENTS OF THE PLANS, SPECIFICATION AND PROPOSAL, DRUMS FURNISHED BY THE CONTRACTOR SHALL BE NEW AND UNUSED AT THE TIME OF ARRIVAL ON THE PROJECT. ANY DRUMS BROUGHT ON THE PROJECT, WHICH HAVE PREVIOUSLY BEEN USED ELSEWHERE, WILL NOT BE ACCEPTED. DRUMS SHALL ALSO BE DOUBLE BALLASTED.

PAYMENT FOR DRUMS SHALL BE INCLUDED IN THE LUMP SUM PRICE BID FOR MAINTAINING TRAFFIC UNLESS SEPARATELY ITEMIZED.

ITEM 614 - REPLACEMENT SIGN

FLATSHEET SIGNS FURNISHED BY THE CONTRACTOR IN ACCORDANCE WITH THE REQUIREMENTS OF THE PLANS, SPECIFICATIONS AND PROPOSAL WHICH BECOME DAMAGED BY TRAFFIC FOR REASONS BEYOND THE CONTROL OF THE CONTRACTOR SHALL BE REPLACED IN KIND WHEN ORDERED BY THE ENGINEER. REPLACEMENT SIGNS SHALL BE NEW. OTHER MATERIALS MAY BE USED, BUT GOOD, CONDITION SUBJECT TO APPROVAL BY THE ENGINEER.

PAYMENT FOR THE NEW SIGNS SHALL BE MADE AT THE CONTRACT PRICE PER EACH FOR ITEM 614, REPLACEMENT SIGN, AND SHALL INCLUDE THE COST OF REMOVING AND DISPOSING OF DAMAGED SIGNS, HARDWARE AND SUPPORTS, AND PROVIDING THE NECESSARY REPLACEMENT HARDWARE, SUPPORTS, ETC.

AN ESTIMATED QUANTITY OF 50 EACH HAS BEEN CARRIED TO THE GENERAL SUMMARY.

ITEM 614 - REPLACEMENT DRUM

DRUMS FURNISHED BY THE CONTRACTOR IN ACCORDANCE WITH THE REQUIREMENTS OF THE PLANS, SPECIFICATIONS AND PROPOSAL WHICH BECOME DAMAGED BY TRAFFIC FOR REASONS BEYOND THE CONTROL OF THE CONTRACTOR SHALL BE REPLACED IN KIND WHEN ORDERED BY THE ENGINEER. REPLACEMENT DRUMS SHALL BE NEW.

PAYMENT FOR THE NEW DRUMS SHALL BE MADE AT THE CONTRACT PRICE PER EACH FOR ITEM 614, REPLACEMENT DRUM, AND SHALL INCLUDE THE COST OF REMOVING AND DISPOSING OF THE DAMAGED DRUM, AND PROVIDING AND MAINTAINING THE REPLACEMENT DRUM IN ACCORDANCE WITH THE CONTRACT REQUIREMENTS FOR THE ORIGINAL DRUM.

AN ESTIMATED QUANTITY OF 300 EACH HAS BEEN CARRIED TO THE GENERAL SUMMARY.

FLOODLIGHTING

FLOODLIGHTING OF THE WORK SITE FOR OPERATIONS CONDUCTED DURING NIGHTTIME PERIODS SHALL BE ACCOMPLISHED SO THAT THE LIGHTS DO NOT CAUSE GLARE TO THE DRIVERS ON THE ROADWAY. TO ENSURE THE ADEQUACY OF THE FLOODLIGHT PLACEMENT, THE CONTRACTOR AND THE ENGINEER SHALL DRIVE THROUGH THE WORK SITE EACH NIGHT WHEN THE LIGHTING IS IN PLACE AND OPERATIVE PRIOR TO COMMENCING ANY WORK. IF GLARE IS DETECTED, THE LIGHT PLACEMENT AND SHIELDING SHALL BE ADJUSTED TO THE SATISFACTION OF THE ENGINEER BEFORE WORK PROCEEDS.

PAYMENT FOR ALL LABOR, EQUIPMENT AND MATERIALS SHALL BE INCLUDED IN THE LUMP SUM CONTRACT PRICE FOR ITEM 614 - MAINTAINING TRAFFIC.

MAINTENANCE OF TRAFFIC FOR MARKING PAVEMENT REPAIRS

PROVIDE LANE CLOSURES AS PER THE MAINTENANCE OF TRAFFIC NOTES IN THESE PLANS A MINIMUM OF 24 HOURS PRIOR TO PERFORMING PAVEMENT REPAIRS TO ALLOW THE ENGINEER TO IDENTIFY AND MARK THE AREAS OF THE PAVEMENT IN NEED OF REPAIRS.

PAYMENT FOR ALL LABOR, EQUIPMENT, MATERIALS, LEO HOURS, AND INCIDENTALS NEEDED TO PERFORM THE ABOVE LISTED WORK IS CONSIDERED INCIDENTAL TO MAINTAINING TRAFFIC ON THE PROJECT AND WILL BE INCLUDED IN THE LUMP SUM BID PRICE FOR ITEM 614 MAINTAINING TRAFFIC.

DELINEATION OF PORTABLE AND PERMANENT BARRIER

BARRIER REFLECTORS AND OBJECT MARKERS SHALL BE INSTALLED ON ALL PORTABLE BARRIER (PB) USED FOR TRAFFIC CONTROL; AND, ON PERMANENT CONCRETE BARRIER (INCLUDING BRIDGE PARAPETS) LOCATED WITHIN 5 FEET OF THE EDGE OF THE ADJACENT TRAVEL LANE.

BARRIER REFLECTORS SHALL CONFORM TO C&MS 626, EXCEPT THAT THE SPACING SHALL BE AS PER TRAFFIC SCD MT-101.70. OBJECT MARKERS AND THEIR INSTALLATION SHALL CONFORM TO C&MS 614.03 AND SCD MT-101.70. WHEN THE PB CONTAINS GLARE SCREEN, ONE SET OF THREE VERTICAL STRIPES OF SHEETING SHALL BE CONSIDERED EQUIVALENT TO AN OBJECT MARKER, ONE-WAY.

INCREASED BARRIER DELINEATION, AS SPECIFIED HEREIN, SHALL BE INSTALLED ON ALL PB AND PERMANENT CONCRETE BARRIER LOCATED WITHIN 5 FEET OF THE EDGE OF THE TRAVELED LANE UNDER EITHER OF THE FOLLOWING CONDITIONS: ALONG TAPERS AND TRANSITION AREAS; OR ALONG CURVES (OUTSIDE ONLY) WITH DEGREE OF CURVATURE GREATER THAN OR EQUAL TO 3 DEGREES.

THE INCREASED BARRIER DELINEATION SHALL CONSIST OF EITHER DELINEATION PANELS OR THE TRIPLE STACKING OF WORK ZONE BARRIER REFLECTORS.

DELINEATION PANELS SHALL CONSIST OF PANELS OF DELINEATION, APPROXIMATELY 34 INCHES LONG AND 6 INCHES WIDE AND SHALL BE "CRIMPED." PANELS SHALL BE INSTALLED AND SPACED PER TRAFFIC SCD MT101.70.

TRIPLE-STACKED BARRIER REFLECTORS SHALL CONSIST OF ALIGNING THREE BARRIER REFLECTORS VERTICALLY, AT LOCATIONS WHERE A SINGLE BARRIER REFLECTOR WOULD BE OTHERWISE ATTACHED. THERE SHALL BE NO OPEN SPACE BETWEEN THE ADJACENT BARRIER REFLECTORS. THE TRIPLE-STACKED BARRIER REFLECTORS SHALL CONFORM TO C&MS 626, EXCEPT THAT THEY SHALL BE SPACED AND ALIGNED PER TRAFFIC SCD MT101.70.

THE FOLLOWING ESTIMATED QUANTITIES HAVE BEEN INCLUDED IN THE PLANS AND CARRIED TO THE GENERAL SUMMARY:

ITEM 614, BARRIER REFLECTOR, TYPE 1 (ONE-WAY OR BI-DIRECTIONAL) 2425 EACH
ITEM 614, OBJECT MARKER, ONE-WAY 832 EACH
ITEM 614, INCREASED BARRIER DELINEATION 41560 FEET

PAYMENT SHALL BE FULL COMPENSATION FOR ALL MATERIAL, LABOR, INCIDENTALS AND EQUIPMENT NECESSARY FOR FURNISHING, INSTALLING, MAINTAINING AND REMOVING EACH OF THE ABOVE ITEMS.

ALONG RUNS OF INCREASED BARRIER DELINEATION WHERE THIS ITEM IS PROVIDED, THE QUANTITY SHALL BE MEASURED AS THE ENTIRE LENGTH OF THE RUN OF INCREASED BARRIER DELINEATION, INCLUDING THE SPACES BETWEEN THE INDIVIDUAL DELINEATION PANELS OR STACKS OF BARRIER REFLECTORS.

DELINEATION OF TEMPORARY AND PERMANENT GUARDRAIL

BARRIER REFLECTORS SHALL BE INSTALLED ON ALL TEMPORARY GUARDRAIL USED FOR TRAFFIC CONTROL; AND, ON ALL PERMANENT GUARDRAIL LOCATED WITHIN 5 FEET OF THE EDGE OF THE ADJACENT TRAVEL LANE. BARRIER REFLECTORS SHALL CONFORM TO C&MS 626 AND THE SPACING SHALL BE APPROXIMATELY 50 FEET.

OBJECT MARKERS SHALL BE INSTALLED ON ALL TEMPORARY AND PERMANENT GUARDRAIL LOCATED WITHIN 5 FEET OF THE EDGE OF THE ADJACENT TRAVEL LANE. GUARDRAIL-MOUNTING OF OBJECT MARKERS SHALL BE MADE BY INSTALLING THE OBJECT MARKERS ON THE EXTENSION BLOCKS RATHER THAN DIRECTLY ONTO THE GUARDRAIL ITSELF. OBJECT MARKERS SHALL CONFORM TO C&MS 614.03 AND THE SPACING SHALL BE APPROXIMATELY 50 FEET WITH A 25 FOOT OFFSET FROM THE BARRIER REFLECTORS.

THE FOLLOWING ESTIMATED QUANTITIES HAVE BEEN INCLUDED IN THE PLANS AND CARRIED TO THE GENERAL SUMMARY:

ITEM 614, BARRIER REFLECTOR, TYPE 2, ONE-WAY 497 EACH
ITEM 614, OBJECT MARKER, ONE-WAY 497 EACH

PAYMENT SHALL BE FULL COMPENSATION FOR ALL MATERIAL, LABOR, INCIDENTALS AND EQUIPMENT NECESSARY FOR FURNISHING, INSTALLING, MAINTAINING AND REMOVING THE ABOVE ITEMS.

ITEM 614 - WORK ZONE RAISED PAVEMENT MARKER, AS PER PLAN

WORK ZONE RAISED PAVEMENT MARKERS, AS PER PLAN, AND THEIR INSTALLATION SHALL CONFORM TO C&MS 614 OR C&MS 621 AS SPECIFIED HEREIN.

- RAISED PAVEMENT MARKERS IN USE DURING THE SNOW-PLOWING SEASON SHALL CONFORM TO 621.
- RAISED PAVEMENT MARKERS IN USE DURING THE NON-SNOW-PLOW SEASON SHALL CONFORM TO EITHER 614 OR TO 621.

THE SNOW-PLOWING SEASON SHALL RUN FROM OCTOBER 15 THROUGH APRIL 1.

IF PROJECT DELAYS, NOT THE FAULT OF ODOT, CAUSE THE WORK TO EXTEND INTO THE SNOW-PLOWING SEASON, THE CONTRACTOR SHALL BE RESPONSIBLE FOR REPLACING WORK ZONE RAISED PAVEMENT MARKERS (WZRPMS) CONFORMING TO C&MS 614, WITH RAISED PAVEMENT MARKERS CONFORMING TO 621, AS DETERMINED BY THE ENGINEER, AT THE CONTRACTOR'S EXPENSE.

THIS ITEM SHALL INCLUDE PURCHASE, INSTALLATION AND REMOVAL OF ITEM 614 WORK ZONE RAISED PAVEMENT MARKER, AS PER PLAN, INCLUDING FILLING OF ANY DEPRESSIONS CREATED IN THE PAVEMENT AS PER C&MS 621.08.

RESURFACING OF THE TRANSITION AREAS SHALL BE PERFORMED AT THE TIME THAT THE SURFACE COURSE IS BEING APPLIED TO THE ENTIRE PROJECT. PRIOR TO APPLICATION OF THE SURFACE COURSE ON THE PROJECT, THE EXISTING PAVEMENT WITHIN THE TRANSITION AREA SHALL BE REMOVED TO A DEPTH NECESSARY TO REACH THE LEVEL OF THE INTERMEDIATE COURSE OF THE PAVEMENT, AS DETERMINED BY THE ENGINEER.

AN ESTIMATED QUANTITY HAS BEEN PROVIDED IN THE MAINTENANCE OF TRAFFIC SUBSUMMARY.

ITEM 614 - WORK ZONE PAVEMENT MARKING MISC.: DOTTED LINE, CLASS 1, 12", 807 PAINT

IN ADDITION TO THE REQUIREMENT OF ITEM 614 THE PAVEMENT MARKINGS SHALL BE PER ODOT ITEM 807 PAINT.

PAYMENT FOR THIS ITEM SHALL BE AT THE CONTRACT UNIT PRICE BID PER FT, INSTALLED AND MAINTAINED.

LANE VALUE CONTRACT TABLE

THE CONTRACTOR SHALL BE ASSESSED A DISINCENTIVE AS DESIGNATED IN THE LANE VALUE CONTRACT TABLE FOR EACH UNIT OF TIME A LANE/SHOULDER/RAMP IS CLOSED BY THE CONTRACTOR'S ACTION WHILE NOT OTHERWISE PERMITTED BY THE LANE VALUE CONTRACT TABLE.

Table with columns: Section (SLM), Existing Number of Lanes per Direction, Lane Reduction, Mon to Fri, Sat, Sun, Disincentive Amounts per minute per lane. Includes sections like College Avenue, Hamilton Road, I-270, Brice Road, and Fairfield County line.

Table with columns: Section (SLM), Existing Number of Lanes per Direction, Lane Reduction, Mon to Fri, Sat, Sun, Disincentive Amounts per minute per lane. Includes sections like SR 317, US 40, Livingston Avenue, and Noe Bixby Road.

c:\pwworking\pi11\16073448\95639_MN001.dgn 3/22/2022 11:00 PM tofman

CALCULATED
BPT
CHECKED
EMW

MAINTENANCE OF TRAFFIC NOTES

FRA-70-22.61

c:\pwworking\pitt@d1607344\95639_MS0001.dgn 3/22/2022 11:05 PM To:man

CALCULATED
BPT
CHECKED
EMW

MAINTENANCE OF TRAFFIC SUBSUMMARY

FRA - 70 - 22.61

ITEM	EXTENSION	TOTAL FROM SHEET					TOTAL	UNIT	DESCRIPTION	SEE SHEET
		55	56	57	58	59				
202	35100			68			68	FT	PIPE REMOVED, 24" AND UNDER	
611	04400			68			68	FT	12" CONDUIT, TYPE B	
614	11000						LS		MAINTAINING TRAFFIC	46
614	11110						1000	HOUR	LAW ENFORCEMENT OFFICER WITH PATROL CAR FOR ASSISTANCE	50
614	11630						41560	FT	INCREASED BARRIER DELINEATION	47
614	12380						33	EACH	WORK ZONE IMPACT ATTENUATOR, 24" WIDE HAZARDS, (UNIDIRECTIONAL)	51
614	12420						LS		DETOUR SIGNING	
614	12484						42	EACH	WORK ZONE INCREASED PENALTIES SIGN	50
614	12500						50	EACH	REPLACEMENT SIGN	46
614	12600						300	EACH	REPLACEMENT DRUM	46
614	12801						2487	EACH	WORK ZONE RAISED PAVEMENT MARKER, AS PER PLAN	47
614	13310						2425	EACH	BARRIER REFLECTOR, TYPE 1, ONE-WAY	47
614	13312						187	EACH	BARRIER REFLECTOR, TYPE 2, ONE-WAY	47
614	13350						1329	EACH	OBJECT MARKER, ONE WAY	47
614	18601						2	SNMT	PORTABLE CHANGEABLE MESSAGE SIGN, AS PER PLAN	49
614	20056	0.43	1.93	2.82	4.77	4.77	14.72	MILE	WORK ZONE LANE LINE, CLASS I, 6", 807 PAINT	
614	21050	0.81					0.81	MILE	WORK ZONE CENTER LINE, CLASS I, 807 PAINT, DOUBLE SOLID	
614	22056	1.81	3.88	2.10	3.82	3.76	15.37	MILE	WORK ZONE, EDGE LINE, CLASS I, 6", 807 PAINT, WHITE	
614	22056	1.08	3.98	1.88	3.96	3.19	14.09	MILE	WORK ZONE, EDGE LINE, CLASS I, 6", 807 PAINT, YELLOW	
614	23110	4898	16160	8727	9886	6846	46517	FT	WORK ZONE CHANNELIZING LINE, CLASS I, 12", 807 PAINT	
614	24102	907			2290	12110	15307	FT	WORK ZONE DOTTED LINE, CLASS I, 6", 807 PAINT	
614	25200	397	294	399	126		1216	FT	WORK ZONE TRANSVERSE/DIAGONAL LINE, CLASS I, 642 PAINT	
614	98000				0.05	3.10	3.15	MILE	WORK ZONE PAVEMENT MARKING, MISC.: LANE LINE, CLASS I, 5" 642 PAINT	48
614	98000	0.94			0.09		1.03	MILE	WORK ZONE PAVEMENT MARKING, MISC.: EDGE LINE, CLASS I, 5", 642 PAINT, WHITE	48
614	98000	0.02					0.02	MILE	WORK ZONE PAVEMENT MARKING, MISC.: EDGE LINE, CLASS I, 5", 740.06, TYPE I, YELLOW	48
614	98100				394		394	FT	WORK ZONE PAVEMENT MARKING, MISC.: CHANNELIZING LINE, CLASS I, 10" PAINT	48
614	98100	69					69	FT	WORK ZONE PAVEMENT MARKING, MISC.: DOTTED LINE, 5", 740.06, TYPE I	48
614	98100	1659	1703	977	1308		5647	FT	WORK ZONE PAVEMENT MARKING, MISC.: DOTTED LINE, CLASS I, 12" 807 PAINT	47
614	98100	12					12	FT	WORK ZONE PAVEMENT MARKING, MISC.: STOP LINE, 20", 642 PAINT	48
615	10000						LS		ROADS FOR MAINTAINING TRAFFIC	47
615	25000						10106	SY	PAVEMENT FOR MAINTAINING TRAFFIC, CLASS B	
616	10000						1007	MGAL	WATER	
622	41050	4050	8900	8640	14490	5480	2	EACH	PORTABLE BARRIER, "Y" CONNECTOR	
622	41100	4050	8900	8640	14490	5480	41560	FT	PORTABLE BARRIER, UNANCHORED	
808	18700						120	SNMT	DIGITAL SPEED LIMIT (DSL) SIGN ASSEMBLY	49
TOTALS CARRIED TO GENERAL SUMMARY, SHEET 210										

c:\pwworking\pitt@d1607344\B95639_MS0001.dgn 3/11/2022 4:01:46 PM To:man

REF NO.	SHEET NO.		LOCATION	STATION TO STATION		614	614	614	614	614	614	614	614	614	614	614	614	614	622		
				TO	TO	WORK ZONE LANE LINE, CLASS I, 6", 807 PAINT	WORK ZONE CENTER LINE, CLASS I, 807 PAINT, DOUBLE SOLID	WORK ZONE, EDGE LINE, CLASS I, 6", 807 PAINT, WHITE	WORK ZONE, EDGE LINE, CLASS I, 6", 807 PAINT, YELLOW	WORK ZONE CHANNELIZING LINE, CLASS I, 12", 807 PAINT	WORK ZONE DOTTED LINE, CLASS I, 6", 807 PAINT	WORK ZONE PAVEMENT MARKING, MISC.: DOTTED LINE, CLASS I, 12" 807 PAINT	WORK ZONE TRANSVERSE/DIAGONAL LINE, CLASS I, 642 PAINT	WORK ZONE PAVEMENT MARKING, MISC.: LANE LINE, CLASS I, 5" 642 PAINT	WORK ZONE PAVEMENT MARKING, MISC.: EDGE LINE, CLASS I, 5", 740.06, TYPE I, YELLOW	WORK ZONE PAVEMENT MARKING, MISC.: CHANNELIZING LINE, CLASS I, 10" PAINT	WORK ZONE PAVEMENT MARKING, MISC.: DOTTED LINE, 5", 740.06, TYPE I	WORK ZONE PAVEMENT MARKING, MISC.: STOP LINE, 20", 642 PAINT	PORTABLE BARRIER, UNANCHORED		
		TO			TO	MILE	MILE	MILE	MILE	FT	FT	FT	FT	MILE	MILE	MILE	FT	FT	FT	FT	
PHASE 1																					
ELW-1	68	TO	81	RAMP	2055+25.00	TO	1083+09.00														
PB-1	70	TO	70	RAMP	100+31.00	TO	103+31.00													320	
ELW-2	70	TO	72	RAMP	1016+93.00	TO	104+31.00		0.18												
PB-1	70	TO	70	IR-70	531+49.00	TO	534+89.00													340	
CH-1	72	TO	73	IR-270	1028+17.00	TO	1039+89.00					1156									
ELY-1	73	TO	75	IR-270	1031+17.00	TO	1069+97.00				0.73										
ELW-3	73	TO	73	IR-270	1031+17.00	TO	1035+92.00		0.09												
CH-2	73	TO	74	IR-270	1035+92.00	TO	1046+00.00					990									
CV-1	73	TO	73	IR-270	1035+92.00	TO	1043+09.00						397								
CH-3	73	TO	73	IR-270	1035+94.00	TO	1043+09.00					704									
ELY-2	73	TO	81	RAMP	1035+94.00	TO	2039+08.00		0.35												
PB-3	73	TO	81	RAMP	2035+10.00	TO	1059+29.00													3390	
LL-1	73	TO	75	IR-270	1039+89.00	TO	1062+75.00	0.43													
DL-1	74	TO	75	IR-270	1046+00.00	TO	1062+75.00						1659								
CH-4	75	TO	76	IR-270	1062+75.00	TO	1073+98.00					1024									
CH-5	75	TO	76	IR-270	1062+75.00	TO	1073+98.00					1024									
DL6-1	76	TO	77	IR-270	1077+05.00	TO	1086+12.00						907								
ELW-4	82	TO	83	SCARBOROUGH BLVD	30+29.07	TO	36+00.00									0.12					
CL-1	82	TO	87	SCARBOROUGH BLVD	30+29.07	TO	55+67.00		0.49												
ELW-5	82	TO	87	SCARBOROUGH BLVD	30+29.07	TO	55+67.00									0.49					
DL6-1	87	TO	87	SCARBOROUGH BLVD	55+67.00	TO	56+33.00												69		
ELY-3	87	TO	87	SCARBOROUGH BLVD	56+33.00	TO	57+12.00									0.02					
PHASE 1A																					
ELW-6	90	TO	91	SCARBOROUGH BLVD	29+68.00	TO	37+00.00									0.14					
CL-2	90	TO	93	SCARBOROUGH BLVD	29+68.00	TO			0.32												
ELW-7	91	TO	93	SCARBOROUGH BLVD	39+36.00	TO	47+70.00									0.16					
SL-1	93	TO	93	SCARBOROUGH BLVD	46+44.00	TO	46+44.00													12	
ELW-8	93	TO	93	SCARBOROUGH BLVD	55+59.00	TO	56+66.00									0.03					
TOTALS CARRIED TO SUMMARY SHEET						54		0.43	0.81	1.81	1.08	4898	907	1659	397		0.94	0.02	69	12	4050

CALCULATED BPT CHECKED EMW	MAINTENANCE OF TRAFFIC PHASE 1 SUBSUMMARY	FRA - 70 - 22.61	55 1199
-------------------------------------	--	------------------	------------

c:\pwworking\pitt\1607344\95639_MS0001.dgn 3/11/2022 4:01:47 PM ToTman

REF NO.	SHEET NO.		LOCATION	STATION TO STATION	202	611	614	614	614	614	614	614	614	614	614	614	614	614	614	622
					PIPE REMOVED, 24" AND UNDER FT	12" CONDUIT, TYPE B FT	WORK ZONE LANE LINE, CLASS I, 6", 807 PAINT MILE	WORK ZONE CENTER LINE, CLASS I, 1, 807 PAINT, DOUBLE SOLID MILE	WORK ZONE, EDGE LINE, CLASS I, 6", 807 PAINT, WHITE MILE	WORK ZONE, EDGE LINE, CLASS I, 6", 807 PAINT, YELLOW MILE	WORK ZONE CHANNELIZING LINE, CLASS I, 12", 807 PAINT FT	WORK ZONE DOTTED LINE, CLASS I, 6", 807 PAINT FT	WORK ZONE PAVEMENT MARKING, MISC.: DOTTED LINE, CLASS I, 12" 807 PAINT FT	WORK ZONE TRANSVERSE/DIAGONAL LINE, CLASS I, 642 PAINT FT	WORK ZONE PAVEMENT MARKING, MISC.: LANE LINE, CLASS I, 5" 642 PAINT MILE	WORK ZONE PAVEMENT MARKING, MISC.: EDGE LINE, CLASS I, 5", 642 PAINT, WHITE MILE	WORK ZONE PAVEMENT MARKING, MISC.: EDGE LINE, CLASS I, 5",740.06, TYPE I, YELLOW MILE	WORK ZONE PAVEMENT MARKING, MISC.: CHANNELIZING LINE, CLASS I, 10" PAINT FT	WORK ZONE PAVEMENT MARKING, MISC.: DOTTED LINE, 5", 740.06, TYPE I FT	WORK ZONE PAVEMENT MARKING, MISC.: STOP LINE, 20", 642 PAINT FT
PHASE 3																				
ELW-1	121	TO 121	RAMP	506+60.00 TO 510+11.00					0.08											
CH-1	121	TO 146	RAMP	505+90.00 TO 996+21.00						621										
CV-1	121	TO 121	RAMP	508+41.00 TO 996+00.00									134							
CH-2	121	TO 121	RAMP	508+41.00 TO 510+21.00						215										
ELY-1	123	TO 134	IR-70	526+81.00 TO 596+69.00								1.33								
CH-3	123	TO 122	IR-70	523+81.00 TO 535+84.00									1204							
CH-4	123	TO 122	IR-70	526+81.00 TO 535+84.00									905							
ELW-2	123	TO 122	IR-70	526+81.00 TO 532+86.00					0.12											
CH-5	123	TO 122	IR-70	532+86.00 TO 107+68.51									233							
LL-1	123	TO 134	IR-70	535+84.00 TO 588+69.00			1.01													
LL-2	123	TO 134	IR-70	535+84.00 TO 588+69.00			1.01													
LL-3	123	TO 133	IR-70	535+19.00 TO 577+35.00			0.8													
ELY-2	123	TO 122	RAMP	100+00.00 TO 105+41.00								0.11								
ELW-3	123	TO 133	IR-70	100+00.00 TO 578+25.00					0.97											
CH-6	123	TO 122	RAMP	105+41.00 TO 107+68.51									226							
PB-1	123	TO 122	RAMP	106+95.00 TO 107+35.00															40	
PB-2	123	TO 131	IR-70	535+49.00 TO 552+13.00															1670	
DT101	123	TO 123	RAMP						68	68										
PB-3	131	TO 131	IR-70	552+03.00 TO 558+63.00															660	
PB-4	131	TO 149	IR-70	559+83.00 TO 9+88.00															3430	
DL-1	132	TO 133	IR-70	572+26.00 TO 576+47.00										420						
CH-7	133	TO 133	IR-70	576+47.00 TO 580+23.00										375						
CH-8	133	TO 133	RAMP C1	576+47.00 TO 578+25.00										179						
DL-2	133	TO 133	RAMP G2	577+35.00 TO 582+92.00																
ELW-4	133	TO 133	RAMP G2	580+23.00 TO 587+61.00					0.14					557						
CH-9	133	TO 134	IR-70	582+92.00 TO 589+02.00										610						
CH-10	133	TO 134	RAMP G2	582+92.00 TO 589+12.00										621						
CH-11	134	TO 134	IR-70	588+69.00 TO 599+69.00										1100						
CH-12	134	TO 134	RAMP G1	588+69.00 TO 599+69.00										1100						
ELW-5	134	TO 134	IR-70	591+69.00 TO 596+69.00					0.15											
PB-5	134	TO 134	IR-70	589+02.00 TO 591+69.00																
PB-6	134	TO 155	RAMP G1	589+02.00 TO 8599+07.00															260	
ELY-3	134	TO 155	RAMP G1	589+12.00 TO 8600+01.00								0.15							720	
PB-7	134	TO 134	IR-70	596+69.00 TO 598+93.00															230	
PB-8	134	TO 155	RAMP G2	1107+73.00 TO 1115+46.00															790	
ELY-4	134	TO 155	RAMP G2	1106+89.00 TO 1115+46.00								0.17								
CH-13	134	TO 134	RAMP G2	1115+46.00 TO 1116+42.00										110						
ELW-6	140	TO 141	RAMP A2	2006+61.00 TO 2986+80.71					0.16											
ELY-5	140	TO 140	RAMP A2	2006+61.00 TO 2012+47.00								0.12								
CH-14	140	TO 141	RAMP A2	2006+61.00 TO 2986+80.71										825						
CV-2	140	TO 141	RAMP A2	2006+61.00 TO 2986+80.71																
CH-15	140	TO 141	RAMP A2	2006+61.00 TO 2986+80.71										403						
ELW-7	146	TO 147	RAMP D2	996+21.00 TO 1021+09.00					0.48											
PB-9	147	TO 147	RAMP D2	1013+90.00 TO 1022+44.00															840	
TOTALS CARRIED TO SUMMARY SHEET					54	68	68	2.82	2.10	1.88	8727	977	399							8640

MAINTENANCE OF TRAFFIC PHASE 3 SUBSUMMARY

FRA-70-22.61

CALCULATED
BPT
CHECKED
EMW

c:\pwworking\p11\BID\607344B\95639_MS0001.dgn 3/21/2022 12:08:10 PM totman



REF NO.	SHEET NO.			LOCATION	STATION TO STATION		614	614	614	614	614	614	614	614	614	614	614	614	622					
							WORK ZONE LANE LINE, CLASS I, 6", 807 PAINT	WORK ZONE CENTER LINE, CLASS I, 807 PAINT, DOUBLE SOLID	WORK ZONE, EDGE LINE, CLASS I, 6", 807 PAINT, WHITE	WORK ZONE, EDGE LINE, CLASS I, 6", 807 PAINT, YELLOW	WORK ZONE CHANNELIZING LINE, CLASS I, 12", 807 PAINT	WORK ZONE DOTTED LINE, CLASS I, 6", 807 PAINT	WORK ZONE PAVEMENT MARKING, MISC.: DOTTED LINE, CLASS I, 12" 807 PAINT	WORK ZONE TRANSVERSE/DIAGONAL LINE, CLASS I, 642 PAINT	WORK ZONE PAVEMENT MARKING, MISC.: LANE LINE, CLASS I, 5" 642 PAINT	WORK ZONE PAVEMENT MARKING, MISC.: EDGE LINE, CLASS I, 5", 740.06, TYPE I, YELLOW	WORK ZONE PAVEMENT MARKING, MISC.: CHANNELIZING LINE, CLASS I, 10" PAINT	WORK ZONE PAVEMENT MARKING, MISC.: DOTTED LINE, 5", 740.06, TYPE I	WORK ZONE PAVEMENT MARKING, MISC.: STOP LINE, 20", 642 PAINT	PORTABLE BARRIER, UNANCHORED				
PHASE 4																								
MILE	MILE	MILE	MILE	FT	FT	FT	FT	FT	FT	FT	FT	FT	FT	FT	FT	FT	FT	FT	FT	FT	FT	FT		
ELY-1	159	TO	171	IR-70	494+20.00	TO	644+05.00				2.87													
CH-1	159	TO	160	IR-70	491+24.00	TO	505+97.00					1381												
CH-2	159	TO	160	IR-70	497+20.00	TO	501+99.00					480												
CH-3	159	TO	160	IR-70	497+20.00	TO	499+89.00					269												
CV-1	159	TO	160	IR-70	497+20.00	TO	500+99.00							126										
LL-1	160	TO	170	IR-70	505+97.00	TO	638+15.00	2.53																
ELW-1	160	TO	163	IR-70	501+99.00	TO	539+37.00			0.71														
PB-1	160	TO	161	IR-70	501+90.00	TO	522+29.00															2040		
PB-2	160	TO	160	IR-70	501+90.00	TO	505+58.00															390		
PB-3	162	TO	162	IR-70	531+59.00	TO	534+88.00															320		
ELY-2	162	TO	174	RAMP	1016+93.00	TO	532+00.00			0.18														
PB-4	162	TO	162	RAMP	527+93.00	TO	531+02.00															320		
LL-2	162	TO	176	RAMP A2	3011+50.00	TO	3033+20.00	0.4																
CH-4	163	TO	164	IR-70	539+37.00	TO	549+36.00					1000												
CH-5	163	TO	164	RAMP	539+37.00	TO	549+36.00					1001												
ELW-2	163	TO	164	RAMP	539+37.00	TO	557+52.00			0.19														
LL-3	163	TO	176	RAMP C1	3011+50.00	TO	6033+97.00	0.15																
DL6-1	163	TO	164	RAMP C1	6033+97.00	TO	6039+98.00					815												
ELW-3	163	TO	180	RAMP C1	6033+97.00	TO	8+31.00			0.93														
LL-4	164	TO	170	IR-70	549+36.00	TO	638+15.00	1.69																
CH-6	164	TO	165	IR-70	557+52.00	TO	569+34.00					1182												
CH-7	164	TO	165	RAMP A2	557+52.00	TO	569+34.00					1182												
DL6-2	164	TO	165	RAMP A2	557+52.00	TO	564+77.00					815												
ELW-4	164	TO	180	RAMP A2	3041+72.00	TO	8599+00.00			0.83														
ELY-3	164	TO	180	RAMP C2	3048+17.00	TO	8+58.00			0.66														
DL-1	165	TO	166	IR-70	569+34.00	TO	582+92.00							1308										
PB-5	165	TO	180	IR-70	570+92.00	TO	8598+19.00															2410		
PB-6	165	TO	180	RAMP C1	6059+55.00	TO	11+96.00															3360		
CH-8	166	TO	167	RAMP G1	582+92.00	TO	590+51.00					760												
CH-9	166	TO	167	RAMP G1	582+92.00	TO	590+51.00					760												
ELW-5	167	TO	167	IR-70	590+51.00	TO	597+89.00			0.14														
ELY-4	167	TO	180	RAMP G1	590+51.00	TO	8599+65.00				0.13													
CH-10	167	TO	167	IR-70	597+89.00	TO	600+14.00					225												
CH-11	167	TO	167	RAMP G2	597+89.00	TO	600+14.00					226												
DL6-3	167	TO	168	IR-70	600+14.00	TO	506+74.00					660												
ELY-5	167	TO	180	RAMP G2	1107+76.00	TO	1113+84.00			0.12														
ELW-6	167	TO	180	RAMP G2	1107+76.00	TO	648+05.00			1.02														
PB-7	167	TO	180	RAMP G2	1106+16.00	TO	612+84.00															2070		
PB-8	168	TO	169	IR-70	612+74.00	TO	619+34.00															660		
PB-9	169	TO	171	IR-70	620+74.00	TO	641+05.00															2060		
CH-12	170	TO	171	IR-70	638+15.00	TO	648+05.00					710												
CH-13	170	TO	171	IR-70	638+15.00	TO	648+05.00					710												
PB-11	174	TO	174	IR-270 SB	1013+74.00	TO	1017+56.00															390		
PB-10	179	TO	180	BRICE RD	10+04.00	TO	14+63.00															470		
ELW-7	179	TO	180	BRICE RD	9+28.00	TO	13+85.00																	
LL-5	179	TO	180	BRICE RD	13+13.00	TO	10+53.00							0.05		0.09								
CH-14	180	TO	180	BRICE RD	6+96.00	TO	9+28.00															232		
CH-15	180	TO	180	BRICE RD	6+96.00	TO	8+58.00															162		
TOTALS CARRIED TO SUMMARY SHEET							54	4.77		3.82	3.96	9886	2290	1308	126	0.05	0.09			394				14490

MAINTENANCE OF TRAFFIC PHASE 4 SUBSUMMARY

FRA-70-22.61

CALCULATED
BPT
CHECKED
EMW

c:\pwworking\pitt@d1607344\B95639_MP2008.dgn 3/21/2022 10:42:16 AM ToTman

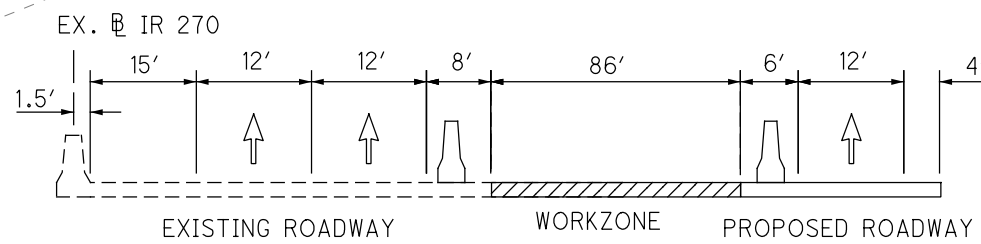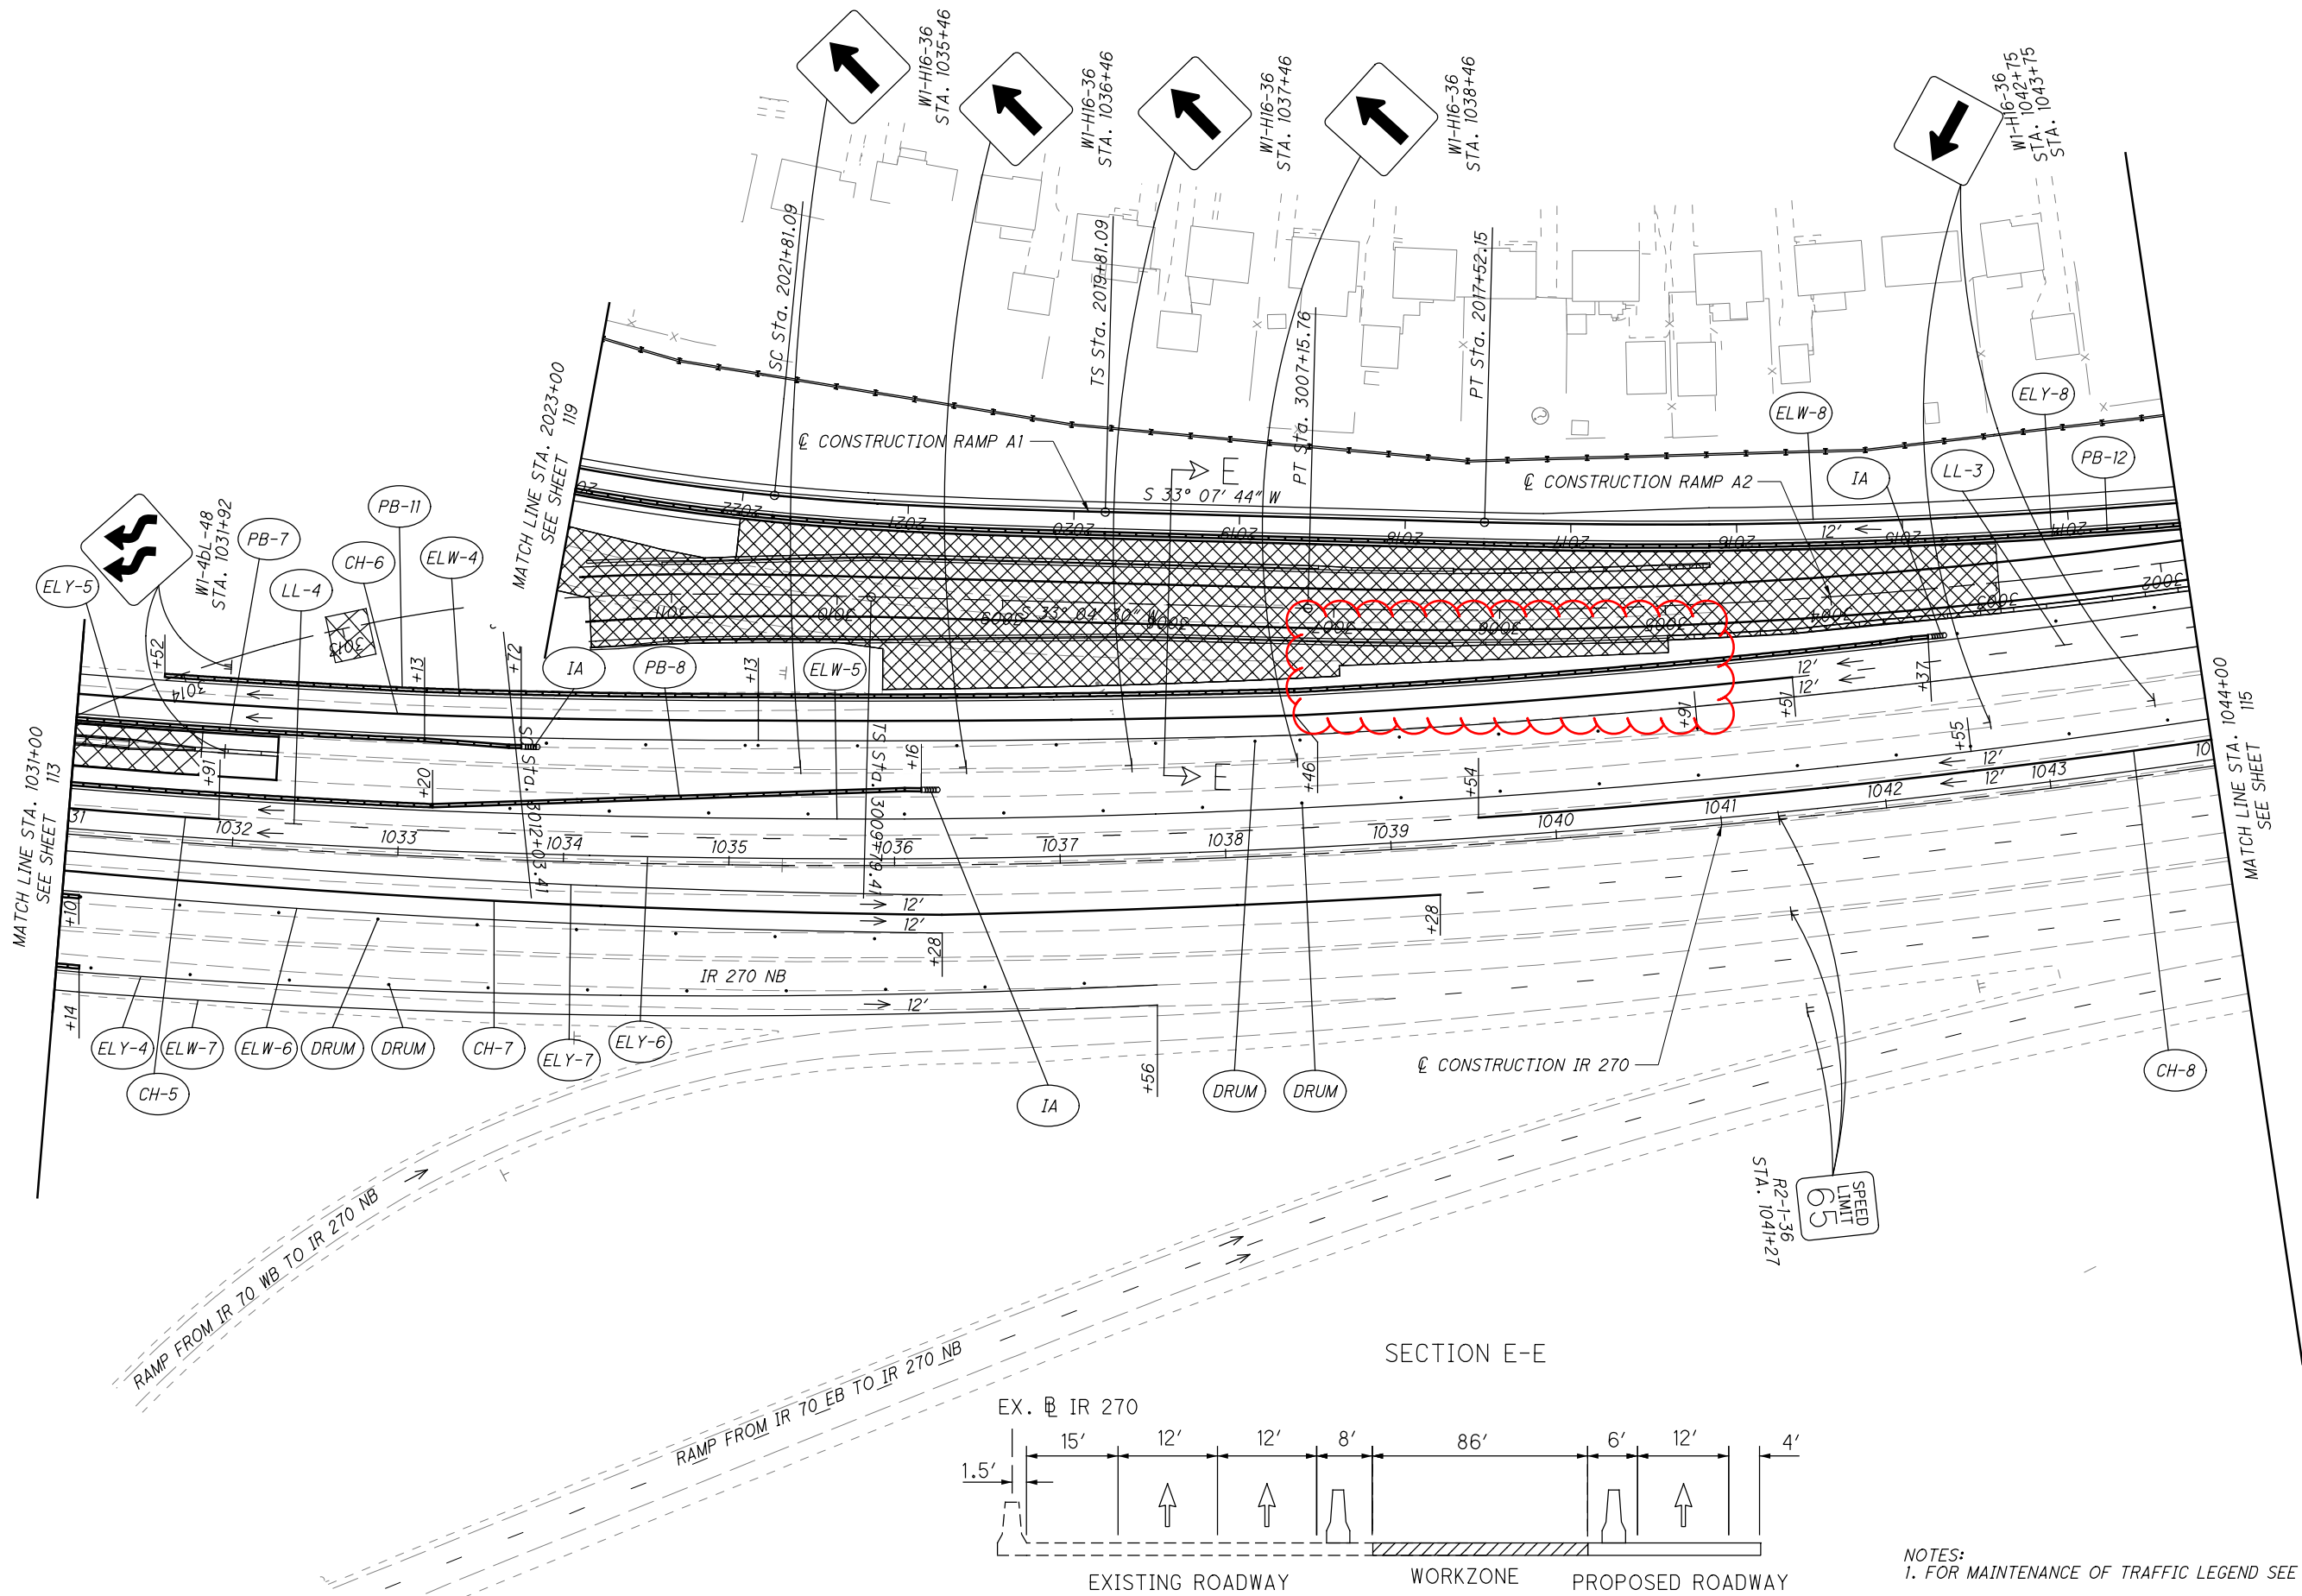

NOTES:
 1. FOR MAINTENANCE OF TRAFFIC LEGEND SEE SHEET 66 .




MAINTENANCE OF TRAFFIC PLAN - PHASE 2
 STA. 1031+00 TO STA. 1044+00

FRA-70-22.61

114
1199

CALCULATED
BPT
CHECKED
EMW

c:\pwworking\pitt@d1607344\95639_MP4201.dgn 3/21/2022 4:25:33 PM tofman

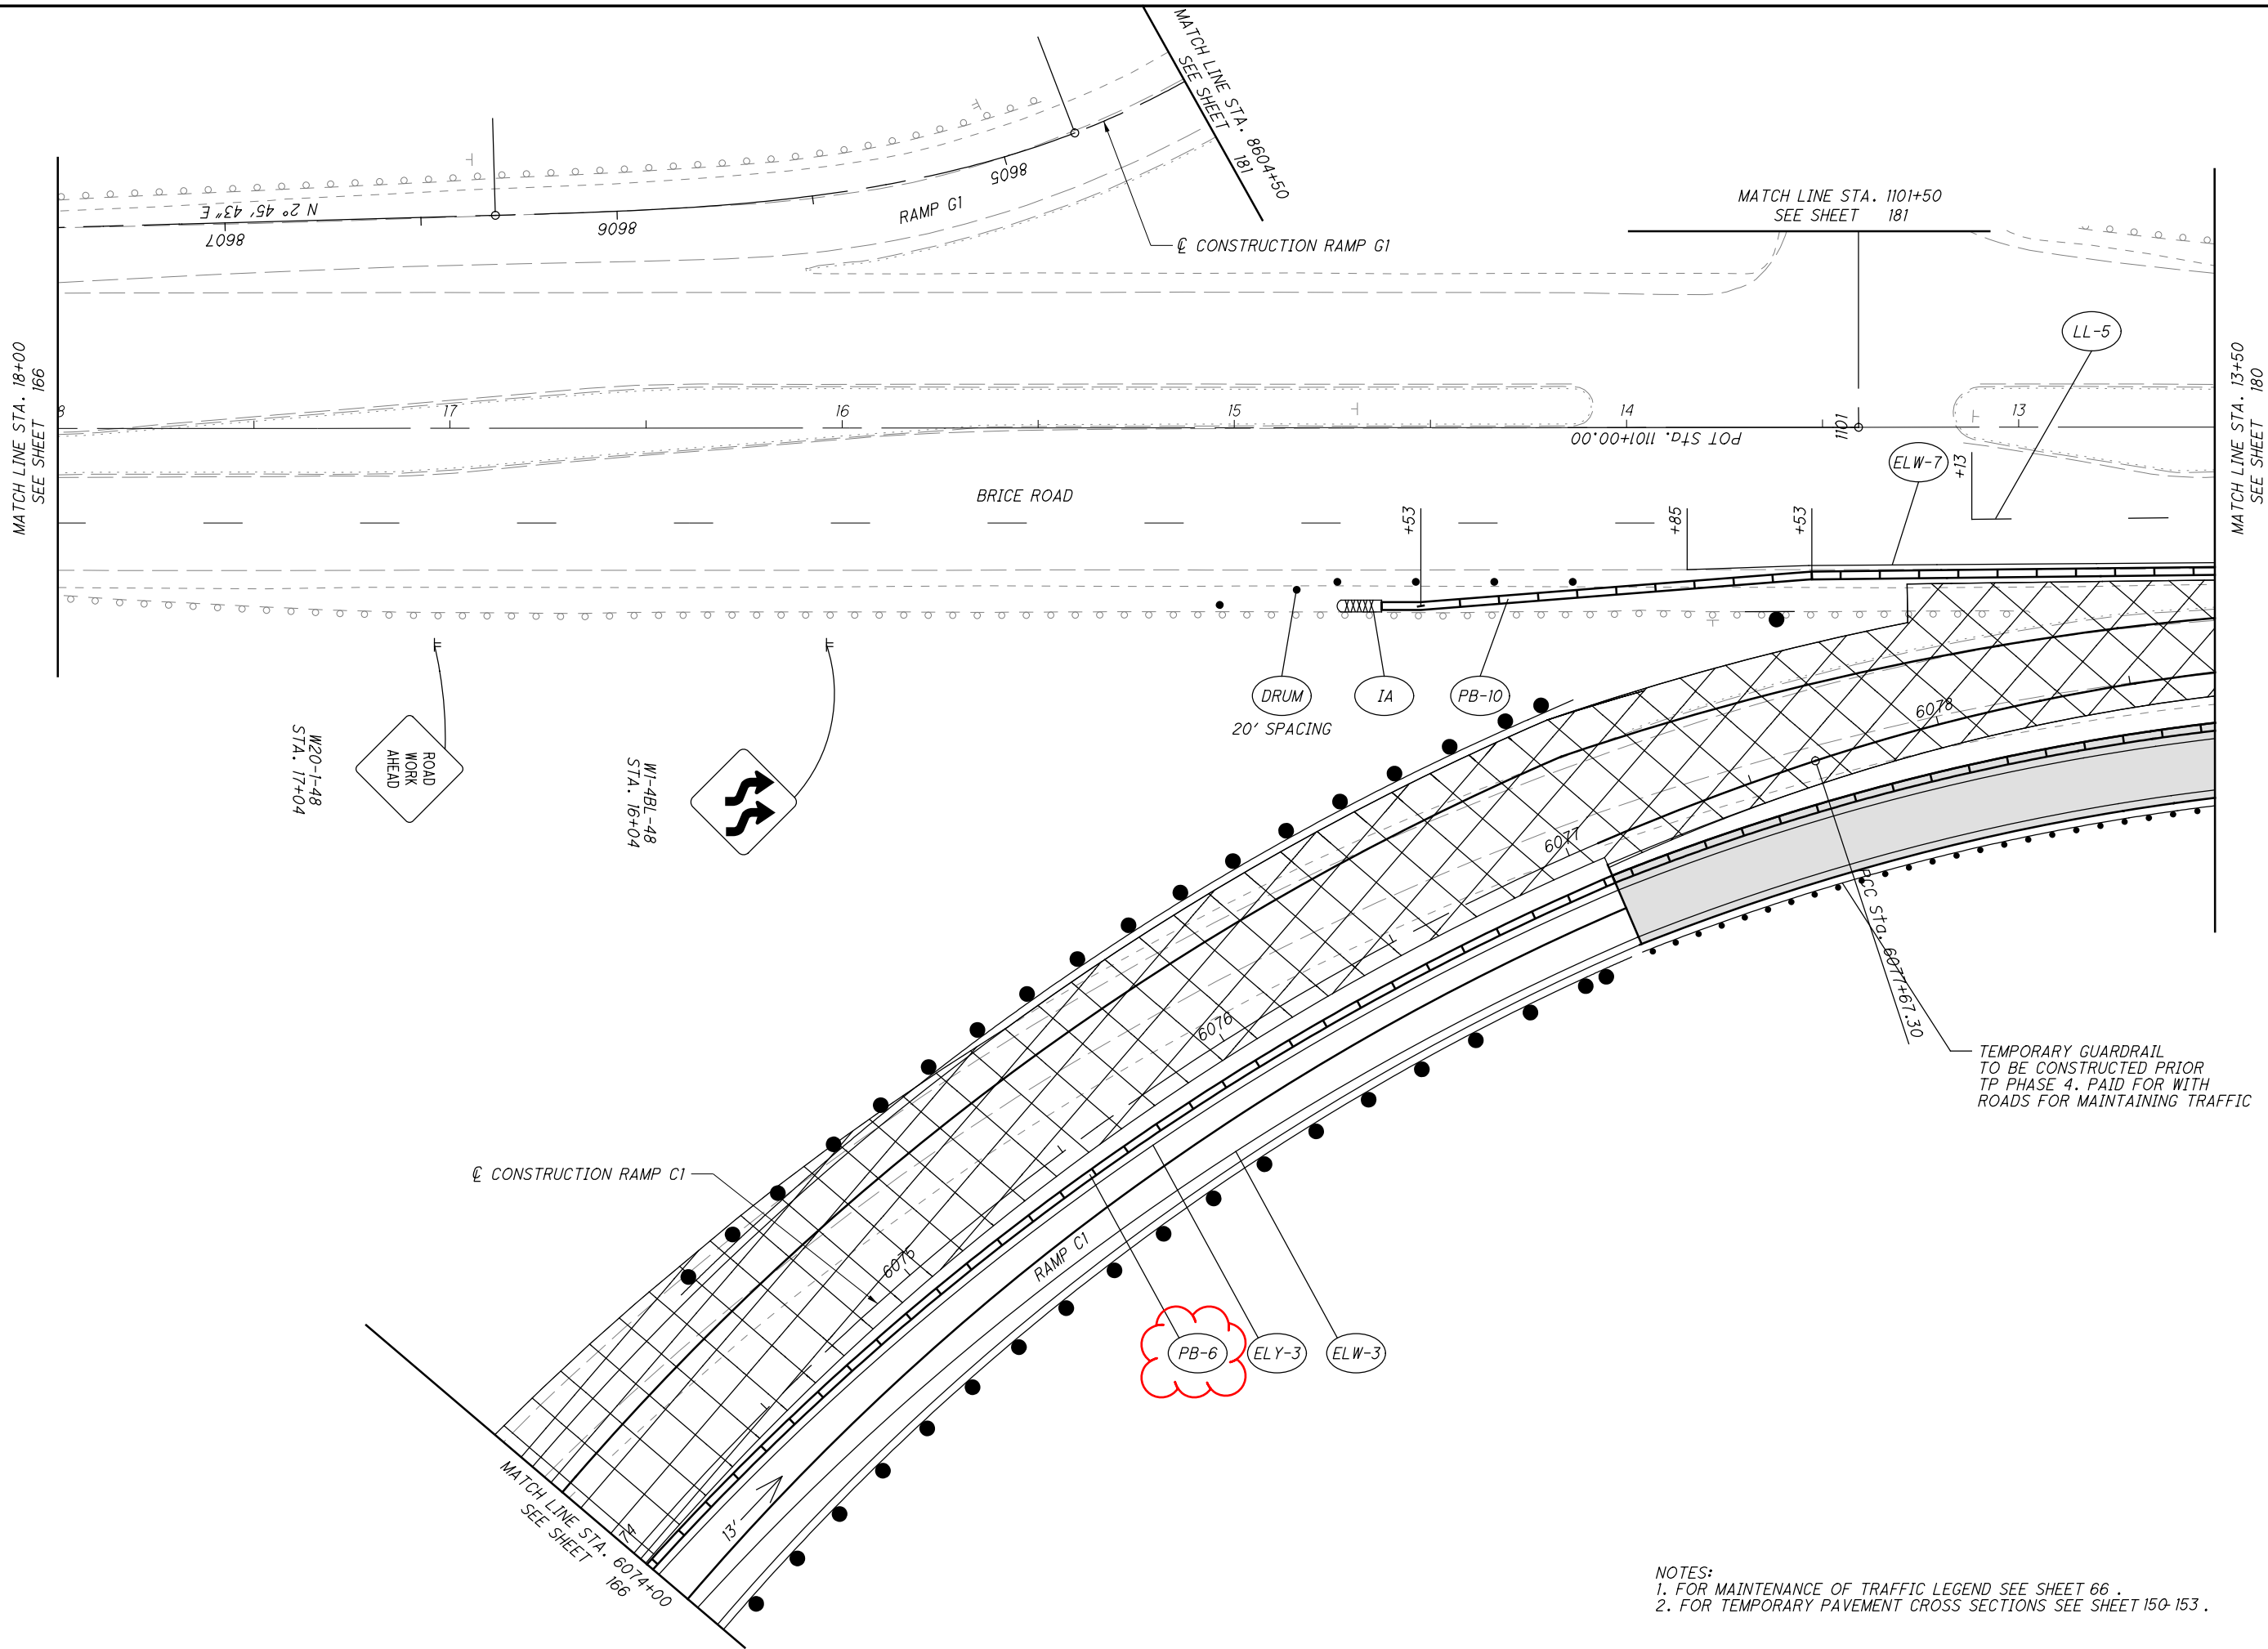

CALCULATED	BPT	CHECKED	EMW
------------	-----	---------	-----

MAINTENANCE OF TRAFFIC PLAN - PHASE 4
STA. 18+00 TO STA. 13+50

FRA-70-22.61

179
1199

NOTES:
 1. FOR MAINTENANCE OF TRAFFIC LEGEND SEE SHEET 66.
 2. FOR TEMPORARY PAVEMENT CROSS SECTIONS SEE SHEET 150-153.

c:\pwworking\pitt\p\d1607352\95639_G51501.dgn 3/23/2022 10:07:49 AM TSCHOEN

STATION TO STATION		SIDE	LENGTH L (FT)	AVERAGE WIDTH W (FT)	SURFACE AREA A = LxW (SF)	CADD MEASURED AREAS (SF)	202	204	204	254	255	301	304	407	407	442	442	442	
							PAVEMENT REMOVED SY	SUBGRADE COMPACTION SY	PROOF ROLLING HOUR	PAVEMENT PLANING, ASPHALT CONCRETE SY	FULL DEPTH PAVEMENT SAWING, AS PER PLAN FT	ASPHALT CONCRETE BASE, PG64-22 CY	AGGREGATE BASE CY	NON-TRACKING TACK COAT GAL	NON-TRACKING TACK COAT GAL	ASPHALT CONCRETE INTERMEDIATE COURSE, 19 MM, TYPE A (446) CY	ASPHALT CONCRETE SURFACE COURSE, 12.5 MM, TYPE A (447), AS PER PLAN CY	ANTI-SEGREGATION EQUIPMENT CY	
FROM	TO																		
IR 270																			
979+14.42	981+39.00	RT	224.58	0.50	112					12	225			1		1	1		
				8.40	1886							79		50		10	9		
				2.98	669							12							
				11.88	2668	1742	194	296.4	0				49						
981+39.00	982+39.00	RT	100.00	0.50	50					6	106			1		0	0		
				6.50	650													7	
				15.00	1500							63		40		8	7		
				2.98	298							6							
				18.48	1848	995	111	205.3	0				34						
982+39.00	987+81.18	RT	542.18	6.00	3253					361	542			22	33	18	15		
				12.00	6506													65	
				14.00	7591							181		202		41	35		
				2.00	1084	2843	316	120.5	0				20						
987+81.18	990+45.51	RT	264.33	6.00	1586					176	264			11	16	9	7		
				14.00	3701													37	
				16.03	4237							110		56		23	20		
				4.03	1065	1438	160	118.4	0				20						
990+45.51	995+26.44	RT	480.93	7.62	3665					407	482			24	37	20	17		
				28.00	13466													135	
				29.34	14110							468		188		76	65		
				17.34	8339	1016	113	926.6	0				154						
978+28.25	980+00.00	RT	171.75	11.26	1934														
								214.9	0				36						
980+00.00	995+26.44	RT	1526.44	10.00	15264								283						
1013+16.39	1018+93.81	LT	577.42			8039				893	256			54	80	43	37		
						3104	345												
1035+93.00	1038+74.50	LT	281.50	12.00	3378					375	282			23	34	18	16		
						7074	786												
1038+74.50	1040+77.61	LT	203.11			3250				361	218			22	33	18	15		
				1.67	339														
				8.33	1693							14	6						
				13.00	13161							71	31	45		9	8		
1040+77.61	1050+90.00	LT	1012.39	2.70	2731					1462	1012			88	132	71	61		
															27	15			
1050+90.00	1055+87.11	LT	497.11	12.00	5965						528	249	110	159		32	28		
				10.00	4971									33		27	23		
				10.33	5137							71		34					
				10.83	5385							75		36					
				11.33	5634							78		38					
				11.83	5882			653.6	0				109						
						11737				1304				78	117	63	54		
				24.00	11931													120	
						6057	673												
TOTALS CARRIED TO SUBSUMMARY SHEET							223	2885	5120	2	5359	3914	1475	853	1720	504	417	364	

CALCULATED TJS CHECKED CO
PAVEMENT SUBSUMMARY - IR 270
FRA - 70 - 22.61
 222
 1199

c:\pwworking\pitt@d1607352\95639_GS1501.dgn 3/23/2022 9:56:05 AM TSCHOEN

STATION TO STATION		SIDE	LENGTH L (FT)	AVERAGE WIDTH W (FT)	SURFACE AREA A=LxW (SF)	CADD MEASURED AREAS (SF)	202	204	204	254	255	301	304	407	407	442	442	442		
							PAVEMENT REMOVED SY	SUBGRADE COMPACTION SY	PROOF ROLLING HOUR	PAVEMENT PLANING, ASPHALT CONCRETE SY	FULL DEPTH PAVEMENT SAWING, AS PER PLAN FT	ASPHALT CONCRETE BASE, PG64-22 CY	AGGREGATE BASE CY	NON-TRACKING TACK COAT GAL	NON-TRACKING TACK COAT GAL	ASPHALT CONCRETE INTERMEDIATE COURSE, 19 MM, TYPE A (446) CY	ASPHALT CONCRETE SURFACE COURSE, 12.5 MM, TYPE A (447), AS PER PLAN CY	ANTI-SEGREGATION EQUIPMENT CY		
FROM	TO																			
IR 270 (CONTINUED)																				
985+10.35	989+89.65	LT/RT				1779 2242 3192 3462 3998	198			249				15 21	22	12 17	10 15			
1028+16.18	1030+57.75	RT	241.57 241.57	24.50 29.20	5918 7054	6372	708		783.8	0	568	294	131	188		38	27			
1029+47.30	1032+24.05	LT	276.75 276.75	21.30 25.60	5895 7085	6447	716		787.2	0	643	295	131	189		38	27			
1054+53.66	1056+45.55	LT	191.89 191.89	5.30 8.00	1017 1535	1096	122		170.6	0	392	64	28	41		8	5			
SUBTOTALS THIS SHEET							1744	2185.8	1	249	1603	653	354	477	114	85	0			
TOTALS CARRIED FROM SUBSUMMARY SHEET 222							2885	5120	2	5359	3914	1475	853	1720	504	417	364			
TOTALS CARRIED TO SUBSUMMARY SHEET 234							4629	7306.1	4	5609	5518	2129	1208	2197	618	502	364			

CALCULATED TJS CHECKED CO	PAVEMENT SUBSUMMARY - IR 270	FRA - 70 - 22.61
223 1199		

c:\pwworking\pitt@d1607352\95639_GS1601.dgn 3/23/2022 9:56:06 AM TSCHOEN



STATION TO STATION		SIDE	LENGTH L (FT)	AVERAGE WIDTH W (FT)	SURFACE AREA A=LXW (SF)	CADD MEASURED AREAS (SF)	202	204	204	301	304	407	442	442	442					
							PAVEMENT REMOVED SY	SUBGRADE COMPACTION SY	PROOF ROLLING HOUR	ASPHALT CONCRETE BASE, PG64-22 CY	AGGREGATE BASE CY	NON-TRACKING TACK COAT GAL	ASPHALT CONCRETE SURFACE COURSE, 12.5 MM, TYPE A (446), AS PER PLAN CY	ASPHALT CONCRETE INTERMEDIATE COURSE, 19 MM, TYPE A (446) CY	ANTI-SEGREGATION EQUIPMENT CY					
FROM	TO																			
RAMP A1																				
2016+16.59	2017+70.14	LT/RT	153.55	33.60	5159								20							
				36.80	5650							38	31							
				37.13	5702				92			38								
				37.63	5778				94			39								
				38.13	5855			651	0.3		108									
				16.00	2457														23	
2017+70.14	2022+00.00	LT/RT	429.86	36.40	15647								60							
				38.07	16363			1818	0.9	265	303	327		88						
				16.00	6878														64	
2022+00.00	2031+00.00	LT/RT	900.00	26.00	23400							156	90	126						
				26.67	24000					389		160								
				27.67	24900					403		166								
				28.67	25800			2867	1.4		478									
				16.00	14400														133	
						31801	3533													
RAMP A2																				
2995+09.95	3004+72.03	LT/RT	962.08	0.00	50761	50761						338	196	274						
				0.33	51082					828		341								
				0.83	51883					841		346								
				1.33	53166			5907	3.0		985									
						32934													305	
2995+09.96	3012+04.22	LT/RT	1694.26			40683	4520													
3000+98.97	3004+72.03	RT	373.06	16.00	5969			663	0.3	193	111	119	23	32	55					
3004+72.03	3008+17.84	LT/RT	345.81	40.00	13832			1537	0.8	448	256	277	53	75						
				24.00	8299														77	
3008+17.84	3008+83.41	LT/RT	65.57	41.21	2702			300	0.2	88	50	54	10	15						
				24.00	1574														15	
3008+83.41	3011+05.33	LT/RT	221.92	44.50	9875			1097	0.5	320	183	198	38	53						
				24.00	5326														49	
3028+34.17	3030+79.11	LT/RT	244.94	43.50	10655			1184	0.6	345	197	213	41	58						
				25.50	6246														58	
3030+79.11	3030+99.11	LT/RT	20.00	44.00	880			98	0.1	29	16	18	3	5						
				24.00	480														4	
3030+99.11	3031+45.19	LT/RT	46.08	46.00	2120			236	0.1	69	39	42	8	11						
				24.00	1106														10	
3031+45.19	3038+44.46	LT/RT	699.27	29.33	20512			2279	1.1	665	380	410	79	111						
				12.00	8391														78	
3031+45.19	3037+07.37	LT	562.18	12.00	6746			750	0.4	219	125	135	26	36						
3037+07.37	3038+44.46	LT	137.09	9.25	1268			141	0.1	41	23	25	5	7						
3031+45.19	3037+69.15	LT	623.96	14.00	8735			971	0.5	283	162	175	34	47	81					
3037+69.15	3038+44.46	LT	75.31	16.00	1205			134	0.1	39	22	24	5	7	11					
3038+44.46	3038+57.64	LT/RT	13.18	30.25	399			44	0.1	13	7	8	2	2						
TOTALS CARRIED TO SUBSUMMARY SHEET						234		8054	20676	10.5	5664.0	3446	3647	694	979	963				

CALCULATED TJS CHECKED CO
PAVEMENT SUBSUMMARY - RAMPS A1 & A2
FRA - 70-22.61
 224
 1199

	202	204	204	254	255	301	302	304	305	407	441	441	442	442	442	442	442	452	452	608	875	
	PAVEMENT REMOVED	SUBGRADE COMPACTION	PROOF ROLLING	PAVEMENT PLANING, ASPHALT CONCRETE	FULL DEPTH PAVEMENT SAWING, AS PER PLAN	ASPHALT CONCRETE BASE, PG64-22	ASPHALT CONCRETE BASE, PG64-22.	AGGREGATE BASE	8" CONCRETE BASE, CLASS QC IP	NON-TRACKING TACK COAT	ASPHALT CONCRETE SURFACE COURSE, TYPE 1, (448), (DRIVEWAYS), (PG64-22)	ASPHALT CONCRETE INTERMEDIATE COURSE, TYPE 2, (448), (DRIVEWAYS), (PG64-22)	ASPHALT CONCRETE SURFACE COURSE, 12.5 MM, TYPE A (446), AS PER PLAN	ASPHALT CONCRETE INTERMEDIATE COURSE, 19 MM, TYPE A (446)	ASPHALT CONCRETE SURFACE COURSE, 12.5 MM, TYPE A (447), AS PER PLAN	ASPHALT CONCRETE SURFACE COURSE, 12.5 MM, TYPE A (448), (PG70-22M)	ASPHALT CONCRETE INTERMEDIATE COURSE, 19 MM, TYPE A (448)	ANTI-SEGREGATION EQUIPMENT	8" NON-REINFORCED CONCRETE PAVEMENT, CLASS QC IP	9" NON-REINFORCED CONCRETE PAVEMENT, CLASS QC IP	8" CONCRETE SIDEWALK	LONGITUDINAL JOINT ADHESIVE
TOTALS CARRIED FROM SUBSUMMARY SHEET 221	17288	29599	14.8	12349	12489	2687	9326	6670		8820				1931	1621			2189				
TOTALS CARRIED FROM SUBSUMMARY SHEET 223	4629	7307	3.6	5609	5518	2129		1208		2197				618	502			364				
TOTALS CARRIED FROM SUBSUMMARY SHEET 224	8054	20676	10.5			5664		3446		3647			694	979				963				
TOTALS CARRIED FROM SUBSUMMARY SHEET 227		47747	24.4	101	310	8273		9721		7123			1295	1914				1998		5382		
TOTALS CARRIED FROM SUBSUMMARY SHEET 228	2165	725	1.0	675	556	252		121		261			46	65				36				74
TOTALS CARRIED FROM SUBSUMMARY SHEET 229	1106	4969	2.5					829												4865		
TOTALS CARRIED FROM SUBSUMMARY SHEET 231	1379	2777	1.4	837	724	241	878	765		777			92	118	50			165				
TOTALS CARRIED FROM SUBSUMMARY SHEET 233	14872	11089	7.8			148		1854	7225	1247	45	60				407	407		99		70	
TOTALS CARRIED TO GENERAL SUBSUMMARY	49493	124889	66.0	19571	19597	19394	10204	24614	7225	24072	45	60	2127	5625	2173	407	407	5715	99	10247	70	74


PAVEMENT SUBSUMMARY	CALCULATED TJS CHECKED CO
FRA - 70 - 22.61	234 1199

c:\pwworking\pitt\df607352\95639_GPI207.dgn 3/23/2022 8:40:47 AM TSCHOEN

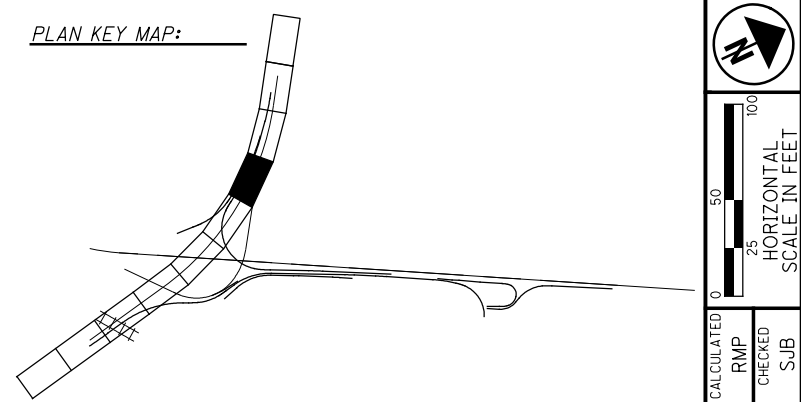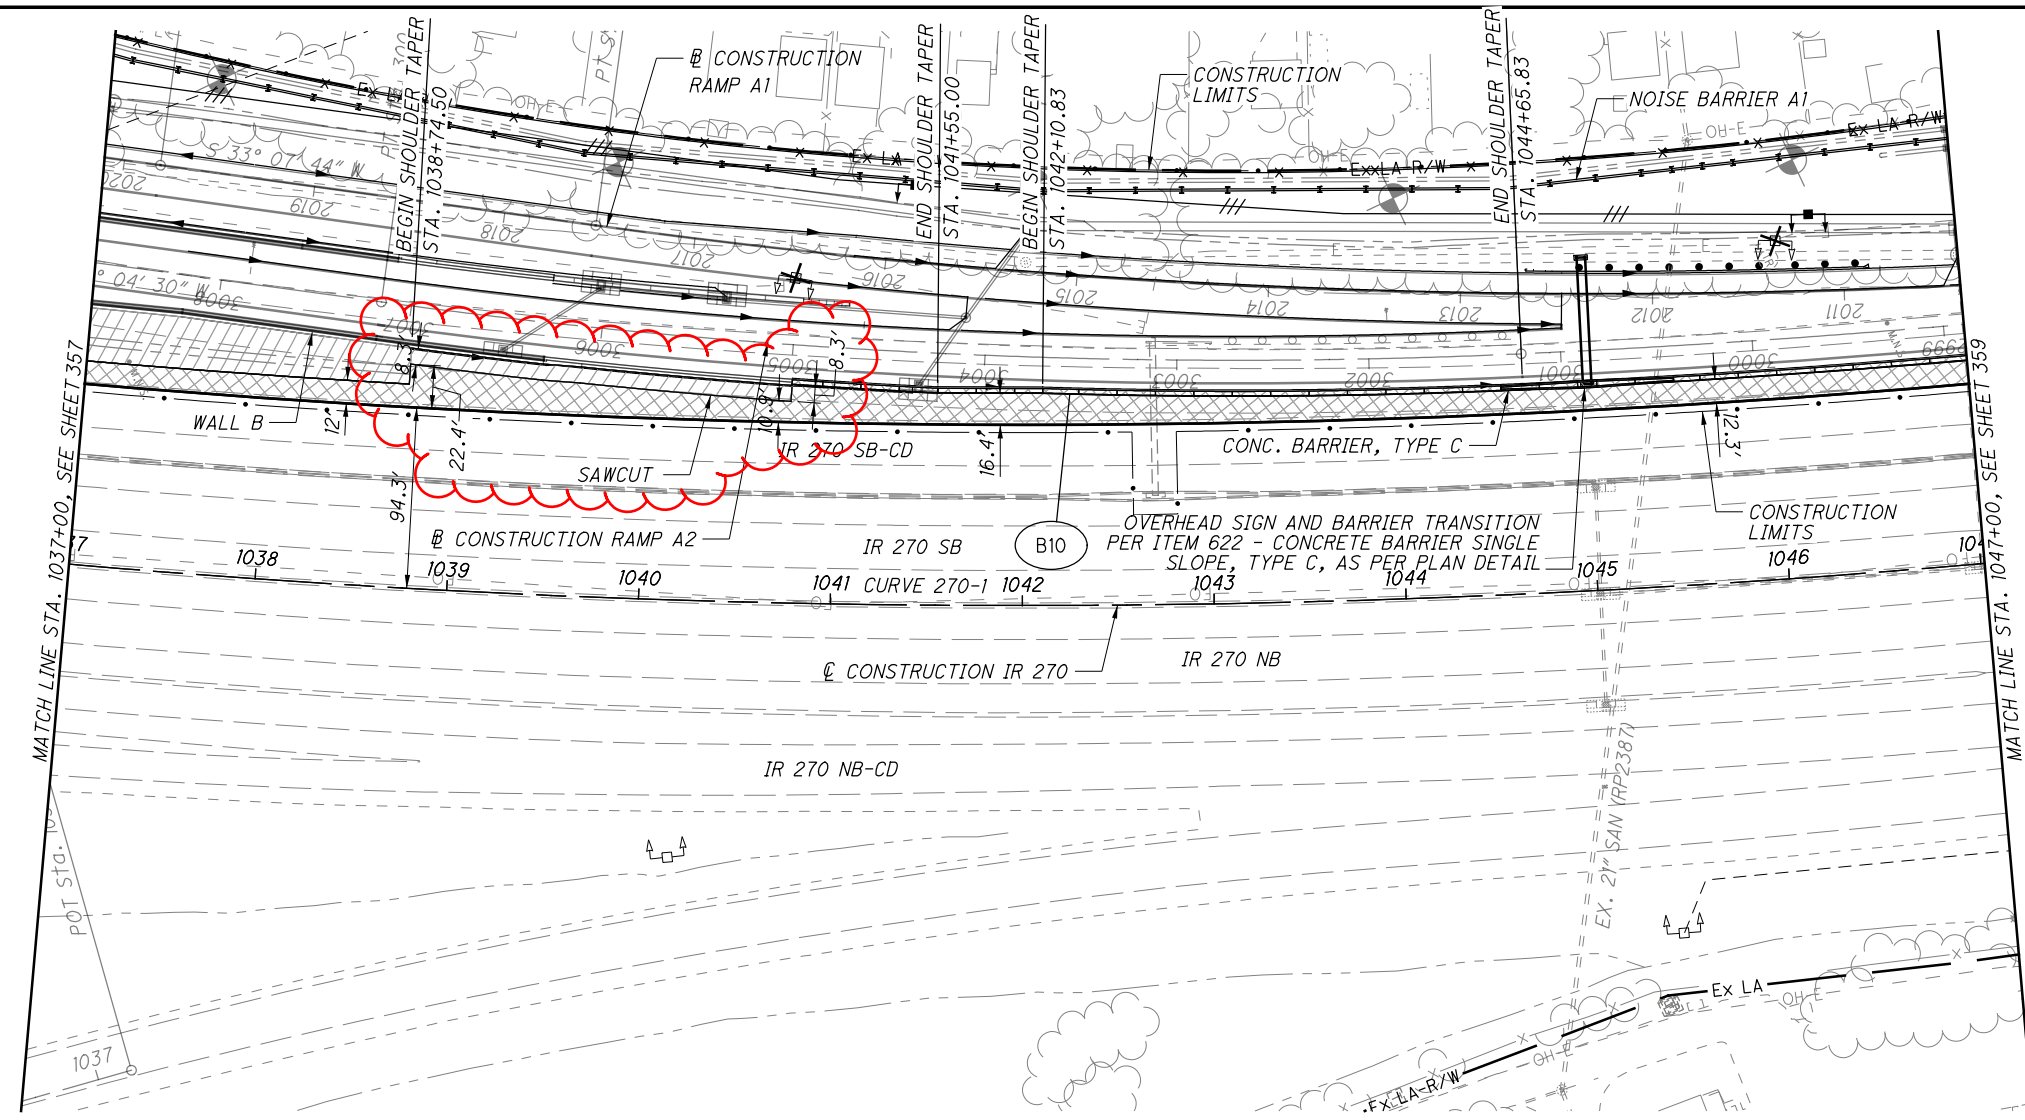

CROSS REFERENCES	
SHEET NO.	DESCRIPTION
3 - 7	☉ REFERENCE & BENCHMARKS
212 - 213	ESTIMATED QUANTITIES
362 - 399	IR 270 CROSS SECTIONS
400 - 406	RAMP A1 PLAN AND PROFILES
407 - 422	RAMP A1 CROSS SECTIONS
423 - 438	RAMP A2 PLAN AND PROFILES
439 - 466	RAMP A2 CROSS SECTIONS
703 - 753	DRAINAGE
701 - 702	GRADING PLAN
670 - 683	TERMINAL DETAILS

GEOMETRIC DATA:
 ☉ CONSTRUCTION IR 270
 CURVE 270-1
 P.I. Sta. 1036+65.35
 $\Delta = 45^\circ 38' 24''$ (LT)
 $Dc = 1^\circ 00' 00''$
 $R = 5,729.58'$
 $T = 2,410.85'$
 $L = 4,564.00'$
 $E = 486.55'$
 $C = 4,444.29'$
 $C.B. = N 31^\circ 53' 44'' E$
 $eMAX = 0.033$

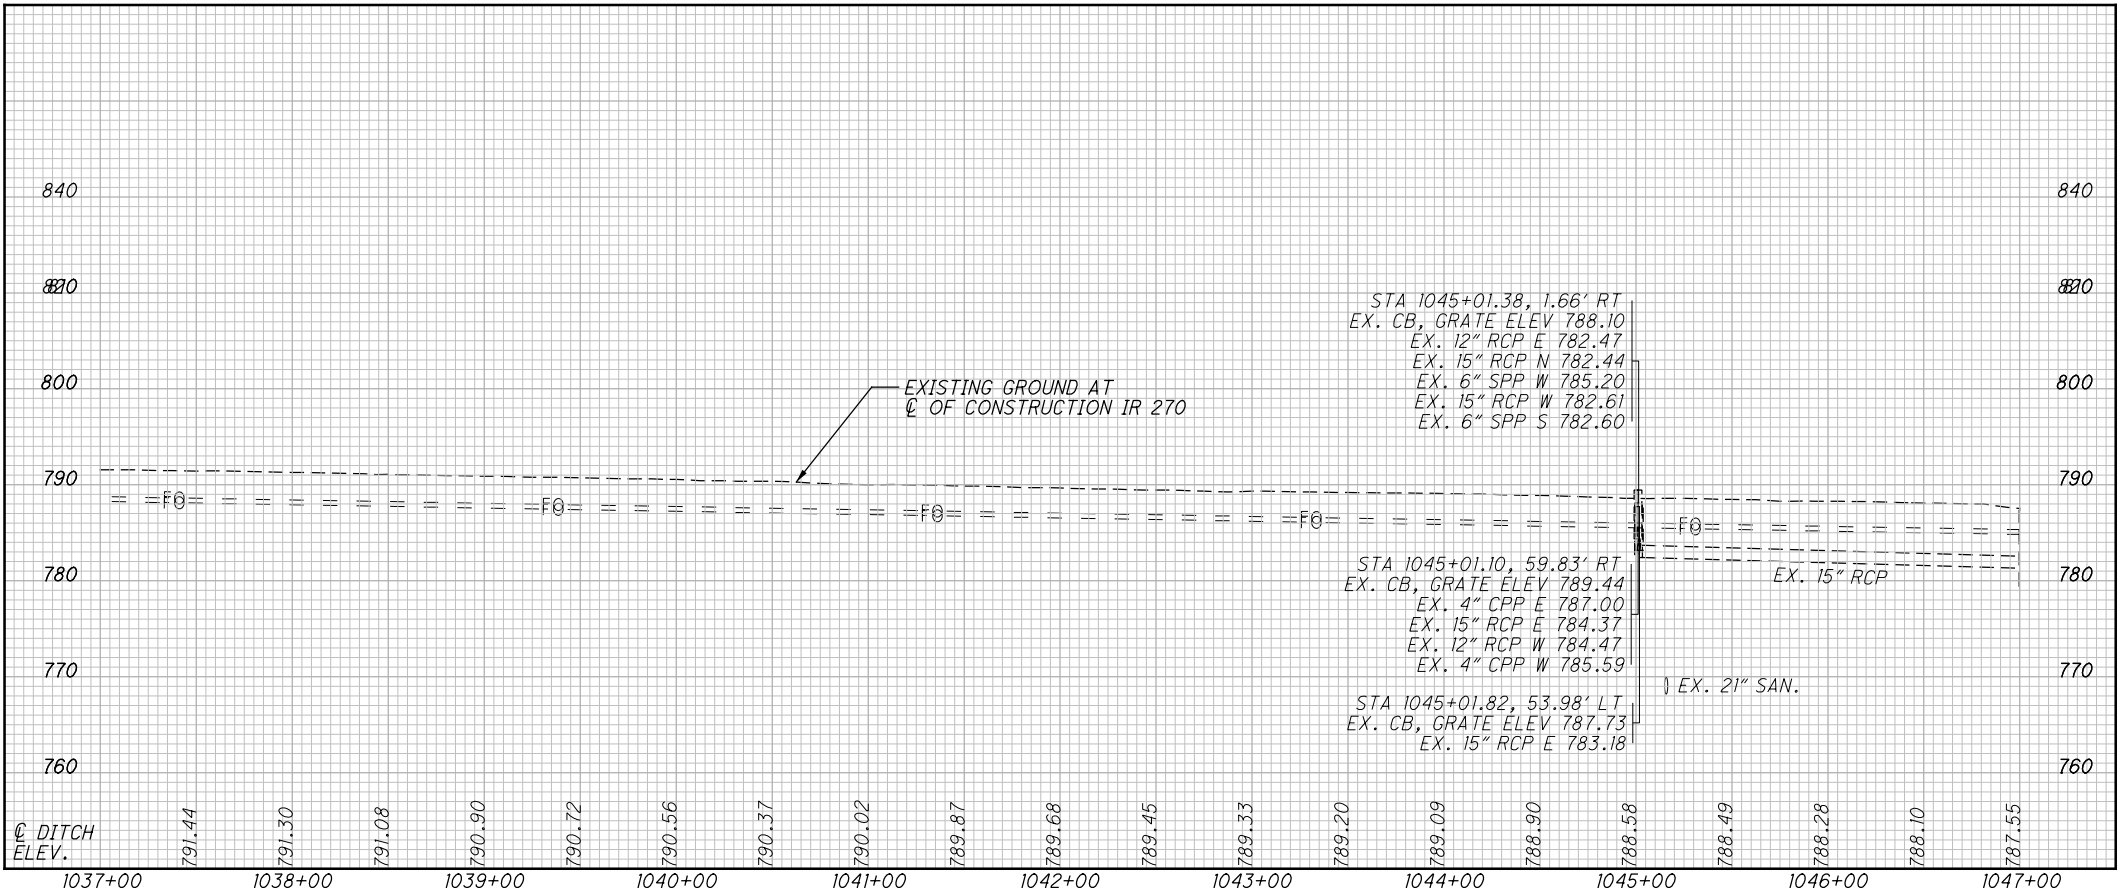

NOTES:

LEGEND:

- PAVEMENT PLANING
- PAVEMENT REMOVED
- EXISTING WETLAND

NOTES:

LEGEND:

 PAVEMENT REMOVED


GEOMETRIC DATA:

@ CONSTRUCTION RAMP A2
 CURVE DATA A2-3
 P.I. Sta. 3004+18.96
 $\Delta = 10^\circ 25' 01''$ (RT)
 $D_c = 1^\circ 45' 00''$
 $R = 3,274.04'$
 $T = 298.45'$
 $L = 595.25'$
 $E = 13.57'$
 $C = 594.43'$
 $C.B. = S 27^\circ 51' 59'' W$
 $e_{MAX} = 0.0410$
 $DS = 60$ mph

CROSS REFERENCES



SHEET NO.	DESCRIPTION	SHEET NO.	DESCRIPTION
3 - 7	@ REFERENCE & BENCHMARKS	352 - 361	IR 270 PLAN AND PROFILES
212 - 213	ESTIMATED QUANTITIES	362 - 399	IR 270 CROSS SECTIONS
439 - 466	RAMP A2 CROSS SECTIONS	703 - 753	DRAINAGE
400 - 406	RAMP A1 PLAN AND PROFILES	701 - 702	DRAINAGE PLAN
407 - 422	RAMP A1 CROSS SECTIONS	670 - 683	TERMINAL DETAILS

PLAN KEY MAP:

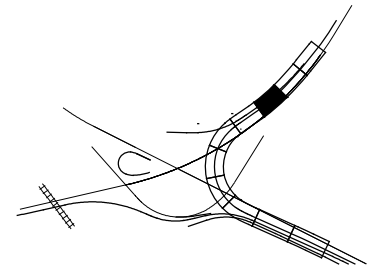

0 20 40
 HORIZONTAL
 SCALE IN FEET

CALCULATED
 RMP
 CHECKED
 SUB

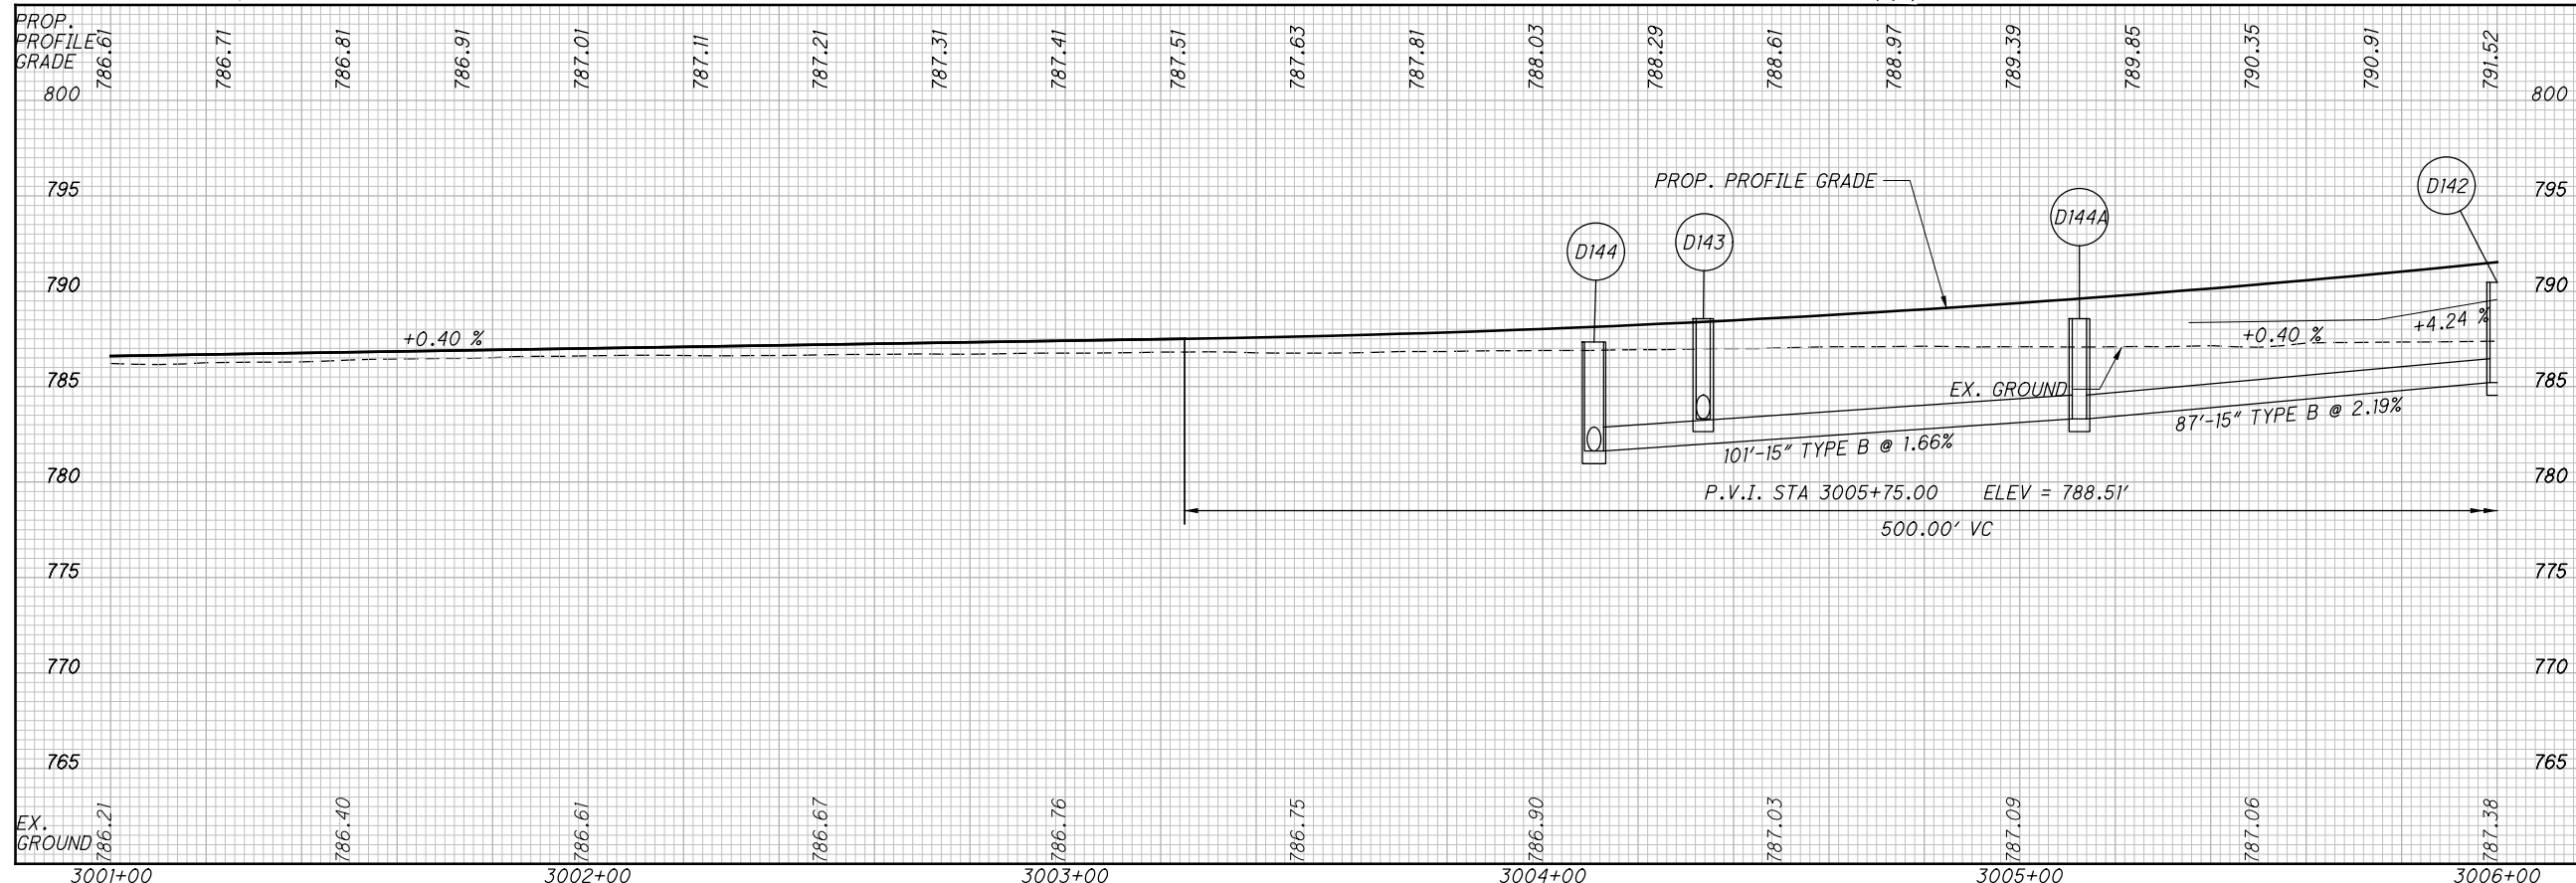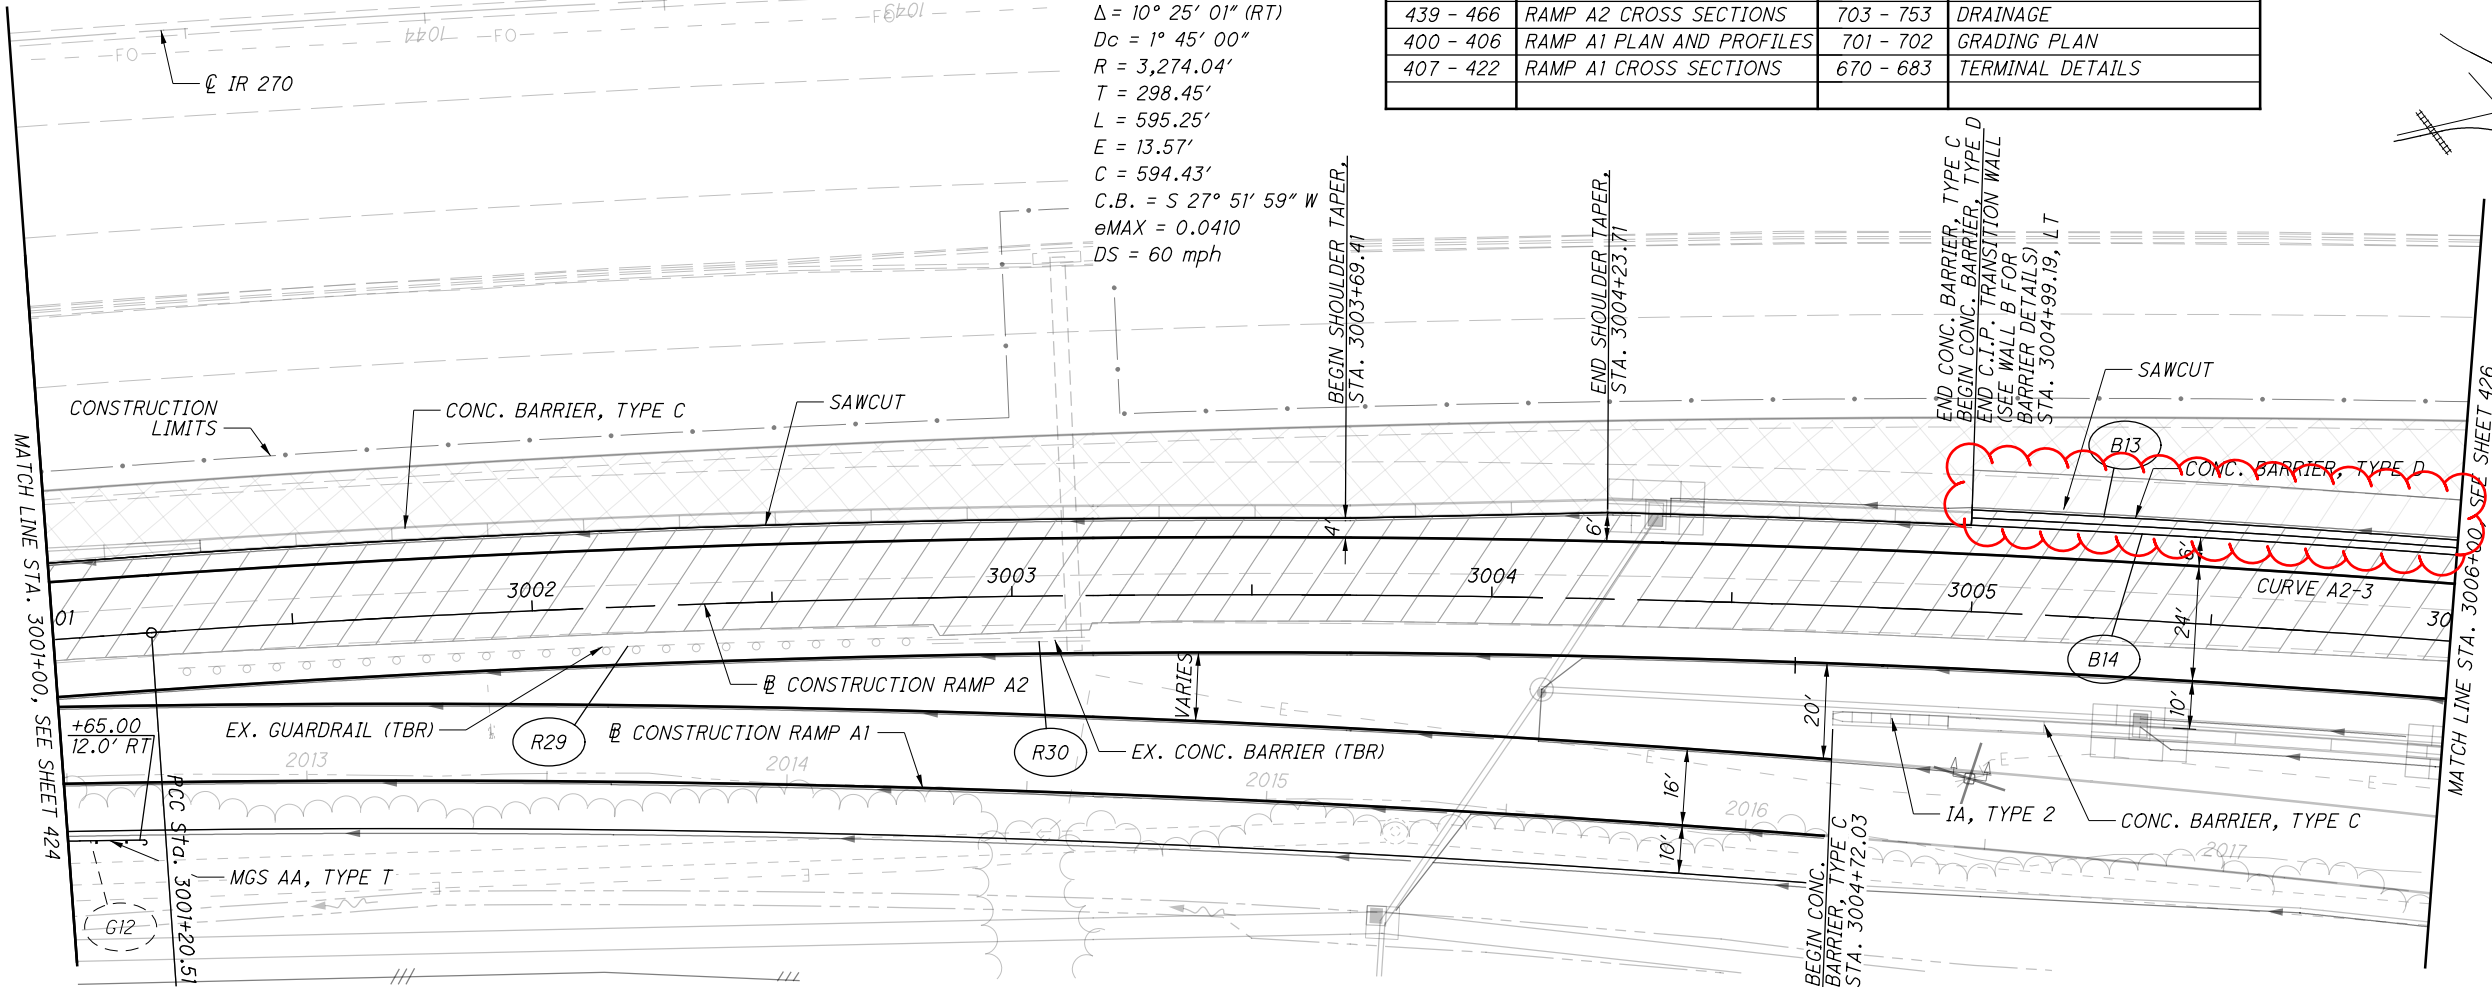

PLAN AND PROFILE - RAMP A2
 STA. 3001+00 TO STA. 3006+00

FRA-70-22.61

425
 1199

c:\pwworking\pitt\df607352\95639_GPI404.dgn 3/23/2022 8:44:19 AM TSCHOEN

NOTES:

LEGEND:

PAVEMENT REMOVED

TRANSITION TOP WIDTH OF CONCRETE BARRIER, SINGLE SLOPE, TYPE D FROM 12" TO 19.5" OVER 20'

GEOMETRIC DATA:

CONSTRUCTION RAMP A2
 CURVE DATA A2-3
 P.I. Sta. 3004+18.96
 $\Delta = 10^\circ 25' 01''$ (RT)
 $D_c = 1^\circ 45' 00''$
 $R = 3,274.04'$
 $T = 298.45'$
 $L = 595.25'$
 $E = 13.57'$
 $C = 594.43'$
 $C.B. = S 27^\circ 51' 59'' W$
 $e_{MAX} = 0.0410$
 $DS = 60$ mph

GEOMETRIC DATA:


CONSTRUCTION RAMP A2
 SPIRAL 1 DATA A2-4
 P.I. STA. 3011+28.88
 $L_s = 224.00'$
 $f_s = 7^\circ 28' 00''$
 $LT = 149.47'$
 $ST = 74.79'$
 $x = 223.62'$
 $y = 9.72'$
 $k = 111.94'$
 $p = 2.43'$

GEOMETRIC DATA:

CONSTRUCTION RAMP A2
 CURVE DATA A2-4
 P.I. Sta. 3026+28.01
 $\Delta = 121^\circ 18' 47''$ (LT)
 $D_c = 6^\circ 40' 00''$
 $R = 859.44'$
 $\Delta c = 102^\circ 38' 47''$ (LT)
 $L_c = 1,539.70'$
 $E = 902.42'$
 $C = 1,341.90'$
 $C.B.1 = S 30^\circ 35' 11'' W$
 $C.B. = S 25^\circ 42' 54'' E$
 $C.B.2 = N 84^\circ 30' 22'' W$
 $e_{MAX} = 0.0600$
 $DS = 50$ mph

CROSS REFERENCES			
SHEET NO.	DESCRIPTION	SHEET NO.	DESCRIPTION
3 - 7	REFERENCE & BENCHMARKS	352 - 361	IR 270 PLAN AND PROFILES
212 - 213	ESTIMATED QUANTITIES	362 - 399	IR 270 CROSS SECTIONS
439 - 466	RAMP A2 CROSS SECTIONS	703 - 753	DRAINAGE
400 - 406	RAMP A1 PLAN AND PROFILES	670 - 683	TERMINAL DETAILS
407 - 422	RAMP A1 CROSS SECTIONS		

PLAN KEY MAP:

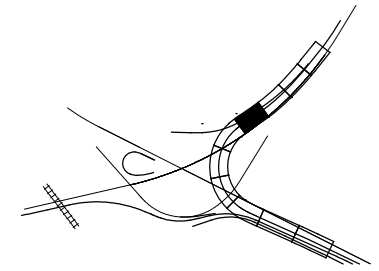



0 20 40
 HORIZONTAL SCALE IN FEET

CALCULATED
 RMP
 CHECKED
 SUB

PLAN AND PROFILE - RAMP A2
 STA. 3006+00 TO STA. 3011+00

FRA-70-22.61

426
 1199

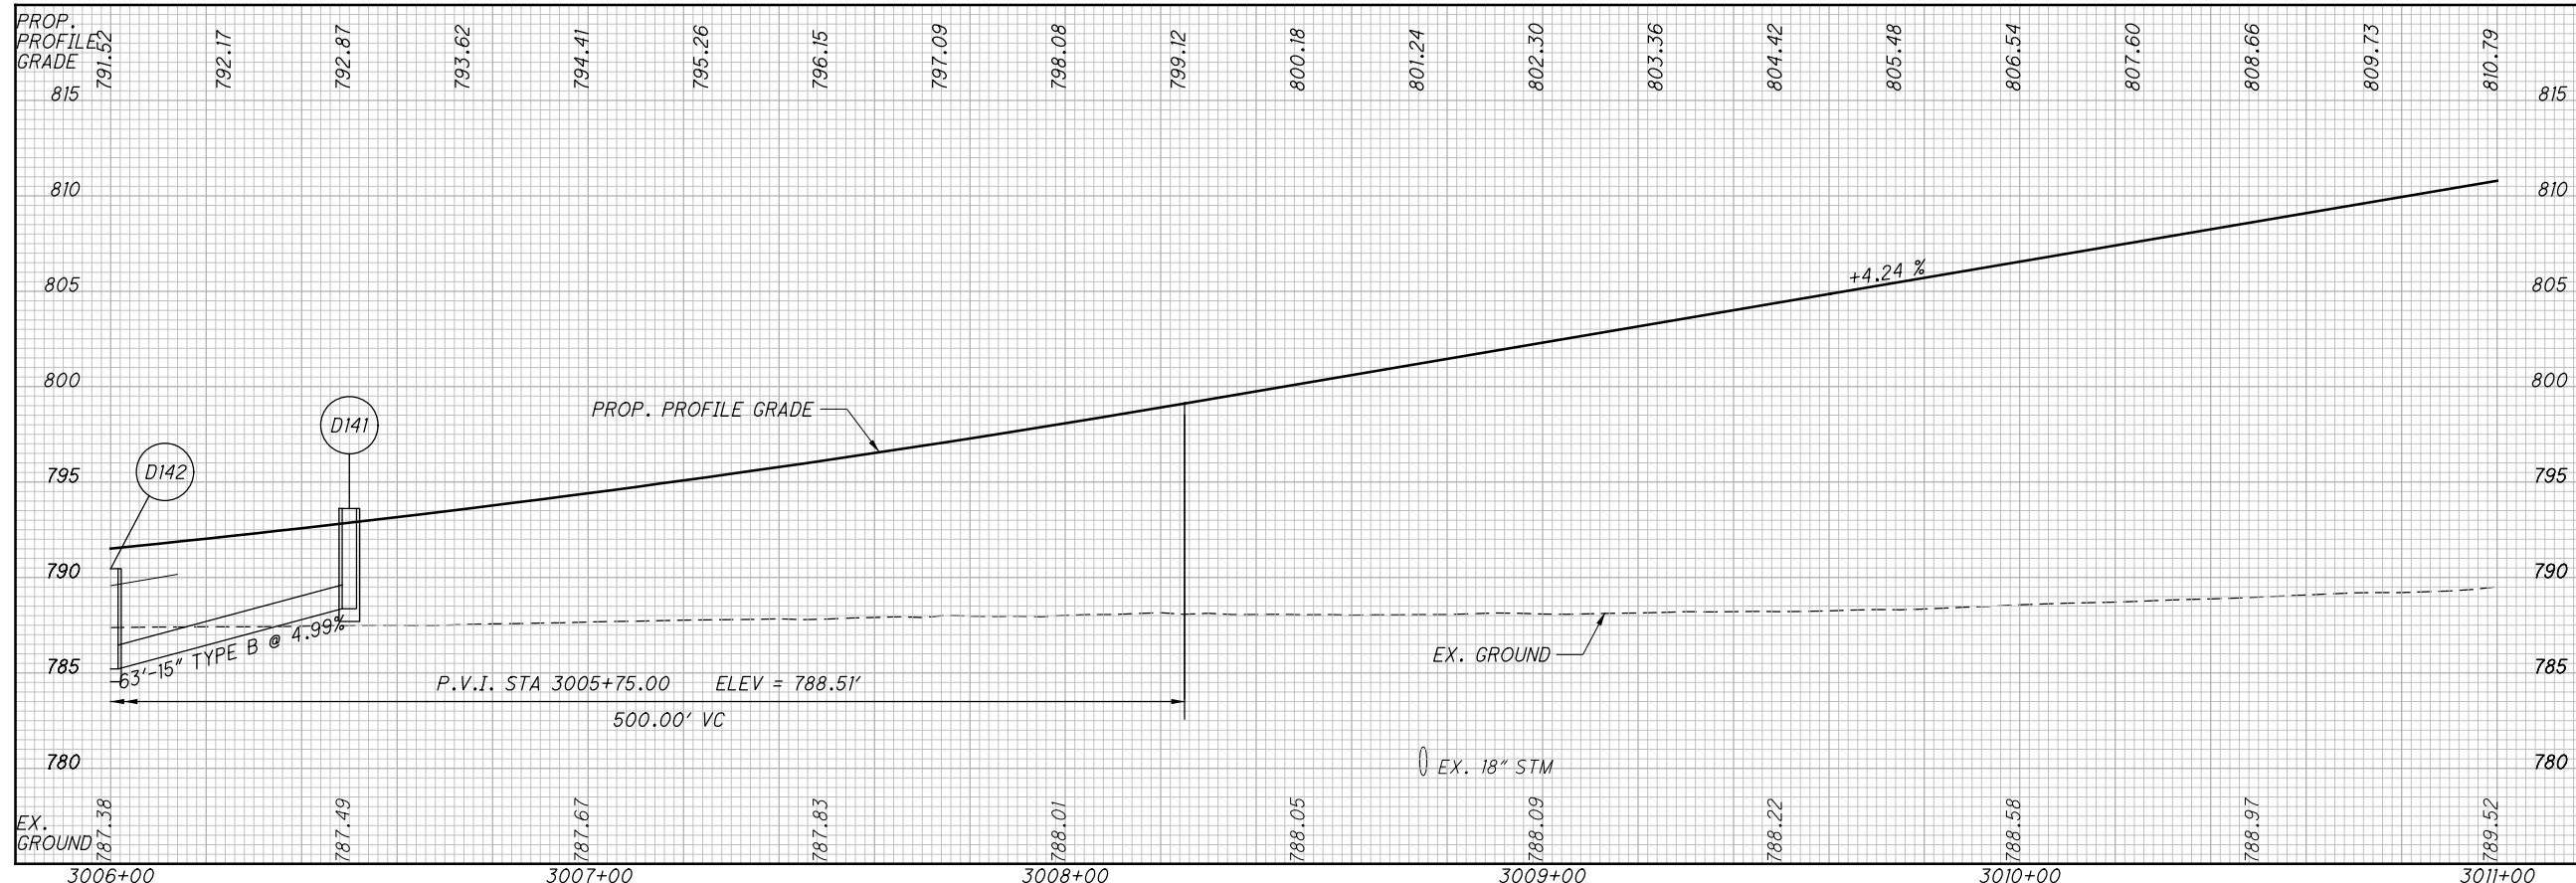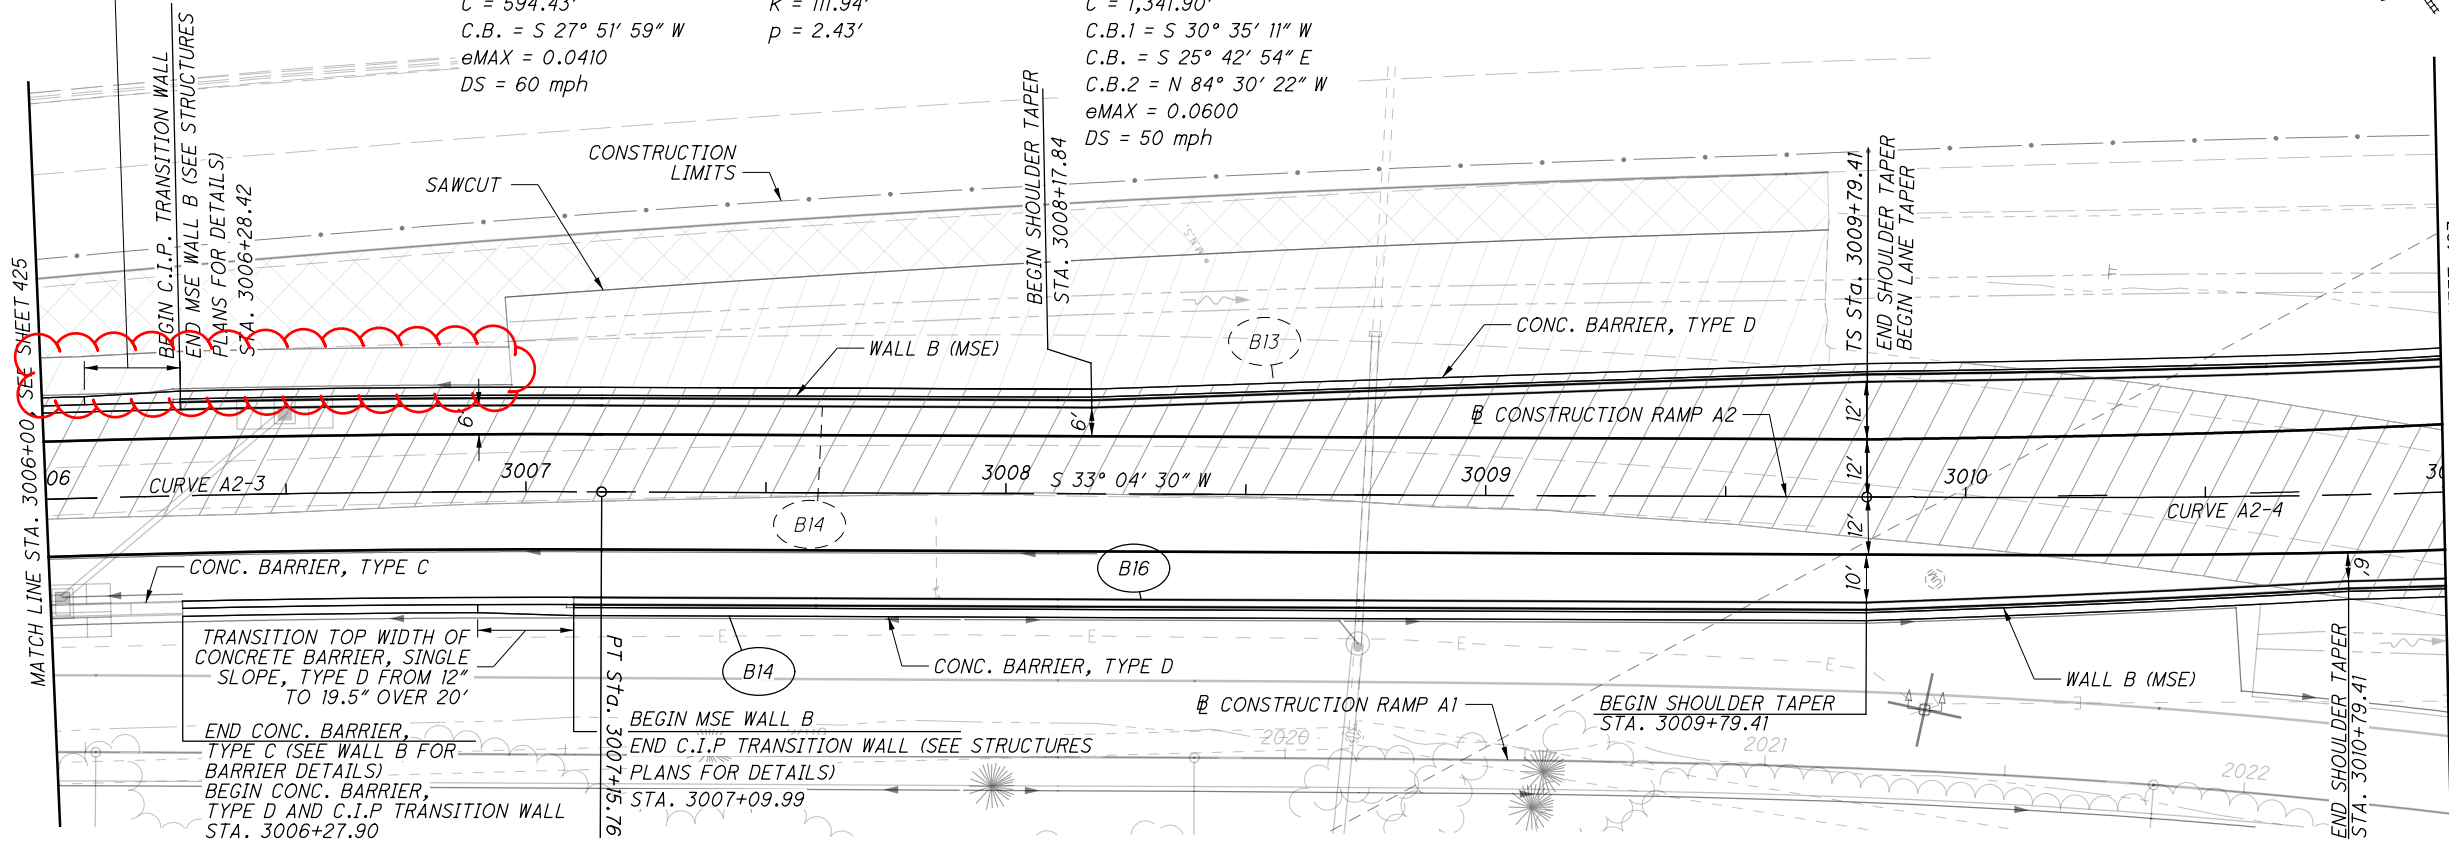

c:\pwworking\pitt\df607352\956639_GPI405.dgn 3/23/2022 8:44:29 AM TSCHOEN