

SHEET NUMBER											PART.			ITEM	ITEM EXT	GRAND TOTAL	UNIT	DESCRIPTION	SEE SHEET NO.
4	6	7	8	9	16						01/STR	02/SAF							
																		ROADWAY	
				888	367						888	367		202	30000	1,255	SF	WALK REMOVED	
				60							60			202	32000	60	FT	CURB REMOVED	
					326							326		203	10000	326	CY	EXCAVATION	
					845							845		204	10000	845	SY	SUBGRADE COMPACTION	
	1,590										1,040	550		209	10000	1,590	FT	DITCH CLEANOUT	
	0.3										0.2	0.1		209	60500	0.3	MILE	LINEAR GRADING	
	8.14										8.14								
				213	364						213	364		209	72050	8.14	MILE	PREPARING SUBGRADE FOR SHOULDER PAVING	
				975							975			608	10000	577	SF	4" CONCRETE WALK	
														608	52000	975	SF	CURB RAMP	
																		EROSION CONTROL	
				3	736						3	736		659	10001	739	SY	SEEDING AND MULCHING, AS PER PLAN	4
					1,000							1,000		832	30000	1,000	EACH	EROSION CONTROL	
																		DRAINAGE	
1											1			611	98630	1	EACH	CATCH BASIN ADJUSTED TO GRADE	
6											5	1		611	99654	6	EACH	MANHOLE ADJUSTED TO GRADE	
																		PAVEMENT	
					871							871		252	01500	871	FT	FULL DEPTH PAVEMENT SAWING	
1,468											1,468			253	02000	1,468	CY	PAVEMENT REPAIR	
	72,084	3,914		72							74,698	1,372		254	01000	76,070	SY	PAVEMENT PLANING, ASPHALT CONCRETE 1.50"	
	39,042	333									39,375			254	01000	39,375	SY	PAVEMENT PLANING, ASPHALT CONCRETE 3.75"	
					104							104		301	56000	104	CY	ASPHALT CONCRETE BASE, PG64-22, (449)	
					135							135		304	20000	135	CY	AGGREGATE BASE	
	6,054	212			91						6,266	91		407	20000	6,357	GAL	NON-TRACKING TACK COAT	
	7,968	340									8,308			407	20000	8,308	GAL	NON-TRACKING TACK COAT, INTERMEDIATE	
	4,150										4,150			408	10000	4,150	GAL	PRIME COAT	
	4,781	178		0.19	30						4,959.19	30		441	50100	4,989.19	CY	ASPHALT CONCRETE SURFACE COURSE, TYPE 1, (448), PG70-22M	
	6,227	267			44						6,494	44		442	20200	6,538	CY	ASPHALT CONCRETE INTERMEDIATE COURSE, 19 MM, TYPE A (448)	
					97							97		609	26000	97	FT	CURB, TYPE 6	
	331										331			617	10100	331	CY	COMPACTED AGGREGATE	
																		WATER WORK	
3											3			638	10800	3	EACH	VALVE BOX ADJUSTED TO GRADE	
																		OTHER UTILITIES	
2											2		SPECIAL	61199700	2	EACH	GAS VALVE BOX ADJUSTED TO GRADE	4	
																		TRAFFIC CONTROL	
			706								706			621	00100	706	EACH	RPM	
			661								661			621	54000	661	EACH	RAISED PAVEMENT MARKER REMOVED	
				32							32			630	03100	32	FT	GROUND MOUNTED SUPPORT, NO. 3 POST	
					27.6							27.6		630	06400	27.6	FT	GROUND MOUNTED STRUCTURAL BEAM SUPPORT, S4X7.7	
					2							2		630	09000	2	EACH	BREAKAWAY STRUCTURAL BEAM CONNECTION	
				22	32						22	32		630	80100	54	SF	SIGN, FLAT SHEET	
					2							2		630	84500	2	EACH	GROUND MOUNTED STRUCTURAL BEAM SUPPORT FOUNDATION	
					1							1		630	85100	1	EACH	REMOVAL OF GROUND MOUNTED SIGN AND REERECTION	
					2							2		630	86002	2	EACH	REMOVAL OF GROUND MOUNTED POST SUPPORT AND DISPOSAL	
					2							2		630	86102	2	EACH	REMOVAL OF GROUND MOUNTED STRUCTURAL BEAM SUPPORT AND DISPOSAL	
			14.52								14.52			642	00104	14.52	MILE	EDGE LINE, 6", TYPE 1	
			7.26								7.26			642	00300	7.26	MILE	CENTER LINE, TYPE 1	
		134									134			642	00620	134	FT	CROSSWALK LINE, 12", TYPE 1	
		343	60								403			644	00500	403	FT	STOP LINE	
				134							134			644	00620	134	FT	CROSSWALK LINE, 12"	
				162							162			644	00630	162	FT	CROSSWALK LINE, 24", HIGH VISIBILITY	
				2							2			644	01110	2	EACH	SCHOOL SYMBOL MARKING, 96"	
					4							4		644	01300	4	EACH	LANE ARROW	
																		MAINTENANCE OF TRAFFIC	
82											80	2		614	12460	82	EACH	WORK ZONE MARKING SIGN	
			21.78								21.78			614	21100	21.78	MILE	WORK ZONE CENTER LINE, CLASS I, 642 PAINT	
			21.78								21.78			614	21500	21.78	MILE	WORK ZONE CENTER LINE, CLASS II, 642 PAINT	
																		INCIDENTALS	
LS											LS	LS		614	11000	LS		MAINTAINING TRAFFIC	
LS											LS	LS		623	10000	LS		CONSTRUCTION LAYOUT STAKES AND SURVEYING	4
											LS	LS		624	10000	LS		MOBILIZATION	

GENERAL SUMMARY

DESIGN AGENCY



DESIGNER

BAC

REVIEWER

KWK 07-28-25

PROJECT ID

119116


SHEET

5


TOTAL

16


NOTE:
TAPERS SHALL BE 20:1

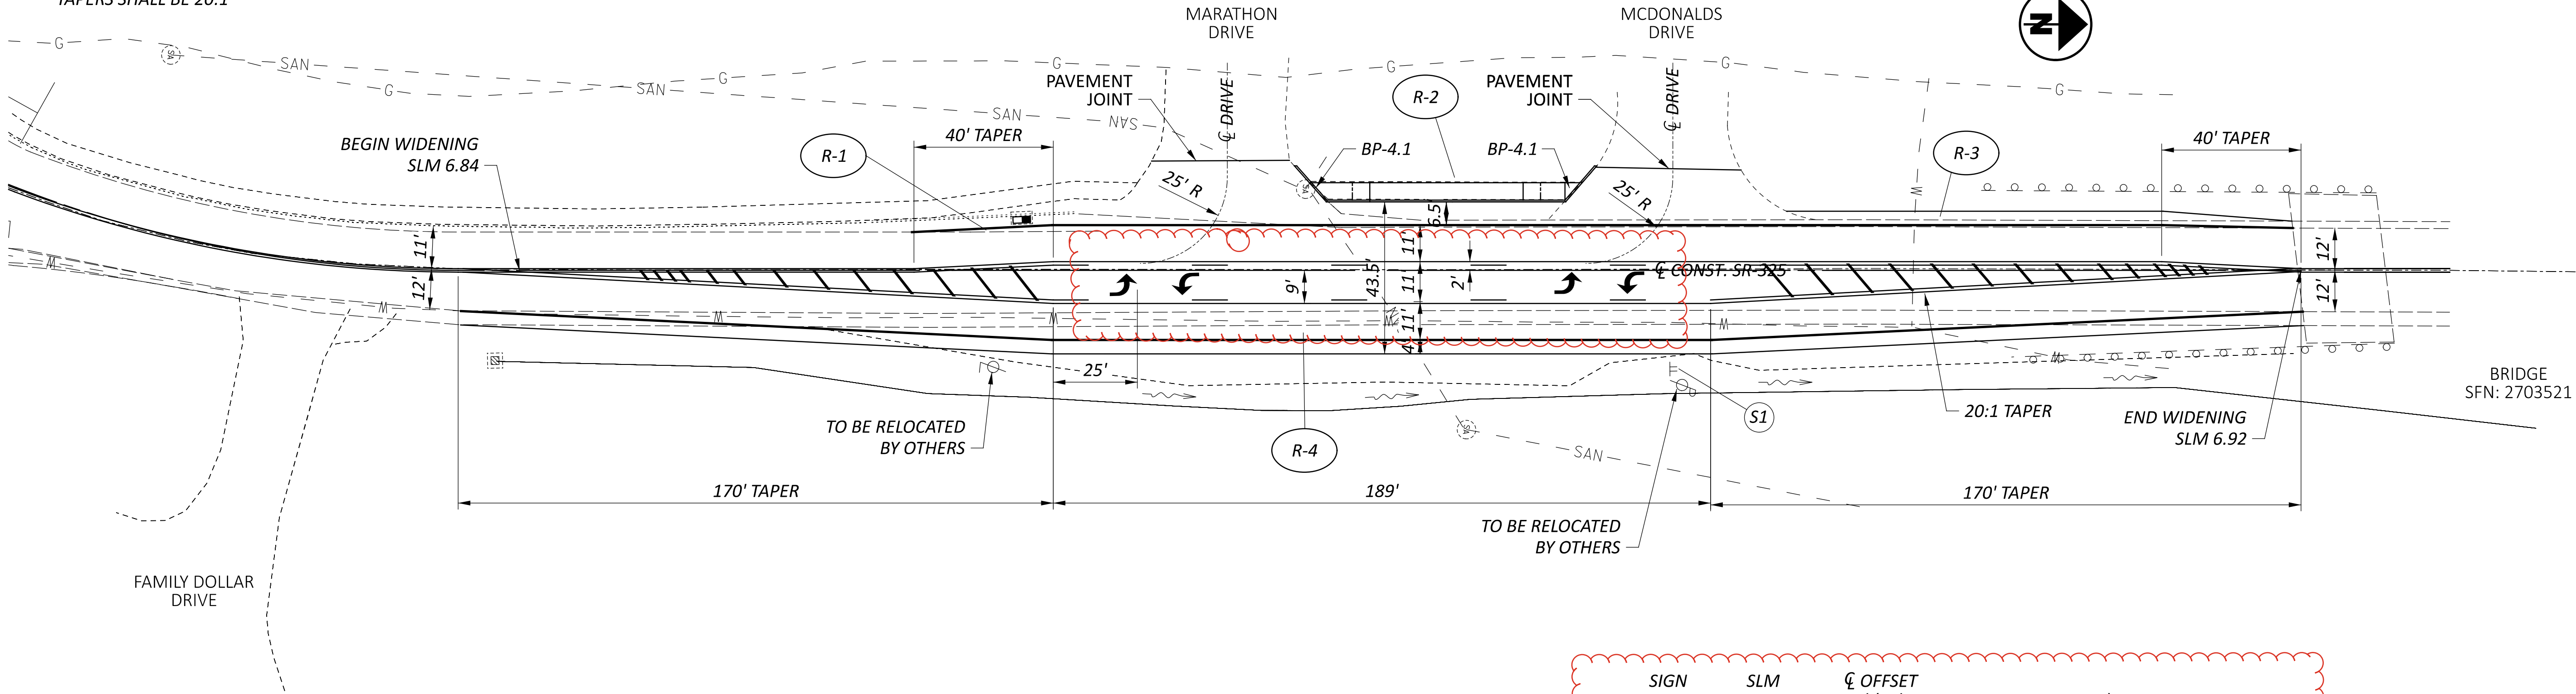

NOTE:
UTILITY POLES WILL BE SET BACK A MINIMU OF 15' FROM EDGE OF PAVEMENT BY OWNERS.

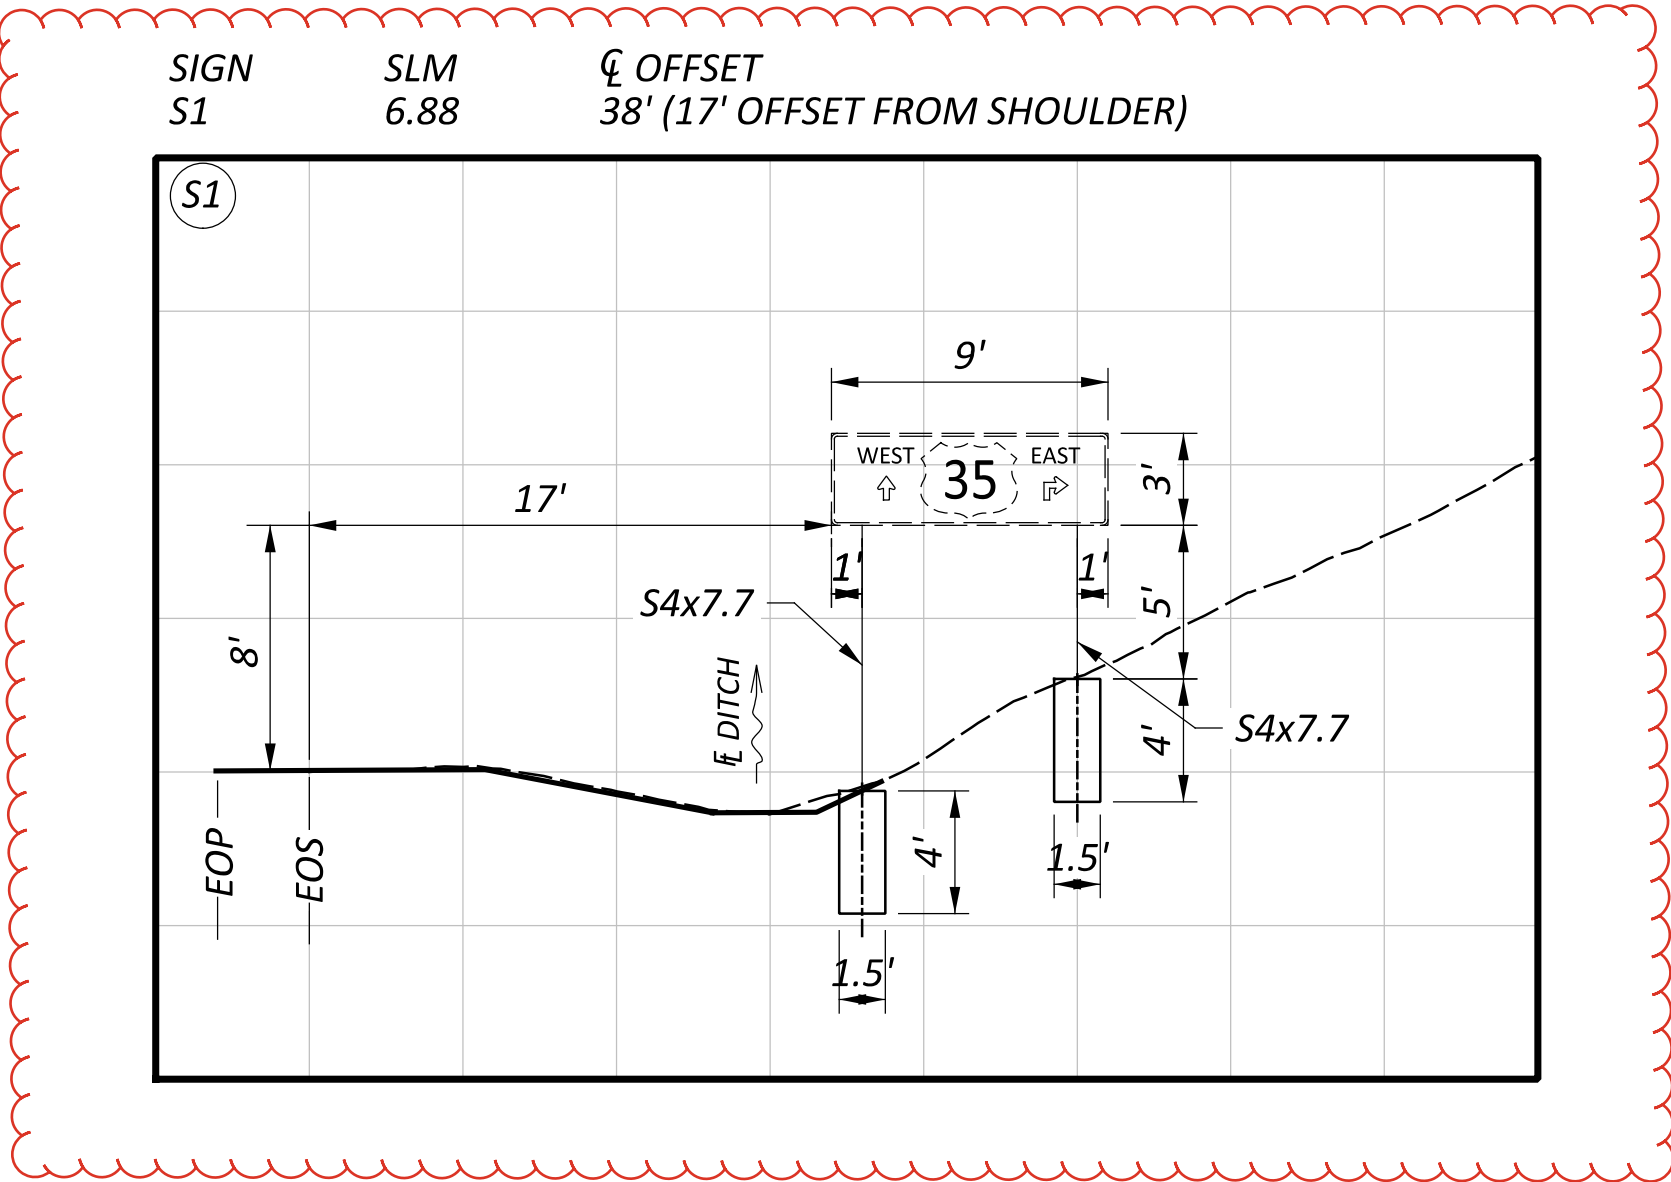

REFERENCE NUMBER	STRAIGHT LINE MILE	SIDE	203	204	304	301	442	441	407	407	644	202	608	609	630	630	252	630	630	630	630	659	630
			EXCAVATION	SUBGRADE COMPACTION	AGGREGATE BASE	ASPHALT CONCRETE BASE, PG64-22, (449)	ASPHALT CONCRETE INTERMEDIATE COURSE, 19 MM, TYPE A (448)	ASPHALT CONCRETE SURFACE COURSE, TYPE 1, (448), PG70-22M	NON-TRACKING TACK COAT	NON-TRACKING TACK COAT	LANE ARROW	WALK REMOVED	4" CONCRETE WALK	CURB, TYPE 6	SIGN, FLAT SHEET	REMOVAL OF GROUND MOUNTED SIGN AND REERECTION	FULL DEPTH PAVEMENT SAWING	GROUND MOUNTED STRUCTURAL BEAM SUPPORT FOUNDATION	BREAKAWAY STRUCTURAL BEAM CONNECTION	REMOVAL OF GROUND MOUNTED POST SUPPORT AND DISPOSAL	REMOVAL OF GROUND MOUNTED STRUCTURAL BEAM SUPPORT AND DISPOSAL	SEEDING AND MULCHING, AS PER PLAN	GROUND MOUNTED STRUCTURAL BEAM SUPPORT, S4X7.7
			CY	SY	CY	CY	CY	CY	GAL	GAL	EACH	SF	SF	FT	SF	EACH	FT	EACH	EACH	EACH	EACH	SY	FT
R-1	6.84	LT	5.05	25.00	4.07	1.71	0.77	0.52	0.99	0.62													
R-2	6.87	LT	23.17	94.00	9.43	8.15	3.06	2.38	3.92	2.45	4	367	364	97									
R-3	6.89	LT	42.38	104.00	17.24	11.76	4.41	2.93	5.68	3.55							358						
R-4	6.87	RT	254.80	622.00	103.60	82.28	35.18	23.45	45.04	28.15					32		513						
S-1	6.88	RT														1		2	2	2	2	700	27.6
SUBTOTAL SPLIT			2								4	367	364	97	32	1	871	2	2	2	2	736	27.6
TOTALS CARRIED TO GENERAL SUMMARY										91	4	367	364	97	32	1	871	2	2	2	2	736	27.6

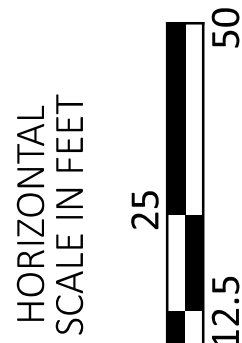

PLAN VIEW
STATE ROUTE 325

DESIGN AGENCY

DESIGNER

BAC

REVIEWER

KWK 07-28-25

PROJECT ID

119116

SHEET

16

TOTAL

16