
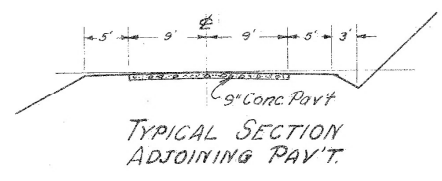



PLAN	DATE
DESIGNED	
CHECKED	
NOTED	
DATE	

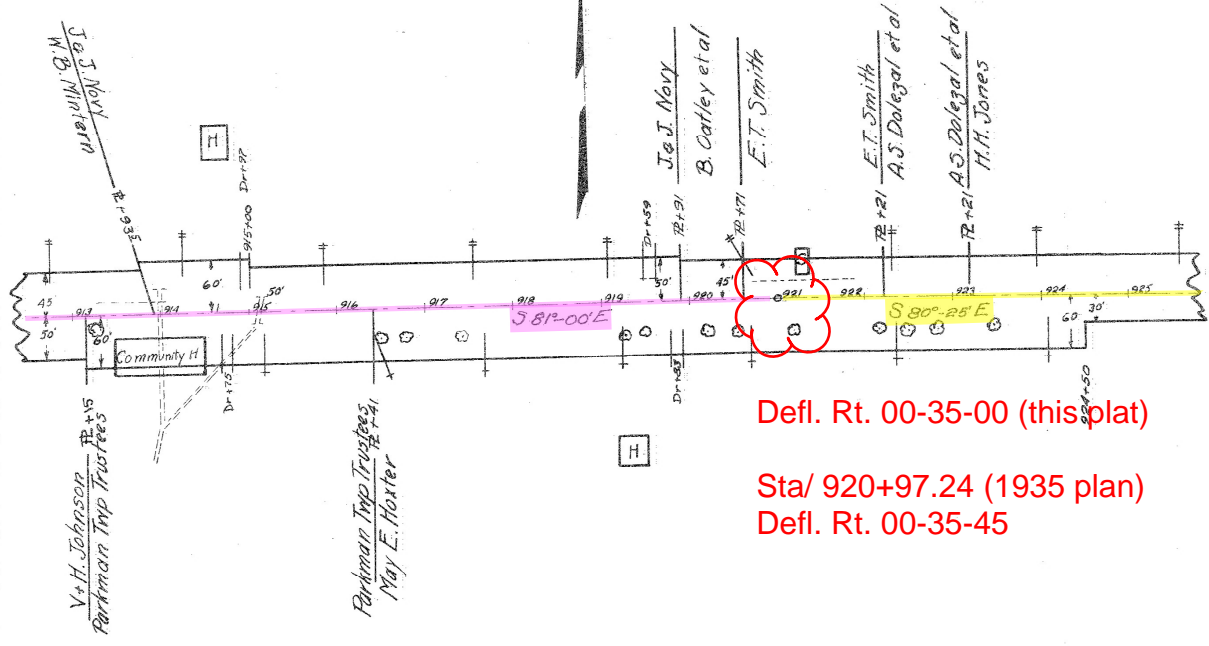

Defl. Rt. 00-35-00 (this plat)

Sta/ 920+97.24 (1935 plan)

Defl. Rt. 00-35-45

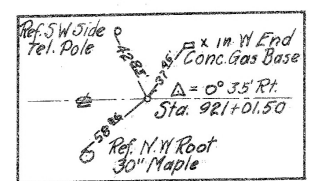

PROFILE	DATE
DESIGNED	
CHECKED	
NOTED	
DATE	

