


STATE OF OHIO  
DEPARTMENT OF TRANSPORTATION  
**GRE-US 35-5.63**  
BEAVERCREEK TOWNSHIP  
GREENE COUNTY

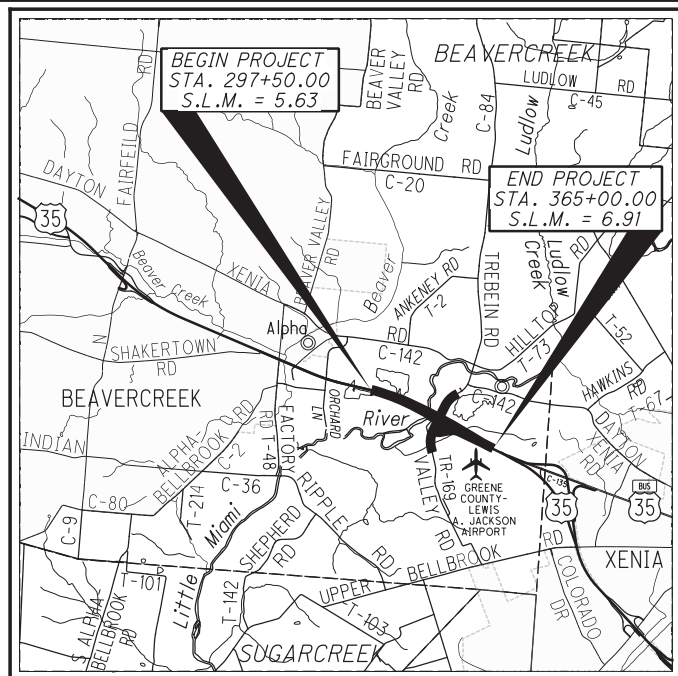

LOCATION MAP

LATITUDE: 39°42'00" LONGITUDE: -83°59'50"



|                         |       |
|-------------------------|-------|
| PORTION TO BE IMPROVED  | ————— |
| INTERSTATE HIGHWAY      | ————— |
| FEDERAL ROUTES          | ————— |
| STATE ROUTES            | ————— |
| COUNTY & TOWNSHIP ROADS | ————— |
| OTHER ROADS             | ————— |

DESIGN DESIGNATION

| DESIGN DESIGNATION                | US 35                                   | VALLEY ROAD (TR 169)/ TREBEIN ROAD (CR 84) |
|-----------------------------------|---|--|
| CURRENT ADT (2025)                | 36,990                                  | 7,850                                      |
| DESIGN YEAR ADT (2045)            | 45,220                                  | 9,200                                      |
| DESIGN HOURLY VOLUME (2045)       | 5,480                                   | 930  |
| DIRECTIONAL DISTRIBUTION          | 53%                                     | 51%  |
| TRUCKS (24 HOUR B&C)              | 12%                                     | 7%   |
| DESIGN SPEED                      | 65 MPH                                  | 60 MPH                                     |
| LEGAL SPEED                       | 55 MPH                                  | 55 MPH                                     |
| DESIGN FUNCTIONAL CLASSIFICATION: | 02 OTHER FREEWAYS & EXPRESSWAYS (URBAN) | 05 MAJOR COLLECTOR ROADS (URBAN)           |
| NHS PROJECT                       | YES                                     |  |

DESIGN EXCEPTION: NONE REQUIRED

ADA DESIGN WAIVER: NONE REQUIRED

**UNDERGROUND UTILITIES**  
Contact Two Working Days Before You Dig  
  
OHIO811. 8-1-1 or 1-800-362-2764 (Non-members must be called directly)

PLAN PREPARED BY:

**Jacobs**

2 CROWN POINT COURT, SUITE 100  
CINCINNATI, OHIO 45241  
TEL: (513) 595 7500

INDEX OF SHEETS:

|                                 |  |  |   |
|---------------------------------|--|--|---|
| TITLE SHEET                     | 1  | STRUCTURE (20' AND UNDER)                  |   |
| SCHEMATIC PLAN                  | 2-3  | US 35 OVER FLOODPLAIN RELIEF DITCH         |   |
| HORIZONTAL AND VERTICAL CONTROL | 4-5  | STRUCTURE NO. GRE-035-0604                 | 523-527                                     |
| INTERCHANGE GEOMETRIC LAYOUT    | 6-10   | US 35 OVER TRIBUTARY TO LITTLE MIAMI RIVER |   |
| TYPICAL SECTIONS                | 11-29  | STRUCTURE NO. GRE-035-0654                 | 528-530                                     |
| GENERAL NOTES                   | 30-35  | STRUCTURE (OVER 20')                       |   |
| MAINTENANCE OF TRAFFIC          | 36-55, 57-103, 105-158, 165-172, 172A, 172B, 172C, 172D, 172E, 172F, 173-176 | US 35 OVER LITTLE MIAMI RIVER              |   |
| NOT USED                        | 56, 104, 159-164   | STRUCTURE NO. GRE-035-0614                 | 531-537                                     |
| GENERAL SUMMARY                 | 177-182  | RAMP E OVER LITTLE MIAMI RIVER             |   |
| SUBSUMMARIES                    | 183-202  | STRUCTURE NO. GRE-035-0610                 | 538-572, 572A, 572B, 572C, 572D, 572E, 572F |
| NOT USED                        | 203-204  | VALLEY/TREBEIN ROAD OVER US 35             |   |
| PROJECT SITE PLAN               | 205-207  | STRUCTURE NO. GRE-035-0627                 | 573-601, 601A                               |
| PLAN (US 35)                    | 208-232  | FENCE PLAN                                 | 602-606                                     |
| PROFILE (US 35)                 | 233-241  | RIGHT-OF-WAY                               | 607-638                                     |
| PLAN AND PROFILE (RAMPS)        | 242-262  | SOIL PROFILE                               | 639-698                                     |
| CROSS SECTIONS (US 35)          | 263-323  |  |   |
| CROSS SECTIONS (RAMPS)          | 324-354  |  |   |
| PLAN AND PROFILE (SIDE ROADS)   | 355-366  |  |   |
| CROSS SECTIONS (SIDE ROADS)     | 367-403  |  |   |
| EXISTING PAVEMENT REMOVAL       | 404-405  |  |   |
| SUPERELEVATION TABLES           | 406-411  |  |   |
| PAVEMENT DETAILS                | 412-417  |  |   |
| INTERSECTION DETAILS            | 418-421  |  |   |
| PAVEMENT JOINT DETAILS          | 422-426  |  |   |
| DRIVE DETAILS                   | 427-430  |  |   |
| BARRIER DETAILS                 | 431-432, 432A  |  |   |
| DITCH PLAN AND ELEVATION        | 433-433  |  |   |
| STORM SEWER PROFILES            | 434-438  |  |   |
| CULVERT DETAILS                 | 439-444  |  |   |
| DRAINAGE DETAILS                | 445-448, 448A, 449   |  |   |
| RETAINING WALLS                 | 450-472  |  |   |
| TEMPORARY RETAINING WALLS       | 473-475  |  |   |
| TRAFFIC CONTROL                 | 476-506, 506A, 506B, 507, 507A, 507B   |  |   |
| LIGHTING                        | 508-509, 509A, 510, 511, 511A, 511B, 512, 512A, 512B, 513-516, 516A, 517-522 |  |   |

ENGINEERS SEAL:  
  
SIGNED: Daniel Baah  
DATE: 08-24-2022

| STANDARD CONSTRUCTION DRAWINGS |                 |         |              |           |         |           |         |           |         |           |          | SUPPLEMENTAL SPECIFICATIONS | SPECIAL PROVISIONS |          |              |  |
|--------------------------------|-----------------|---------|--------------|-----------|---------|-----------|---------|-----------|---------|-----------|----------|-----------------------------|--------------------|----------|--------------|--|
| BP-1.1                         | 7/28/00         | I-3B    | 3B1, 7/15/22 | MGS-4.3   | 1/18/13 | SBR-2-20  | 1/15/21 | HL-60.31  | 1/17/20 | MT-102.20 | 4/19/19  | TC-52.10                    | 10/18/13           | 800-2019 | SEE PROPOSAL |  |
| BP-2.1                         | 1/21/22         | I-3C    | 3C1, 7/15/22 | MGS-5.3   | 7/15/16 | SICD-1-21 | 1/21/22 |           |         | MT-102.30 | 10/16/15 | TC-52.20                    | 1/15/21            | 807      | 1/21/22      |  |
| BP-2.2                         | 1/15/21         | I-3D    | 7/15/22      | MGS-6.1   | 1/19/18 | SICD-2-14 | 1/15/21 | MT-95.30  | 7/19/19 | MT-103.10 | 1/21/22  | TC-61.10                    | 1/17/20            | 808      | 1/18/19      |  |
| BP-2.3                         | 7/18/14         |         |              |           |         | TST-1-99  | 1/15/21 | MT-95.45  | 1/17/20 | MT-104.10 | 10/16/15 | TC-61.30                    | 7/19/19            | 813      | 10/19/18     |  |
| BP-3.1                         | 1/21/22         | MH-3    | 7/16/21      | RM-1.1    | 1/15/21 | VPF-1-90  | 7/20/18 | MT-95.50  | 7/21/17 | MT-105.10 | 1/17/20  | TC-65.10                    | 1/17/14            | 821      | 4/20/12      |  |
|                                |                 |         |              | RM-4.1    | 7/21/17 |           |         | MT-95.71  | 1/17/20 | MT-120.00 | 7/15/22  | TC-65.11                    | 7/15/22            | 832      | 10/19/18     |  |
| CB-2-2A                        | 2B, 2C, 7/15/22 | BP-4.1  | 7/19/13      | RM-4.2    | 4/17/20 | HL-10.11  | 7/15/22 | MT-97.10  | 4/19/19 |           |          | TC-71.10                    | 7/15/22            | 836      | 1/19/18      |  |
| CB-2-3                         | 2-4, 7/16/21    | BP-5.1  | 7/15/22      | RM-4.3    | 1/21/22 | HL-10.12  | 1/20/17 | MT-98.10  | 1/17/20 | TC-9.31   | 7/16/21  | TC-72.20                    | 7/20/18            | 839      | 7/16/21      |  |
| CB-3                           | 7/16/21         | BP-7.1  | 7/17/20      | RM-4.4    | 7/19/19 | HL-10.13  | 4/17/20 | MT-98.11  | 1/17/20 | TC-12.31  | 4/15/22  | TC-73.20                    | 1/17/20            | 840      | 4/16/21      |  |
| CB-3A                          | 7/16/21         | BP-9.1  | 1/18/19      | RM-4.5    | 7/21/17 | HL-20.11  | 1/15/21 | MT-98.20  | 4/19/19 | TC-15.116 | 7/16/21  |                             |                    | 846      | 4/17/15      |  |
| CB-6                           | 1/21/22         |         |              | RM-4.6    | 7/19/13 | HL-20.13  | 7/15/22 | MT-98.21  | 1/17/20 | TC-21.11  | 7/16/21  |                             |                    | 850      | 1/21/22      |  |
| CB-8                           | 7/16/21         | F-2.1   | 7/20/18      |           |         | HL-30.11  | 1/15/21 | MT-98.28  | 1/17/20 | TC-21.21  | 7/15/22  |                             |                    | 851      | 1/21/22      |  |
| CB-4A                          | 5A, 8A, 7/16/21 | F-3.1   | 7/19/13      | A-1-20    | 1/21/22 | HL-30.21  | 4/17/20 | MT-99.20  | 4/19/19 | TC-21.50  | 4/17/20  |                             |                    | 867      | 1/15/21      |  |
|                                |                 | F-3.3   | 7/19/13      | AS-1-15   | 7/17/15 | HL-30.22  | 1/15/21 | MT-99.30  | 1/17/20 | TC-22.20  | 1/17/14  |                             |                    | 878      | 1/21/22      |  |
| DM-1.1                         | 7/17/20         | F-3.4   | 7/19/13      | AS-2-15   | 1/18/19 | HL-30.31  | 4/17/20 | MT-99.60  | 7/15/16 | TC-41.10  | 7/19/13  |                             |                    | 902      | 7/19/19      |  |
| DM-1.2                         | 7/16/21         |         |              | BR-2-15   | 1/21/22 | HL-30.32  | 4/17/20 | MT-100.00 | 7/16/21 | TC-41.20  | 10/18/13 |                             |                    | 905      | 4/17/20      |  |
| DM-2.1                         | 1/18/13         | MGS-1.1 | 7/16/21      | EXJ-4-87  | 7/15/22 | HL-30.33  | 1/21/22 | MT-101.60 | 1/17/20 | TC-41.30  | 10/18/13 |                             |                    | 908      | 10/20/17     |  |
| DM-4.1                         | 7/17/20         | MGS-2.1 | 1/19/18      | GSD-1-19  | 1/15/21 | HL-30.41  | 1/21/22 | MT-101.70 | 1/17/20 | TC-41.50  | 10/18/13 |                             |                    | 913      | 4/16/21      |  |
| DM-4.3                         | 1/15/16         | MGS-3.1 | 1/19/18      | HW-2.1    | 7/20/18 | HL-40.20  | 7/15/22 | MT-101.75 | 1/17/20 | TC-42.10  | 10/18/13 |                             |                    | 921      | 4/20/12      |  |
| DM-4.4                         | 1/15/16         | MGS-3.2 | 1/18/13      | HW-2.2    | 7/20/18 | HL-50.21  | 7/15/22 | MT-101.90 | 7/17/20 | TC-42.20  | 10/18/13 |                             |                    | 939      | 1/17/20      |  |
|                                |                 | MGS-4.2 | 7/19/13      | PSID-1-13 | 1/15/21 | HL-60.11  | 7/21/17 | MT-102.10 | 1/17/20 | TC-51.11  | 1/15/16  |                             |                    | 1120     | 4/15/22      |  |

PROJECT DESCRIPTION

THIS PROJECT CONSISTS OF RECONSTRUCTING US 35, REMOVING AT-GRADE INTERSECTION AND CONSTRUCTING A NEW INTERCHANGE, WHILE MAINTAINING LOCAL ACCESS. THIS IMPROVEMENT INVOLVES UPGRADING APPROXIMATELY 1.28 MILES OF US 35 TO A LIMITED-ACCESS FACILITY, INCLUDING THREE HIGHWAY BRIDGE STRUCTURES, RETAINING WALLS, AND RECONSTRUCTION OF APPROXIMATELY 0.68 MILES OF SIDE ROADS.

EARTH DISTURBED AREAS

PROJECT EARTH DISTURBED AREA: 53.28 ACRES  
ESTIMATED CONTRACTOR EARTH DISTURBED AREA: 19.70 ACRES  
NOTICE OF INTENT EARTH DISTURBED AREA: 72.98 ACRES

LIMITED ACCESS

THIS IMPROVEMENT IS ESPECIALLY DESIGNED FOR THROUGH TRAFFIC AND HAS BEEN DECLARED A LIMITED ACCESS HIGHWAY, OR FREEWAY, BY ACTION OF THE DIRECTOR IN ACCORDANCE WITH THE PROVISIONS OF SECTION 5511.02 OF THE OHIO REVISED CODE.

2019 SPECIFICATIONS

THE STANDARD SPECIFICATIONS OF THE STATE OF OHIO, DEPARTMENT OF TRANSPORTATION, INCLUDING SUPPLEMENTAL SPECIFICATIONS LISTED IN THE PLANS AND CHANGES LISTED IN THE PROPOSAL SHALL GOVERN THIS IMPROVEMENT.

I HEREBY APPROVE THESE PLANS AND DECLARE THAT THE MAKING OF THIS IMPROVEMENT WILL NOT REQUIRE THE CLOSING TO TRAFFIC OF THE HIGHWAY EXCEPT AS SHOWN ON SHEETS NO. 59 & 59, AND THAT THE PROVISIONS FOR MAINTENANCE AND SAFETY OF TRAFFIC WILL BE AS SET FORTH ON THE PLANS AND ESTIMATES.

APPROVED:   
DATE: 8-30-22 DISTRICT DEPUTY DIRECTOR

APPROVED: \_\_\_\_\_  
DATE: \_\_\_\_\_ DIRECTOR, DEPARTMENT OF TRANSPORTATION

| ENGINEERS SEAL:<br>FOR TRAFFIC CONTROL AND LIGHTING | ENGINEERS SEAL:<br>FOR STRUCTURES              |
|---|--|
| <br>SIGNED: Ramnarayan Nunna<br>DATE: 08/24/22      | <br>SIGNED: Jason T. Centers<br>DATE: 08/24/22 |

| ENGINEERS SEAL:<br>FOR SOIL PROFILE              |
|--|
| <br>SIGNED: Brian R. Trenner<br>DATE: 08/23/2022 |

FEDERAL PROJECT NO. E180373  
CONSTRUCTION PROJECT NO. 107217  
RAILROAD INVOLVEMENT NONE  
GRE-US 35-5.63  
1/698

**SURFACE WATER PROTECTION**

STREAMBANK VEGETATION WILL BE LEFT UNDISTURBED TO THE MAXIMUM EXTENT POSSIBLE. AREAS WHERE THE VEGETATION IS TEMPORARILY REMOVED WILL BE RE-VEGETATED WITH NATIVE FLOODPLAIN SPECIES FROM THE NATIVE VEGETATION LIST OF THE ODNR SCENIC RIVERS PROGRAM. MEASURES WILL BE TAKEN TO AVOID DAMAGE TO TREE TRUNKS, ROOTS, OR LIMBS OF LIVE STANDING TREES. TREES AND SHRUBS THAT MUST BE REMOVED WITHIN 25 FEET OF THE BANK OF THE LITTLE MIAMI RIVER MUST BE REPLACED IN ACCORDANCE WITH THE STIPULATIONS OF THE NATIONAL PARK SERVICE. EXCESSED LANDS IN THE AREA OF THE LITTLE MIAMI RIVER FLOODPLAIN WILL BE RESTORED WITH NATIVE FLOODPLAIN VEGETATION. NATIVE GRASSES AND FORBS MAY BE USED IN LIEU OF WOODY VEGETATION WHERE APPROPRIATE.

NO WORK WILL BE PERFORMED WITHIN THE BED AND BANKS OF THE LITTLE MIAMI RIVER. IMPACTS AT THE RIVER WILL BE LIMITED TO CONNECTING ROADSIDE DRAINAGE SWALES BETWEEN AUGUST 1st-OCTOBER 31st. ALL HEAVY EQUIPMENT MUST REMAIN ABOVE THE ORDINARY HIGH WATER MARK OF THE LITTLE MIAMI RIVER. ANY WORK BELOW OHWM OF THE LITTLE MIAMI RIVER SHALL BE CONDUCTED DURING DRY PERIODS OF EXTREMELY LOW FLOW (AUGUST 1 THROUGH OCTOBER 31). IN-STREAM WORK IS DEFINED AS THE ACTIVE REMOVAL OR PLACEMENT OF FILL BELOW THE ORDINARY HIGH-WATER MARK (OHWM).

ALL FILL MATERIAL USED IN LMR-1 SHALL BE RELATIVELY FREE FROM FINE PARTICULATE MATTER. IN-STREAM WORK SHOULD BE CONDUCTED THROUGH THE USE OF WATER DIVERSIONS NOT REQUIRING THE PLACEMENT OF EARTHEN FILL (I.E. SHEET PILING, MEMBRANE DAMS, ETC.) WHEREVER POSSIBLE. ANY FILL WILL BE COMPLETELY REMOVED FROM THE STREAMBED IMMEDIATELY UPON COMPLETION OF WORK NECESSITATING USE OF IN-STREAM WORK PLATFORMS.

IF DEWATERING IS REQUIRED, NO WASTEWATER OF ANY KIND WILL BE DIRECTLY DISCHARGED INTO THE LITTLE MIAMI STATE AND NATIONAL SCENIC RIVER OR ANY OF ITS TRIBUTARY STREAMS, DRAINAGE WAYS OR DITCHES. IF DEWATERING IS NECESSARY TO FACILITATE IN-STREAM WORK, ALL WASTEWATER SHALL BE PUMPED ONTO A VEGETATED AREA A SUFFICIENT DISTANCE FROM THE RIVER TO ALLOW FOR COMPLETE INFILTRATION. IF DISCHARGE TO A VEGETATED AREA IS NOT FEASIBLE, THEN WASTEWATER SHALL BE DISCHARGED INTO A SEDIMENT FILTER BAG OR INTO A TEMPORARY DETENTION/RETENTION POND OR APPROPRIATE SEDIMENT CONTROL SUFFICIENT RETENTION TIME TO PERMIT FOR THE SETTLING OF ALL SUSPENDED SOLIDS.

ANY AND ALL CONSTRUCTION DEBRIS, EARTHEN DEBRIS, EXCESS ASPHALT OR CONCRETE, WOOD DEBRIS FROM CLEARING, EXCESS FILL MATERIAL, EXCAVATED MATERIAL AND TRASH WILL BE DISPOSED OF AT AN APPROVED UPLAND SITE OR LAND FILL ABOVE 100 YEAR FLOOD ELEVATIONS. CONSTRUCTION AND/OR WORKER GENERATED DEBRIS WILL BE CONTAINED ON SITE IN PROPERLY COVERED CONTAINERS; DAILY CLEAN-UP WILL BE PERFORMED TO PREVENT MATERIALS FROM ENTERING THE RIVER.

DISPOSAL OF ANY SUCH MATERIALS WITHIN 1000 FEET OF THE LITTLE MIAMI STATE AND NATIONAL SCENIC RIVER IS PROHIBITED.

**PARKS**

THE CONTRACTOR WILL NOTIFY THE DISTRICT ENVIRONMENTAL COORDINATOR AT LEAST ONE WEEK IN ADVANCE OF ANY CONSTRUCTION ACTIVITIES AFFECTING THE GLENN THOMPSON RESERVE, INCLUDING ACCESS FROM TREBEIN ROAD.

ODOT WILL COORDINATE DETAILS OF PROJECT DESIGN, CONSTRUCTION, AND SITE RESTORATION AT THE GLENN THOMPSON RESERVE WITH THE GREENE COUNTY PARKS AND TRAILS AND ODNR DURING DETAILED DESIGN, INCLUDING SIGNAGE AT THE PARK ENTRANCE, AND RECONSTRUCTION OF THE EAGLE PASS CANOE LAUNCH AND TRAILS. THE RIGHT-OF-WAY FENCE ALONG US 35 AT THE PARK WILL BE RECONSTRUCTED.

THE CONTRACTOR WILL BE REQUIRED TO MAINTAIN ACCESS TO THE GLENN THOMPSON RESERVE AT ALL TIMES THROUGHOUT CONSTRUCTION.

TEMPORARY CONSTRUCTION FENCING WILL BE INSTALLED ALONG THE PROPOSED CONSTRUCTION LIMITS AT THE PARK PRIOR TO THE START OF CONSTRUCTION ACTIVITIES IN ORDER TO PROTECT THE PARK PROPERTY, AND THE PUBLIC. NO STAGING AND/OR STORAGE OF CONSTRUCTION EQUIPMENT WILL OCCUR OUTSIDE OF THE PROJECT CONSTRUCTION LIMITS WITHIN THE GLENN THOMPSON RESERVE.

AREAS OF THE PARK PROPERTY THAT ARE TEMPORARILY DISTURBED WILL BE FULLY RESTORED, I.E., THE PROPOSED FINAL CONDITION OF THE LAND WILL BE AT LEAST AS GOOD AS THE CURRENT CONDITION.

**SCENIC RIVERS PROGRAM**

THE CONTRACTOR SHALL INVITE THE SOUTHWEST OHIO ASSISTANT REGIONAL SCENIC RIVERS MANAGER, AARON ROURKE, TO A PRE-CONSTRUCTION MEETING WITH THE CONTRACTOR PRESENT. THE CONTRACTOR SHALL NOTIFY AARON OF THE PROJECT START DATE ONE WEEK PRIOR TO THE COMMENCEMENT OF WORK. AARON MAY BE CONTACTED AT (614) 230-8534 OR AARON.ROURKE@DNR.OHIO.GOV. PERIODIC INSPECTIONS OF THE PROJECT SHOULD TAKE PLACE TO ENSURE SCENIC RIVER REQUIREMENTS ARE BEING MET. AARON SHALL ALSO BE CONTACTED ONE WEEK PRIOR TO COMPLETION OF THE PROJECT TO CONDUCT A FINAL SITE INSPECTION. THE FINAL SITE INSPECTION SHALL BE SCHEDULED WHILE THE CONTRACTOR IS PRESENT TO ENSURE THAT FINAL SITE STABILIZATION HAS BEEN ACHIEVED.

**ENDANGERED BAT HABITAT REMOVAL**

THIS PROJECT IS LOCATED WITHIN THE KNOWN HABITAT RANGES OF THE FEDERALLY LISTED AND PROTECTED INDIANA BAT, AND NORTHERN LONG-EARED BAT. NO TREES SHALL BE REMOVED UNDER THIS PROJECT FROM APRIL 1 THROUGH SEPTEMBER 30. ALL NECESSARY TREE REMOVAL SHALL OCCUR FROM OCTOBER 1 THROUGH MARCH 31. THIS REQUIREMENT IS NECESSARY TO AVOID AND MINIMIZE IMPACTS TO THESE SPECIES AS REQUIRED BY THE ENDANGERED SPECIES ACT (ESA). FOR THE PURPOSES OF THIS NOTE, A TREE IS DEFINED AS: A LIVE, DYING, OR DEAD WOODY PLANT, WITH A TRUNK 3 INCHES OR GREATER IN DIAMETER AT A HEIGHT OF 4.5 FEET ABOVE THE GROUND SURFACE, AND WITH A MINIMUM HEIGHT OF 13 FEET. DEMARCATÉ CLEARING LIMITS IN ADVANCE TO AVOID ANY UNAUTHORIZED TREE CLEARING.

**OTHER RARE SPECIES**

THIS PROJECT IS WITHIN THE RANGE OF THE EASTERN MASSASAUGA RATTLESNAKE (SISTRURUS CATENATUS) A STATE ENDANGERED AND FEDERAL CANDIDATE SPECIES. DO NOT HARM OR KILL THE SNAKES AND USE CAUTION SINCE THE MASSASAUGA RATTLESNAKE IS A VENOMOUS SPECIES. IF EASTERN MASSASAUGA RATTLESNAKES ARE ENCOUNTERED WITHIN THE CONSTRUCTION LIMITS, STOP ALL CONSTRUCTION OPERATIONS WITHIN THE VICINITY OF THE SNAKE IMMEDIATELY. THE PROJECT ENGINEER WILL IMMEDIATELY CONTACT THE DISTRICT ENVIRONMENTAL COORDINATOR. DO NOT RESUME CONSTRUCTION ACTIVITIES WITHIN THE VICINITY OF THE SNAKE UNTIL THE DISTRICT ENVIRONMENTAL COORDINATOR DETERMINES THE COORDINATION/CONSULTATION WITH ODNR AND THE US FISH AND WILDLIFE SERVICE IS COMPLETE.

IF INITIAL CLEARING AND GRUBBING WILL OCCUR IN GRASSLANDS DURING THE BREEDING SEASON OF PROTECTED THE NORTHERN HARRIER (APRIL 1 TO AUGUST 1), A SURVEY FOR THE NORTHERN HARRIER WILL BE CONDUCTED IN SUITABLE HABITATS PRIOR TO CONSTRUCTION.

THE CONTRACTOR SHALL CONTACT THE ODOT DISTRICT ENVIRONMENTAL COORDINATOR IN ADVANCE OF ANY WORK IN STREAM LMR-1 (PERENNIAL TRIBUTARY EAST OF THE LITTLE MIAMI RIVER) TO ENSURE A MUSSEL SALVAGE AND RELOCATION HAS BEEN COMPLETED AND APPROVAL HAS BEEN RECEIVED FROM ODNR.

**PAINTING AND BLASTING**

IF PAINTING, SAND, OR WATER BLASTING ANY PORTION OF THE BRIDGE IS NECESSARY, THEN APPROPRIATE APRONS SHOULD BE UTILIZED TO PROVIDE FOR COMPLETE CONTAINMENT OF ALL PAINT DEBRIS PARTICLES AND OTHER DEBRIS. APPROPRIATE APRONS SHALL BE UTILIZED TO PROVIDE FOR COMPLETE CONTAINMENT OF ALL PAINT AND/OR SEALANT OVERSPRAY. ANY SUCH DEBRIS SHALL BE REMOVED IMMEDIATELY FROM 1000 FEET OF THE LITTLE MIAMI STATE AND NATIONAL SCENIC RIVER AND DISPOSED OF AT AN APPROVED UPLAND SITE ABOVE THE 100-YEAR FLOOD ELEVATIONS. DISPOSAL IN WETLANDS, FLOODPLAINS OR WITHIN 1000 OF THE LITTLE MIAMI STATE AND NATIONAL SCENIC RIVER IS PROHIBITED.

**SOLE SOURCE AQUIFER**

THIS PROJECT IS LOCATED WITHIN THE GREATER MIAMI SOLE SOURCE AQUIFER AND IS LOCATED WITHIN THE DRINKING WATER PROTECTION AREA THE GREENE COUNTY NORTHWEST REGIONAL VALLEY SPRINGS WELLHEAD PROTECTION AREA (US 35 STA 285+00 TO 265+00 AND VALLEY ROAD/TREBEIN ROAD STA 862+00 TO STA 898+00). USE PROPER CONTAINMENT AND DIKING IN REFUELING AREAS. DO NOT STORE FUELS, TOXIC/HAZARDOUS MATERIALS, AND CHEMICALS NEAR DRAINAGE WAYS, DITCHES, OR STREAMS. MAINTAIN A SPILL KIT ON-SITE THROUGHOUT CONSTRUCTION ACTIVITIES. IMMEDIATELY MITIGATE ANY EVENT, SUCH AS A SPILL OF FUELS, OILS, OR CHEMICALS, THAT COULD THREATEN TO CONTAMINATE THE DRINKING WATER SUPPLY. THE CONTRACTOR WILL DEVELOP A SPILL PREVENTION COUNTERMEASURE AND CONTINGENCY PLAN (SPCC) IN THE EVENT OF A SPILL OR BREAK IN AN EQUIPMENT HYDRAULIC LINE, WHICH MAY DISCHARGE INTO SURFACE WATERS OR GROUNDWATER. REPORT ALL SPILLS OR EVENTS TO THE BEAVERCREEK FIRE DEPARTMENT AT (937) 426-1213. IF THE SPILL IS A REPORTABLE AMOUNT (PER OHIO EPA'S RELEASE REPORTING REQUIREMENTS) CONTACT THE BEAVERCREEK FIRE DEPARTMENT AT (937) 426-1213 OR THE OHIO EPA'S SPILLS HOTLINE 1-800-282-9378 FOR CLEAN-UP OF THE SPILL.

**MUSSEL SURVEY**

THE MUSSEL SURVEY AND MUSSEL RELOCATION HAVE BEEN COMPLETED. THERE ARE NO IN-STREAM WORK RESTRICTIONS RELATED TO MUSSELS.

**CANOE MAINTENANCE OF TRAFFIC**

THE CONTRACTOR SHALL CONTACT NATALIE PIRVU, ODNR DIVISION OF PARKS AND WATERCRAFT LAND AND WATER ADMINISTRATOR TO ASSIST WITH ANY NECESSARY SIGNAGE, COORDINATION, AND COMMUNICATIONS. SHE CAN BE REACHED AT 614-265-6466 OR NATALIE.PIRVU@DNR.OHIO.GOV. THE ODNR DIVISION OF PARKS AND WATERCRAFT SHALL BE NOTIFIED BY THE CONTRACTOR AT LEAST 2 WEEKS IN ADVANCE OF CONSTRUCTION TO POST NOTICE OF THE IMPENDING PROJECT ON ODNR'S ONLINE BOATING WEBPAGE AND ANY ASSOCIATED MAPS. IF ON-THE-WATER LAW ENFORCEMENT ASSISTANCE IS NEEDED DURING ANY PORTION OF THE DEMOLITION OR CONSTRUCTION PHASE OR IF YOU HAVE ANY SPECIFIC QUESTIONS ABOUT NAVIGATION ON THE LITTLE MIAMI RIVER PLEASE CONTACT THE DIVISION OF PARKS AND WATERCRAFT LAW ENFORCEMENT SUPERVISOR, SHANNON HOFFER AT 937-902-4950 OR SHANNON.HOFFER@DNR.OHIO.GOV.

**SCENIC RIVER SIGNAGE**

SIGNS STATING LITTLE MIAMI STATE AND NATIONAL SCENIC RIVER SHALL BE PROVIDED AND INSTALLED AT THE ENDS OF BOTH APPROACHES OF THE NEW BRIDGE. A SIGN STATING (BRIDGE NAME, TRAIL NAME/NUMBER) SHALL BE INSTALLED ON THE UPSTREAM AND DOWNSTREAM SIDE OF THE NEW BRIDGE SO AS TO PROVIDE A LOCATIONAL REFERENCE TO RECREATIONAL BOATERS USING THE LITTLE MIAMI STATE AND NATIONAL SCENIC RIVER.

**SWPPP AND SPILLS**

THE SWPPP SHALL BE DESIGNED TO ADDRESS SPILLS OF TOXIC AND/OR HAZARDOUS MATERIALS THAT HAVE THE POTENTIAL TO BE CONVEYED TO THE LITTLE MIAMI STATE AND NATIONAL SCENIC RIVER AND/OR ITS FLOODPLAIN, TRIBUTARIES, OR DRAINAGE WAYS. PETROCHEMICALS AND TOXIC/HAZARDOUS MATERIALS SHOULD NOT BE DISCHARGED INTO THE LITTLE MIAMI STATE AND NATIONAL SCENIC RIVER, ITS FLOODPLAIN OR ANY OF ITS TRIBUTARY DRAINAGE WAYS, DITCHES, OR STREAMS.

**TREE REMOVAL PRIOR TO WATERWAY PERMIT APPROVAL**

TREE REMOVAL WORK WITHIN THE DELINEATED STREAMS AND WETLANDS SHALL BE LIMITED TO DROPPING THE CUT TREES IN PLACE ONLY, UNTIL THE WATERWAY PERMITS (SECTION 404 AND 401) ARE APPROVED. NO HEAVY EQUIPMENT CAN BE USED WITHIN THESE AREAS UNTIL THE WATERWAY PERMITS ARE APPROVED.

Martin.Pierce@jacobs.com

12/2/2022 10:13:31 AM

107217GN005.dgn

CALCULATED

CHECKED

GENERAL NOTES

GRE-US 35-5.63

**TEMPORARY WALLS AND TEMPORARY SHORING**

WHERE TEMPORARY RETAINING WALLS OR TEMPORARY SHORING ARE REQUIRED TO COMPLETE WORK IDENTIFIED IN THE PLANS AS "CONSTRUCTION CRITICAL FOR NEXT PHASE", DETAILS FOR THE TEMPORARY WALLS OR TEMPORARY SHORING ARE INCLUDED IN THE PROJECT PLANS.

WORK IDENTIFIED IN THE PLANS AS "CONSTRUCTION AVAILABLE THIS PHASE" MAY NOT BE ABLE TO BE COMPLETED ENTIRELY DURING THAT PARTICULAR PHASE WITHOUT THE NEED FOR ADDITIONAL TEMPORARY WALLS OR SHORING. IF THE CONTRACTOR ELECTS TO ACCELERATE WORK IN AREAS IDENTIFIED AS "CONSTRUCTION AVAILABLE THIS PHASE" SUCH THAT ADDITIONAL TEMPORARY WALLS OR SHORING ARE REQUIRED, THE CONTRACTOR IS RESPONSIBLE FOR DESIGN AND CONSTRUCTION OF THE TEMPORARY WALLS OR SHORING AT NO ADDITIONAL COST TO THE DEPARTMENT.

**TEMPORARY SHORING FOR STORM PIPE INSTALLATION**

TEMPORARY SHORING REQUIRED FOR STORM PIPE INSTALLATION (DUE TO PART WIDTH CONSTRUCTION) SHALL BE CONSIDERED INCIDENTAL TO ITEM 614, MAINTENANCE OF TRAFFIC. NO SEPARATE PAYMENT SHALL BE MADE.

**TRAFFIC INCIDENT MANAGEMENT (TIM) DURING MOT**

OHIO TIM IS OHIO'S TRAFFIC INCIDENT MANAGEMENT PROGRAM WHICH IS COMMITTED TO MAINTAINING THE SAFE AND EFFECTIVE FLOW OF TRAFFIC DURING EMERGENCIES AS TO PREVENT FURTHER DAMAGE, INJURY OR UNDUE DELAY OF THE MOTORING PUBLIC. IN ADDITION TO COMPLYING WITH THE PROVISION OF OMUTCD CHAPTER 6I, CONTROL OF TRAFFIC THROUGH TRAFFIC INCIDENT MANAGEMENT AREAS, THE CONTRACTOR SHALL ACTIVELY PARTICIPATE IN TIM PLANNING AND IMPLEMENTATION AS OUTLINED BELOW.

1. SUPERINTENDENT SHALL IDENTIFY THE INDIVIDUAL PERSONS ON THE PROJECT WHO WILL, OR MAY NEED TO, PERFORM THE DUTIES HEREIN. AT A MINIMUM, INCLUDE THE SUPERINTENDENT, FOREMEN AND SUPERVISORS (OR EQUIVALENT) AS WELL AS THE WORKSITE TRAFFIC SUPERVISOR (WTS; IF APPLICABLE TO THE PROJECT). THESE INDIVIDUALLY IDENTIFIED PERSONS SHALL COLLECTIVELY BE KNOWN AS CONTRACTOR TRAFFIC INCIDENT MANAGEMENT (TIM) CONTACTS. NOTIFY THE PROJECT ENGINEER OF THE CONTRACTOR TIM CONTACTS (ALONG WITH CONTACT INFORMATION FOR EACH) AT OR BEFORE THE PRECONSTRUCTION MEETING.
2. SUPERINTENDENT SHALL NOTIFY THE ENGINEER IMMEDIATELY IF ANY CONTRACTOR TIM CONTACT IS ADDED, REMOVED OR THE CONTACT INFORMATION CHANGES OVER THE COURSE OF THE PROJECT.
3. PRIOR THE FIRST DAY OF WORK IN THE FIELD, EACH CONTRACTOR TIM CONTACT ON THE PROJECT SHALL HAVE ATTENDED AND SUCCESSFULLY COMPLETED OHIO TIM TRAINING PROVIDED BY THE DEPARTMENT OR DESIGNEE. TRAINING INFORMATION CAN BE FOUND AT WWW.OHIOTIM.COM.
4. SUPERINTENDENT, AT A MINIMUM, SHALL ATTEND AND ACTIVELY PARTICIPATE IN A DEPARTMENT SCHEDULED TIM MEETING BEFORE CONSTRUCTION WORK BEGINS AND BEFORE EACH PHASE CHANGE. THESE MEETINGS WILL RESULT IN A DEPARTMENT ISSUED PROJECT SPECIFIC TRAFFIC INCIDENT MANAGEMENT PLAN (TIMP). AT THE TIM MEETINGS THE ATTENDING CONTRACTOR TIM CONTACTS SHALL:
  - A. COLLABORATE WITH ODOT AND SAFETY FORCES;
  - B. SHARE PROJECT SPECIFIC DETAILS THAT IMPACT TIM RESPONDERS; AND

**TRAFFIC INCIDENT MANAGEMENT (TIM) DURING MOT (CONT'D)**

C. RECOMMEND WAYS TO INCORPORATE NECESSARY EMERGENCY ACCESS AND OTHER TIM ELEMENTS FOR TIM RESPONDERS GIVEN PROJECT SPECIFIC WORK BEING COMPLETED AND PROJECT SPECIFIC PHASING.

5. CONTRACTOR TIM CONTACTS SHALL IMPLEMENT COMPONENTS OF THE RESULTING TIMP (SUCH AS APPROVED EMERGENCY INGRESS/EGRESS POINTS, ETC), AS DIRECTED BY THE ENGINEER IN ACCORDANCE WITH 109.05.
6. CONTRACTOR TIM CONTACTS SHALL PERFORM, AT A MINIMUM, THE FOLLOWING FUNCTIONS WHEN AN INCIDENT/CRASH OCCURS:
  - A. IF OBSERVED OR PRESENT WHEN OCCURS, CALL 911 AND THEN NOTIFY THE TRAFFIC MANAGEMENT CENTER (TMC) TO PROVIDE THE FOLLOWING:
    - I. LOCATION, INCLUDING MILEPOST NUMBER AND DIRECTION OF TRAVEL
    - II. NUMBER AND TYPE OF VEHICLES INVOLVED, IF KNOWN
    - III. ESTIMATED EXTENT OF DAMAGE OR INJURY, IF KNOWN
    - IV. ESTIMATED NUMBER OF PATIENTS INVOLVED, IF KNOWN
    - V. ANY POTENTIAL HAZARDOUS CONDITIONS, IF KNOWN
    - VI. THE PLACARD NUMBER ON ANY HAZARDOUS MATERIALS PLACARD FROM A SAFE DISTANCE, IF APPLICABLE AND VISIBLE
  - B. FOLLOWING AN INCIDENT/CRASH:
    - I. INITIATE TRAFFIC MANAGEMENT/PROVIDE TEMPORARY TRAFFIC CONTROL AS INDICATED IN THE TIMP, AS DIRECTED BY THE ENGINEER IN ACCORDANCE WITH 109.05.
    - II. RECOMMEND ROADWAY REPAIR NEEDS.
    - III. PROVIDE REPAIR RESOURCES AND INITIATE REPAIRS, AS DIRECTED BY THE ENGINEER IN ACCORDANCE WITH 109.05.
    - IV. ATTEND AND PARTICIPATE IN AN AFTER ACTION REVIEW (AAR).

ALL COSTS, UNLESS OTHERWISE SPECIFIED, RESULTING FROM THE ABOVE REQUIREMENTS SHALL BE CONSIDERED TO BE INCLUDED IN THE LUMP SUM PRICE FOR ITEM 614, MAINTAINING TRAFFIC. FAILURE TO PERFORM THE REQUIREMENTS OF THIS PLAN NOTE WILL RESULT IN A DAILY FINE OF 2% OF ITEM 614, MAINTAINING TRAFFIC AND MAY RESULT IN ONE OR MORE CONTRACTOR TIM CONTACTS BEING REMOVED FROM THE LIST OF OHIO TIM TRAINED INDIVIDUALS (AT THE SOLE DISCRETION OF THE OHIO TIM EXECUTIVE COMMITTEE). IN THE EVENT AN INDIVIDUAL IS REMOVED FROM THE OHIO TIM TRAINED LIST, THE INDIVIDUAL WILL BE REMOVED FROM CONTRACTOR TIM CONTACT RESPONSIBILITIES ON ALL PROJECTS.

**ITEM 614, WORK ZONE RAISED PAVEMENT MARKER, AS PER PLAN**

WORK ZONE RAISED PAVEMENT MARKERS, AS PER PLAN, AND THEIR INSTALLATION SHALL CONFORM TO C&MS 614 OR C&MS 621 AS SPECIFIED HEREIN.

RAISED PAVEMENT MARKERS IN USE DURING THE SNOW-PLOWING SEASON SHALL CONFORM TO 621.

RAISED PAVEMENT MARKERS IN USE DURING THE NON-SNOW-PLOW SEASON SHALL CONFORM TO EITHER 614 OR TO 621.

THE SNOW-PLOWING SEASON SHALL RUN FROM OCTOBER 15 THROUGH APRIL 1.

IF PROJECT DELAYS, NOT THE FAULT OF ODOT, CAUSE THE WORK TO EXTEND INTO THE SNOW-PLOWING SEASON, THE CONTRACTOR SHALL BE RESPONSIBLE FOR REPLACING WORK ZONE RAISED PAVEMENT MARKERS (WZRPMS) CONFORMING TO C&MS 614, WITH RAISED PAVEMENT MARKERS CONFORMING TO 621, AS DETERMINED BY THE ENGINEER, AT THE CONTRACTOR'S EXPENSE.

THIS ITEM SHALL INCLUDE PURCHASE, INSTALLATION AND REMOVAL OF ITEM 614 WORK ZONE RAISED PAVEMENT MARKER, AS PER PLAN, INCLUDING FILLING OF ANY DEPRESSIONS CREATED IN THE PAVEMENT AS PER C&MS 621.08.

AN ESTIMATED QUANTITY OF 2480 EACH OF ITEM 614 WORK ZONE RAISED PAVEMENT MARKER, AS PER PLAN, HAS BEEN PROVIDED AND CARRIED TO THE GENERAL SUMMARY.

**DELINEATION OF PORTABLE AND PERMANENT BARRIER**

BARRIER REFLECTORS AND OBJECT MARKERS SHALL BE INSTALLED ON ALL PORTABLE BARRIER (PB) USED FOR TRAFFIC CONTROL; AND, ON PERMANENT CONCRETE BARRIER (INCLUDING BRIDGE PARAPETS) LOCATED WITHIN 5 FEET OF THE EDGE OF THE ADJACENT TRAVEL LANE.

BARRIER REFLECTORS SHALL CONFORM TO C&MS 626, EXCEPT THAT THE SPACING SHALL BE AS PER TRAFFIC SCD MT-101.70. OBJECT MARKERS AND THEIR INSTALLATION SHALL CONFORM TO C&MS 614.03 AND SCD MT-101.70. WHEN THE PB CONTAINS GLARE SCREEN, ONE SET OF THREE VERTICAL STRIPES OF SHEETING SHALL BE CONSIDERED EQUIVALENT TO AN OBJECT MARKER, ONE-WAY.

INCREASED BARRIER DELINEATION, AS SPECIFIED HEREIN, SHALL BE INSTALLED ON ALL PB AND PERMANENT CONCRETE BARRIER LOCATED WITHIN 5 FEET OF THE EDGE OF THE TRAVELED LANE UNDER EITHER OF THE FOLLOWING CONDITIONS: ALONG TAPERS AND TRANSITION AREAS; OR ALONG CURVES (OUTSIDE ONLY) WITH DEGREE OF CURVATURE GREATER THAN OR EQUAL TO 3 DEGREES.

THE INCREASED BARRIER DELINEATION SHALL CONSIST OF EITHER DELINEATION PANELS OR THE TRIPLE STACKING OF WORK ZONE BARRIER REFLECTORS.

DELINEATION PANELS SHALL CONSIST OF PANELS OF DELINEATION, APPROXIMATELY 34 INCHES LONG AND 6 INCHES WIDE AND SHALL BE "CRIMPED." PANELS SHALL BE INSTALLED AND SPACED PER TRAFFIC SCD MT-101.70.

TRIPLE-STACKED BARRIER REFLECTORS SHALL CONSIST OF ALIGNING THREE BARRIER REFLECTORS VERTICALLY, AT LOCATIONS WHERE A SINGLE BARRIER REFLECTOR WOULD BE OTHERWISE ATTACHED. THERE SHALL BE NO OPEN SPACE BETWEEN THE ADJACENT BARRIER REFLECTORS. THE TRIPLE-STACKED BARRIER REFLECTORS SHALL CONFORM TO C&MS 626, EXCEPT THAT THEY SHALL BE SPACED AND ALIGNED PER TRAFFIC SCD MT-101.70.

**DELINEATION OF PORTABLE AND PERMANENT BARRIER (CONT'D)**

THE FOLLOWING ESTIMATED QUANTITIES HAVE BEEN INCLUDED IN THE PLANS AND CARRIED TO THE GENERAL SUMMARY:

- ITEM 614, BARRIER REFLECTOR, TYPE 1 (ONE-WAY) 1018 EACH
- ITEM 614, BARRIER REFLECTOR, TYPE 1 (TWO-WAY) 132 EACH
- ITEM 614, OBJECT MARKER, ONE-WAY 1150 EACH
- ITEM 614, INCREASED BARRIER DELINEATION 2412 FEET

PAYMENT SHALL BE FULL COMPENSATION FOR ALL MATERIAL, LABOR, INCIDENTALS AND EQUIPMENT NECESSARY FOR FURNISHING, INSTALLING, MAINTAINING AND REMOVING EACH OF THE ABOVE ITEMS.

**DELINEATION OF TEMPORARY AND PERMANENT GUARDRAIL**

BARRIER REFLECTORS SHALL BE INSTALLED ON ALL TEMPORARY GUARDRAIL USED FOR TRAFFIC CONTROL; AND, ON ALL PERMANENT GUARDRAIL LOCATED WITHIN 5 FEET OF THE EDGE OF THE ADJACENT TRAVEL LANE. BARRIER REFLECTORS SHALL CONFORM TO C&MS 626 AND THE SPACING SHALL BE APPROXIMATELY 50 FEET.

OBJECT MARKERS SHALL BE INSTALLED ON ALL TEMPORARY AND PERMANENT GUARDRAIL LOCATED WITHIN 5 FEET OF THE EDGE OF THE ADJACENT TRAVEL LANE. GUARDRAIL-MOUNTING OF OBJECT MARKERS SHALL BE MADE BY INSTALLING THE OBJECT MARKERS ON THE EXTENSION BLOCKS RATHER THAN DIRECTLY ONTO THE GUARDRAIL ITSELF. OBJECT MARKERS SHALL CONFORM TO C&MS 614.03 AND THE SPACING SHALL BE APPROXIMATELY 50 FEET WITH A 25 FOOT OFFSET FROM THE BARRIER REFLECTORS.

THE FOLLOWING ESTIMATED QUANTITIES HAVE BEEN INCLUDED IN THE PLANS AND CARRIED TO THE GENERAL SUMMARY:

- ITEM 614, BARRIER REFLECTOR, TYPE 2, ONE-WAY 28 EACH
- ITEM 614, OBJECT MARKER, ONE-WAY 28 EACH

PAYMENT SHALL BE FULL COMPENSATION FOR ALL MATERIAL, LABOR, INCIDENTALS AND EQUIPMENT NECESSARY FOR FURNISHING, INSTALLING, MAINTAINING AND REMOVING THE ABOVE ITEMS).

**ITEM 614 - DETOUR SIGNING**

THE CONTRACTOR SHALL ERECT, MAINTAIN, AND SUBSEQUENTLY REMOVE ALL DETOUR SIGNING AND SUPPORTS SPECIFIED IN THE DETOUR-SIGNING PLANS, AND IN ACCORDANCE WITH CMS 614.06. AN INTERIM COMPLETION TIME PERIOD HAS BEEN ESTABLISHED FOR THE DETOUR OPERATION

SHOULD THE CONTRACTOR FAIL TO REMOVE THE DETOUR SIGNING AND SUPPORTS BY THE REQUIRED TIME LIMIT, LIQUIDATED DAMAGES AS SPECIFIED IN PLAN NOTES, SHALL BE ASSESSED IN ACCORDANCE WITH CMS 108.07.

PAYMENT SHALL BE MADE AT THE LUMP SUM CONTRACT PRICE FOR ITEM 614, DETOUR SIGNING. PAYMENT SHALL INCLUDE ALL LABOR, EQUIPMENT, MATERIALS AND OTHER INCIDENTALS NECESSARY TO INSTALL AND ERECT, MAINTAIN, AND REMOVE THE DESIGNATED DETOUR ROUTE.

**ITEM 606, ANCHOR ASSEMBLY, TYPE T**

USE TYPE T ANCHOR ASSEMBLIES ON THE TRAILING END OF EXISTING GUARDRAIL RUNS AS SPECIFIED ON THE PHASING PLANS AND IN ACCORDANCE WITH DETAILS SHOWN ON SHEETS 102-103.

AN ESTIMATED QUANTITY OF 3 EACH OF ITEM 606 ANCHOR ASSEMBLY, TYPE T HAS BEEN PROVIDED AND CARRIED TO THE GENERAL SUMMARY.

OPEN TO TRAFFIC:

- ADJUST EXISTING SIGNAL HEADS FOR US 35 WESTBOUND AND EASTBOUND AT THE EXISTING VALLEY ROAD/TREBEIN ROAD INTERSECTION FOR ALL TRAFFIC PHASES OF CONSTRUCTION. ALL MATERIALS AND LABOR REQUIRED FOR ADJUSTING AND MODIFYING SIGNAL HEADS AND TRAFFIC LANE USE SIGNS FOR THE PURPOSE OF MAINTAINING TRAFFIC SHALL BE CONSIDERED INCIDENTAL TO ITEM 614, MAINTENANCE OF TRAFFIC.
- SHIFT US 35 WESTBOUND TRAFFIC TOWARD OUTSIDE SHOULDER
- SHIFT PORTION OF US 35 EASTBOUND TRAFFIC TOWARD OUTSIDE SHOULDER FOR CROSSOVERS CONSTRUCTION
- NEW VALLEY ROAD/TREBEIN ROAD
- GLENN THOMPSON ACCESS DRIVE
- DRIVE AT VALLEY ROAD, STA 869+02.36, LT
- EXISTING VALLEY ROAD AT US 35 INTERSECTION (SOUTH)

CLOSED TO TRAFFIC:

- EXISTING TREBEIN ROAD AT US 35 INTERSECTION (NORTH)
- TURN LANES ON NEW VALLEY ROAD/TREBEIN ROAD TO RAMP E AND RAMP G

CONSTRUCTION CRITICAL TO PHASE 2, STEP 2

TEMPORARY ROADWAY (DIVERSIONS)

- DIVERSION NO. 4A – US 35 WESTBOUND EXISTING MEDIAN SHOULDER WIDENING, WEST OF EXISTING VALLEY ROAD/TREBEIN ROAD INTERSECTION
- DIVERSION NO. 4B – US 35 WESTBOUND EXISTING MEDIAN SHOULDER WIDENING, EAST OF EXISTING VALLEY ROAD/TREBEIN ROAD INTERSECTION
- CROSSOVER NO. 1 (WEST END OF PROJECT) - PARTIAL
- CROSSOVER NO. 2 (EAST END OF PROJECT) – PARTIAL

CONSTRUCTION AVAILABLE THIS TRAFFIC PHASE

PERMANENT ROADWAY CONSTRUCTION

- RAMP E STA 721+00 TO STA 727+50
- RAMP H STA 1030+90 TO STA 1045+00

PERMANENT BRIDGE CONSTRUCTION

- GRE-035-0610: RAMP E OVER LITTLE MIAMI RIVER

PERMANENT RETAINING WALL CONSTRUCTION

- RW-02A: RAMP E
- RW-02B: RAMP H

**PHASE 2, STEP 2**

TRAFFIC ROUTING – SAME AS IN PHASE 2, STEP 1 EXCEPT AS NOTED BELOW:

- SHIFT US 35 WESTBOUND TRAFFIC TOWARD EXISTING MEDIAN SHOULDER WIDENED IN PHASE 2, STEP 1

CONSTRUCTION CRITICAL TO PHASE 3

TEMPORARY ROADWAY (DIVERSIONS)

- DIVERSION NO. 6 – US 35 WESTBOUND OUTSIDE SHOULDER WIDENING, WEST OF VALLEY ROAD/TREBEIN ROAD
- DIVERSION NO. 7 – US 35 WESTBOUND OUTSIDE SHOULDER WIDENING, EAST OF VALLEY ROAD/TREBEIN ROAD

PERMANENT ROADWAY CONSTRUCTION

- RAMP E
- RAMP H
- COMPLETION OF CROSSOVER NO. 1 (WEST END OF PROJECT)
- COMPLETION OF CROSSOVER NO. 2 (EAST END OF PROJECT)

PERMANENT BRIDGE CONSTRUCTION

- GRE-035-0610: RAMP E OVER LITTLE MIAMI RIVER

PERMANENT RETAINING WALL CONSTRUCTION

- RW-02A: RAMP E
- RW-02B: RAMP H

**PHASE 3 CONSTRUCTION**

OBJECTIVE: CONSTRUCT US 35 EASTBOUND MAINLINE PAVEMENT REHABILITATION

PRE-PHASE 3

- INSTALL TEMPORARY TRAFFIC SIGNALS AT RAMP E AND RAMP H INTERSECTION WITH NEW TREBEIN ROAD. TEMPORARY TRAFFIC SIGNALS SHALL BE MAINTAINED AND SUBSEQUENTLY REMOVED AT PROJECT COMPLETION.

- RECONFIGURE AND INSTALL TEMPORARY TRAFFIC SIGNAL AT EXISTING VALLEY ROAD AND US 35 INTERSECTION. EXISTING VALLEY ROAD AT US 35 INTERSECTION REMAINS OPEN. ALL MATERIALS AND LABOR REQUIRED FOR RECONFIGURING AND INSTALLING TEMPORARY TRAFFIC SIGNAL FOR THE PURPOSE OF MAINTAINING TRAFFIC SHALL BE CONSIDERED INCIDENTAL TO ITEM 614, MAINTENANCE OF TRAFFIC

PRE-PHASE 3 TRAFFIC ROUTING:

- DIVERT US 35 WB TO USE NEWLY CONSTRUCTED RAMP E AND RAMP H
- INSTALL PORTABLE BARRIER ALONG EDGE OF EXISTING MEDIAN SHOULDER FROM STA 318+00, 13' RT TO STA 321+25, 13' RT ON EASTBOUND US 35
- EB US 35 TRAFFIC REMAINS AS IN PHASE 2, STEP 2
- PROPOSED CULVERT (MIDDLE PORTION) UNDER EXISTING WB – INSTALL MIDDLE PORTION OF PROPOSED CULVERT AS SHOWN ON SHEET 152.
- INSTALL TEMPORARY PAVEMENT TO RESTORE EXISTING PAVEMENT OVER CULVERT.

CONSTRUCT PHASE 3 CONSTRUCTION IN 2 STEPS.

**PHASE 3, STEP 1**

TRAFFIC ROUTING

OPEN TO TRAFFIC:

- RAMP E
- RAMP H
- NEW VALLEY ROAD/TREBEIN ROAD (SAME AS IN PHASE 2, STEPS 1 AND 2, EXCEPT TURN LANES TO RAMP E ARE OPENED)

- MAINTAIN US 35 WB ON NEWLY CONSTRUCTED RAMP E AND RAMP H

- EXISTING VALLEY ROAD AND US 35 AT-GRADE INTERSECTION FOR EASTBOUND

CONSTRUCTION CRITICAL TO PHASE 3, STEP 2

PERMANENT ROADWAY CONSTRUCTION

- US 35 EASTBOUND STA 297+50 TO 329+75
- US 35 EASTBOUND STA 345+00 TO 365+00

**PHASE 3, STEP 2**

TRAFFIC ROUTING - SAME AS PHASE 3, STEP 1 EXCEPT AS NOTED BELOW:

OPEN TO TRAFFIC:

- EXIT RAMP F (EB) OPEN TO NEW INTERCHANGE

CLOSED TO TRAFFIC:

VALLEY ROAD/TREBEIN ROAD TO US 35 EB (RAMP G IS CLOSED) - THREE WEEKS

- CLOSURE OF EXISTING VALLEY ROAD/US 35 INTERSECTION TO COMPLETE PLUG-IN (FOR US 35 EB)

DETOUR

- DIVERT VALLEY ROAD/TREBEIN ROAD TO US 35 EB TRAFFIC TO USE THE SUPER STREET TURNAROUND (ORCHARD LANE) VIA RAMP E (WESTBOUND ENTRANCE RAMP)

CONSTRUCTION CRITICAL TO NEXT TRAFFIC PHASE

PERMANENT BRIDGE CONSTRUCTION

- EXISTING BRIDGE GRE-035-0614 (US 35 OVER LITTLE MIAMI RIVER) TO REMAIN, EXCEPT REMOVE EXISTING RAISED CONCRETE MEDIAN TRAFFIC ISLAND AND CONSTRUCT NEW MEDIAN CONCRETE BARRIER

**PHASE 4 CONSTRUCTION**

OBJECTIVE: COMPLETE US 35 MAINLINE WESTBOUND RECONSTRUCTION

**TRAFFIC PHASE 4**

TRAFFIC ROUTING – SAME AS IN PHASE 3, STEP 2, EXCEPT AS FOLLOWS:

OPEN TO TRAFFIC:





- SHIFT US 35 EASTBOUND BACK TO EASTBOUND LANES
- RAMP G (FULL)
- RAMP F (FULL)
- MAINTAIN US 35 WESTBOUND VIA RAMP E AND RAMP H

CONSTRUCTION CRITICAL TO NEXT TRAFFIC PHASE


PERMANENT ROADWAY CONSTRUCTION

- US 35 WESTBOUND STA 297+50 TO 365+00
- BMP IN US 35 MEDIAN (STA 285+00 TO STA 297+50; STA 365+00 TO STA 385+00).

107217mp304.dgn 12/1/2022 1:31:52 PM Martin.Pierce@jacobs.com

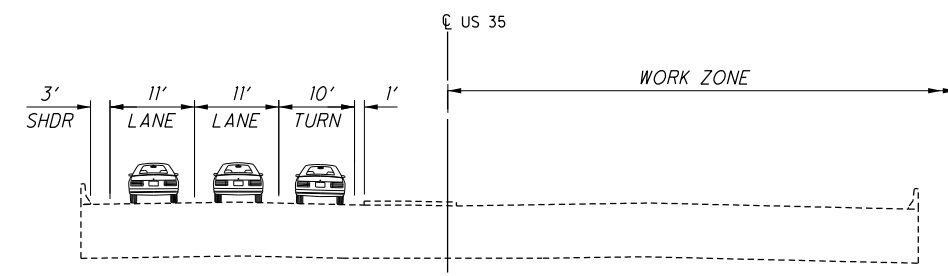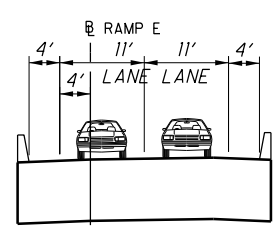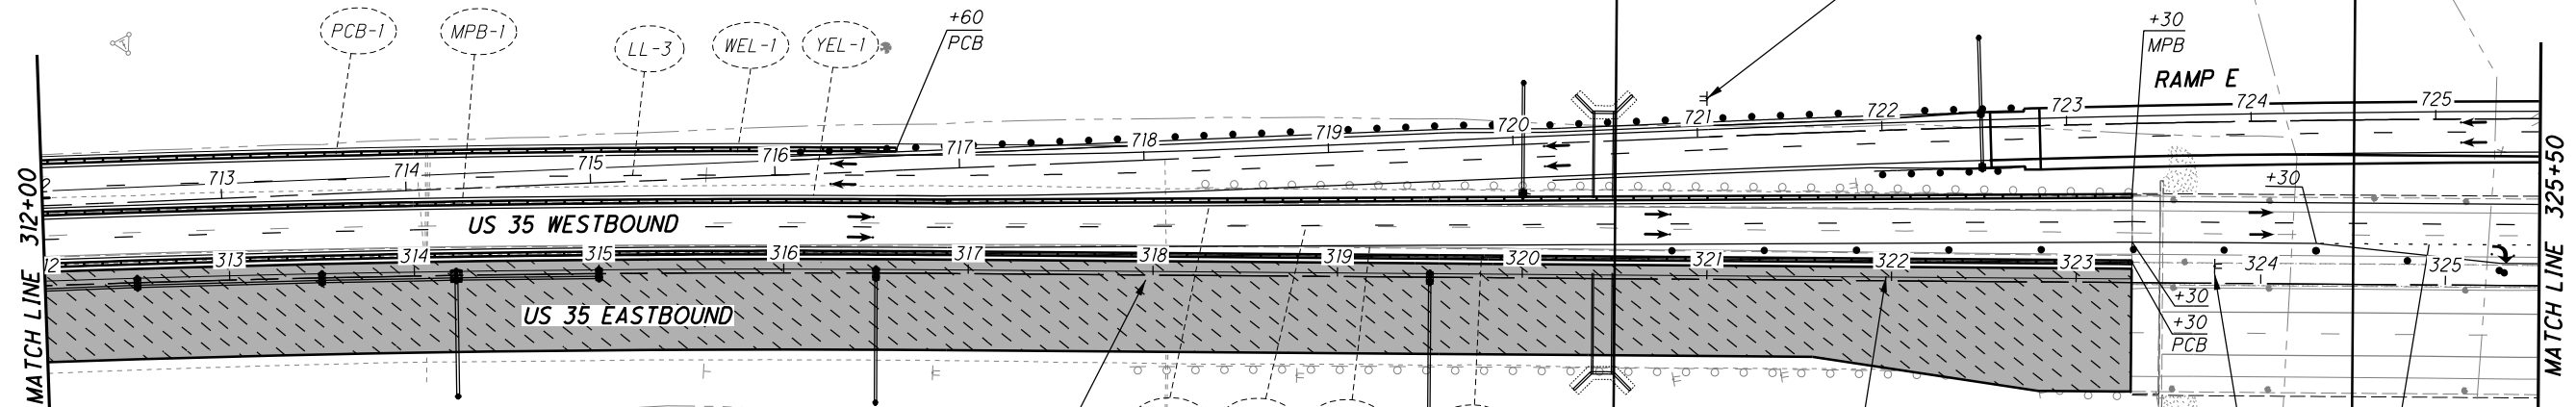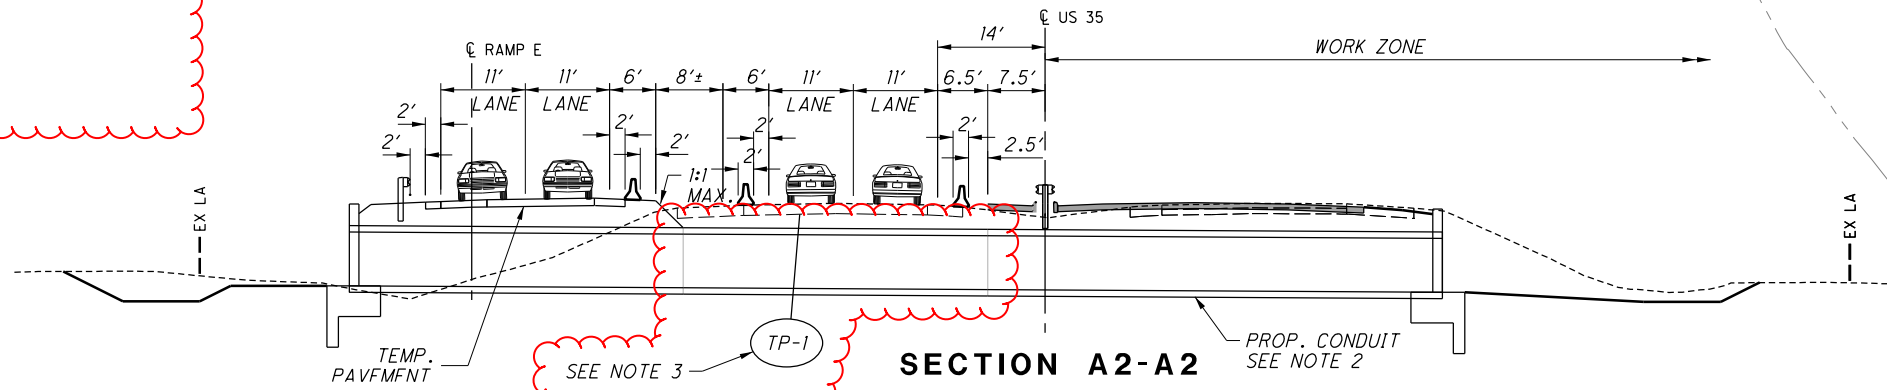

SECTION A-A

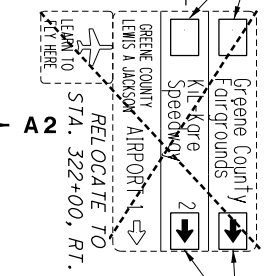

- NOTES:
- SEE SHEET 41 FOR LEGEND.
  - TEMPORARY SHORING REQUIRED FOR STORM PIPE INSTALLATION SHALL BE CONSIDERED INCIDENTAL TO ITEM 614, MAINTAINING TRAFFIC. NO SEPARATE PAYMENT SHALL BE MADE.
  - SEE SHEET 43 FOR SEQUENCE OF CONSTRUCTION NOTES FOR TEMPORARY PAVEMENT INSTALLATION AND MIDDLE PORTION OF CULVERT INSTALLATION (PRE-PHASE 3 CONSTRUCTION).

CALCULATED  
CHECKED


HORIZONTAL SCALE IN FEET

**MAINTENANCE OF TRAFFIC - PHASE 3 - STEP 1**  
**US 35 - STA. 312+00 TO STA. 325+50**

**GRE-US 35-5.63**

**NOTES:**

- 1. SEE SHEET 41 FOR LEGEND.
- 2. FOR PAVEMENT MARKINGS AND SIGNAGE, SEE TRAFFIC CONTROL SHEETS 476 - 507B.
- 3. FOR SHOULDER CLOSURE DETAILS AND SIGNAGE, SEE STANDARD CONSTRUCTION DRAWING MT-95.45.

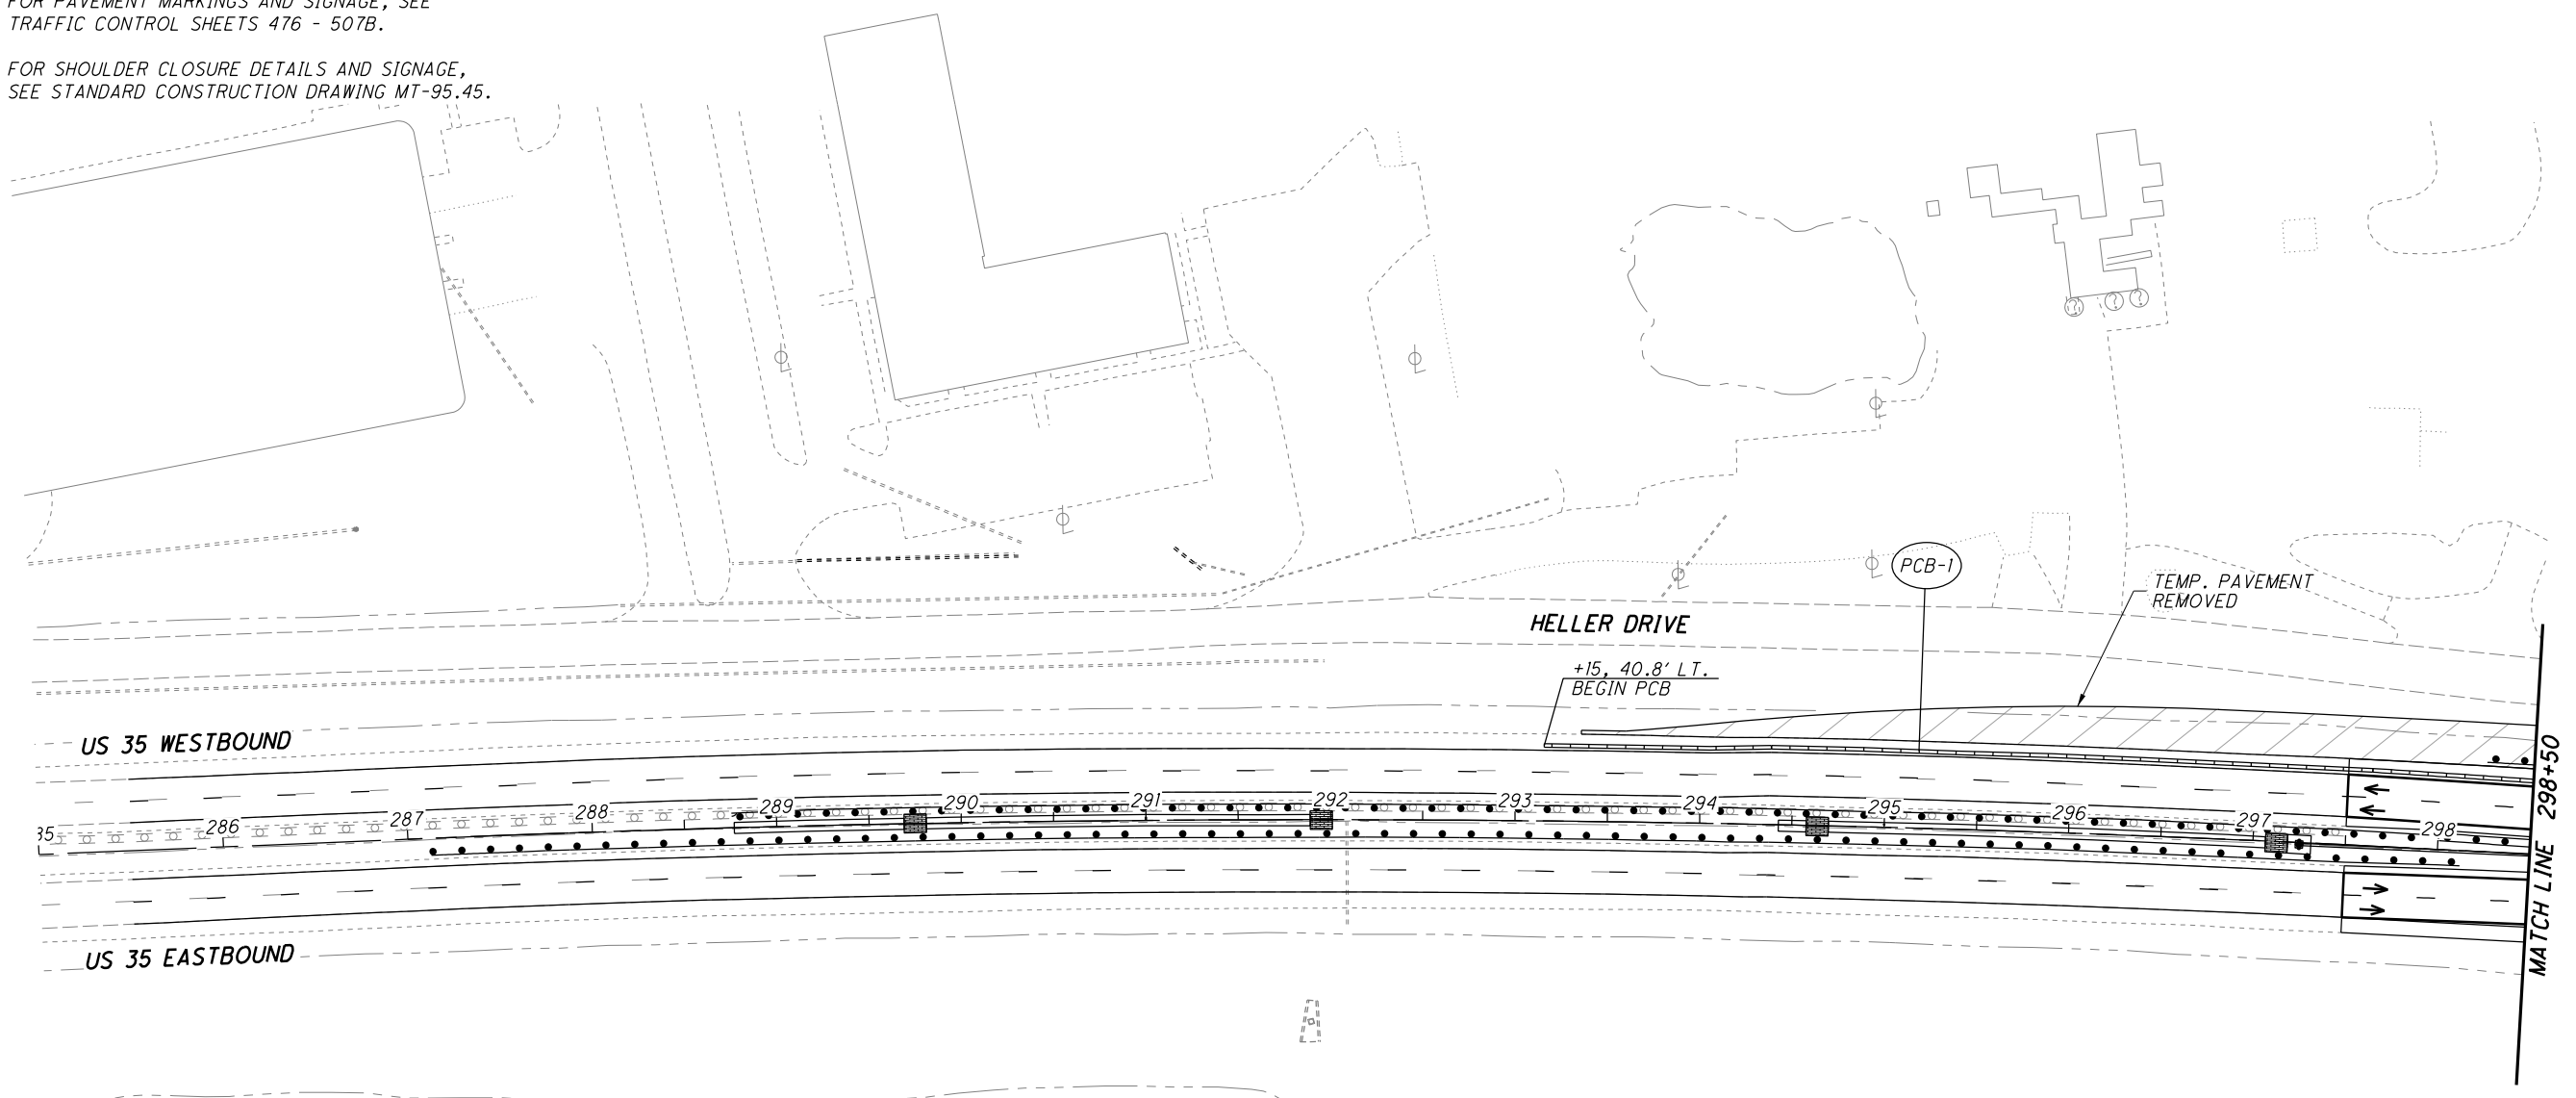

CALCULATED  
CHECKED

0 50 100  
HORIZONTAL  
SCALE IN FEET

**MAINTENANCE OF TRAFFIC - PHASE 5**  
**US 35 - STA. 285+00 TO STA. 298+50**


**GRE-US 35-5.63**

172A  
698

107217mp502.dgn 12/1/2022 11:59:05 AM Martin.Pierce@jacobs.com

**NOTES:**

- 1. SEE SHEET 41 FOR LEGEND.
- 2. FOR PAVEMENT MARKINGS AND SIGNAGE, SEE TRAFFIC CONTROL SHEETS 476 - 507B.
- 3. FOR SHOULDER CLOSURE DETAILS AND SIGNAGE, SEE STANDARD CONSTRUCTION DRAWING MT-95.45.

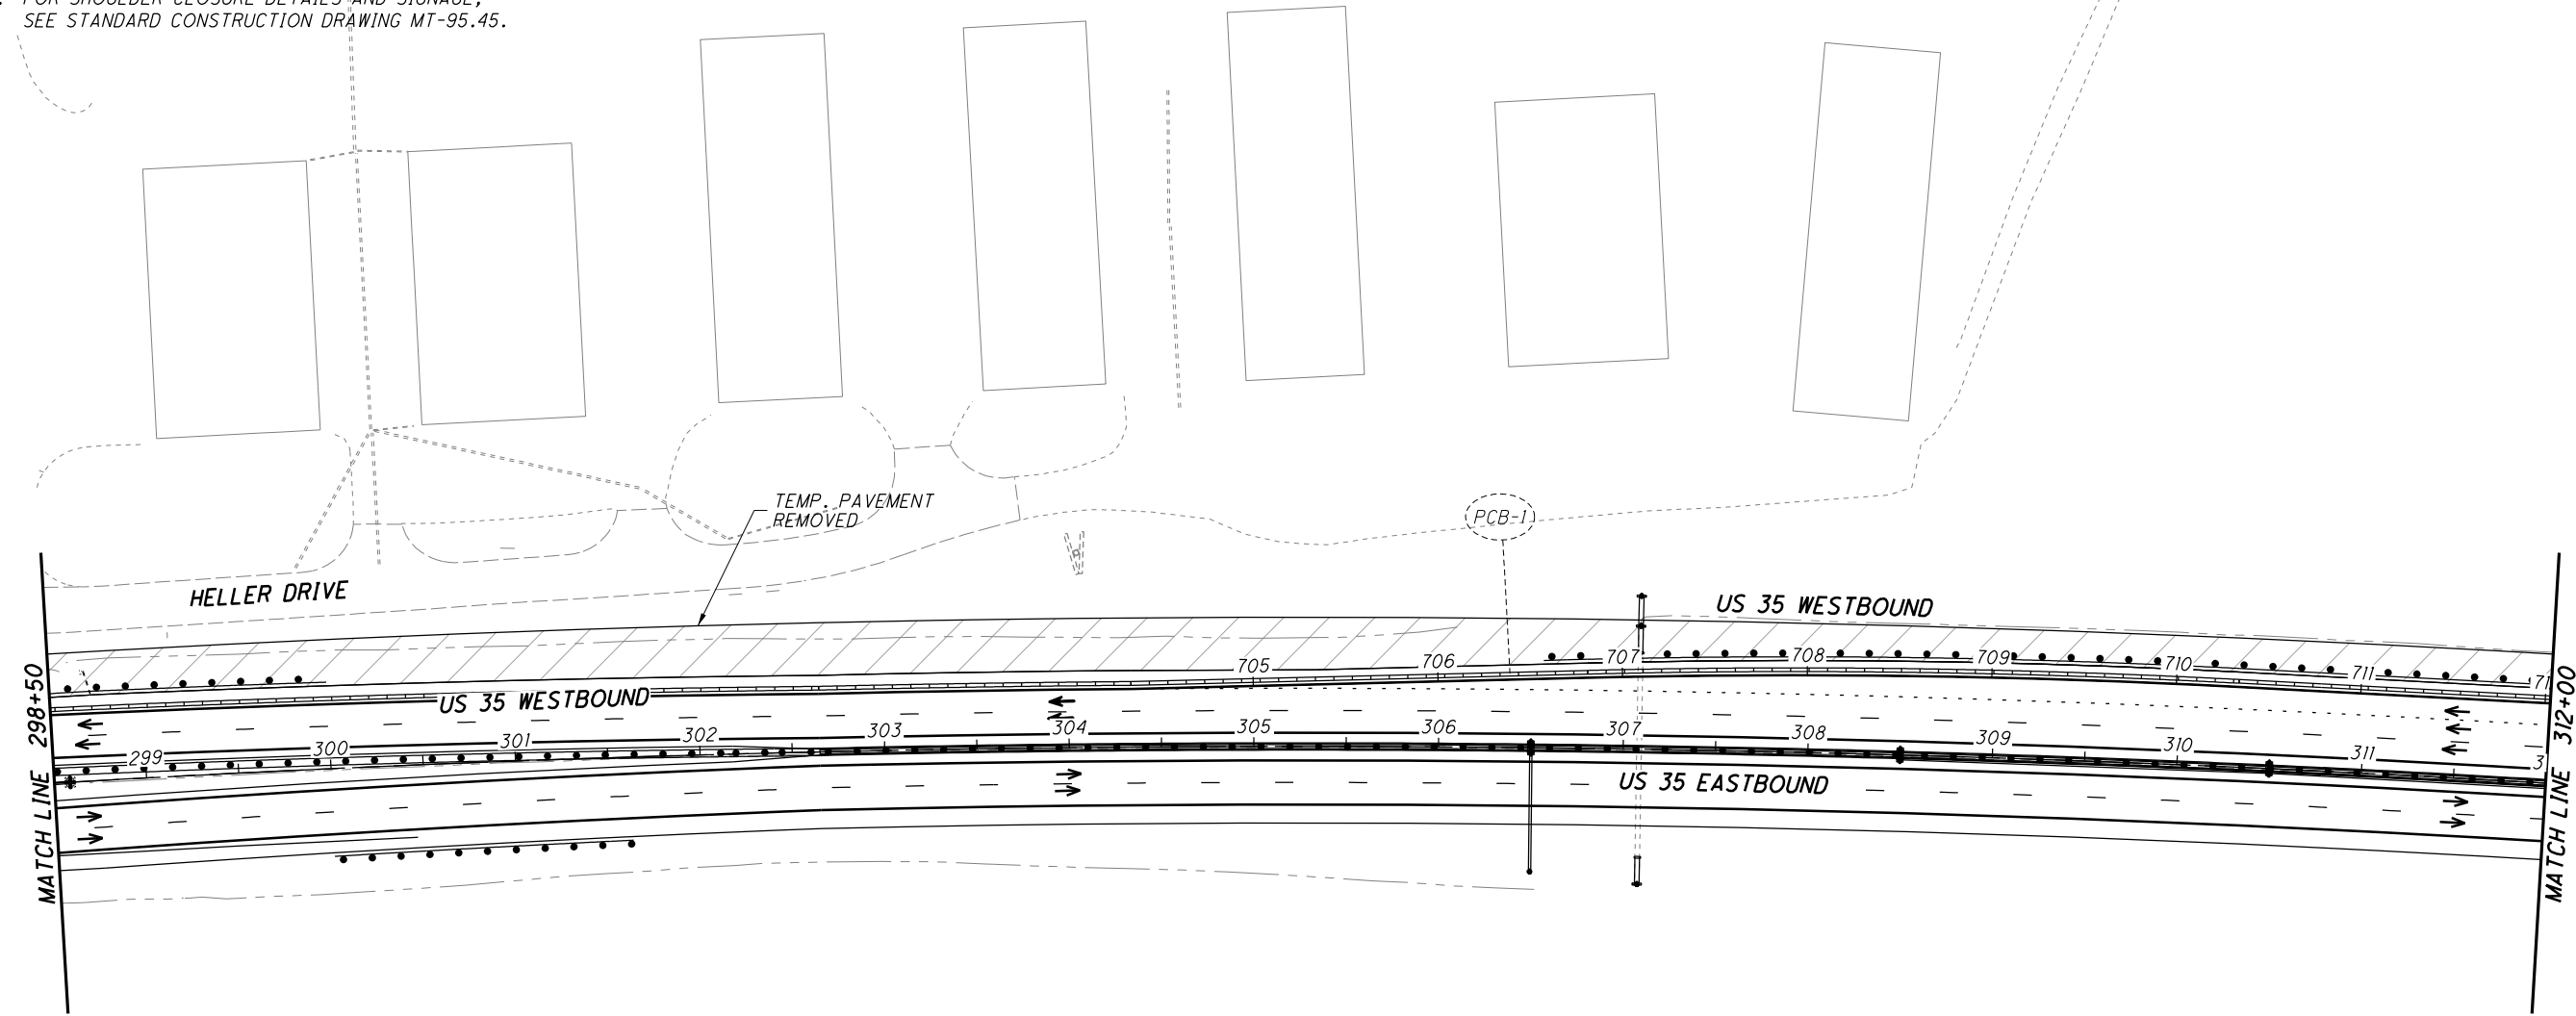

CALCULATED  
CHECKED

0 50 100  
HORIZONTAL SCALE IN FEET

**MAINTENANCE OF TRAFFIC - PHASE 5**  
**US 35 - STA. 298+50 TO STA. 312+00**


**GRE-US 35-5.63**

172B  
698

107217mp503.dgn 12/1/2022 11:59:14 AM Martin.Pierce@jacobs.com

**NOTES:**

- 1. SEE SHEET 41 FOR LEGEND.
- 2. FOR PAVEMENT MARKINGS AND SIGNAGE, SEE TRAFFIC CONTROL SHEETS 476 - 507B.
- 3. FOR SHOULDER CLOSURE DETAILS AND SIGNAGE, SEE STANDARD CONSTRUCTION DRAWING MT-95.45.

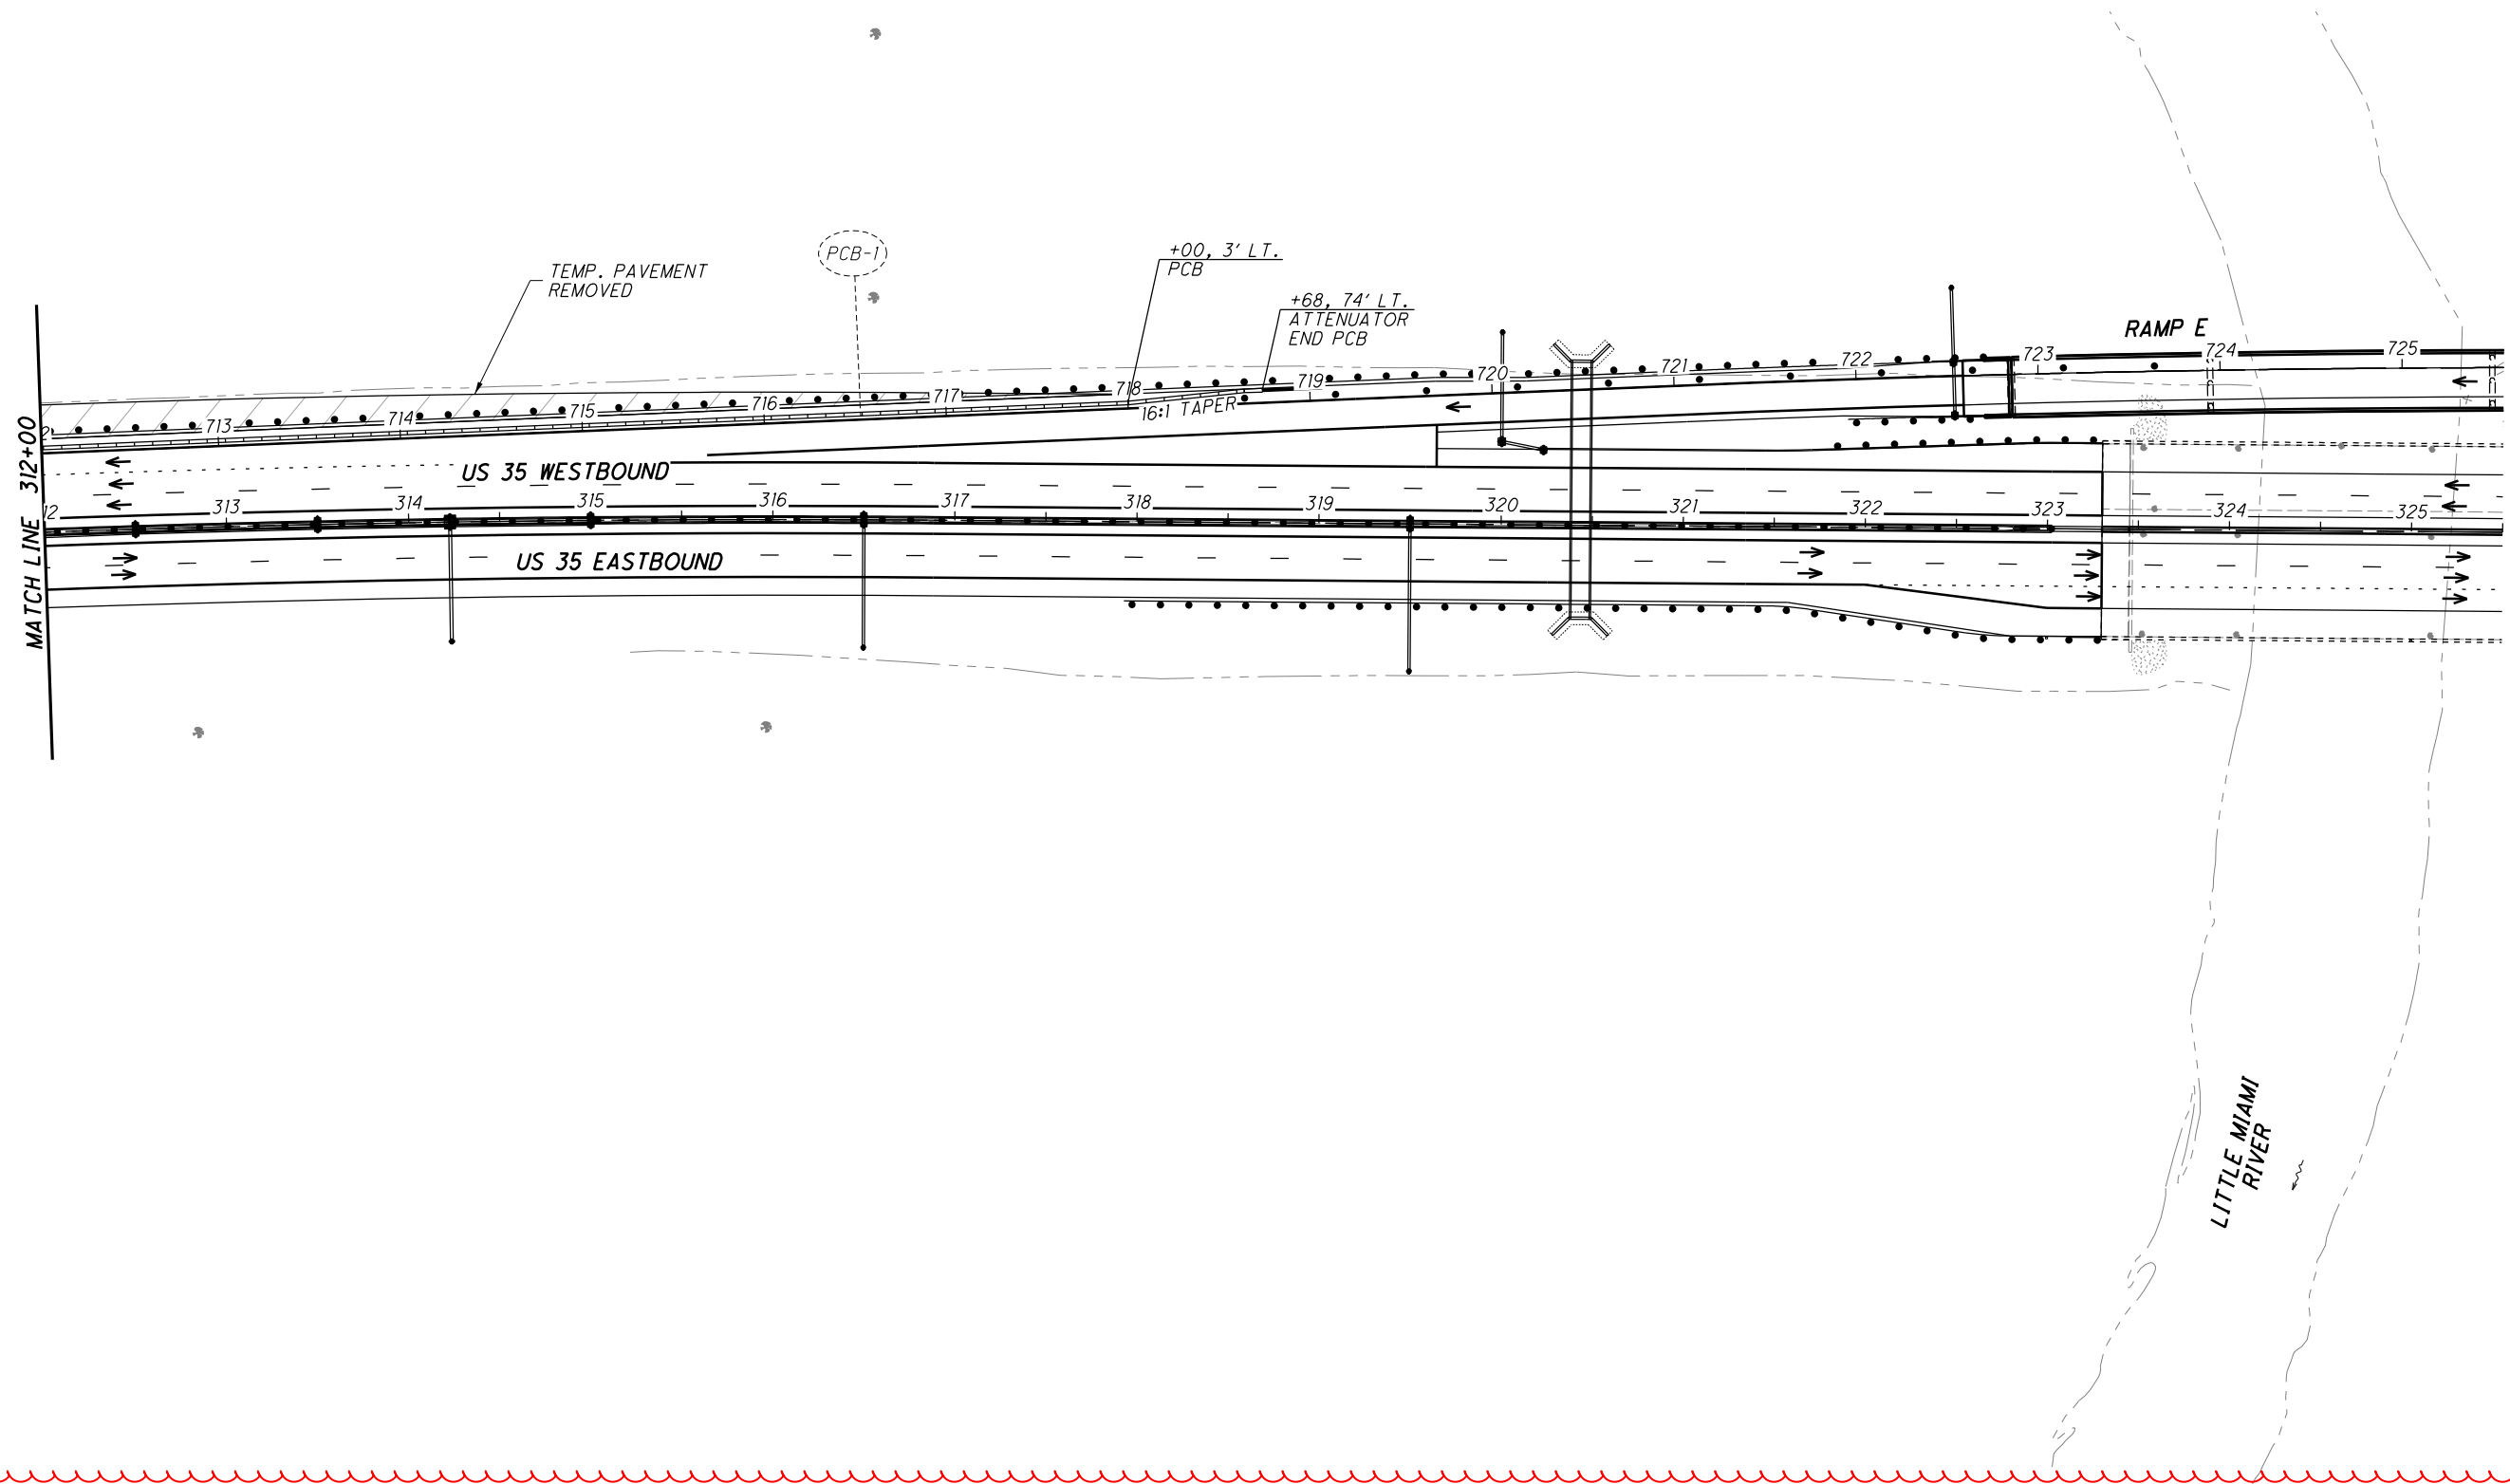

Martin.Pierce@jacobs.com

12/1/2022 11:59:25 AM

107217mp504.dgn

CALCULATED  
CHECKED

0 50 100  
HORIZONTAL  
SCALE IN FEET

**MAINTENANCE OF TRAFFIC - PHASE 5**  
**US 35 - STA. 312+00 TO STA. 325+50**


**GRE-US 35-5.63**

172C  
698



**NOTES:**

1. SEE SHEET 41 FOR LEGEND.
2. FOR PAVEMENT MARKINGS AND SIGNAGE, SEE TRAFFIC CONTROL SHEETS 476 - 507B.
3. FOR SHOULDER CLOSURE DETAILS AND SIGNAGE, SEE STANDARD CONSTRUCTION DRAWING MT-95.45.

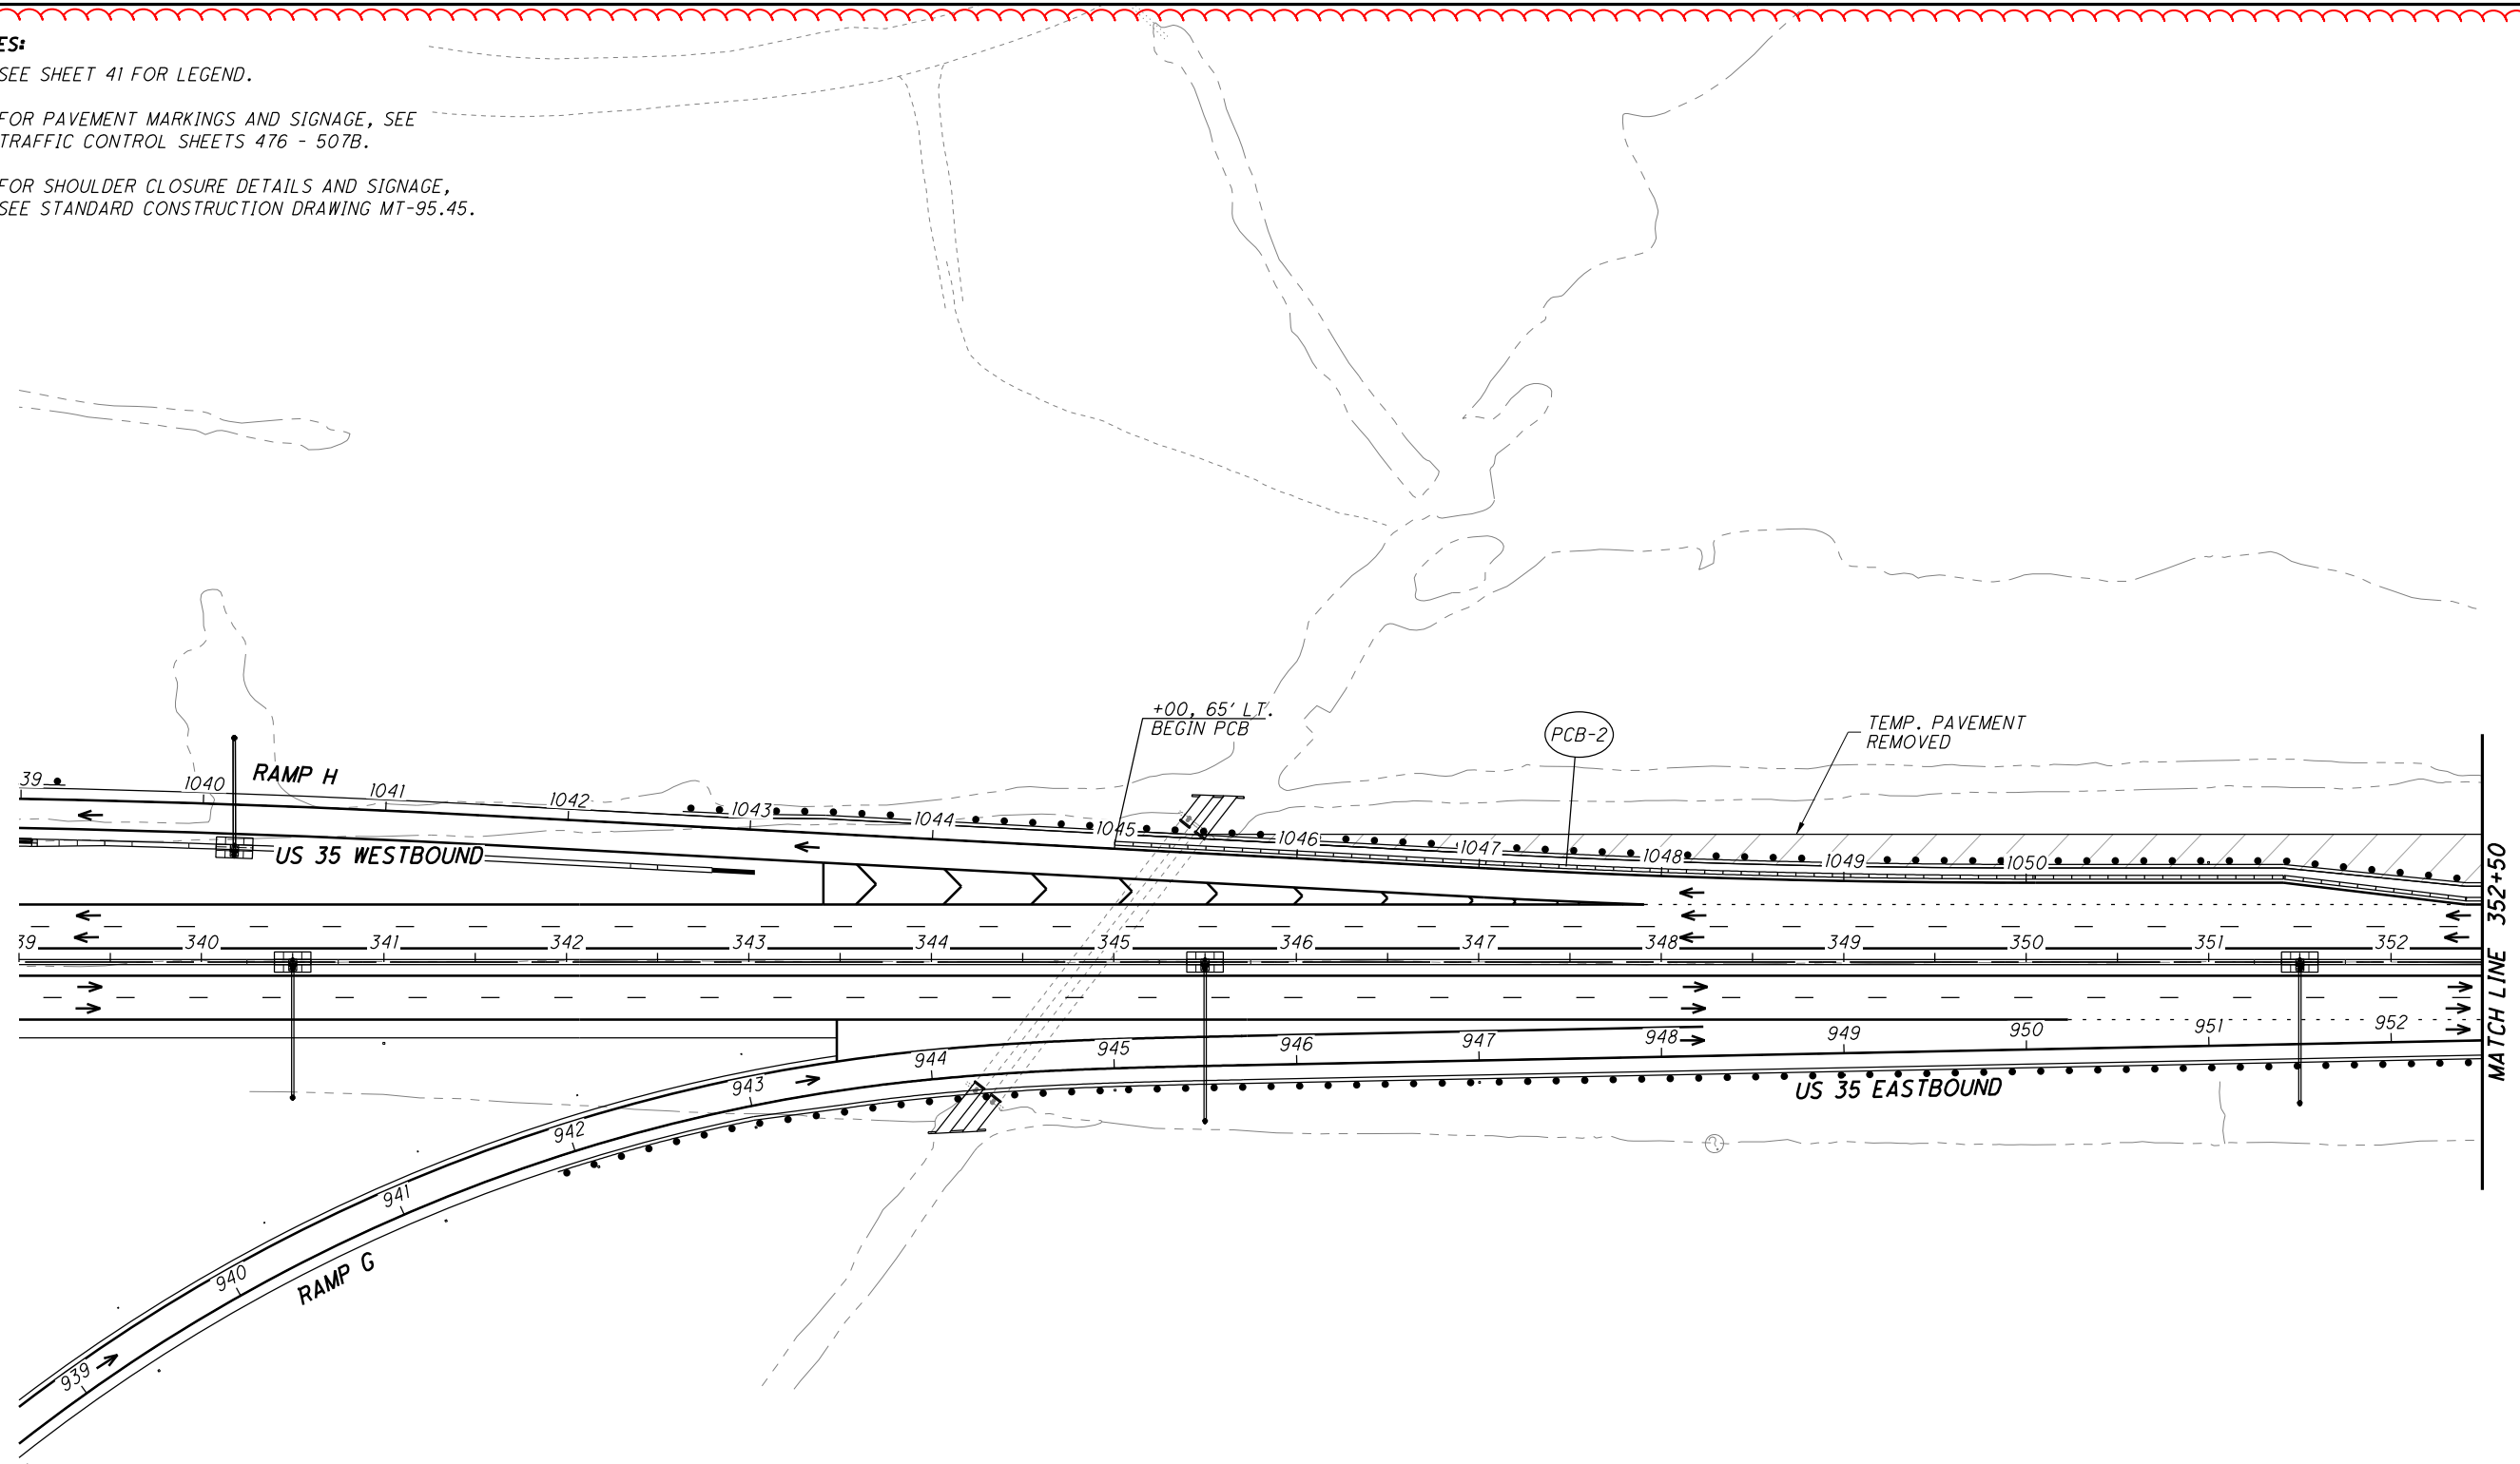

CALCULATED  
CHECKED

0 50 100  
HORIZONTAL  
SCALE IN FEET

**MAINTENANCE OF TRAFFIC - PHASE 5**  
**US 35 - STA. 339+00 TO STA. 352+50**


**GRE-US 35-5.63**

172D  
698

107217mp506.dgn 12/1/2022 11:59:33 AM Martin.Pierce@jacobs.com

**NOTES:**

1. SEE SHEET 41 FOR LEGEND.
2. FOR PAVEMENT MARKINGS AND SIGNAGE, SEE TRAFFIC CONTROL SHEETS 476 - 507B.
3. FOR SHOULDER CLOSURE DETAILS AND SIGNAGE, SEE STANDARD CONSTRUCTION DRAWING MT-95.45.

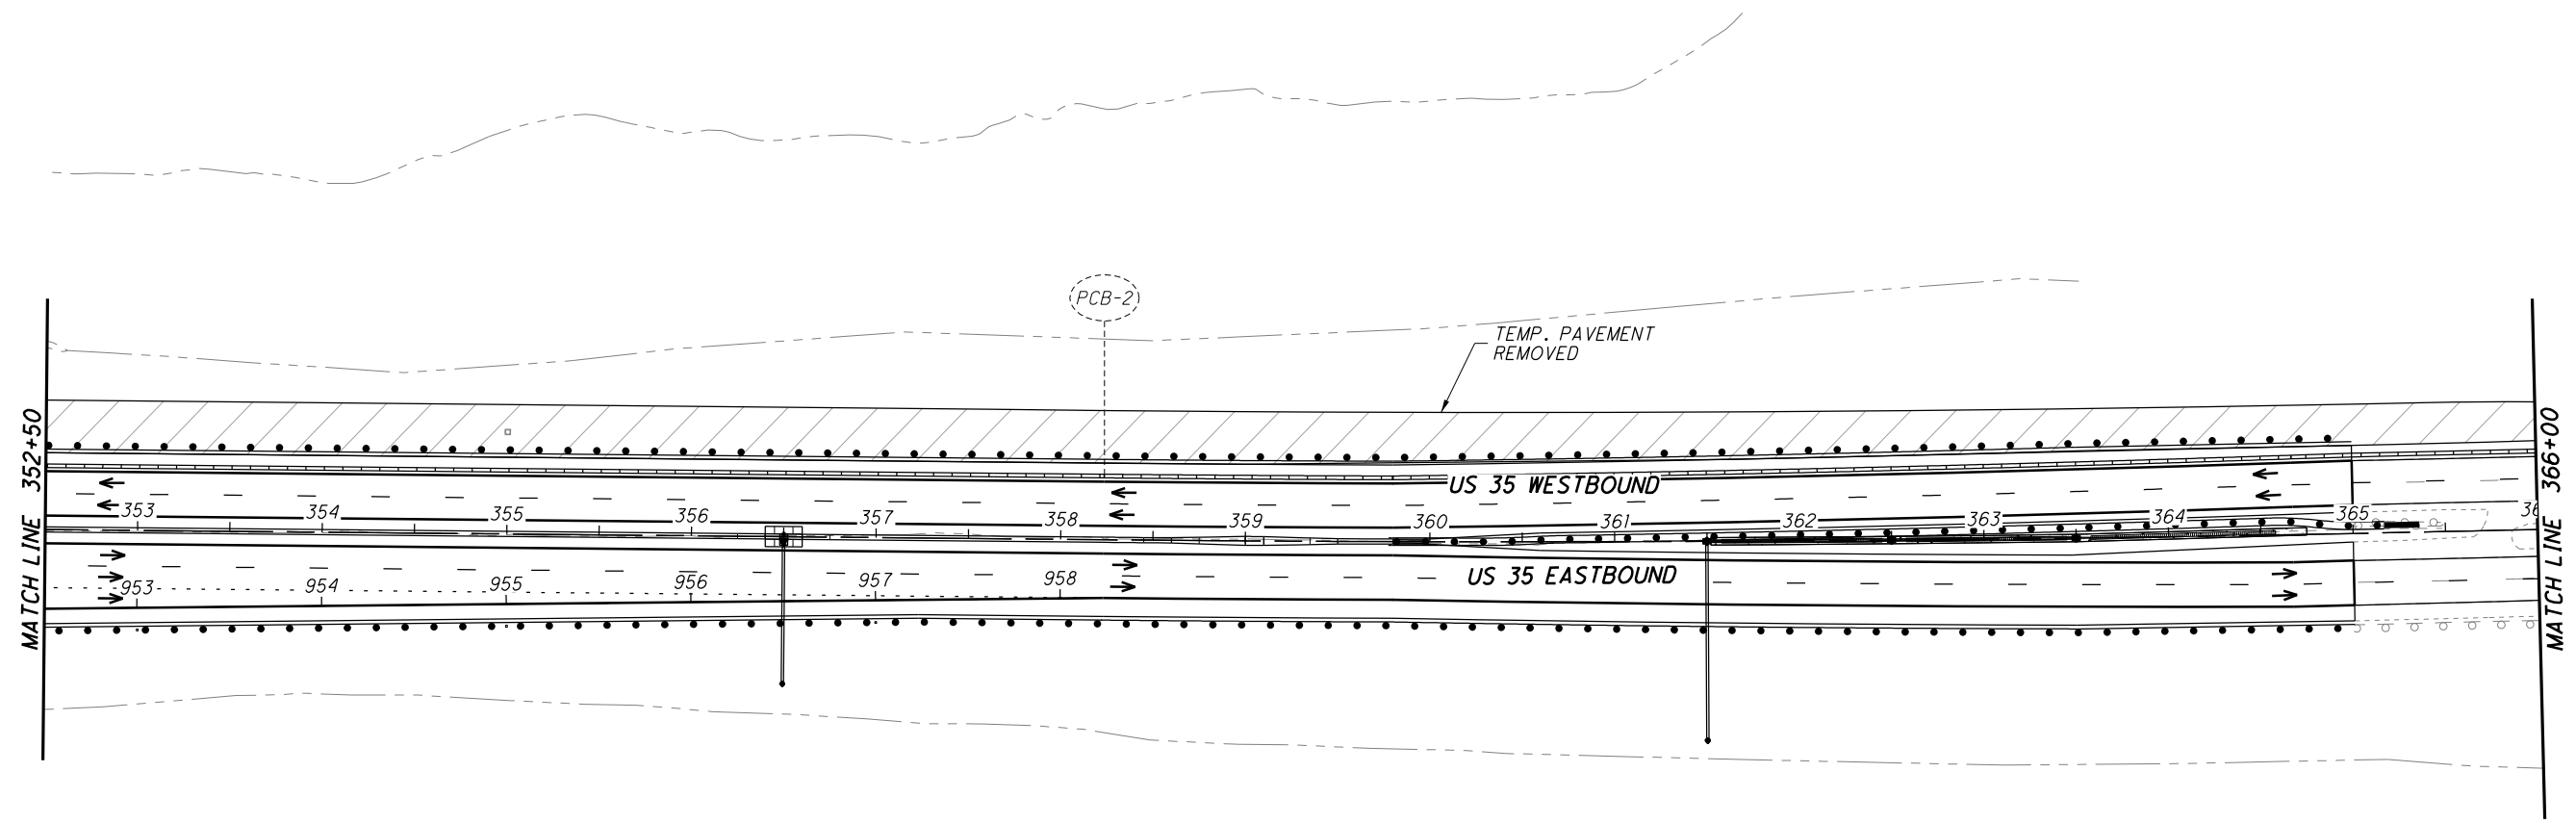

107217mp507.dgn 12/1/2022 11:59:44 AM Martin.Pierce@jacobs.com

CALCULATED  
CHECKED

0 50 100  
HORIZONTAL SCALE IN FEET


**MAINTENANCE OF TRAFFIC - PHASE 5**  
**US 35 - STA. 352+50 TO STA. 366+00**

**GRE-US 35-5.63**

172E  
698

**NOTES:**

1. SEE SHEET 41 FOR LEGEND.
2. FOR PAVEMENT MARKINGS AND SIGNAGE, SEE TRAFFIC CONTROL SHEETS 476 - 507B.
3. FOR SHOULDER CLOSURE DETAILS AND SIGNAGE, SEE STANDARD CONSTRUCTION DRAWING MT-95.45.

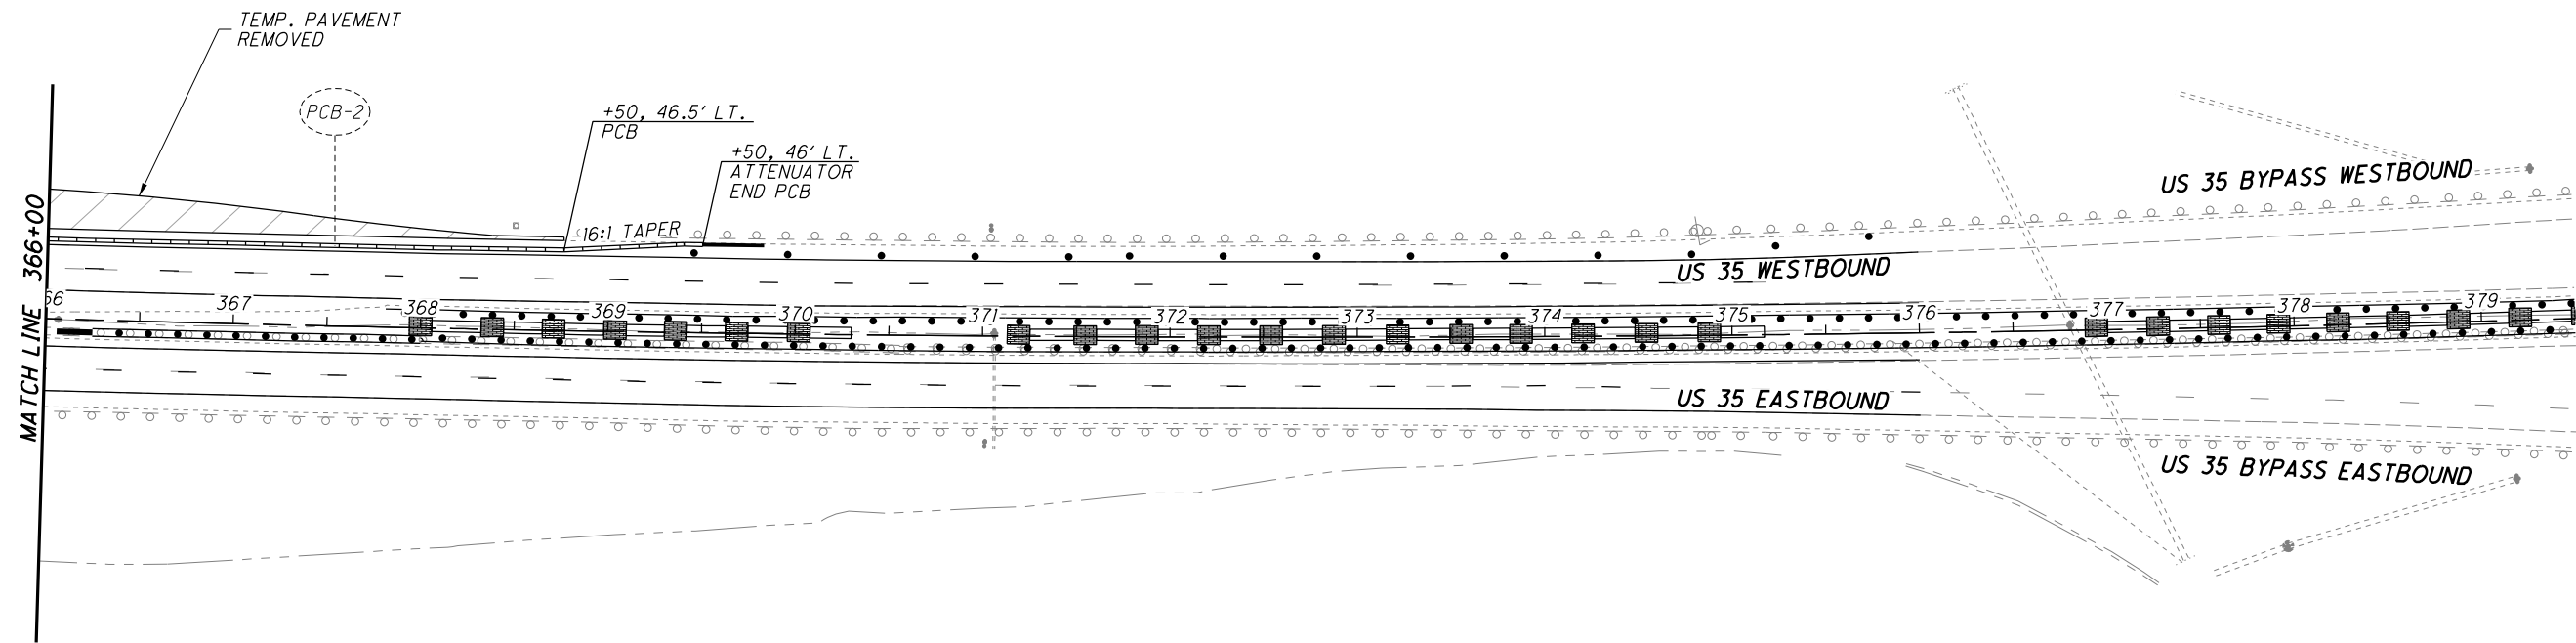

107217mp508.dgn 12/1/2022 11:59:54 AM Martin.Pierce@jacobs.com

CALCULATED  
CHECKED

0 50 100  
HORIZONTAL  
SCALE IN FEET

**MAINTENANCE OF TRAFFIC - PHASE 5**  
**US 35 - STA. 366+00 TO STA. 379+50**

**GRE-US 35-5.63**

172F  
698

107217gg001.dgn Sheet 11/29/2022 1:55PM CH\_OD0TV8:\_Half\_BW\_pen ProjectWise\_Dynamic\_Composition\_Server JEGSVCPWU01

| SHEET NUM. |  |        |     |         |  |     |  |       |        | PART.            |           |           | ITEM | ITEM<br>EXT | GRAND<br>TOTAL | UNIT    | DESCRIPTION           | SEE<br>SHEET<br>NO.  |           |
|------------|--|--------|-----|---------|--|-----|--|-------|--------|------------------|-----------|-----------|------|-------------|----------------|---------|-----------------------|--|-----------|
| 30         |  | 185    | 186 | 187     |  | 189 |  | 195   | 602    | Office<br>Calcs. | 01/NHS/OT | 02/NHS/BR |      |             |                |         |                       |  | 03/NHS/BR |
|            |  |            |  | LS         |  |        |     |         |  |     |  |       |        |                  | LS        |           |      | 201         | 11000          | LS      | CLEARING AND GRUBBING |  |           |
| 24         |  | 64,886 |     |         |  |     |  |       |        |                  | 64,910    |           |      | 202         | 23001          | 64,910  | SY                    | PAVEMENT REMOVED, AS PER PLAN  | 32        |
|            |  | 769    |     |         |  |     |  |       |        |                  | 769       |           |      | 202         | 30600          | 769     | SY                    | CONCRETE MEDIAN REMOVED  |           |
|            |  | 1,725  |     |         |  |     |  |       |        |                  | 1,725     |           |      | 202         | 35100          | 1,725   | FT                    | PIPE REMOVED, 24" AND UNDER  |           |
|            |  | 90     |     |         |  | 39  |  |       |        |                  | 129       |           |      | 202         | 35200          | 129     | FT                    | PIPE REMOVED, OVER 24"   |           |
|            |  | 5,097  |     |         |  |     |  |       |        |                  | 5,097     |           |      | 202         | 38000          | 5,097   | FT                    | GUARDRAIL REMOVED  |           |
|            |  | 9,132  |     |         |  |     |  |       |        |                  | 9,132     |           |      | 202         | 38300          | 9,132   | FT                    | GUARDRAIL REMOVED, BARRIER DESIGN  |           |
|            |  | 8      |     |         |  |     |  |       |        |                  | 8         |           |      | 202         | 47800          | 8       | EACH                  | IMPACT ATTENUATOR REMOVED  |           |
|            |  | 2      |     |         |  |     |  |       |        |                  | 2         |           |      | 202         | 53100          | 2       | EACH                  | MAILBOX REMOVED  |           |
|            |  | 1      |     |         |  |     |  |       |        |                  | 1         |           |      | 202         | 56100          | 1       | EACH                  | BUILDING DEMOLISHED, GRAIN SILO  |           |
|            |  | 11     |     |         |  |     |  |       |        |                  | 11        |           |      | 202         | 58100          | 11      | EACH                  | CATCH BASIN REMOVED  |           |
|            |  | 6      |     |         |  |     |  |       |        |                  | 6         |           |      | 202         | 58200          | 6       | EACH                  | INLET REMOVED  |           |
|            |  |        |     |         |  |     |  |       | 15,046 |                  | 15,046    |           |      | 202         | 75000          | 15,046  | FT                    | FENCE REMOVED  |           |
|            |  |        |     |         |  |     |  |       | 3      |                  | 3         |           |      | 202         | 75250          | 3       | EACH                  | GATE REMOVED   |           |
|            |  | 1      |     |         |  |     |  |       |        |                  | 1         |           |      | 202         | 98100          | 1       | EACH                  | REMOVAL MISC.: SEPTIC TANK AND LEACH FIELD                               |           |
|            |  | 2      |     |         |  |     |  |       |        |                  | 2         |           |      | 202         | 98100          | 2       | EACH                  | REMOVAL MISC.: PRECAST CONCRETE OUTLET                                   |           |
|            |  | 2      |     |         |  |     |  |       |        |                  | 2         |           |      | 202         | 98100          | 2       | EACH                  | REMOVAL MISC.: PRIVATE WOODEN SIGN                                       |           |
|            |  | 9      |     |         |  |     |  |       |        |                  | 9         |           |      | 202         | 98100          | 9       | EACH                  | REMOVAL MISC.: CONCRETE BUMPER BLOCKS                                    |           |
|            |  | 2      |     |         |  |     |  |       |        |                  | 2         |           |      | 202         | 98100          | 2       | EACH                  | REMOVAL MISC.: CONCRETE FOUNDATION                                       |           |
|            |  | 21     |     |         |  |     |  |       |        |                  | 21        |           |      | 202         | 98300          | 21      | SY                    | REMOVAL MISC.: ROCK CHANNEL PROTECTION                                   |           |
|            |  | 10     |     |         |  |     |  |       |        |                  | 10        |           |      | 202         | 98700          | 10      | FT                    | ABANDON MISC.: PIPE 24" AND UNDER  |           |
|            |  | 131    |     | 24,705  |  |     |  |       |        |                  | 24,836    |           |      | 203         | 10000          | 24,836  | CY                    | EXCAVATION   |           |
|            |  |        |     |         |  |     |  | 1,479 |        |                  | 1,479     |           |      | 203         | 10001          | 1,479   | CY                    | EXCAVATION, AS PER PLAN (VERTICAL SIDES ONLY)                            | 32        |
|            |  | 2,753  |     | 227,731 |  |     |  | 84    |        |                  | 230,568   |           |      | 203         | 20000          | 230,568 | CY                    | EMBANKMENT   |           |
|            |  |        |     |         |  |     |  |       |        | 6,586            | 6,586     |           |      | 203         | 20001          | 6,586   | CY                    | EMBANKMENT, AS PER PLAN  | 32        |
|            |  |        |     |         |  |     |  |       |        |                  | 12        |           |      | SPECIAL     | 20365000       | 12      | EACH                  | SETTLEMENT PLATFORM  | 35        |
|            |  |        |     |         |  |     |  |       |        | 4,224            | 4,224     |           |      | 204         | 10000          | 4,224   | SY                    | SUBGRADE COMPACTION  |           |
|            |  |        |     |         |  |     |  |       |        | 162              | 162       |           |      | 204         | 13000          | 162     | CY                    | EXCAVATION OF SUBGRADE   |           |
|            |  |        |     |         |  |     |  |       |        |                  | 162       |           |      | 204         | 30020          | 162     | CY                    | GRANULAR MATERIAL, TYPE C  |           |
| 57         |  |        |     |         |  |     |  |       |        |                  | 57        |           |      | 204         | 45000          | 57      | hour                  | PROOF ROLLING  |           |
|            |  |        |     |         |  |     |  |       |        |                  | 2,517     | 2,517     |      | 204         | 50000          | 2,517   | SY                    | GEOTEXTILE FABRIC  |           |
|            |  |        |     |         |  |     |  |       |        |                  | 2,764     | 2,764     |      | 206         | 10500          | 2,764   | TON                   | CEMENT   |           |
|            |  |        |     |         |  |     |  |       |        |                  | 106,793   | 106,793   |      | 206         | 11000          | 106,793 | SY                    | CURING COAT  |           |
|            |  |        |     |         |  |     |  |       |        |                  | 106,793   | 106,793   |      | 206         | 15010          | 106,793 | SY                    | CEMENT STABILIZED SUBGRADE, 12 INCHES DEEP                               |           |
|            |  |        |     |         |  |     |  |       |        |                  | LS        | LS        |      | 206         | 30000          | LS      |                       | MIXTURE DESIGN FOR CHEMICALLY STABILIZED SOILS                           |           |
|            |  |        |     |         |  |     |  |       |        |                  | 18,250    |           |      | 606         | 15050          | 18,250  | FT                    | GUARDRAIL, TYPE MGS  |           |
|            |  |        |     |         |  |     |  |       |        |                  | 6,462     |           |      | 606         | 15100          | 6,462   | FT                    | GUARDRAIL, TYPE MGS WITH LONG POSTS                                      |           |
|            |  |        |     |         |  |     |  |       |        |                  | 2,800     |           |      | 606         | 15550          | 2,800   | FT                    | GUARDRAIL, BARRIER DESIGN, TYPE MGS                                      |           |
|            |  |        |     |         |  |     |  |       |        |                  | 3         |           |      | 606         | 20000          | 3       | EACH                  | FLARED END SECTION   |           |
|            |  |        |     |         |  |     |  |       |        |                  | 12        |           |      | 606         | 26150          | 12      | EACH                  | ANCHOR ASSEMBLY, MGS TYPE E, MASH 2016                                   |           |
|            |  |        |     |         |  |     |  |       |        |                  | 14        |           |      | 606         | 26550          | 14      | EACH                  | ANCHOR ASSEMBLY, MGS TYPE T  |           |
|            |  |        |     |         |  |     |  |       |        |                  | 5         |           |      | 606         | 35002          | 5       | EACH                  | MGS BRIDGE TERMINAL ASSEMBLY, TYPE 1                                     |           |
|            |  |        |     |         |  |     |  |       |        |                  | 5         |           |      | 606         | 35102          | 5       | EACH                  | MGS BRIDGE TERMINAL ASSEMBLY, TYPE 2                                     |           |
|            |  |        |     |         |  | 1   |  |       |        |                  | 1         |           |      | 606         | 60022          | 1       | EACH                  | IMPACT ATTENUATOR, TYPE 2 (UNIDIRECTIONAL), SPEED = 60 MPH, HAZARD = 28" |           |
|            |  |        |     |         |  |     |  |       |        |                  | 3         |           |      | 606         | 60028          | 3       | EACH                  | IMPACT ATTENUATOR, TYPE 2 (BIDIRECTIONAL), SPEED = 60 MPH, HAZARD = 36"  |           |
|            |  |        |     |         |  |     |  |       |        |                  | 16,057    |           |      | 607         | 15000          | 16,057  | FT                    | FENCE, TYPE 47   |           |
| 3,600      |  |        |     |         |  |     |  |       |        |                  | 3,600     |           |      | 607         | 30000          | 3,600   | FT                    | FENCE, SNOW  |           |
|            |  |        |     |         |  |     |  |       |        |                  | 7         |           |      | 607         | 35000          | 7       | FT                    | FENCE REMOVED AND REBUILT  |           |
|            |  |        |     |         |  |     |  |       |        |                  | 2,785     |           |      | 622         | 10100          | 2,785   | FT                    | CONCRETE BARRIER, SINGLE SLOPE, TYPE B1                                  |           |
|            |  |        |     |         |  |     |  |       |        |                  | 205       |           |      | 622         | 10120          | 205     | FT                    | CONCRETE BARRIER, SINGLE SLOPE, TYPE C                                   |           |
|            |  |        |     |         |  |     |  |       |        |                  | 40        |           |      | 622         | 10121          | 40      | FT                    | CONCRETE BARRIER, SINGLE SLOPE, TYPE C, AS PER PLAN                      | 32        |
|            |  |        |     |         |  |     |  |       |        |                  | 862       |           |      | 622         | 10160          | 862     | FT                    | CONCRETE BARRIER, SINGLE SLOPE, TYPE D                                   |           |
|            |  |        |     |         |  |     |  |       |        |                  | 94        |           |      | 622         | 10161          | 94      | FT                    | CONCRETE BARRIER, SINGLE SLOPE, TYPE D, AS PER PLAN A                    | 32        |
|            |  |        |     |         |  |     |  |       |        |                  | 156       |           |      | 622         | 10161          | 156     | FT                    | CONCRETE BARRIER, SINGLE SLOPE, TYPE D, AS PER PLAN B                    | 32        |
|            |  |        |     |         |  |     |  |       |        |                  | 1         |           |      | 622         | 24840          | 1       | EACH                  | CONCRETE BARRIER END SECTION, TYPE B                                     |           |
|            |  |        |     |         |  |     |  |       |        |                  | 2         |           |      | 622         | 24850          | 2       | EACH                  | CONCRETE BARRIER END SECTION, TYPE B1                                    |           |
|            |  |        |     |         |  |     |  |       |        |                  | 1         |           |      | 622         | 25000          | 1       | EACH                  | CONCRETE BARRIER END SECTION, TYPE D                                     |           |

CALCULATED  
TES  
CHECKED  
JAE

GENERAL SUMMARY

GRE - US 35 - 5.63



107217gg003.dgn Sheet 11/29/2022 3:23PM CH\_ODOTV8i\_Half\_BW\_pen ProjectWise Dynamic Composition Server JEGSVCFWU01

| SHEET NUM.      |  |     |       |     |  |     |  |      |     | PART.            |           |           | ITEM | ITEM<br>EXT | GRAND<br>TOTAL | UNIT   | DESCRIPTION | SEE<br>SHEET<br>NO.   |
|-----------------|--|-----|-------|-----|--|-----|--|------|-----|------------------|-----------|-----------|------|-------------|----------------|--------|-------------|---|
| 30              |  | 187 | 188   | 189 |  | 192 |  | 483  | 509 | Office<br>Calcs. | 01/NHS/OT | 02/NHS/BR |      |             |                |        |             |   |
| <b>DRAINAGE</b> |  |     |       |     |  |     |  |      |     |                  |           |           |      |             |                |        |             |   |
|                 |  |     |       | 56  |  |     |  |      |     |                  | 56        |           |      | 611         | 10900          | 56     | FT          | 24" CONDUIT, TYPE D, 706.02   |
|                 |  |     |       | 30  |  |     |  |      |     |                  | 30        |           |      | 611         | 13200          | 30     | FT          | 30" CONDUIT, TYPE A, 707.01 (ALUMINIZED), 707.04  |
|                 |  |     |       | 72  |  |     |  |      |     |                  | 72        |           |      | 611         | 13200          | 72     | FT          | 30" CONDUIT, TYPE A, 706.02 OR 36" 707.01 (ALUMINIZED), 707.04, 707.21, 707.33          |
|                 |  |     |       | 184 |  |     |  |      |     |                  | 184       |           |      | 611         | 13200          | 184    | FT          | 30" CONDUIT, TYPE A, 706.02, 707.01 (ALUMINIZED), 707.04, 707.21, 707.33, 748.06 (0.5") |
|                 |  |     | 207   |     |  |     |  |      |     |                  | 207       |           |      | 611         | 13400          | 207    | FT          | 30" CONDUIT, TYPE B   |
|                 |  |     |       | 284 |  |     |  |      |     |                  | 284       |           |      | 611         | 21100          | 284    | FT          | 48" CONDUIT, TYPE C   |
|                 |  |     |       | 60  |  |     |  |      |     |                  | 60        |           |      | 611         | 23600          | 60     | FT          | 60" CONDUIT, TYPE A, 707.33   |
|                 |  |     |       | 80  |  |     |  |      |     |                  | 80        |           |      | 611         | 52300          | 80     | FT          | 19" X 30" CONDUIT, TYPE A, 706.04   |
|                 |  |     |       | 50  |  |     |  |      |     |                  | 50        |           |      | 611         | 97400          | 50     | FT          | CONDUIT, MISC.: 33" CONDUIT, TYPE D   |
|                 |  |     |       | 2   |  |     |  |      |     |                  | 2         |           |      | 611         | 98150          | 2      | EACH        | CATCH BASIN, NO. 3  |
|                 |  |     |       | 20  |  |     |  |      |     |                  | 20        |           |      | 611         | 98180          | 20     | EACH        | CATCH BASIN, NO. 3A   |
|                 |  |     |       | 3   |  |     |  |      |     |                  | 3         |           |      | 611         | 98370          | 3      | EACH        | CATCH BASIN, NO. 6  |
|                 |  |     |       | 2   |  |     |  |      |     |                  | 2         |           |      | 611         | 98410          | 2      | EACH        | CATCH BASIN, NO. 8  |
|                 |  |     |       | 1   |  |     |  |      |     |                  | 1         |           |      | 611         | 98434          | 1      | EACH        | CATCH BASIN, NO. 8A   |
|                 |  |     |       | 1   |  |     |  |      |     |                  | 1         |           |      | 611         | 98634          | 1      | EACH        | CATCH BASIN RECONSTRUCTED TO GRADE  |
|                 |  |     |       | 7   |  |     |  |      |     |                  | 7         |           |      | 611         | 99100          | 7      | EACH        | INLET, NO. 3 FOR SINGLE SLOPE BARRIER, TYPE B1  |
|                 |  |     |       | 1   |  |     |  |      |     |                  | 1         |           |      | 611         | 99101          | 1      | EACH        | INLET, NO. 3 FOR SINGLE SLOPE BARRIER, TYPE B1, AS PER PLAN                             |
|                 |  |     |       | 1   |  |     |  |      |     |                  | 1         |           |      | 611         | 99110          | 1      | EACH        | INLET, NO. 3 FOR SINGLE SLOPE BARRIER, TYPE C1  |
|                 |  |     |       | 3   |  |     |  |      |     |                  | 3         |           |      | 611         | 99114          | 3      | EACH        | INLET, NO. 3 FOR SINGLE SLOPE BARRIER, TYPE D   |
|                 |  |     |       | 5   |  |     |  |      |     |                  | 5         |           |      | 611         | 99115          | 5      | EACH        | INLET, NO. 3 FOR SINGLE SLOPE BARRIER, TYPE D, AS PER PLAN                              |
|                 |  |     |       | 1   |  |     |  |      |     |                  | 1         |           |      | 611         | 99574          | 1      | EACH        | MANHOLE, NO. 3  |
|                 |  |     |       |     |  | 32  |  |      |     |                  | 32        |           |      | 611         | 99710          | 32     | EACH        | PRECAST REINFORCED CONCRETE OUTLET  |
|                 |  |     |       | 308 |  |     |  |      |     |                  | 308       |           |      | 839         | 30000          | 308    | FT          | TRENCH DRAIN, TYPE B WITH STANDARD GRATE  |
| <b>PAVEMENT</b> |  |     |       |     |  |     |  |      |     |                  |           |           |      |             |                |        |             |   |
| 9               |  |     |       |     |  |     |  |      |     | 1,596            | 1,605     |           |      | 301         | 56000          | 1,605  | CY          | ASPHALT CONCRETE BASE, PG64-22, (449)   |
|                 |  |     |       |     |  |     |  |      |     | 11,106           | 11,106    |           |      | 302         | 56000          | 11,106 | CY          | ASPHALT CONCRETE BASE, PG64-22, (449)   |
|                 |  |     |       |     |  |     |  |      |     | 17,977           | 17,977    |           |      | 304         | 20000          | 17,977 | CY          | AGGREGATE BASE, 6"  |
|                 |  |     |       |     |  |     |  |      |     | 486              | 486       |           |      | 304         | 20000          | 486    | CY          | AGGREGATE BASE, 8"  |
|                 |  |     |       |     |  |     |  |      |     | 252              | 252       |           |      | 304         | 20000          | 252    | CY          | AGGREGATE BASE, 12"   |
|                 |  |     |       |     |  |     |  |      |     | 7,983            | 7,983     |           |      | 407         | 20000          | 7,983  | GAL         | NON-TRACKING TACK COAT  |
|                 |  |     |       |     |  |     |  |      |     | 372              | 372       |           |      | 441         | 50000          | 372    | CY          | ASPHALT CONCRETE SURFACE COURSE, TYPE 1, (448), PG64-22                                 |
|                 |  |     |       |     |  |     |  |      |     | 526              | 526       |           |      | 441         | 50300          | 526    | CY          | ASPHALT CONCRETE INTERMEDIATE COURSE, TYPE 2, (448)                                     |
|                 |  |     |       |     |  |     |  |      |     | 3,416            | 3,416     |           |      | 442         | 10080          | 3,416  | CY          | ASPHALT CONCRETE INTERMEDIATE COURSE, 12.5 MM, TYPE A (446)                             |
|                 |  |     |       |     |  |     |  |      |     | 2,868            | 2,868     |           |      | 442         | 10300          | 2,868  | CY          | ASPHALT CONCRETE SURFACE COURSE, 12.5 MM, TYPE A (447)                                  |
|                 |  |     |       |     |  |     |  |      |     | 242              | 242       |           |      | SPECIAL     | 45130000       | 242    | FT          | PRESSURE RELIEF JOINT, TYPE A   |
|                 |  |     |       |     |  |     |  |      |     | 7,455            | 7,455     |           |      | 452         | 12020          | 7,455  | SY          | 8" NON-REINFORCED CONCRETE PAVEMENT, CLASS QC 1P WITH QC/QA                             |
|                 |  |     |       |     |  |     |  |      |     | 14,097           | 14,097    |           |      | 452         | 14122          | 14,097 | SY          | 11.5" NON-REINFORCED CONCRETE PAVEMENT, CLASS QC 1P WITH QC/QA                          |
|                 |  |     | 4,542 |     |  |     |  |      |     | 4,542            |           |           |      | 609         | 24510          | 4,542  | FT          | CURB, TYPE 4-C  |
|                 |  |     | 35.5  |     |  |     |  |      |     | 35.5             |           |           |      | 609         | 72100          | 35.5   | CY          | CONCRETE MEDIAN, 6"   |
|                 |  |     |       |     |  |     |  |      |     | 235              | 235       |           |      | 617         | 10100          | 235    | CY          | COMPACTED AGGREGATE   |
|                 |  |     |       |     |  |     |  | 6.86 |     | 6.86             |           |           |      | 618         | 40600          | 6.86   | MILE        | RUMBLE STRIPS, SHOULDER (ASPHALT CONCRETE)  |
| <b>LIGHTING</b> |  |     |       |     |  |     |  |      |     |                  |           |           |      |             |                |        |             |   |
|                 |  |     |       |     |  |     |  |      | 36  | 36               |           |           |      | 625         | 00450          | 36     | EACH        | CONNECTION, FUSED PULL APART  |
|                 |  |     |       |     |  |     |  |      | 18  | 18               |           |           |      | 625         | 00460          | 18     | EACH        | CONNECTION, UNFUSED PULL APART  |
|                 |  |     |       |     |  |     |  |      | 12  | 12               |           |           |      | 625         | 00470          | 12     | EACH        | CONNECTION, UNFUSED BOLTED  |
|                 |  |     |       |     |  |     |  |      | 123 | 123              |           |           |      | 625         | 00480          | 123    | EACH        | CONNECTION, UNFUSED PERMANENT   |
|                 |  |     |       |     |  |     |  |      | 18  | 18               |           |           |      | 625         | 10490          | 18     | EACH        | LIGHT POLE, CONVENTIONAL, AT15B40   |
|                 |  |     |       |     |  |     |  |      | 1   | 1                |           |           |      | 625         | 10490          | 1      | EACH        | LIGHT POLE, CONVENTIONAL, A15B40  |
|                 |  |     |       |     |  |     |  |      | 18  | 18               |           |           |      | 625         | 14100          | 18     | EACH        | LIGHT POLE FOUNDATION, 24" X 8' DEEP  |
|                 |  |     |       |     |  |     |  |      | 1   | 1                |           |           |      | 625         | 14300          | 1      | EACH        | MEDIAN LIGHT POLE FOUNDATION, 8' DEEP   |

CALCULATED  
TES  
CHECKED  
JAE

GENERAL SUMMARY

107217gg005.dgn Sheet 12/11/2022 12:16PM CH\_OD0TV81\_Half\_BW\_pen ProjectWise\_Dynamic\_Composition\_Server JEGSVCPWU01

| SHEET NUM. |  |    |    |  |     |  |     |     |     | PART. |           |           | ITEM | ITEM EXT | GRAND TOTAL | UNIT  | DESCRIPTION | SEE SHEET NO.  |           |
|------------|--|----|----|--|-----|--|-----|-----|-----|-------|-----------|-----------|------|----------|-------------|-------|-------------|--|-----------|
| 36         |  | 40 | 41 |  | 201 |  | 476 | 479 | 481 | 482   | 01/NHS/OT | 02/NHS/BR |      |          |             |       |             |  | 03/NHS/BR |
|            |  |    |    |  |     |  |     | 2   |     |       |           |           |      | 630      | 89100       | 2     | EACH        | TRAFFIC CONTROL<br>REMOVAL OF OVERHEAD SIGN SUPPORT AND REERECTION, TYPE TC-12.30      |           |
|            |  |    |    |  |     |  | 2   |     |     |       |           |           |      | 630      | 89804       | 2     | EACH        | REMOVAL OF OVERHEAD SIGN SUPPORT AND DISPOSAL, TYPE TC-15.115                          |           |
|            |  |    |    |  |     |  |     |     |     | 1.8   | 1.8       |           |      | 644      | 00100       | 1.8   | MILE        | EDGE LINE, 4"  |           |
|            |  |    |    |  |     |  |     |     |     | 0.04  | 0.04      |           |      | 644      | 00200       | 0.04  | MILE        | LANE LINE, 4"  |           |
|            |  |    |    |  |     |  |     |     |     | 1.44  | 1.44      |           |      | 644      | 00300       | 1.44  | MILE        | CENTER LINE  |           |
|            |  |    |    |  |     |  |     |     | 18  | 421   | 421       |           |      | 644      | 00400       | 421   | FT          | CHANNELIZING LINE, 8"  |           |
|            |  |    |    |  |     |  |     |     |     | 36    | 54        |           |      | 644      | 00500       | 54    | FT          | STOP LINE  |           |
|            |  |    |    |  |     |  |     |     |     | 754   | 754       |           |      | 644      | 00700       | 754   | FT          | TRANSVERSE/DIAGONAL LINE   |           |
|            |  |    |    |  |     |  |     |     | 293 |       | 293       |           |      | 644      | 00720       | 293   | FT          | CHEVRON MARKING  |           |
|            |  |    |    |  |     |  |     |     | 39  |       | 39        |           |      | 644      | 00900       | 39    | SF          | ISLAND MARKING   |           |
|            |  |    |    |  |     |  |     |     | 12  | 7     | 19        |           |      | 644      | 01300       | 19    | EACH        | LANE ARROW   |           |
|            |  |    |    |  |     |  |     |     | 2   |       | 2         |           |      | 644      | 01350       | 2     | EACH        | LANE REDUCTION ARROW   |           |
|            |  |    |    |  |     |  |     |     | 2   |       | 2         |           |      | 644      | 01360       | 2     | EACH        | WRONG WAY ARROW  |           |
|            |  |    |    |  |     |  |     |     |     | 56    | 56        |           |      | 644      | 01510       | 56    | FT          | DOTTED LINE, 6"  |           |
|            |  |    |    |  |     |  |     |     |     | 15    | 15        |           |      | 644      | 01514       | 15    | FT          | DOTTED LINE, 8"  |           |
|            |  |    |    |  |     |  |     |     | 18  |       | 18        |           |      | 644      | 20800       | 18    | FT          | YIELD LINE   |           |
|            |  |    |    |  |     |  |     |     |     | 0.08  | 0.08      |           |      | 646      | 10000       | 0.08  | MILE        | EDGE LINE, 4"  |           |
|            |  |    |    |  |     |  |     |     |     | 156   | 156       |           |      | 646      | 10300       | 156   | FT          | CHANNELIZING LINE, 8"  |           |
|            |  |    |    |  |     |  |     |     | 12  |       | 12        |           |      | 646      | 10400       | 12    | FT          | STOP LINE  |           |
|            |  |    |    |  |     |  |     |     |     | 3     | 3         |           |      | 646      | 20300       | 3     | EACH        | LANE ARROW   |           |
|            |  |    |    |  |     |  |     |     |     | 155   | 155       |           |      | 646      | 20506       | 155   | FT          | DOTTED LINE, 8"  |           |
|            |  |    |    |  |     |  |     |     |     | 19    | 19        |           |      | 646      | 90000       | 19    | FT          | PAVEMENT MARKING, MISC.: CENTER LINE   | 497       |
|            |  |    |    |  |     |  |     |     |     | 0.69  | 0.69      |           |      | 807      | 12010       | 0.69  | MILE        | WET REFLECTIVE EPOXY PAVEMENT MARKING, EDGE LINE, 6"                                   |           |
|            |  |    |    |  |     |  |     |     |     | 1     | 1         |           |      | 807      | 12110       | 1     | MILE        | WET REFLECTIVE EPOXY PAVEMENT MARKING, LANE LINE, 6"                                   |           |
|            |  |    |    |  |     |  |     |     |     | 1     | 1         |           |      | 807      | 12410       | 1     | FT          | WET REFLECTIVE EPOXY PAVEMENT MARKING, DOTTED LINE, 6"                                 |           |
|            |  |    |    |  |     |  |     |     |     | 7.7   | 7.7       |           |      | 807      | 13010       | 7.7   | MILE        | WET REFLECTIVE SPRAY THERMOPLASTIC PAVEMENT MARKING, EDGE LINE, 6"                     |           |
|            |  |    |    |  |     |  |     |     |     | 3.4   | 3.4       |           |      | 807      | 13110       | 3.4   | MILE        | WET REFLECTIVE SPRAY THERMOPLASTIC PAVEMENT MARKING, LANE LINE, 6"                     |           |
|            |  |    |    |  |     |  |     |     |     | 4,389 | 4,389     |           |      | 807      | 13310       | 4,389 | FT          | WET REFLECTIVE SPRAY THERMOPLASTIC PAVEMENT MARKING, CHANNELIZING LINE, 12"            |           |
|            |  |    |    |  |     |  |     |     |     | 3,362 | 3,362     |           |      | 807      | 13410       | 3,362 | FT          | WET REFLECTIVE SPRAY THERMOPLASTIC PAVEMENT MARKING, DOTTED LINE, 6"                   |           |
|            |  |    |    |  |     |  |     |     |     | 10.62 | 10.62     |           |      | 850      | 10010       | 10.62 | MILE        | GROOVING FOR 6" RECESSED PAVEMENT MARKING, (ASPHALT)                                   |           |
|            |  |    |    |  |     |  |     |     |     | 3,592 | 3,592     |           |      | 850      | 10110       | 3,592 | FT          | GROOVING FOR 6" RECESSED PAVEMENT MARKING, (ASPHALT)                                   |           |
|            |  |    |    |  |     |  |     |     |     | 4,370 | 4,370     |           |      | 850      | 10130       | 4,370 | FT          | GROOVING FOR 12" RECESSED PAVEMENT MARKING, (ASPHALT)                                  |           |
|            |  |    |    |  |     |  |     |     |     | 1.21  | 1.21      |           |      | 850      | 20010       | 1.21  | MILE        | GROOVING FOR 6" RECESSED PAVEMENT MARKING, (CONCRETE)                                  |           |
|            |  |    |    |  |     |  |     |     |     |       |           |           |      |          |             |       |             | <b>RETAINING WALLS (RW-01, RW-02A &amp; RW-02B)</b>                                    |           |
|            |  |    |    |  |     |  |     |     |     |       |           |           |      |          |             |       |             | FOR RETAINING WALL GENERAL SUMMARY   | 451       |
|            |  |    |    |  |     |  |     |     |     |       |           |           |      |          |             |       |             | <b>RETAINING WALLS (TEMPORARY RETAINING WALL NOS. 1 &amp; 2)</b>                       |           |
|            |  |    |    |  |     |  |     |     |     |       |           |           |      |          |             |       |             | FOR RETAINING TEMPORARY WALL GENERAL SUMMARY   | 473       |
|            |  |    |    |  |     |  |     |     |     |       |           |           |      |          |             |       |             | <b>STRUCTURE 20 FOOT SPAN AND UNDER (GRE-035-0604)</b>                                 |           |
|            |  |    |    |  |     |  |     |     |     |       |           |           |      |          |             |       |             | FOR US 35 OVER FLOOD PLAIN RELIEF DITCH GENERAL SUMMARY                                | 524       |
|            |  |    |    |  |     |  |     |     |     |       |           |           |      |          |             |       |             | <b>STRUCTURE 20 FOOT SPAN AND UNDER (GRE-035-0654)</b>                                 |           |
|            |  |    |    |  |     |  |     |     |     |       |           |           |      |          |             |       |             | FOR US 35 OVER TRIBUTARY TO LITTLE MIAMI RIVER GENERAL SUMMARY                         | 529       |
|            |  |    |    |  |     |  |     |     |     |       |           |           |      |          |             |       |             | <b>STRUCTURE OVER 20 FOOT SPAN (GRE-035-0614)</b>                                      |           |
|            |  |    |    |  |     |  |     |     |     |       |           |           |      |          |             |       |             | FOR US 35 OVER LITTLE MIAMI RIVER GENERAL SUMMARY                                      | 532       |
|            |  |    |    |  |     |  |     |     |     |       |           |           |      |          |             |       |             | <b>STRUCTURE OVER 20 FOOT SPAN (GRE-035-0610)</b>                                      |           |
|            |  |    |    |  |     |  |     |     |     |       |           |           |      |          |             |       |             | FOR RAMP E OVER LITTLE MIAMI RIVER GENERAL SUMMARY                                     | 541       |
|            |  |    |    |  |     |  |     |     |     |       |           |           |      |          |             |       |             | FOR VALLEY/TREBEIN ROAD OVER US 35 GENERAL SUMMARY                                     | 575       |
|            |  |    |    |  |     |  |     |     |     |       |           |           |      |          |             |       |             | <b>MAINTENANCE OF TRAFFIC</b>  |           |
|            |  |    |    |  |     |  |     |     |     | 800   | 800       |           |      | 253      | 02000       | 800   | CY          | PAVEMENT REPAIR  |           |
|            |  |    |    |  |     |  |     |     |     | 3     | 3         |           |      | 606      | 26500       | 3     | EACH        | ANCHOR ASSEMBLY, TYPE T  |           |
| 2,000      |  |    |    |  |     |  |     |     |     | 2,000 | 2,000     |           |      | 614      | 11110       | 2,000 | hour        | LAW ENFORCEMENT OFFICER WITH PATROL CAR FOR ASSISTANCE                                 |           |
|            |  |    |    |  |     |  |     |     |     | 2,412 | 2,412     |           |      | 614      | 11630       | 2,412 | FT          | INCREASED BARRIER DELINEATION  |           |
|            |  |    |    |  |     |  |     |     |     | 21    | 21        |           |      | 614      | 12380       | 21    | EACH        | WORK ZONE IMPACT ATTENUATOR, 24" WIDE HAZARDS, (UNIDIRECTIONAL)                        |           |
|            |  |    |    |  |     |  |     |     |     | 1     | 1         |           |      | 614      | 12390       | 1     | EACH        | WORK ZONE IMPACT ATTENUATOR, OVER 24" AND LESS THAN 36" WIDE HAZARDS, (UNIDIRECTIONAL) |           |

CALCULATED  
TES  
CHECKED  
JAE

GENERAL SUMMARY

GRE - US 35 - 5.63

107217gg006.dgn Sheet 12/11/2022 12:16PM CH\_ODOTV81\_Half\_BW\_pen ProjectWise\_Dynamic\_Composition\_Server JEGSVCPWU01

| SHEET NUM. |    |    |       |    |     |        |           |           |           | PART. |  |     | ITEM  | ITEM EXT | GRAND TOTAL | UNIT   | DESCRIPTION | SEE SHEET NO. |
|------------|----|----|-------|----|-----|--------|-----------|-----------|-----------|-------|--|-----|-------|----------|-------------|--|-------------|---------------|
| 37         | 38 | 39 | 40    | 41 | 201 | 202    | 01/NHS/OT | 02/NHS/BR | 03/NHS/BR |       |  |     |       |          |             |  |             |               |
|            |    |    | LS    |    |     |        |           | LS        |           |       |  | 614 | 12420 | LS       |             | MAINTENANCE OF TRAFFIC                                   |             |               |
| 8          |    |    |       |    |     |        |           | 8         |           |       |  | 614 | 12484 | 8        | EACH        | DETOUR SIGNING   |             |               |
| 25         |    |    |       |    |     |        |           | 25        |           |       |  | 614 | 12500 | 25       | EACH        | WORK ZONE INCREASED PENALTIES SIGN                       |             |               |
| 100        |    |    |       |    |     |        |           | 100       |           |       |  | 614 | 12600 | 100      | EACH        | REPLACEMENT SIGN   |             |               |
| 2          |    |    |       |    |     |        |           | 2         |           |       |  | 614 | 12756 | 2        | EACH        | REPLACEMENT DRUM   |             |               |
|            |    |    |       |    |     |        |           |           |           |       |  | 614 |       |          | EACH        | WORK ZONE CROSSOVER LIGHTING SYSTEM                      |             |               |
|            |    |    | 2,480 |    |     |        |           | 2,480     |           |       |  | 614 | 12801 | 2,480    | EACH        | WORK ZONE RAISED PAVEMENT MARKER, AS PER PLAN            | 40          |               |
|            |    |    | 1,018 |    |     |        |           | 1,018     |           |       |  | 614 | 13310 | 1,018    | EACH        | BARRIER REFLECTOR, TYPE 1, ONE WAY                       |             |               |
|            |    |    | 28    |    |     |        |           | 28        |           |       |  | 614 | 13312 | 28       | EACH        | BARRIER REFLECTOR, TYPE 2, ONE WAY                       |             |               |
|            |    |    | 1,178 |    |     |        |           | 1,178     |           |       |  | 614 | 13350 | 1,178    | EACH        | OBJECT MARKER, ONE WAY                                   |             |               |
|            |    | 52 |       |    |     |        |           | 52        |           |       |  | 614 | 18601 | 52       | SNMT        | PORTABLE CHANGEABLE MESSAGE SIGN, AS PER PLAN            | 39          |               |
|            |    |    |       |    |     | 5.16   |           | 3.4       |           |       |  | 614 | 20056 | 8.56     | MILE        | WORK ZONE LANE LINE, CLASS I, 6", 807 PAINT              |             |               |
|            |    |    |       |    |     | 0.52   |           | 0.04      |           |       |  | 614 | 20110 | 0.56     | MILE        | WORK ZONE LANE LINE, CLASS I, 6", 642 PAINT              |             |               |
|            |    |    |       |    |     |        |           | 3.44      |           |       |  | 614 | 20560 | 3.44     | MILE        | WORK ZONE LANE LINE, CLASS III, 6", 642 PAINT            |             |               |
|            |    |    |       |    |     |        |           | 1.44      |           |       |  | 614 | 21100 | 1.44     | MILE        | WORK ZONE CENTER LINE, CLASS I, 642 PAINT                |             |               |
|            |    |    |       |    |     |        |           | 1.44      |           |       |  | 614 | 21550 | 1.44     | MILE        | WORK ZONE CENTER LINE, CLASS III, 642 PAINT              |             |               |
|            |    |    |       |    |     | 16.12  |           | 9.23      |           |       |  | 614 | 22056 | 25.35    | MILE        | WORK ZONE EDGE LINE, CLASS I, 6", 807 PAINT              |             |               |
|            |    |    |       |    |     | 8.52   |           | 1.88      |           |       |  | 614 | 22110 | 10.4     | MILE        | WORK ZONE EDGE LINE, CLASS I, 6", 642 PAINT              |             |               |
|            |    |    |       |    |     |        |           | 1.88      |           |       |  | 614 | 22350 | 1.88     | MILE        | WORK ZONE EDGE LINE, CLASS III, 4", 642 PAINT            |             |               |
|            |    |    |       |    |     |        |           | 9.23      |           |       |  | 614 | 22360 | 9.23     | MILE        | WORK ZONE EDGE LINE, CLASS III, 6", 642 PAINT            |             |               |
|            |    |    |       |    |     | 12,952 |           |           |           |       |  | 614 | 23100 | 12,952   | FT          | WORK ZONE CHANNELIZING LINE, CLASS I, 8", 807 PAINT      |             |               |
|            |    |    |       |    |     |        |           | 4,389     |           |       |  | 614 | 23110 | 4,389    | FT          | WORK ZONE CHANNELIZING LINE, CLASS I, 12", 807 PAINT     |             |               |
|            |    |    |       |    |     |        |           | 1,041     |           |       |  | 614 | 23200 | 1,041    | FT          | WORK ZONE CHANNELIZING LINE, CLASS I, 8", 642 PAINT      |             |               |
|            |    |    |       |    |     |        |           | 1,041     |           |       |  | 614 | 23680 | 1,041    | FT          | WORK ZONE CHANNELIZING LINE, CLASS III, 8", 642 PAINT    |             |               |
|            |    |    |       |    |     |        |           | 4,389     |           |       |  | 614 | 23690 | 4,389    | FT          | WORK ZONE CHANNELIZING LINE, CLASS III, 12", 642 PAINT   |             |               |
|            |    |    |       |    |     | 170    |           | 3,362     |           |       |  | 614 | 24102 | 3,532    | FT          | WORK ZONE DOTTED LINE, CLASS I, 6", 807 PAINT            |             |               |
|            |    |    |       |    |     |        |           | 226       |           |       |  | 614 | 24200 | 226      | FT          | WORK ZONE DOTTED LINE, CLASS I, 4", 642 PAINT            |             |               |
|            |    |    |       |    |     |        |           | 226       |           |       |  | 614 | 24610 | 226      | FT          | WORK ZONE DOTTED LINE, CLASS III, 4", 642 PAINT          |             |               |
|            |    |    |       |    |     |        |           | 3,362     |           |       |  | 614 | 24612 | 3,362    | FT          | WORK ZONE DOTTED LINE, CLASS III, 6", 642 PAINT          |             |               |
|            |    |    |       |    |     |        |           | 754       |           |       |  | 614 | 25200 | 754      | FT          | WORK ZONE TRANSVERSE/DIAGONAL LINE, CLASS I, 642 PAINT   |             |               |
|            |    |    |       |    |     |        |           | 754       |           |       |  | 614 | 25620 | 754      | FT          | WORK ZONE TRANSVERSE/DIAGONAL LINE, CLASS III, 642 PAINT |             |               |
|            |    |    |       |    |     |        |           | 30        |           |       |  | 614 | 26000 | 30       | FT          | WORK ZONE STOP LINE, CLASS I                             |             |               |
|            |    |    |       |    |     | 133    |           | 36        |           |       |  | 614 | 26200 | 169      | FT          | WORK ZONE STOP LINE, CLASS I, 642 PAINT                  |             |               |
|            |    |    |       |    |     |        |           | 66        |           |       |  | 614 | 26610 | 66       | FT          | WORK ZONE STOP LINE, CLASS III, 642 PAINT                |             |               |
|            |    |    |       |    |     |        |           | 39        |           |       |  | 614 | 32700 | 39       | SF          | WORK ZONE ISLAND MARKING, CLASS I                        |             |               |
|            |    |    |       |    |     |        |           | 39        |           |       |  | 614 | 32800 | 39       | SF          | WORK ZONE ISLAND MARKING, CLASS III, 642 PAINT           |             |               |
|            |    |    | LS    |    |     |        |           | LS        |           |       |  | 615 | 10001 | LS       |             | ROADS FOR MAINTAINING TRAFFIC, AS PER PLAN               |             |               |
|            |    |    |       |    |     | 14,704 |           | 14,704    |           |       |  | 615 | 20001 | 14,704   | SY          | PAVEMENT FOR MAINTAINING TRAFFIC, CLASS A, AS PER PLAN   | 39          |               |
|            |    |    |       |    |     | 7,021  |           | 7,021     |           |       |  | 615 | 25001 | 7,021    | SY          | PAVEMENT FOR MAINTAINING TRAFFIC, CLASS B, AS PER PLAN   | 39          |               |
|            |    |    | 800   |    |     |        |           | 800       |           |       |  | 616 | 10000 | 800      | MGAL        | WATER  |             |               |
|            |    |    |       |    |     | 6,458  |           | 6,458     |           |       |  | 622 | 41011 | 6,458    | FT          | PORTABLE BARRIER, 50", AS PER PLAN                       | 39          |               |
|            |    |    |       |    |     | 51,744 |           | 51,744    |           |       |  | 622 | 41100 | 51,744   | FT          | PORTABLE BARRIER, UNANCHORED                             |             |               |
|            |    |    |       |    |     |        |           | 30        |           |       |  | 644 | 00500 | 30       | FT          | STOP LINE  |             |               |
|            |    |    |       |    |     |        |           | 39        |           |       |  | 644 | 00900 | 39       | SF          | ISLAND MARKING   |             |               |
|            |    |    |       |    |     |        |           | 9.23      |           |       |  | 648 | 00104 | 9.23     | MILE        | EDGE LINE, 6"  |             |               |
|            |    |    |       |    |     |        |           | 3.4       |           |       |  | 648 | 00204 | 3.4      | MILE        | LANE LINE, 6"  |             |               |
|            |    |    |       |    |     |        |           | 4,389     |           |       |  | 648 | 00404 | 4,389    | FT          | CHANNELIZING LINE, 12"                                   |             |               |
|            |    |    |       |    |     |        |           | 3,362     |           |       |  | 648 | 01510 | 3,362    | FT          | DOTTED LINE, 6"  |             |               |
|            |    | 96 |       |    |     |        |           |           |           |       |  | 808 | 18700 | 96       | SNMT        | DIGITAL SPEED LIMIT (DSL) SIGN ASSEMBLY                  |             |               |
|            |    |    |       |    |     |        |           |           |           |       |  |     |       |          |             |  |             |               |
|            |    |    |       |    |     |        |           |           |           |       |  | 614 | 11000 | LS       |             | INCIDENTALS  |             |               |
|            |    |    |       |    |     |        |           |           |           |       |  | 619 | 16020 | 27       | MNTH        | FIELD OFFICE, TYPE C                                     |             |               |
|            |    |    |       |    |     |        |           |           |           |       |  | 623 | 10000 | LS       |             | CONSTRUCTION LAYOUT STAKES AND SURVEYING                 |             |               |
|            |    |    |       |    |     |        |           |           |           |       |  | 624 | 10000 | LS       |             | MOBILIZATION   |             |               |

CALCULATED  
TES  
CHECKED  
JAE

GENERAL SUMMARY

GRE-US 35-5.63



107217DS002.dgn Sheet 11/29/2022 2:57PM CH\_000TV8;\_Half\_BW\_pen ProjectWise Dynamic Composition Server JEGSVCPWU01

| REF. NO.                                 | SHEET NO. | STATION                     |           | SIDE | 202                    | 503                               | 503  | 601    | 601   | 601   | 602              | 611                 | 611                 | 611                         | 611  | 611  | 611   | 611                         | 611                               |                     |
|--|-----------|-----------------------------|-----------|------|------------------------|-----------------------------------|--|--------|---|---|------------------|---------------------|---------------------|-----------------------------|--|--|---|-----------------------------|-----------------------------------|---------------------|
|  |           | FROM                        | TO        |      | PIPE REMOVED, OVER 24" | COFFERDAMS AND EXCAVATION BRACING | COFFERDAMS AND EXCAVATION BRACING, AS PER PLAN A | RIPRAP | ROCK CHANNEL PROTECTION, TYPE B WITH FILTER | ROCK CHANNEL PROTECTION, TYPE C WITH FILTER | CONCRETE MASONRY | 12" CONDUIT, TYPE D | 15" CONDUIT, TYPE D | 24" CONDUIT, TYPE D, 706.02 | 30" CONDUIT, TYPE A, 707.01 (ALUMINIZED), 707.04 | 30" CONDUIT, TYPE A, 706.02 OR 36" 707.01 (ALUMINIZED), 707.04, 707.21, 707.33 | 30" CONDUIT, TYPE A, 706.02, 707.01 (ALUMINIZED), 707.04, 707.21, 707.33, 748.06 (0.5') | 60" CONDUIT, TYPE A, 707.33 | 19" X 30" CONDUIT, TYPE A, 706.04 | 33" CONDUIT, TYPE D |
|  |           |                             |           |      | FT                     | LS                                | LS   | SY     | CY  | CY  | CY               | FT                  | FT                  | FT                          | FT   | FT   | FT  | FT                          | FT                                | FT                  |
|  |           | <b>VALLEY ROAD</b>          |           |      |                        |                                   |  |        |   |   |                  |                     |                     |                             |  |  |   |                             |                                   |                     |
| D-52                                     | 355       | 862+57.59                   | 863+07.58 | LT   |                        |                                   |  |        |   | 1.33  |                  |                     |                     |                             |  |  |   |                             |                                   | 50                  |
| D-53                                     | 355       | 862+59.82                   | 863+07.83 | RT   |                        |                                   |  |        |   | 1.33  |                  |                     |                     |                             |  |  |   |                             |                                   |                     |
|  |           | <b>TREBEIN ROAD</b>         |           |      |                        |                                   |  |        |   |   |                  |                     |                     |                             |  |  |   |                             |                                   |                     |
| D-54                                     | 363       | 889+96.54                   | 890+37.32 | RT   |                        |                                   |  |        |   |   |                  | 40                  |                     |                             |  |  |   |                             |                                   |                     |
| D-55                                     | 363       | 890+56.63                   | 891+13.64 | RT   |                        |                                   |  |        |   |   |                  | 56                  |                     |                             |  |  |   |                             |                                   |                     |
|  |           | <b>US 35</b>                |           |      |                        |                                   |  |        |   |   |                  |                     |                     |                             |  |  |   |                             |                                   |                     |
|  | 439       | 307+08.60                   |           | CL   | 30                     |                                   | LS   |        |   | 4.20  | 1.2              |                     |                     |                             |  | 30   |   |                             |                                   |                     |
|  |           | <b>VALLEY ROAD</b>          |           |      |                        |                                   |  |        |   |   |                  |                     |                     |                             |  |  |   |                             |                                   |                     |
|  | 440       | 865+00.69                   |           | CL   | 9                      | LS                                |  |        | 15.6  |   | 3.6              |                     |                     |                             |  |  |   |                             | 60                                |                     |
|  |           | <b>RAMP F</b>               |           |      |                        |                                   |  |        |   |   |                  |                     |                     |                             |  |  |   |                             |                                   |                     |
|  | 441       | 835+00.00                   |           | CL   |                        |                                   |  | 3.83   | 2.00  | 1.5   |                  |                     |                     |                             |  | 72   |   |                             |                                   |                     |
|  |           | <b>GLENN THOMPSON DRIVE</b> |           |      |                        |                                   |  |        |   |   |                  |                     |                     |                             |  |  |   |                             |                                   |                     |
|  | 442       | 6+50.00                     |           | CL   |                        |                                   |  |        | 1.80  | 0.9   |                  |                     | 56                  |                             |  |  |   |                             |                                   |                     |
|  |           | <b>TREBEIN ROAD</b>         |           |      |                        |                                   |  |        |   |   |                  |                     |                     |                             |  |  |   |                             |                                   |                     |
|  | 443       | 884+58.15                   |           | CL   |                        |                                   |  |        | 1.80  | 1.2   |                  |                     |                     |                             |  | 184  |   |                             |                                   |                     |
|  |           | <b>TREBEIN ROAD</b>         |           |      |                        |                                   |  |        |   |   |                  |                     |                     |                             |  |  |   |                             |                                   |                     |
|  | 444       | 891+13.71                   |           | CL   |                        |                                   |  | 3.83   | 1.33  | 0.7   |                  |                     |                     |                             |  |  |   |                             | 80                                |                     |
| <b>TOTALS CARRIED TO GENERAL SUMMARY</b> |           |                             |           |      | 39                     | LS                                | LS   | 7.66   | 16  | 14  | 9                | 40                  | 104                 | 56                          | 30   | 72   | 184   | 60                          | 80                                | 50                  |

|                                     |                     |                |            |
|-------------------------------------|---------------------|----------------|------------|
| CALCULATED<br>TES<br>CHECKED<br>CTS | DRAINAGE SUBSUMMARY | GRE-US 35-5.63 | 189<br>698 |
|-------------------------------------|---------------------|----------------|------------|


107217ms301.dgn 12/11/2022 5:26:19 PM Martin.Pierce@jacobs.com

| REF. SHEET NO.                                | SHEET NO. | STATION              |        | SIDE    | 614  |      | 614  |      | 614  |    | 614  |      | 614  |      | 614   |     | 615 |    | 622   |        |
|---|-----------|----------------------|--------|---------|------|------|------|------|------|----|------|------|------|------|-------|-----|-----|----|-------|--------|
|   |           | FROM                 | TO     |         | EACH | EACH | MILE | MILE | MILE | FT | MILE | MILE | MILE | FT   | FT    | SY  | SY  | FT | FT    |        |
|   |           | MOT-PHASE 3 - STEP 1 |        |         |      |      |      |      |      |    |      |      |      |      |       |     |     |    |       |        |
|   |           | US 35                |        |         |      |      |      |      |      |    |      |      |      |      |       |     |     |    |       |        |
| LL-1  | 150       | 286+00               | 289+20 | LT      |      |      |      |      |      |    |      | 0.06 |      |      |       |     |     |    |       |        |
| LL-2  | 150       | 285+00               | 287+40 | RT      |      |      |      |      |      |    |      | 0.05 |      |      |       |     |     |    |       |        |
| WEL-1   | 150       | 286+00               | 329+96 | LT      |      |      |      |      |      |    |      |      | 0.84 |      |       |     |     |    |       |        |
| CH-1  | 150       | 289+20               | 300+00 | LT      |      |      |      |      |      |    |      |      |      | 1086 |       |     |     |    |       |        |
| YEL-1   | 150       | 286+00               | 373+00 | LT      |      |      |      |      |      |    |      |      |      | 1.65 |       |     |     |    |       |        |
| WEL-2   | 150       | 285+00               | 327+77 | LT & RT |      |      |      |      |      |    |      |      | 0.81 |      |       |     |     |    |       |        |
| CH-2  | 150       | 287+40               | 300+00 | LT & RT |      |      |      |      |      |    |      |      |      | 1264 |       |     |     |    |       |        |
| YEL-2   | 150       | 285+00               | 375+40 | LT & RT |      |      |      |      |      |    |      |      |      | 1.71 |       |     |     |    |       |        |
| MPB-1   | 150       | 291+45               | 323+30 | LT      |      |      |      |      |      |    |      |      |      |      |       |     |     |    | 3195  |        |
| PCB-1   | 150       | 293+40               | 316+60 | LT      |      |      |      |      |      |    |      |      |      |      |       |     |     |    |       | 2335   |
| PCB-2   | 150       | 297+32               | 323+30 | RT      | 1    |      |      |      |      |    |      |      |      |      |       |     |     |    |       | 2600   |
| LL-3  | 151       | 300+00               | 329+96 | LT      |      |      |      |      |      |    |      | 0.57 |      |      |       |     |     |    |       |        |
| LL-4  | 151       | 300+00               | 328+00 | LT      |      |      |      |      |      |    |      | 0.53 |      |      |       |     |     |    |       |        |
| DWL-1   | 152       | 324+30               | 326+00 | LT      |      |      |      |      |      |    |      |      |      |      | 170   |     |     |    |       |        |
| TP-1  | 152       | 320+25               | 320+63 | LT & RT |      |      |      |      |      |    |      |      |      |      |       | 163 |     |    |       |        |
| WEL-3   | 153       | 326+00               | 328+00 | LT      |      |      |      |      |      |    |      |      | 0.04 |      |       |     |     |    |       |        |
| PCB-3   | 153       | 327+55               | 329+73 | LT      |      |      |      |      |      |    |      |      |      |      |       |     |     |    |       | 218    |
| PCB-4   | 153       | 328+34               | 265+07 | LT      |      |      |      |      |      |    |      |      |      |      |       |     |     |    |       | 3748   |
| SL-1  | 153       |                      |        | LT      |      |      |      |      |      |    | 41   |      |      |      |       |     |     |    |       |        |
| WEL-4   | 153       | 331+24               | 334+00 | LT      |      |      |      |      |      |    |      |      | 0.05 |      |       |     |     |    |       |        |
| WEL-5   | 153       | 331+74               | 373+00 | LT      |      |      |      |      |      |    |      |      | 0.78 |      |       |     |     |    |       |        |
| LL-5  | 153       | 331+24               | 362+41 | LT      |      |      |      |      |      |    |      | 0.59 |      |      |       |     |     |    |       |        |
| PCB-5   | 155       | 344+88               | 368+59 | LT      | 1    |      |      |      |      |    |      |      |      |      |       |     |     |    |       | 2369   |
| MPB-2   | 155       | 341+37               | 374+00 | LT      |      |      |      |      |      |    |      |      |      |      |       |     |     |    | 3263  |        |
| WEL-6   | 155       | 328+96               | 374+40 | LT      |      |      |      |      |      |    |      |      | 0.86 |      |       |     |     |    |       |        |
| LL-6  | 155       | 328+96               | 362+41 | LT      |      |      |      |      |      |    |      | 0.63 |      |      |       |     |     |    |       |        |
| CH-3  | 156       | 362+41               | 373+00 | LT      |      |      |      |      |      |    |      |      |      |      | 1058  |     |     |    |       |        |
| CH-4  | 156       | 362+41               | 375+40 | LT      |      |      |      |      |      |    |      |      |      |      | 1306  |     |     |    |       |        |
| PCB-5A  | 43        | 318+00               | 321+25 | RT      | 1    |      |      |      |      |    |      |      |      |      |       |     |     |    |       | 303    |
|   |           | TREBEIN ROAD         |        |         |      |      |      |      |      |    |      |      |      |      |       |     |     |    |       |        |
| SL-2  | 153       |                      |        | LT      |      |      |      |      |      |    |      |      | 27   |      |       |     |     |    |       |        |
|   |           | VALLEY ROAD          |        |         |      |      |      |      |      |    |      |      |      |      |       |     |     |    |       |        |
| SL-3  | 153       |                      |        | RT      |      |      |      |      |      |    |      |      |      |      |       |     |     |    |       |        |
| DY-1  | 153       |                      |        | RT      |      |      |      |      |      |    |      | 0.02 |      |      |       |     |     |    |       |        |
| WEL-7   | 153       |                      |        | RT      |      |      |      |      |      |    |      | 0.04 |      |      |       |     |     |    |       |        |
| WEL-8   | 153       |                      |        | RT      |      |      |      |      |      |    |      | 0.03 |      |      |       |     |     |    |       |        |
| <b>TOTALS THIS SHEET CARRIED TO SHEET 201</b> |           |                      |        |         | 3    | 0    | 0.00 | 0.07 | 0.02 | 79 |      | 2.43 | 3.38 | 3.36 | 4,714 | 170 | 163 | 0  | 6,458 | 11,573 |


|   |                       |
|---|-----------------------|
| <b>MAINTENANCE OF TRAFFIC SUBSUMMARY</b><br><b>PHASE 3 - STEP 1</b> | CALCULATED<br>CHECKED |
| <b>GRE-US 35-5.63</b>   | 200<br>698            |

107217.ms321.dgn 12/11/2022 11:04:29 AM Mar.tn.Pierce@jacobs.com

| REF. SHEET NO.                                  | SHEET NO. | STATION              |        | SIDE | 614  |      | 614  |      | 614  |      | 614  |      | 614  |      | 614  |      | 614    |     | 614    |       | 615 |    | 615 |    | 622 |        | 622    |    |
|---|-----------|----------------------|--------|------|------|------|------|------|------|------|------|------|------|------|------|------|--------|-----|--------|-------|-----|----|-----|----|-----|--------|--------|----|
|   |           | FROM                 | TO     |      | EACH | EACH | MILE | MILE | MILE | FT   | MILE | MILE | MILE | MILE | FT   | FT   | SY     | SY  | FT     | FT    | SY  | SY | FT  | FT | FT  | FT     | FT     | FT |
|   |           | MOT-PHASE 3 - STEP 2 |        |      |   |           | US 35                |        |      | WEL-1   | 158       | 328+77               | 333+50 | RT   |      |      |      |      |      |      |      |      | 0.09 |      |      |      |        |     |        |       |     |    |     |    |     |        |        |    |
| YEL-1   | 158       | 328+77               | 334+00 | RT   |      |      | PCB-1   | 158       | 329+85               | 331+35 | RT   |      |      |      | 1    |      |      |      |      |      |      |      |      |        |     |        |       |     |    |     |    |     |        | 173    |    |
| PCB2  | 158       | 329+85               | 330+95 | RT   |      |      110    |    |
|   |           | MOT-PHASE 4          |        |      |   |           | US 35                |        |      | PCB-1   | 165       | 286+58               | 303+00 | RT   | 1    |      |      1642   |    |
| PCB-2   | 169       | 342+93               | 343+93 | LT   |      |      100    |    |
| PCB-3   | 170       | 359+82               | 391+10 | RT   | 1    |      |      3128   |    |
| PCB-4   | 171       | 368+24               | 393+05 | LT   | 1    |      |      2481   |    |
|   |           | MOT-PHASE 5          |        |      |   |           | US 35                |        |      | PCB-1   |           | 296+15               | 318+68 | LT   | 1    |      |      2253   |    |
| PCB-2   |           | 345+00               | 369+50 | LT   | 1    |      |      2450   |    |
| TOTALS THIS SHEET                               |           |                      |        |      | 5    | 1    |      |      | 0.00 | 0.00 | 0.00 | 0    |      | 0.00 | 0.09 | 0.10 | 0      | 0   | 0      | 0     | 0   | 0  | 0   | 0  | 0   | 0      | 12337  |    |
| TOTALS FROM MOT PH 1 & PH 1A STEP 1 THRU STEP 2 |           |                      |        |      | 6    | 0    |      |      | 0.52 | 2.22 | 2.38 | 0    |      | 0.00 | 0.00 | 0.10 | 0      | 0   | 680    | 6912  | 0   | 0  | 0   | 0  | 0   | 5358   |        |    |
| TOTALS FROM MOT PH 1A STEP 3                    |           |                      |        |      | 1    | 0    |      |      | 0.00 | 2.19 | 1.64 | 54   |      | 0.00 | 0.14 | 0.26 | 0      | 0   | 0      | 109   | 0   | 0  | 0   | 0  | 0   | 581    |        |    |
| TOTALS FROM MOT PH 2 STEP 1                     |           |                      |        |      | 3    | 0    |      |      | 0.00 | 0.00 | 0.00 | 0    |      | 2.08 | 2.95 | 2.62 | 3700   | 0   | 6057   | 0     | 0   | 0  | 0   | 0  | 0   | 10,471 |        |    |
| TOTALS FROM MOT PH 2 STEP 2                     |           |                      |        |      | 4    | 0    |      |      | 0.00 | 0.00 | 0.00 | 0    |      | 0.65 | 1.65 | 1.47 | 4538   | 0   | 7804   | 0     | 0   | 0  | 0   | 0  | 0   | 11,727 |        |    |
| TOTALS FROM MOT PH 3 STEP 1                     |           |                      |        |      | 2    | 0    |      |      | 0.00 | 0.07 | 0.02 | 79   |      | 2.43 | 3.38 | 3.36 | 4714   | 170 | 163    | 0     | 0   | 0  | 0   | 0  | 0   | 6458   |        |    |
| TOTALS CARRIED TO GENERAL SUMMARY               |           |                      |        |      | 21   | 1    |      |      | 0.52 | 4.48 | 4.04 | 133  |      | 5.16 | 8.21 | 7.91 | 12,952 | 170 | 14,704 | 7,021 | 0   | 0  | 0   | 0  | 0   | 0      | 51,744 |    |

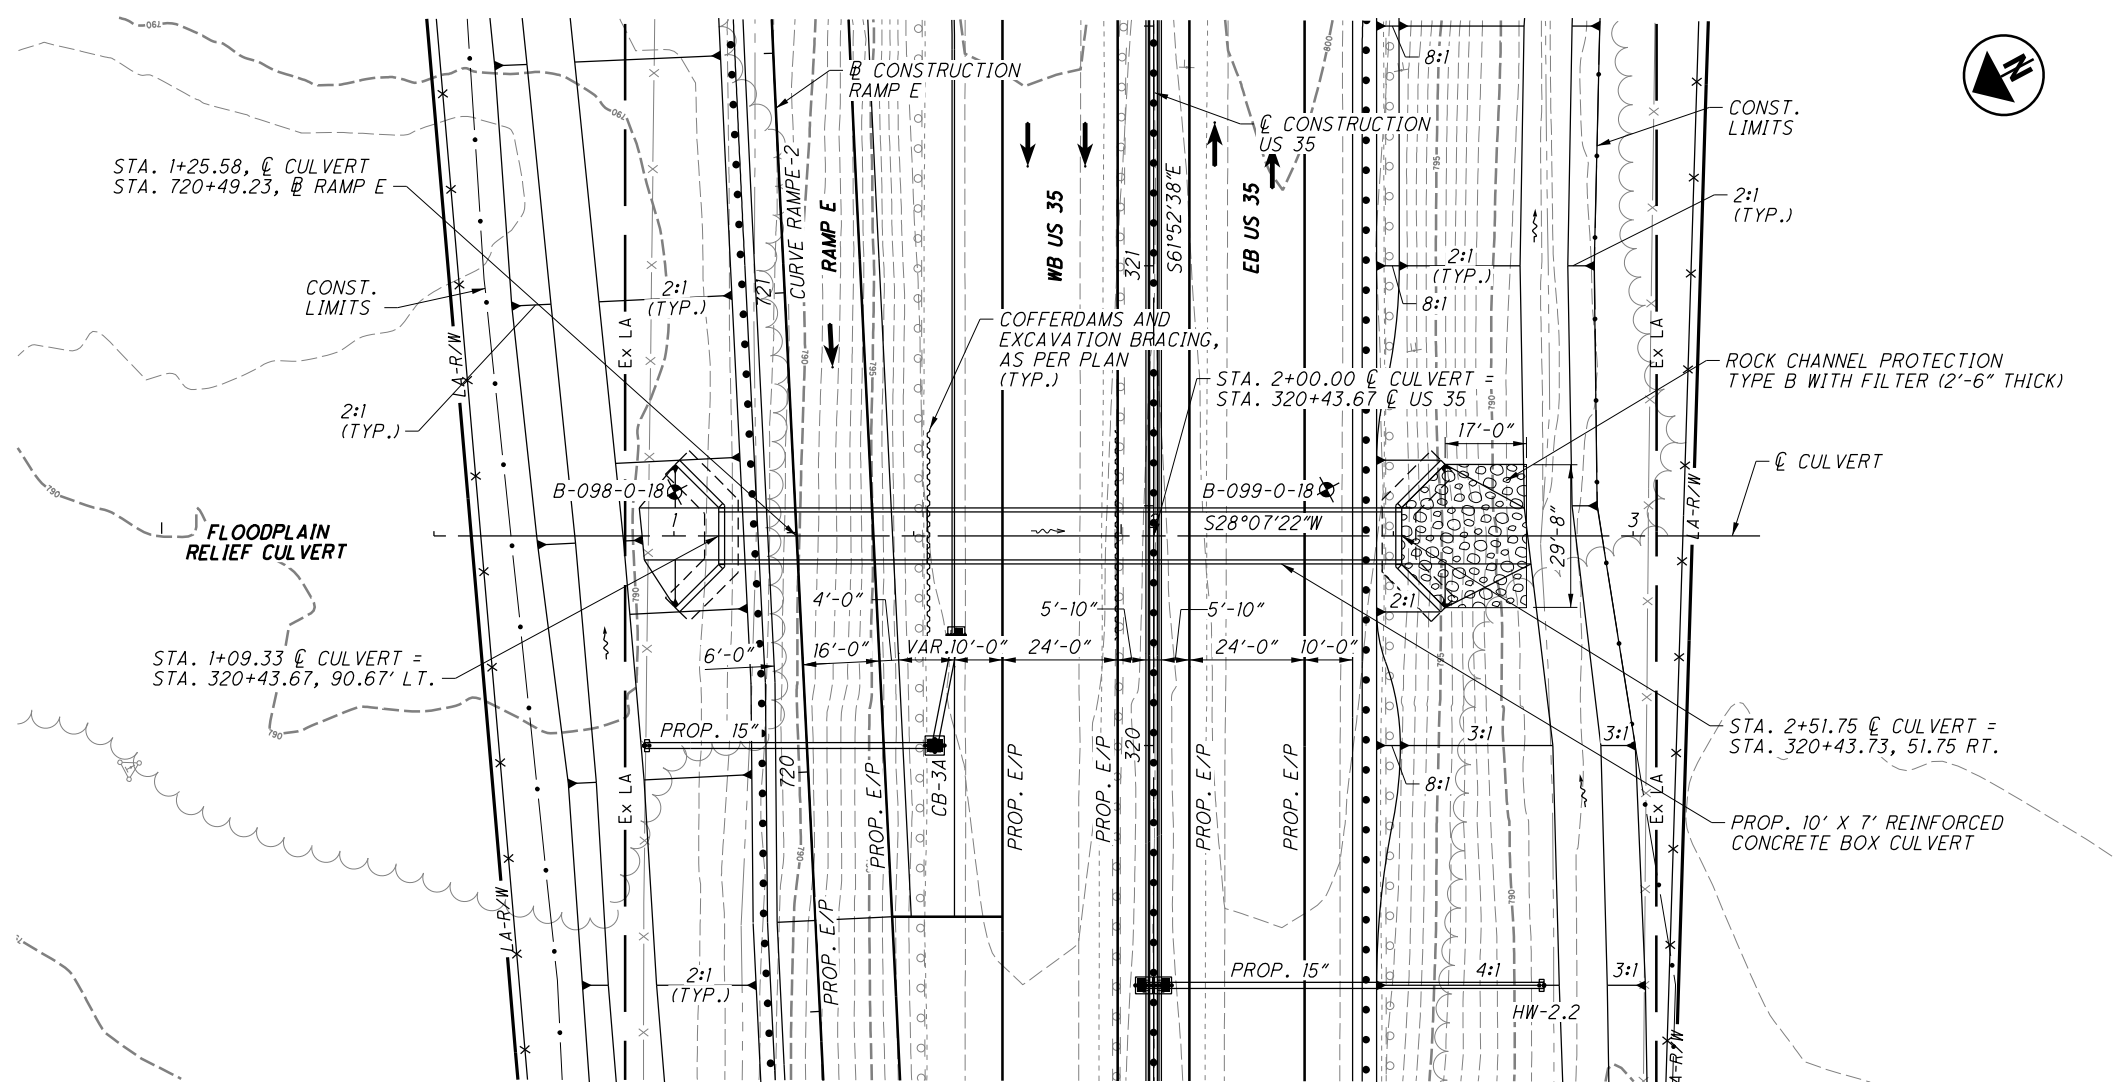

PLAN

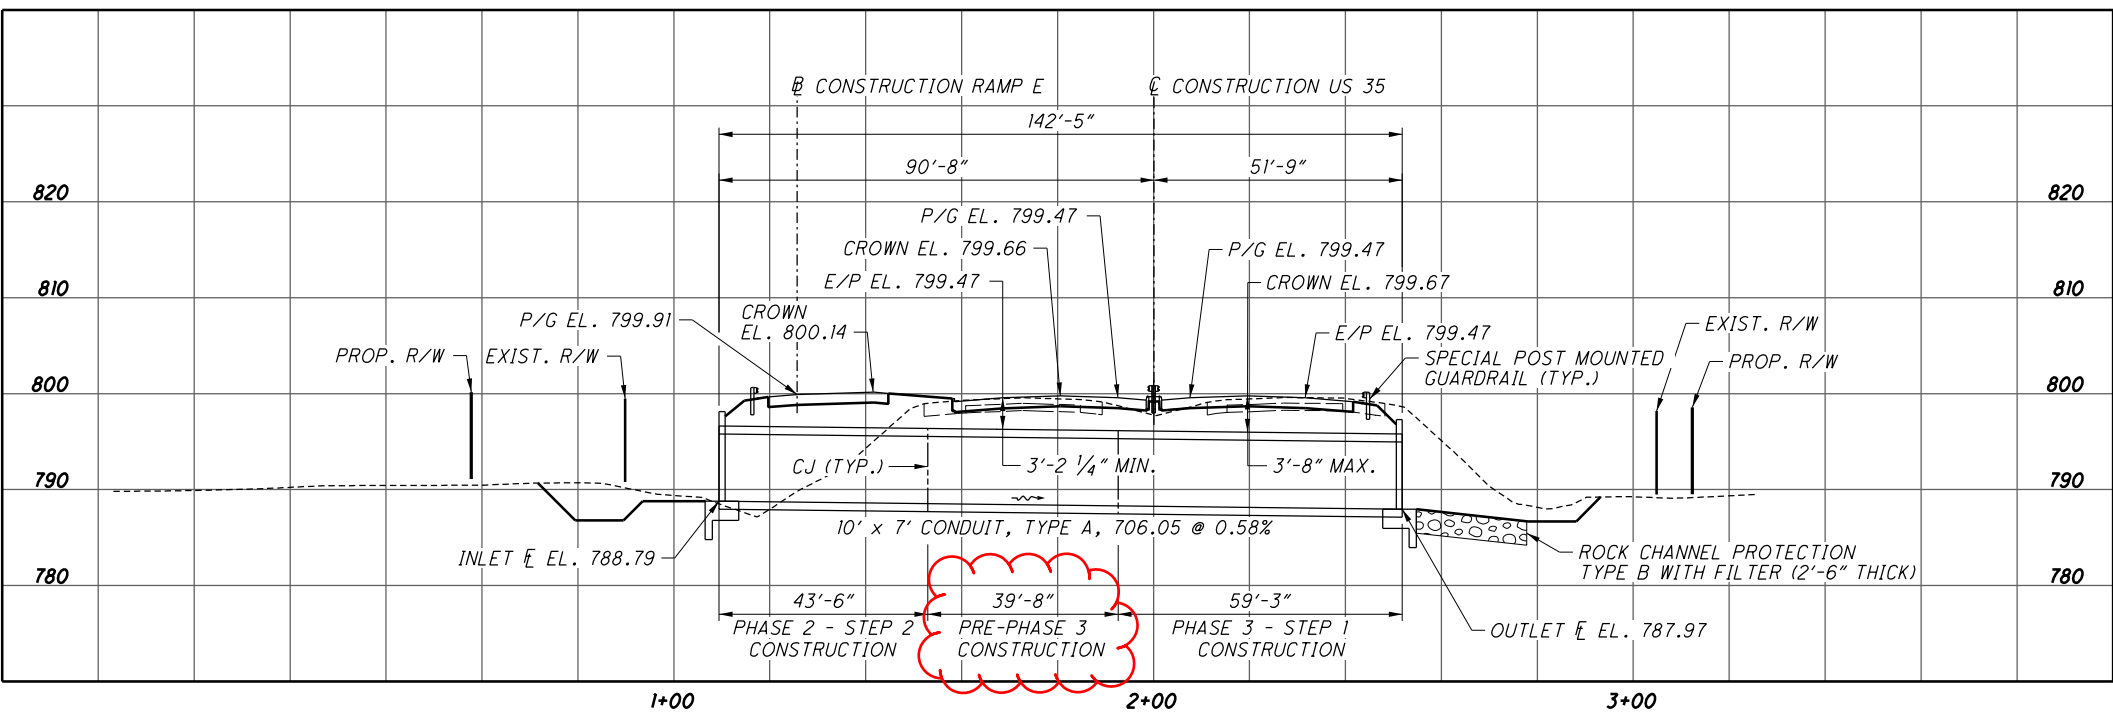

PROFILE ALONG CULVERT

| BENCHMARK DATA  |  |
|---|--|
| BM #8 STA. 322+55.38, ELEV. 800.45, OFFSET 0.16' LT.  |  |
| BM #9 STA. 333+64.82, ELEV. 795.50, OFFSET 48.82' RT. |  |

FOR ADDITIONAL BENCHMARK INFORMATION. SEE ROADWAY PLAN SHEET 5/698

**NOTES:**  
EARTHWORK LIMITS SHOWN ARE APPROXIMATE. ACTUAL SLOPES SHALL CONFORM TO PLAN CROSS SECTIONS.

**DESIGN TRAFFIC:**  
2025 ADT = 33,790    2025 ADTT = 4060  
2045 ADT = 40,970    2045 ADTT = 4920  
DIRECTIONAL DISTRIBUTION = 0.51

**LEGEND:**  
BORING LOCATION

**CURVE RAMPE-2**  
P.I. STA. 723+87.32  
 $\Delta = 2^\circ 48' 42''$  (RT.)  
 $D_c = 0^\circ 30' 00''$   
 $R = 11,459.16$   
 $T = 281.21'$   
 $L = 562.31'$   
 $E = 3.45'$

EXISTING STRUCTURE - NONE

**PROPOSED STRUCTURE**  
TYPE: 10' X 7' PRECAST REINFORCED CONCRETE SECTION (ASTM C 1577) WITH REINFORCED CONCRETE FORESLOPE WALLS AND WINGWALLS  
SPAN: 10'-0"  
ROADWAY: 125'-11" F/F GUARDRAIL  
LOADING: HL-93  
SKEW: NONE  
ALIGNMENT: TANGENT  
COORDINATES: LATITUDE N 39°42'06"  
LONGITUDE W 84°00'03"

DESIGN AGENCY  
**JACOBS**  
1880 WATCROSS ROAD  
CINCINNATI, OHIO 45240

|                       |         |
|-----------------------|---------|
| DATE                  | 9/19    |
| REVIEWED              | FBW     |
| STRUCTURE FILE NUMBER | 2900217 |
| DRAWN                 | MME     |
| DESIGNED              | JTC     |
| CHECKED               | EJ      |
| REVISED               |         |

**SITE PLAN**


BRIDGE NO. GRE-035-0604  
OVER FLOODPLAIN RELIEF DITCH

**GRE-US 35-5.63**  
PID No. 107217


1 / 5

523  
698

035\_0604sp001.dgn 11/30/2022 4:43:16 AM Jason.Center.s@jacobs.com

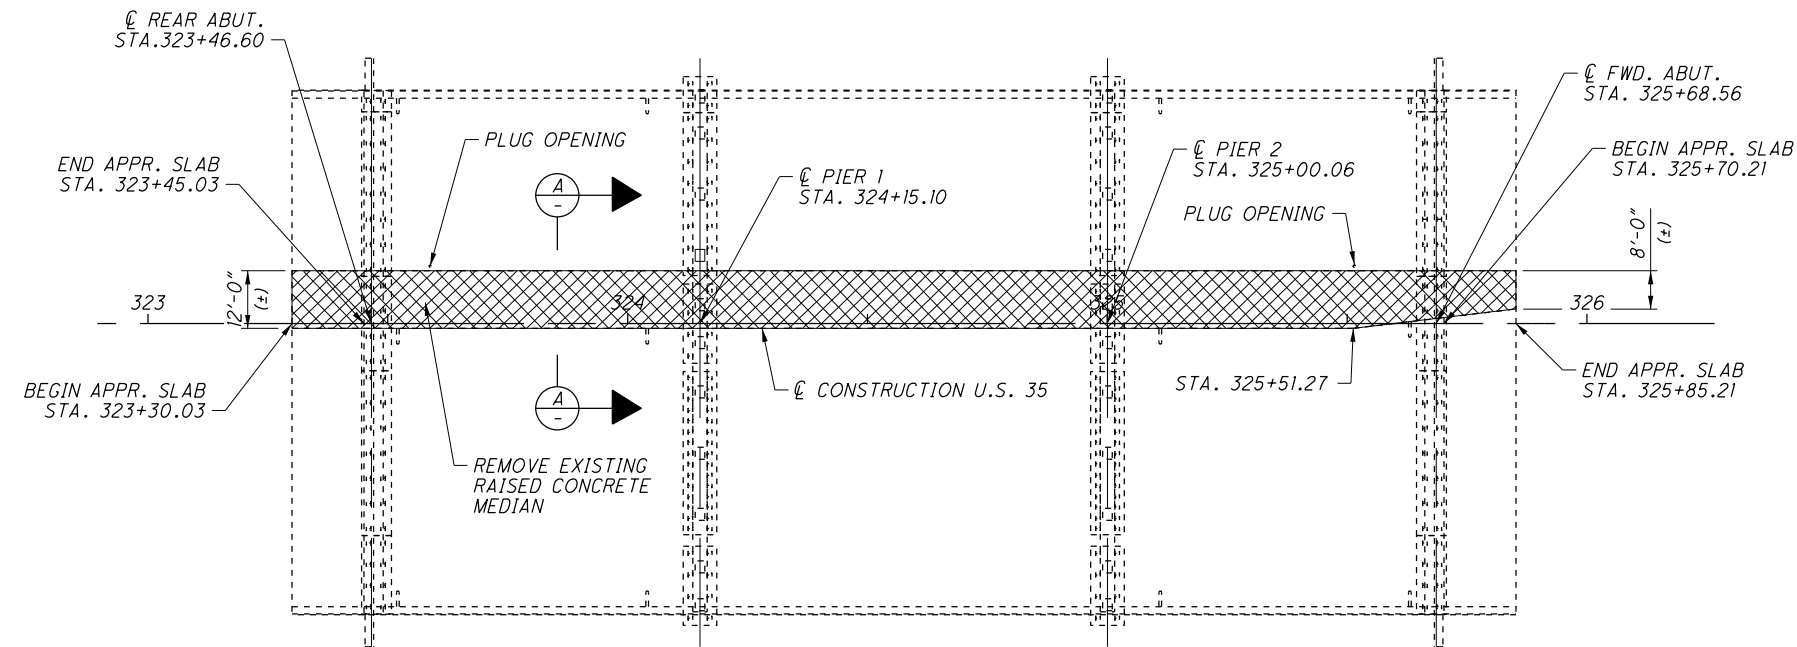

PLAN

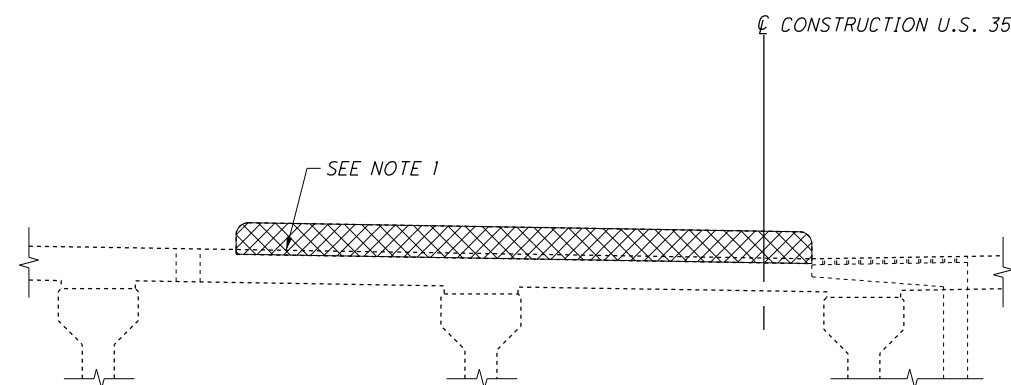


SECTION A


NOTES:

1. REMOVE RAISED MEDIAN, INCLUDING 1/4" OF THE EXISTING DECK WITHIN LIMITS OF RAISED MEDIAN. CUT ALL REINFORCING STEEL FLUSH WITH TOP OF CONCRETE. REPLACE THE PORTION OF DECK REMOVED WITH MICRO SILICA MODIFIED CONCRETE OVERLAY. PAYMENT FOR 1/4" DECK REMOVAL (USING HYDRODEMOLITION) WILL BE INCLUDED WITH ITEM 202 - PORTIONS OF STRUCTURE REMOVED, AS PER PLAN AND 1/4" OVERLAY WILL BE INCLUDED WITH ITEM 848 - MICRO SILICA MODIFIED CONCRETE OVERLAY USING HYDRODEMOLITION, AS PER PLAN. AFTER THE OVERLAY MATERIAL HAS BEEN CONSOLIDATED FINISHED AND CURED, IT SHALL BE SAWED TRANSVERSELY (MATCHING EXISTING) WITH SAW CUTS PER CMS 511.17.

LEGEND:

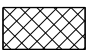 ITEM 202 - PORTIONS OF STRUCTURE REMOVED, AS PER PLAN

035\_0610SP001.dgn 11/30/2022 8:18:03 AM Jason.Centers@jacobs.com

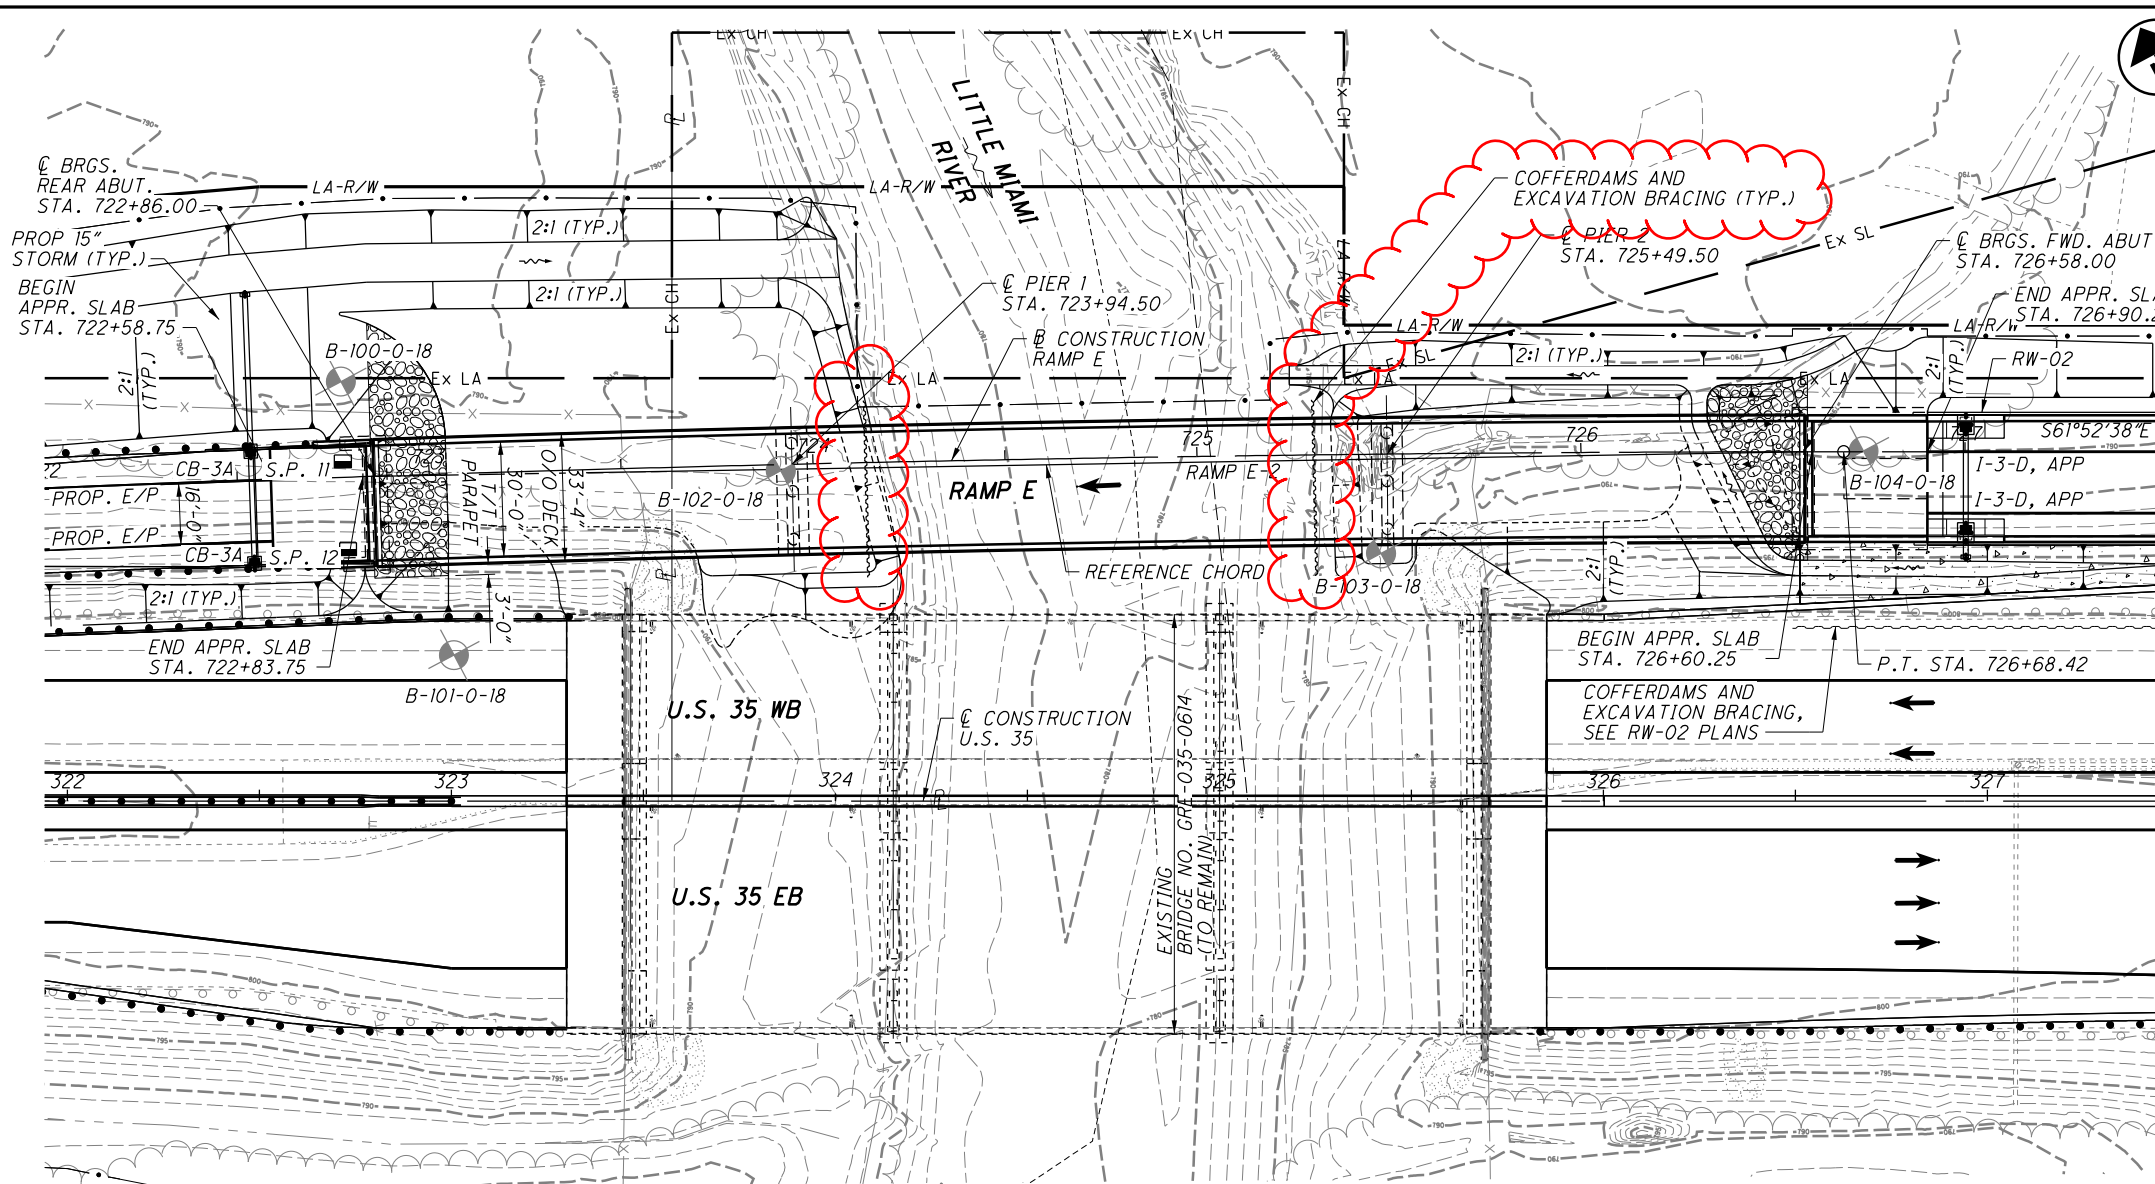

| BENCHMARK DATA                                       |  |
|--|--|
| BM #8 STA. 322+55.38, ELEV. 800.45, OFFSET 0.16 LT.  |  |
| BM #9 STA. 333+64.82, ELEV. 795.50, OFFSET 48.82 RT. |  |

FOR ADDITIONAL BENCHMARK INFORMATION, SEE ROADWAY PLAN SHEET 5/698


- NOTES**
- EARTHWORK LIMITS SHOWN ARE APPROXIMATE. ACTUAL SLOPES SHALL CONFORM TO PLAN CROSS SECTIONS.
  - FOR SETTLEMENT PLATFORM LOCATION TABLE AND NOTES, SEE SHEET 35/698.

**DESIGN TRAFFIC:**  
 2025 ADT = 2280      2025 ADTT = 160  
 2045 ADT = 3230      2045 ADTT = 230  
 DIRECTIONAL DISTRIBUTION = 1.00

**HYDRAULIC DATA**  
 DRAINAGE AREA = 295.0 SQ. MILES  
 DESIGN STORM = 50 YEAR  
 Q (50) = 22,100 CFS      Q (100) = 26,400 CFS  
 V (50) = 15.6 FPS      V (100) = 12.3 FPS  
 HW (50) = 797.05      HW (100) = 797.89  
 FREEBOARD HW (50) = 2.73 FEET.

- LEGEND**
- ⊕ BORING LOCATION
  - ▣ SETTLEMENT PLATFORM (SEE NOTE 2)

**CURVE DATA (RAMP E-2)**  
 P.I. STA. = 723+87.32  
 $\Delta$  = 2°48'42" RT.  
 D<sub>c</sub> = 0°30'00"  
 R = 11,459.16'  
 T = 281.21'  
 L = 562.32'  
 E = 3.45'

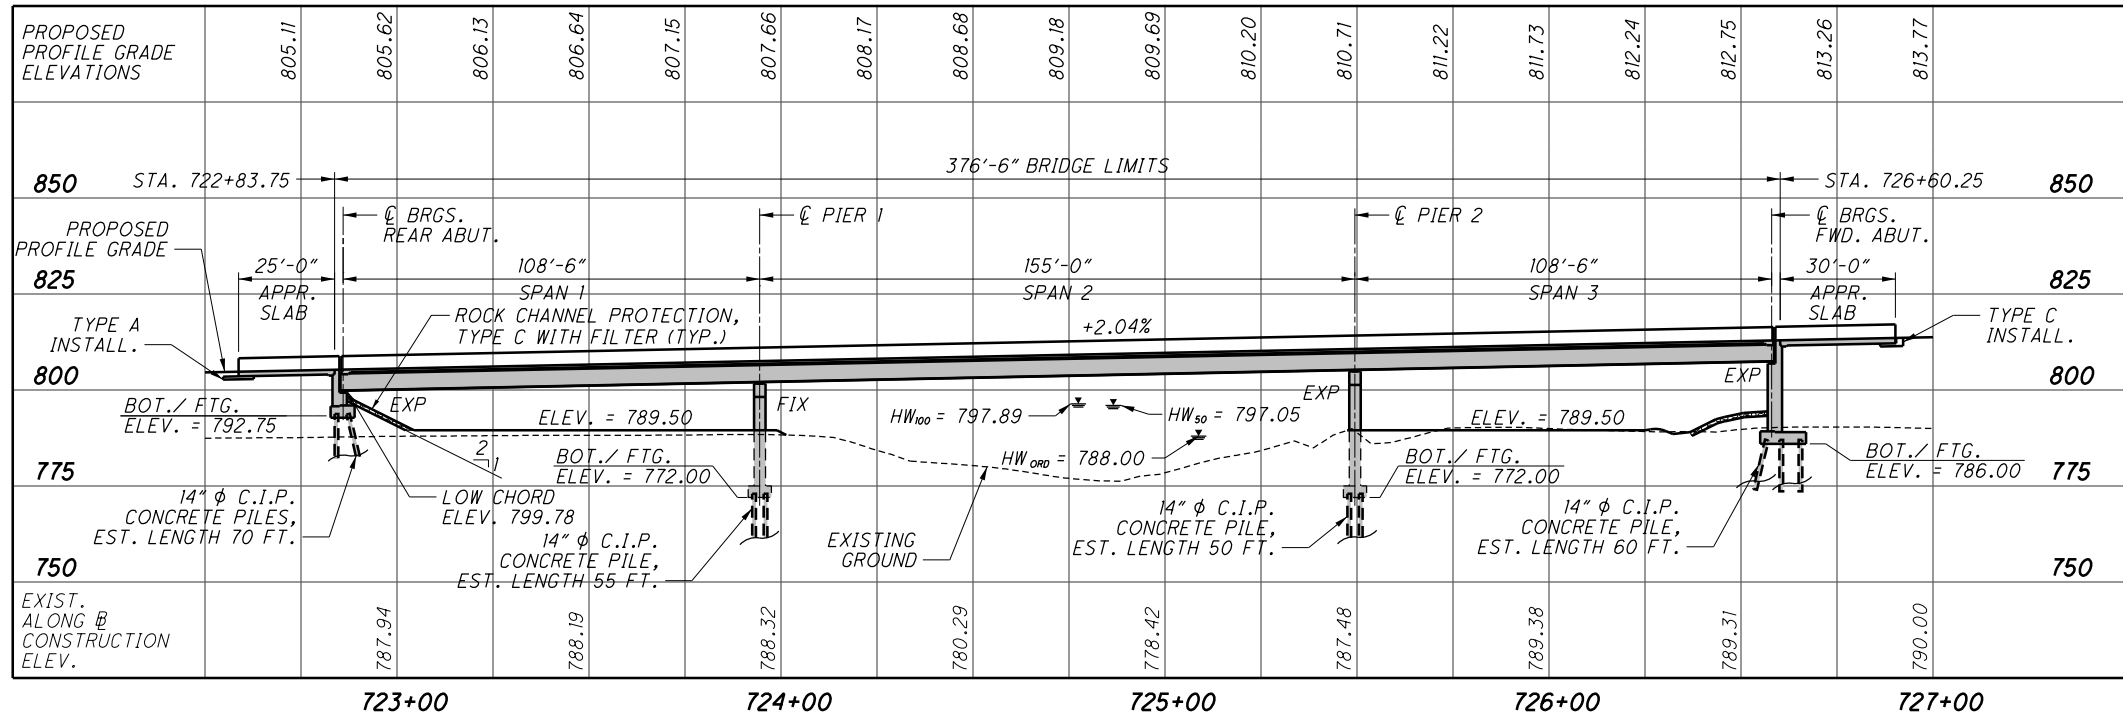

**EXISTING STRUCTURE - NONE**

**PROPOSED STRUCTURE**

TYPE: 3-SPAN CONTINUOUS CURVED COMPOSITE STEEL PLATE GIRDERS (ASTM A709 GRADE 50W) WITH REINFORCED CONCRETE DECK & SUBSTRUCTURES ON PILES.

SPANS: 108'-6", 155'-0", 108'-6" C/C BEARINGS  
 ROADWAY: 30'-0" TOE/TOE PARAPET  
 LOADING: HL-93, FWS=60 PSF  
 WEARING SURFACE: MONOLITHIC CONCRETE  
 SKEW: NONE (RADIAL)  
 APPROACH SLABS: REAR = AS-1-15, 25'-0" LONG;  
 FWD = AS-1-15, 30'-0" LONG AS-2-15 INSTALLATION  
 ALIGNMENT: 0°30'00" RIGHT CURVE  
 SUPERELEVATION: 0.016 FT/FT  
 COORDINATES: LATITUDE N39°42'05"  
 LONGITUDE W83°59'58"

DESIGN AGENCY: **JACOBS**  
 1880 WATCROSS ROAD  
 CINCINNATI, OHIO 45240  
 DATE: 9/20  
 STRUCTURE FILE NUMBER: 2900215  
 REVIEWED: JTC  
 DRAWN: PEG  
 DESIGNED: PEG  
 CHECKED: FBW  
 GREENE COUNTY  
 STA. 722+83.75  
 STA. 726+60.25  
**SITE PLAN**  
 BRIDGE NO. GRE-035-0610  
 RAMP E OVER LITTLE MIAMI RIVER  
**GRE-US 35-5.63**  
 PID No. 107217  
 1/36  
 538  
 698

035\_0610S0001.dgn 11/30/2022 8:24:58 AM Jason.Centers@jacobs.com

**ITEM 511, CLASS OC2 CONCRETE WITH OC/OA, BRIDGE DECK, AS PER PLAN**

THIS ITEM MODIFIES THE STANDARD 511 CONCRETE FOR STRUCTURES SPECIFICATION TO INCLUDE CORROSION INHIBITORS INTO THE SUPERSTRUCTURE CONCRETE. THIS ITEM SHALL CONFORM TO CMS 511 WITH THE FOLLOWING CONDITIONS AND REVISIONS:

PROVIDE MATERIALS CONFORMING TO 511.02 EXCEPT AS MODIFIED BELOW:

PORTLAND CEMENT CONCRETE 499.03, CLASS OC 2 MEETING A DESIGN STRENGTH OF 4,500 PSI  
CORROSION INHIBITOR 515.15

THE CLASS OC2 CONCRETE FOR THE SUPERSTRUCTURE SHALL MEET THE FOLLOWING CRITERIA:  
WATER/CEMENT RATIO = 0.40 MAXIMUM

MIX SHALL INCLUDE A MIGRATING CORROSION INHIBITOR AS MANUFACTURED BY AN APPROVED SUPPLIER LISTED ON ODOT'S QUALIFIED APPROVED SUPPLIERS, ITEM 515.15. THE DOSAGE RATE LISTED ON THE ODOT QUALIFIED APPROVED SUPPLIERS LIST WILL APPLY.

THE BATCH WEIGHTS SHALL BE CORRECTED TO COMPENSATE FOR THE MOISTURE CONTAINED IN THE AGGREGATE AT THE TIME OF USE. A CHEMICAL ADMIXTURE (705.12, TYPE A OR D) SHALL BE USED.

CONCRETE SUPPLIERS SHOULD RECOGNIZE THAT THE CORROSION INHIBITOR AND ADMIXTURES MAY HAVE AN EFFECT ON STRENGTH, ENTRAINED AIR CONTENT, WORKABILITY, ETC. OF THEIR CONCRETE MIXES. THE CORROSION INHIBITOR IS SUGGESTED TO BE A MCI PRODUCT BY CORTEC OR AN APPROVED EQUAL FROM THE QUALIFIED PRODUCTS LIST. THE CONCRETE SUPPLIER'S CHOICE OF ONE OF THESE CORROSION INHIBITORS DOES NOT ALLEVIATE MEETING DESIGN REQUIREMENTS. PLEASE BE ADVISED THAT SOME PRODUCTS ON THE LIST EFFECT THE DELIVERED MIX PROPERTIES GREATLY WHILE OTHER PRODUCTS DO NOT.

APPROACH SLABS AND DIAPHRAGMS ARE TO USE THE SAME MIX DESIGN AS THE BRIDGE DECK. THE CONTRACTOR SHOULD BE ADVISED THAT CONCRETE RETARDING AGENTS MAY NEED TO BE ADDED TO OFFSET THE EFFECTS OF THE MIGRATING CORROSION INHIBITOR SELECTED.

THE CONTRACTOR SHALL PROVIDE TRADITIONAL BRIDGE DECK FORMS CONFORMING TO CMS 508. PERMANENT STAY-IN-PLACE (SIP) FORMS ARE NOT ALLOWED. THE PLACING OF THE DECK AND THE APPROACH SLABS IN THE SAME CONCRETE POUR IS NOT PERMITTED.

**ITEM 511, CLASS OC2 CONCRETE WITH OC/OA, BRIDGE DECK (PARAPET), AS PER PLAN**

THIS ITEM MODIFIES THE STANDARD 511 CONCRETE FOR STRUCTURES SPECIFICATION TO INCLUDE MACRO-SYNTHETIC FIBERS, AND CORROSION INHIBITORS INTO THE SUPERSTRUCTURE CONCRETE. THIS ITEM SHALL CONFORM TO CMS 511 WITH THE FOLLOWING CONDITIONS AND REVISIONS:

PROVIDE MATERIALS CONFORMING TO 511.02 EXCEPT AS MODIFIED BELOW:

PORTLAND CEMENT CONCRETE 499.03, CLASS OC 2 MEETING A DESIGN STRENGTH OF 4,500 PSI, WITH MACRO-SYNTHETIC FIBERS WITH MODIFICATION PER 511.02  
FIBERS FOR CONCRETE CORROSION INHIBITOR ASTM C 1116, TYPE III 515.15

THE CLASS OC2 CONCRETE FOR THE SUPERSTRUCTURE SHALL MEET THE FOLLOWING CRITERIA:  
WATER/CEMENT RATIO = 0.40 MAXIMUM; MINIMUM 5 LBS/CY MACRO-SYNTHETIC FIBERS (1.5 IN. MIN. TO 2.5 IN. MAX.) MEETING ASTM C1116 TYPE III SHALL BE ADDED TO THE MIX.

MIX SHALL INCLUDE A MIGRATING CORROSION INHIBITOR AS MANUFACTURED BY AN APPROVED SUPPLIER LISTED ON ODOT'S QUALIFIED APPROVED SUPPLIERS, ITEM 515.15. THE DOSAGE RATE LISTED ON THE ODOT QUALIFIED APPROVED SUPPLIERS LIST WILL APPLY.

**ITEM 511, CLASS OC2 CONCRETE WITH OC/OA, BRIDGE DECK (PARAPET), AS PER PLAN, CONT'D.**

THE MACRO-SYNTHETIC FIBERS SHALL BE INCORPORATED INTO THE MIX IN SUCH A WAY THAT NO 'BALLING' OCCURS. UPON INSPECTION OF THE MIX AT THE TIME OF PLACEMENT, IF ANY 'BALLING' OCCURS, THE ENGINEER SHALL REJECT THE REMAINDER OF THE LOAD AT ANY TIME DURING THE POUR. IT IS IMPORTANT TO FOLLOW INDUSTRY STANDARDS AND ASTM SPECIFICATIONS ON THE PREMIXING OF THE CEMENT, AGGREGATE, AND MACRO-SYNTHETIC FIBERS PRIOR TO THE ADDITION OF WATER AND ADMIXTURES. PROVIDE MACRO-SYNTHETIC FIBERS THAT ARE MONOFILAMENT FIBERS MADE FROM VIRGIN POLYPROPYLENE, POLYETHYLENE, OR COPOLYMERS THAT ARE INERT TO ALKALI ATTACK. ENSURE THE MACRO-SYNTHETIC FIBERS HAVE A MINIMUM TENSILE STRENGTH OF 70 KSI, A MINIMUM MODULUS OF ELASTICITY OF 800 KSI, A MINIMUM FILAMENT DIAMETER OF 0.012 INCHES, AND ASPECT RATIO BETWEEN 60 AND 100, AND ARE BETWEEN 1.0 AND 2.5 INCHES IN LENGTH. STORE THE MACRO-SYNTHETIC FIBERS ACCORDING TO THE MANUFACTURER'S RECOMMENDATION AND KEEP THE MATERIAL FREE FROM DUST, DIRT AND MOISTURE. PLACING THE BAG THAT THE FIBERS COME IN INTO THE CONCRETE MIX IS NOT PERMITTED.

USE A MINIMUM DOSAGE RATE OF MACRO-SYNTHETIC FIBERS OF 5.0 LBS/CY OF CONCRETE. ENSURE THE FINAL PROPOSED MIX IS WORKABLE AND ABLE TO BE PRODUCED SUCH THAT BALLING OR CLUMPING OF THE FIBERS IS NOT A PROBLEM AS DETERMINED BY THE ENGINEER. BEFORE USE, SUBMIT DOCUMENTATION TO THE PROJECT ENGINEER CERTIFYING BOTH THE MACRO-SYNTHETIC FIBERS AND THE MIX MEET OR EXCEED THE REQUIRED PROPERTIES. SAMPLING WILL BE ALLOWED FOR TESTING PURPOSES. A DEMONSTRATION OF THE MIX PRODUCTION OR TRIAL MIX, MAY BE REQUIRED BY THE ENGINEER PRIOR TO PLACING ANY OF THE MIX ON THE PROJECT.

THE BATCH WEIGHTS SHALL BE CORRECTED TO COMPENSATE FOR THE MOISTURE CONTAINED IN THE AGGREGATE AT THE TIME OF USE. A CHEMICAL ADMIXTURE (705.12, TYPE A OR D) SHALL BE USED. THE TRANSIT MIXER CHARGE SHALL BE LIMITED TO 3#40F ITS RATED CAPACITY OR 6 CUBIC YARDS, WHICHEVER IS SMALLER. THE FIRST THREE TRANSIT MIXER LOADS ARE REQUIRED TO BE AT THE MINIMUM YARDAGE LISTED ABOVE TO SHOW PROOF OF THE SUCCESSFUL BATCHING OPERATION. AFTER CONSISTENCY IN THE DELIVERED MATERIAL HAS BEEN ESTABLISHED, THE CONCRETE SUPPLIER MAY INCREASE THE BATCH DELIVERED QUANTITIES AS LONG AS THE QUALITY REMAINS ACCEPTABLE TO THE ENGINEER. THE ENGINEER CAN REDUCE THE BATCH LOAD SIZE AT ANY TIME AS NEEDED TO CORRECT/IMPROVE CONCRETE QUALITY.

CONCRETE SUPPLIERS SHOULD RECOGNIZE THAT THE CORROSION INHIBITOR AND ADMIXTURES MAY HAVE AN EFFECT ON STRENGTH, ENTRAINED AIR CONTENT, WORKABILITY, ETC. OF THEIR CONCRETE MIXES. THE CORROSION INHIBITOR IS SUGGESTED TO BE A MCI PRODUCT BY CORTEC OR AN APPROVED EQUAL FROM THE QUALIFIED PRODUCTS LIST. THE CONCRETE SUPPLIER'S CHOICE OF ONE OF THESE CORROSION INHIBITORS DOES NOT ALLEVIATE MEETING DESIGN REQUIREMENTS. PLEASE BE ADVISED THAT SOME PRODUCTS ON THE LIST EFFECT THE DELIVERED MIX PROPERTIES GREATLY WHILE OTHER PRODUCTS DO NOT.

THE CONTRACTOR SHOULD BE ADVISED THAT CONCRETE RETARDING AGENTS MAY NEED TO BE ADDED TO OFFSET THE EFFECTS OF THE MIGRATING CORROSION INHIBITOR SELECTED. THIS SPECIFICATION IS INTENDED FOR USE ON NON DECORATIVE BRIDGE RAILING. USE SELF-COMPACTING CONCRETE ON DECORATIVE RAILING SIMILAR TO TEXAS RAILING AND MACRO-SYNTHETIC CONCRETE PER THIS SPECIFICATION ON TRADITIONAL CONCRETE RAILING WHEN APPLICABLE.

**ITEM 512, SEALING OF CONCRETE SURFACES (EPOXY-URETHANE), AS PER PLAN**

DUE TO THE RECENT SUPPLY SHORTAGES, THE DEPARTMENT HAS BEEN MADE AWARE OF DIFFICULTIES THAT SUPPLIERS ARE HAVING IN OBTAINING THE NECESSARY MATERIALS FOR EPOXY. ON THIS PROJECT THE CONTRACTOR CAN USE TRADITIONAL EPOXY-URETHANE SEALERS APPROVED ON THE OPL OR ELECT TO SUBSTITUTE BRIDGE COTE XL-70 W/SILANE THAT IS LISTED ON THE APPROVED NOISE SUPPLIER LIST UNDER APPROVED SEALERS FOR NOISE BARRIERS. APPROVEDNOISESUPPLIERSLIST.PDF (OHIO.GOV).

IF BRIDGE COTE XL-70 W/SILANE IS CHOSEN, MEET THE REQUIREMENTS OF THE BRIDGE COTE XL-70 W/SILANE TECHNICAL DATA SHEET WITH THE EXCEPTION OF THE SURFACE PREPARATION THAT WILL STILL FOLLOW THE REQUIREMENTS LISTED UNDER C&S 512 FOR EPOXY URETHANE SEALERS.

| PART.  | ESTIMATED QUANTITIES |       |        |       |  | DESCRIPTION | ABUT. | PIERS  | SUPER | GEN. | SHEET |
|--------|----------------------|-------|--------|-------|--|-------------|-------|--------|-------|------|-------|
|        | 02/NHS/BR            | ITEM  | EXT.   | TOTAL | UNIT   |             |       |        |       |      |       |
| 2497   | 203                  | 20001 | 2497   | CY    | EMBANKMENT, AS PER PLAN  | 2431        | 66    |        |       |      | 3/36  |
| LS     | 503                  | 11100 | LS     |       | COFFERDAMS AND EXCAVATION BRACING  |             | LS    |        |       |      |       |
| LS     | 503                  | 21300 | LS     |       | UNCLASSIFIED EXCAVATION  | LS          | LS    |        |       |      | 3/36  |
| LS     | 505                  | 11100 | LS     |       | PILE DRIVING EQUIPMENT MOBILIZATION  | LS          | LS    |        |       |      |       |
| 5800   | 507                  | 00600 | 5800   | FT    | 14" CAST-IN-PLACE REINFORCED CONCRETE PILES, DRIVEN  | 4120        | 1680  |        |       |      |       |
| 6290   | 507                  | 00650 | 6290   | FT    | 14" CAST-IN-PLACE REINFORCED CONCRETE PILES, FURNISHED   | 4450        | 1840  |        |       |      |       |
|        |                      |       |        | LB    |  |             |       |        |       |      |       |
| 190393 | 509                  | 26000 | 190393 | LB    | GALVANIZED STEEL REINFORCEMENT   | 40207       | 27795 | 122391 |       |      |       |
|        |                      |       |        | CY    |  |             |       |        |       |      |       |
| 366    | 511                  | 34447 | 366    | CY    | CLASS OC2 CONCRETE WITH OC/OA, BRIDGE DECK, AS PER PLAN  |             |       | 366    |       |      | 4/36  |
| 123    | 511                  | 34451 | 123    | CY    | CLASS OC2 CONCRETE WITH OC/OA, BRIDGE DECK (PARAPET), AS PER PLAN  |             |       | 123    |       |      | 4/36  |
| 41     | 511                  | 41012 | 41     | CY    | CLASS OC1 CONCRETE WITH OC/OA, PIER ABOVE FOOTINGS   |             | 41    |        |       |      |       |
| 67     | 511                  | 43512 | 67     | CY    | CLASS OC1 CONCRETE WITH OC/OA, ABUTMENT INCLUDING FOOTING  | 67          |       |        |       |      |       |
| 186    | 511                  | 44112 | 186    | CY    | CLASS OC1 CONCRETE WITH OC/OA, ABUTMENT NOT INCLUDING FOOTING  | 186         |       |        |       |      |       |
|        |                      |       |        | CY    |  |             |       |        |       |      |       |
| 126    | 511                  | 46512 | 126    | CY    | CLASS OC1 CONCRETE WITH OC/OA, FOOTING   | 104         | 22    |        |       |      |       |
|        |                      |       |        | SY    |  |             |       |        |       |      |       |
| 1365   | 512                  | 10101 | 1365   | SY    | SEALING OF CONCRETE SURFACES (EPOXY-URETHANE), AS PER PLAN   | 270         | 220   | 875    |       |      | 4/36  |
| 16     | 512                  | 33000 | 16     | SY    | TYPE 2 WATERPROOFING   | 16          |       |        |       |      |       |
|        |                      |       |        | LB    |  |             |       |        |       |      |       |
| 404562 | 513                  | 10300 | 404562 | EACH  | STRUCTURAL STEEL MEMBERS, LEVEL 5  |             |       | 404562 |       |      |       |
| 3840   | 513                  | 20000 | 3840   | EACH  | WELDED STUD SHEAR CONNECTORS   |             |       | 3840   |       |      |       |
|        |                      |       |        | SF    |  |             |       |        |       |      |       |
| 1307   | 514                  | 00060 | 1307   | SF    | FIELD PAINTING STRUCTURAL STEEL, INTERMEDIATE COAT   |             |       | 1307   |       |      | 17/36 |
| 1307   | 514                  | 00066 | 1307   | SF    | FIELD PAINTING STRUCTURAL STEEL, FINISH COAT   |             |       | 1307   |       |      | 17/36 |
|        |                      |       |        | FT    |  |             |       |        |       |      |       |
| 35     | 516                  | 10010 | 35     | FT    | ARMORLESS PREFORMED JOINT SEAL   |             |       |        |       | 35   |       |
| 69     | 516                  | 11210 | 69     | SF    | STRUCTURAL EXPANSION JOINT INCLUDING ELASTOMERIC STRIP SEAL  |             |       | 69     |       |      |       |
| 164    | 516                  | 13600 | 164    | EACH  | 1" PREFORMED EXPANSION JOINT FILLER  |             |       | 164    |       |      |       |
| 4      | 516                  | 44101 | 4      | EACH  | ELASTOMERIC BEARING WITH INTERNAL LAMINATES AND LOAD PLATE (NEOPRENE), AS PER PLAN (16" x 26" x 2.50" PAD WITH 17" x 34" x 2" PLATE) |             | 4     |        |       |      | 24/36 |
|        |                      |       |        | EACH  |  |             |       |        |       |      |       |
| 4      | 516                  | 44201 | 4      | EACH  | ELASTOMERIC BEARING WITH INTERNAL LAMINATES AND LOAD PLATE (NEOPRENE), AS PER PLAN (16" x 26" x 3.50" PAD WITH 17" x 27" x 2" PLATE) |             | 4     |        |       |      | 24/36 |
|        |                      |       |        | EACH  |  |             |       |        |       |      |       |
| 8      | 516                  | 44301 | 8      | EACH  | ELASTOMERIC BEARING WITH INTERNAL LAMINATES AND LOAD PLATE (NEOPRENE), AS PER PLAN (14" x 16" x 4.70" PAD WITH 15" x 17" x 2" PLATE) | 8           |       |        |       |      | 24/36 |
|        |                      |       |        | SY    |  |             |       |        |       |      |       |
| 268    | 518                  | 20000 | 268    | CY    | PREFABRICATED GEOCOMPOSITE BOARD   | 268         |       |        |       |      |       |
| 34     | 518                  | 21200 | 34     | FT    | POROUS BACKFILL WITH GEOTEXTILE FABRIC   | 34          |       |        |       |      |       |
| 129    | 518                  | 40000 | 129    | FT    | 6" PERFORATED CORRUGATED PLASTIC PIPE  | 129         |       |        |       |      |       |
| 38     | 518                  | 40010 | 38     | FT    | 6" NON-PERFORATED CORRUGATED PLASTIC PIPE, INCLUDING SPECIALS  | 38          |       |        |       |      |       |
|        |                      |       |        | EACH  |  |             |       |        |       |      |       |
| 8      | 523                  | 20000 | 8      | EACH  | DYNAMIC LOAD TESTING   | 4           | 4     |        |       |      |       |
|        |                      |       |        | SY    |  |             |       |        |       |      |       |
| 96     | 526                  | 25010 | 96     | SY    | REINFORCED CONCRETE APPROACH SLABS WITH OC/OA (T=15")  |             |       |        |       |      | 96    |
| 115    | 526                  | 30010 | 115    | FT    | REINFORCED CONCRETE APPROACH SLABS WITH OC/OA (T=17")  |             |       |        |       |      | 115   |
| 35     | 526                  | 90010 | 35     | FT    | TYPE A INSTALLATION  |             |       |        |       |      | 35    |
| 35     | 526                  | 90030 | 35     | FT    | TYPE C INSTALLATION  |             |       |        |       |      | 35    |
|        |                      |       |        | CY    |  |             |       |        |       |      |       |
| 1319   | 840                  | 23000 | 1319   | CF    | SELECT GRANULAR BACKFILL   | 1319        |       |        |       |      |       |
|        |                      |       |        | CF    |  |             |       |        |       |      |       |
| 35     | 846                  | 00110 | 35     | CF    | POLYMER MODIFIED ASPHALT EXPANSION JOINT SYSTEM  |             |       |        |       |      | 35    |

DESIGN AGENCY: **JACOBS**  
1880 WATERCROSS ROAD  
CINCINNATI, OHIO 45240

DATE: 9/20  
REVIEWED: JTC  
STRUCTURE FILE NUMBER: 2900215


DESIGNED: PEG  
CHECKED: FBW

GENERAL NOTES II & ESTIMATED QUANTITIES  
BRIDGE NO. GRE-035-0610  
RAMP E OVER LITTLE MIAMI RIVER

GRE-US 35-5.63  
PID No. 107217

4 / 36  
541  
698

035\_0627SP001.dgn 11/30/2022 9:06:30 AM Jason.Centers@jacobs.com

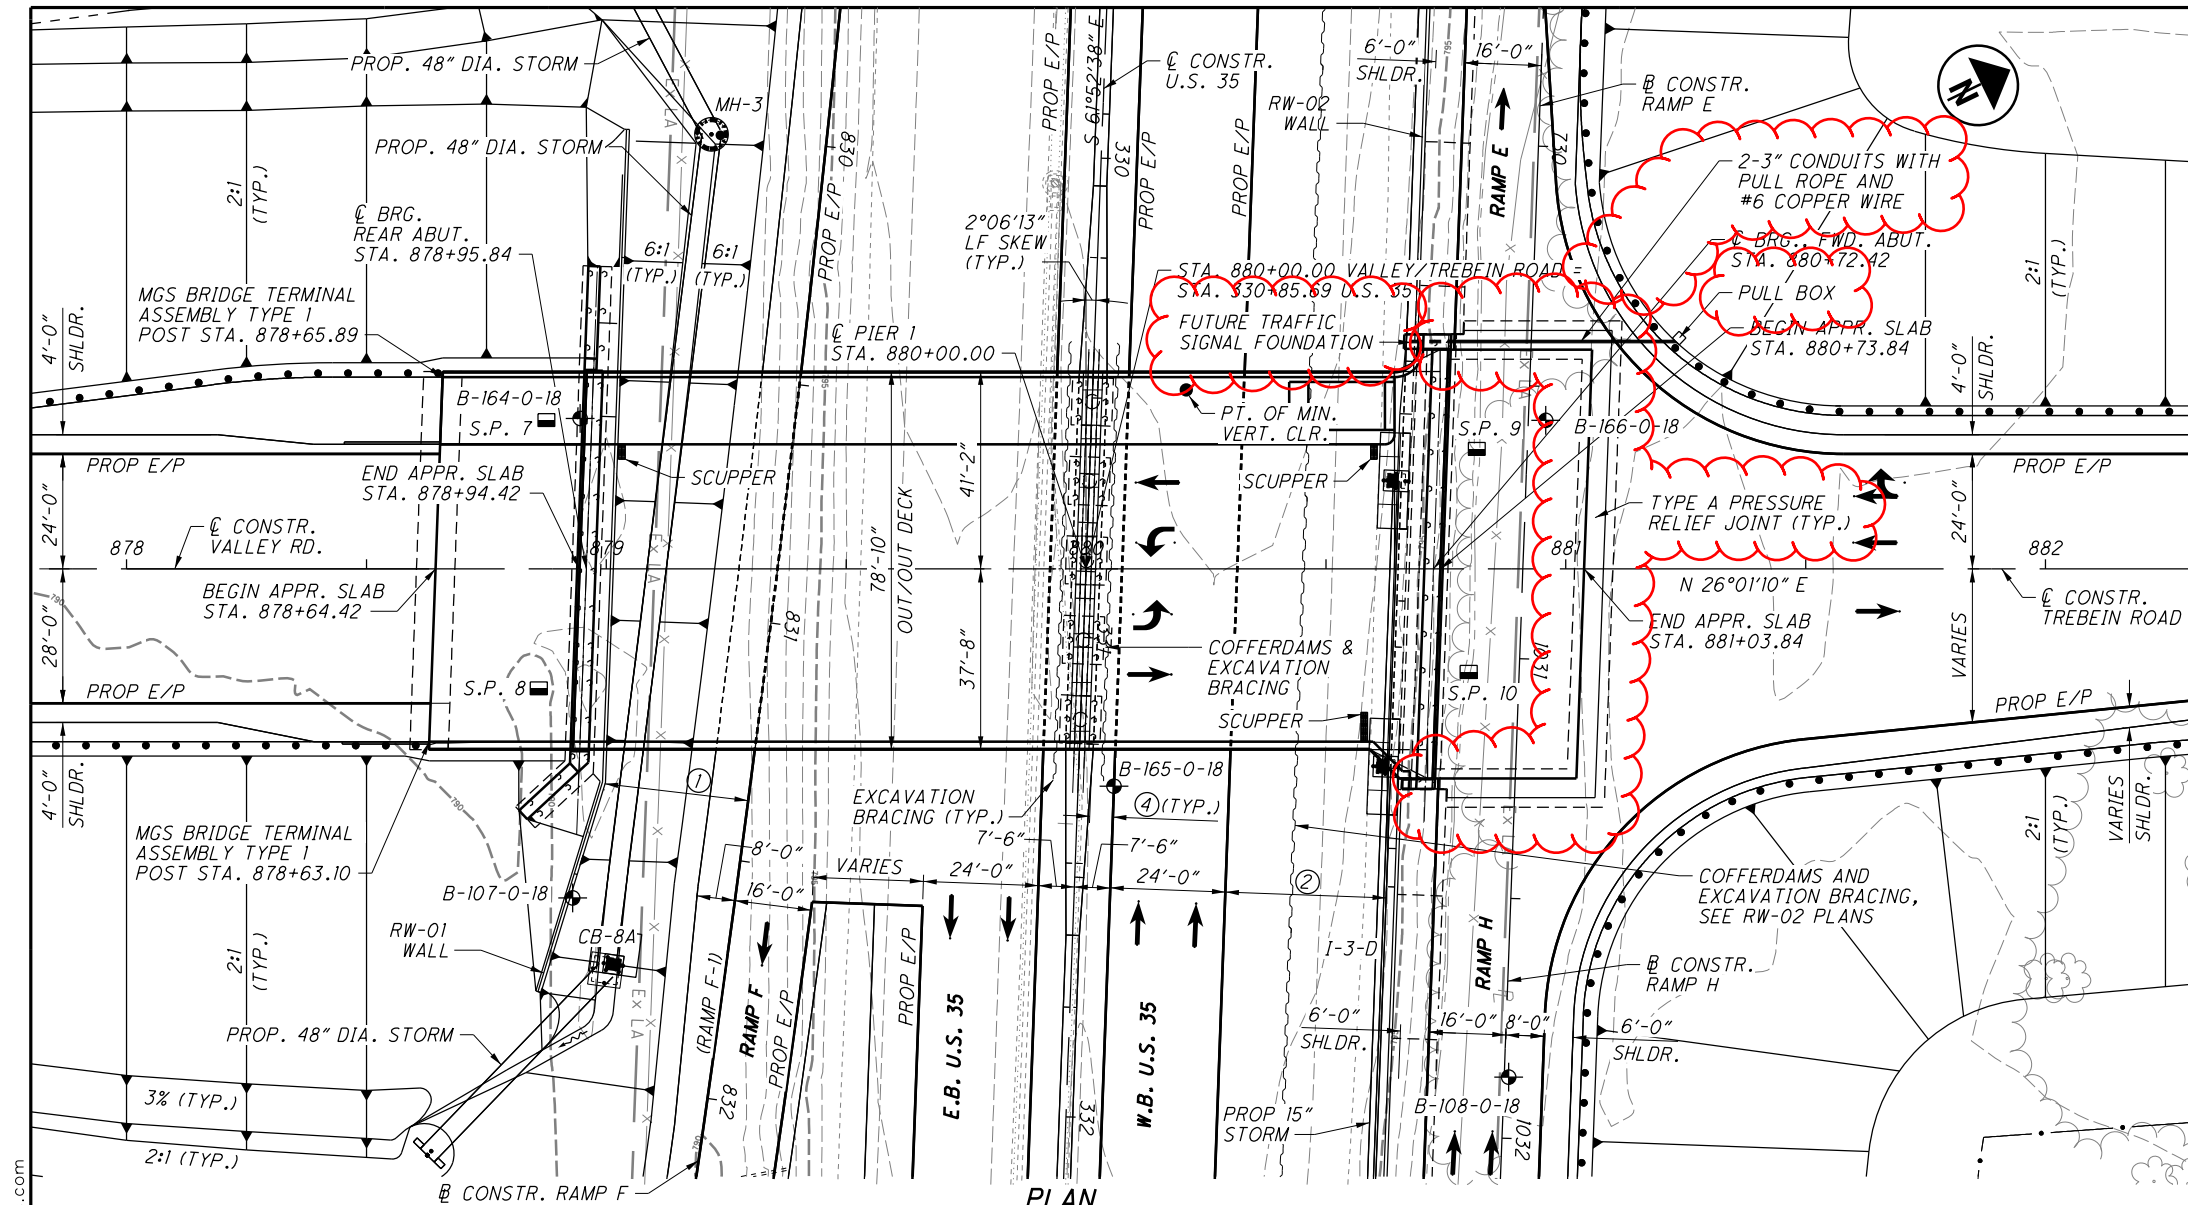

### BENCHMARK DATA

|   |
|---|
| BM #8 STA. 322+55.38, ELEV. 800.45, OFFSET 0.16' LT.  |
| BM #9 STA. 333+64.82, ELEV. 795.50, OFFSET 48.82' RT. |

FOR ADDITIONAL BENCHMARK INFORMATION, SEE ROADWAY PLAN SHEET

- ### NOTES
- EARTHWORK LIMITS SHOWN ARE APPROXIMATE. ACTUAL SLOPES SHALL CONFORM TO PLAN CROSS SECTIONS.
  - FOR SETTLEMENT PLATFORM LOCATION TABLE AND NOTES, SEE SHEET 35/698.
  - FOR PAVEMENT JOINT DETAIL SHEET, SEE SHEET 424/698.

DESIGN TRAFFIC:  
 2025 ADT = 7840      2025 ADTT = 550  
 2045 ADT = 9190      2045 ADTT = 640  
 DIRECTIONAL DISTRIBUTION = 0.51

- ### LEGEND
- BORING LOCATION
  - SETTLEMENT PLATFORM (SEE NOTE 2)

### CURVE DATA

|             | RAMP E-2     | RAMP F-1     | RAMP H-1     |
|-------------|--------------|--------------|--------------|
| P.I. STA. = | 723+87.32    | 829+13.55    | 1039+50.74   |
| Δ =         | 2°48'42" RT. | 6°14'56" RT. | 3°00'47" RT. |
| Dc =        | 0°30'00"     | 1°00'00"     | 0°45'00"     |
| R =         | 11,459.16'   | 5729.58'     | 7,639.44'    |
| T =         | 218.21'      | 312.76'      | 200.91'      |
| L =         | 562.31'      | 624.89'      | 401.74'      |
| E =         | 3.45'        | 8.53'        | 2.64'        |


- MIN. HORIZONTAL CLEARANCE  
30'-0" REQUIRED  
30'-0" PROVIDED
- MIN. HORIZONTAL CLEARANCE  
30'-0" REQUIRED  
33'-6" PROVIDED TO TOE OF BARRIER
- MIN. VERTICAL CLEARANCE  
17'-0" REQUIRED  
17'-1" PROVIDED
- MIN. HORIZONTAL CLEARANCE  
4'-0" REQUIRED  
4'-10" PROVIDED TO TOE OF BARRIER

EXISTING STRUCTURE - NONE

### PROPOSED STRUCTURE

TYPE: 2-SPAN CONTINUOUS COMPOSITE WIDE FLANGE PRESTRESSED BEAMS WITH REINFORCED CONCRETE DECK, PIERS, AND SEMI-INTEGRAL ABUTMENTS BEHIND MSE WALLS.

SPANS: 104'-2" - 72'-5" C/C BEARINGS  
 ROADWAY: 62'-0" TOE/PARAPET TO FACE/CURB  
 LOADING: HL-93, FWS=60 PSF  
 SKEW: 2°06'13" LF  
 APPROACH SLABS: 30'-0" LONG (AS-1-15 MODIFIED) & AS-2-15 INSTALLATION  
 ALIGNMENT: TANGENT      WEARING SURFACE: MONOLITHIC CONCRETE  
 CROWN: 0.02 FT/FT  
 COORDINATES: LATITUDE N 39°42'02"  
 LONGITUDE W 83°59'52"

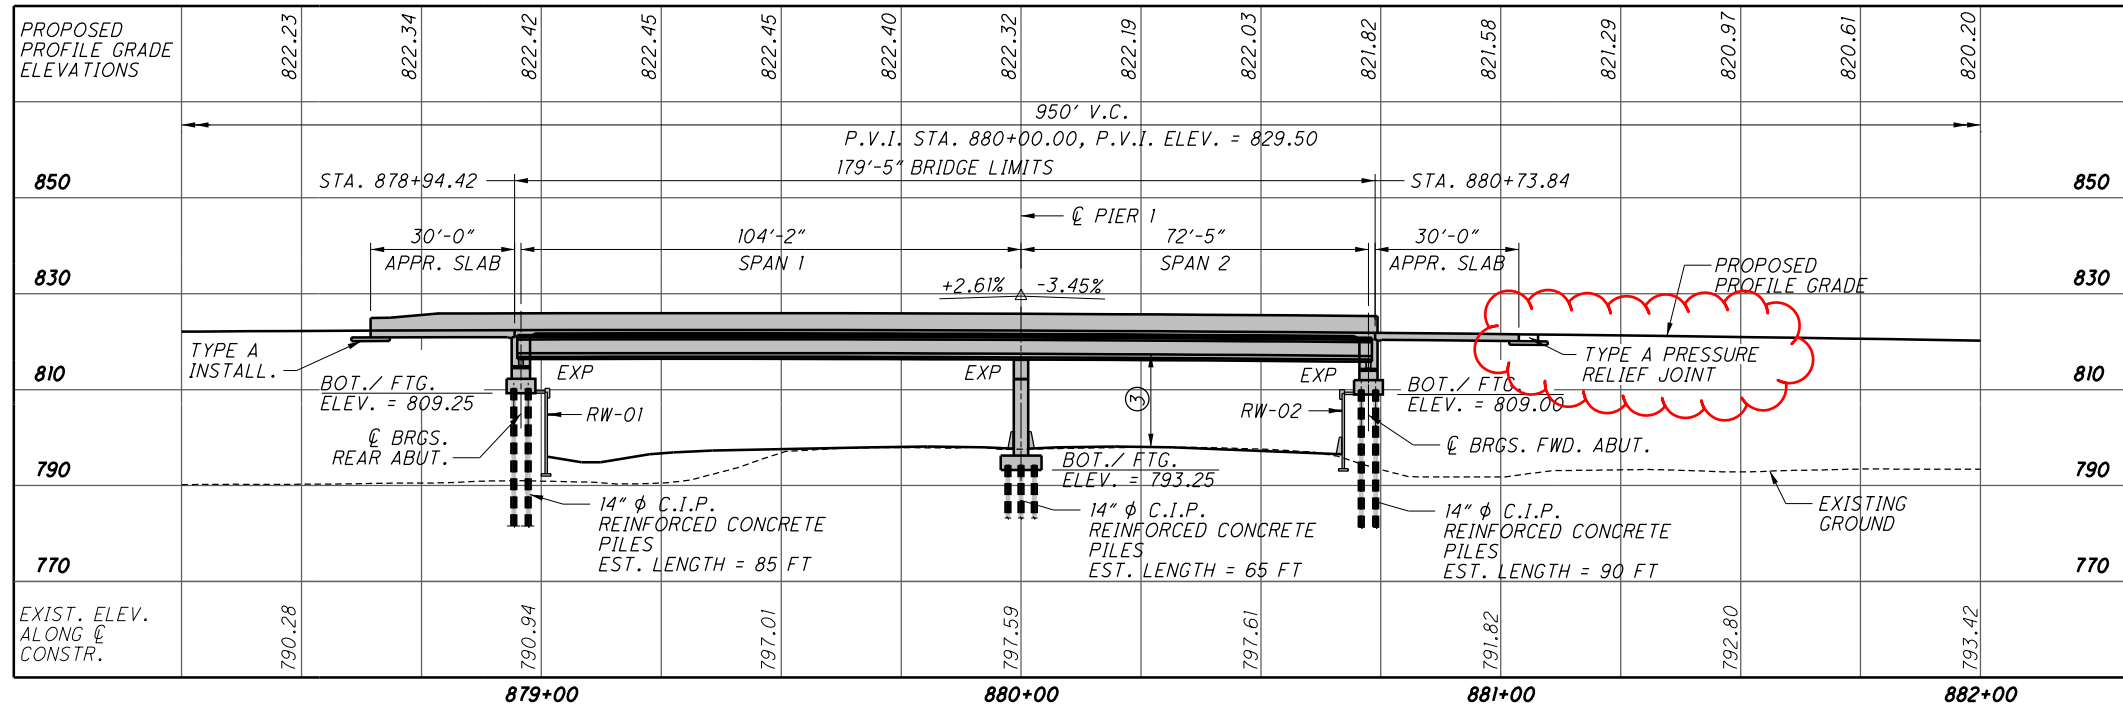

PROFILE ALONG VALLEY/TREBEIN ROAD

DESIGN AGENCY: **JACOBS**  
 1880 WATCROSS ROAD  
 CINCINNATI, OHIO 45240

DATE: 5/2022  
 STRUCTURE FILE NUMBER: 2900213

REVIEWED: JTC  
 DRAWN: EJ  
 CHECKED: FBW

GREENE COUNTY  
 STA. 878+94.42  
 STA. 880+73.84

SITE PLAN  
 BRIDGE NO. GRE-035-0627  
 VALLEY/TREBEIN ROAD OVER U.S. 35

GRE-US 35-5.63  
 PID No. 107217

1/30  
 573  
 698



**STANDARD DRAWINGS AND SUPPLEMENTAL SPECIFICATIONS:**

REFER TO THE FOLLOWING STANDARD BRIDGE DRAWINGS:

|           |         |          |                                |
|-----------|---------|----------|--------------------------------|
| AS-1-15   | REVISED | 07-17-15 |                                |
| AS-2-15   | REVISED | 01-18-19 |                                |
| BR-2-15   | REVISED | 01-21-22 |                                |
| PSID-1-13 | REVISED | 01-15-21 |                                |
| SBR-1-13  | REVISED | 07-20-18 | (SEE INSERTS SHEETS 572B-572F) |
| SICD-1-21 | REVISED | 01-21-22 |                                |
| SICD-2-14 | REVISED | 01-15-21 |                                |
| TST-1-99  | REVISED | 01-15-21 |                                |
| VPF-1-90  | REVISED | 07-20-18 |                                |

**DESIGN SPECIFICATION:**

THIS STRUCTURE CONFORMS TO THE "LRFD BRIDGE DESIGN SPECIFICATIONS" ADOPTED BY THE AMERICAN ASSOCIATION OF STATE HIGHWAY AND TRANSPORTATION OFFICIALS, 8TH EDITION AND THE ODOT BRIDGE DESIGN MANUAL, 2020.

**DESIGN LOADING:**

HL-93  
FUTURE WEARING SURFACE (FWS) OF 0.060 KIPS/SQ.FT.

**DESIGN DATA:**

CONCRETE CLASS OC2 - COMPRESSIVE STRENGTH 4.5 KSI (SUPERSTRUCTURE)

CONCRETE CLASS OC1 - COMPRESSIVE STRENGTH 4.0 KSI (SUBSTRUCTURE)

EPOXY COATED STEEL REINFORCEMENT - MIN. YIELD STRENGTH 60 KSI  
GALVANIZED STEEL REINFORCEMENT - MIN. YIELD STRENGTH 60 KSI

CONCRETE FOR PRESTRESSED BEAMS-  
COMPRESSIVE STRENGTH (FINAL) - 7.5 KSI  
COMPRESSIVE STRENGTH (RELEASE) - 6.0 KSI

WELDED WIRE FABRIC:  
YIELD STRENGTH - 70 KSI

PRESTRESSING STRANDS:  
AREA = 0.217 SQ.IN (0.6"  $\phi$ )  
ULTIMATE STRENGTH = 270 KSI  
INITIAL STRESS = 202.5 KSI (LOW RELAXATION STRANDS)

**MONOLITHIC WEARING SURFACE:**

MONOLITHIC WEARING SURFACE IS ASSUMED, FOR DESIGN PURPOSES, TO BE 1 INCH THICK.

**DECK PLACEMENT DESIGN ASSUMPTIONS:**

THE FOLLOWING ASSUMPTIONS OF CONSTRUCTION MEANS AND METHODS WERE MADE FOR THE ANALYSIS AND DESIGN OF THE SUPERSTRUCTURE. THE CONTRACTOR IS RESPONSIBLE FOR THE DESIGN OF THE FALSEWORK SUPPORT SYSTEM WITHIN THE PARAMETERS AND WILL ASSUME RESPONSIBILITY FOR SUPERSTRUCTURE ANALYSIS FOR DEVIATION FROM THESE DESIGN ASSUMPTIONS.

AN EIGHT WHEEL FINISHING MACHINE WITH MAXIMUM WHEEL LOAD OF 2.65 KIPS

A MINIMUM OUT-TO-OUT WHEEL SPACING AT EACH END OF THE MACHINE OF 103"

A MAXIMUM SPACING OF OVERHANG FALSEWORK BRACKETS OF 48 INCHES.

A MAXIMUM DISTANCE FROM THE CENTERLINE OF THE FASCIA GIRDER TO THE FACE OF THE SAFETY HANDRAIL OF 65"

**ITEM 625 - STRUCTURE GROUNDING SYSTEM**

IN ORDER TO PROPERLY GROUND THIS STRUCTURE, A QUANTITY OF 1 EACH - STRUCTURE GROUNDING SYSTEM IS CARRIED IN THE GENERAL SUMMARY.

**PROPRIETARY RETAINING WALL DATA:**

THE PROPRIETARY WALL SUPPLIER SHALL DESIGN THE INTERNAL STABILITY OF A MECHANICALLY STABILIZED EARTH (MSE) WALL IN ACCORDANCE WITH SS840 TO SUPPORT THE ABUTMENT. THE DESIGN FOR THE INTERNAL STABILITY SHALL INCLUDE A NOMINAL (I.E. UNFACTORED) HORIZONTAL STRIP LOAD DUE TO FRICTION (FR) FROM THE SUPERSTRUCTURE OF 4.04K/FT FOR THE REAR ABUTMENT AND 2.66 K/FT FOR THE FORWARD ABUTMENT, APPLIED PERPENDICULAR TO THE FACE OF WALL AT THE BASE OF THE CONCRETE FOOTING. THIS STRIP LOAD DOES NOT INCLUDE EARTH PRESSURE LOADS FROM THE ABUTMENT BACKFILL. HOWEVER, THE PROPRIETARY WALL SUPPLIER SHALL INCLUDE EARTH PRESSURE LOADS FROM THE ABUTMENT BACKFILL IN THE DESIGN CALCULATIONS.

**PILE DRIVING CONSTRAINTS**

PILE DRIVING TO THE DESIGN LOADS MAY NOT BEGIN UNTIL SUFFICIENT EMBANKMENT AND MSE WALL SETTLEMENT HAS OCCURRED AS DOCUMENTED BY THE SETTLEMENT PLATFORMS. THE ANTICIPATED WAITING PERIOD TO PERMIT SUFFICIENT EMBANKMENT SETTLEMENT IS 60 DAYS. THE DISTRICT GEOTECHNICAL ENGINEER MAY REDUCE OR EXTEND THE WAITING PERIOD BASED ON THE MAGNITUDE AND RATE OF THE EMBANKMENT SETTLEMENT AS DETERMINED BY THE SETTLEMENT PLATFORMS. THE SETTLEMENT WAITING PERIOD BEGINS ONCE THE APPROACH EMBANKMENT REACHES THE DESIGN SUBGRADE LEVEL FOR A MINIMUM DISTANCE OF 100 FT. BEHIND EACH ABUTMENT. THE PLANS HAVE PROVISIONS FOR A TEMPORARY SURCHARGE AT THE ABUTMENT LOCATION TO PERMIT PLACEMENT OF EMBANKMENT TO THE DESIGN SUBGRADE LEVEL. BEGIN PILE DRIVING ONLY FOLLOWING TERMINATION OF THE SETTLEMENT MONITORING WAITING PERIOD BY THE DISTRICT GEOTECHNICAL ENGINEER. THE CONTRACTOR MAY PARTIALLY DRIVE THE PILES TO PRIOR TO MSE WALL CONSTRUCTION TO PERMIT PROPER PLACEMENT.

PILES DRIVEN TO TIP ELEVATION FOR PILE/SOIL SETUP THE ULTIMATE BEARING VALUE IS 390 KIPS PER PILE FOR THE ABUTMENT PILES. THE ULTIMATE BEARING VALUE IS 390 KIPS PER PILE FOR THE PIER PILES. PART OF THE ULTIMATE BEARING VALUE WILL BE ACHIEVED THROUGH PILE/SOIL SETUP, WHICH IS A TIME-DEPENDENT INCREASE IN RESISTANCE THAT OCCURS IN SOME SOILS.

NOTIFY THE ENGINEER AT LEAST 5 DAYS BEFORE DRIVING PILES SO THAT THE ENGINEER CAN NOTIFY THE DISTRICT GEOTECHNICAL ENGINEER, THE OFFICE OF CONSTRUCTION ADMINISTRATION, AND THE OFFICE OF GEOTECHNICAL ENGINEERING.

DRIVE THE FIRST TWO PILES IN EACH SUBSTRUCTURE TO THE TIP ELEVATION GIVEN BELOW FOR THE SUBSTRUCTURE. DRIVE THE THIRD AND FOURTH PILES TO 75% AND 85% OF THE LENGTH OF THE FIRST TWO PILES. PERFORM DYNAMIC LOAD TESTING ON ALL FOUR PILES WHILE DRIVING. AFTER DRIVING THE FOUR PILES, CEASE ALL DRIVING OPERATIONS AT THE SUBSTRUCTURE FOR A MINIMUM OF 7 DAYS. INCLUDE THE WAITING PERIOD AS A SEPARATE ACTIVITY IN THE PROGRESS SCHEDULE. AFTER THE WAITING PERIOD, PERFORM PILE RESTRIKES ON THE FOUR PILES (TWO RESTRIKE ITEMS). SUBMIT ALL TEST RESULTS TO THE ENGINEER. THE ENGINEER WILL REVIEW THE TEST RESULTS AND ESTABLISH DRIVING CRITERIA FOR THE PILING IN THE SUBSTRUCTURE WITH THE ASSISTANCE OF THE DISTRICT GEOTECHNICAL ENGINEER, THE OFFICE OF CONSTRUCTION ADMINISTRATION, AND THE OFFICE OF GEOTECHNICAL ENGINEERING. THE DRIVING CRITERIA WITH PILE SETUP SHALL BE PERFORMED FOR THE FIRST STAGE OF BRIDGE CONSTRUCTION. THE CONTRACTOR SHALL NOT ORDER PILES FOR SUBSEQUENT PHASES UNTIL AFTER THE DRIVING CRITERIA HAS BEEN ESTABLISHED WITH SETUP. THE DEPARTMENT WILL ADJUST THE FURNISHED PILE QUANTITIES BASED ON THE RESTRIKE TEST RESULTS.

IF THE DYNAMIC LOAD TESTING INDICATES A PILE HAS ACHIEVED THE ULTIMATE BEARING VALUE ABOVE THE TIP ELEVATION DURING THE INITIAL DRIVING (BEFORE THE WAITING PERIOD), STOP DRIVING AND NOTIFY THE ENGINEER. IF THE RESTRIKE TEST RESULTS ON THE FOUR PILES INDICATE THAT A PILE DID NOT ACHIEVE THE REQUIRED ULTIMATE BEARING VALUE, DRIVE THE PILE TO THE ESTABLISHED DRIVING CRITERIA. SPLICING OF THE PILES BEYOND THE ESTIMATED LENGTH PROVIDED IN THE PLANS WILL BE PAID BY THE DEPARTMENT UNDER CMS 109.05 WITH A NEGOTIATED PRICE PER SPLICE.

REAR ABUTMENT  
32 PILES 90 FEET LONG, ORDER LENGTH  
TIP ELEVATION, 728.50 FEET  
2 DYNAMIC LOAD TESTING ITEMS  
2 RESTRIKES

PIER 1  
30 PILES 70 FEET LONG, ORDER LENGTH  
TIP ELEVATION, 730.30 FEET  
2 DYNAMIC LOAD TESTING ITEMS  
2 RESTRIKES

FORWARD ABUTMENT  
26 PILES 95 FEET LONG, ORDER LENGTH  
TIP ELEVATION, 724.00 FEET  
2 DYNAMIC LOAD TESTING ITEMS  
2 RESTRIKES

**ITEM 690, SPECIAL - MISC.: TEMPORARY SURCHARGE**

DESCRIPTION: THIS ITEM CONSISTS OF DESIGNING, CONSTRUCTING, AND REMOVING A TEMPORARY SURCHARGE AT THE REAR AND FORWARD ABUTMENTS OF THE STRUCTURE TO THE LOCATIONS AND LIMITS SHOWN IN THE PLANS.

AS DIRECTED IN THE PILE DRIVING CONSTRAINTS, A TEMPORARY SURCHARGE IS NECESSARY AT THE ABUTMENTS FOR THIS BRIDGE TO MITIGATE EMBANKMENT SETTLEMENT. CONSTRUCT THE TEMPORARY SURCHARGE SO IT EXTENDS VERTICALLY FROM THE ELEVATION TO THE BOTTOM OF THE PROPOSED ABUTMENT FOOTING TO THE PROPOSED ROADWAY SUBGRADE ELEVATION. CONSTRUCT THE TEMPORARY SURCHARGE USING ITEM 203 EMBANKMENT WITH A DRY DENSITY OF AT LEAST 105 PCF AFTER COMPACTION. ALTERNATE MATERIALS, SUCH AS PRECAST CONCRETE, MAY BE UTILIZED FOR ALL OR A PORTION OF THE REQUIRED SURCHARGE LOAD PROVIDED THE APPLIED SURCHARGE IS GREATER THAN OR EQUIVALENT TO THE SURCHARGE OF EMBANKMENT WITH A DRY UNIT WEIGHT OF 110 PCF. SUPPORT THE SIDES OF THE TEMPORARY SURCHARGE SO THAT THE TOP OF THE SURCHARGE MATERIAL ALIGNS WITH THE REAR OF THE ABUTMENT FOOTING. CONSTRUCT THE TEMPORARY SURCHARGE SO THAT IT EXTENDS AT LEAST 100 FEET BEHIND EACH ABUTMENT.

**ABBREVIATIONS:**

|         |                         |            |                        |         |                |
|---------|-------------------------|------------|------------------------|---------|----------------|
| ABUT.   | ABUTMENT                | FTG.       | FOOTING                | PROP.   | PROPOSED       |
| APPR.   | APPROACH                | FWD.       | FORWARD                | R.A.    | REAR ABUTMENT  |
| APPROX. | APPROXIMATE             | LT.        | LEFT                   | REF.    | REFERENCE      |
| BOT.    | BOTTOM                  | MAX.       | MAXIMUM                | REQ.    | REQUIRED       |
| BRG.    | BEARING                 | M.O.T.     | MAINTENANCE OF         | RT.     | RIGHT          |
| C/C     | CENTER TO CENTER        |            | TRAFFIC                | SB      | SOUTHBOUND     |
| C.I.P.  | CAST-IN-IRON            | NB         | NORTHBOUND             | SER.    | SERIES         |
| C.J.    | CONSTRUCTION JOINT      | N.F.       | NEAR FACE              | SHLDR.  | SHOULDER       |
| CLR.    | CLEAR                   | NO.        | NUMBER                 | SPA.    | SPACING        |
| CONSTR. | CONSTRUCTION            | N.P.C.P.P. | NON-PERFORATED         | STA.    | STATION        |
| CONT.   | CONTINUED               |            | CORRUGATED             | TYP.    | TYPICAL        |
| C.P.P.  | CORRUGATED PLASTIC PIPE |            | PLASTIC PIPE           | T/SLOPE | TOP OF SLOPE   |
|         |                         | N.T.S.     | NOT TO SCALE           | T/T     | TOE TO TOE     |
| DIA.    | DIAMETER                | O/O        | OUT TO OUT             | U.N.O.  | UNLESS NOTED   |
| EL.     | ELEV. - ELEVATION       | OFF        | OFFSET                 |         | OTHERWISE      |
| EX.     | EXIST. - EXISTING       | P.C.P.P.   | PERFORATED             | VAR.    | VARIES         |
| EXP.    | EXPANSION               |            | CORRUGATED             | V.C.    | VERTICAL CURVE |
| E.F.    | EACH FACE               |            | PLASTIC PIPE           | VERT.   | VERTICAL       |
| F.A.    | FORWARD ABUTMENT        | P.E.J.F.   | PREFORMED              |         |                |
| F.F.    | FAR FACE                |            | EXPANSION JOINT FILLER |         |                |


PREPARE AND PROVIDE SHOP DRAWINGS AND DESIGN CALCULATIONS FOR THE TEMPORARY SURCHARGE, INCLUDING THE METHOD USED TO SUPPORT THE SIDES OF THE TEMPORARY SURCHARGE AND ALL DETAILS OF THE SUPPORT SYSTEM. ENSURE THE TEMPORARY SURCHARGE DESIGN ACCOMMODATES THE LOCATION AND COMPOSITION OF THE PROPOSED MSE WALLS FOR THE BRIDGE STRUCTURE. HAVE TWO OHIO REGISTERED ENGINEERS SIGN, SEAL, AND DATE THE DRAWINGS AND CALCULATIONS ACCORDING TO C&MS 501.05. SUBMIT THE DRAWINGS AND CALCULATIONS TO THE ENGINEER AT LEAST 30 DAYS BEFORE CONSTRUCTION OF THE TEMPORARY SURCHARGE BEGINS.

REMOVE THE TEMPORARY SURCHARGE AFTER THE CONDITIONS SPECIFIED IN THE PILE DRIVING CONSTRAINTS ARE SATISFIED AND THE ENGINEER AUTHORIZES REMOVAL.

BASIS OF PAYMENT: THE DEPARTMENT WILL PAY FOR ALL LABOR, EQUIPMENT AND MATERIALS NECESSARY TO DESIGN, CONSTRUCT AND REMOVE THE TEMPORARY SURCHARGE AT THE REAR AND FORWARD ABUTMENTS FOR THE BRIDGE AT THE CONTRACT LUMP SUM BID PRICE FOR ITEM SPECIAL 690E98400 SPECIAL-MISC.: TEMPORARY SURCHARGE.

**NOTES:**

2 SHALL NOT BE POURED PRIOR TO 1 WITHOUT APPROVAL BY THE ENGINEER. SEQUENCE OF SPAN POURS SHALL BE DETERMINED BY THE CONTRACTOR

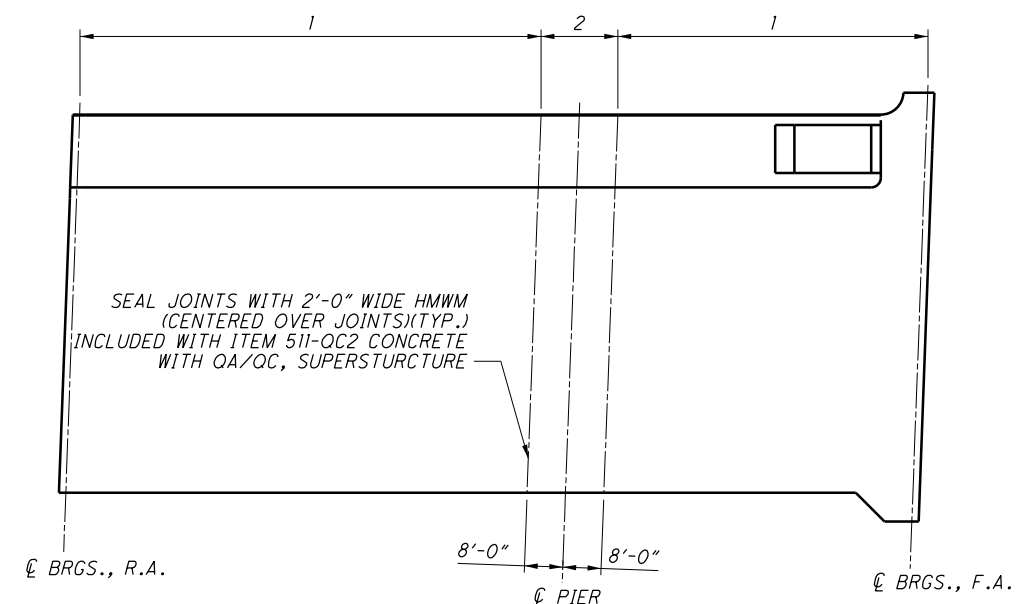

**DECK POUR SEQUENCE PLAN**

Jason.Center@jacobs.com

11/30/2022 9:23:31 AM

035\_0627GN001.dgn

035\_0627EQ001.dgn 11/30/2022 9:47:36 AM Jason.Centers@jacobs.com

**ITEM 511, CLASS OC2 CONCRETE WITH OC/OA, BRIDGE DECK, AS PER PLAN**

THIS ITEM MODIFIES THE STANDARD 511 CONCRETE FOR STRUCTURES SPECIFICATION TO INCLUDE CORROSION INHIBITORS INTO THE SUPERSTRUCTURE CONCRETE. THIS ITEM SHALL CONFORM TO CMS 511 WITH THE FOLLOWING CONDITIONS AND REVISIONS:

PROVIDE MATERIALS CONFORMING TO 511.02 EXCEPT AS MODIFIED BELOW:

PORTLAND CEMENT CONCRETE 499.03, CLASS OC 2 MEETING A DESIGN STRENGTH OF 4,500 PSI  
CORROSION INHIBITOR 515.15

THE CLASS OC2 CONCRETE FOR THE SUPERSTRUCTURE SHALL MEET THE FOLLOWING CRITERIA:  
WATER/CEMENT RATIO = 0.40 MAXIMUM

MIX SHALL INCLUDE A MIGRATING CORROSION INHIBITOR AS MANUFACTURED BY AN APPROVED SUPPLIER LISTED ON ODOT'S QUALIFIED APPROVED SUPPLIERS, ITEM 515.15. THE DOSAGE RATE LISTED ON THE ODOT QUALIFIED APPROVED SUPPLIERS LIST WILL APPLY.

THE BATCH WEIGHTS SHALL BE CORRECTED TO COMPENSATE FOR THE MOISTURE CONTAINED IN THE AGGREGATE AT THE TIME OF USE. A CHEMICAL ADMIXTURE (705.12, TYPE A OR D) SHALL BE USED.

CONCRETE SUPPLIERS SHOULD RECOGNIZE THAT THE CORROSION INHIBITOR AND ADMIXTURES MAY HAVE AN EFFECT ON STRENGTH, ENTRAINED AIR CONTENT, WORKABILITY, ETC. OF THEIR CONCRETE MIXES. THE CORROSION INHIBITOR IS SUGGESTED TO BE A MCI PRODUCT BY CORTEC OR AN APPROVED EQUAL FROM THE QUALIFIED PRODUCTS LIST. THE CONCRETE SUPPLIER'S CHOICE OF ONE OF THESE CORROSION INHIBITORS DOES NOT ALLEVIATE MEETING DESIGN REQUIREMENTS. PLEASE BE ADVISED THAT SOME PRODUCTS ON THE LIST EFFECT THE DELIVERED MIX PROPERTIES GREATLY WHILE OTHER PRODUCTS DO NOT.

APPROACH SLABS AND DIAPHRAGMS ARE TO USE THE SAME MIX DESIGN AS THE BRIDGE DECK. THE CONTRACTOR SHOULD BE ADVISED THAT CONCRETE RETARDING AGENTS MAY NEED TO BE ADDED TO OFFSET THE EFFECTS OF THE MIGRATING CORROSION INHIBITOR SELECTED.

THE CONTRACTOR SHALL PROVIDE TRADITIONAL BRIDGE DECK FORMS CONFORMING TO CMS 508. PERMANENT STAY-IN-PLACE (SIP) FORMS ARE NOT ALLOWED. THE PLACING OF THE DECK AND THE APPROACH SLABS IN THE SAME CONCRETE POUR IS NOT PERMITTED.

**ITEM 511, CLASS OC2 CONCRETE WITH OC/OA, BRIDGE DECK (PARAPET), AS PER PLAN**

THIS ITEM MODIFIES THE STANDARD 511 CONCRETE FOR STRUCTURES SPECIFICATION TO INCLUDE MACRO-SYNTHETIC FIBERS, AND CORROSION INHIBITORS INTO THE SUPERSTRUCTURE CONCRETE. THIS ITEM SHALL CONFORM TO CMS 511 WITH THE FOLLOWING CONDITIONS AND REVISIONS:

PROVIDE MATERIALS CONFORMING TO 511.02 EXCEPT AS MODIFIED BELOW:

PORTLAND CEMENT CONCRETE 499.03, CLASS OC 2 MEETING A DESIGN STRENGTH OF 4,500 PSI, WITH MACRO-SYNTHETIC FIBERS WITH MODIFICATION PER 511.02  
FIBERS FOR CONCRETE CORROSION INHIBITOR ASTM C 1116, TYPE III 515.15

THE CLASS OC2 CONCRETE FOR THE SUPERSTRUCTURE SHALL MEET THE FOLLOWING CRITERIA:  
WATER/CEMENT RATIO = 0.40 MAXIMUM; MINIMUM 5 LBS/CY MACRO-SYNTHETIC FIBERS (1.5 IN. MIN. TO 2.5 IN. MAX.) MEETING ASTM C1116 TYPE III SHALL BE ADDED TO THE MIX.

MIX SHALL INCLUDE A MIGRATING CORROSION INHIBITOR AS MANUFACTURED BY AN APPROVED SUPPLIER LISTED ON ODOT'S QUALIFIED APPROVED SUPPLIERS, ITEM 515.15. THE DOSAGE RATE LISTED ON THE ODOT QUALIFIED APPROVED SUPPLIERS LIST WILL APPLY.

**ITEM 511, CLASS OC2 CONCRETE WITH OC/OA, BRIDGE DECK (PARAPET), AS PER PLAN, CONT'D.**

THE MACRO-SYNTHETIC FIBERS SHALL BE INCORPORATED INTO THE MIX IN SUCH A WAY THAT NO 'BALLING' OCCURS. UPON INSPECTION OF THE MIX AT THE TIME OF PLACEMENT, IF ANY 'BALLING' OCCURS, THE ENGINEER SHALL REJECT THE REMAINDER OF THE LOAD AT ANY TIME DURING THE POUR. IT IS IMPORTANT TO FOLLOW INDUSTRY STANDARDS AND ASTM SPECIFICATIONS ON THE PREMIXING OF THE CEMENT, AGGREGATE, AND MACRO-SYNTHETIC FIBERS PRIOR TO THE ADDITION OF WATER AND ADMIXTURES. PROVIDE MACRO-SYNTHETIC FIBERS THAT ARE MONOFILAMENT FIBERS MADE FROM VIRGIN POLYPROPYLENE, POLYETHYLENE, OR COPOLYMERS THAT ARE INERT TO ALKALI ATTACK. ENSURE THE MACRO-SYNTHETIC FIBERS HAVE A MINIMUM TENSILE STRENGTH OF 70 KSI, A MINIMUM MODULUS OF ELASTICITY OF 800 KSI, A MINIMUM FILAMENT DIAMETER OF 0.012 INCHES, AND ASPECT RATIO BETWEEN 60 AND 100, AND ARE BETWEEN 1.0 AND 2.5 INCHES IN LENGTH. STORE THE MACRO-SYNTHETIC FIBERS ACCORDING TO THE MANUFACTURER'S RECOMMENDATION AND KEEP THE MATERIAL FREE FROM DUST, DIRT AND MOISTURE. PLACING THE BAG THAT THE FIBERS COME IN INTO THE CONCRETE MIX IS NOT PERMITTED.

USE A MINIMUM DOSAGE RATE OF MACRO-SYNTHETIC FIBERS OF 5.0 LBS/CY OF CONCRETE. ENSURE THE FINAL PROPOSED MIX IS WORKABLE AND ABLE TO BE PRODUCED SUCH THAT BALLING OR CLUMPING OF THE FIBERS IS NOT A PROBLEM AS DETERMINED BY THE ENGINEER. BEFORE USE, SUBMIT DOCUMENTATION TO THE PROJECT ENGINEER CERTIFYING BOTH THE MACRO-SYNTHETIC FIBERS AND THE MIX MEET OR EXCEED THE REQUIRED PROPERTIES. SAMPLING WILL BE ALLOWED FOR TESTING PURPOSES. A DEMONSTRATION OF THE MIX PRODUCTION OR TRIAL MIX, MAY BE REQUIRED BY THE ENGINEER PRIOR TO PLACING ANY OF THE MIX ON THE PROJECT.

THE BATCH WEIGHTS SHALL BE CORRECTED TO COMPENSATE FOR THE MOISTURE CONTAINED IN THE AGGREGATE AT THE TIME OF USE. A CHEMICAL ADMIXTURE (705.12, TYPE A OR D) SHALL BE USED. THE TRANSIT MIXER CHARGE SHALL BE LIMITED TO 3#40F ITS RATED CAPACITY OR 6 CUBIC YARDS, WHICHEVER IS SMALLER. THE FIRST THREE TRANSIT MIXER LOADS ARE REQUIRED TO BE AT THE MINIMUM YARDAGE LISTED ABOVE TO SHOW PROOF OF THE SUCCESSFUL BATCHING OPERATION. AFTER CONSISTENCY IN THE DELIVERED MATERIAL HAS BEEN ESTABLISHED, THE CONCRETE SUPPLIER MAY INCREASE THE BATCH DELIVERED QUANTITIES AS LONG AS THE QUALITY REMAINS ACCEPTABLE TO THE ENGINEER. THE ENGINEER CAN REDUCE THE BATCH LOAD SIZE AT ANY TIME AS NEEDED TO CORRECT/IMPROVE CONCRETE QUALITY.

CONCRETE SUPPLIERS SHOULD RECOGNIZE THAT THE CORROSION INHIBITOR AND ADMIXTURES MAY HAVE AN EFFECT ON STRENGTH, ENTRAINED AIR CONTENT, WORKABILITY, ETC. OF THEIR CONCRETE MIXES. THE CORROSION INHIBITOR IS SUGGESTED TO BE A MCI PRODUCT BY CORTEC OR AN APPROVED EQUAL FROM THE QUALIFIED PRODUCTS LIST. THE CONCRETE SUPPLIER'S CHOICE OF ONE OF THESE CORROSION INHIBITORS DOES NOT ALLEVIATE MEETING DESIGN REQUIREMENTS. PLEASE BE ADVISED THAT SOME PRODUCTS ON THE LIST EFFECT THE DELIVERED MIX PROPERTIES GREATLY WHILE OTHER PRODUCTS DO NOT.

THE CONTRACTOR SHOULD BE ADVISED THAT CONCRETE RETARDING AGENTS MAY NEED TO BE ADDED TO OFFSET THE EFFECTS OF THE MIGRATING CORROSION INHIBITOR SELECTED. THIS SPECIFICATION IS INTENDED FOR USE ON NON DECORATIVE BRIDGE RAILING. USE SELF-COMPACTING CONCRETE ON DECORATIVE RAILING SIMILAR TO TEXAS RAILING AND MACRO-SYNTHETIC CONCRETE PER THIS SPECIFICATION ON TRADITIONAL CONCRETE RAILING WHEN APPLICABLE.

**ITEM 512, SEALING OF CONCRETE SURFACES (EPOXY-URETHANE), AS PER PLAN**

DUE TO THE RECENT SUPPLY SHORTAGES, THE DEPARTMENT HAS BEEN MADE AWARE OF DIFFICULTIES THAT SUPPLIERS ARE HAVING IN OBTAINING THE NECESSARY MATERIALS FOR EPOXY. ON THIS PROJECT THE CONTRACTOR CAN USE TRADITIONAL EPOXY-URETHANE SEALERS APPROVED ON THE OPL OR ELECT TO SUBSTITUTE BRIDGE COTE XL-70 W/SILANE THAT IS LISTED ON THE APPROVED NOISE SUPPLIER LIST UNDER APPROVED SEALERS FOR NOISE BARRIERS. APPROVEDNOISESUPPLIERSLIST.PDF (OHIO.GOV).

IF BRIDGE COTE XL-70 W/SILANE IS CHOSEN, MEET THE REQUIREMENTS OF THE BRIDGE COTE XL-70 W/SILANE TECHNICAL DATA SHEET WITH THE EXCEPTION OF THE SURFACE PREPARATION THAT WILL STILL FOLLOW THE REQUIREMENTS LISTED UNDER C&MS 512 FOR EPOXY URETHANE SEALERS.

| PART.  | ESTIMATED QUANTITIES |       |        |       |  | DESCRIPTION | ABUT. | PIERS  | SUPER | GEN.  | SHEET |
|--------|----------------------|-------|--------|-------|--|-------------|-------|--------|-------|-------|-------|
|        | QTY                  | MEM   | EXT.   | TOTAL | UNIT   |             |       |        |       |       |       |
| 158    | 451                  | 30000 | 158    | FT    | SPECIAL - PRESSURE RELIEF JOINT, TYPE A  |             |       |        |       | 158   |       |
| LS     | 503                  | 11100 | LS     |       | COFFERDAMS AND EXCAVATION BRACING  |             | LS    |        |       |       |       |
| LS     | 503                  | 21300 | LS     |       | UNCLASSIFIED EXCAVATION  |             | LS    |        |       |       |       |
| LS     | 505                  | 11100 | LS     |       | PILE DRIVING EQUIPMENT MOBILIZATION  | LS          | LS    |        |       |       |       |
| 7010   | 507                  | 00600 | 7010   | FT    | 14" CAST-IN-PLACE REINFORCED CONCRETE PILES, DRIVEN  | 5060        | 1950  |        |       |       |       |
| 7450   | 507                  | 00650 | 7450   | FT    | 14" CAST-IN-PLACE REINFORCED CONCRETE PILES, FURNISHED   | 5350        | 2100  |        |       |       |       |
| 198337 | 509                  | 26000 | 198337 | LB    | GALVANIZED STEEL REINFORCEMENT   | 29535       | 51153 | 137649 |       |       |       |
| 2      | 511                  | 33500 | 2      | EACH  | SEMI-INTEGRAL DIAPHRAGM GUIDE  | 2           |       |        |       |       |       |
| 148    | 511                  | 34412 | 148    | CY    | CLASS OC2 CONCRETE WITH OC/OA, SUPERSTRUCTURE  |             |       | 148    |       |       |       |
| 436    | 511                  | 34447 | 436    | CY    | CLASS OC2 CONCRETE WITH OC/OA, BRIDGE DECK, AS PER PLAN  |             |       | 436    |       | 3/30  |       |
| 30     | 511                  | 34451 | 30     | CY    | CLASS OC2 CONCRETE WITH OC/OA, BRIDGE DECK (PARAPET), AS PER PLAN  |             |       | 30     |       | 3/30  |       |
| 70     | 511                  | 41012 | 70     | CY    | CLASS OC1 CONCRETE WITH OC/OA, PIER ABOVE FOOTINGS   |             | 70    |        |       |       |       |
| 252    | 511                  | 43512 | 252    | CY    | CLASS OC1 CONCRETE WITH OC/OA, ABUTMENT INCLUDING FOOTING  | 252         |       |        |       |       |       |
| 63     | 511                  | 46512 | 63     | CY    | CLASS OC1 CONCRETE WITH OC/OA, FOOTING   |             | 63    |        |       |       |       |
| 97     | 511                  | 51510 | 97     | CY    | CLASS OC2 CONCRETE, SIDEWALK   |             |       | 97     |       |       |       |
| 682    | 512                  | 10101 | 682    | SY    | SEALING OF CONCRETE SURFACES (EPOXY-URETHANE), AS PER PLAN   | 309         | 158   | 215    |       | 3/30  |       |
| 8      | 515                  | 15110 | 8      | EACH  | DRAPED STRAND PRESTRESSED CONCRETE BRIDGE I-BEAM MEMBERS, LEVEL 3, TYPE WF60-49 (104'-9" LONG)   |             |       | 8      |       |       |       |
| 8      | 515                  | 15110 | 8      | EACH  | DRAPED STRAND PRESTRESSED CONCRETE BRIDGE I-BEAM MEMBERS, LEVEL 3, TYPE WF60-49 (73'-0" LONG)  |             |       | 8      |       |       |       |
| 28     | 515                  | 20000 | 28     | EACH  | INTERMEDIATE DIAPHRAGMS  |             |       | 28     |       |       |       |
| 10     | 516                  | 13600 | 10     | SF    | 1" PREFORMED EXPANSION JOINT FILLER  |             |       | 10     |       |       |       |
| 101    | 516                  | 13900 | 101    | SF    | 2" PREFORMED EXPANSION JOINT FILLER  | 101         |       |        |       |       |       |
| 204    | 516                  | 14020 | 204    | FT    | SEMI-INTEGRAL ABUTMENT EXPANSION JOINT SEAL  | 204         |       |        |       |       |       |
| 8      | 516                  | 44101 | 8      | EACH  | ELASTOMERIC BEARING WITH INTERNAL LAMINATES AND LOAD PLATE (NEOPRENE), AS PER PLAN (14" x 21" x 2.5735" PAD WITH 16" x 25" 1.75" PL)   | 8           |       |        |       | 22/30 |       |
| 8      | 516                  | 44101 | 8      | EACH  | ELASTOMERIC BEARING WITH INTERNAL LAMINATES AND LOAD PLATE (NEOPRENE), AS PER PLAN (14" x 19.5" x 2.5735" PAD WITH 16" x 25" 1.75" PL) | 8           |       |        |       | 22/30 |       |
| 16     | 516                  | 44101 | 16     | EACH  | ELASTOMERIC BEARING WITH INTERNAL LAMINATES AND LOAD PLATE (NEOPRENE), AS PER PLAN (14" x 19.5" x 2.5735" PAD WITH 16" x 40" 1.75" PL) |             | 16    |        |       | 22/30 |       |
| 206    | 517                  | 75120 | 206    | FT    | RAILING (CONCRETE PARAPET WITH TWIN STEEL TUBE RAILING)  |             |       | 206    |       |       |       |
| 2      | 518                  | 12301 | 2      | EACH  | SCUPPERS, INCLUDING SUPPORTS, AS PER PLAN  |             |       | 2      |       | 27/30 |       |
| 213    | 518                  | 40000 | 213    | FT    | 6" PERFORATED CORRUGATED PLASTIC PIPE  | 213         |       |        |       |       |       |
| 54     | 518                  | 40010 | 54     | FT    | 6" NON-PERFORATED CORRUGATED PLASTIC PIPE, INCLUDING SPECIALS  | 54          |       |        |       |       |       |
| 6      | 523                  | 20000 | 6      | EACH  | DYNAMIC LOAD TESTING   | 4           | 2     |        |       |       |       |
| 561    | 526                  | 30011 | 561    | SY    | REINFORCED CONCRETE APPROACH SLABS WITH OC/OA (T=17"), AS PER PLAN   |             |       |        |       | 561   | 23/30 |
| 79     | 526                  | 90010 | 79     | FT    | TYPE A INSTALLATION  |             |       | 79     |       |       |       |
| 165    | 607                  | 39910 | 165    | FT    | VANDAL PROTECTION FENCE, 8' STRAIGHT, COATED FABRIC  |             |       | 165    |       |       |       |
| 165    | 607                  | 39930 | 165    | FT    | VANDAL PROTECTION FENCE, 12' CURVED, COATED FABRIC   |             |       | 165    |       |       |       |
| 20     | 608                  | 53020 | 20     | SF    | DETECTABLE WARNING   |             |       | 20     |       |       |       |
| 110    | 625                  | 25504 | 110    | FT    | CONDUIT, 3", 725.051   |             |       |        |       | 110   |       |
| 1      | 625                  | 30706 | 1      | EACH  | PULL BOX, 725.08, 24"  |             |       |        |       | 1     |       |
| LS     | 690                  | 98400 | LS     |       | SPECIAL - MISC.: TEMPORARY SURCHARGE   |             |       |        |       | LS    | 2/30  |
| 33     | 846                  | 00110 | 33     | CF    | POLYMER MODIFIED ASPHALT EXPANSION JOINT SYSTEM  |             |       |        |       | 33    |       |

DESIGN AGENCY: **JACOBS**  
 1880 WATCROSS ROAD  
 CINCINNATI, OHIO 45240

DATE: 5/2022  
 REVIEWED: JTC  
 DRAWN: MM  
 CHECKED: FBW

STRUCTURE FILE NUMBER: 2900213

GENERAL NOTES II & ESTIMATED QUANTITIES  
 BRIDGE NO. GRE-035-0627  
 VALLEY/TREBEIN ROAD OVER U.S. 35

GRE-US 35-5.63  
 PID No. 107217

3 / 30



575  
698

|                       |         |        |        |
|-----------------------|---------|--------|--------|
| DESIGNED              | MM      | MM     | MM     |
| CHECKED               | FBW     |        |        |
| DRAWN                 | MM      | MM     | MM     |
| REVIEWED              | JTC     | JTC    | JTC    |
| DATE                  | 5/2022  | 5/2022 | 5/2022 |
| STRUCTURE FILE NUMBER | 2900213 |        |        |

REAR ABUTMENT  
 BRIDGE NO. GRE-035-0627  
 VALLEY/TREBEIN ROAD OVER U.S. 35


GRE-US 35-5.63  
 PID No. 107217

035\_0627AR001.dgn 11/30/2022 9:56:32 AM Jason.Centers@jacobs.com

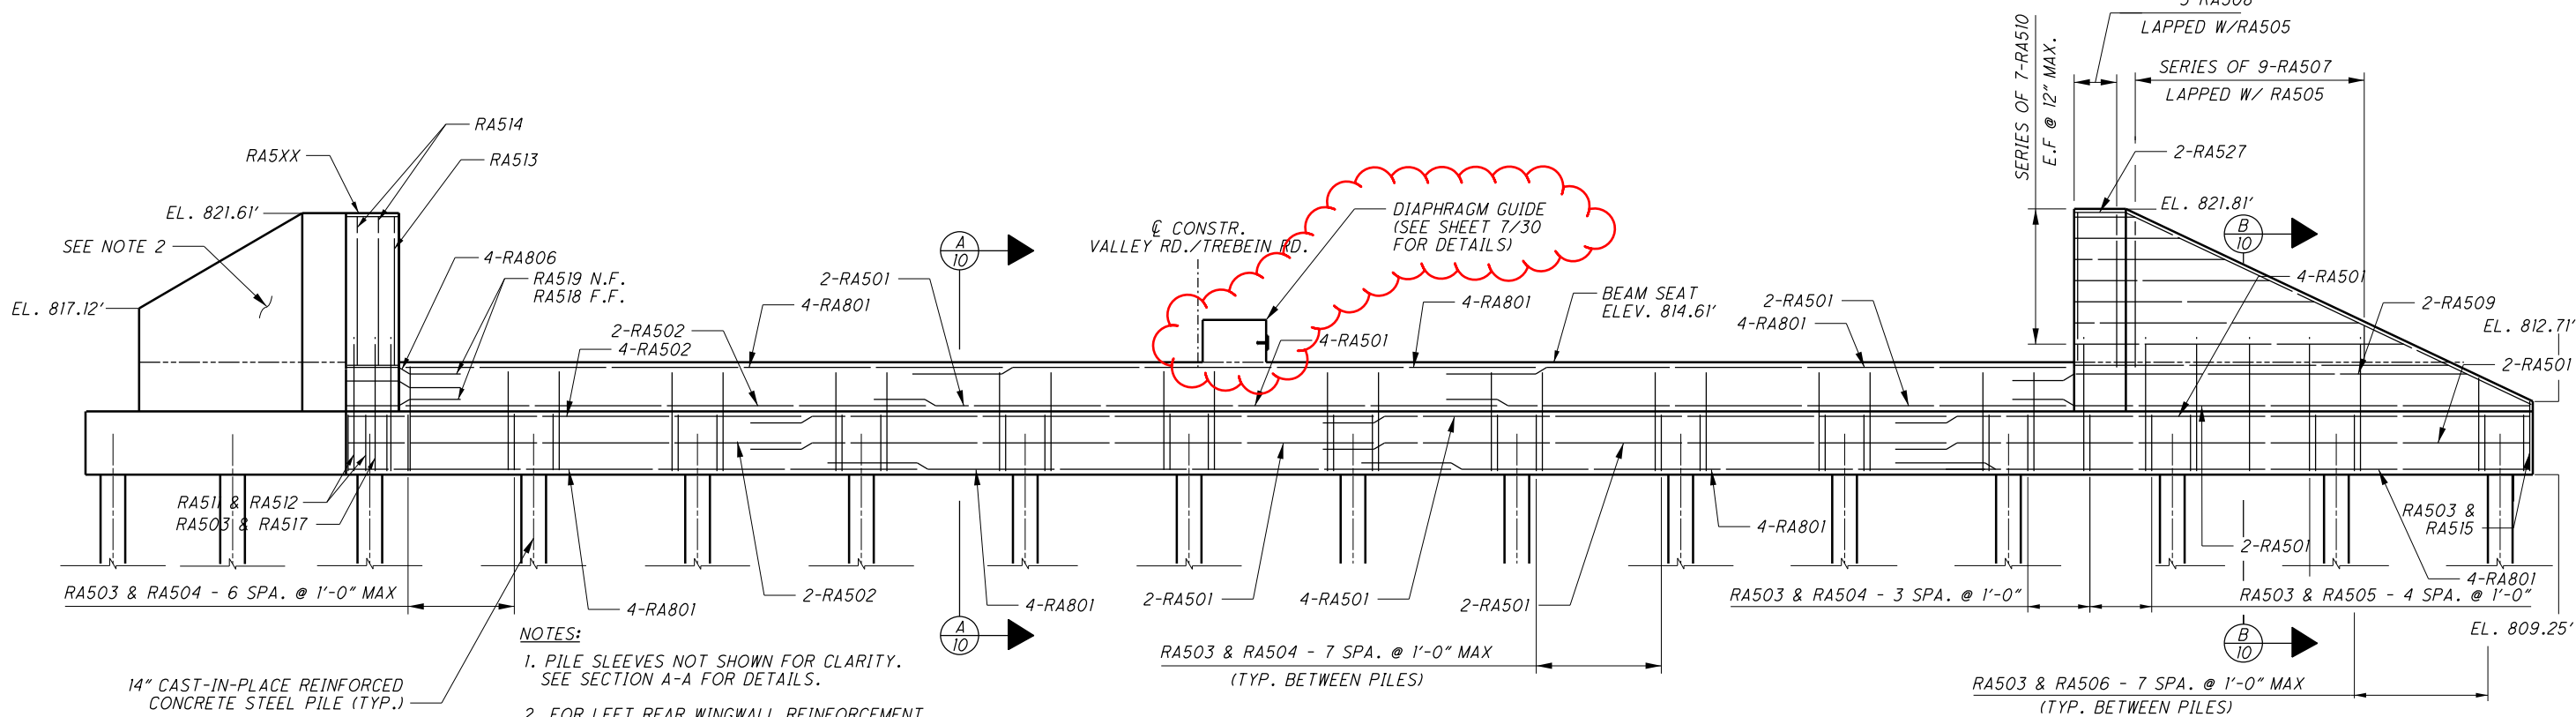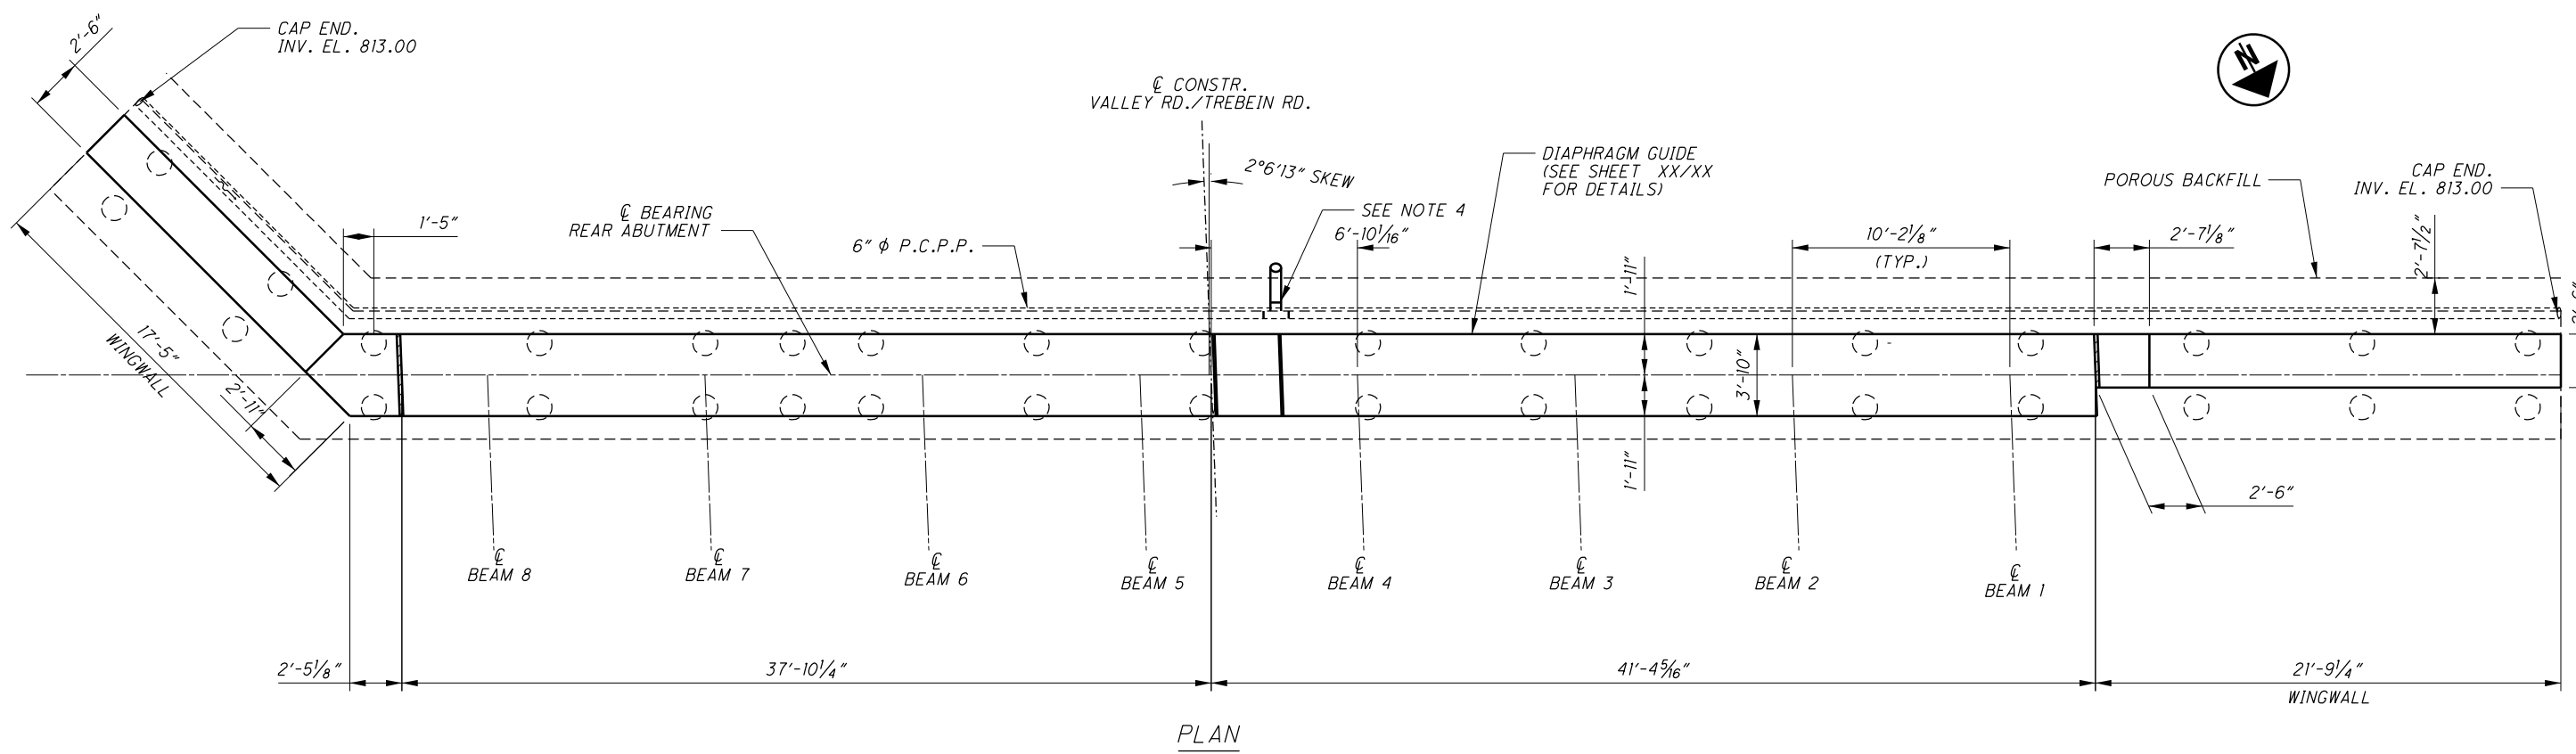


- NOTES:**
- PILE SLEEVES NOT SHOWN FOR CLARITY. SEE SECTION A-A FOR DETAILS.
  - FOR LEFT REAR WINGWALL REINFORCEMENT DETAIL, SEE SHEET 8.
  - LAP LENGTHS:  
 NO. 5 BAR = 3'-1"  
 NO. 8 BAR = 5'-4"
  - 6" NPCPP FITTING AS REQUIRED, INVERT EL. 812.25. PAYMENT FOR PIPE FITTING AND CONNECTING PIPE TO MSE WALL DRAINAGE IS INCLUDED WITH BRIDGE QUANTITIES

5. THIS STRUCTURE REQUIRES GROUNDING RODS AND GROUNDING CONDUCTOR RISER CABLES EMBEDDED IN THE ABUTMENT. SEE STD. DWG. HL-50.21 FOR ADDITIONAL INFORMATION.

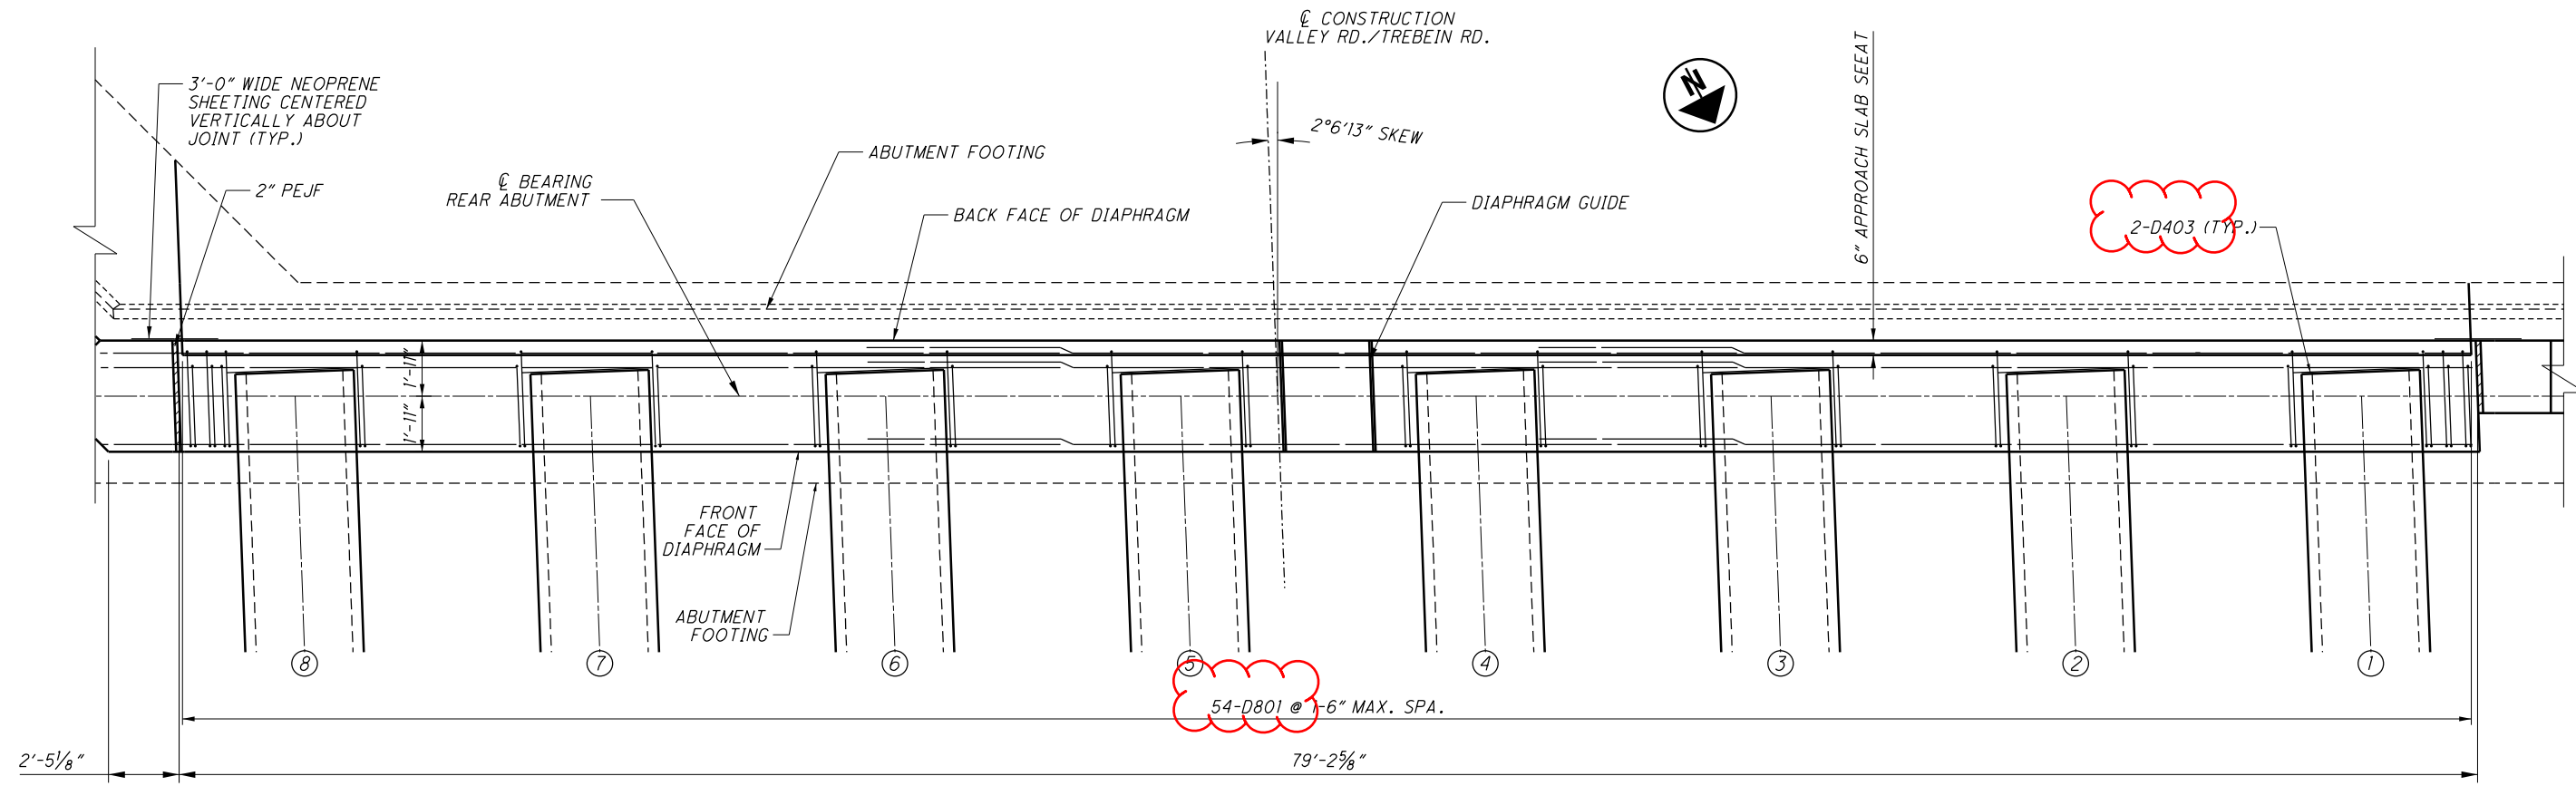




REAR ABUTMENT DIAPHRAM PLAN

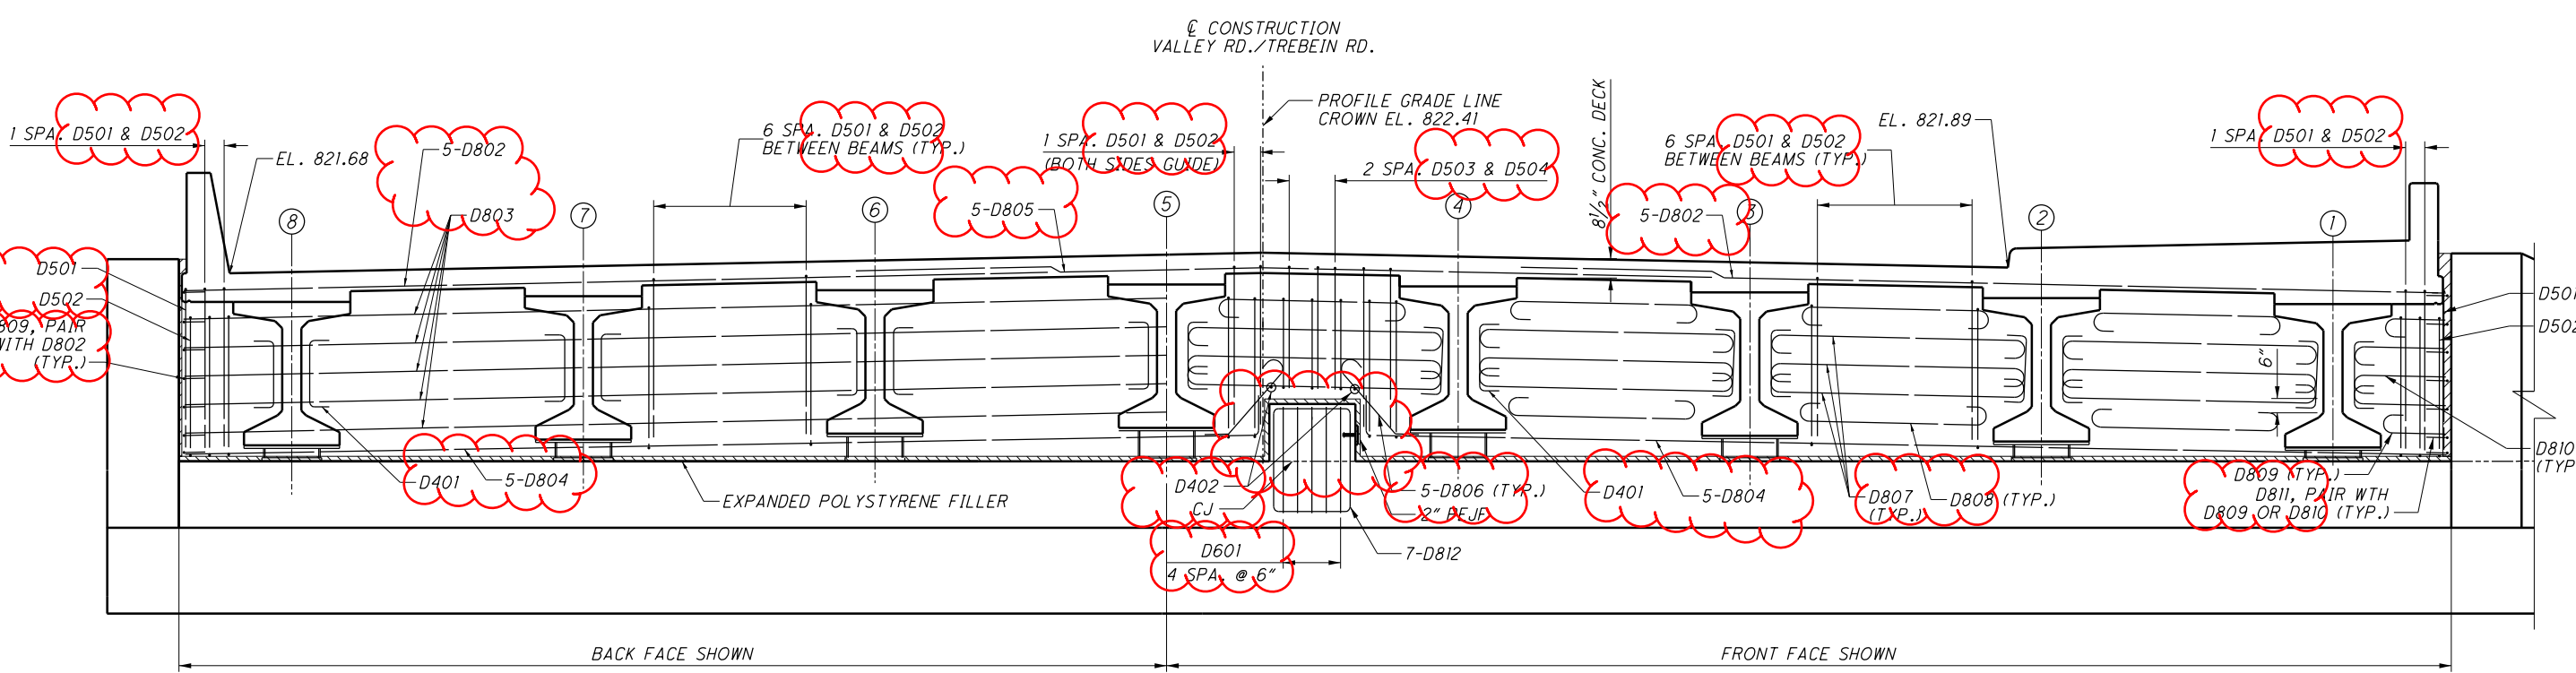

REAR ABUTMENT DIAPHRAM ELEVATION

- NOTES
1. WINGWALLS AND ABUTMENT REINFORCING NOT SHOWN FOR CLARITY.
  2. REINFORCING STEEL MIN. LAP LENGTHS:  
 NO. 5 BARS: 2'-5"  
 NO. 8 TOP BARS: 6'-8"  
 ALL OTHER NO. 8 BARS: 5'-4"

035\_0627/AR002.dgn 11/30/2022 10:07:43 AM Jason.Center@jacobs.com

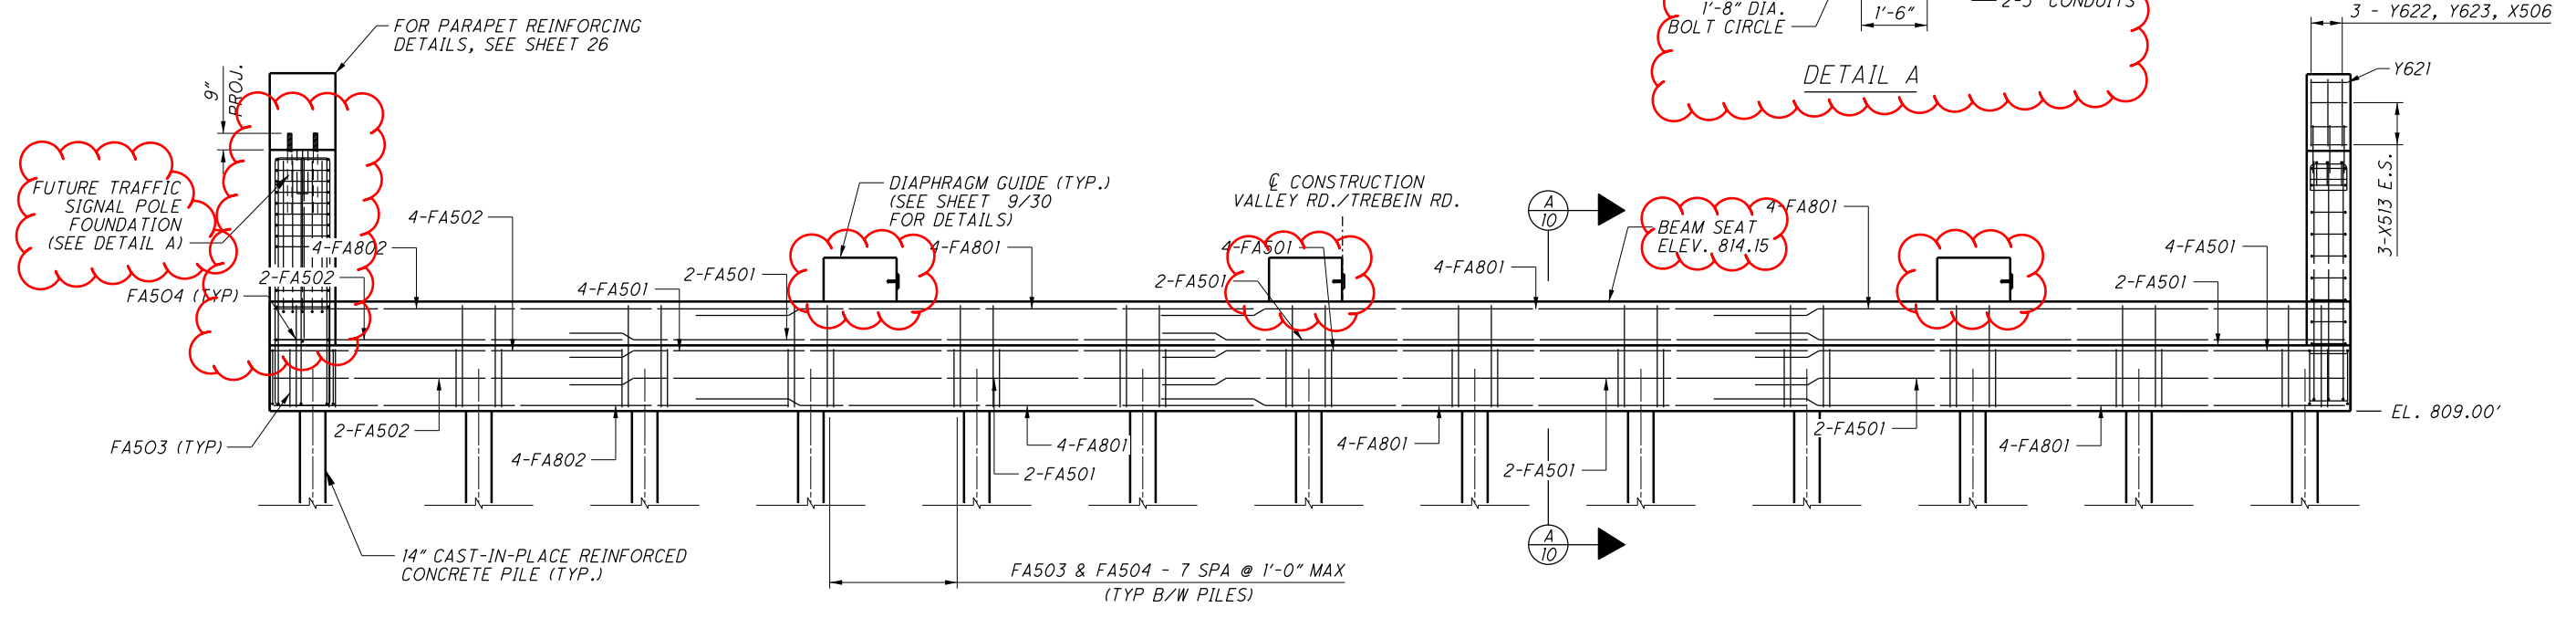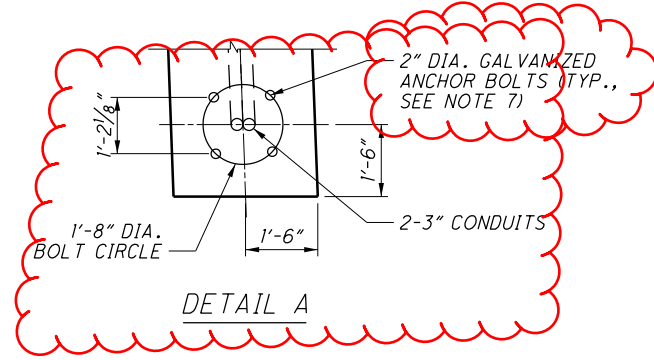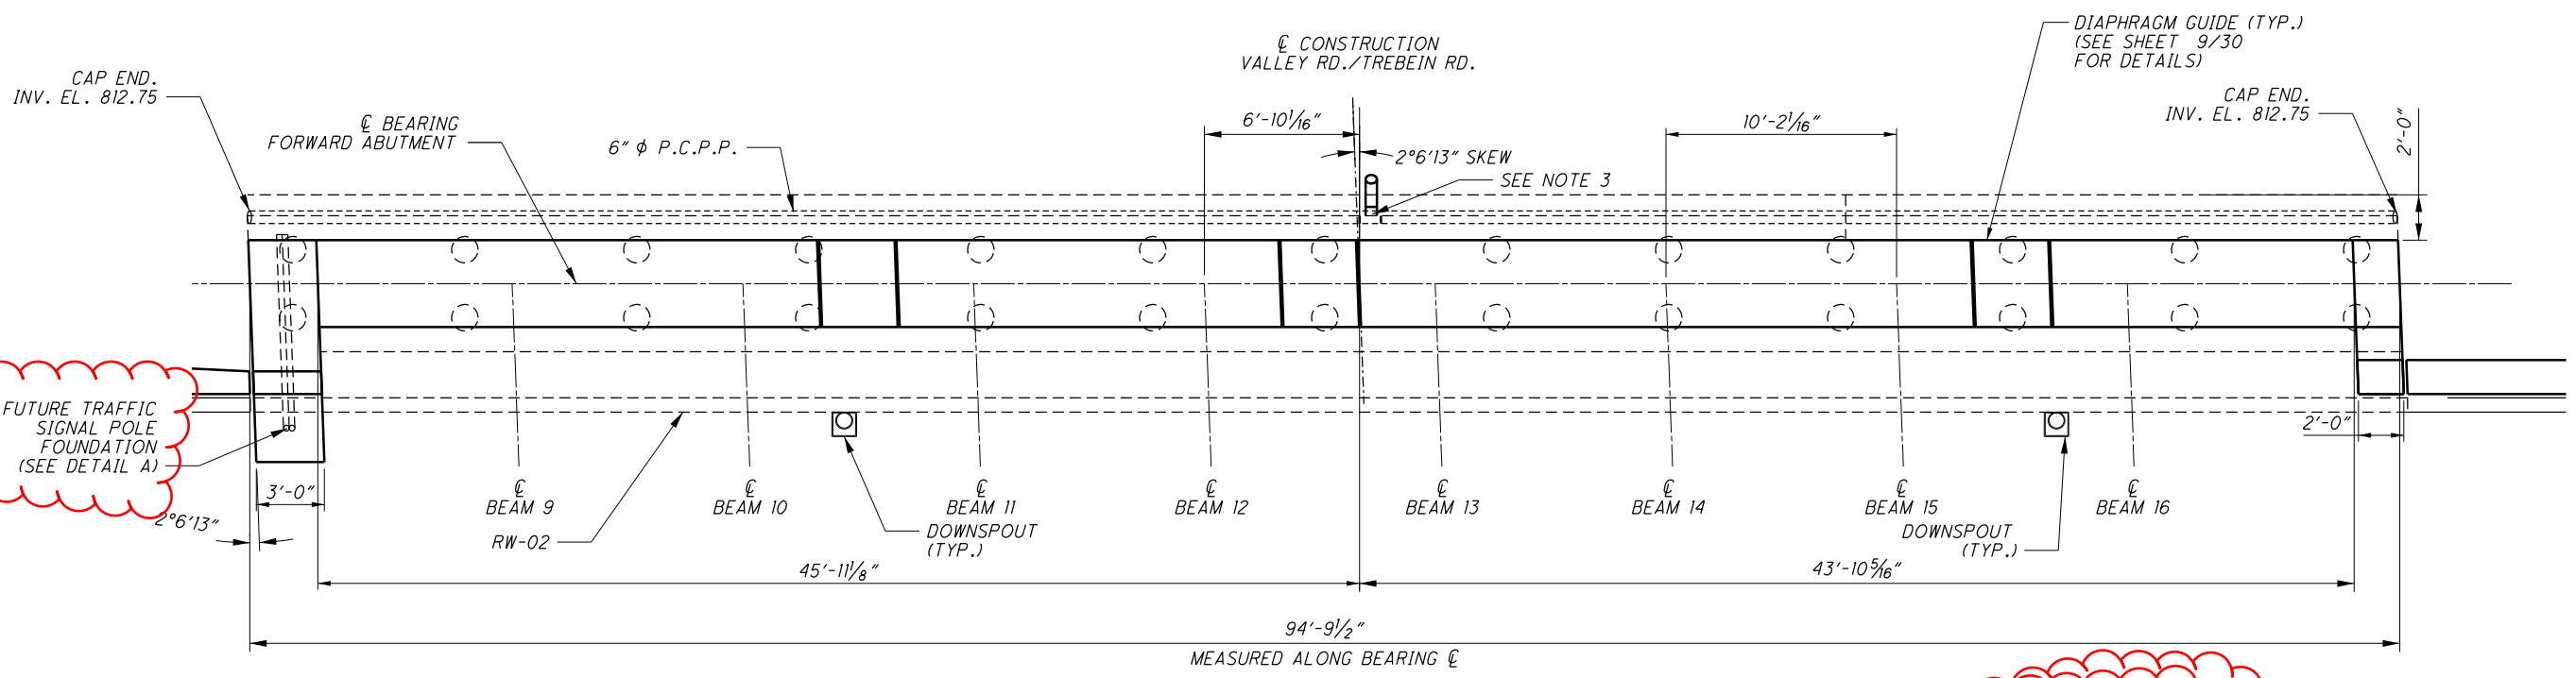


- NOTES:
1. PILE SLEEVES NOT SHOWN FOR CLARITY. SEE SECTION A-A FOR DETAILS.
  2. LAP LENGTHS:  
 NO. 5 BAR = 3'-1"  
 NO. 8 BAR = 5'-4"
  3. 6" NPCPP FITTING AS REQUIRED, INVERT EL. 812.00. PAYMENT FOR PIPE FITTING AND CONNECTING PIPE TO MSE WALL DRAINAGE IS INCLUDED WITH BRIDGE QUANTITIES.
  4. SEE SHEET 11/30 FOR CUTOFF WALL DETAILS.
  5. THIS STRUCTURE REQUIRES GROUNDING RODS AND GROUNDING CONDUCTOR RISER CABLES EMBEDDED IN THE ABUTMENT. SEE STD. DWG. HI-50-21 FOR ADDITIONAL INFORMATION.
  6. FOR ADDITIONAL SIGNAL POLE FOUNDATION DETAILS, SEE STD. DWGS. TC 87.27 DESIGN NO. 127 & 128, 21 & 21.
  7. GALVANIZED ANCHOR BOLTS ARE INCLUDED WITH ITEM 512, CLASS OC1 CONCRETE WITH OC/OA, ABUTMENT INCLUDING FOOTING FOR PAYMENT.


035\_0627/AF001.dgn 11/30/2022 10:13:33 AM Jason.Centerse@jacobs.com

035\_0627/AF002.dgn 11/30/2022 10:19:06 AM Jason.Centers@jacobs.com

FUTURE TRAFFIC SIGNAL POLE FOUNDATION

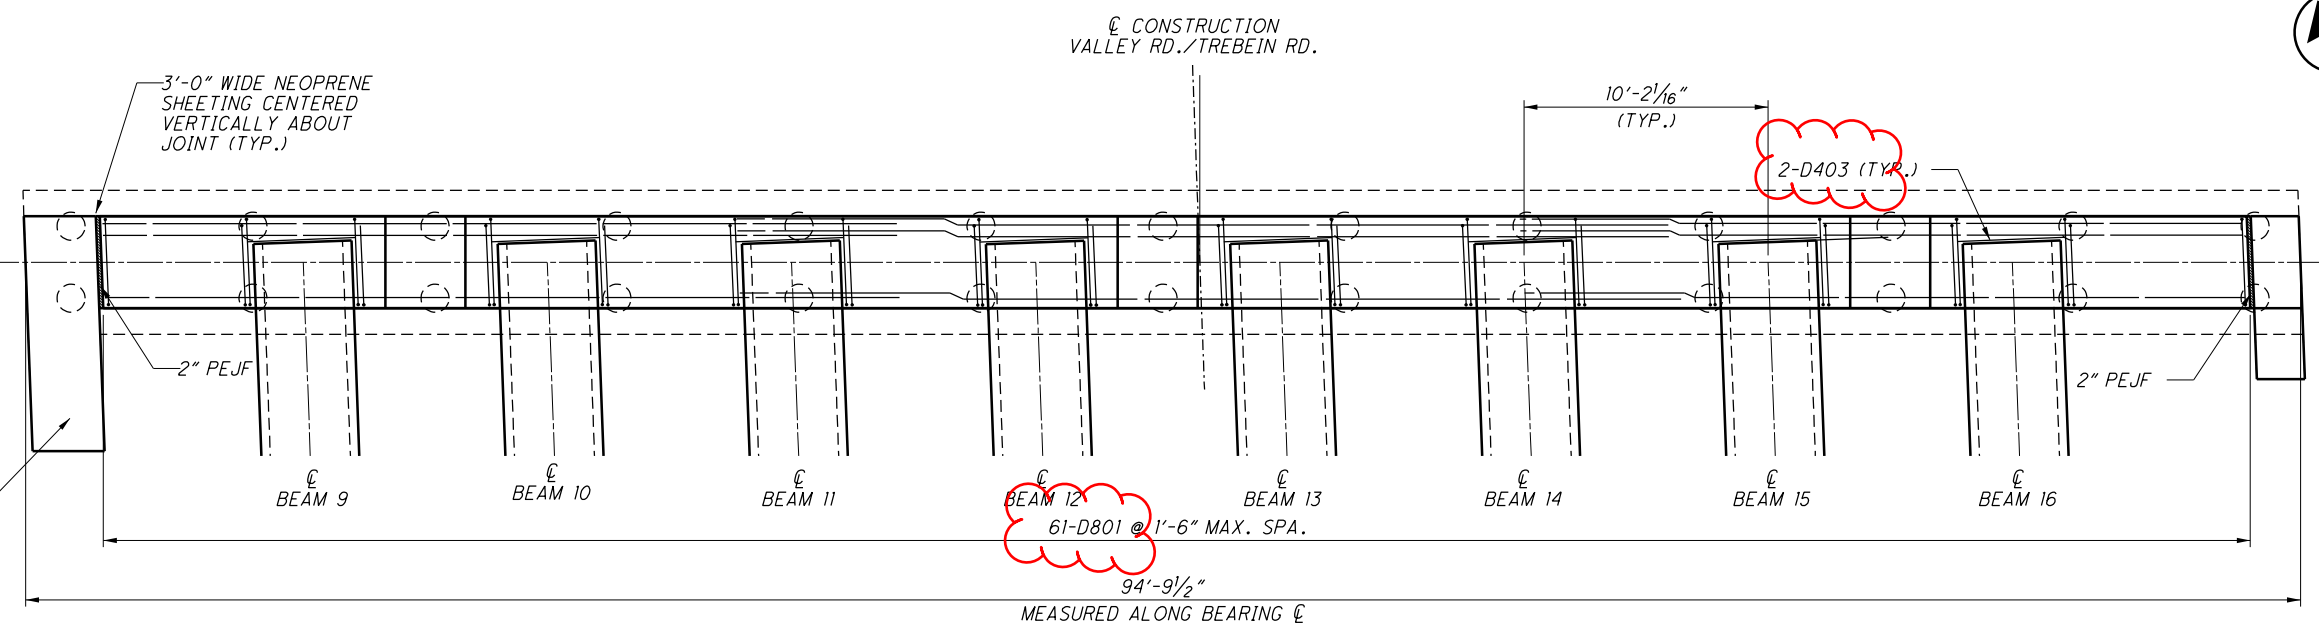

PLAN



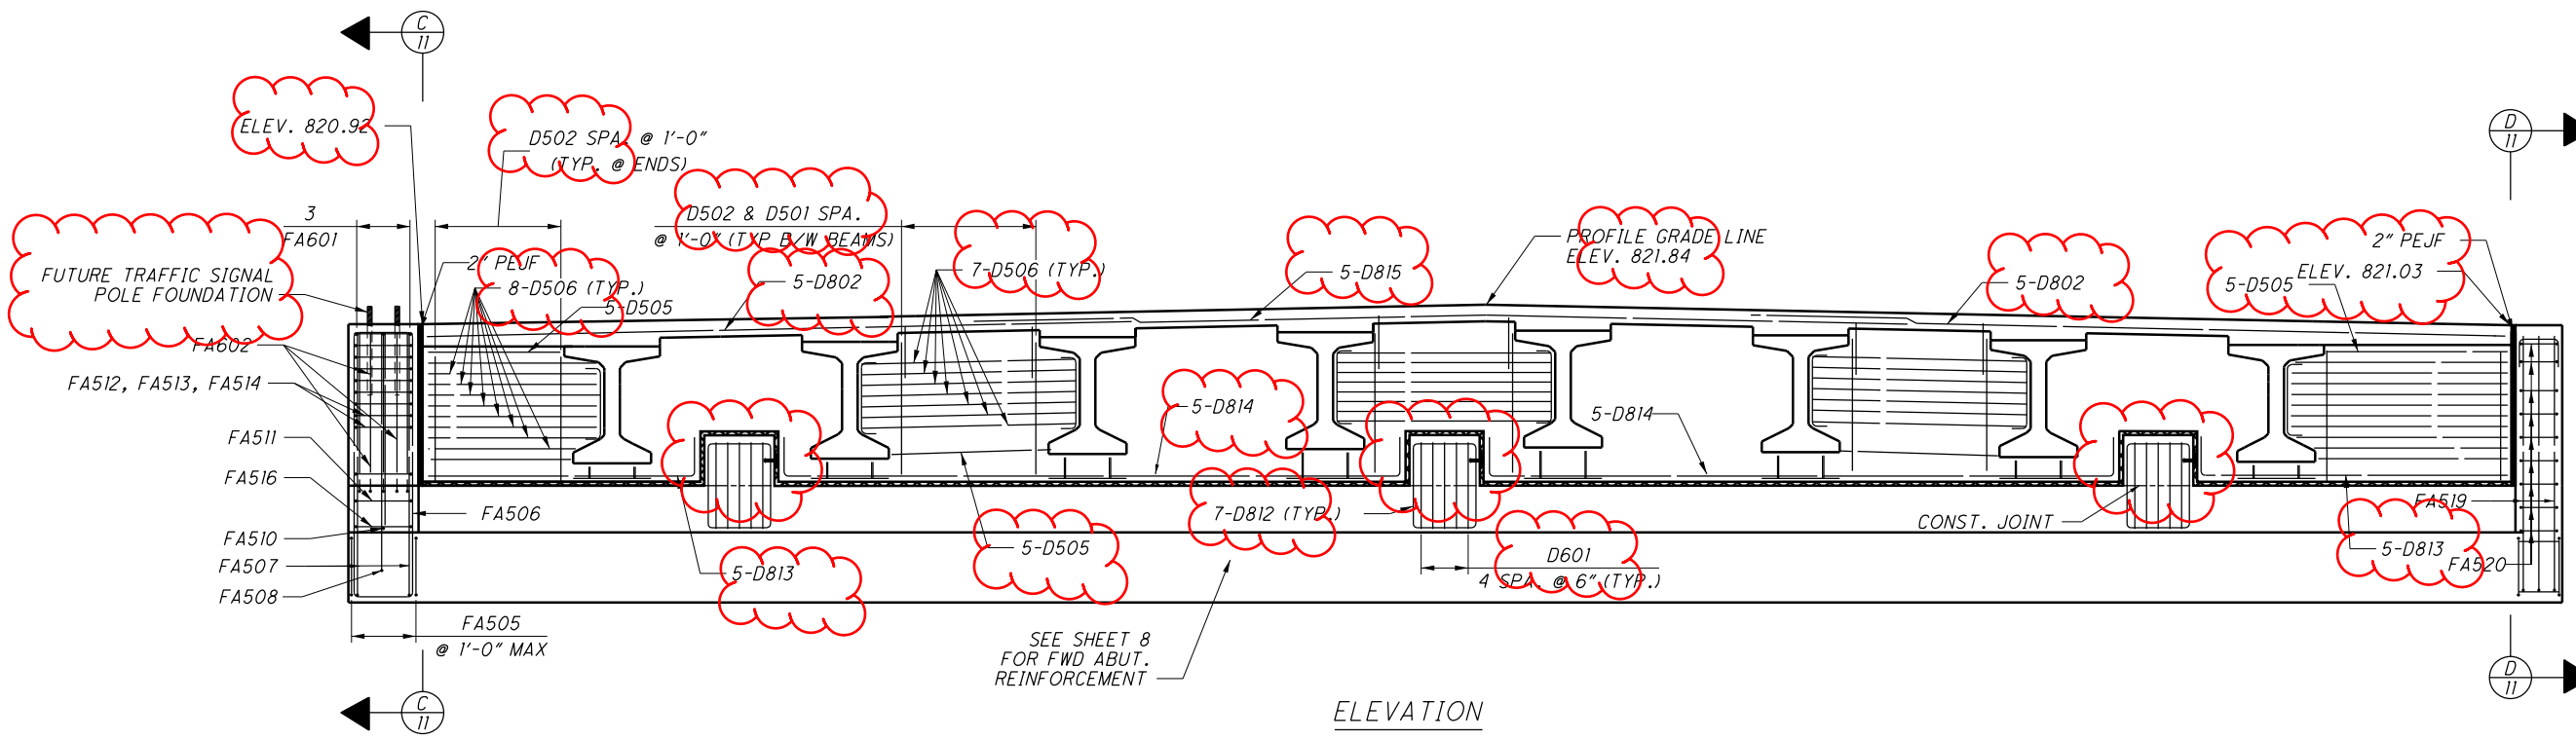


ELEVATION



|   |                          |
|---|--------------------------|
| <b>JACOBS</b><br>DESIGN AGENCY<br>1880 WATCROSS ROAD<br>CINCINNATI, OHIO 45240                    |                          |
| DESIGNED<br>MM<br>CHECKED<br>FBW  | DRAWN<br>MM<br>REVISIONS |
| REVIEWED<br>JTC   | DATE<br>5/2022           |
| STRUCTURE FILE NUMBER<br>2900213  |                          |
| FORWARD ABUTMENT DIAPHRAGM DETAILS<br>BRIDGE NO. GRE-035-0627<br>VALLEY/TREBEIN ROAD OVER U.S. 35 |                          |
| <b>GRE-US 35-5.63</b><br>PID No. 107217   | 9 / 30<br>581<br>698     |

035\_0627SD001.dgn 9/19/2022 9:06:29 AM Nawaza

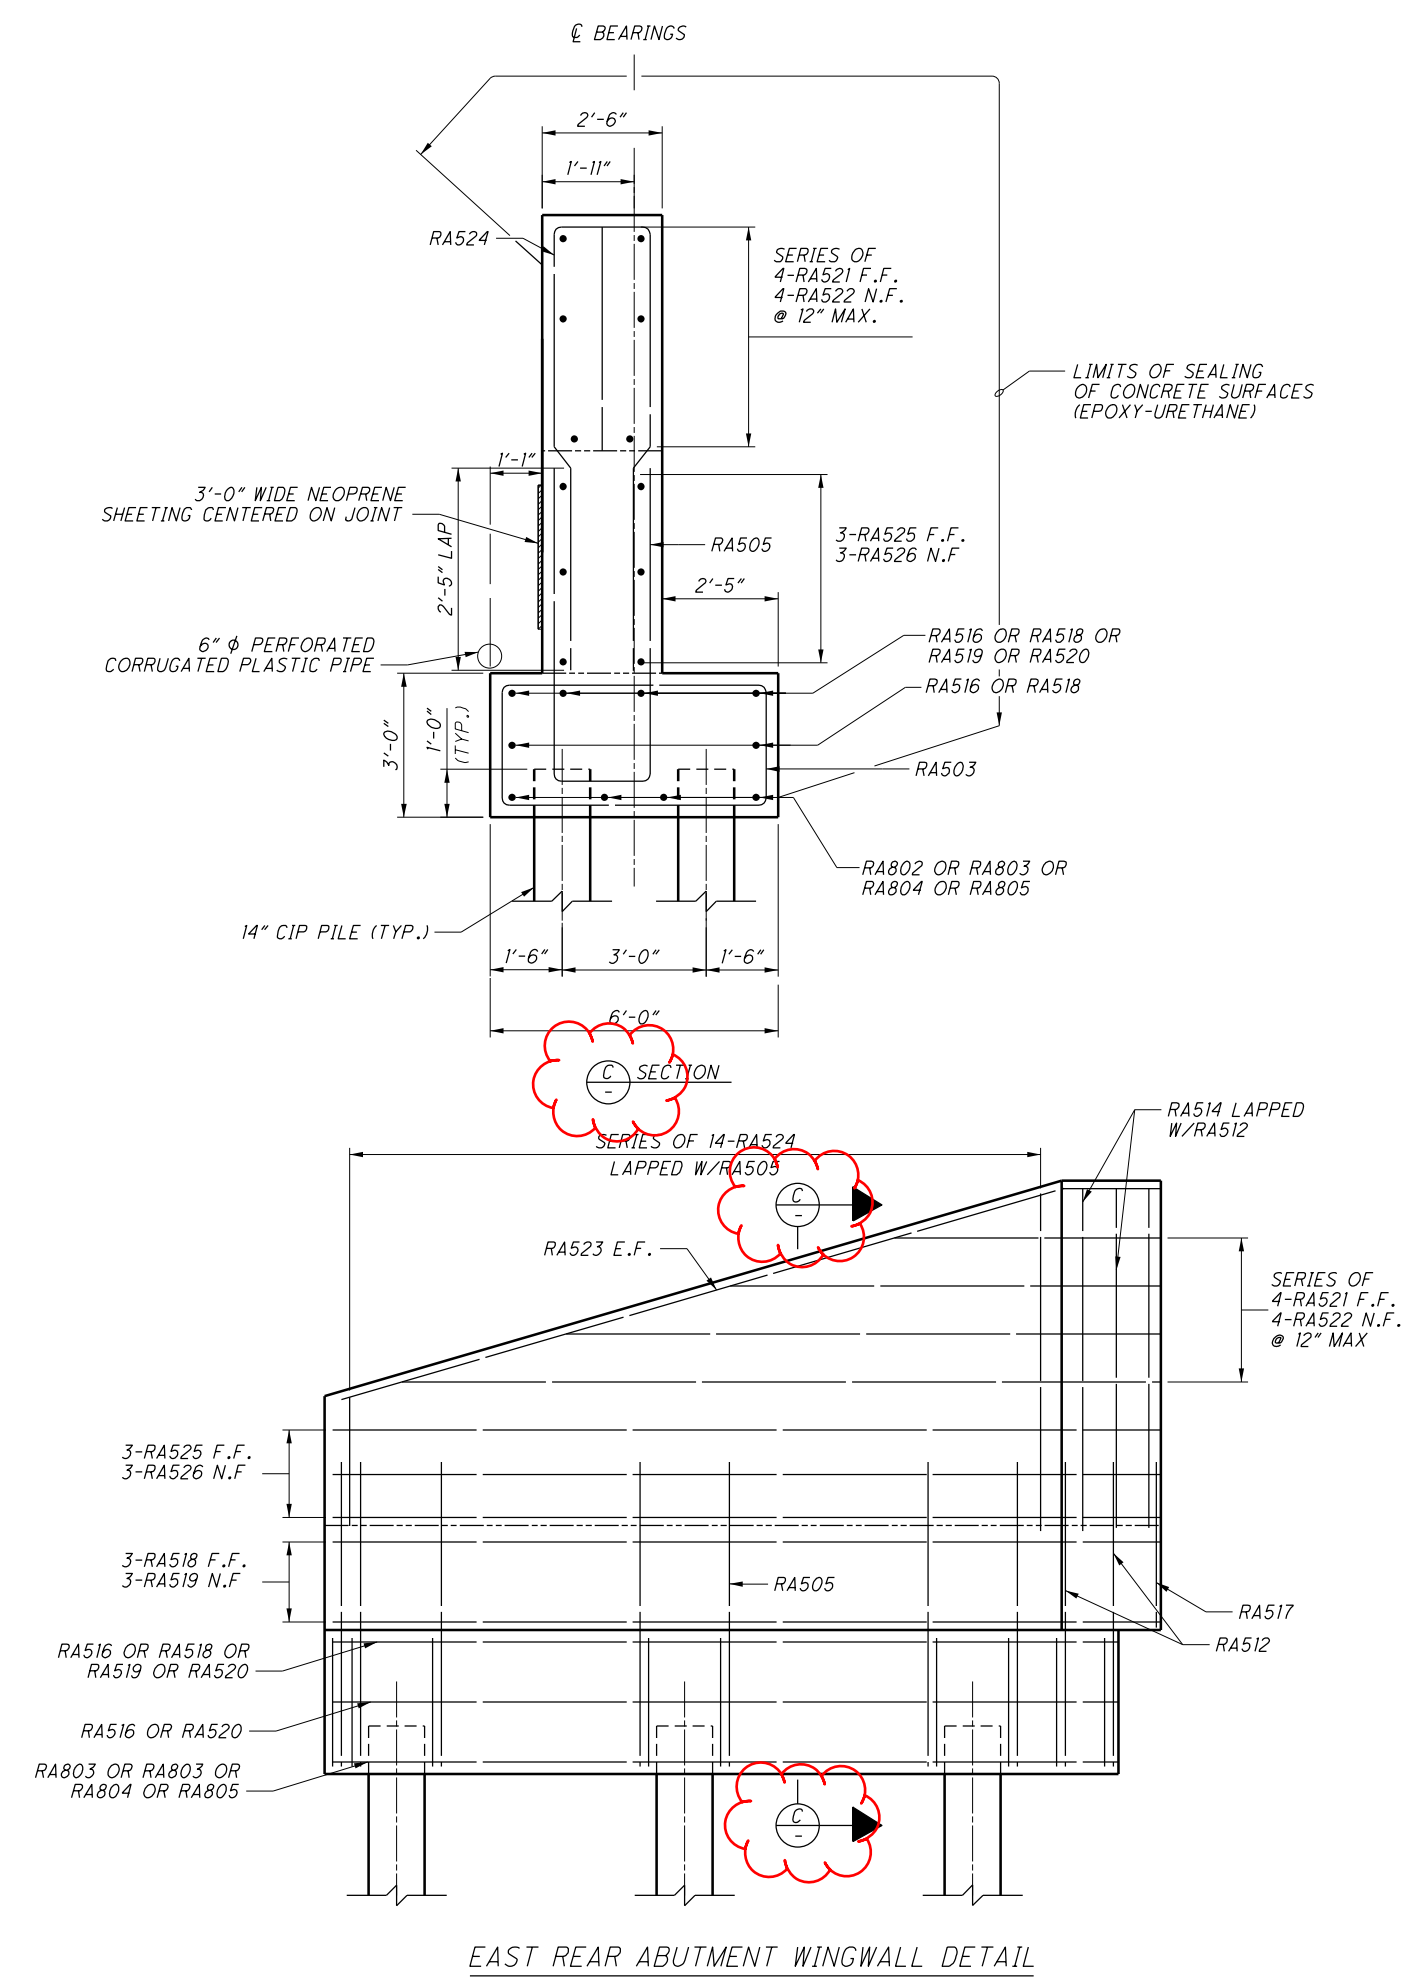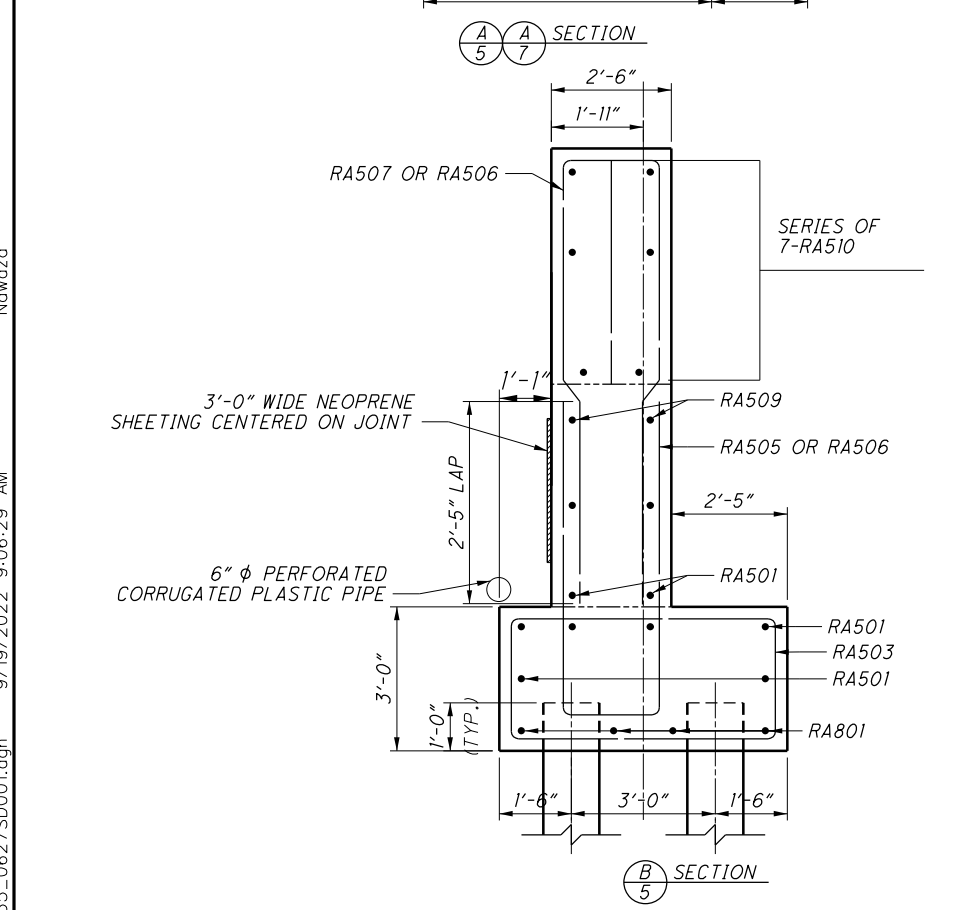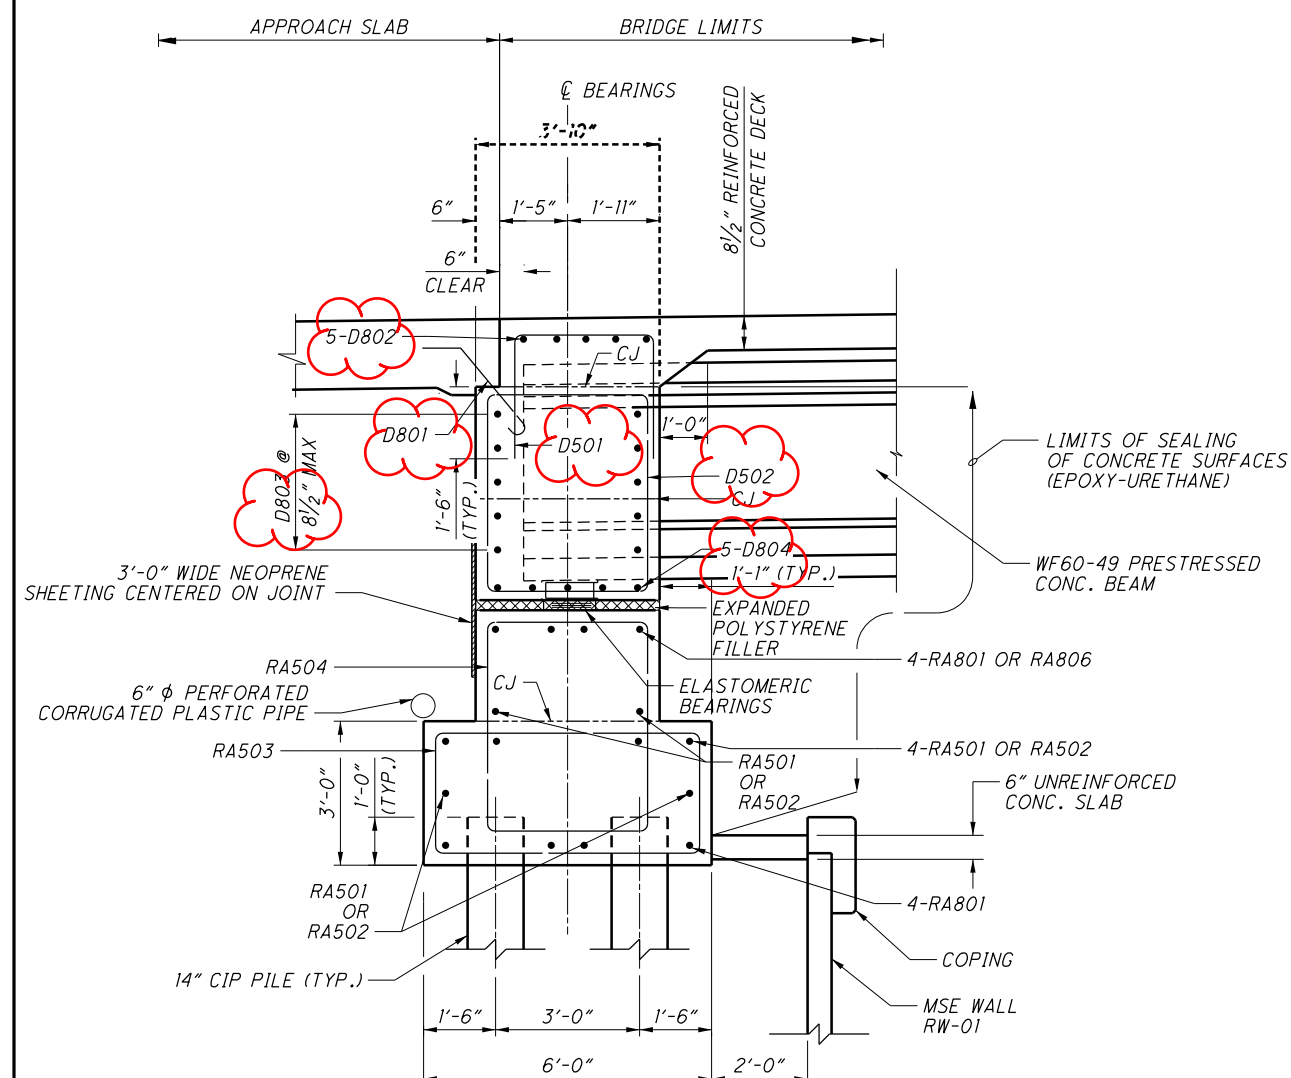

DESIGN AGENCY  
**JACOBS**  
1880 WATCROSS ROAD  
CINCINNATI, OHIO 45240

DESIGNED  
MM  
CHECKED  
FBW

DRAWN  
MM  
REVISED

REVIEWED  
JTC

DATE  
5/2022

STRUCTURE FILE NUMBER  
2900213


ABUTMENT SECTION & DETAILS  
BRIDGE NO. GRE-035-0627  
VALLEY/TREBEIN ROAD OVER U.S. 35

GRE-US 35-5.63  
PID No. 107217


10/30

582  
698





035\_0627SD001a.dgn 9/28/2022 8:37:27 AM Nowaza

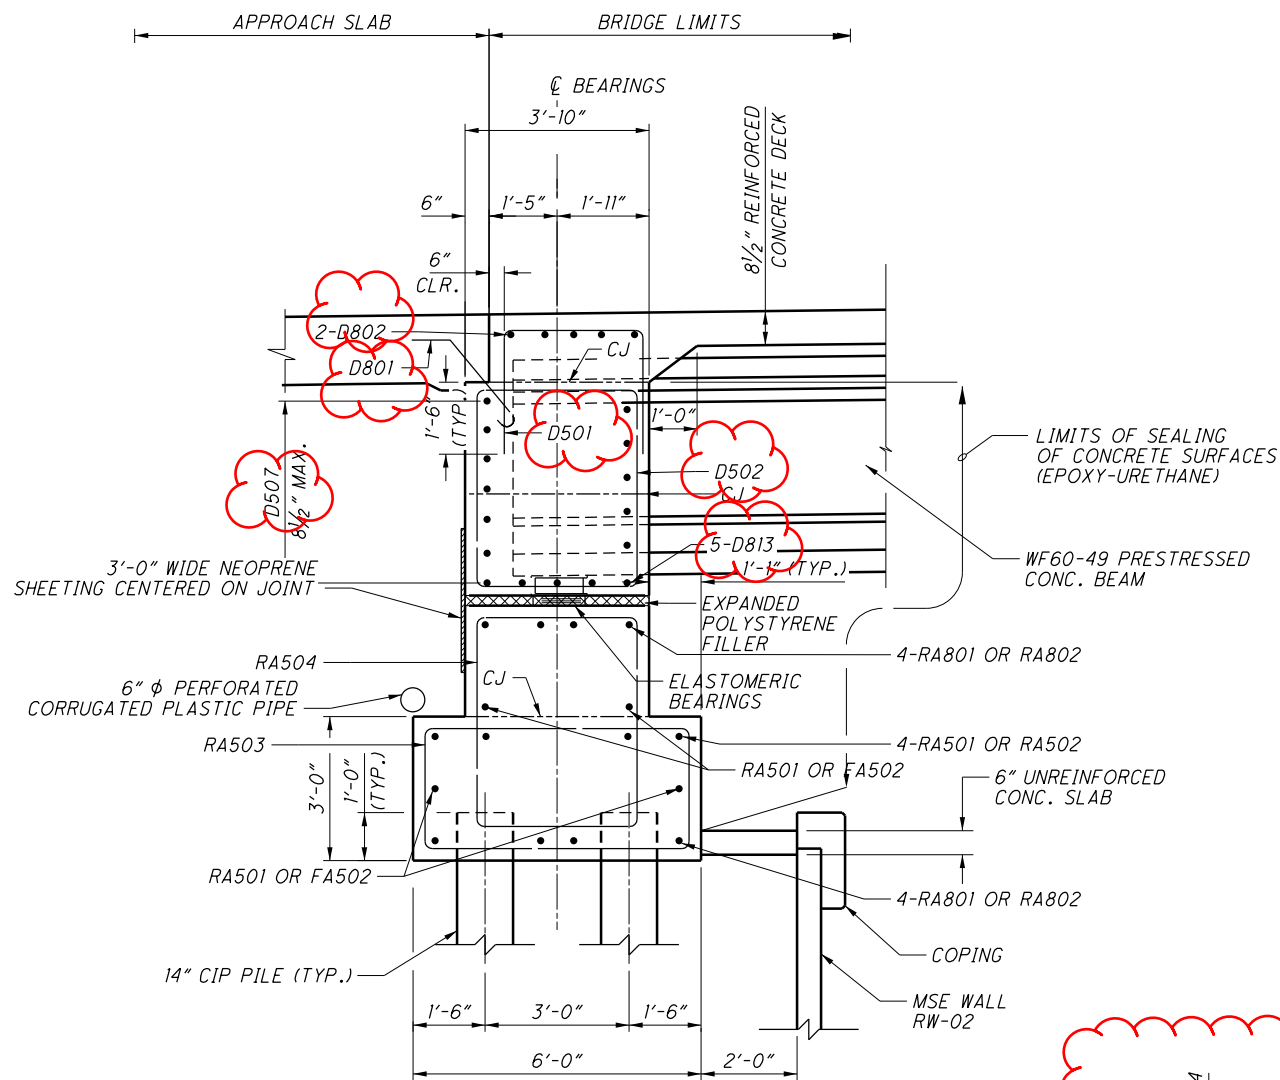

A 5 A 7 SECTION

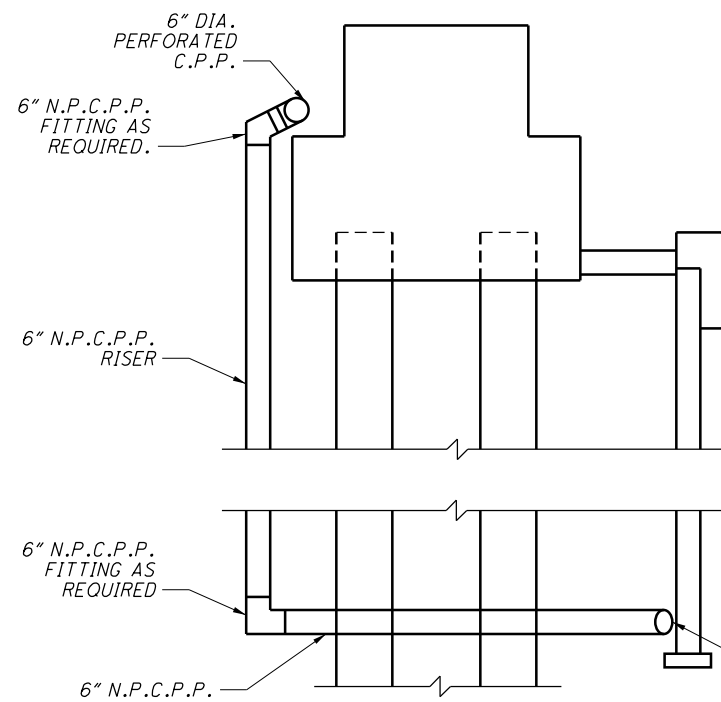

DRAINAGE DETAIL

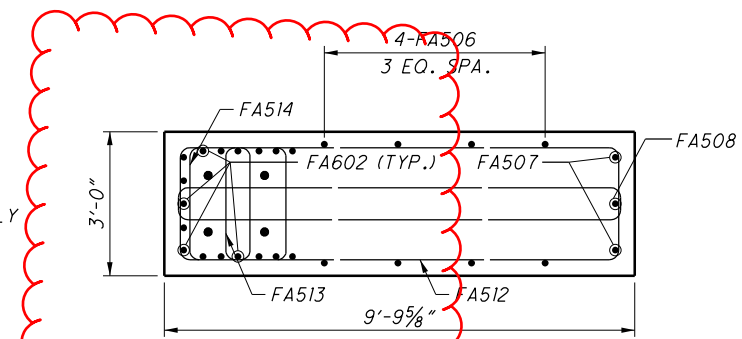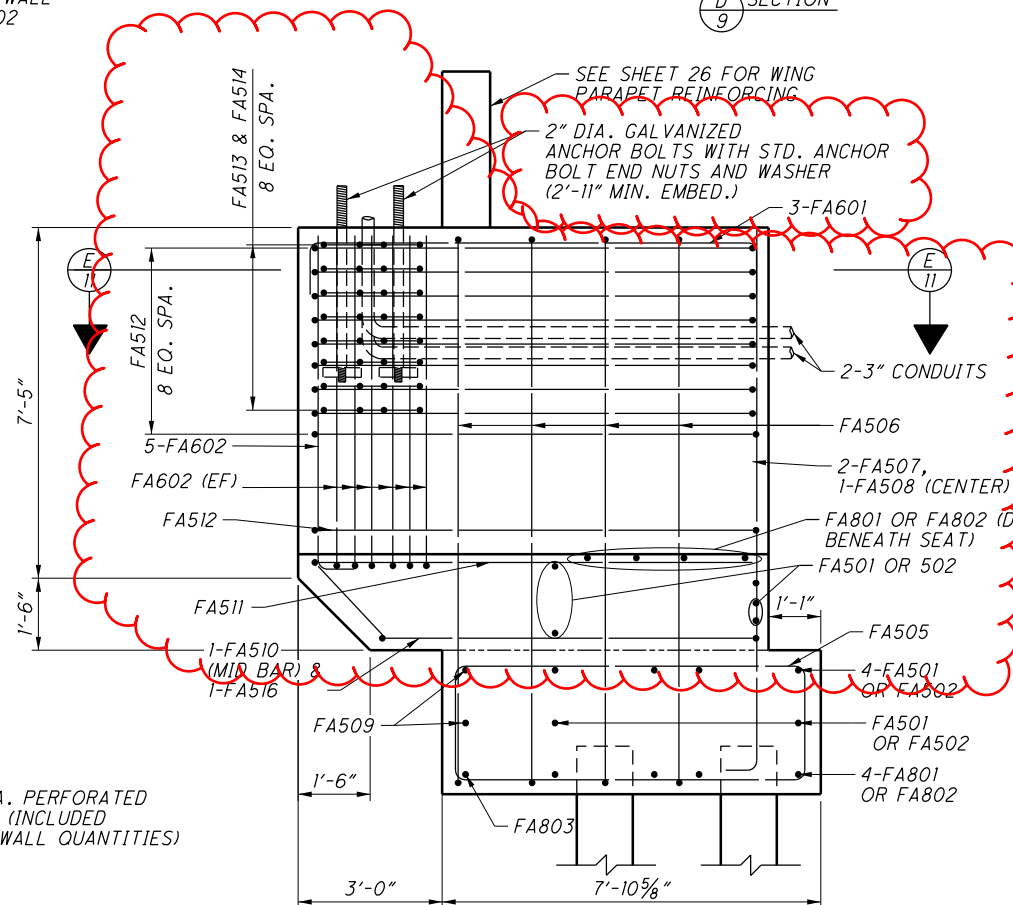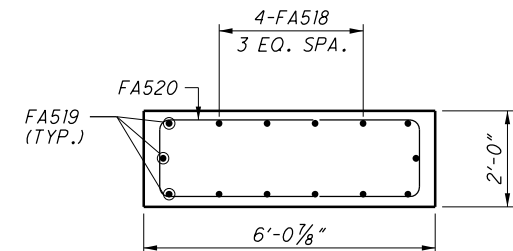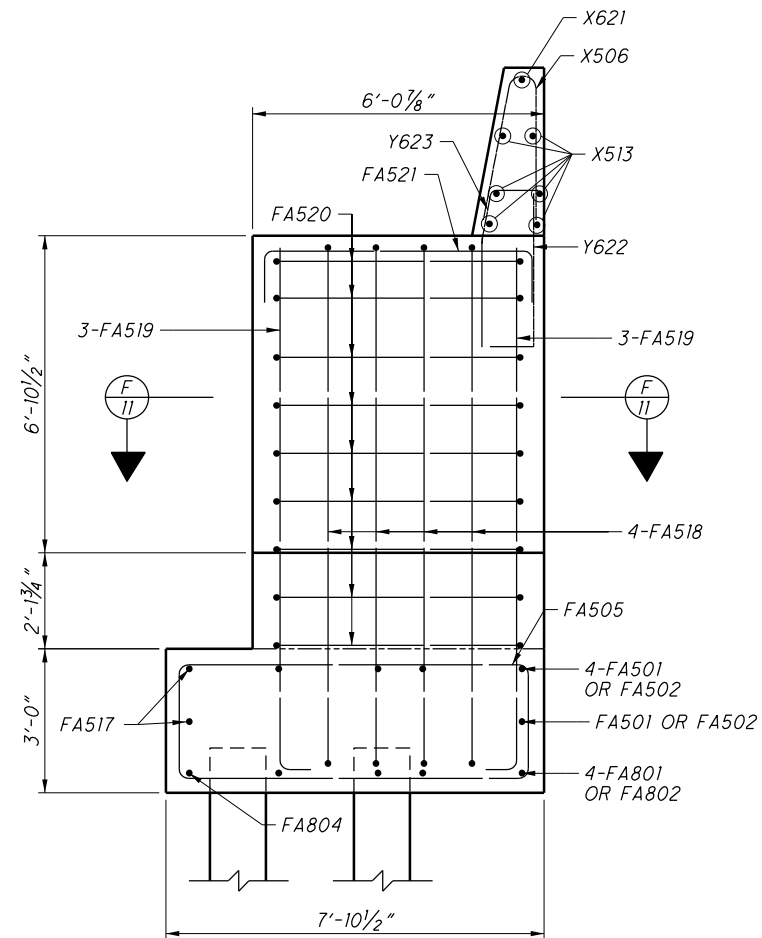



VARIES 78'-10" TO 89'-4 3/4" OUT/OUT DECK

76'-0" TOE/TOE PARAPET

CONSTRUCTION VALLEY/TREBEIN ROAD

12'-0" CURVED VANDAL PROTECTION FENCE, SEE STD. DWG. VPF-1-90

TWIN STEEL TUBE BRIDGE RAILING (SEE STD. DWG. TST-1-99)

BRIDGE SIDEWALK RAILING CONCRETE BARRIER, SEE STD. DWG. BR-2-15 (SEE NOTE 3)

LEVEL CJ  
\* S503 (TYP.) @ 6" MAX.

CONCRETE INTERMEDIATE DIAPHRAGM, SEE STD. DWG. PSID-1-13 (TYP.)

PROFILE GRADE & CROWN

2 1/2" CLEAR  
BEAM (TYP.)

8 1/2" REINFORCED CONCRETE DECK

S505 @ 6" MAX.  
VARIES, 10 1/2" MIN. (DECK & HAUNCH)

8'-0" STRAIGHT VANDAL PROTECTION FENCE, SEE STD. DWG. VPF-1-90

SINGLE SLOPE CONCRETE BARRIER RAILING, SEE STD. DWG. SBR-1-13

LIMITS OF SEALING OF CONCRETE SURFACES (EPOXY-URETHANE) (TYP.)

WF60-49 PRESTRESSED CONCRETE BEAM (TYP.)

\* S403 (TYP.) @ 6" MAX.

\* BUNDLED W/ S513

1  
9

2  
10

3  
11

4  
12

5  
13

6  
14

7  
15

8  
16

VARIES 3'-10" TO 8'-4 1/8"

8 - WF60-49, 7 SPA @ 10'-2" = 71'-2"

VARIES 3'-10" TO 9'-10"

### TRANSVERSE SECTION

15-S512 OR S513 BUNDLED W/ S503 OR S505

6 SETS OF FANNED S503, S501, S507 (TOP AND BOT.)

337-S512 BUNDLED W/ S503 TOP  
337-S403 BUNDLED W/ S501 BOT.

SERIES OF 9-S506 (LAP W/ S503) TOP  
SERIES OF 9-S506 (LAP W/ S501) BOT.

4'-8 3/16" R

# TOP: 11-S401 OR S402 @ EQ. SPA.  
10-S601 OR S602 @ EQ. SPA. (OVER PIERS)  
BOT: 13-S501 OR S502 @ EQ. SPA.  
12-S601 OR S602 @ EQ. SPA. (OVER PIERS)

## TOP: 4-S401 OR S402 @ EQ. SPA.  
3-S601 OR S602 @ EQ. SPA. (OVER PIERS)  
BOT: 5-S501 OR S502 @ EQ. SPA.  
10-S601 OR S602 @ EQ. SPA. (OVER PIERS)  
THIRD: 6-S601 OR S602 @ 6" SPA. (OVER PIERS)

& TOP: 4-S509  
BOT: 4-S509

&& TOP: SERIES OF 3-S509  
BOT: SERIES OF 3-S509

&&& TOP: SERIES OF 5-S510  
BOT: SERIES OF 5-S510

### NOTES:

1. DECK SLAB THICKNESS FOR CONCRETE QUANTITY: THE ESTIMATED QUANTITY OF DECK CONCRETE IS MEASURED ACCORDING TO CMS511. IN ADDITION TO THE DESIGN SLAB THICKNESS, THE QUANTITY INCLUDES A VARIABLE HAUNCH THICKNESS THAT PROVIDES AN ALLOWANCE FOR: VERTICAL GRADE ADJUSTMENT, BEAM CAMBER AND ADDITIONAL SACRIFICIAL HAUNCH THICKNESS.

2. LAP LENGTHS:  
NO. 4 BAR = 1'-11"  
NO. 5 BAR = 3'-0"  
NO. 6 BAR = 3'-7"

3. CONCRETE FOR BRIDGE SIDEWALK RAILING CONCRETE BARRIER SHALL BE IN ACCORDANCE WITH THE GENERAL NOTE ON SHEET 3/30 FOR ITEM 511, CLASS QC2 CONCRETE WITH QC/QA, BRIDGE DECK (PARAPET), AS PER PLAN.


035\_0627T5001.dgn 11/30/2022 10:25:45 AM Jason.Center@jacobs.com

78'-10" OUT/OUT SLAB

6 SETS OF 85-S401, 1 SET OF 85-S402 SPA. @ 11 1/2" MAX. (TOP)

6 SETS OF 101-S501, 1 SET OF 101-S502 SPA. @ 9 3/4" MAX. (BOTTOM)

1-S601 AND 1-S602 TOP AND BOTTOM EQUALLY SPACED BETWEEN S401 AND S501 LONGITUDINAL BARS, STAGGERED AS SHOWN

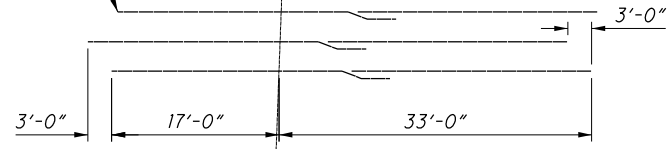

337-S512 BUNDLED W/ S504 TOP  
337-S403 BUNDLED W/ S501 BOT.

4 SETS OF FANNED S503, S501, S504 (TOP AND BOT.)

### SLAB PLAN

SERIES OF 12-S505 (LAP W/ S501) TOP  
SERIES OF 12-S505 (LAP W/ S501) BOT.


035\_0627SD006.dgn 11/30/2022 10:29:36 AM Jason.Center@jacobs.com

| DECK ELEVATIONS      |                     |             |           |           |           |                        |                        |           |           |           |             |
|----------------------|---------------------|-------------|-----------|-----------|-----------|------------------------|------------------------|-----------|-----------|-----------|-------------|
| LOCATION             | DESCRIPTION         | ☉ BRGS R.A. | 0.25 PT   | 0.50 PT   | 0.75 PT   | ☉ BRGS PIER 1 (SPAN 1) | ☉ BRGS PIER 1 (SPAN 2) | 0.25 PT   | 0.50 PT   | 0.75 PT   | ☉ BRGS F.A. |
| LEFT EDGE OF DECK    | STATION             | 878+97.35   | 879+23.12 | 879+48.89 | 879+74.66 | 880+00.43              | 880+02.59              | 880+20.47 | 880+38.35 | 880+56.22 | 880+74.10   |
|                      | FINAL DECK ELEV.    | 821.59      | 821.63    | 821.62    | 821.58    | 821.49                 | 821.48                 | 821.39    | 821.28    | 821.16    | 820.92      |
|                      | SCREED ELEV.        | 821.59      | 821.82    | 821.90    | 821.77    | 821.49                 | 821.48                 | 821.44    | 821.35    | 821.20    | 820.92      |
| ☉ B1/B9              | STATION             | 878+97.21   | 879+22.98 | 879+48.75 | 879+74.52 | 880+00.29              | 880+02.45              | 880+20.29 | 880+38.12 | 880+55.96 | 880+73.79   |
|                      | FINAL DECK ELEV.    | 821.66      | 821.70    | 821.70    | 821.66    | 821.57                 | 821.56                 | 821.47    | 821.36    | 821.23    | 821.09      |
|                      | TOP OF HAUNCH ELEV. | 820.96      | 821.19    | 821.27    | 821.14    | 820.86                 | 820.85                 | 820.80    | 820.72    | 820.57    | 820.38      |
| ☉ B2/B10             | STATION             | 878+96.84   | 879+22.61 | 879+48.38 | 879+74.15 | 879+99.92              | 880+02.08              | 880+19.91 | 880+37.75 | 880+55.58 | 880+73.42   |
|                      | FINAL DECK ELEV.    | 821.87      | 821.91    | 821.90    | 821.86    | 821.77                 | 821.76                 | 821.68    | 821.57    | 821.44    | 821.29      |
|                      | TOP OF HAUNCH ELEV. | 821.16      | 821.40    | 821.49    | 821.36    | 821.06                 | 821.06                 | 821.01    | 820.93    | 820.78    | 820.58      |
| LEFT CURB LINE       | STATION             | 878+96.80   | 879+22.57 | 879+48.34 | 879+74.11 | 879+99.88              | 880+02.04              | 880+19.87 | 880+37.71 | 880+55.54 | 880+69.06   |
|                      | FINAL DECK ELEV.    | 821.89      | 821.93    | 821.93    | 821.88    | 821.80                 | 821.79                 | 821.70    | 821.59    | 821.46    | 820.96      |
|                      | SCREED ELEV.        | 821.89      | 822.14    | 822.22    | 822.09    | 821.80                 | 821.79                 | 821.91    | 822.38    | 822.01    | 820.97      |
| ☉ B3/B11             | STATION             | 878+96.46   | 879+22.23 | 879+48.00 | 879+73.77 | 879+99.54              | 880+01.70              | 880+19.54 | 880+37.37 | 880+55.21 | 880+73.04   |
|                      | FINAL DECK ELEV.    | 822.07      | 822.11    | 822.11    | 822.06    | 821.98                 | 821.97                 | 821.88    | 821.77    | 821.65    | 821.50      |
|                      | TOP OF HAUNCH ELEV. | 821.36      | 821.61    | 821.70    | 821.56    | 821.27                 | 821.26                 | 821.22    | 821.13    | 820.98    | 820.79      |
| ☉ B4/B12             | STATION             | 878+96.09   | 879+21.86 | 879+47.63 | 879+73.40 | 879+99.17              | 880+01.33              | 880+19.17 | 880+37.00 | 880+54.84 | 880+72.67   |
|                      | FINAL DECK ELEV.    | 822.27      | 822.31    | 822.31    | 822.27    | 822.18                 | 822.17                 | 822.09    | 821.98    | 821.85    | 821.71      |
|                      | TOP OF HAUNCH ELEV. | 821.56      | 821.81    | 821.90    | 821.77    | 821.47                 | 821.46                 | 821.42    | 821.34    | 821.19    | 821.00      |
| PROFILE & CROWN      | STATION             | 878+95.84   | 879+21.61 | 879+47.38 | 879+73.15 | 879+98.92              | 880+01.08              | 880+18.92 | 880+36.75 | 880+54.59 | 880+72.42   |
|                      | FINAL DECK ELEV.    | 822.41      | 822.45    | 822.45    | 822.41    | 822.32                 | 822.31                 | 822.22    | 822.12    | 821.99    | 821.84      |
|                      | SCREED ELEV.        | 822.41      | 822.66    | 822.74    | 822.61    | 822.32                 | 822.31                 | 822.27    | 822.18    | 822.04    | 821.84      |
| ☉ B5/B13             | STATION             | 878+95.72   | 879+21.49 | 879+47.26 | 879+73.03 | 879+98.80              | 880+00.96              | 880+18.79 | 880+36.63 | 880+54.46 | 880+72.30   |
|                      | FINAL DECK ELEV.    | 822.34      | 822.38    | 822.38    | 822.34    | 822.25                 | 822.24                 | 822.16    | 822.05    | 821.93    | 821.78      |
|                      | TOP OF HAUNCH ELEV. | 821.63      | 821.88    | 821.97    | 821.84    | 821.55                 | 821.54                 | 821.50    | 821.41    | 821.26    | 821.07      |
| ☉ B6/B14             | STATION             | 878+95.34   | 879+21.11 | 879+46.88 | 879+72.65 | 879+98.42              | 880+00.58              | 880+18.42 | 880+36.25 | 880+54.09 | 880+71.92   |
|                      | FINAL DECK ELEV.    | 822.14      | 822.18    | 822.18    | 822.14    | 822.05                 | 822.04                 | 821.96    | 821.85    | 821.73    | 821.58      |
|                      | TOP OF HAUNCH ELEV. | 821.43      | 821.68    | 821.77    | 821.63    | 821.34                 | 821.33                 | 821.29    | 821.21    | 821.06    | 820.87      |
| ☉ B7/B15             | STATION             | 878+94.97   | 879+20.74 | 879+46.51 | 879+72.28 | 879+98.05              | 880+00.21              | 880+18.05 | 880+35.88 | 880+53.72 | 880+71.55   |
|                      | FINAL DECK ELEV.    | 821.93      | 821.98    | 821.98    | 821.93    | 821.85                 | 821.84                 | 821.76    | 821.65    | 821.52    | 821.38      |
|                      | TOP OF HAUNCH ELEV. | 821.22      | 821.47    | 821.56    | 821.43    | 821.14                 | 821.13                 | 821.09    | 821.01    | 820.86    | 820.67      |
| ☉ B8/B16             | STA.                | 878+94.60   | 879+20.37 | 879+46.14 | 879+71.91 | 879+97.68              | 879+99.84              | 880+17.67 | 880+35.51 | 880+53.34 | 880+71.18   |
|                      | FINAL DECK ELEV.    | 821.73      | 821.77    | 821.77    | 821.73    | 821.65                 | 821.64                 | 821.55    | 821.45    | 821.32    | 821.18      |
|                      | TOP OF HAUNCH ELEV. | 821.02      | 821.25    | 821.34    | 821.21    | 820.94                 | 820.93                 | 820.89    | 820.80    | 820.66    | 820.47      |
| RIGHT TOE OF PARAPET | STATION             | 878+94.52   | 879+20.29 | 879+46.06 | 879+71.83 | 879+97.60              | 879+99.76              | 880+17.59 | 880+35.43 | 880+53.26 | 880+65.83   |
|                      | FINAL DECK ELEV.    | 821.68      | 821.73    | 821.73    | 821.69    | 821.61                 | 821.60                 | 821.51    | 821.41    | 821.28    | 821.03      |
|                      | SCREED ELEV.        | 821.68      | 821.92    | 822.00    | 821.88    | 821.61                 | 821.60                 | 821.55    | 821.47    | 821.32    | 821.04      |
| RIGHT EDGE OF DECK   | STATION             | 878+94.46   | 879+20.23 | 879+46.00 | 879+71.77 | 879+97.54              | 879+99.70              | 880+17.48 | 880+35.26 | 880+53.04 | 880+70.82   |
|                      | FINAL DECK ELEV.    | 821.65      | 821.69    | 821.70    | 821.66    | 821.57                 | 821.56                 | 821.48    | 821.37    | 821.25    | 820.99      |
|                      | SCREED ELEV.        | 821.65      | 821.89    | 821.97    | 821.85    | 821.57                 | 821.56                 | 821.52    | 821.44    | 821.29    | 820.99      |

NOTES

1. FINAL DECK SURFACE ELEVATIONS SHOWN REPRESENT THE DECK SURFACE LOCATION AFTER ALL ANTICIPATED DEAD LOAD DEFLECTIONS HAVE OCCURED.
2. SEE SHEET 21 FOR PLAN LOCATIONS OF DECK ELEVATIONS.

035\_0627MD001.dgn 11/30/2022 10:44:14 AM Jason.Centers@jacobs.com

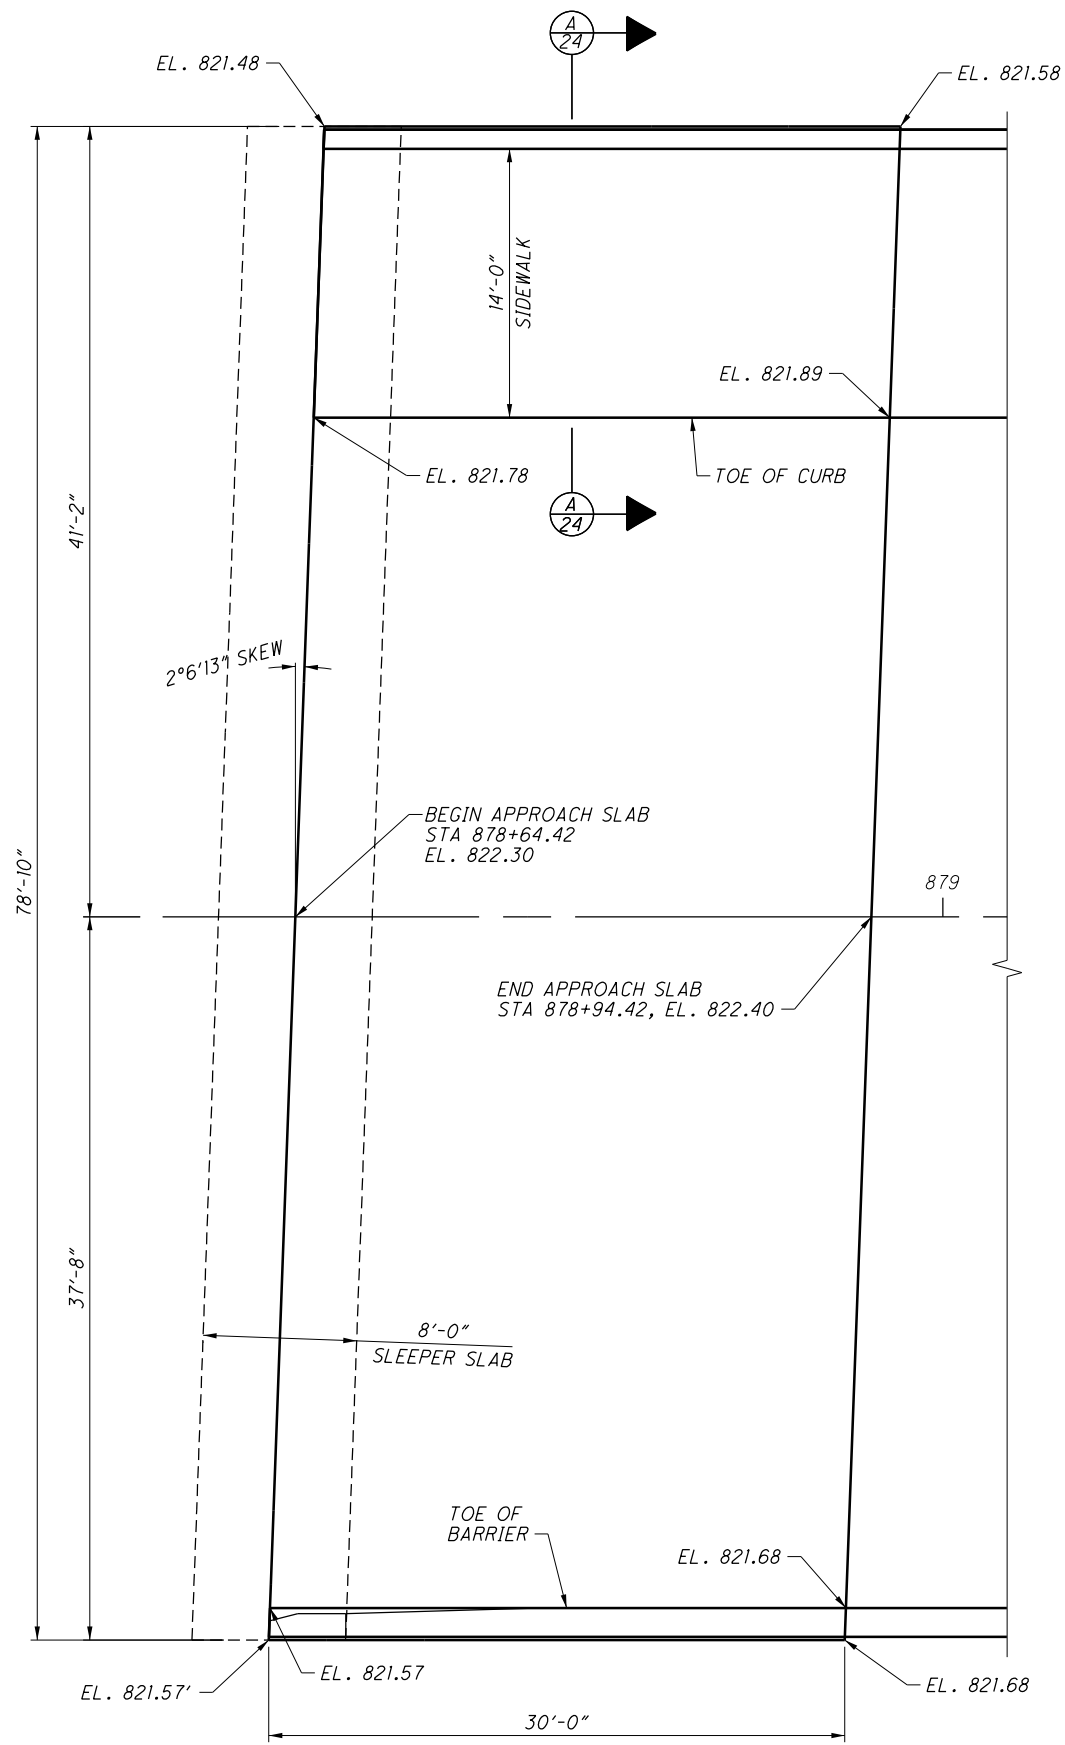


REAR APPROACH SLAB PLAN



VALLEY/TREBEIN RD

NOTES:

1. FOR ADDITIONAL APPROACH SLAB DETAILS, SEE STD. DWGS. AS-1-15 AND AS-2-15.
2. FOR PARAPET ON APPROACH SLAB REINFORCING DETAILS, SEE SHEET 25 & 26.

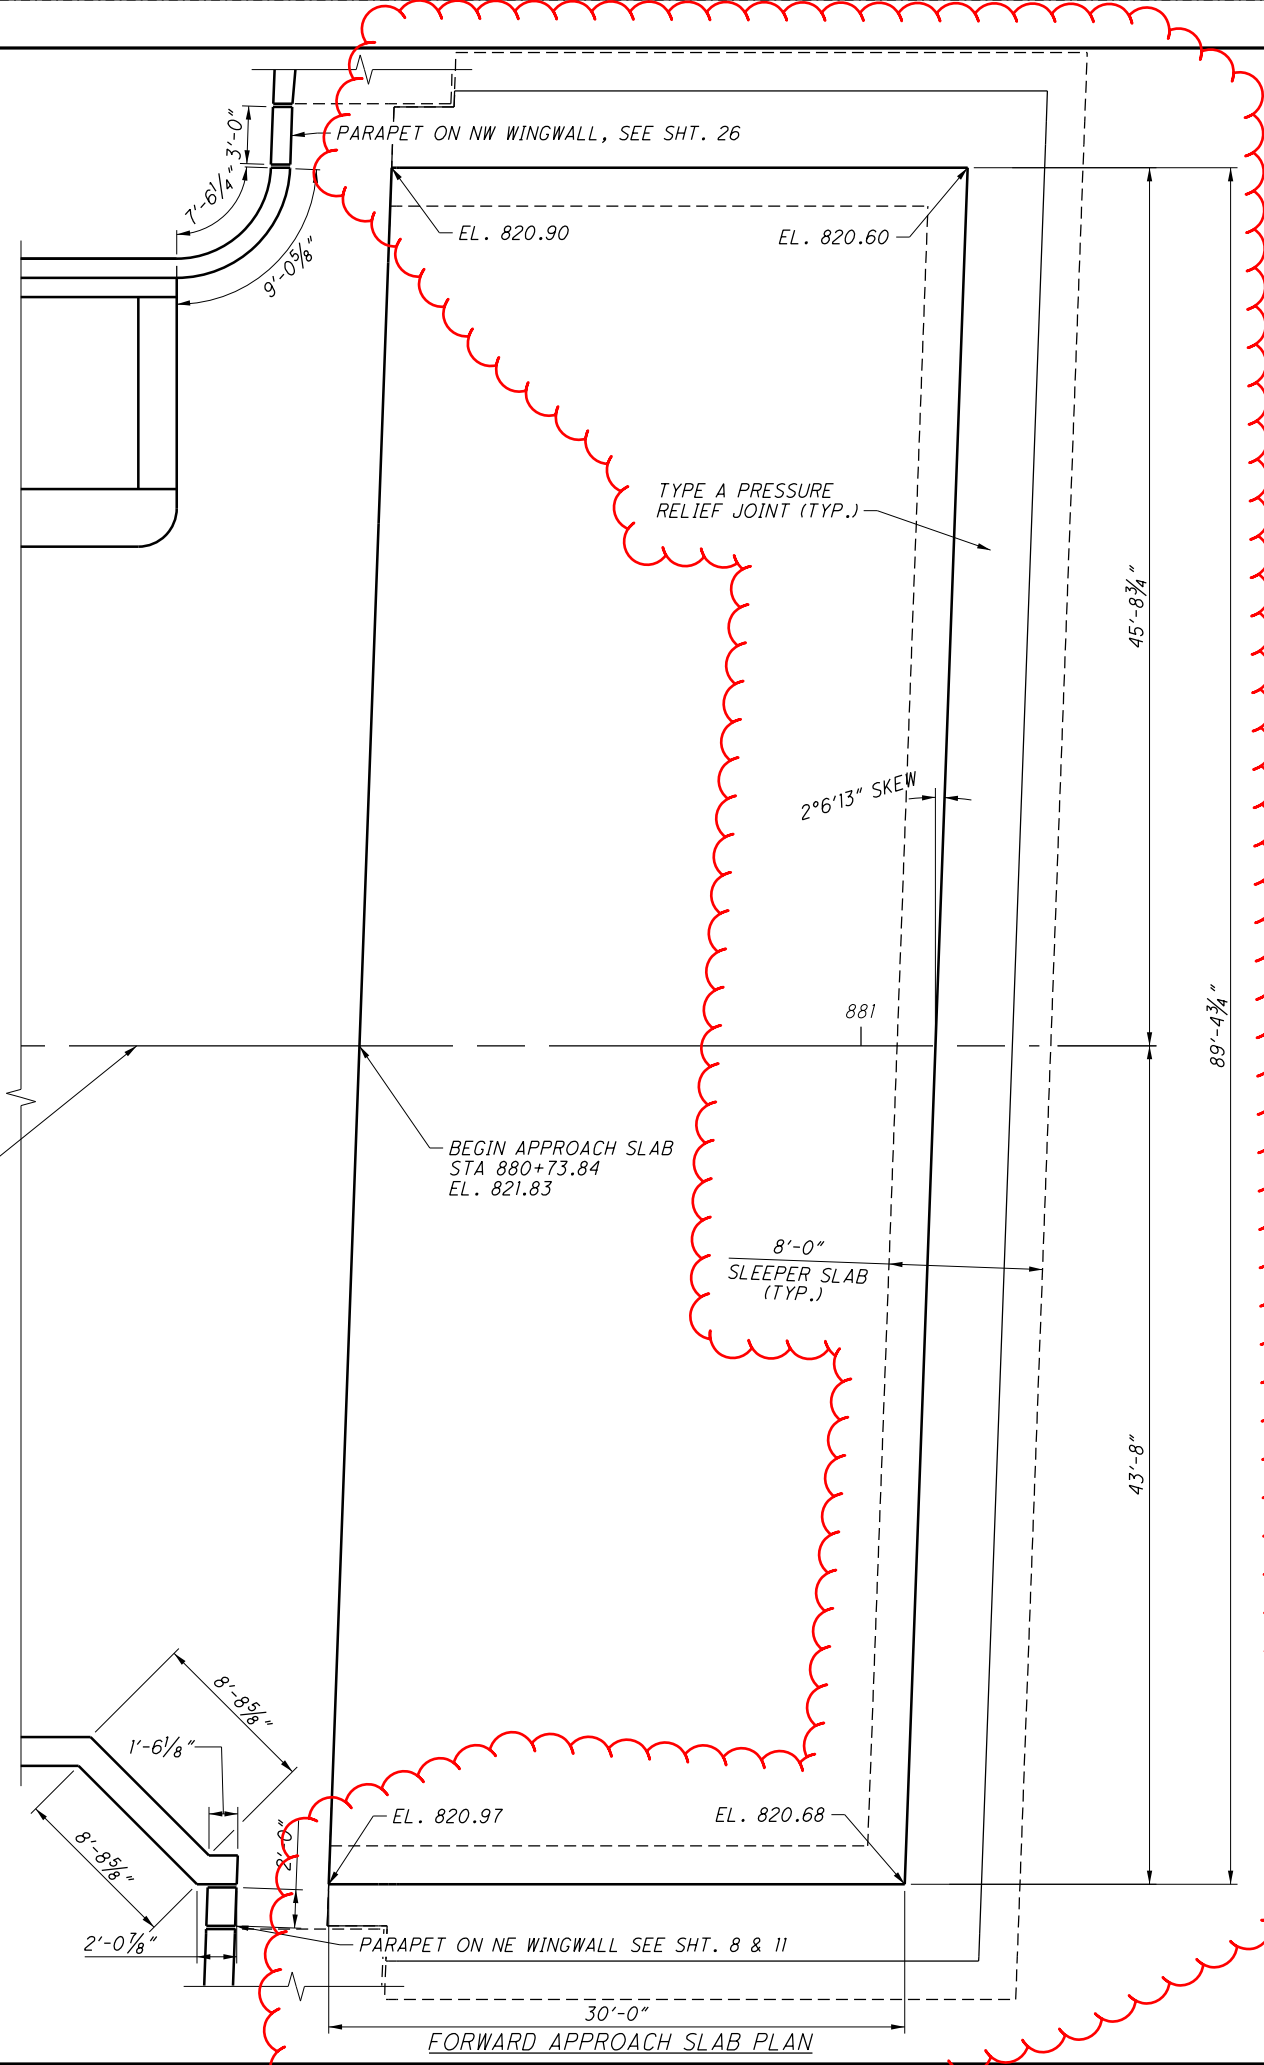

FORWARD APPROACH SLAB PLAN

DESIGN AGENCY  
**JACOBS**  
 1880 WATCROSS ROAD  
 CINCINNATI, OHIO 45240

DATE 5/2022  
 REVIEWED JTC  
 STRUCTURE FILE NUMBER 2900213

DRAWN MM  
 CHECKED FBW  
 REVISIONS

DESIGNED MM  
 CHECKED FBW

BRIDGE NO. GRE-035-0627  
 VALLEY/TREBEIN ROAD OVER U.S. 35

GRE-US 35-5.63  
 PID No. 107217

