


STATE OF OHIO  
DEPARTMENT OF TRANSPORTATION  
**GRE-US 35-5.63**  
BEAVERCREEK TOWNSHIP  
GREENE COUNTY

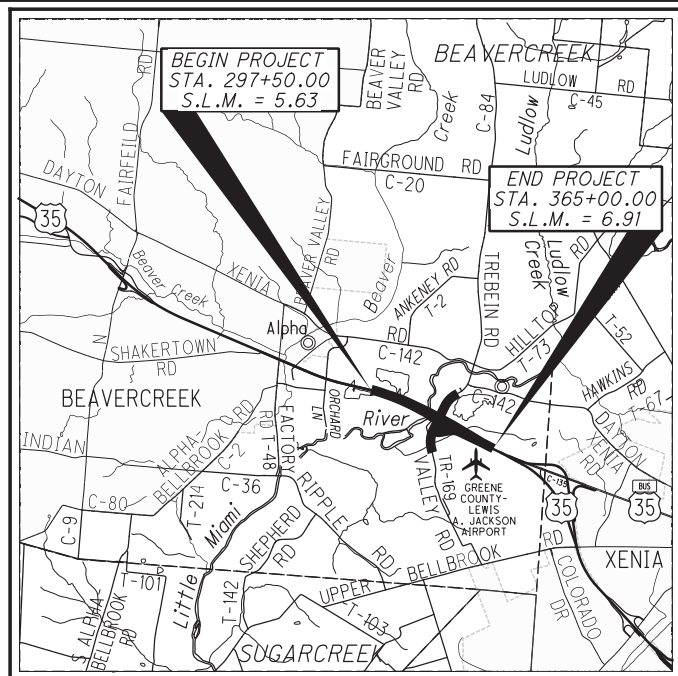

LOCATION MAP

LATITUDE: 39°42'00" LONGITUDE: -83°59'50"



PORTION TO BE IMPROVED

INTERSTATE HIGHWAY	—————
FEDERAL ROUTES	—————
STATE ROUTES	—————
COUNTY & TOWNSHIP ROADS	—————
OTHER ROADS	—————

DESIGN DESIGNATION

	US 35	VALLEY ROAD (TR 169)/ TREBEIN ROAD (CR 84)
CURRENT ADT (2025)	36,990	7,850
DESIGN YEAR ADT (2045)	45,220	9,200
DESIGN HOURLY VOLUME (2045)	5,480	930
DIRECTIONAL DISTRIBUTION	53%	51%
TRUCKS (24 HOUR B&C)	12%	7%
DESIGN SPEED	65 MPH	60 MPH
LEGAL SPEED	55 MPH	55 MPH
DESIGN FUNCTIONAL CLASSIFICATION:	02 OTHER FREEWAYS & EXPRESSWAYS (URBAN)	05 MAJOR COLLECTOR ROADS (URBAN)
NHS PROJECT	YES	

DESIGN EXCEPTION: NONE REQUIRED

ADA DESIGN WAIVER: NONE REQUIRED

**UNDERGROUND UTILITIES**  
Contact Two Working Days Before You Dig  
  
OHIO811. 8-1-1 or 1-800-362-2764 (Non-members must be called directly)

PLAN PREPARED BY:

**Jacobs**

2 CROWN POINT COURT, SUITE 100  
CINCINNATI, OHIO 45241  
TEL: (513) 595 7500

INDEX OF SHEETS:

TITLE SHEET	1	STRUCTURE (20' AND UNDER)	
SCHEMATIC PLAN	2-3	US 35 OVER FLOODPLAIN RELIEF DITCH	
HORIZONTAL AND VERTICAL CONTROL	4-5	STRUCTURE NO. GRE-035-0604	523-527
INTERCHANGE GEOMETRIC LAYOUT	6-10	US 35 OVER TRIBUTARY TO LITTLE MIAMI RIVER	
TYPICAL SECTIONS	11-29	STRUCTURE NO. GRE-035-0654	528-530
GENERAL NOTES	30-35	STRUCTURE (OVER 20')	
MAINTENANCE OF TRAFFIC	36-55,57-103,105-158,165-172,172A,172B,172C,172D,172E,172F,173-176	US 35 OVER LITTLE MIAMI RIVER	
NOT USED	56,104,159-164	STRUCTURE NO. GRE-035-0614	531-537
GENERAL SUMMARY	177-182	RAMP E OVER LITTLE MIAMI RIVER	
SUBSUMARIES	183-202	STRUCTURE NO. GRE-035-0610	538-572,572A,572B,527C,572D,572E,572F
NOT USED	203-204	VALLEY/TREBEIN ROAD OVER US 35	
PROJECT SITE PLAN	205-207	STRUCTURE NO. GRE-035-0627	573-601,601A
PLAN (US 35)	208-232	FENCE PLAN	602-606
PROFILE (US 35)	233-241	RIGHT-OF-WAY	607-638
PLAN AND PROFILE (RAMPS)	242-262	SOIL PROFILE	639-698
CROSS SECTIONS (US 35)	263-323		
CROSS SECTIONS (RAMPS)	324-354		
PLAN AND PROFILE (SIDE ROADS)	355-366		
CROSS SECTIONS (SIDE ROADS)	367-403		
EXISTING PAVEMENT REMOVAL	404-405		
SUPERELEVATION TABLES	406-411		
PAVEMENT DETAILS	412-417		
INTERSECTION DETAILS	418-421		
PAVEMENT JOINT DETAILS	422-426		
DRIVE DETAILS	427-430		
BARRIER DETAILS	431-432,432A		
DITCH PLAN AND ELEVATION	433-433		
STORM SEWER PROFILES	434-438		
CULVERT DETAILS	439-444		
DRAINAGE DETAILS	445-448,448A,449		
RETAINING WALLS	450-472		
TEMPORARY RETAINING WALLS	473-475		
TRAFFIC CONTROL	476-506,506A,506B,507,507A,507B		
LIGHTING	508-509,509A,510,511,511A,511B,512,512A,512B,513-516,516A,517-522		

ENGINEERS SEAL:  
  
SIGNED: Daniel Baah  
DATE: 08-24-2022

STANDARD CONSTRUCTION DRAWINGS												SUPPLEMENTAL SPECIFICATIONS	SPECIAL PROVISIONS		
BP-1.1	7/28/00	I-3B	3B1, 7/15/22	MGS-4.3	1/18/13	SBR-2-20	1/15/21	HL-60.31	1/17/20	MT-102.20	4/19/19	TC-51.11	1/15/16	800-2019	SEE PROPOSAL
BP-2.1	1/21/22	I-3C	3C1, 7/15/22	MGS-5.3	7/15/16	SICD-1-21	1/21/22			MT-102.30	10/16/15	TC-52.10	10/18/13	807	1/21/22
BP-2.2	1/15/21	I-3D	7/15/22	MGS-6.1	1/19/18	SICD-2-14	1/15/21	MT-95.30	7/19/19	MT-103.10	1/21/22	TC-52.20	1/15/21	808	1/18/19
BP-2.3	7/18/14					TST-1-99	1/15/21	MT-95.45	1/17/20	MT-104.10	10/16/15	TC-61.10	1/17/20	813	10/19/18
BP-3.1	1/21/22	MH-3	7/16/21	RM-1.1	1/15/21	VPF-1-90	7/20/18	MT-95.50	7/21/17	MT-105.10	1/17/20	TC-61.30	7/19/19	821	4/20/12
				RM-4.1	7/21/17			MT-95.71	1/17/20	MT-110.10	7/19/13	TC-65.10	1/17/14	832	10/19/18
CB-2-2A	2B, 2C, 7/15/22	BP-4.1	7/19/13	RM-4.2	4/17/20	HL-10.11	7/15/22	MT-97.10	4/19/19	MT-120.00	7/15/22	TC-65.11	7/15/22	836	1/19/18
CB-2-3	2-4, 7/16/21	BP-5.1	7/15/22	RM-4.3	1/21/22	HL-10.12	1/20/17	MT-98.10	1/17/20			TC-71.10	7/15/22	839	7/16/21
CB-3	7/16/21	BP-7.1	7/17/20	RM-4.4	7/19/19	HL-10.13	4/17/20	MT-98.11	1/17/20	TC-9.31	7/16/21	TC-72.20	7/20/18	840	4/16/21
CB-3A	7/16/21	BP-9.1	1/18/19	RM-4.5	7/21/17	HL-20.11	1/15/21	MT-98.20	4/19/19	TC-12.31	4/15/22	TC-73.20	1/17/20	846	4/17/15
CB-6	1/21/22			RM-4.6	7/19/13	HL-20.13	7/15/22	MT-98.21	1/17/20	TC-15.116	7/16/21			850	1/21/22
CB-8	7/16/21	F-2.1	7/20/18			HL-30.11	1/15/21	MT-98.28	1/17/20	TC-21.11	7/16/21			851	1/21/22
CB-4A	5A, 8A, 7/16/21	F-3.1	7/19/13	A-1-20	1/21/22	HL-30.21	4/17/20	MT-99.20	4/19/19	TC-21.21	7/15/22			867	1/15/21
		F-3.3	7/19/13	AS-1-15	7/17/15	HL-30.22	1/15/21	MT-99.30	1/17/20	TC-21.50	4/17/20			878	1/21/22
DM-1.1	7/17/20	F-3.4	7/19/13	AS-2-15	1/18/19	HL-30.31	4/17/20	MT-99.60	7/15/16	TC-22.20	1/17/14			902	7/19/19
DM-1.2	7/16/21			BR-2-15	1/21/22	HL-30.32	4/17/20	MT-100.00	7/16/21	TC-41.10	7/19/13			905	4/17/20
DM-2.1	1/18/13	MGS-1.1	7/16/21	EXJ-4-87	7/15/22	HL-30.33	1/21/22	MT-101.60	1/17/20	TC-41.20	10/18/13			908	10/20/17
DM-4.1	7/17/20	MGS-2.1	1/19/18	GSD-1-19	1/15/21	HL-30.41	1/21/22	MT-101.70	1/17/20	TC-41.30	10/18/13			913	4/16/21
DM-4.3	1/15/16	MGS-3.1	1/19/18	HW-2.1	7/20/18	HL-40.20	7/15/22	MT-101.75	1/17/20	TC-41.50	10/18/13			921	4/20/12
DM-4.4	1/15/16	MGS-3.2	1/18/13	HW-2.2	7/20/18	HL-50.21	7/15/22	MT-101.90	7/17/20	TC-42.10	10/18/13			939	1/17/20
		MGS-4.2	7/19/13	PSID-1-13	1/15/21	HL-60.11	7/21/17	MT-102.10	1/17/20	TC-42.20	10/18/13			1120	4/15/22

PROJECT DESCRIPTION

THIS PROJECT CONSISTS OF RECONSTRUCTING US 35, REMOVING AT-GRADE INTERSECTION AND CONSTRUCTING A NEW INTERCHANGE, WHILE MAINTAINING LOCAL ACCESS. THIS IMPROVEMENT INVOLVES UPGRADING APPROXIMATELY 1.28 MILES OF US 35 TO A LIMITED-ACCESS FACILITY, INCLUDING THREE HIGHWAY BRIDGE STRUCTURES, RETAINING WALLS, AND RECONSTRUCTION OF APPROXIMATELY 0.68 MILES OF SIDE ROADS.

EARTH DISTURBED AREAS

PROJECT EARTH DISTURBED AREA: 53.28 ACRES  
ESTIMATED CONTRACTOR EARTH DISTURBED AREA: 19.70 ACRES  
NOTICE OF INTENT EARTH DISTURBED AREA: 72.98 ACRES

LIMITED ACCESS

THIS IMPROVEMENT IS ESPECIALLY DESIGNED FOR THROUGH TRAFFIC AND HAS BEEN DECLARED A LIMITED ACCESS HIGHWAY, OR FREEWAY, BY ACTION OF THE DIRECTOR IN ACCORDANCE WITH THE PROVISIONS OF SECTION 5511.02 OF THE OHIO REVISED CODE.

2019 SPECIFICATIONS


THE STANDARD SPECIFICATIONS OF THE STATE OF OHIO, DEPARTMENT OF TRANSPORTATION, INCLUDING SUPPLEMENTAL SPECIFICATIONS LISTED IN THE PLANS AND CHANGES LISTED IN THE PROPOSAL SHALL GOVERN THIS IMPROVEMENT.

I HEREBY APPROVE THESE PLANS AND DECLARE THAT THE MAKING OF THIS IMPROVEMENT WILL NOT REQUIRE THE CLOSING TO TRAFFIC OF THE HIGHWAY EXCEPT AS SHOWN ON SHEETS NO. 59 & 59, AND THAT THE PROVISIONS FOR MAINTENANCE AND SAFETY OF TRAFFIC WILL BE AS SET FORTH ON THE PLANS AND ESTIMATES.

APPROVED: *Tony K. Cepbell*  
DATE: 8-30-22 DISTRICT DEPUTY DIRECTOR

APPROVED: \_\_\_\_\_  
DATE: \_\_\_\_\_ DIRECTOR, DEPARTMENT OF TRANSPORTATION

ENGINEERS SEAL: FOR TRAFFIC CONTROL AND LIGHTING  SIGNED: Ramnarayan Nunna DATE: 08/24/22	ENGINEERS SEAL: FOR STRUCTURES  SIGNED: Jason T. Centers DATE: 08/24/22
ENGINEERS SEAL: FOR SOIL PROFILE  SIGNED: Brian R. Trenner DATE: 08/23/2022	

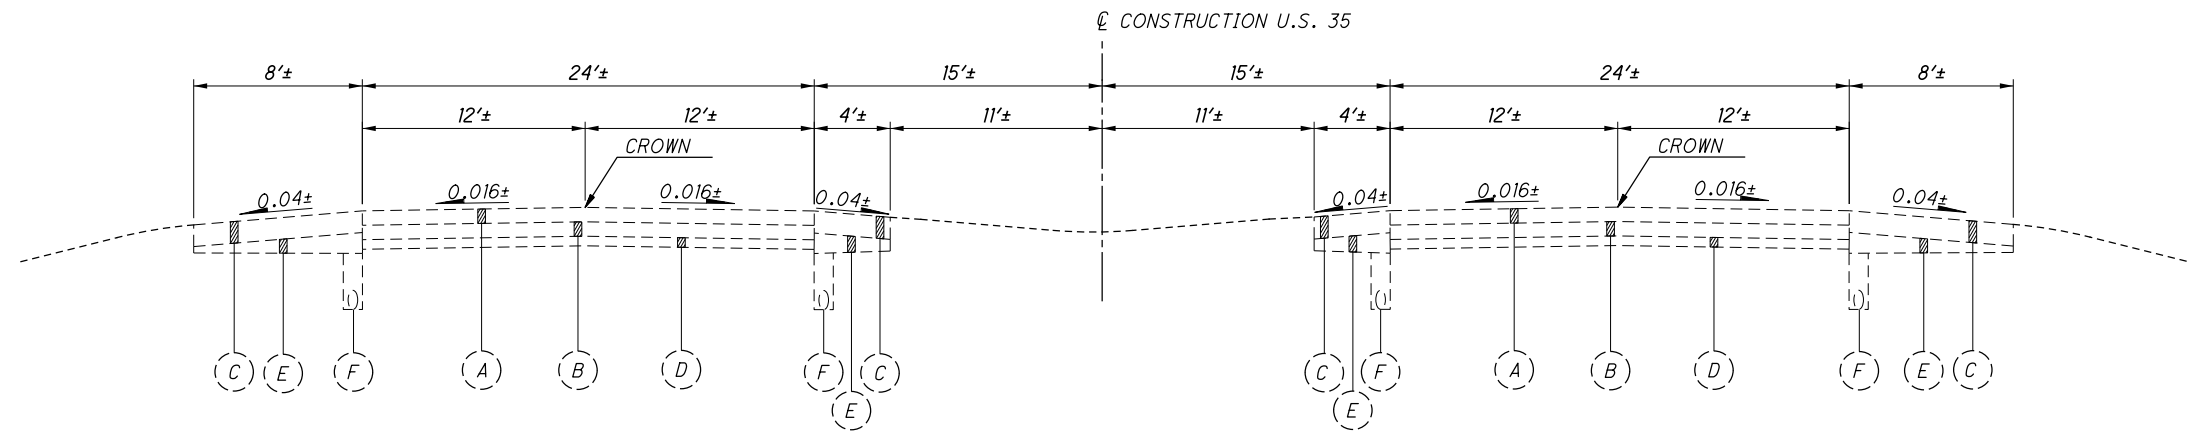

**EXISTING NORMAL SECTION - U.S. 35**  
 STA. 288+75.00 TO STA. 322+56.00  
 STA. 334+25.00 TO STA. 391+00.00

**EXISTING LEGEND**

- (A) 8½"± ASPHALT CONCRETE
- (B) 6"±-12"± VARIABLE THICKNESS REINFORCED CONCRETE
- (C) 13½"± ASPHALT CONCRETE
- (D) 4"± AGGREGATE BASE
- (E) 4"±-9¼"± VARIABLE THICKNESS AGGREGATE BASE
- (F) 6" PIPE UNDERDRAIN
- (G) CONCRETE MEDIAN
- (H) 12"± CONCRETE APPROACH SLAB
- (J) AGGREGATE BASE
- (K) 9½"± ASPHALT CONCRETE
- (L) 13"± ASPHALT CONCRETE

**PROPOSED LEGEND**

- (1) ITEM 442 - 1½" ASPHALT CONCRETE SURFACE COURSE, 12.5 mm, TYPE A (447)
- (2) ITEM 442 - 1¾" ASPHALT CONCRETE INTERMEDIATE COURSE, 12.5 mm TYPE A (446)
- (3) ITEM 302 - 6" ASPHALT CONCRETE BASE, PG64-22
- (4) ITEM 304 - 6" AGGREGATE BASE
- (5) ITEM 452 - 11½" NON-REINFORCED CONCRETE PAVEMENT, CLASS QC 1P WITH QC/QA
- (6) ITEM 452 - 8" NON-REINFORCED CONCRETE PAVEMENT, CLASS QC 1P WITH QC/QA
- (7) ITEM 441 - 1¼" ASPHALT CONCRETE SURFACE COURSE, TYPE 1 (448)
- (8) ITEM 441 - 1¾" ASPHALT CONCRETE INTERMEDIATE COURSE, TYPE 2, (448) PG64-22
- (9) ITEM 301 - 6" ASPHALT CONCRETE BASE, PG64-22
- (10) ITEM 407 - NON-TRACKING TACK COAT (0.050 GAL/SY)
- (11) ITEM 605 - 6" SHALLOW PIPE UNDERDRAINS, 707.31 OR 707.41
- (12) ITEM 605 - 6" BASE PIPE UNDERDRAINS, 707.31 OR 707.41
- (13) RETAINING WALL
- (14) ITEM 659 - SEEDING AND MULCHING
- (15) ITEM 606 - GUARDRAIL, TYPE MGS
- (16) ITEM 606 - GUARDRAIL, BARRIER DESIGN, TYPE MGS
- (17) ITEM 609 - CONCRETE MEDIAN, 6"
- (18) ITEM 526 - REINFORCED CONCRETE APPROACH SLAB WITH QC/QA (T=17")
- (19) ITEM 526 - REINFORCED CONCRETE APPROACH SLAB WITH QC/QA (T=15")
- (20) ITEM 526 - REINFORCED CONCRETE APPROACH SLAB WITH QC/QA (T=17"), AS PER PLAN A
- (21) ITEM 526 - REINFORCED CONCRETE APPROACH SLAB WITH QC/QA (T=17"), AS PER PLAN B
- (22) ITEM 204 - SUBGRADE COMPACTION
- (23) ITEM 609 - CURB, TYPE 4-C
- (24) ITEM 622 - CONCRETE BARRIER, SINGLE SLOPE, TYPE B1
- (25) ITEM 622 - CONCRETE BARRIER, SINGLE SLOPE, TYPE C
- (26) ITEM 622 - CONCRETE BARRIER, SINGLE SLOPE, TYPE D
- (27) ITEM 601 - PAVED GUTTER, TYPE 1-4, AS PER PLAN
- (28) NOT USED
- (29) ITEM 204 - GEOTEXTILE FABRIC
- (30) ITEM 304 - 8" AGGREGATE BASE
- (31) ITEM 617 - COMPACTED AGGREGATE, 4"
- (32) ITEM 206 - CEMENT STABILIZED SUBGRADE, 12" DEEP
- (33) ITEM 601 - PAVED GUTTER, TYPE 1-2, AS PER PLAN
- (34) STANDARD LONGITUDINAL JOINT
- (35) ITEM 204 - PROOF ROLLING
- (36) ITEM 606 - GUARDRAIL, TYPE MGS WITH LONG POST
- (37) ITEM 304 - 12" AGGREGATE BASE
- (38) ITEM 204 - EXCAVATION OF SUBGRADE, 12" DEEP GRANULAR MATERIAL, TYPE C

107217GY001.dgn Sheet 1/3/2023 9:10AM CH\_ODOTV81\_Half\_BW.pen ProjectWise Dynamic Composition Server JEGSYCPWU01

**UTILITIES**

LISTED BELOW ARE ALL UTILITIES LOCATED WITHIN THE PROJECT CONSTRUCTION LIMITS TOGETHER WITH THEIR RESPECTIVE OWNERS:

AES OHIO  
1900 DRYDEN ROAD  
DAYTON, OH 45439  
CONTACT: MR. WILLIAM WARD  
PHONE: (937) 554-9063  
WILLIAM.WARD@AES.COM

GREENE COUNTY SANITARY ENGINEERING:  
667 DAYTON XENIA ROAD  
XENIA, OH 45385  
CONTACT: PROJECT MANAGER  
SED\_PM@CO.GREENE.OH.US

ODOT DISTRICT 8:  
505 SOUTH STATE ROUTE 741  
PO BOX 272  
BUILDING 2801  
LEBANON, OH 45036  
CONTACT: MS. JIM JUDD  
PHONE: (513) 933-6692

TELEPHONE:  
AT&T METRO/LNS  
CCI NETWORKS, LLC  
2649 GARDNER ROAD  
BROADVIEW, IL 60155  
CONTACT: TIM LAPOINTE  
PHONE: (713) 830-7437  
t10695@att.com

TELEPHONE:  
AT&T TRANSMISSION LONG DISTANCE  
7555 E. PLEASANT VALLEY RD. SUITE 140  
INDEPENDANCE, OH 44131  
CONTACT: MICHAEL DIEDERICH  
PHONE: (216) 750-0135  
MD4145@ATT.COM

TELEPHONE:  
AT&T OHIO  
DAYTON, OH 45459  
CONTACT: HOWARD LAUDERMILK  
PHONE: (937) 296-3588

THE LOCATION OF THE UNDERGROUND UTILITIES SHOWN ON THE PLANS ARE AS OBTAINED FROM THE OWNERS AS REQUIRED BY SECTION 153.64 O.R.C.

**ROUNDING**

THE ROUNDING AT SLOPE BREAKPOINTS SHOWN ON THE TYPICAL SECTIONS APPLIES TO ALL CROSS-SECTIONS, EVEN THOUGH OTHERWISE SHOWN.

**EXISTING PLANS**

EXISTING PLANS ENTITLED GRE-35-(0.13-9.45) AND GRE-35-1.17 MAY BE INSPECTED IN THE ODOT DISTRICT 8 OFFICE IN LEBANON, OHIO

**SURVEYING PARAMETERS**

PRIMARY PROJECT CONTROL MONUMENTS GOVERN ALL POSITIONING ON ODOT PROJECTS. SEE SHEET NO. 5 OF THE PLANS FOR A TABLE CONTAINING PROJECT CONTROL INFORMATION.

USE THE FOLLOWING PROJECT CONTROL, VERTICAL POSITIONING, AND HORIZONTAL POSITIONING PARAMETERS FOR ALL SURVEYING:

**PROJECT CONTROL**

POSITIONING METHOD: STATIC GNSS  
MONUMENT TYPE: A

**VERTICAL POSITIONING**

ORTHOMETRIC HEIGHT DATUM: NAVD88  
GEOID: GEOID03

**HORIZONTAL POSITIONING**

REFERENCE FRAME: NAD85(1995)  
ELLIPSOID: GRS80  
MAP PROJECTION: LAMBERT CONFORMAL CONIC  
COORDINATE SYSTEM: OHIO STATE PLANE SOUTH ZONE  
COMBINED SCALE FACTOR: 0.99991836  
ORIGIN OF COORDINATE SYSTEM: 0,0

USE THE POSITIONING METHODS AND MONUMENT TYPE USED IN THE ORIGINAL SURVEY TO RESTORE ALL MONUMENTS RELATED TO PRIMARY PROJECT CONTROL THAT ARE DAMAGED OR DESTROYED BY CONSTRUCTION ACTIVITIES. RESTORE THE DAMAGED OR DESTROYED MONUMENTS IN ACCORDANCE WITH CMS 623.

UNITS ARE IN U.S. SURVEY FEET. USE THE FOLLOWING CONVERSION FACTOR: 1 METER = 3.280833333 U.S. SURVEY FEET.

**WORK LIMITS**

THE WORK LIMITS SHOWN ON THESE PLANS ARE FOR PHYSICAL CONSTRUCTION ONLY. PROVIDE THE INSTALLATION AND OPERATION OF ALL WORK ZONE TRAFFIC CONTROL AND WORK ZONE TRAFFIC CONTROL DEVICES REQUIRED BY THESE PLANS WHETHER INSIDE OR OUTSIDE THESE WORK LIMITS.

**CLEARING AND GRUBBING**

THE DEPARTMENT HAS NOT MARKED INDIVIDUAL TREES AND STUMPS FOR REMOVAL. UNLESS SPECIFICALLY DESIGNATED AS "DO NOT DISTURB" IN THE PLANS, REMOVE ALL TREES AND STUMPS WITHIN THE CONSTRUCTION LIMITS UNDER THE LUMP SUM BID FOR ITEM 201 CLEARING AND GRUBBING. TREE REMOVAL IS NOT REQUIRED FOR FENCE REPLACEMENT ACTIVITIES. THE FOLLOWING IS AN APPROXIMATE ESTIMATE OF THE NUMBER OF TREES AND STUMPS TO BE REMOVED.

SIZES	TOTAL
18"	939
30"	166
48"	6

**BENCHING OF FOUNDATION SLOPES**

ALTHOUGH CROSS-SECTIONS INDICATE SPECIFIC DIMENSIONS FOR PROPOSED BENCHING OF THE EMBANKMENT FOUNDATIONS IN CERTAIN AREAS, NO WAIVER OF THE SPECIFICATIONS IS INTENDED. BENCH ALL OTHER SLOPED EMBANKMENT AREAS AS SET FORTH IN SECTION 203.05 OF THE CONSTRUCTION AND MATERIAL SPECIFICATIONS (C&MS). NO ADDITIONAL PAYMENT WILL BE MADE FOR BENCHING REQUIRED UNDER THE PROVISIONS OF SECTION 203.05.

**ITEM 204 - PROOF ROLLING**

THE FOLLOWING QUANTITY IS PROVIDED IN THE GENERAL SUMMARY TO ADDRESS LOCATIONS REQUIRING PROOF ROLLING.

ITEM 204 - PROOF ROLLING 45 HOURS.

**AIRWAY/HIGHWAY CLEARANCE FOR AIRPORTS AND HELIPORTS**

THIS PROJECT HAS BEEN IDENTIFIED AS BEING WITHIN THE INFLUENCE AREA OF A PUBLIC USE AIRPORT OR HELIPORT. NO TEMPORARY STRUCTURES OR CONSTRUCTION EQUIPMENT AT MAXIMUM OPERATING HEIGHT SHALL EXCEED A HEIGHT OF 50 FT. IF ANY TEMPORARY STRUCTURES OR CONSTRUCTION EQUIPMENT WILL EXCEED THIS HEIGHT, FURTHER COORDINATION WITH THE FEDERAL AVIATION ADMINISTRATION (FAA), AND ODOT OFFICE OF AVIATION, WILL BE NECESSARY PRIOR TO ERECTING SUCH TEMPORARY STRUCTURES OR OPERATING SUCH EQUIPMENT ON THE PROJECT. THE CONTRACTOR WILL BE REQUIRED TO SUBMIT FORM 7460-1 TO THE FAA. NOTIFY THE ODOT OFFICE OF AVIATION WHEN SUBMITTING FAA FORM 7460-1.

NO TEMPORARY STRUCTURES OR CONSTRUCTION EQUIPMENT SHALL EXCEED THE PERMISSIBLE HEIGHT, UNTIL A COPY OF THE FAA APPROVAL AND THE ODOT OFFICE OF AVIATION PERMIT HAS BEEN FURNISHED TO THE PROJECT ENGINEER.

FEDERAL AVIATION ADMINISTRATION  
SOUTHWEST REGIONAL OFFICE  
OBSTRUCTION EVALUATION GROUP  
10101 HILLWOOD PARKWAY  
FORT WORTH, TX 76177  
FAX: (817) 222-5920  
HTTP://CEAAA.FAA.GOV

OHIO DEPARTMENT OF TRANSPORTATION  
OFFICE OF AVIATION  
2829 WEST DUBLIN-GRANVILLE ROAD  
COLUMBUS, OHIO 43235  
OHIO.AIRPORT.PROTECTION@DOT.OHIO.GOV

**PART-WIDTH CONSTRUCTION**

BECAUSE OF THE NECESSITY TO BUILD THIS PROJECT UNDER TRAFFIC AND TO CONSTRUCT THE FULL PAVEMENT WIDTH IN STAGES, EXERCISE CARE TO PREVENT THE CONSTRUCTION OF A BUTT JOINT IN THE BASE COURSES. LAP LONGITUDINAL JOINTS AS SHOWN ON STANDARD CONSTRUCTION DRAWING BP-3.1.

**CONNECTION BETWEEN EXISTING AND PROPOSED GUARDRAIL**

WHEN IT IS NECESSARY TO SPLICE PROPOSED GUARDRAIL TO EXISTING GUARDRAIL, ONLY THE EXISTING GUARDRAIL SHALL BE CUT, DRILLED, OR PUNCHED. THE CONNECTION SHALL BE MADE USING A W-BEAM, BEAM SPLICE AS SHOWN IN AASHTO M 180-12, EXCEPT THE BEAM WASHERS ARE NOT TO BE USED. PAYMENT SHALL BE INCLUDED IN THE CONTRACT PRICE FOR THE RESPECTIVE GUARDRAIL ITEMS.

**CONTRACTION AND/OR EXPANSION JOINTS**

ALTHOUGH SPECIFIC LOCATIONS OF CERTAIN CONTRACTION AND EXPANSION JOINTS HAVE BEEN DETAILED ON THIS PLAN, NO WAIVER OF THE SPECIFICATIONS IS INTENDED. IN ALL CASES, THE PROVISION OF EXPANSION JOINTS AT ALL MAJOR STRUCTURES INCLUDING THE MAXIMUM SPACING BETWEEN CONTRACTION JOINTS IS IN ACCORDANCE WITH STANDARD CONSTRUCTION DRAWING BP-2.2 AND THE SPECIFICATIONS.

**FENCE LENGTHS**

THE LENGTHS OF FENCE SHOWN IN THE PLANS ARE HORIZONTAL DIMENSIONS. MEASUREMENTS OF THE FINAL QUANTITIES WILL BE IN ACCORDANCE WITH ITEM 607.

**EXISTING PAVEMENT THICKNESS**

THE EXISTING PAVEMENT THICKNESS SHOWN ON SHEETS 11,12, 27, AND 29 ARE APPROXIMATE ONLY. THE CONTRACTOR IS TO REFER TO THE CORRESPONDING BORING LOG/SOIL PROFILE INFORMATION SHEETS FOR THE PAVEMENT THICKNESS AT SPECIFIC LOCATIONS.

**PAVEMENT RESTORATION FOR PIPE INSTALLATIONS AND/OR REMOVALS**

THE FOLLOWING QUANTITY HAS BEEN PROVIDED FOR PAVEMENT RESTORATION FOLLOWING INSTALLATION AND/OR REMOVAL OF PIPES.

ITEM 301 - ASPHALT CONCRETE BASE, PG64-22 9 CU. YDS.  
ITEM 202 - PAVEMENT REMOVED, AS PER PLAN 24 SQ. YDS.

THE ABOVE QUANTITY IS BASED ON A 301 THICKNESS OF 13" INCHES AND A PAVEMENT RESTORATION WIDTH THAT INCLUDES THE TRENCH WIDTH PLUS TWO FEET ON EACH SIDE OF THE TRENCH.

PROVIDE ANY MATERIALS USED OUTSIDE THE LIMITS STATED ABOVE AT NO ADDITIONAL COST.

**ORANGE PLASTIC CONSTRUCTION FENCE**

ORANGE PLASTIC CONSTRUCTION FENCE SHALL BE CONSTRUCTED AND MAINTAINED IN ACCORDANCE WITH MT-110.10, EXCEPT THE FENCE SHALL BE 72" HIGH AND THE TOP EDGE SHALL NOT SAG BELOW 60". THE FOLLOWING ESTIMATED QUANTITY HAS BEEN PROVIDED FOR PLACING THE ORANGE PLASTIC CONSTRUCTION FENCE.

LOCATION:  
US 35 STA. 295+00 LT. TO STA. 323+50 LT.  
TREBEIN RD. STA. 890+50 RT. TO 898+00 RT.

ORANGE PLASTIC CONSTRUCTION FENCE 3600 FT

PAYMENT FOR THE ABOVE WORK SHALL BE INCLUDED IN THE LUMP SUM BID FOR ITEM 614, MAINTENANCE OF TRAFFIC AND SHALL INCLUDE ALL MATERIAL, EQUIPMENT, PARTS, LABOR, AND TOOLS NEEDED TO SECURELY PLACE, MAINTAIN, AND REMOVE THE ORANGE PLASTIC CONSTRUCTION FENCE.

**ITEM 206 - MIXTURE DESIGN FOR CHEMICALLY STABILIZED SOILS, AS PER PLAN**

OBTAIN SOIL SAMPLES AS OUTLINED IN SUPPLEMENT 1120 FOLLOWING EXCAVATION OR EMBANKMENT PLACEMENT TO THE DESIGN SUBGRADE LEVEL. THE SOIL SAMPLES FOR SUPPLEMENT 1120 TESTING ARE TO BE OBTAINED FROM THE ACTUAL SUBGRADE SOILS. SAMPLING OF THE SOILS OUTSIDE THE ACTUAL STABILIZATION LIMITS OR FROM A BORROW AREA IS PROHIBITED. THE CONSTRUCTION SCHEDULE SHALL INCLUDE SPECIFIC ACTIVITIES FOR SAMPLING AND TESTING OF THE SUBGRADE SOILS FOR ALL PHASES OR PARTIAL PHASES OF CONSTRUCTION. THE INDIVIDUAL CONSTRUCTION PHASES ARE CONSIDERED TO BE PHASE 1, 1A, 2, 3, AND 4. PERFORM THE MIXTURE DESIGN PROCEDURE FOR EACH PHASE AS OUTLINED IN SUPPLEMENT 1120. DURING CONSTRUCTION, OBTAIN FIELD VERIFICATION SAMPLES FOR EACH PHASE OF CONSTRUCTION AND SUBMIT THE TEST RESULTS FOR EACH PHASE AS THE LABORATORY TESTING IS COMPLETE.

107217GN001.dgn Sheet 1/4/2023 6:19AM CH\_ODOTV81\_Half\_BW.pen ProjectWise Dynamic Composition Server JEGSVCPWU01

CALCULATED  
CHECKED

GENERAL NOTES

GRE-US 35-5.63

107217gg001.dgn Sheet 1/4/2023 5:36AM CH\_ODOTV81\_Half\_BW\_pen ProjectWise\_Dynamic\_Composition\_Server JEGSYCPWU01

SHEET NUM.										PART.			ITEM	ITEM EXT	GRAND TOTAL	UNIT	DESCRIPTION	SEE SHEET NO.
30	185	186	187	189	195	602	Office Calcs.	01/NHS/OT	02/NHS/BR	03/NHS/BR								
<b>ROADWAY</b>																		
LS								LS				201	11000	LS		CLEARING AND GRUBBING		
24	64,886							64,910				202	23001	64,910	SY	PAVEMENT REMOVED, AS PER PLAN	32	
	769							769				202	30600	769	SY	CONCRETE MEDIAN REMOVED		
	1,725							1,725				202	35100	1,725	FT	PIPE REMOVED, 24" AND UNDER		
	90					39		129				202	35200	129	FT	PIPE REMOVED, OVER 24"		
	5,485							5,485				202	38000	5,485	FT	GUARDRAIL REMOVED		
	9,132							9,132				202	38300	9,132	FT	GUARDRAIL REMOVED, BARRIER DESIGN		
	8							8				202	47800	8	EACH	IMPACT ATTENUATOR REMOVED		
	2							2				202	53100	2	EACH	MAILBOX REMOVED		
	1							1				202	56100	1	EACH	BUILDING DEMOLISHED, GRAIN SILO		
	11							11				202	58100	11	EACH	CATCH BASIN REMOVED		
	6							6				202	58200	6	EACH	INLET REMOVED		
								15,096				202	75000	15,096	FT	FENCE REMOVED		
								3				202	75250	3	EACH	GATE REMOVED		
								1				202	98100	1	EACH	REMOVAL MISC.: SEPTIC TANK AND LEACH FIELD		
								2				202	98100	2	EACH	REMOVAL MISC.: PRECAST CONCRETE OUTLET		
								2				202	98100	2	EACH	REMOVAL MISC.: PRIVATE WOODEN SIGN		
								9				202	98100	9	EACH	REMOVAL MISC.: CONCRETE BUMPER BLOCKS		
								2				202	98100	2	EACH	REMOVAL MISC.: CONCRETE FOUNDATION		
								21				202	98300	21	SY	REMOVAL MISC.: ROCK CHANNEL PROTECTION		
								10				202	98700	10	FT	ABANDON MISC.: PIPE 24" AND UNDER		
	131		24,705					24,836				203	10000	24,836	CY	EXCAVATION		
								1,479				203	10001	1,479	CY	EXCAVATION, AS PER PLAN (VERTICAL SIDES ONLY)	32	
	2,753		227,731					230,568				203	20000	230,568	CY	EMBANKMENT		
								6,586				203	20001	6,586	CY	EMBANKMENT, AS PER PLAN	32	
								12				SPECIAL	20365000	12	EACH	SETTLEMENT PLATFORM	35	
								4,224	4,224			204	10000	4,224	SY	SUBGRADE COMPACTION		
								162	162			204	13000	162	CY	EXCAVATION OF SUBGRADE		
								162	162			204	30020	162	CY	GRANULAR MATERIAL, TYPE C		
57								57				204	45000	57	HOUR	PROOF ROLLING		
								2,517	2,517			204	50000	2,517	SY	GEOTEXTILE FABRIC		
								2,764	2,764			206	10500	2,764	TON	CEMENT		
								106,793	106,793			206	11000	106,793	SY	CURING COAT		
								106,793	106,793			206	15010	106,793	SY	CEMENT STABILIZED SUBGRADE, 12 INCHES DEEP		
								LS	LS			206	30000	LS		MIXTURE DESIGN FOR CHEMICALLY STABILIZED SOILS		
								LS	LS			206	30001	LS		MIXTURE DESIGN FOR CHEMICALLY STABILIZED SOILS, AS PER PLAN	30	
								12,175.5	12,175.5			606	15050	12,175.5	FT	GUARDRAIL, TYPE MGS		
								6,462	6,462			606	15100	6,462	FT	GUARDRAIL, TYPE MGS WITH LONG POSTS		
								2,800	2,800			606	15550	2,800	FT	GUARDRAIL, BARRIER DESIGN, TYPE MGS		
								3	3			606	20000	3	EACH	FLARED END SECTION		
								12	12			606	26150	12	EACH	ANCHOR ASSEMBLY, MGS TYPE E, MASH 2016		
								14	14			606	26550	14	EACH	ANCHOR ASSEMBLY, MGS TYPE T		
								5	5			606	35002	5	EACH	MGS BRIDGE TERMINAL ASSEMBLY, TYPE 1		
								5	5			606	35102	5	EACH	MGS BRIDGE TERMINAL ASSEMBLY, TYPE 2		
								1	1			606	60022	1	EACH	IMPACT ATTENUATOR, TYPE 2 (UNIDIRECTIONAL), SPEED = 60 MPH, HAZARD = 28"		
								3	3			606	60028	3	EACH	IMPACT ATTENUATOR, TYPE 2 (BIDIRECTIONAL), SPEED = 60 MPH, HAZARD = 36"		
								16,057	16,057			607	15000	16,057	FT	FENCE, TYPE 47		
								7	7			607	35000	7	FT	FENCE REMOVED AND REBUILT		
								2,785	2,785			622	10100	2,785	FT	CONCRETE BARRIER, SINGLE SLOPE, TYPE B1		
								205	205			622	10120	205	FT	CONCRETE BARRIER, SINGLE SLOPE, TYPE C		
								40	40			622	10121	40	FT	CONCRETE BARRIER, SINGLE SLOPE, TYPE C, AS PER PLAN	32	
								862	862			622	10160	862	FT	CONCRETE BARRIER, SINGLE SLOPE, TYPE D		
								94	94			622	10161	94	FT	CONCRETE BARRIER, SINGLE SLOPE, TYPE D, AS PER PLAN A	32	
								156	156			622	10161	156	FT	CONCRETE BARRIER, SINGLE SLOPE, TYPE D, AS PER PLAN B	32	
								1	1			622	24840	1	EACH	CONCRETE BARRIER END SECTION, TYPE B		
								2	2			622	24850	2	EACH	CONCRETE BARRIER END SECTION, TYPE B1		
								1	1			622	25000	1	EACH	CONCRETE BARRIER END SECTION, TYPE D		

CALCULATED  
TES  
CHECKED  
JAE

GENERAL SUMMARY

GRE-US 35-5.63





107217qs003.dgn Sheet 1/3/2023 9:10AM CH\_OD0TV81\_Half\_BW\_pen ProjectWise Dynamic Composition Server JEGSYCPWU01

REF. NO.	SHEET NO.	STATION		SIDE	202	202	202	202	202	202	202	202	202	202	202	202	202	202	202	202	202	203	203	
		FROM	TO		PAVEMENT REMOVED, AS PER PLAN SY	CONCRETE MEDIAN REMOVED SY	PIPE REMOVED, 24" AND UNDER FT	PIPE REMOVED, OVER 24" FT	GUARDRAIL REMOVED FT	GUARDRAIL REMOVED, BARRIER DESIGN FT	IMPACT ATTENUATOR REMOVED EACH	MAILBOX REMOVED EACH	BUILDING DEMOLISHED, GRAIN SILO EACH	CATCH BASIN REMOVED EACH	INLET REMOVED EACH	REMOVAL MISC.: SEPTIC TANK AND LEACH FIELD LS	REMOVAL MISC.: PRECAST CONCRETE OUTLET EACH	REMOVAL MISC.: PRIVATE WOODEN SIGN EACH	REMOVAL MISC.: CONCRETE BUMPER BLOCKS EACH	REMOVAL MISC.: CONCRETE FOUNDATION EACH	REMOVAL MISC.: ROCK CHANNEL PROTECTION SY	ABANDON MISC.: PIPE 24" AND UNDER FT	EXCAVATION CY	EMBANKMENT CY
		<b>US 35</b>																						
R-1	404	297+50.00	323+30.03	LT	10422																			
R-2	404	297+50.00	323+30.03	RT	10459																			
R-3	405	325+85.20	365+00.00	LT	17344																			
R-4	405	325+85.20	365+00.00	RT	16844																			
		<b>VALLEY ROAD</b>																						
R-5	405	862+00.00	879+53.00	LT	4727																		2753	
		<b>TREBEIN ROAD</b>																						
R-6	405	880+64.00	802+04.00	LT	676																	131		
R-7	405	884+95.00	897+90.97	LT	4414																			
<b>TOTALS THIS SHEET</b>					64886	0	0	0	0	0	0	0	0	0	0	0	0	0	0	0	0	131	2753	
<b>TOTALS FROM SHEET 183</b>					0	769	1127	30	2277	4706	3	0	0	6	6	0	2	1	0	0	21	10	0	0
<b>TOTALS FROM SHEET 184</b>					0	0	598	60	3208	4426	5	2	1	5	0	1	0	1	9	2	0	0	0	0
<b>TOTALS CARRIED TO GENERAL SUMMARY</b>					64886	769	1725	90	5485	9132	8	2	1	11	6	1	2	2	9	2	21	10	131	2753

CALCULATED JAE	CHECKED DYB
ROADWAY SUBSUMMARY	
GRE-US 35-5.63	
<div style="border: 1px solid black; border-radius: 50%; width: 30px; height: 30px; display: flex; align-items: center; justify-content: center; margin: 0 auto;"> <span style="font-size: 0.8em;">185</span> </div> <div style="border: 1px solid black; border-radius: 50%; width: 30px; height: 30px; display: flex; align-items: center; justify-content: center; margin: 0 auto;"> <span style="font-size: 0.8em;">698</span> </div>	

107217gs004.dgn Sheet 1/3/2023 9:10AM CH\_ODOTV81\_Half\_BW\_pen ProjectWise Dynamic Composition Server JEGSVCPU01


REF. NO.	SHEET NO.	STATION		SIDE	606													626			
		FROM	TO		GUARDRAIL, TYPE MGS	GUARDRAIL, TYPE MGS WITH LONG POST	GUARDRAIL, BARRIER DESIGN, TYPE MGS	FLARED END SECTION	ANCHOR ASSEMBLY, MGS TYPE E, MASH 2016	ANCHOR ASSEMBLY, MGS TYPE T	MGS BRIDGE TERMINAL ASSEMBLY, TYPE 1	MGS BRIDGE TERMINAL ASSEMBLY, TYPE 2	IMPACT ATTENUATOR, TYPE 2 (BIDIRECTIONAL) SPEED = 60 MPH, HAZARD = 36"	BARRIER REFLECTOR, TYPE 2, ONE-WAY (WHITE)	BARRIER REFLECTOR, TYPE 2, BIDIRECTIONAL (YELLOW/YELLOW)	BARRIER REFLECTOR, TYPE 2, BIDIRECTIONAL (YELLOW/RED)	BARRIER REFLECTOR, TYPE 2, BIDIRECTIONAL (WHITE/RED)				
		FT	FT	FT	EACH	EACH	EACH	EACH	EACH	EACH	EACH	EACH	EACH	EACH	EACH	EACH	EACH				
		<b>US 35</b>																			
GR-1	484	273+87.50	275+62.50	RT	112.5				1	1				3							
GR-1A	209	287+12.50	298+12.50	RT	50.0				1	1					24						
GR-2	209	288+75.63	323+02.53	LT/CL	50.5	987.5	874.5	2475.0	2		1			36							
GR-3	211	298+24.50	299+99.50	LT	112.5					1	1			3							
GR-4	212	300+00.00	301+62.50	RT	100.0					1	1			3							
GR-5	216	317+93.13	323+32.53	RT	462.5						1			7							
GR-6	217	321+80.03	323+32.03	LT	137.5						1		1	3							
GR-7	218	325+83.20	328+47.70	RT	250.0						1		1	4							
GR-8	221	336+46.00	338+21.00	RT	112.5					1	1			3							
GR-9	223	941+87.50, RAMP G	365+00.00	RT	2262.5					1				25							
GR-10	223	1042+62.50, RAMP H	368+87.50	LT	2612.5						1			28							
GR-11	227	359+77.50	365+16.90	LT/CL	512.5						1		1	7							
GR-12	229	366+25.00	391+12.50	RT		2300.0	175.0	1			1		1	26							
GR-13	229	367+81.25	392+43.75	LT		2300.0	150.0				1		1	26							
		<b>RAMP E</b>																			
GR-20	214	706+57.51	722+72.01	LT	1600.0						1		1				18				
	214	722+72.01	729+39.92	LT													8				
GR-21	244	721+94.97	722+71.97	RT	62.5						1		1		2						
	244	722+71.97	730+50.00	RT										9							
		<b>RAMP H</b>																			
GR-22	258	1039+24.22	866+13.16, TREBEIN RD	LT/RT	1187.5					2				6			8				
	258	1031+29.00	1039+06.37	RT											9						
		<b>VALLEY ROAD</b>																			
GR-30	357	869+53.39	878+67.89	LT	900.0						1		1	11							
	360	878+67.52	881+70.00	LT										4							
GR-31	358	870+51.68	933+61.99, RAMP G	RT	562.5					1	1			4			5				
GR-32	359	841+34.63, RAMP F	878+65.45	RT	487.5					1		1		5			2				
	360	878+65.45	881+67.00	RT										4							
		<b>TREBEIN ROAD</b>																			
GR-33	360	729+51.42, RAMP E	886+99.76	LT	600.0					1		1		6			2				
<b>TOTALS CARRIED TO GENERAL SUMMARY</b>					12175.5	6462.0	2800.0	3	12	14	5	5	3	119	119	20	43				

CALCULATED JAE CHECKED DYB	ROADWAY SUBSUMMARY	GRE-US 35-5.63	186 698
-------------------------------------	--------------------	----------------	------------





107217DE003.dgn 1/3/2023 3:22:23 PM Joe.EveretteJr@jacobs.com

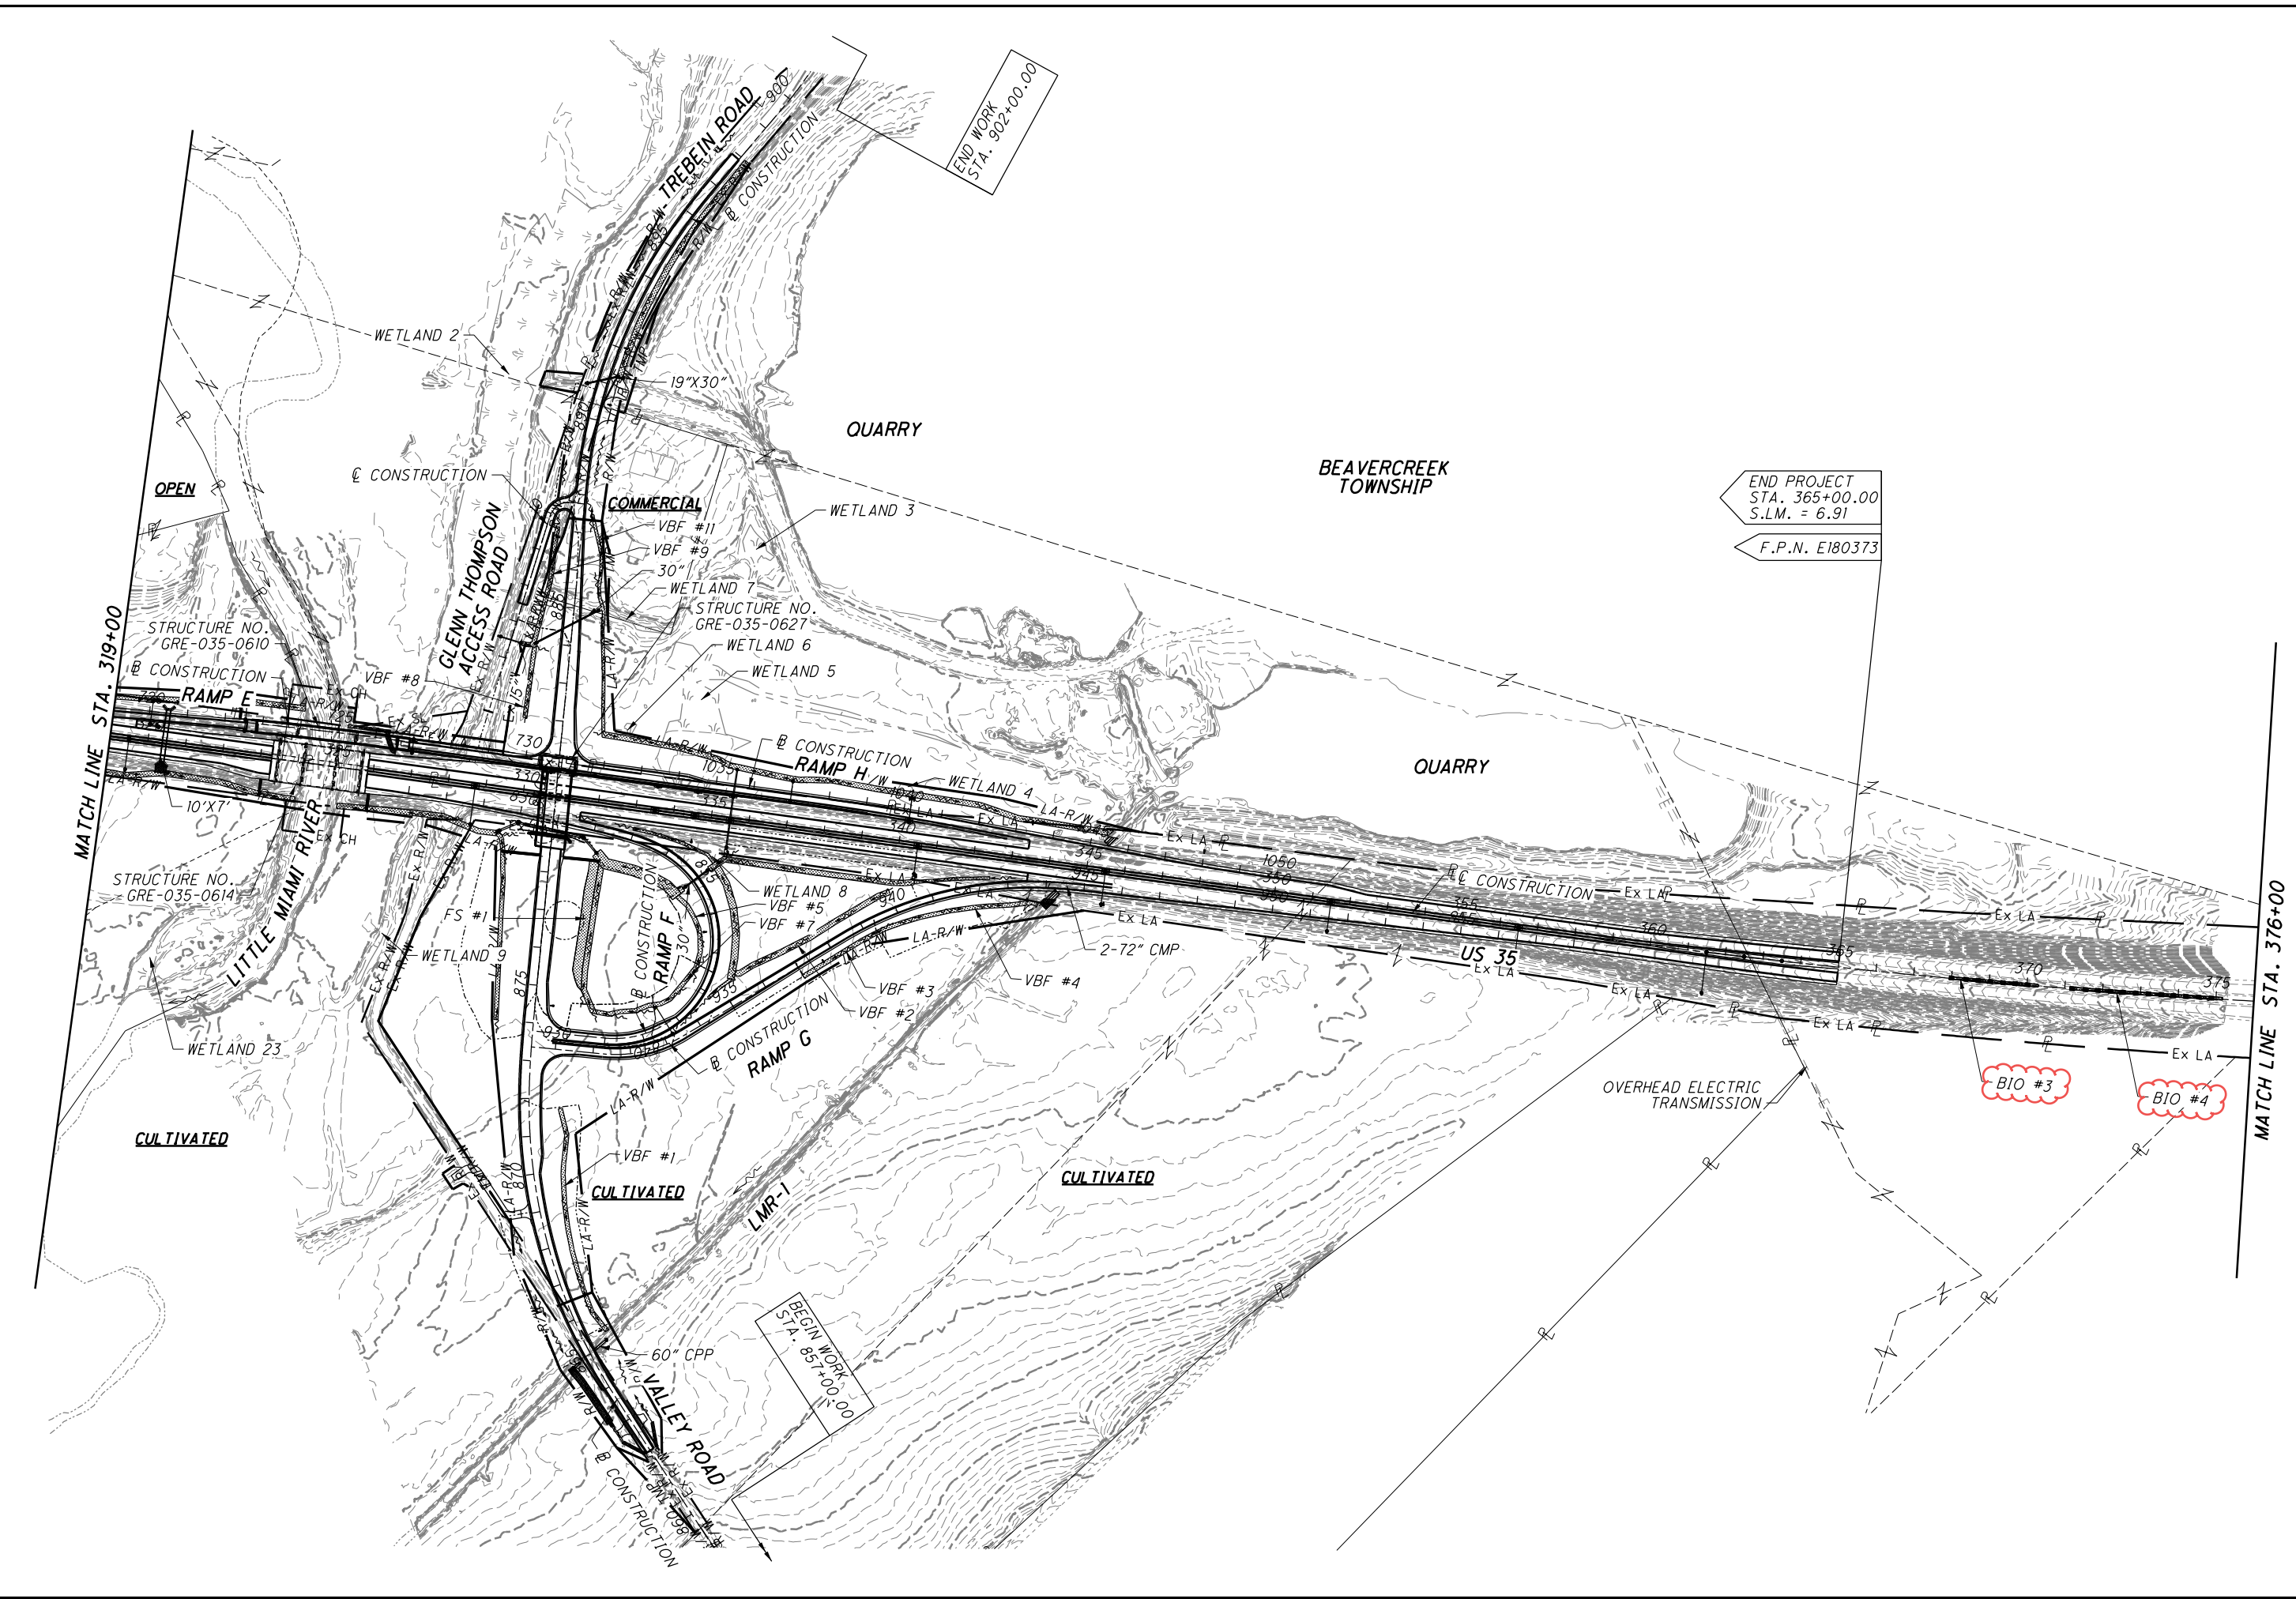

PROJECT SITE PLAN  
US 35 STA. 319+00 TO STA. 376+00

GRE-US 35-5.63


206  
698

107217gp040.dgn Sheet 1/3/2023 9:10AM CH\_ODOTV81\_Half\_BW.pen ProjectWise Dynamic Composition Server JEGSYCPWU01

NOTES:

1. FOR EROSION PROTECTION LEGEND,  
SEE SHEET 208

BEA, BI = BARRIER END ANCHORAGE, TYPE B1

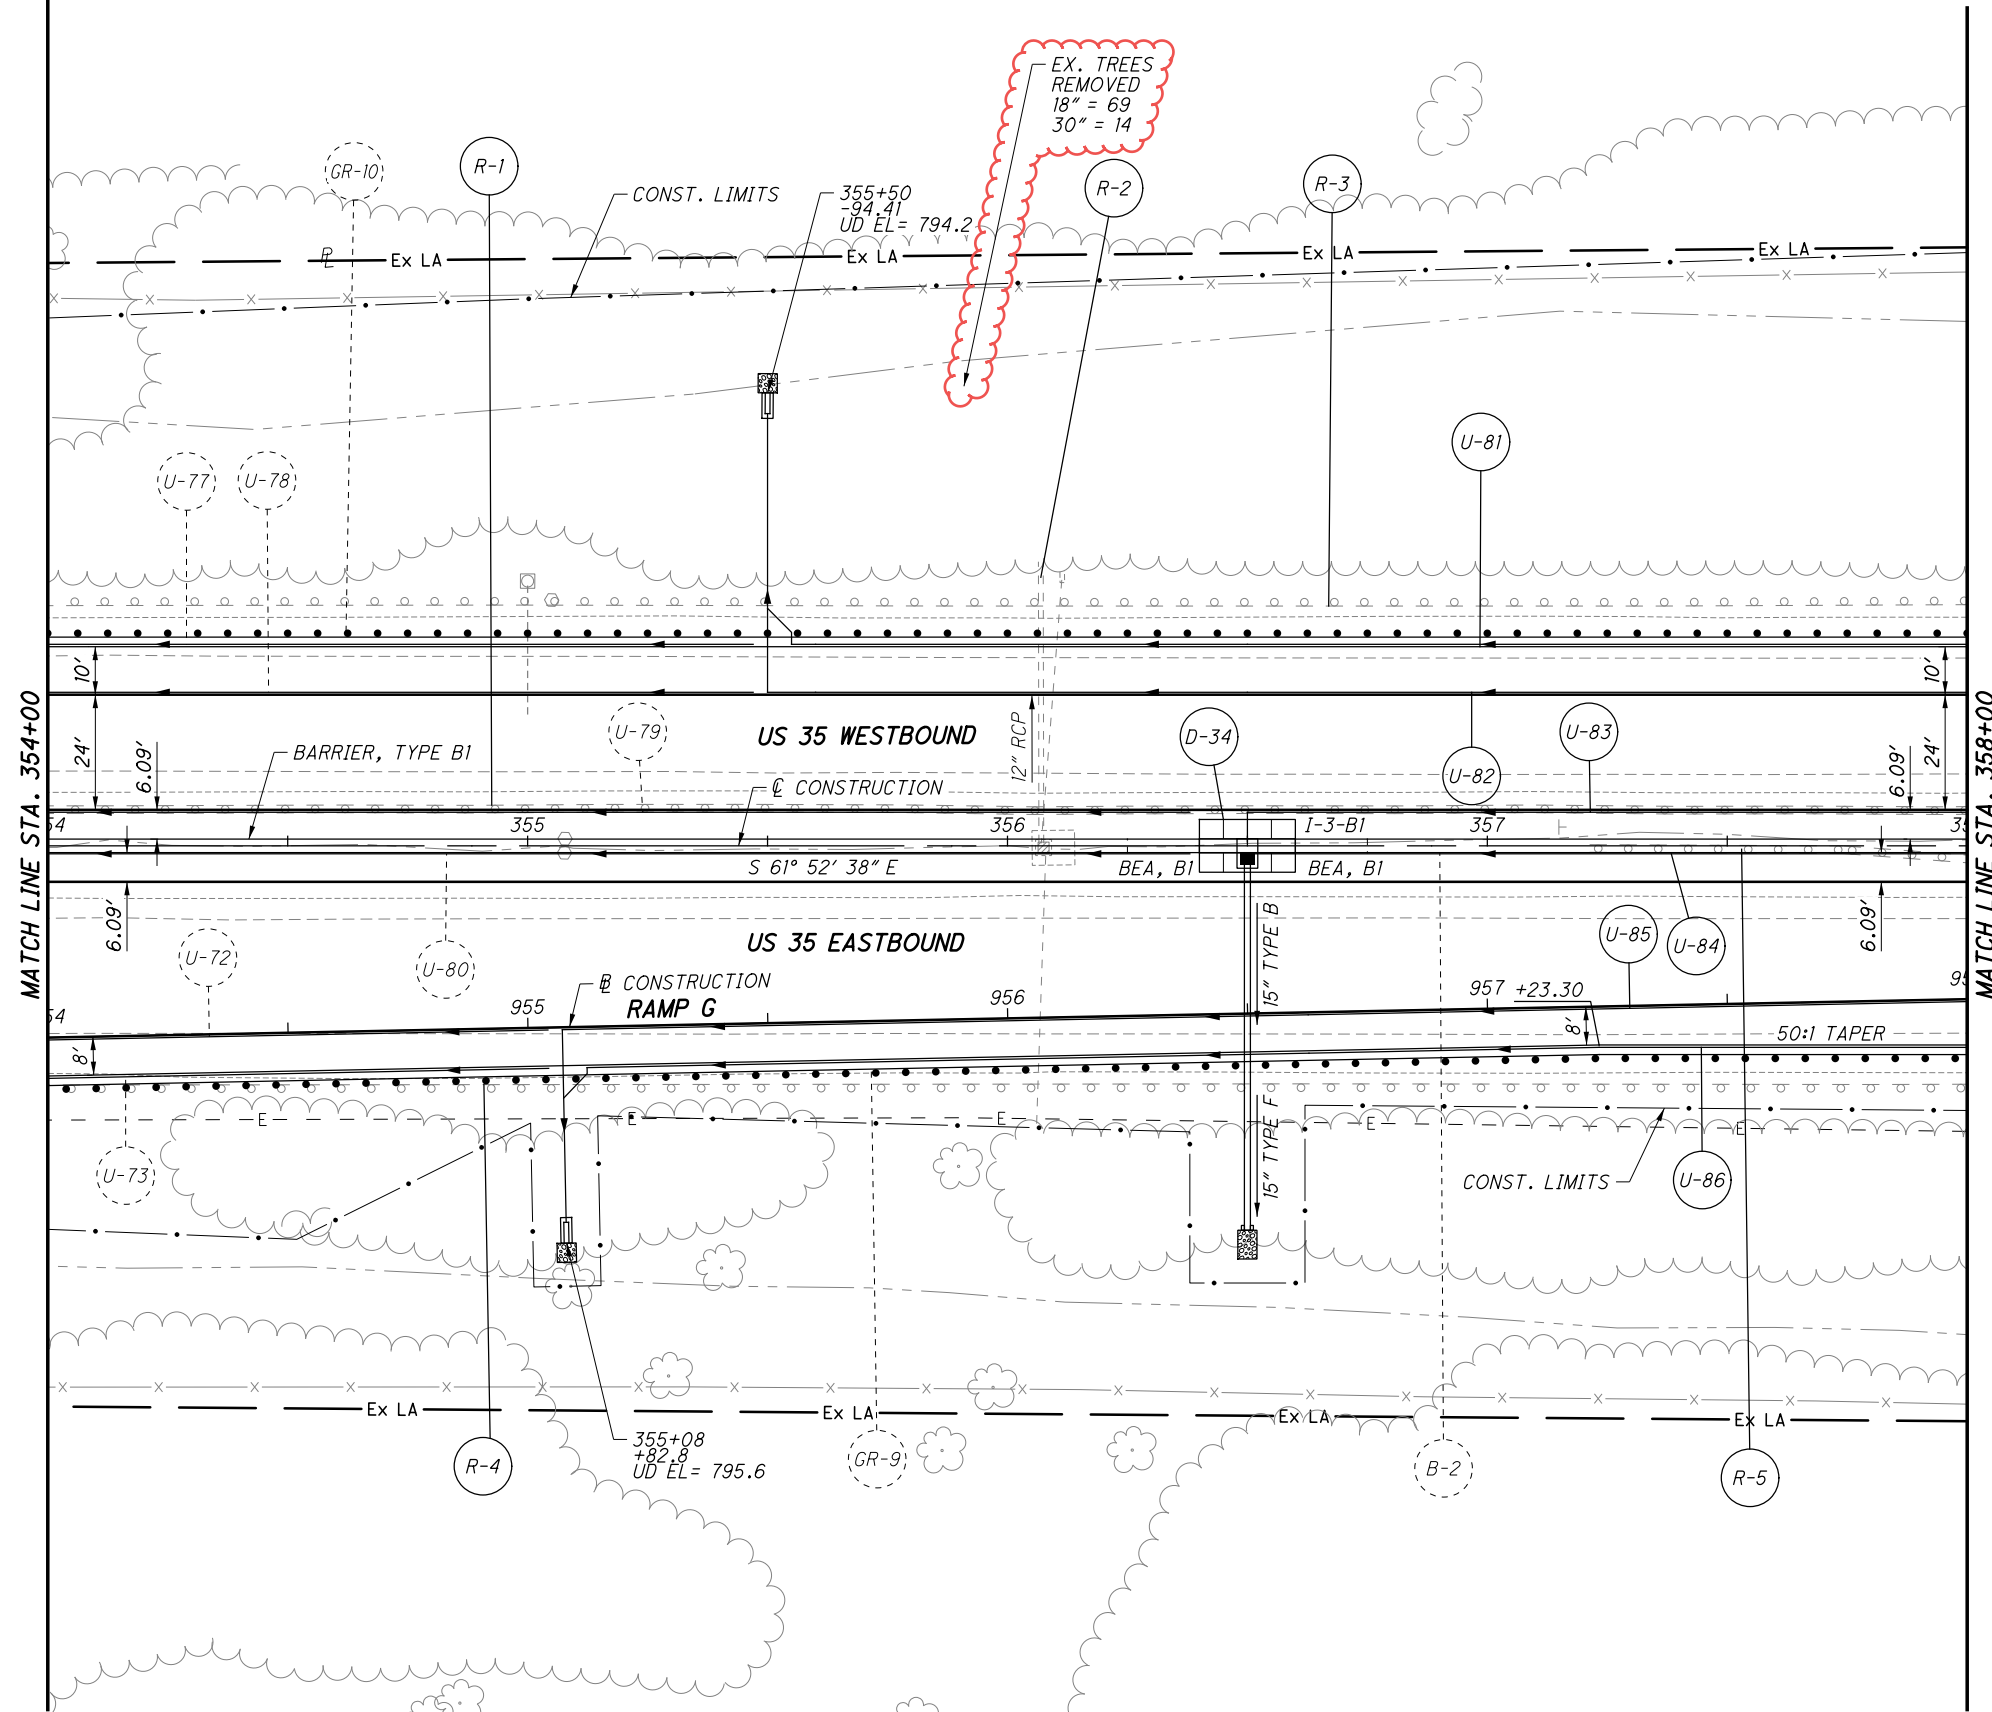


CALCULATED  
CHECKED

0 10 20 40  
HORIZONTAL  
SCALE IN FEET

PLAN - US 35  
STA. 354+00 TO STA. 358+00

GRE-US 35-5.63

107217gp041.dgn Sheet 1/3/2023 9:10AM CH\_OD01V81\_Half\_BW.pen ProjectWise Dynamic Composition Server JEGSVCPWU01

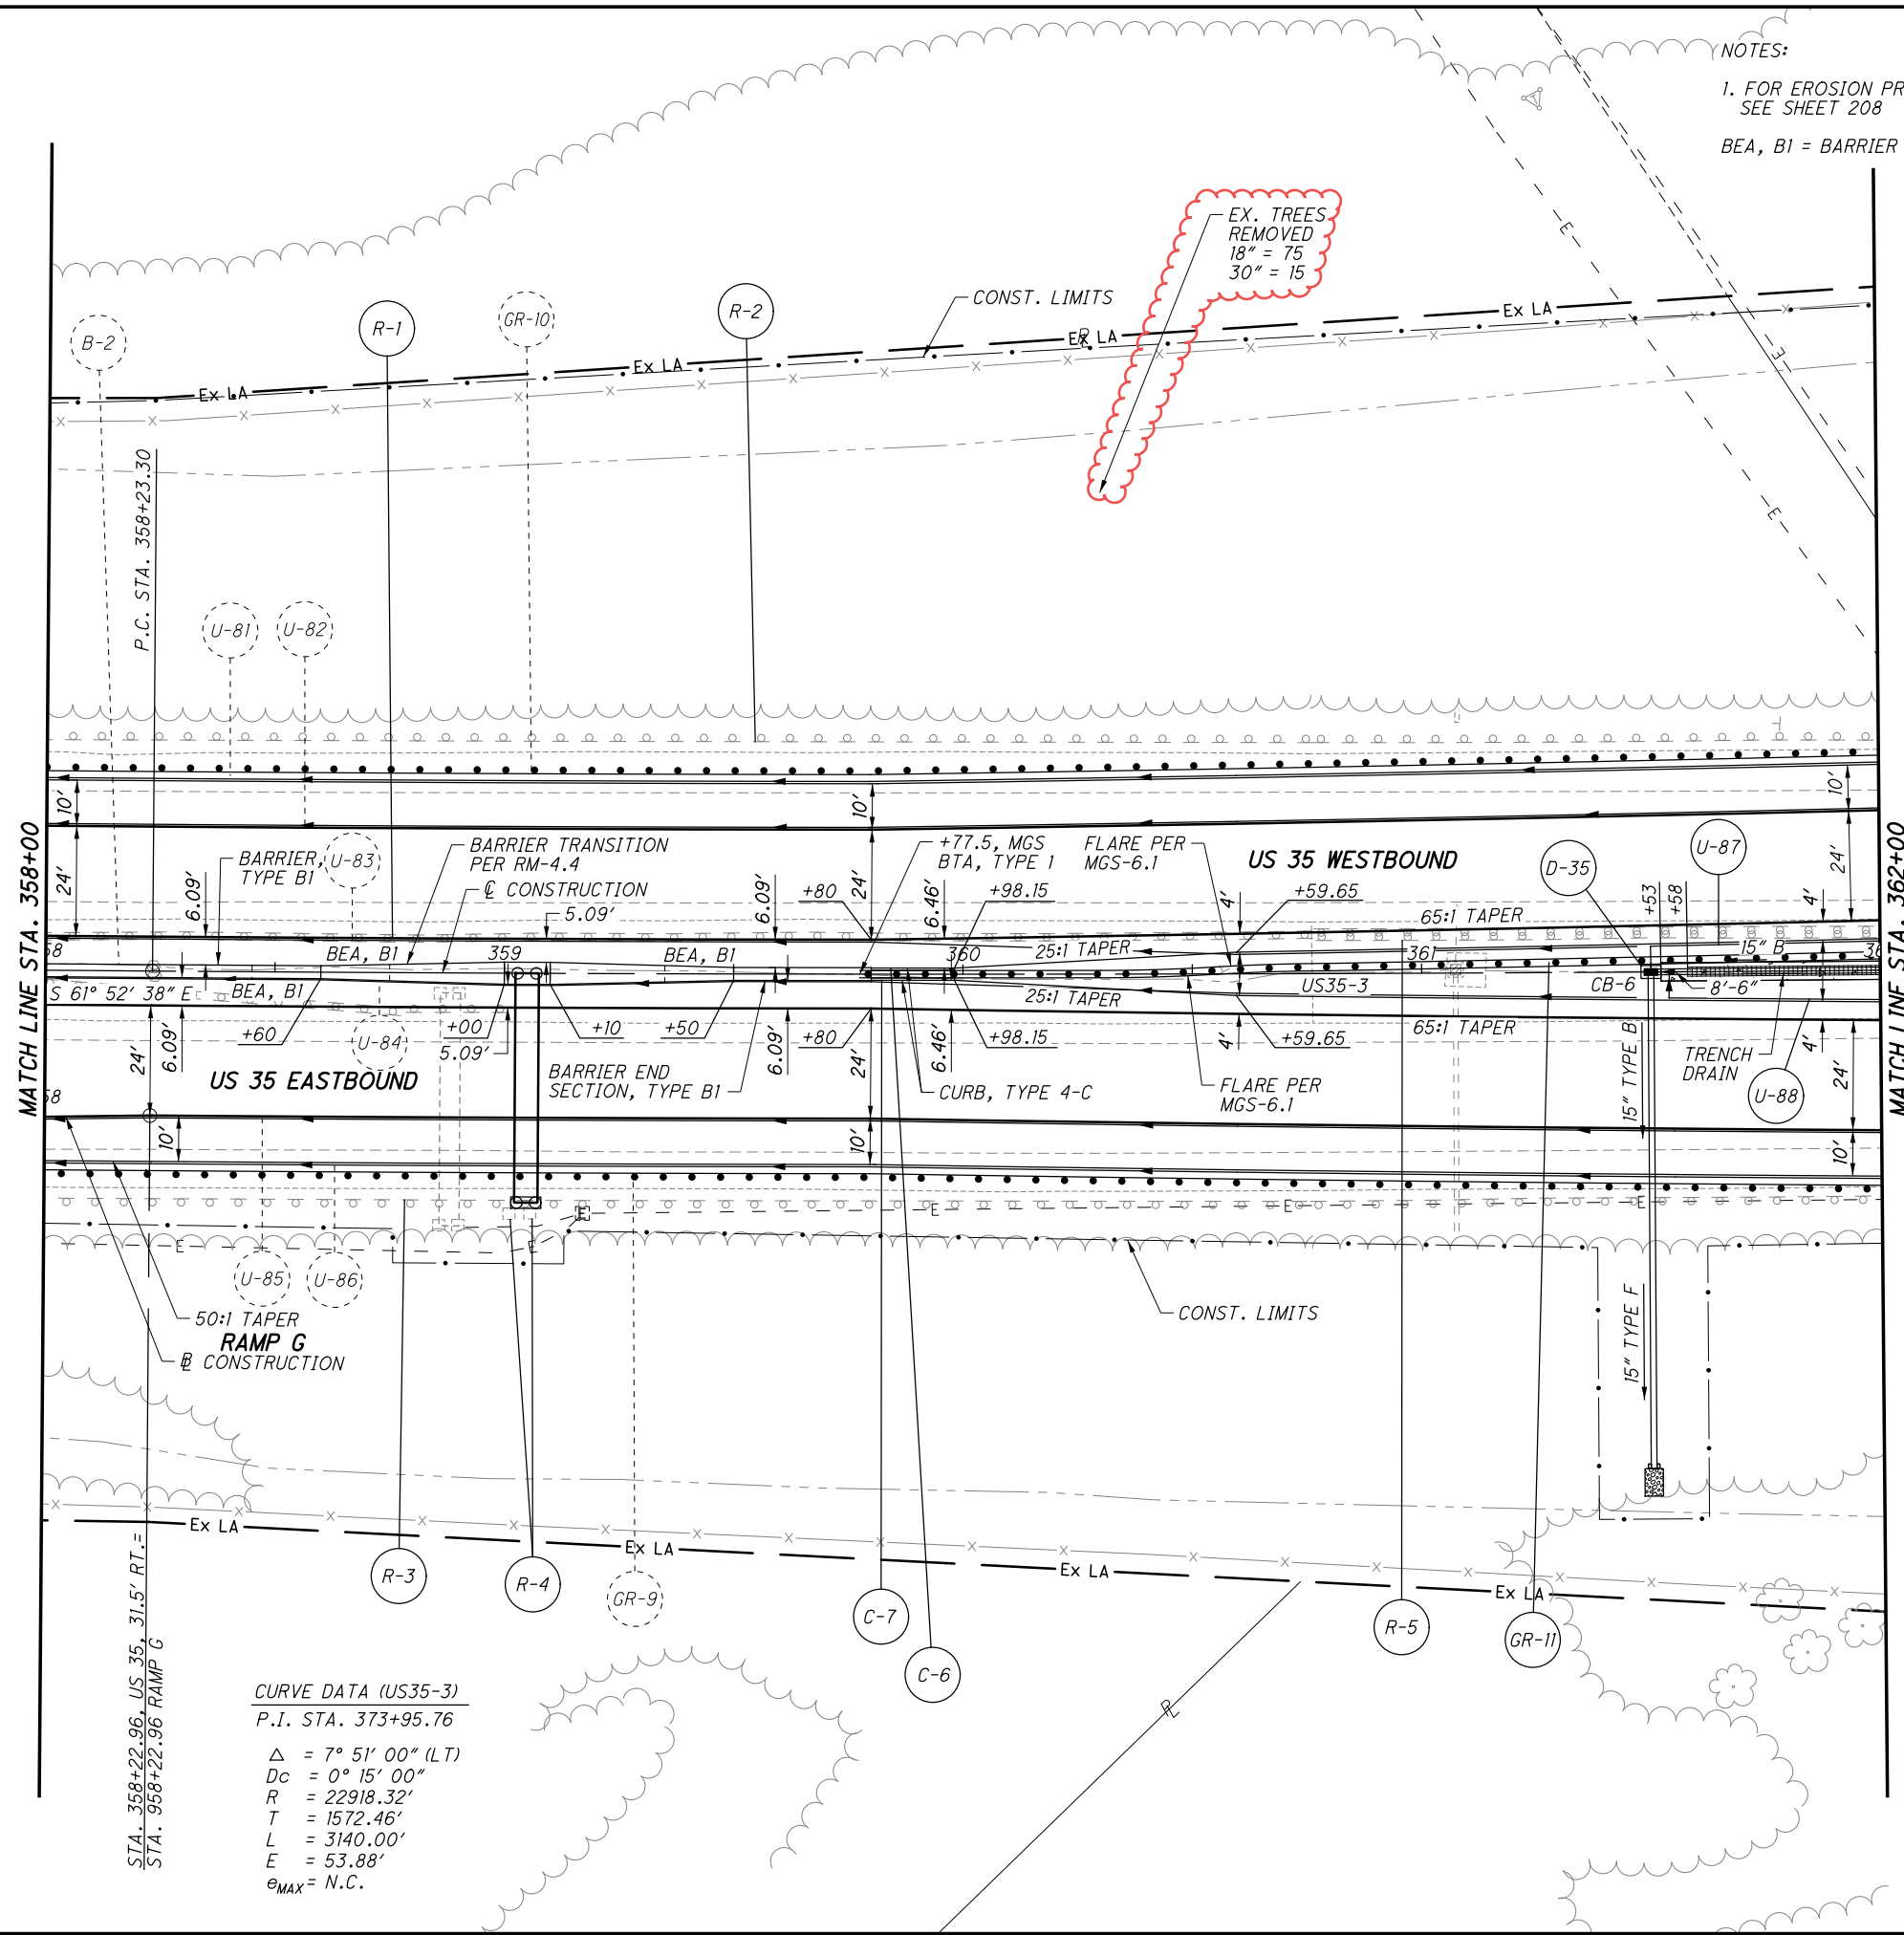

NOTES:  
 1. FOR EROSION PROTECTION LEGEND,  
 SEE SHEET 208  
 BEA, B1 = BARRIER END ANCHORAGE, TYPE B1

EX. TREES  
 REMOVED  
 18" = 75  
 30" = 15

**CURVE DATA (US35-3)**  
 P.I. STA. 373+95.76  
 $\Delta = 7^\circ 51' 00''$  (LT)  
 $D_c = 0^\circ 15' 00''$   
 $R = 22918.32'$   
 $T = 1572.46'$   
 $L = 3140.00'$   
 $E = 53.88'$   
 $e_{MAX} = N.C.$

STA. 358+22.96, US 35, 31.5' RT. =  
 STA. 958+22.96 RAMP G




PLAN - US 35  
 STA. 358+00 TO STA. 362+00

GRE-US 35-5.63  
 227  
 698



107217gp043.dgn Sheet 1/3/2023 9:10AM CH\_ODOTV81\_Half\_BW.pen ProjectWise\_Dynamic Composition Server JEGSYCPWU01

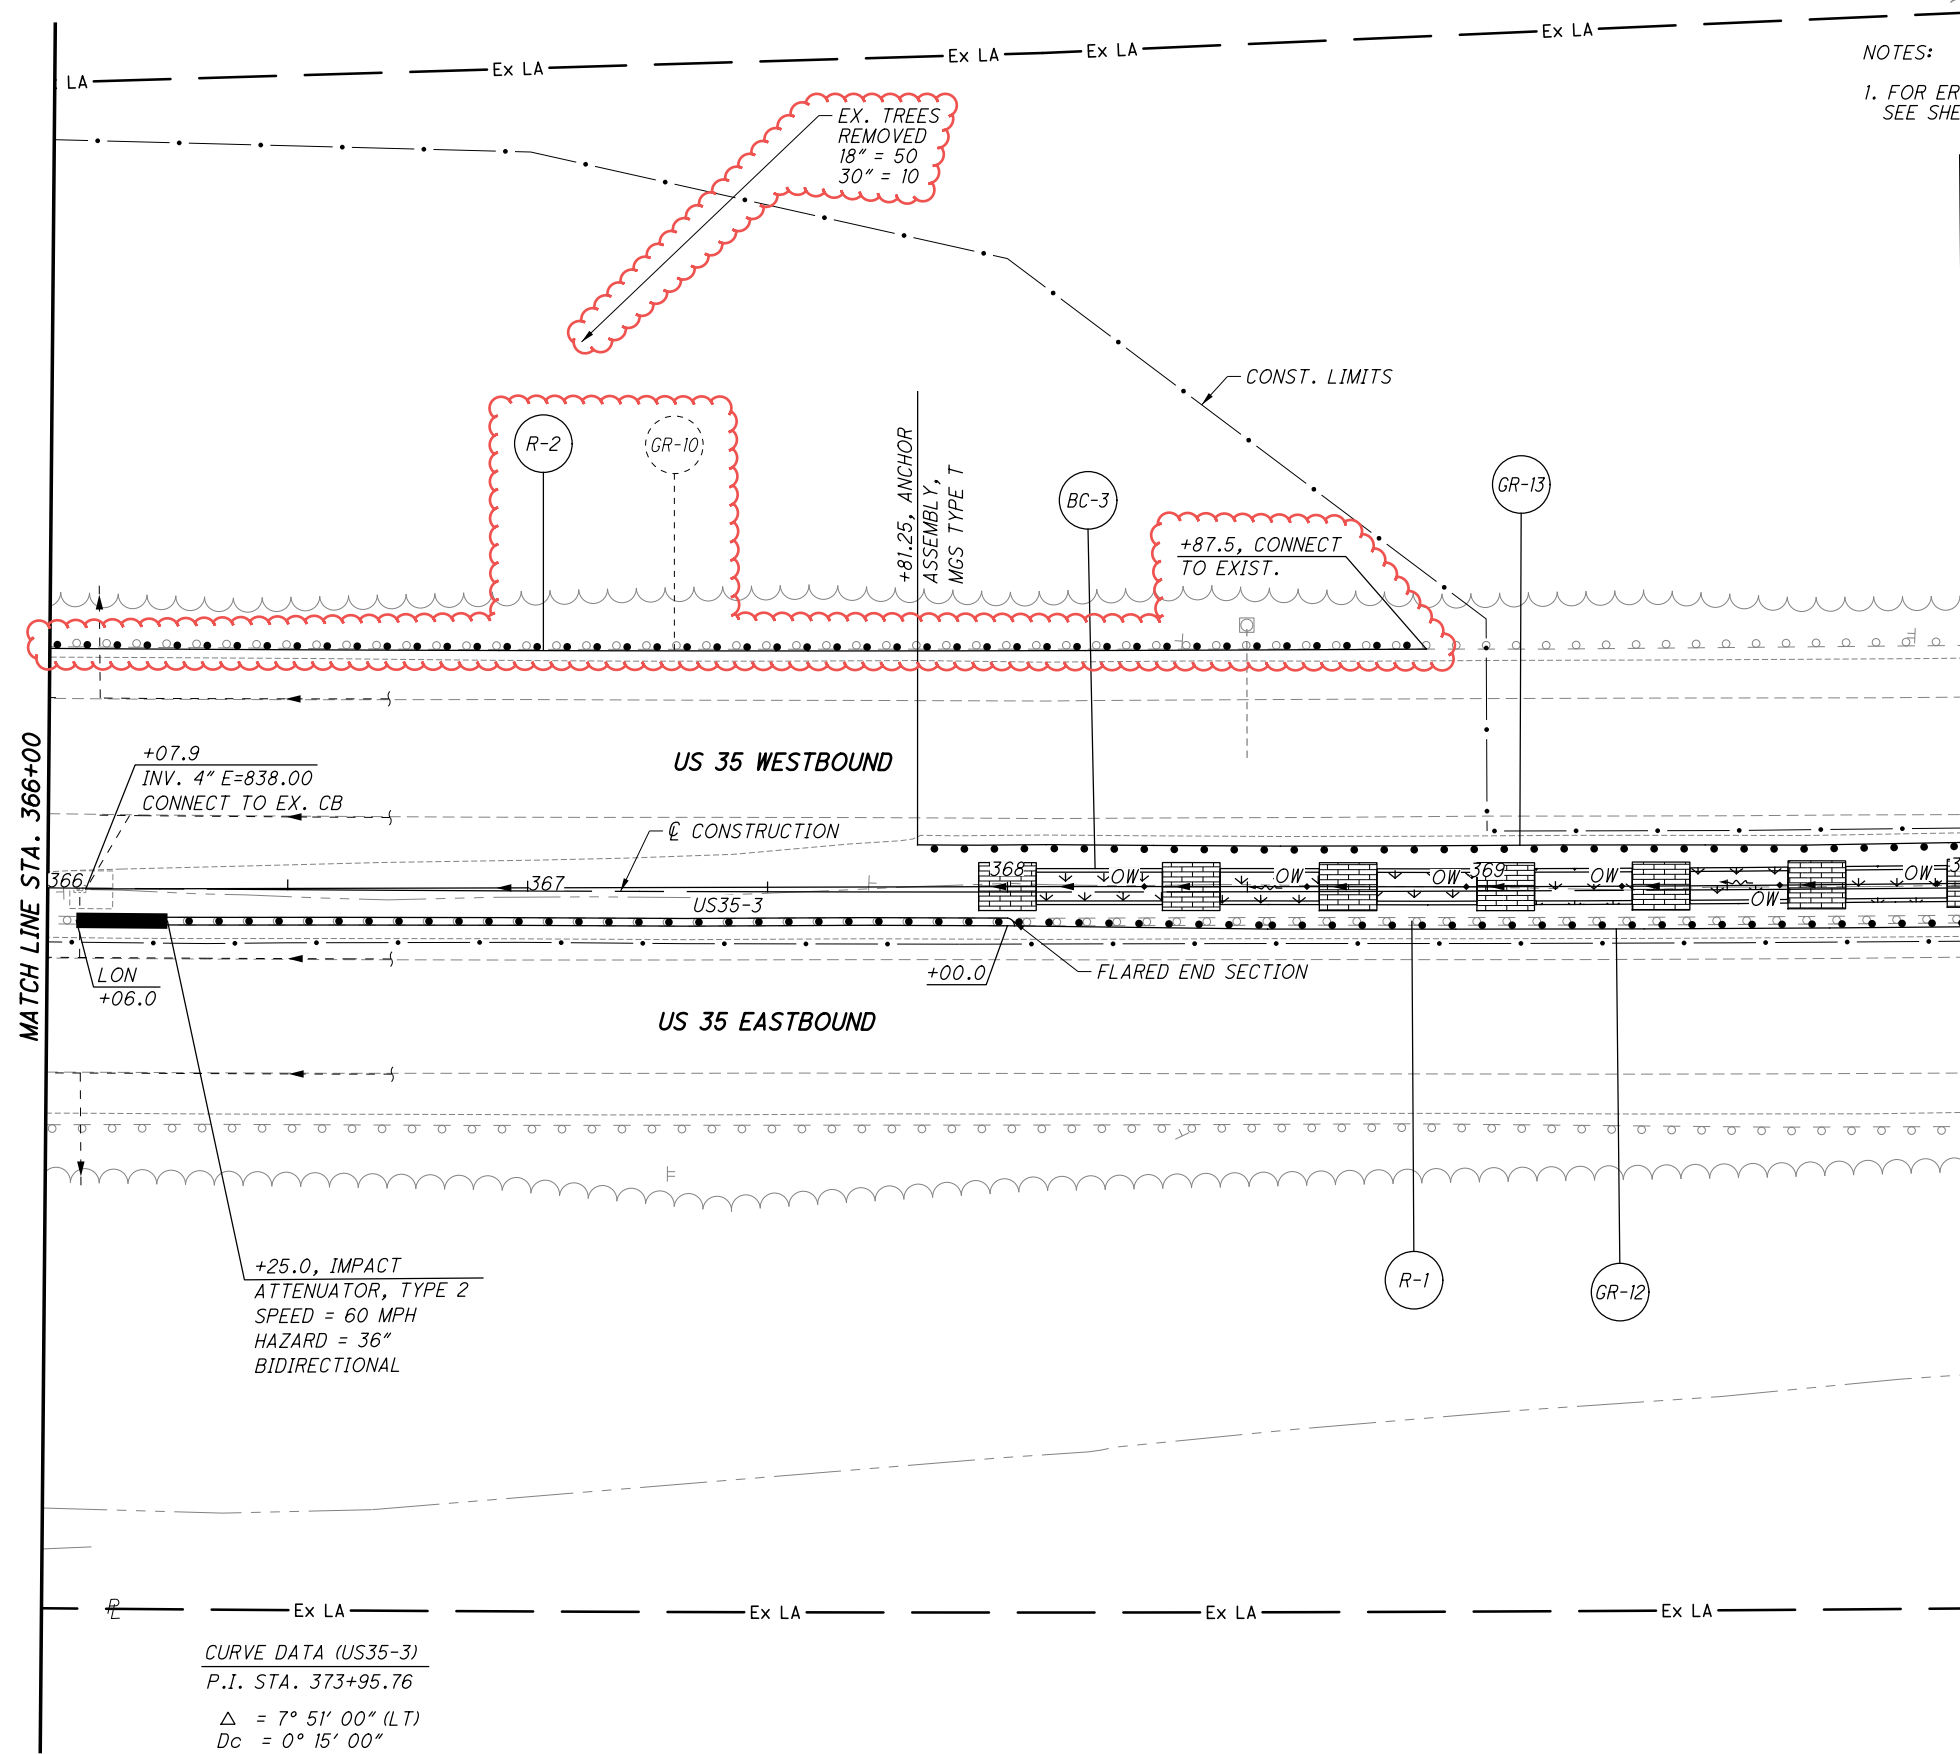

NOTES:  
 1. FOR EROSION PROTECTION LEGEND, SEE SHEET 208

**CURVE DATA (US35-3)**  
 P.I. STA. 373+95.76  
 $\Delta = 7^\circ 51' 00''$  (LT)  
 $D_c = 0^\circ 15' 00''$   
 $R = 22918.32'$   
 $T = 1572.46'$   
 $L = 3140.00'$   
 $E = 53.88'$   
 $\theta_{MAX} = N.C.$



PLAN - US 35  
 STA. 366+00 TO STA. 370+00

GRE-US 35-5.63  
 229  
 698

035\_0610S0001.dgn 1/4/2023 3:37:02 PM Jason.Center@jacobs.com

**ITEM 511, CLASS OC2 CONCRETE WITH OC/OA, BRIDGE DECK, AS PER PLAN**

THIS ITEM MODIFIES THE STANDARD 511 CONCRETE FOR STRUCTURES SPECIFICATION TO INCLUDE CORROSION INHIBITORS INTO THE SUPERSTRUCTURE CONCRETE. THIS ITEM SHALL CONFORM TO CMS 511 WITH THE FOLLOWING CONDITIONS AND REVISIONS:

PROVIDE MATERIALS CONFORMING TO 511.02 EXCEPT AS MODIFIED BELOW:

PORTLAND CEMENT CONCRETE 499.03, CLASS OC 2 MEETING A DESIGN STRENGTH OF 4,500 PSI  
CORROSION INHIBITOR 515.15

THE CLASS OC2 CONCRETE FOR THE SUPERSTRUCTURE SHALL MEET THE FOLLOWING CRITERIA:  
WATER/CEMENT RATIO = 0.40 MAXIMUM

MIX SHALL INCLUDE A MIGRATING CORROSION INHIBITOR AS MANUFACTURED BY AN APPROVED SUPPLIER LISTED ON ODOT'S QUALIFIED APPROVED SUPPLIERS, ITEM 515.15. THE DOSAGE RATE LISTED ON THE ODOT QUALIFIED APPROVED SUPPLIERS LIST WILL APPLY.

THE BATCH WEIGHTS SHALL BE CORRECTED TO COMPENSATE FOR THE MOISTURE CONTAINED IN THE AGGREGATE AT THE TIME OF USE. A CHEMICAL ADMIXTURE (705.12, TYPE A OR D) SHALL BE USED.

CONCRETE SUPPLIERS SHOULD RECOGNIZE THAT THE CORROSION INHIBITOR AND ADMIXTURES MAY HAVE AN EFFECT ON STRENGTH, ENTRAINED AIR CONTENT, WORKABILITY, ETC. OF THEIR CONCRETE MIXES. THE CORROSION INHIBITOR IS SUGGESTED TO BE A MCI PRODUCT BY CORTEC OR AN APPROVED EQUAL FROM THE QUALIFIED PRODUCTS LIST. THE CONCRETE SUPPLIER'S CHOICE OF ONE OF THESE CORROSION INHIBITORS DOES NOT ALLEVIATE MEETING DESIGN REQUIREMENTS. PLEASE BE ADVISED THAT SOME PRODUCTS ON THE LIST EFFECT THE DELIVERED MIX PROPERTIES GREATLY WHILE OTHER PRODUCTS DO NOT.

APPROACH SLABS AND DIAPHRAGMS ARE TO USE THE SAME MIX DESIGN AS THE BRIDGE DECK. THE CONTRACTOR SHOULD BE ADVISED THAT CONCRETE RETARDING AGENTS MAY NEED TO BE ADDED TO OFFSET THE EFFECTS OF THE MIGRATING CORROSION INHIBITOR SELECTED.

THE CONTRACTOR SHALL PROVIDE TRADITIONAL BRIDGE DECK FORMS CONFORMING TO CMS 508. PERMANENT STAY-IN-PLACE (SIP) FORMS ARE NOT ALLOWED. THE PLACING OF THE DECK AND THE APPROACH SLABS IN THE SAME CONCRETE POUR IS NOT PERMITTED.

**ITEM 511, CLASS OC2 CONCRETE WITH OC/OA, BRIDGE DECK (PARAPET), AS PER PLAN**

THIS ITEM MODIFIES THE STANDARD 511 CONCRETE FOR STRUCTURES SPECIFICATION TO INCLUDE MACRO-SYNTHETIC FIBERS, AND CORROSION INHIBITORS INTO THE SUPERSTRUCTURE CONCRETE. THIS ITEM SHALL CONFORM TO CMS 511 WITH THE FOLLOWING CONDITIONS AND REVISIONS:

PROVIDE MATERIALS CONFORMING TO 511.02 EXCEPT AS MODIFIED BELOW:

PORTLAND CEMENT CONCRETE 499.03, CLASS OC 2 MEETING A DESIGN STRENGTH OF 4,500 PSI, WITH MACRO-SYNTHETIC FIBERS WITH MODIFICATION PER 511.02  
FIBERS FOR CONCRETE ASTM C 1116, TYPE III  
CORROSION INHIBITOR 515.15

THE CLASS OC2 CONCRETE FOR THE SUPERSTRUCTURE SHALL MEET THE FOLLOWING CRITERIA:  
WATER/CEMENT RATIO = 0.40 MAXIMUM; MINIMUM 5 LBS/CY MACRO-SYNTHETIC FIBERS (1.5 IN. MIN. TO 2.5 IN. MAX.) MEETING ASTM C1116 TYPE III SHALL BE ADDED TO THE MIX.

MIX SHALL INCLUDE A MIGRATING CORROSION INHIBITOR AS MANUFACTURED BY AN APPROVED SUPPLIER LISTED ON ODOT'S QUALIFIED APPROVED SUPPLIERS, ITEM 515.15. THE DOSAGE RATE LISTED ON THE ODOT QUALIFIED APPROVED SUPPLIERS LIST WILL APPLY.

**ITEM 511, CLASS OC2 CONCRETE WITH OC/OA, BRIDGE DECK (PARAPET), AS PER PLAN, CONT'D.**

THE MACRO-SYNTHETIC FIBERS SHALL BE INCORPORATED INTO THE MIX IN SUCH A WAY THAT NO 'BALLING' OCCURS. UPON INSPECTION OF THE MIX AT THE TIME OF PLACEMENT, IF ANY 'BALLING' OCCURS, THE ENGINEER SHALL REJECT THE REMAINDER OF THE LOAD AT ANY TIME DURING THE POUR. IT IS IMPORTANT TO FOLLOW INDUSTRY STANDARDS AND ASTM SPECIFICATIONS ON THE PREMIXING OF THE CEMENT, AGGREGATE, AND MACRO-SYNTHETIC FIBERS PRIOR TO THE ADDITION OF WATER AND ADMIXTURES. PROVIDE MACRO-SYNTHETIC FIBERS THAT ARE MONOFILAMENT FIBERS MADE FROM VIRGIN POLYPROPYLENE, POLYETHYLENE, OR COPOLYMERS THAT ARE INERT TO ALKALI ATTACK. ENSURE THE MACRO-SYNTHETIC FIBERS HAVE A MINIMUM TENSILE STRENGTH OF 70 KSI, A MINIMUM MODULUS OF ELASTICITY OF 800 KSI, A MINIMUM FILAMENT DIAMETER OF 0.012 INCHES, AND ASPECT RATIO BETWEEN 60 AND 100, AND ARE BETWEEN 1.0 AND 2.5 INCHES IN LENGTH. STORE THE MACRO-SYNTHETIC FIBERS ACCORDING TO THE MANUFACTURER'S RECOMMENDATION AND KEEP THE MATERIAL FREE FROM DUST, DIRT AND MOISTURE. PLACING THE BAG THAT THE FIBERS COME IN INTO THE CONCRETE MIX IS NOT PERMITTED.

USE A MINIMUM DOSAGE RATE OF MACRO-SYNTHETIC FIBERS OF 5.0 LBS/CY OF CONCRETE. ENSURE THE FINAL PROPOSED MIX IS WORKABLE AND ABLE TO BE PRODUCED SUCH THAT BALLING OR CLUMPING OF THE FIBERS IS NOT A PROBLEM AS DETERMINED BY THE ENGINEER. BEFORE USE, SUBMIT DOCUMENTATION TO THE PROJECT ENGINEER CERTIFYING BOTH THE MACRO-SYNTHETIC FIBERS AND THE MIX MEET OR EXCEED THE REQUIRED PROPERTIES. SAMPLING WILL BE ALLOWED FOR TESTING PURPOSES. A DEMONSTRATION OF THE MIX PRODUCTION OR TRIAL MIX, MAY BE REQUIRED BY THE ENGINEER PRIOR TO PLACING ANY OF THE MIX ON THE PROJECT.

THE BATCH WEIGHTS SHALL BE CORRECTED TO COMPENSATE FOR THE MOISTURE CONTAINED IN THE AGGREGATE AT THE TIME OF USE. A CHEMICAL ADMIXTURE (705.12, TYPE A OR D) SHALL BE USED. THE TRANSIT MIXER CHARGE SHALL BE LIMITED TO 3#40F ITS RATED CAPACITY OR 6 CUBIC YARDS, WHICHEVER IS SMALLER. THE FIRST THREE TRANSIT MIXER LOADS ARE REQUIRED TO BE AT THE MINIMUM YARDAGE LISTED ABOVE TO SHOW PROOF OF THE SUCCESSFUL BATCHING OPERATION. AFTER CONSISTENCY IN THE DELIVERED MATERIAL HAS BEEN ESTABLISHED, THE CONCRETE SUPPLIER MAY INCREASE THE BATCH DELIVERED QUANTITIES AS LONG AS THE QUALITY REMAINS ACCEPTABLE TO THE ENGINEER. THE ENGINEER CAN REDUCE THE BATCH LOAD SIZE AT ANY TIME AS NEEDED TO CORRECT/IMPROVE CONCRETE QUALITY.

CONCRETE SUPPLIERS SHOULD RECOGNIZE THAT THE CORROSION INHIBITOR AND ADMIXTURES MAY HAVE AN EFFECT ON STRENGTH, ENTRAINED AIR CONTENT, WORKABILITY, ETC. OF THEIR CONCRETE MIXES. THE CORROSION INHIBITOR IS SUGGESTED TO BE A MCI PRODUCT BY CORTEC OR AN APPROVED EQUAL FROM THE QUALIFIED PRODUCTS LIST. THE CONCRETE SUPPLIER'S CHOICE OF ONE OF THESE CORROSION INHIBITORS DOES NOT ALLEVIATE MEETING DESIGN REQUIREMENTS. PLEASE BE ADVISED THAT SOME PRODUCTS ON THE LIST EFFECT THE DELIVERED MIX PROPERTIES GREATLY WHILE OTHER PRODUCTS DO NOT.

THE CONTRACTOR SHOULD BE ADVISED THAT CONCRETE RETARDING AGENTS MAY NEED TO BE ADDED TO OFFSET THE EFFECTS OF THE MIGRATING CORROSION INHIBITOR SELECTED. THIS SPECIFICATION IS INTENDED FOR USE ON NON DECORATIVE BRIDGE RAILING. USE SELF-COMPACTING CONCRETE ON DECORATIVE RAILING SIMILAR TO TEXAS RAILING AND MACRO-SYNTHETIC CONCRETE PER THIS SPECIFICATION ON TRADITIONAL CONCRETE RAILING WHEN APPLICABLE.

**ITEM 512, SEALING OF CONCRETE SURFACES (EPOXY-URETHANE), AS PER PLAN**

DUE TO THE RECENT SUPPLY SHORTAGES, THE DEPARTMENT HAS BEEN MADE AWARE OF DIFFICULTIES THAT SUPPLIERS ARE HAVING IN OBTAINING THE NECESSARY MATERIALS FOR EPOXY. ON THIS PROJECT THE CONTRACTOR CAN USE TRADITIONAL EPOXY-URETHANE SEALERS APPROVED ON THE OPL OR ELECT TO SUBSTITUTE BRIDGE COTE XL-70 W/SILANE THAT IS LISTED ON THE APPROVED NOISE SUPPLIER LIST UNDER APPROVED SEALERS FOR NOISE BARRIERS. APPROVEDNOISESUPPLIERSLIST.PDF (OHIO.GOV).

IF BRIDGE COTE XL-70 W/SILANE IS CHOSEN, MEET THE REQUIREMENTS OF THE BRIDGE COTE XL-70 W/SILANE TECHNICAL DATA SHEET WITH THE EXCEPTION OF THE SURFACE PREPARATION THAT WILL STILL FOLLOW THE REQUIREMENTS LISTED UNDER C&MS 512 FOR EPOXY URETHANE SEALERS.

PART.	ESTIMATED QUANTITIES					DESCRIPTION	ABUT.	PIERS	SUPER	GEN.	SHEET
	02/NHS/BR	ITEM	EXT.	TOTAL	UNIT						
2497	203	20001	2497	CY	EMBANKMENT, AS PER PLAN	2431	66				3/36
LS	503	11100	LS		COFFERDAMS AND EXCAVATION BRACING		LS				
LS	503	21300	LS		UNCLASSIFIED EXCAVATION	LS	LS				3/36
LS	505	11100	LS		PILE DRIVING EQUIPMENT MOBILIZATION	LS	LS				
5860	507	00600	5860	FT	14" CAST-IN-PLACE REINFORCED CONCRETE PILES, DRIVEN	4180	1680				
6355	507	00650	6355	FT	14" CAST-IN-PLACE REINFORCED CONCRETE PILES, FURNISHED	4515	1840				
190393	509	26000	190393	LB	GALVANIZED STEEL REINFORCMENT	40207	27795	122391			
374	511	34447	374	CY	CLASS OC2 CONCRETE WITH OC/OA, BRIDGE DECK, AS PER PLAN				374		4/36
127	511	34451	127	CY	CLASS OC2 CONCRETE WITH OC/OA, BRIDGE DECK (PARAPET), AS PER PLAN				127		4/36
79	511	41012	79	CY	CLASS OC1 CONCRETE WITH OC/OA, PIER ABOVE FOOTINGS		79				
67	511	43512	67	CY	CLASS OC1 CONCRETE WITH OC/OA, ABUTMENT INCLUDING FOOTING	67					
231	511	44112	231	CY	CLASS OC1 CONCRETE WITH OC/OA, ABUTMENT NOT INCLUDING FOOTING	231					
182	511	46512	182	CY	CLASS OC1 CONCRETE WITH OC/OA, FOOTING	123	59				
1365	512	10101	1365	SY	SEALING OF CONCRETE SURFACES (EPOXY-URETHANE), AS PER PLAN	270	220	875			4/36
16	512	33000	16	SY	TYPE 2 WATERPROOFING	16					
404562	513	10300	404562	LB	STRUCTURAL STEEL MEMBERS, LEVEL 5				404562		
3840	513	20000	3840	EACH	WELDED STUD SHEAR CONNECTORS				3840		
1307	514	00060	1307	SF	FIELD PAINTING STRUCTURAL STEEL, INTERMEDIATE COAT				1307		17/36
1307	514	00066	1307	SF	FIELD PAINTING STRUCTURAL STEEL, FINISH COAT				1307		17/36
69	516	11210	69	FT	STRUCTURAL EXPANSION JOINT INCLUDING ELASTOMERIC STRIP SEAL				69		
164	516	13600	164	SF	1" PREFORMED EXPANSION JOINT FILLER				164		
4	516	44101	4	EACH	ELASTOMERIC BEARING WITH INTERNAL LAMINATES AND LOAD PLATE (NEOPRENE), AS PER PLAN (16" x 26" X 2.50" PAD WITH 17" x 34" x 2" PLATE)		4				24/36
4	516	44201	4	EACH	ELASTOMERIC BEARING WITH INTERNAL LAMINATES AND LOAD PLATE (NEOPRENE), AS PER PLAN (16" x 26" X 3.50" PAD WITH 17" x 27" x 2" PLATE)		4				24/36
8	516	44301	8	EACH	ELASTOMERIC BEARING WITH INTERNAL LAMINATES AND LOAD PLATE (NEOPRENE), AS PER PLAN (14" x 16" X 4.70" PAD WITH 15" x 17" x 2" PLATE)	8					24/36
268	518	20000	268	SY	PREFABRICATED GEOCOMPOSITE BOARD	268					
34	518	21200	34	CY	POROUS BACKFILL WITH GEOTEXTILE FABRIC	34					
129	518	40000	129	FT	6" PERFORATED CORRUGATED PLASTIC PIPE	129					
38	518	40010	38	FT	6" NON-PERFORATED CORRUGATED PLASTIC PIPE, INCLUDING SPECIALS	38					
8	523	20000	8	EACH	DYNAMIC LOAD TESTING	4	4				
8	523	20500	8	EACH	RESTRIKE	4	4				
85	526	25010	85	SY	REINFORCED CONCRETE APPROACH SLABS WITH OC/OA (T=15")						85
100	526	30010	100	SY	REINFORCED CONCRETE APPROACH SLABS WITH OC/OA (T=17")						100
1319	840	23000	1319	CY	SELECT GRANULAR BACKFILL	1319					

**GENERAL NOTES II & ESTIMATED QUANTITIES**

BRIDGE NO. GRE-035-0610  
RAMP E OVER LITTLE MIAMI RIVER

GRE-US 35-5.63  
PID No. 107217

035\_0627EQ001.dgn 1/5/2023 4:37:28 AM Jason.Center@jacobs.com

**ITEM 511, CLASS OC2 CONCRETE WITH OC/OA, BRIDGE DECK, AS PER PLAN**

THIS ITEM MODIFIES THE STANDARD 511 CONCRETE FOR STRUCTURES SPECIFICATION TO INCLUDE CORROSION INHIBITORS INTO THE SUPERSTRUCTURE CONCRETE. THIS ITEM SHALL CONFORM TO CMS 511 WITH THE FOLLOWING CONDITIONS AND REVISIONS:

PROVIDE MATERIALS CONFORMING TO 511.02 EXCEPT AS MODIFIED BELOW:

PORTLAND CEMENT CONCRETE 499.03, CLASS OC 2 MEETING A DESIGN STRENGTH OF 4,500 PSI  
CORROSION INHIBITOR 515.15

THE CLASS OC2 CONCRETE FOR THE SUPERSTRUCTURE SHALL MEET THE FOLLOWING CRITERIA:  
WATER/CEMENT RATIO = 0.40 MAXIMUM

MIX SHALL INCLUDE A MIGRATING CORROSION INHIBITOR AS MANUFACTURED BY AN APPROVED SUPPLIER LISTED ON ODOT'S QUALIFIED APPROVED SUPPLIERS, ITEM 515.15. THE DOSAGE RATE LISTED ON THE ODOT QUALIFIED APPROVED SUPPLIERS LIST WILL APPLY.

THE BATCH WEIGHTS SHALL BE CORRECTED TO COMPENSATE FOR THE MOISTURE CONTAINED IN THE AGGREGATE AT THE TIME OF USE. A CHEMICAL ADMIXTURE (705.12, TYPE A OR D) SHALL BE USED.

CONCRETE SUPPLIERS SHOULD RECOGNIZE THAT THE CORROSION INHIBITOR AND ADMIXTURES MAY HAVE AN EFFECT ON STRENGTH, ENTRAINED AIR CONTENT, WORKABILITY, ETC. OF THEIR CONCRETE MIXES. THE CORROSION INHIBITOR IS SUGGESTED TO BE A MCI PRODUCT BY CORTEC OR AN APPROVED EQUAL FROM THE QUALIFIED PRODUCTS LIST. THE CONCRETE SUPPLIER'S CHOICE OF ONE OF THESE CORROSION INHIBITORS DOES NOT ALLEVIATE MEETING DESIGN REQUIREMENTS. PLEASE BE ADVISED THAT SOME PRODUCTS ON THE LIST EFFECT THE DELIVERED MIX PROPERTIES GREATLY WHILE OTHER PRODUCTS DO NOT.

APPROACH SLABS AND DIAPHRAGMS ARE TO USE THE SAME MIX DESIGN AS THE BRIDGE DECK. THE CONTRACTOR SHOULD BE ADVISED THAT CONCRETE RETARDING AGENTS MAY NEED TO BE ADDED TO OFFSET THE EFFECTS OF THE MIGRATING CORROSION INHIBITOR SELECTED.

THE CONTRACTOR SHALL PROVIDE TRADITIONAL BRIDGE DECK FORMS CONFORMING TO CMS 508. PERMANENT STAY-IN-PLACE (SIP) FORMS ARE NOT ALLOWED. THE PLACING OF THE DECK AND THE APPROACH SLABS IN THE SAME CONCRETE POUR IS NOT PERMITTED.

**ITEM 511, CLASS OC2 CONCRETE WITH OC/OA, BRIDGE DECK (PARAPET), AS PER PLAN**

THIS ITEM MODIFIES THE STANDARD 511 CONCRETE FOR STRUCTURES SPECIFICATION TO INCLUDE MACRO-SYNTHETIC FIBERS, AND CORROSION INHIBITORS INTO THE SUPERSTRUCTURE CONCRETE. THIS ITEM SHALL CONFORM TO CMS 511 WITH THE FOLLOWING CONDITIONS AND REVISIONS:

PROVIDE MATERIALS CONFORMING TO 511.02 EXCEPT AS MODIFIED BELOW:

PORTLAND CEMENT CONCRETE 499.03, CLASS OC 2 MEETING A DESIGN STRENGTH OF 4,500 PSI, WITH MACRO-SYNTHETIC FIBERS WITH MODIFICATION PER 511.02  
FIBERS FOR CONCRETE CORROSION INHIBITOR ASTM C 1116, TYPE III 515.15

THE CLASS OC2 CONCRETE FOR THE SUPERSTRUCTURE SHALL MEET THE FOLLOWING CRITERIA:  
WATER/CEMENT RATIO = 0.40 MAXIMUM; MINIMUM 5 LBS/CY MACRO-SYNTHETIC FIBERS (1.5 IN. MIN. TO 2.5 IN. MAX.) MEETING ASTM C1116 TYPE III SHALL BE ADDED TO THE MIX.

MIX SHALL INCLUDE A MIGRATING CORROSION INHIBITOR AS MANUFACTURED BY AN APPROVED SUPPLIER LISTED ON ODOT'S QUALIFIED APPROVED SUPPLIERS, ITEM 515.15. THE DOSAGE RATE LISTED ON THE ODOT QUALIFIED APPROVED SUPPLIERS LIST WILL APPLY.

**ITEM 511, CLASS OC2 CONCRETE WITH OC/OA, BRIDGE DECK (PARAPET), AS PER PLAN, CONT'D.**

THE MACRO-SYNTHETIC FIBERS SHALL BE INCORPORATED INTO THE MIX IN SUCH A WAY THAT NO 'BALLING' OCCURS. UPON INSPECTION OF THE MIX AT THE TIME OF PLACEMENT, IF ANY 'BALLING' OCCURS, THE ENGINEER SHALL REJECT THE REMAINDER OF THE LOAD AT ANY TIME DURING THE POUR. IT IS IMPORTANT TO FOLLOW INDUSTRY STANDARDS AND ASTM SPECIFICATIONS ON THE PREMIXING OF THE CEMENT, AGGREGATE, AND MACRO-SYNTHETIC FIBERS PRIOR TO THE ADDITION OF WATER AND ADMIXTURES. PROVIDE MACRO-SYNTHETIC FIBERS THAT ARE MONOFILAMENT FIBERS MADE FROM VIRGIN POLYPROPYLENE, POLYETHYLENE, OR COPOLYMERS THAT ARE INERT TO ALKALI ATTACK. ENSURE THE MACRO-SYNTHETIC FIBERS HAVE A MINIMUM TENSILE STRENGTH OF 70 KSI, A MINIMUM MODULUS OF ELASTICITY OF 800 KSI, A MINIMUM FILAMENT DIAMETER OF 0.012 INCHES, AND ASPECT RATIO BETWEEN 60 AND 100, AND ARE BETWEEN 1.0 AND 2.5 INCHES IN LENGTH. STORE THE MACRO-SYNTHETIC FIBERS ACCORDING TO THE MANUFACTURER'S RECOMMENDATION AND KEEP THE MATERIAL FREE FROM DUST, DIRT AND MOISTURE. PLACING THE BAG THAT THE FIBERS COME IN INTO THE CONCRETE MIX IS NOT PERMITTED.

USE A MINIMUM DOSAGE RATE OF MACRO-SYNTHETIC FIBERS OF 5.0 LBS/CY OF CONCRETE. ENSURE THE FINAL PROPOSED MIX IS WORKABLE AND ABLE TO BE PRODUCED SUCH THAT BALLING OR CLUMPING OF THE FIBERS IS NOT A PROBLEM AS DETERMINED BY THE ENGINEER. BEFORE USE, SUBMIT DOCUMENTATION TO THE PROJECT ENGINEER CERTIFYING BOTH THE MACRO-SYNTHETIC FIBERS AND THE MIX MEET OR EXCEED THE REQUIRED PROPERTIES. SAMPLING WILL BE ALLOWED FOR TESTING PURPOSES. A DEMONSTRATION OF THE MIX PRODUCTION OR TRIAL MIX, MAY BE REQUIRED BY THE ENGINEER PRIOR TO PLACING ANY OF THE MIX ON THE PROJECT.

THE BATCH WEIGHTS SHALL BE CORRECTED TO COMPENSATE FOR THE MOISTURE CONTAINED IN THE AGGREGATE AT THE TIME OF USE. A CHEMICAL ADMIXTURE (705.12, TYPE A OR D) SHALL BE USED. THE TRANSIT MIXER CHARGE SHALL BE LIMITED TO 3#40F ITS RATED CAPACITY OR 6 CUBIC YARDS, WHICHEVER IS SMALLER. THE FIRST THREE TRANSIT MIXER LOADS ARE REQUIRED TO BE AT THE MINIMUM YARDAGE LISTED ABOVE TO SHOW PROOF OF THE SUCCESSFUL BATCHING OPERATION. AFTER CONSISTENCY IN THE DELIVERED MATERIAL HAS BEEN ESTABLISHED, THE CONCRETE SUPPLIER MAY INCREASE THE BATCH DELIVERED QUANTITIES AS LONG AS THE QUALITY REMAINS ACCEPTABLE TO THE ENGINEER. THE ENGINEER CAN REDUCE THE BATCH LOAD SIZE AT ANY TIME AS NEEDED TO CORRECT/IMPROVE CONCRETE QUALITY.

CONCRETE SUPPLIERS SHOULD RECOGNIZE THAT THE CORROSION INHIBITOR AND ADMIXTURES MAY HAVE AN EFFECT ON STRENGTH, ENTRAINED AIR CONTENT, WORKABILITY, ETC. OF THEIR CONCRETE MIXES. THE CORROSION INHIBITOR IS SUGGESTED TO BE A MCI PRODUCT BY CORTEC OR AN APPROVED EQUAL FROM THE QUALIFIED PRODUCTS LIST. THE CONCRETE SUPPLIER'S CHOICE OF ONE OF THESE CORROSION INHIBITORS DOES NOT ALLEVIATE MEETING DESIGN REQUIREMENTS. PLEASE BE ADVISED THAT SOME PRODUCTS ON THE LIST EFFECT THE DELIVERED MIX PROPERTIES GREATLY WHILE OTHER PRODUCTS DO NOT.

THE CONTRACTOR SHOULD BE ADVISED THAT CONCRETE RETARDING AGENTS MAY NEED TO BE ADDED TO OFFSET THE EFFECTS OF THE MIGRATING CORROSION INHIBITOR SELECTED. THIS SPECIFICATION IS INTENDED FOR USE ON NON DECORATIVE BRIDGE RAILING. USE SELF-COMPACTING CONCRETE ON DECORATIVE RAILING SIMILAR TO TEXAS RAILING AND MACRO-SYNTHETIC CONCRETE PER THIS SPECIFICATION ON TRADITIONAL CONCRETE RAILING WHEN APPLICABLE.

**ITEM 512, SEALING OF CONCRETE SURFACES (EPOXY-URETHANE), AS PER PLAN**

DUE TO THE RECENT SUPPLY SHORTAGES, THE DEPARTMENT HAS BEEN MADE AWARE OF DIFFICULTIES THAT SUPPLIERS ARE HAVING IN OBTAINING THE NECESSARY MATERIALS FOR EPOXY. ON THIS PROJECT THE CONTRACTOR CAN USE TRADITIONAL EPOXY-URETHANE SEALERS APPROVED ON THE OPL OR ELECT TO SUBSTITUTE BRIDGE COTE XL-70 W/SILANE THAT IS LISTED ON THE APPROVED NOISE SUPPLIER LIST UNDER APPROVED SEALERS FOR NOISE BARRIERS. APPROVEDNOISESUPPLIERSLIST.PDF (OHIO.GOV).

IF BRIDGE COTE XL-70 W/SILANE IS CHOSEN, MEET THE REQUIREMENTS OF THE BRIDGE COTE XL-70 W/SILANE TECHNICAL DATA SHEET WITH THE EXCEPTION OF THE SURFACE PREPARATION THAT WILL STILL FOLLOW THE REQUIREMENTS LISTED UNDER C&MS 512 FOR EPOXY URETHANE SEALERS.

PART.	ESTIMATED QUANTITIES										
	02/NHS/BR	ITEM	EXT.	TOTAL	UNIT	DESCRIPTION	ABUT.	PIERS	SUPER	GEN.	SHEET
	LS	503	11100	LS		COFFERDAMS AND EXCAVATION BRACING		LS			
	LS	503	21300	LS		UNCLASSIFIED EXCAVATION		LS			
	LS	505	11100	LS		PILE DRIVING EQUIPMENT MOBILIZATION	LS	LS			
	7010	507	00600	7010	FT	14" CAST-IN-PLACE REINFORCED CONCRETE PILES, DRIVEN	5060	1950			
	7450	507	00650	7450	FT	14" CAST-IN-PLACE REINFORCED CONCRETE PILES, FURNISHED	5350	2100			
	198337	509	26000	198337	LB	GALVANIZED STEEL REINFORCEMENT	29535	31153	137649		
	4	511	33500	4	EACH	SEMI-INTEGRAL DIAPHRAGM GUIDE	4				
	148	511	34412	148	CY	CLASS OC2 CONCRETE WITH OC/OA, SUPERSTRUCTURE			148		
	436	511	34447	436	CY	CLASS OC2 CONCRETE WITH OC/OA, BRIDGE DECK, AS PER PLAN			436		3/30
	30	511	34451	30	CY	CLASS OC2 CONCRETE WITH OC/OA, BRIDGE DECK (PARAPET), AS PER PLAN			30		3/30
	70	511	41012	70	CY	CLASS OC1 CONCRETE WITH OC/OA, PIER ABOVE FOOTINGS		70			
	252	511	43512	252	CY	CLASS OC1 CONCRETE WITH OC/OA, ABUTMENT INCLUDING FOOTING	252				
	63	511	46512	63	CY	CLASS OC1 CONCRETE WITH OC/OA, FOOTING		63			
	97	511	51510	97	CY	CLASS OC2 CONCRETE, SIDEWALK			97		
	682	512	10101	682	SY	SEALING OF CONCRETE SURFACES (EPOXY-URETHANE), AS PER PLAN	309	158	215		3/30
	8	515	15110	8	EACH	DRAPED STRAND PRESTRESSED CONCRETE BRIDGE I-BEAM MEMBERS, LEVEL 3, TYPE WF60-49 (104'-9" LONG)			8		
	8	515	15110	8	EACH	DRAPED STRAND PRESTRESSED CONCRETE BRIDGE I-BEAM MEMBERS, LEVEL 3, TYPE WF60-49 (73'-0" LONG)			8		
	28	515	20000	28	EACH	INTERMEDIATE DIAPHRAGMS			28		
	10	516	13600	10	SF	1" PREFORMED EXPANSION JOINT FILLER			10		
	101	516	13900	101	SF	2" PREFORMED EXPANSION JOINT FILLER	101				
	204	516	14020	204	FT	SEMI-INTEGRAL ABUTMENT EXPANSION JOINT SEAL	204				
	8	516	44101	8	EACH	ELASTOMERIC BEARING WITH INTERNAL LAMINATES AND LOAD PLATE (NEOPRENE), AS PER PLAN (14" x 21" X 2.5735" PAD WITH 16" x 25" 1.75" PL)	8				22/30
	8	516	44101	8	EACH	ELASTOMERIC BEARING WITH INTERNAL LAMINATES AND LOAD PLATE (NEOPRENE), AS PER PLAN (14" x 19.5" X 2.5735" PAD WITH 16" x 25" 1.75" PL)	8				22/30
	16	516	44101	16	EACH	ELASTOMERIC BEARING WITH INTERNAL LAMINATES AND LOAD PLATE (NEOPRENE), AS PER PLAN (14" x 19.5" X 2.5735" PAD WITH 16" x 40" 1.75" PL)		16			22/30
	206	517	75120	206	FT	RAILING (CONCRETE PARAPET WITH TWIN STEEL TUBE RAILING)			206		
	3	518	12301	3	EACH	SCUPPERS, INCLUDING SUPPORTS, AS PER PLAN			3		27/30
	213	518	40000	213	FT	6" PERFORATED CORRUGATED PLASTIC PIPE	213				
	54	518	40010	54	FT	6" NON-PERFORATED CORRUGATED PLASTIC PIPE, INCLUDING SPECIALS	54				
	6	523	20000	6	EACH	DYNAMIC LOAD TESTING	4	2			
	6	523	20500	6	EACH	RESTRIKE	4	2			
	561	526	30011	561	SY	REINFORCED CONCRETE APPROACH SLABS WITH OC/OA (T=17"), AS PER PLAN				561	23/30
	79	526	90010	79	FT	TYPE A INSTALLATION			79		
	165	607	39910	165	FT	VANDAL PROTECTION FENCE, 8' STRAIGHT, COATED FABRIC			165		
	165	607	39930	165	FT	VANDAL PROTECTION FENCE, 12' CURVED, COATED FABRIC			165		
	20	608	53020	20	SF	DETECTABLE WARNING			20		
	110	625	25504	110	FT	CONDUIT, 3", 725.051				110	
	1	625	30706	1	EACH	PULL BOX, 725.08, 24"				1	
	LS	690	98400	LS		SPECIAL - MISC.: TEMPORARY SURCHARGE				LS	2/30
	33	846	00110	33	CF	POLYMER MODIFIED ASPHALT EXPANSION JOINT SYSTEM				33	

DESIGN AGENCY: **JACOBS**  
1880 WATCROSS ROAD  
CINCINNATI, OHIO 45240

DATE: 5/2022  
REVIEWED: JTC  
DRAWN: MM  
DESIGNED: MM  
CHECKED: FBW

STRUCTURE FILE NUMBER: 2900213


GENERAL NOTES II & ESTIMATED QUANTITIES  
BRIDGE NO. GRE-035-0627  
VALLEY/TREBEIN ROAD OVER U.S. 35

GRE-US 35-5.63  
PID No. 107217


3 / 30  
575  
698



DIMENSION	STA. 879+03.23 LT.	STA. 880+60.00 LT.	STA. 880+58.00 RT.
'A'	0'-0"	6'-8 $\frac{1}{16}$ "	6'-8 $\frac{3}{4}$ "
'B'	0'-0"	2'-8 $\frac{1}{16}$ "	2'-8 $\frac{1}{16}$ "
'C'	8'-6 $\frac{3}{8}$ "	5'-9 $\frac{15}{16}$ "	5'-9 $\frac{15}{16}$ "
'D'	2'-8 $\frac{1}{16}$ "	2'-8 $\frac{1}{16}$ "	5'-7 $\frac{3}{8}$ "

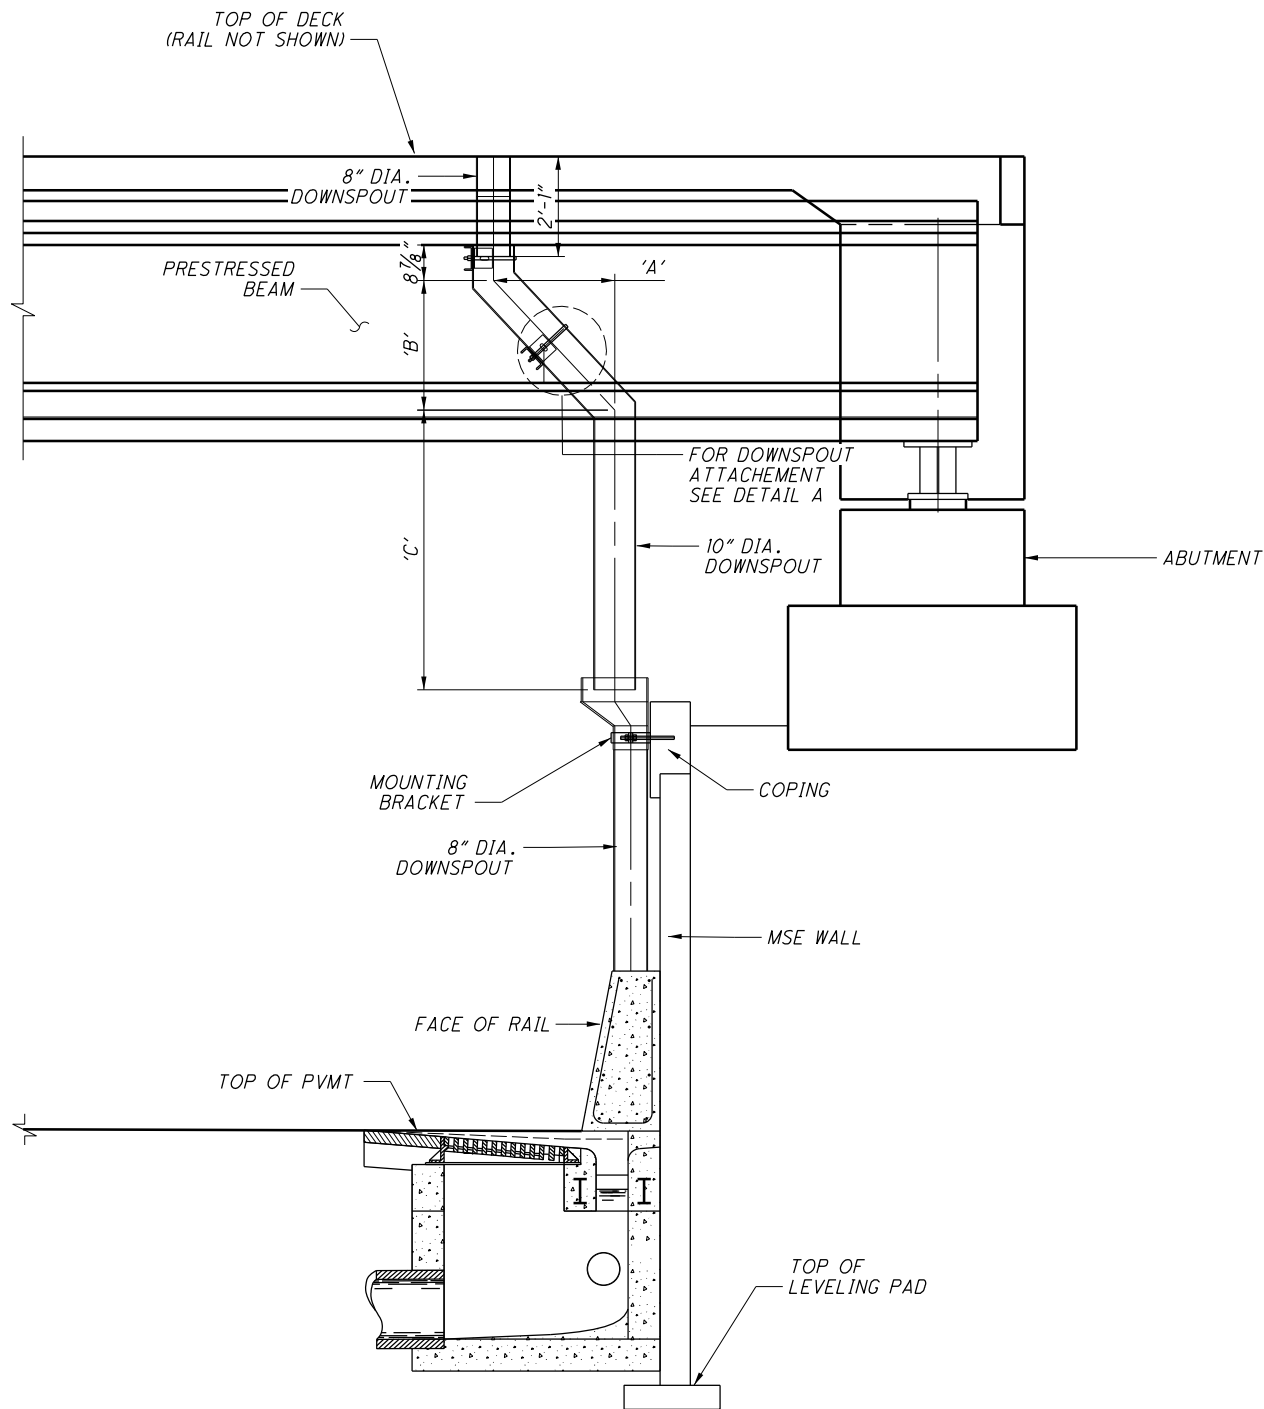

LEFT SIDE ELEVATION

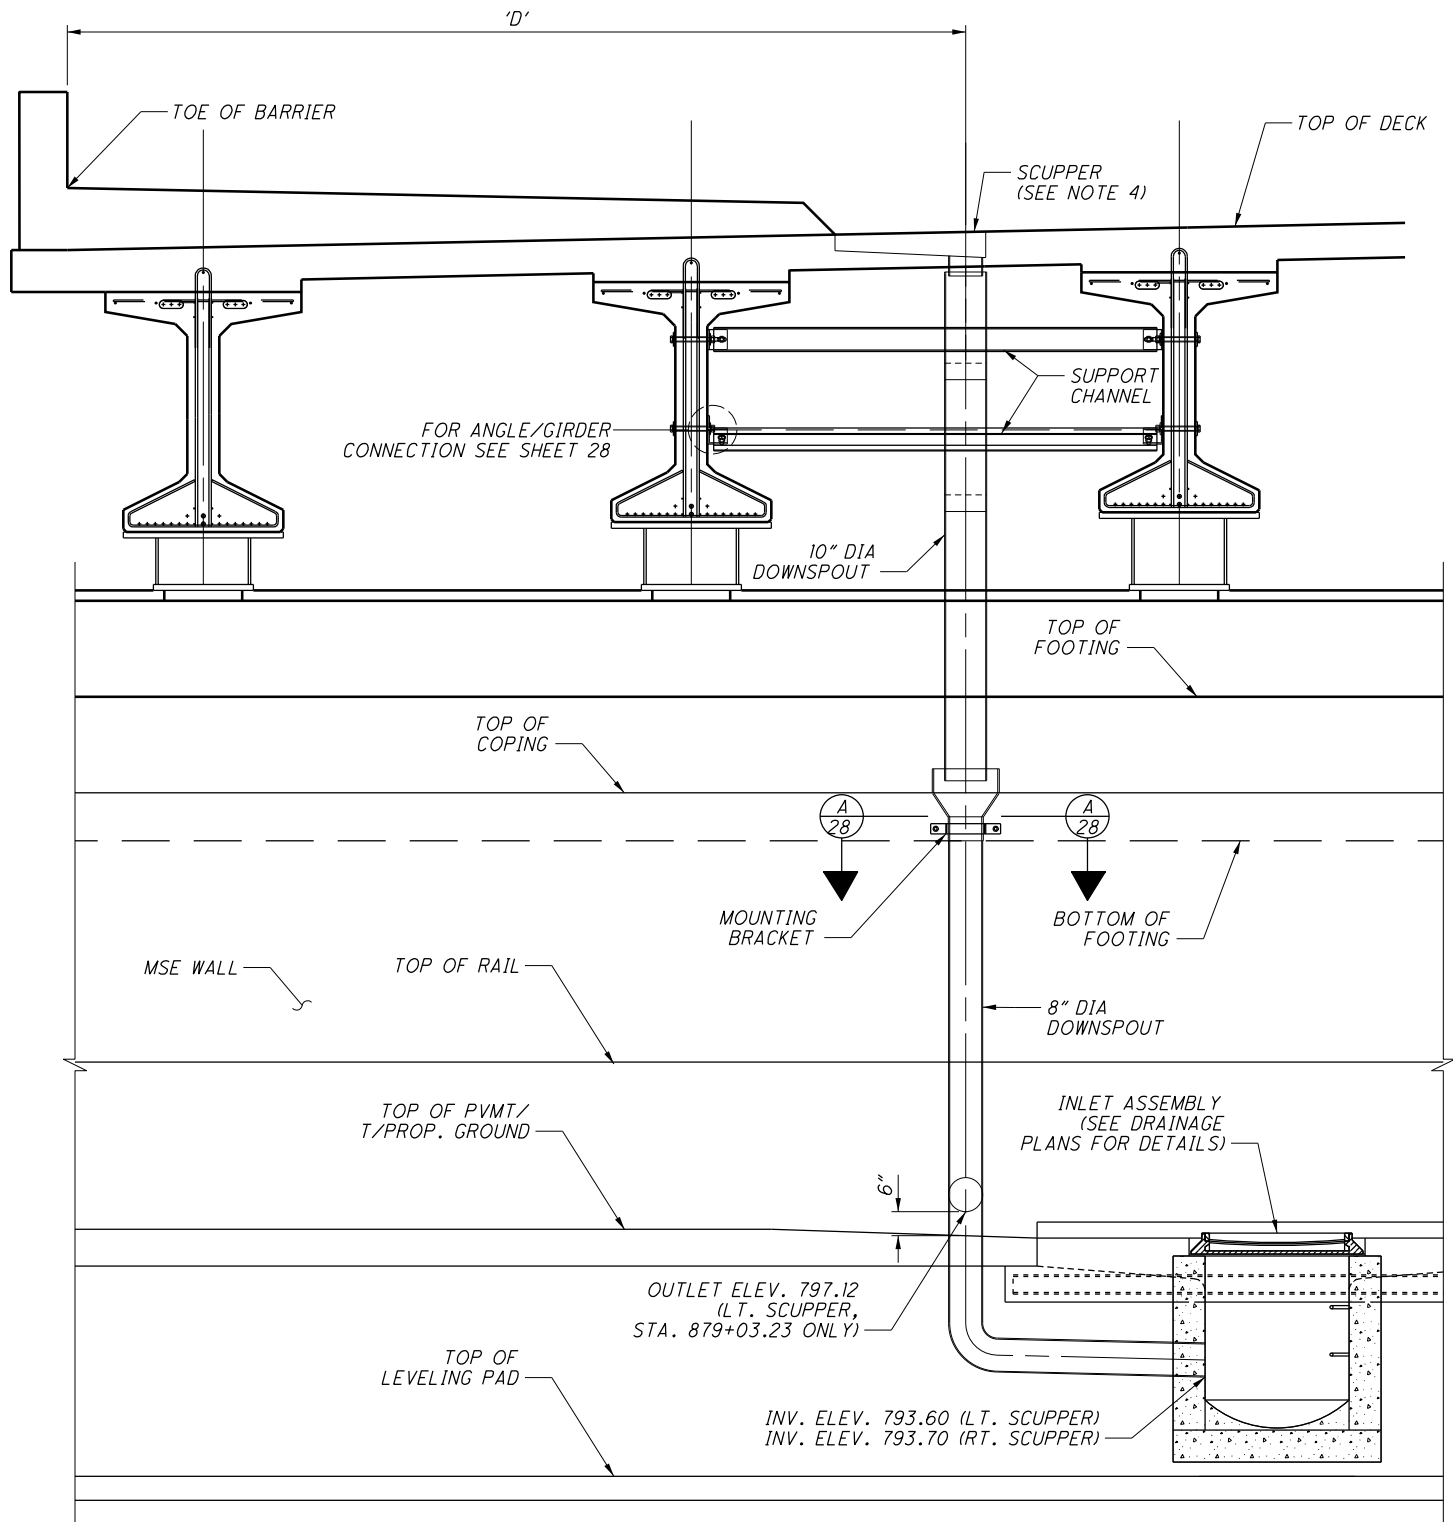

LEFT SIDE SECTION  
(RIGHT SIDE IS A MIRROR IMAGE OF THE LEFT)

NOTES:

1. DOWNSPOUT PIPE SHALL BE PER CMS 748.06.
2. DOWNSPOUTS AND ALL ASSOCIATED HARDWARE SHALL BE GALVANIZED PER CMS 711.02 AND INCLUDED WITH ITEM 518, SCUPPERS, INCLUDING SUPPORTS, AS PER PLAN FOR PAYMENT.
3. SEE SHEET 28 FOR ADDITIONAL SCUPPER AND DOWNSPOUT DETAILS.
4. FOR THE LEFT SCUPPERS, PROVIDE A NEENAH FOUNDRY MODEL R-3910-V OR AN APPROVED EQUAL. FOR THE RIGHT SCUPPER, PROVIDE A NEENAH FOUNDRY MODEL R-3945-A DESIGNED FOR CONTINUOUS TRAFFIC LOADING (WITH ~2% SLOPE) OR AN APPROVED EQUAL.

035\_0627MD002.dgn 1/6/2023 9:02:35 AM Jason.Centers@jacobs.com

**JACOBS**  
 DESIGN AGENCY  
 1880 WATCROSS ROAD  
 CINCINNATI, OHIO 45240

---

SCUPPER DETAILS  
 BRIDGE NO. GRE-035-0627  
 VALLEY/TREBEIN ROAD OVER U.S. 35

---


**GRE-US 35-5.63**  
 PID No. 107217

---


27 / 30  
 599  
 698

**NOTES:**


1. SCUPPER AND DOWNSPOUT STEEL PIPE IN ACCORDANCE WITH CMS 748.06. ALL OTHER STEEL SHAPES SHALL BE ASTM A709 GRADE 50. BOLTS SHALL BE ASTM A325, TYPE 1.
2. GALVANIZE SCUPPER, DOWNSPOUT PIPE, ALL ASSOCIATED STEEL HARDWARE, AND BOLTS IN ACCORDANCE WITH CMS 711.02 AND INCLUDED WITH ITEM 518, SCUPPERS, INCLUDING SUPPORTS, AS PER PLAN FOR PAYMENT.
3. ADHESIVE ANCHORS SHALL BE ANCHOR BOLTS IN HOLES FILLED WITH NONSHRINKING EPOXY GROUT MEETING THE REQUIREMENTS OF CMS 705.20. CARE SHALL BE TAKEN NOT TO DAMAGE REINFORCING STEEL WHILE DRILLING FOR ADHESIVE ANCHORS.
4. SEE SHEET 27 FOR SECTION A-A LOCATION.

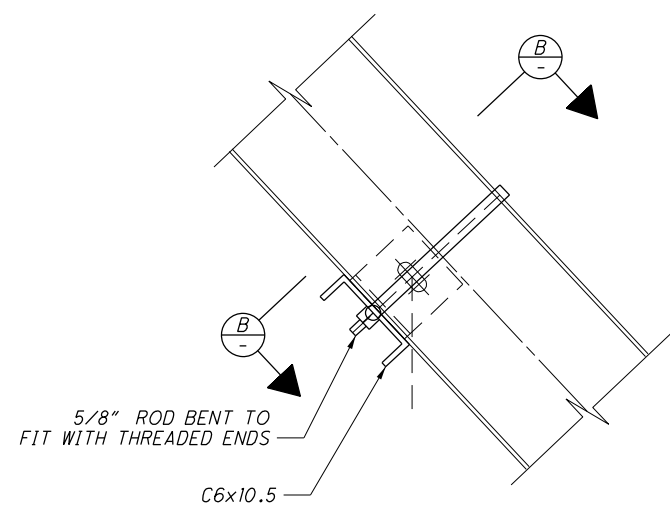

**DETAIL A**  
(LOWER SUPPORT BRACKET SHOWN, UPPER SUPPORT BRACKET SIMILAR)

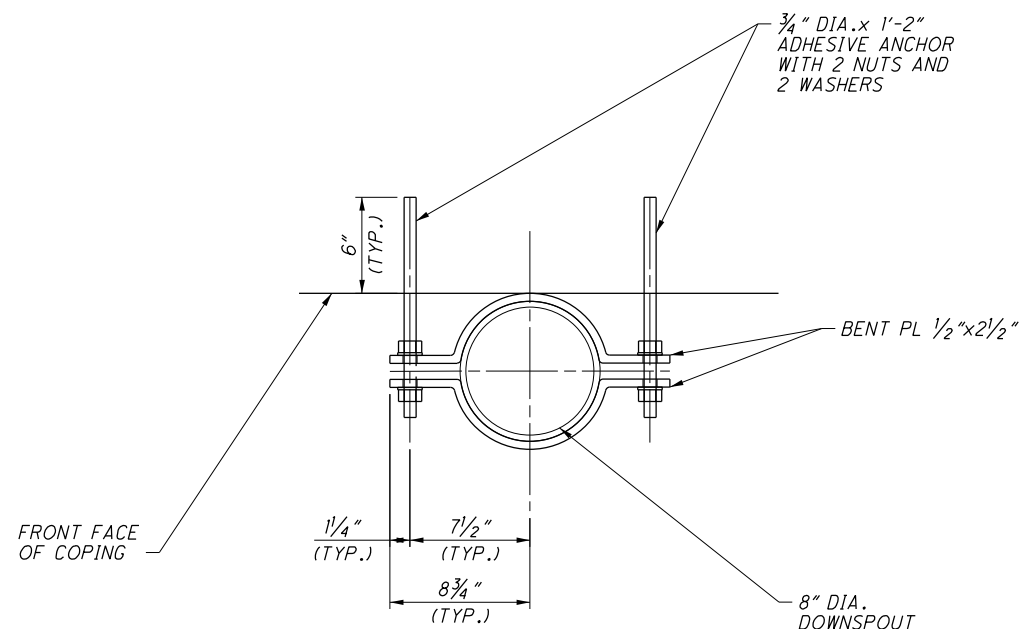

**SECTION A-A**

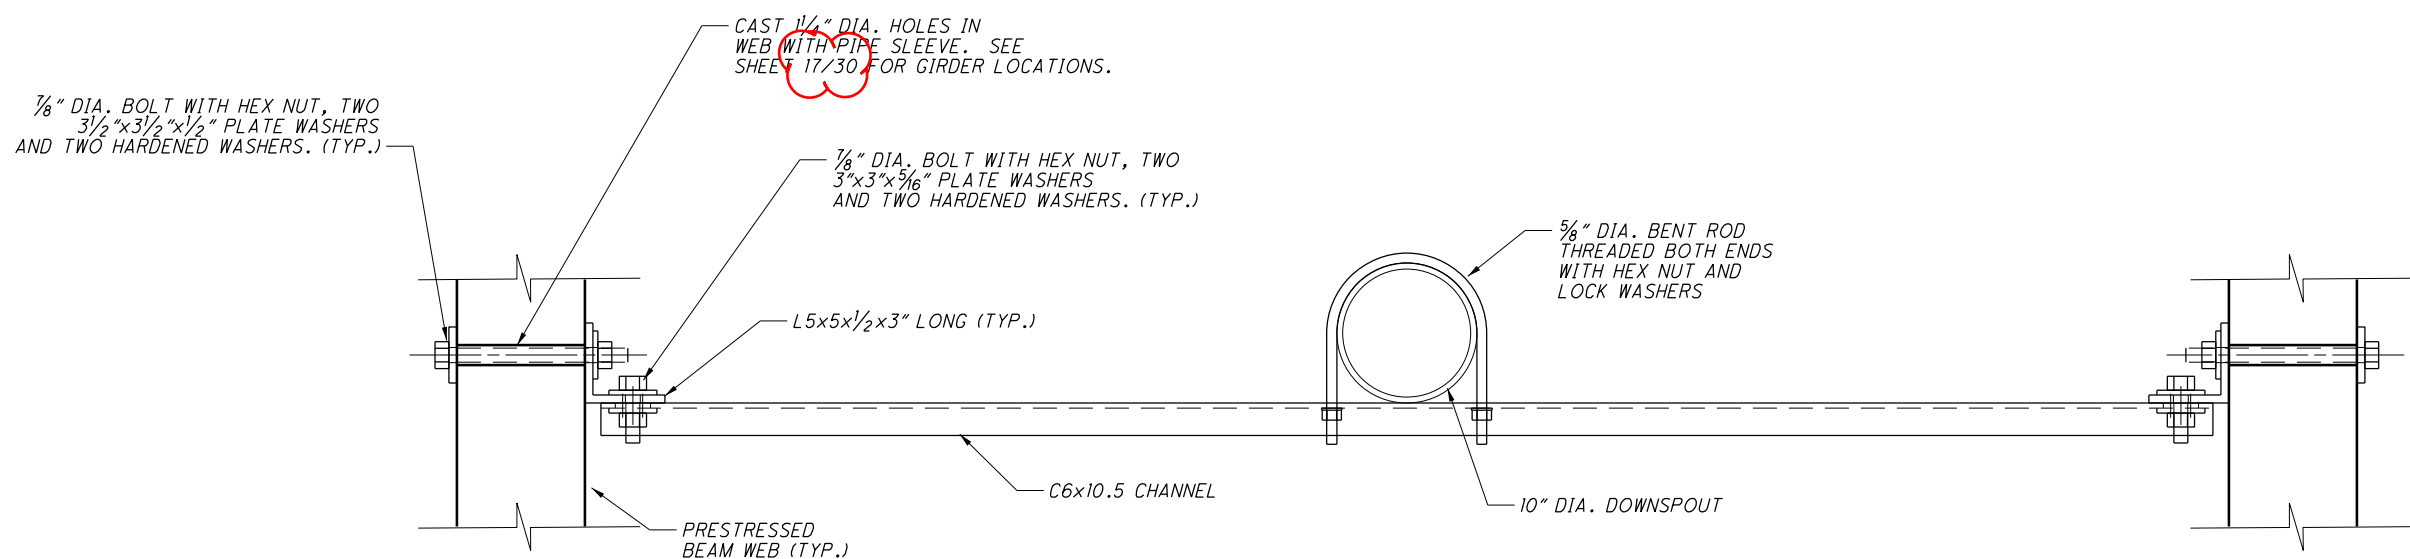

**SECTION B-B**

035\_0627MD003.dgn 1/6/2023 9:09:42 AM Jason.Centers@jacobs.com

<p><b>GRE-US 35-5.63</b></p> <p>PID No. 107217</p>	<p><b>SCUPPER DETAILS</b></p> <p>BRIDGE NO. GRE-035-0627</p> <p>VALLEY/TREBEIN ROAD OVER U.S. 35</p>	<p>DESIGNED: MM</p> <p>CHECKED: FBW</p>	<p>DRAWN: MM</p> <p>REVIS: FBW</p>	<p>REVIEWED: JTC</p> <p>STRUCTURE FILE NUMBER: 2900213</p>	<p>DATE: 5/2022</p>
<p>28/30</p>	<p>600</p> <p>698</p>	<p>DESIGN AGENCY: <b>JACOBS</b></p> <p>1880 WATCROSS ROAD</p> <p>CINCINNATI, OHIO 45240</p>			

