



MODEL: Sheet PAPER: 34x22 (in.) DATE: 8/10/2022 TIME: 8:39:20 AM USER: jdwis4
 p:\vohodol-pw-bentley.com\ohodol-pw-02\Documents\01 Active Projects\District 08\Greens\96668\40-Engineering\Roadway\Streets\96668_P\001.dgn

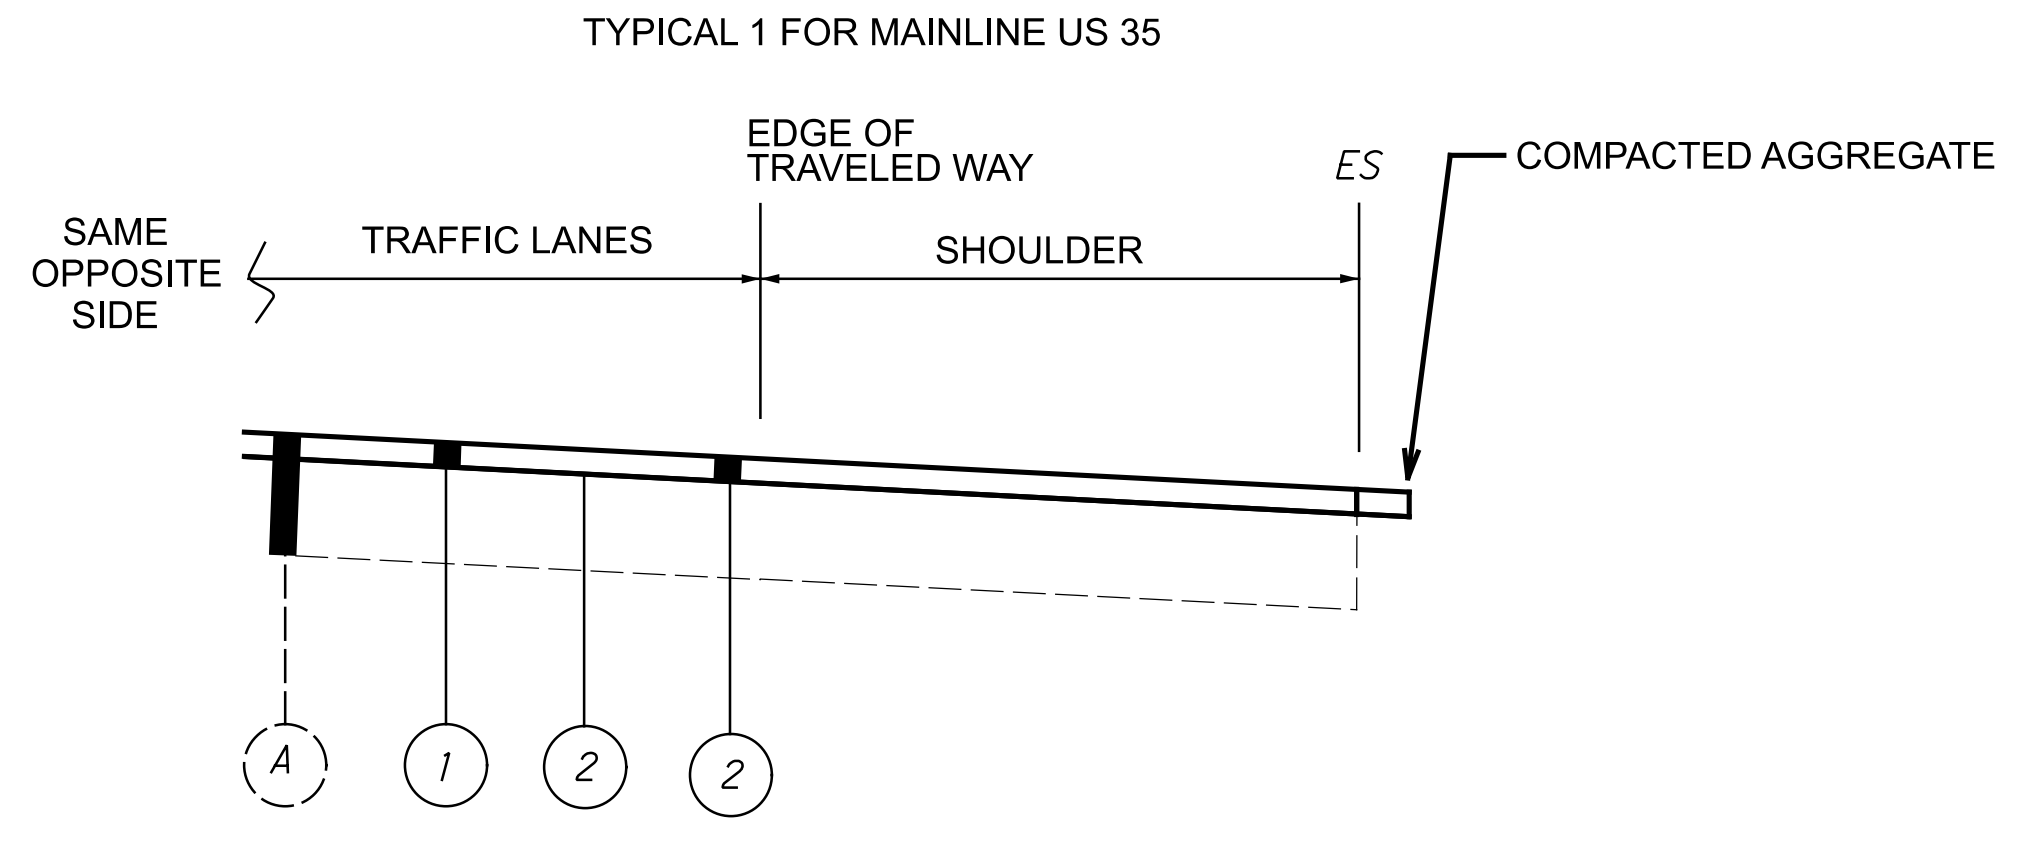

- (A) EXISTING ASPHALT CONCRETE PAVEMENT
- (1) ITEM 424 - 1.0" FINE GRADED POLYMER ASPHALT CONCRETE, TYPE B (448)
- (2) ITEM 407 - NON-TRACKING TACK COAT @ 0.06 GAL/SQ YD
- (3) ITEM 897 - 1" PAVEMENT PLANING, ASPHALT CONCRETE, CLASS A

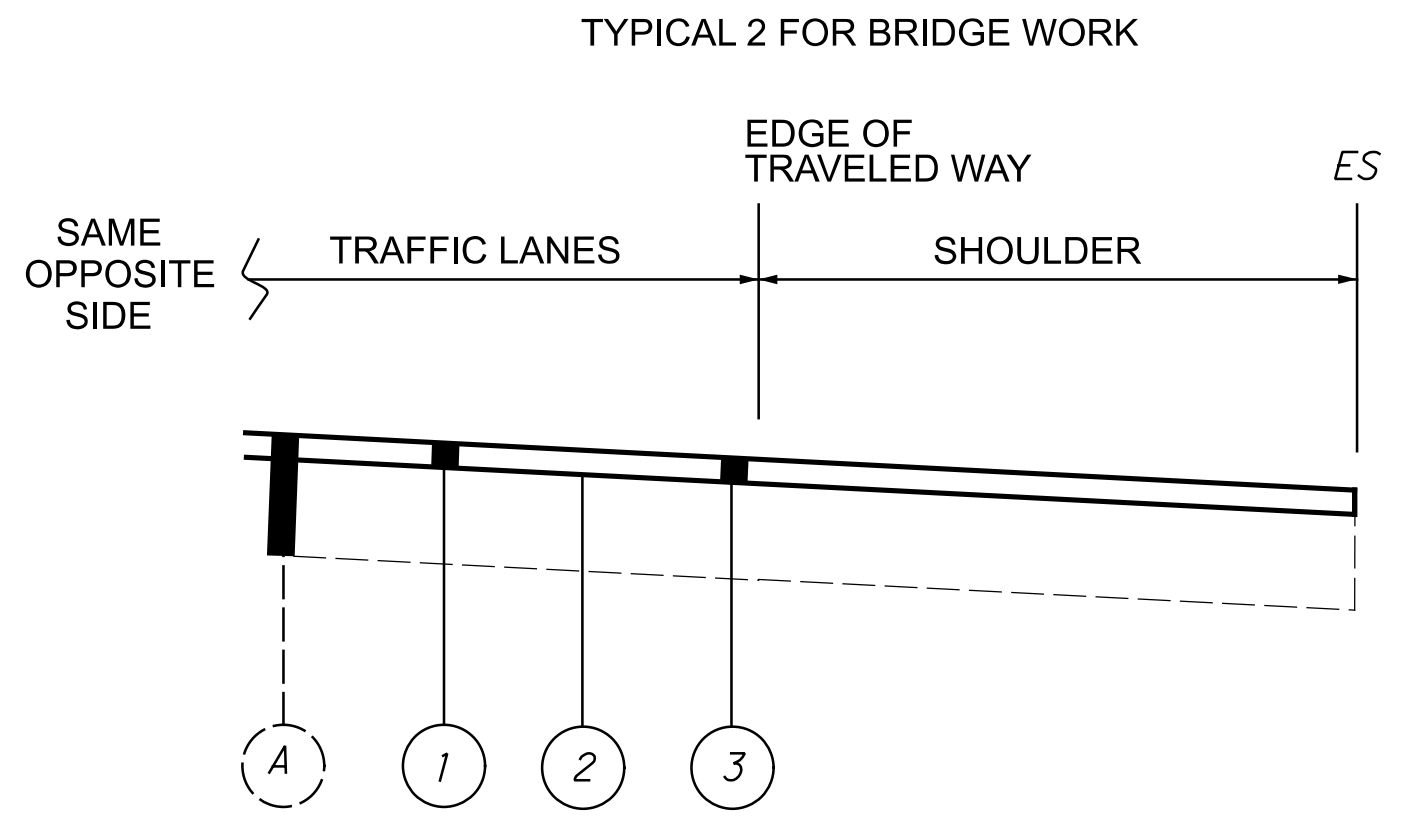


- (A) EXISTING ASPHALT CONCRETE PAVEMENT
- (1) ITEM 441 - 1.5" ASPHALT CONCRETE SURFACE COURSE, TYPE (448)
- (2) ITEM 407 - NON-TRACKING TACK COAT @ 0.06 GAL/SQ YD
- (3) ITEM 254 - 1.5" PAVEMENT PLANING, ASPHALT CONCRETE

PLAN SPLIT	COUNTY-ROUTE	LOG POINT (MILE)		LENGTH		PAVEMENT AREA (Micro-Station Generated Area)	PAVEMENT AREA	254		PAVEMENT PLANING PORTLAND CEMENT CONCRETE 1.5"	SAWED AND SEALED JOINT, APP	897		NON TRACKING TACK COAT @ 0.06 GAL/SQ YD	424		441		617		618	NOTES				
		FROM	TO	MILES	FT			PAVEMENT PLANING ASPHALT CONCRETE	PATCHING PLANED SURFACE			DEPTH	SQ YD		PAVEMENT PLANING ASPHALT CONCRETE, CLASS A	PATCHING PLANED SURFACE	THICKNESS	CU YD	THICKNESS	CU YD			COMPACTED AGGREGATE, TYPE A, 1.5" DEPTH, 12" WIDTH	SHOULDER PREPARATION	WATER @ 20 GAL/CU YD	RUMBLE STRIPS, SHOULDER (ASPHALT CONCRETE)
								INCHES	SQ YD			SQ YD	SQ YD		INCHES	SQ YD	SQ YD	GAL	INCHES	CU YD			INCHES	CU YD	CU YD	SQ YD
01/NHS/PV	GRE-US 35 EB	20.94	27.23	6.29	33211	1397471	155275					1.00	155274.6	1553	9316.5	1.00	4313.2			307.5	7380.3	6.2	12.58	CROSSOVERS INCLUDED IN QUANTITIES		
01/NHS/PV	GRE-US 35 WB	20.94	27.23	6.29	33211	1373981	152665					1.00	152664.6	1527	9159.9	1.00	4240.7			307.5	7380.3	6.2	12.58			
01/NHS/PV	GRE-US35-EB	OLD 35 RAMP TO EB 35		0.15	792	23112	2568					1.00	2568.0	26	154.1	1.00	71.3			7.3	176.0	0.1				
01/NHS/PV	GRE-US35-WB	WB 35 TO OLD 35 RAMP		0.29	1531	39196	4355					1.00	4355.1	44	261.3	1.00	121.0			14.2	340.3	0.3				
01/NHS/PV	GRE-US 35-EB	35 EB RAMP TO ST RT 72		0.23	1214	32200	3578					1.00	3577.8	36	214.7	1.00	99.4			11.2	269.9	0.2				
01/NHS/PV	GRE-US 35-EB	ST RT 72 TO EB US 35		0.14	739	20735	2304					1.00	2303.9	24	138.2	1.00	64.0			6.8	164.3	0.1				
01/NHS/PV	GRE-US 35-WB	35 WB RAMP TO ST RT 72		0.02	121	30420	3380					1.00	3380.0	34	202.8	1.00	93.9			1.1	27.0	0.0				
01/NHS/PV	GRE-US 35-WB	ST RT 72 TO WB US 35		0.14	739	20660	2296					1.00	2295.6	23	137.7	1.00	63.8			6.8	164.3	0.1				
02/NHS/BR	STRINGTOWN RD SOUTH SIDE			50	1263	140	1.50	140.3	2.0	72.0	30.0				8.4			1.50	5.8						BRIDGE GRE 35 1649	
02/NHS/BR	STRINGTOWN RD NORTH SIDE			50	1210	134	1.50	134.4	2.0	70.0	30.0				8.1			1.50	5.6							
02/NHS/BR	S. CHARLESTON RD SOUTH SIDE			75	2038	226	1.50	226.4	3.0	112.0	30.0				13.6			1.50	9.4						BRIDGE GRE 35 2297	
02/NHS/BR	S CHARLESTON RD NORTH SIDE			75	2171	241	1.50	241.0	3.0	110.0	30.0				14.5			1.50	10.1							
02/NHS/BR	N JEFFERSONVILLE RD SOUTH SIDE			50	1330	148	1.50	147.8	2.0	85.0	40.0				8.9			1.50	6.2					BRIDGE GRE 35 2450		
02/NHS/BR	N. JEFFERSONVILLE RD NORTH SIDE			50	1390	154	1.50	154.4	2.0	87.0	40.0				9.3			1.50	6.4							
02/NHS/BR	BRYAN RD SOUTH SIDE			50	1522	169	1.50	169.1	2.0	93.0	40.0				10.1			1.50	7.0					BRIDGE GRE 35 2705		
02/NHS/BR	BRYAN RD NORTH SIDE			50	1520	169	1.50	168.9	2.0	90.0	40.0				10.1			1.50	7.0							
TOTALS CARRIED TO GENERAL SUMMARY									1385	18	719	280		326420	3267			9068		58	663	15902	13	25.16		

PAVEMENT QUANTITIES

DESIGN AGENCY



DESIGNER: JED
 REVIEWER: JDO
 PROJECT ID: 96668
 SHEET: P.7 TOTAL: 9