

AUXILIARY MARKING DATA

COUNTY	LOCATION	ROUTE	DESCRIPTION	SIDE	644								PAVEMENT MARKING MISC.: NO PARKING DESIGNATION	HANDICAP MARKING SYMBOL, B125 (BLUE/WHITE)	REMARKS PLACE PER DETAILS BELOW OR AS DIRECTED BY THE ENGINEER STOP BARS SHALL BE PLACED A MINIMUM OF 4' FROM EDGE OF PAVEMENT	
					CHANNELIZING LINE, 8"	CROSSWALK LINE, 12"	STOP LINE, 24"	PARKING STALL MARKING		LANE ARROW 96"						WORD ON PAVEMENT 96"
								WHITE FT.	YELLOW FT.	THRU EACH	LT. EACH	RT. EACH				
GUE	SALT FORK	R-5	AT CHECK-IN			40	18									
			R-5 EXTRA AREAS:													
			A (PARKING LOT)			35		965	795	3		1		3	SEE SHEET 11	
			B (PULL OFF)				18					1			SEE SHEET 12	
			R-19				10								SEE SHEET 12	
			C (SHOWER HOUSE PARKING)					60	120					1	SEE SHEET 13	
			D (SHOWER HOUSE PARKING)				55	60	140					1	SEE SHEET 14	
			E (SHOWER HOUSE PARKING)					120	140					1	SEE SHEET 17	
			R-17/F (PARKING LOT)					1,260	365				1	2	SEE SHEET 18	
			G (PARKING LOT)					1,480	270					2	SEE SHEET 18	
			R-5 CAMP ROADS:													
			R-10 (A1-A34)				13								SEE SHEET 13	
			R-13 (C1-C18)				15								SEE SHEET 14	
			R-24 (E1-E32)				20								SEE SHEET 15	
			R-25 (F1-F50)				20								SEE SHEET 16	
			R-6 (G1-G57)				20								SEE SHEET 17	
		R-14	AT R-1		100					2	2				SEE SHEET 19	
			R-14 EXTRA AREAS:													
			A (PARKING LOT)				13	575	370					2	SEE SHEET 19	
			B (PARKING LOT)				10	500	210					2	SEE SHEET 20	
			C (PARKING LOT)					60							SEE SHEET 20	
			D (PARKING LOT)					80	145					1	SEE SHEET 20	
			E (PARKING LOT)					100	75						SEE SHEET 20	
			F (PARKING LOT)				17	4,260	810					8	SEE SHEET 21	
			G (PARKING LOT)				22	1,220	710					3	SEE SHEET 21	
			H (PARKING LOT)					5,920	865					6	SEE SHEET 22	
			SUB-TOTALS					16,660	5,015	3	2	4				
TOTALS CARRIED TO GENERAL SUMMARY					100	130	196	21,675		9			1	1	32	



CALCULATED LIME CHECKED JSL
PAVEMENT MARKING DATA (AUXILIARY)
GUE SALT FORK RESURFACING FY22
 9/24

I:\ProjectData\GUE\1160\Design\Roadway\Sheets\1160_T0002.dgn Sheet 12/10/2021 1:46:45 PM jjutzi


HSM = HANDICAP SYMBOL MARKING
 CWL = CROSSWALK LINE, 12"
 DYC = DOUBLE YELLOW CENTER LINE
 LA = LANE ARROW, 96"
 STL = STOP LINE
 WEL = WHITE EDGE LINE
 WOP = WORD ON PAVEMENT, 96"
 WSM = WHITE PARKING STALL MARKING
 YEL = YELLOW EDGE LINE
 YSM = YELLOW PARKING STALL MARKING

SEE SHEET 5 FOR CURB RAMP QUANTITIES


SEE SHEETS 7-8 FOR PAVMENT MARKING QUANTITIES

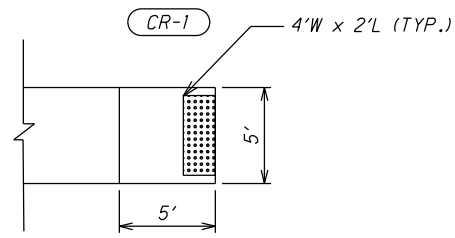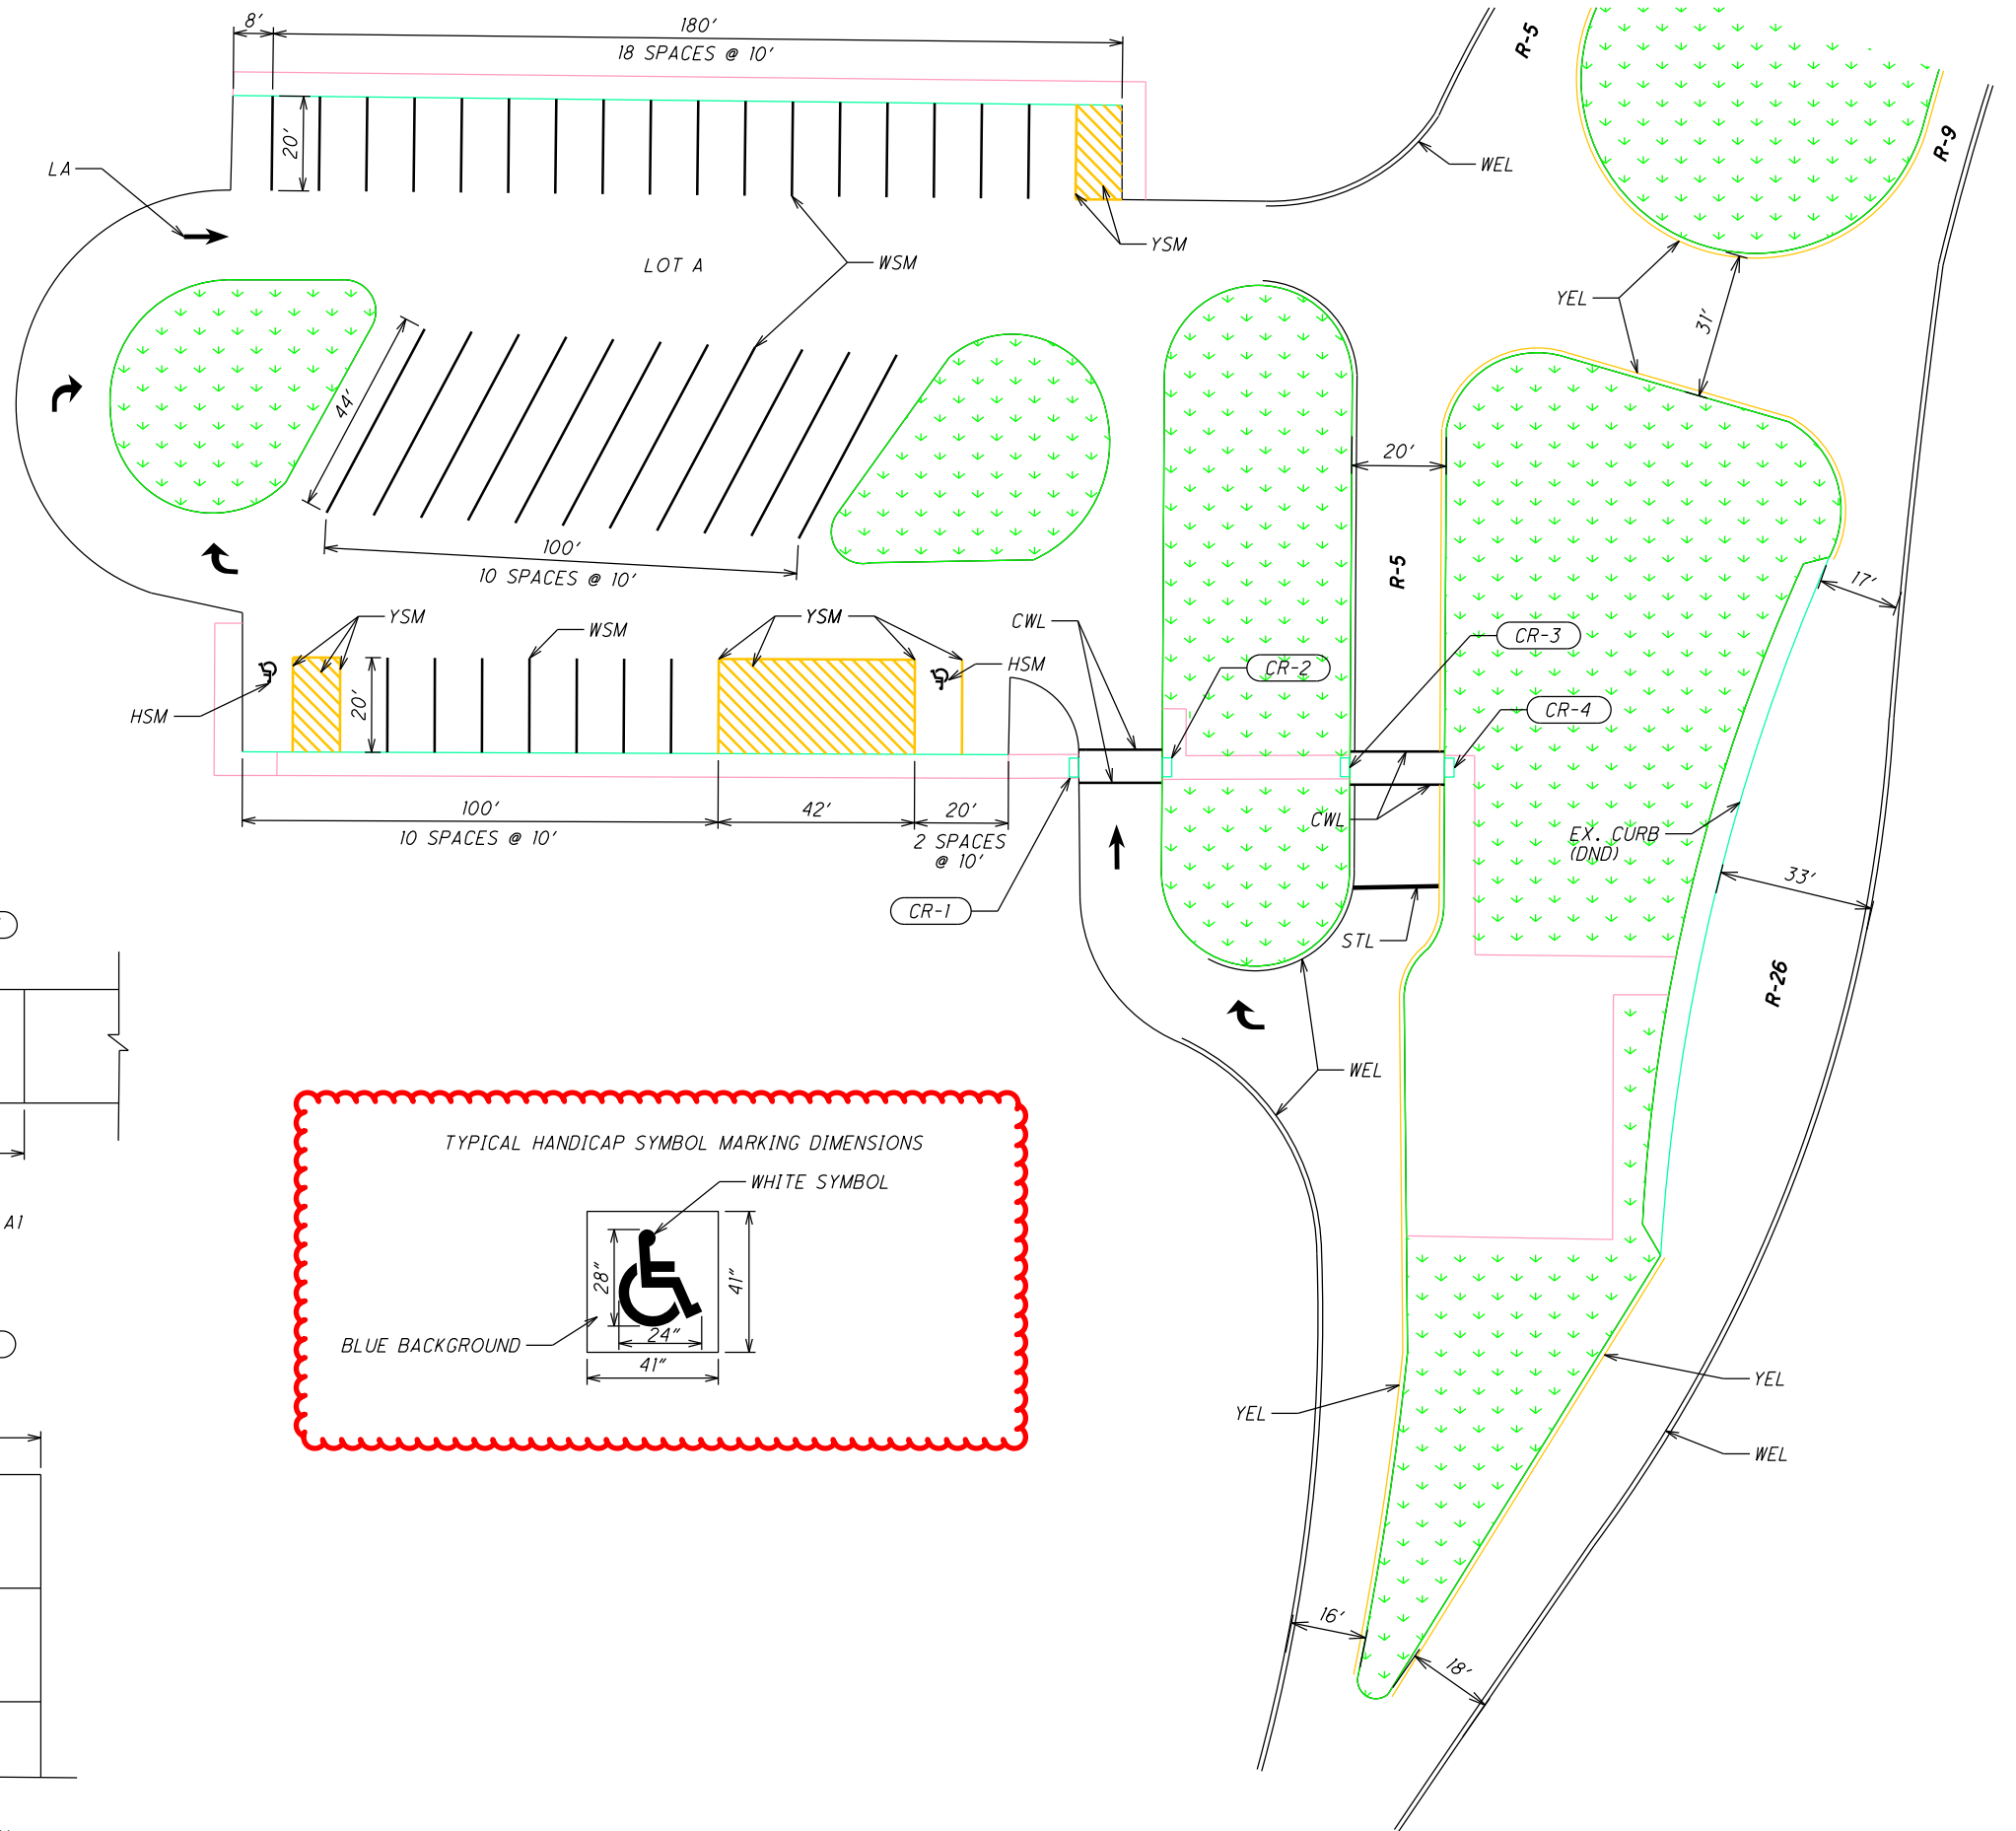


WALK WITH
DETECTABLE WARNING

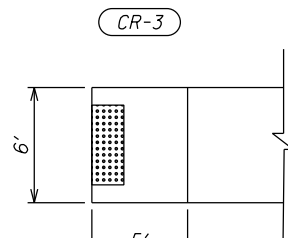


TYPE A1

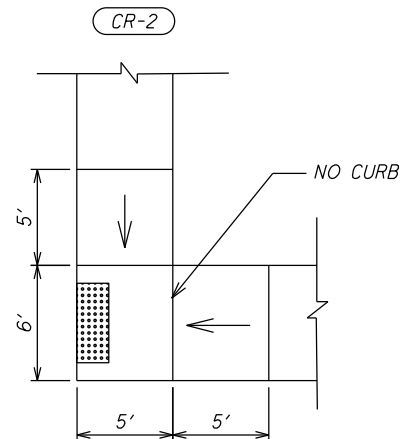


TYPE B1 MODIFIED
(NO BACKSIDE CURB)

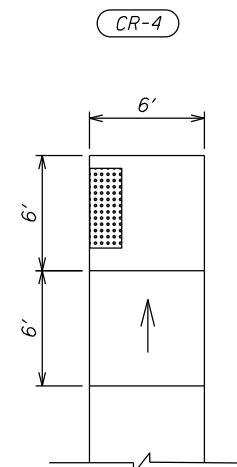

TYPE B1

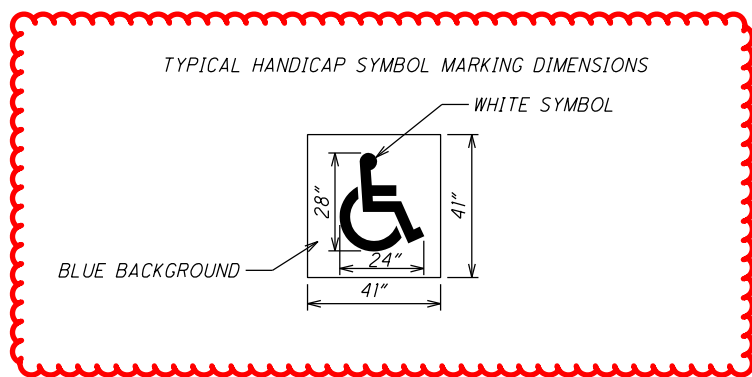

TYPICAL HANDICAP SYMBOL MARKING DIMENSIONS

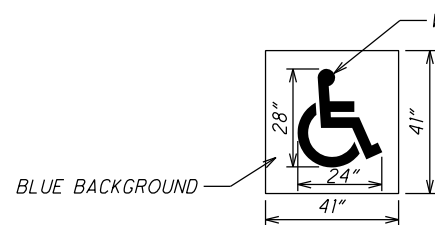

CALCULATED
LIME
CHECKED
JSL


0 20 40
HORIZONTAL
SCALE IN FEET

PLAN SHEET
R-5, R-26, LOT A

GUE SALT FORK
RESURFACING FY22


I:\Projec+Data\GUE\1160\Design\Roadway\Sheets\1160_GP002.dgn Sheet 12/10/2021 11:45:53 AM jltzlj

I:\ProjectData\GUE\1160\Design\Roadway\Sheets\1160_GPO09.dgn Sheet 12/10/2021 3:03:59 PM jluTZL

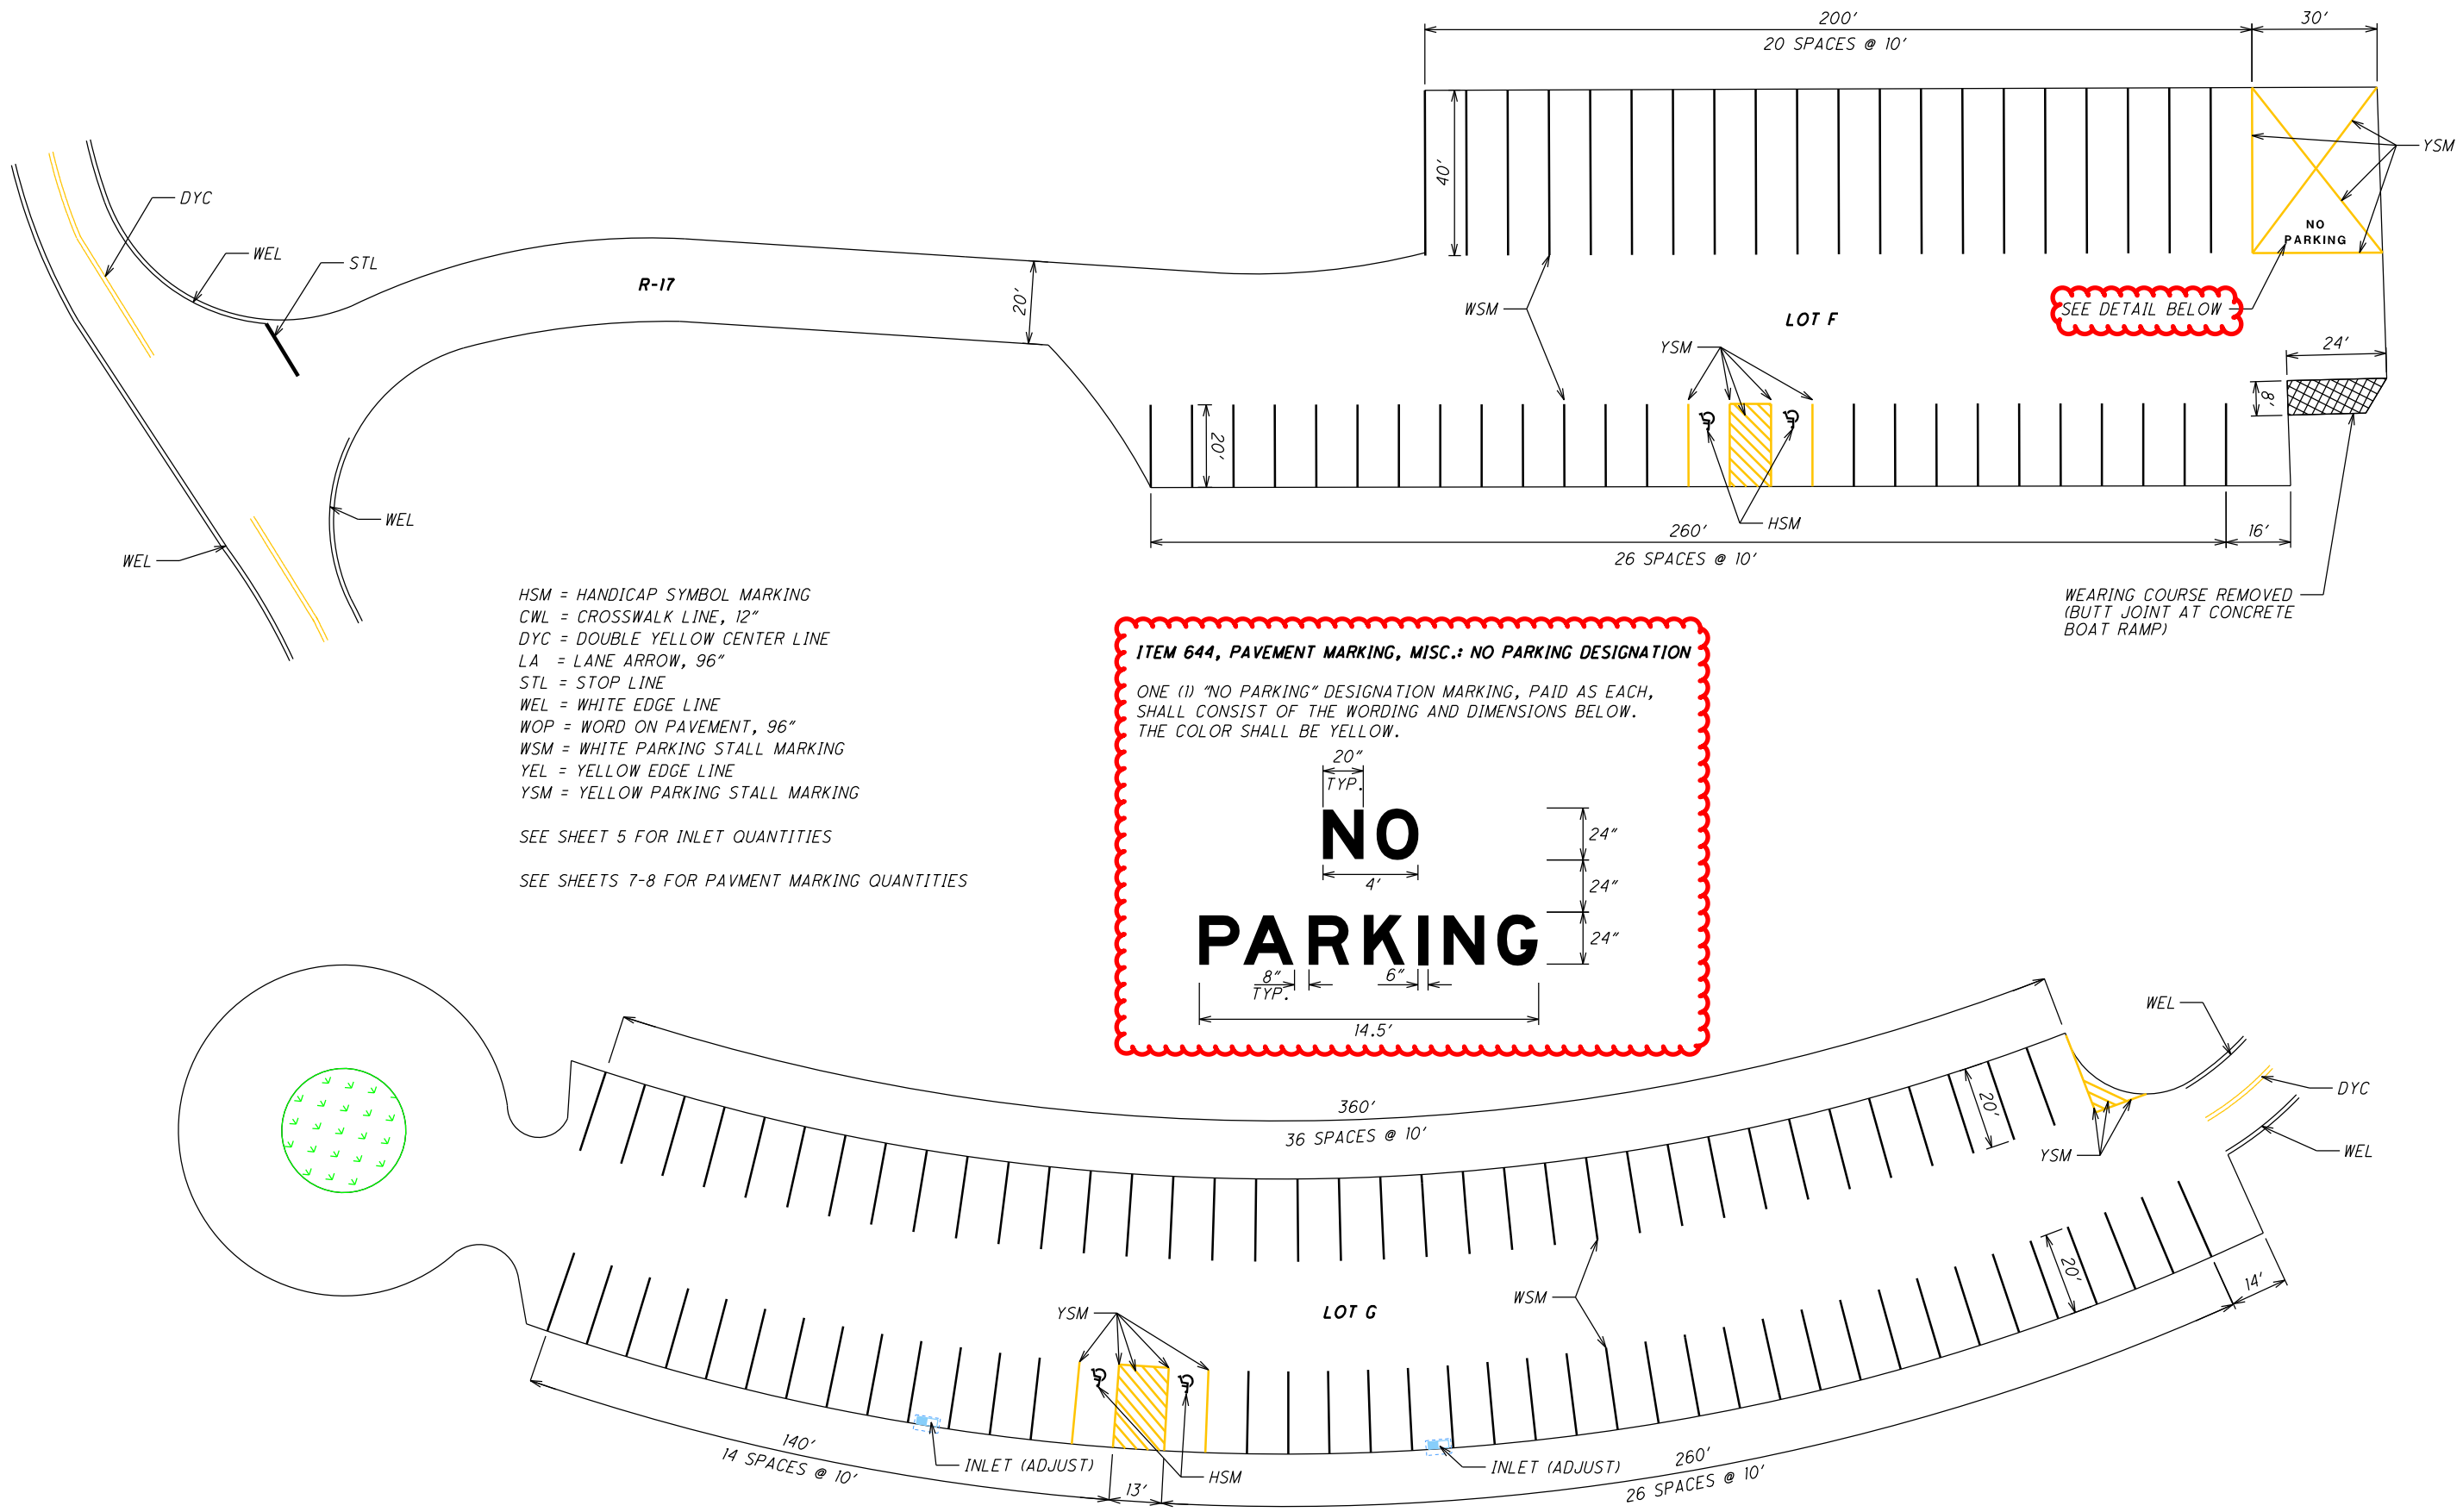

HSM = HANDICAP SYMBOL MARKING
 CWL = CROSSWALK LINE, 12"
 DYC = DOUBLE YELLOW CENTER LINE
 LA = LANE ARROW, 96"
 STL = STOP LINE
 WEL = WHITE EDGE LINE
 WOP = WORD ON PAVEMENT, 96"
 WSM = WHITE PARKING STALL MARKING
 YEL = YELLOW EDGE LINE
 YSM = YELLOW PARKING STALL MARKING

SEE SHEET 5 FOR INLET QUANTITIES
 SEE SHEETS 7-8 FOR PAYMENT MARKING QUANTITIES

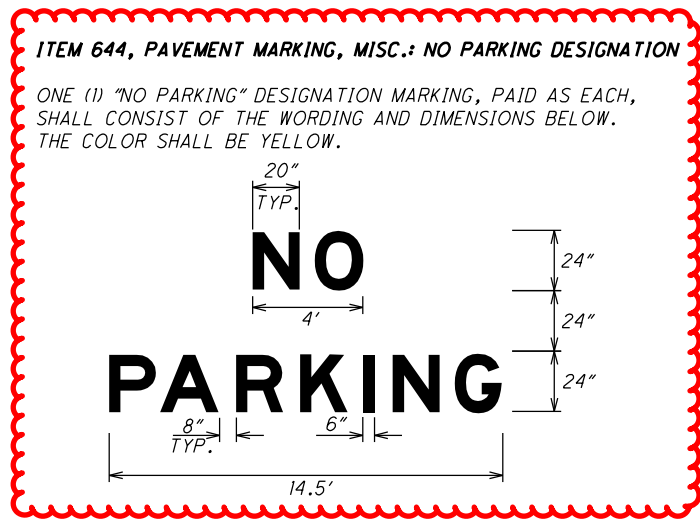

CALCULATED LIME CHECKED JSL

PLAN SHEET
R-5, R-17, LOT F, LOT G

GUE SALT FORK
RESURFACING FY22

