


I:\ProjectData\GUE\76470\Design\Roadway\Sheets\76470_10001.dgn_Sheet 5/22/2020 10:33:20 AM jlutzi

EDGE LINE DATA											
LOCATION	COUNTY	ROUTE	S.L.M.		TOTAL LENGTH (MILES)	INFORMATION ONLY		618	644	REMARKS	
			FROM	TO		WHITE EDGE LINE QUANTITIES		RUMBLE STRIPES, EDGE LINE (ASPHALT CONCRETE)	EDGE LINE, 6"		
						TOTAL MILES	HIGHWAY MILES				MILE
1	GUE	U.S. 22	15.16	17.50	2.34	4.68	4.68	4.68	4.68	SLM TO FOGLE RD.	
			17.50	23.70	6.20	12.40	12.40		12.40	FOGLE RD. TO SLM (NO RUMBLES)	
			23.70	27.20	3.50	7.00	7.00		7.00		
			27.20	27.64	0.44	0.88	0.88			0.88	LONDONDERRY (NO RUMBLES IN 45 MPH ZONE)
			27.64	30.87	3.23	6.46	6.46	6.46	6.46		
			30.87	31.04	0.17	0.34	0.34		0.34	END AT HAR. CO. (NO RUMBLES IN 45 MPH ZONE)	
LOCATION 1 TOTALS (CARRIED TO SUB-SUMMARY)								18.14	31.76		
2	GUE	S.R. 800	0.00	2.48	2.48	4.96	4.96		4.96	BEL. CO. TO U.S. 22	
			LOCATION 2 TOTALS (CARRIED TO SUB-SUMMARY)								4.96

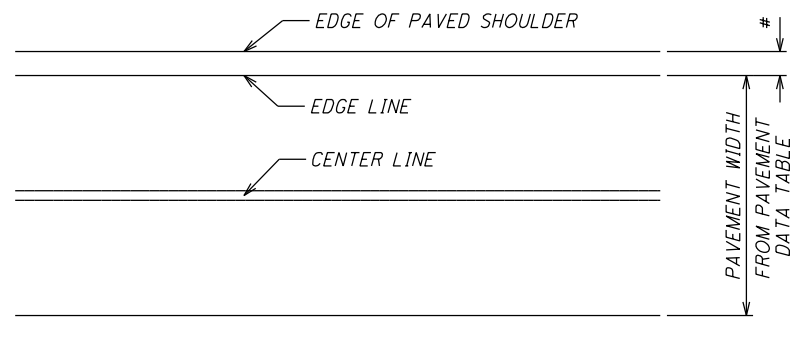

EDGE LINES SHALL BE PLACED A MINIMUM OF 6" FROM EDGE OF PAVED SHOULDER

CENTER LINE DATA										
LOCATION	COUNTY	ROUTE	S.L.M.		TOTAL LENGTH (MILES)	INFORMATION ONLY		644	REMARKS	
			FROM	TO		CENTER LINE QUANTITIES		CENTER LINE		
						TOTAL MILES	EQUIVALENT SOLID LINE			MILES
1	GUE	U.S. 22	15.16	31.04	15.88	16.07	26.793	16.07	ADDED 0.20 MILE FOR SALT FORK TURN LANE	
			LOCATION 1 TOTALS (CARRIED TO SUB-SUMMARY)							
2	GUE	S.R. 800	0.00	2.48	2.48	2.48	4.584	2.48	BEL. CO. TO U.S. 22	
			LOCATION 2 TOTALS (CARRIED TO SUB-SUMMARY)							

CALCULATED LIME CHECKED JSL

PAVEMENT MARKING DATA - LONG LINE

GUE-22/800-15.16 / 0.00

I:\Project\GUE\76470\Design\Roadway\Sheets\76470_GS001.dgn_Sheet 5/22/2020 10:20:48 AM jltzl

LOCATION 1 SHEET TOTALS										ITEM	ITEM EXT.	GRAND TOTALS	UNIT	DESCRIPTION
2	3	4	5	6	8	9	11	13	16					
														ROADWAY
	530				7,630	589				202	23500	8,749	SY	WEARING COURSE REMOVED
				31.64						209	72501	31.64	MILE	PREPARING SUBGRADE FOR SHOULDER PAVING, AS PER PLAN
														PAVEMENT
1,050										253	02000	1,050	CY	PAVEMENT REPAIR
	1,880		211,136	37,668						254	01000	250,684	SY	PAVEMENT PLANING, ASPHALT CONCRETE ,1.25"
			7,071	6,055						254	01000	13,126	SY	PAVEMENT PLANING, ASPHALT CONCRETE ,2.25"
			28,367	5,767	613	48				407	20000	34,795	GAL	NON-TRACKING TACK COAT
				14,652						408	10001	14,652	GAL	PRIME COAT, AS PER PLAN
					268					441	50000	268	CY	ASPHALT CONCRETE SURFACE COURSE, TYPE 1, (448), PG64-22
75	84		7,577	1,789		20				441	50100	9,545	CY	ASPHALT CONCRETE SURFACE COURSE, TYPE 1, (448), PG70-22M
60	25		6,062	1,215						441	50200	7,362	CY	ASPHALT CONCRETE INTERMEDIATE COURSE, TYPE 1, (448)
							314			516	31011	314	FT	2" DEEP JOINT SEALER, AS PER PLAN
				2,060						617	10101	2,060	CY	COMPACTED AGGREGATE, AS PER PLAN
							18.14			618	41000	18.14	MILE	RUMBLE STRIPES, EDGE LINE (ASPHALT CONCRETE)
														TRAFFIC CONTROL
									1,449	621	00100	1,449	EACH	RPM
									1,449	621	54000	1,449	EACH	RAISED PAVEMENT MARKER REMOVED
							31.76			644	00104	31.76	MILE	EDGE LINE, 6"
							16.07			644	00300	16.07	MILE	CENTER LINE
								1,160		644	00400	1,160	FT	CHANNELIZING LINE, 8"
								758		644	00500	758	FT	STOP LINE
								300		644	00700	300	FT	TRANSVERSE/DIAGONAL LINE
								5		644	01300	5	EACH	LANE ARROW
								2		644	01410	2	EACH	WORD ON PAVEMENT, 96"
														MAINTENANCE OF TRAFFIC
		107								614	12460	107	EACH	WORK ZONE MARKING SIGN
		6								614	13000	6	CY	ASPHALT CONCRETE FOR MAINTAINING TRAFFIC
		15.88								614	21100	15.88	MILE	WORK ZONE CENTER LINE, CLASS I, 642 PAINT
		15.88								614	21550	15.88	MILE	WORK ZONE CENTER LINE, CLASS III, 642 PAINT
		2.30								614	22100	2.30	MILE	WORK ZONE EDGE LINE, CLASS I, 4", 642 PAINT
		1,160								614	23200	1,160	FT	WORK ZONE CHANNELIZING LINE, CLASS I, 8", 642 PAINT
		1,160								614	23680	1,160	FT	WORK ZONE CHANNELIZING LINE, CLASS III, 8", 642 PAINT

CALCULATED LIME CHECKED JSL
LOCATION 1 SUB-SUMMARY
GUE-22 / 800-
15.16 / 0.00
 17
 19

I:\ProjectData\GUE\76470\Design\Roadway\Sheets\76470_GS002.dgn Sheet 5/22/2020 10:23:18 AM jlutzi

LOCATION 2 SHEET TOTALS									ITEM	ITEM EXT.	GRAND TOTALS	UNIT	DESCRIPTION
2	3	4	5	6	8	11	13	16					
													ROADWAY
	180				1,449				202	23500	1,629	SY	WEARING COURSE REMOVED
				4.96					209	72501	4.96	MILE	PREPARING SUBGRADE FOR SHOULDER PAVING, AS PER PLAN
													PAVEMENT
300									253	02000	300	CY	PAVEMENT REPAIR
	460		32,311	2,910					254	01000	35,681	SY	PAVEMENT PLANING, ASPHALT CONCRETE ,1.25"
			4,201	379	117				407	20000	4,697	GAL	NON-TRACKING TACK COAT
				2,328					408	10001	2,328	GAL	PRIME COAT, AS PER PLAN
					51				441	50000	51	CY	ASPHALT CONCRETE SURFACE COURSE, TYPE 1, (448), PG64-22
	23		1,122	140					441	50100	1,285	CY	ASPHALT CONCRETE SURFACE COURSE, TYPE 1, (448), PG70-22M
	8		898	81					441	50200	987	CY	ASPHALT CONCRETE INTERMEDIATE COURSE, TYPE 1, (448)
				324					617	10101	324	CY	COMPACTED AGGREGATE, AS PER PLAN
													TRAFFIC CONTROL
								211	621	00100	211	EACH	RPM
								211	621	54000	211	EACH	RAISED PAVEMENT MARKER REMOVED
						4.96			644	00104	4.96	MILE	EDGE LINE, 6"
						2.48			644	00300	2.48	MILE	CENTER LINE
							225		644	00500	225	FT	STOP LINE
													MAINTENANCE OF TRAFFIC
		19							614	12460	19	EACH	WORK ZONE MARKING SIGN
		2							614	13000	2	CY	ASPHALT CONCRETE FOR MAINTAINING TRAFFIC
		2.48							614	21100	2.48	MILE	WORK ZONE CENTER LINE, CLASS I, 642 PAINT
		2.48							614	21550	2.48	MILE	WORK ZONE CENTER LINE, CLASS III, 642 PAINT
		0.70							614	22100	0.70	MILE	WORK ZONE EDGE LINE, CLASS I, 4", 642 PAINT

CALCULATED
LIME
CHECKED
JSL

LOCATION 2 SUB-SUMMARY

GUE-22 / 800-
15.16 / 0.00

I:\ProjectData\GUE\76470\Design\Roadway\Sheets\76470_GG001.dgn Sheet 5/22/2020 10:51:33 AM jlu7zi

LOCATION TOTALS		PLAN SPLITS		ITEM	ITEM EXT.	GRAND TOTAL	UNIT	DESCRIPTION	SEE SHEET
LOCATION 1 (U.S. 22)	LOCATION 2 (S.R. 800)	01/STR/PV	02/NHS/PV						
ROADWAY									
8,749	1,629	1,629	8,749	202	23500	10,378	SY	WEARING COURSE REMOVED	
31.64	4.96	4.96	31.64	209	72051	36.60	MILE	PREPARING SUBGRADE FOR SHOULDER PAVING, AS PER PLAN	3
PAVEMENT									
1,050	300	300	1,050	253	02000	1,350	CY	PAVEMENT REPAIR	
250,684	35,681	35,681	250,684	254	01000	286,365	SY	PAVEMENT PLANING, ASPHALT CONCRETE ,1.25"	
13,126			13,126	254	01000	13,126	SY	PAVEMENT PLANING, ASPHALT CONCRETE ,2.25"	
34,795	4,697	4,697	34,795	407	20000	39,492	GAL	NON-TRACKING TACK COAT	
14,652	2,328	2,328	14,652	408	10001	16,980	GAL	PRIME COAT, AS PER PLAN	
268	51	51	268	441	50000	319	CY	ASPHALT CONCRETE SURFACE COURSE, TYPE 1, (448), PG64-22	
9,545	1,285	1,285	9,545	441	50100	10,830	CY	ASPHALT CONCRETE SURFACE COURSE, TYPE 1, (448), PG70-22M	
7,362	987	987	7,362	441	50200	8,349	CY	ASPHALT CONCRETE INTERMEDIATE COURSE, TYPE 1, (448)	
314			314	516	31011	314	FT	2" DEEP JOINT SEALER, AS PER PLAN	2
2,060	324	324	2,060	617	10101	2,384	CY	COMPACTED AGGREGATE, AS PER PLAN	2
18.14			18.14	618	41000	18.14	MILE	RUMBLE STRIPES, EDGE LINE (ASPHALT CONCRETE)	
TRAFFIC CONTROL									
1,449	211	211	1,449	621	00100	1,660	EACH	RPM	
1,449	211	211	1,449	621	54000	1,660	EACH	RAISED PAVEMENT MARKER REMOVED	
31.76	4.96	4.96	31.76	644	00104	36.72	MILE	EDGE LINE, 6"	
16.07	2.48	2.48	16.07	644	00300	18.55	MILE	CENTER LINE	
1,160			1160	644	00400	1,160	FT	CHANNELIZING LINE, 8"	
758	225	225	758	644	00500	983	FT	STOP LINE	
300			300	644	00700	300	FT	TRANSVERSE/DIAGONAL LINE	
5			5	644	01300	5	EACH	LANE ARROW	
2			2	644	01410	2	EACH	WORD ON PAVEMENT, 96"	
MAINTENANCE OF TRAFFIC									
107	19	19	107	614	12460	126	EACH	WORK ZONE MARKING SIGN	
6	2	2	6	614	13000	8	CY	ASPHALT CONCRETE FOR MAINTAINING TRAFFIC	
15.88	2.48	2.48	15.88	614	21100	18.36	MILE	WORK ZONE CENTER LINE, CLASS I, 642 PAINT	
15.88	2.48	2.48	15.88	614	21550	18.36	MILE	WORK ZONE CENTER LINE, CLASS III, 642 PAINT	
2.30	0.70	0.70	2.30	614	22100	3.00	MILE	WORK ZONE EDGE LINE, CLASS I, 4", 642 PAINT	
1,160			1,160	614	23200	1,160	FT	WORK ZONE CHANNELIZING LINE, CLASS I, 8", 642 PAINT	
1,160			1,160	614	23680	1,160	FT	WORK ZONE CHANNELIZING LINE, CLASS III, 8", 642 PAINT	
INCIDENTALS									
		LS	LS	614	11000		LS	MAINTAINING TRAFFIC	
		LS	LS	623	10000		LS	CONSTRUCTION LAYOUT STAKES AND SURVEYING	
		LS	LS	624	10000		LS	MOBILIZATION	

CALCULATED LIME CHECKED JSL	GENERAL SUMMARY	GUE-22 / 800- 15.16 / 0.00
--------------------------------------	-----------------	-------------------------------