


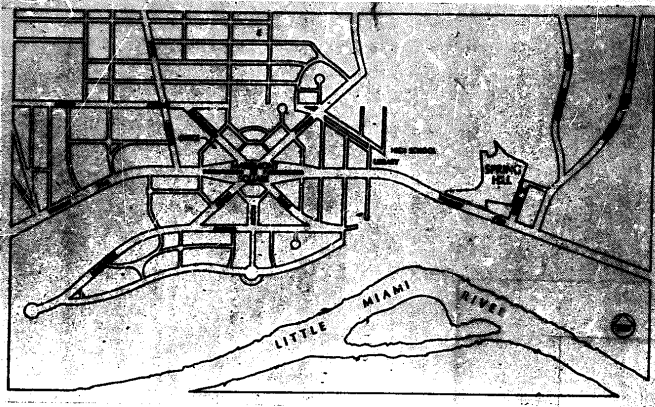

VICINITY MAP

THE UNDERSIGNED DO HEREBY CERTIFY THAT
THIS DRAWING DOES ACCURATELY SHOW
THE BUILDINGS AS CONSTRUCTED.

Jack P. Hill
REGISTERED ARCHITECT OHIO NO. 1828

Jimmy Lansdale
REGISTERED SURVEYOR OHIO NO. 5-5611

