


| BEARING       | DISTANCE | SINE   | COSINE | N.     | S.     | E.     | W.     |
|---------------|----------|--------|--------|--------|--------|--------|--------|
| N. 32° 03' E. | 268.37   | .53066 | .84759 | 227.47 |        | 142.41 |        |
| S. 58° 44' E. | 178.46   | .85476 | .51902 |        | 92.62  | 152.54 |        |
| S. 31° 47' W. | 268.51   | .52671 | .85005 |        | 228.25 |        | 141.43 |
| N. 58° 41' W. | 179.70   | .85431 | .51977 | 93.40  |        |        | 153.52 |
|               |          |        |        | 320.87 | 320.87 | 294.95 | 294.95 |

SECTION 3, COLUMBIA TWP.  
HAMILTON COUNTY, OHIO  
SCALE 1"=40'  
MARCH 1960

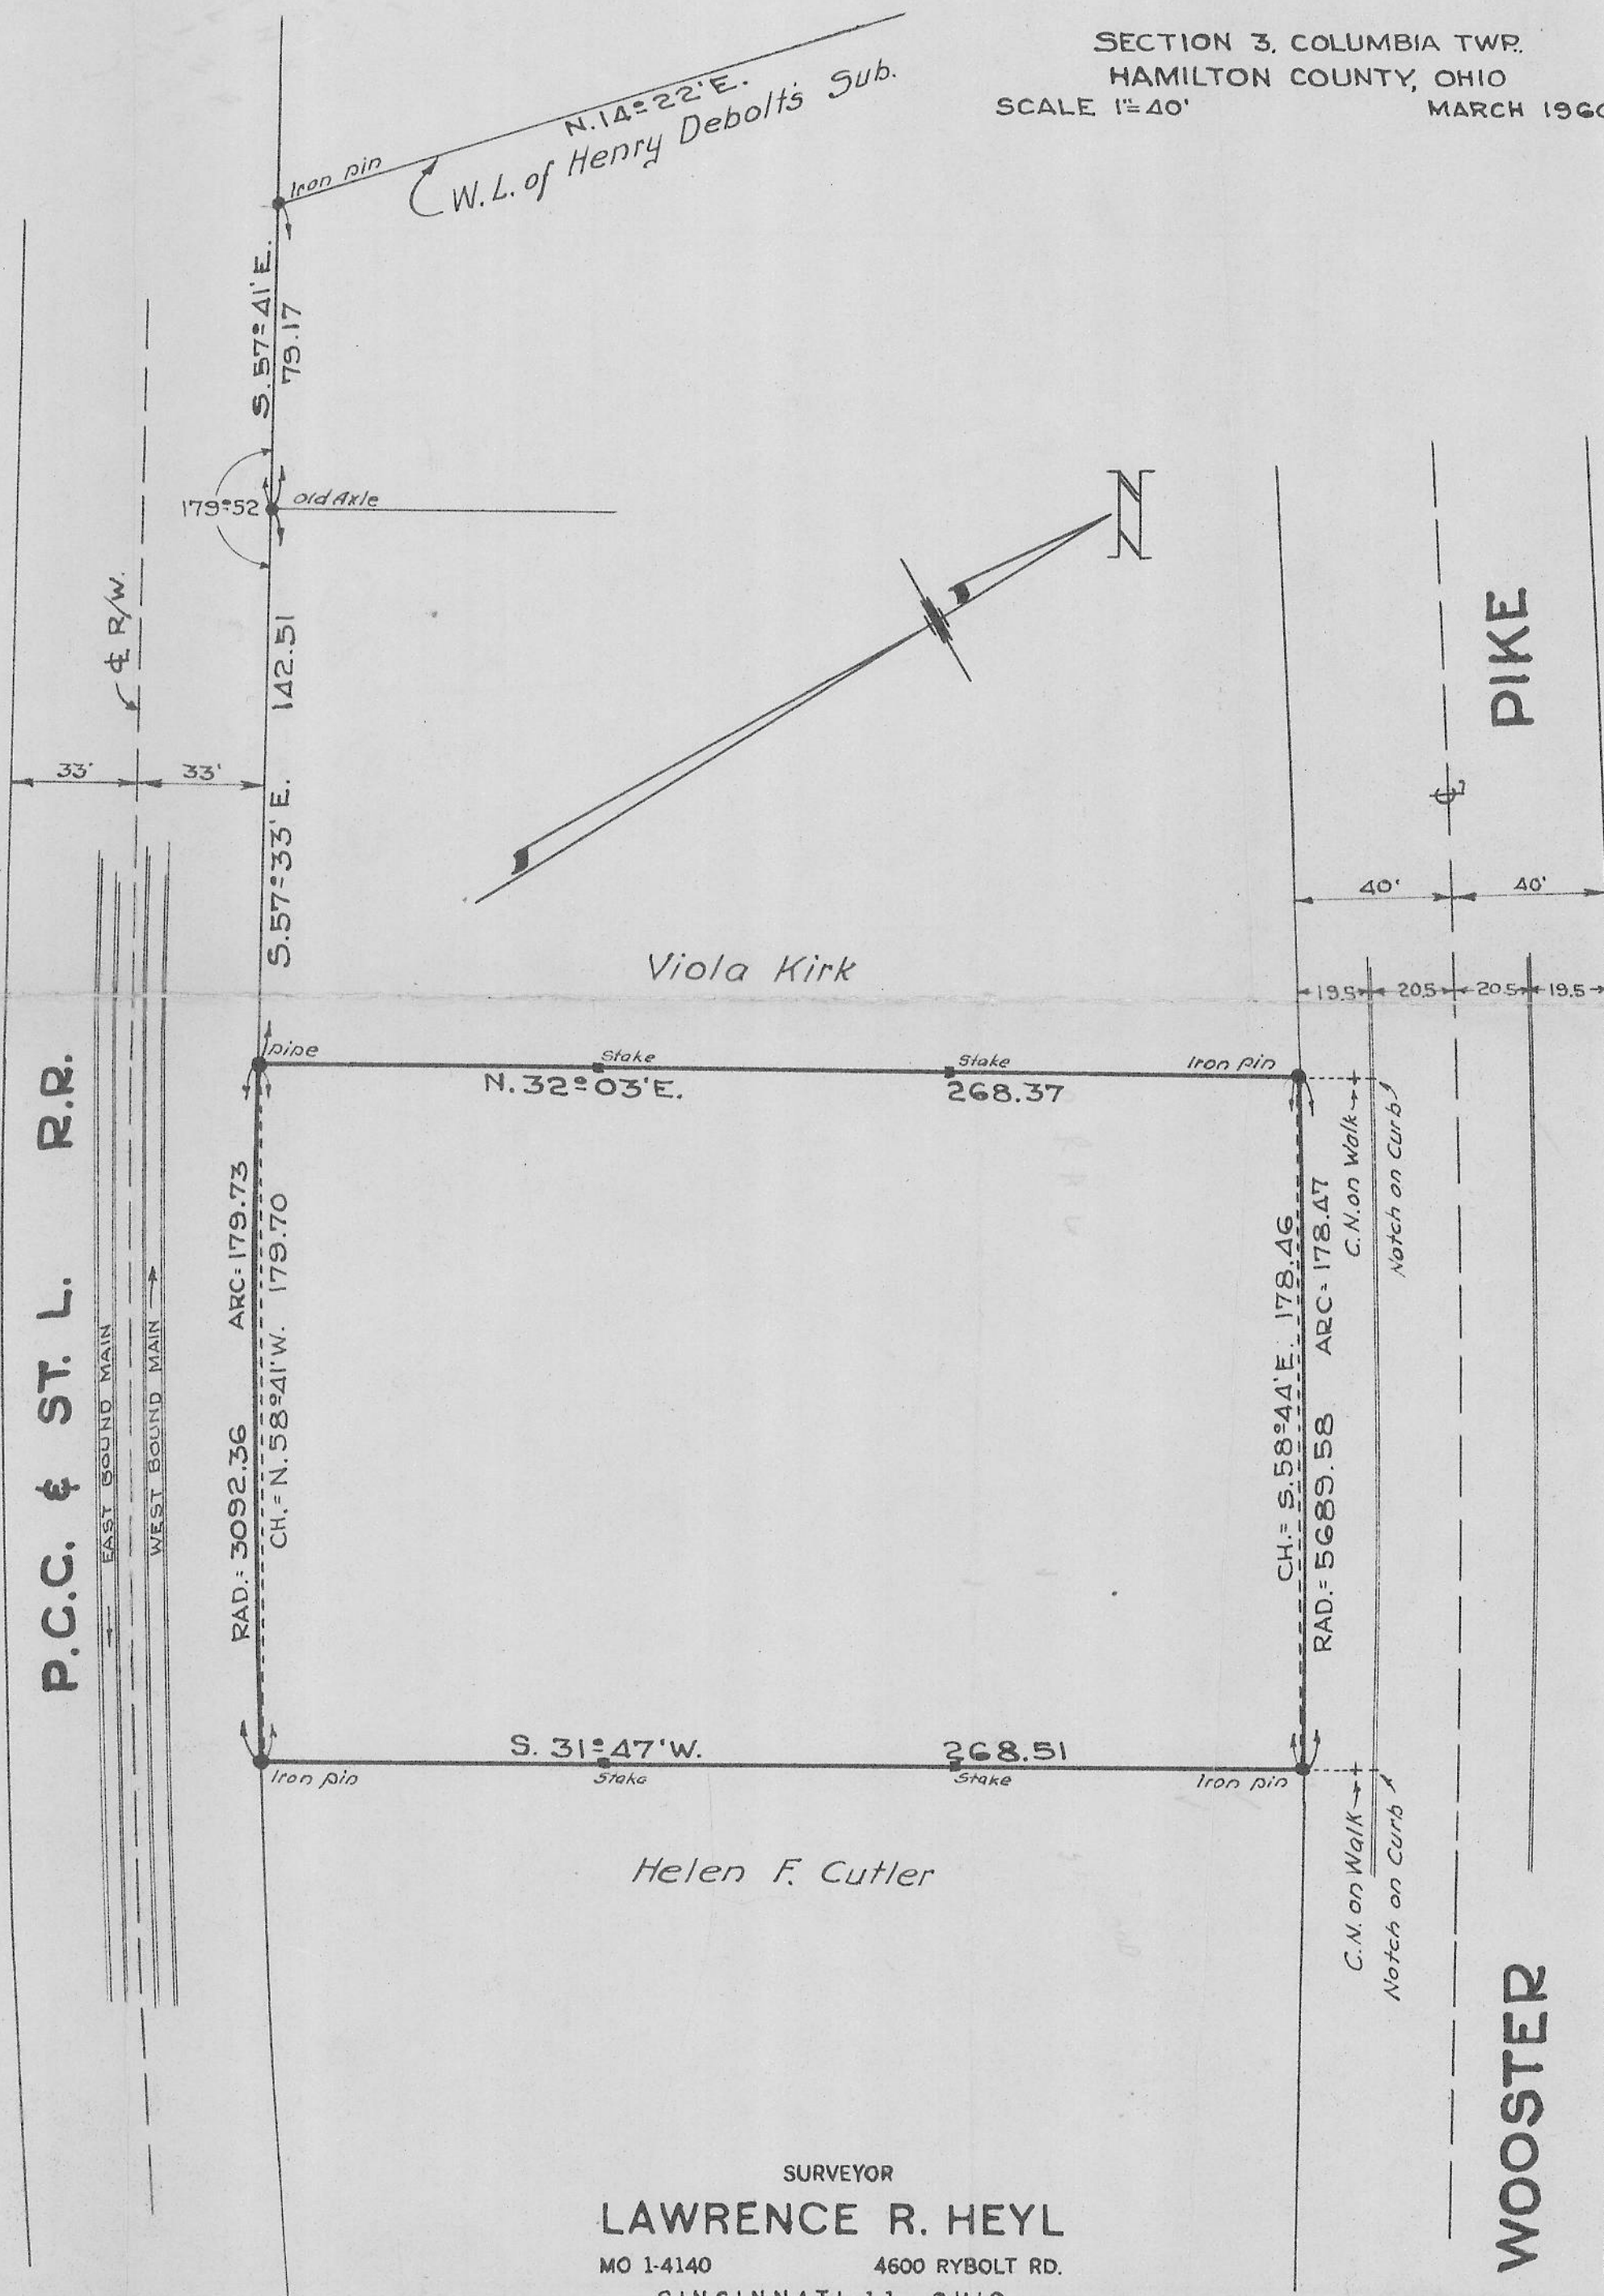

SURVEYOR  
**LAWRENCE R. HEYL**  
MO 1-4140 4600 RYBOLT RD.  
CINCINNATI 11, OHIO

88  
92  
180

79.17  
142.51  
227.68