


RECORDS
DEPT. OF REVENUE SURVEYED

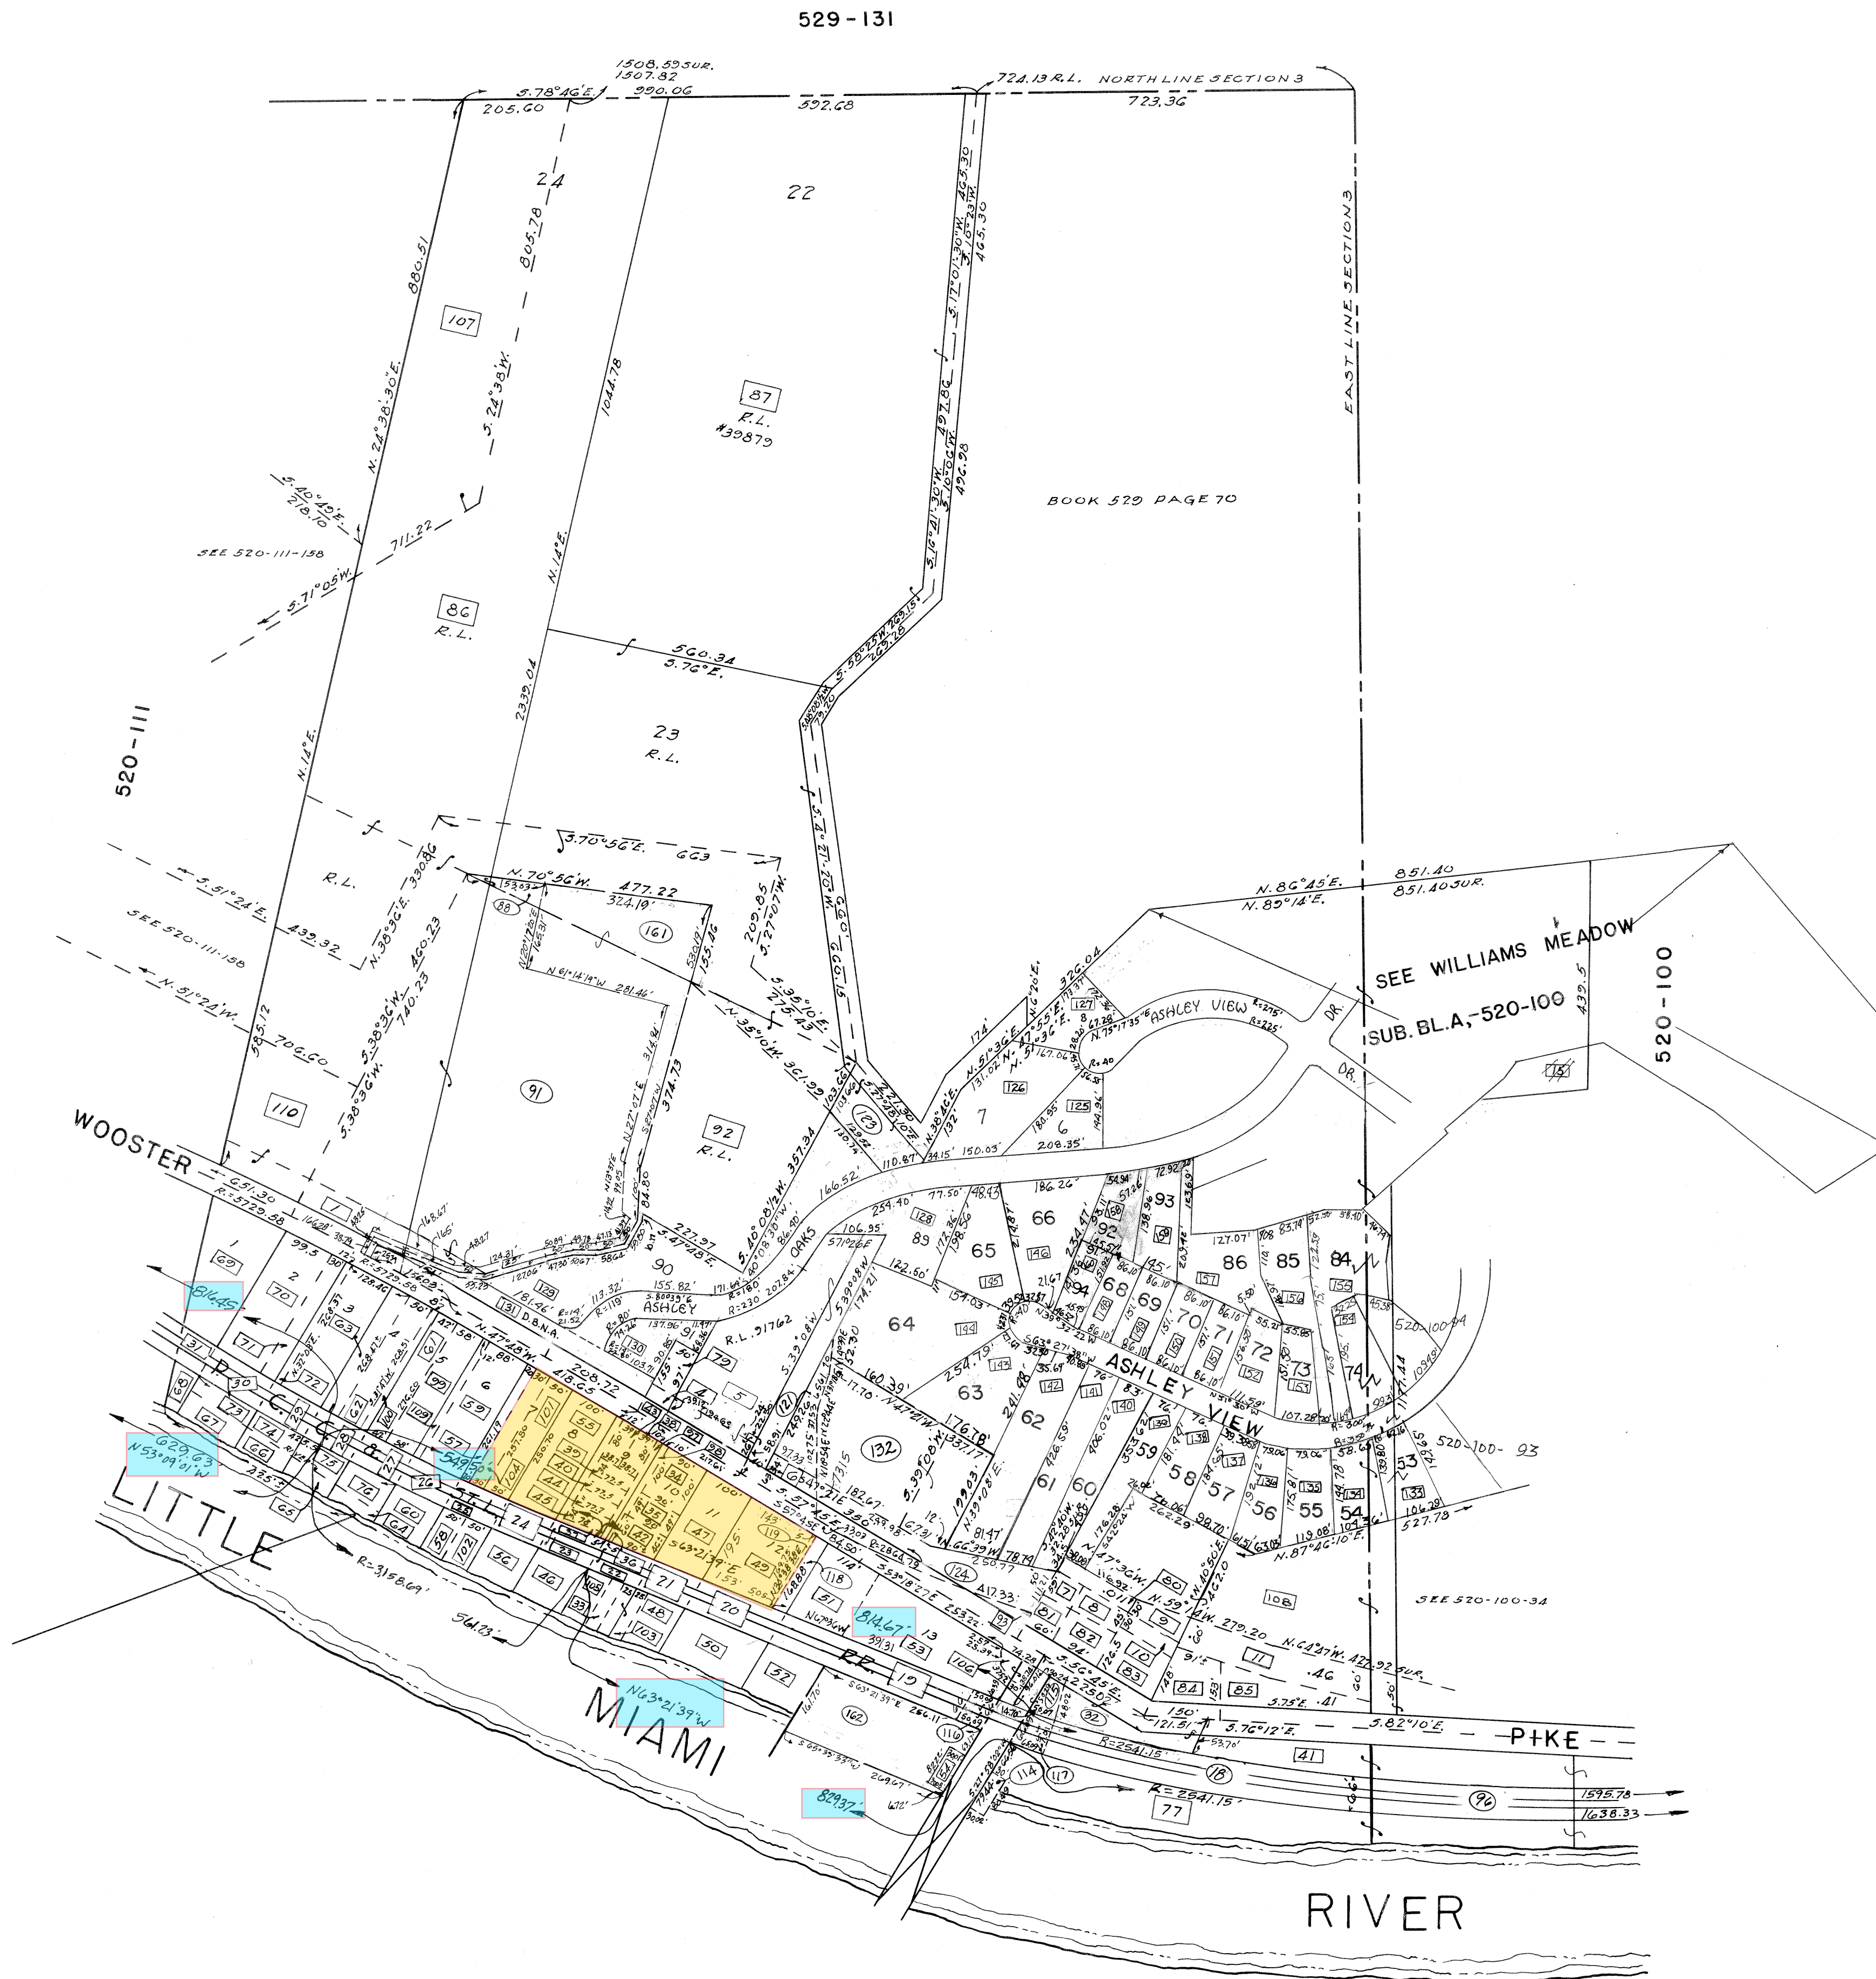

WILLIAMS MEADOW SUB. BL.C P.B.62 P.24 R.L.

- WILLIAMS MEADOW SUB. BL.A,P.B.53 P.45&46 R.L.
- HENRY DEBOLT'S SUB. P.B.1 P.311 R.O.
- WILLIAMS MEADOW SUB. BL.B P.B.270 P.16,17 R.L.