


REVISED	
DATE	ORDER
5-78	M-2476A
12-79	M-843-C
7-04	P-2386-P1
7-08	M666E

MARIEMONT VILLAGE
MARIEMONT TWP
HAMILTON CO. OHIO
CODE 20
MADISONVILLE W.C.

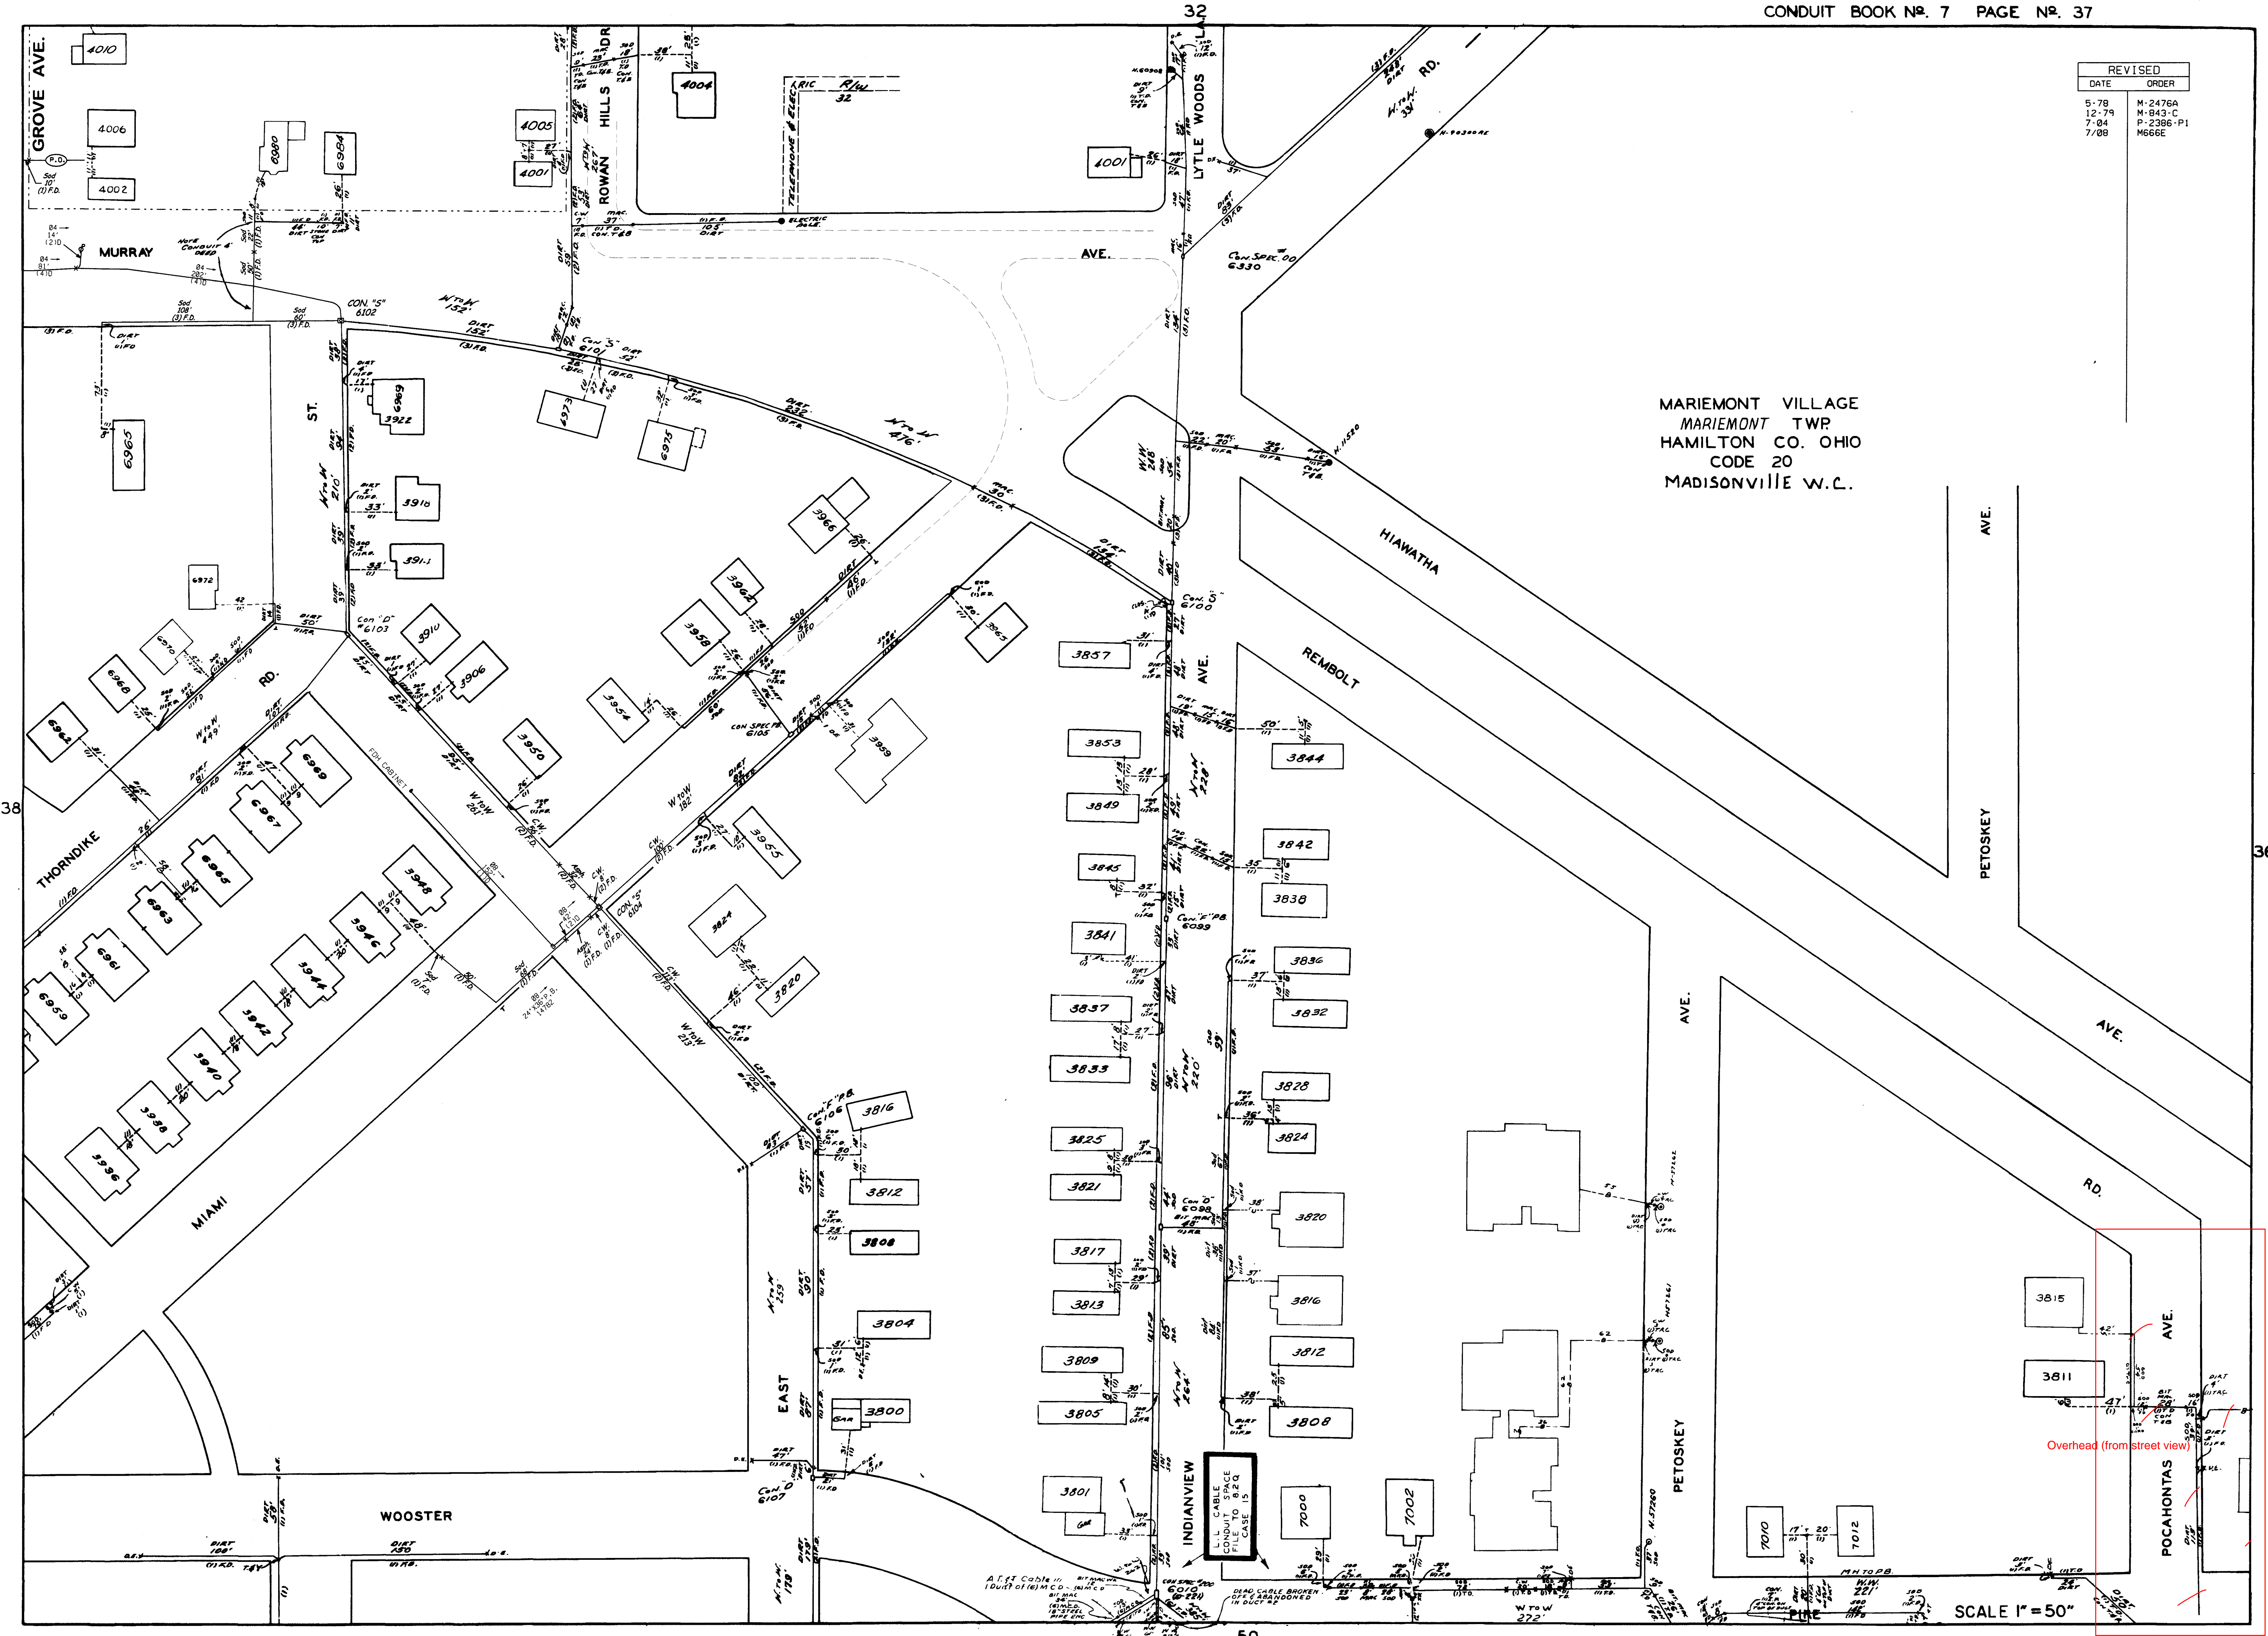

SCALE 1" = 50'