


49

51

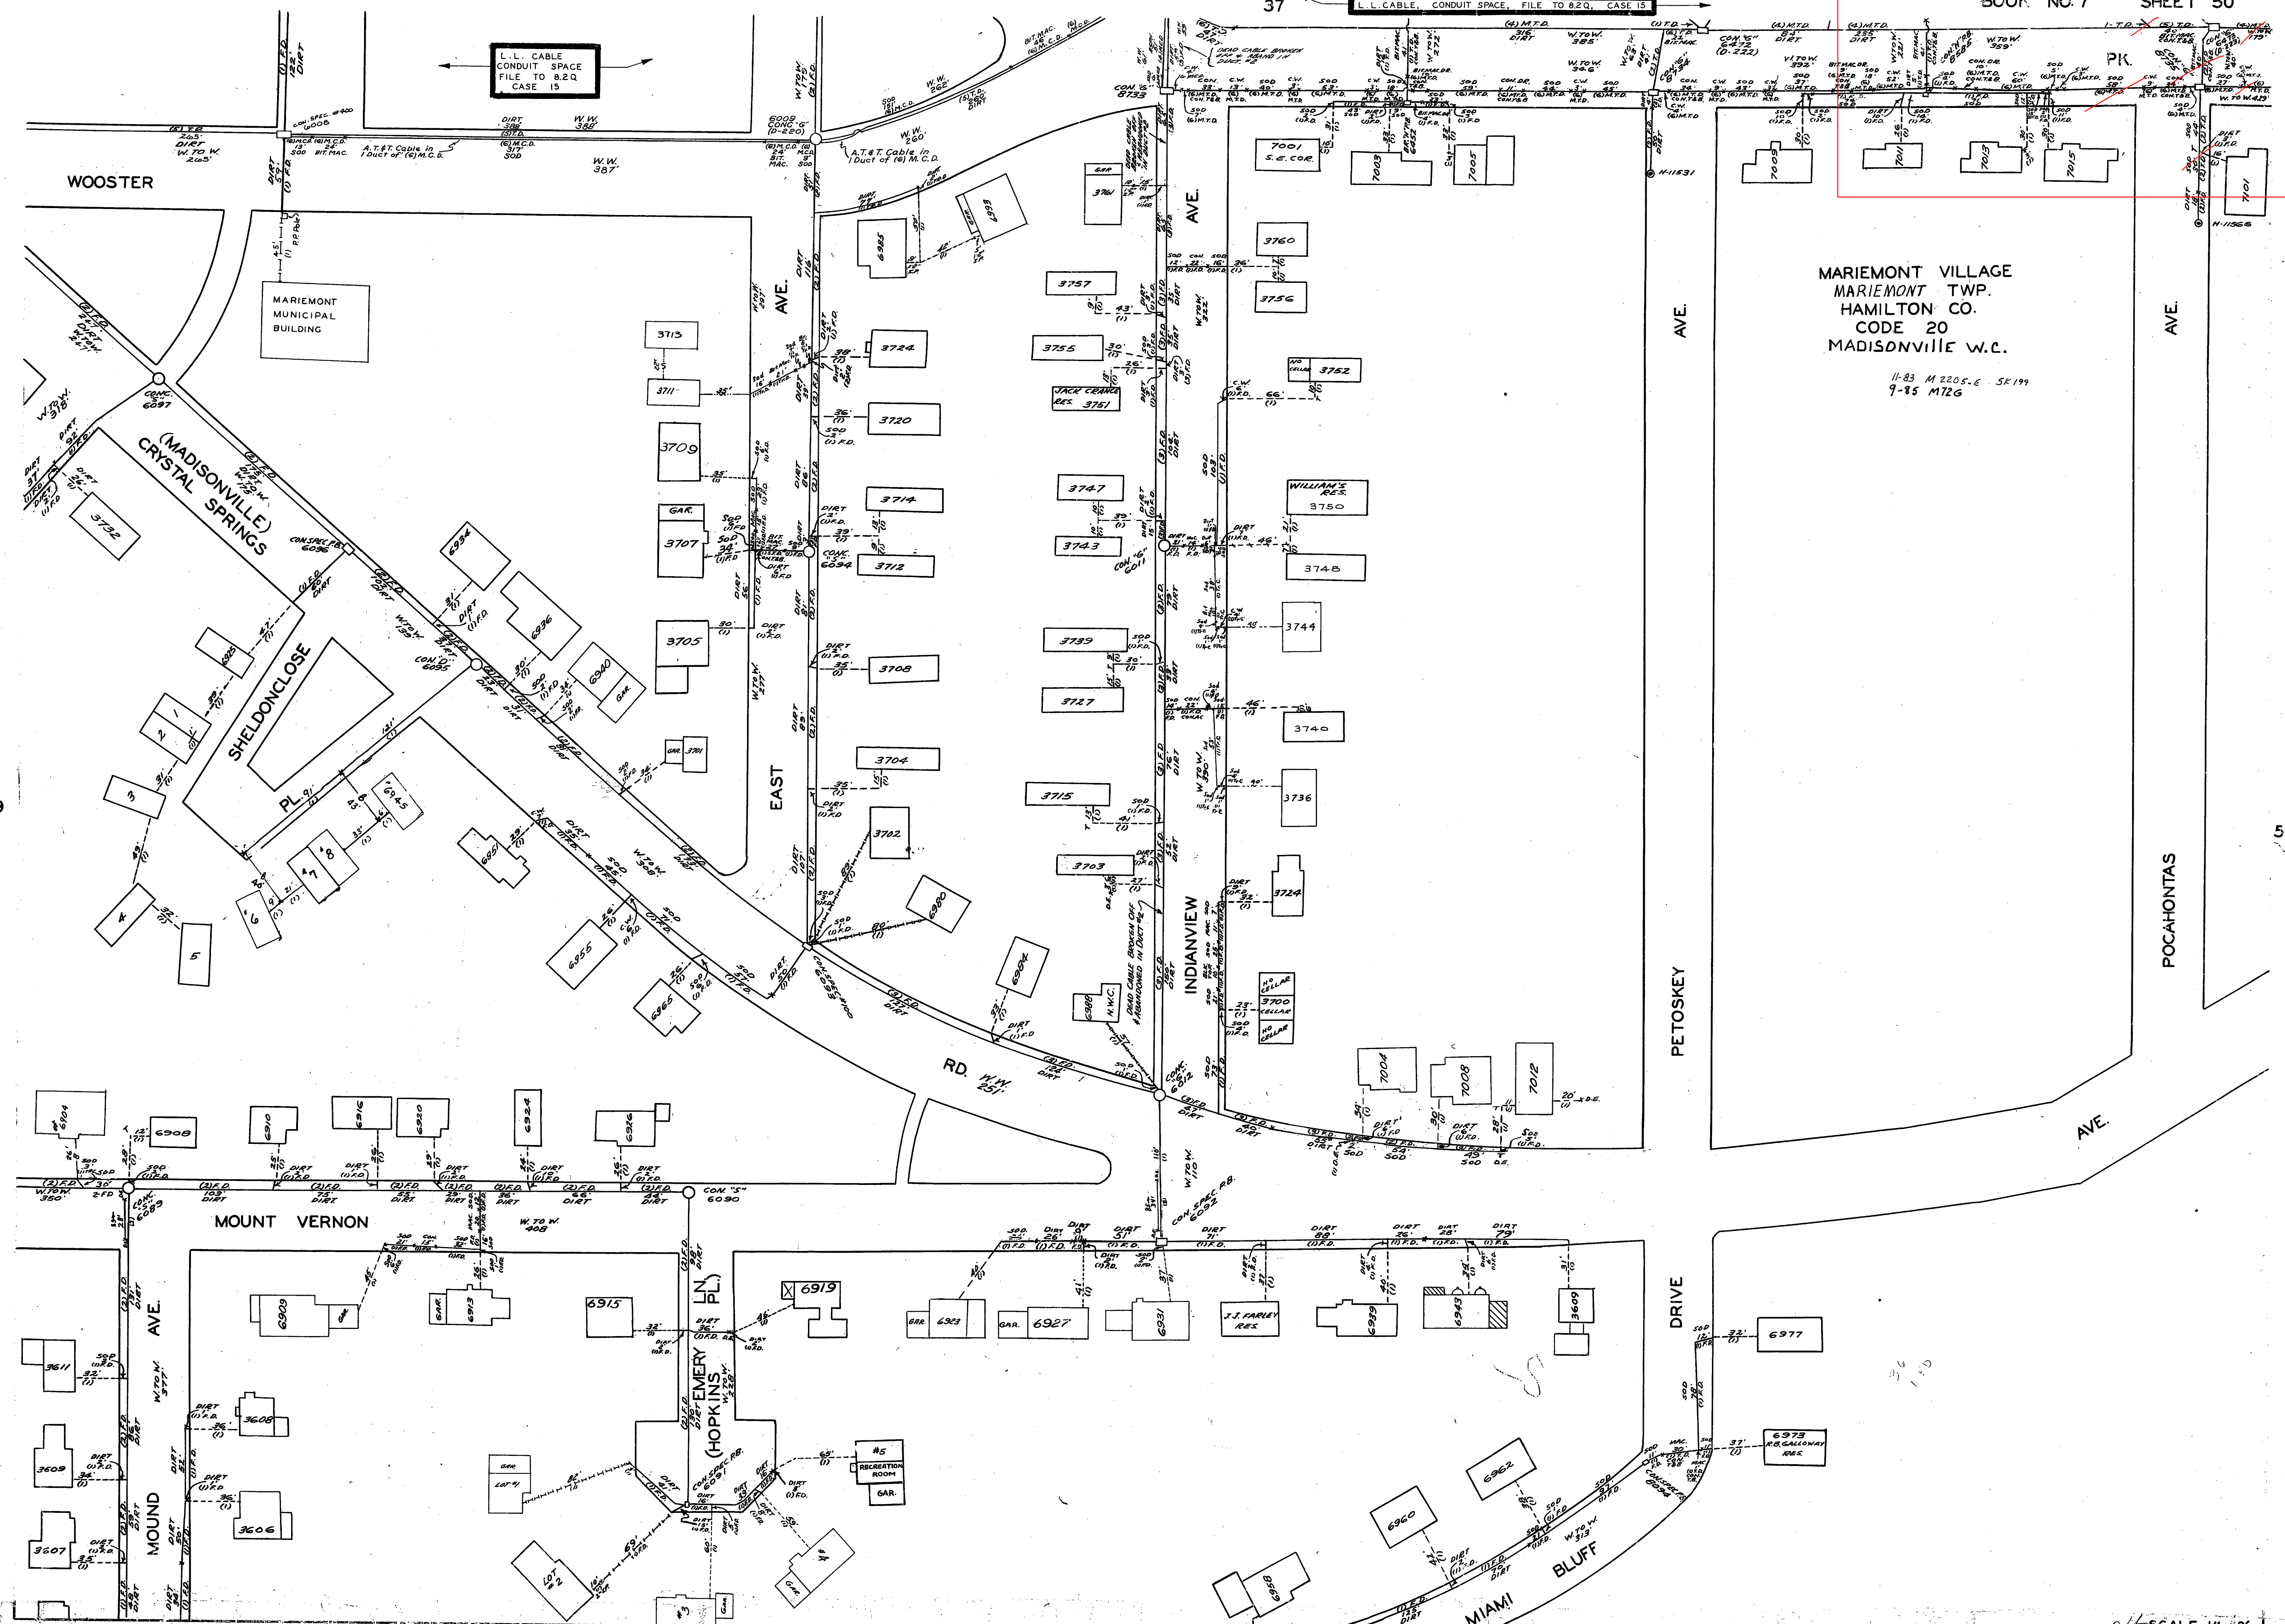

MARIEMONT VILLAGE
MARIEMONT TWP.
HAMILTON CO.
CODE 20
MADISONVILLE W.C.

11-83 M 2205-E SK 199
9-85 M72G

SCALE 1"=30'