




REVISED	
DATE	ORDER
2/86	RESTORED
10/85	M618F
2/06	P2400-P1

CODE 19
MADISONVILLE W.C.

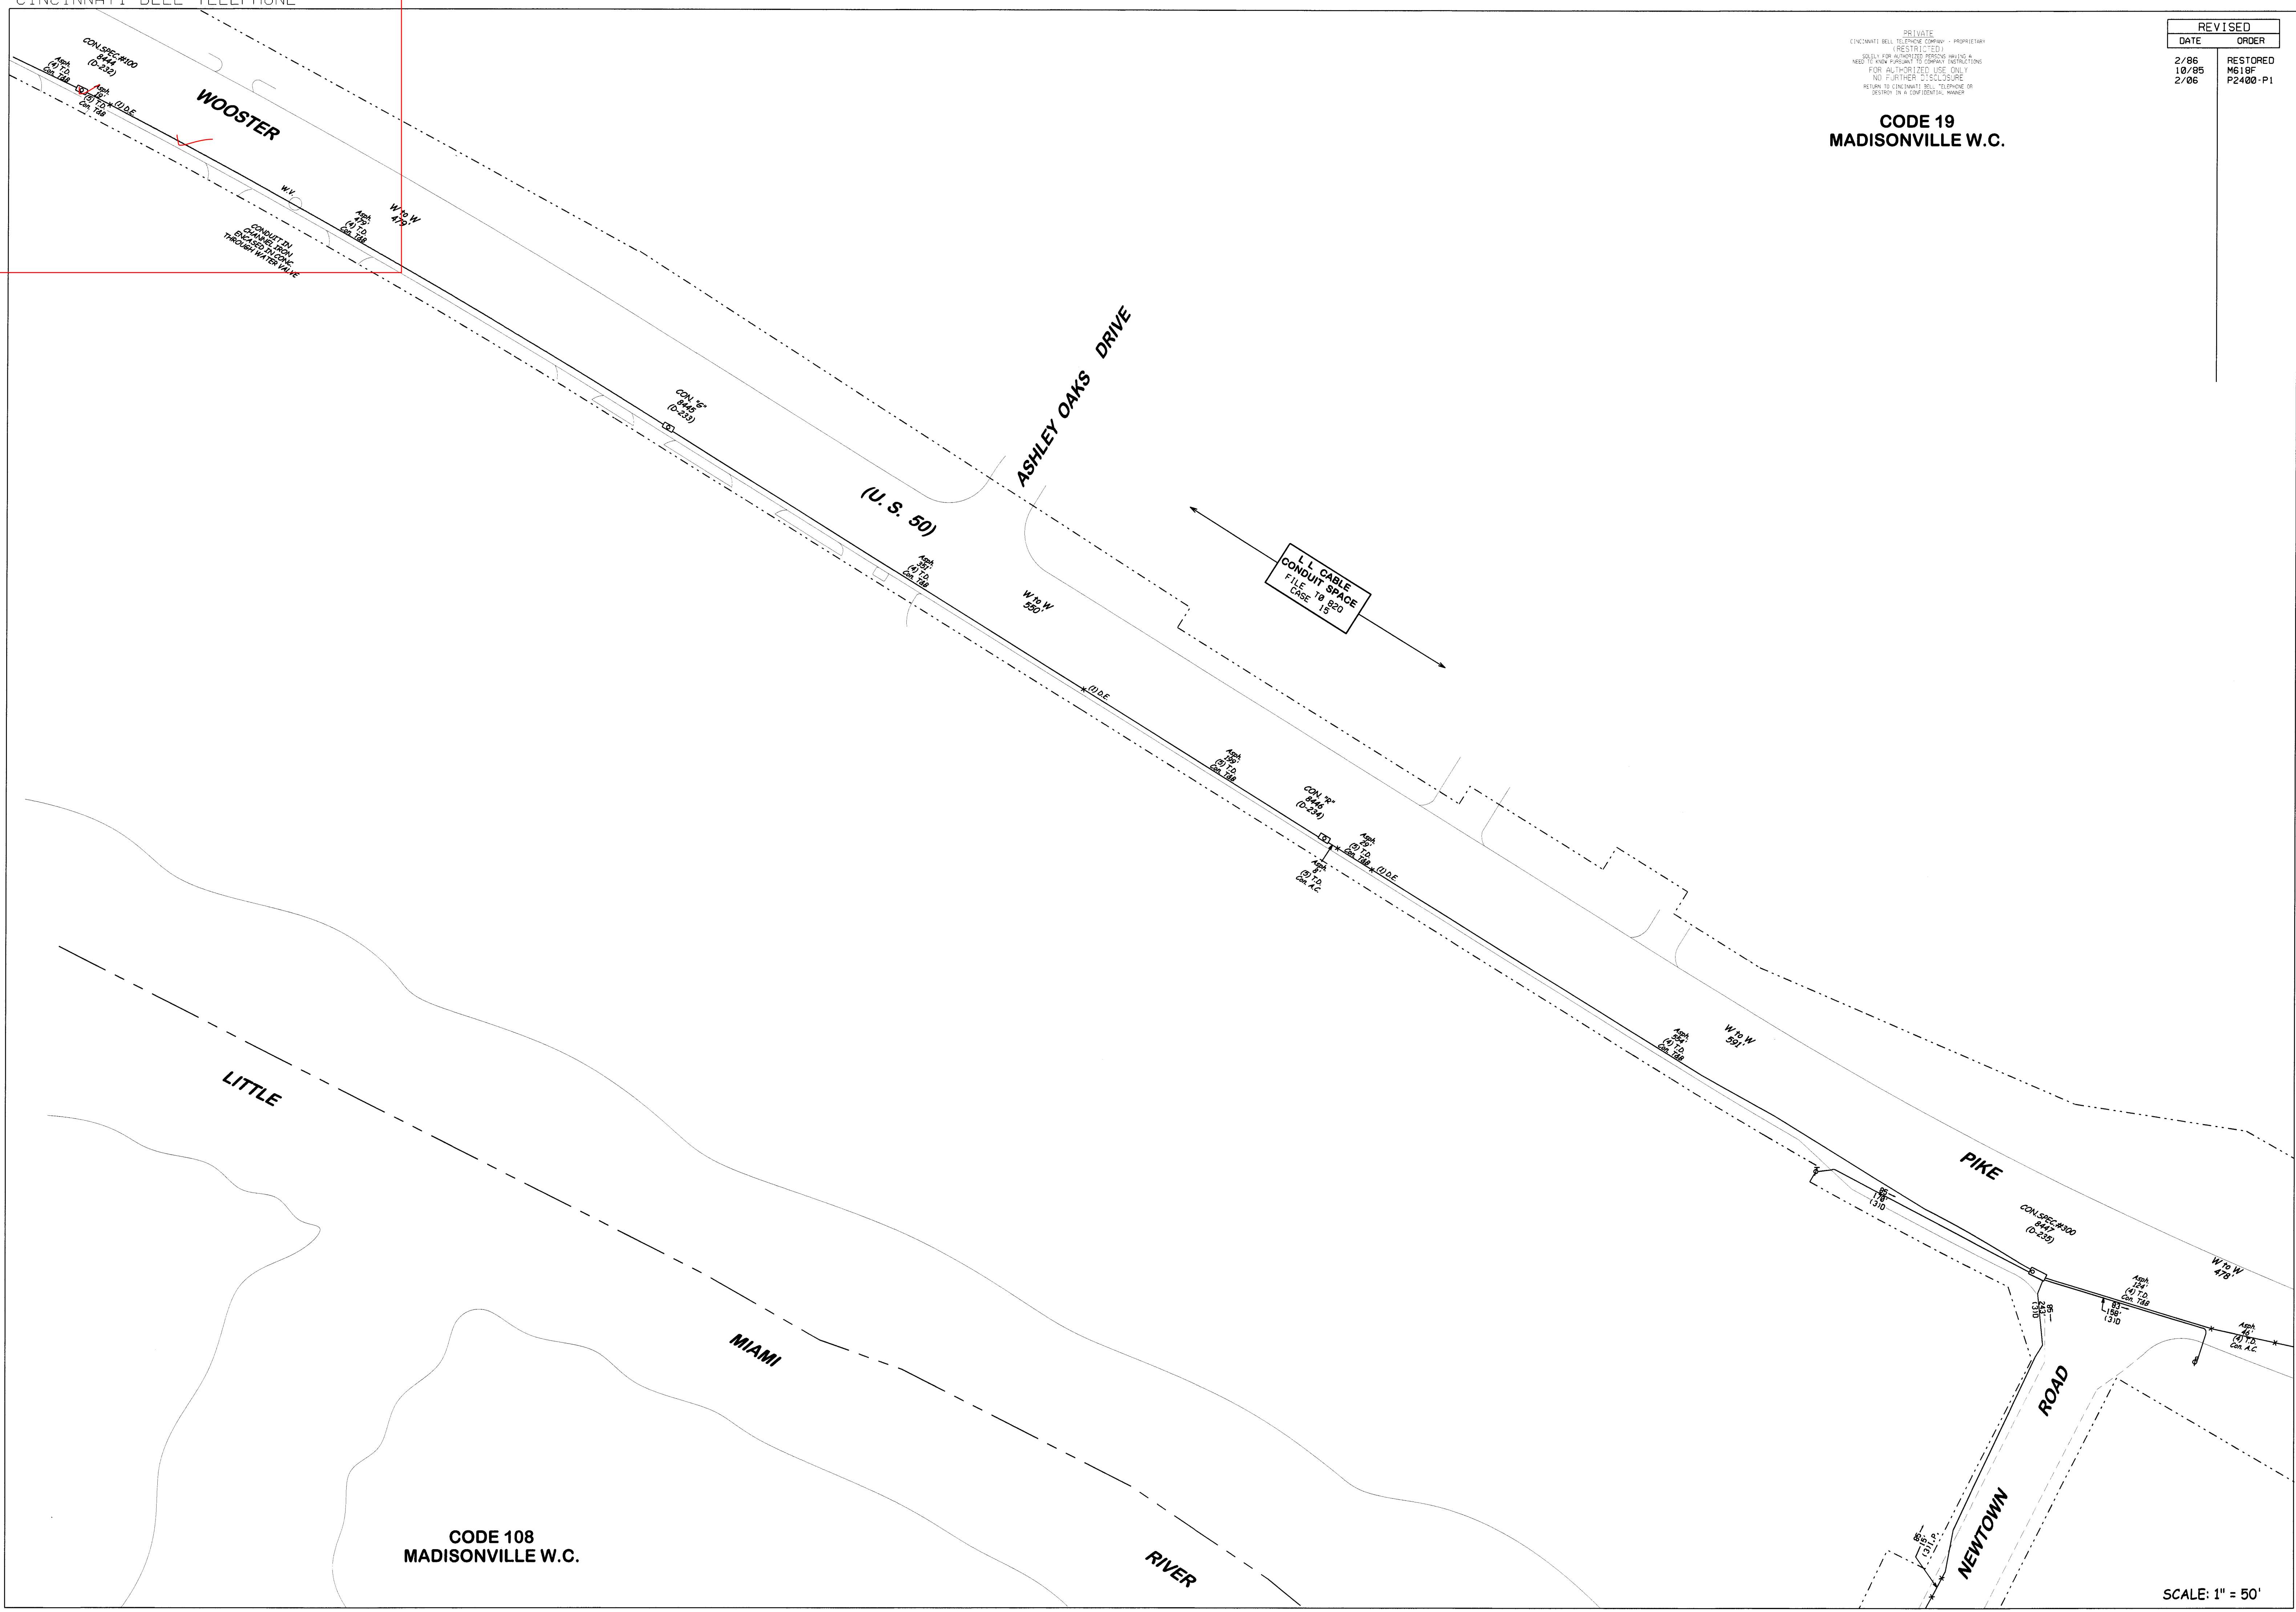

SCALE: 1" = 50'

54A