
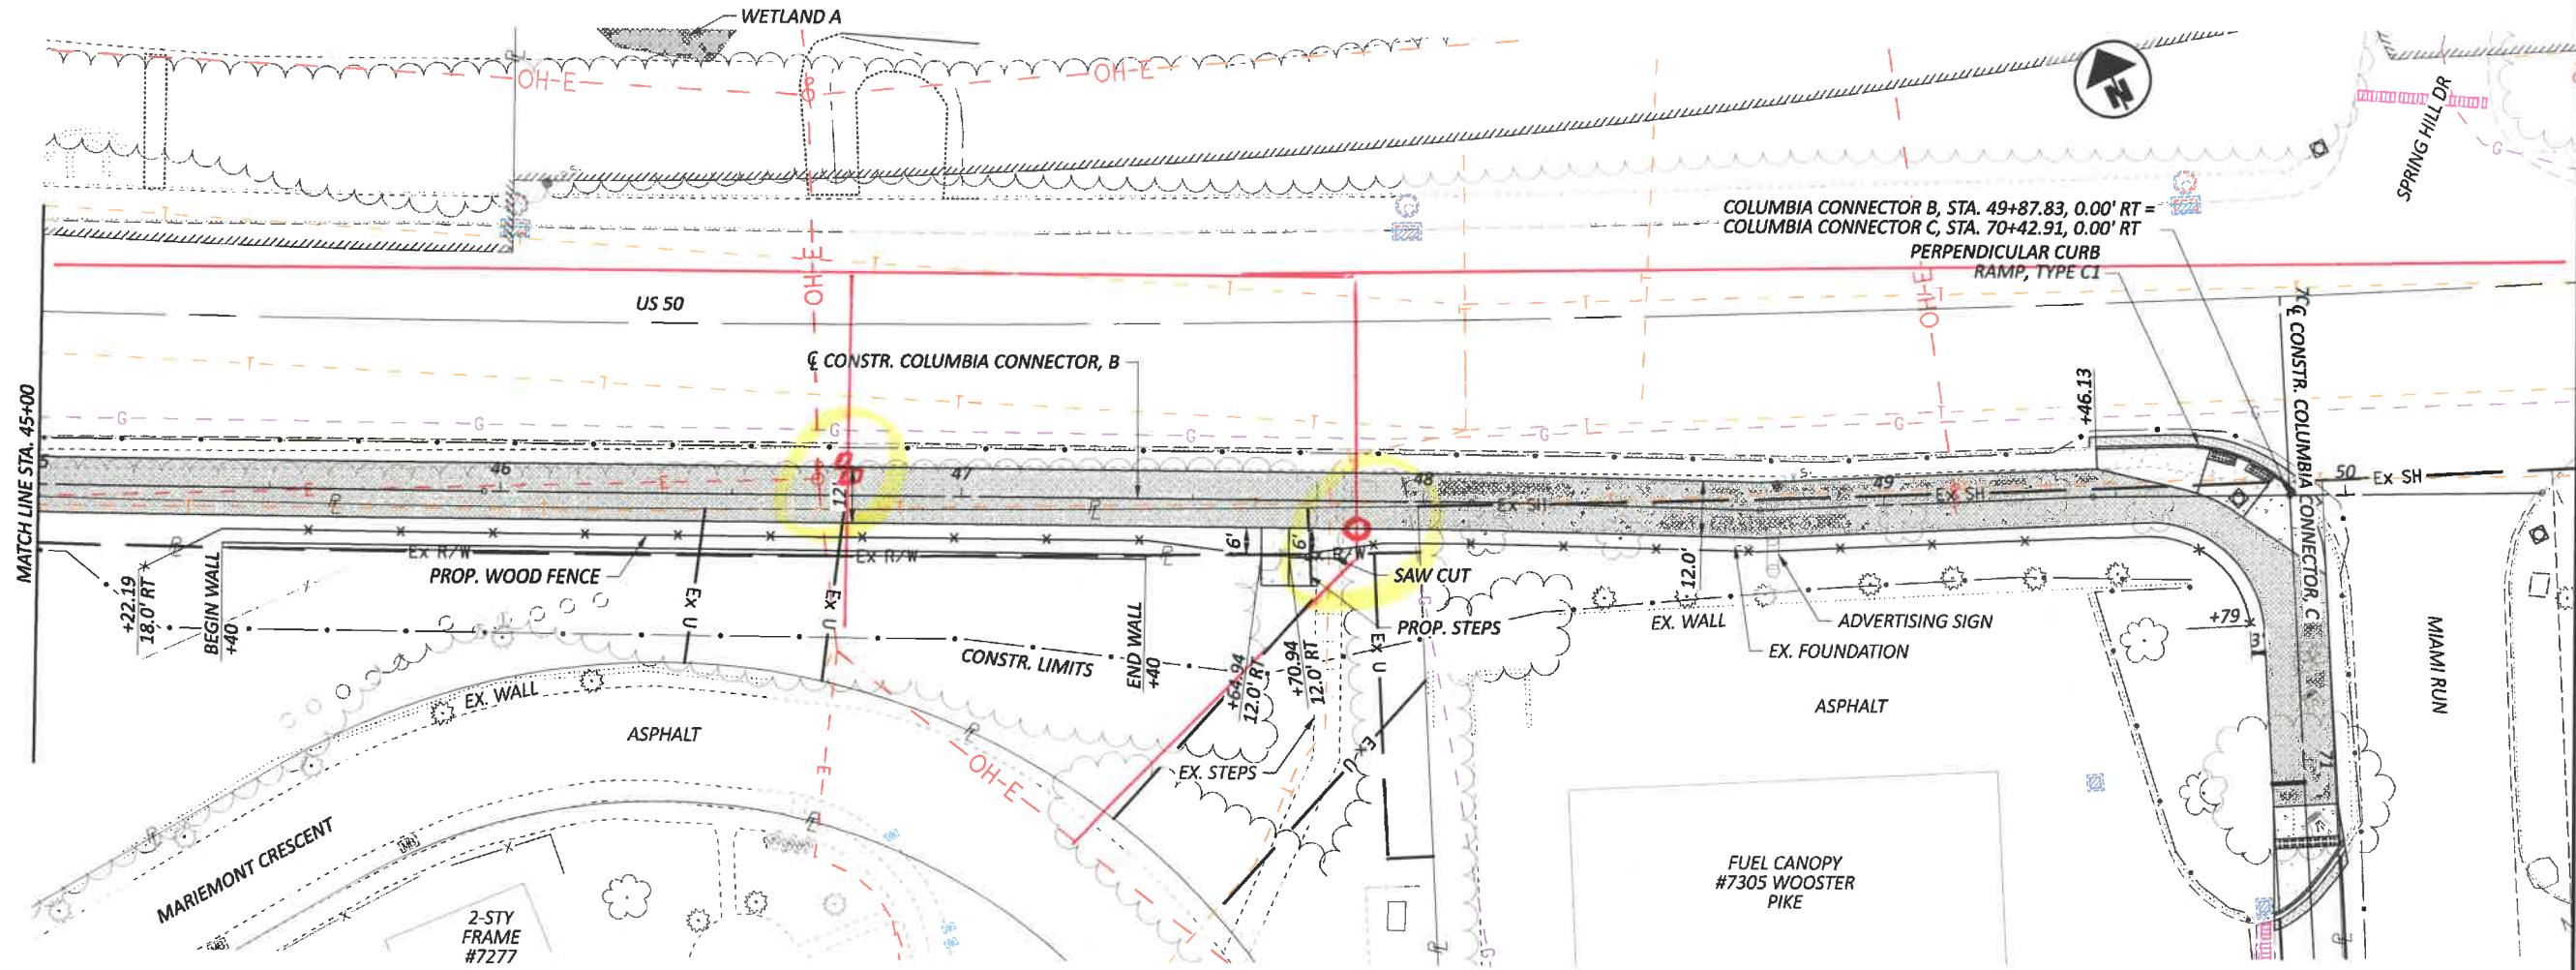


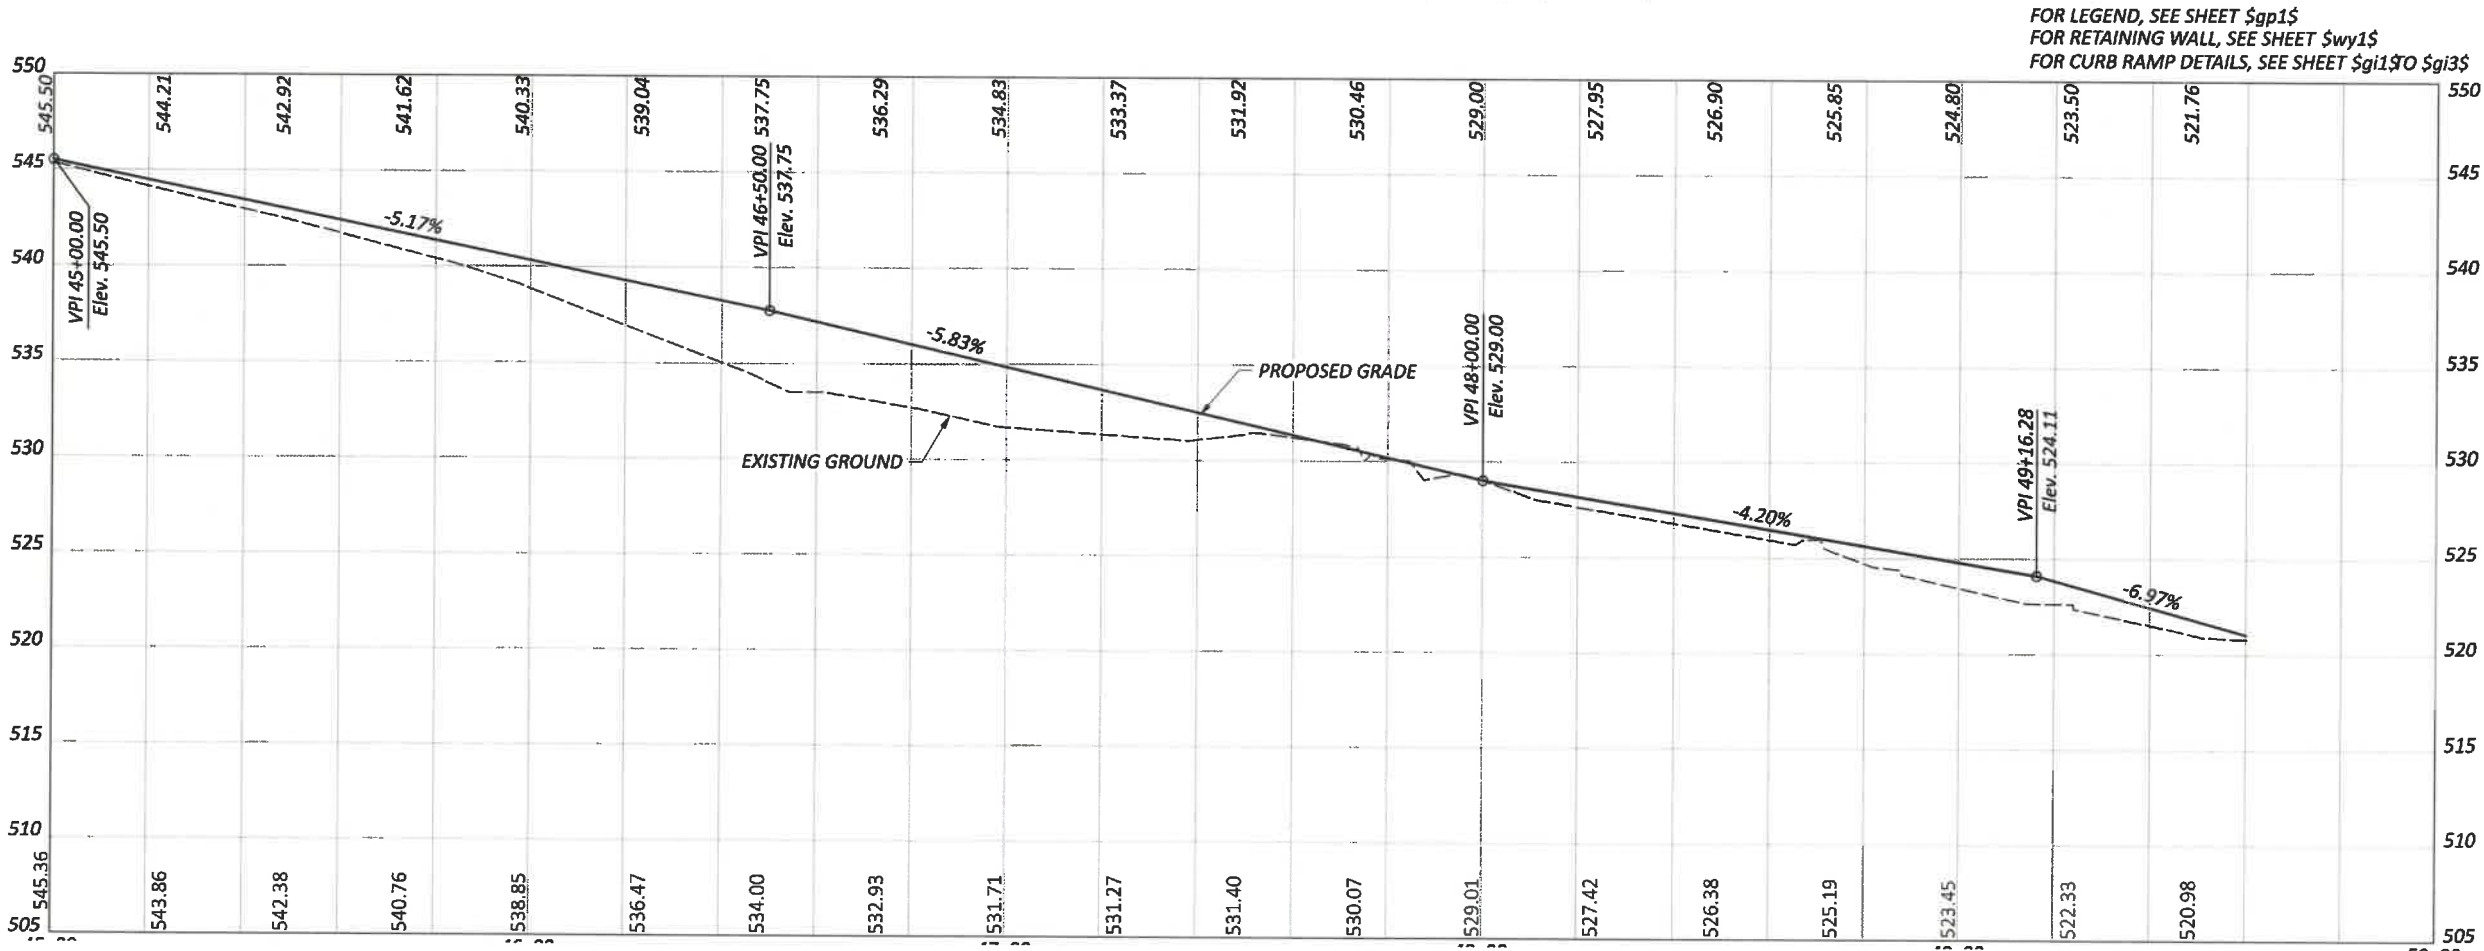

PLAN AND PROFILE
STA. 45+00.00 TO STA. 50+00.00