




**LEGEND**



- ① ITEM 442, 1/2" ASPHALT CONCRETE SURFACE COURSE, 12.5 MM, TYPE A (446)
- ② ITEM 407, NON-TRACKING TACK COAT
- ③ ITEM 254, PAVEMENT PLANING, ASPHALT CONCRETE, 1 1/2"
- ④ NOT USED
- ⑤ NOT USED
- ⑥ NOT USED
- ⑦ ITEM 203, GRANULAR MATERIAL, TYPE B
- ⑧ ITEM 304, 6" AGGREGATE BASE
- ⑨ NOT USED
- ⑩ ITEM 452, 13 1/2" NON-REINFORCED CONCRETE PAVEMENT, CLASS QC1
- ⑪ ITEM 204, PROOF ROLLING
- ⑫ ITEM 618, RUMBLE STRIPS, ASPHALT
- ⑬ ITEM 605, 6" SHALLOW PIPE UNDERDRAINS
- ⑭ NOT USED
- ⑮ ITEM 659, SEEDING AND MULCHING
- ⑯ ITEM 606, GUARDRAIL, TYPE MGS
- ⑰ ITEM 206, CEMENT STABILIZED SUBGRADE (DEPTH 16"), RIDGE AVE. (DEPTH 12")
- ⑱ ITEM 622, CONCRETE BARRIER, SINGLE SLOPE, TYPE D
- ⑲ ITEM 609, TYPE 4-C CURB
- ⑲ ITEM 609, TYPE 6 CURB
- ⑲ ITEM 204, SUBGRADE COMPACTION
- ⑲ ITEM 608, 5" CONCRETE WALK
- ⑲ ITEM 609, 4" CONCRETE TRAFFIC ISLAND

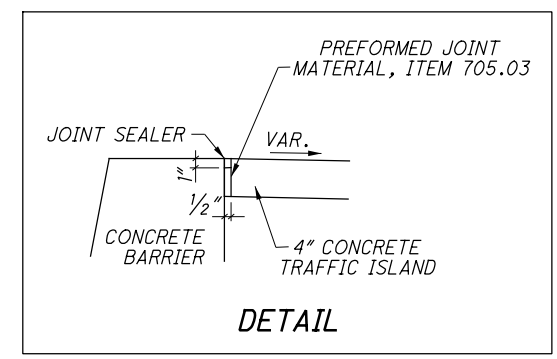


⑦ USE GRANULAR MATERIAL, TYPE B AS BACKFILL BETWEEN BARRIERS ALONG RAMP P.

NOTE: SOME PORTIONS OF THE BARRIER IN THIS AREA HAVE BEEN CONSTRUCTED. TIE TO EXISTING BARRIERS AS NEEDED IN THIS AREA.

① RAMP P LEFT SHOULDER VARIES FROM -0.031 @ STA 417+50 TO +0.039 @ STA 418+00.

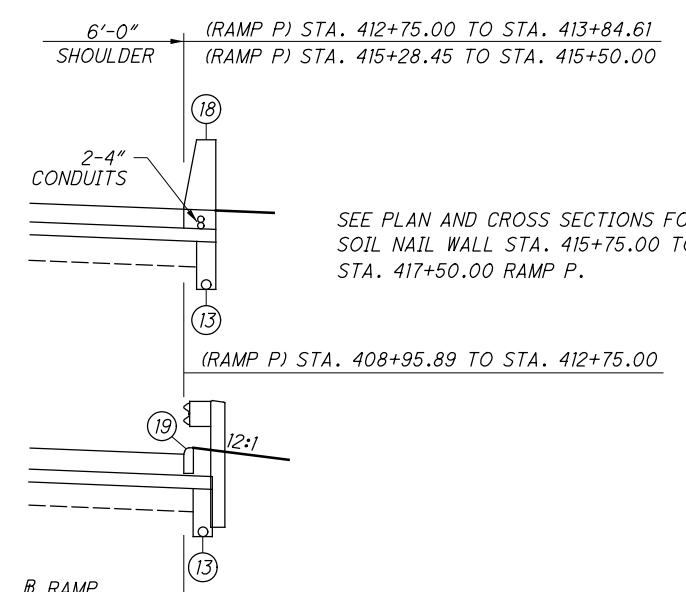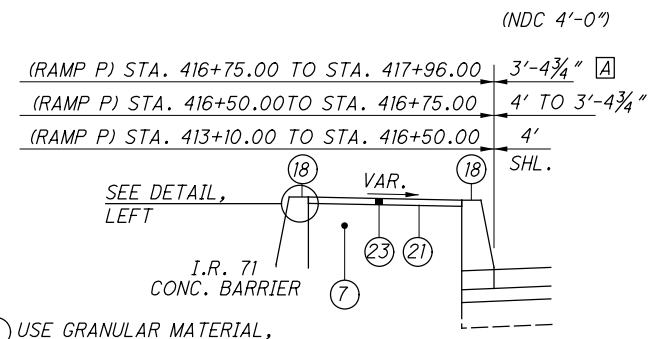


SEE PLAN AND CROSS SECTIONS FOR SOIL NAIL WALL STA. 415+75.00 TO STA. 417+50.00 RAMP P.

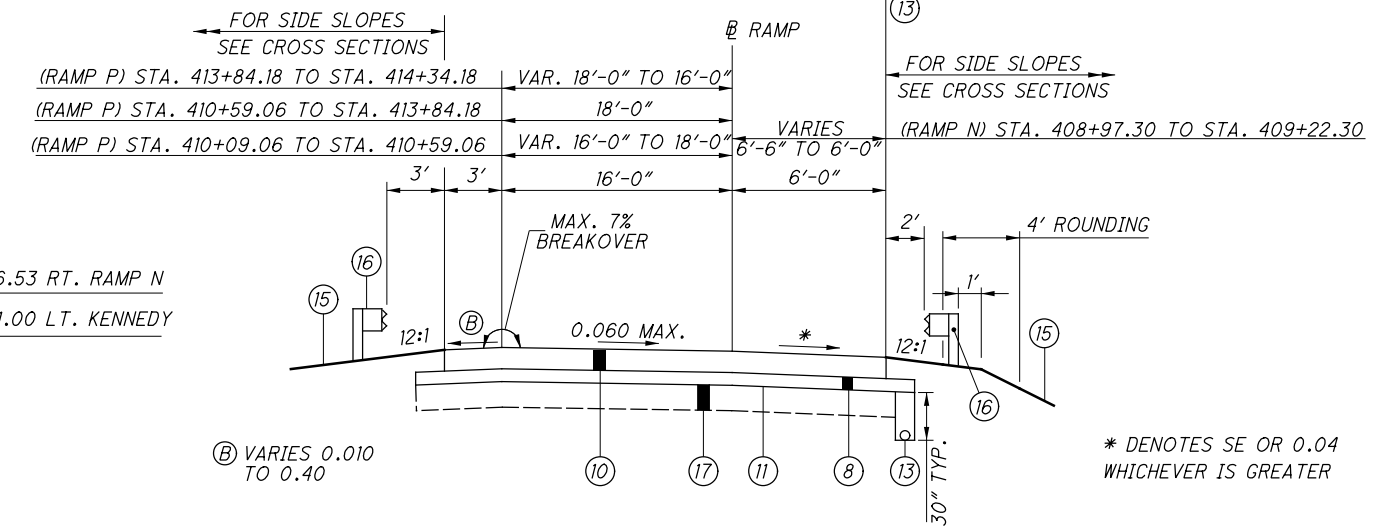


**SUPERELEVATED RAMP TYPICAL**

- (RAMP N)  
STA. 408+97.30 TO STA. 410+22.30 (TRAN.)  
STA. 410+22.30 TO STA. 410+95.18 (0.060)  
STA. 410+95.18 TO STA. 412+25.55 (TRAN.)\*\*
  - (RAMP P\*\*)  
\*\*STA. 409+60.55 TO STA. 410+74.10 (TRAN.)  
STA. 410+74.10 TO STA. 412+34.18 (0.060)  
STA. 412+34.18 TO STA. 413+84.14 (TRAN.)
  - (RAMP P)  
STA. 415+28.45 TO STA. 415+96.60 (TRAN.)  
STA. 415+96.60 TO STA. 418+00.00 (0.039)
- \*\*SEE INTERSECTION DETAIL SHEET 69 FOR STA. 412+25.55 TO STA. 414+36.74 (RAMP N) STA. 408+18.39 TO STA. 409+60.55 (RAMP P)

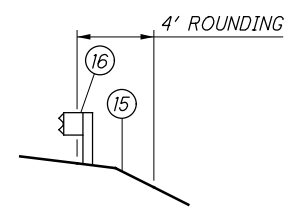


**STEP DETAIL**

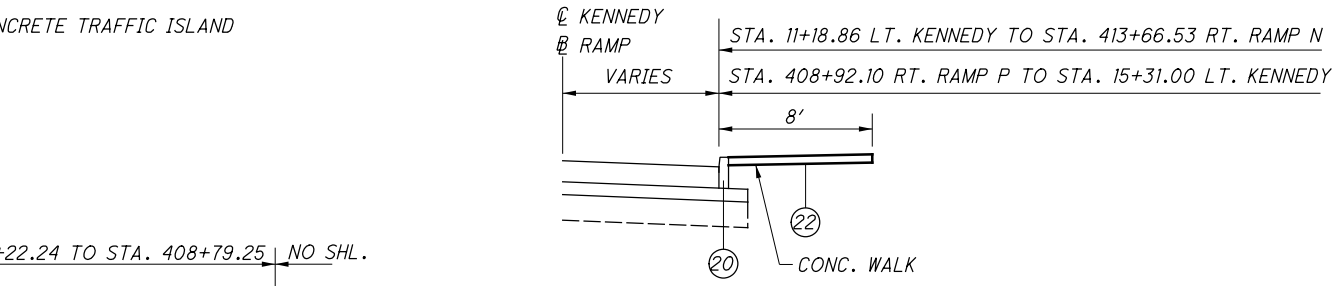


- (RAMP P) STA. 408+22.24 TO STA. 408+79.25 NO SHL.
- (RAMP P) STA. 408+41.07 TO STA. 410+36.85 3' SHL.
- (RAMP N) STA. 412+00.00 TO STA. 414+00.00 3' SHL.

**4" CONC. TRAFFIC ISLAND**

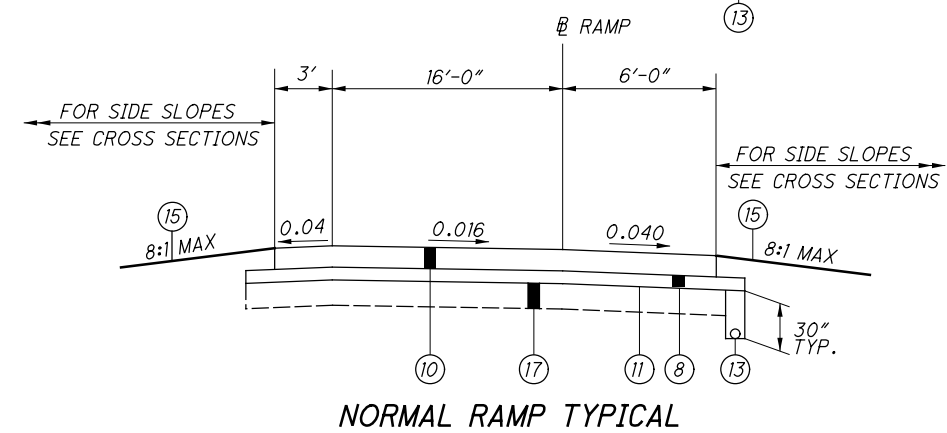

- (RAMP N) STA. 412+25.55 TO STA. 414+36.74
- (RAMP P) STA. 408+18.39 TO STA. 409+60.55
- (RAMP P) STA. 413+84.14 TO STA. 415+28.45

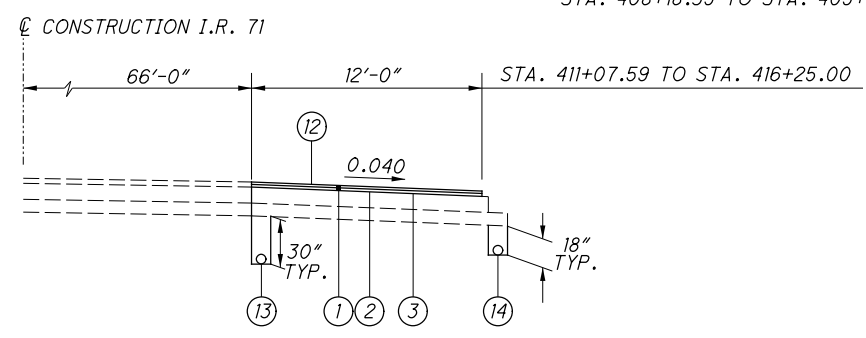

**I.R. 71 NORMAL TYPICAL**  
STA. 410+90.00 TO STA. 416+27.62

V:\1736\active\173620049\engineering\114992\Design\Roadway\Sheets\114992\_GY001.dgn 8/18/2023 8:57:36 AM eadkins

**ROUNDING**

THE ROUNDING AT SLOPE BREAKPOINTS SHOWN ON THE TYPICAL SECTIONS APPLIES TO ALL CROSS-SECTIONS EVEN THOUGH OTHERWISE SHOWN.

**UTILITIES**

LISTED BELOW ARE ALL UTILITIES LOCATED WITHIN THE PROJECT CONSTRUCTION LIMITS TOGETHER WITH THEIR RESPECTIVE OWNERS:

**ELECTRIC:**  
DUKE ENERGY  
139 EAST FOURTH STREET, ROOM 467A  
CINCINNATI, OHIO 45202  
(513) 287-3674 (AARON WRIGHT)

**ELECTRIC TRANSMISSION:**  
DUKE ENERGY  
139 EAST FOURTH STREET, ROOM 552A  
CINCINNATI, OHIO 45202  
(513) 287-1266 (TIM MEYER)

**GAS:**  
DUKE ENERGY  
139 EAST FOURTH STREET, ROOM 460A  
CINCINNATI, OHIO 45202  
(513) 287-1205 (KELSEY PACE)

**TELEPHONE:**  
CINCINNATI BELL  
221 EAST FOURTH STREET, BLDG. 121-900  
CINCINNATI, OHIO 45202  
(513) 565-7043 (MARK CONNER)

**CINCINNATI BELL AERIAL & PLACING**  
209 WEST SEVENTH STREET, BLDG. 121-900  
CINCINNATI, OHIO 45202  
(513) 566-5120 (DORIAN JOHNSON)

**WATER:**  
GREATER CINCINNATI WATER WORKS  
4747 SPRING GROVE AVENUE  
CINCINNATI, OHIO 45232  
(513) 591-7362 (JON HUNSEDER)  
EMERGENCIES (513) 591-7900

**SANITARY:**  
METROPOLITAN SEWER DISTRICT (MSD)  
1600 GEST STREET  
CINCINNATI, OHIO 45204  
(513) 557-7108 (ROB FRANKLIN)  
EMERGENCIES (513) 352-4900 OR (513) 244-5500

**CABLE:**  
CHARTER COMMUNICATIONS (FKA) TIME WARNER CABLE  
11252 CORNELL PARK DRIVE  
CINCINNATI, OHIO 45242  
(513) 469-5483 (KENT RIEGER)

**STORMWATER MANAGEMENT:**  
CINCINNATI STORMWATER MANAGEMENT UTILITY  
225 W. GALBRAITH ROAD  
CINCINNATI, OHIO 45215  
(513) 352-4287 (JEFF OXENHAM)

**TRAFFIC:**  
CITY OF CINCINNATI TRAFFIC  
801 PLUM STREET, ROOM 320  
CINCINNATI, OHIO 45202  
(513) 352-6229 (JEFF WILHOIT)

**UTILITIES (CONTINUED)**

TRAFFIC MAINTENANCE:  
ODOT DISTRICT 8  
505 SOUTH STATE ROUTE 741  
LEBANON, OH 45036  
PHONE: (513) 933-6689

**ITS:**  
ODOT OFFICE OF TRAFFIC OPERATIONS  
1606 W. BROAD STREET  
COLUMBUS, OH 43223  
PHONE: (614) 752-8846

**ITS:**  
CENTRAL OFFICE ITS LAB  
614-387-4113 - PHONE  
614-887-4134 - FAX  
CEN.ITS.LAB@DOT.OHIO.GOV - EMAIL

THE OHIO DEPARTMENT OF TRANSPORTATION HAS UTILITY FACILITIES (HIGHWAY LIGHTING, TRAFFIC SIGNALS, AND ITS) WITHIN THE LIMITS OF THIS PROJECT.

IN ADDITION TO THE INFORMATION OUTLINED IN THE UTILITY NOTE OF THIS CONTRACT, THE CONTRACTOR SHALL TAKE THE FOLLOWING ACTION TO PROTECT ODOT'S FACILITIES DURING CONSTRUCTION:

HIGHWAY LIGHTING AND TRAFFIC SIGNALS:

EVEN THOUGH ODOT IS LISTED AS A MEMBER OF THE OHIO UTILITIES PROTECTION SERVICE (OUPS), THE CONTRACTOR ON THIS PROJECT IS REQUIRED TO CONTACT ODOT, DISTRICT 8 TRAFFIC MAINTENANCE DEPARTMENT DIRECTLY SO THAT THE ODOT UTILITIES LOCATED WITHIN THIS PROJECT ARE MARKED. THE CONTRACTOR SHALL NOTIFY DISTRICT 8 TRAFFIC MAINTENANCE AT 513-933-6689 AND THE PROJECT ENGINEER, FOURTEEN (14) CALENDAR DAYS IN ADVANCE OF ANY WORK, FOR THE NEED TO MARK ODOT OWNED UTILITIES.

THE ABOVE REQUIREMENTS ARE IN ADDITION TO SECTION 105.07 & 107.16 OF THE CONSTRUCTION AND MATERIAL SPECIFICATIONS AND THE UTILITY PROPOSAL NOTE.

THE CONTRACTOR SHALL NOTIFY OTHER UTILITIES THROUGH OUPS OR DIRECTLY A MINIMUM OF FORTY-EIGHT (48) HOURS IN ADVANCE OF ANY WORK.

THE COST FOR THE ABOVE DESCRIBED WORK IS INCIDENTAL TO THE OVERALL BID PRICE OF THE PROJECT.

THE LOCATION OF THE UNDERGROUND UTILITIES SHOWN ON THE PLANS ARE AS OBTAINED FROM THE OWNERS AS REQUIRED BY SECTION 153.64 O.R.C.

**ITEM 206 - CURING COAT, AS PER PLAN**

CURE THE CHEMICALLY STABILIZED SUBGRADE WITH RAPID SETTING EMULSIFIED ASPHALT, CONFORMING TO 702.04. NO SUBSTITUTE FOR THE EMULSIFIED ASPHALT CURE SHALL BE PERMITTED. ALL OTHER ITEMS OF ITEM 206, CHEMICALLY STABILIZED SUBGRADE SHALL APPLY.

**IN STREAM WORK**

IN STREAM WORK IS NOT PERMITTED BETWEEN APRIL 15 THROUGH JUNE 30, IN ORDER TO PROTECT AQUATIC HABITAT:

ALSO NO WASTEWATER OF ANY KIND SHALL BE DISCHARGED INTO YONONTE CREEK. NO STORAGE OF ANY IDLE EQUIPMENT, FUELS, LUBRICANTS, OR OTHER POTENTIALLY TOXIC OR HAZARDOUS MATERIALS SHALL BE PERMITTED WITHIN THE 100-YEAR FLOODPLAIN OF YONONTE CREEK.

**CONSTRUCTION NOISE**

THE CONTRACTOR SHALL COMPLY WITH ALL LOCAL NOISE ORDINANCES FOR ALL WORK OUTSIDE OF THE LIMITED ACCESS RIGHT-OF-WAY.

**SURVEYING PARAMETERS**

PRIMARY PROJECT CONTROL MONUMENTS GOVERN ALL POSITIONING ON ODOT PROJECTS. SEE SHEET 26 OF THE PLANS FOR A TABLE CONTAINING PROJECT CONTROL INFORMATION.

USE THE FOLLOWING PROJECT CONTROL, VERTICAL POSITIONING, AND HORIZONTAL POSITIONING PARAMETERS FOR ALL SURVEYING:

PROJECT CONTROL

POSITIONING METHOD: GPS OPUS  
MONUMENT TYPE: 30" x 3/4" IRON PIN W/ CAP

VERTICAL POSITIONING

ORTHOMETRIC HEIGHT DATUM: NAVD 88  
GEOID: 12A

HORIZONTAL POSITIONING

REFERENCE FRAME: NAD-83 (2011) (EPOCH 2010.0000)  
ELLIPSOID: (GRS-80)  
MAP PROJECTION: LAMBERT CONFORMAL  
COORDINATE SYSTEM: SPC (3402 OH SOUTH)  
COMBINED SCALE FACTOR: 1.000080436  
ORIGIN OF COORDINATE SYSTEM: 0,0

USE THE POSITIONING METHODS AND MONUMENT TYPE USED IN THE ORIGINAL SURVEY TO RESTORE ALL MONUMENTS RELATED TO PRIMARY PROJECT CONTROL THAT ARE DAMAGED OR DESTROYED BY CONSTRUCTION ACTIVITIES. RESTORE THE DAMAGED OR DESTROYED MONUMENTS IN ACCORDANCE WITH CMS 623. UNITS ARE IN U.S. SURVEY FEET. USE THE FOLLOWING CONVERSION FACTOR: 1 METER = 3.280833333 U.S. SURVEY FEET.

**WORK LIMITS**

THE WORK LIMITS SHOWN ON THESE PLANS ARE FOR PHYSICAL CONSTRUCTION ONLY. PROVIDE THE INSTALLATION AND OPERATION OF ALL WORK ZONE TRAFFIC CONTROL AND WORK ZONE TRAFFIC CONTROL DEVICES REQUIRED BY THESE PLANS WHETHER INSIDE OR OUTSIDE THESE WORK LIMITS.

**CLEARING AND GRUBBING**

ALTHOUGH THERE ARE NO TREES OR STUMPS SPECIFICALLY MARKED FOR REMOVAL WITHIN THE LIMITS OF THE PROJECT, A LUMP SUM QUANTITY IS INCLUDED IN THE GENERAL SUMMARY FOR ITEM 201, CLEARING AND GRUBBING. ALL PROVISIONS AS SET FORTH IN THE SPECIFICATIONS UNDER THIS ITEM ARE INCLUDED IN THE LUMP SUM PRICE BID FOR ITEM 201, CLEARING AND GRUBBING.

**BENCHING OF FOUNDATION SLOPES**

ALTHOUGH CROSS-SECTIONS INDICATE SPECIFIC DIMENSIONS FOR PROPOSED BENCHING OF THE EMBANKMENT FOUNDATIONS IN CERTAIN AREAS, NO WAIVER OF THE SPECIFICATIONS IS INTENDED. BENCH ALL OTHER SLOPED EMBANKMENT AREAS AS SET FORTH IN 203.05. NO ADDITIONAL PAYMENT WILL BE MADE FOR BENCHING REQUIRED UNDER THE PROVISIONS OF 203.05.

**AIRWAY/HIGHWAY CLEARANCE FOR AIRPORTS AND HELIPORTS**

THIS PROJECT HAS BEEN IDENTIFIED AS BEING WITHIN THE INFLUENCE AREA OF A PUBLIC USE AIRPORT OR HELIPORT. NO TEMPORARY STRUCTURES OR CONSTRUCTION EQUIPMENT AT MAXIMUM OPERATING HEIGHT SHALL EXCEED A HEIGHT OF 60 FT.. IF ANY TEMPORARY STRUCTURES OR CONSTRUCTION EQUIPMENT WILL EXCEED THIS HEIGHT, FURTHER COORDINATION WITH THE FEDERAL AVIATION ADMINISTRATION (FAA), AND ODOT OFFICE OF AVIATION, WILL BE NECESSARY PRIOR TO ERECTING SUCH TEMPORARY STRUCTURES OR OPERATING SUCH EQUIPMENT ON THE PROJECT. THE CONTRACTOR WILL BE REQUIRED TO SUBMIT FORM 7460-1 TO THE FAA. NOTIFY THE ODOT OFFICE OF AVIATION WHEN SUBMITTING AN FAA FORM 7460-1.

NO TEMPORARY STRUCTURES OR CONSTRUCTION EQUIPMENT SHALL EXCEED THE PERMISSIBLE HEIGHT, UNTIL A COPY OF THE FAA APPROVAL AND ODOT OFFICE OF AVIATION PERMIT HAS BEEN FURNISHED TO THE PROJECT ENGINEER.

EXPRESS PROCESSING CENTER  
THE FEDERAL AVIATION ADMINISTRATION  
SOUTHWEST REGIONAL OFFICE  
AIR TRAFFIC AIRSPACE BRANCH ASW-520  
2601 MEACHAN BLVD.  
FORT WORTH, TX 76137-4298

OHIO DEPARTMENT OF TRANSPORTATION  
OFFICE OF AVIATION  
2829 WEST DUBLIN-GRANVILLE ROAD  
COLUMBUS, OHIO 43235  
614-387-2346

**CONNECTION BETWEEN EXISTING AND PROPOSED GUARDRAIL**

WHEN IT IS NECESSARY TO SPLICE PROPOSED GUARDRAIL TO EXISTING GUARDRAIL, ONLY THE EXISTING GUARDRAIL SHALL BE CUT, DRILLED, OR PUNCHED. THE CONNECTION SHALL BE MADE USING A W-BEAM, BEAM SPLICE AS SHOWN IN AASHTO M 180-12, EXCEPT THE BEAM WASHERS ARE NOT TO BE USED. PAYMENT SHALL BE INCLUDED IN THE CONTRACT PRICE FOR THE RESPECTIVE GUARDRAIL ITEMS.

V:\1736\active\173620049\engineering\114992\Design\Roadway\Sheets\114992\_GN001.dgn 8/18/2023 8:59:49 AM eadkins

CALCULATED  
LBA  
CHECKED  
SNS

GENERAL NOTES

HAM-71-8.65

**REVIEW OF DRAINAGE FACILITIES**

BEFORE ANY WORK IS STARTED ON THE PROJECT AND AGAIN BEFORE FINAL ACCEPTANCE BY THE STATE, REPRESENTATIVES OF THE STATE AND THE CONTRACTOR, ALONG WITH LOCAL REPRESENTATIVES, SHALL MAKE AN INSPECTION OF ALL EXISTING SEWERS WHICH ARE TO REMAIN IN SERVICE AND WHICH MAY BE AFFECTED BY THE WORK. THE CONDITION OF THE EXISTING CONDUITS AND THEIR APPURTENANCE SHALL BE DETERMINED FROM FIELD OBSERVATIONS. RECORDS OF THE INSPECTION SHALL BE KEPT IN WRITING BY THE STATE.

ALL NEW CONDUITS, INLETS, CATCH BASINS, AND MANHOLES CONSTRUCTED AS A PART OF THE PROJECT SHALL BE FREE OF ALL FOREIGN MATTER AND IN A CLEAN CONDITION BEFORE THE PROJECT WILL BE ACCEPTED BY THE STATE.

ALL EXISTING SEWERS INSPECTED INITIALLY BY THE ABOVE MENTIONED PARTIES SHALL BE MAINTAINED AND LEFT IN A CONDITION REASONABLY COMPARABLE TO THAT DETERMINED BY THE ORIGINAL INSPECTION. ANY CHANGE IN THE CONDITION RESULTING FROM THE CONTRACTOR'S OPERATIONS SHALL BE CORRECTED BY THE CONTRACTOR TO THE SATISFACTION OF THE ENGINEER.

PAYMENT FOR ALL OPERATIONS DESCRIBED ABOVE SHALL BE INCLUDED IN THE CONTRACT PRICE FOR THE PERTINENT 611 CONDUIT ITEMS.

**UNRECORDED STORM WATER DRAINAGE**

FURNISH A CONTINUANCE FOR ALL UNRECORDED STORM WATER DRAINAGE, SUCH AS ROOF DRAINS, FOOTER DRAINS, OR YARD DRAINS, DISTURBED BY THE WORK. FURNISH EITHER AN OPEN CONTINUANCE OR AN UNOBSTRUCTED CONTINUANCE BY CONNECTING A CONDUIT THROUGH THE CURB OR INTO A DRAINAGE STRUCTURE. THE LOCATION, TYPE, SIZE AND GRADE OF THE NEEDED CONDUIT TO REPLACE OR EXTEND AN EXISTING DRAIN WILL BE DETERMINED BY THE ENGINEER. ALL SUCH CONTINUANCE REQUIRES A RIGHT OF WAY USE PERMIT.

THE FOLLOWING CONDUIT TYPES MAY BE USED: 707.33, 707.41 NON-PERFORATED, 707.42, 707.43, 707.45, 707.46, 707.47, 707.51, 707.52 SDR35.

THE FOLLOWING ESTIMATED QUANTITIES HAVE BEEN INCLUDED IN THE GENERAL SUMMARY FOR USE AS DIRECTED BY THE ENGINEER FOR THE WORK NOTED ABOVE:

- 611, 6" CONDUIT, TYPE B, FOR DRAINAGE CONNECTION 100 FT.
- 611, 6" CONDUIT, TYPE C, FOR DRAINAGE CONNECTION 100 FT.
- 611, 6" CONDUIT, TYPE E, FOR DRAINAGE CONNECTION 100 FT.
- 611, 6" CONDUIT, TYPE F, FOR DRAINAGE CONNECTION 100 FT.

**POST CONSTRUCTION STORM WATER DESIGN**

THIS PLAN UTILIZES STRUCTURAL BEST MANAGEMENT PRACTICES (BMP'S) FOR POST CONSTRUCTION STORM WATER TREATMENT.

**SEEDING AND MULCHING**

THE FOLLOWING QUANTITIES ARE PROVIDED TO PROMOTE GROWTH AND CARE OF PERMANENT SEEDED AREAS:

- 659, SOIL ANALYSIS TEST 1 EACH
- 659, SEEDING AND MULCHING 20373 SQ. YD.
- 659, REPAIR SEEDING AND MULCHING 1020 SQ. YD
- 659, COMMERCIAL FERTILIZER 3 TONS
- 659, LIME 5 ACRES
- 659, WATER 111 M. GAL.
- 659, MOWING 46 M. SQ. FT.

SEEDING AND MULCHING SHALL BE APPLIED TO ALL AREAS OF EXPOSED SOIL BETWEEN THE RIGHT-OF-WAY LINES, AND WITHIN THE CONSTRUCTION LIMITS FOR AREAS OUTSIDE THE RIGHT-OF-WAY LINES COVERED BY WORK AGREEMENT OR SLOPE EASEMENT. QUANTITY CALCULATIONS FOR SEEDING AND MULCHING ARE BASED ON THESE LIMITS.

**ITEM 204 - PROOF ROLLING**

THE FOLLOWING QUANTITY IS PROVIDED IN THE GENERAL SUMMARY TO ADDRESS LOCATIONS REQUIRING PROOF ROLLING. SEE PLAN SHEET NO. 49 FOR ADDITIONAL INFORMATION.

ITEM 204 - PROOF ROLLING 3 HOURS.

**MONUMENT ASSEMBLIES**

CONSTRUCT A MONUMENT ASSEMBLY IN ACCORDANCE WITH THE DETAILS SHOWN ON THE STANDARD CONSTRUCTION DRAWINGS AT STATION 412+39.63 AS SHOWN ON SHEET NO. 2 OF 18 IN THE HAM-71-6.86 RIGHT OF WAY PLANS.

THE FOLLOWING QUANTITY HAS BEEN CARRIED TO THE GENERAL SUMMARY FOR THIS WORK.

ITEM 623 REFERENCE MONUMENT 1 EACH

**CONSTRUCTION OF THE LEVEE AND WORK IN THE USACE PERMITTED AREA**

ALL WORK PERFORMED ON THE USACE LEVEE AND PERMITTED AREAS SHALL CONFORM TO ALL RESTRICTIONS AND REGULATIONS SET FORTH IN THE 408 PERMIT ONCE APPROVED.

**621 RAISED PAVEMENT MARKER REMOVED**

THE FOLLOWING QUANTITY HAS BEEN CARRIED TO THE GENERAL SUMMARY FOR PURPOSES OF REMOVING RAISED PAVEMENT MARKERS.

ITEM 621 RAISED PAVEMENT MARKER REMOVED 10 EACH

**SPECIAL REQUIREMENT FOR PROTECTION OF ENDANGERED SPECIES HABITAT - INDIANA BAT, NORTHERN LONG-EARED BAT**

UNAVOIDABLE CUTTING OF TREES, 3" DIAMETER OR GREATER, WILL BE PERFORMED ONLY BEFORE APRIL 1 OR AFTER SEPTEMBER 30 WHEN BATS, INCLUDING THE INDIANA BAT AND THE NORTHERN LONG-EARED BAT, WILL NOT BE USING TREES FOR ROOST HABITAT. NO TREES SHALL BE CLEARED PRIOR TO THE ISSUANCE OF ALL REQUIRED WATERWAY PERMITS.

**WATERWAY PERMITTING**

CONSTRUCTION ACTIVITIES IN STREAMS AND WETLANDS ("WATERS OF THE U.S.") ARE SUBJECT TO U.S. ARMY CORPS OF ENGINEER'S (USACE) AND OHIO EPA JURISDICTION UNDER THE CLEAN WATER ACT. ODOT IS APPLYING FOR A USACE/OHIO EPA PERMIT AUTHORIZATION FOR THE ACTIVITIES SHOWN IN THE PLANS. THE FINAL PERMIT IS PENDING. EXCAVATION, DISCHARGE OF FILL MATERIAL, EQUIPMENT OPERATION, AND OTHER DISTURBANCES IN STREAMS AND/OR WETLANDS WITHIN THE CONSTRUCTION LIMITS MUST BE CONDUCTED IN ACCORDANCE WITH THE PLANS, AND THE CONTRACTOR MUST ABIDE BY ALL CONDITIONS AND REQUIREMENTS IN THE WATERWAY PERMIT SPECIAL PROVISIONS.

THE CONTRACTOR SHALL NOT DISTURB ANY WETLAND OR PORTION THEREOF OUTSIDE OF THE CONSTRUCTION LIMITS AS SHOWN ON THE PLANS.

**DRAINAGE FACILITY REPAIR**

THIS WORK SHALL CONSIST OF THE FOLLOWING:

FOR REPAIR - THE CONTRACTOR SHALL CAREFULLY REMOVE THE DAMAGED AREA(S) AND REPAIR SO THAT STRUCTURE IS AT OR NEAR ORIGINAL CONDITION AND FUNCTIONS PROPERLY. REPAIR CONCRETE PER CMS 519 - PATCHING CONCRETE STRUCTURE.

ALL MATERIAL REMOVED SHALL BE DISPOSED OF AS PER CMS 105

PAYMENT INCLUDES FURNISHING ALL MATERIALS, EQUIPMENT, LABOR, AND ALL INCIDENTALS REQUIRED TO COMPLETE THE DRAINAGE FACILITY REPAIRS, COMPLETE AND APPROVED BY THE ENGINEER.

**MATERIALS FURNISHED BY PREVIOUS CONTRACTS:**

SOME MATERIALS FOR THIS WORK HAVE ALREADY BEEN PURCHASED IN PREVIOUS CONTRACTS. THESE MATERIALS ARE BEING STORED WITHIN THE EXISTING INFIELD AREAS AND AT DISTRICT 8'S BLUE ASH STORAGE YARD. THE CONTRACTOR WILL BE RESPONSIBLE FOR TRANSPORTING ALL PREVIOUSLY FURNISHED MATERIALS TO THE CONSTRUCTION SITE IN A DESIGNATED LOCATION APPROVED BY THE ENGINEER. THESE MATERIALS SHALL BE STORED WITHIN THE CONSTRUCTION LIMITS AND IN A MANNER THAT WILL PRECLUDE THEM FROM BEING DAMAGED.

THE FOLLOWING IS A LIST OF THESE ITEMS.

BOX CULVERT EXTENSION ITEMS STORED AT THE DISTRICT'S BLUE ASH STORAGE YARD:

- EXTENSION SECTIONS
- PRECAST HEADWALLS

**MATERIALS FURNISHED BY PREVIOUS CONTRACTS (CONTINUED):**

DRAINAGE ITEMS STORED IN THE INFIELD AREA ON RAMP P:

- CULVERT PIPE
- 15" TYPE B - 100'
- 18" TYPE B - 120'
- 24" TYPE C - 40'
- 30" TYPE C - 340'

**STRUCTURES**

- D2 - INLET, NO. 3 FOR SINGLE SLOPE BARRIER, TYPE D
- D6 - CATCH BASIN, NO. 3A
- D7 - CATCH BASIN, NO. 3A
- D8 - CATCH BASIN, NO. 2-3
- D9 - MANHOLE, NO. 3
- D20 - CATCH BASIN, NO. 3A
- D21 CB - CATCH BASIN, NO. 3
- D21 MH - MANHOLE, NO. 3
- D 24 - MANHOLE, NO. 3

**UNDERDRAIN**

- 6" PIPE, UNDERDRAIN - 3100'
- 6" CONDUIT, TYPE F FOR UNDERDRAIN OUTLET - 240'
- 6" UD FITTINGS:
- WYE - 8
- EACH TEE - 28 EACH
- 45 BEND - 8 EACH
- CROSS - 5 EACH
- 90 BEND - 2 EACH
- COUPLING - 1 EACH
- 6" PRECAST INLET - 2 EACH

PAYMENT FOR THESE ITEMS SHALL BE MADE ACCORDING TO THE FOLLOWING CORRESPONDING PAY ITEMS:

- ITEM 511 - CLASS QC1 CONCRETE, HEADWALL, AS PER PLAN
- ITEM 611 - 15" CONDUIT, TYPE B, AS PER PLAN
- ITEM 611 - 18" CONDUIT, TYPE B, AS PER PLAN
- ITEM 611 - 24" CONDUIT, TYPE C, AS PER PLAN
- ITEM 611 - 30" CONDUIT, TYPE C, AS PER PLAN
- ITEM 611 - CATCH BASIN, NO. 3, AS PER PLAN
- ITEM 611 - CATCH BASIN, NO. 3A, AS PER PLAN
- ITEM 611 - CATCH BASIN, NO. 2-3, AS PER PLAN
- ITEM 611 - INLET, NO. 3 FOR SINGLE SLOPE BARRIER, TYPE D, AS PER PLAN
- ITEM 611 - MANHOLE NO. 3, AS PER PLAN
- ITEM 611 - CONDUIT, MISC., EXTENSION SECTIONS, AS PER PLAN

IN THE EVENT ANY OF THE MATERIAL FURNISHED PRIOR TO AWARD IS FOUND DEFICIENT BY THE DEPARTMENT, THE CONTRACTOR SHALL BE COMPENSATED PER C&MS 109.05 TO REPLACE THE MATERIAL IN KIND. ANY DELAY TO THE PROJECT TO ORDER NEW MATERIAL WILL BE AN EXCUSABLE, NON-COMPENSABLE DELAY PER C&MS 108.06.B.8.

PAYMENT SHALL BE MADE AT THE CORRESPONDING CONTRACT BID PRICE PER UNIT FOR EACH ITEM AND SHALL INCLUDE ALL EQUIPMENT, LABOR, AND INCIDENTALS (INCLUDING INCIDENTAL MATERIALS NOT PREVIOUSLY FURNISHED) REQUIRED TO COMPLETE THE WORK. THERE SHALL BE NO WAIVER OF ANY ITEM SPECIFICATION EXCEPT THAT THE LISTED MATERIALS WILL NOT BE FURNISHED BY THE CONTRACTOR. THE CONTRACTOR SHALL DELIVER ALL UNUSED MATERIAL TO DISTRICT 8'S BLUE ASH STORAGE YARD AT THE CONCLUSION OF THE PROJECT.

V:\1736\active\173620049\engineering\114992\Design\Roadway\Sheets\114992\_GN001.dgn 8/18/2023 10:37:47 AM eodkins

V:\1736\active\173620049\engineering\114992\Design\Roadway\Sheets\114992\_GN001.dgn 8/18/2023 11:25:12 AM eodkins

**ITEM 611 CONDUIT MISC.; SEWER INSPECTION**

REQUIREMENTS OF PACP CCTV AND MANHOLE SEWER INSPECTIONS

MSD CONFORMS TO THE NATIONAL ASSOCIATION OF SEWER SERVICE COMPANIES' (NASSCO) PIPELINE ASSESSMENT CERTIFICATION PROGRAM (PACP) AND MANHOLE INSPECTION UTILIZING MSD INSPECTION FORMS. THESE INSPECTIONS WILL BE MAINTAINED WITHIN MSD'S LIBRARY OF SEWER INSPECTIONS AND IT IS IMPERATIVE THAT THEY MEET ALL APPROPRIATE MSD REQUIREMENTS. ALL PACP CCTV WORK TO BE PERFORMED VIA THIS CONTRACT SHALL THEREFORE CONFORM TO ALL CURRENT NASSCO STANDARDS EXCEPT WHERE SPECIFICALLY INSTRUCTED OTHERWISE BY THE MSDGC PROGRAM MANAGER (PM). THESE STANDARDS INCLUDE BUT ARE NOT LIMITED TO: SPEED OF CAMERA TRAVEL, CENTERING OF CAMERA IN PIPE, CODING OF DEFECTS/STRUCTURAL FEATURES/OBSERVATIONS, PANNING OF DEFECTS/STRUCTURAL FEATURES, CAMERA LIGHTING, HEADER INFORMATION, FLOW CONTROL, AND REVERSAL INSPECTIONS. MSD GIS STANDARDS AND DESIGNATIONS SHALL APPLY FOR HEADER INFORMATION INCLUDING, BUT NOT LIMITED TO: MANHOLE NUMBERS, ASSET ID NUMBERS, CITYWORKS® WORK ORDER NUMBERS, BUILDING SEWER NAMES AND IDENTIFICATION, AND PREVIOUSLY UNDOCUMENTED MANHOLES.

ALL PACP CCTV WORK TO BE PERFORMED VIA THIS WORK ORDER SHALL BE CARRIED OUT UTILIZING A COLOR PAN AND TILT ROTATING HEAD CAMERA SPECIFICALLY DESIGNED AND CONSTRUCTED FOR SEWER INSPECTION. ALL CCTV WORK SHALL BE RECORDED ENTIRELY IN DIGITAL MP4 FORMAT ENCODED WITH A FILE COMPRESSION OF HIGH EFFICIENCY VIDEO CODING (HEVC OR H.265) (OTHER FORMATS NEED MSDGC PM APPROVAL) WITH AN APPROPRIATE PACP DATABASE FILE (NASSCO PACP DATABASE HAVING COMPATIBILITY WITH PIPETECH® PIPELINE INSPECTION SOFTWARE), AND ALL VIDEO MUST BE CONTINUOUSLY METERED.

THE PERSON CODING THE PIPELINE INSPECTION MUST BE NASSCO PACP CERTIFIED WITH A MINIMUM OF THREE YEARS OF FULL-TIME EXPERIENCE CODING DEFECTS USING THE NASSCO STANDARD. PACP CERTIFICATION NUMBERS MUST BE PROVIDED TO MSDGC AND PROOF OF EXPERIENCE MUST BE DEMONSTRATED BY DOCUMENTATION SUCH AS A RESUME WITH REFERENCES.

**ROBOTIC PACP & MANHOLE INSPECTION**

THE CONTRACTOR SHALL BE RESPONSIBLE FOR:

CONDUCTING A FINAL MANHOLE-TO-MANHOLE (MH-MH), TELEVISIONING OF THE MAINLINE SEWER SECTION TO EVALUATE THE CONDITION OF THE SEWER AFTER ALL APPROPRIATE CLEANING, TRIMMING, GRINDING, AND FLUSHING HAS BEEN PERFORMED. IN THE EVENT AN INSPECTION CANNOT BE COMPLETED FROM ONE SET-UP DUE TO A STRUCTURAL OR MAINTENANCE DEFECT, THE INSPECTOR SHALL PERFORM A REVERSE INSPECTION FROM AN ADDITIONAL SET-UP THE SAME DAY. THE INSPECTOR SHALL SUBMIT TWO INSPECTION REPORTS AS THE FINAL INSPECTION. THIS FINAL TELEVISIONING SHALL BE IN PACP AND SHALL FOLLOW ALL PACP V 7.0 STANDARDS.

EMPLOYING VARIOUS FLOW CONTROL METHODS AS APPROPRIATE TO ENSURE VISIBILITY OF THE ENTIRE CIRCUMFERENCE OF THE SEWER.

CONDUCTING A FINAL TELEVISIONING OF EACH INDIVIDUAL BUILDING SEWER FROM THE MAIN SEWER LINE TO THE PUBLIC RIGHT OF WAY DESIGNATION OR SEWER EASEMENT LIMIT. UNLESS OTHERWISE DIRECTED BY MSD PERSONNEL, THE EASEMENT LIMIT SHOULD BE ASSUMED TO BE A MINIMUM OF 10'. IF A FULL MAINLINE TO RIGHT OF WAY OR EASEMENT INSPECTION IS UNABLE TO BE COMPLETED DUE TO AN OBSTRUCTION OF ANY SORT, SAID OBSTRUCTION MUST BE LOCATED AND REPORTED TO THE MSD PM IMMEDIATELY.

WALK THROUGH PACP INSPECTION (MANNED ENTRY)

THE CONTRACTOR SHALL BE RESPONSIBLE FOR:

THE OPERATOR ENTERING INTO LARGE DIAMETER SEWERS IN ORDER TO CONDUCT A FINAL MANHOLE-TO-MANHOLE (MH-MH) TELEVISIONING OF THE SEWER AFTER ALL APPROPRIATE CLEANING, TRIMMING, GRINDING, AND FLUSHING HAS BEEN PERFORMED. THE FINAL TELEVISIONING SHALL BE IN PACP AND SHALL FOLLOW ALL PACP V7.0 STANDARDS. THE CONTRACTOR MAY UTILIZE ROBOTIC EQUIPMENT TO PERFORM A PACP INSPECTION IN PIPE SIZES GREATER THAN 60 INCHES AT THE DIRECTION/APPROVAL OF THE MSD PM.

ALL MAN ENTRY INTO THE SEWER WILL FOLLOW THE CONTRACTOR'S HEALTH AND SAFETY PLAN WITH REGARDS TO CONFINED SPACE ENTRY.

THE CONTRACTOR SHALL SUBMIT WORK IN THE FORMAT REQUIRED BY MSDGC AND SHALL FOLLOW GUIDELINES FROM THE MSDGC PROJECT PM. IN ORDER TO CONTINUE IMPROVING THE UPLOADING OF DATA AND SUBMITTALS, THE MSDGC PM MAY UPDATE THE REQUIREMENTS AT ANY TIME, BUT WILL GIVE THE CONTRACTOR SUFFICIENT ACCESS TO MSD'S PROGRAMS AS NEEDED.

SUBMITTAL OF WORK TO MSDGC

WORK COMPLETED AND SUBMITTED TO MSDGC SHALL FOLLOW THE SPECIFICATIONS DETAILED IN THE SUBSECTIONS BELOW.

REQUIREMENTS OF ALL PACP CCTV SUBMITTALS AND MANHOLE INSPECTION SUBMITTALS ALL SUBMITTALS OF PACP INSPECTIONS SHALL CONFORM TO THE FOLLOWING SPECIFICATIONS:

EACH SUBMITTAL - THE PACP DATABASE FILE AND ITS CORRESPONDING VIDEO FILES - SHALL CONTAIN WORK FROM ONLY 1 (ONE) INSPECTOR AND ONLY 1 (ONE) CCTV WORK CATEGORY FROM THE LIST BELOW:

SANITARY AND/OR COMBINED MAINLINE SEWER INSPECTIONS (PACP)

STORM MAINLINE SEWER INSPECTIONS (PACP)

EACH SUBMITTAL SHALL BE ASSIGNED A UNIQUE TRACKING IDENTIFIER.

IN THE EVENT THAT A SUBMITTAL IS REJECTED AS UNACCEPTABLE, THE MSD PM SHALL DIRECT THE CONTRACTOR WHETHER TO REUSE THE ORIGINAL OR TO ASSIGN A NEW TRACKING IDENTIFIER.

EACH SUBMITTAL SHALL INCLUDE INSPECTIONS FROM ONLY ONE CALENDAR MONTH.

EACH PACP VIDEO FILE MUST BE IN STANDARD \*.MP4 FORMAT AND NAMED AS DESCRIBED BELOW:

[MONTH]\_[DAY]\_[YEAR]\_[HOUR]\_[MINUTE]\_[AM/PM]-[INSPECTOR NAME]\_[WORK ORDER NUMBER].MP4

E.G., "1\_03\_2012-11\_23\_AM-M LONGMIRE-411032.MP4"

EACH MANHOLE INSPECTION SHALL FOLLOW THE FORMAT PROVIDED BY MSD UTILIZING THEIR MANHOLE INSPECTION FORM.

ALL PACP AND MANHOLE INSPECTIONS MUST BE SUBMITTED WITHIN FOURTEEN (14) CALENDAR DAYS OF THE DATE OF WORK.

IN THE CASE OF REJECTION OF A WHOLE OR ANY PART OF A SUBMITTAL, CONTRACTOR SHALL HAVE FOURTEEN (14) CALENDAR DAYS FROM THE DATE OF NOTIFICATION OF SAID REJECTION TO ADDRESS, CORRECT, AND/OR RE-PERFORM AND THEN RE-SUBMIT SAID WORK TO MSDGC.

PAYMENT FOR THE LABOR, MATERIALS, EQUIPMENT AND INCIDENTALS NECESSARY TO COMPLETE THE ABOVE WORK SHALL BE AT THE LUMP SUM PRICE BID FOR ITEM 611 CONDUIT MISC.; SEWER INSPECTION

**ITEM 202 REMOVAL MISC.; SANDBAGS**

THIS ITEM IS FOR THE REMOVAL OF SANDBAGS PLACED AS A TEMPORARY MEASURE TO RESTOR THE FUNCTION OF THE USACE LEVEE THAT WAS DISTURBED BY A PREVIOUS CONTRACT.

PAYMENT FOR THE LABOR, MATERIALS, EQUIPMENT AND INCIDENTALS NECESSARY TO COMPLETE THE ABOVE WORK SHALL BE AT THE UNIT PRICE BID PER CUBIC YARD FOR ITEM 203 ROADWAY MISC.; FLOOD CONTROL EMBANKMENT.

CALCULATED  
LBA  
CHECKED  
SNS

GENERAL NOTES

HAM-71-8.65

6A  
129

V:\1736\active\173620049\engineer\ing\14992\Design\Roadway\Sheets\14992\_GG001.dgn 8/18/2023 9:31:51 AM eadk:ms

SHEET NUM.												PART.	ITEM	ITEM	GRAND	UNIT	DESCRIPTION	SEE SHEET NO.
4	6	6A	19	20	21	22						01/IMS/OT	EXT	TOTAL				
<b>ROADWAY</b>																		
LS												LS	201	11000	LS	CLEARING AND GRUBBING		
				3								3	202	20010	3	EACH	HEADWALL REMOVED	
				1,595	43							1,638	202	23000	1,638	SY	PAVEMENT REMOVED	
				75								75	202	30700	75	FT	CONCRETE BARRIER REMOVED	
				810	538							1,348	202	32000	1,348	FT	CURB REMOVED	
				134								134	202	32700	134	SY	GUTTER REMOVED	
				477								477	202	35101	477	FT	PIPE REMOVED, 24" AND UNDER, AS PER PLAN	
				152								152	202	35200	152	FT	PIPE REMOVED, OVER 24"	
				675								675	202	38000	675	FT	GUARDRAIL REMOVED	
				6								6	202	58100	6	EACH	CATCH BASIN REMOVED	
				50								50	SPECIAL	20270000	50	FT	FILL AND PLUG EXISTING CONDUIT. 12"	
				LS								LS	202	98000	LS		REMOVAL MISC.: LIGHT TOWER RETAINING WALL	
		LS										LS	202	98000	LS		REMOVAL MISC.: SANDBAGS	
		20,257										20,257	203	10000	20,257	CY	EXCAVATION	
		6,143										6,143	203	20000	6,143	CY	EMBANKMENT	
		438										438	203	35110	438	CY	GRANULAR MATERIAL, TYPE B	
		2,155										2,155	203	98000	2,155	CY	ROADWAY, MISC.:FLOOD CONTROL EMBANKMENT	
		562										562	203	98000	562	CY	ROADWAY, MISC.:UNDERCUT	
	3											3	204	45000	3	HOUR	PROOF ROLLING	
		207										207	206	10500	207	TON	CEMENT	
		5,226										5,226	206	11001	5,226	SY	CURING COAT, AS PER PLAN	
						5,425						5,425	206	15030	5,425	SY	CEMENT STABILIZED SUBGRADE, 16 INCHES DEEP	
					831.25							831.25	606	15050	831.25	FT	GUARDRAIL, TYPE MGS	
					3							3	606	26150	3	EACH	ANCHOR ASSEMBLY, MGS TYPE E(INCHRP 350 OR MASH 2016)	
					1							1	606	26500	1	EACH	ANCHOR ASSEMBLY, TYPE T	
					3							3	606	35002	3	EACH	MGS BRIDGE TERMINAL ASSEMBLY, TYPE 1	
					1							1	606	35103	1	EACH	MGS BRIDGE TERMINAL ASSEMBLY, TYPE 2, AS PER PLAN	
					4,655							4,655	608	12000	4,655	SF	5" CONCRETE WALK	
					306							306	608	52000	306	SF	CURB RAMP	
					943							943	622	10160	943	FT	CONCRETE BARRIER, SINGLE SLOPE, TYPE D	
					3							3	622	25000	3	EACH	CONCRETE BARRIER END SECTION, TYPE D	
					4							4	622	25050	4	EACH	CONCRETE BARRIER, END ANCHORAGE, REINFORCED, TYPE D	
	1											1	623	40500	1	EACH	REFERENCE MONUMENT	
					13							13	626	00102	13	EACH	BARRIER REFLECTOR, TYPE 1, 1 WAY	
					20							20	626	00110	20	EACH	BARRIER REFLECTOR, TYPE 2, 1 WAY	
												LS	878	25000	LS		INSPECTION AND COMPACTION TESTING OF UNBOUND MATERIALS	

**GENERAL SUMMARY**

CALCULATED  
LBA  
CHECKED  
SNS

**HAM-71-8.65**

SHEET NUM.										PART.	ITEM	ITEM	GRAND	UNIT	DESCRIPTION	SEE SHEET NO.	CALCULATED LBA CHECKED SNS
5	6	20	21	22	23	25				01/IMS/OT		EXT	TOTAL				
<b>DRAINAGE</b>																	
					1.12					1.12	602	20000	1.12	CY	CONCRETE MASONRY		
						1,253 64				1,253 64	605 611	11101 00511	1,253 64	FT	6" SHALLOW PIPE UNDERDRAINS, AS PER PLAN, 707.31, 707.41	6	
	100									100	611	00900	100	FT	6" CONDUIT, TYPE F FOR UNDERDRAIN OUTLETS, AS PER PLAN	6	
	100									100	611	01100	100	FT	6" CONDUIT, TYPE B FOR DRAINAGE CONNECTION		
	100									100	611	01400	100	FT	6" CONDUIT, TYPE C FOR DRAINAGE CONNECTION		
	100									100	611	01500	100	FT	6" CONDUIT, TYPE E FOR DRAINAGE CONNECTION		
					6					6	611	04600	6	FT	12" CONDUIT, TYPE C		
					138					138	611	05900	138	FT	15" CONDUIT, TYPE B		
					100					100	611	05901	100	FT	15" CONDUIT, TYPE B, AS PER PLAN	6	
					96					96	611	06700	96	FT	15" CONDUIT, TYPE F		
					13					13	611	07401	13	FT	18" CONDUIT, TYPE B, AS PER PLAN	6	
					136					136	611	07600	136	FT	18" CONDUIT, TYPE C		
					295					295	611	10600	295	FT	24" CONDUIT, TYPE C		
					40					40	611	10601	40	FT	24" CONDUIT, TYPE C, AS PER PLAN	6	
					154					154	611	13400	154	FT	30" CONDUIT, TYPE B		
					235					235	611	13601	235	FT	30" CONDUIT, TYPE C, AS PER PLAN	6	
										LS	611	97300	LS		CONDUIT, MISC.: SEWER INSPECTION	6A	
					1					1	611	98150	1	EACH	CATCH BASIN, NO. 3		
					1					1	611	98151	1	EACH	CATCH BASIN, NO. 3, AS PER PLAN	6	
					1					1	611	98180	1	EACH	CATCH BASIN, NO. 3A		
					3					3	611	98181	3	EACH	CATCH BASIN, NO. 3A, AS PER PLAN	6	
					1					1	611	98470	1	EACH	CATCH BASIN, NO. 2-2B		
					1					1	611	98511	1	EACH	CATCH BASIN, NO. 2-3, AS PER PLAN	6	
					1					1	611	99114	1	EACH	INLET, NO. 3 FOR SINGLE SLOPE BARRIER, TYPE D		
					1					1	611	99115	1	EACH	INLET, NO. 3 FOR SINGLE SLOPE BARRIER, TYPE D, AS PER PLAN	6	
					2					2	611	99574	2	EACH	MANHOLE, NO. 3		
					3					3	611	99575	3	EACH	MANHOLE, NO. 3, AS PER PLAN	6	
<b>PAVEMENT</b>																	
					717					717	254	01000	717	SY	PAVEMENT PLANING, ASPHALT CONCRETE, 1 1/2"		
					905					905	304	20000	905	CY	AGGREGATE BASE		
					9					9	301	36000	9	CY	ASPHALT CONCRETE BASE, PG64-22, (449)		
					79					79	407	20000	79	GAL	NON-TRACKING TACK COAT		
	1.5				1.5					1.5	441	50000	1.5	CY	ASPHALT CONCRETE SURFACE COURSE, TYPE X, (448), PG64-22		
					30					30	442	10000	30	CY	ASPHALT CONCRETE SURFACE COURSE, 12.5 MM, TYPE A (446)		
					4,912					4,912	452	6060	4,912	SY	13.5" NON-REINFORCED CONCRETE PAVEMENT, CLASS CC IR WITH CC/OA		
					66					66	609	24510	66	FT	CURB, TYPE 4-C		
					1,835					1,835	609	26000	1,835	FT	CURB, TYPE 6		
		347			180					337	609	50000	337	SY	4" CONCRETE TRAFFIC ISLAND		

**GENERAL SUMMARY**

V:\1736\octfive\173620049\engineer\ing\14992\Design\Roadway\Sheets\14992\_GG006.dgn 8/18/2023 9:18:04 AM eadkins

Table with columns: SHEET NUM. (51, 74, 108, 120), PART. (01/IMS/OT), ITEM, ITEM EXT, GRAND TOTAL, UNIT, DESCRIPTION, SEE SHEET NO. The table lists various construction items such as conduits, trenches, signal heads, foundations, and retaining walls, categorized under 'TRAFFIC SIGNALS' and 'STRUCTURE 20 FOOT SPAN AND UNDER'. Some rows are highlighted with red wavy lines.

CALCULATED  
LBA  
CHECKED  
SNS

GENERAL SUMMARY

HAM-71-8.65





V:\1736\active\173620049\engineering\114992\Design\Roadway\Sheets\114992\_GS002.dgn 8/18/2023 11:05:48 AM eodkins

REF. NO.	SHEET NO.	STATION <i>P = RAMP P N = RAMP N K = KENNEDY R = RIDGE</i>		SIDE	202										609		SPECIAL		REMARKS
					HEADWALL REMOVED	PAVEMENT REMOVED	CONCRETE BARRIER REMOVED	CURB REMOVED	GUTTER REMOVED	PIPE REMOVED, 24" AND UNDER	PIPE REMOVED, OVER 24"	GUARDRAIL REMOVED	CATCH BASIN REMOVED	REMOVAL MISC.:	4" CONCRETE TRAFFIC ISLAND	FILL & PLUG EXISTING CONDUIT			
																	EACH	SQ YD	
R1																			
R2																			
R3																			
R4																			
R5																			
R6																			
R7																			
R8	29	411+85.93	412+50.89	RT	1					118			2						
R9	29-30	411+39.04	414+90.75	RT			75												
R10																			
R11																			
R12																			
R13	30	412+91.78	417+96.00	RT										347					
R14																			
R15																			
R16																			
R17																			
R18																			
R19																			
R20																			
R21																			
R22																			
R23																			
R24																			
R25	29,31	412+03.60 P	14+67.00 K	LT/LT								675.00							
R26	29,31	411+96.04 P	13+87.47 K	LT/LT		1595													
R27	31	409+95.00 P	411+76.00 N	RT/RT	1					237			1						
R28	31	12+19.34 K	12+69.46 K	LT						72			1						
R29	31	12+69.46 K		LT						4	8								
R30	31	413+28.00 N	12+69.46 K	RT/LT							144								
R31	31	411+69.84 N	413+84.40 N	RT/LT					134										
R32	31	11+18.86 K	11+92.00 K	LT			83												
R33	31	12+10.65 K	13+78.92 K	LT			581												
R34	31	13+87.88 K	15+31.00 K	LT			146												
R35																			
R36	31	412+22.63 N	412+56.98 N	RT									LUMP						LIGHT TOWER RETAINING WALL
R37	31	413+03.47 N	413+10.65 N	RT	1					46			1						
R38	31	14+50.00 K		LT/RT									1						PLUG AND SEAL 12" CONDUIT
<b>TOTALS CARRIED TO GENERAL SUMMARY</b>					3	1595	75	810	134	477	152	675	6	LUMP	347	50			

ROADWAY QUANTITIES

HAM-71-8.65

CALCULATED  
LEH  
CHECKED  
SNS

REF. NO.	SHEET NO.	STATION		SIDE	202	202	441	452	519	606				608			609		622			626			
		FROM	TO		PAVEMENT REMOVED SQ YD	CURB REMOVED FOOT	1-1/2" ASPHALT CONCRETE SURFACE COURSE, TYPE 1, (448), PG64-22 CY	9" NON-REINFORSED CONCRETE PAVEMENT, CLASS QCI SQ YD	PATCHING CONCRETE STRUCTURE SQ FT	GUARDRAIL, TYPE MGS FOOT	ANCHOR ASSEMBLY, MGS TYPE E (NCHRP 350/MASH 2016) EACH	ANCHOR ASSEMBLY, MGS TYPE T EACH	MGS BRIDGE TERMINAL ASSEMBLY, TYPE 1 EACH	BRIDGE TERMINAL ASSEMBLY, TYPE 2, AS PER PLAN EACH	CURB RAMP, TYPE AI SQ FT	CURB RAMP, TYPE BI SQ FT	5" CONCRETE WALK SQ FT	CURB, TYPE 4-C FOOT	CURB, TYPE 6 FOOT	4" CONCRETE TRAFFIC ISLAND SQ YD	CONCRETE BARRIER, SINGLE SLOPE, TYPE D FOOT	CONCRETE BARRIER END SECTION, TYPE D EACH	CONCRETE BARRIER, END ANCHORAGE, REINFORCED, TYPE D EACH	BARRIER REFLECTOR, TYPE 1, INWAY EACH	BARRIER REFLECTOR, TYPE 2, INWAY EACH
G1		I.R. 71 NOT USED																							
G2	29	411+15.23	412+40.23	RT									50												2
G3		NOT USED																							
G4	29-30	412+32.58	413+10.60	LT									12.50												2
G5	29-30,31	18+90.39 KENNEDY	409+15.61	LT/RT									468.75												16
G6	30,31	408+95.89	412+75.60	RT									300												
C1		I.R. 71 NOT USED																							
C2	29	412+21.63	412+39.63	RT																					
C3	29-30	412+92.00	413+10.00	LT																					
C4	29	412+57.00	412+75.00	RT																					
C5	31	408+95.89	412+75.60	LT																					
C6	31	408+22.24	408+79.25	RT																					
C7	31	412+00.00	414+00.00	LT																					
C8	31	KENNEDY AVENUE 11+18.86 413+66.53 RAMP N		LT/RT	18	159	0.8	18																	
C9	31	408+95.89 RAMP P 18+87.73		RT/LT	43	379	1.8	43																	
B1		I.R. 71 NOT USED																							
B2		NOT USED																							
B3	29-30	412+39.63	416+24.99	RT																					
B4		RAMP P NOT USED																							
B5	30	413+10.00	417+00.19	LT																					
B6	29-30	412+75.00	415+50.00	RT																					
W1	31	KENNEDY AVE 11+18.86 18+90.39		LT																					
IP1	31	KENNEDY AVE 12+26.53		LT					10																
<b>TOTALS CARRIED TO GENERAL SUMMARY</b>					61	538	2.6	61	10	831.25	3	1	3	1	306	4655	66	1835	0	190	943	3	4	13	20

V:\1736\active\173620049\engineering\114992\Design\Roadway\Sheets\114992\_GS003.dgn 8/18/2023 1:23:45 PM eodkins

V:\736\active\173620049\engineering\114992\Design\Roadway\Sheets\114992\_GS004.dgn 8/18/2023 9:18:47 AM eadkins

REF. NO.	SHEET NO.	STATION		SIDE	COMPUTER GENERATED AREA						REMARKS	
		FROM	TO		SQ FT	206 SQ YD	254 SQ YD	304 CU YD	407 GAL	442 CU YD		452 SQ YD
		I.R. 71										
P1		NOT USED										
P2		NOT USED										
P3	29	410+90.00	413+00.00	RT	2520	280		31	11.67			
P4	30	413+00.00	416+27.62	RT	3931	436.78		48	18.20			
P5		NOT USED										
P6		NOT USED										
P7		NOT USED										
P8		NOT USED										
P9		NOT USED										
P10		NOT USED										
		RAMP N										
P11		NOT USED										
P12		NOT USED										
P13		NOT USED										
P14	29	408+97.30	410+50.00	LT/RT	3918	487.56	81.26		435.33		ADD 470 SF FOR 206, 304	
P15	31	410+50.00	12+73.83 KENNEDY	LT/RT	10183	1260.00	210.00		1131.44		ADD 1157 SF FOR 206, 304	
		RAMP P										
P16	31	15+31.00 KENNEDY	411+50.00	LT/RT	14392	1759.00	293.17		1599.11		ADD 1439 SF FOR 304, 206	
P17	29	411+50.00	413+00.00	LT/RT	4207	518.78	86.46		467.44		ADD 462 SF FOR 304, 206	
P18	30	413+00.00	418+00.00	LT/RT	11500	1399.33	233.22		1277.78		ADD 1094 SF FOR 206, 304, 452	
SUBTOTAL					5424.67	716.78	904.11	79.00	29.87	4911.10		
<b>TOTALS CARRIED TO GENERAL SUMMARY</b>					5425	717	905	79	30	4912		

CALCULATED LEH	CHECKED SNS
PAVEMENT QUANTITIES	
HAM-71-8.65	
22	129

**ITEM 203 ROADWAY MISC.; FLOOD CONTROL EMBANKMENT**

THE PLACING OF EMBANKMENT WITHIN THE LEVEE LIMITS SHALL REQUIRE THE FOLLOWING:

THE EXISTING GROUND SURFACE SHALL BE STRIPPED OF ORGANICS AND TOPSOIL TO A DEPTH OF APPROXIMATELY 6 INCHES PRIOR TO BENCHING THE FLOOD CONTROL EMBANKMENT.

THE SOIL ON WHICH THE BACKFILL IS TO BE PLACED SHOULD NOT BE EXCAVATED UNTIL IMMEDIATELY BEFORE BACKFILLING, AND SHALL NOT BE ALLOWED TO BECOME OVERLY WET OR DRY WHILE EXPOSED. THE SURFACE AREA OF THE SOIL SHALL BE SCARIFIED AS NECESSARY TO ENSURE A GOOD BOND BETWEEN THE EXISTING SOIL AND THE BACKFILL MATERIAL.

BACKFILL MATERIAL MUST BE LOW PERMEABILITY SOILS - IMPERMEABLE SOILS (E.G. SC, CL OR CL-ML WITH AN ESTIMATED HYDRAULIC CONDUCTIVITY LESS THAN  $1 \times 10^{-5}$  CM/SEC) IN ACCORDANCE WITH ASTM 2488 - USCS CLASSIFICATION SYSTEM.

BACKFILL MATERIAL SHALL BE PLACED IN LOOSE LIFTS WITH THICKNESSES NOT TO EXCEED 6-INCHES AND COMPACTED TO A MINIMUM OF 95 PERCENT STANDARD PROCTOR DENSITY DETERMINED AT OPTIMUM MOISTURE CONTENT ACCORDING TO ASTM D-698. MOISTURE CONTROL LIMITS ARE TO BE WITHIN -1% TO +3% OF OPTIMUM.

COMPACTION TEST RESULTS OF WORK ACCOMPLISHED AS DESCRIBED ABOVE SHALL BE SUBMITTED TO THE US ARMY CORPS OF ENGINEERS FOR REVIEW AND APPROVAL THROUGHOUT THE CONSTRUCTION PROCESS.

THE DISTURBED AREAS SHALL BE SEEDING AND COVERED WITH A BIO-DEGRADABLE GEOTEXTILE CONFORMING TO ODOT SPECIFICATION 712.11 FOR TYPE B TEMPORARY EROSION CONTROL MAT, WHEN FINAL GRADING IS COMPLETE.

THE TYPE B TEMPORARY EROSION CONTROL MAT IS INCLUDED IN ITEM 203 ROADWAY MISC.; FLOOD CONTROL EMBANKMENT FOR PAYMENT. SEEDING AND MULCHING IS PAID FOR SEPERATELY UNDER ITEM 659 SEEDING AND MULCHING.

PAYMENT FOR THE LABOR, MATERIALS, EQUIPMENT AND INCIDENTALS NECESSARY TO COMPLETE THE ABOVE WORK SHALL BE AT THE UNIT PRICE BID PER CUBIC YARD FOR ITEM 203 ROADWAY MISC.; FLOOD CONTROL EMBANKMENT.

**ITEM 203 ROADWAY MISC.; UNDERCUT**

THE UNDERCUT AREAS ON THE PROPOSED LEVEE AND YONONTE CREEK CROSS SECTIONS ARE LOCATIONS WHERE THE EXISTING SOIL MUST BE REMOVED AND REPLACED WITH ITEM 203 ROADWAY MISC.; FLOOD CONTROL EMBANKMENT FOR THE PURPOSE OF PREVENTING SEEPAGE UNDER THE PROPOSED LEVEE.

PAYMENT FOR THE UNDERCUTTING / EXCAVATION OF THE EXISTING SOILS, AS SHOWN IN THE PLANS, AND PAYMENT FOR THE REPLACEMENT OF THIS UNDERCUT SOIL WITH FLOOD CONTROL EMBANKMENT, ACCORDING TO THE NOTE ABOVE, SHALL BE INCLUDED IN THE UNIT PRICE BID PER CUBIC YARD FOR ITEM 203 ROADWAY MISC.; UNDERCUT. THIS PAYMENT SHALL INCLUDE ALL LABOR, MATERIALS, EQUIPMENT AND INCIDENTALS NECESSARY TO COMPLETE THE WORK.

**ITEM 630 SIGNING, MISC; LEVEE SIGNAGE**

FIVE SIGNS, AS SHOWN BELOW, SHALL BE PLACED ALONG THE LENGTH OF THE I-WALL. SIGNS SHALL BE SPACED NO MORE THAN 150 FEET APART AND SHOULD BE LOCATED TO MINIMIZE ANY IMPACTS TO INSPECTION, OPERATION AND MAINTENANCE, OR ABILITY TO PERFORM EFFORTS DURING HIGH WATER OR FLOOD EVENTS. SIGNS SHALL MEET ALL THE REQUIREMENTS OF ITEM 630.



PAYMENT FOR THE LABOR, MATERIALS, EQUIPMENT AND INCIDENTALS NECESSARY TO COMPLETE THE ABOVE WORK SHALL BE INCLUDED IN THE FOLLOWING QUANTITIES CARRIED TO THE GENERAL SUMMARY.

ITEM 630 SIGNING, MISC; LEVEE SIGNAGE 5 EACH

**RIPRAP REPAIR**

THE CONTRACTOR SHALL TAKE CARE TO NOT DAMAGE THE CONCRETE LINING OF THE YONONTE CREEK CHANNEL. ANY DAMAGE TO THE CHANNEL LINING SHALL BE REPAIRED USING ITEM 601 RIPRAP, TYPE D AS DEFINED IN THE ODOT CMS. REPAIRING DAMAGE SHALL BE AT THE CONTRACTOR'S EXPENSE.

**ITEM 202 PIPE REMOVED, 24" AND UNDER, AS PER PLAN**

THIS ITEM SHALL BE IDENTICAL TO ITEM 202 PIPE REMOVED, 24" AND UNDER WITH THE EXCEPTION THAT ALL BACKFILL FOR THE REMOVAL SHALL USE ITEM 203 ROADWAY MISC.; FLOOD CONTROL EMBANKMENT WITHIN THE FLOODWALL INFLUENCE ZONE. THE FLOODWALL INFLUENCE ZONE IS 15' FROM THE OUTERMOST FLOODWALL FEATURE THAT EXTENDS AT A 1:1 SLOPE INTO THE GROUND.

**I-WALL ESTIMATED QUANTITIES**

ITEM	EXTENSION	TOTAL	UNIT	DESCRIPTION	GEN.	SHEET #
503	21300	LUMP	LS	UNCLASSIFIED EXCAVATION	1	
504	11101	5014	SF	STEEL SHEET PILING LEFT IN PLACE, AS PER PLAN	5014	131-131B
509	10000	11,485	LB	EPOXY COATED REINFORCING STEEL	11,485	131G
511	46010	139	CY	CLASS QC1 CONCRETE, RETAINING/WINGWALL NOT INCLUDING FOOTING	139	131-131B
512	10100	288	SY	SEALING OF CONCRETE SURFACES (EPOXY-URETHANE)	288	131G
516	13601	533	SF	1" PREFORMED EXPANSION JOINT FILLER, APP	533	131G


CALCULATED  
EDA  
CHECKED  
PJD

**GENERAL NOTES**

**HAM-71-8.65**

V:\1736\octfive\173620049\engineering\14992\Design\Roadway\Sheets\14992\_GN002.dgn 8/18/2023 9:19:14 AM eadkins


V:\1736\active\173620049\engineering\14992\Design\Drainage\Sheets\9474IDC002.dgn 8/18/2023 9:20:11 AM eadkins

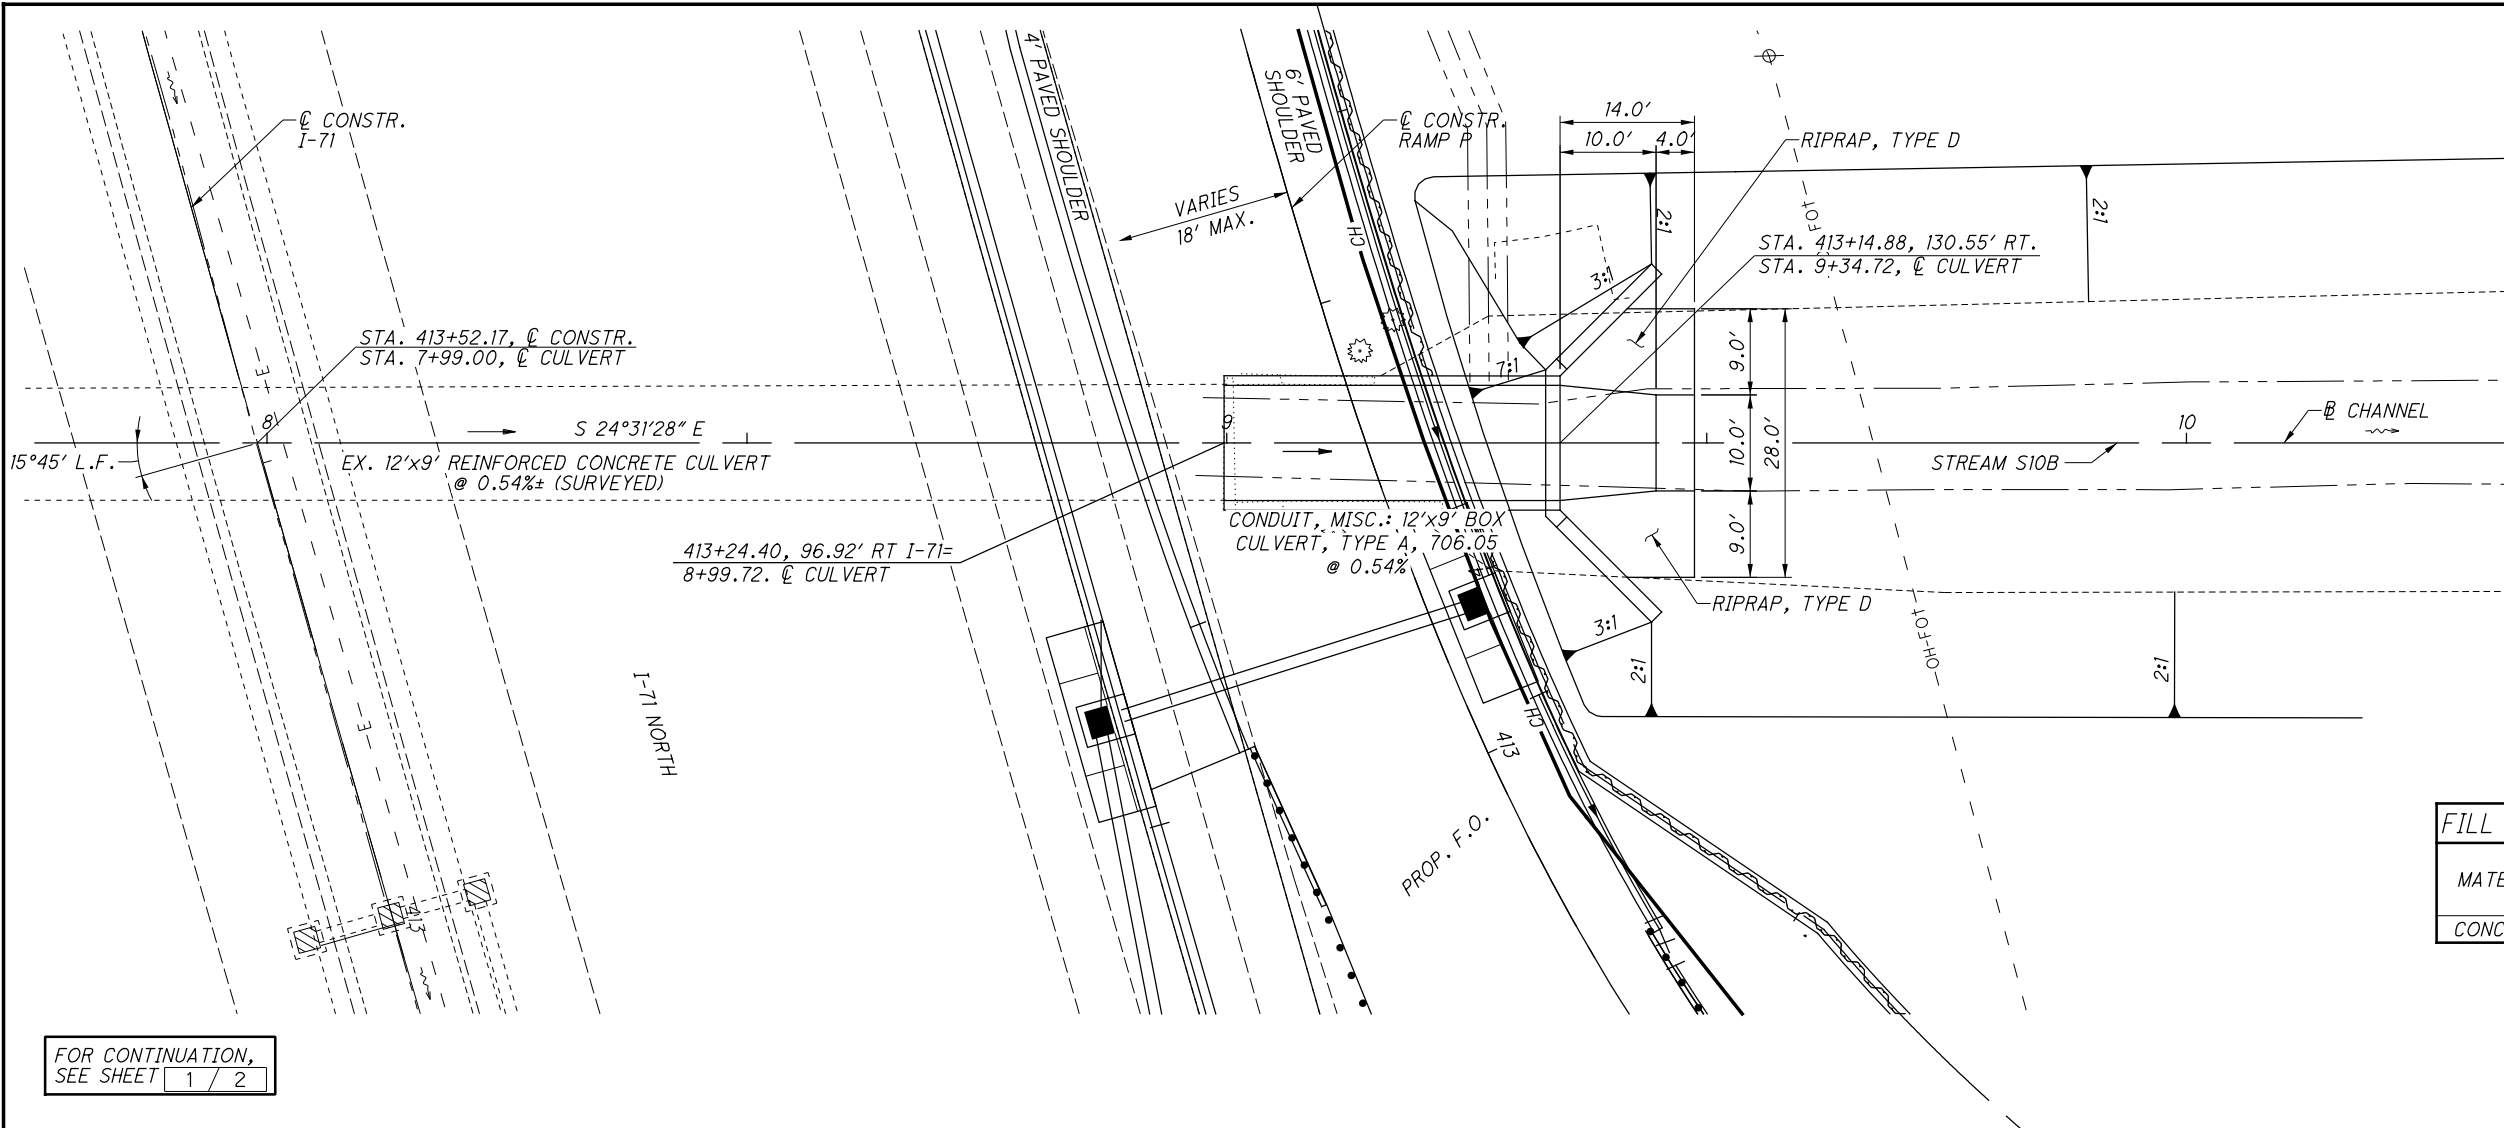

HYDRAULIC DESIGN DATA	
DRAINAGE AREA	= 1024 Ac.
Q <sub>10</sub>	= 830 cfs
Q <sub>50</sub>	= 1360 cfs
Q <sub>100</sub>	= 1470 cfs
HW <sub>10</sub>	= 554.2
HW <sub>50</sub>	= 559.1
HW <sub>100</sub>	= 560.6
V <sub>10</sub>	= 3.5 fps
V <sub>50</sub>	= 2.1 fps
V <sub>100</sub>	= 1.71 fps
DESIGN SERVICE LIFE	= 75 YRS.
pH	= 7.01
ABRASION LEVEL:	1
EXISTING STRUCTURE	
SFN	3115275
TYPE:	12'x9' REINFORCED CONCRETE CULVERT
SKEW:	15°45' L.F.
ALIGNMENT:	TANGENT
LENGTH:	276 FT
DATE BUILT:	1966

FILL BELOW OHWM FOR STREAM SLOB			
MATERIAL	LENGTH (FT)	SURFACE AREA (ACRE)	VOLUME (CY)
CONCRETE	49	0.0146	12

FOR CONTINUATION, SEE SHEET 1 / 2

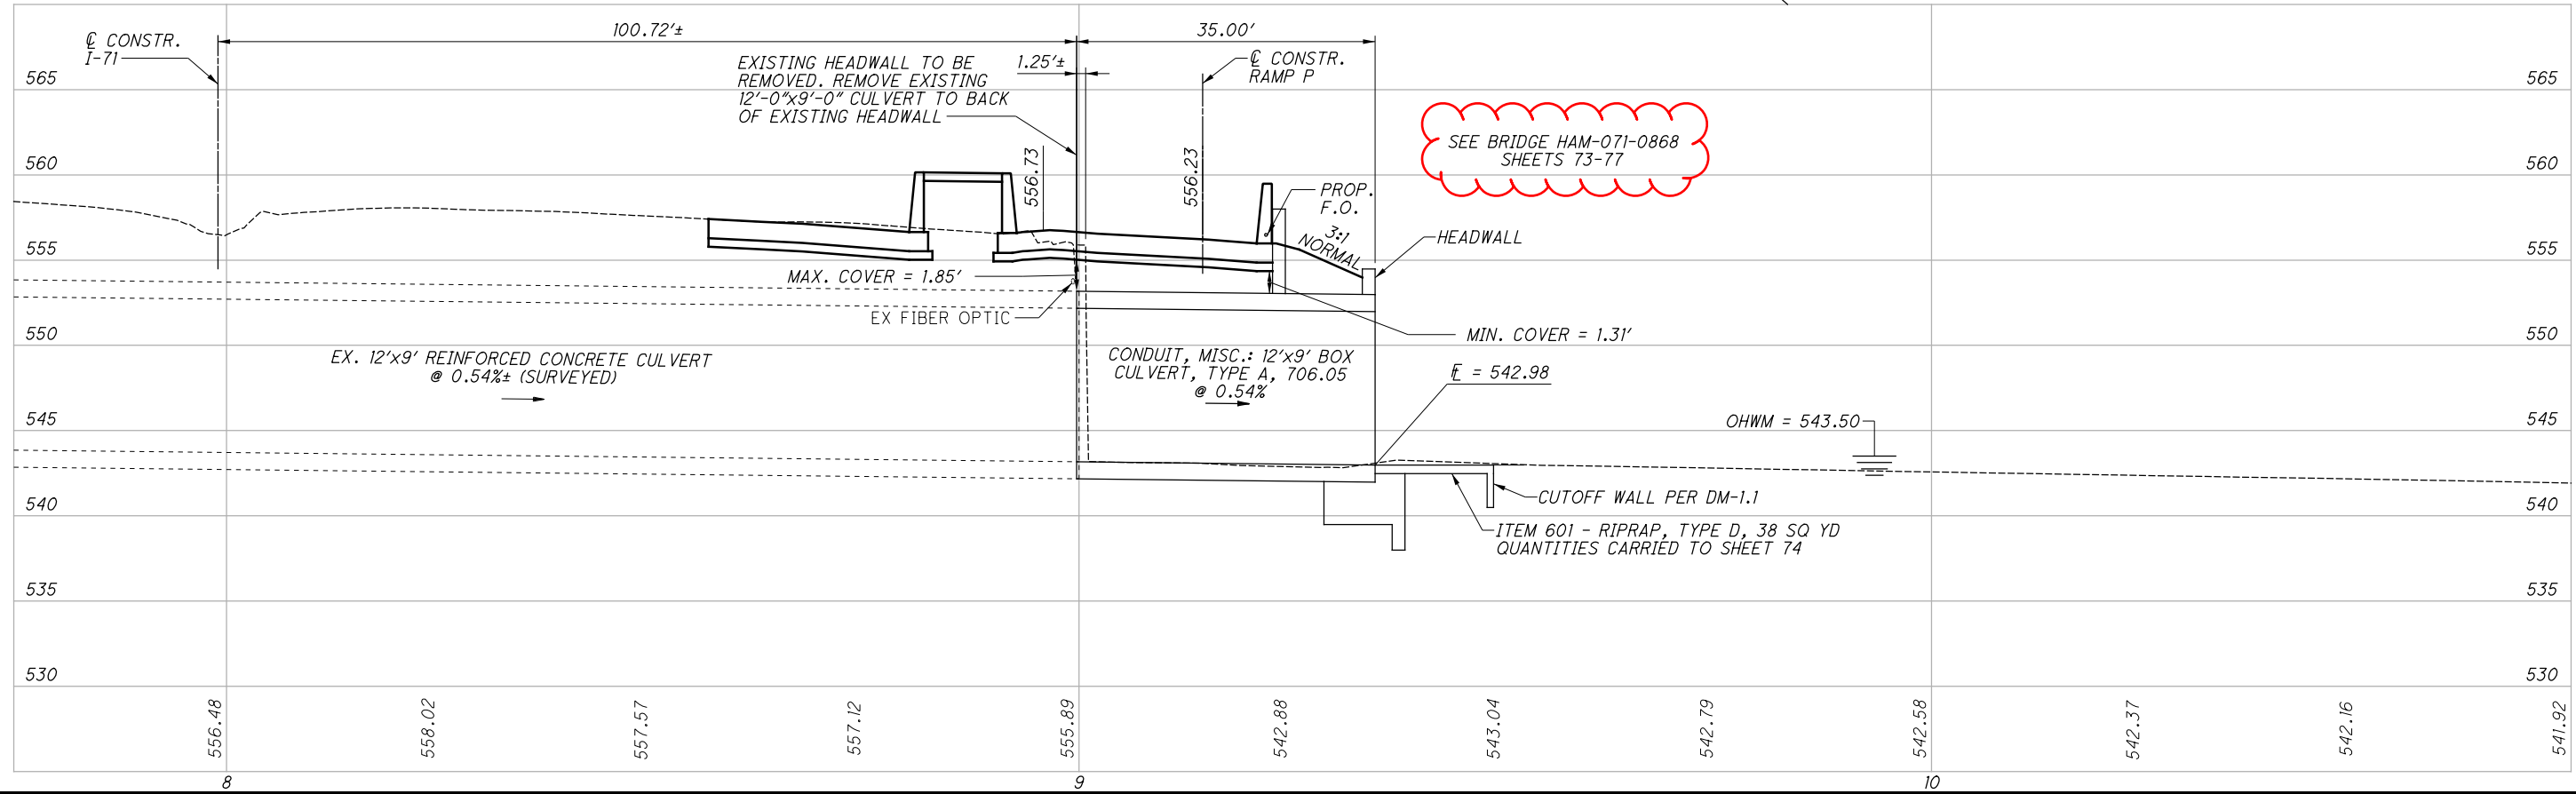

**CULVERT DETAIL**  
**I-71 STA. 413+52.17**

**HAM-71-6.86**

2 / 2

72 / 129

V:\1736\active\173620049\engineering\114992\Design\Drainage\Sheets\114992\_EQ001.dgn 8/18/2023 9:22:26 AM eadkins

ESTIMATED QUANTITIES - CARRIED TO GENERAL SUMMARY

ITEM	ITEM EXTENSION	TOTAL	UNIT	DESCRIPTION	AS PER PLAN SHEET NUMBER
202	11201	LUMP		PORTIONS OF STRUCTURE REMOVED, AS PER PLAN	1 / 5
503	11100	LUMP		COFFERDAMS AND EXCAVATION BRACING	
503	21301	LUMP		UNCLASSIFIED EXCAVATION, AS PER PLAN	1 / 5
509	10000	10121	POUND	EPOXY COATED REINFORCING STEEL	
511	46210	91	CU YD	CLASS QC1 CONCRETE, RETAINING/WINGWALL INCLUDING FOOTING	
511	46611	2	CU YD	CLASS QC1 CONCRETE, HEADWALL, AS PER PLAN	
512	10100	68	SQ YD	SEALING OF CONCRETE SURFACES (EPOXY-URETHANE)	
512	33000	150	SQ YD	TYPE 2 WATERPROOFING	
516	13600	38	SQ FT	1" PREFORMED EXPANSION JOINT FILLER	
518	21200	12	CU YD	POROUS BACKFILL WITH GEOTEXTILE FABRIC	
601	11000	38	SQ YD	RIPRAP, TYPE D	
611	97400	35	FT	CONDUIT, MISC.: 12' X 9' CONDUIT, TYPE A, 706.05, DESIGN COVER 3 FT, AS PER PLAN	1 / 5

QUANTITIES COMPUTED BY: JBR 8/16  
 QUANTITIES CHECKED BY: AMT 3/17

**ESTIMATED QUANTITIES**  
 BRIDGE No. HAM-071-0868  
 I-71 OVER TRIBUTARY OF DUCK CREEK

**HAM-71-8.65**  
 PID No. 114992


2 / 5

74  
129

DESIGNED	DRAWN	REVIEWED	DATE
AMT	MNM	DWS	7-17
CHECKED	REVISED	STRUCTURE FILE NUMBER	
SJM	JWG	3115275	


DESIGN AGENCY  
 LIB Inc. • 2500 Newmark Drive  
 Marietta, OH 45754  
 (937) 256-5000 (tel) • (937) 256-5100 (fax) • LIBinc.com

V:\1736\active\173620049\engineering\114992\Design\Drainage\Sheets\114992\_SD001.dgn 8/18/2023 9:22:55 AM eadkins

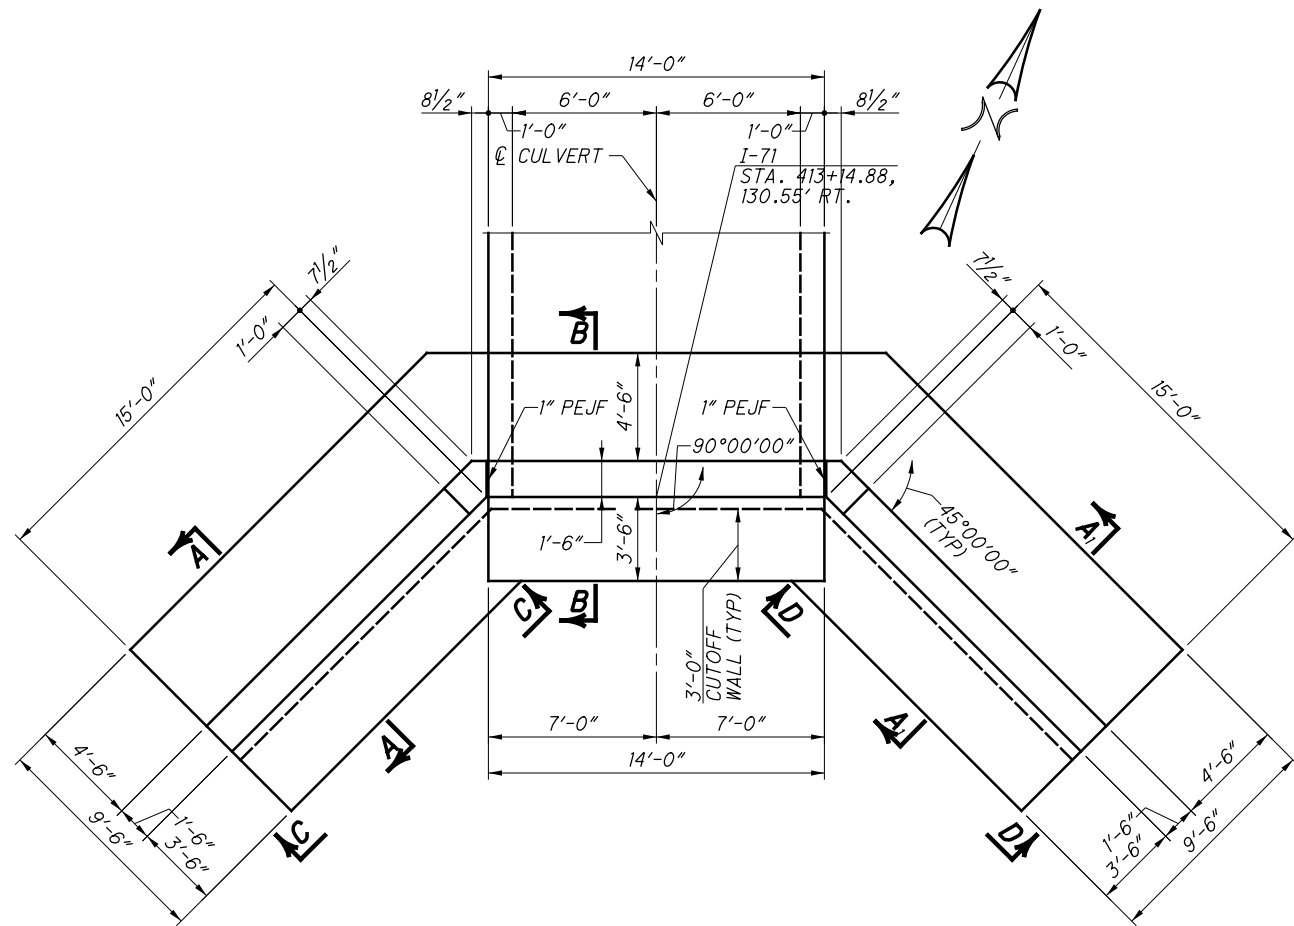


**HEADWALL AND WINGWALL PLAN**

FOR 6" REINFORCED CONCRETE  
RIPRAP LIMITS, SEE SHEET

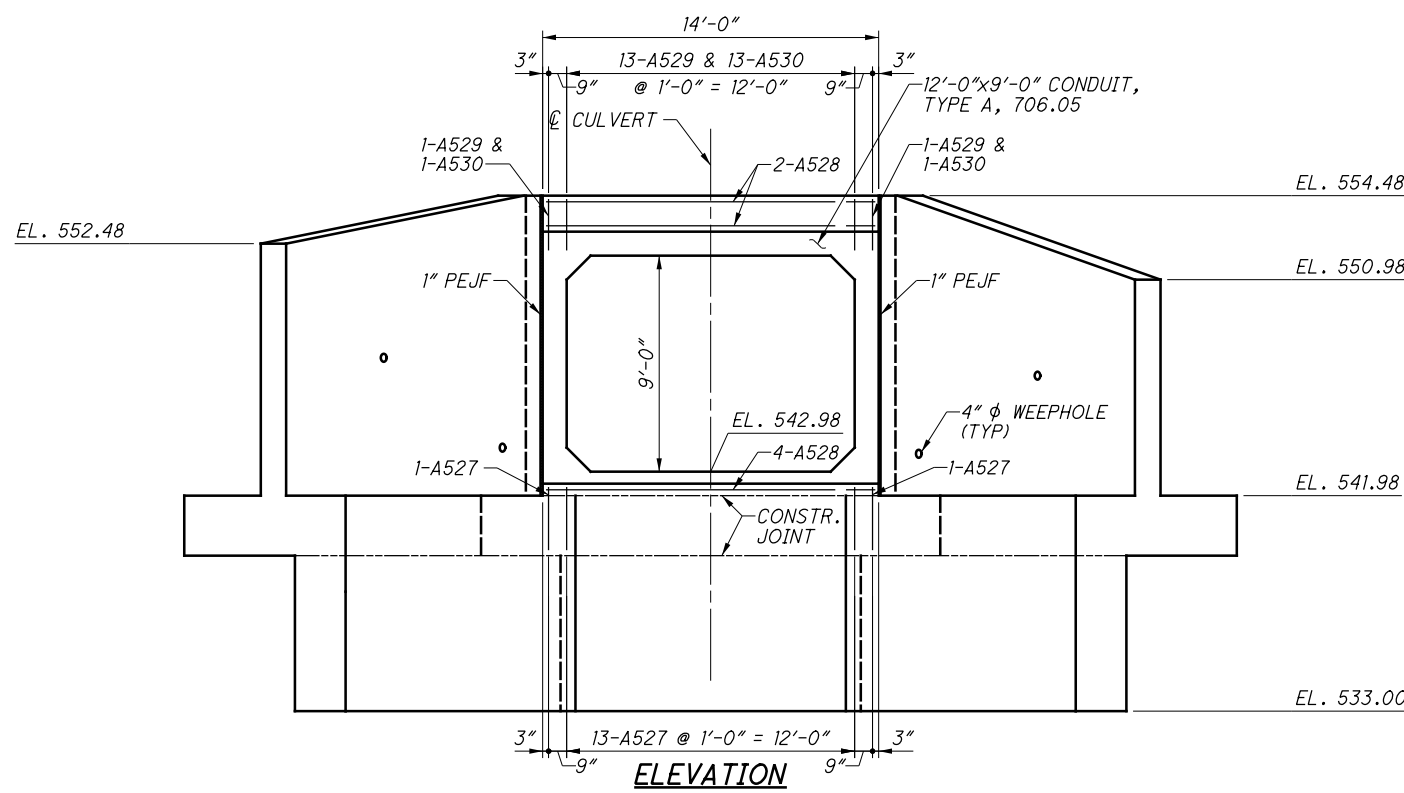

**ELEVATION**

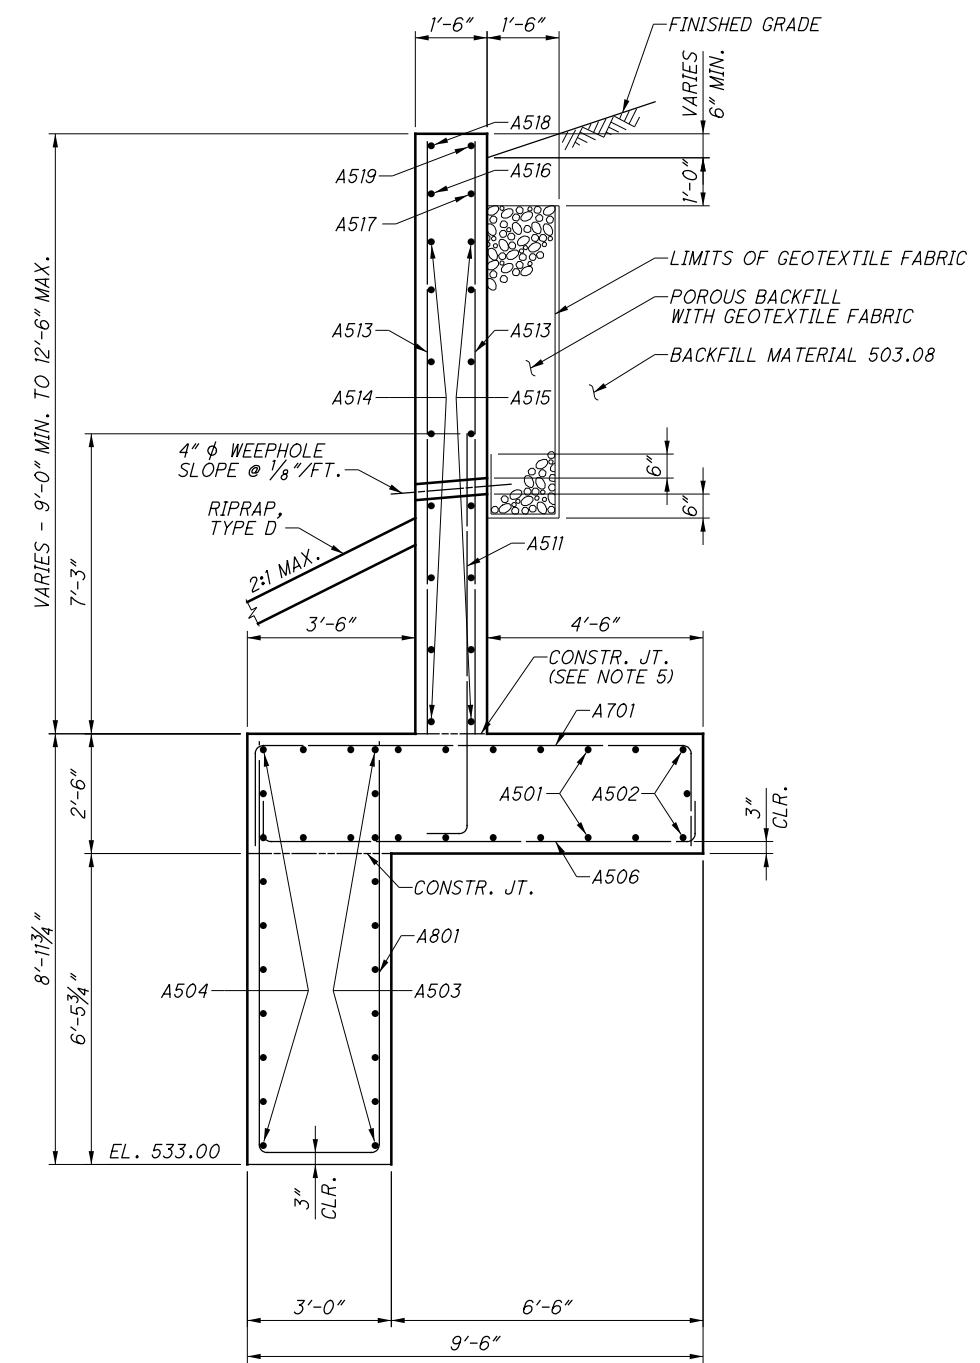

**SECTION A-A**

(SECTION A<sub>1</sub>-A<sub>1</sub> SIMILAR)

**LEGEND**

PEJF = PREFORMED EXPANSION  
JOINT FILLER

**NOTES**

1. FOR GENERAL NOTES, SEE SHEET 1 / 5.
2. FOR REINFORCING STEEL LIST, SEE SHEET 5 / 5.
3. FOR SECTION B-B, SEE SHEET 4 / 5.
4. FOR VIEWS C-C AND D-D, SEE SHEET 4 / 5.
5. THE INTERFACE BETWEEN THE TOP OF FOOTING AND BASE OF WINGWALL STEM SHALL BE INTENTIONALLY ROUGHENED TO A FULL AMPLITUDE OF APPROXIMATELY 1/4" BY MEANS OF A SERRATED TROWEL.

<b>DESIGN AGENCY</b> LIB Inc. • 2500 Newmark Drive Miamisburg, OH 45342 1937 254-0000 (tel.) • 1937 254-5100 (fax) • libinc.com		<b>DATE</b> 7-17
		<b>REVIEWED</b> DWS
<b>DESIGNED</b> AMT	<b>STRUCTURE FILE NUMBER</b> 3115275	<b>DATE</b> 7-17
<b>CHECKED</b> SUM	<b>REVISIONS</b> JWG	<b>REVIEWED</b> DWS
<b>HEADWALL AND WINGWALL PLAN, ELEVATION AND SECTION DETAIL</b>		
BRIDGE No. HAM-071-0868 I-71 OVER TRIBUTARY OF DUCK CREEK		
<b>HAM-71-8.65</b>	<b>PID No. 114992</b>	3 / 5
129		75