

LOCATION MAP

LATITUDE: 39°14'27" LONGITUDE: -84°46'19"



PORTION TO BE IMPROVED	=====
INTERSTATE HIGHWAY	=====
FEDERAL ROUTES	=====
STATE ROUTES	=====
COUNTY & TOWNSHIP ROADS	=====
OTHER ROADS	-----

DESIGN DESIGNATION	DRY FORK RD. N OF I-74	DRY FORK RD. S OF I-74	I-74 RAMP 'C'	I-74 RAMP 'D'
CURRENT ADT (2026)	7465	9161	6556	6609
DESIGN YEAR ADT (2046)	12333	15256	9411	10354
DESIGN HOURLY VOLUME (2046)	1233	1526	941	1035
DIRECTIONAL DISTRIBUTION	0.59	0.53	N/A	N/A
TRUCKS (24 HOUR B&C)	4%	4%	8%	8%
DESIGN SPEED	40 MPH	40 MPH	N/A	N/A
LEGAL SPEED	35 MPH	35 MPH	N/A	N/A
DESIGN FUNCTIONAL CLASSIFICATION:	MAJOR COLLECTOR (URBAN)	MINOR ARTERIAL (URBAN)	INTERSTATE (URBAN)	INTERSTATE (URBAN)
NHS PROJECT	YES			

DESIGN EXCEPTIONS

NONE

ADA DESIGN WAIVERS

NONE REQUIRED

UNDERGROUND UTILITIES
Contact Two Working Days Before You Dig

OHIO811, 8-1-1, or 1-800-362-2764 (Non members must be called directly)

PLAN PREPARED BY:
TEC ENGINEERING
7288 CENTRAL PARKE BLVD.
MASON, OH 45040

STATE OF OHIO
DEPARTMENT OF TRANSPORTATION

HAM-CR14-3.49 Dry Fork Rd

CITY OF HARRISON
HARRISON TOWNSHIP
HAMILTON COUNTY

INDEX OF SHEETS:

TITLE SHEET	1
SCHEMATIC PLAN	2
TYPICAL SECTIONS	3-6
GENERAL NOTES	7-8
MAINTENANCE OF TRAFFIC	9-18
GENERAL SUMMARY	19-23
SUBSUMMARY	24-26
PROJECT SITE PLAN	27
PLAN AND PROFILE - DRY FORK RD (C.R.14)	28-29
PLAN AND PROFILE - RAMPS	30-35
CROSS SECTIONS - DRY FORK RD (C.R.14)	36-53
CROSS SECTIONS - RAMPS	54-77
INTERSECTION DETAILS	78-80
PAVEMENT JOINT DETAILS	81-82
STORM SEWER	83-85
GUARDRAIL PLAN	86-89
TRAFFIC CONTROL - SUBSUMMARY	90-92
TRAFFIC CONTROL - DRY FORK RD (C.R.14)	93-94
TRAFFIC CONTROL - RAMPS	95-96
SIGN ELEVATION VIEW	97-100
TRAFFIC SIGNAL PLAN	101-113
LIGHTING PLAN	114-122
STRUCTURE PLAN	123-159
SOIL PROFILES	160-172

STANDARD CONSTRUCTION DRAWINGS												SUPPLEMENTAL SPECIFICATIONS		SPECIAL PROVISIONS	
BP-1.1	7/28/00	MGS-1.1	1/17/25	AS-1-15	1/20/23	MT-95.30	7/18/25	TC-9.11	1/9/24	TC-74.10	7/21/23	800-2023	7/18/25		
BP-2.1	1/21/22	MGS-2.1	7/18/25	AS-2-15	7/21/23	MT-95.45	7/21/23	TC-12.31	7/18/25	TC-81.22	1/17/25	809	7/18/25		
BP-2.2	1/15/21	MGS-3.1	7/18/25			MT-95.50	7/21/17	TC-21.21	7/18/25	TC-83.10	1/17/20	813	7/21/23		
BP-2.5	7/19/24	MGS-3.2	7/18/25	BR-2-15	7/19/24	MT-98.20	4/19/19	TC-22.10	1/17/25	TC-83.20	7/18/25	825	7/19/24		
BP-3.1	1/19/24	MGS-4.2	7/18/25			MT-98.21	7/21/23	TC-22.20	7/18/25	TC-85.10	1/19/24	832	7/18/25		
BP-5.1	7/18/25	MGS-4.3	7/18/25	GSD-1-19	7/19/24	MT-98.28	1/17/20	TC-41.10	7/19/13	TC-85.20	4/21/23	869	10/17/14		
BP-6.1	7/19/13	MGS-5.2	7/15/16			MT-98.29	1/17/20	TC-41.20	10/18/13			875	1/17/25		
BP-7.1	7/18/25	MGS-5.3	7/15/16	PCB-91	7/17/20	MT-99.30	7/18/25	TC-41.30	4/21/23	ITS-12.50	1/17/25	878	1/21/22		
BP-8.1	7/19/24	MGS-6.1	1/19/18			MT-101.60	1/17/25	TC-41.50	10/18/13			909	7/18/25		
				SBR-1-20	7/19/24	MT-101.70	7/19/24	TC-42.10	10/18/13	HL-10.11	7/21/23	913	4/16/21		
DM-1.1	1/17/25					MT-101.75	7/21/23	TC-42.20	10/18/13	HL-10.12	7/21/23				
DM-1.2	1/17/25			SICD-1-96	7/18/14	MT-101.90	7/17/20	TC-51.11	7/18/25	HL-10.13	1/20/23				
DM-4.1	7/17/20			SICD-2-14	1/15/21	MT-103.10	7/18/25	TC-52.10	10/18/13	HL-20.11	7/18/25				
DM-4.2	7/20/12	CB-3A	7/19/24			MT-105.10	1/17/20	TC-52.20	1/15/21	HL-30.11	7/21/23				
DM-4.3	1/15/16			VPF-1-90	7/19/24	MT-110.10	7/19/13	TC-61.30	7/19/24	HL-30.21	4/17/20				
DM-4.4	1/15/16							TC-65.10	1/17/14	HL-30.22	1/17/25				
		RM-4.3	7/18/25	HW-2.1	7/15/22			TC-65.11	1/17/25	HL-40.20	7/18/25				
		RM-4.4	1/17/25	HW-2.2	7/20/18			TC-71.10	7/18/25	HL-50.21	7/15/22				
		RM-4.5	7/18/25					TC-72.20	7/18/25	HL-60.11	7/21/17				
		RM-4.6	7/18/25					TC-73.20	1/17/25	HL-60.31	7/19/24				

FEDERAL PROJECT NUMBER

231052

RAILROAD INVOLVEMENT

NONE

PROJECT DESCRIPTION

WIDENING OF DRY FORK ROAD (C.R.14) BRIDGE OVER I.R.74 FOR LEFT TURN LANES. WIDENING I.R.74 WESTBOUND OFF-RAMP "D" TO EXTEND SECOND LANE BACK TO THE GORE AREA. WIDENING I.R. 74 EASTBOUND ON-RAMP "C" FOR ADDITIONAL RECEIVING LANE. ADD SIDEWALK ON WEST SIDE OF THE BRIDGE.

EARTH DISTURBED AREAS

PROJECT EARTH DISTURBED AREA:	3.92 ACRES
ESTIMATED CONTRACTOR EARTH DISTURBED AREA:	0.00 ACRES
NOTICE OF INTENT EARTH DISTURBED AREA:	3.92 ACRES

LIMITED ACCESS

THIS IMPROVEMENT IS ESPECIALLY DESIGNED FOR THROUGH TRAFFIC AND HAS BEEN DECLARED A LIMITED ACCESS HIGHWAY OR FREEWAY BY ACTION OF THE DIRECTOR IN ACCORDANCE WITH THE PROVISIONS OF SECTION 5511.02 OF THE OHIO REVISED CODE.

2023 SPECIFICATIONS

THE STANDARD SPECIFICATIONS OF THE STATE OF OHIO, DEPARTMENT OF TRANSPORTATION, INCLUDING SUPPLEMENTAL SPECIFICATIONS LISTED IN THE PLANS, CHANGES LISTED IN THE PROPOSAL, AND THE SUPPLEMENTAL SPECIFICATION 800 VERSION INDICATED ON THE PROPOSAL SHALL GOVERN THIS IMPROVEMENT.

I HEREBY APPROVE THESE PLANS AND DECLARE THAT THE MAKING OF THIS IMPROVEMENT WILL REQUIRE THE CLOSING TO TRAFFIC OF THE HIGHWAY AND THAT DETOURS WILL BE PROVIDED AS INDICATED ON SHEET 008.

DISTRICT DEPUTY DIRECTOR

Douglas A. Gruver
Douglas A. Gruver, P.E.
District 08 Deputy Director

DIRECTOR, DEPARTMENT OF TRANSPORTATION

Pamela Boratyn
Pamela Boratyn


ENGINEER'S SEAL:

BRIDGE NO. HAM-74-0358



SIGNED: *Christopher L. Bettinger*
DATE: 8/2/2025

ENGINEER'S SEAL:

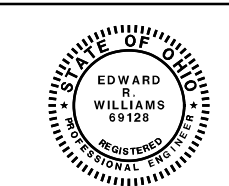

SIGNED: _____
DATE: _____


REVISED ON
11/25/25

DESIGN AGENCY	TEC
PLANNED BY:	TEC Engineering, Inc.
7288 Central Parke Blvd.	Mason, OH 45040
DESIGNER	KLL
REVIEWER	ERW
PROJECT ID	118472
SHEET	001
TOTAL	172

SHEET NUM.											PART.			ITEM	ITEM EXT	GRAND TOTAL	UNIT	DESCRIPTION	SEE SHEET NO.
7	8	11	24	25	26	90	91	92	105	114	01/MPO/HARR	02/BRO/HARR	03/SAF/HARR						
																		ROADWAY	
											LS			201	11000	LS	CLEARING AND GRUBBING		
			8,077								8,077			202	23000	8,077	SY	PAVEMENT REMOVED	
			216								216			202	30700	216	FT	CONCRETE BARRIER REMOVED	
			1,894								1,894			202	38000	1,894	FT	GUARDRAIL REMOVED	
			10								10			202	42207	10	EACH	ANCHOR ASSEMBLY REMOVED, AS PER PLAN	8
			4								4			202	47001	4	EACH	BRIDGE TERMINAL ASSEMBLY REMOVED, AS PER PLAN	8
			7								7			202	98100	7	EACH	REMOVAL MISC.: LOOP DETECTORS	8
											4,800			203	10000	4,800	CY	EXCAVATION	
											7,600			203	20000	7,600	CY	EMBANKMENT	
											11,692			204	10000	11,692	SY	SUBGRADE COMPACTION	
											3,778			204	13000	3,778	CY	EXCAVATION OF SUBGRADE, 12"	
											3,778			204	30020	3,778	CY	GRANULAR MATERIAL, TYPE C, 12"	
	4										4			204	45000	4	HOUR	PROOF ROLLING	
											11,327			204	50000	11,327	SY	GEOTEXTILE FABRIC	
			2								2			606	60028	2	EACH	IMPACT ATTENUATOR, TYPE 2 (BIDIRECTIONAL), 36"	
			1,162.5								1,162.5			606	15050	1,162.5	FT	GUARDRAIL, TYPE MGS	
			250								250			606	15100	250	FT	GUARDRAIL, TYPE MGS WITH LONG POSTS	
			50								50			606	15200	50	FT	GUARDRAIL, TYPE MGS HALF POST SPACING WITH LONG POSTS	
			6								6			606	26150	6	EACH	ANCHOR ASSEMBLY, MGS TYPE E, MASH 2016	8
			8								8			606	26550	8	EACH	ANCHOR ASSEMBLY, MGS TYPE T	
			4								4			606	35002	4	EACH	MGS BRIDGE TERMINAL ASSEMBLY, TYPE 1	
			2								2			606	35102	2	EACH	MGS BRIDGE TERMINAL ASSEMBLY, TYPE 2	
			949								949			608	12000	949	SF	5" CONCRETE WALK	
			315								315			608	52000	315	SF	CURB RAMP	
			2								2			622	25050	2	EACH	CONCRETE BARRIER, END ANCHORAGE, REINFORCED, TYPE D	
			316								316			622	10060	316	FT	CONCRETE BARRIER, SINGLE SLOPE, TYPE B	
			198								198			622	10160	198	FT	CONCRETE BARRIER, SINGLE SLOPE, TYPE D	
			2								2			622	25000	2	EACH	CONCRETE BARRIER END SECTION, TYPE D	
			2								2			622	25004	2	EACH	CONCRETE BARRIER, END ANCHORAGE, REINFORCED, TYPE B	
														EROSION CONTROL					
				4							4			601	21050	4	SY	TIED CONCRETE BLOCK MAT WITH TYPE 1 UNDERLAYMENT	
				1							1			601	32200	1	CY	ROCK CHANNEL PROTECTION, TYPE C WITH FILTER	
1,010											1,010			659	00300	1,010	CY	TOPSOIL	
9,097											9,097			659	10000	9,097	SY	SEEDING AND MULCHING	
455											455			659	14000	455	SY	REPAIR SEEDING AND MULCHING	
1.23											1.23			659	20000	1.23	TON	COMMERCIAL FERTILIZER	
1.88											1.88			659	31000	1.88	ACRE	LIME	
49											49			659	35000	49	MGAL	WATER	
21											21			659	40000	21	MSF	MOWING	
											LS			832	15000	LS		STORM WATER POLLUTION PREVENTION PLAN	
											LS			832	15002	LS		STORM WATER POLLUTION PREVENTION INSPECTIONS	
											LS			832	15010	LS		STORM WATER POLLUTION PREVENTION INSPECTION SOFTWARE	
											30,000			832	30000	30,000	EACH	EROSION CONTROL	
														DRAINAGE					
				2.1							2.1			602	20000	2.1	CY	CONCRETE MASONRY	
				4,082							4,082			605	14000	4,082	FT	6" BASE PIPE UNDERDRAINS	
				12							12			611	97400	12	FT	CONDUIT, MISC.: 33" CONDUIT, TYPE C	
				1							1			611	98450	1	EACH	CATCH BASIN, NO. 2-2A	8
				227							227			611	04600	227	FT	12" CONDUIT, TYPE C	
				105							105			611	13600	105	FT	30" CONDUIT, TYPE C	
				4							4			611	98180	4	EACH	CATCH BASIN, NO. 3A	
				1							1			611	99574	1	EACH	MANHOLE, NO. 3	
				2							2			611	99710	2	EACH	PRECAST REINFORCED CONCRETE OUTLET	


REVISION 11/25/25

GENERAL SUMMARY

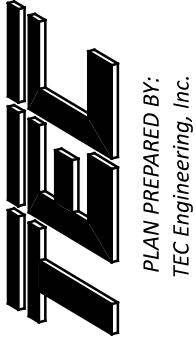DESIGN AGENCY

 PLAN PREPARED BY:
 TEL Engineering, Inc.
 7288 Central Parke Blvd.
 Mason, OH 45040
 DESIGNER
 KLL
 REVIEWER
 ERW 12/01/25
 PROJECT ID
 118472
 SHEET TOTAL
 019 | 172

SHEET NUM.											PART.			ITEM	ITEM EXT	GRAND TOTAL	UNIT	DESCRIPTION	SEE SHEET NO.
7	8	11	24	25	26	90	91	92	105	114	01/MPO/HARR	02/BRO/HARR	03/SAF/HARR						
					1,015						1,015			254	01000	1,015	SY	PAVEMENT PAVEMENT PLANING, ASPHALT CONCRETE, 3.75" DEPTH	
					754						754			301	56000	754	CY	ASPHALT CONCRETE BASE, PG64-22, (449), 6"	
					1,953						1,953			304	20000	1,953	CY	AGGREGATE BASE, 6"	
					124						124			305	13010	124	SY	9" CONCRETE BASE, CLASS QC 1P (REINFORCED)	
					755						755			407	20000	755	GAL	NON-TRACKING TACK COAT	
					244						244			442	20000	244	CY	ASPHALT CONCRETE SURFACE COURSE, 12.5 MM, TYPE A (448), 1.5"	
			REVISION 11/25/25		407						407			442	20200	407	CY	ASPHALT CONCRETE INTERMEDIATE COURSE, 19 MM, TYPE A (448), 2.25"	
					6,323						6,323			452	15010	6,323	SY	12" NON-REINFORCED CONCRETE PAVEMENT, CLASS QC 1P	
					75						75			609	23001	75	FT	COMBINATION CURB AND GUTTER, TYPE 4, AS PER PLAN	8
					426						426			609	26000	426	FT	CURB, TYPE 6	
																		LIGHTING	
									4	28	28		4	625	00450	32	EACH	CONNECTION, FUSED PULL APART	
									8	14	14		8	625	00460	22	EACH	CONNECTION, UNFUSED PULL APART	
									6	24	24		6	625	00480	30	EACH	CONNECTION, UNFUSED PERMANENT	
										14	14			625	10491	14	EACH	LIGHT POLE, CONVENTIONAL, AS PER PLAN, AT15B36	115
										14	14			625	14000	14	EACH	LIGHT POLE FOUNDATION, 24" X 6' DEEP	
										330	330			625	22910	330	FT	NO. 2/0 AWG 2400 VOLT DISTRIBUTION CABLE	
										1,965	1,965			625	23100	1,965	FT	NO. 2 AWG 600 VOLT DISTRIBUTION CABLE	
									264	2,562	2,562		264	625	23400	2,826	FT	NO. 10 AWG POLE AND BRACKET CABLE	
										6,080	6,080			625	24330	6,080	FT	1-1/2" DUCT CABLE WITH THREE NO. 2 AWG 2400 VOLT CABLES	
										131	131			625	25400	131	FT	CONDUIT, 2", 725.04	
										544	544			625	25902	544	FT	CONDUIT, JACKED OR DRILLED, 725.04, 3"	
										14	14			625	26253	14	EACH	LUMINAIRE, CONVENTIONAL, SOLID STATE (LED), AS PER PLAN, 240v, 17000-20000 LUMENS	115
									243	6,211	6,211		243	625	29002	6,454	FT	TRENCH, 24" DEEP	
										9	9			625	30700	9	EACH	PULL BOX, 725.08, 18"	
									13	15	15		13	625	32000	28	EACH	GROUND ROD	
										1	1			625	34001	1	EACH	POWER SERVICE, AS PER PLAN	115
										6,211	6,211			625	36010	6,211	FT	UNDERGROUND WARNING/MARKING TAPE	
										1	1			625	76000	1	EACH	ARC FLASH CALCULATIONS AND LABEL, LCC	
										47	50			621	00100	97	EACH	TRAFFIC CONTROL RPM	
			17								17			626	00110	17	EACH	BARRIER REFLECTOR, TYPE 2, ONE-WAY	
											16			630	08530	16	FT	STREET NAME SIGN SUPPORT, NO. 4 POST	
											165			630	03100	165	FT	GROUND MOUNTED SUPPORT, NO. 3 POST	
											43.4			630	06500	43.4	FT	GROUND MOUNTED STRUCTURAL BEAM SUPPORT, W6X9	
											162			630	08004	162	FT	ONE WAY SUPPORT, NO. 3 POST	
											13			630	08600	13	EACH	SIGN POST REFLECTOR	
											2			630	09000	2	EACH	BREAKAWAY STRUCTURAL BEAM CONNECTION	
											6		6	630	79100	6	EACH	SIGN HANGER ASSEMBLY, MAST ARM	
										225.9	45.5		45.5	630	80100	271.4	SF	SIGN, FLAT SHEET	
										344	344			630	80200	344	SF	SIGN, GROUND MOUNTED EXTRUSHEET	
										2	2			630	80500	2	EACH	SIGN, DOUBLE FACED, STREET NAME	
										2	2			630	84500	2	EACH	GROUND MOUNTED STRUCTURAL BEAM SUPPORT FOUNDATION	
										23	23			630	84900	23	EACH	REMOVAL OF GROUND MOUNTED SIGN AND DISPOSAL	
										1	1			630	85100	1	EACH	REMOVAL OF GROUND MOUNTED SIGN AND REERECTION	
										5	5			630	85400	5	EACH	REMOVAL OF GROUND MOUNTED MAJOR SIGN AND DISPOSAL	
										17	17			630	86002	17	EACH	REMOVAL OF GROUND MOUNTED POST SUPPORT AND DISPOSAL	
										10	10			630	86102	10	EACH	REMOVAL OF GROUND MOUNTED STRUCTURAL BEAM SUPPORT AND DISPOSAL	
										85	85			644	00720	85	FT	CHEVRON MARKING	
						0.28	0.03				0.31			644	00104	0.31	MILE	EDGE LINE, 6"	
						0.08	0.12				0.2			644	00300	0.2	MILE	CENTER LINE	

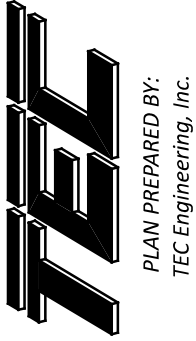GENERAL SUMMARY

DESIGN AGENCY

 PLAN PREPARED BY:
 TEC Engineering, Inc.
 7288 Central Parke Blvd.
 Mason, OH 45040

DESIGNER
KLL


REVIEWER
ERW 12/01/25

PROJECT ID
118472

SHEET TOTAL
020 172

STATION RANGE			TYPICAL SECTION	DISTANCE (D)	AVERAGE WIDTH (W)	SURFACE AREA (A) A=D*W/9	CADD GENERATED AREA	SUBGRADE AREA	204	204	204	204	254	301	304	305	407	411	442	442	452	609	609			
									SUBGRADE COMPACTION	EXCAVATION OF SUBGRADE, 12"	GRANULAR MATERIAL, TYPE C, 12"	GEOTEXTILE FABRIC	PAVEMENT PLANING, ASPHALT CONCRETE, 3.75" DEPTH	ASPHALT CONCRETE BASE, PG64-22, (449), 6"	AGGREGATE BASE, 6"	9" CONCRETE BASE, CLASS QC 1P (REINFORCED)	NON-TRACKING TACK COAT	STABILIZED CRUSHED AGGREGATE, 2"	ASPHALT CONCRETE SURFACE COURSE, 12.5 MM, TYPE A (448), 1.5"	ASPHALT CONCRETE INTERMEDIATE COURSE, 19 MM, TYPE A (448), 2.25"	12" NON-REINFORCED CONCRETE PAVEMENT, CLASS QC 1P	COMBINATION CURB AND GUTTER, TYPE 4, AS PER PLAN	CURB, TYPE 6			
				FT	FT	SQ YD	SQ YD	SQ YD	SY	CY	CY	SY	SY	CY	CY	SY	GAL	CY	CY	CY	SY	FT	FT			
16+87.90	TO	18+51.94	DF	164.04	65.00	1184.73	1164	1209	1209	403	403															
21+55.44	TO	26+75.00	DF	519.56	65.00	3752.38	3002	3100	3100	1034	1034															
25+25.28		26+75.00	DF-P	149.72	20.00	332.71	333	-					333													
0+35.17	TO	6+42.00	RC-C	606.83	34.00	2292.47	2391	2459	2459	820	820															
6+42.00	TO	10+80.00	RC-W	438.00	9.00	438.00	494	519	519	173	173															
6+42.00	TO	10+80.00	RC-P	438.00	14.00	681.33	682	-					682													
0+31.77	TO	9+42.00	RD-C	910.23	34.00	3438.65	3441	3543	3543	1181	1181															
18+29.00	TO	18+54.00		25.00		0.00																				
198+53.00	TO	198+78.00		25.00		0.00																				
199+78.00	TO	200+03.00		25.00		0.00																				
17+56.00	TO	18+51.94	RA-C	95.94	34.00	362.44	229	235	235	79	79															
11+79.00		12+36.00	RB-C	57.00	36.00	228.00	262	262	262	88	88															
198+20.00	TO	200+38.00	RT-B	218.00		0.00	42	121	121					20	21		6		2	7						
			C-B				96	96	96						16											
			LT-B				56	148	148					24	25		8		3	9						
SUBTOTALS									11692	3778	3778		11327	1015	754	1953	124		755		244	407		6323	75	426

PAVEMENT SUBSUMMARY

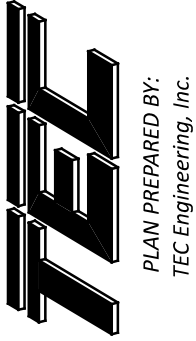
DESIGN AGENCY

 PLAN PREPARED BY:
 TEC Engineering, Inc.
 7288 Central Parke Blvd.
 Mason, OH 45040

DESIGNER
 KLL

REVIEWER
 ERW 12/01/25

PROJECT ID
 118472

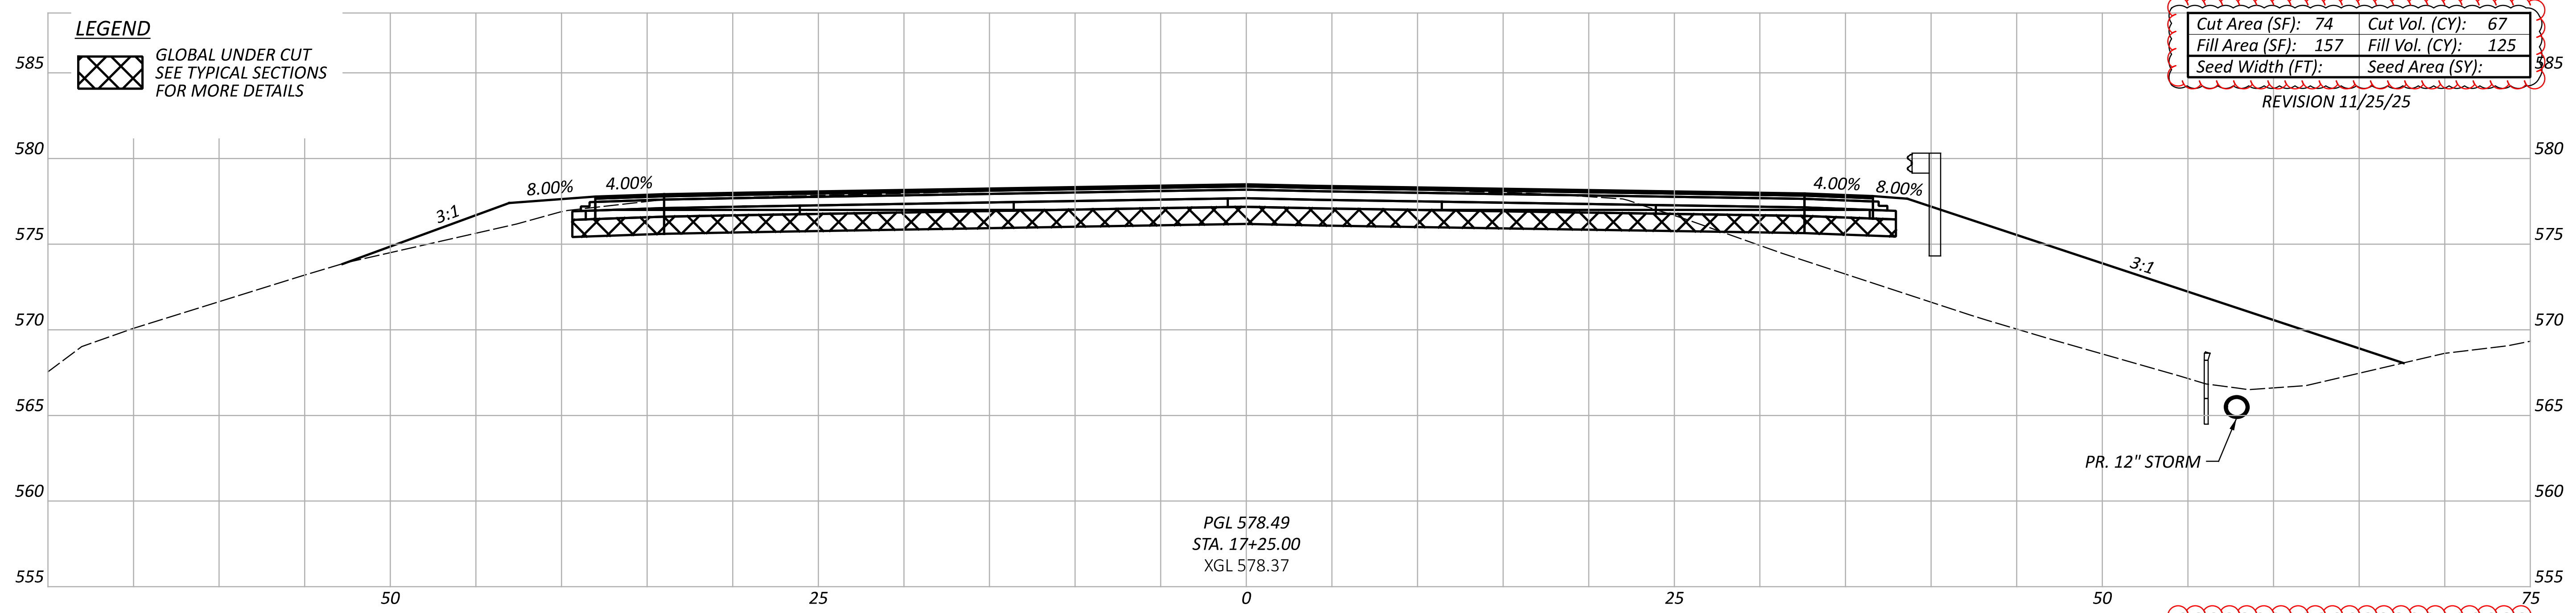
SHEET TOTAL
 026 172



Cut Area (SF): 74	Cut Vol. (CY): 67
Fill Area (SF): 157	Fill Vol. (CY): 125
Seed Width (FT):	Seed Area (SY):

REVISION 11/25/25


PGL 578.49
 STA. 17+25.00
 XGL 578.37

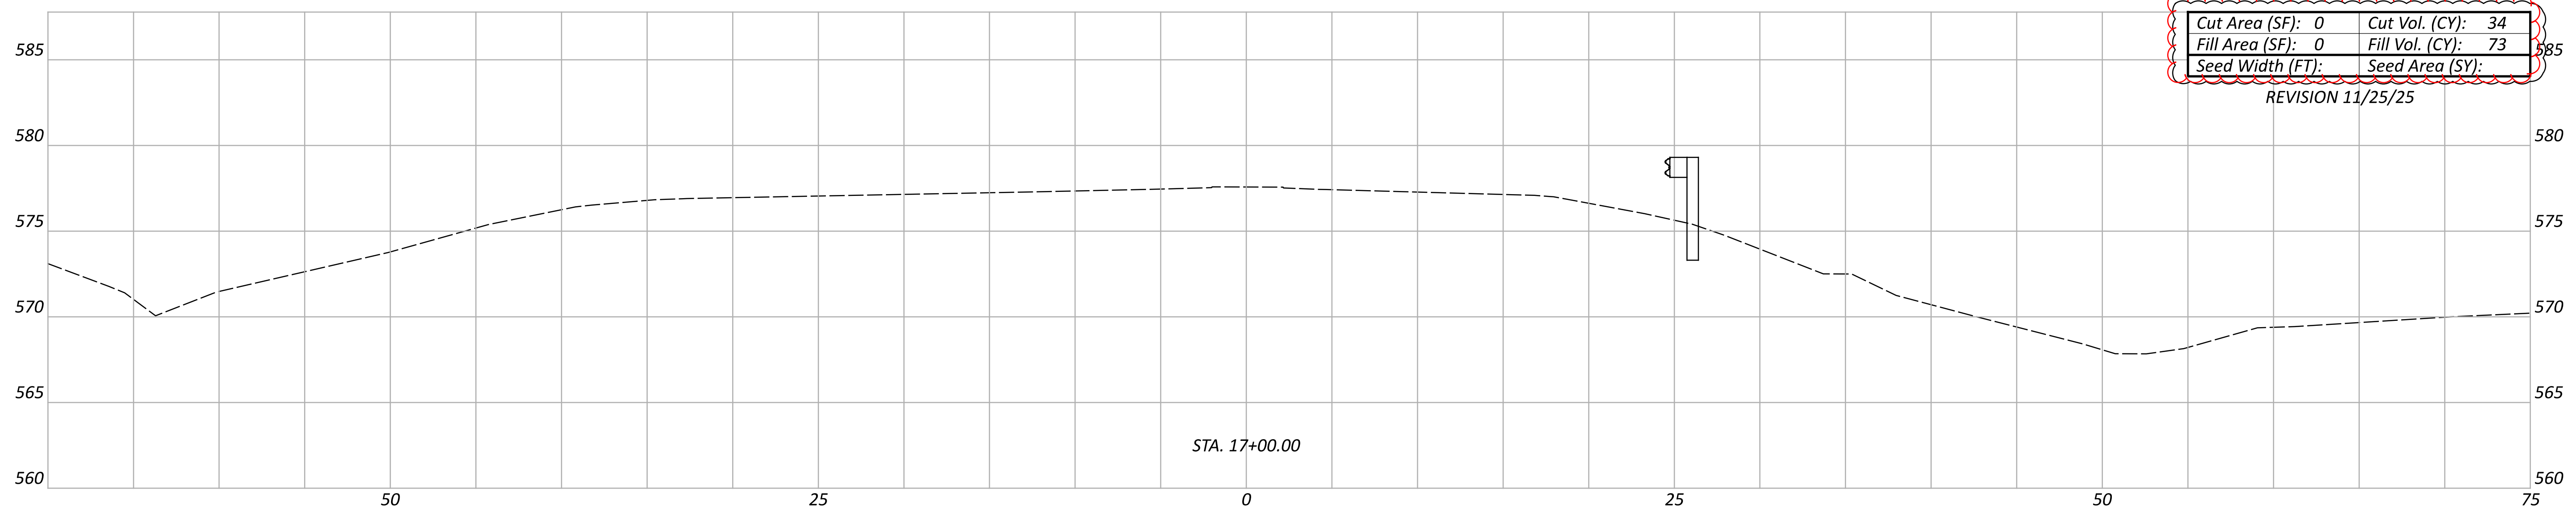

Cut Area (SF): 0	Cut Vol. (CY): 34
Fill Area (SF): 0	Fill Vol. (CY): 73
Seed Width (FT):	Seed Area (SY):


REVISION 11/25/25

STA. 17+00.00

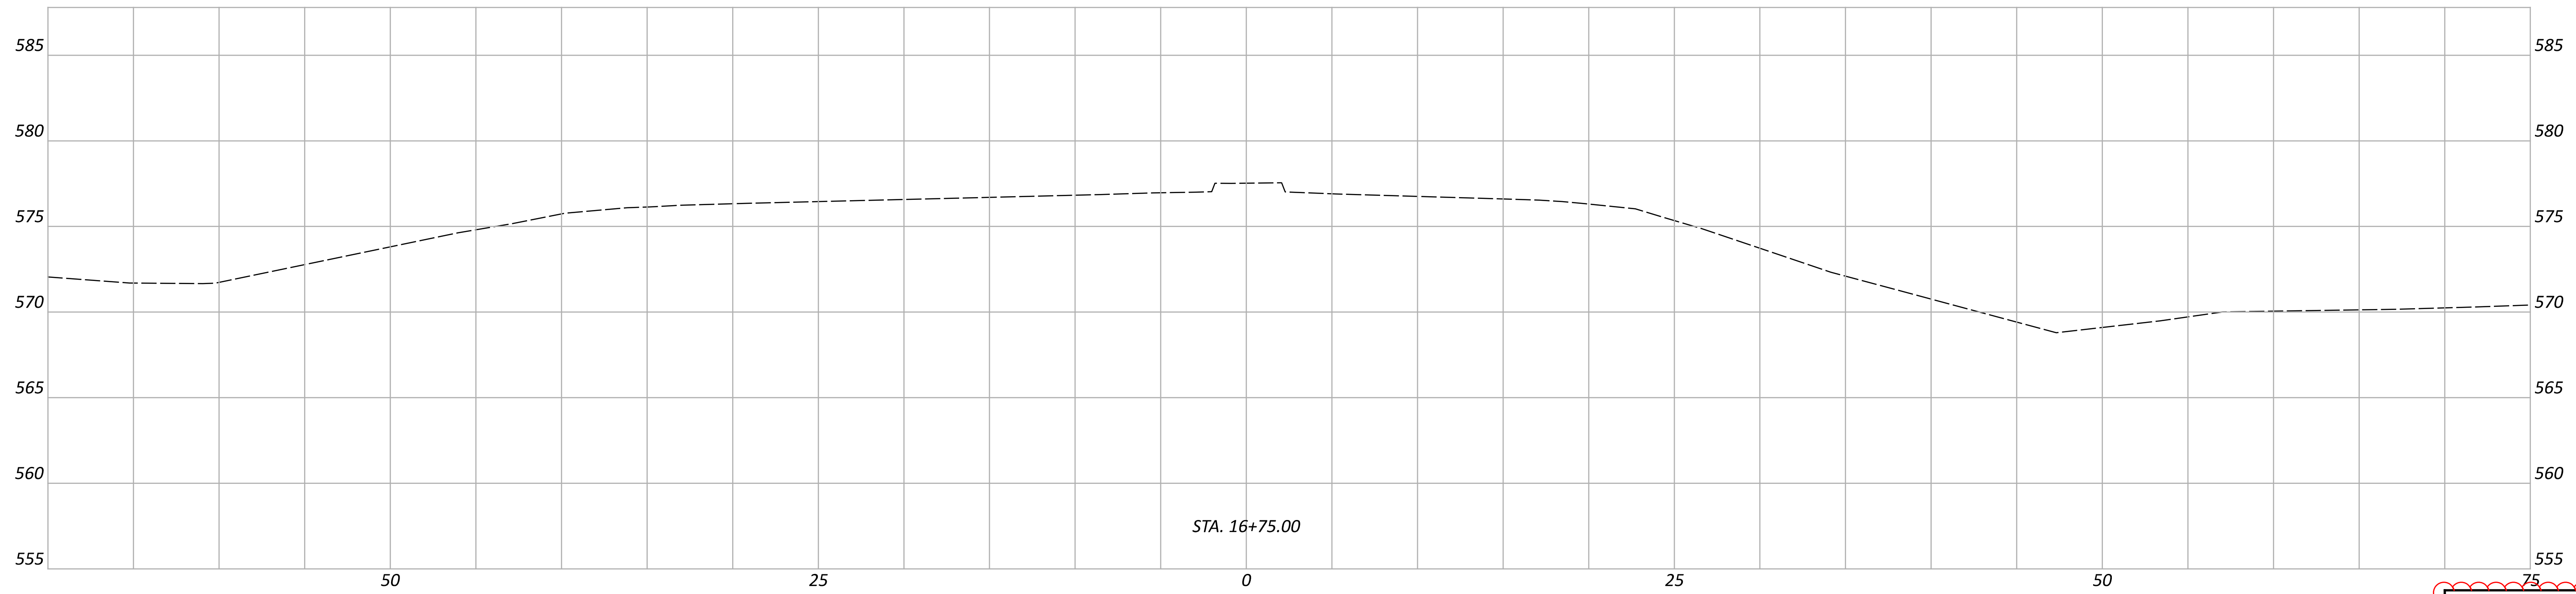



STA. 16+75.00

CROSS SECTIONS - C.R.14 (DRY FORK RD.)
 STA. 16+75 TO 17+25

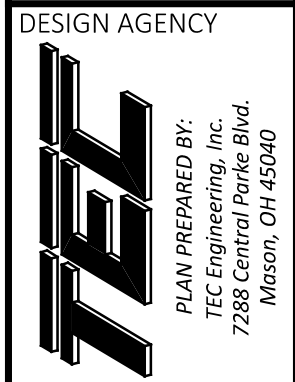

DESIGN AGENCY
 DESIGNER
 KLL
 REVIEWER
 ERW 12/01/25

Sheet Totals			118472	
Seeding	Cut	Fill	SHEET	TOTAL
101	198	036	036	172

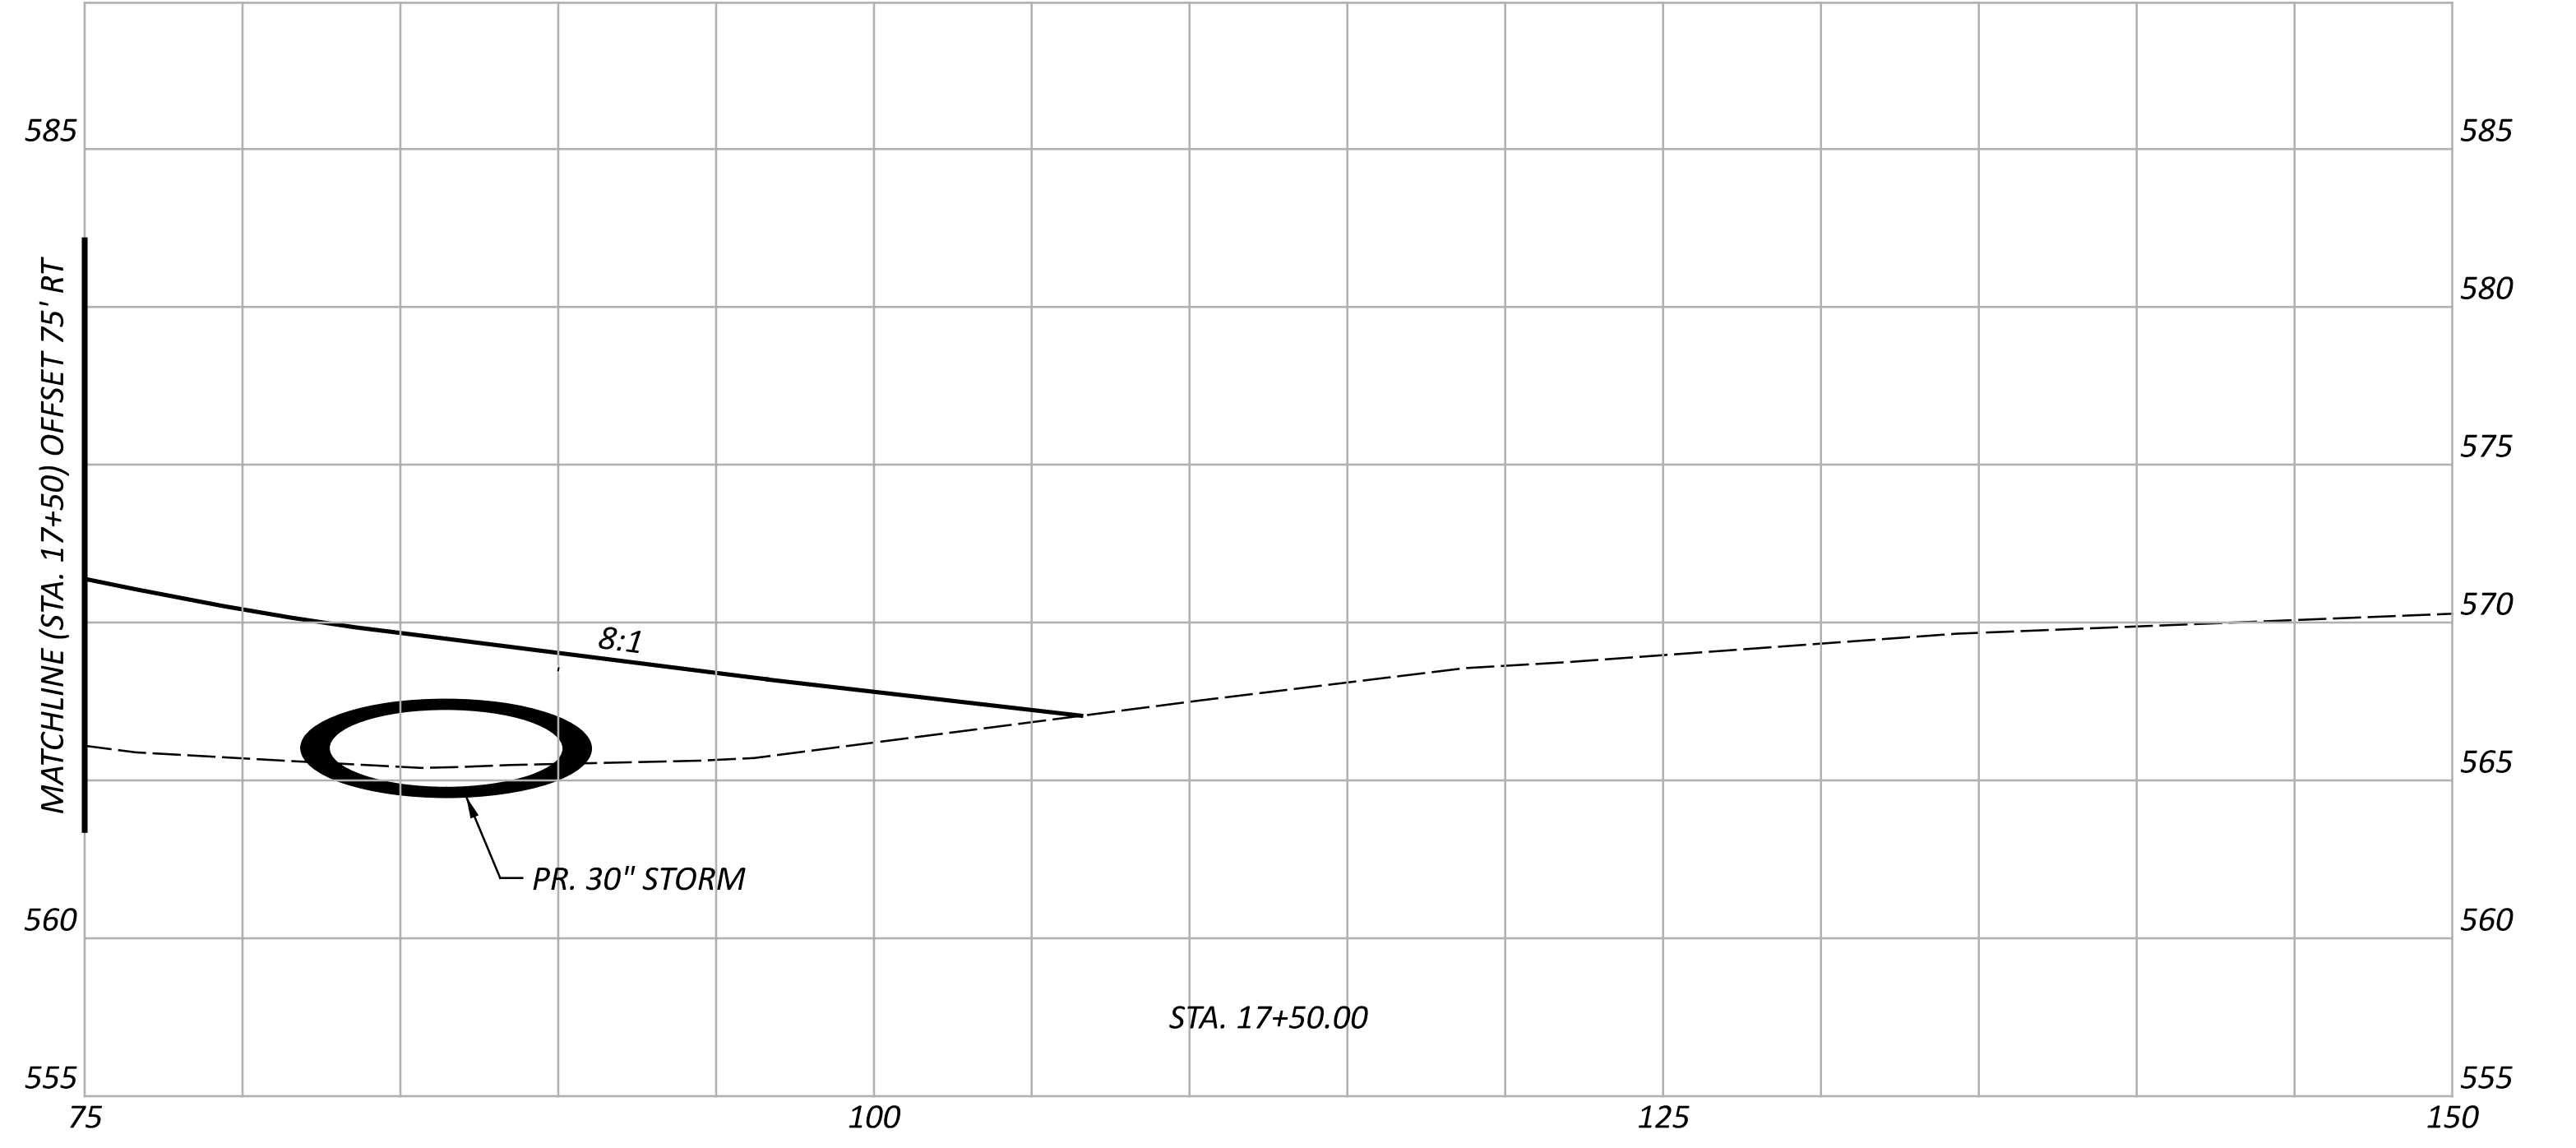
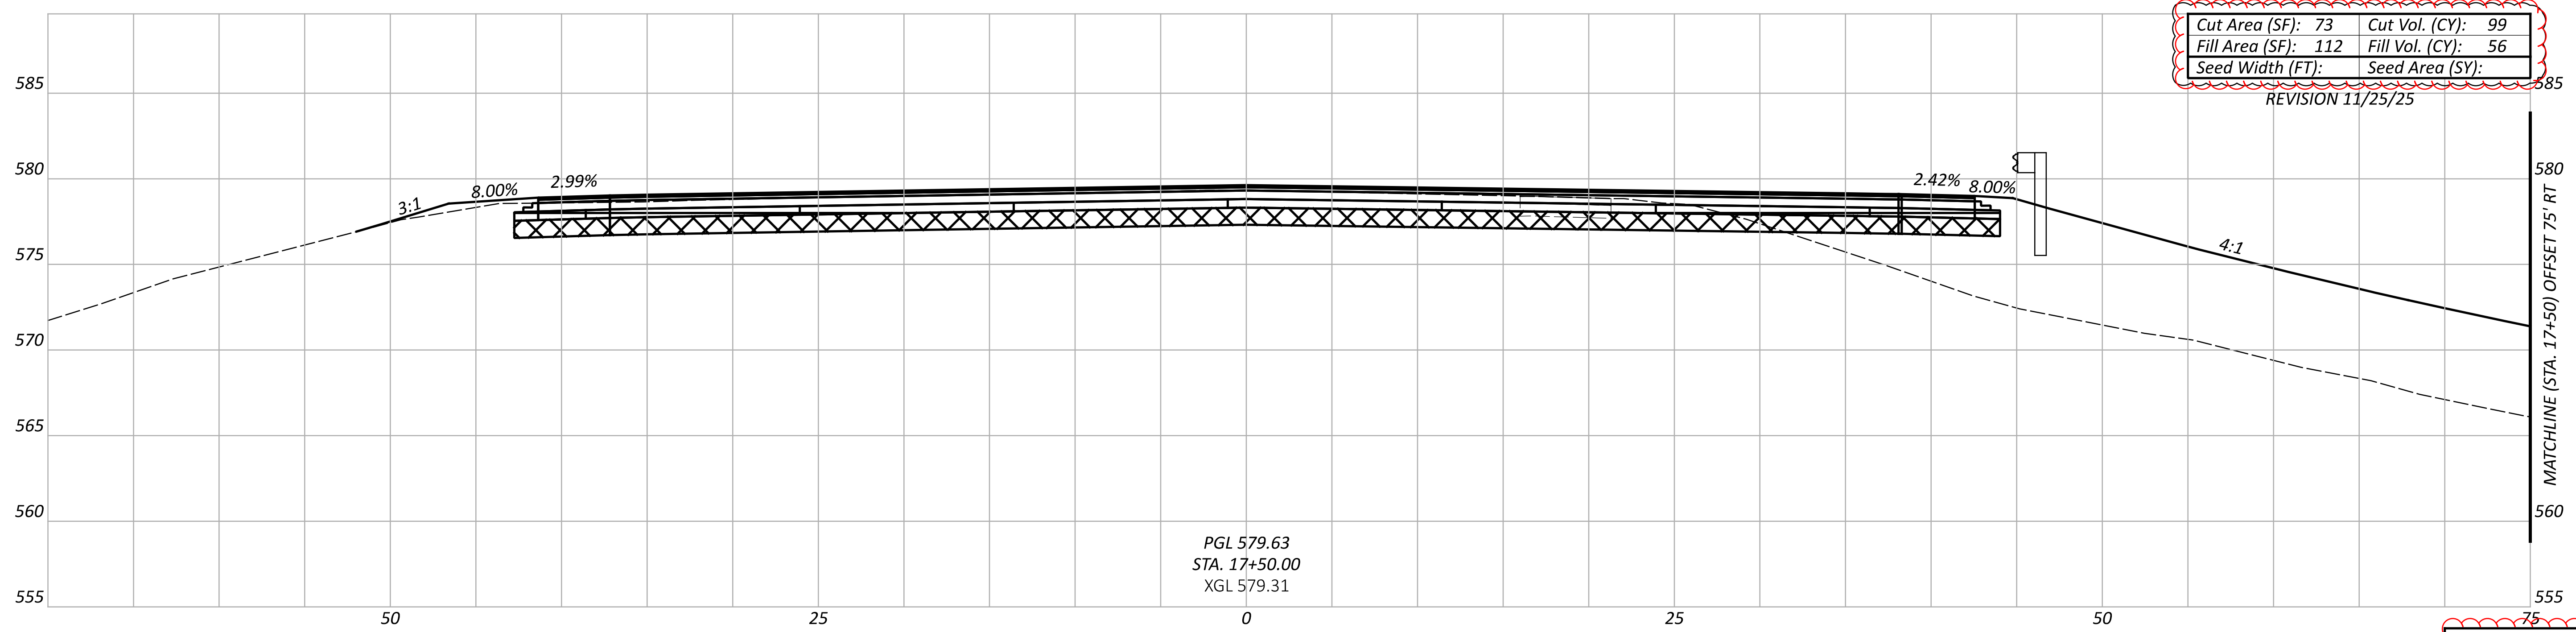


PGL 579.63
 STA. 17+50.00
 XGL 579.31

Sheet Totals			118472	
Seeding	Cut	Fill	SHEET	TOTAL
99	56	037	172	



CROSS SECTIONS - C.R.14 (DRY FORK RD.)
 STA. 17+50

DESIGN AGENCY
TEC
 PLAN PREPARED BY:
 TEC Engineering, Inc.
 7288 Central Parke Blvd.
 Mason, OH 45040
 DESIGNER
 KLL
 REVIEWER
 ERW 12/01/25
 PROJECT ID
 118472

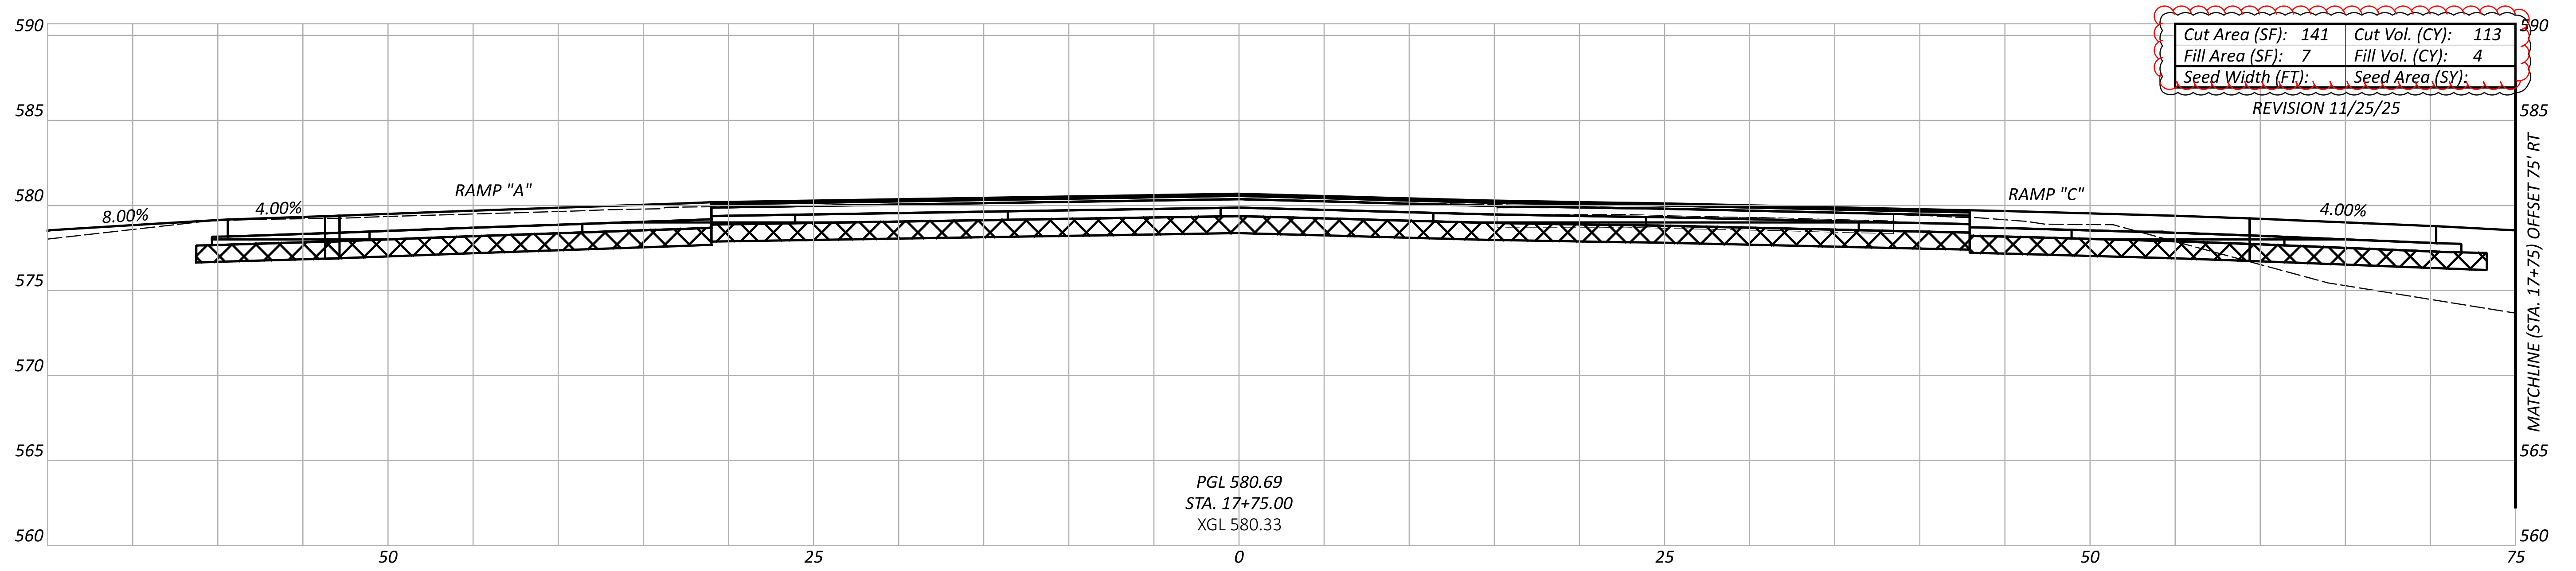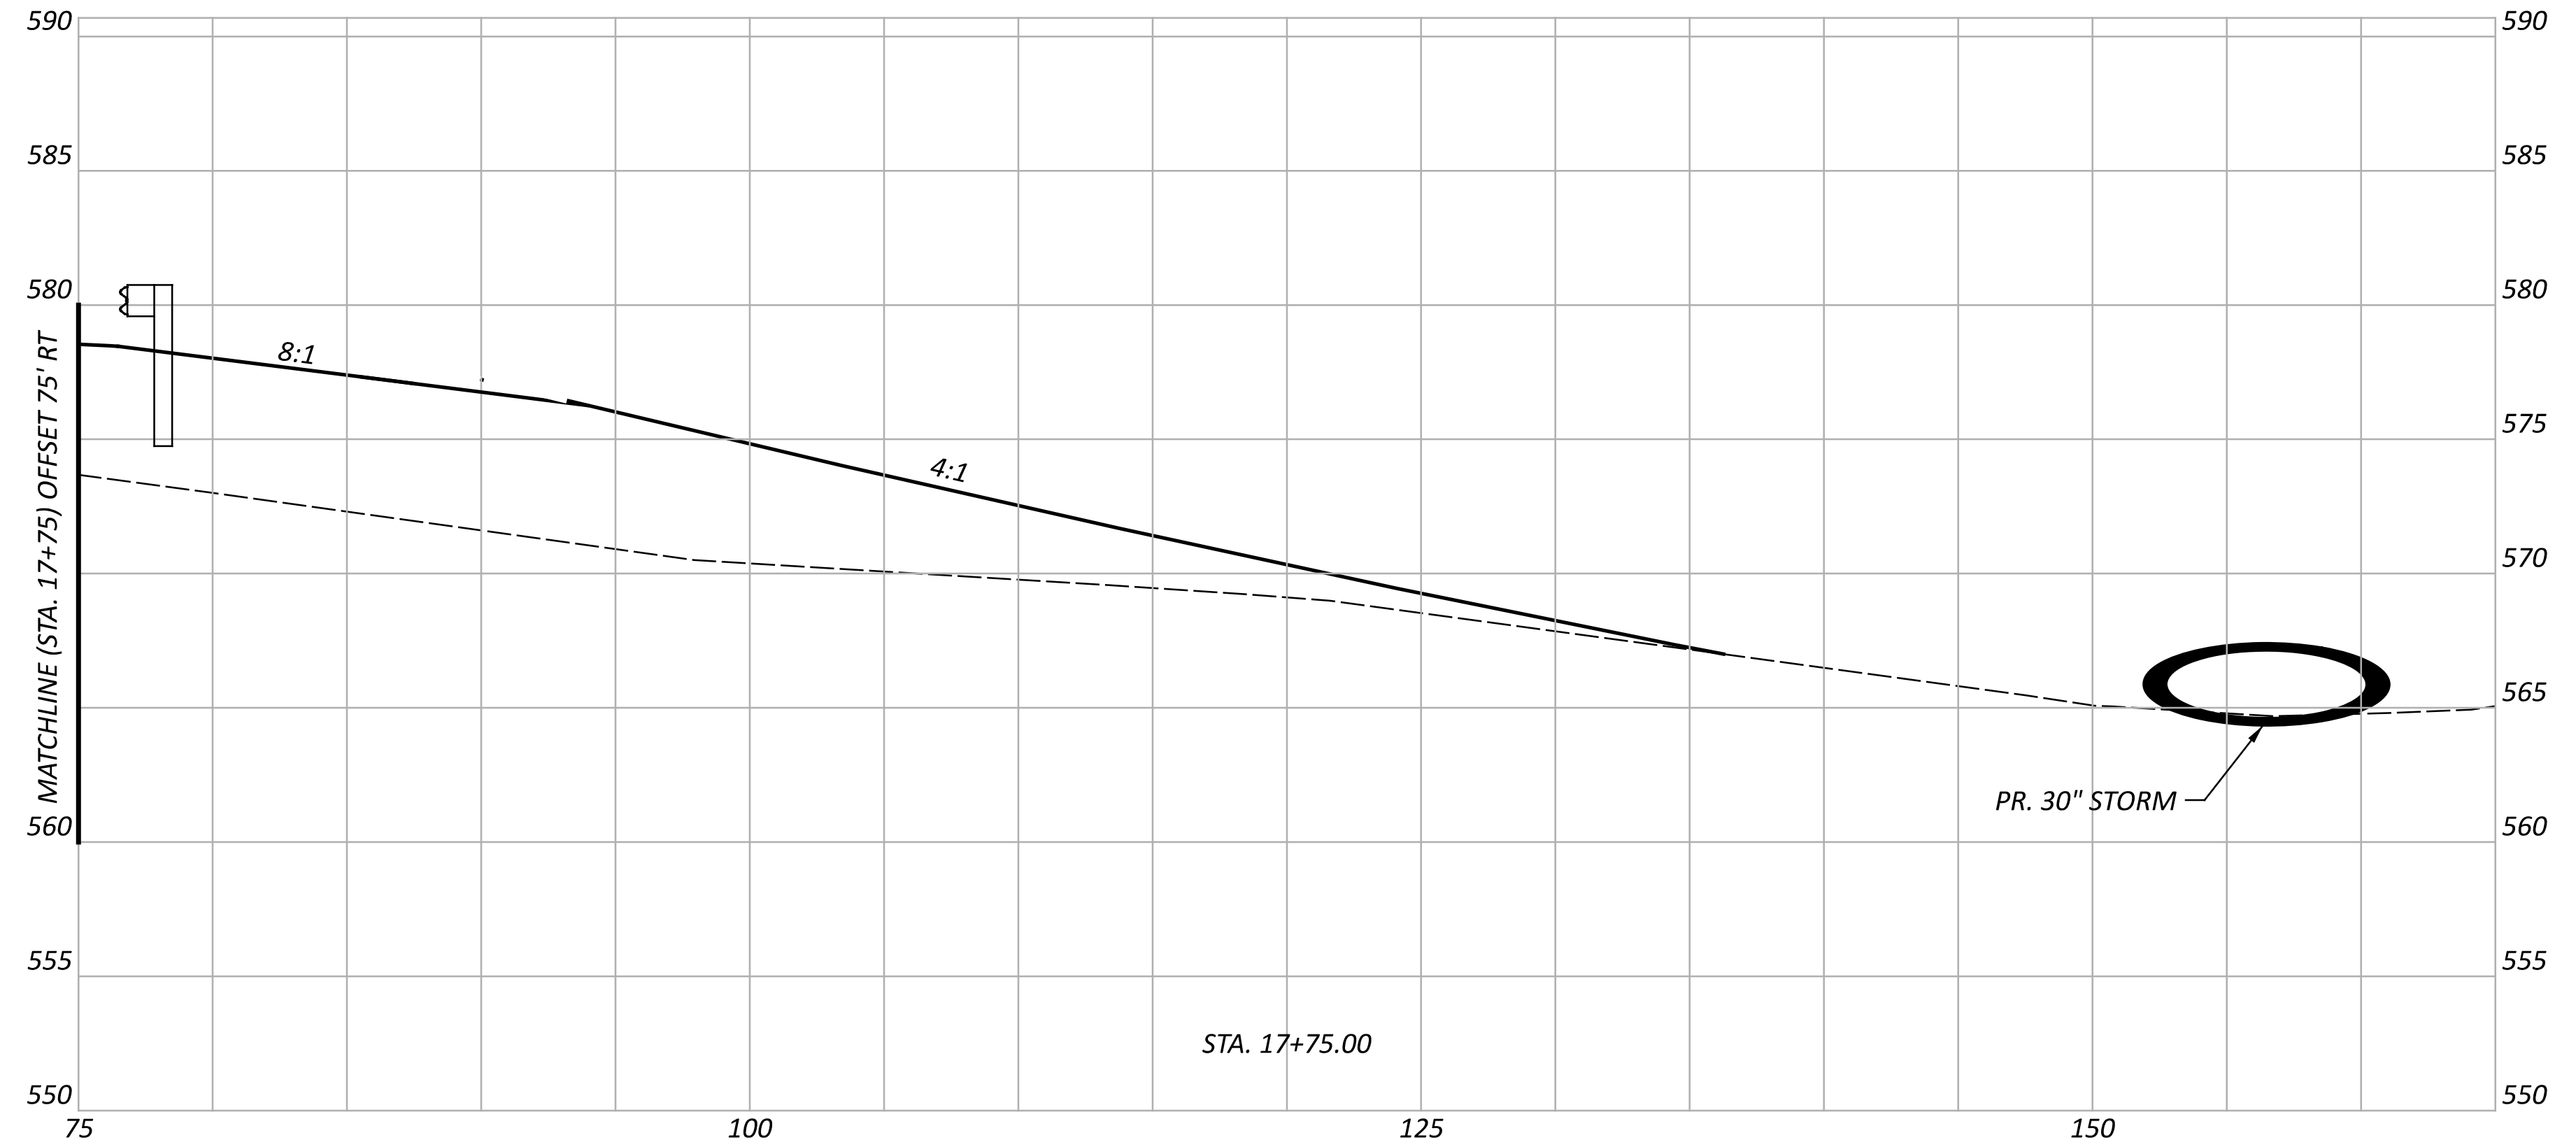

PGL 580.69
 STA. 17+75.00
 XGL 580.33

Sheet Totals		118472	
Seeding	Cut	Fill	TOTAL
113	4	038	172

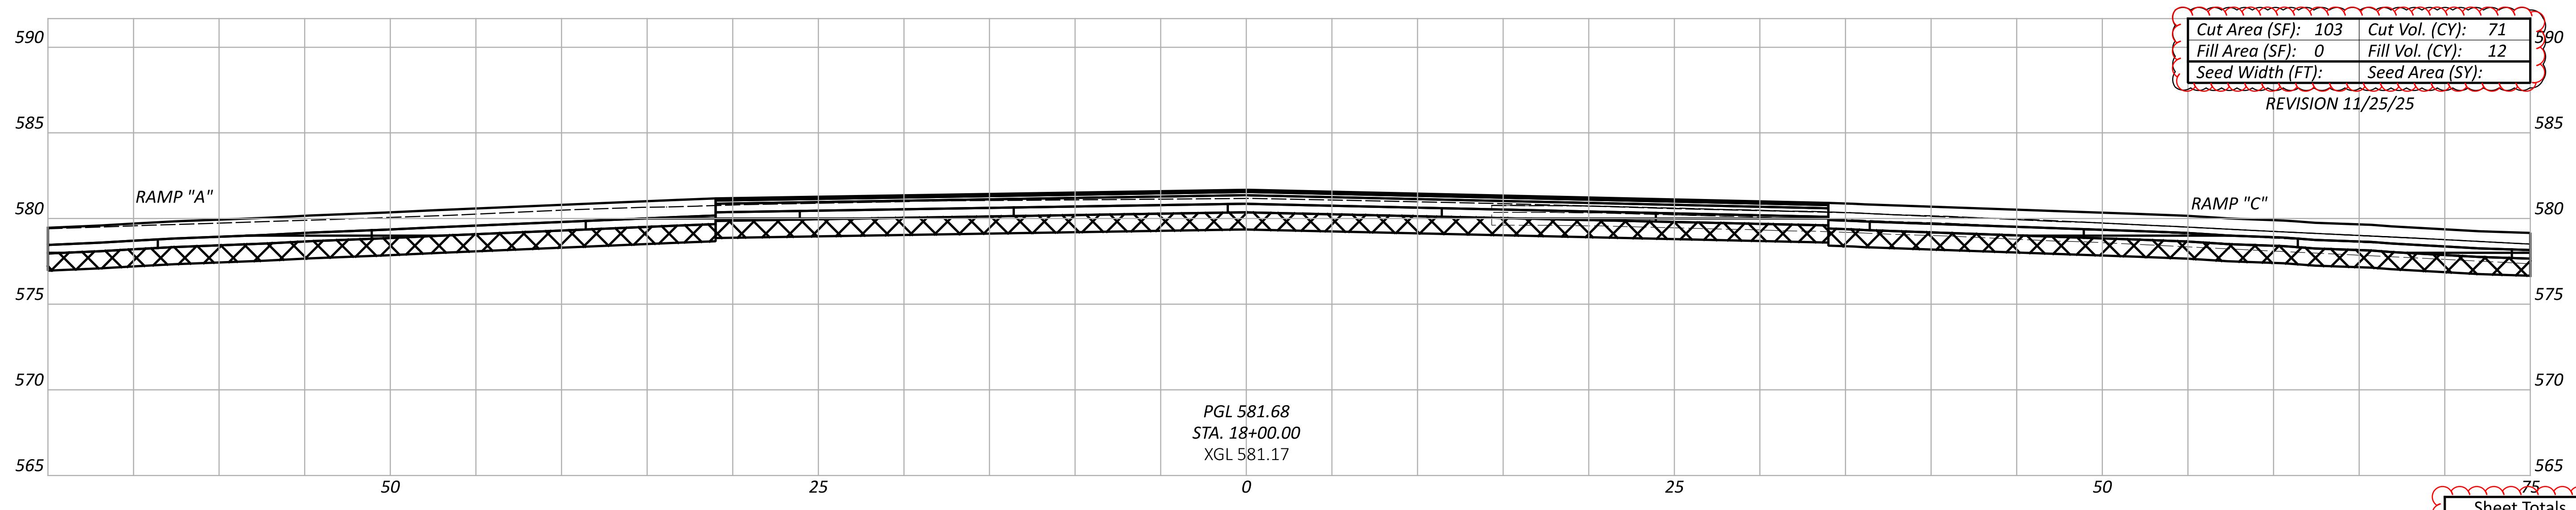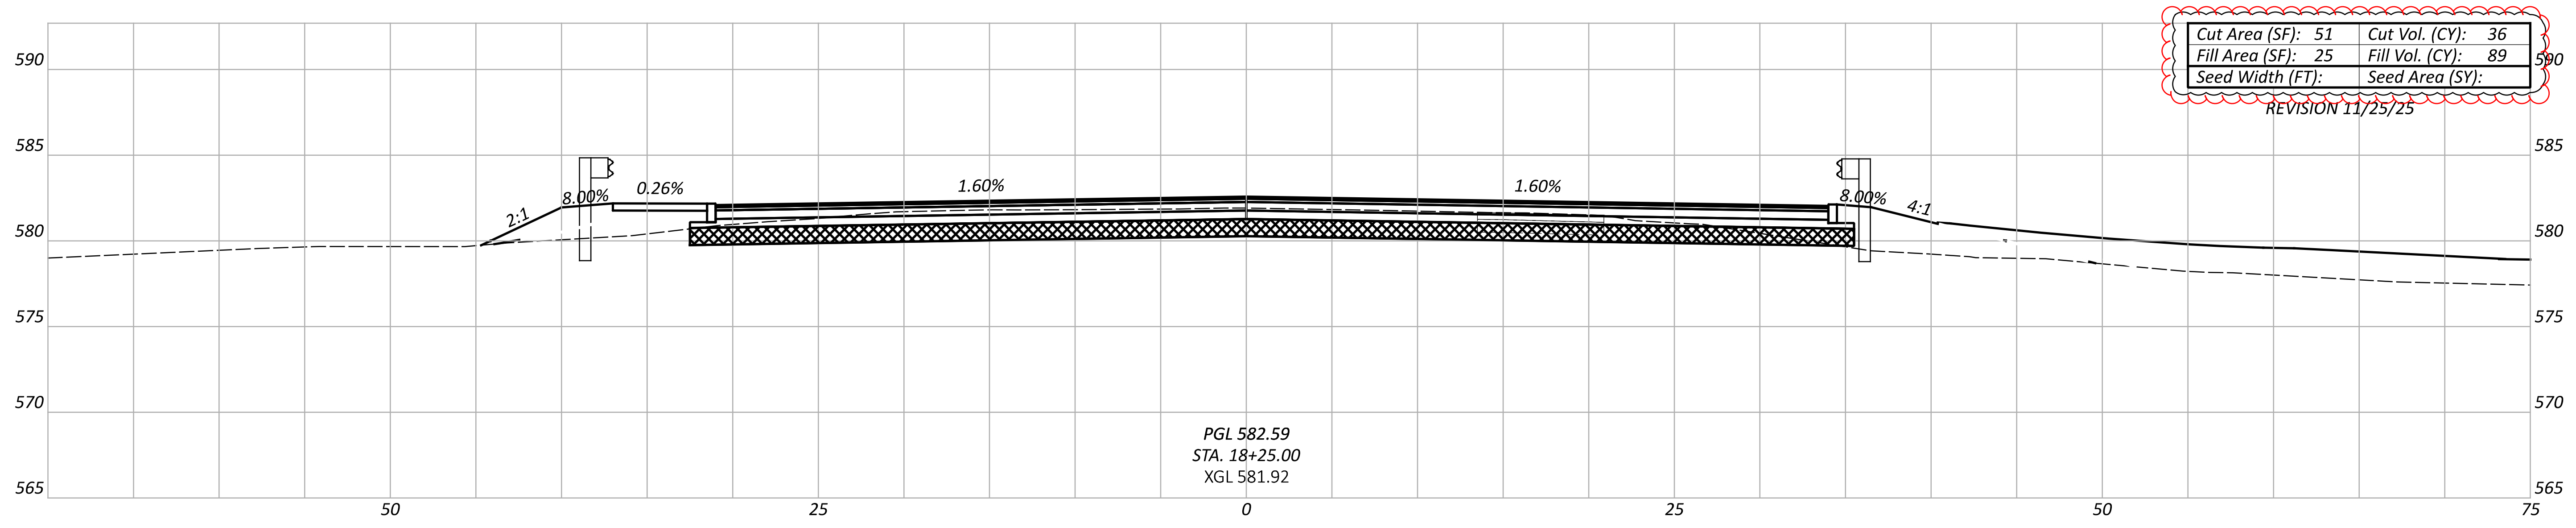


Sheet Totals			118472	
Seeding	Cut	Fill	SHEET	TOTAL
	107	101	039	172

CROSS SECTIONS - C.R.14 (DRY FORK RD.)
 STA. 18+00 TO 18+25

DESIGN AGENCY
TEL
 PLAN PREPARED BY:
 TEC Engineering, Inc.
 7288 Central Parke Blvd.
 Mason, OH 45040


DESIGNER
 KLL
 REVIEWER
 ERW 12/01/25
 PROJECT ID
 118472

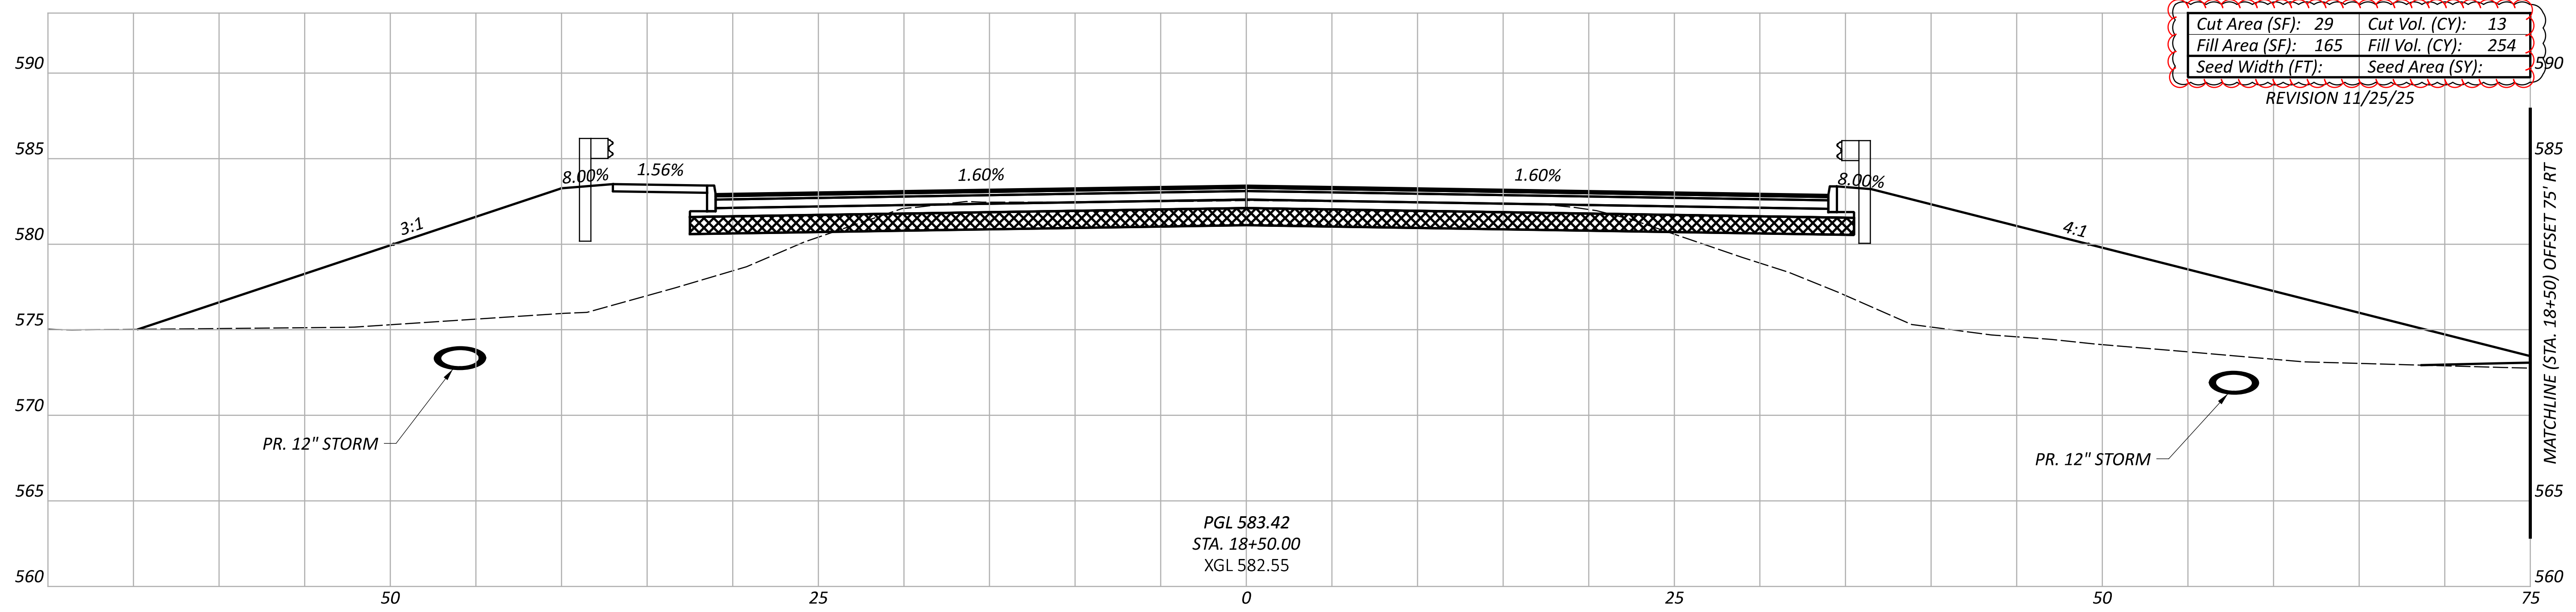

PGL 583.42
 STA. 18+50.00
 XGL 582.55

Cut Area (SF):	29	Cut Vol. (CY):	13
Fill Area (SF):	165	Fill Vol. (CY):	254
Seed Width (FT):		Seed Area (SY):	



REVISION 11/25/25

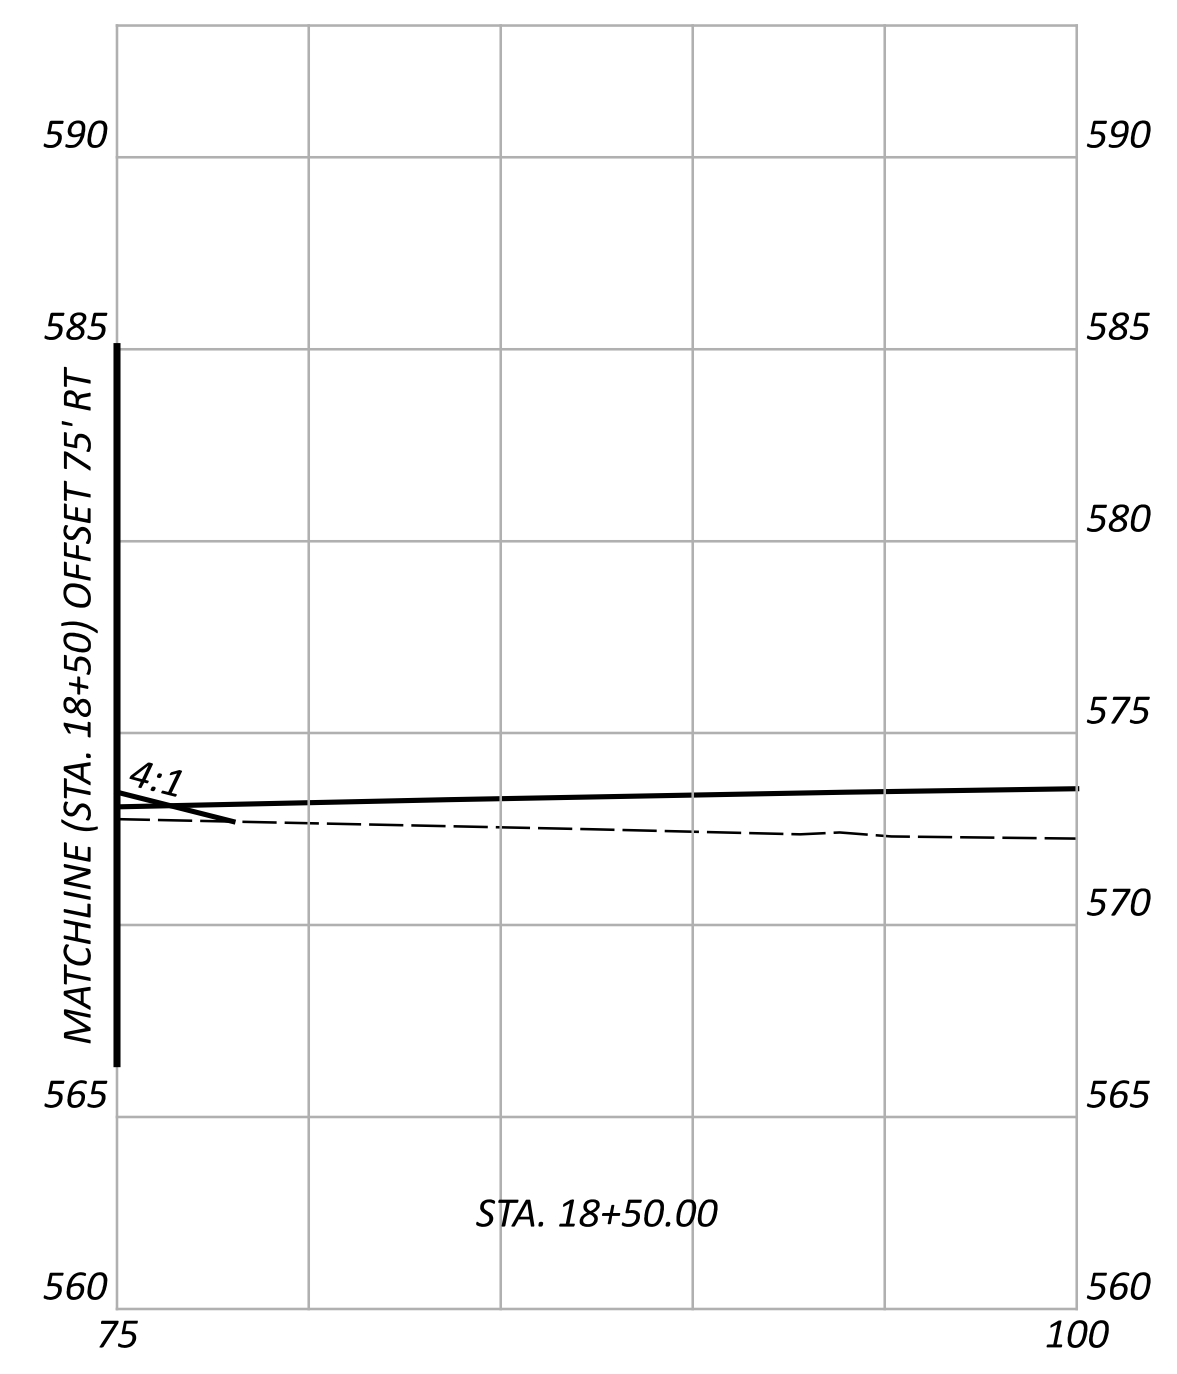

Sheet Totals			SHEET TOTAL	
Seeding	Cut	Fill	040	172
	13	254		

DESIGN AGENCY
TEC
 PLAN PREPARED BY:
 TEC Engineering, Inc.
 7288 Central Park Blvd.
 Mason, OH 45040
 DESIGNER
 KLL
 REVIEWER
 ERW 12/01/25
 PROJECT ID
 118472

CROSS SECTIONS - C.R.14 (DRY FORK RD.)
 STA. 18+50

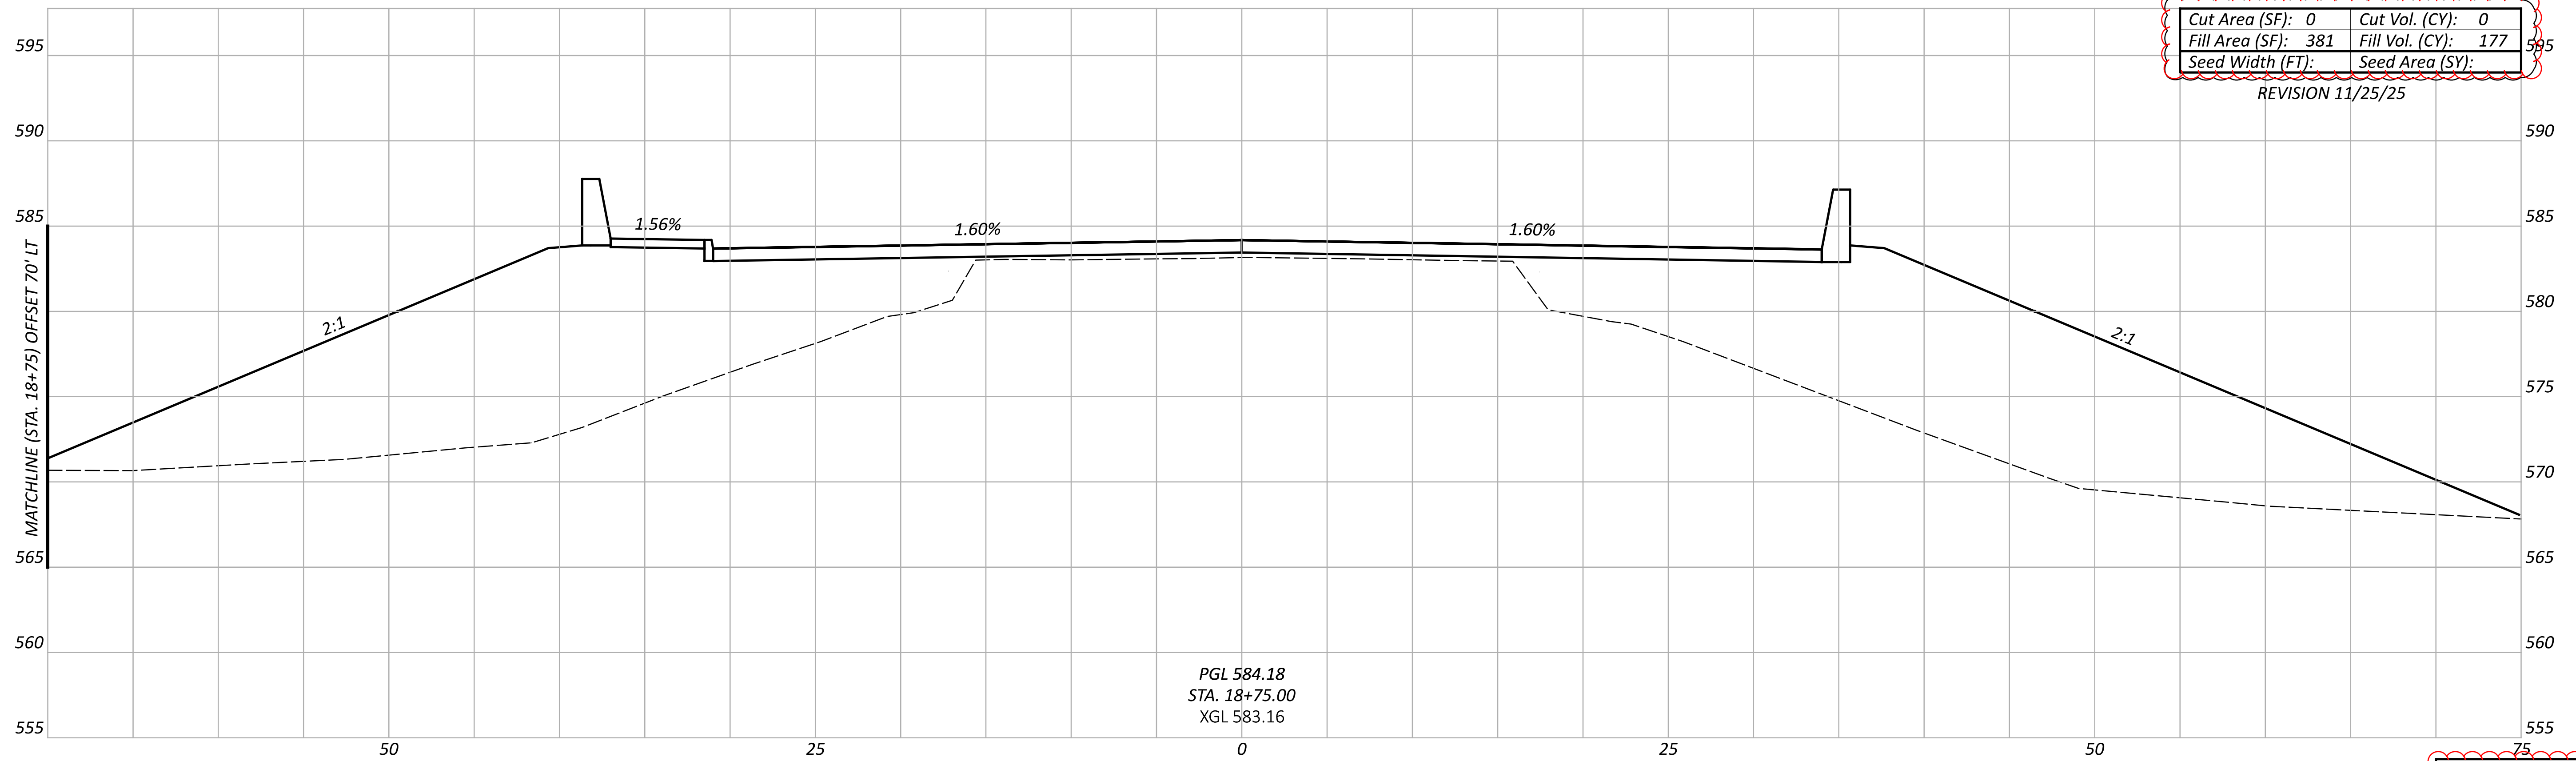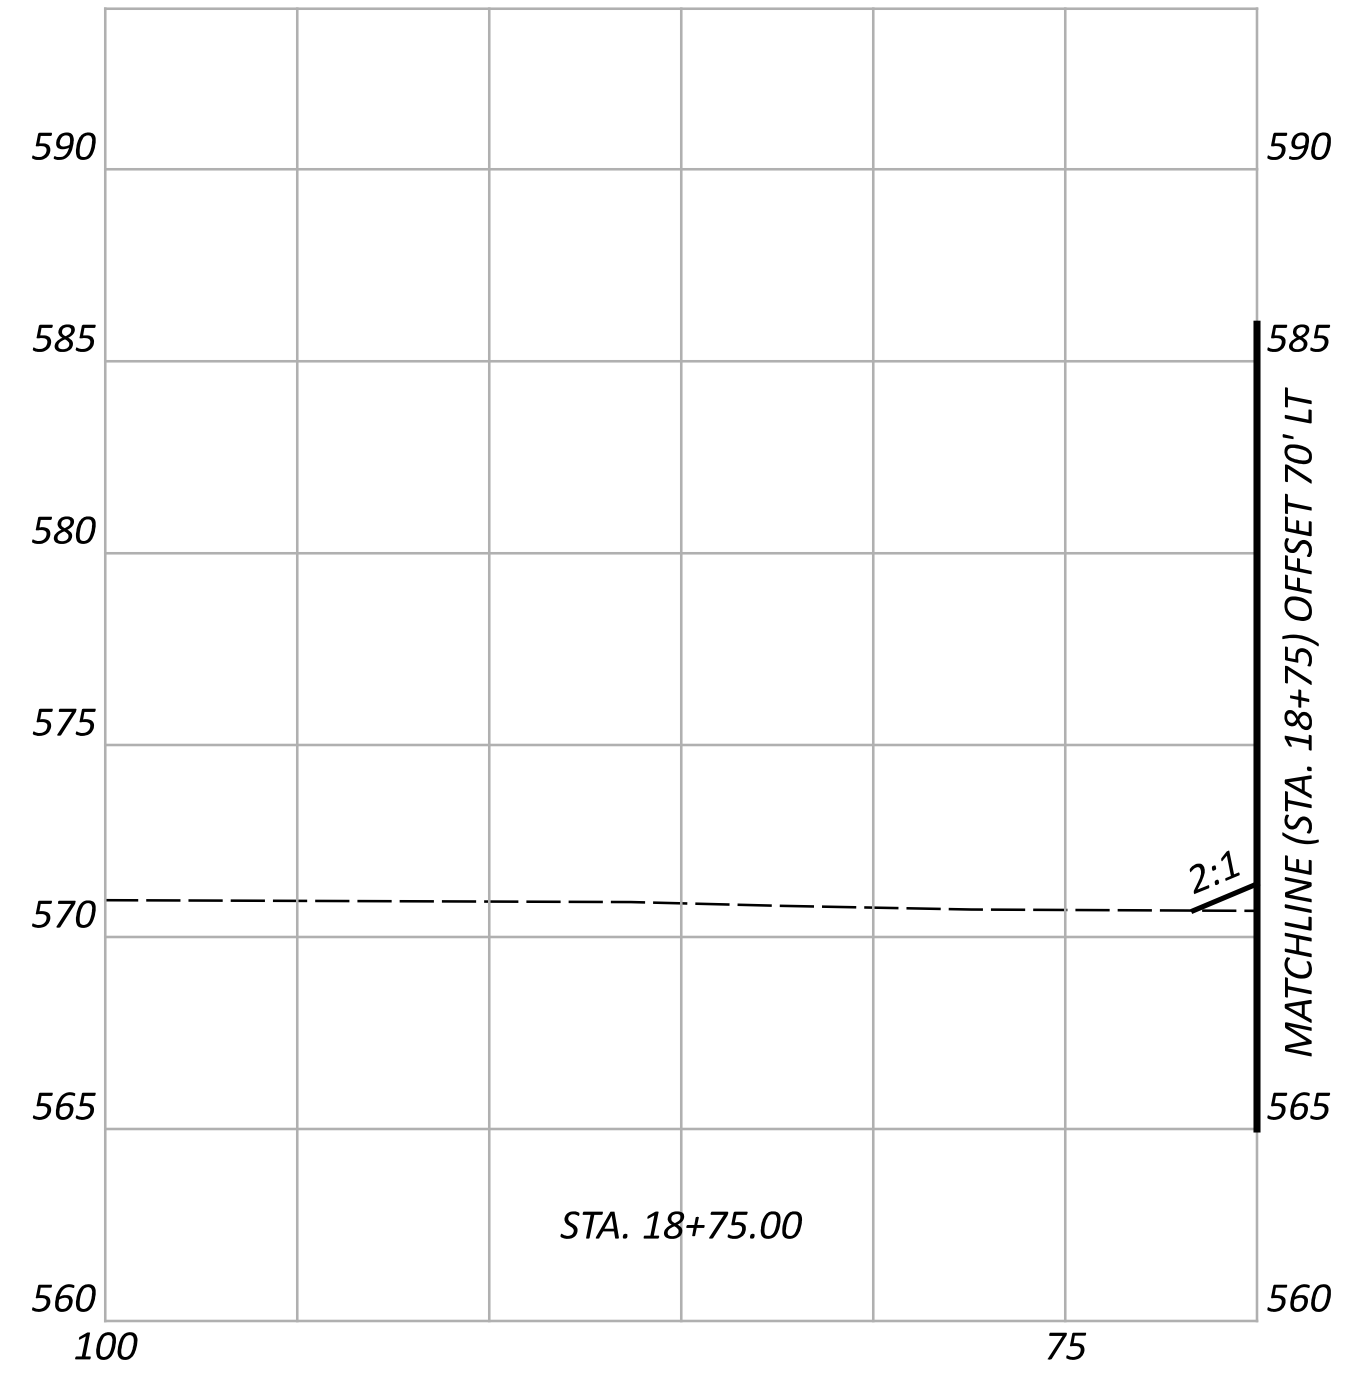


Cut Area (SF): 0	Cut Vol. (CY): 0
Fill Area (SF): 381	Fill Vol. (CY): 177
Seed Width (FT):	Seed Area (SY):

REVISION 11/25/25

CROSS SECTIONS - C.R.14 (DRY FORK RD.)
STA. 18+75

DESIGN AGENCY

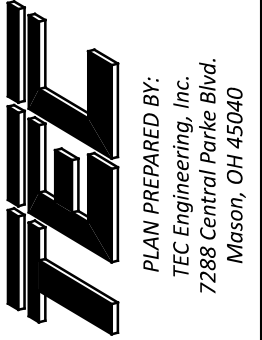


DESIGNER
KLL

REVIEWER
ERW 12/01/25

PROJECT ID
118472

Sheet Totals			118472	
Seeding	Cut	Fill	SHEET	TOTAL
0	177	041	041	172

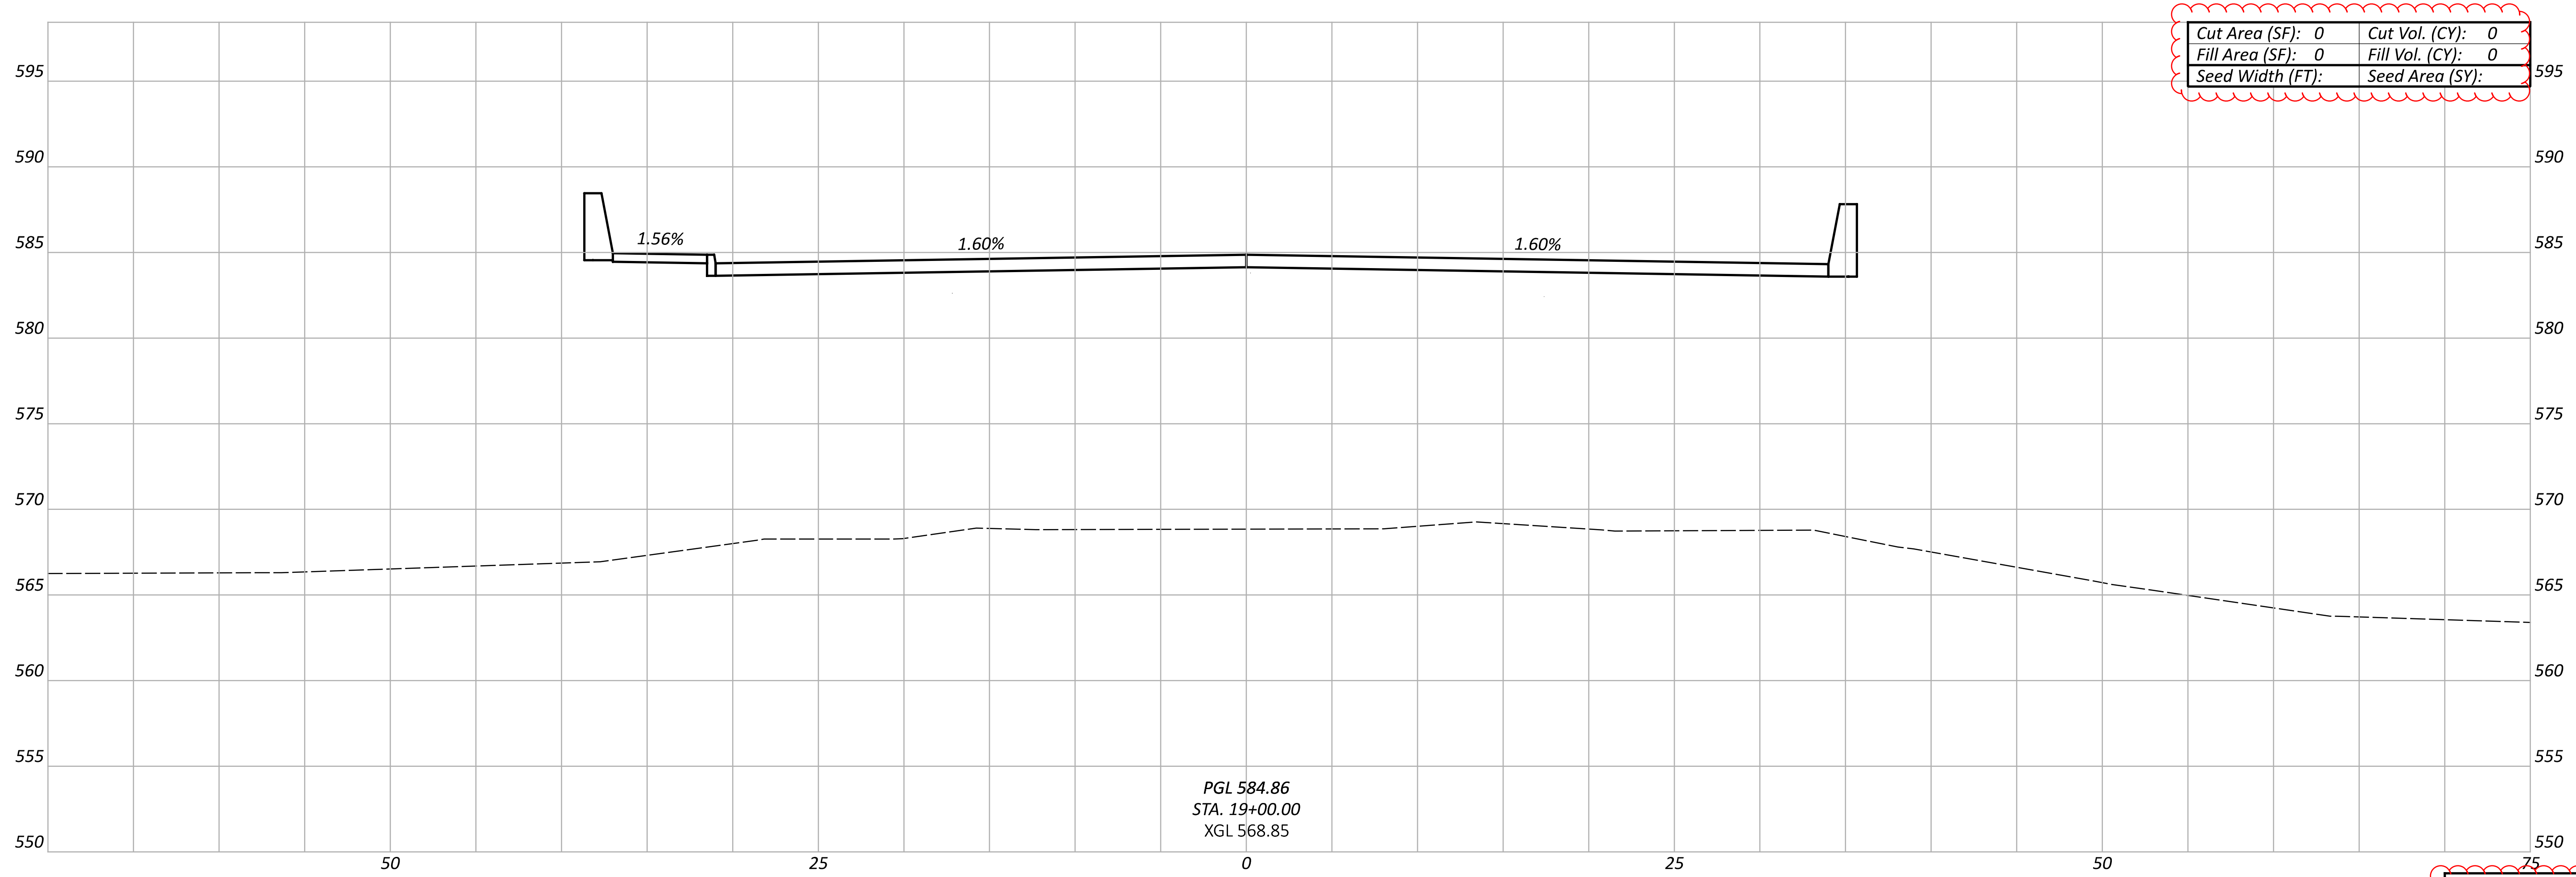

PGL 584.86
STA. 19+00.00
XGL 568.85

Cut Area (SF): 0	Cut Vol. (CY): 0
Fill Area (SF): 0	Fill Vol. (CY): 0
Seed Width (FT):	Seed Area (SY):

Sheet Totals		
Seeding	Cut	Fill
0	0	0

CROSS SECTIONS - C.R.14 (DRY FORK RD.)
STA. 19+00

DESIGN AGENCY




 PLAN PREPARED BY:
 TEC Engineering, Inc.
 7288 Central Parke Blvd.
 Mason, OH 45040

DESIGNER
KLL

REVIEWER
ERW 12/01/25

PROJECT ID
118472

SHEET	TOTAL
042	172

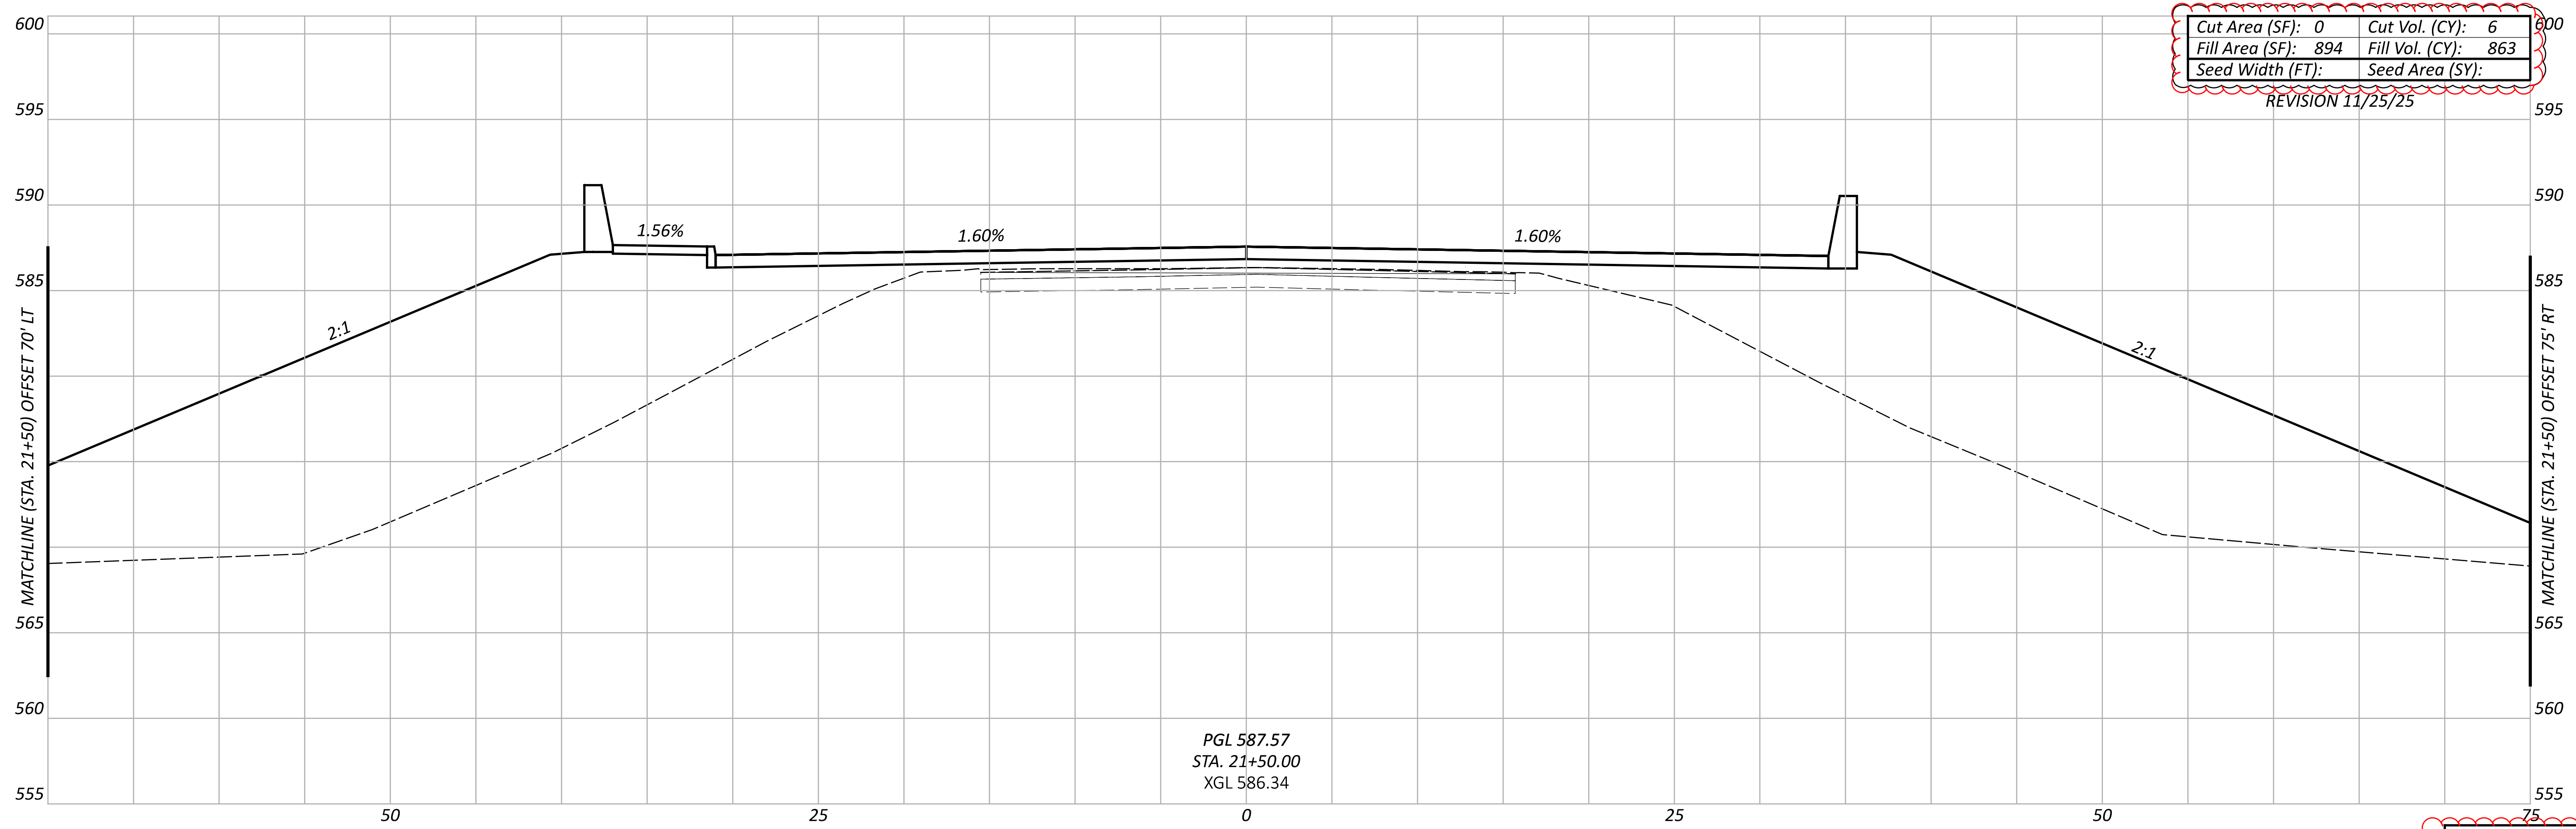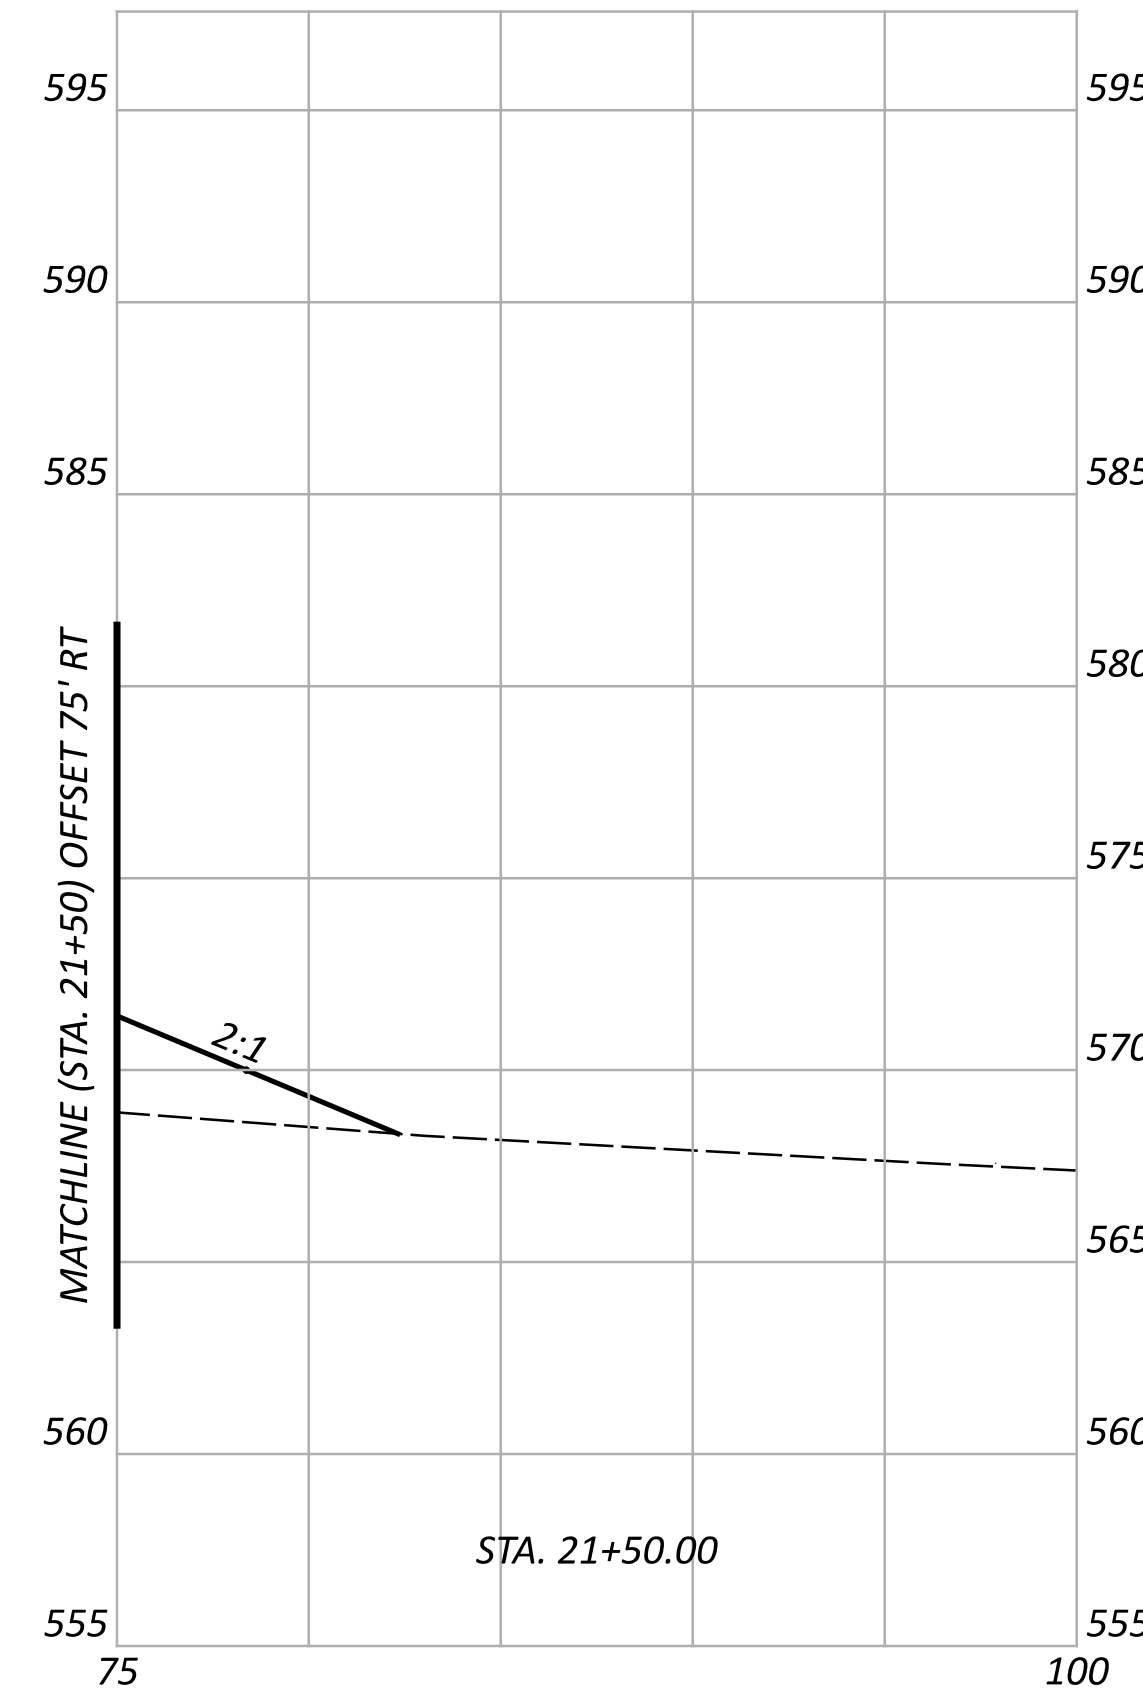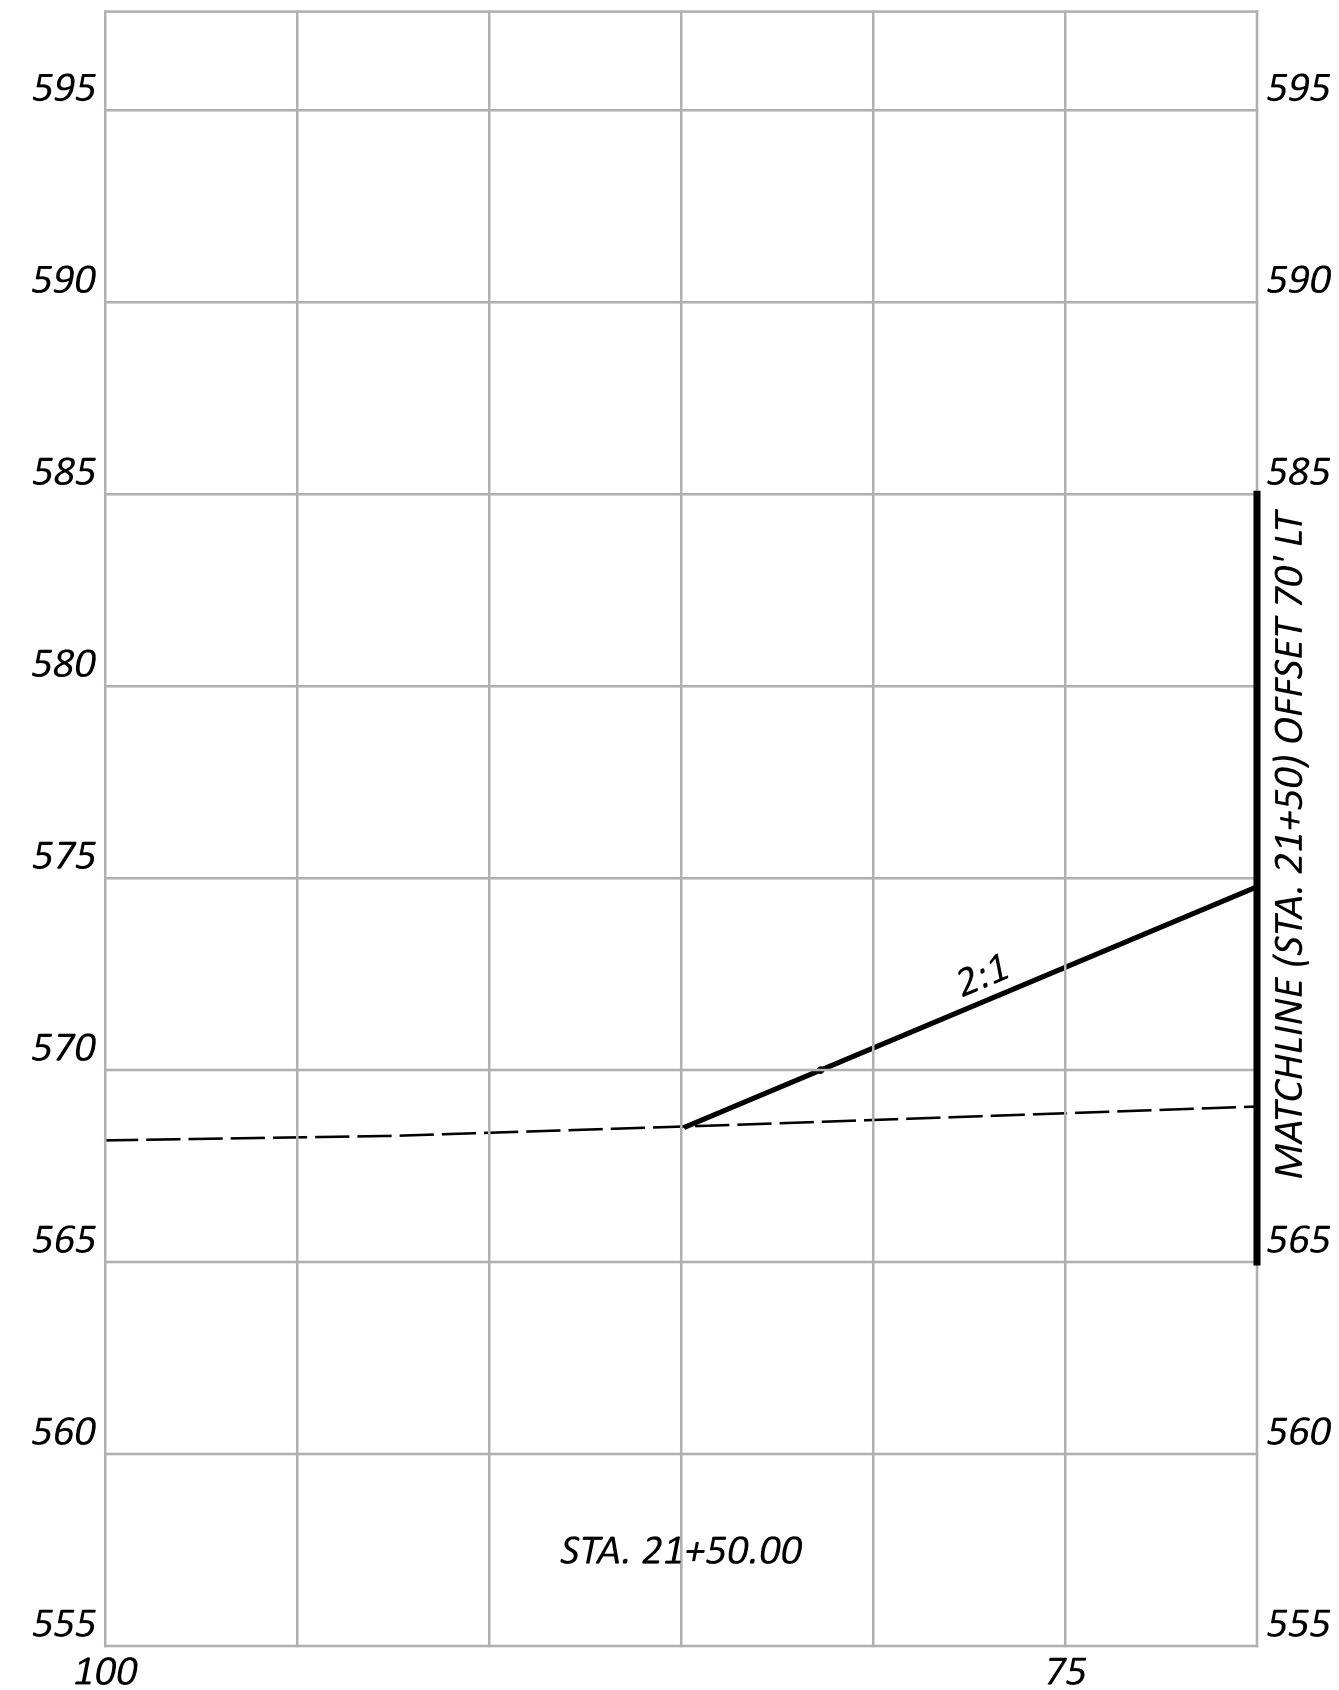

PGL 587.57
 STA. 21+50.00
 XGL 586.34

Cut Area (SF): 0	Cut Vol. (CY): 6
Fill Area (SF): 894	Fill Vol. (CY): 863
Seed Width (FT):	Seed Area (SY):

REVISION 11/25/25

Sheet Totals			118472	
Seeding	Cut	Fill	SHEET	TOTAL
6	863	043	043	172

CROSS SECTIONS - C.R.14 (DRY FORK RD.)
 STA. 21+50




DESIGN AGENCY

 PLAN PREPARED BY:
 TEC Engineering, Inc.
 7288 Central Parke Blvd.
 Mason, OH 45040

DESIGNER
 KLL

REVIEWER
 ERW 12/01/25

PROJECT ID
 118472

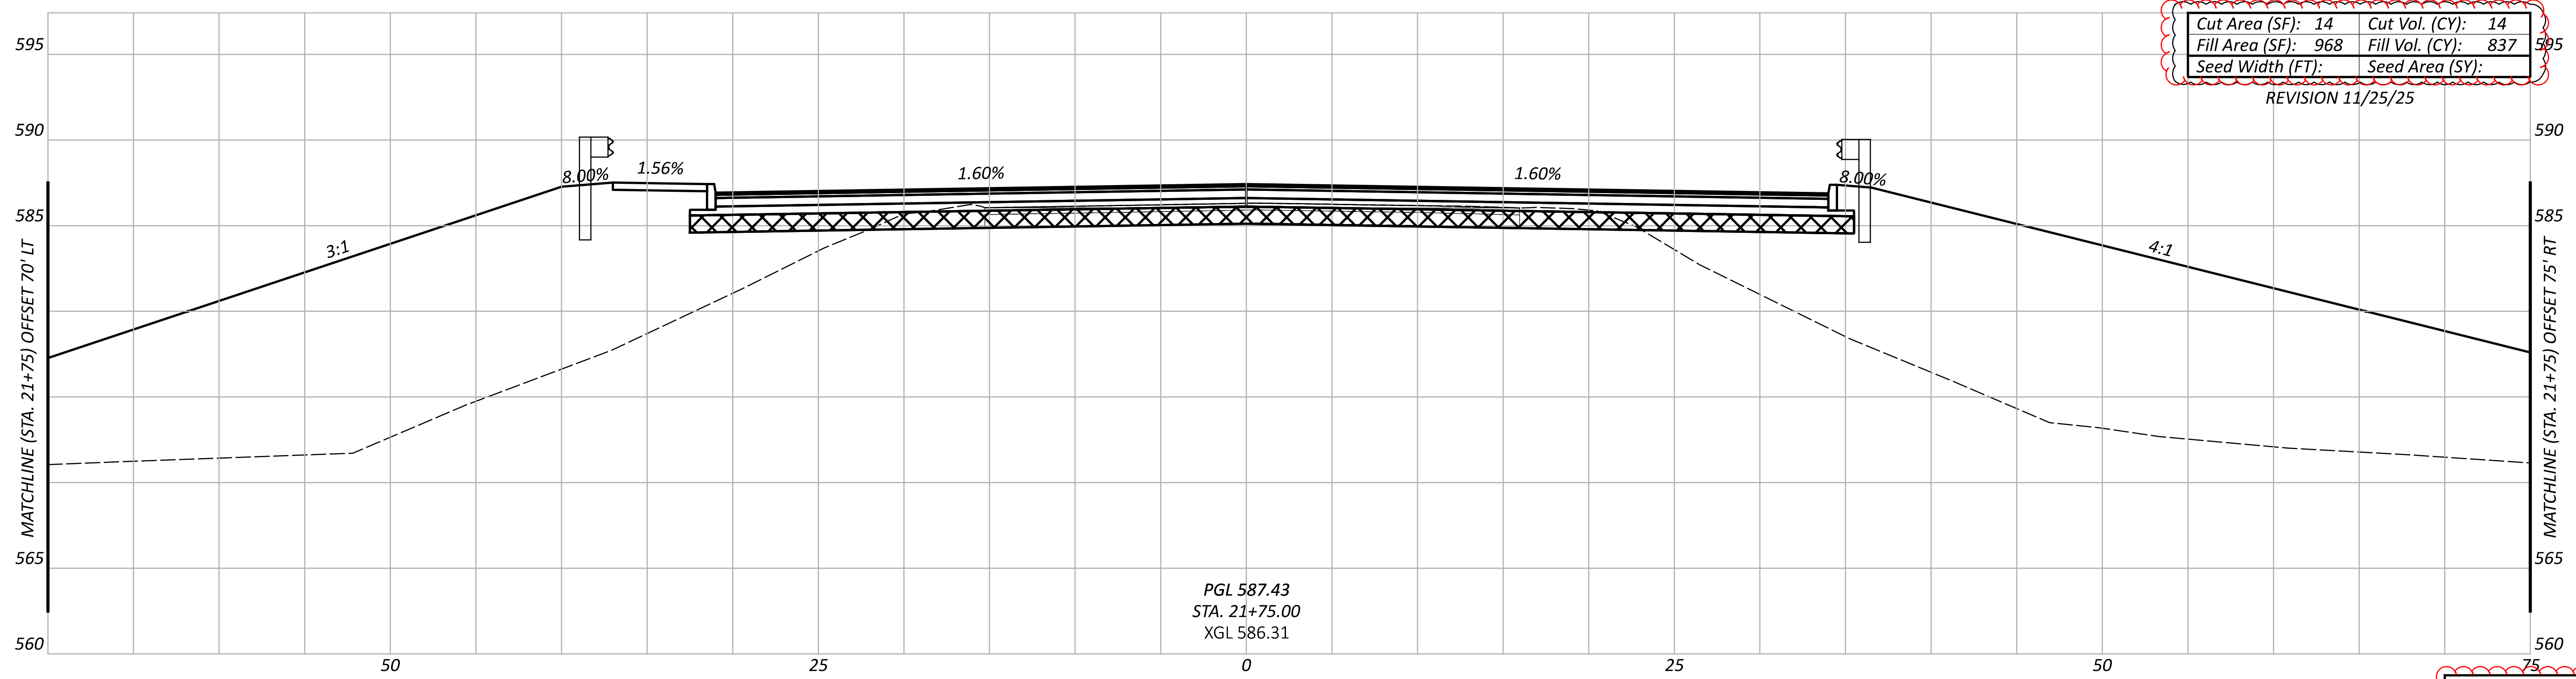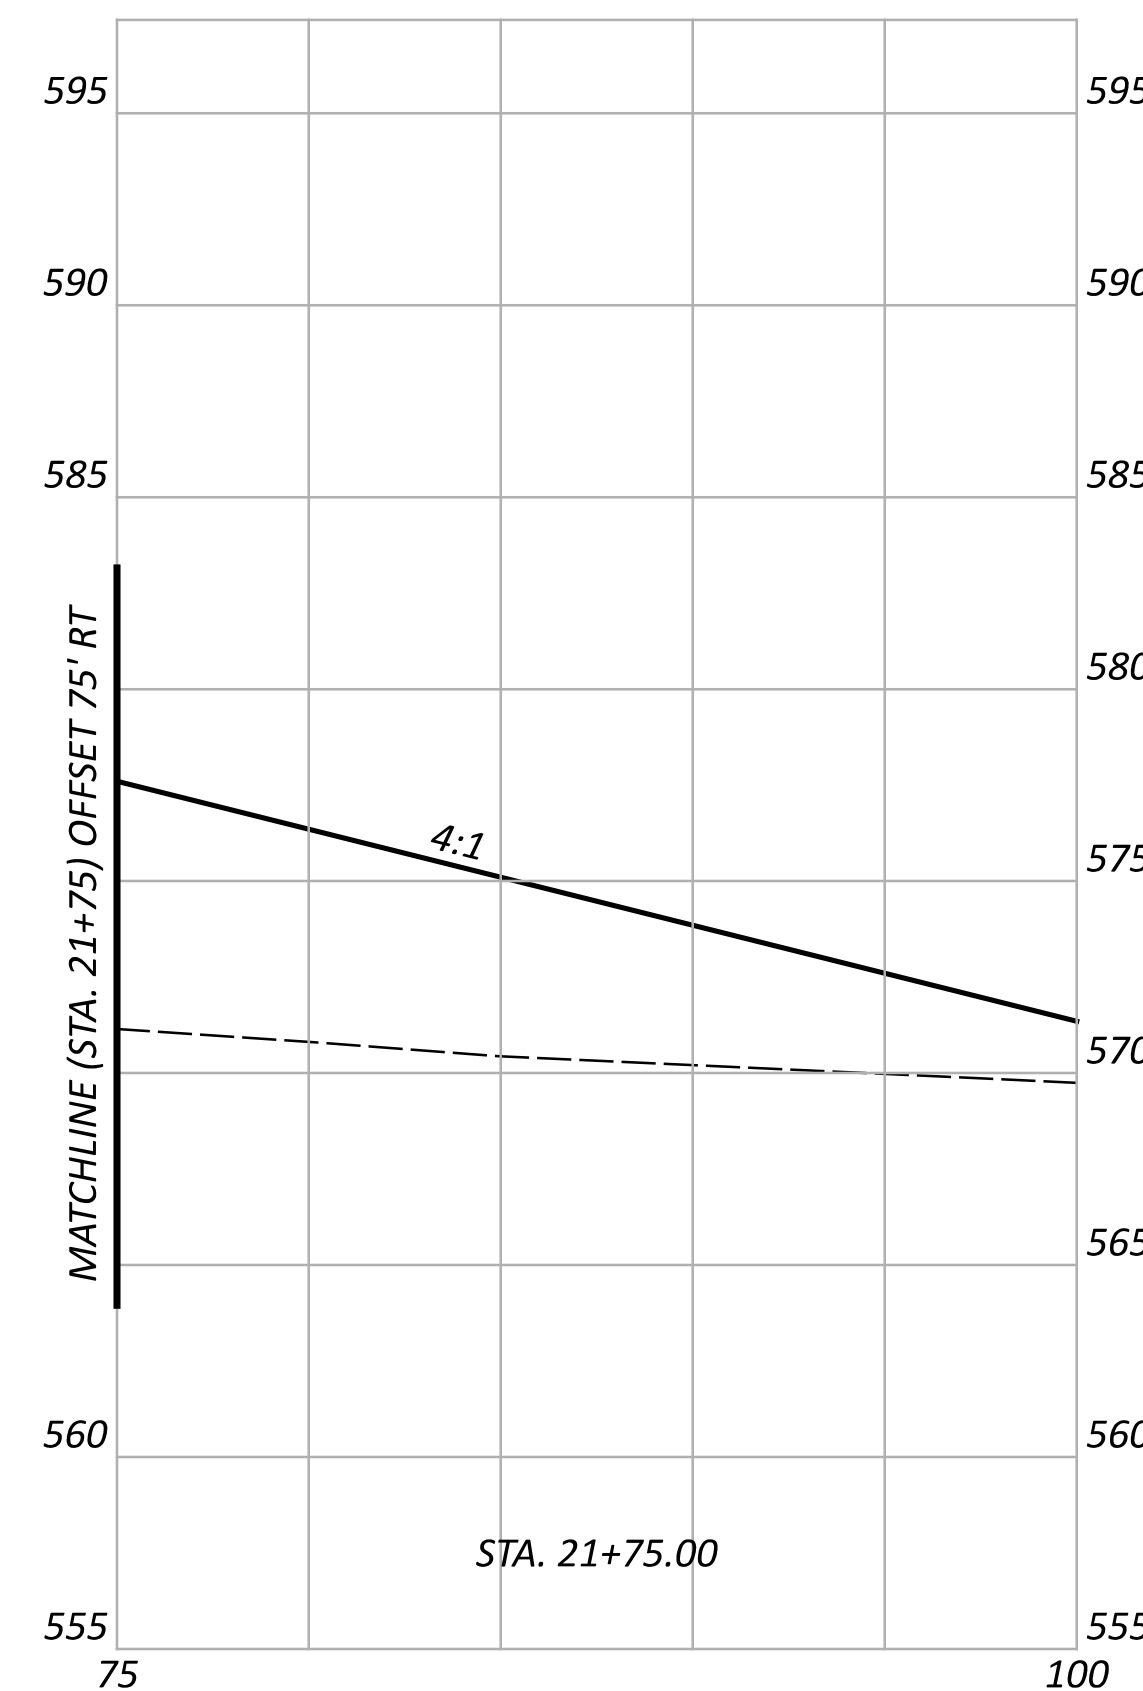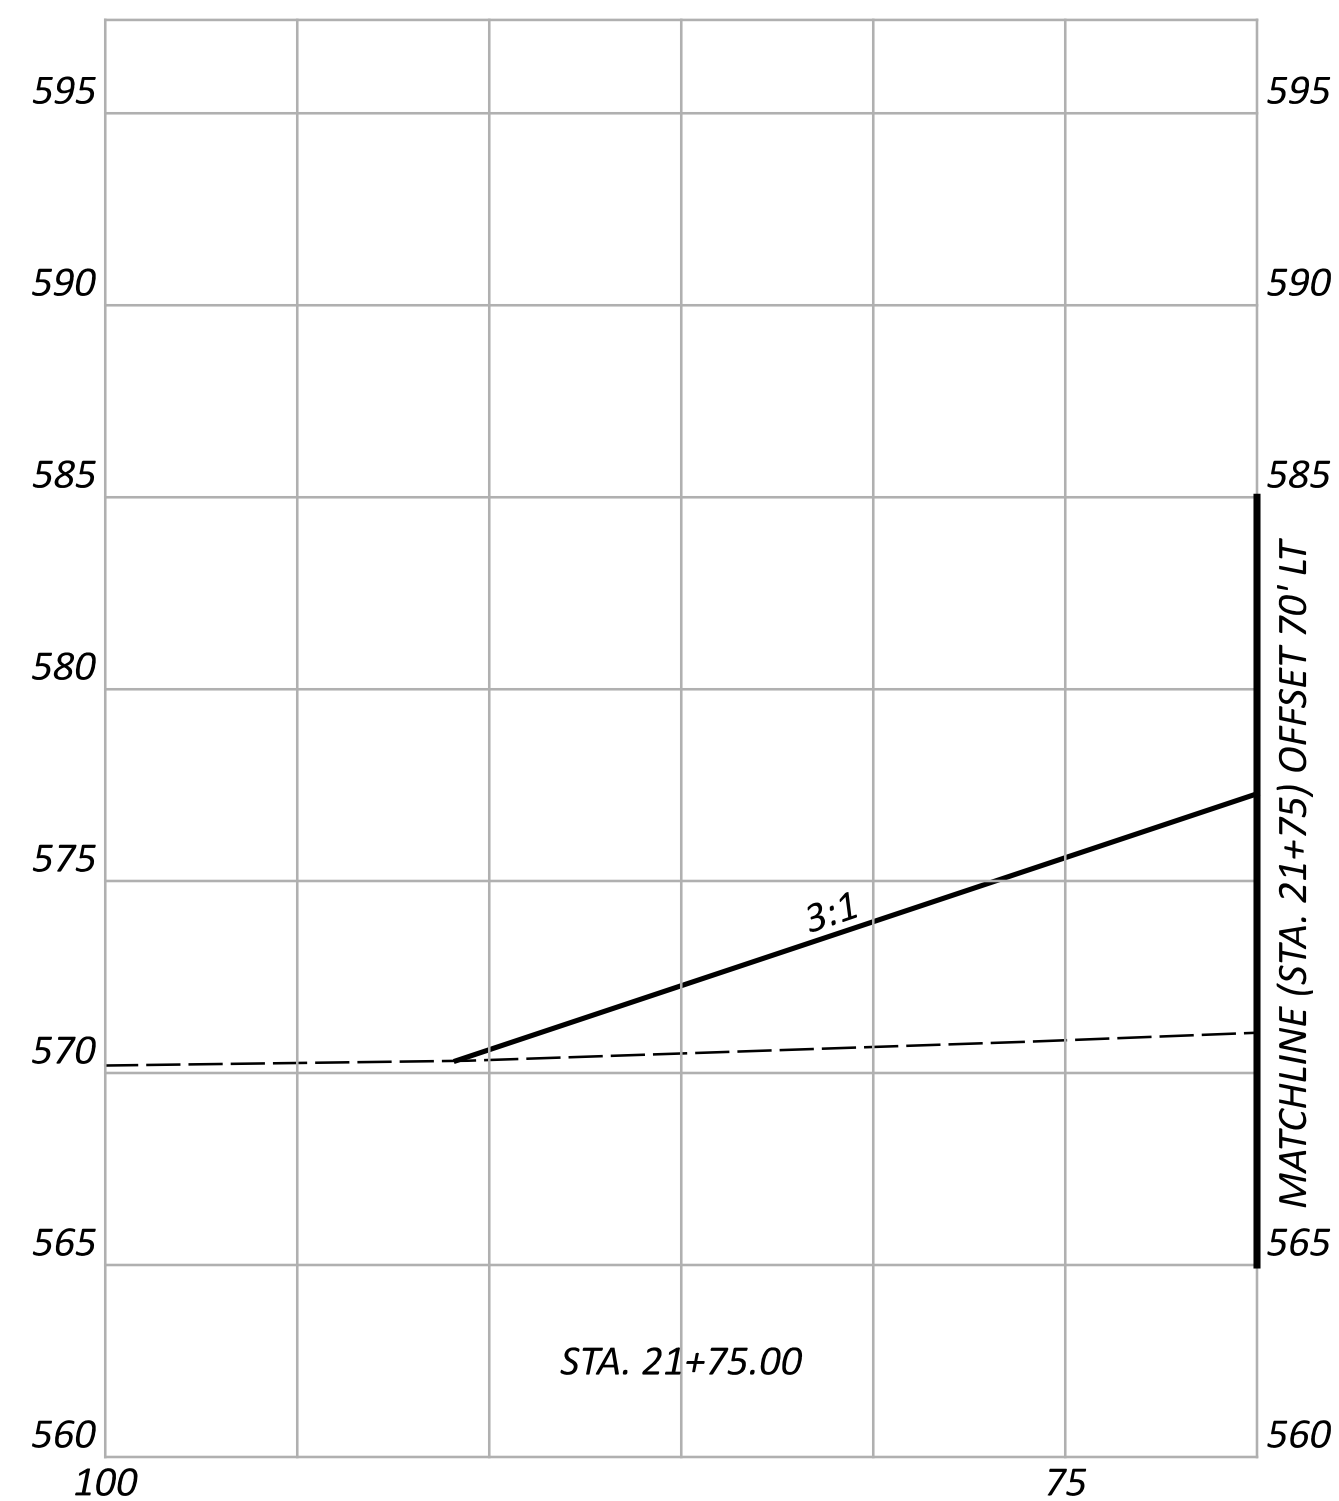

PGL 587.43
 STA. 21+75.00
 XGL 586.31

Cut Area (SF): 14	Cut Vol. (CY): 14
Fill Area (SF): 968	Fill Vol. (CY): 837
Seed Width (FT):	Seed Area (SY):

REVISION 11/25/25

Sheet Totals			118472
Seeding	Cut	Fill	TOTAL
14	837	044	172

CROSS SECTIONS - C.R.14 (DRY FORK RD.)
 STA. 21+75




DESIGN AGENCY

 PLAN PREPARED BY:
 TEC Engineering, Inc.
 7288 Central Park Blvd.
 Mason, OH 45040

DESIGNER
 KLL

REVIEWER
 ERW 12/01/25

PROJECT ID
 118472

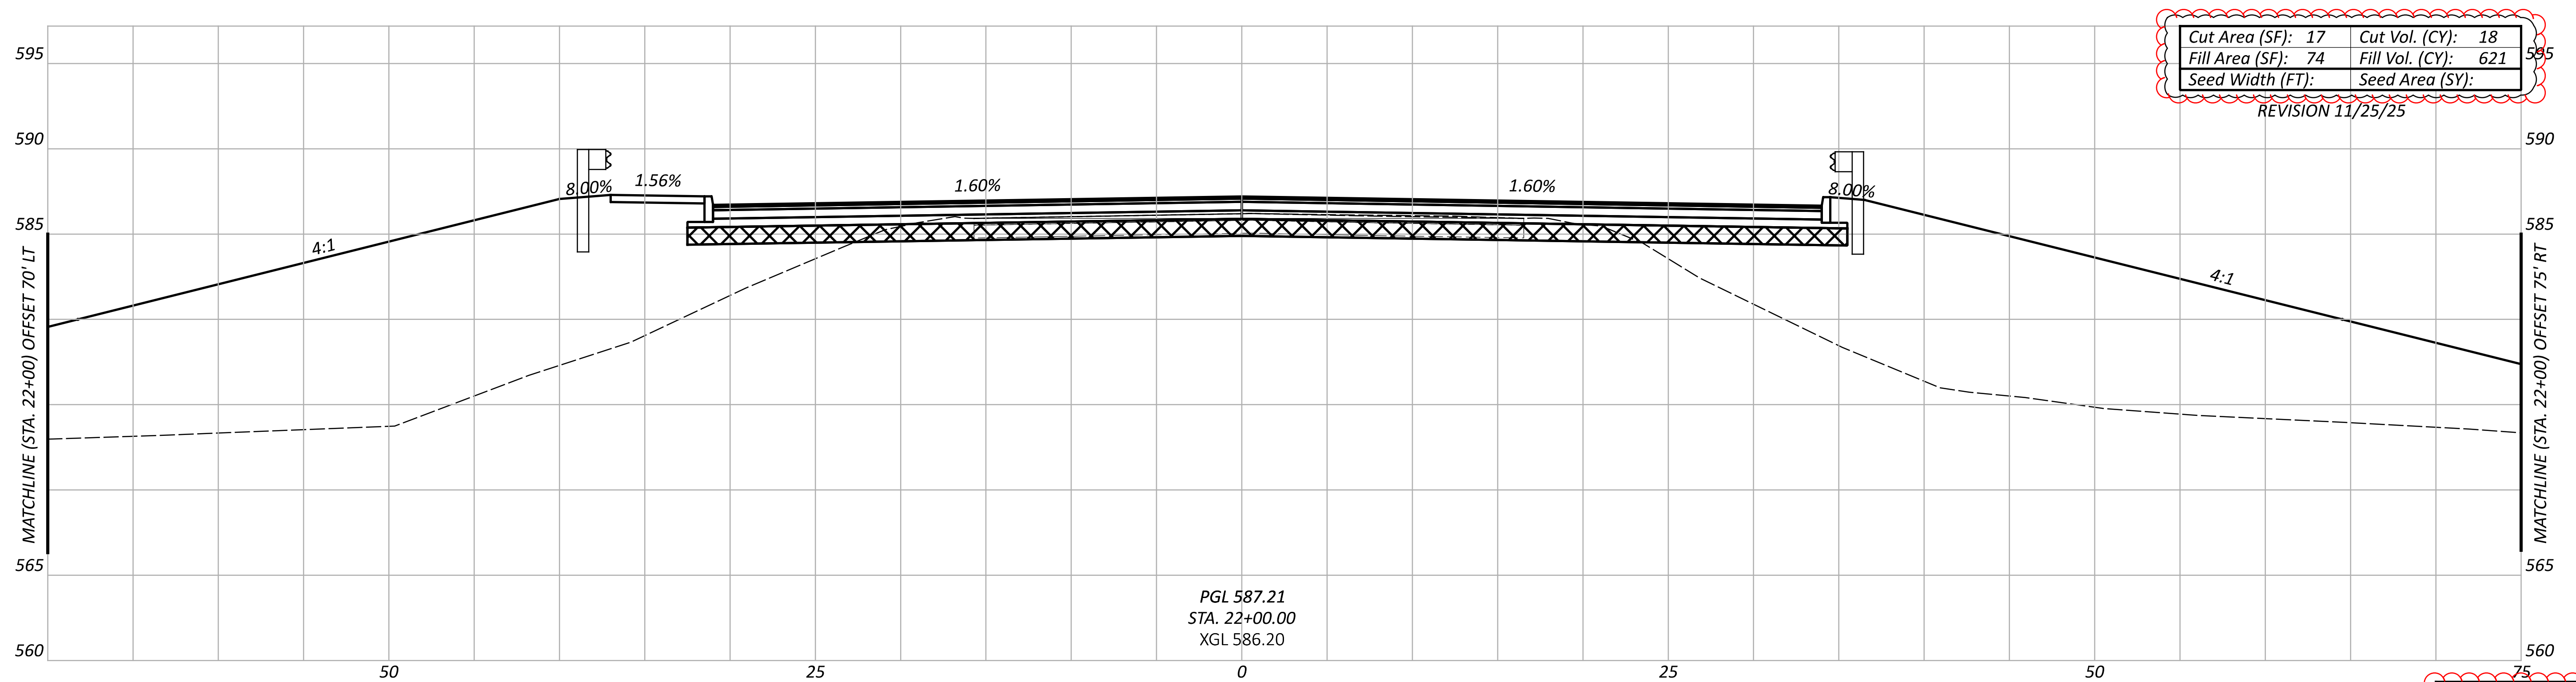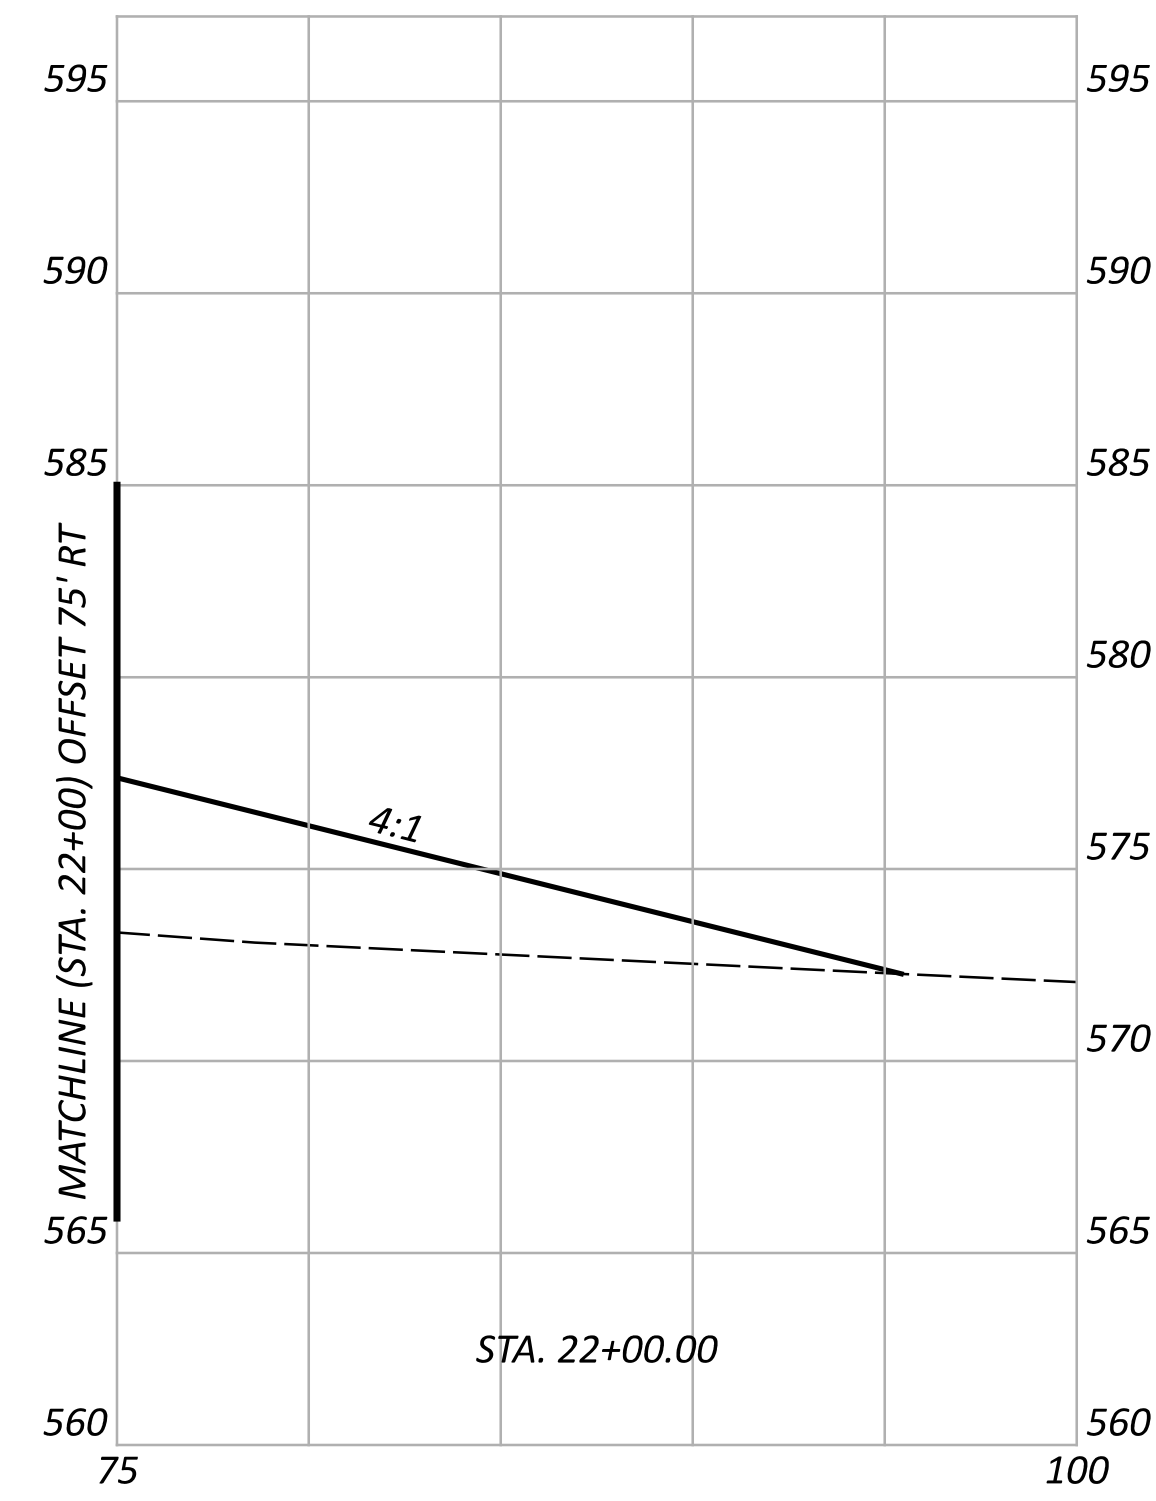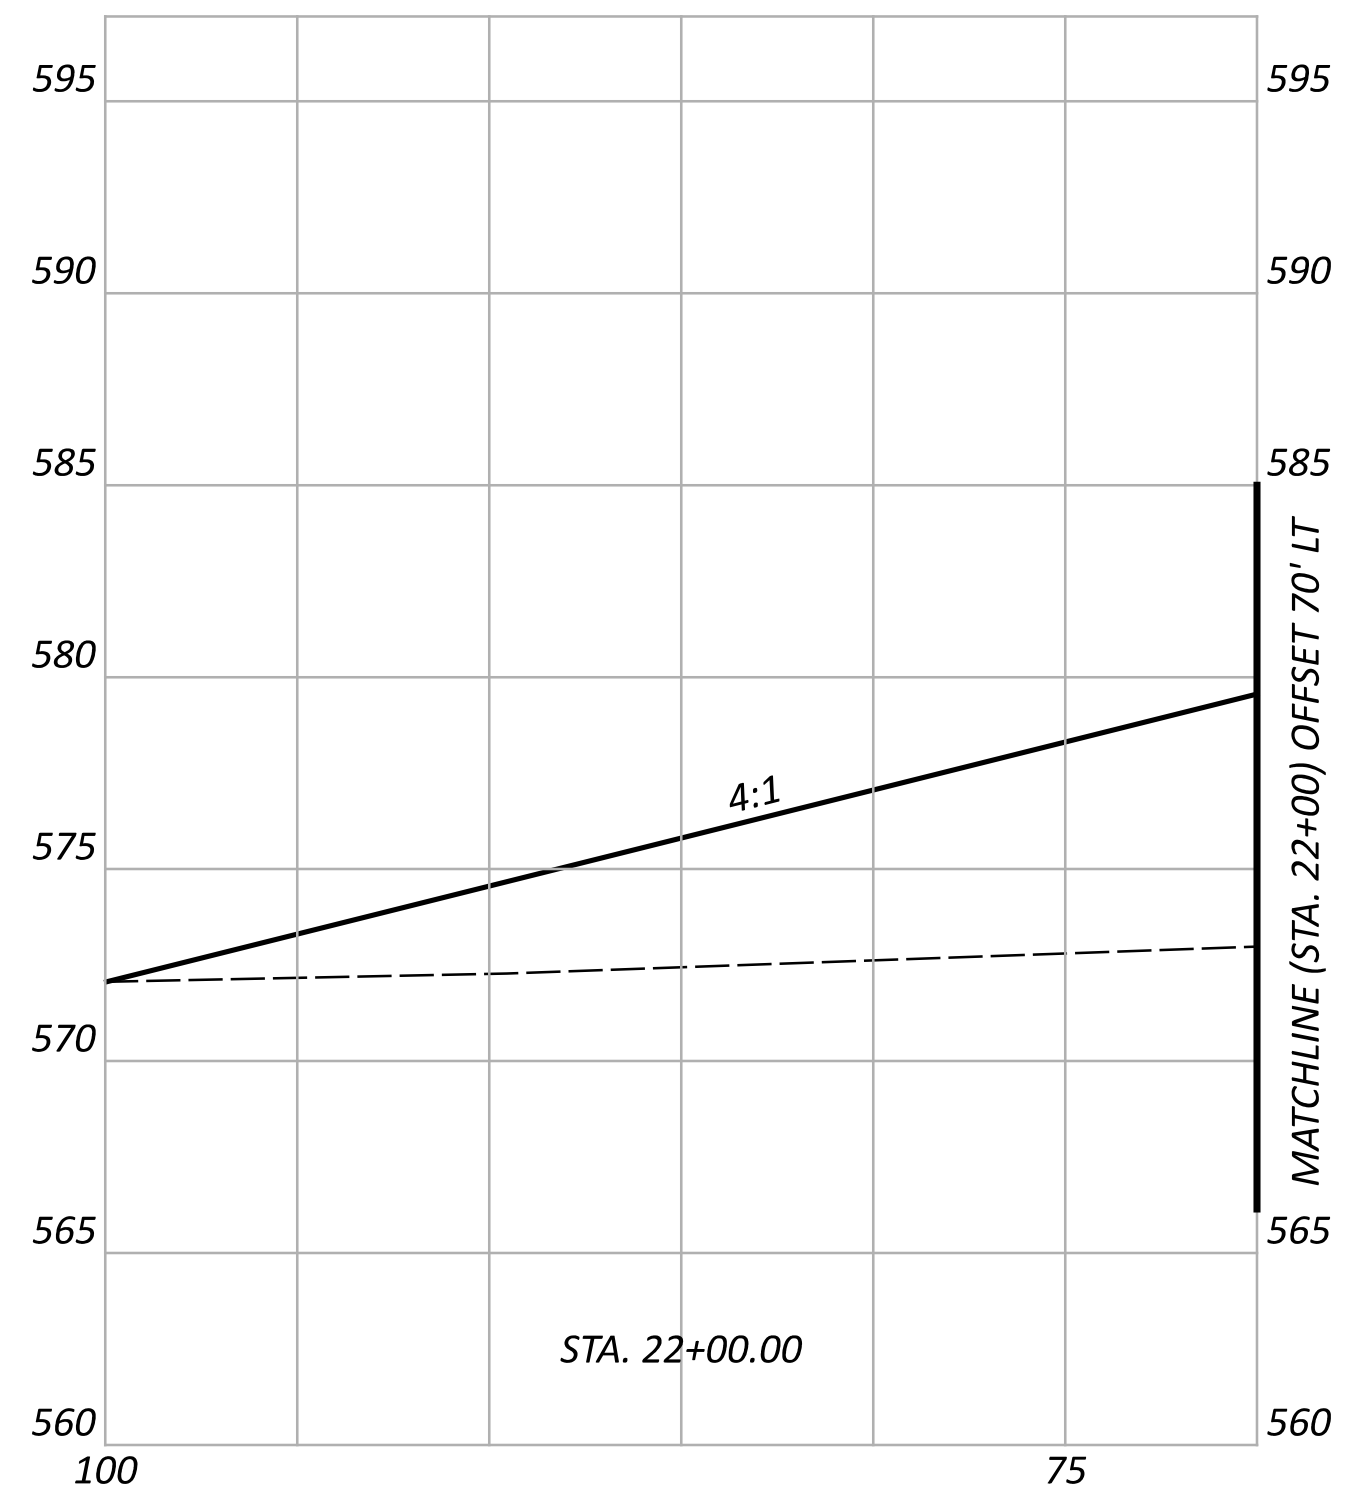

PGL 587.21
 STA. 22+00.00
 XGL 586.20

Sheet Totals			118472	
Seeding	Cut	Fill	SHEET	TOTAL
18	621	045	045	172




CROSS SECTIONS - C.R.14 (DRY FORK RD.)
 STA. 22+00

DESIGN AGENCY
TEC
 PLAN PREPARED BY:
 TEC Engineering, Inc.
 7288 Central Parke Blvd.
 Mason, OH 45040

DESIGNER
 KLL

REVIEWER
 ERW 12/01/25

PROJECT ID
 118472

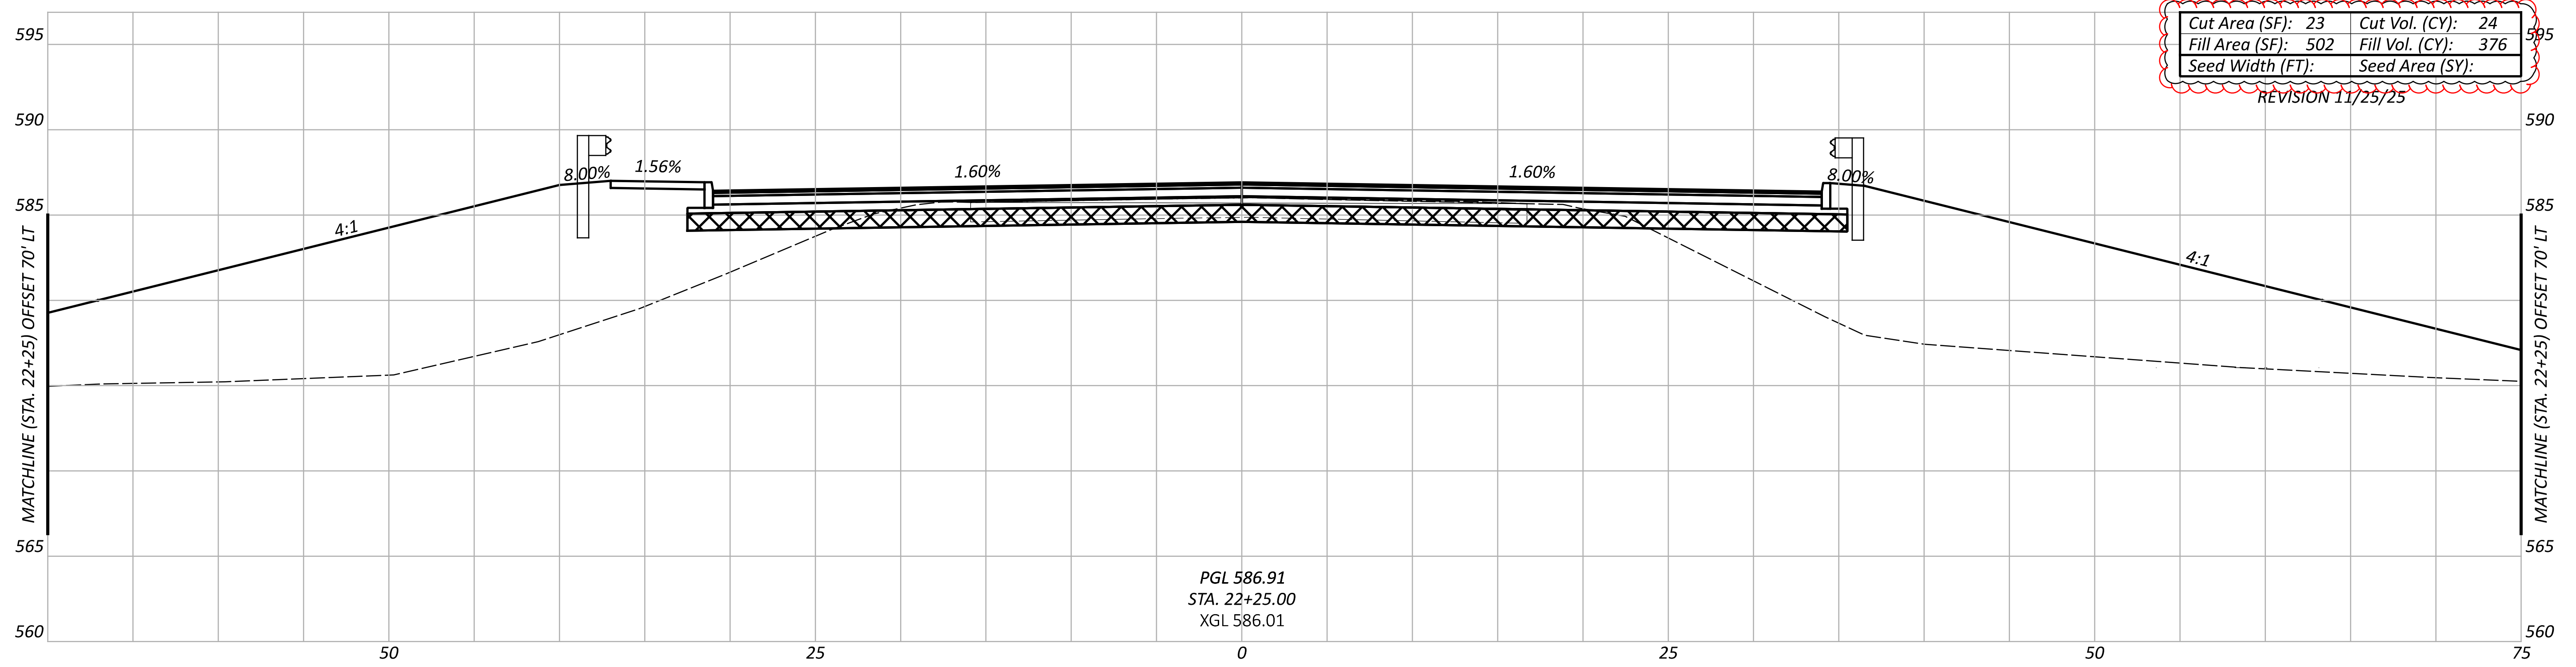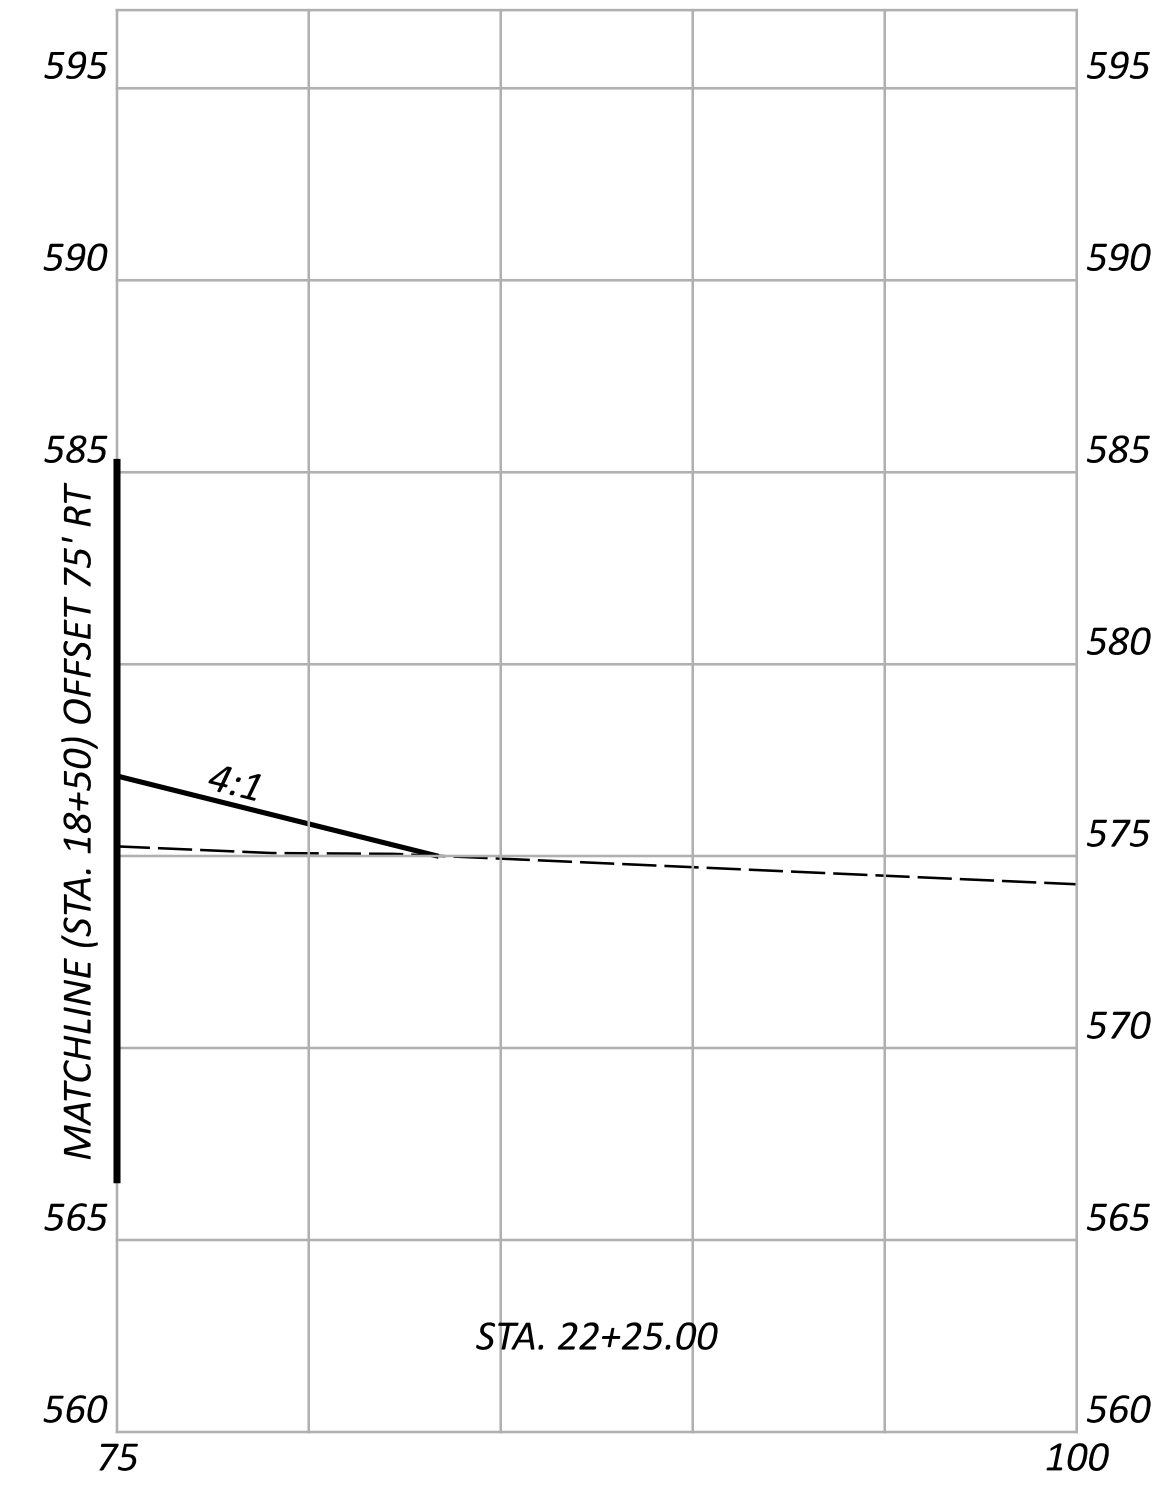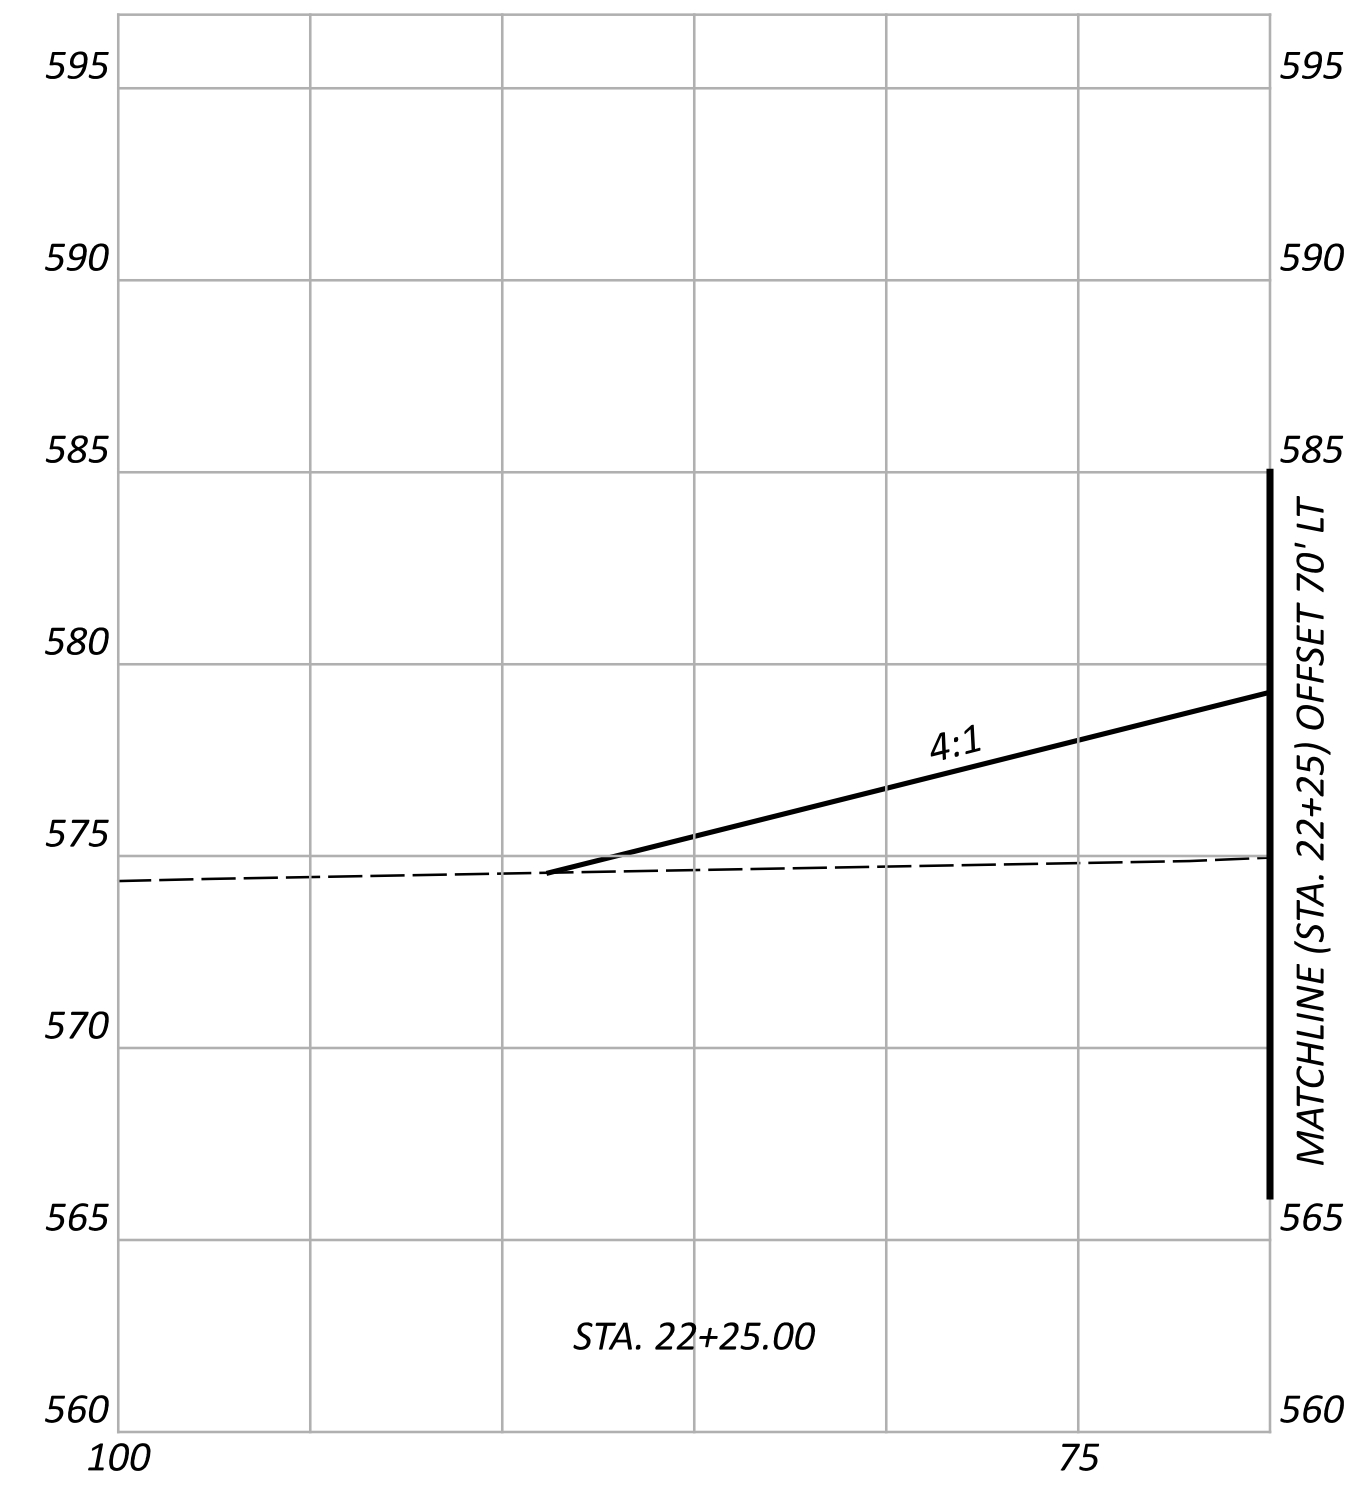


PGL 586.91
 STA. 22+25.00
 XGL 586.01

Cut Area (SF): 23	Cut Vol. (CY): 24
Fill Area (SF): 502	Fill Vol. (CY): 376
Seed Width (FT):	Seed Area (SY):




REVISION 11/25/25

CROSS SECTIONS - C.R.14 (DRY FORK RD.)
 STA. 22+25

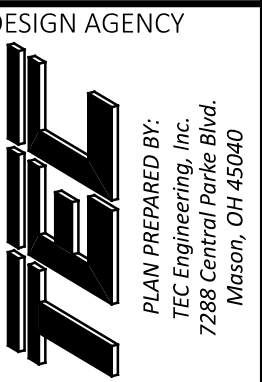

DESIGNER
 KLL
 REVIEWER
 ERW 12/01/25
 PROJECT ID
 118472

Sheet Totals			118472
Seeding	Cut	Fill	TOTAL
046	24	376	046 172

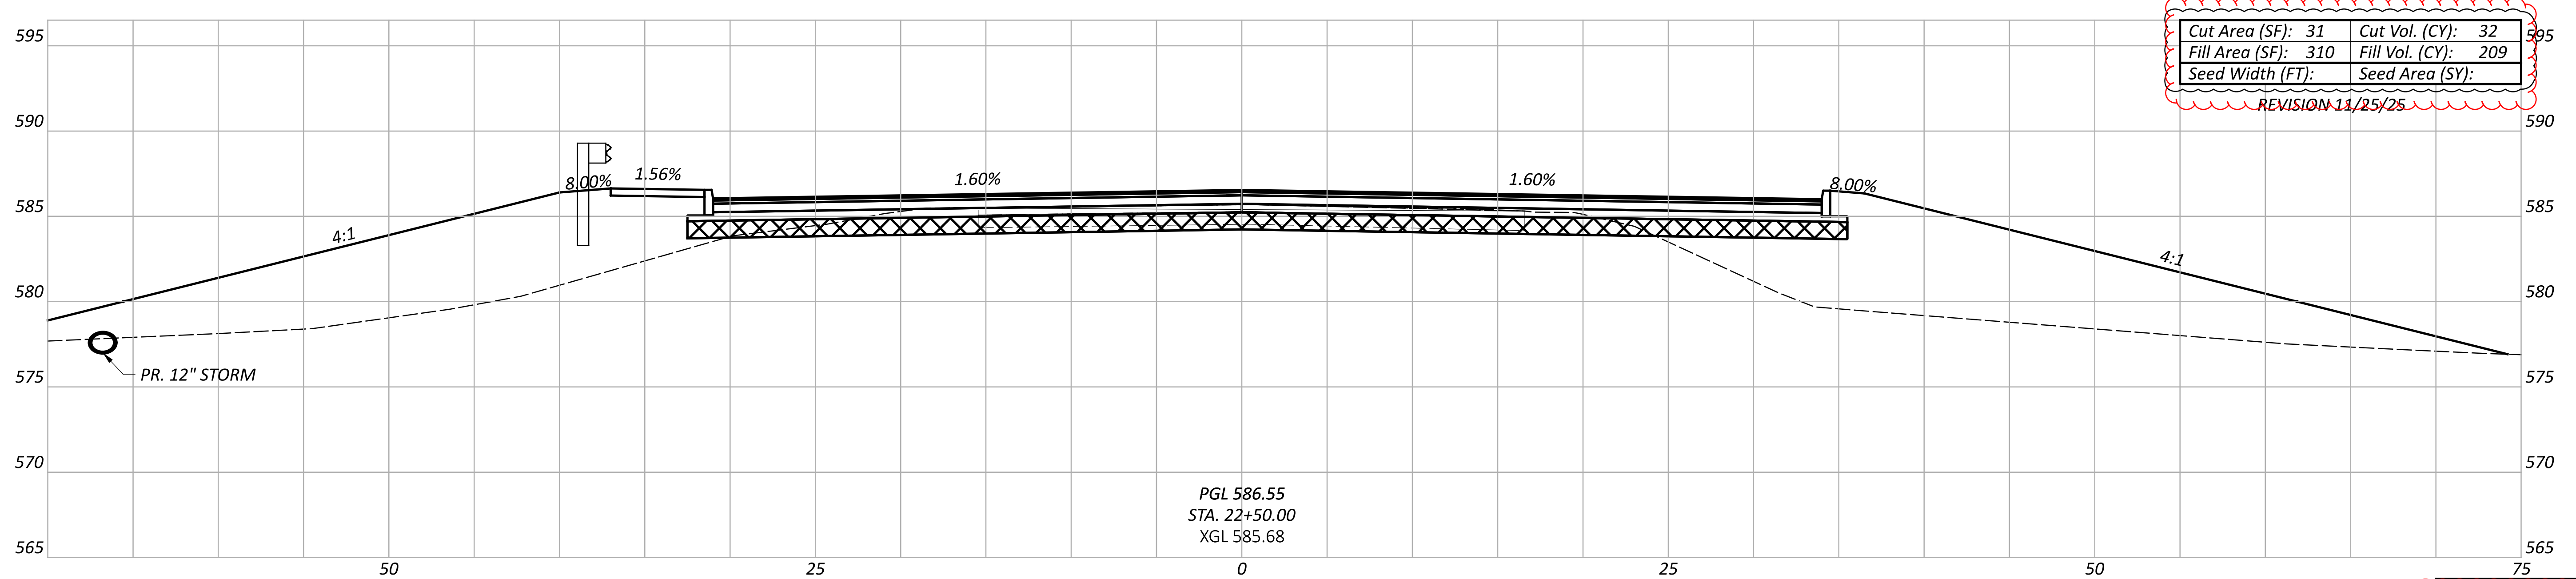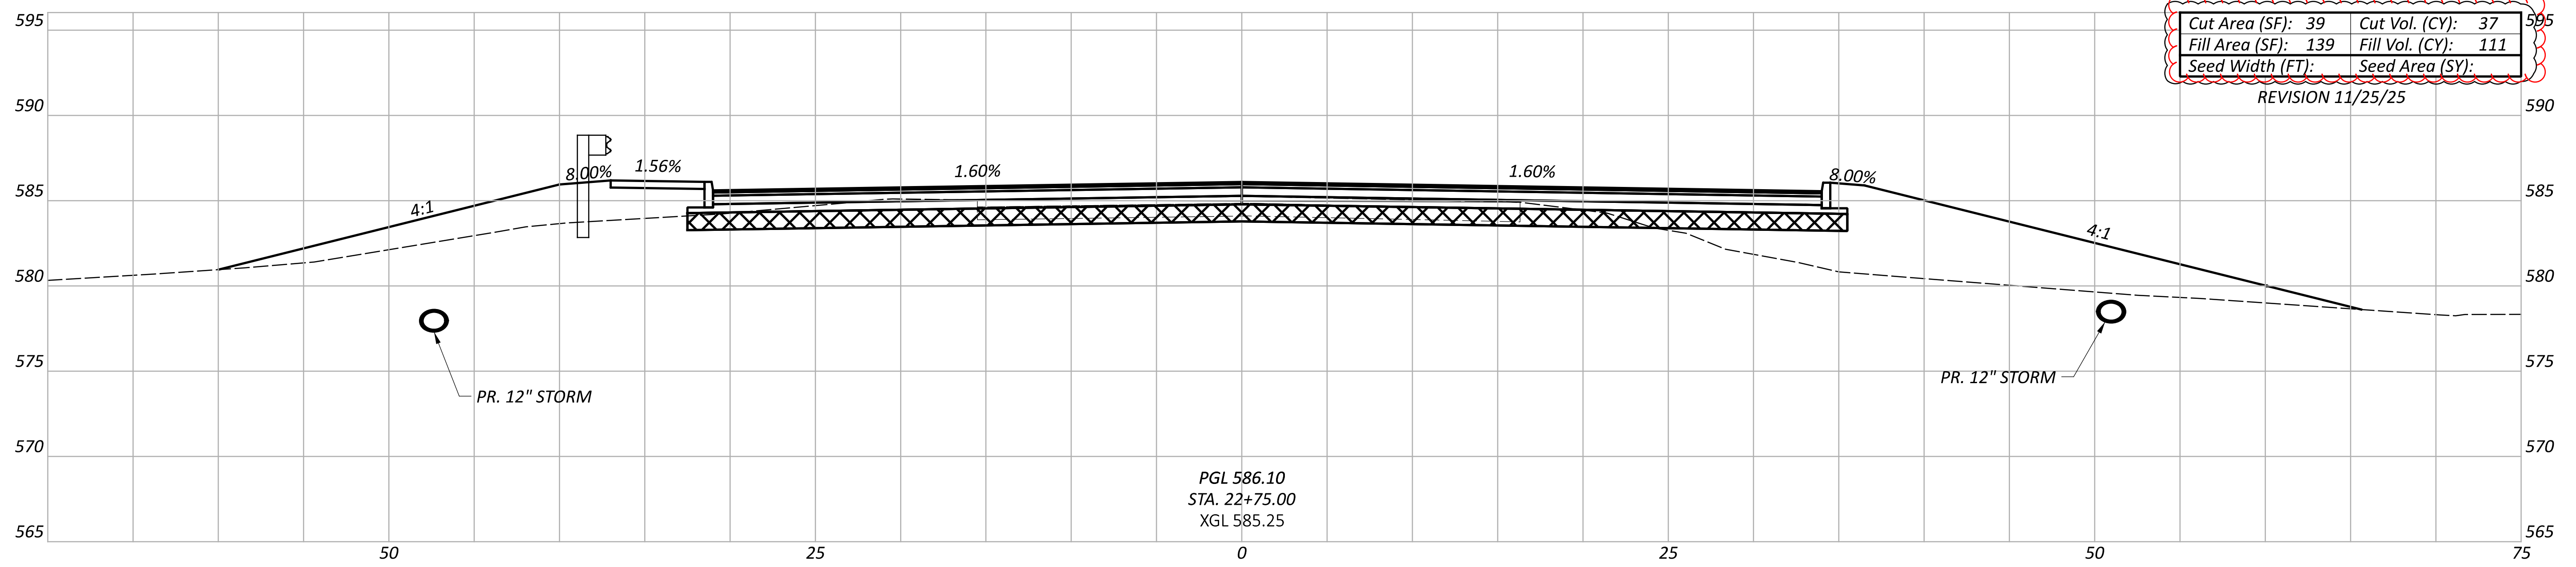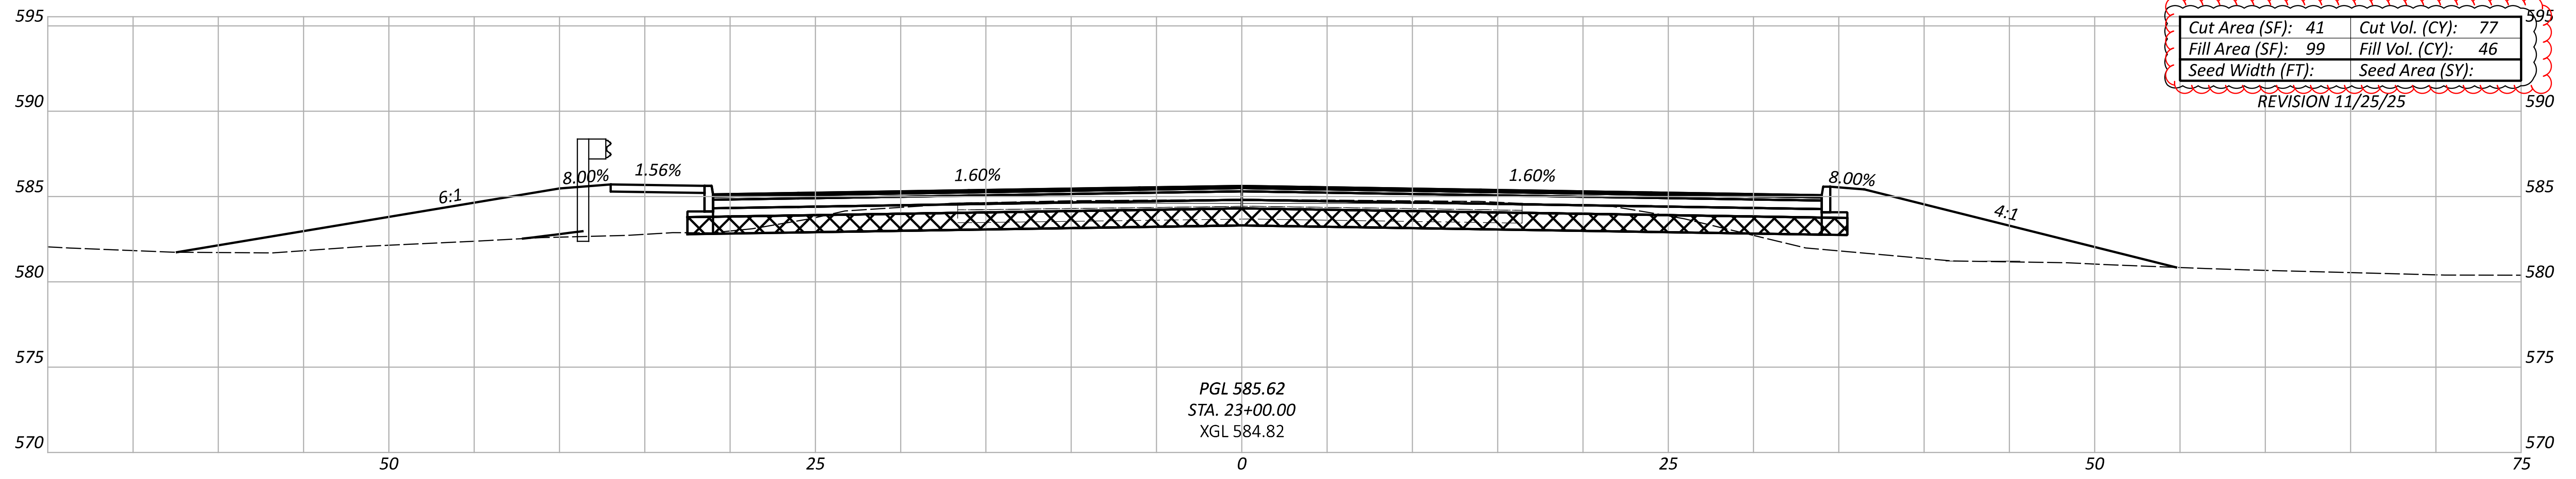

Sheet Totals			
Seeding	Cut	Fill	SHEET TOTAL
146	366	047	172

CROSS SECTIONS - C.R.14 (DRY FORK RD.)
 STA. 22+50 TO 23+00




DESIGN AGENCY

 PLAN PREPARED BY:
 TEC Engineering, Inc.
 7288 Central Park Blvd.
 Mason, OH 45040

DESIGNER
 KLL

REVIEWER
 ERW 12/01/25

PROJECT ID
 118472

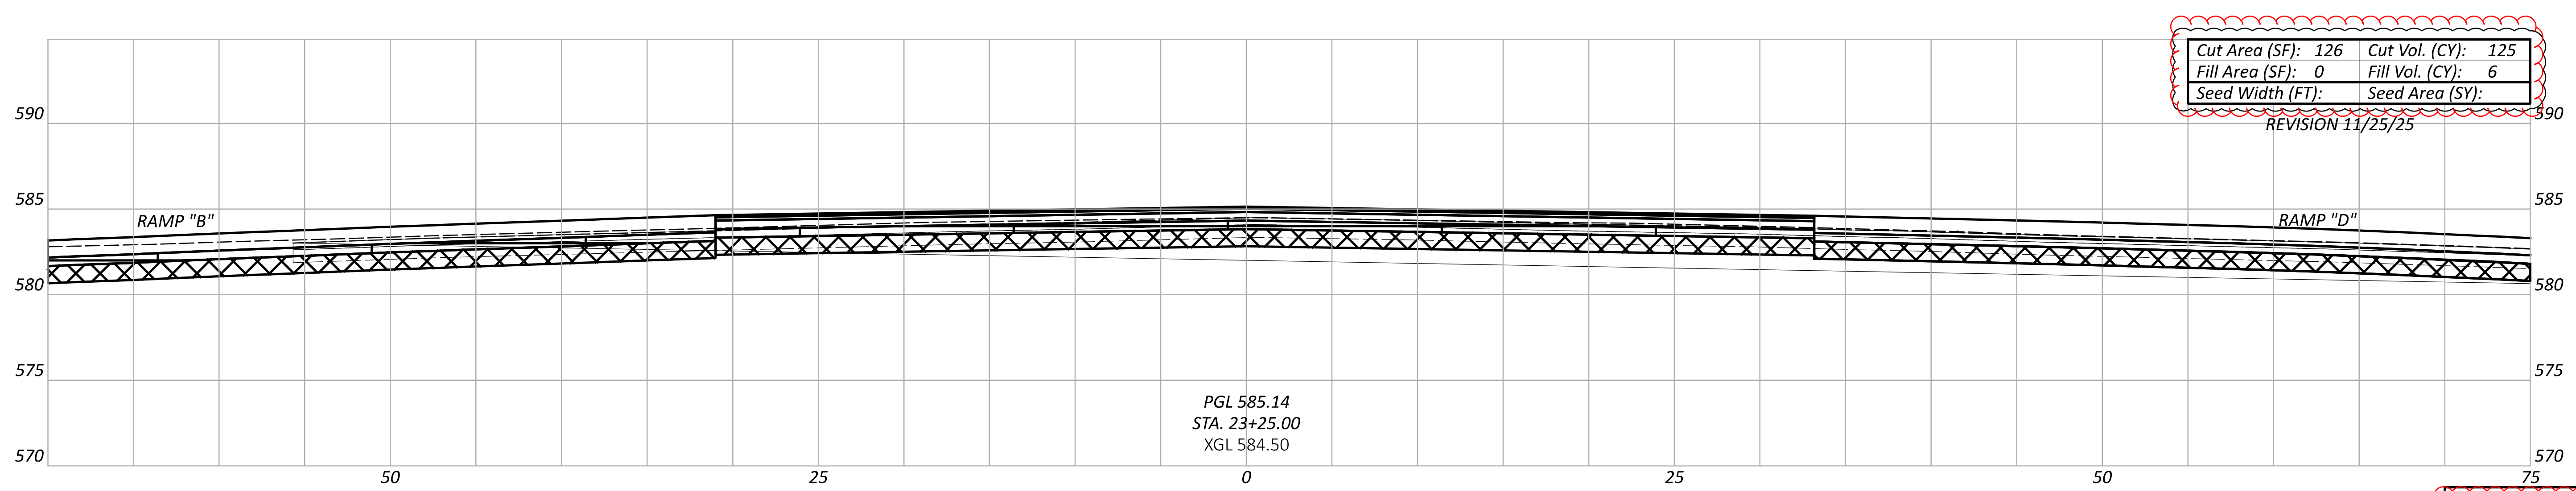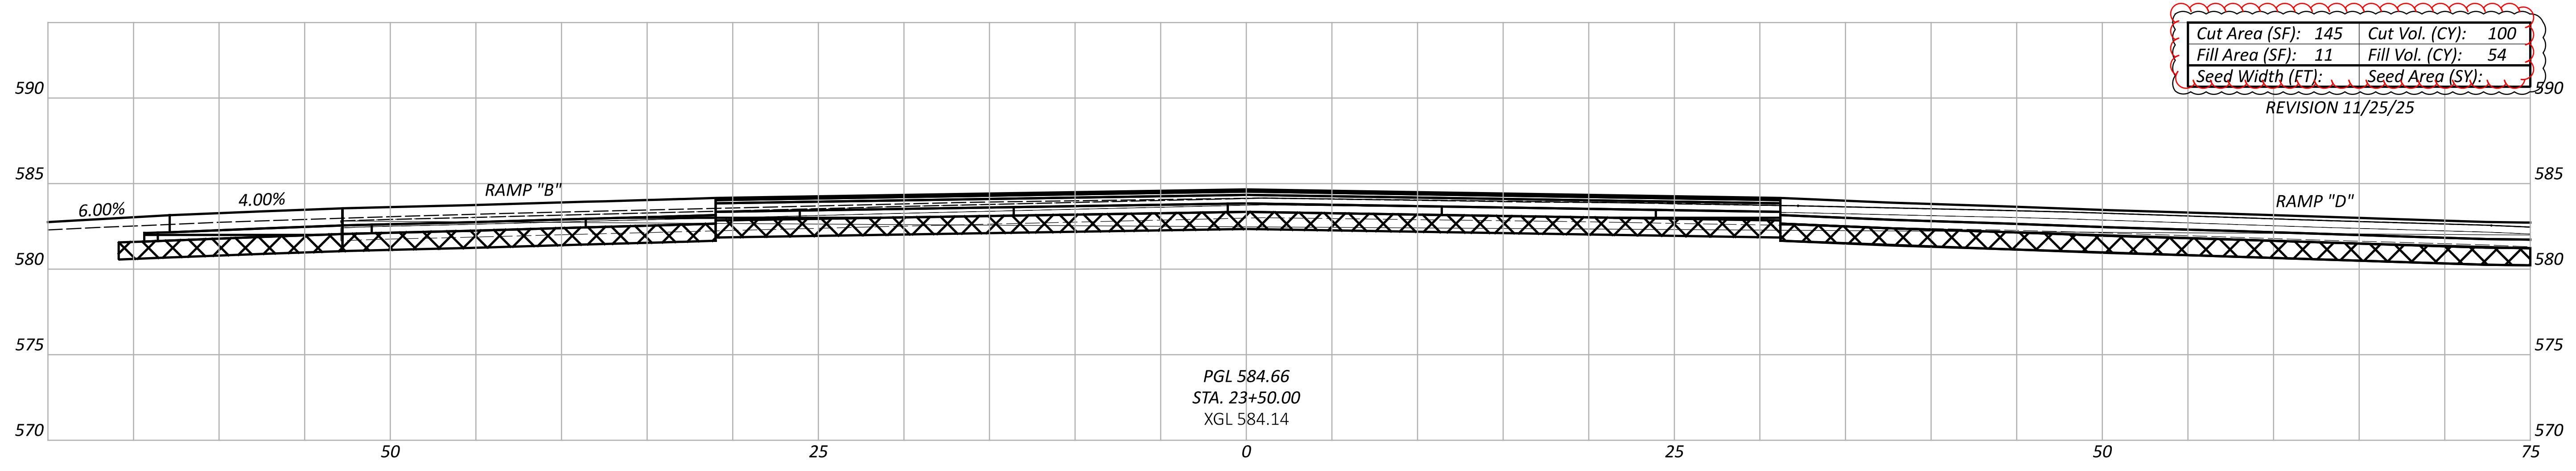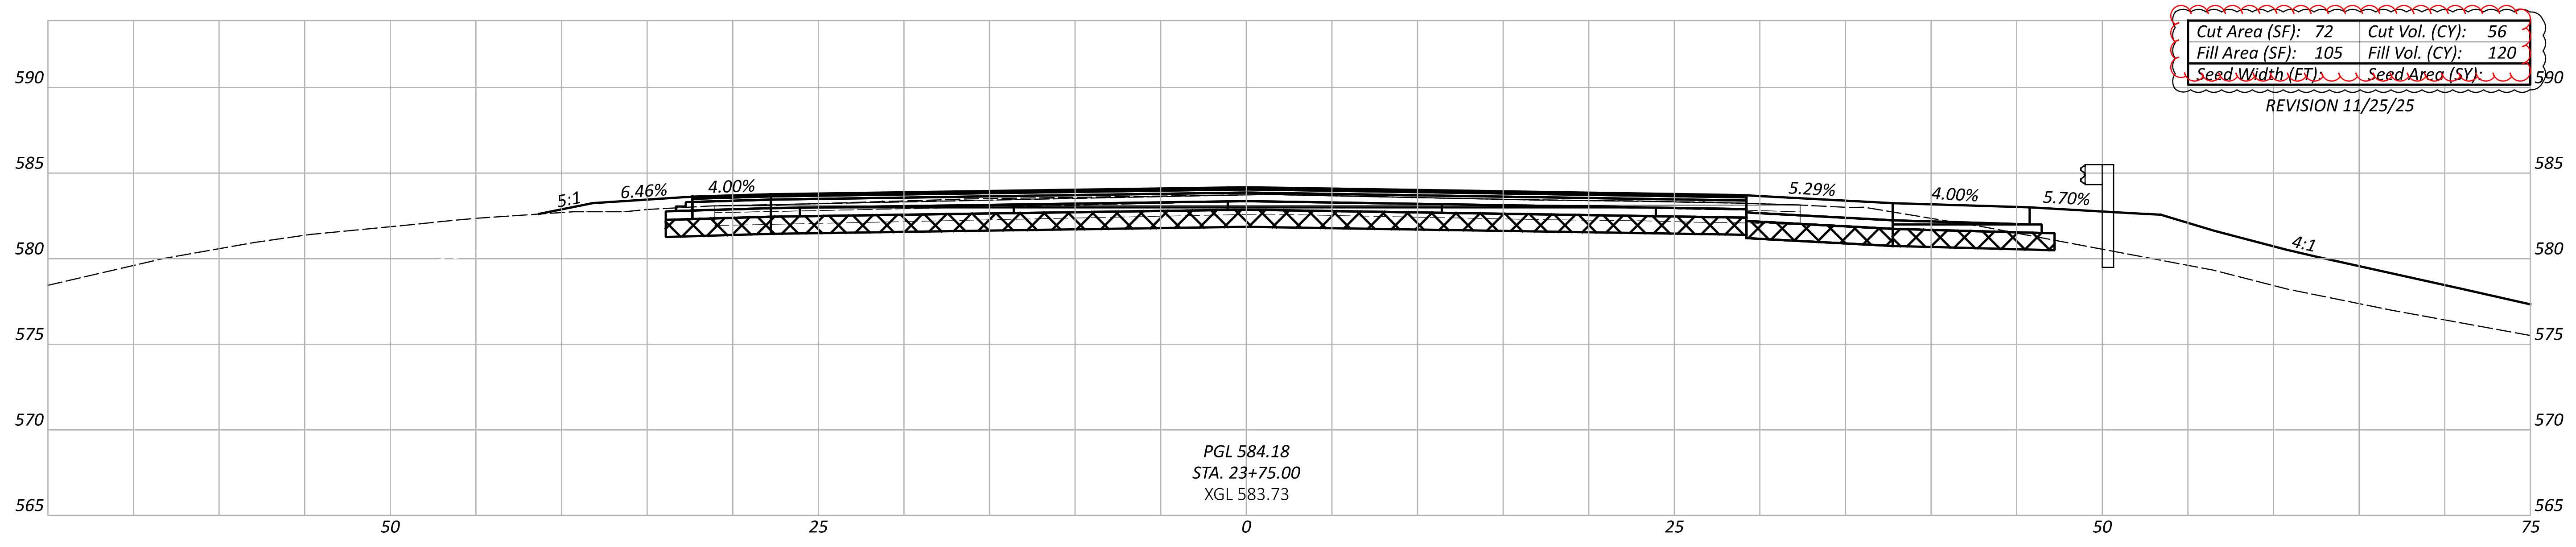

Sheet Totals			
Seeding	Cut	Fill	TOTAL
281	180	048	172

CROSS SECTIONS - C.R.14 (DRY FORK RD.)
STA. 23+25 TO 23+75

DESIGN AGENCY



 PLAN PREPARED BY:
 TEC Engineering, Inc.
 7288 Central Park Blvd.
 Mason, OH 45040

DESIGNER
KLL

REVIEWER
ERW 12/01/25

PROJECT ID
118472

SHEET TOTAL
048 172

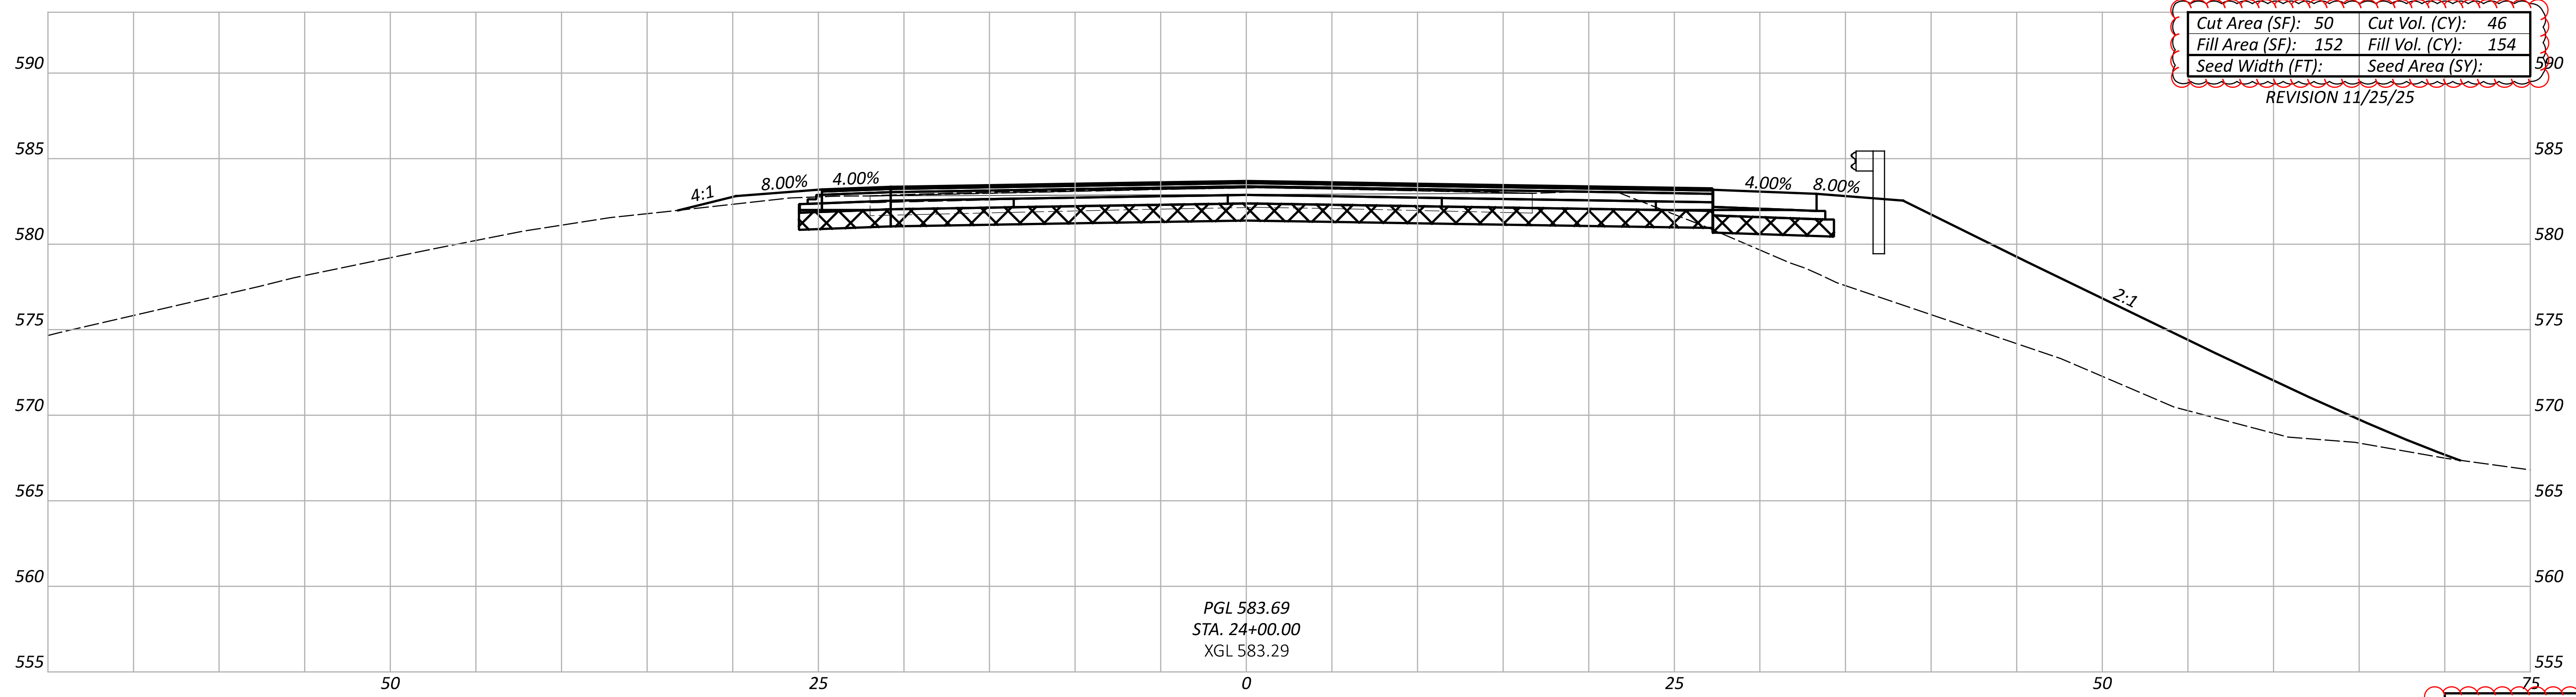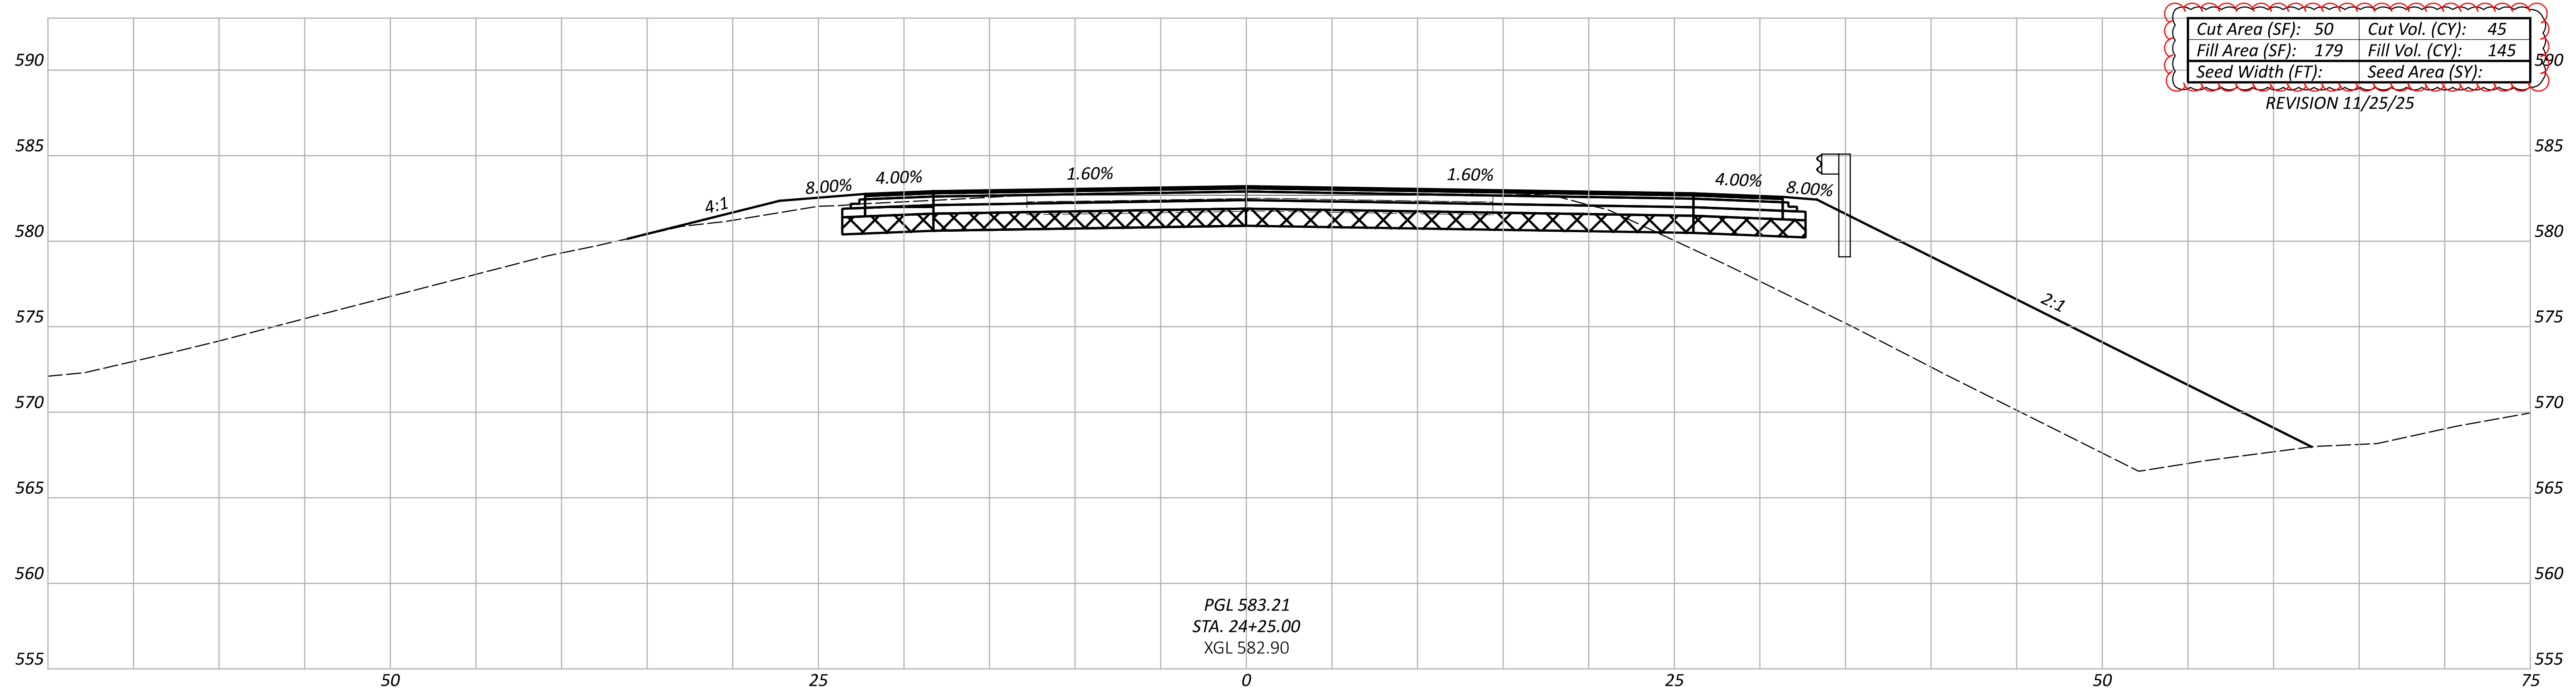

CROSS SECTIONS - C.R.14 (DRY FORK RD.)
 STA. 24+00 TO 24+25



DESIGN AGENCY
TEC
 PLAN PREPARED BY:
 TEC Engineering, Inc.
 7288 Central Park Blvd.
 Mason, OH 45040

DESIGNER
 KLL

REVIEWER
 ERW 12/01/25

PROJECT ID
 118472


Sheet Totals			118472
Seeding	Cut	Fill	TOTAL
91	299	049	172

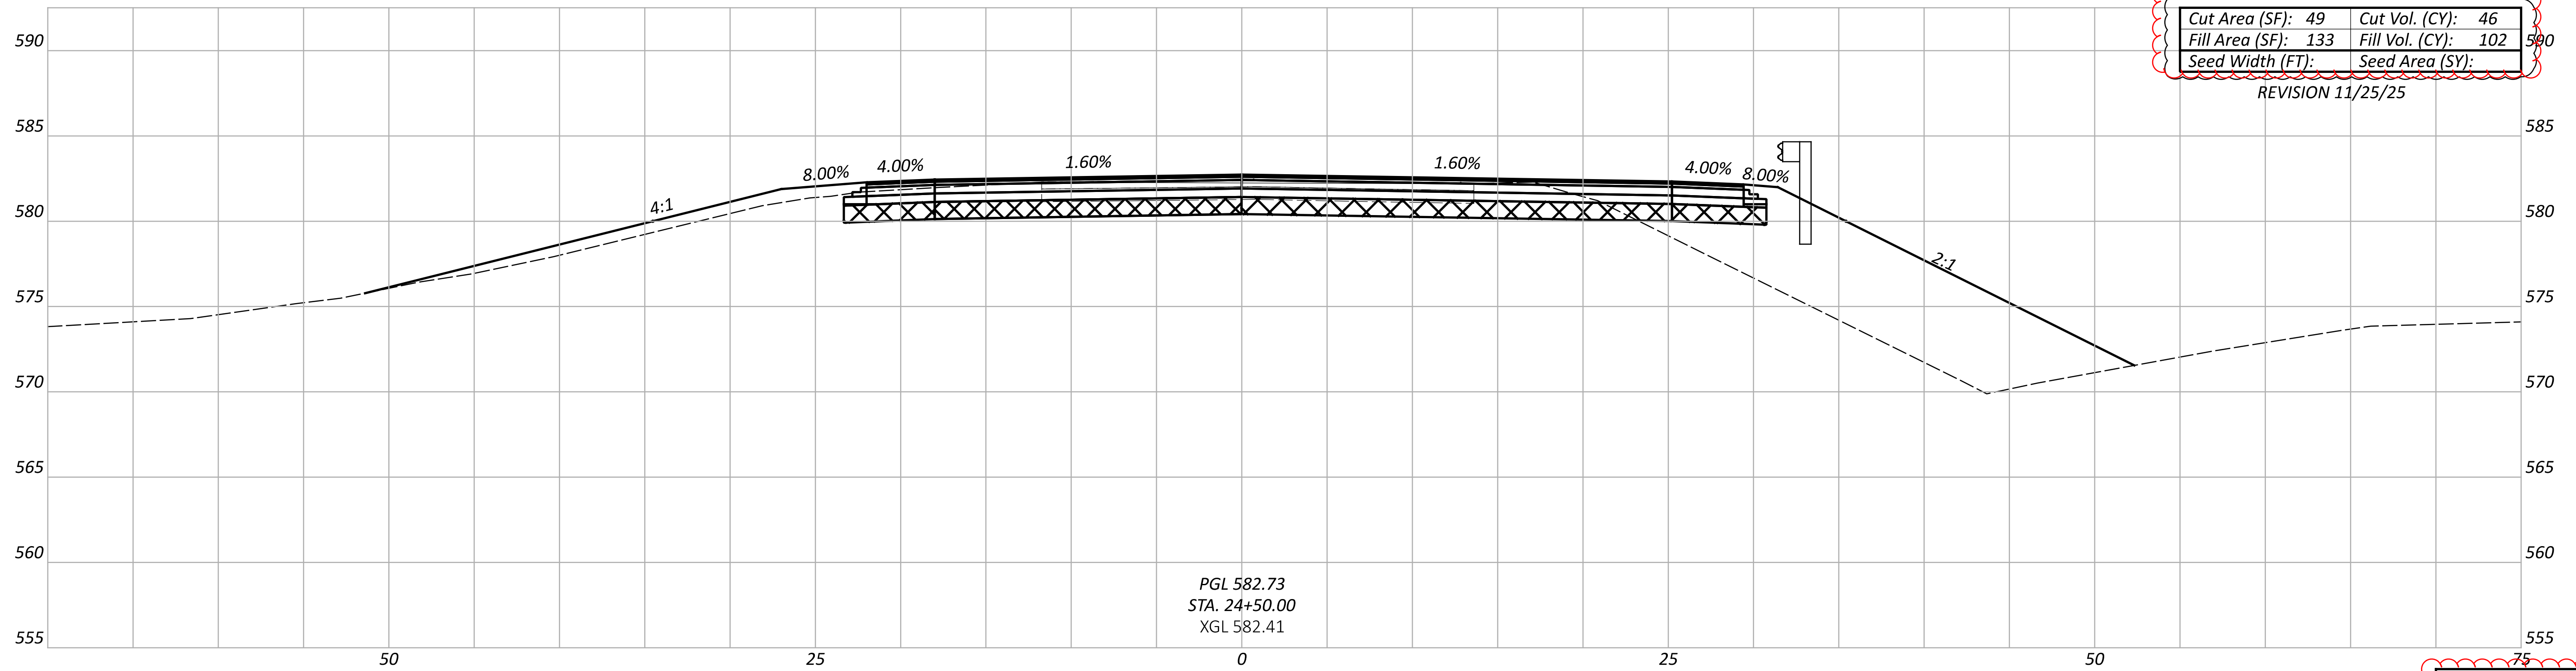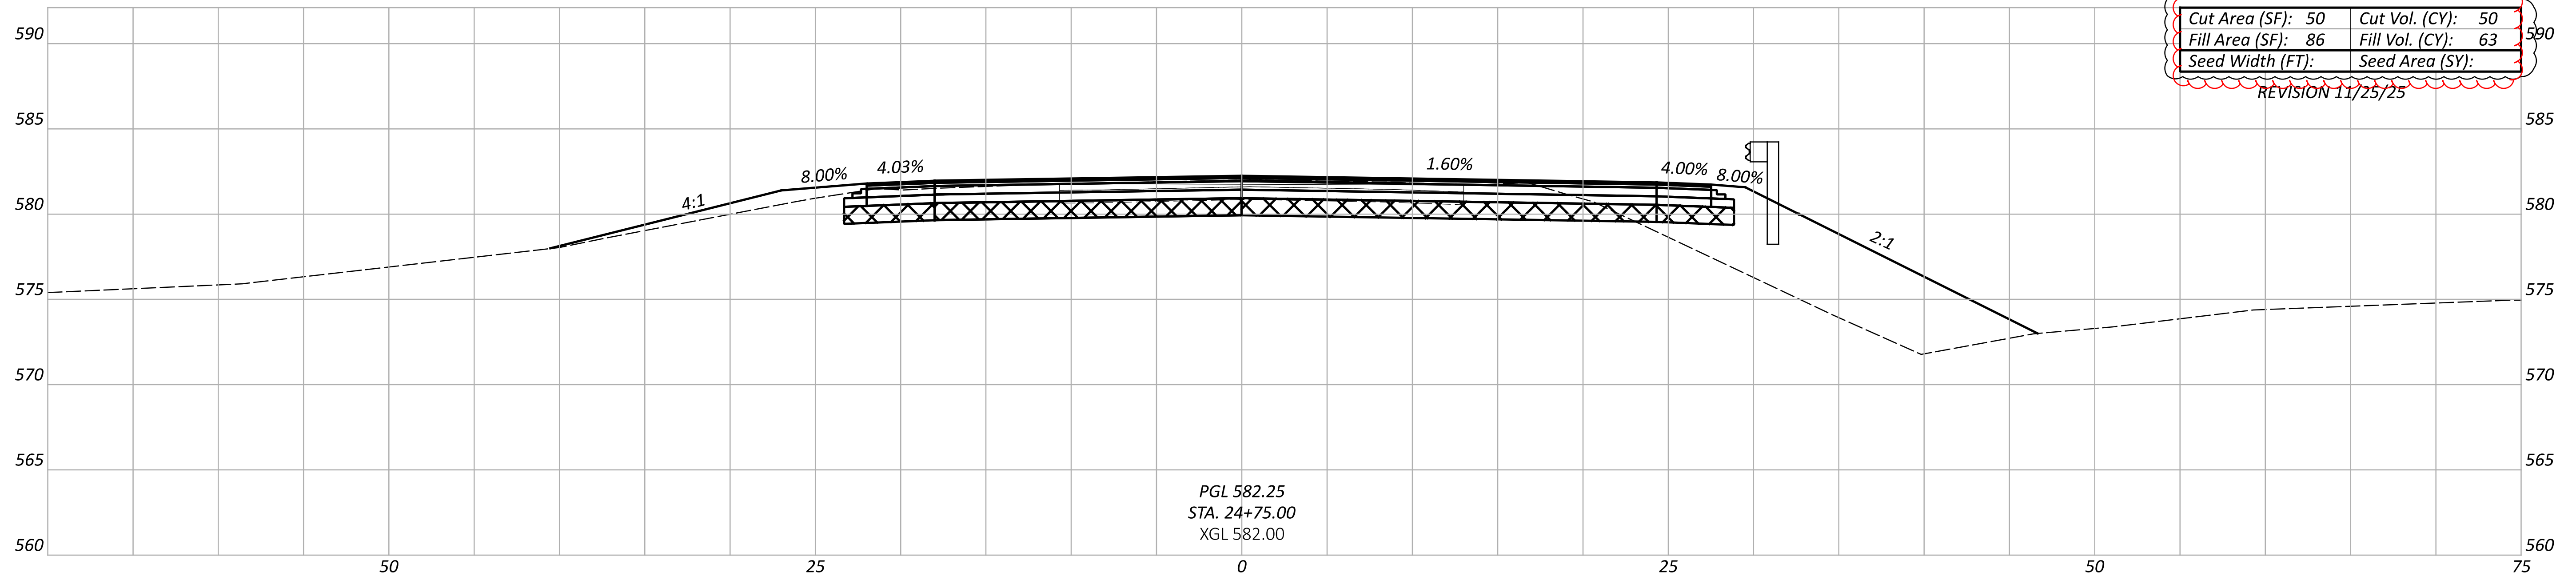

Sheet Totals			118472
Seeding	Cut	Fill	TOTAL
96	165	050	172

CROSS SECTIONS - C.R.14 (DRY FORK RD.)
 STA. 24+50 TO 24+75

DESIGN AGENCY

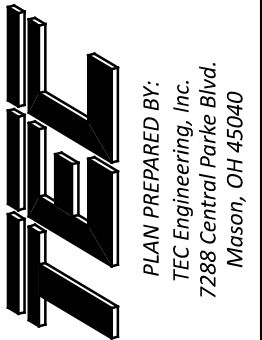

DESIGNER

KLL

REVIEWER

ERW 12/01/25

PROJECT ID




118472

SHEET

050

TOTAL

172

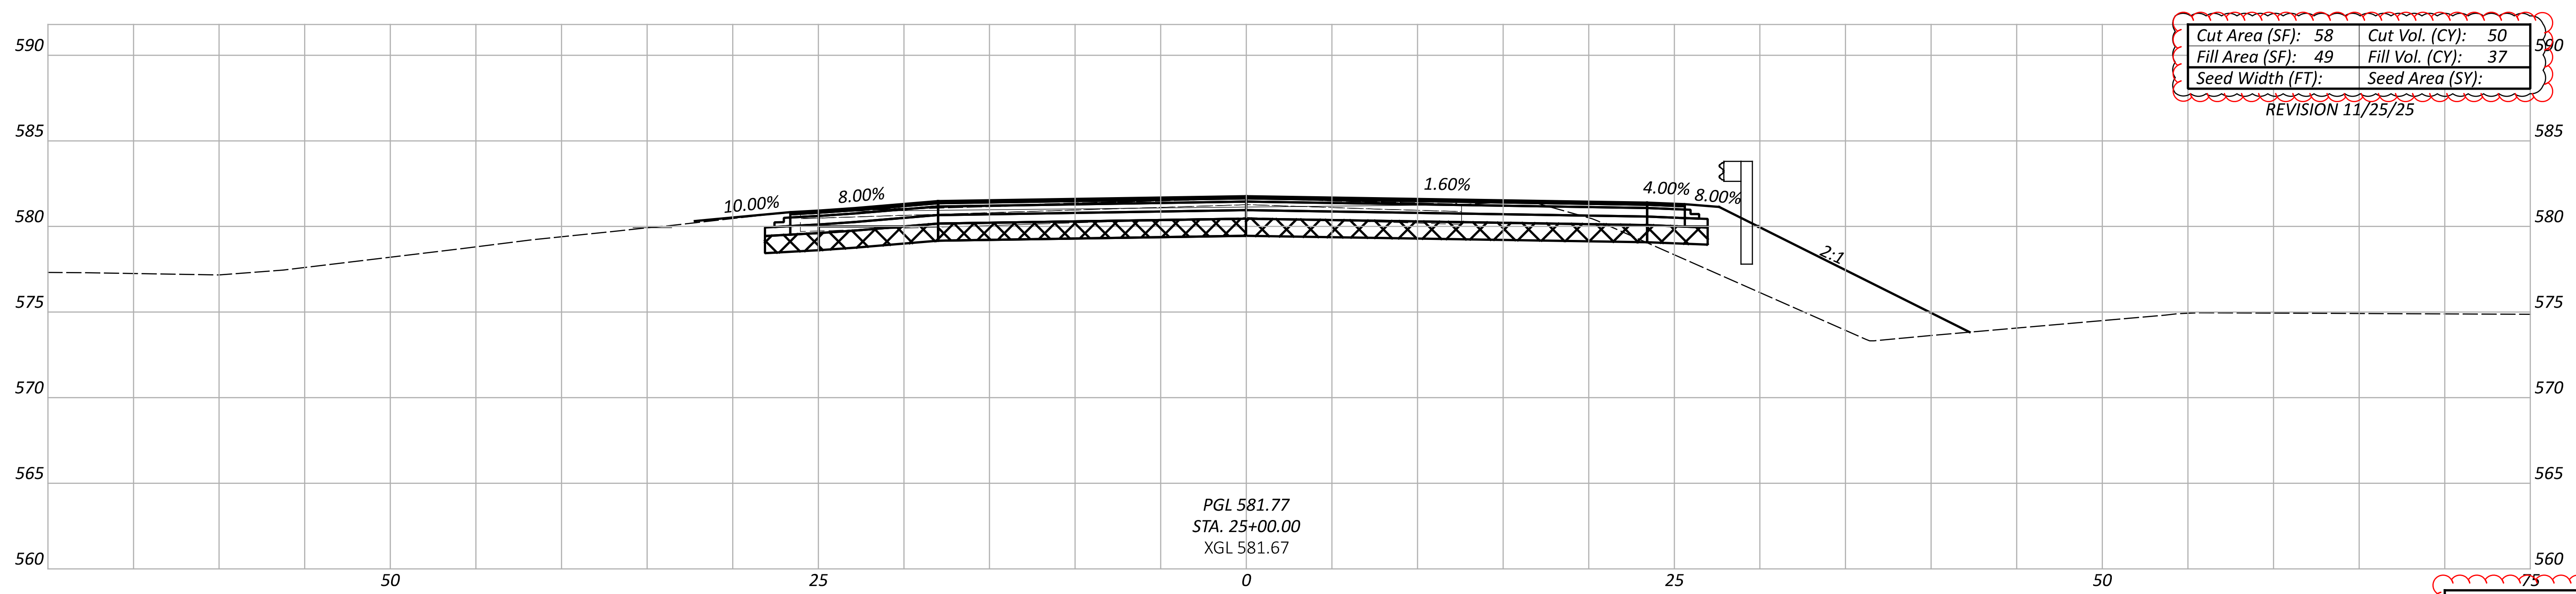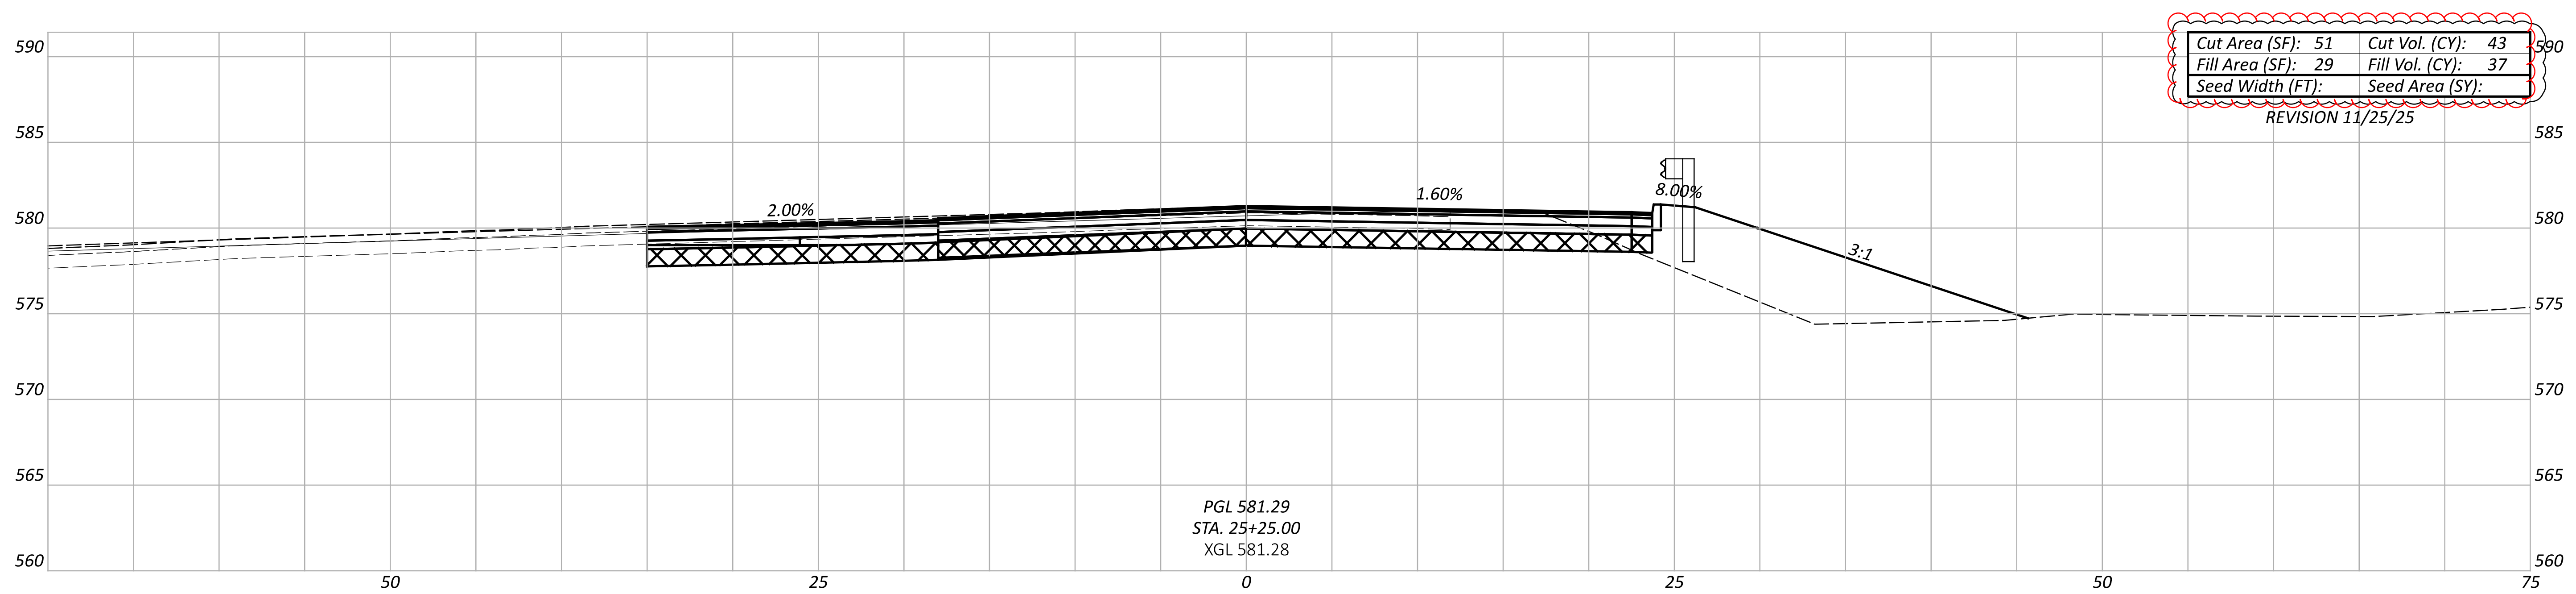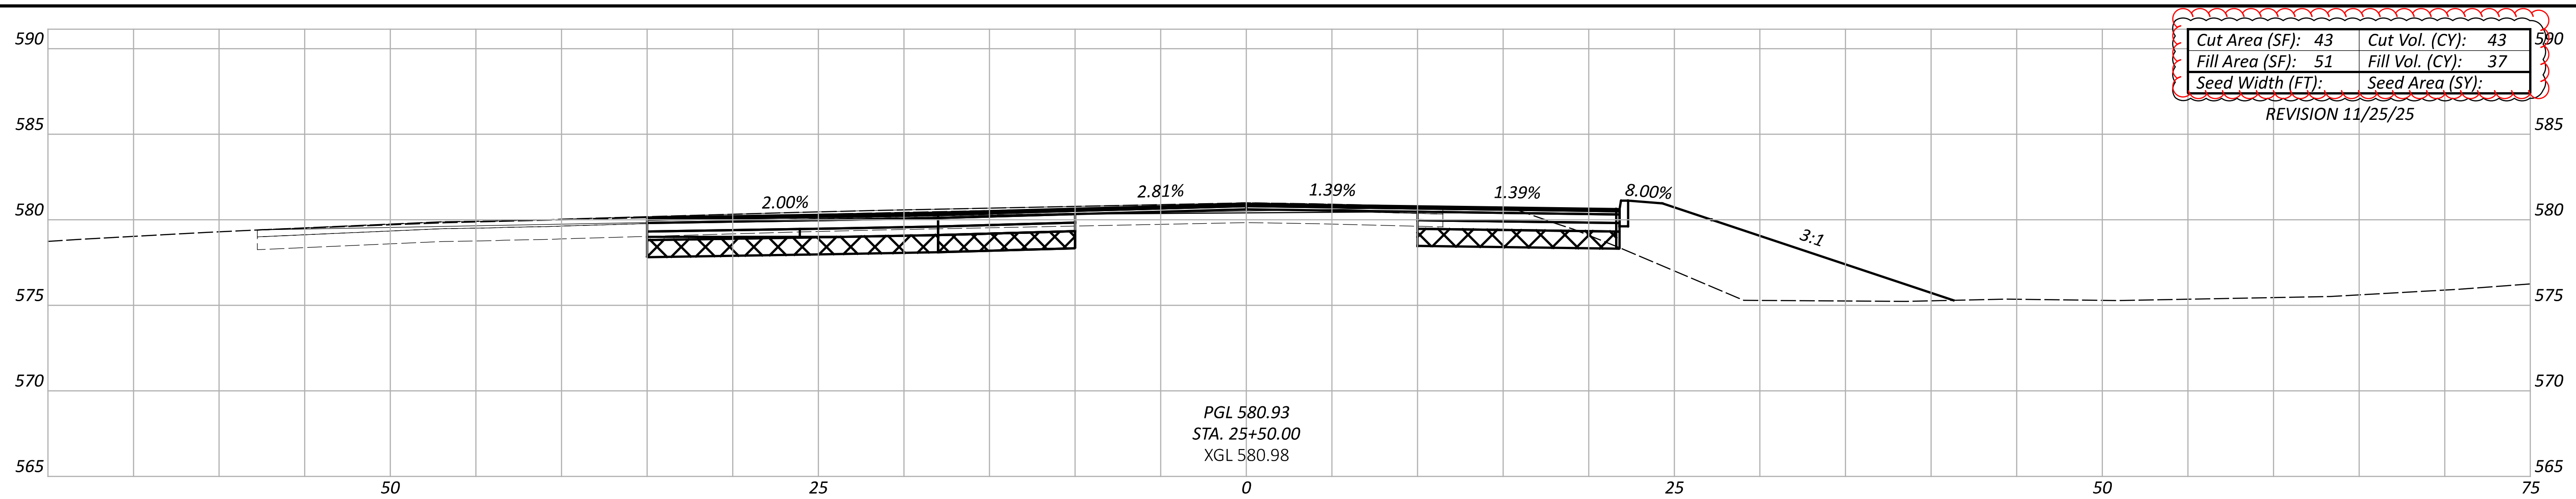

CROSS SECTIONS - C.R.14 (DRY FORK RD.)
 STA. 25+00 TO 25+50

DESIGN AGENCY

 PLAN PREPARED BY:
 TEC Engineering, Inc.
 7288 Central Park Blvd.
 Mason, OH 45040




DESIGNER
 KLL

REVIEWER
 ERW 12/01/25


PROJECT ID
 118472

Sheet Totals	118472
Seeding	051
Cut	172
Fill	136

Seeding	Cut	Fill	SHEET	TOTAL
136	172	136	051	172

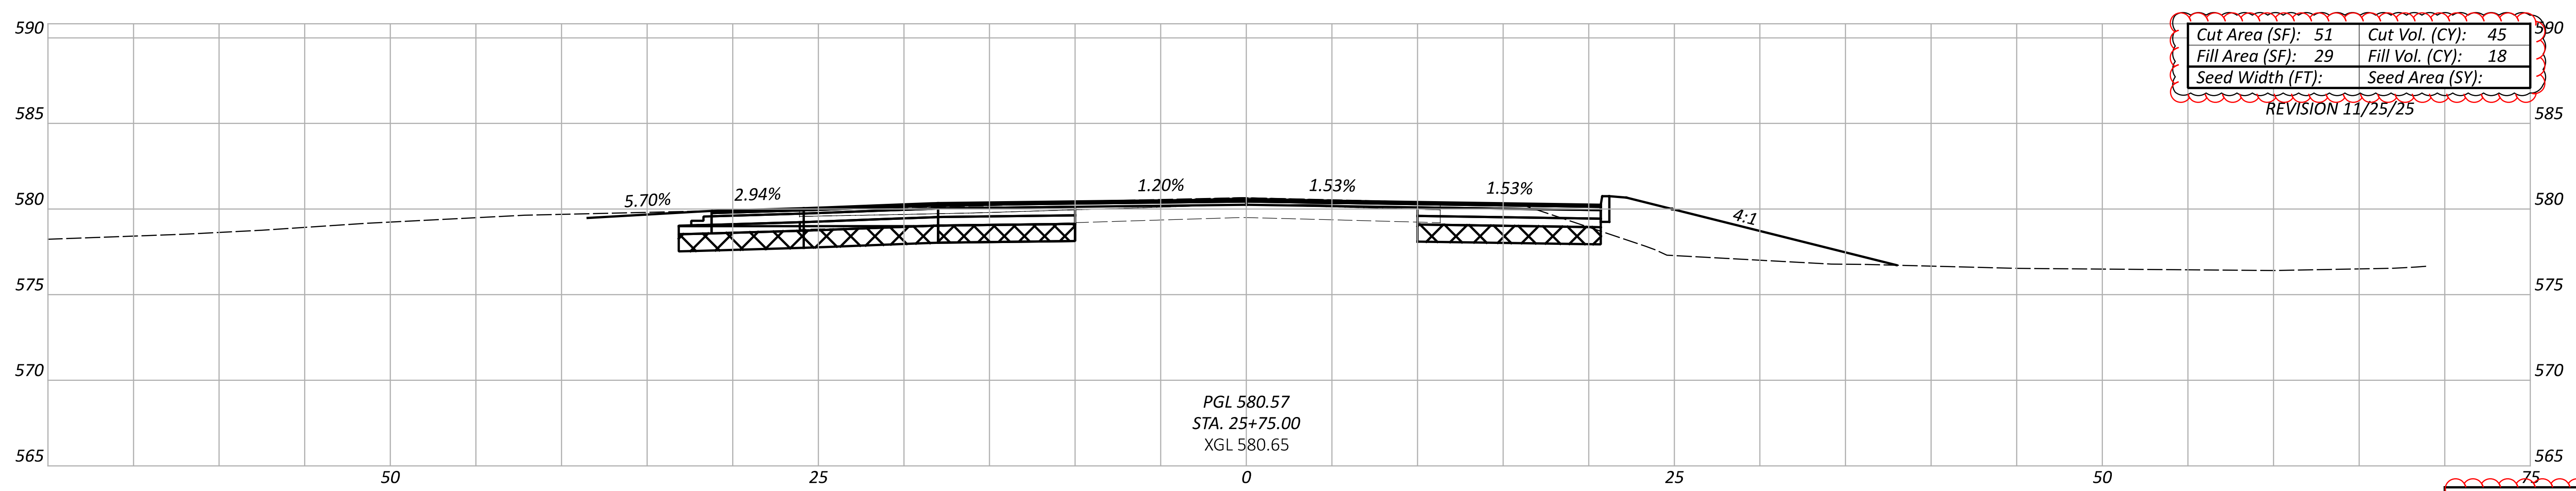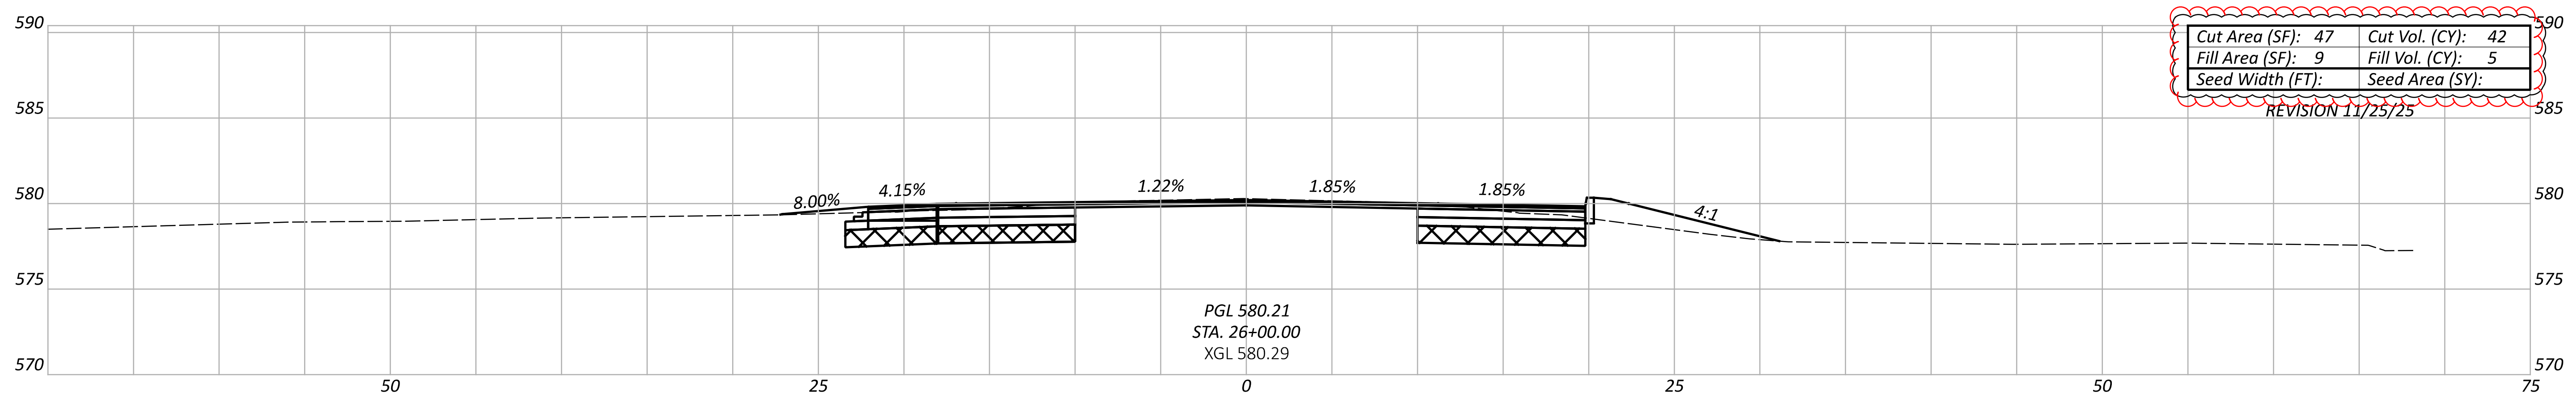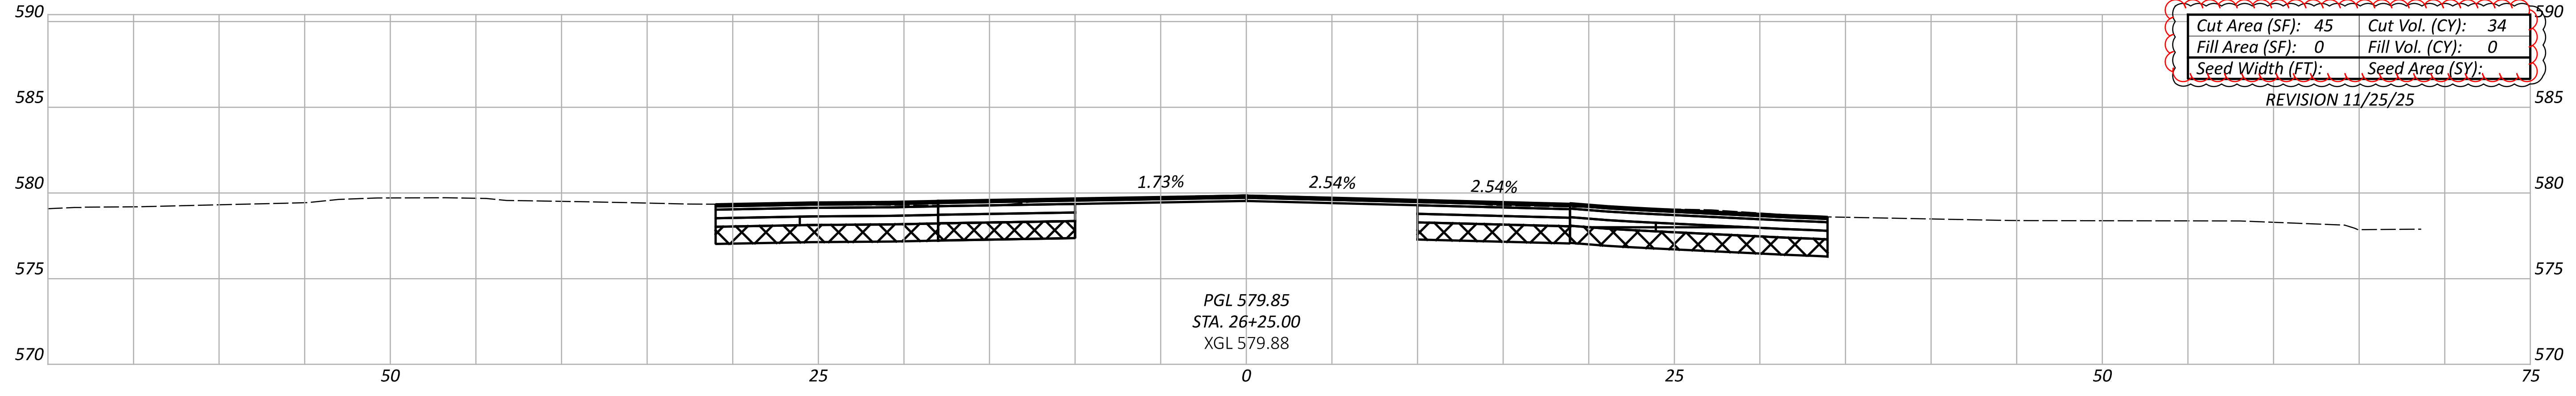

CROSS SECTIONS - C.R.14 (DRY FORK RD.)
 STA. 25+75 TO 26+25

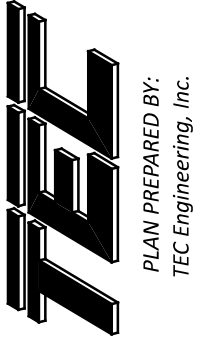
DESIGN AGENCY

 PLAN PREPARED BY:
 TEL Engineering, Inc.
 7288 Central Park Blvd.
 Mason, OH 45040

DESIGNER
 KLL

REVIEWER
 ERW 12/01/25

PROJECT ID
 118472

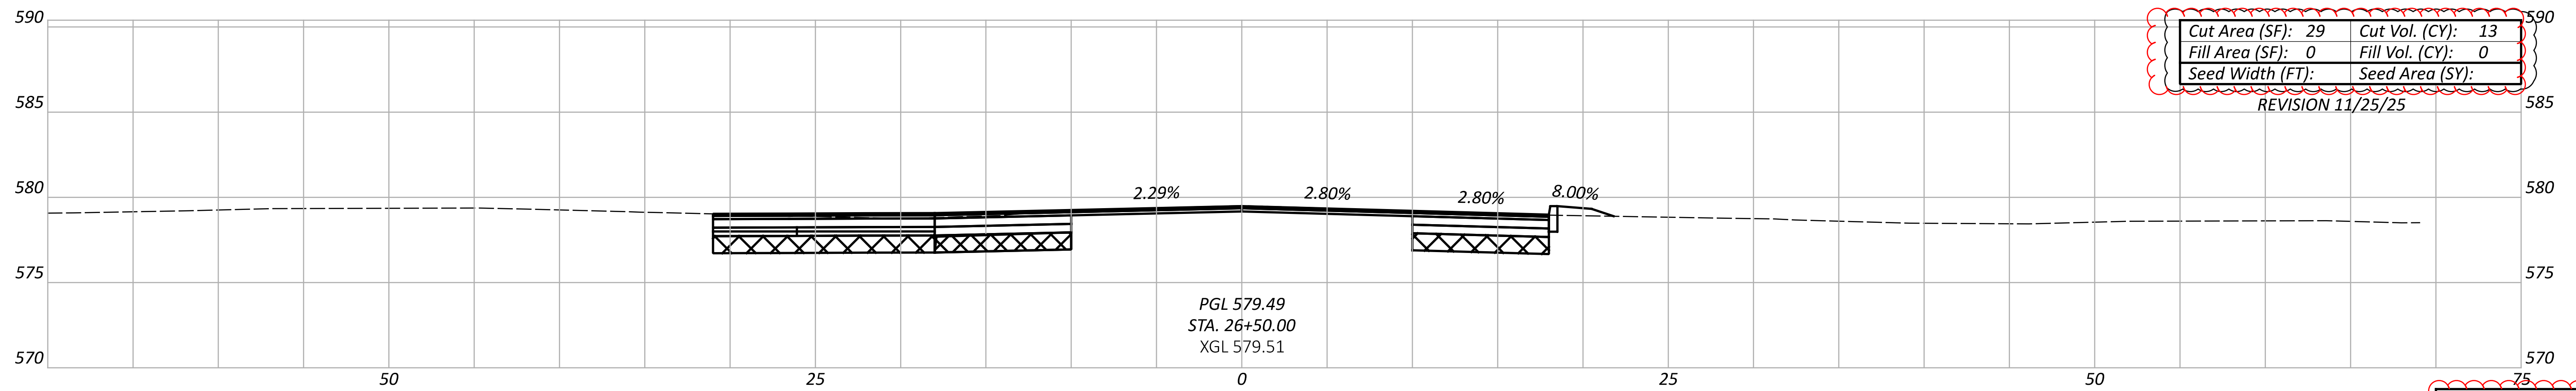Sheet Totals			118472	
Seeding	Cut	Fill	SHEET	TOTAL
121	23	052	052	172




PGL 579.49
 STA. 26+50.00
 XGL 579.51

Cut Area (SF):	29	Cut Vol. (CY):	13
Fill Area (SF):	0	Fill Vol. (CY):	0
Seed Width (FT):		Seed Area (SY):	

REVISION 11/25/25

Sheet Totals			118472
Seeding	Cut	Fill	TOTAL
13	0	053	172


CROSS SECTIONS - C.R.14 (DRY FORK RD.)
 STA. 26+50

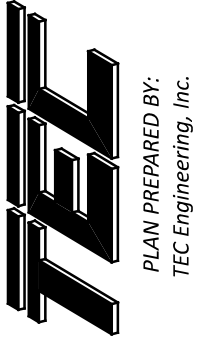DESIGN AGENCY

 PLAN PREPARED BY:
 TEL Engineering, Inc.
 7286 Central Park Blvd.
 Mason, OH 45040

DESIGNER
 KLL


REVIEWER
 ERW 12/01/25

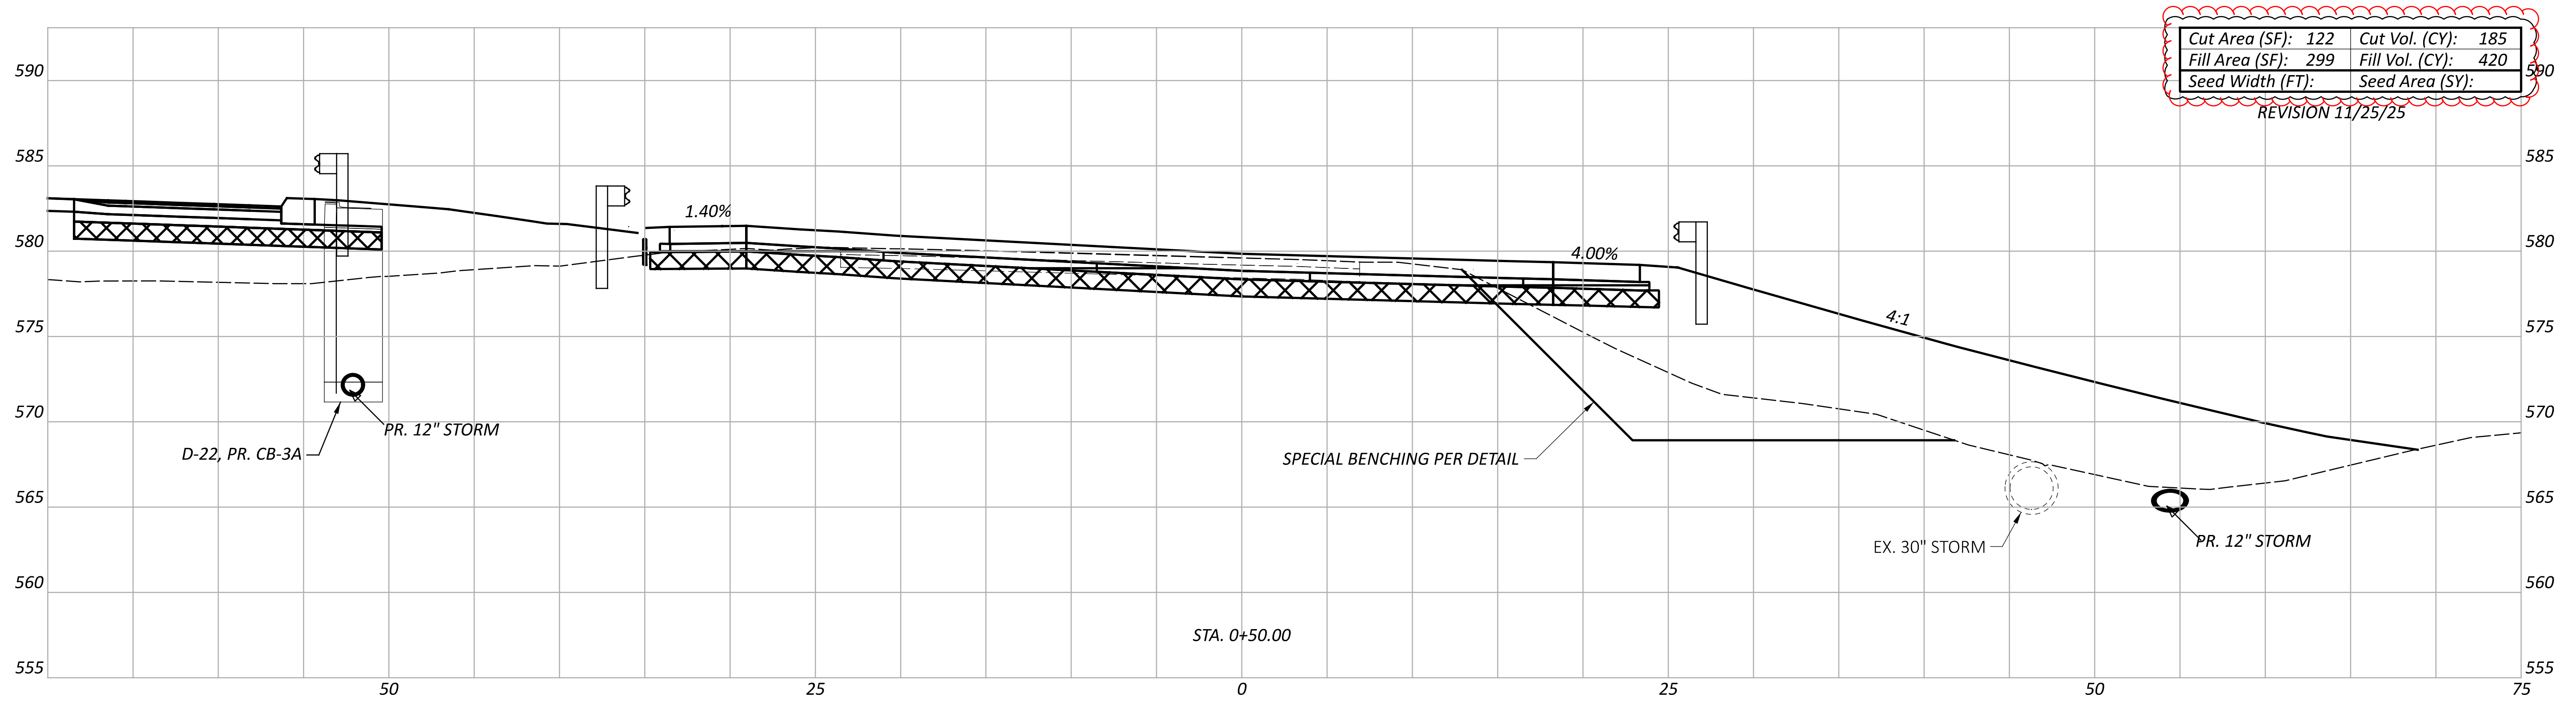PROJECT ID
 118472



Cut Area (SF): 122	Cut Vol. (CY): 185
Fill Area (SF): 299	Fill Vol. (CY): 420
Seed Width (FT):	Seed Area (SY):

REVISION 11/25/25

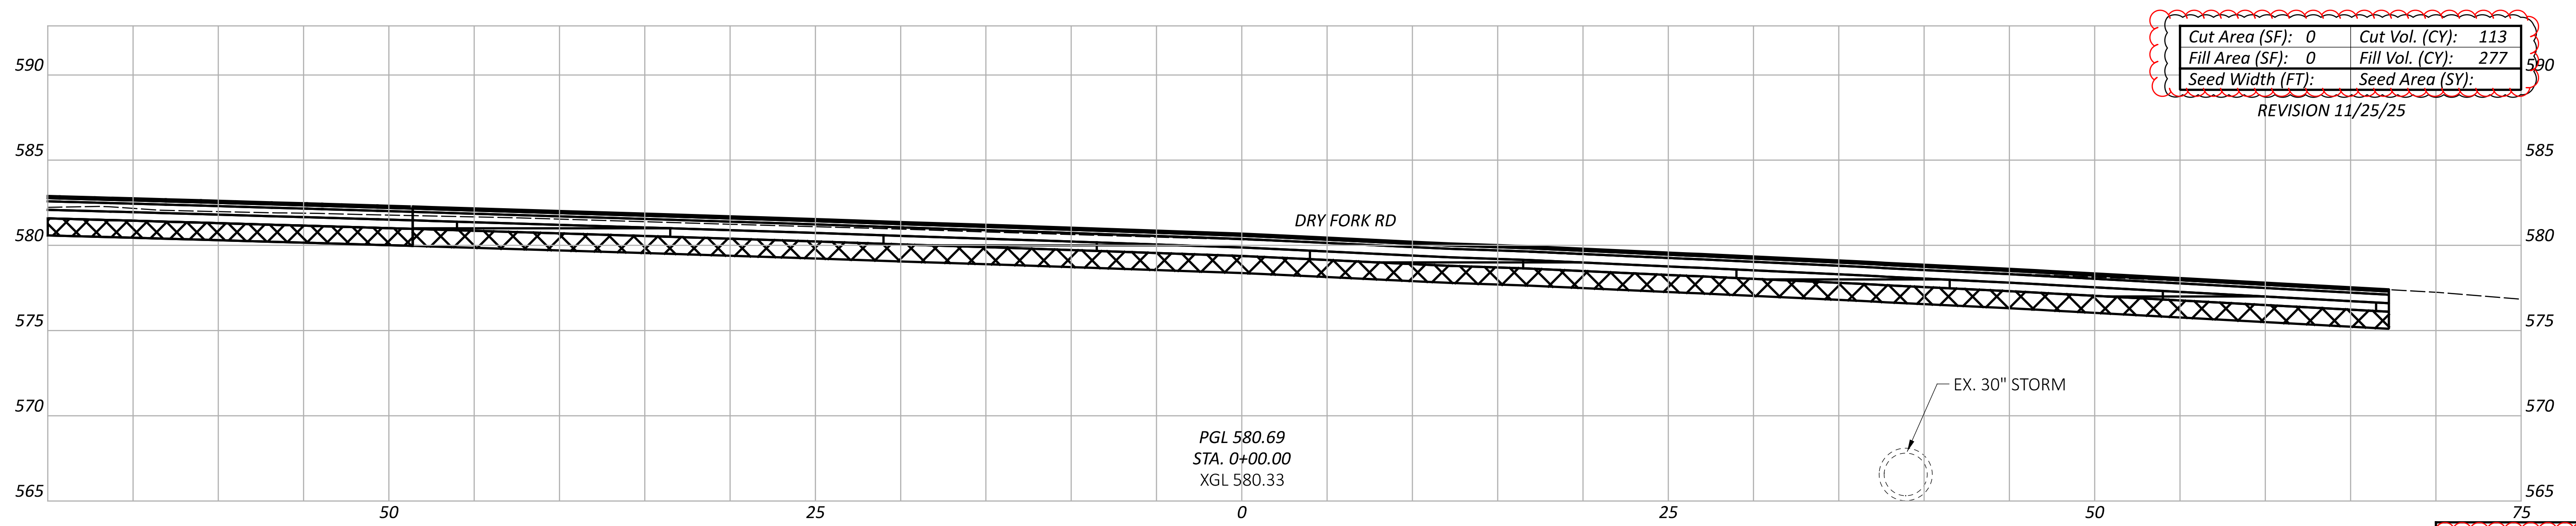

Cut Area (SF): 0	Cut Vol. (CY): 113
Fill Area (SF): 0	Fill Vol. (CY): 277
Seed Width (FT):	Seed Area (SY):

REVISION 11/25/25

PGL 580.69
 STA. 0+00.00
 XGL 580.33

Sheet Totals			118472	
Seeding	Cut	Fill	SHEET	TOTAL
298	697	055	055	172



CROSS SECTIONS - RAMP "C"
 STA. 0+00 TO 0+50

DESIGN AGENCY
TEL
 PLAN PREPARED BY:
 TEL Engineering, Inc.
 7288 Central Park Blvd.
 Mason, OH 45040

DESIGNER
 KLL

REVIEWER
 ERW 12/01/25

PROJECT ID
 118472

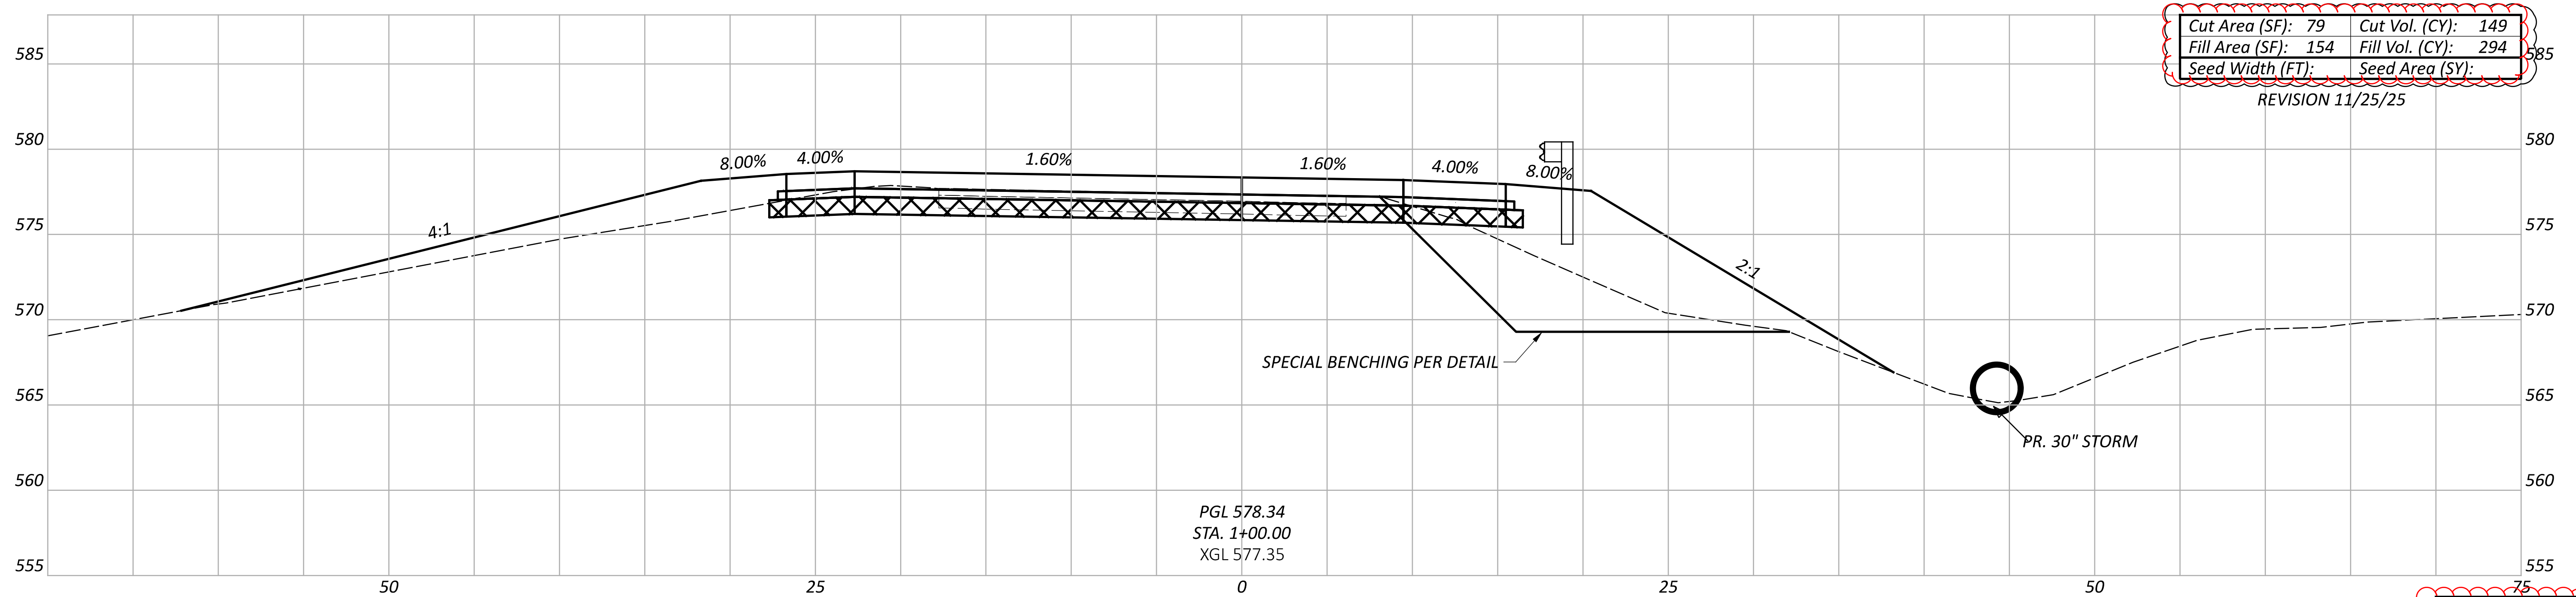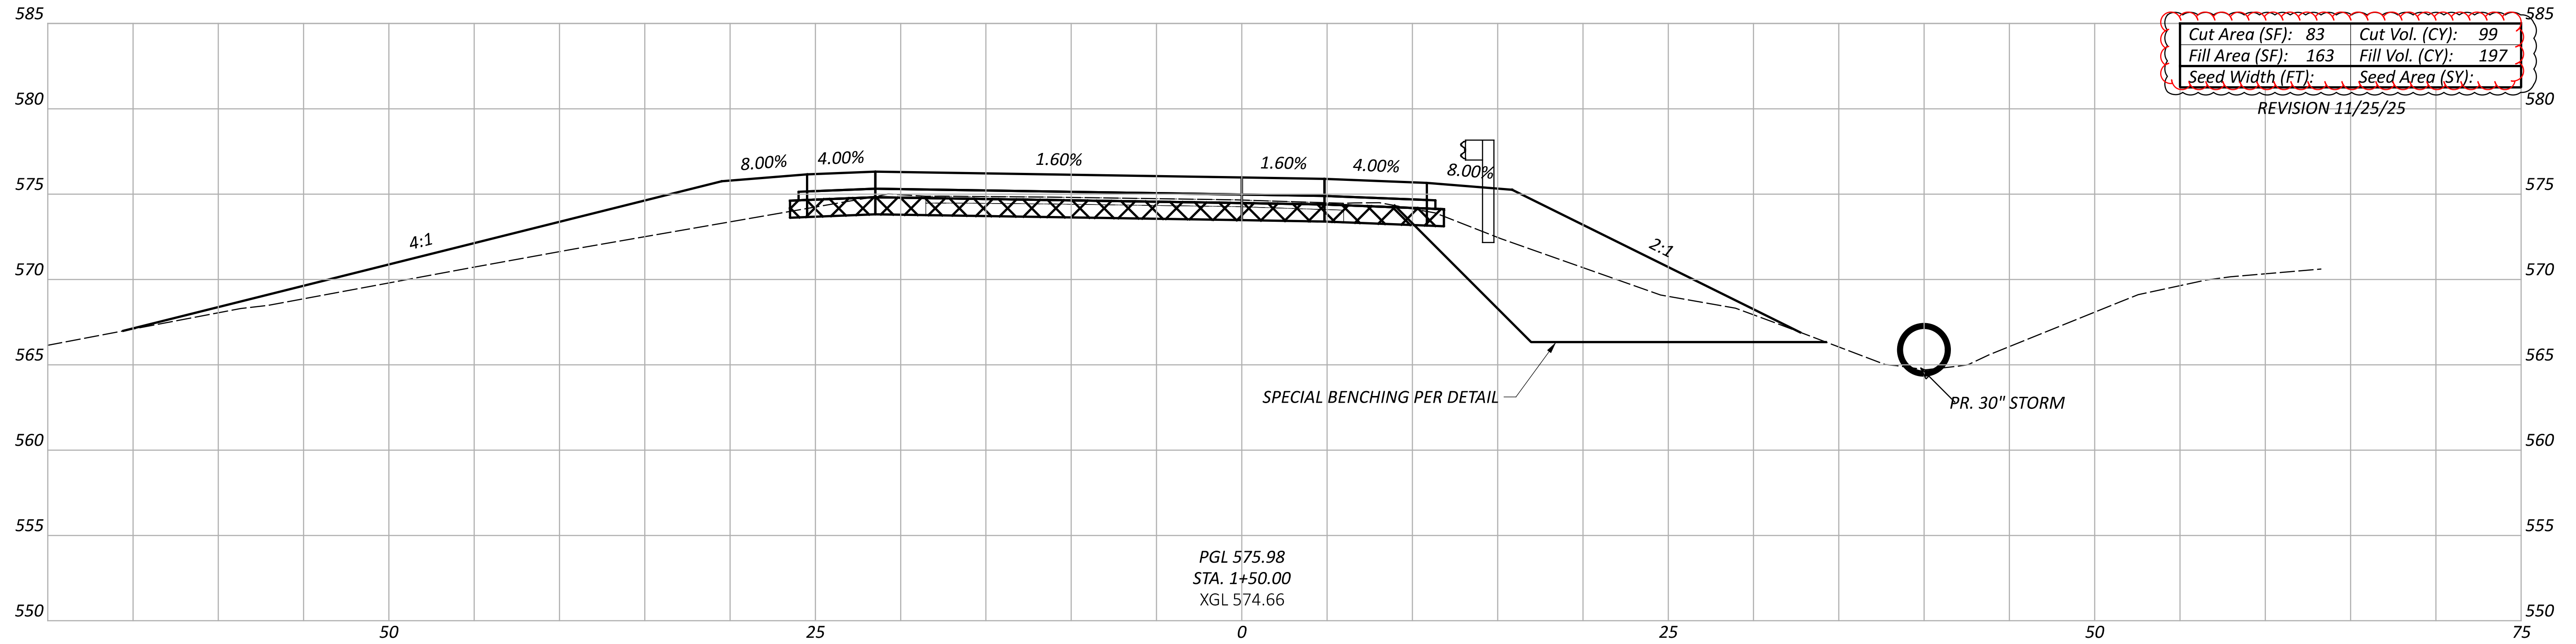

Sheet Totals			118472	
Seeding	Cut	Fill	SHEET	TOTAL
248	491	056	056	172

CROSS SECTIONS - RAMP "C"
 STA. 1+00 TO 1+50

DESIGN AGENCY



PLAN PREPARED BY:
 TEL Engineering, Inc.
 7288 Central Park Blvd.
 Mason, OH 45040

DESIGNER


KLL

REVIEWER

ERW 12/01/25


PROJECT ID

118472

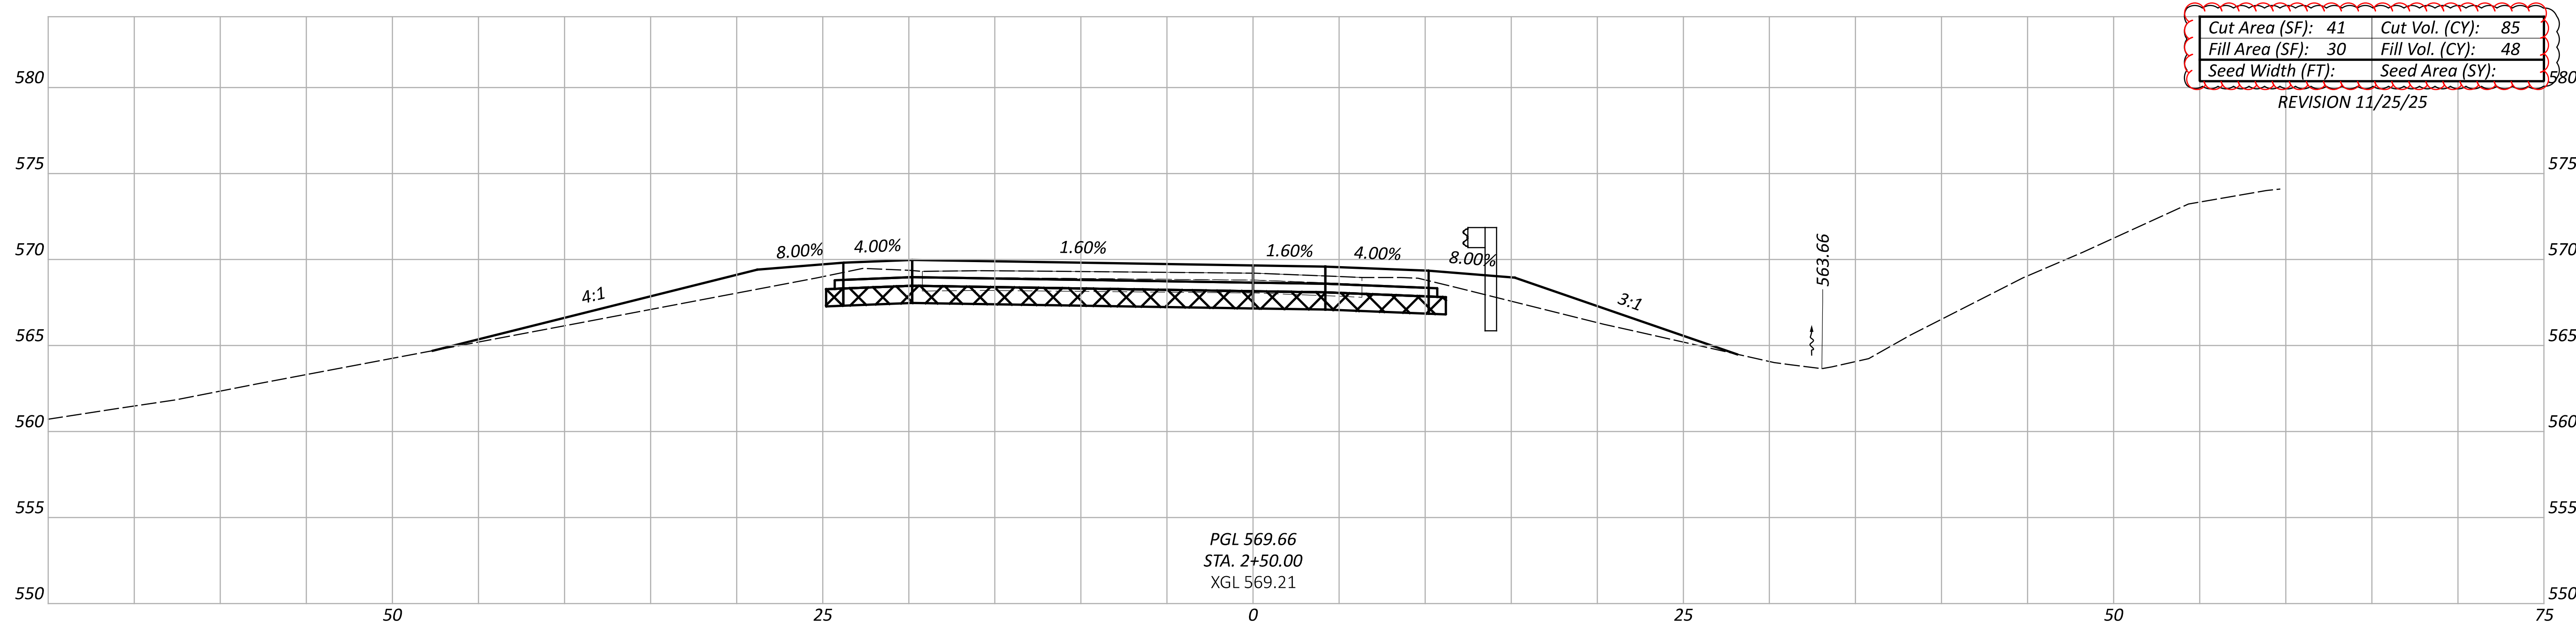

Cut Area (SF): 41	Cut Vol. (CY): 85
Fill Area (SF): 30	Fill Vol. (CY): 48
Seed Width (FT):	Seed Area (SY):

REVISION 11/25/25

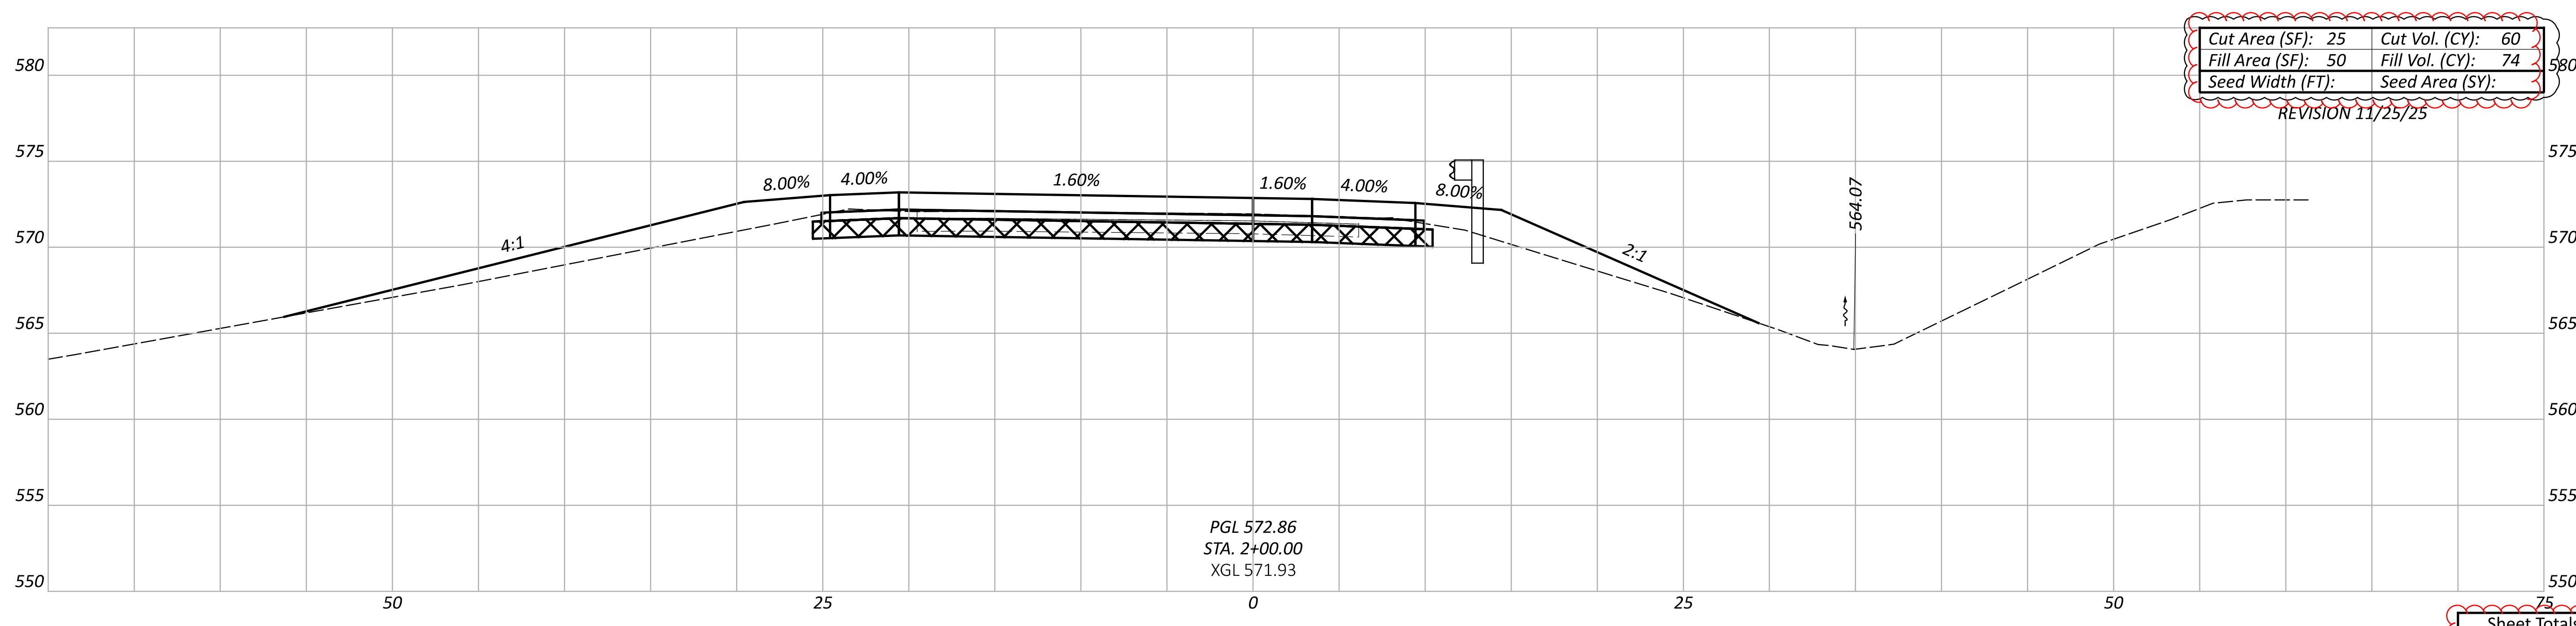


Cut Area (SF): 25	Cut Vol. (CY): 60
Fill Area (SF): 50	Fill Vol. (CY): 74
Seed Width (FT):	Seed Area (SY):

REVISION 11/25/25

Sheet Totals			118472	
Seeding	Cut	Fill	SHEET	TOTAL
145	122	057	057	172



CROSS SECTIONS - RAMP "C"
 STA. 2+00 TO 2+50

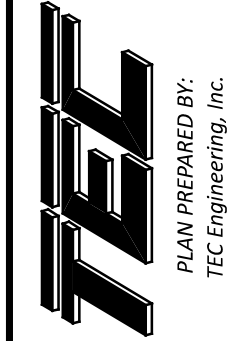DESIGN AGENCY

 PLAN PREPARED BY:
 TEC Engineering, Inc.
 7288 Central Parke Blvd.
 Mason, OH 45040


DESIGNER
 KLL

REVIEWER
 ERW 12/01/25

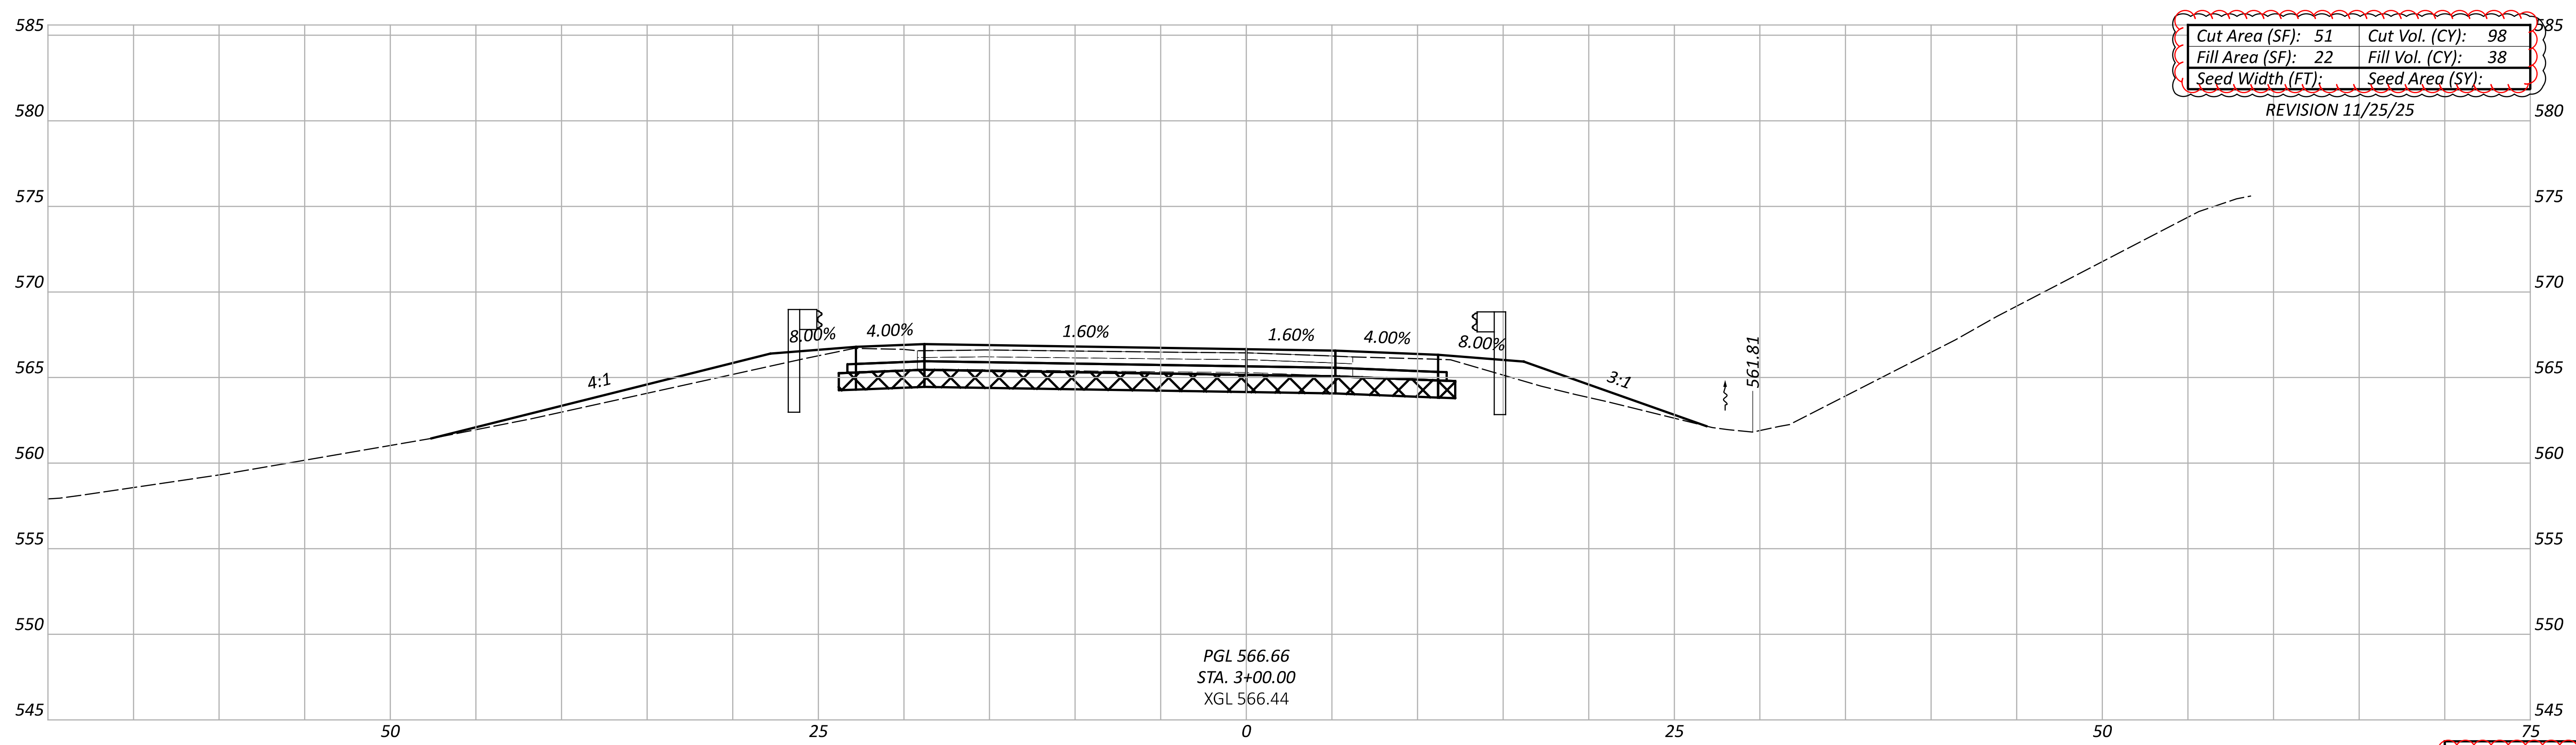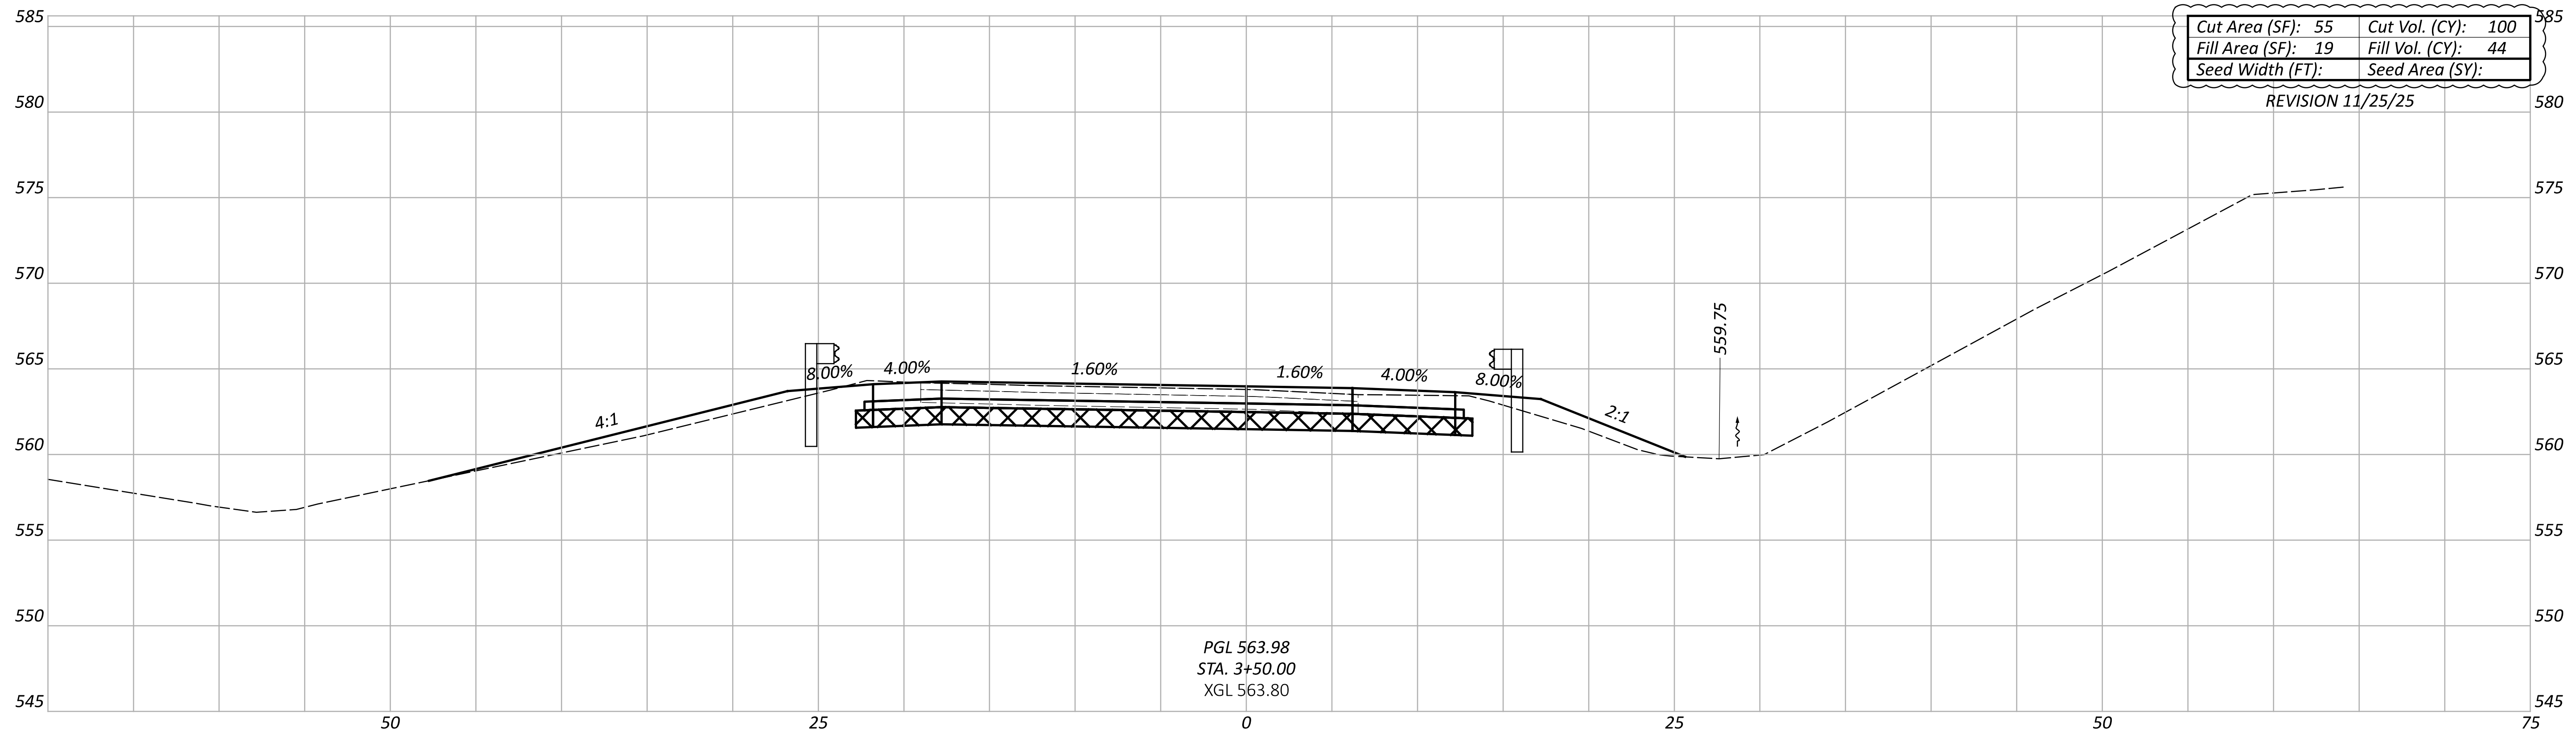PROJECT ID
 118472



CROSS SECTIONS - RAMP "C"
 STA. 3+00 TO 3+50

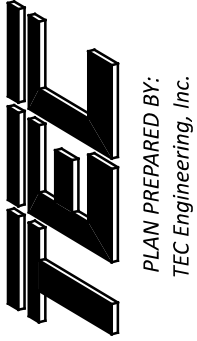DESIGN AGENCY

 PLAN PREPARED BY:
 TEC Engineering, Inc.
 7288 Central Parke Blvd.
 Mason, OH 45040



DESIGNER
 KLL

REVIEWER
 ERW 12/01/25

PROJECT ID
 118472

Sheet Totals		
Seeding	Cut	Fill
198	82	058


SHEET TOTAL
 058 172

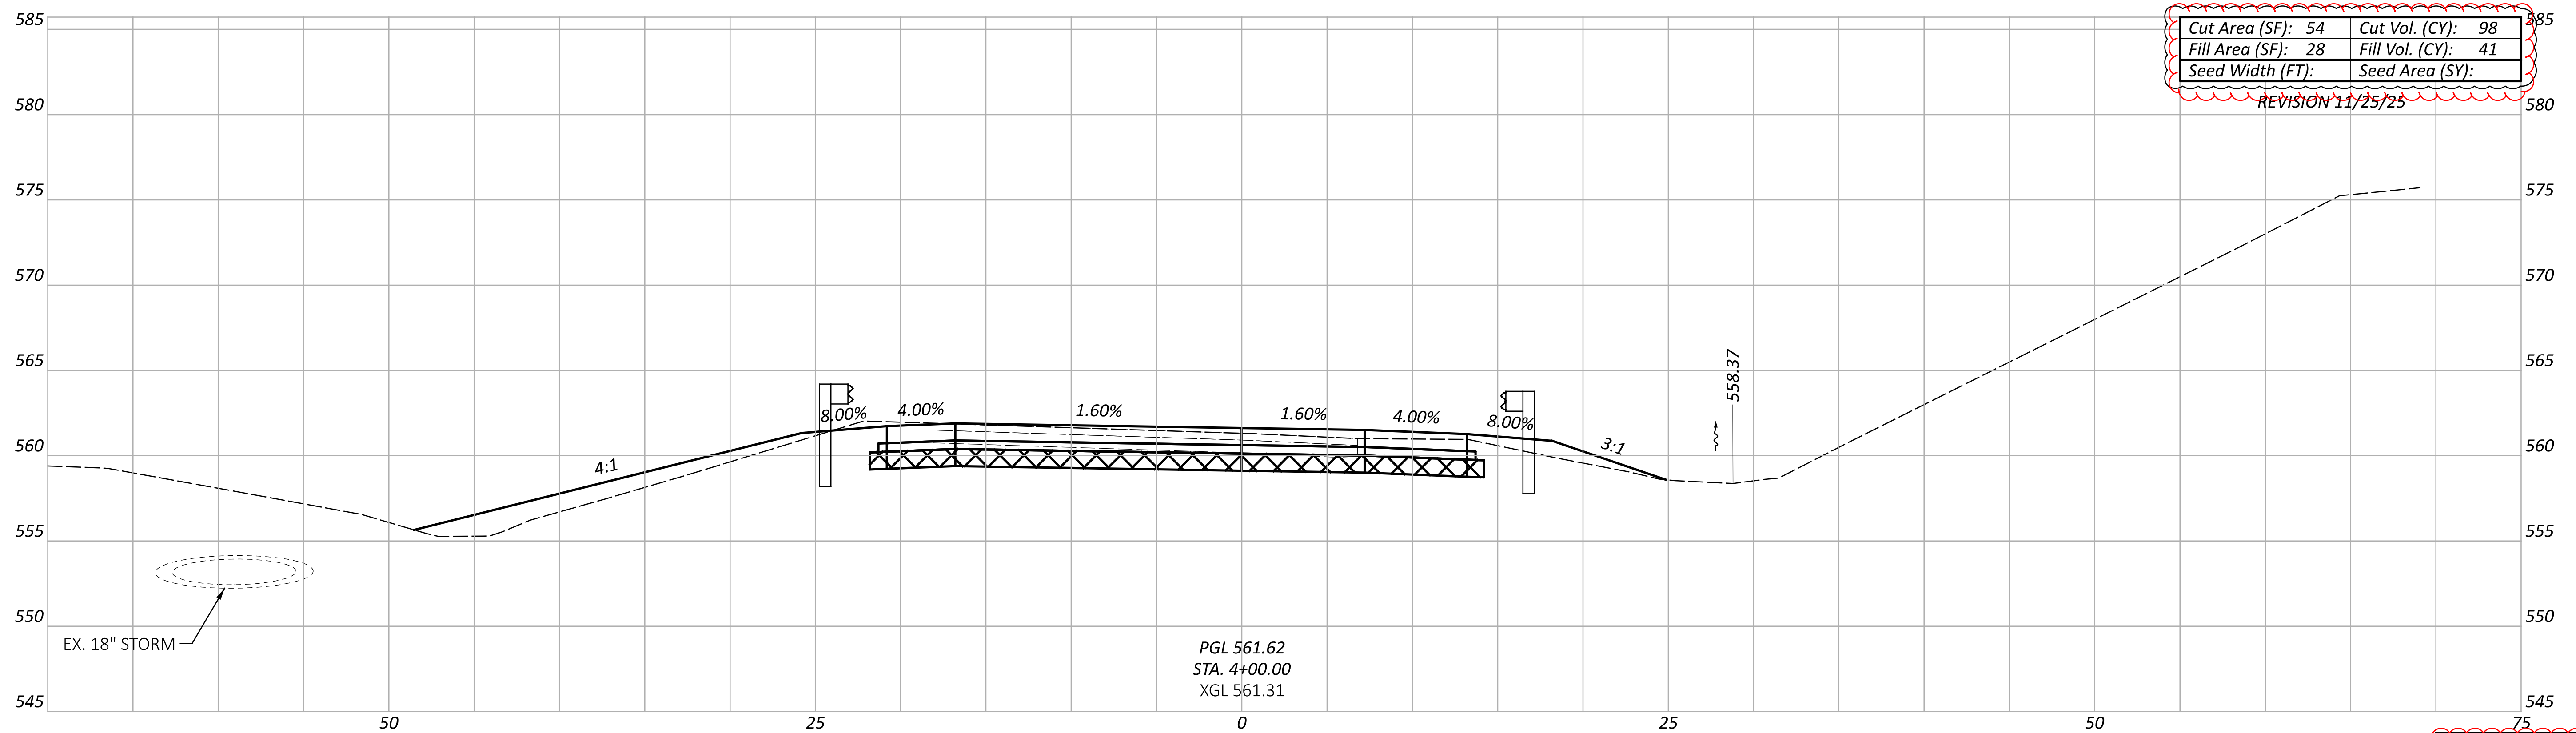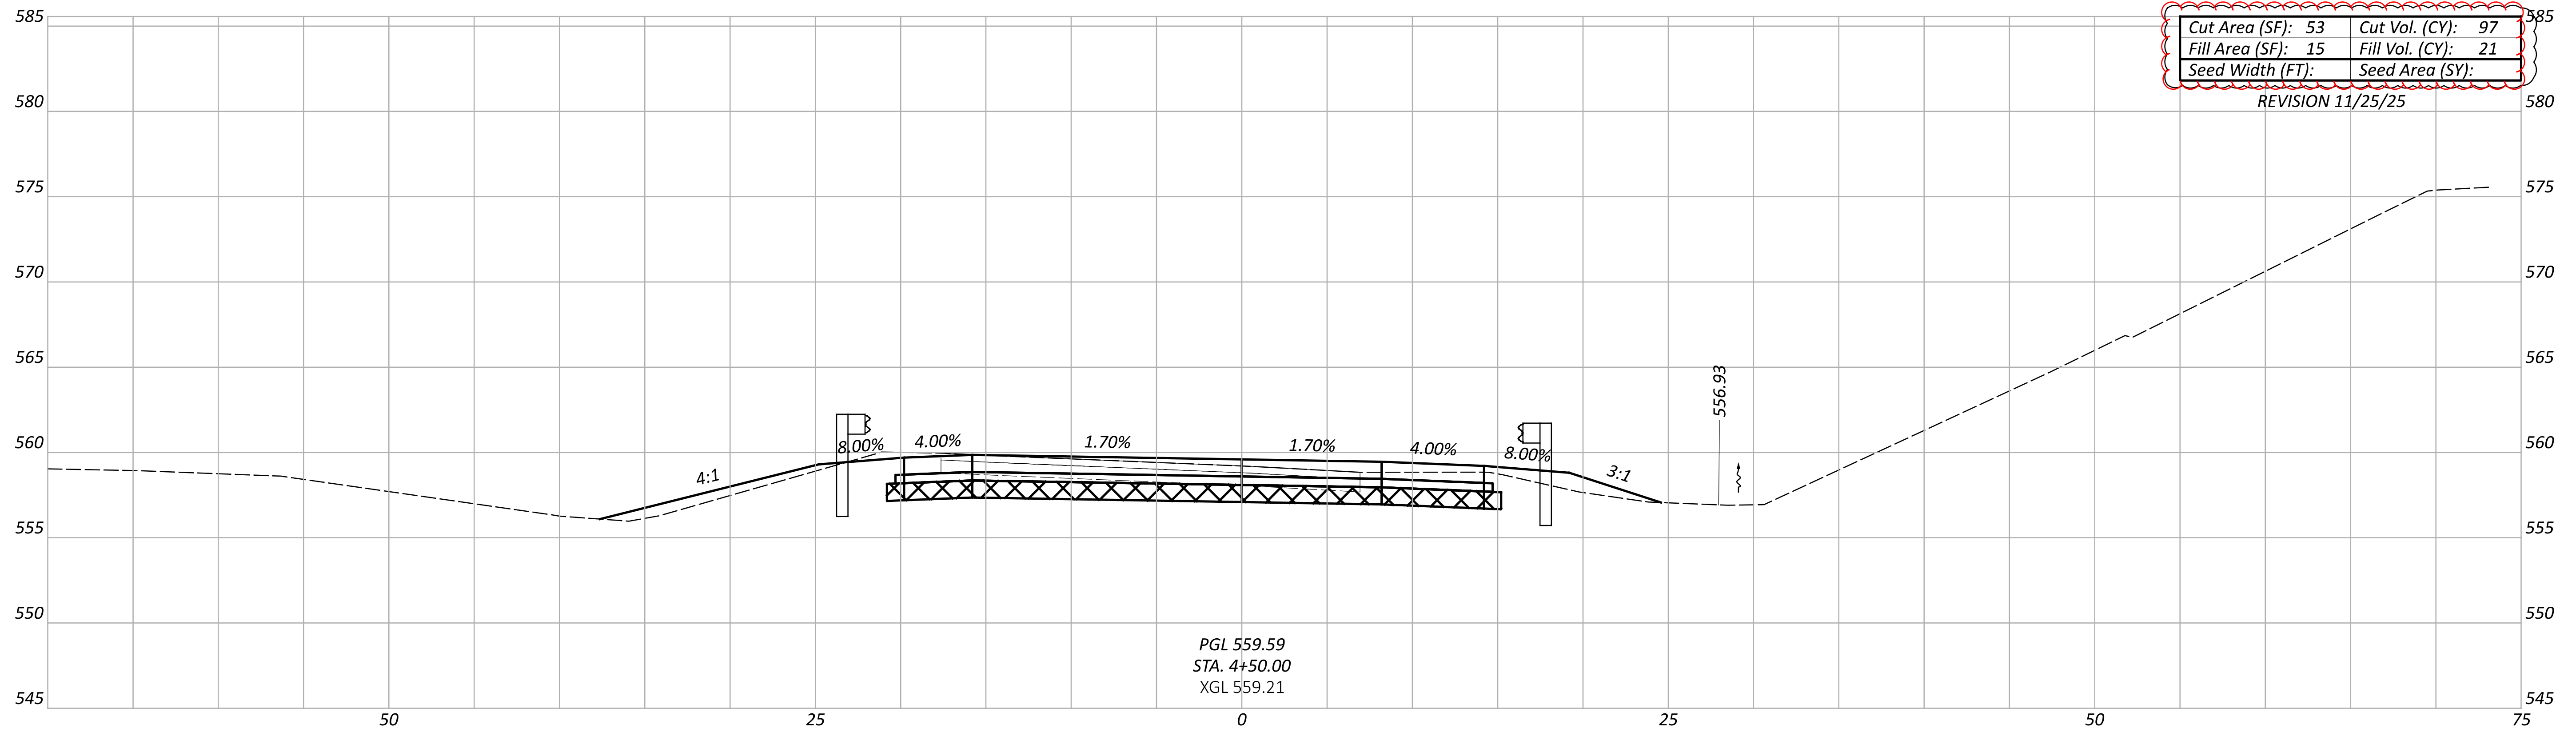

Sheet Totals			118472
Seeding	Cut	Fill	TOTAL
195	62	059	172

CROSS SECTIONS - RAMP "C"
 STA. 4+00 TO 4+50

DESIGN AGENCY

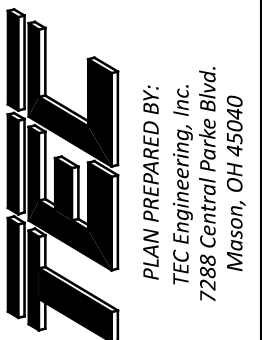

DESIGNER

KLL

REVIEWER



ERW 12/01/25

PROJECT ID

118472

SHEET TOTAL

059 172

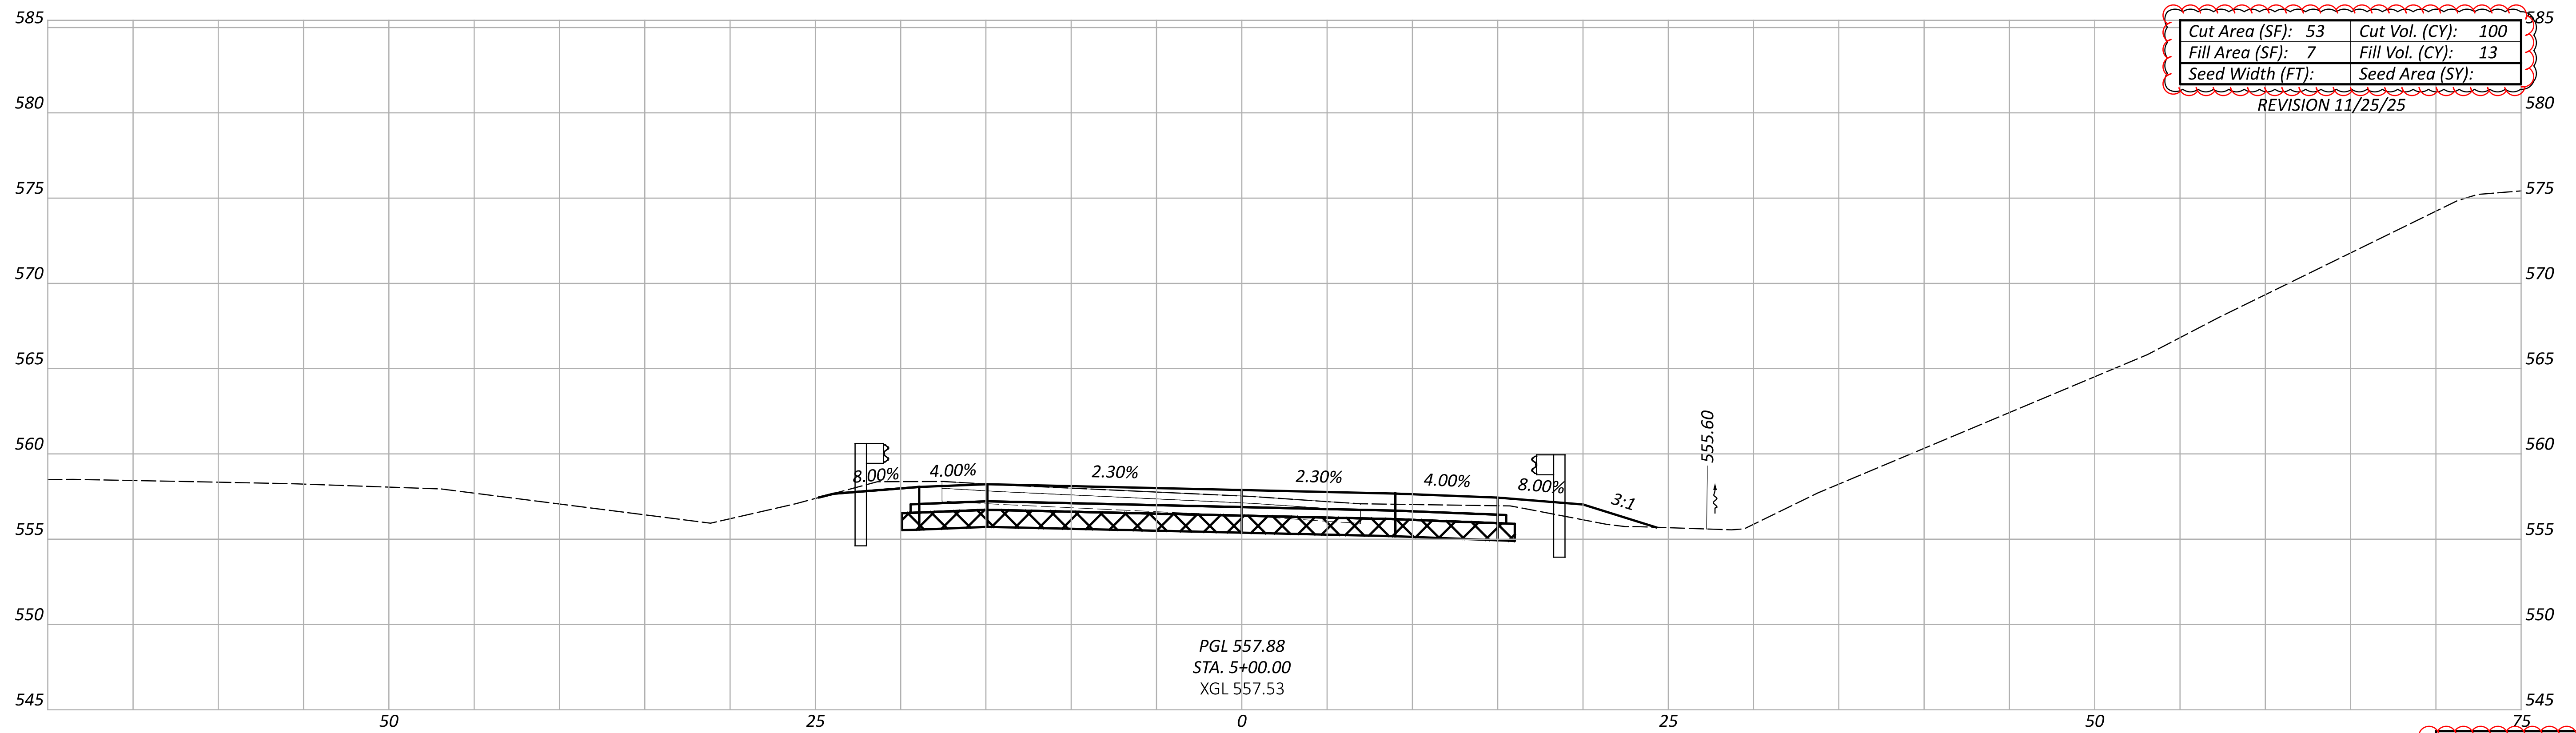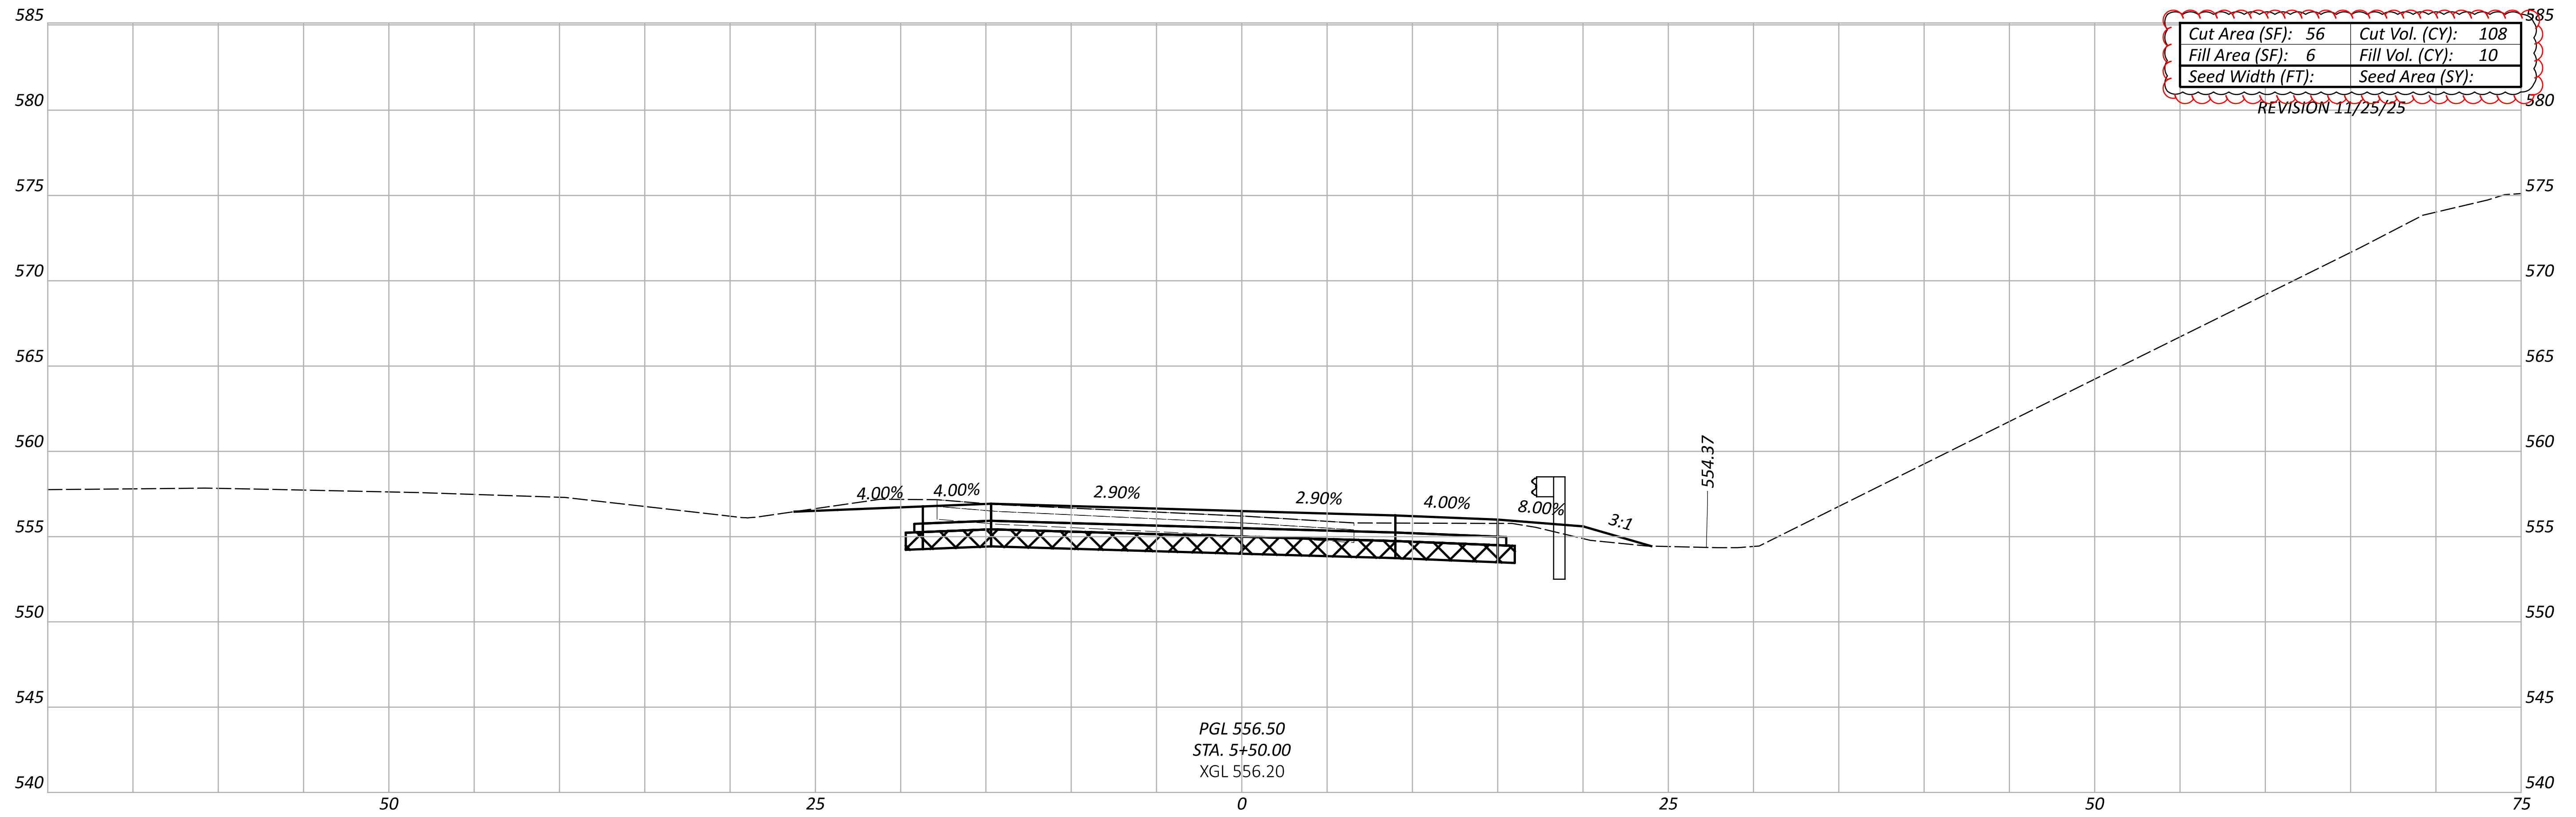

Sheet Totals			118472	
Seeding	Cut	Fill	SHEET	TOTAL
208	23	060	060	172



CROSS SECTIONS - RAMP "C"
 STA. 5+00 TO 5+50

DESIGN AGENCY
TEL
 PLAN PREPARED BY:
 TEL Engineering, Inc.
 7288 Central Parke Blvd.
 Mason, OH 45040


DESIGNER
 KLL

REVIEWER
 ERW 12/01/25

PROJECT ID
 118472

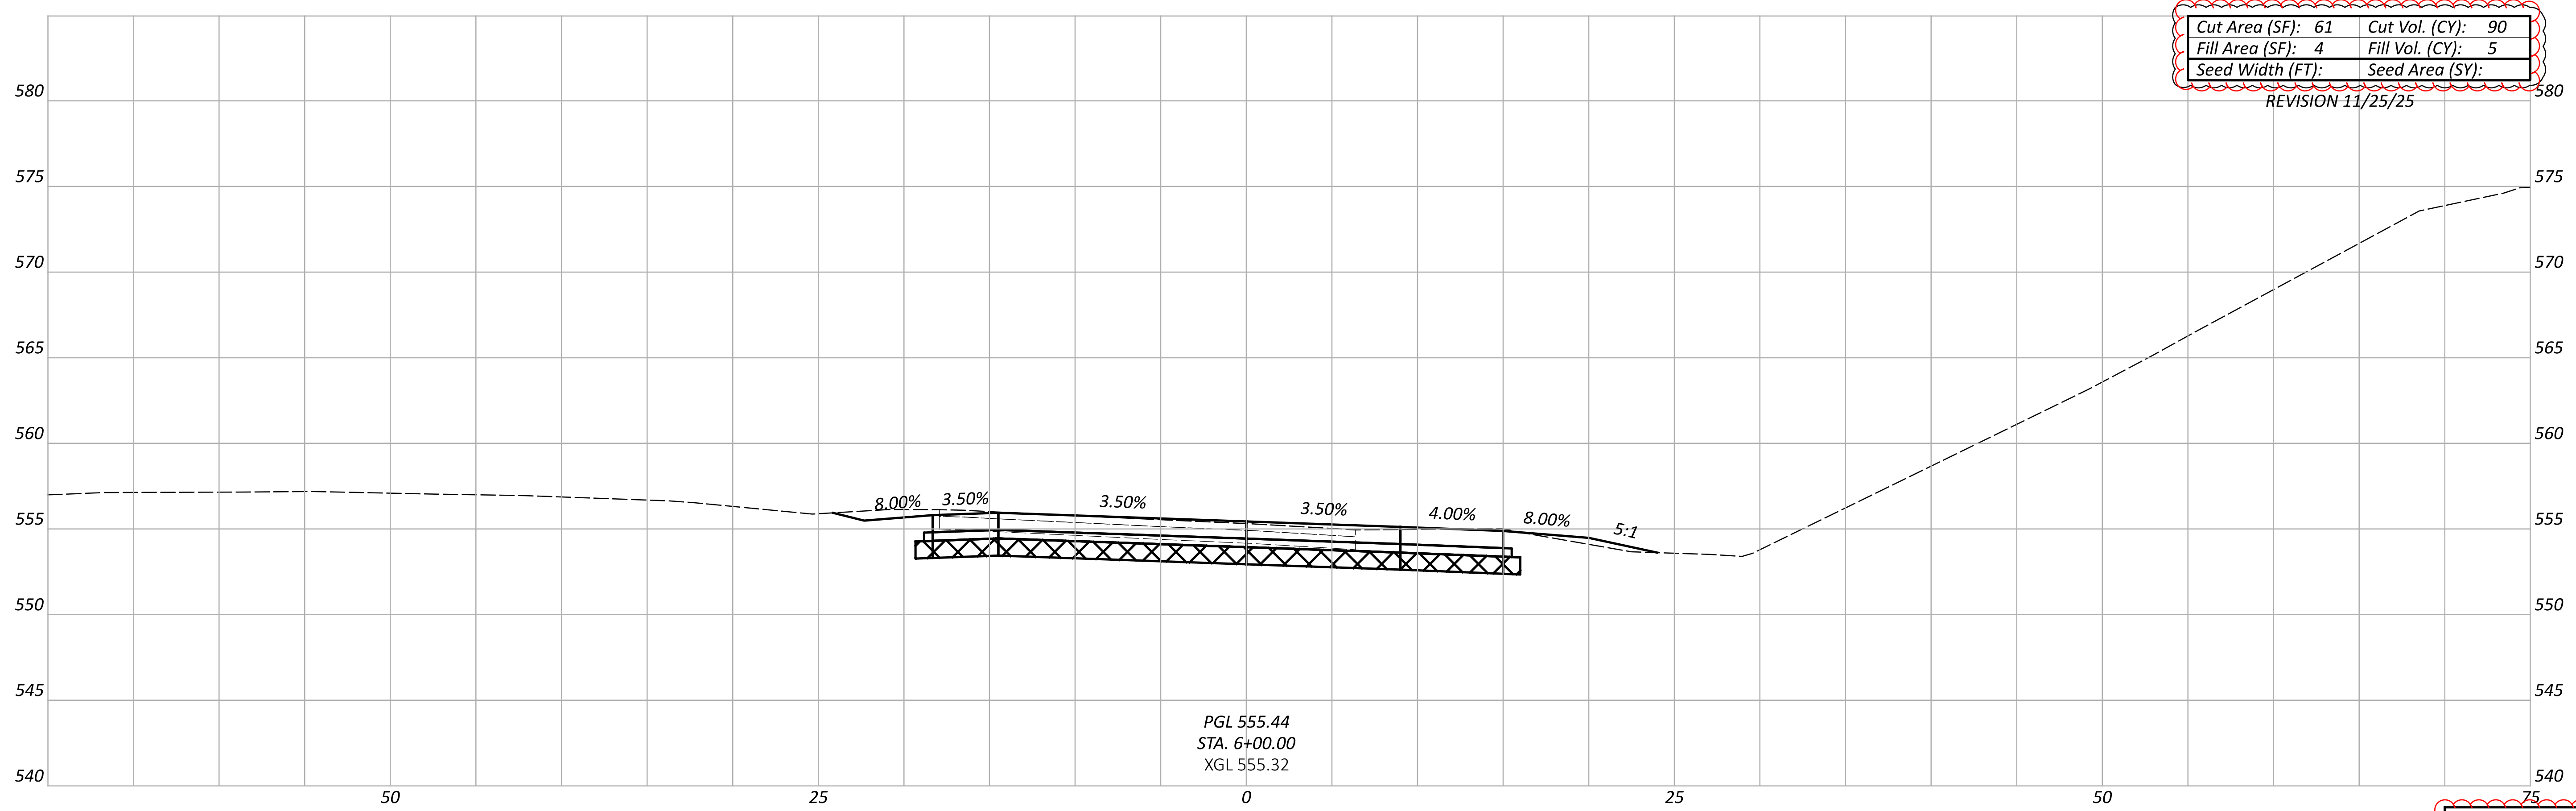
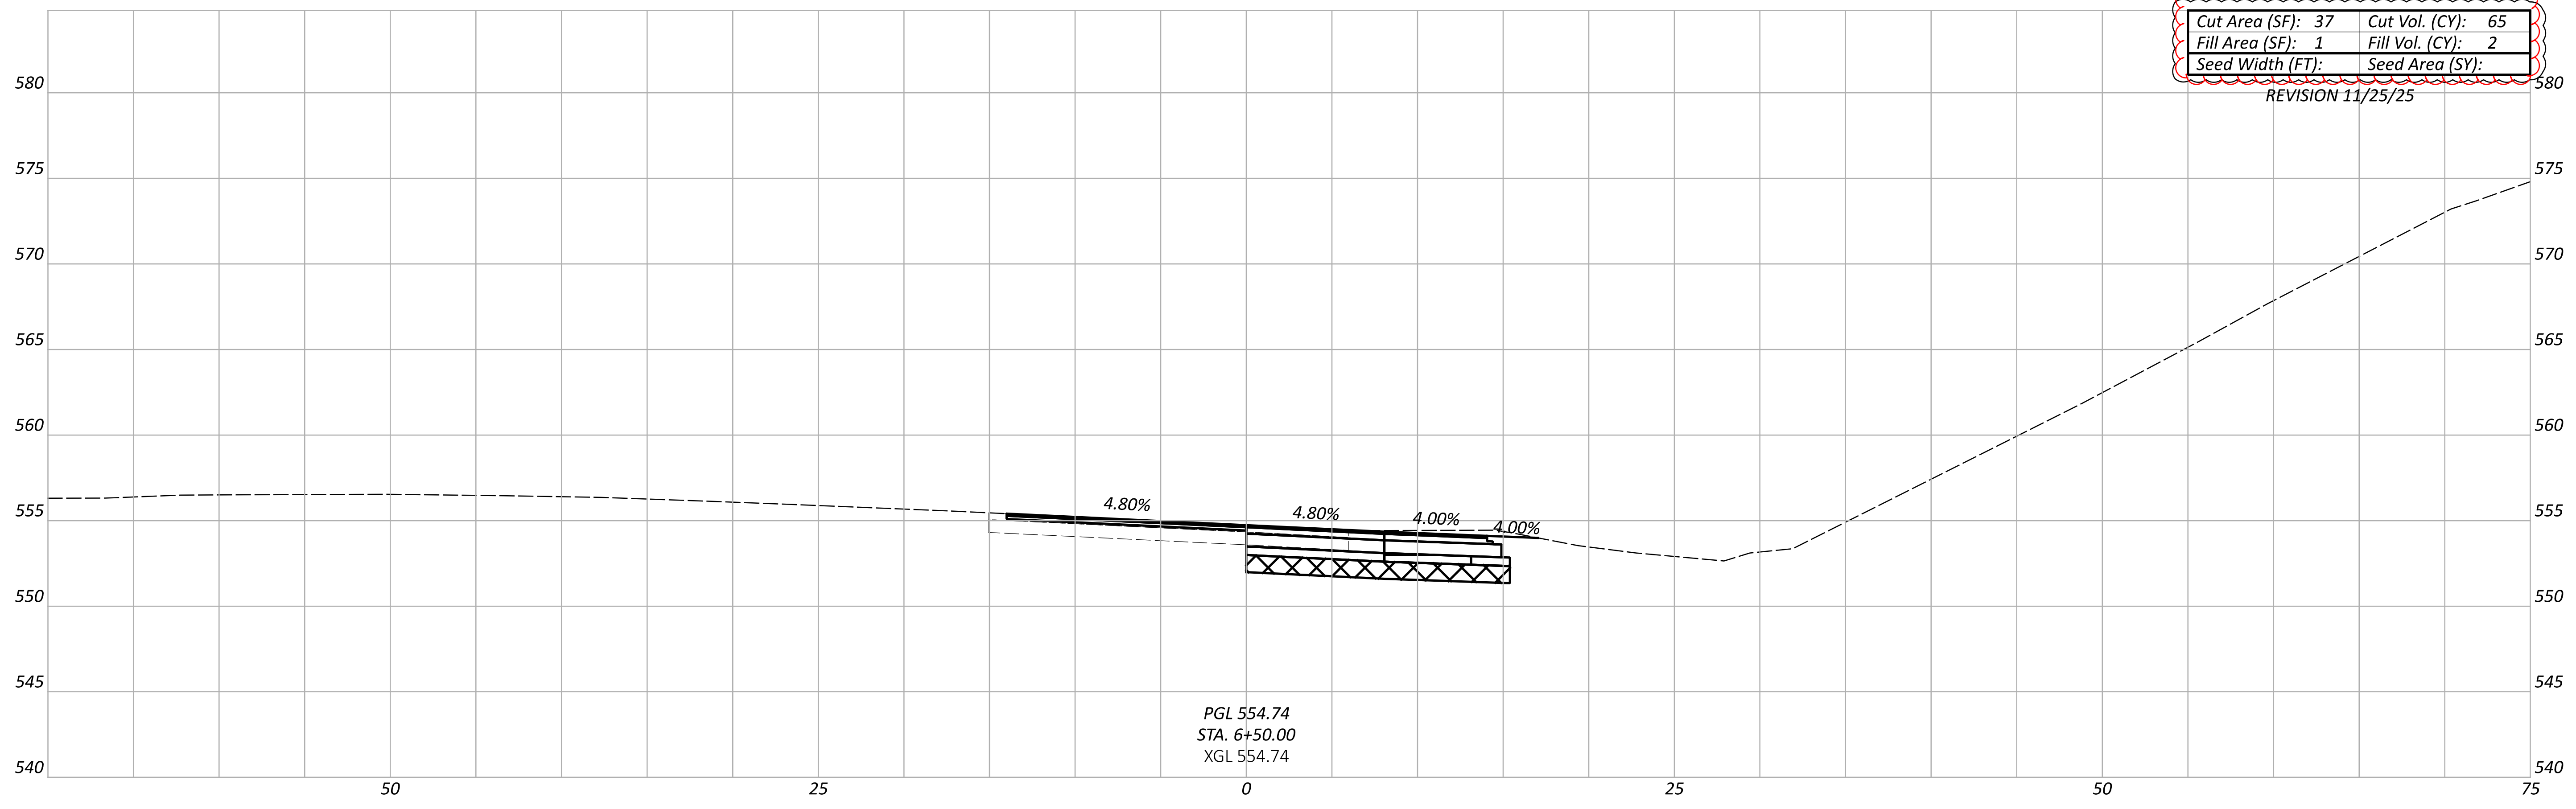


CROSS SECTIONS - RAMP "C"
 STA. 6+00 TO 6+50

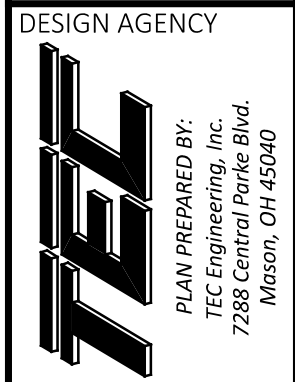

DESIGN AGENCY
 KLL
 REVIEWER
 ERW 12/01/25
 PROJECT ID

Sheet Totals			118472
Seeding	Cut	Fill	SHEET TOTAL
155	7	061	172

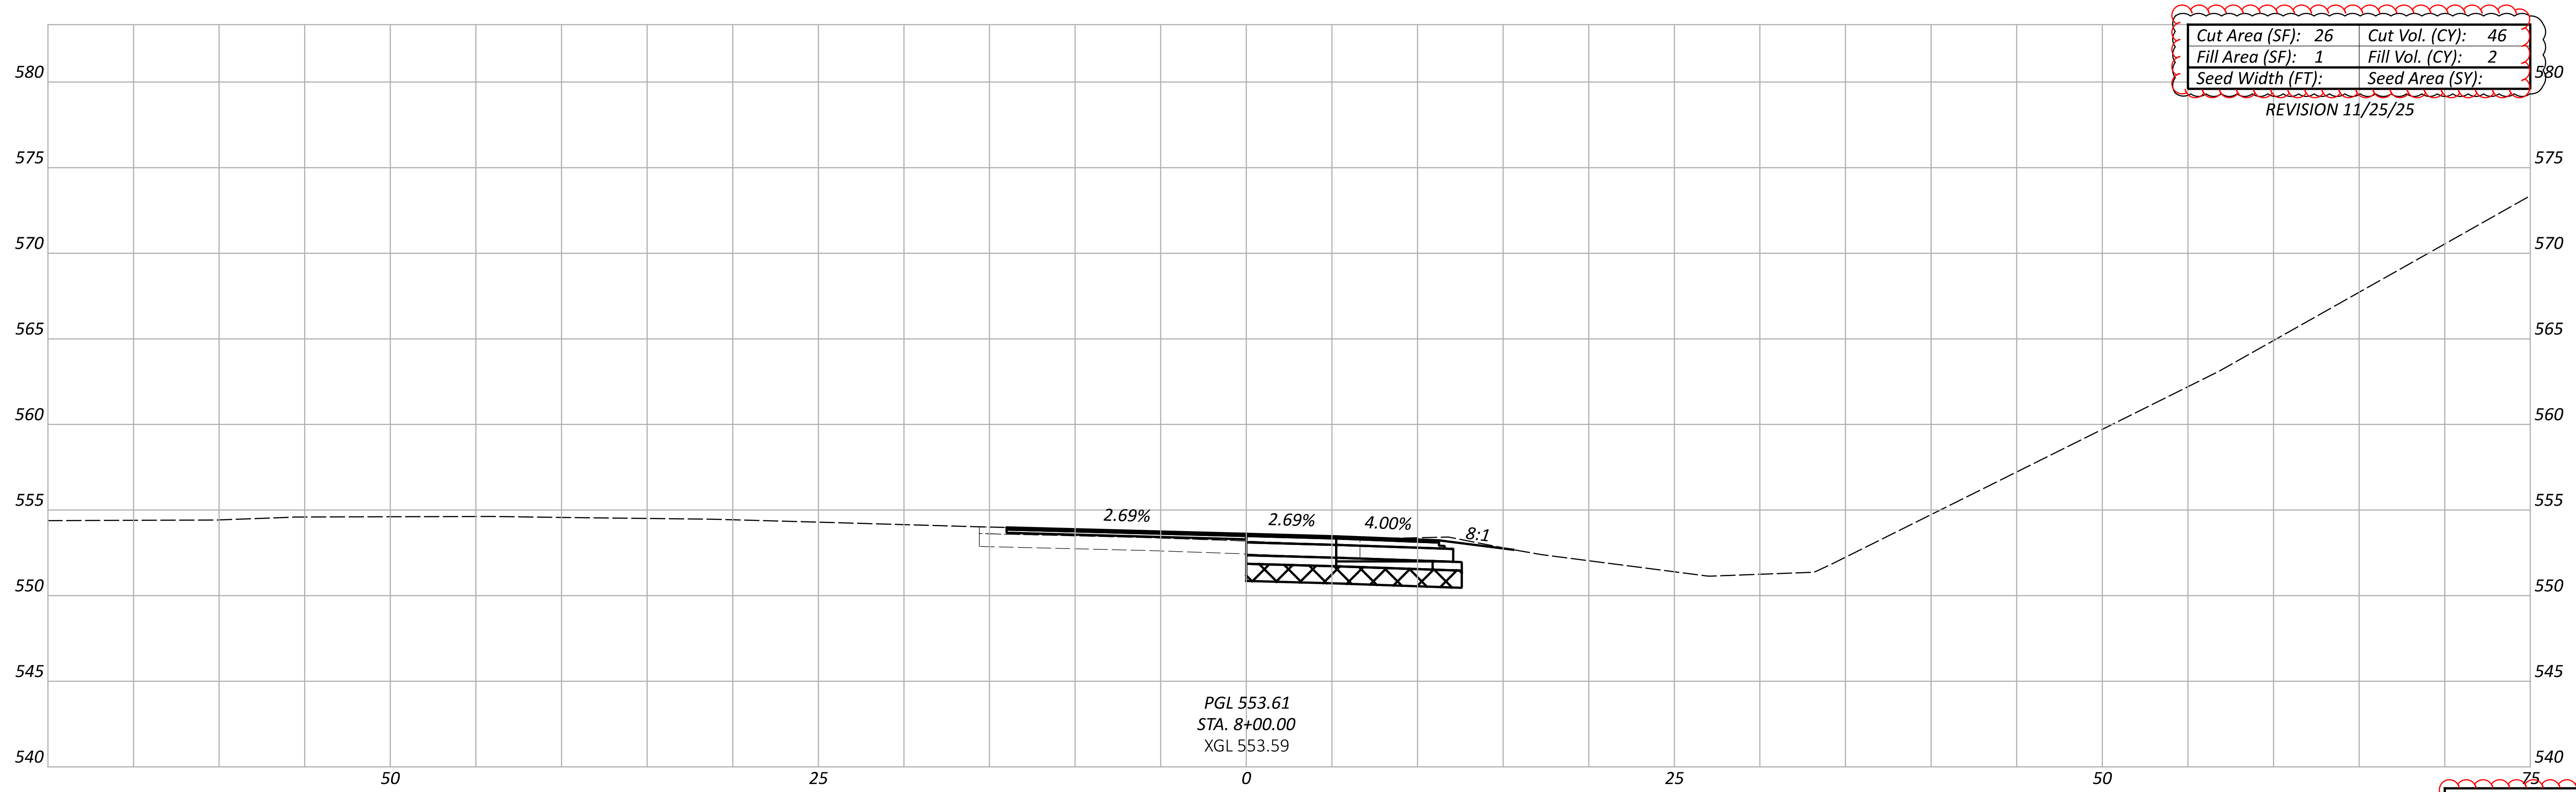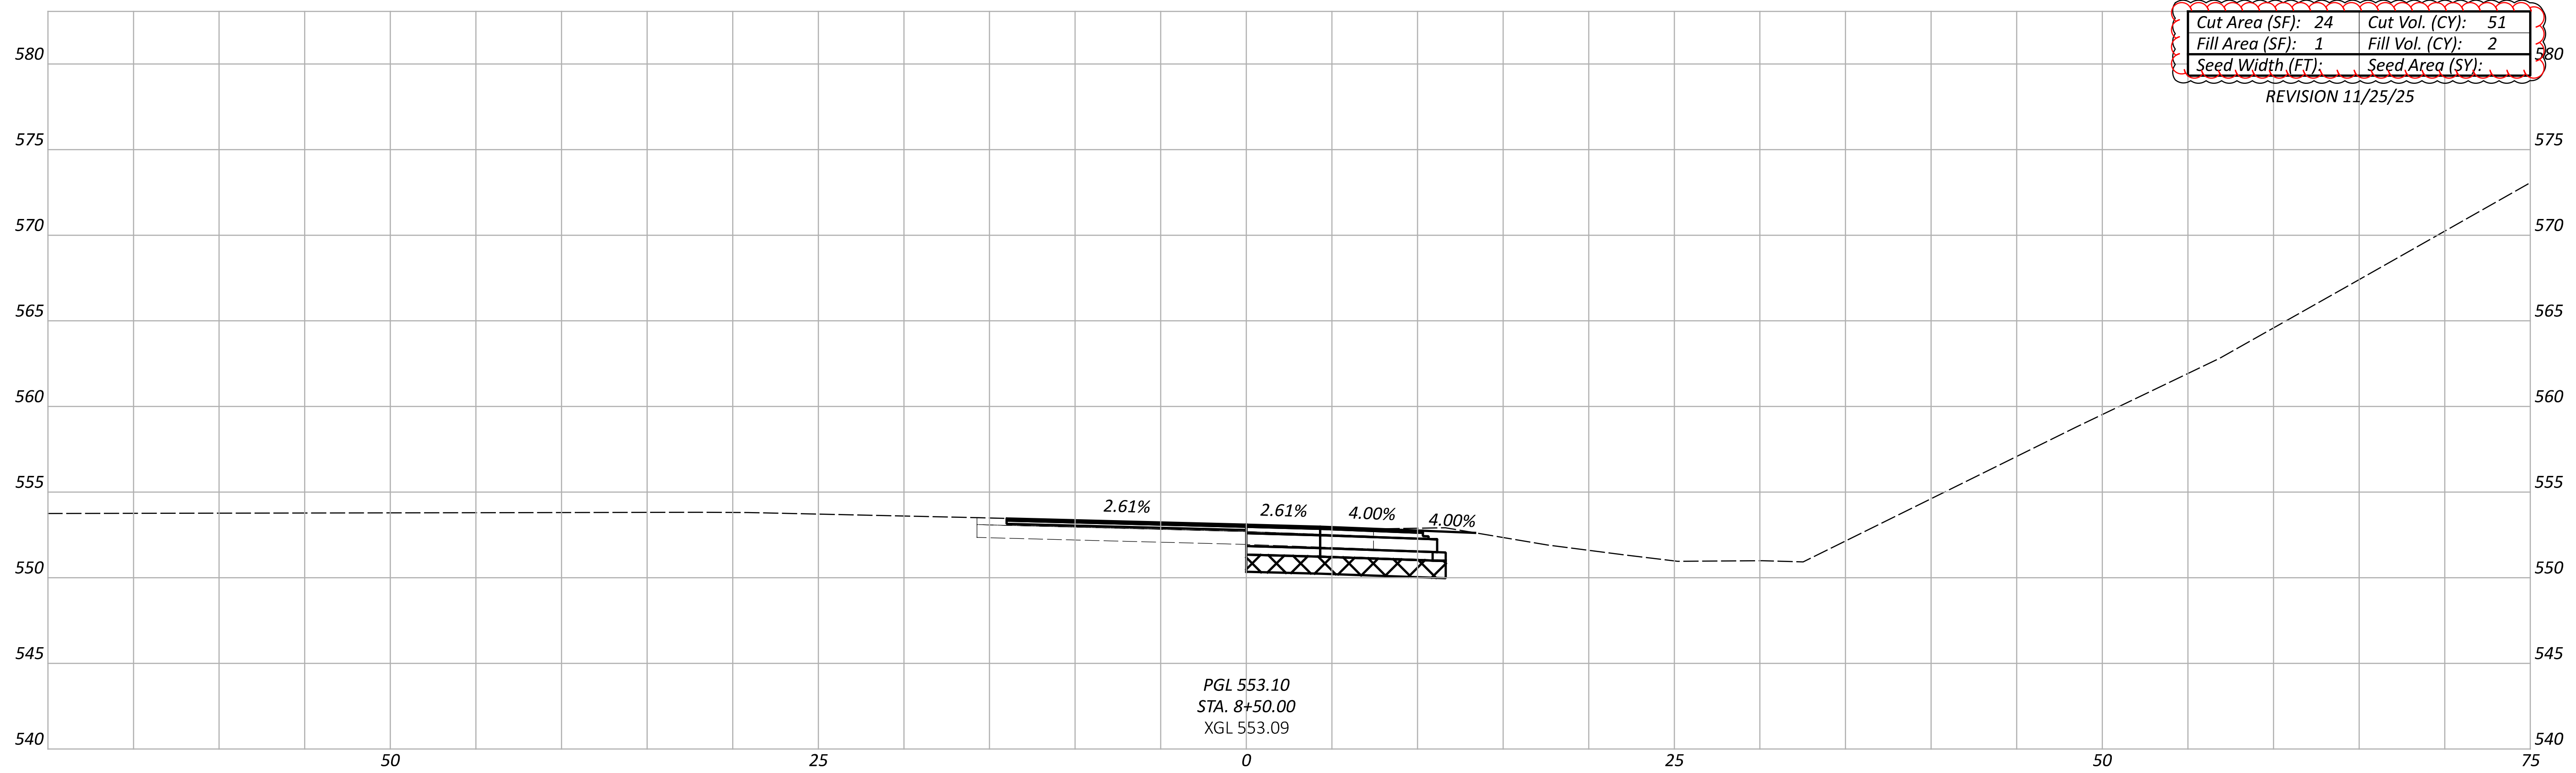




CROSS SECTIONS - RAMP "C"
 STA. 8+00 TO 8+50

DESIGN AGENCY
TEC
 PLAN PREPARED BY:
 TEC Engineering, Inc.
 7288 Central Parke Blvd.
 Mason, OH 45040


DESIGNER
 KLL
 REVIEWER
 ERW 12/01/25

PROJECT ID
 118472

Sheet Totals			118472
Seeding	Cut	Fill	SHEET TOTAL
97	4	063	172

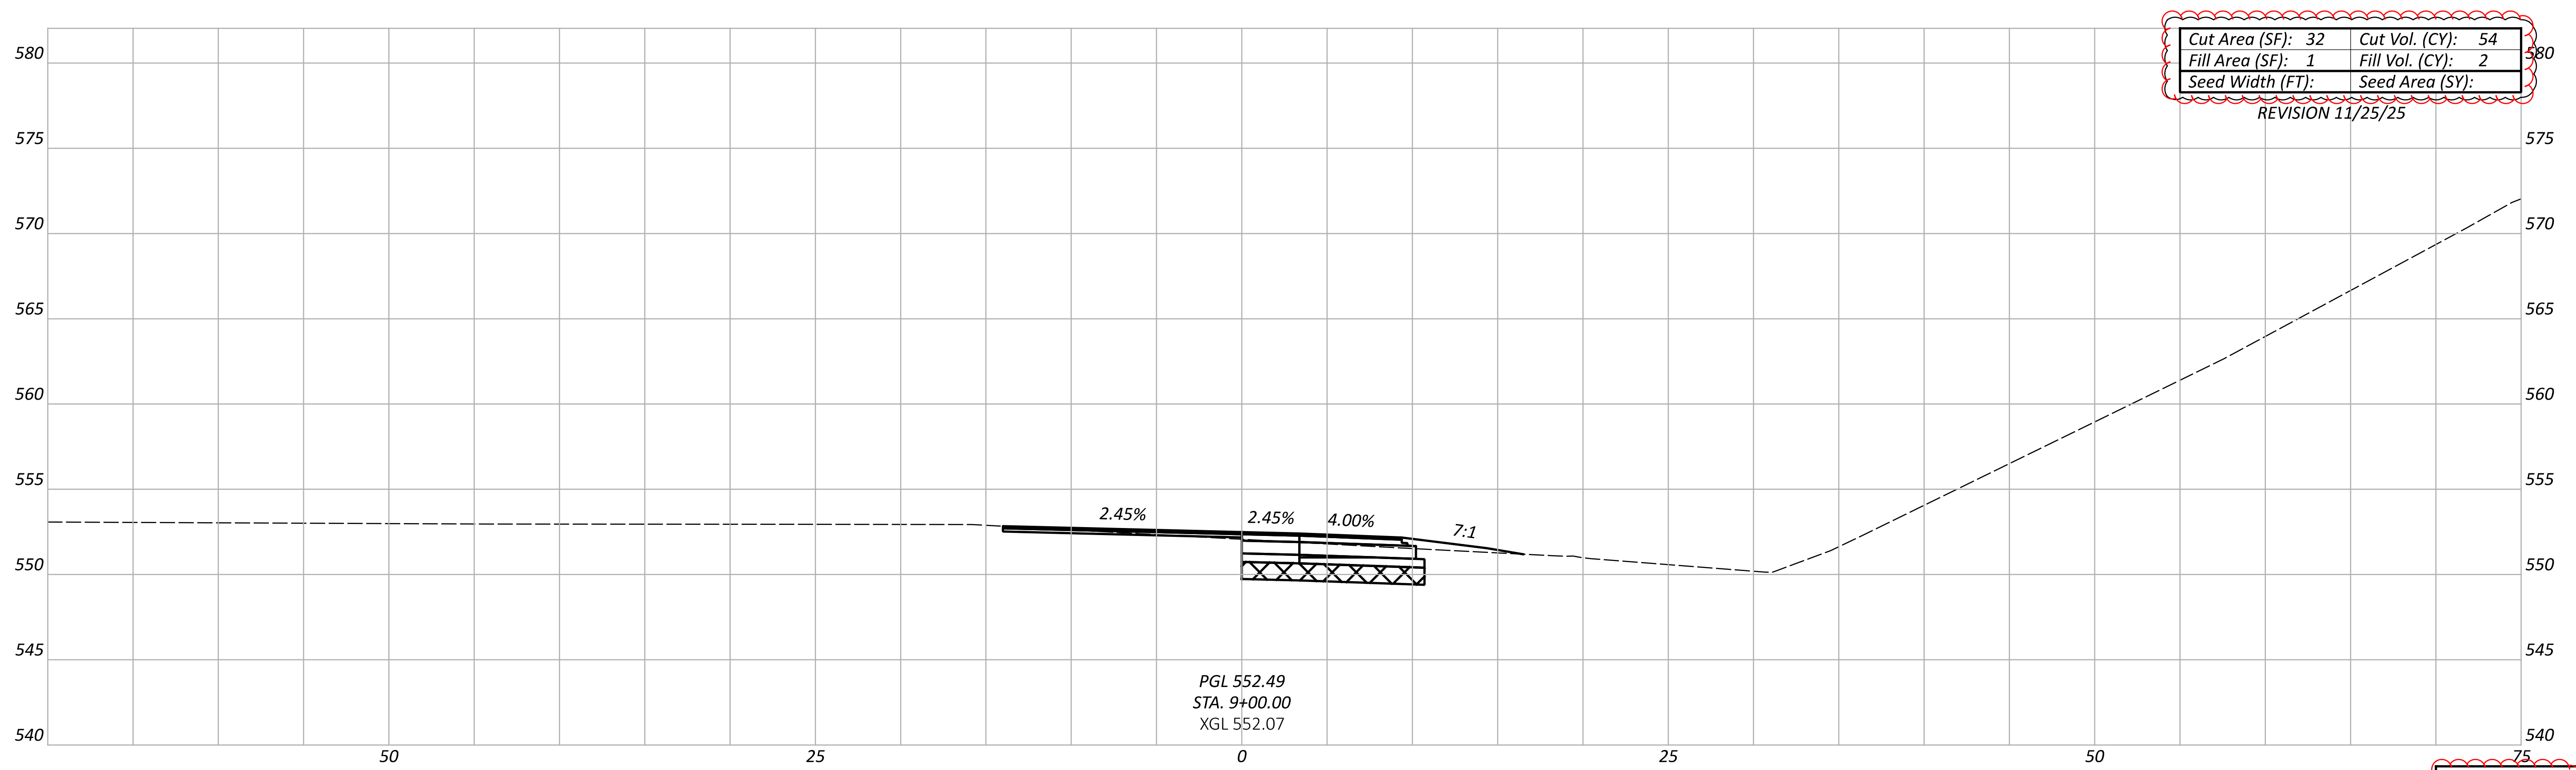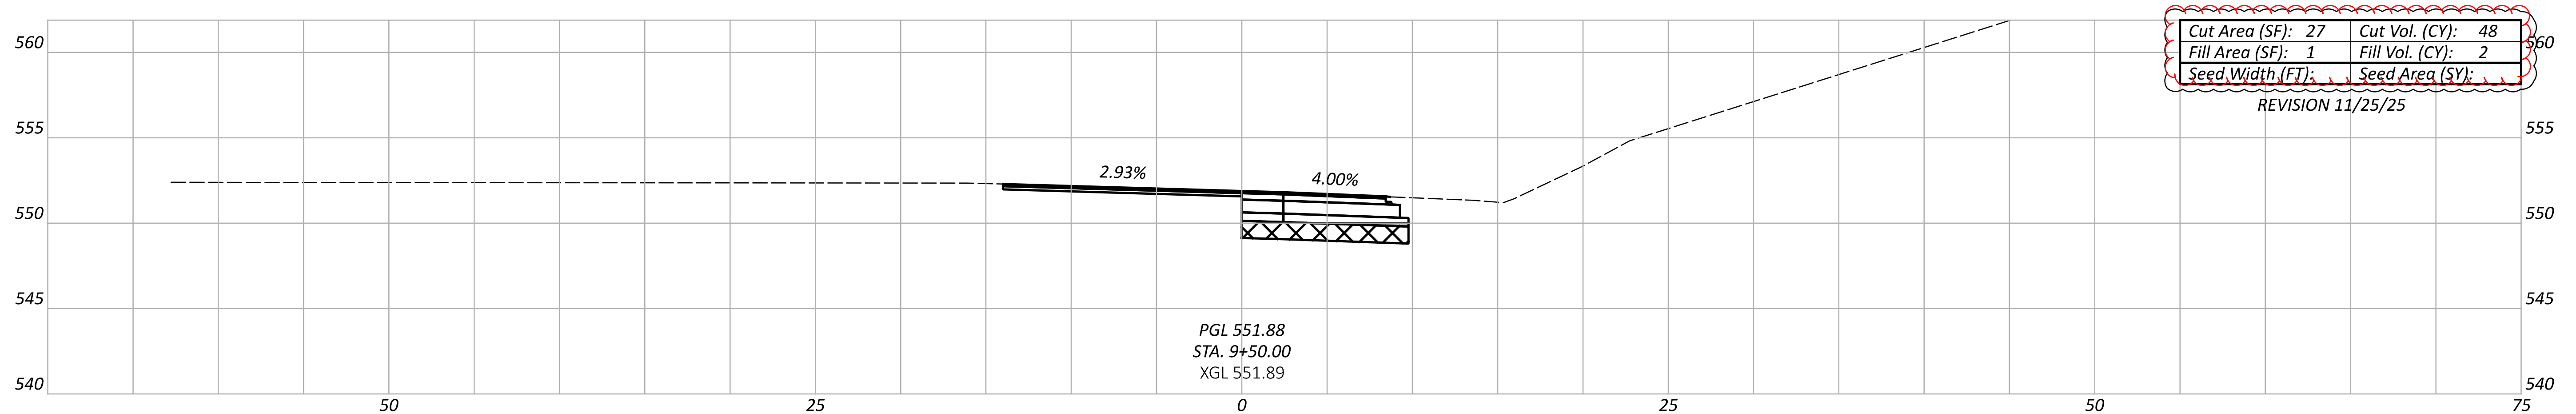
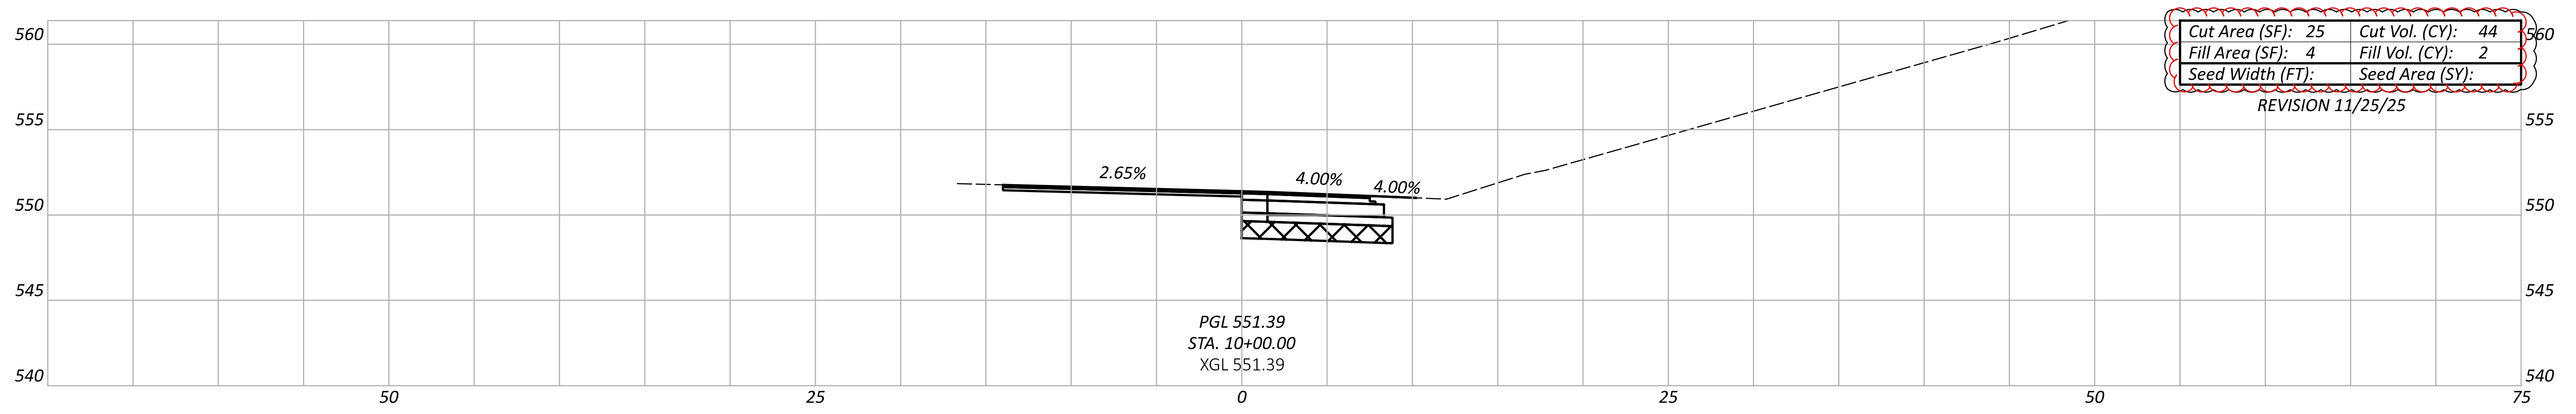


CROSS SECTIONS - RAMP "C"
STA. 9+00 TO 10+00

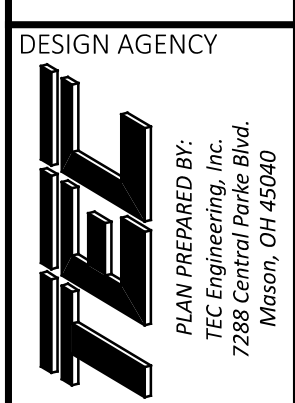


DESIGN AGENCY
 DESIGNER
 KLL
 REVIEWER
 ERW 12/01/25
 PROJECT ID

Sheet Totals			118472	
Seeding	Cut	Fill	SHEET	TOTAL
146	6		064	172

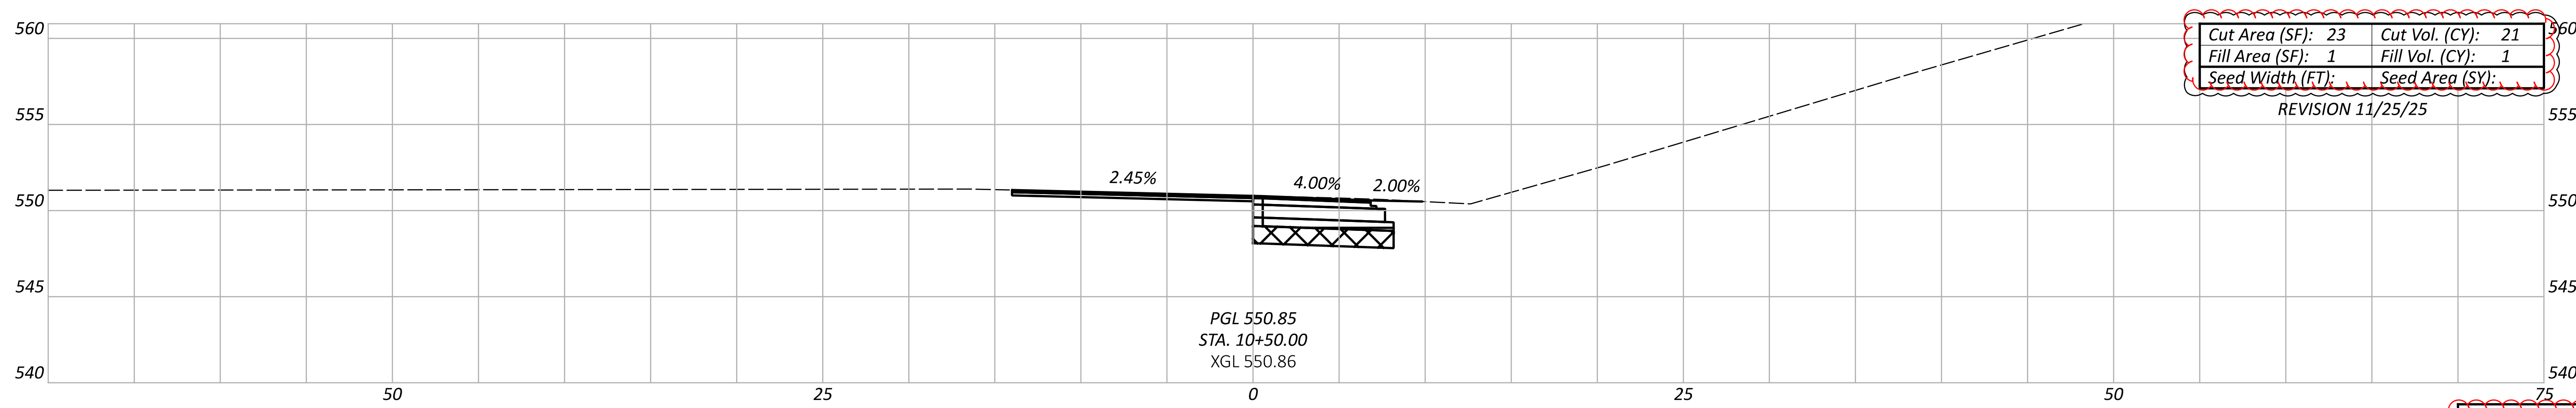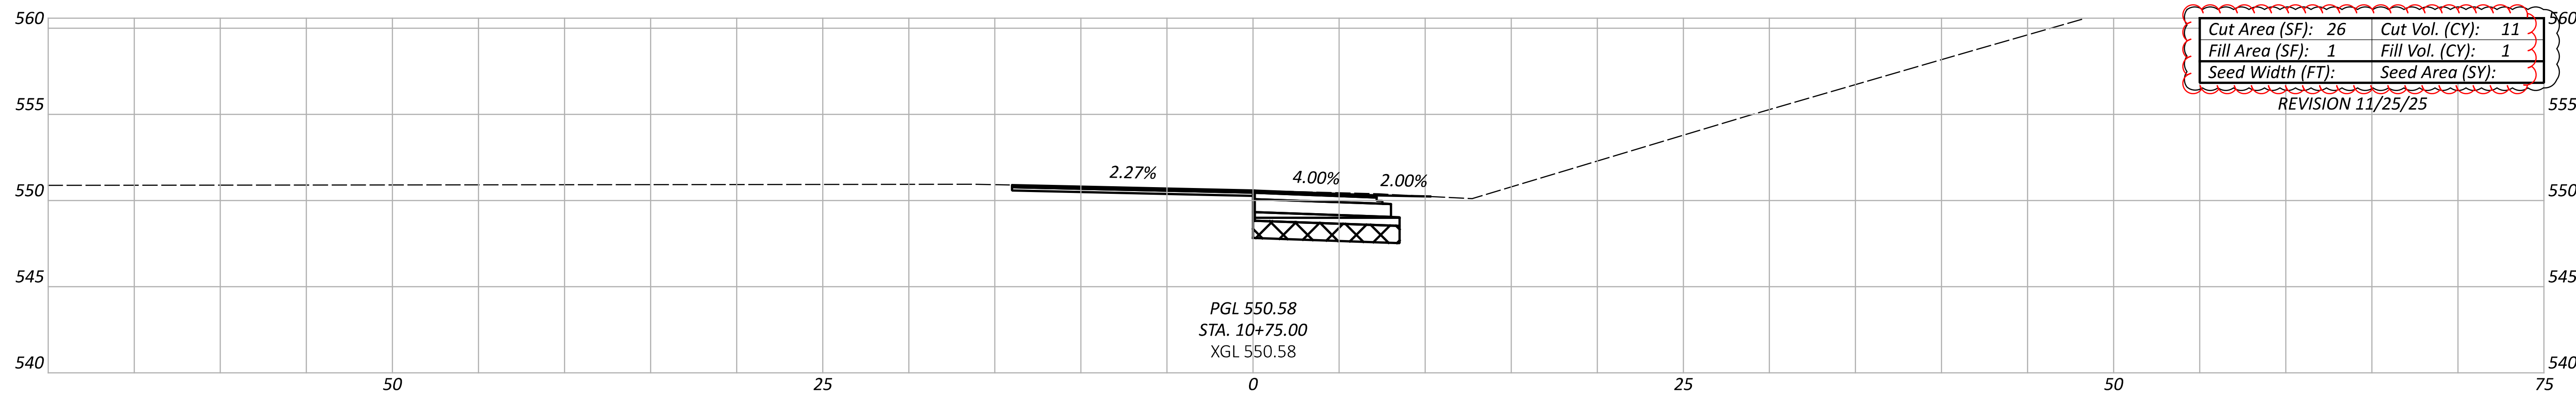

Sheet Totals			118472	
Seeding	Cut	Fill	SHEET	TOTAL
33	2	065	065	172


CROSS SECTIONS - RAMP "C"
 STA. 10+50 TO 10+75

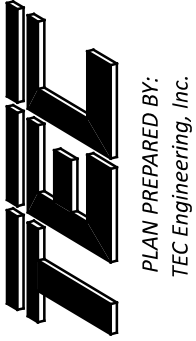DESIGN AGENCY

 PLAN PREPARED BY:
 TEL Engineering, Inc.
 7286 Central Park Blvd.
 Mason, OH 45040

DESIGNER
 KLL

REVIEWER
 ERW 12/01/25

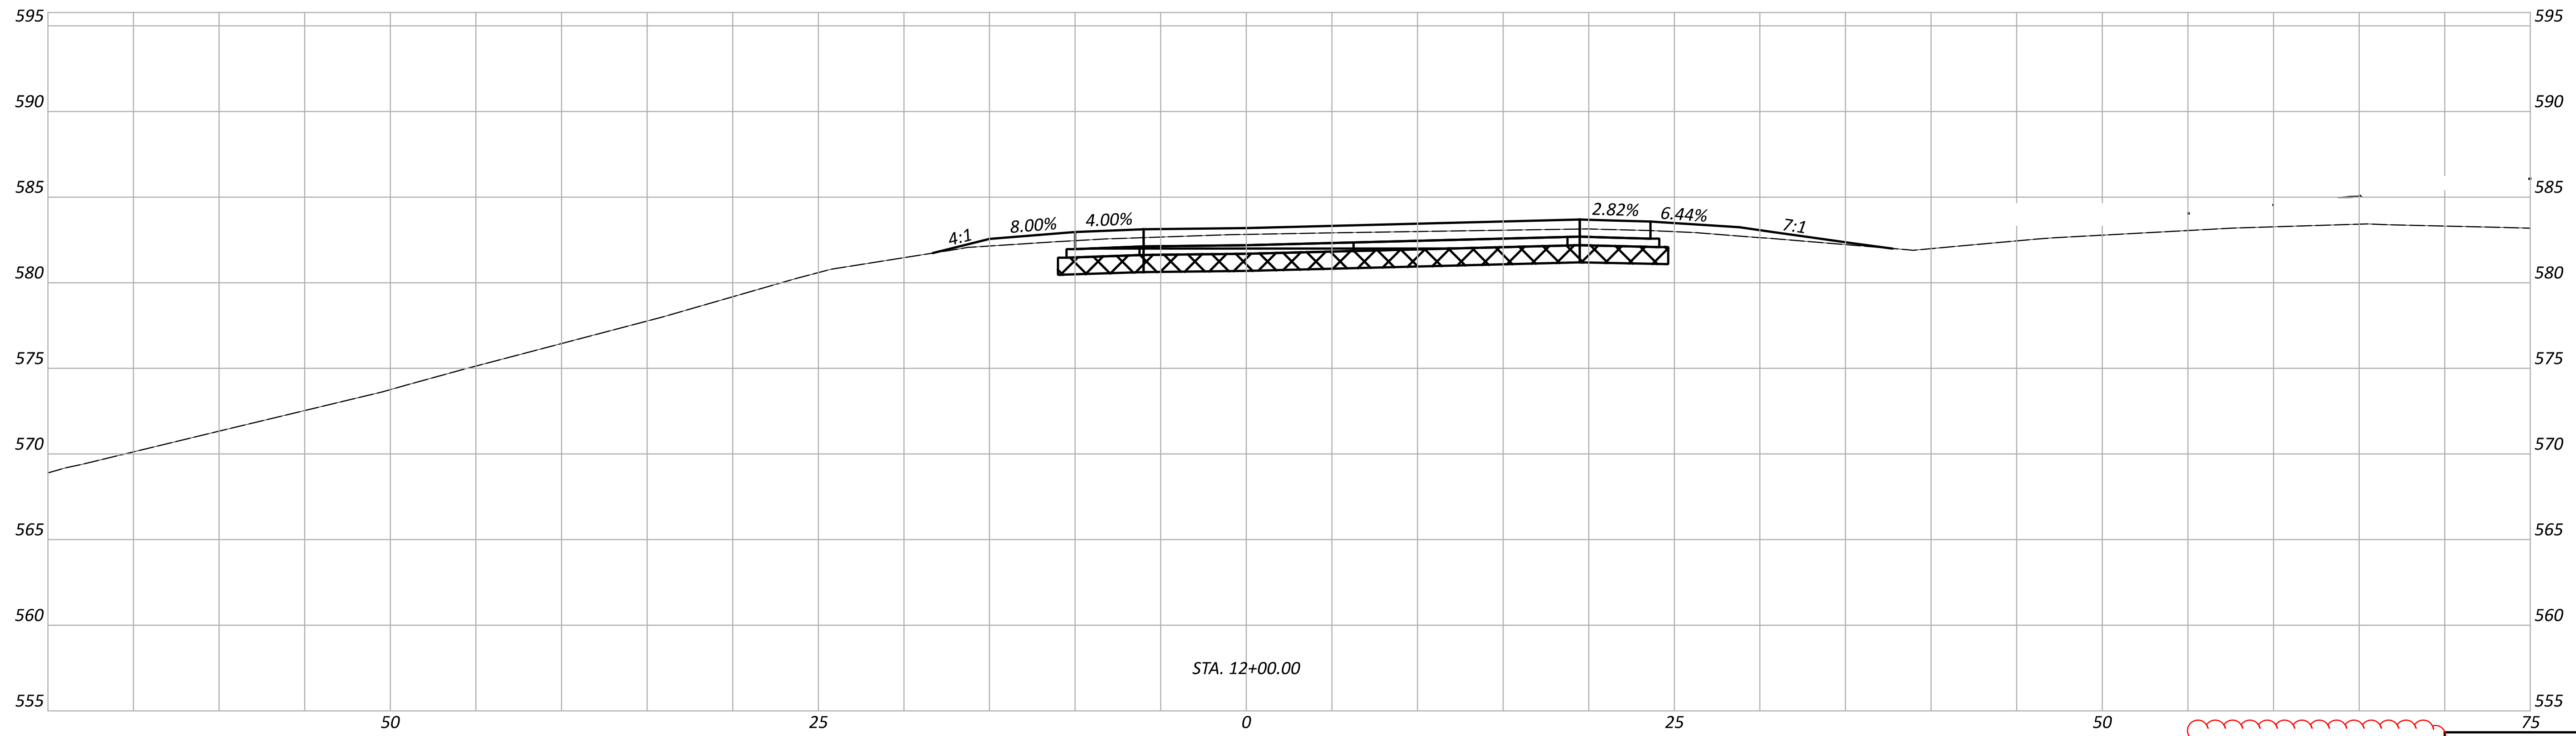PROJECT ID
 118472




STA. 12+00.00

CUT/FILL ACCOUNTED FOR ON DRY FORK ROAD


Sheet Totals		
Seeding	Cut	Fill

DESIGN AGENCY	TEC
DESIGNER	KLL
REVIEWER	ERW 09/23/25
PROJECT ID	118472
SHEET	066
TOTAL	172

CROSS SECTIONS - RAMP "B"
 BEGIN TO END

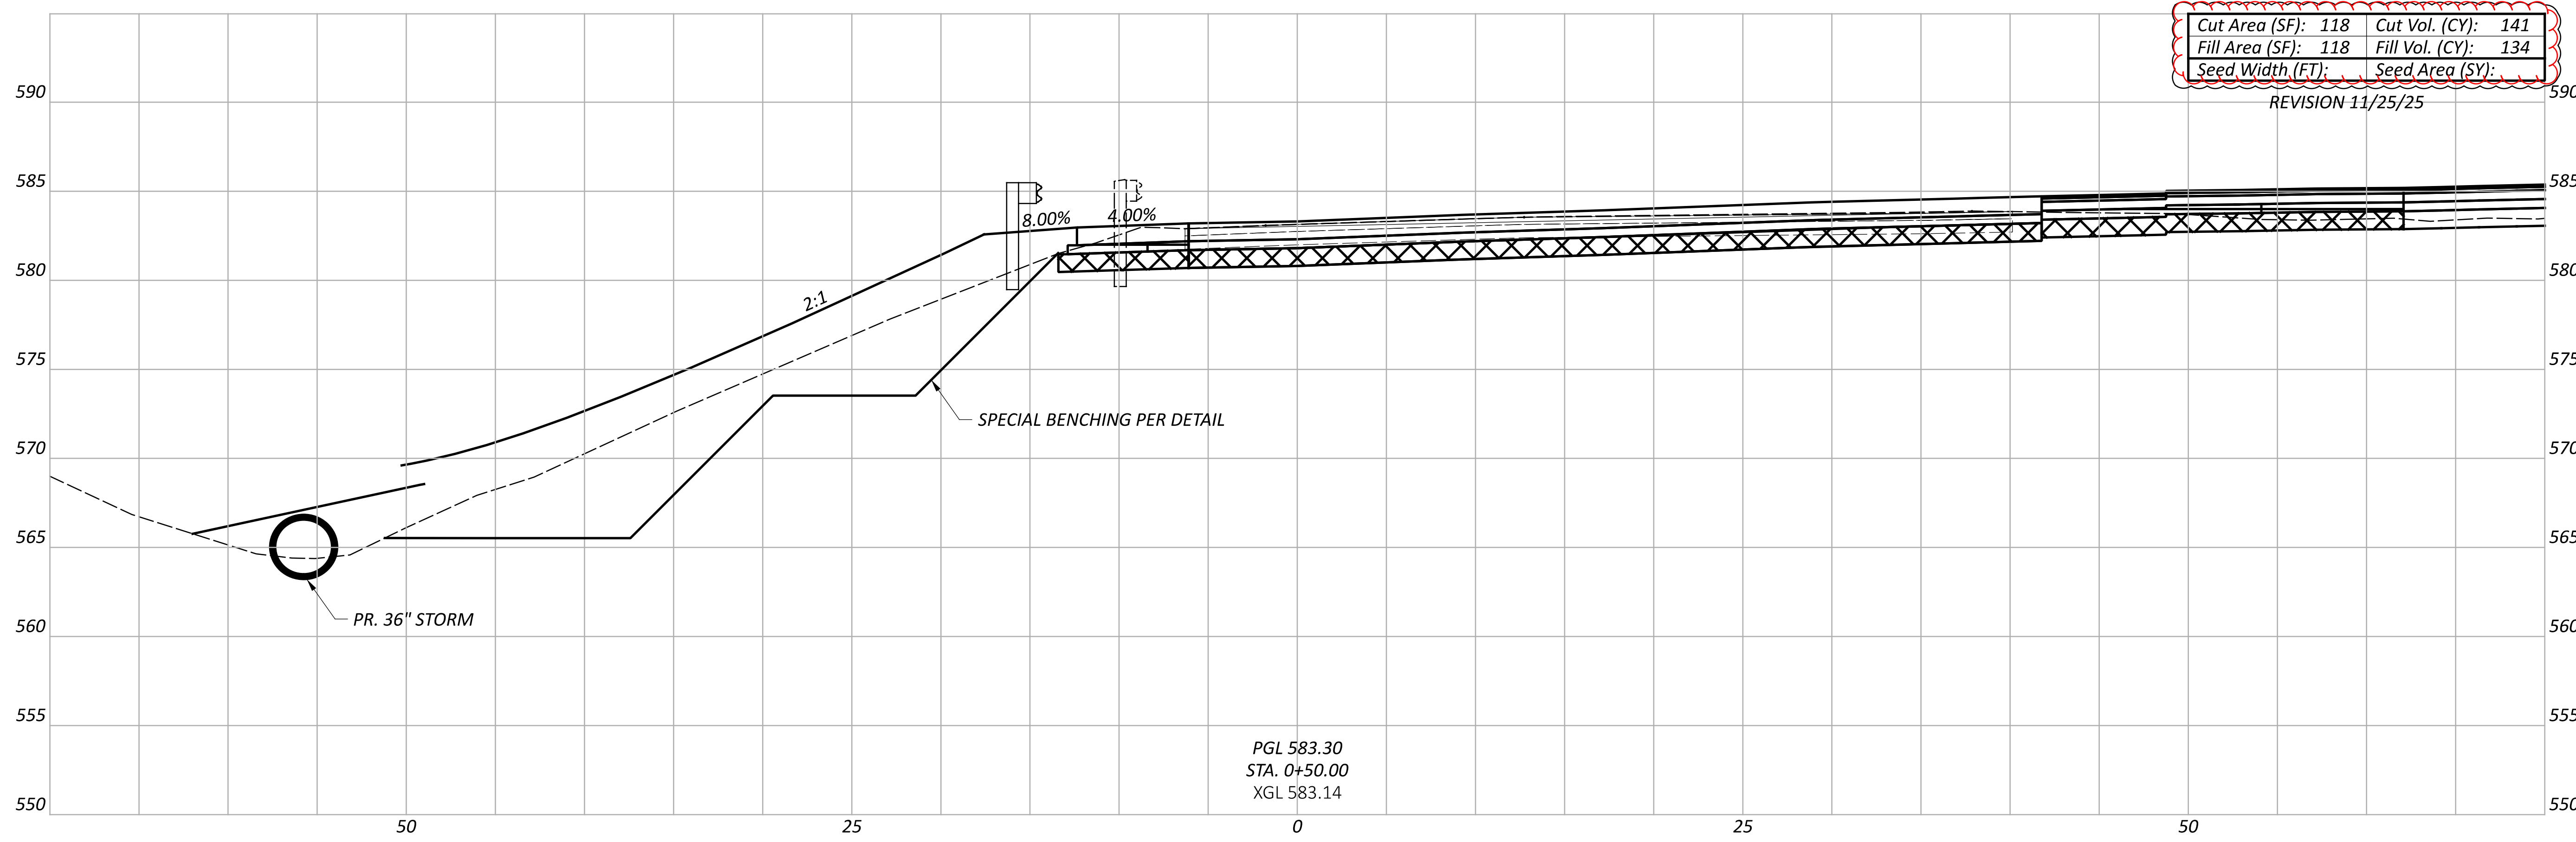


PGL 583.30
 STA. 0+50.00
 XGL 583.14

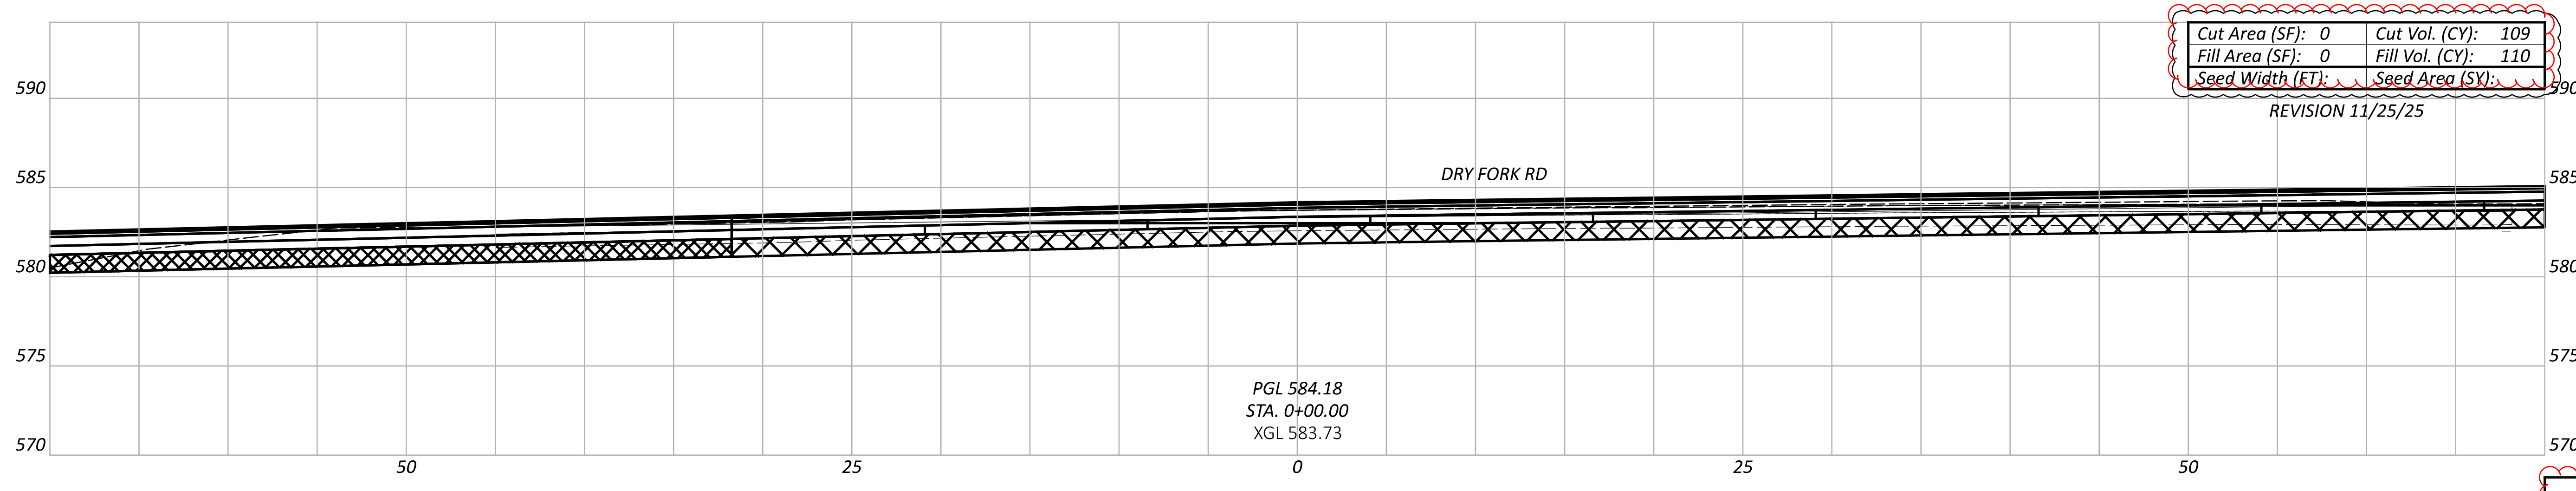

PGL 584.18
 STA. 0+00.00
 XGL 583.73

CROSS SECTIONS - RAMP "D"
 STA. 00+00 TO STA. 00+50.00


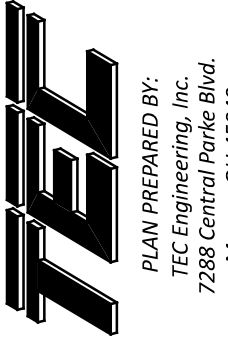
DESIGN AGENCY

 PLAN PREPARED BY:
 TEC Engineering, Inc.
 7288 Central Parke Blvd.
 Mason, OH 45040

DESIGNER
 KLL

REVIEWER
 ERW 12/01/25


PROJECT ID
 118472

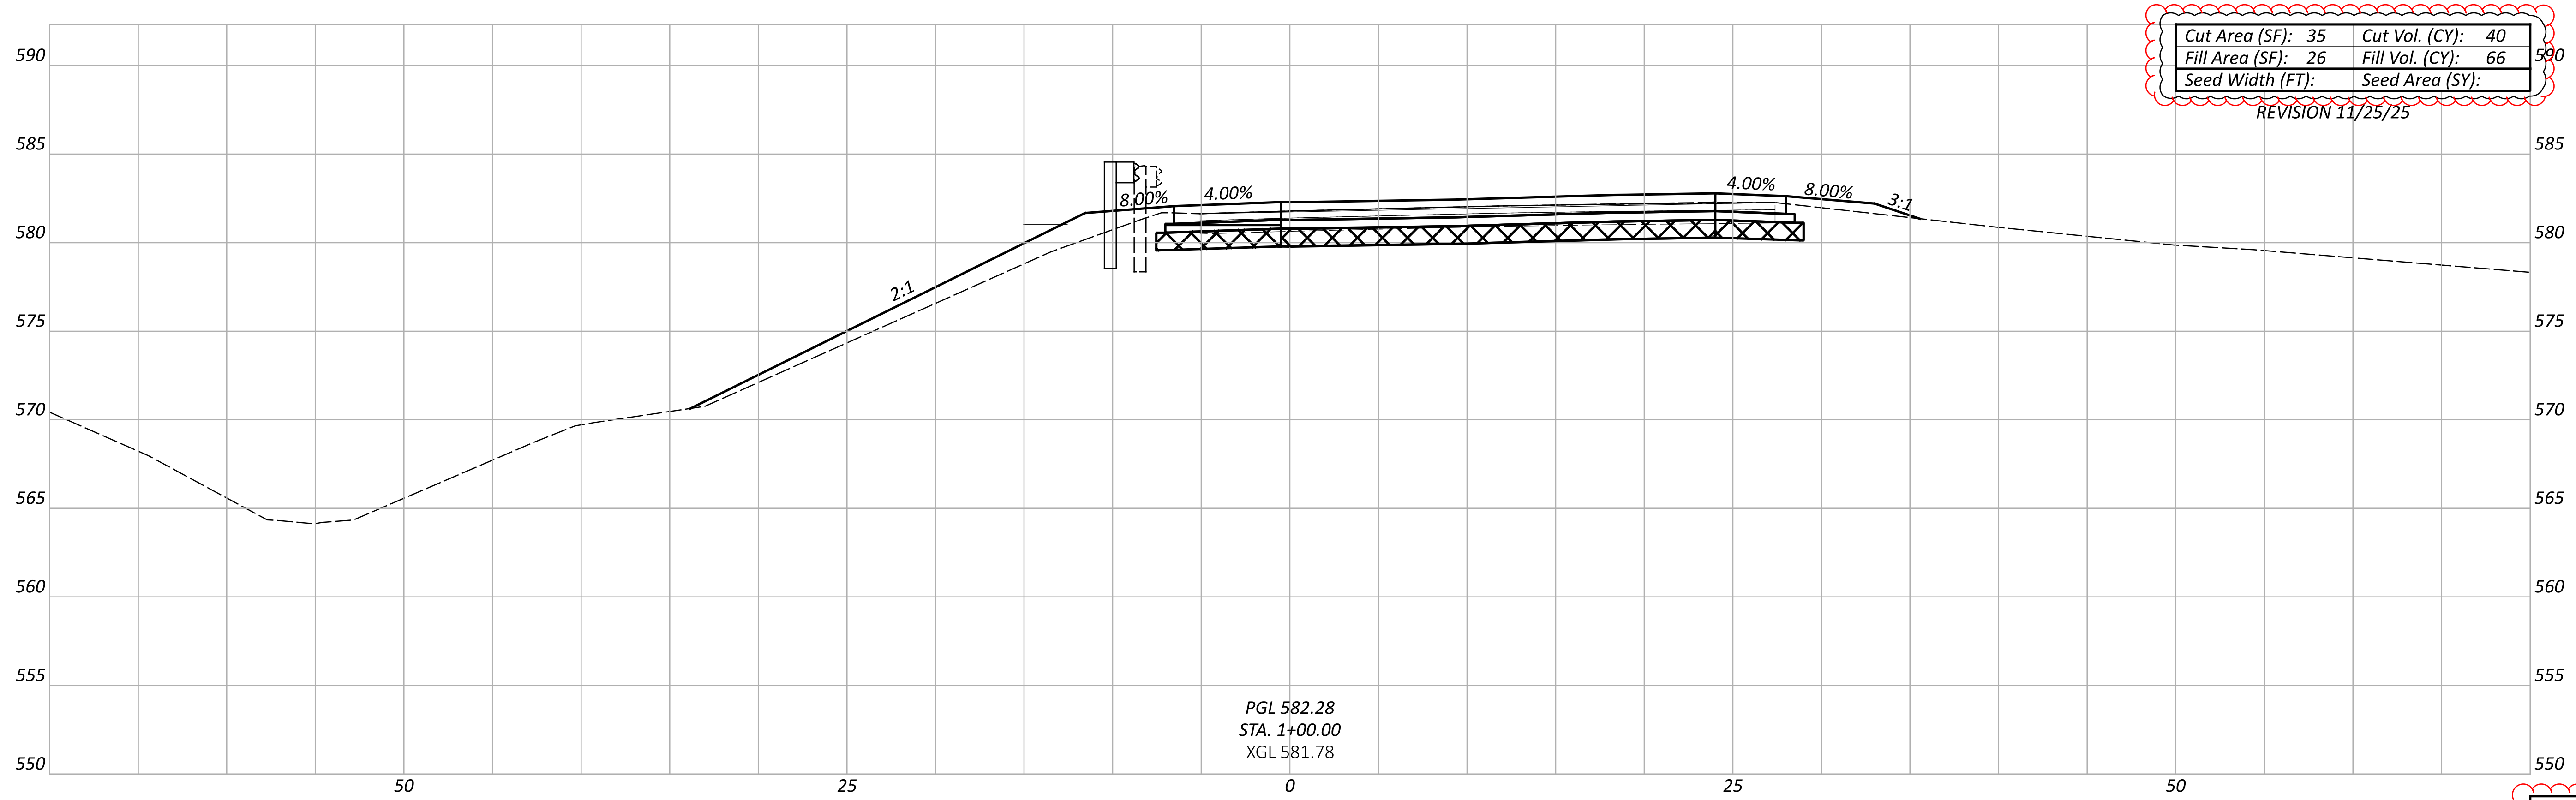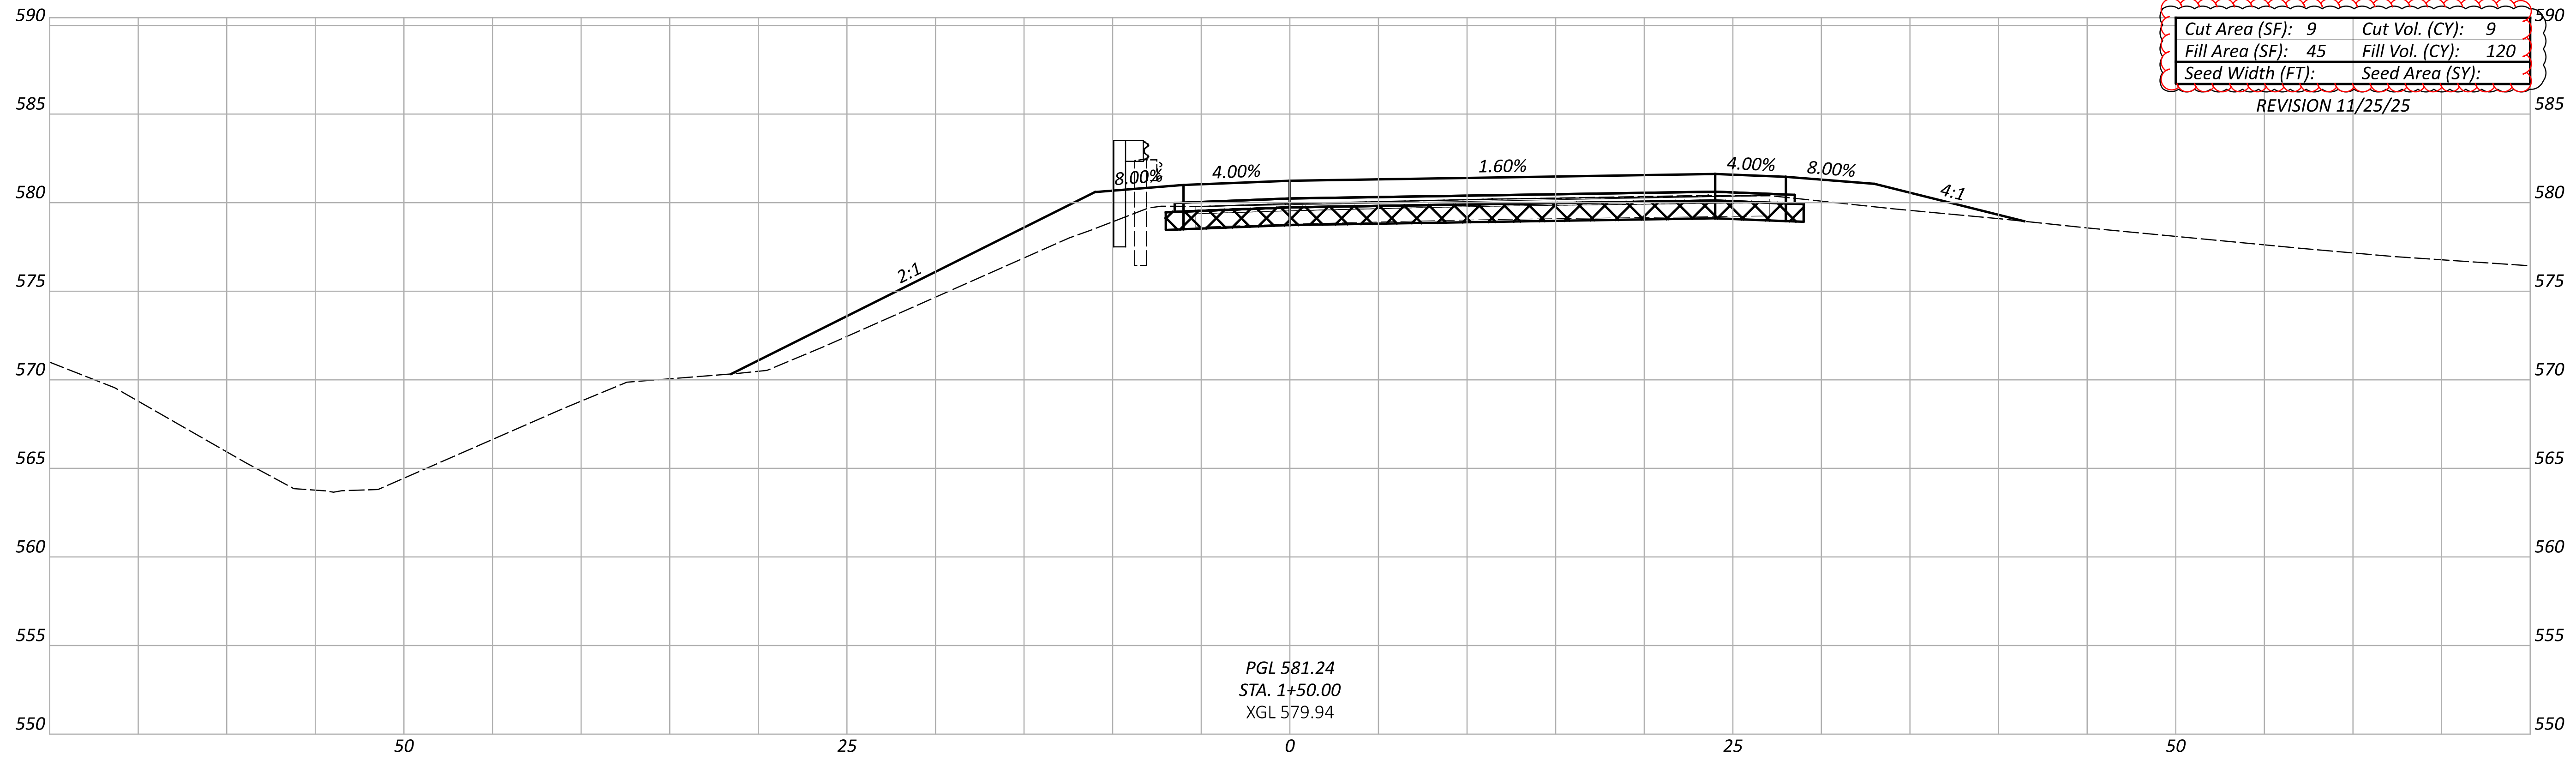Sheet Totals			118472
Seeding	Cut	Fill	SHEET TOTAL
	250	244	067 172



Sheet Totals			118472
Seeding	Cut	Fill	TOTAL
49	186	068	172



CROSS SECTIONS - RAMP "D"
 STA. 01+00.00 TO STA. 01+50.00

DESIGN AGENCY

 PLAN PREPARED BY:
 TEL Engineering, Inc.
 7288 Central Park Blvd.
 Mason, OH 45040


DESIGNER
 KLL

REVIEWER
 ERW 12/01/25

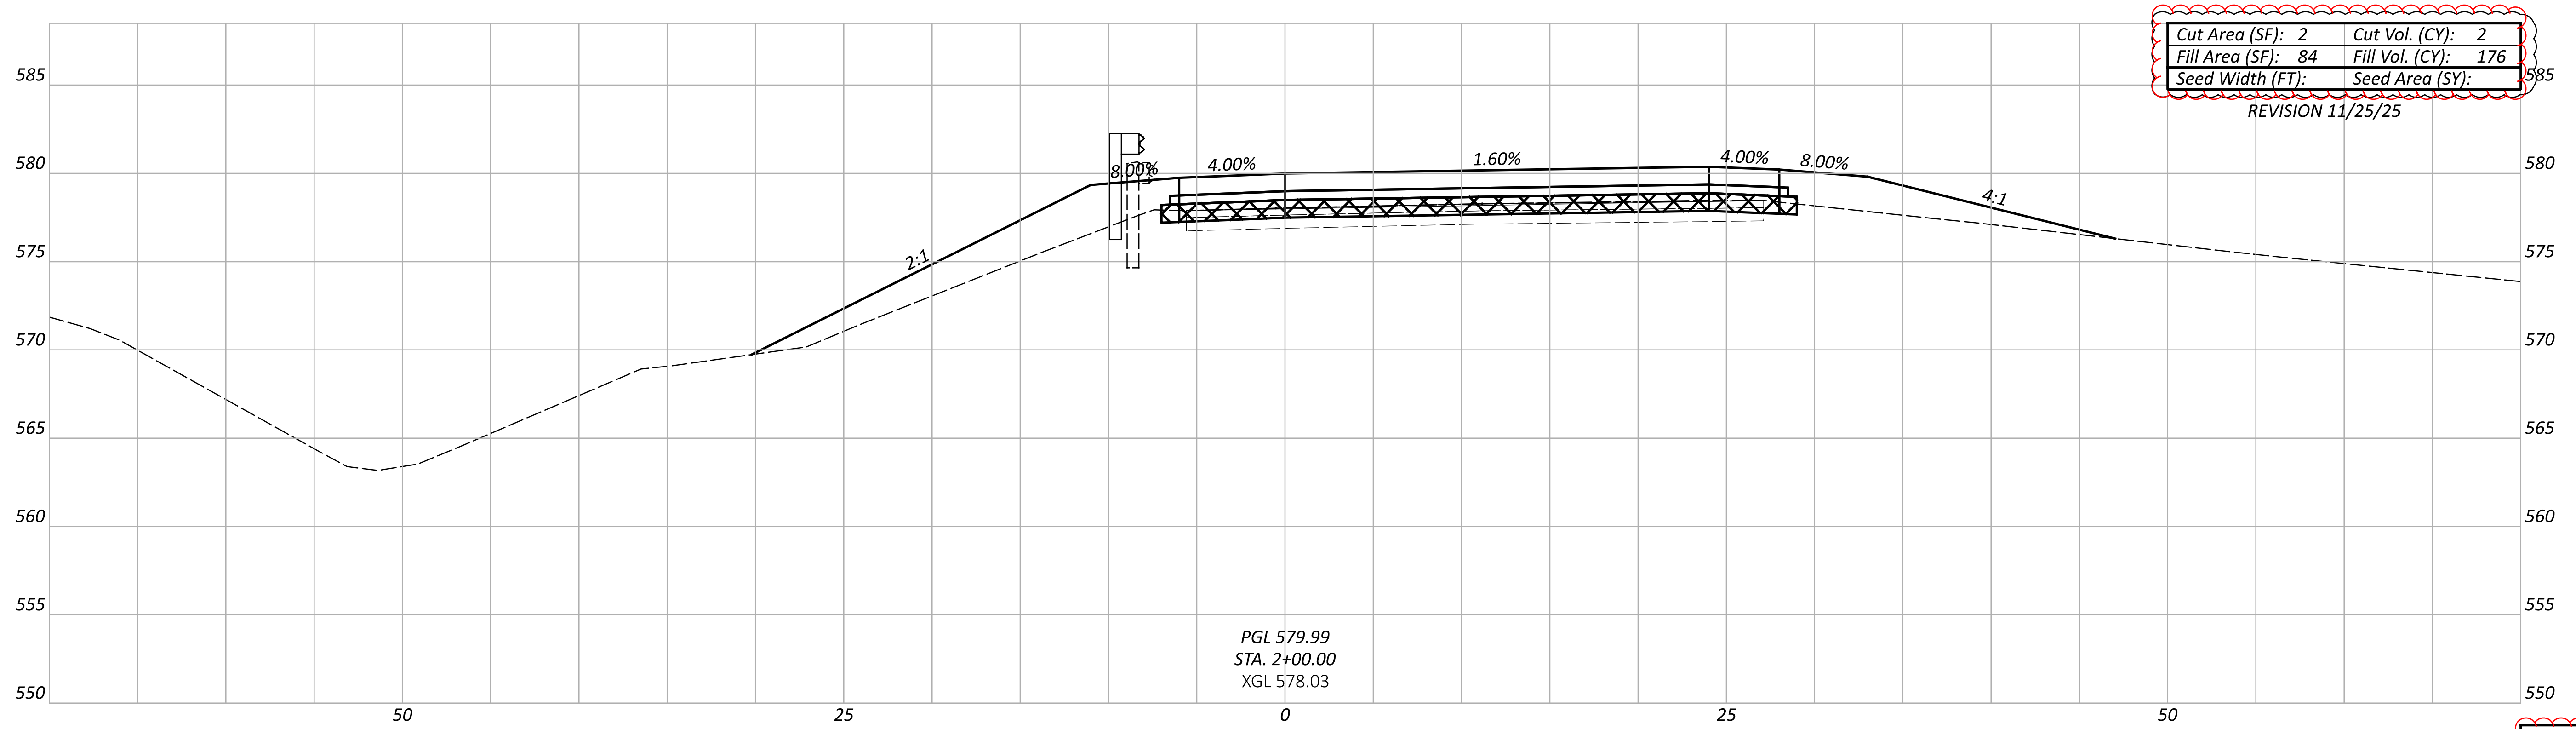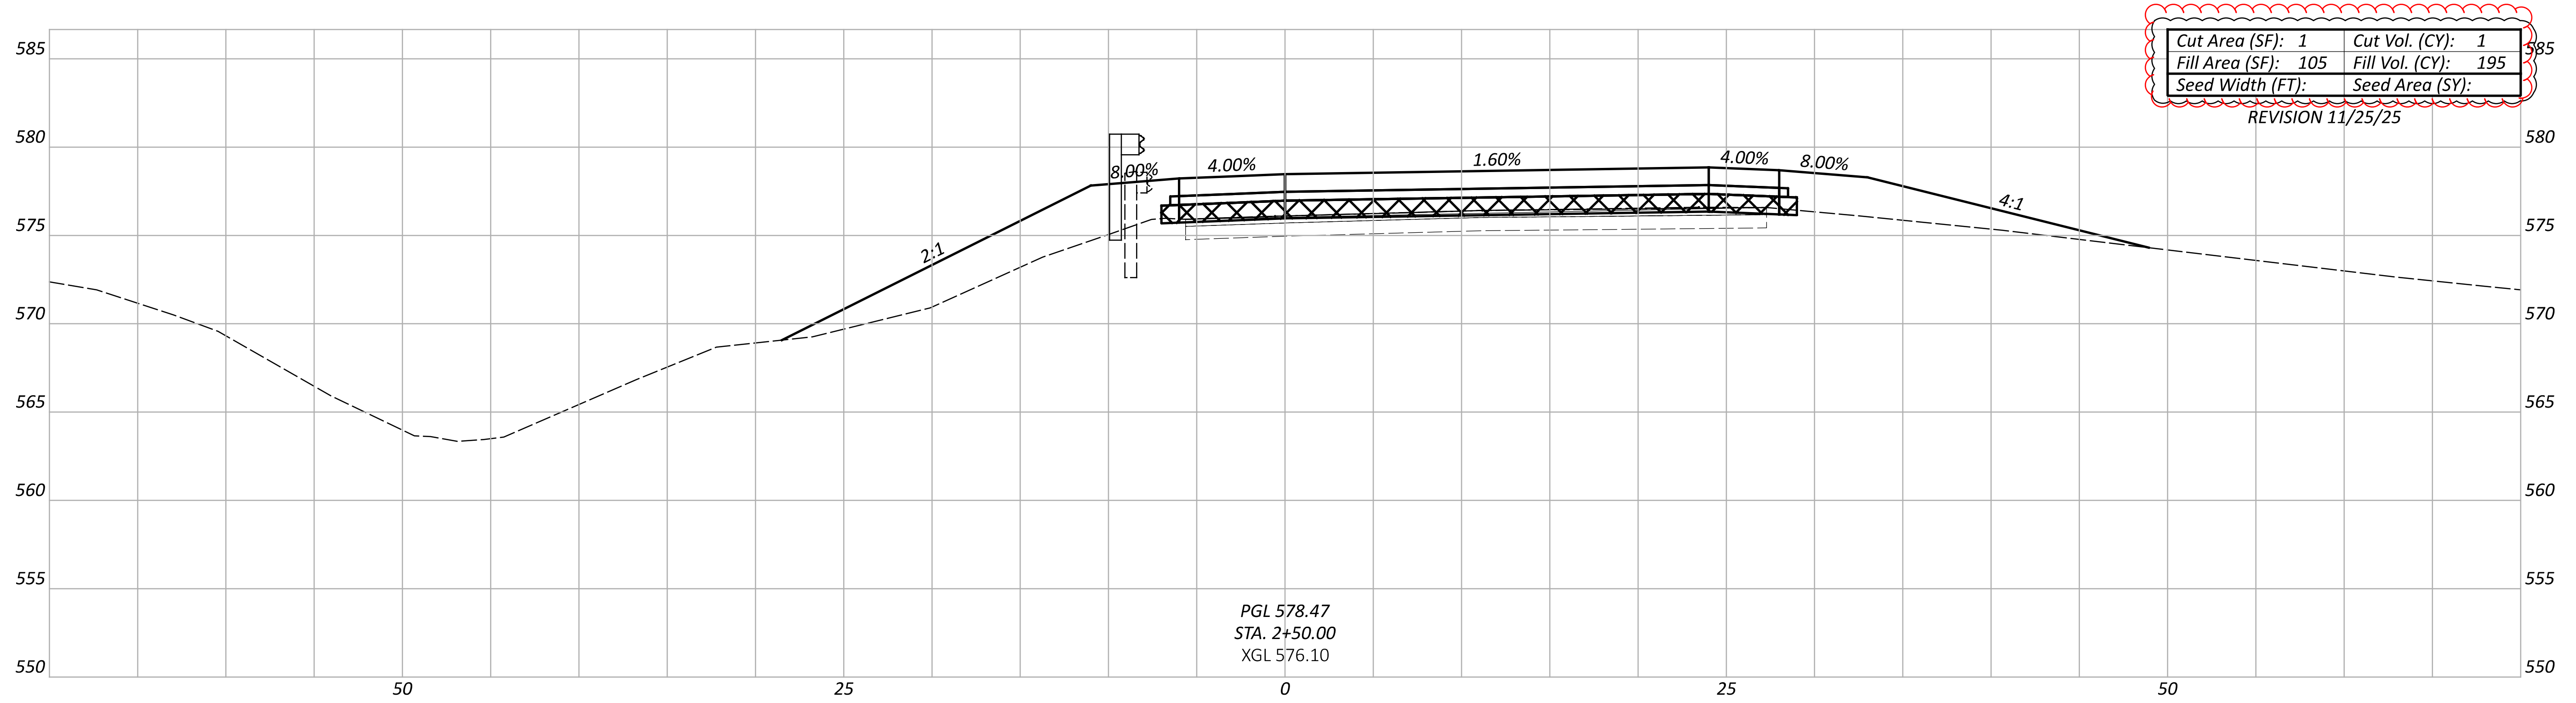PROJECT ID
 118472




CROSS SECTIONS - RAMP "D"
 STA. 02+00.00 TO STA. 02+50.00

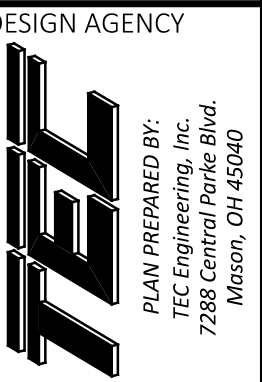

DESIGNER
 KLL
 REVIEWER
 ERW 12/01/25

PROJECT ID
 118472


Sheet Totals			118472	
Seeding	Cut	Fill	SHEET	TOTAL
3	374	069	172	

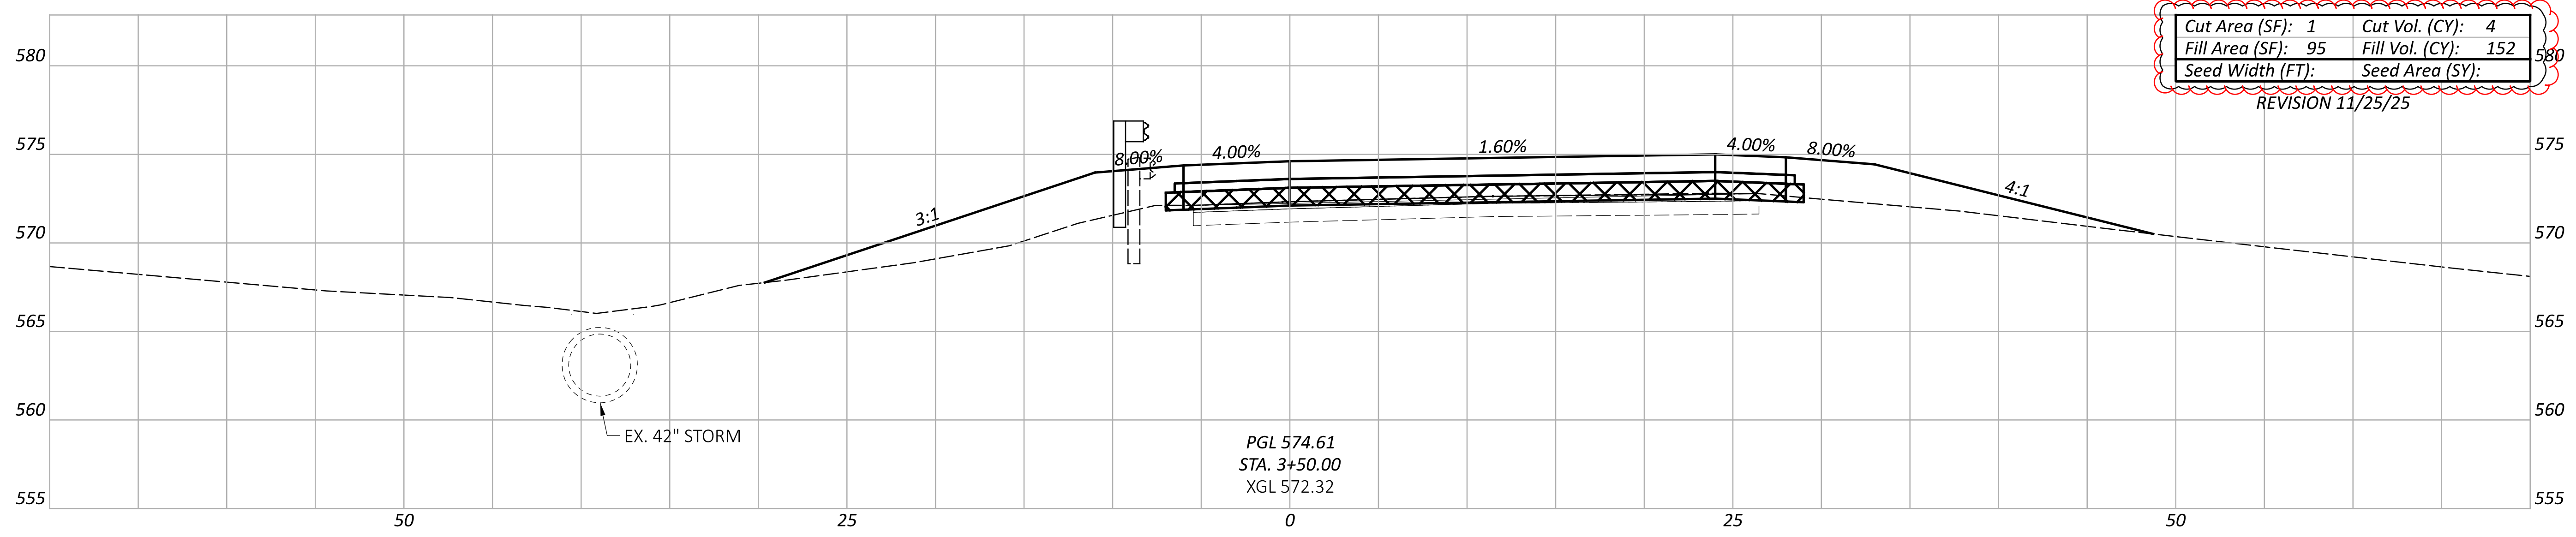

Cut Area (SF):	1	Cut Vol. (CY):	4
Fill Area (SF):	95	Fill Vol. (CY):	152
Seed Width (FT):		Seed Area (SY):	

REVISION 11/25/25

PGL 574.61
 STA. 3+50.00
 XGL 572.32

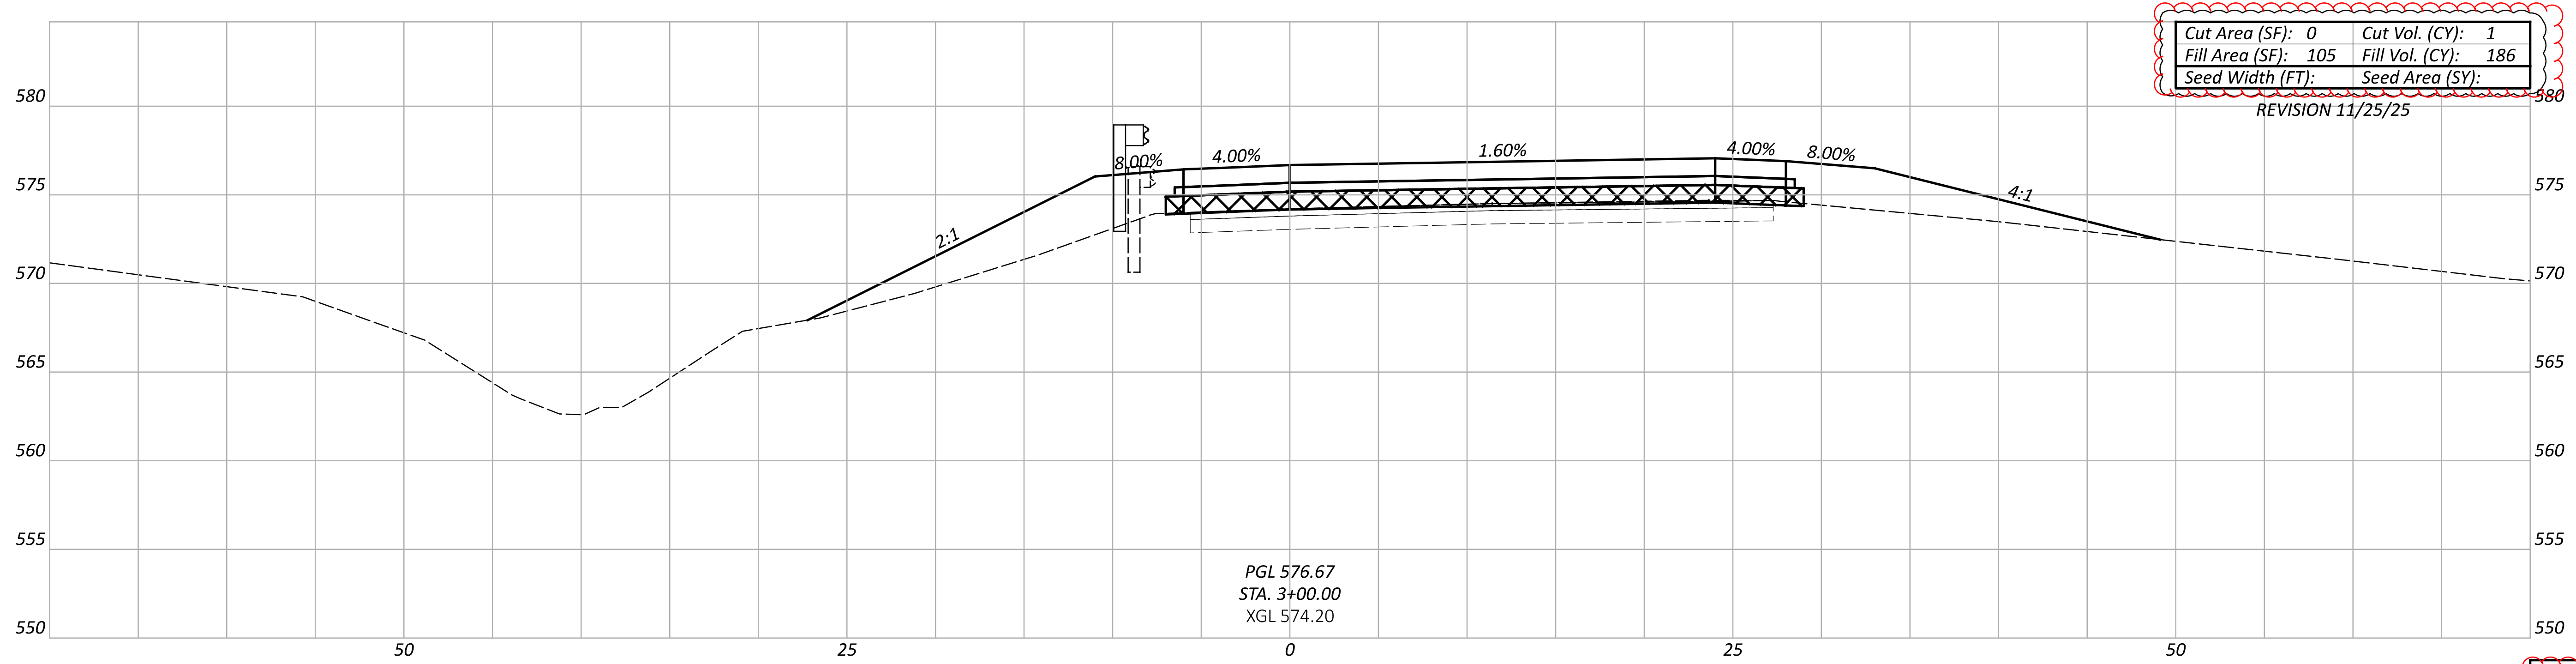

Cut Area (SF):	0	Cut Vol. (CY):	1
Fill Area (SF):	105	Fill Vol. (CY):	186
Seed Width (FT):		Seed Area (SY):	

REVISION 11/25/25

PGL 576.67
 STA. 3+00.00
 XGL 574.20

Sheet Totals			
Seeding	Cut	Fill	TOTAL
5	338	070	172

DESIGN AGENCY

 PLAN PREPARED BY:
 TEC Engineering, Inc.
 7288 Central Parke Blvd.
 Mason, OH 45040



DESIGNER
 KLL

REVIEWER
 ERW 12/01/25

PROJECT ID
 118472


SHEET TOTAL
 070 172

CROSS SECTIONS - RAMP "D"
 STA. 03+00.00 TO STA. 03+50.00

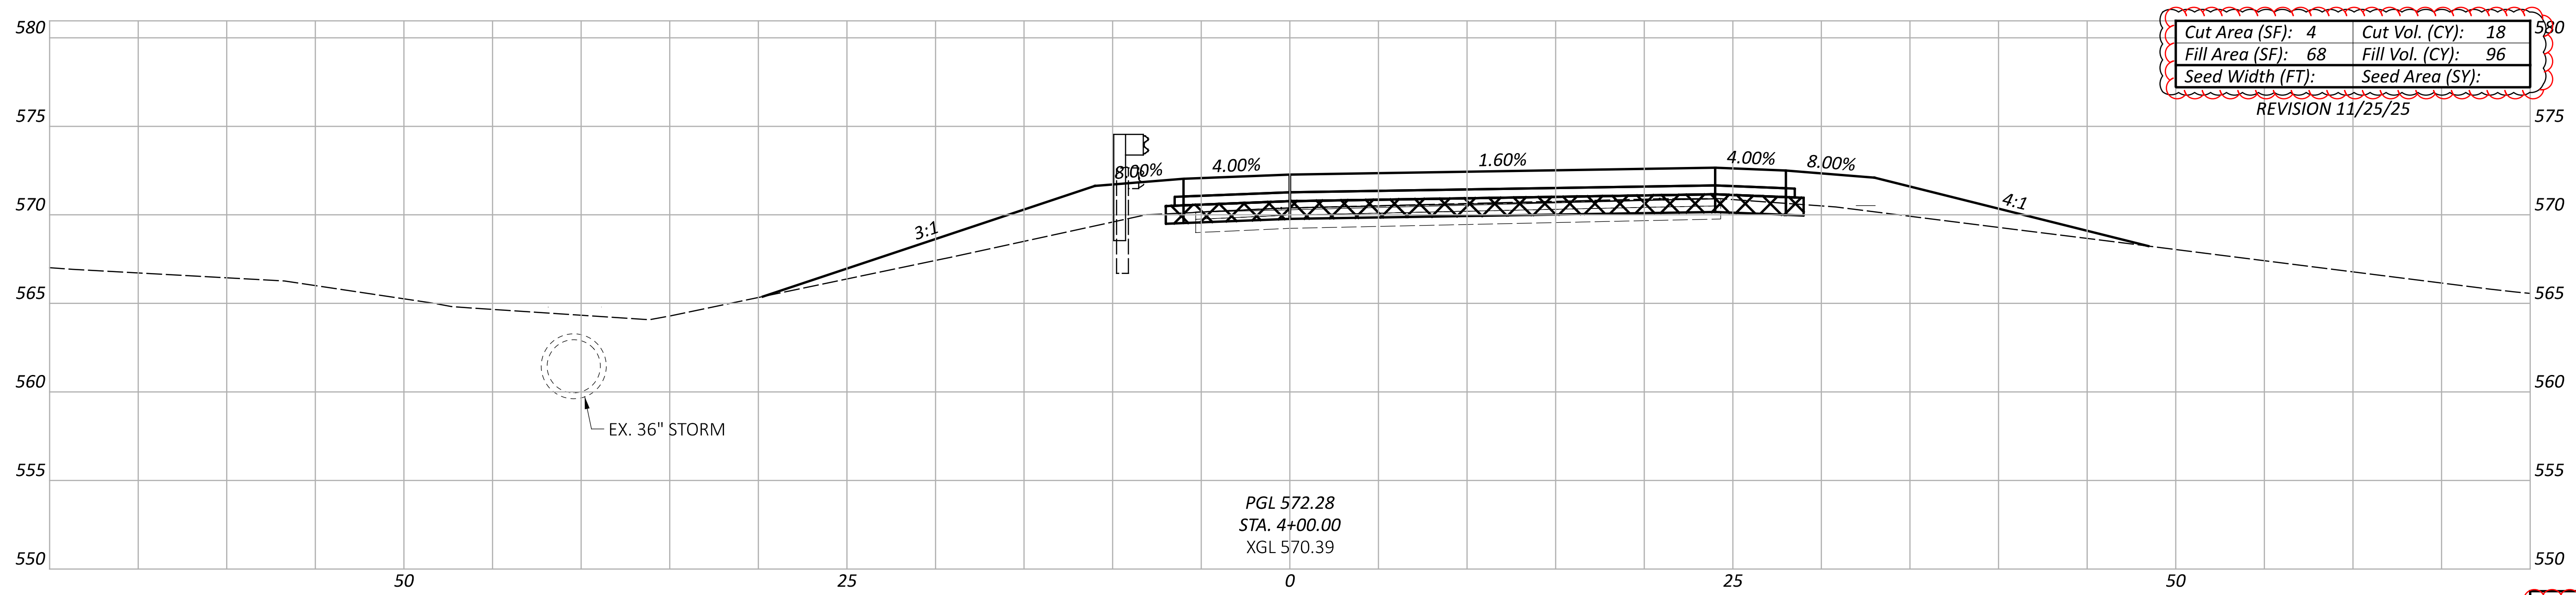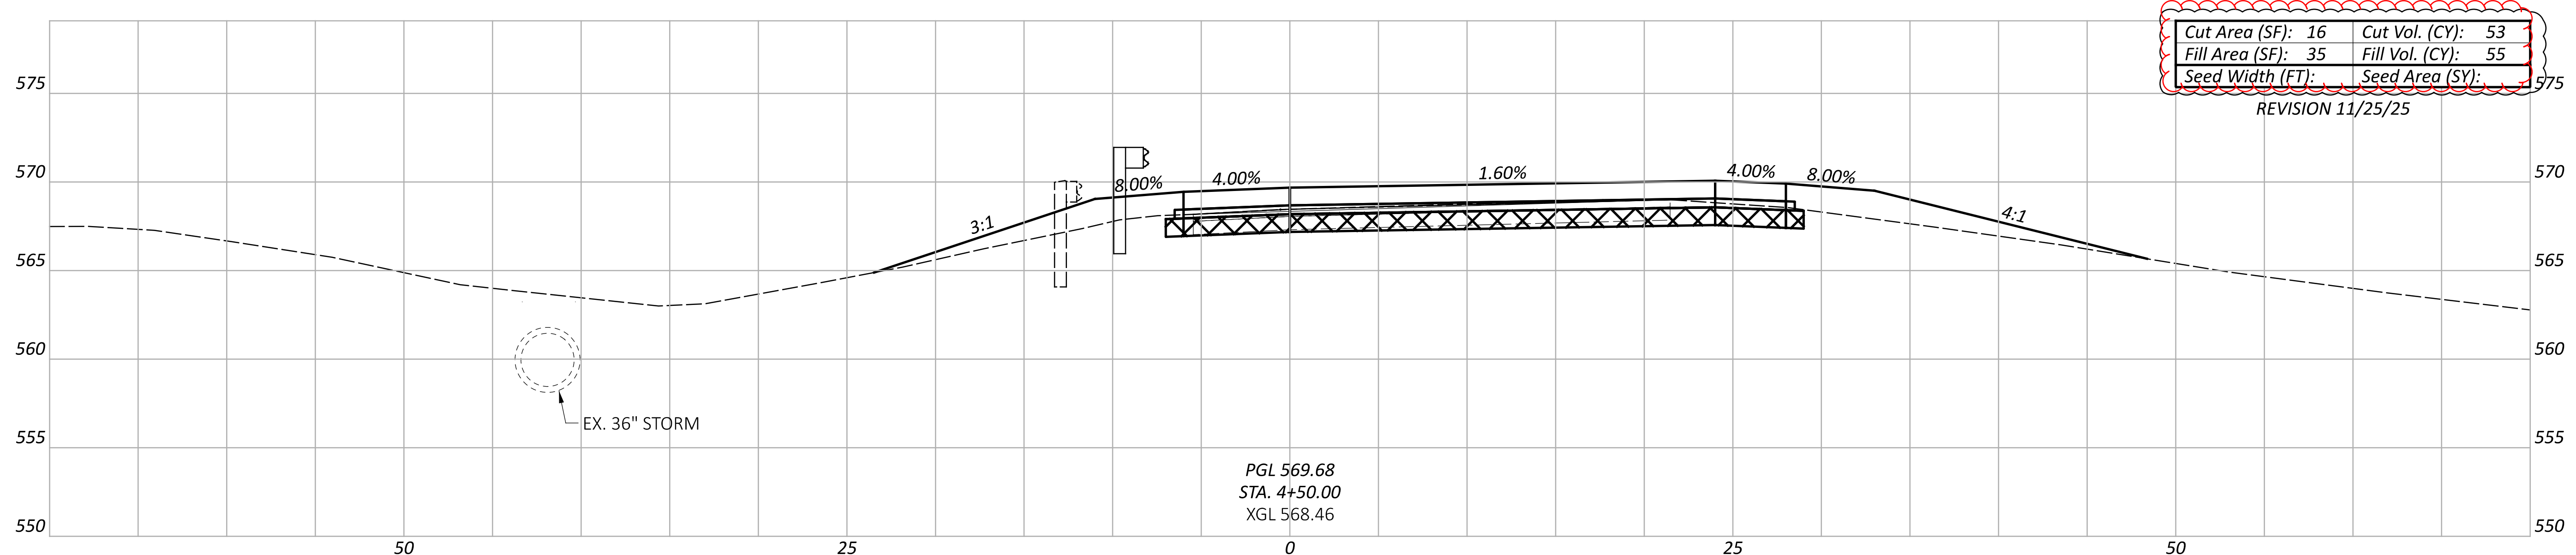

Sheet Totals			
Seeding	Cut	Fill	TOTAL
71	151	071	172



CROSS SECTIONS - RAMP "D"
 STA. 04+00.00 TO STA. 04+50.00

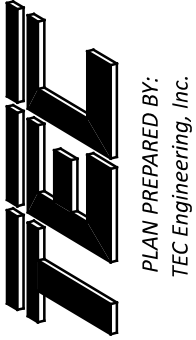DESIGN AGENCY

 PLAN PREPARED BY:
 TEL Engineering, Inc.
 7288 Central Parke Blvd.
 Mason, OH 45040

DESIGNER
 KLL

REVIEWER
 ERW 12/01/25

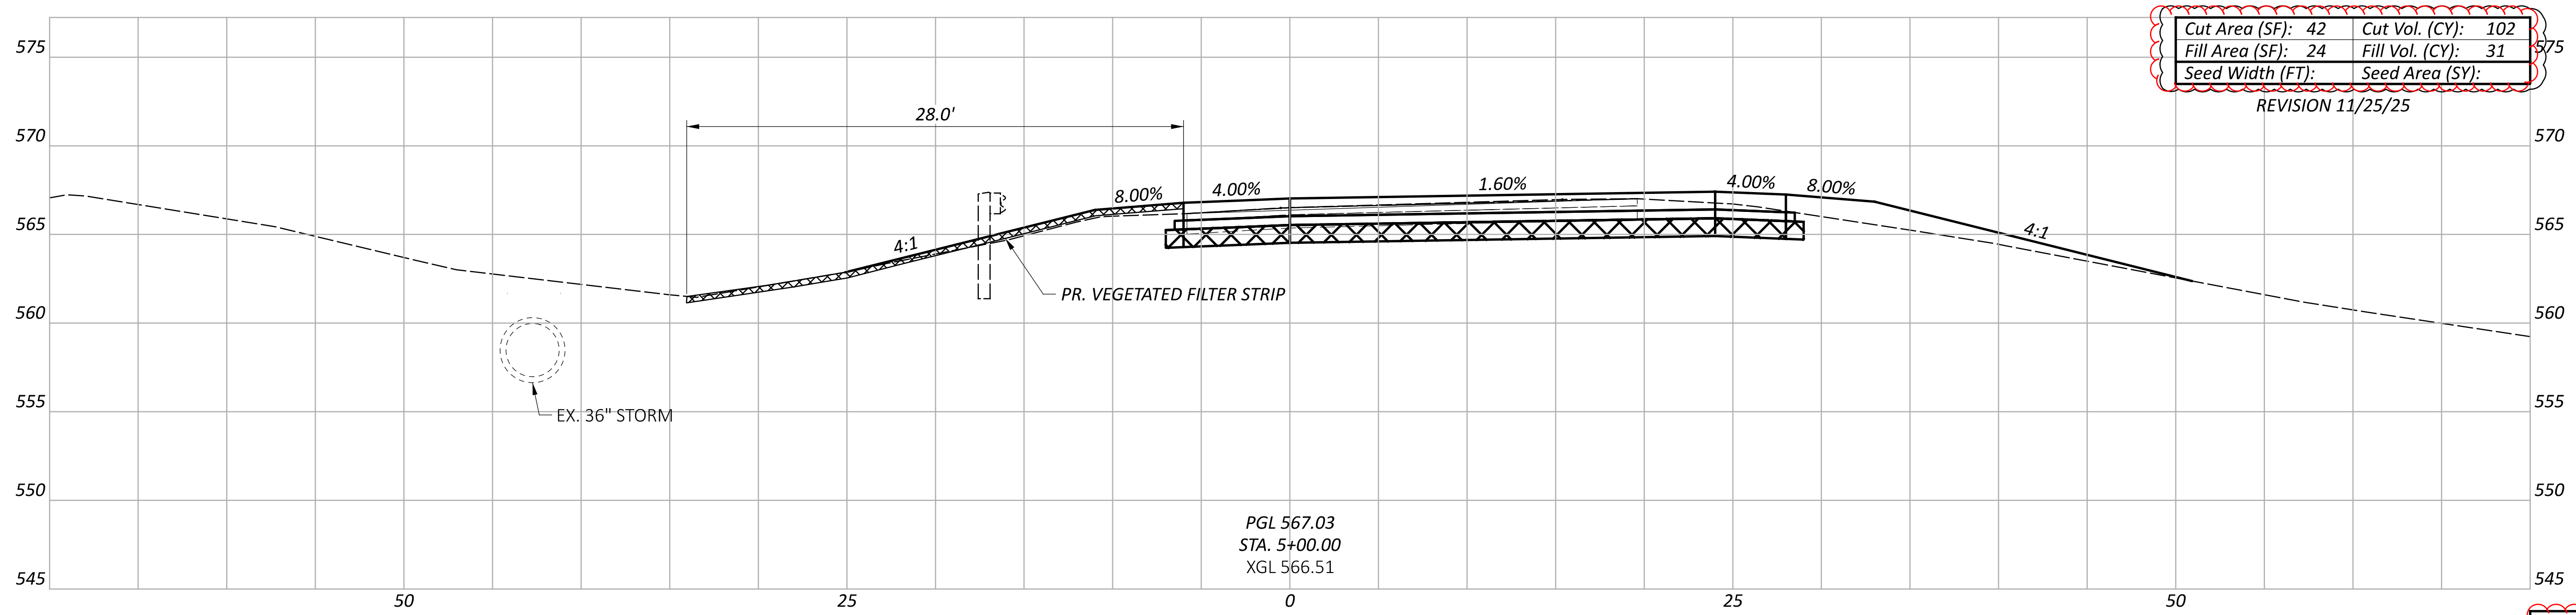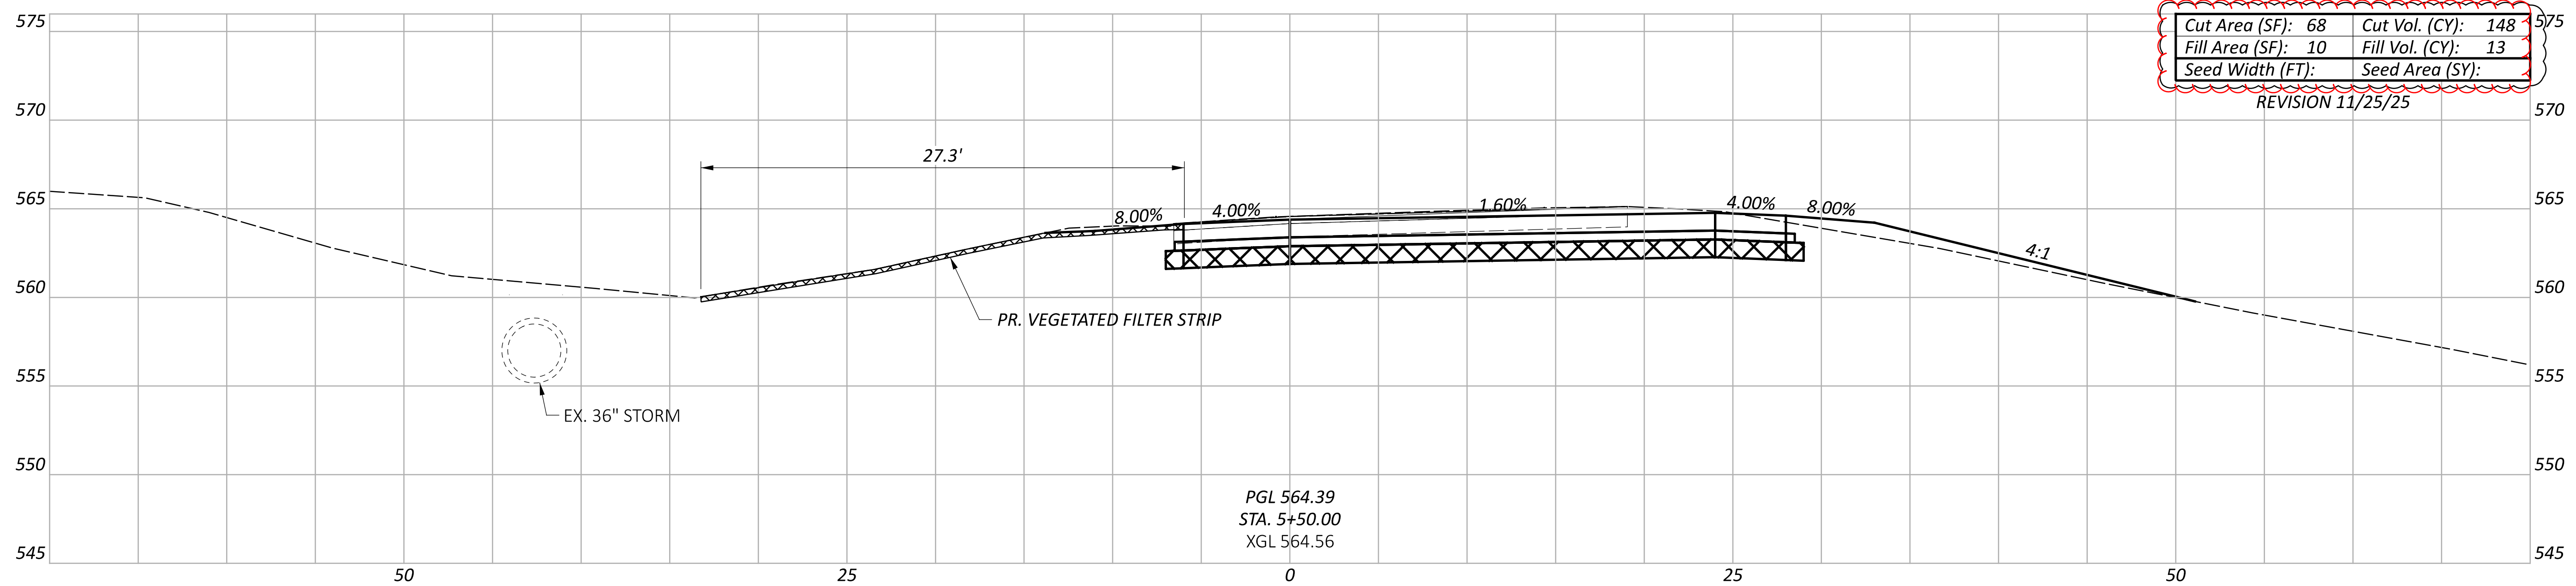PROJECT ID
 118472



Sheet Totals			
Seeding	Cut	Fill	TOTAL
250	44	072	172



DESIGN AGENCY
TEL
 PLAN PREPARED BY:
 TEC Engineering, Inc.
 7288 Central Parke Blvd.
 Mason, OH 45040

DESIGNER
 KLL

REVIEWER
 ERW 12/01/25

PROJECT ID
 118472

CROSS SECTIONS - RAMP "D"
 STA. 05+00.00 TO STA. 05+50.00

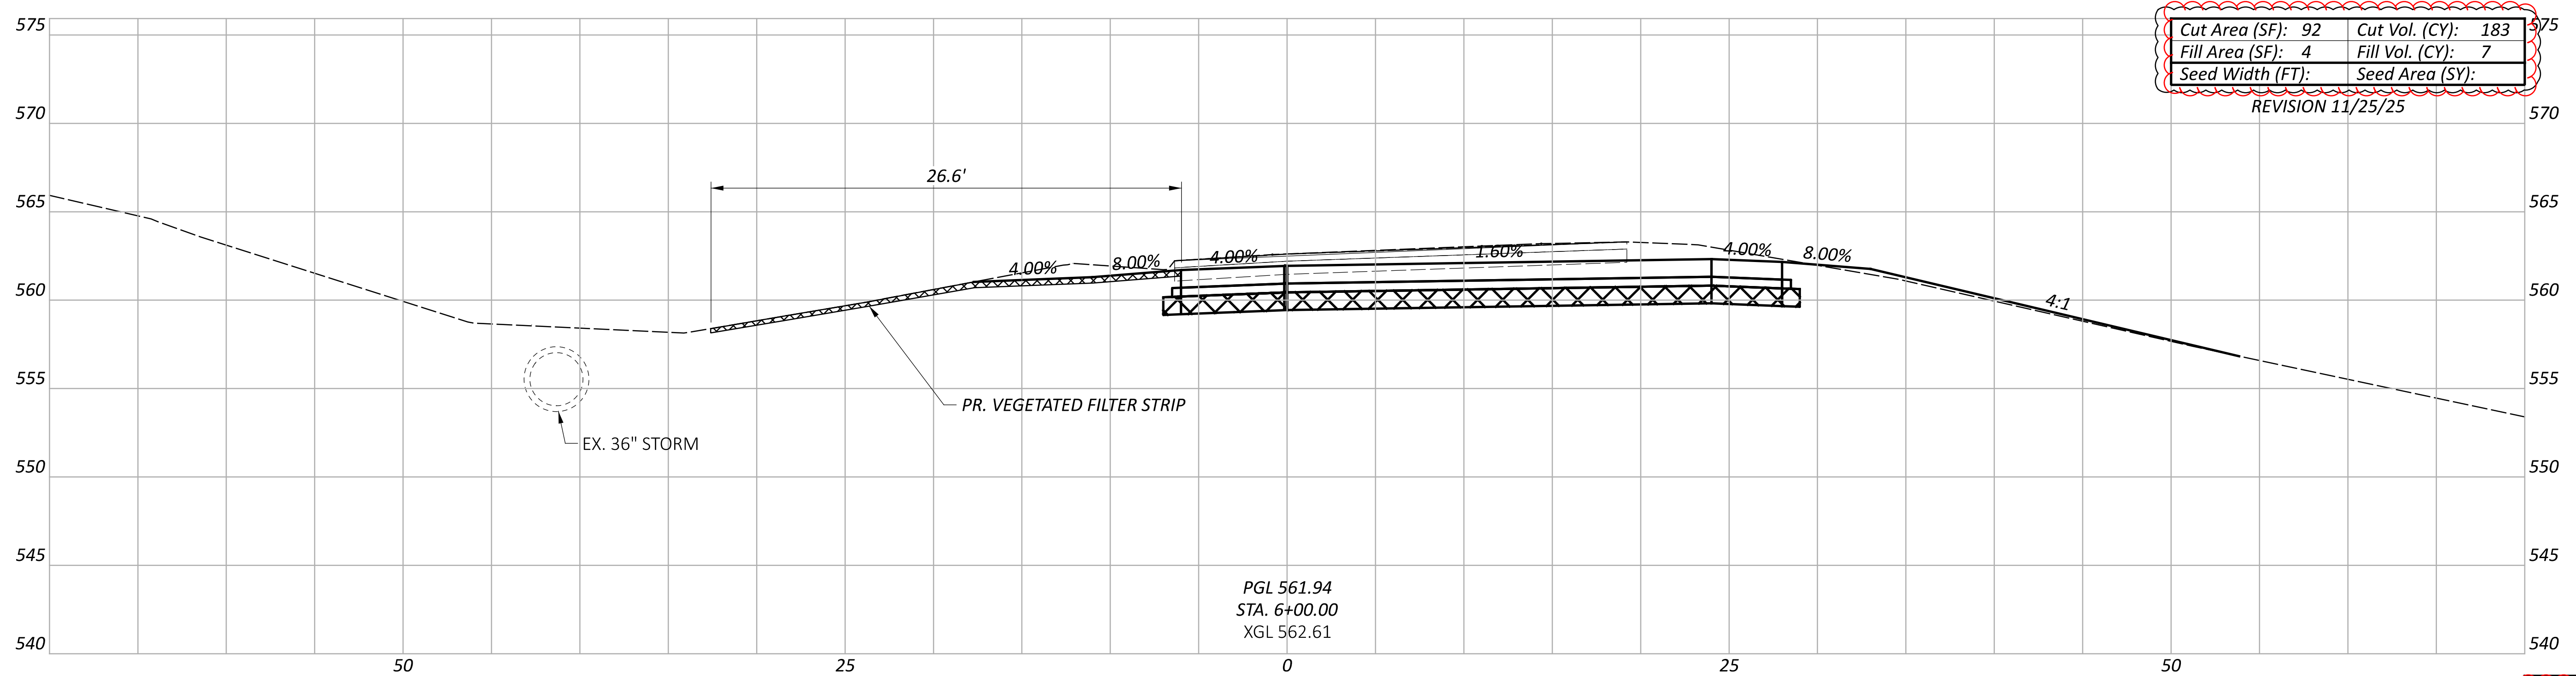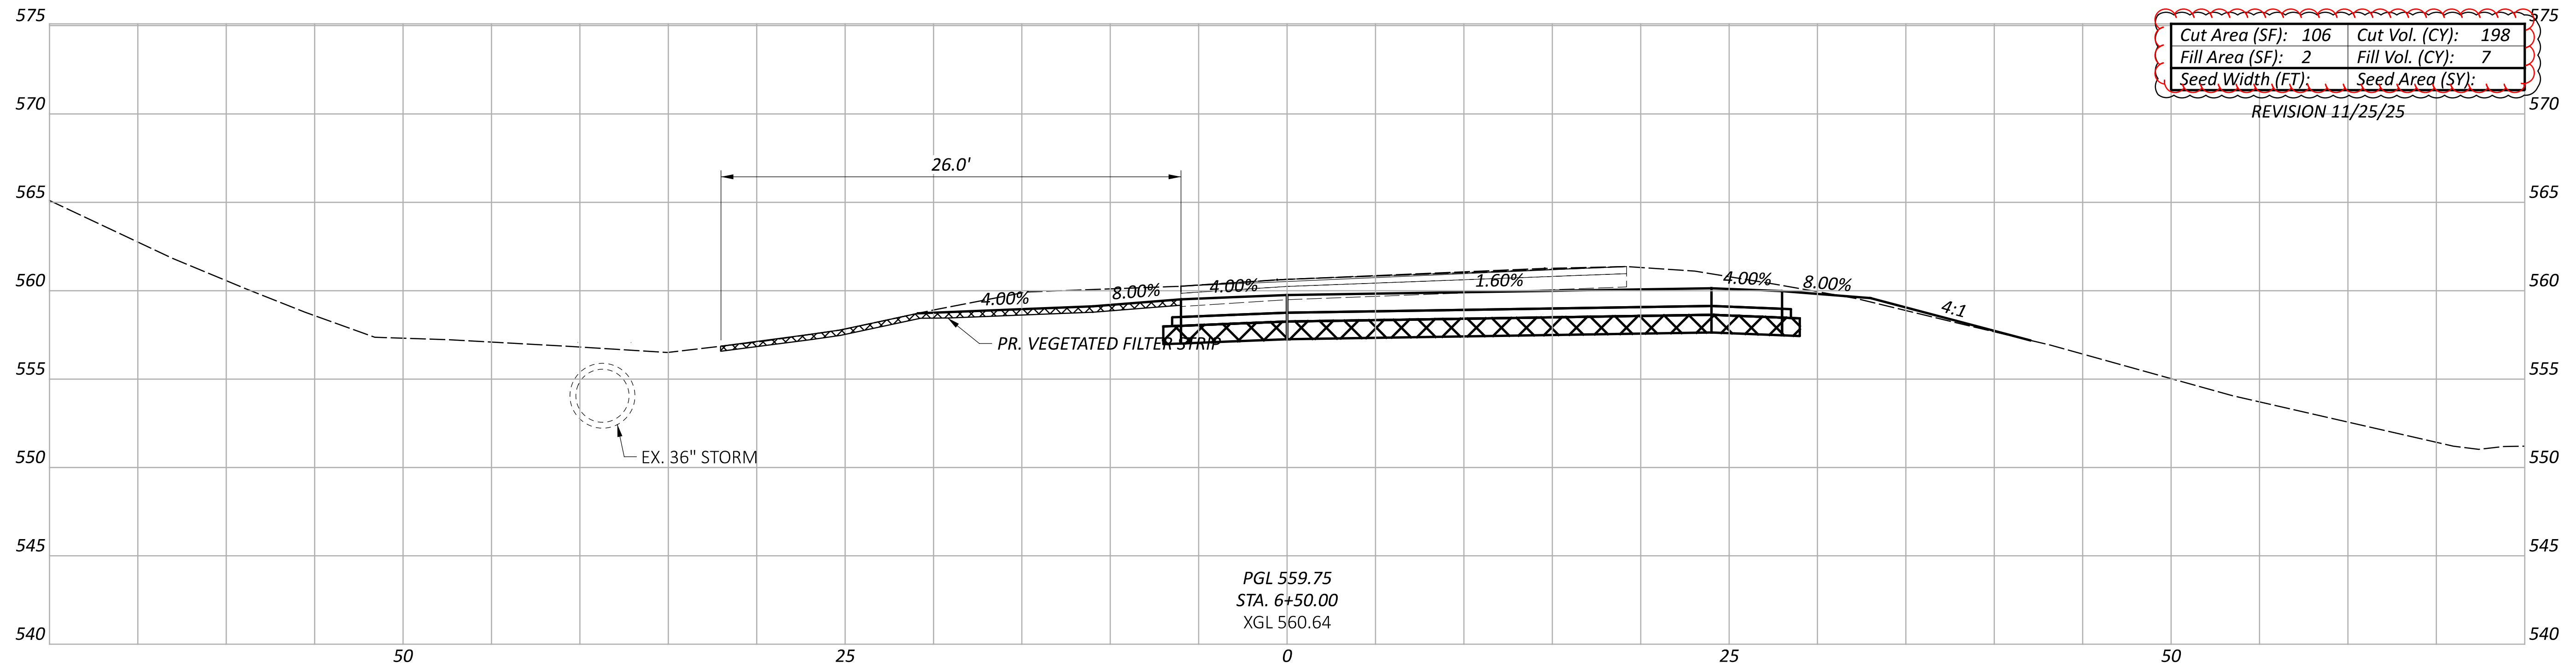

Sheet Totals			118472
Seeding	Cut	Fill	TOTAL
381	24	073	172



CROSS SECTIONS - RAMP "D"
 STA. 06+00.00 TO STA. 06+50.00

DESIGN AGENCY
TEL
 PLAN PREPARED BY:
 TEL Engineering, Inc.
 7288 Central Park Blvd.
 Mason, OH 45040

DESIGNER
 KLL


REVIEWER
 ERW 12/01/25

PROJECT ID
 118472

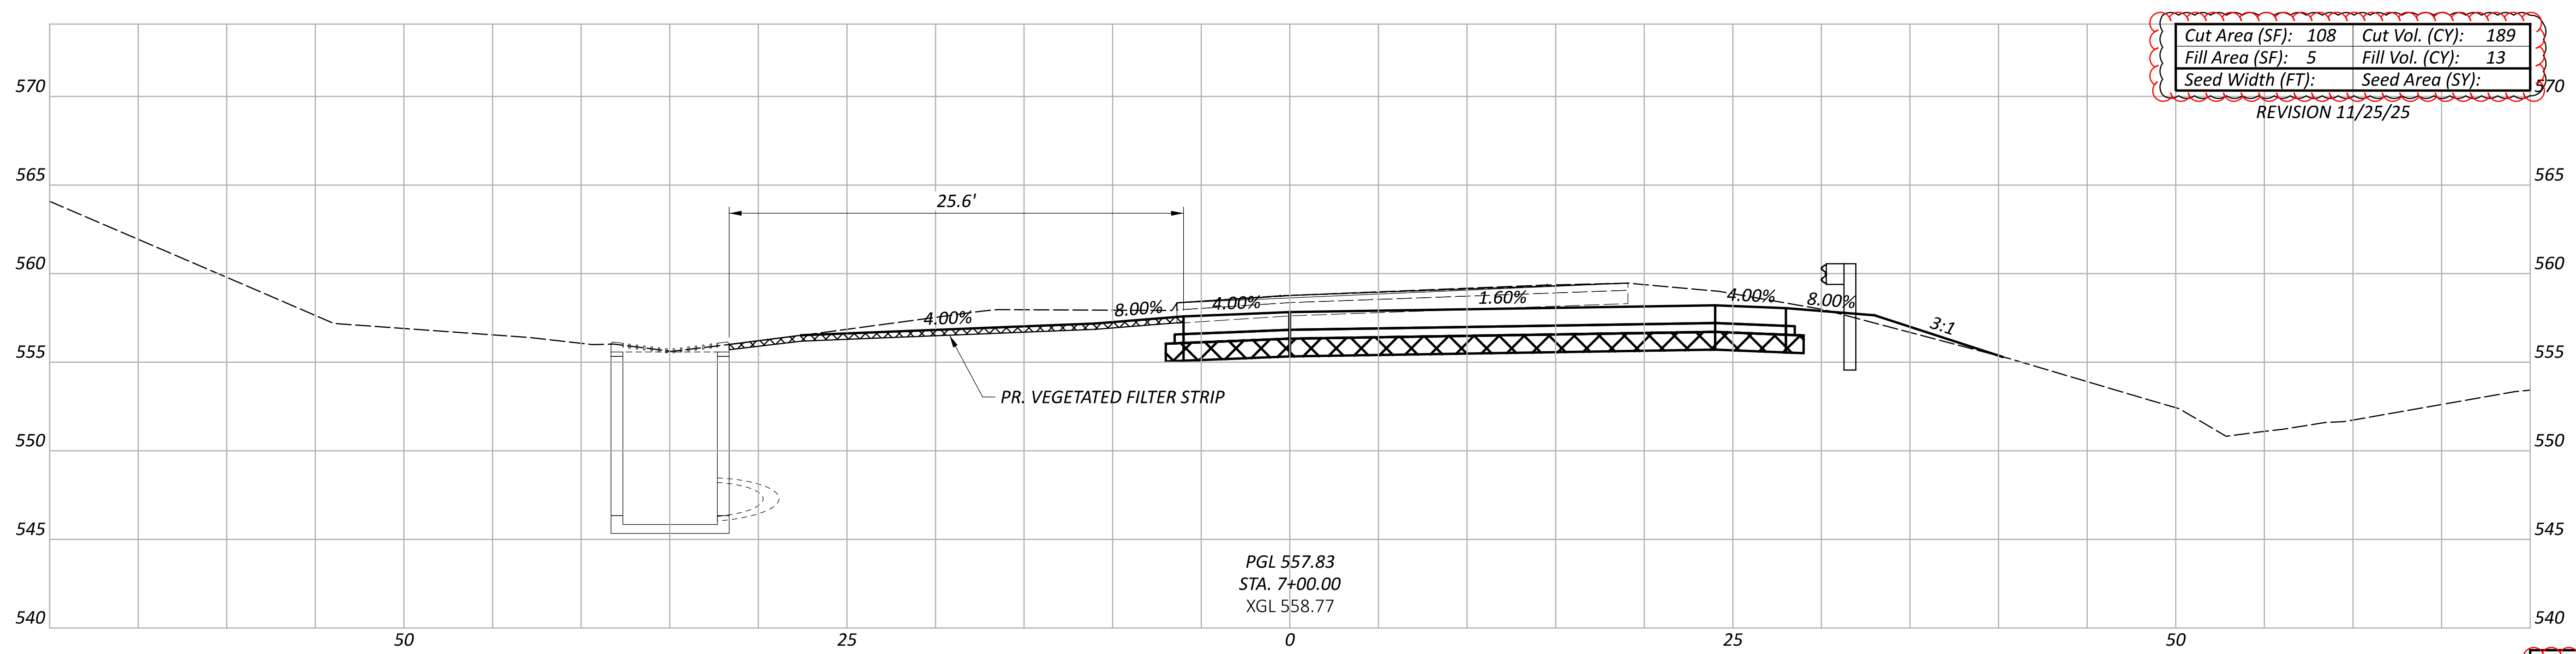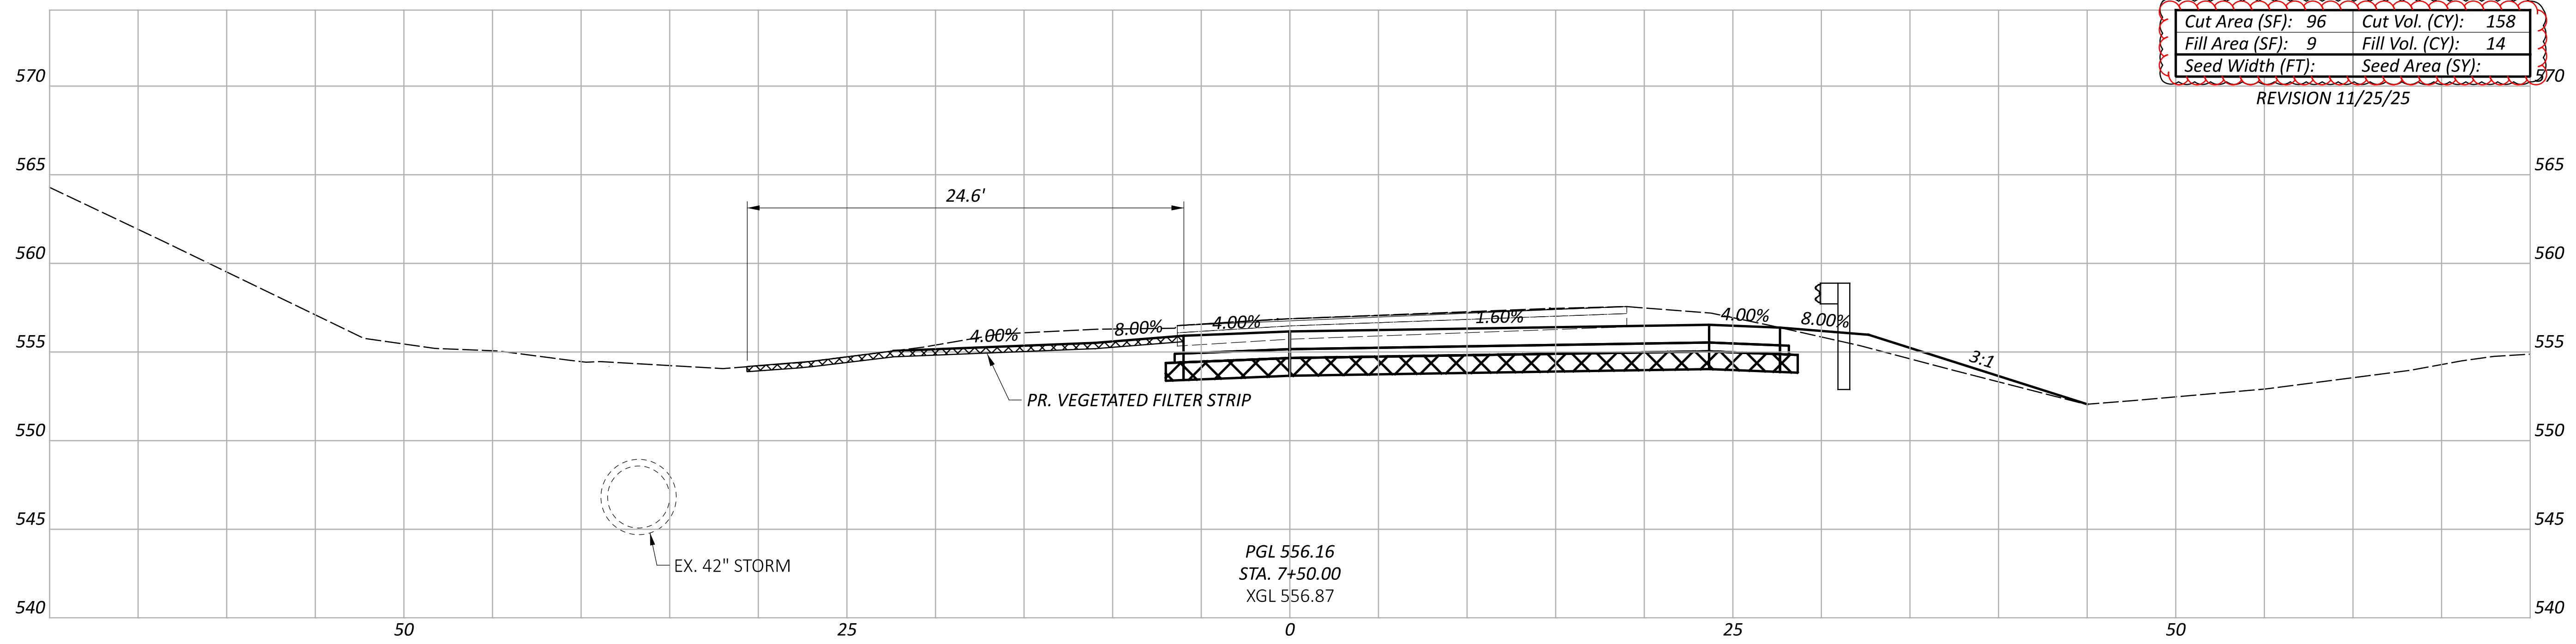

Sheet Totals			118472
Seeding	Cut	Fill	TOTAL
347	27	074	172



CROSS SECTIONS - RAMP "D"
STA. 07+00.00 TO STA. 07+50.00

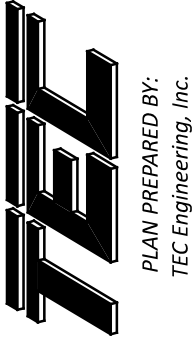DESIGN AGENCY

 PLAN PREPARED BY:
 TEC Engineering, Inc.
 7288 Central Park Blvd.
 Mason, OH 45040

DESIGNER
KLL

REVIEWER
ERW 12/01/25

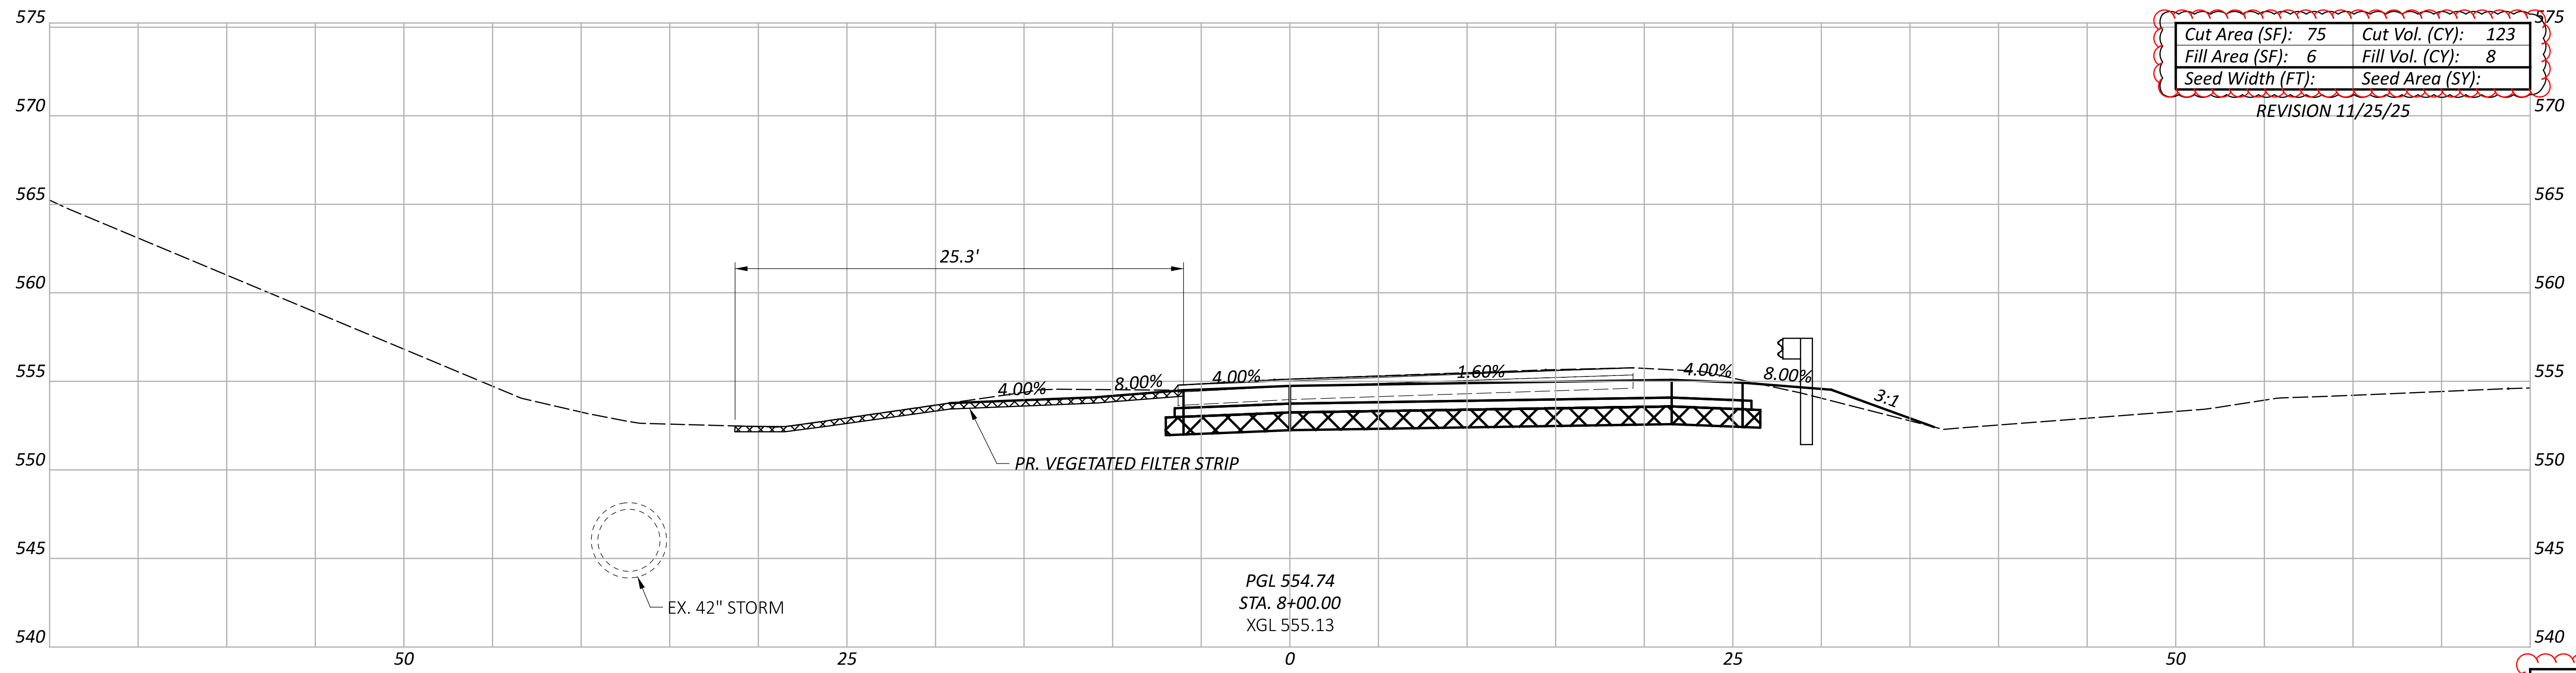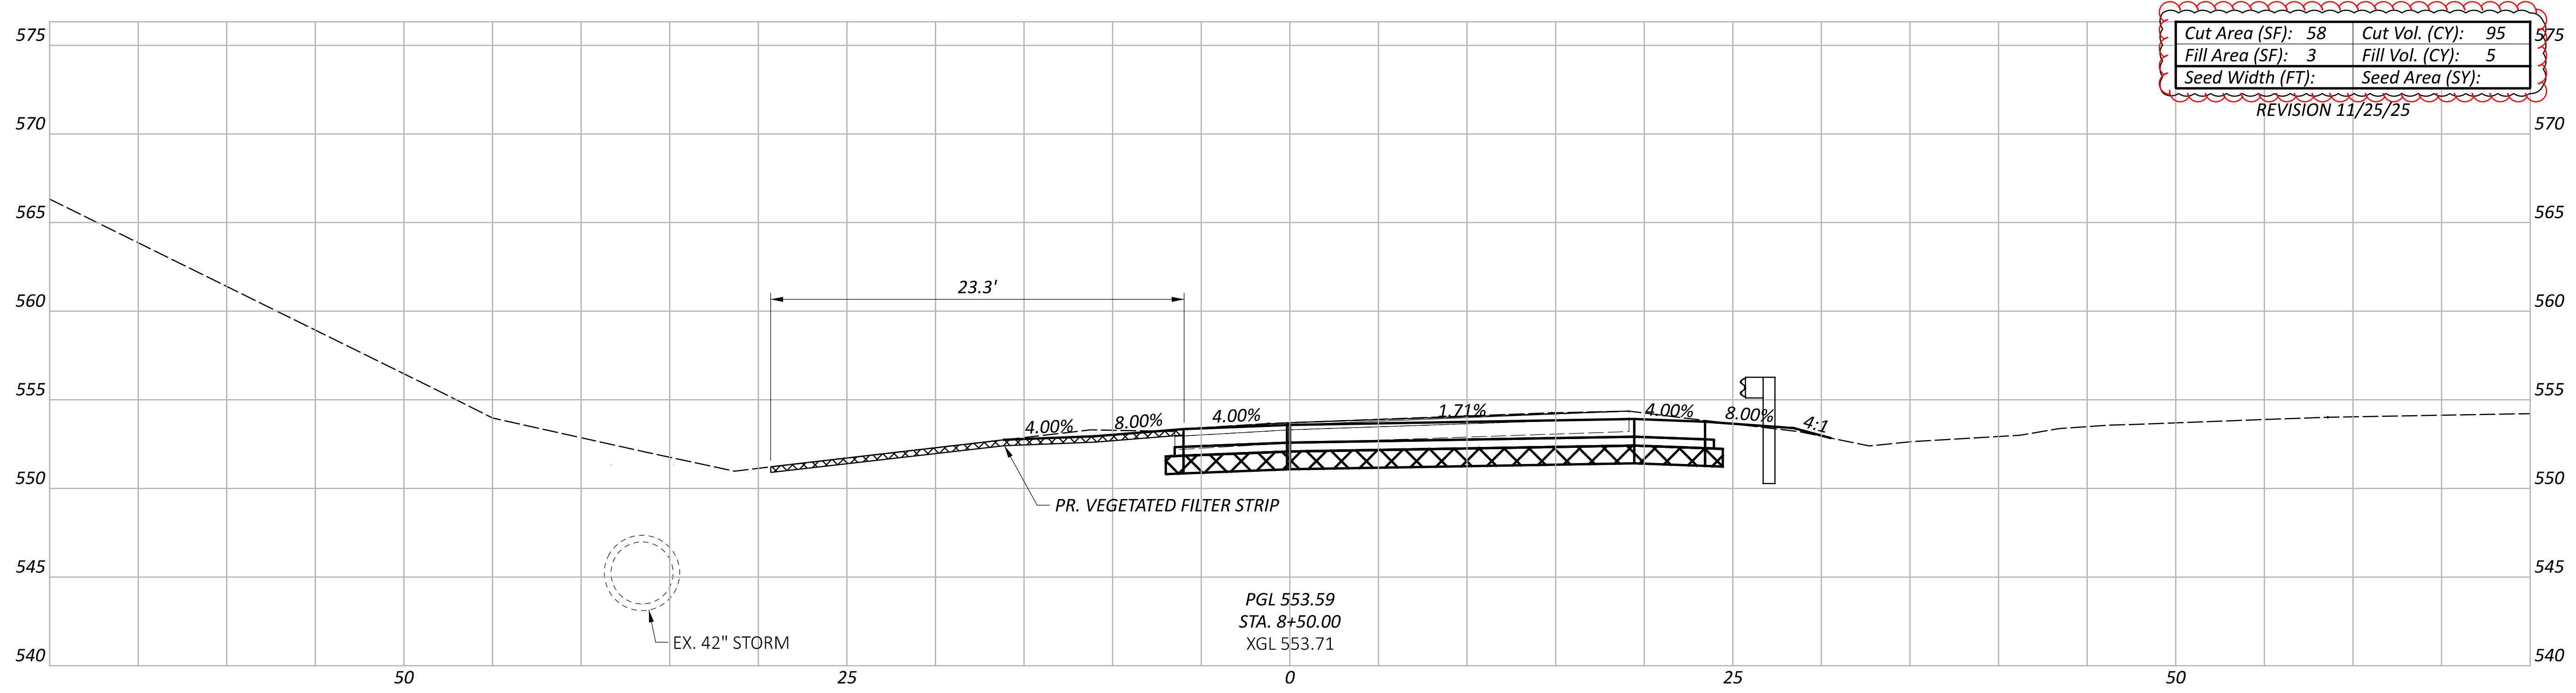PROJECT ID
118472



Sheet Totals			118472	
Seeding	Cut	Fill	SHEET	TOTAL
218	13		075	172



CROSS SECTIONS - RAMP "D"
 STA. 08+00.00 TO STA. 08+50.00

DESIGN AGENCY
TEC
 PLAN PREPARED BY:
 TEC Engineering, Inc.
 7288 Central Parke Blvd.
 Mason, OH 45040

DESIGNER
 KLL

REVIEWER
 ERW 12/01/25

PROJECT ID
 118472

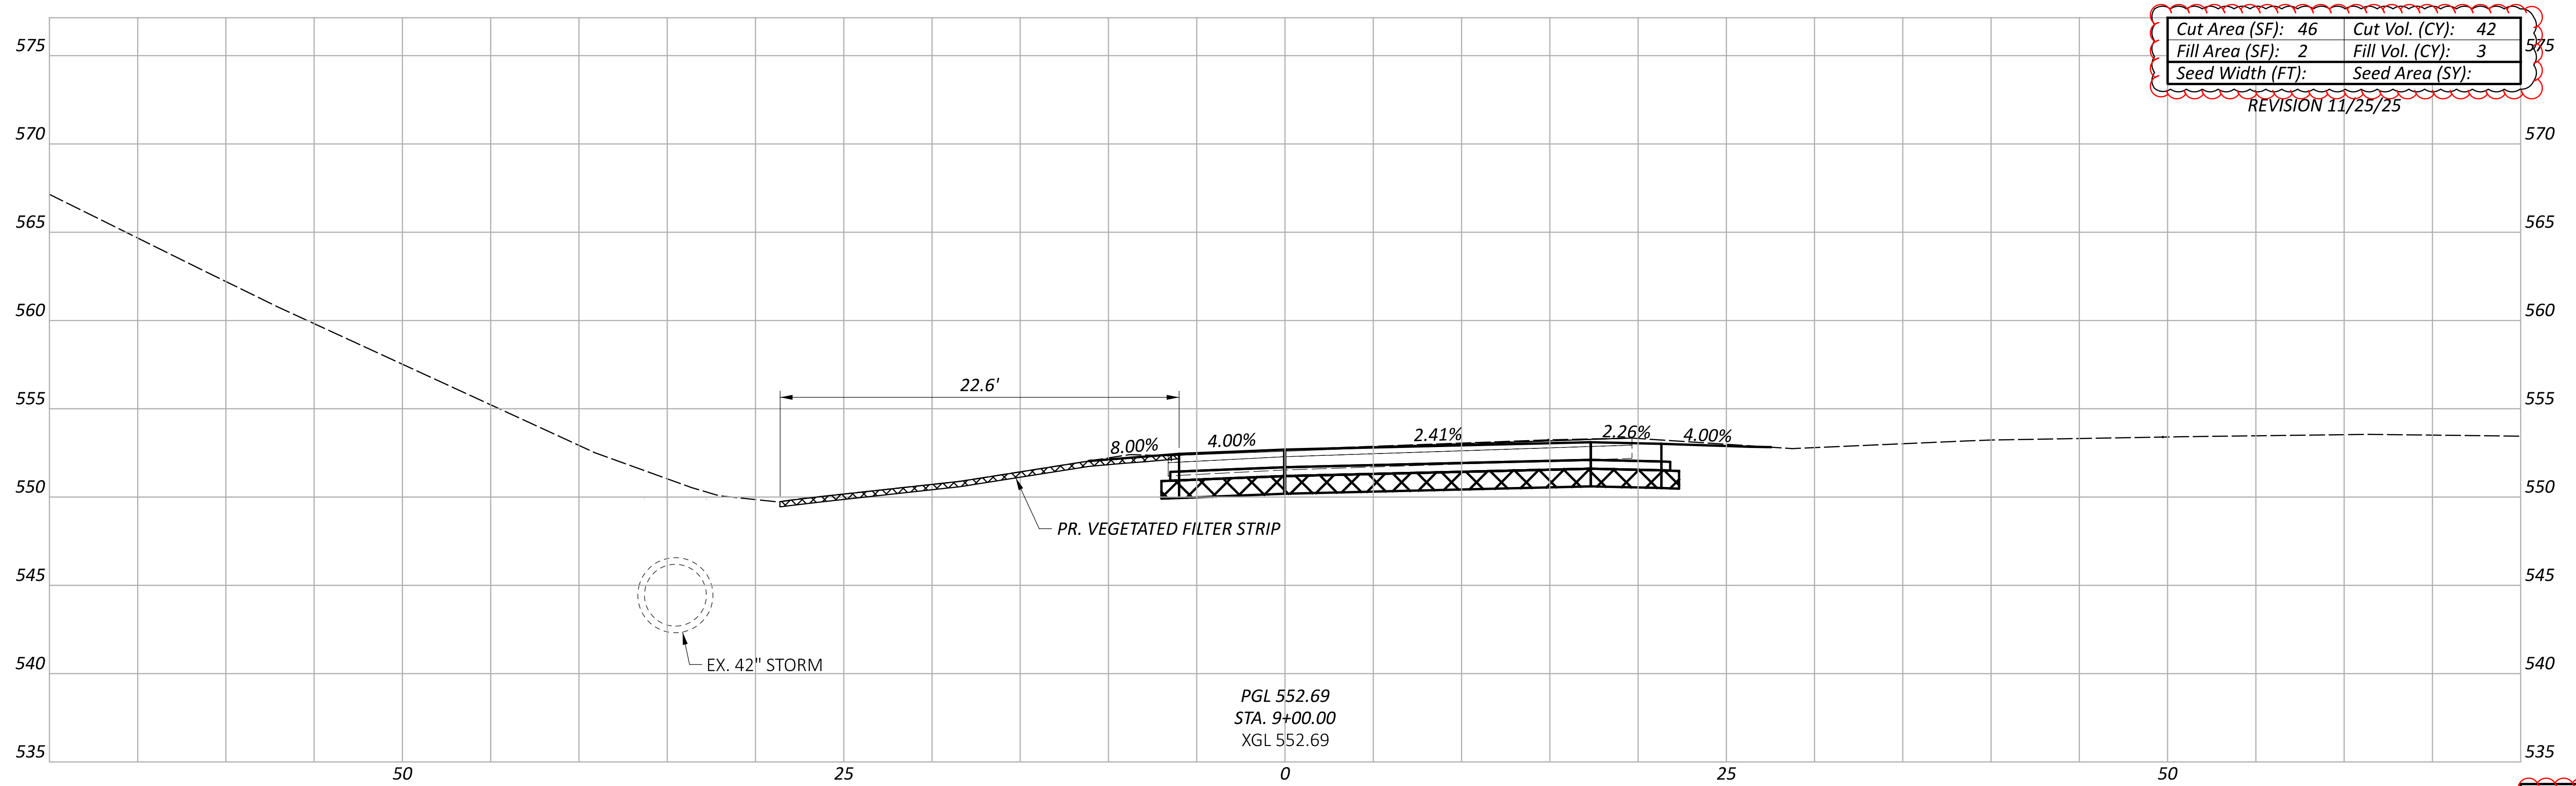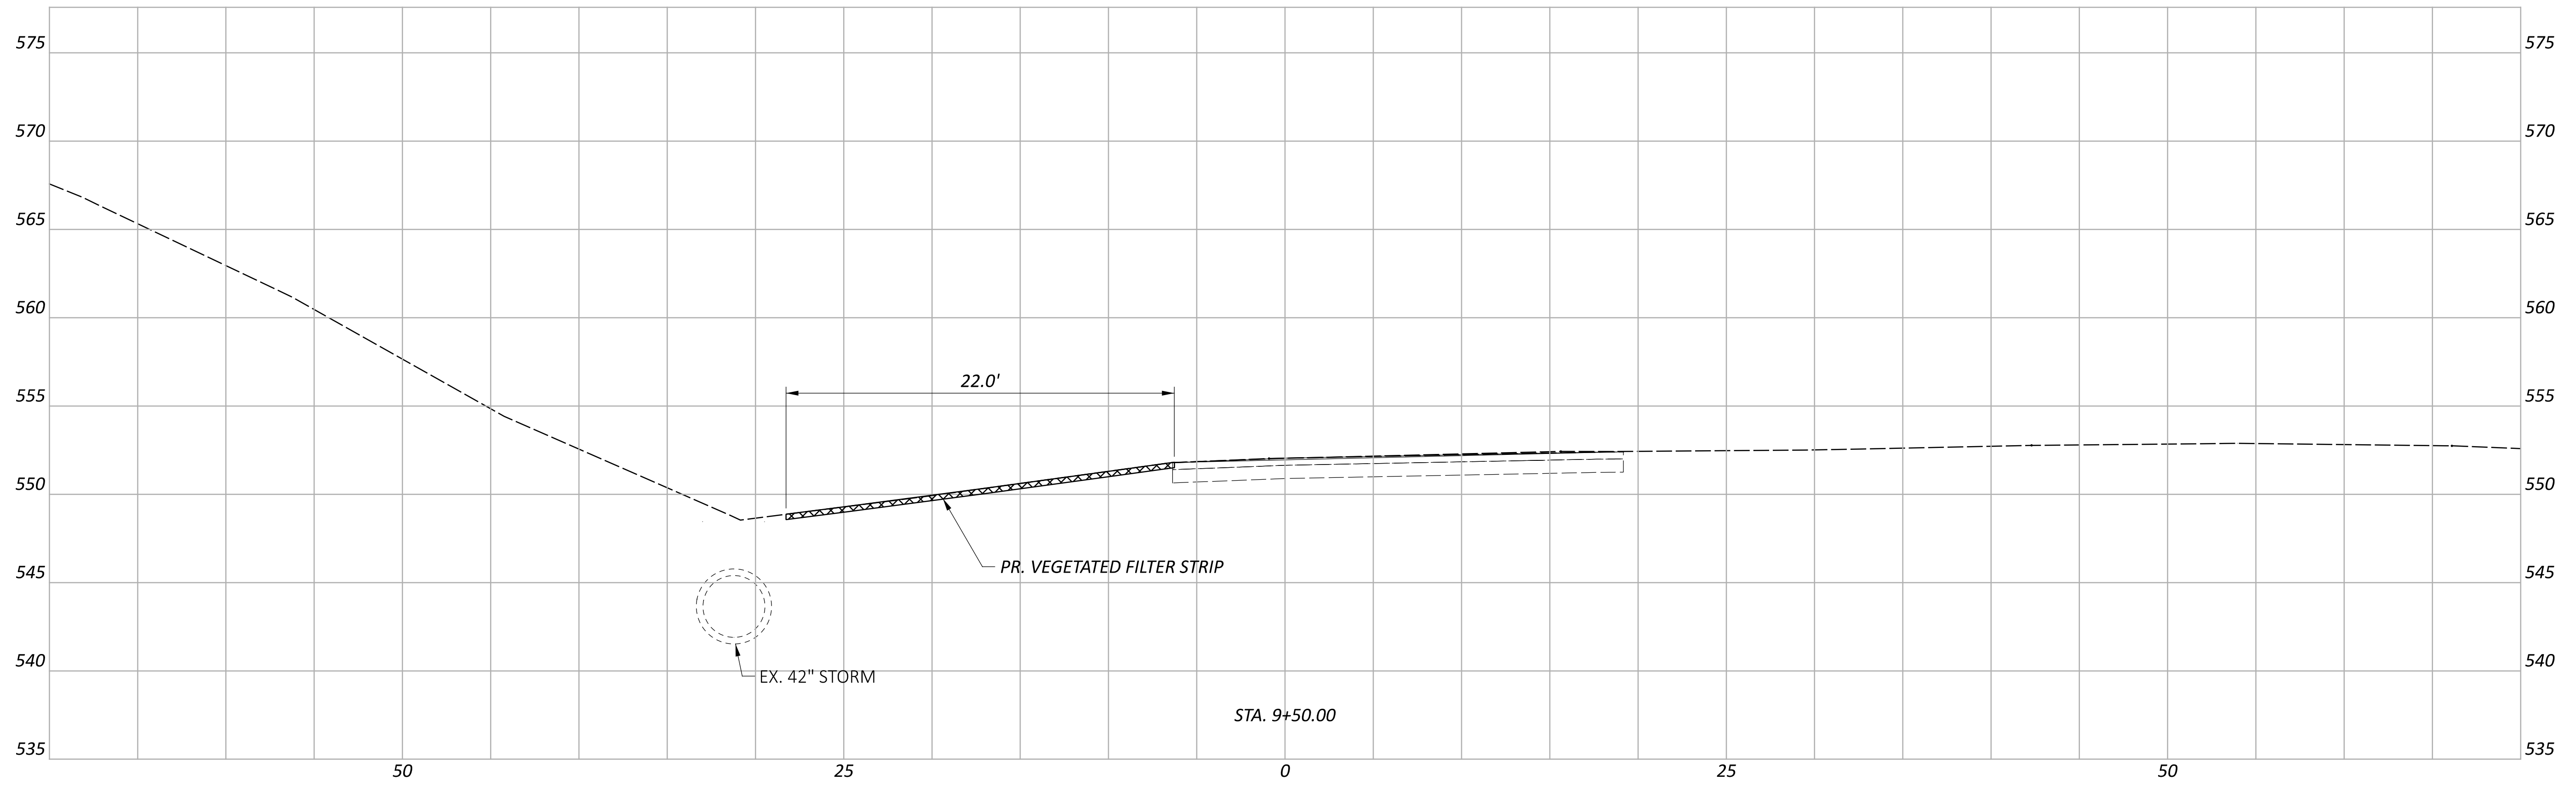

Cut Area (SF):	46	Cut Vol. (CY):	42
Fill Area (SF):	2	Fill Vol. (CY):	3
Seed Width (FT):		Seed Area (SY):	

REVISION 11/25/25

Sheet Totals			
Seeding	Cut	Fill	TOTAL
	42	3	076

DESIGN AGENCY
TEC
 PLAN PREPARED BY:
 TEC Engineering, Inc.
 7286 Central Parke Blvd.
 Mason, OH 45040

DESIGNER
 KLL

REVIEWER
 ERW 12/01/25

PROJECT ID
 118472

SHEET TOTAL
 076 172

CROSS SECTIONS - RAMP "D"
 STA. 09+00.00 TO STA. 09+50.00