


MODEL: Sheet PAPER/DATE: 3/4/22 (m) DATE: 2/24/2026 TIME: 10:28:47 AM PLTDRV: OHDOT_PDF.plt USER: khrville@eceng.com WORKSPACE: O:\DOTCEV02\WORKSET\23351-001\PRODUCT: OpenRoadsDesigner 24.00.00.205
 \10.1.14\projects\2023\Projects\23351\Delhi\Township\0011\HAM CR 196\23351-001\1400-Engineering\Roadway\Sheets\23351-001_GT001.dgn

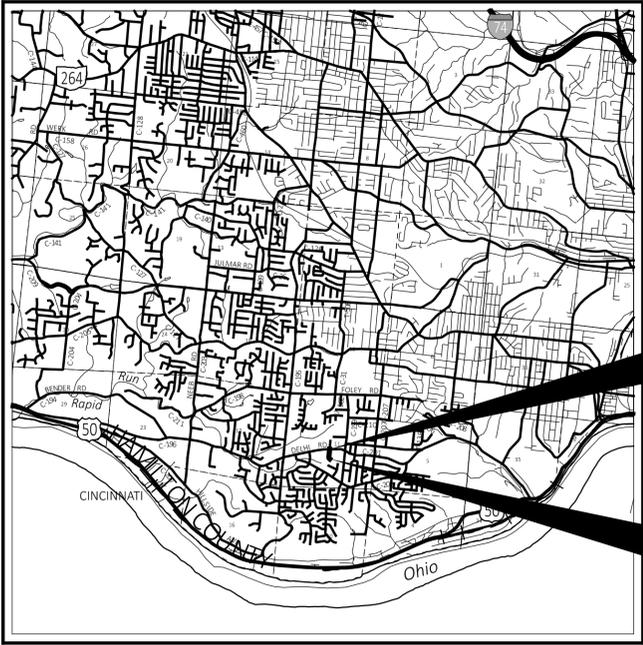

LOCATION MAP
 LATITUDE: 39°05'42" LONGITUDE: -84°36'32"

PORTION TO BE IMPROVED	-----
INTERSTATE HIGHWAY	=====
FEDERAL ROUTES	=====
STATE ROUTES	=====
COUNTY & TOWNSHIP ROADS	=====
OTHER ROADS	-----

DESIGN DESIGNATION	DELHI ROAD	KLEMME DRIVE
CURRENT ADT (2026)	15,520	76
DESIGN YEAR ADT (2046)	17,000	84
DESIGN HOURLY VOLUME (2046)	1,700	8
DIRECTIONAL DISTRIBUTION	0.51	0.50
TRUCKS (24 HOUR B&C)	1%	0.5%
DESIGN SPEED	35	25
LEGAL SPEED	35	25
DESIGN FUNCTIONAL CLASSIFICATION:	URBAN MINOR ARTERIAL	URBAN LOCAL
NHS PROJECT	NO	

DESIGN EXCEPTIONS

NONE

ADA DESIGN WAIVERS

REQUIRED

UNDERGROUND UTILITIES
 Contact Two Working Days Before You Dig

OHIO811.org
 Before You Dig

OHIO811, 8-1-1, or 1-800-362-2764
 (Non members must be called directly)

PLAN PREPARED BY:
 TEC ENGINEERING, INC.
 7288 CENTRAL PARKE BLVD,
 MASON, OH 54040

ENGINEER'S SEAL

STATE OF OHIO
 KELLIE L. LINVILLE
 E-80232
 REGISTERED PROFESSIONAL ENGINEER

**STATE OF OHIO
 DEPARTMENT OF TRANSPORTATION**

HAM-CR196-1.89

DELHI TOWNSHIP
 HAMILTON COUNTY

INDEX OF SHEETS:

TITLE SHEET	01
SCHEMATIC PLAN	02
TYPICAL SECTION	03
GENERAL NOTES	04-05
MAINTAINENCE OF TRAFFIC	06-08
GENERAL SUMMARY	09-11
SUBSUMMARY	12-14
PLAN AND PROFILE	15-16
CROSS SECTIONS	17-20
INTERSECTION DETAILS	21-24
DRIVEWAY DETAILS	25-26
STORM SEWER	27-28
WATER WORKS PLAN	29-30
TRAFFIC CONTROL SUBSUMMARY	31-32
TRAFFIC CONTROL PLAN	33-34
TRAFFIC SIGNAL NOTES	35-37
TRAFFIC SIGNAL PLAN (DELHI & TOWNE SQUARE)	38-42
TRAFFIC SIGNAL PLAN (DELHI & KLEMME)	43-47

FEDERAL PROJECT NUMBER

E250067

RAILROAD INVOLVEMENT

NONE

PROJECT DESCRIPTION

THIS PROJECT INCLUDES A WIDENED APPROACH OF KLEMME DR SOUTH OF DELHI PIKE AND TRAFFIC SIGNAL REBUILDS AT DELHI PIKE/KLEMME DR AND DELHI PIKE/DELHI TOWNE SQUARE.

EARTH DISTURBED AREAS

PROJECT EARTH DISTURBED AREA:	0.309 ACRES
ESTIMATED CONTRACTOR EARTH DISTURBED AREA:	0.125 ACRES
NOTICE OF INTENT EARTH DISTURBED AREA:	N/A

2023 SPECIFICATIONS

THE STANDARD SPECIFICATIONS OF THE STATE OF OHIO, DEPARTMENT OF TRANSPORTATION, INCLUDING SUPPLEMENTAL SPECIFICATIONS LISTED IN THE PLANS, CHANGES LISTED IN THE PROPOSAL, AND THE SUPPLEMENTAL SPECIFICATION 800 VERSION INDICATED ON THE PROPOSAL SHALL GOVERN THIS IMPROVEMENT.

CLOSED REVISIONS - 2/24/26
 -INVERT CHANGE FOR STORM CONDUIT, P-3
 -SIGNAL ITEM NUMBER CHANGE FOR PEDESTAL WITH TRANSFORMER BASE

DATES UPDATED

STANDARD CONSTRUCTION DRAWINGS						SUPPLEMENTAL SPECIFICATIONS		SPECIAL PROVISIONS	
BP-4.1	7/19/13	MT-95.31	7/18/25	TC-12.31	1/16/26	800	1/16/26		
BP-5.1	1/16/26	MT-97.10	7/18/25	TC-21.21	7/18/25	809	1/16/26		
BP-7.1	1/16/26	MT-101.90	7/17/20	TC-41.20	10/18/13	813	7/21/23		
		MT-105.10	1/17/20	TC-41.30	4/21/23	832	7/18/25		
CB-3A	1/16/26	MT-110.10	7/19/13	TC-41.40	1/16/26	870	7/18/25		
MH-3	7/19/24			TC-42.20	10/18/13	909	1/16/26		
DM-1.1	1/17/25	HL-10.11	1/16/26	TC-52.10	10/18/13	913	4/16/21		
DM-4.3	1/15/16	HL-10.12	1/16/26	TC-52.20	1/15/21				
DM-4.4	1/15/16	HL-30.11	1/16/26	TC-71.10	1/16/26				
		HL-40.10	1/16/26	TC-74.10	1/16/26				
		HL-60.11	7/21/17	TC-81.22	1/16/26				
				TC-83.10	1/16/26				
				TC-83.20	1/16/26				
				TC-85.10	1/16/26				
				TC-85.20	4/21/23				

I HEREBY APPROVE THESE PLANS AND DECLARE THAT THE MAKING OF THIS IMPROVEMENT WILL NOT REQUIRE THE CLOSING TO TRAFFIC OF THE HIGHWAY EXCEPT AS NOTED ON SHEET 06, AND THAT PROVISIONS FOR THE MAINTENANCE AND SAFETY OF TRAFFIC WILL BE AS SET FORTH ON THE PLANS AND ESTIMATES.

Douglas A. Gruver
 Douglas A. Gruver, P.E.
 District 08 Deputy Director

Pamela Boratyn
 Pamela Boratyn
 Director, Department of Transportation

TITLE SHEET

DESIGN AGENCY
TEC
 PLAN PREPARED BY:
 TEC ENGINEERING, INC.
 7288 CENTRAL PARKE BLVD.
 MASON, OH 45040


DESIGNER
 JMD

REVIEWER
 KLL 02/24/26

PROJECT ID
 119070

SHEET TOTAL
 01 47

- LEGEND**
- PR. FULL DEPTH ASPHALT PAVEMENT
 - PR. ASPHALT DRIVE
 - PR. WALK
 - ATG - ADJUST TO GRADE
 - TBR - TO BE REMOVED
 - RBO - REMOVAL BY OTHERS
 - DND - DO NOT DISTURB

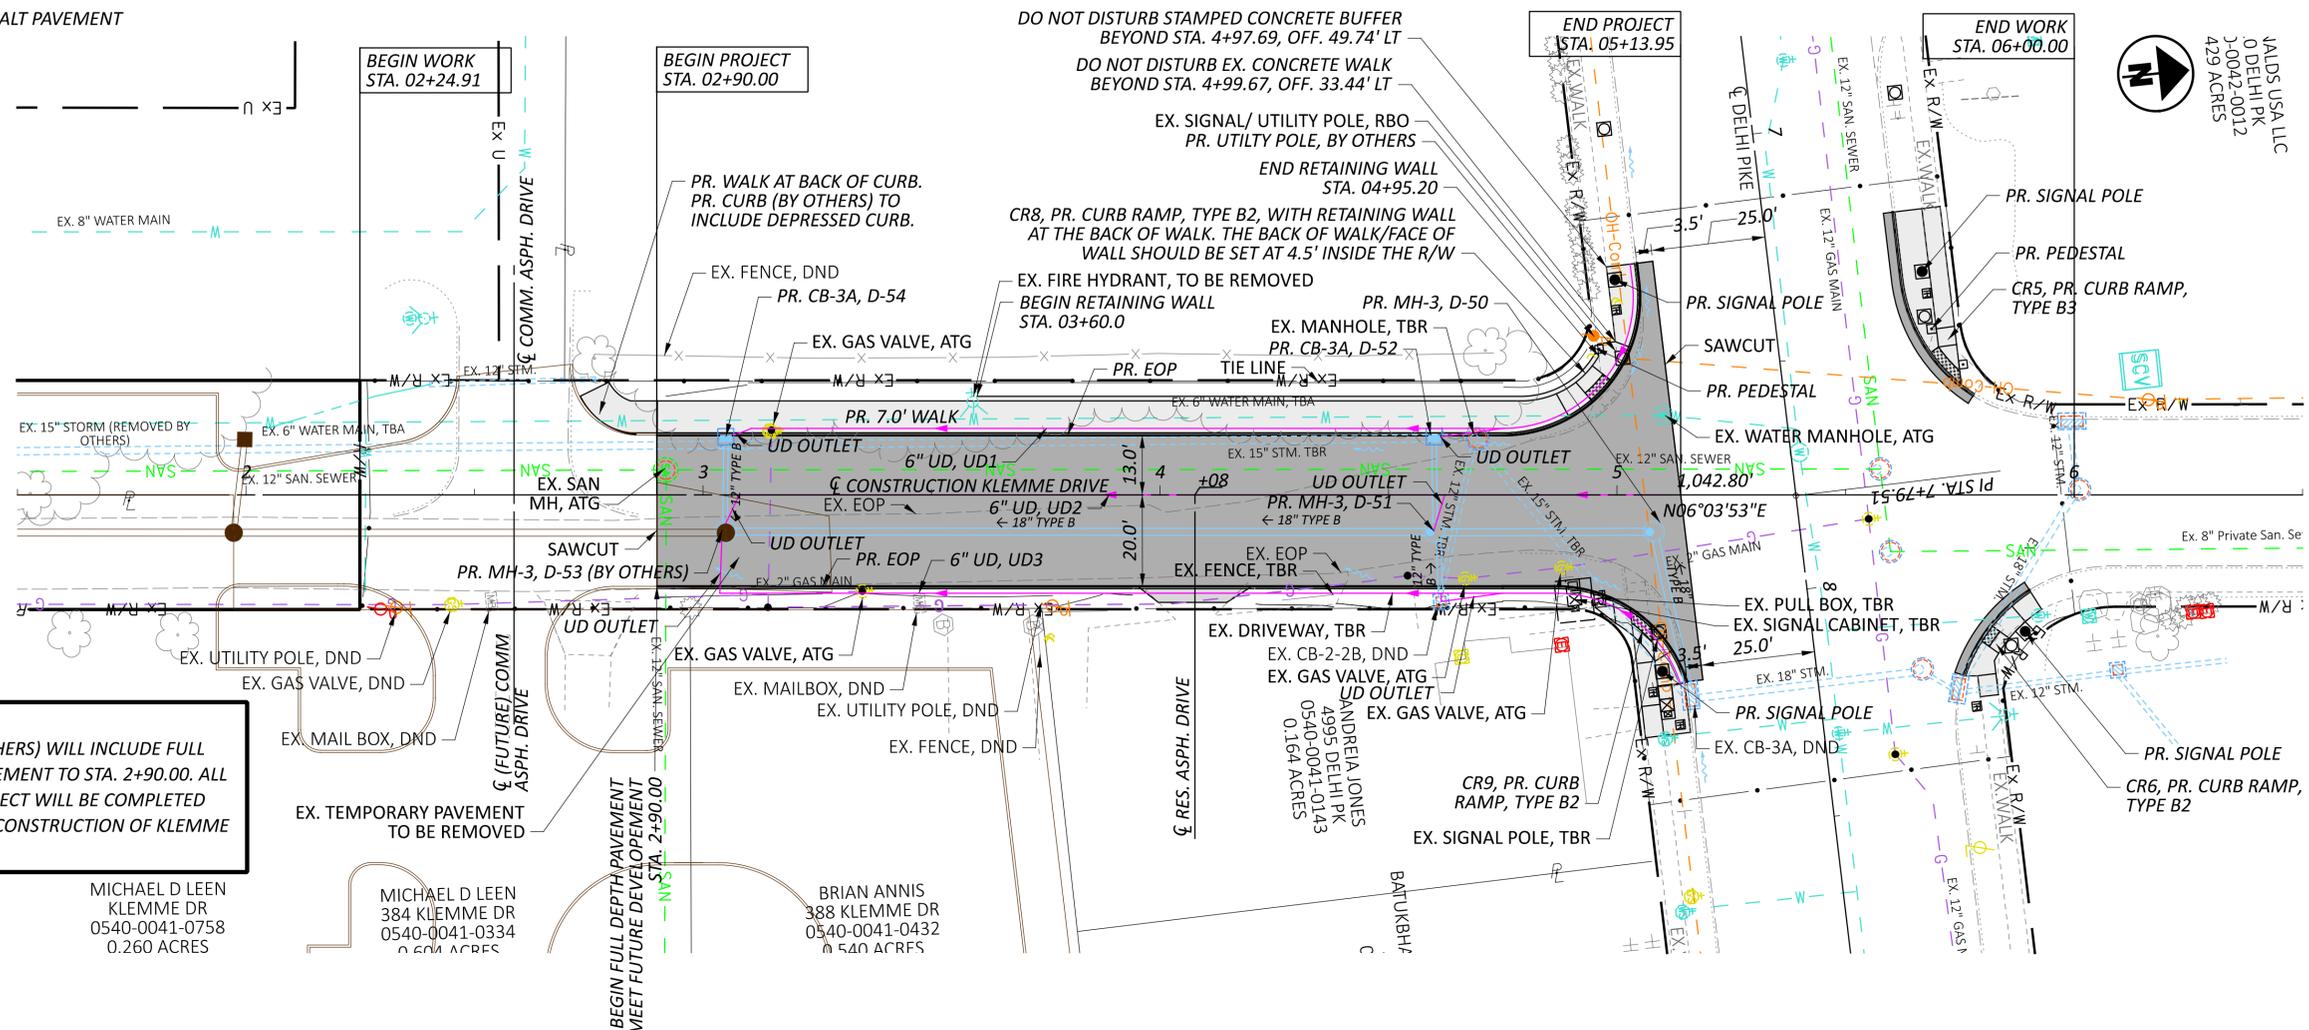

NOTE:
 FUTURE PROJECT (BY OTHERS) WILL INCLUDE FULL WIDTH/FULL DEPTH PAVEMENT TO STA. 2+90.00. ALL WORK FOR FUTURE PROJECT WILL BE COMPLETED PRIOR TO THE START OF CONSTRUCTION OF KLEMMER DRIVE.


MICHAEL D LEEN
 KLEMMER DR
 0540-0041-0758
 0.260 ACRES

MICHAEL D LEEN
 384 KLEMMER DR
 0540-0041-0334
 0.604 ACRES

BRIAN ANNIS
 388 KLEMMER DR
 0540-0041-0432
 0.540 ACRES

ANDREA IONES
 4995 DELHI PK
 0540-0041-0143
 0.164 ACRES


JALDS USA LLC
 0 DELHI PK
 0042-0012
 429 ACRES

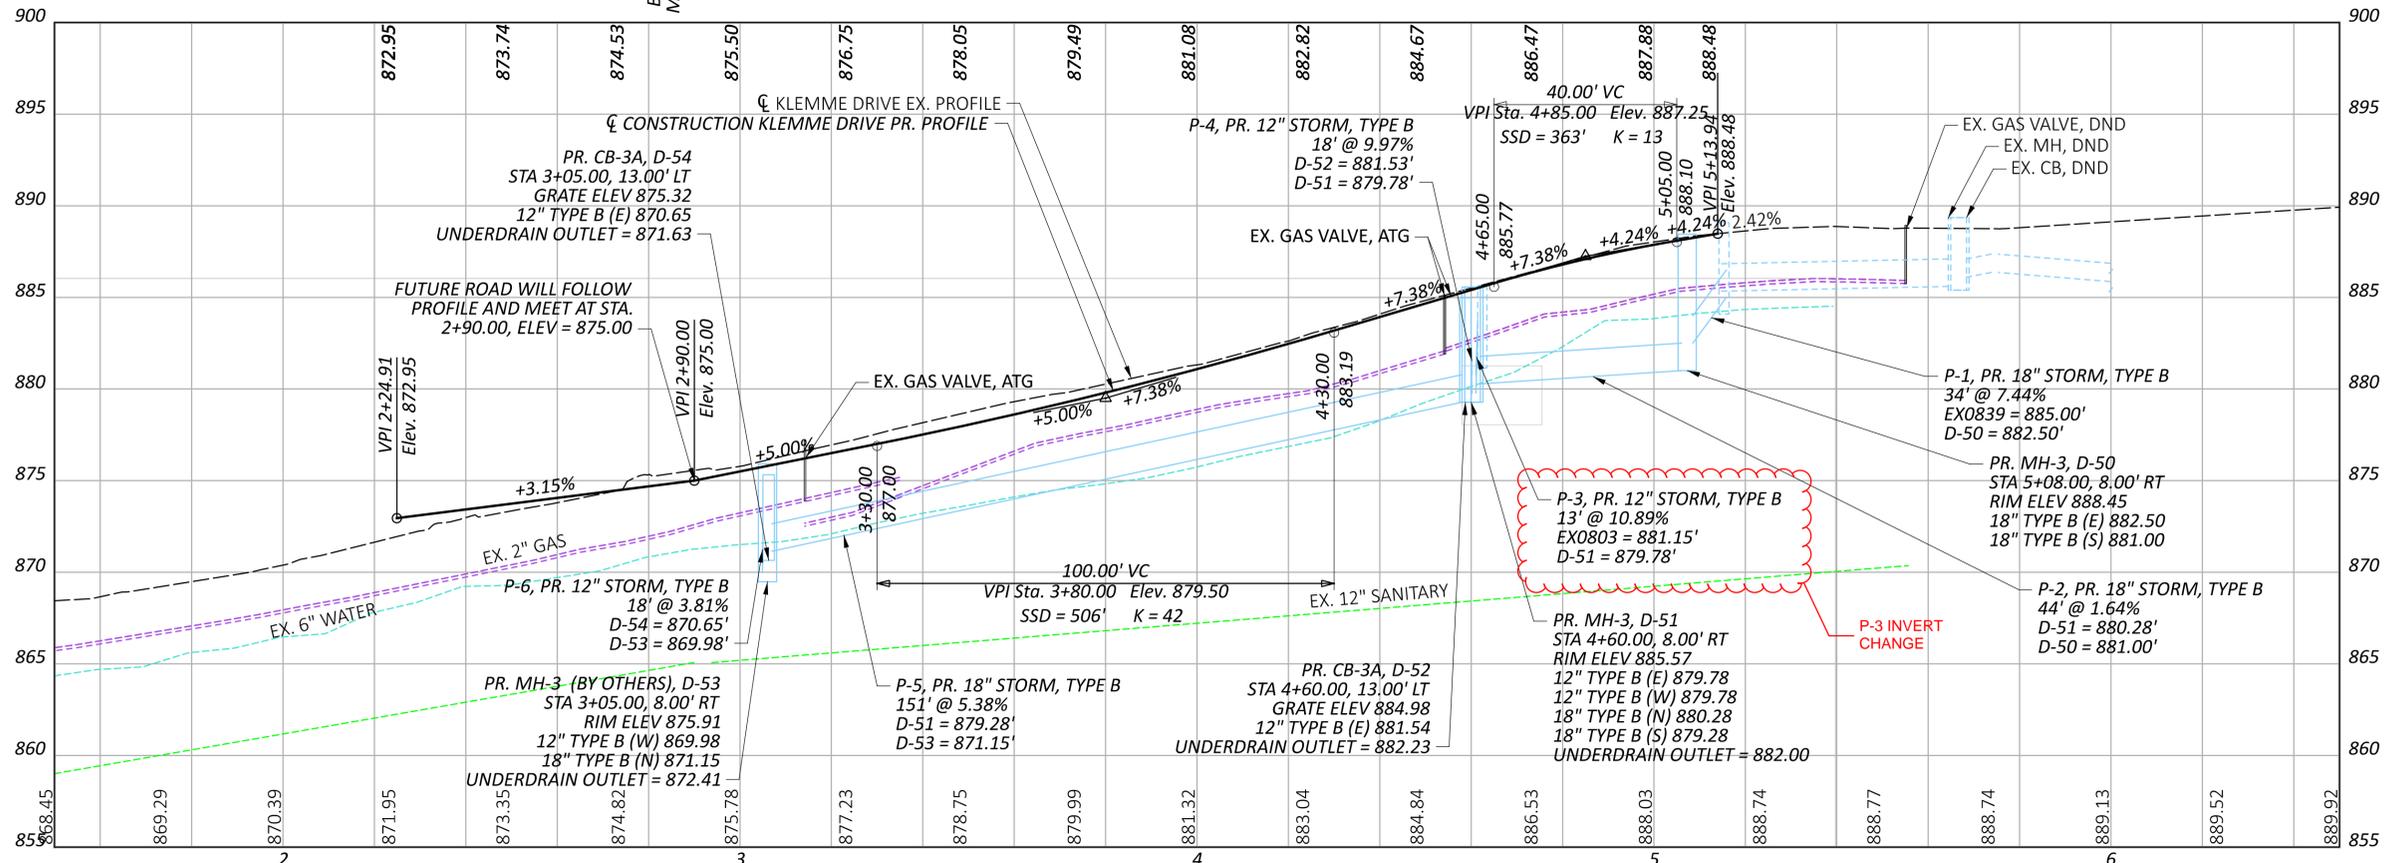

**PLAN AND PROFILE
 KLEMMER DRIVE**



DESIGN AGENCY	
TEL	
DESIGNER	
JMD	
REVIEWER	
KLL 02/24/26	
PROJECT ID	
119070	
SHEET	TOTAL
16	47

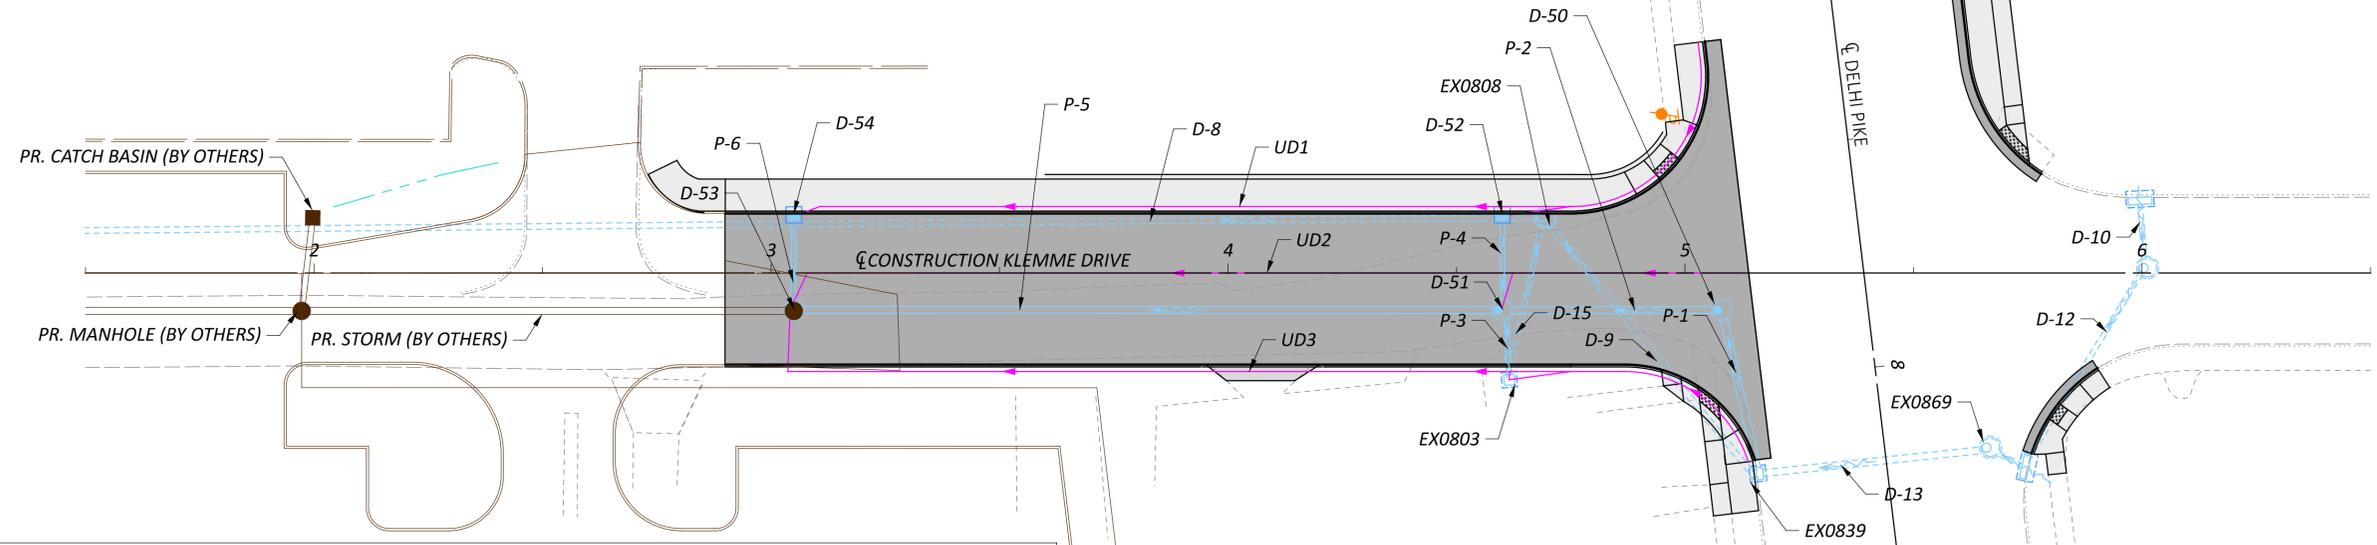

DRAINAGE CONDUIT DETAILS


REFERENCE	LENGTH (FT)	SIZE (IN)	TYPE	SLOPE	START STRUCTURE REFERENCE	START INVERT ELEV.	STOP STRUCTURE REFERENCE	STOP INVERT ELEV.	EXISTING DISPOSITION
D-13	50	18	EX.	0.52	EX0869	885.60	EX0839	885.34	EX. DO NOT DISTURB
P-1	34	18	TYPE B	7.44	EX0839	885.00	D-50	882.50	
P-2	44	18	TYPE B	1.64	D-50	881.00	D-51	880.28	
P-3	13	12	TYPE B	10.89	EX0803	881.15	D-51	879.78	
P-4	18	12	TYPE B	9.97	D-52	881.53	D-51	879.78	
P-5	151	18	TYPE B	5.38	D-51	879.28	D-53	871.15	
P-6	18	12	TYPE B	3.81	D-54	870.65	D-53	869.98	
D-9	70	15	EX.	7.27	EX0839	884.09	EX0808	878.98	TO BE REMOVED
D-15	33	12	EX.	6.48	EX0803	881.15	EX0808	878.98	TO BE REMOVED
D-8	188	15	EX.	4.39	EX0808	878.98	D-17	859.76	TO BE REMOVED

DRAINAGE STRUCTURE DETAILS

REFERENCE	REFERENCE ALIGNMENT	STATION	OFFSET	SIDE	TYPE	GRATE/RIM ELEV.	INVERT ELEV.	CONNECTED PIPES	EXISTING DISPOSITION
EX0869	CONSTRUCTION KLEMME DR	5+66.83	38.04	RT	EX. MH	889.35	885.60	(OUT) D-13 EX. 18" S 885.60	
EX0839	CONSTRUCTION KLEMME DR	5+15.65	43.84	RT	EX. CB-3A	889.09	885.00	(IN) D-13 EX. 18" N 885.34, (OUT) P-1 18" SW 885.00	REMOVE EX. PIPE TO THE SOUTHEAST
D-50	CONSTRUCTION KLEMME DR	5+08.00	8.00	RT	MH-3	888.45	881.00	(IN) P-1 18" NE 882.50, (OUT) P-2 18" S 881.00	
EX0803	CONSTRUCTION KLEMME DR	4+61.53	23.30	RT	EX. CB2-2B	885.64	882.80	(OUT) P-3 12" W 881.15, 6" UD3 882.90	REMOVE EX. CONNECTING PIPE
D-51	CONSTRUCTION KLEMME DR	4+60.00	8.00	LT	MH-3	885.57	879.28	(IN) P-2 18" N 880.28, (IN) P-3 12" E 879.78, (IN) P-4 12" W 879.78, (OUT) P-5 18" S 879.28, 6" UD2 882.00	
D-52	CONSTRUCTION KLEMME DR	4+60.00	13.00	LT	CB-3A	884.98	881.54	(OUT) P-4 12" E 881.54, 6" UD1 882.23	
D-54	CONSTRUCTION KLEMME DR	3+05.00	13.00	LT	CB-3A	875.32	870.65	(OUT) P-6 12" E 870.65, 6" UD1 871.63	
D-53-BYOTHER	CONSTRUCTION KLEMME DR	3+05	8.00	RT	MH-3	875.91	869.48	(IN) P-5 18" N 871.15, (IN) P-6 12" W 869.98, 6" UD2 AND UD3 872.42	TO BE CONSTRUCTED BY OTHERS
EX0808	CONSTRUCTION KLEMME DR	4+70.14	12.20	LT	EX. MH	889.09	878.98		TO BE REMOVED

P-3 PIPE INVERT CHANGE




P-3 PIPE INVERT CHANGE

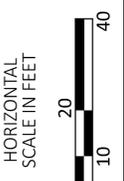

STORM SEWER SCHEMATIC PLAN



DESIGNER	JMD
REVIEWER	KLL
DATE	02/24/26
PROJECT ID	119070
SHEET	27
TOTAL	47

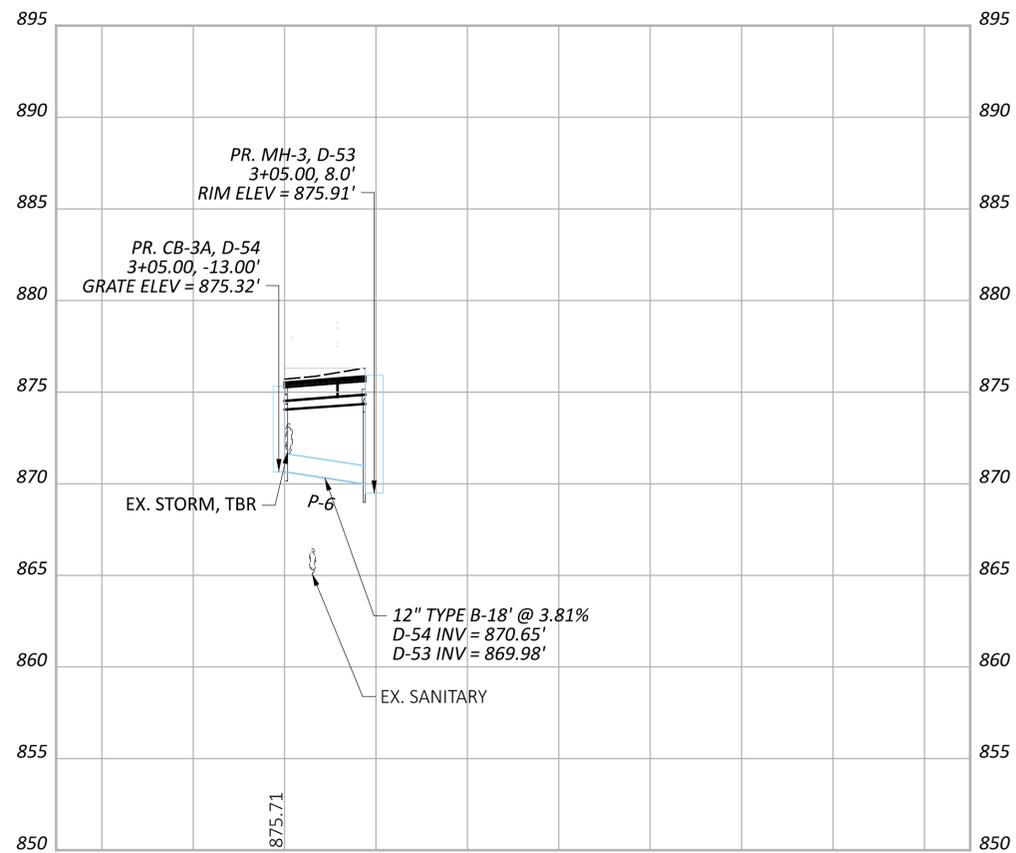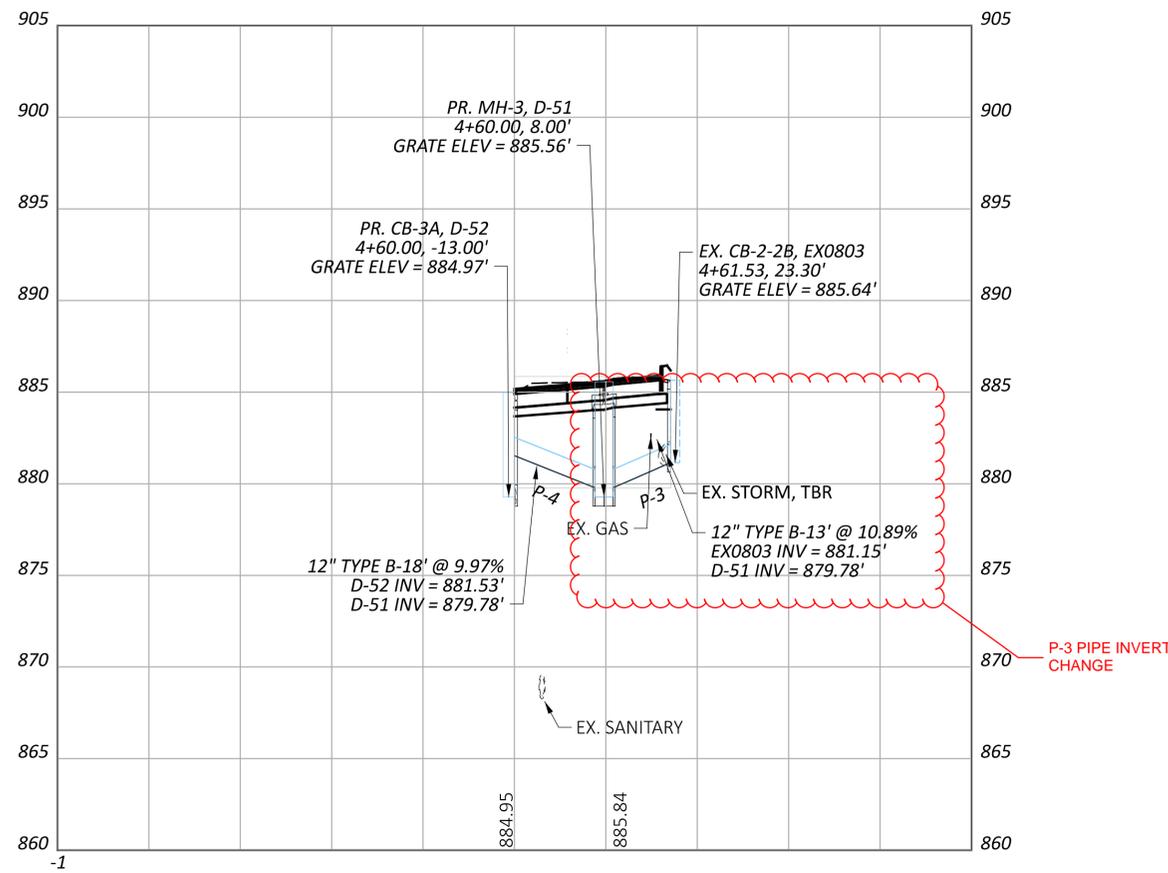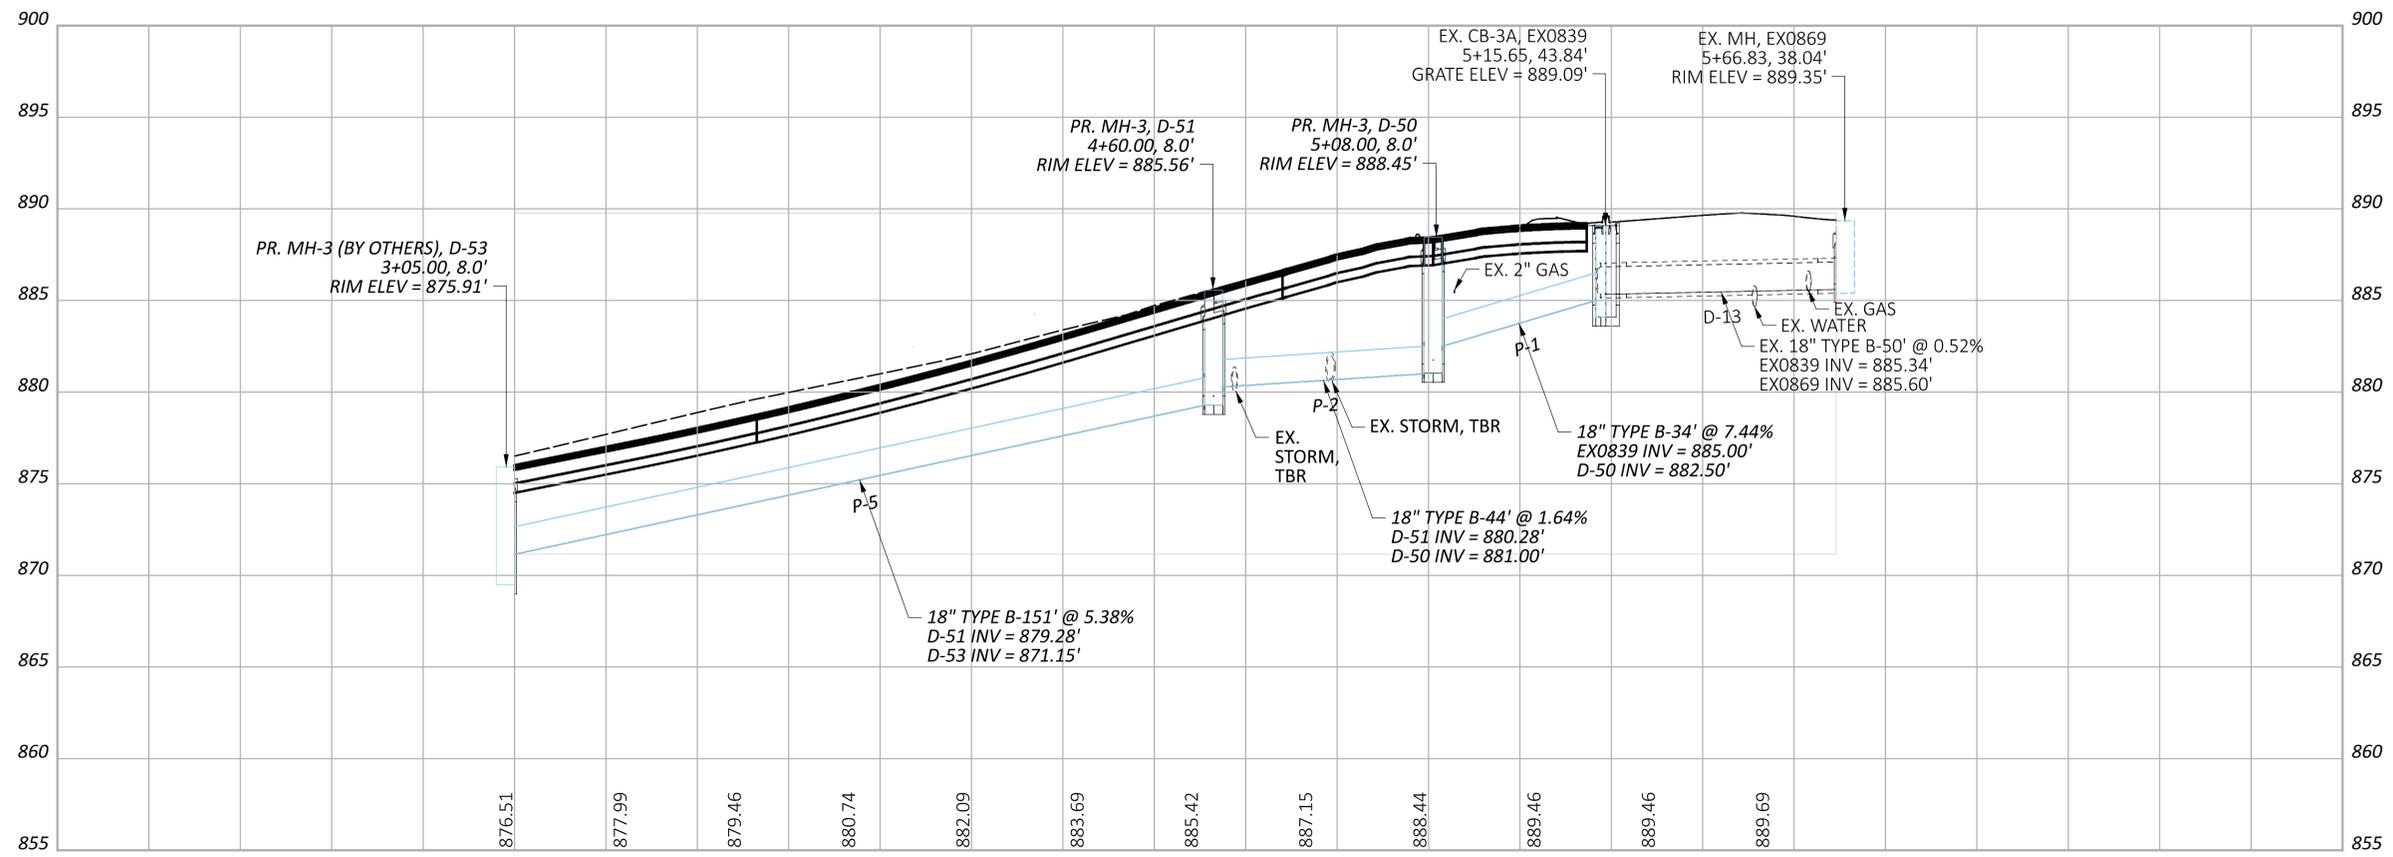

STORM SEWER
PROFILES

DESIGN AGENCY



DESIGNER
JMD

REVIEWER
KLL 02/24/26

PROJECT ID
119070

SHEET TOTAL
28 47

625, BRACKET ARM, BY LENGTH, AS PER PLAN

IN ADDITION TO THE PROVISIONS OF THE ODOT C&MS, THE BRACKET ARM SHALL BE POWDER COAT SEMI-GLOSS BLACK IN ACCORDANCE WITH SUPPLEMENTAL SPECIFICATION 916.

ARMS SHALL BE ODOT STYLE HIGH RISE, TRUSS ARM PER HL-10.11 AND SHALL PROVIDE A FINAL LUMINAIRE MOUNTING HEIGHT OF 36.5'.

PAYMENT FOR ITEM 625 "BRACKET ARM, BY LENGTH, AS PER PLAN" SHALL BE MADE AT THE CONTRACT UNIT PRICE PER EACH COMPLETE AND IN PLACE AND SHALL INCLUDE ALL LABOR, MATERIALS, AND EQUIPMENT NECESSARY TO COMPLETE THE WORK.

ITEM 625 - LUMINAIRE, CONVENTIONAL, SOLID STATE (LED), AS PER PLAN PLAN, 120V, 16000-21000 LUMENS

IN ADDITION TO THE REQUIREMENTS OF THE ODOT C&MS, CONVENTIONAL LUMINAIRES WITH TYPE II DISTRIBUTION INSTALLED ON THIS PROJECT SHALL BE AS FOLLOWS:

LUMINAIRES FOR CONVENTIONAL LIGHTING UNITS SHALL BE ONE OF THE FOLLOWING:

1. EVOLVE ERL2 AS MANUFACTURED BY CURRENT LIGHTING SOLUTIONS, LLC (CATALOG #: ERL2-0-21-C5-30-GRAY)
2. AUTOBAHN ATBM AS MANUFACTURED BY AMERICAN ELECTRIC LIGHTING (CATALOG #: ATBM-P40-MVOLT-R3-3K)
3. ROADFOCUS PLUS (RPM) AS MANUFACTURED BY LUMEC/SIGNIFY (CATALOG #: RPM-110W80LED-730-G1-R2M-UNV-GY3)
4. OR APPROVED EQUAL

LUMINAIRES SHALL HAVE A COLOR TEMPERATURE OF 3000K.

ANY SUBMITTED EQUALS MUST BE APPROVED BY THE ENGINEER.

PAYMENT WILL BE MADE AT THE CONTRACT UNIT BID PRICE FOR EACH "ITEM 625 - LUMINAIRE, CONVENTIONAL, SOLID-STATE (LED), AS PER PLAN, 120V, 16000-21000 LUMENS" WHICH SHALL BE FULL COMPENSATION FOR ALL LABOR, MATERIALS, EQUIPMENT, AND INCIDENTALS REQUIRED TO COMPLETE THIS ITEM IN A SATISFACTORY AND WORKMANLIKE MANNER.

632, SIGNAL SUPPORT, (BY TYPE), AS PER PLAN

IN ADDITION TO THE REQUIREMENTS OF THE ODOT C&MS, FURNISH AND INSTALL SIGNAL POLES AS SPECIFIED IN THE PLANS.

ALL SIGNAL SUPPORTS SHALL BE POWDER COAT SEMI-GLOSS BLACK IN ACCORDANCE WITH ODOT SS 916.

PAYMENT FOR ITEM 632 "SIGNAL SUPPORT, (BY TYPE), AS PER PLAN" SHALL BE MADE AT THE CONTRACT UNIT PRICE PER EACH COMPLETE AND IN PLACE AND SHALL INLCUDE ALL LABOR, MATERIALS, AND EQUIPMENT NECESSARY TO COMPLETE THE WORK.

632, COMBINATION SIGNAL SUPPORT, (BY TYPE), AS PER PLAN

IN ADDITION TO THE REQUIREMENTS OF THE ODOT C&MS, FURNISH AND INSTALL SIGNAL POLES AS SPECIFIED IN THE PLANS

ALL SIGNAL SUPPORTS SHALL BE POWDER COAT SEMI-GLOSS BLACK IN ACCORDANCE WITH ODOT SS 916.

PAYMENT FOR ITEM 632 "COMBINATION SIGNAL SUPPORT, (BY TYPE), AS PER PLAN" SHALL BE MADE AT THE CONTRACT UNIT PRICE PER EACH COMPLETE AND IN PLACE AND SHALL INCLUDE ALL LABOR, MATERIALS, AND EQUIPMENT NECESSARY TO COMPLETE THE WORK.

ITEM - 632 PEDESTRIAN SIGNAL HEAD (LED), (COUNTDOWN), TYPE D2, AS PER PLAN

IN ADDITION TO THE REQUIREMENTS OF C&MS 632 AND 732 THE FOLLOWING SHALL APPLY:

1. SIGNAL HEADS AND VISORS SHALL BE CONSTRUCTED OF BLACK POLYCARBONATE PLASTIC AND MEET ITE SPECIFICATIONS.
2. PROPER EXTERIOR COLORS SHALL BE OBTAINED BY USE OF COLORED PLASTIC MATERIAL RATHER THAN PAINTING.
3. PIPE, SPACERS AND FITTINGS CONSTRUCTED OF POLYCARBONATE PLASTIC MAY BE USED IN LIEU OF GALVANIZED STEEL OR ALUMINUM.
4. THE PEDESTRIAN SIGNAL HEAD SHALL BE OF THE LED COUNTDOWN TYPE.
5. NEW ATTACHMENT HARDWARE AND FITTINGS SHALL BE USED.
6. THE LIGHT EMITTING DIODE (LED) MODULES SHALL MEET THE REQUIREMENTS OF C&MS 732.04. THE CONTRACTOR SHALL PROVIDE ODOT, IN WRITING, WITH THE LED MANUFACTURER NAME, SERIAL NUMBER, PART NUMBER, DESCRIPTION OF LAMP, AND DATE OF MANUFACTURE FOR ALL LED UNITS THAT ARE TO BE USED IN THE SIGNAL HEAD PRIOR TO INSTALLATION, FOR ACCEPTANCE AND WARRANTY PURPOSES.

PAYMENT FOR ITEM 632 PEDESTRIAN SIGNAL HEAD (LED), (COUNTDOWN), TYPE D2, AS PER PLAN SHALL BE MADE FOR THE NUMBER OF COMPLETE SIGNAL HEAD FURNISHED AND INSTALLED, INCLUDING ALL LABOR, EQUIPMENT, MATERIALS AND NEW ATTACHMENT HARDWARE.

PAYMENT FOR ITEM 632 PEDESTRIAN SIGNAL HEAD (LED), (COUNTDOWN), TYPE D2, AS PER PLAN SHALL BE MADE FOR THE NUMBER OF COMPLETE SIGNAL HEAD FURNISHED AND INSTALLED, INCLUDING ALL LABOR, EQUIPMENT, MATERIALS AND NEW ATTACHMENT HARDWARE.

ITEM 632 - SIGNAL SUPPORT FOUNDATION

PRIOR TO ORDERING THE SIGNAL SUPPORTS, THE CONTRACTOR SHALL CONTACT OUPS TO HAVE ALL THE UTILITIES LOCATED IN THE FIELD. THEN THE CONTRACTOR SHALL MEET THE PROJECT ENGINEER TO LOCATE THE PROPOSED SUPPORT LOCATIONS TO ENSURE THERE ARE NO CONFLICTS WITH UTILITIES. IF THERE ARE ISSUES, THE PROJECT ENGINEER SHALL PROVIDE GUIDANCE AS TO THE RELOCATION OF THE SUPPORTS.

DUE TO THE FURTHER POSSIBILITY OF CONFLICT WITH EXISTING OR PROPOSED UNDERGROUND OBSTRUCTIONS (INCLUDING THE POSSIBILITY OF UNRECORDED OBSTRUCTIONS) WHICH COULD AFFECT THE LOCATION OF THE FOUNDATION FOR THIS ITEM, AND CONSEQUENTLY, THE DESIGN OF THE SUPPORT AND/OR ARMS, THE CONTRACTOR SHALL NOT PLACE FINAL ORDERS FOR THE ITEM UNTIL THE FOUNDATIONS HAVE BEEN INSTALLED, AT FINAL GRADE, AND THE CONTRACTOR HAS RECEIVED, FROM ENGINEER, WRITTEN NOTICE TO PROCEED WITH THE ORDERS FOR THE ITEM.

IF ANY FOUNDATION LOCATIONS MUST BE ADJUSTED, THE CONTRACTOR SHALL NOTIFY THE ENGINEER AND MAINTAINING AGENCY, WHO WILL DETERMINE THE REVISED LOCATION AND IF NEEDED, THE SUPPORT DESIGN. THE CONTRACTOR WILL NOT BE RESPONSIBLE FOR DETERMINING THE REVISED DESIGN. THE ENGINEER WILL INFORM THE CONTRACTOR OF ANY CHANGES NECESSARY AND AUTHORIZE THE CONTRACTOR TO ORDER THE SUPPORT.

THE CONTRACTOR SHALL, WHEN DEVELOPING THE PROGRESS SCHEDULE, AND THOSE OF SUBCONTRACTORS, ENSURE THAT THE FOUNDATIONS ARE INSTALLED AT THE EARLIEST TIME AS IS FEASIBLE AND PRACTICAL, AND SHALL INCLUDE SUFFICIENT TIME IN THE PROGRESS SCHEDULE FOR ORDERING, MANUFACTURING, DELIVERY, AND INSTALLATION OF THE SUPPORT ITEMS AFTER THE FOUNDATIONS ARE IN PLACE.

NO PAYMENTS FOR DELIVERED MATERIALS FOR THE FOUNDATION OR SUPPORT ITEMS SHALL BE MADE UNTIL THE FOUNDATIONS ARE IN PLACE, AND IF CHANGES IN THE DESIGN OF THIS ITEM ARE REQUIRED, NO PAYMENT SHALL BE MADE FOR THE ITEMS MANUFACTURED TO THE ORIGINAL DESIGN.

PAYMENT WILL BE AT THE CONTRACT UNIT PRICE AND WILL BE FULL COMPENSATION FOR ALL LABOR, MATERIALS, TOOLS, EQUIPMENT AND OTHER INCIDENTALS NECESSARY FOR EACH SUPPORT FURNISHED, IN PLACE, COMPLETE AND ACCEPTED.

ITEM 632 - POWER SERVICE, AS PER PLAN

CONSTRUCT A COMPLETE AND OPERATIONAL POWER SERVICE FOR INTERSECTION SIGNALS IN ACCORDANCE WITH THE RULES AND REGULATIONS SET FORTH BY THE OHIO ELECTRIC CODE, DUKE ENERGY AND ODOT SCD TC-83.10. ALL NECESSARY MATERIAL AND LABOR, INCLUDING BUT NOT LIMITED TO ELECTRIC METER, RISER, HOUSING, AND SEPERATE DISCONNECTS FOR LIGHTING AND SIGNALS, SHALL BE SUPPLIED BY THE CONTRACTOR AS PART OF THIS ITEM.

PAYMENT WILL BE AT THE CONTRACT UNIT PRICE FOR EACH POWER SERVICE FURNISHED AND INSTALLED INLCUDING ALL LABOR, MATERIALS, AND EQUIPMENT NECESSARY FOR INSTALLATION.

ITEM 632 - SIGNALIZATION, MISC.: VACUUM EXCAVATION OF FOUNDATION

THIS ITEM SHALL BE APPLIED AT THE DISCRETION OF THE ENGINEER AT FOUNDATIONS IN PROXIMITY TO UTILITIES. VACUUM EXCAVATION SHALL BE COMPLETED BY A QUALIFIED CONTRACTOR ONLY AT SPECIFIED FOUNDATIONS AT THE ENGINEER'S DISCRETION.

PAYMENT SHALL BE ON A CONTINGENCY BASIS AND INCLUDE ALL LABOR MATERIALS, TOOLS, EQUIPMENT AND INCIDENTALS REQUIRED TO FULLY EXCAVATE THE AREA AROUND A FOUNDATION.

A QUANTITY OF 4 FOUNDATIONS ARE CARRIED TO THE GENSUM FOR USE AT THE ENGINEER'S DISCRETION.

ITEM - 632 REMOVAL OF TRAFFIC SIGNAL INSTALLATION, AS PER PLAN

TRAFFIC SIGNAL INSTALLATIONS, INCLUDING SIGNAL HEADS, CABLE, MESSENGER WIRE, SIGNAL SUPPORTS, CABINET(S), CONTROLLER, ETC., SHALL BE REMOVED IN ACCORDANCE WITH C&MS 632.26 AND AS INDICATED ON THE PLANS. UNLESS NOTED, POWER SERVICES SHALL BE REMOVED IN ACCORDANCE WITH C&MS 625.21.F. REMOVED ITEMS SHALL BE REUSED AS PART OF A NEW INSTALLATION ON THE PROJECT OR STORED ON THE PROJECT FOR SALVAGE BY THE HAMILTON COUNTY ENGINEER'S OFFICE IN ACCORDANCE WITH THE LISTING GIVEN HEREIN.

ITEMS TO BE REMOVED FOR STORAGE: CONTROLLER, CABINET (INCLUDING ALL CONTENTS), DETECTORS, UPS WITH CABINET, SIGNAL & PEDESTRIAN HEADS

REMOVED ITEMS SHALL BE DELIVERED TO THE NEAREST COUNTY FACILITY WHOSE ADDRESS IS LISTED BELOW:

HAMILTON COUNTY ENGINEERS OFFICE, ATTN: 513-946-4250

223 WEST GALBRAITH RD.
CINCINNATI, OH 45215

IN THE EVENT THE ITEMS STORED ON THE PROJECT FOR SALVAGE BY THE LOCAL AGENCY ARE NOT REMOVED, THE CONTRACTOR SHALL, WHEN DIRECTED BY THE ENGINEER IN WRITING, REMOVE AND DISPOSE OF THE ITEMS AT NO ADDITIONAL COST TO THE PROJECT.

SIGNAL ITEM NUMBER CHANGE

ITEM 632 - PEDESTAL, 10.7' TALL, TRANSFORMER BASE, AS PER PLAN

IN ADDITION TO THE REQUIREMENTS OF THE ODOT C&MS, FURNISH AND INSTALL PEDESTALS AS SPECIFIED IN THE PLANS.

ALL PEDESTALS SHALL BE POWDER COAT SEMI-GLOSS BLACK IN ACCORDANCE WITH ODOT SS 916.

PAYMENT FOR ITEM 632 "PEDESTAL, 10.7' TALL, TRANSFORMER BASE, AS PER PLAN" SHALL BE MADE AT THE CONTRACT PRICE PER EACH COMPLETE AND IN PLACE AND SHALL INCLUDE ALL LABOR, MATERIALS, AND EQUIPMENT NECESSARY TO COMPLETE THE WORK.

ITEM 632 - PEDESTAL FOUNDATION, AS PER PLAN

IN ADDITION TO THE REQUIREMENTS OF ITEM 632 "PEDESTAL FOUNDATION", THIS ITEM SHALL CONFORM TO THE REQUIREMENTS PROVIDED IN ITEM 632 " SIGNAL SUPPORT FOUNDATION."

ITEM - 632 ACCESSIBLE PEDESTRIAN PUSHBUTTON (POLARA) (ALTERNATE 2)

IN ADDITION TO THE REQUIREMENTS OF ITEM 632 "ACCESSIBLE PEDESTRIAN PUSHBUTTON", THIS ITEM SHALL BE A POLARA ACCESSIBLE PUSHBUTTON.

ITEM - 632 VEHICULAR SIGNAL HEAD, (LED), 3-SECTION, 12" LENS, 1-WAY, POLYCARBONATE, BLACK, AS PER PLAN


THIS ITEM SHALL CONFORM TO THE REQUIREMENTS OF ITEM 632 "VEHICULAR SIGNAL HEAD, (LED), 3-SECTION, 12" LENS, 1-WAY, POLYCARBONATE, BLACK" WITH THE ADDITIONAL REQUIREMENT THAT THE FLASHING YELLOW ARROW SHALL HAVE A BI-MODAL HEAD TO ALLOW FOR BOTH SOLID YELLOW ARROW AND FLASHING YELLOW ARROW OPERATION.

SIGNAL TIMING CHART

INTERSECTION: DELHI PIKE & DELHI TOWNE SQUARE									
MAINTAINING AGENCY: HAMILTON COUNTY ENGINEER'S OFFICE									
START UP		DUAL ENTRY: YES		PHASES: 2&6					
START IN: ALL-RED-FLASH		REST IN RED:		RING 1		RING 2			
TIME FOR FLASH OR ALL RED: 6,9		OVERLAP		A		B		C D	
FIRST PHASE(S): 2 & 6		PHASES		-		-		-	
COLOR DISPLAYED: GREEN									
INTERVAL OR FEATURE									
INTERSECTION MOVEMENT (PHASE)									
CONTROLLER MOVEMENT NO.									
DIRECTION									
MINIMUM GREEN (INITIAL) (SEC.)									
ADDED INITIAL *(SEC./ACTUATION)									
MAXIMUM INITIAL (SEC.)									
PASSAGE TIME (PRESET GAP) (SEC.)									
TIME BEFORE REDUCTION *(SEC.)									
MINIMUM GAP *(SEC.)									
TIME TO REDUCE *(SEC.)									
MAXIMUM GREEN I (SEC.)									
MAXIMUM GREEN II (SEC.)									
YELLOW CHANGE (SEC.)									
ALL RED CLEARANCE (SEC.)									
DELAYED GREEN (LPI) (SEC.)									
FLASHING YELLOW ARROW DELAY (SEC.)									
WALK (SEC.)									
PEDESTRIAN CLEARANCE (SEC.)									
RECALL		MAXIMUM (ON/OFF)		OFF		OFF		OFF	
		MINIMUM (ON/OFF)		OFF		ON		OFF	
		PEDESTRIAN (ON/OFF)		-		OFF		-	
MEMORY		(ON/OFF)		-		-		-	

*VOLUME DENSITY CONTROLS
OMIT CALLS TO $\phi 1$ & $\phi 5$ DURING $\phi 2$ & $\phi 6$ GREEN.

PHASING DIAGRAM

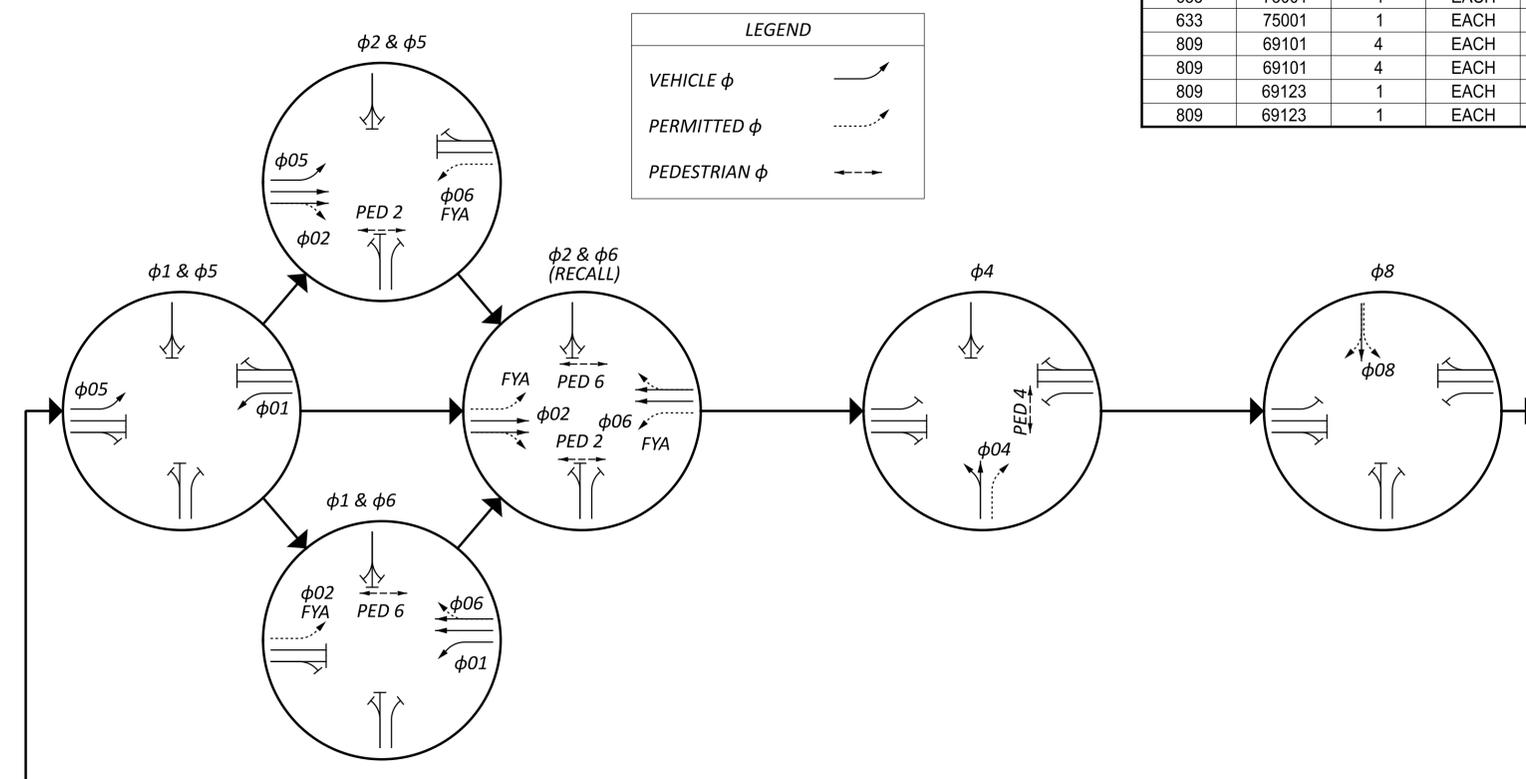


RADAR DETECTION CHART

DETECTION ZONE	MOVEMENT	PULSE OR PRESENCE	ASSOCIATED PHASE	RADAR NUMBER	DELAY IN CONTROLLER (SEC)	EXTENSION PROGRAMMED IN CONTROLLER (SEC.)	PURPOSE	DETECTION ZONE LENGTH (FT)
RDZ1	WBLT	PRESENCE	$\phi 1$	RD4	-	-	STOP BAR	50
RDZ4A	NBRT	PRESENCE	$\phi 4$	RD3	-	-	STOP BAR	50
RDZ4B	NBTL	PRESENCE	$\phi 4$	RD3	-	-	STOP BAR	50
RDZ5	EBLT	PRESENCE	$\phi 5$	RD2	-	-	STOP BAR	50
RDZ8	SBTRL	PRESENCE	$\phi 8$	RD1	-	-	STOP BAR	50

NOTE: DILEMMA ZONE SPEED THRESHOLD >30 MPH

ITEM	EXTENSION	TOTAL	UNIT	DESCRIPTION	SEE SHEET
625	00450	1	EACH	CONNECTION, FUSED PULL APART	
625	00460	2	EACH	CONNECTION, UNFUSED PULL APART	
625	00480	1	EACH	CONNECTION, UNFUSED PERMANENT	
625	18401	1	EACH	BRACKET ARM, 20', AS PER PLAN	36
625	18511	1	EACH	BRACKET ARM, 30', AS PER PLAN	36
625	23304	36	FT	NO. 8 AWG 600 VOLT DISTRIBUTION CABLE	
625	23400	258	FT	NO. 10 AWG POLE AND BRACKET CABLE	
625	25408	30	FT	CONDUIT, 2", 725.051	
625	25604	30	FT	CONDUIT, 4", 725.051	
625	25908	248	FT	CONDUIT, JACKED OR DRILLED, 725.052, 4"	
625	26253	2	EACH	LUMINAIRE, CONVENTIONAL, SOLID STATE (LED), AS PER PLAN, 120V, 16000-21000 LUMENS	36
625	29002	51	FT	TRENCH, 24" DEEP	
625	30706	5	EACH	PULL BOX, 725.08, 24"	
625	32000	7	EACH	GROUND ROD	
630	79100	8	EACH	SIGN HANGER ASSEMBLY, MAST ARM	
630	79500	2	EACH	SIGN SUPPORT ASSEMBLY, POLE MOUNTED	
630	80100	60.5	SF	SIGN, FLAT SHEET	
632	05006	6	EACH	VEHICULAR SIGNAL HEAD, (LED), 3-SECTION, 12" LENS, 1-WAY, POLYCARBONATE, BLACK	
632	05007	2	EACH	VEHICULAR SIGNAL HEAD, (LED), 3-SECTION, 12" LENS, 1-WAY, POLYCARBONATE, AS PER PLAN, BLACK	36
632	05086	2	EACH	VEHICULAR SIGNAL HEAD, (LED), 5-SECTION, 12" LENS, 1-WAY, POLYCARBONATE, BLACK	
632	20731	6	EACH	PEDESTRIAN SIGNAL HEAD (LED), TYPE D2, COUNTDOWN, AS PER PLAN	36
632	25000	10	EACH	COVERING OF VEHICULAR SIGNAL HEAD	
632	25010	6	EACH	COVERING OF PEDESTRIAN SIGNAL HEAD	
632	40500	966	FT	SIGNAL CABLE, 5 CONDUCTOR, NO. 14 AWG	
632	40700	1079	FT	SIGNAL CABLE, 7 CONDUCTOR, NO. 14 AWG	
632	64010	2	EACH	SIGNAL SUPPORT FOUNDATION	36
632	64021	4	EACH	PEDESTAL FOUNDATION, AS PER PLAN	36
632	65300	936	FT	LOOP DETECTOR LEAD-IN CABLE, 2 CONDUCTOR, NO. 14 AWG	
632	66104	32	FT	POWER CABLE, 3 CONDUCTOR, NO. 10 AWG	
632	69800	101	FT	SERVICE CABLE, 3 CONDUCTOR, NO. 6 AWG	
632	70001	1	EACH	POWER SERVICE, AS PER PLAN	
632	71389	1	EACH	SIGNAL SUPPORT, TYPE TC-12.31 DESIGN 10 POLE, WITH MAST ARMS TC-81.22 DESIGN 14 AND DESIGN 12, AS PER PLAN	36
632	78349	1	EACH	COMBINATION SIGNAL SUPPORT, TYPE TC-12.31 DESIGN 10 POLE, WITH MAST ARMS TC-81.22 DESIGN 12 AND DESIGN 12, AS PER PLAN	36
632	89921	4	EACH	PEDESTAL, 10.7' TALL, TRANSFORMER BASE, AS PER PLAN	34
632	90101	1	EACH	REMOVAL OF TRAFFIC SIGNAL INSTALLATION, AS PER PLAN	36
633	65521	1	EACH	CABINET, TYPE 332, AS PER PLAN	37
633	67101	1	EACH	CABINET FOUNDATION, AS PER PLAN	37
633	67200	1	EACH	CONTROLLER WORK PAD	
ALTERNATE ITEMS					
632	20750	6	EACH	ACCESSIBLE PEDESTRIAN PUSHBUTTON, (ALTERNATE 1)	
632	20750	6	EACH	ACCESSIBLE PEDESTRIAN PUSHBUTTON, (POLARA) (ALTERNATE 2)	36
633	45000	1	EACH	GPS (GLOBAL POSITIONING SYSTEM) CLOCK ASSEMBLY, (ALTERNATE 1)	37
633	45000	1	EACH	GPS (GLOBAL POSITIONING SYSTEM) CLOCK ASSEMBLY, (Q-FREE) (ALTERNATE 2)	37
633	75001	1	EACH	UNINTERRUPTIBLE POWER SUPPLY (UPS), 1000 WATT, AS PER PLAN, (ALTERNATE 1)	37
633	75001	1	EACH	UNINTERRUPTIBLE POWER SUPPLY (UPS), 1000 WATT, AS PER PLAN, (ALPHA) (ALTERNATE 2)	37
809	69101	4	EACH	STOP LINE RADAR DETECTION, AS PER PLAN, (ALTERNATE 1)	37
809	69101	4	EACH	STOP LINE RADAR DETECTION, AS PER PLAN, (WAVETRONIX) (ALTERNATE 2)	37
809	69123	1	EACH	ATC CONTROLLER, AS PER PLAN, (ALTERNATE 1)	37
809	69123	1	EACH	ATC CONTROLLER, AS PER PLAN, (INTELIGHT) (ALTERNATE 2)	37

SIGNAL ITEM NUMBER CHANGE

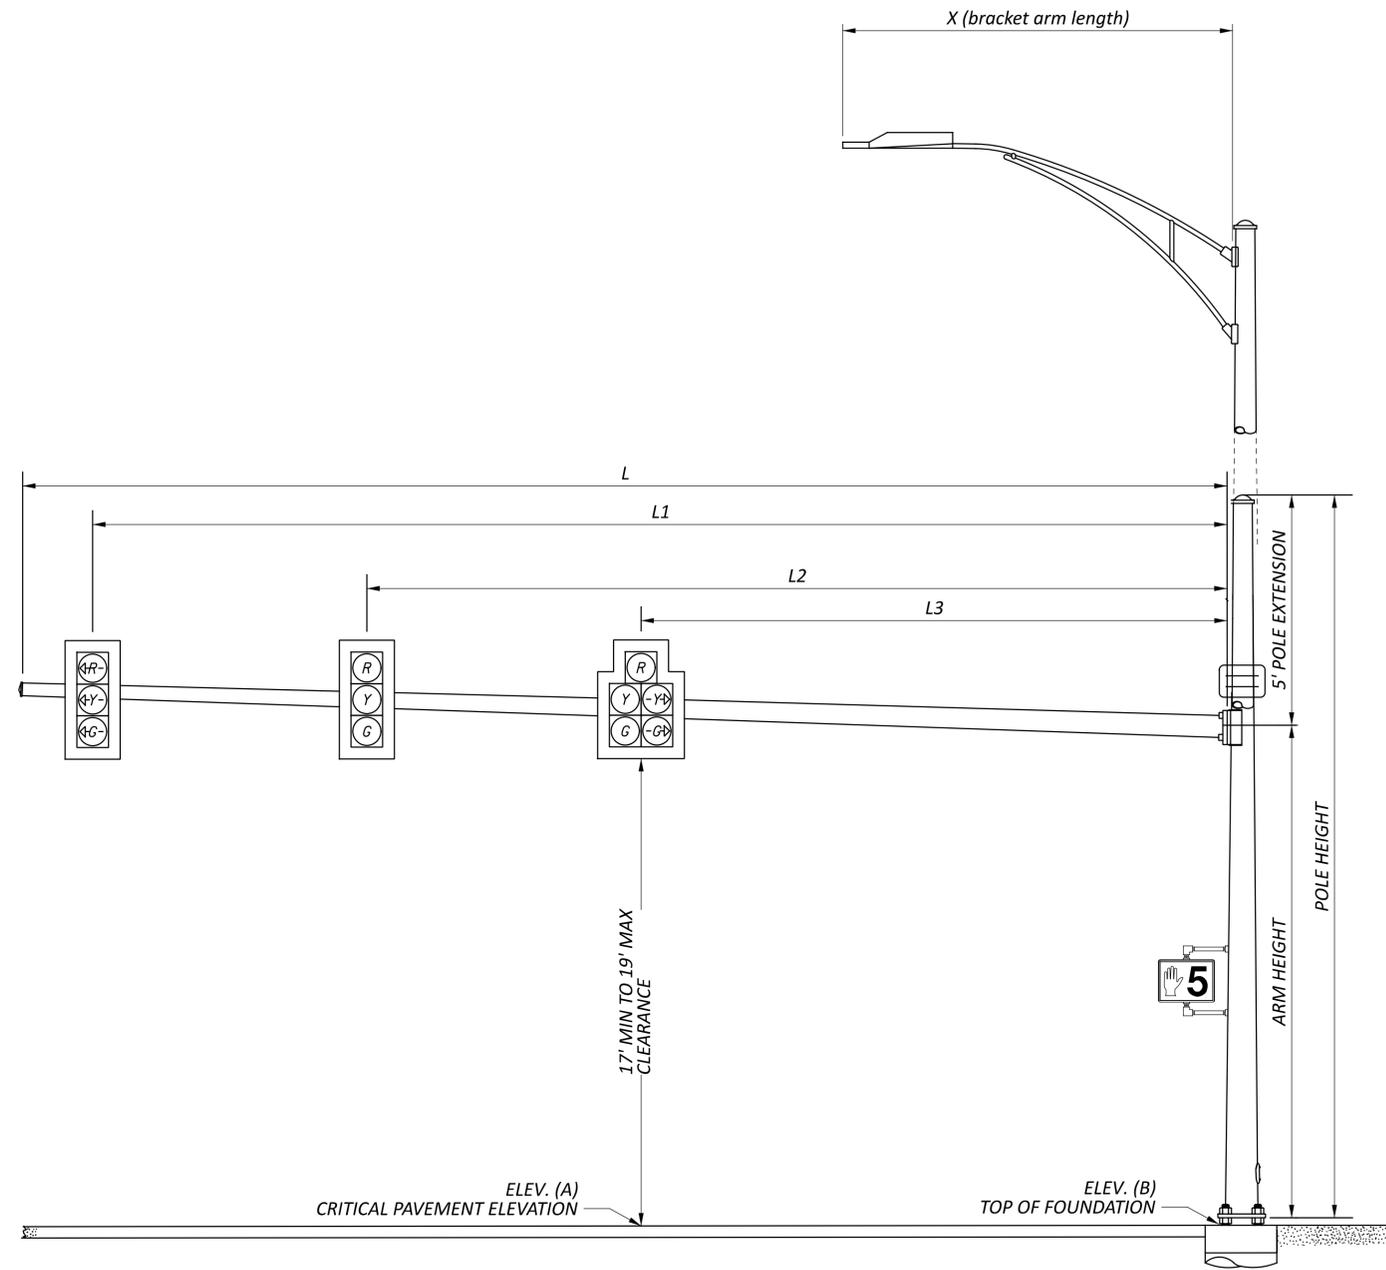


SIGNAL SUPPORT ELEVATION (TYPICAL)

MAST ARM TABLE

SUPPORT NO.	STATION	OFFSET	ELEVATION		SIGNAL SUPPORT DETAILS														ORIENTATION ANGLES FROM MAST ARM A								
			A	B	DESIGN TYPE	POLE DESIGN NO.	ARM DESIGN NO.	POLE HEIGHT	ARM HEIGHT	L	L1	L2	L3	L4	L5	L6	BRACKET ARM MOUNTING HEIGHT	X	MAST ARM A ANGLE	MAST ARM B ANGLE	PEDESTRIAN SIGNAL	PEDESTRIAN BUTTON	POWER SERVICE	CONTROLLER	SIGN	BRACKET ARM	HANDHOLE
			FT	FT																							
SP-1	4+51.7	37.9' LT	884.53	883.99	TC-12.31	10	12	30.5	20.5	45	42	33	12	-	-	-	30	20	270	-	-	-	180	-	90	0	180
			883.62				12		20.5	41	38	38	34	27	19	-	29	30	-	90	-	-	-	-	-	90	-
SP-2	5+23.5	37.6' RT	883.26	885.19	TC-12.31	10	14	21.5	17.5	65	62	53	53	42	42	-	-	-	270	-	-	-	-	-	-	-	180
			884.80				12		20	40	37	37	33	26	16	-	-	-	-	90	-	-	-	-	-	-	-
PS-1	4+59.9	38.9' LT	-	884.23	TC-83.20	-	-	10.7	-	-	-	-	-	-	-	-	-	-	0	-	0	0	-	-	-	-	-
PS-2	5+11.8	34.1' LT	-	884.86	TC-83.20	-	-	10.7	-	-	-	-	-	-	-	-	-	-	0	-	90/180	90/180	-	-	-	-	-
PS-3	4+07.5	34.3' RT	-	883.16	TC-83.20	-	-	10.7	-	-	-	-	-	-	-	-	-	-	0	-	180	180	-	-	-	-	-
PS-4	5+11.9	34.4' RT	-	884.94	TC-83.20	-	-	10.7	-	-	-	-	-	-	-	-	-	-	0	-	180/270	180/270	-	-	-	-	-

HEIGHT CHANGE DUE TO ITEM NUMBER CHANGE

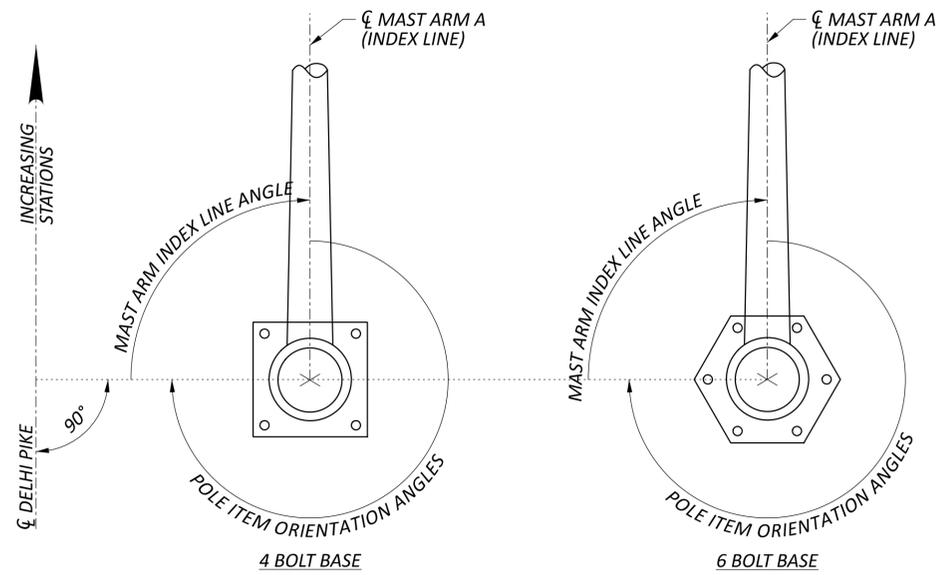

- NOTE:
 1. ALL ANGLES ARE MEASURED CLOCKWISE.
 2. BASE PLATE IS ORIENTED SQUARE TO MAST ARM A, EVEN IF THE SUPPORT HAS TWO ARMS.



POLE ORIENTATION

SIGNAL TIMING CHART

INTERSECTION: DELHI PIKE & KLEMME DR./DELHI PARK									
MAINTAINING AGENCY: HAMILTON COUNTY ENGINEER'S OFFICE									
START UP		DUAL ENTRY: YES		PHASES: 2&6, 4&8					
START IN: ALL-RED-FLASH		REST IN RED:		RING 1		RING 2			
TIME FOR FLASH OR ALL RED: 6,9		OVERLAP		A		B		C D	
FIRST PHASE(S): 2 & 6		PHASES		-		-		-	
COLOR DISPLAYED: GREEN									
INTERVAL OR FEATURE									
INTERSECTION MOVEMENT (PHASE)									
CONTROLLER MOVEMENT NO.									
DIRECTION									
MINIMUM GREEN (INITIAL) (SEC.)									
ADDED INITIAL *(SEC./ACTUATION)									
MAXIMUM INITIAL (SEC.)									
PASSAGE TIME (PRESET GAP) (SEC.)									
TIME BEFORE REDUCTION *(SEC.)									
MINIMUM GAP *(SEC.)									
TIME TO REDUCE *(SEC.)									
MAXIMUM GREEN I (SEC.)									
MAXIMUM GREEN II (SEC.)									
YELLOW CHANGE (SEC.)									
ALL RED CLEARANCE (SEC.)									
DELAYED GREEN (LPI) (SEC.)									
FLASHING YELLOW ARROW DELAY (SEC.)									
WALK (SEC.)									
PEDESTRIAN CLEARANCE (SEC.)									
RECALL		MAXIMUM (ON/OFF)		OFF		OFF		OFF	
		MINIMUM (ON/OFF)		OFF		ON		OFF	
		PEDESTRIAN (ON/OFF)		-		OFF		-	
MEMORY		MAXIMUM (ON/OFF)		-		-		-	

*VOLUME DENSITY CONTROLS
OMIT CALLS TO $\phi 1$ & $\phi 5$ DURING $\phi 2$ & $\phi 6$ GREEN.

PHASING DIAGRAM

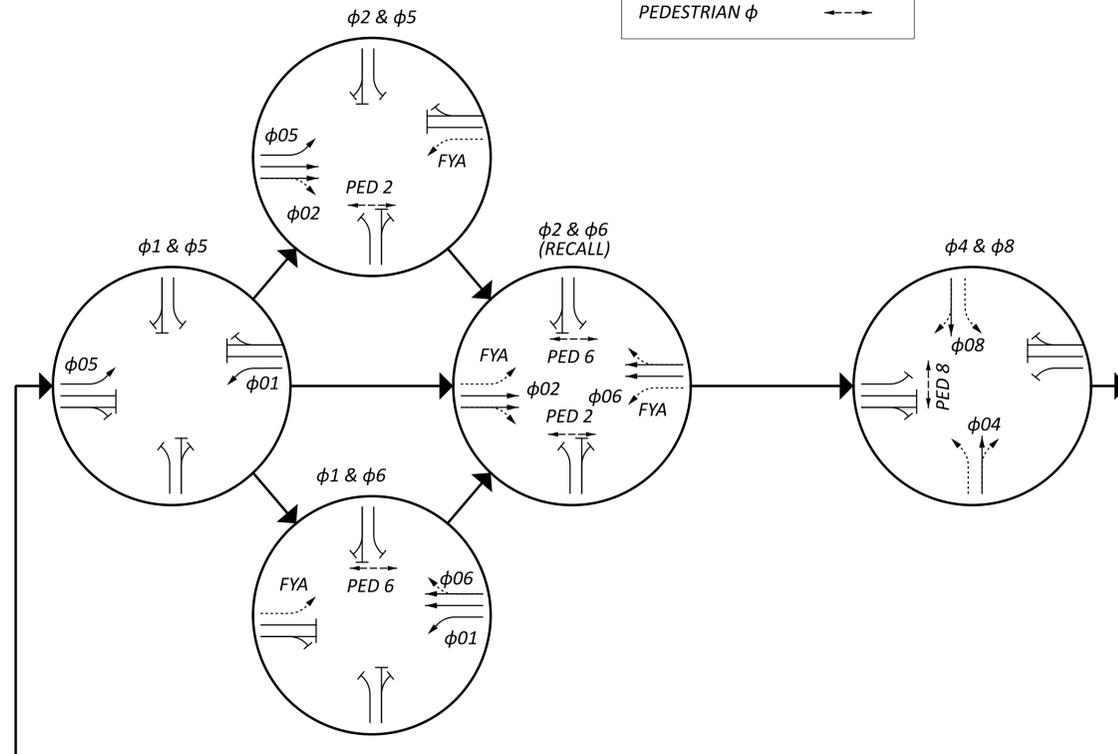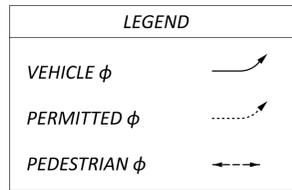


ITEM	EXTENSION	TOTAL	UNIT	DESCRIPTION	SEE SHEET
SPECIAL	61411300	1	EACH	WORK ZONE TRAFFIC SIGNAL	7
625	00450	3	EACH	CONNECTION, FUSED PULL APART	
625	00460	6	EACH	CONNECTION, UNFUSED PULL APART	
625	00480	3	EACH	CONNECTION, UNFUSED PERMANENT	
625	18511	3	EACH	BRACKET ARM, 30', AS PER PLAN	36
625	23304	972	FT	NO. 8 AWG 600 VOLT DISTRIBUTION CABLE	
625	23400	495	FT	NO. 10 AWG POLE AND BRACKET CABLE	
625	25408	36	FT	CONDUIT, 2", 725.051	
625	25604	65	FT	CONDUIT, 4", 725.051	
625	25908	217	FT	CONDUIT, JACKED OR DRILLED, 725.052, 4"	
625	26253	3	EACH	LUMINAIRE, CONVENTIONAL, SOLID STATE (LED), AS PER PLAN, 120V, 16000-21000 LUMENS	36
625	29002	96	FT	TRENCH, 24" DEEP	
625	30706	5	EACH	PULL BOX, 725.08, 24"	
625	32000	8	EACH	GROUND ROD	
630	79100	10	EACH	SIGN HANGER ASSEMBLY, MAST ARM	
630	79500	2	EACH	SIGN SUPPORT ASSEMBLY, POLE MOUNTED	
630	80100	89	SF	SIGN, FLAT SHEET	
632	05006	8	EACH	VEHICULAR SIGNAL HEAD, (LED), 3-SECTION, 12" LENS, 1-WAY, POLYCARBONATE, BLACK	
632	05007	2	EACH	VEHICULAR SIGNAL HEAD, (LED), 3-SECTION, 12" LENS, 1-WAY, POLYCARBONATE, AS PER PLAN, BLACK	36
632	20731	6	EACH	PEDESTRIAN SIGNAL HEAD (LED), TYPE D2, COUNTDOWN, AS PER PLAN	36
632	25000	10	EACH	COVERING OF VEHICULAR SIGNAL HEAD	
632	25010	6	EACH	COVERING OF PEDESTRIAN SIGNAL HEAD	
632	40500	848	FT	SIGNAL CABLE, 5 CONDUCTOR, NO. 14 AWG	
632	40700	1103	FT	SIGNAL CABLE, 7 CONDUCTOR, NO. 14 AWG	
632	64010	4	EACH	SIGNAL SUPPORT FOUNDATION	36
632	64021	3	EACH	PEDESTAL FOUNDATION, AS PER PLAN	36
632	65300	818	FT	LOOP DETECTOR LEAD-IN CABLE, 2 CONDUCTOR, NO. 14 AWG	
632	66104	15	FT	POWER CABLE, 3 CONDUCTOR, NO. 10 AWG	
632	69800	123	FT	SERVICE CABLE, 3 CONDUCTOR, NO. 6 AWG	
632	70001	1	EACH	POWER SERVICE, AS PER PLAN	36
632	72141	1	EACH	SIGNAL SUPPORT, TYPE TC-81.22, DESIGN 13, AS PER PLAN	36
632	79111	3	EACH	COMBINATION SIGNAL SUPPORT, TYPE TC-81.22, DESIGN 4, AS PER PLAN	36
632	89921	3	EACH	PEDESTAL, 10.7' TALL, TRANSFORMER BASE, AS PER PLAN	36
632	90101	1	EACH	REMOVAL OF TRAFFIC SIGNAL INSTALLATION, AS PER PLAN	36
633	65521	1	EACH	CABINET, TYPE 332, AS PER PLAN	37
633	67101	1	EACH	CABINET FOUNDATION, AS PER PLAN	37
633	67200	1	EACH	CONTROLLER WORK PAD	
ALTERNATE ITEMS					
632	20750	6	EACH	ACCESSIBLE PEDESTRIAN PUSHBUTTON, (ALTERNATE 1)	
632	20750	6	EACH	ACCESSIBLE PEDESTRIAN PUSHBUTTON, (POLARA) (ALTERNATE 2)	36
633	45000	1	EACH	GPS (GLOBAL POSITIONING SYSTEM) CLOCK ASSEMBLY, (ALTERNATE 1)	
633	45000	1	EACH	GPS (GLOBAL POSITIONING SYSTEM) CLOCK ASSEMBLY, (ALTERNATE 2)	
633	75001	1	EACH	UNINTERRUPTIBLE POWER SUPPLY (UPS), 1000 WATT, AS PER PLAN, (ALTERNATE 1)	37
633	75001	1	EACH	UNINTERRUPTIBLE POWER SUPPLY (UPS), 1000 WATT, AS PER PLAN, (ALPHA) (ALTERNATE 2)	37
809	69101	4	EACH	STOP LINE RADAR DETECTION, AS PER PLAN, (ALTERNATE 1)	37
809	69101	4	EACH	STOP LINE RADAR DETECTION, AS PER PLAN, (WAVETRONIX) (ALTERNATE 2)	37
809	69123	1	EACH	ATC CONTROLLER, AS PER PLAN, (ALTERNATE 1)	37
809	69123	1	EACH	ATC CONTROLLER, AS PER PLAN, (INTELIGHT) (ALTERNATE 2)	37

SEE SHEET 8 FOR WORK ZONE TRAFFIC SIGNAL LAYOUT AND DETAILS

RADAR DETECTION CHART

DETECTION ZONE	MOVEMENT	PULSE OR PRESENCE	ASSOCIATED PHASE	RADAR NUMBER	DELAY IN CONTROLLER (SEC)	EXTENSION PROGRAMMED IN CONTROLLER (SEC.)	PURPOSE	DETECTION ZONE LENGTH (FT)
RDZ1	WBLT	PRESENCE	$\phi 1$	RD4	-	-	STOP BAR	50
RDZ4A	NBTR	PRESENCE	$\phi 4$	RD3	-	-	STOP BAR	50
RDZ4B	NBLT	PRESENCE	$\phi 4$	RD3	-	-	STOP BAR	50
RDZ5	EBLT	PRESENCE	$\phi 5$	RD1	-	-	STOP BAR	50
RDZ8A	SBTR	PRESENCE	$\phi 8$	RD2	-	-	STOP BAR	50
RDZ8B	SBLT	PRESENCE	$\phi 8$	RD2	-	-	STOP BAR	50

NOTE: DILEMMA ZONE SPEED THRESHOLD >30 MPH

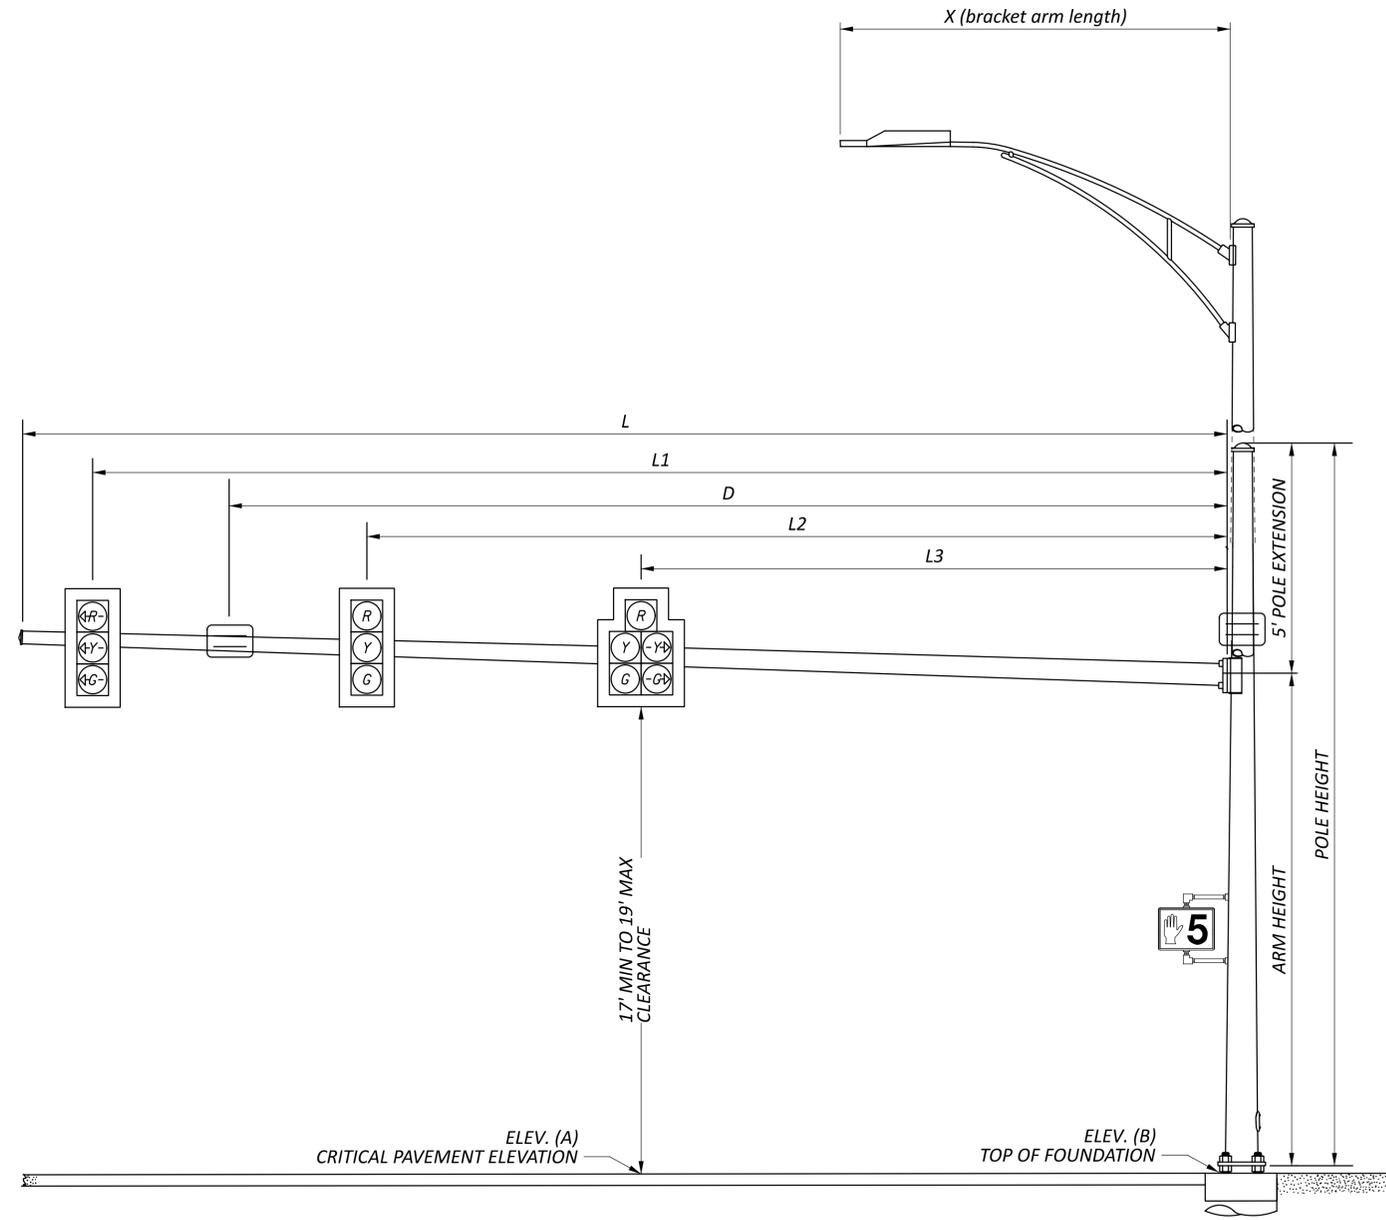


SIGNAL SUPPORT ELEVATION (TYPICAL)

MAST ARM TABLE

SUPPORT NO.	STATION	OFFSET	ELEVATION		SIGNAL SUPPORT DETAILS													MAST ARM A ANGLE	ORIENTATION ANGLES FROM MAST ARM A								
			A	B	DESIGN TYPE	DESIGN NO.	POLE HEIGHT	ARM HEIGHT	L	L1	L2	L3	L4	L5	L6	L7	X		MAST ARM B ANGLE	PEDESTRIAN SIGNAL	PEDESTRIAN BUTTON	POWER SERVICE	CONTROLLER	SIGN	BRACKET ARM	HANDHOLE	CABLE ENTRANCE 12" FROM TOP
			FT	FT	FT	FT	FT	FT	FT	FT	FT	FT	FT	FT	FT	FT	FT		DEG	DEG	DEG	DEG	DEG	DEG	DEG	DEG	DEG
SP-1	7+34.2	33.3' LT	887.76	888.15	TC-81.22	4	35	20	34	31	31	27	22	14	8	-	20	0	-	-	-	-	-	-	0	180	-
SP-2	8+14.9	46.3' LT	890.73	889.85	TC-81.22	4	33.5	19	32	30	23	15	8	-	-	-	20	90	-	270	270	-	-	270	0	180	-
SP-3	7+28.0	33.7' RT	888.14	888.00	TC-81.22	13	21	19.5	52	50	43	32	8	-	-	-	-	90	-	-	-	-	-	-	-	180	-
SP-4	8+14.1	33.6' RT	889.66	889.78	TC-81.22	4	30.5	20.5	35	32	32	28	23	14	7	-	20	0	-	180	180	180	-	0	0	180	-
PS-1	7+46.5	33.6' LT	-	888.21	TC-83.20	-	10.7	-	-	-	-	-	-	-	-	-	-	0	-	270	270	-	-	-	-	-	-
PS-2	7+55.4	39.4' LT	-	888.22	TC-83.20	-	10.7	-	-	-	-	-	-	-	-	-	-	0	-	0	0	-	-	-	-	-	-
PS-3	7+42.6	38.9' RT	-	888.22	TC-83.20	-	10.7	-	-	-	-	-	-	-	-	-	-	0	-	0/90	0/90	-	-	-	-	-	-

HEIGHT CHANGE DUE TO ITEM NUMBER CHANGE

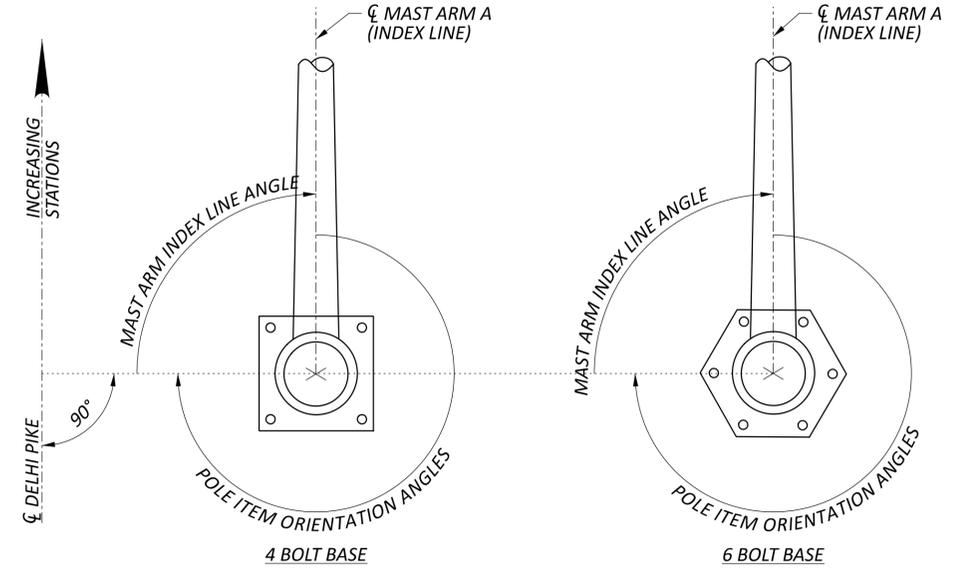

- NOTE:
 1. ALL ANGLES ARE MEASURED CLOCKWISE.
 2. BASE PLATE IS ORIENTED SQUARE TO MAST ARM A, EVEN IF THE SUPPORT HAS TWO ARMS.

POLE ORIENTATION