PROJECT

LOCATION MAP LATITUDE: 39°10'28" LONGITUDE: 84°29'23"

PORTION TO BE IMPROVED ._____

INTERSTATE HIGHWAY ______ FEDERAL ROUTES .______

COUNTY & TOWNSHIP ROADS _______

OTHER ROADS ______

CURRENT ADT (2024)______ 144430

DESIGN YEAR ADT (2044)______ 173316

DESIGN HOURLY VOLUME (2044)______ 15599

DIRECTIONAL DISTRIBUTION _____ 60 %

DESIGN SPEED ______ 60

LEGAL SPEED _____ 55

NHS PROJECT ______ YES

I.R. 75

S.R. 562

69330

83196

7488

60%

4%

(01) URBAN (02) URBAN FREEWAY

STATE OF OHIO DEPARTMENT OF TRANSPORTATION

HAM-75-7.80

HAMILTON COUNTY

INDEX OF SHEETS:

TITLE SHEET	P.1
TYPICAL SECTIONS	P.2
GENERAL NOTES	P.3-P.5
MAINTENANCE OF TRAFFIC	P.6-P.9
GENERAL SUMMARY	P.10
SUBSUMMARY	P.11
I.R. 75 PLAN	P.12
GEOTECHNICAL BORING LOG	P.13-P.14

CITY OF CINCINNATI

FEDERAL PROJECT NUMBER

FAN E240501

RAILROAD INVOLVEMENT

NONE

PROJECT DESCRIPTION

THIS PROJECT INCLUDES THE DESIGN OF, FURNISHING THE MATERIALS FOR, AND INSTALLATION OF A LOAD TRANSFER PLATFORM (LTP) SUPPORTED BY RIGID INCLUSIONS ON I.R. 75 NORTHBOUND AT THE INTERCHANGE WITH S.R. 562. THE PRIMARY PURPOSE OF THE LTP AND RIGID INCLUSIONS IS TO MITIGATE PAVEMENT SETTLEMENT AND PROVIDE PERMANENT SUPPORT FOR

EARTH DISTURBED AREAS

PROJECT EARTH DISTURBED AREA: 0.2 ACRES ESTIMATED CONTRACTOR EARTH DISTURBED AREA: 2.3 ACRES

NOTICE OF INTENT EARTH DISTURBED AREA: N/A (NOI NOT REQUIRED)* * ROUTINE MAINTENANCE PROJECT

LIMITED ACCESS

THIS IMPROVEMENT IS ESPECIALLY DESIGNED FOR THROUGH TRAFFIC AND HAS BEEN DECLARED A LIMITED ACCESS HIGHWAY OR FREEWAY BY ACTION OF THE DIRECTOR IN ACCORDANCE WITH THE PROVISIONS OF SECTION 5511.02 OF THE OHIO REVISED CODE.

2023 SPECIFICATIONS

THE STANDARD SPECIFICATIONS OF THE STATE OF OHIO, DEPARTMENT OF TRANSPORTATION, INCLUDING SUPPLEMENTAL SPECIFICATIONS LISTED IN THE PLANS, CHANGES LISTED IN THE PROPOSAL, AND THE SUPPLEMENTAL SPECIFICATION 800 VERSION INDICATED ON THE PROPOSAL SHALL GOVERN THIS IMPROVEMENT.

I HEREBY APPROVE THESE PLANS AND DECLARE THAT THE MAKING OF THIS IMPROVEMENT WILL REQUIRE THE CLOSING TO TRAFFIC OF THE HIGHWAY AND THAT DETOURS WILL BE PROVIDED AS INDICATED ON SHEET P.9.

DISTRICT DEPUTY DIRECTOR

DESIGN EXCEPTIONS

DESIGN FUNCTIONAL CLASSIFICATION:

DESIGN DESIGNATION


NONE REQUIRED

ADA DESIGN WAIVERS

NONE REQUIRED





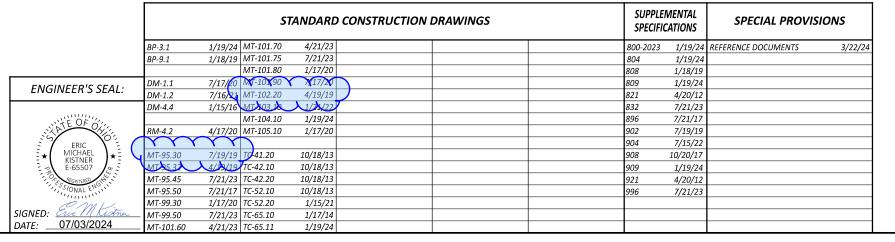



SNS MK 07-02-24

119436

LISTED BELOW ARE ALL UTILITIES LOCATED WITHIN THE PROJECT CONSTRUCTION LIMITS TOGETHER WITH THEIR RESPECTIVE OWNERS:

SANITARY

UTILITIES

CINCINNATI METROPOLITAN SEWER DISTRICT

SEWER ROBERT FRANKLIN

1600 GEST STREET CINCINNATI, OH 45204

513-577-7188

MSDUTILITYREVIEW@CINCINNATI-OH.GOV ROB.FRANKLIN@CINCINNATI-OH.GOV

STORM CINCINNATI STORMWATER MANAGEMENT UTILITY

> ROBERT GOODPASTER 4747 SPRING GROVE AVENUE CINCINNATI, OHIO 45232

513-591-7746

ROBERT.GOODPASTER@CINCINNATI-OH.GOV SMUPLANREVIEW@CINCINNATI-OH.GOV

ODOT ITS

CENTRAL OFFICE ODOT ITS 1606 WEST BROAD STREET COLUMBUS, OH 43223 614.387.4113

CEN.ITS.LAB@DOT.OHIO.GOV

ODOT TRAFFIC MAINTENANCE

ODOT DISTRICT 8 505 SOUTH STATE ROUTE 741

LEBANON, OH 45036 513.933.6689

THE LOCATION OF THE UNDERGROUND UTILITIES SHOWN ON THE PLANS ARE AS OBTAINED FROM THE OWNERS AS REQUIRED BY SECTION 153.64 O.R.C.

UTILITY NOTIFICATION

THE OHIO DEPARTMENT OF TRANSPORTATION HAS UTILITY FACILITIES (HIGHWAY LIGHTING AND ITS) WITHIN THE LIMITS OF THIS PROJECT.

IN ADDITION TO THE INFORMATION OUTLINED IN THE 4A NOTES OF THIS CONTRACT, AND EVEN THOUGH ODOT IS LISTED AS A MEMBER OF THE OHIO UTILITIES PROTECTION SERVICES (OUPS), THE CONTRACTOR ON THIS PROJECT IS REQUIRED TO CONTACT ODOT, DISTRICT 8, TRAFFIC MAINTENANCE, AND CENTRAL OFFICE ODOT ITS DIRECTLY SO THAT THE ODOT UTILITIES, LOCATED WITHIN THIS PROJECT, ARE MARKED. THE CONTRACTOR SHALL NOTIFY DISTRICT 8 TRAFFIC MAINTENANCE AT 513-933-6689, CENTRAL OFFICE ODOT ITS AT 614-387-4113, AND THE PROJECT ENGINEER, FOURTEEN (14) CALENDAR DAYS IN ADVANCE OF ANY WORK. FOR THE NEED TO MARK ODOT'S OWNED UTILITIES.

THE ABOVE REQUIREMENTS ARE IN ADDITION TO SECTION 105.07 & 107.16 OF ODOT CONSTRUCTION AND MATERIAL SPECIFICATIONS (C&MS) AND THE PROPOSAL NOTE.

THE CONTRACTOR SHALL NOTIFY OTHER UTILITIES THOUGH OUPS OR DIRECTLY A MINIMUM OF FORTY-EIGHT (48) HOURS IN ADVANCE OF ANY WORK.

THE COST FOR THE ABOVE DESCRIBED WORK IS IDENTICAL TO THE OVERALL BID PRICE OF THE PROJECT.

SURVEYING PARAMETERS

PRIMARY PROJECT CONTROL MONUMENTS GOVERN ALL POSITIONING ON ODOT PROJECTS. PROJECT CONTROL INFORMATION IS SHOWN ON SHEET P.12.

USE THE FOLLOWING PROJECT CONTROL, VERTICAL POSITIONING, AND HORIZONTAL POSITIONING PARAMETERS FOR ALL SURVEYING:

PROJECT CONTROL

POSITIONING METHOD: STATIC GPS OBSERVATIONS FOR HORIZONTAL CONTROL AND DIFFERENTIAL LEVELING FOR VERTICAL CONTROL

MONUMENT TYPE: TYPE A

VERTICAL POSITIONING

ORTHOMETRIC HEIGHT DATUM: NAVD 88

GEOID: 03

HORIZONTAL POSITIONING

REFERENCE FRAME: NAD 83 (1995)

ELLIPSOID: GRS 80

MAP PROJECTION: LAMBERT CONFORMAL CONIC COORDINATE SYSTEM: OHIO STATE PLANE (SOUTH ZONE)

COMBINED SCALE FACTOR: 0.999916593

ORIGIN OF COORDINATE

SYSTEM: NORTHING: 0.0, EASTING 0.0

USE THE POSITIONING METHODS AND MONUMENT TYPE USED IN THE ORIGINAL SURVEY TO RESTORE ALL MONUMENTS RELATED TO PRIMARY PROJECT CONTROL THAT ARE DAMAGED OR DESTROYED BY CONSTRUCTION ACTIVITIES. RESTORE THE DAMAGED OR DESTROYED MONUMENTS IN ACCORDANCE WITH SUPPLEMENTAL SPECIFICATION 623.

UNITS ARE IN U.S. SURVEY FEET. USE THE FOLLOWING CONVERSION FACTOR: 1 METER = 3.280833333 U.S. SURVEY FFFT.

UNDERDRAIN CONNECTIONS

ALL EXISTING UNDERDRAINS SHALL BE CONNECTED INTO THE PROPOSED UNDERDRAINS AS SHOWN IN UNDERDRAIN PLAN AND DETAILS. SECTIONS OF EXISTING UNDERDRAIN DESIGNATED TO BE REMOVED SHALL BE CONSIDERED TO BE INCIDENTAL TO THE EXCAVATION. ALL MATERIAL, LABOR AND INCIDENTALS, INCLUDING BENDS AND BRANCHES NECESSARY TO PROVIDE THE CONNECTION OF THE EXISTING UNDERDRAINS SHALL BE INCLUDED IN ITEM 611 - 6" CONDUIT, TYPE F.

THE FOLLOWING ESTIMATED QUANTITY HAS BEEN INCLUDED IN THE GENERAL SUMMARY FOR THE WORK NOTED ABOVE:

ITEM 611. 6" CONDUIT. TYPE F 20 FT

ITEM SPECIAL - STRUCTURES, MISC.: DETENTION VAULT INSPECTION

AS PART OF THE HAM-75-6.78 PROJECT A PRECAST UNDERGROUND VAULT SYSTEM WAS INSTALLED IN THE INFIELD ADJACENT TO LR. 75 NB AND SR 562 EB. PRIOR TO ANY WORK AT THE SITE, PROTECT THE EXISTING MANHOLES IN THE INFIELD OF I.R. 75 NB TO SR 562 EB THAT SERVE THE UNDERGROUND DETENTION VAULT. ADDITIONALLY, STAKE THE LIMITS OF THE UNDERGROUND VAULT SUCH THAT EQUIPMENT AND STORAGE LIMITATIONS CAN EASILY BE DETERMINED IN THE FIELD. SHOP DRAWINGS OF THE DETENTION VAULT WILL BE INCLUDED IN THE SPECIAL PROVISIONS PACKAGE. INSPECT AND DOCUMENT THE EXISTING CONDITION OF THIS STRUCTURE BEFORE AND AFTER THE WORK. A REPORT, STAMPED BY A REGISTERED ENGINEER, SHALL BE SUBMITTED TO THE ENGINEER DOCUMENTING THE EXISTING CONDITION OF THIS STRUCTURE PRIOR TO THE WORK. THE REPORT SHALL INCLUDE DISCUSSIONS AND RECOMMENDATIONS OF ANY NECESSARY REPAIRS. A SECOND REPORT SHALL BE SUBMITTED DOCUMENTING THE CONDITION OF THE STRUCTURE AFTER THE WORK. CORRECTION TO THE UNDERGROUND VAULT SYSTEM DUE TO DAMAGE CAUSED BY THE LOAD TRANSFER PLATFORM INSTALLATION (INCLUDING TEMPORARY LOADS IMPARTED DURING CONSTRUCTION), WILL NOT BE CONSIDERED FOR ADDITIONAL COMPENSATION.

PAYMENT FOR THE ABOVE WORK SHALL BE MADE AT THE LUMP SUM BID PRICE FOR ITEM SPECIAL - STRUCTURES, MISC.: DETENTION VAULT INSPECTION AND SHALL INCLUDE ALL MATERIALS, EQUIPMENT, LABOR, AND INCIDENTALS NECESSARY TO COMPLETE THE WORK.

ITEM 832 - EROSION CONTROL

THE FOLLOWING QUANTITY HAS BEEN CARRIED TO THE GENERAL SUMMARY FOR LOCATING, FURNISHING, INSTALLING, AND MAINTAINING TEMPORARY SEDIMENT AND EROSION CONTROL FOR EARTH DISTURBED

ITEM 832, EROSION CONTROL 1000 EACH

THE PROPOSED WORK CANNOT IMPACT THE EXISTING STORMWATER

VAULT IN A TEMPORARY OR PERMANENT MANNER. STOCKPILING OF CONSTRUCTION MATERIALS OVER THE EXISTING VAULT IS LIMITED TO A MAXIMUM DEPTH OF 5 FT. STREET LEGAL EQUIPMENT CAN BE PARKED OR TRAVERSE OVER THE VAULT. CONSTRUCTION EQUIPMENT SUCH AS CRANES, DRILL RIGS, ETC. ARE PROHIBITED FROM TRAVELLING OVER THE EXISTING STORMWATER VAULT. PERFORMANCE OF A PRECONSTRUCTION AND POST CONSTRUCTION SURVEY IS A CONTRACT REQUIREMENT.

ITEM 611 - DRAINAGE STRUCTURE MISC.: DRAINAGE SYSTEM INSPECTION

PRIOR TO COMMENCEMENT OF ANY WORK, INSPECT AND DOCUMENT THE EXISTING CONDITIONS OF ALL DRAINAGE STRUCTURES AND CONDUITS FROM STA, 412+50 TO STA, 415+00 ON LR, 75 NORTHBOUND, THE INITIAL INSPECTION WILL SERVE AS THE BASELINE CONDITIONS. FOLLOWING COMPLETION OF THE LOAD TRANSFER PLATFORM WORK, RE-INSPECT AND DOCUMENT THE DRAINAGE STRUCTURES AND CONDUITS. PROVIDE A DRAINAGE INSPECTION REPORT TO THE DEPARTMENT PRIOR TO THE FULL-DEPTH PAVEMENT WORK, THE DRAINAGE INSPECTION REPORT DATAILING THE INSPECTION AND DOCUMENTATION OF ALL DRAINAGE STRUCTURES AND CONDUITS PRIOR TO AND AFTER THE WORK SHALL CONFORM TO A PERFORMANCE INSPECTION PER C&MS 611.12. OUTLINE RECOMMENDATIONS NEEDED FOR DRAINAGE CORRECTIONS DUE TO DAMAGE CAUSED BY THE LOAD TRANSFER PLATFORM INSTALLATION. CORRECTION OF DAMAGE TO THE DRAINAGE SYSTEM WILL NOT BE CONSIDERED FOR ADDITIONAL COMPENSATION.

PAYMENT FOR THE ABOVE WORK SHALL BE MADE AT THE LUMP SUM BID PRICE FOR ITEM 611 - DRAINAGE STRUCTURE, MISC.: DRAINAGE SYSTEM INSPECTION AND SHALL INCLUDE ALL MATERIALS, EQUIPMENT, LABOR, AND INCIDENTALS NECESSARY TO COMPLETE THE WORK

CONTRACTOR COORDINATION

PID 119436 AND PID 102886 (HAM-562 REHABILITATION) WILL BE UNDER CONSTRUCTION AT THE SAME TIME. PID 102886 WILL HAVE THE MOTPE DIRECTIONAL CLOSURES (80 DAYS PER DIRECTION) AND OVERNIGHT LANE CLOSURES. THE CONTRACTOR FOR PID 119436 SHALL COORDINATE THEIR WORK AND MOT WITH THE ADJACENT PROJECT; WORK AND MOT ON PID 102886 GOVERNS AND CONTROLS

PID 77889 (DESIGN BUILD PROJECT FOR THE REPLACEMENT OF THREE RAILROAD BRIDGES OVER PROSSER, 175, AND SR562 ALONG WITH A MINOR REALIGNMENT OF 175) WILL BE UNDER CONSTRUCTION AT THE SAME TIME. IT IS ANTICIPATED PID 77889 WILL HAVE TRAFFIC SHIFTED IN THE NORTHBOUND DIRECTION, THE CONTRACTOR FOR PID 119436 SHALL COORDINATE THEIR WORK AND MOT WITH PID 77889.

THE INFIELD AREA NORTH OF THE ROSS RUN SEWER (14' X 20') (MSD) IS CURRENTLY BEING USED AS A WASTE AREA FOR PID 77889.

THE FOLLOWING ESTIMATED QUANTITIES LISTED BELOW HAVE BEEN CARRIED TO THE GENERAL SUMMARY FOR USE AS DIRECTED BY THE ENGINEER.

ITEM 614 WORK ZONE RAISED PAVEMENT MARKER 100 EACH ITEM 614 WORK ZONE EDGE LINE, CLASS I 0.2 MILE ITEM 614 WORK ZONE CHANNELIZING LINE. CLASS I. 12" 1000 FT

Stantec Cincinnati, OH 45242 (513) 842-8200

SNS

MK 07-02-24

119436

P.3 14