


STATE OF OHIO DEPARTMENT OF TRANSPORTATION

HAN-US68/SR15-INTERCHANGE

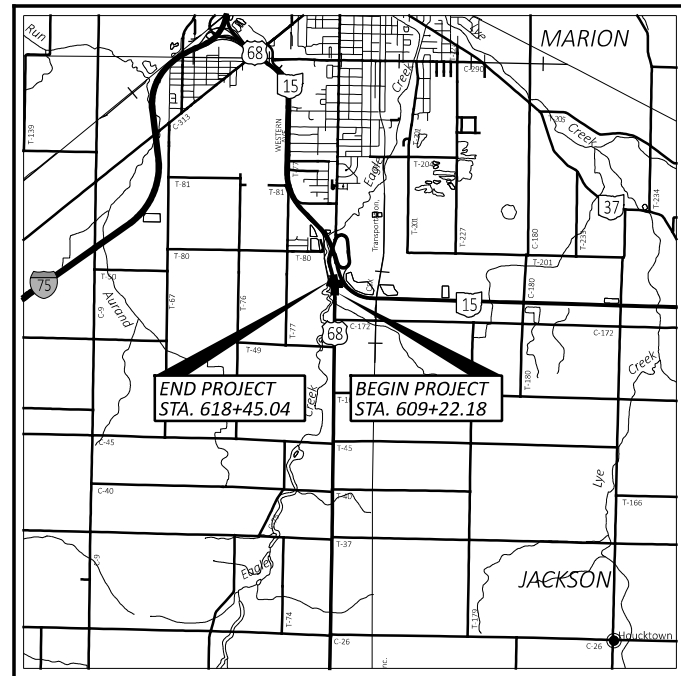

LOCATION MAP

LATITUDE: 40°59'23" LONGITUDE: 83°38'49"



PORTION TO BE IMPROVED	-----	=====
INTERSTATE HIGHWAY	-----	=====
FEDERAL ROUTES	-----	=====
STATE ROUTES	-----	=====
COUNTY & TOWNSHIP ROADS	-----	=====
OTHER ROADS	-----	=====

FOR DESIGN DESIGNATIONS SEE SHEET 2

INDEX OF SHEETS:

TITLE SHEET	P.1	CROSS SECTIONS	
SCHEMATIC PLAN	P.2	U.S. 68	P.44-P.51
ROUNDAABOUT GEOMETRIC DATA	P.3	RAMP A	P.52-P.62
TYPICAL SECTION	P.4-P.8	T.R. 80	P.63-P.67
GENERAL NOTES	P.9-P.11	SUPERELEVATION TABLE	P.68
MAINTENANCE OF TRAFFIC	P.12-P.15	ROUNDAABOUT GRADING PLAN	P.69
GENERAL SUMMARY	P.16-P.18	PAVEMENT DETAILS	P.70-P.74
SUBSUMMARY	P.19-P.20	STORM SEWER PROFILES	P.75-P.76
PAVEMENT CALCULATIONS	P.21-P.22	CULVERT DETAILS	P.77-P.78
PROJECT SITE PLAN	P.23	UNDERDRAIN TABLE	P.79
PLAN AND PROFILE		TRAFFIC CONTROL	P.80-P.98
U.S. 68	P.24-P.26	LIGHTING	P.99-P.101
RAMP A	P.27-P.31	LANDSCAPING PLAN	P.102-P.103
EXISTING RAMP A REMOVAL	P.32-P.33	GEOTECHNICAL PROFILE - ROADWAY	P.104-P.109
T.R. 80	P.34-P.38		
REFERENCE LINE PROFILES	P.39-P.43		

FEDERAL PROJECT NUMBER

E230(864)

RAILROAD INVOLVEMENT

NONE

PROJECT DESCRIPTION

THIS PROJECT INVOLVES 0.17 MILES OF IMPROVEMENTS ALONG US 68 INCLUDING RECONFIGURING THE INTERSECTION OF US 68 AND THE SR 15 RAMPS TO PROVIDE A SINGLE LANE ROUNDAABOUT. A PORTION OF THE EXISTING SR 15 SOUTHBOUND OFF RAMP WILL BE REMOVED AND RELOCATED TO TIE INTO THE RECONFIGURED INTERSECTION WHILE 0.38 MILES OF THE EXISTING SOUTHBOUND OFF RAMP WILL BE CONVERTED TO A TWO-LANE TOWNSHIP ROAD AS PART OF THIS PROJECT. WORK WILL ALSO INCLUDE INSTALLING ROUNDAABOUT LIGHTING, DRAINAGE AND PERMANENT TRAFFIC CONTROL.

EARTH DISTURBED AREAS

PROJECT EARTH DISTURBED AREA: 8.0 ACRES
ESTIMATED CONTRACTOR EARTH DISTURBED AREA: 1.3 ACRES
NOTICE OF INTENT EARTH DISTURBED AREA: 9.3 ACRES

LIMITED ACCESS

THIS IMPROVEMENT IS ESPECIALLY DESIGNED FOR THROUGH TRAFFIC AND HAS BEEN DECLARED A LIMITED ACCESS HIGHWAY OR FREEWAY BY ACTION OF THE DIRECTOR IN ACCORDANCE WITH THE PROVISIONS OF SECTION 5511.02 OF THE OHIO REVISED CODE.

2023 SPECIFICATIONS

THE STANDARD SPECIFICATIONS OF THE STATE OF OHIO, DEPARTMENT OF TRANSPORTATION, INCLUDING SUPPLEMENTAL SPECIFICATIONS LISTED IN THE PLANS AND CHANGES LISTED IN THE PROPOSAL SHALL GOVERN THIS IMPROVEMENT.

I HEREBY APPROVE THESE PLANS AND DECLARE THAT THE MAKING OF THIS IMPROVEMENT WILL REQUIRE THE CLOSING TO TRAFFIC OF THE HIGHWAY AND THAT DETOURS WILL BE PROVIDED AS INDICATED ON SHEET P.15.

DISTRICT DEPUTY DIRECTOR

Christopher A. Hughes

Christopher A. Hughes, P.E.
District 01 Deputy Director

DIRECTOR, DEPARTMENT OF TRANSPORTATION

Jack Marchbanks
Jack Marchbanks, PhD
Director, Department of Transportation

ADA DESIGN WAIVERS

NONE REQUIRED


UNDERGROUND UTILITIES
Contact Two Working Days Before You Dig

OHIO811.org
Before You Dig


OHIO811, 8-1-1, or 1-800-362-2764
(Non members must be called directly)



ENGINEER'S SEAL
ROADWAY & LANDSCAPING PLAN
FOR SHEETS P.1-P.79, P.102-P.103

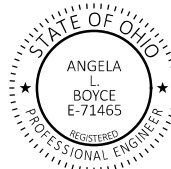

ENGINEER'S SEAL
TRAFFIC CONTROL & LIGHTING
FOR SHEETS P.80-P.101

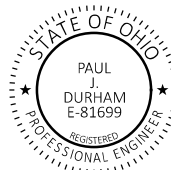

STANDARD CONSTRUCTION DRAWINGS								SUPPLEMENTAL SPECIFICATIONS		SPECIAL PROVISIONS		
BP-3.1	1/21/22	LA-1.2	1/16/09	HL-10.12	7/21/23	TC-21.11	7/16/21	TC-72.20	7/21/23	800-2023	10/20/23	WATERWAY PERMIT SPECIAL PROVISIONS, 1/16/2024
BP-4.1	7/19/13			HL-10.13	1/20/23	TC-21.21	1/20/23			813	7/21/23	
BP-5.1	7/15/22	MGS-1.1	7/16/21	HL-20.11	7/21/23	TC-41.10	7/19/13			821	4/20/12	
BP-9.1	1/18/19	MGS-2.1	1/19/18	HL-30.11	7/21/23	TC-41.20	10/18/13			832	7/21/23	
		MGS-3.1	1/19/18	HL-30.22	1/15/21	TC-41.30	4/21/23			836	1/18/18	
CB-3	7/16/21	MGS-4.2	7/19/13	HL-40.20	7/21/23	TC-41.40	10/18/13			902	7/19/19	
CB-3A	7/16/21	MGS-4.3	1/18/13	HL-60.11	7/21/17	TC-41.50	10/18/13			913	4/16/21	
CB-8	7/16/21			HL-60.31	7/21/23	TC-42.10	10/18/13			921	4/20/12	
		MH-3	7/21/23			TC-42.20	10/18/13					
DM-1.1	7/17/20			MT-95.40	7/21/23	TC-51.11	1/15/16					
DM-1.2	7/16/21	RM-4.2	4/17/20	MT-95.45	7/21/23	TC-51.12	1/15/16					
DM-4.2	7/20/12			MT-101.70	4/21/23	TC-52.10	10/18/13					
DM-4.3	1/15/16	HW-2.1	7/15/22	MT-101.90	7/17/20	TC-52.20	1/15/21					
DM-4.4	1/15/16	HW-2.2	7/20/18	MT-103.10	1/21/22	TC-65.10	1/17/14					
				MT-105.10	1/17/20	TC-65.11	7/15/22					
F-3.3	7/19/13	HL-10.11	7/21/23			TC-71.10	4/21/23					

TITLE SHEET

HAN US68/SR15 INTERCHANGE

MODEL: Sheet PAPER SIZE: 17x11 (in.) DATE: 1/29/2024 TIME: 9:53:01 AM USER: SLParker U:\174316204\transportation\112280\400-Engineering\Roadway\Sheets\112280_GT001.dgn

DESIGN AGENCY
Stantec
1500 LAKE SHORE DRIVE, SUITE 100, COLUMBUS, OH 43204 (614) 486-4383

DESIGNER
SLP

REVIEWER
ALB 10/30/23

PROJECT ID
112280

SHEET TOTAL
P.1 | 109

CURVE DATA
 U.S. 68
 CURVE NO. 1
 P.I. = Sta. 613+84.85
 Δ = 16°29'38" LT
 Dc = 02°23'14"
 R = 2,400.00'
 T = 347.85'
 L = 690.89'
 E = 25.08'
 Emax = NC
 PC = STA. 610+37.00
 PT = STA. 617+27.89

CURVE DATA
 RAMP A
 CURVE NO. 2
 P.I. = Sta. 616+07.57
 Δ = 100°32'41" LT
 Dc = 28°38'52"
 R = 200.00'
 T = 240.67'
 L = 350.97'
 E = 112.92'
 Emax = 5.73%
 PC = STA. 613+66.90
 PT = STA. 617+17.87

CURVE DATA
 RAMP A
 CURVE NO. 3
 P.I. = Sta. 620+04.61
 Δ = 08°49'05" RT
 Dc = 03°49'11"
 R = 1,500.00'
 T = 115.66'
 L = 230.86'
 E = 4.45'
 Emax = 5.07%
 PC = STA. 618+88.96
 PT = STA. 621+19.81

CURVE DATA
 RAMP A
 CURVE NO. 4
 P.I. = Sta. 625+15.12
 Δ = 06°29'02" LT
 Dc = 01°21'45"
 R = 4,205.00'
 T = 238.19'
 L = 475.87'
 E = 6.74'
 Emax = 3.45%
 PC = STA. 622+76.94
 PT = STA. 627+52.80

Emax = MATCH EX.
 = STA. Linear Annotation.Point Station
 = STA. Linear Annotation.Point Station

CURVE DATA
 RAMP B
 CURVE NO. 5
 EX. R/W & CONSTRUCTION S.R. 15
 CURVE NO. 6
 P.I. = Sta. 640+13.14
 Δ = 28°31'42" LT
 Dc = 02°01'21"
 R = 2,832.78'
 Ls = 248.60'
 θs = 02°30'51"
 LT = 165.75'
 ST = 82.88'
 Lc = 1,161.88'
 Ts = 844.70'
 Es = 91.05'
 Emax = MATCH EX.
 T.S. = STA. 631+68.44
 S.C. = STA. 634+17.04
 C.S. = STA. 645+78.92
 S.T. = STA. 648+27.52


CURVE DATA
 EX. R/W & CONSTRUCTION S.R. 15
 CURVE NO. 7
 P.I. = Sta. 609+82.04
 Δ = 72°34'40" RT
 Dc = 03°00'00"
 R = 1,909.86'
 Ls = 400.00'
 θs = 06°00'00"
 LT = 266.82'
 ST = 133.47'
 Lc = 2,019.26'
 Ts = 1,604.85'
 Es = 463.90'
 Emax = MATCH EX.
 T.S. = STA. 593+77.19
 S.C. = STA. 597+77.19
 C.S. = STA. 617+96.45
 S.T. = STA. 621+96.45

CURVE DATA
 T.R. 80
 CURVE NO. 8
 P.I. = Sta. 12+03.49
 Δ = 86°41'45" RT
 Dc = 114°35'30"
 R = 50.00'
 T = 47.20'
 L = 75.66'
 E = 18.76'
 Emax = 1.60%
 PC = STA. 11+56.29
 PT = STA. 12+31.95

CURVE DATA
 T.R. 80
 CURVE NO. 10
 P.I. = Sta. 28+52.51
 Δ = 50°07'16" LT
 Dc = 16°00'00"
 R = 358.10'
 T = 167.45'
 L = 313.26'
 E = 37.21'
 Emax = MATCH EX.
 PC = STA. 26+85.06
 PCC = STA. 29+98.32

CURVE DATA
 T.R. 80
 CURVE NO. 9
 P.I. = Sta. 15+93.47
 Δ = 08°09'51" LT
 Dc = 1°30'26"
 R = 3800.00'
 T = 271.19'
 L = 541.47'
 E = 9.66'
 Emax = MATCH EX.
 PC = STA. 13+22.27
 PT = STA. 18+63.74

CURVE DATA
 T.R. 80
 CURVE NO. 11
 P.I. = Sta. 30+71.58
 Δ = 36°04'20" LT
 Dc = 25°27'53"
 R = 225.00'
 T = 73.26'
 L = 141.65'
 E = 11.63'
 Emax = NC
 PCC = STA. 29+98.32
 PT = STA. 31+39.98

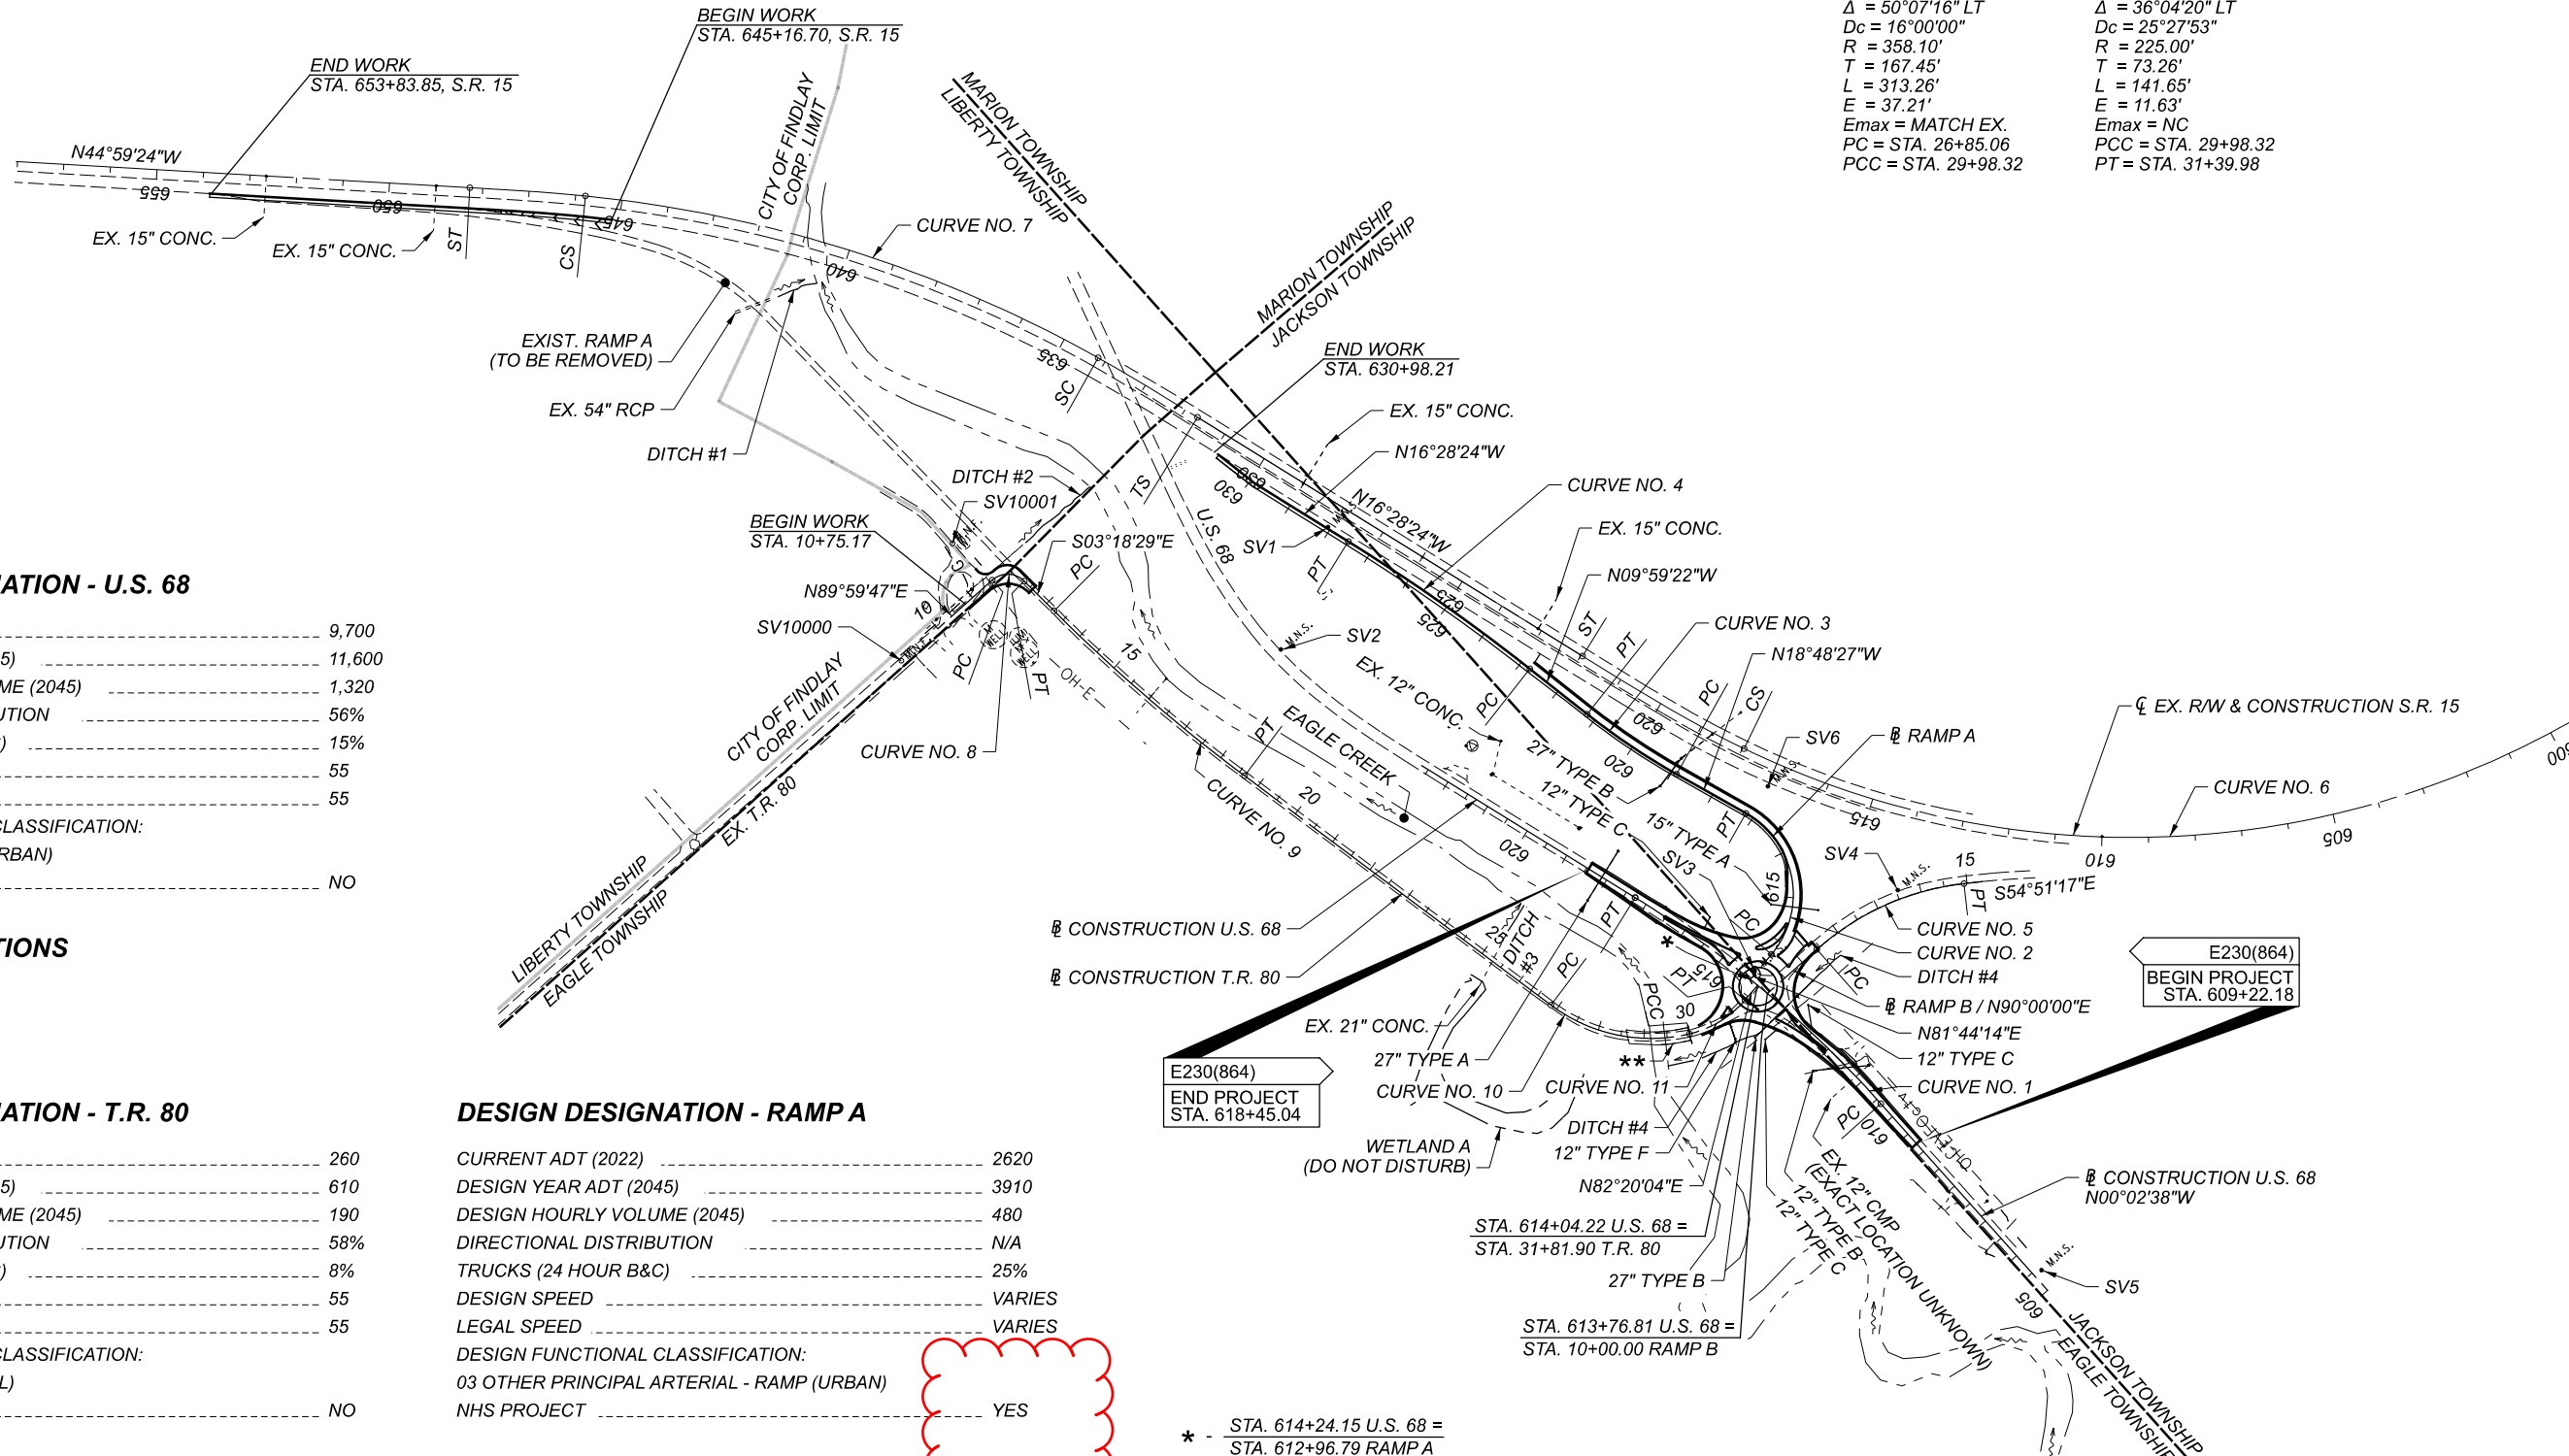

DESIGN DESIGNATION - U.S. 68

CURRENT ADT (2022)	9,700
DESIGN YEAR ADT (2045)	11,600
DESIGN HOURLY VOLUME (2045)	1,320
DIRECTIONAL DISTRIBUTION	56%
TRUCKS (24 HOUR B&C)	15%
DESIGN SPEED	55
LEGAL SPEED	55
DESIGN FUNCTIONAL CLASSIFICATION:	
04 MINOR ARTERIAL (URBAN)	
NHS PROJECT	NO

DESIGN EXCEPTIONS

NONE REQUIRED

DESIGN DESIGNATION - T.R. 80

CURRENT ADT (2022)	260
DESIGN YEAR ADT (2045)	610
DESIGN HOURLY VOLUME (2045)	190
DIRECTIONAL DISTRIBUTION	58%
TRUCKS (24 HOUR B&C)	8%
DESIGN SPEED	55
LEGAL SPEED	55
DESIGN FUNCTIONAL CLASSIFICATION:	
07 LOCAL ROAD (RURAL)	
NHS PROJECT	NO

DESIGN EXCEPTIONS


NONE REQUIRED

DESIGN DESIGNATION - RAMP A

CURRENT ADT (2022)	2620
DESIGN YEAR ADT (2045)	3910
DESIGN HOURLY VOLUME (2045)	480
DIRECTIONAL DISTRIBUTION	N/A
TRUCKS (24 HOUR B&C)	25%
DESIGN SPEED	VARIES
LEGAL SPEED	VARIES
DESIGN FUNCTIONAL CLASSIFICATION:	
03 OTHER PRINCIPAL ARTERIAL - RAMP (URBAN)	
NHS PROJECT	YES

DESIGN EXCEPTIONS

NONE REQUIRED

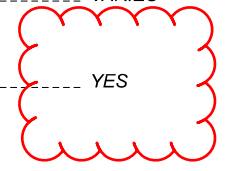

- * - STA. 614+24.15 U.S. 68 = STA. 612+96.79 RAMP A
- ** - EX. BRIDGE SFN: 3202046

NOTE: THERE ARE NO LANDSCAPED AREAS WITHIN THE WORK LIMITS.



SCHEMATIC PLAN

DESIGN AGENCY

 1500 LAKE SHORE DRIVE, SUITE 100, COLUMBUS, OH 43204 (614) 486-4383
 DESIGNER: SLP
 REVIEWER: ALB 10/30/23
 PROJECT ID: 112280
 SHEET TOTAL: P.2 | 109

SHEET NUM.										PART.	ITEM	ITEM	GRAND	UNIT	DESCRIPTION	SEE SHEET NO.
P.9	P.10	P.11	P.19	P.20	P.21	P.69	P.79			01/NHS/66	EXT	TOTAL				
ROADWAY																
LS			5							LS	201	11001	LS		CLEARING AND GRUBBING, AS PER PLAN	P.9
					9,862					5	202	20010	5	EACH	HEADWALL REMOVED	
			246							9,862	202	23000	9,862	SY	PAVEMENT REMOVED	
			136							246	202	35100	246	FT	PIPE REMOVED, 24" AND UNDER	
										136	202	35200	136	FT	PIPE REMOVED, OVER 24"	
			89							89	202	35201	89	FT	PIPE REMOVED, OVER 24", AS PER PLAN	P.10
			377							377	202	38000	377	FT	GUARDRAIL REMOVED	
			3							3	202	42010	3	EACH	ANCHOR ASSEMBLY REMOVED, TYPE E	
			1							1	202	47000	1	EACH	BRIDGE TERMINAL ASSEMBLY REMOVED	
			1							1	202	58000	1	EACH	MANHOLE REMOVED	
			1							1	202	58100	1	EACH	CATCH BASIN REMOVED	
			94							94	202	75000	94	FT	FENCE REMOVED	
			2,793							2,793	203	10000	2,793	CY	EXCAVATION	
2,233			17,811			25				20,069	203	20000	20,069	CY	EMBANKMENT	
	1,909				11,654					13,563	204	10000	13,563	SY	SUBGRADE COMPACTION	
2,233	476									2,709	204	13000	2,709	CY	EXCAVATION OF SUBGRADE	
	476									476	204	30020	476	CY	GRANULAR MATERIAL, TYPE C	
5										5	204	45000	5	HOUR	PROOF ROLLING	
	1,909									1,909	204	50000	1,909	SY	GEOTEXTILE FABRIC	
			12.5							12.5	606	15051	12.5	FT	GUARDRAIL, TYPE MGS, AS PER PLAN	P.10
			2							2	606	26150	2	EACH	ANCHOR ASSEMBLY, MGS TYPE E, (MASH 2016)	
			1							1	606	26550	1	EACH	ANCHOR ASSEMBLY, MGS TYPE T	
			1							1	606	35003	1	EACH	MGS BRIDGE TERMINAL ASSEMBLY, TYPE 1, AS PER PLAN	P.10
			2							2	607	98100	2	EACH	FENCE, MISC.: END POST ASSEMBLY	P.10
										LS	623	50000	LS		PRECONSTRUCTION SURVEY MONUMENT VERIFICATION AND REPORT	
										LS	623	51000	LS		POST CONSTRUCTION SURVEY MONUMENT VERIFICATION AND REPORT	
EROSION CONTROL																
							9			9	601	21050	9	SY	TIED CONCRETE BLOCK MAT WITH TYPE 1 UNDERLAYMENT	
			43							43	601	32200	43	CY	ROCK CHANNEL PROTECTION, TYPE C WITH FILTER	
		2,123								2,123	659	00300	2,123	CY	TOPSOIL	
			19,126			80				19,206	659	10000	19,206	SY	SEEDING AND MULCHING	
		957								957	659	14000	957	SY	REPAIR SEEDING AND MULCHING	
		957								957	659	15000	957	SY	INTER-SEEDING	
		2.67								2.67	659	20000	2.67	TON	COMMERCIAL FERTILIZER	
		3.95								3.95	659	31000	3.95	ACRE	LIME	
		106								106	659	35000	106	MGAL	WATER	
		576								576	670	00500	576	SY	SLOPE EROSION PROTECTION	
			704							704	670	00720	704	SY	DITCH EROSION PROTECTION MAT, TYPE B	
										LS	832	15000	LS		STORM WATER POLLUTION PREVENTION PLAN	
										LS	832	15002	LS		STORM WATER POLLUTION PREVENTION INSPECTIONS	
										LS	832	15010	LS		STORM WATER POLLUTION PREVENTION INSPECTION SOFTWARE	
										80,000	832	30000	80,000	EACH	EROSION CONTROL	
			8							8	836	10000	8	SY	SEEDING AND EROSION CONTROL WITH TURF REINFORCING MAT, TYPE 1	

