



The Subsurface Utility Engineering Company

449 Munroe Falls Road Tallmadge, OH 44278 (330) 794-4455

Test Hole Certification Form Utility Quality Level A Data

ASCE C/I 38-02

Corporate Headquarters 8397 Euclid Avenue Manassas Park, VA 20111 (703) 361-6005

Control # EZQE017 Test Hole # 63 Plan Scale 1" = 50' Sheet # 19 Proposed GRADE CHANGE Date AUGUST 1, 2013

City, County, State HANCOCK CO., OHIO Gen. Loc. I-75 S., JUST N. OF W. BIGELOW AVE. OVERPASS Recorded Size/Material/Type 10" STEEL GAS LINE Foreman/Truck#/Form By T. / BARRETT / 221 / S. ERICKSON

Condition of paving prior to work NO PAVING

B.M. 1 Elev. = 834.68' is CALCULATED

Description: (TBM#23) 1/2" I.R. SET, 66± LT OF PROPOSED CL STA 994+28±, I-75

B.M. 2 Elev. = 831.75' is CALCULATED

Description: (TBM#22) 1/2" I.R. SET, 74± LT OF PROPOSED CL STA 991+38±, I-75

Benchmarks Check BY 0.01' Elevations are referenced to B.M.#1

So-Deep will attempt to use the BM/ HI most applicable to your design. If however, BMs differ by more than .05', resulting differences could cause design conflicts.

Recorded Size/Type of utility WAS FOUND

There WERE NOT additional utilities in the test hole

The utility WAS in good condition

Paving Thickness and type NO PAVING

Color of ribbon installed YELLOW


Soil Type WET STICKY CLAY

Truck Location GRASS R/W


T.H. tied to PEG

10 3/4" COATED STEEL GAS LINE \*

Size/Material/Type Portion of pipe exposed for O.D. measurement: FULL

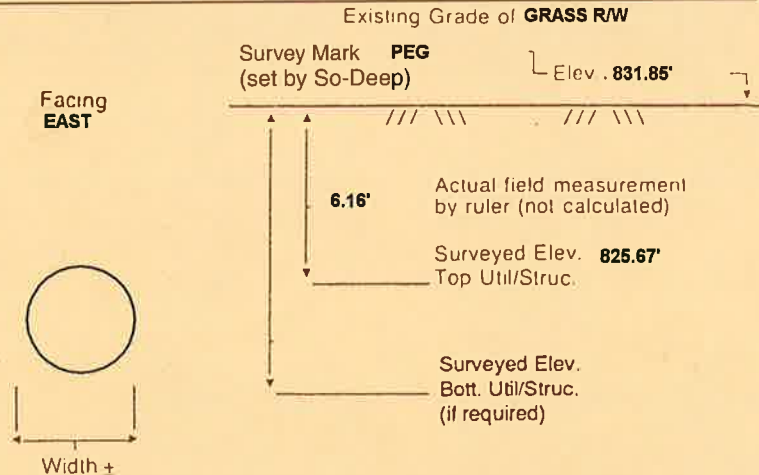

Remarks: \* SIZE AND MATERIAL WAS CONFIRMED BY NICHOLAS J. DRUMMELSMITH SUNOCO INSPECTOR ON SITE. CELL (419) 455-3800.

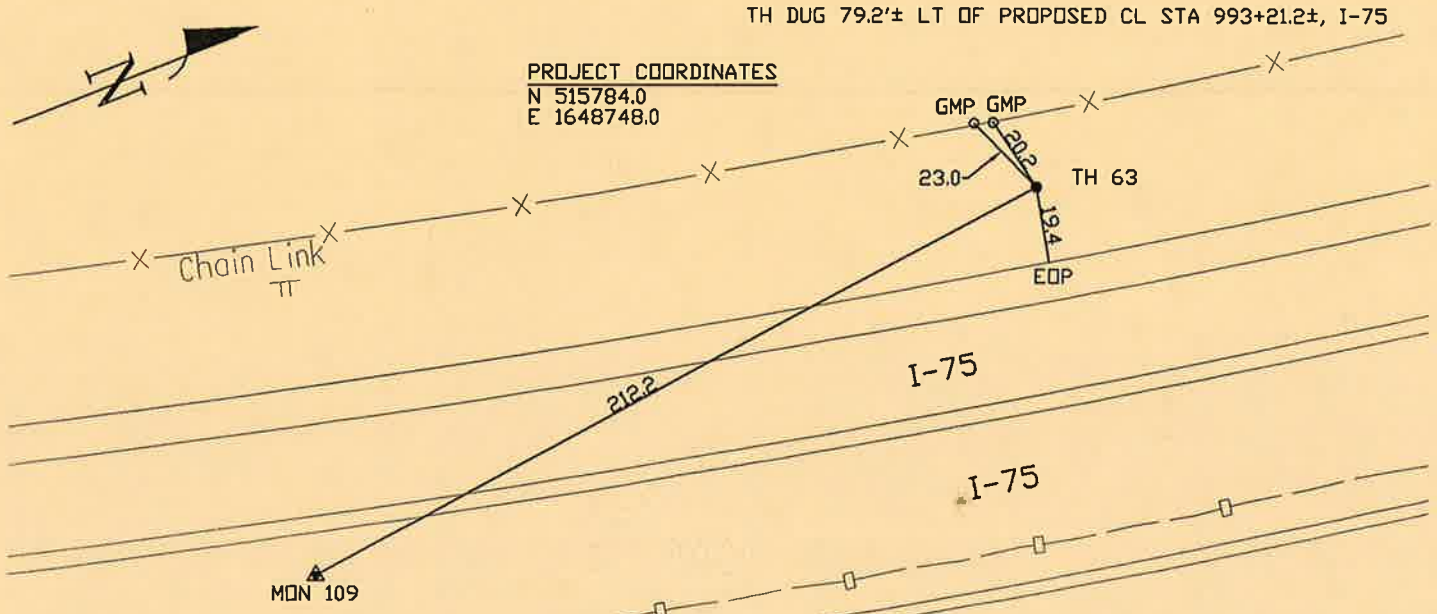

- FO = Fiber-Optic Cable MTD = Multi Tile Duct R/W = Rights of Way N.T.S. = Not to Scale \* = Not Shown on Plan PCC = Precast Concrete COND. = Conduit CONC. = Concrete O.D. = Outside Diameter C.I. = Cast Iron D.I. = Ductile Iron RPC = Rough Pour Concrete CL = Centerline T.C. = Tera Cotta PLAS. = Plastic BL = Base Line ELEC. = Electric TELE. = Telephone T.H. = Test Hole SW = Sidewalk DW = Driveway BM = Benchmark C.B. = Catch Basin GV = Gas Valve

Handwritten signature of Paul R. Cole

Performing out-of-sight work...with vision™

Note: To Eliminate mistakes and check this work, So-Deep suggests you scale and plot all dimensions onto the plans and review all elevations carefully. So-Deep is responsible only for information shown on our forms.

- .08" = 1" .16" = 2" .25" = 3" .33" = 4" .42" = 5" .50" = 6" .58" = 7" .67" = 8" .75" = 9" .83" = 10" .92" = 11" Sewer Manhole Test Hole Fire Hydrant Pole Fence Line Electric Manhole = T.S. = Traverse Station Valve Water Meter Telephone Manhole Telephone Pedestal