






SEEDING  
END WIDTH SO. YDS.

END AREA VOLUME  
CUT FILL CUT FILL  
CALCULATED ABS CHECKED NAH

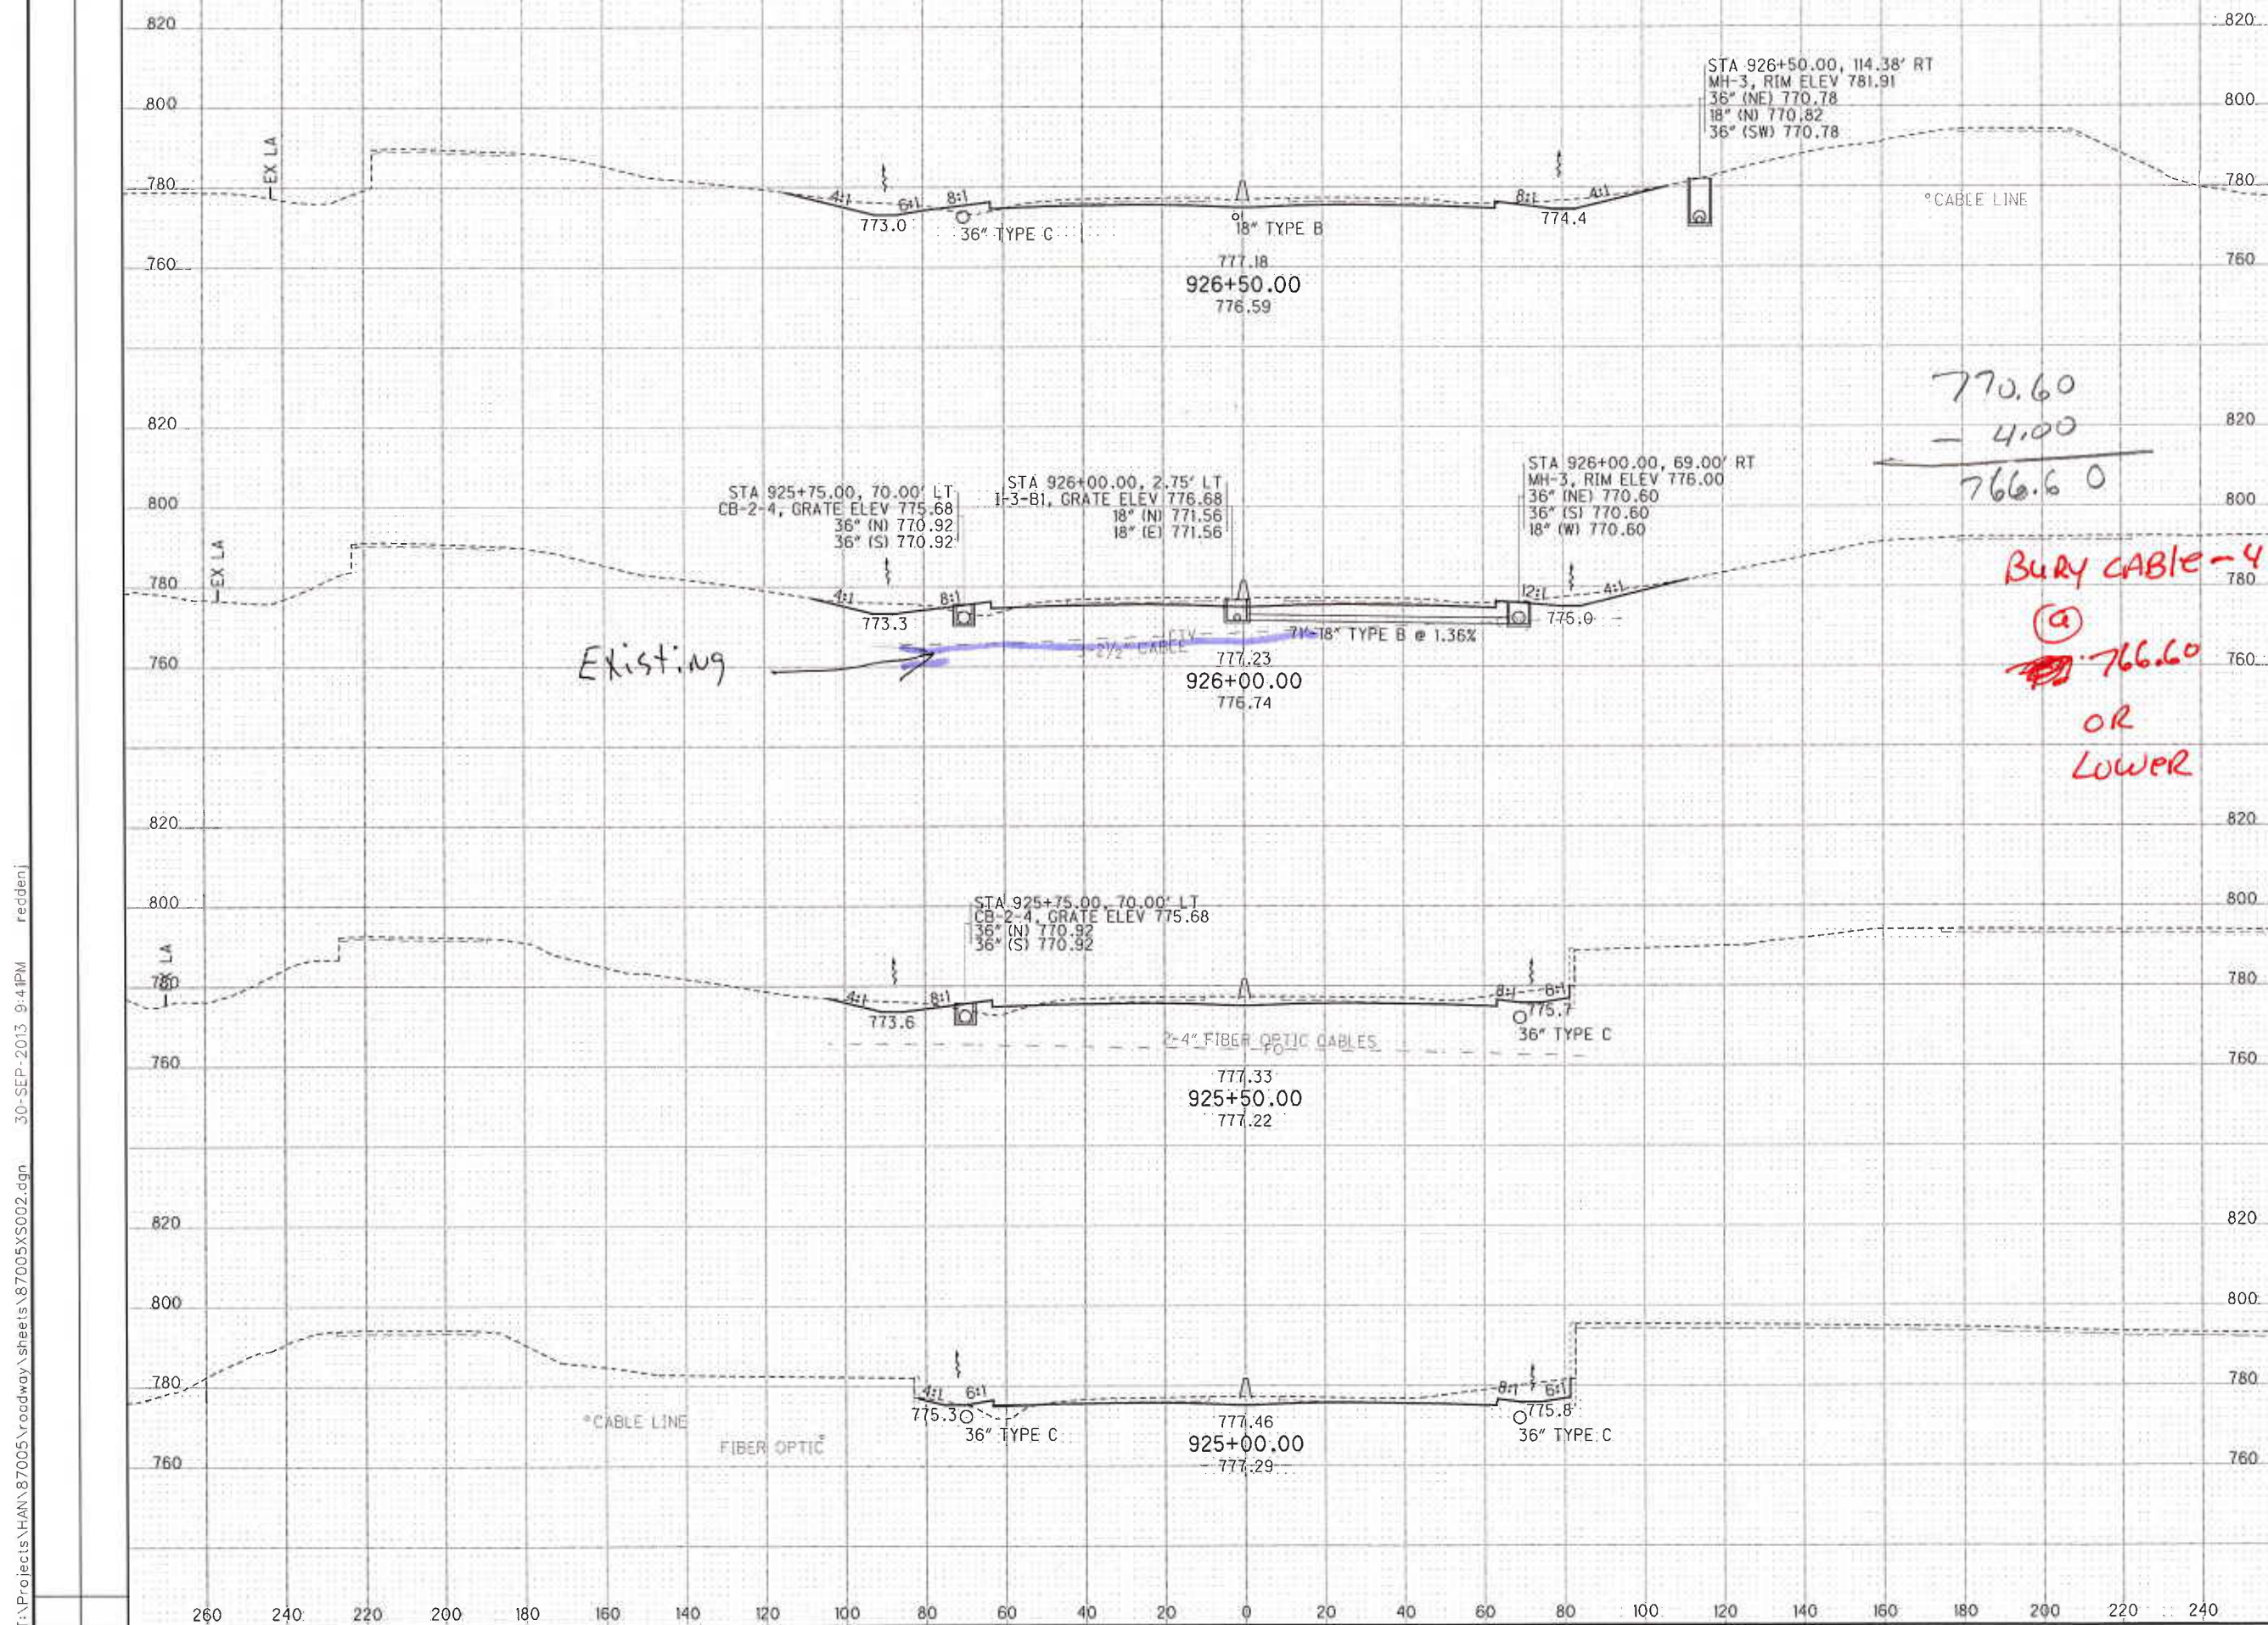

770.60  
- 4.00  
-----  
766.60

Bury CABLE - 4 FT  
ⓐ  
766.60  
OR  
LOWER

T:\Projects\HAN\B7005\roadway\sheet\87005XS002.dgn 30-SEP-2013 9:41PM redderj

CROSS SECTIONS - I-75  
STA. 925+00.00 TO STA. 926+50.00

HAN-75-14.39

227  
842