CITY OF NAPOLEON HENRY COUNTY

GENERAL SUMMARY STRUCTURES HEN-6-1247R 4-7

PROJECT DESCRIPTION

BRIDGE COLLISION REPAIR, INCLUDING HEAT STRAIGHTENING OF BEAMS, REPLACEMENT OF CROSSFRAME MEMBERS, AND REPAIRING PAINT ON FASCIA BEAMS OF STRUCTURE HEN-06-1247.

EARTH DISTURBED AREAS

PROJECT EARTH DISTURBED AREA: ESTIMATED CONTRACTOR EARTH DISTURBED AREA: N/A ACRES NOTICE OF INTENT EARTH DISTURBED AREA: N/A ACRES

THE STANDARD SPECIFICATIONS OF THE STATE OF

I HEREBY APPROVE THESE PLANS AND DECLARE THAT THE MAKING OF THIS IMPROVEMENT WILL REQUIRE THE CLOSING TO TRAFFIC OF THE HIGHWAY AND THAT DE-TOURS WILL BE PROVIDED AS INDICATED ON SHEET 2.

2019 SPECIFICATIONS

OHIO. DEPARTMENT OF TRANSPORTATION, INCLUDING SUPPLEMENTAL SPECIFICATIONS LISTED IN THE PLANS AND CHANGES LISTED IN THE PROPOSAL SHALL GOVERN THIS IMPROVEMENT.

INDEX OF SHEETS: TITLE SHEET MAINTENANCE OF TRAFFIC

PORTION TO BE IMPROVED____ INTERSTATE HIGHWAY _____ FEDERAL ROUTES STATE ROUTES COUNTY & TOWNSHIP ROADS _____ OTHER ROADS

LOCATION MAP

SCALE IN MILES

LATITUDE: 41°24'28.44" LONGITUDE: -84°07'55.91"

DESIGN DESIGNATION

	HEN-6-12.47	HEN-108-17.32
CURRENT ADT (2020)	24,000	8,700
DESIGN YEAR ADT (2040)	33,000	11,000
DESIGN HOURLY VOLUME (2040)	3,000	1,100
DIRECTIONAL DISTRIBUTION	52%	54%
TRUCKS (24 HOUR B&C)	33%	9%
DESIGN SPEED	75	<i>55</i>
LEGAL SPEED		50
DESIGN FUNCTIONAL CLASSIFICATION:	URBAN FREEWAY	URBAN MINOR ARTERIAL

HEN-6-1247R

NHS PROJECT


DESIGN EXCEPTIONS

NONE

UNDERGROUND UTILITIES Contact Two Working Days Before You Dig

OHIO811, 8-1-1, or 1-800-362-2764 (Non-members must be called directly)

PLAN PREPARED BY: OHIO DEPARTMENT OF TRANSPORTATION DISTRICT TWO BOWLING GREEN, OHIO

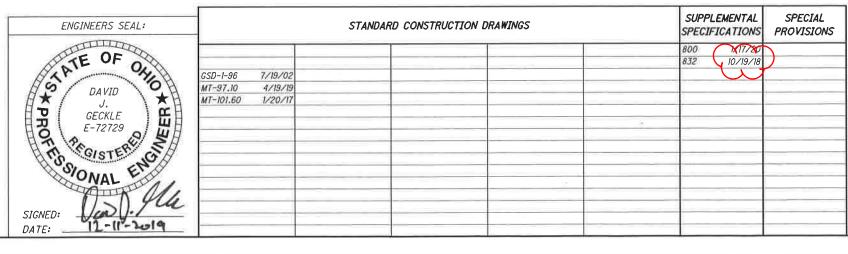

DISTRICT DEPUTY DIRECTOR

APPROVED_ DIRECTOR, DEPARTMENT OF TRANSPORTATION

N

HEN

 α

EDE

Щ

Z O

Z

111101

NO

 \bigcirc

 \bigcirc