

UTILITIES

THERE ARE NO UNDERGROUND UTILITIES SHOWN ON THIS PLAN. THE NATURE OF THE WORK REQUIRED BY THIS PROJECT WILL NOT AFFECT ANY KNOWN UNDERGROUND UTILITIES THAT EXIST UNDER OR ADJACENT TO THE WORK AREA.

LISTED BELOW ARE ALL UTILITIES LOCATED WITHIN THE PROJECT CONSTRUCTION LIMITS TOGETHER WITH THEIR RESPECTIVE OWNERS:

AMERICAN ELECTRIC POWER (DISTRIBUTION)
850 TECH CENTER DRIVE
GAHANNA, OHIO 43230
MR. PAUL PAXTON
740-348-5322

AMERICAN ELECTRIC POWER (TRANSMISSION)
8600 SMITHS MILL RD.
NEW ALBANY, OHIO 43054
MR. MIKE CARR
380-205-5072

SOUTH CENTRAL POWER COMPANY
P.O. BOX 250
LANCASTER, OHI 43130
MR. ZACHARY REED
74-689-6150

AT&T OHIO
7201 FAR HILLS AVE.
DAYTON, OHIO 45459
MR. HOWARD LAUDERMILK II
937-296-3588

HORIZON NETWORK PARTNERS
1123 GOODALE BLVD. SUITE 550
COLUMBUS, OHIO 43212
hnoc@horizonconnects.com
(a representative will be assigned)

CHARTER COMMUNICATIONS
10920 KENWOOD RD.
CINCINNATI, OHIO 45242
MR. JOSEPH ANGEL
513-233-5705

HIGHLAND COUNTY WATER COMPANY
P.O. BOX 940
HILLSBORO, OHIO 45133
MR. ROB SMITH
937-393-4281, EXT. 108

CITY OF HILLSBORO WATER & SEWER
130 NORTH HIGH STREET
HILLSBORO, OHIO 45133
937-393-3447

UTILITY PIPELINE, LTD.
P.O. BOX 249
HILLSBORO, OHIO 45133
MR. KIRK SEELING
330-498-9130, EXT. 405

HIGHLAND COUNTY ENGINEER
138 BOWERS AVENUE
P.O. BOX 297
HILLSBORO, OHIO 45133
MR. CHRIS FAUBER, COUNTY ENGINEER
937-393-3496

WORK LIMITS

THE WORK LIMITS SHOWN ON THESE PLANS ARE FOR PHYSICAL CONSTRUCTION ONLY. PROVIDE THE INSTALLATION AND OPERATION OF ALL WORK ZONE TRAFFIC CONTROL AND WORK ZONE TRAFFIC CONTROL DEVICES REQUIRED BY THESE PLANS WHETHER INSIDE OR OUTSIDE THESE WORK LIMITS.

WINDOW CONTRACT TABLE

DESCRIPTION OF CRITICAL WORK	CALENDAR DAYS TO COMPLETE
ALL WORK ON PROJECT	90

PROFILE AND ALIGNMENT

PLACE THE PROPOSED PAVEMENT TO FOLLOW THE ALIGNMENT AND PROFILE OF THE EXISTING PAVEMENT. PLACE THE PROPOSED ASPHALT CONCRETE, TYPE 1, (448), PG64-22 OVERLAY AS SHOWN ON THE TYPICAL SECTIONS.

DISPOSAL OF ASPHALT GRINDINGS

ASPHALT GRINDINGS FROM THIS PROJECT ARE TO BECOME THE PROPERTY OF THE CONTRACTOR.

PART-WIDTH CONSTRUCTION

BECAUSE OF THE NECESSITY TO BUILD THIS PROJECT UNDER TRAFFIC AND TO CONSTRUCT THE FULL PAVEMENT WIDTH IN STAGES, EXERCISE CARE TO PREVENT THE CONSTRUCTION OF A BUTT JOINT IN THE BASE COURSES. LAP LONGITUDINAL JOINTS AS SHOWN ON STANDARD CONSTRUCTION DRAWING BP-3.1.

WORK SEQUENCE

RUMBLE STRIPE, TRAFFIC PAINT, AND RPM WORK SHALL BE PERFORMED AS FOLLOWS OR AS DIRECTED BY THE ENGINEER.

1. GRIND CENTER LINE RUMBLE STRIPES, ITEM 618
2. APPLY TRAFFIC PAINT, ITEM 644
3. PLACE RPM'S AS SHOWN IN PLANS, ITEM 621

RPM

IN ADDITION TO CMS 621.03, RPMs SHALL NOT BE INSTALLED ON BRIDGES OR APPROACH SLABS THAT HAVE A CONCRETE SURFACE. INSTALL RPMs IN ASPHALT CONCRETE BEFORE AND AFTER THE SUPERSTRUCTURE. RPM'S LOCATED IN EXISTING CONCRETE BRIDGE DECKS OR APPROACH SLABS SHALL BE LEFT IN PLACE.

INSTALL NEW RPMs IN ACCORDANCE WITH ODOT STANDARD DRAWINGS TC-65.10 AND TC-65.11.

ITEM 254- PATCHING PLANED SURFACE

THIS ITEM SHALL BE IN ACCORDANCE WITH SECTION 254 OF THE CONSTRUCTION AND MATERIALS SPECIFICATIONS AND AS DIRECTED BY THE ENGINEER.


ESTIMATED QUANTITIES HAVE BEEN PROVIDED FOR THE FOLLOWING WORK: ITEM 254 PATCHING PLANED SURFACE 12,235 SQ.YD.

617 COMPACTED AGGREGATE

THE FOLLOWING ESTIMATED QUANTITIES ARE TO BE USED AS DIRECTED BY THE ENGINEER, FOR THE PURPOSE OF BERM REPAIRS.

TOTAL: 250 CY 01/STR/PV

ITEM 251 - PARTIAL DEPTH PAVEMENT REPAIR, AS PER PLAN

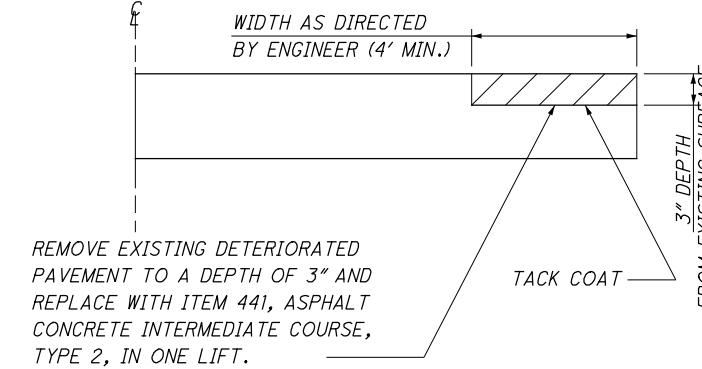

REMOVE EXISTING DETERIORATED PAVEMENT TO A DEPTH OF 3" AND REPLACE WITH ITEM 441, ASPHALT CONCRETE INTERMEDIATE COURSE, TYPE 2, IN ONE LIFT.

THE FOLLOWING ESTIMATED QUANTITIES HAVE BEEN INCLUDED AND CARRIED TO THE GENERAL SUMMARY FOR USE AS DIRECTED BY THE ENGINEER:

ITEM 251	PARTIAL DEPTH PAVEMENT REPAIR (441),AS PER PLAN	
	01/STR/PV TOTALS:	250 SY

I:\Project+Data\HIG\100504_HIG_62_1038\Design\Roadway\Sheets\00504_GN001.dgn_Sheet 5/1/2020 3:30:27 PM ewoodbr1

CALCULATED
ZDH
CHECKED
CLC

GENERAL NOTES

HIG-62-10.38