

# HOC-216/595-0.10/0.80

MODEL: Sheet PAPER/SIZE: 8.5x11 (in.) DATE: 9/15/2022 TIME: 7:51:57 AM USER: wclose  
 pw:\lohodot-pw-bentley.com\lohodot-pw-02\Documents\01.Active Projects\District 10\Hocking\115385\400-Engineering\Roadway\Sheets\115385\_G6001.dgn

SHEET NUM.		PART.		ITEM	ITEM EXT	GRAND TOTAL	UNIT	DESCRIPTION	SEE SHEET NO.
7	8	01/STR/PV	02/INF/PV						
149,836		116,527	33,309	422	11000	149,836	SY	PAVEMENT AGGREGATE, SINGLE CHIP SEAL, TYPE A	
55,439		43,115	12,324	422	25000	55,439	GAL	EMULSION, CHIP SEAL	
22,475		17,479	4,996	886	11000	22,475	GAL	FOG SEAL	
								TRAFFIC CONTROL	
1,291		805	486	621	00100	1,291	EACH	RPM	
1,291		805	486	621	54000	1,291	EACH	RAISED PAVEMENT MARKER REMOVED	
21.72		17.26	4.46	642	00104	21.72	MILE	EDGE LINE, 6", TYPE 1	
10.88		8.63	2.23	642	00300	10.88	MILE	CENTER LINE, TYPE 1	
32.58		25.89	6.69	642	30030	32.58	MILE	REMOVAL OF PAVEMENT MARKING	
180		96	84	642	00500	180	FT	STOP LINE, TYPE 1	
180		96	84	644	30000	180	FT	REMOVAL OF PAVEMENT MARKING	
								MAINTENANCE OF TRAFFIC	
57		44	13	614	12460	57	EACH	WORK ZONE MARKING SIGN	
32.58		25.89	6.69	614	21500	32.58	MILE	WORK ZONE CENTER LINE, CLASS II, 642 PAINT	
32.58		25.89	6.69	614	21550	32.58	MILE	WORK ZONE CENTER LINE, CLASS III, 642 PAINT	
								INCIDENTALS	
		LS	LS	614	11000	LS		MAINTAINING TRAFFIC	
		LS	LS	623	10001	LS		CONSTRUCTION LAYOUT STAKES AND SURVEYING, AS PER PLAN	4
		LS	LS	624	10000	LS		MOBILIZATION	


DESIGN AGENCY	
DESIGNER	WBC
REVIEWER	MRF MM-DD-Y
PROJECT ID	115385
SHEET	TOTAL
6	8

GENERAL SUMMARY


# HOC-216/595-0.10/0.80

MODEL: Sheet PAPER SIZE: 8.5x11 (in.) DATE: 9/15/2022 TIME: 7:52:12 AM USER: wclose  
 pw:\ohiodot-pw\beniley.com\ohiodot-pw-02\Documents\01 Active Projects\District 10\Hocking\115385\400-Engineering\Roadway\Sheets\115385\_G5002.dgn

SPLIT	STRAIGHT LINE MILES (ROUNDED TO NEAREST 0.01 MILE)		DISTANCE (D)	621	621	642	642	644	644	644	614	614	614	NOTES
	FROM	TO												
	<b>HOC-216</b>													
1	0.10	4.68	24183											
1	0.10	0.68	3063											
1	0.68	0.99	1637											
1	0.99	1.28	1532											
1	1.28	1.66	2007											
1	1.66	2.86	6336											
1	2.86	3.59	3855											
1	3.59	4.68	5756											
	<b>HOC-595</b>													
2	0.80	3.03	11775											
1	3.03	7.08	21384											
1	0.80	3.03	11775											
2	3.03	3.95	4858											
2	3.95	4.25	1584											
2	4.25	5.99	9188											
2	5.99	6.43	2324											
2	6.43	7.08	3432											
	<b>SPLIT 1 TOTAL</b>													
				805	805	17.26	8.63	96	96	25.89	25.89	25.89		
	<b>SPLIT 2 TOTAL</b>													
				486	486	4.46	2.23	84	84	6.69	6.69	6.69		
	<b>CARRIED TO GENERAL SUMMARY</b>													
				1291	1291	21.72	10.86	180	180	32.58	32.58	32.58		

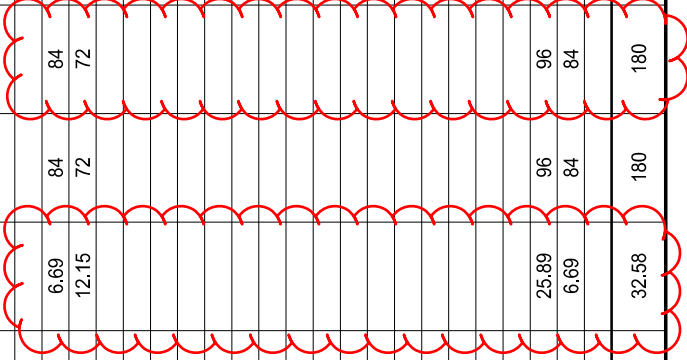

## PAVEMENT MARKING SUBSUMMARY

DESIGN AGENCY  
  
 DESIGNER  
**WBC**  
 REVIEWER  
**MRF MM-DD-YY**  
 PROJECT ID  
**115385**  
 SHEET TOTAL  
**8 8**